

**ODOT District 4**  
**No Passing Zone Log (POR)**

Page: 1 of 1  
8 18

Route: **0088R (SPORSR00088\*\*C)**  
 Length: **0.999** Direction: **North**

From: **7.000 S0014R**  
 To: **7.999 ENTER GEA CO**

| Length | Left           | C/L | Right          | Length | Control Points         | Scale: 1.00 mile/page |
|--------|----------------|-----|----------------|--------|------------------------|-----------------------|
| 0.045  | 7.999<br>7.955 |     | 7.999<br>7.955 | 0.045  | 7.983 S0088R SPUR RT   |                       |
|        |                |     | 7.938          | 0.045  | 7.947 S0303R RT        |                       |
|        |                |     |                | 0.163  |                        |                       |
|        |                |     | 7.775          |        |                        |                       |
|        | 7.584          |     |                |        |                        |                       |
| 0.403  |                |     | 7.414          |        | 7.415 S0303R LT        |                       |
|        |                |     |                | 0.233  |                        |                       |
|        | 7.181          |     | 7.181          |        | 7.176 C0211 FREEDOM RT |                       |
|        |                |     | 7.166          |        | 7.176 S0700R LT        |                       |
|        |                |     | 7.105          | 0.061  |                        |                       |

Page: 1 of 1

From: 8.000 S0014R

Direction: **North**

To: **8.999 ENTER GEA CO**

| Length | Left  | C/L | Right | Length | Control Points                     |
|--------|-------|-----|-------|--------|------------------------------------|
|        |       |     |       |        | 8.991 Mile Post = 009              |
| 0.206  | 8.693 |     | 8.580 |        | 8.594 T0226 ANDERSON LT            |
|        | 8.487 |     |       | 0.263  | 8.495 I0080K Bridge (hwy Over Hwy) |
|        |       |     | 8.317 |        |                                    |
| 0.170  | 8.170 |     |       |        |                                    |
|        | 8.000 |     | 8.000 |        |                                    |

## No Passing Zone Log (POR)



# ODOT Dist 4 - Portage Co - FINAL No Passing Zone Log (POR)

Page: 11 of 18


Route: 0088R (SPORSR00088\*\*C)

From: 1.260 S0014R

Length: 15.167

Direction: North

To: 16.427 ENTER GEA CO

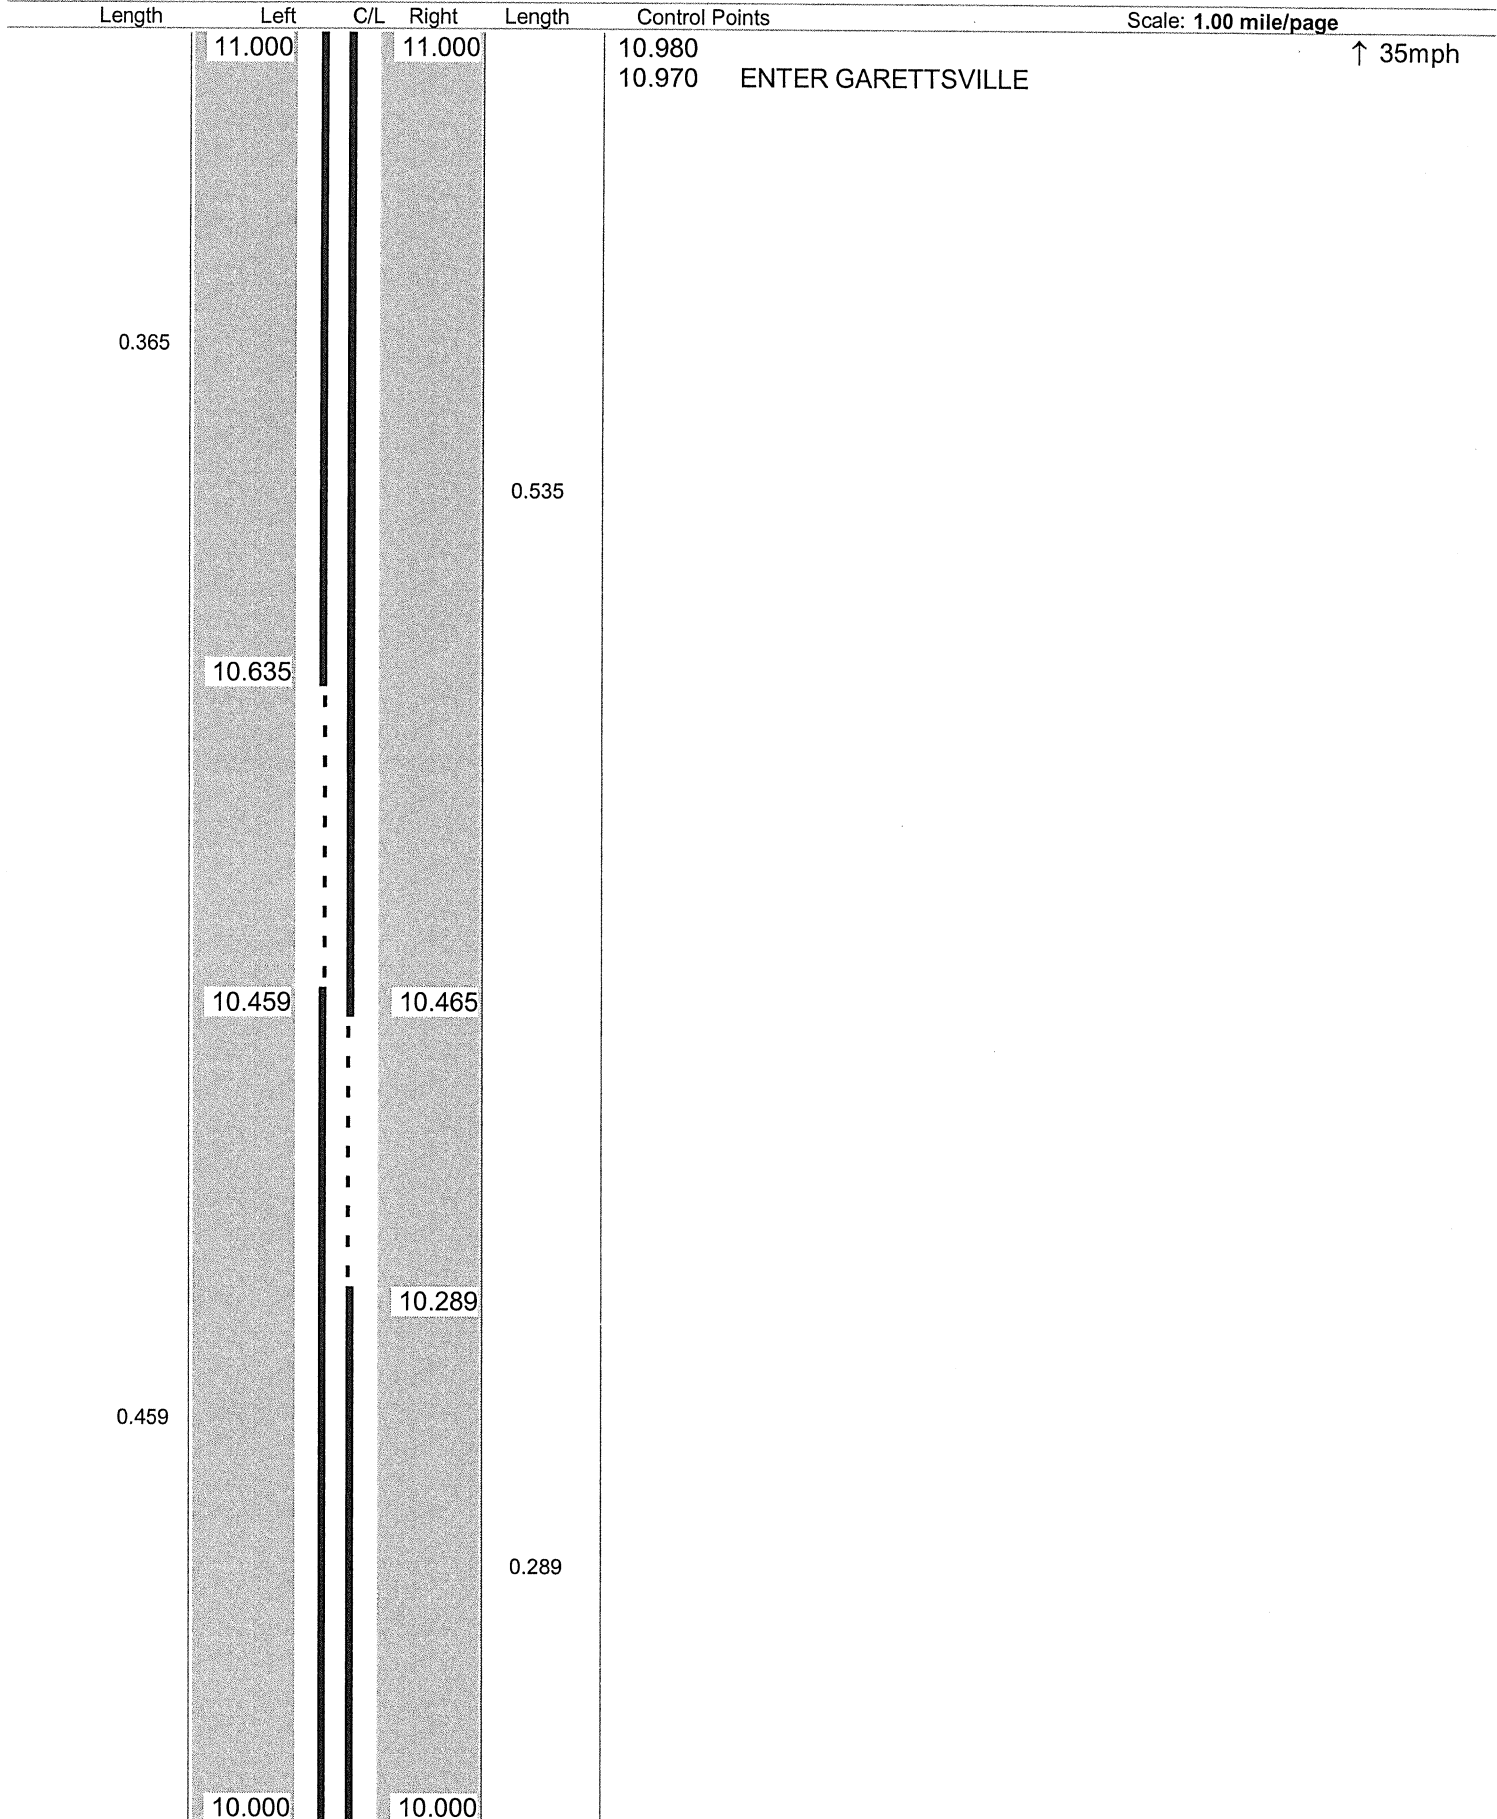

Sheet total equivalent length of solid line: 1.735

Accum. total: 9.930

© 2004 - MasterMind Systems, Inc. - Traffic Safety Suite

## No Passing Zone Log (POR)

To: 16.427 ENTER GEA CO

© 2004 - MasterMind Systems, Inc. - Traffic Safety Suite

# ODOT Dist 4 - Portage Co - FINAL No Passing Zone Log (POR)

Page: 13 of 18


Route: 0088R (SPORSR00088\*\*C)

From: 1.260 S0014R

Length: 15.167

Direction: North

To: 16.427 ENTER GEA CO

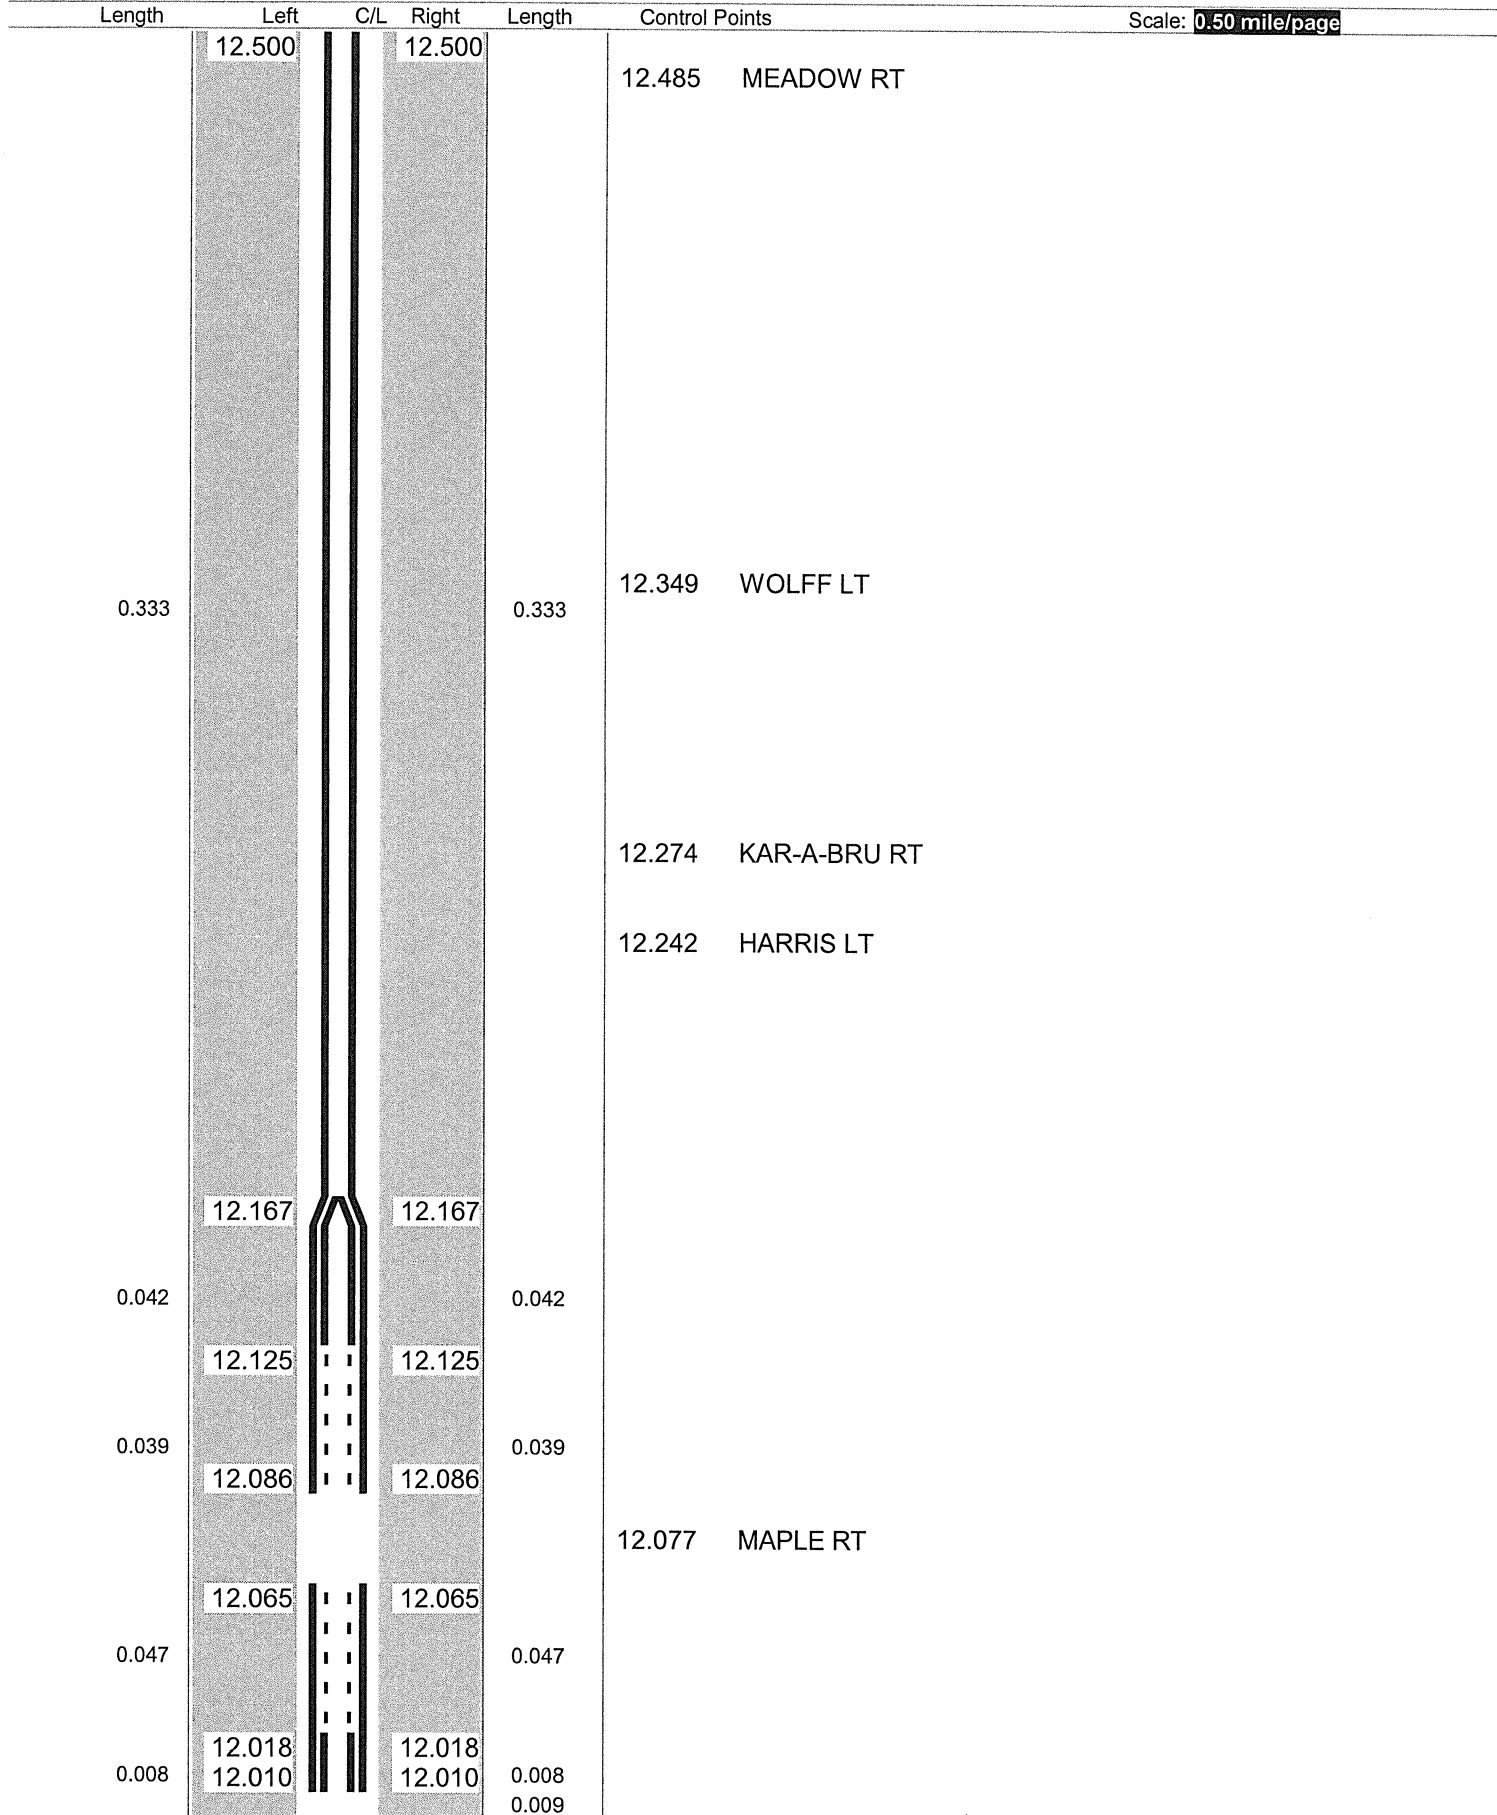

Sheet total equivalent length of solid line: 1.099

Accum. total: 12.972

© 2004 - MasterMind Systems, Inc. - Traffic Safety Suite

ODOT Dist 4 - Portage Co - FINAL  
No Passing Zone Log (POR)

Page: 14 of 18


Route: 0088R (SPORSR00088\*\*C)

From: 1.260 S0014R

Length: 15.167

Direction: North

To: 16.427 ENTER GEA CO

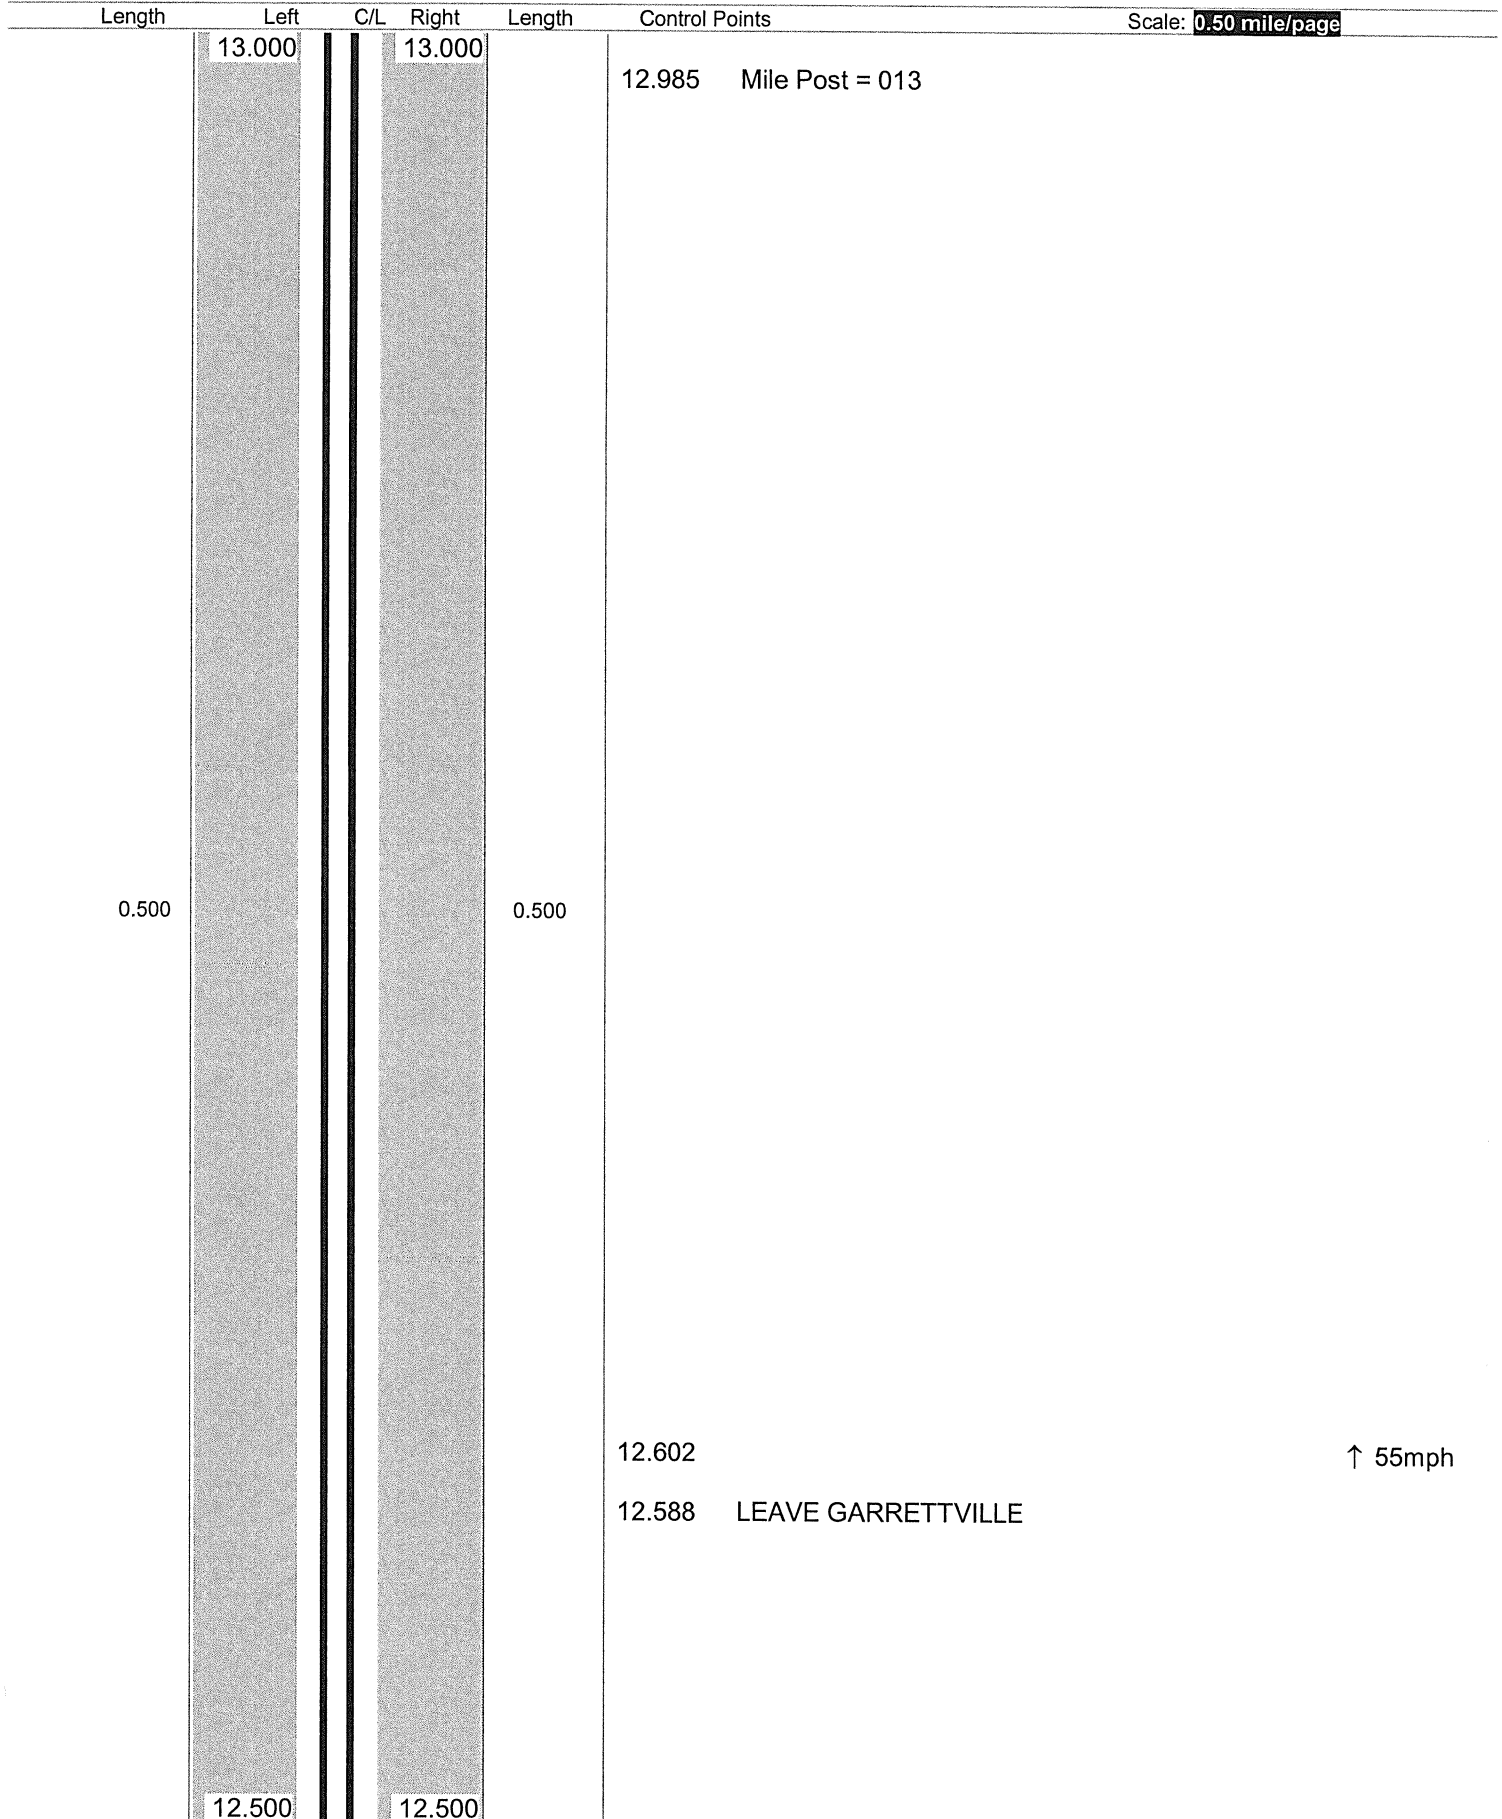

Sheet total equivalent length of solid line: 1.000

Accum. total: 13.972


© 2004 - MasterMind Systems, Inc. - Traffic Safety Suite

**ODOT District 4**  
**No Passing Zone Log (POR)**

Page: 15 of 18

Route: **0088R (SPORSR00088\*\*C)**  
 Length: **0.999** Direction: **North**

From: **13.000 S0014R**  
 To: **13.999 ENTER GEA CO**

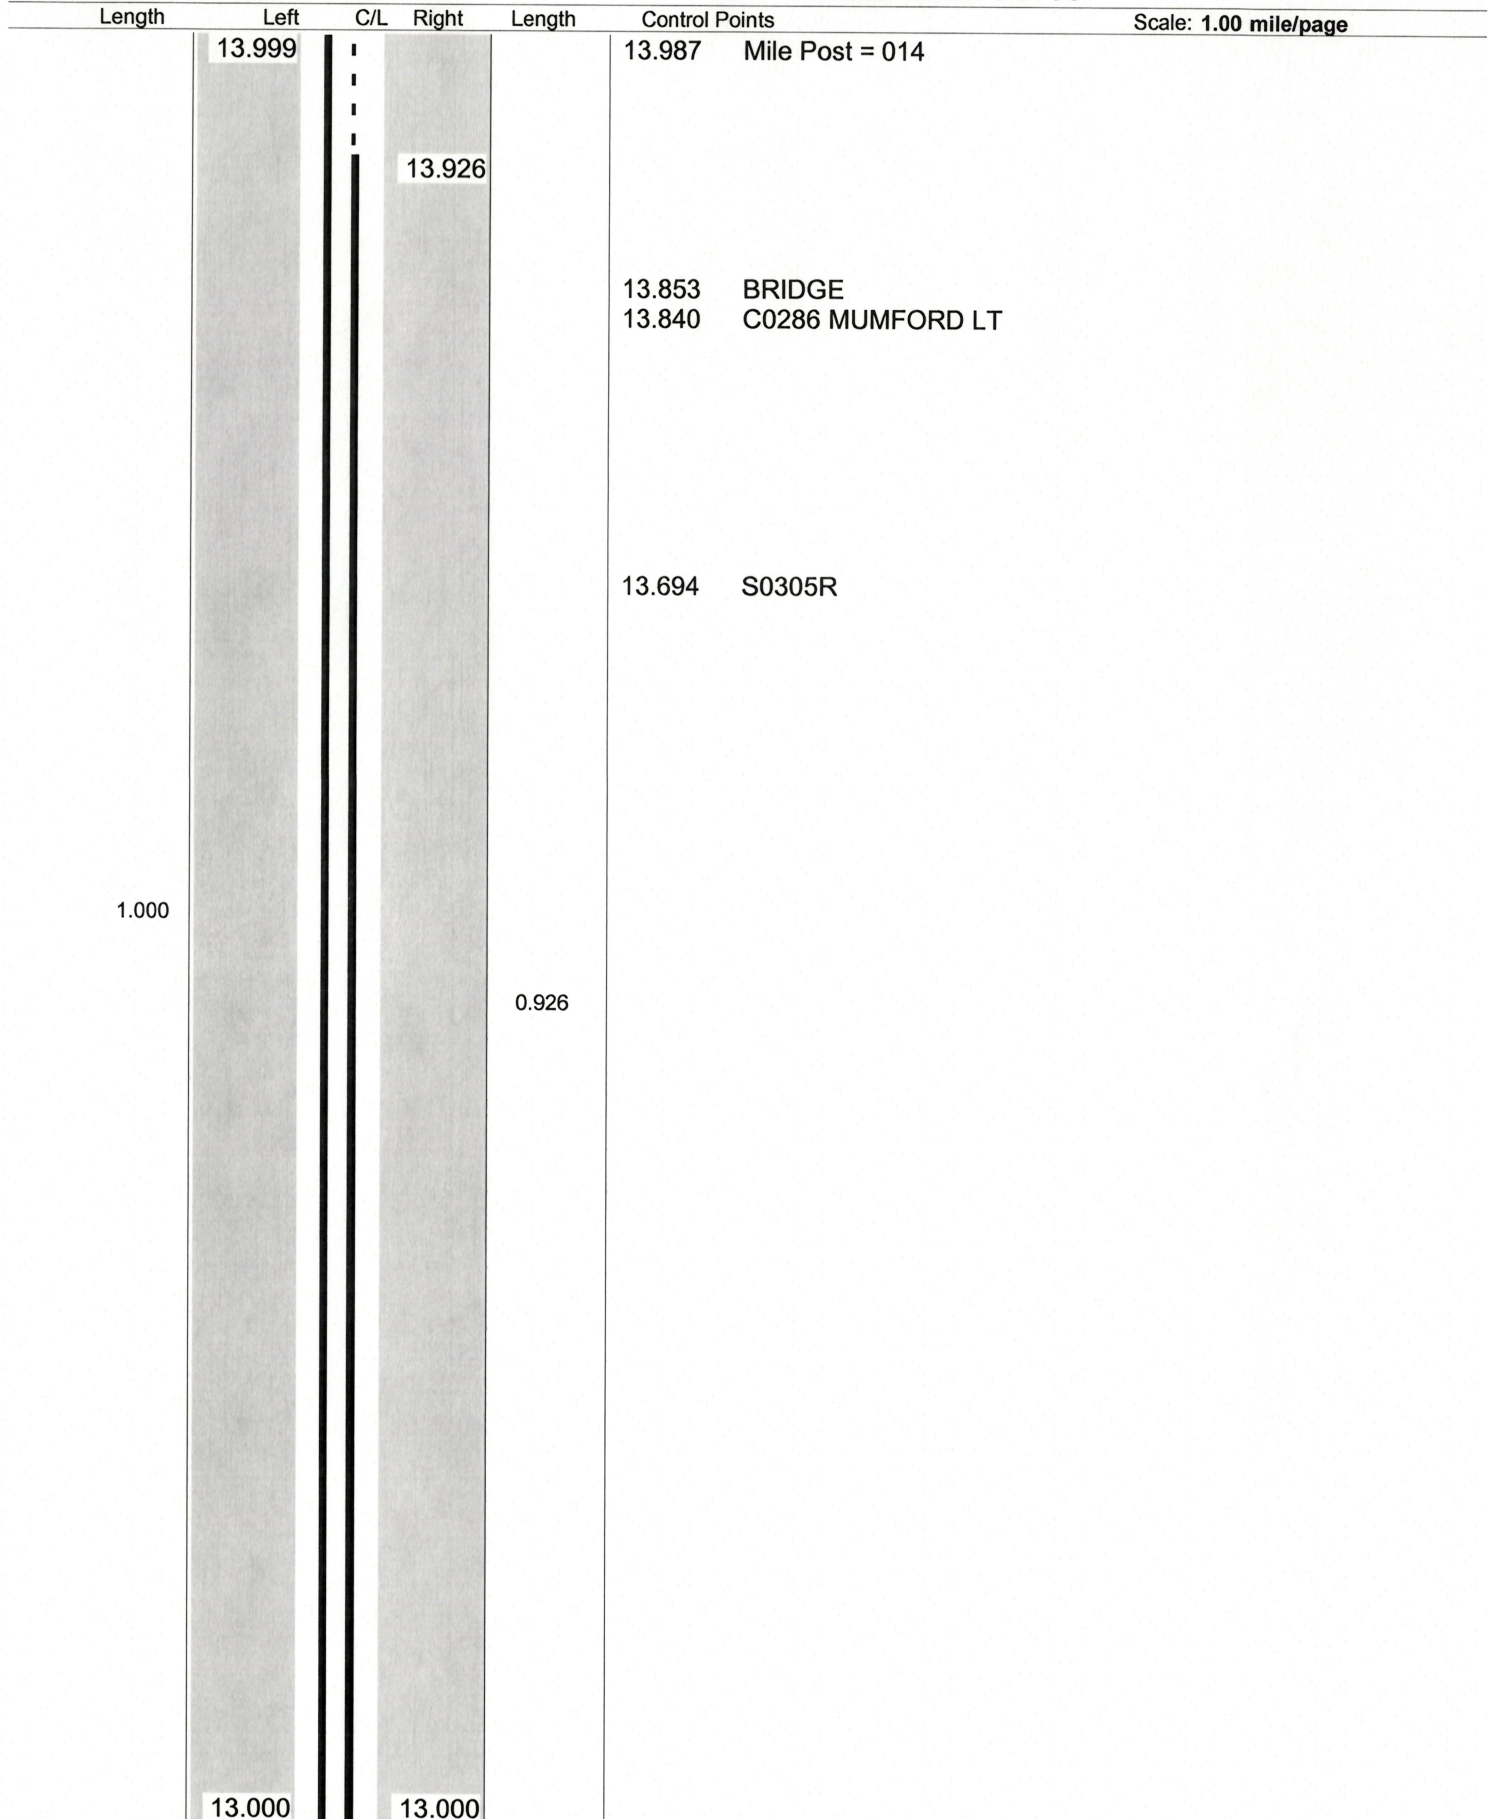

Sheet total equivalent length of solid line: 1.943

Accum. total: 1.943