

LEGEND

WORK AREA



DRUMS

PORTABLE BARRIER (PB)

REMOVE EXISTING MARKINGS

ATTENUATOR

DIRECTION OF TRAVEL

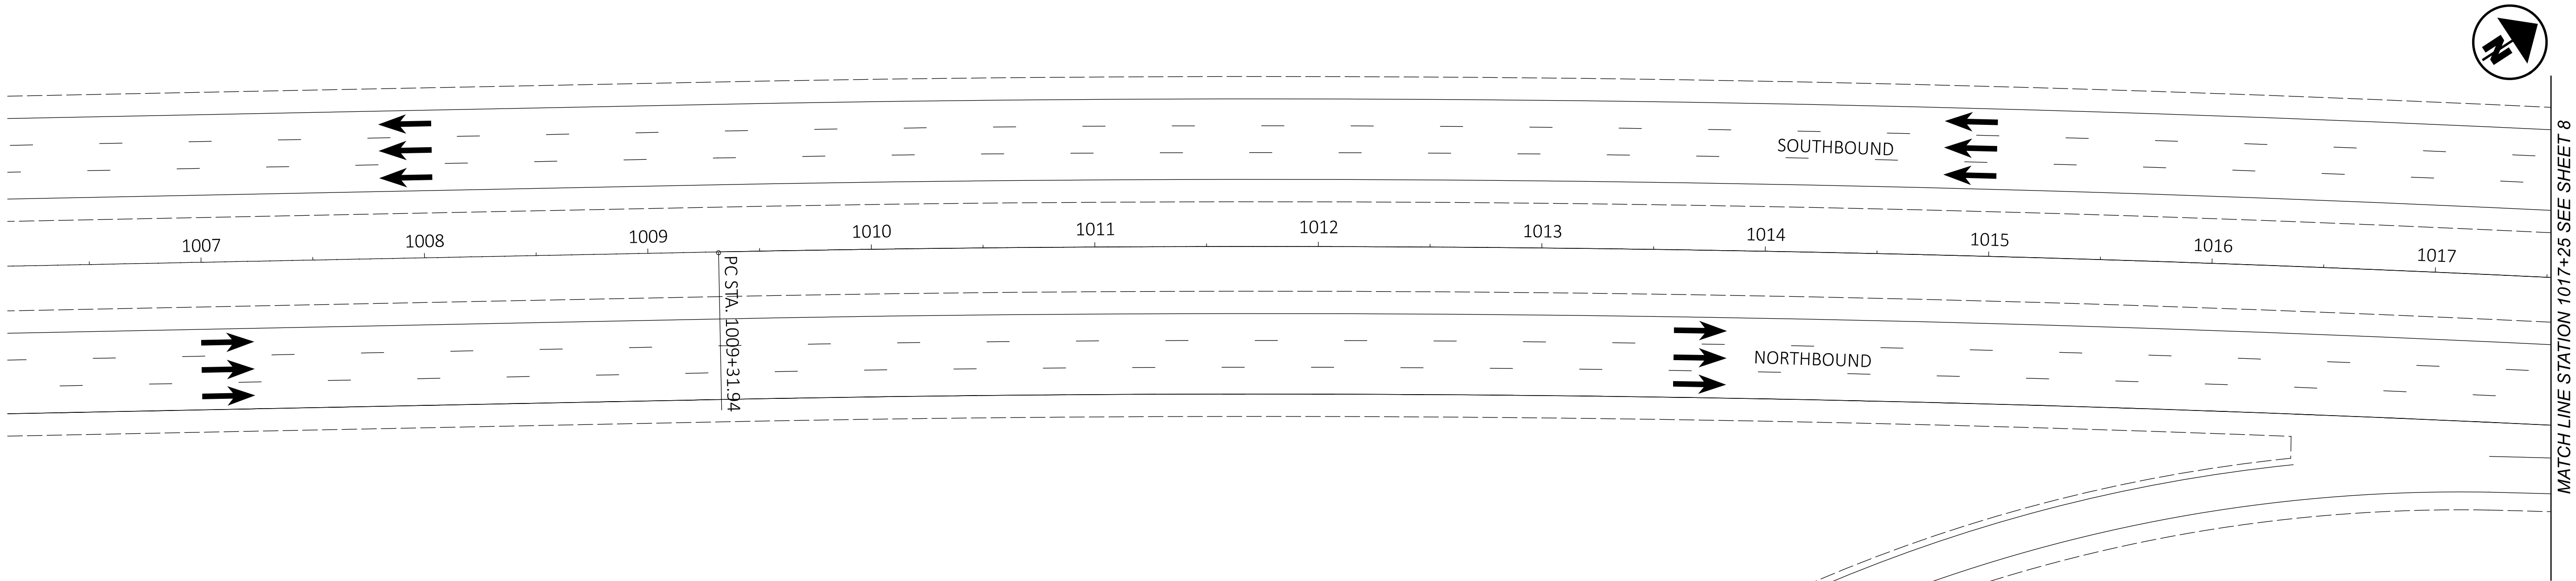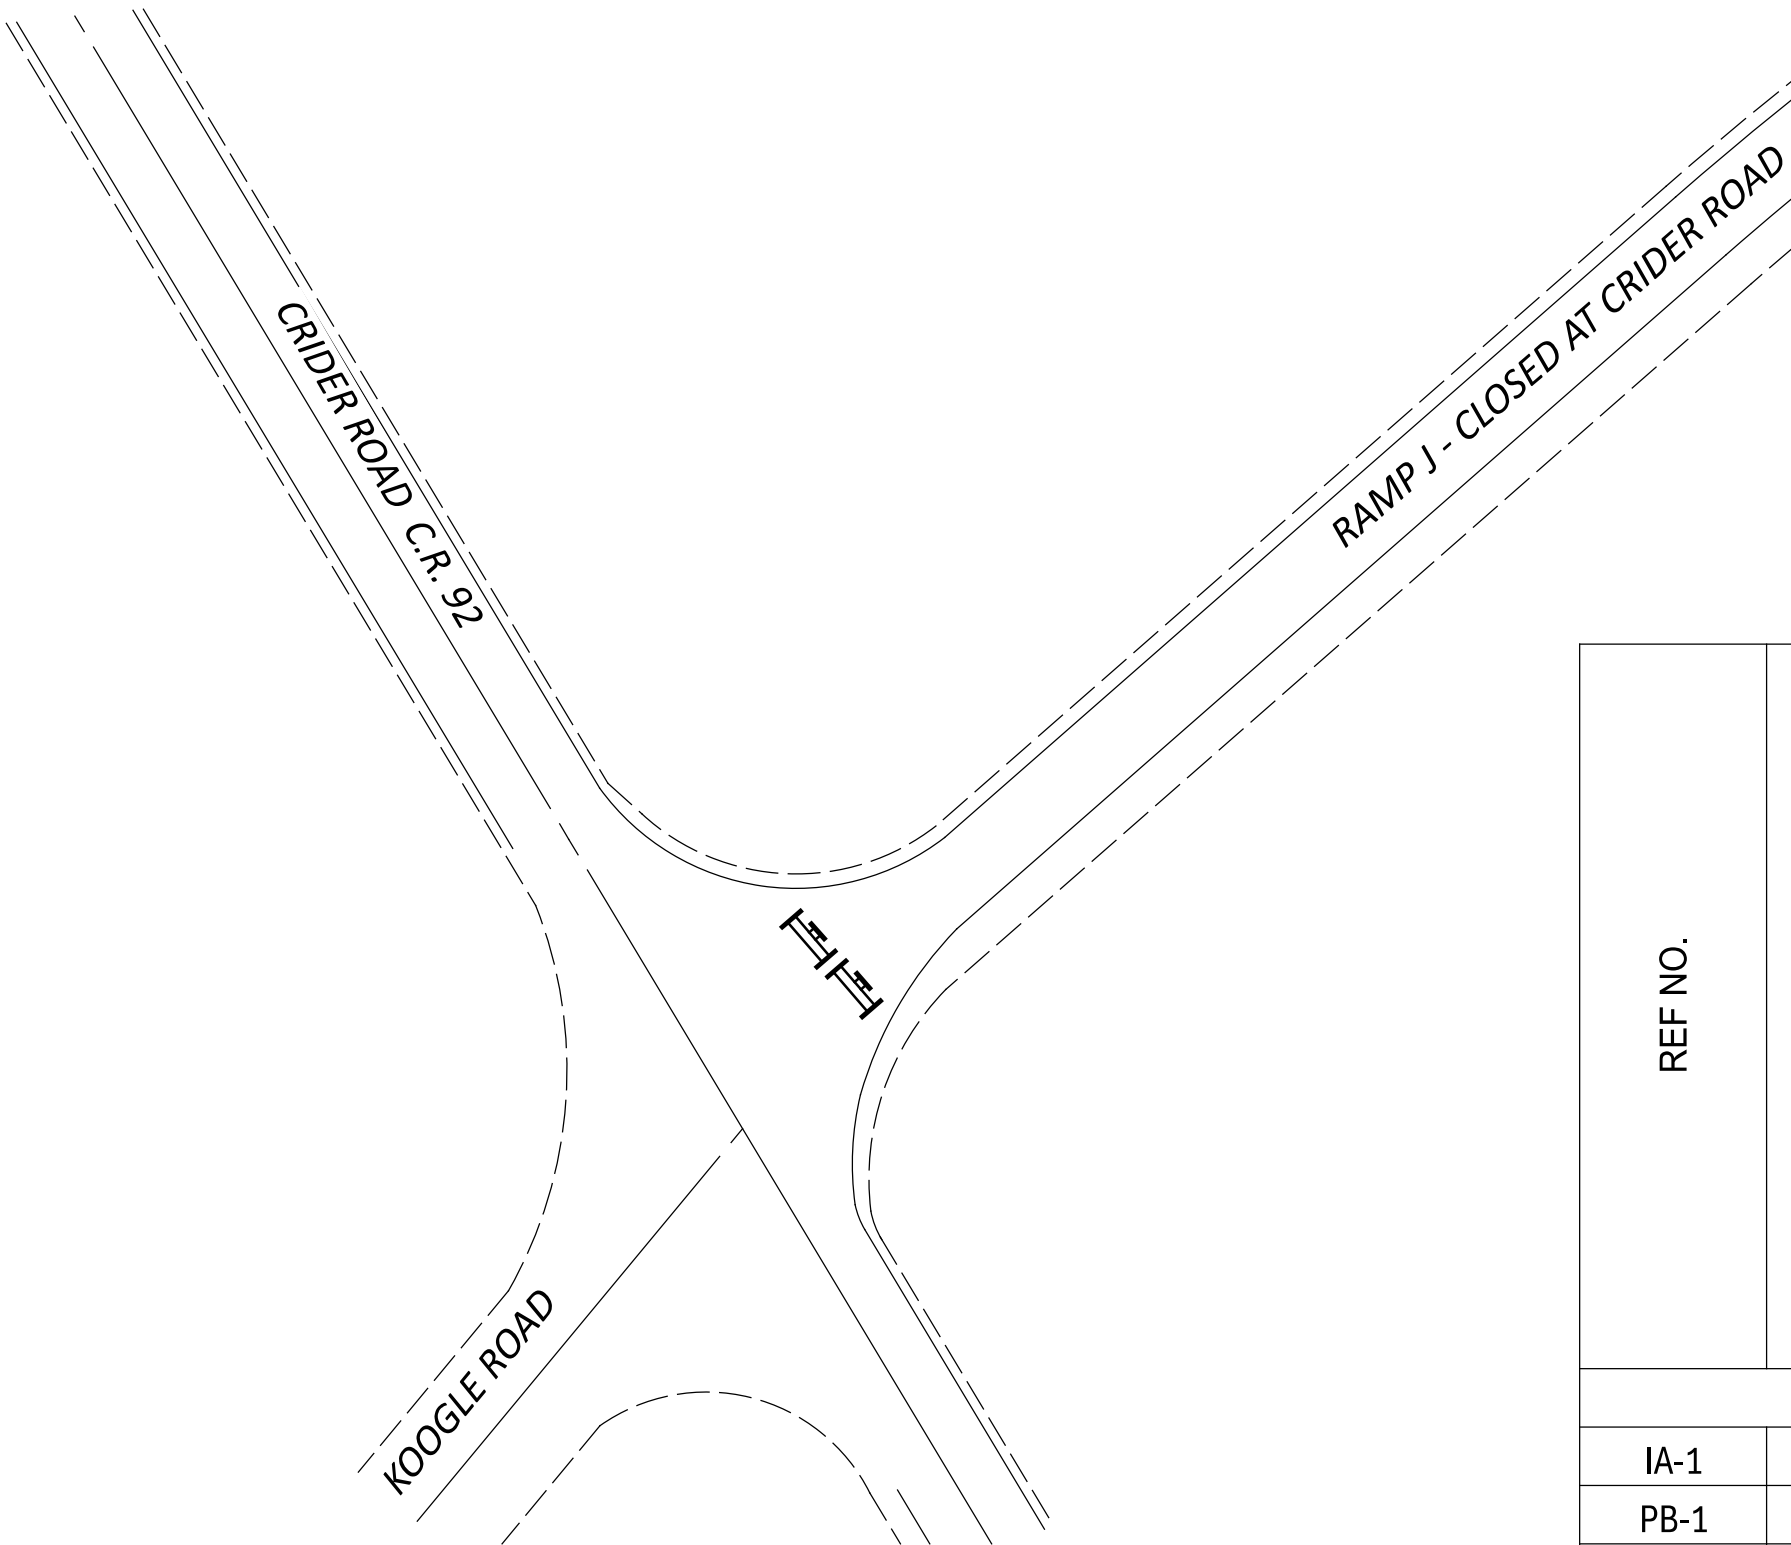

REF NO.	SHEET NO.	STATION TO STATION				614	614	614	614	622	642	644	
						WORK ZONE IMPACT ATTENUATOR, 24" WIDE HAZARDS, (UNIDIRECTIONAL)	BARRIER REFLECTOR, TYPE 1 (ONE WAY)	OBJECT MARKER, ONE WAY	WORK ZONE EDGE LINE, CLASS I, 6", 642 PAINT(WHITE)	PORTABLE BARRIER, UNANCHORED	REMOVAL OF PAVEMENT MARKING	EDGE LINE, 6" (WHITE)	
						EACH	EACH	EACH	MILE	FT	FT	MILE	
NORTHBOUND													
IA-1	8	1031+50	TO	1036+30		1							
PB-1	8	1031+50	TO	1036+30			10	10		480			
WEL-1	8,9	1031+00	TO	1036+30					0.10		530		
EL-1	8,9	1031+00	TO	1036+30								0.10	
SOUTHBOUND													
IA-2	8	1033+40	TO	1038+20		1							
PB-2	8	1033+40	TO	1038+20			10	10		530			
WEL-2	8,9	1033+40	TO	1038+70					0.10		530		
EL-1	8,9	1033+40	TO	1038+70								0.10	
TOTALS CARRIED TO GENERAL SUMMARY						2	20	20	0.20	1010	1060	0.20	