

PORTION TO BE IMPROVED	
INTERSTATE HIGHWAY	
FEDERAL ROUTES	
STATE ROUTES	
COUNTY & TOWNSHIP ROADS	
OTHER ROADS	

DESIGN DESIGNATION CURRENT ADT (2025)

	52000
LL)	CEE00

RIC-71-

15.76

65500
9000
60%
35%
70
70
FREEWAY/ EXPRESSWAY
YES

DESIGN EXCEPTIONS

NONE

ADA DESIGN WAIVERS

NONE

STATE OF OHIO DEPARTMENT OF TRANSPORTATION

RIC-71-15.76

MIFFLIN TOWNSHIP

RICHLAND COUNTY

INDEX OF SHEETS:	
TITLE SHEET	1
SCHEMATIC PLAN	2
TYPICAL SECTIONS	3
GENERAL NOTES	4
MAINTENANCE OF TRAFFIC NOTES	5 - 7
MAINTENANCE OF TRAFFIC DETAILS	8 - 9
GENERAL SUMMARY	10
SUBSUMMARIES	11
PLAN VIEW	12 - 13
BARRIER DETAILS	14
BARRIER TRANŠITION DETAILS 🕺 🎽 🎽	15
🖌 GEOTECHNICAL PROFILE - ROCKFALL	GP.1 - GP.6
uuuuu	U C

	SPECIAL PROVISIONS	SUPPLEMENTAL SPECIFICATIONS	VINGS	CONSTRUCTION L	ANDARD	57		
		800-2023 7/19/24			7/19/19	MT-95.30	1/19/24	BP-3.1
		821 4/20/12			7/21/23	MT-95.40		
		832 7/19/24			7/21/23	MT-95.45	1/15/16	DM-4.3
ENGINEER'S SEAL		862 🖌 1/17/25			7/21/17	MT-95.50	1/15/16	DM-4.4
	-	921 7/19/24			7/19/24	MT-101.70		
					7/21/23	MT-101.75	7/16/21	MGS-1.1
					7/17/20	MT-101.90	1/19/18	MGS-2.1
NTE OF OXY					1/17/20	MT-105.10	1/19/18	MGS-3.1
:57 10:-							1/18/13	MGS-4.3
DVAN					10/18/13	TC-41.20	1/19/18	MGS-6.1
FOSTER E-81255					10/18/13	TC-42.10		
1- POL RECOMPTER AND					10/18/13	TC-42.20	7/19/24	RM-4.2
SONAL ENGLY							7/21/23	RM-4.4
CONTRACTOR OF THE OWNER							7/19/24	RM-4.5
							7/19/24	RM-4.6

UNDERGROUND UTILITIES Contact Two Working Days Before You Dig ᆔᄂ 🗯 OHIO 811.org - Before You Dig OHI0811, 8-1-1, or 1-800-362-2764 (Non members must be called directly)

FEDERAL PROJECT NUMBER

E240511

RAILROAD INVOLVEMENT

NONE

PROJECT DESCRIPTION

ROCKFALL MITIGATION BY REMOVING LOOSE AND OVERHANGING ROCK BY HAND SCALING WITH INSTALLATION OF PROTECTION BARRIER.

EARTH DISTURBED AREAS

N/A* PROJECT EARTH DISTURBED AREA: N/A* ESTIMATED CONTRACTOR EARTH DISTURBED AREA: N/A* NOTICE OF INTENT EARTH DISTURBED AREA:

*MAINTENANCE PROJECT

LIMITED ACCESS

THIS IMPROVEMENT IS ESPECIALLY DESIGNED FOR THROUGH TRAFFIC AND HAS BEEN DECLARED A LIMITED ACCESS HIGHWAY OR FREEWAY BY ACTION OF THE DIRECTOR IN ACCORDANCE WITH THE PROVISIONS OF SECTION 5511.02 OF THE OHIO REVISED CODE.

2023 SPECIFICATIONS

THE STANDARD SPECIFICATIONS OF THE STATE OF OHIO, DEPARTMENT OF TRANSPORTATION, INCLUDING SUPPLEMENTAL SPECIFICATIONS LISTED IN THE PLANS, CHANGES LISTED IN THE PROPOSAL, AND THE SUPPLEMENTAL SPECIFICATION 800 VERSION INDICATED ON THE PROPOSAL SHALL GOVERN THIS IMPROVEMENT.

SHEET TITLE

PLANS PREPARED BY: Ohio Department of **TRANSPORTATION** DISTRICT THREE ENGINEERING

MAINTENANCE OF TRAFFIC ENDORSEMENT

HEREBY APPROVE THESE PLANS AND DECLARE THAT THE MAKING OF THIS MPROVEMENT WILL NOT REQUIRE THE CLOSING TO TRAFFIC OF THE HIGHWAY AND THAT PROVISIONS FOR THE MAINTENANCE AND SAFETY OF TRAFFIC VILL BE AS SET FORTH ON THE PLANS AND ESTIMATES.

OBERT WEAVER, PE, PS ISTRICT DEPUTY DIRECTOR

Tamela Bolatyn AMELA BORATYN **IRECTOR, DEPARTMENT OF TRANSPORTATION**



PROJECT DESCRIPTION

ROCKFALL MITIGATION BY REMOVING LOOSE AND OVERHANGING ROCK BY HAND SCALING WITH INSTALLATION OF PROTECTION BARRIER.

HISTORIC RECORDS

HISTORICAL RECORDS WERE OBTAINED FROM ODOT'S TRANSPORTATION INFORMATION MAPPING SYSTEM (TIMS) FOR RIC-1-12.03, SUB-BATCH 14544, COMPLETED IN 1959 FOR THE PROPOSED CONSTRUCTION OF CURRENT I.R. 71 ALIGNMENT. THREE (3) BORINGS WERE COMPLETED FOR THE EXISTING PROJECT CUT AREA. RESULTS OF THIS EXPLORATION INDICATED THAT SHALLOW OVERBURDEN SOILS WERE UNDERLAIN BY SANDSTONE WHICH WAS DESCRIBED AS FLAT BEDDED, MEDIUM HARD (SOFT NEAR SURFACE), POROUS, FINE GRAINED, IRON OXIDE CEMENTED. ALL THREE (3) BORINGS EXTENDED THROUGH THE DEPTH OF THE CUT AND WERE REPORTED AS DRY AT COMPLETION. DUE TO THE LIMITED INFORMATION PROVIDED WITH THESE BORINGS, THEY ARE NOT PRESENTED FOR CLARITY.

GEOLOGY

THE PROJECT IS LOCATED WITHIN THE KILLBUCK GLACIATED PITTSBURGH PLATEAU PHYSIOGRAPHIC REGION WHICH IS CHARACTERIZED BY MODERATE RELIEF. THIN GLACIALLY DEPOSITED SOILS ARE PRESENT EXCEPT WITHIN MAJOR DRAINAGE VALLEYS WHERE THE DEPOSITS BECOME THICKER WITHIN STEEP WALLED. BURIED BEDROCK PRE-GLACIAL DRAINAGE VALLEYS WHICH ARE FOUND IN THE PROJECT AREA. THE OHIO DEPARTMENT OF NATURAL RESOURCES (ODNR) INTERACTIVE GEOLOGIC MAP INDICATES THAT THE PROJECT AREA IS COVERED BY GLACIALLY DEPÓSITED GROUND MORAINE DEPOSITS WHICH BECOME HUMMOCKY ON THE OUTSLOPES. BENEATH THE OVERBURDEN SOILS THE AREA CONTAINS SANDSTONE AND SHALE UNITS FROM THE MISSISSIPPIAN-AGED LOGAN AND CUYAHOGA FORMATIONS.

RECONNAISSANCE AND FINDINGS

THE PROJECT AREA CONSISTS OF A THRU CUT FOR THE ROADWAY WITH SINGLE ANGLED, BENCHED CUT FACES ON EITHER SIDE. THE GENERAL CHARACTERISTICS OF THE SLOPES ARE APPROXIMATELY 60° ANGLE SLOPES, FROM HORIZONTAL, WITH A BENCH APPROXIMATELY MID-SLOPE. THE BASE OF THE CUT IS COMPRISED OF INTERBEDDED SANDSTONE AND SHALE. THE SANDSTONE ACCOUNTS FOR APPROXIMATELY 80% OF THE UNIT BEING DESCRIBED AS GRAYISH BROWN WITH LIGHT BROWN, HIGHLY TO MODERATELY WEATHERED, MEDIUM TO COARSE GRAINED, MODERATELY STRONG, THIN BEDDED. THE SHALE WAS DESCRIBED AS BROWNISH GRAY AND BROWN, SEVERELY TO HIGHLY WEATHERED, VERY WEAK TO WEAK, LAMINATED TO VERY THIN BEDDED.

THE REMAINING SLOPES CONSISTED PREDOMINANTLY OF GRAYISH BROWN WITH LIGHT BROWN SANDSTONE WHICH WAS HIGHLY TO MODERATELY WEATHERED, MEDIUM TO COARSE GRAINED, MODERATELY STRONG, THIN TO THICK BEDDED. THE MID-SLOPE BENCH WAS VARIABLE WIDTH, GENERALLY RUNNING BETWEEN 15 AND 18 FEET WIDE. THE SLOPE FACES WERE RAVELING WITH SMALL TO LARGE BLOCKS NOTED AS POTENTIALLY UNSTABLE. SEVERAL BLOCKS WERE NOTED WITHIN THE CATCHMENT AREA BETWEEN THE BASE OF THE CUT AND THE PAVED SHOULDER. WITHIN THE VICINITY OF STATION 841+50 A LARGE OPEN JOINT WAS NOTED RUNNING ALONG THE OUTSIDE OF THE MID-SLOPE BENCH CREATING A LARGE BLOCK WHICH COULD DETACH. THE CATCHMENT AREA WAS WELL VEGETATED WITH GRASS. THE PAVEMENT WAS NOTED AS BEING IN GOOD CONDITION. THE ADJACENT RIDGE LINE WAS NOTED AS BEING WOODED.

SPECIFICATIONS


THIS GEOTECHNICAL EXPLORATION WAS PERFORMED IN ACCORDANCE WITH THE STATE OF OHIO, DEPARTMENT OF TRANSPORTATION, OFFICE OF GEOTECHNICAL ENGINEERING, SPECIFICATIONS FOR GEOTECHNICAL EXPLORATIONS, DATED JULY 2024.

AVAILABLE INFORMATION

THE SOIL, BEDROCK, AND GROUNDWATER INFORMATION COLLECTED FOR THIS SUBSURFACE EXPLORATION THAT CAN BE CONVENIENTLY DISPLAYED ON THE GEOTECHNICAL PROFILE SHEETS HAS BEEN PRESENTED. GEOTECHNICAL REPORTS, IF PREPARED, ARE AVAILABLE FOR REVIEW ON THE OFFICE OF CONTRACT SALES WEBSITE.

L/	EGEND	
	DESCRIPTION	ODOT CLASS
	SANDSTONE	VISUAL
	INTERBEDDED SANDSTONE AND SHALE	VISUAL
	INDICATES EXPOSED BEDROCK.	VISUAL

 $\stackrel{\scriptstyle <}{\times}$

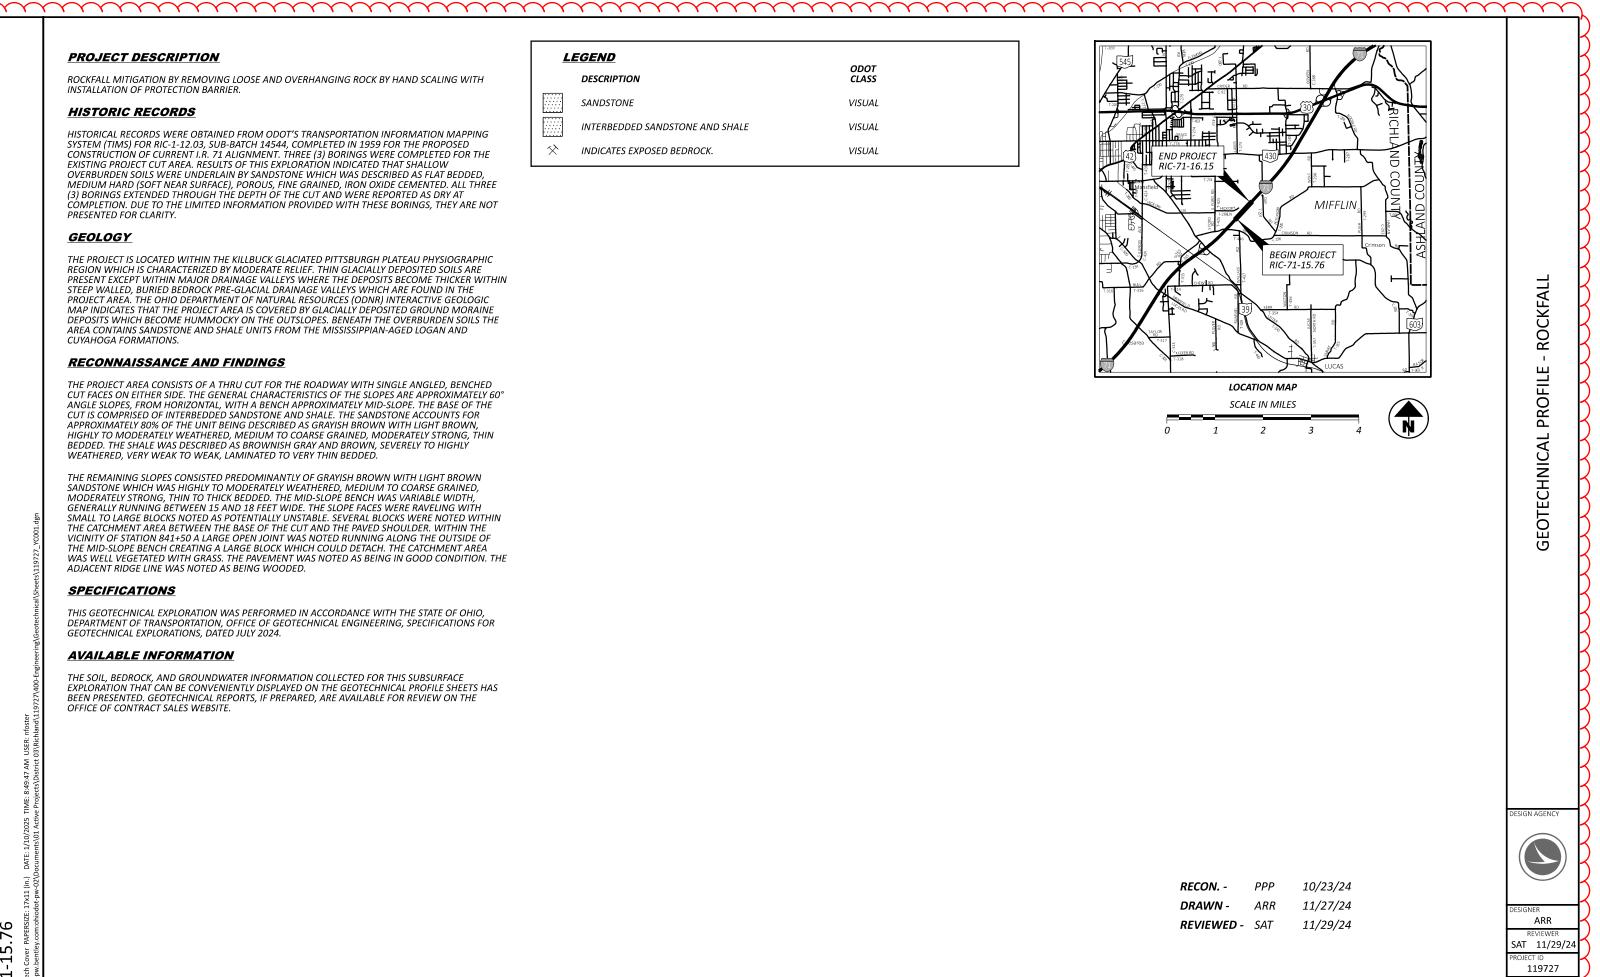

6

GP.6


1


GP.1

76

71-15.


RIC-

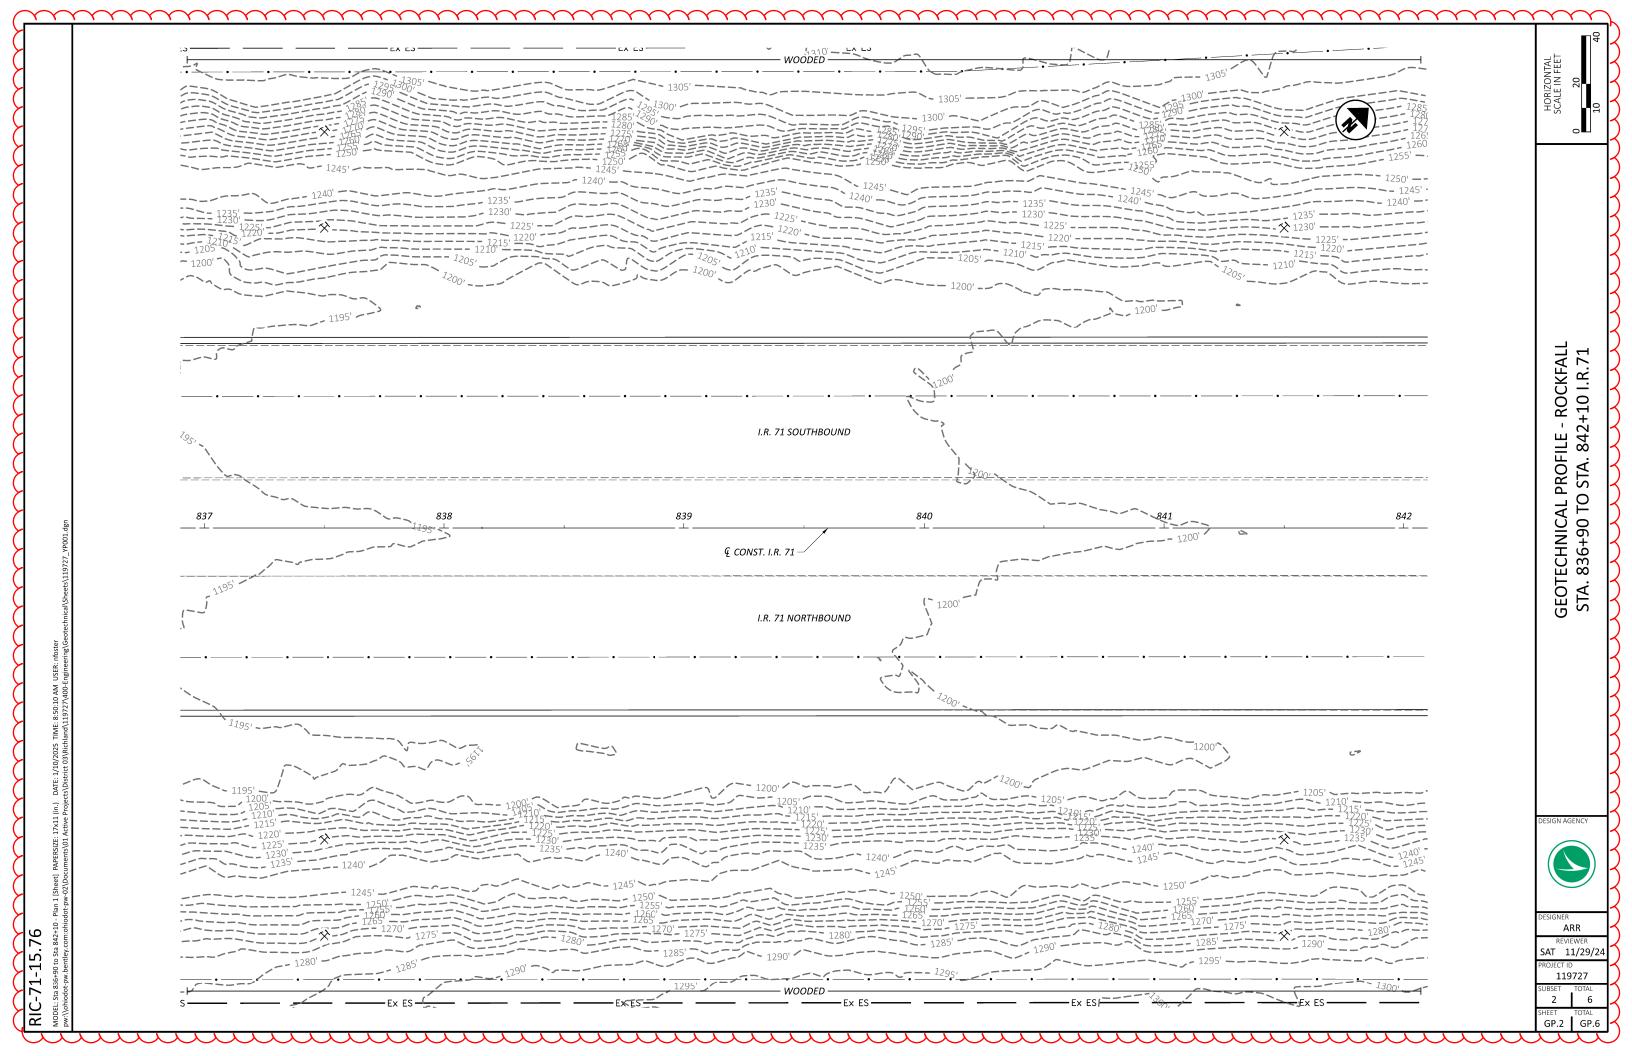

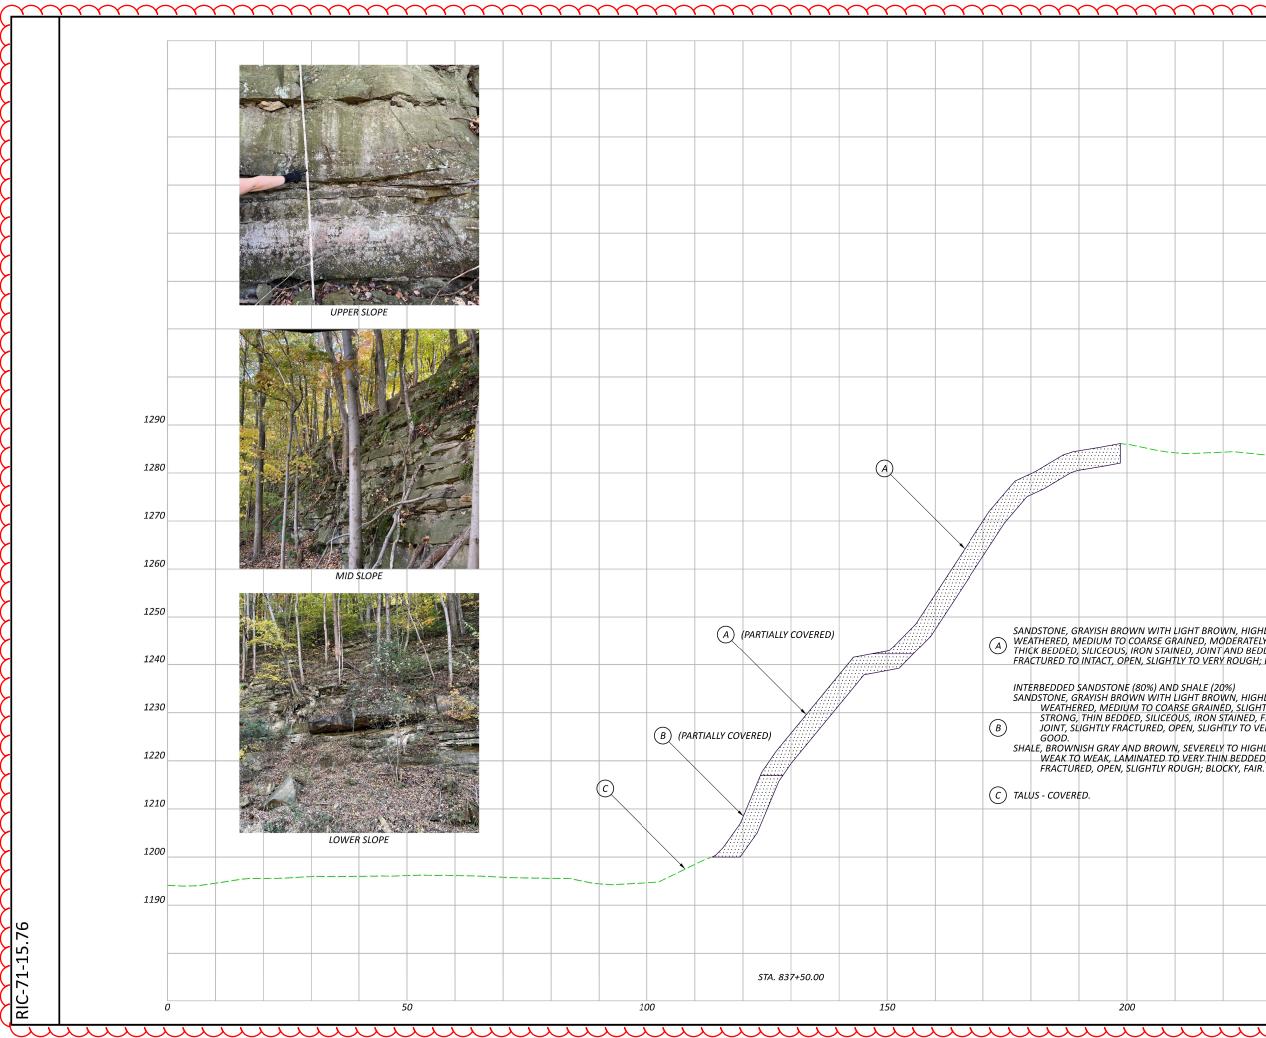


RIC-71-15.76

$\gamma\gamma$	\sim	\sim	\sim	\sim	\sim		•
				1	1		2
							く
							5
							2
					-		4
							3
					-		2
							$\langle \rangle$
					-		3
							2
					_	<u> </u>	$\left\langle \right\rangle$
							3
					-	1 N 00	2
						Ч- Ч- Г-	$\left\langle \right\rangle$
							3
					1290	GEOTECHNICAL PROFILE - ROCKFALL OSS SECTION STA. 837+50 I.R. 71 NORTHBOUND	2
					-	AL F 83.	$\langle \rangle$
					1280	AIC	く
						CH N S	5
					1270		$\left\langle \right\rangle$
							く
					1260	SS :	5
						CRO	$\left\langle \right\rangle$
					1250		く
INFD. MC	DFRATFLY	(TO MODE STRONG, TI ING, SLIGH	HIN TO				5
Y TO VERY	(ROUGH; B	LOĆKY, GO	D.		1240		$\boldsymbol{\zeta}$
SHALE (20 GHT BRON	WŃ. HIGHL	TO MODE	RATELY				く
IS, IRON S	TAINED, FII	Y TO MODE VING TO BA Y ROUGH; I	SAL BED,		1230		5
SEVERELY	TO HIGHL	WEATHER	ED, VERY		1220		$\left\langle \right\rangle$
	N BEDDED, CKY, FAIR.	JOINT AND	BEDDING,		1220		3
					1210		5
					-	DESIGN AGENCY	$\left\langle \right\rangle$
					1200		3
							2
					1190	DECICNED	$\left\langle \right\rangle$
						DESIGNER ARR REVIEWER	3
						SAT 11/29/24 PROJECT ID	2
						119727 SUBSET_TOTAL	$\left\langle \right\rangle$
			2:	50		3 6 SHEET TOTAL	く
						GP.3 GP.6	3

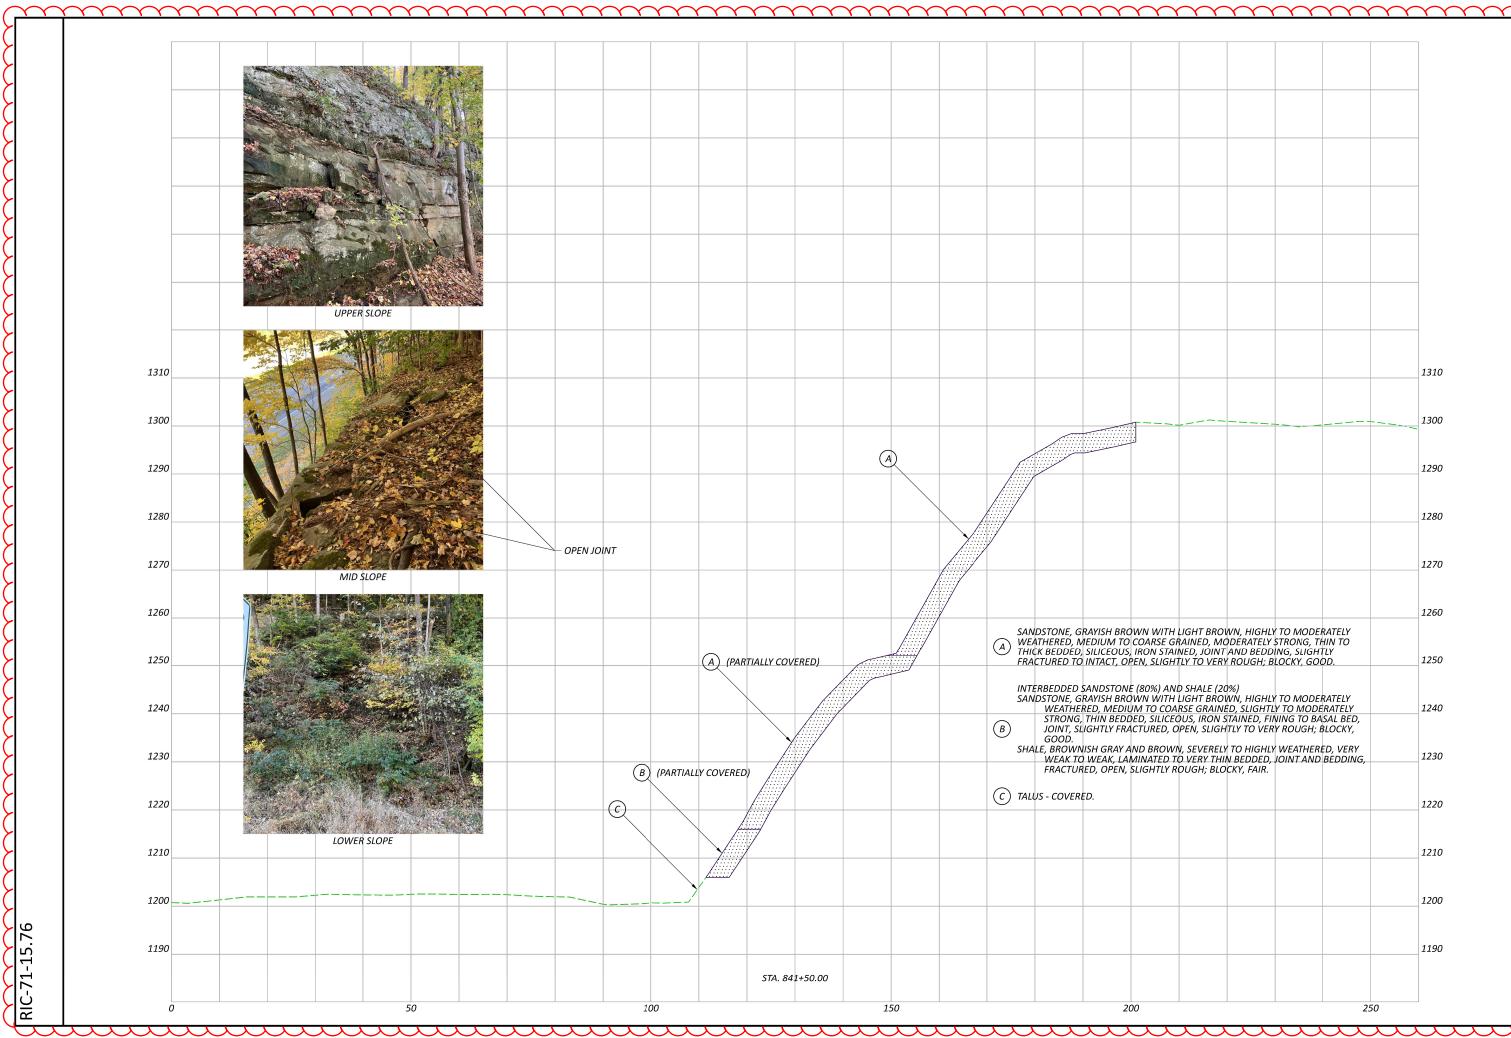

\sim	\sim	\sim	\sim	\sim	
					\mathbf{D}
					$\left \right\rangle$
					4
					3
					2
					$\left\langle \right\rangle$
					2
					3
				D	2
				NU	\mathcal{L}
				BO	2
				ALL	3
				CKF JOF	\mathcal{I}
				71 N	\mathcal{L}
			1310	Е- К. 7	4
				FIL 0 I.	3
			1300	GEOTECHNICAL PROFILE - ROCKFALL OSS SECTION STA. 841+50 I.R. 71 NORTHBOUND	2
				NL F 841	$\left\langle \right\rangle$
			1290	IIC∕	4
				CHN N S ⁻	3
			1280	TEC	2
				ECT	$\left\langle \right\rangle$
			1270	G S SI	3
				sos	5
			1260	CF	2
GHT BROWN, HIGHLY 1 INED, MODERATELY ST					$\left \right\rangle$
D, JOINT AND BEDDIN TO VERY ROUGH; BLC	IG, SLIGHTLY		1250		3
5HALE (20%)					5
GHT BROWŃ, HIGHLY T E GRAINED, SLIGHTLY	TO MODERATELY		1240		2
IS, IRON STAINED, FINI EN, SLIGHTLY TO VERY					3
SEVERELY TO HIGHLY V VERY THIN BEDDED, JC			1230		3
JGH; BLOCKY, FAIR.					2
			1220		$\left<\right.$
				DESIGN AGENCY	3
			1210		5
					\mathbf{X}
			1200	DESIGNER	K
				ARR REVIEWER	5
			1190	SAT 11/29/24 PROJECT ID	2
				119727 SUBSET TOTAL	$\left \right\rangle$
		50		4 6 SHEET TOTAL	K
	2			GP.4 GP.6	K

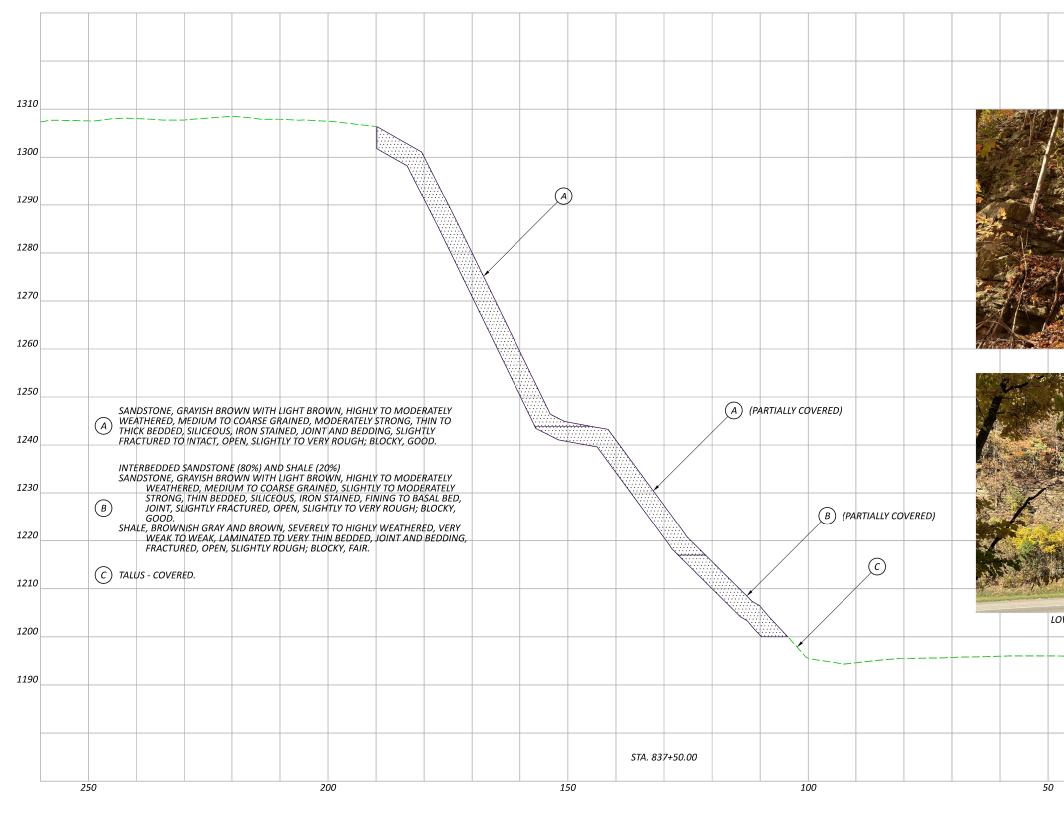

RIC-71-15.76

0%) AND SHALE (20%) I WITH LIGHT BROWN, HIGHLY TO MODERATELY TO COARSE GRAINED, SLIGHTLY TO MODERATELY SULCEOUS, IRON STAINED, FINING TO BASAL BED, IRED, OPEN, SLIGHTLY TO VERY ROUGH; BLOCKY, BROWN, SEVERELY TO HIGHLY WEATHERED, VERY ATED TO VERY THIN BEDDED, JOINT AND BEDDING.		C TALUS - COVERED.	WEATHERED, MEDIUM STRONG, ITHIN BEDDED, JOINT, SLIGHTLY FRACTU GOOD. SHALE. BROWNISH GRAY AND	FRACIURED TO INTACT, OPEN,	0	0	70	20	10
(PARTIALLY COVERED) (PARTIALLY COVERED) (B) (PARTIALLY COVERED) (B) (PARTIALLY COVERED) (C)		NATED TO VERY THIN BEDDED, JOINT AND BEDDING, GHTLY ROUGH; BLOCKY, FAIR.	N WITH LIGHT BROWN, HIGHLY TO MODERATELY I TO COARSE GRAINED, SLIGHTLY TO MODERATELY), SILICEOUS, IRON STAINED, FINING TO BASAL BED, TURED, OPEN, SLIGHTLY TO VERY ROUGH; BLOCKY, D BROWN, SEVERELY TO HIGHLY WEATHERED, VERY	N, SLIGHTLY TO VERY ROUGH; BLOCKY, GOOD.					
A (PARTIALLY COVERED) B (PARTIALLY COVERED) C									
RED)		C	B (PARTIALLY COVER	(A) (PARTIALLY COVERED)					
	LOWER & MID SLOPE		ED)						

GP.5

GP.6

