





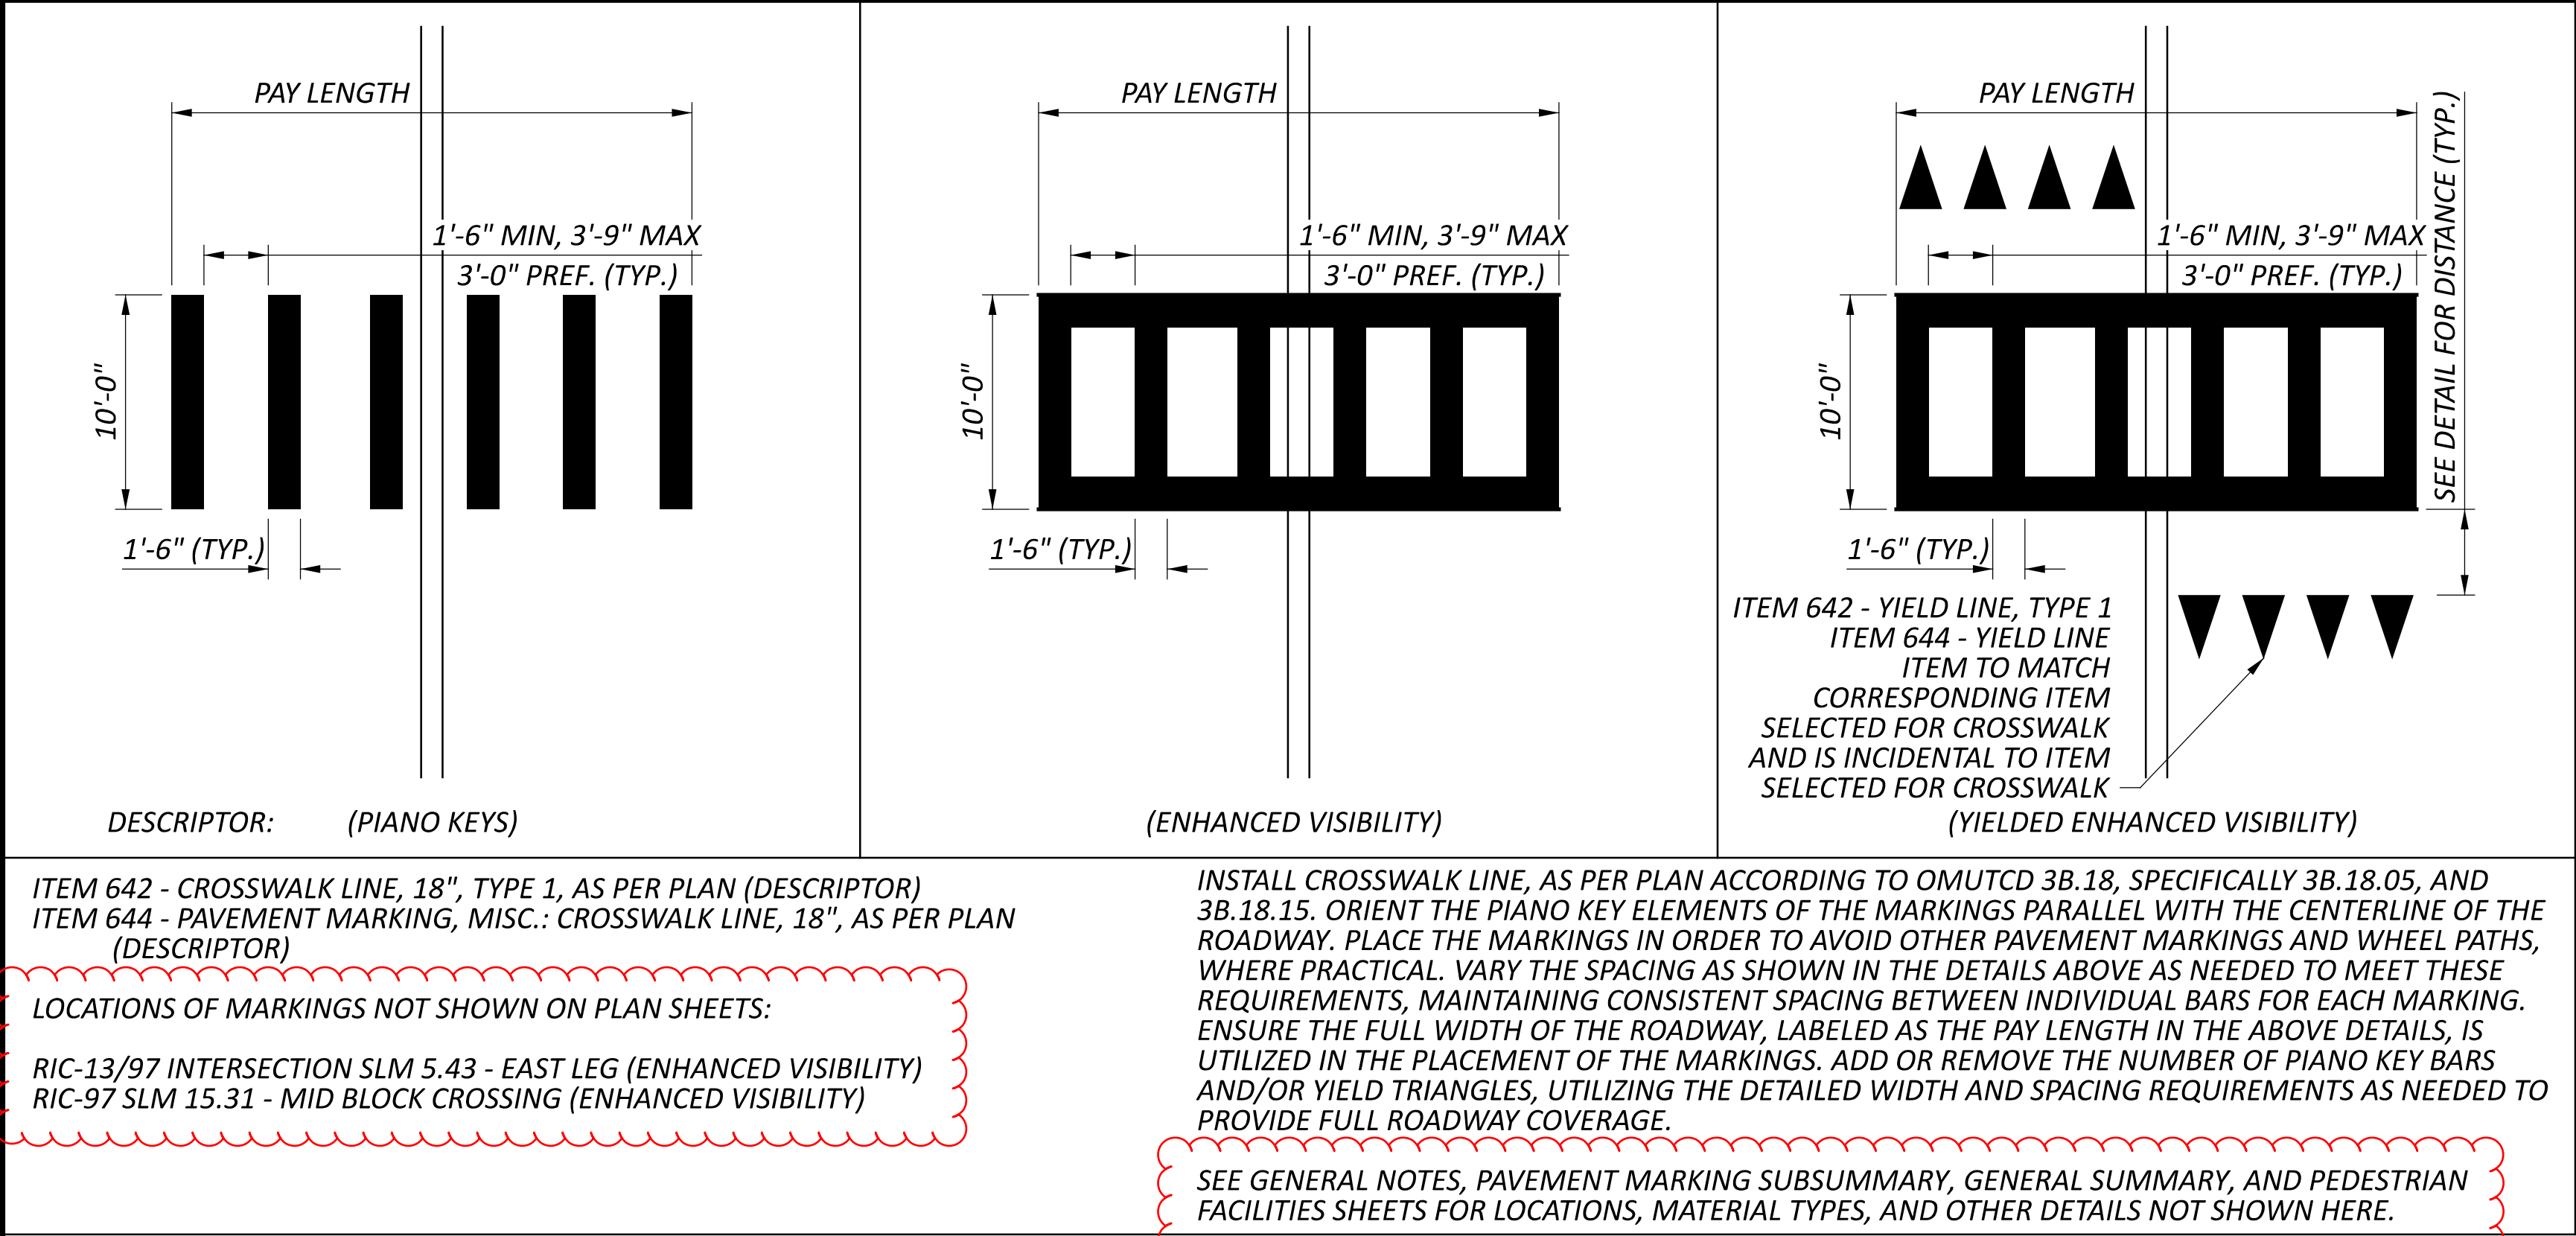



REVISION HISTORY		DOB: 02/19/25	
DATE:	DESCRIPTION OF CHANGE:	DATE:	DESCRIPTION OF CHANGE:


LEGEND & NOTES

- "*" MINIMUM "NO PARKING ZONE" DISTANCE FROM CROSS STREET, DRIVEWAY, ALLEY, OR FIRE HYDRANT.
- "++" ONE PARKING STALL AT EACH END OF PARALLEL PARKING STALLS SHALL BE 20' IN LENGTH.
- "***" INTERIOR PARKING STALLS, BETWEEN END STALLS, SHALL BE EQUAL IN LENGTH (22' TO 26').
- MAXIMIZE THE NUMBER OF PARKING STALLS DURING INSTALLATION.
- PARALLEL PARKING STALLS SHALL BE 8' WIDE UNLESS OTHERWISE SHOWN.
- WHEEL CHAIR SYMBOL (40" WIDE x 40" HEIGHT), AS SHOWN TO THE RIGHT, SHALL BE MARKED IN ALL DISABILITY PARKING STALLS.
- ALL BUFFERS SHOWN IN THE PARELLEL PARKING DIAGRAM ARE THE SIMILAR FOR ANGLED AND PERPENDICULAR PARKING AS WELL.


THROUGH APPROACH/
STOP APPROACH/
SIGNALIZED APPROACH

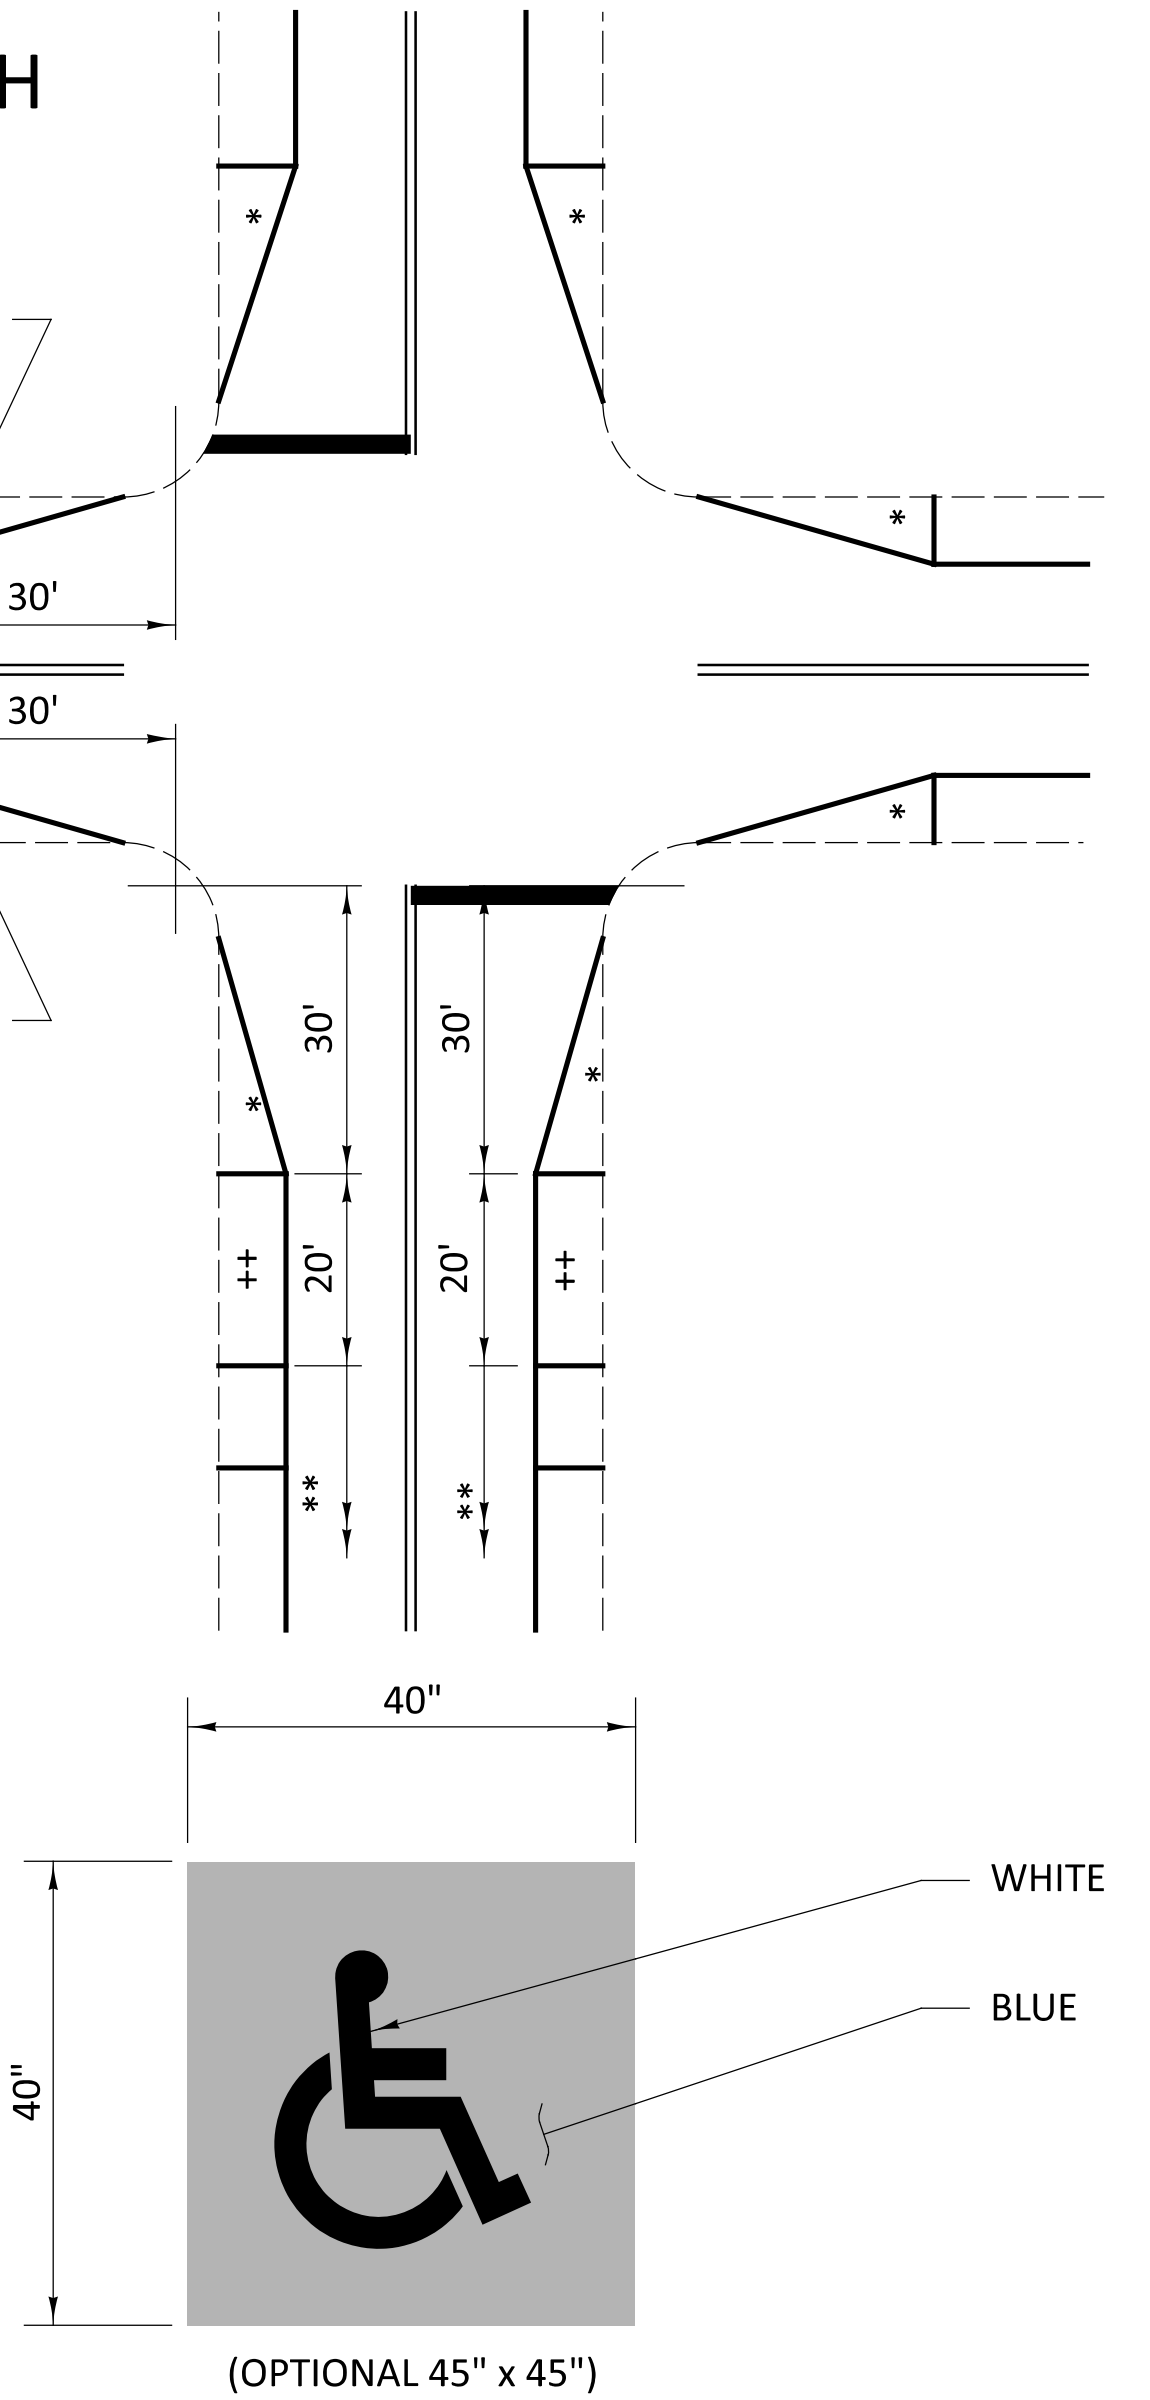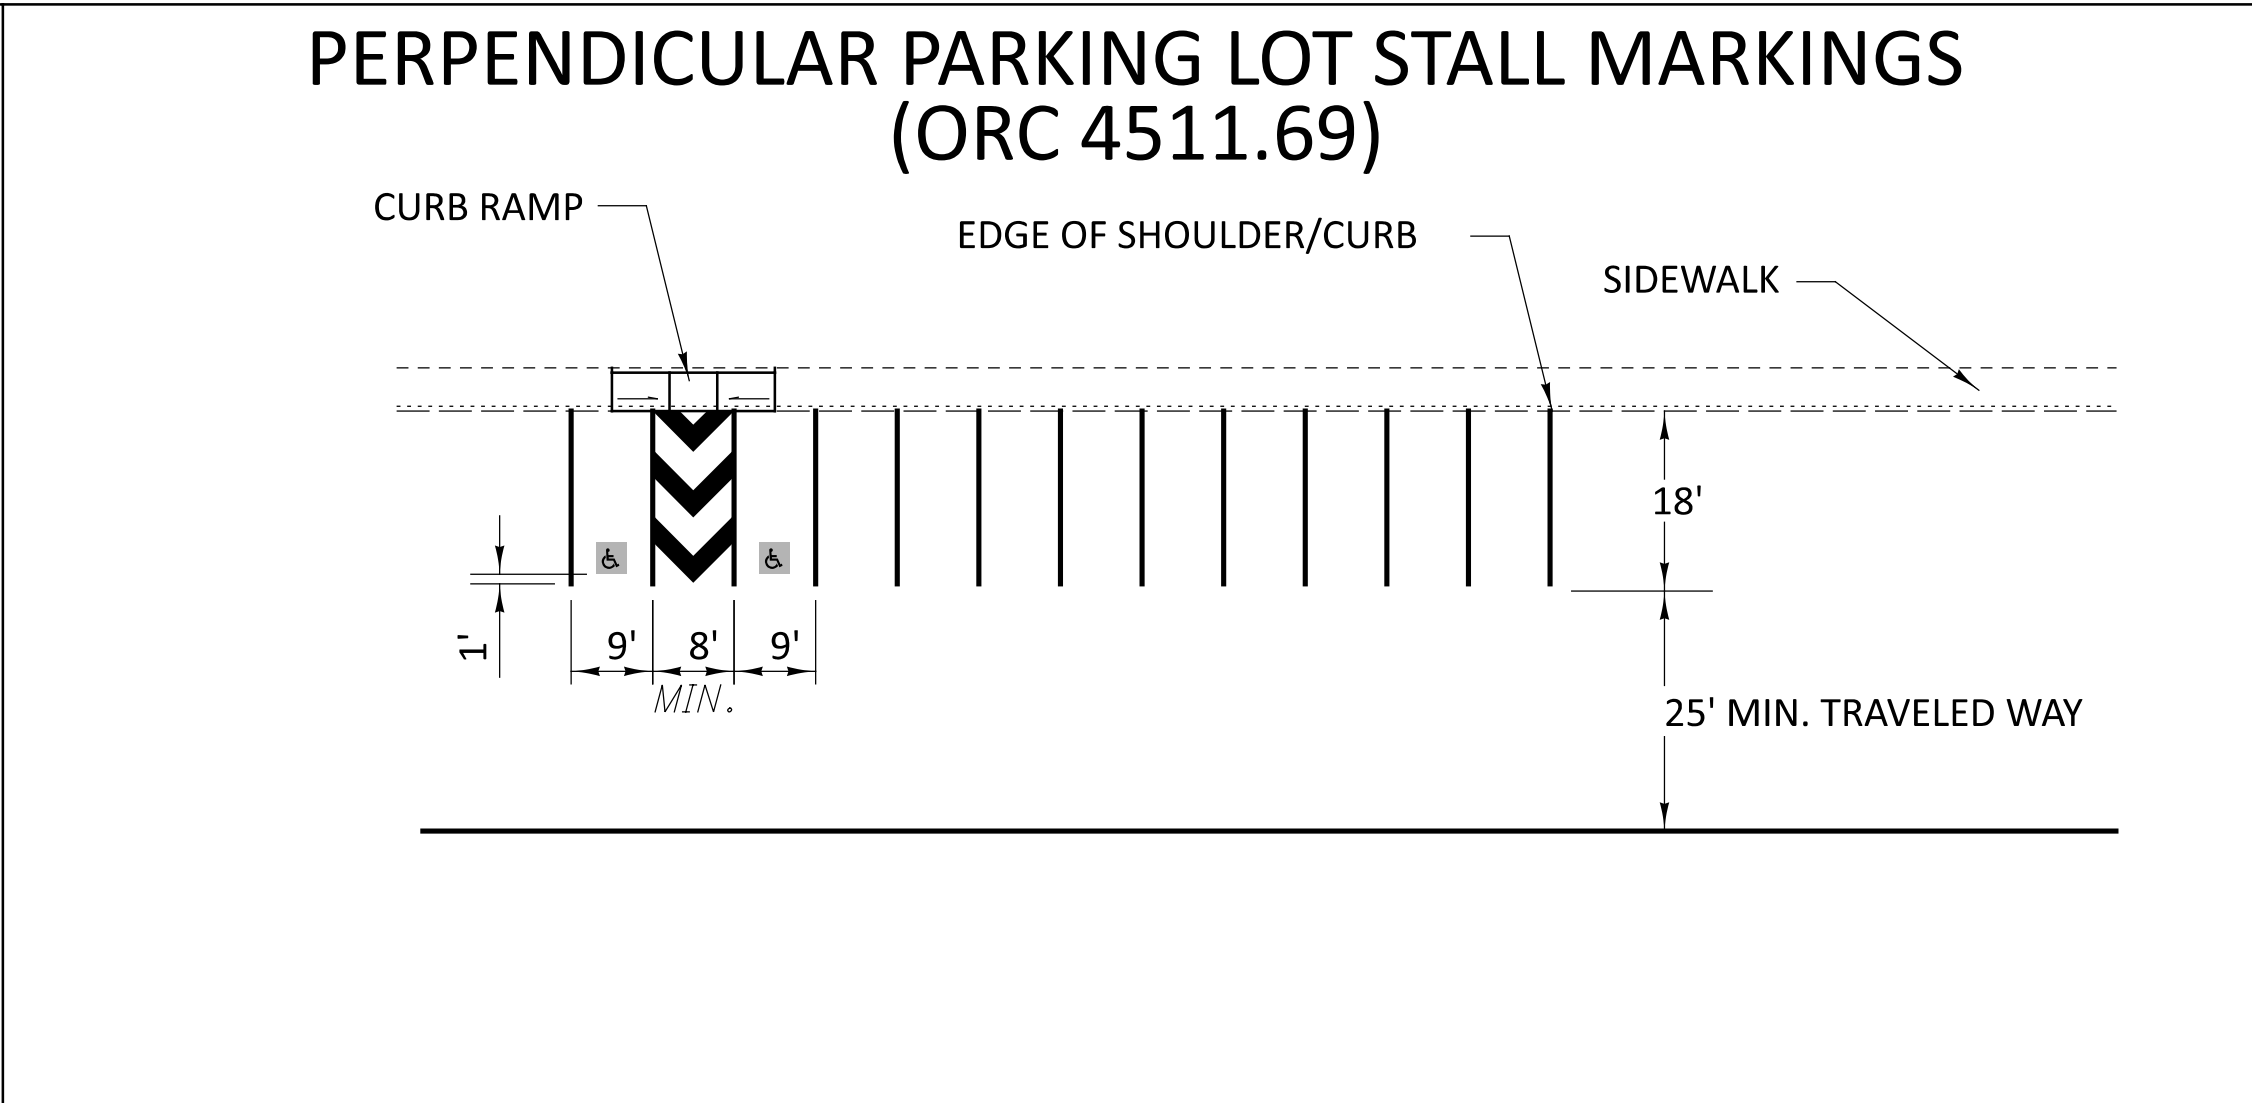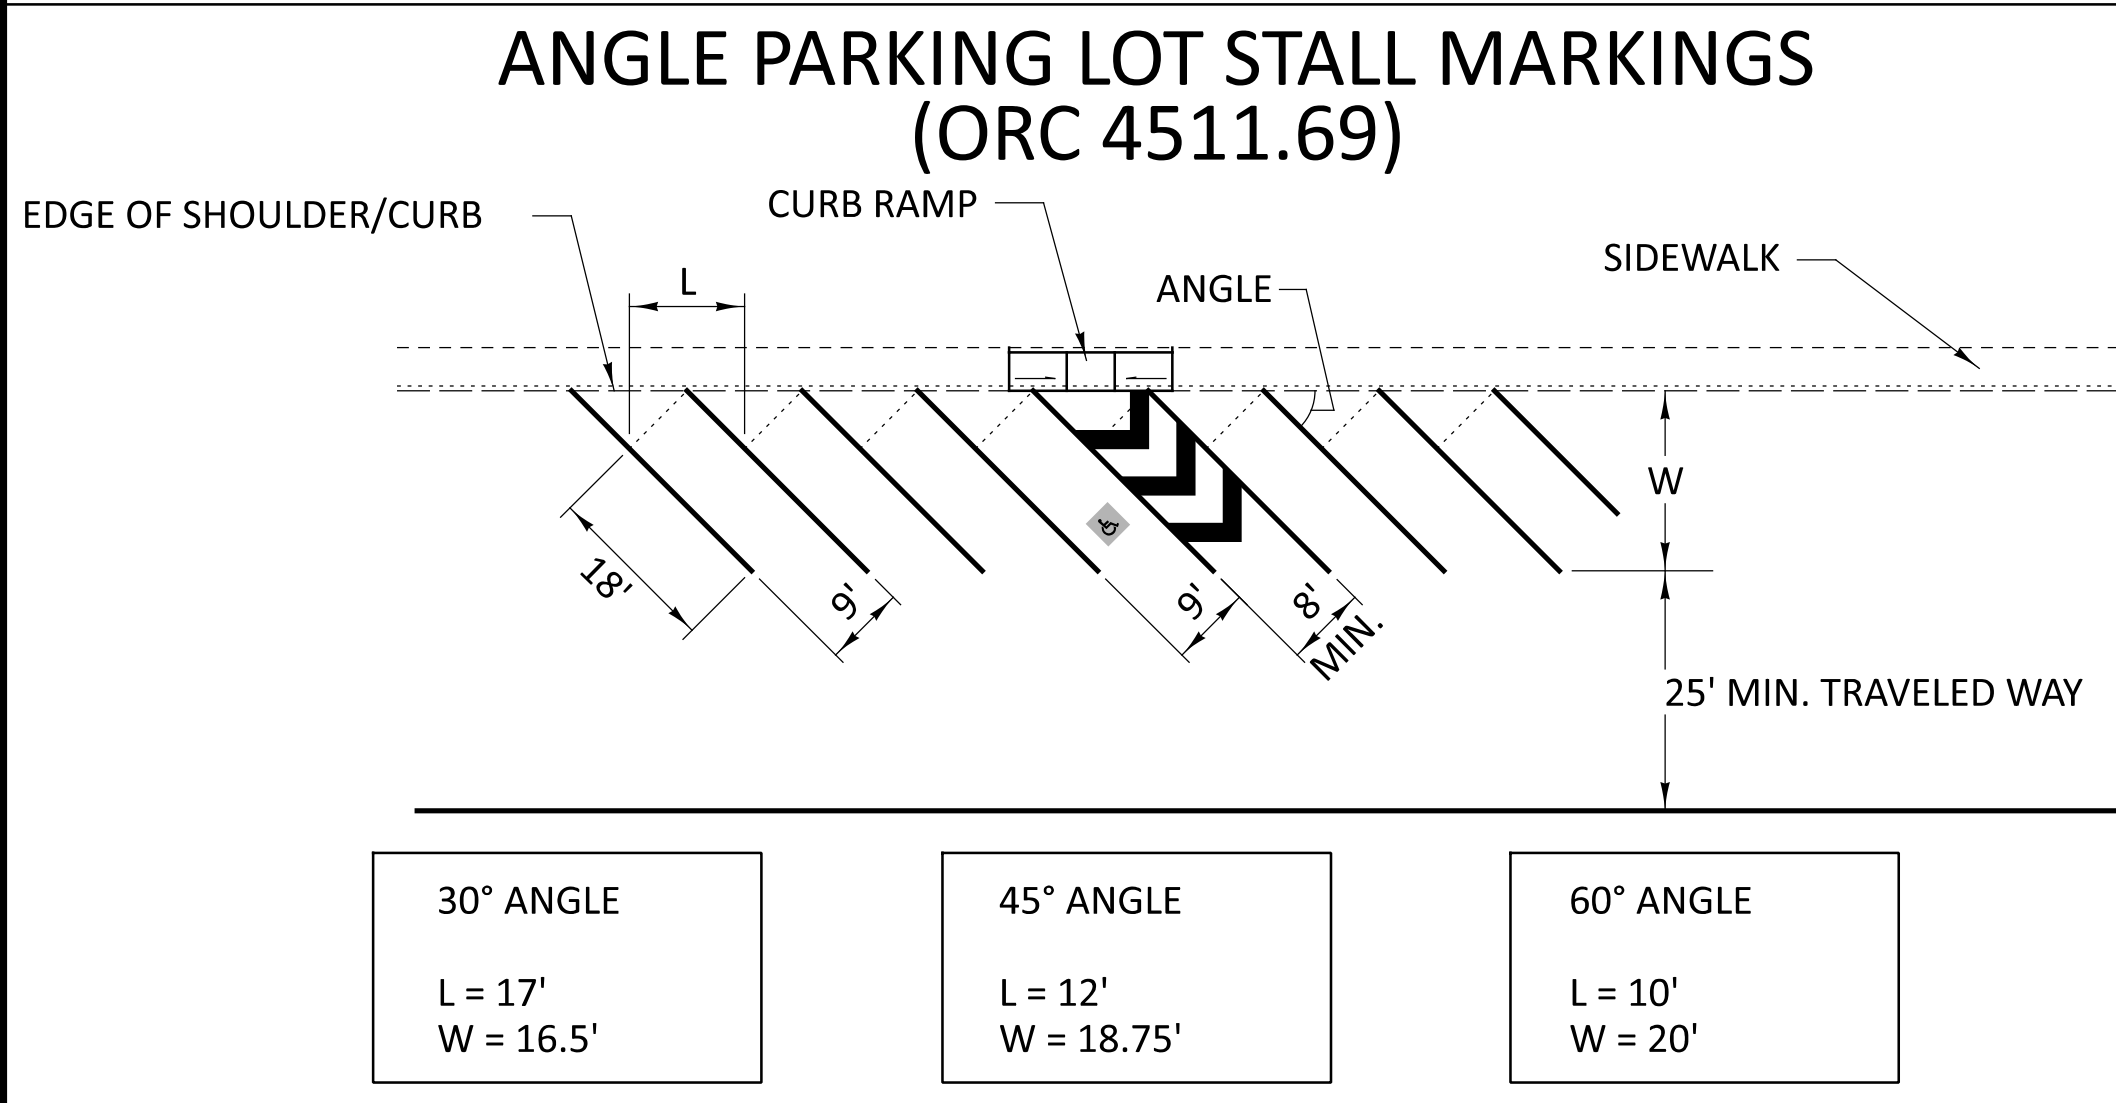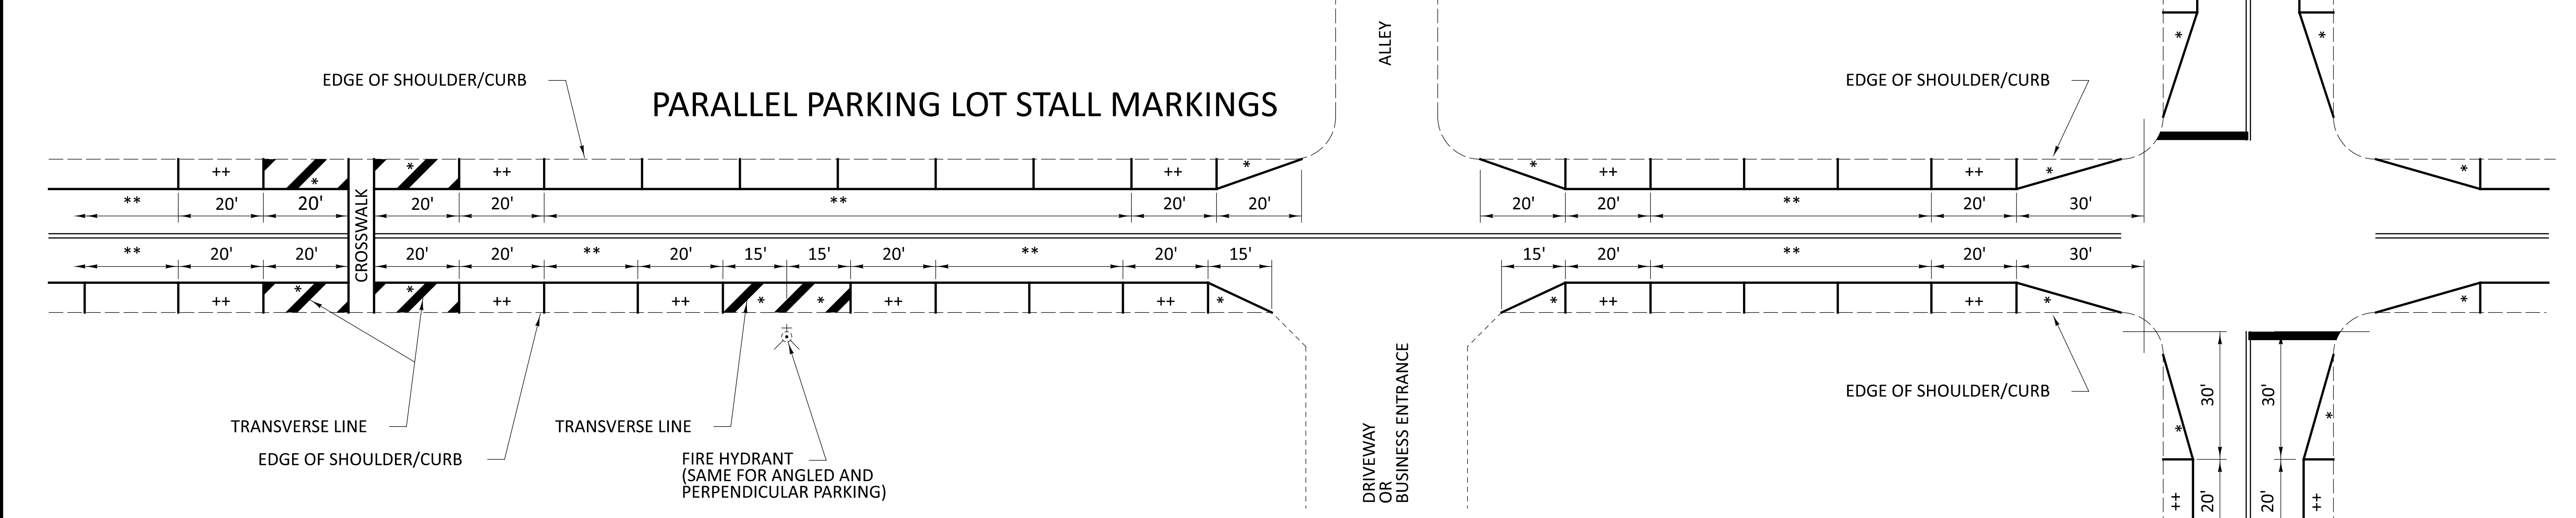

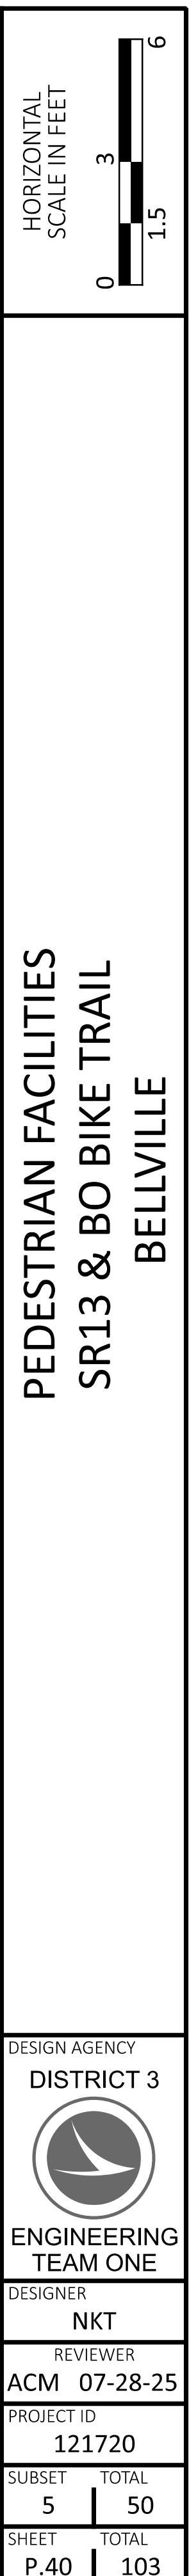


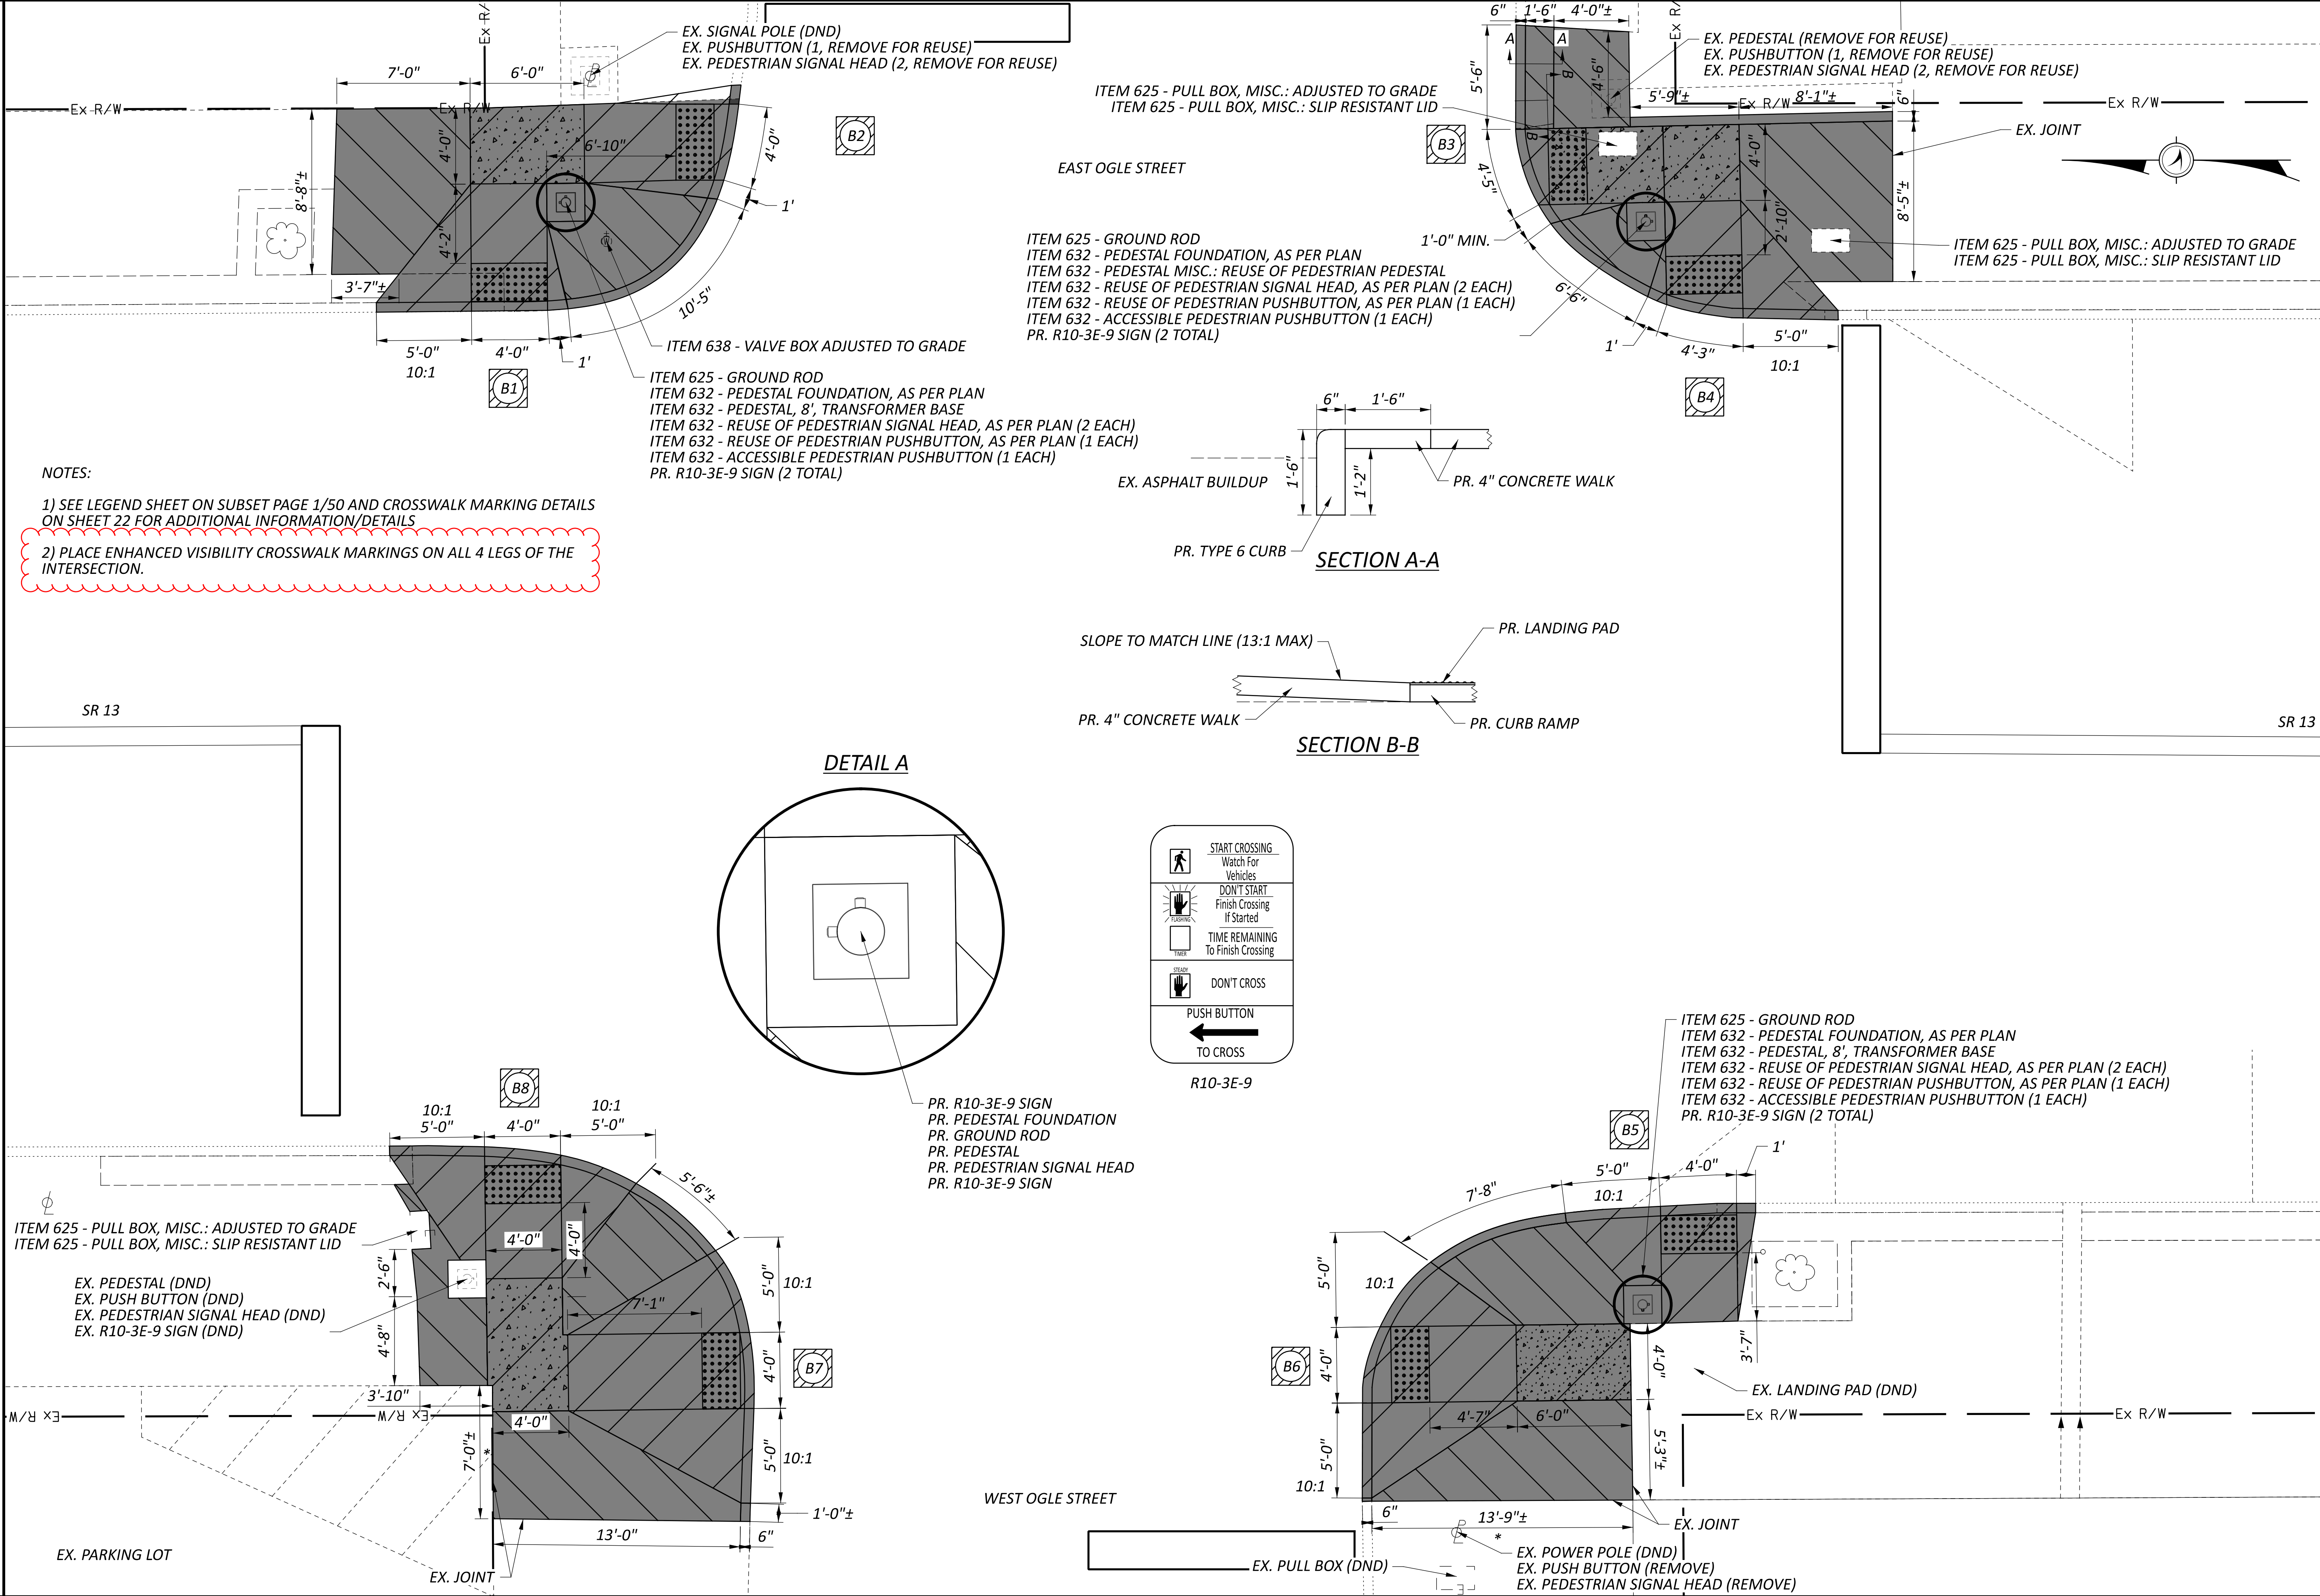

PEDESTRIAN FACILITIES
OGLE ST & SR 13
BELLVILLE

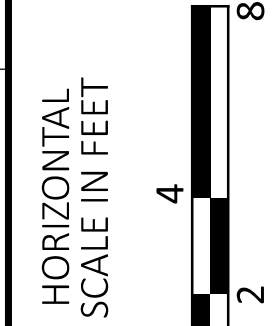

DESIGN AGENCY	
DISTRICT 3	
	
ENGINEERING TEAM ONE	
DESIGNER	
NKT	
REVIEWER	
ACM 07-30-25	
PROJECT ID	
121720	
SUBSET	TOTAL
6	50
SHEET	TOTAL
P.41	103

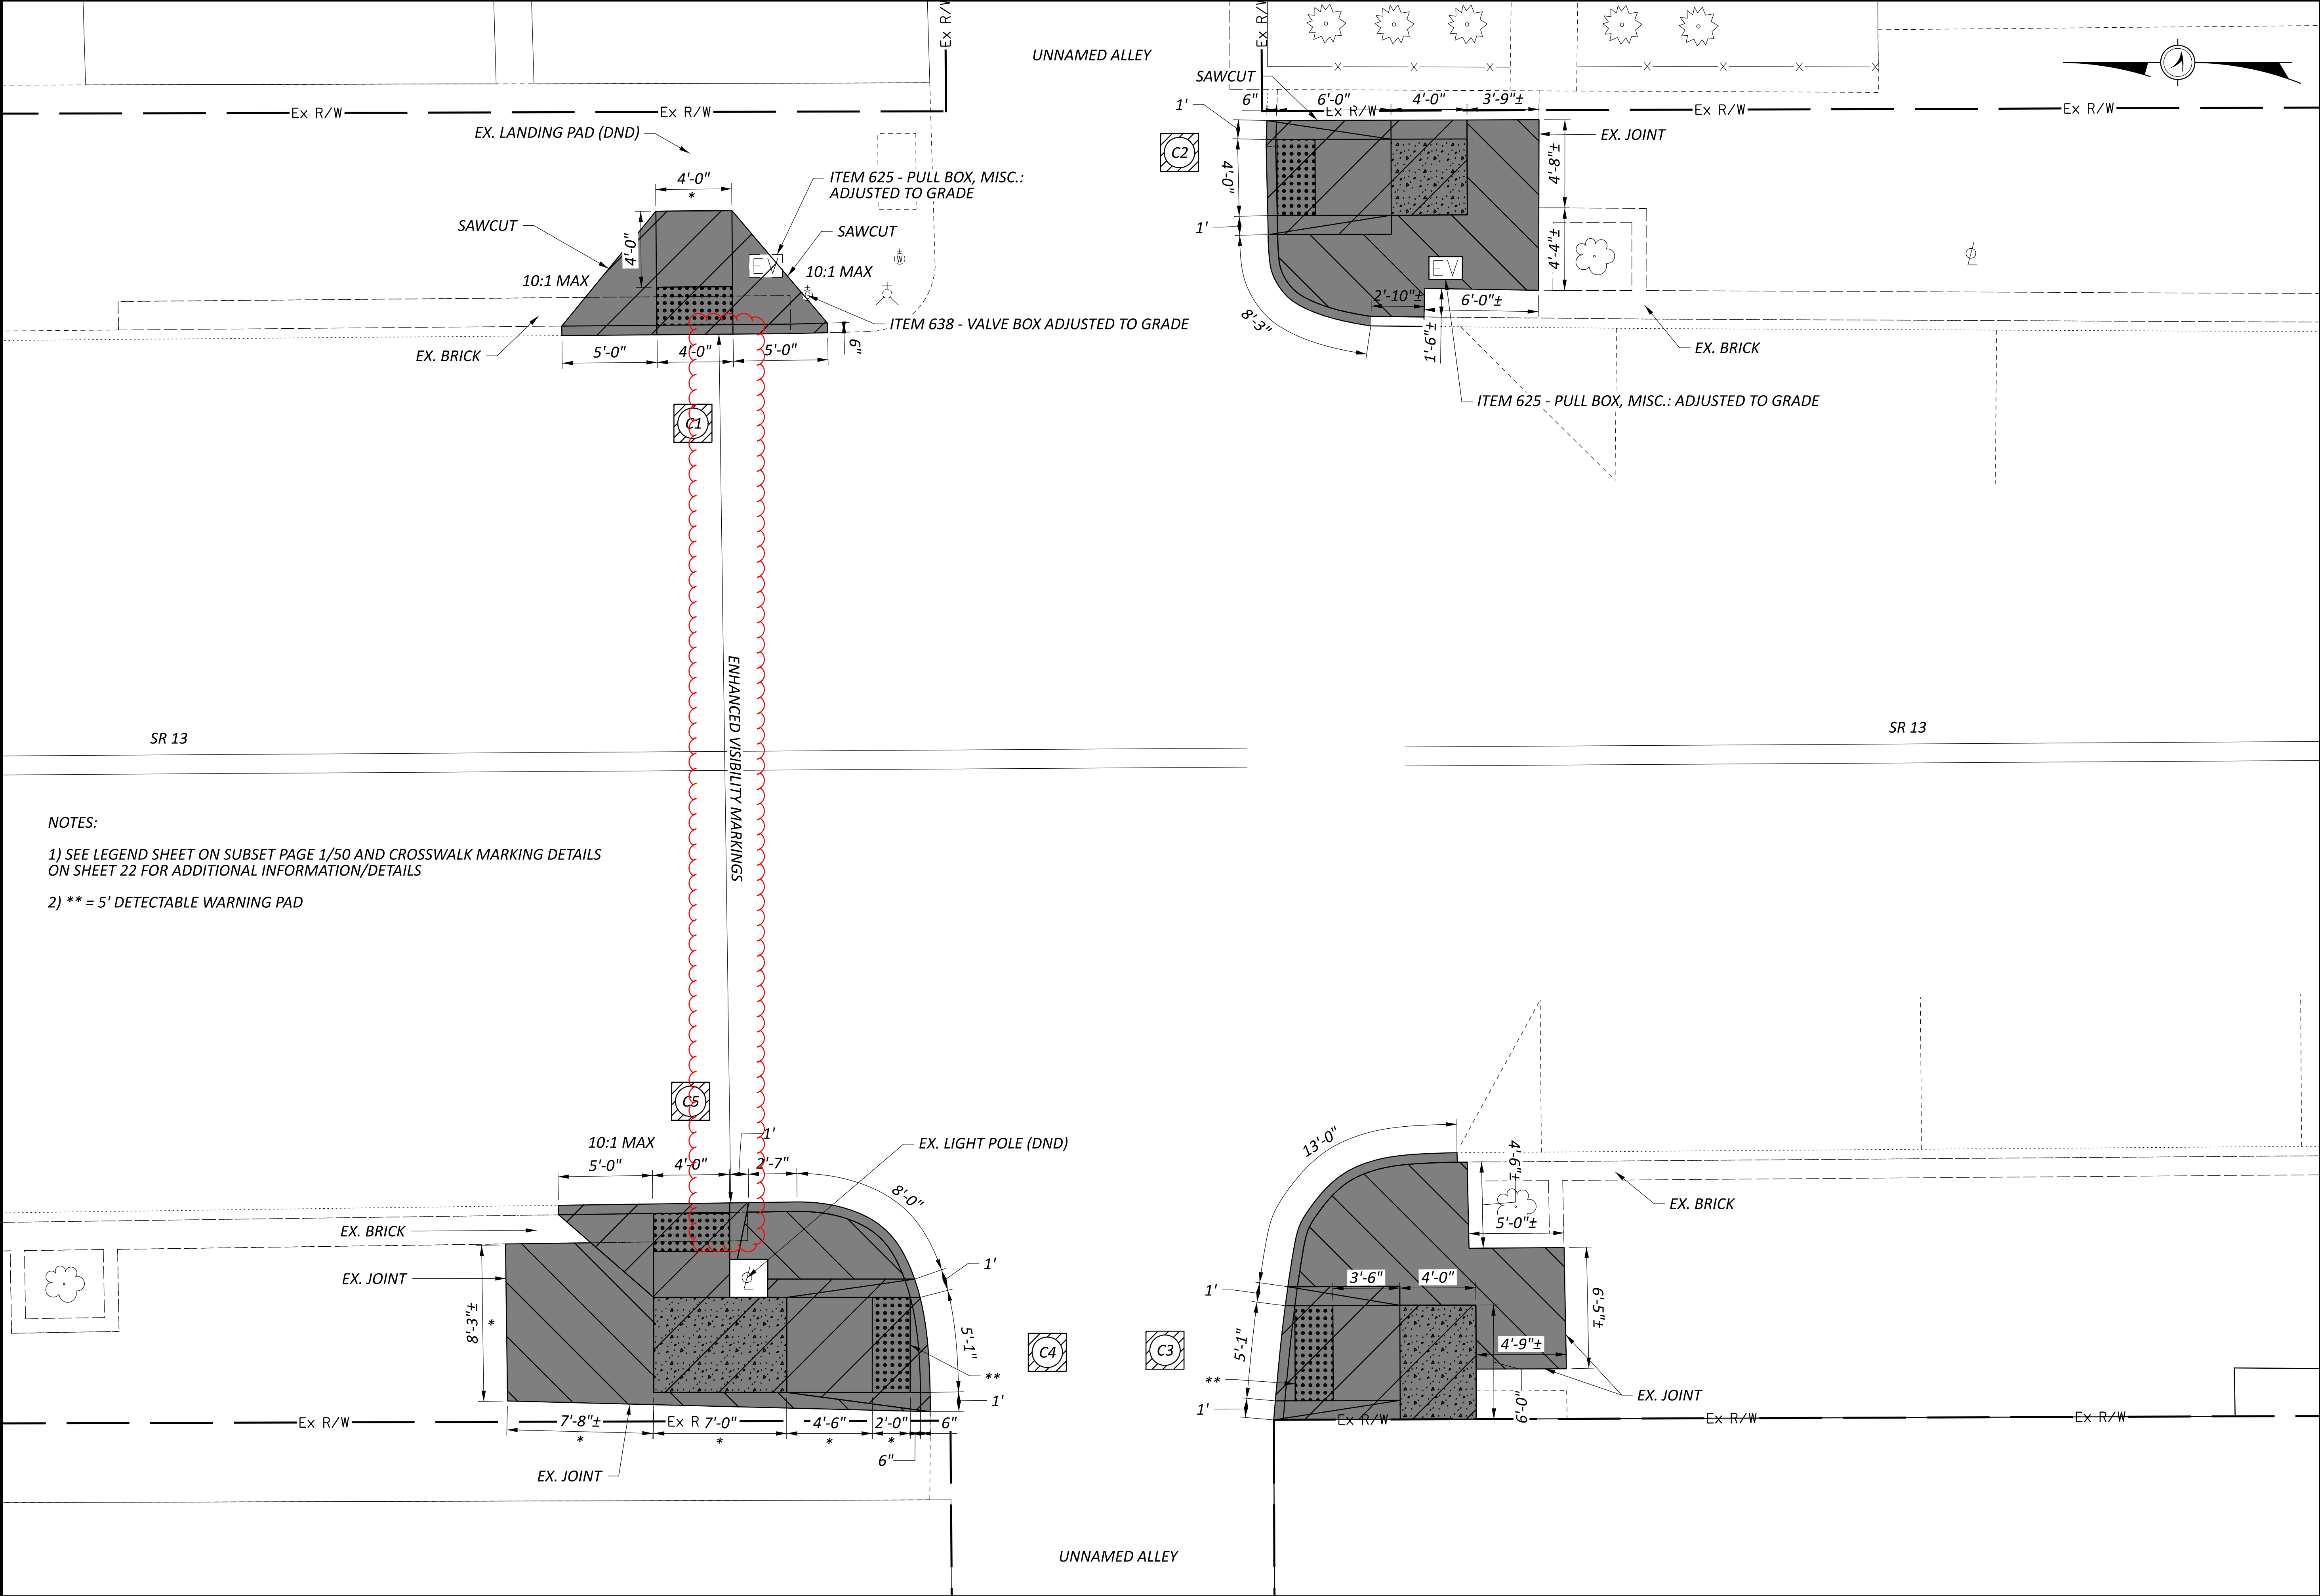

NOTES:


- 1) SEE LEGEND SHEET ON SUBSET PAGE 1/50 AND CROSSWALK MARKING DETAILS ON SHEET 22 FOR ADDITIONAL INFORMATION/DETAILS
- 2) ** = 5' DETECTABLE WARNING PAD


PEDESTRIAN FACILITIES
SR 13 & ALLEY 3
BELLVILLE

DESIGN AGENCY	
DISTRICT 3	
	
ENGINEERING TEAM ONE	
DESIGNER	
NKT	
REVIEWER	
ACM 07-30-25	
PROJECT ID	
121720	
SUBSET	TOTAL
7	50
SHEET	TOTAL
P.42	103






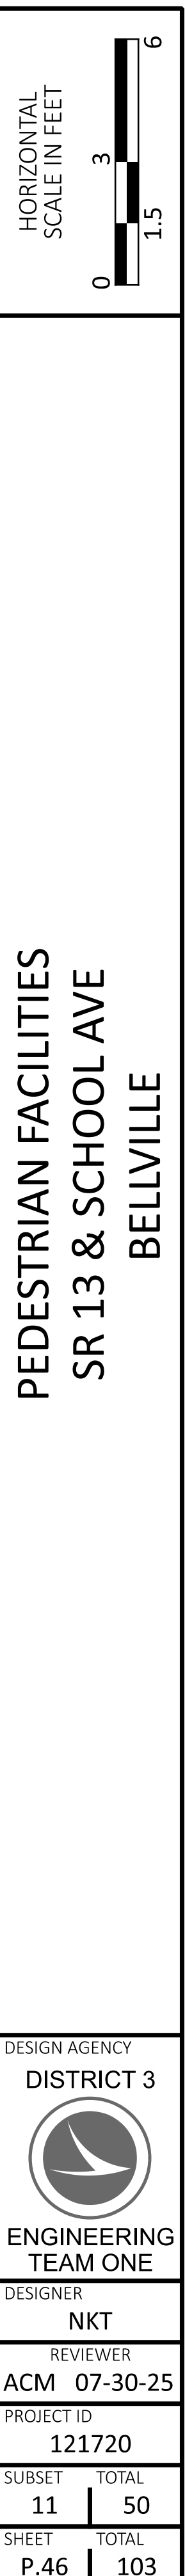


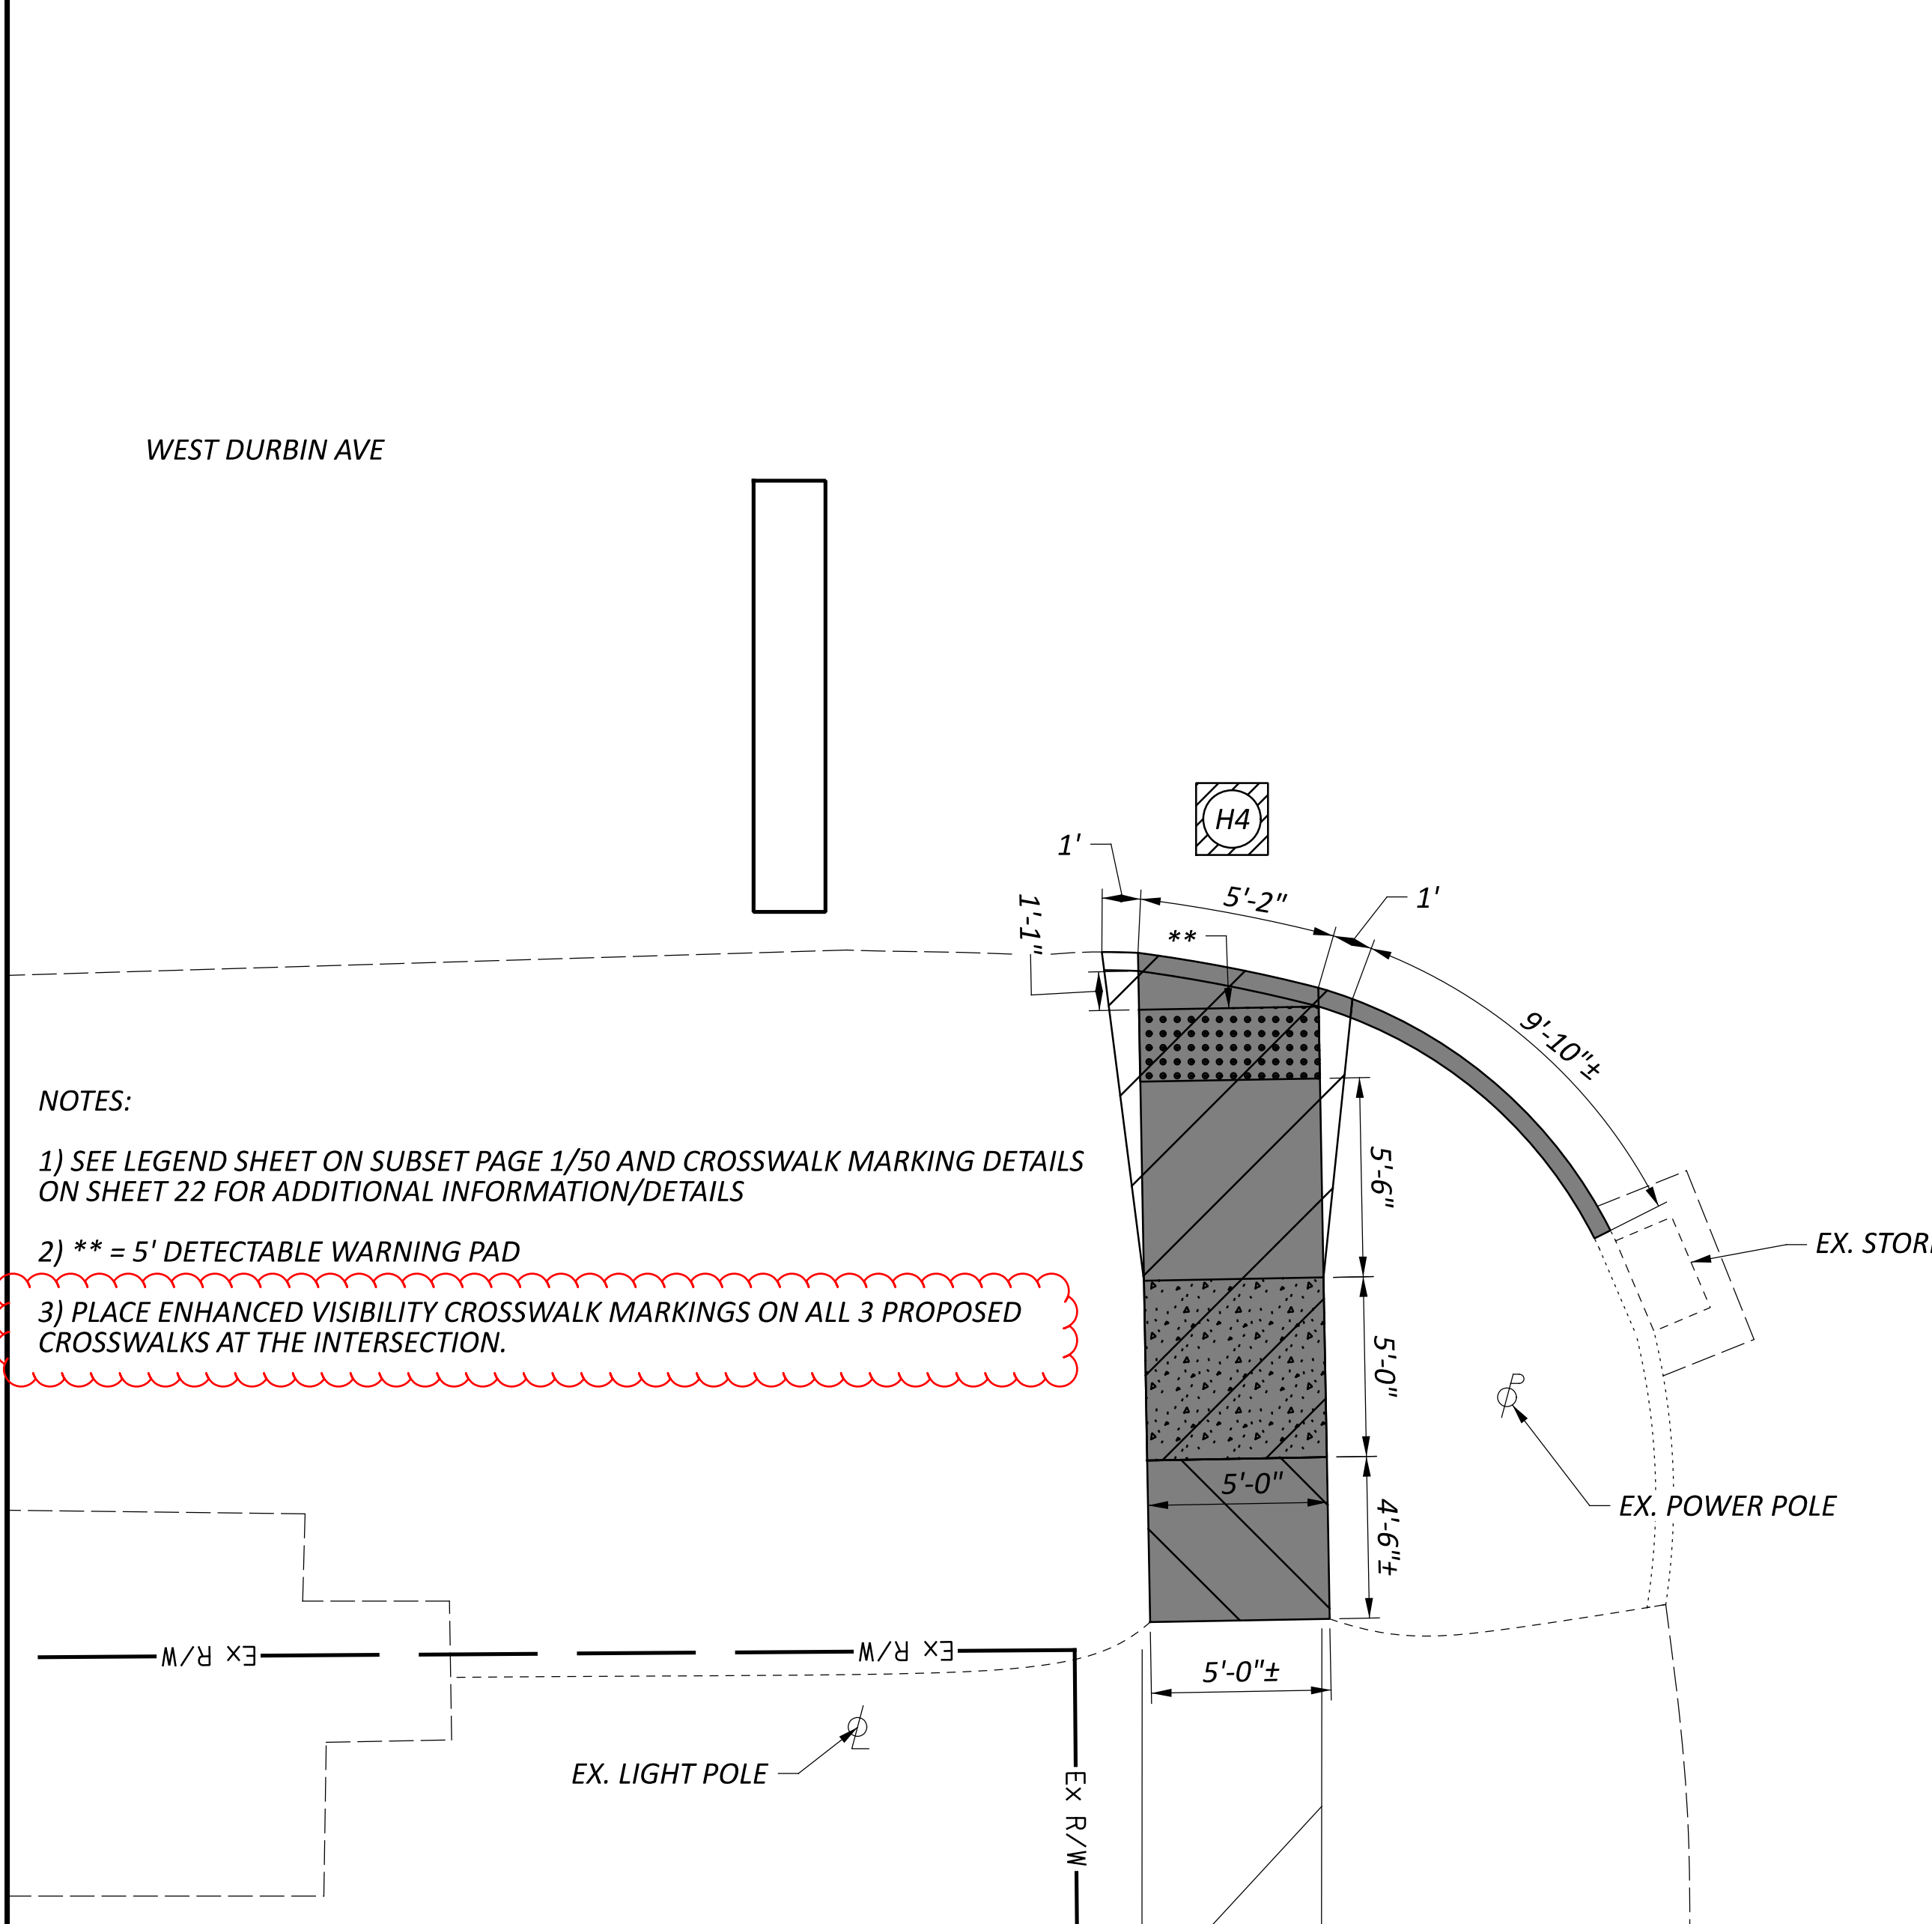

SR 13

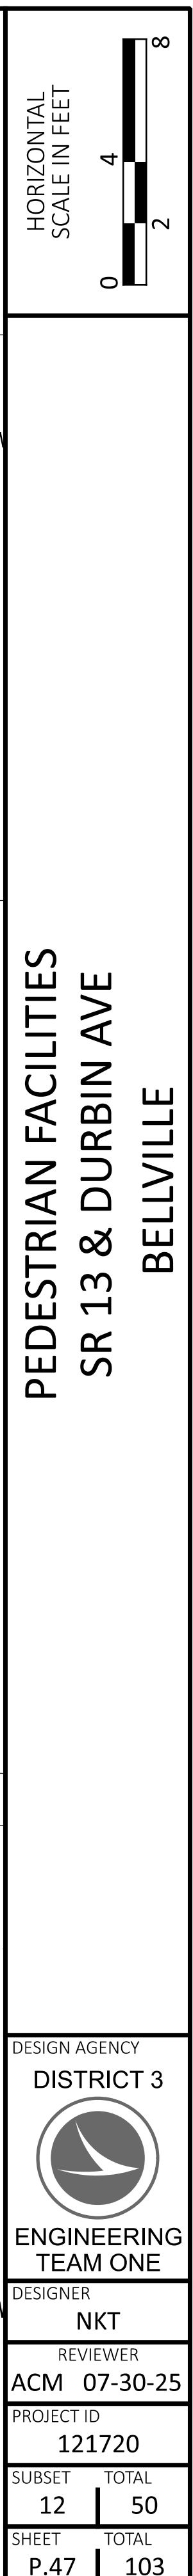






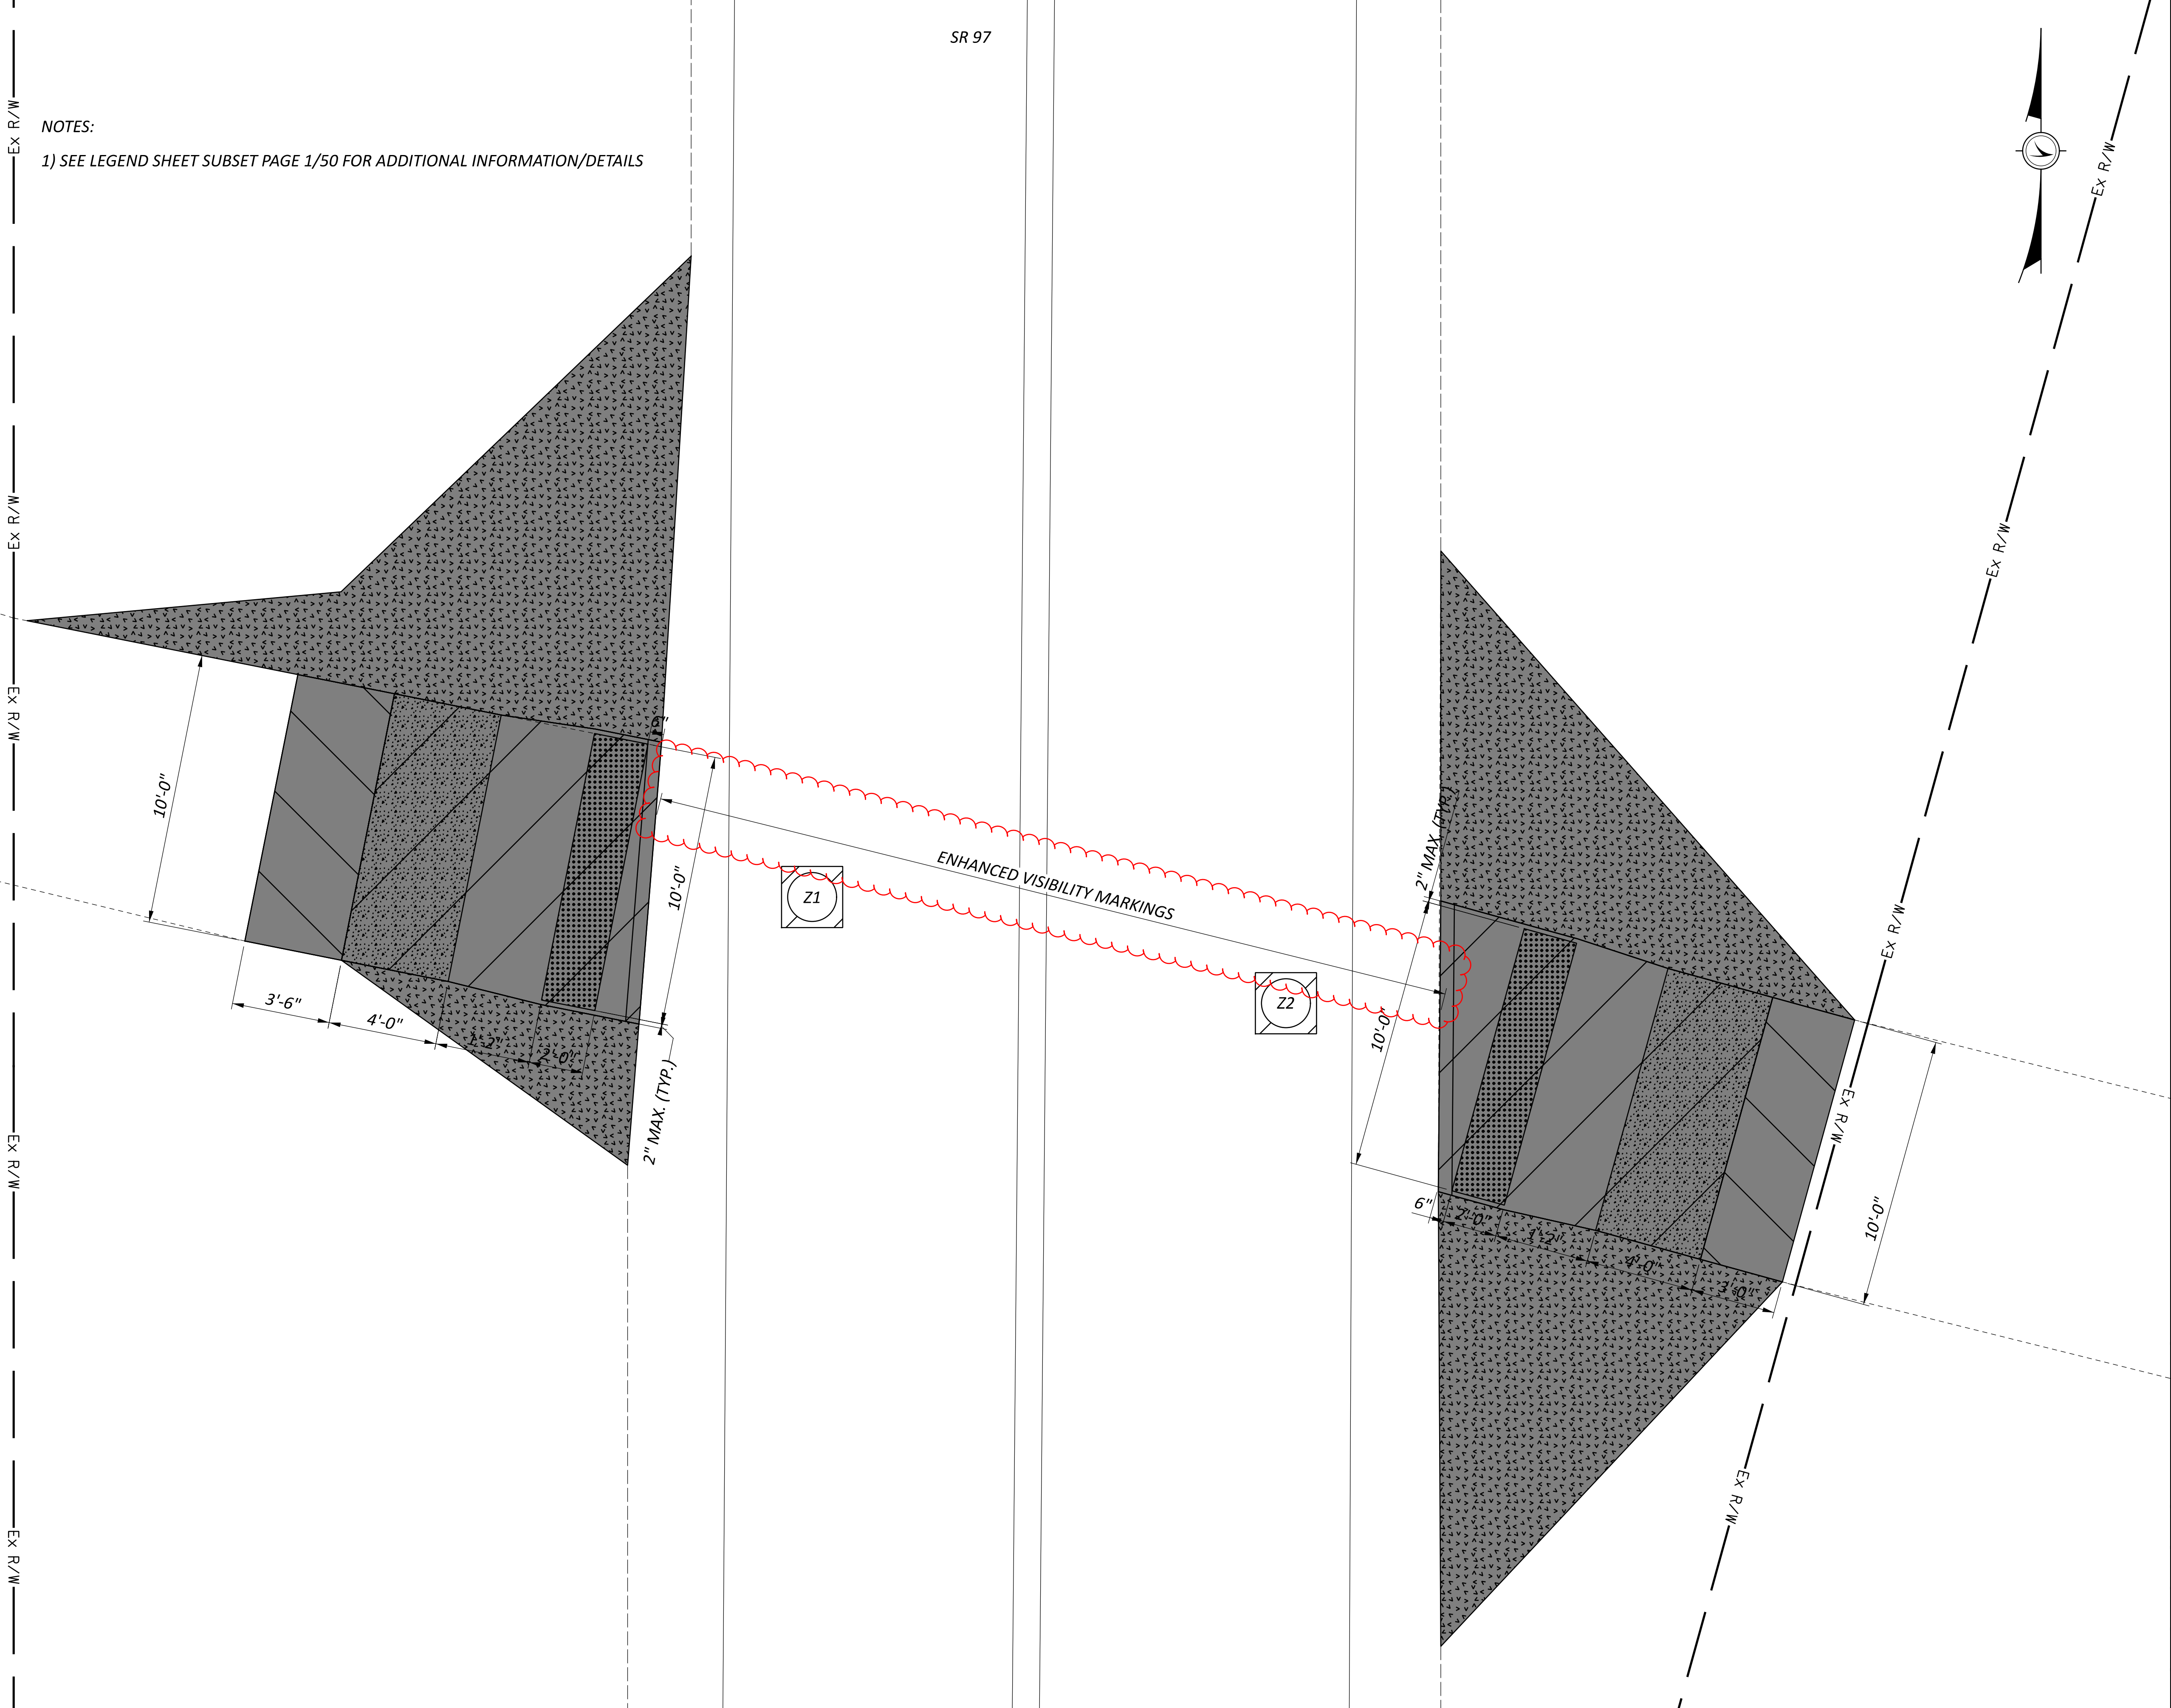


NOTES:
1) SEE LEGEND SHEET SUBSET PAGE 1/50 FOR ADDITIONAL INFORMATION/DETAILS

DESIGN AGENCY	
DISTRICT 3	
	
ENGINEERING TEAM ONE	
DESIGNER	
SMH	
REVIEWER	
ACM 07-30-25	
PROJECT ID	
121720	
SUBSET	TOTAL
30	50
SHEET	TOTAL
P.65	103


PEDESTRIAN FACILITIES
SR 97 & BIKE TRAIL (WORTHINGTON)
BUTLER

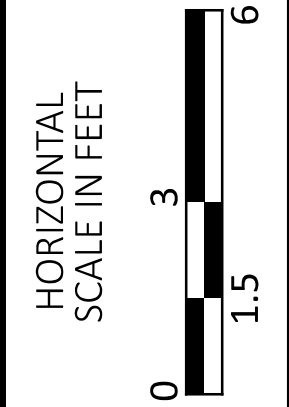

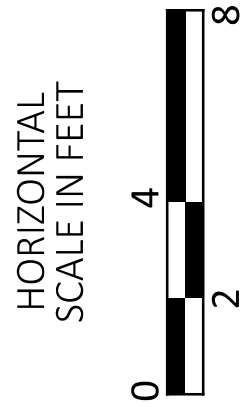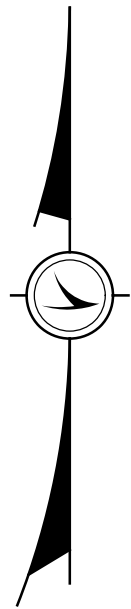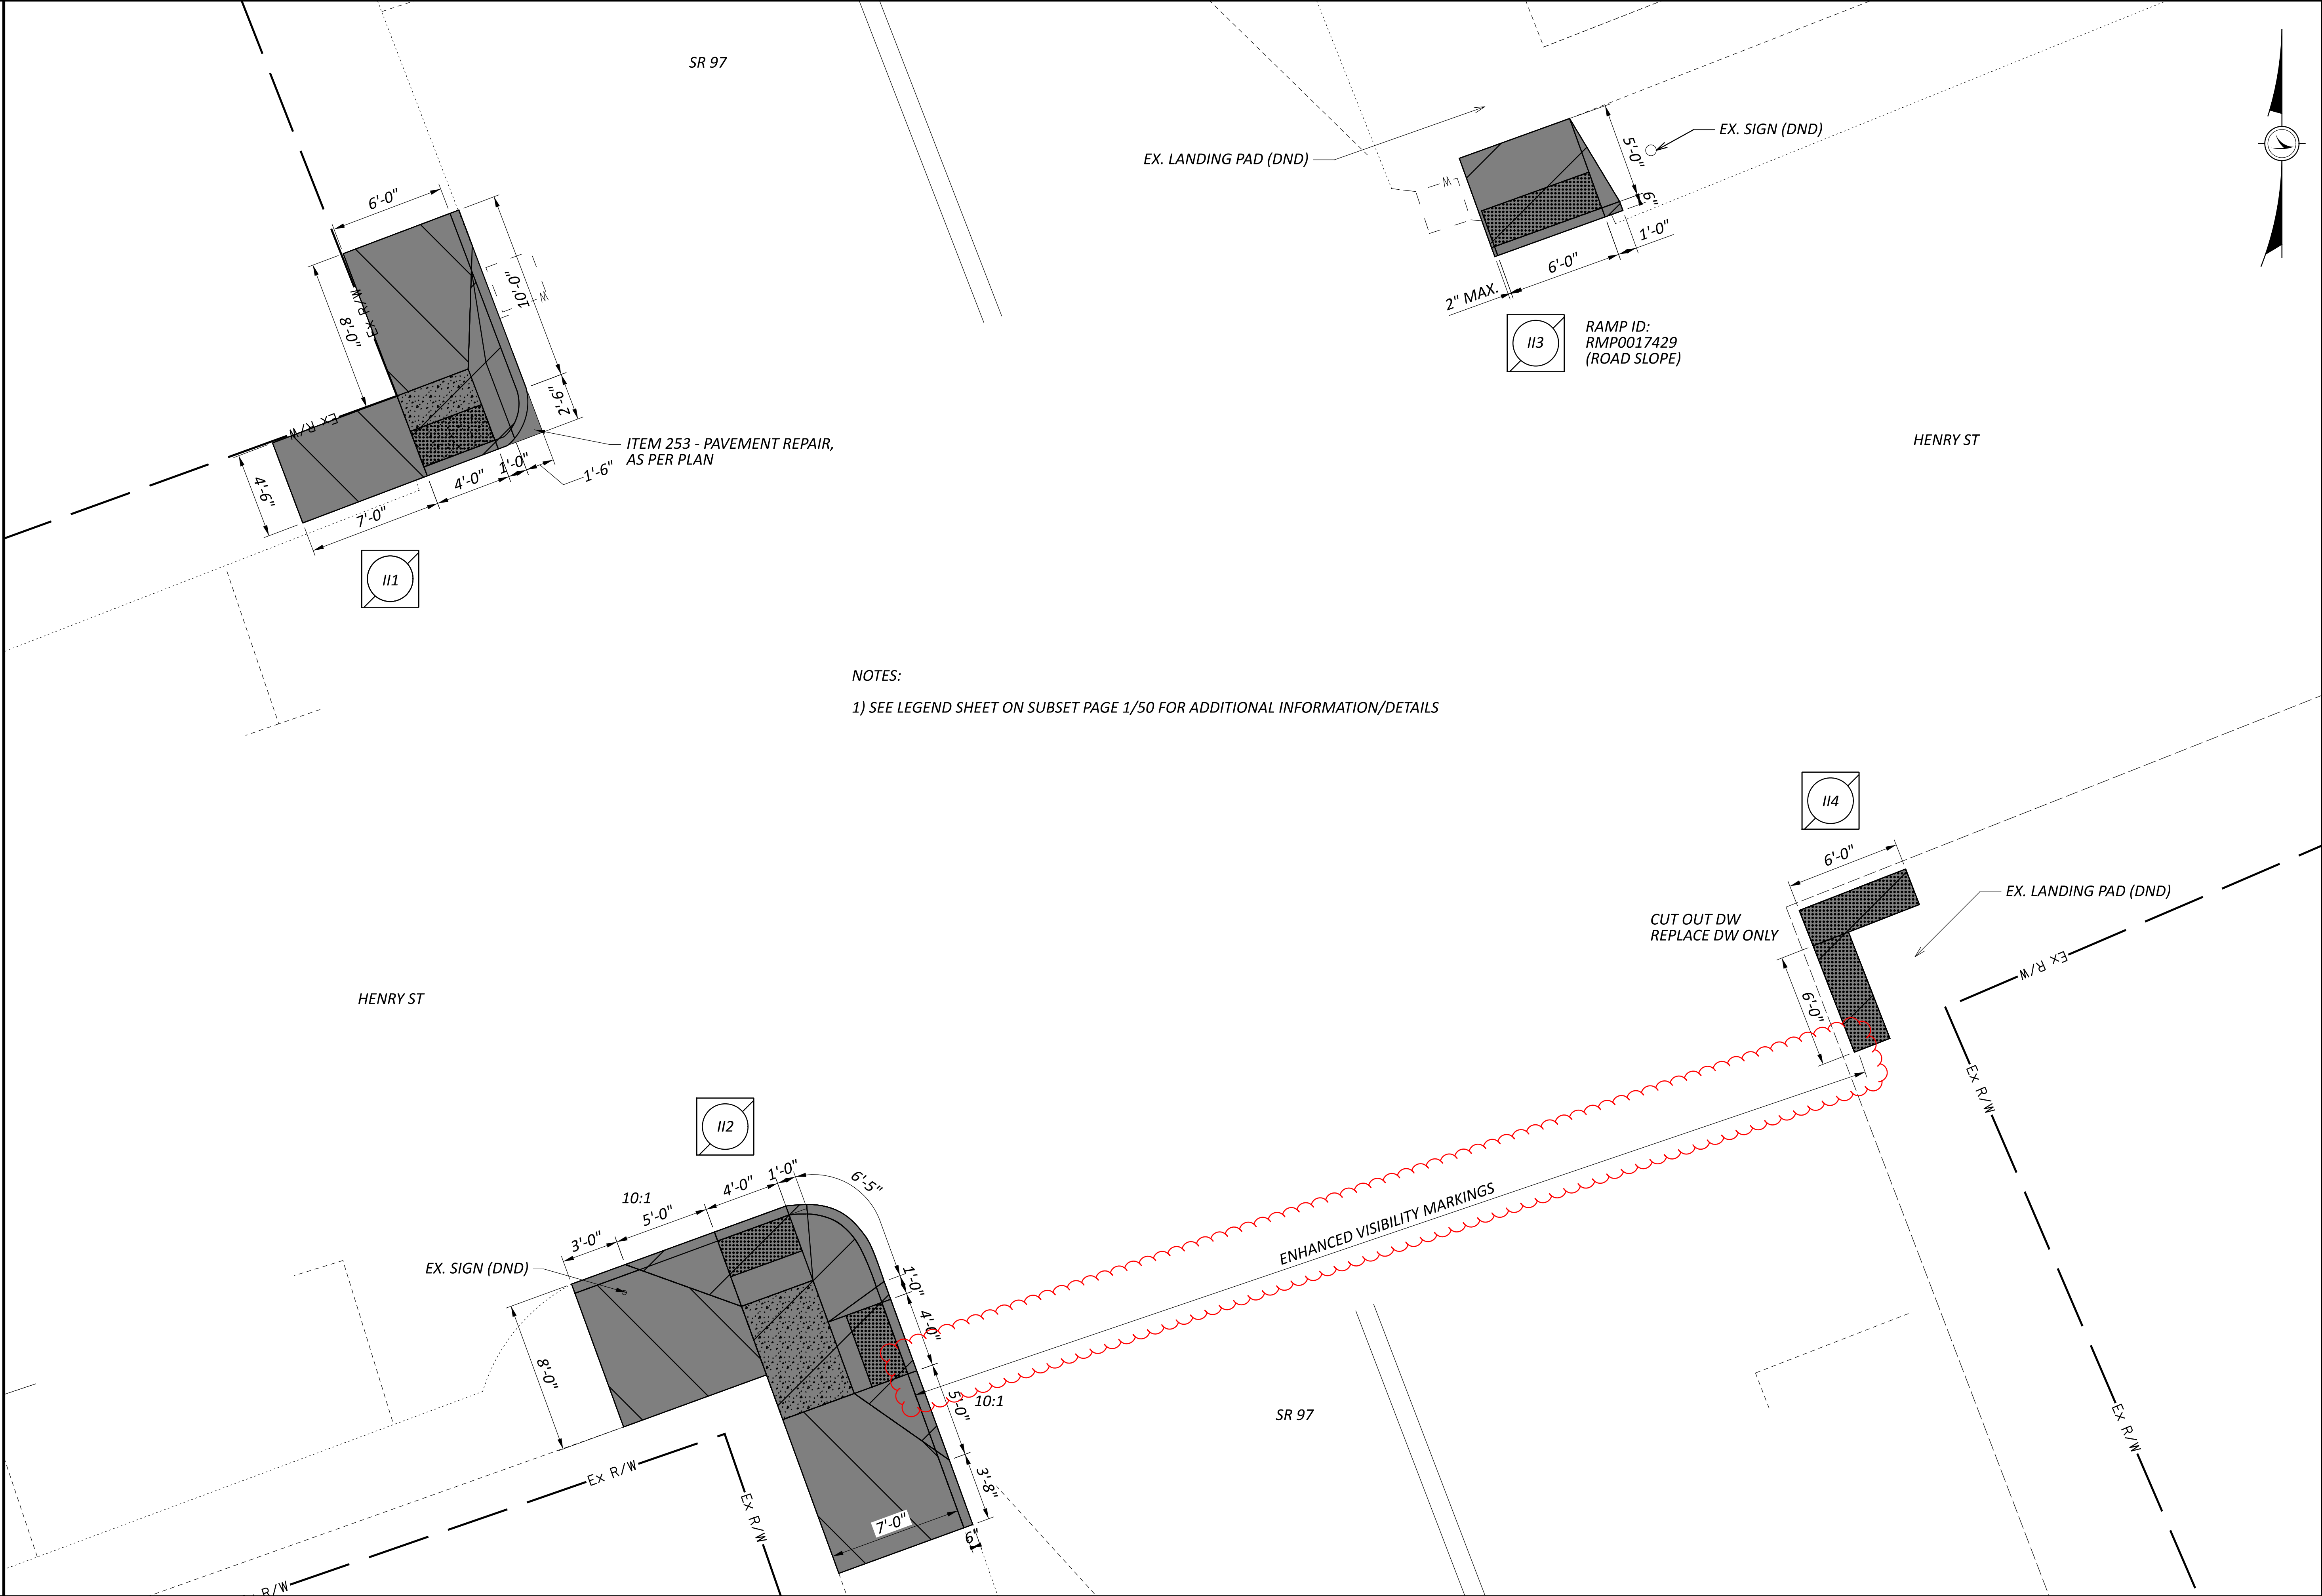


PEDESTRIAN FACILITIES
HENRY ST & SR 97
BUTLER


DESIGN AGENCY	
DISTRICT 3	
	
ENGINEERING TEAM ONE	
DESIGNER	
SMH	
REVIEWER	
ACM 07-30-25	
PROJECT ID	
121720	
SUBSET	TOTAL
39	50
SHEET	TOTAL
P.74	103

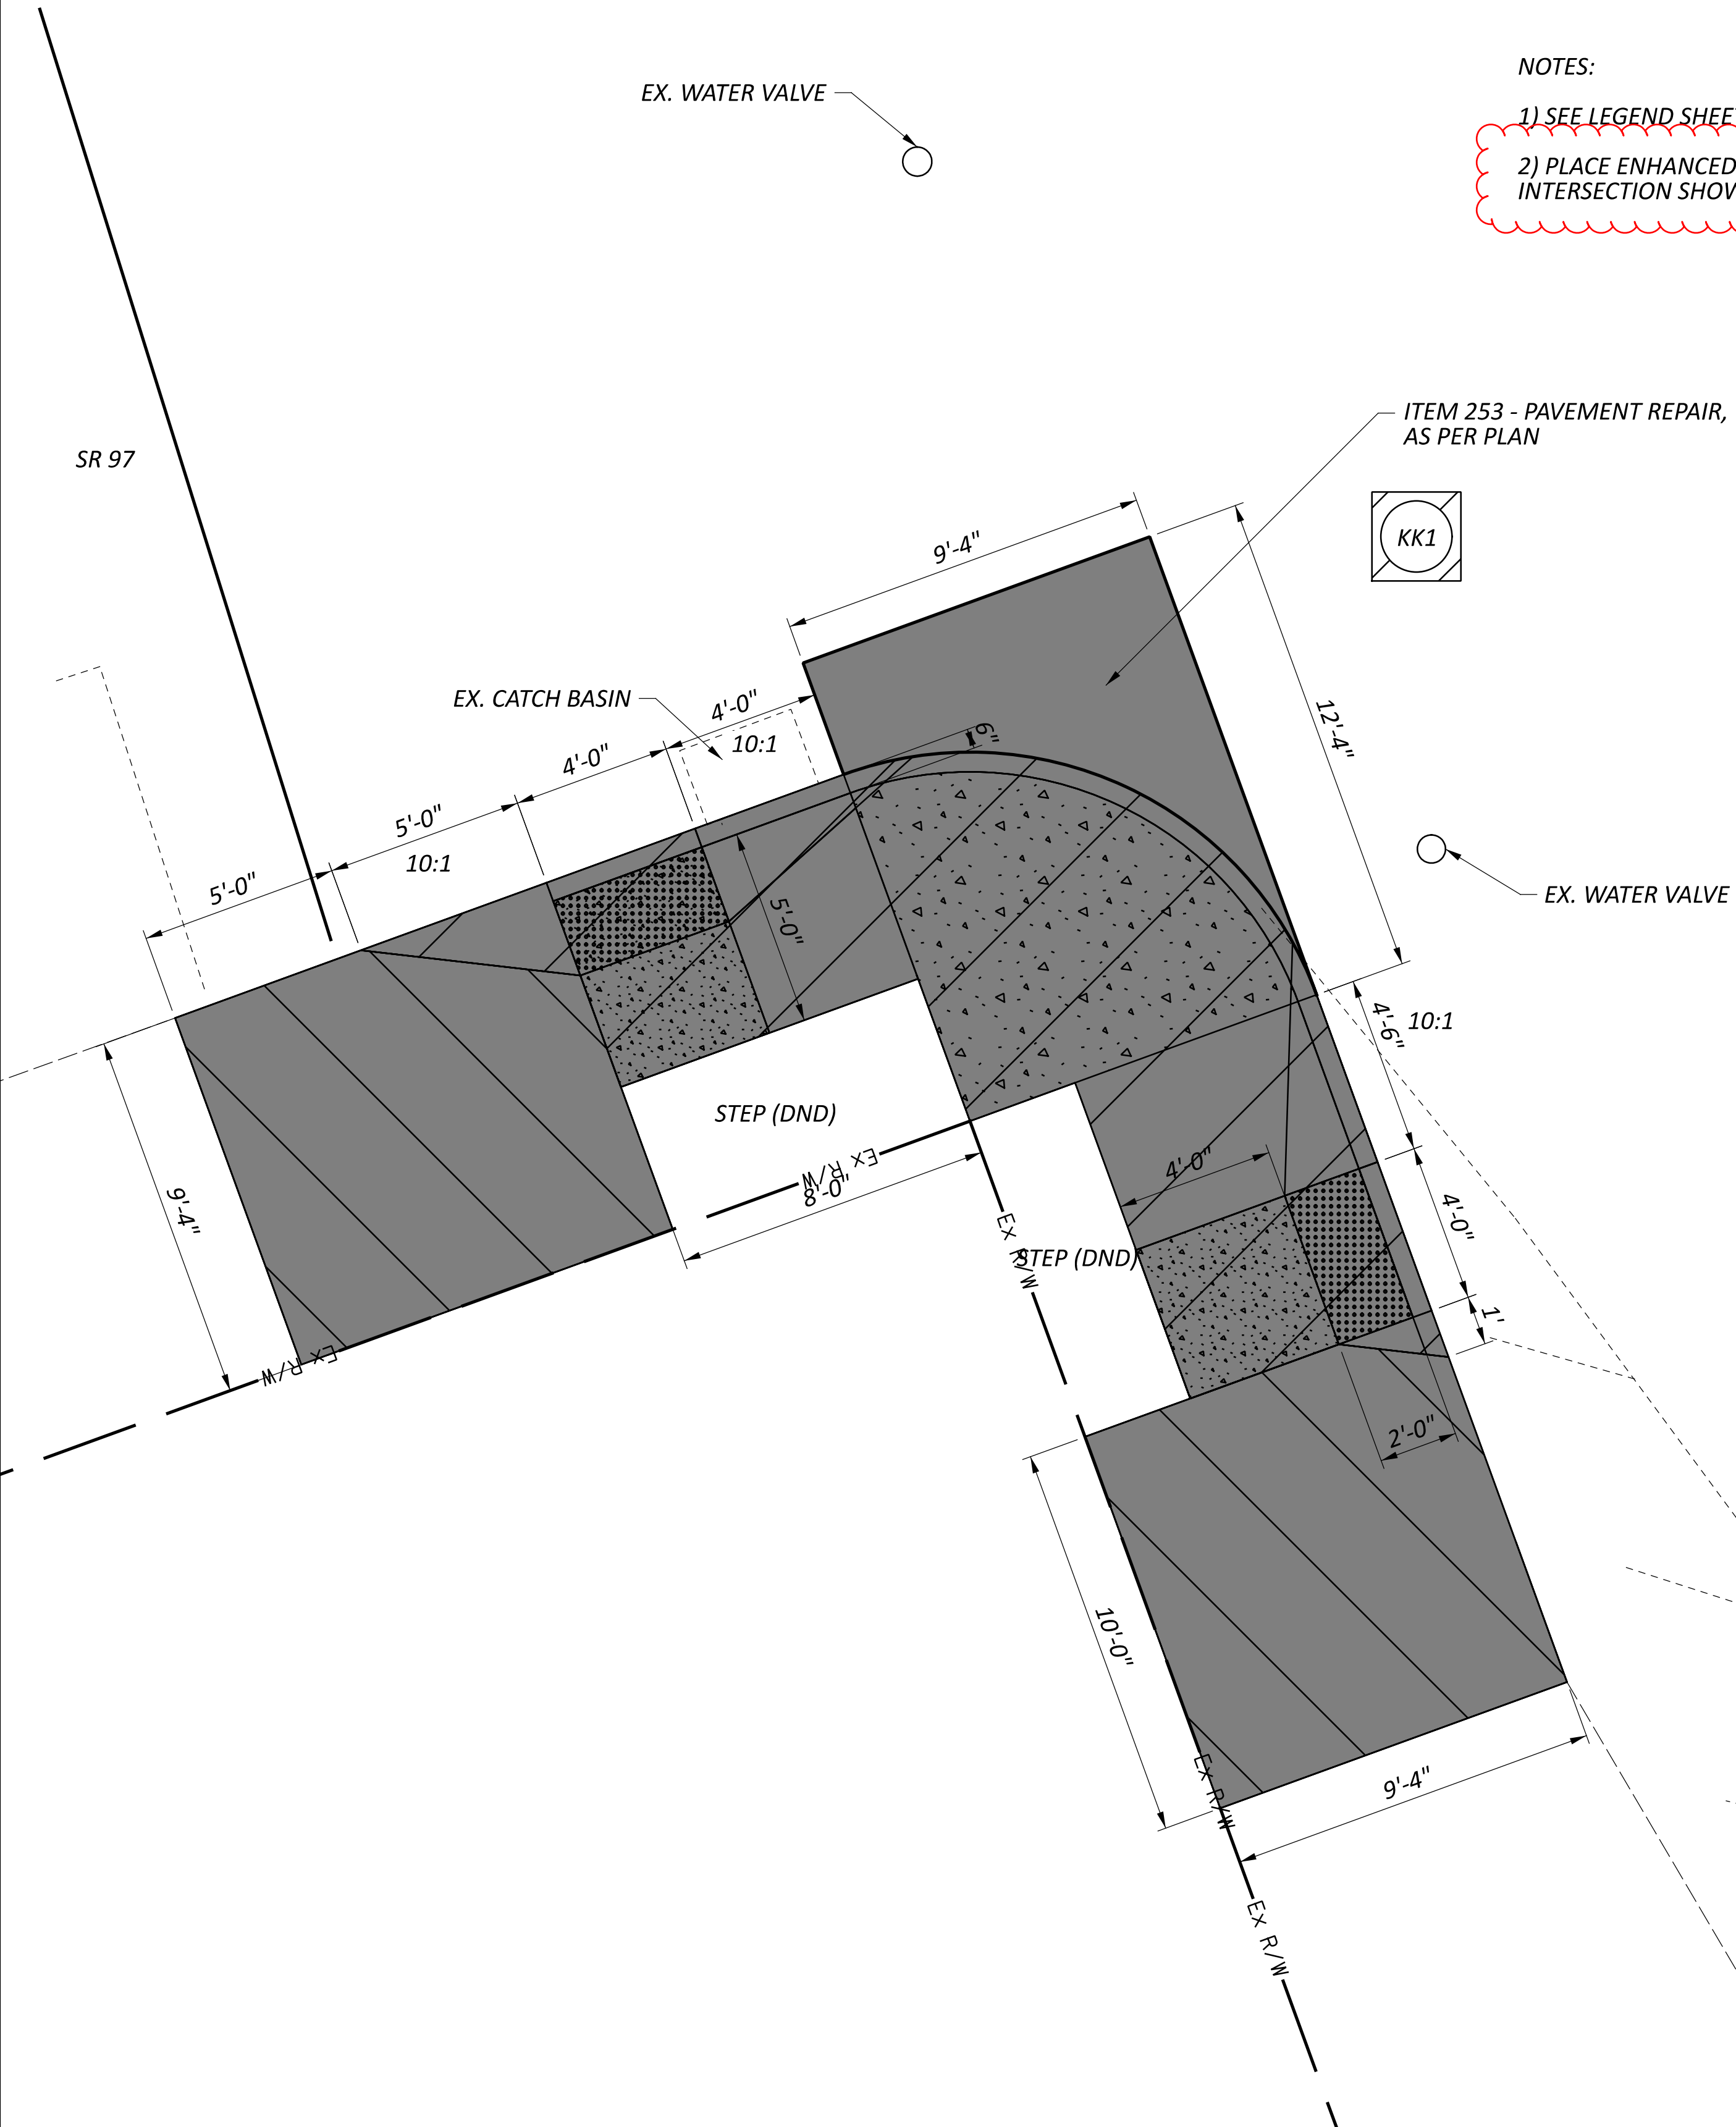

NOTES:
1) SEE LEGEND SHEET ON SUBSET PAGE 1/50 FOR ADDITIONAL INFORMATION/DETAILS
2) PLACE ENHANCED VISIBILITY CROSSWALK MARKINGS ON BOTH LEGS OF THE INTERSECTION SHOWN ON THIS SHEET.

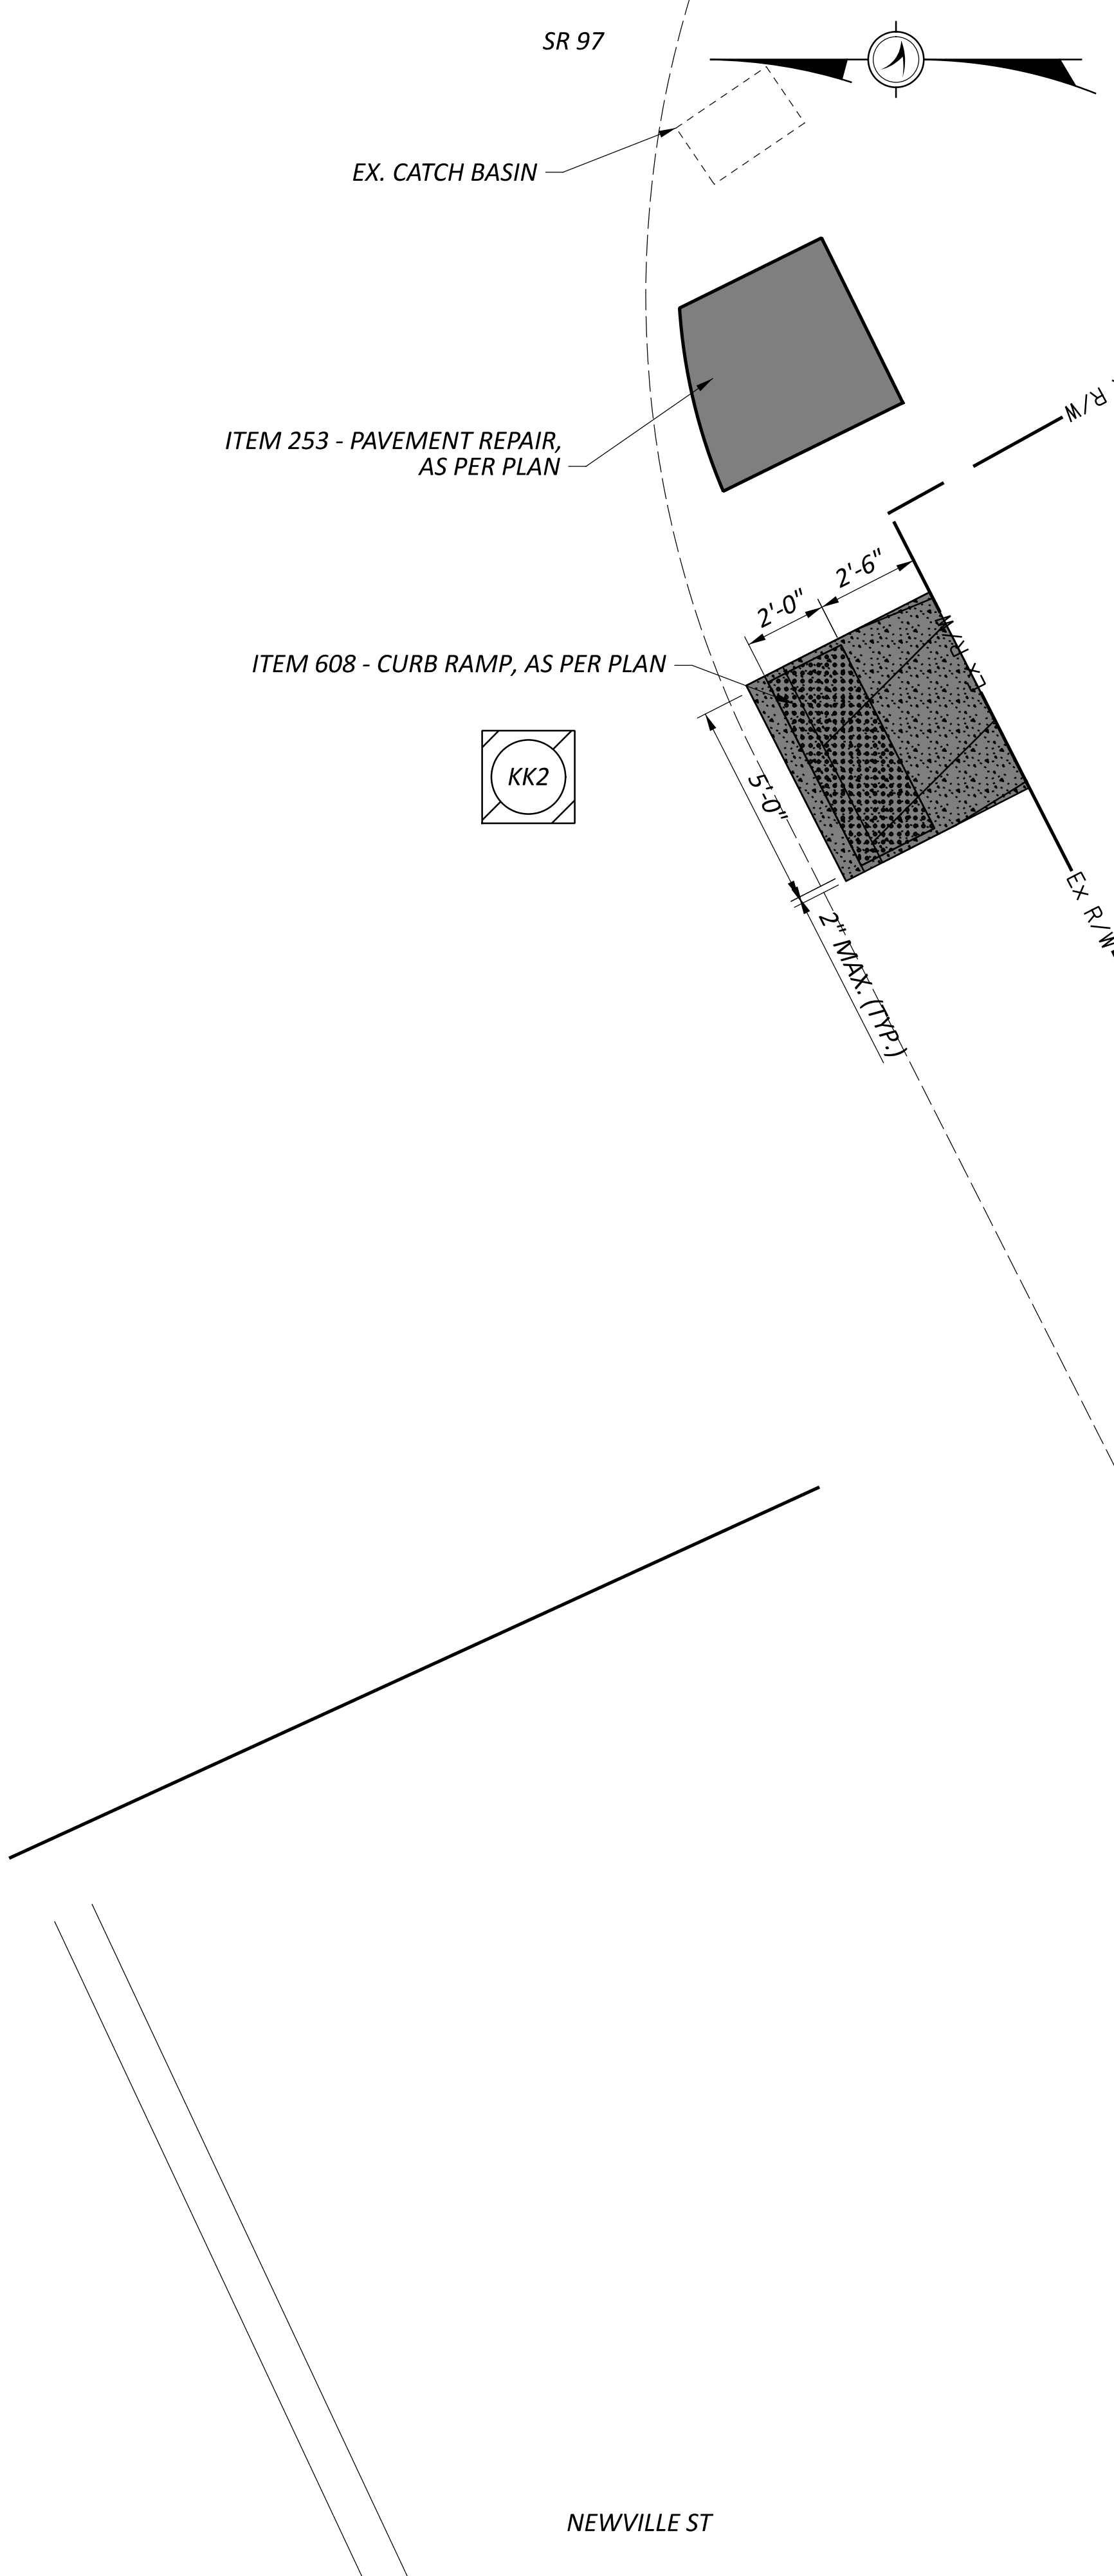



PEDESTRIAN FACILITIES
SR 97 & NEWVILLE ST
BUTLER

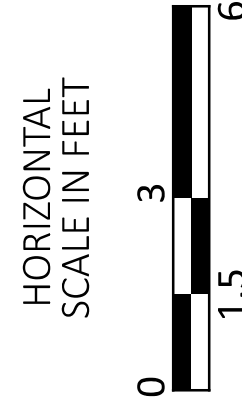

DESIGN AGENCY	
DISTRICT 3	
ENGINEERING TEAM ONE	
DESIGNER	
SMH	
REVIEWER	
ACM 07-30-25	
PROJECT ID	
121720	
SUBSET	TOTAL
41	50
SHEET	TOTAL
P.76	103



DESIGN AGENCY	
DISTRICT 3	
	
ENGINEERING TEAM ONE	
DESIGNER	
SMH	
REVIEWER	
ACM 07-30-2	
PROJECT ID	
121720	
SUBSET	TOTAL
42	50
SHEET	TOTAL
P. 77	103

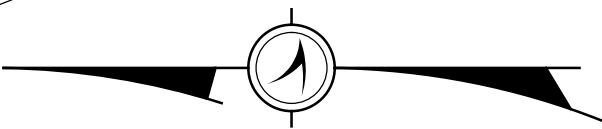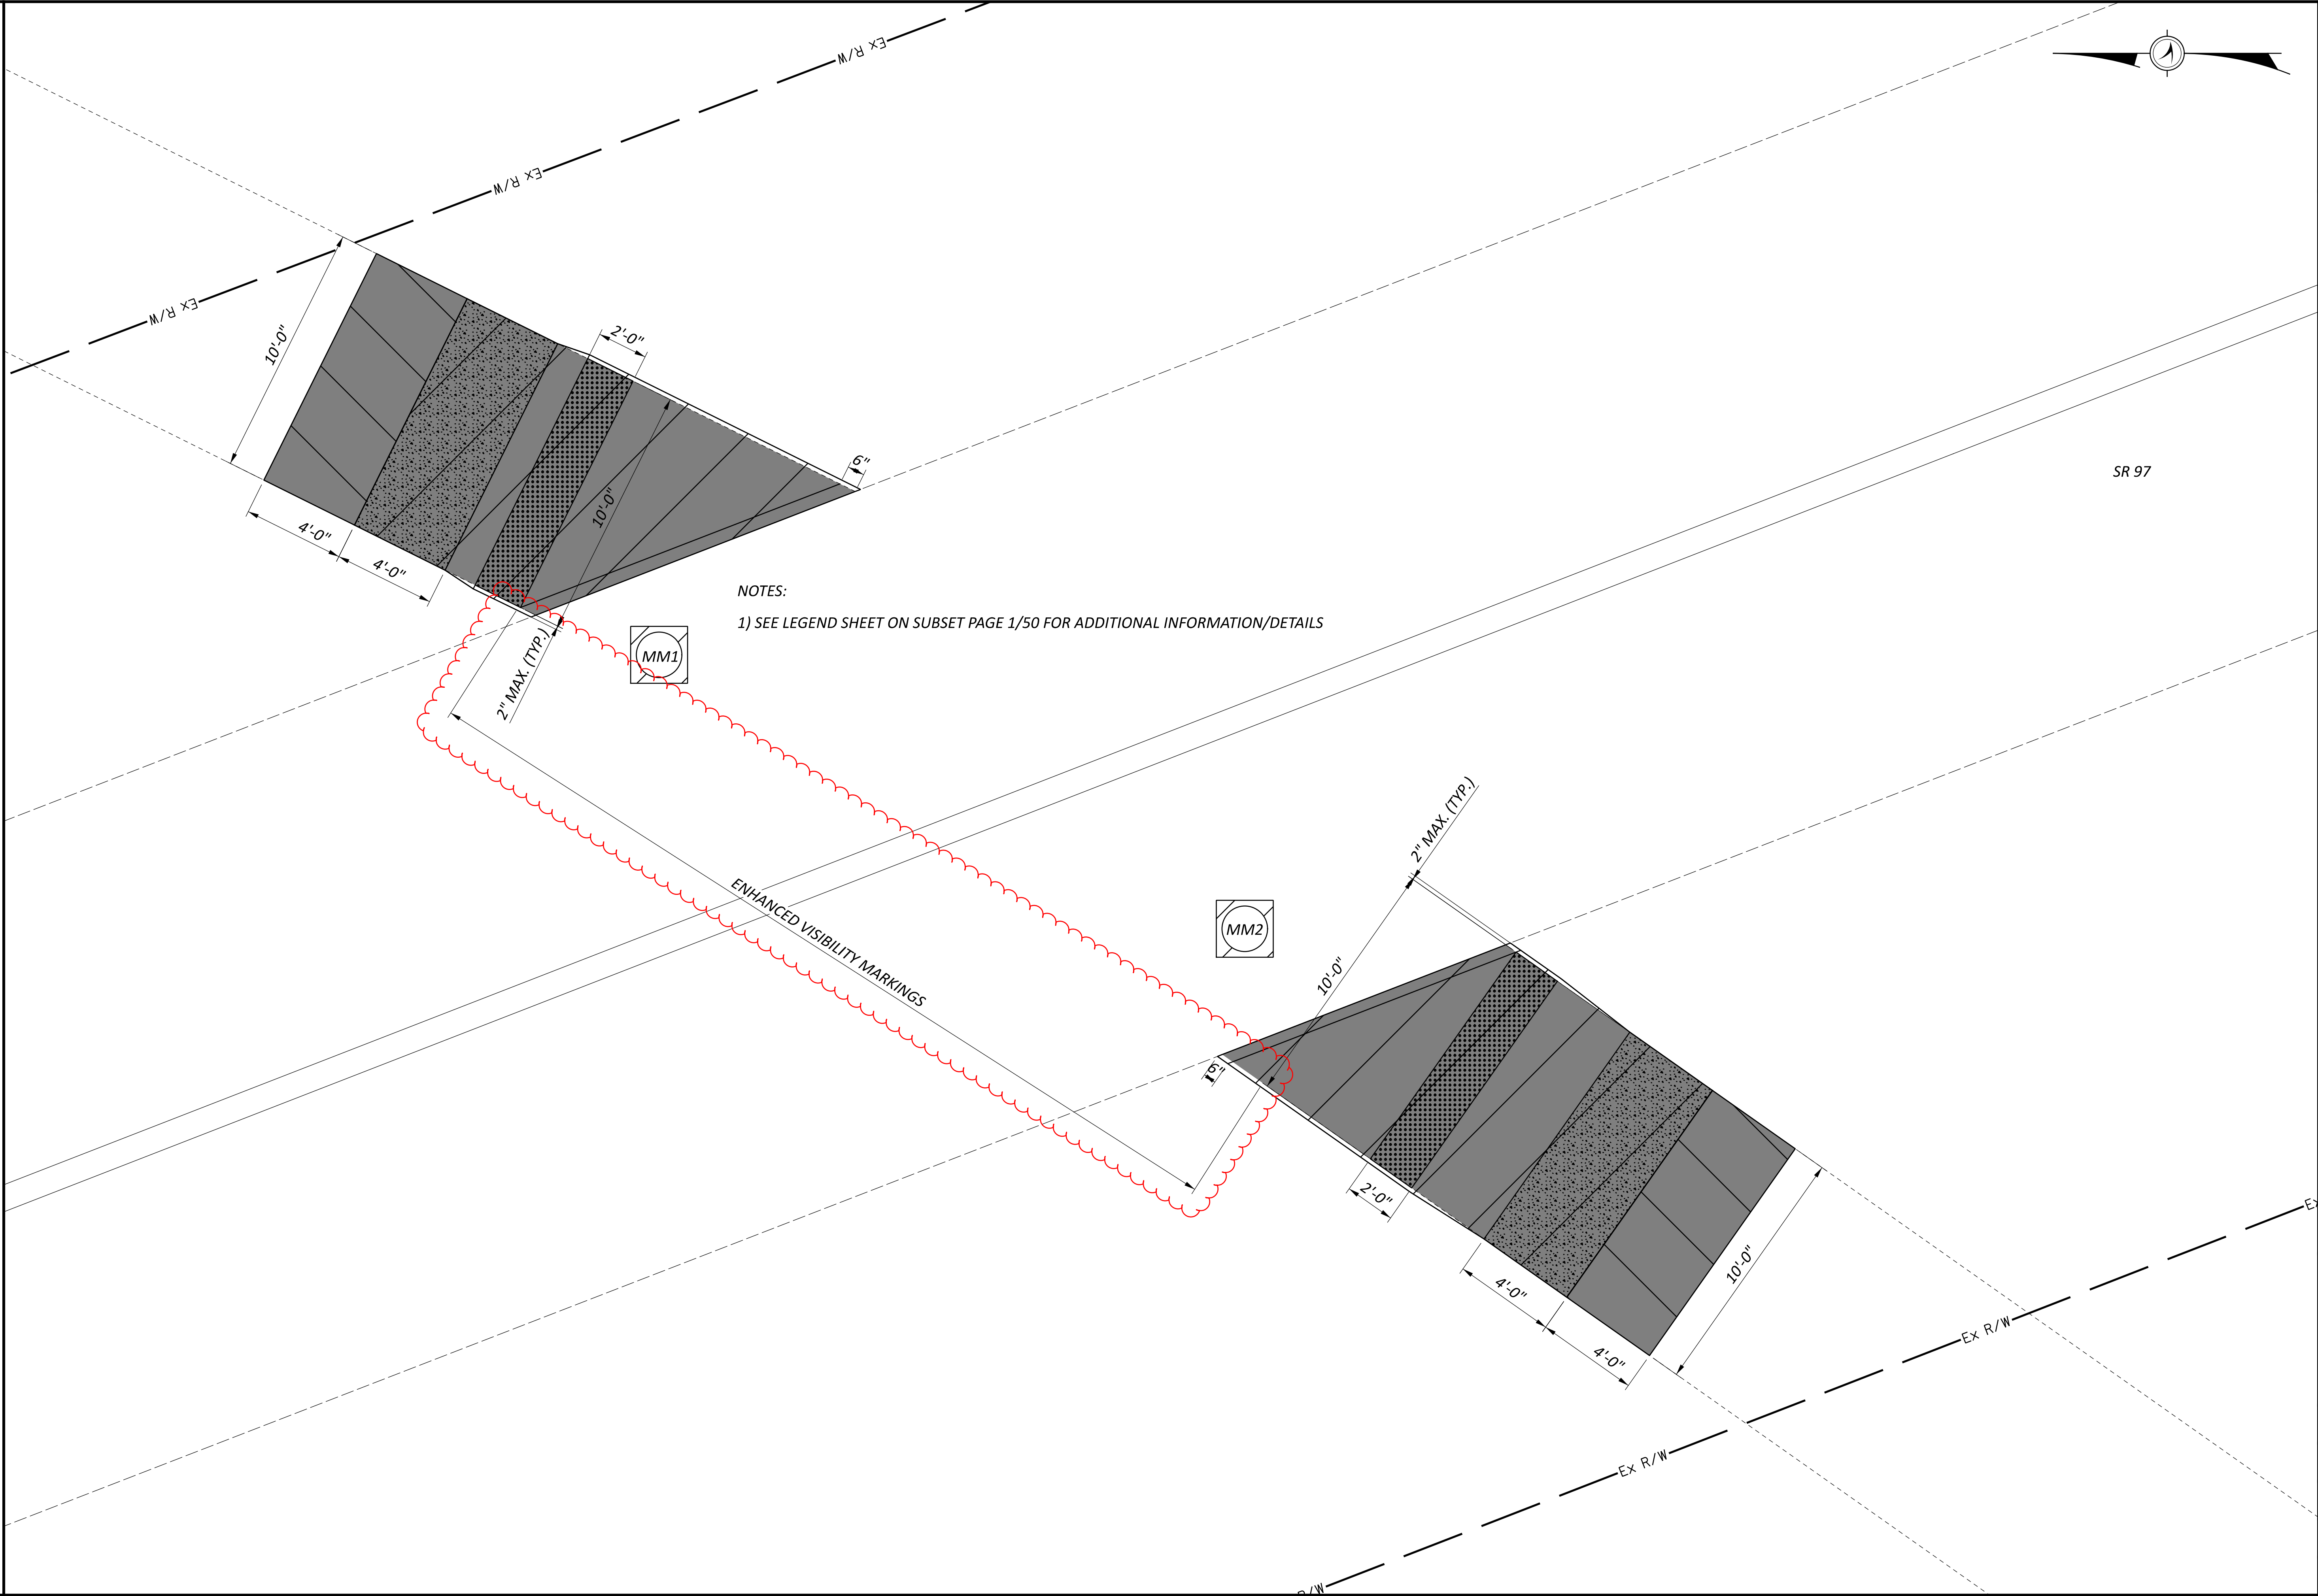

PEDESTRIAN FACILITIES
SR 97 & BIKE TRAIL (NEWVILLE)
BUTLER

DESIGN AGENCY	
DISTRICT 3	
	
ENGINEERING TEAM ONE	
DESIGNER	
SMH	
REVIEWER	
ACM 07-30-25	
PROJECT ID	
121720	
SUBSET	TOTAL
43	50
SHEET	TOTAL
P.78	103