

**INDEX OF SHEETS:**

TITLE SHEET	1
INDEX, DESIGN DESIGNATION, MONUMENTATION AND BENCHMARKS	2-3
SCHEMATIC PLAN	4-11
TYPICAL SECTIONS	12-31
GENERAL NOTES	32-38,38A,38B
MAINTENANCE OF TRAFFIC	39-65,65A,65B, 65C,65D,65E,65F, 66-124,124A,124B, 125-351
GENERAL SUMMARY	352-356,356A
SUBSUMMARIES	357,357A,358-360, 360A,361-366, 366A,367-369, 369A,370-395*
PROJECT SITE PLAN	396-404
PLAN AND PROFILE - U.S. 30	405-425,425A, 426-433,433A, 434-447,447A, 448-451,451A,452
PLAN AND PROFILE - TRIMBLE ROAD	453
PLAN AND PROFILE - LONGVIEW AVENUE WEST	454-455
PLAN AND PROFILE - S.R. 39	456-467
PLAN AND PROFILE - RELOCATED LONGVIEW AVENUE	468-472
PLAN AND PROFILE - BOWMAN STREET	473-474
PLAN AND PROFILE - WISE AVENUE	475-478
PLAN AND PROFILE - LONGVIEW AVENUE EAST	479-492
PLAN AND PROFILE - S.R. 545	493-504
PLAN AND PROFILE - TRIMBLE ROAD RAMPS	505-524
PLAN AND PROFILE - S.R. 39 RAMPS	525-548
PLAN AND PROFILE - S.R. 13/545 RAMPS	549-576
PLAN AND PROFILE - FIFTH AVENUE RAMPS	577-593
CROSS SECTIONS - U.S. 30	594-710
CROSS SECTIONS - LONGVIEW AVENUE WEST	711-714
CROSS SECTIONS - S.R. 39	715-722,722A, 722B,723-728
CROSS SECTIONS - RELOCATED LONGVIEW AVENUE	729-735
CROSS SECTIONS - BOWMAN STREET	736-737
CROSS SECTIONS - WISE AVENUE	738-743


CROSS SECTIONS - LONGVIEW AVENUE EAST	744-757
CROSS SECTIONS - S.R. 545	758,758A,759-773
CROSS SECTIONS - TRIMBLE ROAD RAMPS	774-789
CROSS SECTIONS - S.R. 39 RAMPS	790-812,812A,813-819
CROSS SECTIONS - S.R. 13/545 RAMPS	820-856
CROSS SECTIONS - FIFTH AVENUE RAMPS	857-868
SUPERELEVATION TABLES	869-875
INTERCHANGE DETAILS & GRADING PLAN	876-903
INTERSECTION DETAILS	904-905,905A,906-915
DRIVE DETAILS	916-923
STORM SEWER PROFILES	924-938
CULVERT DETAILS	939-953
DRAINAGE DETAILS	954-957
NOISE BARRIER	958-972,972A,972B
RETAINING WALLS	973-974,974A,975-985
WATER WORK	986-991
MISCELLANEOUS DETAILS	992-1003
TRAFFIC SURVEILLANCE	1004-1008,1008A,1008B,1008C, 1008D,1008E,1008F,1008G,1008H, 1008I,1008J,1008K,1008L, 1008M,1008N,1008O,1008P 1009-1032,1032A,1033-1148,1148A 1149-1169,1169A,1169B, 1170-1172,1172A,1172B, 1172C,1172D,1173-1198
TRAFFIC CONTROL LIGHTING	
STRUCTURES (OVER 20 FOOT SPAN)	
-RIC-30-0982 TRIMBLE RD. OVER U.S. 30	1199,1199A,1200-1203,1203A
-RIC-30-1074 OVER S.R. 39	1204-1253,1253A,1253B,1254-1289
-RIC-30-1135 OVER BOWMAN ST.	1270-1314,1314A,1314B,1314C,1315-1325
-RIC-30-1156 OVER S.R. 13	1326-1333
-RIC-30-1212 OVER PRIVATE DRIVE	1334-1343,1343A
-RIC-30-1219 OVER ASHLAND RAILWAY	1344-1422
NOT USED	1423-1424
-RIC-30-1236 OVER S.R. 545	1425-1497
NOT USED	1498-1504
-RIC-30-1283 FIFTH AVENUE OVER U.S. 30	1505-1509,1509A
FENCE PLAN	1510-1521
RIGHT OF WAY	1522-1639
SUBSURFACE UTILITY ENGINEERING DATA SHEETS	1640-1669
SOIL PROFILES & STRUCTURE FOUNDATION EXPLORATION	

\* ADDITIONAL SHEETS NOT USED 374 & 378

ENGINEERS SEAL:	ENGINEERS SEAL:	ENGINEERS SEAL:	ENGINEERS SEAL:	ENGINEERS SEAL:	ENGINEERS SEAL:
FOR OVERALL PLAN, EXCEPT AS NOTED	STRUCTURES, EXCEPT RIC-30-1156, RIC-30-1212, & RIC-30-1236 SUBSTRUCTURE	RETAINING WALLS & RIC-30-1156, RIC-30-1212 & RIC-30-1236 SUBSTRUCTURE	TRAFFIC CONTROL, EXCLUDING SIGNING EAST OF RIC-30-1156	SIGNING EAST OF RIC-30-1156	LIGHTING & I.T.S.
SIGNED: <i>Sheldon Schlabach</i> DATE: 11/20/19	SIGNED: <i>Herbert Koger</i> DATE: 11-20-19	SIGNED: <i>Nikhil C. Khedekar</i> DATE: 11-18-19	SIGNED: <i>Neal Underwood</i> DATE: 11-19-19	SIGNED: <i>S. Sam Khorsidi</i> DATE: 11/18/19	SIGNED: <i>Jordan Steele</i> DATE: 11/19/19




STANDARD CONSTRUCTION DRAWINGS (CONTINUED FROM SHEET 1)										SUPPLEMENTAL SPECIFICATIONS	SPECIAL PROVISIONS
HL-10.11	7-19-19	HL-60.11	7-21-17	TC-7.65	7-20-18	TC-51.12	1-15-16	TC-61.30	7-19-19	902	7-19-19
HL-10.12	1-20-17	HL-60.12	7-15-16	TC-12.30	1-19-18	TC-52.10	10-18-13	TC-64.10	10-18-19	907	10-18-19
HL-10.13	7-20-18	HL-60.31	1-18-19	TC-21.10	7-19-19	TC-52.20	7-20-18			908	10-20-17
HL-20.11	4-21-17			TC-21.20	7-20-18	TC-65.10	1-17-14			913	4-21-17
HL-20.13	1-19-18			TC-21.50	7-15-16	TC-65.11	7-21-17			916	1-19-18
HL-20.14	1-18-19			TC-22.10	10-18-13	TC-71.10	1-19-18			921	4-20-12
HL-30.11	7-19-19			TC-22.20	01-17-14	TC-72.20	7-20-18			929	1-20-17
HL-30.21	1-17-14			TC-41.10	7-19-13	TC-73.20	7-21-17			961	10-18-19
HL-30.22	1-17-14			TC-41.20	10-18-13	TC-81.10	7-15-16			977	4-17-09
HL-30.33	1-17-14			TC-41.30	10-18-13	TC-81.21	1-18-19				
HL-30.41	1-19-18			TC-41.40	10-18-13	TC-82.10	7-19-19				
HL-40.10	1-20-17			TC-41.50	10-18-13	TC-83.10	1-19-18				
HL-40.20	7-19-19			TC-42.10	10-18-13	TC-83.20	7-21-17				
HL-50.11	1-16-15			TC-42.20	10-18-13	TC-85.20	7-20-18				
HL-50.21	1-18-19			TC-51.11	1-15-16						

M:\5074\93455\Design\Roadway\Sheet s\93455GT0002.dgn 11/18/2019 9:18:19 AM kja282

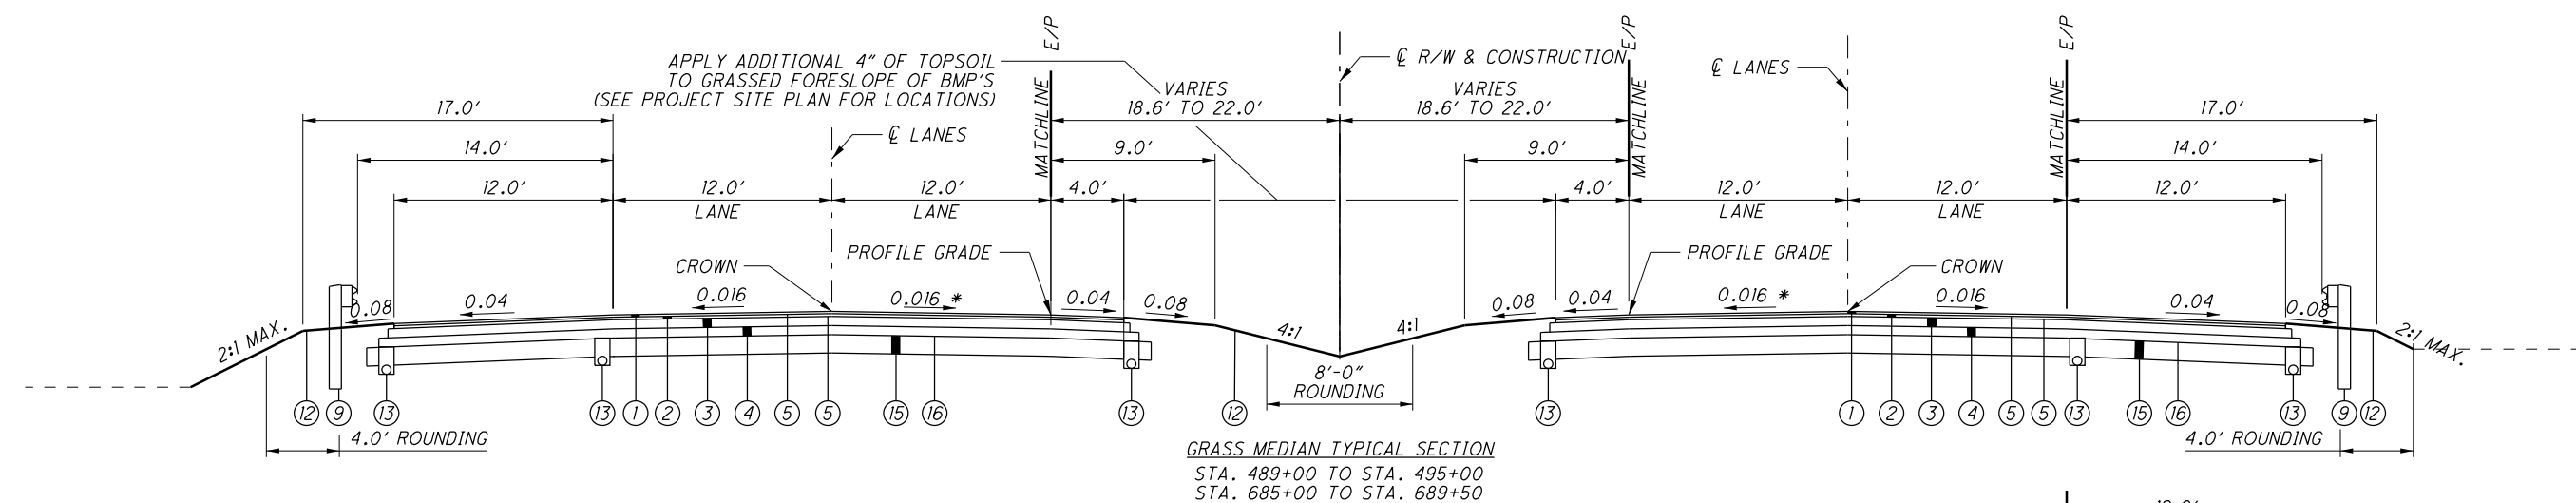

PROPOSED ITEM LEGEND



- ① ITEM 442 - 1 1/2" ASPHALT CONCRETE SURFACE COURSE, 12.5MM, TYPE A (447) (SEE NOTE 3)
- ② ITEM 442 - 1 3/4" ASPHALT CONCRETE INTERMEDIATE COURSE, 19MM, TYPE A (446), AS PER PLAN
- ③ ITEM 302 - 6" ASPHALT CONCRETE BASE, PG64-22, AS PER PLAN
- ④ ITEM 301 - 6" AGGREGATE BASE
- ⑤ ITEM 407 - NON-TRACKING TACK COAT
- ⑥ ITEM 407 - TACK COAT
- ⑦ ITEM 526 - REINFORCED CONCRETE APPROACH SLABS (T=13")
- ⑧ ITEM 622 - CONCRETE BARRIER, SINGLE SLOPE, TYPE B1 (WITH TWO 4" RACEWAYS)
- ⑨ ITEM 606 - GUARDRAIL, TYPE MGS
- ⑩ ITEM 204 - SUBGRADE COMPACTION
- ⑪ ITEM 609 - CURB, TYPE 6
- ⑫ ITEM 659 - SEEDING AND MULCHING
- ⑬ ITEM 605 - 6" BASE PIPE UNDERDRAIN WITH GEOTEXTILE FABRIC, 707.31 OR 707.41 (18" NORMAL DEPTH)
- ⑭ ITEM 452 - 10.5" NON-REINFORCED CONCRETE PAVEMENT, CLASS OCIP WITH OC/OA
- ⑮ ITEM 206 - CEMENT STABILIZED SUBGRADE, 12 INCHES DEEP
- ⑯ ITEM 206 - CURING COAT
- ⑰ ITEM 609 - 6" CONCRETE TRAFFIC ISLAND
- ⑱ ITEM 526 - REINFORCED CONCRETE APPROACH SLABS (T=15")
- ⑲ ITEM 608 - 4" CONCRETE WALK
- ⑳ ITEM 609 - CURB, TYPE 4-C
- ㉑ ITEM 254 - PAVEMENT PLANING, ASPHALT CONCRETE (SEE TYPICALS FOR DEPTH)
- ㉒ ITEM 617 - COMPACTED AGGREGATE (AVERAGE THICKNESS - 2")
- ㉓ ITEM 442 - ASPHALT CONCRETE INTERMEDIATE COURSE, 19MM, TYPE A (448), AS PER PLAN (VARIABLE THICKNESS - SEE TYPICALS FOR DEPTH)
- ㉔ ITEM 202 - WEARING COURSE REMOVED
- ㉕ ITEM 442 - 2 1/2" ASPHALT CONCRETE INTERMEDIATE COURSE, 19MM, TYPE A (446), AS PER PLAN
- ㉖ ITEM 442 - ASPHALT CONCRETE INTERMEDIATE COURSE, 19MM, TYPE A (448), AS PER PLAN (VARIABLE THICKNESS - 1 3/4" TO 2 1/2")
- ㉗ ITEM 305 - 9" CONCRETE BASE, CLASS OCIP
- ㉘ ITEM 516 - 1" PREFORMED EXPANSION JOINT FILLER
- ㉙ ITEM 622 - CONCRETE BARRIER, SINGLE SLOPE, TYPE D
- ㉚ ITEM 622 - CONCRETE BARRIER, SINGLE SLOPE, TYPE D, AS PER PLAN
- ㉛ ITEM 622 - CONCRETE BARRIER, SINGLE SLOPE, TYPE C1 (WITH 4" RACEWAY)
- ㉜ ITEM 608 - 4" CONCRETE MEDIAN
- ㉝ ITEM 302 - ASPHALT CONCRETE BASE, PG64-22 (VARIABLE THICKNESS - SEE TYPICALS FOR DEPTH)
- ㉞ ITEM 302 - 6" ASPHALT CONCRETE BASE, PG64-22

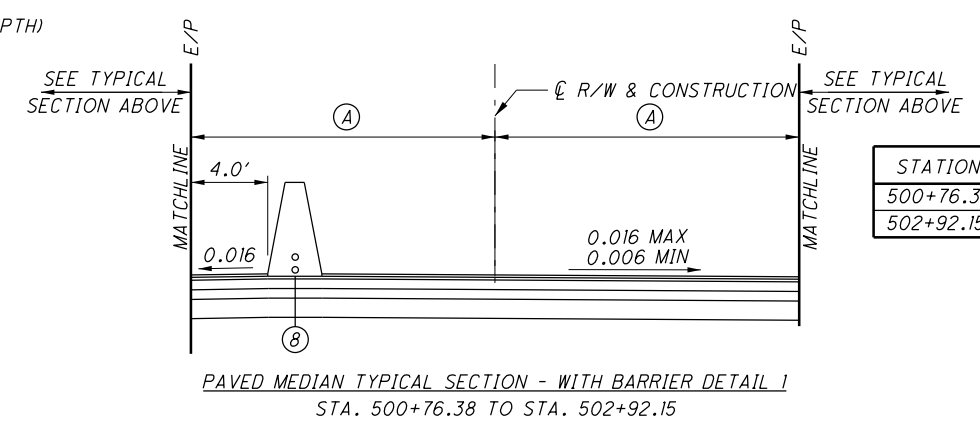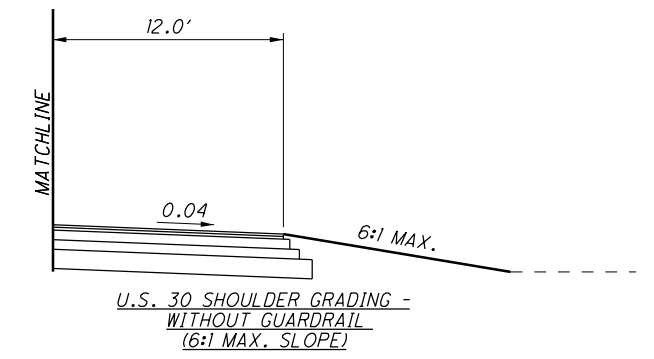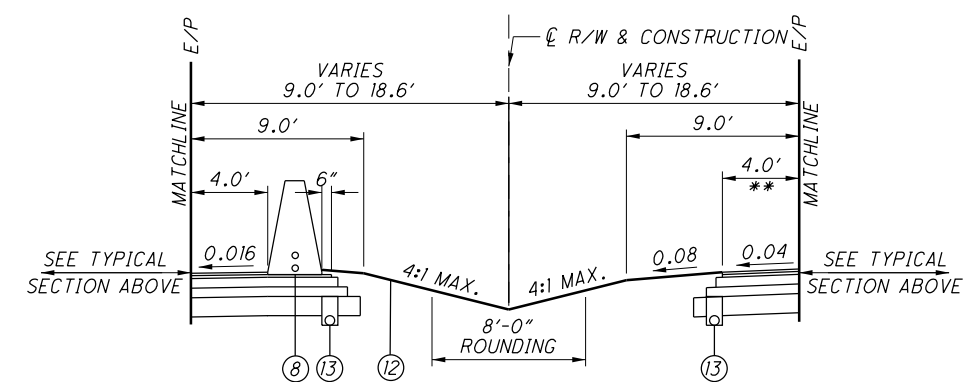








STATION	(A)
500+76.38	9.0'
502+92.15	5.4'

NOTE:

- 1. SEE SHEET 26 FOR LEGEND OF EXISTING PAVEMENT.
- 2. FOR SPEED CHANGE LANE TYPICAL SECTION SEE SHEET 18.
- 3. THE CONTRACTOR SHALL PROVIDE ANTI-SEGREGATION EQUIPMENT FOR ASPHALT SURFACE COURSE.
- \* TRANSITION CROSS-SLOPE FROM 0.016 TO -0.016 (SLOPE TOWARDS OUTSIDE SHOULDER) FROM STA. 494+00 TO STA. 495+00 AND STA. 685+00 TO STA. 686+00
- \*\* TRANSITION SHOULDER CROSS-SLOPE FROM -0.04 TO +0.009 FROM STA. 500+26.45 TO STA. 500+76.45
- \*\*\* VEGETATED BIOFILTERS SHALL NOT BE ROUNDED. REFER TO SITE PLAN FOR LOCATIONS.
- + OR AS SHOWN ON CROSS SECTIONS

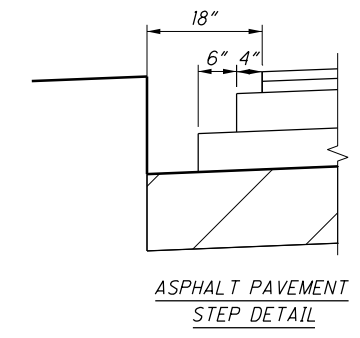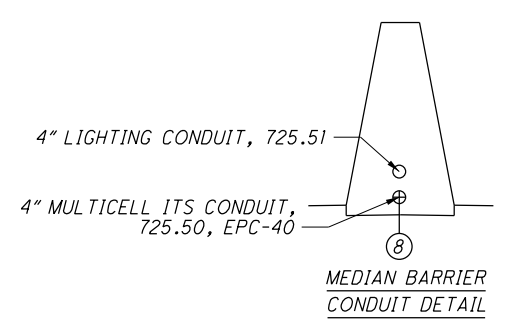

M:\15074\93455\Roadway\Sheets\93455\0001.dgn 2/21/2020 10:22:22 PM acb284

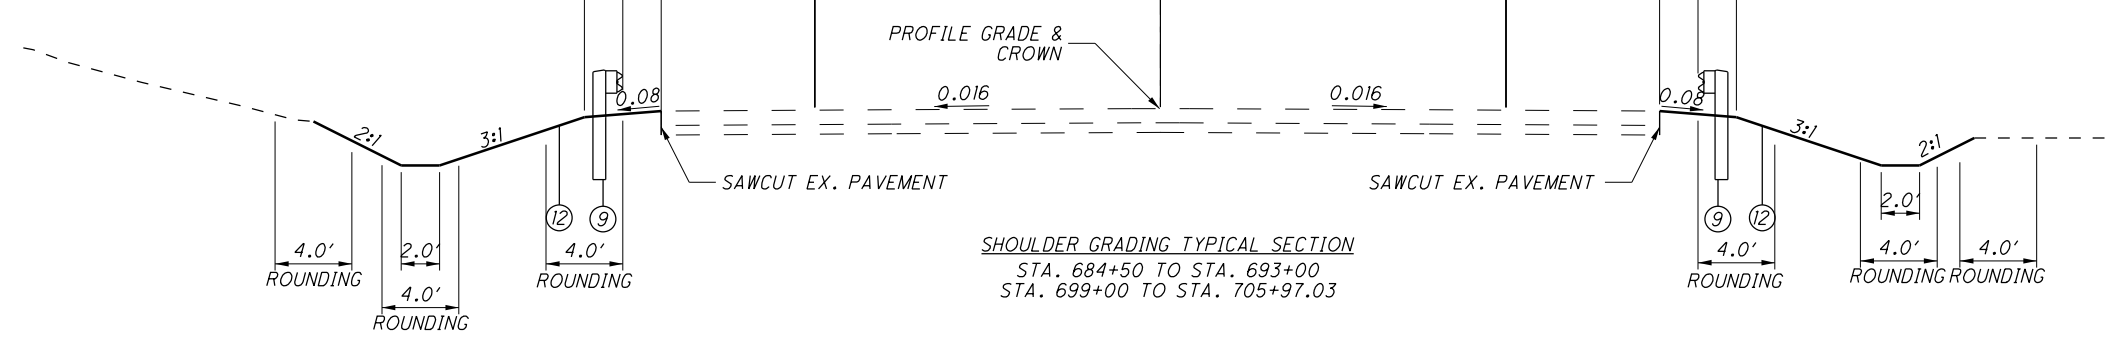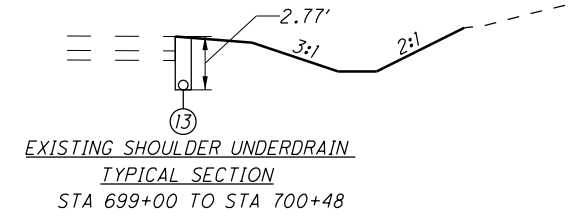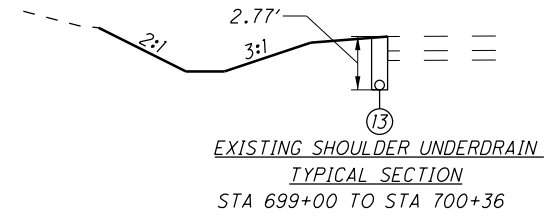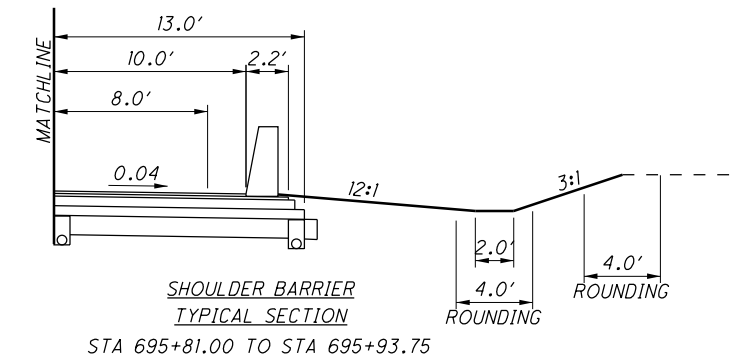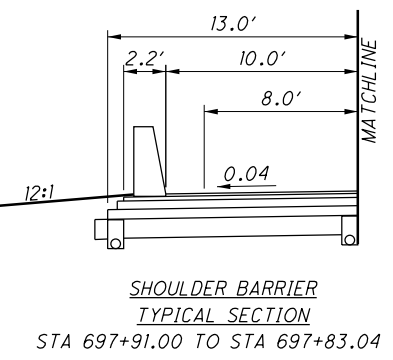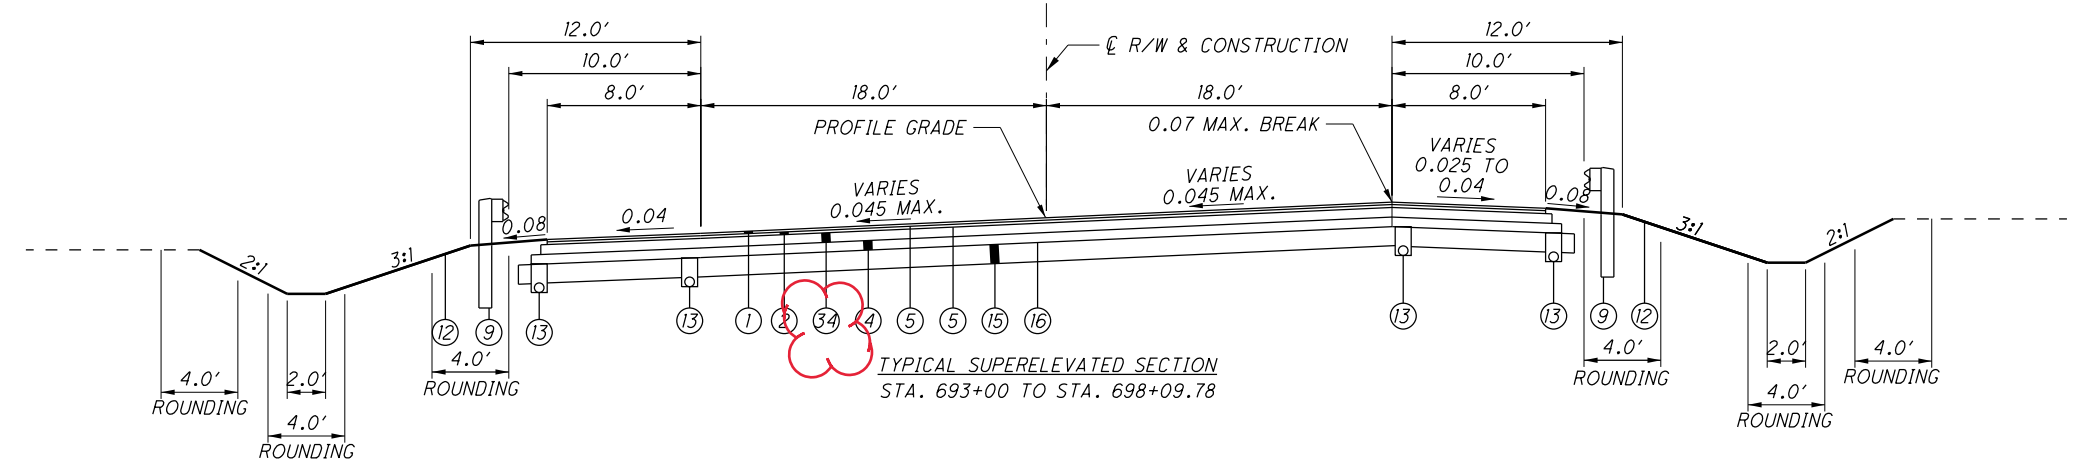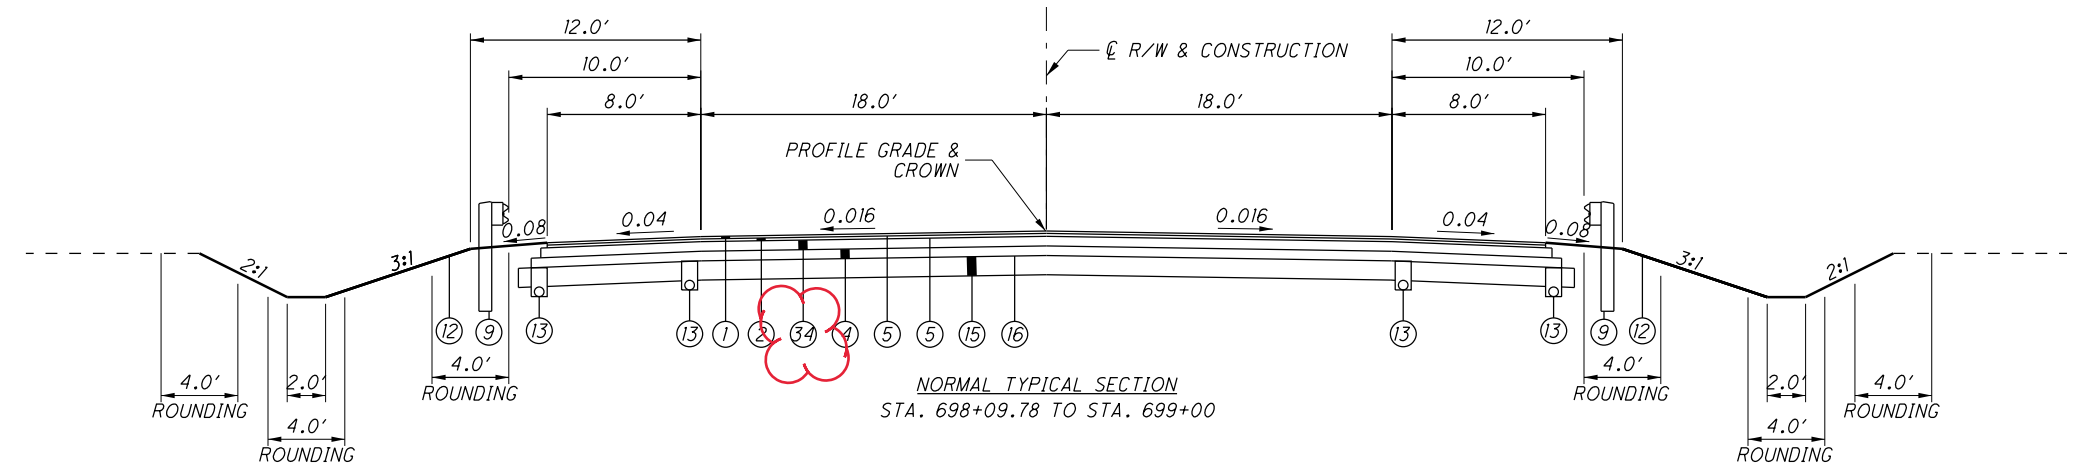


- NOTE:**
- SEE SHEET 12 FOR LEGEND.
  - FOR EXISTING PAVEMENT DETAILS SEE SHEET 26.

M:\15074\93455\Design\Roadway\Sheets\93455\10009.dgn 2/20/2020 4:08:39 PM acb284


STATION	B	
	LEFT	RIGHT
101+16.19	0.00'	99.00'
101+50	10.5'	109.50'
102+00	10.5'	82.67'
102+50	10.5'	19.83'
103+00	10.5'	14.27'
103+18.50	10.5'	12.63'

\* LONGVIEW AVE. W ONLY  
 \*\* RELOCATED LONGVIEW AVE. ONLY

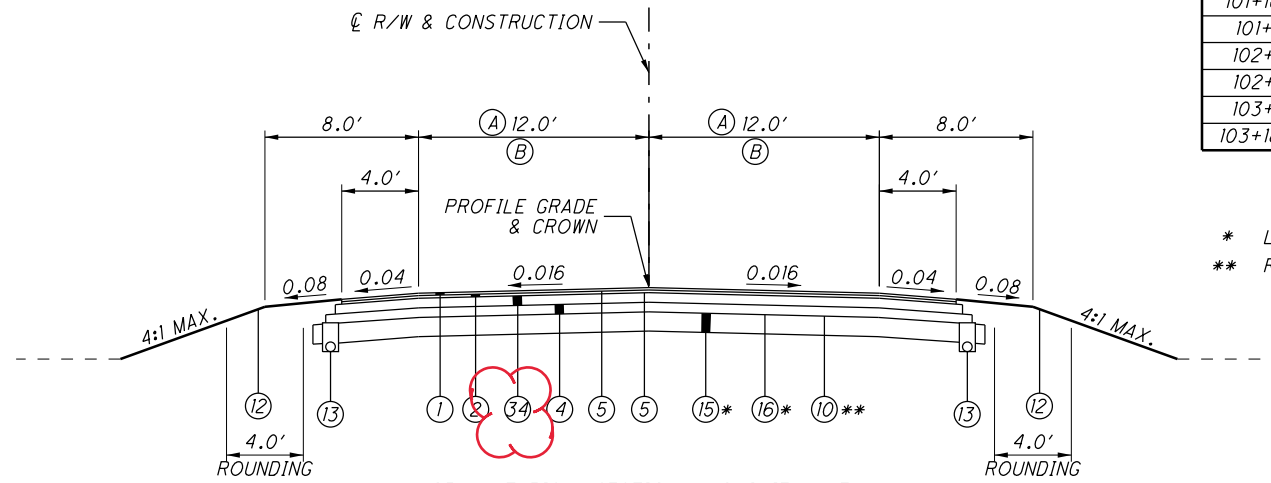


NORMAL TYPICAL SECTION - LONGVIEW AVE. W  
 & RELOCATED LONGVIEW AVE.

- B STA. 101+16.09 TO STA. 103+18.50
- A STA. 302+75 TO STA. 302+94.16
- STA. 308+14.89 TO STA. 308+94.86

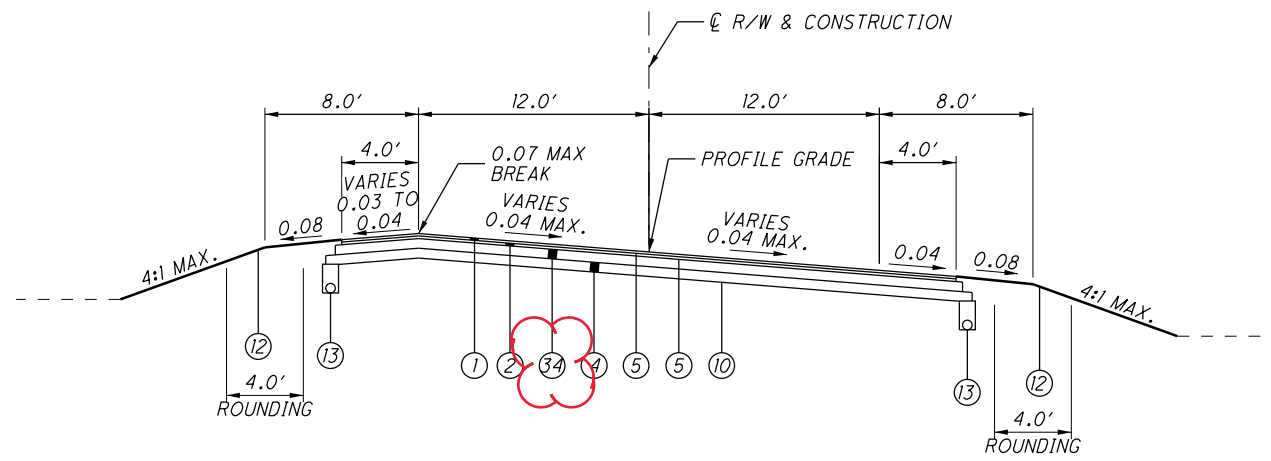


SUPERELEVATED TYPICAL SECTION - RELOCATED LONGVIEW AVE.

- STA. 302+94.16 TO STA. 308+14.89
- STA. 308+94.86 TO STA. 309+86.31

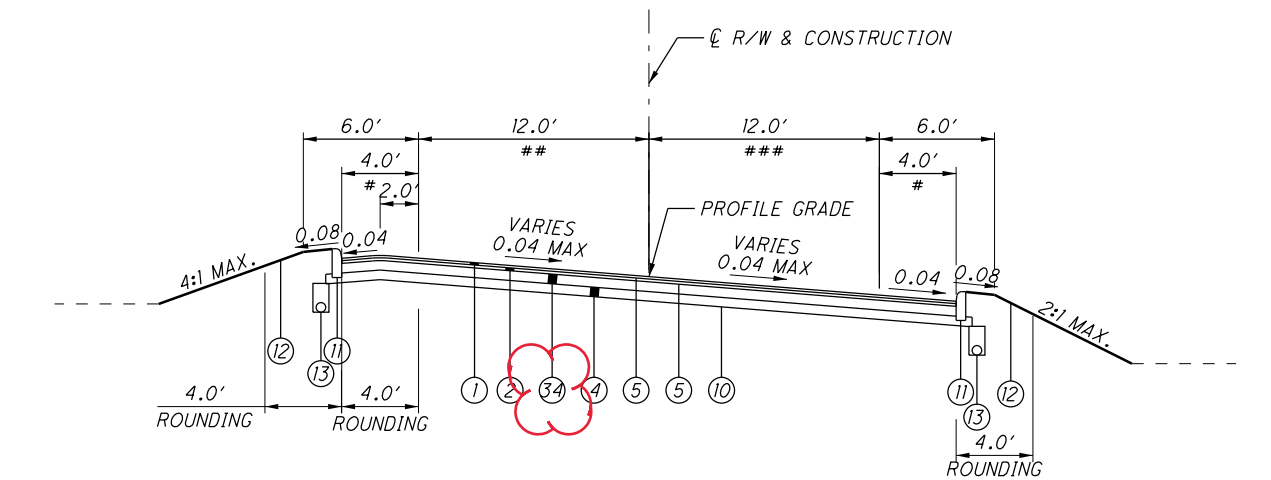

SUPERELEVATED TYPICAL SECTION WITH CURB - RELOCATED LONGVIEW AVE.

- STA. 309+86.31 TO STA. 311+30 # VARIES 1.0' TO 2.0' LT, 4.0' TO 2.1' RT
- STA. 311+30 TO STA. 311+75 ## VARIES 12.0' TO 10.5'
- ### VARIES 12.0' TO 13.5'

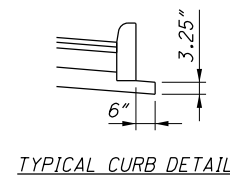

NOTE:


1. SEE SHEET 12 FOR LEGEND.
2. SEE SHEET 12 FOR STANDARD DITCH GRADING TYPICAL SECTION.

M:\15074\93455\Design\Roadway\Sheets\93455\_1\_0010.dgn 2/20/2020 4:12:48 PM acb284


CALCULATED  
 CHECKED

TYPICAL SECTIONS - LONGVIEW AVE.

RIC-30-9.26

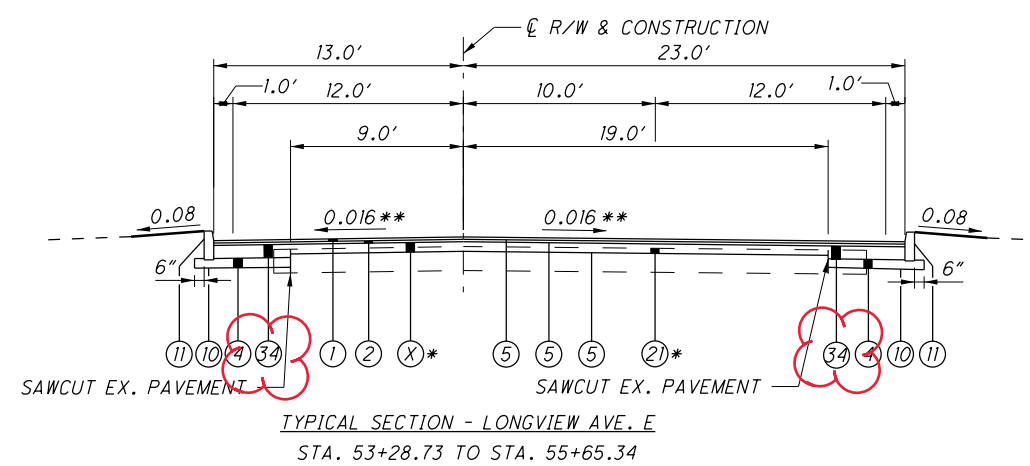


TYPICAL SECTION - LONGVIEW AVE. E  
STA. 53+28.73 TO STA. 55+65.34

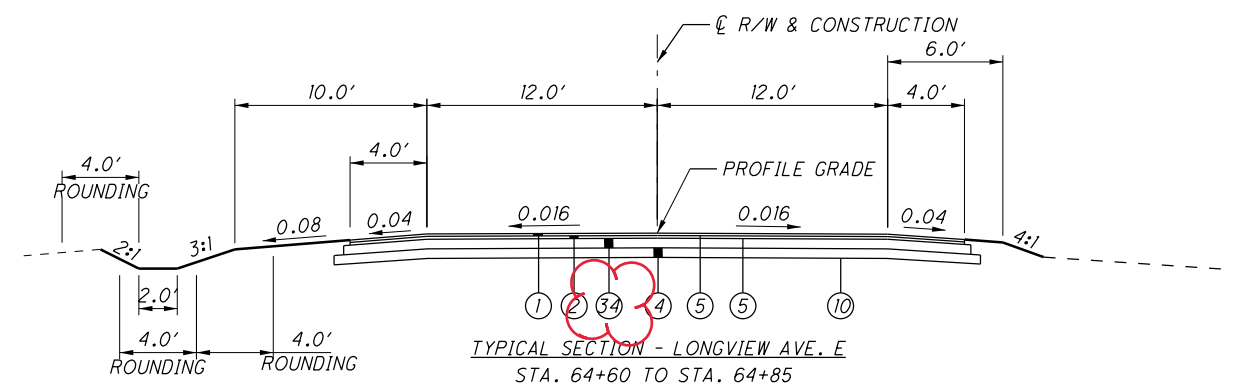


TYPICAL SECTION - LONGVIEW AVE. E  
STA. 64+60 TO STA. 64+85

STATION	CROSS SLOPE LEFT	CROSS SLOPE RIGHT
54+50	-0.016	-0.016
54+75	-0.016	-0.014
55+00	-0.016	-0.007
55+25	-0.016	0.000
55+50	-0.017	0.007
55+75	-0.011	0.003
56+00	-0.019	-0.004
56+25	-0.019	-0.010
56+50	-0.010	-0.007
56+75	-0.011	-0.009
57+00	-0.011	-0.007
57+25	-0.003	-0.007
57+50	-0.007	-0.002
57+75	-0.015	-0.007
58+00	-0.002	-0.005
58+25	0.002	-0.003
58+50	-0.011	0.001
58+75	-0.016	-0.005
59+00	-0.016	-0.012
59+25	-0.016	-0.016


\*\* SEE THE INTERSECTION DETAILS, MISCELLANEOUS DETAILS, SUPERELEVATION TABLES, AND THE TABLE ON THIS SHEET.

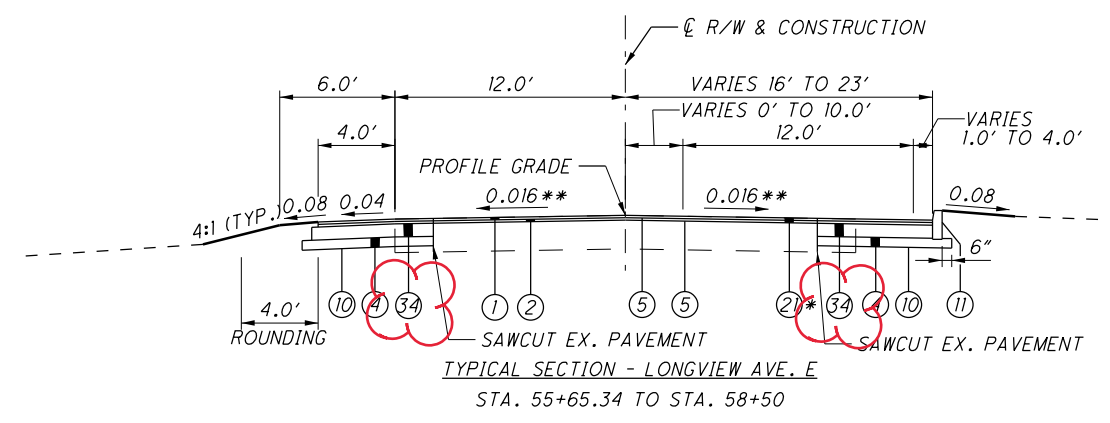


TYPICAL SECTION - LONGVIEW AVE. E  
STA. 55+65.34 TO STA. 58+50

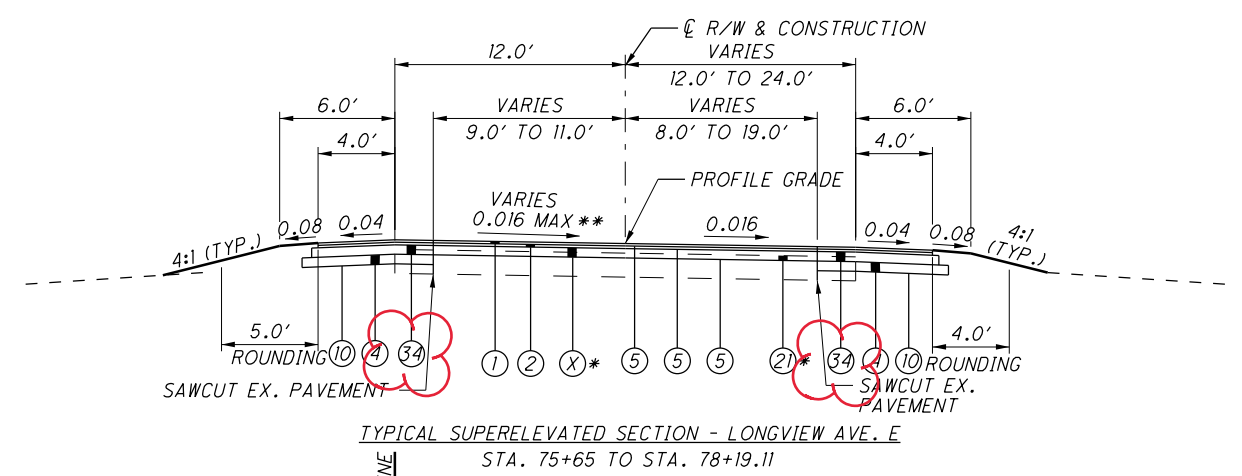

TYPICAL SUPERELEVATED SECTION - LONGVIEW AVE. E  
STA. 75+65 TO STA. 78+19.11

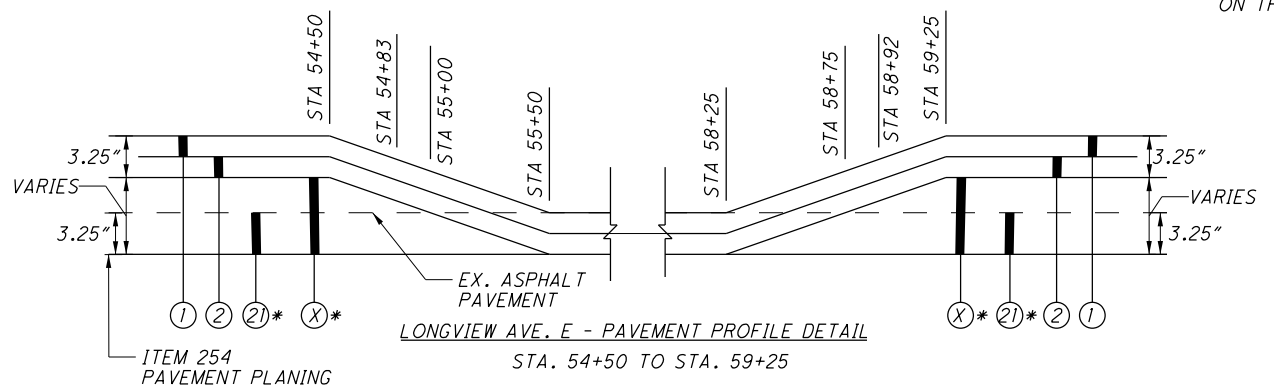


LONGVIEW AVE. E - PAVEMENT PROFILE DETAIL  
STA. 54+50 TO STA. 59+25

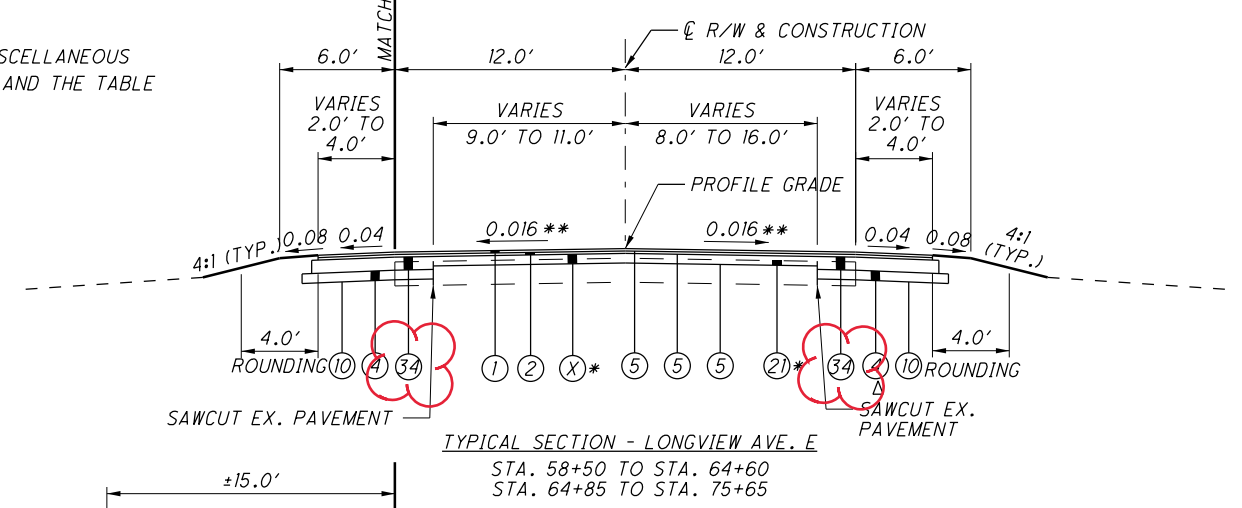

TYPICAL SECTION - LONGVIEW AVE. E  
STA. 58+50 TO STA. 64+60  
STA. 64+85 TO STA. 75+65

Δ NO FULL DEPTH PAVEMENT ON THE RIGHT SHOULDER FROM STATION 58+50 TO STATION 62+00.

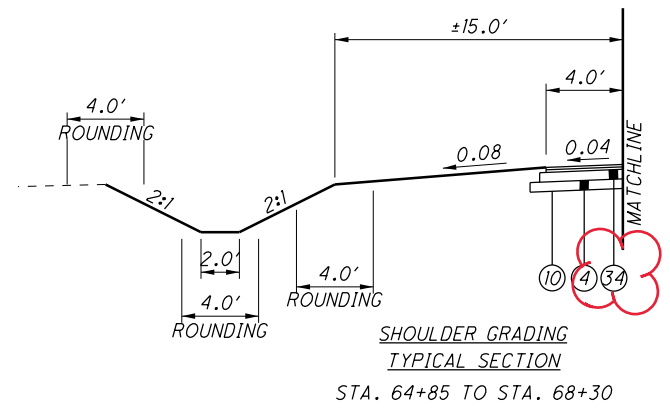

SHOULDER GRADING  
TYPICAL SECTION  
STA. 64+85 TO STA. 68+30

\* NOTES:

- SEE SHEET 12 FOR LEGEND.
- PLANE 3.25" AT THE CENTERLINE WITH A CROSS SLOPE OF -0.016 EXCEPT WHERE NOTED ON THIS SHEET.
- BALLOON (X) IS EITHER AN ITEM 442 SCRATCH COURSE OR ITEM 302 ASPHALT CONCRETE BASE COURSE THAT VARIES IN THICKNESS AS SHOWN ON THE TABLE TO PROVIDE THE REQUIRED PAVEMENT SURFACE ELEVATIONS.
- SEE REFERENCE SPREADSHEET FOR ADDITIONAL INFORMATION.

BALLOON (X) DETAILS				
STATION	TO	STATION	THICKNESS	BALLOON
53+28.73		55+50	0"-6"	(23)
55+50		58+25	0"	-
58+25		59+00	0"-4.5"	(23)
59+00		64+60	4.5"-7.25"	(33)
64+85		65+50	4.25"-7.25"	(33)
65+50		72+50	0"-4.5"	(23)
72+50		77+50	4.5"-6"	(33)
77+50		78+19.11	0"-4.5"	(23)

STATION	SAWCUT OFFSET LEFT	STATION	SAWCUT OFFSET RIGHT
53+24.40	VARIES	53+19.83	VARIES
53+70.40	9.0'	53+58.64	19.0'
57+00	9.0'	57+28.50	19.0'
57+50	10.0'	58+00	14.0'
68+50	10.0'	58+50 (BACK)	14.0'
69+00	11.0'	58+50 (AHEAD)	16.0'
75+50	11.0'	62+00 (BACK)	16.0'
76+00	10.0'	62+00 (AHEAD)	14.0'
77+00	10.0'	67+50	8.0'
77+60	11.0'	75+50	8.0'
		76+00	12.0'
		77+80	12.0'

TRANSITION SAWCUT LINE BETWEEN THE OFFSETS SHOWN IN THE ABOVE TABLE.


M:\15074\93455\Design\Roadway\Sheets\93455\_1\_0011.dgn 2/20/2020 4:15:29 PM ocb284

M:\15074\93455\Design\Roadway\Sheets\93455\10012.dgn 2/20/2020 4:16:40 PM acb284


CALCULATED  
CHECKED

TYPICAL SECTIONS - BOWMAN ST. & WISE AVE.

RIC-30-9.26





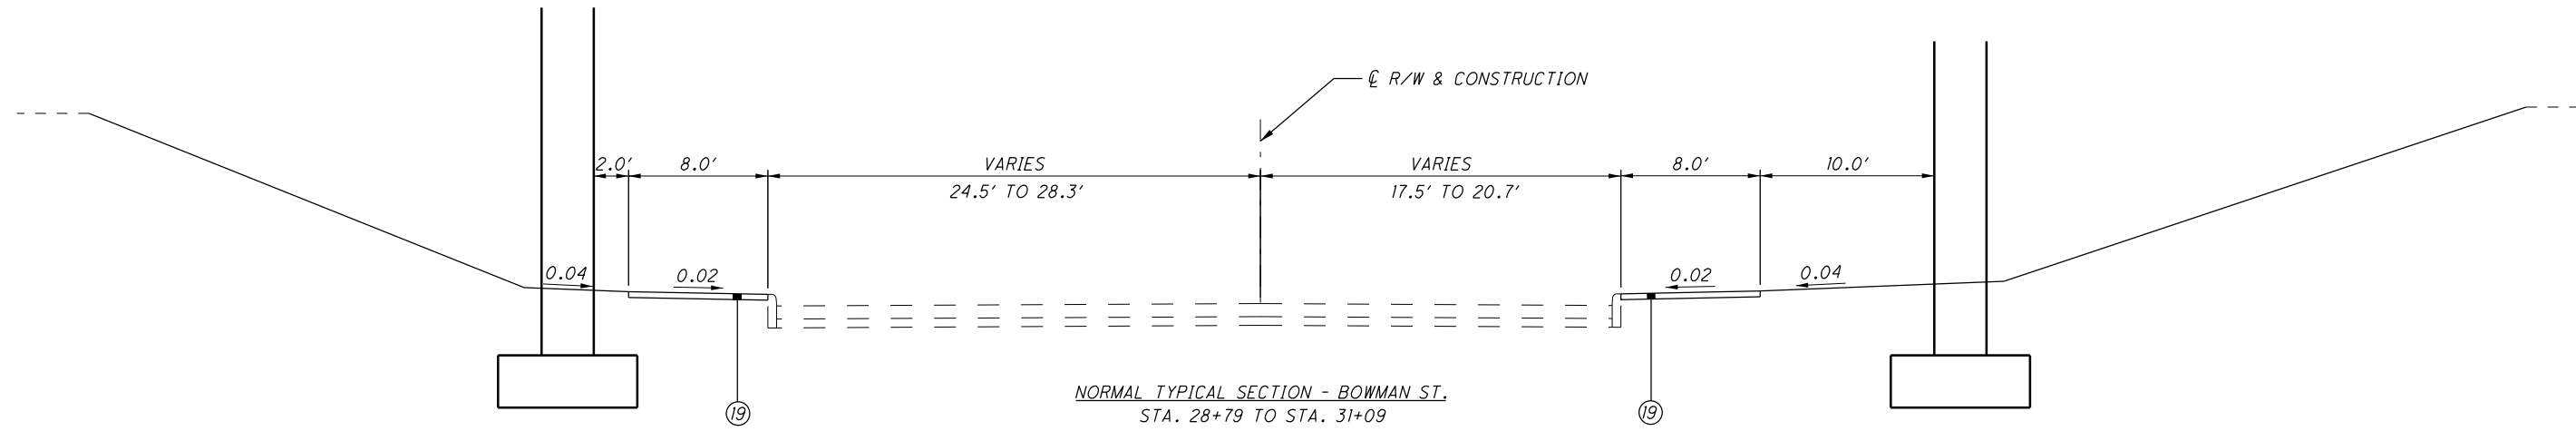


NORMAL TYPICAL SECTION - BOWMAN ST.  
STA. 28+79 TO STA. 31+09

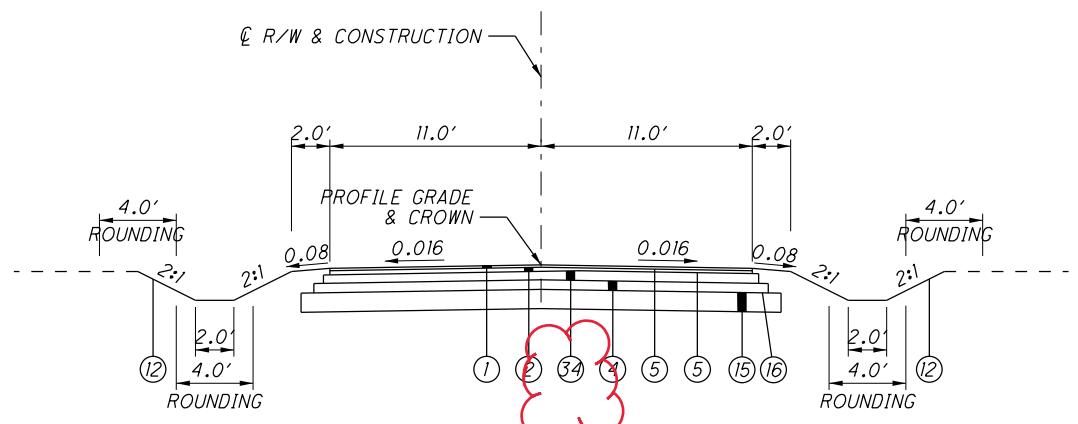

NORMAL TYPICAL SECTION - WISE AVE.  
STA 20+25.09 TO STA 31+65


NOTE:  
1. SEE SHEET 12 FOR LEGEND.

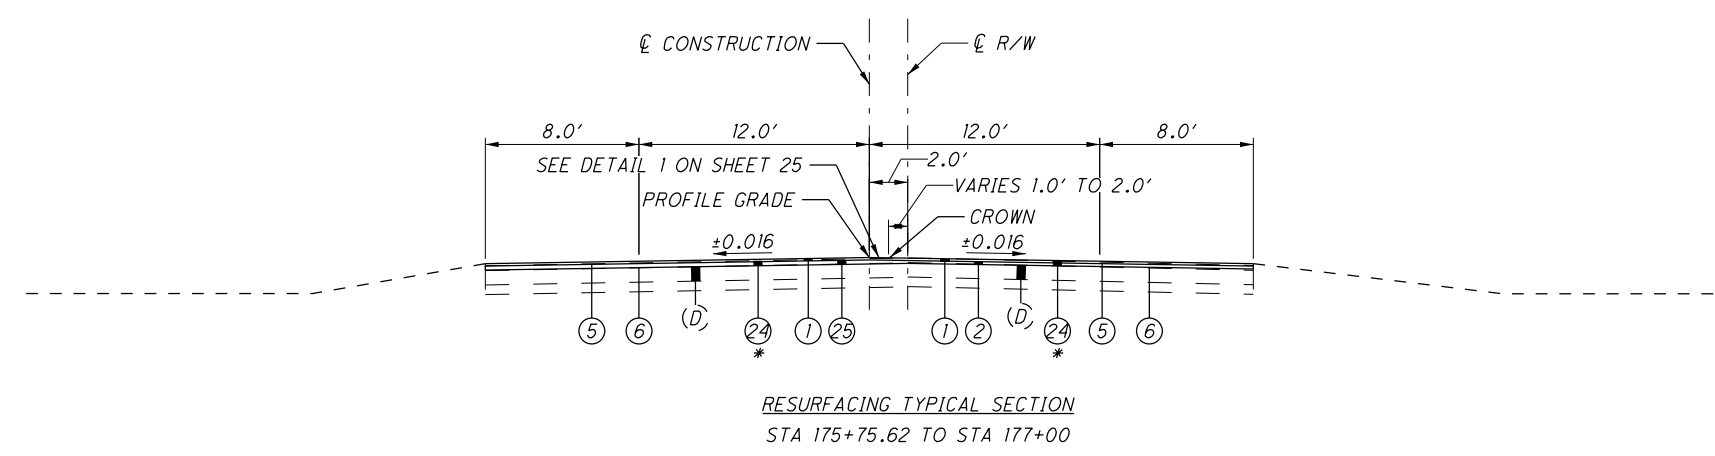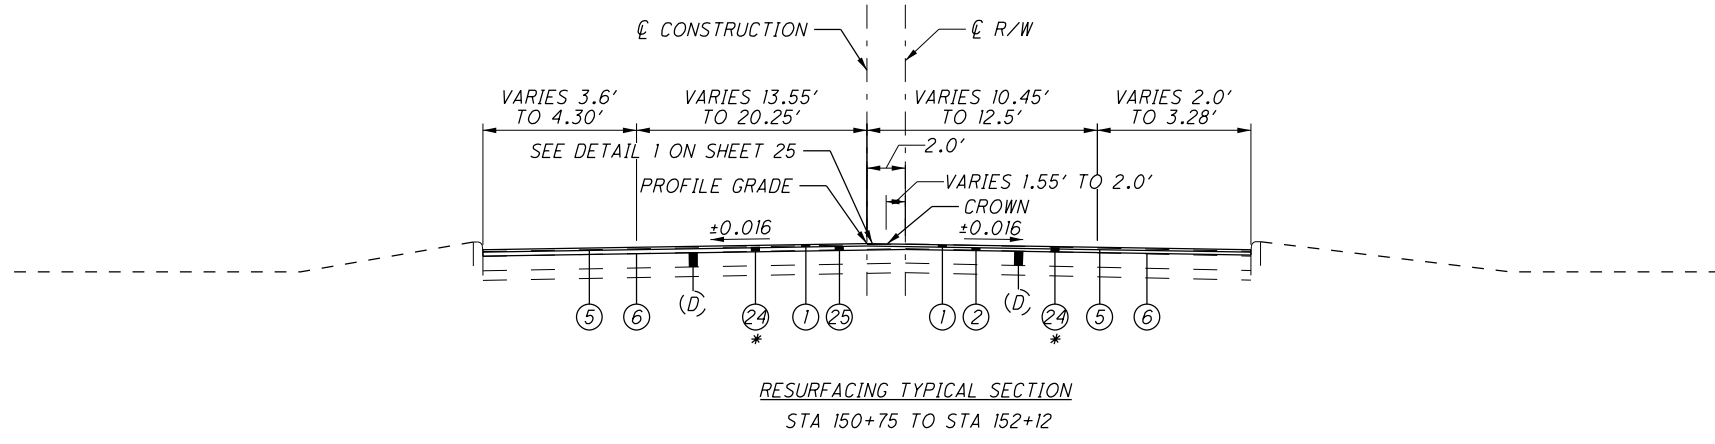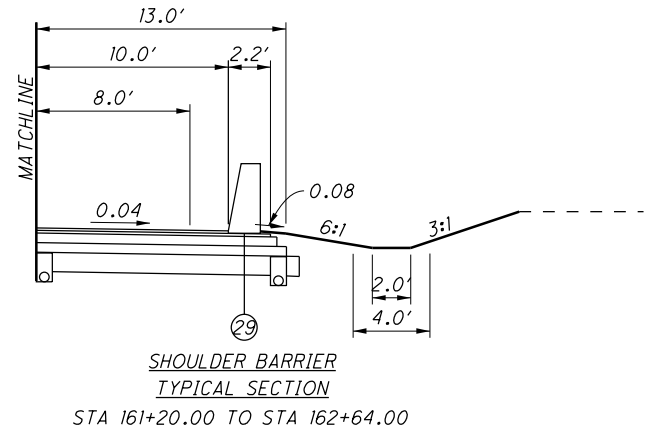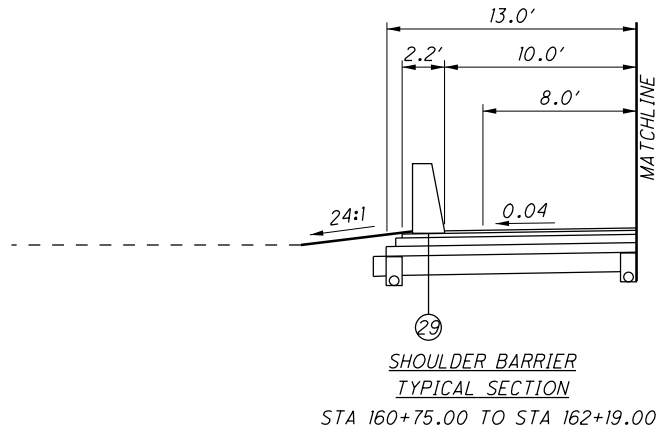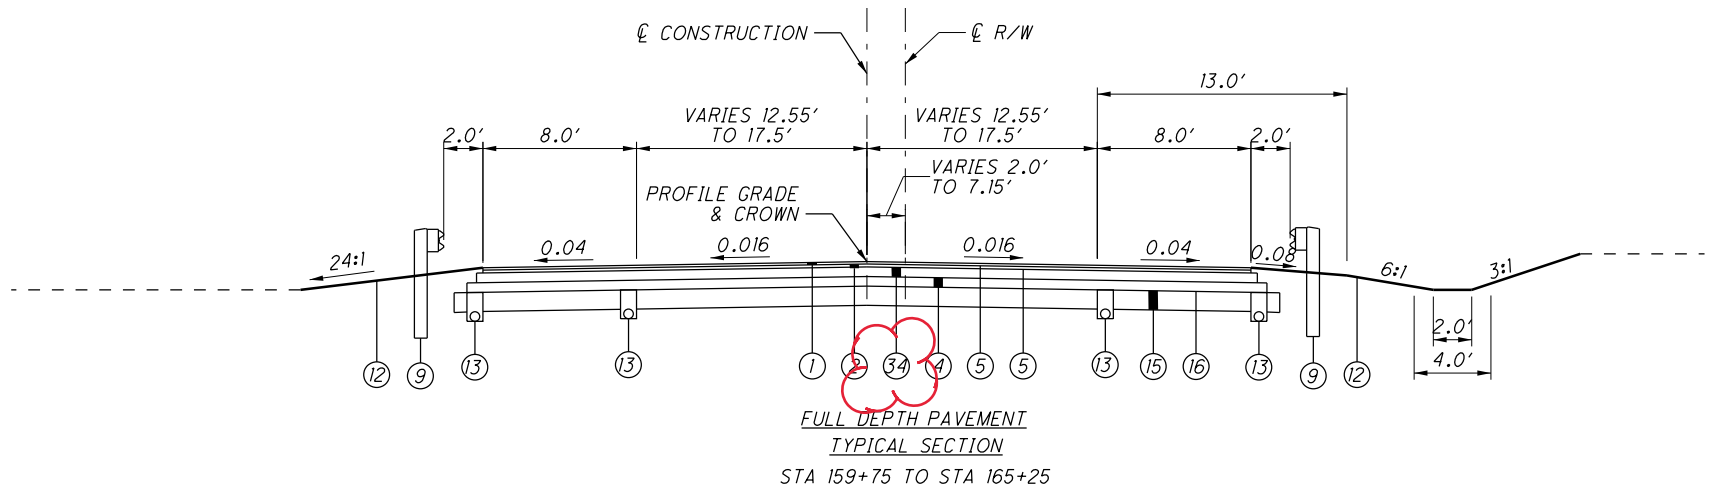





**NOTE:**

1. SEE SHEET 12 FOR PROPOSED ITEM LEGEND.
  2. SEE SHEET 26 FOR EXISTING ITEM LEGEND.
- \* THE CONTRACTOR SHALL MILL OFF THE EXISTING ASPHALT OVERLAY TO EXISTING CONCRETE PAVEMENT THEN RESURFACE WITH ASPHALT SURFACE AND INTERMEDIATE COURSE.

M:\15074\93455\Design\Roadway\Sheets\93455\_1\_0013.dgn 2/20/2020 4:17:56 PM acb284

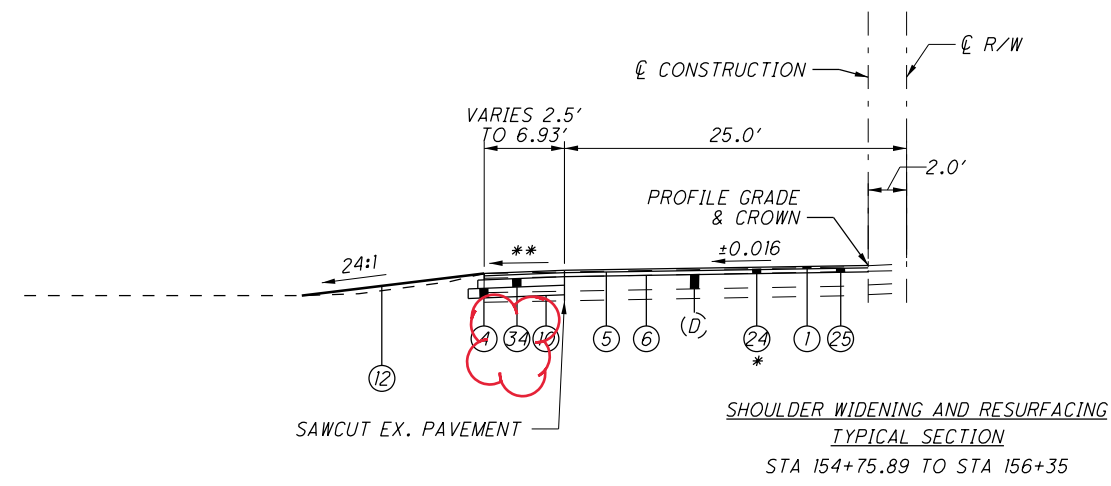

\*\* - VARIES  
±0.016 IN LANE AREAS  
±0.04 IN SHOULDER AREAS

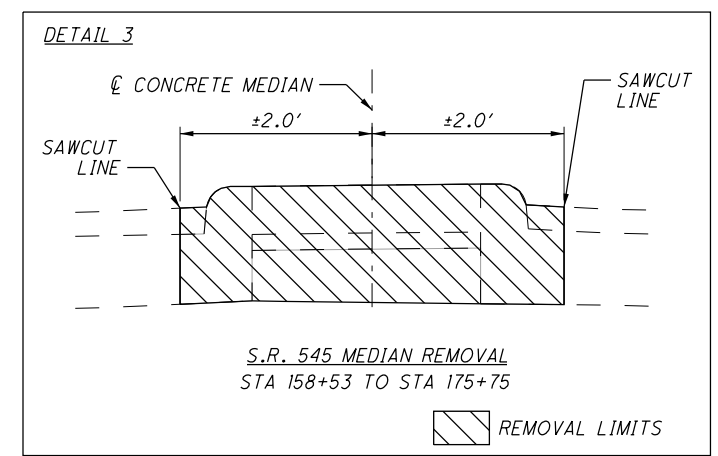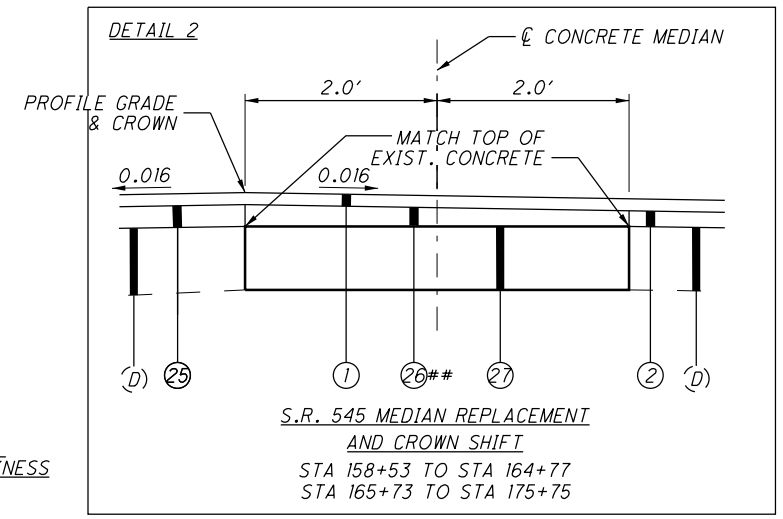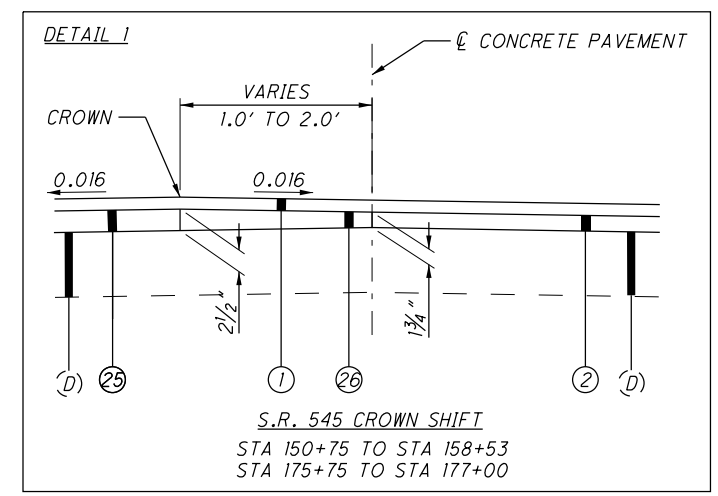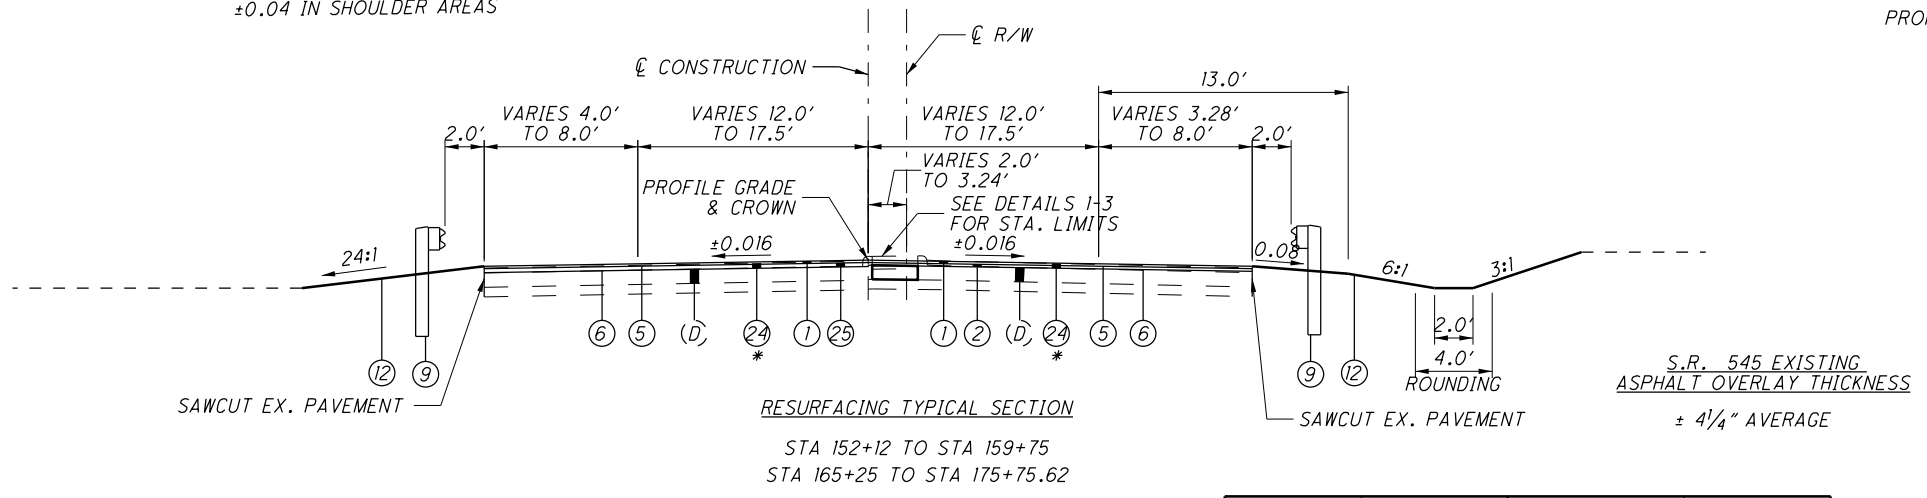

STATION	SAWCUT OFFSET LEFT	STATION	SAWCUT OFFSET RIGHT
152+77	28.01'	152+70#	26.15'
152+77	23' (AHEAD)	152+76	20.5'
153+50	23'	154+50	20.5'
153+95.60**	61.61'	155+00	20.0'
154+18.60**	81.61'	155+11.50	20.0'
154+50	23'	155+21.31#	29.81'
156+35	23' (BACK)	155+72.36#	30.64'
156+35	26.41' (AHEAD)	155+83	20.0'
159+25	20.0'	157+30	20.0'
159+50	20.0'	157+51.5#	29.46'
159+75	21.00' (BACK)	158+26#	30.09'
165+25	17.5' (AHEAD)	158+40	20.0'
166+42.02	17.5' (BACK)	159+25	20.0'
166+42.02	25.5' (AHEAD)	159+75	21.00' (BACK)
166+50	25.5'	165+25	25.5' (AHEAD)
169+00	20.0'	166+50	25.5'
175+40.15	20.0'	169+00	20.0'
175+71.63	25.25'	175+02.30	20.0'
		175+09.96#	38.91'
		175+21.96#	39.79'
		175+29.60	20.0'
		177+00	20.0'
		177+10.28	24.23'

\*\* - NO SAWCUT ACROSS LONGVIEW INTERSECTION  
# - NO SAWCUT ACROSS DRIVE APPROACHES

- NOTE:**
- SEE SHEET 12 FOR PROPOSED ITEM LEGEND.
  - SEE SHEET 26 FOR EXISTING ITEM LEGEND.
- \* THE CONTRACTOR SHALL MILL OFF THE EXISTING ASPHALT OVERLAY TO EXISTING CONCRETE PAVEMENT THEN RESURFACE WITH ASPHALT SURFACE AND INTERMEDIATE COURSE. THE EXISTING ASPHALT OVERLAY THICKNESS IS ESTIMATED AT ± 4.25" AVERAGE.
- \*\* TRANSITION 26 FROM 2 1/2" ON THE LEFT EDGE TO 1 3/4" ON THE RIGHT SIDE

M:\15074\93455\Design\Roadway\Sheets\93455\1\_0014.dgn 2/20/2020 4:18:42 PM acb284



**CROSSINGS AND CONNECTIONS TO EXISTING PIPES AND UTILITIES**

WHERE PLANS PROVIDE FOR A PROPOSED CONDUIT TO BE CONNECTED TO, OR CROSS OVER OR UNDER AN EXISTING SEWER OR UNDERGROUND UTILITY, THE CONTRACTOR SHALL LOCATE THE EXISTING PIPES OR UTILITIES BOTH AS TO LINE AND GRADE BEFORE STARTING TO LAY THE PROPOSED CONDUIT.

IF IT IS DETERMINED THAT THE ELEVATION OF THE EXISTING CONDUIT, OR EXISTING APPURTENANCE TO BE CONNECTED, DIFFERS FROM THE PLAN ELEVATION OR RESULTS IN A CHANGE IN THE PLAN CONDUIT SLOPE, THE ENGINEER SHALL BE NOTIFIED BEFORE STARTING CONSTRUCTION OF ANY PORTION OF THE PROPOSED CONDUIT WHICH WILL BE AFFECTED BY THE VARIANCE IN THE EXISTING ELEVATIONS.

IF IT IS DETERMINED THAT THE PROPOSED CONDUIT WILL INTERSECT AN EXISTING SEWER OR UNDERGROUND UTILITY IF CONSTRUCTED AS SHOWN ON THE PLAN, THE ENGINEER SHALL BE NOTIFIED BEFORE STARTING CONSTRUCTION OF ANY PORTION OF THE PROPOSED CONDUIT WHICH WOULD BE AFFECTED BY THE INTERFERENCE WITH AN EXISTING FACILITY.

PAYMENT FOR ALL THE OPERATIONS DESCRIBED ABOVE SHALL BE INCLUDED IN THE CONTRACT PRICE FOR THE PERTINENT 611 CONDUIT ITEM.

**ITEM 611 - CONDUIT BORED OR JACKED**

WHERE IT IS SPECIFIED THAT A CONDUIT BE INSTALLED BY THE METHOD OF BORING OR JACKING, NO TRENCH EXCAVATION SHALL BE CLOSER THAN 15 FEET TO THE EDGE OF PAVEMENT OR THE NEAREST RAIL. PROVIDE A STEEL CASING PIPE CONFORMING TO 748.06 HAVING JOINTS WITH A CIRCUMFERENCIAL FULLY PENETRATING B-U4B WELD THAT IS PERFORMED BY AN ODOT APPROVED FIELD WELDER OR MACHINED INTERLOCKING JOINTS ARE PERMITTED. THE INSTALLED CASING PIPE IS THE STORM WATER CONVEYANCE CARRIER UNLESS OTHERWISE SPECIFIED IN THE PLANS. HYDROSTATIC TESTING IS NOT REQUIRED FOR THE CASING PIPE. CASING PIPE IS NOT REQUIRED FOR THE TWO LOCATIONS UNDER THE ASHLAND RAILWAY.

**ITEM SPECIAL - MISCELLANEOUS METAL**

EXISTING CASTINGS MAY PROVE TO BE UNSUITABLE FOR REUSE, AS DETERMINED BY THE ENGINEER. IT SHALL BE THE CONTRACTOR'S RESPONSIBILITY TO PROVIDE THE CASTINGS OF THE REQUIRED TYPE, SIZE AND STRENGTH (HEAVY OR LIGHT DUTY) FOR THE PARTICULAR STRUCTURE IN QUESTION. ALL MATERIAL SHALL MEET ITEM 611 OF THE SPECIFICATIONS AND SHALL HAVE THE PRIOR APPROVAL OF THE ENGINEER.

THE CONTRACTOR IS CAUTIONED TO USE EXTREME CARE IN THE REMOVAL, STORAGE AND REPLACEMENT OF ALL EXISTING CASTINGS. CASTINGS DAMAGED BY THE NEGLIGENCE OF THE CONTRACTOR, AS DETERMINED BY THE ENGINEER, SHALL BE REPLACED WITH THE PROPER NEW CASTINGS AT THE EXPENSE OF THE CONTRACTOR.

PROJECT QUANTITIES SHALL BE DETERMINED BY THE PROJECT PERSONNEL AND WILL BE PAID FOR AS A CHANGE ORDER TO THE PROJECT.

**ITEM 611 - CONDUIT UNDER RAILROAD (ASHLAND RAILWAY)**

THE STATE SHALL PAY TO THE RAIL COMPANY ALL COSTS FOR WATCHMEN OR FLAGGERS DEEMED NECESSARY BY THE RAIL COMPANY, OR OCCASIONED BY THE OPERATIONS OF THE CONTRACTOR, OR ANY SUB-CONTRACTOR, IN CARRYING FORWARD THE INSTALLATION OF PIPE OR CONDUIT UNDER THE RAILROAD PER THE PLAN. THE COSTS FOR WATCHMEN OR FLAGGERS REQUIRED BY AN ALTERNATE METHOD OF INSTALLATION SHALL BE PAID TO THE RAIL COMPANY BY THE CONTRACTOR. THE COSTS FOR WATCHMEN OR FLAGGERS OCCASIONED BY THE NEGLIGENCE OF THE CONTRACTOR, OR ANY SUB-CONTRACTOR, IN CONNECTION WITH THE INSTALLATION OF THE PIPE OR CONDUIT SHALL BE PAID BY THE CONTRACTOR.

TRACK SUPPORTS REQUIRED BY THE RAIL COMPANY IN CONNECTION WITH THE INSTALLATION OF THE PIPE OR CONDUIT PER THE PLAN SHALL BE INCLUDED IN THE COMPANY FORCE ACCOUNT WORK AND PAID BY THE STATE. THE COST OF ANY TRACK SUPPORTS REQUIRED BY AN ALTERNATE METHOD OF INSTALLATION OF THE PIPE OR CONDUIT SHALL BE PAID TO THE RAIL COMPANY BY THE CONTRACTOR.

THE CONTRACTOR SHALL SECURE APPROVAL OF HIS OPERATIONS FROM THE STATE AND THE RAIL COMPANY. THE RAIL COMPANY WILL PERFORM AN ENGINEERING REVIEW OF METHODS OF OPERATIONS AND ENGINEERING SUPERVISION OF CONSTRUCTION WITHOUT COST TO THE CONTRACTOR.

PRIOR TO BIDDING, THE CONTRACTOR SHALL COORDINATE WITH THE RAIL COMPANY TO AGREE UPON THE REQUIREMENTS OF WATCHMEN AND FLAGGERS TO PROTECT OPERATIONS. THE CONTRACTOR SHALL EXECUTE A BOND IN FAVOR OF BOTH THE STATE AND THE COMPANY AS REQUIRED BY SECTION 5525.16 OF THE REVISED CODE OF OHIO.

THE CONTRACTOR SHALL CO-OPERATE WITH THE RAILROAD OFFICIALS CONCERNING WORK ADJACENT TO RAILROAD TRACKS, IN ORDER TO AVOID DELAY TO, OR INTERFERENCE WITH RAILROAD TRAFFIC, AND SHALL NOTIFY THE COMPANY 15 CALENDAR DAYS IN ADVANCE OF CONSTRUCTION OPERATIONS.

**SEEDING AND MULCHING**

THE FOLLOWING QUANTITIES ARE PROVIDED TO PROMOTE GROWTH AND CARE OF PERMANENT SEEDED AREAS:

659, SOIL ANALYSIS TEST	3 EACH
659, TOPSOIL	29691 CU. YD.
659, REPAIR SEEDING AND MULCHING	13374 SQ. YD.
659, INTER-SEEDING	13374 SQ. YD.
659, COMMERCIAL FERTILIZER	37.31 TON
659, LIME	55.27 ACRES
659, WATER	1481 M. GAL.
659, MOWING	600 M. SO. FT

SEEDING AND MULCHING SHALL BE APPLIED TO ALL AREAS OF EXPOSED SOIL BETWEEN THE RIGHT-OF-WAY LINES, AND WITHIN THE CONSTRUCTION LIMITS FOR AREAS OUTSIDE THE RIGHT-OF-WAY LINES COVERED BY WORK AGREEMENT OR SLOPE EASEMENT. QUANTITY CALCULATIONS FOR SEEDING AND MULCHING ARE BASED ON THESE LIMITS.

**REVIEW OF DRAINAGE FACILITIES**

BEFORE ANY WORK IS STARTED ON THE PROJECT AND AGAIN BEFORE FINAL ACCEPTANCE BY THE STATE, REPRESENTATIVES OF THE STATE AND THE CONTRACTOR, ALONG WITH LOCAL REPRESENTATIVES, SHALL MAKE AN INSPECTION OF ALL EXISTING SEWERS WHICH ARE TO REMAIN IN SERVICE AND WHICH MAY BE AFFECTED BY THE WORK. THE CONDITION OF THE EXISTING CONDUITS AND THEIR APPURTENANCE SHALL BE DETERMINED FROM FIELD OBSERVATIONS. RECORDS OF THE INSPECTION SHALL BE KEPT IN WRITING BY THE STATE.

ALL NEW CONDUITS, INLETS, CATCH BASINS, AND MANHOLES CONSTRUCTED AS A PART OF THE PROJECT SHALL BE FREE OF ALL FOREIGN MATTER AND IN A CLEAN CONDITION BEFORE THE PROJECT WILL BE ACCEPTED BY THE STATE.

ALL EXISTING SEWERS INSPECTED INITIALLY BY THE ABOVE MENTIONED PARTIES SHALL BE MAINTAINED AND LEFT IN A CONDITION REASONABLY COMPARABLE TO THAT DETERMINED BY THE ORIGINAL INSPECTION. ANY CHANGE IN THE CONDITION RESULTING FROM THE CONTRACTOR'S OPERATIONS SHALL BE CORRECTED BY THE CONTRACTOR TO THE SATISFACTION OF THE ENGINEER.

PAYMENT FOR ALL OPERATIONS DESCRIBED ABOVE SHALL BE INCLUDED IN THE CONTRACT PRICE FOR THE PERTINENT 611 CONDUIT ITEMS.

**ITEM 611 - INLET, NO. 4 FOR SINGLE SLOPE BARRIER, TYPE BI, AS PER PLAN**

THE INLET IS LOCATED IN A BARRIER WIDTH TRANSITION ZONE FOR AN ADJACENT LIGHT POLE FOUNDATION. THE TROUGH AND BARRIER WIDTH SHALL TRANSITION TO MATCH STANDARD CONSTRUCTION DRAWING RM-4.4.

**POST CONSTRUCTION STORM WATER TREATMENT**

THIS PLAN UTILIZES STRUCTURAL BEST MANAGEMENT PRACTICES (BMP'S) FOR POST CONSTRUCTION STORM WATER TREATMENT.

**VEGETATED FILTER STRIP**

THIS PLAN UTILIZES VEGETATED FILTER STRIP(S) FOR POST CONSTRUCTION STORM WATER TREATMENT. PLACE EITHER ITEM 660 SODDING OR ITEM 659 SEEDING AND MULCHING WITH A 4-INCH LIFT OF TOPSOIL AND ITEM 670, SLOPE EROSION PROTECTION TO ALL DISTURBED AREAS DESIGNATED AS VEGETATED FILTER STRIPS, THE EDGE OF SHOULDER, AND THE FORESLOPE AS SPECIFIED IN THE PLANS.

**VEGETATED BIOFILTER**

THIS PLAN UTILIZES VEGETATED BIOFILTER(S) FOR POST CONSTRUCTION STORM WATER TREATMENT. PLACE EITHER ITEM 660 - SODDING OR ITEM 659 - SEEDING AND MULCHING WITH A 4-INCH LIFT OF TOPSOIL AS SHOWN IN THE PLANS TO ANY DISTURBED AREA ON THE SHOULDER AND FORESLOPE DRAINING TO A VEGETATED BIOFILTER. THE DITCH FOR EACH VEGETATED BIOFILTER SHALL BE TRAPEZOIDAL, AS SHOWN IN THE PLANS.

**ITEM - 302 ASPHALT CONCRETE BASE, PG64-22, AS PER PLAN**

MIX DESIGN - FOLLOW THE REQUIREMENTS OF 302.02 EXCEPT AS MODIFIED BELOW:

- USE A MAXIMUM F/A RATIO OF 1.4
- MINIMUM TSR IS 0.70 AS DETERMINED USING SUPPLEMENT 1051. ADD ANTISTRIP ADDITIVE AS SPECIFIED IN 441.04 IF REQUIRED BASED ON TSR.

NOTIFICATION - NOTIFY ERIC BIEHL AT 614-275-1380 AND JULIE MILLER AT 614-466-3165 ONE WEEK PRIOR TO PLANNED BEGINNING PRODUCTION AND PLACEMENT.

QUALITY CONTROL AND ACCEPTANCE - FOLLOW THE REQUIREMENTS OF 403 USING 446 ACCEPTANCE EXCEPT AS MODIFIED BELOW:

- REPLACE MSG COMPARISON IN TABLE 403.06-1 WITH 0.015.

THE REQUIREMENTS OF 441.09 AND 441.10 APPLY, EXCEPT AS MODIFIED BELOW:

- MAINTAIN THE F/A RATIO LESS THAN 1.4.
- IF THE F/A RATIO IS GREATER THAN 1.2, RECALCULATE THE F/A RATIO USING THE EFFECTIVE ASPHALT BINDER CONTENT AND ENSURE THE RECALCULATED F/A RATIO IS LESS THAN 1.4.

- COMPACT AIR VOIDS SPECIMENS USING A SIX-INCH MARSHALL HAMMER WITH 70 BLOWS ON EACH SIDE ACCORDING TO 302.02. OUT-OF-SPECIFICATION LIMITS FOR AIR VOIDS IS 2.5 TO 5.5 PERCENT (DESIGN AIR VOIDS OF 4.0 PERCENT).

- FOR INFORMATION PURPOSES ONLY: COMPACT THREE SPECIMENS USING THE SUPERPAVE GYRATORY AT 50 GYRATIONS AND THREE AT 65 GYRATIONS EACH PRODUCTION DAY. USE THE SAME SAMPLE FOR BOTH GYRATORY LEVELS. PROPERLY LABEL EACH SPECIMEN WITH GYRATORY LEVEL AND LOT SPLIT SAMPLE ID AND SET ASIDE FOR DISTRICT TESTING TO TAKE POSSESSION. DO NOT DISPOSE OF SPECIMENS.

DENSITY ACCEPTANCE - FOLLOW THE REQUIREMENTS OF 446 ASPHALT CONCRETE CORE DENSITY ACCEPTANCE, INCLUDING JOINT CORES, EXCEPT AS MODIFIED BELOW:

- OBTAIN 6-INCH DIAMETER CORES ON EACH LIFT PLACED.
- OBTAIN JOINT CORES AT COLD LONGITUDINAL JOINTS SUCH THAT THE CORE'S CLOSEST EDGE IS 6 INCHES (152 MM) FROM THE EDGE OF THE MAT.
- PAY FACTORS FOR EACH LIFT OF 302 APP WILL BE AS SPECIFIED IN THE FOLLOWING TABLE.

MEAN OF LOT CORE DENSITY[1]	PAY FACTOR
	302, AS PER PLAN
>98.0%	[2]
>97.0% TO 98.0%	[3]
92.0% TO 97.0%	1
91.0% TO 91.9%	0.9
90.0% TO 90.9%	0.8
89.0% TO 89.9%	0.7
<89.0%	[4]

[1] MEAN OF CORES AS PERCENT OF AVERAGE MSG FOR THE PRODUCTION DAY.

[2] THE DISTRICT WILL DETERMINE WHETHER THE MATERIAL MAY REMAIN IN PLACE. THE PAY FACTOR FOR MATERIAL ALLOWED TO REMAIN IN PLACE IS 0.50.

[3] THE DISTRICT WILL DETERMINE WHETHER THE MATERIAL MAY REMAIN IN PLACE. THE PAY FACTOR FOR MATERIAL ALLOWED TO REMAIN IN PLACE IS 0.70.

[4] THE DISTRICT WILL DETERMINE WHETHER THE MATERIAL MAY REMAIN IN PLACE. THE PAY FACTOR FOR MATERIAL ALLOWED TO REMAIN IN PLACE IS 0.50.

IF MATERIAL IS REMOVED AND REPLACED, REMOVE AND REPLACE THE FULL LIFT AND ALL COURSES PAVED ON THE LIFT.

**PHASE 8**

GENERAL: THIS PHASE WILL UTILIZE THE NEW PAVEMENT AND REQUIRE A LANE CLOSURE IN EACH DIRECTION PER SCD MT-95.30 TO CONSTRUCT THE ASPHALT SURFACE COURSE, FINAL PAVEMENT MARKINGS, RPM'S AND SHOULDER RUMBLE STRIPS ON US 30. THE LANE CLOSURES ON US 30 SHALL MEET THE PLCS. SOME OF THESE ITEMS MAY BE COMPLETED IN PHASE 9 AS NOTED BELOW, IF NECESSARY.

- 1. RAMP CLOSURES SHALL ONLY TO BE IN EFFECT DURING CONSTRUCTION WORK ON THE RAMP AND DURING THE TIME WHEN PERMITTED TO BE CLOSED.
- 2. ALL ENTRANCE RAMPS MAY BE CLOSED BETWEEN 8:00 PM TO 6:00 AM UNLESS OTHERWISE NOTED IN THIS PHASE. REFER TO SCD MT-98.29 AND SCD MT-98.30.
- 3. THE US 309 EB ENTRANCE RAMP TO US 30 AND THE US 30 WB EXIT TO SR 309 SHALL REMAIN OPEN AT ALL TIMES. ENTRANCE RAMP D FROM TRIMBLE ROAD IS TO BE CLOSED WHEN WORKING ON US 30 WB BETWEEN STATION 489+00 TO STATION 513+00 AS PERMITTED BY THE PLCS. EXIT RAMP A TO TRIMBLE ROAD MAY BE CLOSED WHEN WORKING ON US 30 EB BETWEEN STATION 489+00 TO STATION 513+00 WHEN PERMITTED BY THE PLCS.
- 4. EXIT RAMPS A AND B TO TRIMBLE ROAD AND EXIT RAMPS A AND C TO FIFTH AVENUE ARE TO BE CLOSED WHEN WORKING ON THESE RAMPS ONLY BETWEEN 9:00 PM TO 6:00 AM. RAMP A AT TRIMBLE ROAD HAS ADDITIONAL RESTRICTIONS AS NOTED IN NOTE 3. ALL OTHER EXIT RAMPS MAY EITHER REMAIN OPEN USING SCD MT-98.20 AND BE CONSTRUCTED WITH THE ADJACENT US 30 WORK OR CLOSED AND CONSTRUCTED BETWEEN 9:00 PM TO 6:00 AM.

ADDITIONAL RAMP CLOSURE LIMITATIONS:

- 1. US 30 EB EXIT RAMP A TO TRIMBLE ROAD AND THE US 30 EB EXIT RAMP G TO SR 39 SHALL NOT BE CLOSED AT THE SAME TIME.
- 2. US EB ENTRANCE RAMP C FROM TRIMBLE ROAD AND THE US 30 EB ENTRANCE RAMP I AT SR 39 SHALL NOT BE CLOSED AT THE SAME TIME.
- 3. US 30 EB ENTRANCE RAMP I FROM SR 39 AND US 30 EB ENTRANCE RAMP X AT LONGVIEW AVENUE EAST SHALL NOT BE CLOSED AT THE SAME TIME.
- 4. THE US 30 EB ENTRANCE RAMP X FROM LONGVIEW AVENUE EAST AND THE US 30 EB ENTRANCE RAMP B AT FIFTH AVENUE SHALL NOT BE CLOSED AT THE SAME TIME.
- 5. THE US 30 WB ENTRANCE RAMP D FROM FIFTH AVENUE AND THE US 30 WB ENTRANCE RAMP C FROM SR 13 SHALL NOT BE CLOSED AT THE SAME TIME.
- 6. THE US 30 ENTRANCE RAMP C FROM SR 13 AND THE US 30 WB ENTRANCE RAMP HL AT SR 39 SHALL NOT BE CLOSED AT THE SAME TIME.
- 7. THE US 30 ENTRANCE RAMP HL FROM SR 39 AND THE US 30 EXIT RAMP B AT TRIMBLE ROAD MAY BE CLOSED AT THE SAME TIME.
- 8. THE US 30 WB ENTRANCE RAMP HL AT SR 39 AND THE US 30 ENTRANCE RAMP D FROM TRIMBLE ROAD SHALL NOT BE CLOSED AT THE SAME TIME.

WORK TO BE PERFORMED AS FOLLOWS:

- A. REMOVE THE CROSSOVERS AND RECONSTRUCT THE U-TURN MEDIANS. REMOVE PAVEMENT FOR MAINTAINING TRAFFIC AND GRADE. PLACE THE TACK COAT, SURFACE COURSE, SHOULDER RUMBLE STRIPS, PAVEMENT MARKINGS AND RPM'S. FINISH GRADING ALONG THE COMPLETED PAVEMENT. SEED AND MULCH.
- B. US 309 EB ENTRANCE RAMP TO US 30 AND THE US 30 WB EXIT TO SR 309 SHALL REMAIN OPEN AT ALL TIMES.
- C. INSTALL THE DETOUR SIGNING AND CLOSE US 30 EB EXIT RAMP A TO TRIMBLE ROAD. SEE DETOUR PLAN 8C MAP.
- D. INSTALL THE DETOUR SIGNING AND CLOSE US 30 EB ENTRANCE C FROM TRIMBLE ROAD. SEE DETOUR PLAN 8D MAP.
- E. INSTALL THE DETOUR SIGNING AND CLOSE US 30 EB ENTRANCE RAMP I FROM SR 39. SEE DETOUR PLAN 8E MAP.
- F. INSTALL THE DETOUR SIGNING AND CLOSE US 30 EB ENTRANCE RAMP X FROM LONGVIEW AVENUE EAST. SEE DETOUR PLAN 8F MAP.
- G. INSTALL THE DETOUR SIGNING AND CLOSE US 30 EB EXIT RAMP A TO FIFTH AVENUE. SEE DETOUR PLAN 8G MAP.
- H. INSTALL THE DETOUR SIGNING AND CLOSE US 30 EB ENTRANCE RAMP B FROM FIFTH AVENUE. SEE DETOUR PLAN 8H MAP.
- I. INSTALL THE DETOUR SIGNING AND CLOSE US 30 WB EXIT RAMP C TO FIFTH AVENUE. SEE DETOUR PLAN 8I MAP.
- J. INSTALL THE DETOUR SIGNING AND CLOSE US 30 WB ENTRANCE RAMP D FROM FIFTH AVENUE. SEE DETOUR PLAN 8J MAP.
- K. INSTALL THE DETOUR SIGNING AND CLOSE THE US 30 WB ENTRANCE RAMP C FROM SR 13. SEE DETOUR PLAN 8K MAP.
- L. INSTALL THE DETOUR SIGNING AND CLOSE THE US 30 WB ENTRANCE RAMP HL FROM SR 39. SEE DETOUR PLAN 8L MAP.
- M. INSTALL THE DETOUR SIGNING AND CLOSE THE US 30 WB EXIT RAMP B TO TRIMBLE ROAD. SEE DETOUR PLAN 8M MAP.
- N. INSTALL THE DETOUR SIGNING AND CLOSE THE US 30 WB ENTRANCE RAMP D FROM TRIMBLE ROAD. SEE DETOUR PLAN 8N MAP.

**PHASE 9**

GENERAL: ALL PROJECT WORK EXCEPT THE WORK LISTED BELOW SHALL BE COMPLETED BY OCTOBER 30, 2022. WORK LISTED BELOW SHALL BE COMPLETED BY MAY 26, 2023. PHASE 9 SHALL ONLY BE UTILIZED IF THE LISTED EXCEPTIONS WERE NOT COMPLETED IN PHASE 8. THE CONTRACTOR SHALL NOTIFY THE ENGINEER IN WRITING OF THE ITEMS NOT EXPECTED TO BE COMPLETED BY OCTOBER 30, 2022 AT LEAST 15 WORKING DAYS PRIOR TO OCTOBER 30, 2022.

LANE CLOSURES, IF REQUIRED, SHALL FOLLOW SCD MT-95.30. PAVEMENT MARKINGS SHALL FOLLOW SCD MT-99.20.

EXCEPTED WORK: PAVEMENT MARKINGS, RPM'S, AND CONCRETE SEALING NOT PLACED IN PHASE 8 DUE TO APPLICATION TEMPERATURE RESTRICTIONS, PERMANENT SEEDING, FIELD TOUCH-UP BRIDGE PAINT, RUMBLE STRIPS, INCOMPLETE PUNCH LIST ITEMS, AND MISCELLANEOUS ITEMS THAT HAVE APPLICATION TEMPERATURE RESTRICTIONS.

**SR 39 WORK**

GENERAL: THE WORK ON SR 39 CONSISTS OF MULTIPLE PHASES WHICH WILL BE PERFORMED AT VARIOUS TIMES INCLUDING SOME WHICH COINCIDE WITH US 30 BRIDGE WORK. THE POSTED SPEED LIMIT ON SR 39 IS 35 MPH.

WORK TO BE PERFORMED AS FOLLOWS:

1. LOWERING THE SR 39 PAVEMENT UNDER US 30 (SR 39 PHASES A AND B): THIS WORK SHALL OCCUR AT THE SAME TIME AS PHASE 1 US 30 CONSTRUCTION. NOTE THAT THE EXISTING PIER FOUNDATIONS OF THE EXISTING US 30 BRIDGES OVER SR 39 CONFLICT WITH A PORTION OF THE PROPOSED SR 39 WORK. THE VERTICAL CLEARANCE OF THE NEW BRIDGE BEAMS AND THE EXISTING SR 39 PAVEMENT PROVIDES APPROXIMATELY 13.29 FEET CLEARANCE WHICH IS UNACCEPTABLE TO MAINTAIN TRUCK TRAFFIC. MAINTAIN THE EXISTING VERTICAL CLEARANCES ON SR 39 UNDER THESE TWO BRIDGES. THE EXCAVATION FOR THE FULL DEPTH PAVEMENT IS TO BE COMPLETED BETWEEN THE FACES OF THE FOUNDATIONS OF THE EXISTING BRIDGE PIERS. ONLY THE FULL DEPTH PAVEMENT REPLACEMENT UP TO AND INCLUDING THE SURFACE COURSE MATERIAL AT A MINIMUM OF 20 FEET EACH SIDE OF THE CENTER LINE OF CONSTRUCTION OF SR 39 UNDER THE US 30 BRIDGES AND FULL WIDTH BEYOND THE BRIDGES SHALL BE COMPLETED BEFORE ANY OF THE NEW BRIDGE BEAMS ARE TO BE PLACED AND/OR THE EXISTING VERTICAL CLEARANCE IS REDUCED. PAVEMENT MARKINGS FOR THE CENTER LINE AND EDGE LINES SHALL BE PAINT. AVOID DAMAGING THE NEW PAVEMENT ON SR 39 DURING THE REMOVAL AND CONSTRUCTION OF THE PIERS.

A. DETOUR FOR DRAINAGE CONSTRUCTION: THE CLOSURE OF SR 39 AND DETOUR SHALL ONLY OCCUR BETWEEN THE HOURS OF 5:00 PM FRIDAY TO 9:00 PM SUNDAY. ADDITIONAL RESTRICTIONS APPLY PER THE "LANES OPEN DURING HOLIDAYS OR SPECIAL EVENTS". A PORTION OF THE PROPOSED STORM SEWER WORK AND REMOVAL OF A PORTION OF THE EXISTING STORM SEWERS LOCATED NEAR THE US 30 BRIDGES OVER SR 39 SHALL BE COMPLETED. THE TOP 6" OF THE TRENCHES SHALL BE FILLED WITH ITEM 301 ASPHALT CONCRETE BASE MATERIAL ONLY WHERE THE PAVEMENT WILL REMAIN TO BE USED FOR TRAFFIC IN PHASES WHICH FOLLOW. THIS WORK SHALL BE COMPLETED BEFORE THE PROPOSED PAVEMENT IS PLACED. CLOSE SR 39 USING BARRICADES PER SCD MT-101.60.

- 1. DETOUR SB SR 39 TRAFFIC. SEE DETOUR PLAN SR 39-1A1 MAP.
- 2. DETOUR NB SR 39 TRAFFIC. SEE DETOUR PLAN SR 39-1A2 MAP.

3. DRAINAGE AT STA. 695+02, 52 FEET RIGHT: DUE TO THE PHASING OF WORK, A TEMPORARY DRAINAGE CONNECTION IS TO BE PROVIDED FROM THE PROPOSED MANHOLE AT STA. 695+02.57, 52 FEET RIGHT AND THE EXISTING 42" REINFORCED CONCRETE PIPE. FROM THE PROPOSED MANHOLE AND USING THE KNOCKOUT FOR THE PROPOSED 48" TYPE C CONDUIT ON THE OUTLET, CONSTRUCT 16 FEET OF TEMPORARY 42" OR 48" CONDUIT, A TEMPORARY MANHOLE NO. 3, AND 8 FEET OF TEMPORARY 42" CONDUIT CONNECTING TO THE EXISTING PIPE ON THE OUTLET SIDE OF THE TEMPORARY MANHOLE. WHEN THE PROPOSED 48" TYPE C CONDUIT IS CONSTRUCTED IN PHASE 3 DURING THE RAMP RECONSTRUCTION IN THIS AREA, THE TEMPORARY 42" CONDUIT AND TEMPORARY MANHOLE NO. 3 ARE TO BE REMOVED. THE COST OF THIS WORK IS TO BE INCLUDED IN THE LUMP SUM BID OF ITEM 614 MAINTAINING TRAFFIC.

B. PHASE A PAVEMENT (YEAR 1): CONSTRUCT THE EAST HALF OF SR 39 WHILE MAINTAINING THE LANES ON THE WEST HALF. SHIFT TRAFFIC, ONE LANE IN EACH DIRECTION, TO THE WEST SIDE AS SHOWN IN THE SR 39 PHASE A DETAILS. CONSTRUCT THE PAVEMENT REMOVAL, FULL DEPTH PAVEMENT, THE SIGNAL POLES AND CONSTRUCTION DRAINAGE ON THE EAST HALF OF THE ROADWAY INCLUDING THE TIE-IN TO THE NEW RAMP I. CONSTRUCTION DRAINS CAN BE PLACED BETWEEN THE NEW PAVEMENT AND THE EXISTING PIER FOUNDATIONS AND OUTLET TO THE EXISTING OR NEW STORM SEWERS LOCATED NEAR THE BRIDGE. THE US 30 WB EXIT RAMP J TO SR 39 WILL BE PERMANENTLY CLOSED AND TRAFFIC TO BE DETOURED TO TRIMBLE ROAD, THEN EB ON US 30 AND EXIT AT SR 39.

C. PHASE B PAVEMENT (YEAR 1): INSTALL A SIGNALIZED CLOSURE ON SR 39 PER SCD MT-96.11. CONSTRUCT THE TEMPORARY EXIT RAMP CONNECTOR FROM THE LOOP RAMP TO SR 39 BEFORE SETTING UP THE PORTABLE BARRIER AND THE SIGNALIZED CLOSURE. THIS EXIT RAMP SHALL REMAIN OPEN DURING THIS PHASE. PLACE ONE LANE OF TRAFFIC ON THE NEW PAVEMENT CONSTRUCTED IN SR 39 PHASE A AS SHOWN IN THE SR 39 PHASE B DETAILS. CONSTRUCT THE FULL DEPTH PAVEMENT AND CONSTRUCTION DRAINAGE ON THE WEST HALF OF THE ROADWAY. CONSTRUCTION DRAINS MAY BE PLACED BETWEEN THE NEW PAVEMENT AND THE EXISTING PIER FOUNDATIONS AND OUTLET TO THE EXISTING OR NEW STORM SEWERS LOCATED NEAR THE BRIDGE.

D. PHASE C (YEAR 1 AND OVER THE WINTER): PROVIDE ONE LANE OF TRAFFIC IN EACH DIRECTION ON SR 39 AT THE CENTER PORTION OF THE ROADWAY ON THE NEW PAVEMENT CONSTRUCTED IN SR 39 PHASES A AND B. SR 39 TRAFFIC SHALL USE NEW RAMP I WHEN IT IS OPERATIONAL. REMOVE THE EXISTING US 30 EB RAMP I AND PART OF SR 39 PAVEMENT TO RELOCATED LONGVIEW AVENUE.

2. PHASE D (YEAR 2 - PHASE 3): CONSTRUCT THE WEST HALF OF SR 39 WHILE MAINTAINING TRAFFIC IN THE LANES ON THE EAST HALF. THIS PHASE SHALL OCCUR WHEN RAMPS HL AND HR AND H ARE UNDER CONSTRUCTION IN US 30 PHASE 3. SHIFT ONE LANE OF TRAFFIC IN EACH DIRECTION TO THE EAST SIDE AS SHOWN IN THE PHASE D DETAILS. CONSTRUCT THE REMAINING PAVEMENT REMOVALS ON THE WEST HALF OF THE ROADWAY NORTH OF US 30.

3. PHASE E (YEARS 2 AND 3 - PHASES 4-6): MAINTAIN 1 LANE OF TRAFFIC IN EACH DIRECTION ON SR 39 DURING WORK ON THE US 30 BRIDGES AS SHOWN IN THE DETAILS.

4. PHASE F (YEAR 3 - PHASE 7): RAMPS H AND I ARE OPEN TO TRAFFIC. WORK ON THE WEST SIDE OF SR 39 FROM THE US 30 BRIDGES TO ARNOLD STREET ON THE WEST SIDE OF SR 39 IS TO BE COMPLETED DURING PHASE 7 WHEN RAMP G IS CLOSED. WORK ON THE PAVEMENT AT THE US 30 BRIDGES INCLUDING BARRIER CONSTRUCTION SHALL BE COMPLETED. THE RAMP G INTERSECTION WITH SR 39 SHALL BE COMPLETED. MAINTAIN 1 LANE OF TRAFFIC IN EACH DIRECTION ON SR 39 AS SHOWN IN THE DETAILS. MAINTAIN TRAFFIC USING FLAGGERS AND CONSTRUCT THE FINAL PAVEMENT MARKINGS ON SR 39 WHEN THIS WORK IS COMPLETED.

M:\15074\93455\Design\MOT\Sheets\93455\MNO15.dgn 2/20/2020 2:36:25 PM acb284

CALCULATED  
BAD  
CHECKED  
SDS

SEQUENCE OF CONSTRUCTION NOTES

RIC-30-9.26

M:\15074-93455\Design\Roadway\Sheets\93455\G0001.dgn 2/25/2020 8:23:33 AM kja282

SHEET NUM.												PART.				ITEM	ITEM EXT	GRAND TOTAL	UNIT	DESCRIPTION	SEE SHEET NO.		
32-38B	40-65	66-67	369-371	380-383	390	395	918	959	991	1510-1511	1531-1585	OFFICE CALCS	01/NHS/BR	02/NHS/PV	03/NHS/BR							04/NHS/BR	
<b>ROADWAY</b>																							
LS														LS				201	11001	LS	CLEARING AND GRUBBING, AS PER PLAN	32	
283			27				594					154,219		155,123				202	23000	155,123	SY	PAVEMENT REMOVED	
662														662				202	23001	662	SY	PAVEMENT REMOVED, AS PER PLAN	35
			387				1,097					72,521		74,005				202	23010	74,005	SY	PAVEMENT REMOVED, ASPHALT	
												15,051		15,051				202	23500	15,051	SY	WEARING COURSE REMOVED	
			1,658											1,658				202	30500	1,658	FT	CONCRETE MEDIAN REMOVED	
														1,626				202	30501	1,626	FT	CONCRETE MEDIAN REMOVED, AS PER PLAN	36
	502		10,359											10,861				202	30700	10,861	FT	CONCRETE BARRIER REMOVED	
			6,658											6,658				202	32000	6,658	FT	CURB REMOVED	
			808											808				202	32600	808	FT	GUTTER REMOVED	
			27											27				202	32800	27	SY	CONCRETE SLOPE PROTECTION REMOVED	
														5,488				202	35100	5,488	FT	PIPE REMOVED, 24" AND UNDER	
														1,331				202	35200	1,331	FT	PIPE REMOVED, OVER 24"	
	181		24,443											24,624				202	38000	24,624	FT	GUARDRAIL REMOVED	
			401											401				202	38300	401	FT	GUARDRAIL REMOVED, BARRIER DESIGN	
	14													14				202	42010	14	EACH	ANCHOR ASSEMBLY REMOVED, TYPE E	49
			8											8				202	58000	8	EACH	MANHOLE REMOVED	
			68											68				202	58100	68	EACH	CATCH BASIN REMOVED	
			3											3				202	58200	3	EACH	INLET REMOVED	
			64											64				SPECIAL	20270000	64	FT	FILL AND PLUG EXISTING CONDUIT, 12"	33
			314											314				SPECIAL	20270000	314	FT	FILL AND PLUG EXISTING CONDUIT, 15"	33
			444											444				SPECIAL	20270000	444	FT	FILL AND PLUG EXISTING CONDUIT, 18"	33
			297											297				SPECIAL	20270000	297	FT	FILL AND PLUG EXISTING CONDUIT, 24"	33
			176											176				SPECIAL	20270000	176	FT	FILL AND PLUG EXISTING CONDUIT, 30"	33
			356											356				SPECIAL	20270000	356	FT	FILL AND PLUG EXISTING CONDUIT, 36"	33
			609											609				SPECIAL	20270000	609	FT	FILL AND PLUG EXISTING CONDUIT, 48"	33
			271											271				SPECIAL	20270000	271	FT	FILL AND PLUG EXISTING CONDUIT, 60"	33
			182											182				SPECIAL	20270000	182	FT	FILL AND PLUG EXISTING CONDUIT, 66"	33
			232											232				SPECIAL	20270000	232	FT	FILL AND PLUG EXISTING CONDUIT, 78"	33
			253							10,430				10,683				202	75000	10,683	FT	FENCE REMOVED	
			2											2				202	75250	2	EACH	GATE REMOVED	
			1											1				202	98100	1	EACH	REMOVAL MISC.: POLE BASE	33
			23											23				202	98100	23	EACH	REMOVAL MISC.: STEEL POST	33
			4											4				202	98100	4	EACH	REMOVAL MISC.: WOOD POST	33
			5											5				202	98100	5	EACH	REMOVAL MISC.: CONCRETE DRAIN OUTLET	33
1														1				202	98100	1	EACH	REMOVAL MISC.: SIGN - PARCEL 116, BUSINESS SIGN	33
1														1				202	98100	1	EACH	REMOVAL MISC.: SIGN - PARCEL 205, PIPELINES INC	33
1														1				202	98100	1	EACH	REMOVAL MISC.: BILLBOARD - PARCEL 240	33
2,948						201,609							185	201,624				203	10000	201,609	CY	EXCAVATION	
LS						165,927							13,811	155,064				203	20000	168,875	CY	EMBANKMENT	
														LS				203	98500	LS		ROADWAY, MISC.: SURCHARGE	36
							910							7,319				204	10000	8,229	SY	SUBGRADE COMPACTION	
80														80				204	45000	80	HOUR	PROOF ROLLING	
														6,172				206	10500	6,172	TON	CEMENT	
6,172														238,524				206	11000	238,524	SY	CURING COAT	
														238,524				206	15010	238,524	SY	CEMENT STABILIZED SUBGRADE, 12 INCHES DEEP	
LS														LS				206	30000	LS		MIXTURE DESIGN FOR CHEMICALLY STABILIZED SOILS	
	88		17,170											17,258				606	15050	17,258	FT	GUARDRAIL, TYPE MGS	
			37											37				606	26150	37	EACH	ANCHOR ASSEMBLY, MGS TYPE E (MASH 2016)	33
	14													14				606	26150	14	EACH	ANCHOR ASSEMBLY, MGS TYPE E, OFFSET DESIGN (MASH 2016)	49
	1		31											32				606	26550	32	EACH	ANCHOR ASSEMBLY, MGS TYPE T	
			21											21				606	35002	21	EACH	MGS BRIDGE TERMINAL ASSEMBLY, TYPE 1	
														11				606	35102	11	EACH	MGS BRIDGE TERMINAL ASSEMBLY, TYPE 2	
														1				606	60028	1	EACH	IMPACT ATTENUATOR, TYPE 2 (BIDIRECTIONAL), 30 MPH/36 INCH	
														5				606	70000	5	EACH	THRIE BEAM BULLNOSE	
			600											600				606	71000	600	FT	THRIE BEAM GUARDRAIL	

GENERAL SUMMARY



SHEET NO.	STATION TO STATION		203	203	203	203	659	863	863	0
			EXCAVATION (01/NHS/BR)	EXCAVATION (02/NHS/PV)	EMBANKMENT (01/NHS/BR)	EMBANKMENT (02/NHS/PV)	SEDDING AND MULCHING	GEOGRID, TYPE PI	GEOGRID, TYPE SI	REINFORCED EMBANKMENT
			CY	CY	CY	CY	SY	SY	SY	CY
	<b>U.S. 30</b>									
594	444+00	448+00		0		0				
595	449+00	453+00		0		0				
596	454+00	458+00		0		0				
597	459+00	463+00		0		0				
598	464+00	468+00		0		0				
599	469+00	473+00		0		0				
600	474+00	478+00		0		0				
601	479+00	483+00		0		0				
602	484+00	488+00		0		0				
603	489+00	490+00		212		68	631			
604	490+50	491+50		228		485	1652			
605	492+00	493+50		878		1967	2919			
606	494+00	495+50		266		909	2264			
607	496+00	497+50		119		669	1820			
608	498+00	499+50		249		965	1680			
609	500+00	501+50		316		937	1272			
610	502+00	503+50		45		649	805			
611	504+00	505+50		56		738	792			
612	506+00	507+50		12		1123	694			
613	508+00	509+50		1		930	546			
614	510+00	511+50		6		566	0			
615	512+00	513+50		86		453	324			
616	514+00	515+50		609		303	1363			
617	516+00	517+50		1626		55	1606			
618	518+00	519+50		1863		0	1291			
619	520+00	521+50		1102		44	1414			
620	522+00	523+50		410		281	1649			
621	524+00	525+50		230		376	808			
622	526+00	527+50		32		375	14			
623	528+00	529+50		318		540	551			
624	530+00	531+50		1029		681	1905			
625	532+00	533+50		840		793	1935			
626	534+00	535+50		278		838	1275			
627	536+00	537+50		88		708	941			
628	538+00	539+50		32		610	1059			
629	540+00	541+50		131		466	1206			
630	542+00	543+50		212		394	1289			
631	544+00	545+50		344		338	1430			
632	546+00	547+50		732		179	1575			
633	548+00	549+50		662		84	1034			
634	550+00	551+50		639		78	925			
635	552+00	553+50		1064		93	1170			
636	554+00	555+50		1156		199	1592			
<b>SHEET SUBTOTALS CARRIED TO SHEET 395</b>										

SHEET NO.	STATION TO STATION		203	203	203	203	659	863	863	863
			EXCAVATION (01/NHS/BR)	EXCAVATION (02/NHS/PV)	EMBANKMENT (01/NHS/BR)	EMBANKMENT (02/NHS/PV)	SEDDING AND MULCHING	GEOGRID, TYPE PI	GEOGRID, TYPE SI	REINFORCED EMBANKMENT
			CY	CY	CY	CY	SY	SY	SY	CY
	<b>U.S. 30</b>									
637	556+00	557+50		472		205	928			
638	558+00	559+50		138		85	325			
639	560+00	561+50		1133		156	1503			
640	562+00	563+50		752		111	1353			
641	564+00	565+50		2335		24	1603			
642	566+00	566+50		1214		512	1740			
643	568+50	569+50		931		9	986			
644	570+00	571+50		788		13	1203			
645	572+00	573+50		435		23	783			
646	574+00	575+50		1029		36	1130			
647	576+00	577+50		674		1993	1718			
648	578+00	579+50		833		3216	2242			
649	580+00	581+50		1189		3553	2297			
650	582+00	583+50		1037		3209	2428			
651	584+00	585+50		529		482	1130			
652	586+00	587+50		975		51	1367			
653	588+00	589+50		1255		228	1675			
654	590+00	591+50		731		1266	1622			
655	592+00	593+50		1400		2633	2105			
656	594+00	595+50		1660		4453	2889			
657	596+00	597+50		1424		5517	3606			
658	598+00	599+00		1654		4530	2617			
659	601+00	601+50		822		1621	920			
660	602+00	603+50		2008		2077	2128			
661	604+00	605+50		2081		1748	1503			
662	606+00	607+50		653		248	671			
663	608+00	609+50		450		6	533			
664	610+00			164		5	176			
665	627+00	627+50		191		19	89			
666	628+00	629+50		312		346	508			
667	630+00	631+50		619		422	2100			
668	632+00	633+50		267		369	1240			
669	634+00	635+50		81		252	0			
670	636+00	637+00		89		234	246			
671	637+50	639+00		214		2134	1448			
672	639+50	640+00		244		4361	1711			
673	640+50	641+50	63	16	10767	416	1783			
674	642+00	642+50	122	86	3044	62	1072			
675	643+00	643+50		1041		2183	2124	1270	680	1689
676	646+50	647+50		3319		3150	2854			
<b>SHEET SUBTOTALS CARRIED TO SHEET 395</b>			185	51116	13811	69852	99787	1270	680	1689

CALCULATED	JGL	CHECKED	JUM
<b>EARTHWORK SUBSUMMARY</b>			
<b>RIC-30-9.26</b>			
391 1669			

M:\15074\93455\Design\Roadway\Sheet\93455\S0005.dgn 2/21/2020 2:59:43 PM acb284

SHEET NO.	STATION TO STATION		203	203	203	203	659	863	863	863
			EXCAVATION (01/NHS/BR) CY	EXCAVATION (02/NHS/PV) CY	EMBANKMENT (01/NHS/BR) CY	EMBANKMENT (02/NHS/PV) CY	SEEDING AND MULCHING SY	GEOGRID, TYPE PI SY	GEOGRID, TYPE SI SY	REINFORCED EMBANKMENT CY
<b>S.R. 545 RAMP RR</b>										
849	2+50			640		0	176			
<b>S.R. 545 RAMP RL</b>										
850	2+50			144		0	50			
<b>S.R. 545 RAMP R</b>										
851	3+00	4+00		3998		0	1611			
852	4+50	5+50		1816		1	1727			
<b>S.R. 545 RAMP RR</b>										
853	4+50	5+00		262		0	258			
854	5+50	6+00		200		0	383			
<b>S.R. 545 RAMP RL</b>										
855	4+50	5+50		209		0	395			
856	6+00	6+50		33		16	277			
<b>FIFTH AVE RAMP A</b>										
857	170+50	172+00		122		27	605			
858	172+50	174+00		317		8	710			
859	174+50	176+00		602		5	697			
860	176+50	178+00		1103		7	1203			
861	178+50	180+00		357		8	980			
<b>FIFTH AVE RAMP B</b>										
862	369+00	371+00		374		5	658			
863	371+50	373+50		454		24	614			
<b>FIFTH AVE RAMP D</b>										
864	473+50	475+00		315		1	387			
865	475+50	477+00		915		5	803			
866	477+50	478+50		569		1	651			
867	479+00	480+00		587		512	855			
868	480+50	481+50		233		219	432			
<b>SUBTOTALS</b>			0	13,250	0	839	13,472	0	0	0
<b>SUBTOTALS FROM SHEET 391</b>			185	51,116	13,811	69,852	99,787	1,270	680	1,689
<b>SUBTOTALS FROM SHEET 392</b>			0	71,906	0	27,266	56,088	0	0	0
<b>SUBTOTALS FROM SHEET 393</b>			0	33,448	0	12,572	50,140	0	0	0
<b>SUBTOTALS FROM SHEET 394</b>			0	31,904	0	41,587	48,001	5,716	2,995	7,352
<b>TOTALS CARRIED TO GENERAL SUMMARY</b>			201,809		165,927		267,488	6,986	3,675	9,041

**SEEDING AND MULCHING CALCULATIONS**

**ITEM 659 - TOPSOIL**  
 $267488 \text{ SQ YD} \times 111 \text{ CU YD} / 1000 = 29691.17 \text{ CU YD}$  USE 29,691 CU YD

**ITEM 659 - REPAIR SEEDING AND MULCHING**  
 $267488 \text{ SQ YD} \times 0.05 = 13374.40 \text{ SQ YD}$  USE 13,374 SQ YD

**ITEM 659 - INTER-SEEDING**  
 $267488 \text{ SQ YD} \times 0.05 = 13374.40 \text{ SQ YD}$  USE 13,374 SQ YD


**ITEM 659 - COMMERCIAL FERTILIZER**  
 $267488 \text{ SQ YD} \times 9 = 2407392.00 \text{ SQ FT}$   
 $2407392.00 \times 30 \text{ LBS} / 1000 \text{ SQ FT} = 72221.76 \text{ LBS}$   
 $13374 \text{ SQ YD} \times 9 = 120366.00 \text{ SQ FT}$   
 $120366.00 \times 20 \text{ LBS} / 1000 \text{ SQ FT} = 2407.32 \text{ LBS}$   
 $72221.76 \text{ LBS} + 2407.32 \text{ LBS} = 74629.08 \text{ LBS} / 2000 = 37.31 \text{ TON}$  USE 37.31 TON

**ITEM 659 - LIME**  
 $267488 \text{ SQ YD} \times 9 = 2407392.00 \text{ SQ FT}$   
 $2407392.00 \text{ SQ FT} / 43560 = 55.2661157 \text{ ACRE}$  USE 55.27 ACRE

**ITEM 659 - WATER**  
 $267488 \text{ SQ YD} \times 9 = 2407392.00 \text{ SQ FT}$   
 $2407392.00 \text{ SQ FT} / 1000 \times 300 \text{ GAL} \times 2 \text{ APPLICATIONS} = 1444.44 \text{ M GAL}$   
 $13374 \text{ SQ YD} \times 9 = 120366.00 \text{ SQ FT}$   
 $120366.00 \text{ SQ FT} / 1000 \times 300 \text{ GAL} = 36.11 \text{ M GAL}$   
 $1444.44 \text{ M GAL} + 36.11 \text{ M GAL} = 1480.55 \text{ M GAL}$  USE 1481 M GAL

TOTALS CARRIED TO GENERAL NOTES SHEET 34.

M:\15074\93455\Design\Roadway\Sheets\93455X50059.dgn 2/20/2020 3:50:48 PM acb284

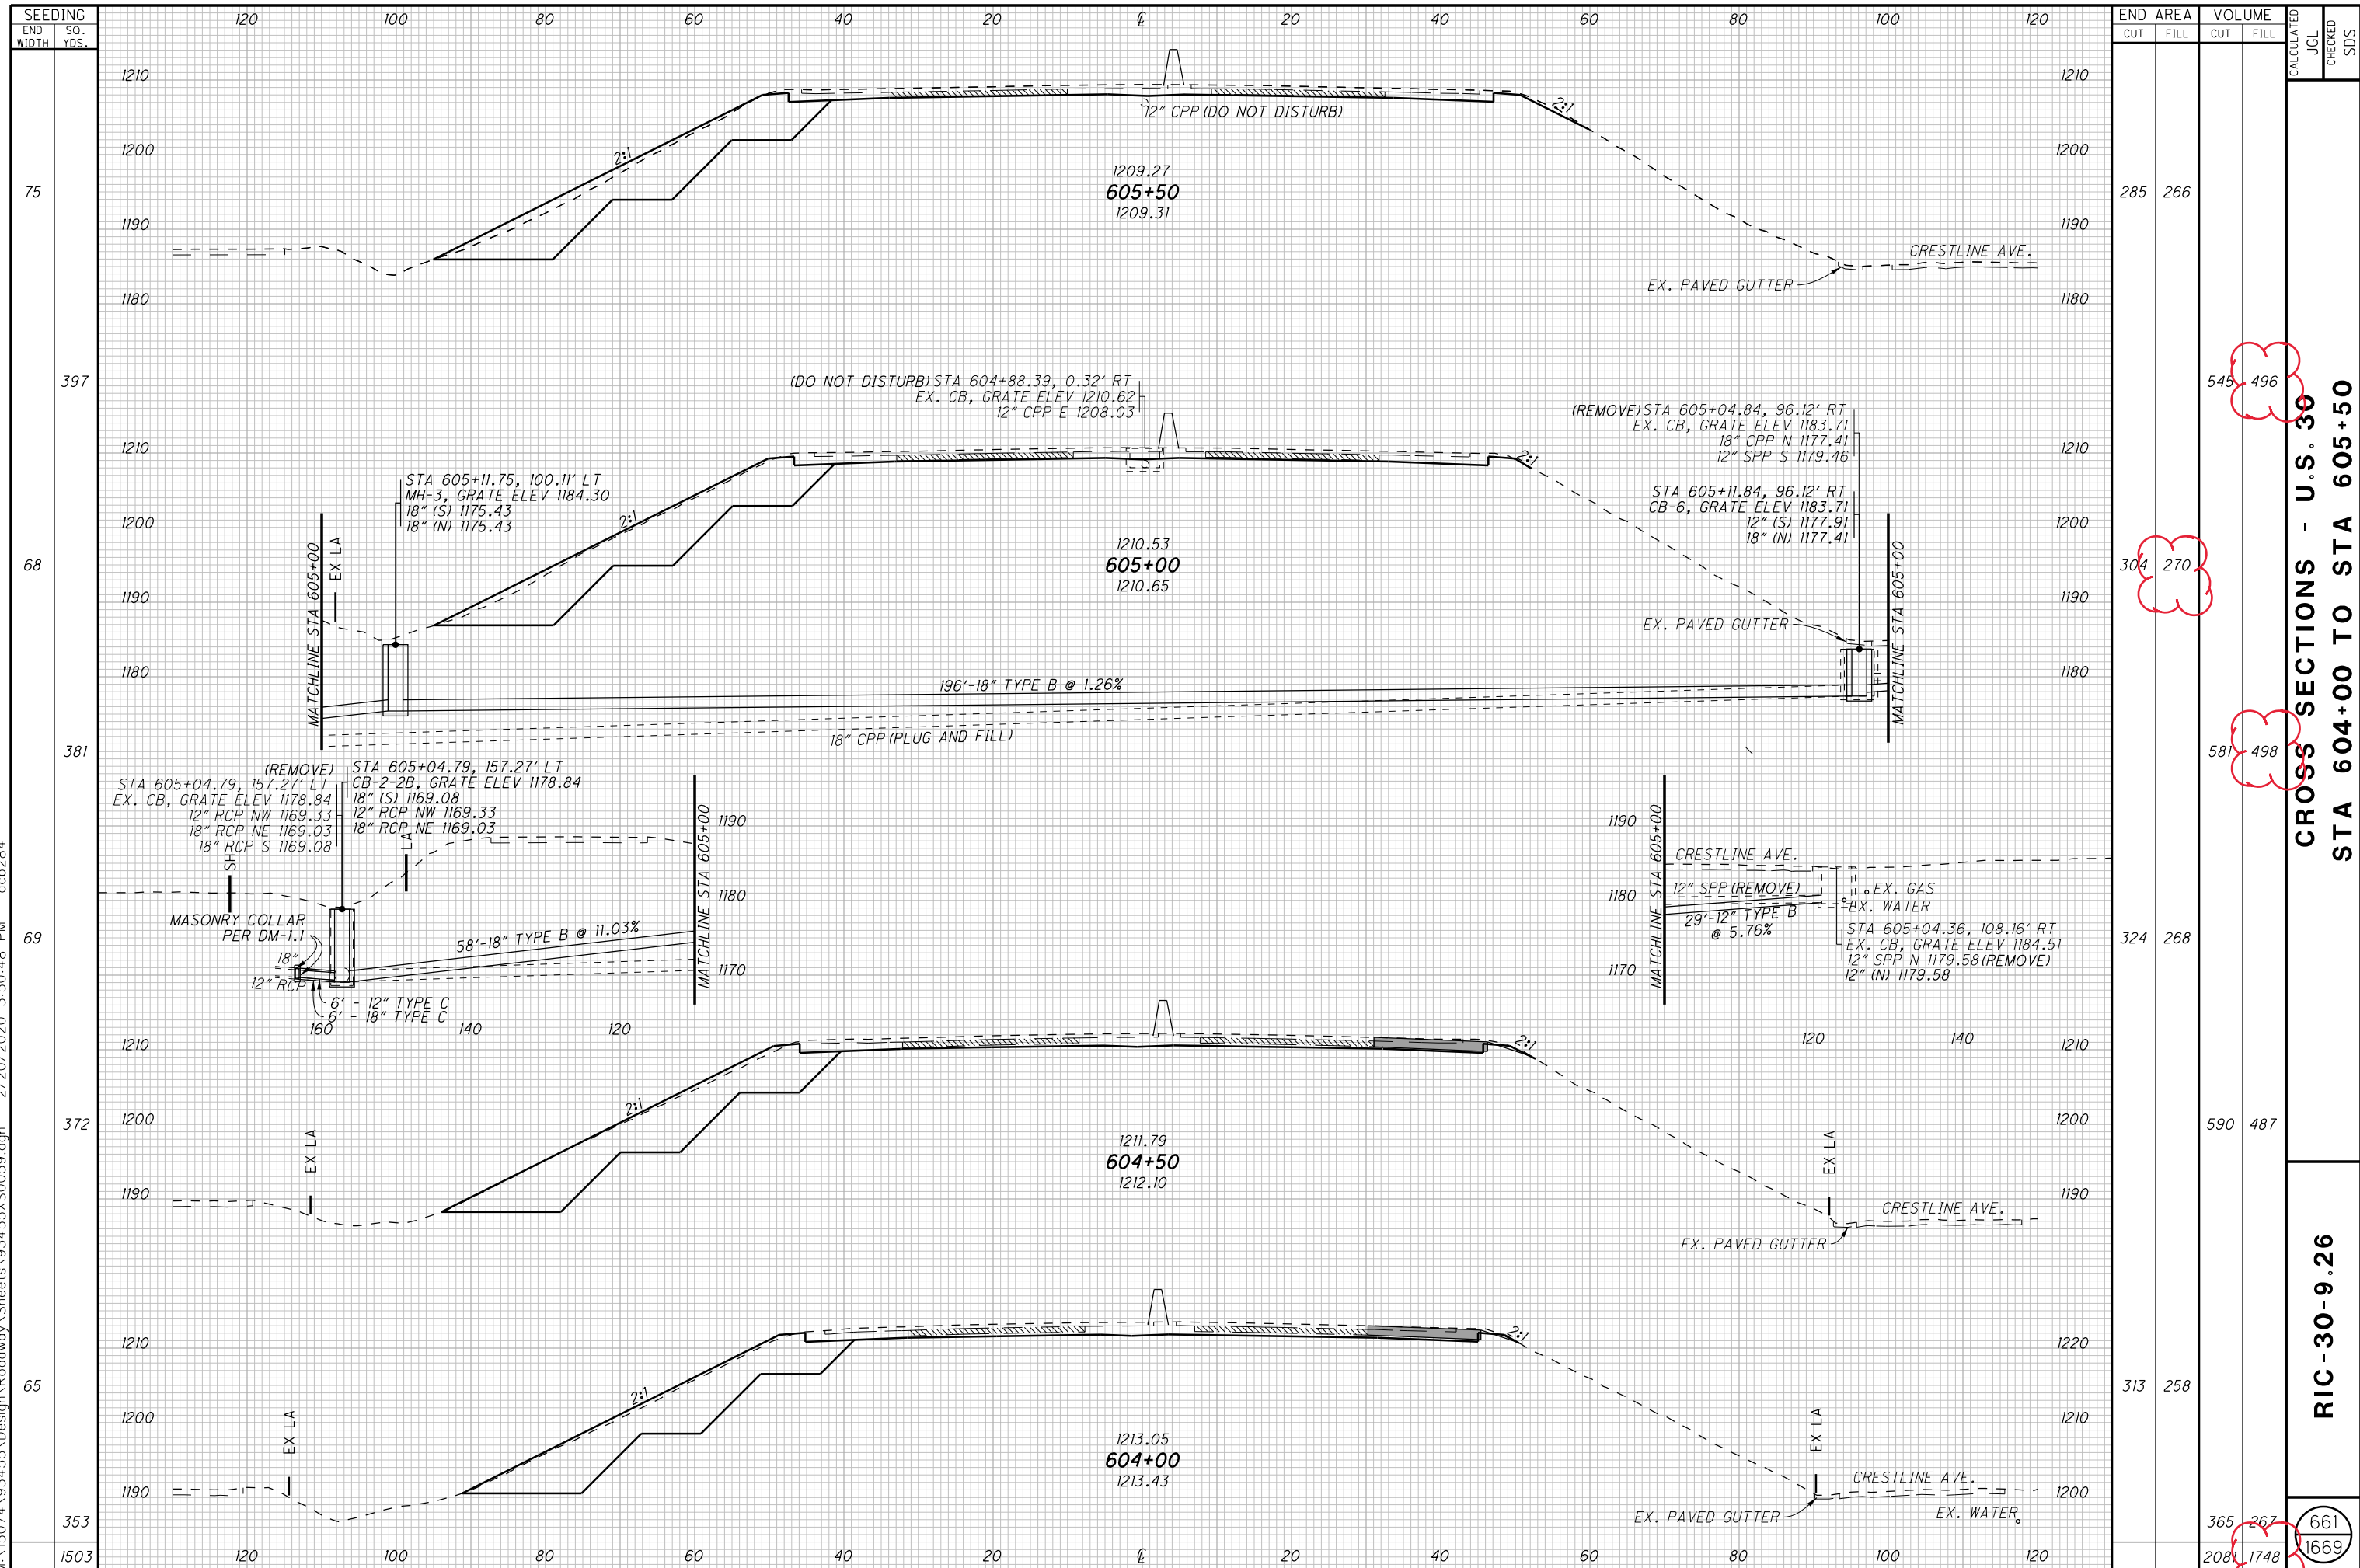


SEEDING	END AREA		VOLUME		CALCULATED	JGL	CHECKED	SDS
	CUT	FILL	CUT	FILL				
75	285	266						
397			545	496				
68	304	270						
381			581	498				
69	324	268						
372			590	487				
65	313	258						
353	365	267						
1503	2081	1748						


CROSS SECTIONS - U.S. 30  
STA 604+00 TO STA 605+50

RIC-30-9.26

661  
1669

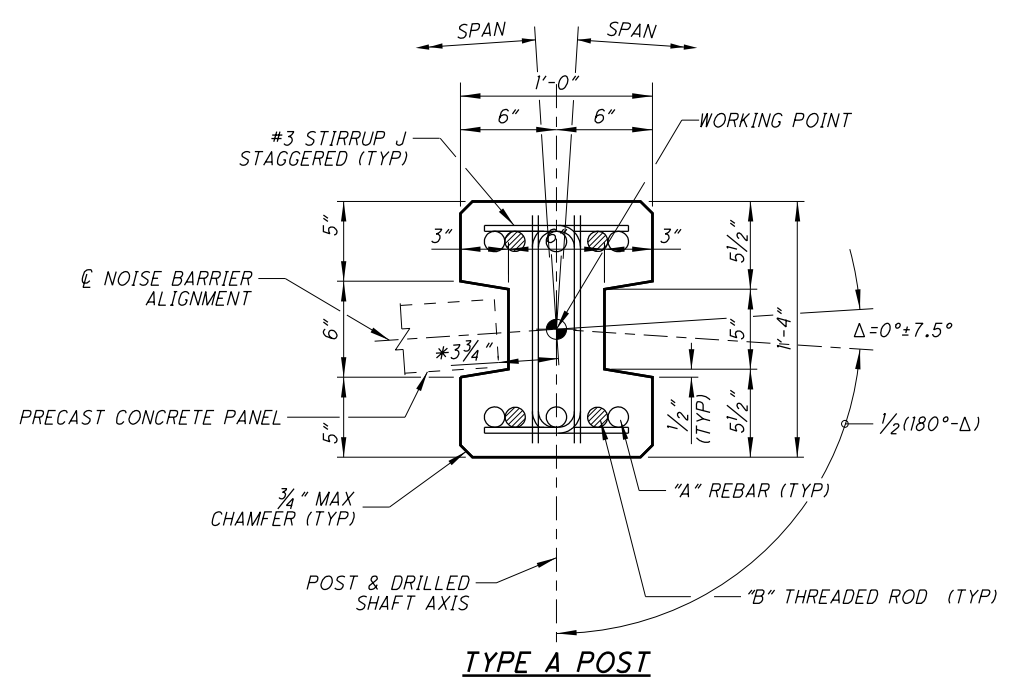

**TYPE A POST**

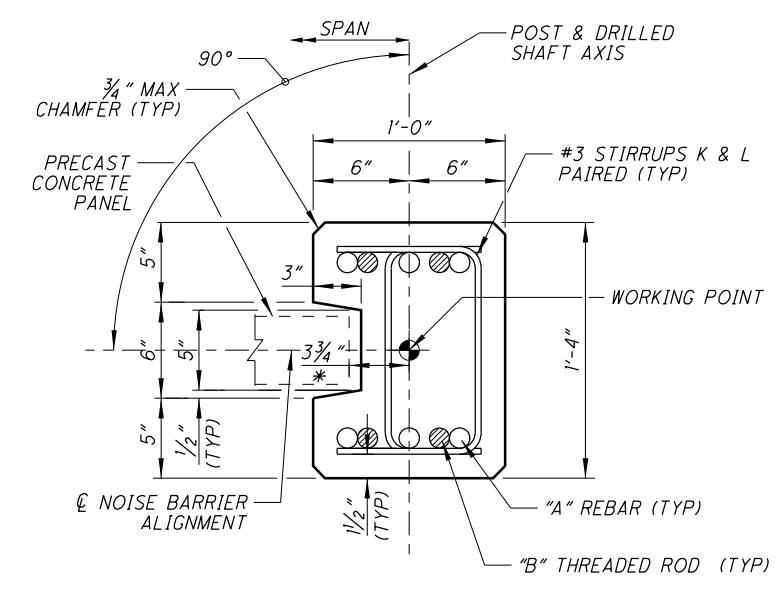


**TYPE B POST**

16" PRECAST CONCRETE POST DATA											
GEOMETRY		TYPE A POST					TYPE B POST				
BARRIER HEIGHT (BH)	MAX POST SPACING (SPAN)	"A" REBAR	"B" THREADED ROD		STIRRUP SPACING (SS)	"A" REBAR	"B" THREADED ROD		STIRRUP SPACING (SS)		
		SIZE	SIZE	Ø		TR.E	SIZE	SIZE		Ø	TR.E
		(IN.)	(IN.)	(IN.)	(IN.)	(IN.)	(IN.)	(IN.)	(IN.)		
8' ≤ BH ≤ 16'	16'-0"	#6	#6	3/4	30	#5	#5	5/8	25	10	
	24'-0"	#7	#7	7/8	34	#6	#6	3/4	29	10	
16' ≤ BH ≤ 25'	16'-0"	#10	#10	1 1/4	67	#7	#7	7/8	34	10	
	24'-0"	◇	◇	◇	◇	◇	◇	◇	◇	◇	

◇ - USE 20" PRECAST CONCRETE POST; SEE SHEET 972/1669.


#3 STIRRUP SCHEDULE					
MARK	TYPE	LENGTH	DIMENSIONS		
			A	B	C
J	1	1'-11"	6"	1'-1"	
K	1	2'-5"	9"	1'-1"	
L	1	1'-11"	6"	1'-1"	
M	1	1'-4 1/2"	3 1/2"	1 1/2"	
N	1	2'-3 1/2"	9"	1 1/2"	
P	2	1'-8"	4 1/2"	1'-1"	4 1/2"
R	2	1'-6 1/4"	4 1/2"	1'-0 1/4"	3 1/2"

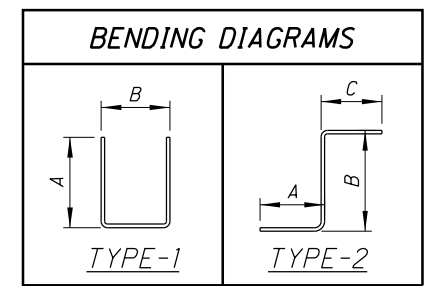


**LEGEND**

- \* = PANEL LENGTH DEDUCTION (PLD) DIMENSION AS SHOWN IN "PLD TABLE" ON SHEET 5/13 OF STANDARD DRAWING NBS-1-09.
- TR.E = THREADED ROD EMBEDMENT, SEE SHEET 7/13 OF STANDARD DRAWING NBS-1-09.
- SS = STIRRUP SPACING, SEE SHEET 7/13 OF STANDARD DRAWING NBS-1-09.
- φ = MINIMUM NOMINAL THREAD DIAMETER
- ◇ = CENTER OF DRILLED SHAFT




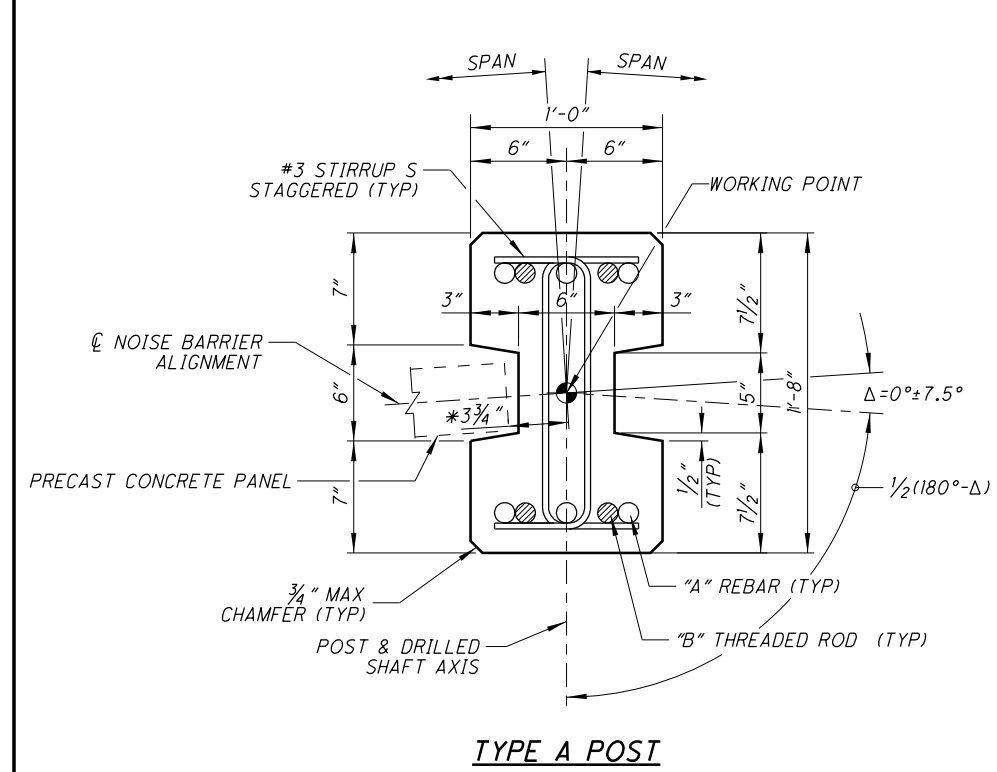

**TYPE A POST**

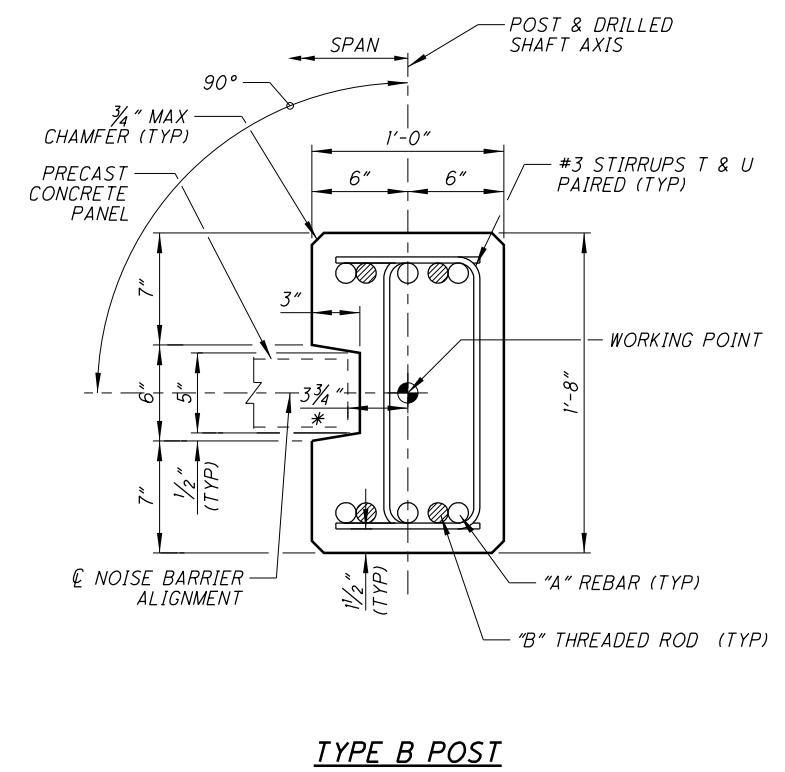


**TYPE B POST**

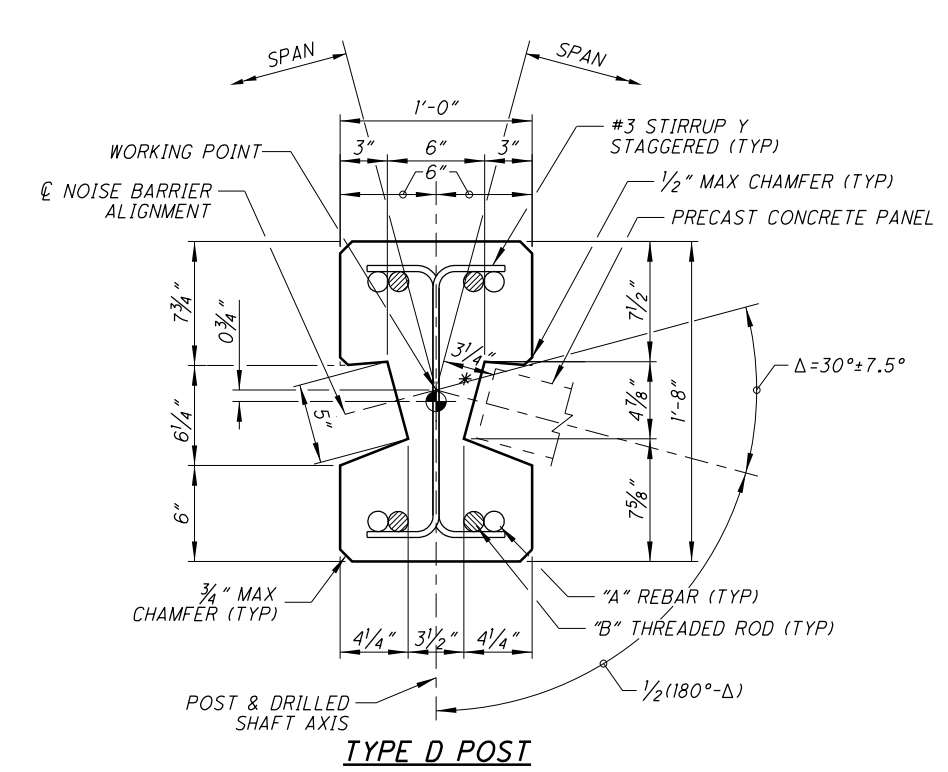

**TYPE D POST**

20" PRECAST CONCRETE POST DATA																
GEOMETRY		TYPE A POST					TYPE B POST					TYPE D POST				
BARRIER HEIGHT (BH)	MAX POST SPACING (SPAN)	"A" REBAR		"B" THREADED ROD			"A" REBAR		"B" THREADED ROD			"A" REBAR		"B" THREADED ROD		
		SIZE	SIZE	Ø	TR.E	SS	SIZE	SIZE	Ø	TR.E	SS	SIZE	SIZE	Ø	TR.E	SS
		(IN.)	(IN.)	(IN.)	(IN.)	(IN.)	(IN.)	(IN.)	(IN.)	(IN.)	(IN.)	(IN.)	(IN.)	(IN.)	(IN.)	(IN.)
BH<23'	24'-0"	#10	#10	1/4"	67	12	#7	#7	7/8"	34	13	#11	#11	1 3/8"	81	10
BH<24'	23'-0"	#10	#10	1/4"	67	12	#7	#7	7/8"	34	13	#11	#11	1 3/8"	81	10
BH<25'	21'-0"	#10	#10	1/4"	67	12	#7	#7	7/8"	34	13	#11	#11	1 3/8"	81	10
BH<25'	16'-0"	#8	#8	1"	42	12	#6	#6	3/4"	30	13	#10	#10	1 1/4"	67	12

#3 STIRRUP SCHEDULE					
MARK	TYPE	LENGTH	DIMENSIONS		
			A	B	C
S	1	2'-3"	6"	1'-5"	
T	1	2'-9"	9"	1'-5"	
U	1	2'-3"	6"	1'-5"	
W	1	1'-7"	3 1/2"	1'-2"	
X	1	2'-6"	9"	1'-2"	
Y	2	2'-0"	4 1/2"	1'-5"	4 1/2"
Z	2	1'-9 3/4"	4 1/2"	1'-3 3/4"	3 1/2"


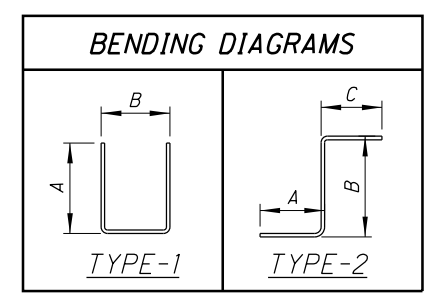


**LEGEND**

- \* = PANEL LENGTH DEDUCTION (PLD) DIMENSION AS SHOWN IN "PLD TABLE" ON SHEET 5/13 OF STANDARD DRAWING NBS-1-09.
- TR.E = THREADED ROD EMBEDMENT, SEE SHEET 7/13 OF STANDARD DRAWING NBS-1-09.
- SS = STIRRUP SPACING, SEE SHEET 7/13 OF STANDARD DRAWING NBS-1-09.
- Ø = MINIMUM NOMINAL THREAD DIAMETER
- ⊕ = CENTER OF DRILLED SHAFT

M:\15074\93455\Design\Roadway\Sheets\93455\WD00002.dgn 2/24/2020 9:26:42 AM ocb284

M:\15074\93455\Design\Structures\RIC030\_0982C\Sheets\030\_0982CCP001.dgn 2/24/2020 9:28:54 AM ocb284

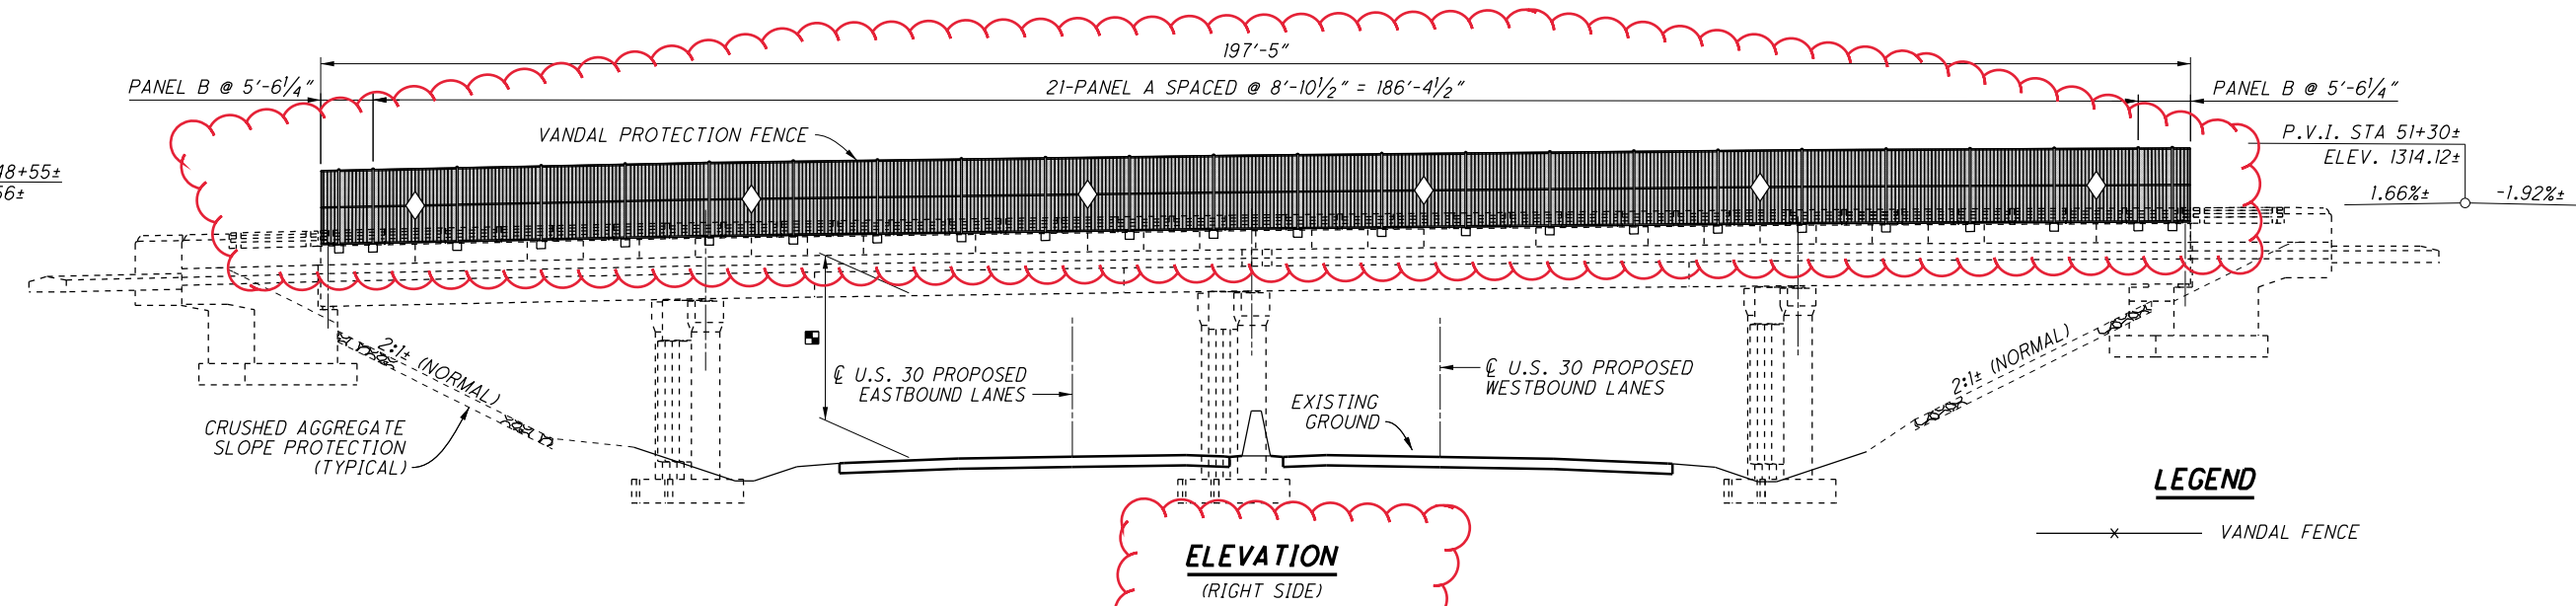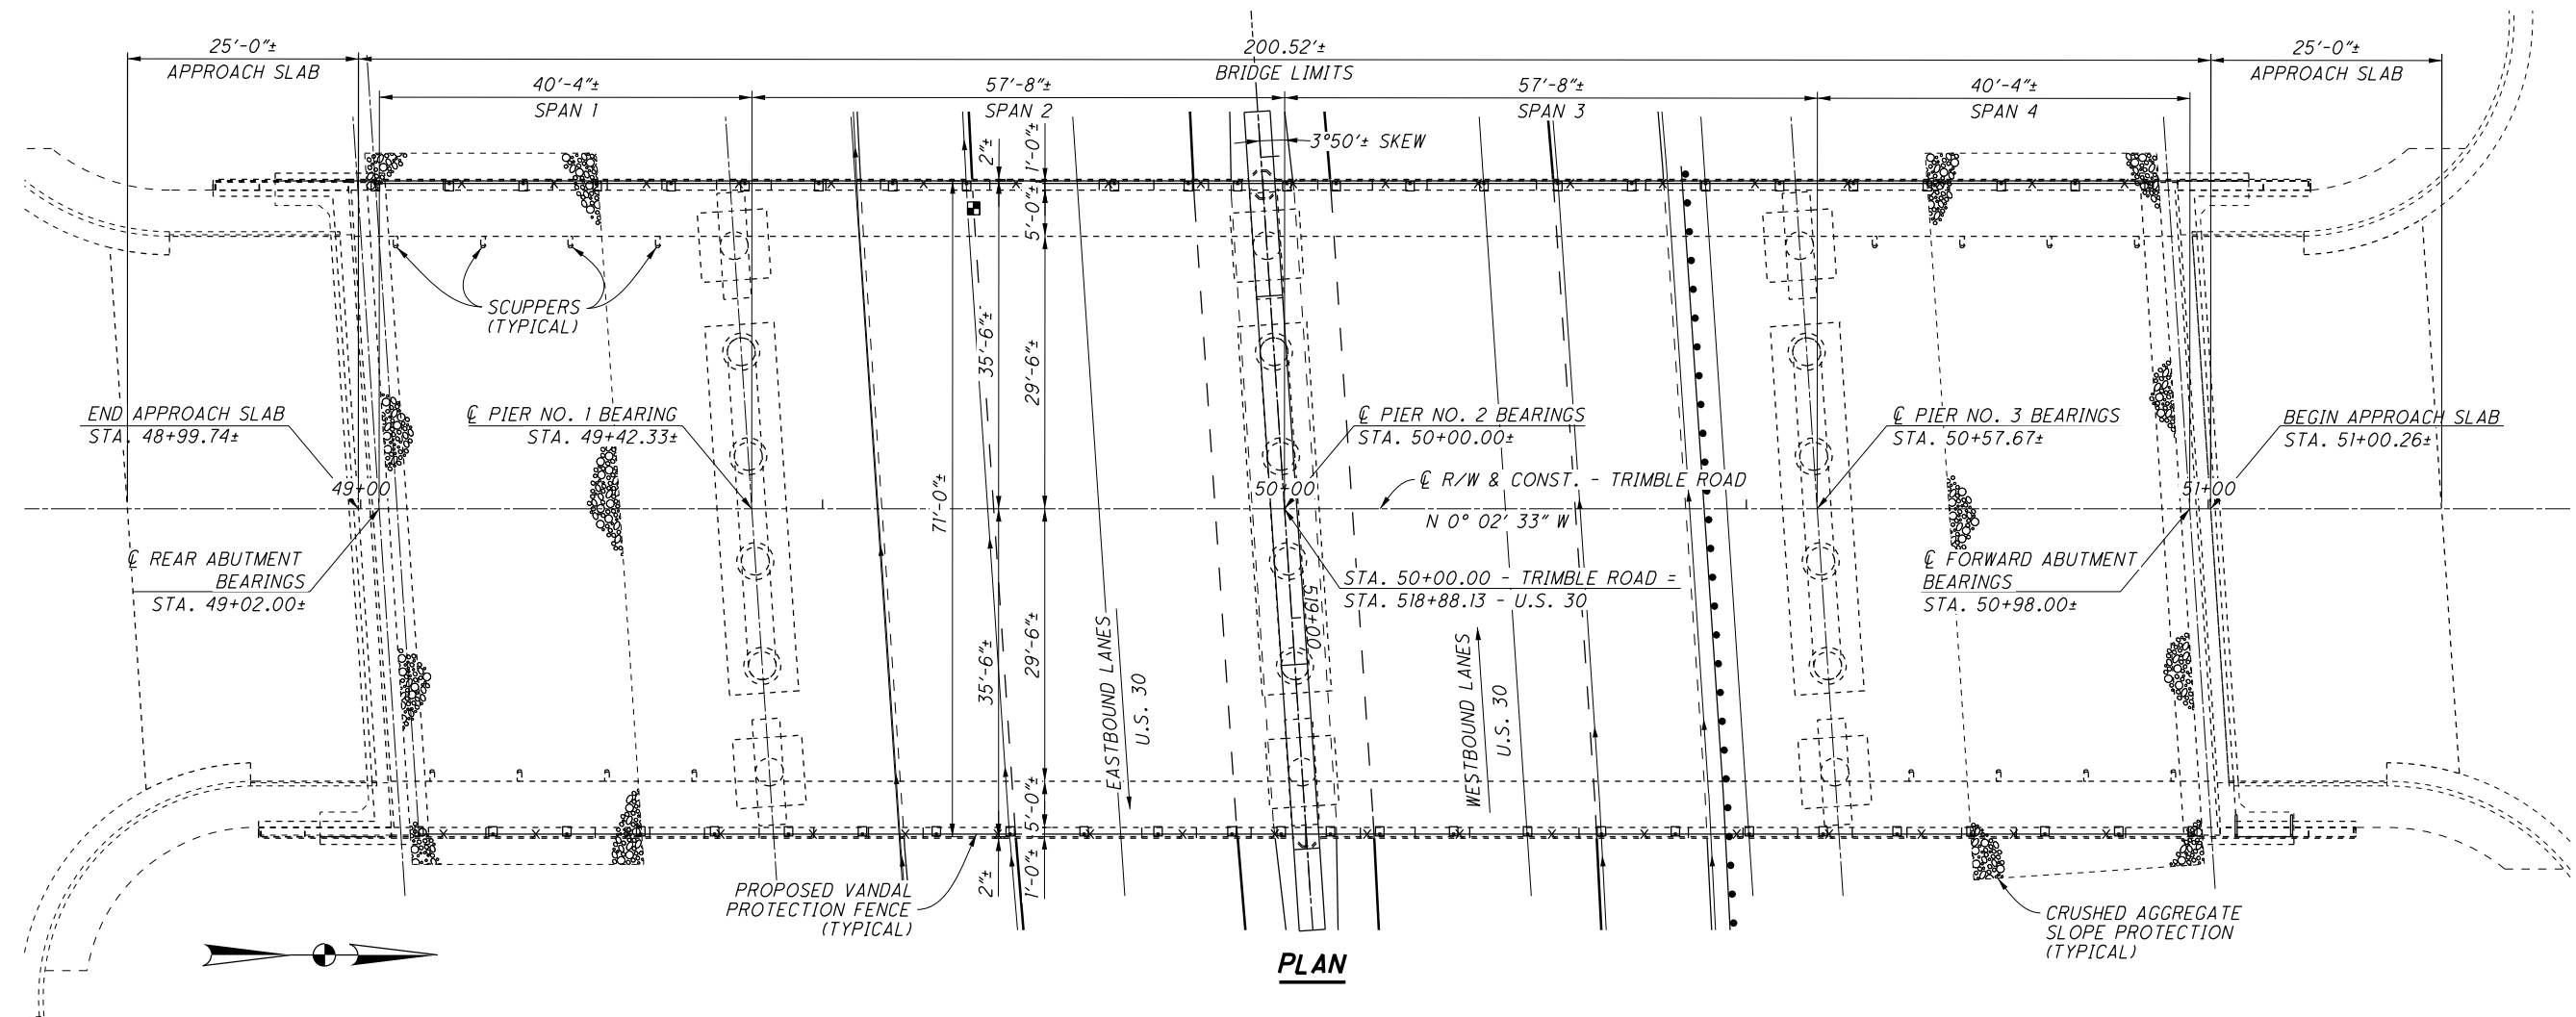

**VERTICAL CLEARANCE**

EXISTING:	15.19'
PROPOSED:	16.75'
REQUIRED:	16.50'

**VERTICAL CURVE DATA**

L = 200'±	L = 350'±
g <sup>1</sup> = 4.88%±	g <sup>1</sup> = 1.66%±
g <sup>2</sup> = 1.66%±	g <sup>2</sup> = -1.92%±
PVI STA. 48+55±	PVI STA. 51+30±
ELEV. 1309.56±	ELEV. 1314.12±

- NOTES**
- FOR PANEL A AND PANEL B DETAILS SEE SHEET 6/7.
  - FOR DETAILS OF THE LEFT SIDE OF BRIDGE SEE SHEET 2/7.

DESIGN AGENCY: ENGINEERING ASSOCIATES, INC.  
 895 EAGLE PASS - MOOSTER, OHIO 44691  
 TELEPHONE: (330) 345-6656  
 FAX: (330) 345-8077

DATE: 9-24-19  
 SDS: 9-24-19  
 STRUCTURE FILE NUMBER: 7001088

DESIGNED: HK  
 CHECKED: BDH


DRAWN: TAC  
 REVISED:

**GENERAL PLAN AND FENCE DETAIL**  
 BRIDGE NO. RIC-30-0982  
 UNDER TRIMBLE ROAD

RIC-30-9.26  
 PID No. 98911

1/7  
 1199  
 1669

M:\15074\93455\Design\Structures\RIC030\_0982C\Sheets\030\_0982CSA001.dgn 2/24/2020 10:17:38 AM ocb284

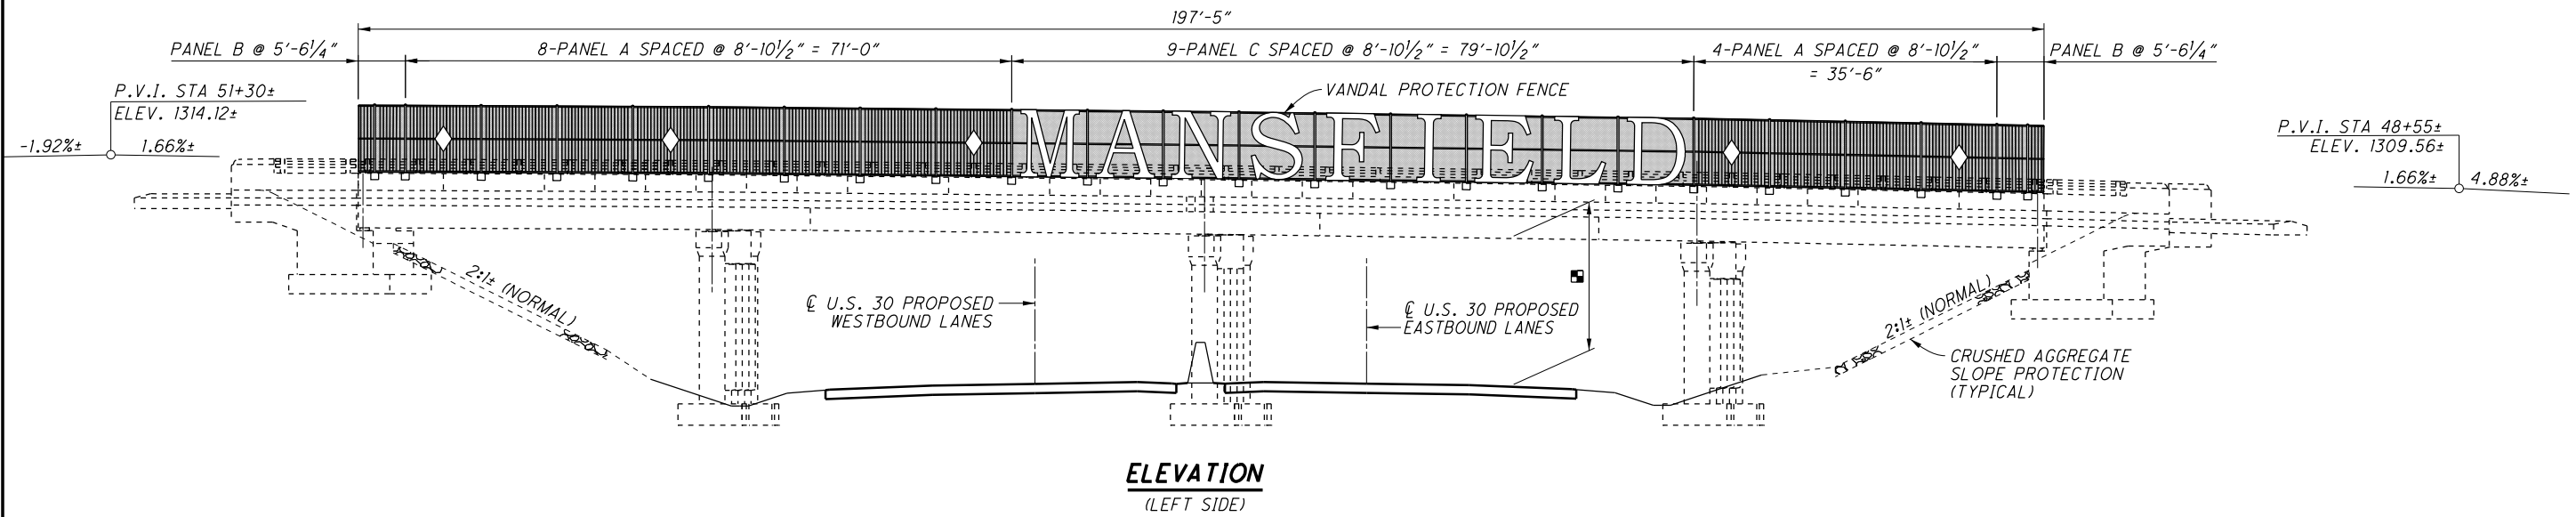

**VERTICAL CLEARANCE**


EXISTING: 15.19'  
 PROPOSED: 16.75'  
 REQUIRED: 16.50'

**LEGEND**

—x— VANDAL FENCE

**NOTES**

1. FOR PANEL A AND PANEL B DETAILS SEE SHEET 6/7.
2. FOR PANEL C DETAILS SEE SHEET 7/7.
3. FOR FENCE DETAILS ON RIGHT SIDE OF BRIDGE SEE SHEET 1/7.

	DESIGN AGENCY <b>ENGINEERING ASSOCIATES, INC.</b> 4955 EAGLE PASS • MOOSTER, OHIO 44691 TELEPHONE: (330) 345-6656 FAX: (330) 345-8077
REVIEWED SDS	DATE 9-24-19 STRUCTURE FILE NUMBER 7001088
DRAWN TAC	REVISIONS REVISED
DESIGNED HK	CHECKED BDH
<b>FENCE ELEVATION</b> BRIDGE NO. RIC-30-0982 UNDER TRIMBLE ROAD	
<b>RIC-30-9.26</b>	PID No. 98911
2 / 7	1199A 1669

## ESTIMATED QUANTITIES

ITEM	EXTENSION	TOTAL 03/NHS/BR	UNIT	DESCRIPTION	ABUT.	PIERS	SUPER.	GEN.	SEE SHEET
607	39911	395	FT	VANDAL PROTECTION FENCE, 8' STRAIGHT, COATED FABRIC, AS PER PLAN			395		1/7 THRU 7/7

**ITEM 607 VANDAL PROTECTION FENCE, 8' STRAIGHT, COATED FABRIC, AS PER PLAN DESCRIPTION:** THIS ITEM CONSISTS OF FURNISHING AND INSTALLING VANDAL FENCING AND LETTERS ON EXISTING CONCRETE BRIDGE RAILING. FENCE IS TO BE CONSTRUCTED IN A MANNER THAT PROVIDES A RIGID, TAUT FENCE CLOSELY CONFORMING TO THE TOP SURFACE OF THE EXISTING RAILING. UNLESS OTHERWISE SPECIFIED IN THE PLANS, INSTALL POSTS PLUMB.

**POSTS:** POSTS SHALL BE 2 1/2" SQUARE (OUTSIDE DIMENSION) WITH 1/8" WALL THICKNESS AND WELDED IRON CAP. THE PROTECTIVE COATING SHALL BE POWDER COATED BLACK TO MATCH FENCE.

**HORIZONTAL MEMBERS:** HORIZONTAL MEMBERS SHALL BE 1/2" SQUARE CHANNEL WITH 1/8" WALL THICKNESS. THE PROTECTIVE COATING SHALL BE POWDER COATED BLACK TO MATCH FENCE.

**PICKETS:** PICKETS SHALL BE 3/4" SQUARE SOLID IRON. THE PROTECTIVE COATING SHALL BE POWDER COATED BLACK TO MATCH THE FENCE.

**BASE PLATES:** BASE PLATES SHALL BE ASTM A709 GRADE 36 OR 50 STEEL. THE PROTECTIVE COATING SHALL BE POWDER COATED BLACK TO MATCH FENCE.

**FASTENERS:** THE 1/2" DIAMETER, HIGH STRENGTH BOLTS, THREADED ANCHORS, 1/2" DIAMETER BOLTS, NUTS AND WASHERS SHALL MEET THE REQUIREMENTS OF ASTM A325. ALL HARDWARE PROTECTIVE COATING SHALL BE POWDER COATED BLACK TO MATCH THE FENCE. THE 1/2" DIAMETER THREADED ROD FOR ADHESIVE ANCHORS SHALL BE ASTM A193, GRADE B7 WITH ASTM A 563 NUTS AND ASTM F 436 WASHERS.

USE AN ANCHOR ADHESIVE EVALUATED ACCORDING TO ICCES REPORT AC308, "ACCEPTANCE CRITERIA FOR POST-INSTALLED ADHESIVE ANCHORS IN CONCRETE ELEMENTS". FOR CRACKED AND UN-CRACKED CONCRETE APPLICATIONS. PUBLISHED ICCES REPORTS FOR ACCEPTABLE PRODUCTS ARE AVAILABLE AT: [WWW.ICC-ES.ORG/EVALUATION\\_REP/INDEX.SHTML](http://WWW.ICC-ES.ORG/EVALUATION_REP/INDEX.SHTML)

**SELECT FROM ONE OF THE FOLLOWING APPROVED PRODUCTS:**  
 POWERS PE1000+ EPOXY ADHESIVE ANCHOR SYSTEM (ICCES REPORT ESR-2583)  
 CHEMOFAST C-RE 385 EPOXY ADHESIVE ANCHOR SYSTEM (ICCES REPORT ESR-2538)  
 SIMPSON STRONG-TIE SET-XP EPOXY ADHESIVE ANCHORS (ICCES REPORT ESR-2508)  
 WURTH WIT-PE500 EPOXY ADHESIVE ANCHORS (ICCES REPORT ESR-3051)  
 HILTI-HY 200-R ADHESIVE ANCHOR SYSTEM (ICCES REPORT ESR-3187)

INSTALL ADHESIVE ANCHORS ACCORDING TO THE MANUFACTURER'S INSTALLATION INSTRUCTIONS PUBLISHED IN SECTION 4.3 OF THE ICCES REPORTS LISTED ABOVE. THE MINIMUM EMBEDMENT DEPTH FOR ANCHORS SHALL BE 7".

THE CONTRACTOR MAY SUBSTITUTE MECHANICAL ANCHORS FOR THE HORIZONTAL ANCHORS IN LIEU OF INTERNALLY THREADED ADHESIVE ANCHORS. THE FACTORED LOADING ON THE TWO ANCHOR HORIZONTAL CONNECTION CONSIST OF 7.1 KIPS OF TENSION AND 1.4 KIPS OF SHEAR. THE MECHANICAL ANCHORS SHALL BE EVALUATED ACCORDING TO ICCES REPORT AC193, "ACCEPTANCE CRITERIA FOR MECHANICAL ANCHORS IN CONCRETE ELEMENTS", FOR CRACKED AND UN-CRACKED APPLICATIONS. PUBLISHED ICCES REPORTS FOR ACCEPTABLE PRODUCTS ARE AVAILABLE AT: [WWW.ICC-ES.ORG/EVALUATION\\_REP/INDEX.SHTML](http://WWW.ICC-ES.ORG/EVALUATION_REP/INDEX.SHTML)

THE CONTRACTOR SHALL SUPPLY DOCUMENTATION SEALED BY AN OHIO REGISTERED PROFESSIONAL ENGINEER ENSURING THAT THE SELECTED MECHANICAL ANCHORAGE PROVIDES SUFFICIENT CAPACITY FOR THIS APPLICATION IN ACCORDANCE WITH AC193. INSTALL ANCHORS ACCORDING TO THE MANUFACTURER'S INSTALLATION INSTRUCTIONS PUBLISHED IN THE ICCES REPORT.

**TENSION BARS:** TENSION BARS SHALL BE 3/16" x 1/2" STEEL. THE PROTECTIVE COATING SHALL BE POWDER COATED BLACK TO MATCH FENCE.

**TENSION BANDS:** TENSION BANDS SHALL BE 1/8" x 1" STEEL ASSEMBLED WITH 3/8" DIAMETER x 1/4" BOLTS. THE PROTECTIVE COATING SHALL BE POWDER COATED BLACK TO MATCH THE FENCE. ONE TENSION BAND SHALL BE SUPPLIED FOR EACH FOOT OF FABRIC HEIGHT.

**ITEM 607 VANDAL PROTECTION FENCE, 8' STRAIGHT, COATED FABRIC, AS PER PLAN (CONTINUED)**

**DOUBLE WRAP FABRIC TIES:** DOUBLE WRAP FABRIC TIES SHALL BE 0.091 INCH CORE DIAMETER PVC COATED STEEL WIRE 15 1/4" LONG. THE PVC COATING SHALL BE POWDER COATED BLACK TO MATCH FENCE. TO CONNECT THE FABRIC TO HORIZONTAL MEMBERS USE DOUBLE WRAP TIES 2 TO 3 INCHES ON EACH SIDE OF THE POSTS AND AT SPACING NOT TO EXCEED 12" BETWEEN POSTS.

**FABRIC:** FABRIC SHALL CONSIST OF A 1" DIAMOND MESH USING 0.12 INCH DIAMETER (11 GAGE) WIRE CONFORMING TO ASTM F668 CLASS 2A OR 2B EXCEPT AS NOTED. THE PVC COATING SHALL BE POWDER COATED BLACK IN COLOR CLOSELY APPROXIMATING FEDERAL STANDARD NO. 595B-17038. SELVAGES SHALL BE KNUCKLED AT BOTH ENDS. HANDLE ALL PVC COATED FABRIC WITH CARE. IF THE PVC COATING IS DAMAGED, REPLACE THE DAMAGED PORTION OF THE FABRIC AT NO COST TO THE DEPARTMENT.

**LETTERS AND DIAMONDS:** LETTERS AND DIAMONDS SHALL BE GALVANIZED PER CMS 711.02. PRIOR TO GALVANIZING, ALL CORNERS OF THERMALLY CUT OR SHEARED EDGES SHALL HAVE A 1/16 INCH RADIUS OR EQUIVALENT FLAT SURFACE AT A SUITABLE ANGLE. VENT HOLES WHERE REQUIRED FOR GALVANIZING SHALL BE DETAILED BY THE FABRICATOR AND PLACED IN THE UNDERSIDE OF THE MEMBER.

AFTER GALVANIZING, ZINC HIGH SPOTS SUCH AS METAL DRIP LINES AND OTHER FLAWS THAT WOULD DETRACT FROM THE PAINT APPEARANCE SHALL BE MADE FLUSH WITH THE SURROUNDING SURFACE BY RETEXTURING TO SSPC SP2 OR SP3. CARE SHALL BE TAKEN THAT THE BASE GALVANIZED COATING IS NOT REMOVED. REPAIRED AREAS SHALL BE CHECKED FOR REQUIRED COATING THICKNESS.

GALVANIZED COATINGS DAMAGED IN THE SHOP SHALL BE REPAIRED PER ASTM A780 METHOD A3. GALVANIZED COATINGS DAMAGED IN THE FIELD SHALL BE REPAIRED PER ASTM A780 METHOD A1.

AFTER REMOVING HIGH SPOTS, THE GALVANIZED COATING SHALL BE CLEANED PER SSPC SP1. THE CLEANING SOLUTION SHALL BE AN ALKALINE WITH A PH RANGING FROM A MINIMUM OF 11 TO A MAXIMUM OF 12. THIS SOLUTION CAN BE APPLIED BY IMMERSION, SPRAY OR SOFT NYLON BRUSH. FOLLOWING CLEANING WITH A HOT WATER OR HOT PRESSURE WASHER RINSE, INDIVIDUAL PIECES SHALL BE SEPARATED AND POSITIONED TO FACILITATE DRAINAGE AND DRYING. THE PIECES SHALL BE COMPLETELY DRY BEFORE PROCEEDING.

AFTER CLEANING, THE PIECES SHALL BE ABRASIVE BLASTED PER SSPC SPT BRUSH-OFF BLAST CLEANING. THE BLASTING OPERATION SHALL ROUGHEN THE GALVANIZED SURFACE TO AN ANGULAR SURFACE PROFILE OF 0.25 TO 0.5 MILS. THE BLASTING EQUIPMENT, TECHNIQUE AND ABRASIVE MATERIAL SHALL BE SELECTED TO PROVIDE FOR THE SPECIFIED SURFACE PROFILE WITHOUT REMOVAL OF ZINC LAYERS. THE FINAL ZINC MILLAGE SHALL NOT BE LESS THAN 3.0 MILS. ALL ABRASIVE RESIDUE SHALL BE REMOVED WITH CLEAN COMPRESSED AIR OR OTHER METHODS ACCEPTABLE TO THE DEPARTMENT. FIELD CONNECTION AREAS SHALL HAVE A UNIFORM GALVANIZED COATING FREE OF LOCAL EXCESSIVE ROUGHNESS WHICH WOULD PREVENT THE CONNECTIONS FROM MAKING INTIMATE CONTACT.

ALL LETTERS AND DIAMONDS PROTECTIVE COATING SHALL BE POWDER COATED BLACK TO MATCH THE FENCE.

**FILLET WELDS:** FILLET WELDS SHALL CONFORM TO CMS 513.

**SHIM PLATES:** SHIM PLATES SHALL BE MADE FROM ANY MULTI-POLYMER PLASTIC WITH A MINIMUM COMPRESSIVE STRENGTH OF 5,000 PSI. IN ORDER TO INSTALL POSTS PLUMB, ENDS OF POSTS AND SLEEVES MAY BE CUT ON A BIAS.

**ACCESS OPENING AT LIGHT POLE:** ALL 3/8" DIAMETER HEX HEAD BOLTS WITH WASHERS AND HEX NUT SHALL MEET THE REQUIREMENTS OF ASTM A325. THE 1/4"x2"x1'-8" PLATES AND 1'-8" SQUARE x 3/16" ACCESS COVER, ALL HARDWARE PROTECTIVE COATING SHALL BE POWDER COATED BLACK TO MATCH THE FENCE.

**FIELD TOUCH-UP AND REPAIR OF PROTECTIVE COATING:** FOR TOUCH-UP AND REPAIR OF POWDER COATING FOLLOW MANUFACTURERS GUIDE LINES.

**SHOP DRAWINGS:** PROVIDE SHOP DRAWINGS FOR ORNAMENTAL RAILING (POSTS, HORIZONTAL MEMBERS, BASE PLATES AND PICKETS) PER CMS 501.04.

**MAINTENANCE OF TRAFFIC:** MAINTAIN TRAFFIC AS INDICATED IN THE PLANS.

(SEE SHEET 40/1669)

**ITEM 607 VANDAL PROTECTION FENCE, 8' STRAIGHT, COATED FABRIC, AS PER PLAN (CONTINUED)**

**CAULKING COMPOUND:** CAULKING COMPOUND SHALL CONFORM TO FEDERAL SPECIFICATION TT-S-00230C TYPE II CLASS A, ALUMINUM GRAY. WHEN APPLYING THE CAULK TO THE BASE PLATE, PROVIDE A 1" OPENING THROUGH THE CAULKING ON LOW SIDE OF BASE PLATE.

**FENCE GROUNDING:** VANDAL PROTECTION FENCE SHALL BE GROUNDED AS SHOWN IN THE PLANS AND SHALL INCLUDE ALL EQUIPMENT MATERIALS AND LABOR NECESSARY TO COMPLETE THE WORK.

**CONSTRUCTION PROCEDURE:**


- FIELD VERIFY THE PLAN LOCATIONS OF ALL BASE PLATES AND MARK PARAPETS ACCORDINGLY.
- MARK AND DRILL HOLES FOR THE 1/2" HIGH STRENGTH THREADED ANCHORS, 1/2" BOLTS OR APPROVED 1/2" INSERTS USING A BASE PLATE OR TEMPLATE.
- INSTALL 1/2" DIAMETER HIGH STRENGTH THREADED ANCHORS, 1/2" BOLTS, OR APPROVED 1/2" INSERTS.
- INSTALL POSTS AND BASE PLATES AND SHIM WHERE REQUIRED.
- CAULK EDGES OF BASE PLATES, SHIMS AND SLEEVES.
- COMPLETE INSTALLATION OF FENCE.

**METHOD OF MEASUREMENT:** THE DEPARTMENT WILL MEASURE THE QUANTITY BY THE FOOT. THE DEPARTMENT WILL MEASURE ALONG THE BOTTOM OF THE FENCE FROM CENTER TO CENTER OF END POSTS.

**BASIS OF PAYMENT:** THE DEPARTMENT WILL MAKE PAYMENT FOR THE COMPLETED AND ACCEPTED QUANTITIES OF VANDAL FENCE AS FOLLOWS:


**ITEM UNIT DESCRIPTION**

607 FT VANDAL PROTECTION FENCE, 8' STRAIGHT, COATED FABRIC, AS PER PLAN

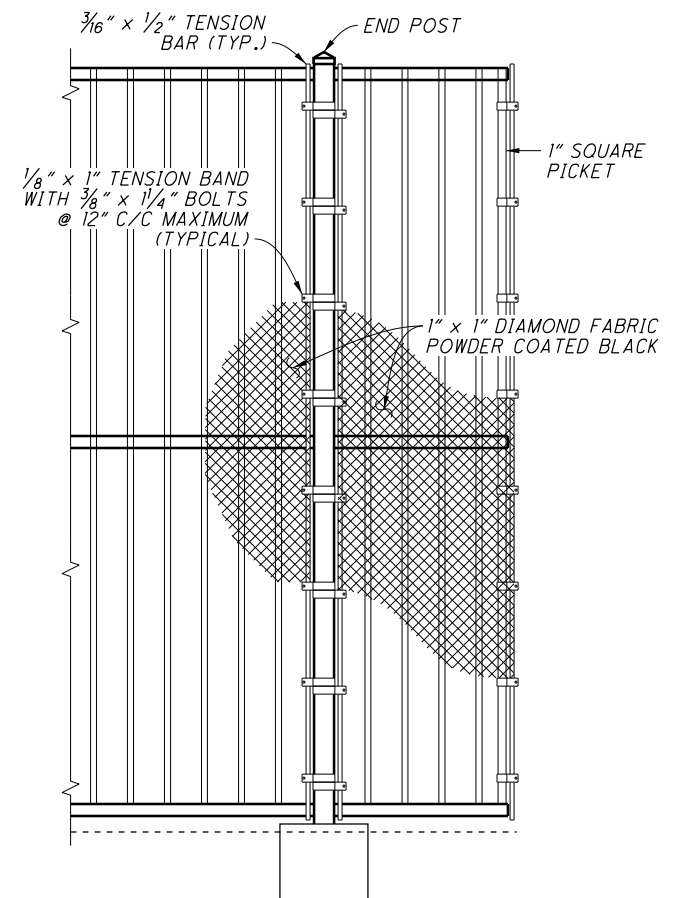


**END POST DETAIL**

M:\15074\93455\Design\Structures\RIC030\_0982C\Sheets\030\_0982CSA004.dgn 2/24/2020 10:21:18 AM acb284

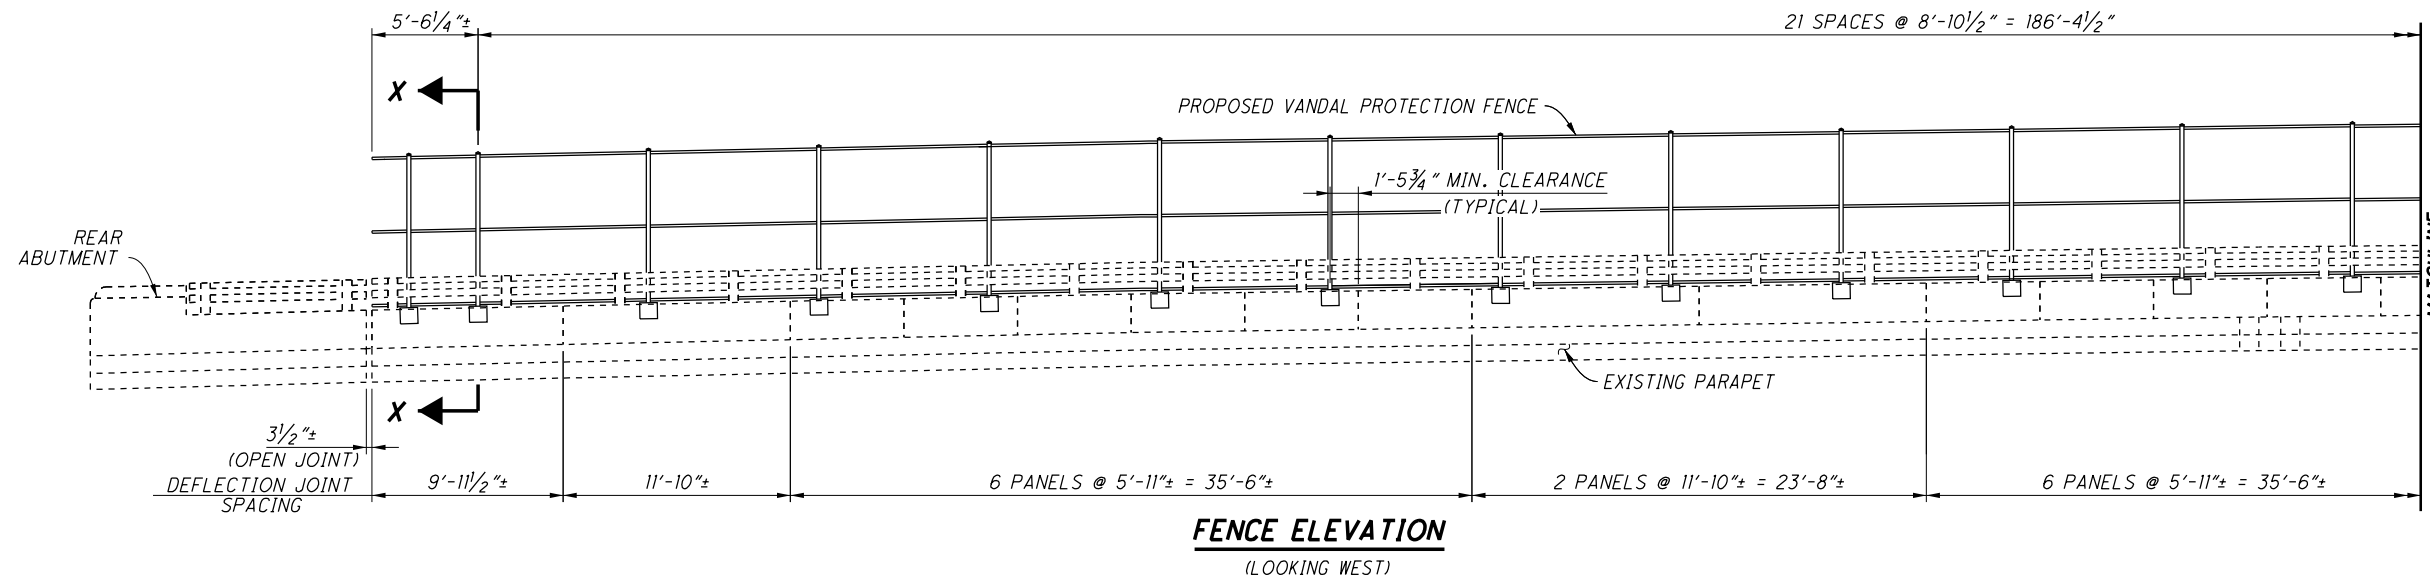

**FENCE ELEVATION**  
(LOOKING WEST)

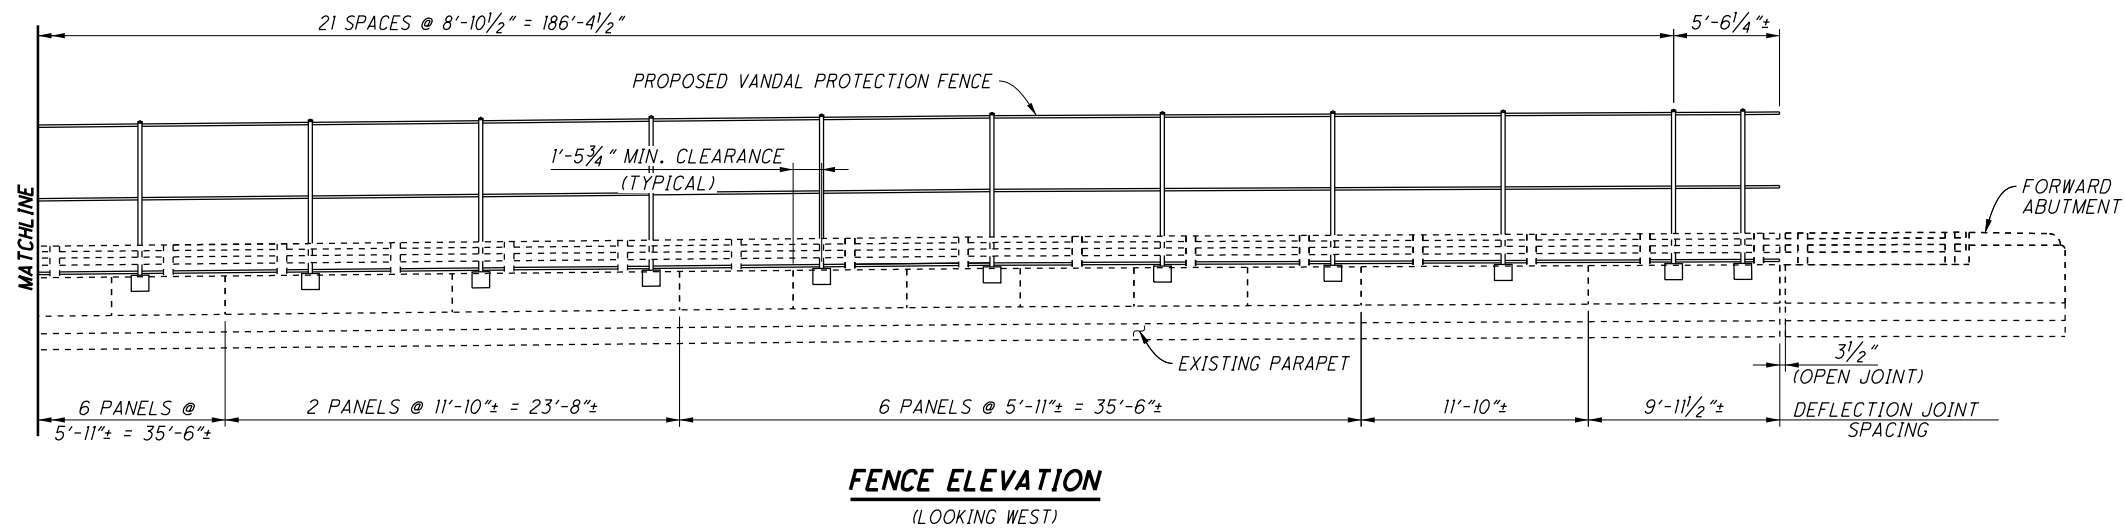


**FENCE ELEVATION**  
(LOOKING WEST)

**NOTES**


1. FOR SECTION X-X SEE SHEET 5/7

<b>RIC-30-09.26</b> PID No. 93455	<b>FENCE ELEVATION</b> BRIDGE NO. RIC-30-0982 UNDER TRIMBLE ROAD	DESIGNED HK CHECKED BDH	DRAWN TAC REVISED	REVIEWED SDS STRUCTURE FILE NUMBER 7001088	DATE 9-24-19	DESIGN AGENCY <b>ENGINEERING ASSOCIATES, INC.</b> 895 EAGLE PASS - MOOSTER, OHIO 44691 TELEPHONE: (330) 346-6666 FAX: (330) 346-8077
		4 / 7 1201 1669				


M:\15074\93455\Design\Structures\RIC030\_0982C\Sheets\030\_0982CSA005.dgn 2/24/2020 10:23:47 AM acb284

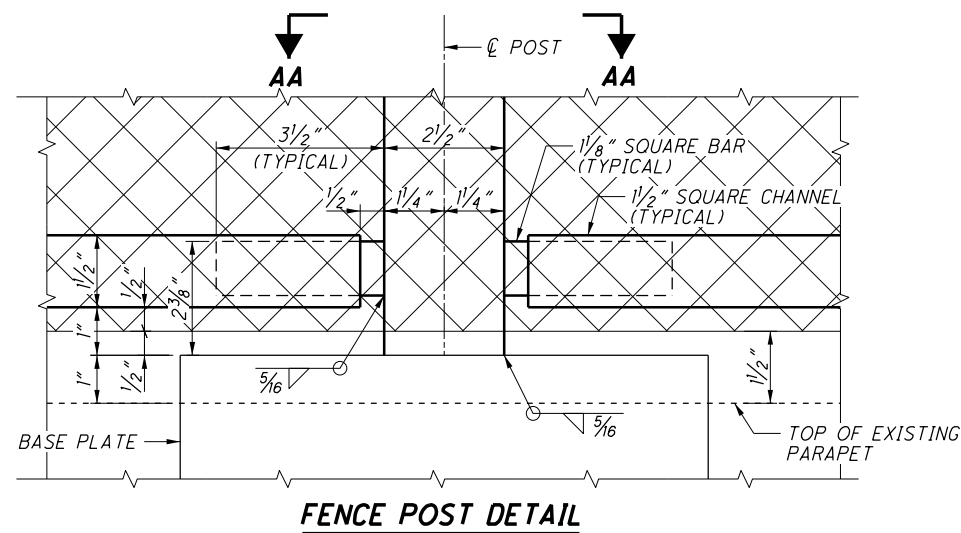


**FENCE POST DETAIL**

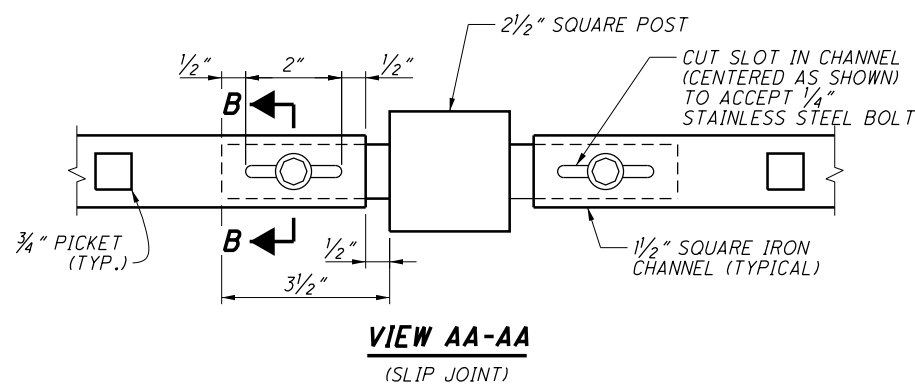


**VIEW AA-AA  
(SLIP JOINT)**

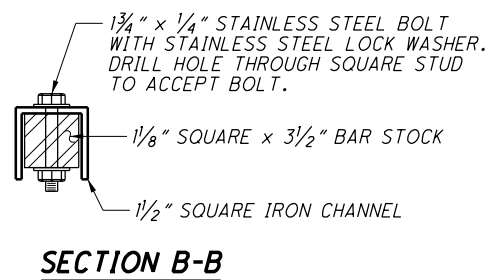

**SECTION B-B**

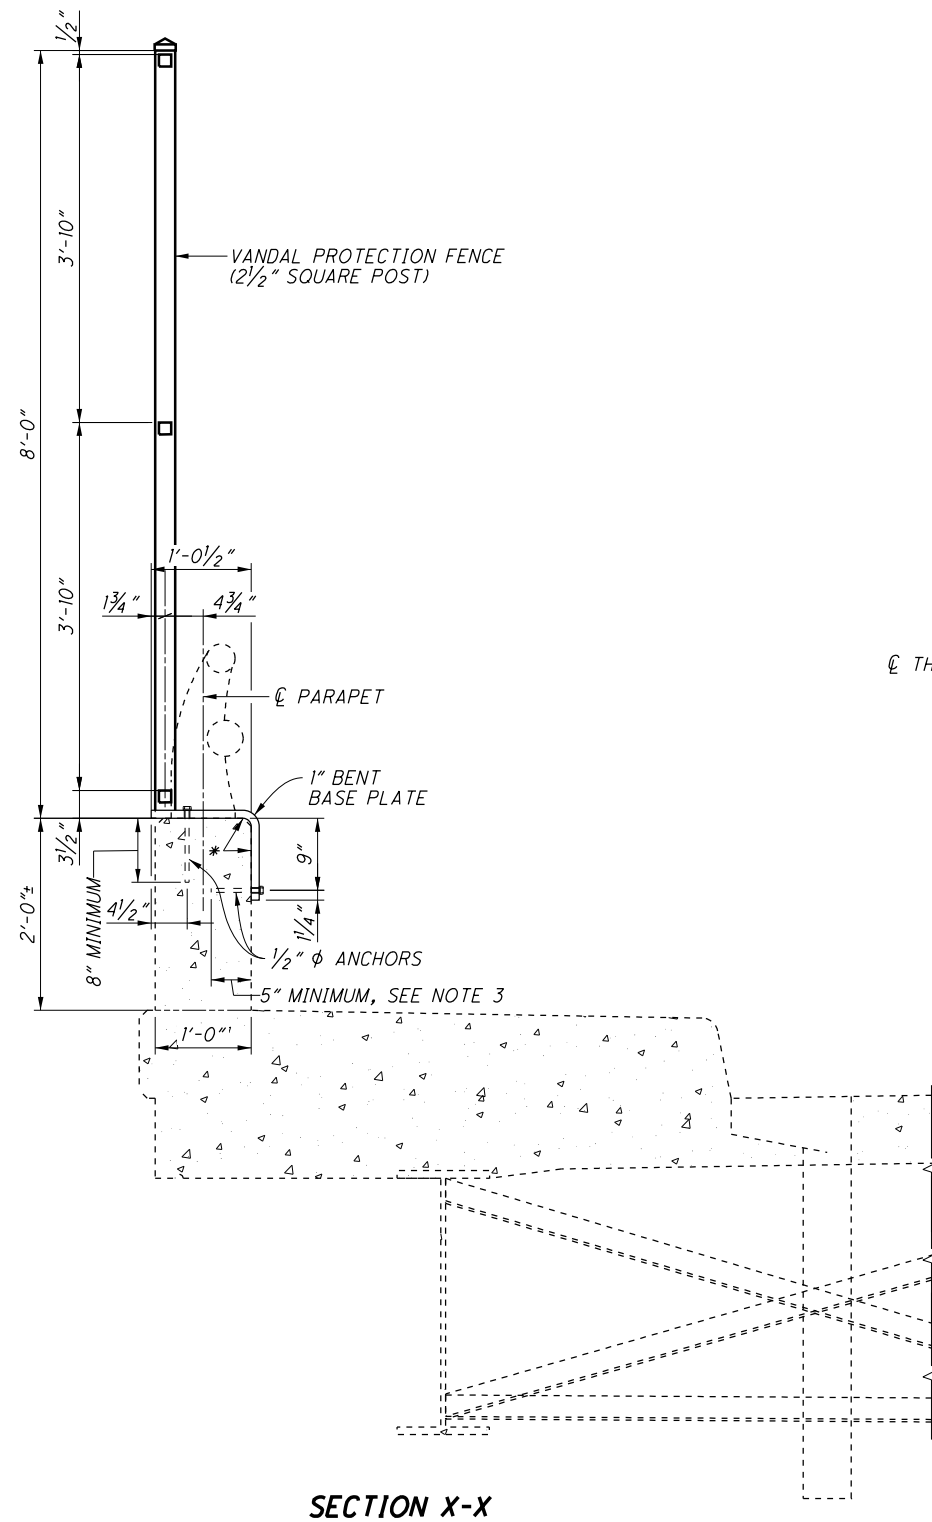

**SECTION X-X**

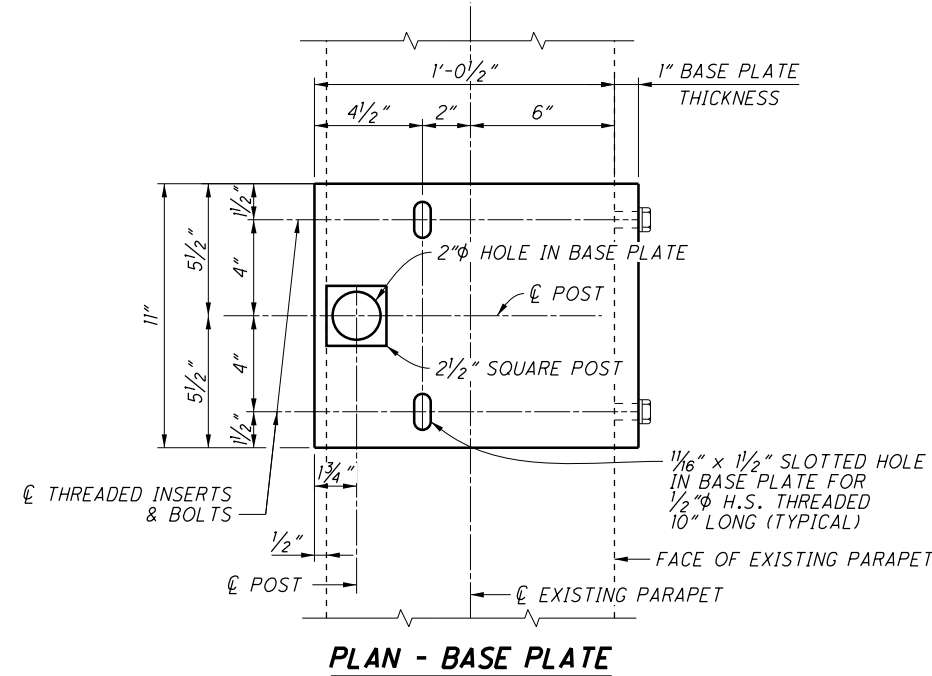

**PLAN - BASE PLATE**







**LEGEND**

\* - CAULKING COMPOUND

**NOTES**

- EXISTING STRUCTURE VERIFICATION: DETAILS AND DIMENSIONS SHOWN ON THESE PLANS PERTAINING TO THE EXISTING STRUCTURE HAVE BEEN OBTAINED FROM PLANS OF THE EXISTING STRUCTURE. CONSEQUENTLY, THEY ARE INDICATIVE OF THE EXISTING STRUCTURE AND THE PROPOSED WORK BUT THEY SHALL BE CONSIDERED TENTATIVE AND APPROXIMATE. THE CONTRACTOR IS REFERRED TO CMS SECTIONS 102.05 AND 105.02. BASE CONTRACT BID PRICES UPON A RECOGNITION OF THE UNCERTAINTIES DESCRIBED ABOVE AND UPON A PREBID EXAMINATION OF THE EXISTING STRUCTURE. HOWEVER, THE DEPARTMENT WILL PAY FOR ALL PROJECT WORK BASED UPON ACTUAL DETAILS AND DIMENSIONS THAT HAVE BEEN VERIFIED IN THE FIELD.
- FOR FENCE ELEVATION SEE SHEET 4 / 7.
- INTERNALLY THREADED ADHESIVE ANCHOR INSERTS REQUIRED FOR THIS LOCATION. SEE FENCE NOTES FOR SUBSTITUTING MECHANICAL ANCHORS.

M:\15074\93455\Design\Structures\RIC030\_0982C\Sheets\030\_0982CSA006.dgn 2/24/2020 10:25:10 AM ocb284

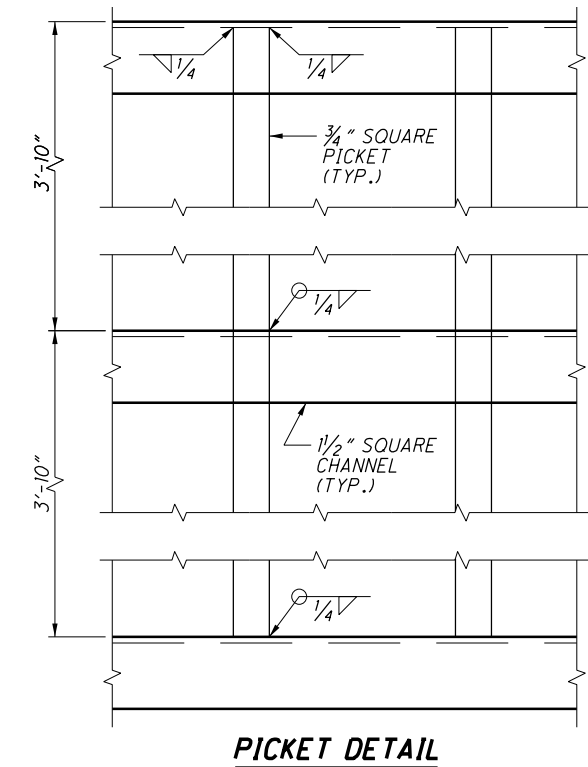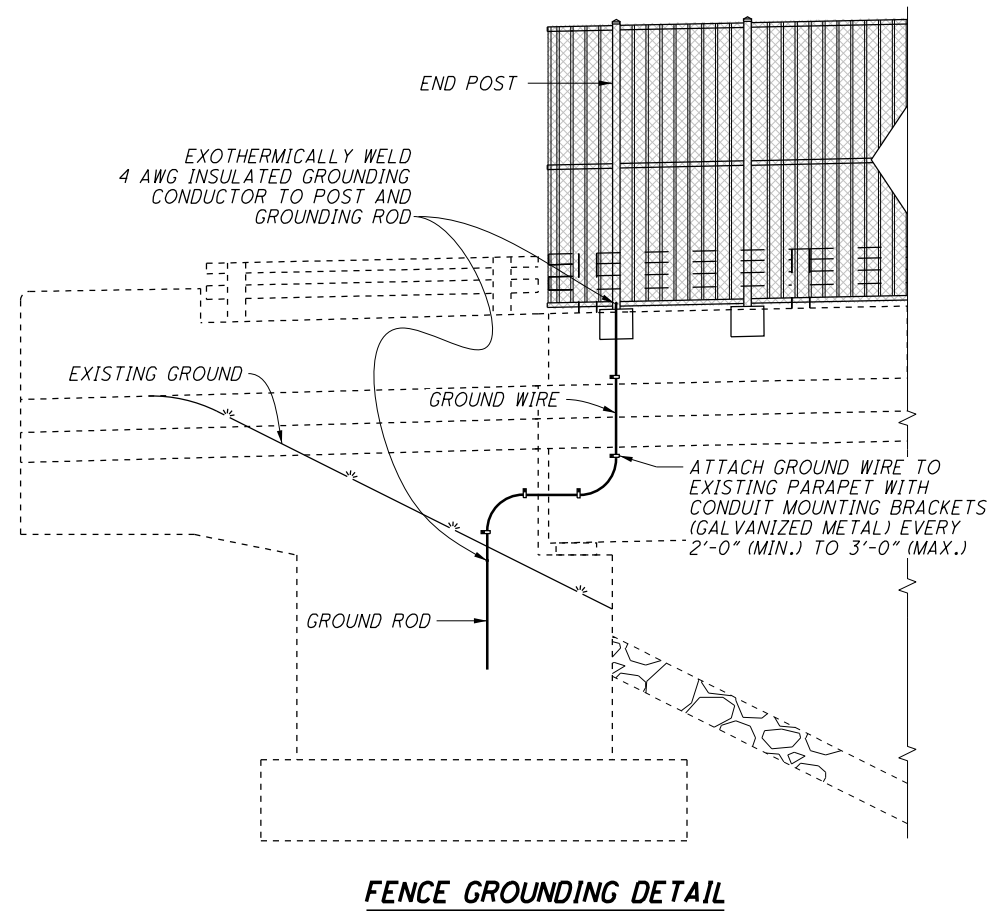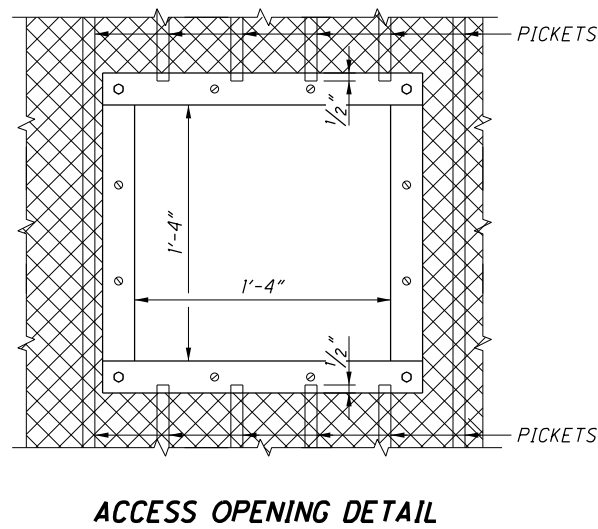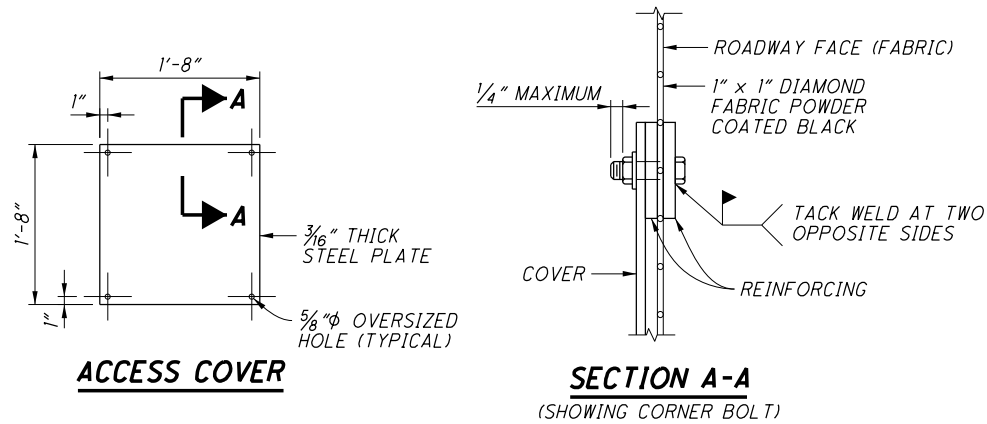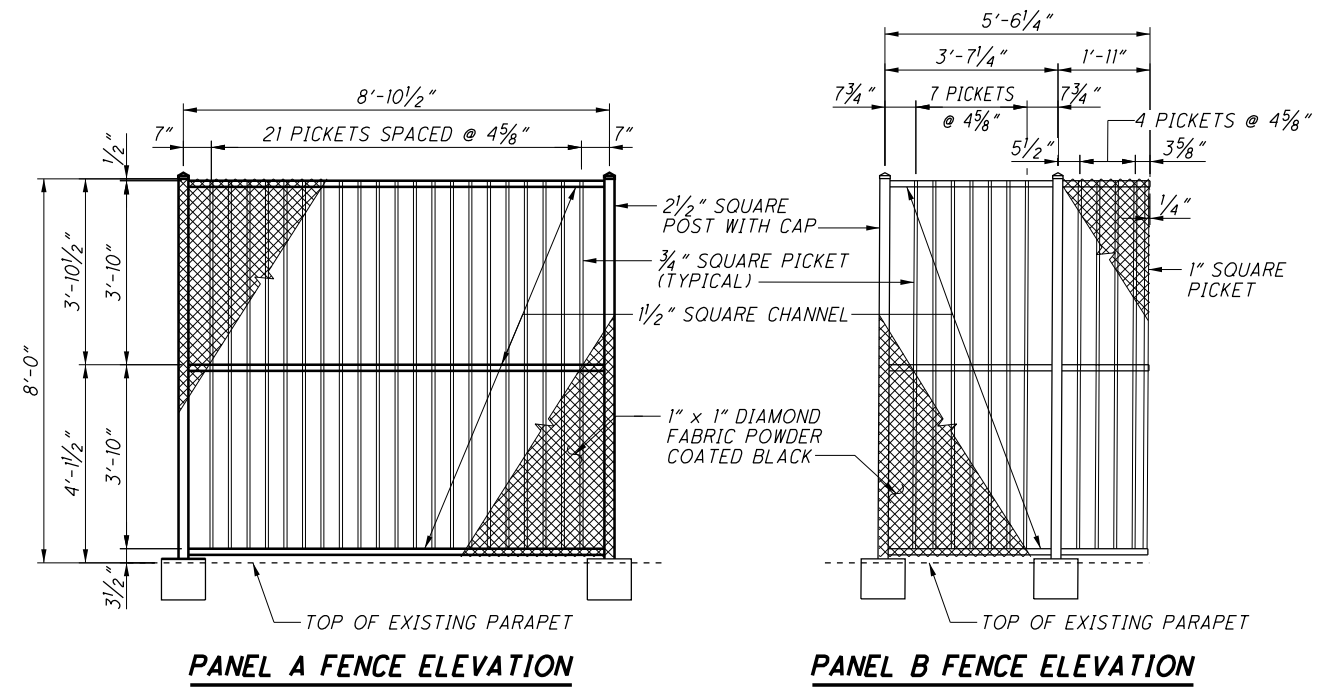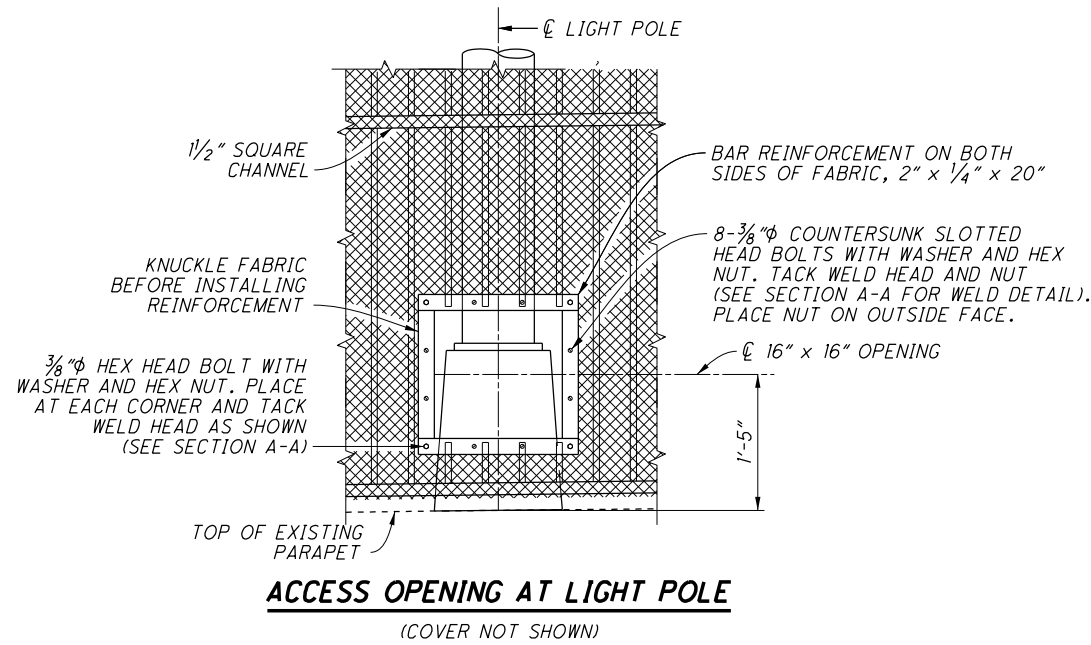

**NOTES**

1. FOR ADDITIONAL DETAILS AND NOTES SEE SHEET 5/7.
2. GROUND EACH CORNER OF THE BRIDGE.

DESIGN AGENCY: ENGINEERING ASSOCIATES, INC.  
 895 EAGLE PASS - MOOSTER, OHIO 44691  
 TELEPHONE: (330) 345-6656  
 FAX: (330) 345-8077

DESIGNED: HK  
 CHECKED: BDH

DRAWN: TAC  
 REVISED:


REVIEWED: SDS  
 STRUCTURE FILE NUMBER: 7001088

DATE: 9-24-19


BRIDGE NO. RIC-30-0892  
 UNDER TRIMBLE ROAD

RIC-30-09.26  
 PID No. 93455

6/7  
 1203  
 1669

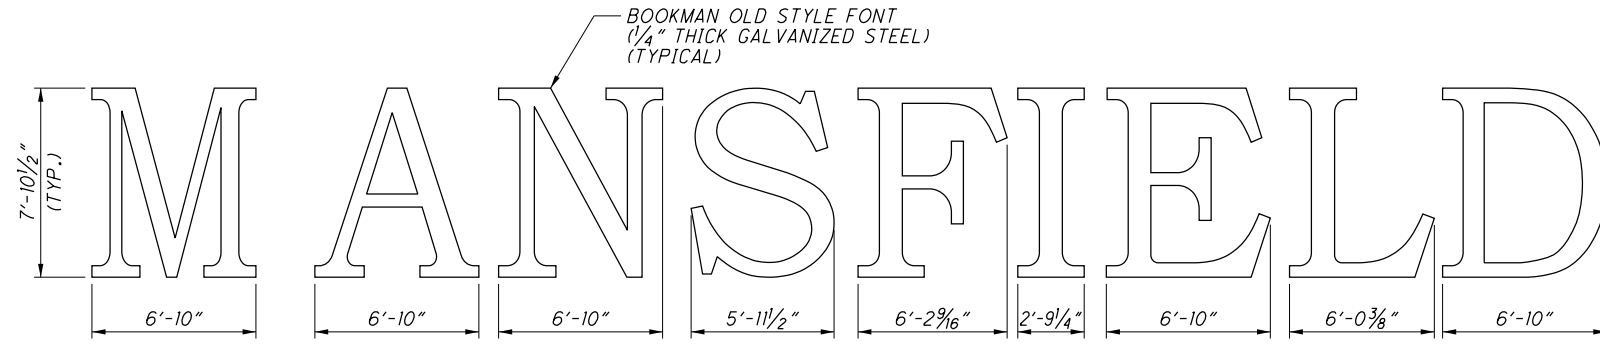


**LETTER DETAILS**

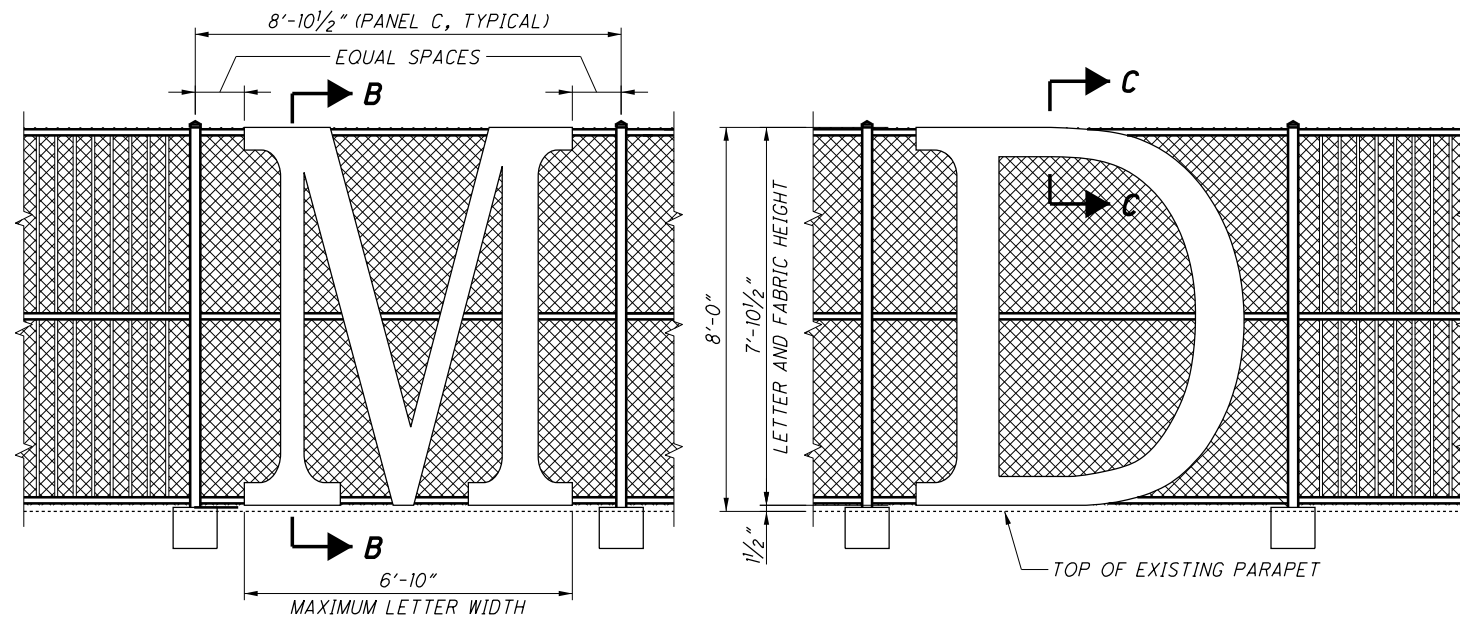


**PANEL C - LETTER LOCATION DETAIL**  
(PICKETS ARE NOT IN PANEL C)

LETTER	FONT	AREA (S.F.)	WEIGHT (LB.)	QTY.	TOTAL WEIGHT
M	BOOKMAN OLD STYLE	21.36	218.05	1	218.05
A	BOOKMAN OLD STYLE	14.7	150.06	1	150.06
N	BOOKMAN OLD STYLE	19.35	197.53	1	197.53
S	BOOKMAN OLD STYLE	17.84	182.12	1	182.12
F	BOOKMAN OLD STYLE	15.78	161.09	1	161.09
I	BOOKMAN OLD STYLE	9.5	96.98	1	96.98
E	BOOKMAN OLD STYLE	19.63	200.39	1	200.39
L	BOOKMAN OLD STYLE	12.89	131.59	1	131.59
D	BOOKMAN OLD STYLE	18.71	191.00	1	191.00
◇	SEE DIAMOND DETAIL	3.0	30.63	11	336.93

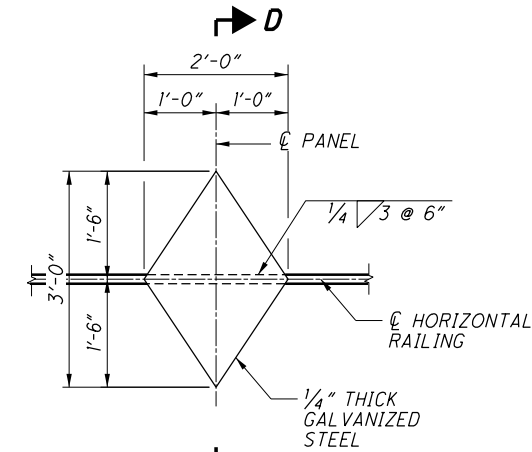


**DIAMOND DETAIL**


(PLACE DIAMONDS ON FENCE PANEL A AS SHOWN IN THE PLANS)

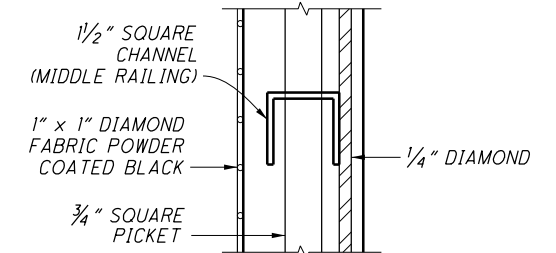


**SECTION D-D**

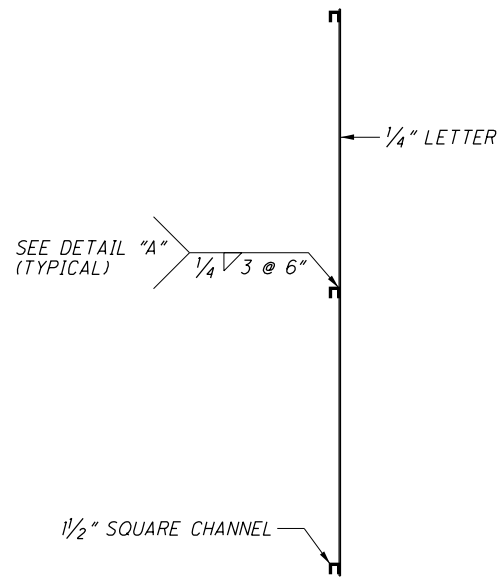

**SECTION B-B**

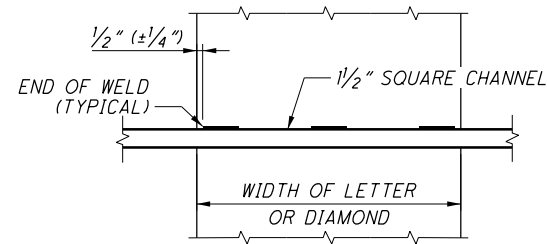

**DETAIL "A"**

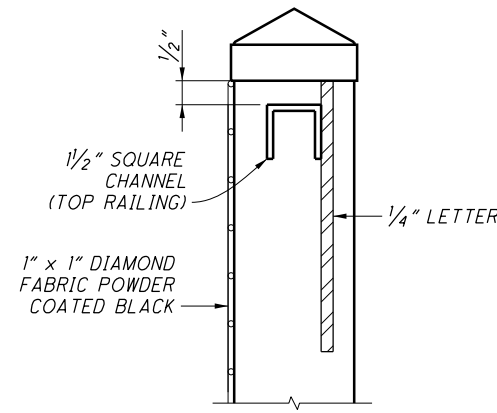

**SECTION C-C**

**NOTES**

- DIMENSIONS GIVEN FOR FENCE LETTERING ARE INCOMPLETE. OVERALL DIMENSIONS AND THE APPROXIMATE AREAS AND WEIGHT ARE GIVEN. OTHER DIMENSIONS ARE PROPORTIONAL TO THE FONT. AN ELECTRONIC COPY OF THIS FILE WILL BE MADE AVAILABLE TO THE CONTRACTOR THROUGH THE OHIO DEPARTMENT OF TRANSPORTATION IF REQUESTED.
- EACH LETTER SHALL BE 1/4" THICK GALVANIZED STEEL. EACH LETTER SHALL BE CENTERED HORIZONTALLY ON THE 8'-0" WIDE FENCE PANELS INDICATED. SEE FENCE NOTES FOR DETAILS ABOUT GALVANIZING AND PAINTING OF FENCE.
- AFTER GALVANIZING OF LETTERED FENCE UNITS HAS OCCURRED, WARPAGE OF LETTERS AND DIAMONDS SHALL BE CORRECTED TO WITHIN 1/2" ± OF ITS ORIGINAL FLAT SHAPE.
- ALL LETTERS SHALL BE WELDED TO THE TOP, MIDDLE AND BOTTOM RAIL. WHERE THE LENGTH OF CONTACT BETWEEN THE LETTER AND THE RAIL IS GREATER THAN 10", STITCH WELDING SHALL BE USED AS SHOWN IN SECTION B-B AND DETAIL "A". WHERE THE LENGTH OF CONTACT IS LESS THAN 10" A CONTINUOUS 1/4" FILLET WELD TERMINATING 1/2" FROM THE EDGE OF THE LETTER SHALL BE USED.
- DIAMONDS SHALL BE PLACED IN FENCE PANEL AS SHOWN IN THE PLANS.

M:\15074\93455\Design\Structures\RIC030\_0982C\Sheets\030\_0982CSA007.dgn 2/24/2020 10:26:42 AM ocb284



**STANDARD DRAWINGS**

REFER TO THE FOLLOWING STANDARD BRIDGE DRAWINGS:

AS-1-15	REVISED	7-17-15
AS-2-15	REVISED	1-18-19
GSD-1-19	DATED	1-18-19
PCB-91	REVISED	1-18-13
SBR-1-13	REVISED	7-20-18
SBR-2-13	REVISED	7-20-18
SICD-1-96	REVISED	7-18-14
SICD-2-14	DATED	7-18-14
VPF-1-90	REVISED	7-20-18

**DESIGN SPECIFICATIONS**

THIS STRUCTURE CONFORMS TO THE "LRFD BRIDGE DESIGN SPECIFICATIONS" ADOPTED BY THE AMERICAN ASSOCIATION OF STATE HIGHWAY AND TRANSPORTATION OFFICIALS, 2017, 8TH EDITION AND THE ODOT BRIDGE DESIGN MANUAL, 2019.

**OPERATIONAL IMPORTANCE**

A LOAD MODIFIER OF 1.0 HAS BEEN ASSUMED FOR THE DESIGN OF THIS STRUCTURE IN ACCORDANCE WITH THE AASHTO LRFD BRIDGE DESIGN SPECIFICATIONS, ARTICLE 1.3.5 AND THE ODOT BRIDGE DESIGN MANUAL, 2019.

**DESIGN LOADING**

HL-93  
FUTURE WEARING SURFACE (FWS) OF 0.060 KIPS/FT<sup>2</sup>.

**DESIGN DATA**

CONCRETE CLASS QC2 WITH QC/OA - COMPRESSIVE STRENGTH 4.5 KSI (SUPERSTRUCTURE)

CONCRETE CLASS QC1 WITH QC/OA - COMPRESSIVE STRENGTH 4.0 KSI (SUBSTRUCTURE)

REINFORCING STEEL - MINIMUM YIELD STRENGTH 60 KSI

STRUCTURAL STEEL - ASTM A709 GRADE 50 - YIELD STRENGTH 50 KSI

STEEL H-PILES - ASTM A572 - YIELD STRENGTH 50 KSI

**DECK PROTECTION METHOD**

EPOXY COATED REINFORCING STEEL  
2 1/2" CONCRETE COVER

**MONOLITHIC WEARING SURFACE**

MONOLITHIC WEARING SURFACE IS ASSUMED, FOR DESIGN PURPOSES, TO BE 1 INCH THICK.

**ITEM 202, PORTIONS OF STRUCTURE REMOVED, OVER 20 FOOT SPAN, AS PER PLAN:**

THIS ITEM SHALL INCLUDE THE ELEMENTS INDICATED IN THE PLANS AND GENERAL NOTES AND THAT ARE NOT SEPARATELY LISTED FOR PAYMENT, EXCEPT FOR WEARING COURSE REMOVAL. ITEMS TO BE REMOVED INCLUDE ALL EXISTING MATERIALS BEING REPLACED BY NEW CONSTRUCTION AND MISCELLANEOUS ITEMS THAT ARE NOT SHOWN TO BE INCORPORATED INTO THE FINAL CONSTRUCTION AND ARE DIRECTED TO BE REMOVED BY THE ENGINEER. THE USE OF EXPLOSIVES, HEADACHE BALLS AND/OR HOE-RAMS WILL NOT BE PERMITTED. THE METHOD OF REMOVAL AND THE WEIGHT OF HAMMER SHALL BE APPROVED BY THE ENGINEER. PERFORM ALL WORK IN A MANNER THAT WILL NOT CUT, ELONGATE OR DAMAGE THE EXISTING REINFORCING STEEL TO BE PRESERVED. CHIPPING HAMMERS SHALL NOT BE HEAVIER THAN THE NOMINAL 90-POUND CLASS. PNEUMATIC HAMMERS SHALL NOT BE PLACED IN DIRECT CONTACT WITH REINFORCING STEEL THAT IS TO BE RETAINED IN THE REBUILT STRUCTURE. SUBMIT CONSTRUCTION PLANS ACCORDING TO C&MS 501.05

**ITEM 203 EMBANKMENT, AS PER PLAN**

PLACE AND COMPACT EMBANKMENT MATERIAL IN 6 INCH LIFTS FOR THE CONSTRUCTION OF THE APPROACH EMBANKMENT BETWEEN STATIONS 564+75 TO 570+75.

**PILE DRIVING CONSTRAINTS**

PRIOR TO DRIVING PILES, CONSTRUCT THE SPILL THROUGH SLOPES AND THE BRIDGE APPROACH EMBANKMENT BEHIND THE ABUTMENTS UP TO THE LEVEL OF THE SUBGRADE ELEVATION FOR A MINIMUM DISTANCE OF 200 FEET BEHIND EACH ABUTMENT. DO NOT BEGIN THE EXCAVATION FOR THE ABUTMENT FOOTINGS AND THE INSTALLATION OF THE ABUTMENT AND THE PIER PILES, UNTIL AFTER THE ABOVE REQUIRED EMBANKMENT HAS BEEN CONSTRUCTED.

**ITEM 503, COFFERDAMS AND EXCAVATION BRACING, AS PER PLAN**

THE DESIGN SHOWN ON THE PLANS FOR TEMPORARY SUPPORT OF EXCAVATION IS ONE REPRESENTATIVE DESIGN THAT MAY BE USED TO CONSTRUCT THE PROJECT. THE CONTRACTOR MAY CONSTRUCT THE DESIGN SHOWN ON THE PLANS OR PREPARE AN ALTERNATE DESIGN TO SUPPORT THE SIDES OF EXCAVATION. IF CONSTRUCTING AN ALTERNATE DESIGN FOR TEMPORARY SUPPORT OF EXCAVATION, PREPARE AND PROVIDE PLANS IN ACCORDANCE WITH C&MS 501.05. THE DEPARTMENT WILL PAY FOR THE TEMPORARY SUPPORT OF EXCAVATION AT THE CONTRACT LUMP SUM PRICE FOR COFFERDAMS AND EXCAVATION BRACING. NO ADDITIONAL PAYMENT WILL BE MADE FOR PROVIDING AN ALTERNATE DESIGN.

**DECK PLACEMENT ASSUMPTIONS**

THE FOLLOWING ASSUMPTIONS OF CONSTRUCTION MEANS AND METHODS WERE MADE FOR THE ANALYSIS AND DESIGN OF THE SUPERSTRUCTURE. THE CONTRACTOR IS RESPONSIBLE FOR THE DESIGN OF THE FALSEWORK SUPPORT SYSTEM WITHIN THESE PARAMETERS AND WILL ASSUME RESPONSIBILITY FOR SUPERSTRUCTURE ANALYSIS FOR DEVIATION FROM THESE DESIGN ASSUMPTIONS.

AN EIGHT WHEEL FINISHING MACHINE WITH A MAXIMUM WHEEL LOAD OF 2.42 KIPS.

A MINIMUM OUT-TO-OUT WHEEL SPACING AT EACH END OF THE MACHINE OF 103".

A MAXIMUM SPACING OF OVERHANG FALSEWORK BRACKETS OF 48".

A MAXIMUM DISTANCE FROM THE CENTERLINE OF THE FASCIA GIRDER TO THE FACE OF THE SAFETY HANDRAIL OF 65".

**PILES TO BEDROCK**

DRIVE PILES TO REFUSAL ON BEDROCK. THE DEPARTMENT WILL CONSIDER REFUSAL TO BE OBTAINED WHEN THE PILE PENETRATION IS AN INCH OR LESS AFTER RECEIVING AT LEAST 20 BLOWS FROM THE PILE HAMMER. SELECT THE HAMMER SIZE TO ACHIEVE THE REQUIRED DEPTH TO BEDROCK AND REFUSAL.

THE TOTAL FACTORED LOAD IS 125 KIPS PER PILE FOR THE ABUTMENT PILES. THE TOTAL FACTORED LOAD IS 262 KIPS PER PILE FOR THE PIER NO. 1 PILES.

ABUTMENT PILES: (HP 10X42)  
70 PILES 45 FEET LONG, ORDER LENGTH


PIER NO. 1 PILES (HP 10X42)  
36 PILES 35 FEET LONG, ORDER LENGTH

PIER NO. 2 PILES (HP 10X42)  
36 PILES 20 FEET LONG, ORDER LENGTH

**STRUCTURE PAINTING:** ALL BRIDGE FINISH COATS SHALL BE THE SAME COLOR.


**ABBREVIATIONS**

- ABUT. - ABUTMENT
- APPR. - APPROACH
- BRG. - BEARING
- BOT. - BOTTOM
- CONST. JT. - CONSTRUCTION JOINT
- CLR. - CLEAR
- CONST. - CONSTRUCTION
- CORR. - CORRUGATED
- DIA. - DIAMETER
- DIM. - DIMENSION
- DWG. - DRAWING
- EL. - ELEVATION
- E.F. - EACH FACE
- EXIST. - EXISTING
- F.A. - FORWARD ABUTMENT
- FWD. - FORWARD
- F.F. - FRONT FACE
- FT. - FEET
- LBS. - POUNDS
- MAX. - MAXIMUM
- MEAS. - MEASURED
- MIN. - MINIMUM
- OPT. - OPTIONAL
- P.E.J.F. - PREFORMED EXPANSION JOINT FILLER
- R.A. - REAR ABUTMENT
- R.F. - REAR FACE
- REQ'D. - REQUIRED
- SPA. - SPACING
- STA. - STATION
- T.O.S. - TOP OF SLOPE
- TYP. - TYPICAL
- U.O.N. - UNLESS OTHERWISE NOTED
- VAR. - VARIES
- W/ - WITH

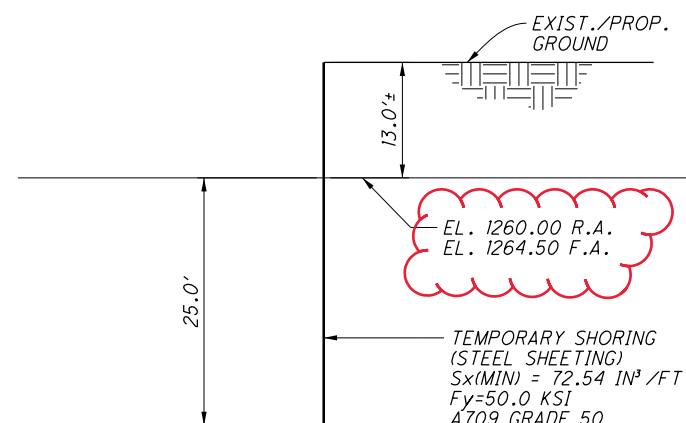

**SECTION A-A  
TEMPORARY SHORING DETAIL**

NOTE: SEE SHEET [2/66] FOR LOCATION.

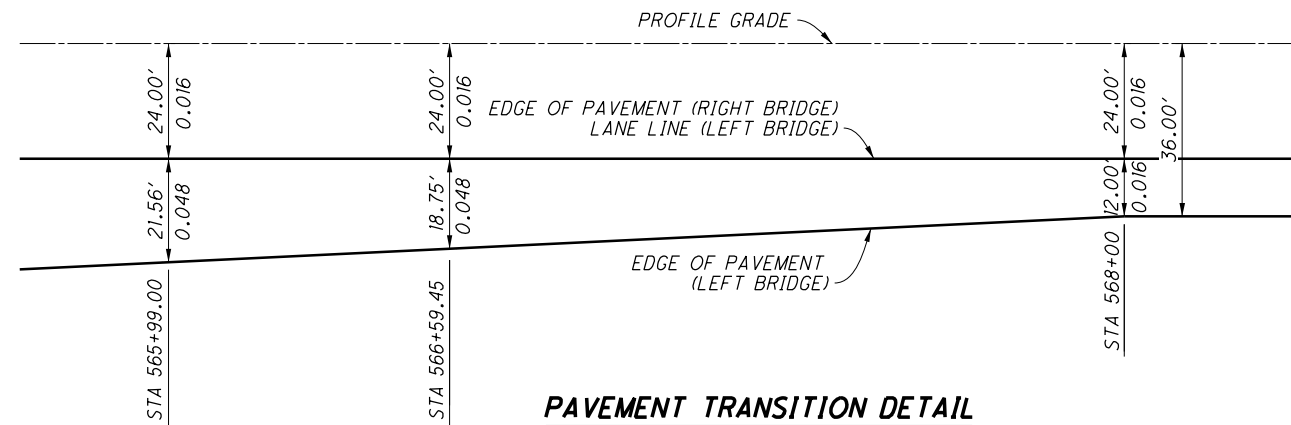

**PAVEMENT TRANSITION DETAIL**

M:\15074\93455\Design\Structures\RIC030\_1074C\Sheets\030\_1074CSN001.dgn 2/24/2020 10:37:22 AM ocb284

DESIGN AGENCY  
**ENGINEERING ASSOCIATES, INC.**  
935 EAGLE PASS - WOOSTER, OHIO 44691  
TELEPHONE: (330) 345-6556  
FAX: (330) 345-8077

DATE  
9-24-19  
REVIEWED  
SDS  
STRUCTURE FILE NUMBER  
7001119

DRAWN  
TAC  
CHECKED  
BDH

**GENERAL NOTES**  
BRIDGE NO. RIC-30-1074  
OVER S.R. 39

**RIC-30-9-26**  
PID No. 93455

3 / 66

1206  
1669

CALC: TAC DATE: 5/7/2019  
 CHECKED: RLE DATE: 5/21/2019

ESTIMATED QUANTITIES

ITEM	EXTENSION	TOTAL 01/NHS/BR	UNIT	DESCRIPTION	ABUT.	PIERS	SUPER.	GEN.	SEE SHEET
202	11203	LS		PORTIONS OF STRUCTURE REMOVED, OVER 20 FOOT SPAN, AS PER PLAN				LS	3/66
202	22900	311	SY	APPROACH SLAB REMOVED				311	
202	23500	311	SY	WEARING COURSE REMOVED				311	
202	98200	124	FT	REMOVAL MISC.:STEEL PILE (HPI2x53)	54	70			17/66 & 18/66
503	11101	LS		COFFERDAMS AND EXCAVATION BRACING, AS PER PLAN				LS	3/66
503	21100	1174	CY	UNCLASSIFIED EXCAVATION	747	427			
505	11100	LS		PILE DRIVING EQUIPMENT MOBILIZATION				LS	
507	00101	5130	FT	STEEL PILES HPI0X42, FURNISHED, AS PER PLAN	3150	1980			17/66 & 18/66
507	00151	4420	FT	STEEL PILES HPI0X42, DRIVEN, AS PER PLAN	2800	1620			17/66 & 18/66
507	93300	142	EACH	STEEL POINTS OR SHOES				142	
509	10000	304979	LB	EPOXY COATED REINFORCING STEEL	38719	67518	198742		
511	21523	878	CY	CLASS QC2 CONCRETE WITH QC/QA, SUPERSTRUCTURE, AS PER PLAN			878		35/66
511	33500	4	EACH	SEMI-INTEGRAL DIAPHRAGM GUIDE			4		
511	41012	206	CY	CLASS QC1 CONCRETE WITH QC/QA, PIER ABOVE FOOTINGS		206			
511	44112	178	CY	CLASS QC1 CONCRETE WITH QC/QA, ABUTMENT NOT INCLUDING FOOTING	178				
511	46512	360	CY	CLASS QC1 CONCRETE WITH QC/QA, FOOTING	232	128			
512	10100	1590	SY	SEALING OF CONCRETE SURFACES (EPOXY-URETHANE)	93	606	804	87	
512	10300	408	SY	SEALING CONCRETE BRIDGE DECKS WITH HMMW RESIN			368	40	
512	33000	27	SY	TYPE 2 WATERPROOFING	27				
513	10260	603922	LB	STRUCTURAL STEEL MEMBERS, LEVEL 3			603922		
513	20000	11466	EACH	WELDED STUD SHEAR CONNECTORS			11466		
514	00800	603922	LB	FIELD PAINTING STRUCTURAL STEEL, INTERMEDIATE COAT			603922		
514	00851	603922	LB	FIELD PAINTING STRUCTURAL STEEL, FINISH COAT, AS PER PLAN			603922		3/66
514	10000	29	EACH	FINAL INSPECTION REPAIR			29		
516	10010	264	FT	ARMORLESS PREFORMED JOINT SEAL				264	
516	13600	32	SF	1" PREFORMED EXPANSION JOINT FILLER			32		
516	13900	624	SF	2" PREFORMED EXPANSION JOINT FILLER			181	443	
516	14020	333	FT	SEMI-INTEGRAL ABUTMENT EXPANSION JOINT SEAL	333				
516	44101	26	EACH	ELASTOMERIC BEARING WITH INTERNAL LAMINATES AND LOAD PLATE (NEOPRENE), AS PER PLAN 2 13/16"x1'-2 1/2"x1'-5" W/ 1 x1'-3 1/2"x1'-6" BEVELED LOAD PLATE		26			31/66
516	44101	26	EACH	ELASTOMERIC BEARING WITH INTERNAL LAMINATES AND LOAD PLATE (NEOPRENE), AS PER PLAN 2 15/16"x1'-0"x1'-1" W/ 1 5/8"x1'-1"x1'-2" BEVELED LOAD PLATE	26				31/66
518	21200	185	CY	POROUS BACKFILL WITH GEOTEXTILE FABRIC	185				
518	40000	348	FT	6" PERFORATED CORRUGATED PLASTIC PIPE	348				
518	40010	62	FT	6" NON-PERFORATED CORRUGATED PLASTIC PIPE, INCLUDING SPECIALS	62				
526	25001	666	SY	REINFORCED CONCRETE APPROACH SLABS (T=15"), AS PER PLAN				666	48/66 THRU 53/66
526	90030	274	FT	TYPE C INSTALLATION				274	
601	21000	1501	SY	CONCRETE SLOPE PROTECTION				1501	
607	39900	354	FT	VANDAL PROTECTION FENCE, 6' STRAIGHT, COATED FABRIC			354		

DESIGN AGENCY  
 ENGINEERING ASSOCIATES, INC.  
 8935 EAGLE PASS - WOOSTER, OHIO 44691  
 TELEPHONE: (330) 345-6556  
 FAX: (330) 345-8077

DATE  
 9-24-19  
 STRUCTURE FILE NUMBER  
 700119

REVIEWED  
 SDS  
 DRAWN  
 TAC  
 CHECKED  
 BDH


ESTIMATED QUANTITIES  
 BRIDGE NO. RIC-30-1074  
 OVER S.R. 39

RIC-30-9-26  
 PID No. 93455


4/66

1207  
 1669

M:\15074\93455\Design\Structures\RIC030\_1074C\Sheets\030\_1074CS0001.dgn 2/24/2020 10:38:44 AM ocb284

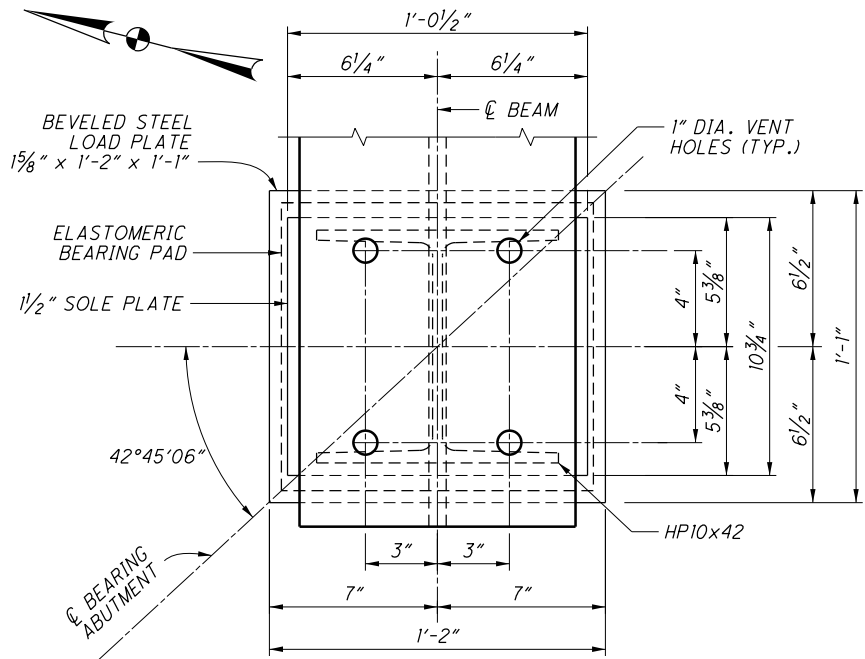


**PLAN AT ABUTMENT**  
(REAR ABUTMENT SHOWN,  
FORWARD ABUTMENT SIMILAR)

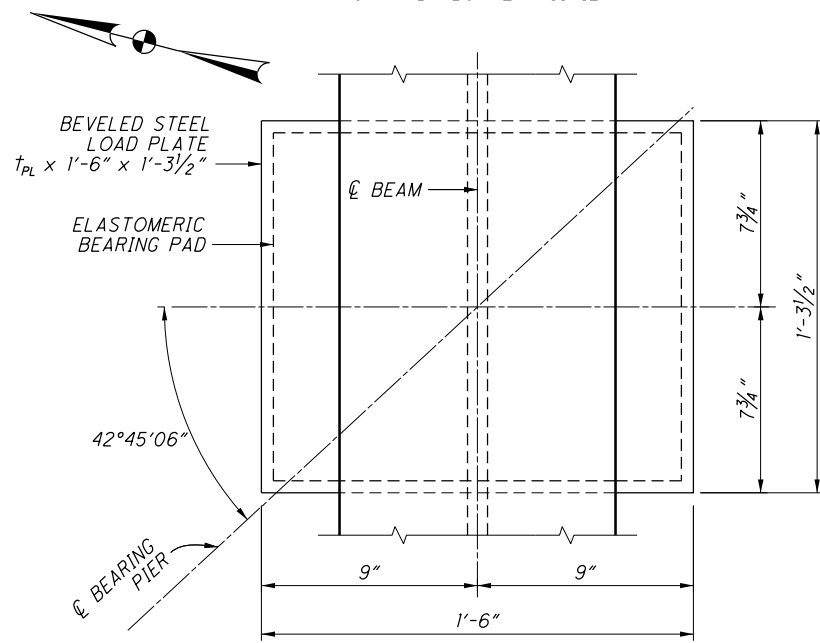


**PLAN AT PIERS**




**BEARING ORIENTATION**

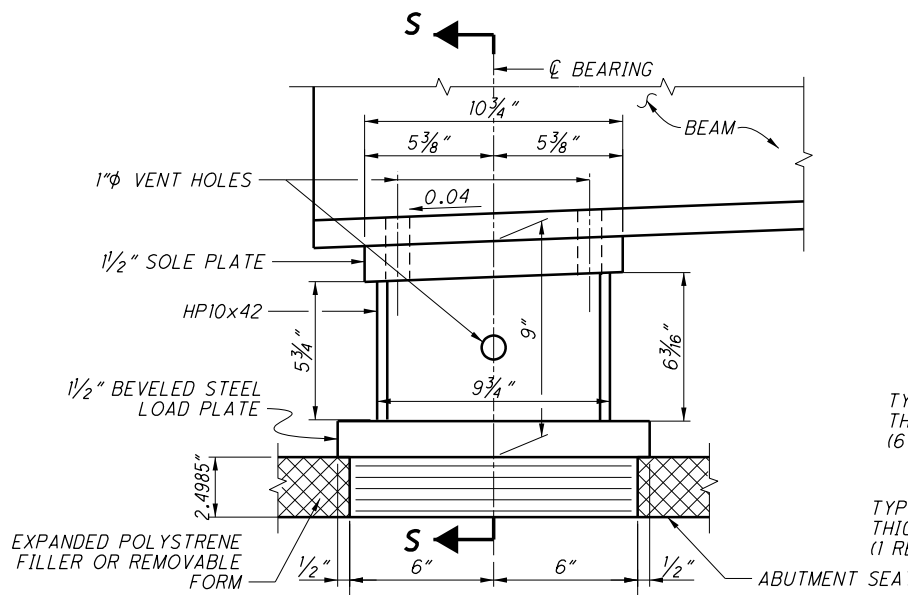


**ABUTMENT BEARING ELEVATION**

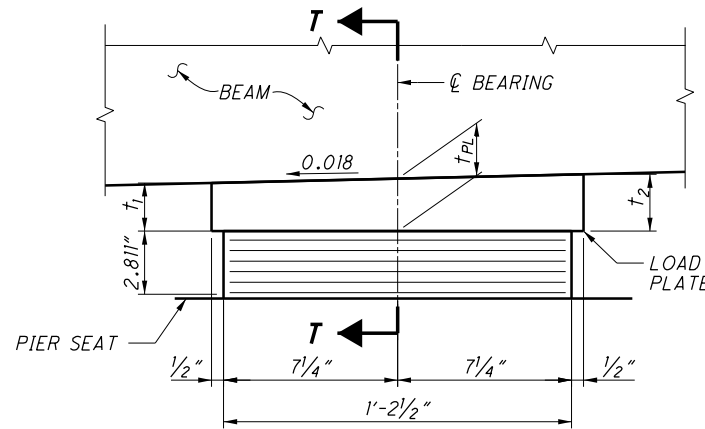

**PIER BEARING ELEVATION**

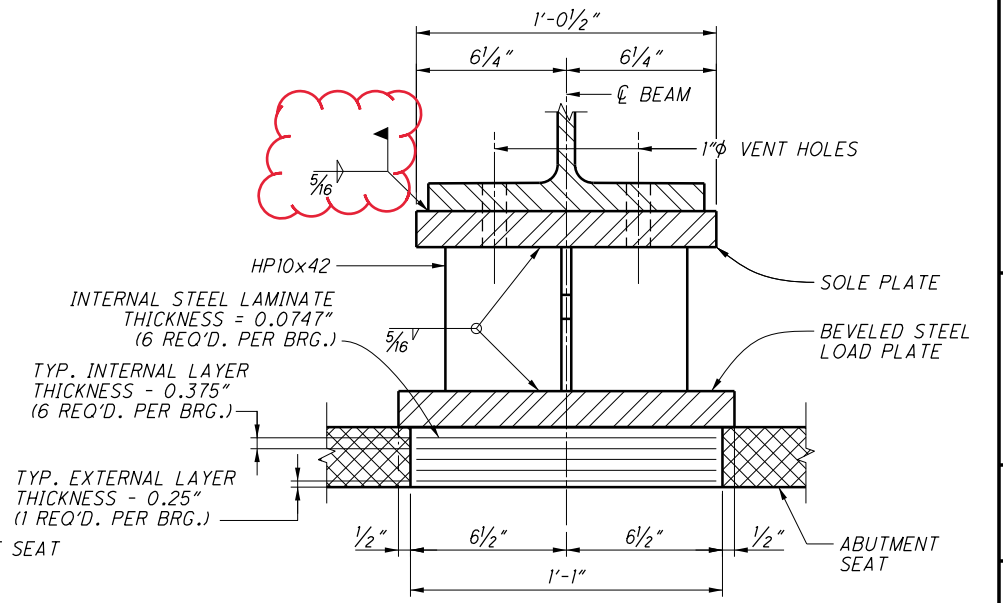

**SECTION S-S**

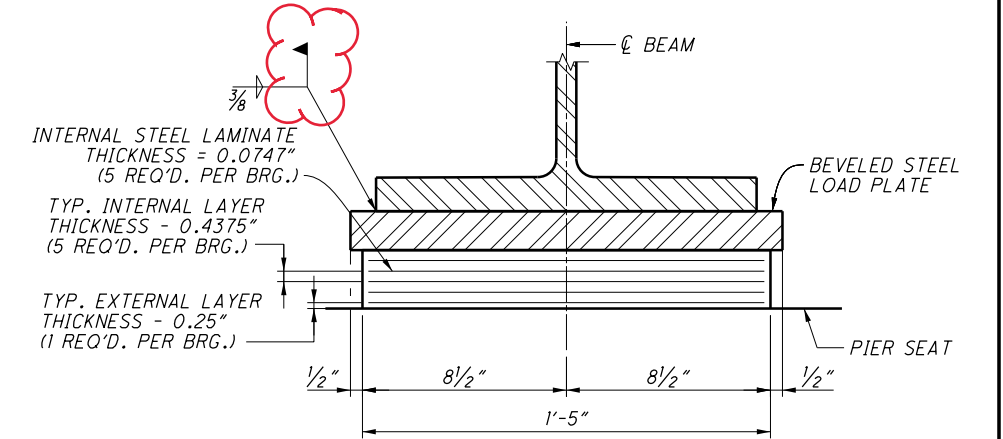

**SECTION T-T**

LOAD PLATE THICKNESS "t"								
LOCATION	H	J	K	L	M	N	A-G	
PIER NO. 1	t <sub>1</sub>	2 3/8"	2 3/8"	2 1/4"	2 1/4"	2 1/8"	2"	2"
	t <sub>PL</sub>	2 1/2"	2 1/2"	2 3/8"	2 3/8"	2 1/4"	2 1/8"	2 1/8"
	t <sub>2</sub>	2 5/8"	2 5/8"	2 1/2"	2 1/2"	2 3/8"	2 1/4"	2 1/4"
PIER NO. 2	t <sub>1</sub>	2 1/2"	2"	2 1/2"	2"	2 5/8"	2"	2"
	t <sub>PL</sub>	2 5/8"	2 1/8"	2 5/8"	2 1/8"	2 3/4"	2 1/8"	2 1/8"
	t <sub>2</sub>	2 3/4"	2 1/4"	2 3/4"	2 1/4"	2 7/8"	2 1/4"	2 1/4"

**BEARING REACTION TABLE (KIPS) (SEE NOTE 6)**


BEARING DESIGNATION	LOCATION	TYPE	NO.	LEFT BRIDGE					RIGHT BRIDGE				
				DEAD LOAD			LIVE LOAD	TOTAL	DEAD LOAD			LIVE LOAD	TOTAL
				DIAPHRAGM	REACTION	TOTAL			DIAPHRAGM	REACTION	TOTAL		
E-148	REAR ABUT.	EXP.	13	46.65	36.97	83.62	64.27	148	42.93	35.6	78.9	60.6	140
E-258	PIER NO. 1	EXP.	13		153.83	153.83	103.91	258		145.3	145.3	97.4	243
E-258	PIER NO. 2	EXP.	13		153.83	153.83	103.91	258		145.3	145.3	97.4	243
E-148	FORWARD ABUT.	EXP.	13	46.65	36.97	83.62	64.27	148	42.93	35.6	78.9	60.6	140

**NOTES**

- ELASTOMERIC BEARINGS: THE ELASTOMER SHALL HAVE A HARDNESS OF 50 DUROMETER. THE BEARINGS WERE DESIGNED IN ACCORDANCE WITH SECTION 14.7.6 (METHOD A) OF THE AASHTO LRFD BRIDGE DESIGN SPECIFICATIONS. THE LONGTERM COMPRESSION PROOF LOAD TEST (AASHTO STANDARD SPECIFICATIONS FOR HIGHWAY BRIDGES, DIVISION II, SECTION 18.7.2.6) IS NOT REQUIRED.
- BASIS FOR PAYMENT FOR ELASTOMERIC BEARING: THE UNIT PRICE BID SHALL INCLUDE ALL MATERIALS, LABOR, TESTING, STEEL SUPPORT POST, BEVELING OF LOAD PLATE WHERE REQUIRED AND INCIDENTALS NECESSARY TO FURNISH AND INSTALL LAMINATED ELASTOMERIC BEARINGS. PAYMENT WILL BE AT THE CONTRACT PRICE FOR THE APPROPRIATE ITEM 516, ELASTOMERIC BEARING WITH INTERNAL LAMINATES AND LOAD PLATE (NEOPRENE), AS PER PLAN.
- FOR ABBREVIATIONS SEE SHEET 3/66.
- ALL BEARINGS SHALL BE MARKED PRIOR TO SHIPPING. THE MARKS SHALL INCLUDE THE BEARING LOCATION ON THE BRIDGE AND A DIRECTION ARROW THAT POINTS UP-STATION, ALL MARKS SHALL BE PERMANENT AND BE VISIBLE AFTER THE BEARING IS INSTALLED.
- THE STEEL LOAD PLATE (ASTM A709, GRADE 50) SHALL BE BONDED BY VULCANIZATION TO ELASTOMER DURING THE MOLDING PROCESS.
- TABLE INCLUDES UNFACTORED DEAD LOADS, LIVE LOAD (WITHOUT IMPACT) AND TOTAL REACTIONS.


M:\15074\93455\Design\Structures\RIC030\_1074C\Sheets\030\_1074CSB001.dgn 2/24/2020 10:41:45 AM acb284

M:\15074\93455\Design\Structures\RIC030\_1074C\Sheets\030\_1074C\SS001.dgn 2/24/2020 10:44:25 AM ocb284

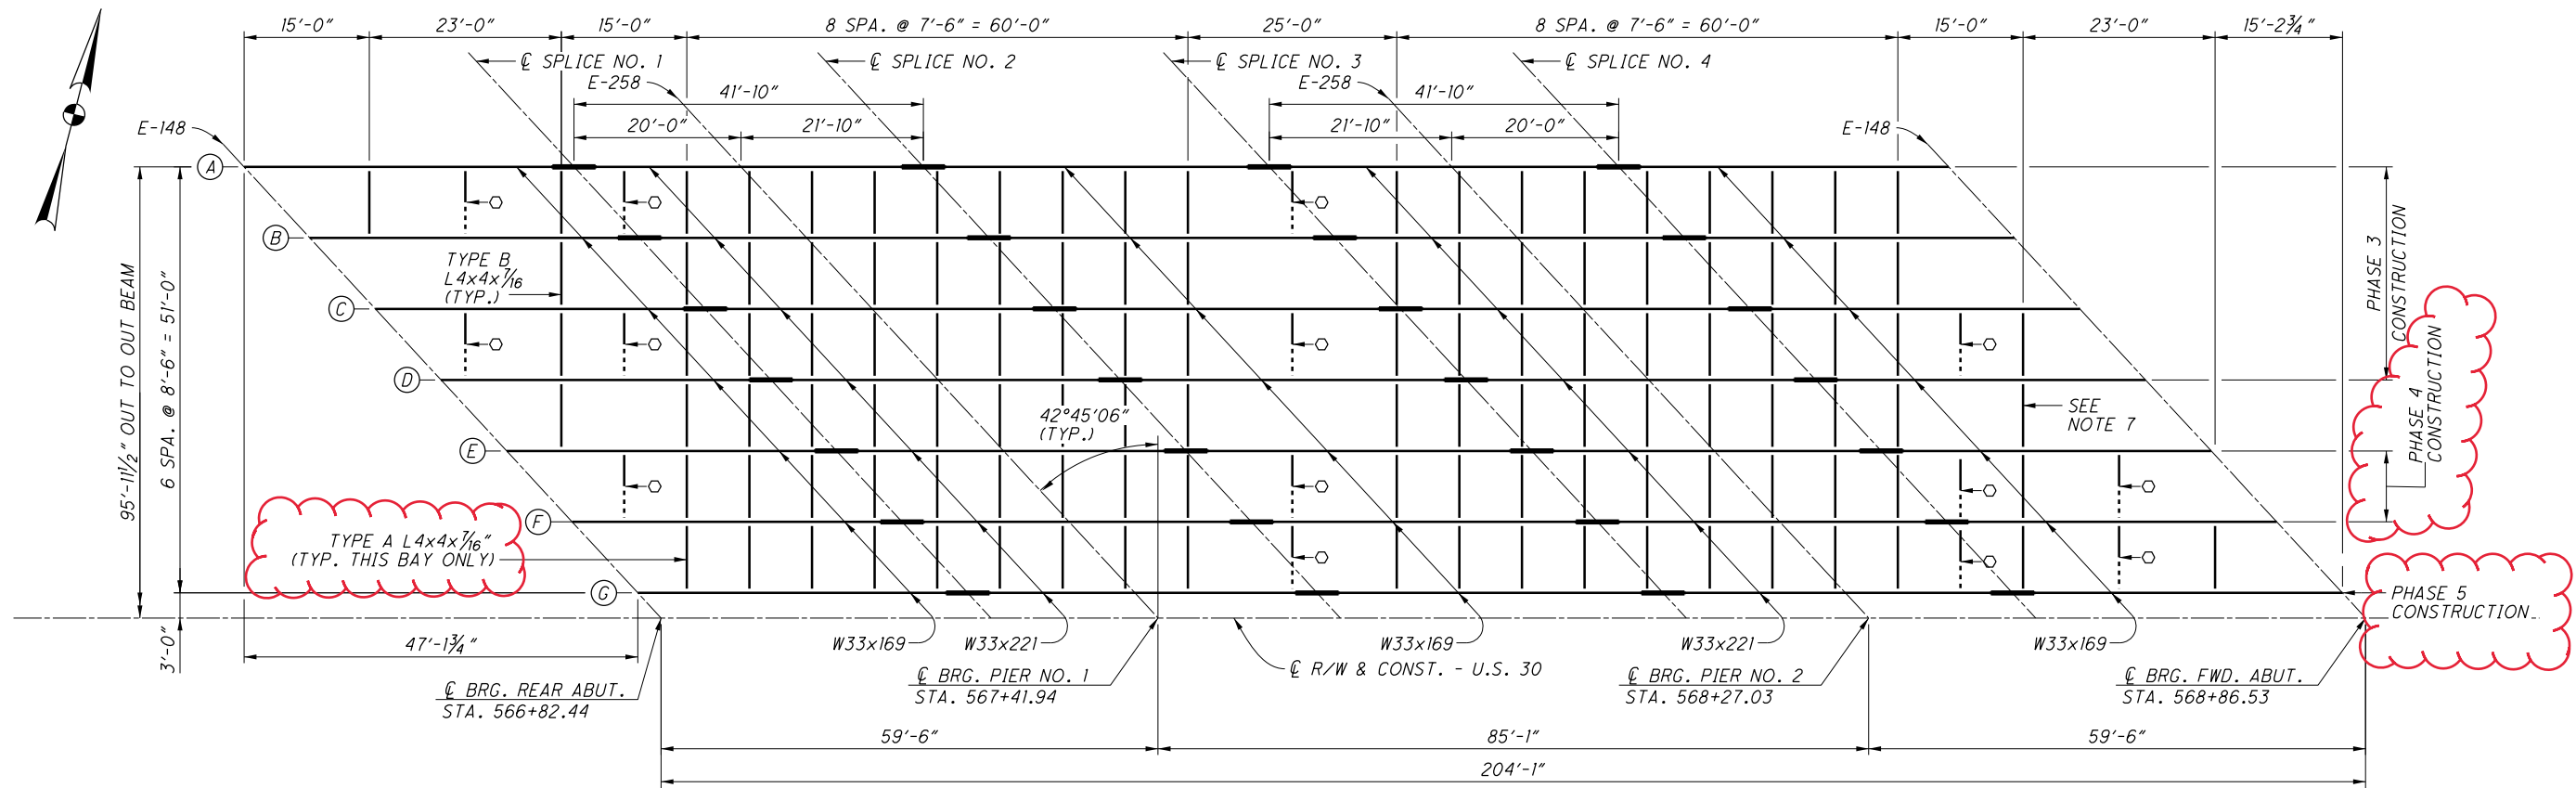

**FRAMING PLAN - WB LANES**  
(LEFT BRIDGE)

○ - TEMPORARY LATERAL SUPPORT  
LOCATE AT 1/2" CROSSFRAME SPACING  
SEE SHEET 35/66

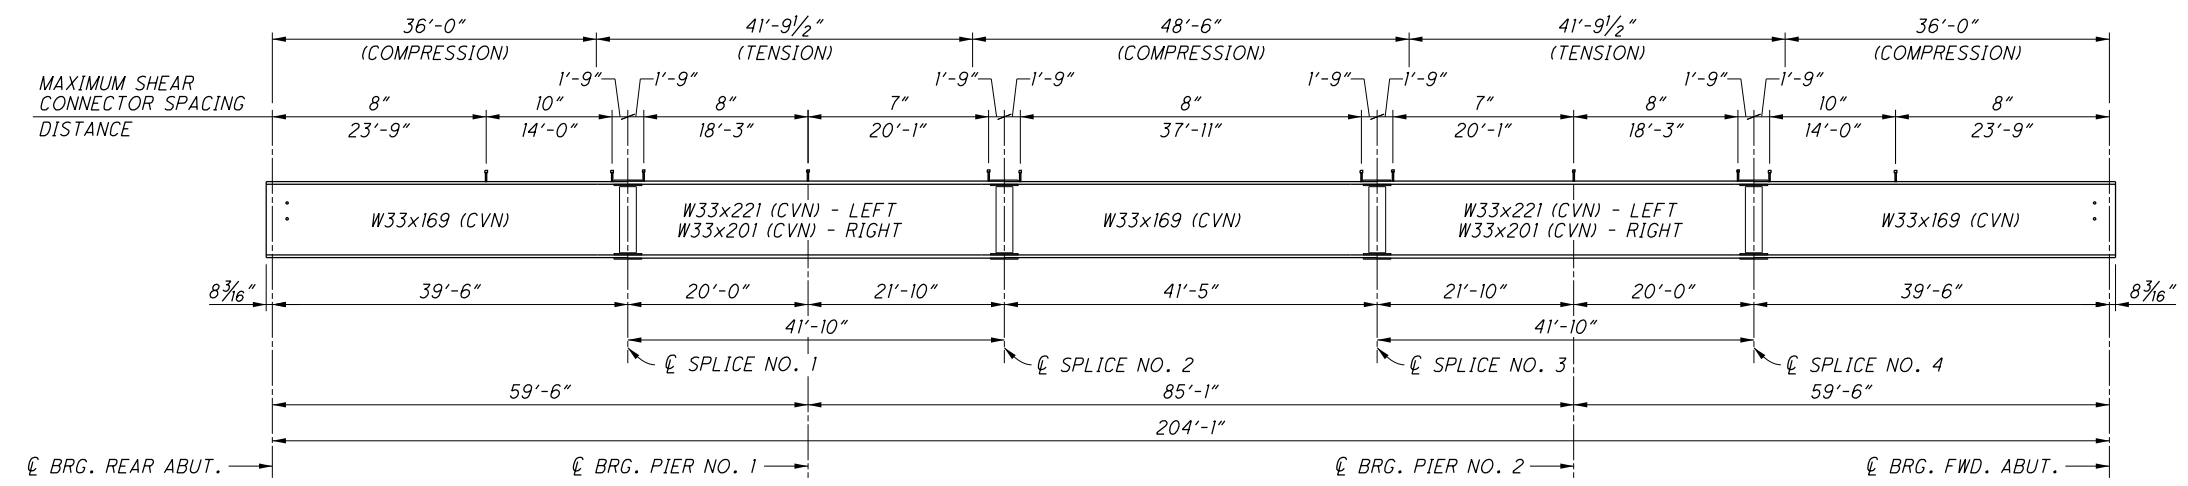

**BEAM ELEVATION**

**NOTES**

- FOR ABBREVIATIONS SEE SHEET 3/66.
- FOR EB LANES FRAMING PLAN AND ADDITIONAL DETAILS SEE SHEET 35/66.
- FOR TRANSVERSE SECTION SEE SHEET 44/66.
- FOR ELASTOMERIC BEARING DETAILS SEE SHEET 31/66.
- FOR SPLICE DETAILS SEE SHEET 36/66.
- WELD ATTACHMENT OF SUPPORTS FOR CONCRETE DECK FINISHING MACHINE TO AREAS OF THE FASCIA STRINGER FLANGES DESIGNATED "COMPRESSION". DO NOT WELD ATTACHMENTS TO AREAS DESIGNATED "TENSION". FILLET WELDS TO COMPRESSION FLANGES SHALL BE AT LEAST 1" FROM EDGE OF FLANGE, BE NO MORE 2" LONG, AND BE AT LEAST 1/4" FOR THICKNESSES UP TO 3/4" OR 5/16" FOR GREATER THAN 3/4" THICK.
- CROSSFRAMES BETWEEN BEAMS D AND E SHALL BE INSTALLED AFTER THE PHASE 3 AND PHASE 4 DECK CONCRETE HAS BEEN POURED AND PRIOR TO DECK CLOSURE POURS.
- CVN: WHERE A SHAPE OR PLATE IS DESIGNATED (CVN), FURNISH MATERIAL THAT MEETS THE MINIMUM NOTCH TOUGHNESS REQUIREMENTS AS SPECIFIED IN 711.01.
- CROSSFRAMES BETWEEN BEAMS F AND G SHALL BE INSTALLED AFTER PHASE 4 DECK CONSTRUCTION. CROSSFRAMES SHALL BE TYPE A. BOLTS SHALL BE TIGHTENED AFTER PHASE 5 DECK CONSTRUCTION.
- FOR INTERMEDIATE CROSS FRAMES SEE STD. DWG GSD-1-19.

DESIGN AGENCY  
**ENGINEERING ASSOCIATES, INC.**  
935 EAGLE PASS - WOOSTER, OHIO 44691  
TELEPHONE: (330) 345-6556  
FAX: (330) 345-8077

DESIGNED: HK  
CHECKED: BDH

DRAWN: TAC  
REVISER: --

REVIEWED: SDS  
DATE: 9-24-19  
STRUCTURE FILE NUMBER: 700119


BRIDGE NO. RIC-30-1074  
OVER S.R. 39

**RIC-30-9.26**  
PID No. 93455

34/66


1237  
1669

M:\15074\93455\Design\Structures\RIC030\_1074C\Sheets\030\_1074CSS002.dgn 2/24/2020 10:46:45 AM ocb284

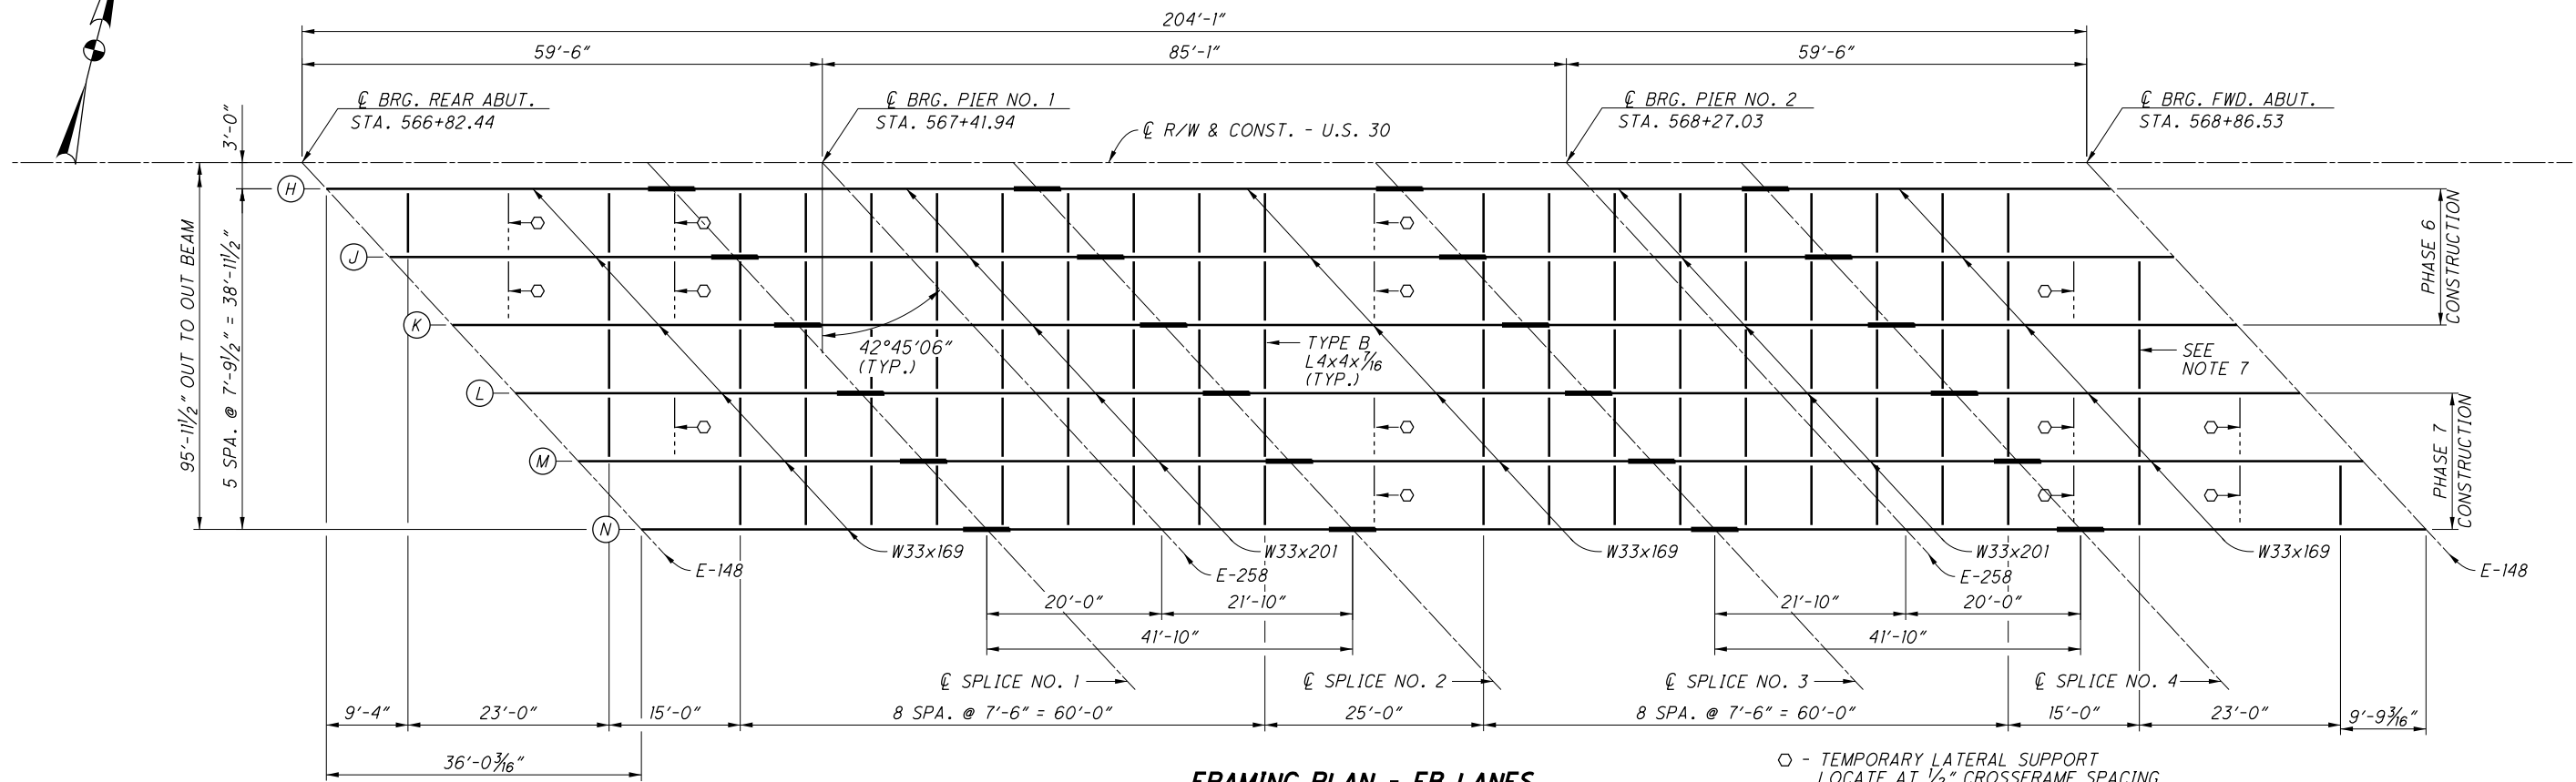


**FRAMING PLAN - EB LANES**  
(RIGHT BRIDGE)

○ - TEMPORARY LATERAL SUPPORT  
LOCATE AT 1/2" CROSSFRAME SPACING

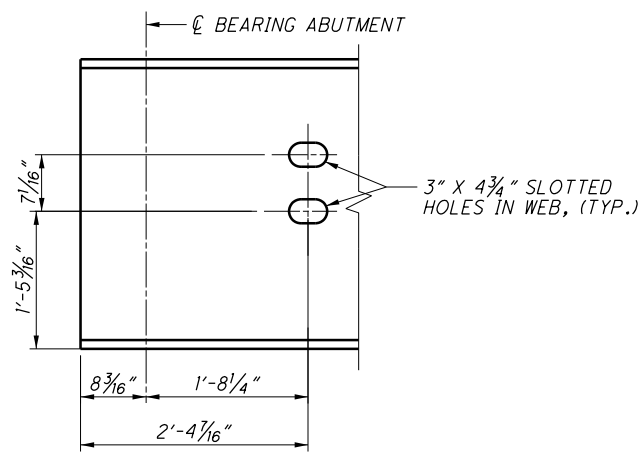


**TYPICAL BEAM END DETAIL**

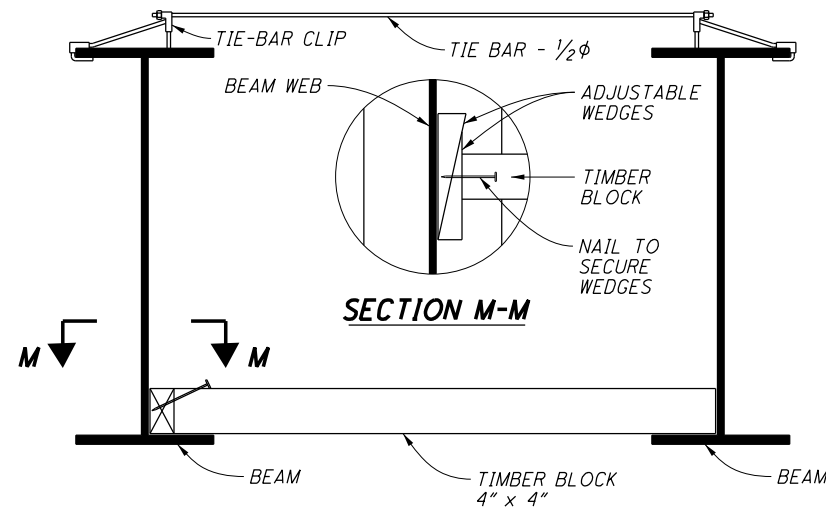

**TEMPORARY LATERAL SUPPORT SYSTEMS**

1. PLACED AS PER PLAN BEFORE DECK POURING.
2. TIMBER BLOCK TO BE REMOVED WHEN DECK IS CURED.

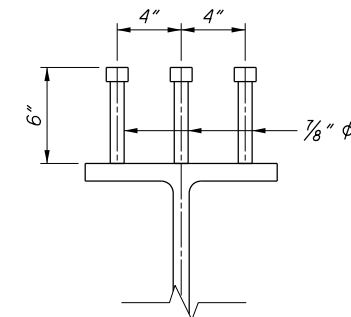


**WELDED STUD SHEAR CONNECTOR DETAIL**

**NOTES**


1. FOR ABBREVIATIONS SEE SHEET [3/66].
2. FOR WB LANES FRAMING PLAN, BEAM ELEVATION AND NOTES SEE SHEET [34/66].
3. FOR TRANSVERSE SECTION SEE SHEET [44/66].
4. FOR ELASTOMERIC BEARING DETAILS SEE SHEET [31/66].
5. FOR SPLICE DETAILS SEE SHEET [36/66].
6. TEMPORARY LATERAL SUPPORTS: THE COST OF MATERIALS, ERECTION AND LABOR SHALL BE INCLUDED IN ITEM 511 CLASS OC2 CONCRETE WITH OC/OA, SUPERSTRUCTURE, AS PER PLAN FOR PAYMENT.
7. CROSSFRAMES BETWEEN BEAMS J AND K SHALL BE INSTALLED AFTER THE PHASE 6 AND PHASE 7 DECK CONCRETE HAS BEEN POURED AND PRIOR TO DECK CLOSURE POURS.
8. FOR INTERMEDIATE CROSS FRAME SEE STD. DWG. GSD-1-19.

DESIGNED	CHK	DRAWN	REVIEWED	DATE	DESIGN AGENCY
BKH	TAC	SDS	9-24-19	ENGINEERING ASSOCIATES, INC.	
CHECKED	REVISED	STRUCTURE FILE NUMBER	700119	895 EAGLE PASS - WOOSTER, OHIO 44691	
BDH	--			TELEPHONE: (330) 345-6556	
				FAX: (330) 345-8077	
<b>FRAMING PLAN - RIGHT (EASTBOUND)</b>					
BRIDGE NO. RIC-30-1074					
OVER S.R. 39					
<b>RIC-30-9-26</b>					
<b>PID No. 93455</b>					
35/66					
1238					
1669					


M:\15074\93455\Design\Structures\RIC030\_1074C\Sheets\030\_1074CST001.dgn 2/24/2020 10:48:26 AM ocb284

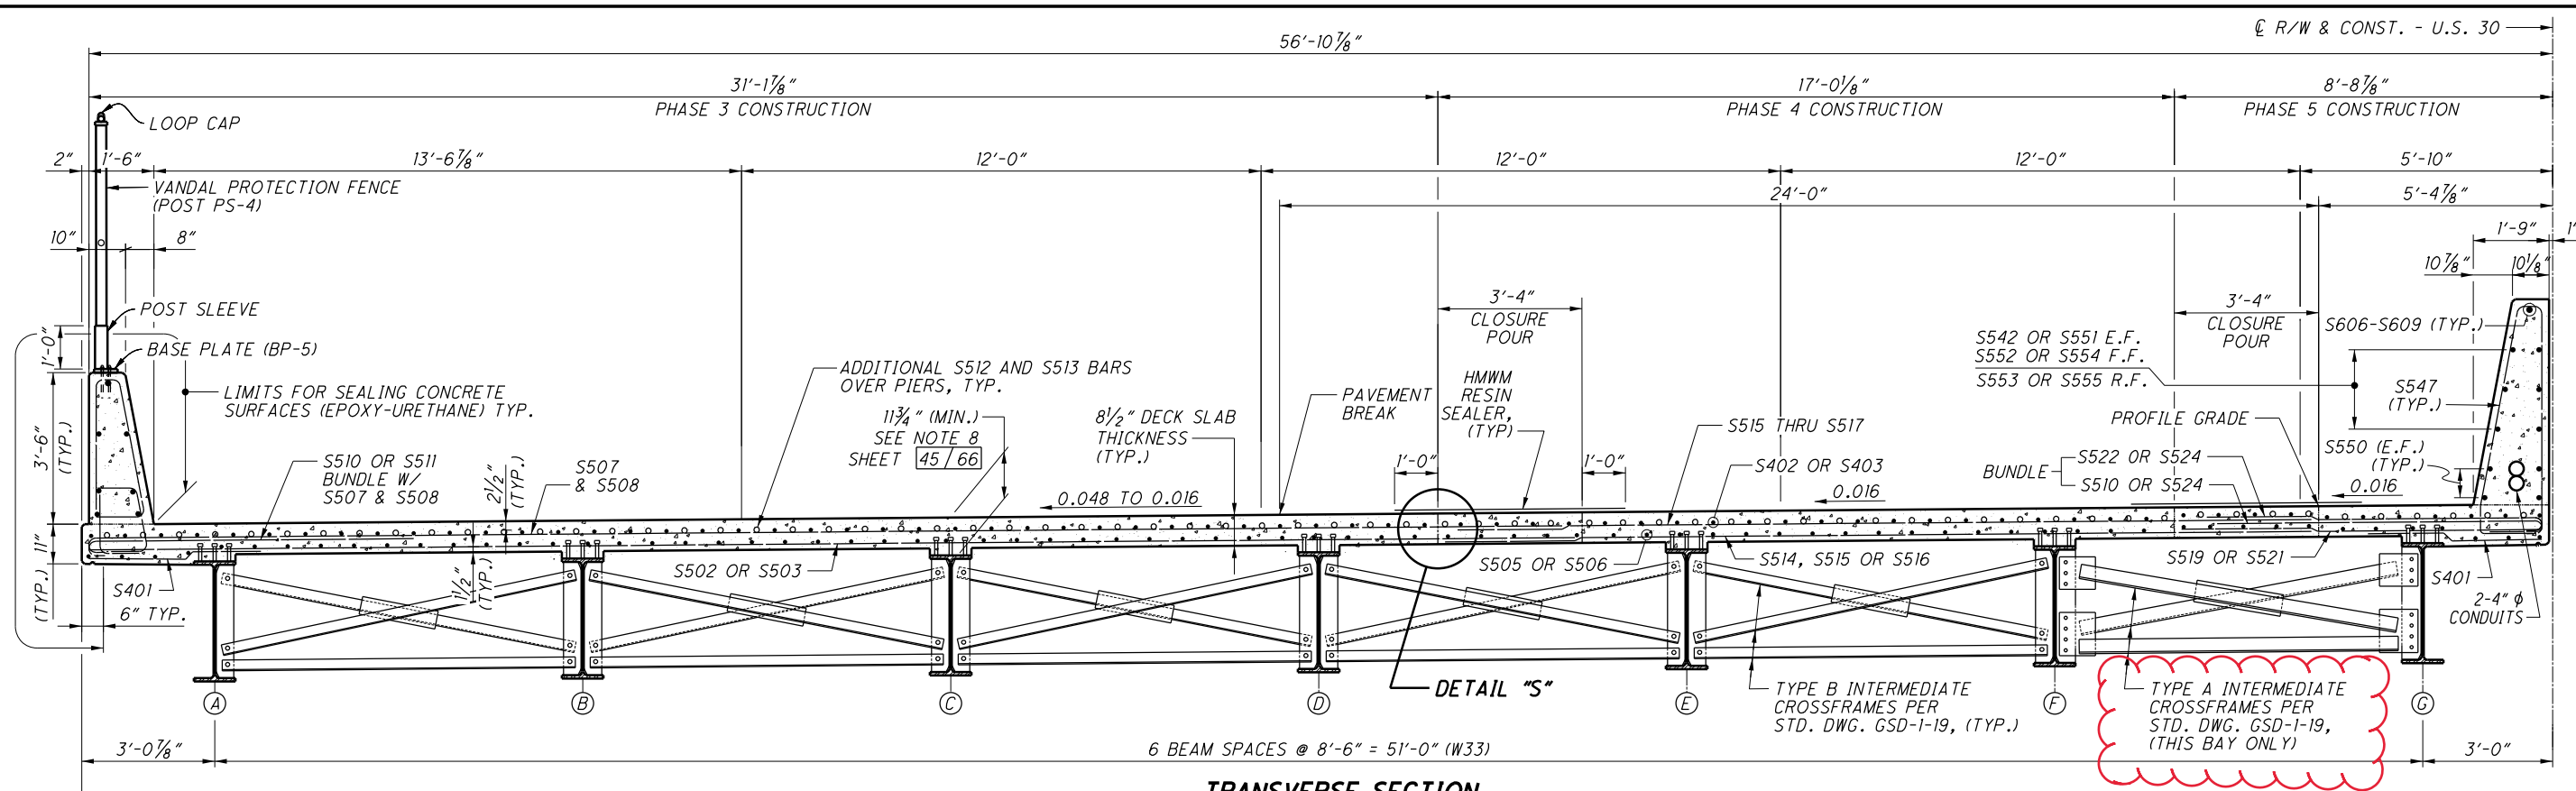

**TRANSVERSE SECTION**

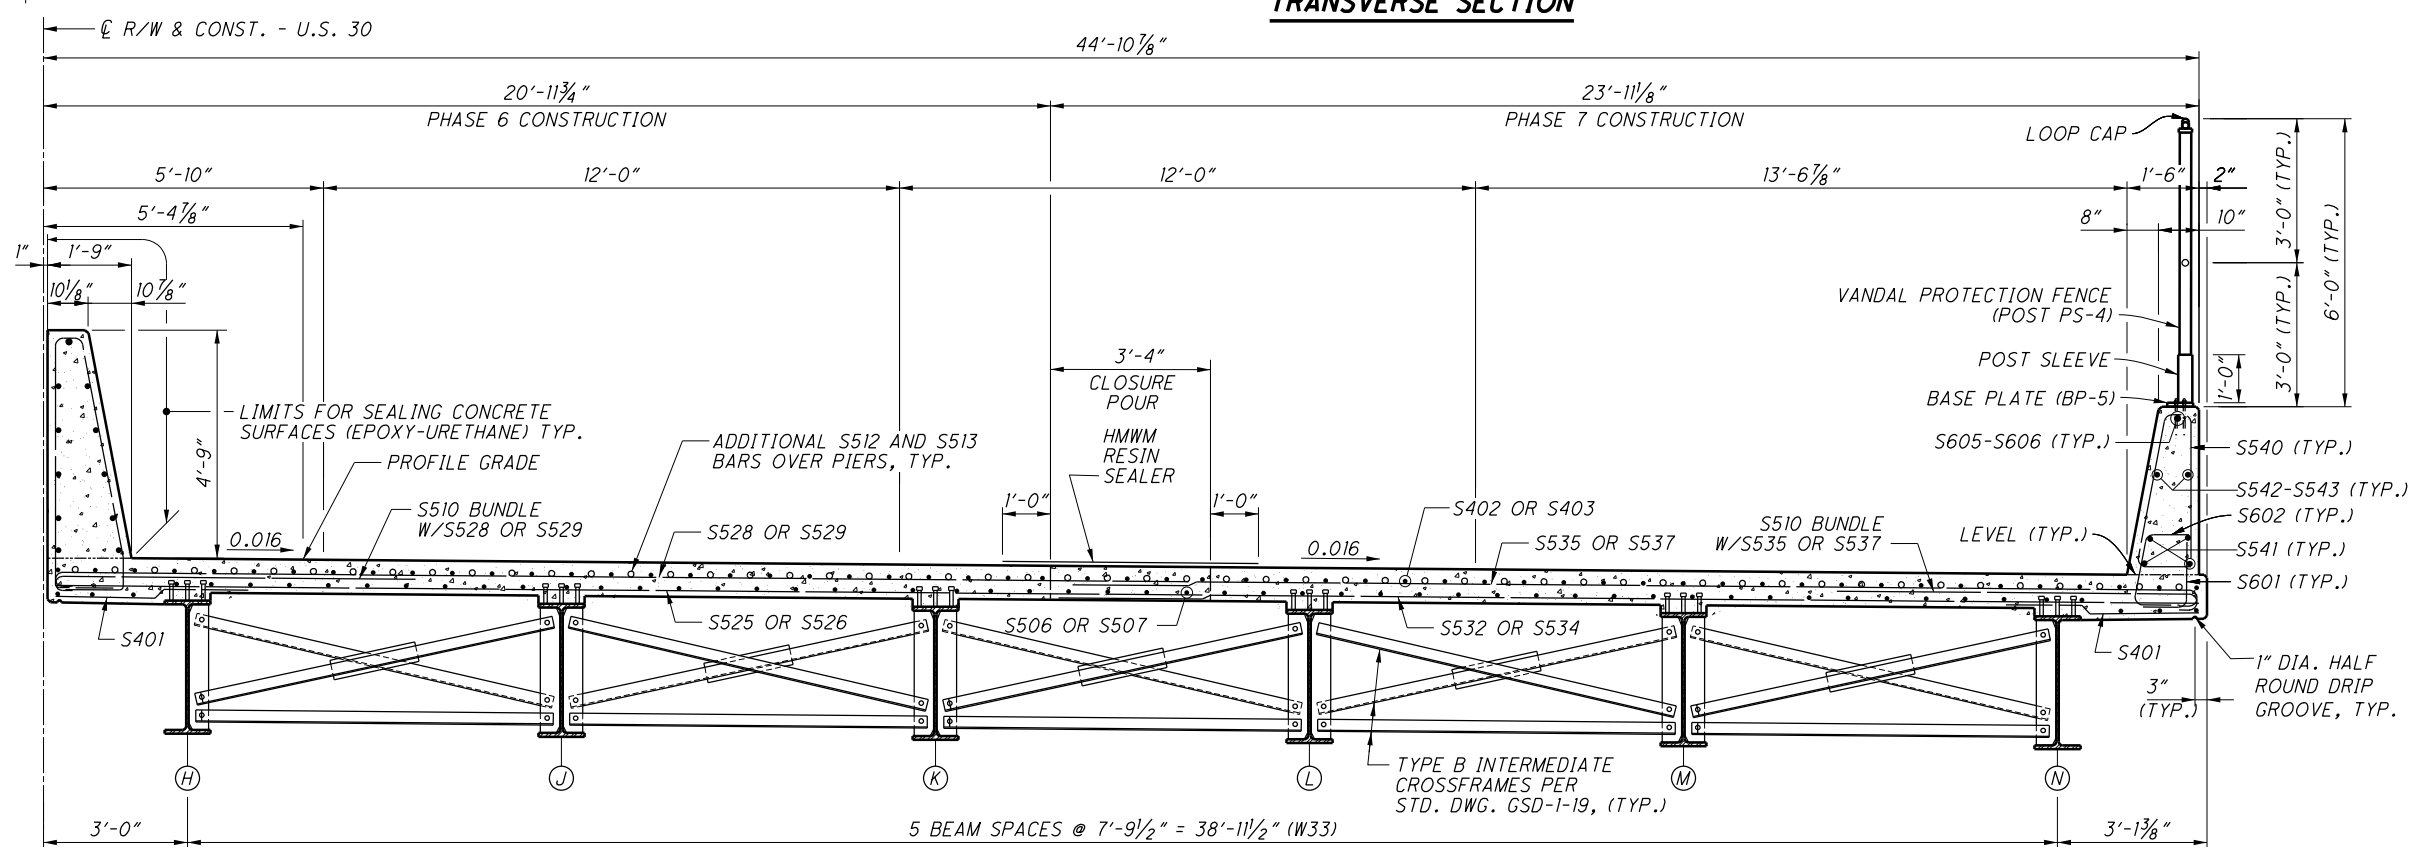

**TRANSVERSE SECTION**

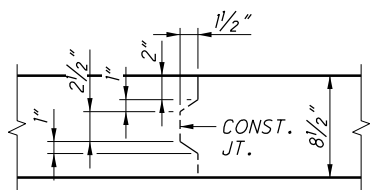

**CONST. JOINT DETAIL  
DETAIL "S" (TYPICAL)**

**NOTES**

1. FOR ABBREVIATIONS SEE SHEET 3/66.
2. FOR SLAB PLAN SEE SHEET 45/66 AND 46/66.
3. FOR SCREED ELEVATIONS SEE SHEET 41/66.
4. FOR BARRIER MEDIAN AND RAILING DETAILS SEE SHEETS 47/66 THRU 50/66.
5. MINIMUM BAR LAPS:  
NO. 4 BAR = 1'-11"  
NO. 5 BARS = 2'-5"  
NO. 5 BARS = 3'-0" S502, S504, S514, S516, S519, S525, S527, S532 & S533  
NO. 6 BAR = 3'-7"
6. THE CLOSURE POUR SHALL BE SEALED WITH HIGH MOLECULAR WEIGHT METHACRYLATE (HMWM) RESIN IN ACCORDANCE OF ITEM 512. THE RESIN SHALL COVER THE ENTIRE CLOSURE POUR SECTION AND OVERLAP EACH CONSTRUCTION JOINT 1'-0".

DESIGN AGENCY: **ENGINEERING ASSOCIATES, INC.**  
 895 EAGLE PASS - WOOSTER, OHIO 44691  
 TELEPHONE: (330) 345-6556  
 FAX: (330) 345-8077

DATE: 9-24-19  
 SDS: 9-24-19  
 STRUCTURE FILE NUMBER: 700119

DESIGNED: BK  
 CHECKED: BDH

**TRANSVERSE SECTION**  
 BRIDGE NO. RIC-30-1074  
 OVER S.R. 39

**RIC-30-9.26**  
 PID No. 93455

44/66  
 1247  
 1669

**STANDARD DRAWINGS**

REFER TO THE FOLLOWING STANDARD BRIDGE DRAWINGS:

AS-1-15	REVISED	7-17-15
AS-2-15	REVISED	1-18-19
GSD-1-19	DATED	1-18-19
PCB-91	REVISED	1-18-13
SBR-1-13	REVISED	7-20-18
SBR-2-13	REVISED	7-20-18
SICD-1-96	REVISED	7-18-14
SICD-2-14	DATED	7-18-14
VPF-1-90	REVISED	7-20-18

**DESIGN SPECIFICATIONS**

THIS STRUCTURE CONFORMS TO THE "LRFD BRIDGE DESIGN SPECIFICATIONS" ADOPTED BY THE AMERICAN ASSOCIATION OF STATE HIGHWAY AND TRANSPORTATION OFFICIALS, 2017, 8TH EDITION AND THE ODOT BRIDGE DESIGN MANUAL, 2019.

**OPERATIONAL IMPORTANCE**

A LOAD MODIFIER OF 1.0 HAS BEEN ASSUMED FOR THE DESIGN OF THIS STRUCTURE IN ACCORDANCE WITH THE AASHTO LRFD BRIDGE DESIGN SPECIFICATIONS, ARTICLE 1.3.5 AND THE ODOT BRIDGE DESIGN MANUAL, 2019.

**DESIGN LOADING**

HL-93  
FUTURE WEARING SURFACE (FWS) OF 0.060 KIPS/FT<sup>2</sup>.

**DESIGN DATA**

CONCRETE CLASS QC2 WITH QC/OA - COMPRESSIVE STRENGTH 4.5 KSI (SUPERSTRUCTURE)

CONCRETE CLASS QCI WITH QC/OA - COMPRESSIVE STRENGTH 4.0 KSI (SUBSTRUCTURE)

CONCRETE CLASS QC5 - COMPRESSIVE STRENGTH 4.5 KSI (DRILLED SHAFT)

REINFORCING STEEL - MINIMUM YIELD STRENGTH 60 KSI

STRUCTURAL STEEL - ASTM A709 GRADE 50 - YIELD STRENGTH 50 KSI

STEEL H-PILES - ASTM A572 - YIELD STRENGTH 50 KSI

**DECK PROTECTION METHOD**

EPOXY COATED REINFORCING STEEL  
2 1/2" CONCRETE COVER

**MONOLITHIC WEARING SURFACE**

MONOLITHIC WEARING SURFACE IS ASSUMED, FOR DESIGN PURPOSES, TO BE 1 INCH THICK.

**ITEM 202, PORTIONS OF STRUCTURE REMOVED, OVER 20 FOOT SPAN, AS PER PLAN:**

THIS ITEM SHALL INCLUDE THE ELEMENTS INDICATED IN THE PLANS AND GENERAL NOTES AND THAT ARE NOT SEPARATELY LISTED FOR PAYMENT, EXCEPT FOR WEARING COURSE REMOVAL. ITEMS TO BE REMOVED INCLUDE ALL EXISTING MATERIALS BEING REPLACED BY NEW CONSTRUCTION AND MISCELLANEOUS ITEMS THAT ARE NOT SHOWN TO BE INCORPORATED INTO THE FINAL CONSTRUCTION AND ARE DIRECTED TO BE REMOVED BY THE ENGINEER. THE USE OF EXPLOSIVES, HEADACHE BALLS AND/OR HOE-RAMS WILL NOT BE PERMITTED. THE METHOD OF REMOVAL AND THE WEIGHT OF HAMMER SHALL BE APPROVED BY THE ENGINEER. PERFORM ALL WORK IN A MANNER THAT WILL NOT CUT, ELONGATE OR DAMAGE THE EXISTING REINFORCING STEEL TO BE PRESERVED. CHIPPING HAMMERS SHALL NOT BE HEAVIER THAN THE NOMINAL 90-POUND CLASS. PNEUMATIC HAMMERS SHALL NOT BE PLACED IN DIRECT CONTACT WITH REINFORCING STEEL THAT IS TO BE RETAINED IN THE REBUILT STRUCTURE. SUBMIT CONSTRUCTION PLANS ACCORDING TO C&MS 501.05

**SUBSTRUCTURE CONCRETE REMOVAL:**

REMOVE CONCRETE BY MEANS OF APPROVED PNEUMATIC HAMMERS EMPLOYING POINTED AND BLUNT CHISEL TOOLS. HYDRAULIC HOE-RAM TYPE HAMMERS WILL NOT BE PERMITTED. THE WEIGHT OF THE HAMMER SHALL NOT BE MORE THAN 35 POUNDS FOR REMOVAL WITHIN 18 INCHES OF PORTIONS TO BE PRESERVED. OUTSIDE THE 18 INCH LIMIT, THE CONTRACTOR MAY USE HAMMERS NOT EXCEEDING 90 POUNDS UPON THE APPROVAL OF THE ENGINEER. DO NOT PLACE PNEUMATIC HAMMERS IN DIRECT CONTACT WITH REINFORCING STEEL THAT IS TO BE RETAINED IN THE REBUILT STRUCTURE.

**ITEM 203 EMBANKMENT, AS PER PLAN**

PLACE AND COMPACT EMBANKMENT MATERIAL IN 6 INCH LIFTS FOR THE CONSTRUCTION OF THE APPROACH EMBANKMENT BETWEEN STATIONS 597+50 TO 602+50.

**PILES TO BEDROCK**

DRIVE PILES TO REFUSAL ON BEDROCK. THE DEPARTMENT WILL CONSIDER REFUSAL TO BE OBTAINED WHEN THE PILE PENETRATION IS AN INCH OR LESS AFTER RECEIVING AT LEAST 20 BLOWS FROM THE PILE HAMMER. SELECT THE HAMMER SIZE TO ACHIEVE THE REQUIRED DEPTH TO BEDROCK AND REFUSAL.

THE TOTAL FACTORED LOAD IS 132 KIPS PER PILE FOR THE ABUTMENT PILES.

REAR ABUTMENT PILES: (HP 10X42)  
23 PILES 50 FEET LONG, ORDER LENGTH

FORWARD ABUTMENT PILES: (HP 10X42)  
23 PILES 60 FEET LONG, ORDER LENGTH

**PILE SPLICES**

IN LIEU OF USING THE FULL PENETRATION BUTT WELDS SPECIFIED IN CMS 507.09 TO SPLICE STEEL H-PILES, THE CONTRACTOR MAY USE A MANUFACTURED H-PILE SPLICER. FURNISH SPLICERS FROM THE FOLLOWING MANUFACTURER:

ASSOCIATED PILE AND FITTING CORPORATION  
8 WOOD HOLLOW RD. PLAZA 1  
PARSIPPANY, NEW JERSEY 07054

INSTALL AND WELD THE SPLICER TO THE PILE SECTIONS IN ACCORDANCE WITH THE MANUFACTURER'S WRITTEN ASSEMBLY PROCEDURE SUPPLIED TO THE ENGINEER BEFORE THE WELDING IS PERFORMED.

**ITEM 503, COFFERDAMS AND EXCAVATION BRACING, AS PER PLAN**

THE DESIGN SHOWN ON THE PLANS FOR TEMPORARY SUPPORT OF EXCAVATION IS ONE REPRESENTATIVE DESIGN THAT MAY BE USED TO CONSTRUCT THE PROJECT. THE CONTRACTOR MAY CONSTRUCT THE DESIGN SHOWN ON THE PLANS OR PREPARE AN ALTERNATE DESIGN TO SUPPORT THE SIDES OF EXCAVATION. IF CONSTRUCTING AN ALTERNATE DESIGN FOR TEMPORARY SUPPORT OF EXCAVATION, PREPARE AND PROVIDE PLANS IN ACCORDANCE WITH C&MS 501.05. THE DEPARTMENT WILL PAY FOR THE TEMPORARY SUPPORT OF EXCAVATION AT THE CONTRACT LUMP SUM PRICE FOR COFFERDAMS AND EXCAVATION BRACING. NO ADDITIONAL PAYMENT WILL BE MADE FOR PROVIDING AN ALTERNATE DESIGN.

**DECK PLACEMENT ASSUMPTIONS**

THE FOLLOWING ASSUMPTIONS OF CONSTRUCTION MEANS AND METHODS WERE MADE FOR THE ANALYSIS AND DESIGN OF THE SUPERSTRUCTURE. THE CONTRACTOR IS RESPONSIBLE FOR THE DESIGN OF THE FALSEWORK SUPPORT SYSTEM WITHIN THESE PARAMETERS AND WILL ASSUME RESPONSIBILITY FOR SUPERSTRUCTURE ANALYSIS FOR DEVIATION FROM THESE DESIGN ASSUMPTIONS.

AN EIGHT WHEEL FINISHING MACHINE WITH A MAXIMUM WHEEL LOAD OF 2.3 KIPS.

A MINIMUM OUT-TO-OUT WHEEL SPACING AT EACH END OF THE MACHINE OF 103".

A MAXIMUM SPACING OF OVERHANG FALSEWORK BRACKETS OF 48".

A MAXIMUM DISTANCE FROM THE CENTERLINE OF THE FASCIA GIRDER TO THE FACE OF THE SAFETY HANDRAIL OF 65".

**MECHANICAL CONNECTORS:**

AN APPROVED TYPE OF MECHANICAL CONNECTOR FOR REINFORCING BARS SHALL BE PROVIDED. INSTALLATION OF CONNECTORS SHALL CONFORM WITH MANUFACTURER'S RECOMMENDED PROCEDURES.

CONNECTORS USED WITH EPOXY COATED BARS SHALL BE EPOXY COATED. COATINGS USED SHALL CONFORM TO THE SAME SPECIFICATION. COATINGS WHICH HAVE BEEN DAMAGED OR WHICH OTHERWISE DO NOT MEET SPECIFICATION WITH RESPECT TO COLOR, CONTINUITY, AND UNIFORMITY MAY BE REPAIRED AS DIRECTED BY THE ENGINEER OR THEY SHALL BE REPLACED WITH MATERIAL WHICH MEET THE SPECIFICATIONS. CONNECTORS SHALL BE INCLUDED IN ITEM 509 FOR PAYMENT.

REINFORCING STEEL LENGTHS IN THE TABLES FOR BARS THAT ARE TO BE MECHANICALLY SPLICED ASSUME AN END TO END TYPE CONNECTOR WILL BE USED. IF THE CONTRACTOR ELECTS TO USE ANOTHER TYPE OF CONNECTOR THE FABRICATOR SHALL BE DIRECTED TO MAKE ADJUSTMENTS TO THE REINFORCING STEEL LENGTHS ACCORDINGLY.

**DRILLED SHAFTS:**

THE MAXIMUM FACTORED LOAD TO BE SUPPORTED BY EACH DRILLED SHAFT IS 265 KIPS AT THE PIERS. THIS LOAD IS RESISTED BY SIDE RESISTANCE WITHIN A PORTION OF THE BEDROCK SOCKET AND ALSO BY TIP RESISTANCE. THE FACTORED RESISTANCE DEVELOPED BY SIDE RESISTANCE IS 0 KIPS, ASSUMED TO ACT ALONG THE BOTTOM 0 FEET OF THE BEDROCK SOCKET FOR THE PIERS. THE FACTORED RESISTANCE PROVIDED BY THE DRILLED SHAFT TIP IS 2400 KIPS.

**CUT LINE CONSTRUCTION JOINT PREPARATION:**

SAW CUT BOUNDARIES OF PROPOSED CONCRETE REMOVALS 1 INCH DEEP. REMOVE CONCRETE TO A ROUGH SURFACE. LEAVE THE EXISTING REINFORCING STEEL, IF REQUIRED IN THE PLANS, IN PLACE. INSTALL DOWEL BARS IF SPECIFIED. PRIOR TO CONCRETE PLACEMENT ABRASIVELY CLEAN JOINT SURFACES AND EXISTING EXPOSED REINFORCEMENT TO REMOVE LOOSE AND DISINTEGRATED CONCRETE AND LOOSE RUST. THOROUGHLY CLEAN THE JOINT SURFACE AND EXPOSED REINFORCEMENT OF ALL DIRT, DUST, RUST OR OTHER FOREIGN MATERIAL BY THE USE OF WATER, AIR UNDER PRESSURE, OR OTHER METHODS THAT PRODUCE SATISFACTORY RESULTS. EXISTING REINFORCING STEEL DOES NOT HAVE TO HAVE A BRIGHT STEEL FINISH BUT REMOVE ALL PACK AND LOOSE RUST. THOROUGHLY DRENCH EXISTING CONCRETE SURFACES WITH CLEAN WATER AND ALLOW TO DRY TO A DAMP CONDITION BEFORE PLACING CONCRETE.

**STRUCTURE PAINTING:** ALL BRIDGE FINISH COATS SHALL BE THE SAME COLOR.

**ABBREVIATIONS**

ABUT.	-	ABUTMENT
APPR.	-	APPROACH
BRG.	-	BEARING
BOT.	-	BOTTOM
CONST. JT.	-	CONSTRUCTION JOINT
CLR.	-	CLEAR
CONST.	-	CONSTRUCTION
CORR.	-	CORRUGATED
DIA.	-	DIAMETER
DIM.	-	DIMENSION
DWG.	-	DRAWING
EL.	-	ELEVATION
E.F.	-	EACH FACE
EXIST.	-	EXISTING
F.A.	-	FORWARD ABUTMENT
FWD.	-	FORWARD
F.F.	-	FRONT FACE
FT.	-	FEET
LBS.	-	POUNDS
MAX.	-	MAXIMUM
MEAS.	-	MEASURED
MIN.	-	MINIMUM
OPT.	-	OPTIONAL
P.E.J.F.	-	PERFORMED EXPANSION JOINT FILLER
R.A.	-	REAR ABUTMENT
R.F.	-	REAR FACE
REQ'D.	-	REQUIRED
SPA.	-	SPACING
STA.	-	STATION
T.O.S.	-	TOP OF SLOPE
TYP.	-	TYPICAL
U.O.N.	-	UNLESS OTHERWISE NOTED
VAR.	-	VARIES
W/	-	WITH

DESIGN AGENCY: ENGINEERING ASSOCIATES, INC.  
 8955 EAGLE PASS - WOOSTER, OHIO 44691  
 TELEPHONE: (330) 345-6556  
 FAX: (330) 345-8077

DATE: 9-24-19  
 FILE NUMBER: 7001143

REVIEWED: SDS  
 STRUCTURE FILE NUMBER: 7001143

DRAWN: TAC  
 TAC REVISED

DESIGNED: HK  
 CHECKED: BDH

**GENERAL NOTES**  
 BRIDGE NO. RIC-30-1135  
 BOWMAN STREET

RIC-30-9-26  
 PID No. 93455

3 / 56

1272  
 1669

M:\15074\93455\Design\Structures\RICO30\_1135C\Sheets\030\_1135CSQ001.dgn 2/24/2020 10:51:14 AM acb284

CALC: RLE DATE: 5/28/2019  
 CHECKED: TAC DATE: 6/1/2019

**ESTIMATED QUANTITIES**

ITEM	EXTENSION	TOTAL 01/NHS/BR	UNIT	DESCRIPTION	ABUT.	PIERS	SUPER.	GEN.	SEE SHEET
202	11203	LS		PORTIONS OF STRUCTURE REMOVED, OVER 20 FOOT SPAN, AS PER PLAN				LS	3/56
202	22900	258	SY	APPROACH SLAB REMOVED				258	
202	23500	258	SY	WEARING COURSE REMOVED				258	
503	11101	LS		COFFERDAMS AND EXCAVATION BRACING, AS PER PLAN				LS	3/56
503	21100	384	CY	UNCLASSIFIED EXCAVATION	384				
504	11100	3840	SF	STEEL SHEET PILING LEFT IN PLACE, Sx = 34.8 IN <sup>3</sup> /FT				3840	
505	11100	LS		PILE DRIVING EQUIPMENT MOBILIZATION				LS	
507	00100	2530	FT	STEEL PILES HPI0X42, FURNISHED	2530				
507	00150	2300	FT	STEEL PILES HPI0X42, DRIVEN	2300				
509	10001	227811	LB	EPOXY COATED REINFORCING STEEL, AS PER PLAN	21843	59290	146678		23/56
510	10000	24	EACH	DOWEL HOLES WITH NONSHRINK, NONMETALLIC GROUT	24				
511	21523	645	CY	CLASS OC2 CONCRETE WITH OC/OA, SUPERSTRUCTURE, AS PER PLAN			645		5/56 & 33/56
511	33500	4	EACH	SEMI-INTEGRAL DIAPHRAGM GUIDE			4		
511	41012	153	CY	CLASS OC1 CONCRETE WITH OC/OA, PIER ABOVE FOOTINGS		153			
511	44112	85	CY	CLASS OC1 CONCRETE WITH OC/OA, ABUTMENT NOT INCLUDING FOOTING	85				
511	46512	148	CY	CLASS OC1 CONCRETE WITH OC/OA, FOOTING	148				
512	10100	1155	SY	SEALING OF CONCRETE SURFACES (EPOXY-URETHANE)	48	397	654	56	
512	10300	233	SY	SEALING CONCRETE BRIDGE DECKS WITH HMWM RESIN			204	29	
512	33000	16	SY	TYPE 2 WATERPROOFING	16				
513	10260	371800	LB	STRUCTURAL STEEL MEMBERS, LEVEL 3			371800		
513	20000	8676	EACH	WELDED STUD SHEAR CONNECTORS			8676		
514	00800	371800	LB	FIELD PAINTING STRUCTURAL STEEL, INTERMEDIATE COAT			371800		
514	00851	371800	LB	FIELD PAINTING STRUCTURAL STEEL, FINISH COAT, AS PER PLAN			371800		3/56
514	10000	19	EACH	FINAL INSPECTION REPAIR			19		
516	10010	176	FT	ARMORLESS PREFORMED JOINT SEAL				176	
516	13600	26	SF	1" PREFORMED EXPANSION JOINT FILLER			26		
516	13900	285	SF	2" PREFORMED EXPANSION JOINT FILLER			60	225	
516	14020	261	FT	SEMI-INTEGRAL ABUTMENT EXPANSION JOINT SEAL	261				
516	44101	24	EACH	ELASTOMERIC BEARING WITH INTERNAL LAMINATES AND LOAD PLATE (NEOPRENE), AS PER PLAN 2 13/16"x1'-2"x1'-5" W/ 1 x1'-3"x1'-6" BEVELED LOAD PLATE		24			28/56
516	44101	24	EACH	ELASTOMERIC BEARING WITH INTERNAL LAMINATES AND LOAD PLATE (NEOPRENE), AS PER PLAN 2 1/2"x11"x1'-0" W/ 1 5/8"x1'-0"x1'-1" BEVELED LOAD PLATE	24				28/56
518	21200	97	CY	POROUS BACKFILL WITH GEOTEXTILE FABRIC	97				
518	40001	220	FT	6" PERFORATED CORRUGATED PLASTIC PIPE, AS PER PLAN	220				15/56 & 19/56
518	40010	22	FT	6" NON-PERFORATED CORRUGATED PLASTIC PIPE, INCLUDING SPECIALS	22				
524	95434	84	FT	DRILLED SHAFTS, 36" DIAMETER, INTO BEDROCK WITH OC/OA		84			
524	95442	278	FT	DRILLED SHAFTS, 42" DIAMETER, ABOVE BEDROCK WITH OC/OA		278			
526	15001	390	SY	REINFORCED CONCRETE APPROACH SLABS (T=13"), AS PER PLAN				390	43/56 THRU 47/56
526	90030	176	FT	TYPE C INSTALLATION				176	
601	21000	932	SY	CONCRETE SLOPE PROTECTION				932	
607	39900	289	FT	VANDAL PROTECTION FENCE, 6' STRAIGHT, COATED FABRIC			289		

DESIGN AGENCY  
**ENGINEERING ASSOCIATES, INC.**  
 8955 EAGLE PASS - WOOSTER, OHIO 44691  
 TELEPHONE: (330) 345-6556  
 FAX: (330) 345-9077


DATE: 9-24-19  
 FILE NUMBER: 7001143  
 REVIEWED: SDS  
 STRUCTURE: XXX  
 DRAWN: TAC  
 CHECKED: XXX  
 DESIGNED: HK  
 CHECKED: BDH

**ESTIMATED QUANTITIES**  
 BRIDGE NO. RIC-30-1135  
 OVER BOWMAN STREET


**RIC-30-9-26**  
 PID No. 93455  
 4/56  
 1273  
 1669




M:\15074\93455\Design\Structures\RIC030\_1135CSB001.dgn 2/24/2020 10:53:03 AM ocb284

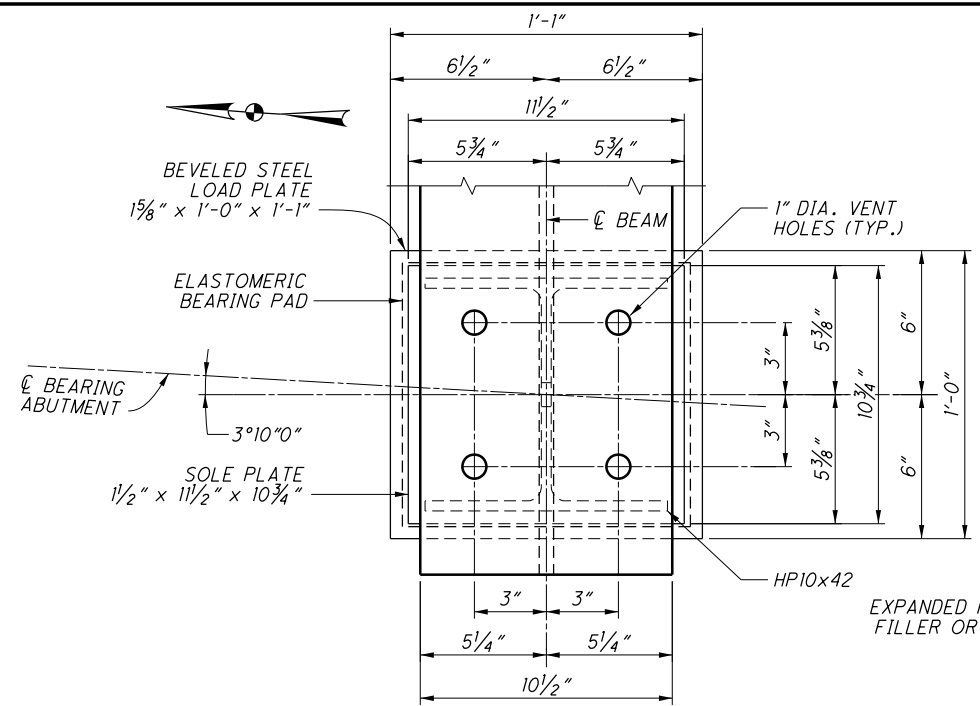


**PLAN AT ABUTMENT**  
(REAR ABUTMENT SHOWN,  
FORWARD ABUTMENT SIMILAR)

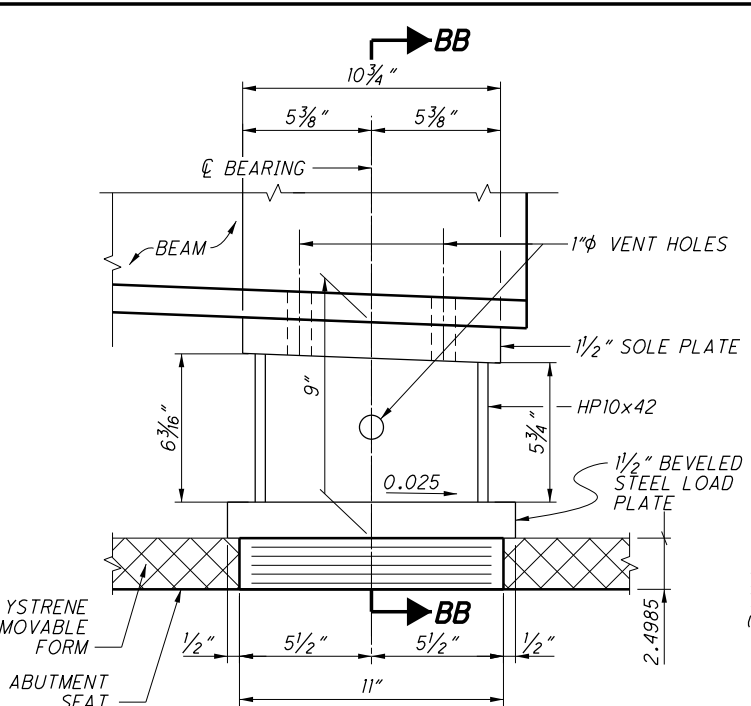


**ABUTMENT BEARING ELEVATION**

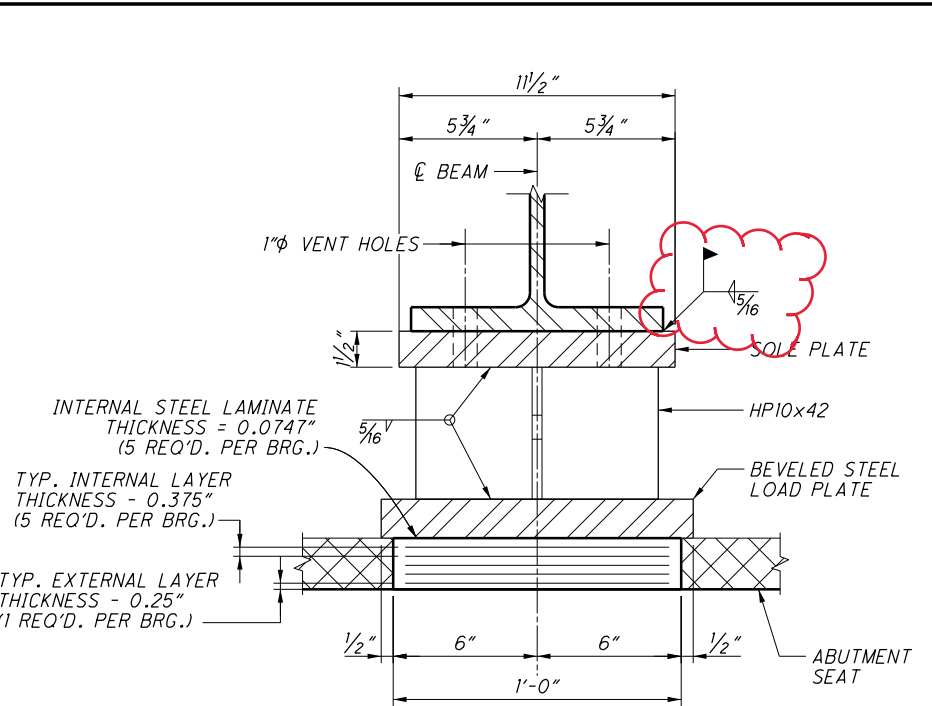


**SECTION BB-BB**

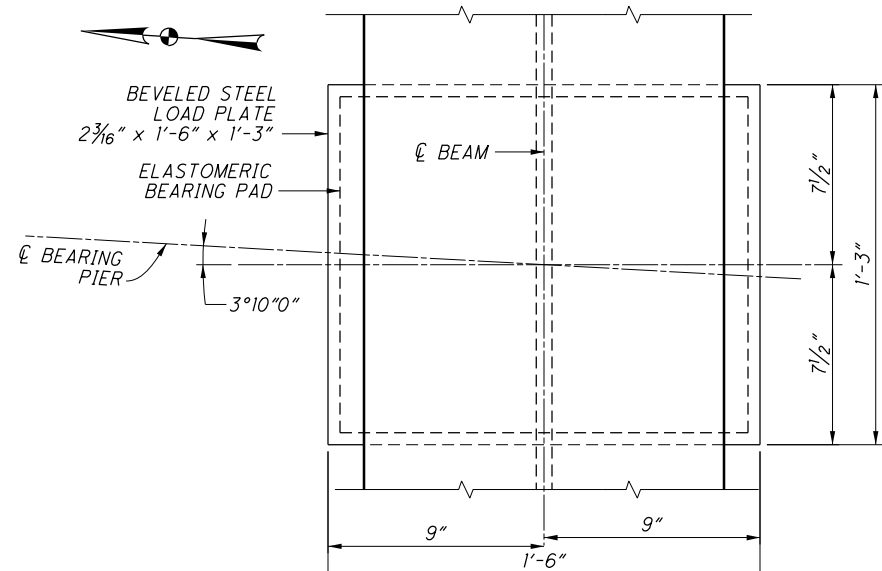

**PLAN AT PIERS**

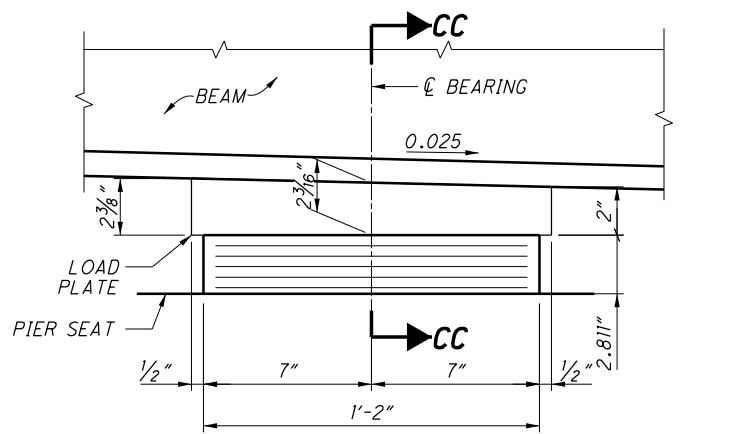

**PIER BEARING ELEVATION**

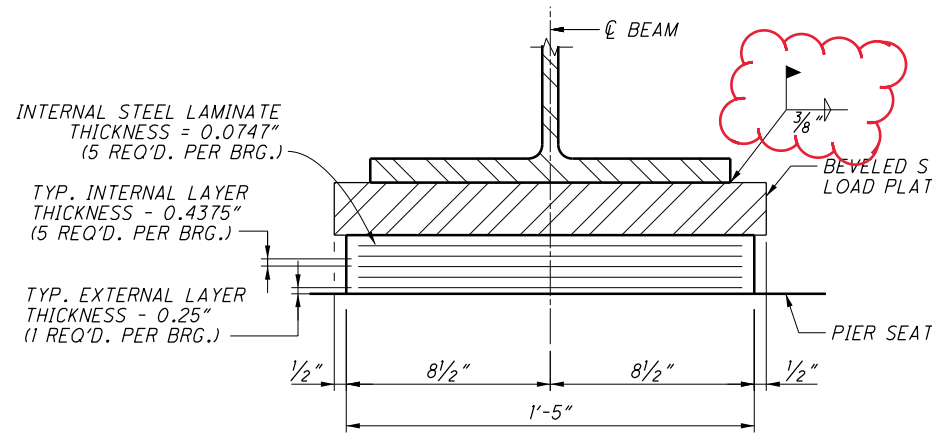

**SECTION CC-CC**



**BEARING ORIENTATION**


**NOTES**

- ELASTOMERIC BEARINGS: THE ELASTOMER SHALL HAVE A HARDNESS OF 50 DUROMETER. THE BEARINGS WERE DESIGNED IN ACCORDANCE WITH SECTION 14.7.6 (METHOD A) OF THE AASHTO LRFD BRIDGE DESIGN SPECIFICATIONS. THE LONGTERM COMPRESSION PROOF LOAD TEST (AASHTO STANDARD SPECIFICATIONS FOR HIGHWAY BRIDGES, DIVISION II, SECTION 18.7.2.6) IS NOT REQUIRED.
- BASIS FOR PAYMENT FOR ELASTOMERIC BEARING: THE UNIT PRICE BID SHALL INCLUDE ALL MATERIALS, LABOR, TESTING, STEEL SUPPORT POST, BEVELING OF LOAD PLATE WHERE REQUIRED AND INCIDENTALS NECESSARY TO FURNISH AND INSTALL LAMINATED ELASTOMERIC BEARINGS. PAYMENT WILL BE AT THE CONTRACT PRICE FOR THE APPROPRIATE ITEM 516, ELASTOMERIC BEARING WITH INTERNAL LAMINATES AND LOAD PLATE (NEOPRENE), AS PER PLAN.
- FOR ABBREVIATIONS SEE SHEET [3/56].
- ALL BEARINGS SHALL BE MARKED PRIOR TO SHIPPING. THE MARKS SHALL INCLUDE THE BEARING LOCATION ON THE BRIDGE AND A DIRECTION ARROW THAT POINTS UP-STATION, ALL MARKS SHALL BE PERMANENT AND BE VISIBLE AFTER THE BEARING IS INSTALLED.
- THE STEEL LOAD PLATE (ASTM A709, GRADE 50) SHALL BE BONDED BY VULCANIZATION TO ELASTOMER DURING THE MOLDING PROCESS.
- TABLE INCLUDES UNFACTORED DEAD LOADS, LIVE LOAD (WITHOUT IMPACT) AND TOTAL REACTIONS.


**BEARING REACTION TABLE (KIPS) (SEE NOTE 6)**

LOCATION	TYPE	NO.	LEFT BRIDGE					RIGHT BRIDGE					BEARING DESIGNATION
			DEAD LOAD			LIVE LOAD	MAX. DESIGN LOAD	DEAD LOAD			LIVE LOAD	MAX. DESIGN LOAD	
			DIAPHRAGM	REACTION	TOTAL			DIAPHRAGM	REACTION	TOTAL			
REAR ABUT.	EXP.	12	26.08	24.14	50.2	55.2	105	26.08	24.14	50.2	55.2	105	E-105
PIER NO. 1	EXP.	12		123.84	123.8	110.3	234		123.84	123.8	110.3	234	E-234
PIER NO. 2	EXP.	12		123.84	123.8	110.3	234		123.84	123.8	110.3	234	E-234
FORWARD ABUT.	EXP.	12	26.08	24.14	50.2	55.2	105	26.08	24.14	50.2	55.2	105	E-105

M:\15074\93455\Design\Structures\RIC030\_1135C\Sheets\030\_1135C\SS001.dgn 2/24/2020 10:54:37 AM acb284

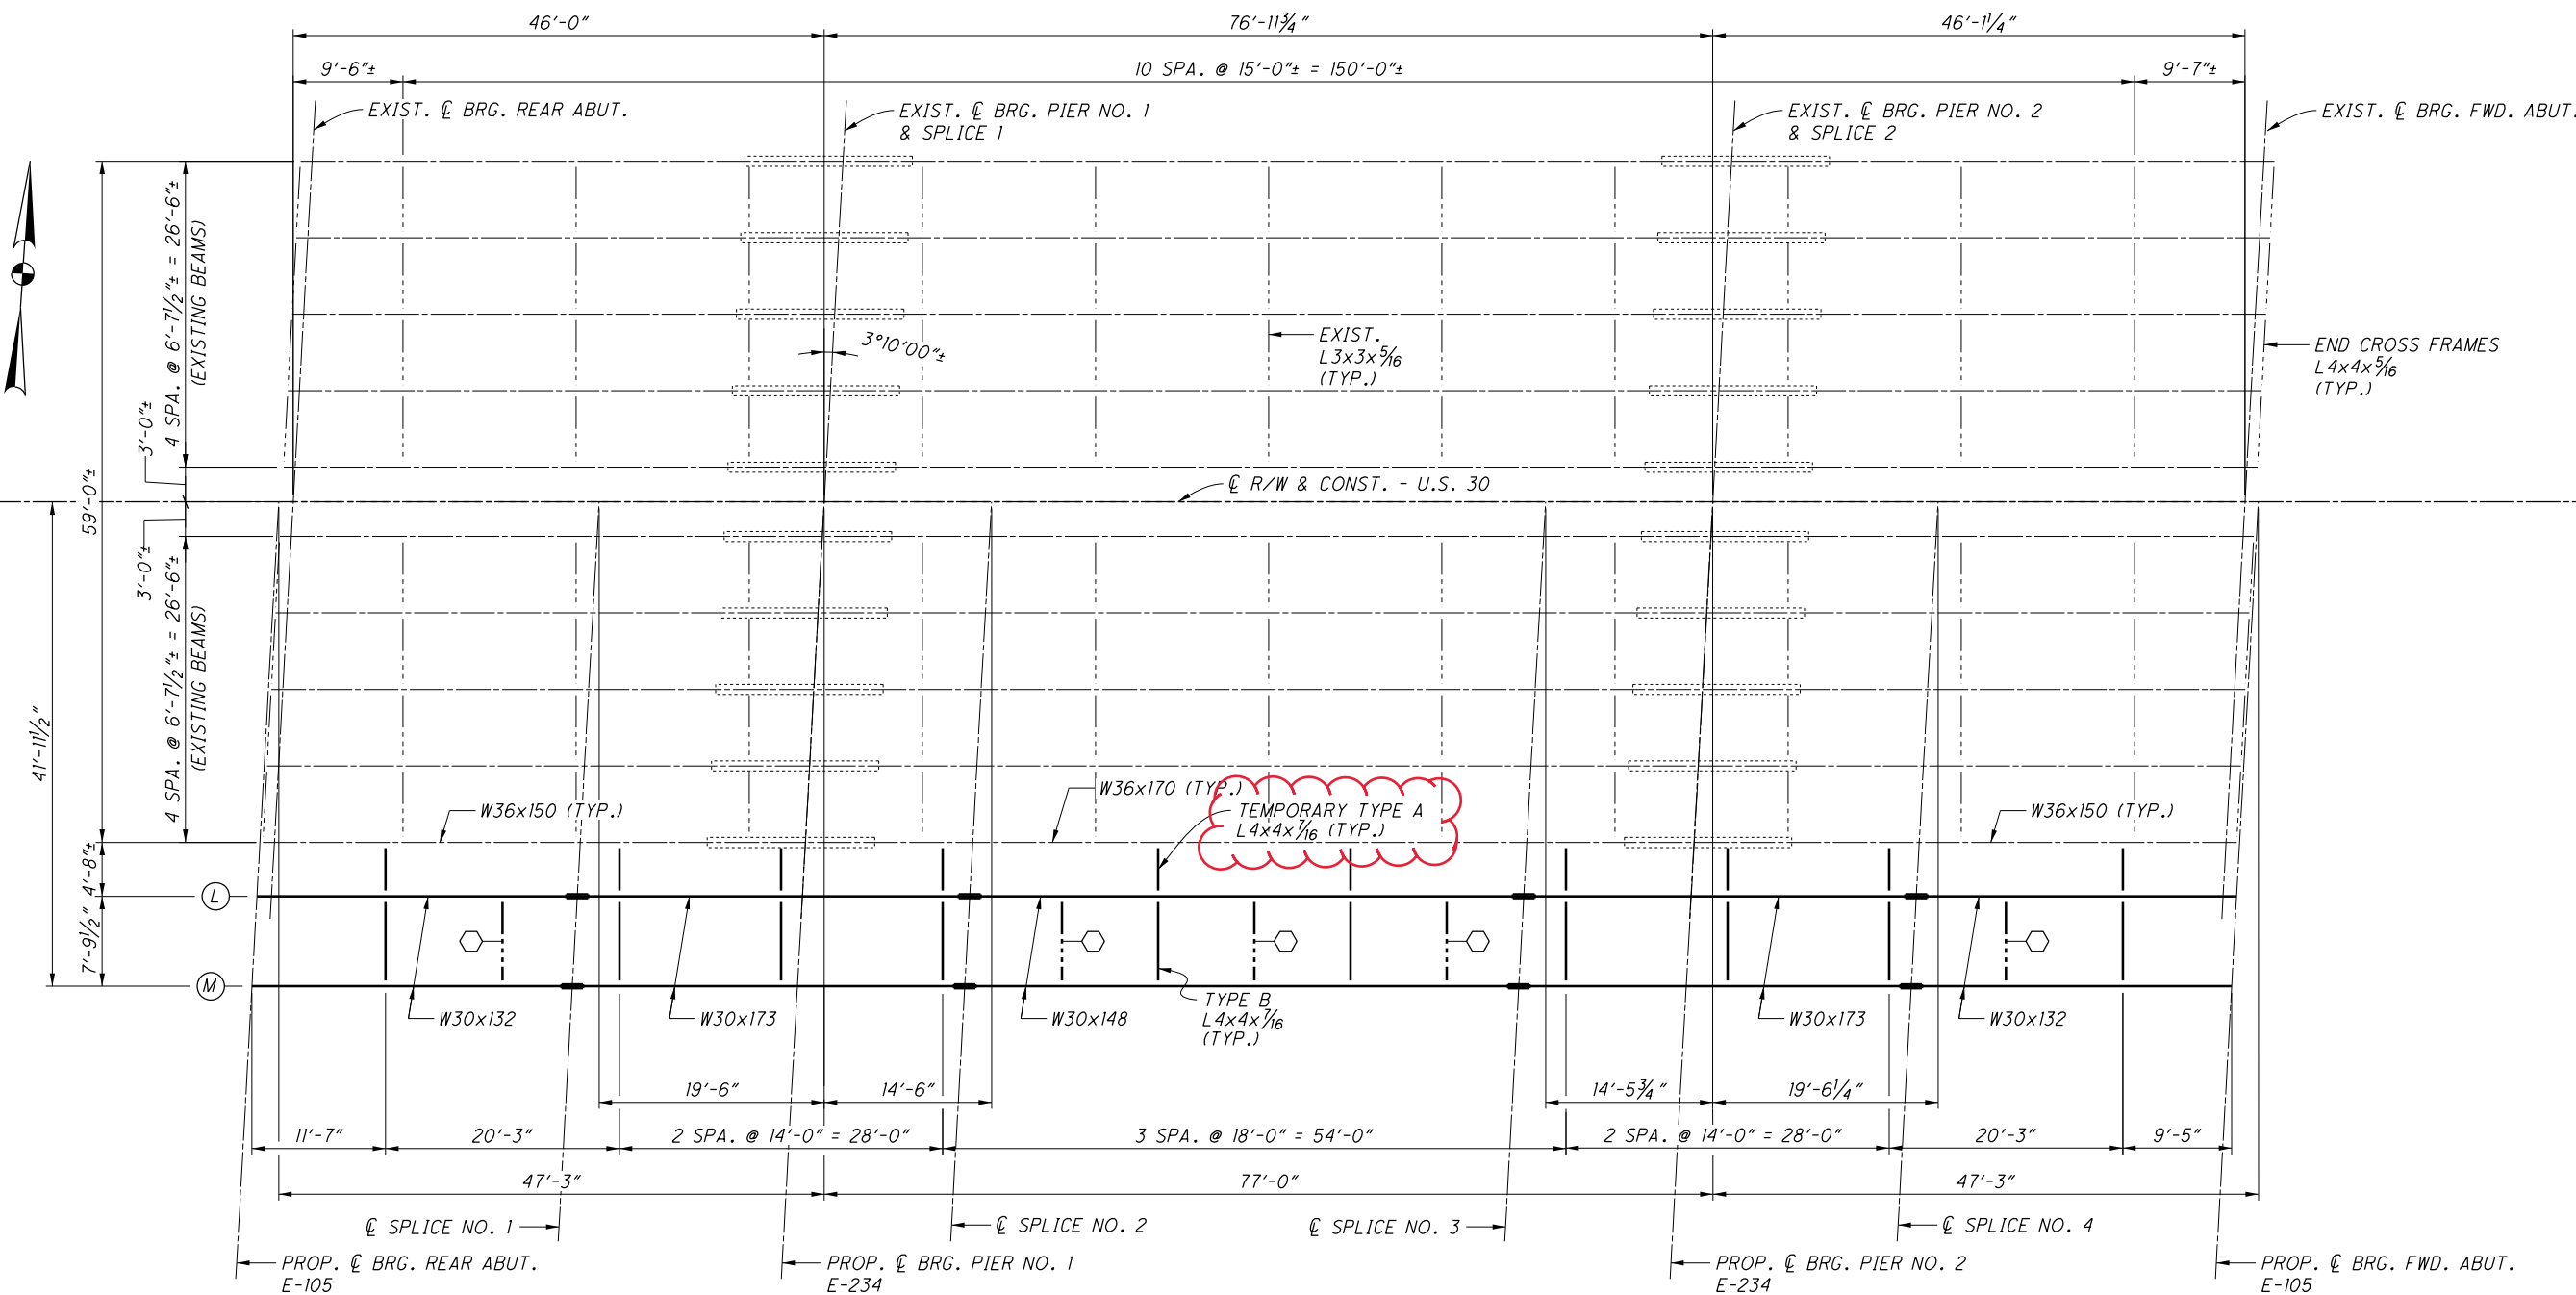

**FRAMING PLAN FOR PHASE 1A CONSTRUCTION**

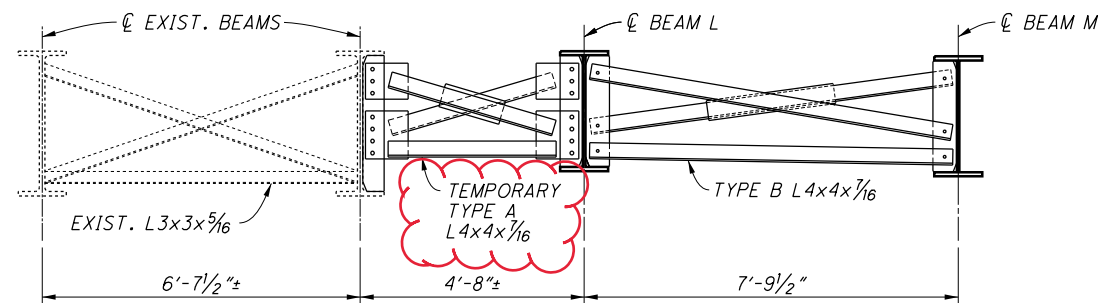

**TEMPORARY INTERMEDIATE CROSSFRAME DETAIL**


**LEGEND**

⬡ - TEMPORARY LATERAL SUPPORT  
LOCATE AT 1/2 CROSSFRAME SPACING


**NOTES**

1. FOR ABBREVIATIONS SEE SHEET [3/56].
2. FOR FRAMING PLANS SEE SHEETS [32/56] & [33/56].
3. FOR BEAM DETAILS AND ADDITIONAL NOTES SEE SHEETS [34/56].
4. FOR INTERMEDIATE CROSS FRAME SEE STD. DWG. GSD-1-19.
5. FOR TEMPORARY LATERAL SUPPORT SEE SHEET [33/56].

M:\15074\93455\Design\Structures\RIC030\_1135C\Sheets\030\_1135C\SS002.dgn 2/24/2020 10:56:17 AM acb284

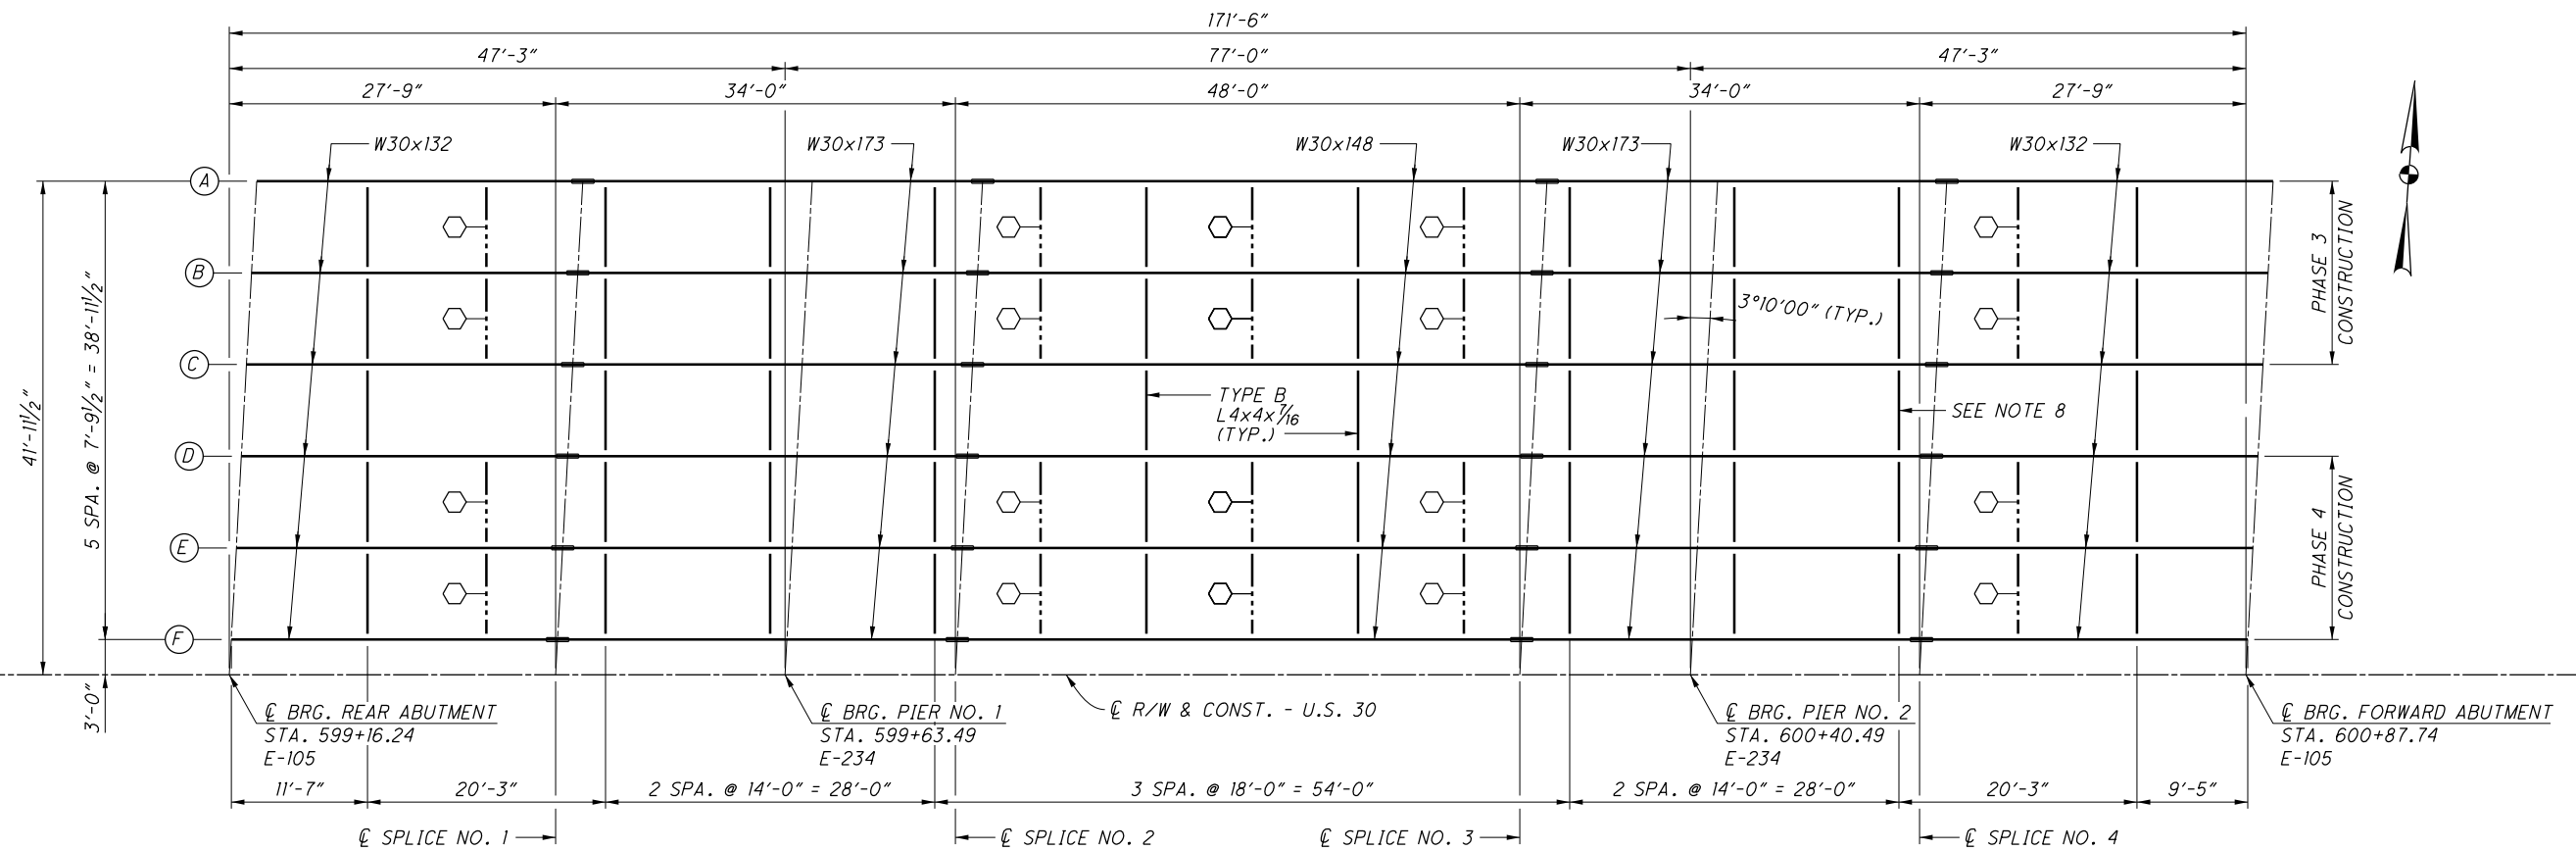

**FRAMING PLAN - WESTBOUND LANES**  
(LEFT BRIDGE)

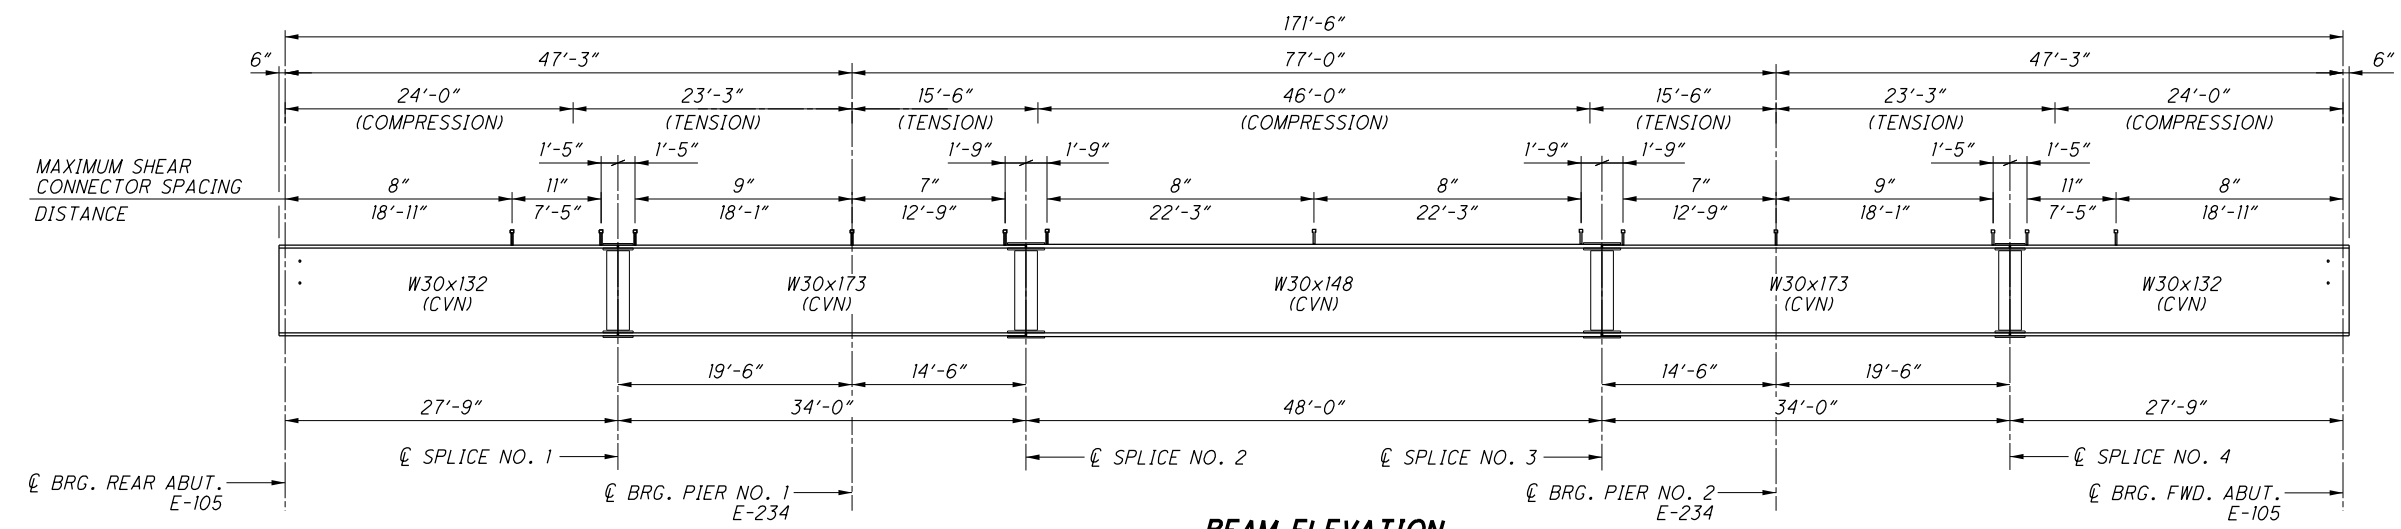

**BEAM ELEVATION**

**LEGEND**

⬡ - TEMPORARY LATERAL SUPPORT, LOCATE AT 1/2 CROSSFRAME SPACING SEE SHEET 33/56.

**NOTES**

1. FOR ABBREVIATIONS SEE SHEET 3/56.
2. FOR EASTBOUND LANES FRAMING PLAN AND ADDITIONAL DETAILS SEE SHEET 33/56.
3. FOR TRANSVERSE SECTION SEE SHEET 40/56.
4. FOR ELASTOMERIC BEARING DETAILS SEE SHEET 28/56.
5. FOR SPLICE DETAILS SEE SHEET 34/56.
6. FOR INTERMEDIATE CROSS FRAME DETAILS SEE STD DWG GSD-1-19.
7. WELD ATTACHMENT OF SUPPORTS FOR CONCRETE DECK FINISHING MACHINE TO AREAS OF THE FASCIA STRINGER FLANGES DESIGNATED "COMPRESSION". DO NOT WELD ATTACHMENTS TO AREAS DESIGNATED "TENSION". FILLET WELDS TO COMPRESSION FLANGES SHALL BE AT LEAST 1" FROM EDGE OF FLANGE, BE NO MORE THAN 2" LONG, AND BE AT LEAST 1/4" FOR THICKNESSES UP TO 3/4" OR 3/16" FOR GREATER THAN 3/4" THICK.
8. CROSSFRAMES BETWEEN BEAMS D AND C SHALL BE INSTALLED AFTER THE PHASE 3 AND PHASE 4 DECK CONCRETE HAS BEEN POURED AND PRIOR TO DECK CLOSURE POURS.
9. CVN: WHERE A SHAPE OR PLATE IS DESIGNATED (CVN), FURNISH MATERIAL THAT MEETS THE MINIMUM NOTCH TOUGHNESS REQUIREMENTS AS SPECIFIED IN 711.01.

DESIGN AGENCY: ENGINEERING ASSOCIATES, INC.  
 895 EAGLE PASS - WOOSTER, OHIO 44691  
 TELEPHONE: (330) 345-6556  
 FAX: (330) 345-9077

DATE: 9-24-19  
 REVIEWED: SDS  
 STRUCTURE FILE NUMBER: 7001143


DRAWN: TAC  
 CHECKED: BDH

DESIGNED: HK


**RIC-30-9-26**  
 BRIDGE NO. RIC-30-1135  
 OVER BOWMAN STREET  
 PID No. 93455

32/56  
 1301  
 1669

M:\15074\93455\Design\Structures\RIC030\_1135C\Sheets\030\_1135C\SS003.dgn 2/24/2020 10:58:54 AM acb284

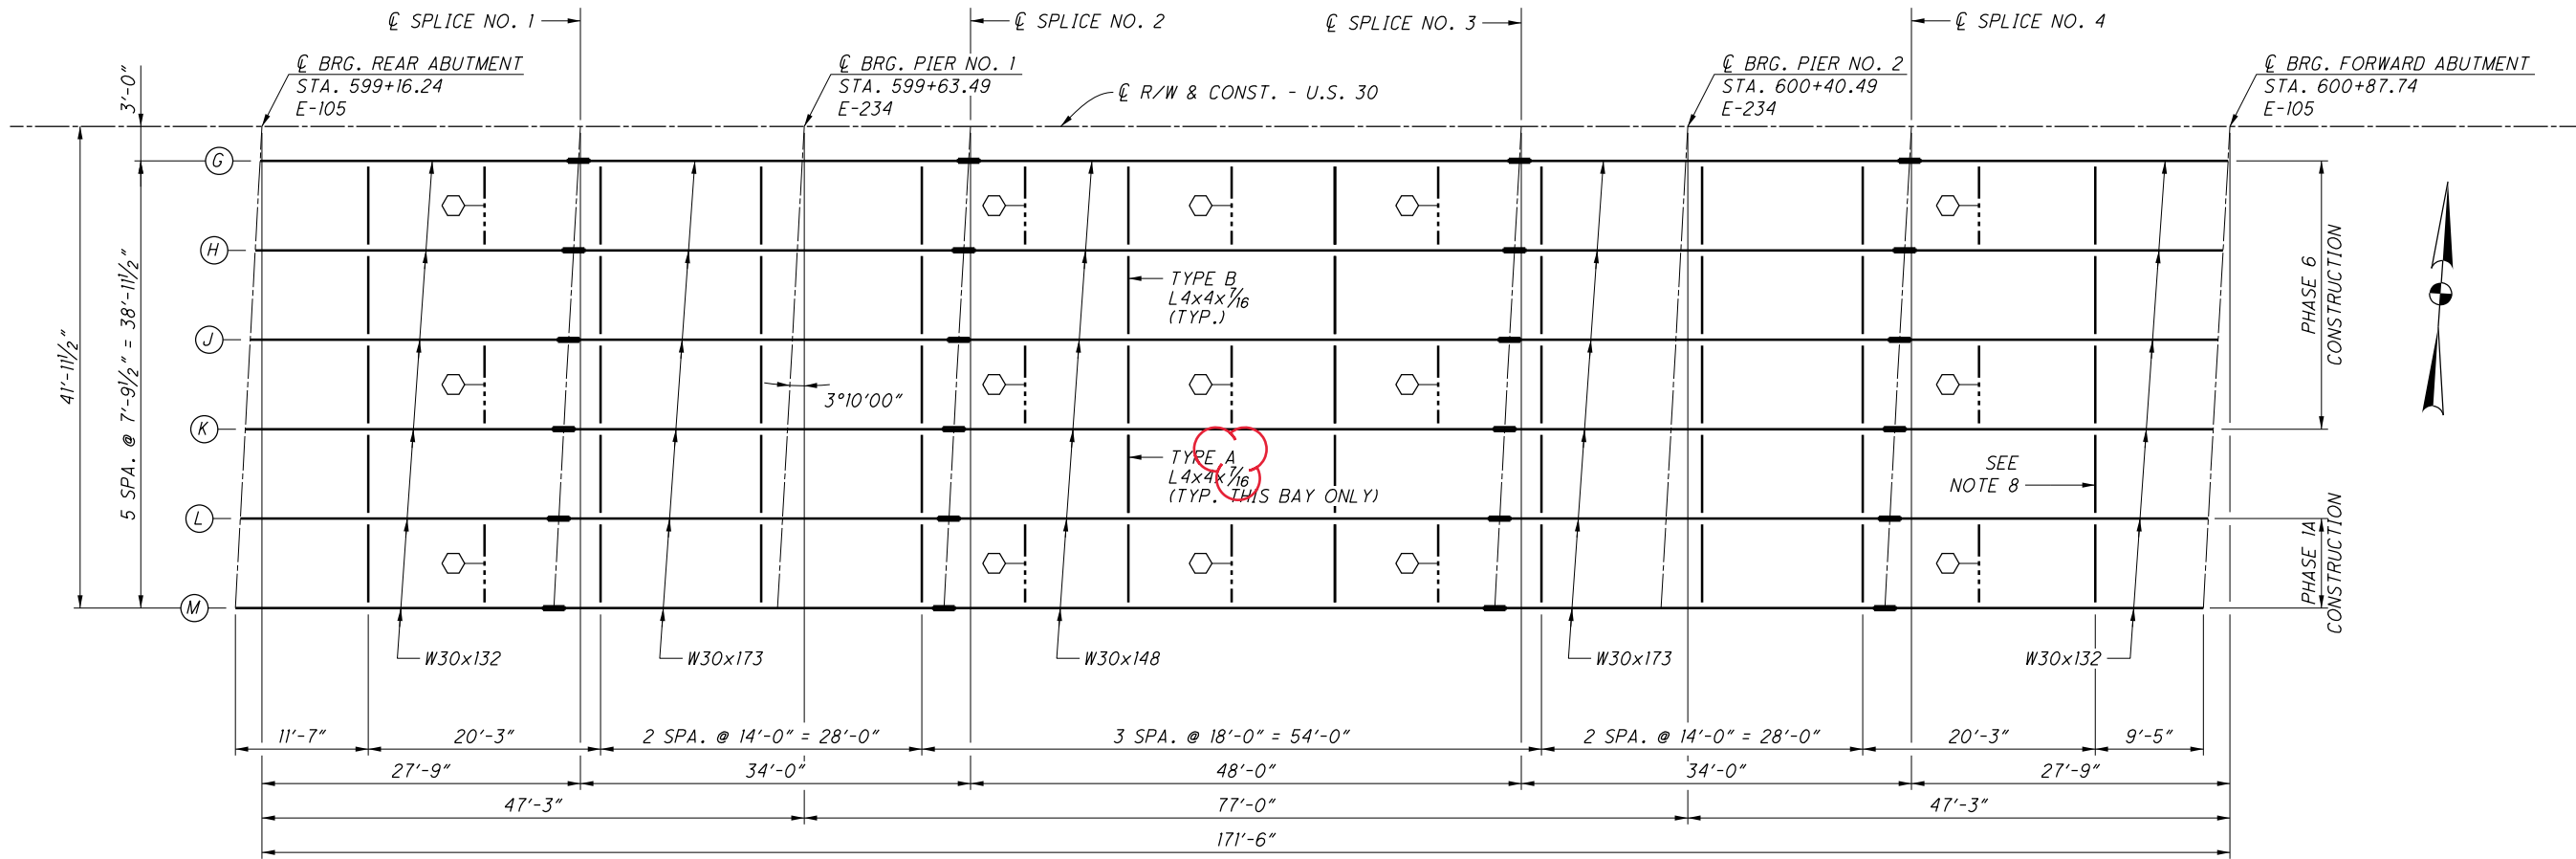


**FRAMING PLAN - EASTBOUND LANES**

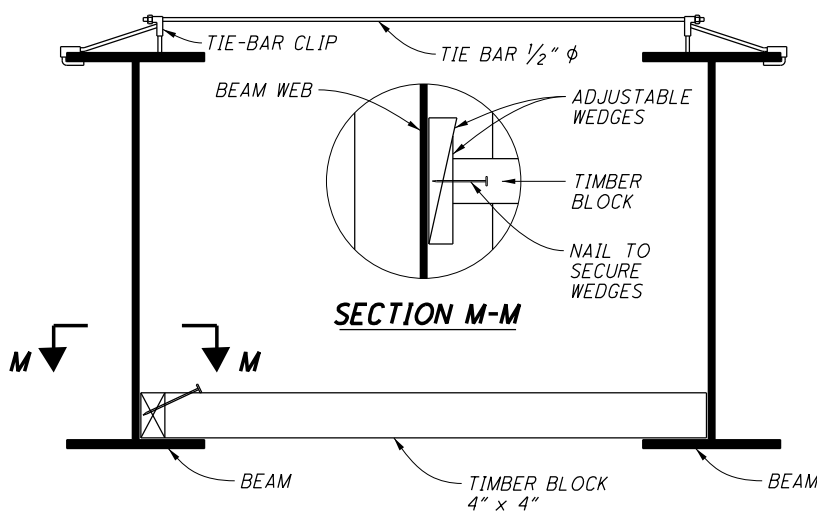


**TEMPORARY LATERAL SUPPORT SYSTEMS**

1. PLACED AS PER PLAN BEFORE DECK POURING.
2. TIMBER BLOCK TO BE REMOVED WHEN DECK IS CURED.

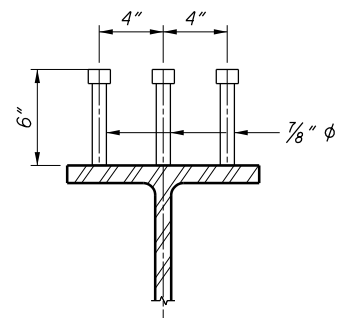

**WELDED STUD SHEAR CONNECTOR DETAIL**

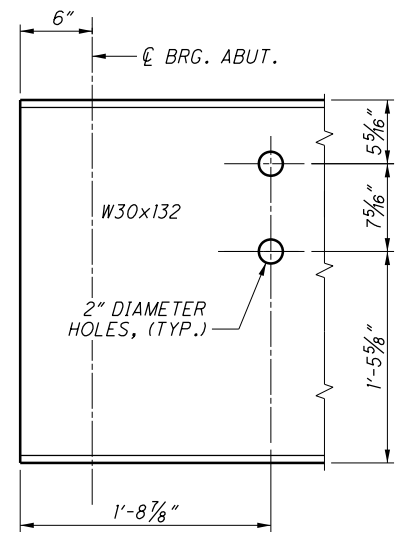

**TYPICAL BEAM END DETAIL**

**LEGEND**

○ - TEMPORARY LATERAL SUPPORT, LOCATE AT 1/2 CROSSFRAME SPACING

**NOTES**

1. FOR ABBREVIATIONS SEE SHEET [3/56].
2. FOR WESTBOUND LANES FRAMING PLAN, BEAM ELEVATION AND NOTES SEE SHEET [32/56].
3. FOR TRANSVERSE SECTION SEE SHEET [40/56].
4. FOR ELASTOMERIC BEARING DETAILS SEE SHEET [28/56].
5. FOR SPLICE DETAILS SEE SHEET [34/56].
6. FOR INTERMEDIATE CROSSFRAME DETAILS SEE STD DWG GSD-I-19.
7. TEMPORARY LATERAL SUPPORTS: THE COST OF MATERIALS, ERECTION AND LABOR SHALL BE INCLUDED IN ITEM 511 CLASS QC2 CONCRETE, SUPERSTRUCTURE, AS PER PLAN FOR PAYMENT.
8. CROSSFRAMES BETWEEN BEAMS K AND L SHALL BE INSTALLED AFTER THE PHASE 6 AND PHASE 1A DECK CONCRETE HAS BEEN POURED AND PRIOR TO PHASE 7.

DESIGN AGENCY: ENGINEERING ASSOCIATES, INC.  
 895 EAGLE PASS - WOOSTER, OHIO 44691  
 TELEPHONE: (330) 345-6656  
 FAX: (330) 345-3077

DATE: 9-24-19  
 REVIEWED: SDS  
 STRUCTURE FILE NUMBER: 700143


DRAWN: TAC  
 CHECKED: BDH

BRIDGE NO. RIC-30-1135  
 OVER BOWMAN STREET


RIC-30-9-26  
 PID No. 93455

33/56  
 1302  
 1669


M:\15074\93455\Design\Structures\RIC030\_1135C\Sheets\030\_1135CST001.dgn 2/24/2020 11:00:27 AM ocb284

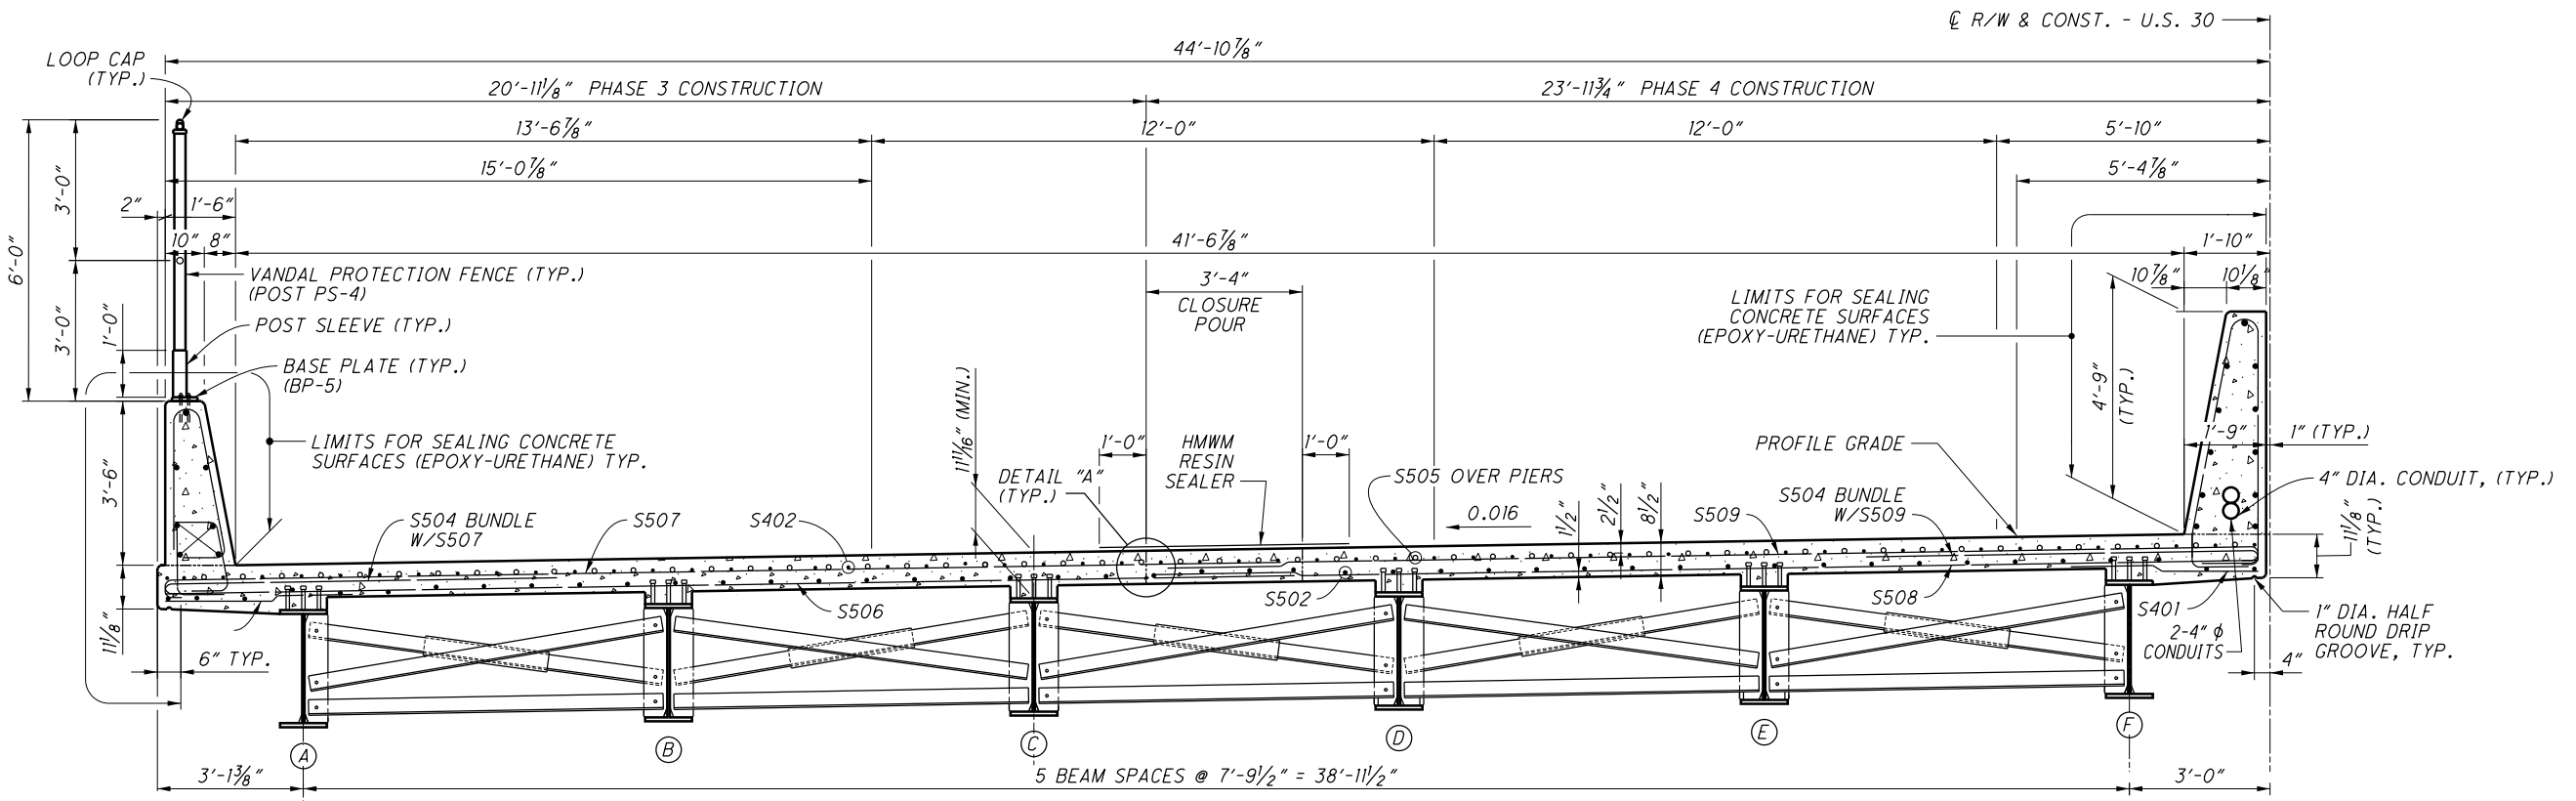

**TRANSVERSE SECTION**  
(WESTBOUND LANES)

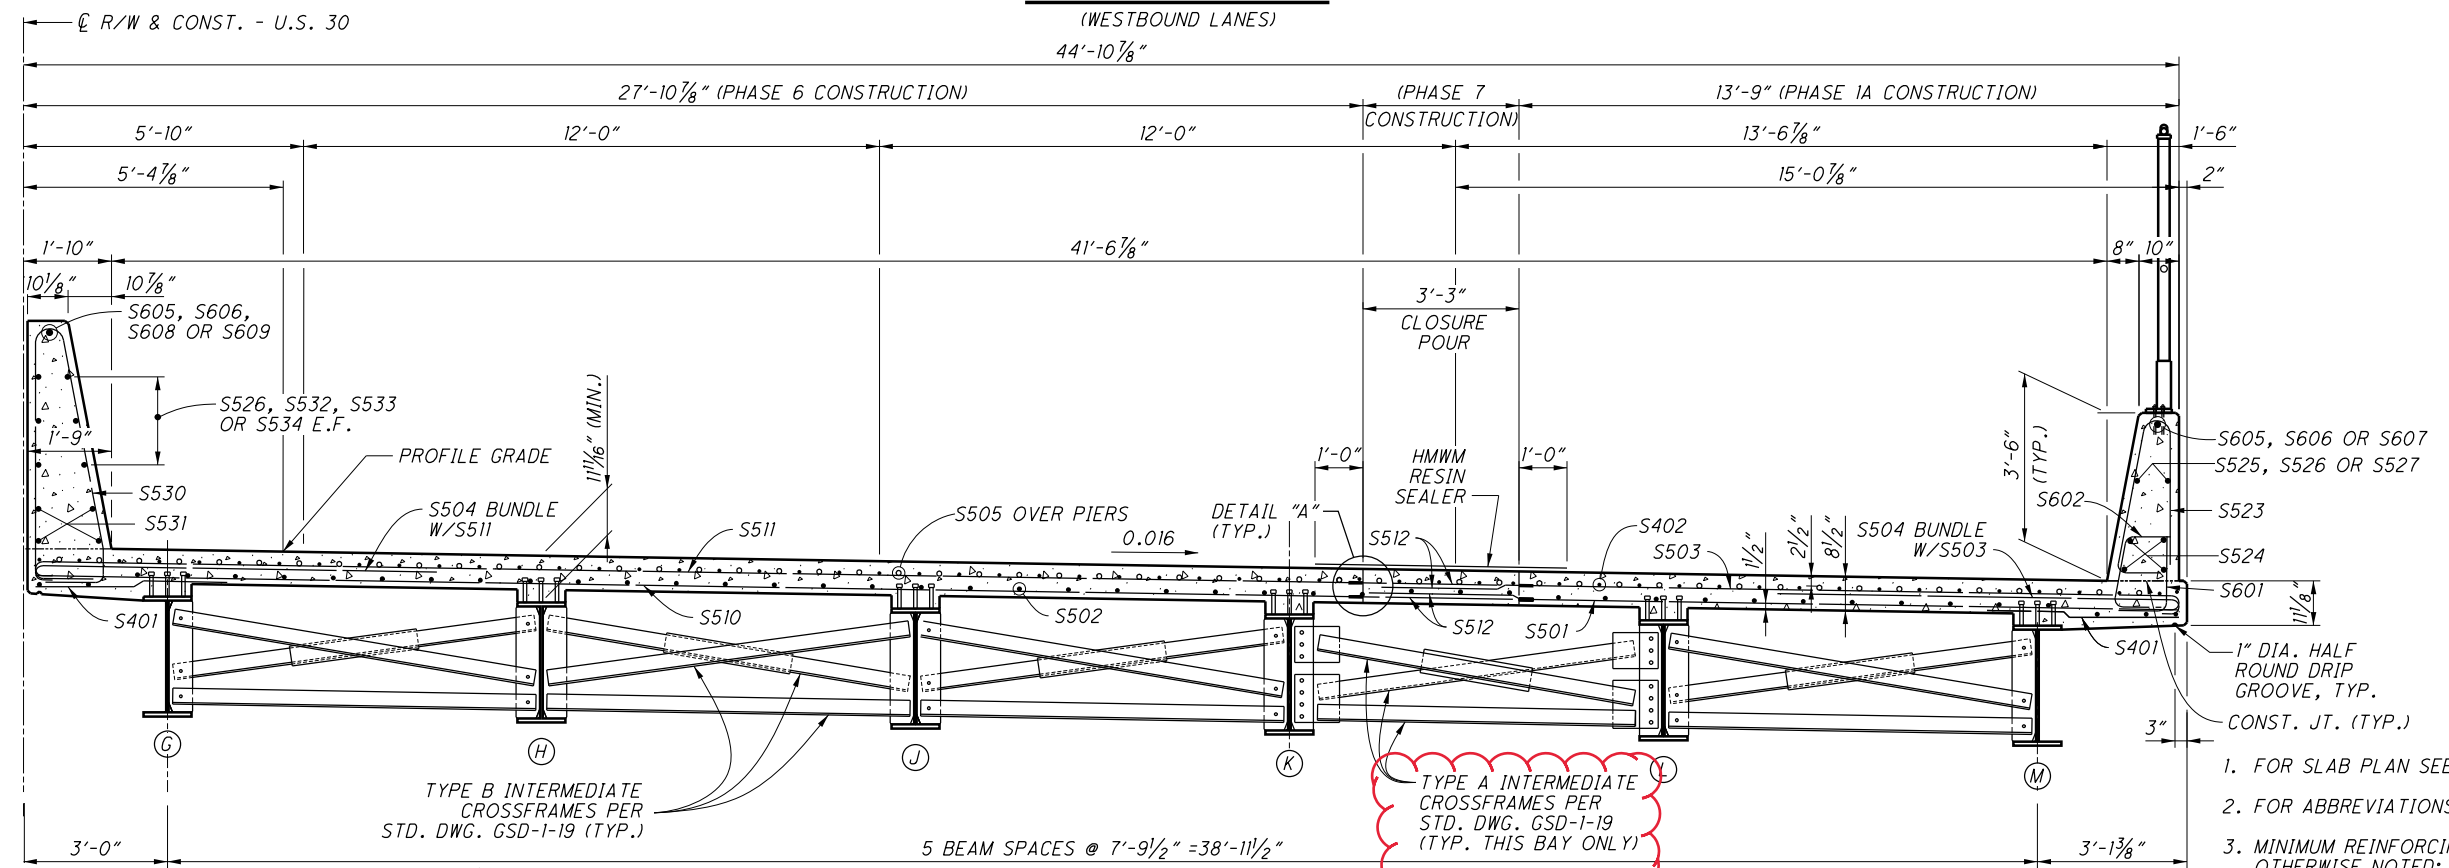

**TRANSVERSE SECTION**  
(EASTBOUND LANES)

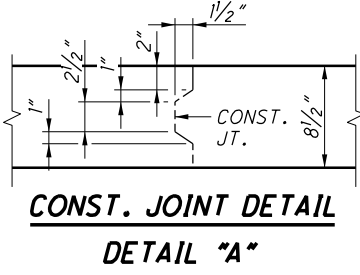

**CONST. JOINT DETAIL**  
**DETAIL "A"**

TYPE A INTERMEDIATE CROSSFRAMES PER STD. DWG. GSD-1-19 (TYP. THIS BAY ONLY)

**LEGEND**

— DENOTES MECHANICAL CONNECTOR

**NOTES**

- FOR SLAB PLAN SEE SHEET 41/56.
- FOR ABBREVIATIONS SEE SHEET 3/56.
- MINIMUM REINFORCING STEEL SPLICE LENGTH UNLESS OTHERWISE NOTED:  
NO. 4 BAR = 1'-11"  
NO. 5 BAR = 2'-5"  
NO. 5 BAR = 3'-0" (BOTTOM OF SLAB)  
NO. 6 BAR = 3'-7"
- FOR BARRIER, MEDIAN AND RAILING DETAILS SEE SHEETS 42/56 THRU 45/56.
- THE CLOSURE POUR SHALL BE SEALED WITH HIGH MOLECULAR WEIGHT METHACRYLATE (HMWM) RESIN IN ACCORDANCE OF ITEM 512. THE RESIN SHALL COVER THE ENTIRE CLOSURE POUR SECTION AND OVERLAP EACH CONSTRUCTION JOINT 1'-0"

DESIGN AGENCY: **ENGINEERING ASSOCIATES, INC.**  
 8955 EAGLE PASS - WOOSTER, OHIO 44691  
 TELEPHONE: (330) 345-6556  
 FAX: (330) 345-8077

DATE: 9-24-19  
 FILE NUMBER: 700143

DESIGNED: HK  
 CHECKED: BDH

DRAWN: TAC  
 REVISED: ---

BRIDGE NO. RIC-30-1135  
 OVER BOWMAN STREET

**RIC-30-9-26**  
 PID No. 93455

40/56  
 1309  
 1669

**STANDARD DRAWINGS**

REFER TO THE FOLLOWING STANDARD BRIDGE DRAWINGS:

AS-1-15	REVISED	7-17-15
AS-2-15	REVISED	1-18-19
GSD-1-19	DATED	1-18-19
PCB-91	REVISED	1-18-13
SBR-1-13	REVISED	7-20-18
SBR-2-13	REVISED	7-20-18
SICD-1-96	REVISED	7-18-14
SICD-2-14	DATED	7-18-14
VPF-1-90	REVISED	7-20-18

**DESIGN SPECIFICATIONS**

THIS STRUCTURE CONFORMS TO THE "LRFD BRIDGE DESIGN SPECIFICATIONS" ADOPTED BY THE AMERICAN ASSOCIATION OF STATE HIGHWAY AND TRANSPORTATION OFFICIALS, 2017, 8TH EDITION AND THE ODOT BRIDGE DESIGN MANUAL, 2019.

**OPERATIONAL IMPORTANCE**

A LOAD MODIFIER OF 1.0 HAS BEEN ASSUMED FOR THE DESIGN OF THIS STRUCTURE IN ACCORDANCE WITH THE AASHTO LRFD BRIDGE DESIGN SPECIFICATIONS, ARTICLE 1.3.5 AND THE ODOT BRIDGE DESIGN MANUAL, 2019.

**DESIGN LOADING**

HL-93  
FUTURE WEARING SURFACE (FWS) OF 0.060 KIPS/FT<sup>2</sup>.

**DESIGN DATA**

CONCRETE CLASS OC2 WITH OC/OA - COMPRESSIVE STRENGTH 4.5 KSI (SUPERSTRUCTURE)

CONCRETE CLASS OC1 WITH OC/OA - COMPRESSIVE STRENGTH 4.0 KSI (SUBSTRUCTURE)

REINFORCING STEEL - MINIMUM YIELD STRENGTH 60 KSI

STRUCTURAL STEEL - ASTM A709 GRADE 50 - YIELD STRENGTH 50 KSI

**DECK PROTECTION METHOD**

EPOXY COATED REINFORCING STEEL  
1/2" CONCRETE COVER

**MONOLITHIC WEARING SURFACE**

MONOLITHIC WEARING SURFACE IS ASSUMED, FOR DESIGN PURPOSES, TO BE 1 INCH THICK.

**PILES DRIVEN TO TIP ELEVATION FOR SOIL/PILE SETUP**

THE ULTIMATE BEARING VALUE IS 220 KIPS PER PILE FOR THE ABUTMENT PILES. THE ULTIMATE BEARING VALUE AT PIERS IS 352.0 KIPS PER PILE LEFT BRIDGE AND 338.5 KIPS PER PILE RIGHT BRIDGE. PART OF THE ULTIMATE BEARING VALUE WILL BE ACHIEVED THROUGH PILE/SOIL SETUP, WHICH IS A TIME DEPENDENT INCREASE IN RESISTANCE THAT OCCURS IN SOME SOILS.

NOTIFY THE ENGINEER AT LEAST 5 DAYS BEFORE DRIVING PILES SO THAT THE ENGINEER CAN NOTIFY THE DISTRICT GEOTECHNICAL ENGINEER, THE OFFICE OF CONSTRUCTION ADMINISTRATION, AND THE OFFICE OF GEOTECHNICAL ENGINEERING.

DRIVE THE FIRST TWO PILES IN EACH SUBSTRUCTURE TO THE TIP ELEVATION GIVEN BELOW FOR THE SUBSTRUCTURE, DRIVE THE THIRD AND FOURTH PILES TO 75% AND 85% OF THE LENGTH OF THE FIRST TWO PILES. PERFORM DYNAMIC LOAD TESTING ON ALL FOUR PILES WHILE DRIVING. AFTER DRIVING THE FOUR PILES, CEASE ALL DRIVING OPERATIONS AT THE SUBSTRUCTURE FOR A MINIMUM OF 7 DAYS. INCLUDE THE WAITING PERIOD AS A SEPARATE ACTIVITY IN THE PROGRESS SCHEDULE. AFTER THE WAITING PERIOD, PERFORM PILE RESTRIKES ON THE FOUR PILES (TWO RESTRIKE ITEMS). SUBMIT ALL TEST RESULTS TO THE ENGINEER. THE ENGINEER WILL REVIEW THE TEST RESULTS AND ESTABLISH DRIVING CRITERIA FOR THE PILING IN THE SUBSTRUCTURE WITH THE ASSISTANCE OF THE DISTRICT GEOTECHNICAL ENGINEER, AND THE OFFICE OF GEOTECHNICAL ENGINEERING.

**PILES DRIVEN TO TIP ELEVATION FOR SOIL/PILE SETUP (CONT.)**

THE DRIVING CRITERIA WITH PILE SETUP SHALL BE PERFORMED FOR THE FIRST STAGE OF BRIDGE CONSTRUCTION. THE CONTRACTOR SHALL NOT ORDER PILES FOR SUBSEQUENT PHASES UNTIL AFTER THE DRIVING CRITERIA HAS BEEN ESTABLISHED WITH SETUP. THE DEPARTMENT WILL ADJUST THE FURNISHED PILE QUANTITIES BASED ON THE RESTRIKE TEST RESULTS.

IF THE DYNAMIC LOAD TESTING INDICATES A PILE HAS ACHIEVED THE ULTIMATE BEARING VALUE ABOVE THE TIP ELEVATION DURING THE INITIAL DRIVING, (BEFORE THE WAITING PERIOD), STOP DRIVING AND NOTIFY THE ENGINEER. IF THE RESTRIKE TEST RESULTS ON THE FOUR PILES INDICATE THAT A PILE DID NOT ACHIEVE THE REQUIRED ULTIMATE BEARING VALUE, DRIVE THE PILE TO THE ESTABLISHED DRIVING CRITERIA. SPLICING OF THE PILES BEYOND THE ESTIMATED LENGTH PROVIDED IN THE PLANS WILL BE PAID BY THE DEPARTMENT UNDER CMS 109.05 WITH A NEGOTIATED PRICE PER SPLICE.

LEFT BRIDGE:	NO. OF PILES	PILE TIP ELEV.	ORDER LENGTH
REAR ABUTMENT	14	1142.9	60'
PIER NO. 1	30	1104.1	75'
PIER NO. 2	30	1104.7	80'
FORWARD ABUTMENT	14	1149.8	60'

RIGHT BRIDGE:	NO. OF PILES	PILE TIP ELEV.	ORDER LENGTH
REAR ABUTMENT	17	1142.9	60'
PIER NO. 1	36	1106.9	80'
PIER NO. 2	36	1109.3	75'
FORWARD ABUTMENT	28	1149.8	60'

ABUTMENT PILES: (12" DIA. C-I-P CONCRETE)

1 DYNAMIC LOAD TEST  
PIER PILES: (16" DIA. C-I-P CONCRETE)  
1 STATIC LOAD TEST  
2 DYNAMIC LOAD TESTS  
2 RESTRIKES

**PILE DRIVING CONSTRAINTS**

PILE DRIVING MAY NOT BEGIN UNTIL SUFFICIENT EMBANKMENT SETTLEMENT HAS OCCURRED AS DOCUMENTED BY THE SETTLEMENT PLATFORMS. THE ANTICIPATED WAITING PERIOD TO PERMIT SUFFICIENT EMBANKMENT SETTLEMENT IS 30 DAYS. THE DISTRICT GEOTECHNICAL ENGINEER MAY REDUCE OR EXTEND THE WAITING PERIOD BASED ON THE MAGNITUDE AND RATE OF THE EMBANKMENT SETTLEMENT AS DETERMINED BY THE SETTLEMENT PLATFORMS. THE SETTLEMENT WAITING PERIOD BEGINS ONCE THE APPROACH EMBANKMENT REACHES THE DESIGN SUBGRADE LEVEL FOR A MINIMUM DISTANCE OF 200 FEET BEHIND EACH ABUTMENT. BEGIN PILE DRIVING ONLY FOLLOWING TERMINATION OF THE SETTLEMENT MONITORING WAITING PERIOD BY THE DISTRICT GEOTECHNICAL ENGINEER.

**ITEM 507 - CAST-IN-PLACE REINFORCED CONCRETE PILES, AS PER PLAN**

MINIMUM PIPE PILE WALL THICKNESS IS 0.375".

FOR ITEM SPECIAL, SETTLEMENT PLATFORM SEE SHEET 1335/1669.

SETTLEMENT PLATFORM LOCATIONS			
POINT	STATION	OFFSET	CONSTRUCTED IN STAGE
1	645+94.24	41.36' LT	-
2	645+82.37	13.81' LT	-
3	645+70.51	13.75' RT	-
4	645+58.64	41.30' RT	-

**ITEM 202, PORTIONS OF STRUCTURE REMOVED, OVER 20 FOOT SPAN, AS PER PLAN:**

THIS ITEM SHALL INCLUDE THE ELEMENTS INDICATED IN THE PLANS AND GENERAL NOTES AND THAT ARE NOT SEPARATELY LISTED FOR PAYMENT, EXCEPT FOR WEARING COURSE REMOVAL. ITEMS TO BE REMOVED INCLUDE ALL EXISTING MATERIALS BEING REPLACED BY NEW CONSTRUCTION AND MISCELLANEOUS ITEMS THAT ARE NOT SHOWN TO BE INCORPORATED INTO THE FINAL CONSTRUCTION AND ARE DIRECTED TO BE REMOVED BY THE ENGINEER. THE USE OF EXPLOSIVES, HEADACHE BALLS AND/OR HOE-RAMS WILL NOT BE PERMITTED. THE METHOD OF REMOVAL AND THE WEIGHT OF HAMMER SHALL BE APPROVED BY THE ENGINEER. PERFORM ALL WORK IN A MANNER THAT WILL NOT CUT, ELONGATE OR DAMAGE THE EXISTING REINFORCING STEEL TO BE PRESERVED. CHIPPING HAMMERS SHALL NOT BE HEAVIER THAN THE NOMINAL 90-POUND CLASS. PNEUMATIC HAMMERS SHALL NOT BE PLACED IN DIRECT CONTACT WITH REINFORCING STEEL THAT IS TO BE RETAINED IN THE REBUILT STRUCTURE. SUBMIT CONSTRUCTION PLANS ACCORDING TO C&MS 501.05

**DECK PLACEMENT ASSUMPTIONS**

THE FOLLOWING ASSUMPTIONS OF CONSTRUCTION MEANS AND METHODS WERE MADE FOR THE ANALYSIS AND DESIGN OF THE SUPERSTRUCTURE. THE CONTRACTOR IS RESPONSIBLE FOR THE DESIGN OF THE FALSEWORK SUPPORT SYSTEM WITHIN THESE PARAMETERS AND WILL ASSUME RESPONSIBILITY FOR SUPERSTRUCTURE ANALYSIS FOR DEVIATION FROM THESE DESIGN ASSUMPTIONS.

AN EIGHT WHEEL FINISHING MACHINE WITH A MAXIMUM WHEEL LOAD OF 2.38 KIPS.

A MINIMUM OUT-TO-OUT WHEEL SPACING AT EACH END OF THE MACHINE OF 103".

A MAXIMUM SPACING OF OVERHANG FALSEWORK BRACKETS OF 48".

A MAXIMUM DISTANCE FROM THE CENTERLINE OF THE FASCIA GIRDER TO THE FACE OF THE SAFETY HANDRAIL OF 65".

**STRUCTURE PAINTING:** ALL BRIDGE FINISH COATS SHALL BE THE SAME COLOR.

**ABBREVIATIONS**

- ABUT. - ABUTMENT
- APPR. - APPROACH
- BRG. - BEARING
- BOT. - BOTTOM
- CONST. JT. - CONSTRUCTION JOINT
- CLR. - CLEAR
- CONST. - CONSTRUCTION
- CORR. - CORRUGATED
- DIA. - DIAMETER
- DIM. - DIMENSION
- DWG. - DRAWING
- EL. - ELEVATION
- E.F. - EACH FACE
- EXIST. - EXISTING
- F.A. - FORWARD ABUTMENT
- FWD. - FORWARD
- F.F. - FRONT FACE
- FT. - FEET
- LBS. - POUNDS
- MAX. - MAXIMUM
- MEAS. - MEASURED
- MIN. - MINIMUM
- OPT. - OPTIONAL
- P.E.J.F. - PREFORMED EXPANSION JOINT FILLER
- R.A. - REAR ABUTMENT
- R.F. - REAR FACE
- REQ'D. - REQUIRED
- SPA. - SPACING
- STA. - STATION
- T.O.S. - TOP OF SLOPE
- TYP. - TYPICAL
- U.O.N. - UNLESS OTHERWISE NOTED
- VAR. - VARIES
- W/ - WITH

DESIGN AGENCY: ENGINEERING ASSOCIATES, INC.  
 8955 EAGLE PASS - WOOSTER, OHIO 44691  
 TELEPHONE: (330) 345-6556  
 FAX: (330) 345-8077

DATE: 9-24-19  
 STRUCTURE FILE NUMBER: 7001232

REVIEWED: SDS  
 TAC: REVISED

DESIGNED: HK  
 CHECKED: BDH

**GENERAL NOTES**  
 BRIDGE NO. RIC-30-1219  
 OVER ASHLAND RAILWAY

**RIC-30-9-26**  
 PID No. 93455

3 / 79

1346  
 1669

CALC: HK DATE: 6/28/2019  
 CHECKED: TAC DATE: 6/28/2019

**ESTIMATED QUANTITIES**

ITEM	EXTENSION	TOTAL 01/NHS/BR	UNIT	DESCRIPTION	ABUT.	PIERS	SUPER.	GEN.	SEE SHEET
202	11203	LS		PORTIONS OF STRUCTURE REMOVED, OVER 20 FOOT SPAN, AS PER PLAN				LS	3 / 79
202	22900	411	SY	APPROACH SLAB REMOVED				411	
202	23500	411	SY	WEARING COURSE REMOVED				411	
SPECIAL	20365000	4	EACH	SETTLEMENT PLATFORM				4	3 / 79
503	11101	LS		COFFERDAMS AND EXCAVATION BRACING, AS PER PLAN				LS	2 / 79
503	21100	1967	CY	UNCLASSIFIED EXCAVATION	810	1157			
505	11100	LS		PILE DRIVING EQUIPMENT MOBILIZATION				LS	
506	11100	LS		STATIC LOAD TEST		LS			
507	00501	4015	FT	12" CAST-IN-PLACE REINFORCED CONCRETE PILES, DRIVEN, AS PER PLAN	4015				3 / 79
507	00551	4380	FT	12" CAST-IN-PLACE REINFORCED CONCRETE PILES, FURNISHED, AS PER PLAN	4380				3 / 79
507	00701	9570	FT	16" CAST-IN-PLACE REINFORCED CONCRETE PILES, DRIVEN, AS PER PLAN		9570			3 / 79
507	00751	10230	FT	16" CAST-IN-PLACE REINFORCED CONCRETE PILES, FURNISHED, AS PER PLAN		10230			3 / 79
509	10000	411193	LB	EPOXY COATED REINFORCING STEEL	42869	136266	232058		
511	21523	1026	CY	CLASS OC2 CONCRETE WITH OC/OA, SUPERSTRUCTURE, AS PER PLAN			1026		42 / 79 & 61 / 79
511	33500	4	EACH	SEMI-INTEGRAL DIAPHRAGM GUIDE			4		
511	41012	437	CY	CLASS OC1 CONCRETE WITH OC/OA, PIER ABOVE FOOTINGS		437			
511	44112	203	CY	CLASS OC1 CONCRETE WITH OC/OA, ABUTMENT NOT INCLUDING FOOTING	203				
511	46512	496	CY	CLASS OC1 CONCRETE WITH OC/OA, FOOTING	256	240			
512	10100	2037	SY	SEALING OF CONCRETE SURFACES (EPOXY-URETHANE)	237	982	723	95	
512	10300	414	SY	SEALING CONCRETE BRIDGE DECKS WITH HMMM RESIN			381	33	
512	33000	42	SY	TYPE 2 WATERPROOFING	42				
513	10260	754305	LB	STRUCTURAL STEEL MEMBERS, LEVEL 3			754305		
513	20000	11778	EACH	WELDED STUD SHEAR CONNECTORS			11778		
514	00800	754305	LB	FIELD PAINTING STRUCTURAL STEEL, INTERMEDIATE COAT			754305		
514	00851	754305	LB	FIELD PAINTING STRUCTURAL STEEL, FINISH COAT, AS PER PLAN			754305		3 / 79
514	10000	3	EACH	FINAL INSPECTION REPAIR			3		
516	10010	249	FT	ARMORLESS PREFORMED JOINT SEAL				249	
516	13600	75	SF	1" PREFORMED EXPANSION JOINT FILLER			75		
516	13900	646	SF	2" PREFORMED EXPANSION JOINT FILLER			245	401	
516	14020	300	FT	SEMI-INTEGRAL ABUTMENT EXPANSION JOINT SEAL	300				
516	44101	28	EACH	ELASTOMERIC BEARING WITH INTERNAL LAMINATES AND LOAD PLATE (NEOPRENE), AS PER PLAN 3 1/8"x1'-4"x1'-7" WITH 2 3/8" (AVG)x1'-5"x1'-8" BEVELED LOAD PLATE		28			38 / 79
516	44101	28	EACH	ELASTOMERIC BEARING WITH INTERNAL LAMINATES AND LOAD PLATE (NEOPRENE), AS PER PLAN 2 1/2"x1'-0"x1'-2" WITH 1 3/4" (AVG)x1'-1"x1'-3" BEVELED LOAD PLATE	28				38 / 79
518	21200	225	CY	POROUS BACKFILL WITH GEOTEXTILE FABRIC	225				
518	40000	320	FT	6" PERFORATED CORRUGATED PLASTIC PIPE	320				
518	40010	45	FT	6" NON-PERFORATED CORRUGATED PLASTIC PIPE, INCLUDING SPECIALS	45				
523	20000	3	EACH	DYNAMIC LOAD TESTING	1	2			
523	20500	2	EACH	RESTRIKE		2			
526	25001	657	SY	REINFORCED CONCRETE APPROACH SLABS (T=15"), AS PER PLAN				657	63 / 79 THRU 65 / 79
526	90030	258	FT	TYPE C INSTALLATION				258	
601	20010	612	CY	CRUSHED AGGREGATE SLOPE PROTECTION				612	

M:\15074\93455\Design\Structures\RIC030\_1219C\Sheets\030\_1219CSQ001.dgn 2/24/2020 11:04:13 AM acb284

DESIGN AGENCY  
**ENGINEERING ASSOCIATES, INC.**  
 8955 EAGLE PASS - WOODSTER, OHIO 44681  
 TELEPHONE: (330) 345-6556  
 FAX: (330) 345-8077

DESIGNED  
 HK  
 CHECKED  
 BDH

DRAWN  
 TAC  
 REVISED

REVIEWED  
 SDS  
 STRUCTURE FILE NUMBER  
 7001232

DATE  
 9-24-19







**ESTIMATED QUANTITIES**  
 BRIDGE NO. RIC-30-1219  
 OVER ASHLAND RAILWAY

**RIC-30-9-26**  
 PID No. 93455

4 / 79

1347  
 1669

M:\15074\93455\Design\Structures\RIC030\_1219C\Sheets\030\_1219CSB001.dgn 2/24/2020 11:06:15 AM acb284

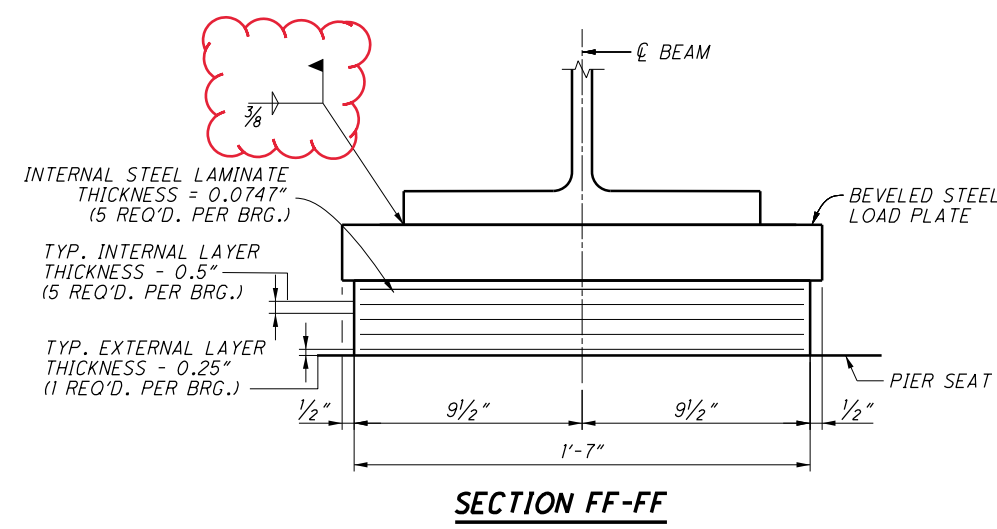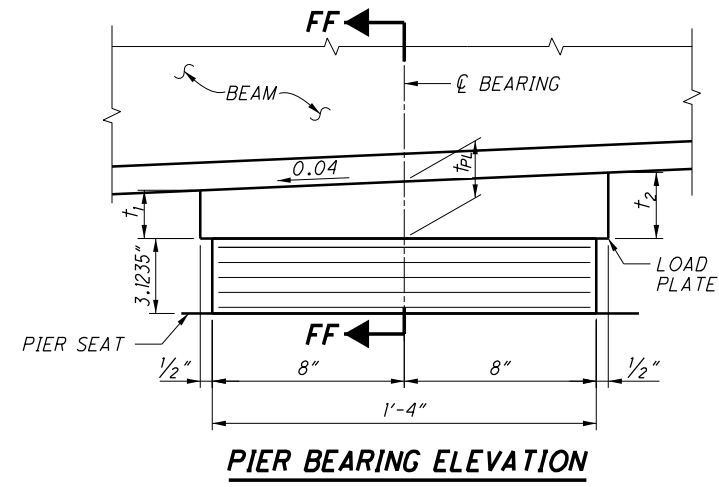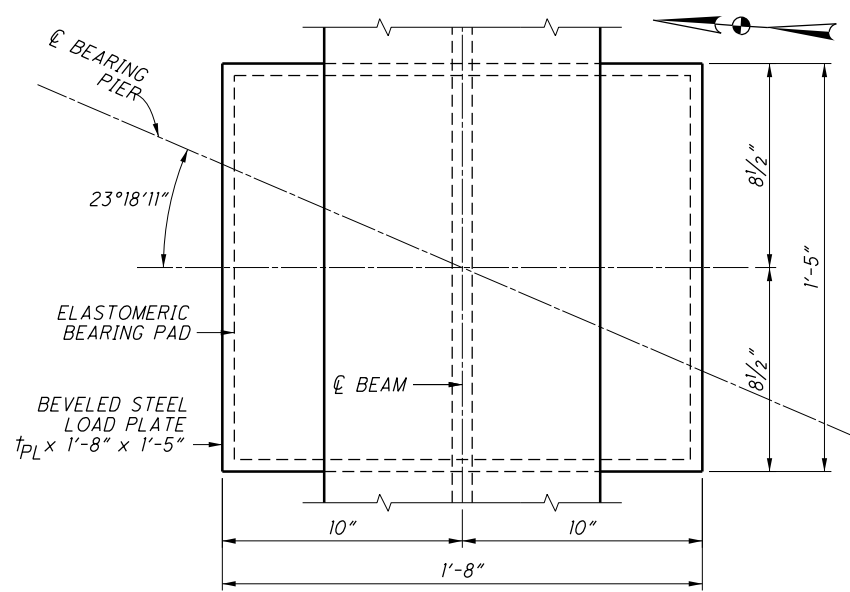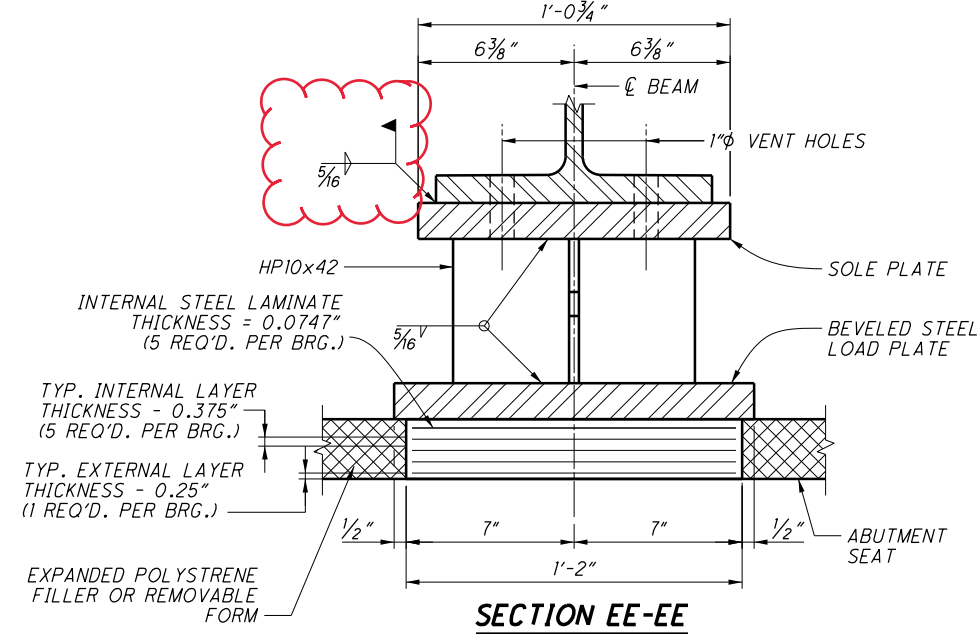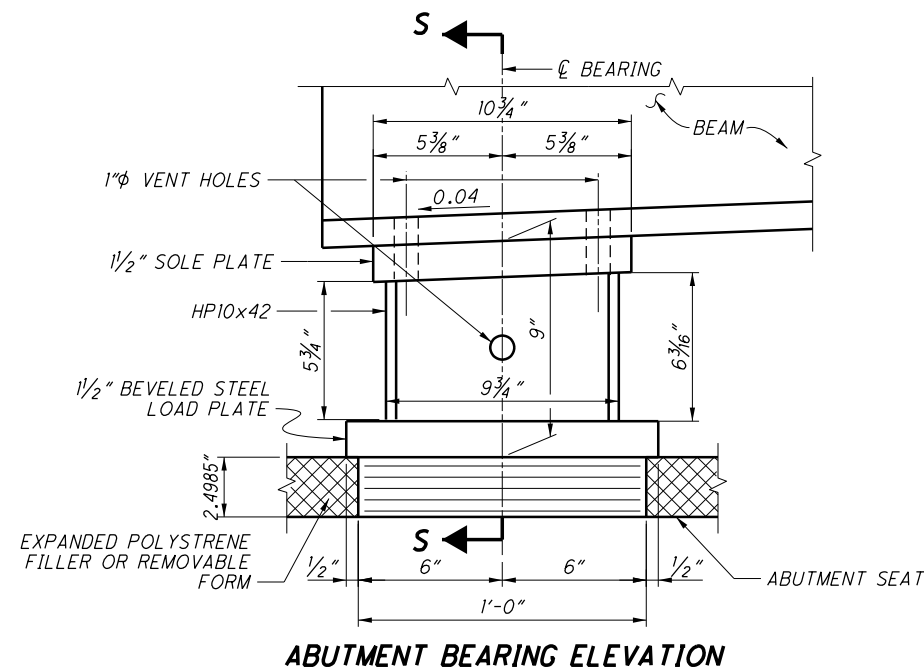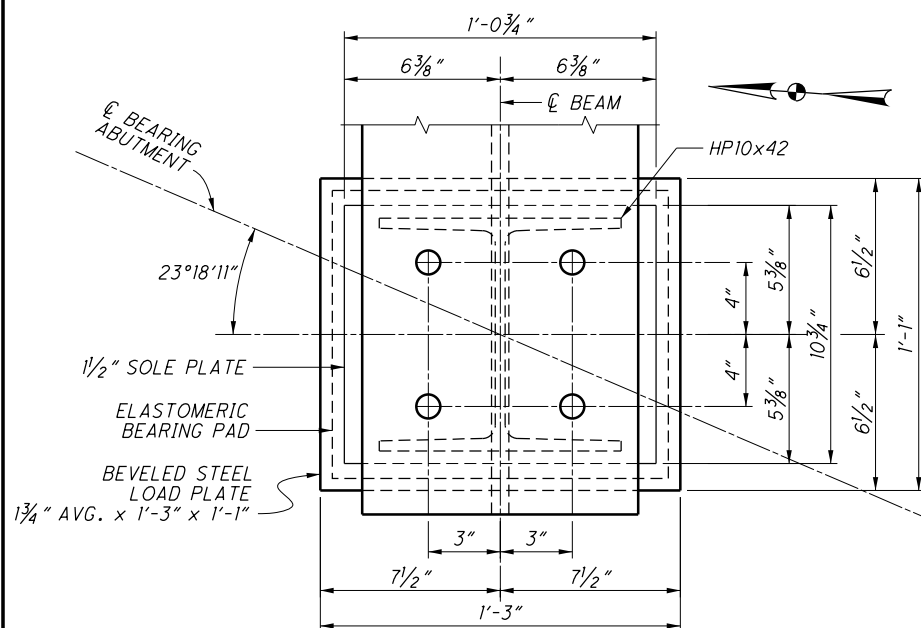

LOC.	PLATE thk. (+) t	BEAM			
		A AND D	B AND E	C AND F	G THRU P
PIER NO. 1	t1	2 1/4	2 1/8	2	2
	tp1	2 5/8	2 1/2	2 3/8	2 3/8
	t2	3	2 7/8	2 3/4	2 3/4
PIER NO. 2	t1	2 3/8	2 1/4	2	2
	tp1	2 3/4	2 5/8	2 3/8	2 3/8
	t2	3 1/8	3	2 3/4	2 3/4


HP 10X42 SECTION LEFT BRIDGE - (WB)				HP 10X42 SECTION RIGHT BRIDGE - (EB)					
LOCATION	REAR ABUT.		FWD. ABUT.		LOCATION	REAR ABUT.		FWD. ABUT.	
	h1	h2	h1	h2		h1	h2	h1	h2
BEAM A	6 1/2"	6 1/2"	6 5/8"	6 5/8"	BEAMS G THRU P	5 3/4"	5 3/4"	5 3/4"	5 3/4"
BEAM B	6 3/8"	6 3/8"	6 3/8"	6 3/8"		5 3/4"	5 3/4"	5 3/4"	5 3/4"
BEAM C	6 1/4"	6 1/4"	6 1/4"	6 1/4"					
BEAM D	6"	6"	6"	6"					
BEAM E	5 7/8"	5 7/8"	5 7/8"	5 7/8"					
BEAM F	5 3/4"	5 3/4"	5 3/4"	5 3/4"					

BEARING DESIGNATION	LOCATION	TYPE	NO.	LEFT BRIDGE (WESTBOUND)				RIGHT BRIDGE (EASTBOUND)					
				DEAD LOAD		LIVE LOAD	TOTAL	DEAD LOAD		LIVE LOAD	TOTAL		
				DIAPHRAGM	REACTION			DIAPHRAGM	REACTION				
E-160	REAR ABUT.	EXP.	14	42.5	42.9	85.4	70.3	155.7	39.3	38.9	78.2	65.7	144.0
E-300	PIER NO. 1	EXP.	14		178.5	178.5	117.8	296.3		159.8	159.8	109.5	269.3
E-300	PIER NO. 2	EXP.	14		178.5	178.5	117.8	296.3		159.8	159.8	109.5	269.3
E-160	FORWARD ABUT.	EXP.	14	42.5	42.9	85.4	70.3	155.7	39.3	38.9	78.2	65.7	144.0


- NOTES**
- ELASTOMERIC BEARINGS: THE ELASTOMER SHALL HAVE A HARDNESS OF 50 DUROMETER. THE BEARINGS WERE DESIGNED IN ACCORDANCE WITH SECTION 14.7.6 (METHOD A) OF THE AASHTO LRFD BRIDGE DESIGN SPECIFICATIONS. THE LONGTERM COMPRESSION PROOF LOAD TEST (AASHTO STANDARD SPECIFICATIONS FOR HIGHWAY BRIDGES, DIVISION II, SECTION 18.7.2.6) IS NOT REQUIRED.
  - BASIS FOR PAYMENT FOR ELASTOMERIC BEARING: THE UNIT PRICE BID SHALL INCLUDE ALL MATERIALS, LABOR, TESTING, STEEL SUPPORT POST, BEVELING OF LOAD PLATE WHERE REQUIRED AND INCIDENTALS NECESSARY TO FURNISH AND INSTALL LAMINATED ELASTOMERIC BEARINGS. PAYMENT WILL BE AT THE CONTRACT PRICE FOR THE APPROPRIATE ITEM 516, ELASTOMERIC BEARING WITH INTERNAL LAMINATES AND LOAD PLATE (NEOPRENE), AS PER PLAN.
  - FOR ABBREVIATIONS SEE SHEET 3/79.
  - ALL BEARINGS SHALL BE MARKED PRIOR TO SHIPPING. THE MARKS SHALL INCLUDE THE BEARING LOCATION ON THE BRIDGE AND A DIRECTION ARROW THAT POINTS UP-STATION, ALL MARKS SHALL BE PERMANENT AND BE VISIBLE AFTER THE BEARING IS INSTALLED.
  - THE STEEL LOAD PLATE (ASTM A709, GRADE 50) SHALL BE BONDED BY VULCANIZATION TO ELASTOMER DURING THE MOLDING PROCESS.
  - TABLE INCLUDES UNFACTORED DEAD LOADS, LIVE LOAD (WITHOUT IMPACT) AND TOTAL REACTIONS.



M:\15074\93455\Design\Structures\RIC030\_1219C\Sheets\030\_1219C\SS001.dgn 2/24/2020 11:07:33 AM aob284

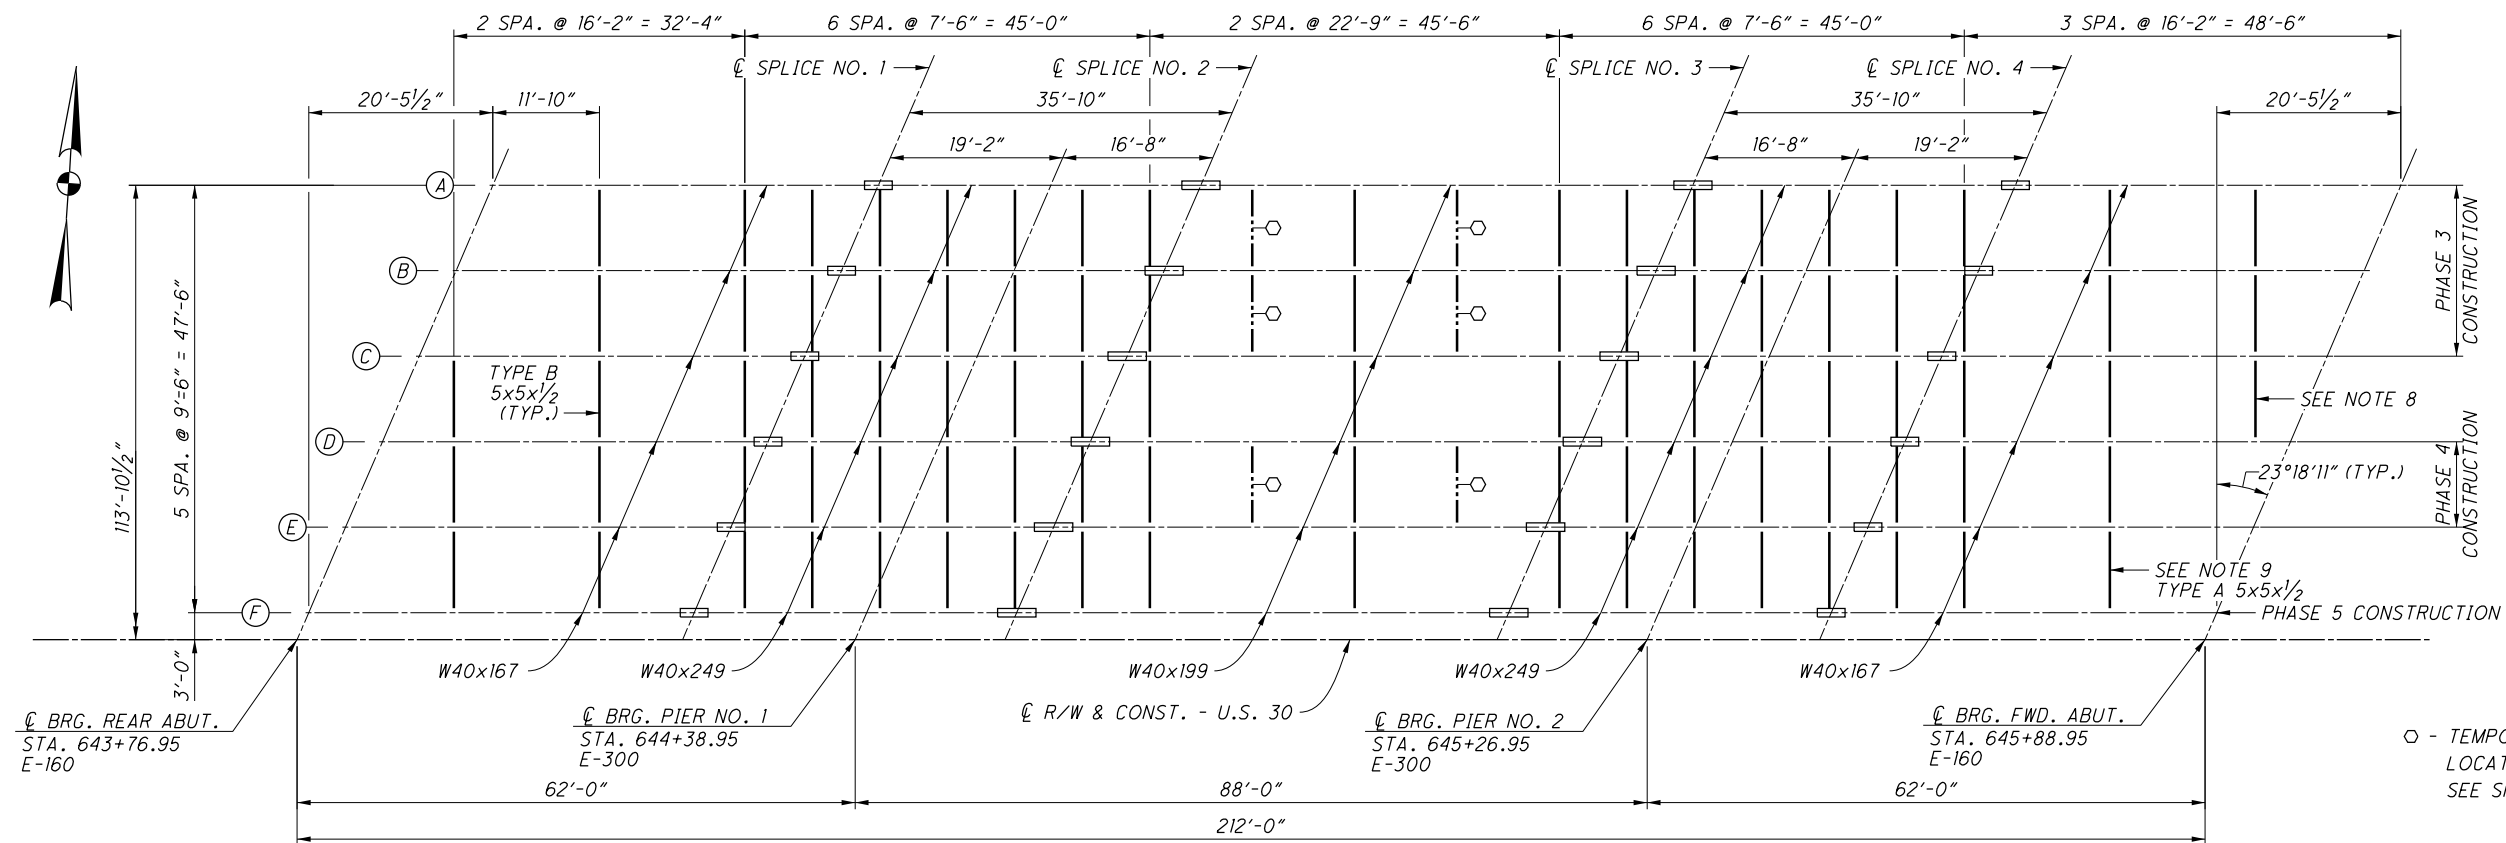

**FRAMING PLAN - WESTBOUND LANES**

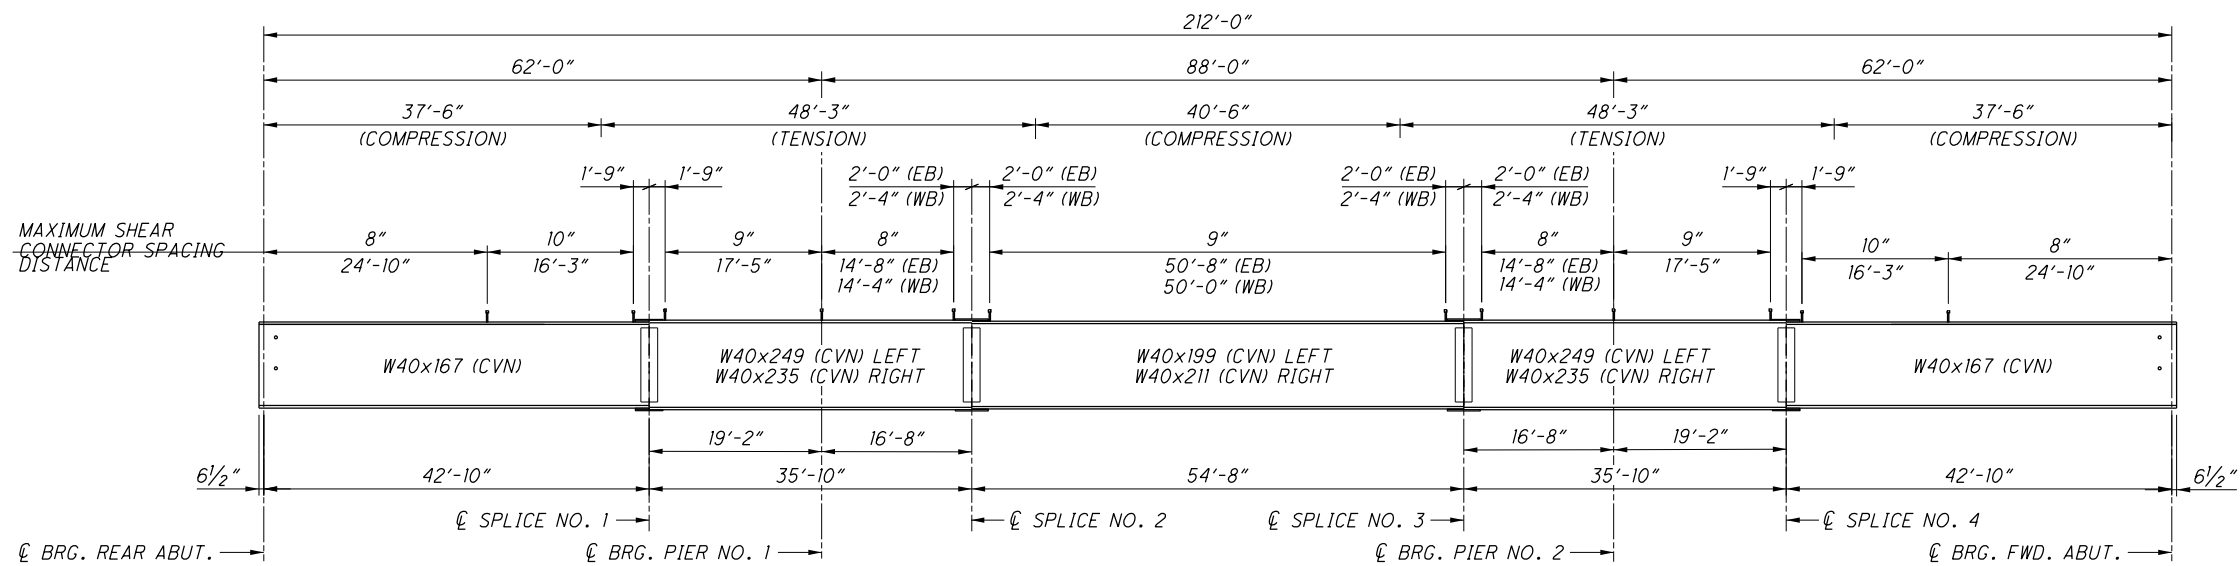

**BEAM ELEVATION**

**NOTES**

1. FOR ABBREVIATIONS SEE SHEET [3/79](#).
2. FOR EASTBOUND LANES FRAMING PLAN AND ADDITIONAL DETAILS SEE SHEET [42/79](#).
3. FOR TRANSVERSE SECTION SEE SHEET [52/79](#) & [53/79](#).
4. FOR ELASTOMERIC BEARING DETAILS SEE SHEET [38/79](#).
5. FOR SPLICE DETAILS SEE SHEET [44/79](#).
6. WELD ATTACHMENT OF SUPPORTS FOR CONCRETE DECK FINISHING MACHINE TO AREAS OF THE FASCIA STRINGER FLANGES DESIGNATED "COMPRESSION". DO NOT WELD ATTACHMENTS TO AREAS DESIGNATED "TENSION". FILLET WELDS TO COMPRESSION FLANGES SHALL BE AT LEAST 1" FROM EDGE OF FLANGE, BE NO MORE 2" LONG, AND BE AT LEAST 1/4" FOR THICKNESSES UP TO 3/4" OR 5/16" FOR GREATER THAN 3/4" THICK.
7. CVN: WHERE A SHAPE OR PLATE IS DESIGNATED (CVN), FURNISH MATERIAL THAT MEETS THE MINIMUM NOTCH TOUGHNESS REQUIREMENTS AS SPECIFIED IN 711.01.
8. CROSSFRAMES BETWEEN BEAMS C AND D SHALL BE INSTALLED AFTER THE PHASE 3 AND PHASE 4 DECK CONSTRUCTION HAS BEEN POURED AND PRIOR TO DECK CLOSURE POUR.
9. ERECT BEAM F AND TYPE A INTERMEDIATE CROSSFRAMES. DO NOT TIGHTEN BOLTS UNTIL PHASE 5 DECK CONSTRUCTION IS COMPLETED.

**LEGEND**

- - TEMPORARY LATERAL SUPPORT LOCATE AT 1/2 CROSSFRAME SPACING SEE SHEET [42/79](#)

DESIGN AGENCY: ENGINEERING ASSOCIATES, INC.  
 895 EAGLE PASS - WOOSTER, OHIO 44691  
 TELEPHONE: (330) 345-6556  
 FAX: (330) 345-9077

DESIGNED: HK  
 CHECKED: BDH

DRAWN: TAC  
 REVISED:

REVIEWED: SDS  
 STRUCTURE FILE NUMBER: 7001232

DATE: 9-24-19

BRIDGE NO. RIC-30-1219  
 OVER ASHLAND RAILWAY



FRAMING PLAN - LEFT (WESTBOUND)

RIC-30-9-26  
 PID No. 93455


41/79

1384  
 1669


M:\15074\93455\Design\Structures\RIC030\_1219C\Sheets\030\_1219C\SS002.dgn 2/27/2020 3:41:15 PM acb284

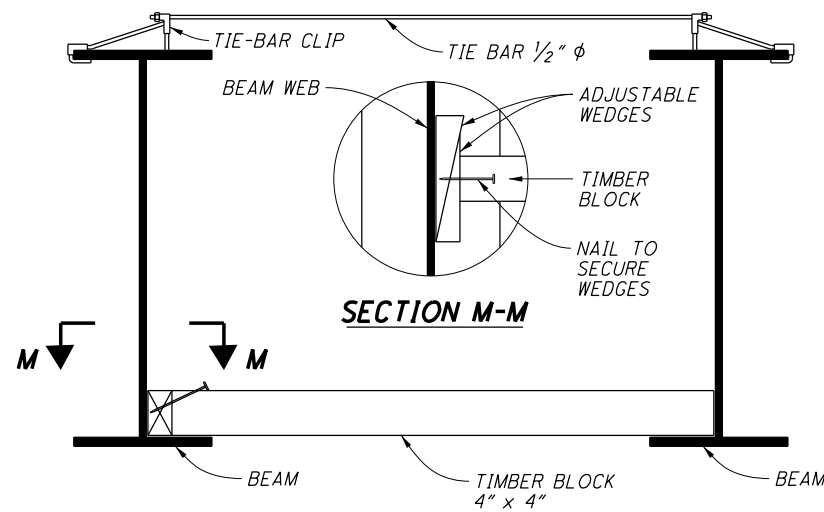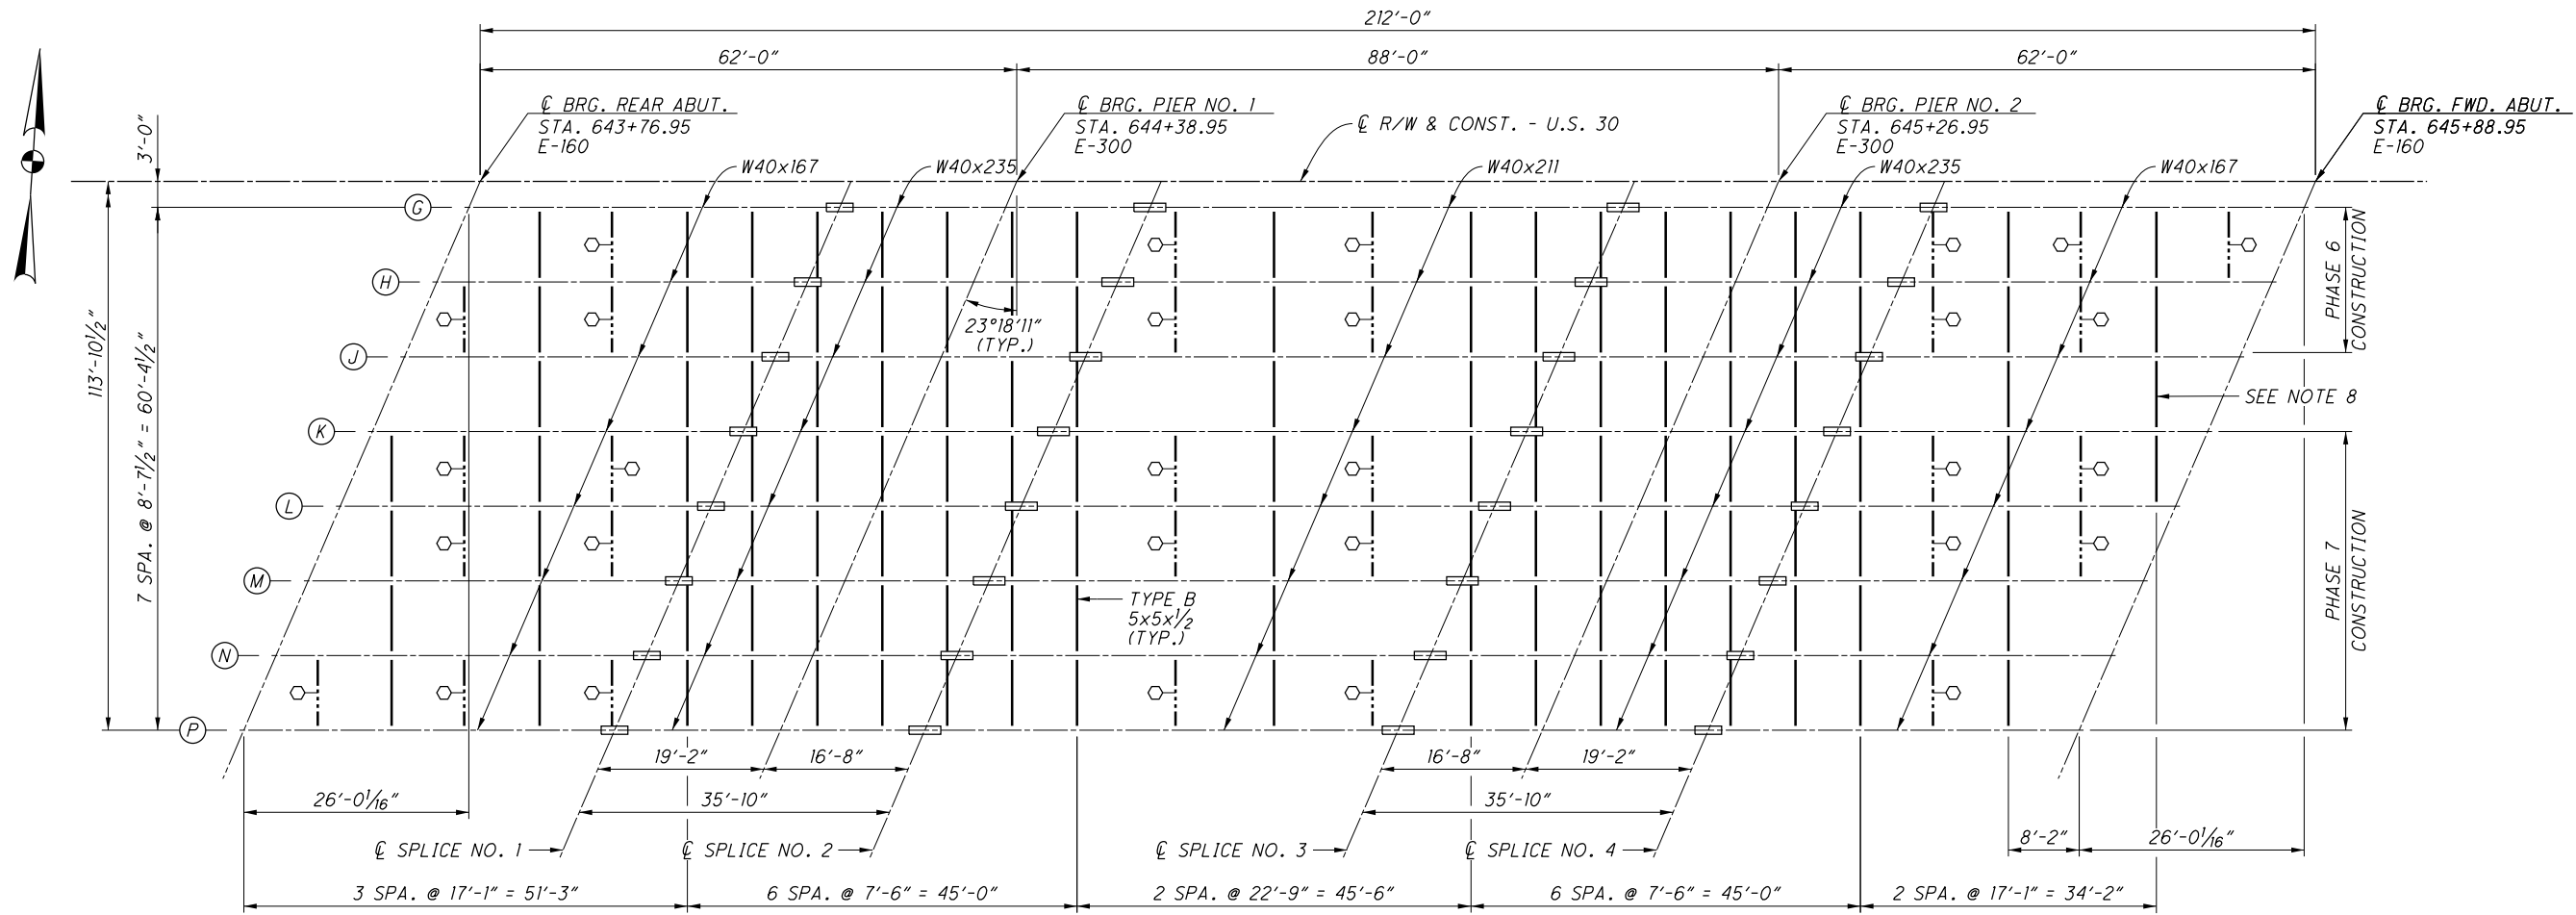

1. PLACED AS PER PLAN BEFORE DECK POURING.
2. TIMBER BLOCK TO BE REMOVED WHEN DECK IS CURED.

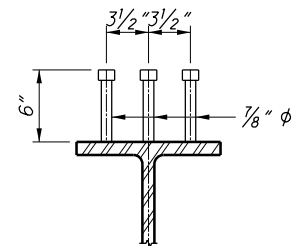

**WELDED STUD SHEAR CONNECTOR DETAIL**

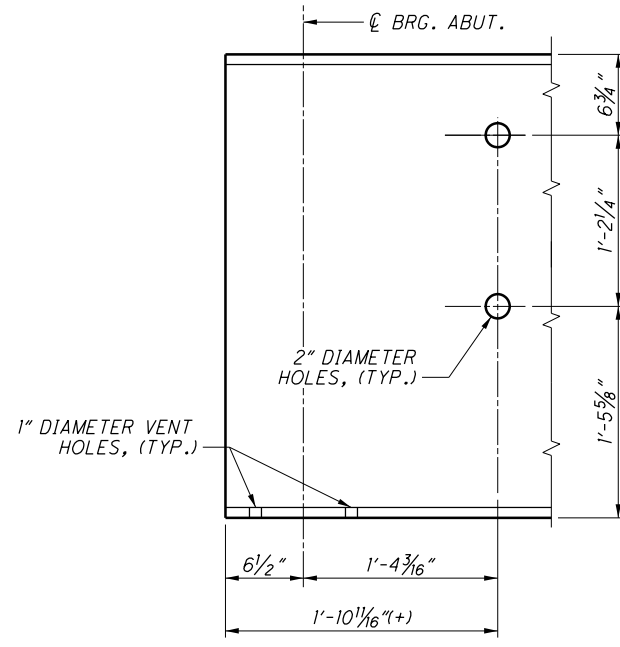

**TYPICAL BEAM END DETAIL**

**LEGEND**

○ - TEMPORARY LATERAL SUPPORT  
LOCATE AT 1/2 OF CROSSFRAME SPACING

**NOTES**

1. FOR ABBREVIATIONS SEE SHEET 3/79.
2. FOR WESTBOUND LANES FRAMING PLAN, BEAM ELEVATION AND NOTES SEE SHEET 41/79.
3. FOR TRANSVERSE SECTION SEE SHEET 52/79 & 53/79.
4. FOR ELASTOMERIC BEARING DETAILS SEE SHEET 38/79.
5. FOR SPLICE DETAILS SEE SHEET 43/79.
6. FOR INTERMEDIATE CROSSFRAME DETAILS SEE STD DWG GSD-I-19.
7. TEMPORARY LATERAL SUPPORTS: THE COST OF MATERIALS, ERECTION AND LABOR SHALL BE INCLUDED IN ITEM 511 CLASS QC2 CONCRETE, SUPERSTRUCTURE, AND AS PER PLAN FOR PAYMENT.
8. CROSSFRAMES BETWEEN BEAMS J AND K SHALL BE INSTALLED AFTER THE PHASE 6 AND PHASE 7 DECK CONCRETE HAS BEEN POURED AND PRIOR TO DECK CLOSURE POURS.
9. DETAIL FOR HOLES DRILLED IN BOTTOM FLANGE ARE ON SHEET 38/79.

DESIGN AGENCY: ENGINEERING ASSOCIATES, INC.  
 8955 EAGLE PASS - WOOSTER, OHIO 44691  
 TELEPHONE: (330) 345-6656  
 FAX: (330) 345-8077

DATE: 9-24-19  
 STRUCTURE FILE NUMBER: 7001232

DESIGNED: HK  
 CHECKED: BDH

DRAWN: TAC  
 REVISED: --

REVIEWED: SDS

BRIDGE NO. RIC-30-1219  
 OVER ASHLAND RAILWAY



**FRAMING PLAN - RIGHT (EASTBOUND)**

RIC-30-9-26  
 PID No. 93455

42/79

1385  
 1669

M:\15074\93455\Design\Structures\RIC030\_1219C\Sheets\030\_1219CST001.dgn 2/24/2020 11:08:50 AM acb284

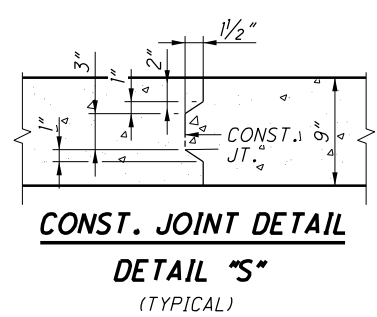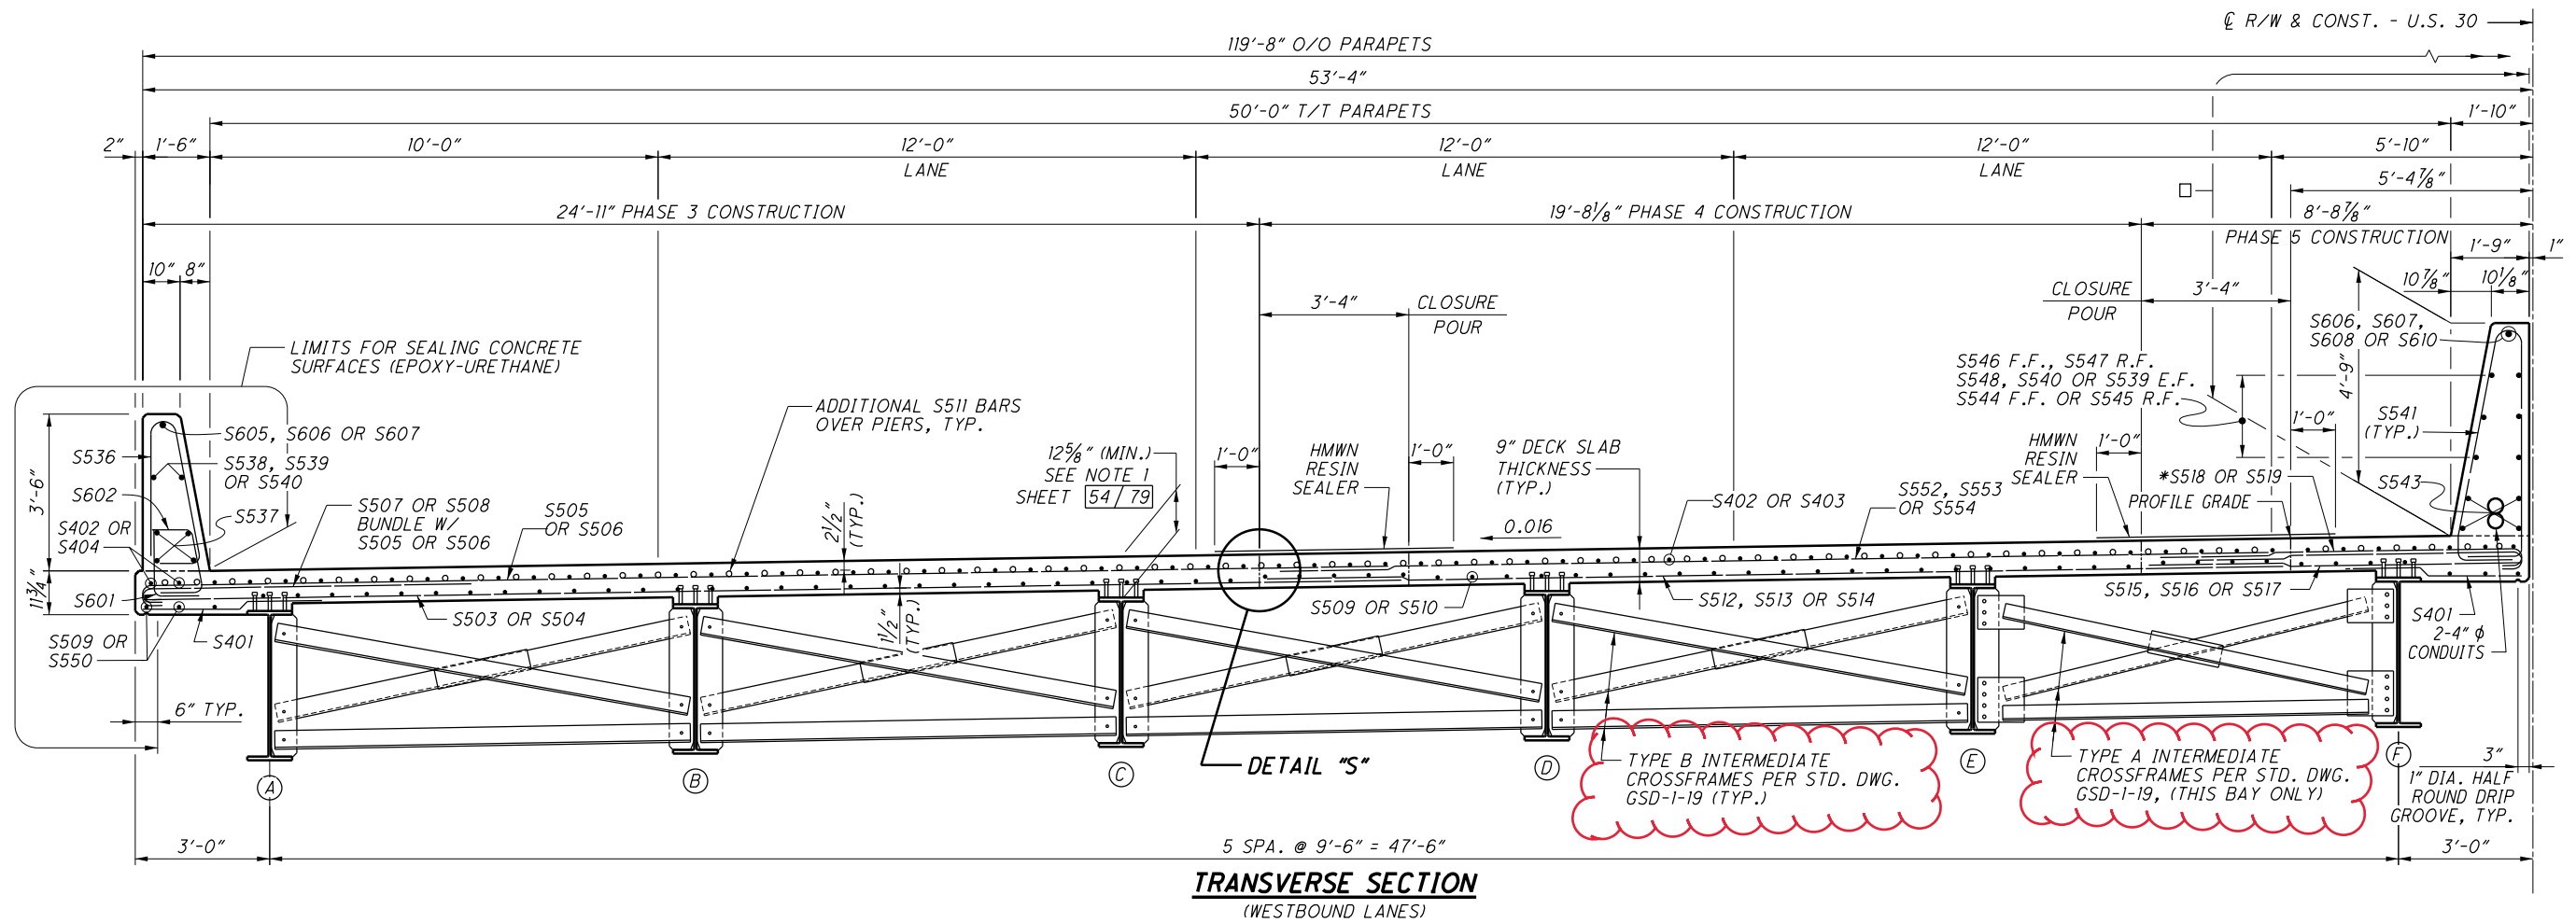

**LEGEND**


- - LIMITS FOR SEALING CONCRETE SURFACES (EPOXY-URETHANE)
- \* - S507 OR S553 BUNDLE W/S518 OR S519

**NOTES**


1. MINIMUM REINFORCING STEEL SPLICE LENGTH UNLESS OTHERWISE NOTED:  
NO. 5 BAR = 2'-5"  
S502 THRU S504,  
S509 & S510,  
S512 THRU S517 = 3'-0" (BOTTOM OF SLAB)
2. FOR RAILING AND MEDIAN BARRIER DETAILS SEE SHEET 56/79 THRU 60/79.
3. FOR SLAB PLAN - LEFT (WESTBOUND) SEE SHEET 54/79.
4. FOR ABBREVIATIONS SEE SHEET 3/79.

<p><b>DESIGN AGENCY</b> ENGINEERING ASSOCIATES, INC. 895 EAGLE PASS - WOOSTER, OHIO 44691 TELEPHONE: (330) 345-6556 FAX: (330) 345-8077</p>	<p><b>DATE</b> 9-24-19</p>	<p><b>REVIEWED</b> SDS</p>	<p><b>STRUCTURE FILE NUMBER</b> 7001232</p>	<p><b>DESIGNED</b> HK</p>	<p><b>CHECKED</b> BDH</p>
<p><b>TRANSVERSE SECTION - LEFT (WESTBOUND)</b> BRIDGE NO. RIC-30-1219 OVER ASHLAND RAILWAY</p>					
<p><b>RIC-30-9.26</b> PID No. 93455</p>					
<p>52/79</p>					
<p>1395 1669</p>					

M:\15074\93455\Design\Structures\RIC030\_1219C\Sheets\030\_1219CST002.dgn 2/24/2020 11:09:59 AM acb284

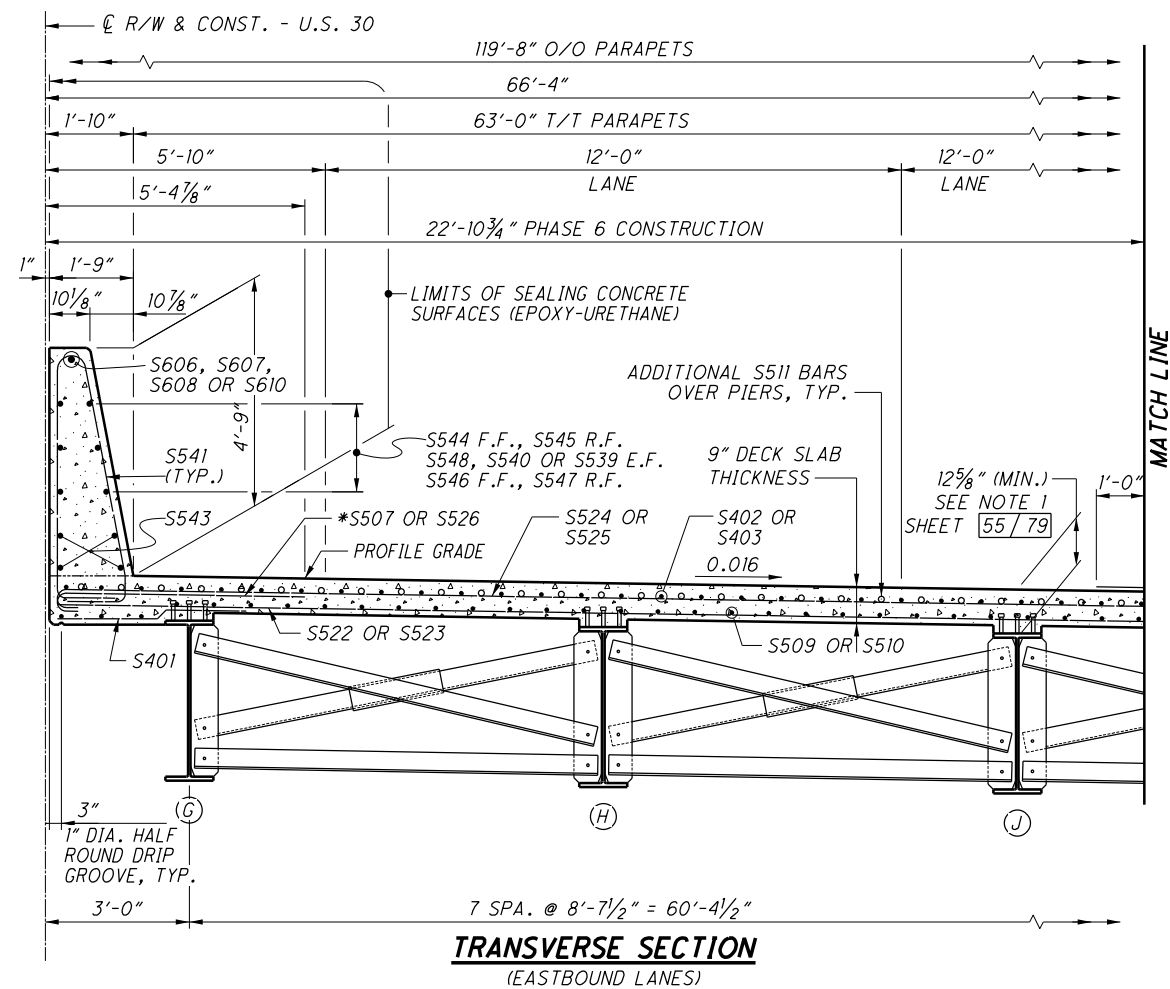

**TRANSVERSE SECTION**  
(EASTBOUND LANES)

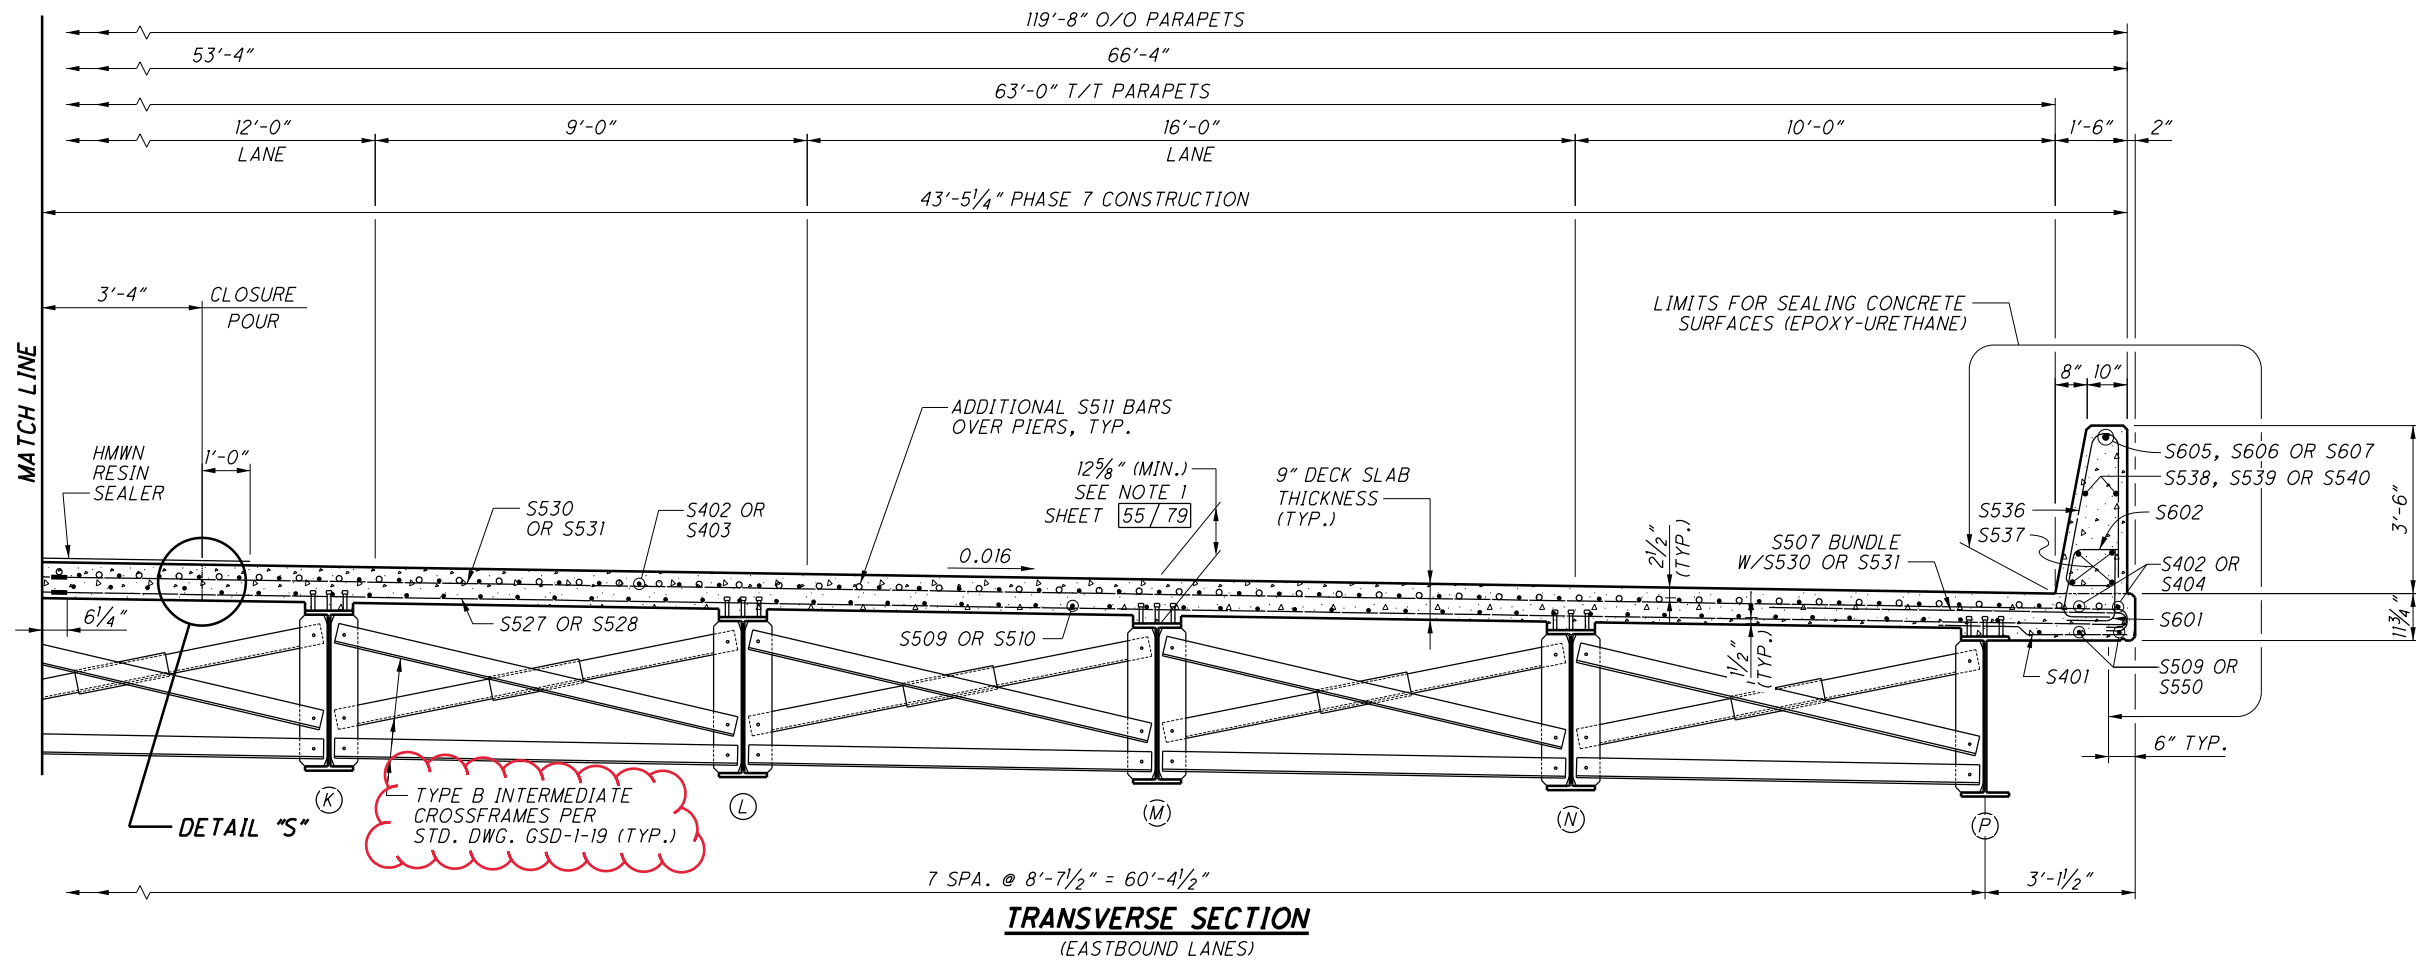

**TRANSVERSE SECTION**  
(EASTBOUND LANES)

**LEGEND**

\* - S507 & S526 BUNDLE WITH S524 OR S525

**NOTES**

1. MINIMUM REINFORCING STEEL SPLICE LENGTH UNLESS OTHERWISE NOTED:  
NO. 5 BAR = 2'-5"  
S521 THRU S523, S527 THRU S529 = 3'-0" (BOTTOM OF SLAB)
2. FOR RAILING AND MEDIAN BARRIER DETAILS SEE SHEET 56/79 THRU 60/79.
3. FOR SLAB PLAN - RIGHT (EASTBOUND) SEE SHEET 55/79.
4. FOR ABBREVIATIONS SEE SHEET 3/79.
5. FOR DETAIL "S" SEE SHEET 52/79.

DESIGN AGENCY  
ENGINEERING ASSOCIATES, INC.  
835 EAGLE PASS - WOOSTER, OHIO 44691  
TELEPHONE: (330) 345-6556  
FAX: (330) 345-8077



DESIGNED	HK	CHECKED	BDH
DRAWN	RLE	REVISED	---
REVIEWED	SDS	DATE	9-24-19
STRUCTURE FILE NUMBER	7001232	FILE NUMBER	

TRANSVERSE SECTION - RIGHT (EASTBOUND)

BRIDGE NO. RIC-30-1219  
OVER ASHLAND RAILWAY

RIC-30-9-26  
PID No. 93455

53/79

1396  
1669

**STANDARD DRAWINGS**

REFER TO THE FOLLOWING STANDARD BRIDGE DRAWINGS:

AS-1-15	REVISED	7-17-15
AS-2-15	REVISED	1-18-19
GSD-1-19	DATED	1-18-19
PCB-91	REVISED	1-18-13
SBR-1-13	REVISED	7-20-18
SBR-2-13	REVISED	7-20-18
SICD-1-96	REVISED	7-18-14
SICD-2-14	DATED	7-18-14
VPF-1-90	REVISED	7-20-18

**DESIGN SPECIFICATIONS**

THIS STRUCTURE CONFORMS TO THE "LRFD BRIDGE DESIGN SPECIFICATIONS" ADOPTED BY THE AMERICAN ASSOCIATION OF STATE HIGHWAY AND TRANSPORTATION OFFICIALS, 2017, 8TH EDITION AND THE ODOT BRIDGE DESIGN MANUAL, 2019.

**OPERATIONAL IMPORTANCE**

A LOAD MODIFIER OF 1.0 HAS BEEN ASSUMED FOR THE DESIGN OF THIS STRUCTURE IN ACCORDANCE WITH THE AASHTO LRFD BRIDGE DESIGN SPECIFICATIONS, ARTICLE 1.3.5 AND THE ODOT BRIDGE DESIGN MANUAL, 2019.

**DESIGN LOADING**

HL-93  
FUTURE WEARING SURFACE (FWS) OF 0.060 KIPS/FT<sup>2</sup>.

**DESIGN DATA**

CONCRETE CLASS QC2 WITH QC/QA - COMPRESSIVE STRENGTH 4.5 KSI (SUPERSTRUCTURE)

CONCRETE CLASS QC1 WITH QC/QA - COMPRESSIVE STRENGTH 4.0 KSI (SUBSTRUCTURE)

REINFORCING STEEL - MINIMUM YIELD STRENGTH 60 KSI

STRUCTURAL STEEL - ASTM A709 GRADE 50 - YIELD STRENGTH 50 KSI

STEEL H-PILES - ASTM A572 - YIELD STRENGTH 50 KSI

**DECK PROTECTION METHOD**

EPOXY COATED REINFORCING STEEL  
2 1/2" CONCRETE COVER

**MONOLITHIC WEARING SURFACE**

MONOLITHIC WEARING SURFACE IS ASSUMED, FOR DESIGN PURPOSES, TO BE 1 INCH THICK.

**ITEM 202, PORTIONS OF STRUCTURE REMOVED, OVER 20 FOOT SPAN, AS PER PLAN:**

THIS ITEM SHALL INCLUDE THE ELEMENTS INDICATED IN THE PLANS AND GENERAL NOTES AND THAT ARE NOT SEPARATELY LISTED FOR PAYMENT, EXCEPT FOR WEARING COURSE REMOVAL. ITEMS TO BE REMOVED INCLUDE ALL EXISTING MATERIALS BEING REPLACED BY NEW CONSTRUCTION AND MISCELLANEOUS ITEMS THAT ARE NOT SHOWN TO BE INCORPORATED INTO THE FINAL CONSTRUCTION AND ARE DIRECTED TO BE REMOVED BY THE ENGINEER. THE USE OF EXPLOSIVES, HEADACHE BALLS AND/OR HOE-RAMS WILL NOT BE PERMITTED. THE METHOD OF REMOVAL AND THE WEIGHT OF HAMMER SHALL BE APPROVED BY THE ENGINEER. PERFORM ALL WORK IN A MANNER THAT WILL NOT CUT, ELONGATE OR DAMAGE THE EXISTING REINFORCING STEEL TO BE PRESERVED. CHIPPING HAMMERS SHALL NOT BE HEAVIER THAN THE NOMINAL 90-POUND CLASS. PNEUMATIC HAMMERS SHALL NOT BE PLACED IN DIRECT CONTACT WITH REINFORCING STEEL THAT IS TO BE RETAINED IN THE REBUILT STRUCTURE. SUBMIT CONSTRUCTION PLANS ACCORDING TO C&MS 501.05

**ITEM 203 EMBANKMENT, AS PER PLAN**

PLACE AND COMPACT EMBANKMENT MATERIAL IN 6 INCH LIFTS FOR THE CONSTRUCTION OF THE APPROACH EMBANKMENT BETWEEN STATIONS 650+50 TO 656+50.

**PILE DRIVING CONSTRAINTS**

PRIOR TO DRIVING PILES, CONSTRUCT THE SPILL THROUGH SLOPES AND THE BRIDGE APPROACH EMBANKMENT BEHIND THE ABUTMENTS UP TO THE LEVEL OF THE SUBGRADE ELEVATION FOR A MINIMUM DISTANCE OF 200 FEET BEHIND EACH ABUTMENT. DO NOT BEGIN THE EXCAVATION FOR THE ABUTMENT FOOTINGS AND THE INSTALLATION OF THE ABUTMENT AND THE PIER PILES, UNTIL AFTER THE ABOVE REQUIRED EMBANKMENT HAS BEEN CONSTRUCTED.

**PILES TO BEDROCK**

DRIVE PILES TO REFUSAL ON BEDROCK. THE DEPARTMENT WILL CONSIDER REFUSAL TO BE OBTAINED WHEN THE PILE PENETRATION IS AN INCH OR LESS AFTER RECEIVING AT LEAST 20 BLOWS FROM THE PILE HAMMER. SELECT THE HAMMER SIZE TO ACHIEVE THE REQUIRED DEPTH TO BEDROCK AND REFUSAL.

THE TOTAL FACTORED LOAD IS 125 KIPS PER PILE FOR THE ABUTMENT PILES. THE TOTAL FACTORED LOAD IS 235 KIPS PER PILE FOR THE PIER PILES.

	LEFT BRIDGE		RIGHT BRIDGE	
	NO. OF PILES	ORDER LENGTH	NO. OF PILES	ORDER LENGTH
REAR ABUTMENT	22	65 FT	23	65 FT
PIER NO. 1	17	50 FT	22	45 FT
PIER NO. 2	16	35 FT	20	35 FT
FORWARD ABUTMENT	17	40 FT	18	45 FT

**PILE SPLICES**

IN LIEU OF USING THE FULL PENETRATION BUTT WELDS SPECIFIED IN CMS 507.09 TO SPLICE STEEL H-PILES, THE CONTRACTOR MAY USE A MANUFACTURED H-PILE SPLICER. FURNISH SPLICERS FROM THE FOLLOWING MANUFACTURER:

ASSOCIATED PILE AND FITTING CORPORATION  
8 WOOD HOLLOW RD. PLAZA 1  
PARSIPPANY, NEW JERSEY 07054

INSTALL AND WELD THE SPLICER TO THE PILE SECTIONS IN ACCORDANCE WITH THE MANUFACTURER'S WRITTEN ASSEMBLY PROCEDURE SUPPLIED TO THE ENGINEER BEFORE THE WELDING IS PERFORMED.

**ITEM 503, COFFERDAMS AND EXCAVATION BRACING, AS PER PLAN**

THE DESIGN SHOWN ON THE PLANS FOR TEMPORARY SUPPORT OF EXCAVATION IS ONE REPRESENTATIVE DESIGN THAT MAY BE USED TO CONSTRUCT THE PROJECT. THE CONTRACTOR MAY CONSTRUCT THE DESIGN SHOWN ON THE PLANS OR PREPARE AN ALTERNATE DESIGN TO SUPPORT THE SIDES OF EXCAVATION. IF CONSTRUCTING AN ALTERNATE DESIGN FOR TEMPORARY SUPPORT OF EXCAVATION, PREPARE AND PROVIDE PLANS IN ACCORDANCE WITH C&MS 501.05. THE DEPARTMENT WILL PAY FOR THE TEMPORARY SUPPORT OF EXCAVATION AT THE CONTRACT LUMP SUM PRICE FOR COFFERDAMS AND EXCAVATION BRACING. NO ADDITIONAL PAYMENT WILL BE MADE FOR PROVIDING AN ALTERNATE DESIGN.

**DECK PLACEMENT ASSUMPTIONS**

THE FOLLOWING ASSUMPTIONS OF CONSTRUCTION MEANS AND METHODS WERE MADE FOR THE ANALYSIS AND DESIGN OF THE SUPERSTRUCTURE. THE CONTRACTOR IS RESPONSIBLE FOR THE DESIGN OF THE FALSEWORK SUPPORT SYSTEM WITHIN THESE PARAMETERS AND WILL ASSUME RESPONSIBILITY FOR SUPERSTRUCTURE ANALYSIS FOR DEVIATION FROM THESE DESIGN ASSUMPTIONS.

AN EIGHT WHEEL FINISHING MACHINE WITH A MAXIMUM WHEEL LOAD OF 2.34 KIPS.

A MINIMUM OUT-TO-OUT WHEEL SPACING AT EACH END OF THE MACHINE OF 103".


A MAXIMUM SPACING OF OVERHANG FALSEWORK BRACKETS OF 48".

A MAXIMUM DISTANCE FROM THE CENTERLINE OF THE FASCIA GIRDER TO THE FACE OF THE SAFETY HANDRAIL OF 65".

**STRUCTURE PAINTING:** ALL BRIDGE FINISH COATS SHALL BE THE SAME COLOR.

**UTILITIES TO REMAIN:** EXISTING TELEPHONE DUCT SHALL NOT BE DISTURBED.

- ABUT. - ABUTMENT
- APPR. - APPROACH
- BRG. - BEARING
- BOT. - BOTTOM
- CONST. JT. - CONSTRUCTION JOINT
- CLR. - CLEAR
- CONST. - CONSTRUCTION
- CORR. - CORRUGATED
- DIA. - DIAMETER
- DIM. - DIMENSION
- DWG. - DRAWING
- EL. - ELEVATION
- E.F. - EACH FACE
- EXIST. - EXISTING
- F.A. - FORWARD ABUTMENT
- FWD. - FORWARD
- F.F. - FRONT FACE
- FT. - FEET
- LBS. - POUNDS
- MAX. - MAXIMUM
- MEAS. - MEASURED
- MIN. - MINIMUM
- OPT. - OPTIONAL
- P.E.J.F. - PERFORMED EXPANSION JOINT FILLER
- R.A. - REAR ABUTMENT
- R.F. - REAR FACE
- REQ'D. - REQUIRED
- SPA. - SPACING
- STA. - STATION
- T.O.S. - TOP OF SLOPE
- TYP. - TYPICAL
- U.O.N. - UNLESS OTHERWISE NOTED
- VAR. - VARIES
- W/ - WITH

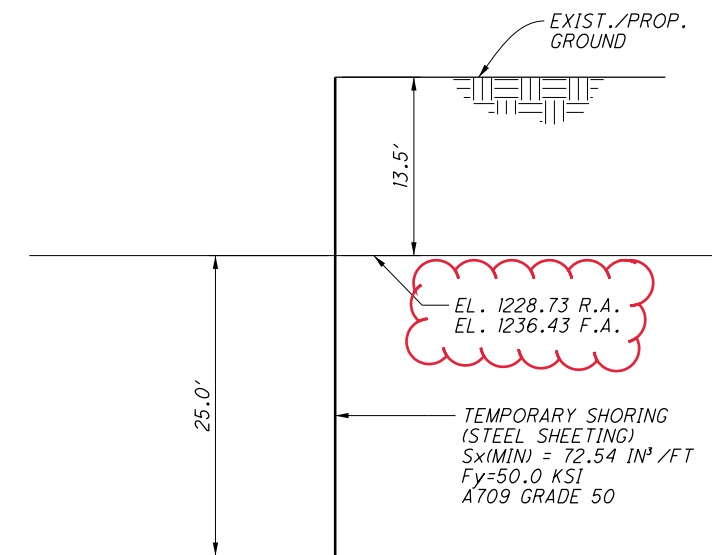

**SECTION A-A  
TEMPORARY SHORING DETAIL**

NOTE: SEE SHEET 2 / 73 FOR LOCATION

M:\15074\93455\Design\Structures\RIC030\_1236C\Sheets\030\_1236CSN001.dgn 2/24/2020 11:11:17 AM acb284

DESIGN AGENCY  
ENGINEERING ASSOCIATES, INC.  
935 EAGLE PASS - WOOSTER, OHIO 44691  
TELEPHONE: (330) 345-6556  
FAX: (330) 345-8077



DATE 9-24-19  
REVIEWED SDS  
STRUCTURE FILE NUMBER 7001267

DRAWN TAC  
CHECKED BDH  
REVISED

GENERAL NOTES  
BRIDGE NO. RIC-30-1236  
OVER S.R. 545

RIC-30-9-26  
PID No. 93455

3 / 73

1427  
1669

CALC: BDH DATE: 8/30/2019  
 CHECKED: HK DATE: 8/30/2019

**ESTIMATED QUANTITIES**

ITEM	EXTENSION	TOTAL 01/NHS/BR	UNIT	DESCRIPTION	ABUT.	PIERS	SUPER.	GEN.	SEE SHEET
202	11203	LS		PORTIONS OF STRUCTURE REMOVED, OVER 20 FOOT SPAN, AS PER PLAN				LS	3 / 73
202	22900	347	SY	APPROACH SLAB REMOVED				347	
202	23500	167	SY	WEARING COURSE REMOVED				167	
503	11101	LS		COFFERDAMS AND EXCAVATION BRACING, AS PER PLAN				LS	3 / 73
503	21100	1693	CY	UNCLASSIFIED EXCAVATION	1234	459			
505	11100	LS		PILE DRIVING EQUIPMENT MOBILIZATION				LS	
507	00100	7515	FT	STEEL PILES HPI0X42, FURNISHED	4415	3100			
507	00150	6740	FT	STEEL PILES HPI0X42, DRIVEN	4015	2725			
507	92200	585	FT	PREBORED HOLES		585			
509	10000	294385	LB	EPOXY COATED REINFORCING STEEL	39137	56695	198553		
511	21523	821	CY	CLASS OC2 CONCRETE WITH QC/OA, SUPERSTRUCTURE, AS PER PLAN			821		35 / 73 & 36 / 73
511	33500	4	EACH	SEMI-INTEGRAL DIAPHRAGM GUIDE			4		
511	41012	189	CY	CLASS OC1 CONCRETE WITH QC/OA, PIER ABOVE FOOTINGS		189			
511	44112	312	CY	CLASS OC1 CONCRETE WITH QC/OA, ABUTMENT NOT INCLUDING FOOTING	312				
511	46512	357	CY	CLASS OC1 CONCRETE WITH QC/OA, FOOTING	226	131			
512	10100	1539	SY	SEALING OF CONCRETE SURFACES (EPOXY-URETHANE)	82	561	823	73	
512	10300	369	SY	SEALING CONCRETE BRIDGE DECKS WITH HMWM RESIN			335	34	
512	33000	35	SY	TYPE 2 WATERPROOFING	35				
513	10260	560936	LB	STRUCTURAL STEEL MEMBERS, LEVEL 3			560936		
513	20000	10335	EACH	WELDED STUD SHEAR CONNECTORS			10335		
514	00800	560936	LB	FIELD PAINTING STRUCTURAL STEEL, INTERMEDIATE COAT			560936		
514	00851	560936	LB	FIELD PAINTING STRUCTURAL STEEL, FINISH COAT, AS PER PLAN			560936		3 / 73
514	10000	25	EACH	FINAL INSPECTION REPAIR			25		
516	10010	256	FT	ARMORLESS PREFORMED JOINT SEAL				256	
516	13600	30	SF	1" PREFORMED EXPANSION JOINT FILLER			30		
516	13900	787	SF	2" PREFORMED EXPANSION JOINT FILLER			230	557	
516	14020	279	FT	SEMI-INTEGRAL ABUTMENT EXPANSION JOINT SEAL	279				
516	44101	26	EACH	ELASTOMERIC BEARING WITH INTERNAL LAMINATES AND LOAD PLATE (NEOPRENE), AS PER PLAN 2 1/2"x1'-0"x1'-2" W/ 1 1/2"x1'-1"x1'-3" BEVELED LOAD PLATE	26				32 / 73
516	44101	26	EACH	ELASTOMERIC BEARING WITH INTERNAL LAMINATES AND LOAD PLATE (NEOPRENE), AS PER PLAN 3 1/8"x1'-3"x1'-6" W/ 2 5/16"(AVG)x1'-4"x1'-7" BEVELED LOAD PLATE		26			32 / 73
518	21200	190	CY	POROUS BACKFILL WITH GEOTEXTILE FABRIC	190				
518	40000	339	FT	6" PERFORATED CORRUGATED PLASTIC PIPE	339				
518	40010	66	FT	6" NON-PERFORATED CORRUGATED PLASTIC PIPE, INCLUDING SPECIALS	66				
526	25001	617	SY	REINFORCED CONCRETE APPROACH SLABS (T=15"), AS PER PLAN				617	53 / 73 THRU 58 / 73
526	90030	267	FT	TYPE C INSTALLATION				267	
601	21000	1154	SY	CONCRETE SLOPE PROTECTION				1154	
607	39900	320	FT	VANDAL PROTECTION FENCE, 6' STRAIGHT, COATED FABRIC			320		

DESIGN AGENCY  
**ENGINEERING ASSOCIATES, INC.**  
 895 EAGLE PASS - WOOSTER, OHIO 44691  
 TELEPHONE: (330) 345-6556  
 FAX: (330) 345-8077

DATE  
 9-24-19  
 REVIEWED  
 SDS  
 STRUCTURE FILE NUMBER  
 7001267

DRAWN  
 TAC  
 CHECKED  
 BDH


**ESTIMATED QUANTITIES**  
 BRIDGE NO. RIC-30-1236  
 OVER S.R. 545

**RIC-30-9-26**  
 PID No. 93455


4 / 73

1428  
 1669

M:\15074\_93455\Design\Structures\RIC030\_1236CSB001.dgn 2/24/2020 11:31:58 AM acb284

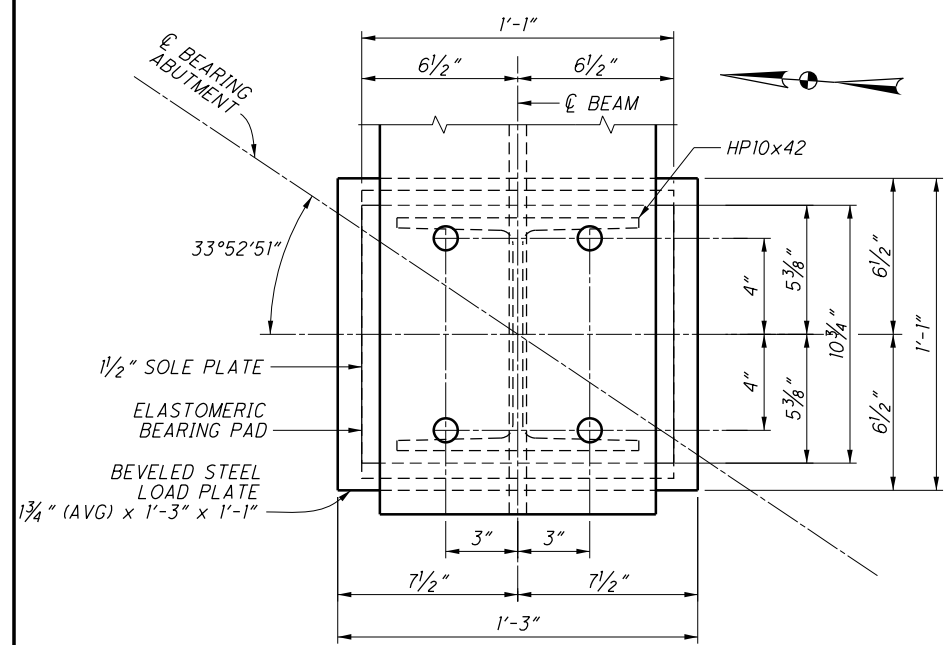


**PLAN AT ABUTMENT**  
(REAR ABUTMENT SHOWN,  
FORWARD ABUTMENT SIMILAR)

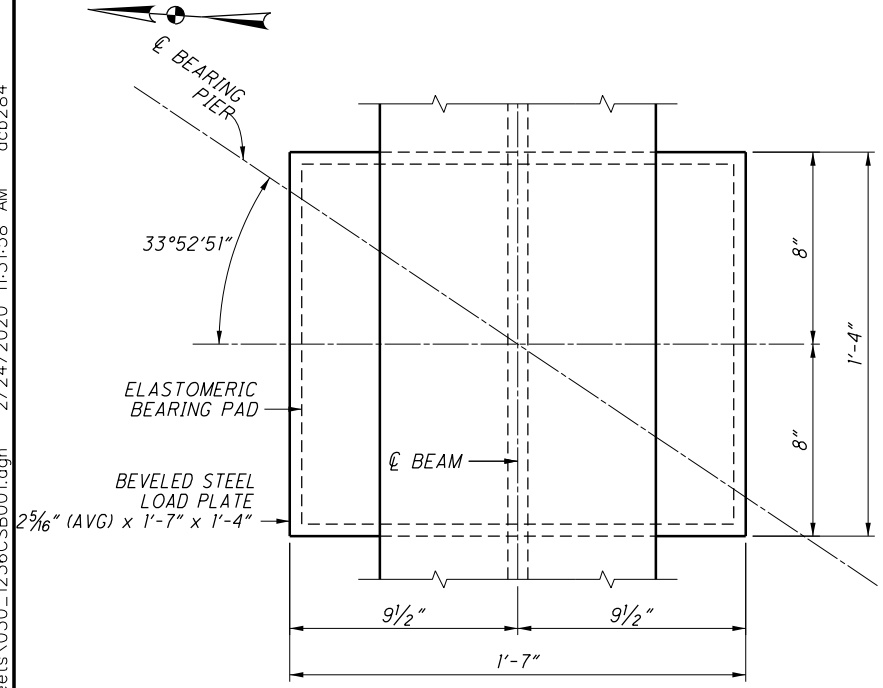


**PLAN AT PIERS**




**BEARING ORIENTATION**

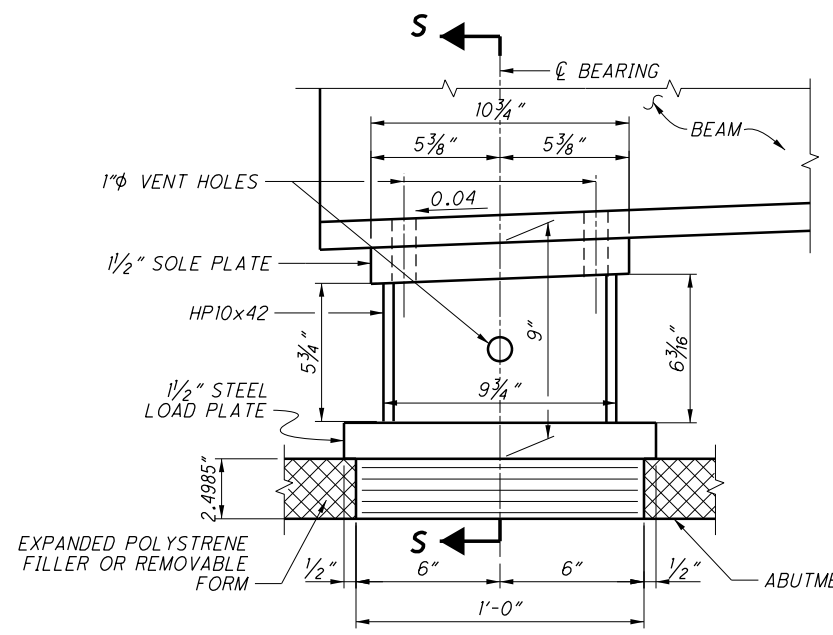


**ABUTMENT BEARING ELEVATION**

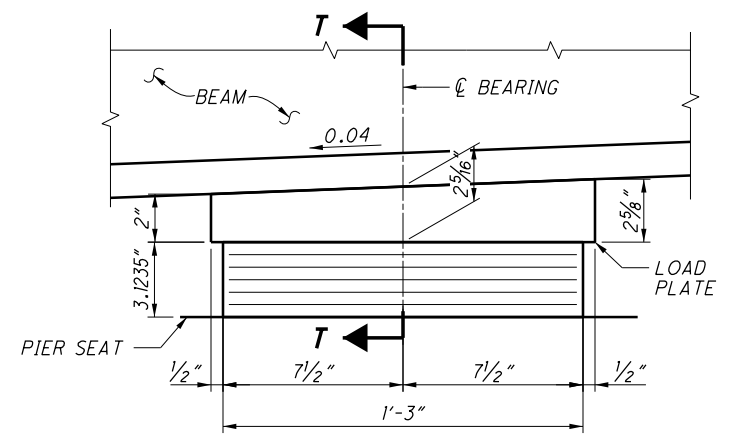

**PIER BEARING ELEVATION**

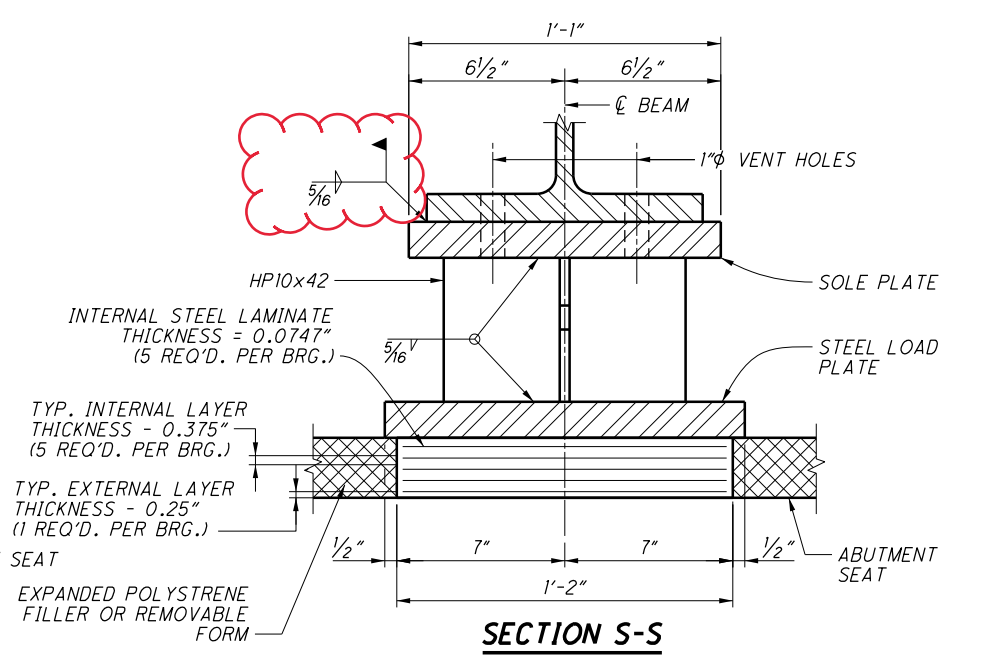

**SECTION S-S**

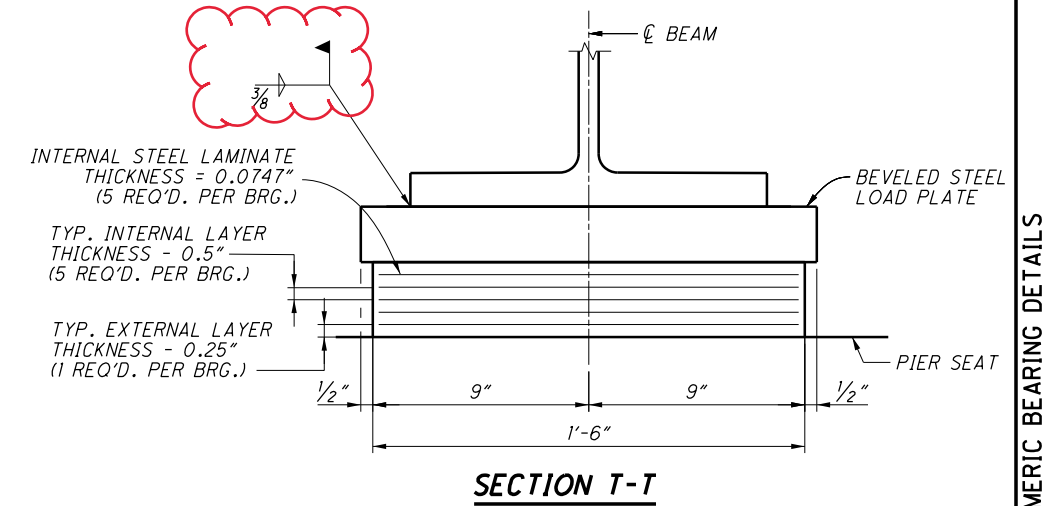

**SECTION T-T**


**NOTES**

- ELASTOMERIC BEARINGS: THE ELASTOMER SHALL HAVE A HARDNESS OF 50 DUROMETER. THE BEARINGS WERE DESIGNED IN ACCORDANCE WITH SECTION 14.7.6 (METHOD A) OF THE AASHTO LRFD BRIDGE DESIGN SPECIFICATIONS. THE LONGTERM COMPRESSION PROOF LOAD TEST (AASHTO STANDARD SPECIFICATIONS FOR HIGHWAY BRIDGES, DIVISION II, SECTION 18.7.2.6) IS NOT REQUIRED.
- BASIS FOR PAYMENT FOR ELASTOMERIC BEARING: THE UNIT PRICE BID SHALL INCLUDE ALL MATERIALS, LABOR, TESTING, STEEL SUPPORT POST, BEVELING OF LOAD PLATE WHERE REQUIRED AND INCIDENTALS NECESSARY TO FURNISH AND INSTALL LAMINATED ELASTOMERIC BEARINGS. PAYMENT WILL BE AT THE CONTRACT PRICE FOR THE APPROPRIATE ITEM 516, ELASTOMERIC BEARING WITH INTERNAL LAMINATES AND LOAD PLATE (NEOPRENE), AS PER PLAN.
- FOR ABBREVIATIONS SEE SHEET [ 3 / 73 ] .
- ALL BEARINGS SHALL BE MARKED PRIOR TO SHIPPING. THE MARKS SHALL INCLUDE THE BEARING LOCATION ON THE BRIDGE AND A DIRECTION ARROW THAT POINTS UP-STATION, ALL MARKS SHALL BE PERMANENT AND BE VISIBLE AFTER THE BEARING IS INSTALLED.
- THE STEEL LOAD PLATE (ASTM A709, GRADE 50) SHALL BE BONDED BY VULCANIZATION TO ELASTOMER DURING THE MOLDING PROCESS.
- TABLE INCLUDES UNFACTORED DEAD LOADS, LIVE LOADS (WITHOUT IMPACT) AND TOTAL REACTIONS.


**BEARING REACTION TABLE (KIPS) (SEE NOTE 6)**

BEARING DESIGNATION	LOCATION	TYPE	NO.	LEFT BRIDGE				RIGHT BRIDGE					
				DEAD LOAD		LIVE LOAD	TOTAL	DEAD LOAD		LIVE LOAD	TOTAL		
				DIAPHRAGM	REACTION			DIAPHRAGM	REACTION				
E-150	REAR ABUT.	EXP.	13	43.6	37.2	80.8	66.8	147.6	42.9	35.3	78.2	66.0	144.2
E-255	PIER NO. 1	EXP.	13		154.5	154.5	99.6	254.1		150.6	150.6	98.9	249.5
E-255	PIER NO. 2	EXP.	13		154.5	154.5	99.6	254.1		150.6	150.6	98.9	249.5
E-150	FORWARD ABUT.	EXP.	13	43.6	37.2	80.8	66.8	147.6	40.4	35.1	75.4	65.5	140.9

M:\15074\93455\Design\Structures\RIC030\_1236C\Sheets\030\_1236C\SS001.dgn 2/28/2020 7:26:46 AM ocb284

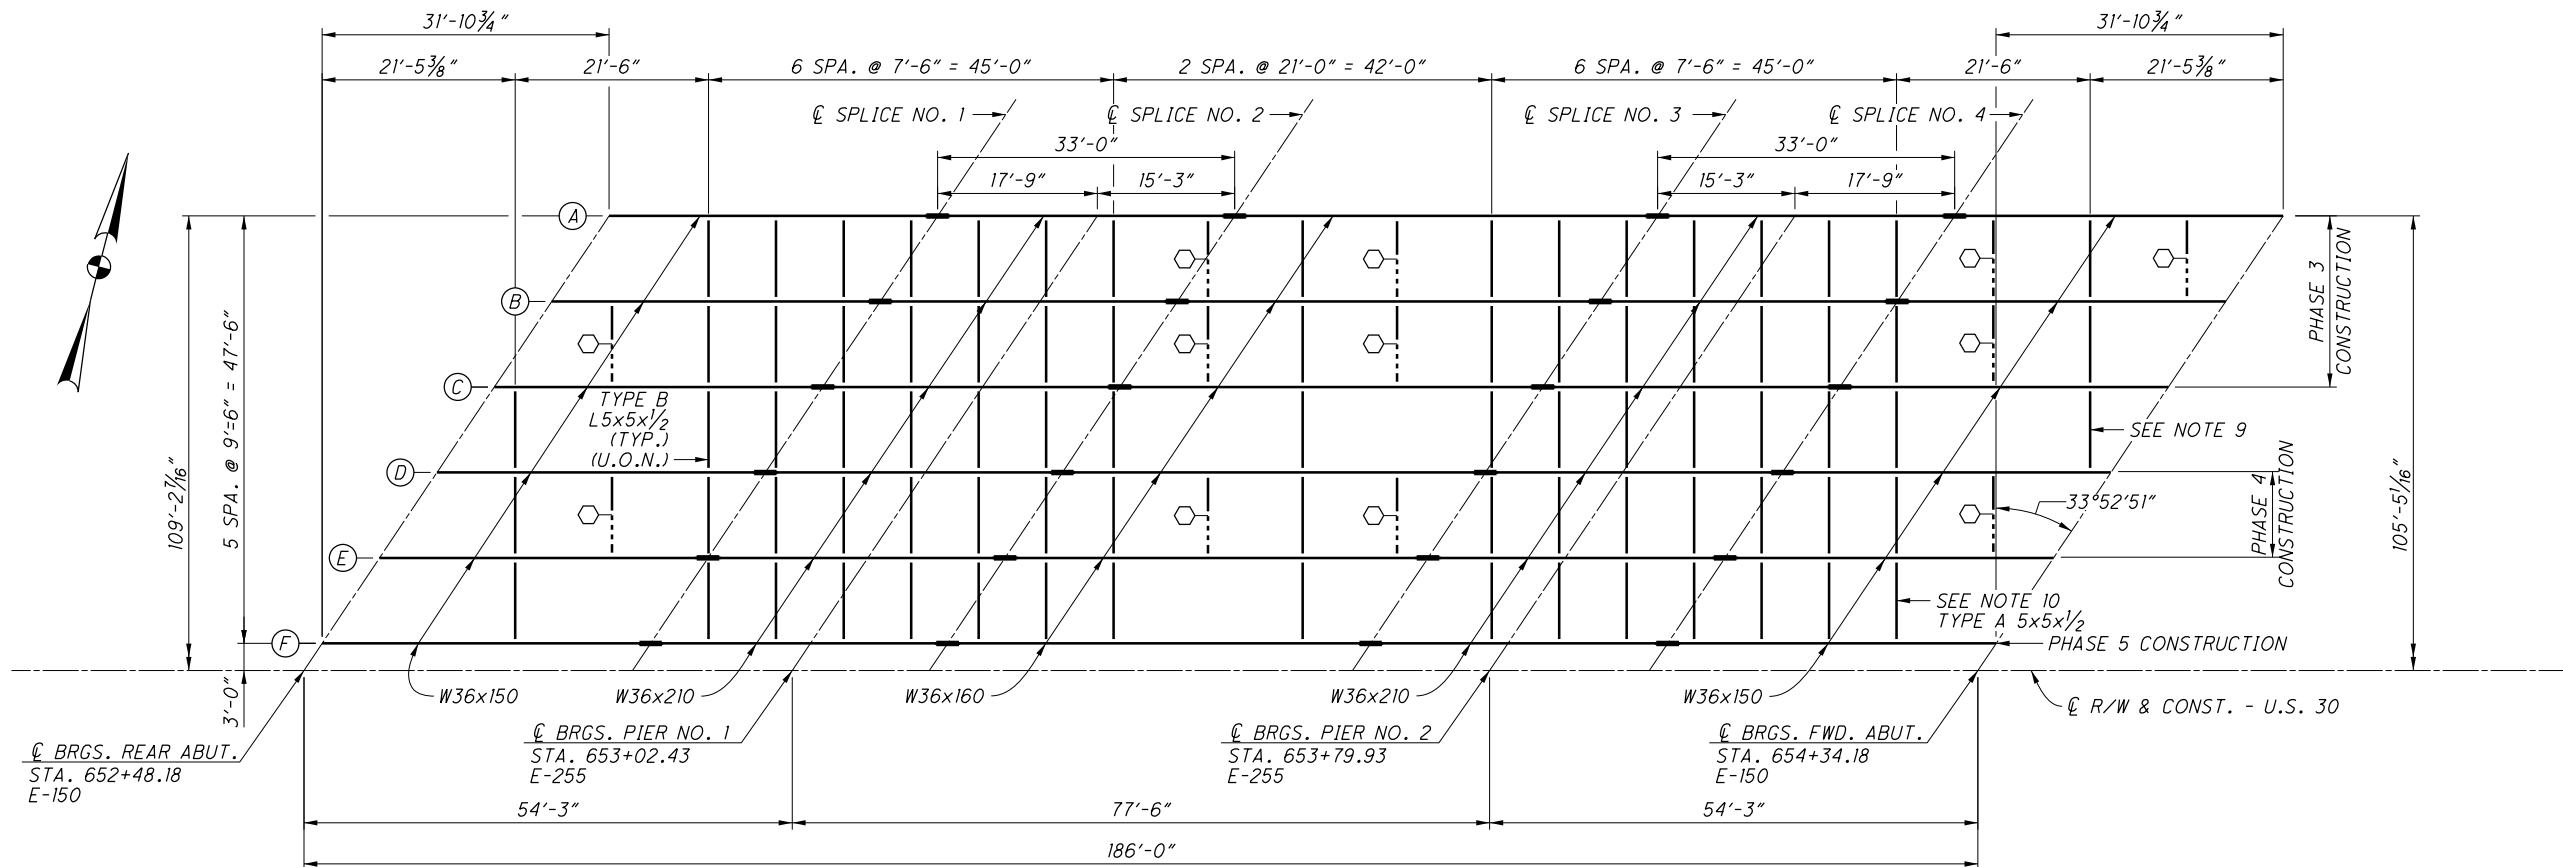

**FRAMING PLAN - WESTBOUND LANES**

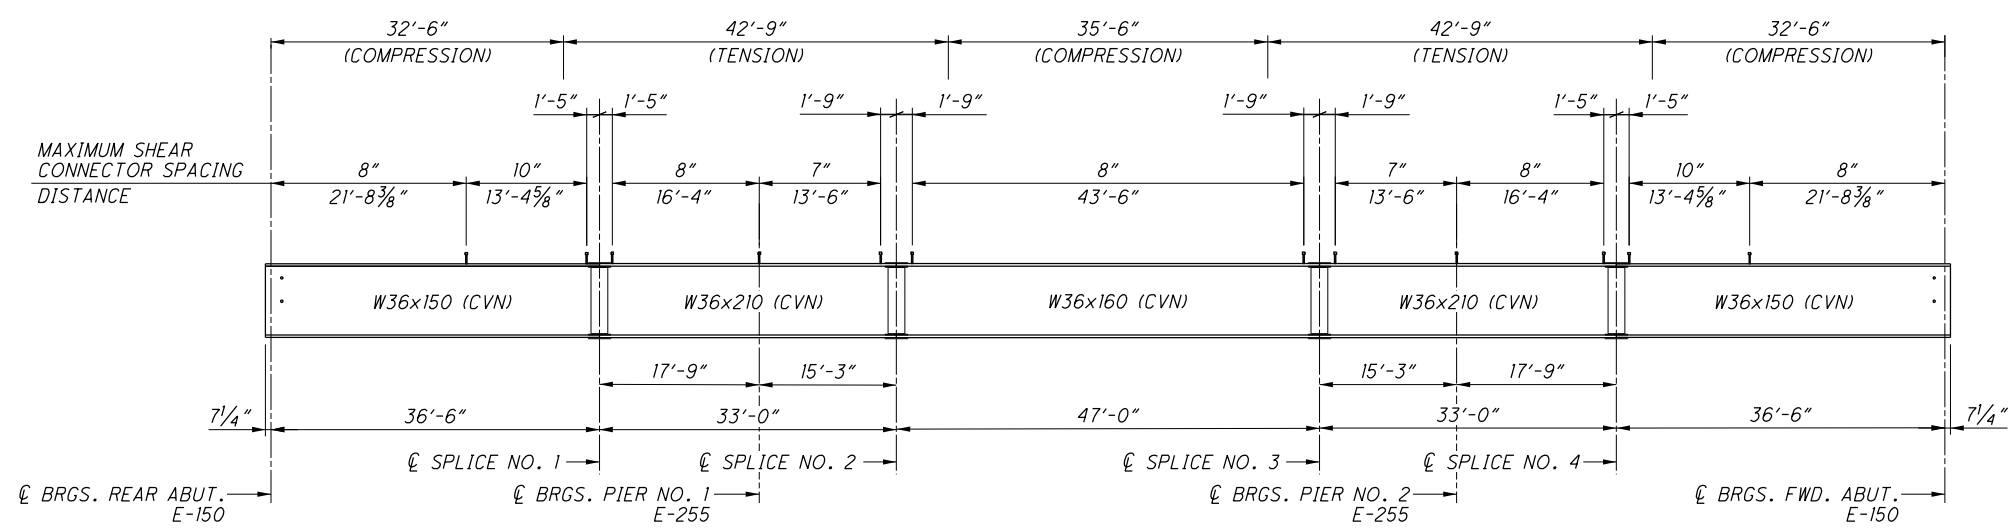

**BEAM ELEVATION - WESTBOUND LANES**

**LEGEND**  
 ○ - TEMPORARY LATERAL SUPPORT SEE SHEET 38/73  
 LOCATE AT 1/2 OF CROSS FRAME SPACING

- NOTES**
- FOR ABBREVIATIONS SEE SHEET 3/73.
  - FOR EB LANES FRAMING PLAN AND ADDITIONAL DETAILS SEE SHEET 36/73.
  - FOR TRANSVERSE SECTION SEE SHEETS 46/73 & 47/73.
  - FOR ELASTOMERIC BEARING DETAILS SEE SHEET 32/73.
  - FOR BEAM DETAILS SEE SHEET 37/73 AND 38/73.
  - WELD ATTACHMENT OF SUPPORTS FOR CONCRETE DECK FINISHING MACHINE TO AREAS OF THE FASCIA STRINGER FLANGES DESIGNATED "COMPRESSION". DO NOT WELD ATTACHMENTS TO AREAS DESIGNATED "TENSION". FILLET WELDS TO COMPRESSION FLANGES SHALL BE AT LEAST 1" FROM EDGE OF FLANGE, BE NO MORE THAN 2" LONG, AND BE AT LEAST 1/4" FOR THICKNESSES UP TO 3/4" OR 5/16" FOR GREATER THAN 3/4" THICK.
  - CVN: WHERE A SHAPE OR PLATE IS DESIGNATED (CVN), FURNISH MATERIAL THAT MEETS THE MINIMUM NOTCH TOUGHNESS REQUIREMENTS AS SPECIFIED IN 711.01.
  - FOR INTERMEDIATE CROSSFRAME DETAILS SEE STD. DWG. GSD-1-19.
  - CROSSFRAMES BETWEEN BEAMS C AND D SHALL BE INSTALLED AFTER THE PHASE 3 AND PHASE 4 DECK CONCRETE HAS BEEN POURED AND PRIOR TO DECK CLOSURE POUR.
  - ERECT BEAM F AND TYPE A CROSSFRAMES. DO NOT TIGHTEN BOLTS UNTIL PHASE 5 DECK CONSTRUCTION IS COMPLETED.

DESIGN AGENCY: ENGINEERING ASSOCIATES, INC.  
 895 EAGLE PASS - WOOSTER, OHIO 44691  
 TELEPHONE: (330) 345-6656  
 FAX: (330) 345-8077

DESIGNED: CEH  
 CHECKED: BDH

DRAWN: TAC  
 REVISED: --

REVIEWED: SDS  
 DATE: 9-24-19  
 STRUCTURE FILE NUMBER: 7001267


BRIDGE NO. RIC-30-1236  
 OVER S.R. 545

RIC-30-9-26  
 PID No. 93455


35/73  
 1459  
 1669




M:\15074\93455\Design\Structures\RIC030\_1236C\Sheets\030\_1236C\SS003.dgn 2/24/2020 11:36:43 AM acb284

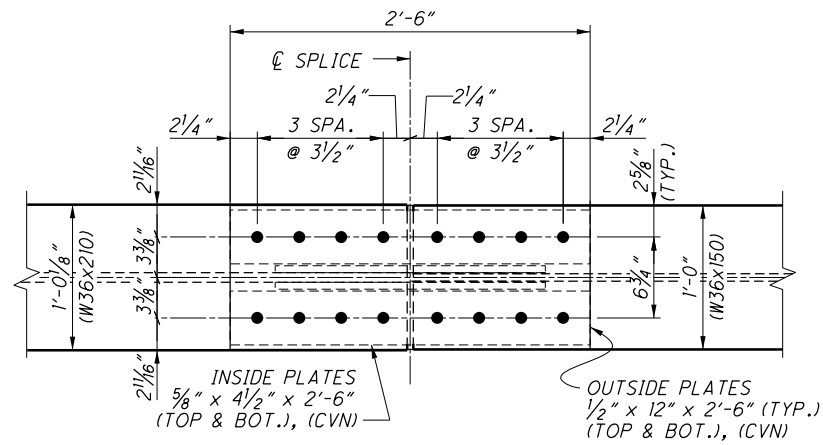


**VIEW K1-K1**

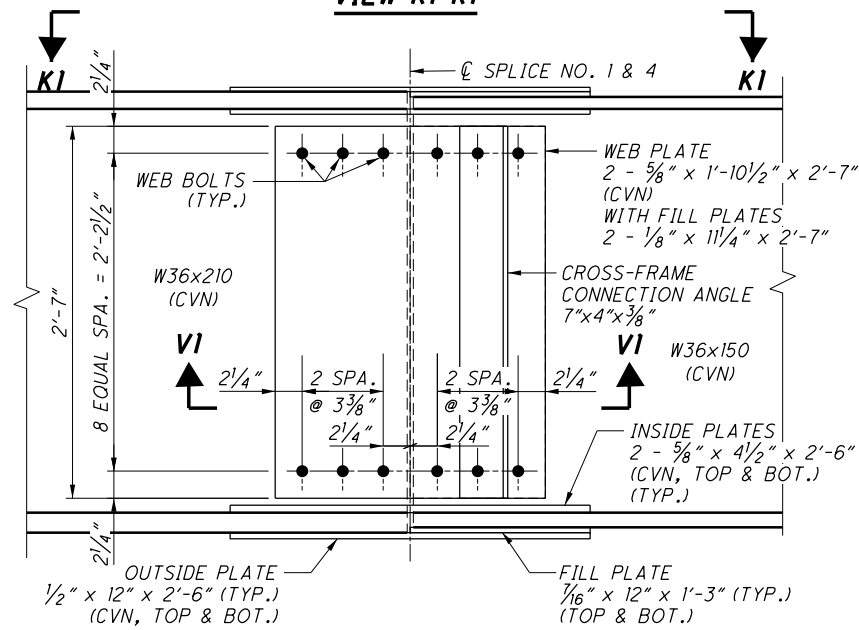


**BEAM SPLICE DETAIL**  
(WESTBOUND STRUCTURE)

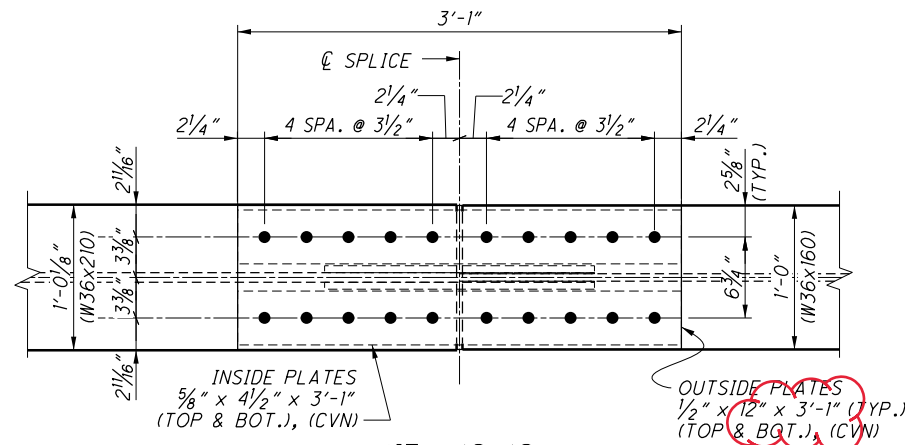


**VIEW K2-K2**

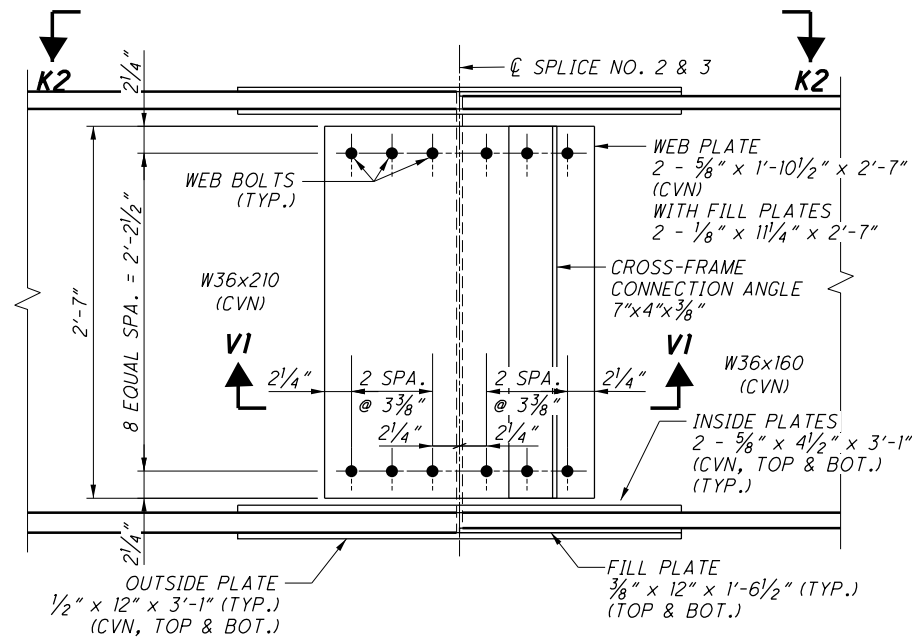

**BEAM SPLICE DETAIL**  
(WESTBOUND STRUCTURE)

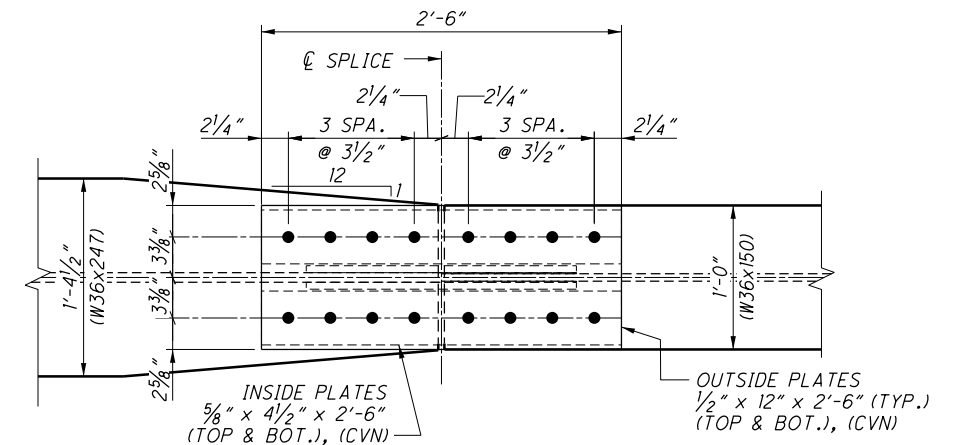


**VIEW K3-K3**

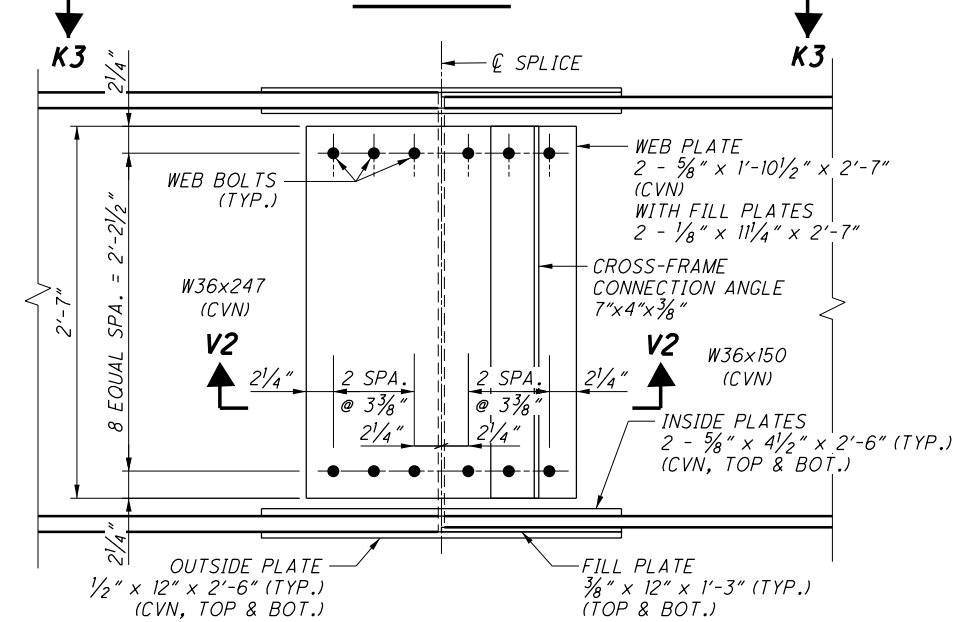


**BEAM SPLICE DETAIL**  
(EASTBOUND STRUCTURE)

Δ LOCATION OF CONNECTION ANGLES ON SPLICE (MAY BE ON EITHER SIDE OF SPLICE ℄)				
BEAM	SPLICE 1	SPLICE 2	SPLICE 3	SPLICE 4
B				0"
C		7 7/8"		
D			7 7/8"	
E	0"			
H	7 7/8"		0"	
J	10 1/8"			
L		10 1/8"		0"
M		7 7/8"		

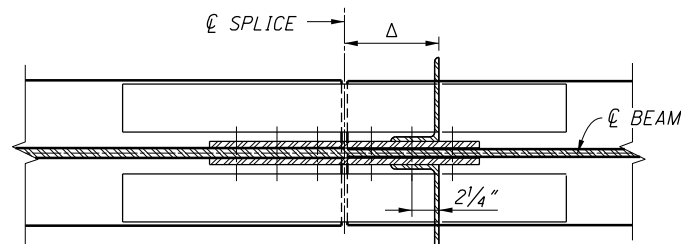

**SECTION VI-VI**

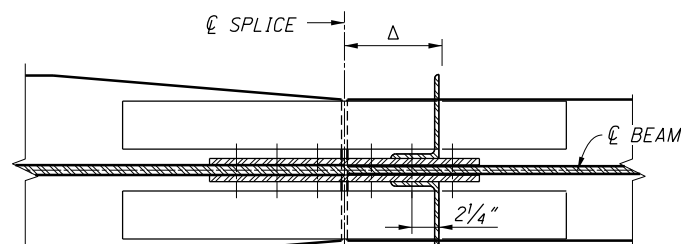

**SECTION V2-V2**

**NOTES**

- FOR ABBREVIATIONS SEE SHEET 3/73.
- FOR FRAMING PLAN, BEAM ELEVATION AND ADDITIONAL NOTES SEE SHEETS 35/73 & 36/73.
- CVN: WHERE A SHAPE OR PLATE IS DESIGNATED (CVN), FURNISH MATERIAL THAT MEETS THE MINIMUM NOTCH TOUGHNESS REQUIREMENTS AS SPECIFIED IN 711.01.
- HIGH STRENGTH BOLTS SHALL BE 1/8" DIAMETER A325, GALVANIZED TYPE I.
- FOR ADDITIONAL BEAM DETAILS SEE SHEET 38/73.

DESIGN AGENCY: ENGINEERING ASSOCIATES, INC.  
 895 EAGLE PASS - WOOSTER, OHIO 44691  
 TELEPHONE: (330) 345-6556  
 FAX: (330) 345-8077

DATE: 9-24-19  
 STRUCTURE FILE NUMBER: 7001267

DESIGNED: CEH  
 CHECKED: BDH

DRAWN: TAC  
 REVISED: ---


REVIEWED: SDS  
 STRUCTURE FILE NUMBER: 7001267

BRIDGE NO. RIC-30-1236  
 OVER S.R. 545


RIC-30-09.26  
 PID No. 93455

37/73  
 1461  
 1669

M:\15074\93455\Design\Structures\RIC030\_1236C\Sheets\030\_1236CST001.dgn 2/24/2020 11:39:19 AM acb284

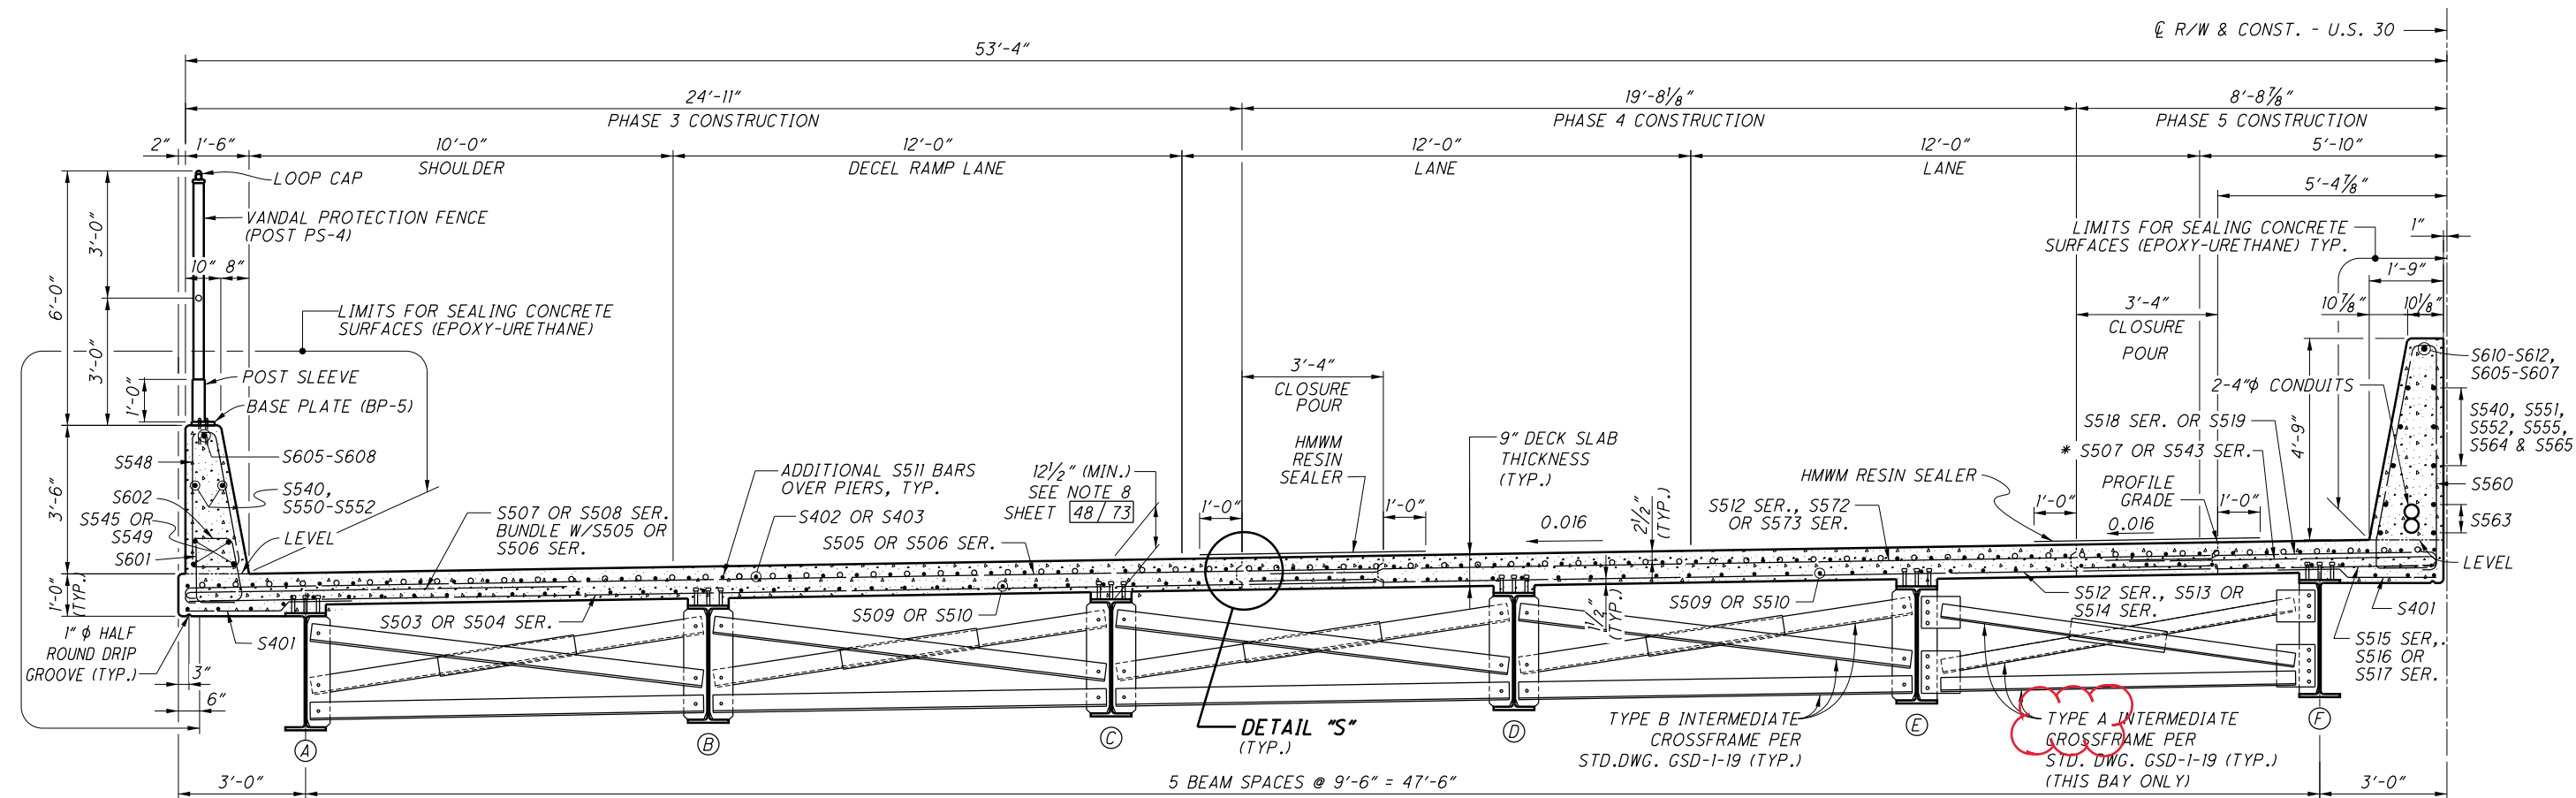

**TRANSVERSE SECTION**  
(WESTBOUND LANES)

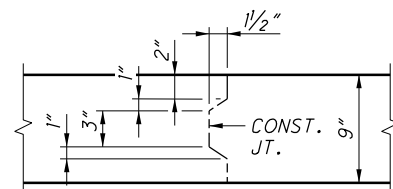

**CONST. JOINT DETAIL**  
**DETAIL "S"**

**LEGEND**

\* - S507 & S543 BUNDLE W/S518 SER., OR S519

**NOTES**

1. FOR ABBREVIATIONS SEE SHEET 3/73 .
2. FOR NOTES SEE SHEETS 48/73 THRU 50/73 .
3. FOR EASTBOUND TRANSVERSE SECTION SEE 47/73 .

DESIGN AGENCY: ENGINEERING ASSOCIATES, INC.  
 895 EAGLE PASS - WOOSTER, OHIO 44691  
 TELEPHONE: (330) 345-6556  
 FAX: (330) 345-8077

DATE: 9-24-19  
 REVIEWED: SDS  
 STRUCTURE FILE NUMBER: 7001267

DRAWN: RLE  
 CHECKED: BDH

DESIGNED: HK


**TRANSVERSE SECTION - LEFT (WESTBOUND)**  
 BRIDGE NO. RIC-30-1236  
 OVER S.R. 545

**RIC-30-9.26**  
**PID No. 93455**


46/73

1470  
 1669

M:\15074\93455\Design\Structures\RIC030\_1236CST002.dgn 2/24/2020 11:40:38 AM acb284

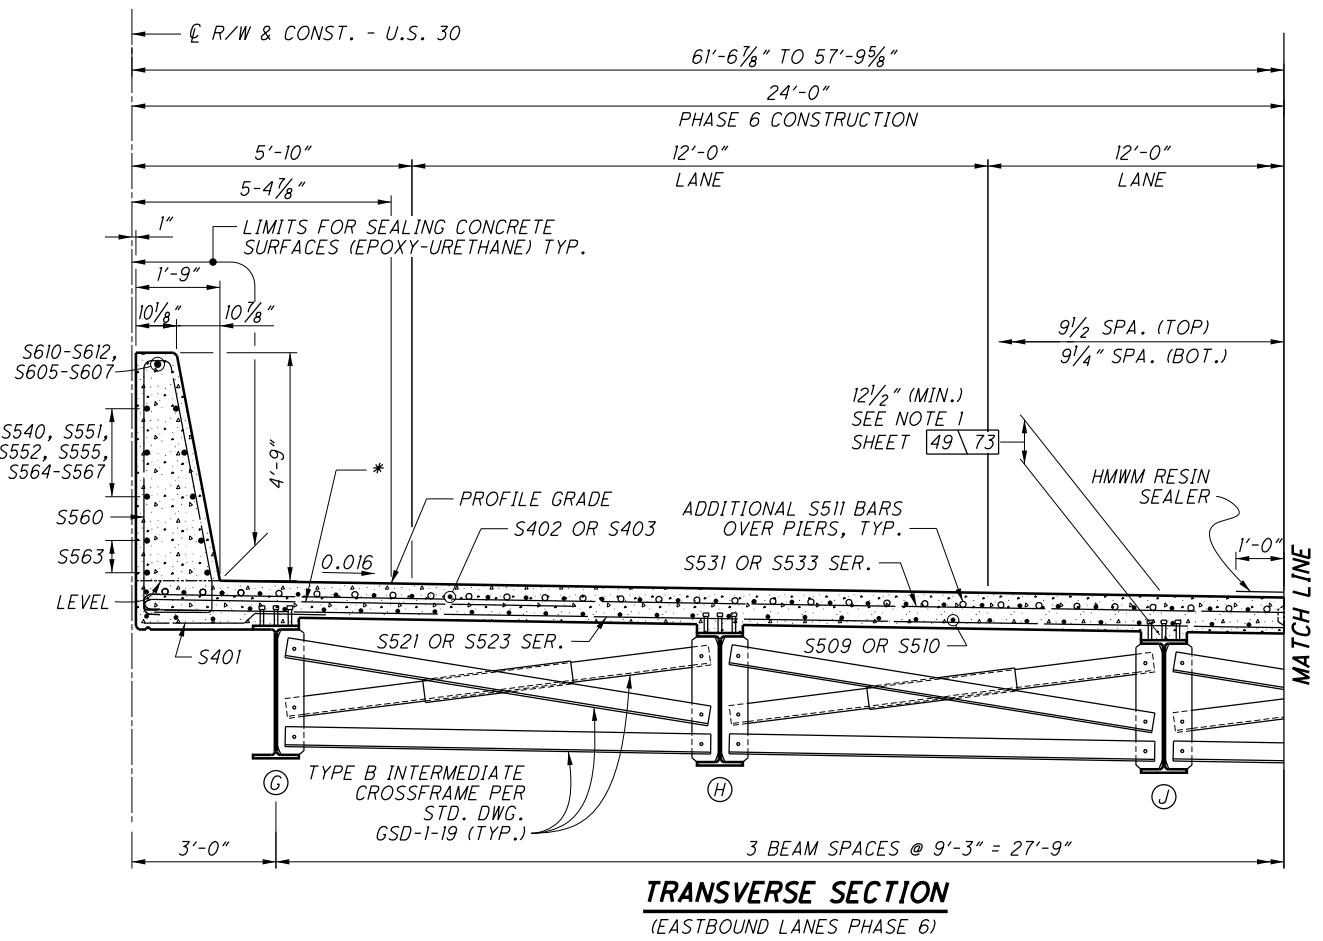

**TRANSVERSE SECTION**  
(EASTBOUND LANES PHASE 6)

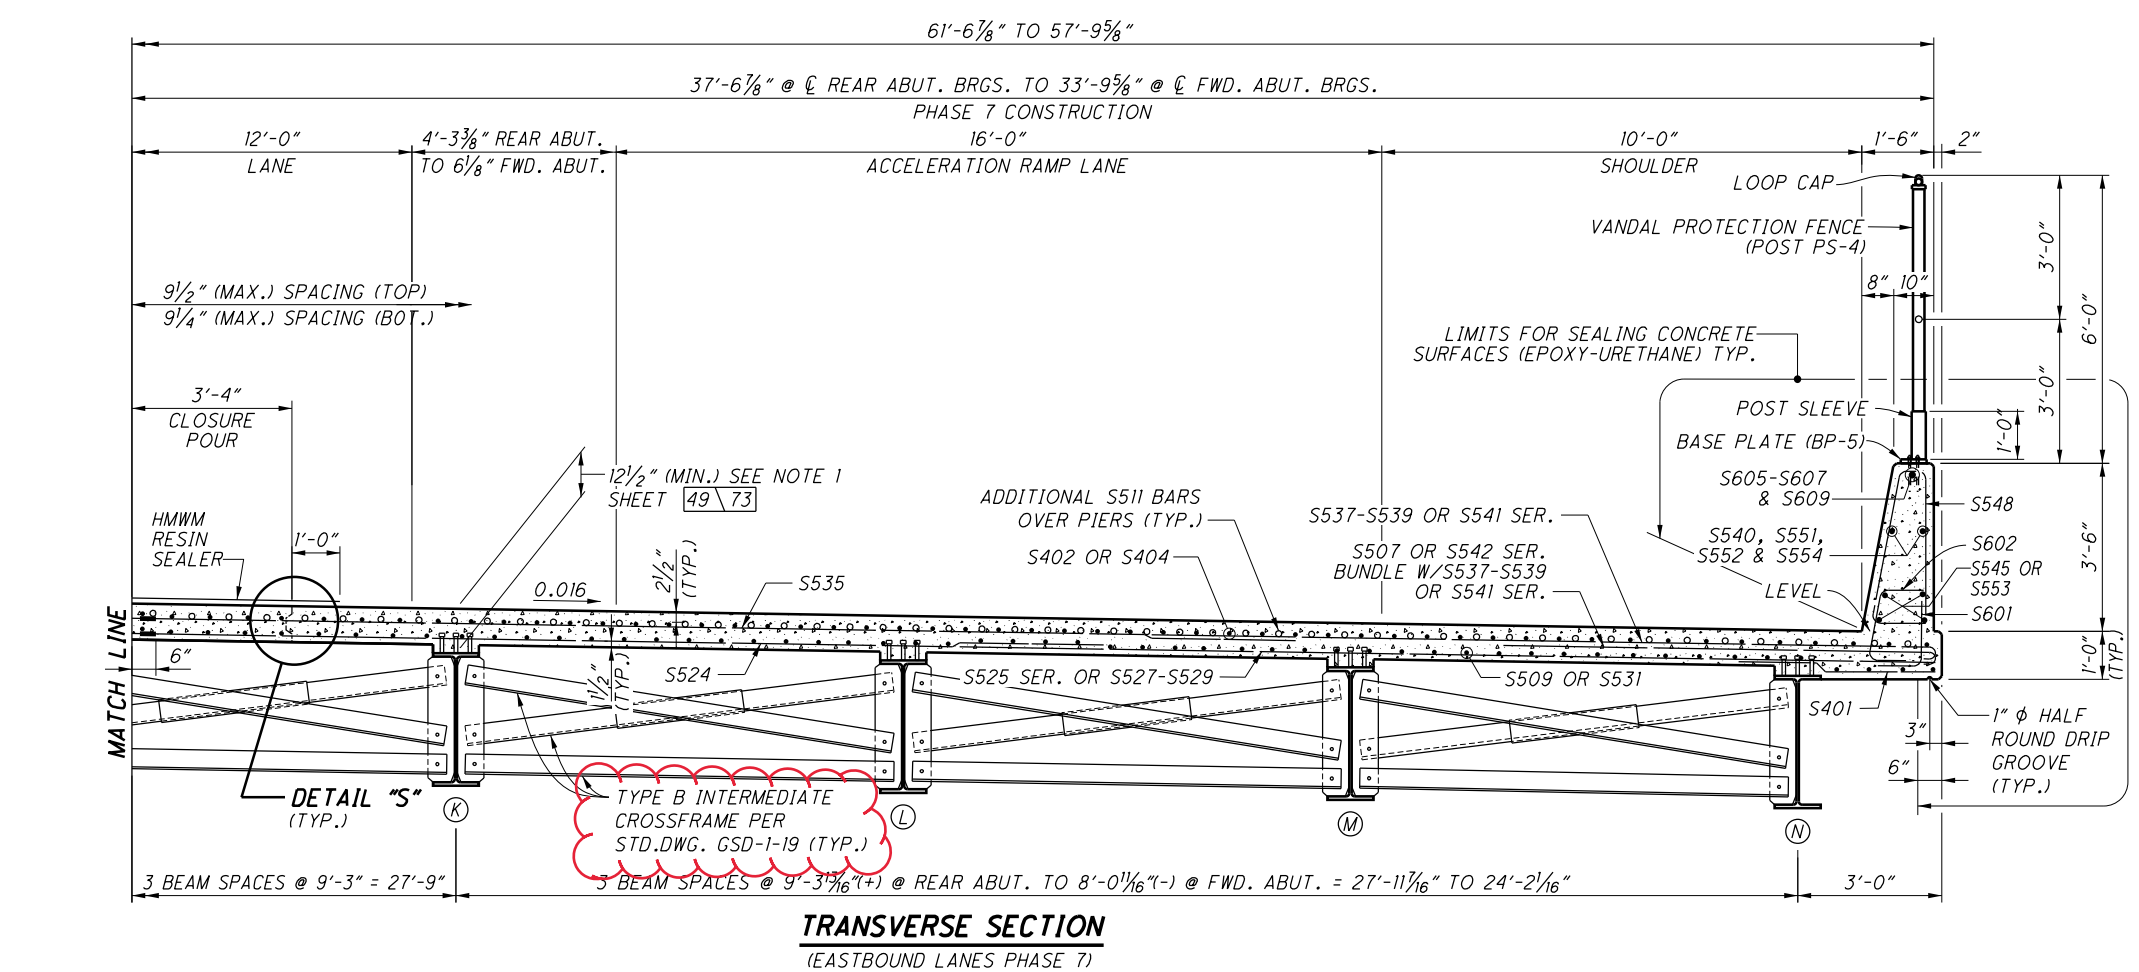

**TRANSVERSE SECTION**  
(EASTBOUND LANES PHASE 7)

- LEGEND**
- DENOTES MECHANICAL REBAR CONNECTOR
  - \* - S507 & S534 SER. BUNDLE W/S531 OR S533 SER.
- NOTES**
1. FOR ABBREVIATIONS SEE SHEET 3/73.
  2. FOR NOTES SEE SHEETS 48/73 THRU 50/73.
  3. FOR WESTBOUND TRANSVERSE SECTION & DETAIL "S" SEE 46/73.

DESIGN AGENCY: ENGINEERING ASSOCIATES, INC.  
 8955 EAGLE PASS - WOOSTER, OHIO 44691  
 TELEPHONE: (330) 345-6556  
 FAX: (330) 345-9077

DATE: 9-24-19  
 REVIEWED: SDS  
 DRAWN: RLE  
 CHECKED: BDH


STRUCTURE FILE NUMBER: 7001267

BRIDGE NO. RIC-30-1236  
 OVER S.R. 545

TRANSVERSE SECTION - RIGHT (EASTBOUND)

RIC-30-9-26  
 PID No. 93455


47/73  
 1471  
 1669

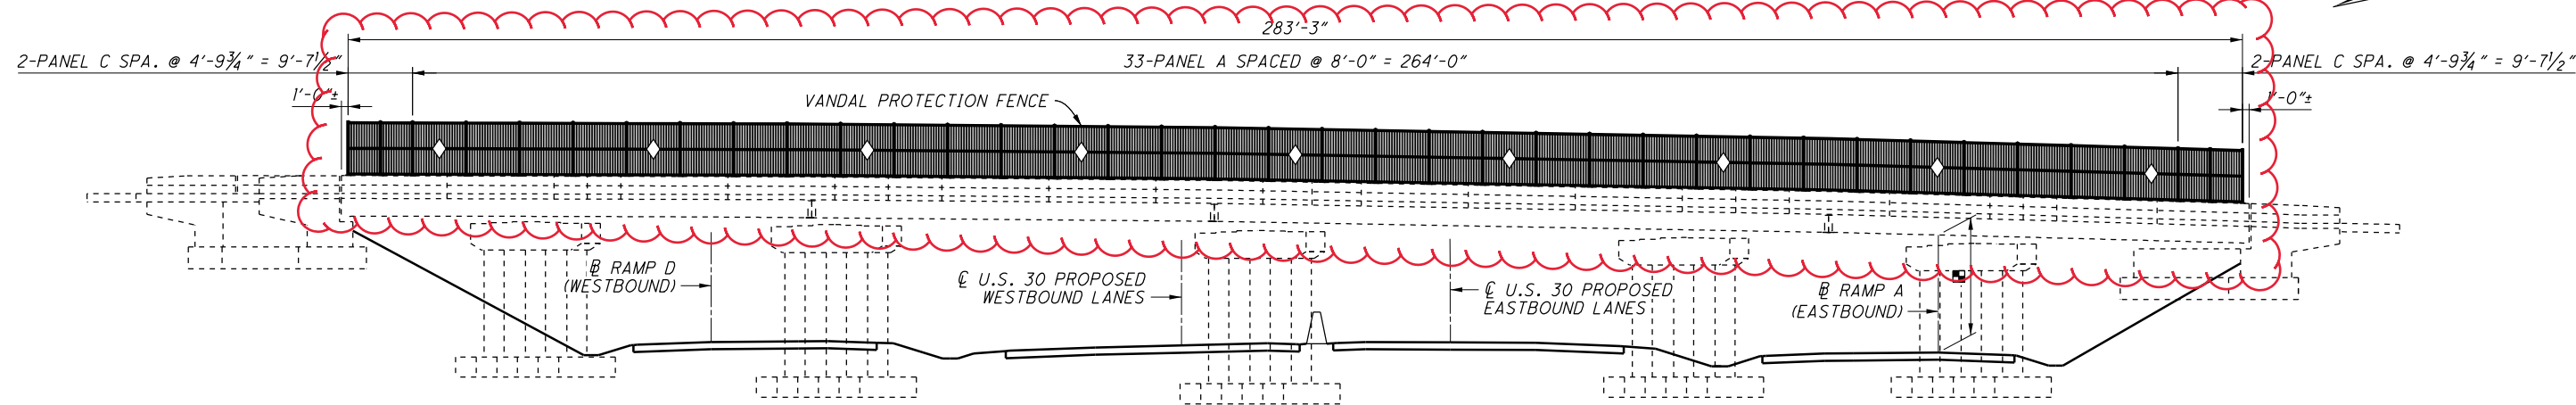

**ELEVATION**  
(LEFT SIDE OF BRIDGE)

**VERTICAL CLEARANCE**

EXISTING:	15.53'
PROPOSED:	16.61'
REQUIRED:	16.50'

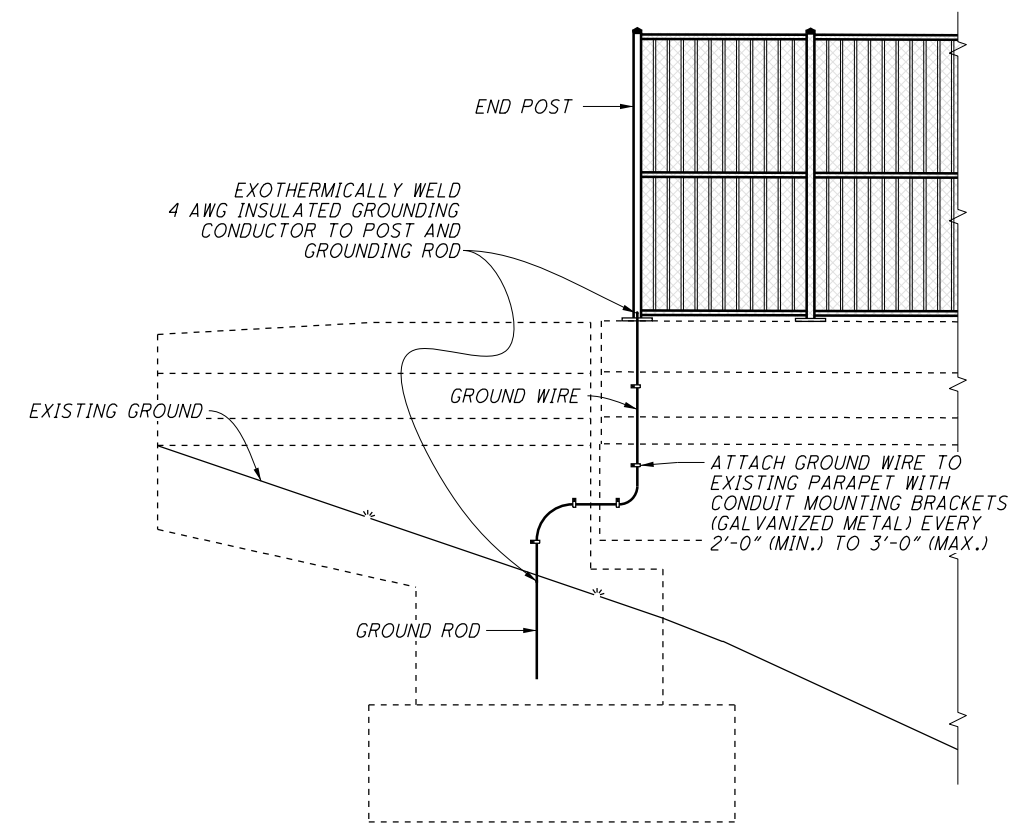


**FENCE GROUNDING DETAIL**

**NOTES**


1. FOR PANEL A AND PANEL C DETAILS SEE SHEET 5/6.
2. FOR FENCE DETAILS OF RIGHT SIDE OF BRIDGE SEE SHEET 1/6.
3. GROUND EACH CORNER OF THE BRIDGE.

M:\15074\93455\Design\Structures\RIC030\_1283C\Sheets\030\_1283CSA001.dgn 2/24/2020 10:35:21 AM acb284


	DESIGN AGENCY <b>ENGINEERING ASSOCIATES, INC.</b> <small>895 EAGLE PASS #WOODSTOCK, OHIO 44881          FAX: (330) 345-8077</small>
DESIGNED HK	DRAWN TAC
CHECKED BDH	REVIEWED SDS
DATE 9-24-19	
STRUCTURE FILE NUMBER 7001290	
<b>FENCE ELEVATION</b> BRIDGE NO. RIC-30-1283 UNDER FIFTH AVE.	
<b>RIC-30-9.26</b>	<b>PID No. 93455</b>
2 / 6	
<div style="border: 1px solid black; border-radius: 50%; width: 30px; height: 30px; display: flex; align-items: center; justify-content: center; margin: 0 auto;"> <span style="font-size: 8px;">1506 1669</span> </div>	

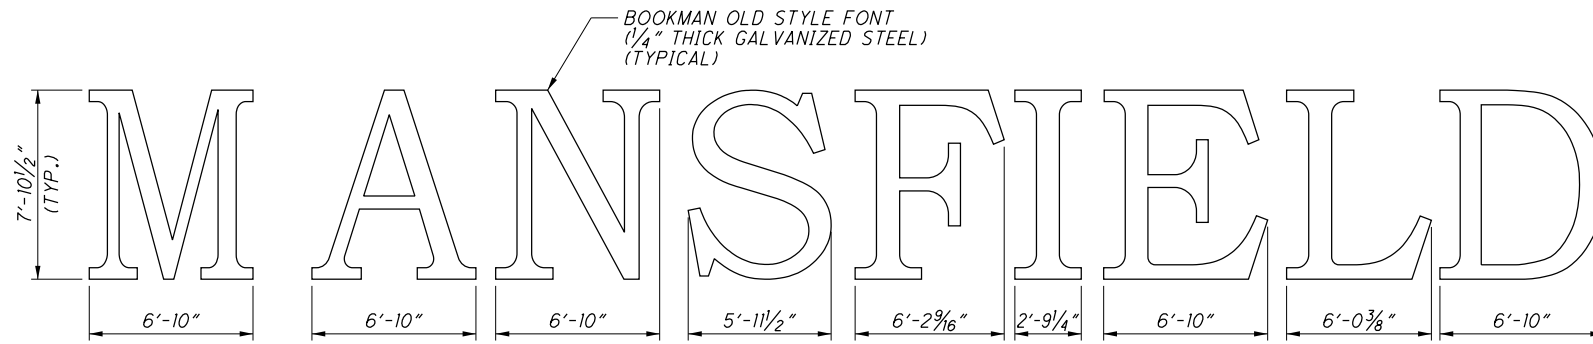

**LETTER DETAILS**

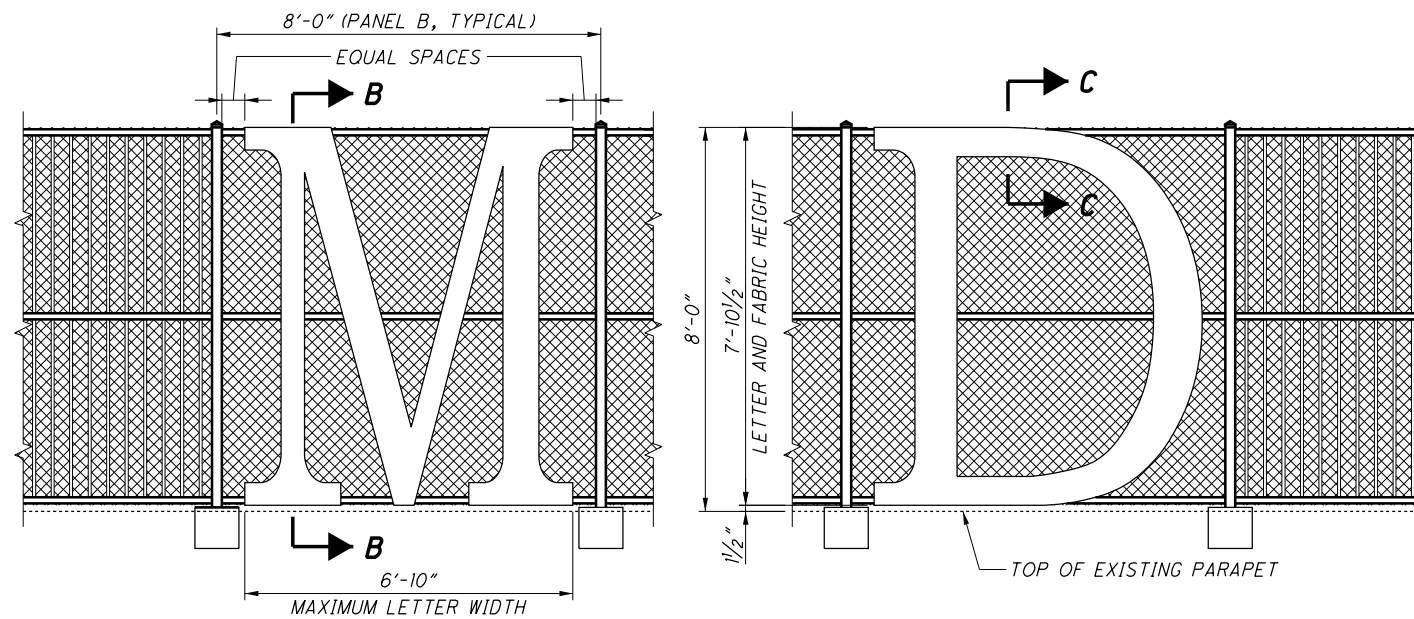

**PANEL B - LETTER LOCATION DETAIL**  
(PICKETS ARE NOT IN PANEL B)

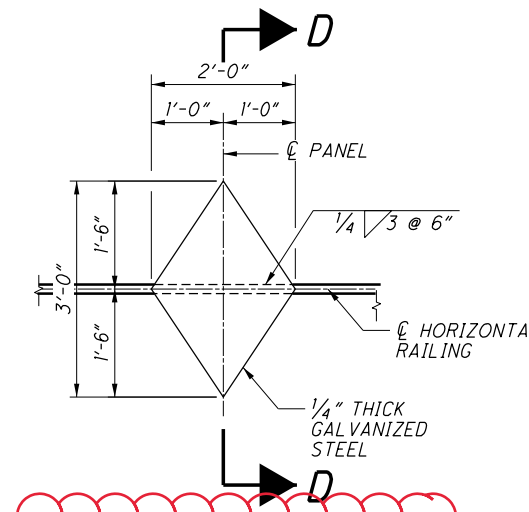


**DIAMOND DETAIL**

(PLACE DIAMONDS ON FENCE PANEL A AS SHOWN IN THE PLANS)


**NOTES**

1. DIMENSIONS GIVEN FOR FENCE LETTERING ARE INCOMPLETE. OVERALL DIMENSIONS AND THE APPROXIMATE AREAS AND WEIGHT ARE GIVEN. OTHER DIMENSIONS ARE PROPORTIONAL TO THE FONT. AN ELECTRONIC COPY OF THIS FILE WILL BE MADE AVAILABLE TO THE CONTRACTOR THROUGH THE OHIO DEPARTMENT OF TRANSPORTATION IF REQUESTED.
2. EACH LETTER SHALL BE 1/4" THICK GALVANIZED STEEL. EACH LETTER SHALL BE CENTERED HORIZONTALLY ON THE 8'-0" WIDE FENCE PANELS INDICATED. SEE FENCE NOTES FOR DETAILS ABOUT GALVANIZING AND PAINTING OF FENCE.
3. AFTER GALVANIZING OF LETTERED FENCE UNITS HAS OCCURRED, WARPAGE OF LETTERS AND DIAMONDS SHALL BE CORRECTED TO WITHIN 1/2" ± OF ITS ORIGINAL FLAT SHAPE.
4. ALL LETTERS SHALL BE WELDED TO THE TOP, MIDDLE AND BOTTOM RAIL. WHERE THE LENGTH OF CONTACT BETWEEN THE LETTER AND THE RAIL IS GREATER THAN 10", STITCH WELDING SHALL BE USED AS SHOWN IN SECTION B-B AND DETAIL "A". WHERE THE LENGTH OF CONTACT IS LESS THAN 10" A CONTINUOUS 1/4" FILLET WELD TERMINATING 1/2" FROM THE EDGE OF THE LETTER SHALL BE USED.
5. DIAMONDS SHALL BE PLACED IN FENCE PANELS AS SHOWN IN THE PLANS.


M:\15074\93455\Design\Structures\RIC030\_1283C\Sheets\030\_1283CSA005.dgn 2/24/2020 10:31:23 AM acb284

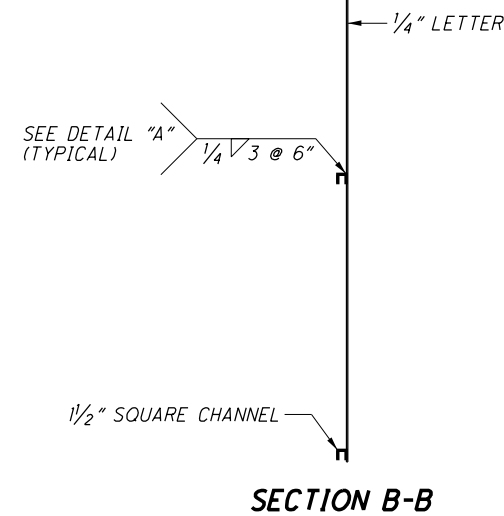


**SECTION B-B**

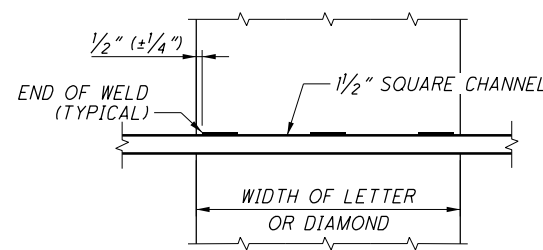

**DETAIL "A"**

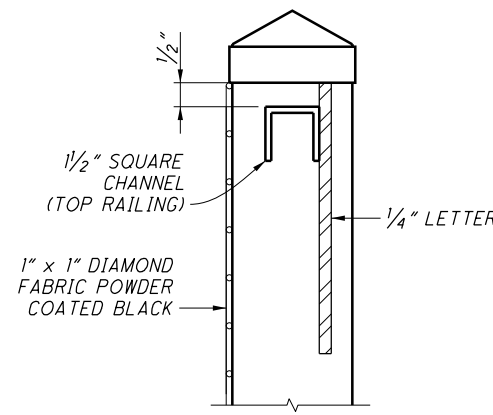

**SECTION C-C**

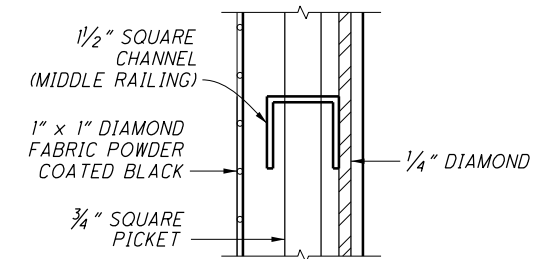


**SECTION D-D**

# RIC-30-9.26 PART 1

## CITY OF MANSFIELD MADISON TOWNSHIP

S.W., N.W. & N.E. QTRS. SECTION 16  
S.W., S.E. & N.E. QTRS. SECTION 17  
S.W. & S.E. QTRS. SECTION 18  
T-21-N, R-18-W

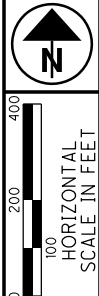


- (I) PARCEL NUMBER
- (A) EASEMENT LETTER

FOR OWNER INFORMATION, SEE SHEET 22.  
FOR EXISTING EASEMENT INFORMATION,  
SEE EASEMENT SUMMARY, SHEETS 23-24.  
FOR PROPOSED RIGHT OF WAY FENCE,  
SEE FENCE PLAN SHEETS 1510 TO 1521.

**STRUCTURE KEY**

- RESIDENTIAL
- COMMERCIAL
- OUT-BUILDING

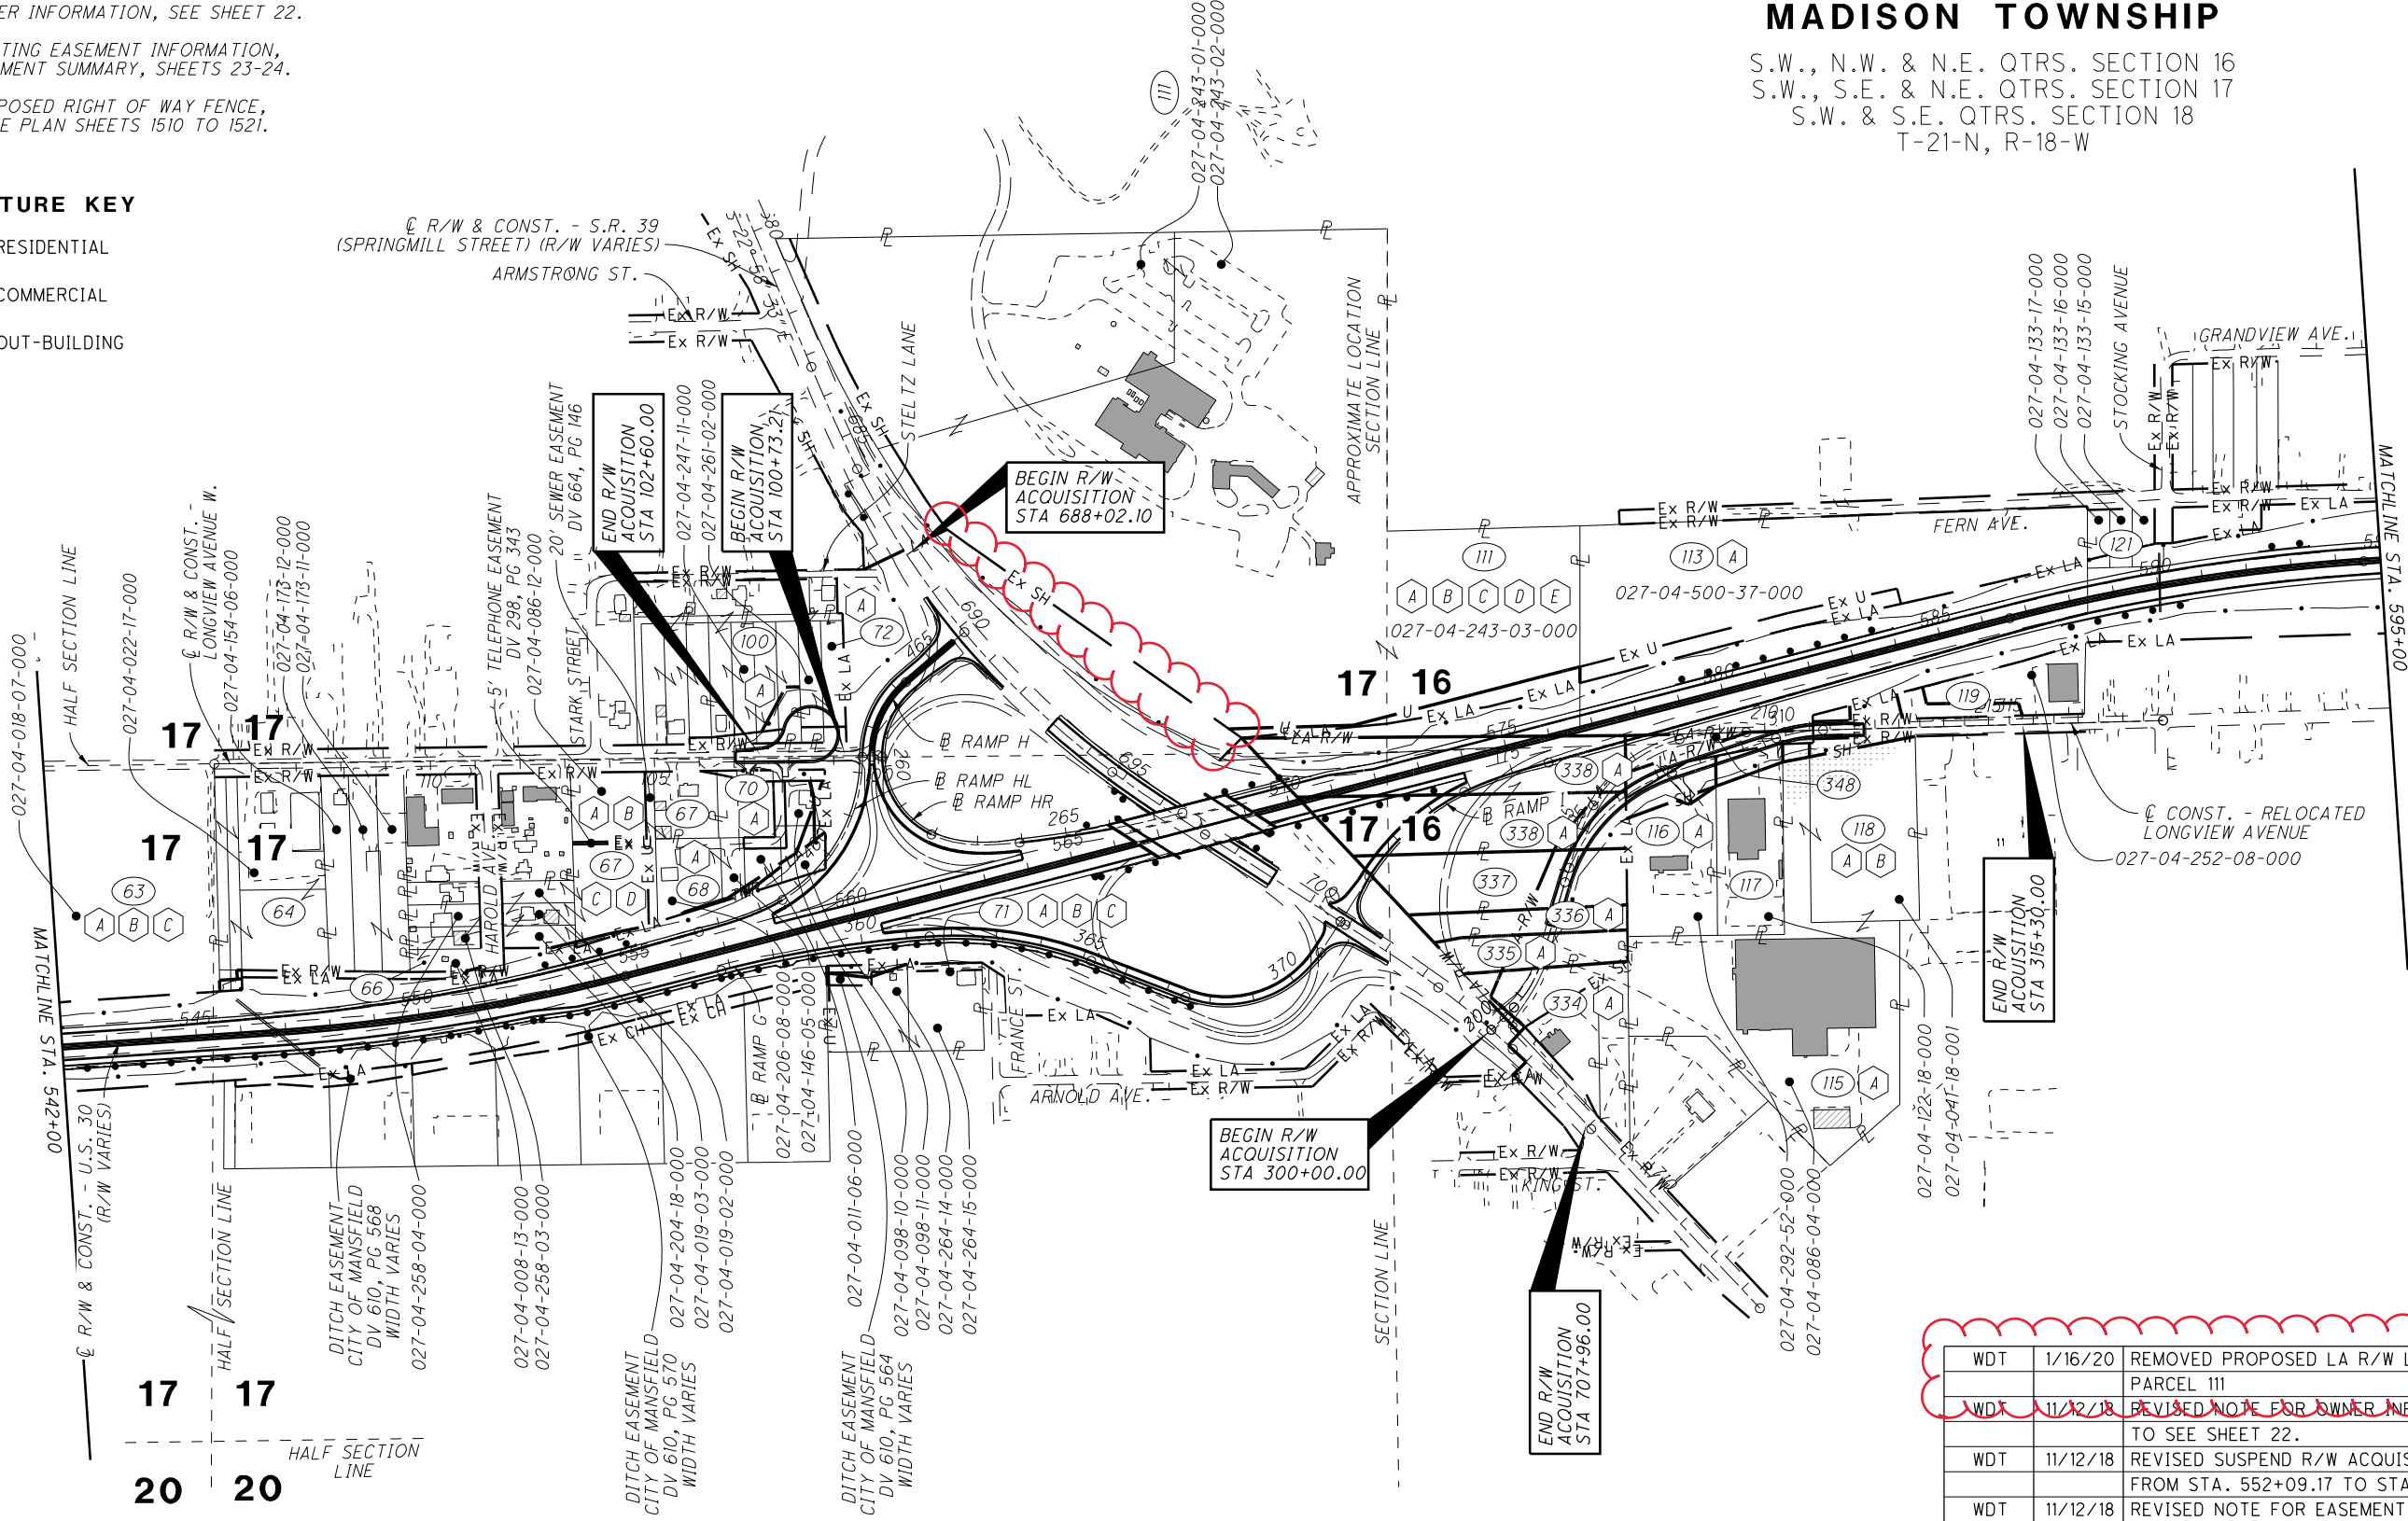

REV. BY	DATE	DESCRIPTION
WDT	1/16/20	REMOVED PROPOSED LA R/W LINE FROM PARCEL 111
WDT	11/12/18	REVISED NOTE FOR OWNER INFORMATION TO SEE SHEET 22.
WDT	11/12/18	REVISED SUSPEND R/W ACQUISITION FLAG FROM STA. 552+09.17 TO STA. 551+57.08
WDT	11/12/18	REVISED NOTE FOR EASEMENT INFORMATION TO SEE SHEETS 23-24.
WDT	10/23/18	REVISED APN 027-04-086-12-000 FROM ODOT NO. 66 TO NO. 67
WDT	10/17/18	REVISED PROPERTY LINE SYMBOLS BETWEEN PARCELS 63 & 64
WDT	8/27/18	REMOVED PARCELS 347WL & 347AWL
<b>REV. BY</b>	<b>DATE</b>	<b>DESCRIPTION</b>
DATE COMPLETED: 6/21/18		

PID NO. **93455**

R/W DESIGNER MDG  
R/W REVIEWER WDT

**PROPERTY MAP**

**RIC-30-9.26  
PART 1**

20 / 49  
1541  
1669

NET TAKE = GROSS TAKE - PRO IN TAKE  
 NET RESIDUE = RECORD AREA - TOTAL PRO - NET TAKE  
 ALL AREAS IN ACRES UNLESS OTHERWISE STATED

**GRANTEE:**  
 ALL RIGHT OF WAY ACQUIRED IN THE NAME OF  
 THE OHIO DEPARTMENT OF TRANSPORTATION  
 UNLESS OTHERWISE SHOWN.

PARCEL NO.	OWNER	SHEET NO.	OWNERS RECORD		AUDITOR'S PARCEL	RECORD AREA	TOTAL P.R.O.	GROSS TAKE	P.R.O. IN TAKE	NET TAKE	STRUC-TURE	NET RESIDUE		TYPE FUND	REMARKS
			BOOK	PAGE								LEFT	RIGHT		
100SHV	WAYNE EDWARD THOMPSON	20, 23, 41	OR 2012 OR 1950	321 813	027-04-247-11-000	1.317 (c)	0.132	0.127	0.000	0.127			1.058	80/20 FEDERAL & STATE	LOTS 18163, 18164, 18165 AND 18166, FORMERLY LOTS 4,5,6 & 7 KENWOOD ADDITION, 6 TREES PV 8 PG 31, AREA BOTH LOTS & VACATED 16' ALLEY TO NORTH OR 1950, PG 813 IS AN AMENDED CERTIFICATE OF TRANSFER GRANTEE: THE CITY OF MANSFIELD
PARCEL NUMBERS 101 THROUGH 110 INCLUSIVE NOT ASSIGNED															
111UV	LUMBERMENS VILLAGE LTD., AN OHIO LIMITED LIABILITY COMPANY	20, 23, 37 38, 47, 48	OR 362	619	027-04-243-01-000 027-04-243-02-000 027-04-243-03-000 027-04-243-06-000	7.180 20.820 4.920 0.317	0.356 2.074 0.887 0.000	0.000 0.095 0.304 0.000	0.000 0.000 0.000 0.000	0.000 0.095 0.304 0.000					NE QTR SEC 17 NE QTR SEC 17, 9 TREES NW QTR SEC 16, 15 TREES GRANTEE: AMERICAN TRANSMISSION SYSTEMS, INC. AND OHIO EDISON COMPANY
TOTAL						33.237	3.317	0.399	0.000	0.399			29.920		
PARCEL NUMBER 112 NOT ASSIGNED															
113	THE CITY OF MANSFIELD, OHIO	20, 24, 44 45	DV 574	593	027-04-500-37-000 027-04-500-45-000 027-04-500-46-000	11.007 (d)	5.412	0.000	0.000	0.000			5.595	0.000	PT NW QTR. SEC. 16, MANSFIELD CITY PARK AUDITOR AREA 5.595 AC WHICH DOES NOT INCLUDE 5.412 AC PRO U.S. 30 BY DEED NO ADDITIONAL R/W REQUIRED
PARCEL NUMBER 114 NOT ASSIGNED															
115SHV	C & D PROPERTIES OF MANSFIELD, LLC	20, 24, 42 45	OR 1815	219	027-04-086-04-000	5.570	0.000	0.048	0.000	0.048			5.522		PT LOT 15016, PARCEL #2 IN DEED PV 20, PG 25
116SHV	LONGVIEW PROPERTIES, LLC AN OHIO LIMITED LIABILITY COMPANY	20, 24, 42 44	OR 2647	320	027-04-292-52-000	1.669	0.000	0.300	0.000	0.300			1.369		NW PT LOT 15016 PV 20, PG 25 PRIVATE SIGN "ADVANTAGE FOSTER CARE", 2 TREES
116T								0.020	0.000	0.020					TO CONSTRUCT DRIVE AND COMPLETE GRADING
117SHV	HOSTETLER'S CATERING, INC. AN OHIO CORPORATION	20, 24, 44 45	DV 517	204	027-04-122-18-000	1.428	0.000	0.186	0.000	0.186			1.242		PT LOT 15016 PV 20, PG 25, 1 TREE
118SHV	C & D PROPERTIES OF MANSFIELD, LLC	20, 24, 45	OR 1815	219	027-04-041-18-001	2.220	0.000	0.104	0.000	0.104			2.116		PT LOT 15016, PARCEL #1 IN DEED PV 20, PG 25, 14 TREES

M:\15074\93455\Design\ROW\Sheets\9.26 Sheets\93455\RS0003.dgn 2/24/2020 1:22:50 PM ocb284

FEDERAL PROJECT NO. E130(382)  
 PID NO. 93455  
 STATE JOB NO. 438371  
 R/W DESIGNER MDG  
 R/W REVIEWER WDT  
**SUMMARY OF ADDITIONAL RIGHT OF WAY**  
 RIC-30-9.26 PART 1  
 27/49  
 1548  
 1669

NOTE: ALL TEMPORARY PARCELS TO BE OF 42 MONTH DURATION.  
 UNDER NO CIRCUMSTANCES ARE TEMPORARY EASEMENTS TO BE USED FOR STORAGE OF MATERIAL OR EQUIPMENT BY THE CONTRACTOR UNLESS NOTED OTHERWISE.


PARCEL LEGEND:  
 WL = WARRANTY LIMITED ACCESS  
 WDV = WARRANTY DEED  
 IN THE NAME OF CITY OF MANSFIELD  
 LA = LIMITED ACCESS EASEMENT  
 SH = STANDARD HIGHWAY EASEMENT  
 SHV = STANDARD HIGHWAY EASEMENT IN THE NAME OF CITY OF MANSFIELD  
 T = TEMPORARY EASEMENT  
 UV = UTILITY EASEMENT  
 PRE = PROPERTY RIGHT EASEMENT  
 CH = CHANNEL EASEMENT

DOCUMENT LEGEND:  
 DV = DEED VOLUME (c) = CALCULATED  
 OR = OFFICIAL RECORD (d) = DEED AREA  
 DOC = DOCUMENT (p) = PLAT RECORD AREA  
 PV = PLAT VOLUME

\* DENOTES R/W ENCROACHMENT

REV. BY	DATE	DESCRIPTION
WDT	1/16/20	REMOVED PARCEL 111PRE
WDT	7/23/19	REVISED OWNERSHIP PARCEL 116
WDT	1/14/19	REVISED PARCEL 100 FROM "SH" TO "SHV"
WDT	11/12/18	ADDED TREES TO BE REMOVED TO REMARKS PARCELS 100, 111, AND 118
WDT	8/21/18	REVISED SHEET NUMBER COLUMN

FIELD REVIEW BY: J. RAKOSKY, C.S.T. DATE: 6/20/18  
 OWNERSHIP VERIFIED BY: O.R. COLAN DATE: 6/18/18  
 DATE COMPLETED: 6/21/18

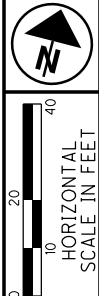

# RIC-30-9.26 PART 1

CITY OF MANSFIELD  
MADISON TOWNSHIP

S.W., N.W. & N.E. QTRS. SECTION 16  
S.W., S.E. & N.E. QTRS. SECTION 17  
S.W. & S.E. QTRS. SECTION 18  
T-21-N, R-18-W

PID NO. **93455**  
R/W DESIGNER MDG  
R/W REVIEWER WDT


RIGHT OF WAY DETAIL SHEET - U.S. 30  
STA. 569+00 TO STA 573+50

RIC-30-9.26  
PART 1

37/49  
1558  
1669

III  
A B C D E  
LUMBERMANS VILLAGE LTD.,  
AN OHIO LIMITED LIABILITY COMPANY  
900 SPRINGMILL STREET  
MANSFIELD, OHIO 44906  
027-04-243-02-000  
20.820 AC

III  
A B C D E  
027-04-243-03-000  
4.920 AC  
WOODS

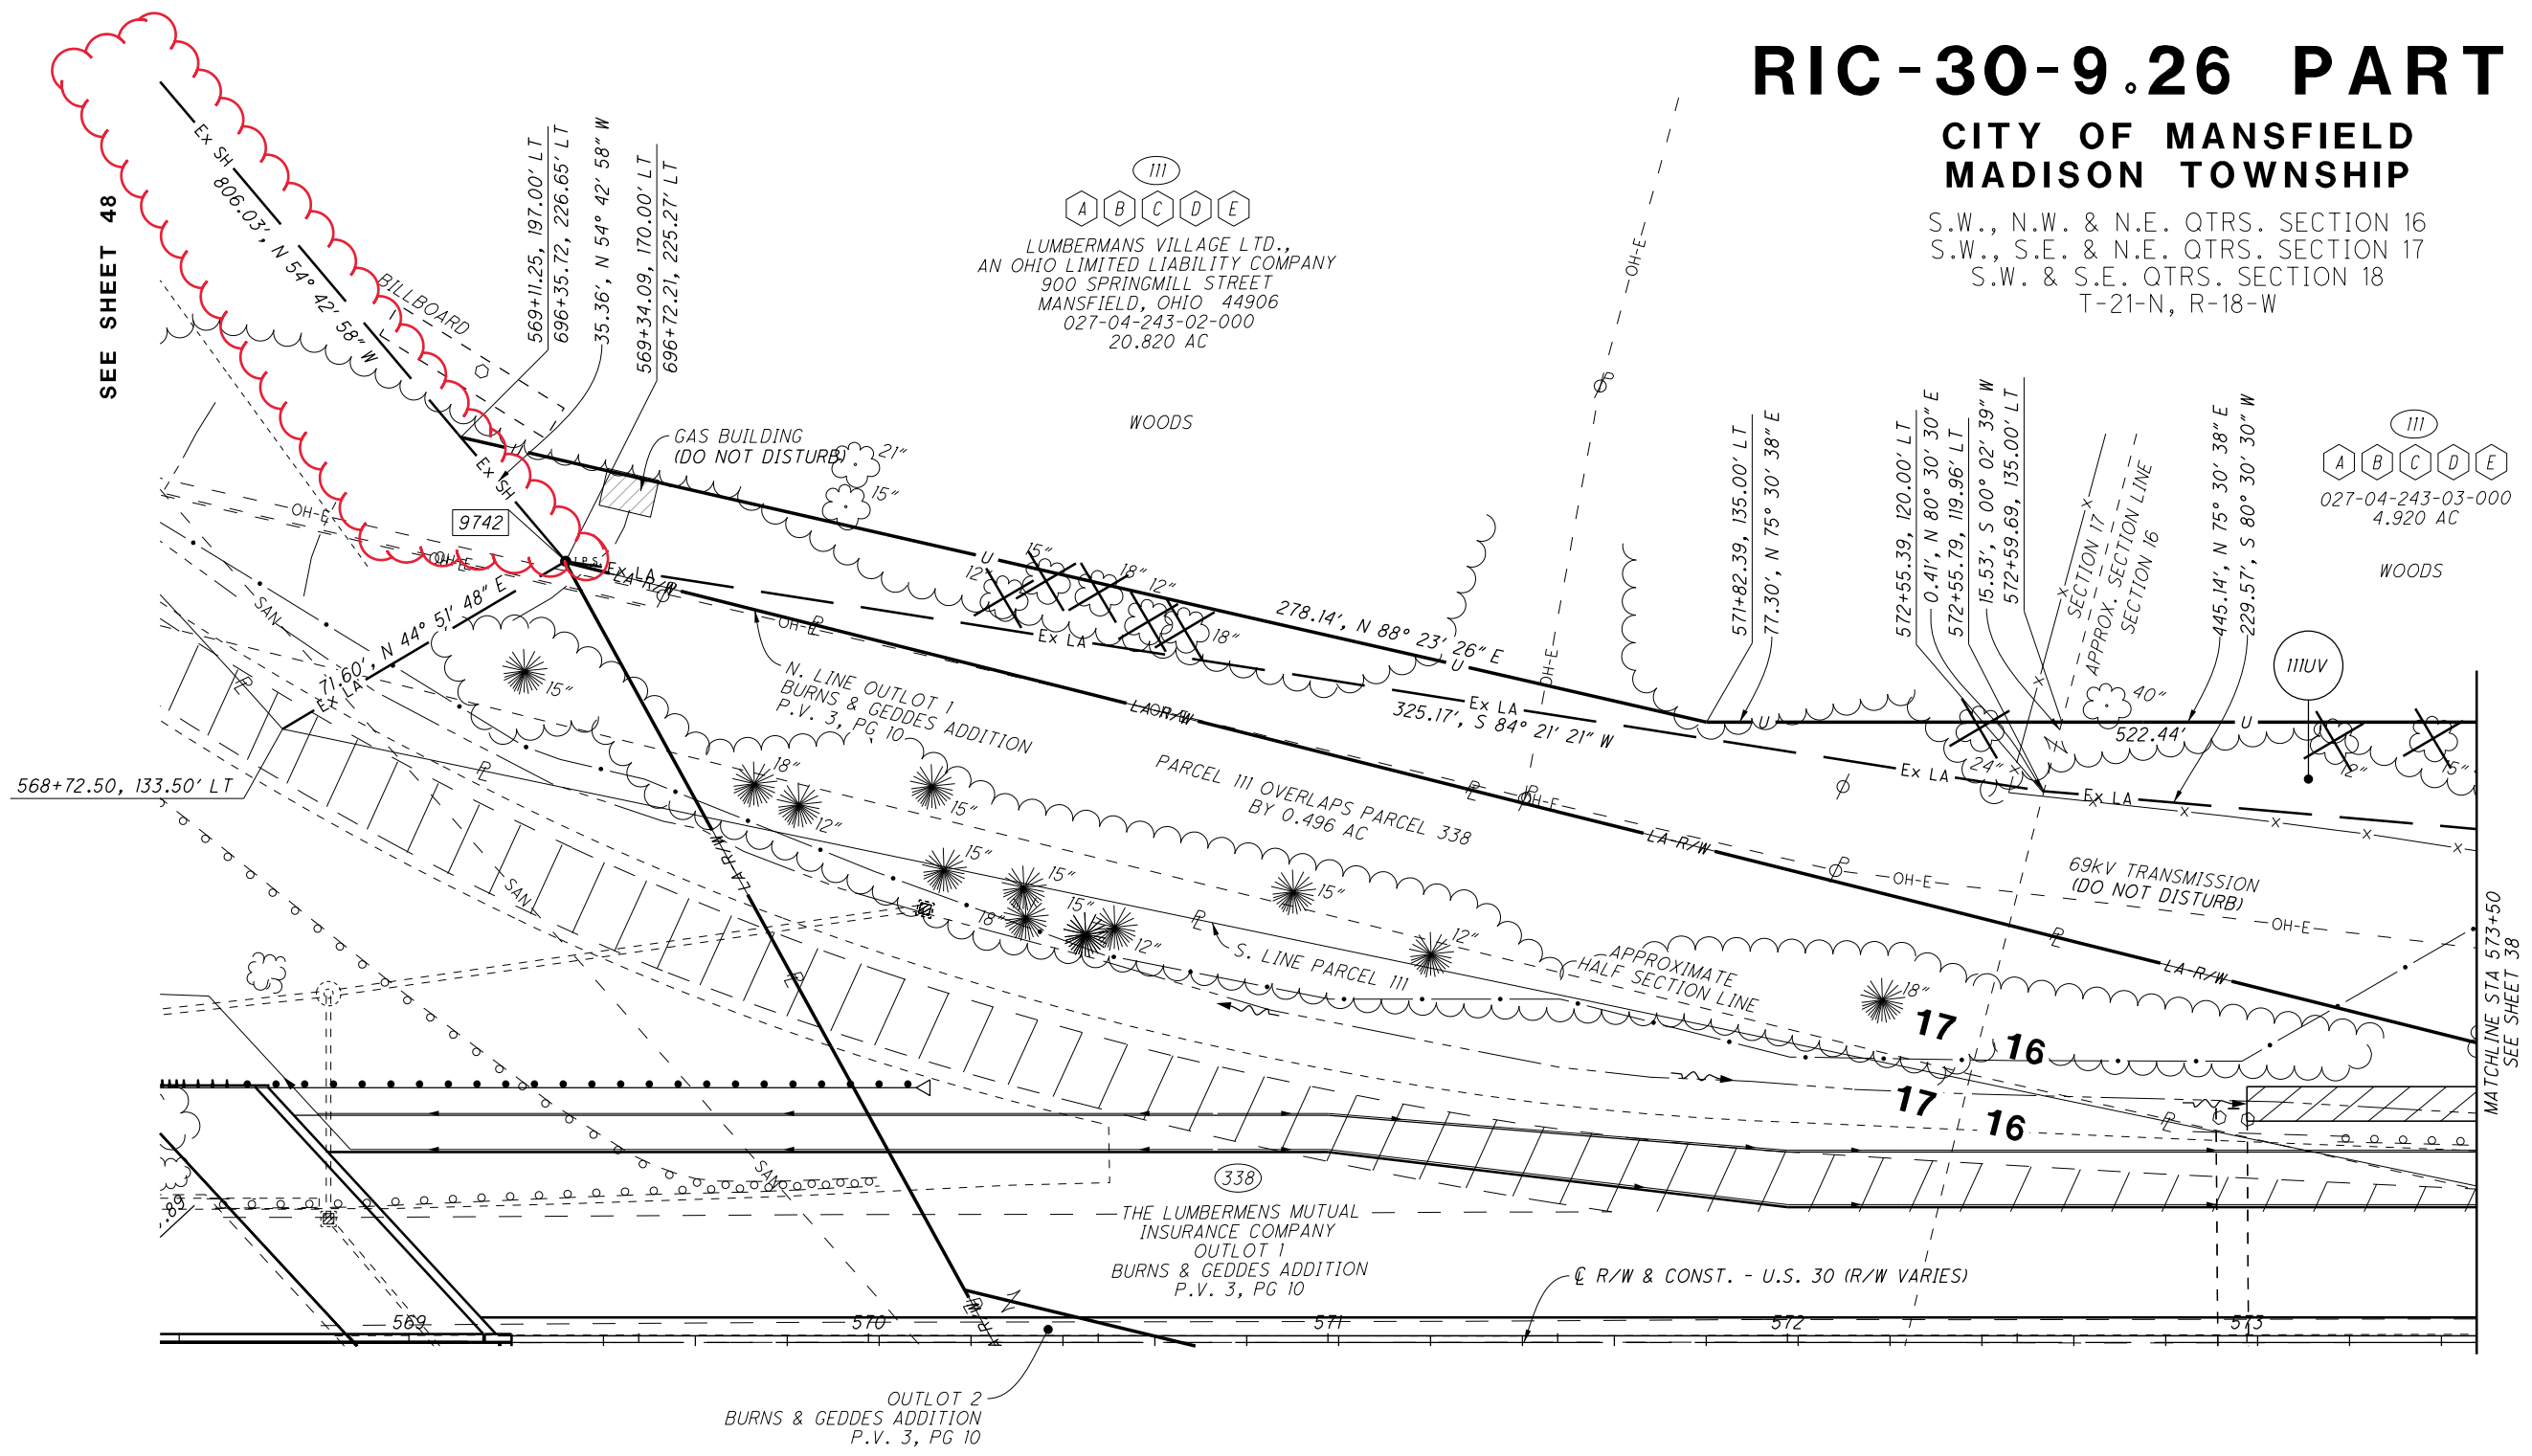

SEE SHEET 48

MATCHLINE STA 573+50  
SEE SHEET 38

- (I) PARCEL NUMBER
- (A) EASEMENT LETTER

FOR EXISTING EASEMENT INFORMATION  
SEE EASEMENT SUMMARY SHEETS 23-24.

FOR PROPOSED RIGHT OF WAY FENCE,  
SEE FENCE PLAN SHEETS 1510 TO 1521.

\* DENOTES RIGHT OF WAY ENCROACHMENT

REV. BY	DATE	DESCRIPTION
WDT	1/16/20	REMOVED PARCEL 111PRE
WDT	1/12/18	REVISION NOTE FOR EASEMENT INFORMATION TO SEE SHEETS 23-24.
WDT	11/12/18	ADDED TREES AND DISPOSITIONS
DATE COMPLETED:		6/21/18

M:\15074\93455\Design\ROW\Sheets\9.26 Sheets\93455RD0007.dgn 2/24/2020 1:24:35 PM acb284



# RIC-30-9.26 PART 1

## CITY OF MANSFIELD MADISON TOWNSHIP

S.W., N.W. & N.E. QTRS. SECTION 16  
S.W., S.E. & N.E. QTRS. SECTION 17  
S.W. & S.E. QTRS. SECTION 18  
T-21-N, R-18-W

RIGHT OF WAY CURVE DATA

CURVE	DELTA	RADIUS	CURVE LENGTH	CHORD LENGTH	CHORD BEARING
C1	04°55'54" LT	1408.09'	121.20'	121.20'	S 34°29'13" E




PID NO. **93455**

R/W DESIGNER TAC  
R/W REVIEWER WDT

R/W DETAIL SHEET - S.R. 39  
STA. 687+00 TO STA 692+50

RIC-30-9.26  
PART 1

47/49  
1568  
1669

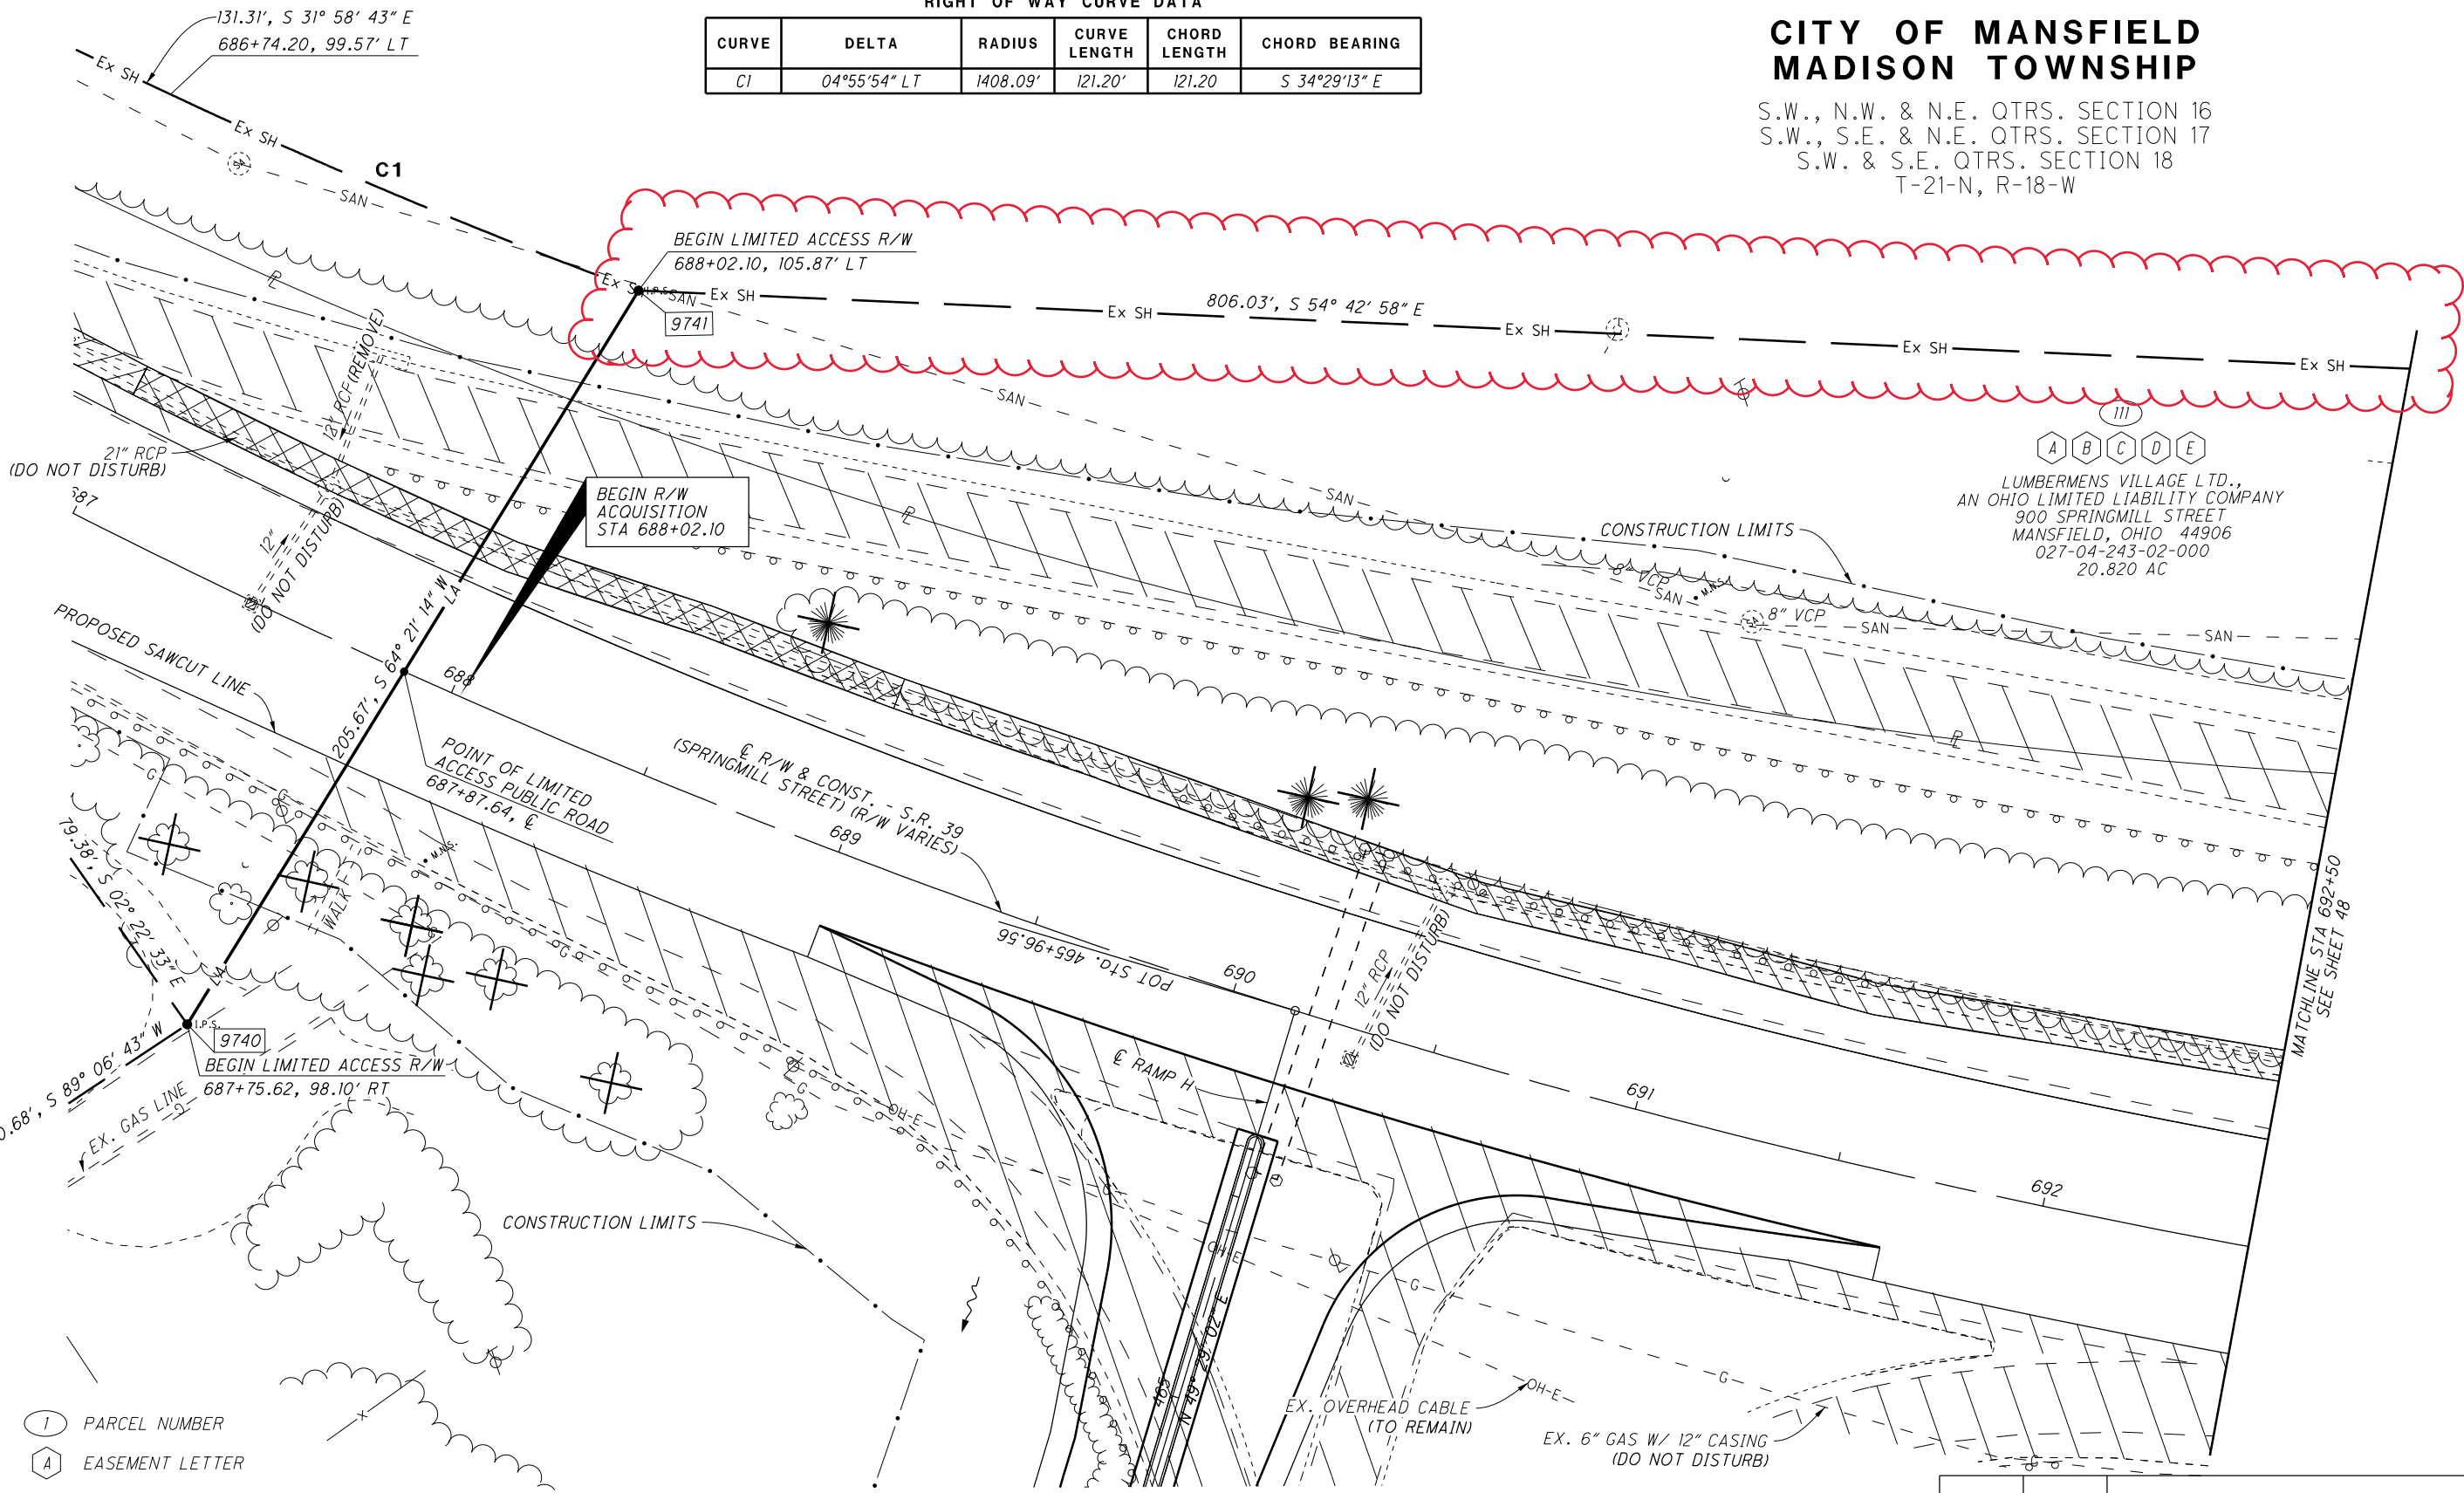

- ① PARCEL NUMBER
- ⬡ EASEMENT LETTER

FOR EXISTING EASEMENT INFORMATION  
SEE EASEMENT SUMMARY SHEETS 23-24.

FOR PROPOSED RIGHT OF WAY FENCE,  
SEE FENCE PLAN SHEETS 1510 TO 1521.

\* DENOTES RIGHT OF WAY ENCROACHMENT


REV. BY	DATE	DESCRIPTION
WDT	1/16/20	REMOVED PARCEL 111PRE
WDT	11/12/18	REVISED NOTE FOR BASEMENT INFORMATION TO SEE SHEETS 23-24.
WDT	11/12/18	ADDED TREES AND DISPOSITIONS
DATE COMPLETED:		6/21/18

M:\15074\93455\Design\ROW\Sheets\9.26 Sheets\93455RD0701.dgn 2/24/2020 1:26:16 PM acb284

# RIC-30-9.26 PART 1

## CITY OF MANSFIELD MADISON TOWNSHIP

S.W., N.W. & N.E. QTRS. SECTION 16  
S.W., S.E. & N.E. QTRS. SECTION 17  
S.W. & S.E. QTRS. SECTION 18  
T-21-N, R-18-W

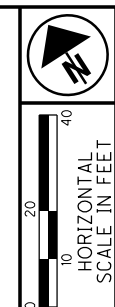


PID NO. **93455**  
R/W DESIGNER TAC  
R/W REVIEWER WDT

R/W DETAIL SHEET - S.R. 39  
STA. 692+50 TO STA 697+50

RIC-30-9.26  
PART 1

48 / 49

1569  
1669

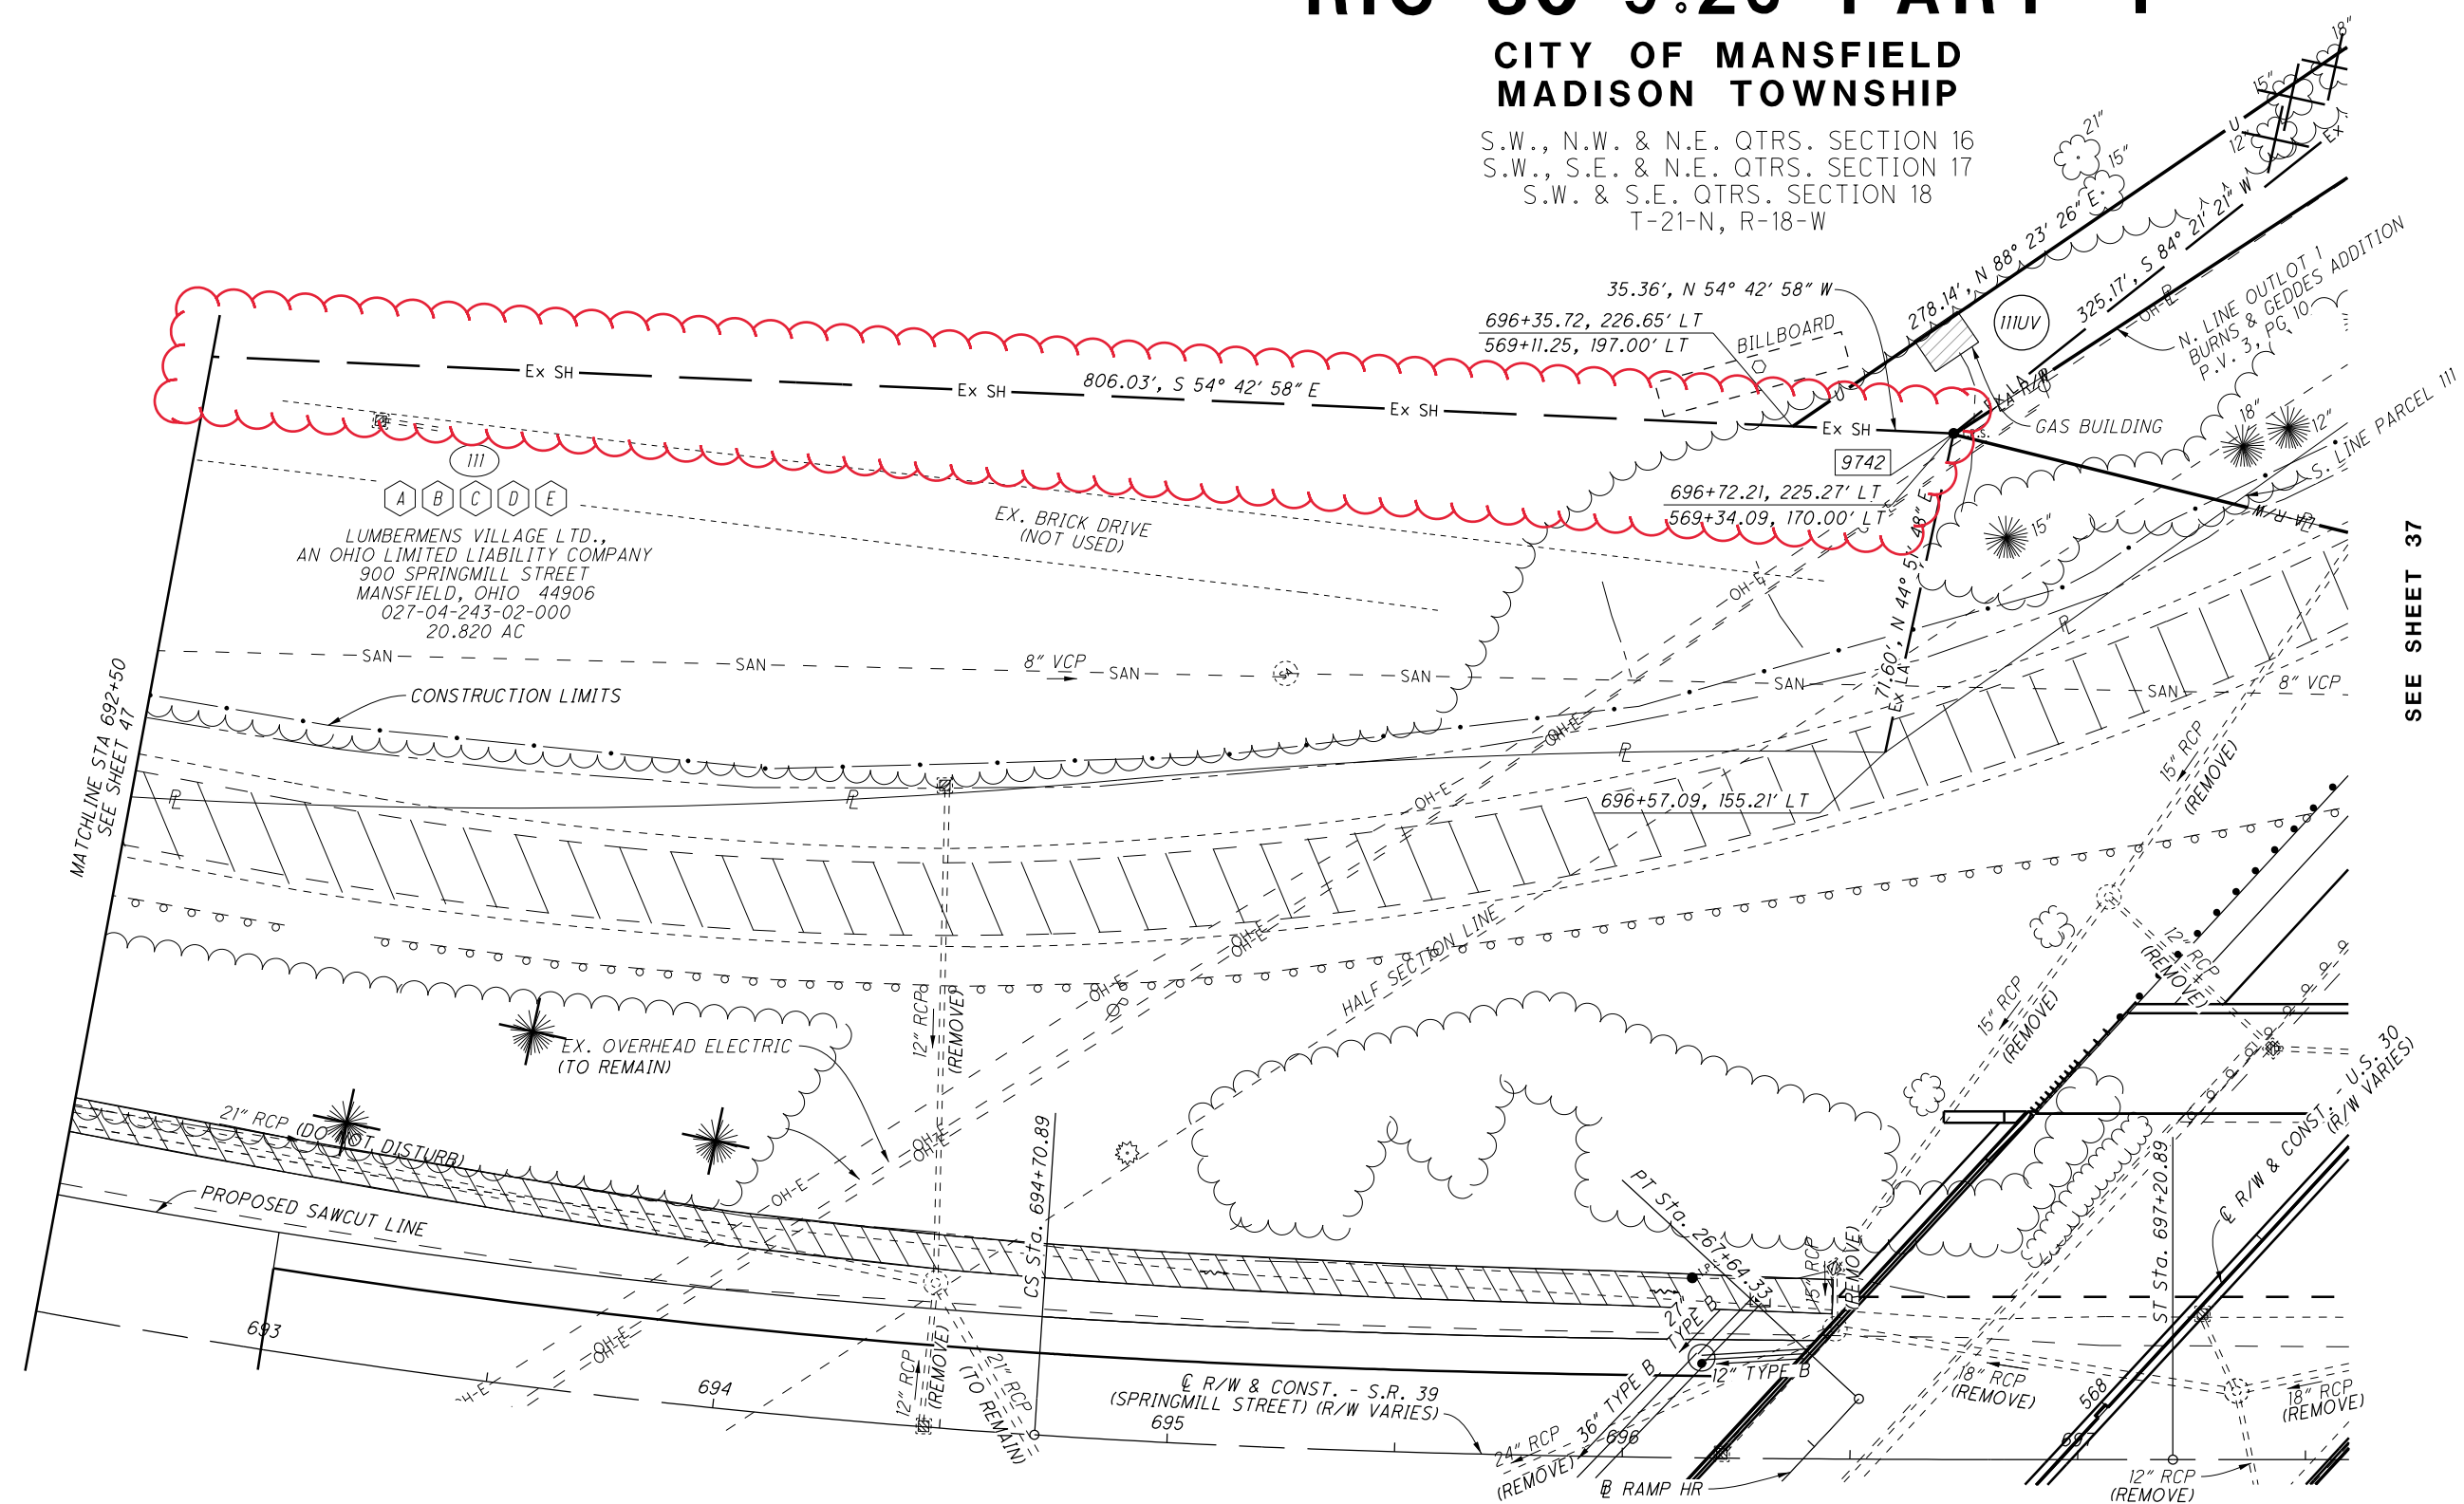

SEE SHEET 37

- ① PARCEL NUMBER
- Ⓐ EASEMENT LETTER

FOR EXISTING EASEMENT INFORMATION  
SEE EASEMENT SUMMARY SHEETS 23-24.  
FOR PROPOSED RIGHT OF WAY FENCE,  
SEE FENCE PLAN SHEETS 1510 TO 1521.

\* DENOTES RIGHT OF WAY ENCROACHMENT

REV. BY	DATE	DESCRIPTION
WDT	1/16/20	REMOVED PARCEL 111PRE
WDT	11/12/18	ADDED SEE SHEET 37 REFERENCE
WDT	11/12/18	REVISED NOTE FOR EASEMENT INFORMATION TO SEE SHEETS 23-24.
WDT	11/12/18	ADDED TREES AND DISPOSITIONS
DATE COMPLETED:	6/21/18	

M:\15074\93455\Design\ROW\Sheets\9.26 Sheets\93455RD0702.dgn 2/24/2020 1:26:52 PM ocb284