

ITEM 614, MAINTAINING TRAFFIC

A MINIMUM OF 1 LANE OF TRAFFIC IN EACH DIRECTION SHALL BE MAINTAINED AT ALL TIMES BY USE OF THE EXISTING PAVEMENT AND THE COMPLETED PAVEMENT.

BEFORE THE WORK BEGINS, THE CONTRACTOR SHALL SUBMIT TO THE ENGINEER THE NAME(S) AND TELEPHONE NUMBER(S) OF A PERSON OR PERSONS WHO CAN BE CONTACTED TWENTY-FOUR (24) HOURS PER DAY BY THE OHIO DEPARTMENT OF TRANSPORTATION AND ALL INTERESTED POLICE AGENCIES. THIS PERSON OR PERSONS SHALL BE RESPONSIBLE FOR PLACING OR REPLACING NECESSARY TRAFFIC CONTROL DEVICES IN ACCORDANCE WITH THE OHIO MANUAL OF UNIFORM TRAFFIC CONTROL DEVICES.

THE CONTRACTOR WILL ADVISE THE DISTRICT PUBLIC INFORMATION OFFICER AT (740) 774-8834, OR FAX (740) 773-2710 FOURTEEN (14) DAYS PRIOR TO THE START OF CONSTRUCTION ACTIVITIES. THE PROJECT ENGINEER WILL PROVIDE ASSISTANCE/CLARIFICATION FOR ANY QUESTIONS.

THE CONTRACTOR SHALL ARRANGE FOR ALL MAINTENANCE OF TRAFFIC OPERATIONS SUCH THAT THERE WILL BE NO OBSTRUCTIONS TO THE CONTINUOUS FLOW OF TRAFFIC. ALL INTERSECTIONS AND DRIVEWAYS SHALL BE OPEN TO TRAFFIC AT ALL TIMES UNLESS OTHERWISE SHOWN IN THE PLAN.

INFORMATION SHOULD INCLUDE, BUT IS NOT LIMITED TO, ALL AND SHALL LIST THE SPECIFIC LOCATION, TYPE OF WORK, ROAD STATUS, DATE AND TIME OF RESTRICTION, DURATION OF RESTRICTION, NUMBER OF LANES MAINTAINED, NUMBER OF LANES CLOSED, MINIMUM VERTICAL CLEARANCE, MINIMUM WIDTH OF DRIVEABLE PAVEMENT DETOUR ROUTES, IF APPLICABLE, AND ANY OTHER INFORMATION REQUESTED BY THE PROJECT ENGINEER.

NOTIFICATION TIME TABLE

ITEM	DURATION OF CLOSURE	NOTICE DUE TO PERMITS & PIO
RAMP &	>= 2 WEEKS	21 CALENDAR DAYS PRIOR TO CLOSURE
ROAD	> 12 HOURS & < 2 WEEKS	14 CALENDAR DAYS PRIOR TO CLOSURE
CLOSURES	<= 12 HOURS	4 BUSINESS DAYS PRIOR TO CLOSURE

LANE	>= 2 WEEKS	14 CALENDAR DAYS PRIOR TO CLOSURE
CLOSURES &	< 2 WEEKS	5 BUSINESS DAYS PRIOR TO CLOSURE

RESTRICTIONS

START OF CONSTRUCTION &	14 CALENDAR DAYS
TRAFFIC PATTERN CHANGES	PRIOR TO IMPLEMENTATION

ANY UNFORESEEN CONDITIONS NOT SPECIFIED IN THE PLANS REQUIRING TRAFFIC RESTRICTIONS SHALL ALSO BE REPORTED TO THE PROJECT ENGINEER USING THE NOTIFICATION TIME TABLE.

THE CONTRACTOR SHALL ARRANGE FOR ALL MAINTENANCE OF TRAFFIC OPERATIONS SUCH THAT THERE WILL BE NO OBSTRUCTIONS TO THE CONTINUOUS FLOW OF TRAFFIC. ALL INTERSECTIONS AND DRIVEWAYS SHALL BE OPEN TO TRAFFIC AT ALL TIMES UNLESS OTHERWISE SHOWN IN THE PLAN.

LENGTH AND DURATION OF LANE CLOSURES AND RESTRICTIONS SHALL BE AT THE APPROVAL OF THE ENGINEER. IT IS THE INTENT TO MINIMIZE THE IMPACT TO THE TRAVELING PUBLIC. LANE CLOSURES OR RESTRICTIONS OVER SEGMENTS OF THE PROJECT IN WHICH NO WORK IS ANTICIPATED WITHIN A REASONABLE TIME FRAME, AS DETERMINED BY THE ENGINEER, SHALL NOT BE PERMITTED. THE LEVEL OF UTILIZATION OF MAINTENANCE OF TRAFFIC DEVICES SHALL BE COMMENSURATE WITH THE WORK IN PROGRESS.

ALL WORK AND TRAFFIC CONTROL DEVICES SHALL BE IN ACCORDANCE WITH C&MS 614 AND OTHER APPLICABLE PORTIONS OF THE SPECIFICATIONS, AS WELL AS THE OHIO MANUAL OF UNIFORM TRAFFIC CONTROL DEVICES. PAYMENT FOR ALL LABOR, EQUIPMENT AND MATERIALS SHALL BE INCLUDED IN THE LUMP SUM CONTRACT PRICE FOR ITEM 614, MAINTAINING TRAFFIC, UNLESS SEPARATELY ITEMIZED IN THE PLAN.

PLACEMENT OF ASPHALT CONCRETE

TWO-WAY TRAFFIC SHALL BE MAINTAINED AT ALL TIMES EXCEPT THAT ONE-WAY TRAFFIC WILL BE PERMITTED FOR MINIMUM PERIODS OF TIME CONSISTENT WITH THE REQUIREMENTS OF THE SPECIFICATIONS FOR PROTECTION OF COMPLETED ASPHALT CONCRETE COURSES.

WORK ZONE MARKINGS AND SIGNS

THE FOLLOWING ESTIMATED QUANTITIES HAVE BEEN CARRIED TO THE GENERAL SUMMARY FOR USE AT LOCATIONS IDENTIFIED BY THE ENGINEER FOR WORK ZONE PAVEMENT MARKINGS AND SIGNS PER THE REQUIREMENTS OF CMS 614.04 AND 614.11.

ITEM 614, WORK ZONE MARKING SIGN	TOTAL	42 EACH
01/STR/PV		40 EACH
02/S<2/PV		2 EACH


ITEM 614, WORK ZONE CENTER LINE,	TOTAL	64 MILES
CLASS III, 642 PAINT	01/STR/PV	60 MILES
	02/S<2/PV	4 MILES

ITEM 614, WORK ZONE EDGE LINE,	TOTAL	128 MILES
CLASS III, 642 PAINT	01/STR/PV	119 MILES
	02/S<2/PV	9 MILES

ITEM 614, WORK ZONE STOP LINE,	TOTAL	72 FT.
CLASS III, 642 PAINT	01/STR/PV	36 FT.
	02/S<2/PV	36 FT.

ITEM 614, WORK ZONE ARROW,	TOTAL	18 EACH
CLASS III, 642 PAINT	01/STR/PV	18 EACH

ITEM 614, WORK ZONE TRANSVERSE/DIAGONAL	TOTAL	780 FT.
LINE CLASS III, 642 PAINT	01/STR/PV	780 FT.

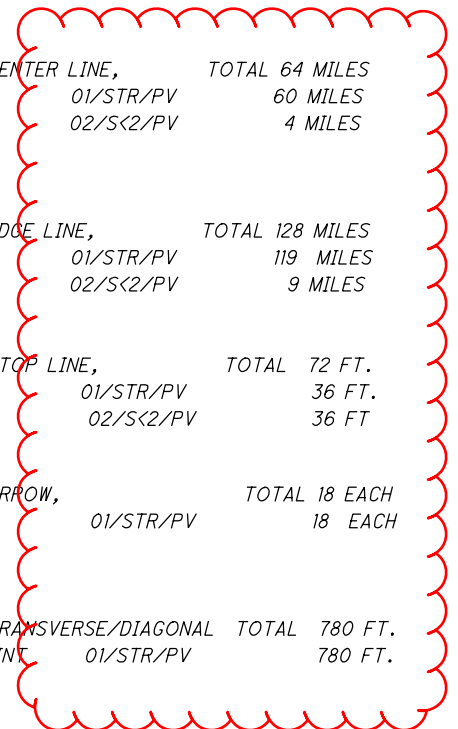

I:\ProjectData\ROS\100846_ROS_138_207_002T_0308_Design\Roadway\Sheets\00846_MN001.dgn Sheet 4/3/2020 9:29:36 AM ewoodbr1

CALCULATED
EWW
CHECKED
CLC

MAINTENANCE OF TRAFFIC GENERAL NOTES

ROS-138-0.27
ROS-207-3.08



I:\ProjectData\ROS\100846_ROS_138_207_0027_0308\Design\Roadway\Sheets\100846_0027_0308_Sheet_4/3/2020 9:29:37 AM ewoodbrl

SHEET NUM.					PART.		ITEM	ITEM EXT	GRAND TOTAL	UNIT	DESCRIPTION	SEE SHEET NO.
5	7	8	9	01/STR/PV	02/SK2/PV							
											EROSION CONTROL	
					900	100	832	30000	1,000	EACH	EROSION CONTROL	
											PAVEMENT	
	153,712	181,538			314,466	20,784	422	11000	335,250	SY	AGGREGATE, SINGLE CHIP SEAL, TYPE A	
	61,485	72,615			125,786	8,314	422	25000	134,100	GAL	EMULSION, CHIP SEAL	
	23,057	27,231			47,170	3,118	886	11000	50,288	GAL	FOG SEAL	
											TRAFFIC CONTROL	
			10		10		620	00500	10	EACH	DELINEATOR, POST GROUND MOUNTED	
			10		10		620	31200	10	EACH	REMOVAL OF DELINEATOR	
			1,674		1,523	151	621	00100	1,674	EACH	RPM	
			1,674		1,523	151	621	54000	1,674	EACH	RAISED PAVEMENT MARKER REMOVED	
			42.66		39.72	2.94	642	00104	42.66	MILE	EDGE LINE, 6", TYPE 1	
			21.33		19.86	1.47	642	00300	21.33	MILE	CENTER LINE, TYPE 1	
			525		525		642	00400	525	FT	CHANNELIZING LINE, 8", TYPE 1	
			24		24		642	00500	24	FT	STOP LINE, TYPE 1	
			260		260		642	00700	260	FT	TRANSVERSE/DIAGONAL LINE, TYPE 1	
			6		6		642	01300	6	EACH	LANE ARROW, TYPE 1	
			809		797	12	644	30000	809	FT	REMOVAL OF PAVEMENT MARKING	
			6		6		644	30020	6	EACH	REMOVAL OF PAVEMENT MARKING	
			63.99		59.58	4.41	644	30030	63.99	MILE	REMOVAL OF PAVEMENT MARKING	
											MAINTENANCE OF TRAFFIC	
42					40	2	614	12460	42	EACH	WORK ZONE MARKING SIGN	
64					60	4	614	21550	64	MILE	WORK ZONE CENTER LINE, CLASS III, 642 PAINT	
128					119	9	614	22360	128	MILE	WORK ZONE EDGE LINE, CLASS III, 6", 642 PAINT	
780					780		614	25620	780	FT	WORK ZONE TRANSVERSE/DIAGONAL LINE, CLASS III, 642 PAINT	
72					36	36	614	26610	72	FT	WORK ZONE STOP LINE, CLASS III, 642 PAINT	
18					18		614	30650	18	EACH	WORK ZONE ARROW, CLASS III, 642 PAINT	
											INCIDENTALS	
					LS	LS	614	11000	LS		MAINTAINING TRAFFIC	
					LS	LS	624	10000	LS		MOBILIZATION	

GENERAL SUMMARY

ROS-138-0.27
ROS-207-3.08



CALCULATED
EJWW
CHECKED
CLC