



BRIDGE NUMBER	LENGTH (BRIDGE LIMITS)	WIDTH	BRIDGE DECK AREA	202	407		441	512	846	COMMENTS	STRUCTURE FILE NUMBER
				WEAING COURSE REMOVED	NON-TRACKING TACK COAT		ASPHALT CONCRETE SURFACE COURSE, TYPE 1, (448), PG64-22	TYPE 3 WATERPROOFING	POLYMER MODIFIED ASPHALT EXPANSION JOINT		
				FT.	FT.	SQ.YD.	SQ. YD.	GAL	3" CU.YD.		
ROS-50-0312	67.00	45.00	335.00	335.00	30.15		27.92	335.00	38.00	CONCRETE SLAB CONTINUOUS	7103069
APPROACHES 2 @ 25'	50	45	250.00							MASSIE RUN	
<b>TOTAL FOR ROS-50-0312 PARTICIPATION SPLIT 03/STR/BR:</b>				<b>335.00</b>	<b>53.00</b>		<b>27.92</b>	<b>335</b>	<b>38</b>	SKEW 0 DEG	

STRUCTURES

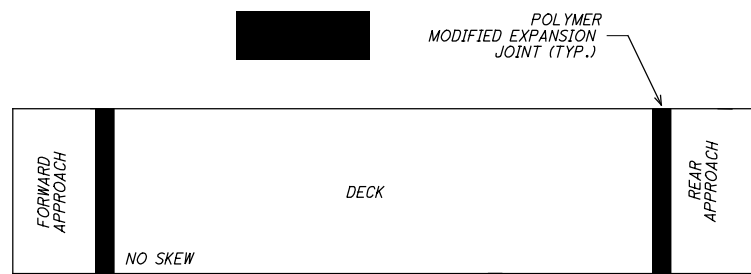

PLAN VIEW  
SFN: 7103069

ITEM 846 POLYMER MODIFIED EXPANSION JOINT SYSTEM  
2 JOINTS X (45' X 3 1/2" X 20 1/2") = 38 CU. FT.

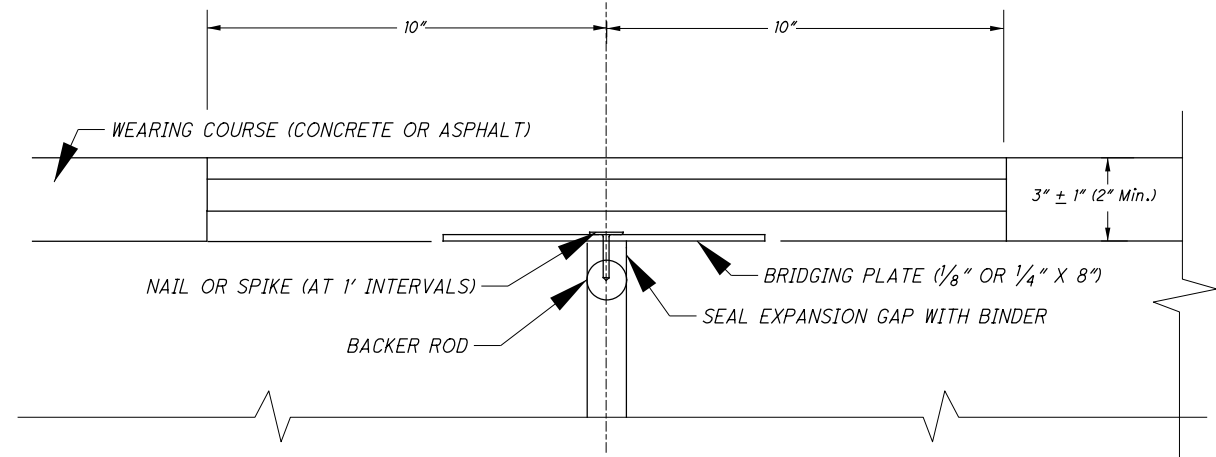

TYPICAL PRESTRESSED BOX BEAM  
OR  
CONCRETE SLAB JOINT

DESIGN AGENCY



DESIGNER  
JBS

REVIEWER  
CLC MM-DD-YY

PROJECT ID  
112918

SHEET TOTAL  
P.8 8