


STATE OF OHIO DEPARTMENT OF TRANSPORTATION

ROS-159-0.41

ROSS COUNTY SCIOTO TOWNSHIP

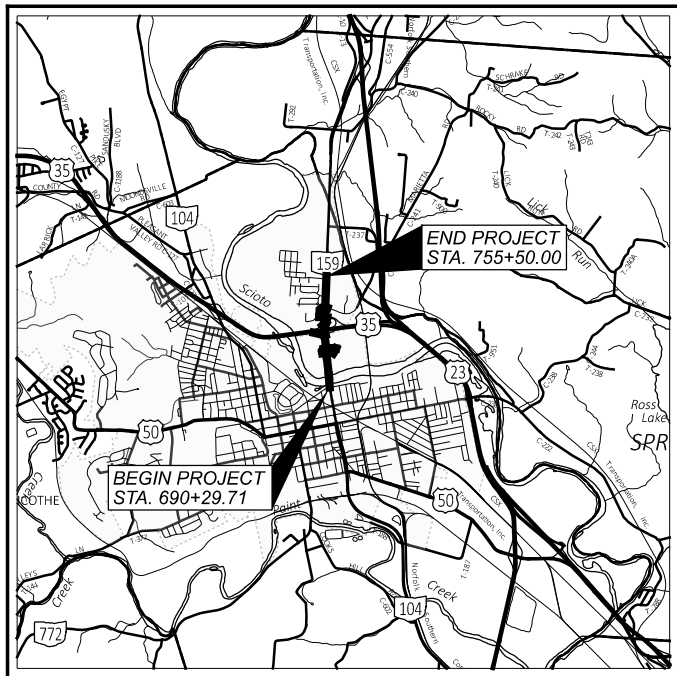

LOCATION MAP

LATITUDE: 39°20'55" LONGITUDE: 82°58'36"



PORTION TO BE IMPROVED	—————
INTERSTATE HIGHWAY	—————
FEDERAL ROUTES	—————
STATE ROUTES	—————
COUNTY & TOWNSHIP ROADS	—————
OTHER ROADS	—————

DESIGN DESIGNATION

SEE SHEET 2

DESIGN EXCEPTIONS

NONE REQUIRED

ADA DESIGN WAIVERS

NONE REQUIRED

ENGINEER'S SEAL:



SIGNED:
DATE:

ENGINEER'S SEAL: SHEETS: 140-145, 321-348 SIGNED: DATE:	ENGINEER'S SEAL: SHEETS: 466-506 SIGNED: DATE:	ENGINEER'S SEAL: SHEETS: 349-350, 518-520 SIGNED: DATE:
ENGINEER'S SEAL: SHEETS: 30-115, 366-465 SIGNED: DATE:	ENGINEER'S SEAL: SHEETS: 351-365 SIGNED: DATE:	ENGINEER'S SEAL: SHEETS: 510-517 SIGNED: DATE:

INDEX OF SHEETS:

TITLE SHEET	1	PAVEMENT PLAN	274 - 280
DESIGN DESIGNATIONS	2	SUPERELEVATION TABLES	281 - 284
SCHEMATIC PLAN	3 - 5	PAVEMENT JOINT DETAILS	285 - 288
GEOMETRIC LAYOUT	6 - 10	INTERSECTION DETAILS	289 - 304
TYPICAL SECTIONS	11 - 26	SPLITTER ISLAND DETAILS	305
GENERAL NOTES	27 - 29	DRIVE DETAILS	306 - 320
MAINTENANCE OF TRAFFIC	30 - 115	STORM SEWER PROFILES	321 - 333
GENERAL SUMMARY	116 - 122	BMP AND GRADING DETAILS	334 - 335
SUBSUMMARIES	123 - 146	UNDERDRAIN PLAN	336 - 348
PROJECT SITE PLAN	147 - 149	RETAINING WALLS	349 - 365
ROADWAY REMOVAL PLAN	150 - 156	TRAFFIC CONTROL	366 - 425
PLAN & PROFILE		TRAFFIC SIGNALS	426 - 465
S.R. 159 (BRIDGE STREET)	157 - 171	LIGHTING	466 - 506
INTERCHANGE RAMP	172 - 177	LANDSCAPING	507 - 509
N. PLAZA, MARIETTA, PAWNEE	178 - 184	STRUCTURES	
STEWART, CONSUMER CENTER	185 - 195	ROS-159-0042 (SCIOTO RIVER BRIDGE)	510 - 517
SHARED USE PATH	196	ROS-35-1972 L&R (US-35 BRIDGE)	518 - 520
CROSS SECTIONS		GEOTECHNICAL PROFILES	521 - 547
S.R. 159 (BRIDGE STREET)	197 - 232	RIGHT OF WAY	548 - 592
INTERCHANGE RAMP	233 - 247		
N. PLAZA, MARIETTA, PAWNEE	248 - 260		
STEWART, CONSUMER CENTER	261 - 269		
SHARED USE PATH	270 - 273		

FEDERAL PROJECT NUMBER

E200947

RAILROAD INVOLVEMENT

NONE

PROJECT DESCRIPTION

IMPROVEMENTS TO S.R. 159 (BRIDGE STREET) & U.S. 35 EB RAMP TO ADDRESS CRASH PATTERNS AND CONGESTION. IMPROVEMENTS INCLUDE ADDING A THIRD NB THROUGH LANE, ADDING CONNECTING SIDE STREETS TO IMPROVE SIGNAL LEVEL OF SERVICE, LANE REASSIGNMENTS, AND RAMP DROP LANE ENTRANCE AT THE S.R. 159 SB TO U.S. 35 WB ON-RAMP AS WELL AS IMPROVING THE U.S. 35 EB OFF-RAMP TO REALIGN WITH S.R. 159 TO MINIMIZE QUEUE LENGTH. PEDESTRIAN FACILITIES WILL ALSO BE ADDED ALONG THE CORRIDOR.

EARTH DISTURBED AREAS

PROJECT EARTH DISTURBED AREA:	21.7 ACRES
ESTIMATED CONTRACTOR EARTH DISTURBED AREA:	4.0 ACRES
NOTICE OF INTENT EARTH DISTURBED AREA:	25.7 ACRES

LIMITED ACCESS

THIS IMPROVEMENT IS ESPECIALLY DESIGNED FOR THROUGH TRAFFIC AND HAS BEEN DECLARED A LIMITED ACCESS HIGHWAY OR FREEWAY BY ACTION OF THE DIRECTOR IN ACCORDANCE WITH THE PROVISIONS OF SECTION 5511.02 OF THE OHIO REVISED CODE.

2023 SPECIFICATIONS

THE STANDARD SPECIFICATIONS OF THE STATE OF OHIO, DEPARTMENT OF TRANSPORTATION, INCLUDING SUPPLEMENTAL SPECIFICATIONS LISTED IN THE PLANS AND CHANGES LISTED IN THE PROPOSAL SHALL GOVERN THIS IMPROVEMENT.

I HEREBY APPROVE THESE PLANS AND DECLARE THAT THE MAKING OF THIS IMPROVEMENT WILL REQUIRE THE PART-TIME CLOSING OF THE HIGHWAY TO TRAFFIC, AS NOTED ON SHEETS 35-34. DURING WHICH TIME DETOURS WILL BE PROVIDED AS SHOWN HEREIN. PROVISIONS FOR THE MAINTENANCE AND SAFETY OF TRAFFIC WILL BE AS SET FORTH ON THE PLANS AND ESTIMATES.

Michael G. Dombrowski

Michael G. Dombrowski
District 09 Deputy Director

Pamela Boratyn

Pamela Boratyn
Director, Department of Transportation

UNDERGROUND UTILITIES
Contact Two Working Days
Before You Dig

OHIO811.org
Before You Dig

OHIO811, 8-1-1, or 1-800-362-2764
(Non members must be called directly)

PLAN PREPARED BY:
BURGESS & NIPLÉ, INC.
330 RUSH ALLEY, SUITE 700
COLUMBUS, OH 43215

STANDARD CONSTRUCTION DRAWINGS										SUPPLEMENTAL SPECIFICATIONS	SPECIAL PROVISIONS
BP-2.1	1/21/22	TC-21.21	1/20/23	MT-95.30	7/19/19	TC-15.116	1/19/24	CB-2-2A, 2B,	800	7/19/24	SECTION 408 PERMIT 6/24/2024
BP-2.2	1/15/21	TC-81.11	1/19/24	MT-95.31	7/19/19	TC-21.11	7/16/21	CB-2C	809	7/19/24	
BP-2.3	7/18/14	TC-81.22	7/21/23	MT-95.32	4/19/19	TC-22.10	4/21/23	CB-2-3, 2-4	821	4/20/24	SIGNAL AND LIGHT SUPPORTS 1/17/2025
BP-2.5	7/19/24	TC-83.20	7/19/24	MT-95.40	7/21/23	TC-22.20	1/17/14	CB-3, CB-3A	832	7/19/24	
BP-3.1	1/19/24	TC-85.20	4/21/23	MT-95.41	7/21/23	TC-41.10	7/19/13	CB-6	872	1/21/22	ITEM 452 - TRAINING 1/21/2025
BP-4.1	7/19/13			MT-95.45	7/21/23	TC-41.20	10/18/13		878	1/21/22	
BP-5.1	7/15/22	HL-10.11	7/21/23	MT-95.50	7/21/17	TC-41.30	4/21/23	I-3D	913	4/16/21	
BP-7.1	7/19/24	HL-10.12	7/21/23	MT-95.60	7/19/24	TC-41.40	10/18/13		921	7/19/24	
		HL-10.13	1/20/23	MT-98.21	7/21/23	TC-41.50	10/18/13	MH-3	902	7/19/19	
MGS-1.1	7/16/21	HL-10.31	7/15/22	MT-98.28	1/17/20	TC-42.10	10/18/13		916	7/21/23	
MGS-2.1	1/19/18	HL-20.11	7/21/23	MT-99.20	4/19/19	TC-42.20	10/18/13	DM-1.1		7/17/20	
MGS-3.1	1/19/18	HL-20.21	1/15/21	MT-99.60	7/19/24	TC-52.10	10/18/13	DM-1.2		7/16/21	
MGS-4.1	1/20/17	HL-30.11	7/21/23	MT-101.70	7/19/24	TC-52.20	1/15/21	DM-2.1		1/18/13	
MGS-4.2	7/19/24	HL-30.21	4/17/20	MT-101.75	7/21/23	TC-61.10	4/21/23	DM-4.1		7/17/20	
MGS-4.3	1/18/13	HL-30.22	1/15/21	MT-101.90	7/17/20	TC-61.30	7/19/24	DM-4.3		1/15/16	
		HL-40.20	7/19/24	MT-102.10	7/21/23	TC-65.10	1/17/14	DM-4.4		1/15/16	
RM-1.1	1/20/23	HL-60.11	7/21/17	MT-105.10	1/17/20	TC-65.11	1/19/24				
RM-3.1	7/20/18	HL-60.12	7/21/23	MT-110.10	7/19/13	TC-71.10	4/21/23	WQ-1.2		1/15/16	
RM-4.2	7/19/24	HL-60.21	7/20/18			TC-72.20	7/21/23				
RM-4.3	1/21/22	HL-60.31	7/19/24			TC-73.20	7/19/24	LA-1.1		10/15/10	
RM-4.4	7/21/23					TC-74.10	7/21/23	LA-1.2		7/19/24	
RM-4.5	7/19/24										
RM-4.6	7/19/24										
RM-5.2	7/21/23										

TITLE SHEET

ROS-159-0.41

MODEL: Sheet PAPER: 17x11 (in.) DATE: 1/24/2025 TIME: 10:04:37 AM USER: soroka pwc:\bnpw\benley.com\pwc\01\Documents\p59055400-Engineering\Roadway\Sheets\113013_GT001

DESIGN AGENCY	B&N burgessniple.com
DESIGNER	DSS
REVIEWER	BDT
PROJECT ID	113013
SHEET	1
TOTAL	592