

I:\ProjectData\SAN\10130_SAN_SIGN_FY2020\DesignRoadway\Sheets\10130_G600.dgn_Sheet 2/13/2020 8:22:20 AM zportier

SHEET NUM.			PART.	ALT	ITEM	ITEM	GRAND	UNIT	DESCRIPTION	SEE
5	6		01/NHS/O T	(X)	EXT	TOTAL				SHEET
										NO.
									ROADWAY	
18318	11270		29588		630	03101	29,588	FT	GROUND MOUNTED SUPPORT, NO. 3 POST, AS PER PLAN	2
266	0		266		630	97900	266	FT	SIGNING, MISC.:4"x6" WOOD POST	2
710	306		1016		630	97900	1,016	FT	SIGNING, MISC.:6"x8" WOOD POST	2
55	16		71		630	84500	71	EACH	GROUND MOUNTED STRUCTURAL BEAM SUPPORT FOUNDATION	2
10175	5942		16117		630	80100	16,117	SF	SIGN, FLAT SHEET	2
1674	1231		2905		630	84900	2,905	EACH	REMOVAL OF GROUND MOUNTED SIGN AND DISPOSAL	
1346	872		2218		630	86003	2,218	EACH	REMOVAL OF GROUND MOUNTED POST SUPPORT AND DISPOSAL, AS PER PLAN	3
3	2		5		630	85100	5	EACH	REMOVAL OF GROUND MOUNTED SIGN AND REERECTION	
366	374		740		630	08601	740	EACH	SIGN POST REFLECTOR, AS PER PLAN(RED)	3
330	170		500		630	08601	500	EACH	SIGN POST REFLECTOR, AS PER PLAN(YELLOW)	3
98	0		98		630	08601	98	EACH	SIGN POST REFLECTOR, AS PER PLAN(WHITE)	3
									INCIDENTALS	
			LS		614	11000	LS		MAINTAINING TRAFFIC	
			LS		624	10000	LS		MOBILIZATION	

CALCULATED ZAP CHECKED CDW
GENERAL SUMMARY
 SAN - SIGN - FY 2020
 4
 279

I:\ProjectData\SAN\010130_SAN_SIGN_FY2020\Design\Roadway\Sheets\010130_GS002.dgn SUBSUMMARY - SANDUSKY-1 2/12/2020 4:17:50 PM zporter

SHEET NO	REF NO	LOCATION	630														
			GROUND MOUNTED SUPPORT, NO. 3 POST, AS PER PLAN	GROUND MOUNTED SUPPORT, 4"x6" WOOD POST	GROUND MOUNTED SUPPORT, 6"x8" WOOD POST	GROUND MOUNTED STRUCTURAL BEAM FOUNDATION	SIGN, FLAT SHEET	REMOVAL OF GROUND MOUNTED SIGN AND DISPOSAL	REMOVAL OF GROUND MOUNTED SUPPORT AND DISPOSAL, AS PER PLAN	REMOVAL OF GROUND MOUNTED SIGN AND REERECTION	SIGN POST REFLECTOR, AS PER PLAN (RED)	SIGN POST REFLECTOR, AS PER PLAN (FLUORESCENT YELLOW)	SIGN POST REFLECTOR, AS PER PLAN (WHITE)				
			FEET	FEET	FEET	EACH	SQ. FT	EACH	EACH	EACH	EACH	EACH	EACH				
7	1-28	US-6	410				151.6	43	28	1		4					
8	29-50	US-6	368				153	43	25			4					
9	51-67	US-6	160		72	4	175.1	32	19								
10	68-89	US-6	422				203	53	38		8		4				
11	90-123	US-6	346				138.4	40	31			4					
12	124-157	US-6	492				172.3	44	36			14					
13	158-186	US-6	470				190.9	39	33			10					
14	187-217	US-6	342				179.9	44	29								
15	218-236	US-6	392	28		2	210.6	56	33		6		2				
16	237-258	US-6	308		40	2	200.8	35	24								
17	259-283	US-6	364				186.6	48	27			8					
18	284-331	US-6	714				337.5	51	51		102						
19	401-429	SR-12	408		18	1	185.7	50	36								
20	430-438	SR-12	154				69	12	11		20						
21	501-507	SR-18	112				45.3	9	7		2						
22	601-626	SR-19	600				272.4	54	45			36					
23	630-649	SR-19	390		20	1	204	43	25								
24	650-681	SR-19	386				207.7	42	30			16					
25	682-709	SR-19	546				251.2	47	36			30					
26	710-740	SR-19	548				265	49	38			10					
27	741-763	SR-19	714				336.4	53	44		24	26					
28	764-781	SR-19	252				113.4	18	18		36						
29	801-839	US-20	576				240	58	61	1							
30	840-868	US-20	400	56	22	5	269.6	55	34								
31	869-896	US-20	372	28	20	3	248	52	34								
32	897-925	US-20	540	42	20	4	372.6	50	52				4				
33	926-953	US-20	366		118	6	387.5	35	35								
34	954-984	US-20	544				258	52	45								
35	985-1017	US-20	474		18	1	228.2	47	38								
36	1018-1050	US-20	640		38	2	437.2	47	49								
37	1051-1082	US-20	552	28	20	3	364.8	49	53								
38	1083-1109	US-20	370		20	1	220.4	46	30								
39	1110-1139	US-20	492	56		4	247.9	43	40	1							
40	1140-1171	US-20	352	28	20	3	319.1	25	22								
41	1172-1196	US-20	378				306	4	4		8						
42	1201-1216	US-20 Ramps	706		80	4	441.9	38	40		16	68	8				
43	1217-1236	US-20 Ramps	636		20	1	359.1	35	26		30	40	16				
44	1237-1250	US-20 Ramps	364		44	2	273.1	23	24		28	20	8				
45	1251-1271	US-20 Ramps	696				349.1	45	36		32	32	16				
46	1272-1293	US-20 Ramps	572		80	4	366.9	41	35		38	8	24				
47	1294-1309	US-20 Ramps	390		40	2	235.5	24	24		16		16				
TOTALS CARRIED TO GENERAL SUMMARY			18,318	266	710	55	10,175	1,674	1,346	3	366	330	98				

I:\ProjectData\SAN\010130_SAN_SIGN_FY2020\Design\Roadway\Sheets\010130_G5002.dgn SUBSUMMARY SANDUSKY-2 2/12/2020 4:18:54 PM zporter

SHEET NO	REF NO	LOCATION	630															
			GROUND MOUNTED SUPPORT, NO. 3 POST, AS PER PLAN	GROUND MOUNTED SUPPORT, 4"x6" WOOD POST	GROUND MOUNTED SUPPORT, 6"x8" WOOD POST	GROUND MOUNTED STRUCTURAL BEAM FOUNDATION	SIGN, FLAT SHEET	REMOVAL OF GROUND MOUNTED SIGN AND DISPOSAL	REMOVAL OF GROUND MOUNTED SUPPORT AND DISPOSAL, AS PER PLAN	REMOVAL OF GROUND MOUNTED SIGN AND REERECTION	SIGN POST REFLECTOR, AS PER PLAN (RED)	SIGN POST REFLECTOR, AS PER PLAN (FLUORESCENT YELLOW)	SIGN POST REFLECTOR, AS PER PLAN (WHITE)					
			FEET	FEET	FEET	EACH	SQ. FT	EACH	EACH	EACH	EACH	EACH	EACH	EACH				
48	1401-1424	SR-51	342		20	1	183.3	35	25	1	10	4						
49	1501-1532	SR-53	344				148	48	39									
50	1535-1566	SR-53	386				157.7	52	33			4						
51	1567-1602	SR-53	472				209.2	56	39	1								
52	1603-1640	SR-53	574				260.1	51	46		38							
53	1641-1644	SR-53	70				31.5	5	5		10							
54	1701-1732	SR-101	392				192.8	52	31									
55	1733-1762	SR-101	468				242	45	31									
56	1763-1793	SR-101	490				248.2	42	33		46	4						
57	1801-1827	SR-105	366		22	1	215.9	47	32		4	12						
58	1901-1929	SR-300	400		18	1	234.8	53	29			8						
59	1930-1942	SR-300	182		18	1	112.2	18	15		20							
60	2001-2031	SR-412	380				159.7	49	36									
61	2032-2060	SR-412	500				221.8	47	35			24						
62	2061-2086	SR-412	462		38	2	264.9	44	34		4	18						
63	2087-2123	SR-412	574				262.6	45	39		52							
64	2201-2229	SR-510	400		20	1	207.1	48	33		6	8						
65	2230-2257	SR-510	374		38	2	238.1	41	32		22	4						
66	2301-2305	SR-523	70		36	2	79.8	12	5		2							
67	2401-2424	SR-582	290		20	1	223.1	39	23		10	8						
68	2501-2526	SR-590	376				193.2	41	29		4	12						
69	2527-2551	SR-590	298		20	1	194	42	26		8							
70	2552-2579	SR-590	370		20	1	227	43	33		8	4						
71	2580-2613	SR-590	562				275.8	45	35		48	8						
72	2701-2727	SR-600	370				175.8	43	25			4						
73	2728-2756	SR-600	364		36	2	250.8	45	29		12	4						
74	2757-2771	SR-600	238				111.1	17	17		34							
75	2801-2834	SR-635	486				245.8	52	37		8	20						
76	2835-2866	SR-635	486				274.6	54	33		8	20						
77	2867-2878	SR-635	184				100.6	20	13		16	4						
TOTALS CARRIED TO GENERAL SUMMARY			11,270	0	306	16	5,942	1,231	872	2	370	170	0					

I:\ProjectData\SAN\101130_SAN_SIGN_FY2020_Design\Roadway\Sheets\SAN-6 Subsummary 3.dgn Sheet 2/11/2020 1:01:17 PM zporter

SHEET NO.	REFERENCE NO.	LOCATION	SLM	CODE	SIZE (INCHES)	630																	
						COLOR, SEE LEGEND, SHEET 2	GROUND MOUNTED SUPPORT, NO. 3 POST, AS PER PLAN	GROUND MOUNTED SUPPORT, 4"x6" WOOD POST	GROUND MOUNTED SUPPORT, 6"x8" WOOD POST	GROUND MOUNTED STRUCTURAL BEAM FOUNDATION	SIGN, FLAT SHEET	REMOVAL OF GROUND MOUNTED SIGN AND DISPOSAL	REMOVAL OF GROUND MOUNTED SUPPORT AND DISPOSAL, AS PER PLAN	REMOVAL OF GROUND MOUNTED SIGN AND REERECTION	SIGN POST REFLECTOR, AS PER PLAN (RED)	SIGN POST REFLECTOR, AS PER PLAN (FLUORESCENT YELLOW)	SIGN POST REFLECTOR, AS PER PLAN (WHITE)						
						EACH	FEET	FEET	FEET	EACH	SQ. FT	EACH	EACH	EACH	EACH	EACH	EACH	EACH	EACH				
88	51	EB US-6	10.03	M3-2	24x12	BLK/W			20	1	2	2											
				M1-4	24x24	BLK/W					4												
				M6-3	21x15	BLK/W					2.2												
				M3-1	24x12	BLK/W					2												
				M1-5	30x24	BLK/W					5												
				M6-1	21x15	BLK/W					2.2												
				M3-3	24x12	BLK/W					2												
				M1-5	30x24	BLK/W					5												
				M6-1	21x15	BLK/W					2.2												
88	52	EB US-6	10.05									2		1									
88	53	EB US-6	10.12	R2-1	24x30	BLK/W	14				5	1		1									
88	54	EB US-6	10.23									1		2									
88	55	EB US-6	10.36	D2-H2	72x24	W/G	14/14				12												
88	56	EB US-6	10.95	W2-2R	36x36	BLK/FY	14/14				9	2		1									
				W16-H8	48x8	BLK/FY					2.7												
88	57	EB US-6	11.00	D10-h8	12x12	BLK/W	10				1												
				D10-h8	12x12	BLK/W					1												
89	58	EB US-6	11.12	M3-2	24x12	BLK/W	14				2	2		1									
				M1-4	24x24	BLK/W					4												
89	59	EB US-6	11.92	I-3	36x18	W/G	14				4.5	2		2									
				I-H25A	12x12	BLK/W					1												
89	60	EB US-6	12.00	D10-h8	12x12	BLK/W	10				1	2		1									
				D10-h8	12x12	BLK/W					1												
90	61	EB US-6	12.70	M3-2	24x12	BLK/W	14				2												
				M1-4	24x24	BLK/W					4												
				M6-1	21x15	BLK/W					2.2												
				M3-4	24x12	BLK/W	14				2												
				M1-4	24x24	BLK/W					4												
				M6-1	21x15	BLK/W					2.2												
90	62	EB US-6	12.74									1		1									
90	63	EB US-6	12.78	M3-2	30x15	BLK/W			16	1	3.2	3		1									
				M1-4	30x30	BLK/W					6.3												
				M5-1L	24x18	BLK/W					3												
				M2-1	24x18	BLK/W					3												
				M1-5	30x30	BLK/W					6.3												
				M6-H9	24x18	BLK/W					3												
90	64	EB US-6	12.78	M3-2	30x15	BLK/W			16	1	3.2	6		2									
				M1-4	30x30	BLK/W					6.3												
				M5-1L	24x18	BLK/W					3												
				M2-1	24x18	BLK/W					3												
				M1-5	30x30	BLK/W					6.3												
				M6-H9	24x18	BLK/W					3												
90	65	EB US-6	12.84	D7-H1A	96x24	W/BRN		14/14		2	16	3		2									
				D1-H1A	96x18	W/G					12												
				D1-H1A	96x12	W/G					8												
90	66	EB US-6	12.92	R3-H8bn	36x30	BLK/W	14				7.5	1		2									
90	67	EB US-6	12.99	M3-2	24x12	BLK/W			20	1	2	7		3									
				M1-4	24x24	BLK/W					4												
				M6-1	21x15	BLK/W					2.2												
				D9-2	24x24	W/BLU					4												
				M6-3	21x15	W/BLU					2.2												
				M3-1	24x12	BLK/W					2												
				M1-5	24x24	BLK/W					4												
				M6-1	21x15	BLK/W					2.2												
				M3-3	24x12	BLK/W					2												
				M1-5	24x24	BLK/W					4												
				M6-1	21x15	BLK/W					2.2												
TOTALS CARRIED TO SANDUSKY CO. SUBSUMMARY							160		72	4	175.1	32		19									



SHEET NO.	REFERENCE NO.	LOCATION	SLM	CODE	SIZE (INCHES)	630																	
						COLOR, SEE LEGEND, SHEET 2	GROUND MOUNTED SUPPORT, NO. 3 POST, AS PER PLAN	GROUND MOUNTED SUPPORT, 4"x6" WOOD POST	GROUND MOUNTED SUPPORT, 6"x8" WOOD POST	GROUND MOUNTED STRUCTURAL BEAM FOUNDATION	SIGN, FLAT SHEET	REMOVAL OF GROUND MOUNTED SIGN AND DISPOSAL	REMOVAL OF GROUND MOUNTED SUPPORT AND DISPOSAL, AS PER PLAN	REMOVAL OF GROUND MOUNTED SIGN AND REECTION	SIGN POST REFLECTOR, AS PER PLAN (RED)	SIGN POST REFLECTOR, AS PER PLAN (FLUORESCENT YELLOW)	SIGN POST REFLECTOR, AS PER PLAN (WHITE)						
						EACH	FEET	FEET	FEET	EACH	SQ. FT	EACH	EACH	EACH	EACH	EACH	EACH	EACH	EACH				
126	682	NB SR-19	17.01-17.04	W1-8R	30x36	BLK/FY	14					7.5	3	3					2				
				W1-8R	30x36	BLK/FY	14					7.5							2				
				W1-8R	30x36	BLK/FY	14					7.5							2				
126	683	NB SR-19	17.12	M3-1	24x12	BLK/W	14					2	2	1									
				M1-5	24x24	BLK/W						4											
126	684	NB SR-19	17.16	I-3	24x18	W/G	14					3	2	1									
126	685 A	SB SR-19	17.40	I-H25A	12x12	BLK/W						1	1	2									
126	685	SB SR-19	17.40	I-H21	48x24	W/G	14/14					8	2	1									
126	686	SB SR-19	17.44	M3-3	24x12	BLK/W	14					2											
				M1-5	24x24	BLK/W						4											
126	687	SB SR-19	17.18	I-3	24x18	W/G	14					3	1	1									
126	688	SB SR-19	17.10	W1-1L	36x36	BLK/FY	14/14					9	2	1									
				W13-1	24x24	BLK/FY						4											
126	689	SB SR-19	17.03-17.01	W1-8L	30x36	BLK/FY	14					7.5	2	2					2				
				W1-8L	30x36	BLK/FY	14					7.5							2				
126	690	SB SR-19	17.00	W1-6	48x24	BLK/FY	14/14					8	1	2					4				
126	691	SB SR-19	16.99-16.96	W1-8L	30x36	BLK/FY	14					7.5	3	3					2				
				W1-8L	30x36	BLK/FY	14					7.5							2				
				W1-8L	30x36	BLK/FY	14					7.5							2				
126	692	SB SR-19	16.88	M3-3	24x12	BLK/W	14					2	1	1									
				M1-5	24x24	BLK/W						4											
125	693	SB SR-19	16.65	W1-1R	36x36	BLK/FY	14/14					9	2	1									
				W13-1	24x24	BLK/FY						4											
125	694	SB SR-19	16.59	M3-3	24x12	BLK/W	14					2											
				M1-5	24x24	BLK/W						4											
				M5-1R	21x15	BLK/W						2.2											
125	695	SB SR-19	16.53-16.52	W1-8R	30x36	BLK/FY	14					7.5	2	2					2				
				W1-8R	30x36	BLK/FY	14					7.5							2				
125	696	SB SR-19	16.51										3	1									
125	697	SB SR-19	16.51	M3-3	24x12	BLK/W	14					2	3	1									
				M1-5	24x24	BLK/W						4											
				M6-1	21x15	BLK/W						2.2											
125	698	SB SR-19	16.51-16.49	W1-8R	30x36	BLK/FY	14					7.5	3	3					2				
				W1-8R	30x36	BLK/FY	14					7.5							2				
				W1-8R	30x36	BLK/FY	14					7.5							2				
125	699	SB SR-19	16.42	M3-3	24x12	BLK/W	14					2											
				M1-5	24x24	BLK/W						4											
125	700	SB SR-19	16.16										3	1									
125	701	SB SR-19	16.11	M2-1	21x15	BLK/W	14					2.2											
				M1-5	30x24	BLK/W						5											
				M5-1L	21x15	BLK/W						2.2											
125	702	SB SR-19	16.05	R3-H8bh	36x30	BLK/W	14					7.5	1	2									
124	703	SB SR-19	16.00	M3-2	24x12	BLK/W	14					2	2	1									
				M1-5	30x24	BLK/W						5											
				M6-1	21x15	BLK/W						2.2											
				M3-3	24x12	BLK/W	14					2											
				M1-5	24x24	BLK/W						4											
				M6-3	21x15	BLK/W						2.2											
124	704	SB SR-19	15.97										2	1									
124	705	SB SR-19	15.95	D2-H2	72x30	W/G	14/14					15	1	1									
124	706	SB SR-19	15.38	OM-3L	12x36	BLK/FY	14					3	1	1									
124	707	SB SR-19	15.34	OM-3R	12x36	BLK/FY	14					3	1	1									
124	708	SB SR-19	15.31	OM-3L	12x36	BLK/FY	14					3	1	1									
123	709	SB SR-19	14.96	M3-3	24x12	BLK/W	14					2	2	1									
				M1-5	24x24	BLK/W						4											
TOTALS CARRIED TO SANDUSKY CO. SUBSUMMARY								546				251.2	47		36				30				


SHEET NO.	REFERENCE NO.	LOCATION	SLM	CODE	SIZE (INCHES)	630													
						COLOR, SEE LEGEND, SHEET 2	GROUND MOUNTED SUPPORT, NO. 3 POST, AS PER PLAN	GROUND MOUNTED SUPPORT, 4"x6" WOOD POST	GROUND MOUNTED SUPPORT, 6"x8" WOOD POST	GROUND MOUNTED STRUCTURAL BEAM FOUNDATION	SIGN, FLAT SHEET	REMOVAL OF GROUND MOUNTED SIGN AND DISPOSAL	REMOVAL OF GROUND MOUNTED SUPPORT AND DISPOSAL, AS PER PLAN	REMOVAL OF GROUND MOUNTED SIGN AND REERECTION	SIGN POST REFLECTOR, AS PER PLAN (RED)	SIGN POST REFLECTOR, AS PER PLAN (FLUORESCENT YELLOW)	SIGN POST REFLECTOR, AS PER PLAN (WHITE)		
						EACH	FEET	FEET	FEET	EACH	SQ. FT	EACH	EACH	EACH	EACH	EACH	EACH	EACH	
179	1501	NB SR-53	0.00	I-h2f	48 x 24	W/G	14 / 14					8	2	2					
				D10h8	12 x 12	BLK/W					1								
179	1502	NB SR-53	0.51	M3-1	24 x 12	BLK/W					2	2	1						
				M1-5	24 x 24	BLK/W					4								
179	1503	NB SR-53	1.00	D10h8	12 x 12	BLK/W					1	2							
				D10h8	12 x 12	BLK/W					1								
180	1504	NB SR-53	1.68	I-h25a	12 x 12	BLK/W	10				1	1	1						
180	1505	NB SR-53	1.75	M3-1	24 x 12	BLK/W	14				2	2	1						
				M1-5	24 x 24	BLK/W					4								
180	1506	NB SR-53	2.00	D10h8	12 x 12	BLK/W	10				1	2	1						
				D10h8	12 x 12	BLK/W					1								
181	1507	NB SR-53	2.36	M2-1	21 x 15	BLK/W	14				2.2								
				M1-5	24 x 24	BLK/W					4								
				M5-1L	21 x 15	BLK/W					2.2								
181	1508	NB SR-53	2.38									3	1						
181	1509	NB SR-53	2.40	D1-h1a	72 x 12	W/G	14 / 14				6	3	2						
				D1-h1a	72 x 12	W/G					6								
181	1510	NB SR-53	2.44	R3-h8b	48 x 30	BLK/W	14 / 14				10	1	2						
181	1511	NB SR-53	2.52									1	2						
181	1512	NB SR-53	2.52									2	1						
181	1513	NB SR-53	2.54	M3-4	24 x 12	BLK/W	14				2	5	2						
				M1-5	24 x 24	BLK/W					4								
				M6-1	21 x 15	BLK/W					2.2								
				M3-1	24 x 12	BLK/W	14				2								
				M1-5	24 x 24	BLK/W					4								
				M6-3	21 x 15	BLK/W					2.2								
181	1514	NB SR-53	2.57									1	2						
181	1515	NB SR-53	2.58	D2-h2	72 x 30	W/G	14 / 14				15								
181	1516	NB SR-53	2.68	I-h14	48 x 30	W/BLU	14 / 14				10								
182	1517	NB SR-53	3.00	D10h8	12 x 12	BLK/W	10				1	2	1						
				D10h8	12 x 12	BLK/W					1								
182	1518	NB SR-53	3.05	M3-1	24 x 12	BLK/W	14				2	2	1						
				M1-5	24 x 24	BLK/W					4								
182	1519	NB SR-53	3.55	M3-1	24 x 12	BLK/W	14				2	2	1						
				M1-5	24 x 24	BLK/W					4								
182	1520	NB SR-53	4.00	D10h8	12 x 12	BLK/W	10				1								
				D10h8	12 x 12	BLK/W					1								
183	1521	NB SR-53	4.06	M3-1	24 x 12	BLK/W	14				2	2	1						
				M1-5	24 x 24	BLK/W					4								
183	1522	NB SR-53	4.55									1	2						
183	1523	NB SR-53	4.66									1	2						
183	1524	NB SR-53	4.74									1	1						
183	1525	NB SR-53	4.91	W2-1	36 x 36	BLK/FY	14 / 14				9	1	1						
				W16-h8	48 x 8	BLK/FY					2.7								
183	1526	NB SR-53	4.97	R3-h8bh	36 x 30	BLK/W	14				7.5	1	2						
183	1527	NB SR-53	5.00	D10h8	12 x 12	BLK/W	10				1	2	1						
				D10h8	12 x 12	BLK/W					1								
184	1528	NB SR-53	5.07	M3-1	24 x 12	BLK/W	14				2	2	1						
				M1-5	24 x 24	BLK/W					4								
184	1529	NB SR-53	5.31									1	1						
184	1530	NB SR-53	5.35									1	2						
184	1531	NB SR-53	5.44									1	2						
184	1532	NB SR-53	5.76									1	2						
184	1533	NB SR-53	5.82	M2-1	21 x 15	BLK/W	14				2.2	3	2						
				M1-4	24 x 24	BLK/W					4								
				M6-8L	21 x 21	BLK/W					3.1								
TOTALS CARRIED TO SANDUSKY CO. SUBSUMMARY							344				148	48	39						

SHEET NO.	REFERENCE NO.	LOCATION	SLM	CODE	SIZE (INCHES)	630													
						COLOR, SEE LEGEND, SHEET 2	GROUND MOUNTED SUPPORT, NO. 3 POST, AS PER PLAN	GROUND MOUNTED SUPPORT, 4"x6" WOOD POST	GROUND MOUNTED SUPPORT, 6"x8" WOOD POST	GROUND MOUNTED STRUCTURAL BEAM FOUNDATION	SIGN, FLAT SHEET	REMOVAL OF GROUND MOUNTED SIGN AND DISPOSAL	REMOVAL OF GROUND MOUNTED SUPPORT AND DISPOSAL, AS PER PLAN	REMOVAL OF GROUND MOUNTED SIGN AND REERECTION	SIGN POST REFLECTOR, AS PER PLAN (RED)	SIGN POST REFLECTOR, AS PER PLAN (FLUORESCENT YELLOW)	SIGN POST REFLECTOR, AS PER PLAN (WHITE)		
						EACH	FEET	FEET	FEET	EACH	SQ. FT.	EACH	EACH	EACH	EACH	EACH	EACH	EACH	EACH
184	1534	NB SR-53	5.86	D1-h1a	96x12	W/G		14/14		2	8	3	1						
				D1-h1a	96x12	W/G					8								
				D7-h4	96x24	W/BRN					16								
184	1535	NB SR-53	5.94									1							
184	1536	NB SR-53	5.96									1							
184	1537	NB SR-53	6.00	R4-17	24 x 30	BLK/W	14				5	3							
				D10h8	12 x 12	BLK/W					1								
				D10h8	12 x 12	BLK/W					1								
185	1538	NB SR-53	11.75	I-h25a	12 x 12	BLK/W	10				1	1							
185	1539	NB SR-53	12.00	D10h8	12 x 12	BLK/W	10				1	1							
186	1540	NB SR-53	12.55	W2-2L	36 x 36	BLK/FY	14 / 14				9	2							
				W16-h8	48 x 8	BLK/FY					2.7								
186	1541	NB SR-53	12.58	I-3	36 x 18	W/G	14				4.5	2							
				I-h25a	12 x 12	BLK/W					1								
186	1542	NB SR-53	12.64	W1-7	48 x 24	BLK/FY	14 / 14				8	1					4		
186	1543	NB SR-53	12.68									1							
												1							
186	1544	NB SR-53	12.77	R3-h8c	48 x 30	BLK/W	14 / 14				10	1							
186	1545	NB SR-53	12.82									1							
												1							
186	1546	NB SR-53	12.87	M3-1	24 x 12	BLK/W	14				2	2							
				M1-5	24 x 24	BLK/W					4								
187	1547	NB SR-53	13.03	D10h8	12 x 12	BLK/W	10				1	2							
				D10h8	12 x 12	BLK/W					1								
187	1548	NB SR-53	13.05	W4-2R	36 x 36	BLK/FY	14 / 14				9	2							
				W16-2	24 x 18	BLK/FY					3								
187	1549	NB SR-53	13.09	W4-2R	36 x 36	BLK/FY	14				9	1							
187	1550	NB SR-53	13.12	R1-2	48 x 48 x 48	R/W	14 / 14				8	1					4		
187	1551	NB SR-53	13.16	M3-1	24 x 12	BLK/W	14				2	2							
				M1-5	24 x 24	BLK/W					4								
187	1554	NB SR-53	13.35	R2-1	24 x 30	BLK/W	14				5								
187	1555	NB SR-53	13.43	W2-7R	36 x 36	BLK/FY	14 / 14				9	2							
				W16-h8	48 x 8	BLK/FY					2.7								
187	1556	NB SR-53	13.57	M3-1	24 x 12	BLK/W	14				2	2							
				M1-5	24 x 24	BLK/W					4								
187	1557	NB SR-53	13.98	M3-1	24 x 12	BLK/W	14				2	2							
				M1-5	24 x 24	BLK/W					4								
188	1558	NB SR-53	14.00	D10h8	12 x 12	BLK/W	10				1	2							
				D10h8	12 x 12	BLK/W					1								
188	1559	NB SR-53	14.12	R2-1	24 x 30	BLK/W	14				5	1							
188	1560	NB SR-53	14.55									1							
188	1561	NB SR-53	14.81	M3-1	24 x 12	BLK/W	14				2	2							
				M1-5	24 x 24	BLK/W					4								
188	1562	NB SR-53	15.00	D10h8	12 x 12	BLK/W					1	2							
				D10h8	12 x 12	BLK/W					1								
189	1563	NB SR-53	15.41	M3-1	24 x 12	BLK/W	14				2	2							
				M1-5	24 x 24	BLK/W					4								
189	1564	NB SR-53	16.00	D10h8	12 x 12	BLK/W	10				1	2							
				D10h8	12 x 12	BLK/W					1								
190	1565	NB SR-53	16.54	M2-1	21 x 15	BLK/W	14				2.2	3							
				M1-5	30 x 24	BLK/W					5								
				M5-1R	21 x 15	BLK/W					2.2								
190	1566	NB SR-53	16.67	M3-4	24 x 12	BLK/W	14				2	6							
				M1-5	30 x 24	BLK/W					5								
				M6-1	21 x 15	BLK/W					2.2								
				M3-1	24 x 12	BLK/W	14				2								
				M1-5	24 x 24	BLK/W					4								
				M6-3	21 x 15	BLK/W					2.2								
TOTALS CARRIED TO SANDUSKY CO. SUBSUMMARY							386				157.7		52		33				4


SAN-6 Proposed Layouts

MP 12.00-12.99

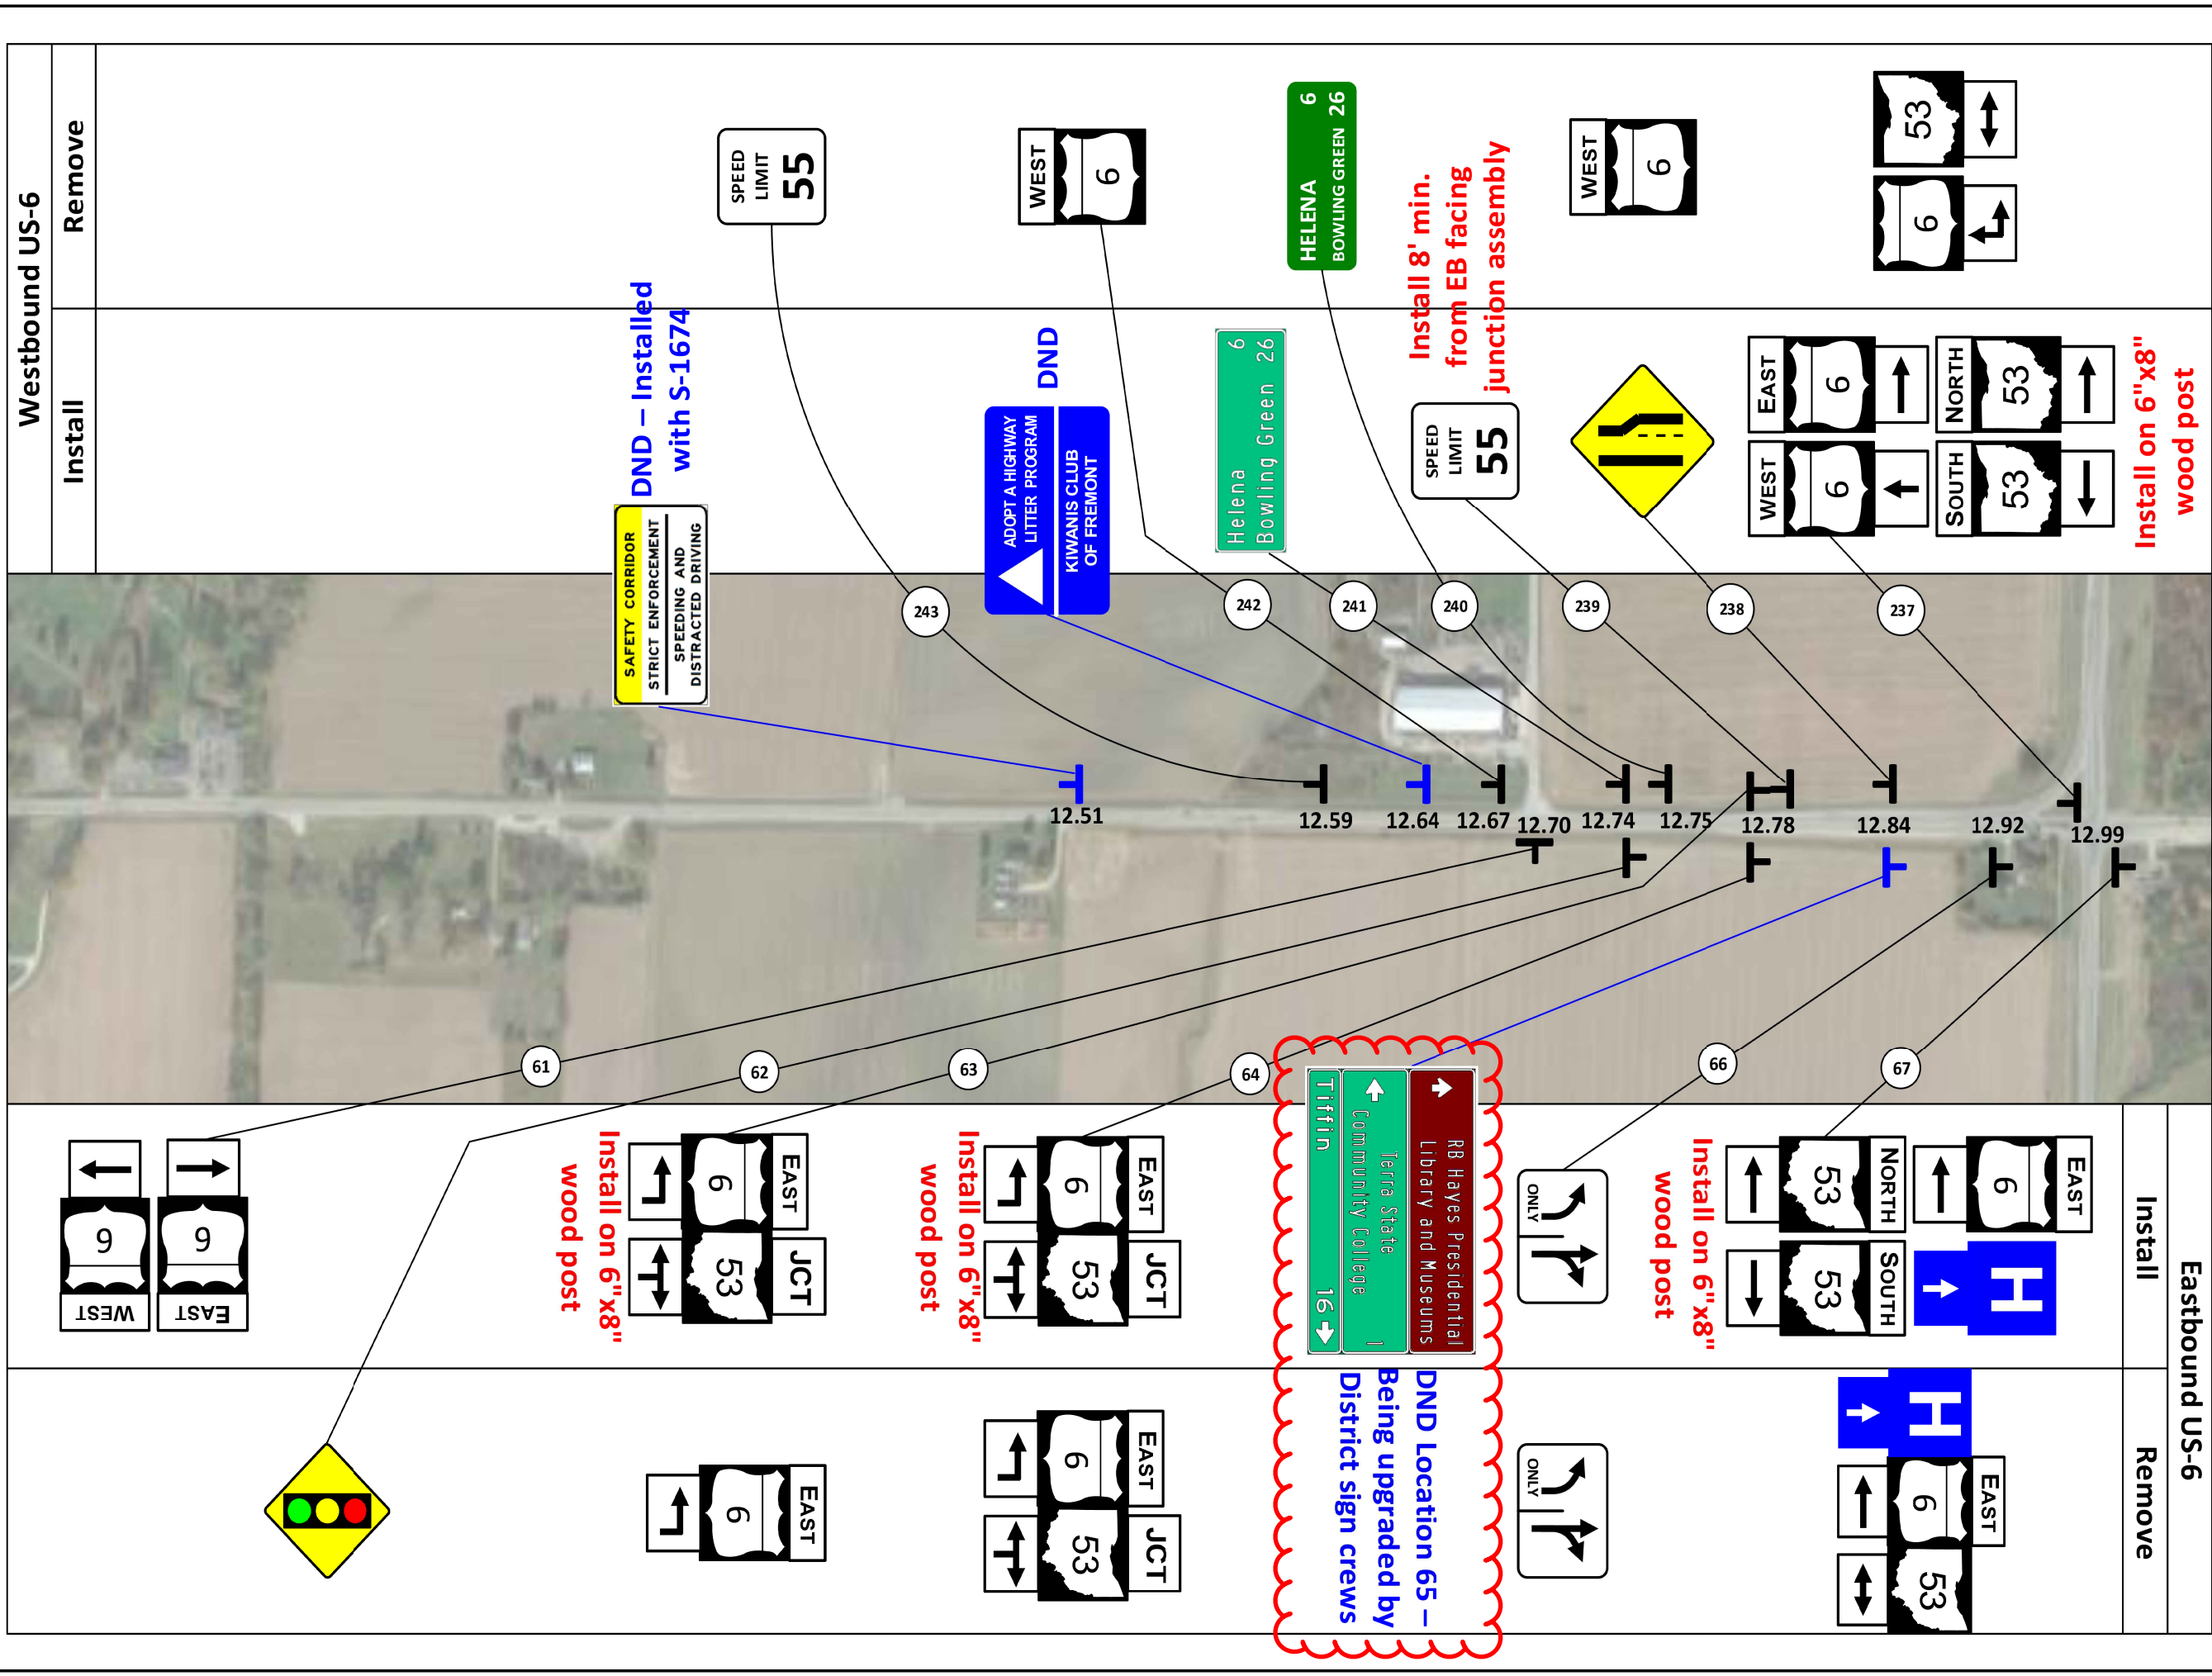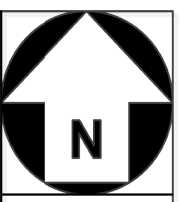


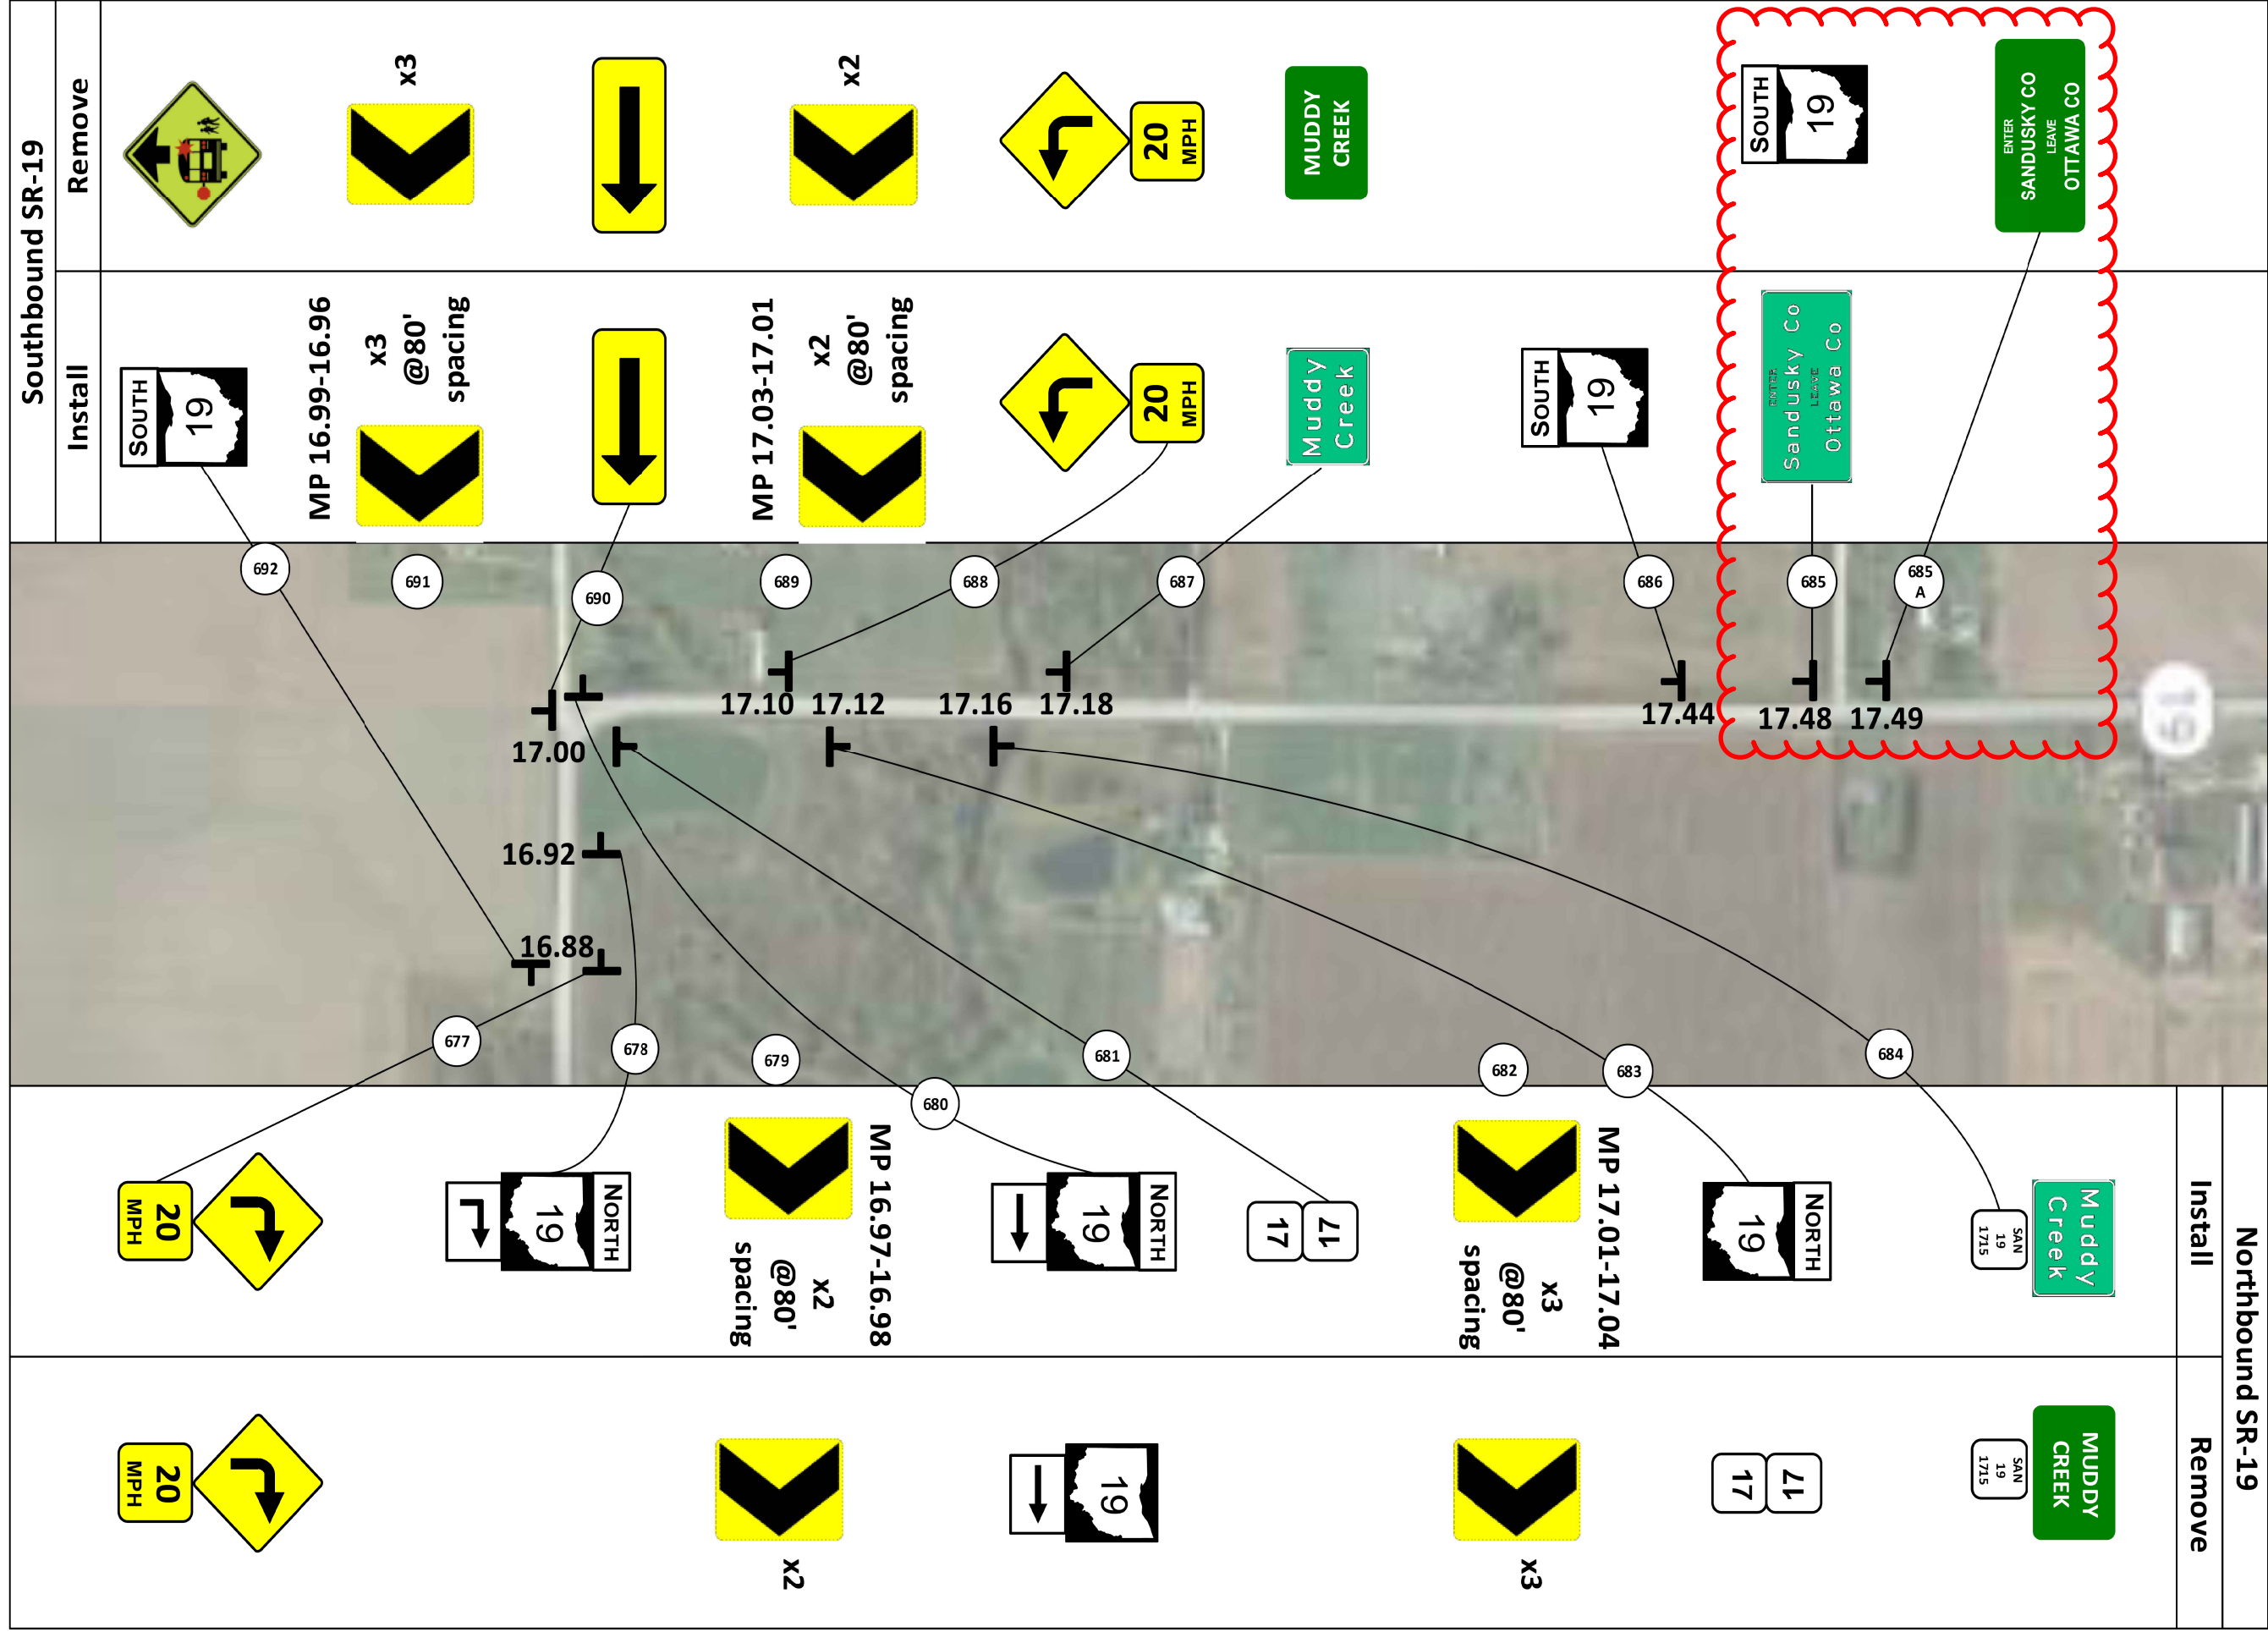

SAN-19 Proposed Layouts MP 16.75-17.49

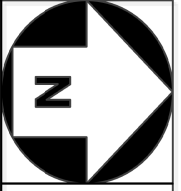


Northbound SR-19	
Install	Remove

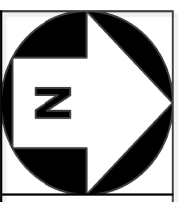

SAN-53 Proposed Layouts

MP 5.00-6.02

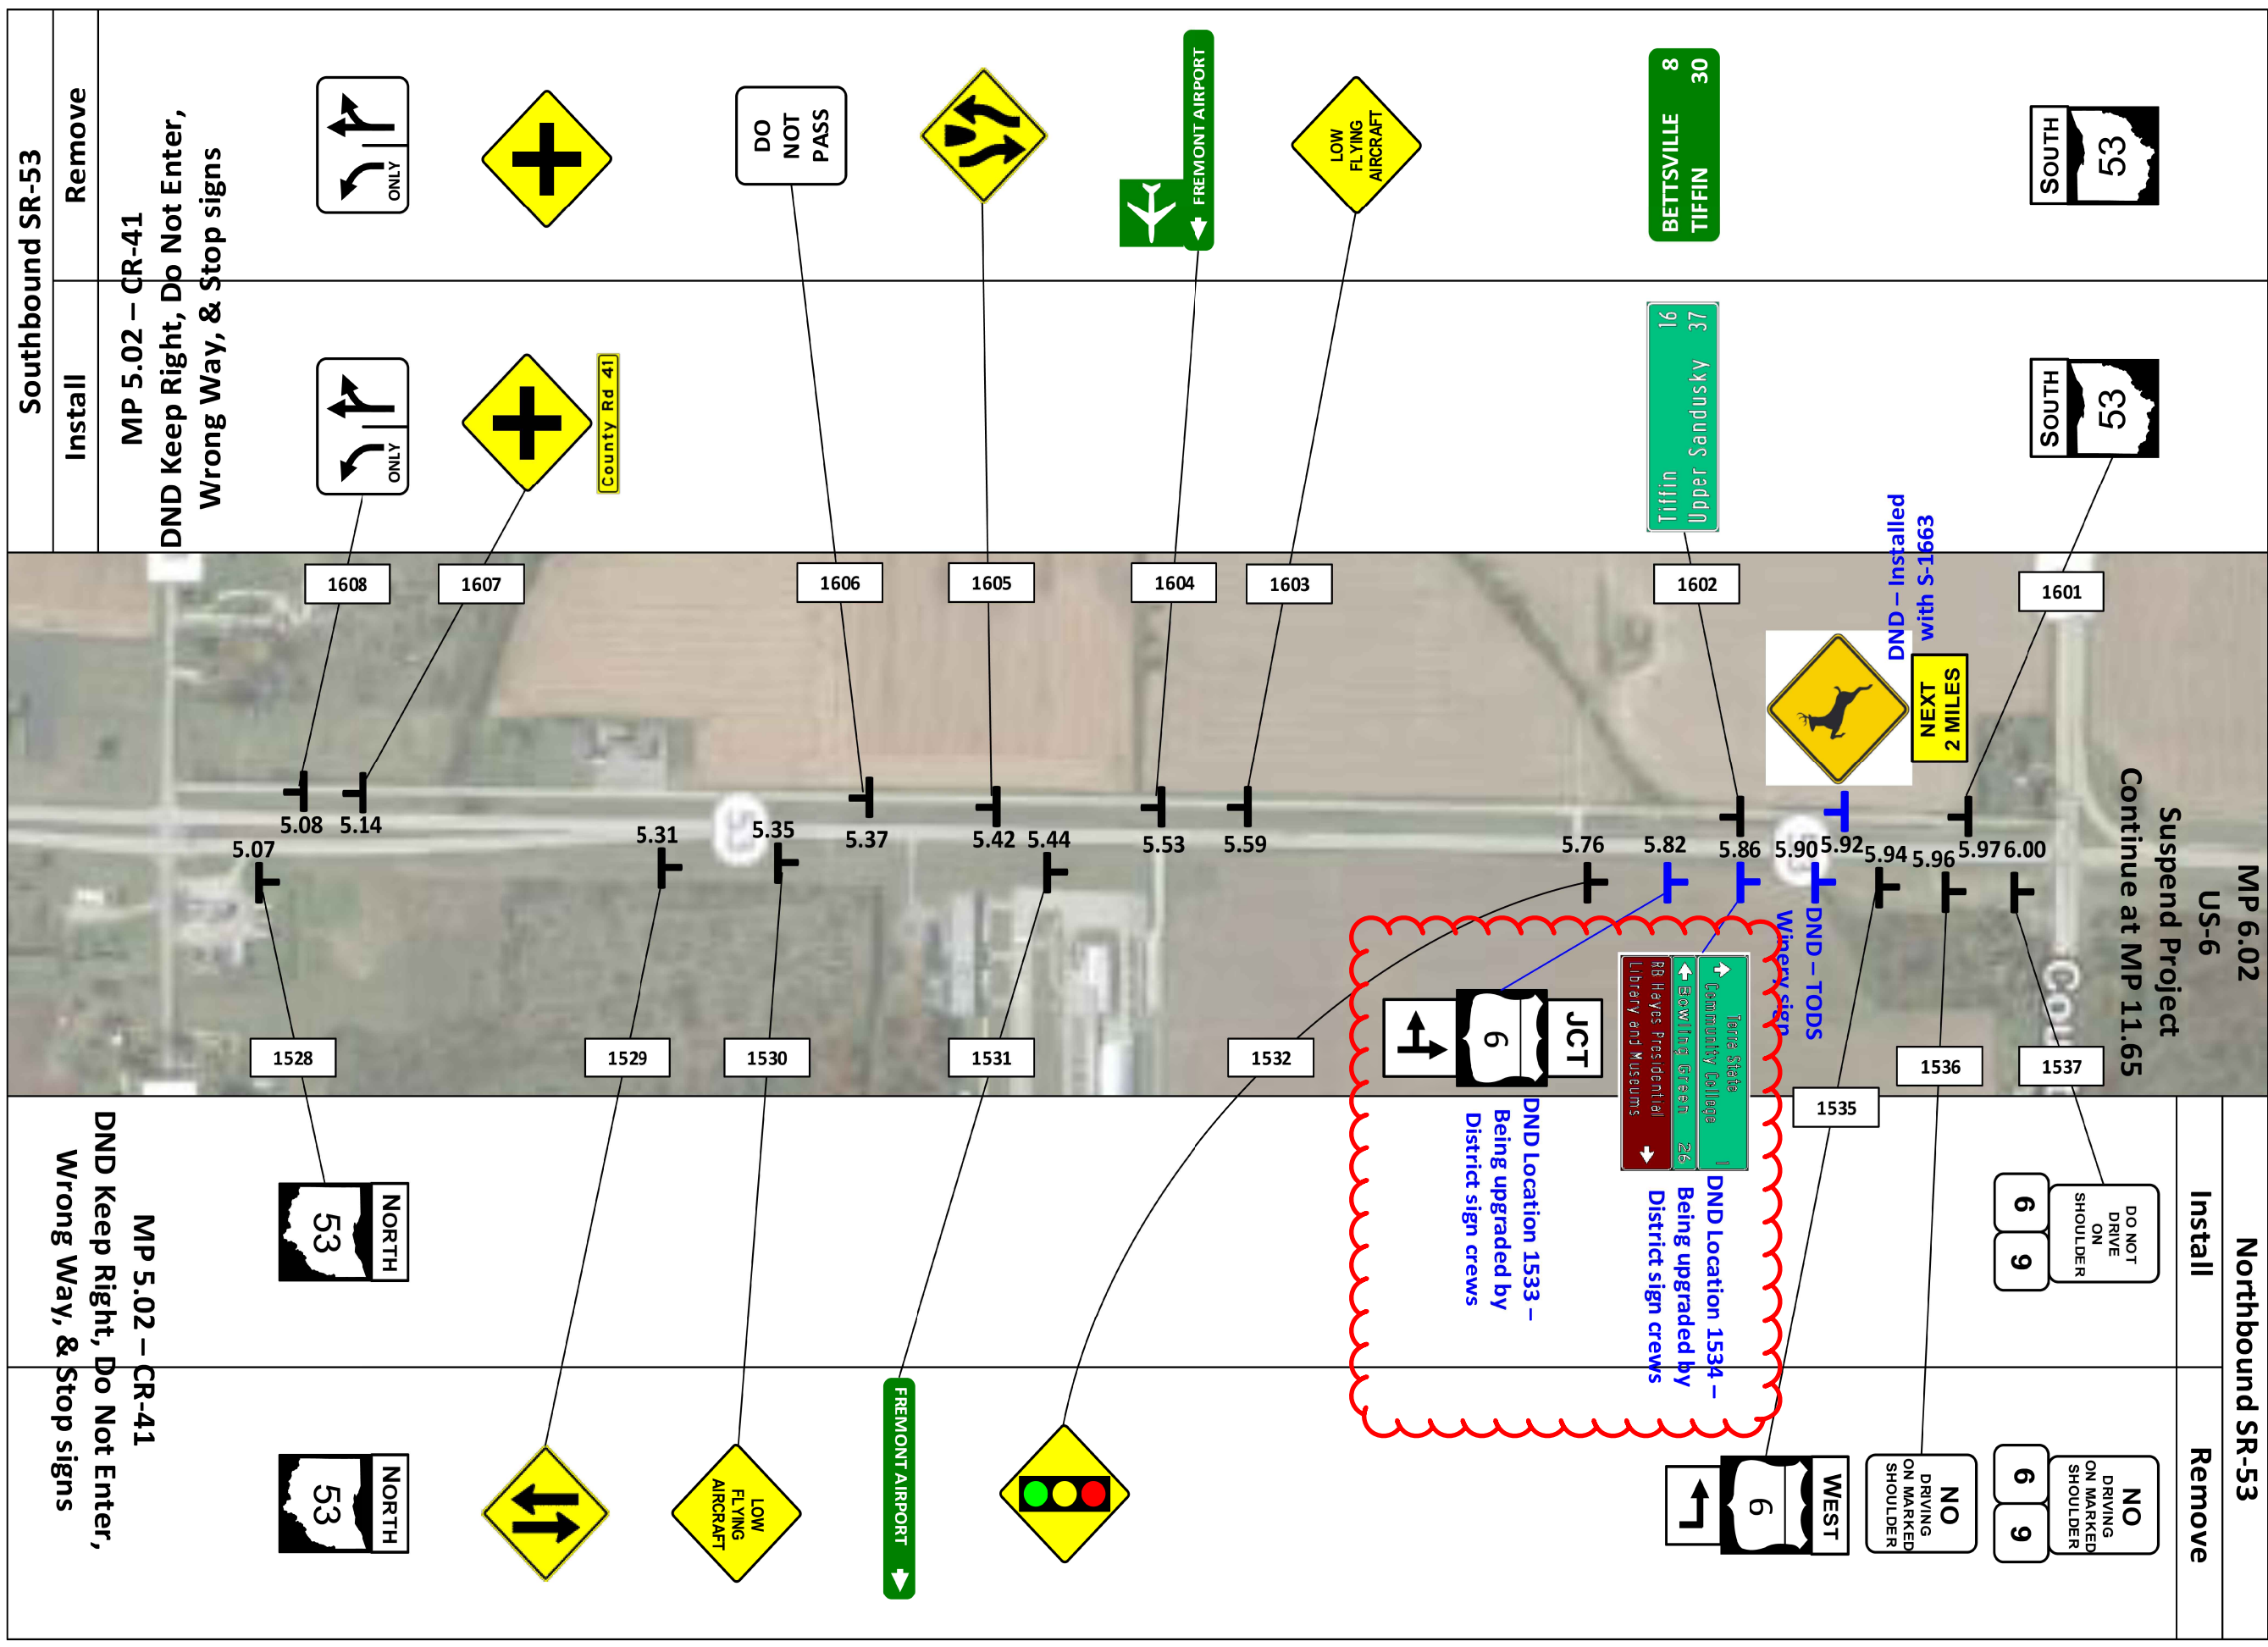

Northbound SR-53

Install

Remove

Suspend Project
US-6
Continue at MP 11.65

DO NOT
DRIVE
ON
SHOULDER
6
9

NO
DRIVING
ON MARKED
SHOULDER
6
9

WEST
6

WEST
6

JCT
6

BETTSVILLE
8
TIFFIN
30

Tiffin
Upper Sandusky
16
37

SOUTH
53

SOUTH
53

NORTH
53

NORTH
53



Southbound SR-53

Install

Remove

MP 5.02 – CR-41
DND Keep Right, Do Not Enter,
Wrong Way, & Stop signs

MP 5.02 – CR-41
DND Keep Right, Do Not Enter,
Wrong Way, & Stop signs

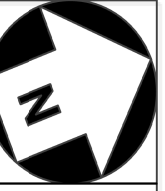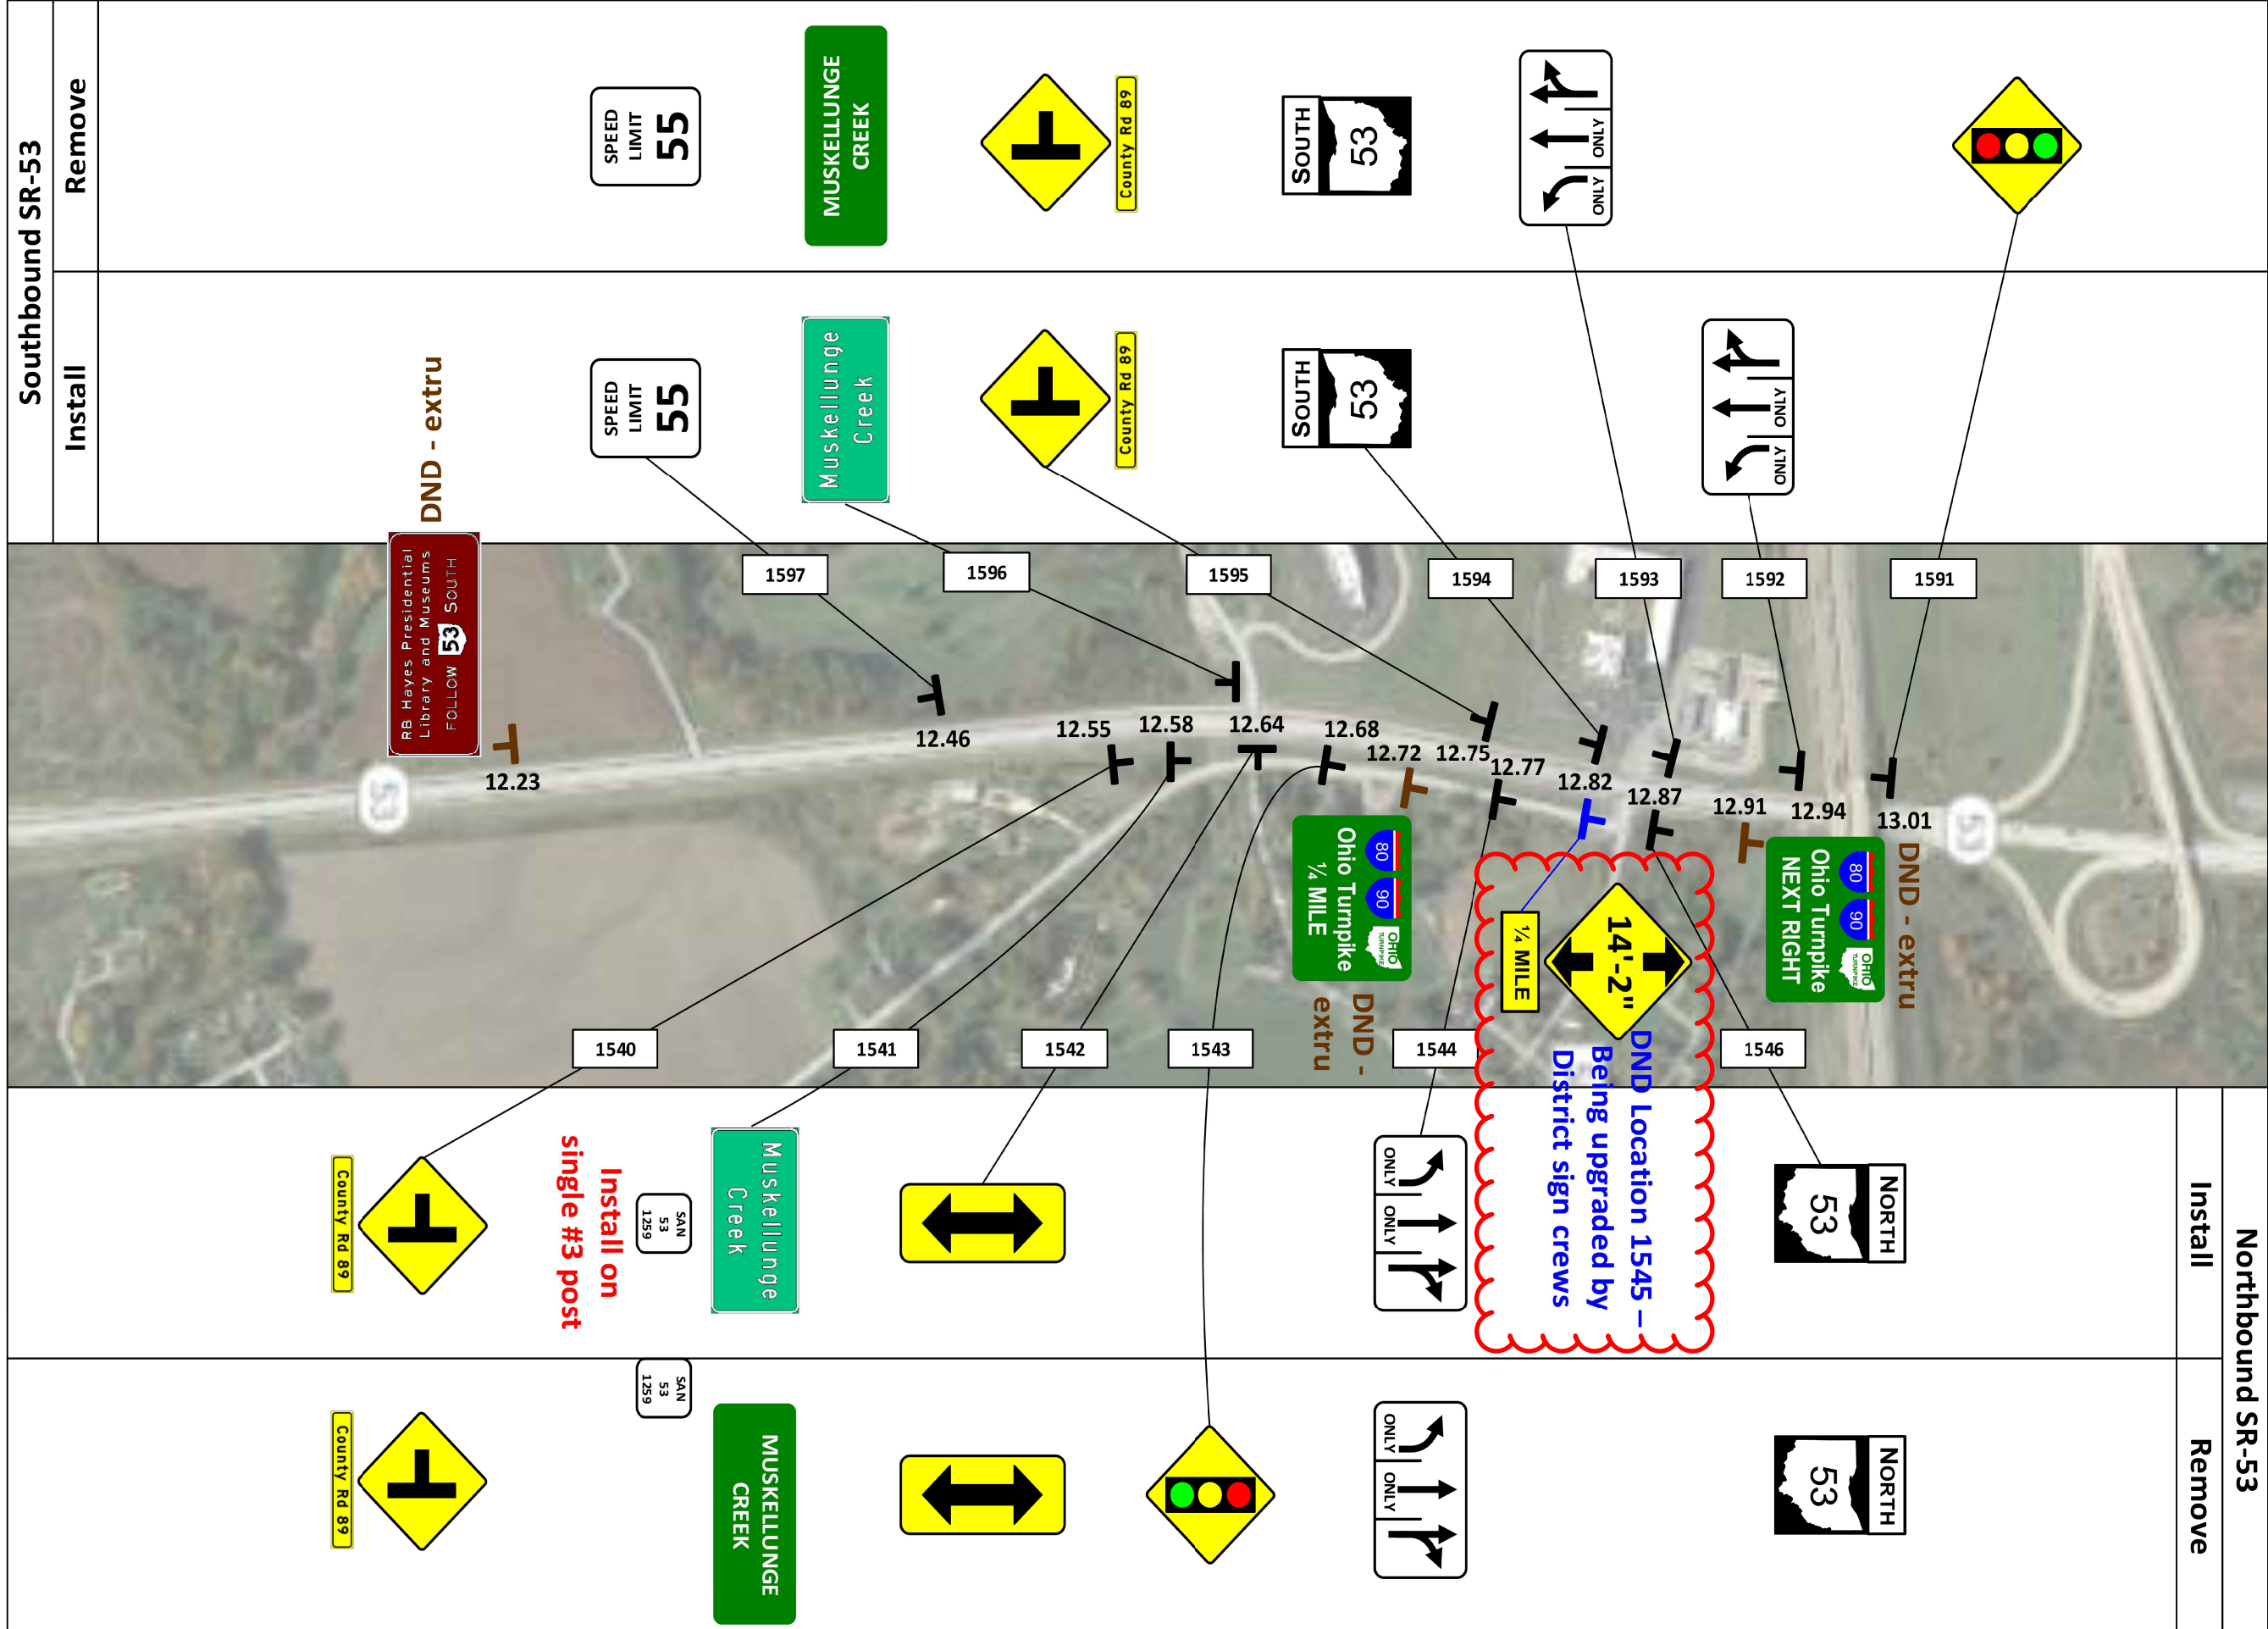


SAN-53 Proposed Layouts

MP 12.00-13.00




Northbound SR-53	
Install	Remove

Southbound SR-53	
Install	Remove

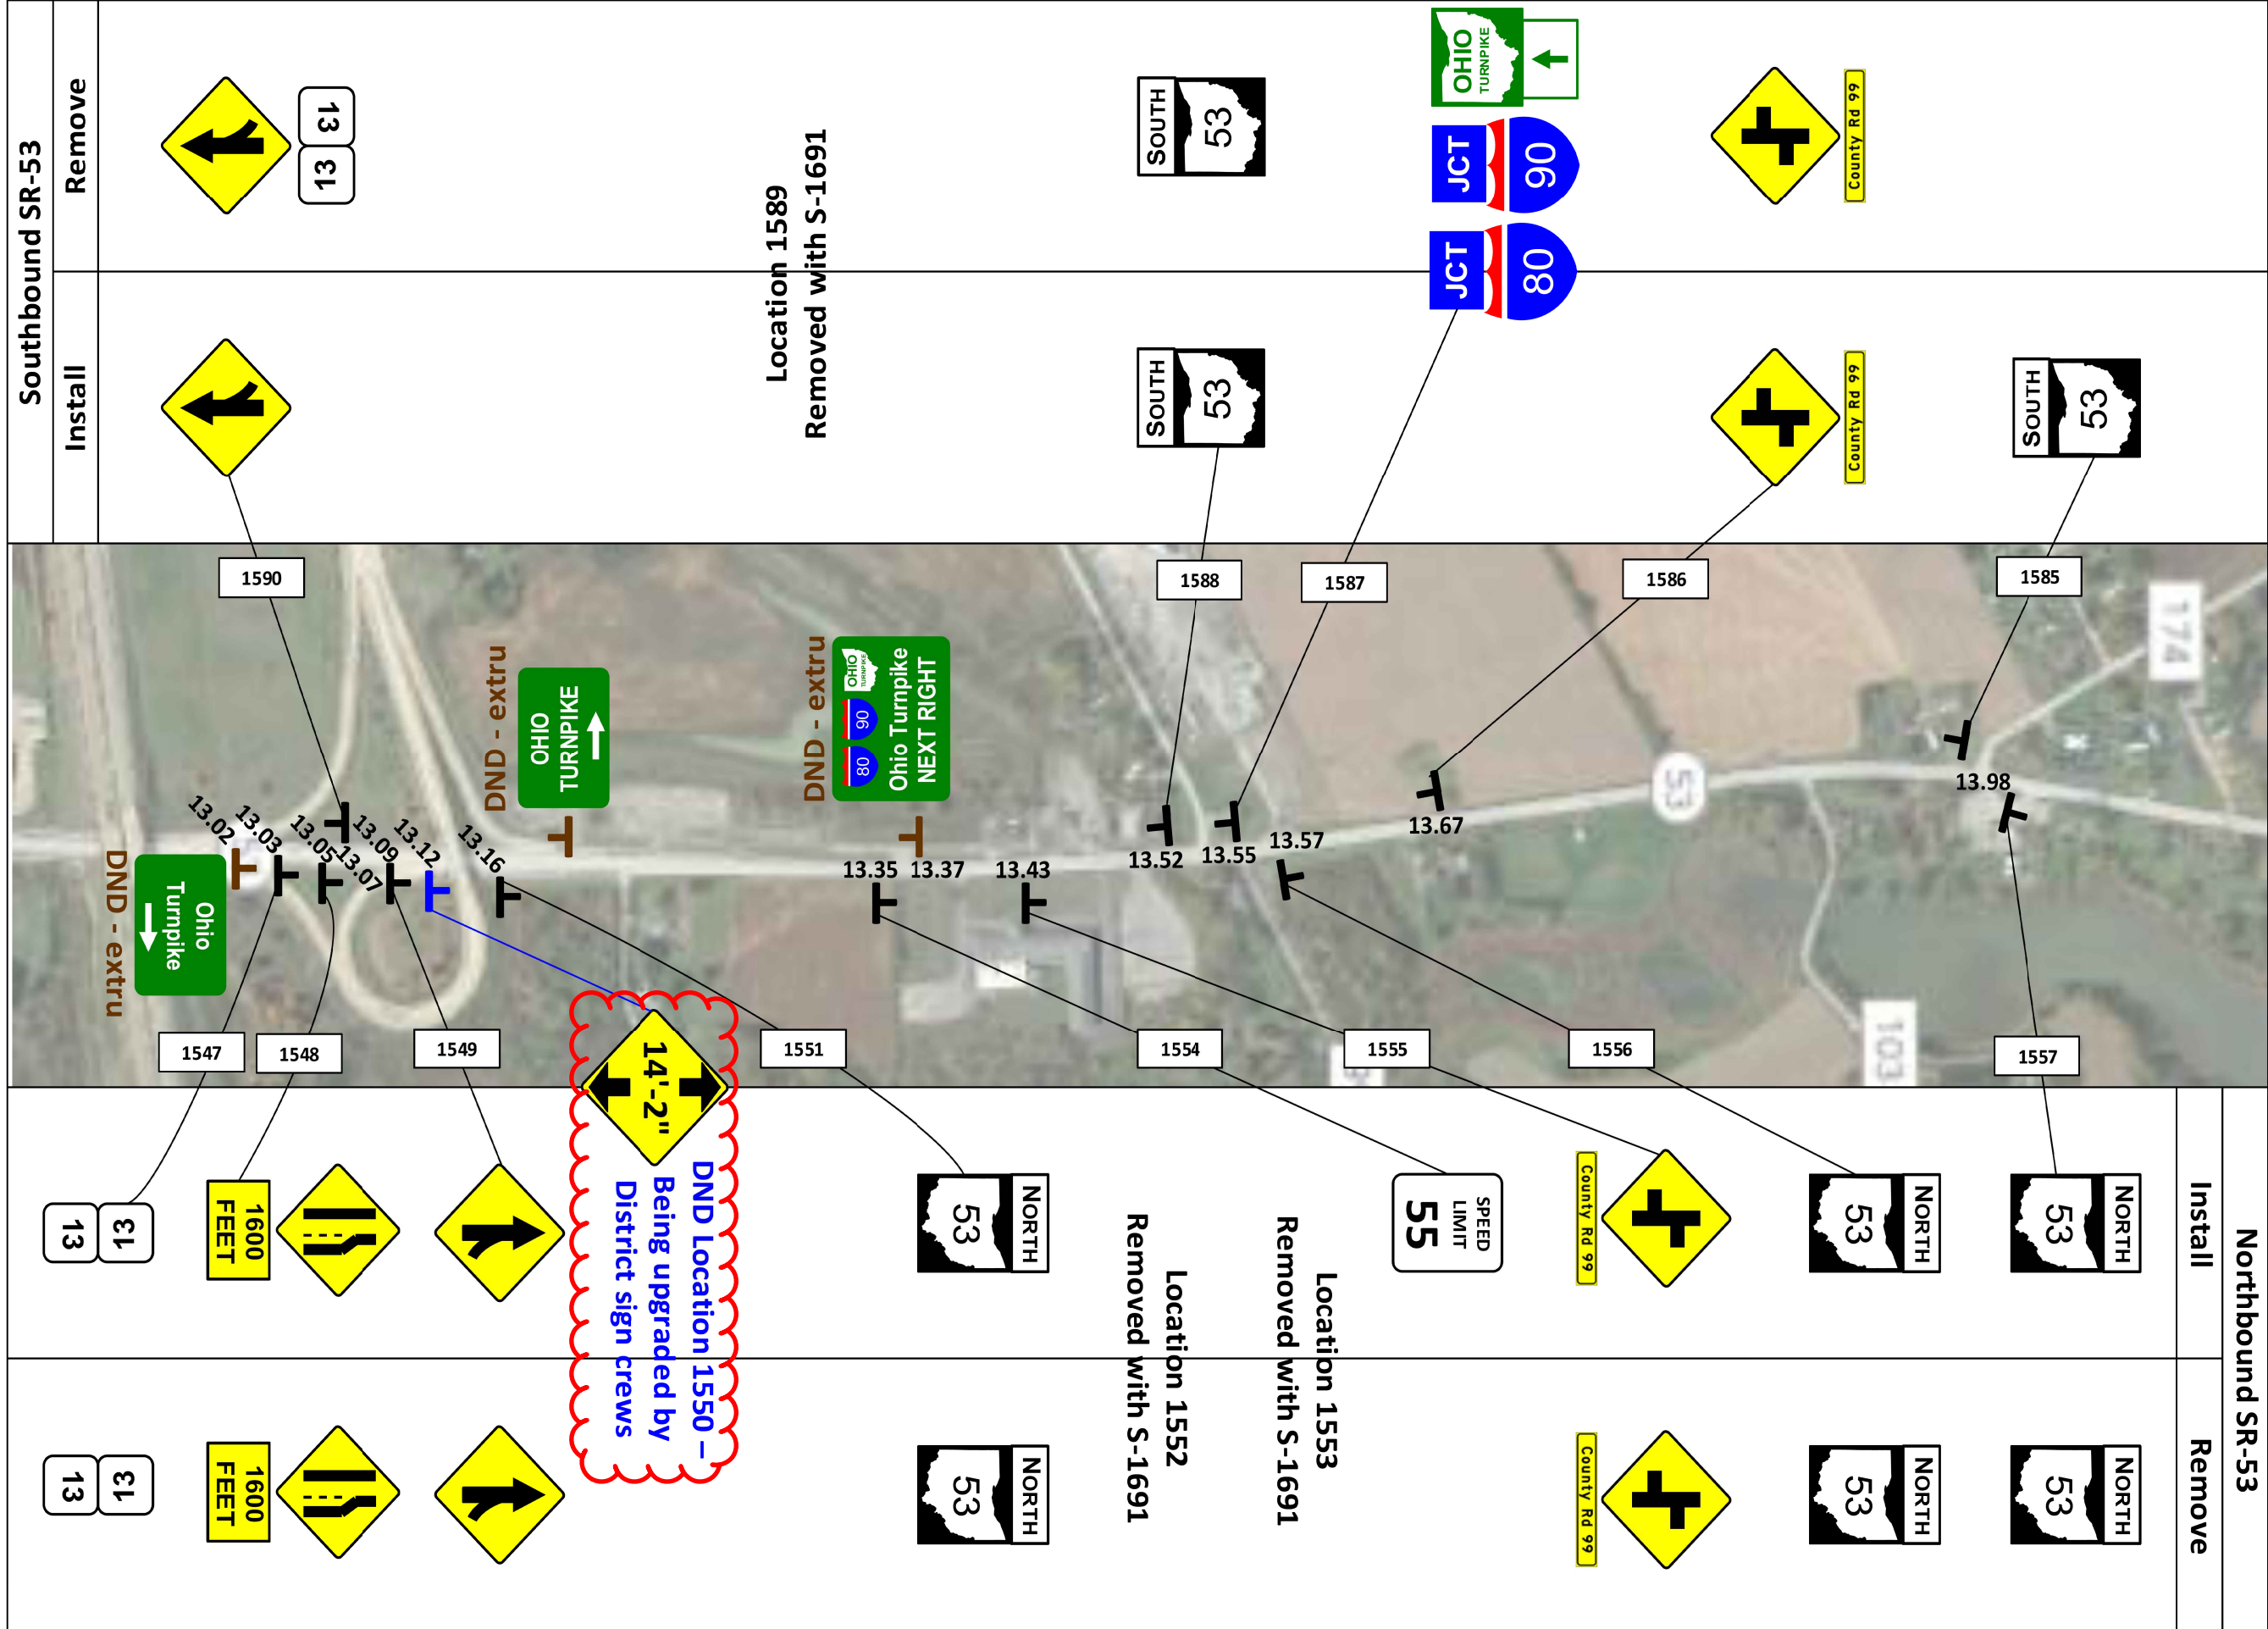

Southbound SR-53

Install Remove

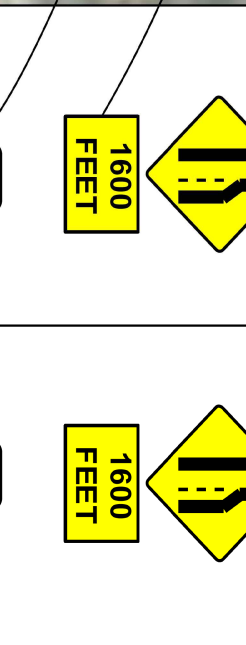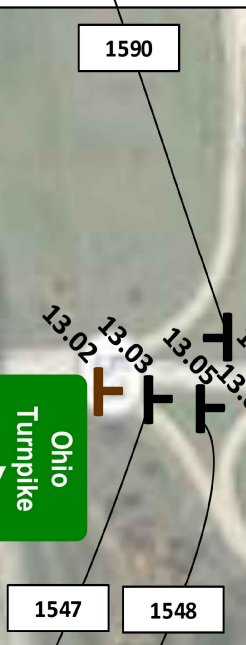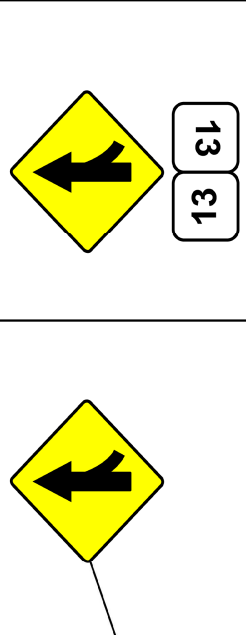

DND Location 1550 -
Being upgraded by
District sign crews

Location 1589
Removed with S-1691

Location 1552
Removed with S-1691

Location 1553
Removed with S-1691



SAN-53 Proposed Layouts
MP 13.00-14.00

Northbound SR-53

Install Remove

