



WORK ZONE CONSTRUCTION DRUM
TRAFFIC MAINTAINED / DIRECTION OF TRAVEL
PORTABLE BARRIER
TYPE 3 BARRICADE(S)
WORK AREA
REMOVE PAVEMENT MARKING
PORTABLE BARRIER
WORK ZONE WHITE EDGE LINE
WORK ZONE DOTTED LINE
START OF WORK ZONE

DIGITAL SPEED LIMIT
(DSL) SIGN ASSEMBLY
865' AHEAD OF WORK AREA

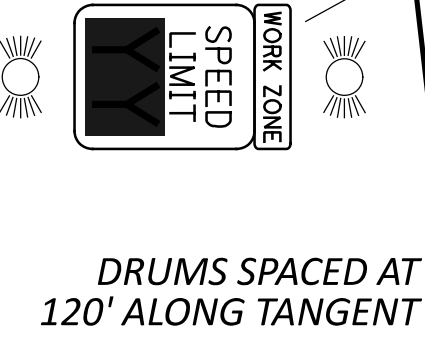

EDGE LINE TANGENT
1060'

ALL COST TO REMOVE EXISTING AND TEMPORARY PAVEMENT MARKINGS IS INCLUDED IN THE LUMP SUM CONTRACT PRICE FOR ITEM 614, MAINTAINING TRAFFIC.

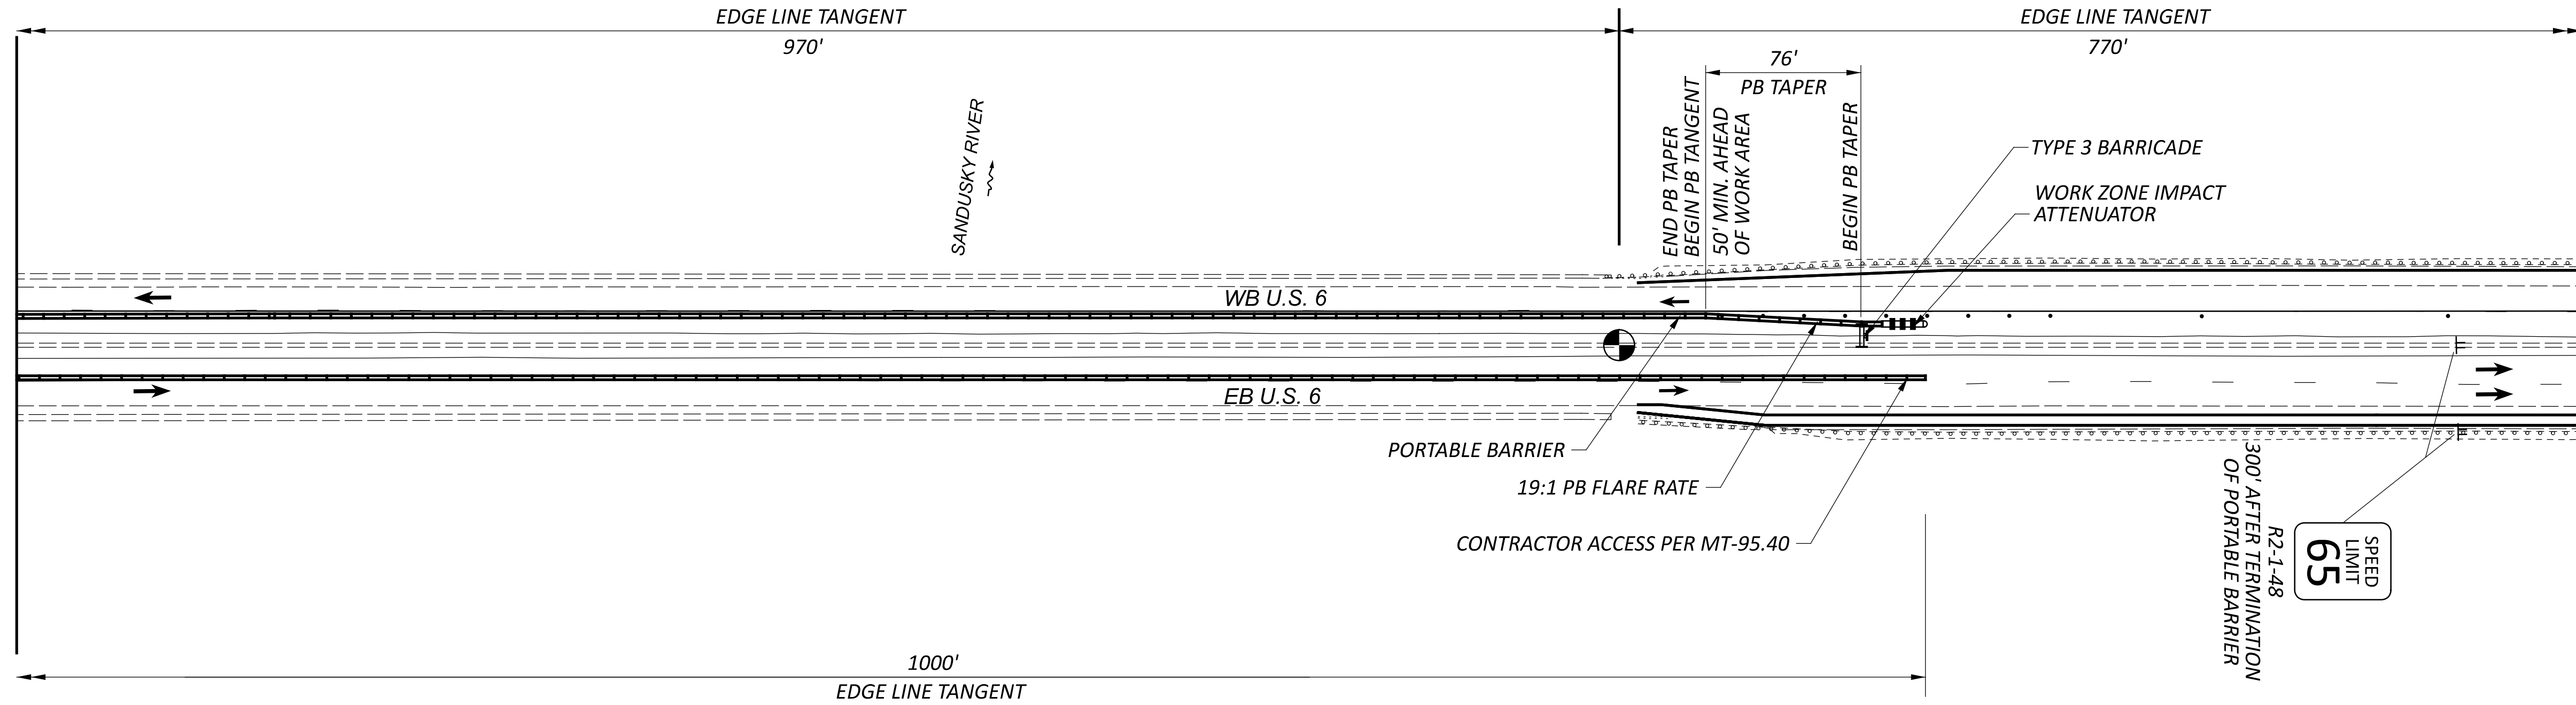


HORIZONTAL
SCALE IN FEET



25 50 100

MAINTENANCE OF TRAFFIC PLAN (2 OF 3)

DESIGN AGENCY

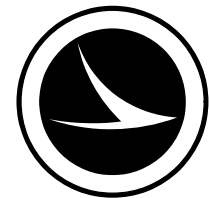

DESIGNER

NMS

REVIEWER
JRC 06/29/26

PROJECT ID
113099

SHEET	TOTAL
P.5	11