

SHEET NUM.					PART.	ITEM	ITEM	GRAND	UNIT	DESCRIPTION	SEE SHEET NO.
7	8	11	12	16	01/NHS/05	EXT	TOTAL				
										<b>ROADWAY</b>	
		319			319	202	23500	319	SY	WEARING COURSE REMOVED	
			1,537.5		1,537.5	202	38000	1,537.5	FT	GUARDRAIL REMOVED	
			12		12	202	42010	12	EACH	ANCHOR ASSEMBLY REMOVED, TYPE E	
			6		6	202	42040	6	EACH	ANCHOR ASSEMBLY REMOVED, TYPE T	
			4		4	202	47000	4	EACH	BRIDGE TERMINAL ASSEMBLY REMOVED	
100				716	816	203	20000	816	CY	EMBANKMENT	
			28		28	209	15000	28	STA	RESHAPING UNDER GUARDRAIL	
100			712.5		100	601	20010	100	CY	CRUSHED AGGREGATE SLOPE PROTECTION	
			825		825	606	15050	712.5	FT	GUARDRAIL, TYPE MGS	
						606	15100	825	FT	GUARDRAIL, TYPE MGS WITH LONG POSTS	
			10		10	606	26150	10	EACH	ANCHOR ASSEMBLY, MGS TYPE E, MASH 2016	
			6		6	606	26550	6	EACH	ANCHOR ASSEMBLY, MGS TYPE T	
			4		4	606	35002	4	EACH	MGS BRIDGE TERMINAL ASSEMBLY, TYPE 1	
			57		57	614	13318	57	EACH	BARRIER REFLECTOR, TYPE 5, BIDIRECTIONAL	
										<b>EROSION CONTROL</b>	
				179	179	659	00300	179	CY	TOPSOIL	
				1,616	1,616	659	10000	1,616	SY	SEEDING AND MULCHING	
				0.15	0.15	659	20000	0.15	TON	COMMERCIAL FERTILIZER	
				0.32	0.32	659	35000	0.32	MGAL	WATER	
					5,000	832	30000	5,000	EACH	EROSION CONTROL	
										<b>DRAINAGE</b>	
1					1	611	98630	1	EACH	CATCH BASIN ADJUSTED TO GRADE	
1					1	611	98634	1	EACH	CATCH BASIN RECONSTRUCTED TO GRADE	
1					1	611	99654	1	EACH	MANHOLE ADJUSTED TO GRADE	
1					1	611	99660	1	EACH	MANHOLE RECONSTRUCTED TO GRADE	
1					1	623	39500	1	EACH	MONUMENT ASSEMBLY ADJUSTED TO GRADE	
1					1	638	10800	1	EACH	VALVE BOX ADJUSTED TO GRADE	
										<b>PAVEMENT</b>	
		10		1,616	1,616	202	23000	1,616	SY	PAVEMENT REMOVED	
					10	209	60500	10	MILE	LINEAR GRADING	
9.62					9.62	209	72050	9.62	MILE	PREPARING SUBGRADE FOR SHOULDER PAVING	
2,312					2,312	253	02000	2,312	CY	PAVEMENT REPAIR	
		92,536			92,536	254	01000	92,536	SY	PAVEMENT PLANING, ASPHALT CONCRETE, 3 1/4"	
				78	78	304	20000	78	CY	AGGREGATE BASE	
					12,910	407	20000	12,910	GAL	NON-TRACKING TACK COAT	
42		12,910			4,992	441	10200	4,992	CY	ASPHALT CONCRETE INTERMEDIATE COURSE, TYPE 2, (446)	
91		4,950			3,947	442	00200	3,947	CY	ASPHALT CONCRETE SURFACE COURSE, 9.5 MM, TYPE A (446)	
2,520		3,856			2,520	SPECIAL	51631200	2,520	FT	SAWING AND SEALING BITUMINOUS CONCRETE JOINTS	7
		1,084			1,084	617	10100	1,084	CY	COMPACTED AGGREGATE	
		9.07			9.07	618	41000	9.07	MILE	RUMBLE STRIPES, EDGE LINE (ASPHALT CONCRETE)	
		4.53			4.53	618	43000	4.53	MILE	RUMBLE STRIPES, CENTER LINE (ASPHALT CONCRETE)	
		23,698			23,698	874	20000	23,698	FT	LONGITUDINAL JOINT PREPARATION	
		858			858	875	10000	858	LB	LONGITUDINAL JOINT ADHESIVE	
										<b>TRAFFIC CONTROL</b>	
			351		351	621	00100	351	EACH	RPM	
			351		351	621	54000	351	EACH	RAISED PAVEMENT MARKER REMOVED	
			9.64		9.64	642	00104	9.64	MILE	EDGE LINE, 6", TYPE 1	
			0.26		0.26	642	00204	0.26	MILE	LANE LINE, 6", TYPE 1	
			4.87		4.87	642	00300	4.87	MILE	CENTER LINE, TYPE 1	
			489		489	644	00404	489	FT	CHANNELIZING LINE, 12"	
			71		71	644	00500	71	FT	STOP LINE	
			68		68	644	00700	68	FT	TRANSVERSE/DIAGONAL LINE	
			4		4	644	01300	4	EACH	LANE ARROW	
			10		10	644	40000	10	EACH	SPEED MEASUREMENT MARKING	
										<b>MAINTENANCE OF TRAFFIC</b>	
	20				20	614	12460	20	EACH	WORK ZONE MARKING SIGN	
	5				5	614	12500	5	EACH	REPLACEMENT SIGN	

Added Quantities from Sheet Detail

Changed Quantity

Added Items

Added Item

Added Item

GENERAL SUMMARY

DESIGN AGENCY



DESIGNER JWZ


REVIEWER JMF MM-DD-YY

PROJECT ID 95760


SHEET TOTAL 9 21

SHEET NUM.										PART.	ITEM	ITEM	GRAND	UNIT	DESCRIPTION	SEE SHEET NO.
7	8	11	12	16						01/NHS/05	EXT	TOTAL				
	5									5	614	12600	5	EACH	REPLACEMENT DRUM	
	0.52									0.52	614	20010	0.52	MILE	WORK ZONE LANE LINE, CLASS I, 6"	
	0.26									0.26	614	20560	0.26	MILE	WORK ZONE LANE LINE, CLASS III, 6", 642 PAINT	
	19.1									19.1	614	22010	19.1	MILE	WORK ZONE EDGE LINE, CLASS I, 6"	
	9.53									9.53	614	22360	9.53	MILE	WORK ZONE EDGE LINE, CLASS III, 6", 642 PAINT	
	9.54									9.54	614	21000	9.54	MILE	WORK ZONE CENTER LINE, CLASS I	
	4.77									4.77	614	21550	4.77	MILE	WORK ZONE CENTER LINE, CLASS III, 642 PAINT	
	688									688	614	23010	688	FT	WORK ZONE CHANNELIZING LINE, CLASS I, 12"	
	344									344	614	23690	344	FT	WORK ZONE CHANNELIZING LINE, CLASS III, 12", 642 PAINT	
	142									142	614	26000	142	FT	WORK ZONE STOP LINE, CLASS I	
	71									71	614	26610	71	FT	WORK ZONE STOP LINE, CLASS III, 642 PAINT	
															<b>INCIDENTALS</b>	
										LS	614	11000	LS		MAINTAINING TRAFFIC	
										LS	623	10000	LS		CONSTRUCTION LAYOUT STAKES AND SURVEYING	
										LS	624	10000	LS		MOBILIZATION	

Items were on Previous Sheet. Moved to this sheet Due to Items Being Added.

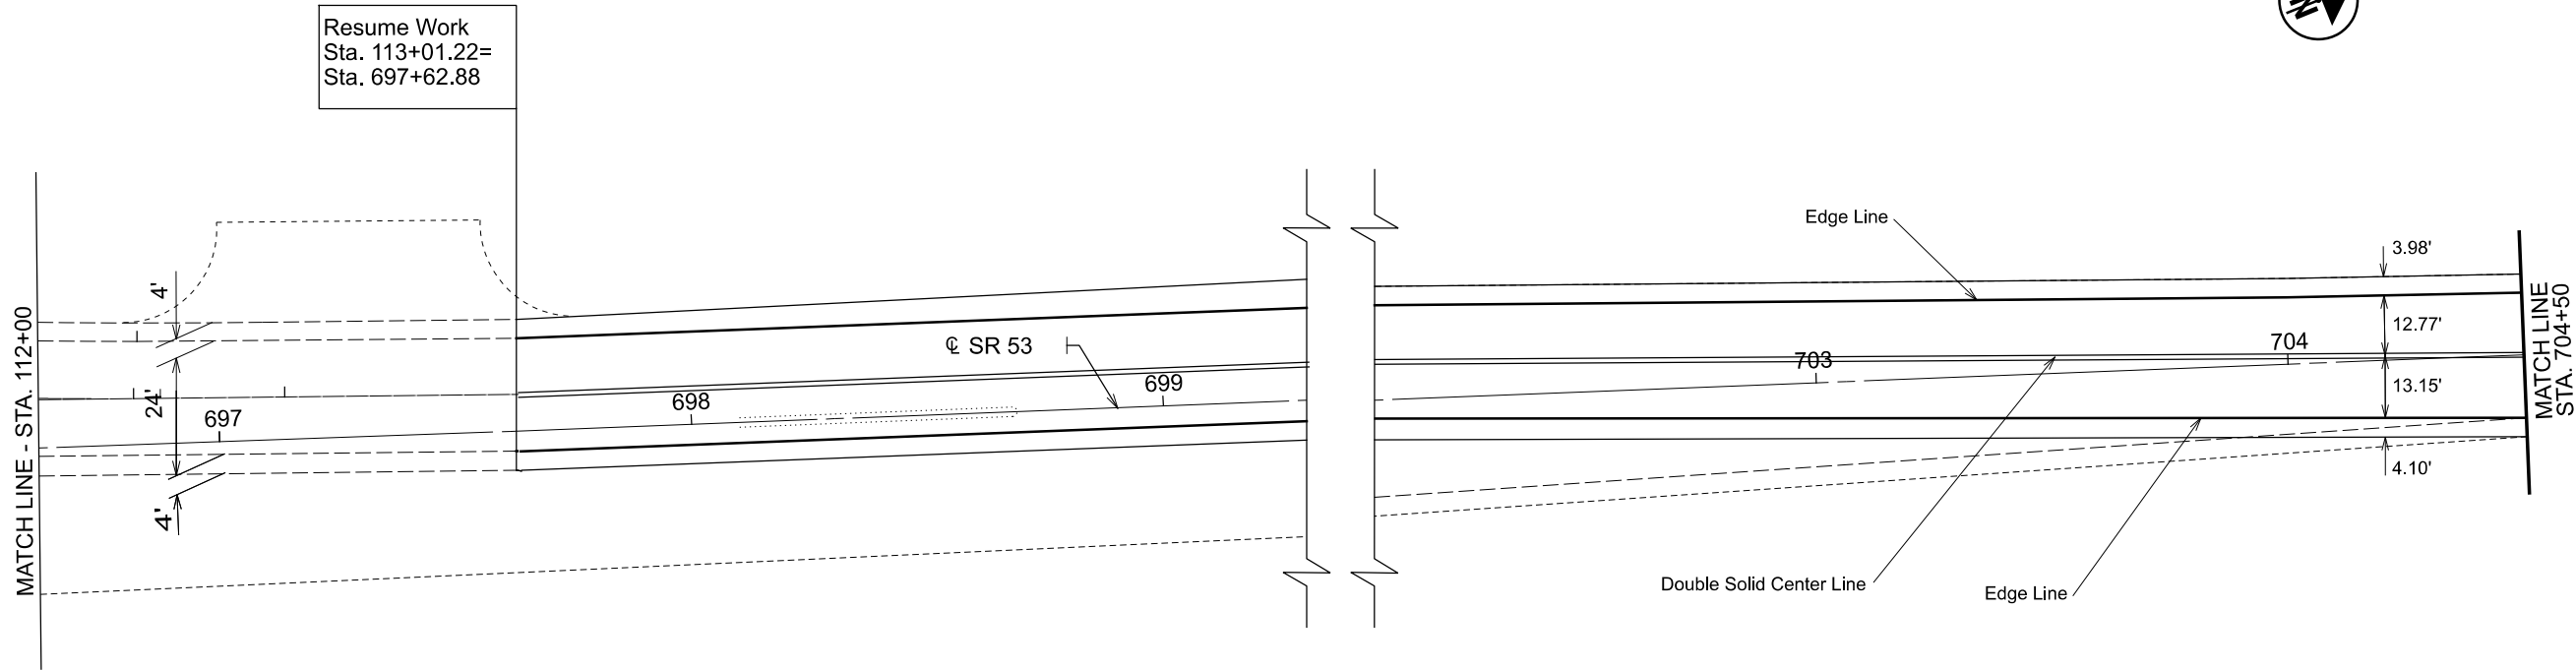


Resume Work  
 Sta. 113+01.22=  
 Sta. 697+62.88

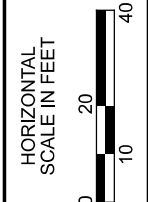

Detail and Items  
 added to this Sheet  
 and then carried to  
 the General  
 Summary

Pavement to be Removed due to the Roundabout Project

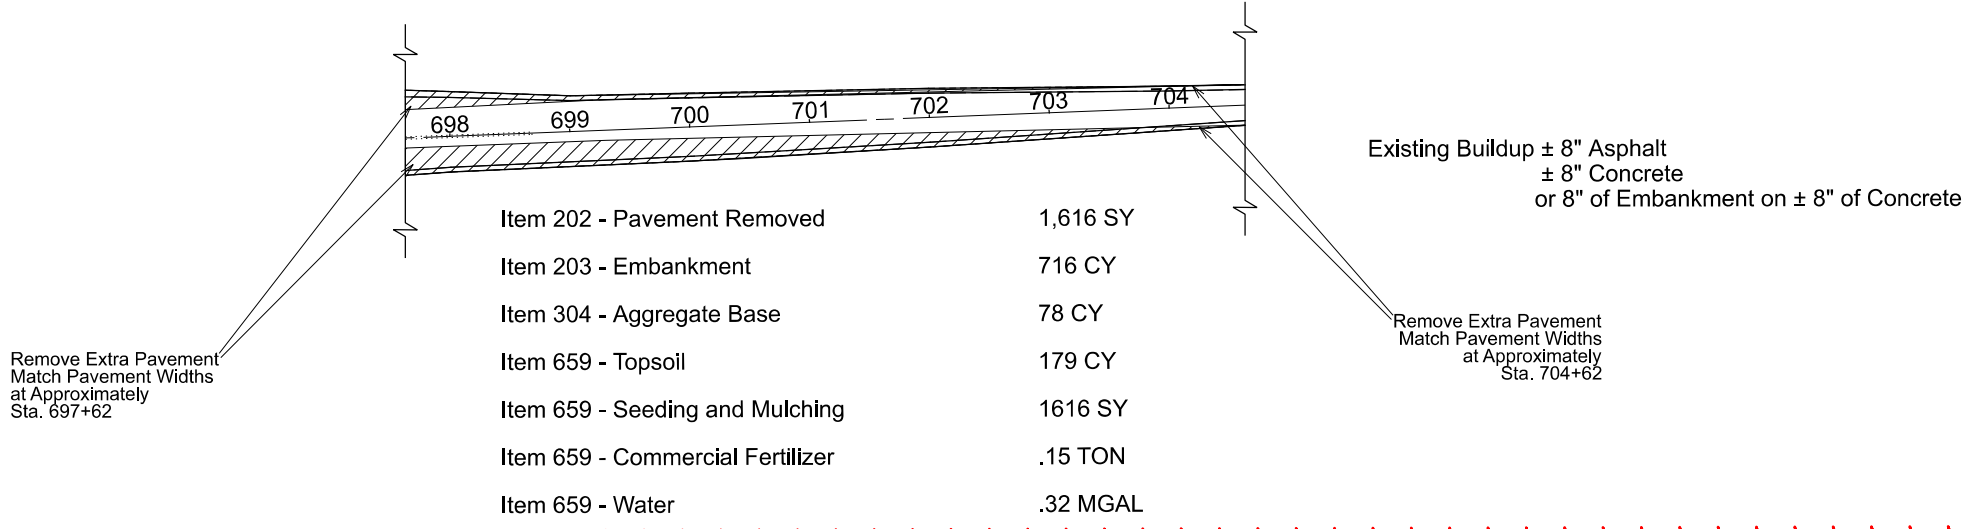

PLAN SHEET  
 STA. 112+00 TO STA. 704+50

DESIGN AGENCY



DESIGNER	JWZ
REVIEWER	JMF MM-DD-YY
PROJECT ID	95760
SHEET	TOTAL
16	21