


SHEET NUM.											PART.	ITEM	ITEM	GRAND	UNIT	DESCRIPTION	SEE SHEET NO.
3		6		OFFICE CALCS							01/NHS/BR	ITEM	EXT	TOTAL			
LS												LS	201	11000	LS		ROADWAY
												264	202	23000	264	SY	CLEARING AND GRUBBING
												61	202	23500	61	SY	PAVEMENT REMOVED
		25										25	202	35100	25	FT	WEARING COURSE REMOVED
		297										297	202	38000	297	FT	PIPE REMOVED, 24" AND UNDER
																	GUARDRAIL REMOVED
												3	202	42010	3	EACH	ANCHOR ASSEMBLY REMOVED, TYPE E
												1	202	42040	1	EACH	ANCHOR ASSEMBLY REMOVED, TYPE T
												93	203	10000	93	CY	EXCAVATION
												156	203	20000	156	CY	EMBANKMENT
												265	204	10000	265	SY	SUBGRADE COMPACTION
												5	209	60200	5	STA	LINEAR GRADING
																	EROSION CONTROL
												38	601	32100	38	CY	ROCK CHANNEL PROTECTION, TYPE B WITH FILTER
135		38										135	659	00300	135	CY	TOPSOIL
												1215	659	10000	1215	SY	SEEDING AND MULCHING
0.11		1215										0.11	659	20000	0.11	TON	COMMERCIAL FERTILIZER
1												1	659	35000	1	MGAL	WATER
												2000	832	30000	2000	EACH	EROSION CONTROL
																	DRAINAGE
												71	611	05200	71	FT	12" CONDUIT, TYPE F
												25	611	06400	25	FT	15" CONDUIT, TYPE D
																	PAVEMENT
												57	301	56000	57	CY	ASPHALT CONCRETE BASE, PG64-22, (449)
												48	304	20000	48	CY	AGGREGATE BASE
												43	441	50000	43	CY	ASPHALT CONCRETE SURFACE COURSE, TYPE 1, (448), PG64-22
												11	407	20000	11	GAL	NON-TRACKING TACK COAT
																	TRAFFIC CONTROL
2												2	621	54000	2	EACH	RAISED PAVEMENT MARKER REMOVED
																	STRUCTURE 20 FOOT SPAN AND UNDER (SEN-23-488)
																	FOR STRUCTURE QUANTITIES SEE SHEET 15
																	INCIDENTALS
												LS	614	11000	LS		MAINTAINING TRAFFIC
												LS	623	10000	LS		CONSTRUCTION LAYOUT STAKES AND SURVEYING
												LS	624	10000	LS		MOBILIZATION

GENERAL SUMMARY

DESIGN AGENCY




DESIGNER  
NMS

REVIEWER  
DJG 10-24-22

PROJECT ID  
109586

SHEET TOTAL  
5 17

ESTIMATED QUANTITIES (01/NHS/BR)					
ITEM	EXTENSION	TOTAL	UNIT	DESCRIPTION	SEE SHEET NO.
202	11000	LS		STRUCTURE REMOVED	
503	21300	LS		UNCLASSIFIED EXCAVATION	
509	10000	4894	LB	EPOXY COATED REINFORCING STEEL	
511	46010	15	CY	CLASS QC1 CONCRETE, RETAINING/WINGWALL NOT INCLUDING FOOTING	
511	46510	36	CY	CLASS QC1 CONCRETE, FOOTING	
512	10050	45	SY	SEALING OF CONCRETE SURFACES (NON-EPOXY)	
512	33000	417	SY	TYPE 2 WATERPROOFING	
516	13600	34	SF	1" PREFORMED EXPANSION JOINT FILLER	
518	21230	LS		POROUS BACKFILL WITH GEOTEXTILE FABRIC	
611	96315	112	FT	14' X 6' CONDUIT, TYPE A, 706.05, AS PER PLAN, DESIGN COVER 2.0 FT.	3

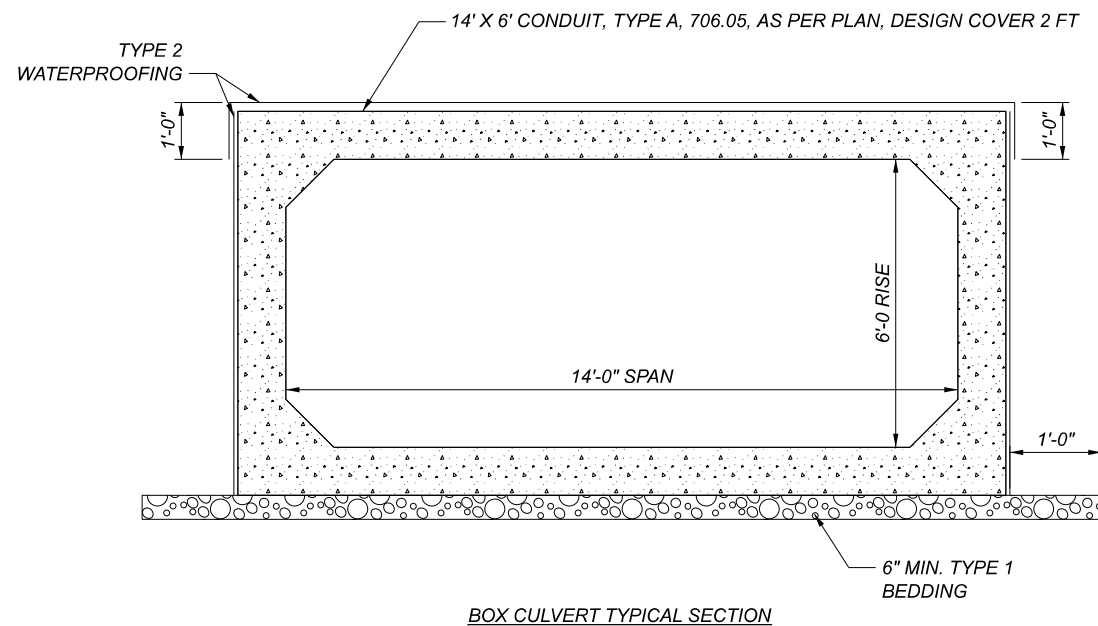

NOTES:

1. ALL REQUIREMENTS OF 706.05 SHALL BE MET EXCEPT AS DETAILED IN SUPPLEMENTAL SPECIFICATION 940.

