


# Pipes Installed Perpendicular Through Wall

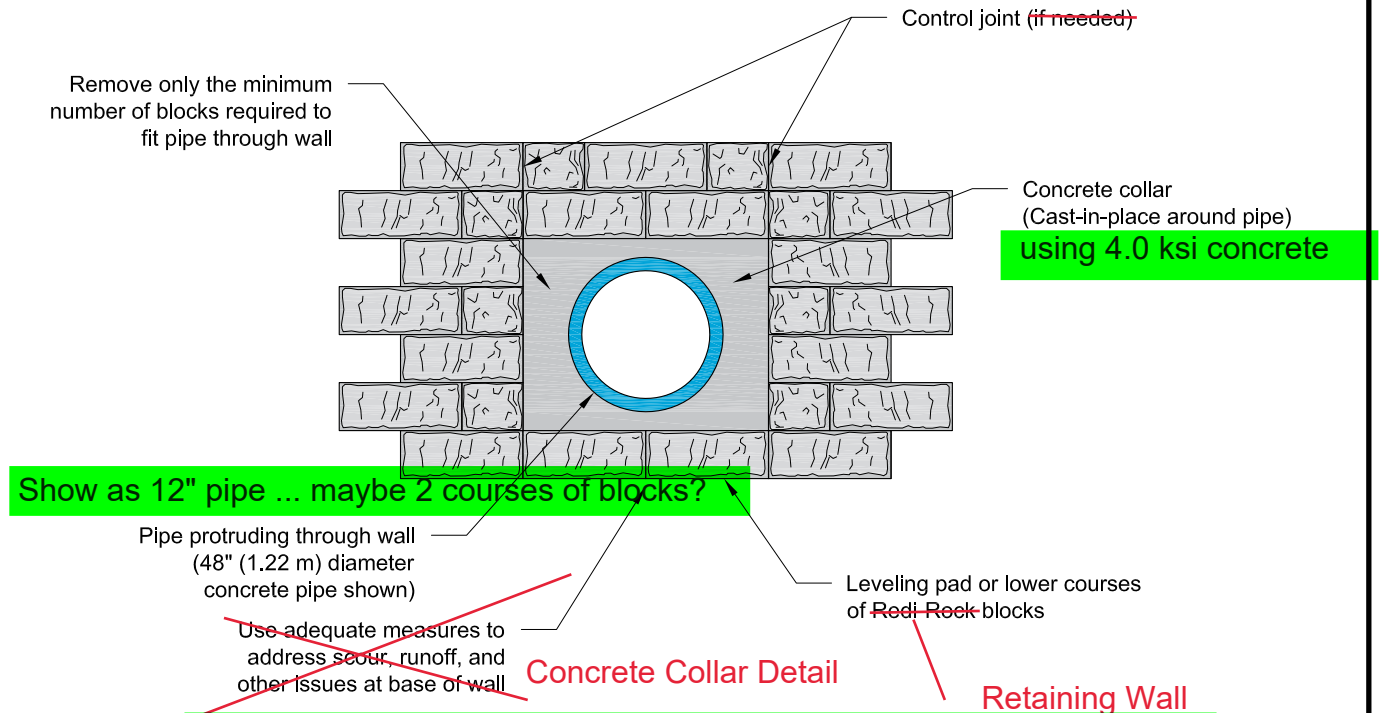


## Plan View

Note: 12" diameter storm sewer passes through the wall in two locations. Concrete collars shall be used at these locations. Concrete collars and any adjustments required to accommodate the pipes shall be included with Item 530, Retaining Wall, Misc. : Segmental Concrete Block Retaining Wall for payment.

Omit section view, except for geotextile note

Add this note above with the concrete collar

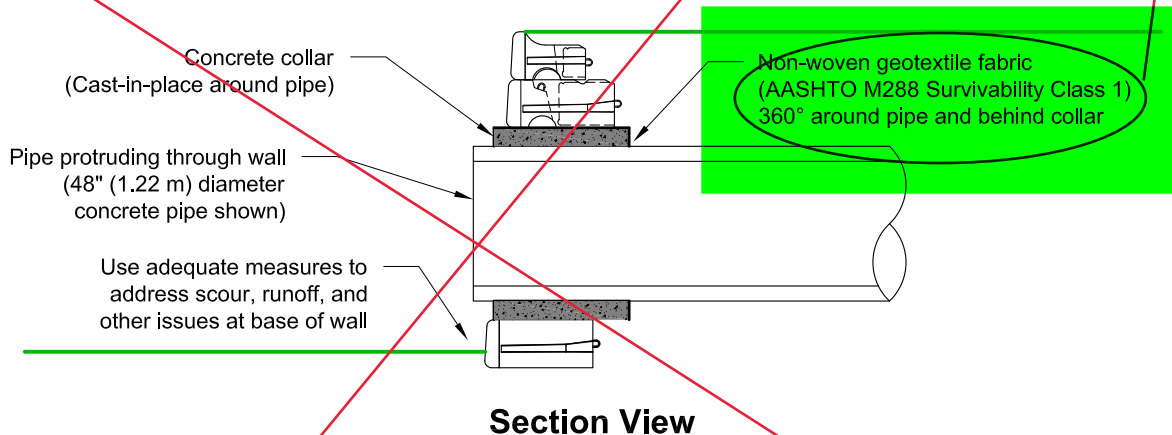

This drawing is for reference only. Determination of the suitability and/or manner of use of any details contained in this document is the sole responsibility of the design engineer of record. Final project designs, including all construction details, shall be prepared by a licensed professional engineer using the actual conditions of the proposed site.

DRAWN BY: JRJ  
APPROVED BY: JRJ  
DATE: 06-22-2015  
SHEET: 1 of 1

TITLE: Pipes Installed Perpendicular Through Wall  
FILE: 1 Pipe Installed Perpendicular Through Wall 062215.dwg

**REDI-ROCK®**  
05481 US 31 SOUTH, CHARLEVOIX, MI 49720  
(866) 222-8400 ext 3010 • engineering@redi-rock.com  
www.redi-rock.com