#### SEQUENCE OF CONSTRUCTION

IT IS THE INTENT OF THE FOLLOWING SEQUENCE OF CONSTRUC-TION TO PROVIDE A WORK AREA FOR THE CONTRACTOR WHILE ALSO MAINTAINING TRAFFIC IN A MANNER WHICH IS SAFE FOR THE TRAVELING PUBLIC; THEREFORE, ALL PHASES SHALL HAVE STRICT ADHERENCE, ALL TEMPORARY OR PERMANENT PAVEMENT MARKINGS SHALL BE IN PLACE BEFORE ANY PAVEMENT IS OPEN TO TRAFFIC. CONTRACTOR SHALL ERECT ALL TRAFFIC CONTROL DEVICES AND ENSURE THEY ARE IN GOOD WORKING ORDER PRIOR TO COMMENCING CONSTRUCTION ACTIVITIES ON THE BRIDGE AND APPROACHES. PRIOR TO ERECTING PORTABLE BARRIER, PAVEMENT FOR MAINTAINING TRAFFIC SHALL BE PLACED AS SHOWN ON ALL PLAN SHEETS. EXISTING GUARDRAIL SHALL BE MAINTAINED IN PLACE FOR THE DURATION OF ALL PHASES THAT DO NOT REQUIRE THE CONSTRUCTION OF PROPOSED GUARDRAIL. ALL WORK ZONE SIGNING AND STRIPING SHALL BE IN PLACE PRIOR TO ERECTING BARRIER.

WORK IN THE VICINITY OF RAMP A, RAMP B, AND SR 225 THAT DOES NOT REQUIRE A DETOUR OR A CLOSURE OF SR 225 OR AFFECT THE EXISTING RAMP MOVEMENTS WITHIN THE US 62T/ SR 225 INTERCHANGE MAY BE PERFORMED CONCURRENTLY WITH OTHER PROJECT ACTIVITIES. US 62T BRIDGE CONSTRUCTION SHALL BE COMPLETE AND US 62T RETURNED TO NORMAL TRAFFIC FLOW BEFORE CLOSING AND DETOURING SR 225. SR 225 WORK SHALL BE FULLY OPENED TO TRAFFIC WITH INTERIM COMPLETION DATE OF 10-31-2022 INCLUDING WORK UP THROUGH THE INTERMEDIATE COURSE.

PART 2 WORK SHALL NOT BE COMPLETED SIMUTANEOIULY WITH ANY SR 225 WORK. DURING THE SETTLEMENT WAITING PERIOD THE CONTRACTOR SHALL MONOTOR SETTLEMENT ALONG SR 225. THE CONTRACTOR SHALL PROVIDE SETTLEMENT RESULTS TO DISTRICT 4 PROJECT ENGINEER, SEE PLAN SHEET 194/194 FOR GENERAL NOTES.

THE LEVELING COURSE. FINAL SURACE AND PAVMENT MARKINGS SHALL NOT BE INSTALLED ALONG SR 225 PRIOR TO WAITING PERIOD NOTED ON PLAN SHEET 194/194.

THE INTERIM COMPLETION DATE FOR ALL WORK IN PART 1 AND 2 SHALL BE 7-31-2023.

PART 3 WORK SHALL BE COMPLETED AFTER PART 1, PART 2 AND BY 9-30-2023

THE FOLLOWING CONTINGENCY QUANTITIES HAVE BEEN CARRIED TO THE GENERAL SUMMARY AND SHALL BE USED TO COMPLETE THE PAVEMENT LEVELING WORK DESCRIBED ABOVE, AS DIRECTED BY THE ENGINEER.

ITEM 254, PAVEMENT PLANING, ASPHALT CONCRETE, 1 3/4" 2950 SY

ITEM 407, NON-TRACKING TACK COAT 250 GAL

ITEM 441, ASPHALT CONCRETE INTERMEDIATE COURSE TYPE 2, (448) 145 CY

### US 62T

CONSTRUCT THE PHASE 1 SINGLE LANE CROSSOVERS USING SCD MT-95.45 AS SHOWN IN THE MAINTENANCE OF TRAFFIC PLANS. INSTALL ALL TEMPORARY TRAFFIC CONTROL REVICES INCLUDING PORTABLE BARRIER, WORK ZONE PAVEMENT MARKINGS AND SIGNAGE, AND TEMPORARY PAVEMENT RUMBLE STRIPE OVERLAY PRIOR TO SHIFTING TRAFFIC INTO THE PHASE 1 SCHEME. PAYMENT FOR ALL

MATERIALS AND LABOR REQUIRED TO PERFORM THE ABOVE WORK SHALL BE INCLUDED IN THE LUMP SUM BID PRICE FOR ITEM 614, MAINTAINING TRAFFIC, AS PER PLAN.

BEFORE SHIFTING TRAFFIC TO THE PHASE 1 LAYOUT. THE CONTRACTOR SHALL CAREFULLY REMOVE THE "BEESON ST" GUIDE SIGN AT STA. 1847+08 EASTBOUND AND REERECT ON TEMPORARY SUPPORTS AT STA. 1847+00 AS PER SCD MT-105.10 FOR THE SINGLE LANE EASTBOUND TRAFFIC THAT WILL CROSS OVER TO THE WESTBOUND SIDE OF US 62T.

# PHASE 1

MAINTAIN TRAFFIC AS SHOWN IN THE PLANS FOR PHASE 1. BEGINNING FAST OF THE STA-62-1.37/1.38 STRUCTURES. REDUCE THE TWO LANES OF EASTBOUND US 62T TRAFFIC TO A SINGLE 12.0' OUTSIDE LANE PER SCD MT-95.30. SHIFT THE SINGLE LANE TO THE INSIDE OF THE WESTBOUND SIDE OF US 62T USING THE CROSSOVER CONSTRUCTED IN THE PRE-PHASE. THE STA-62-1.38L STRUCTURE WILL CARRY TWO-12.0' LANES EACH WITH A 2.0' PORTABLE BARRIER OFFSET AND 5.0'/3.0' SHOULDER OFFSETS FOR EASTBOUND AND WESTBOUND TRAFFIC, RESPECTIVELY. REMOVE AND CONSTRUCT THE STA-62-1.37R STRUCTURE AS SHOWN IN THE BRIDGE PLANS AND ALL EASTBOUND ROADWAY APPROACH WORK UP TO THE PROPOSED INTERMEDIATE COURSE INCLUDING THE APPROACH EASTBOUND MEDIAN GUARDRAIL ATTACHED TO THE PROPOSED BRIDGE PARAPET.

THE EASTBOUND LANE WILL CROSS BACK OVER TO THE EAST-BOUND SIDE OF US 62T AFTER THE WORK AREA AND TRANSITION BACK TO THE EXISTING LANE CONFIGURATION. THE WESTBOUND TRAFFIC WILL INCREASE FROM ONE LANE TO TWO LANES AS PER SCD MT-95.30 AFTER THE EXISTING RAMP MERGE AREA. ALL RAMPS SHALL REMAIN OPEN AT ALL TIMES DURING PHASE 1. TRAFFIC SHALL NOT BE SHIFTED INTO THE PHASE 2 SEQUENCE UNTIL ALL PHASE 1 WORK HAS BEEN COMPLETED AS SHOWN IN

# 

UPON COMPLETION OF PHASE 1 WORK AND BEFORE PHASE 2 IS TO BEGIN REMOVE PHASE 1 CROSSOVERS AND INSTALL PHASE 2 CROSSOVERS UTILIZING SINGLE LANE CLOSURES PER ODOT SCD'S MT-95.45.

# elle contractions and a set of the set of th

MAINTAIN TRAFFIC AS SHOWN IN THE PLANS FOR PHASE 2. BEGINNING EAST OF THE BEESON STREET ENTRANCE RAMP, REDUCE THE TWO LANES OF WESTBOUND US 62T TRAFFIC TO A SINGLE 12.0' OUTSIDE LANE PER SCD MT-95.30. SHIFT THE SINGLE LANE TO THE INSIDE OF THE EASTBOUND SIDE OF US 62T USING THE CROSSOVER CONSTRUCTED IN THE PRE-PHASE. THE STA-62-1.37R STRUCTURE WILL CARRY TWO-12.0' LANES EACH WITH A 2.0' PORTABLE BARRIER OFFSET AND 6.0'/3.5' SHOULDER OFFSETS FOR EASTBOUND AND WESTBOUND TRAFFIC, RESPECTIVELY. REMOVE AND CONSTRUCT THE STA-62-1.38L STRUCTURE AS SHOWN IN THE BRIDGE PLANS AND ALL WESTBOUND ROADWAY APPROACH WORK UP TO THE PROPOSED INTERMEDIATE COURSE INCLUDING THE REMAINING MEDIAN GUARDRAIL ATTACHED TO THE PROPOSED BRIDGE PARAPET.

THE WESTBOUND LANE WILL CROSS BACK OVER TO THE WEST-BOUND SIDE OF US 62T AFTER THE WORK AREA AND TRANSITION BACK TO THE EXISTING LANE CONFIGURATION. THE EASTBOUND TRAFFIC WILL INCREASE FROM ONE LANE TO TWO LANES AS PER SCD MT-95.30 AFTER THE WORK AREA. ALL RAMPS SHALL REMAIN OPEN AT ALL TIMES DURING PHASE 2. TRAFFIC SHALL NOT BE SHIFTED TO THE PROPOSED LANE SEQUENCE UNTIL ALL PHASE 2 WORK HAS BEEN COMPLETED AS SHOWN IN THE PLANS.

#### POST-PHASE

REMOVE TEMPORARY CROSSOVERS UTILIZING SCD MT-95.45, REGRADE BACK TO EXISTING CONDITIONS, AND SEED AND MULCH CROSSOVER AREAS AS PER EXISTING CONDITIONS AND IN ACCORDANCE WITH CMS 659.01. PAYMENT FOR ALL MATERIALS AND LABOR REQUIRED TO PERFORM THE ABOVE WORK SHALL BE INCLUDED IN THE LUMP SUM BID PRICE FOR ITEM 614. MAINTAINING TRAFFIC. AS PER PLAN.

THE FOLLOWING QUANTITIES HAVE BEEN CARRIED TO THE GENERAL SUMMARY AND SHALL BE USED TO FULLY REOPEN US 62T AFTER PHASE 2 AND PRIOR TO PART 3 WORK. PLACEMENT OF THESE TEMPORARY PAVEMENT MARKINGS SHALL FOLLOW THE EXISTING PAVEMENT MARKING LAYOUT AND US 62T TRAFFIC CONTROL SHEETS.

ITEM 614, WORK ZONE LANE LINE, CLASS I, 6", APP 2.6 MILE

ITEM 614, WORK ZONE EDGE LINE, CLASS I, 6", APP 5.2 MILE

#### CR 23 (FRESHLEY AVENUE)

DURING DAYTIME HOURS THE CONTRACTOR SHALL MAINTAIN TRAFFIC ROUTE OF US 62T WEST TO BEESON ST EAST TO US 62T NORTH IN ORDER TO BYPASS THE WORK AREA ALONG SR 225. IN ACCORDANCE WITH SCD MT-97.10 TO PERFORM ALL PROPOSED WORK ON FRESHLEY AVENUE (CR 23) TO ENSURE A MINIMUM OF REMOVE THE EXISTING BRIDGE, INSTALL SETTLEMENT PLATFORMS, ONE LANE SHALL REMAIN OPEN AT ALL TIMES. BEFORE DAILY AND CONSTRUCT FULL DEPTH PAVEMENT UP TO THE INTERMEDIATE CONSTRUCTION ACTIVITIES ARE COMPLETED AND THE ROADWAY COURSE PER THE LIMITS SHOWN IN THE PLANS. INSTALL ALL IS REOPENED TO TWO-WAY TRAFFIC, THE CONTRACTOR PROPOSED ROADWAY ITEMS WITHIN THE SPECIFIED WORK AREA MUST BACKFILL ALL CAVITIES AND PROPERLY GRADE THE INCLUDING GUARDRAIL, GRADING, AND UTILITIES. TRAFFIC AREA, TO THE SATISFACTION OF THE ENGINEER. PAYMENT FOR SHALL REMAIN IN THE TEMPORARY SCHEME UNTIL THE ABOVE ALL MATERIALS AND LABOR REQUIRED TO PERFORM THE ABOVE WORK HAS BEEN COMPLETED TO THE SATISFACTION OF THE WORK SHALL BE INCLUDED IN THE LUMP SUM BID PRICE FOR FNGINFFR. ITEM 614, MAINTAINING TRAFFIC, AS PER PLAN.

#### <u>SR 225</u>

UPON COMPLETION OF PHASE 2 WORK COVER DETOUR SIGNS IN PRF-PHASE CASE THEY ARE NEEDED DURING THE WINTER MONTHS IF EXCESSIVE SETTLEMENT OCCURS. DO NOT REMOVE TEMPORARY CROSSOVERS REPOSITION EXISTING BARRIER ALONG US 62T/SR 225 RAMP 'A' UNTIL THE ENGINEER DETERMINES SETTLEMENT IN THE AREA OF AND CONSTRUCT ALL TEMPORARY SINGLE LANE CROSSOVERS TO BE THE REMOVED BRIDGE WILL NOT REQUIRE THE CLOSURE OF SR 225. USED TO MAINTAIN US 62T/SR 225 INTERCHANGE TRAFFIC USING REMOVE THE REMAINING EXISTING PAVEMENT ALONG US 62T/SR225 SCD MT-98.28 AS SHOWN IN THE MAINTENANCE OF TRAFFIC PLANS. INTERCHANGE TO THE LIMITS SHOWN IN THE MOT PLANS IN THE CONTRACTOR SHALL CLEAN AND RESTORE SR 225 RAMP 'B' ACCORDANCE WITH SCD MT-95.32. REGRADE AND SEED AND MULCH CROSSOVER AREAS AS PER EXISTING CONDITIONS AND IN ACCORDANCE WITH CMS 659.01. PAYMENT FOR ALL MATERIALS AND LABOR REQUIRED TO PERFORM THE ABOVE WORK SHALL BE INCLUDED IN THE LUMP SUM BID PRICE FOR ITEM 614, MAINTAINING INSTALL ALL TEMPORARY TRAFFIC CONTROL DEVICES INCLUDING TRAFFIC, AS PER PLAN.

UNUSED PAVEMENT BACK TO AN ACCEPTABLE CONDITION AS DESCRIBED IN THE SR 225, RAMP B PAVEMENT RESTORATION MOT NOTE.

PORTABLE BARRIER, WORK ZONE PAVEMENT MARKINGS AND SIGNAGE. AND TEMPORARY PAVEMENT RUMBLE STRIPE OVERLAY PRIOR TO SHIFTING TRAFFIC INTO THE TEMPORARY SCHEME.

UPON COMPLETION OF THE PRE-PHASE CAREFULLY REMOVE AND STORE THE EXISTING CONCRETE BARRIER (FOR ODOT'S FUTURE USE) IN THE GRASS INFIELD AREA OF SR 225 RAMP B AS SHOWN ON SHEET 76.

#### PHASE 1

MAINTAIN TRAFFIC AS SHOWN IN THE SR 225 PLANS FOR PHASE 1. SHIFT SR 225 RAMP 'A' TRAFFIC ONTO CROSSOVER 5 TEMPORARY PAVEMENT TO ALLOW FOR A FULL CLOSURE OF THE RAMP DURING THIS PHASE. REDUCE SR 225 TRAFFIC TO A SINGLE INSIDE LANE IN BOTH DIRECTIONS USING SCD MT-95.31. CONSTRUCT THE REMAINDER OF CROSSOVER 6 TEMPORARY PAVEMENT. SR 225 RAMP 'A' (UP TO PROPOSED INTERMEDIATE COURSE) AND SR 225 OUTSIDE SHOULDER IMPROVEMENTS (UP TO PROPOSED INTERMEDIATE COURSE) FROM STA. 21+00 TO STA. 28+50.

AT THE END OF PHASE 1 UTILIZE SCD MT-97.12 TO MILL AND RESURFACE (UP TO INTERMEDIATE COURSE) THE OUTSIDE EASTBOUND AND WESTBOUND LANES AND RAMP 'A' INTERSECTION AS SHOWN ON PHASE 2 MOT PLAN SHEETS 72-74. INSTALL A WEDGE PER SCD MT-101.90 ALONG THE JOINT LINES WHERE THE PROPOSED INTERMEDIATE COURSE PAVEMENT ELEVATIONS ARE HIGHER THAN THE EXISTING SURFACE. THE COST OF REMOVING THE WEDGE COURSE SHALL BE INCLUDED IN ITEM 614, MAINTAINING TRAFFIC, AS PER PLAN.

REMOVE EXISTING CURBED MEDIAN ALONG SR 225 FROM STA. 36+25 TO STA. 36+90 AND CONSTRUCT A SHOULDER IMPROVEMENT SECTION FROM STA. 36+50 (LT) TO STA. 36+61 (LT) UTILIZING SCD MT-95.32 & SCD MT-95.41.

THE FOLLOWING QUANTITIES SHALL BE USED TO COMPLETE THE WEDGE WORK DESCRIBED ABOVE.

ITEM 614, ASPHALT CONCRETE FOR MAINTAINING TRAFFIC 26 CY

### PHASE 2

SET UP DETOUR ROUTE PER MOT PLAN SHEET 67. MAINTAIN TRAFFIC AS SHOWN ON THE SR 225 PLANS FOR PHASE 2. SHIFT NORTHBOUND SR 225 TRAFFIC TO THE MOST EASTERLY LANE USING SCD MT-95.32, IN ORDER TO PROVIDE A SINGLE LANE TO REVERSE FLOW DOWN RAMP A. THE SR 225 NORTH-BOUND LANE SHALL BE CONTROLLED BY A STOP SIGN AT THE INTERSECTION OF THE US 62T WB TO SR 225 NB RAMP. THE SR 225 NORTHBOUND RAMP SHALL BE PERMITTED A RIGHT TURN ONLY ALONG RAMP B IN ORDER TO CONTINUE NORTH-BOUND TO SR 225.

 $\bigcirc$ 

 $\bigcirc$ 

 $\bigcirc$ 

THE SOUTHBOUND 225 TRAFFIC SHALL FOLLOW THE DETOUR

Z

0

Ē

S

Ľ

⊢

S

Ζ

0

 $\mathbf{O}$ 

ш

0

ш

 $\mathbf{O}$ 

Ζ

ш

⊃

Ø

ш

S

C

ш

ш

∢

£

F

ш

0

ш

C

Ζ

◄

Ζ

ш

 $\vdash$ 

AIN

Σ

9

S

1 O

чõ

2 N N N

Ήσ

<u>6</u>2

**∀**<sup>™</sup>

Ηœ

S

16 204

5

2

` N

2

# POST-PHASE

THE CONTRACTOR SHALL COMPLETE THE RESURFACING ALONG SR 225 FROM STA. 21+00 TO STA 28+50 UP TO THE INTERMEDIATE COURSE INCLUDING PAVEMENT PLANING. INTERMEDIATE PAVEMENT COURSE, AND INSTALLATION OF TEMPORARY MARKINGS AND PERMANENT SIGNING UTILIZING SCD MT-97.12.


THE FOLLOWING QUANTITIES HAVE BEEN CARRIED TO THE GENERAL SUMMARY AND SHALL BE USED TO FULLY REOPEN SR 225 AND SR 225 RAMP 'A' AFTER PHASE 2. PLACEMENT OF THESE TEMPORARY PAVEMENT MARKINGS SHALL FOLLOW THE PERMANENT PAVEMENT MARKING LAYOUT SHOWN ON THE SR 225 TRAFFIC CONTROL SHEETS.

ITEM 614, WORK ZONE CENTER LINE, CLASS I, 6", APP 0.29 MILE ITEM 614, WORK ZONE LANE LINE, CLASS I, 6", APP 0.52 MILE ITEM 614, WORK ZONE EDGE LINE, CLASS I, 6", APP 0.78 MILE ITEM 614, WORK ZONE CHANNELIZING LINE, CLASS 1, 12", APP 151 FT ITEM 614, WORK ZONE STOP LINE, CLASS I, 24", APP 27 FT ITEM 614, WORK ZONE ARROW, CLASS I 3 EA

DURING THE PERIOD OF TIME WHEN THE FINAL SURFACE COURSE IS BEING PLACED ALONG SR 225 & SR 225 RAMP 'A', THE CONTRACTOR SHALL MILL ALL OF THE EXISTING PAVEMENT WHERE THE SURFACE HAS BEEN DISTURBED BY TEMPORARY STRIPING OPERATIONS WITHIN THE SR 225 INTERCHANGE PROJECT LIMITS. MILLING SHALL BE PERFORMED FOR THE ENTIRE WIDTH OF THE PAVEMENT INCLUDING THE SHOULDERS. MAINTAIN TRAFFIC IN ACCORDANCE WITH SCD MT-97.12.

PAYMENT FOR ALL LABOR, MATERIALS, AND EQUIPMENT, TO PERFORM THE ABOVE DESCRIBED WORK SHALL BE INCLUDED IN THE UNIT CONTRACT PRICE FOR THE FOLLOWING ITEMS:

ITEM 254, PAVEMENT PLANING, ASPHALT CONCRETE, 11/4" 3110 SY ITEM 441. 11/4 " ASPHALT CONCRETE SURFACE COURSE. TYPE 1, (448), PG64-22, AS PER PLAN [110 CY] ITEM 407, NON-TRACKING TACK COAT [280 GAL] ITEM 621, RPM 20 EA ITEM 621, RAISED PAVEMENT MARKER REMOVED 20 EA ITEM 646, EDGE LINE, 6" 0.31 MI

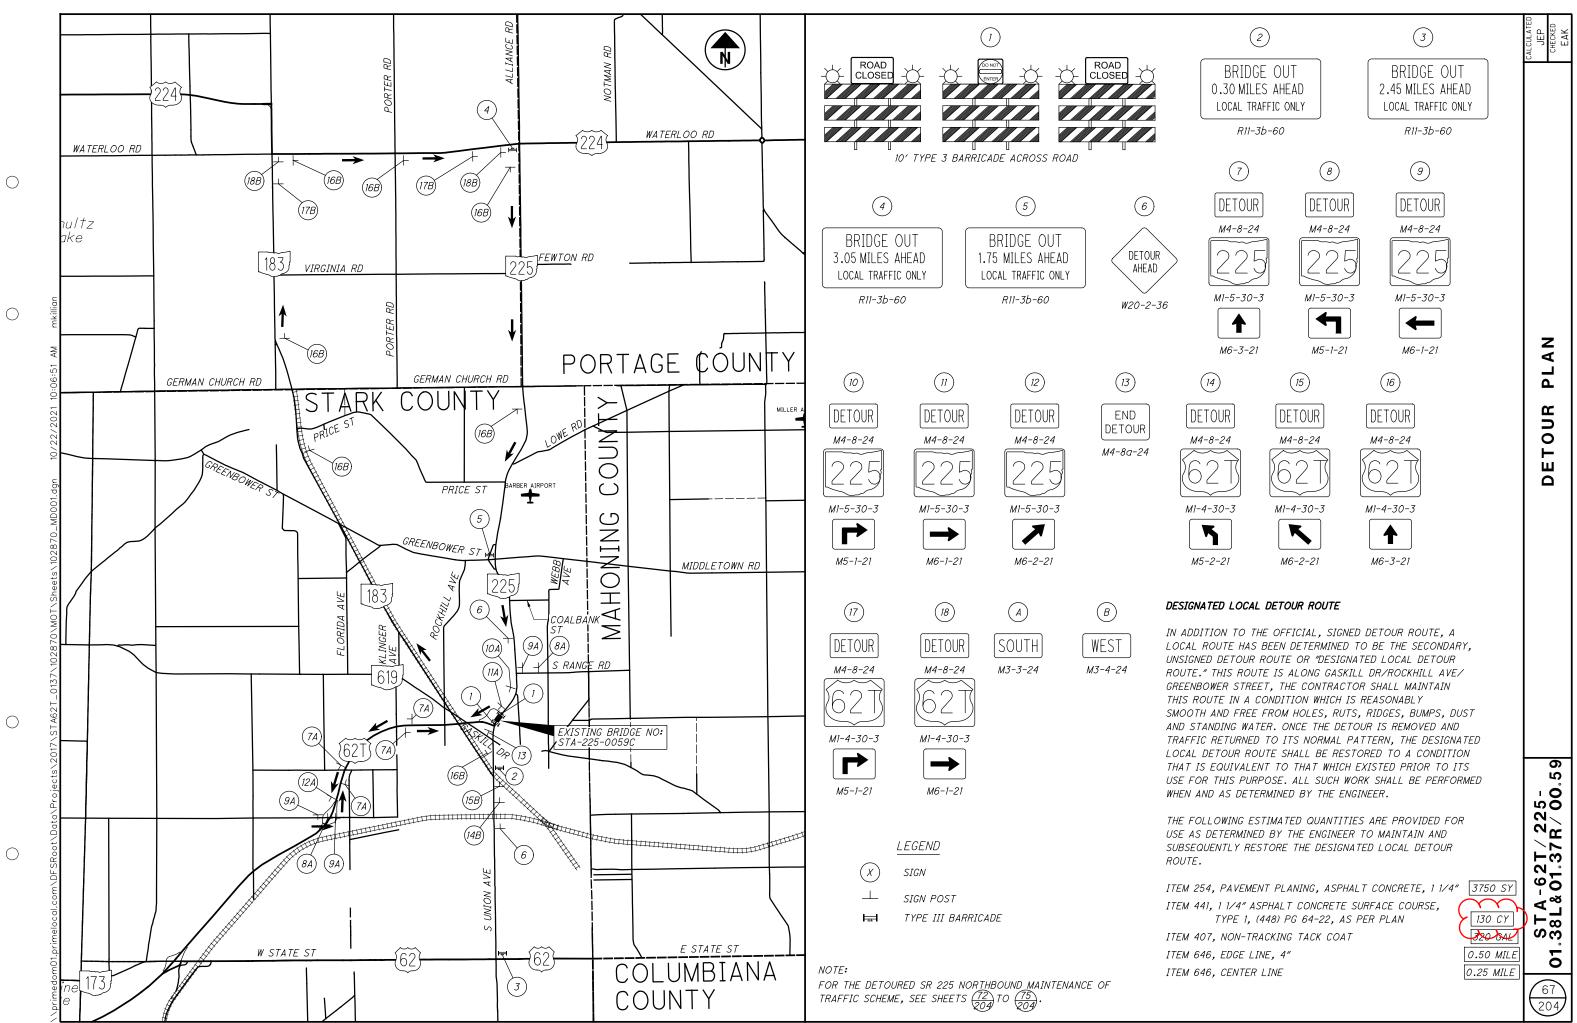

	UNIT	GRAND	ITEM ITEM		۲1.	PAI	-1			1	1	T NUM.	SHEE	·		1		
	51111	TOTAL	EXT	11 [14]	02/s<2BR	01/S<2BR							67	21	20	18	17	16
STRUCTURE O																		
STRUCTURE C																		
STRUCTURE C																		
M PAVEMENT REMOVED	SY	2,880	23000	202	2,880									2,880				
CONCRETE BARRIER REMOVED, AS PER PLAN	FT	600	30701	202	600									600				
PREPARING SUBGRADE FOR SHOULDER PAVIN	MILE	0.16	72050	209	0.16												0.16	
PAVEMENT REPAIR PAVEMENT PLANING, ASPHALT CONCRETE, 1	<u> </u>	360 6,860	01000 01000	253 254	360 6,860								3,750				360	3,110
TAVEMENT TEANING, ASI HAET CONCRETE, T	51	0,000	01000	234	0,000								5,750					5,110
PAVEMENT PLANING, ASPHALT CONCRETE, 1	SY	2,950	01000	254	2,950													2,950
FULL DEPTH PAVEMENT SAWING	FT	1,763	20000	255	1,763			_						1,763				
TACK COAT, 702.13 NON-TRACKING TACK COAT	GAL GAL	32 850	13900 20000	407 407	32 850								320				32	530
TRAFFIC COMPACTED SURFACE, TYPE A	CY	850 100	10000	407 410	100		-	1					520				100	550
STABILIZED CRUSHED AGGREGATE	CY	209	10000	411	~~~~~~~~~~~~~~~~~~~~~~~~~~~~~~~~~~~~~~	149						L	$\frown$	60	149			
ASPHALT CONCRETE SURFACE COURSE, TYPE ASPHALT CONCRETE INTERMEDIATE COURSE,	<u> </u>	240 M5 T	50101 50300	) 441 441	240							•	130	└── <b>`</b>				
LAW ENFORCEMENT OFFICER WITH PATROL C	HOUR	400	50300 11110	614	100	300		-				1	$\sim$			400		140
INCREASED BARRIER DELINEATION	FT	975	11630	614	775	200										975		
WORK ZONE IMPACT ATTENUATOR, 24" WIDE	EACH	10	12380	614	6	4								6	4			
DETOUR SIGNING	LAUN	LS	12420	614	LS	7							LS	0	7			
WORK ZONE CROSSOVER LIGHTING SYSTEM	EACH	3	12756	614	1	2											3	
WORK ZONE RAISED PAVEMENT MARKER, AS	EACH	1,902	12801	614	550	1,352								550	1,352			
ASPHALT CONCRETE FOR MAINTAINING TRAFT	CY	76	13000	614	76		_										50	26
ASPHALT CONCRETE FOR MAINTAINING TRAFT	CY	60	13001	614	10	50										60		
BARRIER REFLECTOR, TYPE 1, ONE WAY		228	13310	614	48	180										228		
BARRIER REFLECTOR, TYPE 2, ONE WAY	EACH	36	13312	614	8	28										36		
OBJECT MARKER, ONE WAY	EACH	92	13350	614	13	79										92		
OBJECT MARKER, TWO WAY	EACH	21	13360	614	4	17										21		
PORTABLE CHANGEABLE MESSAGE SIGN, AS H	SNMT	70	18601	614	42	28										70		
WORK ZONE LANE LINE, CLASS I, 6", AS PER	MILE	3.12	20011	614	0.52	2.6										,,,		3.12
WORK ZONE CENTER LINE, CLASS I, AS PER	MILE	0.29	21001	614	0.29													0.29
WORK ZONE EDGE LINE, CLASS I, 6", AS PER	MILE	16.65	22011	614	2.84	13.81								2.06	8.61			5.98
WORK ZONE CHANNELIZING LINE, CLASS I, 12	FT	1,243	23011	614	276	967								125	967			151
WORK ZONE DOTTED LINE, CLASS I, AS PER	FT	3,824	24001	614		3,824		1			1	1			3,824			
WORK ZONE STOP LINE, CLASS I, AS PER PL	FT	, 82	26001	614	82	,								55	, í			27
WORK ZONE ARROW, CLASS I	EACH	5	30000	614	5									2				3
ROADS FOR MAINTAINING TRAFFIC, AS PER I PAVEMENT FOR MAINTAINING TRAFFIC, CLAS	SY	LS 5,324	10001 20000	615 615	LS 2,294	LS 3,030						-		LS 2,294	LS 3,030			
FAVEMENT FOR MAINTAINING TRAFFIC, CLAS	51	5,524	20000	015	2,294	5,050								2,294	5,050			
WATER	MGAL	180	10000	616	155	25											180	
RUMBLE STRIPS, SHOULDER (ASPHALT CONCE	FT	11,550	40101	618		11,550											11,550	
RPM	EACH	20	00100	621	20 20													20
RAISED PAVEMENT MARKER REMOVED PORTABLE BARRIER, UNANCHORED	EACH FT	20 3,400	54000 41100	621 622		3,020								380	3,020			20
TONTABLE BAIMLER; ONANONONED		5,100	11100	022		0,020								000	0,020			
PORTABLE BARRIER, UNANCHORED, AS PER H	FT	3,040	41101	622	300	2,740								300	2,740			
PORTABLE BARRIER, ANCHORED, AS PER PLA	FT	655	41111	622	655								0.5	655				
EDGE LINE, 4" EDGE LINE, 6"	 MILE	0.5 0.31	10000 10010	646 646	0.5 0.31								0.5					0.31
CENTER LINE	MILE	0.37	10200	646 646	0.37		+	1			1	1	0.25					0.01
			-		-								-					
DEDADTHENTIC CHURE OF THE DECRUTE SEC			50000	10.0							<u> </u>	<u> </u>						
DEPARTMENT'S SHARE OF THE DISPUTE RESC MAINTAINING TRAFFIC, AS PER PLAN		LS LS	50200 11001	100 614	LS LS	LS LS		+										
FIELD OFFICE, TYPE B	MNTH	22	16010	619	11	11		1			1							
CONSTRUCTION LAYOUT STAKES AND SURVE		LS	10000	623	LS	LS												
MOBILIZATION		LS	10000	624	LS	LS												
			60000400	CDEOTAL				-										
SURVEY CONTROL VERIFICATION		LS	69098400	SPECIAL	LS	LS		1	1				1			l		

 $\bigcirc$ 

 $\bigcirc$ 

 $\bigcirc$ 

 $\bigcirc$ 

DESCRIPTION	SEE SHEET NO.	CALCULATED JEP CHECKED EAK
OVER 20 FOOT SPAN (STA-62T-0137R)	149	
OVER 20 FOOT SPAN (STA-62T-0138L)	149	
OVER 20 FOOT SPAN (STA-225-0059)	193	
MAINTENANCE OF TRAFFIC		
N ING	76	
1 1/4"		
1 3/4″		
		≻
		ά.
		A
		Ν
PE 1, (448), AS PER PLAN, PG64-22 E, TYPE 2, (448)	13	SUMMARY
CAR FOR ASSISTANCE		SI
E HAZARDS, (UNIDIRECTIONAL)		GENERAL
· · · · · · · · · · · · · · · · · · ·	19	Я
S PER PLAN	17	
FFIC		Ш
	10	G
FFIC, AS PER PLAN	18	
PER PLAN	18	
ER PLAN	19 19	
ER PLAN	19	
12", AS PER PLAN	19	
R PLAN	19	
PLAN	19	
? PLAN	17, 20, 21	
ISS A		
CRETE), AS PER PLAN	17	25- ⁄ 00.59
		ı Ö
		25
	10	32
2 PLAN LAN	19 19	<u> </u>
		- 2 - 3
		STA-62T/225 01.38L&01.37R/0
		<b>∀</b> <sup>∞</sup> -
INCIDENTALS		8L
SOLUTION ADVISOR	17	ကကို
		6
EYING		
		$\left( \frac{86}{204} \right)$
	14	