




COUNTY:	STARK		
LOCATION:	S.R. 236 @ ERIE AVE. / FORTY CORNERS RD.		
S.L.M.:	2.08		
24" STOP LINE:	26	L.F.	
12" CROSSWALK LINE:		L.F.	
DOTTED LINE:		L.F.	
8" CHANNELIZING LINE:		L.F.	
12" CHANNELIZING LINE:		L.F.	
24" TRANSVERSE LINE (WT):		L.F.	
24" TRANSVERSE LINE (YW):		L.F.	
SYMBOL:			

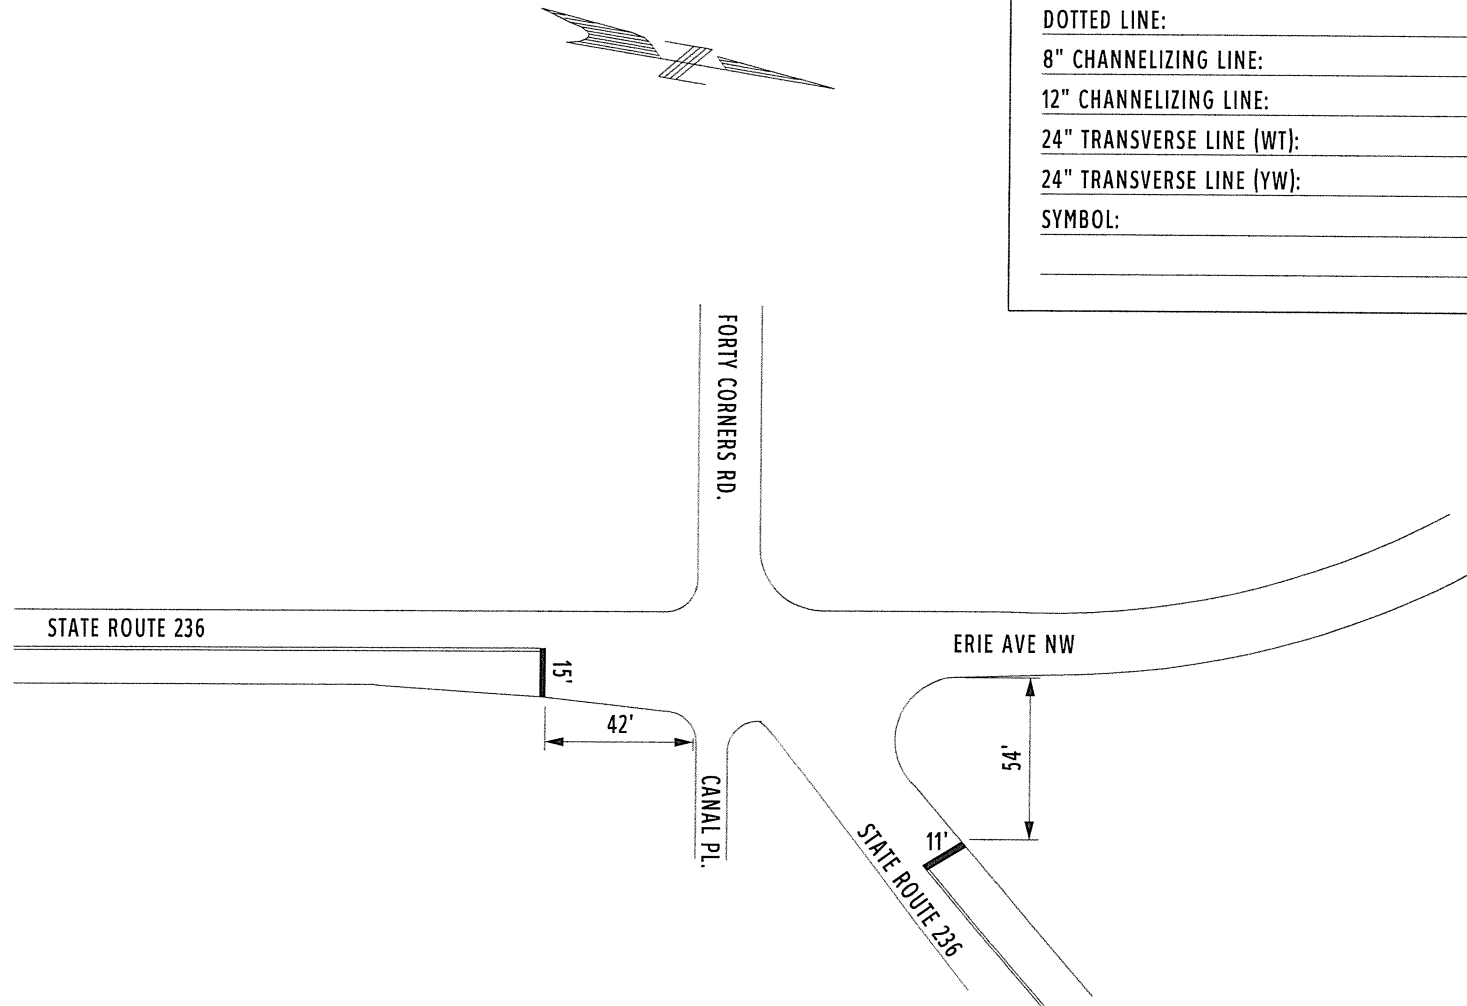


COUNTY:	STARK
LOCATION:	S.R. 236 @ HIGH MILL RD.
S.L.M.:	3.144
24" STOP LINE:	L.F.
12" CROSSWALK LINE:	L.F.
DOTTED LINE:	L.F.
8" CHANNELIZING LINE:	142 L.F.
12" CHANNELIZING LINE:	L.F.
24" TRANSVERSE LINE (WT):	L.F.
24" TRANSVERSE LINE (YW):	L.F.
SYMBOL: 3 - LEFT TURN ARROWS	

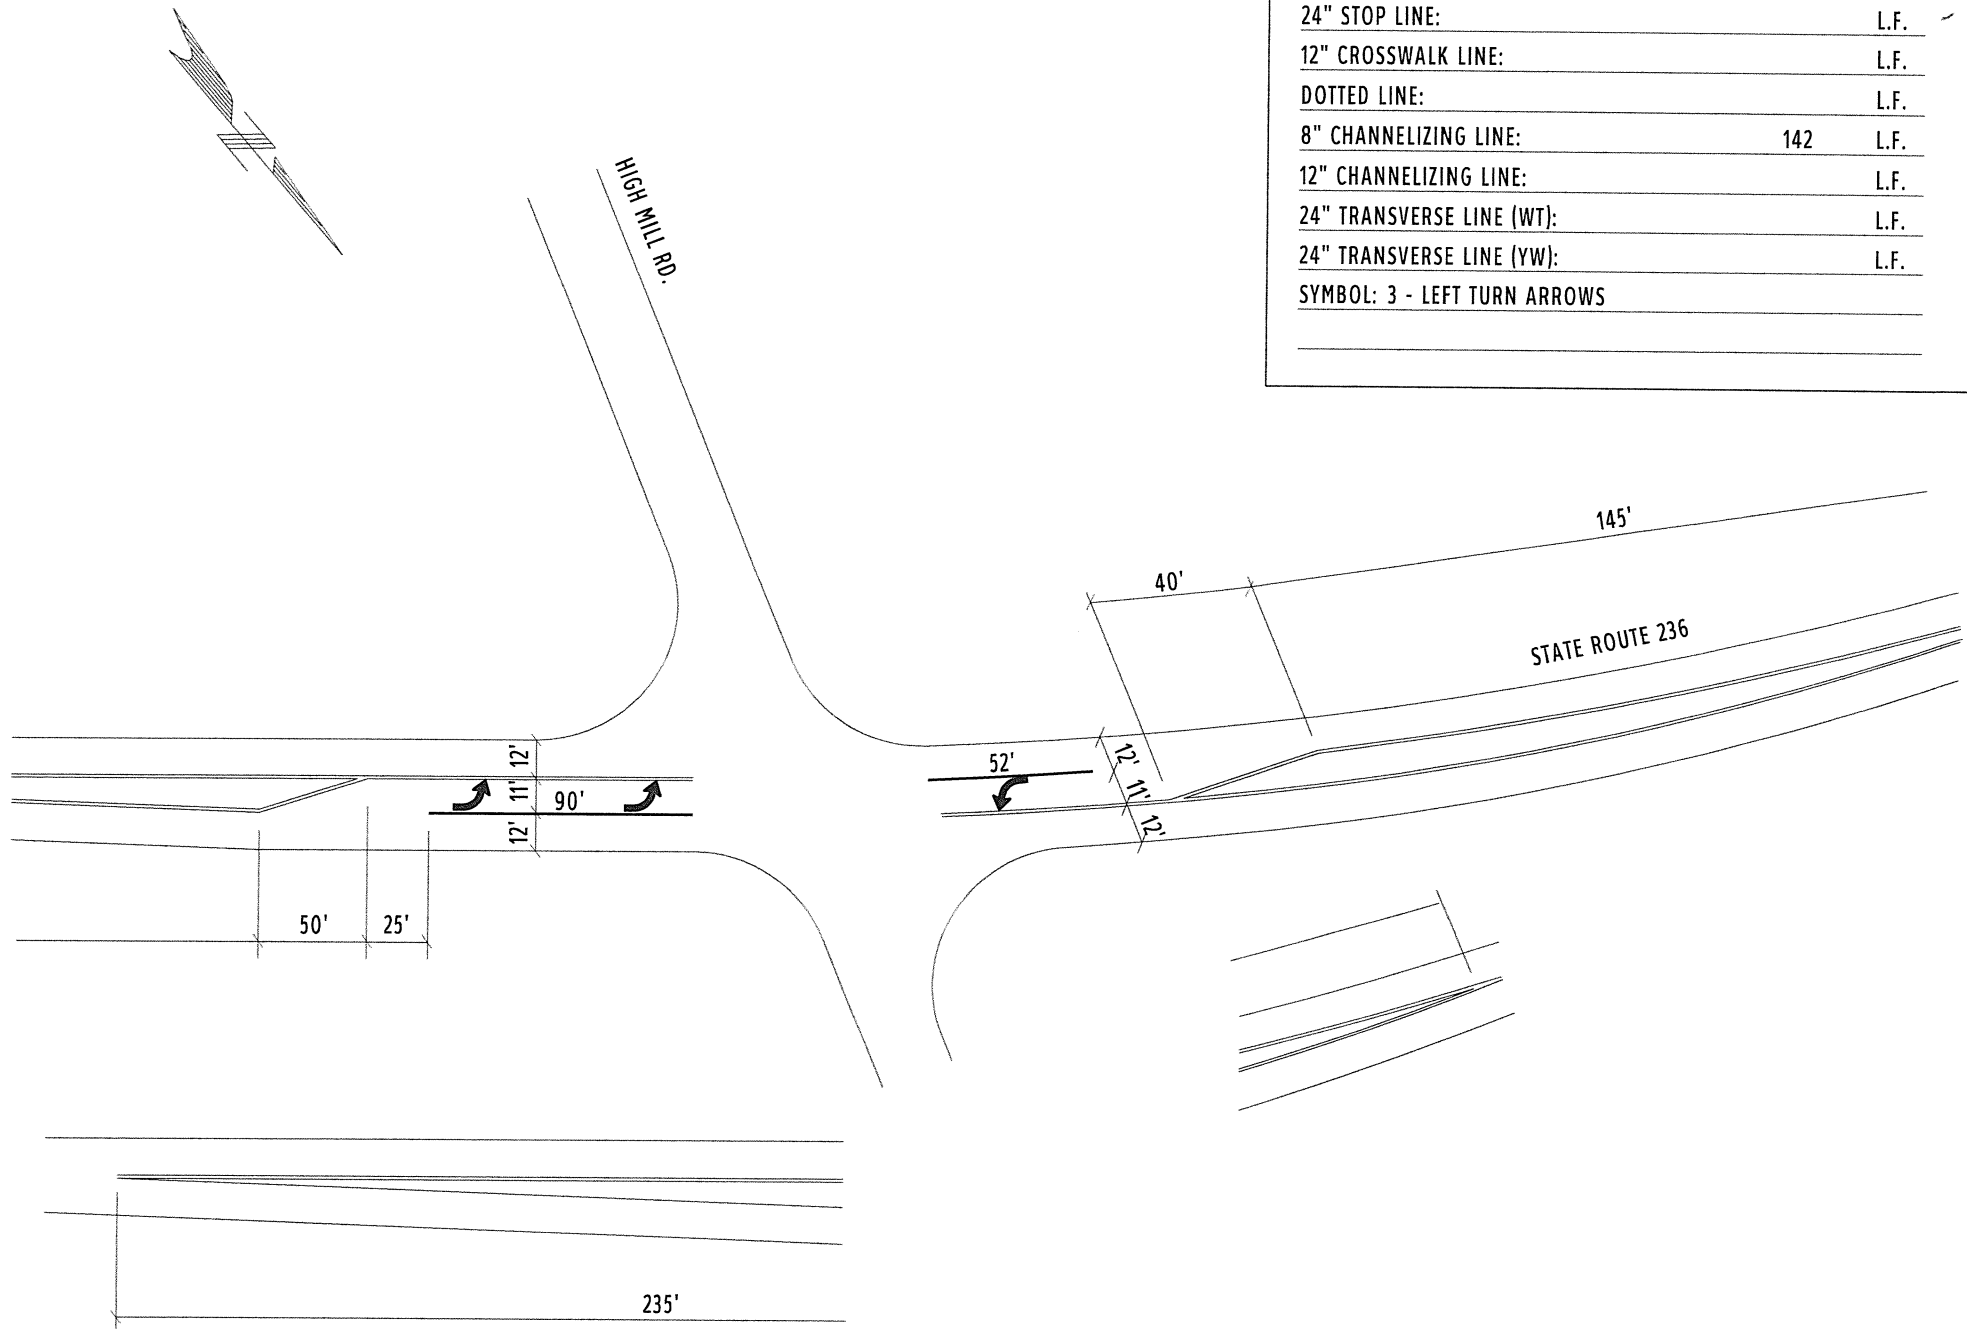

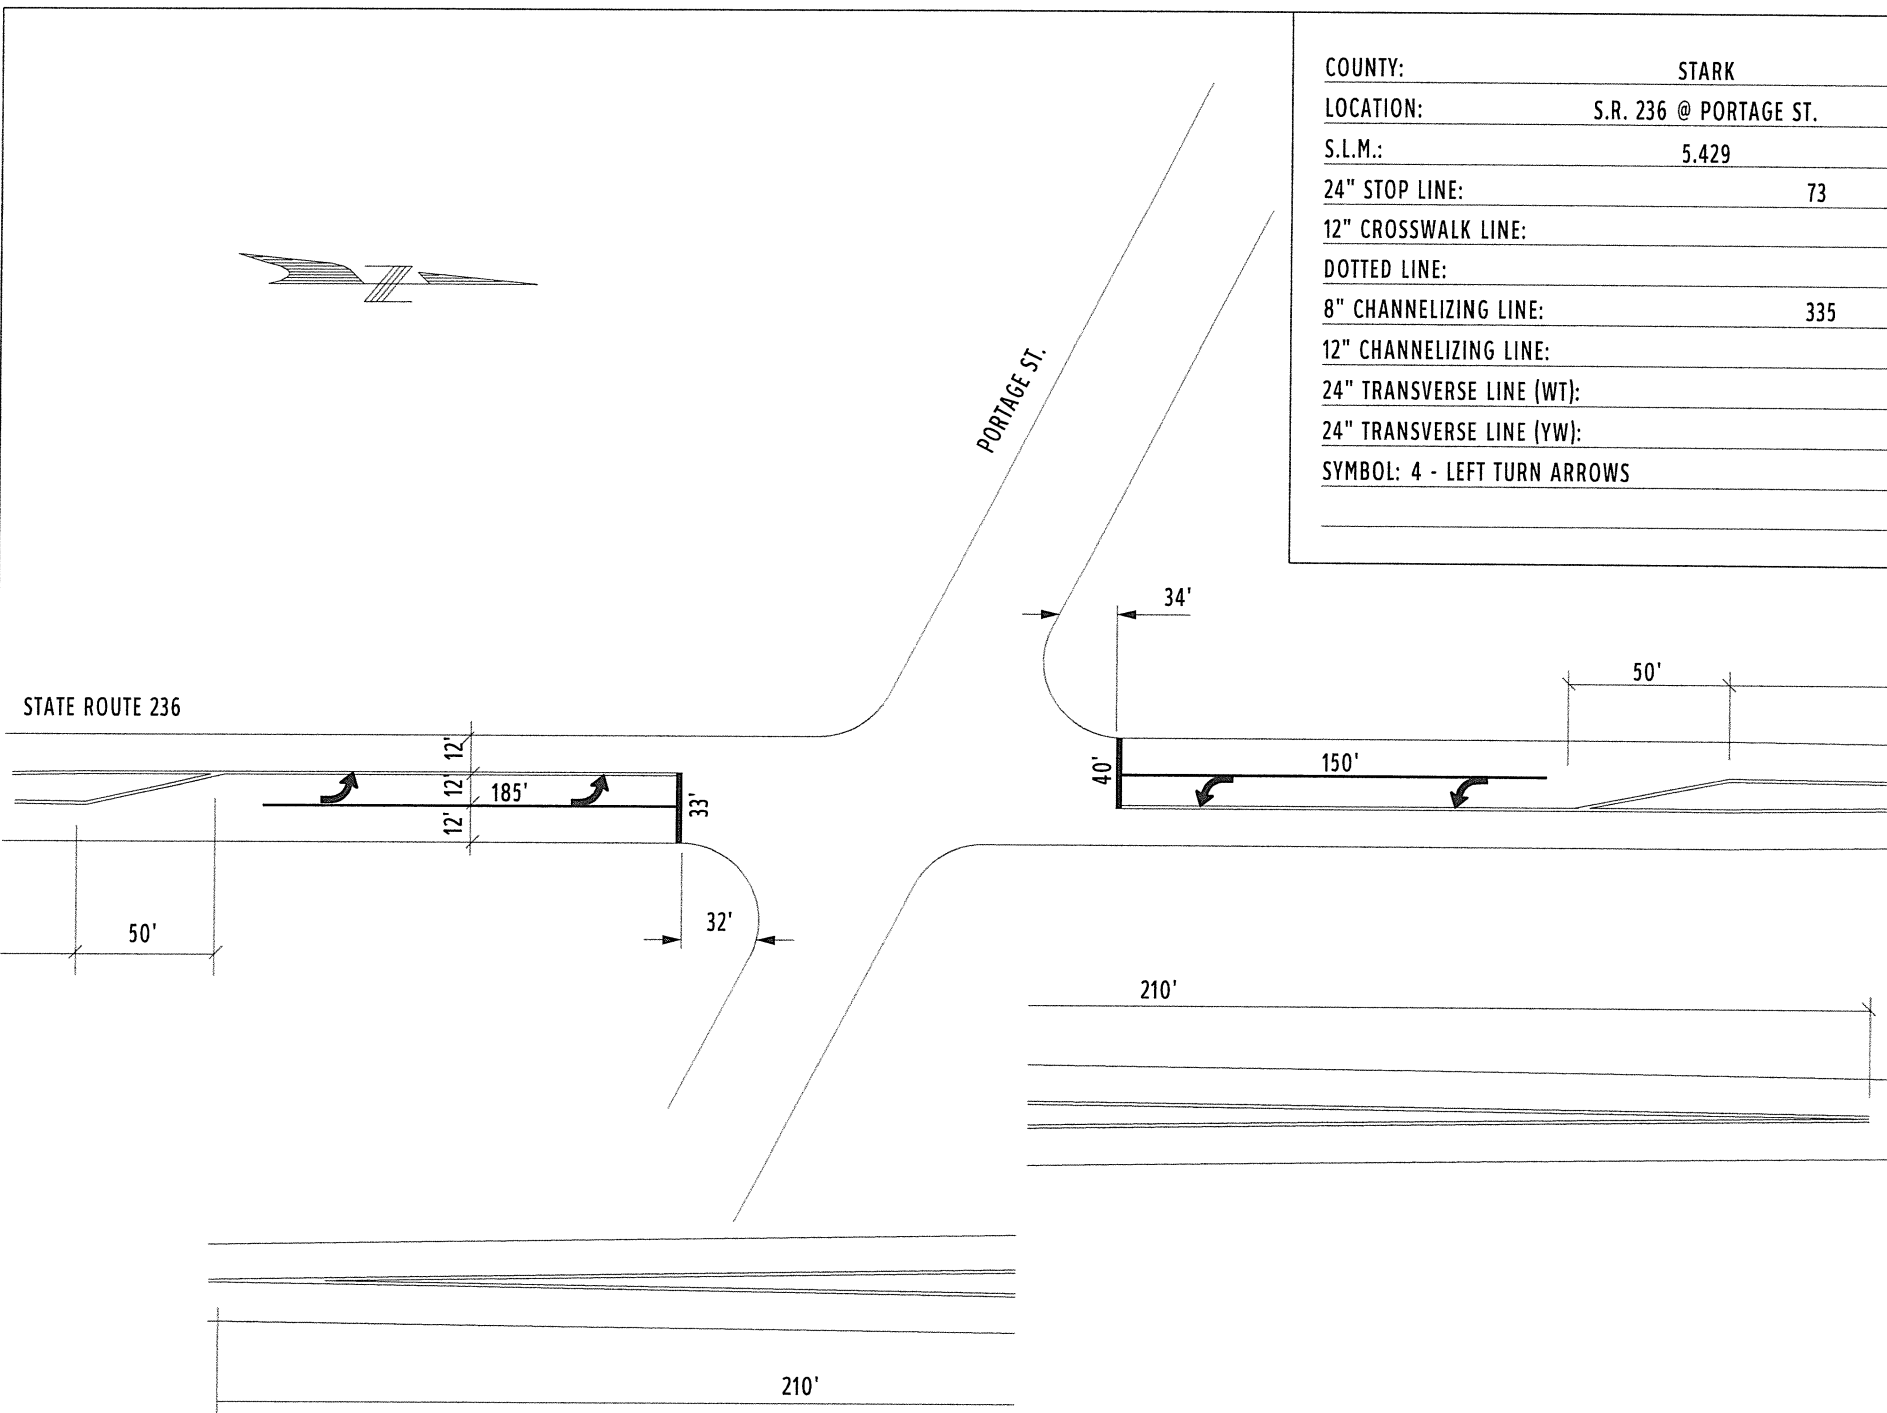

COUNTY:	STARK	
LOCATION:	S.R. 236 @ PORTAGE ST.	
S.L.M.:	5,429	
24" STOP LINE:	73	L.F.
12" CROSSWALK LINE:		L.F.
DOTTED LINE:		L.F.
8" CHANNELIZING LINE:	335	L.F.
12" CHANNELIZING LINE:		L.F.
24" TRANSVERSE LINE (WT):		L.F.
24" TRANSVERSE LINE (YW):		L.F.
SYMBOL: 4 - LEFT TURN ARROWS		

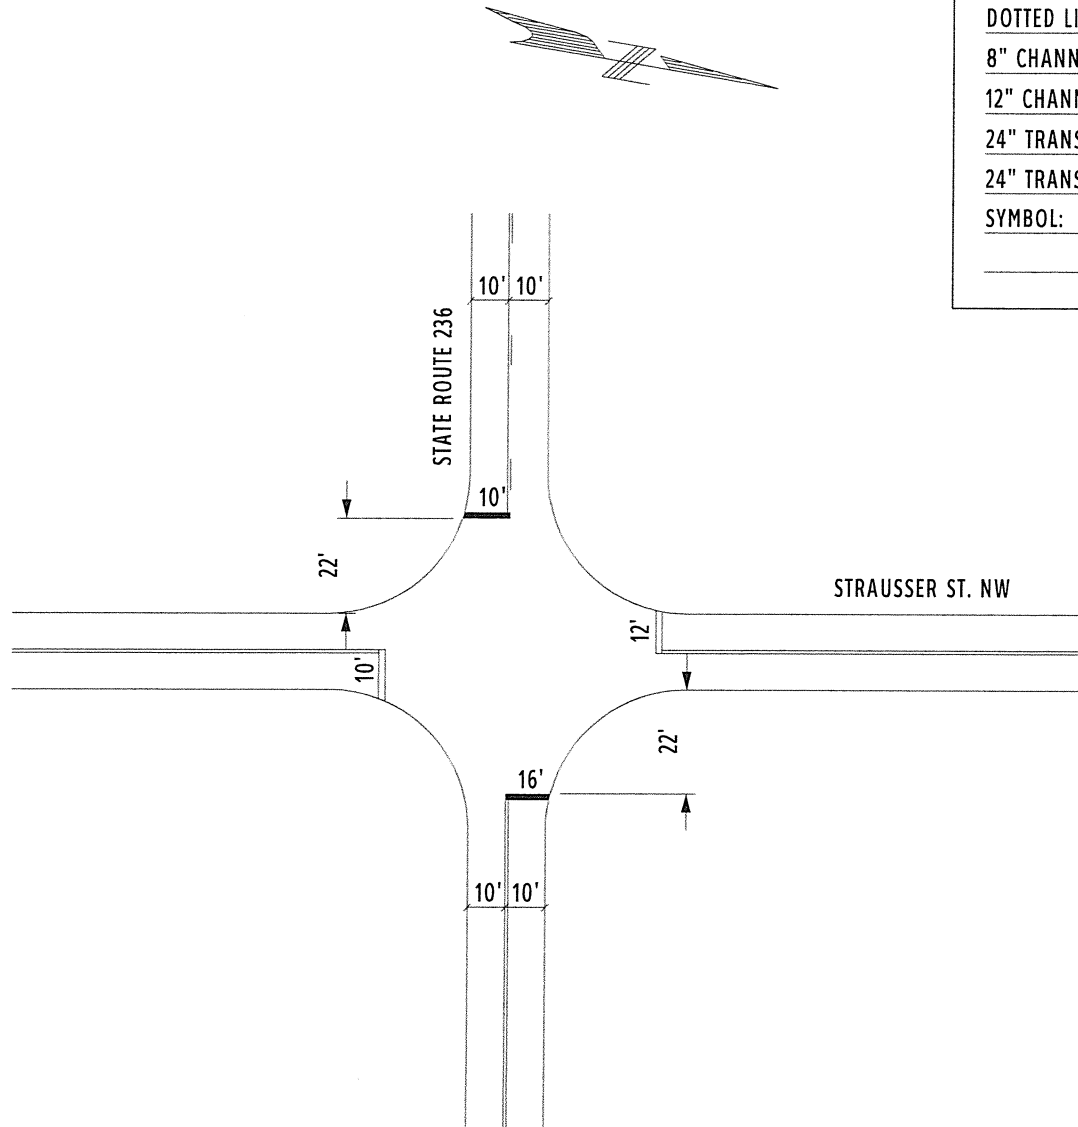

COUNTY:	STARK		
LOCATION:	S.R. 236 @ STAUSSEY ST. NW		
S.L.M.:	6.50		
24" STOP LINE:	26	L.F.	
12" CROSSWALK LINE:		L.F.	
DOTTED LINE:		L.F.	
8" CHANNELIZING LINE:		L.F.	
12" CHANNELIZING LINE:		L.F.	
24" TRANSVERSE LINE (WT):		L.F.	
24" TRANSVERSE LINE (YW):		L.F.	
SYMBOL:			