

COUNTY:	STARK	
LOCATION:	S.R. 241 @ MUDBROOK RD.	
S.L.M.:	14.688	
24" STOP LINE:	49	L.F.
12" CROSSWALK LINE:	224	L.F.
DOTTED LINE:		L.F.
8" CHANNELIZING LINE:	210	L.F.
12" CHANNELIZING LINE:		L.F.
24" TRANSVERSE LINE (WT):	145	L.F.
24" TRANSVERSE LINE (YW):		L.F.
SYMBOL: 57 S.F ISLAND MARKINGS		
5 - LEFT TURN ARROWS		

STATE ROUTE 241

20'

MUDBROOK RD.

20'

250'

37'

42'

24'


65'

25'

100'

50'


210'

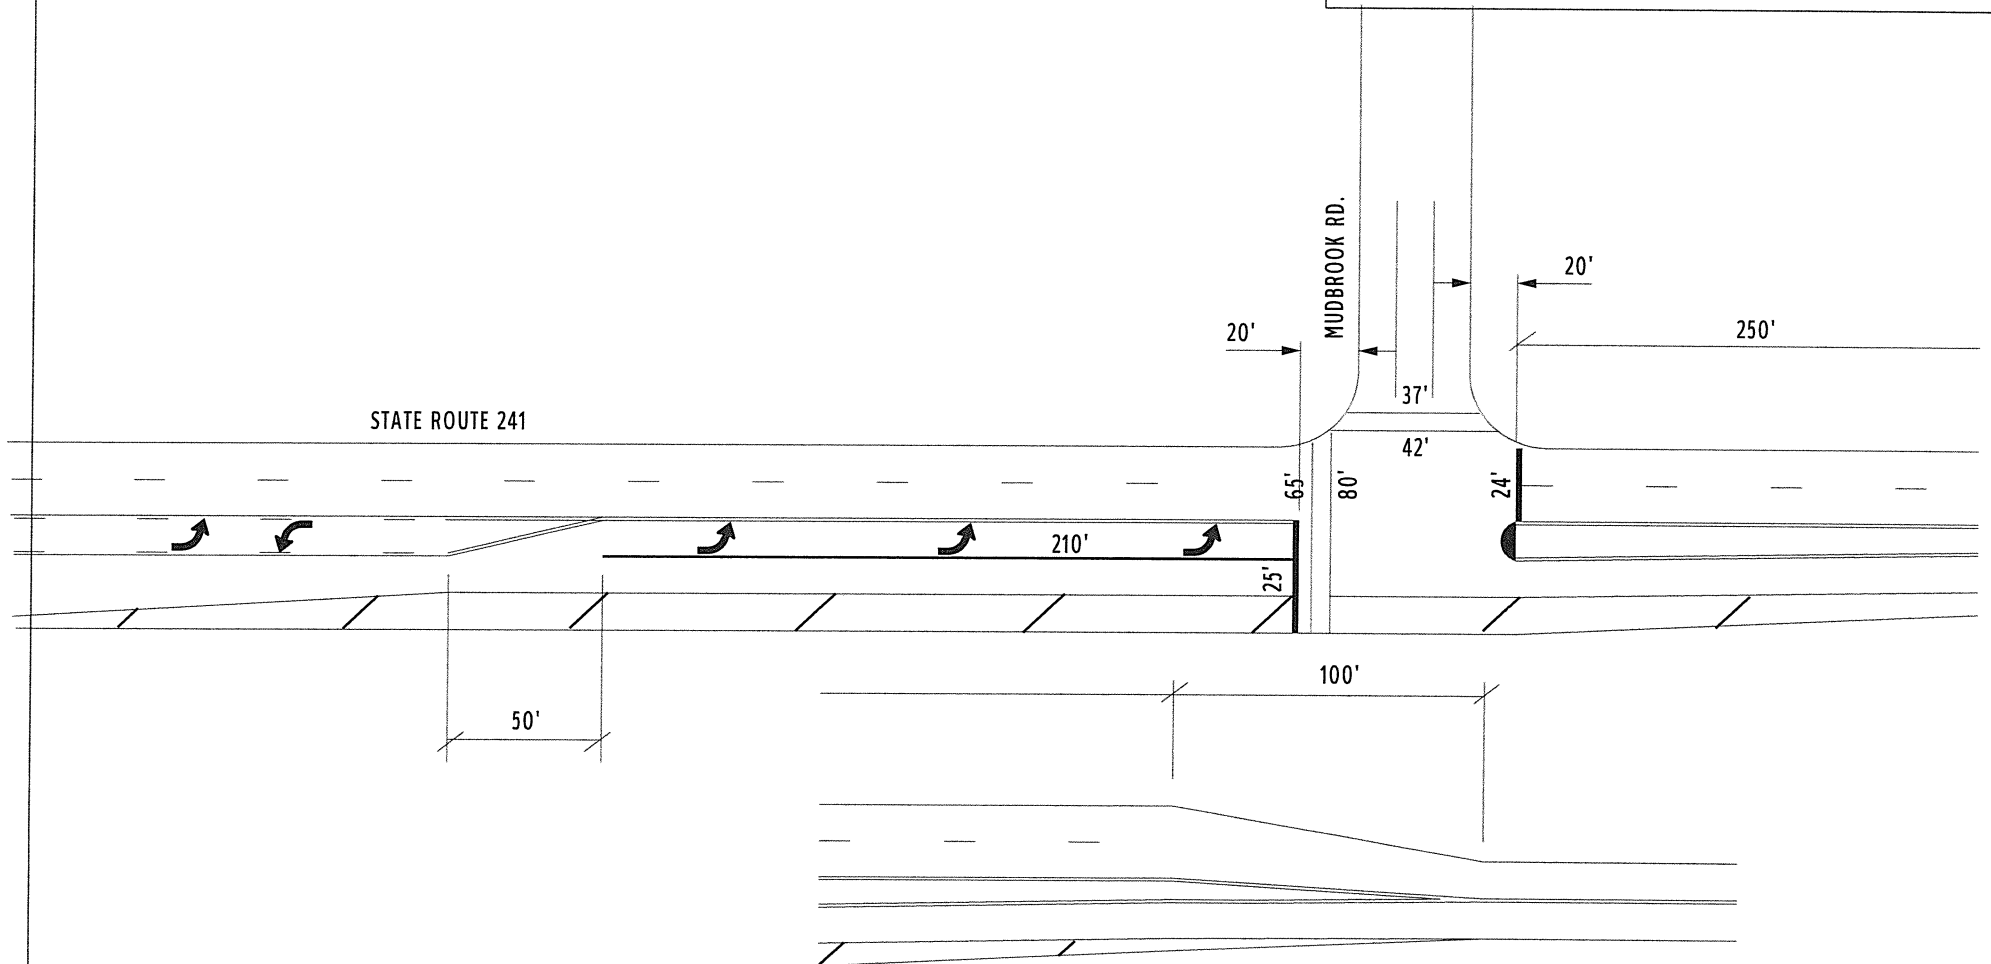




COUNTY:	STARK
LOCATION:	S.R. 241 @ PORTAGE ST.
S.L.M.:	14.704
24" STOP LINE:	L.F.
12" CROSSWALK LINE:	L.F.
DOTTED LINE:	L.F.
8" CHANNELIZING LINE:	L.F.
12" CHANNELIZING LINE:	L.F.
24" TRANSVERSE LINE (WT):	L.F.
24" TRANSVERSE LINE (YW):	L.F.
SYMBOL:	

*ALL QUANTITIES ON SHEET 2

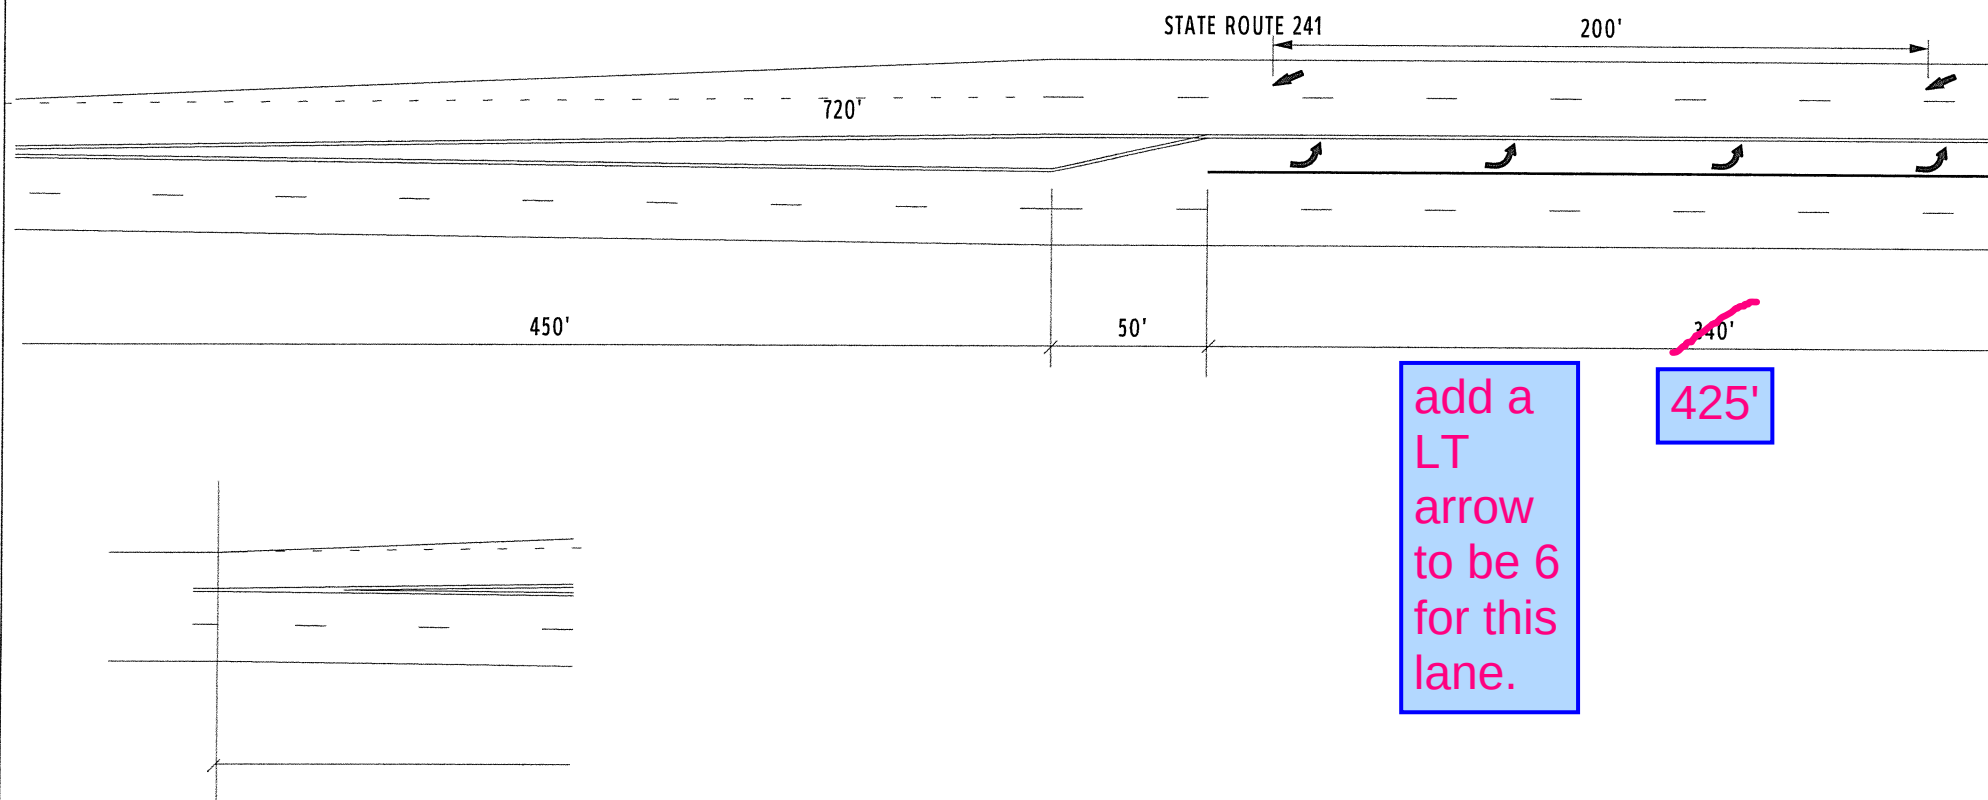



COUNTY:	STARK	
LOCATION:	S.R. 241 @ PORTAGE ST.	
S.L.M.:	14.704	15.00
24" STOP LINE:	76	L.F.
12" CROSSWALK LINE:		L.F.
DOTTED LINE:	1370	L.F.
8" CHANNELIZING LINE:	720	L.F.
12" CHANNELIZING LINE:		L.F.
24" TRANSVERSE LINE (WT):		L.F.
24" TRANSVERSE LINE (YW):		L.F.
SYMBOL:	10 - LEFT TURN ARROWS	
	4 - MERGE ARROWS	

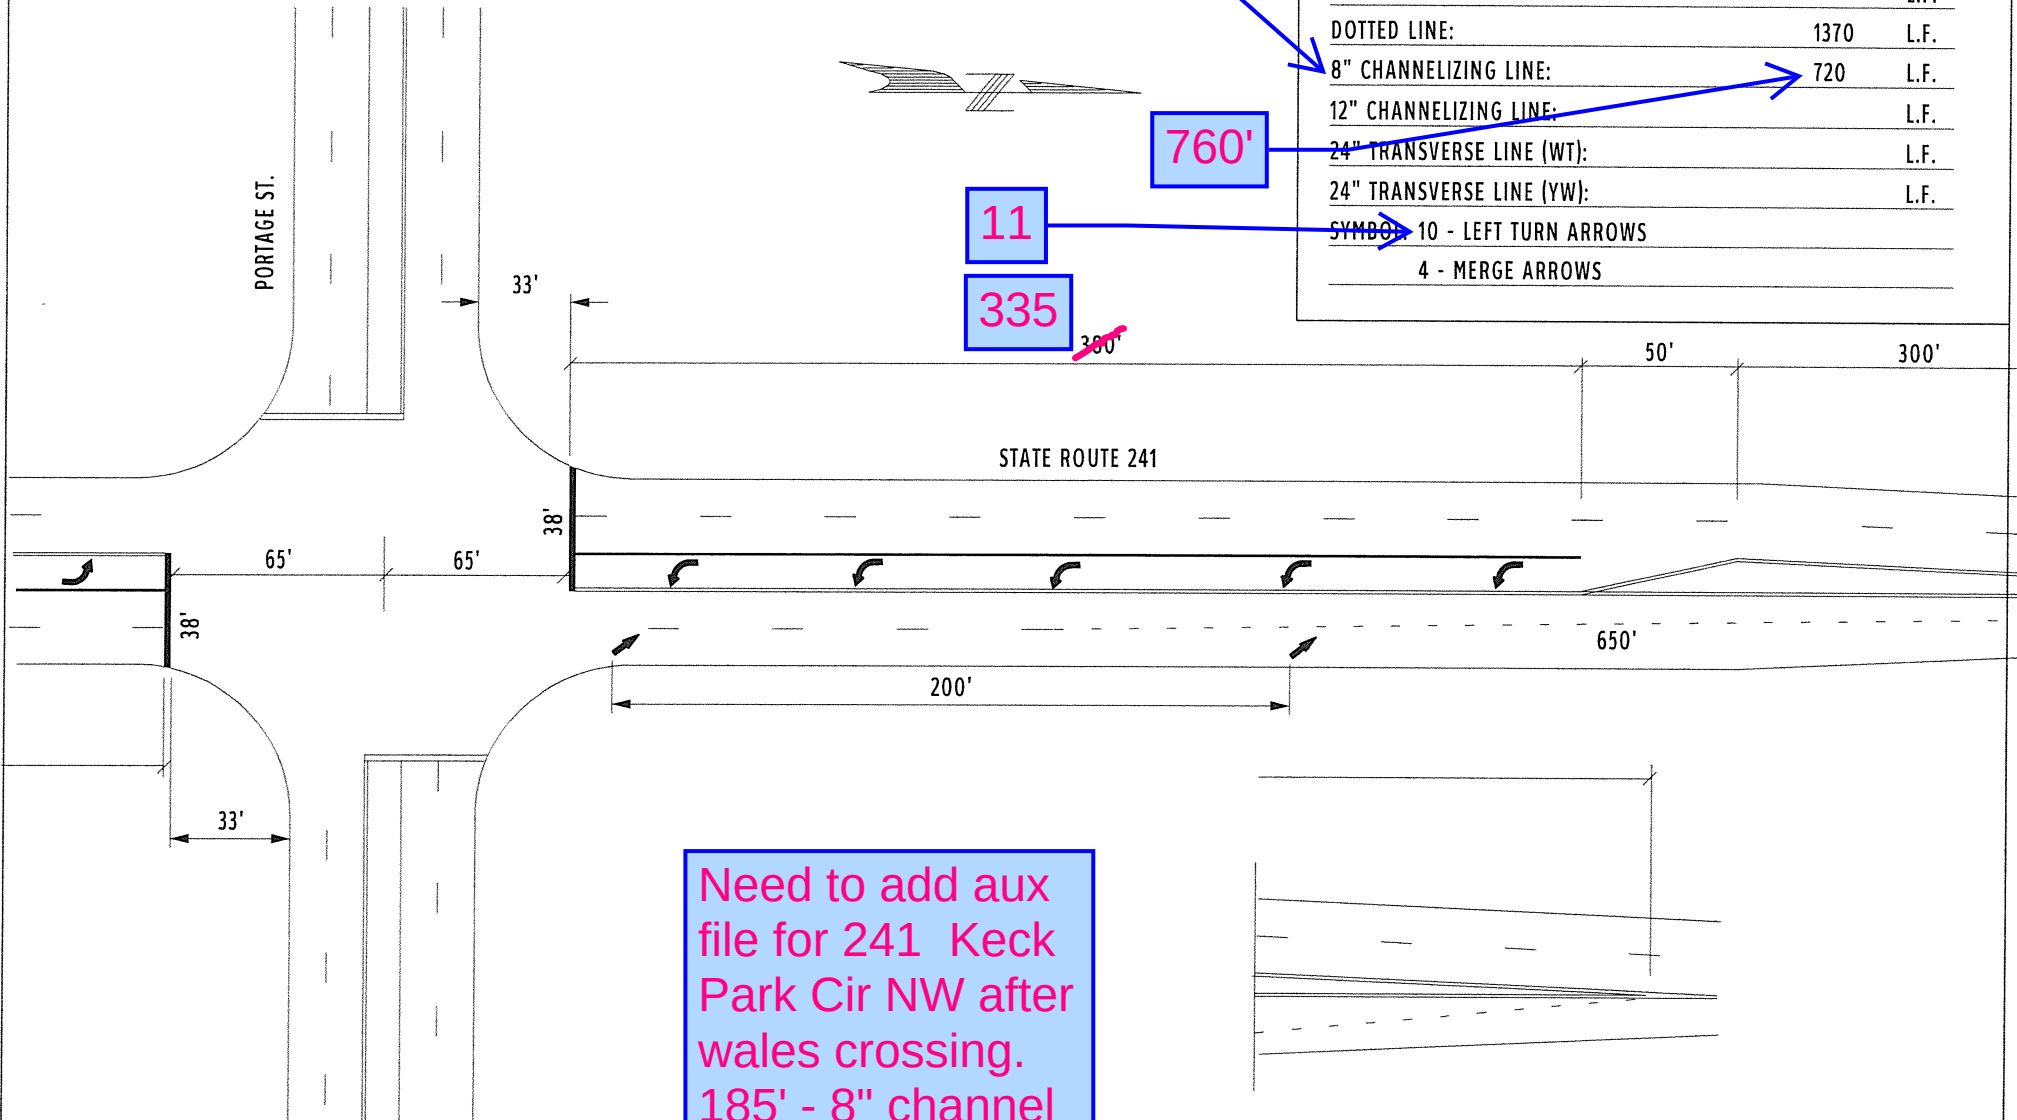



COUNTY:	STARK
LOCATION:	S.R. 241 @ MEARS GATE DR. / WALES CROSSING ST.
S.L.M.:	15.911
24" STOP LINE:	L.F.
12" CROSSWALK LINE:	L.F.
DOTTED LINE:	L.F.
8" CHANNELIZING LINE:	305 L.F.
12" CHANNELIZING LINE:	L.F.
24" TRANSVERSE LINE (WT):	L.F.
24" TRANSVERSE LINE (YW):	L.F.
SYMBOL: 6 - LEFT TURN ARROWS	

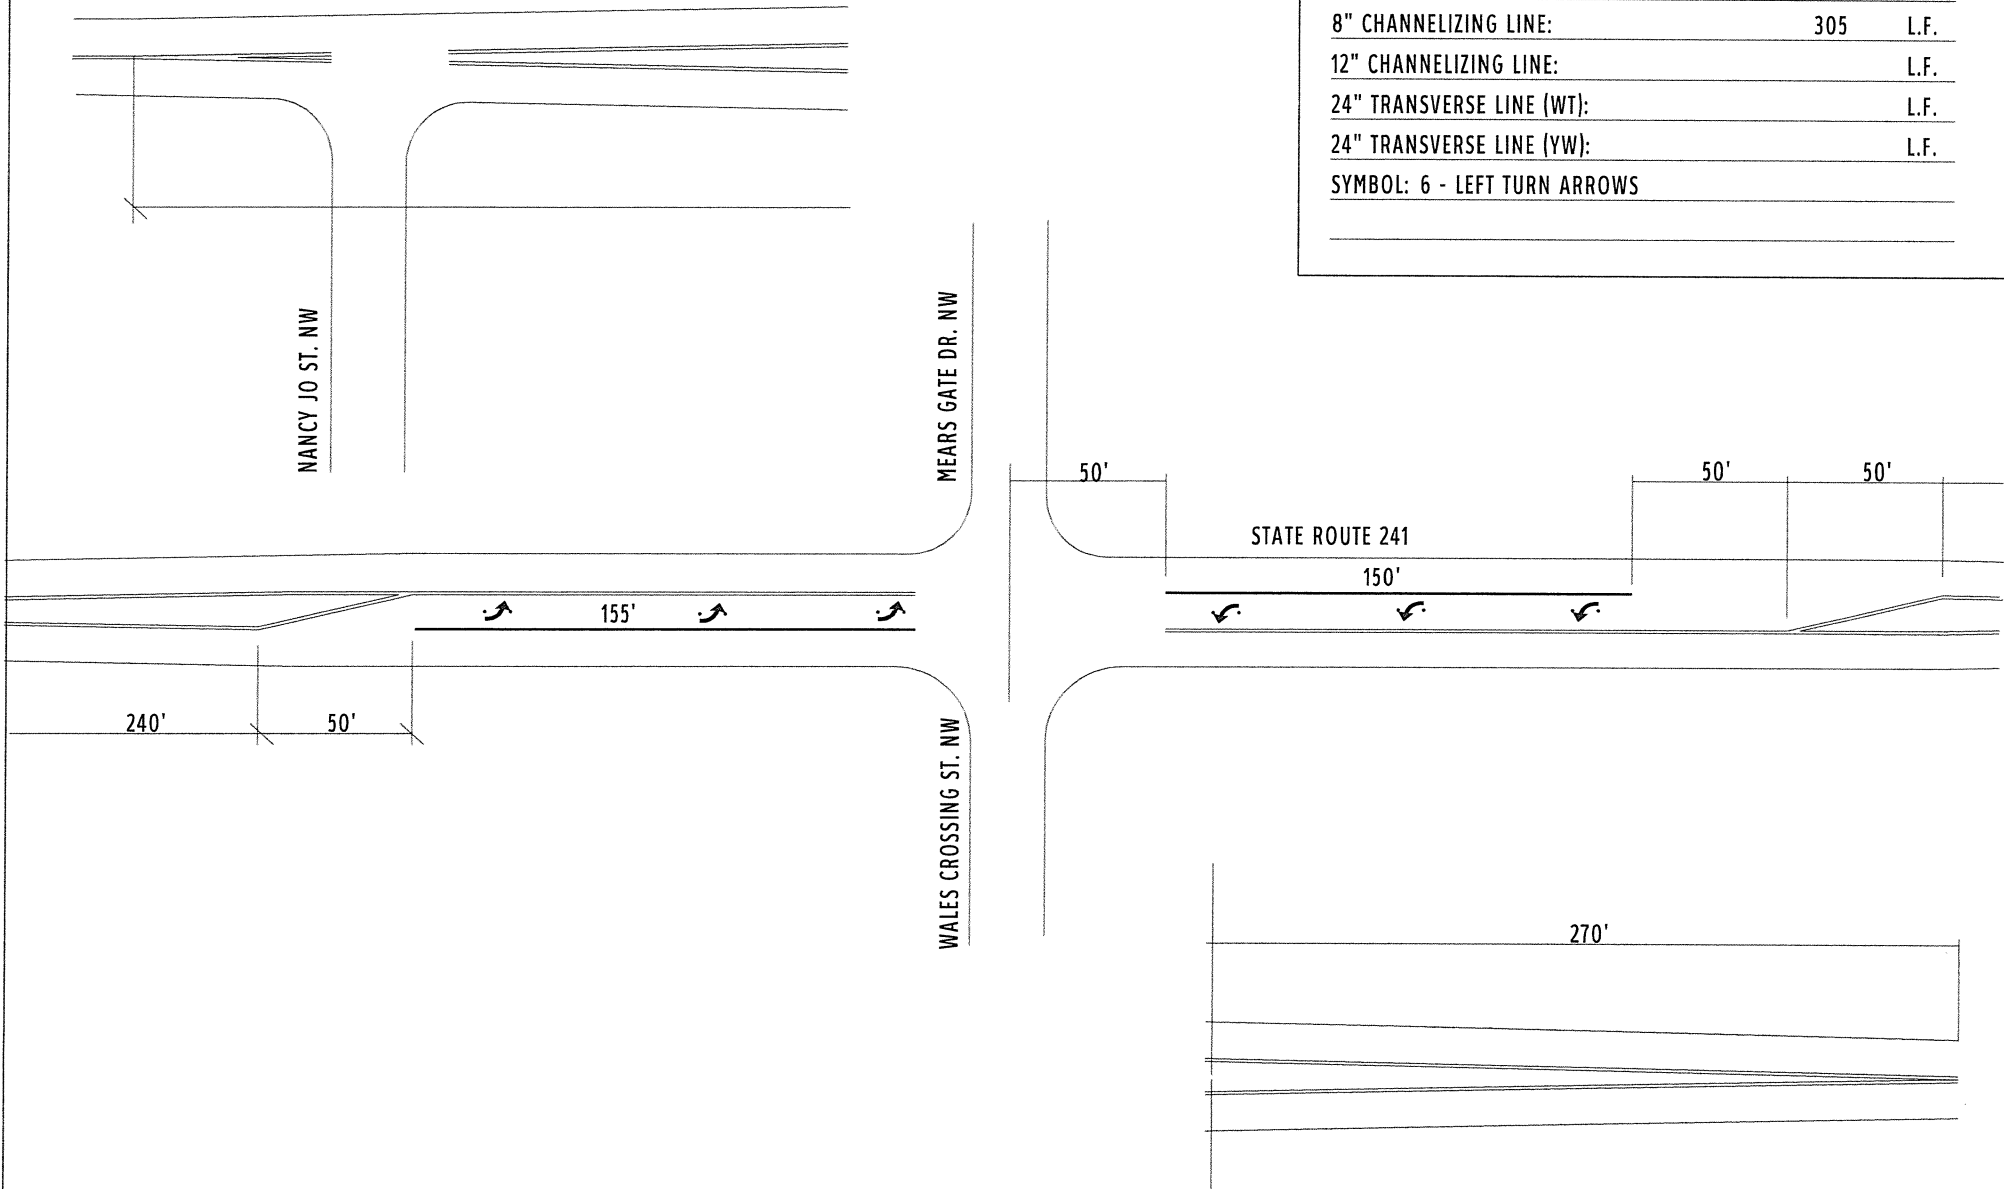

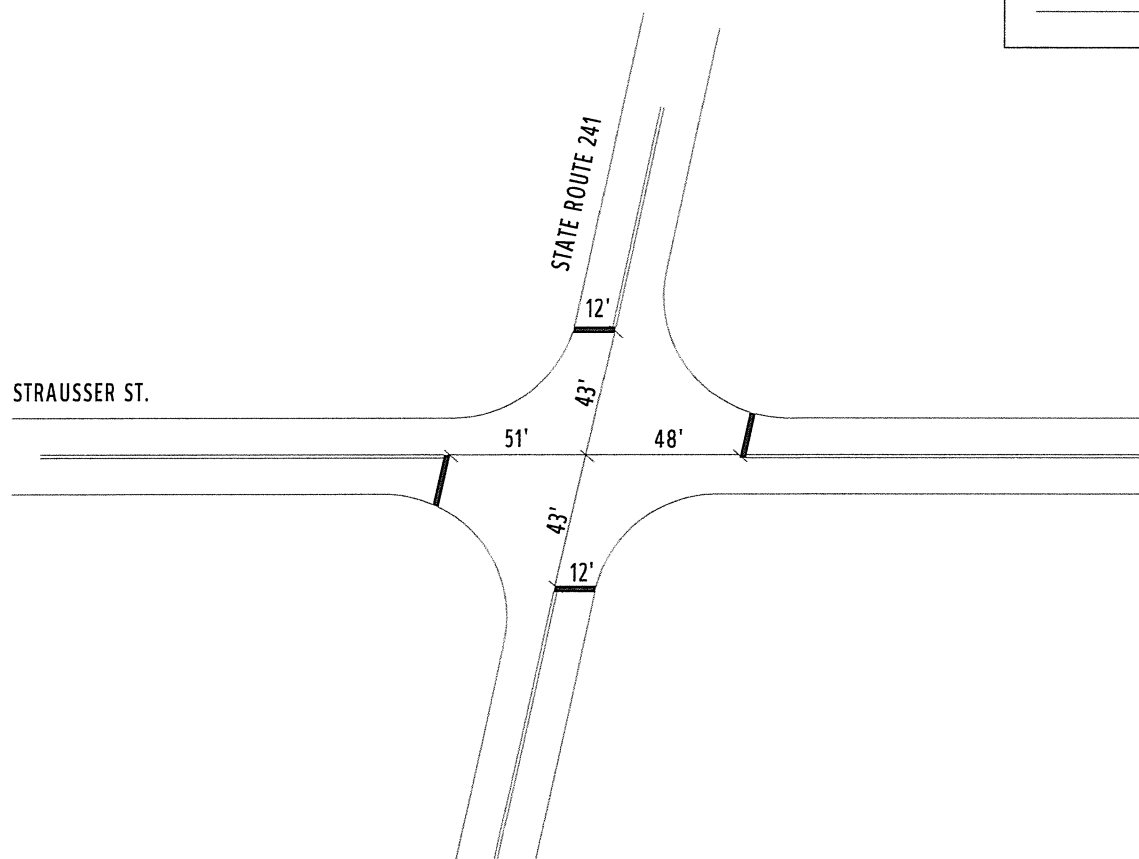

COUNTY:	STARK	
LOCATION:	S.R. 241 @ STRAUSSERS ST.	
S.L.M.:	16.604	
24" STOP LINE:	24	L.F.
12" CROSSWALK LINE:		L.F.
DOTTED LINE:		L.F.
8" CHANNELIZING LINE:		L.F.
12" CHANNELIZING LINE:		L.F.
24" TRANSVERSE LINE (WT):		L.F.
24" TRANSVERSE LINE (YW):		L.F.
SYMBOL:		