## MAINTENANCE OF TRAFFIC

THIS ITEM SHALL CONSIST OF MAINTENANCE OF TRAFFIC ON EXISTING ROADWAYS AND RAMPS IN ACCORDANCE WITH THE OHIO MANUAL OF UNIFORM TRAFFIC CONTROL DEVICES FOR STREETS AND HIGHWAYS, CURRENT EDITION, LATEST REVISION, THE SPECIFICATIONS AND THE FOLLOWING:

1. ON 2 AND 3 LANE SECTIONS: A MINIMUM OF ONE TEN FOOT BIDIRECTIONAL LANE SHALL BE MAINTAINED ON THE EXISTING AND COMPLETED PAVEMENT DURING CONSTRUCTION OF THE WORK.

2. THE CONTRACTOR SHALL INFORM THE DISTRICT OFFICE (330) 786-2208, EIGHTEEN (18) DAYS PRIOR TO THE BEGINNING OF WORK.

3. UNDER NO CIRCUMSTANCES SHALL THE CONTRACTOR BE PERMITTED TO HAVE SUCCESSIVE WORK ZONES UNLESS THE DISTANCE BETWEEN THE DRUMS, BARRICADES OR CONES EXCEEDS ONE (1) MILE.

4. ONLY DURING OFF-PEAK PERIODS (ie ANY PERIOD OTHER THAN 6-8AM AND 3-6PM) SHALL THE CONTRACTOR INSTALL AND SUBSEQUENTLY RESET ALL TRAFFIC CONTROL NECESSARY FOR THE WORK ZONE FOR EACH CONSTRUCTION PHASE.

5. IN ADDITION TO THE REQUIREMENTS OF 614.11 WORK ZONE PAVEMENT MARKINGS, AT THE END OF EACH DAY OF WORK, THE CONTRACTOR SHALL REPLACE (WITH WORK ZONE MARKINGS) ALL LANE, CENTER, STOP OR CHANNELIZING LINES THAT WERE REMOVED OR COVERED DURING THE PAVEMENT REMOVAL OR PLACEMENT OPERATIONS. QUANTITIES FOR SUCH PLACEMENT ARE CARRIED AS PART OF THE ITEMS LISTED UNDER 614 WORK ZONE PAVEMENT MARKINGS.

6. A QUANTITY OF 10 CU. YDS. OF ITEM 614 ASPHALT CONCRETE FOR MAINTAINING TRAFFIC SHALL BE PROVIDED FOR USE IN MAINTAINING PAVEMENT, SHOULDERS AND OTHER LOCATIONS AS DIRECTED BY THE ENGINEER.


7. PRIOR TO OPENING TO TRAFFIC EACH LANE SHALL BE IN A SAFE, PASSABLE CONDITION. ALL TRANSVERSE JOINTS SHALL EXTEND ACROSS THE FULL LANE AND SHOULDER WIDTH AND EACH LANE SHALL BE FREE FROM UNEVEN LONGITUDINAL JOINTS. THE CONTRACTOR SHALL PROVIDE ASPHALT WEDGES FOR TRANSVERSE JOINTS WHEREVER THERE ARE PAVEMENT ELEVATION DIFFERENCES.

8. THE CONTRACTOR SHALL PLACE THE SIGNS: W8-1 [BUMP] PER OMUTCD 2C.28; AND W8-11 [UNEVEN LANES] PER OMUCTD 6F.45. PAYMENT FOR THESE SIGNS SHALL BE INCIDENTAL TO THE LUMP SUM ITEM 614-MAINTAINING TRAFFIC. A QUANTITY OF ITEM 614 WORK ZONE MARKING SIGNS HAS BEEN INCLUDED IN THE PLANS PER CMS 614.04.

#### ADVANCED NOTICE TO PAVE

THE CONTRACTOR SHALL SUBMIT FOR APPROVAL TO THE DISTRICT CONSTRUCTION ENGINEER A DETAILED SCHEDULE 15 DAYS PRIOR TO THE PLACEMENT OF THE OVERLAY COURSES, ON HOW THEY PROPOSE TO PROSECUTE THE PAVING OPERATIONS. THE DETAILS SHALL SHOW THE ORDER OF PERFORMANCE OF EACH STAGE (START TO FINISH) OF THE WORK INCLUDING THE MAINTENANCE OF TRAFFIC THAT WILL BE USED. THE FOLLOWING QUANTITIES SHALL BE USED FOR THE MAIN-TENANCE OF TRAFFIC ON THIS PROJECT:

### SR 44

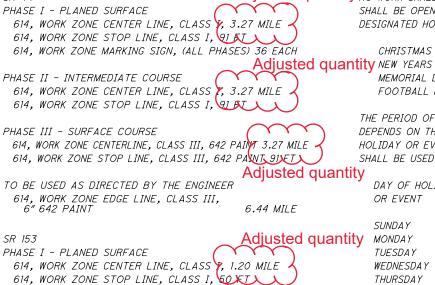

PHASE III - SURFACE COURSE 614, WORK ZONE CENTERLINE, CLASS III, 642 PAINT 1.20 MILE 614, WORK ZONE STOP LINE, CLASS III, 642 PAINT 50 FT

TO BE USED AS DIRECTED BY THE ENGINEER 614, WORK ZONE EDGE LINE, CLASS III, 6" 642 PAINT 1.73 MILE

614, WORK ZONE MARKING SIGN, (ALL PHASES) 36 EACH

#### TIME LIMITATION, TRAFFIC ON A MILLED SURFACE

THE MAXIMUM ALLOWABLE TIME FOR TRAFFIC TO BE PLACED ON A MILLED SURFACE SHALL BE 7 CONSECUTIVE CALENDAR DAYS. SHOULD THE CONTRACTOR FAIL TO MEET THIS REQUIREMENT, THE CONTRACTOR SHALL BE ASSSESSED A DISINCENTIVE IN THE AMOUNT OF \$1500 PER DAY THAT THE TRAFFIC IS PLACED ON A MILLED SURFACE BEYOND THE SPECIFIED LIMT. ITEM 614, MAINTAINING TRAFFIC (LANES OPEN DURING HOLIDAYS OR SPECIAL EVENTS)

Adjusted quantity NO WORK SHALL BE PERFORMED AND ALL EXISTING LANES SHALL BE OPEN TO TRAFFIC DURING THE FOLLOWING DESIGNATED HOLIDAYS OR EVENTS:

> CHRISTMAS FOURTH OF JULY ity NEW YEARS LABOR DAY MEMORIAL DAY THANKSGIVING FOOTBALL HALL OF FAME FESTIVITIES

THE PERIOD OF TIME THAT THE LANES ARE TO BE OPEN DEPENDS ON THE DAY OF THE WEEK ON WHICH THE HOLIDAY OR EVENT FALLS. THE FOLLOWING SCHEDULE SHALL BE USED TO DETERMINE THIS PERIOD:

DAY OF HOLIDAY TIME ALL LANES OR EVENT MUST BE OPEN TO TRAFFIC

SUNDAY12:00N FRIDAY THROUGH 6:00AM MONDAYMONDAY12:00N FRIDAY THROUGH 6:00AM TUESDAYTUESDAY12:00N MONDAY THROUGH 6:00AM WEDNESDAYWEDNESDAY12:00N TUESDAY THROUGH 6:00AM THURSDAYTHURSDAY12:00N WEDNESDAY THROUGH 6:00AM FRIDAYTHURSDAY12:00N WEDNESDAY THROUGH 6:00AM FRIDAYTHURSDAY(THANKSGIVING ONLY)

6:00AM WEDNESDAY THROUGH 6:00AM MONDAY FRIDAY 12:00N THURSDAY THROUGH 6:00AM MONDAY SATURDAY 12:00N FRIDAY THROUGH 6:00AM MONDAY Adjusted quantity

> SHOULD THE CONTRACTOR FAIL TO MEET ANY OF THESE REQUIREMENTS, THE CONTRACTOR SHALL BE ASSESSED A DISINCENTIVE IN THE AMOUNT OF \$3000 FOR EACH HOUR THE ABOVE DESCRIBED LANE CLOSURE RESTRICTIONS ARE VIOLATED.

#### TRAFFIC CONTROL INSPECTOR

THE CONTRACTOR SHALL DESIGNATE AN INDIVIDUAL OTHER THAN THE SUPERINTENDENT AND SUBJECT TO THE APPROVAL OF THE ENGINEER, TO CONTINUOUSLY INSPECT ALL TRAFFIC CONTROL DEVICES WHENEVER CONSTRUCTION WORK IS BEING PERFORMED WITHIN THE WORK LIMITS OF THE PROJECT. THE DESIGNATED INDIVIDUAL SHALL ALSO INSPECT ALL TRAFFIC DEVICES AT THE BEGINNING AND AT THE END OF EACH WORK DAY. THE DESIGNATED INDIVIDUAL OR A QUALIFIED REP-RESENTATIVE SHALL ALSO BE AVAILABLE ON AN AROUND THE CLOCK BASIS TO REPAIR AND/OR REPLACE DAMAGED OR MISS-ING TRAFFIC CONTROL DEVICES. THESE INDIVIDUALS SHALL BE EQUIPPED WITH CELLULAR PHONES AND THEIR NAMES AND PHONE NUMBERS SHALL BE GIVEN TO THE PROJECT ENGINEER AT THE PRE-CONSTRUCTION MEETING. THE DESIGNATED INDIVIDUAL MAY HAVE OTHER CONSTRUCTION RELATED DUTIES AS LONG AS IMMEDIATE ATTENTION IS GIVEN TO TRAFFIC CONTROL. PAYMENT FOR THE SERVICES OF THE TRAFFIC CONTROL INSPECTOR SHALL BE INCLUDED IN THE LUMP SUM PRICE BID FOR ITEM 614 MAINTAINING TRAFFIC.

 $\bigcirc$ 

 $\bigcirc$ 

 $\bigcirc$ 

 $\bigcirc$ 

# NOTIFICATION OF TRAFFIC RESTRICTIONS

THROUGHOUT THE DURATION OF THE PROJECT, THE CONTRACTOR SHALL NOTIFY THE PROJECT ENGINEER IN WRITING OF ALL TRAFFIC RESTRICTIONS AND UPCOMING MAINTENANCE OF TRAFFIC CHANGES. THE CONTRACTOR SHALL ENSURE THE WRITTEN NOTIFICATION IS SUBMITTED IN A TIMELY MANNER TO ALLOW THE PROJECT ENGINEER TO MEET THE REQUIRED TIME FRAMES SET FORTH IN THE TABLE BELOW TO INFORM SPECIAL HAULING PERMITS SECTION (HAULING.PERMITS@DOT.OHIO.GOV) AND THE DISTRICT PUBLIC INFORMATION OFFICE (PIO). THIS NOTIFICATION SHALL BE RECEIVED BY THE PROJECT ENGINEER PRIOR TO THE PHYSICAL SETUP OF ANY APPLICABLE SIGNS OR MESSAGE BOARDS.

INFORMATION SHOULD INCLUDE, BUT IS NOT LIMITED TO, ALL CONSTRUCTION ACTIVITIES THAT IMPACT OR INTERFERE WITH TRAFFIC AND SHALL LIST THE SPECIFIC LOCATION, TYPE OF WORK, ROAD STATUS, DATE AND TIME OF RESTRICTION, DURATION OF RESTRICTION, NUMBER OF LANES MAINTAINED, NUMBER OF LANES CLOSED, MINIMUM VERTICAL CLEARANCE, MINIMUM WIDTH OF DRIVABLE PAVEMENT, DETOUR ROUTES, IF APPLICABLE, AND ANY OTHER INFORMATION REQUESTED BY THE PROJECT ENGINEER.

NOTIFICATION TIME TABLE								
ITEM	DURATION OF CLOSURE	NOTICE DUE TO PERMITS & PIO						
ROAD & RAMP	>= 2WEEKS	21 CALENDAR DAYS PRIOR TO CLOSURE						
CLOSURES	> 12 HOURS & < 2 WEEKS	14 CALENDAR DAYS PRIOR TO CLOSURE						
CLOSUKES	<12 HOURS	4 BUSINESS DAYS PRIOR TO CLOSURE						
	>=2 WEEKS	14 CALENDAR DAYS PRIOR TO CLOSURE						
LANE CLOSURES & RESTRICTIONS	< 2 WEEKS	2 BUSINESS DAYS PRIOR TO CLOSURE						
START OF								
CONSTRUCTION &	N/A	14 CALENDAR DAYS PRIOR TO IMPLEMENTATION						
TRAFFIC PATTERNS	N/A							
CHANGES								

ANY UNFORESEEN CONDITIONS NOT SPECIFIED IN THE PLANS REQUIRING TRAFFIC RESTRICTIONS SHALL ALSO BE REPORTED TO THE PROJECT ENGINEER USING THE NOTIFICATION TIME TABLE.

A S .8.

S

SHEET NUM.					PART. 01/S>2/P 02/S>2/B 03/STR/B 04/S>2/B				ITEM	ITEM	GRAND	UNIT							
	3	4	5	6	9	10	11	12	13		01/S>2/P V	02/S>2/B R	03/STR/B R	04/S>2/B R		EXT	TOTAL	UNIT	
	_			300							300				614	11110	300	HOUR	LAW ENFORCEMEN
			36								36				614	12460	36	EACH	WORK ZONE MARKI
	-	-	10	24							10				614 614	13000 18601	10 24	SNMT	ASPHALT CONCRET
			7.74								7.74	Adjus	ted qua	antity	614	21000	7.74	MILE	WORK ZONE CENTE
	_		4.47								4.47	) Adjus	ted qu	antity	614	21550	4.47	MILE	WORK ZONE CENTE
			8.17								<b>81</b> 232	X			614	22360	8.17	MILE	WORK ZONE EDGE WORK ZONE STOP
		-	232 141								141	Adjus	ted qua	antity	614 614	26000 26610	232 141	FT FT	WORK ZONE STOP
	_	_									LS				614	11000	LS		MAINTAINING TRAFF
											6				619	16010	6	MNTH	FIELD OFFICE, TYPE CONSTRUCTION LAY
	_										LS LS				623 624	10000 10000	LS LS		CONSTRUCTION LAY
															024	10000			MOBILIZATION
	_		_																
	-	+	_	1															
	-		_																
	_																		
	_																		
		-																	
	_	-																	
	_																		
	_																		
	-																		
	-		_																
		-	_																
	-																		
	-																		
	+	+	-	+	-														
				1															
	_		_		<u> </u>														

 $\bigcirc$ 

 $\bigcirc$ 

0

 $\bigcirc$ 

DESCRIPTION	SEE SHEET NO.	CALCULATED AJS CHECKED MJA
MAINTENANCE OF TRAFFIC NT OFFICER WITH PATROL CAR FOR ASSISTANCE		
KING SIGN		
EABLE MESSAGE SIGN, AS PER PLAN ER LINE, CLASS I	5	
ER LINE, CLASS III, 642 PAINT		
E LINE, CLASS III, 6", 642 PAINT P LINE, CLASS I		
LINE, CLASS III, 642 PAINT		
INCIDENTALS		
PE B		
YOUT STAKES AND SURVEYING		
		≻
		Ľ
		٩V
		2
		GENERAL SUMMARY
		SI
		R
		ш
		Z
		ш (5
		3
		44/153 VAR
		_ ~
		44/ VAR
		<b>∀</b> >
		SR .84/
		<sup>.</sup> ه
		T /
		S
		$\left(\begin{array}{c} 8\\ 95\end{array}\right)$
		25