


PIER 2 RIGHT (OUTSIDE)

OPTION A OR OPTION B PATCHING
SHOWN (SF) = 79

updated

updated

SFN		7706871
DESIGN AGENCY		
DESIGNER	CHECKER	
MJA	TJP	
REVIEWER		
TJP	10-03-23	
PROJECT ID		107247
SUBSET	TOTAL	
18	29	
SHEET	TOTAL	
P.23	34	


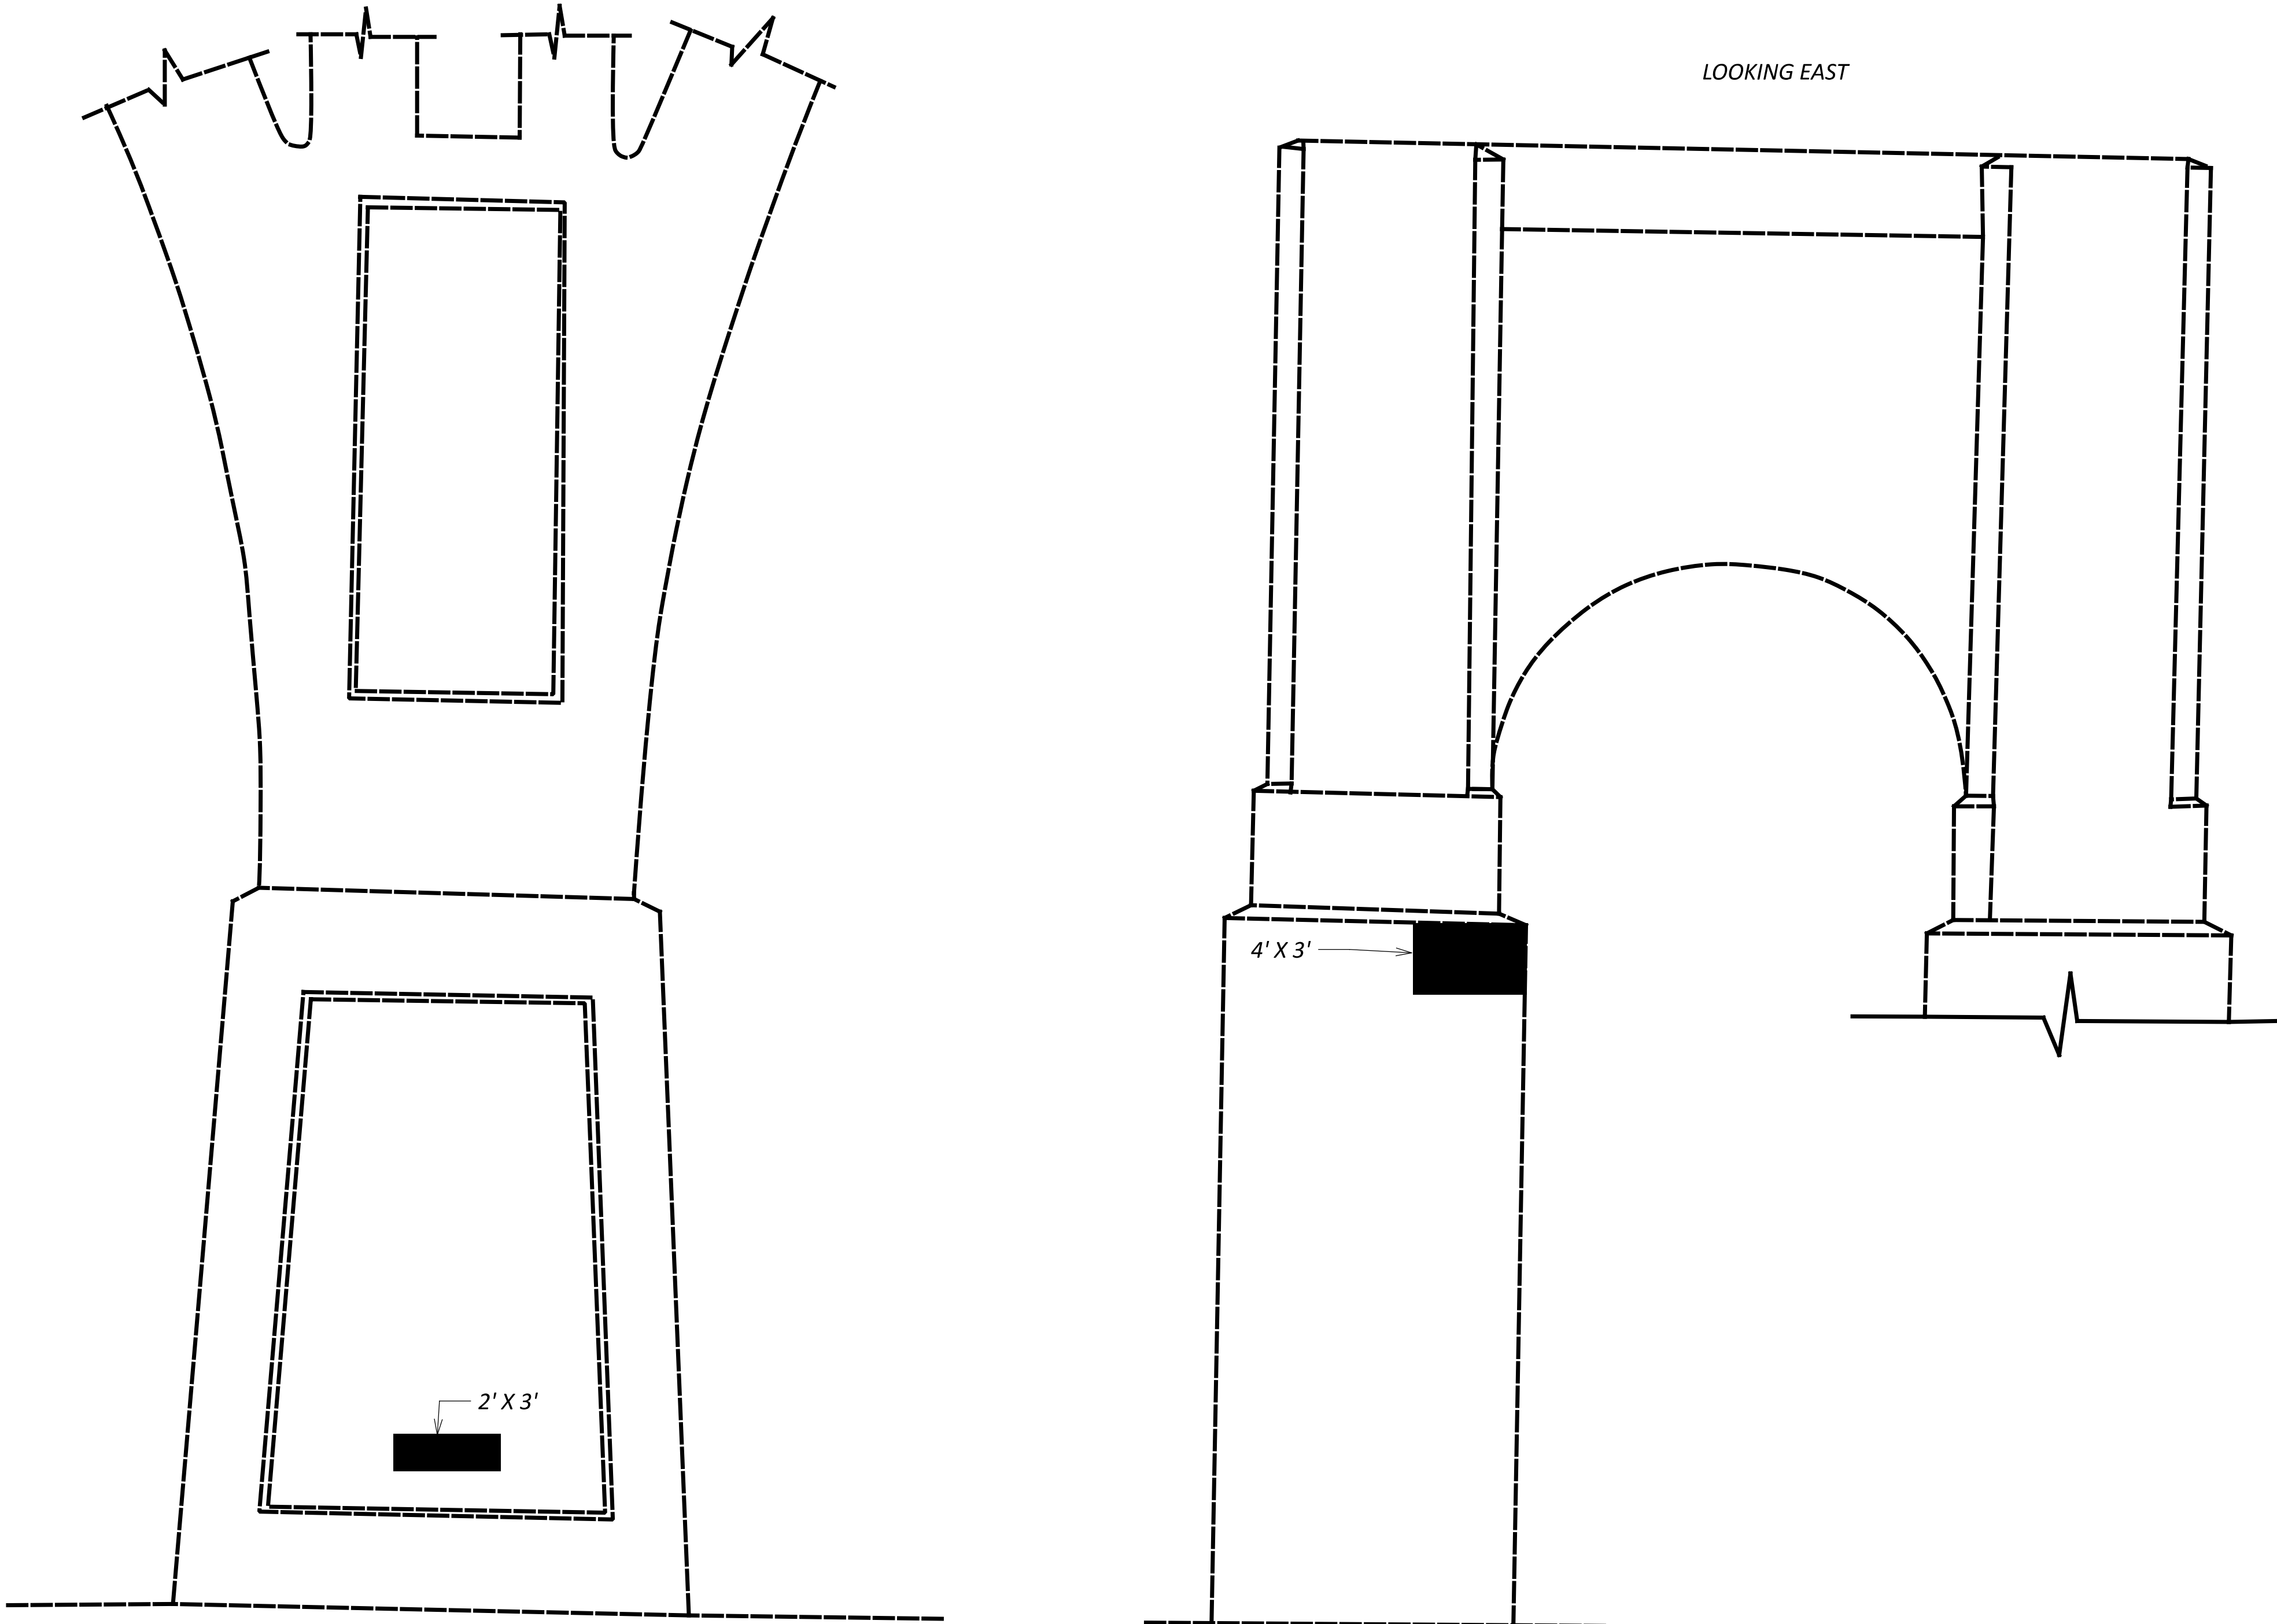


PIER 2 LEFT (OUTSIDE)
OPTION A OR OPTION B PATCHING
SHOWN (SF) = 18

updated

updated

SFN		7706871	
DESIGN AGENCY			
DESIGNER	MJA	CHECKER	TJP
REVIEWER		TJP	
PROJECT ID		107247	
SUBSET	19	TOTAL	29
SHEET	P.24	TOTAL	34

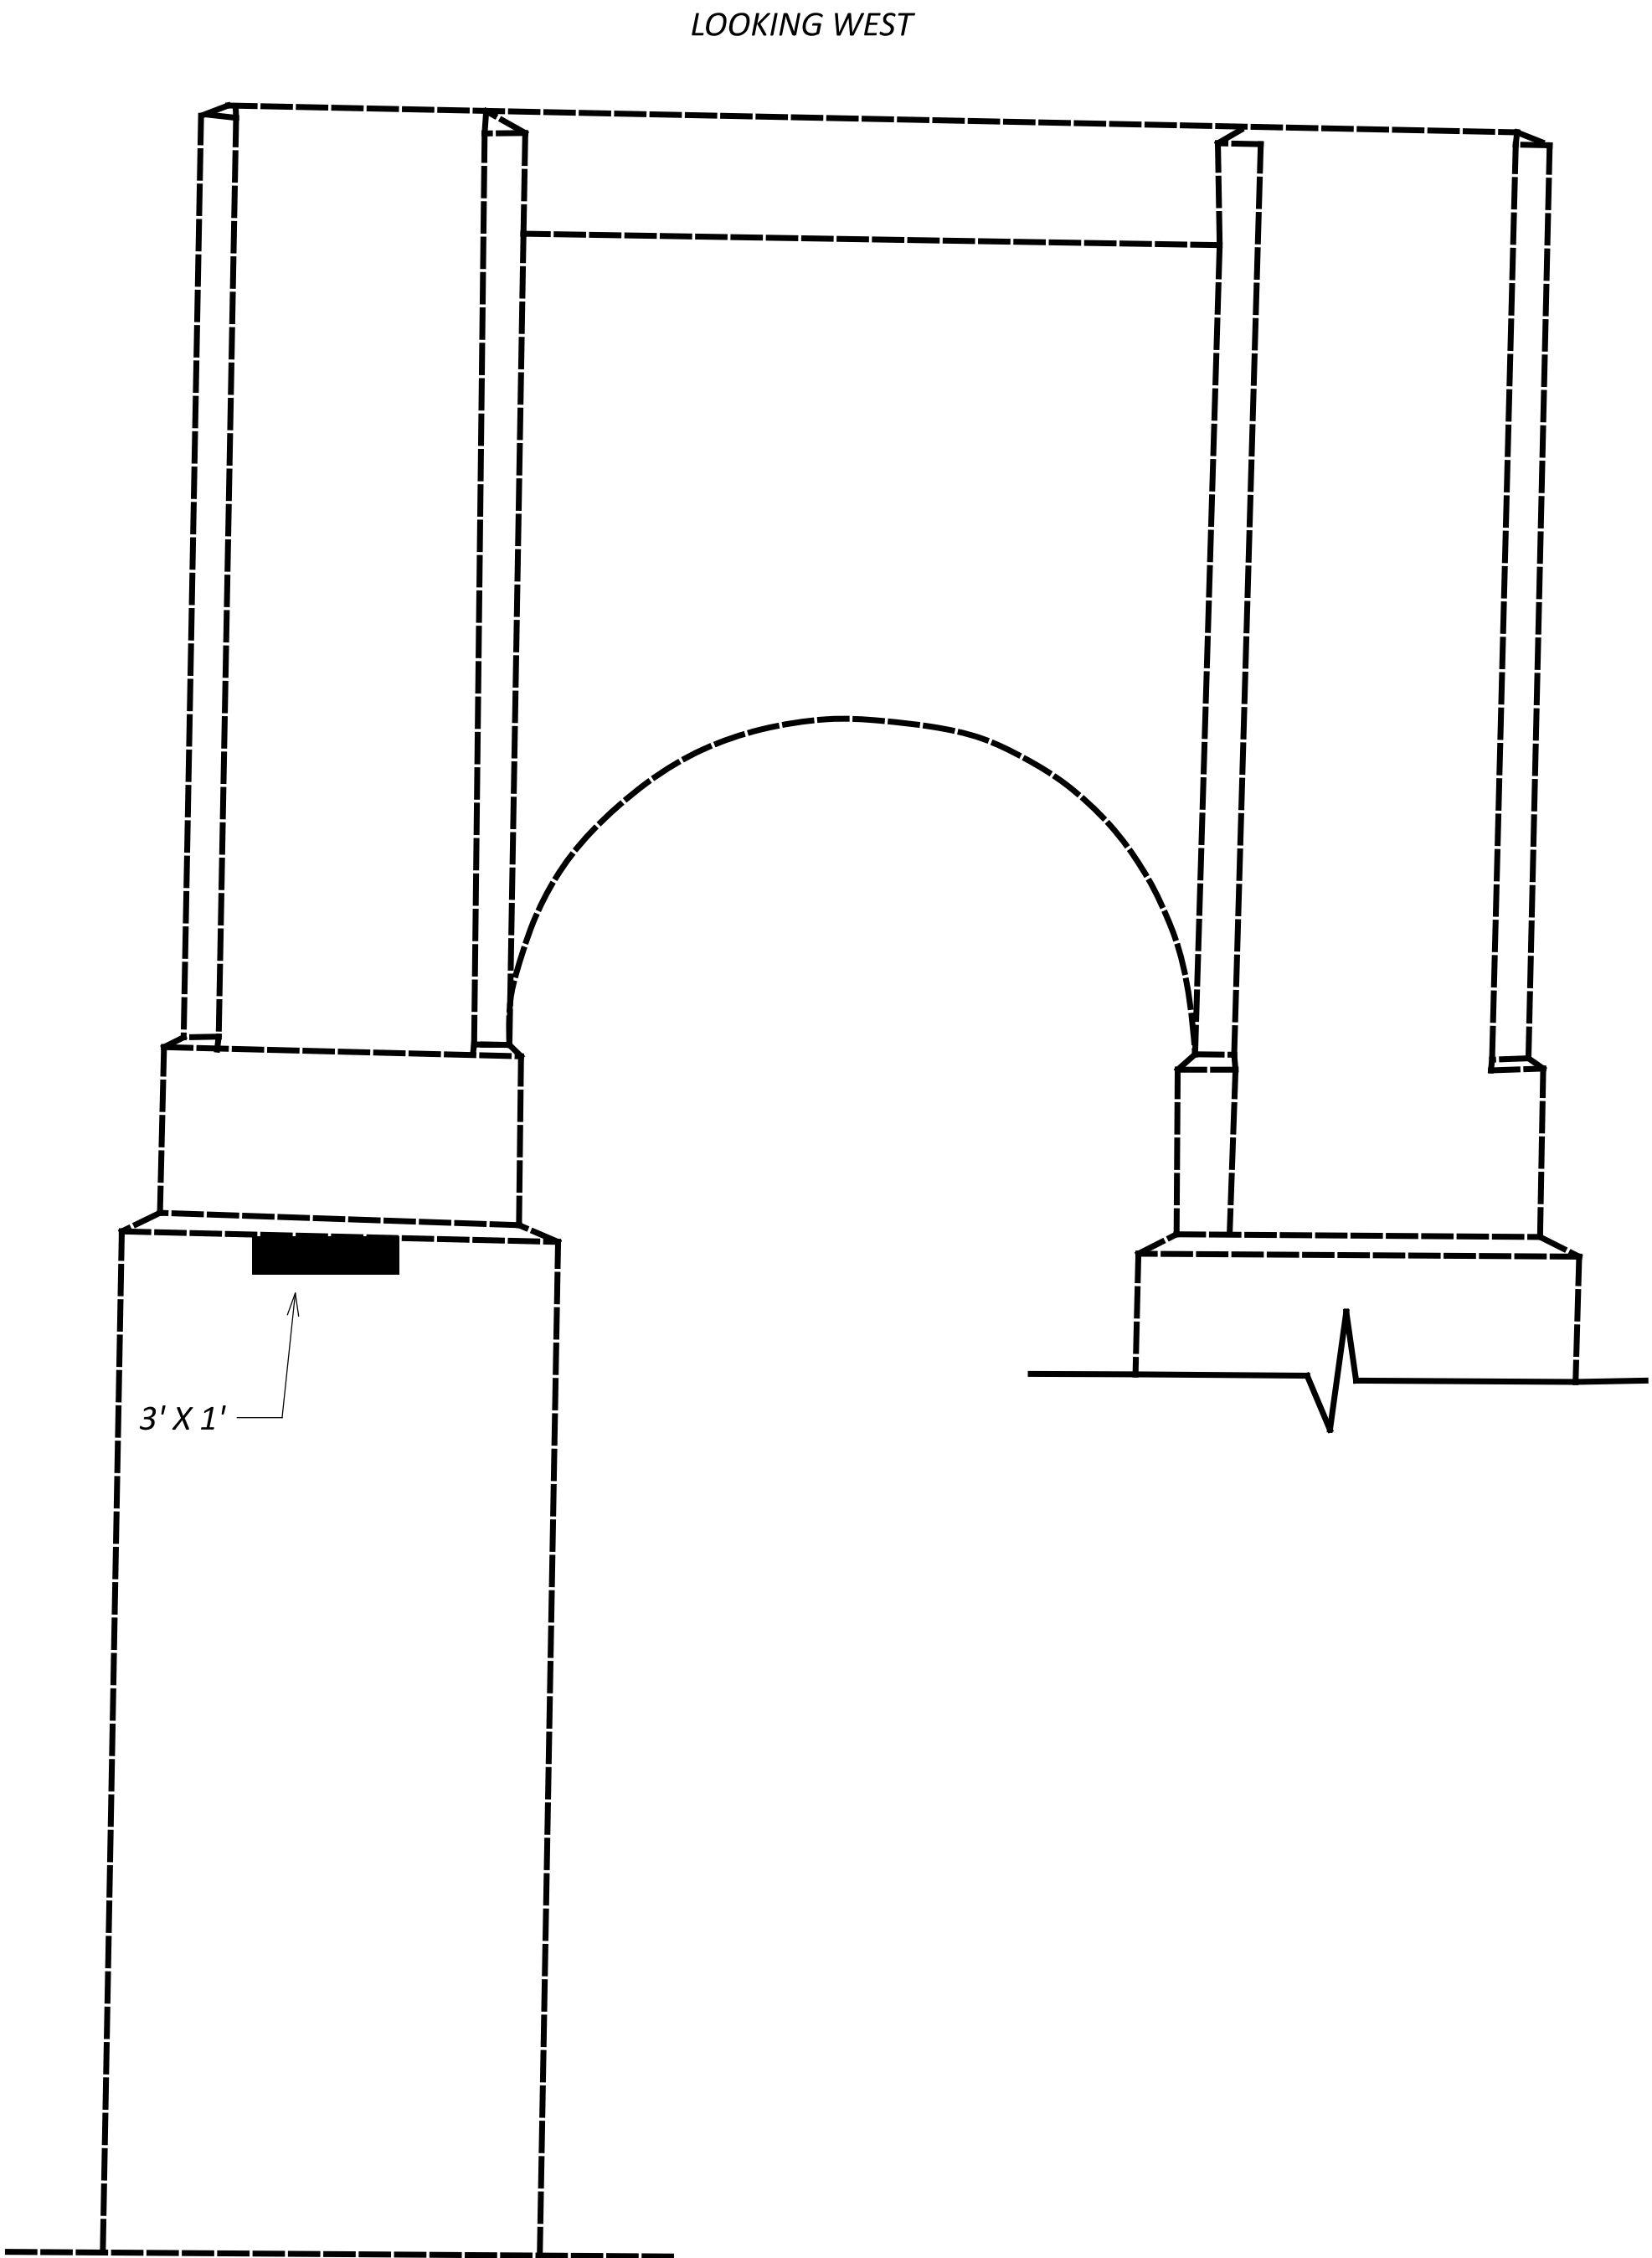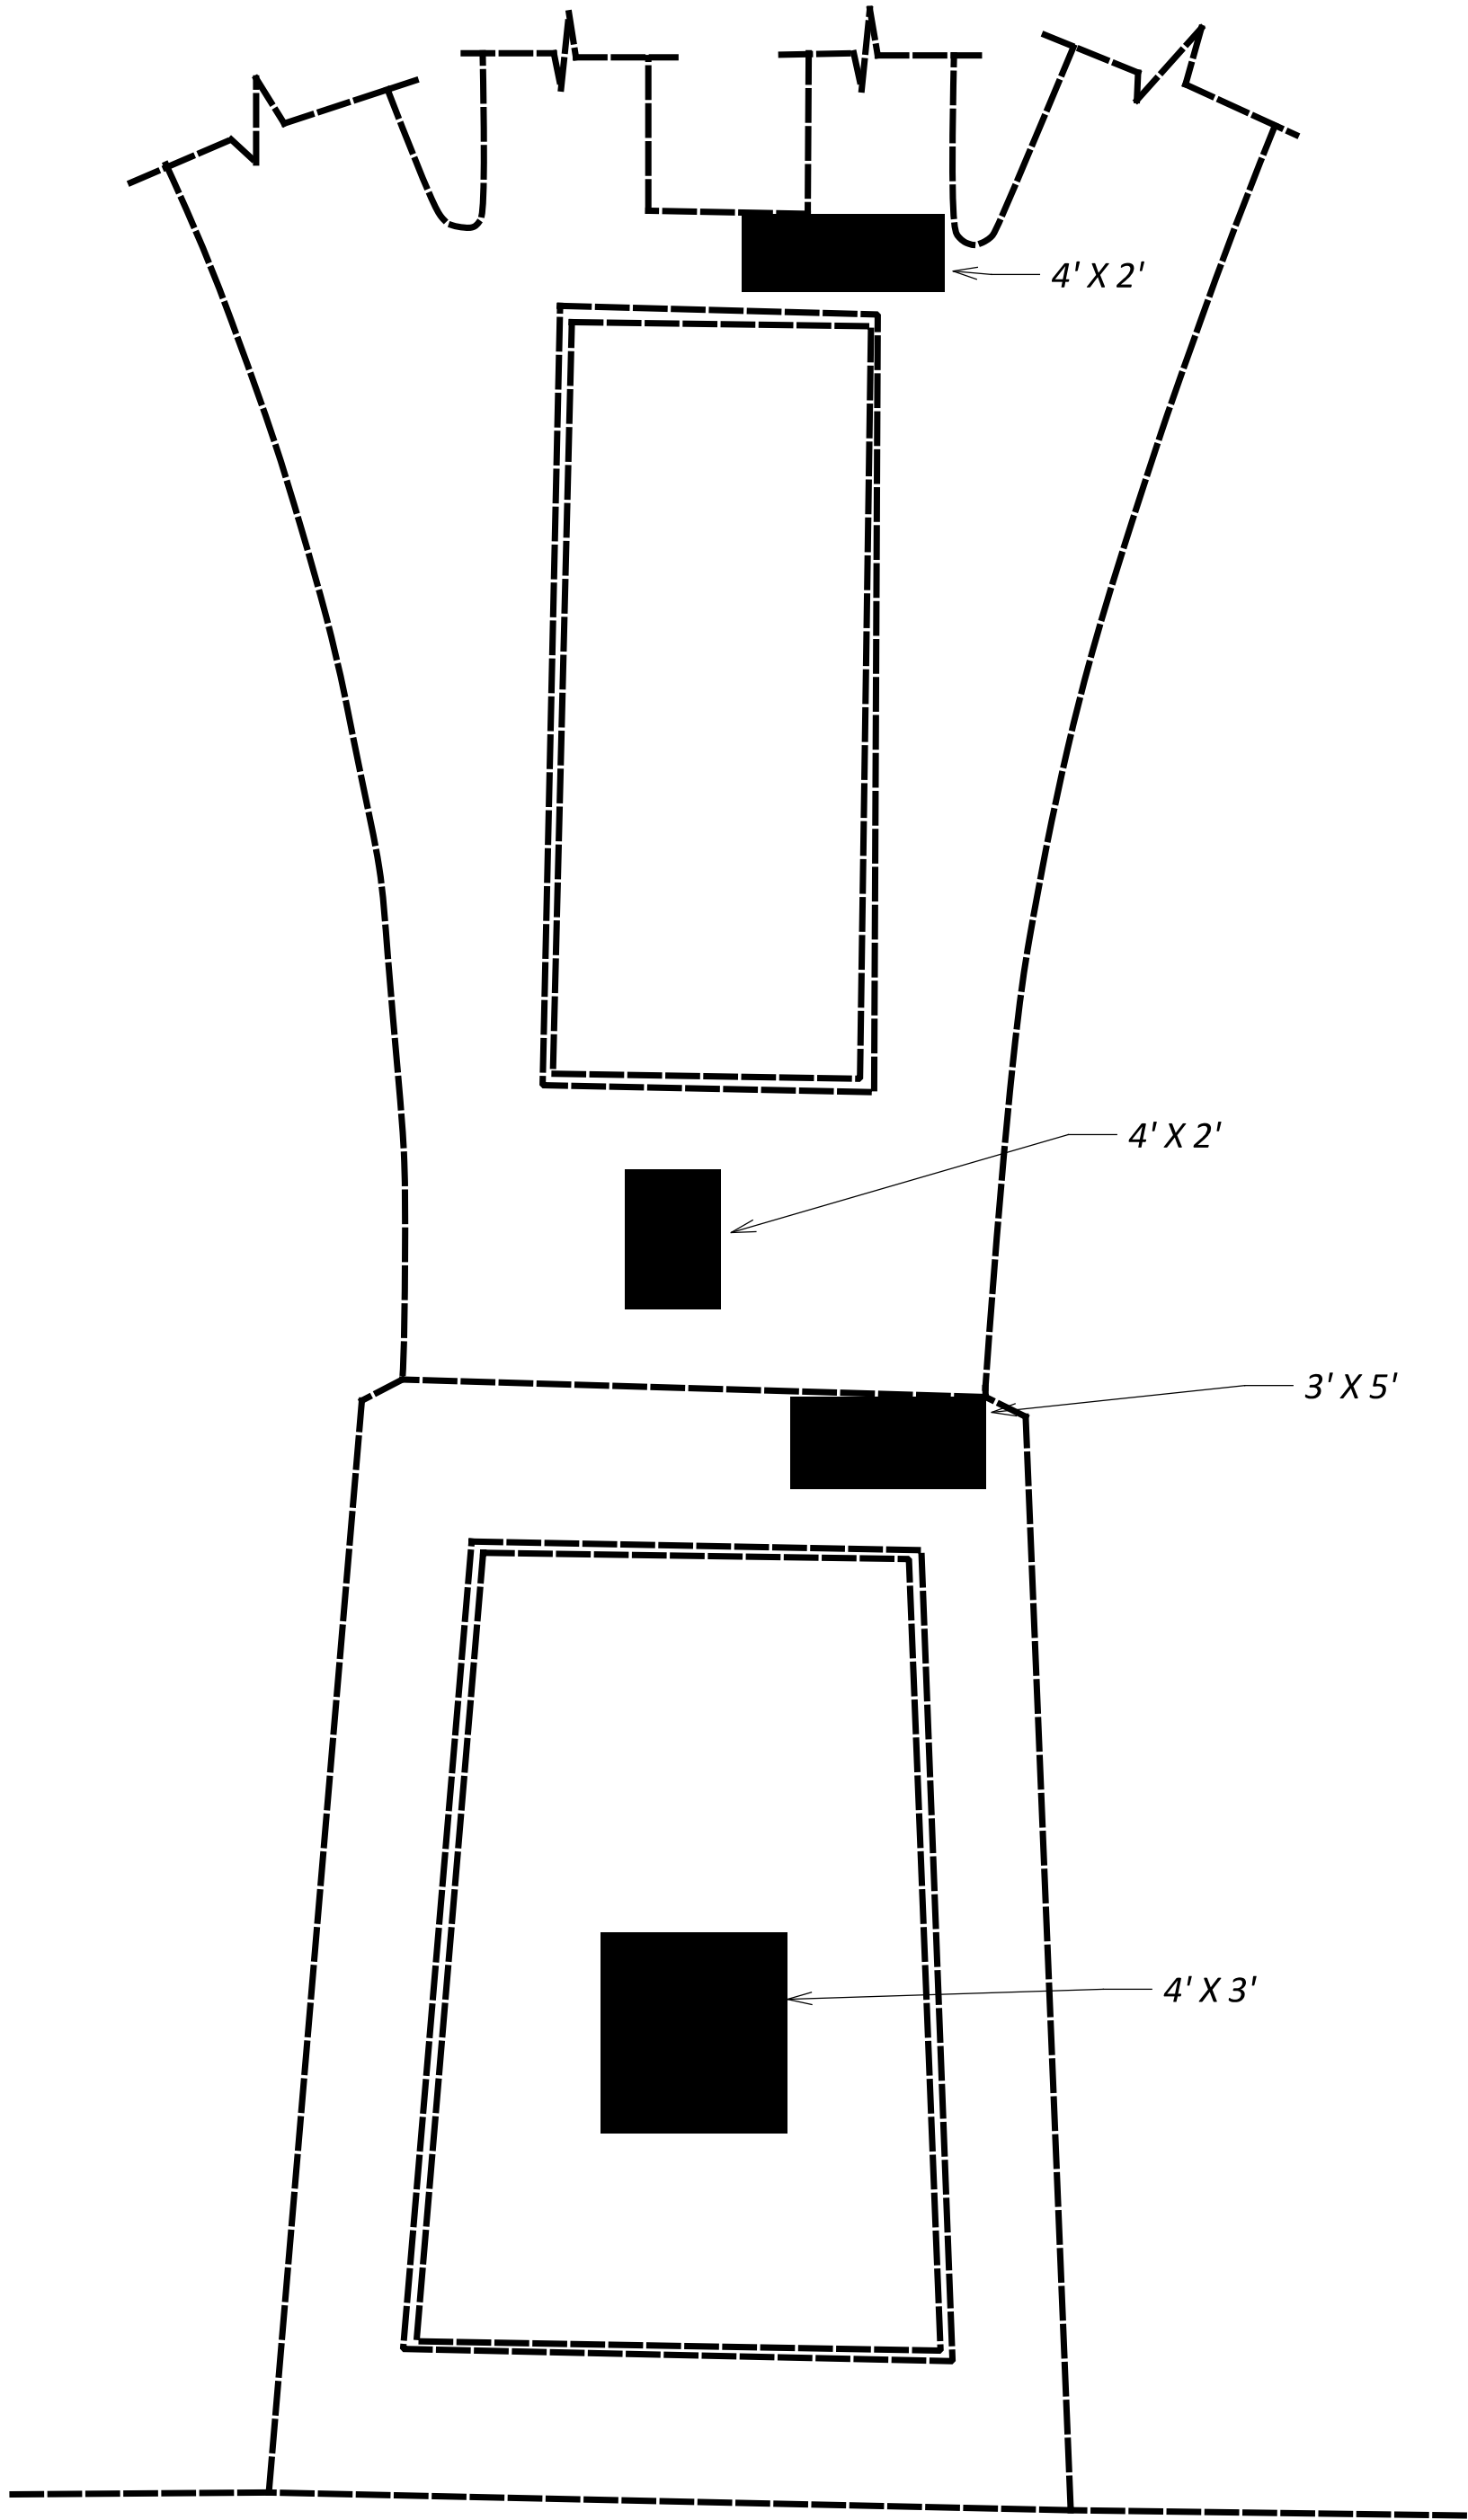

PIER 3 RIGHT (OUTSIDE)

OPTION A OR OPTION B PATCHING
SHOWN (SF) = 46

updated


updated

SFN		7706871	
DESIGNER		CHECKER	
MJA		TJP	
REVIEWER		PROJECT ID	
TJP		10-03-23	
SUBSET		TOTAL	
20		29	
SHEET		TOTAL	
R.25		34	

SUM-82-0000

STRUCTURE DETAILS

PIER 2 RIGHT (OUTSIDE)

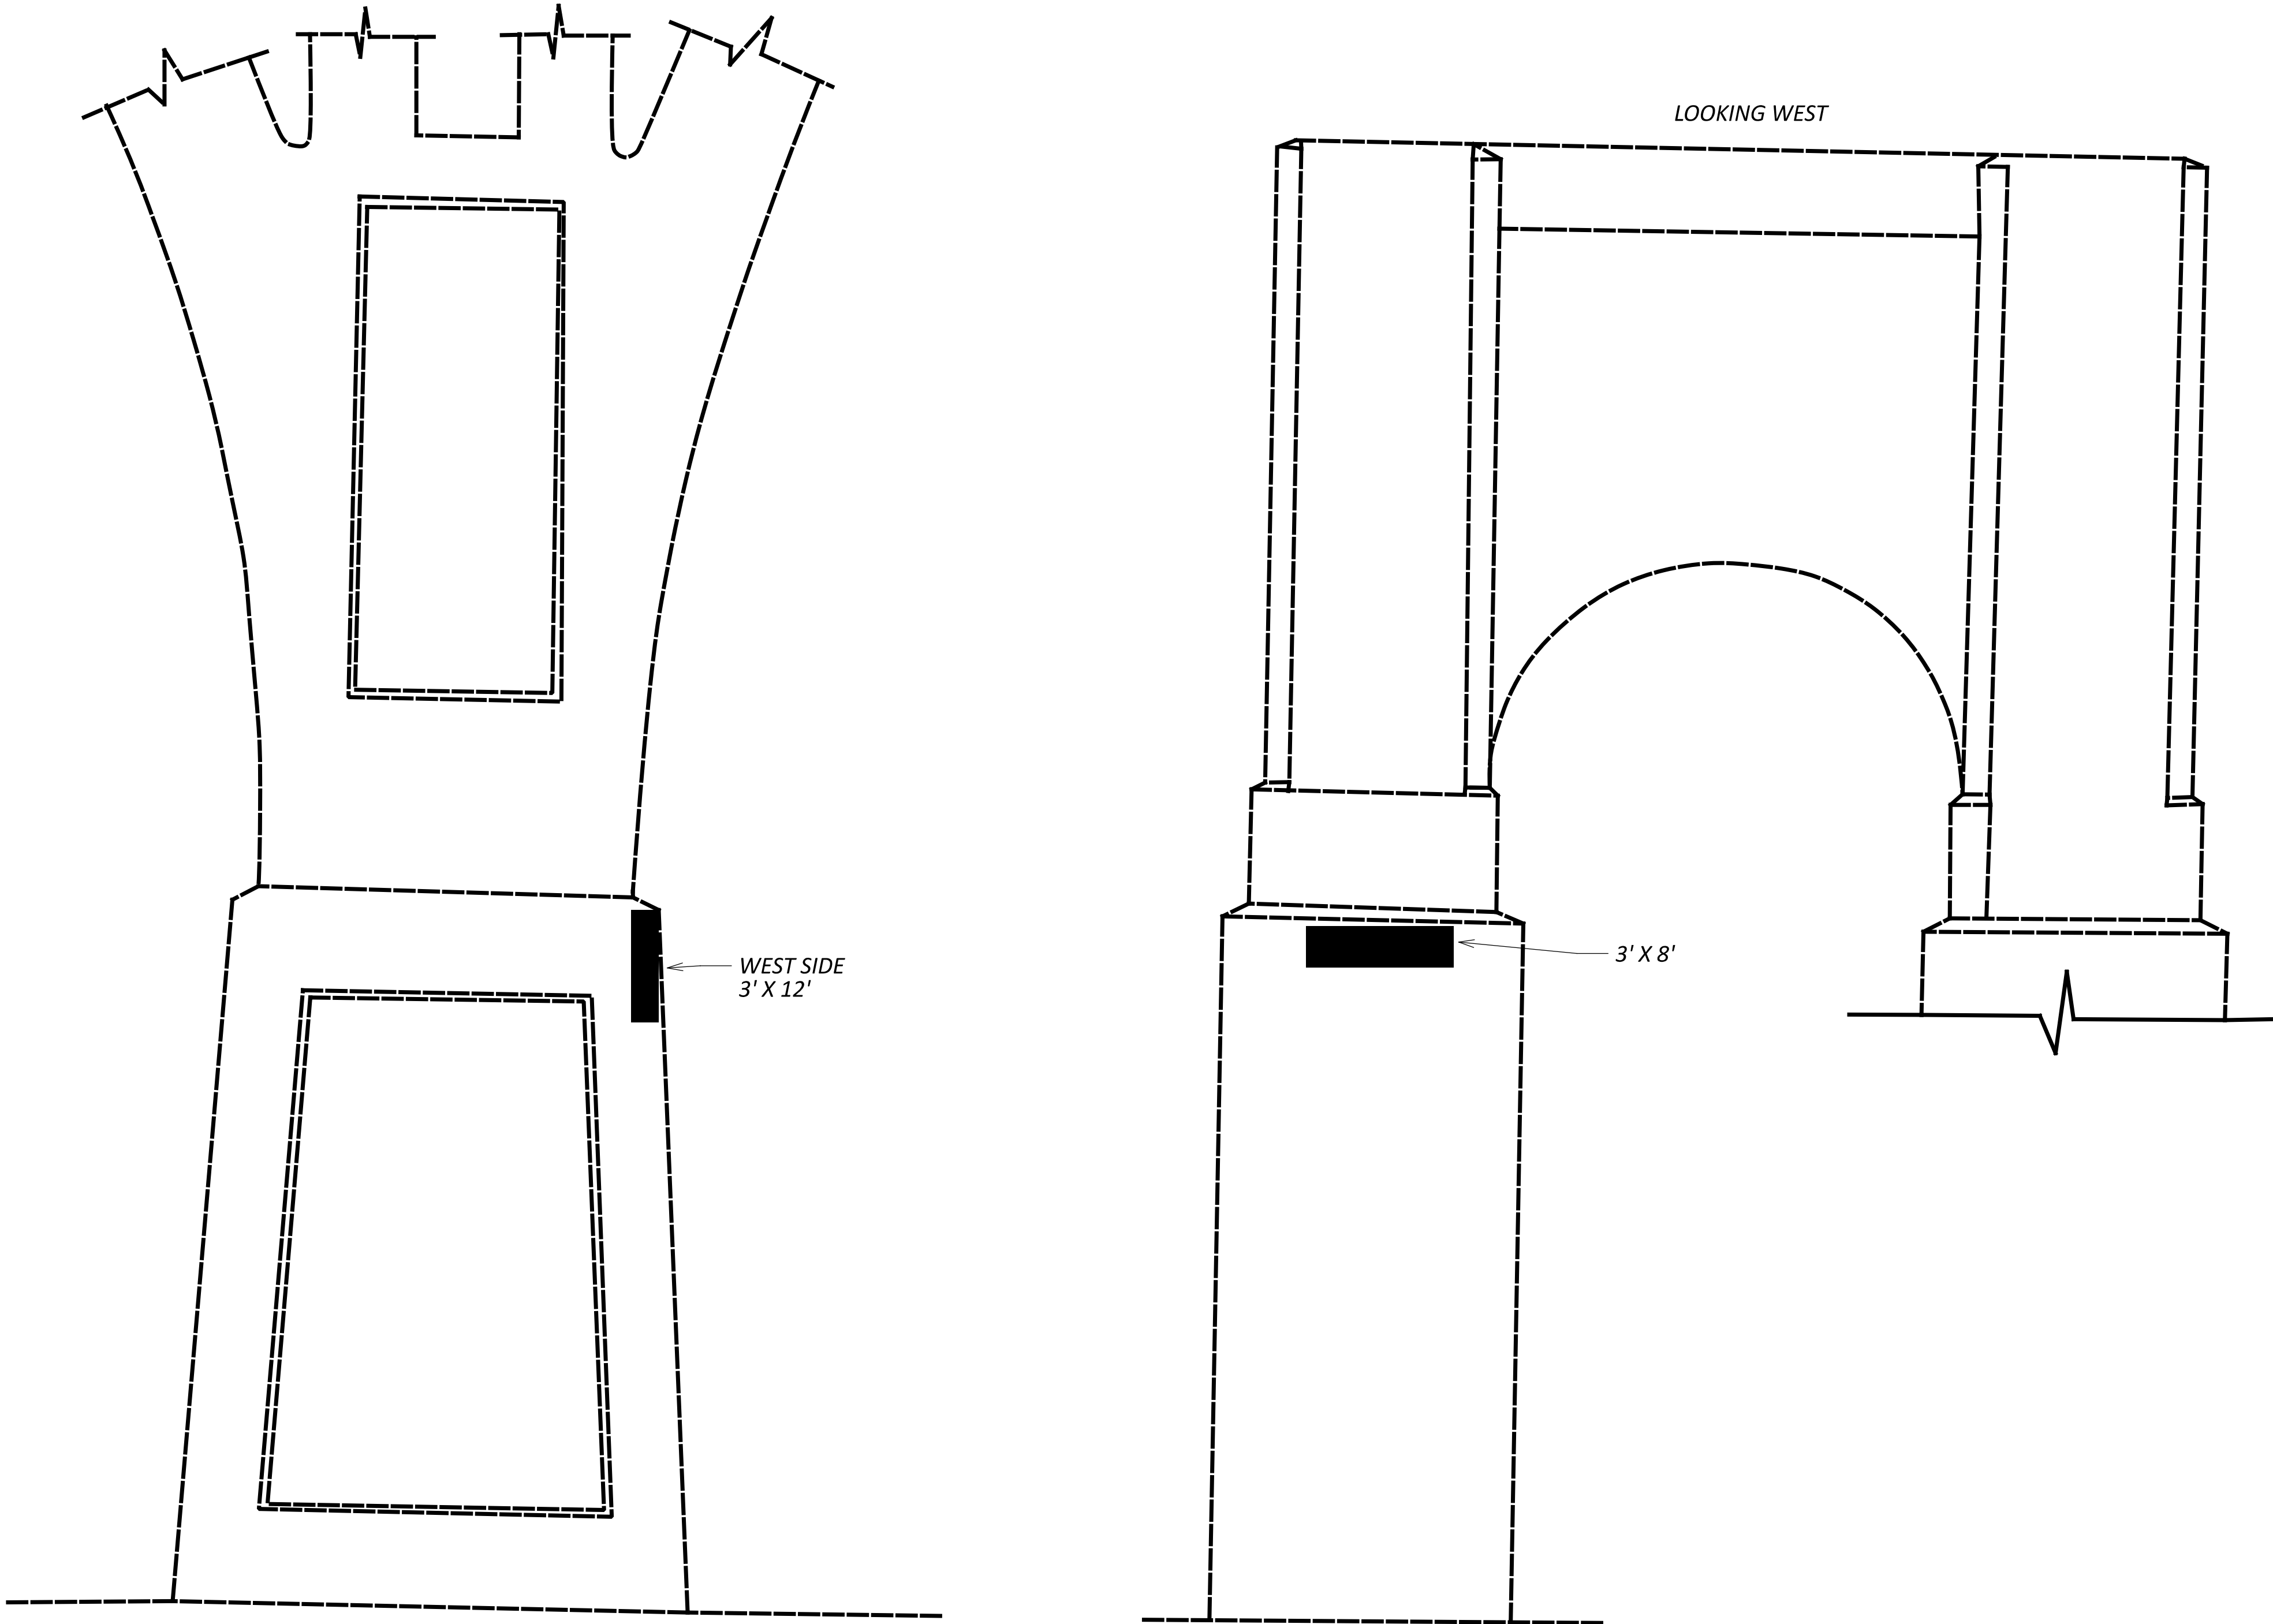

PIER 2 RIGHT (INSIDE)

OPTION A OR OPTION B PATCHING
SHOWN (SF) = 60

updated


SFN		7706871
DESIGN AGENCY		
DESIGNER	CHECKER	
MJA	TJP	
REVIEWER		
TJP	10-03-23	
PROJECT ID		107247
SUBSET	TOTAL	
21	29	
SHEET	TOTAL	
P.26	34	

updated

SUM-82-0000

STRUCTURE DETAILS

PIER 2 RIGHT (INSIDE)

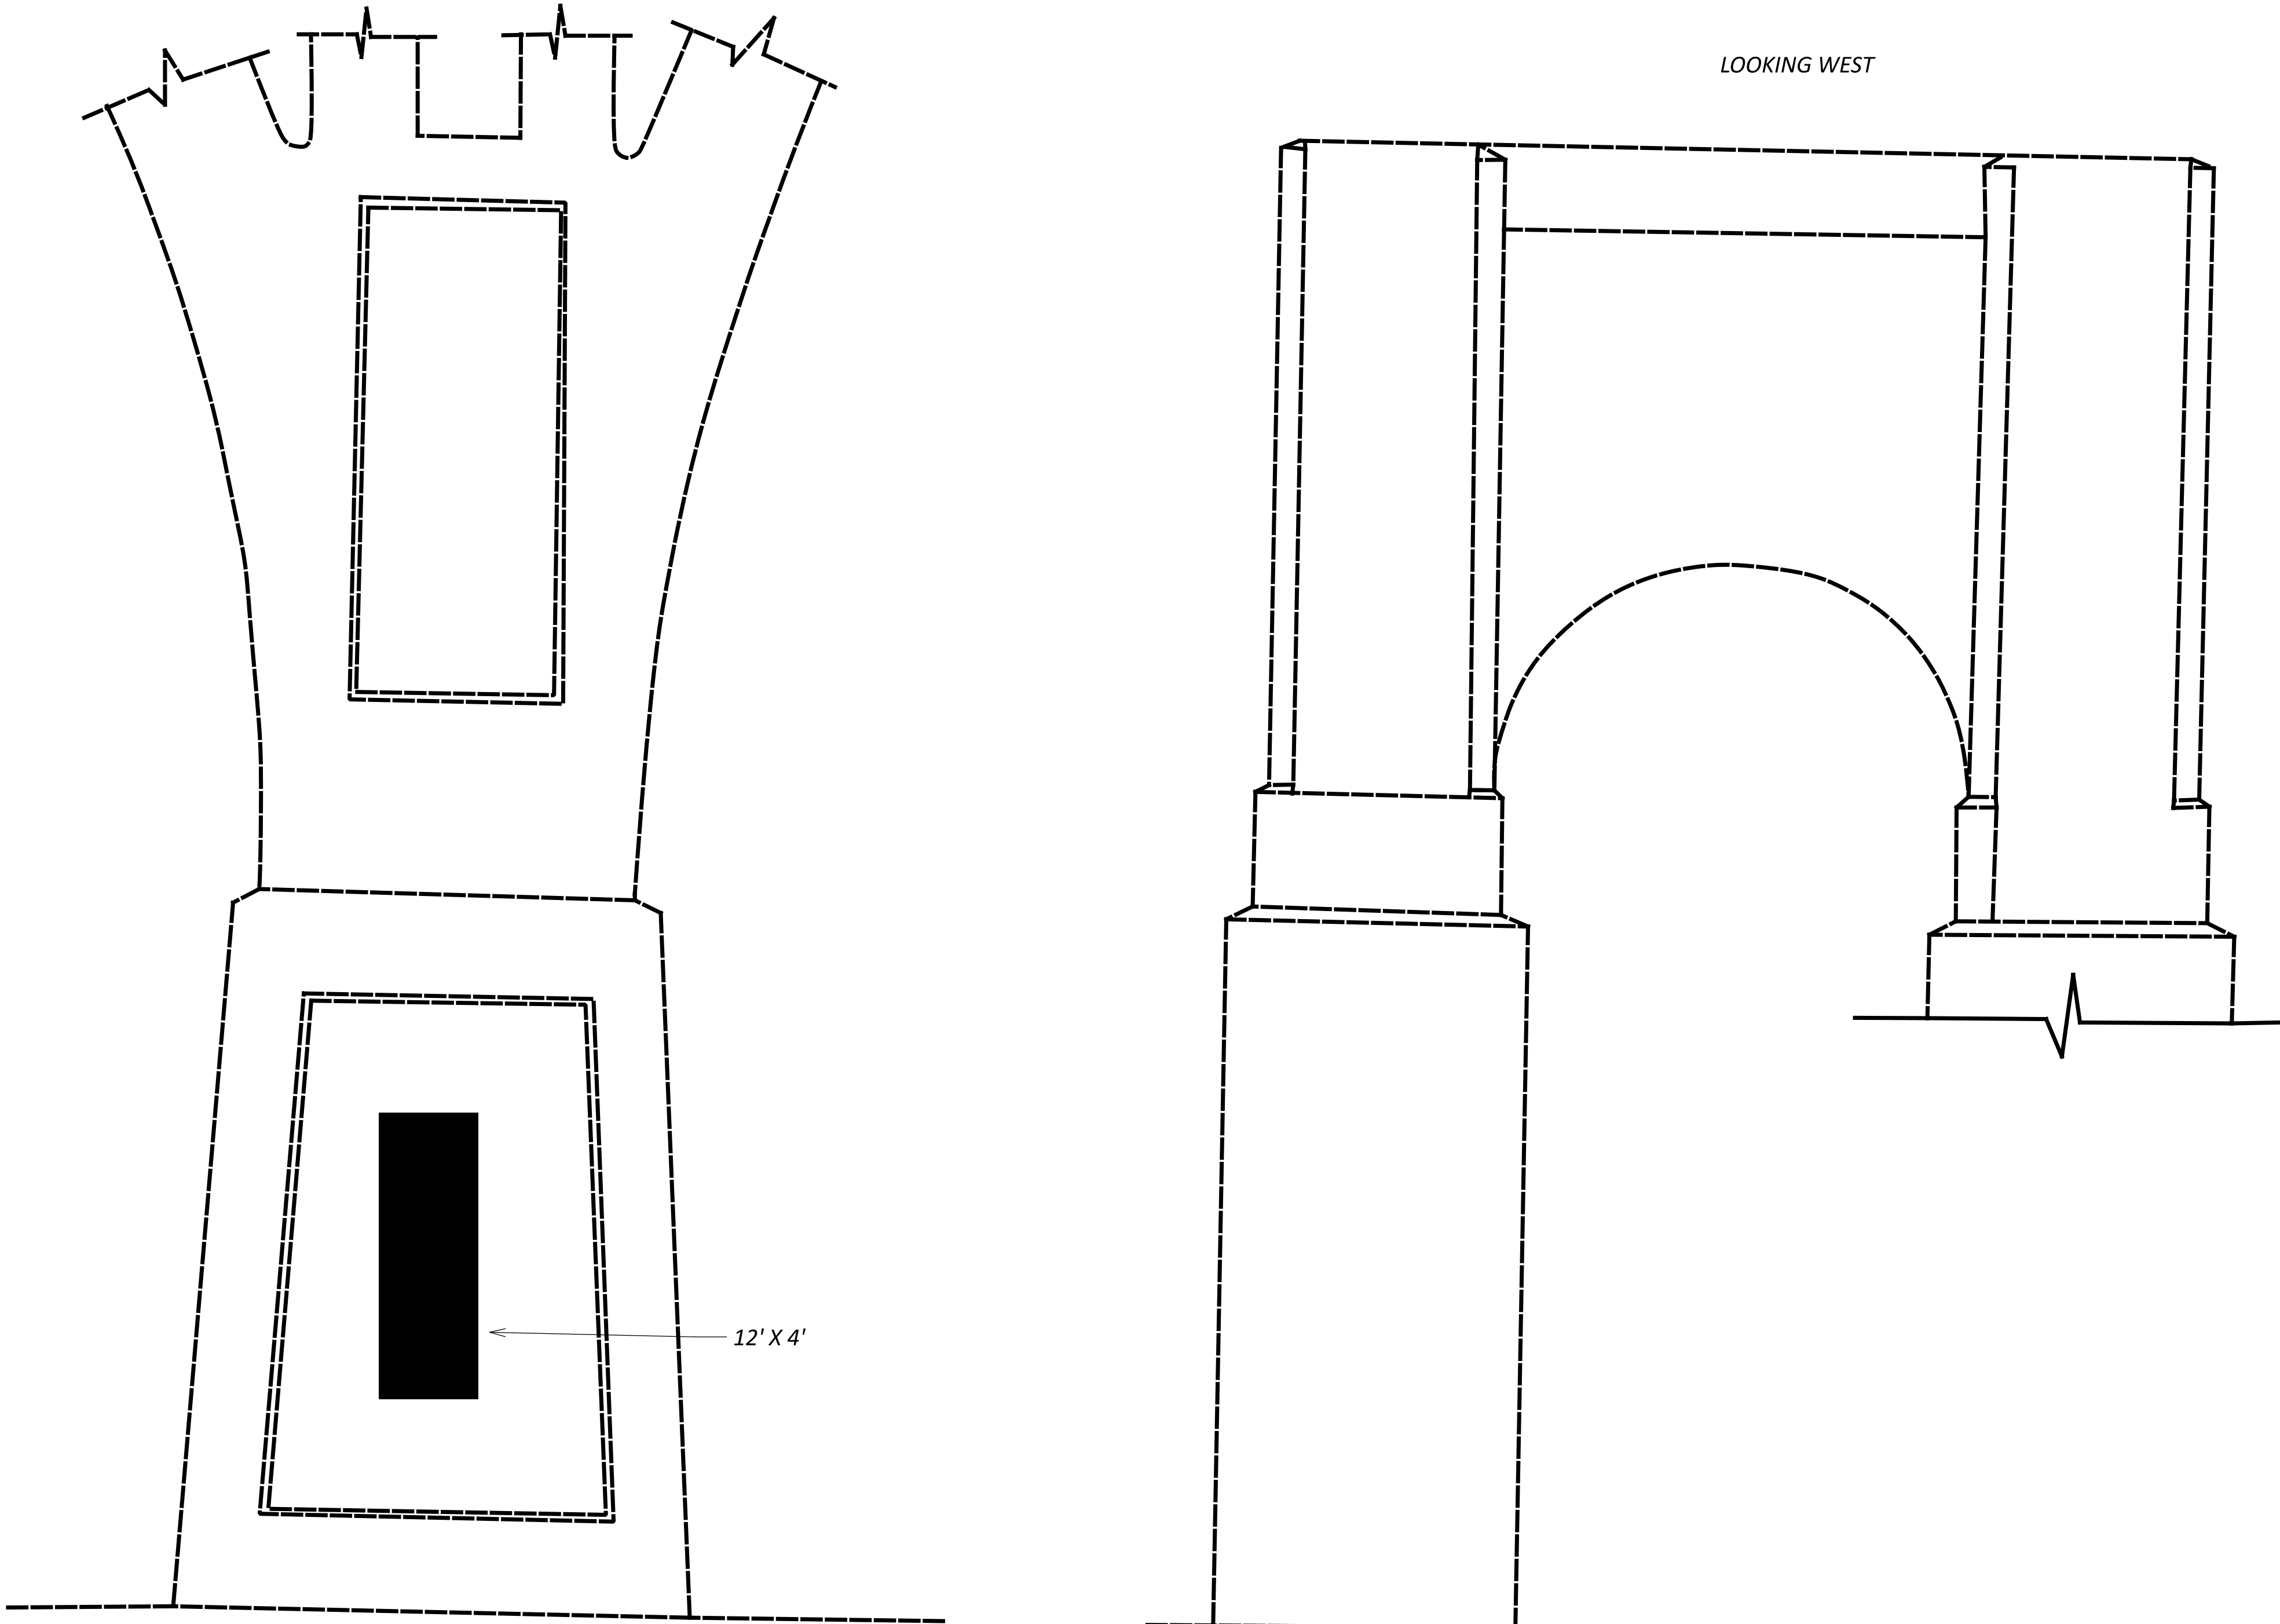

PIER 3 LEFT (OUTSIDE)

OPTION A OR OPTION B PATCHING
SHOWN (SF) = 48

updated



updated

SFN		7706871	
DESIGNER		CHECKER	
MJA		TJP	
REVIEWER		PROJECT ID	
TJP		107247	
SUBSET		TOTAL	
22		29	
SHEET		TOTAL	
P.27		34	

SUM-82-0000

STRUCTURE DETAILS

PIER 2 LEFT (OUTSIDE)

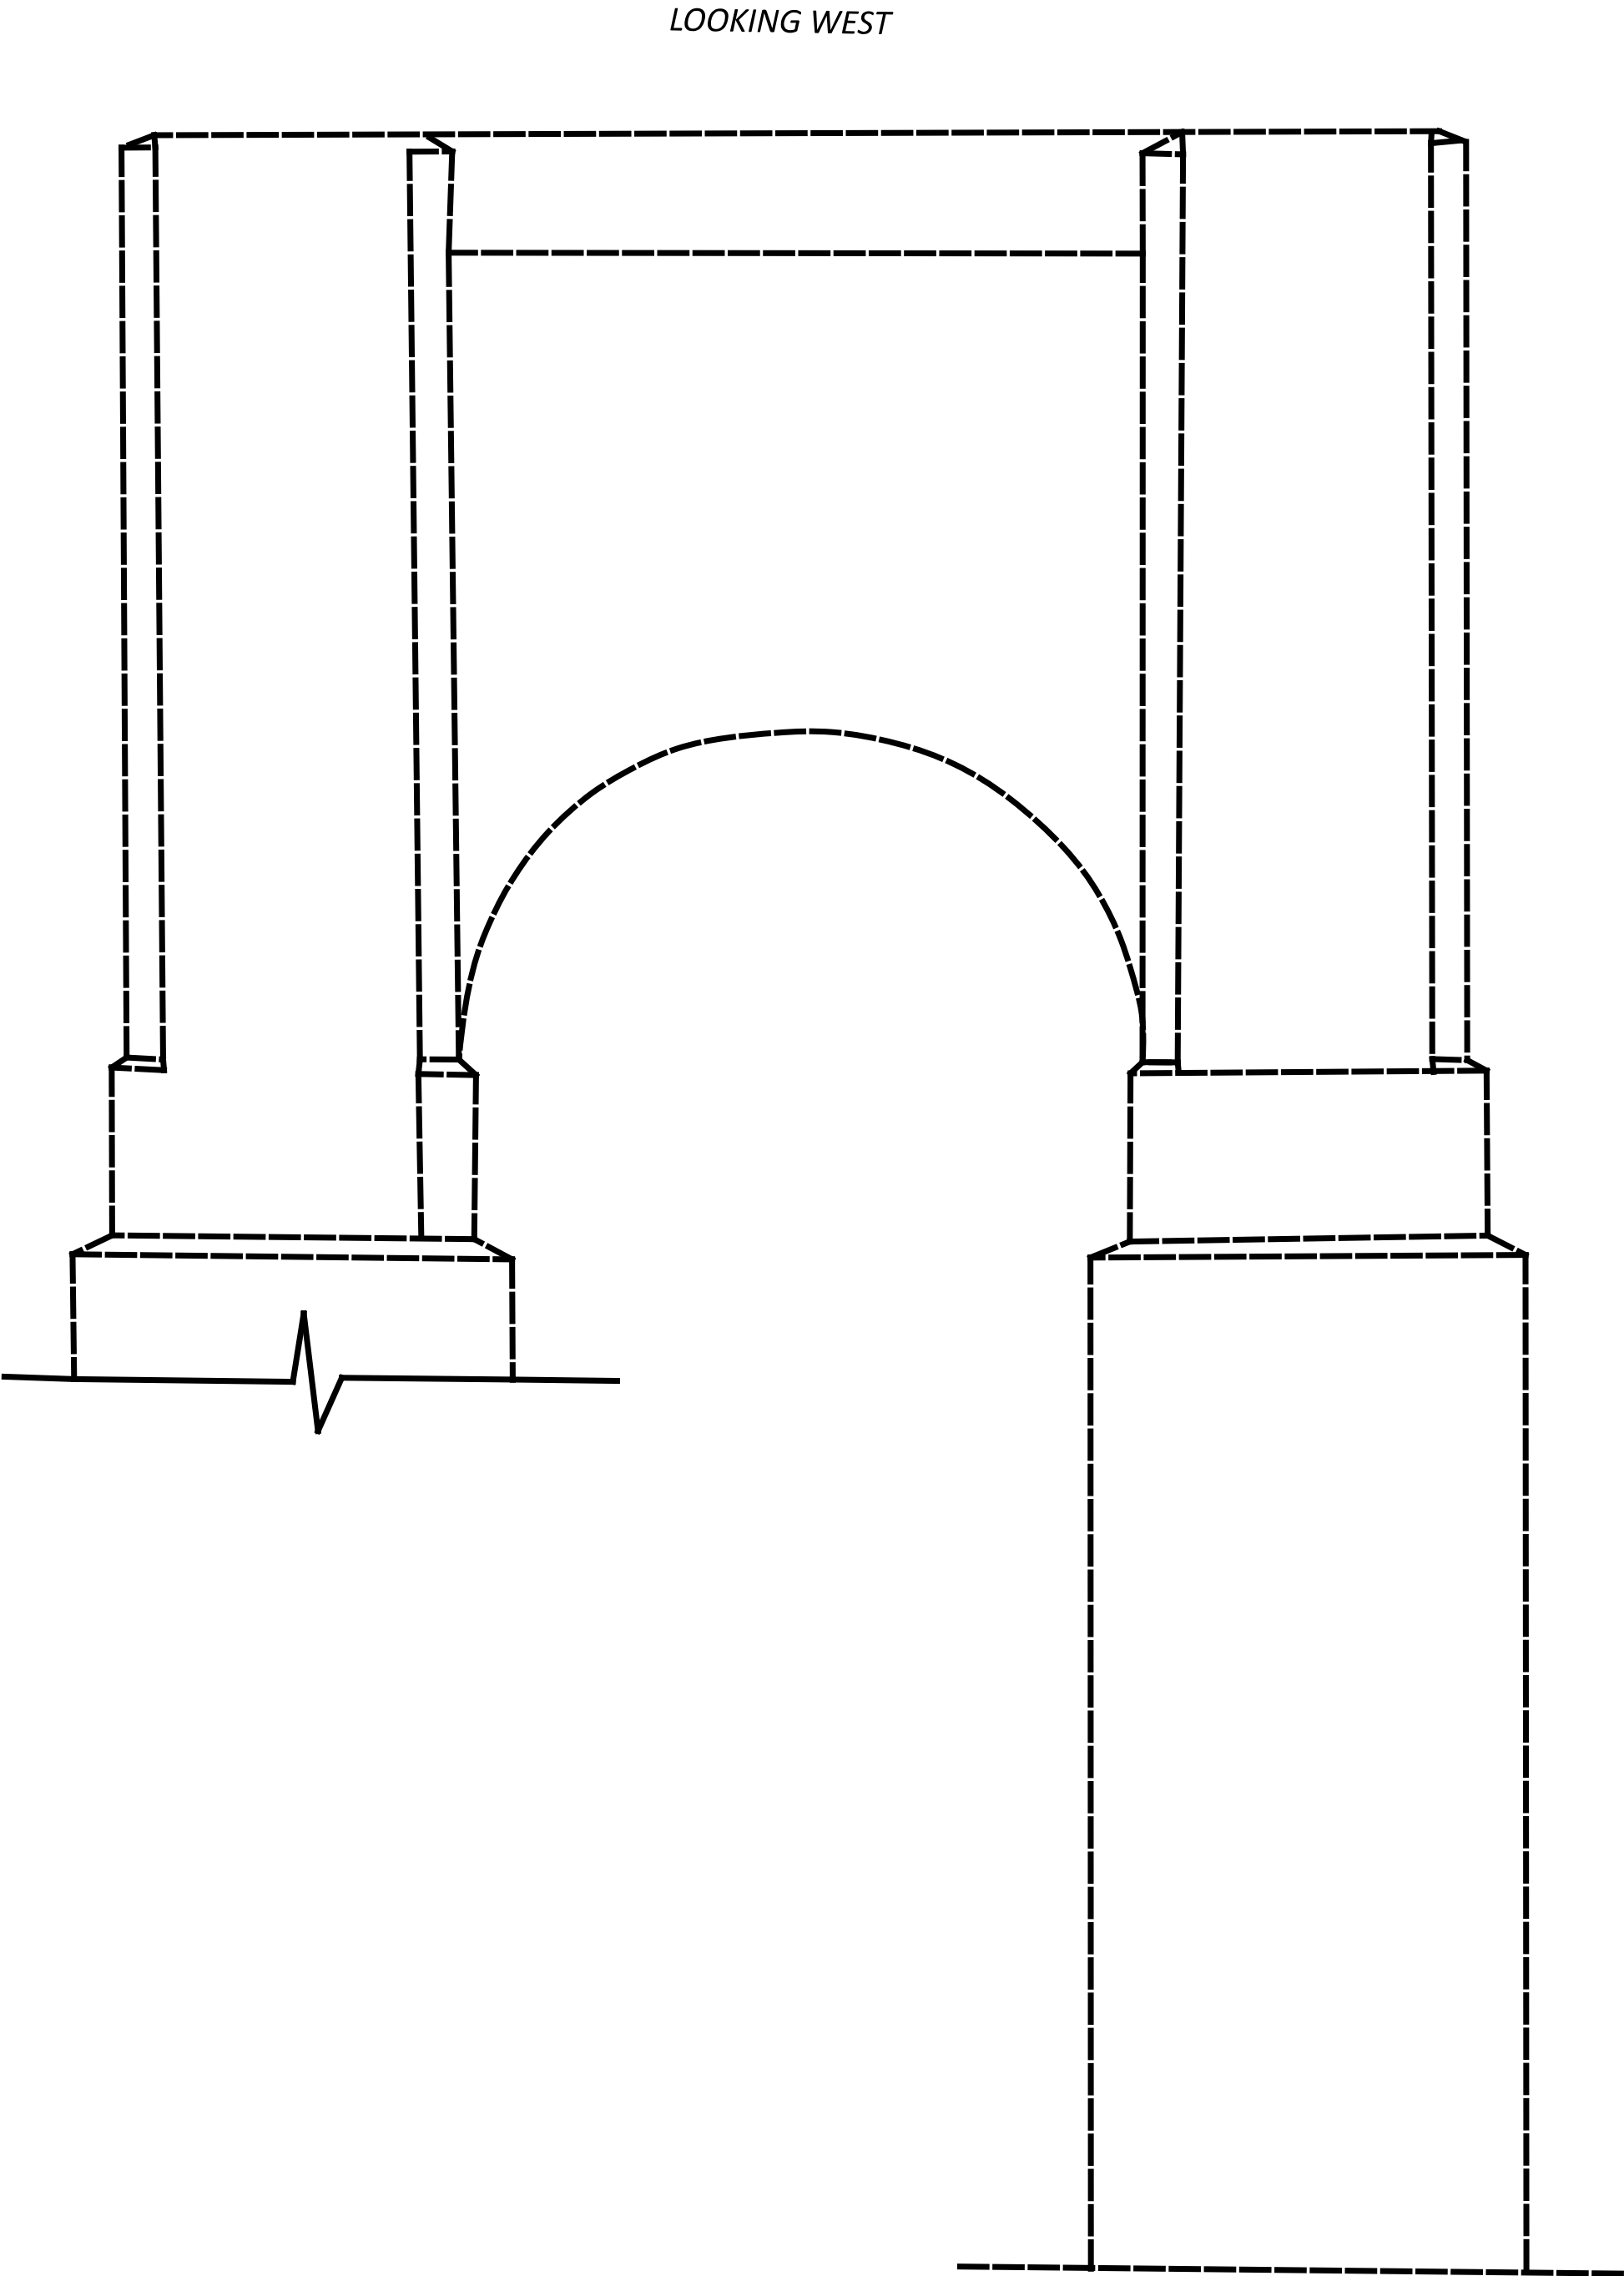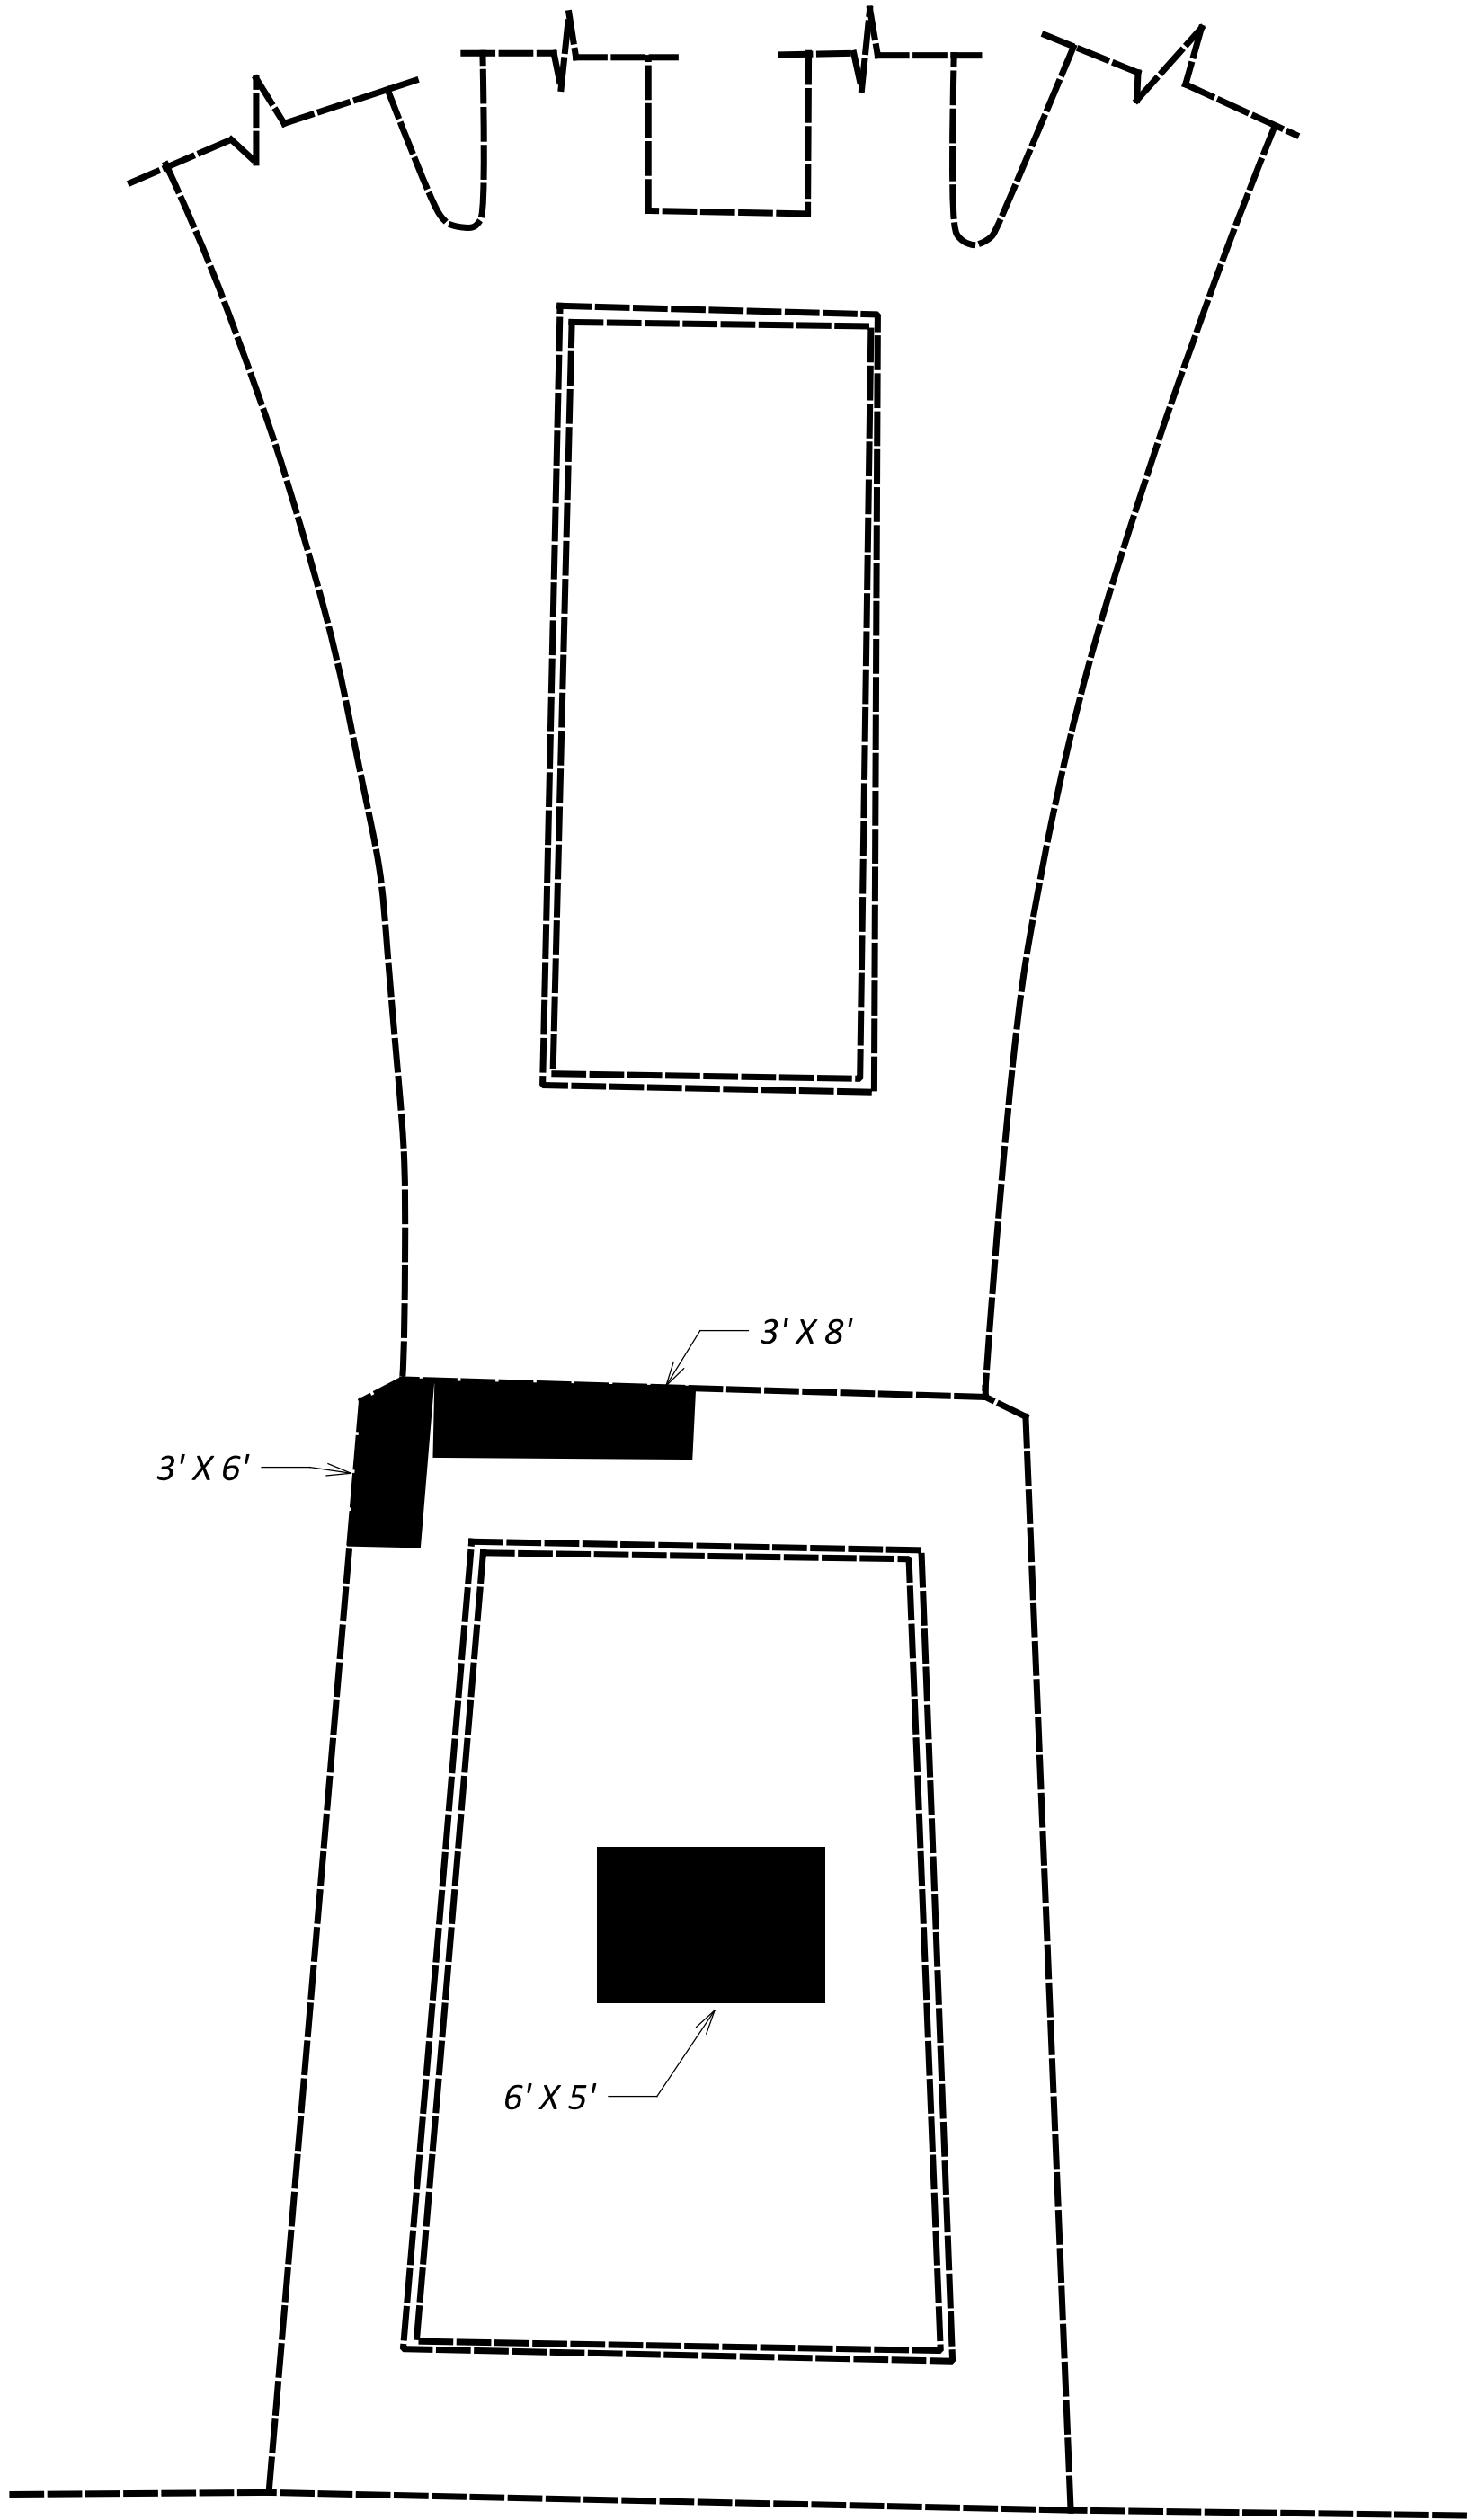

PIER 2 LEFT (INSIDE)

OPTION A OR OPTION B PATCHING
SHOWN (SF) = 90

updated


updated

SFN		7706871	
DESIGNER		CHECKER	
MJA		TJP	
REVIEWER		PROJECT ID	
TJP		10-03-23	
SUBSET		TOTAL	
23		29	
SHEET		TOTAL	
P. 28		34	

SUM-82-0000

STRUCTURE DETAILS

PIER 2 LEFT (INSIDE)

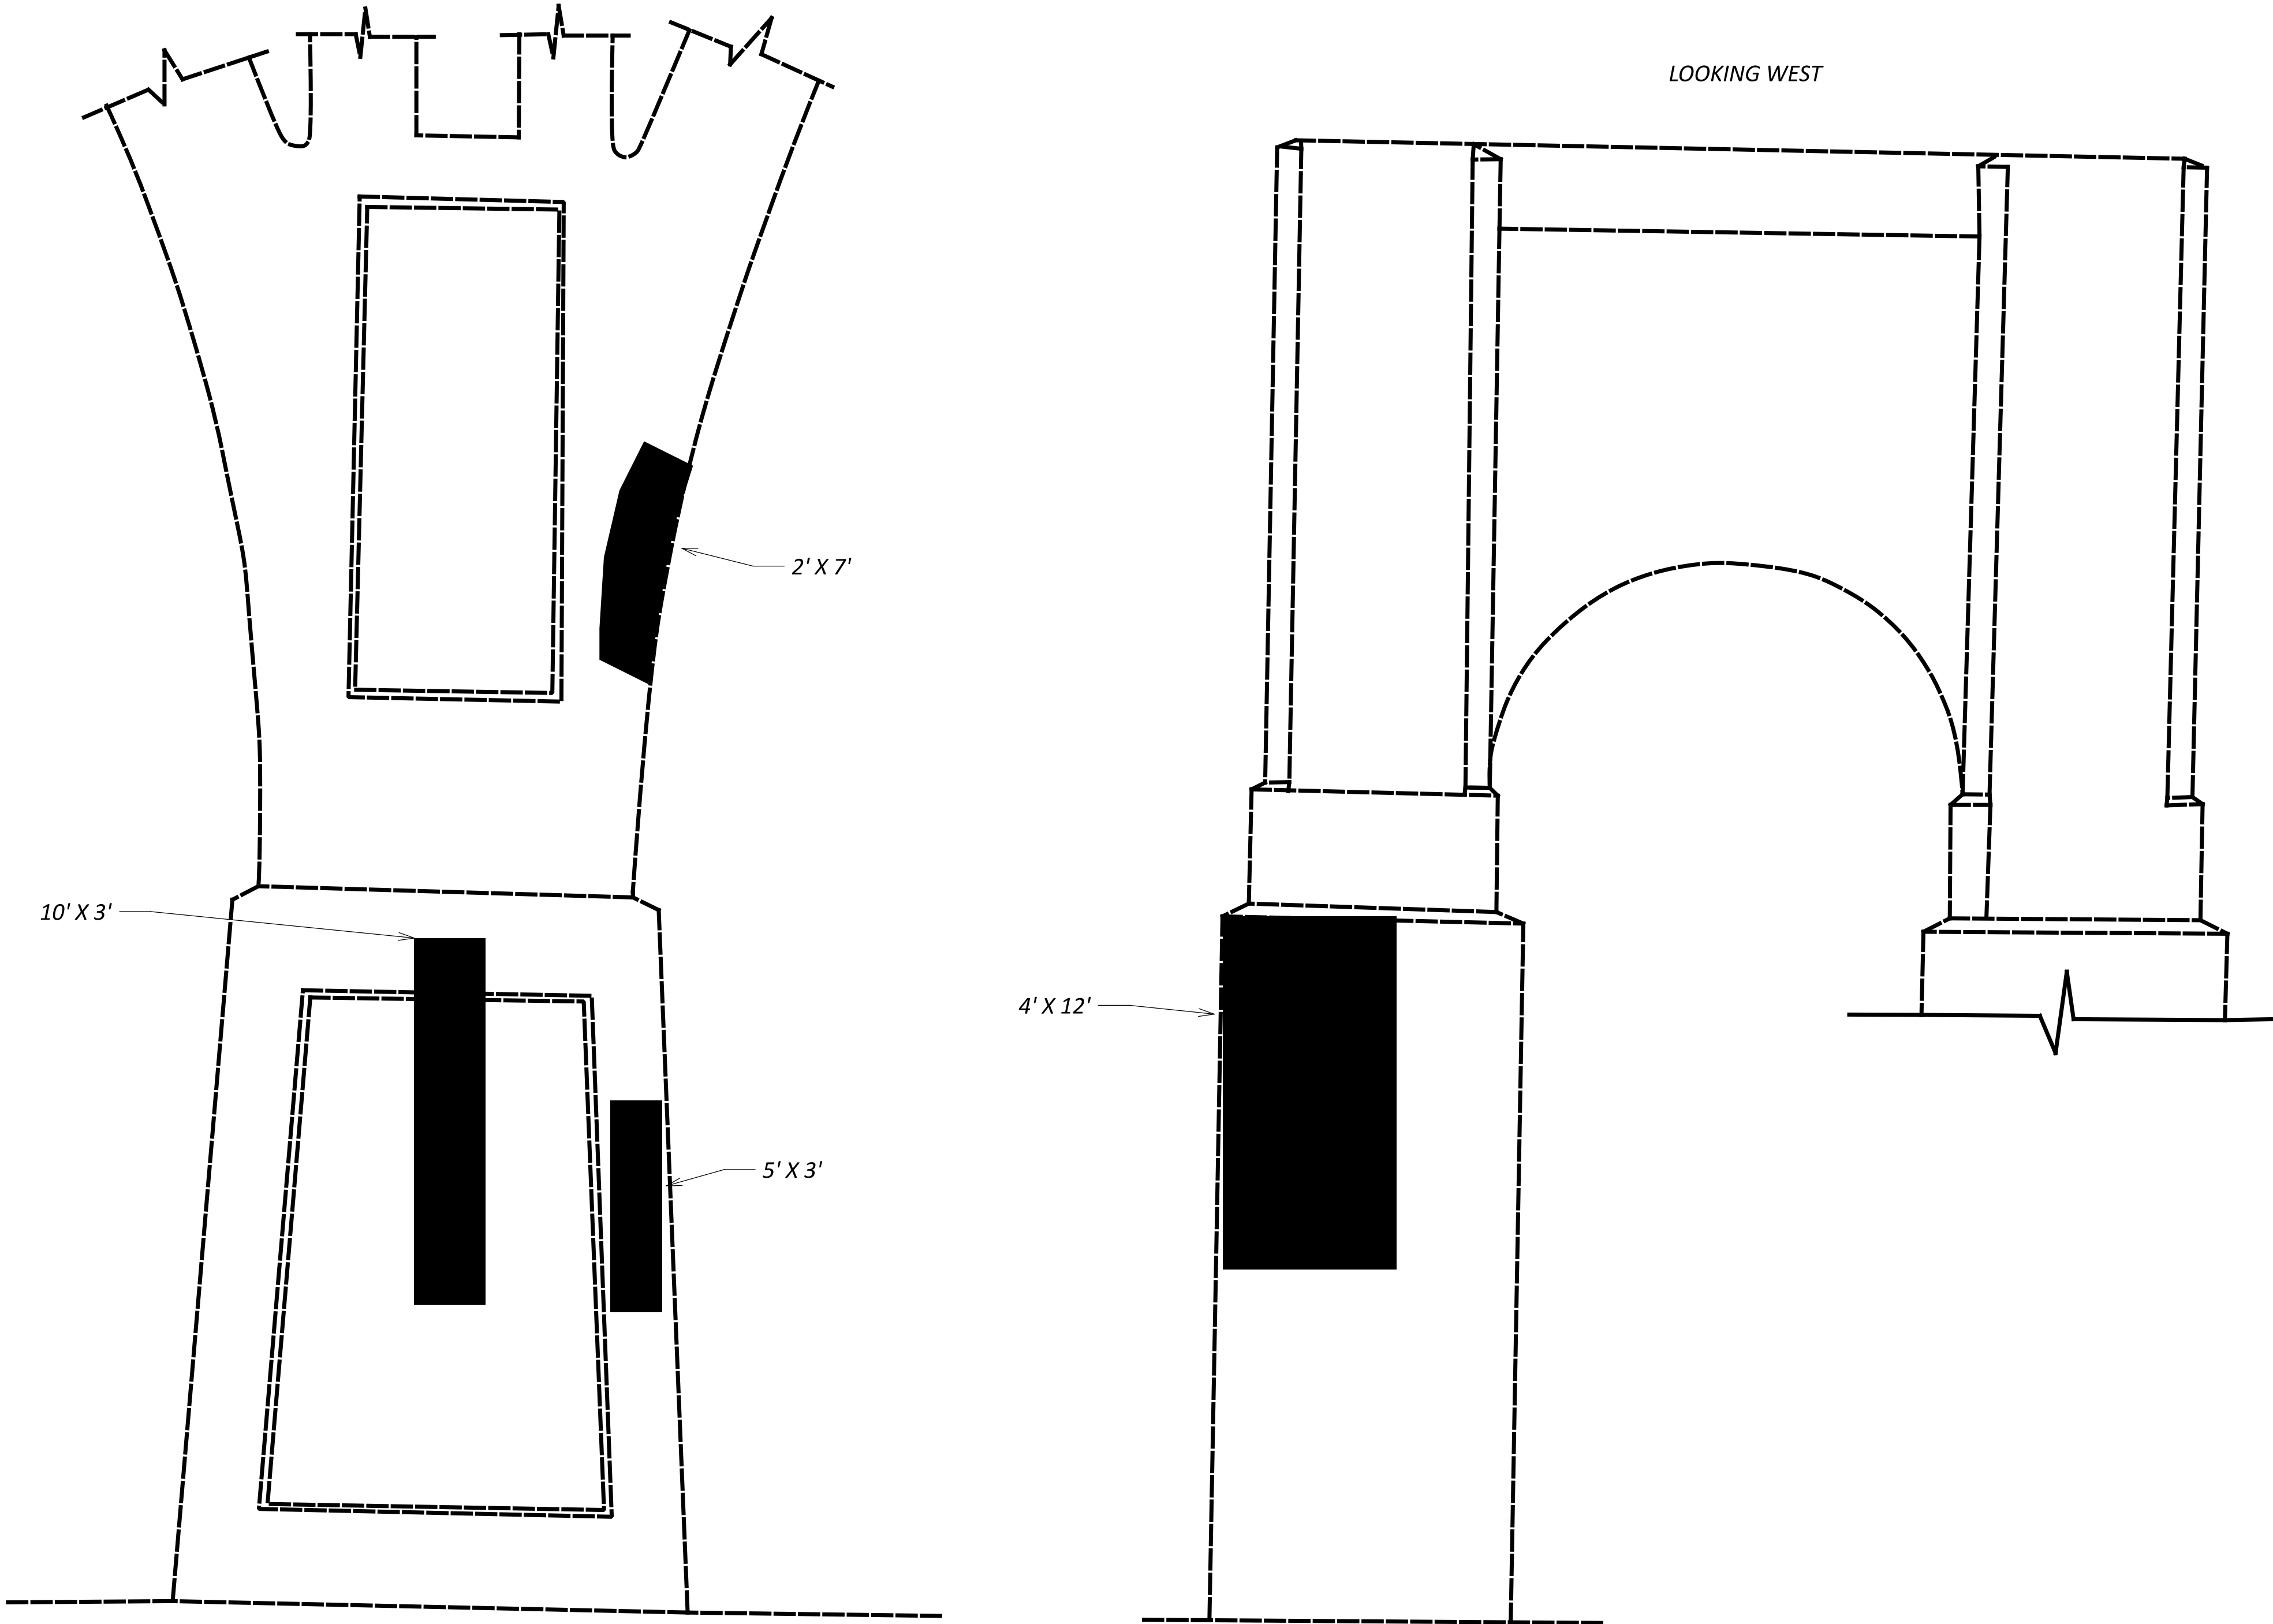

PIER 4 RIGHT (OUTSIDE)

OPTION A OR OPTION B PATCHING
SHOWN (SF) = 107


updated

SFN	
7706871	
DESIGN AGENCY	
DESIGNER	CHECKER
MJA	TJP
REVIEWER	
TJP	10-03-23
PROJECT ID	
107247	
SUBSET	TOTAL
24	29
SHEET	TOTAL
P.29	34

SUM-82-0000

STRUCTURE DETAILS

PIER 3 RIGHT (OUTSIDE)

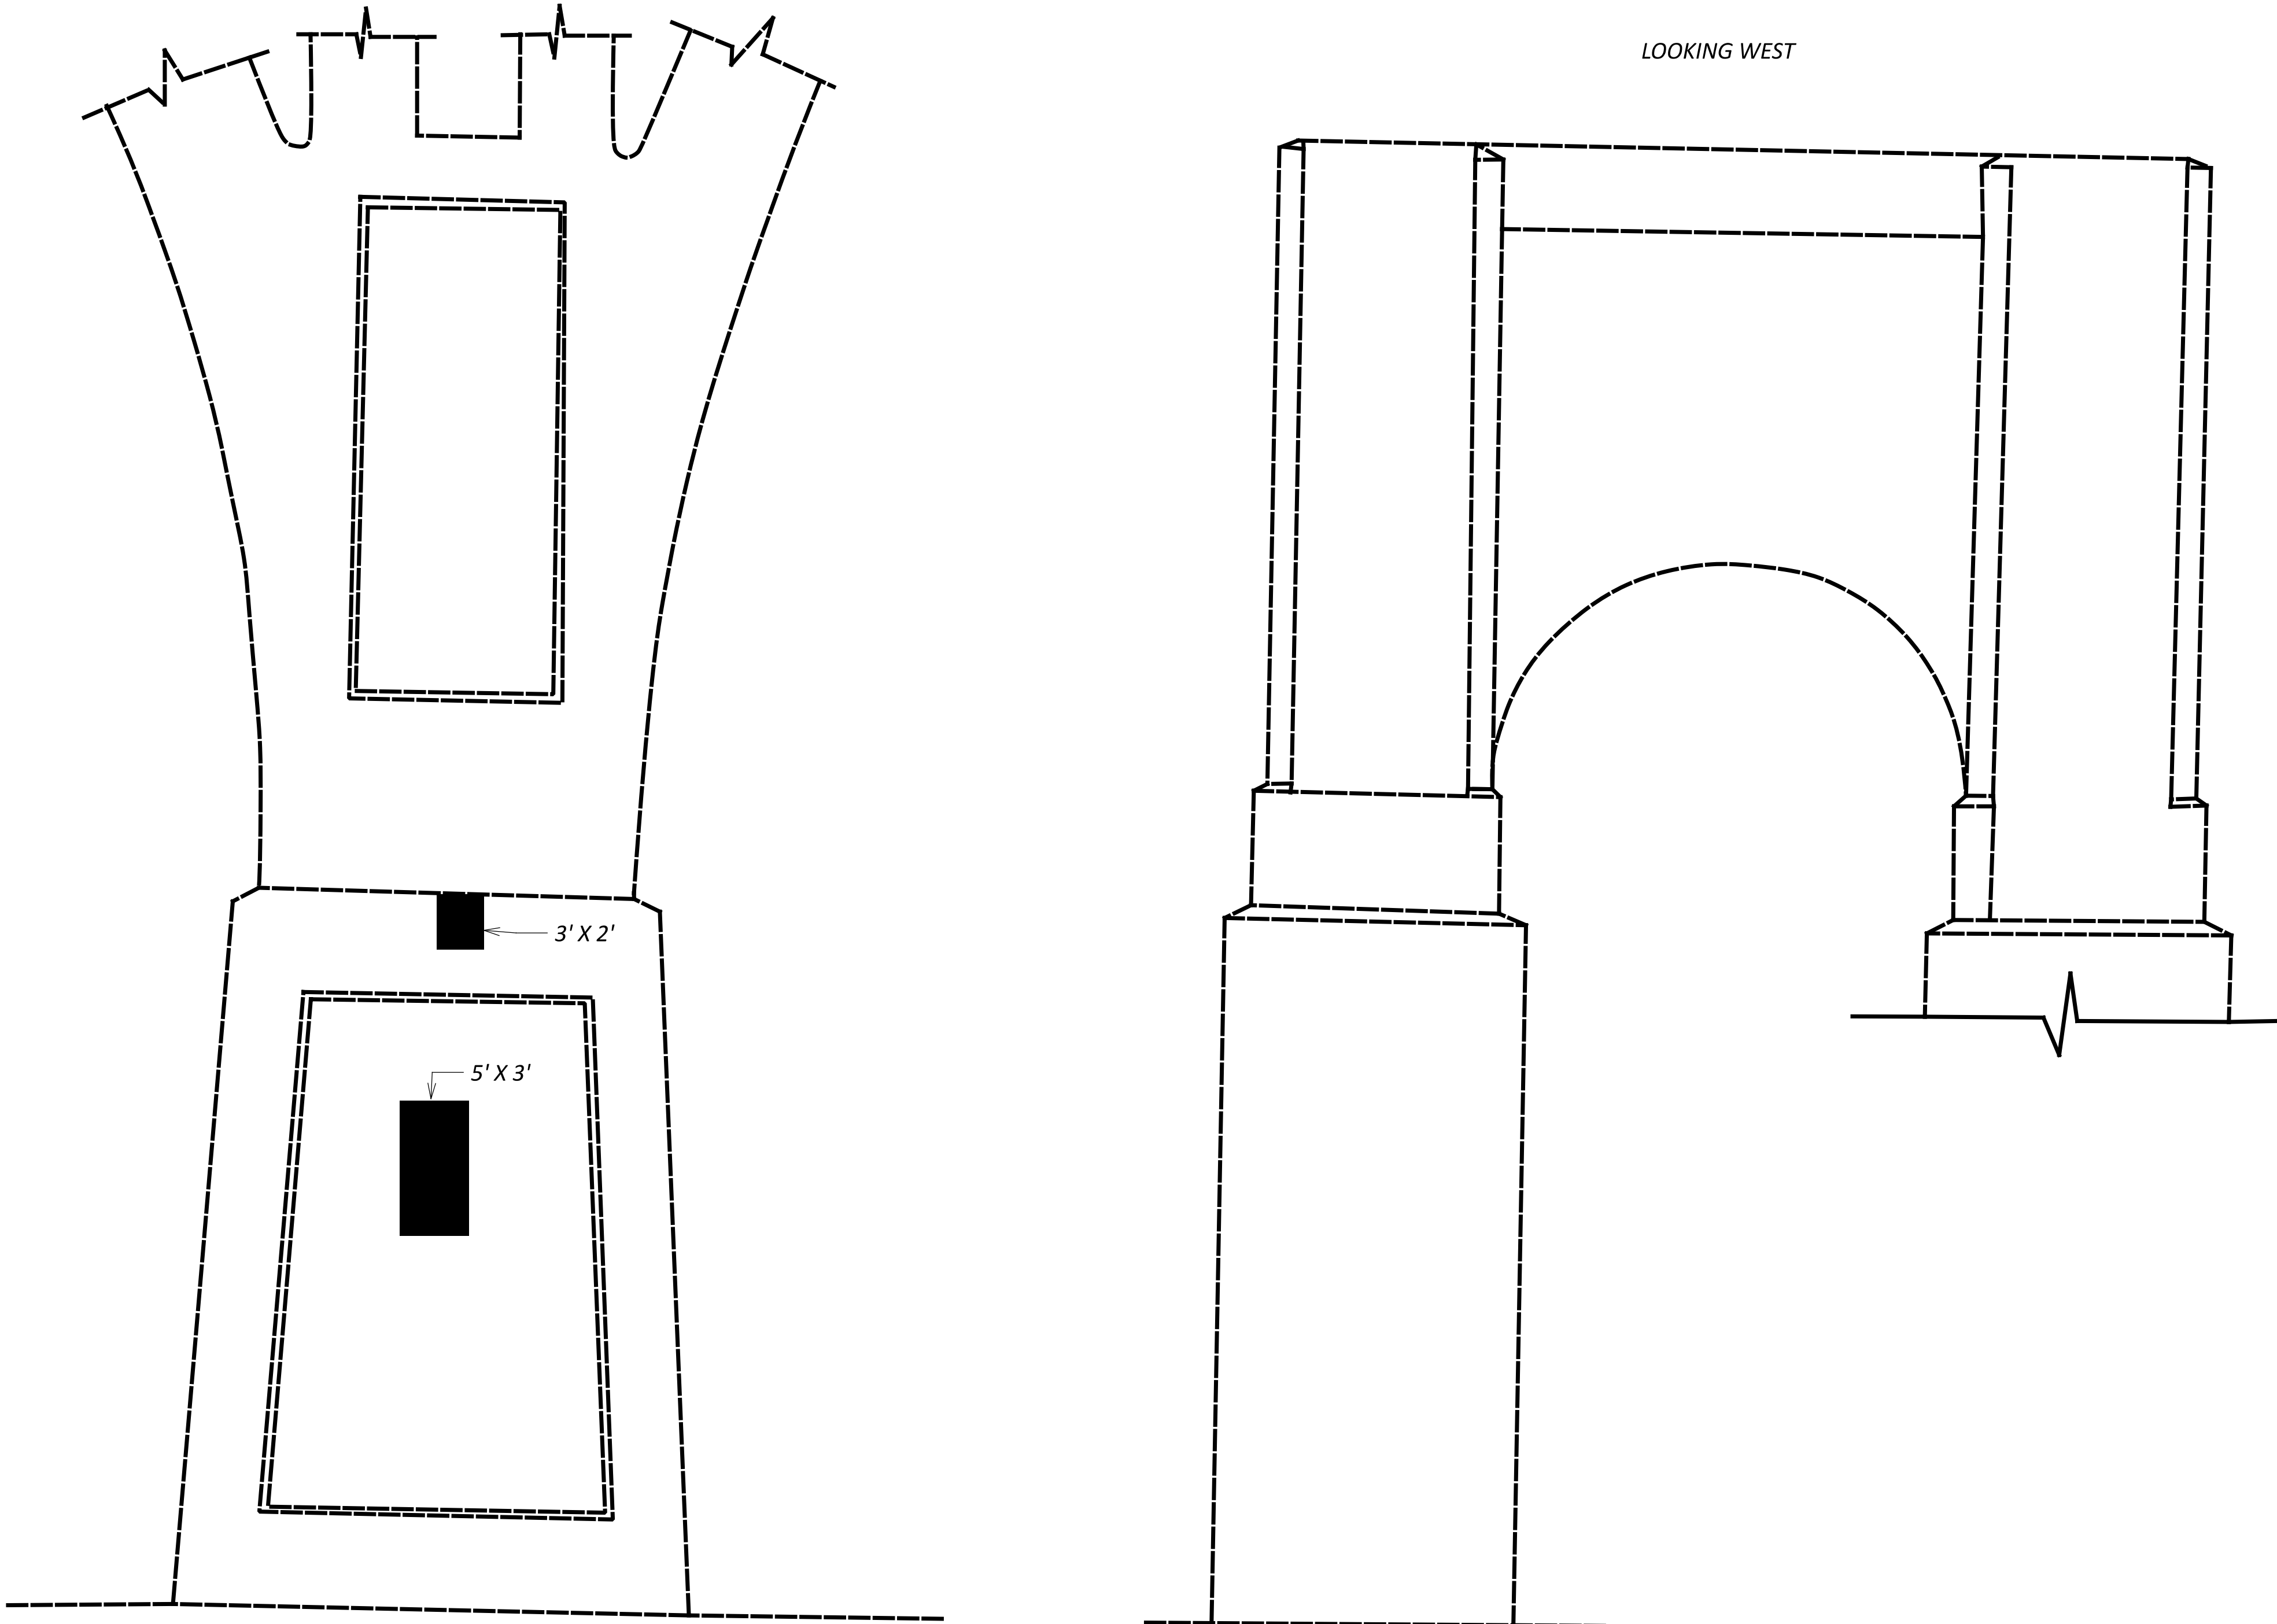

PIER 3 RIGHT (INSIDE)

OPTION A OR OPTION B PATCHING
SHOWN (SF) = 21

updated


updated

SFN		7706871	
DESIGNER		CHECKER	
MJA		TJP	
REVIEWER		PROJECT ID	
TJP		10-03-23	
SUBSET		TOTAL	
25		29	
SHEET		TOTAL	
P.30		34	

SUM-82-0000

STRUCTURE DETAILS


PIER 3 RIGHT (INSIDE)

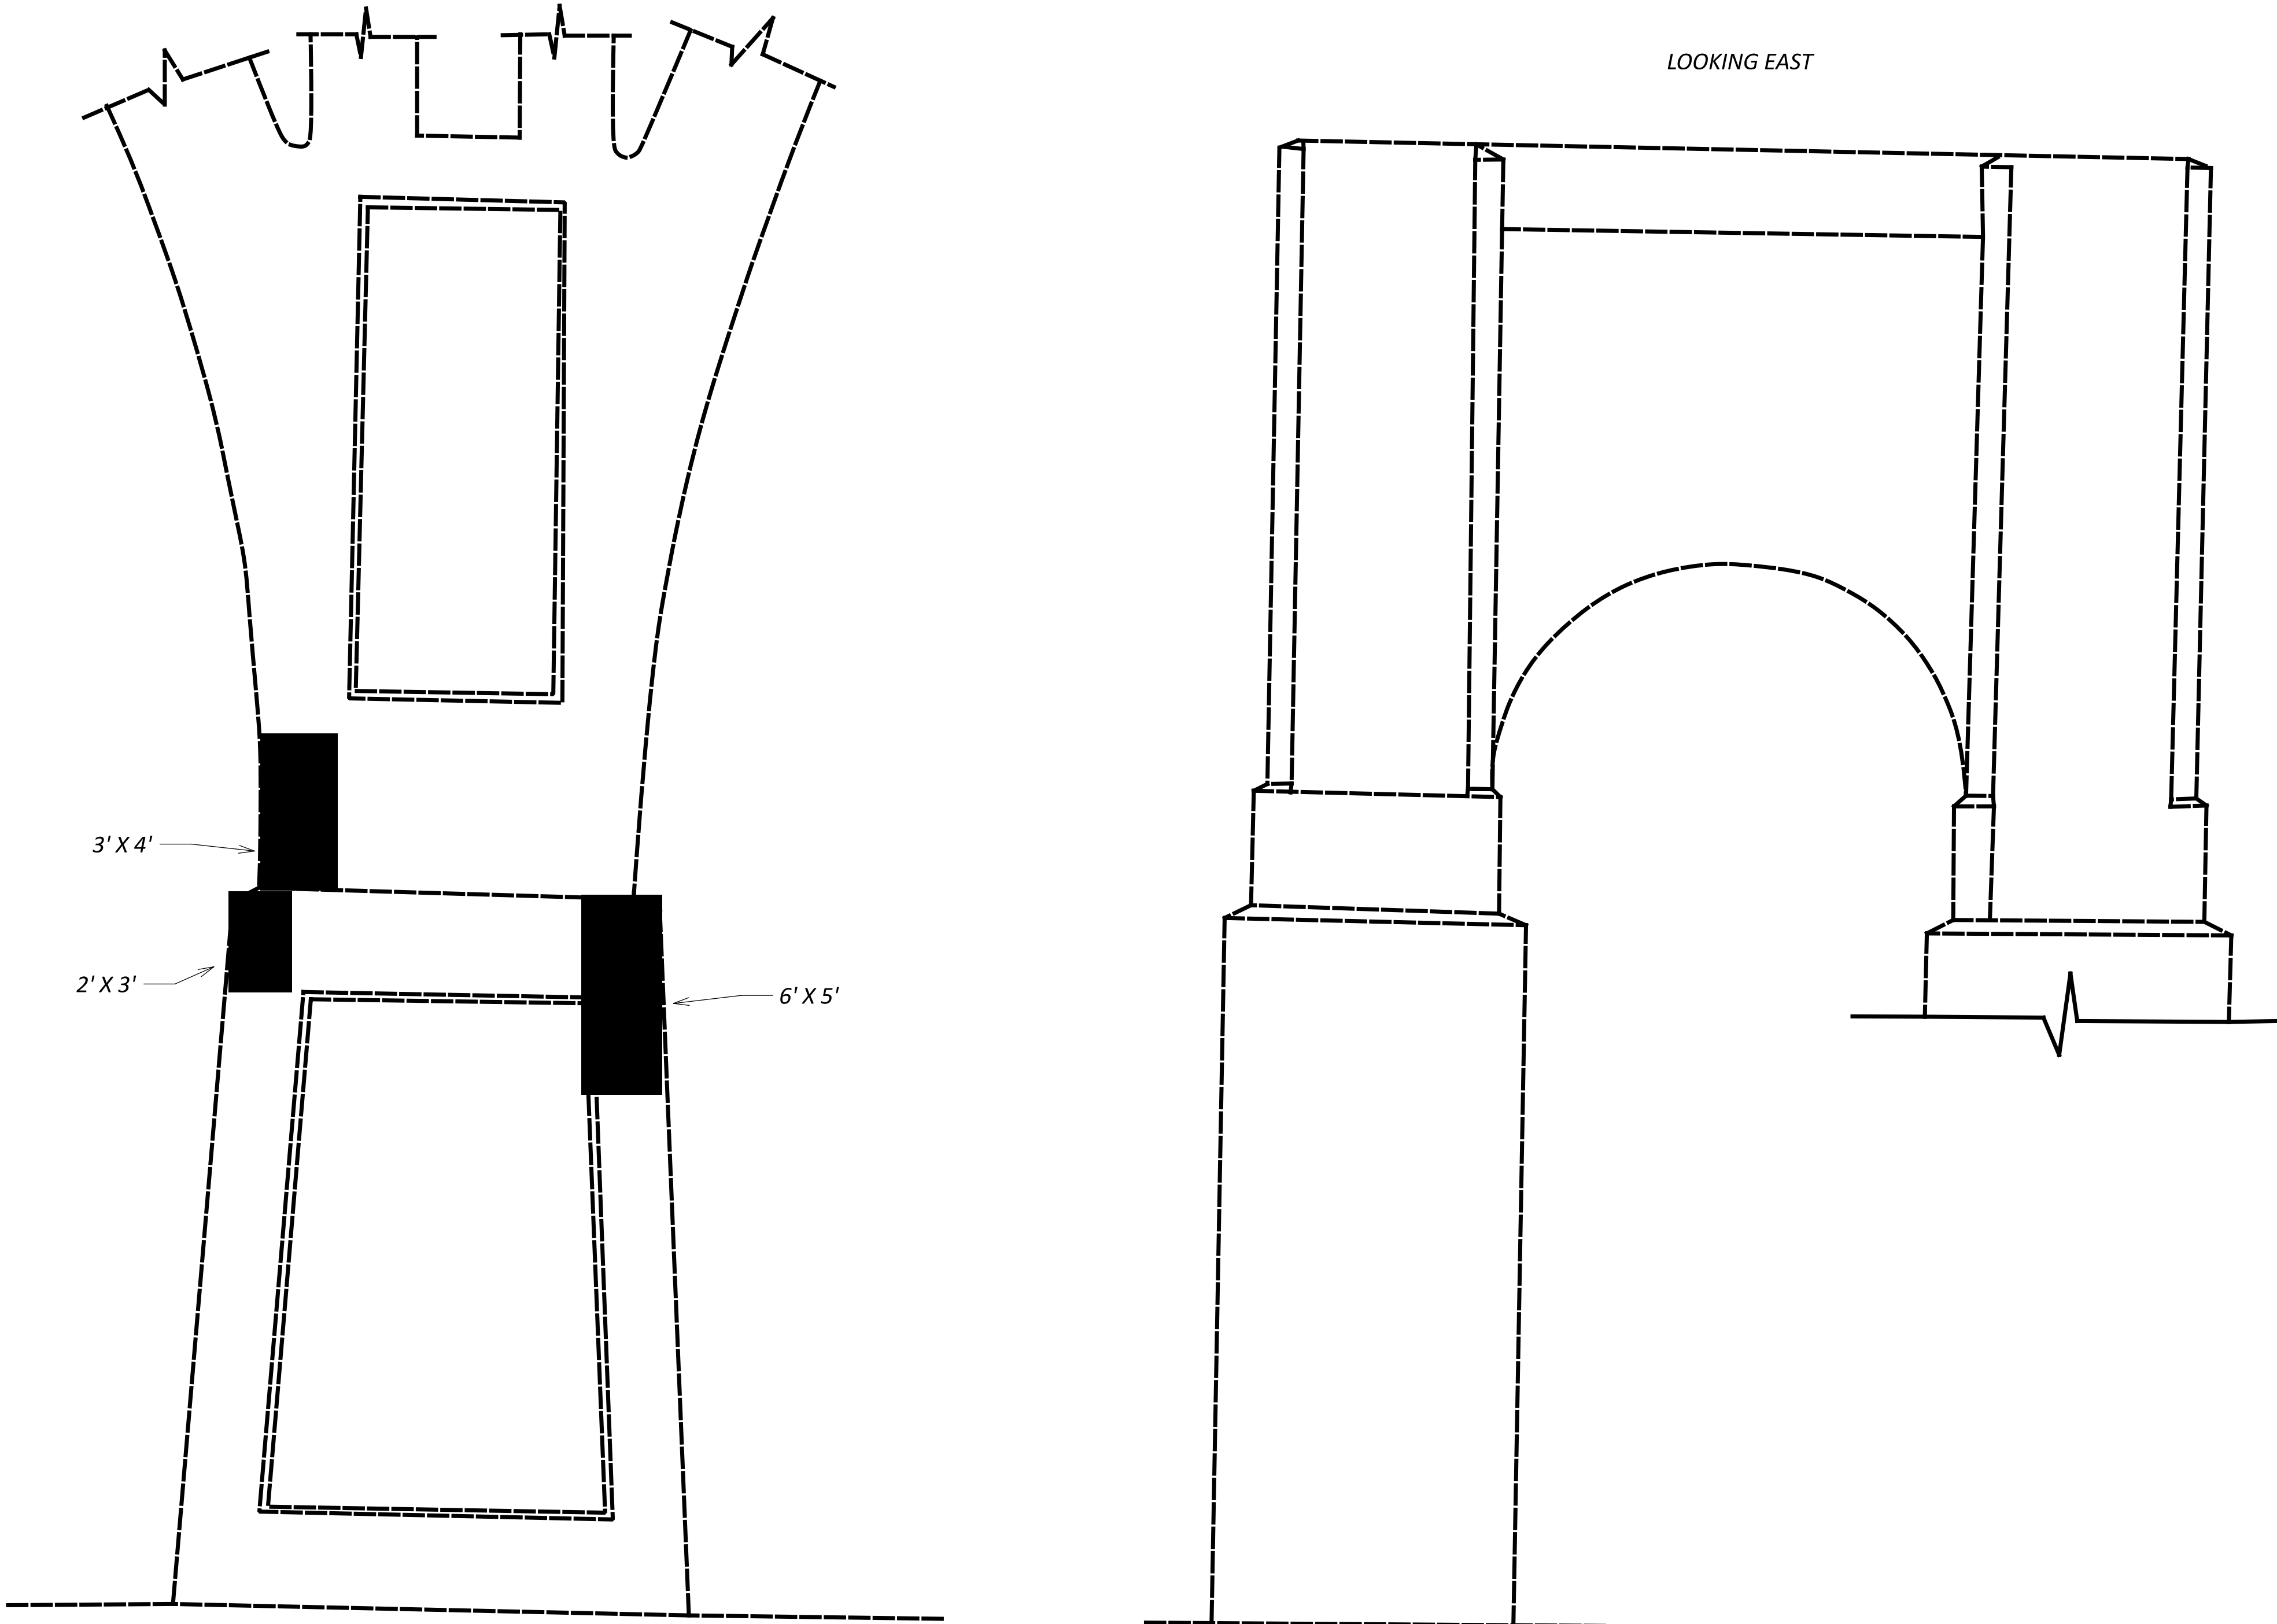


PIER 3 LEFT (INSIDE)

OPTION A OR OPTION B PATCHING
SHOWN (SF) = 48

updated

SFN		7706871	
DESIGN AGENCY			
			
DESIGNER		CHECKER	
MJA		TJP	
REVIEWER			
TJP		10-03-23	
PROJECT ID			
107247			
SUBSET		TOTAL	
26		29	
SHEET		TOTAL	
P.31		34	

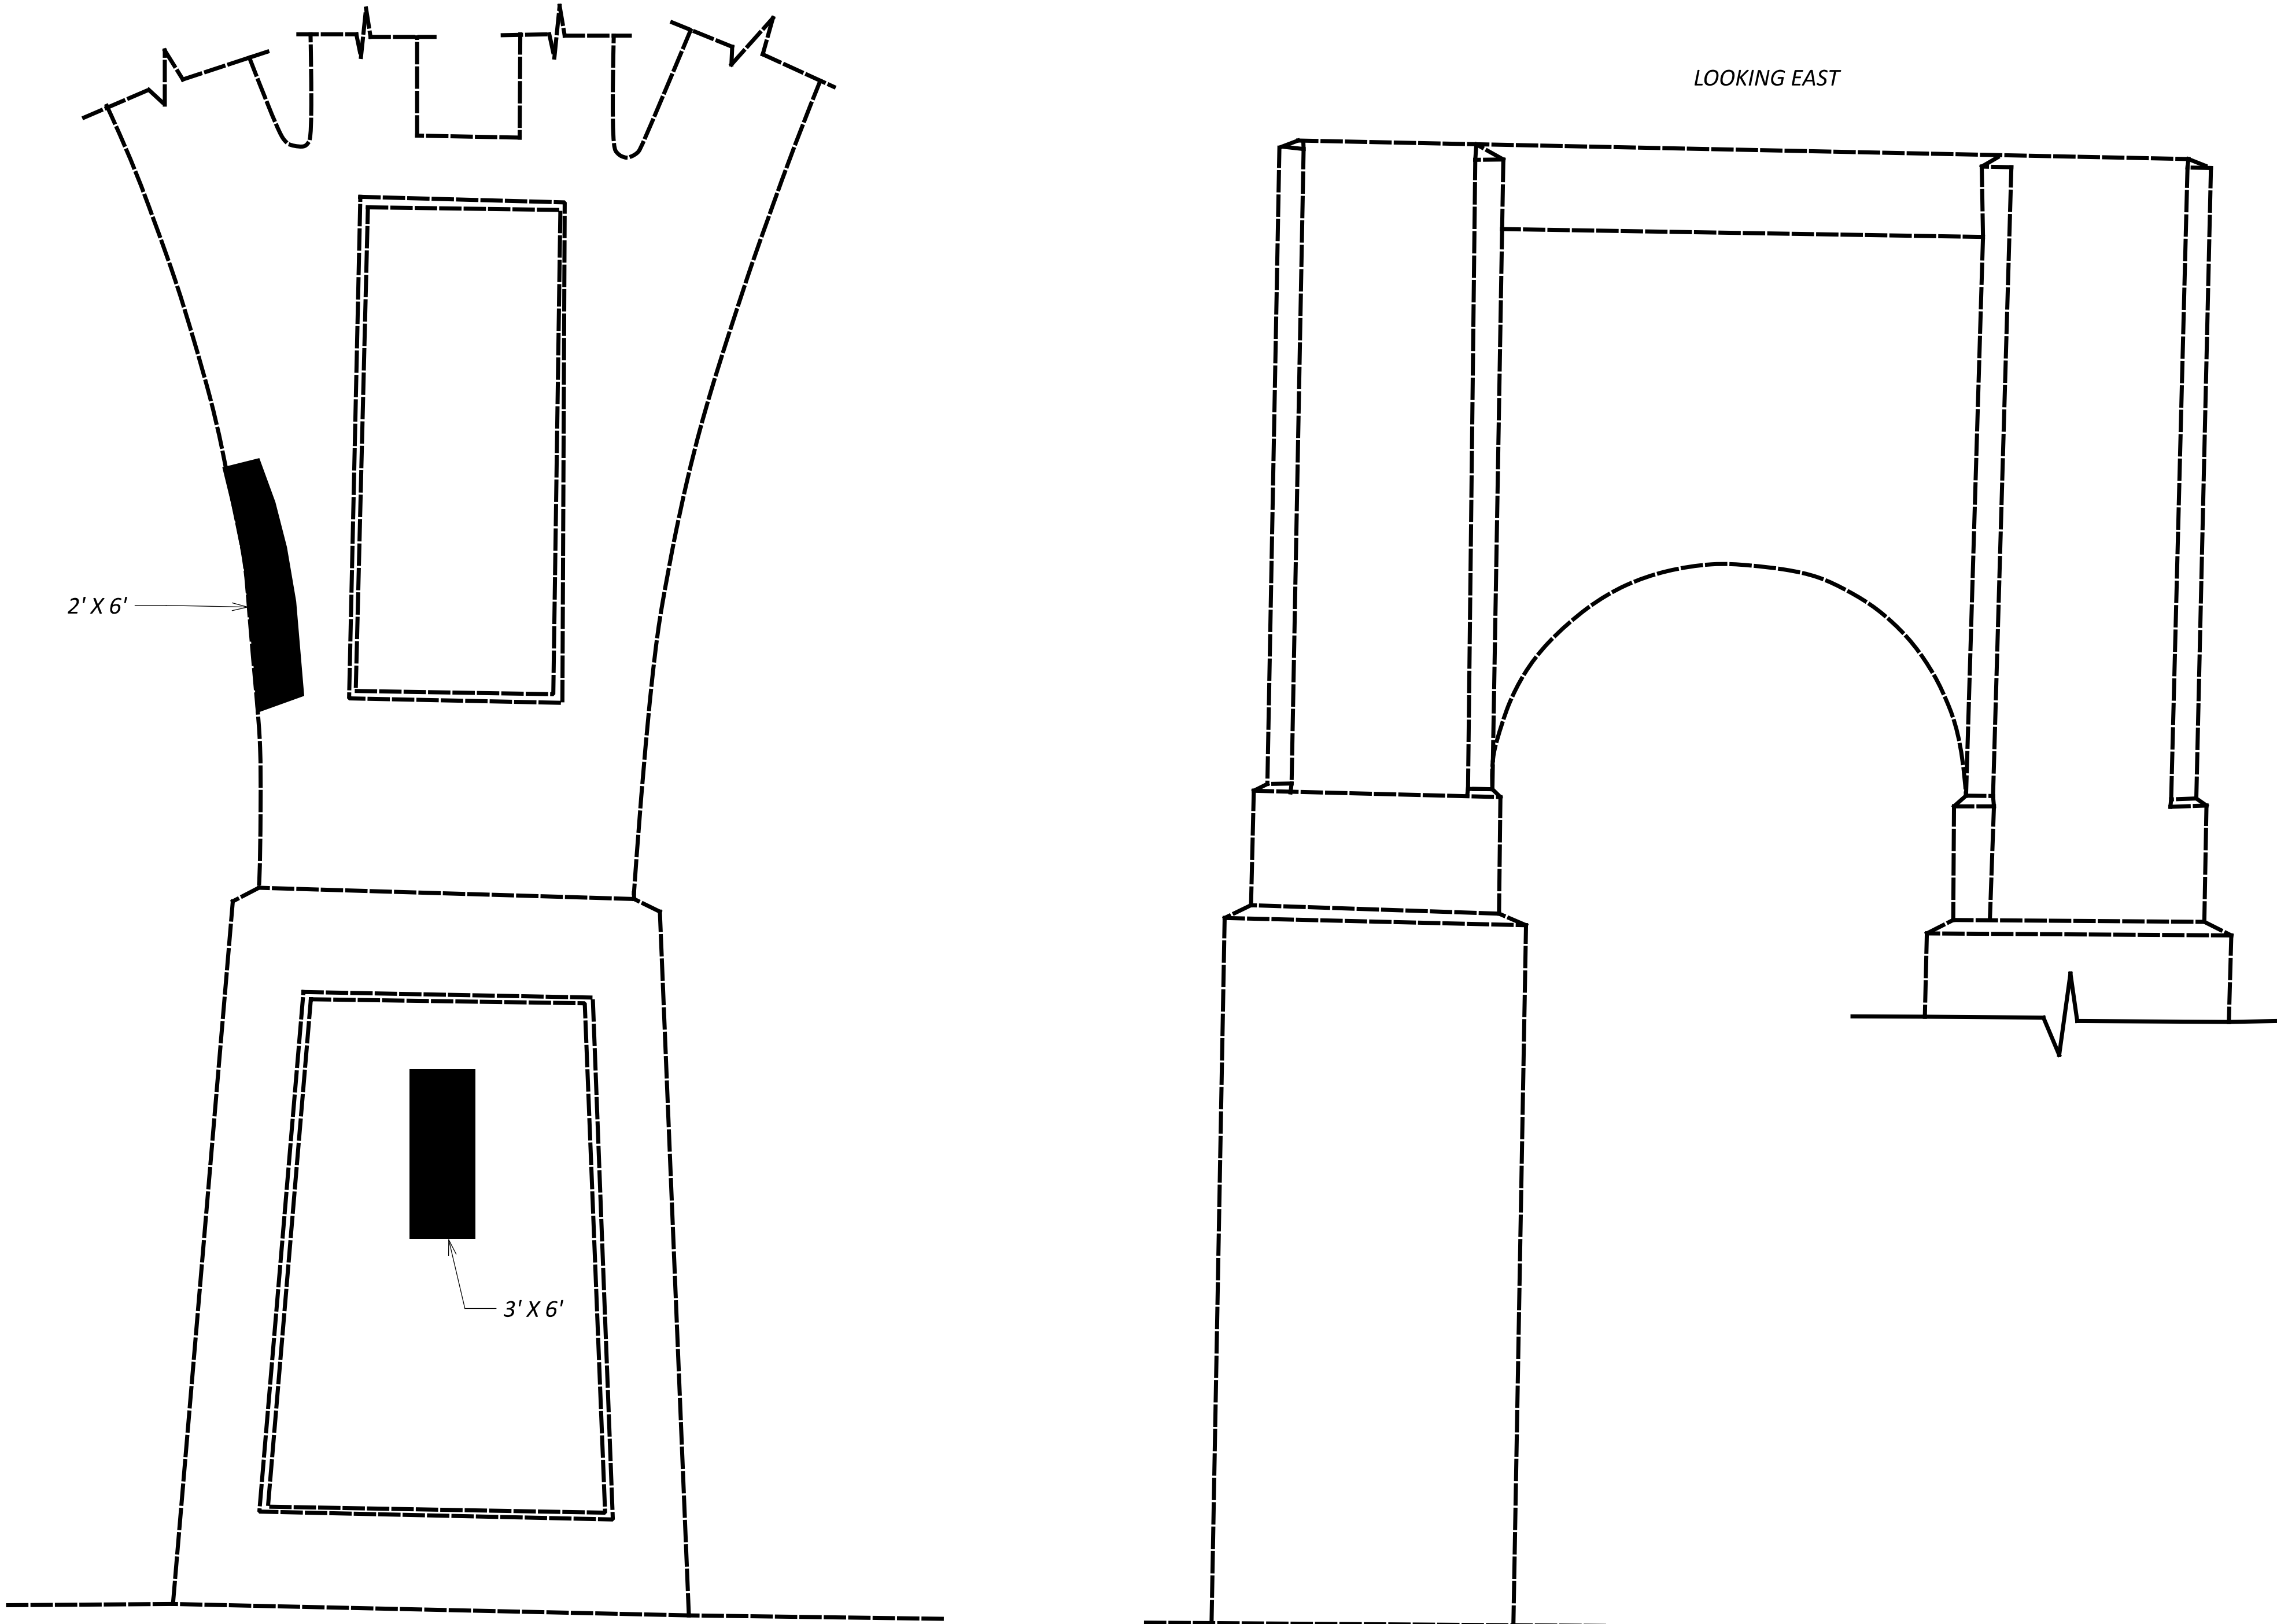

PIER 4 RIGHT (INSIDE)

OPTION A OR OPTION B PATCHING
SHOWN (SF) = 30

updated



updated

SFN		7706871	
DESIGNER		CHECKER	
MJA		TJP	
REVIEWER		PROJECT ID	
TJP		107247	
SUBSET		TOTAL	
27		29	
SHEET		TOTAL	
P.32		34	

SUM-82-0000

STRUCTURE DETAILS

PIER 4 RIGHT (INSIDE)

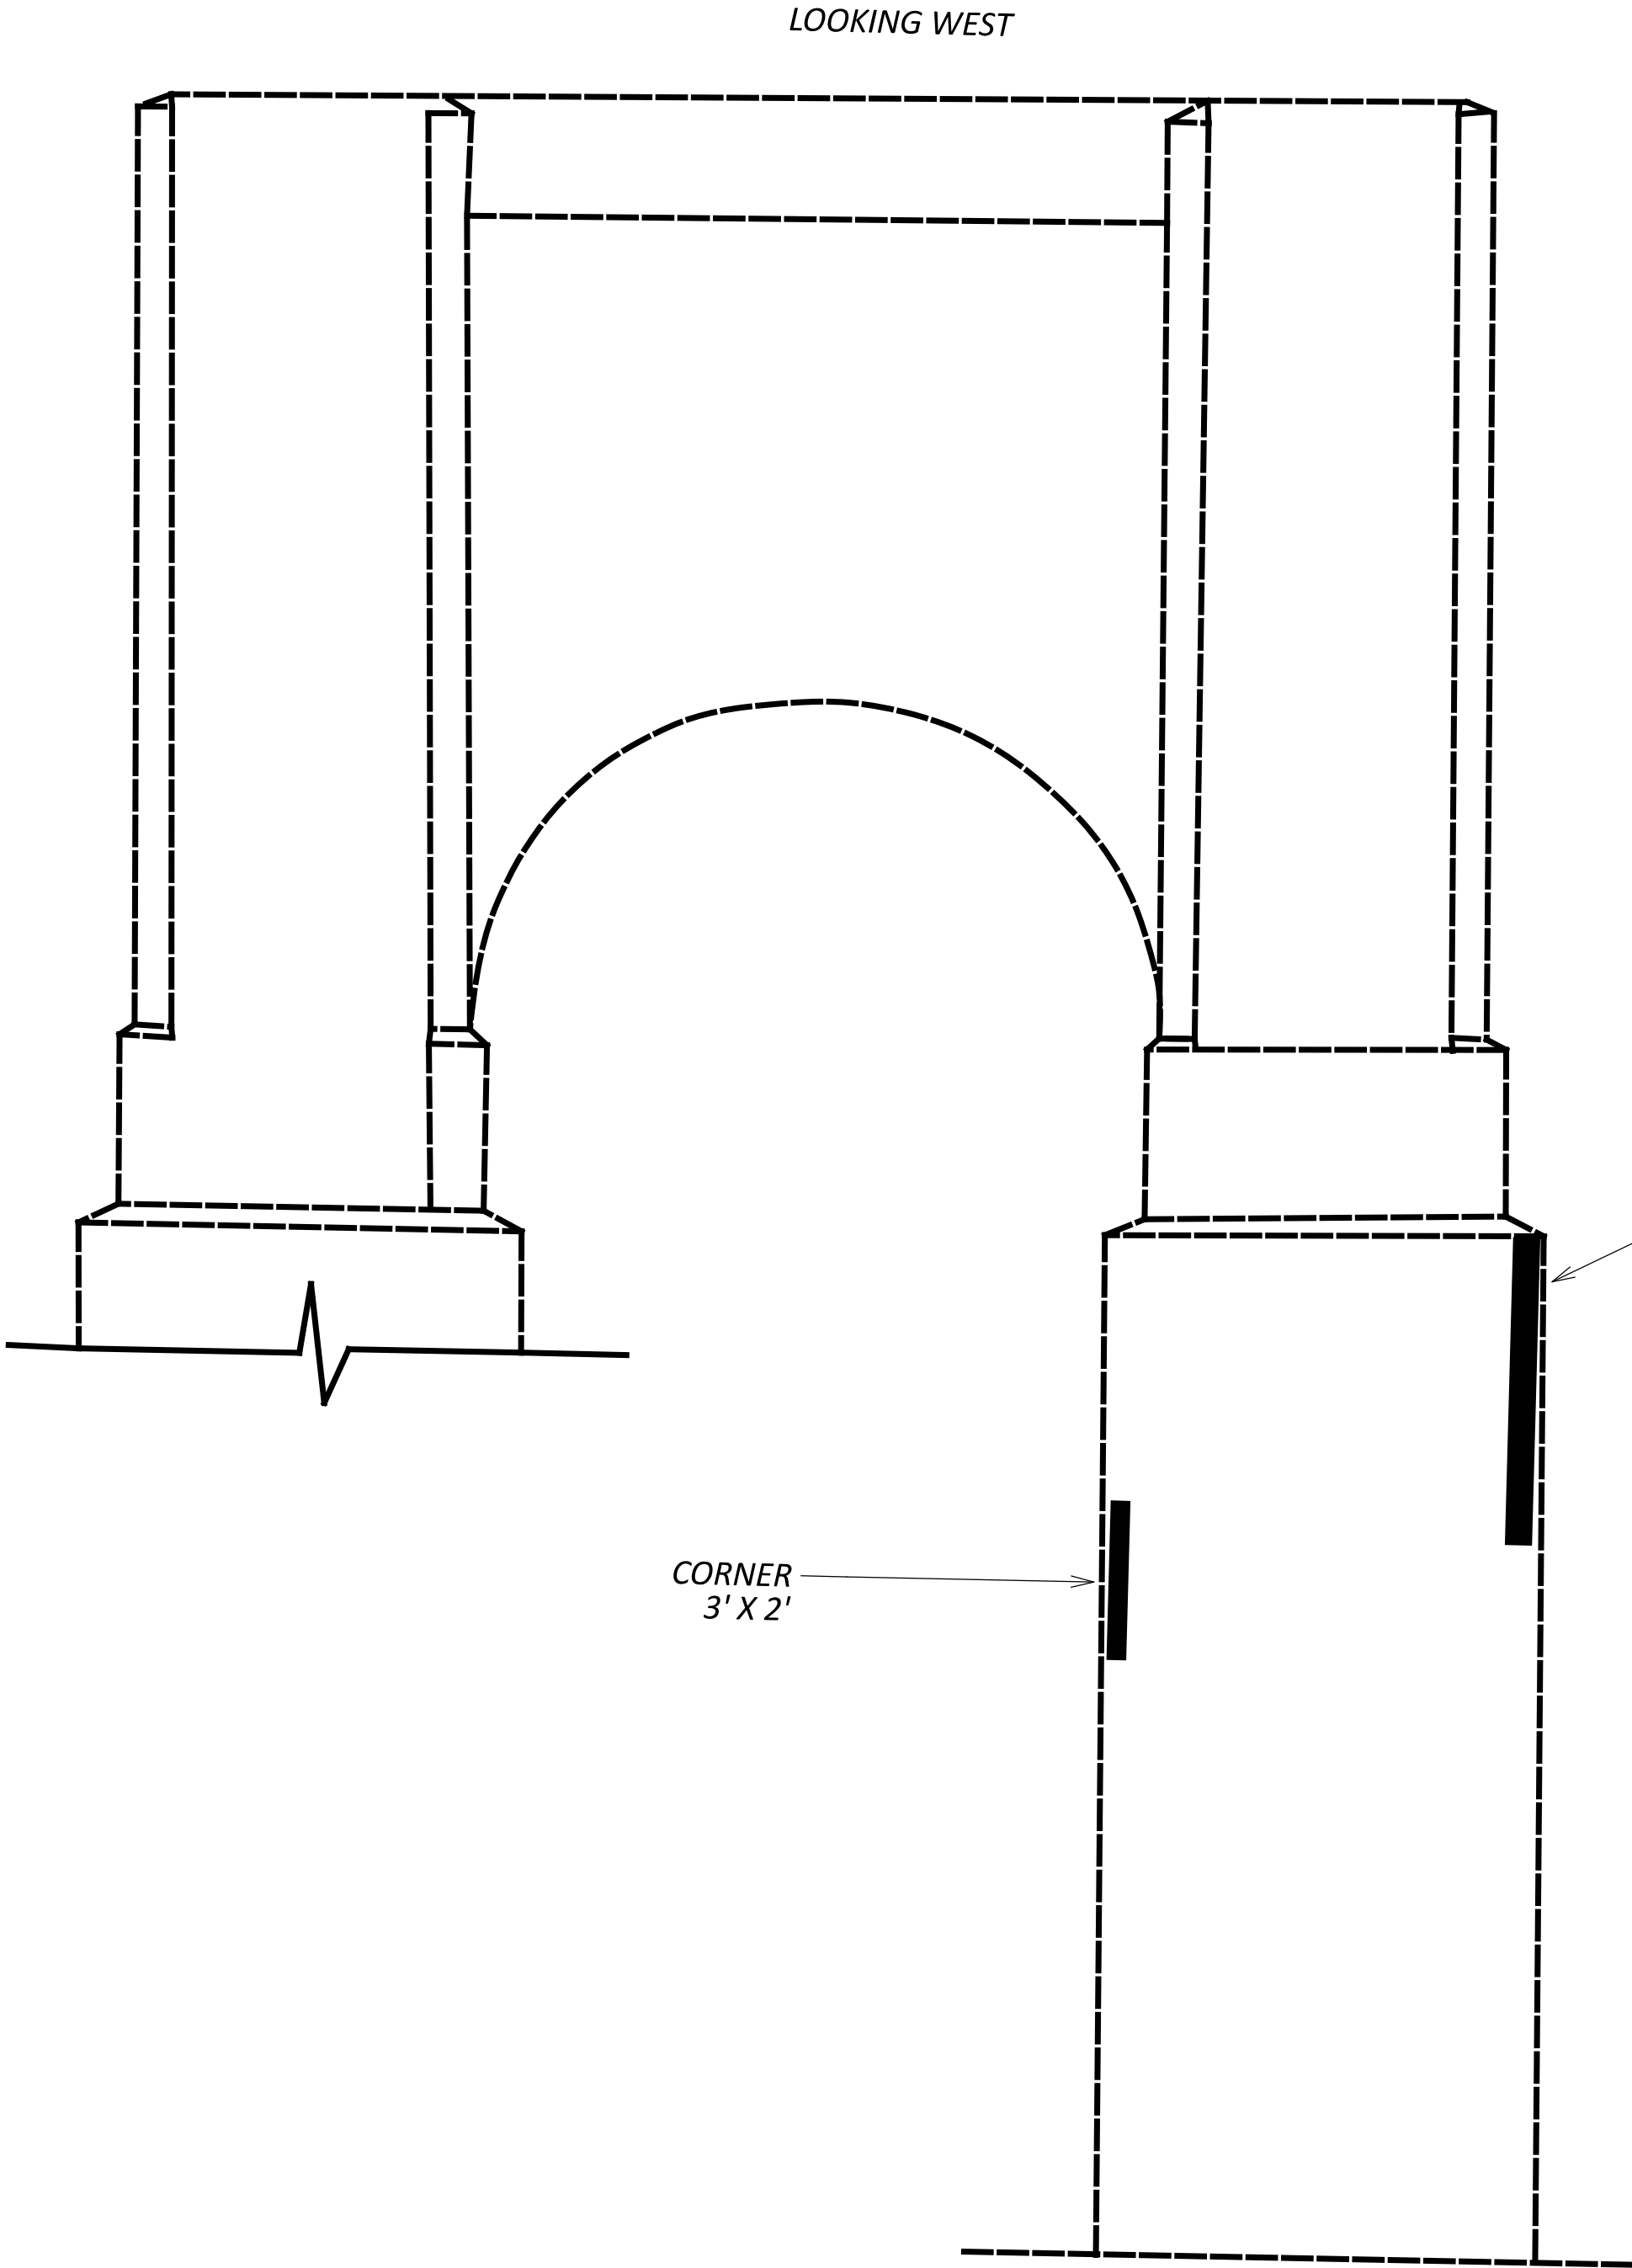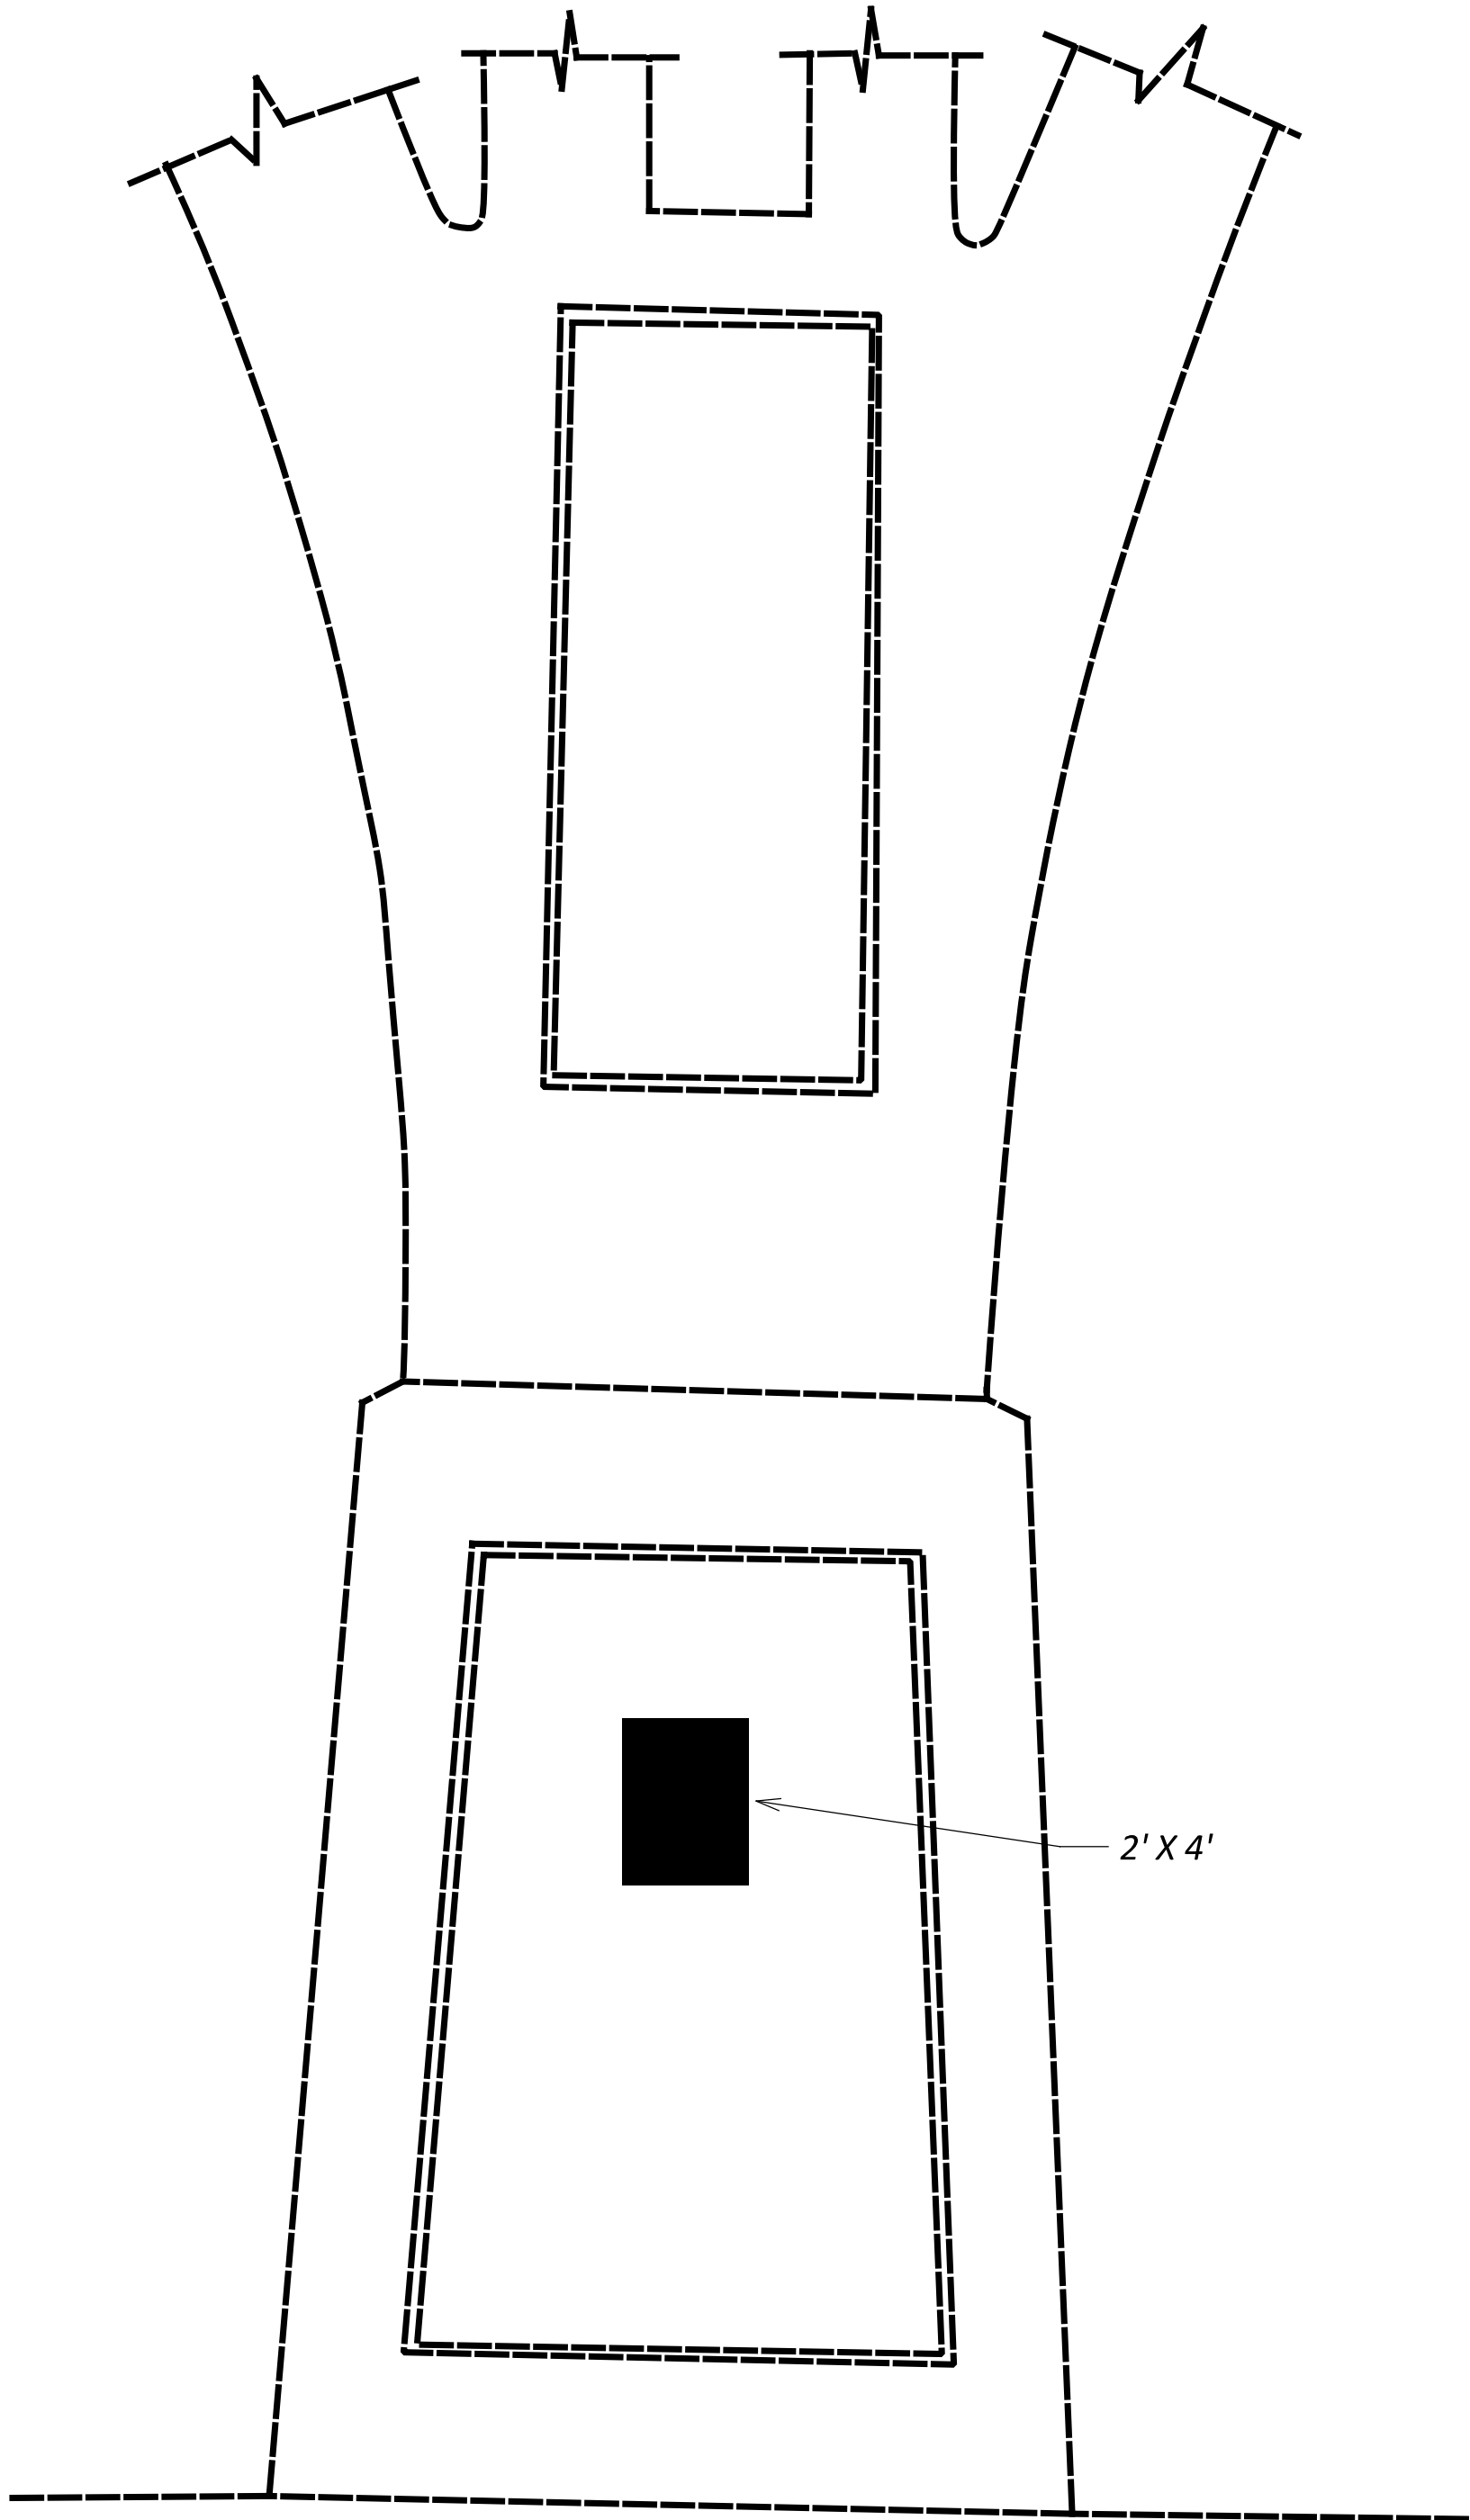

PIER 4 LEFT (INSIDE)


OPTION A OR OPTION B PATCHING
SHOWN (SF) = 34

updated

updated

SUM-82-0000
STRUCTURE DETAILS
PIER 4 LEFT (INSIDE)

SFN 7706871	
DESIGN AGENCY	
DESIGNER MJA	CHECKER TJP
REVIEWER TJP 10-03-23	
PROJECT ID 107247	
SUBSET 28	TOTAL 29
SHEET P.33	TOTAL 34

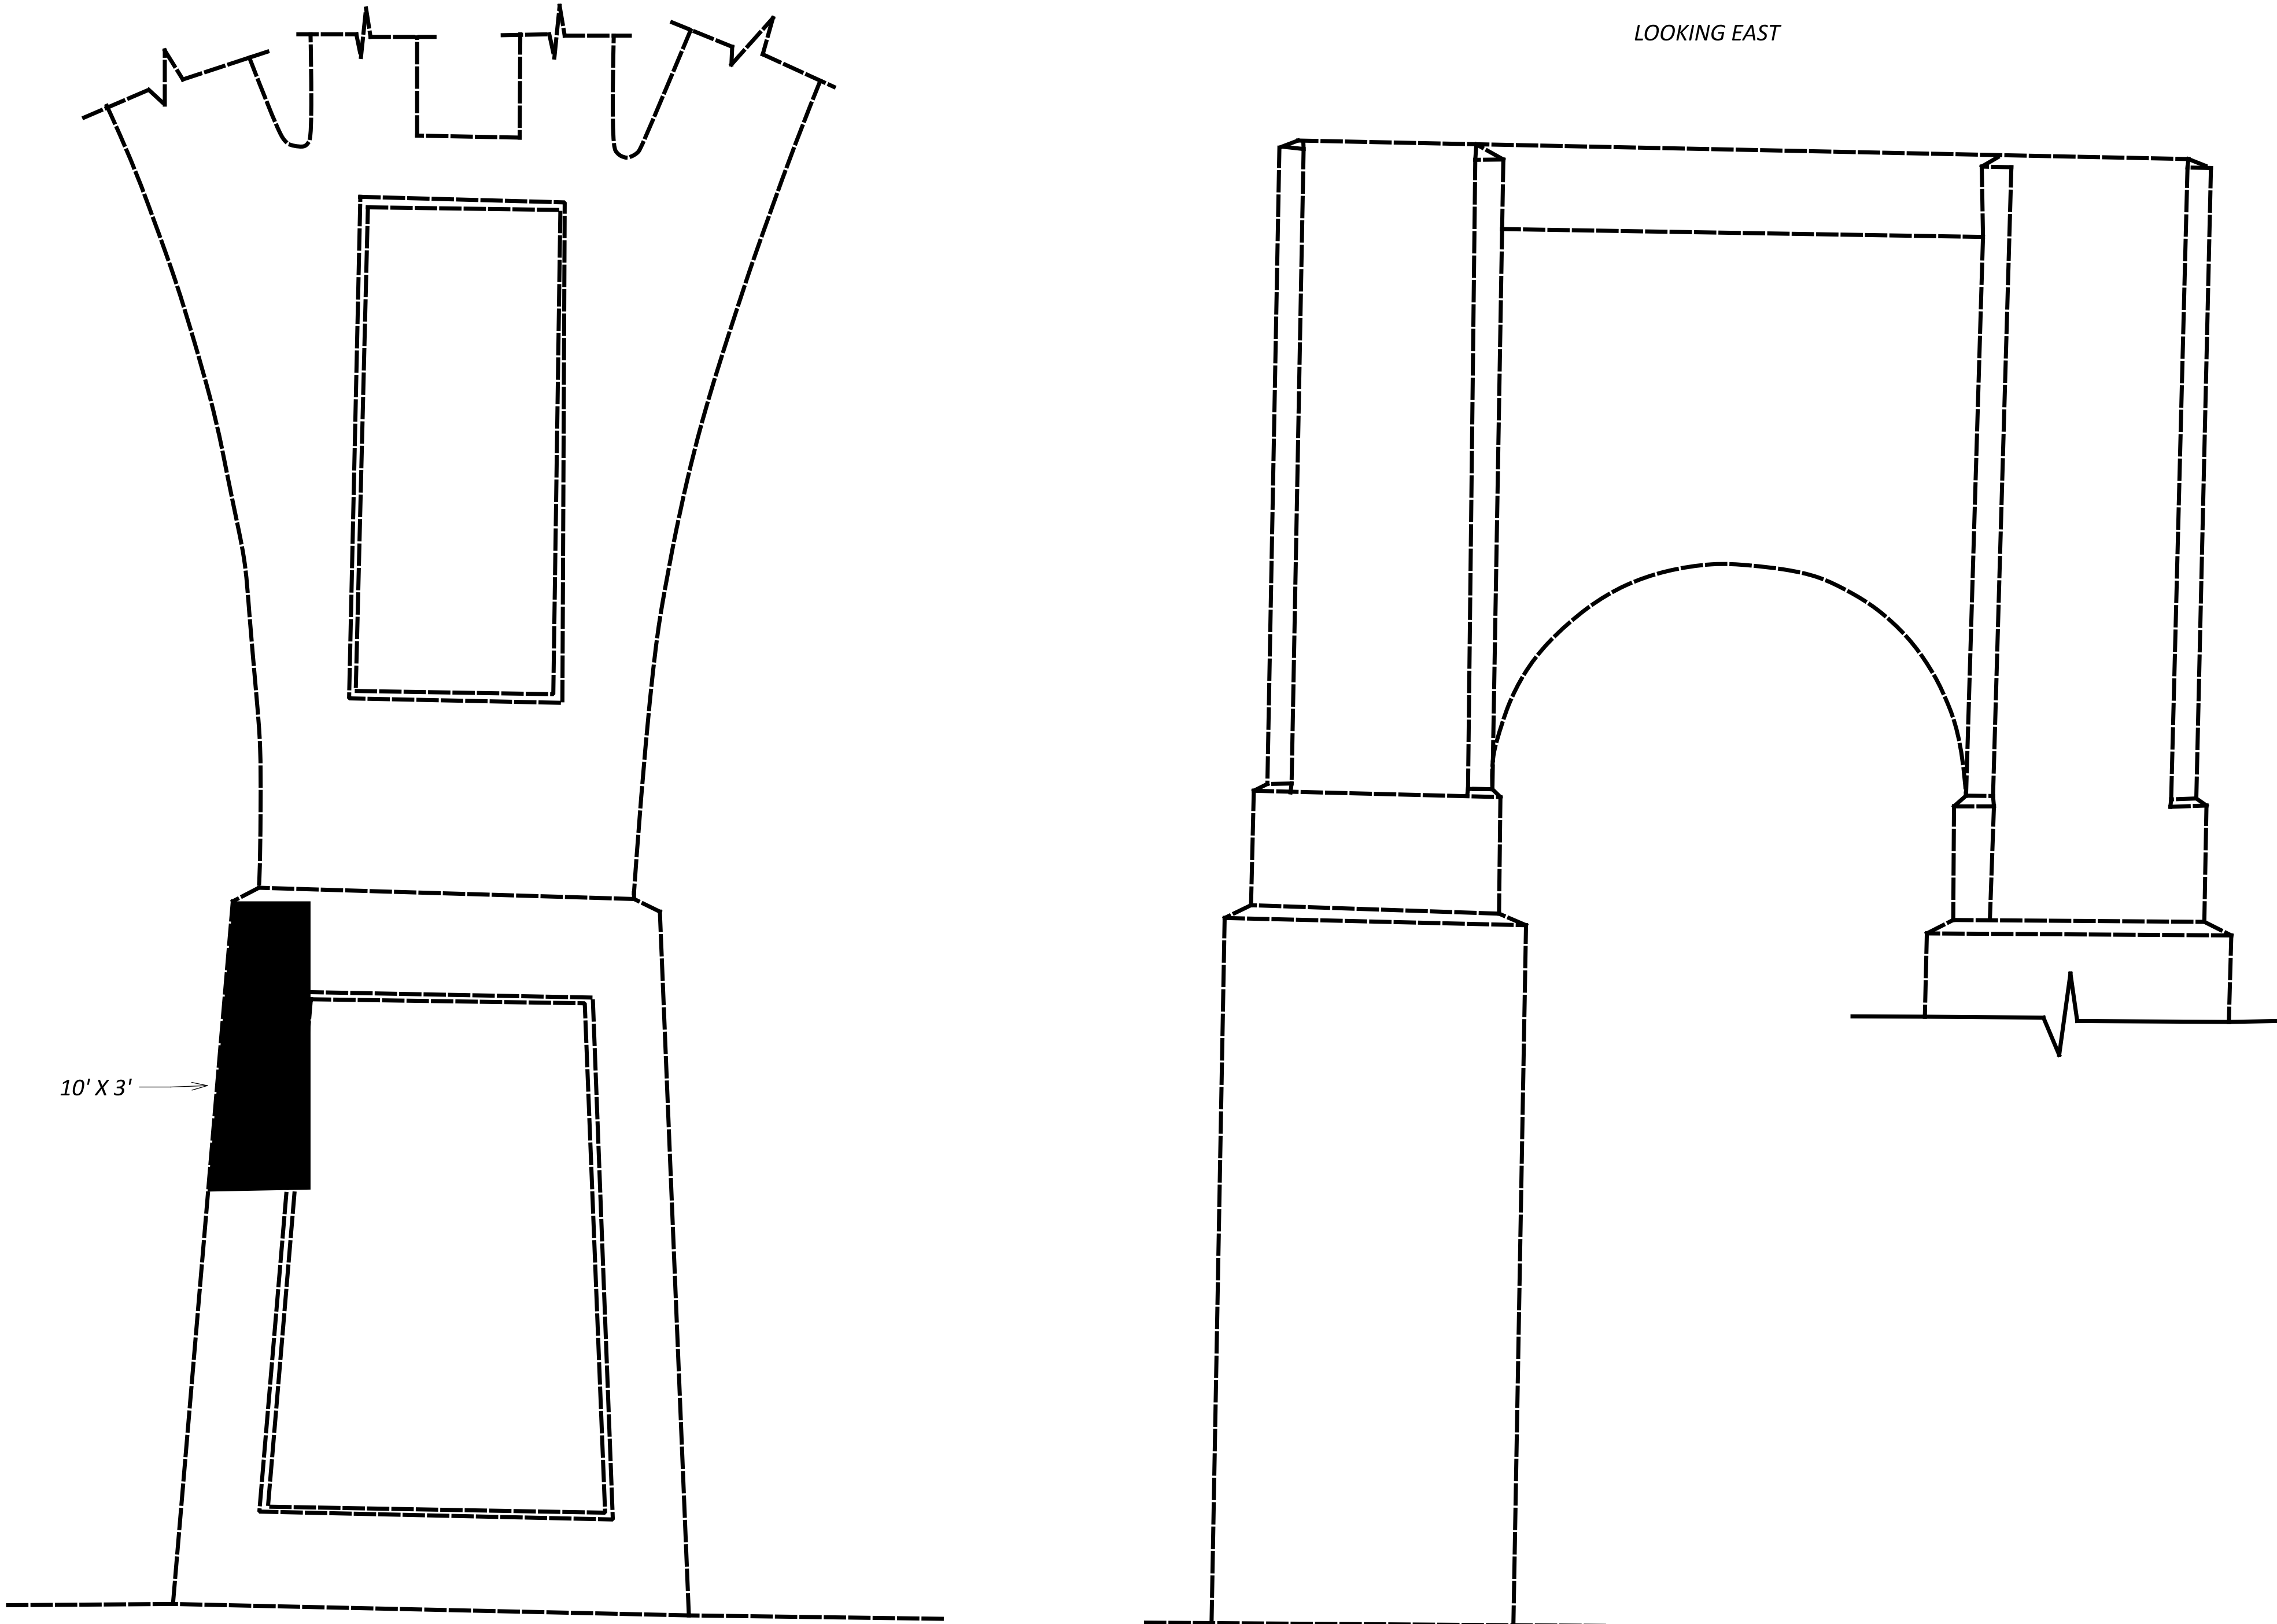

PIER 5 RIGHT (INSIDE)

OPTION A OR OPTION B
PATCHING SHOWN (SF) = 30

updated

updated

SFN		7706871	
DESIGNER		CHECKER	
MJA		TJP	
REVIEWER		PROJECT ID	
TJP		10-03-23	
SUBSET		TOTAL	
29		29	
SHEET		TOTAL	
P.34		34	

SUM-82-0000

STRUCTURE DETAILS

PIER 5 RIGHT (INSIDE)