


COUNTY: SUMMIT
 LOCATION: SR 82 @ RAVENNA/CANNON RD.
 S.L.M.: 8.03
 24" STOP LINE 57 L.F.
 12" CROSSWALK LINE 151 L.F.
 DOTTED LINE L.F.
 8" CHANNELIZING LINE 560 L.F.
 24" TRANSVERSE LINE (WH) L.F.
 24" TRANSVERSE LINE (YW) L.F.
 SYMBOLS 237 S.F. - ISLAND MKG'S 3 - LT. ARROWS
 3 - COMB. ARROWS

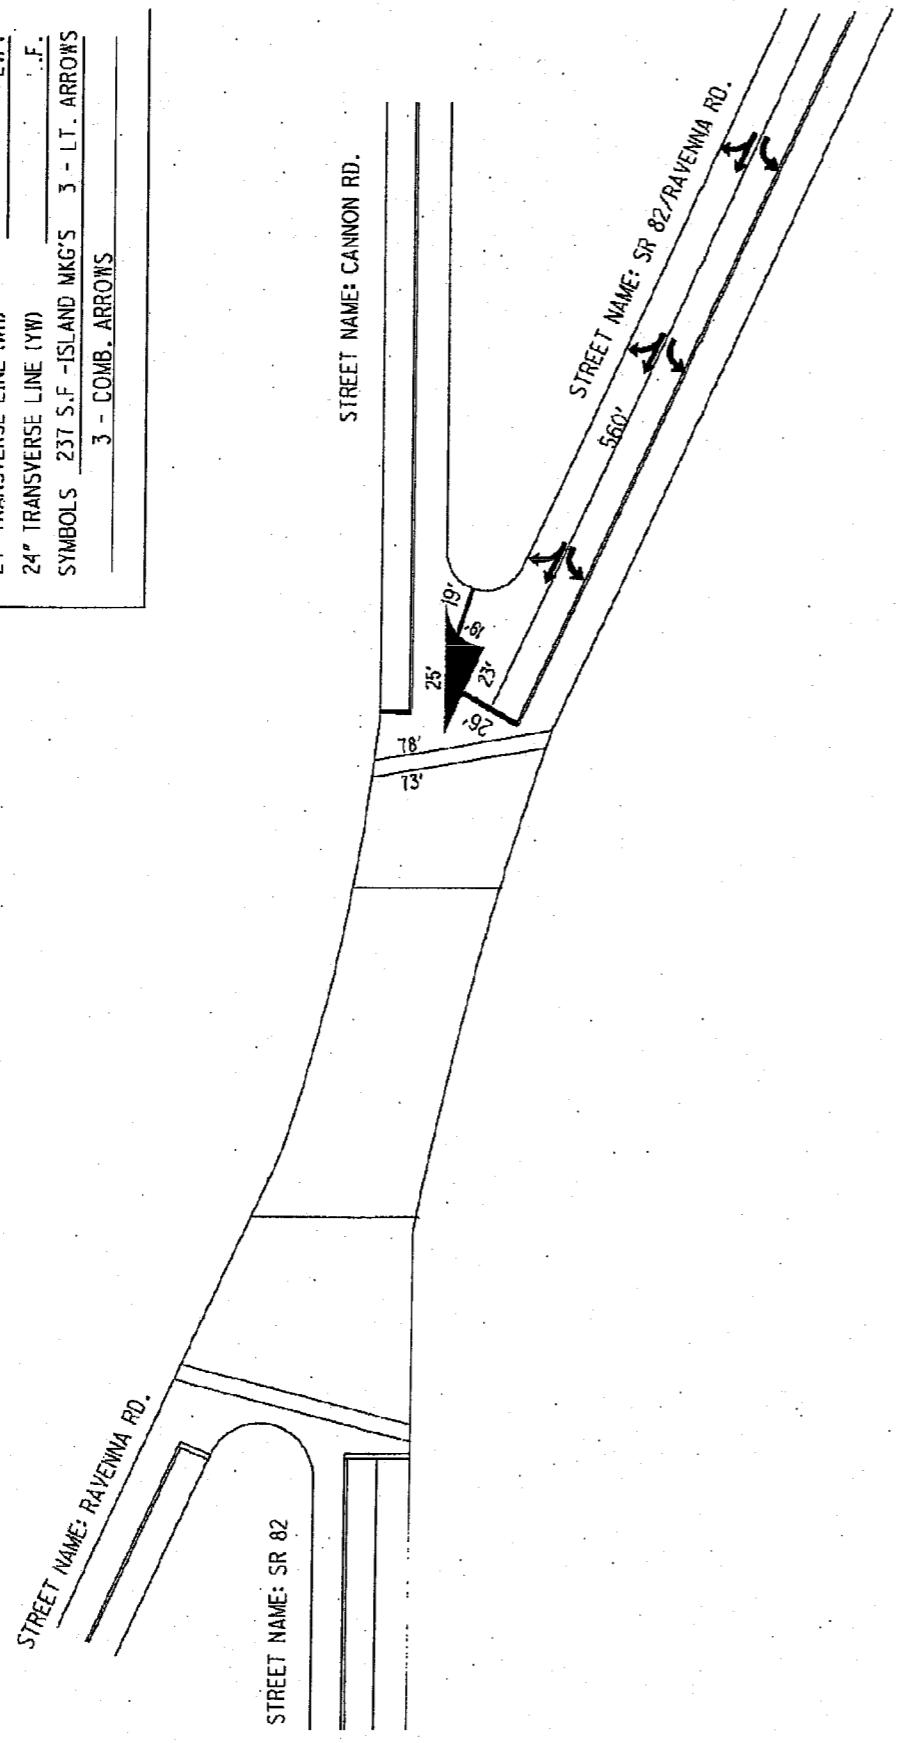

COUNTY: SUMMIT
 LOCATION: SR 82 @ RAVENNA RD.
 S.L.M.: 9.03
 24" STOP LINE 84 L.F.
 12" CROSSWALK LINE 210 L.F.
 DOTTED LINE L.F.
 8" CHANNELIZING LINE 325 L.F.
 24" TRANSVERSE LINE (WH) L.F.
 24" TRANSVERSE LINE (YW) L.F.
 SYMBOLS 5 - LT. ARROWS
 2 RXB SYMBOLS

