


ISSUE RECORD:		DESCRIPTION
NO.	DATE	

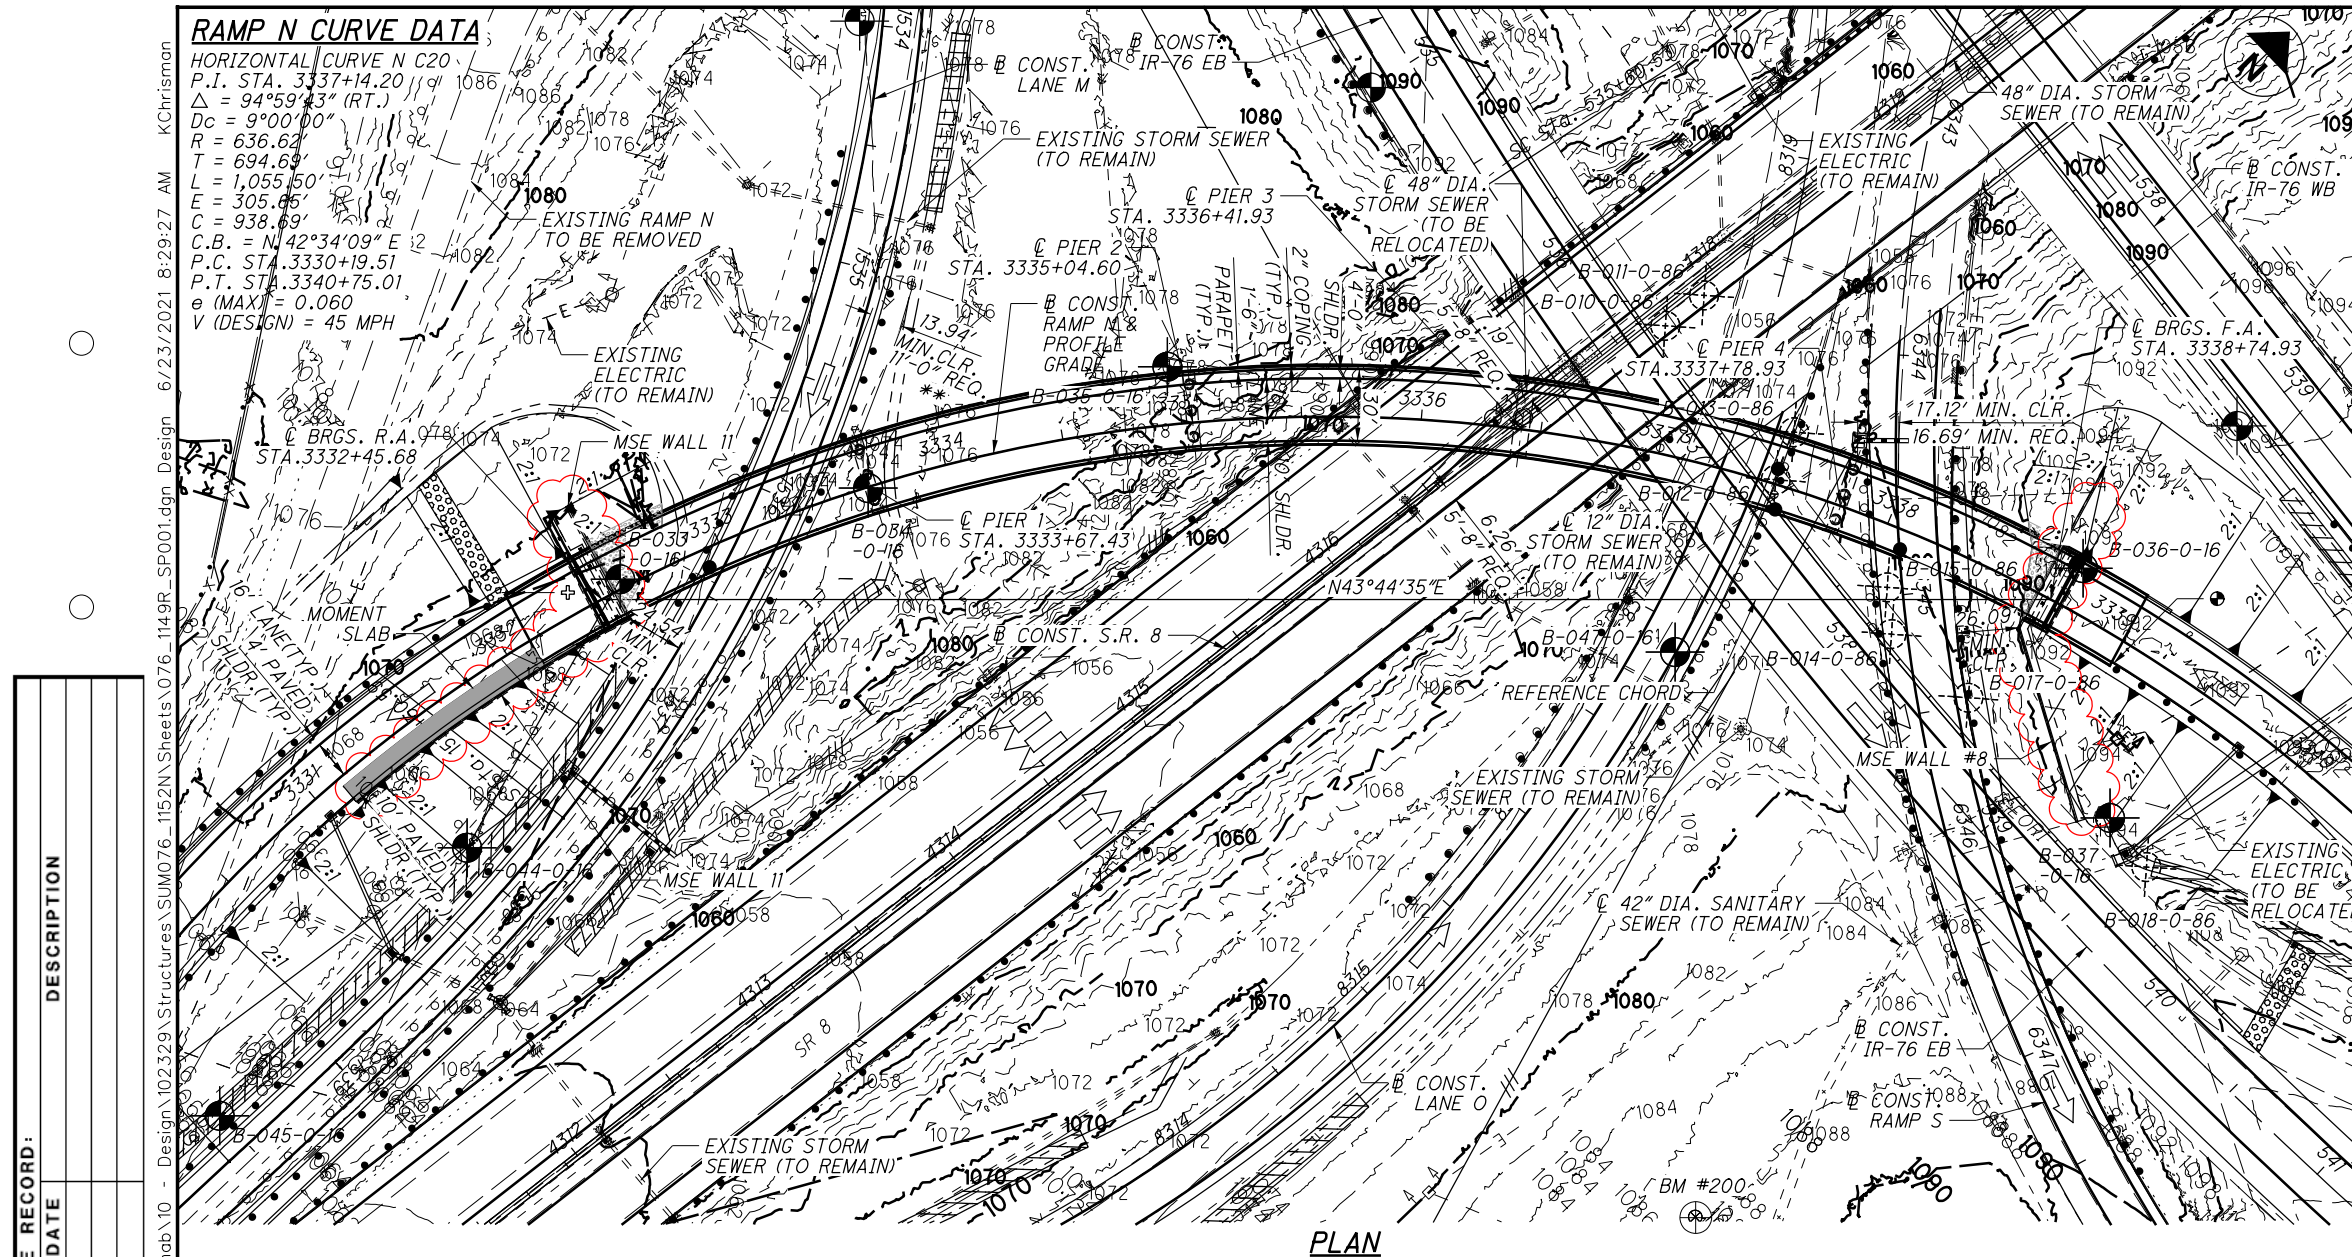

BENCHMARK DATA	
BM #5	STA. 3322+30.18, ELEV. 1082.764, OFFSET 137.48' RT., CMON
BM #200	STA. 3338+59.87, ELEV. 1087.538, OFFSET 296.86' RT. IPIN
STATIONS AND OFFSETS GIVEN WITH RESPECT TO @ CONST. RAMP N	


- FOR ADDITIONAL BENCHMARK INFORMATION. SEE BU-34.
- NOTES**
- EARTHWORK LIMITS SHOWN ARE APPROXIMATE. ACTUAL SLOPES SHALL CONFORM TO PLAN CROSS SECTIONS.
 - REFERENCE CHORD EXTENDS BETWEEN CENTERLINE REAR & FORWARD ABUTMENT BEARINGS AT THE @ CONSTRUCTION RAMP N.

DESIGN TRAFFIC:

2020 ADT = 14,590 2020 ADTT = 1,459
2040 ADT = 15,640 2040 ADTT = 1,564
DIRECTIONAL DISTRIBUTION = 100%

- LEGEND**
- CONST. = CONSTRUCTION SHLDR. = SHOULDER
F.A. = FORWARD ABUTMENT T.O.R. = TOP OF ROCK
R.A. = REAR ABUTMENT
- = PROJECT BORING LOCATIONS (SEE SHEET 2 / 60 FOR CHART AND ADDITIONAL INFORMATION.)
- ⊙ = HISTORIC BORING LOCATIONS (SEE SHEET 2 / 60 FOR CHART AND ADDITIONAL INFORMATION.)
- ⊕ = BENCHMARK LOCATION

- Δ = 16.0' MIN. REQUIRED (18.7' REQUIRED OVER EXISTING BRIDGE TO ACCOMMODATE FUTURE INTERCHANGE IMPROVEMENTS)
18.85'± MIN. CLEARANCE PROVIDED.
- ΔΔ = 16.5' MINIMUM REQUIRED, 27.5'± (OVER LANE M), 16.2'± (I-76 EB OVER LANE O), AND 38.3'± (OVER RAMP S) PROVIDED
- = POINT OF MINIMUM VERTICAL CLEARANCE
- * = BASED ON HORIZONTAL SITE DISTANCE
- ** = BASED ON 4'-0" SHOULDER, 2'-0" TO FACE OF GUARDRAIL, 5'-0" CLEARANCE BEHIND GUARDRAIL
- *** = MINIMUM DRILLED SHAFT TIP ELEVATION:
- ▽ = TOP OF SLOPE ELEVATION, VARIES
EL. 1072.09 TO 1084.49 (REAR ABUTMENT)
EL. 1090.00 TO 1097.50 (FORWARD ABUTMENT)
- ▽▽ = CRUSHED AGGREGATE SLOPE PROTECTION
- ⊕ = MGS BRIDGE TERMINAL ASSEMBLY TYPE 2, 1st POST @ STA. 3332+11.36
- ⊕ = MGS BRIDGE TERMINAL ASSEMBLY TYPE 1, 1st POST @ STA. 3339+10.69
- = PLACE THE PILES IN DRILLED HOLES THAT EXTEND A MINIMUM OF 5'-0" INTO BEDROCK

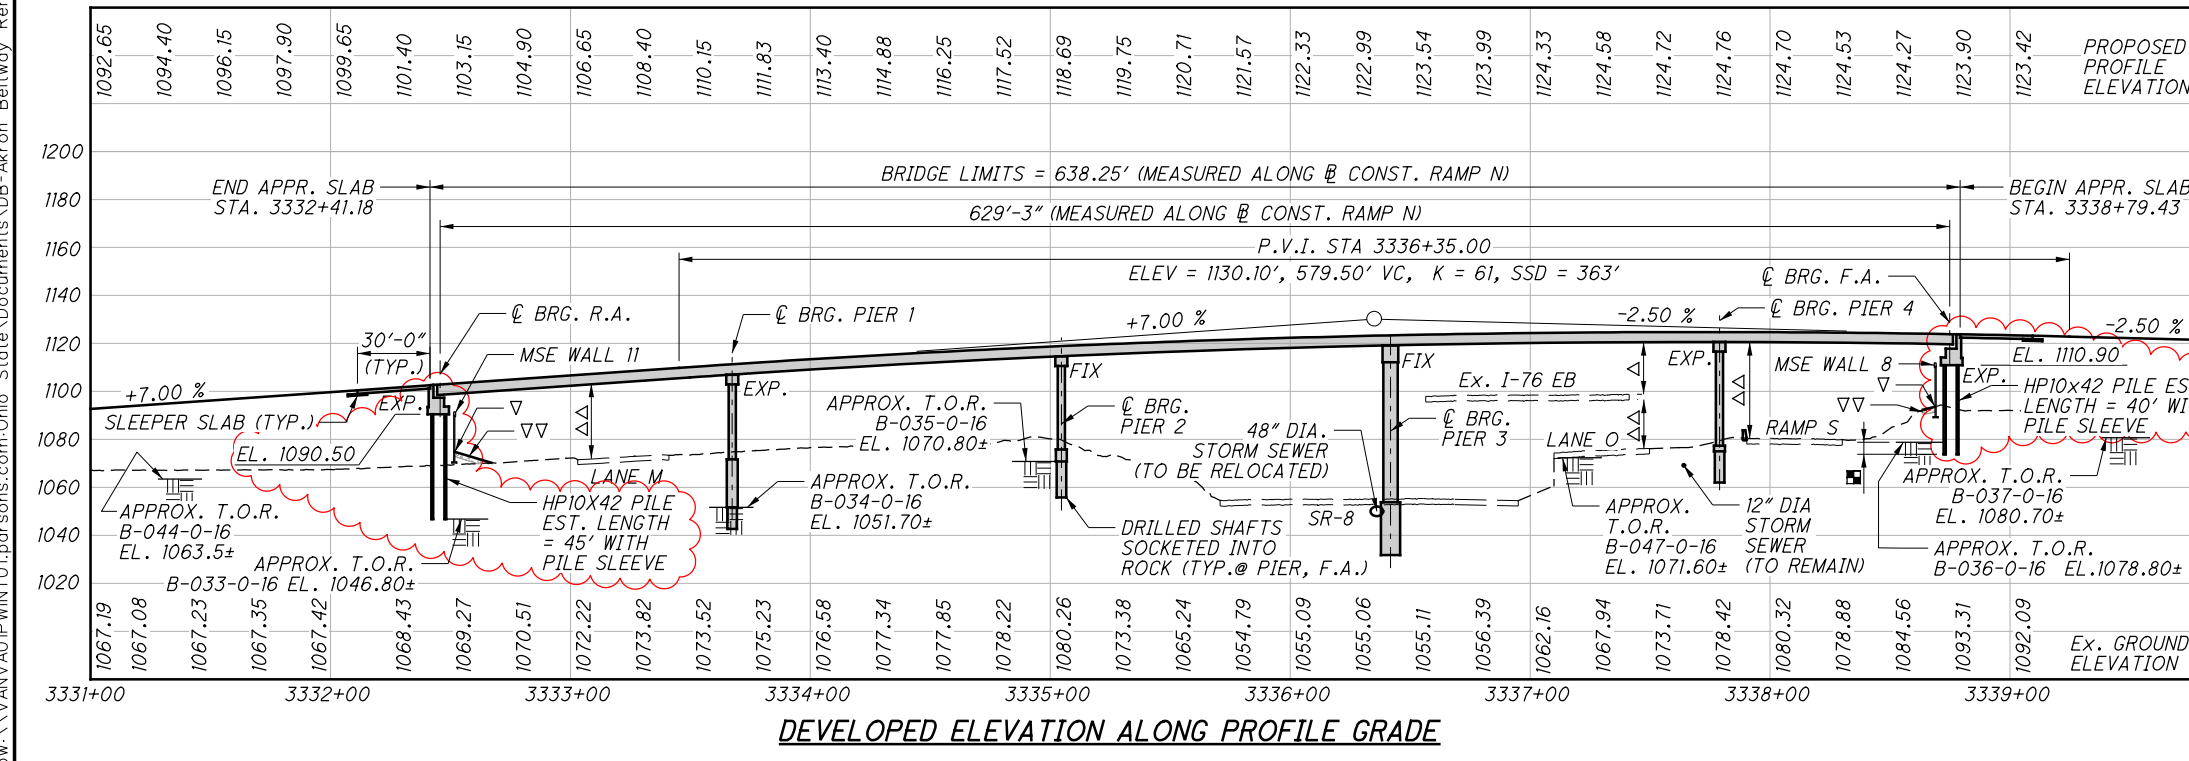

DRILLED SHAFT INFORMATION				
LOCATION	SHAFT DIA. ABOVE ROCK	SHAFT DIA. IN ROCK	TOP OF SHAFT ELEV.	ROCK SOCKET LENGTH ***
PIER 1	4'-6"	4'-0"	1071.70	9'-0"
PIER 2	4'-6"	4'-0"	VARIES	15'-0"
PIER 3	-	8'-0"	1053.80	22'-0"
PIER 4	4'-6"	4'-0"	1077.40	13'-0"

EXISTING STRUCTURE - NONE

PROPOSED STRUCTURE

TYPE: 5-SPAN CONTINUOUS CURVED STEEL PLATE GIRDER WITH COMPOSITE REINFORCED CONCRETE DECK, STUB TYPE ABUTMENTS ON PILES WITH MSE WALLS, AND REINFORCED CONCRETE CAP-AND-COLUMN PIERS ON DRILLED SHAFTS

SPANS: 121'-9", 137'-2", 137'-4", 137'-0", AND 96'-0" c/c BEARINGS (SPANS MEASURED ALONG @ CONST. RAMP N)

ROADWAY: 30'-0" TOE/TOE PARAPET

LOADING: HL93 AND FUTURE WEARING SURFACE (FWS) OF 0.060 KSF

SKEW: ALL SUBSTRUCTURES ARE RADIAL (SKEW ANGLE MEASURED TO REFERENCE CHORD VARIES, SEE LAYOUT DIAGRAM)

WEARING SURFACE: MONOLITHIC CONCRETE

APPROACH SLABS: 30'-0" LONG (AS-I-15 MODIFIED) (AS-2-15)


ALIGNMENT: 9°00'00" RIGHT CURVE

SUPERELEVATION: 0.06 FT./FT. DECK AREA: 21,323 SQ. FT.

COORDINATES: LATITUDE 41° 03' 38.06" N
LONGITUDE 81° 30' 17.28" W

ISSUE RECORD:		DESCRIPTION
NO.	DATE	

p:\V\ANV\A01P\WINT01.parsons.com:Ohio State\Documents\DB-Akron Beltway Rehab\10 - Design\102329\Structures\SUM076_1152N\Sheets\076_1149R_SG001.dgn Design 6/23/2021 8:29:49 AM KChrisman

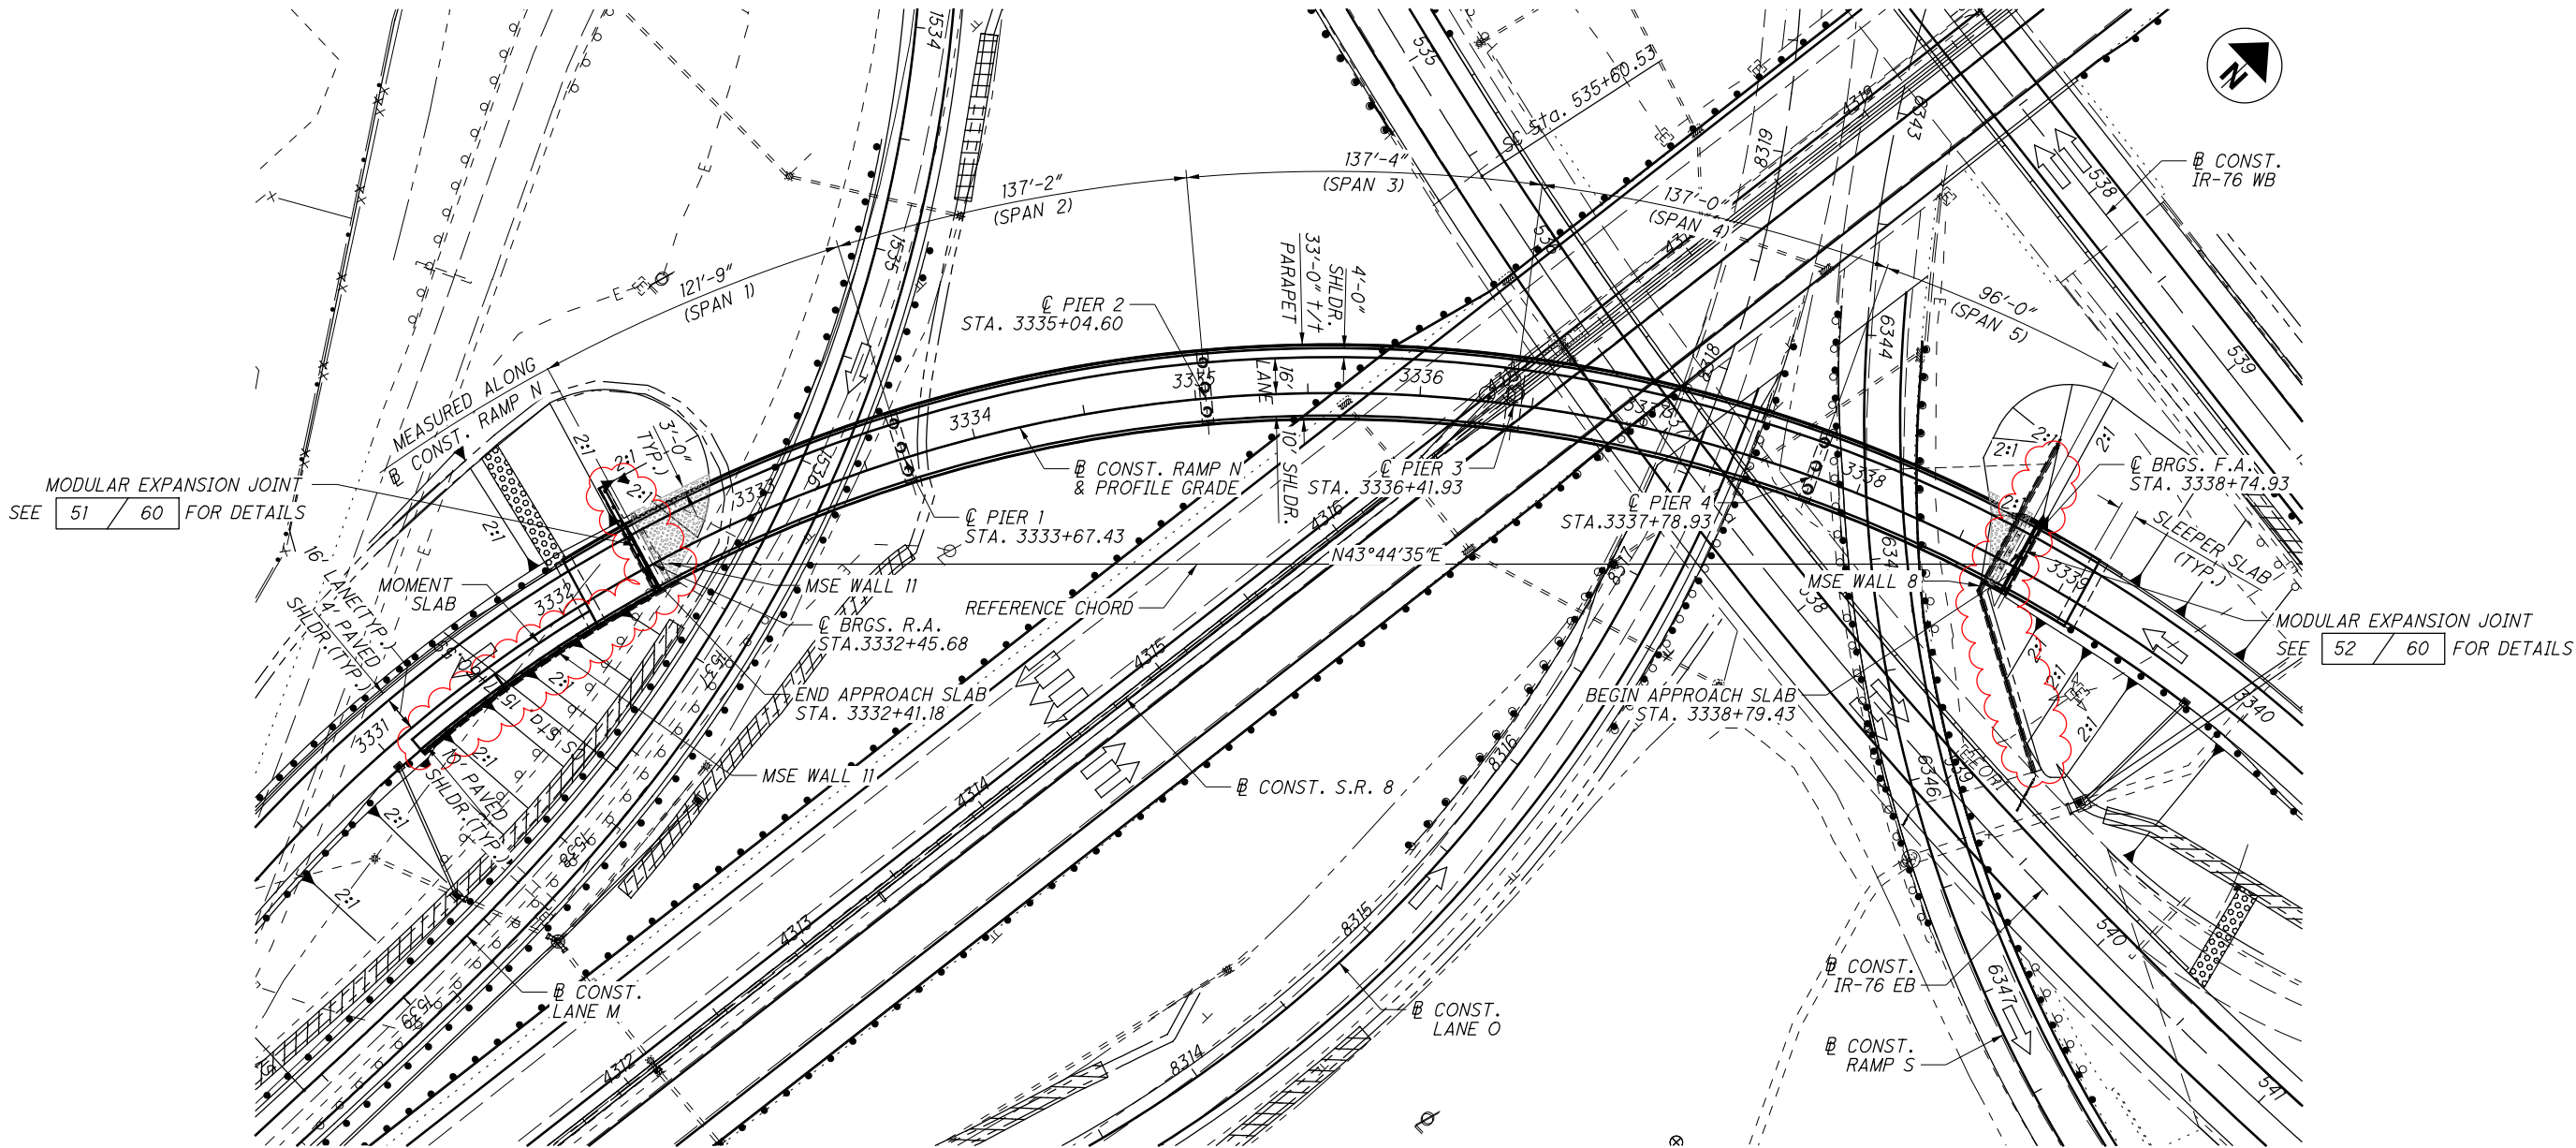

GENERAL PLAN

HISTORIC BORING LOCATIONS AND TOP OF ROCK ELEVATIONS *			
BORING	STATION	OFFSET	T.O.R. ELEVATION
B-010-0-86	3336+92±	53'± LT.	1052.40'
B-011-0-86	3337+04±	68'± LT.	1052.40'
B-012-0-86	3337+50±	2'± LT.	1072.40'
B-013-0-86	3337+51±	23'± LT.	1071.90'
B-014-0-86	3338+20±	42'± RT.	1078.30'
B-015-0-86	3338+10±	25'± RT.	1078.80'
B-017-0-86	3338+63±	52'± RT.	1077.70'
B-018-0-86	3339+75±	72'± RT.	1073.50'

(* = BORING DATA CAME FROM PREVIOUS PROJECTS AND BORING LOCATIONS ARE APPROXIMATE)

PROJECT BORING LOCATIONS AND TOP OF ROCK ELEVATIONS			
BORING	STATION	OFFSET	T.O.R. ELEVATION
B-033-0-16	3332+56.42	3.9' LT.	1046.8'
B-034-0-16	3333+66.27	0.4' RT.	1051.7'
B-035-0-16	3334+96.39	24.2' LT.	1070.8'
B-036-0-16	3338+80.46	17.9' LT.	1078.8'
B-037-0-16	3339+47.44	64.7' RT.	1080.7'
B-044-0-16	3331+37.19	56.1' RT.	1063.5'
B-045-0-16	3329+74.22	62.3' RT.	1062.9'
B-047-0-16	3337+28.21	78.8' RT.	1071.6'

NOTES


- REFERENCE CHORD EXTENDS FROM C BEARINGS REAR ABUTMENT TO C BEARINGS FORWARD ABUTMENT.
- SEE SHEET 3 / 60 FOR GEOMETRIC LAYOUT.
- SEE SHEET 1 / 60 FOR LOCATIONS OF PROJECT BORINGS AND HISTORIC BORINGS.

2025-03-13 - BU-11 - RECORD DRAWING PLANS

GENERAL PLAN		SUMMIT COUNTY		DESIGNED		DRAWN		REVIEWED		DATE		DESIGN AGENCY	
BRIDGE NO. SUM-76-1152N		STA. 3332+41.18		JAT		JAT		SAN		6/14/21		PRIMEITY	
RAMP N OVER RAMP S, LANES O & M, IR-76 EB, SR-8 NB/SB		STA. 3338+79.43		CHECKED		REVISED		STRUCTURE FILE NUMBER		7705973		8455 Pauls Place, Suite 300	
PID No. 102329												Columbus Ohio 43240	

ISSUE RECORD:		DESCRIPTION
NO.	DATE	

pw:\V\ANV\A01PW\INT01.parsons.com:Ohio State\Documents\DB-Akron Beltway Rehab\10 - Design\102329\Structures\SUM076_1152N\Sheets\076_1149R_SG002.dgn Sheet 6/23/2021 8:29:56 AM KChrisman

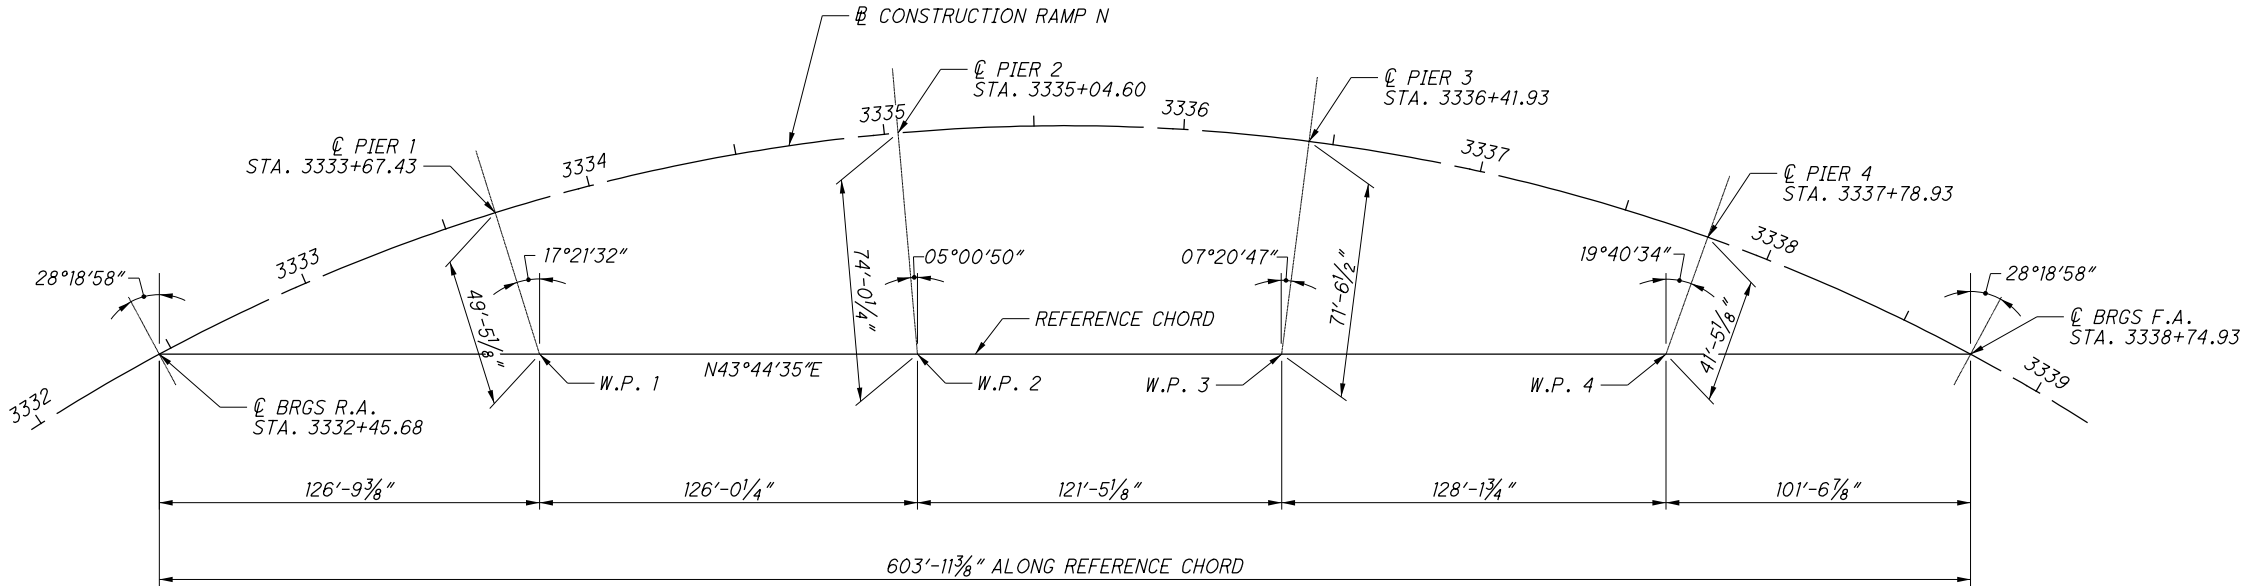

BRIDGE LAYOUT DIAGRAM

NOTES:

- SEE SHEET 1 / 60 FOR RAMP N CURVE DATA.
- ALL SUBSTRUCTURES ARE ORIENTED RADIALLY TO CONSTRUCTION RAMP N.

2025-03-13 - BU-11 - RECORD DRAWING PLANS		BRIDGE LAYOUT DIAGRAM		DESIGN AGENCY
SUM-76/77/8-8.24/9.74/0.00		RAMP N OVER RAMP S, LANE O, IR-76 EB, SR-8 NB/SB, LANE M		BURGESS & NIPLE
PID No. 102329		SUM-76-1152N		Engineers ■ Architects ■ Planners
3 / 60		DESIGNED KK		5045 REED ROAD, COLUMBUS, OHIO 43220
4 / 61		CHECKED MAB		
		DRAWN KK		
		REVIEWED JCS		
		DATE 4/29/19		
		STRUCTURE FILE NUMBER 7705973		

ISSUE RECORD:		DESCRIPTION
NO.	DATE	

REFER TO THE FOLLOWING STANDARD BRIDGE DRAWINGS:

A-1-69 REVISED 7-19-02
AS-1-15 REVISED 7-17-15
AS-2-15 REVISED 1-18-19
SBR-1-13 REVISED 7-20-18

AND TO THE FOLLOWING SUPPLEMENTAL SPECIFICATIONS:

840 DATED 1/15/21
845 DATED 4/20/18

DESIGN SPECIFICATIONS: THIS STRUCTURE CONFORMS TO THE "LRFD BRIDGE DESIGN SPECIFICATIONS" ADOPTED BY THE AMERICAN ASSOCIATION OF STATE HIGHWAY AND TRANSPORTATION OFFICIALS, 8TH EDITION, 2017 AND THE ODOT BRIDGE DESIGN MANUAL, 2007 EDITION WITH REVISIONS THROUGH JULY 2018, EXCEPT AS NOTED ELSEWHERE IN THE PLANS.

SPECIAL DESIGN SPECIFICATIONS: THIS BRIDGE REQUIRED THE USE OF A THREE DIMENSIONAL MODEL USING THE FINITE ELEMENT DESIGN METHOD TO ANALYZE THE STRUCTURE. THE COMPUTER PROGRAM USED FOR STRUCTURAL ANALYSIS WAS MIDAS CIVIL 2019 (VERSION 1.1, BUILD 7/16/18). THIS PROGRAM WAS USED TO CALCULATE FORCES FOR THE DESIGN OF THE STEEL GIRDERS AND CROSSFRAMES AND TO CALCULATE REACTIONS FOR THE DESIGN OF THE BEARINGS AND SUBSTRUCTURES.

DEAD LOAD DISTRIBUTIONS: THE WEIGHT OF THE STEEL SUPERSTRUCTURE AND CONCRETE DECK WAS APPLIED TO EACH ELEMENT IN THE MODEL BASED ON LOCAL SECTION PROPERTIES. THE WEIGHT OF THE FUTURE WEARING SURFACE WAS APPLIED TO EACH GIRDER BASED ON TRIBUTARY AREA. PARAPET WEIGHT WAS APPLIED TO THE EXTERIOR GIRDERS.

UNIT LOADS USED IN THE ANALYSIS ARE LISTED BELOW:

FUTURE WEARING SURFACE = 60 LB/SF
PARAPETS (EACH) = 613 LB/FT

LIVE LOAD DISTRIBUTION: THE DESIGN AND LOAD RATING ANALYSES WERE CARRIED OUT BY APPLYING TRUCK AND LANE LOADS DIRECTLY TO THE FINITE ELEMENT MODELS, RATHER THAN BY USING CALCULATED DISTRIBUTION FACTORS.

REDUNDANCY: THE FOLLOWING ITEMS WERE CONSIDERED NON-REDUNDANT FOR DESIGN AND INCLUDE A LOAD MODIFIER EQUAL TO 1.05 IN ACCORDANCE WITH THE AASHTO LRFD BRIDGE DESIGN SPECIFICATIONS, ARTICLE 1.3.4: PIER 3.

REDUNDANCY: THE DRILLED SHAFTS SUPPORTING THE FOLLOWING SUBSTRUCTURES WERE CONSIDERED NON-REDUNDANT FOR DESIGN AND INCLUDE A MODIFIED RESISTANCE FACTOR FOR TIP RESISTANCE EQUAL TO 0.40 AND A MODIFIED RESISTANCE FACTOR FOR SIDE RESISTANCE EQUAL TO 0.44 IN ACCORDANCE WITH THE AASHTO LRFD BRIDGE DESIGN SPECIFICATIONS, ARTICLE 10.5.5.2.4: PIER 3.

OPERATIONAL IMPORTANCE: A LOAD MODIFIER OF 1.0 HAS BEEN ASSUMED FOR THE DESIGN OF THIS STRUCTURE IN ACCORDANCE WITH THE AASHTO LRFD BRIDGE DESIGN SPECIFICATIONS, ARTICLE 1.3.5 AND THE ODOT BRIDGE DESIGN MANUAL, 2007.

DESIGN LOADING: HL-93
FUTURE WEARING SURFACE (FWS) OF 0.060 KSF

DESIGN DATA:

CONCRETE CLASS QC2 - COMPRESSIVE STRENGTH 4.5 KSI (SUPERSTRUCTURE)
CONCRETE CLASS QC1 - COMPRESSIVE STRENGTH 4.0 KSI (SUBSTRUCTURE) (ABUTMENTS AND PIERS 1, 2 & 4)
MASS CONCRETE CLASS QC4 - COMPRESSIVE STRENGTH 4.0 KSI (SUBSTRUCTURE) (PIER 3)
CONCRETE CLASS QC5 - COMPRESSIVE STRENGTH 4.5 KSI (DRILLED SHAFTS AT PIERS 1, 2 & 4)
MASS CONCRETE CLASS QC4 - COMPRESSIVE STRENGTH 4.5 KSI (DRILLED SHAFT AT PIER 3)
REINFORCING STEEL - MINIMUM YIELD STRENGTH 60 KSI
STRUCTURAL STEEL - ASTM A709 GRADE 50 - YIELD STRENGTH 50 KSI
STEEL H-PILES - ASTM A572 GRADE 50 - YIELD STRENGTH 50 KSI

DECK PROTECTION METHOD:

EPOXY COATED REINFORCING STEEL
2 1/2" CONCRETE COVER
CLASS QC2 CONCRETE

MONOLITHIC WEARING SURFACE IS ASSUMED, FOR DESIGN PURPOSES, TO BE 1 INCH THICK.

PILE DRIVING CONSTRAINTS AT ABUTMENTS ADJACENT TO MSE WALLS: PRIOR TO DRIVING ABUTMENT PILES TO REFUSAL ON BEDROCK, CONSTRUCT THE MSE WALL AND THE BRIDGE APPROACH EMBANKMENT BEHIND THE ABUTMENT UP TO THE BOTTOM OF THE FOOTING FOR A MINIMUM DISTANCE OF 250' BEHIND THE ABUTMENT. THE CONTRACTOR MAY PRE-DRIVE ABUTMENT PILES BEFORE CONSTRUCTING MSE WALLS. PRE-DRIVING CONSISTS OF INSTALLING THE ABUTMENT PILES INTO THE SOIL ONLY AS FAR AS NECESSARY SO THAT THE PILE WILL REMAIN VERTICAL DURING MSE WALL CONSTRUCTION. IF PRE-DRIVING PILES, INSTALL PILE SLEEVES AROUND PILES BEFORE CONSTRUCTING THE MSE WALL. PROVIDE AT LEAST 3-FT OF PILE ABOVE THE TOP OF THE PILE SLEEVE TO MEET THE REQUIREMENTS OF C&MS 507.09 REGARDING SPLICES. DO NOT DRIVE ABUTMENT PILES TO REFUSAL ON BEDROCK UNTIL AFTER THE ABOVE REQUIRED MSE WALL AND EMBANKMENT HAVE BEEN CONSTRUCTED AND A 30 CALENDAR DAY WAITING PERIOD HAS ELAPSED. THE ENGINEER MAY ADJUST THE LENGTH OF THE WAITING PERIOD BASED ON SETTLEMENT PLATFORM READINGS. AFTER THE SPECIFIED WAITING PERIOD HAS ELAPSED, DRIVE ABUTMENT PILES TO REFUSAL ON BEDROCK. IN ORDER TO REMOVE ANY NEGATIVE SKIN FRICTION THAT HAS DEVELOPED DURING THE WAITING PERIOD, DRIVE EACH ABUTMENT PILE A DISTANCE OF AT LEAST 0.5-IN.

THE ABOVE NOTE DOES NOT APPLY AT THE FORWARD ABUTMENT WHERE THE PILES ARE TO BE PLACED IN HOLES, PREBORED INTO ROCK.

IF NOT PRE-DRIVING ABUTMENT PILES, INSTALL THE ABUTMENT PILES THROUGH PILE SLEEVES AFTER THE ABOVE REQUIRED MSE WALL AND EMBANKMENT HAVE BEEN CONSTRUCTED AND THE SPECIFIED WAITING PERIOD HAS ELAPSED.

PILES TO BEDROCK: DRIVE PILES TO REFUSAL ON BEDROCK. THE DEPARTMENT WILL CONSIDER REFUSAL TO BE OBTAINED WHEN THE PILE PENETRATION IS AN INCH OR LESS AFTER RECEIVING AT LEAST 20 BLOWS FROM THE PILE HAMMER. SELECT THE HAMMER SIZE TO ACHIEVE THE REQUIRED DEPTH TO BEDROCK AND REFUSAL.

THE TOTAL FACTORED LOAD IS 219 KIPS PER PILE FOR THE REAR ABUTMENT PILES AND 209 KIPS PER PILE FOR THE FORWARD ABUTMENT PILES.

REAR ABUTMENT PILES:
(12) - HP10X42 PILES, 50 FEET LONG, ORDER LENGTH (PILES 1-12)

FORWARD ABUTMENT PILES:
(10) - HP10X42 PILES, 45 FEET LONG, ORDER LENGTH (PILES 13-22)

PILE SPLICES: IN LIEU OF USING THE FULL PENETRATION BUTT WELDS SPECIFIED IN CMS 507.09 TO SPlice STEEL H-PILES, THE CONTRACTOR MAY USE A MANUFACTURED H-PILE SPLICER. FURNISH SPLICERS FROM THE FOLLOWING MANUFACTURER:

ASSOCIATED PILE AND FITTING CORPORATION
8 WOOD HOLLOW RD. PLAZA 1
PARSIPPANY, NEW JERSEY 07054

INSTALL AND WELD THE SPLICER TO THE PILE SECTIONS IN ACCORDANCE WITH THE MANUFACTURER'S WRITTEN ASSEMBLY PROCEDURE SUPPLIED TO THE ENGINEER BEFORE THE WELDING IS PERFORMED.

PILE DRIVING:

THE MINIMUM RATED ENERGY OF THE HAMMER USED TO INSTALL THE REAR ABUTMENT PILES SHALL BE 20,000 FOOT-POUNDS. ENSURE THAT STRESSES IN THE PILES DURING DRIVING DO NOT EXCEED 45,000 POUNDS PER SQUARE INCH.

DRILLED SHAFTS:

THE FOLLOWING TABLE SUMMARIZES THE DRILLED SHAFT FACTORED LOADS AND FACTORED RESISTANCES AT EACH SUBSTRUCTURE. THE MAXIMUM FACTORED LOAD AT EACH SUBSTRUCTURE IS FULLY SUPPORTED BY THE DRILLED SHAFTS IN TIP RESISTANCE, IGNORING ANY CONTRIBUTION FROM SIDE RESISTANCE. ALL INFORMATION IN THE TABLE IS GIVEN PER EACH DRILLED SHAFT.

LOCATION	MAXIMUM FACTORED LOAD (KIPS)	FACTORED TIP RESISTANCE (KIPS)	TOTAL FACTORED RESISTANCE (KIPS)
PIER 1	1143	6754	6754
PIER 2	1063	6754	6754
PIER 3	2979	18679	18679
PIER 4	1013	3217	3217

ITEM 509 - EPOXY COATED REINFORCING STEEL, AS PER PLAN:

IN ADDITION TO THE PROVISIONS OF ITEM 509, FIELD BEND AND/OR FIELD CUT THE REINFORCING STEEL DESIGNATED IN THE PLANS, AS NECESSARY, IN ORDER TO MAINTAIN THE REQUIRED CLEARANCES AND BAR SPACINGS. REPAIR ALL DAMAGE TO THE EPOXY COATING, AS A RESULT OF THIS WORK, ACCORDING TO 509.

FIELD CUTTING IS REQUIRED AT THE FOLLOWING LOCATIONS:

AT MODULAR EXPANSION JOINT, SEE SHEET 51 / 60

ITEM 524 - DRILLED SHAFTS, 48" DIAMETER, INTO BEDROCK WITH QC/QA, AS PER PLAN:
ITEM 524 - DRILLED SHAFTS, 54" DIAMETER, ABOVE BEDROCK WITH QC/QA, AS PER PLAN:

THE AGGREGATE SHALL BE 3/8" NOMINAL MAXIMUM SIZE.

ITEM 524 - DRILLED SHAFTS, 96" DIAMETER, INTO BEDROCK WITH QC/QA, AS PER PLAN:

CONCRETE SHALL BE CLASS QC4. THE PROVISIONS FOR MASS CONCRETE IN CMS 511.04.A SHALL APPLY. THE MINIMUM COMPRESSIVE STRENGTH SHALL BE 4.5 KSI. THE AGGREGATE SHALL BE 3/8" NOMINAL MAXIMUM SIZE.

ITEM 512 - SEALING OF CONCRETE SURFACES (EPOXY-URETHANE):

SEE AESTHETIC PLANS FOR SEALING COLOR FOR ABUTMENTS AND WINGWALLS. FOR PIERS AND PARAPETS, TINT SO THE FINAL COLOR IS FEDERAL COLOR STANDARD NO. 27769 - LIGHT NEUTRAL.

IN ADDITION TO THE LIMITS OF SEALING SHOWN ON THE PLANS, SEAL ALL EXPOSED CONCRETE SURFACES OF ALL PROPOSED PIERS, EXCLUDING THE TOP HORIZONTAL SURFACES OF THE PIER CAPS.

REFER TO CMS 516.07 FOR SEALING REQUIREMENTS AT BEARING AREAS.

ITEM 526 - REINFORCED CONCRETE APPROCH SLABS (T=17"), AS PER PLAN:

THE REQUIREMENTS OF 511.03 AND 511.04 SHALL APPLY TO THIS ITEM OF WORK. THIS ITEM SHALL INCLUDE, BUT IS NOT LIMITED TO THE CONCRETE AND STEEL REINFORCEMENT NECESSARY TO FORM AND PLACE THE APPROACH SLABS AS SHOWN IN THE PLANS. PAYMENT FOR THIS ITEM SHALL ALSO INCLUDE THE ITEMS LISTED ON STANDARD DRAWING AS-1-15 AND ALL OTHER NECESSARY MATERIALS, LABOR, AND EQUIPMENT AND SHALL BE INCLUDED IN THE UNIT PRICE BID PER SQUARE YARD FOR ITEM 526 - REINFORCED CONCRETE APPROACH SLABS WITH QC/QA (T=17"), AS PER PLAN.

DECK PLACEMENT DESIGN ASSUMPTIONS:

THE FOLLOWING ASSUMPTIONS OF CONSTRUCTION MEANS AND METHODS WERE MADE FOR THE ANALYSIS AND DESIGN OF THE SUPERSTRUCTURE. THE CONTRACTOR IS RESPONSIBLE FOR THE DESIGN OF THE FALSEWORK SUPPORT SYSTEM WITHIN THESE PARAMATERS AND WILL ASSUME RESPONSIBILITY FOR SUPERSTRUCTURE ANALYSIS FOR DEVIATION FROM THESE DESIGN ASSUMPTIONS.

AN EIGHT WHEEL FINISHING MACHINE WITH A MAXIMUM WHEEL LOAD OF 2.2 KIPS.

A MINIMUM OUT-TO-OUT WHEEL SPACING AT EACH END OF THE MACHINE OF 103 INCHES.

A MAXIMUM SPACING OF OVERHANG FALSEWORK BRACKETS OF 48 INCHES.

A MAXIMUM DISTANCE FROM THE CENTERLINE OF THE FASCIA GIRDER TO THE FACE OF THE SAFETY HANDRAIL OF 65 INCHES.

ITEM 524 - DRILLED SHAFTS, MISC.: THERMAL INTEGRITY PROFILER (T.I.P.) WIRE CABLE TESTING OF DRILLED SHAFTS:

PERFORM INTEGRITY TESTING ON ALL DRILLED SHAFTS SUPPORTING SINGLE-COLUMN PIERS (AT PIER 3), ONE DRILLED SHAFT AT EACH MULTI-COLUMN PIER (AT PIERS 1, 2 & 4) BY THERMAL INTEGRITY PROFILING (TIP). PERFORM TIP TESTING PER ASTM D7949 "STANDARD TEST METHODS FOR THERMAL INTEGRITY PROFILING OF CONCRETE DEEP FOUNDATIONS", METHOD B, AND PER THE PROJECT SPECIAL PROVISIONS.

ITEM 840 - CONCRETE COPING:

PROVIDE EPOXY COATED REINFORCING AND CLASS QC CONCRETE AS SHOWN IN THE PLANS. CONCRETE AND REINFORCING STEEL IN THE COPING, AND EXPANSION AND CONTRACTION JOINTS SHALL BE INCLUDED IN THE QUANTITY FOR THIS ITEM.

ITEM 524 - DRILLED SHAFTS, MISC.: CSL TESTING, 96" DIAMETER SHAFT:

PERFORM INTEGRITY TESTING ON ALL DRILLED SHAFTS SUPPORTING SINGLE-COLUMN PIERS (AT PIER 3) BY CROSSHOLE SONIC LOGGING (CSL). PERFORM CSL TESTING PER ASTM D6760 "STANDARD TEST METHOD FOR INTEGRITY TESTING OF CONCRETE DEEP FOUNDATIONS BY ULTRASONIC CROSSHOLE TESTING" AND PER THE PROJECT SPECIAL PROVISIONS. WHERE DIFFERENT SHAFT DIAMETERS ARE USED ABOVE ROCK AND IN ROCK, THE CSL TESTING FOR THE ENTIRE COMBINED SHAFT (ABOVE ROCK AND IN ROCK) SHALL BE INCLUDED IN ONE SINGLE PAY ITEM.

DRILLED SHAFT ROCK SOCKET LENGTHS AND TIP ELEVATIONS:

DUE TO THE PRESENCE OF AN EXISTING STORM SEWER IN THE SR-8 MEDIAN, BOTH A MINIMUM ROCK SOCKET LENGTH AND A MAXIMUM TIP ELEVATION ARE SHOWN AT PIER 3. BOTH CRITERIA SHALL BE MET.

AT PIER 3, IN THE EVENT THAT THE TOP OF ROCK ELEVATION ENCOUNTERED IN THE FIELD AT THE LOCATION OF THE EXISTING STORM SEWER IS LOWER THAN EL. 1046.7, THE TIP ELEVATION SHOWN ON THE PLANS SHALL BE LOWERED BY AN AMOUNT EQUAL TO THE DIFFERENCE BETWEEN EL. 1046.7 AND THE TOP OF ROCK ELEVATION ENCOUNTERED IN THE FIELD AT THE LOCATION OF THE EXISTING STORM SEWER.

MECHANICAL CONNECTORS:

AN APPROVED TYPE OF MECHANICAL CONNECTOR FOR REINFORCING BARS SHALL BE PROVIDED. INSTALLATION OF CONNECTORS SHALL CONFORM WITH MANUFACTURER'S RECOMMENDED PROCEDURES.

CONNECTORS USED WITH EPOXY COATED BARS SHALL BE EPOXY COATED. COATING FOR BOTH CONNECTORS AND BARS SHALL CONFORM TO THE SAME SPECIFICATIONS. COATINGS WHICH HAVE BEEN DAMAGED OR WHICH OTHERWISE DO NOT MEET SPECIFICATIONS WITH RESPECT TO COLOR, CONTINUITY AND UNIFORMITY MAY BE REPAIRED AS DIRECTED BY THE ENGINEER OR THEY SHALL BE REPLACED WITH MATERIAL THAT MEETS THE SPECIFICATIONS.

MECHANICAL CONNECTORS SHALL CONFORM WITH ITEM 509, AND SHALL BE INCLUDED FOR PAYMENT WITH ITEM 509 - EPOXY COATED REINFORCING STEEL, AS PER PLAN.

PROPRIETARY MSE WALL DATA (BRIDGE SUM-76-1152N):

THE PROPRIETARY WALL SUPPLIER SHALL DESIGN THE INTERNAL STABILITY OF A MECHANICALLY STABILIZED EARTH (MSE) WALL IN ACCORDANCE WITH SS840 TO SUPPORT THE ABUTMENT. THE DESIGN FOR INTERNAL STABILITY SHALL INCLUDE A NOMINAL (I.E. UNFACTORED) HORIZONTAL STRIP LOAD DUE TO FRICTION (FR) FROM THE SUPERSTRUCTURE OF 0.00 K/FT AT WALL 8 AND 0.00 K/FT AT WALL 11 APPLIED PERPENDICULAR TO THE FACE OF THE WALL AT THE BASE OF THE CONCRETE FOOTING. THIS STRIP LOAD DOES NOT INCLUDE EARTH PRESSURE LOADS FROM THE ABUTMENT BACKFILL. HOWEVER, THE PROPRIETARY WALL SUPPLIER SHALL INCLUDE EARTH PRESSURE LOADS FROM THE ABUTMENT BACKFILL IN THE DESIGN CALCULATIONS.

ITEM 840 - DRAINAGE PIPE:

PROVIDE A MINIMUM SLOPE OF 1.00% ON ALL MSE WALL DRAINS UNLESS NOTED OTHERWISE.

LOCATE PIPE AS CLOSE AS POSSIBLE TO THE TOP OF THE LEVELING PAD. IT MAY BE LOCATED ABOVE THE BOTTOM ROW OF REINFORCING STRAPS, HOWEVER, AT NO TIME SHALL THE PIPE BE LOCATED WITHIN 1 FOOT OF THE PROPOSED GROUND LINE.

MSE WALL DESIGN CRITERIA:

FOR MSE WALL DESIGN CRITERIA, FACTORED BEARING RESISTANCE, AND DESIGN DETAILS, SEE BU-17 PLANS.

ITEM 507 - PREBORED HOLES, AS PER PLAN:

PLACE THE H-PILES AT FORWARD ABUTMENT IN PREBORED HOLES, WITHOUT DRIVING THE PILES AND FILL THE VOID WITH CLASS QC MISC. CONCRETE UP TO THE TOP OF BEDROCK ELEVATION AFTER PILE INSTALLATION. DRILL THE HOLES AT THE FORWARD ABUTMENT TO AN ELEVATION OF 1071.50 OR 5' INTO ROCK, WHICH EVER IS DEEPER. THE CLASS QC MISC. CONCRETE AND GRANULAR MATERIAL SHALL BE INCLUDED FOR PAYMENT WITH ITEM 507-PREBORED HOLES, AS PER PLAN.

ISSUE RECORD:			DESCRIPTION
NO.	DATE		

ITEM 513 – STRUCTURAL STEEL MEMBERS, MODULAR EXPANSION JOINT, LEVEL UF, AS PER PLAN:

ABUTMENT JOINTS SHALL BE WATSON BOWMAN ACME (WABO® MODULAR), DS BROWN (STEELFLEX® MODULAR), OR APPROVED ALTERNATE.

THE MANUFACTURER SHALL SUBMIT DESIGN CALCULATIONS SHOWING THAT THE DEVICE CAN MEET THE IMPACT AND FATIGUE DESIGN REQUIREMENTS SET FORTH BY THE CURRENT AASHTO LRFD BRIDGE DESIGN SPECIFICATIONS.

A. DESCRIPTION

FURNISH ALL MATERIALS, SERVICES, LABOR, TOOLS, EQUIPMENT AND INCIDENTALS NECESSARY TO DESIGN, FABRICATE, INSPECT, TEST AND INSTALL MODULAR EXPANSION JOINTS IN ACCORDANCE WITH THE PLANS AND THESE NOTES. ALL REQUIREMENTS OF 513, UF LEVEL FABRICATION APPLY, UNLESS MODIFIED BY THESE NOTES.

B. DESIGN

1. PREPARE AND CHECK THE DESIGN UNDER THE AUTHORITY OF AN OHIO REGISTERED PROFESSIONAL ENGINEER. THE REGISTERED ENGINEER SHALL SEAL, SIGN AND DATE THE DESIGN CALCULATIONS AND SHOP DRAWINGS.
2. INCLUDE DESIGN CALCULATIONS WITH THE CONTRACTOR'S SUBMISSION OF SHOP DRAWINGS PER 513.06.
3. PROVIDE A DETAILED INSTALLATION PROCEDURE AND INCLUDE ANY SPECIFIC MANUFACTURER'S NOTES NECESSARY FOR COMPLETION OF THE WORK.
4. DESIGN AND TEST THE MODULAR JOINT COMPONENTS, JOINT ARMOR AND ANCHORAGES ACCORDING TO THE AASHTO LRFD BRIDGE DESIGN SPECIFICATIONS AND THE AASHTO LRFD BRIDGE CONSTRUCTION SPECIFICATIONS.
5. DESIGN TEMPORARY AND FIELD CONNECTIONS TO THE BRIDGE TO ACCOMMODATE ADJUSTMENTS FOR ROADWAY GEOMETRY AND VARYING TEMPERATURE.
6. DESIGN FOR THE PLAN SPECIFIED MOVEMENT PER AASHTO LRFD 3.12.2 FOR A COLD CLIMATE (TEMPERATE RANGE IS FROM -30° F TO +120° F WITH BASE TEMPERATURE SET TO 60° F).
7. SUPPLY SUPPORT BAR BEARINGS TO TRANSFER THE LOAD FROM THE SUPPORT BARS TO THE JOINT ARMOR.
8. FOR DESIGN OF THE DECK JOINT AT ALL LIMIT STATES, THE DYNAMIC LOAD ALLOWANCE (IM) SHALL BE TAKEN AS 125% OF THE STATIC EFFECT OF EITHER THE DESIGN TRUCK OR THE DESIGN TANDEM.
9. SUPPLY EQUALIZATION SPRINGS TO COUNTER THE COMPRESSION FORCES FROM THE SEALING ELEMENTS AND MAINTAIN EQUAL EXPANSION PROPERTIES FOR EACH SEALING ELEMENT ACROSS THE JOINT.
10. SUPPLY CONTROL SPRINGS WHICH WORK LONGITUDINALLY TO MAINTAIN EQUIDISTANT SPACING BETWEEN TRANSVERSE SEPARATION BEAMS.
11. SUPPLY SEPARATION BEAMS/TRANSVERSE DIVIDERS/CENTER BEAMS TO LIMIT TOTAL HORIZONTAL MOVEMENT IN ANY INDIVIDUAL STRIP SEAL.
12. SUPPLY A STRIP SEAL TYPE SEAL CONNECTED TO MATCHING RETAINERS CONNECTED TO THE JOINT ARMOR AND THE SEPARATION BEAMS. DO NOT EXCEED 3.15 INCHES OF TOTAL HORIZONTAL MOVEMENT IN ANY INDIVIDUAL STRIP SEAL.
13. SUPPLY REMOVABLE AND REPLACEABLE NEOPRENE SEALS, SUPPORT BAR BEARINGS AND EQUALIZATION SPRINGS.
14. SET SEALS AND RETAINERS 1/8" LOWER THAN THE ROADWAY SURFACE.

C. MATERIALS

1. SUPPLY STRUCTURAL STEEL MEETING ASTM A709 GRADE 50. SUPPLY SEPARATION BEAMS/TRANSVERSE DIVIDERS/CENTER BEAMS, EDGE BEAMS AND JOINT ARMOR MEETING CHARPY V NOTCH IMPACT REQUIREMENTS PER ASTM A709 TABLE S1.2 ZONE 2 TEMPERATURE RANGE. SUPPLY TUBE SECTIONS MEETING ASTM A501 OR A500 GRADE B.
2. SUPPLY ASTM A240, TYPE 304 STAINLESS STEEL, 13 GAGE MINIMUM THICKNESSES WITH AN 8.0μ IN MIRROR FINISH FOR SLIDING SURFACES IN CONTACT WITH PTFE.
3. SUPPLY TESTING AND REPORTS BY THE MANUFACTURER OR AN INDEPENDENT TESTING LABORATORY FOR ALL ELASTOMERIC, PTFE URETHANE AND PREFORMED FABRIC MATERIALS USED IN ALL BEARINGS AND SPRINGS. THE SUBMISSION OF MATERIAL CERTIFICATION AND TESTING DATA SHALL BE PER 513.08. THE MODULAR BRIDGE JOINT SYSTEM SHALL BE TESTED IN ACCORDANCE WITH THE AASHTO LRFD BRIDGE CONSTRUCTION SPECIFICATIONS APPENDIX A19.
4. SUPPLY STRIP SEALS CONFORMING TO ASTM D5973. SUBMIT CERTIFIED TEST DATA PER 513.08 FROM THE MANUFACTURER OR AN ACCREDITED LABORATORY. D5973 SECTION 8, LOT SIZE IS ONE SAMPLE PER JOINT. A SAMPLE IS A PIECE 4 FEET LONG WITH ALL MANUFACTURES' MARKINGS. THE SEAL AND RETAINER ARE AN INTEGRAL SYSTEM SUPPLIED BY ONE MANUFACTURER.
5. SEAL RETAINERS: EXTRUDE, HOT ROLL OR MACHINE, STEEL RETAINERS INTO A SOLID SHAPE. RETAINERS MANUFACTURED FROM BENT PLATE OR BUILT UP PIECES ARE NOT ACCEPTABLE. THE INTERNAL DIMENSIONS OF THE RETAINER SHALL BE SPECIFIED BY THE MANUFACTURER TO ACHIEVE POSITIVE SEAL ANCHORAGE.

6. SEPARATION BEAMS/TRANSVERSE DIVIDERS/CENTER BEAMS SHALL BE A SOLID, MACHINED OR EXTRUDED STEEL SECTION.
7. LUBRICANT – ADHESIVE. ONE PART MOISTURE CURING POLYURETHANE COMPOUND MEETING THE REQUIREMENTS OF ASTM D4070 AND AS SPECIFIED BY THE SEAL MANUFACTURER.
8. HARDWARE SHALL BE ASTM F3125, GRADE A325 TYPE 1, GALVANIZED.

D. FABRICATION

1. THE MODULAR JOINTS SHALL BE FABRICATED ACCORDING TO C&MS 513.
2. SHOP ASSEMBLE THE MODULAR JOINT WITH ALL COMPONENTS EXCEPT, NEOPRENE SEALS, PER 513.24 EXCEPT THAT FULL ASSEMBLY IS REQUIRED WITH PHASED CONSTRUCTION.
3. JOINTS IN STRIP SEALS: NO JOINTS ARE ALLOWED.
4. JOINTS IN RETAINERS: WELDS ARE WATER TIGHT, PARTIAL PENETRATION WELDS AROUND THE OUTER PERIPHERY OF THE ABUTTING SURFACES. MAKE SPLICES ONLY IN COMPRESSION ZONES OF THE JOINT ARMOR. GRIND FLUSH ALL WELDS IN CONTACT WITH THE SEAL AND JOINT ARMOR. DO NOT USE SHORT PIECES OF RETAINERS LESS THAN 6'-0" LONG, UNLESS REQUIRED AT CURBS OR SIDEWALKS. DO NOT PROVIDE ADDITIONAL SPLICES IN RETAINERS AT CURB OR SIDEWALK SECTIONS OTHER THAN REQUIRED FOR GEOMETRY.
5. SHOP OR FIELD WELDS OF CENTER BEAMS , SHALL BE COMPLETE PENETRATION WELDS, GROUND TO PROVIDE SMOOTH TRANSITIONS AND BE 100% ULTRASONICALLY TESTED PER AASHTO/AWS BRIDGE WELDING CODE, WITH TENSION ACCEPTANCE CRITERIA, WITNESSED BY THE DEPARTMENT.
6. SUPPORT BAR CONNECTIONS SHALL BE COMPLETE PENETRATION WELDS GROUND TO PROVIDE SMOOTH TRANSITIONS AND BE 100% ULTRASONICALLY TESTED PER AASHTO/AWS BRIDGE WELDING CODE, WITH TENSION ACCEPTANCE CRITERIA, WITNESSED BY THE DEPARTMENT.
7. TEMPORARY SUPPORTS: FABRICATOR DESIGNED AND INSTALLED SUPPORTS ARE REQUIRED TO SUPPORT SHIPPING, ERECTION AND CONSTRUCTION FORCES WITHOUT DAMAGE TO THE STEEL ARMOR OR COATINGS. THESE SUPPORTS SHALL BE ADJUSTABLE FOR FIELD TEMPERATURE SETTING. PROVIDE PROTECTIVE LAYERS BETWEEN TEMPORARY SUPPORTS AND COATED SURFACES TO PREVENT DAMAGE.

E. COATING

1. GALVANIZE OR METALIZE ALL STEEL SURFACES AND COMPONENTS, EXCEPT AT STAINLESS STEEL AND PTFE SLIDING SURFACES. THESE COATING MAY BE MIXED ON ONE ASSEMBLY, IF ALL SIMILAR COMPONENTS OF THE ASSEMBLY HAVE THE SAME COATING TYPE.
2. PROVIDE A GALVANIZED COATING PER ASTM A123, WITH A MINIMUM THICKNESS OF 4 MILS. CLEAN EXCESSIVE GALVANIZING AS NECESSARY TO ACHIEVE MECHANICAL MOVEMENT AND SEAL INSTALLATION.
3. PROVIDE A METALIZED COATING PER SOCIETY FOR PROTECTIVE COATINGS (SSPC) SPECIFICATION SSPC-CS23.00 FOR THERMAL SPRAY METALLIC COATINGS. THE COATING SHALL BE A MINIMUM OF 8 MILS THICK. THE METALIZING WIRE SHALL BE 100% ZINC. AREAS OF STRUCTURAL STEEL THAT ARE IN CONTACT WITH CAST-IN-PLACE CONCRETE SHALL HAVE AN ADDITIONAL COATING. THE COATING SHALL BE THE EPOXY INTERMEDIATE COAT SPECIFIED IN CMS 514. THE COATING THICKNESS WILL COVER ALL PEAKS, VALLEYS AND SURFACE ROUGHNESS ATTRIBUTED TO METALIZING.
4. COATING REPAIRS: DAMAGED COATINGS SHALL BE REPAIRED BY ASTM A780, ANNEX "A1. REPAIR USING ZINC BASED ALLOYS". THE PROCEDURE SHALL BE AS FOLLOWS: REMOVE SURFACE CONTAMINATES, PREHEAT TO 600 DEGREES F, AND APPLY ZINC COATING BY RUBBING WITH PURE WITH A PURE ZINC STICK OR SPRINKLING ZINC POWDER ON THE PREHEATED SURFACE, TO ACHIEVE A MINIMUM COATING THICKNESS OF 6 MILS. MAKE COATING REPAIRS OF WELDED SURFACES PRIOR TO CONCRETE PLACEMENT OPERATIONS.
5. THE METALIZED OR GALVANIZED COATINGS SHOULD NOT BE FIELD PAINTED, EXCEPT FOR AREAS DAMAGED BY CONNECTION TO PAINTED SUPERSTRUCTURE STEEL MEMBERS. THESE AREAS SHALL BE PAINTED USING THE SAME SYSTEM SPECIFIED FOR THE SUPERSTRUCTURE.
6. PRIOR TO SHIPPING, RETAINER GROOVES SHALL BE PROTECTED FROM CONSTRUCTION DEBRIS BY THE INSTALLATION OF BACKER RODS OR OTHER EFFECTIVE MASKING TECHNIQUES.

F. INSTALLATION

1. A JOINT MANUFACTURER'S TECHNICAL REPRESENTATIVE TO PHYSICALLY OVERSEE THE FABRICATION, INSTALLATION, ADJUSTMENT AND TESTING DURING ALL OPERATIONS. WHERE SPECIAL INSTRUCTIONS ARE NOT CONTAINED HEREIN OR ELSEWHERE IN THESE NOTES, DIRECTION FOR THE INSTALLATION SHALL BE ACCORDING TO THE RECOMMENDATIONS OF THE TECHNICAL REPRESENTATIVE.
2. COORDINATE AND SCHEDULE THE TECHNICAL REPRESENTATIVE.

3. INSTALL THE SUPERSTRUCTURE SUPPORTING UNITS BEFORE INSTALLING THE MODULAR JOINT. POSITION THE JOINT TO MATCH ROADWAY GEOMETRY SUPERSTRUCTURE CONNECTIONS AND TEMPERATURE OPENING. TAKE CARE TO MAINTAIN EXACT ALIGNMENT OF ADJACENT ENDS OF THE ARMOR AND SEPARATION BEAMS/TRANSVERSE DIVIDERS/CENTER BEAMS FOR FIELD WELDED UNITS. PROVIDE TEMPORARY SUPPORTS AS DIRECTED BY THE MANUFACTURER TO MAINTAIN THE PROPER POSITIONING. FOR PHASED CONSTRUCTION, THE CONTRACTOR'S METHODS FOR INSTALLATION AND TEMPORARY SUPPORTS SHALL ACHIEVE SEPARATION OF THE PHASES AND UNRESTRICTED TEMPERATURE MOVEMENT.
4. THE MODULAR EXPANSION JOINTS SHALL BE INSTALLED, ANCHORED, AND FUNCTIONING WITH UNRESTRICTED TEMPERATURE MOVEMENT PRIOR TO ENCASING IN CONCRETE. THE MODULAR EXPANSION JOINTS SHALL BE INSTALLED AFTER PLACING DECK CONCRETE IN THE MID-SPAN REGIONS, BUT PRIOR TO PLACING CONCRETE IN THE BLOCK OUTS.
5. PERFORM CONCRETE PLACEMENT USING VIBRATION AND HAND WORK AS NECESSARY TO ACHIEVE CONSOLIDATION AND ELIMINATE AIR VOIDS.
6. PLACE THE BLOCK OUT CONCRETE ON THE DECK SIDE FIRST. CHECK THE ABUTMENT OR ADJACENT SPAN SIDE OF THE MODULAR JOINT FOR ALIGNMENT AND TEMPERATURE ADJUSTMENT. TEMPERATURE SHALL BE MEASURED AT THE UNDERSIDE OF THE CONCRETE DECK AT EACH END AND MID-SPAN TO ACHIEVE THE AVERAGE SUPERSTRUCTURE TEMPERATURE. PLACE THE BACKWALL OR ADJACENT SPAN BLOCK OUT CONCRETE SECOND. THE MANUFACTURER'S REPRESENTATIVE SHALL CHECK THAT TEMPERATURE MOVEMENT HAS NOT CAUSED ANY DAMAGE TO THE BOND BETWEEN THE JOINT AND THE CONCRETE.
7. EXAMINE SEAL RETAINERS FOR SOIL OR DEFECTS THAT CAN DAMAGE THE SEAL. REPAIR ANY DEFECTS AS DIRECTED BY THE MANUFACTURER'S REPRESENTATIVE.
8. SOLVENT CLEAN THE NEOPRENE SEAL ELEMENTS AND THE RETAINER GROOVES TO REMOVE OIL, GREASE OR OTHER SOIL IMMEDIATELY PRIOR TO INSTALLING THE SEALS. INSTALL SEALS USING PROCEDURES AND ADHESIVE SPECIFIED BY THE JOINT MANUFACTURER. KEEP THE BONDING SURFACES CLEAN, DRY AND WARMER THAN 45°F.
9. TEST THE INSTALLED MODULAR JOINT FOR LEAKS. FLOOD THE TOTAL EXPANSION JOINT LENGTH WITH WATER FOR A PERIOD OF NOT LESS THAN ONE HOUR. COVER THE ENTIRE JOINT SYSTEM BY EITHER PONDING OR FLOWING WATER. LOCATE ANY POINTS OF LEAKAGE AND TAKE ANY AND ALL MEASURES NECESSARY TO STOP THE LEAKAGE. PERFORM THIS WORK AT THE CONTRACTOR'S EXPENSE. PERFORM A SECOND WATER TEST AFTER ALL REPAIRS HAVE BEEN MADE.

G. METHOD OF MEASUREMENT

THE DEPARTMENT WILL MEASURE EACH ITEM BY THE NUMBER OF FEET HORIZONTALLY ALONG THE JOINT CENTERLINE AND BETWEEN THE OUTER LIMITS OF THE FABRICATED JOINT.

H. BASIS OF PAYMENT

THE DEPARTMENT WILL PAY FOR ACCEPTED QUANTITIES AT THE CONTRACT PRICES AS FOLLOWS:

ITEM	UNIT	DESCRIPTION
513	FT	STRUCTURAL STEEL MEMBERS, MODULAR EXPANSION JOINT, LEVEL UF, AS PER PLAN

5 60 6 61	SUM-76-77/8-8.24/9.74/0.00		PID No. 102329		GENERAL NOTES – 2		DESIGN AGENCY		
	RAMP N OVER RAMP S, LANE O, 1R-76 EB, SR-8 NB/SB, LANE M		SUM-76-1152N		BURGESS & NIPLE		Engineers ■ Architects ■ Planners		
DRAWN AAA		REVIEWED JCS		DATE 4/29/19		STRUCTURE FILE NUMBER 7705973		5045 REED ROAD, COLUMBUS, OHIO 43220	
DESIGNED BES		CHECKED MAB							

ISSUE RECORD:		DESCRIPTION
NO.	DATE	

ITEM 513 - STRUCTURAL STEEL MEMBERS, LEVEL 5, AS PER PLAN:

PERFORM THE WORK PER CMS 513, EXCEPT AS NOTED BELOW.

SELECT ONE OF THE TWO OPTIONS DESCRIBED BELOW:

OPTION 1: FIELD PAINTING

APPLY SHOP COATING PER 513.27.

APPLY INTERMEDIATE AND FINISH COATS IN THE FIELD PER CMS 514 TO ALL STRUCTURAL STEEL SURFACES, INCLUDING BUT NOT LIMITED TO GIRDERS, CROSSFRAMES, STIFFENERS, CONNECTION PLATES, SPLICE PLATES, BOLTS, AND BEARING LOAD PLATES.


FOR THE URETHANE FINISH COAT, USE FEDERAL COLOR STANDARD NO. 10076.

FOR OPTION 1, SURFACE PREPARATION, PRIME COAT, INTERMEDIATE COAT, FINISH COAT, AND REPAIR WORK ARE CONSIDERED INCIDENTAL TO ITEM 513 - STRUCTURAL STEEL MEMBERS, LEVEL 5, AS PER PLAN. ALL APPLICABLE PROVISIONS OF CMS 514 SHALL APPLY.

OPTION 2: SHOP METALIZING AND SHOP PAINTING OF FASCIA GIRDERS

DELETE THE REQUIREMENTS OF 513.27. SHOP METALIZE ALL STRUCTURAL STEEL SURFACES PER SUPPLEMENTAL SPECIFICATION (SS) 845, INCLUDING BUT NOT LIMITED TO GIRDERS, CROSSFRAMES, STIFFENERS, CONNECTION PLATES, SPLICE PLATES, AND BEARING LOAD PLATES, EXCEPT DO NOT METALIZE THE TOP SURFACE OF GIRDER TOP FLANGES. APPLY A PRIME COAT, 708.01, IN THE SHOP TO THE TOP SURFACE OF GIRDER TOP FLANGES. THE PRIME COAT SHALL BE A MIST COATING FROM 0.5 TO 1.5 MILS.

APPLY INTERMEDIATE AND FINISH COATS IN THE SHOP PER CMS 514 TO THE SURFACES NOTED IN THE FOLLOWING DIAGRAM (APPLIES TO BOTH FASCIA GIRDERS, AND INCLUDES STIFFENERS AND SPLICE PLATES/BOLTS ON THE OUTBOARD (FASCIA) SIDE AND BOTTOM OF FASCIA GIRDERS):

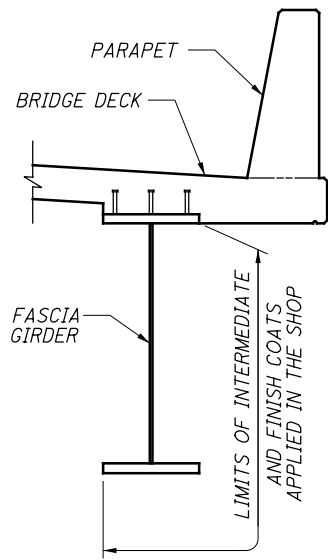

FOR THE URETHANE FINISH COAT, USE FEDERAL COLOR STANDARD NO. 10076.

REPAIR DAMAGE TO THE METALIZING CAUSED DURING STORAGE, TRANSPORTATION, ERECTION, BOLTING, WELDING, FORMING, CONCRETE PLACEMENT, AND FORM REMOVAL OPERATION, ACCORDING TO CMS 711.02. REPAIR DAMAGE TO THE GALVANIZED COATING ON THE NUTS, BOLTS, AND WASHERS, IN THE FIELD DUE TO THE BOLT TIGHTENING OPERATIONS, ACCORDING TO CMS 711.02. EXERCISE EXTREME CARE WHILE HANDLING THE STEEL DURING ERECTION, AND DURING SUBSEQUENT CONSTRUCTION OF THE BRIDGE. INSULATE THE STEEL FROM THE BINDING CHAINS BY SOFTENERS AND PAD ALL HOOKS AND SLINGS THAT ARE USED TO HOIST/ERECT THE STEEL MEMBERS.

FOR OPTION 2, SURFACE PREPARATION, METALIZING, SEALING, PRIME COAT, INTERMEDIATE COAT, FINISH COAT, AND REPAIR WORK ARE CONSIDERED INCIDENTAL TO ITEM 513 - STRUCTURAL STEEL MEMBERS, LEVEL 5, AS PER PLAN. ALL APPLICABLE PROVISIONS OF CMS 514 SHALL APPLY.

ASBESTOS NOTIFICATION:

AN ASBESTOS SURVEY OF BRIDGE NO. SUM-76-1148R WAS CONDUCTED BY A CERTIFIED ASBESTOS HAZARD EVALUATION SPECIALIST. THE SURVEY DETERMINED THAT NO ASBESTOS IS PRESENT.

A COPY OF THE OHIO ENVIRONMENTAL PROTECTION AGENCY (OEPA) NOTIFICATION OF DEMOLITION AND RENOVATION FORM, PARTIALLY COMPLETED AND SIGNED BY THE BRIDGE OWNER, WILL BE PROVIDED TO THE SUCCESSFUL BIDDER AT THE PRECONSTRUCTION MEETING. THE CONTRACTOR SHALL COMPLETE THE FORM AND RETURN IT TO THE DISTRICT CONSTRUCTION ENGINEER ALONG WITH THE PERMIT FEE IF APPLICABLE. THE COMPLETION OF THIS FORM MAY BE PERFORMED AT THE PRECONSTRUCTION MEETING. THE DISTRICT CONSTRUCTION ENGINEER SHALL SUBMIT THE FORM AND CONTRACTOR'S FEE TO THE OEPA DISTRICT OFFICE AT LEAST TEN (10) WORKING DAYS PRIOR TO THE START OF THE DEMOLITION OF THE BRIDGE. THE DISTRICT CONSTRUCTION ENGINEER SHALL PROVIDE A COPY OF THE COMPLETED FORM TO THE CONTRACTOR. THE CONTRACTOR SHALL NOT COMMENCE DEMOLITION OF THE STRUCTURE UNTIL THE ABOVE REQUIREMENTS ARE MET.

INFORMATION ON THIS FORM WILL INCLUDE:
- THE CONTRACTOR'S NAME AND ADDRESS
- THE SCHEDULED DATES FOR THE START AND COMPLETION OF THE BRIDGE REMOVALS
- A DESCRIPTION OF THE PLANNED DEMOLITION WORK AND THE METHODS TO BE USED

A COPY OF THE OEPA FORM IS AVAILABLE FOR INSPECTION AT THE ODOT, DISTRICT 4 OFFICE AT 2088 S. ARLINGTON ROAD, AKRON, OHIO 44306.

BASIS FOR PAYMENT:
THE CONTRACTOR SHALL FURNISH ALL FEES, LABOR, AND MATERIAL NECESSARY TO COMPLETE AND SUBMIT THE OEPA NOTIFICATION FORM. PAYMENT FOR THIS WORK SHALL BE INCLUDED IN THE BID ITEM 202 - STRUCTURE REMOVED, OVER 20 FOOT SPAN, AS PER PLAN.

ITEM 511 - CLASS QC2 CONCRETE WITH QC/QA, BRIDGE DECK (PARAPET), AS PER PLAN:

IN ADDITION TO THE REQUIREMENTS OF CMS 511, THIS ITEM SHALL INCLUDE ALL LABOR, EQUIPMENT, MATERIALS AND INCIDENTALS NECESSARY TO FABRICATE AND INSTALL PARAPET AESTHETIC SIGNS AS SHOWN IN THE AESTHETIC PLANS, INCLUDING SIGNS, MOUNTING HARDWARE, SILICONE CAULK AND OTHER INCIDENTALS NECESSARY TO COMPLETE THIS ITEM OF WORK.

STANDARD ABBREVIATIONS LIST:

APPROX. = APPROXIMATE
BOT. = BOTTOM
BRG. = BEARINGS
BRGS. = BEARINGS
B.S. = BOTH SIDES
B# = BEAM NUMBER
c/c = CENTER-TO-CENTER
C.J. = CONSTRUCTION JOINT
CJP = COMPLETE JOINT PENETRATION
CLR. = CLEAR
CMS OR C&MS = CONSTRUCTION AND MATERIALS SPECIFICATIONS
CONST. = CONSTRUCTION
CS = INDICATES BUTT WELD SUBJECT TO COMPRESSIVE STRESSES ONLY
CVN = CHARPY V-NOTCH
DIA. = DIAMETER
EB = EASTBOUND
E.F. = EACH FACE
EL. = ELEVATION
EMBED. = EMBEDMENT
EQ. = EQUAL
EXP. = EXPANSION
F.A. = FORWARD ABUTMENT
F.F. = FAR FACE
F.S. = FIELD SPLICE
FWD = FORWARD
GFRP = GLASS FIBER REINFORCED POLYMER
G# = GIRDER NUMBER
HMWM = HIGH MOLECULAR WEIGHT METHACRYLATE
LT. = LEFT
MAX. = MAXIMUM
M.C. = MECHANICAL CONNECTOR
M.E. = MATCH EXISTING
MIN. = MINIMUM
MGS = MIDWEST GUARDRAIL SYSTEM
NB = NORTHBOUND
N.F. = NEAR FACE
NPCPP = NON-PERFORATED CORRUGATED PLASTIC PIPE
o/o = OUT-TO-OUT
PCB = PORTABLE CONCRETE BARRIER
PCPP = PERFORATED CORRUGATED PLASTIC PIPE
PEJF = PREFORMED EXPANSION JOINT FILLER
P.G. = PROFILE GRADE
R.A. = REAR ABUTMENT
RAD. = RADIUS
RT. = RIGHT
SB = SOUTHBOUND
SHLD. = SHOULDER
SHT. = SHEET
S.O. = SERIES OF
SPA. = SPACES
STA. = STATION
SYMM. = SYMMETRICAL
T&B = TOP AND BOTTOM
T/R = TOP OF ROCK
t/t = TOE-TO-TOE
U.N.O. = UNLESS NOTED OTHERWISE
VAR. = VARIES
WB = WESTBOUND
W.P. = WORK POINT

ISSUE RECORD:		DESCRIPTION	
NO.	DATE		

pw:\\V\\AN\\A01PW\\INT01.parsons.com:Ohio State\\Documents\\DB-Akron Beltway Rehab\\10 - Design\\102329\\Structures\\SUM076_1152N\\Sheets\\076_1149R_SQ001.dgn Sheet 6/23/2021 8:30:48 AM KChrisman

ESTIMATED QUANTITIES							CALC.	DATE	CHK'D	DATE
							JHL/ASG	5/19/20	SJA	5/19/20
ITEM	ITEM EXT.	UNIT	DESCRIPTION	ABUTMENTS	PIERS	SUPERSTR.	GENERAL	TOTAL	PARTICIPATION 07/IMS/BR	SHEET REF.
OPTION A										
202	11003	LS	STRUCTURE REMOVED, OVER 20 FOOT SPAN, AS PER PLAN				LS	LS	LS	6 , 8 / 60
202	22900	SY	APPROACH SLAB REMOVED				III	III	III	
503	21100	CY	UNCLASSIFIED EXCAVATION	757				757	757	
505	11100	LS	PILE DRIVING EQUIPMENT MOBILIZATION	LS				LS	LS	
507	00100	FT	STEEL PILES HP10X42, FURNISHED	1050				1050	1050	
507	00150	FT	STEEL PILES HP10X42, DRIVEN	940				940	940	
507	00200	FT	STEEL PILES HP12X53, FURNISHED	880				880	880	
507	00250	FT	STEEL PILES HP12X53, DRIVEN	755				755	755	
509	10001	LB	EPOXY COATED REINFORCING STEEL, AS PER PLAN	124900 17874	78000	182900	3500035760420800	314534	420800 314534	4 / 60
511	34446	CY	CLASS QC2 CONCRETE WITH QC/QA, BRIDGE DECK			640		640	640	
511	34451	CY	CLASS QC2 CONCRETE WITH QC/QA, BRIDGE DECK (PARAPET), AS PER PLAN			208-213		208-213	208-213	6 / 60
511	41012	CY	CLASS QC1 CONCRETE WITH QC/QA, PIER ABOVE FOOTINGS		173			173	173	
511	44112	CY	CLASS QC1 CONCRETE WITH QC/QA, ABUTMENT NOT INCLUDING FOOTING	635-96				-635-96	-635-96	
511	45602	CY	CLASS QC4 MASS CONCRETE, SUBSTRUCTURE WITH QC/QA		122			122	122	
511	46512	CY	CLASS QC1 CONCRETE WITH QC/QA, FOOTING	485-87				-485-87	-485-87	
512	10100	SY	SEALING OF CONCRETE SURFACES (EPOXY-URETHANE)	532-169	754	1345	76-104	2707 2344	2707 2372	
512	33000	SY	TYPE 2 WATERPROOFING	31				31	31	
513	10301	LB	STRUCTURAL STEEL MEMBERS, LEVEL 5, AS PER PLAN			816300		816300	816300	6 / 60
513	17001	FT	STRUCTURAL STEEL MEMBERS, MODULAR EXPANSION JOINT, LEVEL UF, AS PER PLAN			67		67	67	5 / 60
513	20000	EACH	WELDED STUD SHEAR CONNECTORS			6543		6543	6543	
513	95030	EACH	STRUCTURAL STEEL, MISC.: PARAPET SLIDING PLATE JOINT			4		4	4	53 / 60
516	13600	SF	1" PREFORMED EXPANSION JOINT FILLER	107 16				107 16	107 16	
516	44101	EACH	ELASTOMERIC BEARING WITH INTERNAL LAMINATES AND LOAD PLATE (NEOPRENE), AS PER PLAN (1'-8" x 1'-5" x 2 ⁷ / ₁₆ ")		8			8	8	37-39 / 60
516	44201	EACH	ELASTOMERIC BEARING WITH INTERNAL LAMINATES AND LOAD PLATE (NEOPRENE), AS PER PLAN (1'-8" x 1'-5" x 3 ¹ / ₁₆ ")		4			4	4	37-39 / 60
516	44301	EACH	ELASTOMERIC BEARING WITH INTERNAL LAMINATES AND LOAD PLATE (NEOPRENE), AS PER PLAN (1'-8" x 1'-5" x 4 ¹ / ₁₆ ")		4			4	4	37-39 / 60
516	44401	EACH	ELASTOMERIC BEARING WITH INTERNAL LAMINATES AND LOAD PLATE (NEOPRENE), AS PER PLAN (1'-8" x 1'-2" x 6 ¹ / ₄ ")	4				4	4	37-39 / 60
516	44401	EACH	ELASTOMERIC BEARING WITH INTERNAL LAMINATES AND LOAD PLATE (NEOPRENE), AS PER PLAN (1'-6" x 1'-2" x 6 ¹⁵ / ₁₆ ")	4				4	4	37-39 / 60
518	21200	CY	POROUS BACKFILL WITH GEOTEXTILE FABRIC	355-48				355-48	355-48	
518	40000	FT	6" PERFORATED CORRUGATED PLASTIC PIPE	205-88				205-88	205-88	
518	40010	FT	6" NON-PERFORATED CORRUGATED PLASTIC PIPE, INCLUDING SPECIALS	45-26				45-26	45-26	
524	95100	EACH	DRILLED SHAFTS, MISC.: THERMAL INTEGRITY PROFILER (T.I.P.) WIRE CABLE TESTING OF DRILLED SHAFTS	2	4			6-4	6-4	4 / 60
524	95100	EACH	DRILLED SHAFTS, MISC.: CSL TESTING, 96" DIAMETER SHAFT		1			1	1	4 / 60
524	95455	FT	DRILLED SHAFTS, 48" DIAMETER, INTO BEDROCK WITH QC/QA, AS PER PLAN	207	III			318-III	318-III	4 / 60
524	95463	FT	DRILLED SHAFTS, 54" DIAMETER, ABOVE BEDROCK WITH QC/QA, AS PER PLAN	152	71			223-71	223-71	4 / 60
524	95535	FT	DRILLED SHAFTS, 96" DIAMETER, INTO BEDROCK WITH QC/QA, AS PER PLAN		22			22	22	4 / 60
526	30011	SY	REINFORCED CONCRETE APPROACH SLABS WITH QC/QA (T=17"), AS PER PLAN				220-225	220-225	220-225	4 / 60
526	90010	FT	TYPE A INSTALLATION				66-68	66-68	66-68	
SPECIAL	53013000	SF	FORM LINER	3524				3524	3524	4 / 60
601	20000	SY	CRUSHED AGGREGATE SLOPE PROTECTION	159-3				159-3	159-3	
OPTION B: ATC										
SPECIAL	20299000	LS	STRUCTURE REMOVED				LS	LS	LS	
SPECIAL	51299000	LS	SEALING OF CONCRETE	LS	LS	LS	LS	LS	LS	
SPECIAL	53099010	LS	SUBSTRUCTURE	LS	LS			LS	LS	
SPECIAL	53099020	LS	SUPERSTRUCTURE			LS		LS	LS	

2025-03-13 - BU-11 - RECORD DRAWING PLANS

ESTIMATED QUANTITIES

SUM-76-1152N

RAMP N OVER RAMP S, LANE O, IR-76 EB, SR-8 NB/SB, LANE M

DESIGN AGENCY

PRIMEITY

8455 Pauls Road
Columbus Ohio 43240

DATE

6/14/21

REVIEWED

SAN

STRUCTURE FILE NUMBER

7705973

DESIGNED

KDC

CHECKED

JAT

DRAWN

KDC

REVISED

SUM-76/77/8-

8.24/9.74/0.00

PID No. 102329

7/60




8

61

ISSUE RECORD:		DESCRIPTION
NO.	DATE	

p:\v\ANV\A01P\WINT01\parsons.com:Ohio State\Documents\DB-Akron Beltway Rehab\10 - Design\102329\Structures\SUM076_1152N\Sheets\076_1149R_SV001.dgn Sheet 6/23/2021 8:30:55 AM KChrismon

MICROFILMED
NOV 27 1989

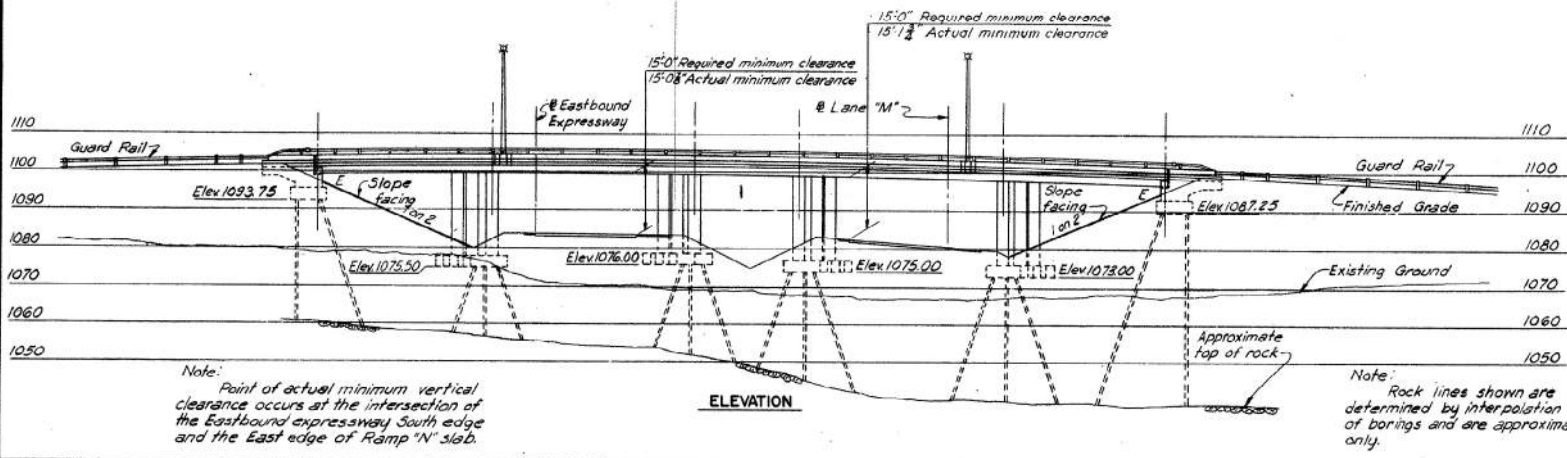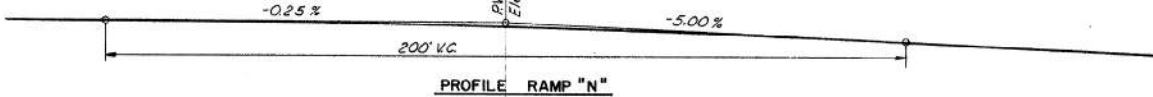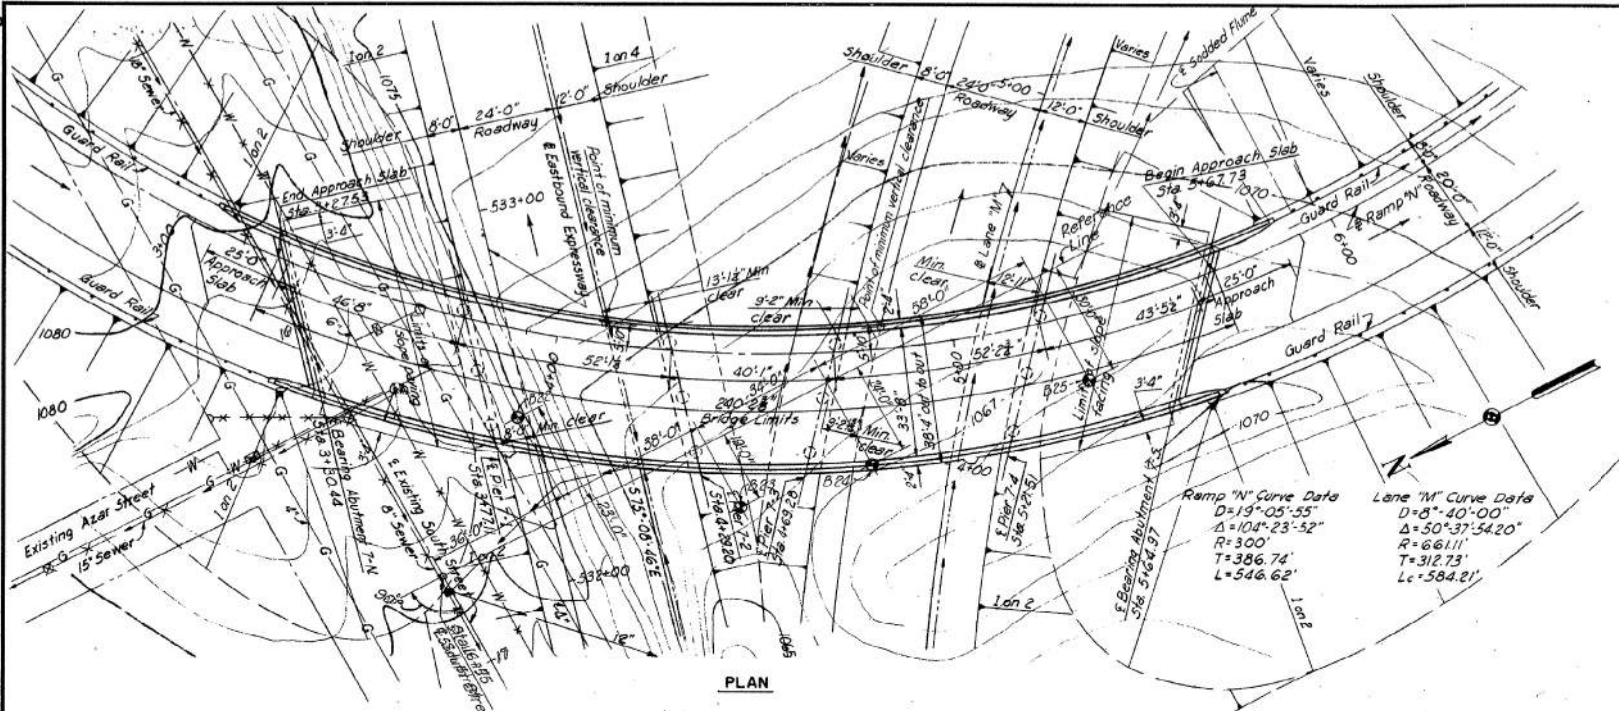

LEGEND

- Existing Manhole
- Existing Inlet
- Sewer Lines to be abandoned or removed.
- Existing Gas Lines
- Existing Hydrant or Valve
- Water Lines to be abandoned or removed.
- New Sewer
- New Manhole
- New Underdrain
- Boring

FED. ROADS
DIV. NO. 2

STATE
OHIO

FED. AID
PROJ. NO. 167

SUMMIT COUNTY
CITY OF AKRON
EXPRESSWAY SYSTEM
SUM-8-11.65

ESTIMATED QUANTITIES									
Item	Description	Unit	Abutments	Piers	Superstructure	General	Total		
E-2	Cofferdams, Cribbs and Sheet piling	Lump Sum					Lump Sum		
E-2	Excavation for Structures (Unclassified)	Cu Yd	190	295			485		
S-1	Class "C" Concrete (Superstructure)	Cu Yd			715		715		
S-1	Class "C" Concrete (Pier Columns)	Cu Yd		65			65		
S-1	Class "E" Concrete (Sub Abutments)	Cu Yd	80				80		
S-1	Class "E" Concrete (Footings)	Cu Yd	70	110			180		
S-3	Type "C" Waterproofing	Sq Yd			860		860		
S-4	Reinforcing Steel	Lbs	8,570	42,700	207,430		258,700		
S-9	Structural Steel Expansion joint	Lbs			8300		8300		
S-9	1/2" Rolled Phosphor Bronze Sliding Plates	Lbs			280		280		
S-14	Aluminum Handrail (Including Fastener)	Lin Ft	59		446		505		
S-16	First Test Pile	Lump Sum					Lump Sum		
S-18	Steel Bearing Piles (12BP53)	Lin Ft	1385	1895			3280		
S-25	2" Rigid Metal Conduit	Lin Ft	34		236		270		
S-29	Porous Backfill	Cu Yd	23				23		
S-29	Subdrainage for Wearing Surface Course	Lin Ft			465		465		
T-35	2" Asphaltic Concrete Surface Course Type C (60-70)	Cu Yd			59		59		
S-29	4" W.I. Scuppers	Each			22		22		
S-29	Slope Facing (S-29.05 type)	Cu Yd	165				165		
S-25	Standards, 24"x9 1/2" pole with 10'-0" bracket	Each			2		2		
S-25	Electrical equipment	Lump sum					Lump sum		

① These quantities are not included in the summary of lighting on sheet 24 of the highway plans.

Notes:

The following items are not included in the bridge plans. See Roadway Plans for details.

- Removal of existing pavements, etc.
- Relocation or removal of existing utilities.
- Approach grading, pavements, and slabs.
- Guard rails.

All piles to be 12BP53 with an estimated average vertical length of 30'-0" for Abutment 7-N, Pier 7-3, and Pier 7-4, 20'-0" for Pier 7-1, 25'-0" for Pier 7-2, and 50'-0" for Abutment 7-S. These estimates are based on boring data and are approximate only. The contractor shall assume full responsibility for lengths of piling selected for driving.

Boring information, logs and samples of materials encountered may be examined at the Division Office in Ravenna, Ohio, and at the Bridge Bureau Office at Columbus, Ohio, but the State does not guarantee these borings to present a complete picture of subsurface conditions to be encountered.

Foundation design and foundation quantities are based on a study of the borings.

The slope facing (S-29.05 type) shall be 12" thick and shall be placed within the limits shown on the plan of the structure.

PROPOSED STRUCTURE

Type: Five span continuous slab bridge with reinforced concrete deck and substructure.

Spans: 46'-8", 52'-8", 40'-5", 52'-2", and 43'-5 1/2" = 234'-6 1/2" ch to ch and bearings.

Abutty: 33'-8" 1/2, 1'-2" safety curbs.

Loading: CF 2000 (Adequate for A.A.S.H.O. alternate loading).

Skew: Varies 32° 00' 51" 24" to 36° 15' 54" 02".

Surface Course: 2" Asphaltic concrete.

Approach Slabs: A5-1-54 (25'-0" long).

H.N.T.B. BR. NO. 7 PART 10

HOWARD, NEEDLES, TAMMEN & BERGENDOFF
CONSULTING ENGINEERS
KANSAS CITY CLEVELAND NEW YORK

SITE PLAN

EASTBOUND EXPRESSWAY UNDER RAMP "N"

BR. NO. SUM-18-1206 STA. 3+2753

SCALE: 1"=20'

AKRON EXPRESSWAY SYSTEM
SUMMIT COUNTY OHIO

DRAWN: S.M.A. TRACED: [initials] DATE: 1/27/50

CHECKED: [initials] REVIEWED: [initials] DATE: 5-29-50 DATE: 9-5-50

1018 SHEET 167

ORIGINAL CONSTRUCTION
PLANS SHOWN FOR
INFORMATION ONLY

- NOTES:**
- THE EXISTING BRIDGE IS TO BE REMOVED AS PER ITEM 202 - STRUCTURE REMOVED, OVER 20 FOOT SPAN, AS PER PLAN.
 - THE EXISTING APPROACH SLABS ARE TO BE REMOVED AS PER ITEM 202 - APPROACH SLAB REMOVED.
 - SUM-18-1206 IS THE HISTORIC BRIDGE NUMBER. THE CURRENT BRIDGE NUMBER IS SUM-76-1148R AND THE STRUCTURE FILE NUMBER IS 7705972.

2025-03-13 - BU-11 - RECORD DRAWING PLANS

DESIGN AGENCY
BURGESS & NIPLE
Engineers & Architects & Planners
5045 REED ROAD, COLUMBUS, OHIO 43220

DATE
4/29/19

REVIEWED
JCS

DRAWN
AAA

DESIGNED
CAS

CHECKED
BES

STRUCTURE FILE NUMBER
7705973

BRIDGE REMOVAL DETAILS
SUM-76-1152N

RAMP N OVER RAMP S, LANE O, IR-76 EB, SR-8 NB/SB, LANE M

SUM-76-77/8-
8.24/9.74/0.00


PID No. 102329

8/60


9/61

ISSUE RECORD:		DESCRIPTION
NO.	DATE	

p:\V\ANV\A01PWINT01\parsons.com:Ohio_State\Documents\DB-Akron Beltway Rehab\10 - Design\102329\Structures\SUM076_1152N\Sheets\076_1149R_S0003.dgn Sheet 6/23/2021 8:31:13 AM KChrisman

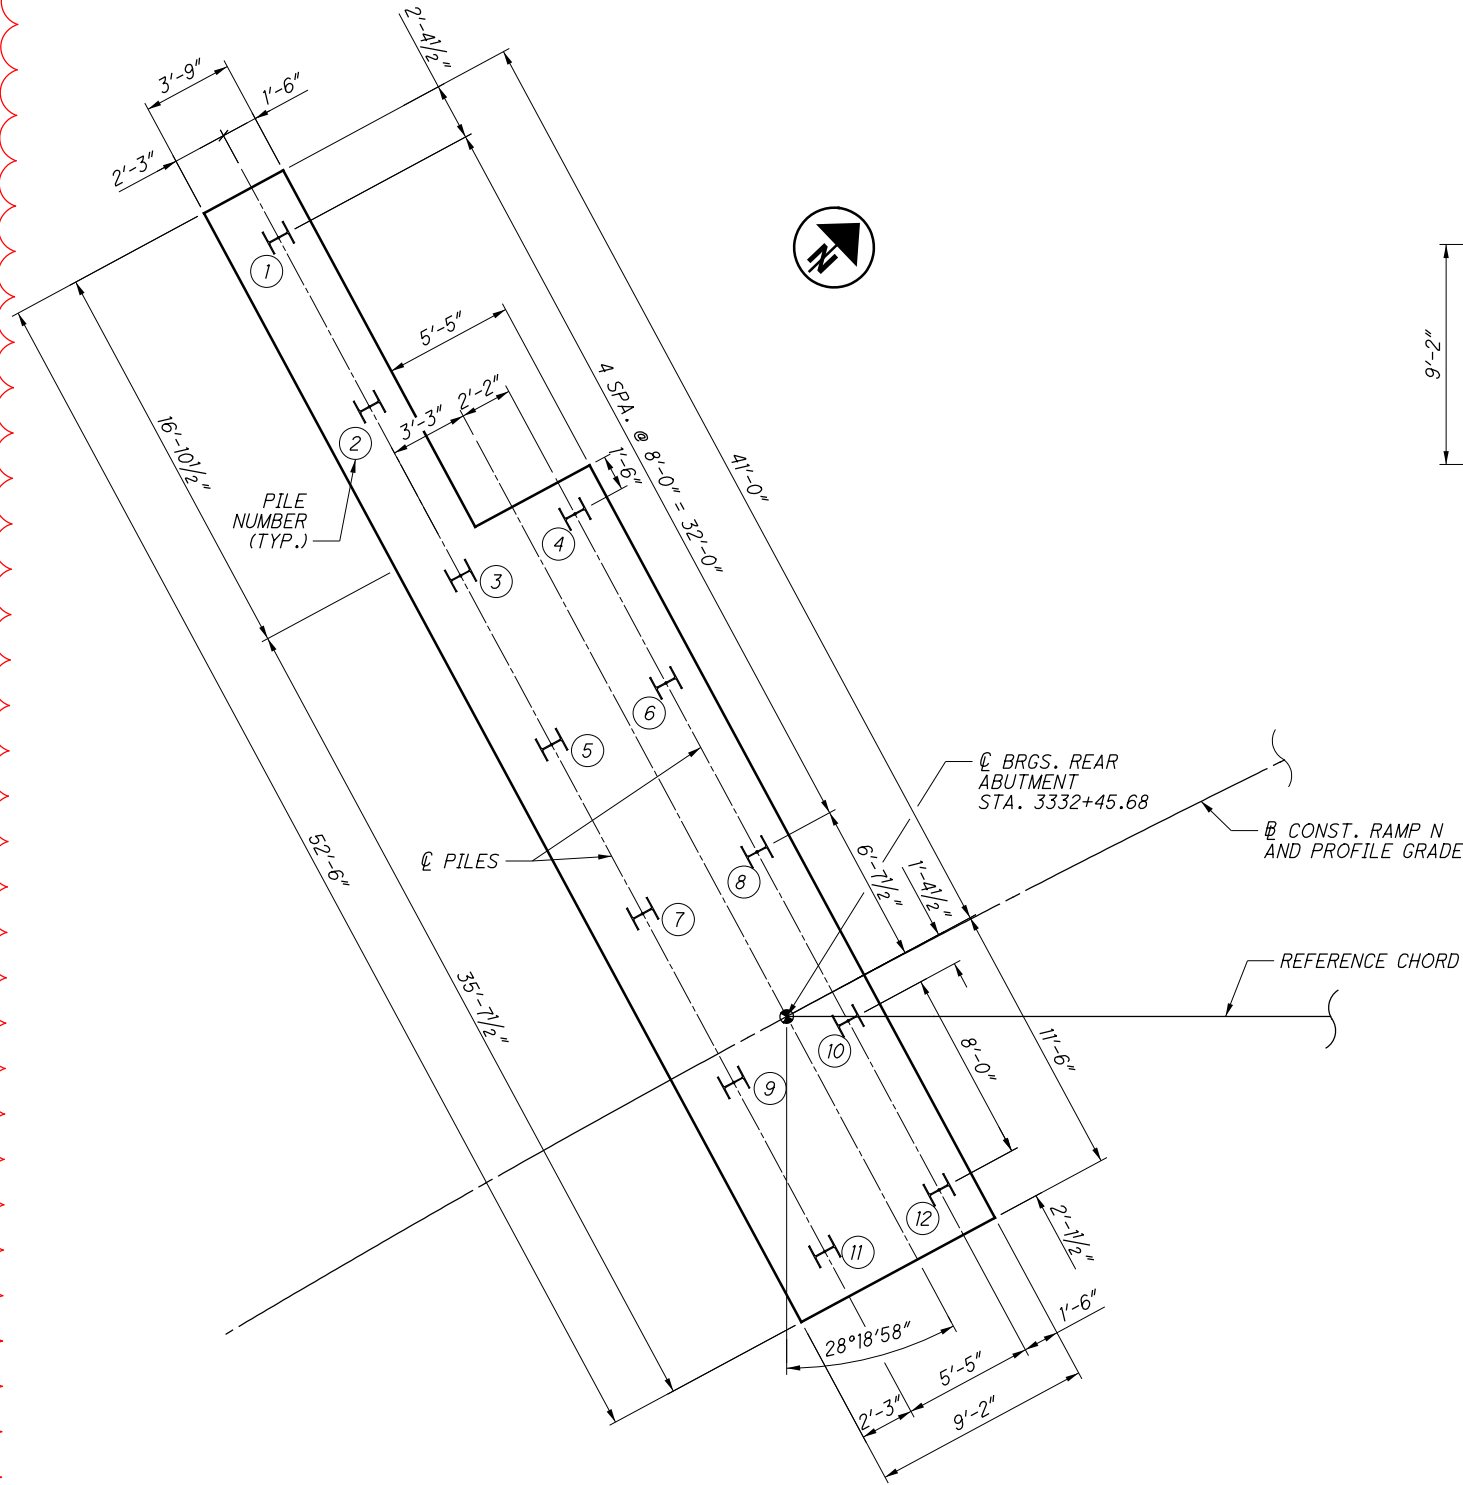

FOUNDATION PLAN - REAR ABUTMENT

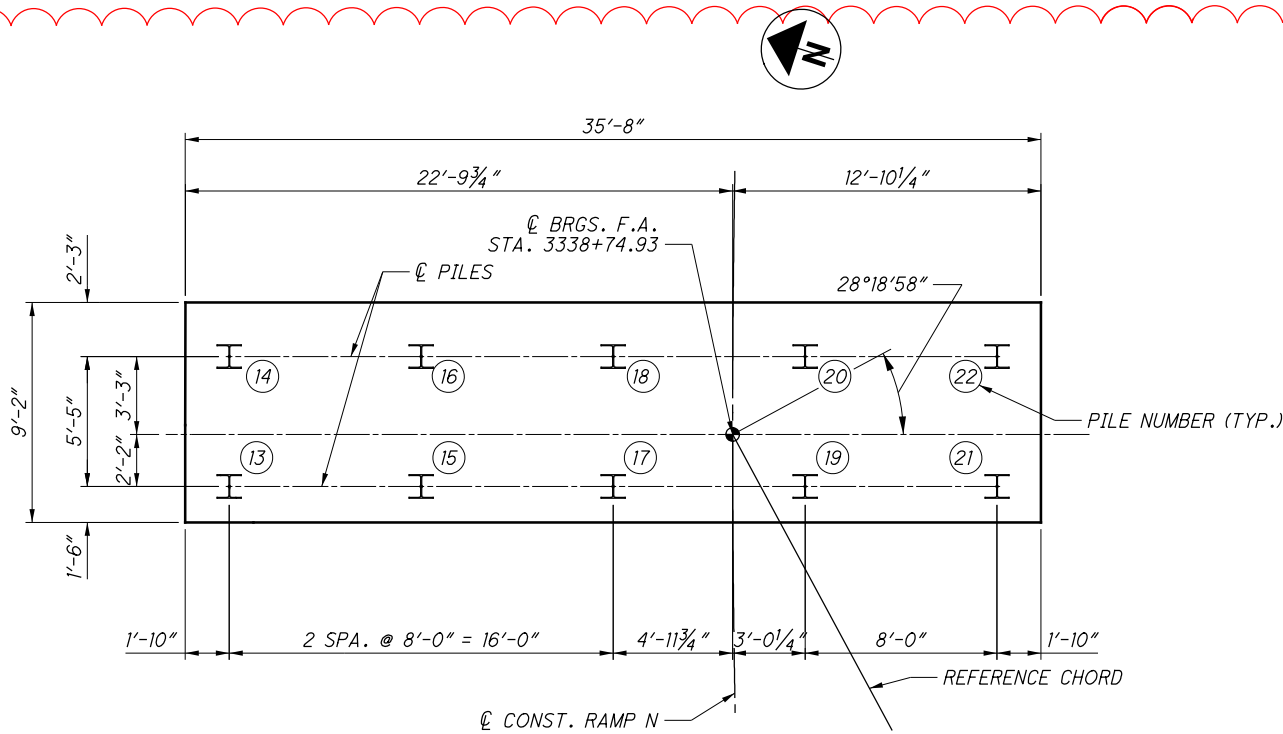

FOUNDATION PLAN - FORWARD ABUTMENT

REAR ABUTMENT PILE LOCATION		
PILE NO.	STA.	OFFSET
1	3332+42.62	38.62' LT
2	3332+42.58	30.63' LT
3	3332+42.54	22.63' LT
4	3332+47.77	22.63' LT
5	3332+42.50	14.63' LT
6	3332+47.80	14.63' LT
7	3332+42.46	6.63' LT
8	3332+47.82	6.63' LT
9	3332+42.38	1.37' RT
10	3332+47.85	1.37' RT
11	3332+42.42	9.37' RT
12	3332+47.88	9.37' RT

FORWARD ABUTMENT PILE LOCATION		
PILE NO.	STA.	OFFSET
13	3338+72.83	20.98' LT
14	3338+78.08	20.98' LT
15	3338+72.80	12.98' LT
16	3338+78.11	12.98' LT
17	3338+72.78	4.98' LT
18	3338+78.15	4.98' LT
19	3338+72.75	3.02' RT
20	3338+78.19	3.02' RT
21	3338+72.72	11.02' RT
22	3338+78.24	11.02' RT

LEGEND:

⌏ = PROPOSED HP10x42 STEEL PILE WITH YELLOW JACKET PILE SLEEVE (VERTICAL)

NOTES:

- SEE SHEETS 10 / 60 AND 12 / 60 FOR DETAILS OF REAR ABUTMENT FOOTING.
- SEE SHEETS 11 / 60 AND 14 / 60 FOR DETAILS OF FORWARD ABUTMENT FOOTING.

2025-03-13 - BU-11 - RECORD DRAWING PLANS

SUM-76/77/8-
8.24/9.74/0.00

PID No. 102329

FOUNDATION PLAN - REAR AND FORWARD ABUTMENTS

SUM-76-1152N

RAMP N OVER RAMP S, LANE O, IR-76 EB, SR-8 NB/SB, LANE M

DESIGNED
KDC

CHECKED
JAT

DRAWN
KDC

REVISED

REVIEWED
SAN

STRUCTURE FILE NUMBER
7705973

DESIGN AGENCY


PRIMEITY

845 Park Plaza, Suite 300
Columbus, Ohio 43240

DATE
6/14/21

ISSUE RECORD:		DESCRIPTION
NO.	DATE	


p:\w:\ANV\A01PWINT01.parsons.com:Ohio State\Documents\DB-Akron Beltway Rehab\10 - Design\102329\Structures\SUM076_1152N\Sheets\076_1149R_SR005.dgn Sheet 6/23/2021 8:31:31 AM KChrisman

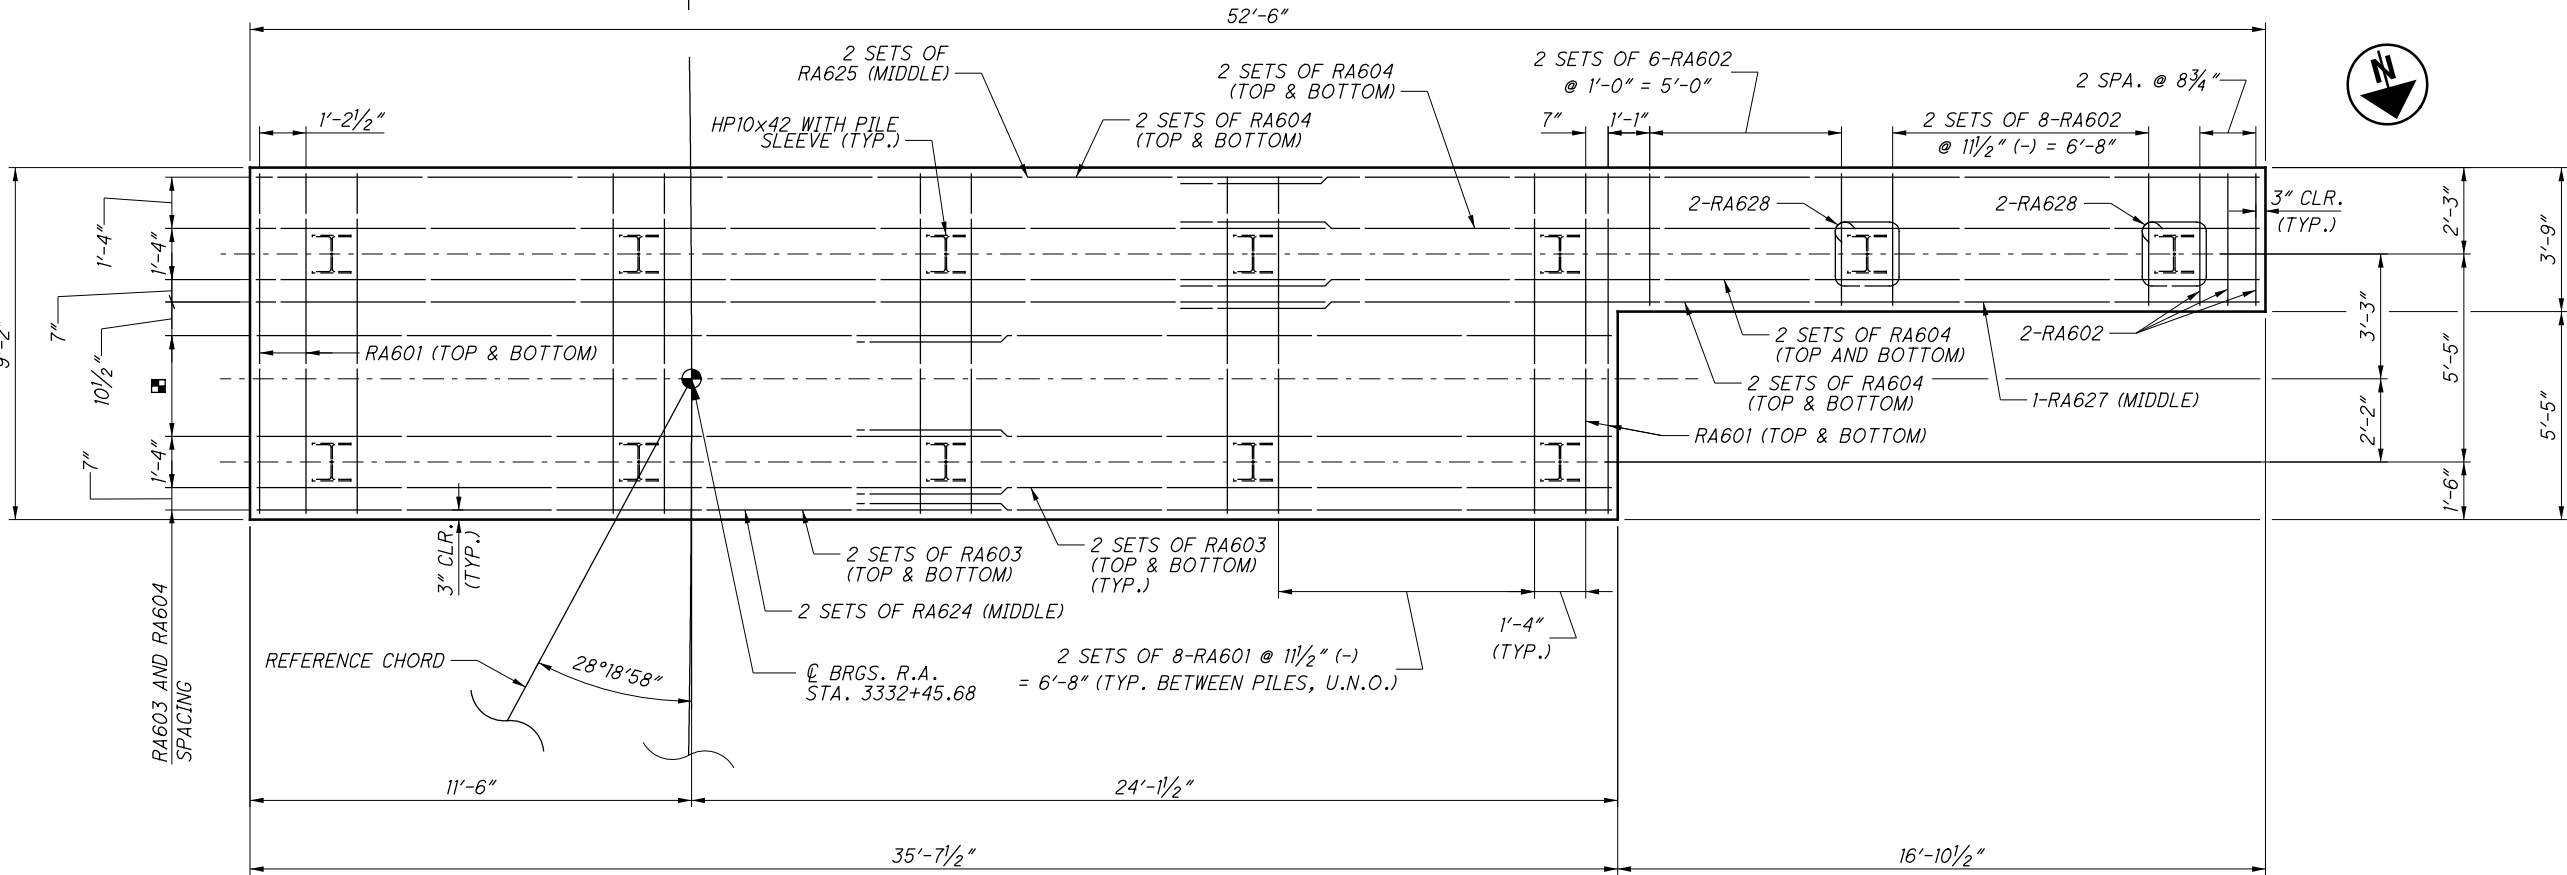

FOOTING PLAN

LEGEND:

- - 3 SPA. @ 10 1/2" = 2'-7 1/2"
- HP10x42 STEEL PILE WITH YELLOW JACKET PILE SLEEVE

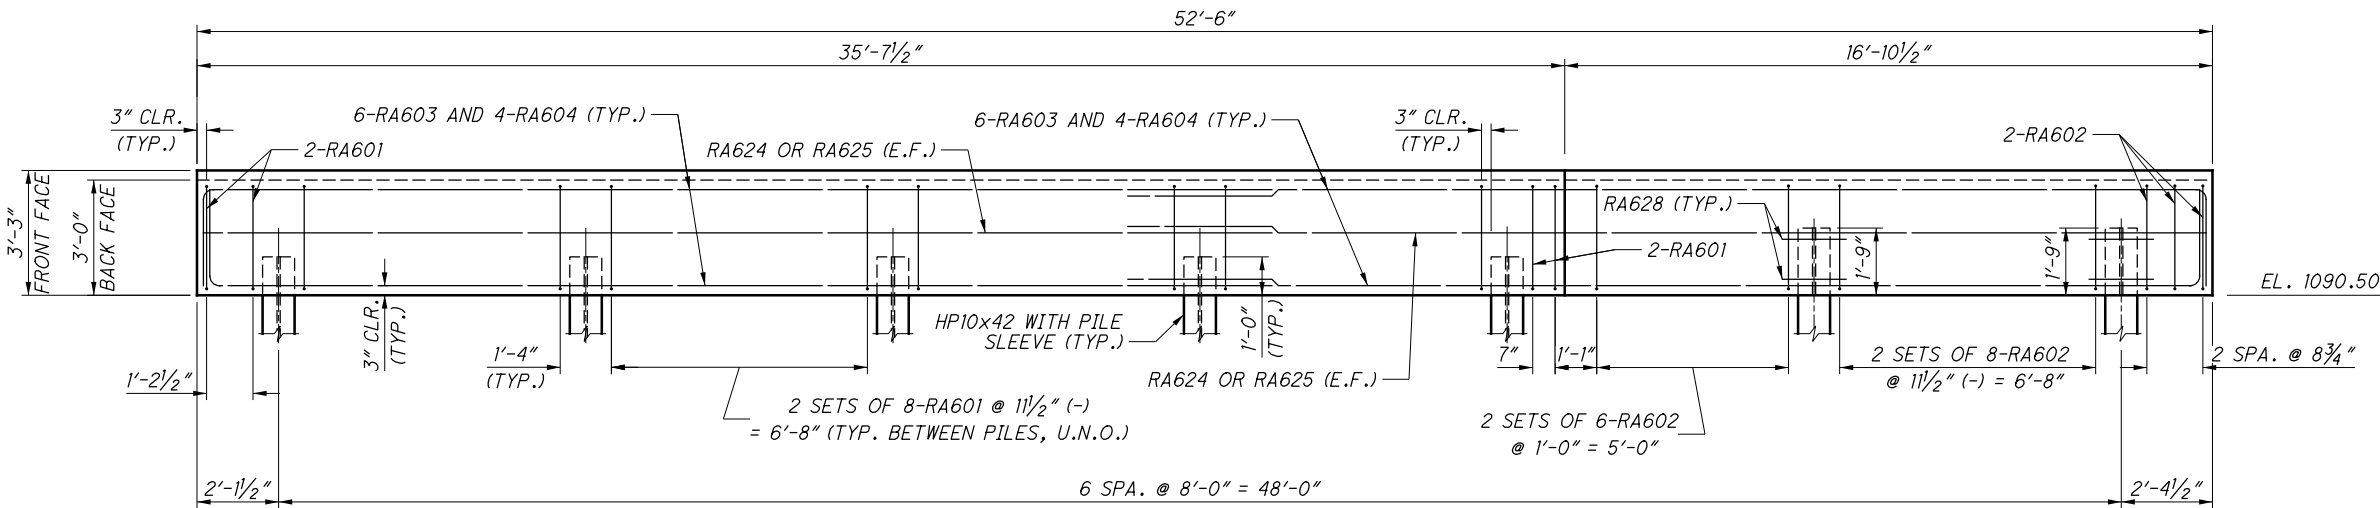

FOOTING ELEVATION

MINIMUM LAP LENGTHS:


#6 BAR = 3'-8"

NOTES:

1. SEE SHEET 9 / 60 FOR PILE LAYOUT AND ADDITIONAL FOOTING DIMENSIONS.

2025-03-13 - BU-11 - RECORD DRAWING PLANS


DESIGN AGENCY		REVIEWED DATE	
PRIMEITY 8415 Pulaski Place Columbus Ohio 43240		SAN 6/14/21	
		STRUCTURE FILE NUMBER 7705973	
REAR ABUTMENT FOOTING PLAN			
SUM-76-1152N			
RAMP N OVER RAMP S, LANE O, IR-76 EB, SR-8 NB/SB, LANE M			
SUM-76/77/8- 8.24/9.74/0.00		PID No. 102329	
10 / 60		11 / 61	

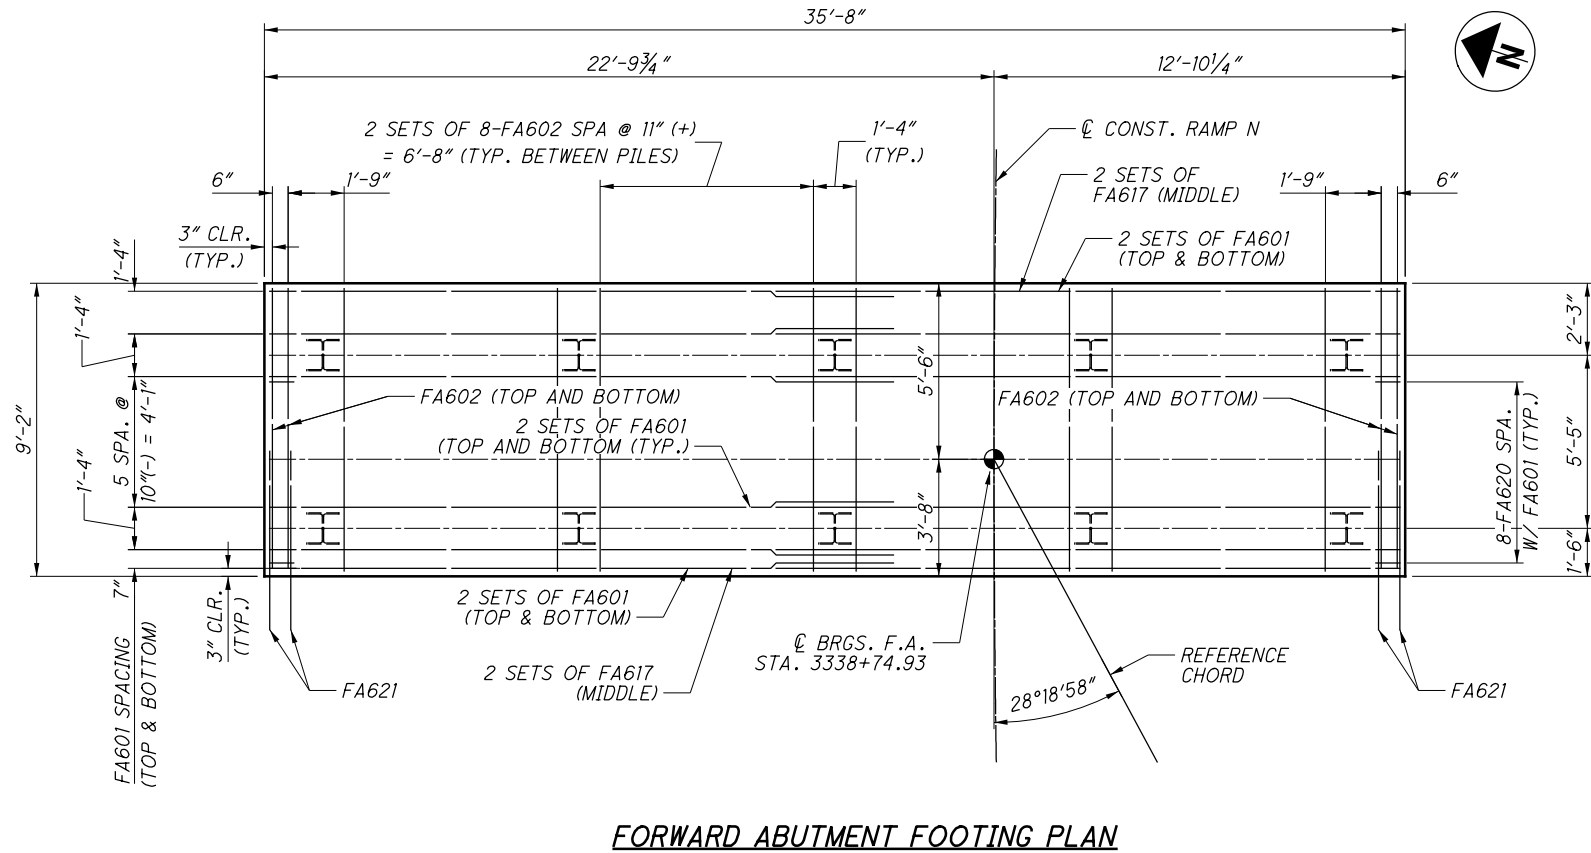

1. SEE SHEET 9 / 60 FOR PILE LAYOUT AND ADDITIONAL FOOTING DIMENSIONS.

2. FOR ADDITIONAL DETAILS ON PREBORED HOLES, SEE SHEET 4 / 60.

ISSUE RECORD:		DESCRIPTION
NO.	DATE	

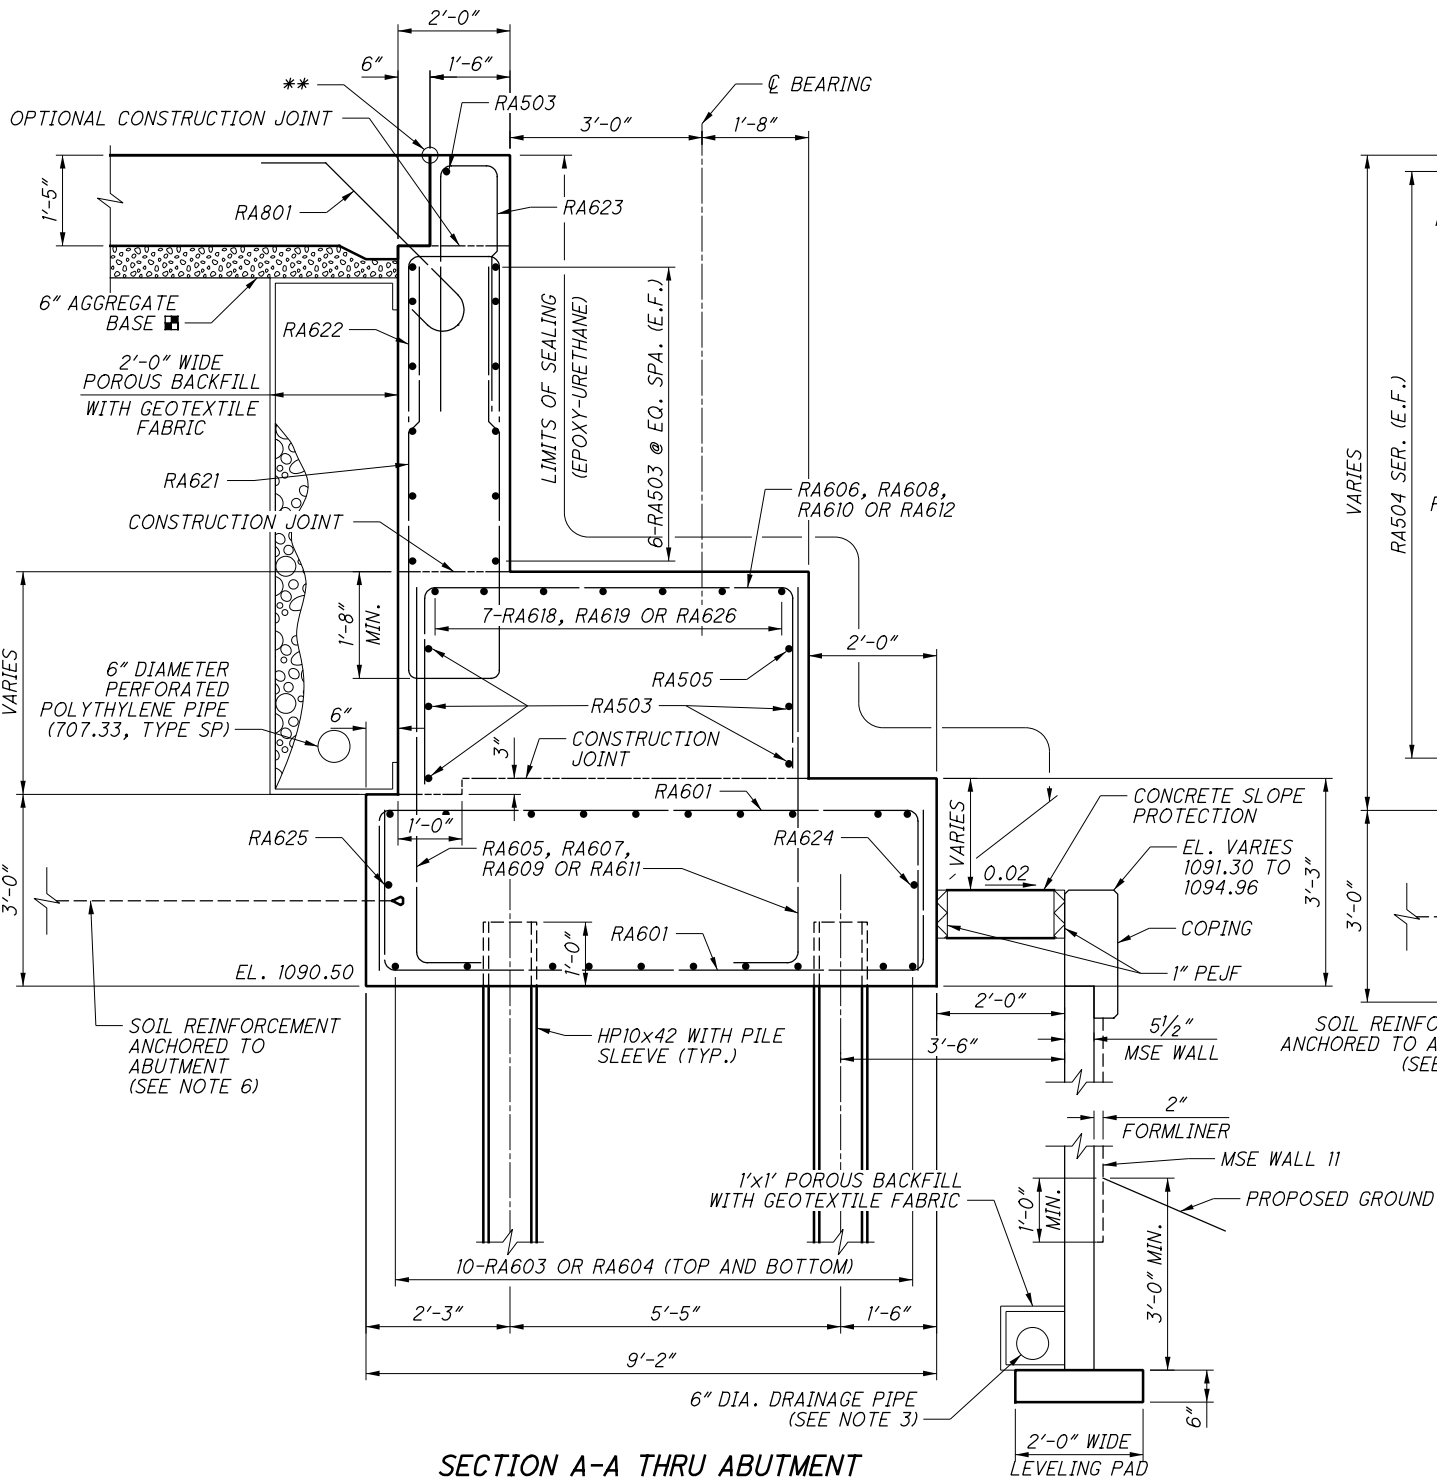

SECTION A-A THRU ABUTMENT


MINIMUM LAP LENGTHS:

#6 BAR = 3'-8"

LEGEND:

** = SEE DETAIL B ON STANDARD DRAWING AS-1-15, SHEET 2/2

■ = SEE ROADWAY PLANS FOR DETAILS

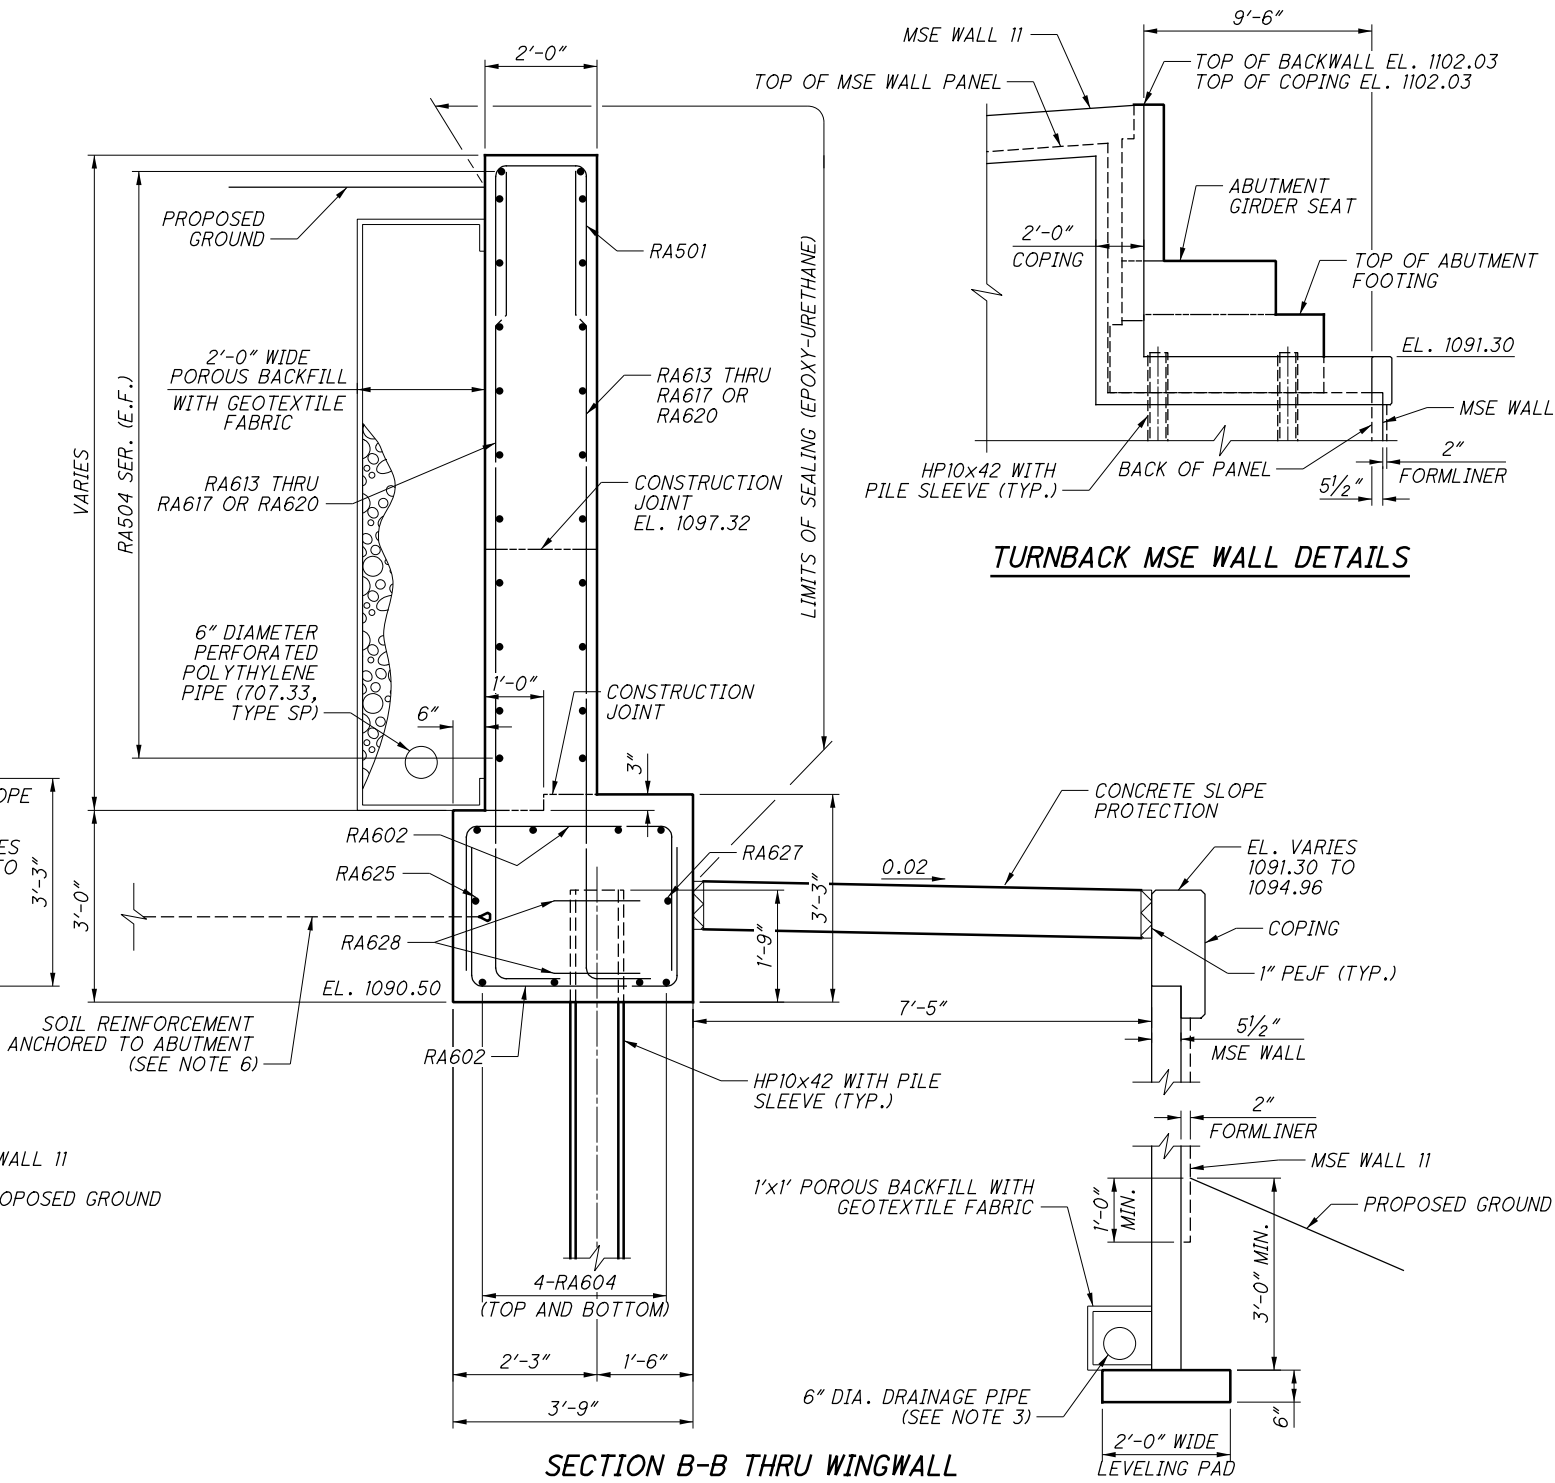


SECTION B-B THRU WINGWALL

NOTES:


1. SEE SHEET 9 / 60 FOR PILE LAYOUT AND ADDITIONAL FOOTING DIMENSIONS.
2. TURN GEOTEXTILE FABRIC UP 6" AT BASE OF WALL AND DOWN 6" AT TOP OF WALL.
3. SLOPE 6" DIA. PCPP AT 1/8" PER FOOT TOWARDS THE OUTLET.
4. SEE BU-17 FOR ADDITIONAL FORMLINER REQUIREMENTS.
5. FOR MSE WALL 11 DETAILS, SEE BU-17.
6. SOIL REINFORCEMENT LOAD = 6.14 KIPS/FT. STRAP CONNECTIONS TO ABUTMENTS TO BE PROVIDED BY MSE MANUFACTURER. SEE GENERAL NOTES FOR MORE INFORMATION.

TURNBACK MSE WALL DETAILS

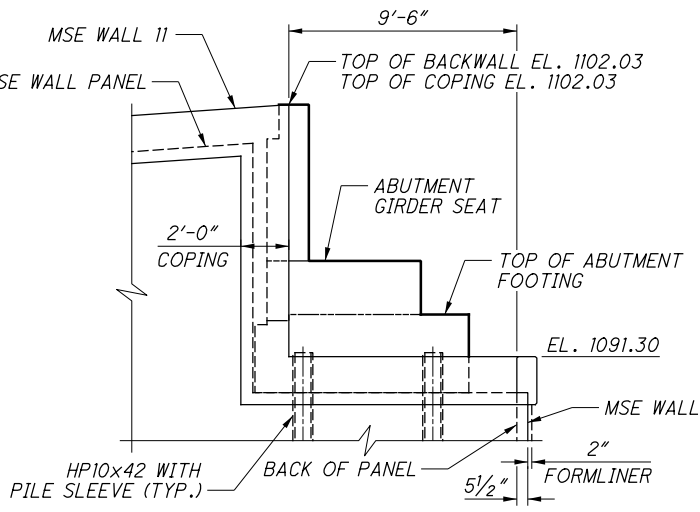


ISSUE RECORD:		DESCRIPTION
NO.	DATE	


p:\w\ANV\A01PWINT01.parsons.com:Ohio State Documents\DB-Akron Beltway Rehab\10 - Design\102329\Structures\SUM076_1152N\Sheets\076_1149R_SF007.dgn Sheet 6/23/2021 8:32:05 AM KChrisman

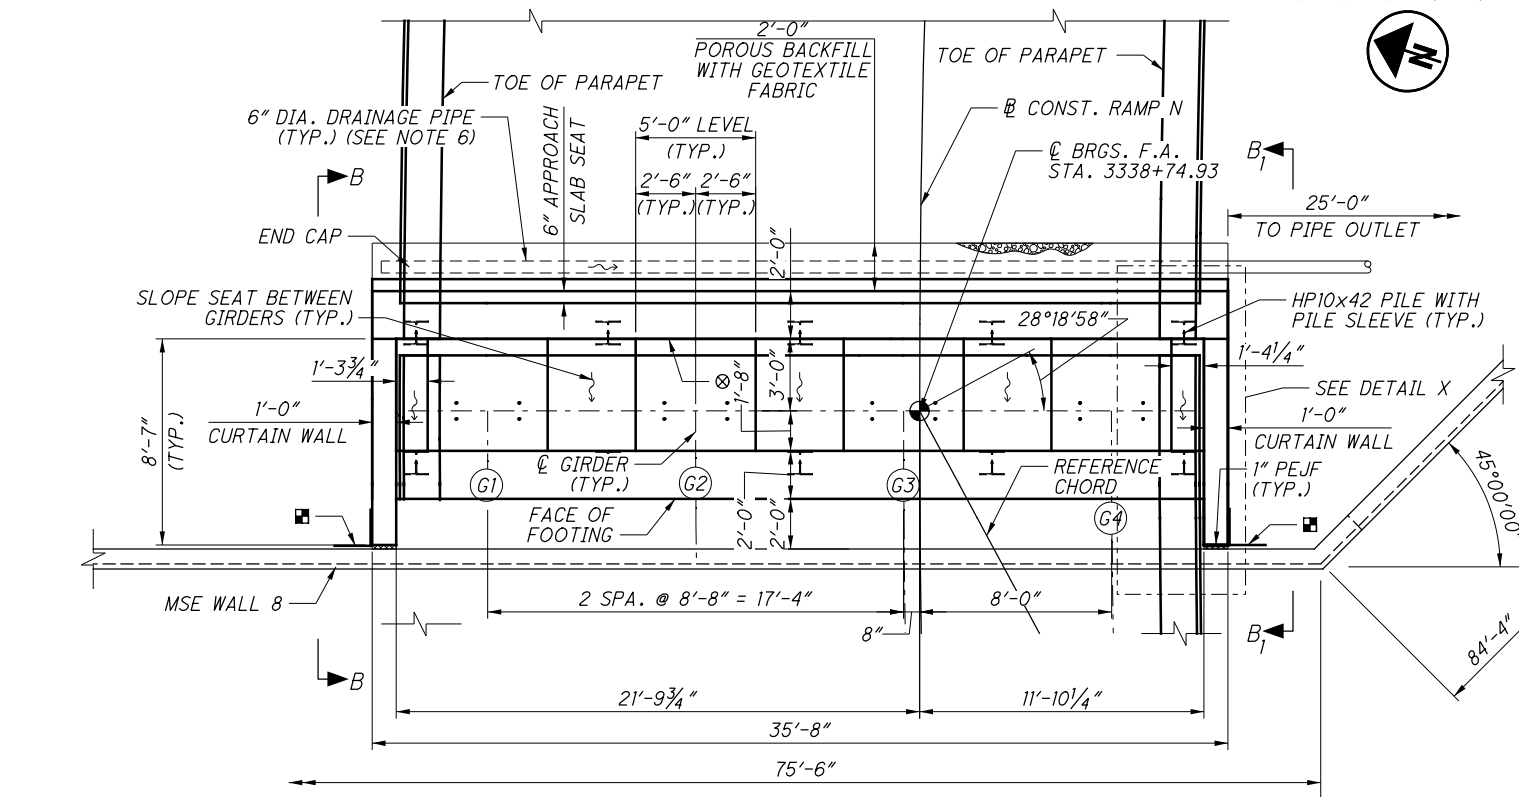


PLAN

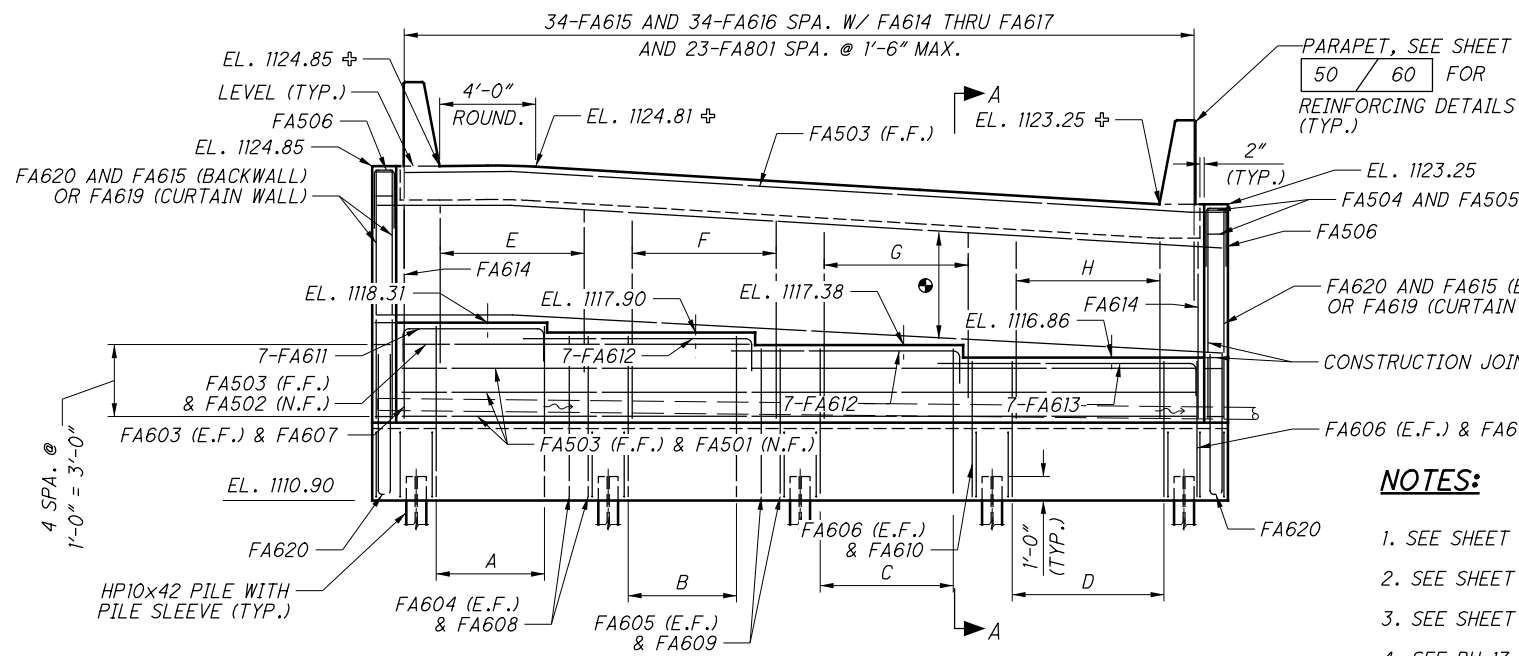


ELEVATION
(FOOTING REINFORCING STEEL NOT SHOWN)
(MSE WALL NOT SHOWN)

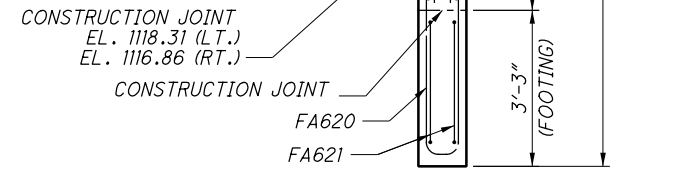

SECTION C-C THRU CURTAIN WALL

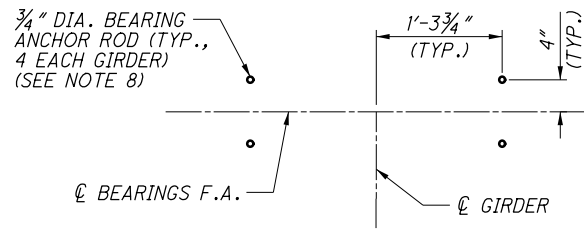

BEARING ANCHOR PLAN

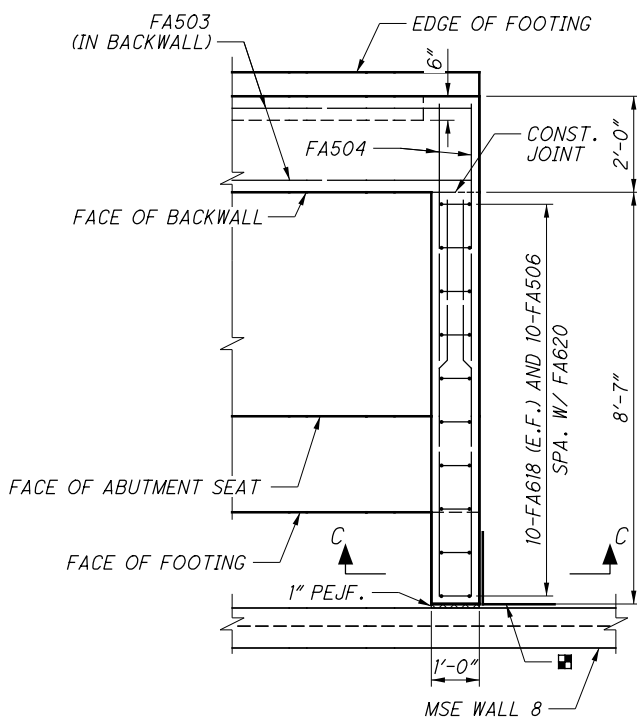

DETAIL X
(RIGHT SIDE SHOWN, LEFT OPPOSITE HAND)

MINIMUM LAP LENGTHS:

#6 BAR = 3'-8"

LEGEND:

- ⊕ = TOP OF BACKWALL ELEVATIONS ARE GIVEN AT FRONT FACE OF BACKWALL
- ⊗ = FRONT FACE OF BACKWALL
- = 3'-0" WIDE TYPE 2 WATERPROOFING (CENTERED ON JOINT, FULL HEIGHT OF ABUTMENT. (SEE NOTE 9))
- A = 6-FA603 SPA. W/ FA602 (E.F.) AND 6-FA607
- B = 6-FA604 SPA. W/ FA602 (E.F.) AND 6-FA608
- C = 7-FA605 SPA. W/ FA602 (E.F.) AND 7-FA609
- D = 8-FA606 SPA. W/ FA602 (E.F.) AND 8-FA610
- E = 8-FA614 SPA. W/ FA603 OR FA604
- F = 8-FA614 SPA. W/ FA604 OR FA605
- G = 8-FA614 SPA. W/ FA605 OR FA606
- H = 8-FA614 SPA. W/ FA606


NOTES:

- SEE SHEET 9 / 60 FOR PILE LAYOUT AND ADDITIONAL FOOTING DIMENSIONS.
- SEE SHEET 11 / 60 FOR ADDITIONAL FOOTING REINFORCING DETAILS.
- SEE SHEET 15 / 60 FOR SECTIONS A-A AND VIEWS B-B & B₁-B₁.
- SEE BU-17 FOR MSE WALL 8 PLANS.
- BRIDGE SEAT REINFORCING, SETTING ANCHORS: PRE-SET BEARING ANCHORS. PLACE REINFORCING STEEL IN THE VICINITY OF THE BRIDGE SEAT TO AVOID INTERFERENCE WITH THE PRE-SET BEARING ANCHORS.
- USE PERFORATED CORRUGATED POLYETHYLENE PIPE INSIDE THE POROUS BACKFILL. USE NON-PERFORATED CORRUGATED POLYETHYLENE PIPE IN ALL OTHER LOCATIONS. ALL DRAINAGE PIPES SHALL SLOPE 1/8" PER FT. TOWARDS THE OUTLET.
- PROVIDE CRUSHED AGGREGATE SLOPE PROTECTION AT PIPE OUTLETS PER STANDARD DRAWING A-1-69.
- SEE SHEET 39 / 60 FOR BEARING ANCHOR ROAD DETAILS AND PAYMENT.
- SECURE TYPE 2 WATERPROOFING TO THE ABUTMENT TO PREVENT MOVEMENT.

2025-03-13-BU-11-RECORD DRAWING PLANS

DESIGN AGENCY		DATE	
PRIME		6/14/21	
8455 Paines Place, Suite 300		STRUCTURE FILE NUMBER	
Columbus Ohio 43240		7705973	
FORWARD ABUTMENT PLAN AND ELEVATION		SUM-76-1152N	
RAMP N OVER RAMP S, LANE O, IR-76 EB, SR-8 NB/SB, LANE M		PID No. 102329	
SUM-76/77/8-8.24/9.74/0.00		14/60	
		15/61	

ISSUE RECORD:		DESCRIPTION
NO.	DATE	

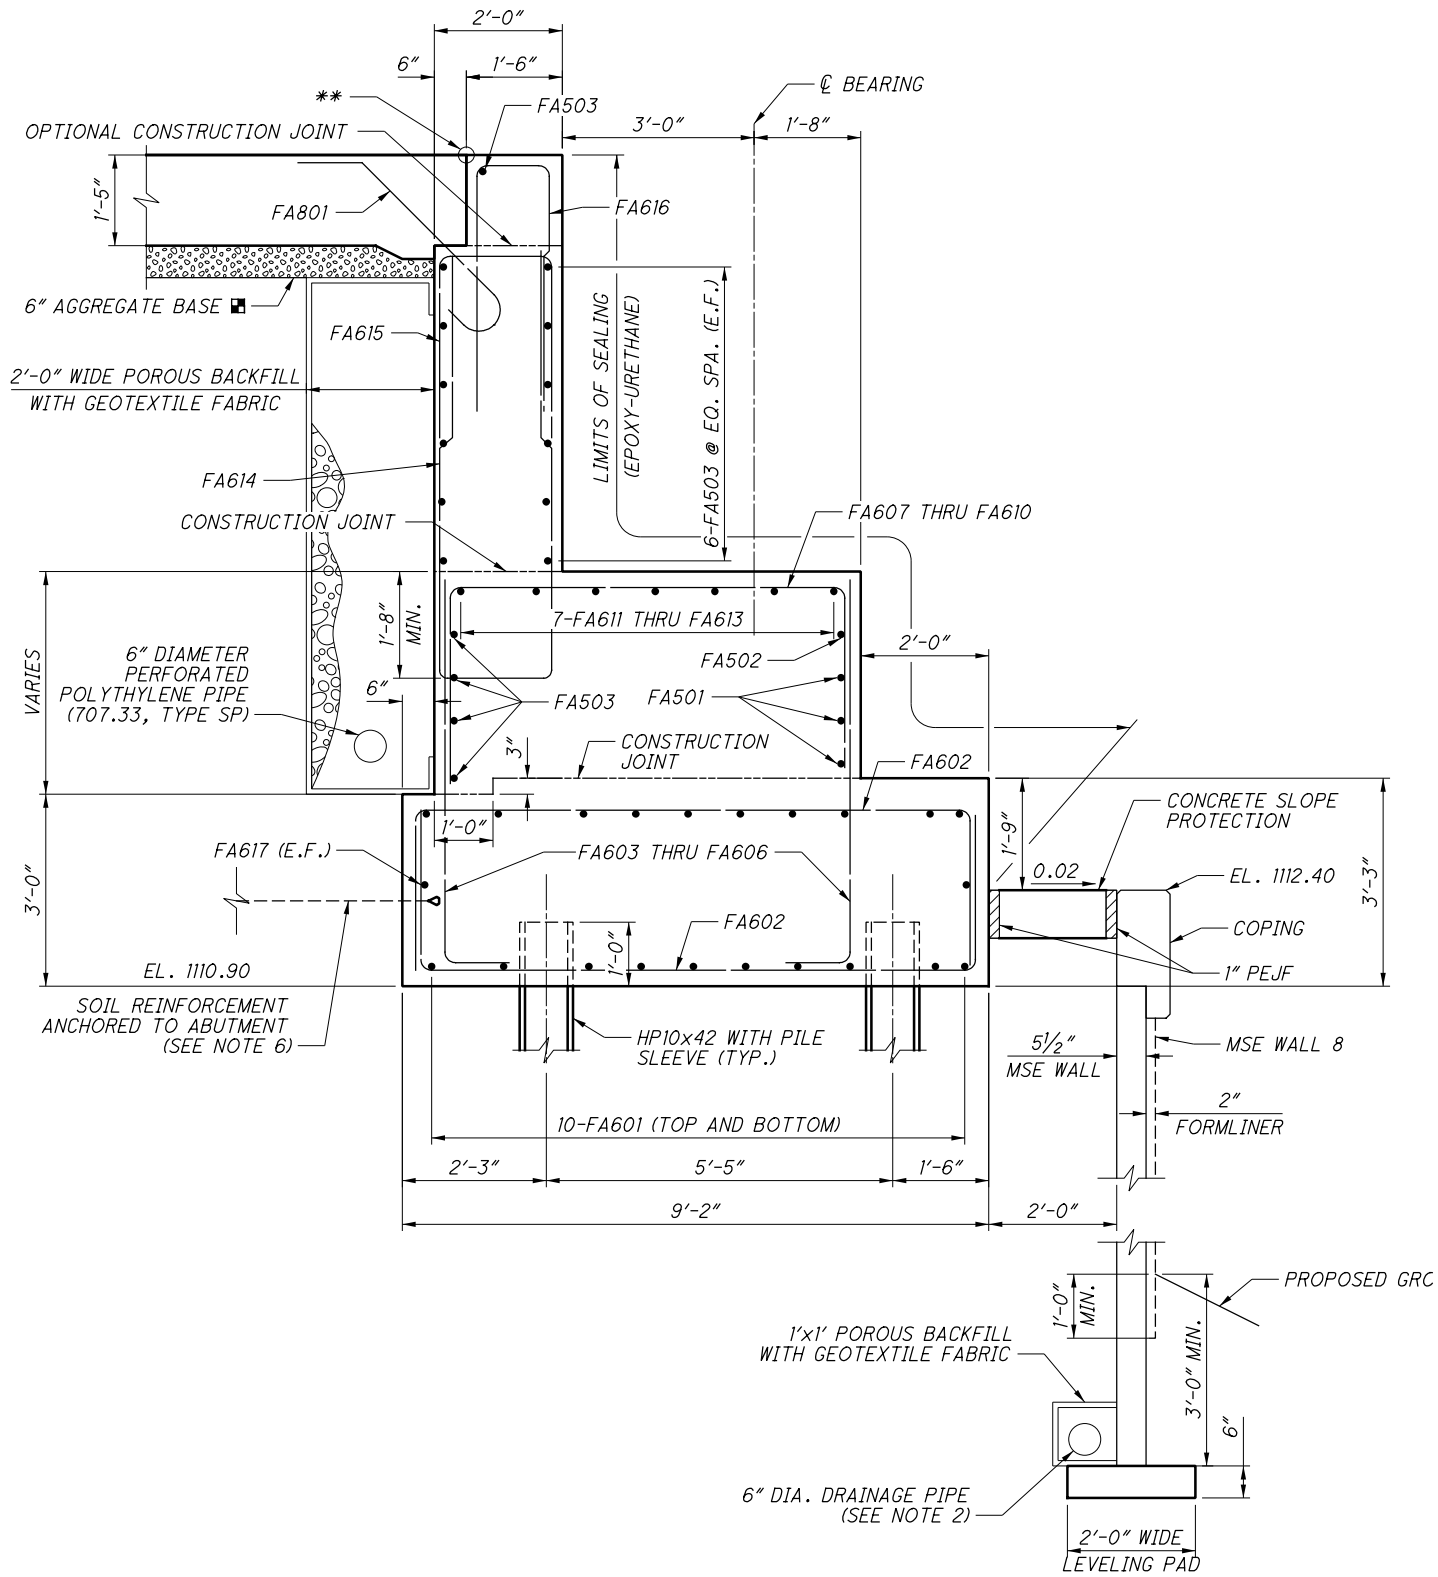


SECTION A-A THRU ABUTMENT

MINIMUM LAP LENGTHS:

#5 BAR = 3'-1"
#6 BAR = 3'-8"

LEGEND:

- ** = SEE DETAIL B ON STANDARD DRAWING AS-1-15, SHEET 2/2
- = SEE ROADWAY PLANS FOR DETAILS & PAYMENT
- = EL. 1121.15 (LEFT), EL. 1121.04 (RIGHT)

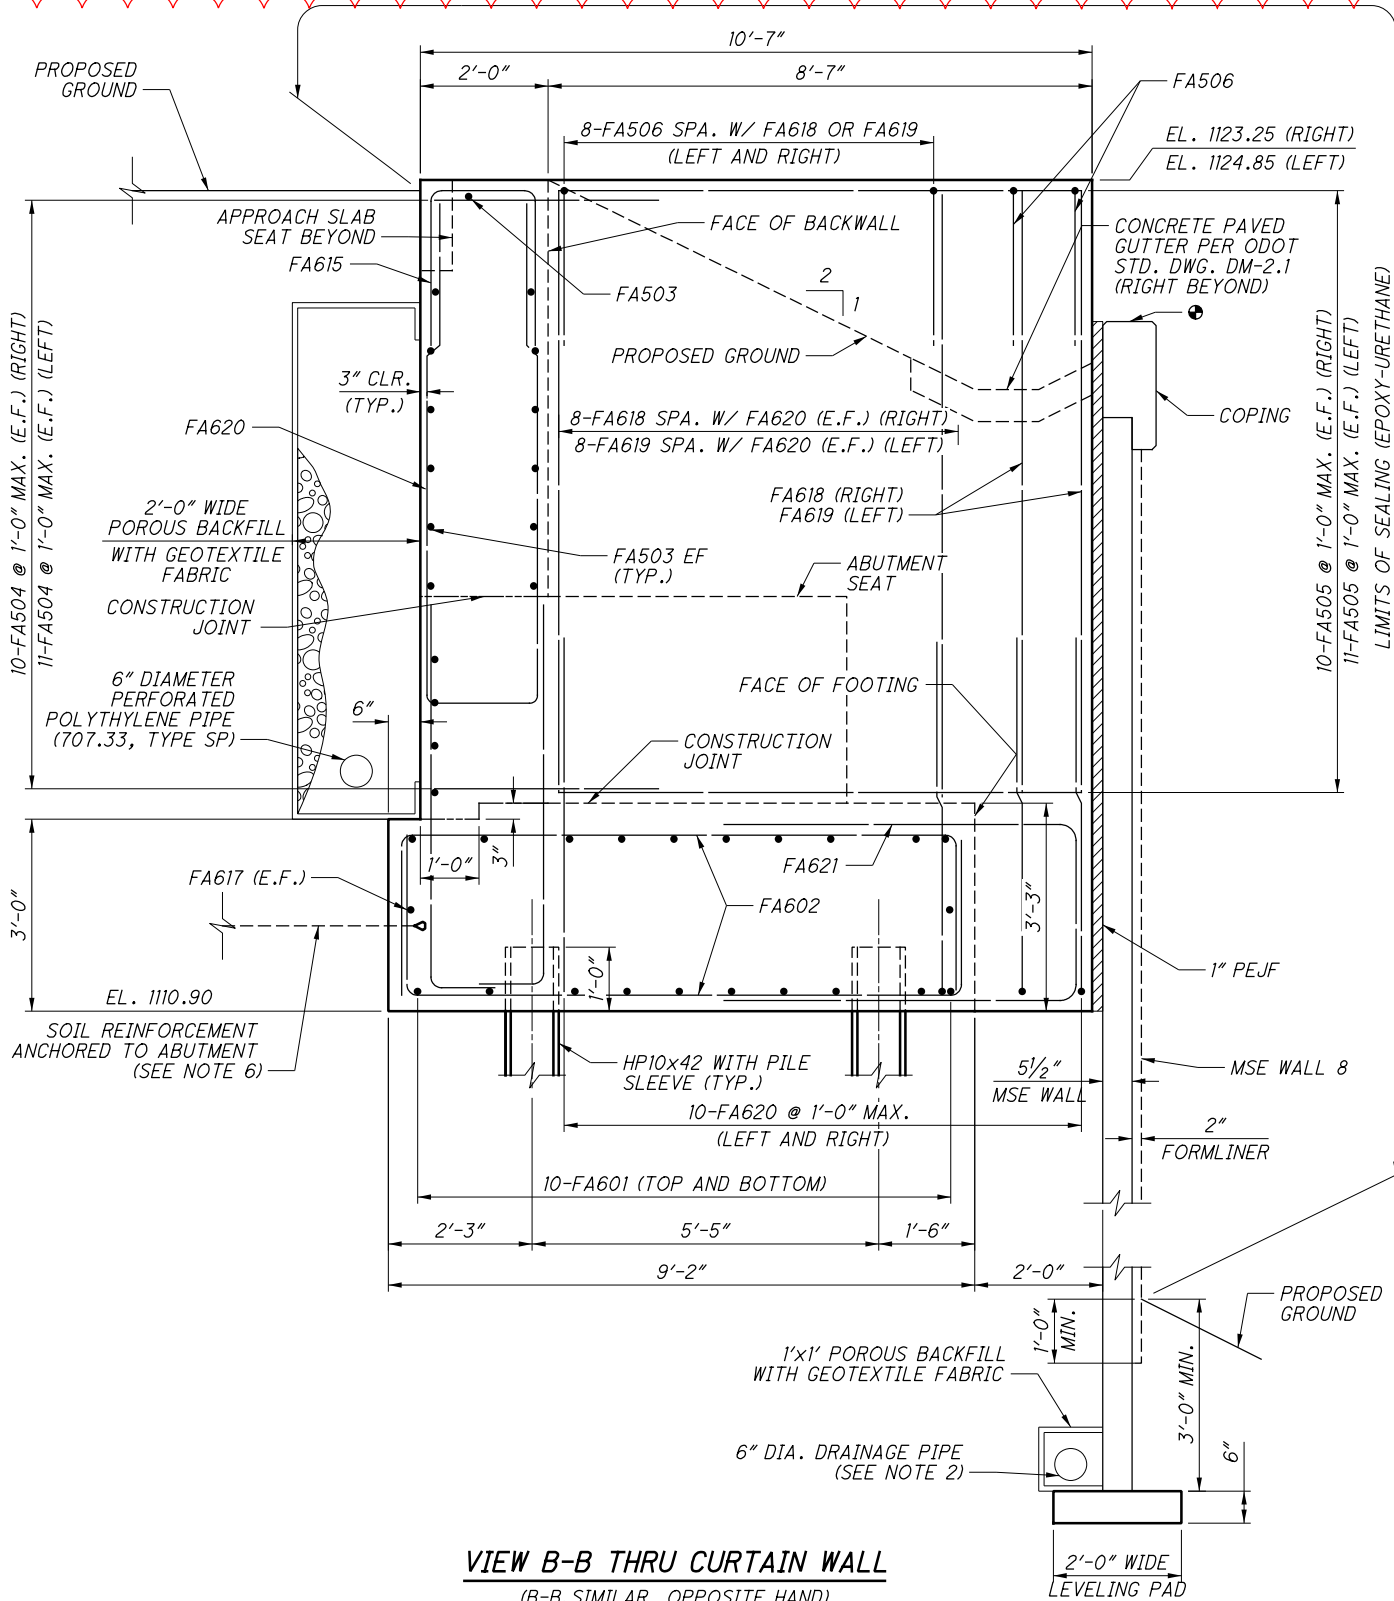


VIEW B-B THRU CURTAIN WALL
(B₁-B₁ SIMILAR, OPPOSITE HAND)

NOTES:


- SEE SHEET 9 / 60 FOR PILE LAYOUT AND ADDITIONAL FOOTING DIMENSIONS.
- SLOPE 6" DIA. PCPP AT 1/8" PER FOOT TOWARDS THE OUTLET.
- TURN GEOTEXTILE FABRIC UP 6" AT BASE OF WALL AND DOWN 6" AT TOP OF WALL.
- FOR MSE WALL 8 DETAILS, SEE BU-17.
- SEE SHEET 14 / 60 FOR LOCATION OF SECTIONS A-A AND B-B.
- SOIL REINFORCEMENT LOAD = 7.43 KIPS/FT. ADDITIONAL STRAPS MAY BE ANCHORED TO THE ABUTMENTS IF NECESSARY TO RESIST LOAD. STRAP CONNECTIONS TO ABUTMENTS TO BE PROVIDED BY MSE MANUFACTURER. SEE GENERAL NOTES FOR MORE INFORMATION.

ISSUE RECORD:		DESCRIPTION
NO.	DATE	

p:\v\ANV\A01P\WINT01.parsons.com:Ohio State\Documents\DB-Akron Beltway Rehab\10 - Design\102329\Structures\SUM076_1152N\Sheets\076_1149_SR010.dgn Sheet 6/23/2021 8:32:16 AM KChrisman

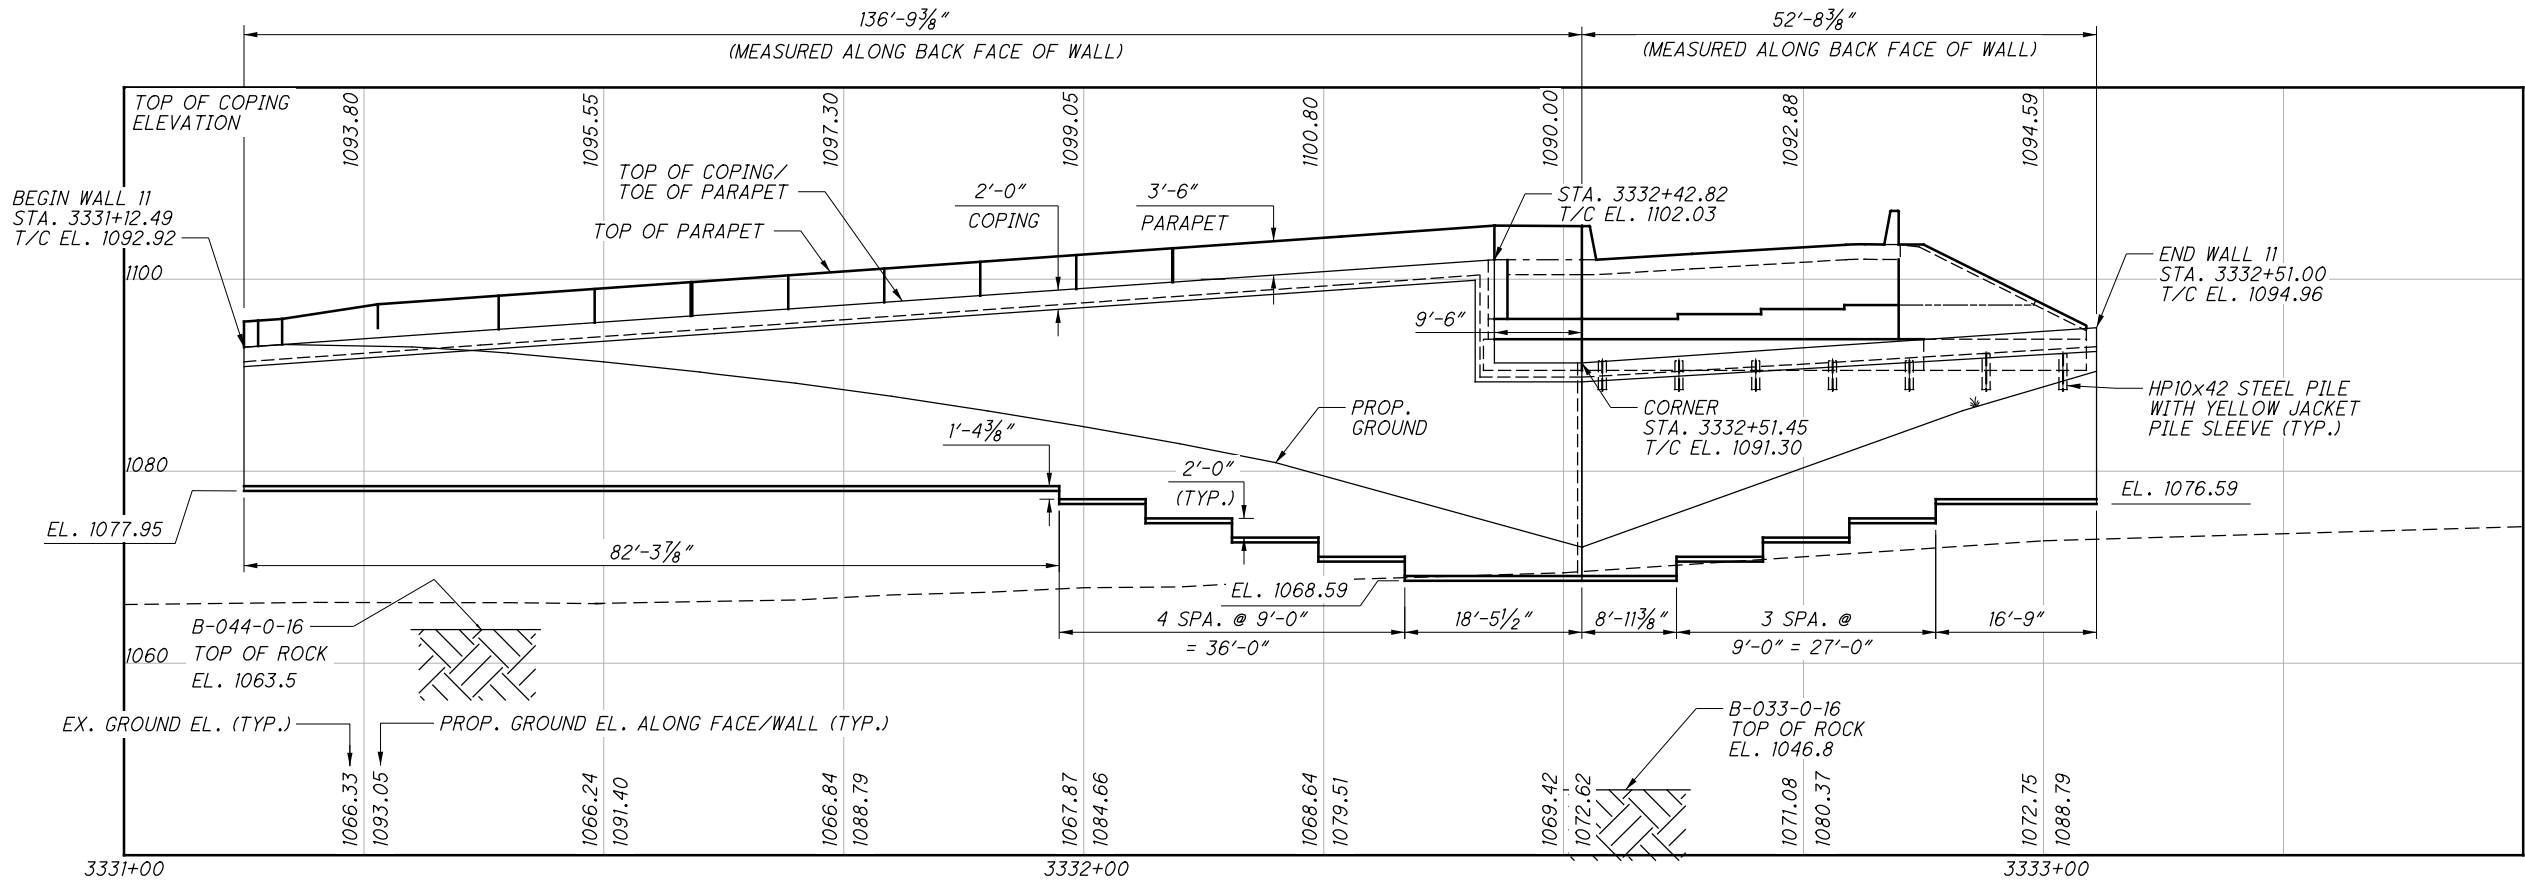

DEVELOPED ELEVATION ALONG FRONT FACE OF MSE WALL 11
(MSE WALL DRAINAGE NOT SHOWN)

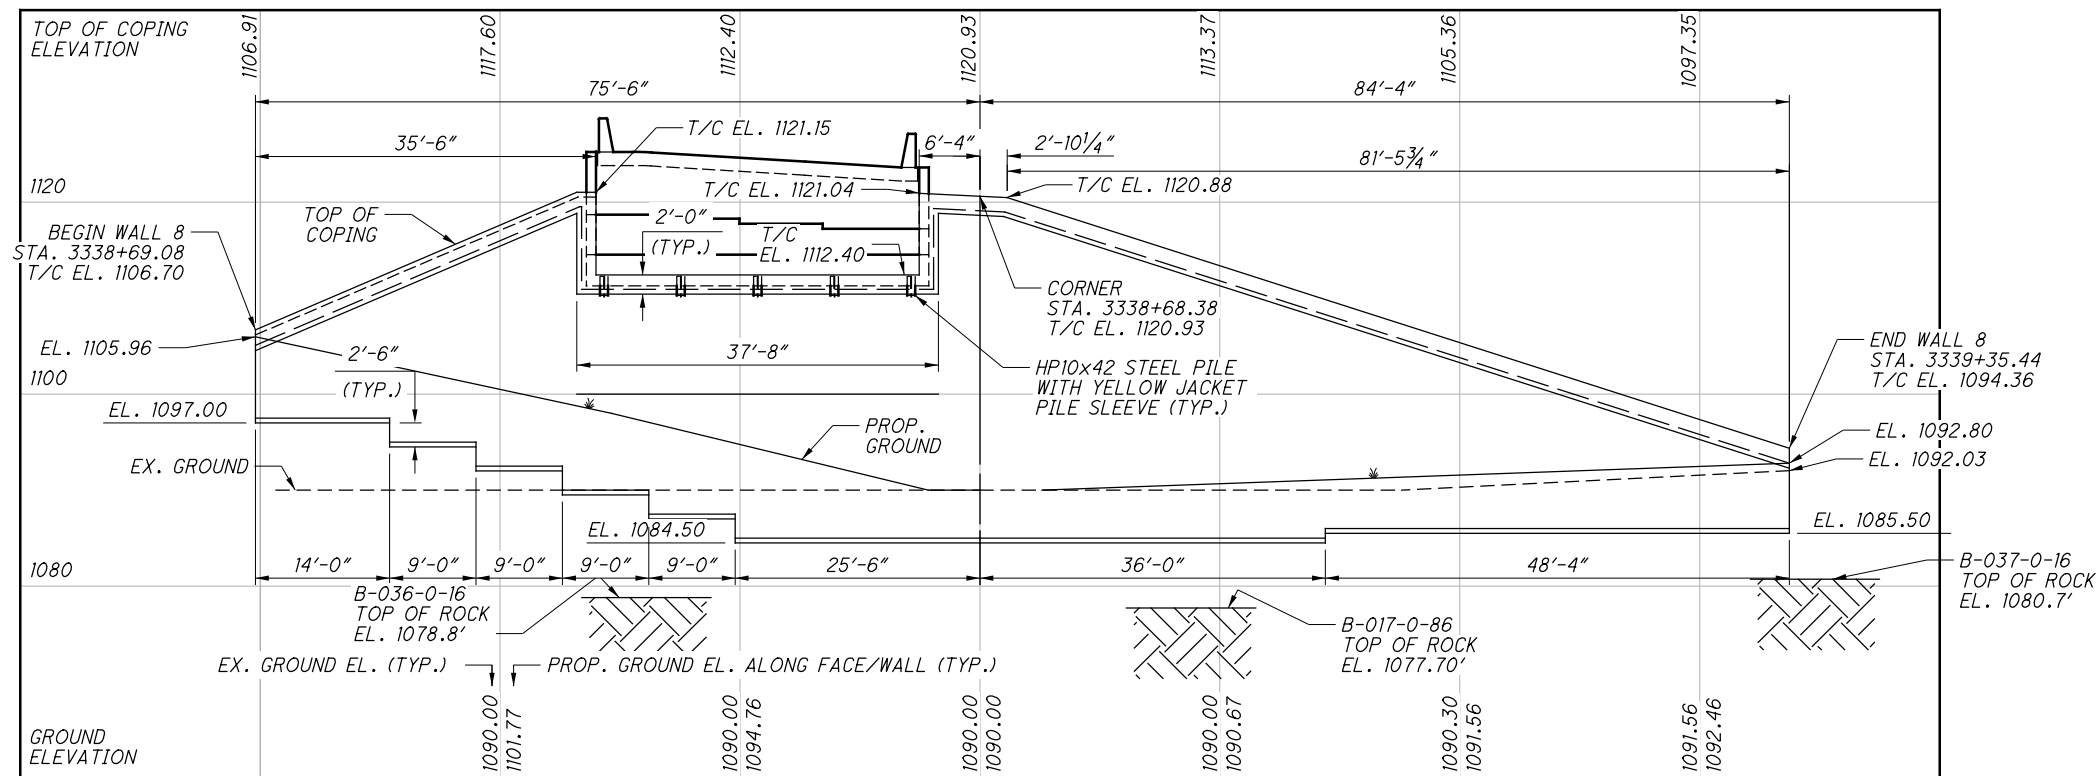

DEVELOPED ELEVATION ALONG FRONT FACE OF MSE WALL 8
(MSE WALL DRAINAGE NOT SHOWN)

NOTE:

1. FOR MSE WALL DETAILS, SEE BU-17.

2025-03-13 - BU-11 - RECORD DRAWING PLANS

SUM-76/77/8-
8.24/9.74/0.00

PID No. 102329

MSE WALL ELEVATIONS
SUM-76-1152N

RAMP N OVER RAMP S, LANE O, IR-76 EB, SR-8 NB/SB, LANE M

DESIGNED
KDC
CHECKED
JAT

DRAWN
KDC
REVISED


REVIEWED
SAN
STRUCTURE FILE NUMBER
7705973

DATE
6/14/21


DESIGN AGENCY
PRIME
845 Pauls Road
Columbus Ohio 43240

ISSUE RECORD:		DESCRIPTION
NO.	DATE	

p:\v\ANV\A01PWINT01\parsons.com:Ohio State\Documents\VB-Akron Beltway Rehab\10 - Design\102329\Structures\SUM076_1152N\Sheets\076_1149R_S1001.dgn Sheet 6/23/2021 8:32:22 AM KChrisman

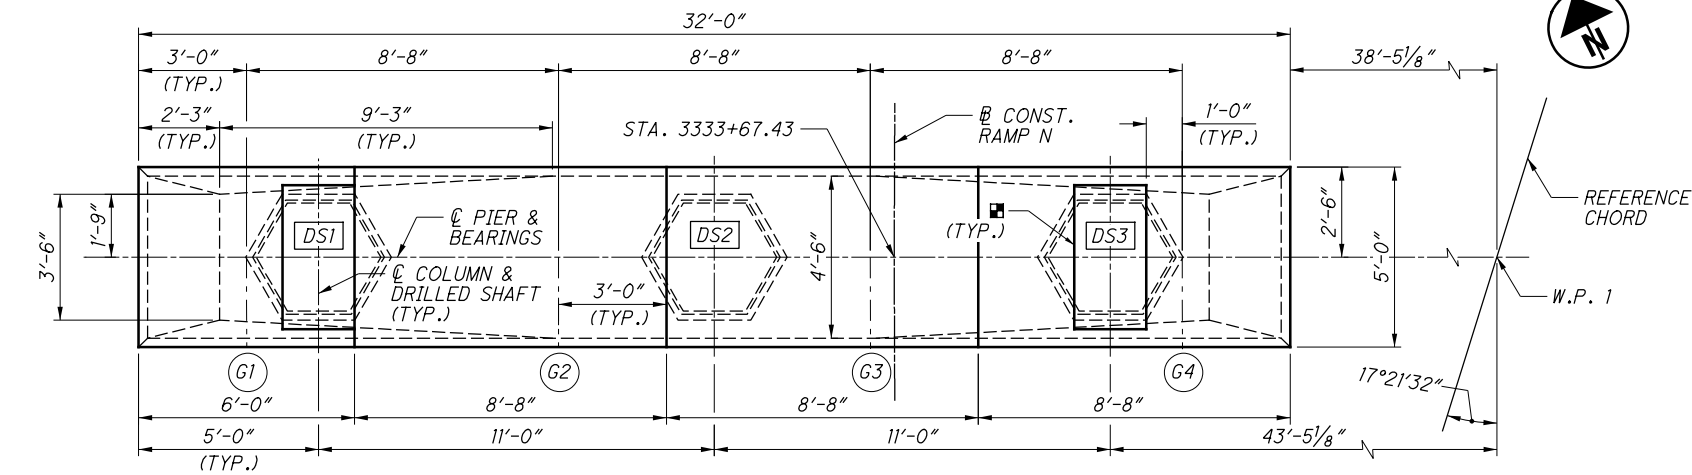


PLAN - PIER 1

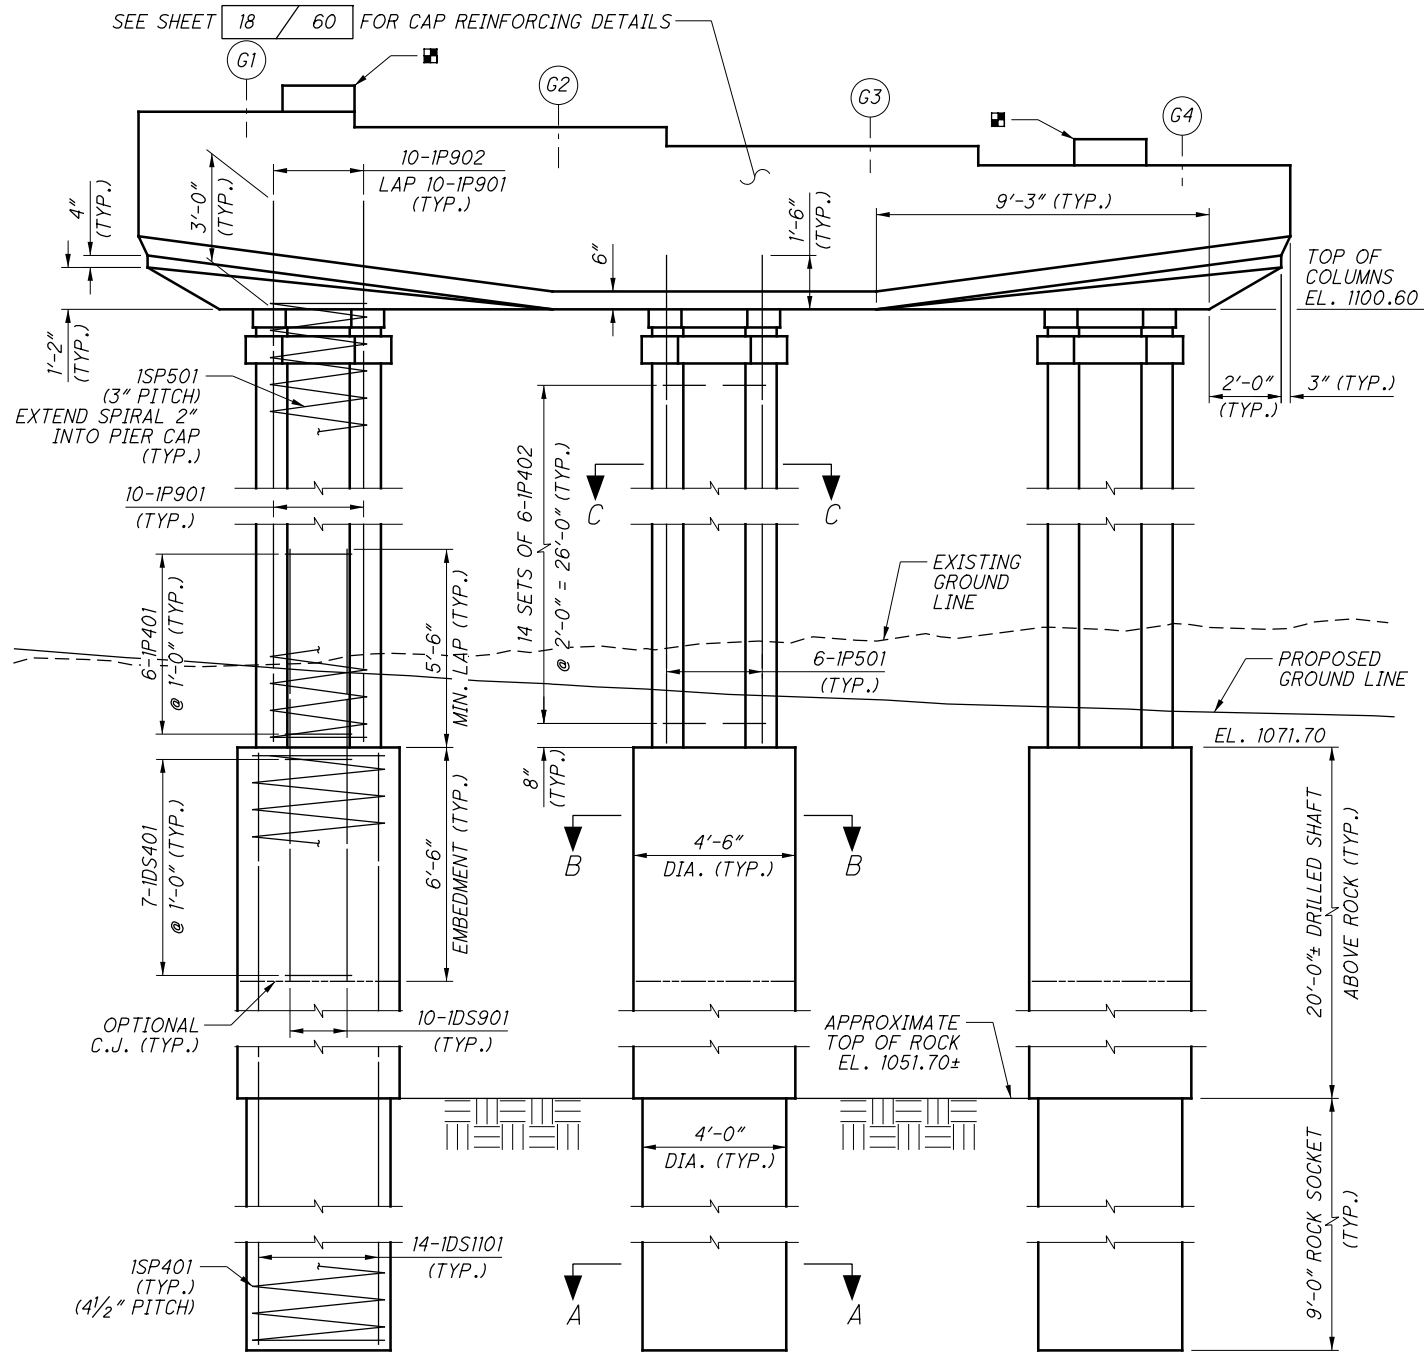


ELEVATION - PIER 1


BEARING SEAT ELEVATIONS	
GIRDER	ELEVATION
G1	1106.09
G2	1105.66
G3	1105.14
G4	1104.60

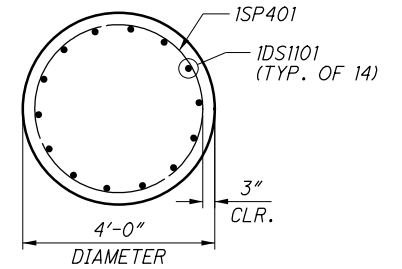


SECTION A-A

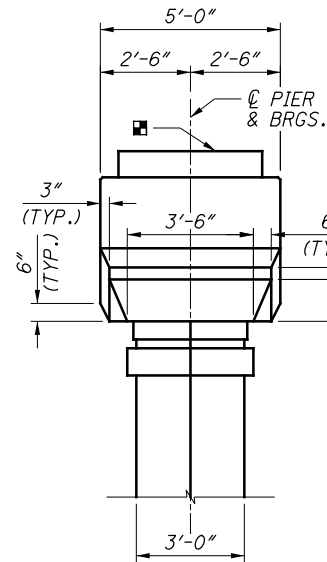


CAP END VIEW
(TYP. BOTH ENDS)

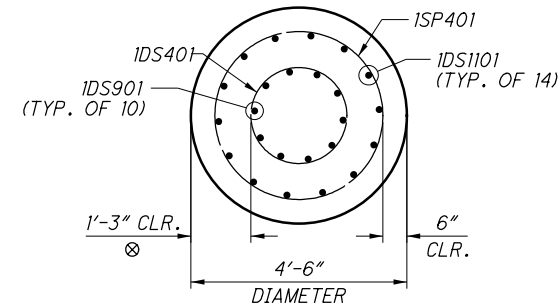


SECTION B-B

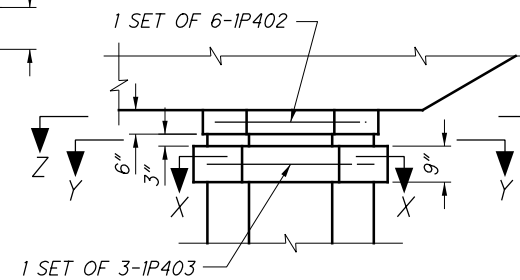


TOP OF COLUMN DETAIL

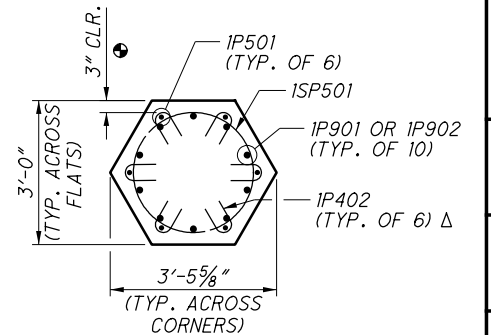


SECTION C-C

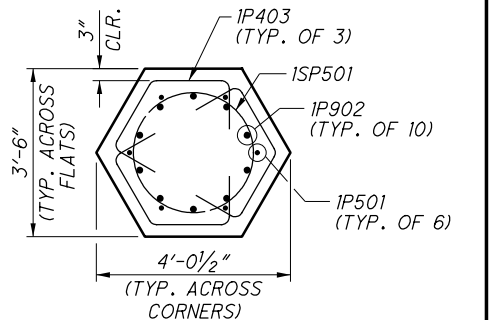

SECTION X-X

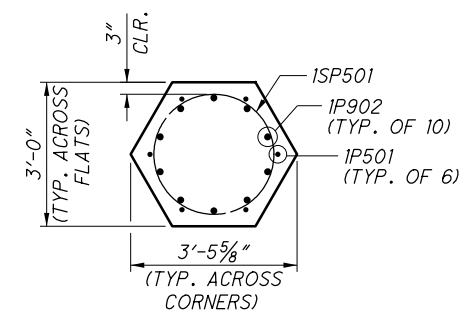

SECTION Y-Y

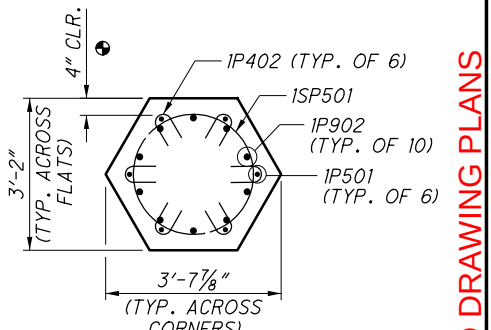

SECTION Z-Z

LEGEND:

- DS# = DRILLED SHAFT NUMBER
- ⊙ = TYP. FOR MAIN SPIRAL BARS AND SUPPLEMENTAL CORNER BARS
- Δ = ROTATE BARS AS NEEDED TO CLEAR MAIN COLUMN VERTICAL BARS
- ⊗ = ADJUST CLEAR COVER FOR SPLICE CAGE TO ENSURE THAT SPLICE CAGE IS CENTERED ON COLUMN.
- = SEISMIC PEDESTAL. SEE SHEET 19 / 60 FOR DETAILS.

NOTES:

- UNLESS NOTED OTHERWISE, MINIMUM LAP LENGTHS SHALL BE AS SHOWN ON THE PLANS AND AS FOLLOWS:
#9 COLUMN BARS: 4'-3"
- REFER TO GENERAL NOTES FOR LIMITS OF SEALING OF CONCRETE SURFACES.

2025-03-13 - BU-11 - RECORD DRAWING PLANS

SUM-76/77/8-
8.24/9.74/0.00
PID No. 102329


17/60

18
61


PIER 1 PLAN AND ELEVATION
SUM-76-1152N
RAMP N OVER RAMP S, LANE O, IR-76 EB, SR-8 NB/SB, LANE M

DESIGNED JHL
CHECKED BES
DRAWN JHL
REVISED
REVIEWED JCS
DATE 4/29/19
STRUCTURE FILE NUMBER 7705973

DESIGN AGENCY
BURGESS & NIPLE
Engineers & Architects & Planners
5045 REED ROAD, COLUMBUS, OHIO 43220

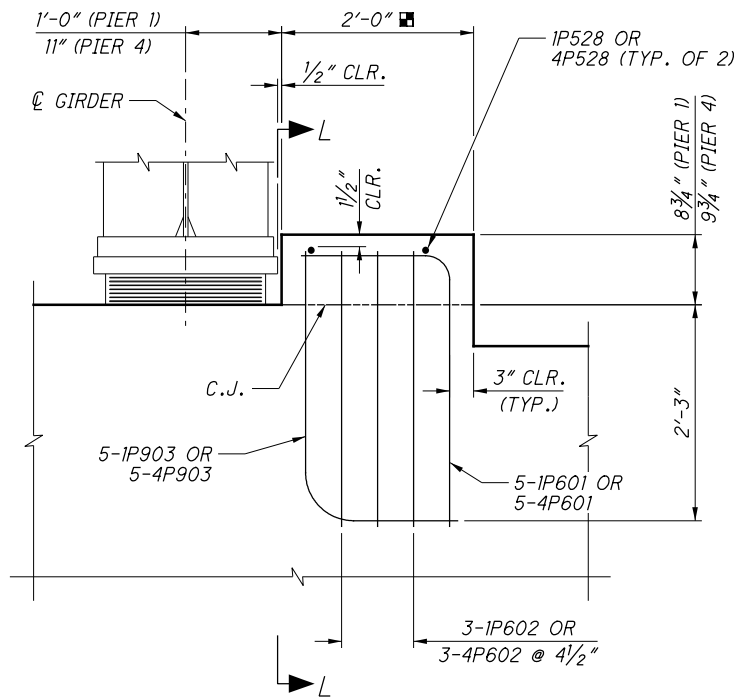[illegible]

SEISMIC PEDESTAL DETAIL
(PIER 1 SHOWN, PIER 4 SIMILAR)

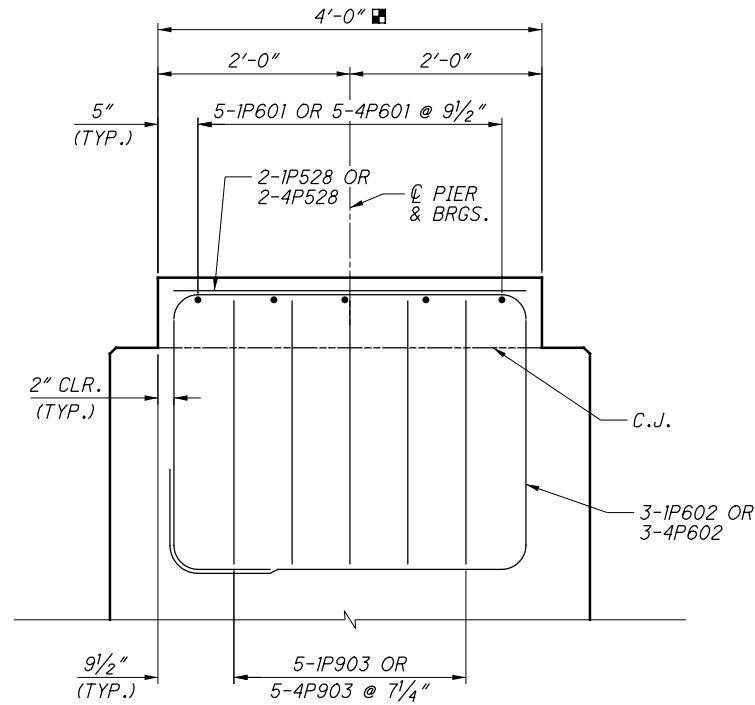

SECTION L-L

LEGEND:


■ = THE SURFACE OF THE BEAM SEAT C.J. IN THIS AREA SHALL BE FINISHED WITH A SERRATED TROWEL. THE SERRATIONS SHALL BE 1/4" DEEP MINIMUM.

	19 / 60	SUM-76/77/8-8.24/9.74/0.00 PID No. 102329	PIER 1 AND 4 CAP DETAILS SUM-76-1152N RAMP N OVER RAMP S, LANE O, IR-76 EB, SR-8 NB/SB, LANE M


DESIGNED	JHL	DRAWN	JHL	REVIEWED	JCS	DATE	4/29/19
CHECKED	BES	REVISED		STRUCTURE FILE NUMBER	7705973		
DESIGN AGENCY BURGESS & NIPLE Engineers ■ Architects ■ Planners 5085 REED ROAD, COLUMBUS, OHIO 43220							

ISSUE RECORD:		DESCRIPTION
NO.	DATE	


p:\v\ANV\A01P\WINT01.parsons.com:Ohio State\Documents\B-Akron Beltway Rehab\10 - Design\102329\Structures\SUM076_1152N\Sheets\076_1149R_S1002.dgn Sheet 6/23/2021 8:32:38 AM KChrisman

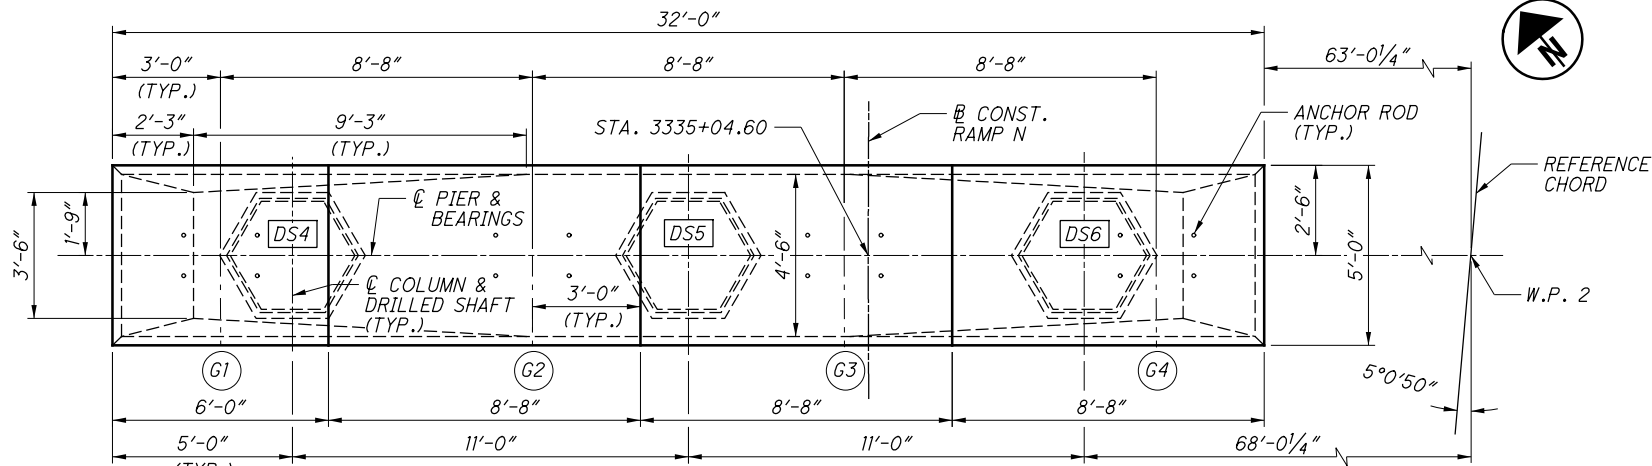


PLAN - PIER 2

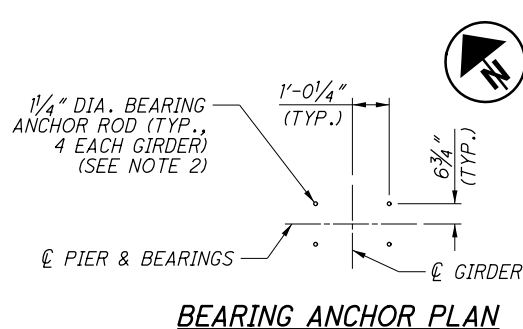


BEARING ANCHOR PLAN

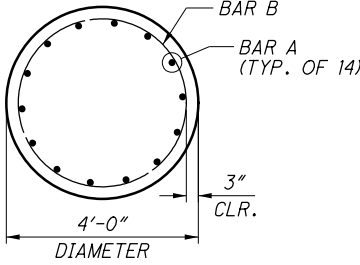


SECTION A-A

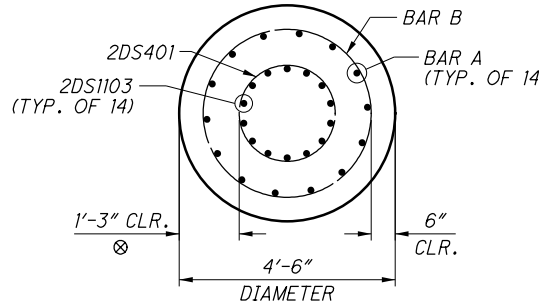


SECTION B-B

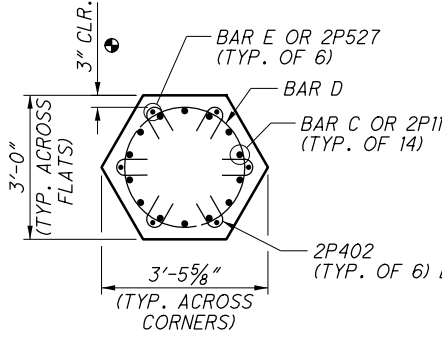


SECTION C-C

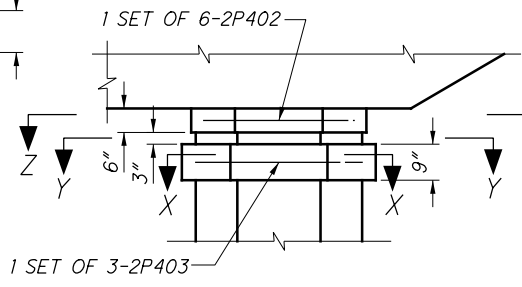


TOP OF COLUMN DETAIL

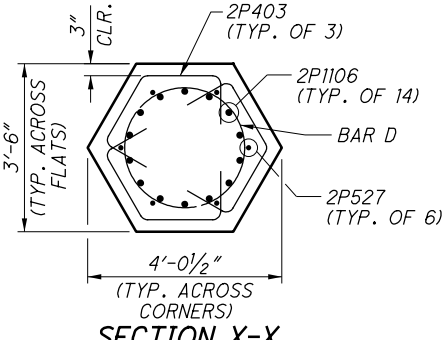

SECTION X-X

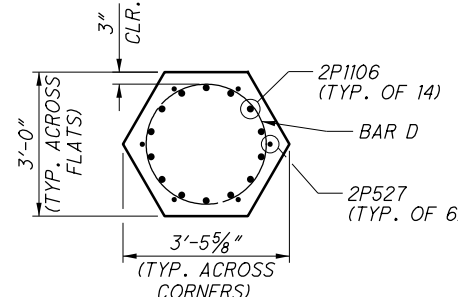

SECTION Y-Y

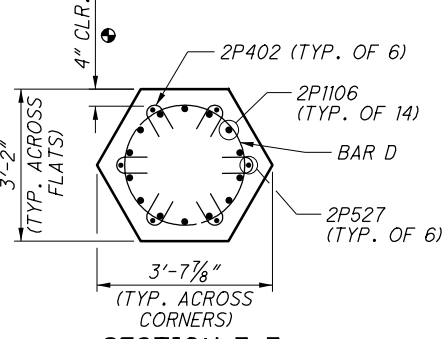

SECTION Z-Z

REINFORCING STEEL IN COLUMNS AND DRILLED SHAFTS			
	LEFT	MIDDLE	RIGHT
BAR A	14-2DS1101	14-2DS1102	14-2DS1102
BAR B	2SP401	2SP402	2SP402
BAR C	14-2P1103	14-2P1104	14-2P1105
BAR D	2SP501	2SP502	2SP503
BAR E	6-2P501	6-2P528	6-2P529


BEARING SEAT ELEVATIONS	
GIRDER	ELEVATION
G1	1113.74
G2	1113.36
G3	1112.84
G4	1112.30

LEGEND:

- DS# = DRILLED SHAFT NUMBER
- ⊙ = TYP. FOR MAIN SPIRAL BARS AND SUPPLEMENTAL CORNER BARS
- Δ = ROTATE BARS AS NEEDED TO CLEAR MAIN COLUMN VERTICAL BARS
- ⊗ = ADJUST CLEAR COVER FOR SPLICE CAGE TO ENSURE THAT SPLICE CAGE IS CENTERED ON COLUMN.

NOTES:

- UNLESS NOTED OTHERWISE, MINIMUM LAP LENGTHS SHALL BE AS SHOWN ON THE PLANS AND AS FOLLOWS:
#5 COLUMN BARS: 1'-3"
#11 COLUMN BARS: 6'-8"
- SEE SHEET 37 / 60 FOR BEARING ANCHOR ROD DETAILS & PAYMENT.
- BRIDGE SEAT REINFORCING, SETTING ANCHORS: PRE-SET BEARING ANCHORS. PLACE REINFORCING STEEL IN THE VICINITY OF THE BRIDGE SEAT TO AVOID INTERFERENCE WITH THE PRE-SET BEARING ANCHORS.
- REFER TO GENERAL NOTES FOR LIMITS OF SEALING OF CONCRETE SURFACES.
- EMBEDMENT IS MEASURED FROM TOP OF ROCK SOCKET FOR MIDDLE AND RIGHT DRILLED SHAFTS.

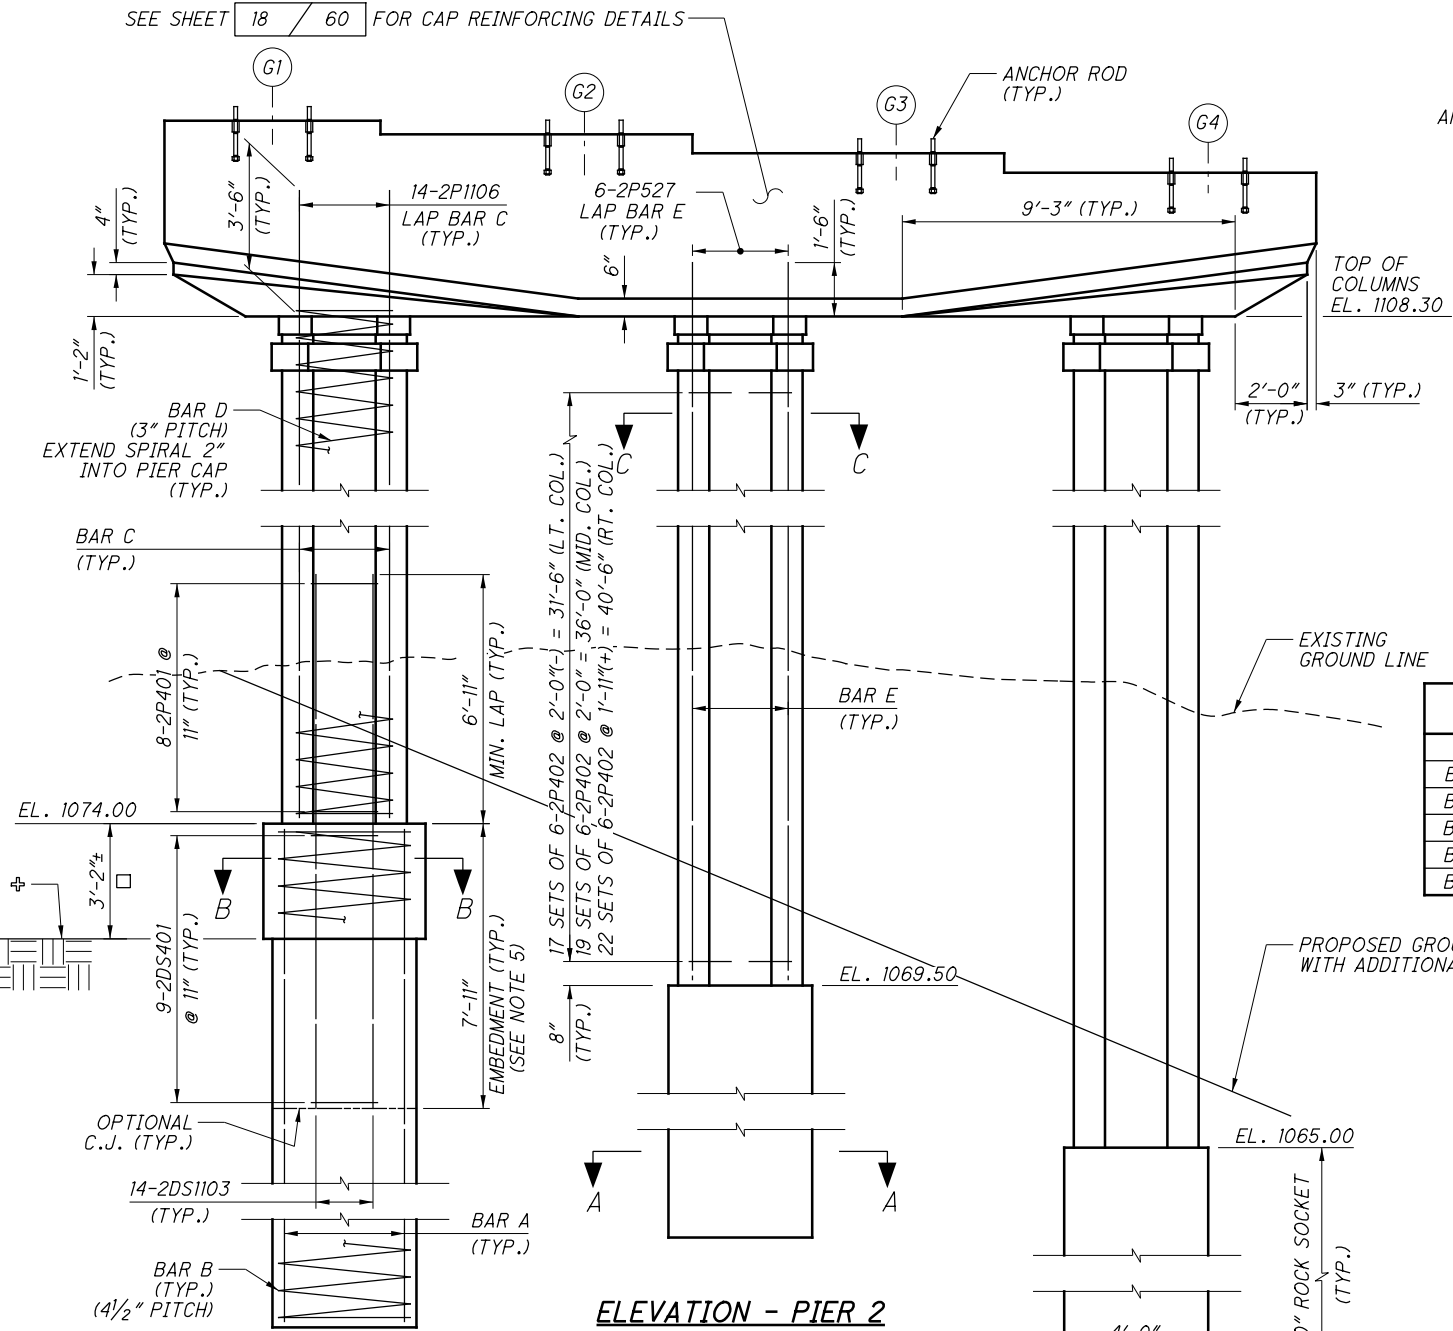

ELEVATION - PIER 2

- = 4'-6" DIA. DRILLED SHAFT ABOVE ROCK (LEFT COLUMN ONLY)
- ⊕ = APPROXIMATE TOP OF ROCK EL. 1070.80±

2025-03-13 - BU-11 - RECORD DRAWING PLANS

SUM-76/77/8-
8.24/9.74/0.00
PID No. 102329

PIER 2 PLAN AND ELEVATION

SUM-76-1152N
RAMP N OVER RAMP S, LANE O, IR-76 EB, SR-8 NB/SB, LANE M

DESIGNED
JHL/JDH
CHECKED
BES

DRAWN
JHL


REVIEWED
JCS
DATE
4/29/19

STRUCTURE FILE NUMBER
7705973


DESIGN AGENCY
BURGESS & NIPLE
Engineers & Architects & Planners
5045 REED ROAD, COLUMBUS, OHIO 43220

ISSUE RECORD:		DESCRIPTION
NO.	DATE	


pw:\V\ANV\A01PWINT01.parsons.com:Ohio State\Documents\DB-Akron Beltway Rehab\10 - Design\102329\Structures\SUM076_1152N\Sheets\076_1149R_S1006.dgn Sheet 6/23/2021 8:33:08 AM KChrisman

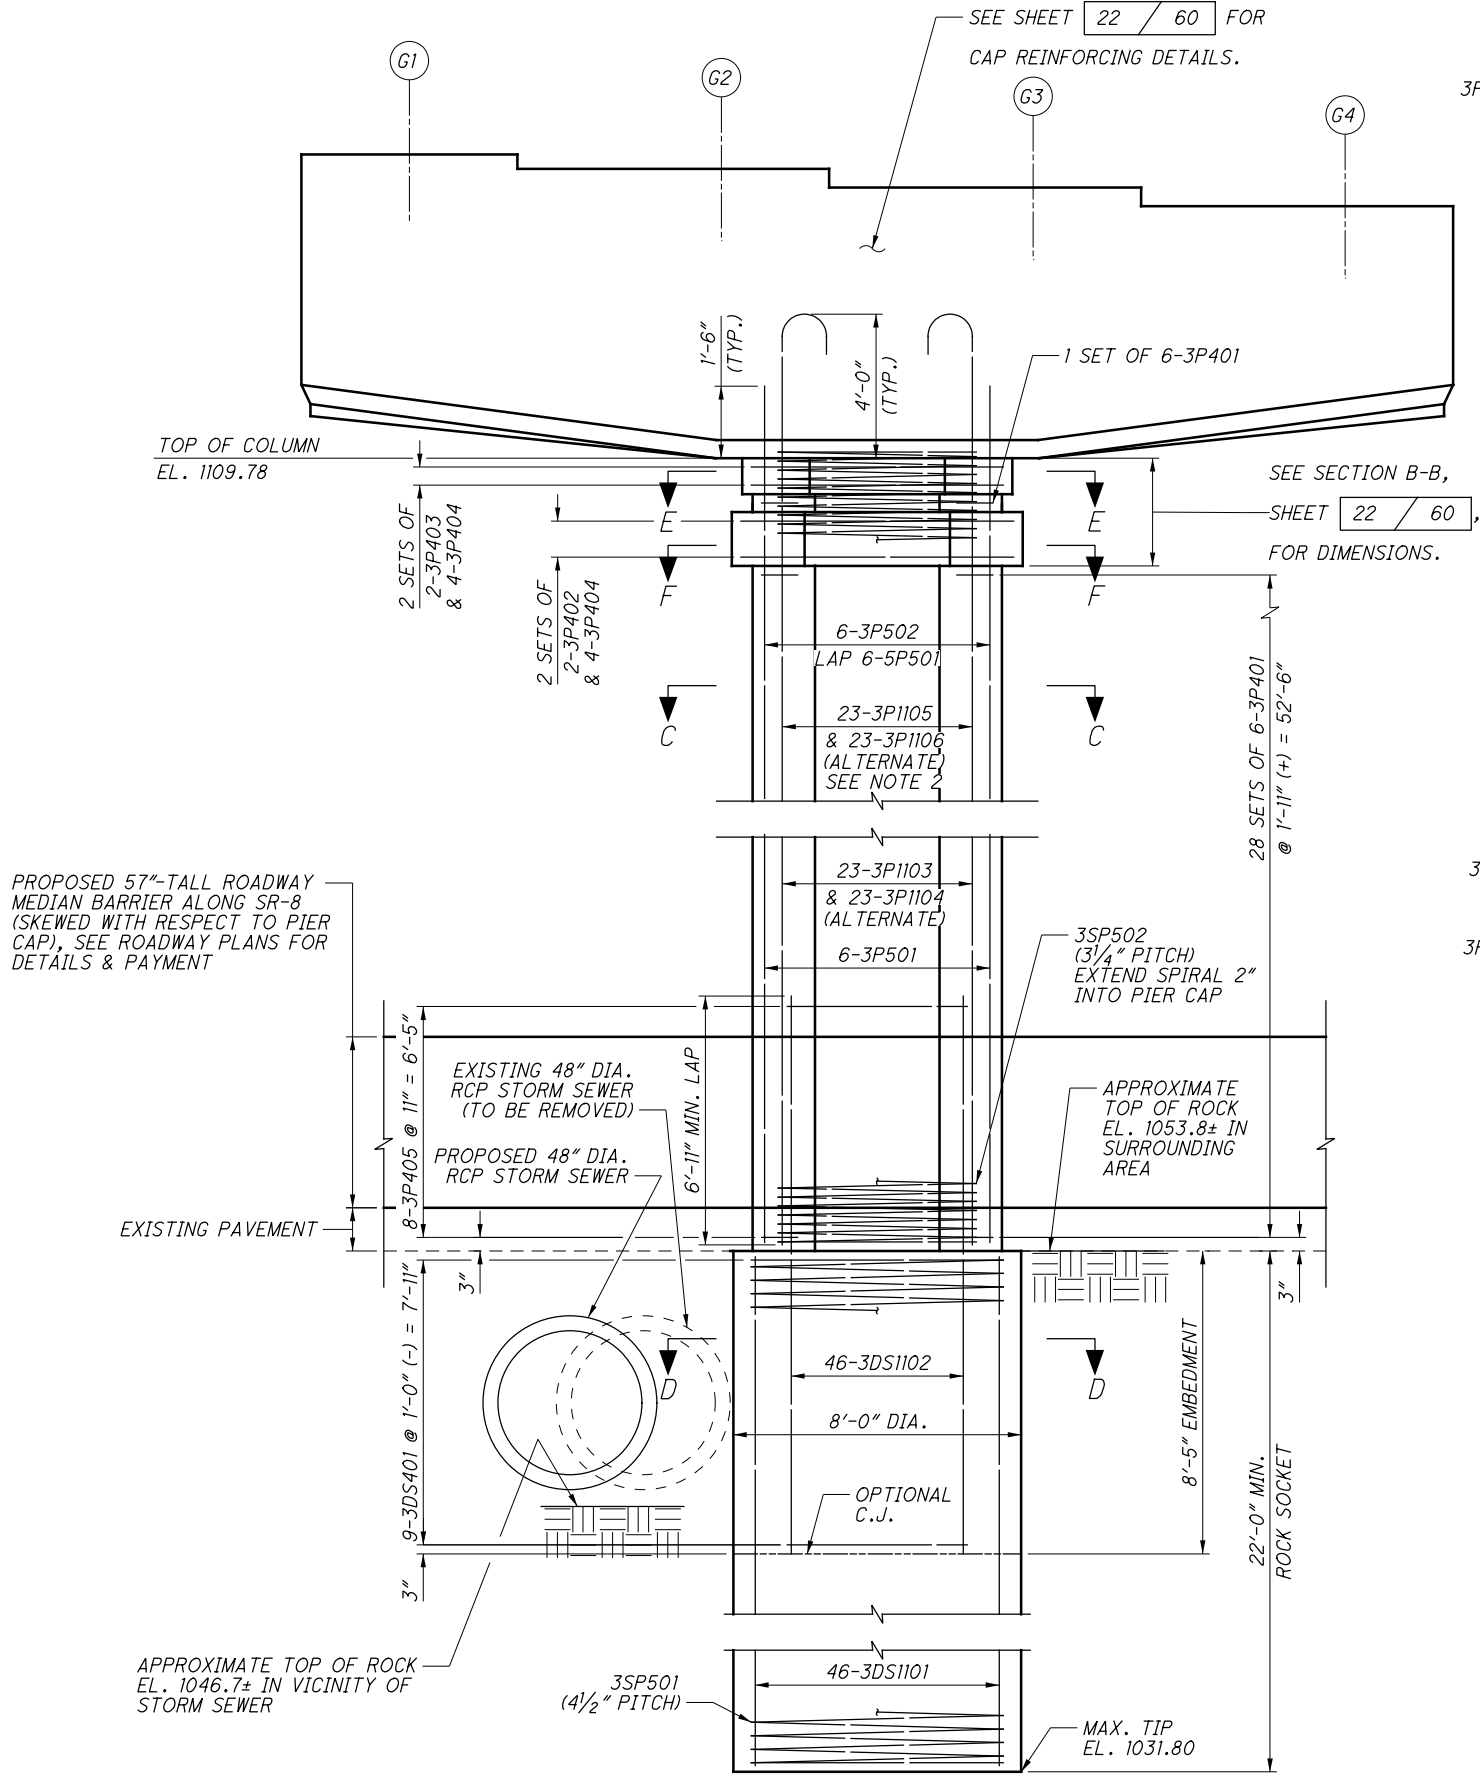


COLUMN ELEVATION - PIER 3

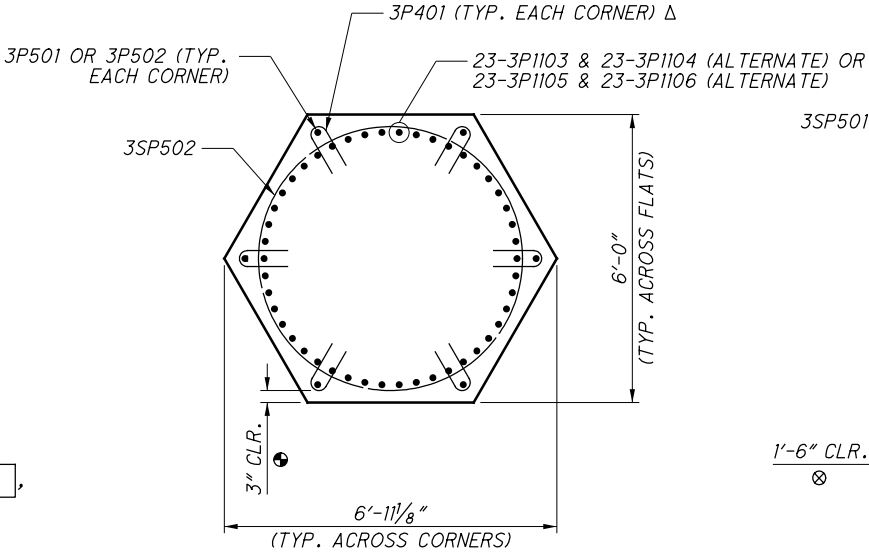

SECTION C-C

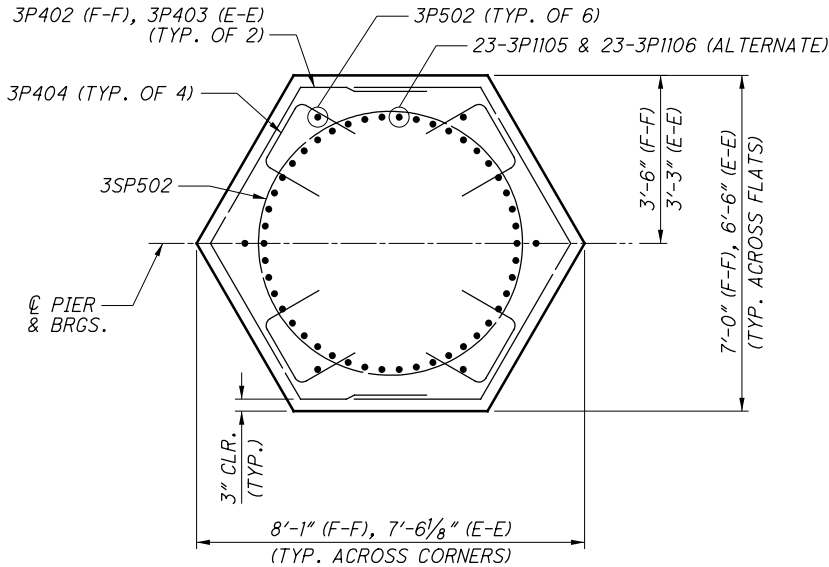

SECTION F-F (SHOWN)
SECTION E-E (AS NOTED)

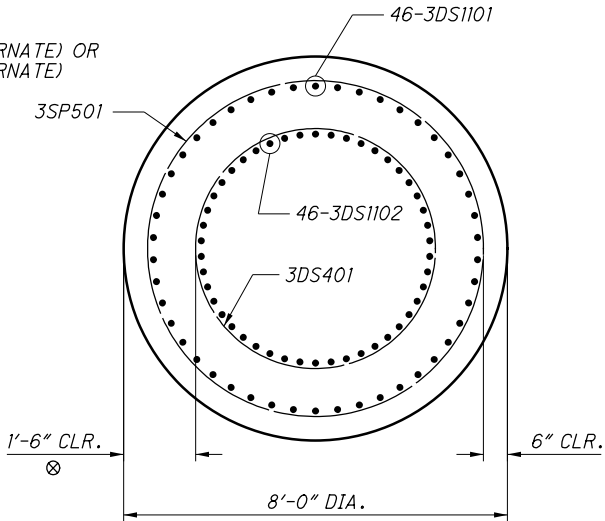

SECTION D-D

NOTES:

- MINIMUM LAP LENGTHS SHALL BE AS FOLLOWS:
#5 COLUMN BARS: 1'-3"
- USE MECHANICAL CONNECTORS TO CONNECT 3P1105 TO 3P1103 BARS, AND 3P1106 TO 3P1104 BARS. MECHANICAL CONNECTORS ARE STAGGERED BY 3'-0" TO FACILITATE BAR COUPLING AND CONCRETE PLACEMENT.

LEGEND:

- = TYP. FOR MAIN SPIRAL BARS AND SUPPLEMENTAL CORNER BARS
- △ = ROTATE BARS AS NEEDED TO CLEAR MAIN COLUMN VERTICAL BARS
- ⊗ = ADJUST CLEAR COVER FOR SPLICE CAGE AS NEEDED TO ENSURE THAT SPLICE CAGE IS CENTERED ON COLUMN

2025-03-13 - BU-11 - RECORD DRAWING PLANS

SUM-76/77/8-
8.24/9.74/0.00
PID No. 102329

PIER 3 COLUMN AND DRILLED SHAFT DETAILS
SUM-76-1152N
RAMP N OVER RAMP S, LANE O, IR-76 EB, SR-8 NB/SB, LANE M

DESIGNED	JDH	CHECKED	BES
DRAWN	JDH	REVISED	---
REVIEWED	JCS	DATE	4/29/19
STRUCTURE FILE NUMBER	7705973	DESIGN AGENCY	BURGESS & NIPLE


Engineers ■ Architects ■ Planners
5045 REED ROAD, COLUMBUS, OHIO 43220

23/60


24
61

ISSUE RECORD:		DESCRIPTION
NO.	DATE	

p:\w\ANV\A01PWINT01.parsons.com:Ohio State\Documents\VB-Akron Beltway Rehab\10 - Design\102329\Structures\SUM076_1152N\Sheets\076_1149R_S1004.dgn Sheet 6/23/2021 8:33:13 AM KChrisman

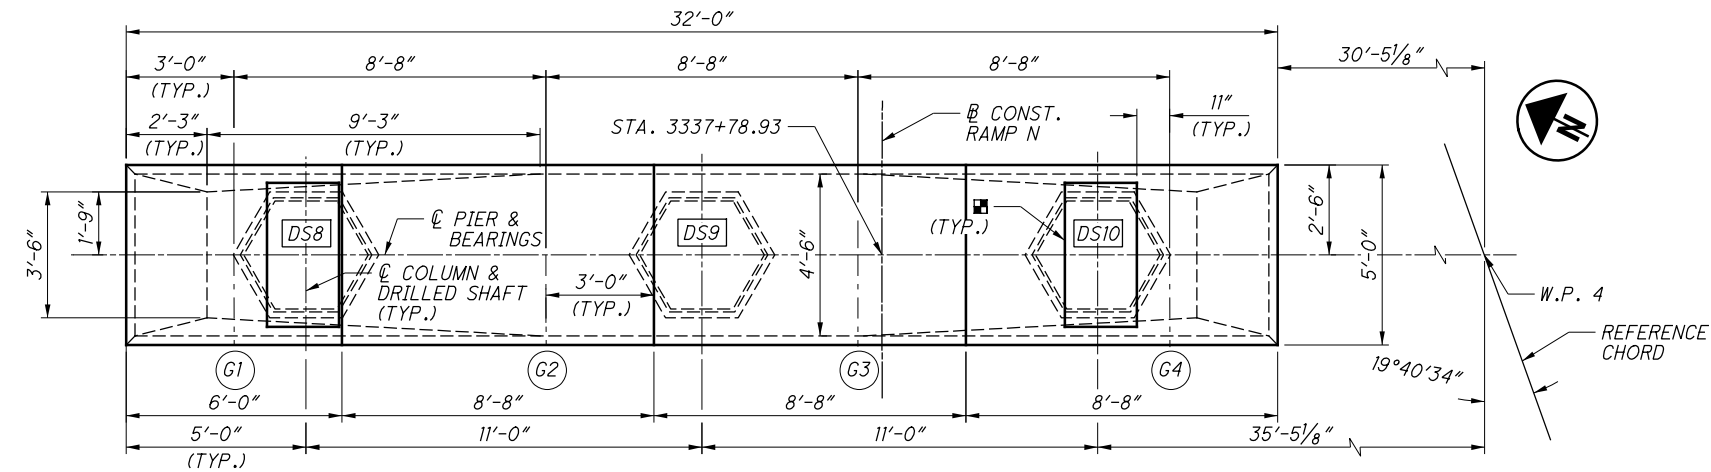


PLAN - PIER 4

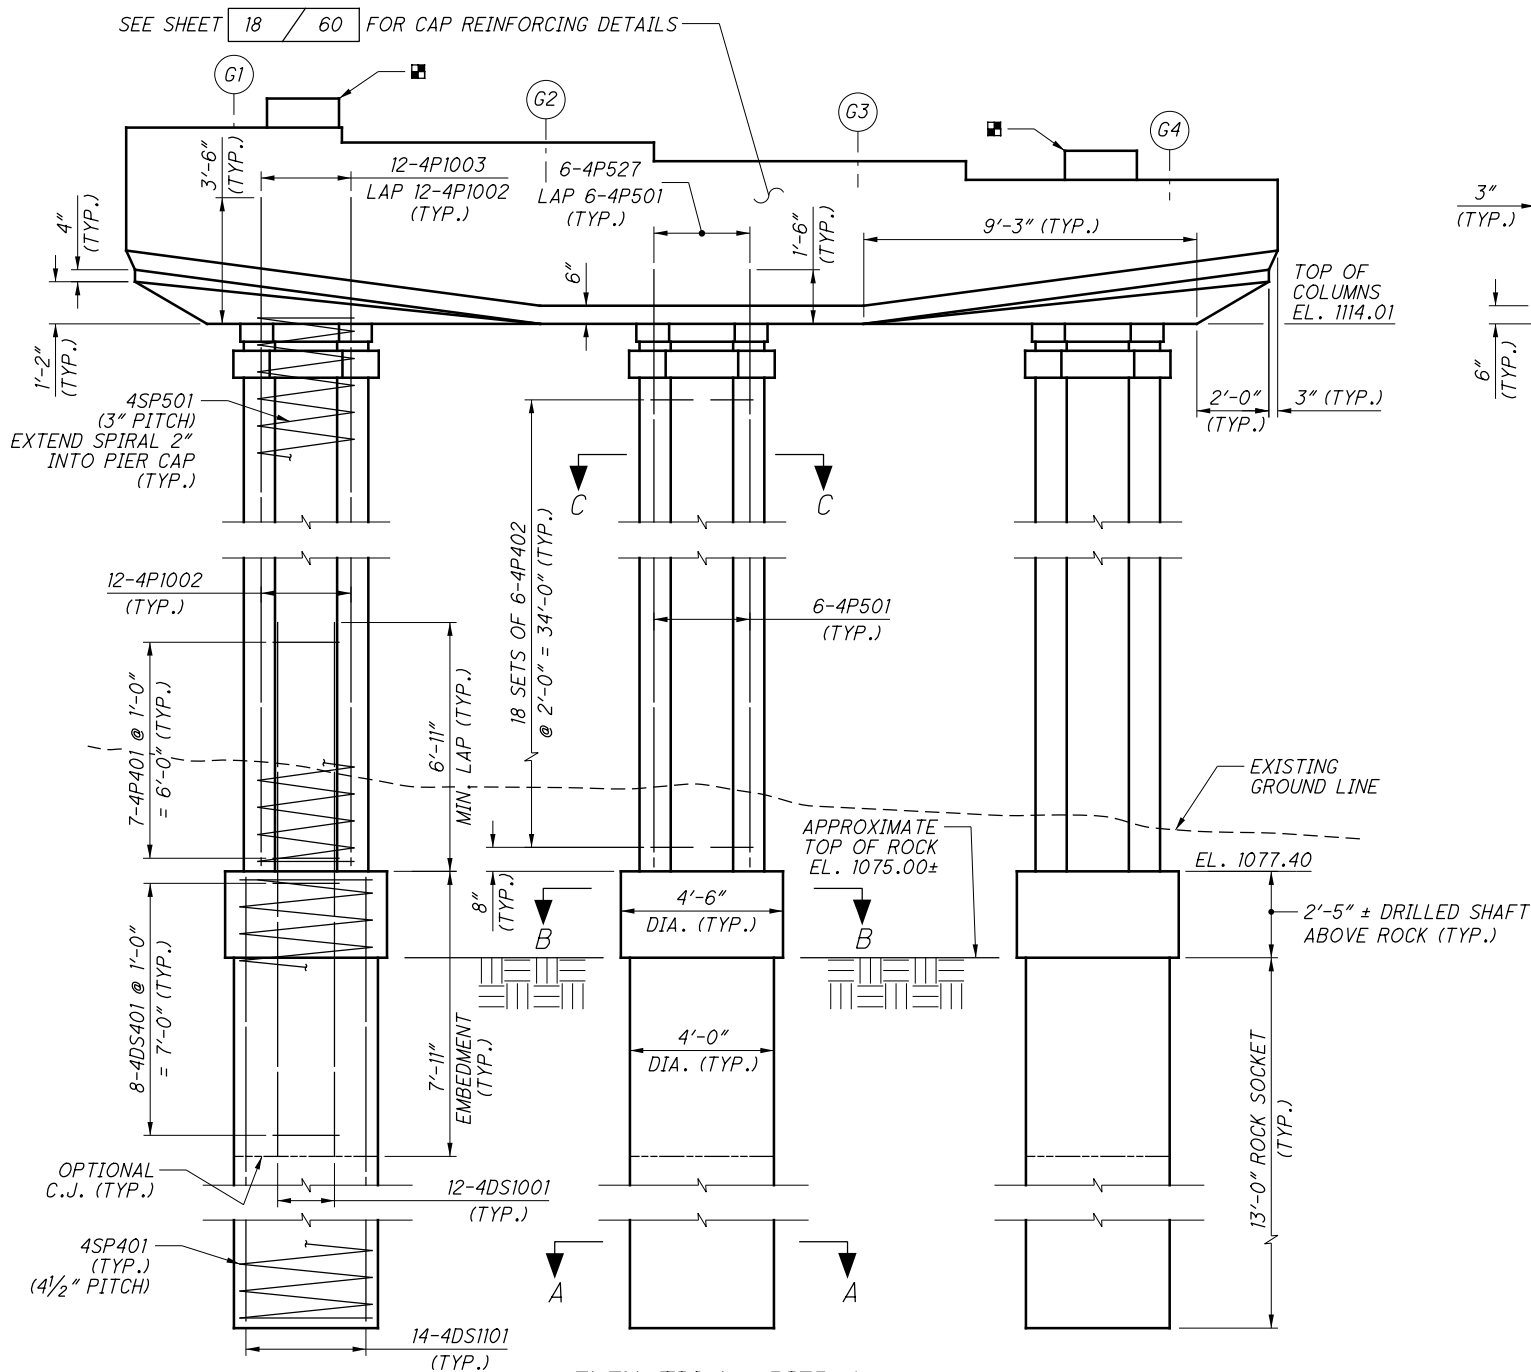


ELEVATION - PIER 4


BEARING SEAT ELEVATIONS	
GIRDER	ELEVATION
G1	1119.46
G2	1119.05
G3	1118.53
G4	1118.01

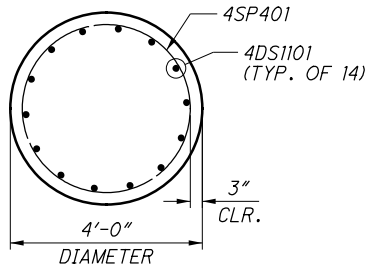


SECTION A-A

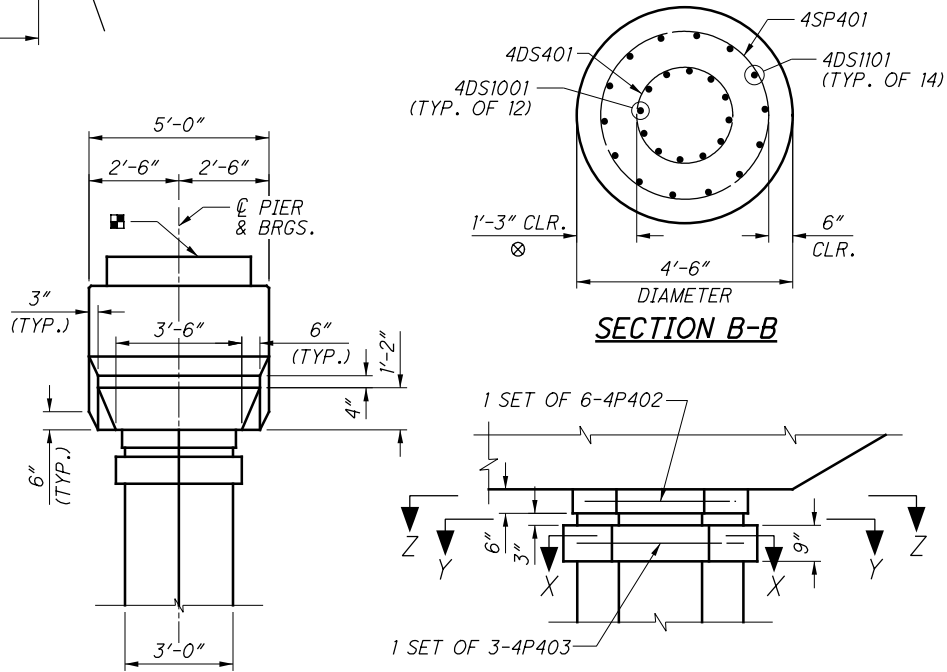


CAP END VIEW
(TYP. BOTH ENDS)

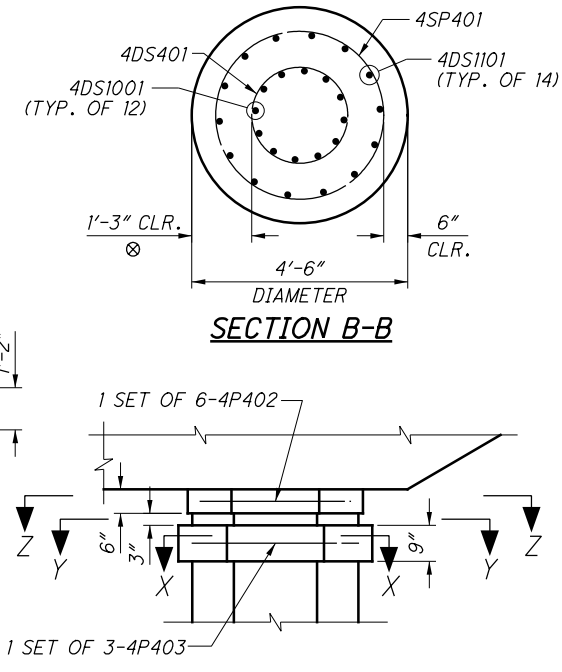


TOP OF COLUMN DETAIL

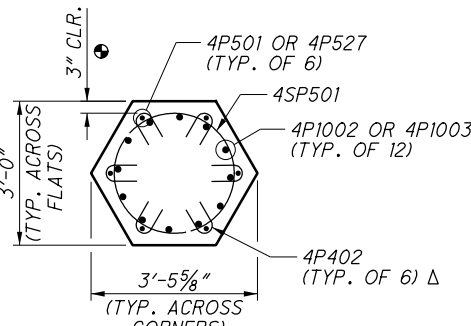


SECTION C-C

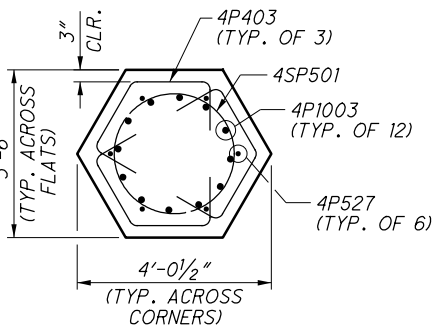

SECTION X-X

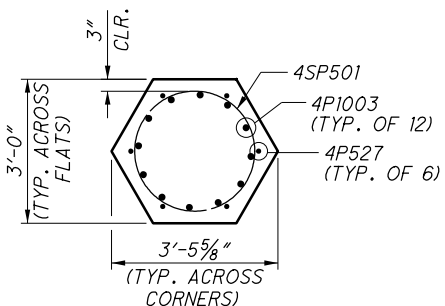

SECTION Y-Y

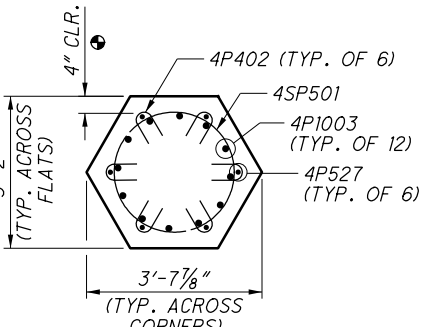

SECTION Z-Z

LEGEND:


- DS# = DRILLED SHAFT NUMBER
- = TYP. FOR MAIN SPIRAL BARS AND SUPPLEMENTAL CORNER BARS
- △ = ROTATE BARS AS NEEDED TO CLEAR MAIN COLUMN VERTICAL BARS
- ⊗ = ADJUST CLEAR COVER FOR SPLICE CAGE TO ENSURE THAT SPLICE CAGE IS CENTERED ON COLUMN.
- = SEISMIC PEDESTAL. SEE SHEET 19 / 60 FOR DETAILS.

NOTES:


- UNLESS NOTED OTHERWISE, MINIMUM LAP LENGTHS SHALL BE AS SHOWN ON THE PLANS AND AS FOLLOWS:
#5 COLUMN BARS: 1'-3"
#10 COLUMN BARS: 6'-0"
- REFER TO GENERAL NOTES FOR LIMITS OF SEALING OF CONCRETE SURFACES.

ISSUE RECORD:		DESCRIPTION
NO.	DATE	


pw:\\V\\AN\\A01PW\\INT01.parsons.com:Ohio State\\Documents\\DB-Akron Beltway Rehab\\10 - Design\\102329\\Structures\\SUM076_1152N\\Sheets\\076_1149R_SS017.dgn Sheet 6/23/2021 8:33:18 AM KChrisman

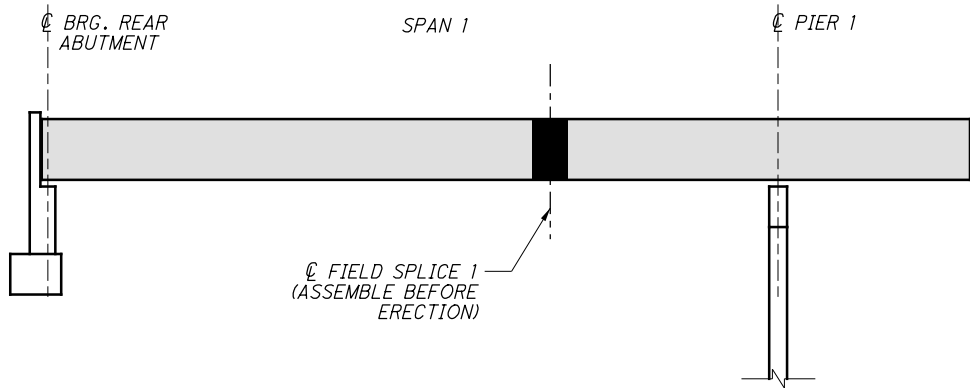

GIRDER ERECTION - SEQUENCE 1

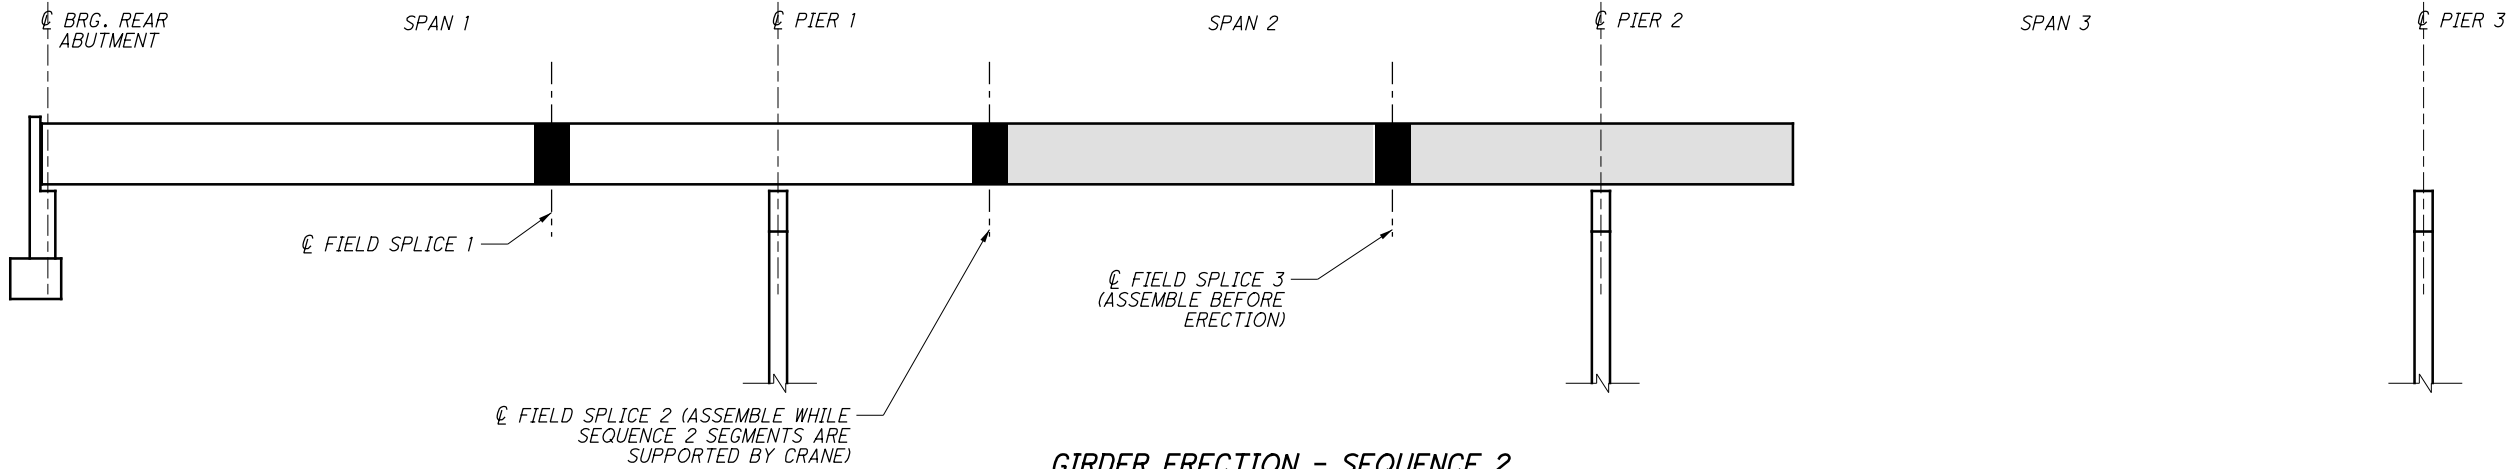

GIRDER ERECTION - SEQUENCE 2

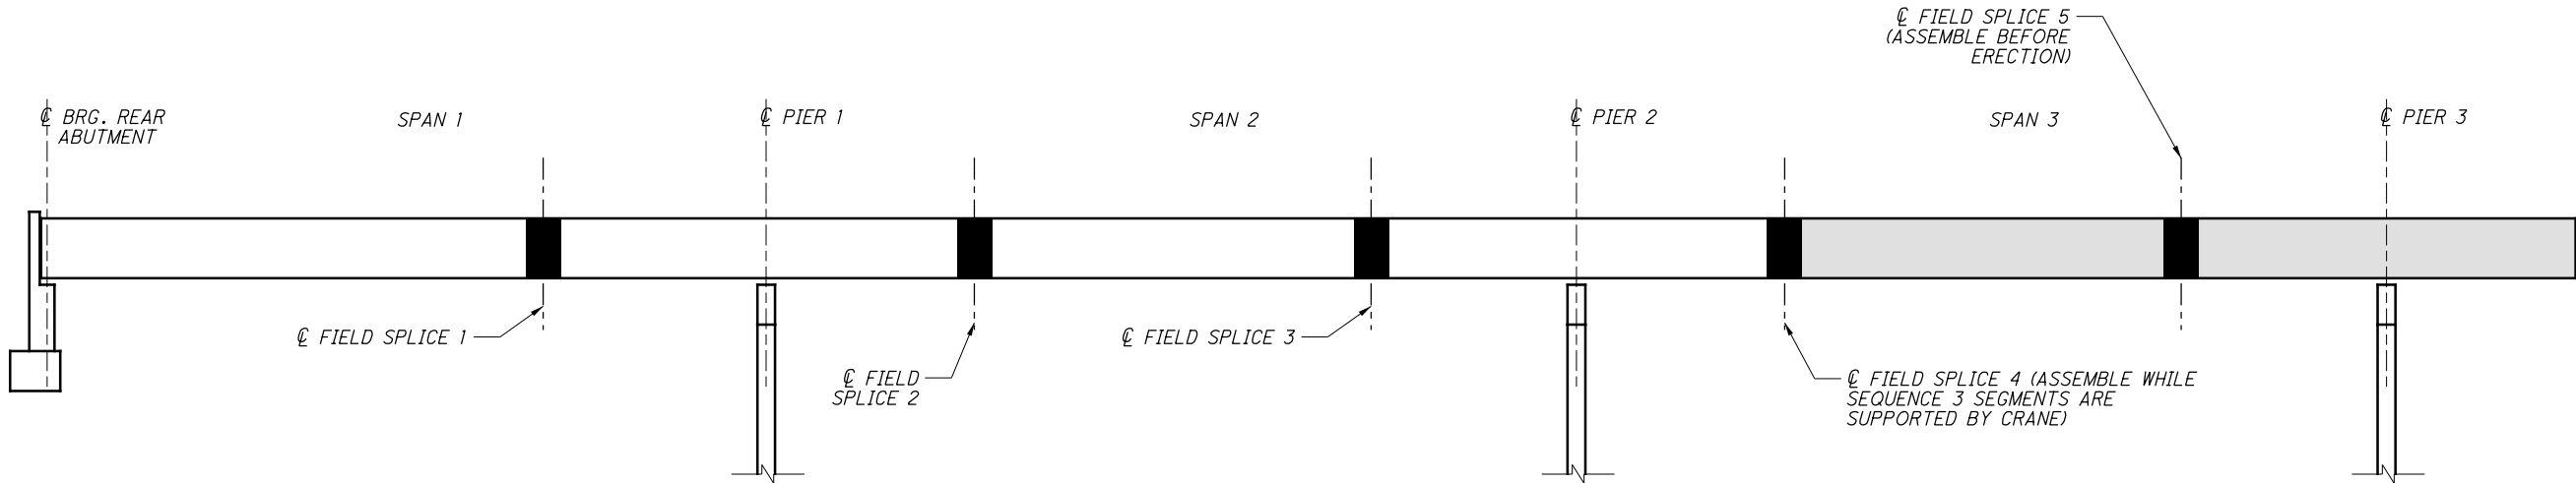

GIRDER ERECTION - SEQUENCE 3

NOTES:

1. THE CONSTRUCTION SEQUENCE SHOWN DEMONSTRATES ONE FEASIBLE ALTERNATIVE TO ERECT THE CURVED GIRDERS. THE CONTRACTOR HAS THE OPTION OF USING AN ALTERNATIVE METHOD OF GIRDER ERECTION.

2. SUBMIT ENGINEERED DRAWINGS WITH PROPOSED GIRDER ERECTION DETAILS IN CONFORMANCE WITH CMS 501 AND 513.

3. VERTICAL AND HORIZONTAL STABILITY SHALL BE MAINTAINED FOR EACH SEQUENCE BY THE CONTRACTOR PER CMS 501.05.B.4.
4. THE ERECTION OF THE GIRDERS SHALL BE CONDUCTED AS FOLLOWS FOR EACH SEQUENCE:

A. ERECT GIRDERS 1 AND 2 AS A SINGLE UNIT WITH ALL CROSSFRAMES FULLY CONNECTED.


B. ERECT GIRDER 3 AND CONNECT CROSSFRAMES BETWEEN GIRDERS 2 AND 3.

C. ERECT GIRDER 4 AND CONNECT CROSSFRAMES BETWEEN GIRDERS 3 AND 4.


2025-03-13 - BU-11 - RECORD DRAWING PLANS

GIRDER ERECTION SEQUENCE - 1		DESIGN AGENCY
SUM-76-1152N		BURGESS & NIPLE
RAMP N OVER RAMP S, LANE O, IR-76 EB, SR-8 NB/SB, LANE M		Engineers ■ Architects ■ Planners
PID No. 102329		5045 REED ROAD, COLUMBUS, OHIO 43220
SUM-76/77/8-8.24/9.74/0.00	DATE	REVIEWED
8.24/9.74/0.00	4/29/19	JCS
STRUCTURE FILE NUMBER		7705973
DRAWN		BCS
DESIGNED		MAB
CHECKED		BES
REVISED		

ISSUE RECORD:	
NO.	DATE DESCRIPTION

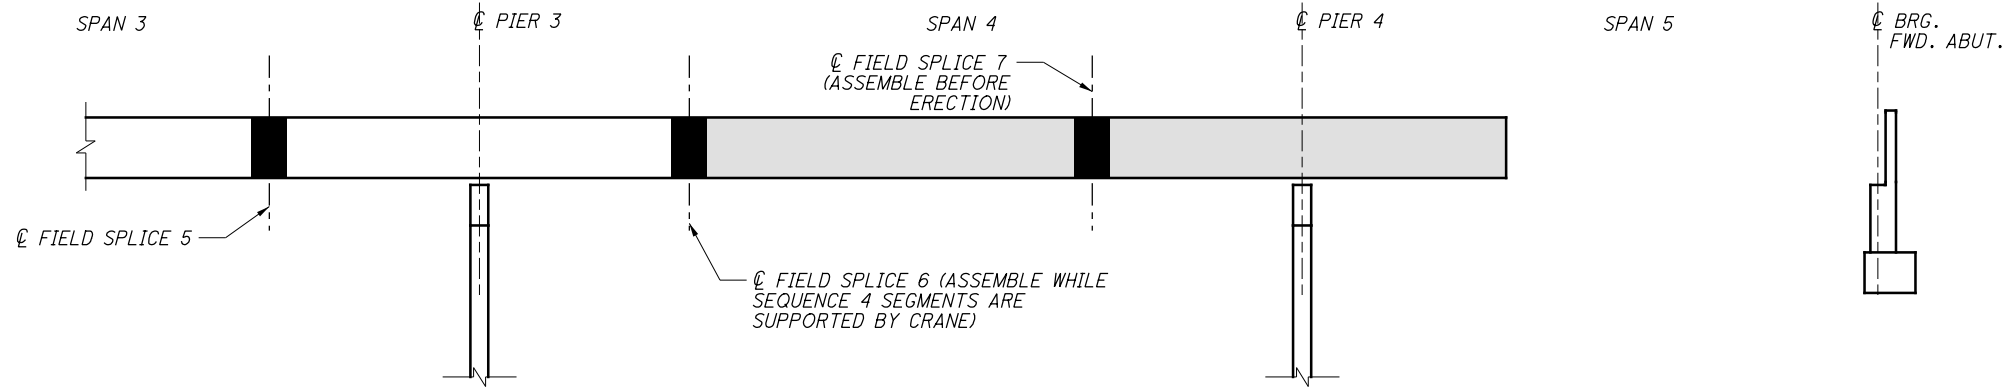

GIRDER ERECTION - SEQUENCE 4

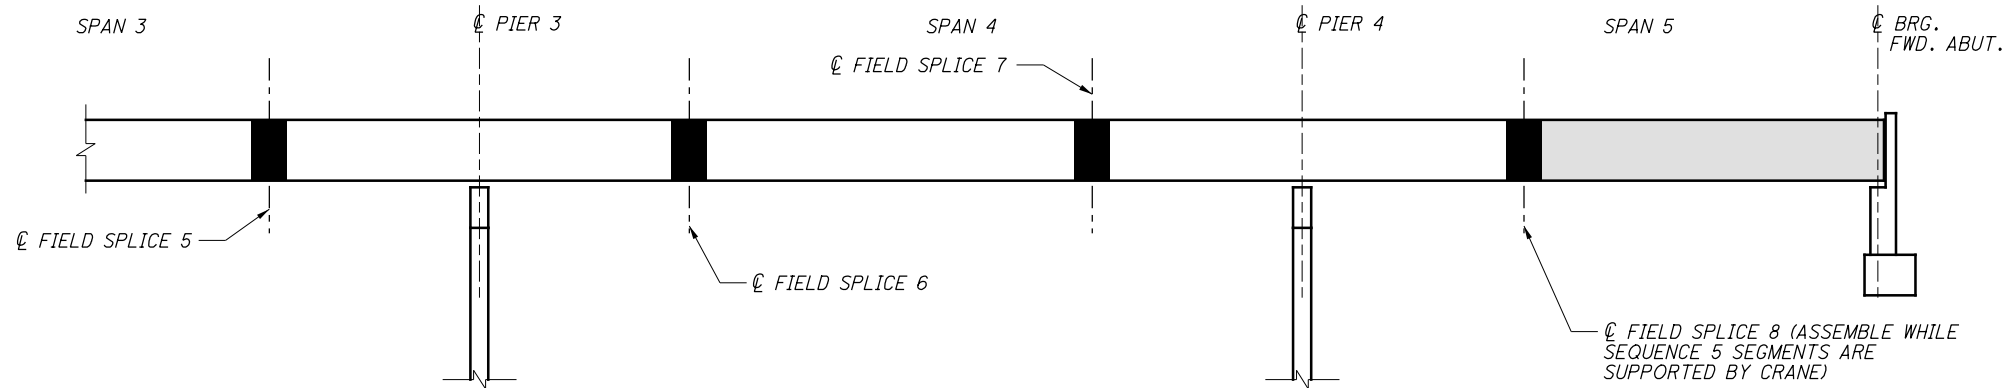

GIRDER ERECTION - SEQUENCE 5

NOTE:


1. SEE SHEET

25	/	60
----	---	----

 FOR NOTES.

ISSUE RECORD:		DESCRIPTION
NO.	DATE	

p:\V\ANV\A01PW\INT01.parsons.com:Ohio State\Documents\DB-Akron Beltway Rehab\10 - Design\102329\Structures\SUM076_1152N\Sheets\076_1149R_SS001.dgn Sheet 6/23/2021 8:33:27 AM KChrisman

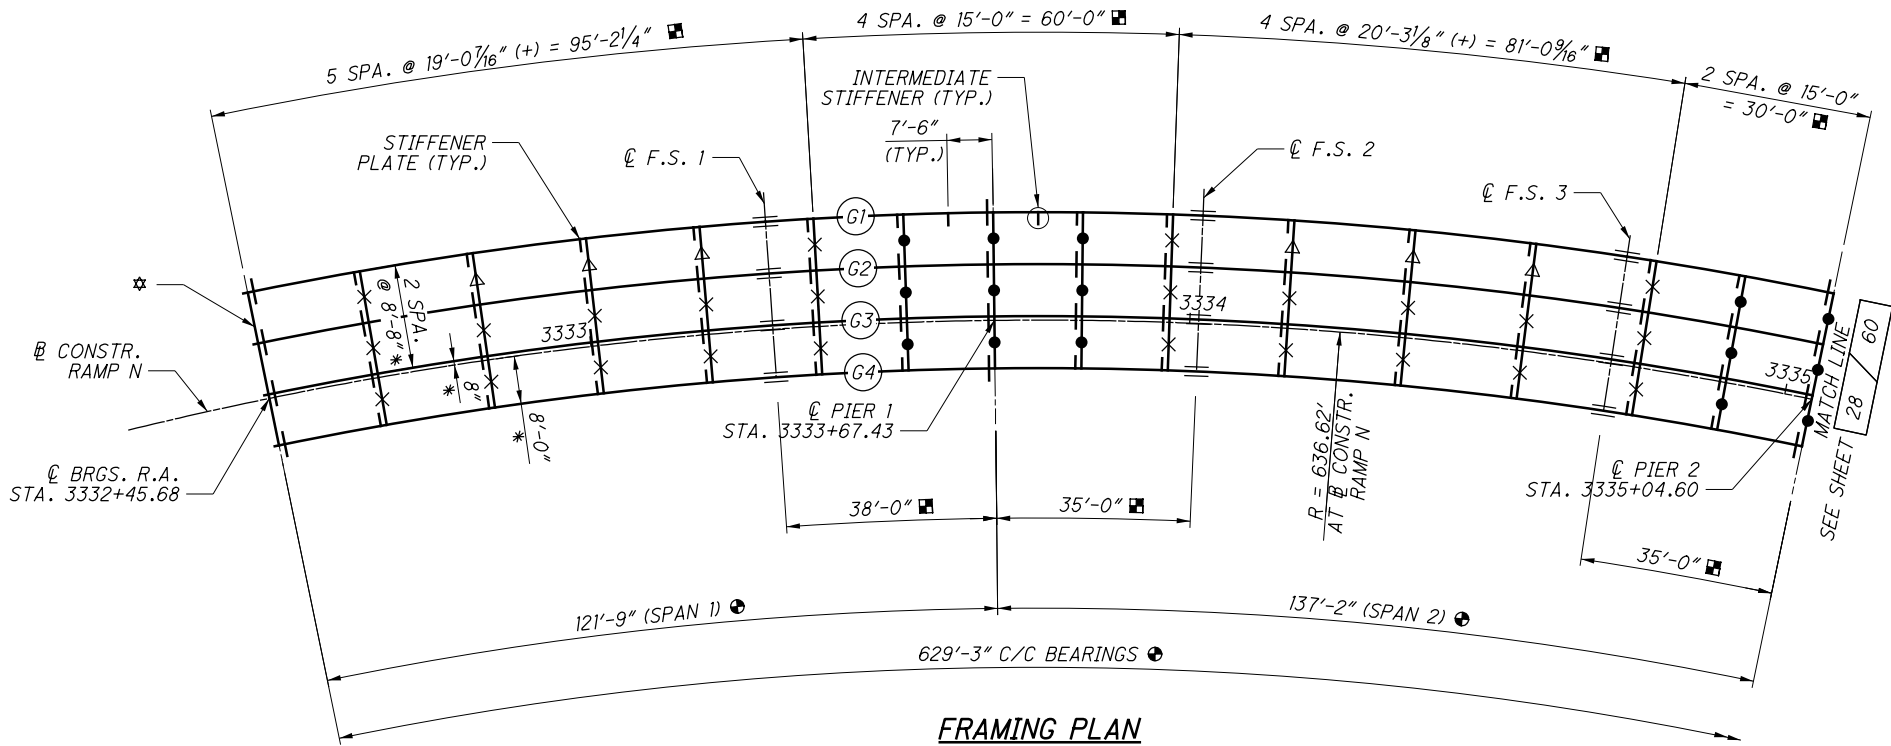

LEGEND:

- * = MEASURED RADIALLY
- ⊙ = MEASURED ALONG ⊙ CONST. RAMP N
- = MEASURED ALONG ⊙ GIRDER G1
- ☆ = END CROSSFRAME, SEE SHEET 36 / 60 FOR DETAILS (TYP.)
- ⊙ = TYPE 1 INTERMEDIATE CROSSFRAME
SEE SHEET 35 / 60 FOR DETAILS
- ✕ = TYPE 2 INTERMEDIATE CROSSFRAME
SEE SHEET 35 / 60 FOR DETAILS
- ⊙ = TYPE 3 INTERMEDIATE CROSSFRAME
SEE SHEET 35 / 60 FOR DETAILS


NOTES:

- ⊙ BRGS. AT ABUTMENTS, ⊙ PIERS, ⊙ FIELD SPLICES, AND ALL INTERMEDIATE CROSSFRAMES ARE ORIENTED RADIALLY TO ⊙ CONST. RAMP N. SEE LAYOUT DIAGRAM ON SHEET 3 / 60 FOR ADDITIONAL SUBSTRUCTURE LAYOUT DETAILS.
- GIRDERS ARE CONCENTRIC WITH ⊙ CONST. RAMP N.
- ALL DIMENSIONS ARE HORIZONTAL.
- PROVIDE 1" DIA. BOLTS WITH OVERSIZED HOLES (1 1/4" DIA.) AT THE LOCATIONS LISTED:
CROSSFRAME STIFFENERS
BEARING STIFFENERS AT PIERS
CROSSFRAME CONNECTION PLATES
- BOLTS SHALL BE ASTM F3125, GRADE A325, TYPE 1 (GALVANIZED).
- INSTALL TWO HARDENED WASHERS AT EACH BOLT WITH OVERSIZED HOLES, ONE AT THE BOLT HEAD AND ONE AT THE NUT.
- CYLINDRICAL DRIFT PINS ACCORDING TO ODOT CMS 513.20C WITH A DIAMETER RANGING FROM 1 1/32" TO 1 1/4" SHALL BE USED DURING INSTALLATION OF ALL MEMBERS WITH OVERSIZED HOLES.



ISSUE RECORD:		DESCRIPTION
NO.	DATE	

p:\V\ANV\A01PW\INT01.parsons.com:Ohio State\Documents\DB-Akron Beltway Rehab\10 - Design\102329\Structures\SUM076_1152N\Sheets\076_1149R_SS002.dgn Sheet 6/23/2021 8:33:31 AM KChrisman

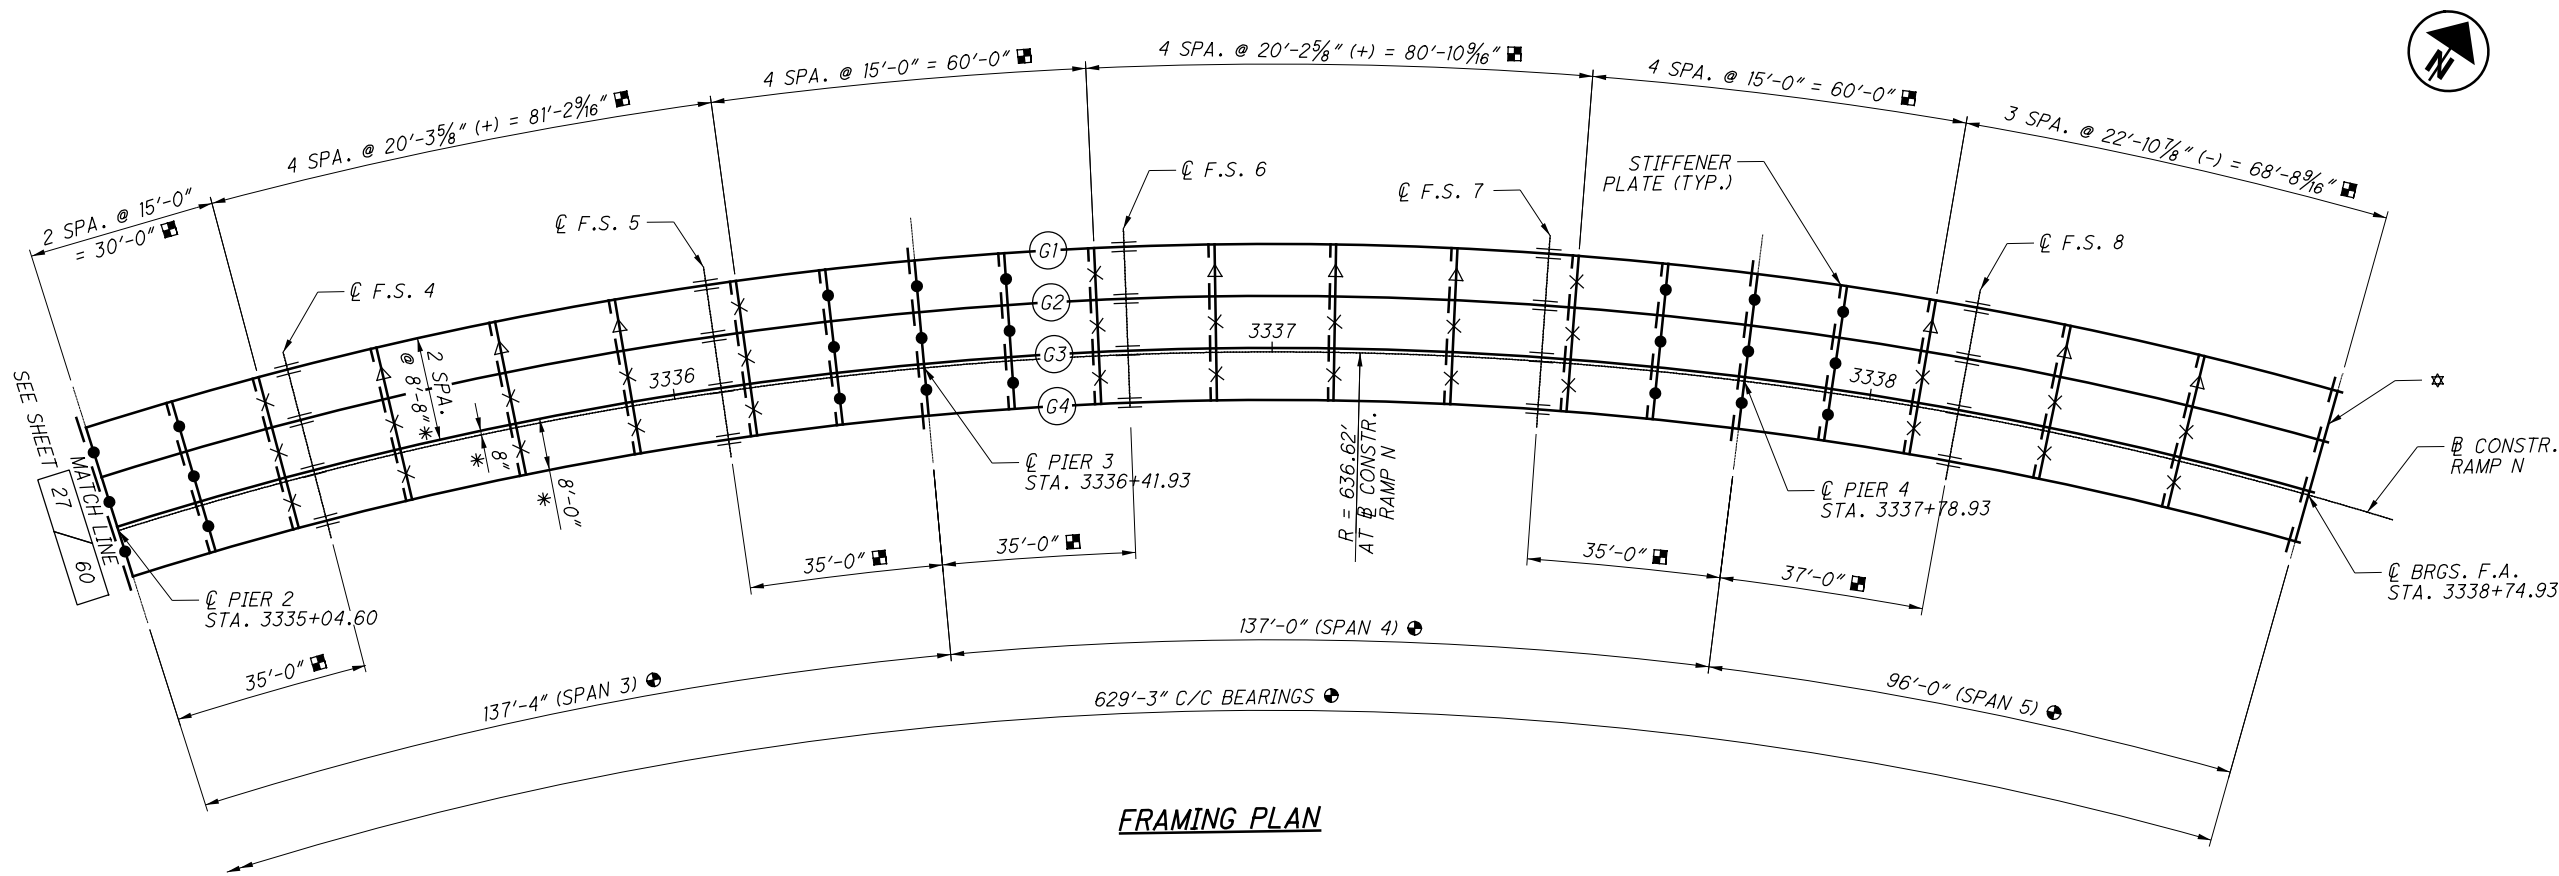

LEGEND:

- * = MEASURED RADIALLY
- ⊕ = MEASURED ALONG ⊕ CONST. RAMP N
- ▣ = MEASURED ALONG ⊕ GIRDER G1
- ☆ = END CROSSFRAME, SEE SHEET 36 / 60 FOR DETAILS (TYP.)
- = TYPE 1 INTERMEDIATE CROSSFRAME
SEE SHEET 35 / 60 FOR DETAILS
- ✕ = TYPE 2 INTERMEDIATE CROSSFRAME
SEE SHEET 35 / 60 FOR DETAILS
- ⤴ = TYPE 3 INTERMEDIATE CROSSFRAME
SEE SHEET 35 / 60 FOR DETAILS

NOTES:

- ⊕ BRGS. AT ABUTMENTS, ⊕ PIERS, ⊕ FIELD SPLICES, AND ALL INTERMEDIATE CROSSFRAMES ARE ORIENTED RADIALLY TO ⊕ CONST. RAMP N. SEE LAYOUT DIAGRAM ON SHEET 3 / 60 FOR ADDITIONAL SUBSTRUCTURE LAYOUT DETAILS.
- GIRDERS ARE CONCENTRIC WITH ⊕ CONST. RAMP N.
- ALL DIMENSIONS ARE HORIZONTAL.
- PROVIDE 1" DIA. BOLTS WITH OVERSIZED HOLES (1 1/4" DIA.) AT THE LOCATIONS LISTED:
CROSSFRAME STIFFENERS
BEARING STIFFENERS AT PIERS
CROSSFRAME CONNECTION PLATES
- BOLTS SHALL BE ASTM F3125, GRADE A325, TYPE 1 (GALVANIZED).
- INSTALL TWO HARDENED WASHERS AT EACH BOLT WITH OVERSIZED HOLES, ONE AT THE BOLT HEAD AND ONE AT THE NUT.
- CYLINDRICAL DRIFT PINS ACCORDING TO ODOT CMS 513.20C WITH A DIAMETER RANGING FROM 1 1/32" TO 1 1/4" SHALL BE USED DURING INSTALLATION OF ALL MEMBERS WITH OVERSIZED HOLES.

2025-03-13 - BU-11 - RECORD DRAWING PLANS

SUM-76/77/8- 8.24/9.74/0.00 PID No. 102329	28/60 29/61
--	----------------


FRAMING PLAN - 2
SUM-76-1152N
RAMP N OVER RAMP S, LANE O, IR-76 EB, SR-8 NB/SB, LANE M

DESIGNED CAS/MAB	DRAWN KK	REVIEWED JCS	DATE 4/29/19
CHECKED JDH	REVISED	STRUCTURE FILE NUMBER 7705973	

DESIGN AGENCY
BURGESS & NIPLE
Engineers ■ Architects ■ Planners
5045 REED ROAD, COLUMBUS, OHIO 43220

ISSUE RECORD:			
NO.		DATE	DESCRIPTION

pww:\ANVAD01P\WINT01.parsons.com:Ohio State Documents\DB-Akron Beltway Rehab\10 - Design\102329\Structures\SUM076_1152N\Sheets\076_1149R_SS005.dgn Sheet 6/23/2021 8:33:36 AM KChrisman

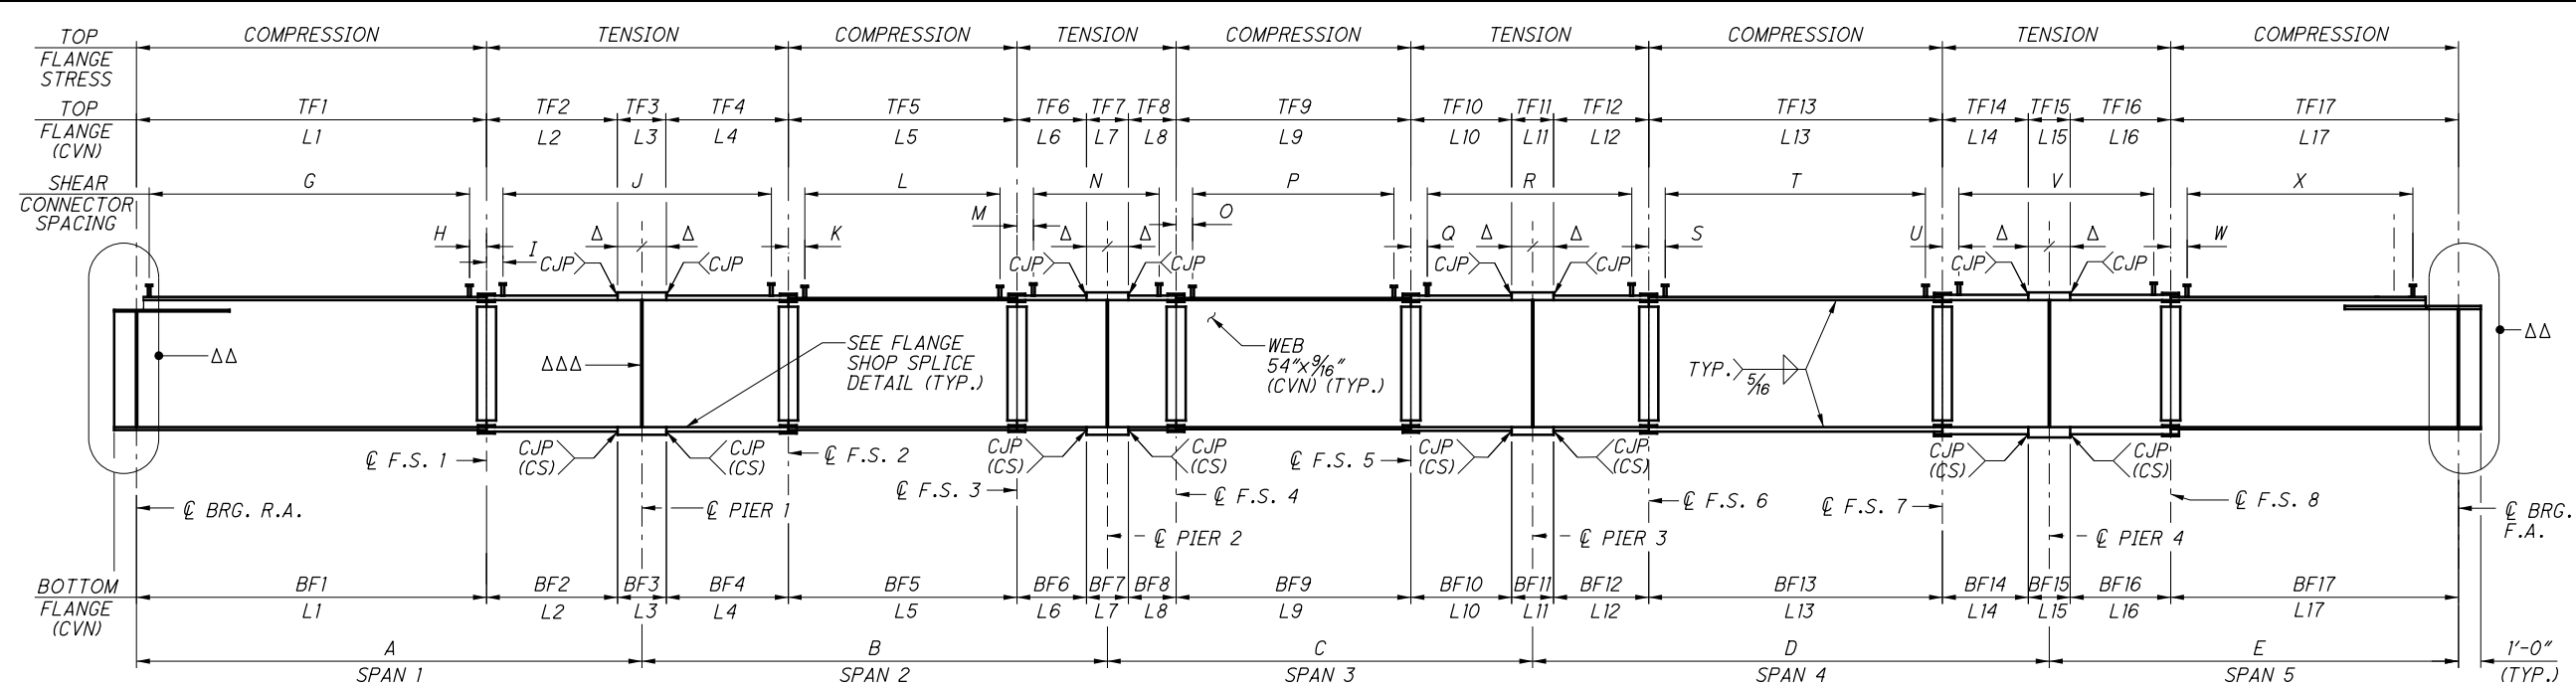

GIRDER ELEVATION

GIRDER	GIRDER TOP FLANGE DIMENSIONS																
	TF1	TF2	TF3	TF4	TF5	TF6	TF7	TF8	TF9	TF10	TF11	TF12	TF13	TF14	TF15	TF16	TF17
G1	18" X 0.875"	20" X 1.25"	20" X 2.25"	20" X 1.25"	16" X 0.875"	20" X 1"	20" X 2"	20" X 1"	16" X 0.875"	20" X 1"	20" X 2"	20" X 1"	16" X 0.875"	18" X 1"	18" X 1.75"	18" X 1"	16" X 0.875"
G2	16" X 0.875"	18" X 1"	18" X 1.5"	18" X 1"	16" X 0.875"	18" X 1"	18" X 1.5"	18" X 1"	16" X 0.875"	20" X 1"	20" X 1.5"	20" X 1"	16" X 0.875"	20" X 1"	20" X 1.5"	20" X 1"	16" X 0.875"
G3	16" X 0.875"	18" X 1"	18" X 1.5"	18" X 1"	16" X 0.875"	18" X 1"	18" X 1.5"	18" X 1"	16" X 0.875"	20" X 1"	20" X 1.5"	20" X 1"	16" X 0.875"	20" X 1"	20" X 1.5"	20" X 1"	16" X 0.875"
G4	16" X 0.875"	18" X 1"	18" X 1.75"	18" X 1"	16" X 0.875"	18" X 1"	18" X 1.5"	18" X 1"	16" X 0.875"	20" X 1"	20" X 1.5"	20" X 1"	16" X 0.875"	20" X 1"	20" X 1.5"	20" X 1"	16" X 0.875"

GIRDER	GIRDER BOTTOM FLANGE DIMENSIONS																
	BF1	BF2	BF3	BF4	BF5	BF6	BF7	BF8	BF9	BF10	BF11	BF12	BF13	BF14	BF15	BF16	BF17
G1	22" X 2"	22" X 1.5"	22" X 2.5"	22" X 1.5"	20" X 2"	20" X 1.5"	20" X 2.5"	20" X 1.5"	20" X 2"	20" X 1.5"	20" X 2.5"	20" X 1.5"	20" X 2"	20" X 1.25"	20" X 2.25"	20" X 2"	22" X 2"
G2	18" X 1.5"	18" X 1.25"	18" X 2"	18" X 1.25"	18" X 1"	20" X 1"	20" X 1.5"	20" X 1"	18" X 1"	20" X 1.25"	20" X 1.75"	20" X 1.25"	18" X 1"	20" X 1"	20" X 1.5"	20" X 1"	18" X 1.25"
G3	18" X 1.5"	18" X 1.25"	18" X 2"	18" X 1.25"	18" X 1"	20" X 1"	20" X 1.5"	20" X 1"	18" X 1"	20" X 1.25"	20" X 1.75"	20" X 1.25"	18" X 1"	20" X 1"	20" X 1.5"	20" X 1"	18" X 1.25"
G4	18" X 1.5"	18" X 1.5"	18" X 2.25"	18" X 1.5"	20" X 1.25"	20" X 1"	20" X 1.75"	20" X 1.25"	20" X 1.25"	20" X 1.25"	20" X 1.75"	20" X 1.25"	20" X 1.25"	20" X 1"	20" X 1.5"	20" X 1.25"	20" X 1.25"

GIRDER	SEGMENT LENGTH (FT.) MEASURED ALONG C OF GIRDER																
	L1	L2	L3	L4	L5	L6	L7	L8	L9	L10	L11	L12	L13	L14	L15	L16	L17
G1	87.191	24.500	27.000	21.500	71.045	21.500	27.000	21.500	71.218	21.500	27.000	21.500	70.872	21.500	27.000	23.500	61.714
G2	86.036	23.997	27.000	21.037	70.104	21.037	27.000	21.037	70.275	21.037	27.000	21.037	69.933	21.037	27.000	23.010	60.897
G3	84.882	23.494	27.000	20.573	69.164	20.573	27.000	20.573	69.332	20.573	27.000	20.573	68.995	20.573	27.000	22.520	60.080
G4	83.728	22.991	27.000	20.110	68.223	20.110	27.000	20.110	68.389	20.110	27.000	20.110	68.057	20.110	27.000	22.030	59.263

GIRDER	SHEAR CONNECTOR SPACING											
	G	H	I	J	K	L	M	N	O	P		
G1	85 SPA @ 12" = 85'-0"	15"	15"	93 SPA @ 9" = 69'-9"	15"	54 SPA @ 15" = 67'-6"	15"	89 SPA @ 9" = 66'-9"	15"	54 SPA @ 15" = 67'-6"		
G2	63 SPA @ 16" = 84'-0"	15"	15"	52 SPA @ 16" = 69'-4"	15"	47 SPA @ 17" = 66'-7"	15"	49 SPA @ 16" = 65'-4"	15"	50 SPA @ 16" = 66'-8"		
G3	62 SPA @ 16" = 82'-8"	15"	15"	51 SPA @ 16" = 68'-0"	15"	49 SPA @ 16" = 65'-4"	15"	49 SPA @ 16" = 65'-4"	15"	49 SPA @ 16" = 65'-4"		
G4	57 SPA @ 17" = 80'-9"	15"	15"	67 SPA @ 12" = 67'-0"	15"	46 SPA @ 17" = 65'-2"	15"	70 SPA @ 11" = 64'-2"	15"	46 SPA @ 17" = 65'-2"		

GIRDER	SHEAR CONNECTOR SPACING (CONTINUED)							
	Q	R	S	T	U	V	W	X
G1	15"	80 SPA @ 10" = 66'-8"	15"	54 SPA @ 15" = 67'-6"	15"	92 SPA @ 9" = 69'-0"	15"	51 SPA @ 14" = 59'-6"
G2	15"	46 SPA @ 17" = 65'-2"	15"	50 SPA @ 16" = 66'-8"	15"	68 SPA @ 12" = 68'-0"	15"	54 SPA @ 13" = 58'-6"
G3	15"	49 SPA @ 16" = 65'-4"	15"	49 SPA @ 16" = 65'-4"	15"	67 SPA @ 12" = 67'-0"	15"	52 SPA @ 14" = 60'-8"
G4	15"	64 SPA @ 12" = 64'-0"	15"	46 SPA @ 17" = 65'-2"	15"	72 SPA @ 11" = 66'-0"	15"	53 SPA @ 13" = 57'-5"

LEGEND:

- Δ = 13'-6"
- $\Delta\Delta$ = SEE END CROSSFRAME DETAILS ON SHEET 36 / 60 FOR ADDITIONAL DETAILS AT GIRDER ENDS.
- $\Delta\Delta\Delta$ = BEARING STIFFENER, EACH SIDE OF WEB (TYP. AT ABUTMENTS & PIERS), SEE SHEET 30 / 60 FOR SIZES.

NOTES:

- ALL DIMENSIONS ARE HORIZONTAL AND REQUIRE ADJUSTMENT FOR CAMBER AND FINISH GRADE.
- WHERE A SHAPE OR PLATE IS DESIGNATED (CVN), FURNISH MATERIAL THAT MEETS THE MINIMUM NOTCH TOUGHNESS REQUIREMENTS AS SPECIFIED IN 711.01.
- WELD ATTACHMENT OF SUPPORTS FOR CONCRETE DECK FINISHING MACHINE TO AREAS OF THE FASCIA STRINGER FLANGES DESIGNATED "COMPRESSION". DO NOT WELD ATTACHMENTS TO AREAS DESIGNATED "TENSION". FILLET WELDS TO COMPRESSION FLANGES SHALL BE AT LEAST 1" FROM EDGE OF FLANGE, BE NO MORE THAN 2" LONG, AND BE AT LEAST 5/16".
- INTERMEDIATE AND CROSSFRAME STIFFENERS NOT SHOWN IN ELEVATION. SEE FRAMING PLAN FOR LOCATIONS.
- ADJUST SHEAR CONNECTOR SPACING LOCALLY AS REQUIRED TO CLEAR FLANGE SHOP SPLICES.
- ALL STRUCTURAL STEEL SHALL BE ASTM A709, GRADE 50.
- SEE GENERAL NOTES FOR COATING REQUIREMENTS.
- GIRDER ENDS SHALL BE FABRICATED TO BE VERTICAL AFTER ERECTION.
- SEE SHEET 30 / 60 FOR ADDITIONAL GIRDER DETAILS.



GIRDER	SPAN LENGTHS (FT.) MEASURED ALONG C OF GIRDER				
	A	B	C	D	E
G1	125.191	141.045	141.218	140.872	98.714
G2	123.533	139.178	139.349	139.007	97.407
G3	121.876	137.310	137.478	137.141	96.100
G4	120.219	135.443	135.609	135.277	94.793

GIRDER RADIUS AT C OF GIRDER	
GIRDER	RADIUS
G1	654.620
G2	645.953
G3	637.286
G4	628.620


ISSUE RECORD:		DESCRIPTION
NO.	DATE	

pw:\\V\\ANV\\A01PW\\INT01.parsons.com:Ohio State\\Documents\\DB-Akron Beltway Rehab\\10 - Design\\102329\\Structures\\SUM076_1152N\\Sheets\\076_1149R_SS006.dgn Sheet 6/23/2021 8:33:41 AM KChrisman


BEARING STIFFENERS				
LOCATION	GIRDER	WIDTH	THICKNESS	HEIGHT
REAR ABUTMENT	1	10"	7⁄8"	46 1⁄8"
PIER 1		10"	7⁄8"	54"
PIER 2		9"	7⁄8"	54"
PIER 3		9"	7⁄8"	54"
PIER 4		9"	7⁄8"	54"
FORWARD ABUTMENT	2	10"	7⁄8"	46 1⁄8"
REAR ABUTMENT		8"	7⁄8"	46 1⁄8"
PIER 1		8"	7⁄8"	54"
PIER 2		9"	7⁄8"	54"
PIER 3		9"	7⁄8"	54"
PIER 4		9"	7⁄8"	54"
FORWARD ABUTMENT	3	8"	7⁄8"	46 1⁄8"
REAR ABUTMENT		8"	7⁄8"	46 1⁄8"
PIER 1		8"	7⁄8"	54"
PIER 2		9"	7⁄8"	54"
PIER 3		9"	7⁄8"	54"
PIER 4		9"	7⁄8"	54"
FORWARD ABUTMENT	4	8"	7⁄8"	46 1⁄8"
REAR ABUTMENT		8"	7⁄8"	46 1⁄8"
PIER 1		8"	7⁄8"	54"
PIER 2		9"	7⁄8"	54"
PIER 3		9"	7⁄8"	54"
PIER 4		9"	7⁄8"	54"
FORWARD ABUTMENT		9"	7⁄8"	46 1⁄8"

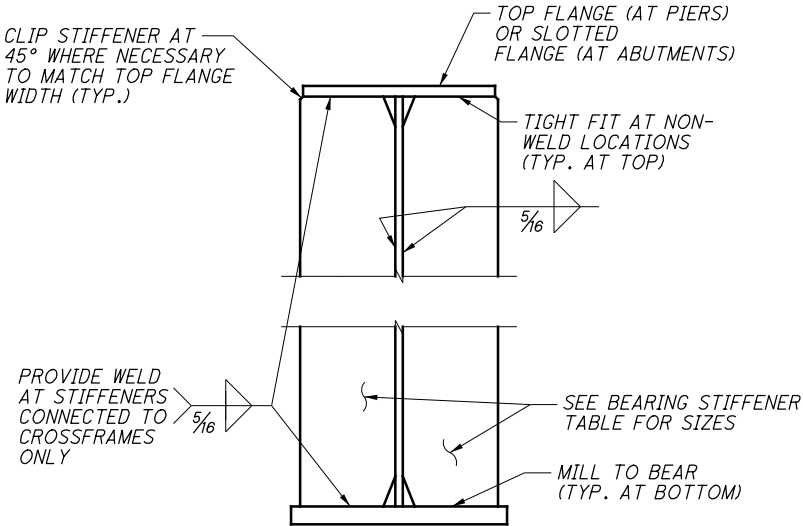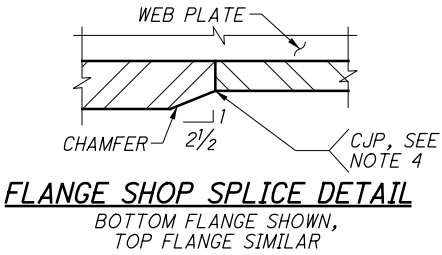

BEARING STIFFENER
(CROSSFRAMES NOT SHOWN, SEE NOTE 6)

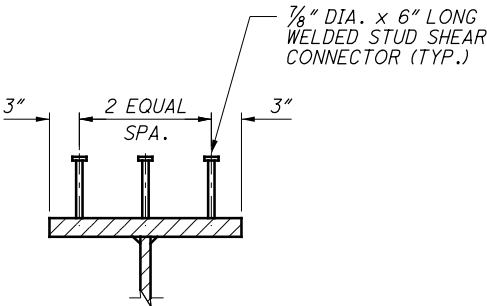

SHEAR CONNECTOR DETAIL

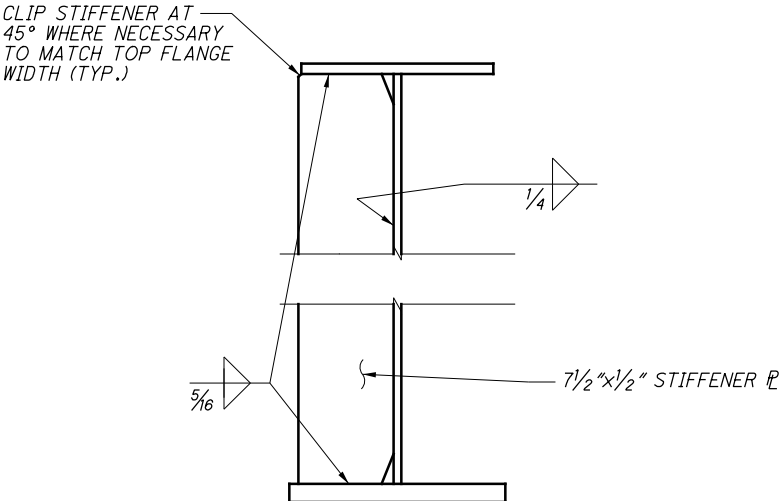

INTERMEDIATE STIFFENER
(PLACE STIFFENER NORMAL TO THE GIRDER WEB)

NOTES:

1. ALL STRUCTURAL STEEL SHALL BE ASTM A709, GRADE 50.
2. SEE GENERAL NOTES FOR COATING REQUIREMENTS.
3. WHERE A SHAPE OR PLATE IS DESIGNATED (CVN), FURNISH MATERIAL THAT MEETS THE MINIMUM NOTCH TOUGHNESS REQUIREMENTS AS SPECIFIED IN 711.01.
4. COMPLETE JOINT PENETRATION WELDS SHALL BE GROUND SMOOTH IN THE LONGITUDINAL DIRECTION TO REMOVE WELD REINFORCEMENT.
5. INSTALL STIFFENERS ACCORDING TO ODOT CMS 513.13.
6. SEE SHEET

35	60
----	----

 FOR CROSSFRAME STIFFENER DETAILS AND ADDITIONAL BEARING STIFFENER DETAILS AT CROSSFRAME LOCATIONS. BEARING STIFFENERS AT CROSSFRAME LOCATIONS SHALL BE DESIGNATED AS (CVN).
7. SEE SHEET


29	60
----	----

 FOR SHEAR CONNECTOR SPACING.
8. SEE FRAMING PLAN FOR LOCATION OF STIFFENERS.


GIRDER DETAILS SUM-76-1152N RAMP N OVER RAMP S, LANE O, IR-76 EB, SR-8 NB/SB, LANE M	DESIGNED MAB	CHECKED JDH	DRAWN MAB	REVISED	REVIEWED JCS	DATE 4/29/19	DESIGN AGENCY BURGESS & NIPLE Engineers ■ Architects ■ Planners 5045 REED ROAD, COLUMBUS, OHIO 43220
	SUM-76-77/8-8.24/9.74/0.00 PID No. 102329				STRUCTURE FILE NUMBER 7705973		

ISSUE RECORD:		DESCRIPTION	
NO.	DATE		

pww:\V\ANV\A01P\WINT01.parsons.com:Ohio State\Documents\DB-Akron Beltway Rehab\10 - Design\102329\Structures\SUM076_1152N\Sheets\076_1149R_SS012.dgn Sheet 6/23/2021 8:33:45 AM KChrisman

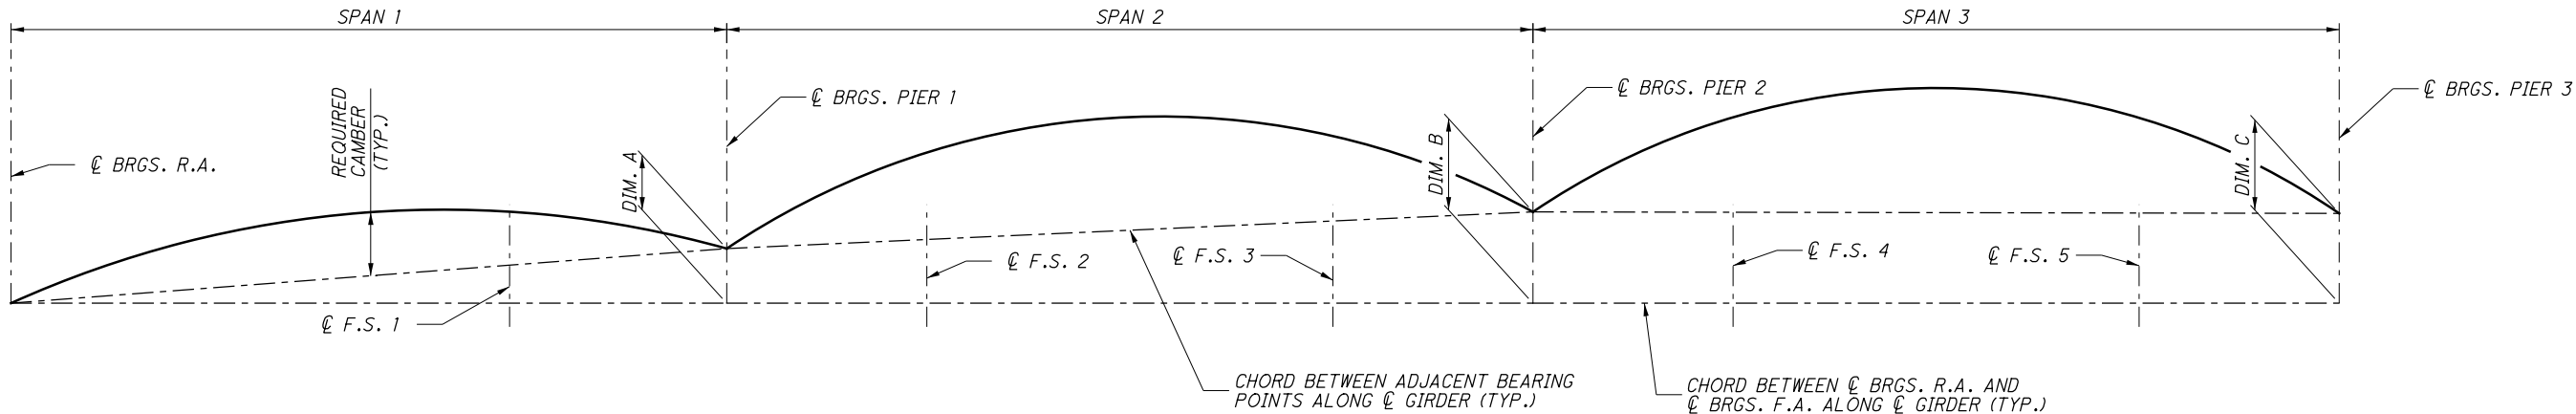

CAMBER AND BLOCKING DIAGRAM
(ALL CHORDS REFERENCED TO TOP OF WEB)
(NOT TO SCALE)

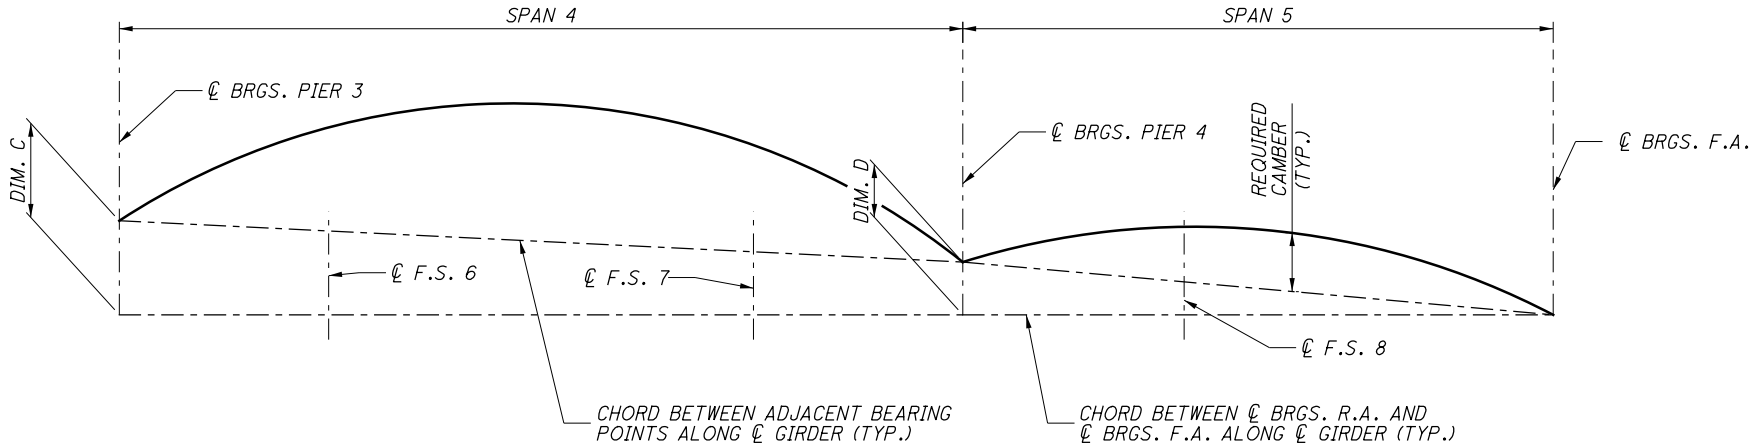

CAMBER AND BLOCKING DIAGRAM (CONT.)
(ALL CHORDS REFERENCED TO TOP OF WEB)
(NOT TO SCALE)

BLOCKING TABLE (VALUES IN INCHES)				
GIRDER	DIM. "A"	DIM. "B"	DIM. "C"	DIM. "D"
G1	52.91	88.57	87.20	48.87
G2	52.91	88.57	87.20	48.87
G3	52.91	88.57	87.20	48.87
G4	52.91	88.57	87.20	48.87

NOTES:

1. POSITIVE CAMBER VALUES INDICATE CAMBER ABOVE CHORD BETWEEN ADJACENT BEARINGS.
2. SEE SHEET $\frac{44}{60}$ FOR GIRDER NUMBER AND CAMBER VALUE LOCATIONS.
3. SEE SHEETS $\frac{32}{60}$ AND $\frac{33}{60}$ FOR CAMBER TABLES
4. IF HEAT CURVING IS USED TO FABRICATE THE GIRDERS, THE FABRICATOR SHALL ADJUST GIRDER CAMBER IN THE AFFECTED AREAS AND SUBMIT CALCULATIONS FOR CAMBER ADJSUTMENTS PER CMS 513.15. ADDITIONALLY, THE CONTRACTOR SHALL ADJUST SCREED AND TOP OF HAUNCH ELEVATIONS FOR THE EFFECTS OF HEAT CURVING, IF USED.

2025-03-13 - BU-11 - RECORD DRAWING PLANS

DESIGN AGENCY BURGESS & NIPLE Engineers ■ Architects ■ Planners 5045 REED ROAD, COLUMBUS, OHIO 43220	
DATE 4/29/19	REVIEWED JCS
STRUCTURE FILE NUMBER 7705973	DRAWN ASG
	DESIGNED ASG
	CHECKED MAB
CAMBER AND BLOCKING DIAGRAMS SUM-76-1152N RAMP N OVER RAMP S, LANE O, IR-76 EB, SR-8 NB/SB, LANE M	
SUM-76/77/8- 8.24/9.74/0.00 PID No. 102329	
31/60	
32/61	

ISSUE RECORD:		DESCRIPTION	
NO.	DATE		

CAMBER TABLE (VALUE IN INCHES)																									
GIRDER NUMBER		€ BRG. R.A.	SPAN 1										€ BRG. PIER 1	SPAN 2										€ BRG. PIER 2	
			0.1 SPAN	0.2 SPAN	0.3 SPAN	0.4 SPAN	MIDSPAN	0.6 SPAN	F.S. 1	0.7 SPAN	0.8 SPAN	0.9 SPAN		0.1 SPAN	0.2 SPAN	F.S. 2	0.3 SPAN	0.4 SPAN	MIDSPAN	0.6 SPAN	0.7 SPAN	F.S. 3	0.8 SPAN		0.9 SPAN
€ GIRDER 1	A	0	0.27	0.50	0.68	0.73	0.72	0.63	0.47	0.46	0.28	0.11	0	-0.02	0.03	0.07	0.12	0.20	0.26	0.23	0.18	0.14	0.09	0.02	0
	B	0	0.94	1.71	2.33	2.49	2.43	2.11	1.57	1.55	0.92	0.37	0	-0.01	0.25	0.43	0.64	0.95	1.17	1.06	0.81	0.63	0.45	0.11	0
	C	0	0.05	0.10	0.15	0.19	0.24	0.29	0.34	0.34	0.39	0.34	0	1.67	2.96	3.45	3.89	4.44	4.63	4.44	3.89	3.45	2.96	1.67	0
	D	0	1.26	2.31	3.16	3.41	3.39	3.03	2.38	2.35	1.59	0.82	0	1.64	3.24	3.95	4.65	5.59	6.06	5.73	4.88	4.22	3.50	1.80	0
€ GIRDER 2	A	0	0.24	0.44	0.60	0.64	0.63	0.55	0.42	0.41	0.25	0.10	0	-0.01	0.05	0.09	0.14	0.21	0.27	0.24	0.19	0.14	0.10	0.03	0
	B	0	0.83	1.52	2.06	2.21	2.16	1.88	1.41	1.39	0.83	0.32	0	0.02	0.30	0.47	0.67	0.97	1.17	1.05	0.81	0.63	0.45	0.13	0
	C	0	0.05	0.10	0.15	0.19	0.24	0.29	0.34	0.34	0.39	0.34	0	1.67	2.96	3.45	3.89	4.44	4.63	4.44	3.89	3.45	2.96	1.67	0
	D	0	1.12	2.06	2.81	3.04	3.03	2.72	2.17	2.14	1.47	0.76	0	1.68	3.31	4.01	4.70	5.62	6.07	5.73	4.89	4.22	3.51	1.83	0
€ GIRDER 3	A	0	0.21	0.38	0.51	0.55	0.54	0.47	0.36	0.35	0.21	0.08	0	0.00	0.07	0.11	0.16	0.23	0.27	0.25	0.19	0.15	0.11	0.03	0
	B	0	0.75	1.38	1.87	2.00	1.96	1.70	1.26	1.25	0.74	0.28	0	0.05	0.35	0.53	0.73	1.02	1.21	1.09	0.84	0.66	0.48	0.14	0
	C	0	0.05	0.10	0.15	0.19	0.24	0.29	0.34	0.34	0.39	0.34	0	1.67	2.96	3.45	3.89	4.44	4.63	4.44	3.89	3.45	2.96	1.67	0
	D	0	1.01	1.86	2.53	2.74	2.74	2.46	1.96	1.94	1.34	0.70	0	1.72	3.38	4.09	4.78	5.69	6.11	5.78	4.92	4.26	3.55	1.84	0
€ GIRDER 4	A	0	0.17	0.31	0.43	0.46	0.45	0.39	0.29	0.29	0.17	0.07	0	0.01	0.08	0.12	0.17	0.23	0.27	0.25	0.19	0.15	0.11	0.03	0
	B	0	0.70	1.27	1.72	1.84	1.79	1.55	1.15	1.13	0.66	0.25	0	0.10	0.43	0.62	0.81	1.11	1.29	1.16	0.90	0.72	0.52	0.16	0
	C	0	0.05	0.10	0.15	0.19	0.24	0.29	0.34	0.34	0.39	0.34	0	1.67	2.96	3.45	3.89	4.44	4.63	4.44	3.89	3.45	2.96	1.67	0
	D	0	0.92	1.68	2.30	2.49	2.48	2.23	1.78	1.76	1.22	0.66	0	1.78	3.47	4.19	4.87	5.78	6.19	5.85	4.98	4.32	3.59	1.86	0

CAMBER TABLE (VALUE IN INCHES) (CONT'D)																										
GIRDER NUMBER		€ BRG. PIER 2	SPAN 3											€ BRG. PIER 3	SPAN 4											€ BRG. PIER 4
			0.1 SPAN	0.2 SPAN	F.S. 4	0.3 SPAN	0.4 SPAN	MIDSPAN	0.6 SPAN	0.7 SPAN	F.S. 5	0.8 SPAN	0.9 SPAN		0.1 SPAN	0.2 SPAN	F.S. 6	0.3 SPAN	0.4 SPAN	MIDSPAN	0.6 SPAN	0.7 SPAN	F.S. 7	0.8 SPAN	0.9 SPAN	
€ GIRDER 1	A	0	0.07	0.19	0.25	0.31	0.40	0.44	0.38	0.28	0.22	0.15	0.04	0	0.05	0.17	0.24	0.31	0.41	0.48	0.43	0.35	0.28	0.21	0.08	0
	B	0	0.24	0.68	0.92	1.14	1.46	1.62	1.40	1.04	0.80	0.56	0.15	0	0.24	0.73	0.99	1.27	1.68	1.93	1.77	1.42	1.17	0.90	0.35	0
	C	0	1.67	2.97	3.46	3.90	4.45	4.64	4.45	3.90	3.46	2.97	1.67	0	1.66	2.95	3.45	3.88	4.43	4.62	4.43	3.88	3.45	2.95	1.66	0
	D	0	1.98	3.84	4.63	5.35	6.31	6.70	6.23	5.22	4.48	3.68	1.86	0	1.95	3.85	4.68	5.46	6.52	7.03	6.63	5.65	4.90	4.06	2.09	0
€ GIRDER 2	A	0	0.06	0.18	0.23	0.29	0.37	0.40	0.35	0.26	0.20	0.15	0.04	0	0.05	0.17	0.23	0.29	0.38	0.44	0.40	0.32	0.26	0.20	0.08	0
	B	0	0.22	0.63	0.85	1.06	1.36	1.51	1.30	0.97	0.74	0.53	0.15	0	0.22	0.67	0.91	1.16	1.54	1.78	1.62	1.30	1.07	0.82	0.32	0
	C	0	1.67	2.97	3.46	3.90	4.45	4.64	4.45	3.90	3.46	2.97	1.67	0	1.66	2.95	3.45	3.88	4.43	4.62	4.43	3.88	3.45	2.95	1.66	0
	D	0	1.95	3.78	4.54	5.25	6.18	6.55	6.10	5.13	4.40	3.65	1.86	0	1.93	3.79	4.59	5.33	6.35	6.84	6.45	5.50	4.78	3.97	2.06	0
€ GIRDER 3	A	0	0.06	0.16	0.21	0.26	0.33	0.37	0.32	0.24	0.19	0.14	0.04	0	0.05	0.15	0.21	0.27	0.35	0.41	0.37	0.30	0.24	0.18	0.07	0
	B	0	0.20	0.61	0.82	1.02	1.30	1.45	1.26	0.94	0.73	0.52	0.15	0	0.21	0.64	0.87	1.11	1.46	1.68	1.53	1.23	1.01	0.77	0.30	0
	C	0	1.67	2.97	3.46	3.90	4.45	4.64	4.45	3.90	3.46	2.97	1.67	0	1.66	2.95	3.45	3.88	4.43	4.62	4.43	3.88	3.45	2.95	1.66	0
	D	0	1.93	3.74	4.49	5.18	6.08	6.46	6.03	5.08	4.38	3.63	1.86	0	1.92	3.74	4.53	5.26	6.24	6.71	6.33	5.41	4.70	3.90	2.03	0
€ GIRDER 4	A	0	0.05	0.14	0.19	0.23	0.30	0.33	0.29	0.22	0.17	0.13	0.04	0	0.05	0.14	0.19	0.24	0.32	0.37	0.33	0.27	0.22	0.17	0.07	0
	B	0	0.21	0.60	0.81	1.00	1.28	1.43	1.25	0.95	0.75	0.54	0.17	0	0.22	0.64	0.86	1.09	1.42	1.62	1.48	1.19	0.98	0.75	0.30	0
	C	0	1.67	2.97	3.46	3.90	4.45	4.64	4.45	3.90	3.46	2.97	1.67	0	1.66	2.95	3.45	3.88	4.43	4.62	4.43	3.88	3.45	2.95	1.66	0
	D	0	1.93	3.71	4.46	5.13	6.03	6.40	5.99	5.07	4.38	3.64	1.88	0	1.93	3.73	4.50	5.21	6.17	6.61	6.24	5.34	4.65	3.87	2.03	0

LEGEND:

A = DEFLECTION DUE TO WEIGHT OF STEEL
B = DEFLECTION DUE TO REMAINING DEAD LOAD
C = ADJUSTMENT FOR VERTICAL & HORIZONTAL CURVE
D = TOTAL (REQUIRED SHOP CAMBER)

NOTES:

1. SEE SHEET 31 / 60 FOR CAMBER DIAGRAM AND ADDITONAL NOTES.
2. SEE SHEET 33 / 60 FOR SPAN 5 CAMBER TABLE.

SUM-76/77/8-8.24/9.74/0.00

PID No. 102329

CAMBER TABLE - 1

SUM-76-1152N

RAMP N OVER RAMP S, LANE O, IR-76 EB, SR-8 NB/SB, LANE M

DESIGNED
ASG

CHECKED
MAB

DRAWN
ASG

REVIEWED
JCS

DATE
4/29/19

STRUCTURE FILE NUMBER
7705973

DESIGN AGENCY
BURGESS & NIPLE
Engineers ■ Architects ■ Planners
5045 REED ROAD, COLUMBUS, OHIO 43220

ISSUE RECORD:		DESCRIPTION	
NO.	DATE		

CAMBER TABLE (VALUE IN INCHES) (CONT'D)													
GIRDER NUMBER		℄ BRG. PIER 4	SPAN 5										℄ BRG. F.A.
			0.1 SPAN	0.2 SPAN	0.3 SPAN	F.S. 8	0.4 SPAN	MIDSPAN	0.6 SPAN	0.7 SPAN	0.8 SPAN	0.9 SPAN	
℄ GIRDER 1	A	0	0.01	0.04	0.08	0.12	0.13	0.17	0.17	0.16	0.13	0.07	0
	B	0	0.01	0.10	0.25	0.39	0.43	0.57	0.59	0.56	0.47	0.24	0
	C	0	0.82	1.45	1.90	2.12	2.18	2.27	2.18	1.90	1.45	0.82	0
	D	0	0.84	1.59	2.23	2.63	2.74	3.01	2.94	2.62	2.05	1.13	0
℄ GIRDER 2	A	0	0.01	0.03	0.07	0.11	0.12	0.15	0.16	0.15	0.12	0.06	0
	B	0	0.01	0.08	0.22	0.35	0.38	0.51	0.54	0.51	0.42	0.21	0
	C	0	0.82	1.45	1.90	2.12	2.18	2.27	2.18	1.90	1.45	0.82	0
	D	0	0.84	1.56	2.19	2.58	2.68	2.93	2.88	2.56	1.99	1.09	0
℄ GIRDER 3	A	0	0.01	0.03	0.07	0.10	0.11	0.14	0.14	0.13	0.11	0.06	0
	B	0	0.01	0.09	0.23	0.35	0.38	0.50	0.53	0.50	0.41	0.21	0
	C	0	0.82	1.45	1.90	2.12	2.18	2.27	2.18	1.90	1.45	0.82	0
	D	0	0.84	1.57	2.20	2.57	2.67	2.91	2.85	2.53	1.97	1.09	0
℄ GIRDER 4	A	0	0.01	0.03	0.06	0.09	0.09	0.12	0.12	0.12	0.10	0.05	0
	B	0	0.04	0.12	0.27	0.39	0.42	0.54	0.56	0.53	0.43	0.22	0
	C	0	0.82	1.45	1.90	2.12	2.18	2.27	2.18	1.90	1.45	0.82	0
	D	0	0.87	1.60	2.23	2.60	2.69	2.93	2.86	2.55	1.98	1.09	0

LEGEND:

A = DEFLECTION DUE TO WEIGHT OF STEEL
B = DEFLECTION DUE TO REMAINING DEAD LOAD
C = ADJUSTMENT FOR VERTICAL & HORIZONTAL CURVE
D = TOTAL (REQUIRED SHOP CAMBER)

NOTES:

1. SEE SHEET 31 / 60 FOR CAMBER DIAGRAM AND ADDITONAL NOTES.
2. SEE SHEET 32 / 60 FOR SPANS 1 - 4 CAMBER TABLE.

SUM-76 / 77 / 8 -
8.24 / 9.74 / 0.00
PID No. 102329

33 / 60

34 / 61

CAMBER TABLE - 2
SUM-76-1152N
RAMP N OVER RAMP S, LANE O, IR-76 EB, SR-8 NB/SB, LANE M

DESIGNED
ASG
CHECKED
MAB

DRAWN
ASG
REVISED





REVIEWED
JCS
STRUCTURE FILE NUMBER
7705973

DATE
4/29/19

DESIGN AGENCY
BURGESS & NIPLÉ
Engineers ■ Architects ■ Planners
5045 REED ROAD, COLUMBUS, OHIO 43220

ISSUE RECORD:		DESCRIPTION
NO.	DATE	

pw:\V\ANV\A01PWINT01.parsons.com:Ohio State\Documents\DB-Akron Beltway Rehab\10 - Design\102329\Structures\SUM076_1152N\Sheets\076_1149R_SS010.dgn Sheet 6/23/2021 8:34:13 AM kChrisman

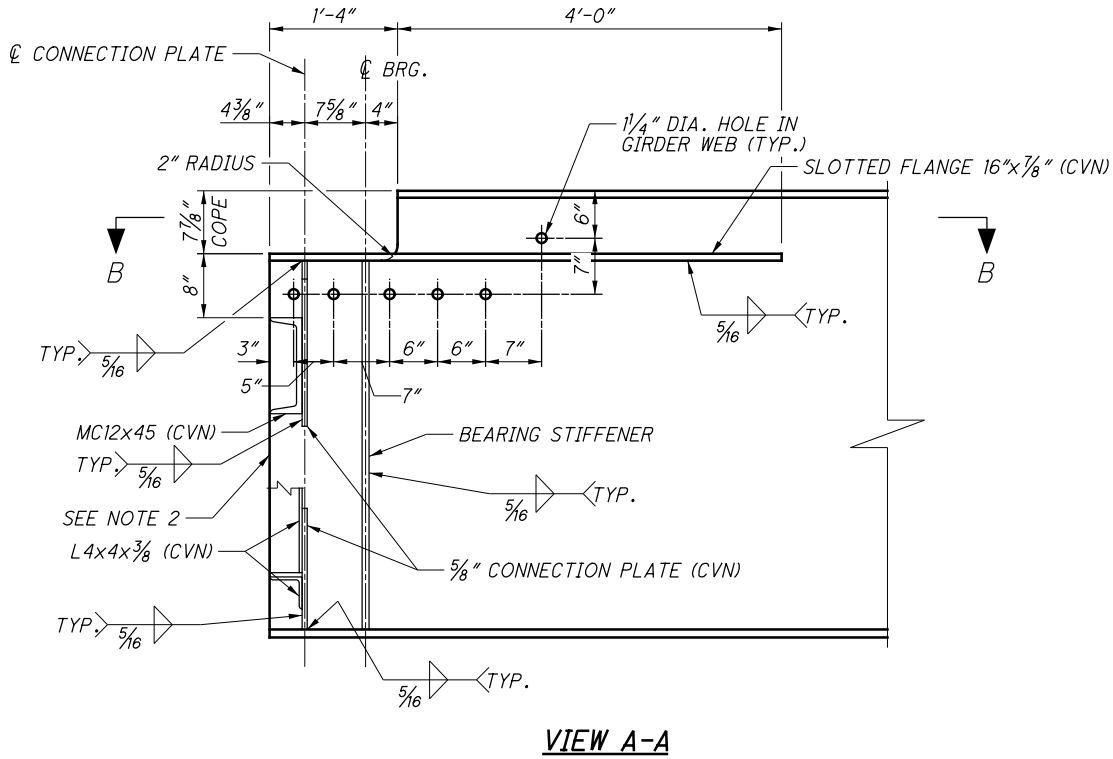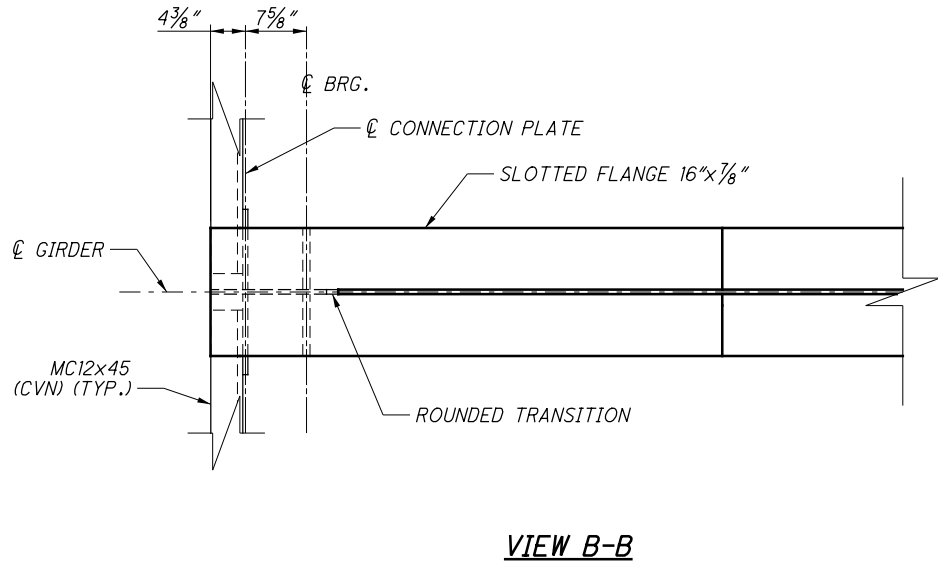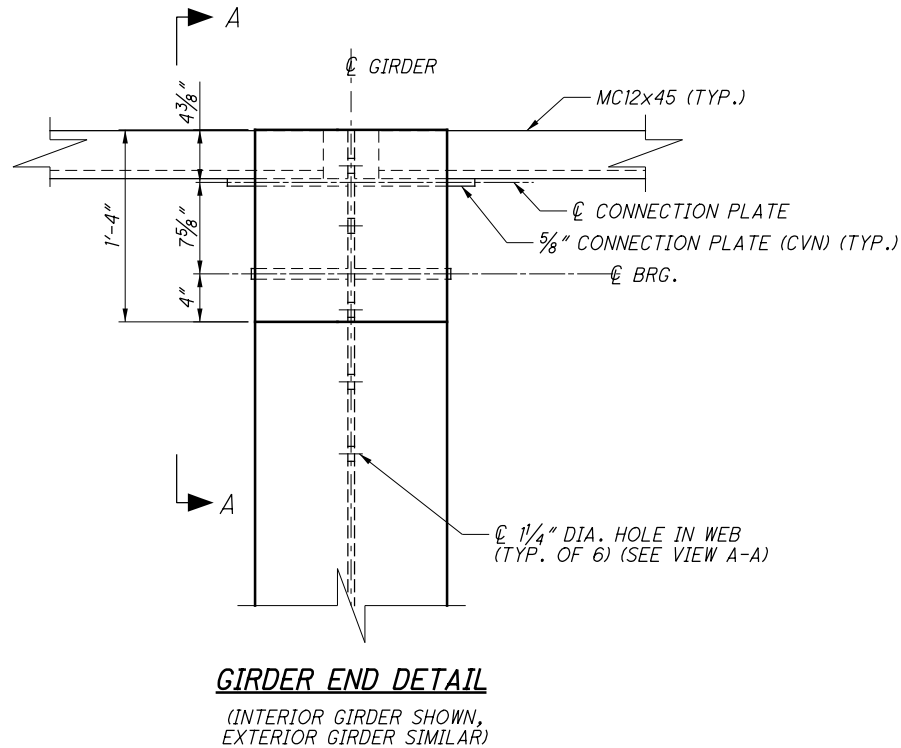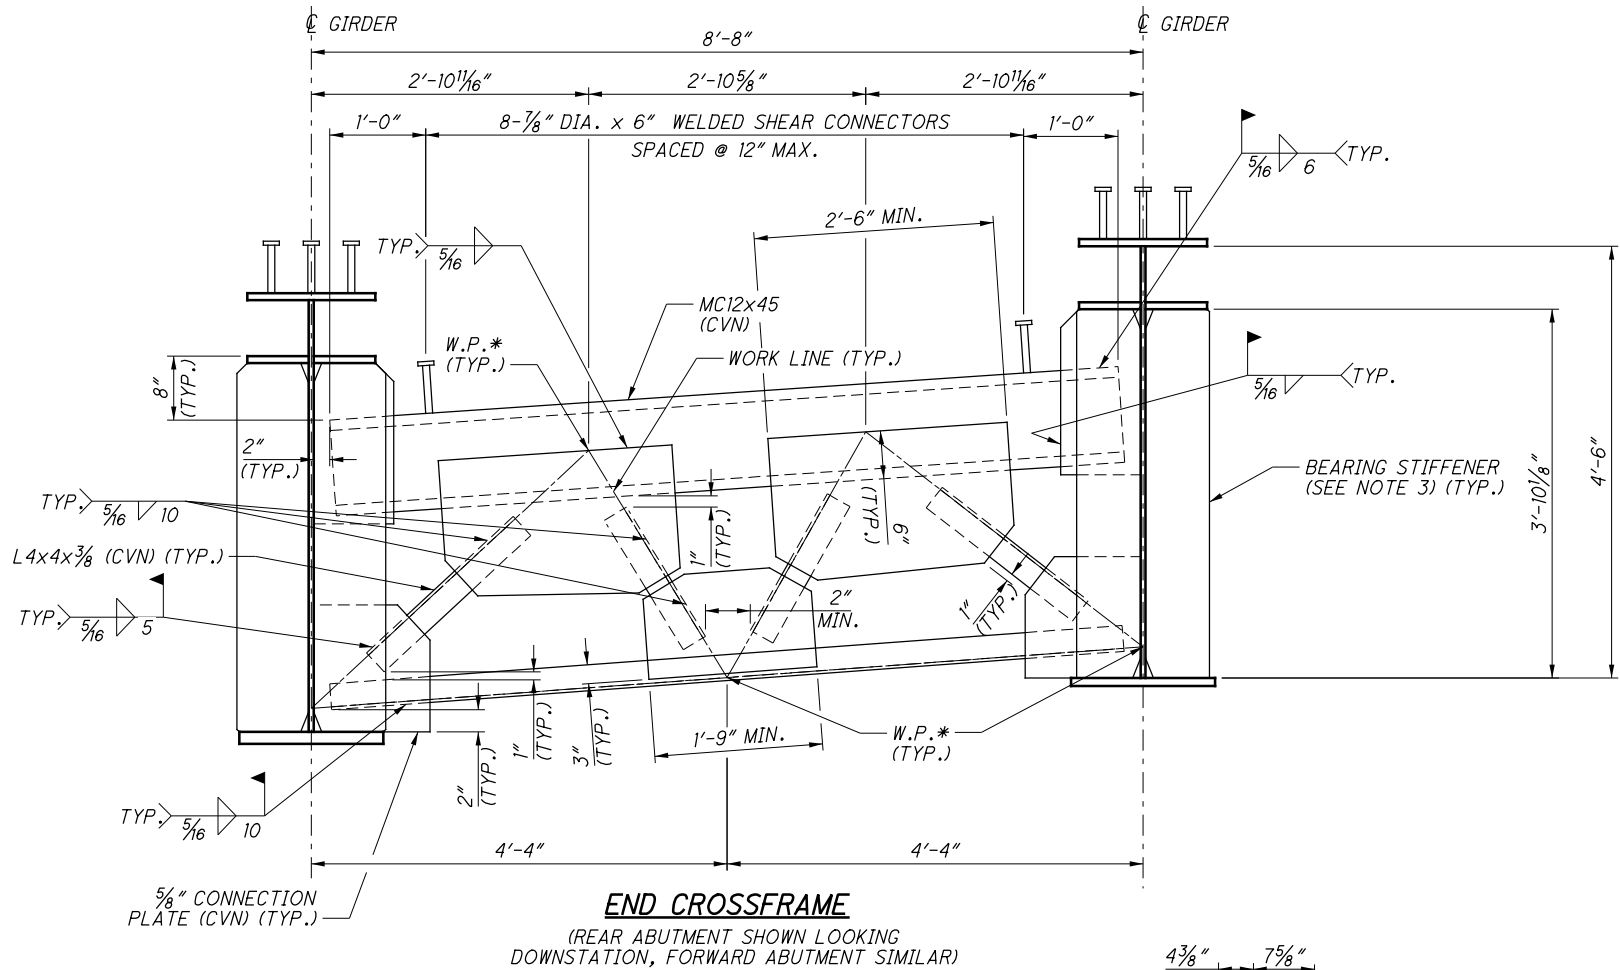

LEGEND:
* = THE WORK LINE SHALL BE THE INSIDE FACE OF THE PROTRUDING ANGLE LEG EXTENDED AS SHOWN


- NOTES:**
1. SHEAR STUD SPACING MAY BE ADJUSTED TO ACCOMMODATE TEMPORARY SUPPORT AND INSTALLATION OF THE MODULAR EXPANSION JOINT. THE TOTAL NUMBER OF SHEAR STUDS PER MC12X45 SHALL NOT BE REDUCED FROM THAT REQUIRED BY THE INDICATED SPACING.
 2. GIRDER ENDS SHALL BE FABRICATED TO BE VERTICAL AFTER ERECTION.
 3. SEE SHEET 30 / 60 FOR BEARING STIFFENER SIZES.
 4. WHERE A SHAPE OR PLATE IS DESIGNATED (CVN), FURNISH MATERIAL THAT MEETS THE MINIMUM NOTCH TOUGHNESS REQUIREMENTS AS SPECIFIED IN 711.01.
 5. ALL STRUCTURAL STEEL SHALL BE ASTM A709, GRADE 50.
 6. SEE GENERAL NOTES FOR COATING REQUIREMENTS.

2025-03-13 - BU-11 - RECORD DRAWING PLANS


SUM-76/77/8- 8.24/9.74/0.00 PID No. 102329	END CROSSFRAME DETAILS		DESIGN AGENCY	
	SUM-76-1152N		BURGES & NIPLE	
	RAMP N OVER RAMP S, LANE O, IR-76 EB, SR-8 NB/SB, LANE M		Engineers ■ Architects ■ Planners	
36/60	DESIGNED	DRAWN	REVIEWED	DATE
	BCS	BCS	JCS	4/29/19
	CHECKED	REVISED	STRUCTURE FILE NUMBER	
37/61	SUA		7705973	
5045 REED ROAD, COLUMBUS, OHIO 43220				

ISSUE RECORD:		DESCRIPTION
NO.	DATE	


pw:\V\ANV\A01PWINT01.parsons.com:Ohio State\Documents\DB-Akron Beltway Rehab\10 - Design\102329\Structures\SUM076_1152N\Sheets\076_1149R_SB001.dgn Sheet 6/23/2021 8:34:18 AM KChrisman

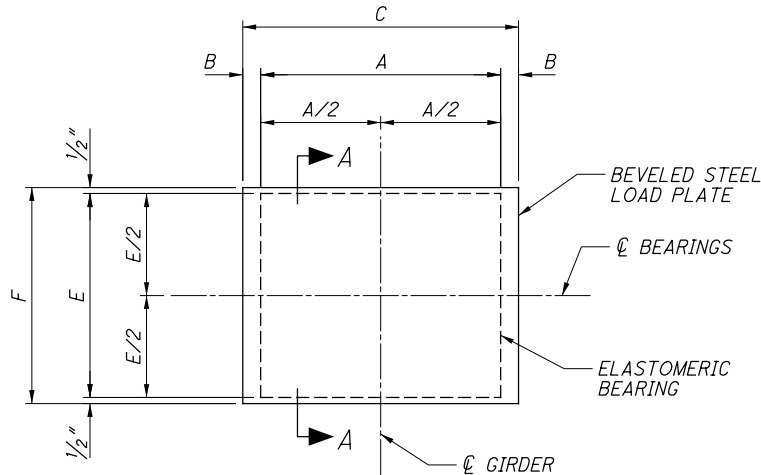


PLAN
(EXPANSION BEARING)
(PIERS 1 AND 4)
(GIRDER NOT SHOWN)

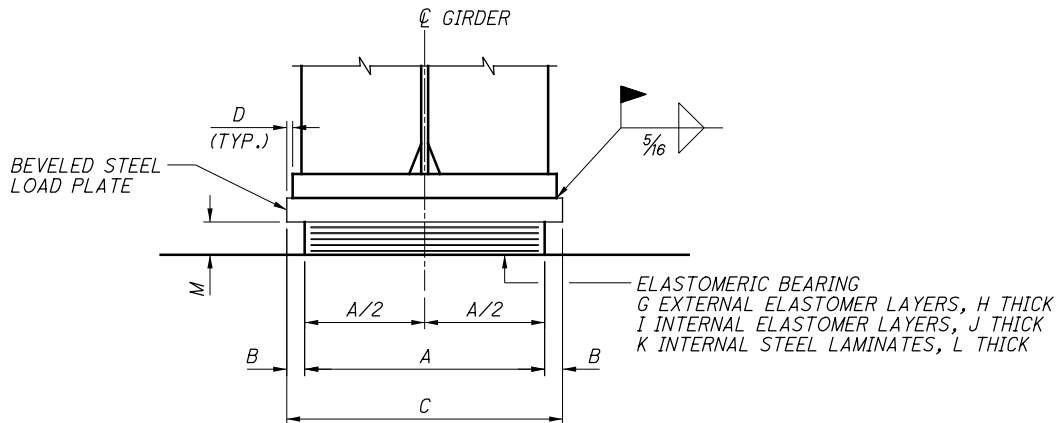


ELEVATION

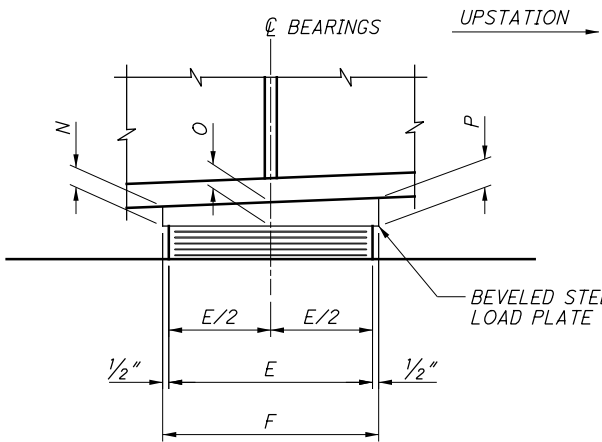


SECTION A-A

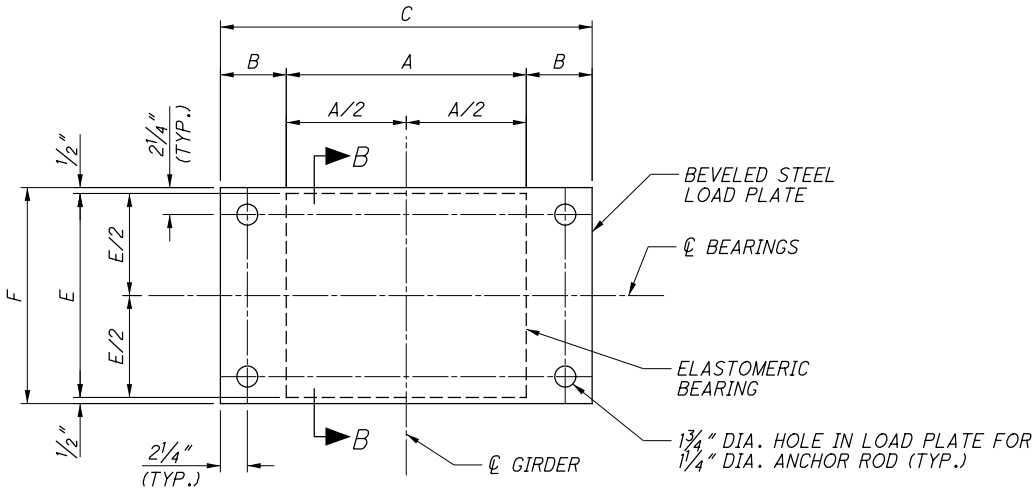

PLAN
(FIXED BEARING)
(PIERS 2 AND 3)
(GIRDER NOT SHOWN)

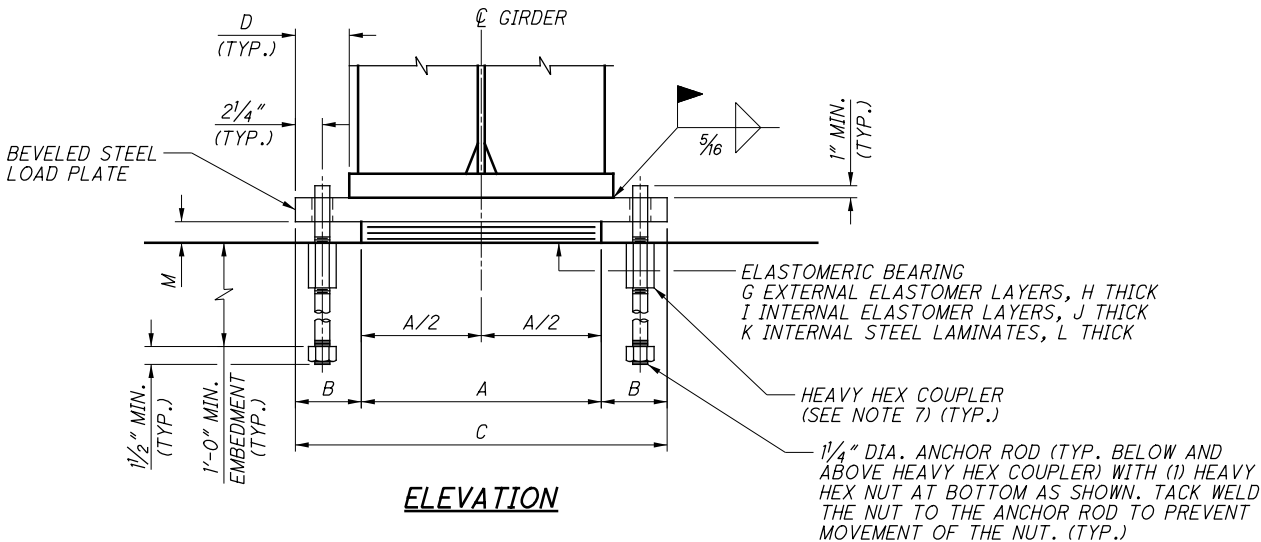

ELEVATION

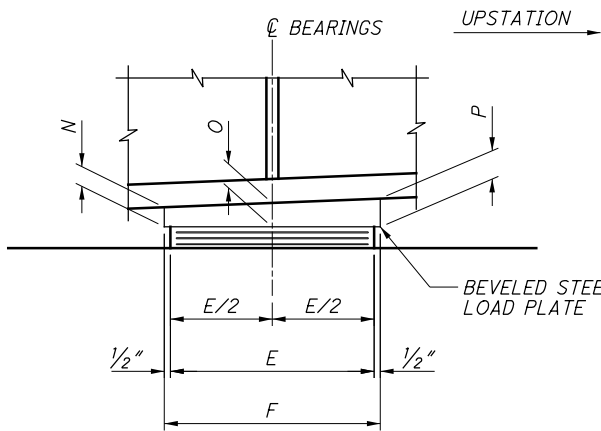

SECTION B-B
(ANCHOR RODS NOT SHOWN)

NOTES:

1. SEE SHEET 39 / 60 FOR NOTES AND TABLE OF DIMENSIONS.

2025-03-13 - BU-11 - RECORD DRAWING PLANS

SUM-76/77/8-8.24/9.74/0.00

PID No. 102329

37 / 60

38 / 61

ELASTOMERIC BEARING DETAILS - 1
SUM-76-1152N
RAMP N OVER RAMP S, LANE O, 1R-76 EB, SR-8 NB/SB, LANE M

DESIGNED	DRAWN	REVIEWED	DATE
SJA	BCS	JCS	4/29/19
CHECKED	REVISED	STRUCTURE FILE NUMBER	
BCS		7705973	

DESIGN AGENCY


BURGESS & NIPLE

Engineers ■ Architects ■ Planners


5045 REED ROAD, COLUMBUS, OHIO 43220

ISSUE RECORD:		DESCRIPTION
NO.	DATE	


pww:\ANV\A01PWINT01\parsons.com\Ohio State\Documents\VB-Akron Beltway Rehab\10 - Design\102329\Structures\SUM076_1152N\Sheets\076_1149R_SB002.dgn Sheet 6/23/2021 8:34:25 AM KChrisman

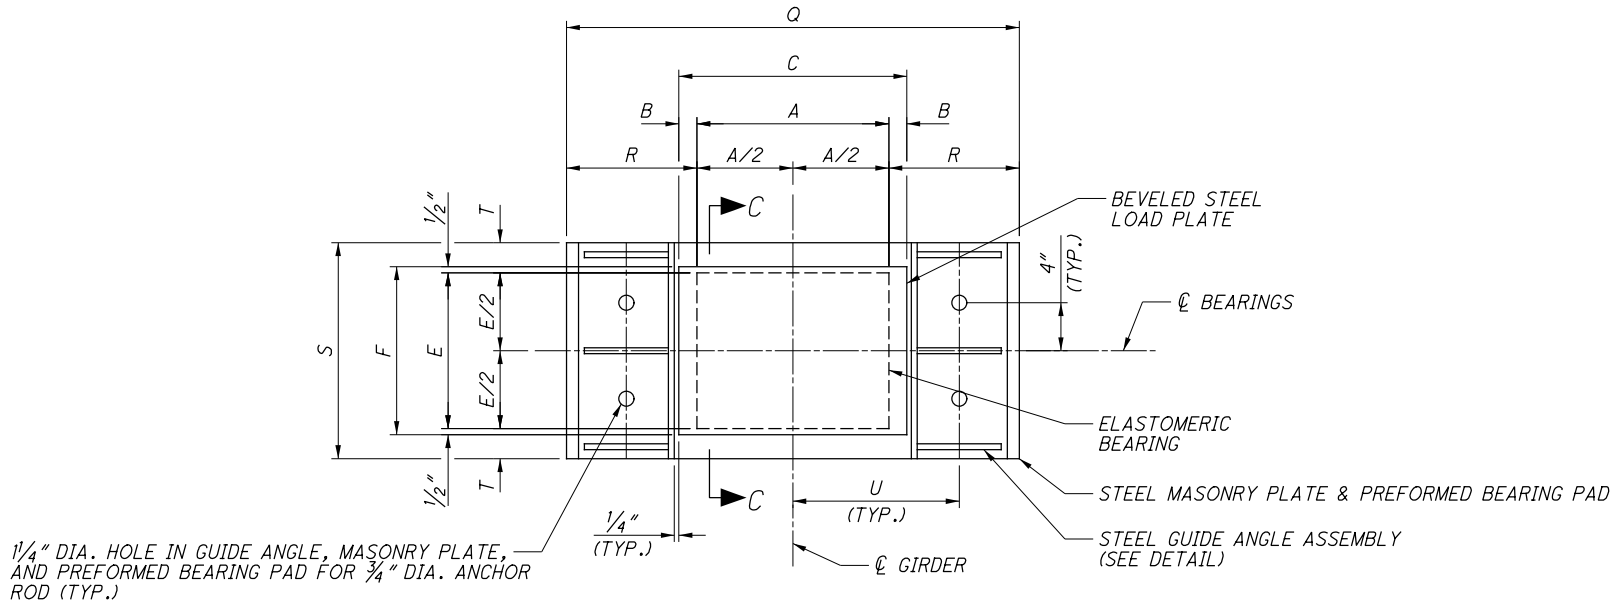

PLAN
(GUIDED AND ANCHORED EXPANSION BEARING)
(REAR ABUTMENT AND FORWARD ABUTMENT)
(GIRDER NOT SHOWN)

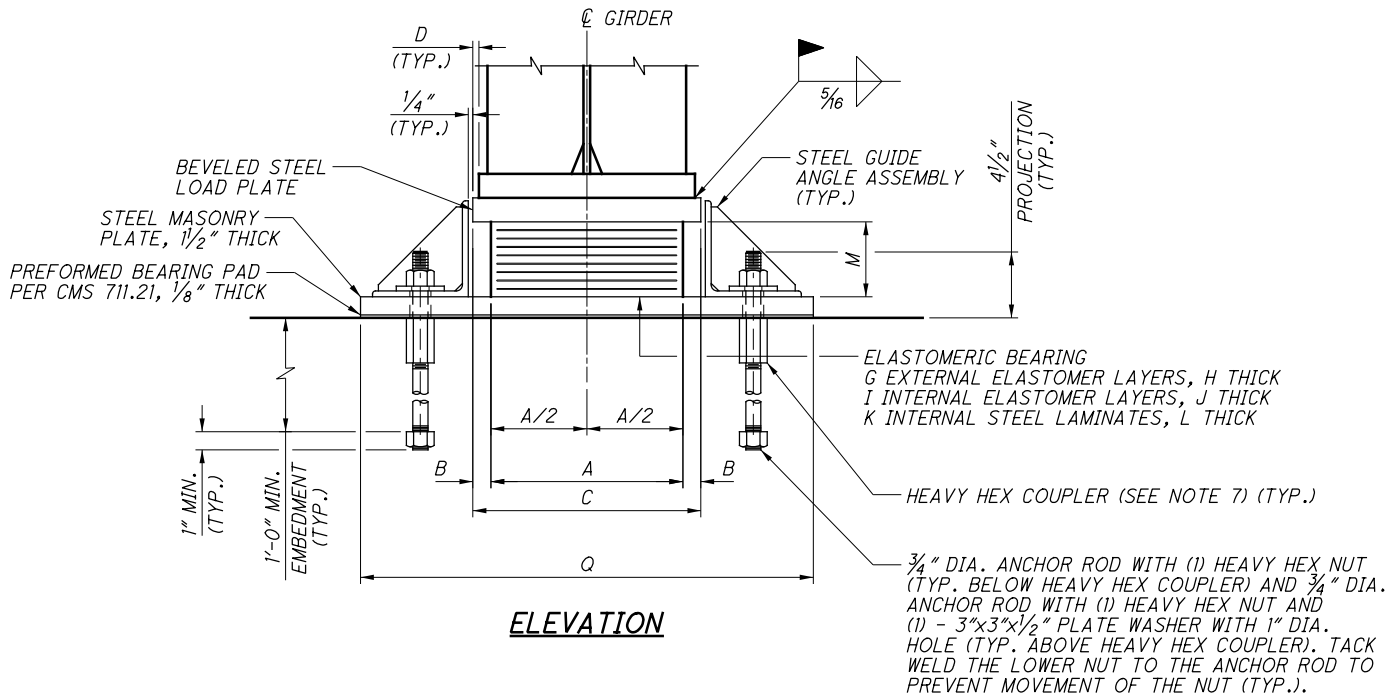


ELEVATION

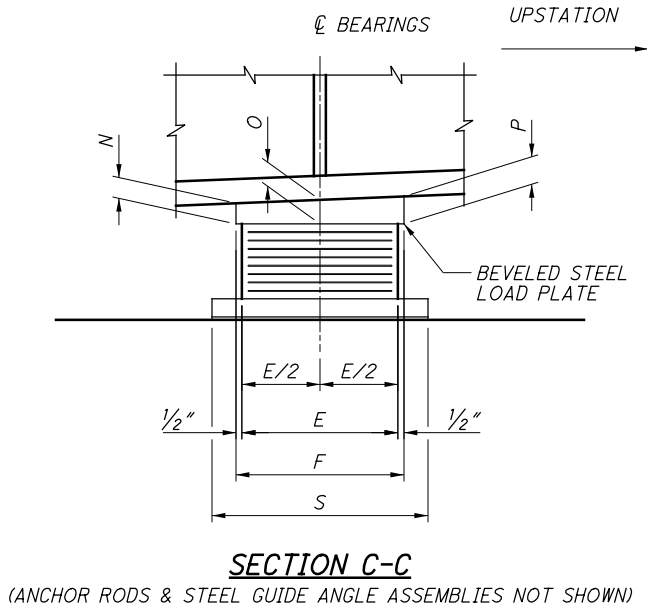


SECTION C-C

(ANCHOR RODS & STEEL GUIDE ANGLE ASSEMBLIES NOT SHOWN)

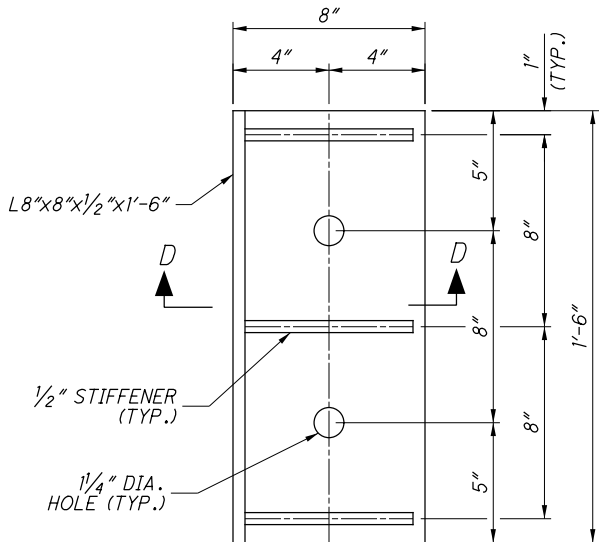

GUIDE ANGLE ASSEMBLY DETAIL

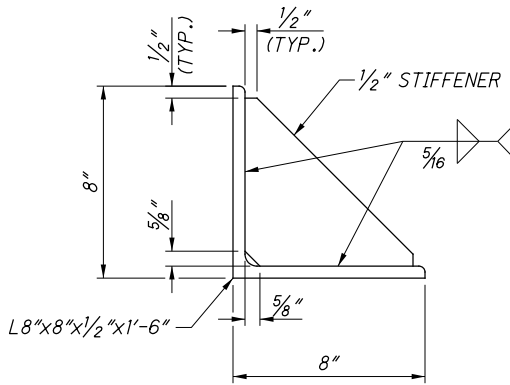

SECTION D-D

NOTES:

1. SEE SHEET 39 / 60 FOR NOTES AND TABLE OF DIMENSIONS.

2025-03-13 - BU-11 - RECORD DRAWING PLANS

SUM-76/77/8-
8.24/9.74/0.00
PID No. 102329

ELASTOMERIC BEARING DETAILS - 2

SUM-76-1152N
RAMP N OVER RAMP S, LANE O, IR-76 EB, SR-8 NB/SB, LANE M

DESIGNED
SJA
CHECKED
BCS

REVIEWED
JCS
DRAWN
BCS
REVISED

DATE
4/29/19
STRUCTURE FILE NUMBER
7705973

DESIGN AGENCY
BURGESS & NIPLE
Engineers ■ Architects ■ Planners
5045 REED ROAD, COLUMBUS, OHIO 43220

38 / 60

39
61

ISSUE RECORD:		DESCRIPTION
NO.	DATE	

BEARING DIMENSIONS																							DESIGN LOADS SERVICE LIMIT STATE (KIPS)		
SUBSTRUCTURE	GIRDER	A	B	C	D	E	F	G	H	I	J	K	L	M	N	O	P	Q	R	S	T	U	DL	LL	TOTAL
REAR ABUTMENT	G1	1'-8"	1½"	1'-11"	0½"	1'-2"	1'-3"	0	--	9	0.625"	8	0.0747"	6¼"	1½"	2"	2½"	3'-4½"	0'-10½"	1'-6"	1½"	1'-3¾"	130.9	100.8	231.7
	G2				2½"																		96.4	80.1	176.5
	G3				2½"																		93.1	84.5	177.6
	G4				2½"																		92.6	71.2	163.8
PIER 1	G1	1'-8"	1½"	1'-11"	0½"	1'-5"	1'-6"	1	0.306"	7	0.4375"	7	0.0747"	3⅞"	1½"	2⅛"	2¾"	--	--	--	--	--	347.1	173.5	520.5
	G2				2½"																		292.3	140.6	432.9
	G3				2½"																		266.4	137.3	403.7
	G4				2½"																		341.2	155.0	496.1
PIER 2	G1	1'-8"	4½"	2'-5"	4½"	1'-5"	1'-6"	1	0.306"	5	0.4375"	5	0.0747"	2⅞"	1⅝"	2"	2¾"	--	--	--	--	--	310.7	173.7	484.4
	G2				4½"																		258.4	140.3	398.7
	G3				4½"																		243.2	134.0	377.2
	G4				4½"																		312.8	154.6	467.4
PIER 3	G1	1'-8"	4½"	2'-5"	4½"	1'-5"	1'-6"	1	0.306"	5	0.4375"	5	0.0747"	2⅞"	1⅝"	2"	2¾"	--	--	--	--	--	321.6	171.3	493.0
	G2				4½"																		281.8	142.8	424.6
	G3				4½"																		264.4	137.0	401.3
	G4				4½"																		323.3	154.4	477.7
PIER 4	G1	1'-8"	0½"	1'-9"	0½"	1'-5"	1'-6"	1	0.306"	9	0.4375"	9	0.0747"	4⅝"	2"	2"	2"	--	--	--	--	--	297.6	162.0	459.6
	G2				0½"																		261.0	136.9	397.9
	G3				0½"																		242.5	131.8	374.2
	G4				0½"																		293.1	143.2	436.3
FORWARD ABUTMENT	G1	1'-6"	2½"	1'-11"	0½"	1'-2"	1'-3"	0	--	10	0.625"	9	0.0747"	6⅝"	2¼"	2⅞"	2"	3'-4½"	0'-11½"	1'-6"	1½"	1'-3¾"	90.5	91.0	181.5
	G2				0½"																		68.4	75.7	144.1
	G3				0½"																		68.4	78.6	147.1
	G4				0½"																		76.0	68.0	144.0

NOTES:

1. ELASTOMERIC BEARINGS: THE ELASTOMER SHALL HAVE A HARDNESS OF 50 DUROMETER. THE BEARINGS WERE DESIGNED IN ACCORDANCE WITH SECTION 14.7.5 (METHOD B) OF THE AASHTO LRFD BRIDGE DESIGN SPECIFICATIONS. PERFORM THE LONG-TERM COMPRESSION PROOF LOAD TEST IN ACCORDANCE WITH THE AASHTO STANDARD SPECIFICATIONS FOR HIGHWAY BRIDGES, DIVISION II, SECTION 18.7.2.6 AND 18.7.4.5.
2. STEEL LOAD PLATES, MASONRY PLATES, GUIDE ANGLE ASSEMBLIES, AND PLATE WASHERS SHALL BE ASTM A709, GRADE 50. STEEL LOAD PLATES SHALL BE FIELD PAINTED (ALTERNATE 1) OR GALVANIZED ACCORDING TO 711.02 (ALTERNATE 2). MASONRY PLATES, GUIDE ANGLE ASSEMBLIES, AND PLATE WASHERS SHALL BE GALVANIZED ACCORDING TO 711.02. ANCHOR RODS SHALL BE ASTM F1554, GRADE 105, GALVANIZED ACCORDING TO 711.02. HEAVY HEX NUTS AND COUPLERS SHALL BE ASTM A563, GRADE DH OR DH3, GALVANIZED ACCORDING TO 711.02, AND LUBRICATED WITH A LUBRICANT CONTAINING A VISIBLE DYE.
3. VULCANIZE THE LOAD PLATE AND MASONRY PLATE (WHERE APPLICABLE) TO THE ELASTOMER DURING THE MOLDING PROCESS.
4. SHOP MARK THE LOAD PLATES WITH THE FOLLOWING INFORMATION: TOP, UPSTATION DIRECTION, AND SUBSTRUCTURE LOCATION (R.A., PIER 1, PIER 3 REAR, ETC.). ALL MARKS SHALL BE PERMANENT AND VISIBLE AFTER THE BEARING IS INSTALLED.

NOTES, CONTINUED:

5. WHERE A MASONRY PLATE IS BONDED TO THE ELASTOMER AT THE BOTTOM OF THE BEARING AND A LOAD PLATE IS BONDED TO THE ELASTOMER AT THE TOP OF THE BEARING, ALL ELASTOMER LAYERS SHALL BE DESIGNATED AS INTERNAL LAYERS. WHERE A LOAD PLATE IS BONDED TO THE ELASTOMER AT THE TOP OF THE BEARING, AND NO MASONRY PLATE IS PRESENT, ONLY THE BOTTOM ELASTOMER LAYER SHALL BE DESIGNATED AS AN EXTERIOR LAYER.
6. ANCHOR RODS SHALL BE CAST-IN-PLACE. DRILLING AND GROUTING WILL NOT BE PERMITTED.
7. UPPER AND LOWER ANCHOR RODS SHALL BE THREADED INTO HEAVY HEX COUPLER BY 1" MINIMUM FOR ¾" DIA. ANCHOR RODS AND 1½" MINIMUM FOR 1¼" DIA. ANCHOR RODS.
8. BASIS OF PAYMENT: THE UNIT PRICE INCLUDES ALL MATERIAL, LABOR, TESTING, AND INCIDENTALS NECESSARY TO FURNISH AND INSTALL LAMINATED ELASTOMERIC BEARINGS INCLUDING BEVELED STEEL LOAD PLATES, MASONRY PLATES, GUIDE ANGLE ASSEMBLIES, PREFORMED BEARING PADS, ANCHOR RODS, NUTS, AND WASHERS. PAYMENT WILL BE INCLUDED WITH THE APPROPRIATE 516 ITEM.

2025-03-13 - BU-11 - RECORD DRAWING PLANS

SUM-76/77/8-8.24/9.74/0.00

PID No. 102329

39/60

4061

ELASTOMERIC BEARING DETAILS - 3

SUM-76-1152N

RAMP N OVER RAMP S, LANE O, IR-76 EB, SR-8 NB/SB, LANE M

DESIGN AGENCY


BURGESS & NIPLE

Engineers ■ Architects ■ Planners

5045 REED ROAD, COLUMBUS, OHIO 43220


ISSUE RECORD:		DESCRIPTION
NO.	DATE	

p:\V\ANV\A01PW\INT01.parsons.com:Ohio State\Documents\VB-Akron Beltway Rehab\10 - Design\102329\Structures\SUM076_1152N\Sheets\076_1149R_SD001.dgn Sheet 6/23/2021 8:34:50 AM KChrismon

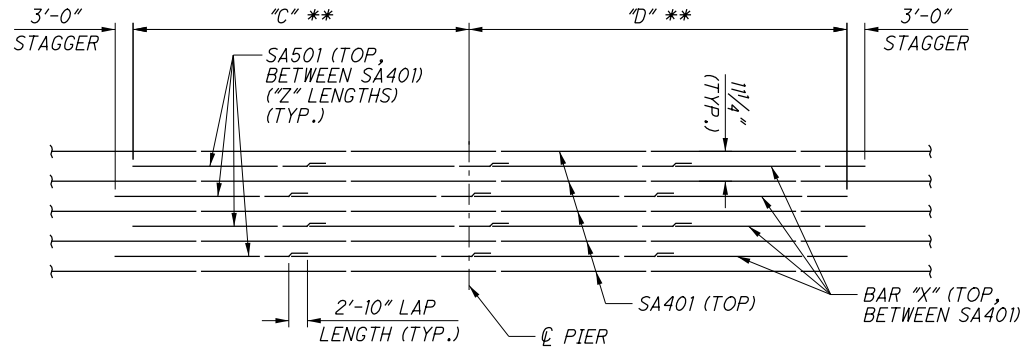

ADDITIONAL REINFORCING OVER PIER DIAGRAM
(** = EVERY OTHER BAR)

	PIER 1	PIER 2	PIER 3	PIER 4
DIM. "C"	49'-0"	51'-0"	48'-0"	29'-0"
DIM. "D"	51'-0"	49'-0"	49'-0"	50'-0"
BAR "X"	SA507	SA507	SA508	N/A
LENGTHS "Z"	3	3	3	3

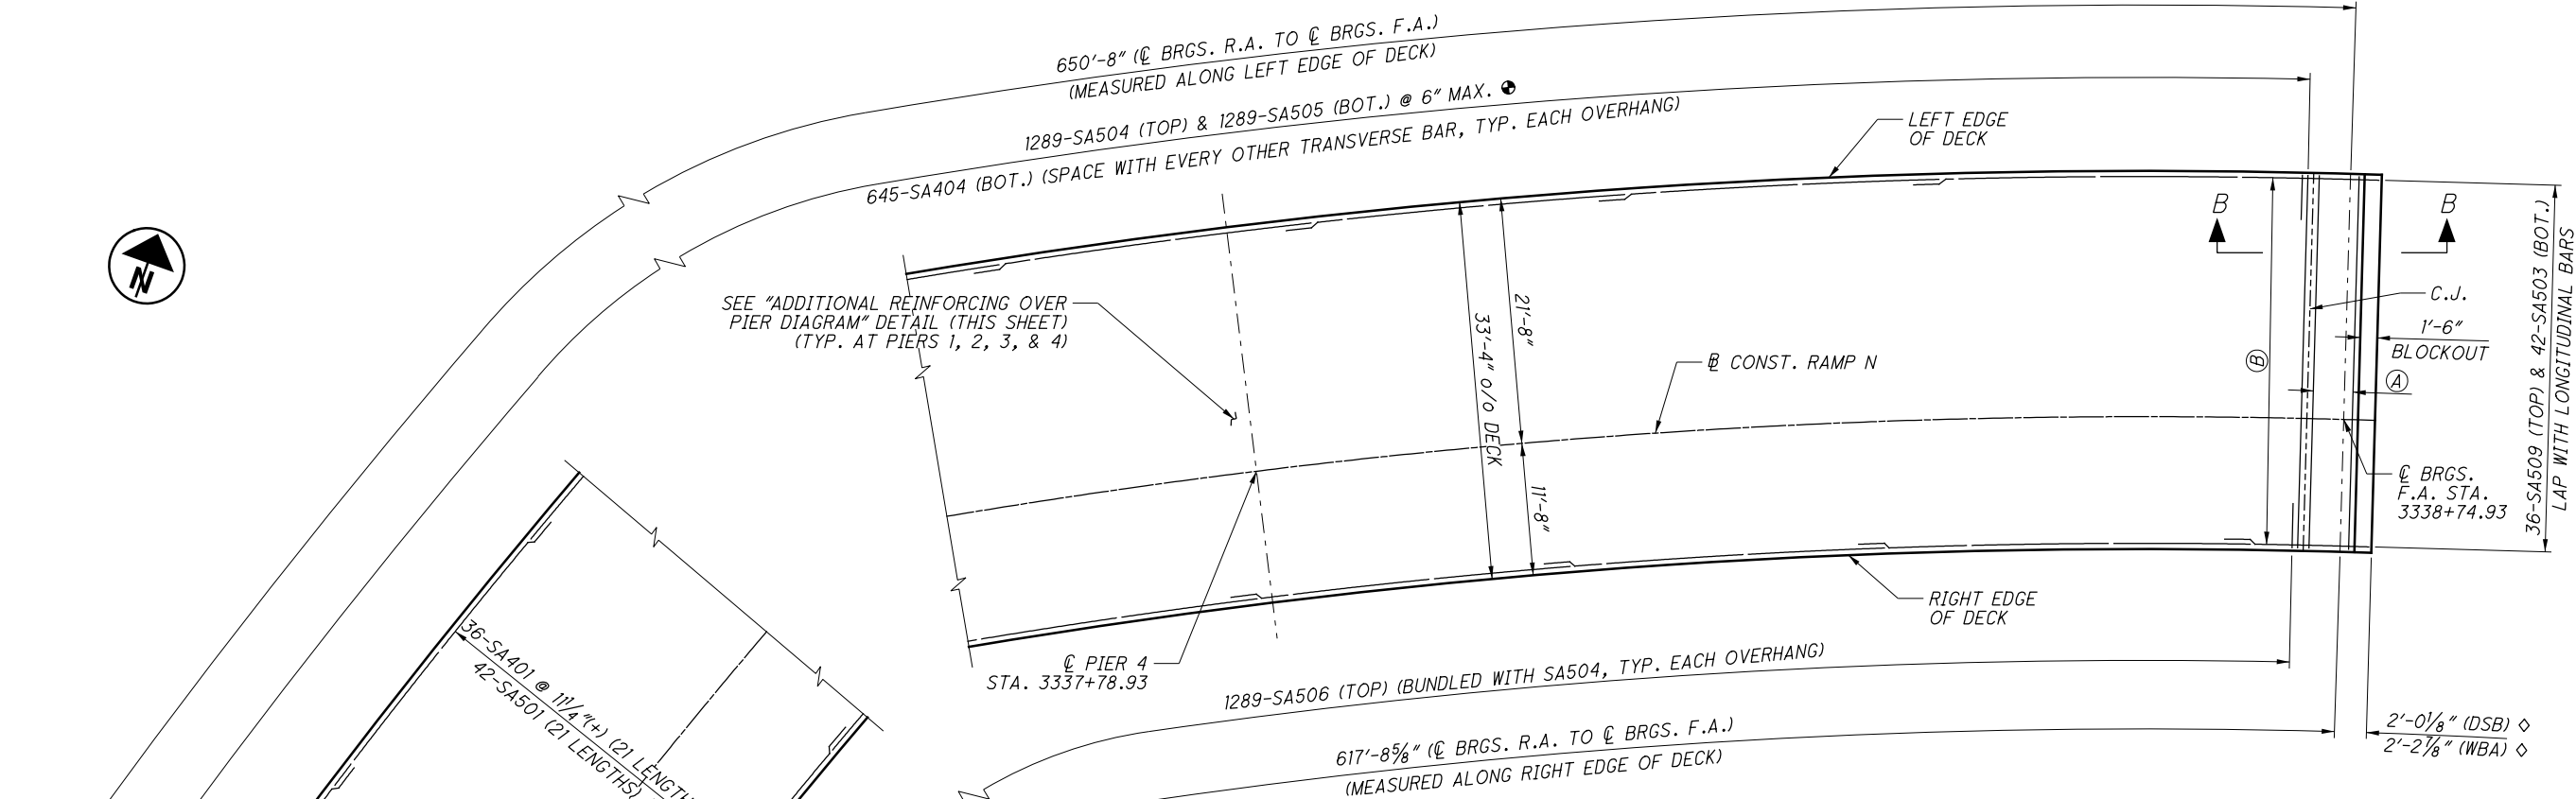

DECK SLAB PLAN

(TRANSVERSE DIMENSIONS ARE MEASURED RADIALLY)

LEGEND:

- DSB = DS BROWN
WBA = WATSON BOWMAN ACME
- Δ = SEE TRANSVERSE SECTION FOR SPACING
- = PLACED RADIALLY TO EDGE OF DECK
- ◇ = DIMENSION VARIES WITH TEMPERATURE. DIMENSION IS SHOWN AT 60°F.
- Ⓐ = 8-SA504 (BUNDLE WITH 8-SA506 AT EACH EDGE OF DECK) @ EQ. SPA. (TOP) & 8-SA505 @ EQ. SPA. (BOT.)
- Ⓑ = 1 S.O. 36-SA402 @ 11 1/4" (+) (TOP)
1 S.O. 42-SA502 (BOT.) Δ

NOTES:

- SEE TRANSVERSE SECTION ON SHEET 40 / 60 FOR ADDITIONAL DECK REINFORCING STEEL DETAILS.
- LAP REINFORCING STEEL THE FOLLOWING MINIMUM LENGTHS:
LONGITUDINAL STEEL:
#4 BARS (TOP) = 1'-10"
#5 BARS (BOT) = 2'-3"
- SEE SHEET 42 / 60 FOR SECTIONS A-A & B-B AND ADDITIONAL REINFORCING STEEL AT ABUTMENT MODULAR JOINTS.
- SEE SHEET 43 / 60 FOR DECK POUR SEQUENCE.
- TRANSVERSE BARS SHALL BE PLACED RADIALLY TO THE EDGE OF DECK. SPACINGS ARE PROVIDED ALONG THE LEFT EDGE OF DECK.

2025-03-13 - BU-11 - RECORD DRAWING PLANS

SUM-76/77/8-8.24/9.74/0.00
PID No. 102329

41/60

42/61

DECK SLAB PLAN
SUM-76-1152N
RAMP N OVER RAMP S, LANE O, IR-76 EB, SR-8 NB/SB, LANE M

DESIGN AGENCY
BURGESS & NIPLE
Engineers ■ Architects ■ Planners
5045 REED ROAD, COLUMBUS, OHIO 43220

DATE
4/29/19

REVIEWED
JCS

DRAWN
ASG



DESIGNED
ASG

CHECKED
XAC

STRUCTURE FILE NUMBER
7705973

ISSUE RECORD:		DESCRIPTION
NO.	DATE	

p:\V\ANV\A01PWINT01.parsons.com:Ohio State\Documents\DB-Akron Beltway Rehab\10 - Design\102329\Structures\SUM076_1152N\Sheets\076_1149R_SDO02.dgn Sheet 6/23/2021 8:34:56 AM KChrisman

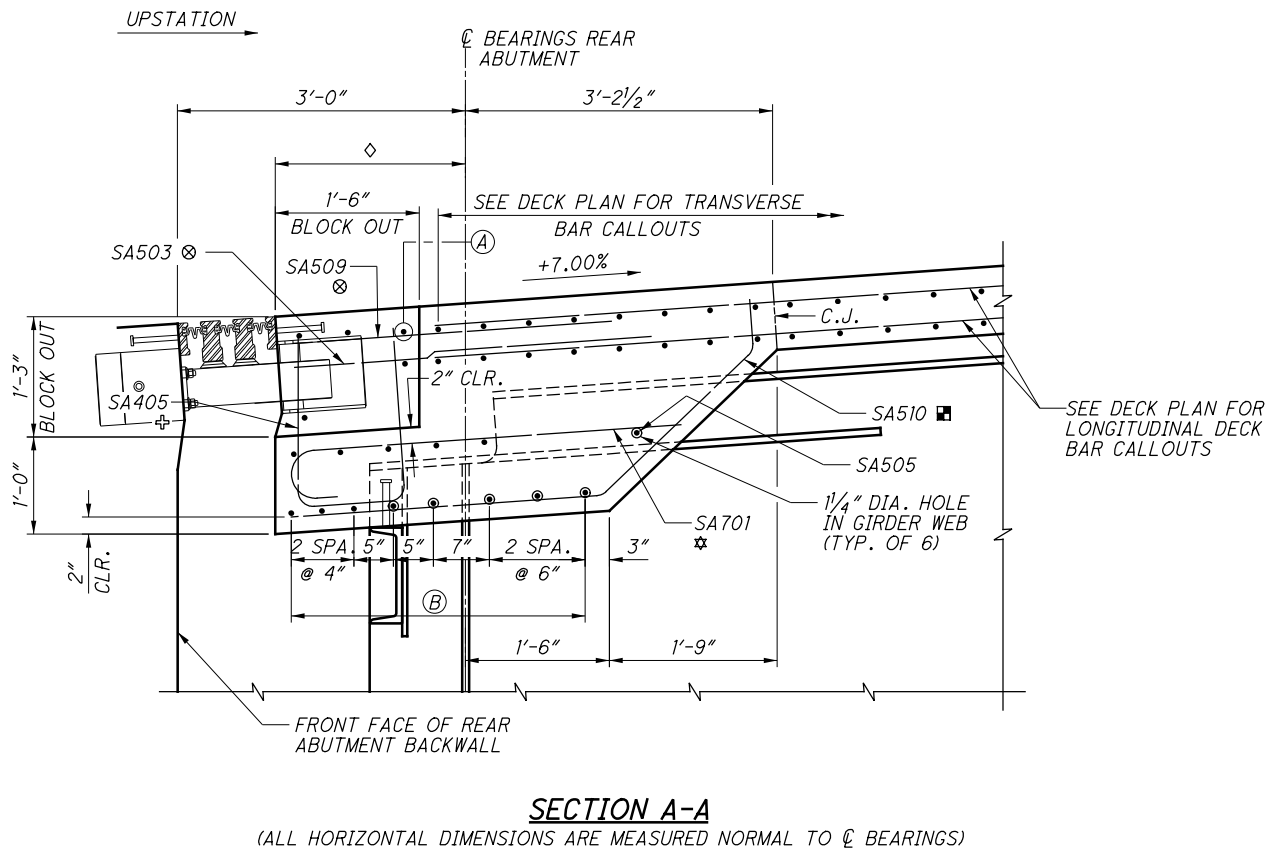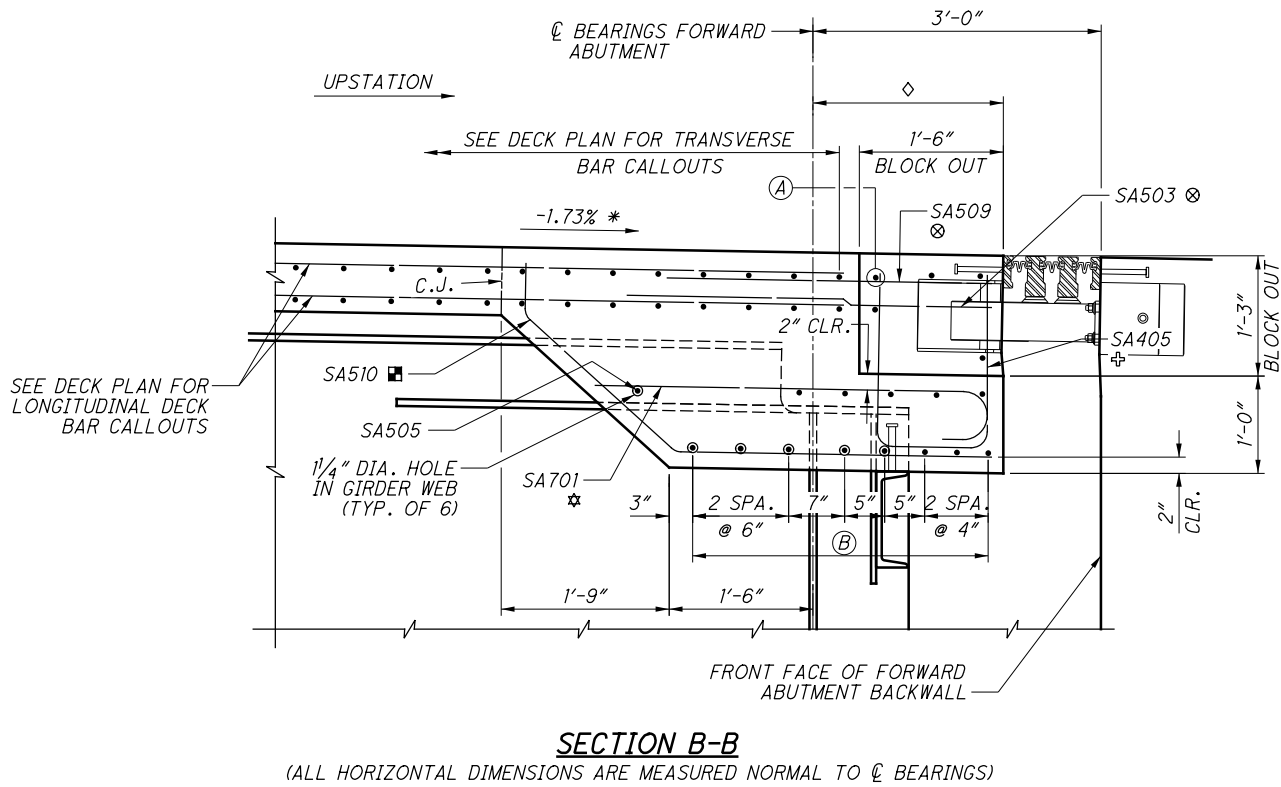

LEGEND:

- WBA = WATSON BOWMAN ACME
- * = GRADE VARIES DUE TO VERTICAL CURVE. THE GRADE SHOWN IS THE INSTANTANEOUS GRADE AT THE FRONT FACE OF THE FORWARD ABUTMENT BACKWALL.
- $\diamond$ = 2'-0 1/8" (DS BROWN), 2'-2 7/8" (WBA), AT 60° F. SEE SHEET 51 / 60 FOR ADJUSTMENT OF JOINT OPENINGS AT TEMPERATURES OTHER THAN 60° F.
- $\otimes$ = LAP WITH LONGITUDINAL DECK BARS (SEE DECK PLANS FOR LAP LENGTHS) AND FIELD CUT AS NECESSARY TO AVOID INTERFERENCE WITH JOINT SUPPORT BOXES. REPAIR FIELD-CUT BAR ENDS PER 509. PLACE SA509 BARS BELOW TOP TRANSVERSE BARS AS SHOWN.
- $\oplus$ = SPACE SA405 BARS WITH BOTTOM LONGITUDINAL DECK BARS AND OMIT SA405 BARS WHERE INTERFERENCE WITH TOP FLANGE OR JOINT SUPPORT BOXES OCCURS. AS AN ALTERNATIVE TO OMITTING BARS AT JOINT SUPPORT BOXES, THE CONTRACTOR MAY FIELD CUT SA405 BARS AT OR NEAR THE BOTTOM OF THE BLOCK OUT. REPAIR FIELD-CUT BAR ENDS PER 509.
- $\star$ = SPACE DESIGNATED BARS WITH BOTTOM LONGITUDINAL DECK BARS.
- $\blacksquare$ = SPACE DESIGNATED BARS WITH BOTTOM LONGITUDINAL DECK BARS AND OMIT BARS WHERE INTERFERENCE WITH TOP FLANGE OCCURS.
- (A) = SA406 (TYP. OF 5 WITHIN BLOCK OUT)
- (B) = 5-SA504 (TOP)
8-SA505 (BOTTOM)
BUNDLE 1-SA506 WITH TOP BARS AT EACH END, SIMILAR TO HOW SHOWN ON DECK SLAB REINFORCING STEEL DETAILS ON SHEET 40 / 60

NOTES:

1. SEE SHEETS 51 / 60 AND 52 / 60 FOR ADDITIONAL MODULAR JOINT DETAILS.

2025-03-13 - BU-11 - RECORD DRAWING PLANS

SUM-76/77/8-
8.24/9.74/0.00
PID No. 102329

DECK DETAILS
SUM-76-1152N

RAMP N OVER RAMP S, LANE O, IR-76 EB, SR-8 NB/SB, LANE M

DESIGNED
ASG/BES

CHECKED
XAC

DRAWN
ASG

REVISED

REVIEWED
JCS

DATE
4/29/19


STRUCTURE FILE NUMBER
7705973

DESIGN AGENCY
BURGESS & NIPLE
Engineers ■ Architects ■ Planners
5045 REED ROAD, COLUMBUS, OHIO 43220

42 / 60

43
61


ISSUE RECORD:		DESCRIPTION
NO.	DATE	

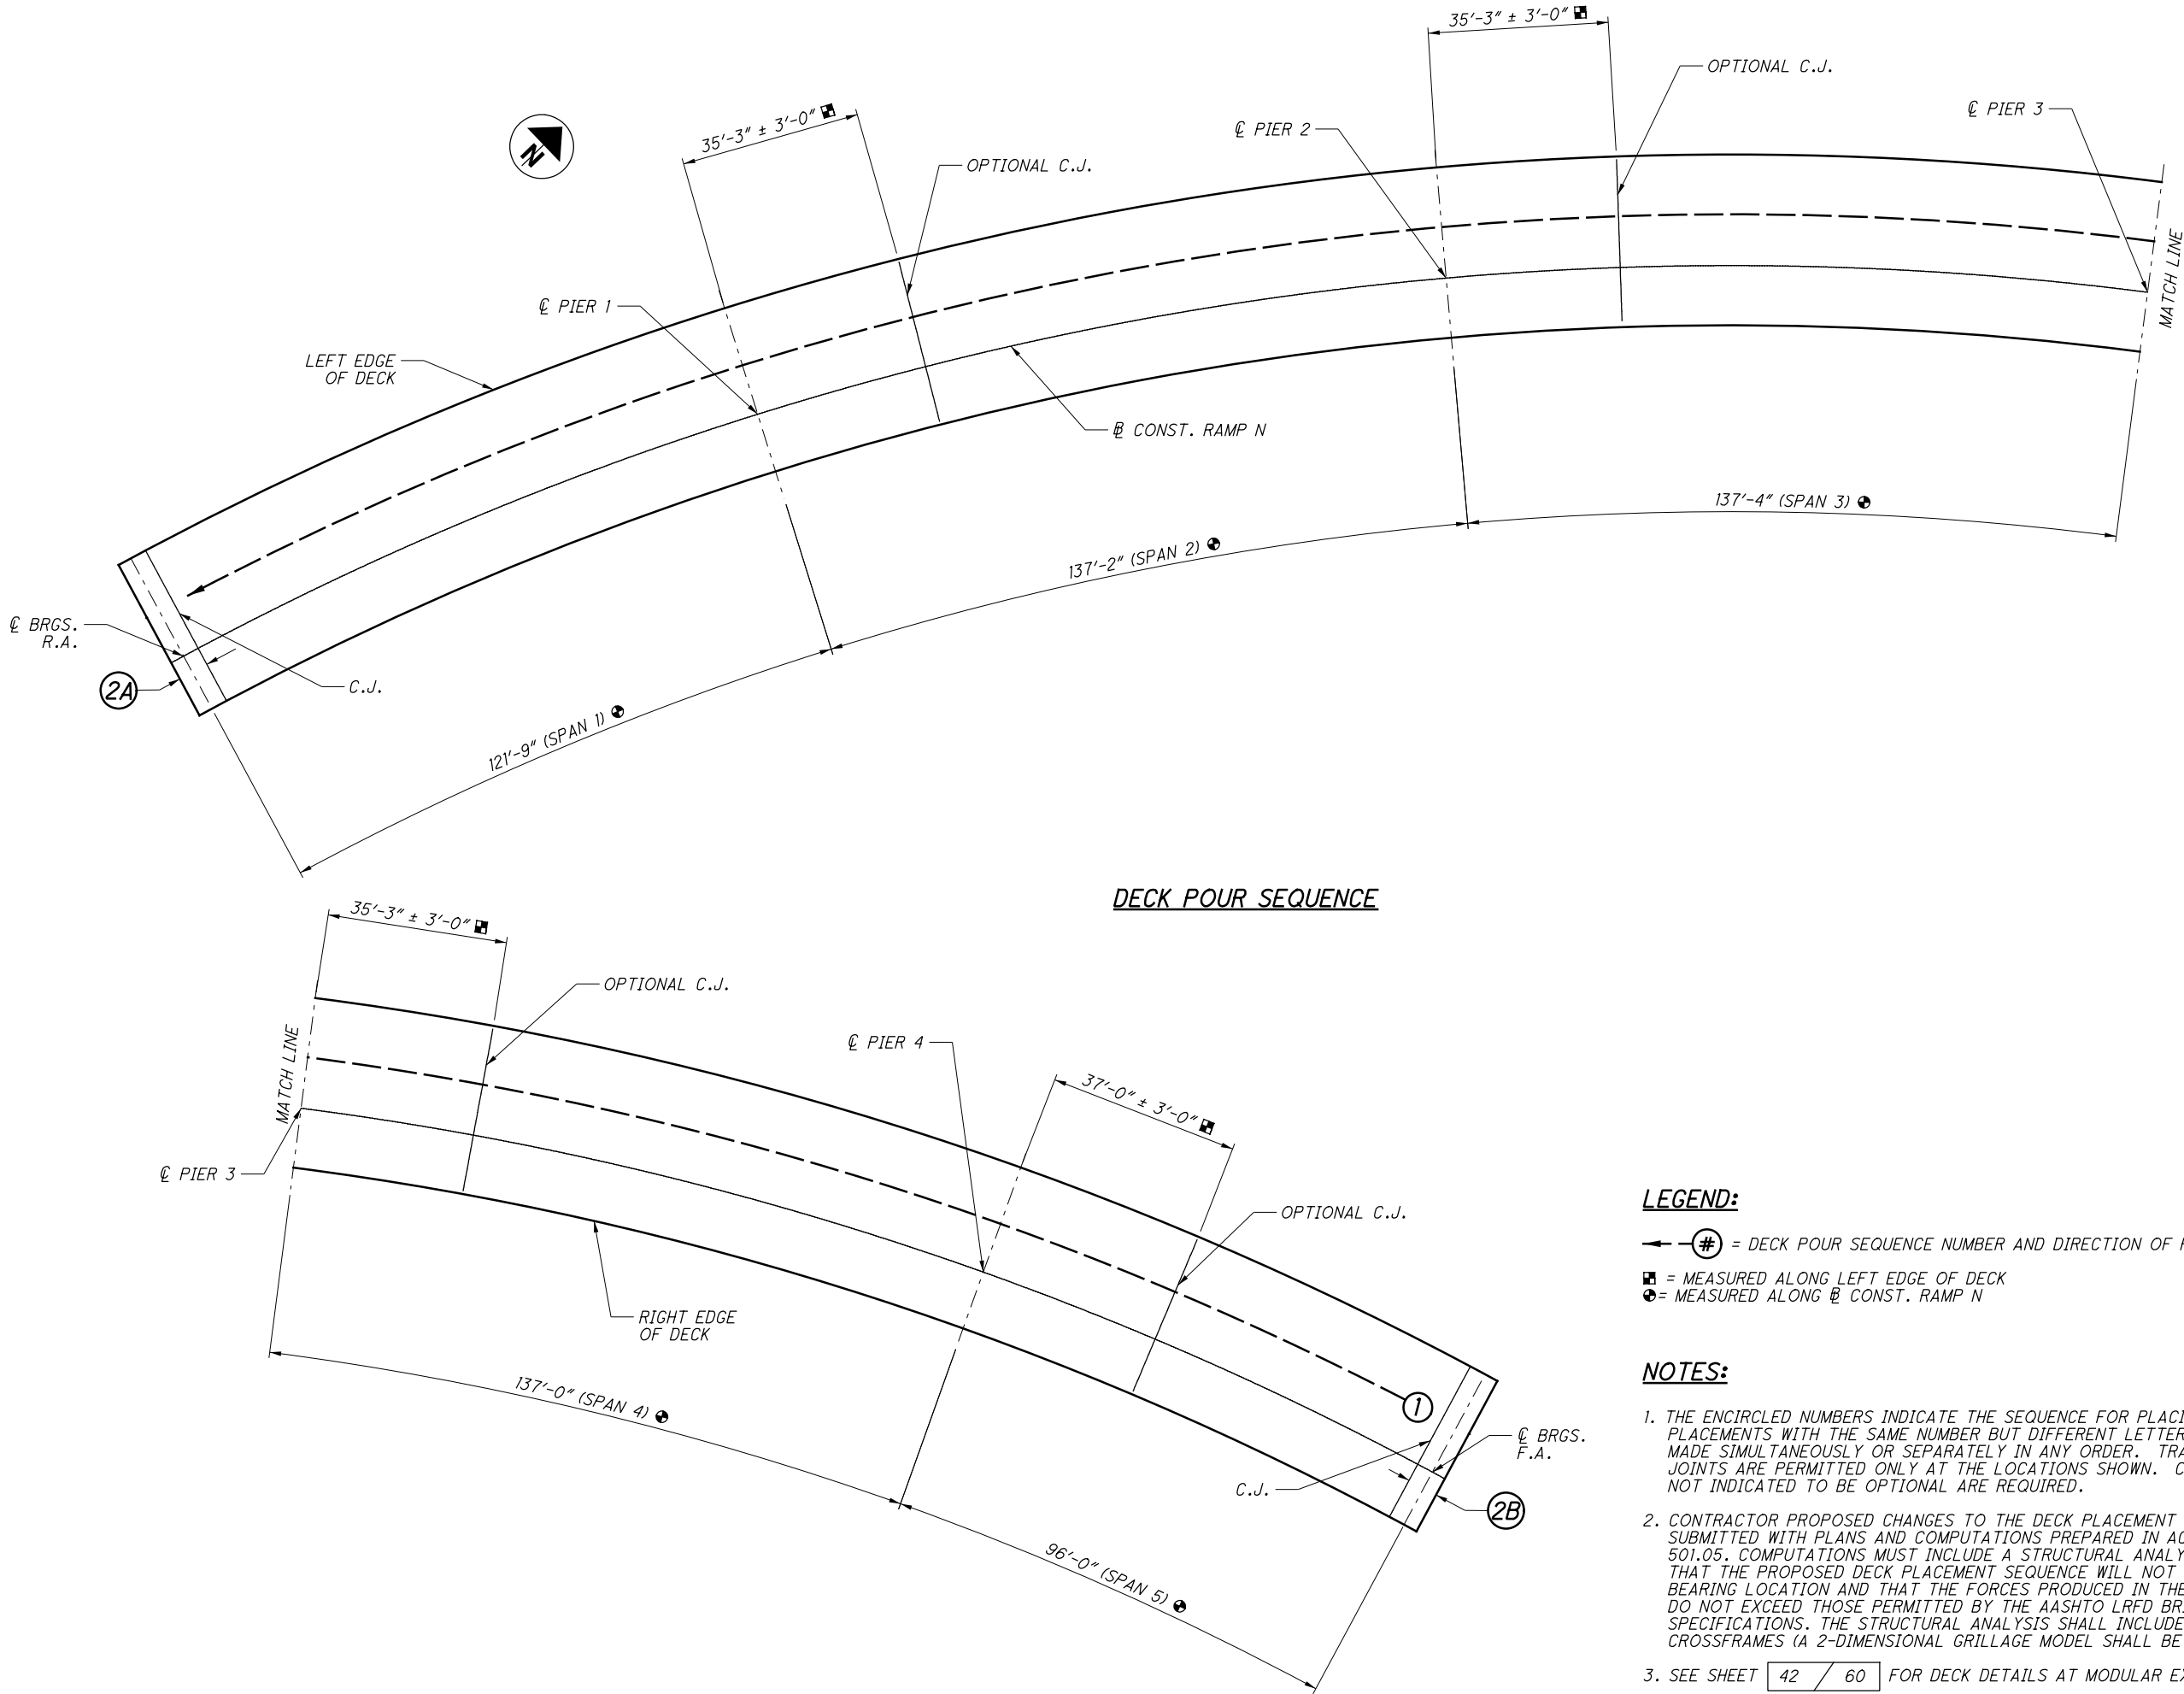


- LEGEND:**
- ➔ (1) = DECK POUR SEQUENCE NUMBER AND DIRECTION OF POUR
 - ▣ = MEASURED ALONG LEFT EDGE OF DECK
 - ⊕ = MEASURED ALONG CL CONST. RAMP N
- NOTES:**
- THE ENCIRCLED NUMBERS INDICATE THE SEQUENCE FOR PLACING THE SLAB SECTIONS. PLACEMENTS WITH THE SAME NUMBER BUT DIFFERENT LETTER DESIGNATIONS MAY BE MADE SIMULTANEOUSLY OR SEPARATELY IN ANY ORDER. TRANSVERSE CONSTRUCTION JOINTS ARE PERMITTED ONLY AT THE LOCATIONS SHOWN. CONSTRUCTION JOINTS NOT INDICATED TO BE OPTIONAL ARE REQUIRED.
 - CONTRACTOR PROPOSED CHANGES TO THE DECK PLACEMENT SEQUENCE MUST BE SUBMITTED WITH PLANS AND COMPUTATIONS PREPARED IN ACCORDANCE WITH CMS 501.05. COMPUTATIONS MUST INCLUDE A STRUCTURAL ANALYSIS DEMONSTRATING THAT THE PROPOSED DECK PLACEMENT SEQUENCE WILL NOT CAUSE UPLIFT AT ANY BEARING LOCATION AND THAT THE FORCES PRODUCED IN THE STEEL SUPERSTRUCTURE DO NOT EXCEED THOSE PERMITTED BY THE AASHTO LRFD BRIDGE DESIGN SPECIFICATIONS. THE STRUCTURAL ANALYSIS SHALL INCLUDE ALL GIRDERS AND CROSSFRAMES (A 2-DIMENSIONAL GRILLAGE MODEL SHALL BE USED AT A MINIMUM).
 - SEE SHEET 42 / 60 FOR DECK DETAILS AT MODULAR EXPANSION JOINTS.

ISSUE RECORD:		DESCRIPTION
NO.	DATE	

p:\V\ANV\A01PW\INT01.parsons.com:Ohio State\Documents\DB-Akron Beltway Rehab\10 - Design\102329\Structures\SUM076_1152N\Sheets\076_1149R_SS003.dgn Sheet 6/23/2021 8:35:08 AM KChrisman

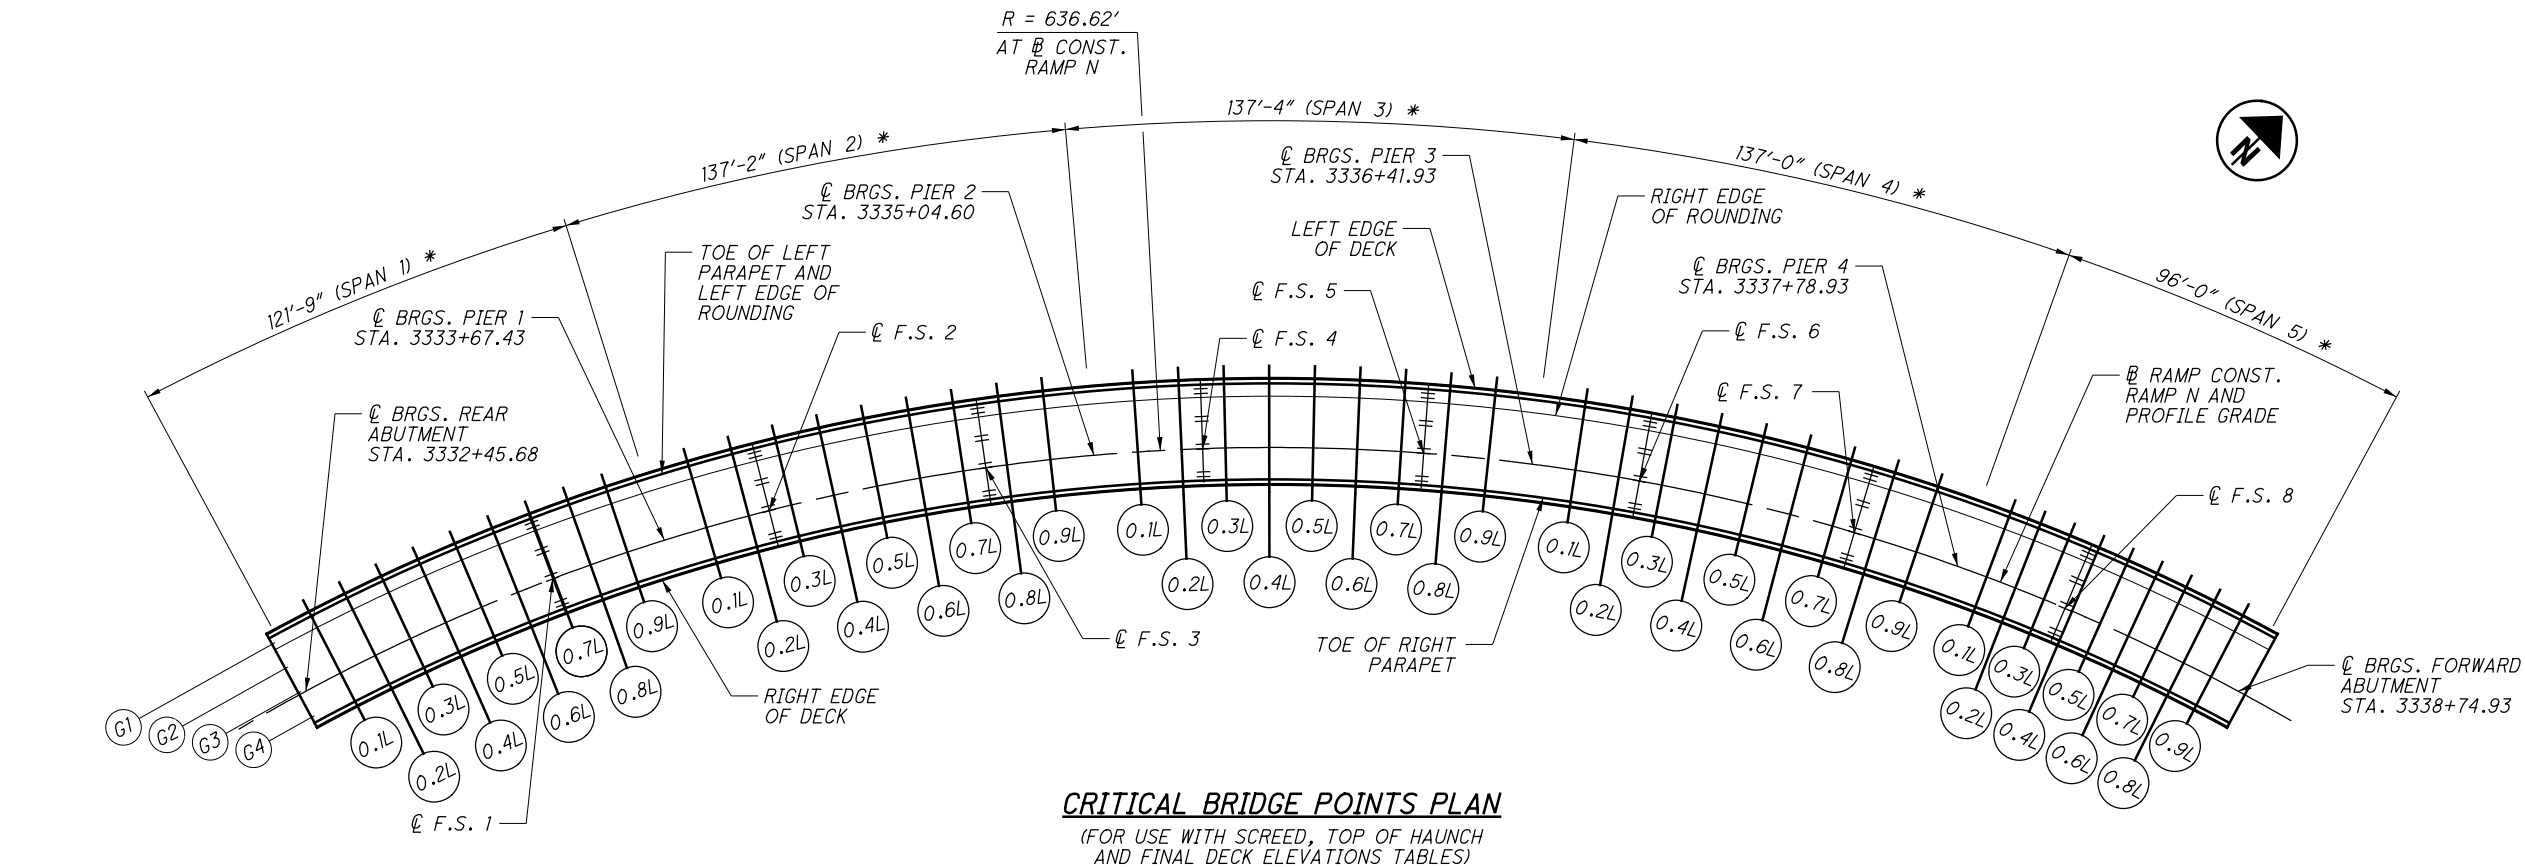

CRITICAL BRIDGE POINTS PLAN
(FOR USE WITH SCREED, TOP OF HAUNCH
AND FINAL DECK ELEVATIONS TABLES)

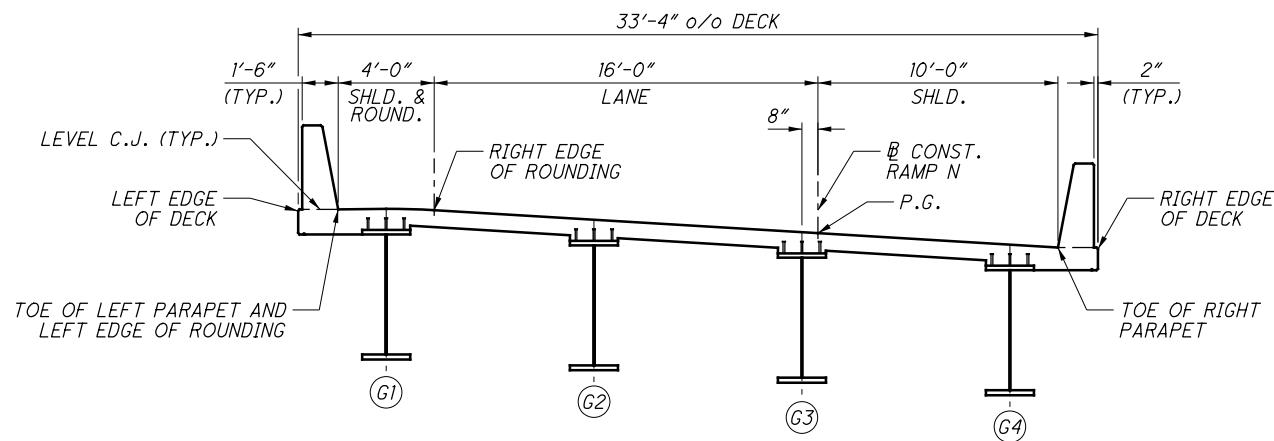

CRITICAL BRIDGE POINTS TRANSVERSE SECTION
(TRANSVERSE DIMENSIONS ARE MEASURED RADIALLY)

LEGEND:

* = MEASURED ALONG $\emptyset$ CONST. RAMP N
L = SPAN LENGTH

NOTES:

- SEE SHEET 46 / 60 FOR TOP OF HAUNCH ELEVATION TABLES.
- SEE SHEET 47 / 60 FOR FINISHED DECK ELEVATION TABLES.
- SEE SHEET 45 / 60 FOR SCREED ELEVATION TABLES.

2025-03-13 - BU-11 - RECORD DRAWING PLANS

SUM-76/77/8-
8.24/9.74/0.00

PID No. 102329

CRITICAL BRIDGE POINTS

SUM-76-1152N
RAMP N OVER RAMP S, LANE O, IR-76 EB, SR-8 NB/SB, LANE M

DESIGNED
ODW
CHECKED
BCS

DRAWN
ODW
REVISED

REVIEWED
JCS
DATE
4/29/19
STRUCTURE FILE NUMBER
7705973

DESIGN AGENCY
BURGESS & NIPLE
Engineers ■ Architects ■ Planners
5045 REED ROAD, COLUMBUS, OHIO 43220

44/60

45/61

ISSUE RECORD:		DESCRIPTION
NO.	DATE	

SCREED ELEVATIONS								
LOCATION	LEFT EDGE OF ROUNDING / TOE OF LEFT PARAPET		RIGHT EDGE OF ROUNDING		PROFILE GRADE		TOE OF RIGHT PARAPET	
	STA.	ELEV.	STA.	ELEV.	STA.	ELEV.	STA.	ELEV.
⌒ BRGS. R. A.	3332+45.68	1103.85	3332+45.68	1103.81	3332+45.68	1102.85	3332+45.68	1102.25
0.1	3332+57.86	1104.77	3332+57.86	1104.74	3332+57.86	1103.76	3332+57.86	1103.16
0.2	3332+70.03	1105.69	3332+70.03	1105.65	3332+70.03	1104.67	3332+70.03	1104.06
0.3	3332+82.21	1106.60	3332+82.21	1106.56	3332+82.21	1105.56	3332+82.21	1104.95
0.4	3332+94.38	1107.46	3332+94.38	1107.42	3332+94.38	1106.42	3332+94.38	1105.81
0.5	3333+06.56	1108.31	3333+06.56	1108.27	3333+06.56	1107.27	3333+06.56	1106.66
0.6	3333+18.73	1109.13	3333+18.73	1109.10	3333+18.73	1108.10	3333+18.73	1107.49
F.S. 1	3333+30.47	1109.91	3333+30.47	1109.87	3333+30.47	1108.89	3333+30.47	1108.28
0.7	3333+30.91	1109.94	3333+30.91	1109.90	3333+30.91	1108.92	3333+30.91	1108.31
0.8	3333+43.08	1110.74	3333+43.08	1110.70	3333+43.08	1109.73	3333+43.08	1109.12
0.9	3333+55.26	1111.54	3333+55.26	1111.50	3333+55.26	1110.53	3333+55.26	1109.93
⌒ PIER 1	3333+67.43	1112.33	3333+67.43	1112.29	3333+67.43	1111.33	3333+67.43	1110.73
0.1	3333+81.15	1113.22	3333+81.15	1113.18	3333+81.15	1112.23	3333+81.15	1111.63
0.2	3333+94.86	1114.11	3333+94.86	1114.07	3333+94.86	1113.12	3333+94.86	1112.52
F.S. 2	3334+01.47	1114.53	3334+01.47	1114.49	3334+01.47	1113.54	3334+01.47	1112.95
0.3	3334+08.58	1114.97	3334+08.58	1114.93	3334+08.58	1113.98	3334+08.58	1113.39
0.4	3334+22.30	1115.80	3334+22.30	1115.76	3334+22.30	1114.81	3334+22.30	1114.22
0.5	3334+36.02	1116.59	3334+36.02	1116.55	3334+36.02	1115.60	3334+36.02	1115.00
0.6	3334+49.73	1117.32	3334+49.73	1117.28	3334+49.73	1116.33	3334+49.73	1115.73
0.7	3334+63.45	1118.01	3334+63.45	1117.97	3334+63.45	1117.02	3334+63.45	1116.42
F.S. 3	3334+70.56	1118.35	3334+70.56	1118.31	3334+70.56	1117.36	3334+70.56	1116.76
0.8	3334+77.17	1118.66	3334+77.17	1118.62	3334+77.17	1117.67	3334+77.17	1117.07
0.9	3334+90.88	1119.28	3334+90.88	1119.24	3334+90.88	1118.28	3334+90.88	1117.69
⌒ PIER 2	3335+04.60	1119.89	3335+04.60	1119.85	3335+04.60	1118.89	3335+04.60	1118.29
0.1	3335+18.33	1120.49	3335+18.33	1120.46	3335+18.33	1119.49	3335+18.33	1118.89
0.2	3335+32.07	1121.09	3335+32.07	1121.05	3335+32.07	1120.08	3335+32.07	1119.48
F.S. 4	3335+38.64	1121.36	3335+38.64	1121.33	3335+38.64	1120.36	3335+38.64	1119.76
0.3	3335+45.80	1121.65	3335+45.80	1121.61	3335+45.80	1120.64	3335+45.80	1120.04
0.4	3335+59.53	1122.17	3335+59.53	1122.14	3335+59.53	1121.16	3335+59.53	1120.56
0.5	3335+73.27	1122.65	3335+73.27	1122.61	3335+73.27	1121.64	3335+73.27	1121.04
0.6	3335+87.00	1123.06	3335+87.00	1123.03	3335+87.00	1122.05	3335+87.00	1121.45
0.7	3336+00.73	1123.43	3336+00.73	1123.40	3336+00.73	1122.43	3336+00.73	1121.83
F.S. 5	3336+07.89	1123.61	3336+07.89	1123.57	3336+07.89	1122.61	3336+07.89	1122.01
0.8	3336+14.46	1123.77	3336+14.46	1123.73	3336+14.46	1122.77	3336+14.46	1122.17
0.9	3336+28.20	1124.07	3336+28.20	1124.03	3336+28.20	1123.07	3336+28.20	1122.48
⌒ PIER 3	3336+41.93	1124.37	3336+41.93	1124.33	3336+41.93	1123.37	3336+41.93	1122.77
0.1	3336+55.63	1124.66	3336+55.63	1124.63	3336+55.63	1123.67	3336+55.63	1123.07
0.2	3336+69.33	1124.95	3336+69.33	1124.91	3336+69.33	1123.95	3336+69.33	1123.35
F.S. 6	3336+75.97	1125.08	3336+75.97	1125.05	3336+75.97	1124.08	3336+75.97	1123.47
0.3	3336+83.03	1125.21	3336+83.03	1125.18	3336+83.03	1124.20	3336+83.03	1123.60
0.4	3336+96.73	1125.43	3336+96.73	1125.39	3336+96.73	1124.42	3336+96.73	1123.81
0.5	3337+10.43	1125.61	3337+10.43	1125.57	3337+10.43	1124.59	3337+10.43	1123.98
0.6	3337+24.13	1125.72	3337+24.13	1125.68	3337+24.13	1124.70	3337+24.13	1124.10
0.7	3337+37.83	1125.78	3337+37.83	1125.74	3337+37.83	1124.77	3337+37.83	1124.16
F.S. 7	3337+44.89	1125.80	3337+44.89	1125.76	3337+44.89	1124.79	3337+44.89	1124.18
0.8	3337+51.53	1125.80	3337+51.53	1125.76	3337+51.53	1124.79	3337+51.53	1124.19
0.9	3337+65.23	1125.78	3337+65.23	1125.75	3337+65.23	1124.78	3337+65.23	1124.18
⌒ PIER 4	3337+78.93	1125.76	3337+78.93	1125.72	3337+78.93	1124.76	3337+78.93	1124.16
0.1	3337+88.53	1125.74	3337+88.53	1125.70	3337+88.53	1124.74	3337+88.53	1124.14
0.2	3337+98.13	1125.71	3337+98.13	1125.68	3337+98.13	1124.71	3337+98.13	1124.12
0.3	3338+07.73	1125.68	3338+07.73	1125.64	3338+07.73	1124.68	3338+07.73	1124.08
F.S. 8	3338+14.91	1125.64	3338+14.91	1125.61	3338+14.91	1124.64	3338+14.91	1124.05
0.4	3338+17.33	1125.63	3338+17.33	1125.59	3338+17.33	1124.63	3338+17.33	1124.03
0.5	3338+26.93	1125.56	3338+26.93	1125.52	3338+26.93	1124.56	3338+26.93	1123.96
0.6	3338+36.53	1125.47	3338+36.53	1125.43	3338+36.53	1124.47	3338+36.53	1123.87
0.7	3338+46.13	1125.36	3338+46.13	1125.32	3338+46.13	1124.36	3338+46.13	1123.76
0.8	3338+55.73	1125.23	3338+55.73	1125.19	3338+55.73	1124.23	3338+55.73	1123.63
0.9	3338+65.33	1125.07	3338+65.33	1125.03	3338+65.33	1124.07	3338+65.33	1123.47
⌒ BRGS. F.A.	3338+74.93	1124.90	3338+74.93	1124.86	3338+74.93	1123.90	3338+74.93	1123.30

NOTES:

1. SCREED ELEVATIONS SHOWN REPRESENT THE THEORETICAL DECK SURFACE LOCATION PRIOR TO DEFLECTIONS CAUSED BY DECK PLACEMENT AND OTHER ANTICIPATED DEAD LOADS.
2. SEE CRITICAL BRIDGE POINTS PLAN ON SHEET 44 / 60 FOR ELEVATION LOCATIONS.

DESIGNED
ASG

CHECKED
MAB

DRAWN
ASG

REVISED

REVIEWED
JCS

STRUCTURE FILE NUMBER
7705973

DATE
4/29/19

DESIGN AGENCY
BURGESS & NIPLE
Engineers ■ Architects ■ Planners
5045 REED ROAD, COLUMBUS, OHIO 43220

SCREED ELEVATIONS
SUM-76-1152N
RAMP N OVER RAMP S, LANE O, 1R-76 EB, SR-8 NB/SB, LANE M


SUM-76/77/8-
8.24/9.74/0.00
PID No. 102329

45 / 60

46
61

ISSUE RECORD:		DESCRIPTION
NO.	DATE	

TOP OF HAUNCH ELEVATIONS								
LOCATION	℄ GIRDER 1		℄ GIRDER 2		℄ GIRDER 3		℄ GIRDER 4	
	STA.	ELEV.	STA.	ELEV.	STA.	ELEV.	STA.	ELEV.
℄ BRGS. R. A.	3332+45.68	1101.63 *	3332+45.68	1101.16 *	3332+45.68	1100.64 *	3332+45.68	1100.12 *
0.1	3332+57.86	1104.10	3332+57.86	1103.62	3332+57.86	1103.09	3332+57.86	1102.57
0.2	3332+70.03	1105.01	3332+70.03	1104.53	3332+70.03	1104.00	3332+70.03	1103.47
0.3	3332+82.21	1105.92	3332+82.21	1105.43	3332+82.21	1104.89	3332+82.21	1104.36
0.4	3332+94.38	1106.78	3332+94.38	1106.29	3332+94.38	1105.76	3332+94.38	1105.22
0.5	3333+06.56	1107.63	3333+06.56	1107.14	3333+06.56	1106.60	3333+06.56	1106.07
0.6	3333+18.73	1108.46	3333+18.73	1107.97	3333+18.73	1107.43	3333+18.73	1106.90
F.S. 1	3333+30.47	1109.23	3333+30.47	1108.75	3333+30.47	1108.22	3333+30.47	1107.69
0.7	3333+30.91	1109.26	3333+30.91	1108.78	3333+30.91	1108.25	3333+30.91	1107.72
0.8	3333+43.08	1110.06	3333+43.08	1109.59	3333+43.08	1109.06	3333+43.08	1108.53
0.9	3333+55.26	1110.86	3333+55.26	1110.39	3333+55.26	1109.86	3333+55.26	1109.34
℄ PIER 1	3333+67.43	1111.65	3333+67.43	1111.18	3333+67.43	1110.66	3333+67.43	1110.14
0.1	3333+81.15	1112.54	3333+81.15	1112.08	3333+81.15	1111.56	3333+81.15	1111.04
0.2	3333+94.86	1113.43	3333+94.86	1112.97	3333+94.86	1112.45	3333+94.86	1111.94
F.S. 2	3334+01.47	1113.85	3334+01.47	1113.38	3334+01.47	1112.87	3334+01.47	1112.36
0.3	3334+08.58	1114.29	3334+08.58	1113.83	3334+08.58	1113.31	3334+08.58	1112.80
0.4	3334+22.30	1115.12	3334+22.30	1114.66	3334+22.30	1114.14	3334+22.30	1113.63
0.5	3334+36.02	1115.91	3334+36.02	1115.44	3334+36.02	1114.93	3334+36.02	1114.42
0.6	3334+49.73	1116.64	3334+49.73	1116.18	3334+49.73	1115.66	3334+49.73	1115.14
0.7	3334+63.45	1117.33	3334+63.45	1116.87	3334+63.45	1116.35	3334+63.45	1115.83
F.S. 3	3334+70.56	1117.67	3334+70.56	1117.21	3334+70.56	1116.69	3334+70.56	1116.17
0.8	3334+77.17	1117.98	3334+77.17	1117.51	3334+77.17	1117.00	3334+77.17	1116.48
0.9	3334+90.88	1118.60	3334+90.88	1118.14	3334+90.88	1117.62	3334+90.88	1117.10
℄ PIER 2	3335+04.60	1119.21	3335+04.60	1118.74	3335+04.60	1118.22	3335+04.60	1117.70
0.1	3335+18.33	1119.82	3335+18.33	1119.35	3335+18.33	1118.83	3335+18.33	1118.31
0.2	3335+32.07	1120.41	3335+32.07	1119.94	3335+32.07	1119.42	3335+32.07	1118.90
F.S. 4	3335+38.64	1120.68	3335+38.64	1120.21	3335+38.64	1119.69	3335+38.64	1119.17
0.3	3335+45.80	1120.97	3335+45.80	1120.50	3335+45.80	1119.98	3335+45.80	1119.45
0.4	3335+59.53	1121.49	3335+59.53	1121.02	3335+59.53	1120.49	3335+59.53	1119.97
0.5	3335+73.27	1121.97	3335+73.27	1121.49	3335+73.27	1120.97	3335+73.27	1120.45
0.6	3335+87.00	1122.38	3335+87.00	1121.91	3335+87.00	1121.39	3335+87.00	1120.87
0.7	3336+00.73	1122.76	3336+00.73	1122.28	3336+00.73	1121.76	3336+00.73	1121.24
F.S. 5	3336+07.89	1122.93	3336+07.89	1122.46	3336+07.89	1121.94	3336+07.89	1121.42
0.8	3336+14.46	1123.09	3336+14.46	1122.62	3336+14.46	1122.10	3336+14.46	1121.58
0.9	3336+28.20	1123.39	3336+28.20	1122.93	3336+28.20	1122.41	3336+28.20	1121.89
℄ PIER 3	3336+41.93	1123.69	3336+41.93	1123.22	3336+41.93	1122.70	3336+41.93	1122.18
0.1	3336+55.63	1123.99	3336+55.63	1123.52	3336+55.63	1123.00	3336+55.63	1122.48
0.2	3336+69.33	1124.27	3336+69.33	1123.80	3336+69.33	1123.28	3336+69.33	1122.76
F.S. 6	3336+75.97	1124.40	3336+75.97	1123.93	3336+75.97	1123.41	3336+75.97	1122.89
0.3	3336+83.03	1124.53	3336+83.03	1124.06	3336+83.03	1123.53	3336+83.03	1123.01
0.4	3336+96.73	1124.75	3336+96.73	1124.28	3336+96.73	1123.75	3336+96.73	1123.22
0.5	3337+10.43	1124.93	3337+10.43	1124.45	3337+10.43	1123.92	3337+10.43	1123.40
0.6	3337+24.13	1125.04	3337+24.13	1124.56	3337+24.13	1124.03	3337+24.13	1123.51
0.7	3337+37.83	1125.10	3337+37.83	1124.63	3337+37.83	1124.10	3337+37.83	1123.58
F.S. 7	3337+44.89	1125.12	3337+44.89	1124.64	3337+44.89	1124.12	3337+44.89	1123.59
0.8	3337+51.53	1125.12	3337+51.53	1124.65	3337+51.53	1124.12	3337+51.53	1123.60
0.9	3337+65.23	1125.11	3337+65.23	1124.64	3337+65.23	1124.12	3337+65.23	1123.59
℄ PIER 4	3337+78.93	1125.08	3337+78.93	1124.61	3337+78.93	1124.09	3337+78.93	1123.57
0.1	3337+88.53	1125.06	3337+88.53	1124.59	3337+88.53	1124.07	3337+88.53	1123.56
0.2	3337+98.13	1125.03	3337+98.13	1124.57	3337+98.13	1124.05	3337+98.13	1123.53
0.3	3338+07.73	1125.00	3338+07.73	1124.53	3338+07.73	1124.01	3338+07.73	1123.49
F.S. 8	3338+14.91	1124.96	3338+14.91	1124.49	3338+14.91	1123.97	3338+14.91	1123.46
0.4	3338+17.33	1124.95	3338+17.33	1124.48	3338+17.33	1123.96	3338+17.33	1123.44
0.5	3338+26.93	1124.88	3338+26.93	1124.41	3338+26.93	1123.89	3338+26.93	1123.37
0.6	3338+36.53	1124.79	3338+36.53	1124.32	3338+36.53	1123.80	3338+36.53	1123.28
0.7	3338+46.13	1124.68	3338+46.13	1124.21	3338+46.13	1123.69	3338+46.13	1123.17
0.8	3338+55.73	1124.55	3338+55.73	1124.08	3338+55.73	1123.56	3338+55.73	1123.04
0.9	3338+65.33	1124.39	3338+65.33	1123.92	3338+65.33	1123.40	3338+65.33	1122.88
℄ BRGS. F.A.	3338+74.93	1122.68 *	3338+74.93	1122.21 *	3338+74.93	1121.69 *	3338+74.93	1121.17 *

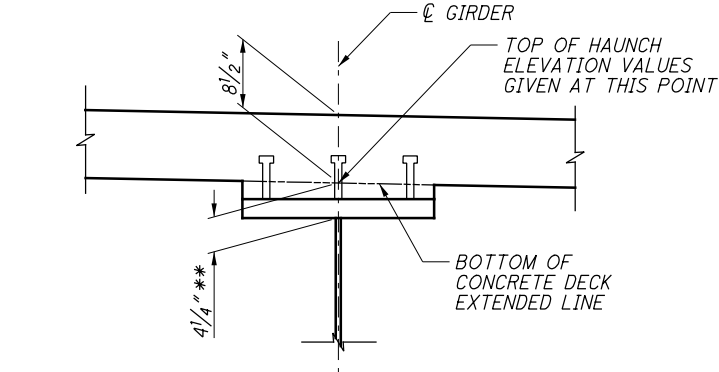

HAUNCH DETAIL
** = TOP OF WEB TO BOTTOM OF CONCRETE DECK EXTENDED LINE

LEGEND:
* = BOTTOM OF CONCRETE DECK ELEVATION AT THICKENED DECK, SEE SECTIONS A-A & B-B ON SHEETS 51 / 60 & 52 / 60 RESPECTIVELY.


NOTES:
1. TOP OF HAUNCH ELEVATIONS SHOWN REPRESENT THE THEORETICAL LOCATION OF THE BOTTOM OF THE DECK ABOVE THE ℄ OF THE GIRDER HAUNCH PRIOR TO DEFLECTIONS CAUSED BY DECK PLACEMENT AND OTHER ANTICIPATED DEAD LOADS.

ISSUE RECORD:		DESCRIPTION
NO.	DATE	

FINAL DECK SURFACE ELEVATIONS																
LOCATION	TOE OF LEFT PARAPET / LEFT EDGE OF ROUNDING		℄ GIRDER 1		RIGHT EDGE OF ROUNDING		℄ GIRDER 2		℄ GIRDER 3		PROFILE GRADE		℄ GIRDER 4		TOE OF RIGHT PARAPET	
	STA.	ELEV.	STA.	ELEV.	STA.	ELEV.	STA.	ELEV.	STA.	ELEV.	STA.	ELEV.	STA.	ELEV.	STA.	ELEV.
℄ BRGS. R. A.	3332+45.68	1103.84	3332+45.68	1103.87	3332+45.68	1103.81	3332+45.68	1103.41	3332+45.68	1102.89	3332+45.68	1102.85	3332+45.68	1102.37	3332+45.68	1102.25
0.1	3332+57.86	1104.70	3332+57.86	1104.73	3332+57.86	1104.66	3332+57.86	1104.26	3332+57.86	1103.74	3332+57.86	1103.70	3332+57.86	1103.22	3332+57.86	1103.10
0.2	3332+70.03	1105.55	3332+70.03	1105.58	3332+70.03	1105.51	3332+70.03	1105.11	3332+70.03	1104.59	3332+70.03	1104.55	3332+70.03	1104.07	3332+70.03	1103.95
0.3	3332+82.21	1106.40	3332+82.21	1106.43	3332+82.21	1106.36	3332+82.21	1105.96	3332+82.21	1105.44	3332+82.21	1105.40	3332+82.21	1104.92	3332+82.21	1104.80
0.4	3332+94.38	1107.25	3332+94.38	1107.28	3332+94.38	1107.22	3332+94.38	1106.82	3332+94.38	1106.30	3332+94.38	1106.26	3332+94.38	1105.78	3332+94.38	1105.66
0.5	3333+06.56	1108.11	3333+06.56	1108.14	3333+06.56	1108.07	3333+06.56	1107.67	3333+06.56	1107.15	3333+06.56	1107.11	3333+06.56	1106.63	3333+06.56	1106.51
0.6	3333+18.73	1108.96	3333+18.73	1108.99	3333+18.73	1108.92	3333+18.73	1108.52	3333+18.73	1108.00	3333+18.73	1107.96	3333+18.73	1107.48	3333+18.73	1107.36
F.S. 1	3333+30.47	1109.78	3333+30.47	1109.81	3333+30.47	1109.74	3333+30.47	1109.34	3333+30.47	1108.82	3333+30.47	1108.78	3333+30.47	1108.30	3333+30.47	1108.18
0.7	3333+30.91	1109.81	3333+30.91	1109.84	3333+30.91	1109.77	3333+30.91	1109.37	3333+30.91	1108.85	3333+30.91	1108.81	3333+30.91	1108.33	3333+30.91	1108.21
0.8	3333+43.08	1110.66	3333+43.08	1110.69	3333+43.08	1110.63	3333+43.08	1110.23	3333+43.08	1109.71	3333+43.08	1109.67	3333+43.08	1109.19	3333+43.08	1109.07
0.9	3333+55.26	1111.51	3333+55.26	1111.54	3333+55.26	1111.47	3333+55.26	1111.07	3333+55.26	1110.55	3333+55.26	1110.51	3333+55.26	1110.03	3333+55.26	1109.91
℄ PIER 1	3333+67.43	1112.33	3333+67.43	1112.36	3333+67.43	1112.29	3333+67.43	1111.89	3333+67.43	1111.37	3333+67.43	1111.33	3333+67.43	1110.85	3333+67.43	1110.73
0.1	3333+81.15	1113.22	3333+81.15	1113.25	3333+81.15	1113.18	3333+81.15	1112.78	3333+81.15	1112.26	3333+81.15	1112.22	3333+81.15	1111.74	3333+81.15	1111.62
0.2	3333+94.86	1114.09	3333+94.86	1114.12	3333+94.86	1114.05	3333+94.86	1113.65	3333+94.86	1113.13	3333+94.86	1113.09	3333+94.86	1112.61	3333+94.86	1112.49
F.S. 2	3334+01.47	1114.49	3334+01.47	1114.52	3334+01.47	1114.45	3334+01.47	1114.05	3334+01.47	1113.53	3334+01.47	1113.49	3334+01.47	1113.01	3334+01.47	1112.89
0.3	3334+08.58	1114.92	3334+08.58	1114.95	3334+08.58	1114.88	3334+08.58	1114.48	3334+08.58	1113.96	3334+08.58	1113.92	3334+08.58	1113.44	3334+08.58	1113.32
0.4	3334+22.30	1115.72	3334+22.30	1115.75	3334+22.30	1115.68	3334+22.30	1115.28	3334+22.30	1114.76	3334+22.30	1114.72	3334+22.30	1114.24	3334+22.30	1114.12
0.5	3334+36.02	1116.49	3334+36.02	1116.52	3334+36.02	1116.46	3334+36.02	1116.06	3334+36.02	1115.54	3334+36.02	1115.50	3334+36.02	1115.02	3334+36.02	1114.90
0.6	3334+49.73	1117.23	3334+49.73	1117.26	3334+49.73	1117.20	3334+49.73	1116.80	3334+49.73	1116.28	3334+49.73	1116.24	3334+49.73	1115.76	3334+49.73	1115.64
0.7	3334+63.45	1117.94	3334+63.45	1117.97	3334+63.45	1117.91	3334+63.45	1117.51	3334+63.45	1116.99	3334+63.45	1116.95	3334+63.45	1116.47	3334+63.45	1116.35
F.S. 3	3334+70.56	1118.30	3334+70.56	1118.33	3334+70.56	1118.26	3334+70.56	1117.86	3334+70.56	1117.34	3334+70.56	1117.30	3334+70.56	1116.82	3334+70.56	1116.70
0.8	3334+77.17	1118.62	3334+77.17	1118.65	3334+77.17	1118.59	3334+77.17	1118.19	3334+77.17	1117.67	3334+77.17	1117.63	3334+77.17	1117.15	3334+77.17	1117.03
0.9	3334+90.88	1119.27	3334+90.88	1119.30	3334+90.88	1119.23	3334+90.88	1118.83	3334+90.88	1118.31	3334+90.88	1118.27	3334+90.88	1117.79	3334+90.88	1117.67
℄ PIER 2	3335+04.60	1119.89	3335+04.60	1119.92	3335+04.60	1119.85	3335+04.60	1119.45	3335+04.60	1118.93	3335+04.60	1118.89	3335+04.60	1118.41	3335+04.60	1118.29
0.1	3335+18.33	1120.47	3335+18.33	1120.50	3335+18.33	1120.44	3335+18.33	1120.04	3335+18.33	1119.52	3335+18.33	1119.48	3335+18.33	1119.00	3335+18.33	1118.88
0.2	3335+32.07	1121.03	3335+32.07	1121.06	3335+32.07	1120.99	3335+32.07	1120.59	3335+32.07	1120.07	3335+32.07	1120.03	3335+32.07	1119.55	3335+32.07	1119.43
F.S. 4	3335+38.64	1121.29	3335+38.64	1121.32	3335+38.64	1121.25	3335+38.64	1120.85	3335+38.64	1120.33	3335+38.64	1120.29	3335+38.64	1119.81	3335+38.64	1119.69
0.3	3335+45.80	1121.56	3335+45.80	1121.59	3335+45.80	1121.52	3335+45.80	1121.12	3335+45.80	1120.60	3335+45.80	1120.56	3335+45.80	1120.08	3335+45.80	1119.96
0.4	3335+59.53	1122.05	3335+59.53	1122.08	3335+59.53	1122.01	3335+59.53	1121.61	3335+59.53	1121.09	3335+59.53	1121.05	3335+59.53	1120.57	3335+59.53	1120.45
0.5	3335+73.27	1122.51	3335+73.27	1122.54	3335+73.27	1122.48	3335+73.27	1122.08	3335+73.27	1121.56	3335+73.27	1121.52	3335+73.27	1121.04	3335+73.27	1120.92
0.6	3335+87.00	1122.95	3335+87.00	1122.98	3335+87.00	1122.91	3335+87.00	1122.51	3335+87.00	1121.99	3335+87.00	1121.95	3335+87.00	1121.47	3335+87.00	1121.35
0.7	3336+00.73	1123.35	3336+00.73	1123.38	3336+00.73	1123.31	3336+00.73	1122.91	3336+00.73	1122.39	3336+00.73	1122.35	3336+00.73	1121.87	3336+00.73	1121.75
F.S. 5	3336+07.89	1123.55	3336+07.89	1123.58	3336+07.89	1123.51	3336+07.89	1123.11	3336+07.89	1122.59	3336+07.89	1122.55	3336+07.89	1122.07	3336+07.89	1121.95
0.8	3336+14.46	1123.72	3336+14.46	1123.75	3336+14.46	1123.68	3336+14.46	1123.28	3336+14.46	1122.76	3336+14.46	1122.72	3336+14.46	1122.24	3336+14.46	1122.12
0.9	3336+28.20	1124.06	3336+28.20	1124.09	3336+28.20	1124.02	3336+28.20	1123.62	3336+28.20	1123.10	3336+28.20	1123.06	3336+28.20	1122.58	3336+28.20	1122.46
℄ PIER 3	3336+41.93	1124.37	3336+41.93	1124.40	3336+41.93	1124.33	3336+41.93	1123.93	3336+41.93	1123.41	3336+41.93	1123.37	3336+41.93	1122.89	3336+41.93	1122.77
0.1	3336+55.63	1124.64	3336+55.63	1124.67	3336+55.63	1124.61	3336+55.63	1124.21	3336+55.63	112						

ISSUE RECORD:		DESCRIPTION	
NO.	DATE		

pw:\V\ANV\A01PW\INT01.parsons.com:Ohio State\Documents\DB-Akron Beltway Rehab\10 - Design\102329\Structures\SUM076_1152N\Sheets\076_1149R_SA001.dgn Sheet 6/23/2021 8:35:33 AM KChrisman

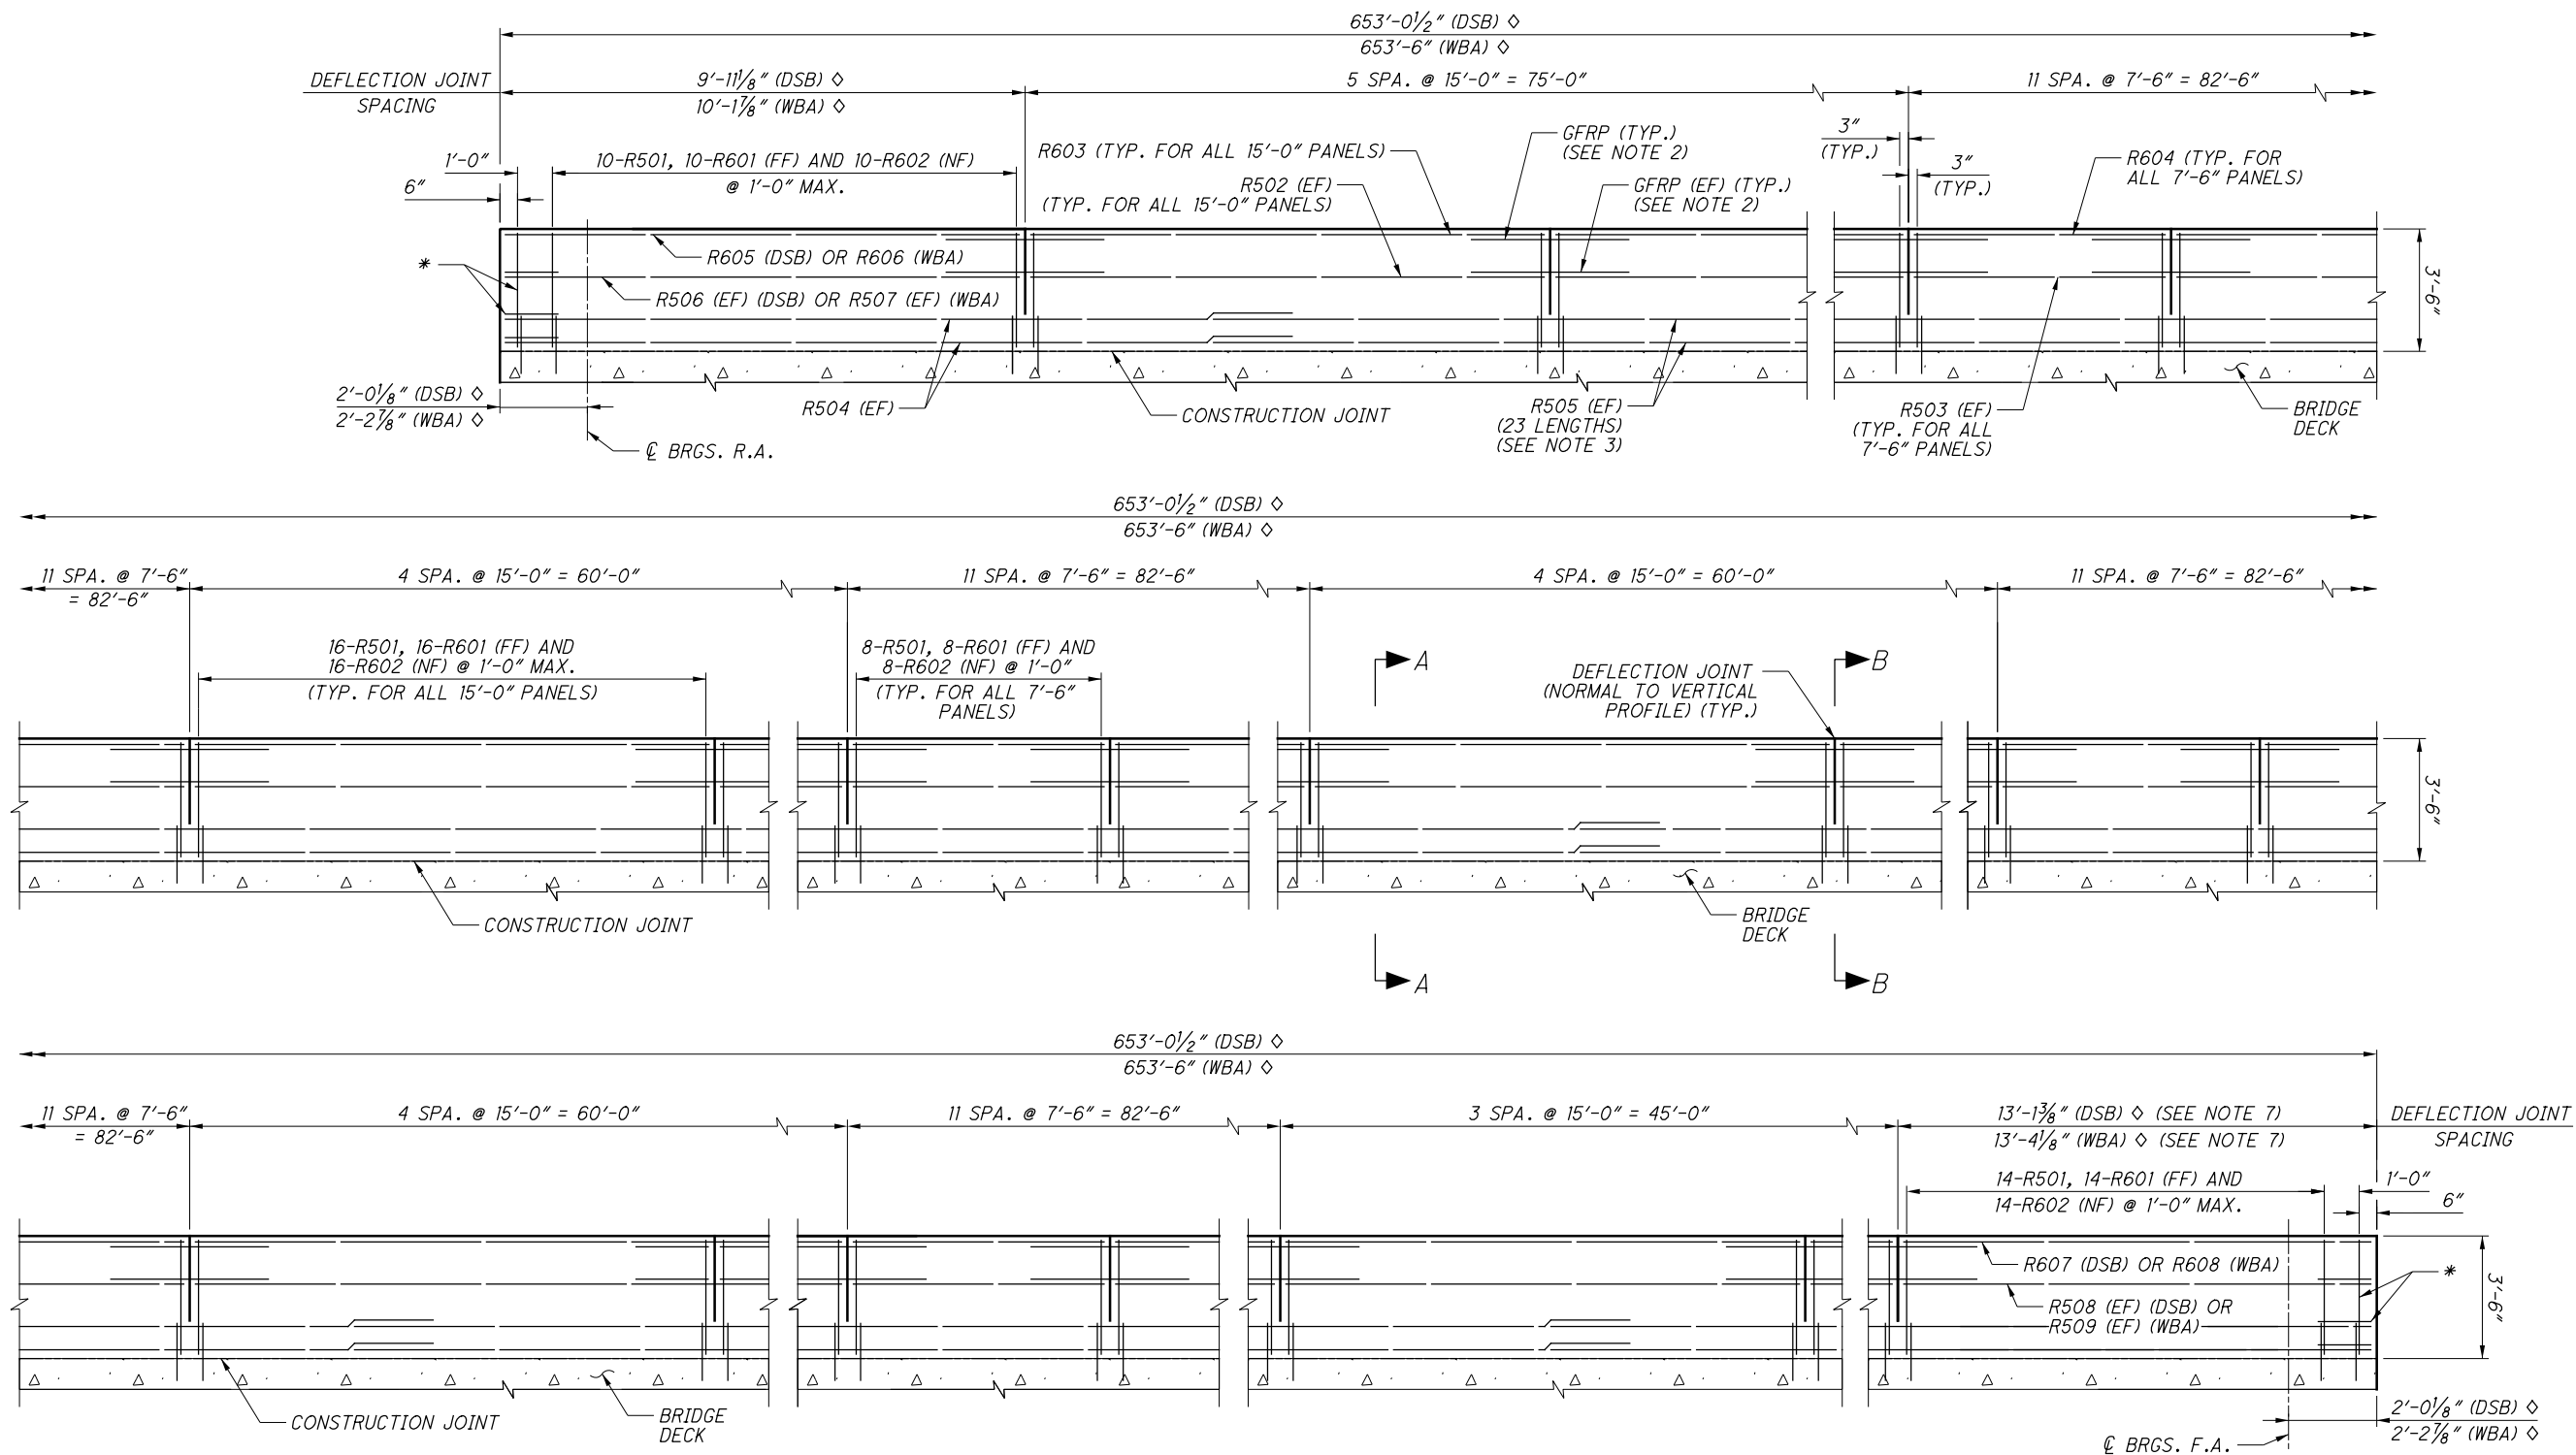

LEFT PARAPET ELEVATION

(LOOKING AT TRAFFIC FACE OF PARAPET)
(ALL DIMENSIONS ARE GIVEN ALONG THE TOE OF PARAPET)
(ALL DIMENSIONS ARE GIVEN ALONG THE HORIZONTAL)

LEGEND:

- ◇ = DIMENSION VARIES WITH TEMPERATURE.
DIMENSION IS SHOWN AT 60°F.
- * = SEE DETAIL A ON SHEET 50 / 60
- DSB = DS BROWN MODULAR JOINT
- WBA = WATSON BOWMAN ACME MODULAR JOINT

NOTES:


- FOR ADDITIONAL INFORMATION SEE STD. DWG. SBR-1-13.
- 1/2" DIA. GFRP STIFFENING REINFORCEMENT, 4'-6" LONG, A TOTAL OF 195 BARS, TO BE CENTERED ON DEFLECTION JOINT.
- MINIMUM REINFORCING STEEL LAP LENGTH FOR NO. 5 BARS SHALL BE 2'-3".
- SEE SHEET 50 / 60 FOR SECTIONS A-A AND B-B.
- FOR MODULAR JOINT DETAILS AT REAR ABUTMENT, SEE SHEET 51 / 60.
- FOR MODULAR JOINT DETAILS AT FORWARD ABUTMENT, SEE SHEET 52 / 60.
- DUE TO THE VERTICAL PROFILE OF THE BRIDGE, THE LENGTH OF THE LAST PANEL IS 7" LONGER THAN THE DIMENSION SHOWN ALONG THE HORIZONTAL. REINFORCEMENT OF THE LAST PANEL IS DETAILED ACCORDING TO THE ACTUAL LENGTH OF THE PANEL.

2025-03-13 - BU-11 - RECORD DRAWING PLANS

DESIGN AGENCY BURGESS & NIPLE Engineers ■ Architects ■ Planners 5045 REED ROAD, COLUMBUS, OHIO 43220	
DATE 4/29/19	REVIEWED JCS
STRUCTURE FILE NUMBER 7705973	DRAWN ODW
DESIGNED ODW	CHECKED BCS
PARAPET DETAILS - 1 SUM-76-1152N RAMP N OVER RAMP S, LANE O, IR-76 EB, SR-8 NB/SB, LANE M	
SUM-76/77/8- 8.24/9.74/0.00 PID No. 102329	
48/60	
49 61	

ISSUE RECORD:		DESCRIPTION
NO.	DATE	

pw:\\V\\AN\\A01PW\\INT01.parsons.com:Ohio State\\Documents\\DB-Akron Beltway Rehab\\10 - Design\\102329\\Structures\\SUM076_1152N\\Sheets\\076_1149R_SA002.dgn Sheet 6/23/2021 8:35:39 AM KChrisman

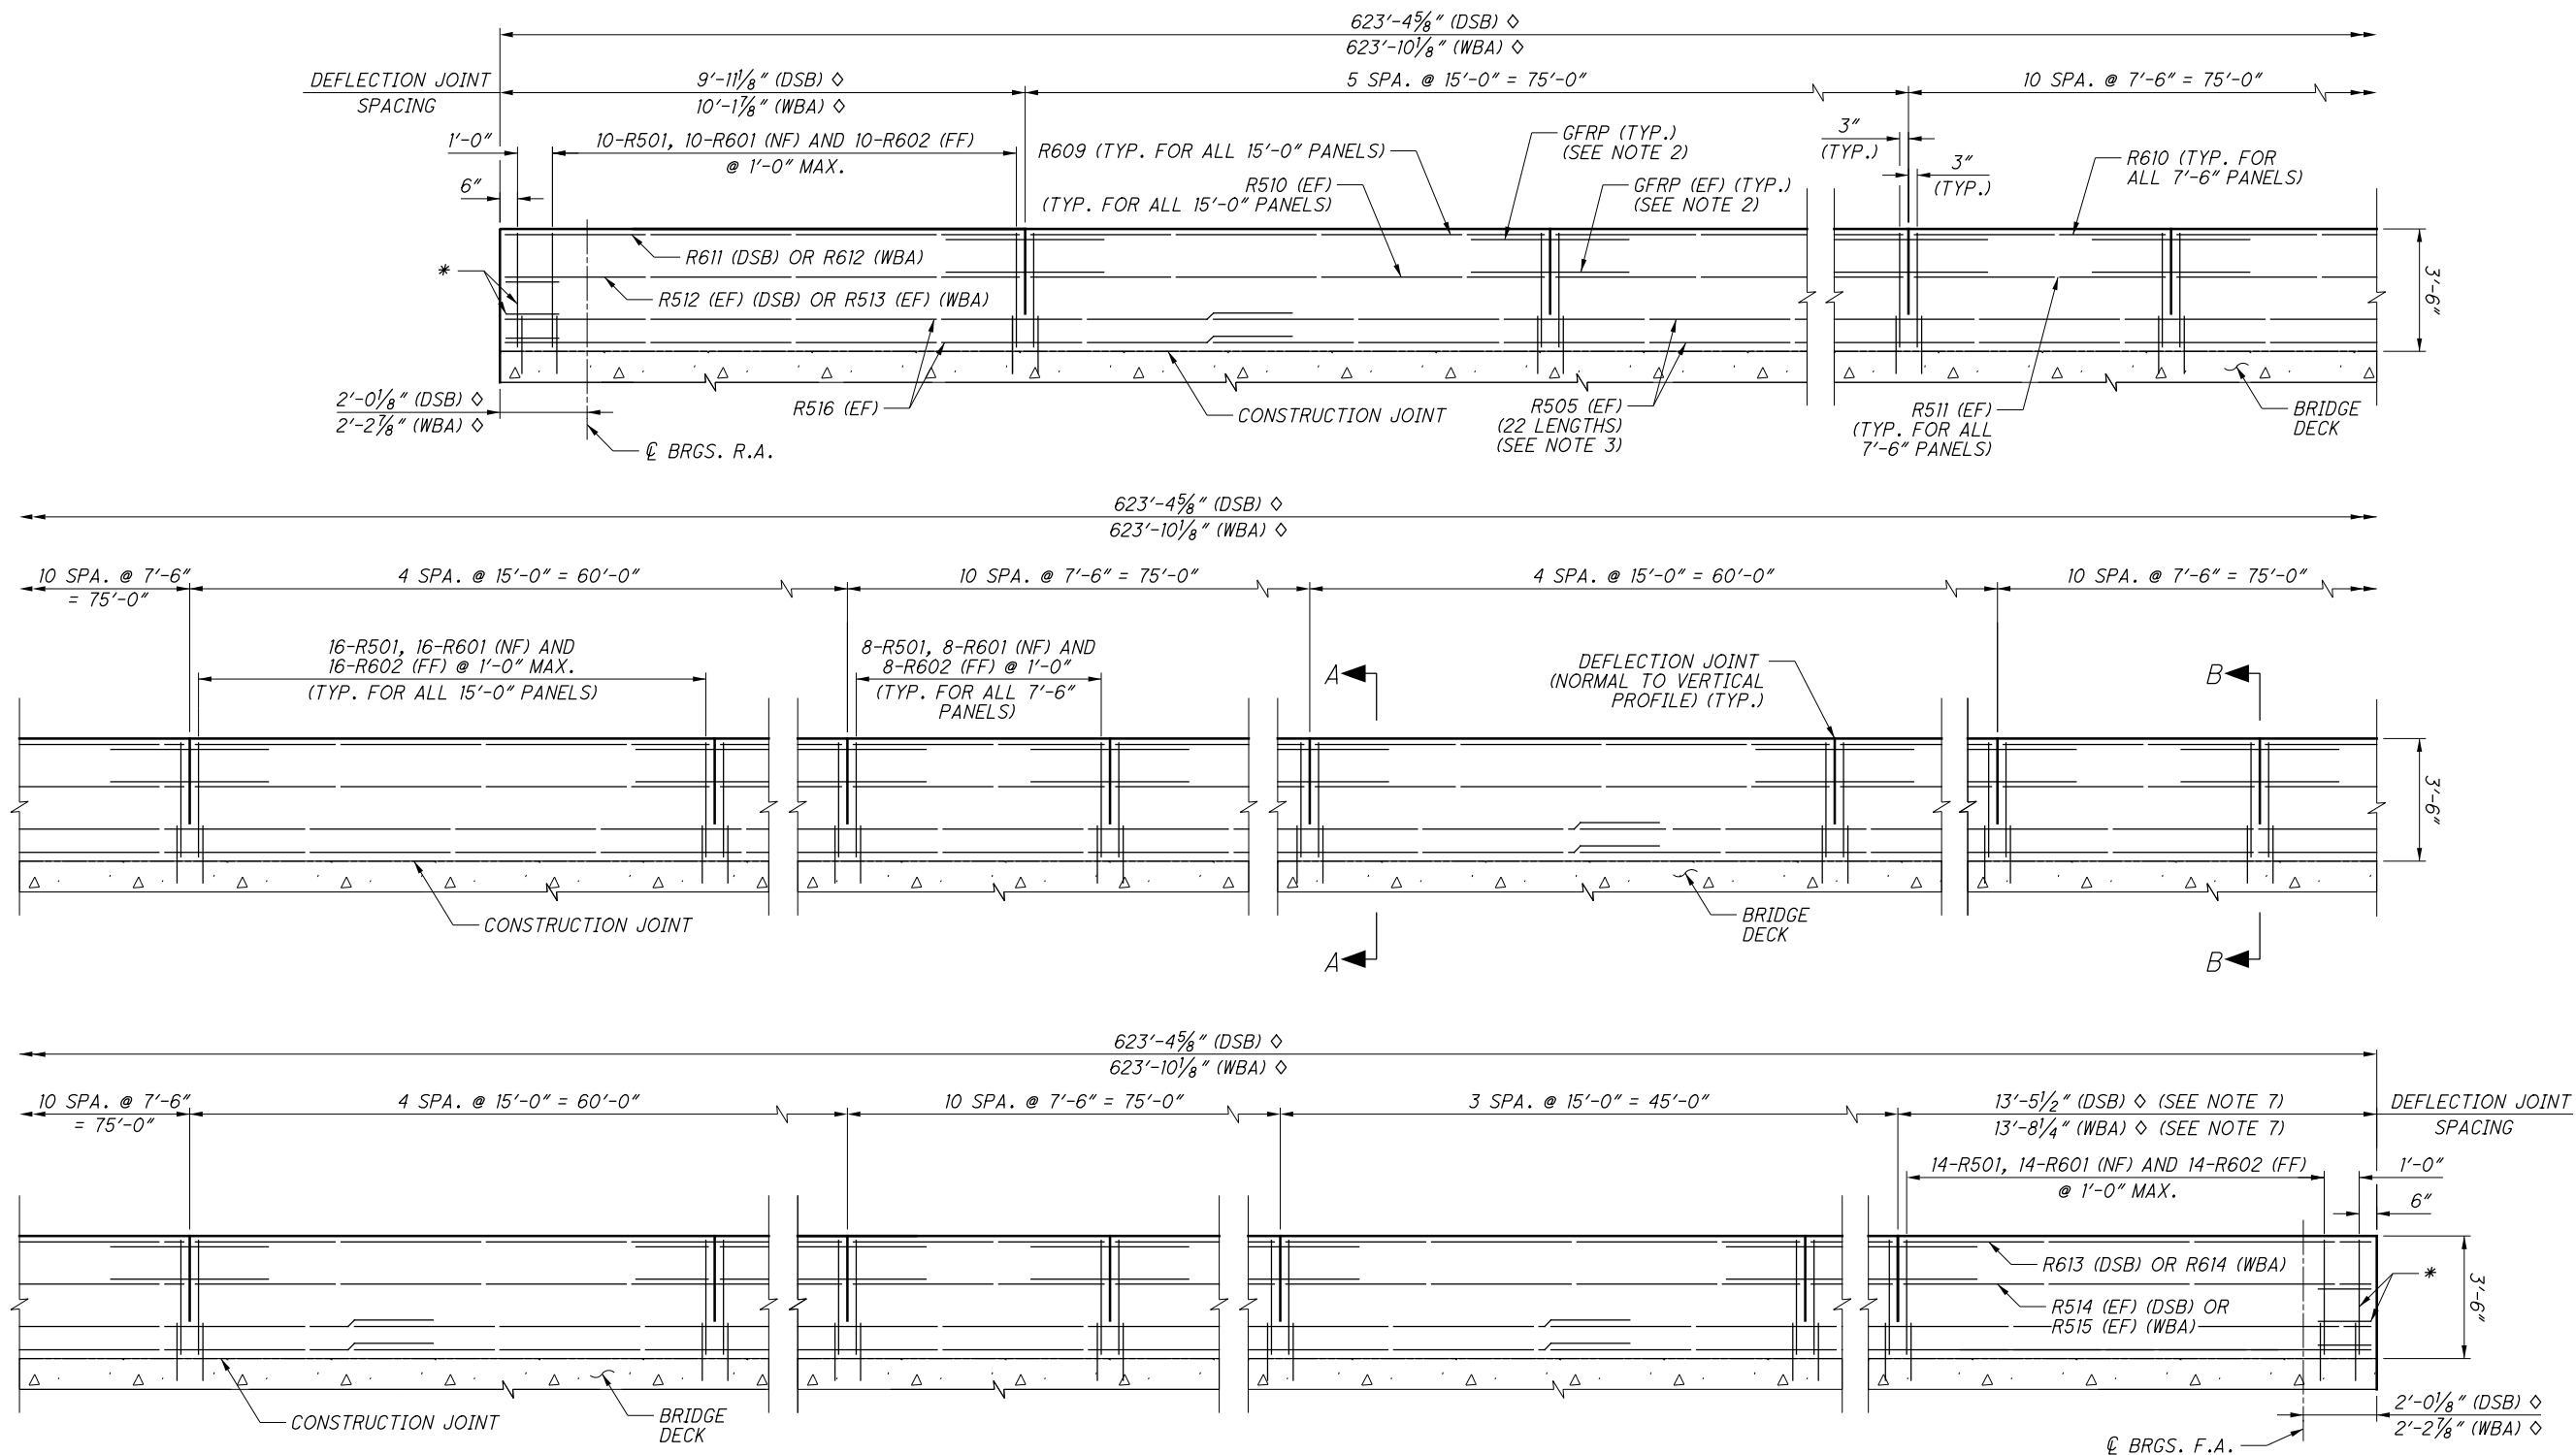

RIGHT PARAPET ELEVATION

(LOOKING AT OUTSIDE FACE OF PARAPET)
(ALL DIMENSIONS ARE GIVEN ALONG THE TOE OF PARAPET)
(ALL DIMENSIONS ARE GIVEN ALONG THE HORIZONTAL)

LEGEND:

◇ = DIMENSION VARIES WITH TEMPERATURE.
DIMENSION IS SHOWN AT 60°F.

* = SEE DETAIL A ON SHEET 50 / 60

DSB = DS BROWN MODULAR JOINT

WBA = WATSON BOWMAN ACME MODULAR JOINT

NOTES:

- FOR ADDITIONAL INFORMATION SEE STD. DWG. SBR-1-13.
- 1/2" DIA. GFRP STIFFENING REINFORCEMENT, 4'-6" LONG, A TOTAL OF 183 BARS, TO BE CENTERED ON DEFLECTION JOINT.
- MINIMUM REINFORCING STEEL LAP LENGTH FOR NO. 5 BARS SHALL BE 2'-3".
- SEE SHEET 50 / 60 FOR SECTIONS A-A AND B-B.
- FOR MODULAR JOINT DETAILS AT REAR ABUTMENT, SEE SHEET 51 / 60.
- FOR MODULAR JOINT DETAILS AT FORWARD ABUTMENT, SEE SHEET 52 / 60.
- DUE TO THE VERTICAL PROFILE OF THE BRIDGE, THE LENGTH OF THE LAST PANEL IS 7 3/8" LONGER THAN THE DIMENSION SHOWN ALONG THE HORIZONTAL. REINFORCEMENT OF THE LAST PANEL IS DETAILED ACCORDING TO THE ACTUAL LENGTH OF THE PANEL.

2025-03-13 - BU-11 - RECORD DRAWING PLANS

SUM-76/77/8-
8.24/9.74/0.00
PID No. 102329

49/60

50
61

PARAPET DETAILS - 2

SUM-76-1152N

RAMP N OVER RAMP S, LANE O, IR-76 EB, SR-8 NB/SB, LANE M

DESIGNED
ODW

CHECKED
BCS

DRAWN
ODW

REVISED

REVIEWED
JCS


DATE
4/29/19

STRUCTURE FILE NUMBER
7705973


DESIGN AGENCY
BURGESS & NIPLE
Engineers ■ Architects ■ Planners
5045 REED ROAD, COLUMBUS, OHIO 43220

ISSUE RECORD:		DESCRIPTION
NO.	DATE	

p:\V\ANV\A01P\WINT01\parsons.com:Ohio State\Documents\DB-Akron Beltway Rehab\10 - Design\102329\Structures\SUM076_1152N\Sheets\076_1149R_SX001.dgn Sheet 6/23/2021 8:35:52 AM KChrisman

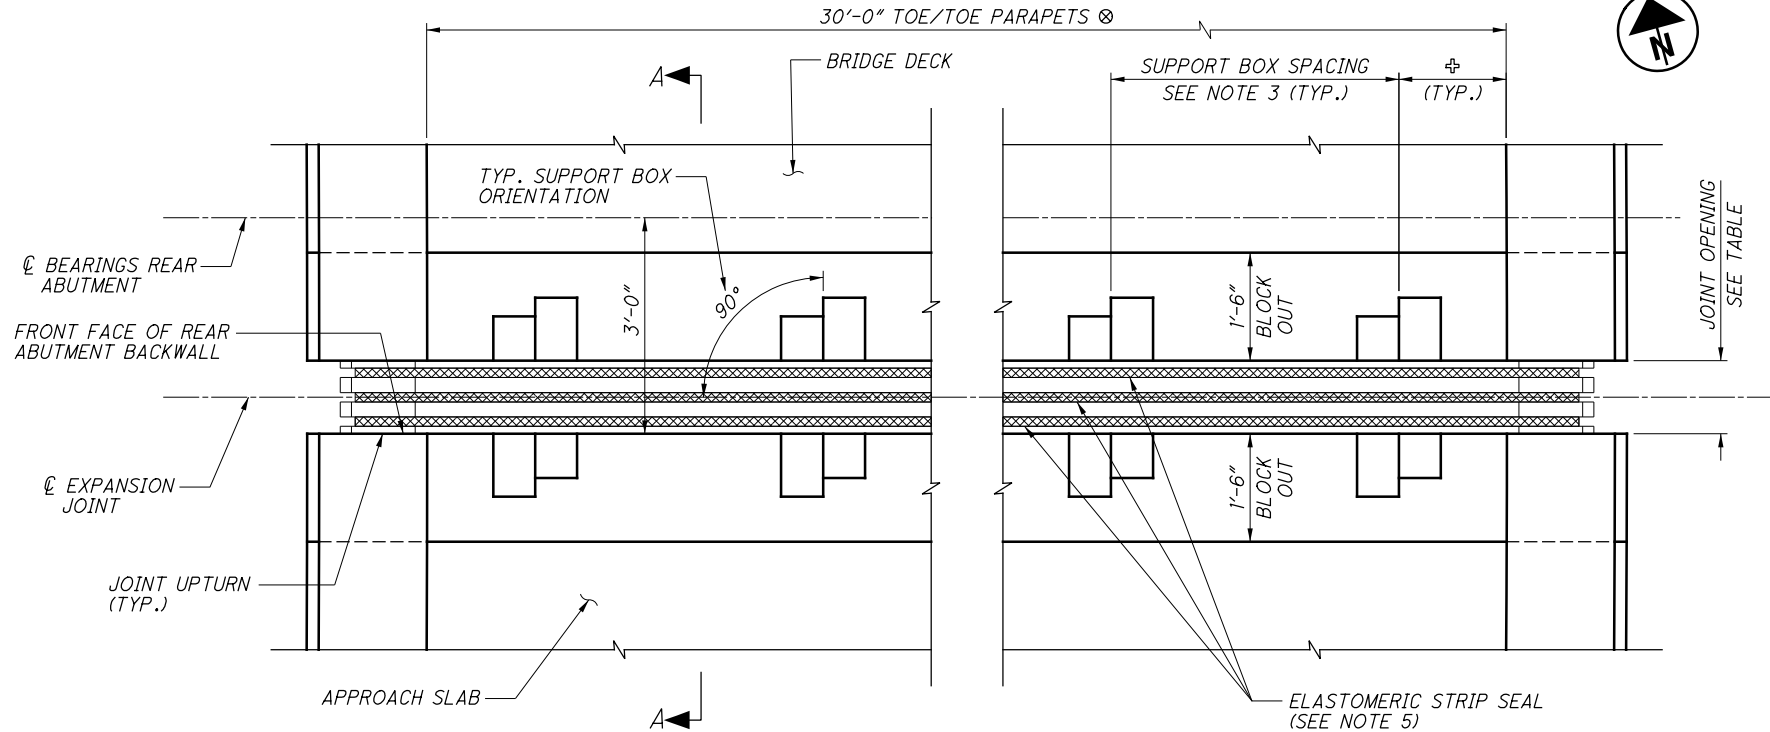


PLAN - REAR ABUTMENT
(JOINT ANCHORAGE NOT SHOWN, SEE NOTE 4)
(PARAPET SLIDING PLATES NOT SHOWN)

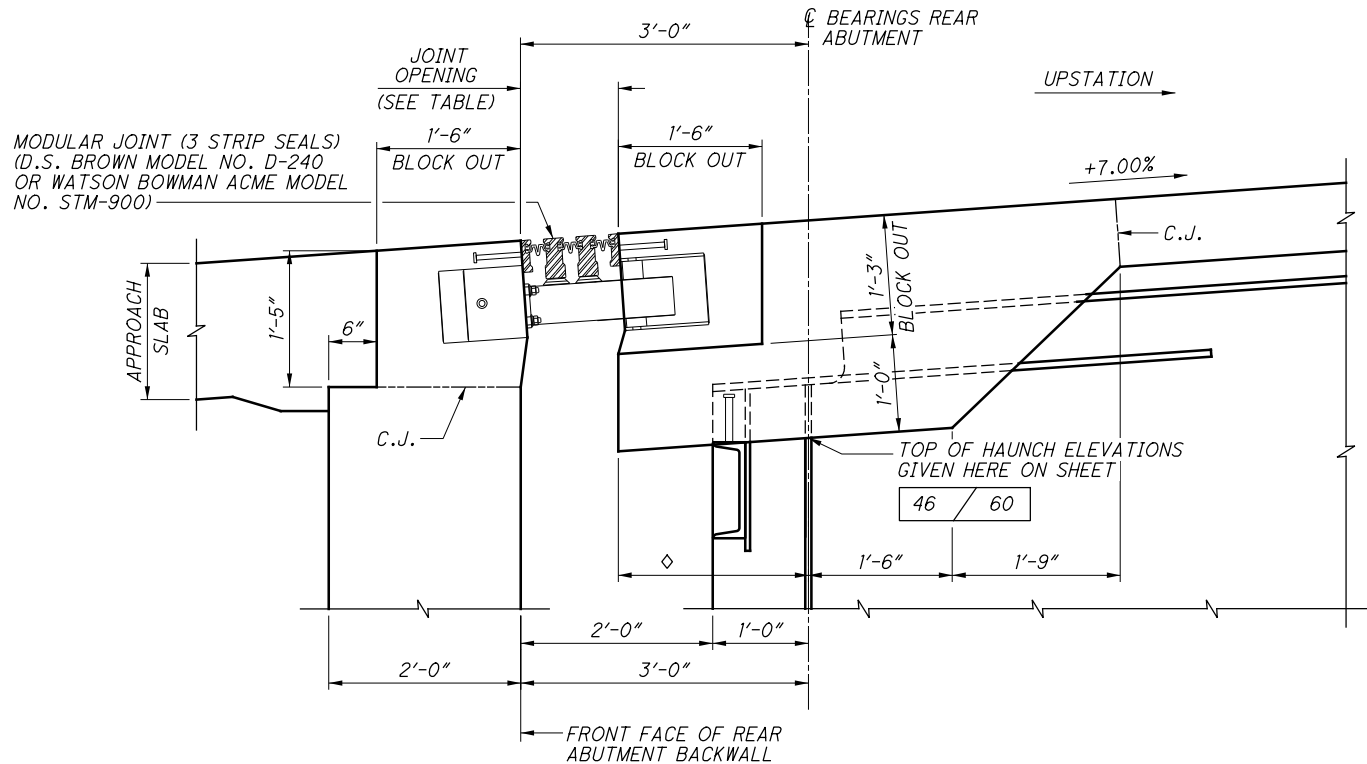

SECTION A-A - REAR ABUTMENT
(HORIZONTAL DIMENSIONS ARE MEASURED NORMAL TO ϕ BEARINGS)
(GIRDER SHEAR STUDS NOT SHOWN)

REAR ABUTMENT EXPANSION JOINT OPENING		
TEMPERATURE ° F	DS BROWN	WBA
30	1'-0 $\frac{3}{4}$ "	10"
40	1'-0 $\frac{1}{16}$ "	9 $\frac{11}{16}$ "
50	1'-0 $\frac{3}{16}$ "	9 $\frac{7}{16}$ "
60	11 $\frac{7}{8}$ "	9 $\frac{1}{8}$ "
70	11 $\frac{9}{16}$ "	8 $\frac{13}{16}$ "
80	11 $\frac{5}{16}$ "	8 $\frac{3}{16}$ "
90	11"	8 $\frac{1}{4}$ "

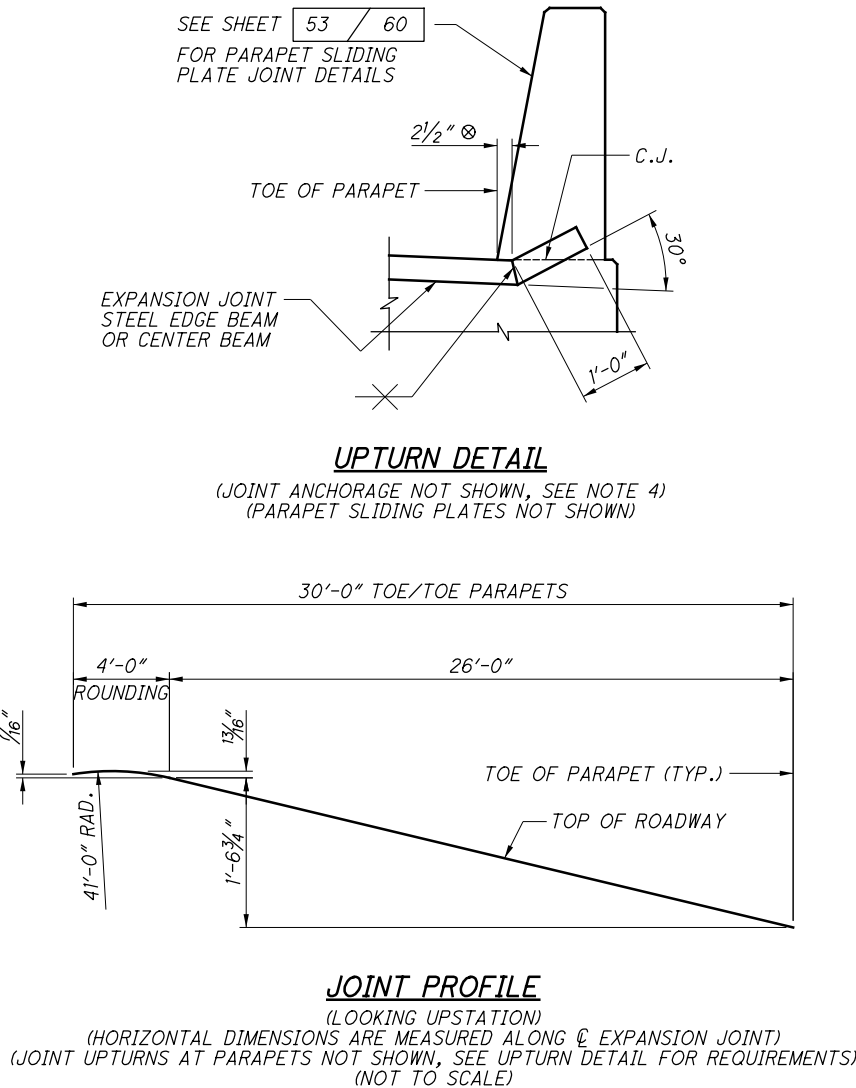


- NOTES:**
- SEE GENERAL NOTES FOR ADDITIONAL REQUIREMENTS FOR MODULAR JOINTS.
 - THE MODULAR JOINTS SHALL BE DESIGNED FOR A TOTAL LONGITUDINAL MOVEMENT RANGE OF 6 $\frac{3}{4}$ " (NORMAL TO ϕ OF THE ABUTMENTS) AND A LATERAL MOVEMENT RANGE OF $\pm\frac{1}{2}$ " (PARALLEL TO ϕ BEARINGS OF THE ABUTMENT). THIS MOVEMENT RANGE IS BASED ON A COLD CLIMATE AS SPECIFIED IN TABLE 3.12.2.1-1 OF THE AASHTO LRFD BRIDGE DESIGN SPECIFICATIONS. THE MOVEMENT RANGE INCLUDES A FACTOR OF 1.2 PER TABLE 3.4.1-1, INCLUDES MOVEMENT DUE TO WIND ON STRUCTURE, INCLUDES AN ADDITIONAL 1" OF MOVEMENT PER TABLE 14.5.6.9.2-1, AND SATISFIES THE 1" MINIMUM OPENING REQUIREMENT ACCORDING TO SECTION 14.5.3.2 OF THE AASHTO LRFD BRIDGE DESIGN SPECIFICATIONS.
 - SEE GENERAL NOTES FOR DESIGN REQUIREMENTS AND SUPPORT BOX SPACING LIMITATIONS.
 - THE MODULAR JOINT SUPPLIER SHALL DETERMINE THE JOINT ANCHORAGE REQUIREMENTS. SEE GENERAL NOTES FOR DESIGN REQUIREMENTS.
 - ELASTOMERIC STRIP SEALS SHALL BE ONE PIECE ACROSS THE ENTIRE WIDTH OF THE BRIDGE. SPLICES ARE NOT PERMITTED.
 - SEE SHEET 53 / 60 FOR PARAPET SLIDING PLATES.


- LEGEND:**
- WBA = WATSON BOWMAN ACME
- $\otimes$ = MEASURED ALONG ϕ EXPANSION JOINT
- $\oplus$ = DIMENSION FROM TOE OF PARAPET TO FIRST SUPPORT BOX TO BE DETERMINED BY JOINT SUPPLIER. SEE GENERAL NOTES FOR DESIGN REQUIREMENTS.
- * = GRADE VARIES DUE TO VERTICAL CURVE. THE GRADE SHOWN IS THE INSTANTANEOUS GRADE AT THE FRONT FACE OF THE FORWARD ABUTMENT BACKWALL.
- $\diamond$ = 2'-0 $\frac{1}{8}$ " (DS BROWN), 2'-2 $\frac{7}{8}$ " (WBA), AT 60° F.

ISSUE RECORD:		DESCRIPTION
NO.	DATE	

pww:\ANV\A01PWINT01\parsons.com:Ohio State\Documents\DB-Akron Beltway Rehab\10 - Design\102329\Structures\SUM076_1152N\Sheets\076_1149R_SX002.dgn Sheet 6/23/2021 8:35:59 AM KChrisman

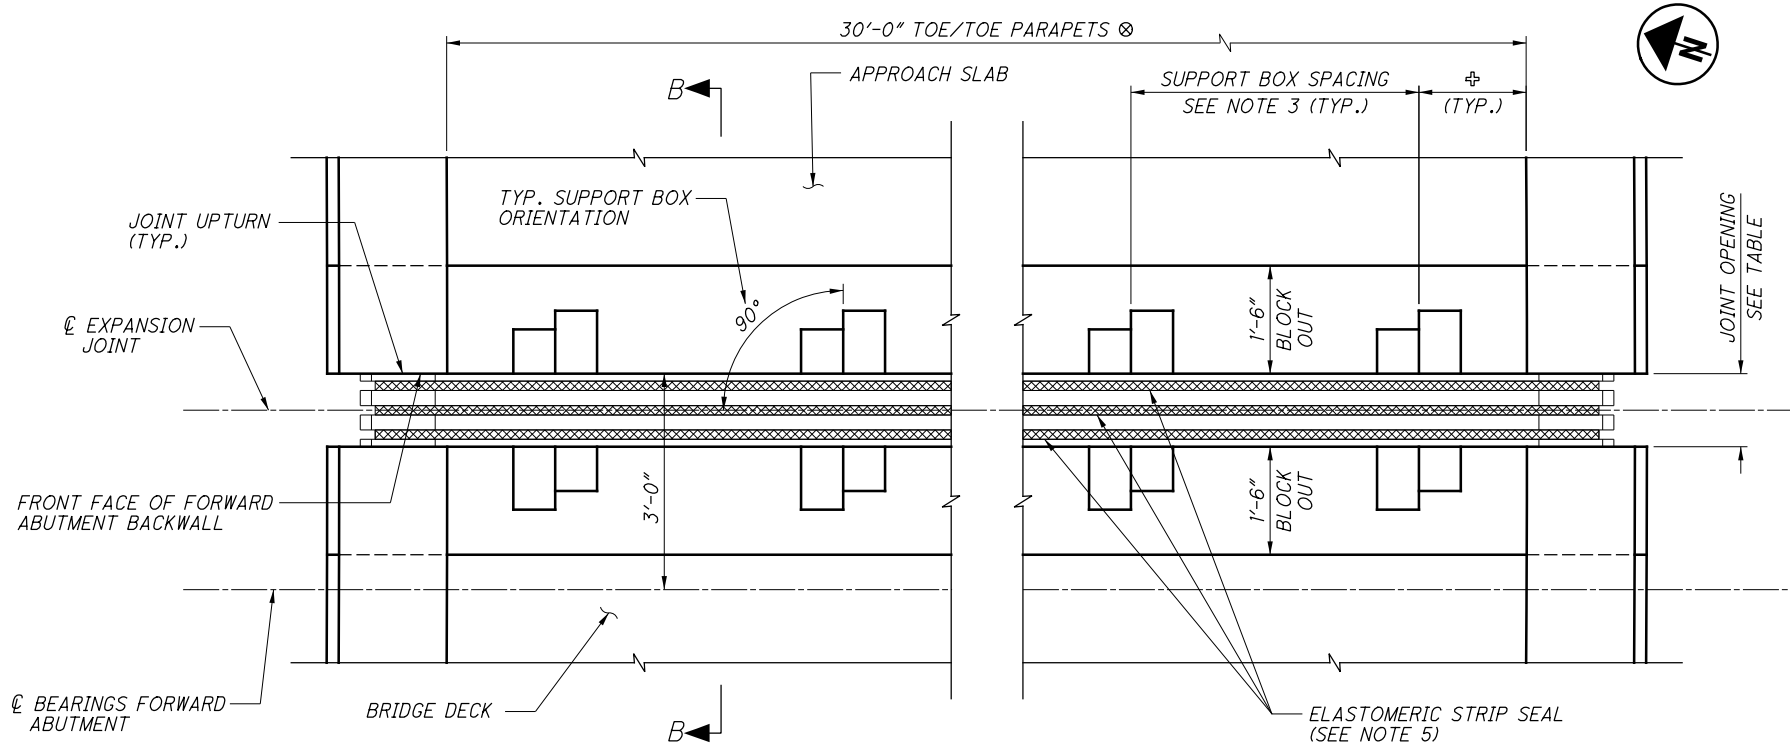

PLAN - FORWARD ABUTMENT
(JOINT ANCHORAGE NOT SHOWN, SEE NOTE 4)
(PARAPET SLIDING PLATES NOT SHOWN)

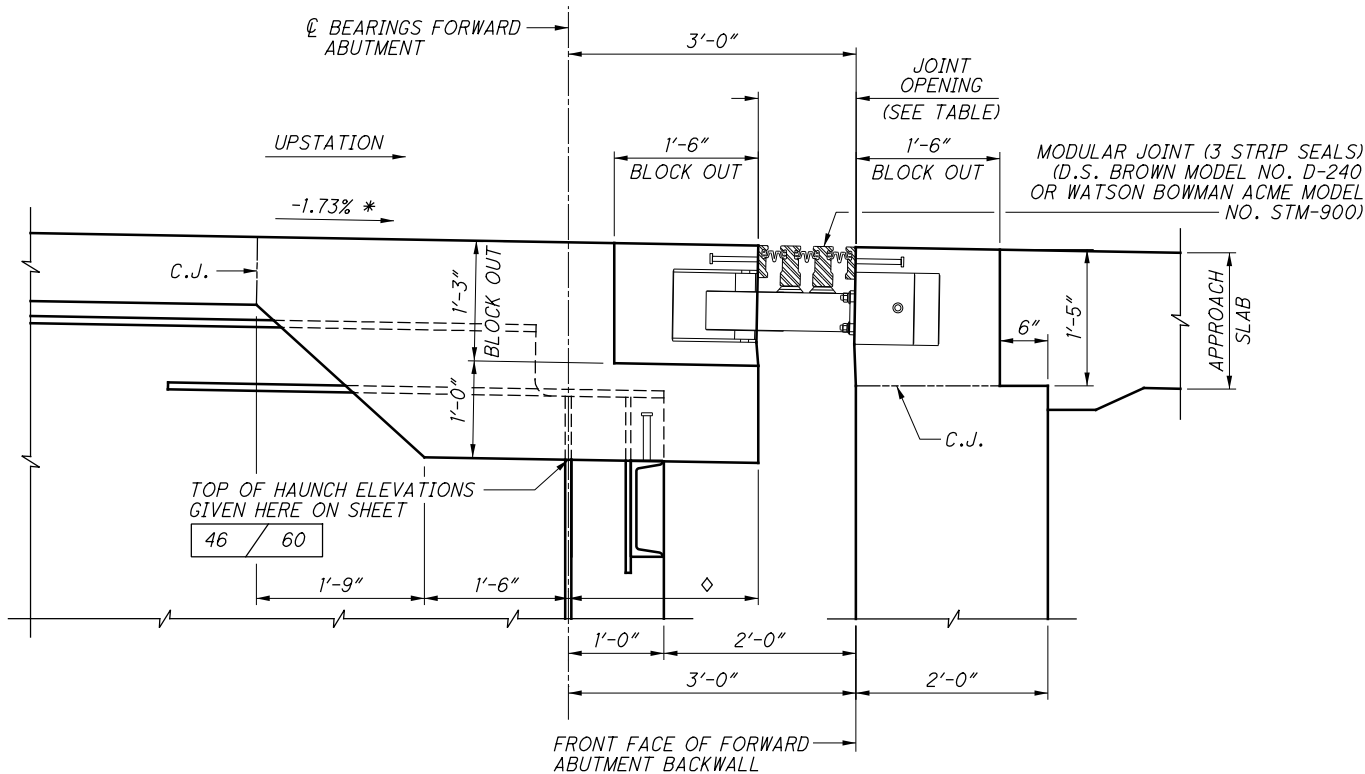


SECTION B-B - FORWARD ABUTMENT
(HORIZONTAL DIMENSIONS ARE MEASURED NORMAL TO ϕ BEARINGS)
(GIRDER SHEAR STUDS NOT SHOWN)

FORWARD ABUTMENT EXPANSION JOINT OPENING		
TEMPERATURE ° F	DS BROWN	WBA
30	1'-0 ³ / ₄ "	10"
40	1'-0 ¹ / ₁₆ "	9 ¹¹ / ₁₆ "
50	1'-0 ³ / ₁₆ "	9 ¹ / ₁₆ "
60	11 ⁷ / ₈ "	9 ¹ / ₈ "
70	11 ⁹ / ₁₆ "	8 ¹³ / ₁₆ "
80	11 ¹ / ₄ "	8 ¹ / ₂ "
90	10 ¹⁵ / ₁₆ "	8 ³ / ₁₆ "

NOTES:

1. SEE SHEET 51 / 60 FOR UPTURN DETAIL, JOINT PROFILE, NOTES AND LEGEND.

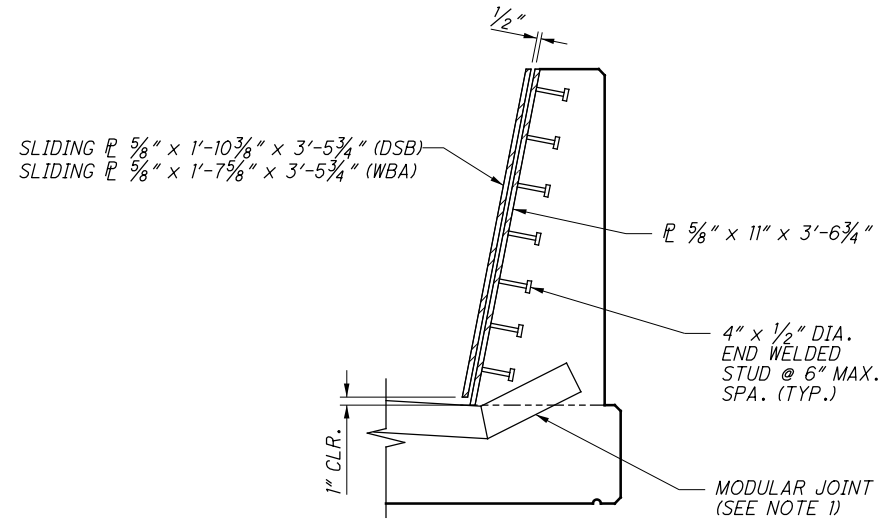


SECTION B-B



- LEGEND:

** = GRADE VARIES DUE TO VERTICAL CURVE. THE GRADE SHOWN IS
 THE INSTANTANEOUS GRADE AT THE FRONT FACE OF THE FORWARD
 ABUTMENT BACKWALL.

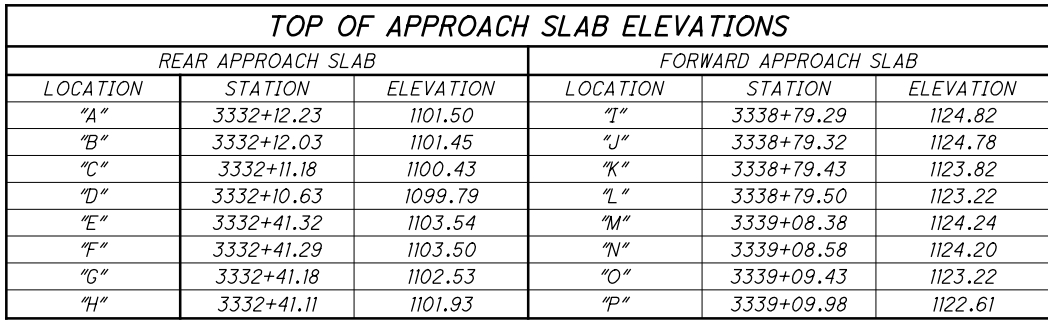

TOP OF SLEEPER SLAB ELEVATIONS					
REAR SLEEPER SLAB			FORWARD SLEEPER SLAB		
LOCATION	STATION	ELEVATION	LOCATION	STATION	ELEVATION
"1"	3332+08.35	1099.81	"9"	3339+04.50	1122.91
"2"	3332+08.12	1099.76	"10"	3339+04.68	1122.87
"3"	3332+07.17	1098.74	"11"	3339+05.42	1121.89
"4"	3332+06.56	1098.09	"12"	3339+05.91	1121.28
"5"	3332+16.11	1100.36	"13"	3339+12.26	1122.74
"6"	3332+15.93	1100.31	"14"	3339+12.49	1122.69
"7"	3332+15.19	1099.30	"15"	3339+13.44	1121.71
"8"	3332+14.70	1098.66	"16"	3339+14.05	1121.10










** = 1'-8" X 4'-0" NOTCH IN SLEEPER SLAB
FOR GUARDRAIL POSTS

NOTES:

1. CROSS-SLOPES AND ROUNDING USED ON APPROACH SLABS SHALL MATCH THE BRIDGE DECK SLAB.
2. REINFORCING STEEL IN THE APPROACH SLABS SHALL BE AS SHOWN ON THE PLANS. REINFORCING STEEL IN THE SLEEPER SLABS SHALL BE AS SHOWN ON STANDARD DRAWING AS-2-15, EXCEPT AS NOTED ON THE PLANS.
3. SEE STD. DWG. AS-1-15 AND STD. DWG. AS-2-15 FOR ADDITIONAL DETAILS AND INFORMATION NOT SHOWN.
4. FOR CALCULATING REINFORCING STEEL BAR LENGTHS FOR SLEEPER SLABS PER STD. DWG. AS-2-15, SHEET 1/14, USE APPROACH SLAB WIDTH, W OF 33'-2" (REAR) AND 33'-4" (FORWARD) AND USE SKEW ANGLE OF 0°. FIELD CUT BARS AT NOTCH IN SLEEPER SLAB AS NEEDED TO PROVIDE 3" CLEAR COVER. REPAIR FIELD-CUT BAR ENDS PER 509.

ISSUE RECORD:		DESCRIPTION
NO.	DATE	

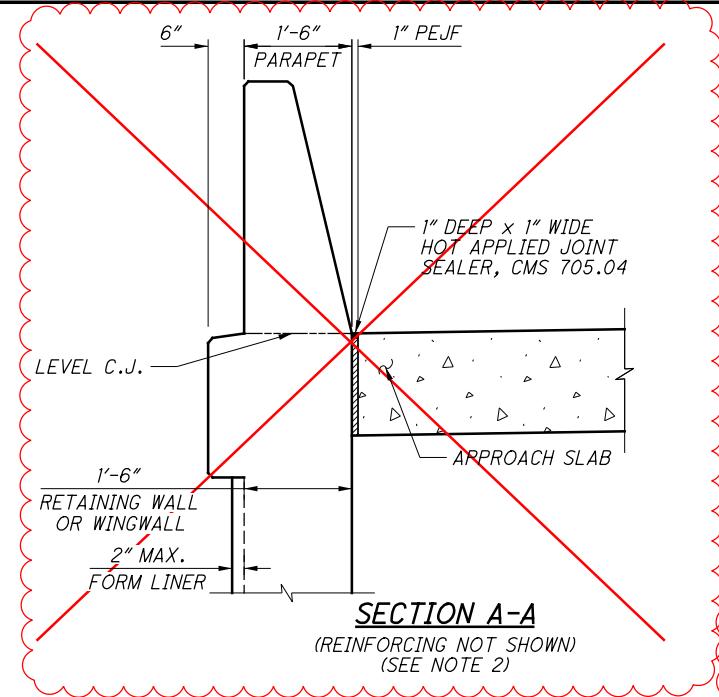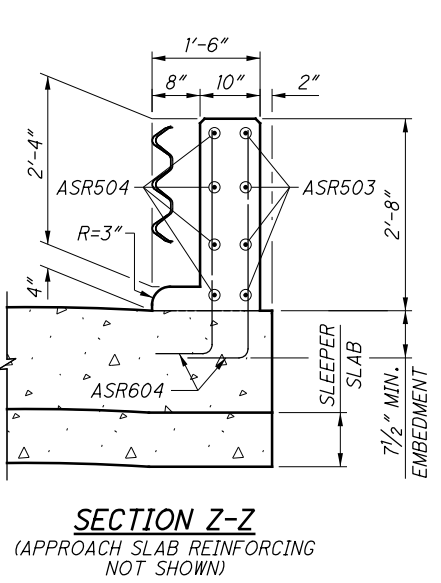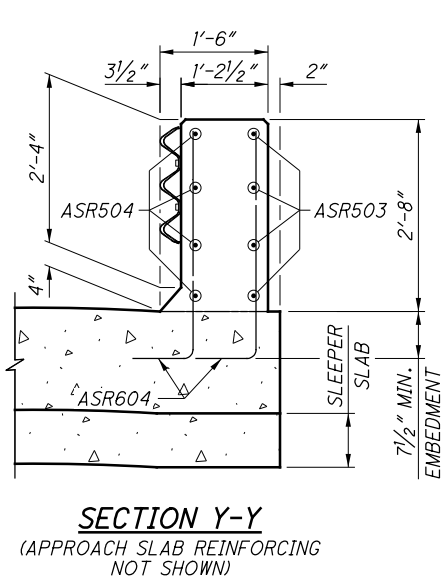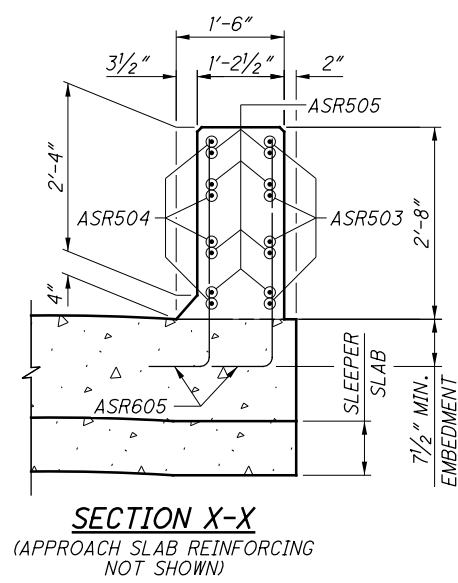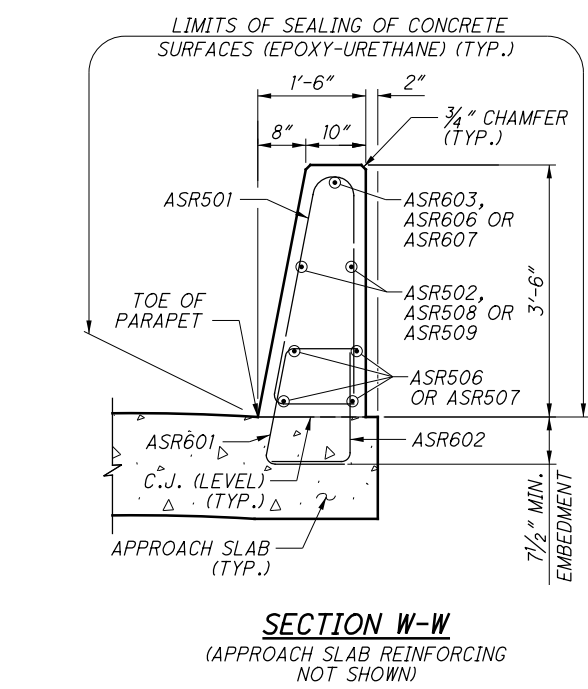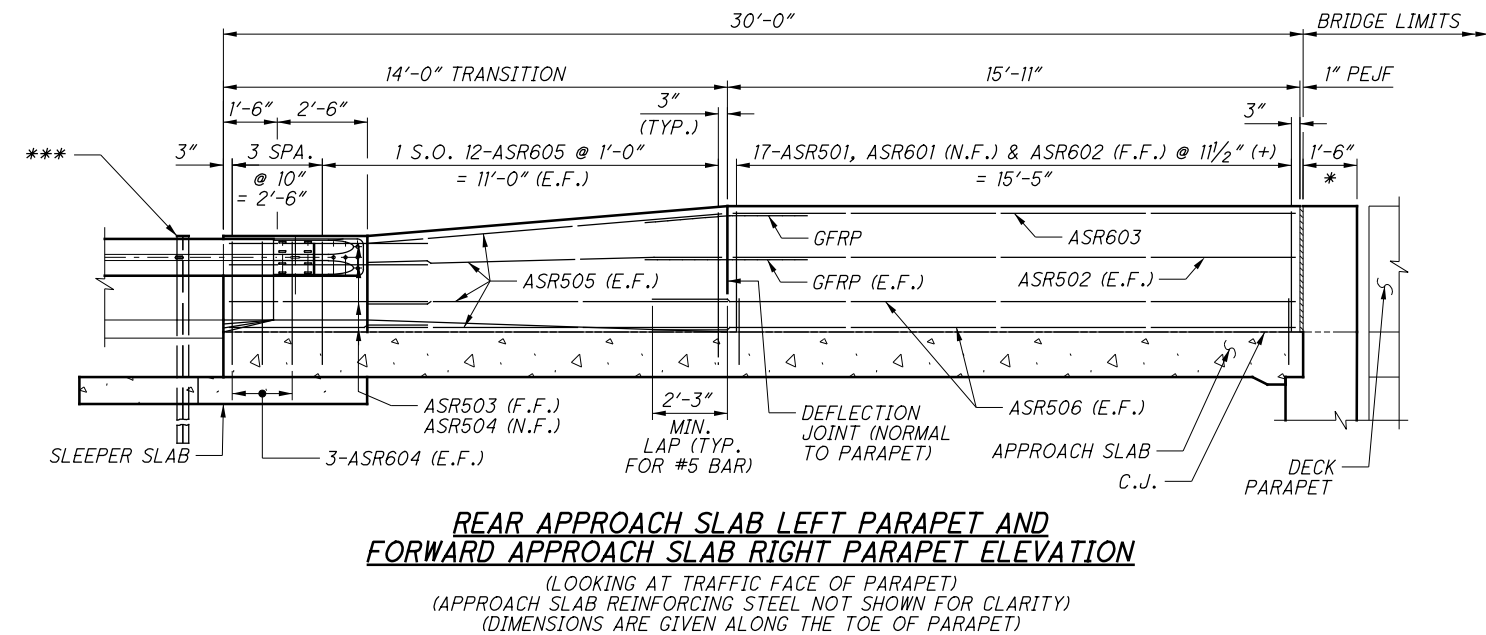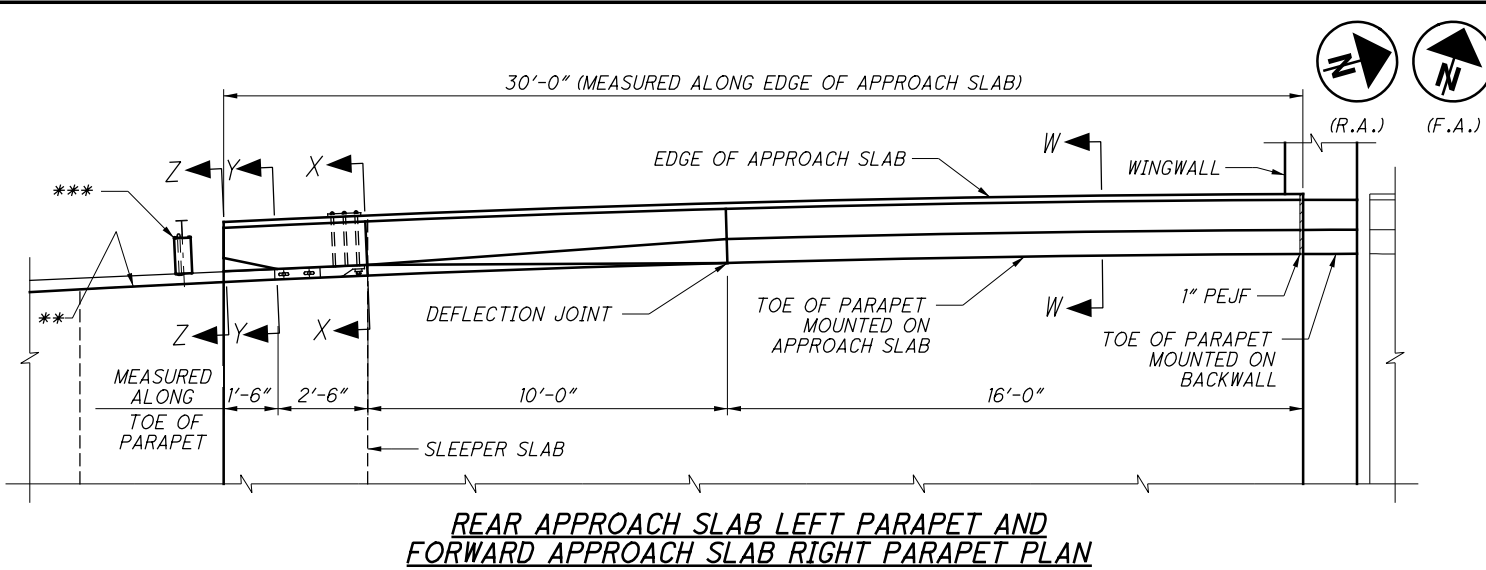

SEE ROADWAY PLANS FOR SINGLE SLOPE BARRIER, TYPE D FOR FORWARD APPROACH DETAILS
SEE BU-17 FOR RIGHT REAR APPROACH DETAILS



LEGEND:


- * = SEE DETAIL X ON SHEET 50 / 60
- ** = 1'-8" x 4'-0" NOTCH IN SLEEPER SLAB FOR GUARDRAIL POSTS
- *** = MGS BRIDGE TERMINAL ASSEMBLY, TYPE 1 (FORWARD APPROACH SLAB) SHOWN OR TYPE 2 (REAR APPROACH SLAB). SEE STANDARD DRAWING MGS-3.1 OR MGS-3.2 FOR BRIDGE TERMINAL ASSEMBLY DETAILS. SEE ROADWAY PLANS FOR PAYMENT.
- ⊕ = INCLUDED FOR PAYMENT WITH BRIDGE QUANTITIES

NOTES:


- SEE STD. DWGS. SBR-1-13, AS-1-15 AND AS-2-15 FOR ADDITIONAL DETAILS AND INFORMATION NOT SHOWN.
- SEE STD. DWG. SBR-1-13 FOR DETAILS REGARDING INSTALLATION AND SEALING OF DEFLECTION JOINTS, AND NOTES FOR THE GFRP STIFFENING REINFORCEMENT. A TOTAL OF 9 GFRP STIFFENING REINFORCEMENT BARS, 1/2" DIA. x 4'-6" LONG, ARE REQUIRED FOR THE APPROACH SLAB PARAPETS.
- PARAPET MOUNTED ON APPROACH SLAB IS INCLUDED FOR PAYMENT WITH ITEM 511 CLASS QC2 CONCRETE WITH QC/QA, BRIDGE DECK (PARAPET). REINFORCING STEEL FOR PARAPET MOUNTED ON APPROACH SLAB (ALL ASR BARS) IS INCLUDED FOR PAYMENT WITH ITEM 509 - EPOXY COATED REINFORCING STEEL, AS PER PLAN.

ISSUE RECORD:		DESCRIPTION
NO.	DATE	


MARK	NUMBER	LENGTH	WEIGHT	TYPE	DIMENSIONS						
	TOTAL				A	B	C	D	E	R	INC
REAR ABUTMENT											
RA501	26	4'-3"	115	2	1'-6"	1'-6"	1'-6"				
RA502	2	18'-10"	39	STR							
RA503	18	32'-8"	613	STR							
	2 SR	6'-1"									
RA504	OF	TO	329	STR							1'-7¾"
	11	22'-7"									
RA505	1	22'-6"	23	STR							
RA601	72	13'-4"	1442	2	2'-6"	8'-8"	2'-6"				
RA602	34	8'-5"	430	2	2'-9"	3'-3"	2'-9"				
RA603	24	21'-9"	784	1	2'-6"	19'-5"					
RA604	16	30'-2"	725	1	2'-6"	27'-10"					
RA605	20	5'-7"	168	1	1'-0"	4'-9"					
RA606	10	10'-1"	151	2	1'-11"	6'-4"	2'-2"				
RA607	18	6'-1"	164	1	1'-0"	5'-3"					
RA608	9	11'-1"	150	2	2'-5"	6'-4"	2'-8"				
RA609	16	6'-7"	158	1	1'-0"	5'-9"					
RA610	8	12'-1"	145	2	2'-11"	6'-4"	3'-2"				
RA611	12	7'-1"	128	1	1'-0"	6'-3"					
RA612	6	13'-1"	118	2	3'-5"	6'-4"	3'-8"				
	2 SR	10'-5"				9'-7"					
RA613	OF	TO	394	1	1'-0"	TO					3½"
	11	13'-4"				12'-6"					
	2 SR	6'-6"				5'-8"					
RA614	OF	TO	270	1	1'-0"	TO					4"
	11	9'-9"				8'-11"					
RA615	2	5'-10"	18	1	1'-0"	5'-0"					
RA616	2	5'-5"	16	1	1'-0"	4'-7"					
RA617	2	5'-1"	15	1	1'-0"	4'-3"					
RA618	14	13'-2"	277	1	1'-0"	12'-4"					
RA619	7	7'-0"	74	2	1'-0"	5'-4"	1'-0"				
RA620	2	13'-5"	40	1	1'-0"	12'-7"					
RA621	33	14'-0"	694	2	6'-5"	1'-6"	6'-5"				
RA622	33	6'-10"	339	2	2'-10'	1'-6"	2'-10"				
RA623	33	10'-4"	512	2	4'-10"	1'-0"	4'-10"				
RA624	2	19'-5"	58	STR							
RA625	2	27'-10"	84	STR							
RA626	7	14'-6"	152	1	1'-0"	13'-8"					
RA627	1	20'-4"	31	STR							
RA628	4	6'-2"	37	3	1'-4"	1'-4"					
RA801	23	5'-0"	307	18	2'-10"	1'-0"	1'-0"				
SUB-TOTAL			9,000								

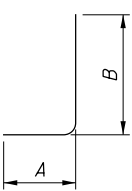


TYPE-1

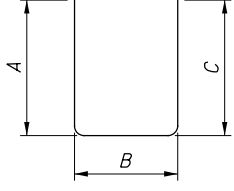


TYPE-2

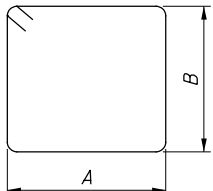

TYPE-3

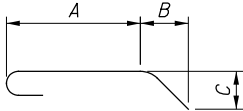

TYPE-18

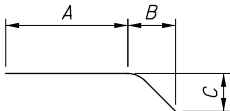

TYPE-19

NOTES:

1. ALL REINFORCING STEEL SHALL BE EPOXY COATED.
2. BAR SIZE: THE BAR SIZE IS INDICATED IN THE BAR MARK. THE MARK BEGINS WITH TWO OR THREE LETTERS OR NUMBERS THAT IDENTIFY THE BAR LOCATION. THE NEXT ONE OR TWO DIGITS INDICATE THE BAR SIZE, AND THE REMAINING TWO DIGITS ARE THE SEQUENCE NUMBER.

EXAMPLE: SA1001
SA = SUPERSTRUCTURE BAR
10 = #10 BAR
01 = BAR SEQUENCE NUMBER 1
3. BAR DIMENSIONS SHOWN ARE OUT-TO-OUT UNLESS OTHERWISE INDICATED.
4. STR. IN THE BAR TYPE COLUMN INDICATES A STRAIGHT BAR.
5. RAD. INDICATES INSIDE RADIUS, UNLESS OTHERWISE NOTED.
6. INCR. INDICATES THE LENGTH INCREMENT FOR SERIES BARS.
7. STD. WRITTEN IN PLACE OF A DIMENSION INDICATES A STANDARD BEND AT THE END OF A BAR.
8. SPIRAL REINFORCING BARS: THE "LENGTH" SHOWN IN THE STEEL LIST FOR THE SPIRAL BARS IS THE LENGTH ALONG THE AXIS OF THE SPIRAL. PROVIDE ONE AND ONE-HALF CLOSED-COIL TURNS AT THE ENDS OF EACH SPIRAL UNIT.


LEGEND:

- * = REINFORCING BAR UTILIZES A MECHANICAL CONNECTOR. BAR LENGTH IS MEASURED TO THE CONSTRUCTION JOINT, EXCEPT AT PIER COLUMNS, WHERE BAR LENGTH IS MEASURED TO THE CENTER OF THE MECHANICAL CONNECTOR. EXTRA BAR LENGTH AND/OR BAR END PREPARATION MAY BE NECESSARY DEPENDING UPON THE TYPE OF MECHANICAL CONNECTOR FURNISHED.
- Δ = REINFORCING BAR IS INCLUDED FOR PAYMENT WITH DRILLED SHAFTS. WEIGHT IS NOT INCLUDED IN TOTAL.
- Δ Δ = ALL APPROACH SLAB REINFORCING BARS ARE INCLUDED FOR PAYMENT WITH ITEM 526 - REINFORCED CONCRETE APPROACH SLABS WITH QC/QA (T=17"), AS PER PLAN.


ISSUE RECORD:		DESCRIPTION
NO.	DATE	

pw:\V\ANV\A01PWINT01.parsons.com:Ohio State\Documents\DB-Akron Beltway Rehab\10 - Design\102329\Structures\SUM076_1152N\Sheets\076_1149R_SL007.dgn Sheet 6/23/2021 8:36:31 AM KChrisman


MARK	NUMBER	LENGTH	WEIGHT	TYPE	DIMENSIONS						
	TOTAL				A	B	C	D	E	R	INC
FORWARD ABUTMENT											
FA501	3	33'-4"	104	STR							
FA502	1	14'-9"	15	STR							
FA503	17	35'-4"	626	STR							
FA504	42	5'-1"	223	STR							
FA505	42	8'-3"	361	STR							
FA506	20	3'-3"	68	2	1'-6"	6	1'-6"				
FA601	40	21'-9"	1307	1	2'-6"	19'-5"					
FA602	72	13'-4"	1442	2	2'-6"	8'-8"	2'-6"				
FA603	14	7'-10"	165	1	1'-0"	7'-0"					
FA604	16	7'-5"	178	1	1'-0"	6'-7"					
FA605	18	6'-10"	185	1	1'-0"	6'-0"					
FA606	20	6'-5"	193	1	1'-0"	5'-6 1/2"					
FA607	7	12'-9"	134	2	4'-0"	5'-4"	3'-9"				
FA608	8	11'-11"	143	2	3'-7"	5'-4"	3'-4"				
FA610	9	10'-9"	145	2	3'-0"	5'-4"	2'-9"				
FA610	10	9'-10"	148	2	2'-6 1/2"	5'-4"	2'-3 1/2"				
FA611	7	11'-1"	117	2	2'-8"	6'-1"	2'-8"				
FA612	14	14'-10"	312	1	2'-8"	12'-4"					
FA613	7	16'-4"	172	1	2'-8"	13'-10"					
FA614	34	14'-10"	758	2	6'-10"	1'-6"	6'-10"				
FA615	38	6'-10"	390	2	2'-10"	1'-6"	2'-10"				
FA616	34	10'-4"	528	2	4'-10"	1'-0"	4'-10"				
FA617	4	19'-5"	117	STR							
FA618	20	8'-9"	263	STR							
FA619	20	10'-4"	310	STR							
FA620	4	13'-6"	81	2	6'-8"	6"	6'-8"				
FA621	4	13'-7"	82	2	5'-7"	2'-9"	5'-7"				
FA801	23	5'-0"	307	18	2'-10"	1'-0"	1'-0"				

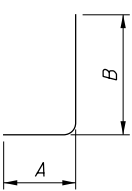

TYPE-1

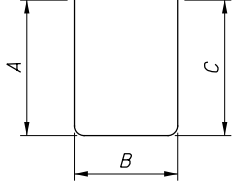

TYPE-2

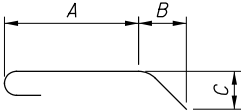

TYPE-18

NOTES:
1. SEE SHEET 56 / 60 FOR LEGEND AND NOTES.

2025-03-13 - BU-11 - RECORD DRAWING PLANS

DESIGN AGENCY PRIMEITY 845 Park Plaza Columbus Ohio 43240		DATE 6/14/21	REVIEWED SAN	DRAWN KDC	DESIGNED KDC	FORWARD ABUTMENT REINFORCING SCHEDULE		STRUCTURE FILE NUMBER 7705973
SUM-76 / 77 / 8 - 8.24 / 9.74 / 0.00		SUM-76-1152N		RAMP N OVER RAMP S, LANE O, IR-76 EB, SR-8 NB/SB, LANE M		PID No. 102329		57 / 60
58 61								

ISSUE RECORD:		DESCRIPTION	
NO.	DATE		

REINFORCING STEEL LIST - PIER 1											
MARK	NO.	LENGTH	WEIGHT	TYPE	DIM. A	DIM. B	DIM. C	DIM. D	DIM. E/RAD.	INCR.	
Δ IDS1101	42	28'-8"	6397	STR							
Δ IDS401	21	8'-2"	115	38	2'-0"	1'-11"					
Δ IDS901	30	12'-2"	1241	STR							
	IP1001	5	27'-7"	593	STR						
	IP1101	7	14'-11"	555	40	9'-5"	4'-0"	0'-3"			
	IP1102	7	23'-8"	880	1	22'-0"	2'-0"				
	IP401	18	8'-2"	98	38	2'-0"	1'-11"				
	IP402	270	1'-6"	271	21	0'-4"	0'-8"				
	IP403	9	5'-1"	31	39A	1'-4¾"	0'-9¾"	0'-10½"	0'-6"		
	IP404	2	12'-5"	17	STR						
	IP405	6	31'-7"	127	STR						
	IP406	2	24'-0"	32	STR						
	IP407	2	15'-3"	20	STR						
	IP408	2	31'-8"	42	26	1'-6"	11'-3"	9'-0"	11'-3"	1'-6"	
	IP409	4	10'-4"	28	STR						
	IP501	18	30'-5"	571	STR						
	IP502	14	7'-0"	102	1	6'-3"	0'-10"				
	IP503	7	7'-0"	51	18	5'-7"	0'-10"	0'-10"			
	IP504	5	5'-5"	28	90	1'-9"					
	IP505	5	6'-8"	35	90	3'-0"					
	IP506	7	5'-7"	41	18	4'-6"	0'-8"	0'-8"			
	IP507	20	9'-9"	203	18	4'-8"	2'-8"	2'-8"			
	IP508	14	8'-4"	122	18	3'-3"	2'-8"	2'-8"			
	IP509	2	8'-1"	17	18	4'-8"	1'-10"	1'-10"			
	IP510	1	8'-10"	9	7	1'-9"	3'-10½"	0'-4¼"	0'-8½"		
	IP511	1	9'-7"	10	7	1'-10"	3'-5"	0'-7"	1'-2"		
	IP512	8	9'-4"	78	6	1'-10"	2'-7"	3'-5"	1'-7"	0'-7"	
		1	10'-5"			2'-3"	3'-9"	0'-5"	1'-1"		
	IP513	S.O.	TO	33	7	TO	TO	TO	TO		0'-2"
		3	10'-9"			2'-8"	3'-11"	0'-4"	0'-9"		
		1	11'-10"			3'-2"	4'-0"	0'-3½"	0'-9"		
	IP514	S.O.	TO	37	7	TO	TO	TO	TO		0'-1"
		3	12'-0"			3'-6"	4'-2"	0'-2½"	0'-5"		
	IP515	20	10'-0"	209	18	3'-3"	3'-6"	3'-6"			
	IP516	20	10'-3"	214	6	3'-3"	3'-1"	3'-8"	0'-4½"	0'-2"	
		1	12'-11"			3'-10"	4'-1"	0'-3"	0'-7"		
	IP517	S.O.	TO	27	7	TO	TO	TO	TO		0'-1"
		2	13'-0"			4'-0"	4'-2"	0'-2½"	0'-5"		
		1	12'-7"			3'-4"	3'-9"	0'-5"	1'-1"		
	IP518	S.O.	TO	40	7	TO	TO	TO	TO		0'-1½"
		3	12'-10"			3'-9"	3'-11"	0'-4"	0'-8½"		
	IP519	6	12'-2"	76	6	3'-3"	2'-7"	4'-10"	1'-7"	0'-7"	
	IP520	1	12'-11"	13	7	3'-2"	3'-6"	0'-6½"	1'-6"		
	IP521	1	12'-4"	13	7	2'-9"	3'-10"	0'-4½"	1'-6"		
	IP522	1	11'-7"	12	7	3'-1"	3'-10"	0'-4½"	0'-9"		
	IP523	2	10'-4"	22	7	2'-1"	3'-7"	0'-6"	1'-3"		
	IP524	2	12'-0"	25	7	3'-6"	4'-3½"	0'-2¼"	0'-4½"		
	IP525	2	13'-4"	28	7	3'-7"	3'-7"	0'-6"	1'-3"		
	IP526	2	5'-1"	11	18	4'-0"	0'-8"	0'-8"			
	IP527			NOT USED							
	IP528	4	3'-8"	15	STR						
	IP601	10	4'-3"	64	1	2'-10½"	1'-7"				
	IP602	6	14'-4"	129	35	3'-8"	2'-11"	1'-0"	1'-0"		
	IP901	30	30'-0"	3060	STR						
	IP902	30	6'-3"	637	STR						
	IP903	10	4'-2"	142	1	2'-10½"	1'-7"				
Δ	ISP401	3	28'-8"	1735	15	3'-6"	0'-4½"				
	ISP501	3	28'-11"	2864	15	2'-6"	0'-3"				
			TOTAL	11632							

REINFORCING STEEL LIST - PIER 2											
MARK	NO.	LENGTH	WEIGHT	TYPE	DIM. A	DIM. B	DIM. C	DIM. D	DIM. E/RAD.	INCR.	
Δ 2DS1101	14	17'-10"	1326	STR							
Δ 2DS1102	28	14'-8"	2182	STR							
Δ 2DS1103	42	15'-0"	3347	STR							
Δ 2DS401	27	8'-2"	147	38	2'-0"	1'-11"					
	2P1001	5	27'-7"	593	STR						
	2P1101	7	14'-11"	555	40	9'-5"	4'-0"	0'-3"			
	2P1102	7	23'-8"	880	1	22'-0"	2'-0"				
	2P1103	14	21'-0"	1562	STR						
	2P1104	14	25'-6"	1897	STR						
	2P1105	14	30'-0"	2231	STR						
	2P1106	42	23'-7"	5263	STR						
	2P401	24	8'-2"	131	38	2'-0"	1'-11"				
	2P402	366	1'-6"	367	21	0'-4"	0'-8"				
	2P403	9	5'-1"	31	39A	1'-4¾"	0'-9¾"	0'-10½"	0'-6"		
	2P404	2	12'-5"	17	STR						
	2P405	6	31'-7"	127	STR						
	2P406	2	24'-0"	32	STR						
	2P407	2	15'-3"	20	STR						
	2P408	2	31'-8"	42	26	1'-6"	11'-3"	9'-0"	11'-3"	1'-6"	
	2P409	4	10'-4"	28	STR						
	2P501	6	21'-0"	131	STR						
	2P502	14	7'-0"	102	1	6'-3"	0'-10"				
	2P503	7	7'-0"	51	18	5'-7"	0'-10"	0'-10"			
	2P504	5	5'-5"	28	90						
	2P505	5	6'-8"	35	90						
	2P506	7	5'-7"	41	18	4'-6"	0'-8"	0'-8"			
	2P507	20	9'-9"	203	18	4'-8"	2'-8"	2'-8"			
	2P508	14	8'-4"	122	18	3'-3"	2'-8"	2'-8"			
	2P509	2	8'-1"	17	18	4'-8"	1'-10"	1'-10"			
	2P510	1	8'-10"	9	7	1'-9"	3'-10½"	0'-4¼"	0'-8½"		
	2P511	1	9'-7"	10	7	1'-10"	3'-5"	0'-7"	1'-2"		
	2P512	8	9'-4"	78	6	1'-10"	2'-7"	3'-5"	1'-7"	0'-7"	
		1	10'-5"			2'-3"	3'-9"	0'-5"	1'-1"		
	2P513	S.O.	TO	33	7	TO	TO	TO	TO		0'-2"
		3	10'-9"			2'-8"	3'-11"	0'-4"	0'-9"		
		1	11'-10"			3'-2"	4'-0"	0'-3½"	0'-9"		
	2P514	S.O.	TO	37	7	TO	TO	TO	TO		0'-1"
		3	12'-0"			3'-6"	4'-2"	0'-2½"	0'-5"		
	2P515	20	10'-0"	209	18	3'-3"	3'-6"	3'-6"			
	2P516	20	10'-3"	214	6	3'-3"	3'-1"	3'-8"	0'-4½"	0'-2"	
		1	12'-11"			3'-10"	4'-1"	0'-3"	0'-7"		
	2P517	S.O.	TO	27	7	TO	TO	TO	TO		0'-1"
		2	13'-0"			4'-0"	4'-2"	0'-2½"	0'-5"		
		1	12'-7"			3'-4"	3'-9"	0'-5"	1'-1"		
	2P518	S.O.	TO	40	7	TO	TO	TO	TO		0'-1½"
		3	12'-10"			3'-9"	3'-11"	0'-4"	0'-8½"		
	2P519	6	12'-2"	76	6	3'-3"	2'-7"	4'-10"	1'-7"	0'-7"	
	2P520	1	12'-11"	13	7	3'-2"	3'-6"	0'-6½"	1'-6"		
	2P521	1	12'-4"	13	7	2'-9"	3'-10"	0'-4½"	1'-6"		
	2P522	1	11'-7"	12	7	3'-1"	3'-10"	0'-4½"	0'-9"		
	2P523	2	10'-4"	22	7	2'-1"	3'-7"	0'-6"	1'-3"		
	2P524	2	12'-0"	25	7	3'-6"	4'-3½"	0'-2¼"	0'-4½"		
	2P525	2	13'-4"	28	7	3'-7"	3'-7"	0'-6"	1'-3"		
	2P526	2	5'-1"	11	18	4'-0"	0'-8"	0'-8"			
	2P527	18	16'-2"	304	STR						
	2P528	6	25'-6"	160	STR						
	2P529	6	30'-0"	188	STR						
Δ	2SP401	1	17'-10"	368	15	3'-6"	0'-4½"				
Δ	2SP402	2	14'-8"	613	15	3'-6"	0'-4½"				
	2SP501	1	34'-3"	1126	15	2'-6"	0'-3"				
	2SP502	1	38'-9"	1271	15	2'-6"	0'-3"				
	2SP503	1	43'-3"	1416	15	2'-6"	0'-3"				
			TOTAL	19828							

NOTES:

1. SEE SHEET

56	/	60
----	---	----

 FOR NOTES AND LEGEND.
2. SEE SHEET


59	/	60
----	---	----

 FOR REINFORCING BAR TYPES.


ISSUE RECORD:		DESCRIPTION
NO.	DATE	

pww:\ANV\A01PWINT01.parsons.com:Ohio State\Documents\DB-Akron Beltway Rehab\10 - Design\102329\Structures\SUM076_1152N\Sheets\076_1149R_SL004.dgn Sheet 6/23/2021 8:36:45 AM KChrisman


REINFORCING STEEL LIST - PIER 3											
MARK	NO.	LENGTH	WEIGHT	TYPE	DIM. A	DIM. B	DIM. C	DIM. D	DIM. E/RAD.	INCR.	
Δ 3DS1101	46	21'-8"	5295	STR							
Δ 3DS1102	46	15'-6"	3788	STR							
Δ 3DS401	9	17'-7"	106	38	5'-0"	1'-11"					
3P1101	12	34'-11"	2226	18	31'-7"	2'-0"	2'-0"				
3P1102	18	31'-7"	3020	STR							
* 3P1103	23	30'-0"	3666	STR							
* 3P1104	23	27'-0"	3299	STR							
* 3P1105	23	31'-7"	3859	19	30'-0"						
* 3P1106	23	34'-7"	4226	19	33'-0"						
3P401	174	2'-2"	252	21	0'-4"	1'-0"					
3P402	4	13'-3"	35	39	3'-3"	1'-11"	2'-11"				
3P403	4	12'-4"	33	39	3'-0"	1'-9"	2'-9"				
3P404	16	4'-4"	46	18	1'-6"	1'-6"	1'-6"				
3P405	8	17'-7"	94	38	5'-0"	1'-11"					
3P501	6	30'-0"	188	STR							
3P502	6	28'-10"	180	STR							
3P601	14	11'-0"	231	STR							
3P602	7	12'-0"	126	26	0'-2"	1'-6"	9'-0"	1'-6"	0'-2"		
3P603	4	7'-4"	44	STR							
3P604	2	17'-6"	53	STR							
3P605	7	6'-7"	69	11	0'-8"	0'-4"	0'-2"	4'-5"	1'-6"		
3P606	7	8'-1"	85	11	0'-8"	0'-4"	0'-2"	5'-11"	1'-6"		
3P607	13	8'-8"	169	18	6'-0"	1'-6"	1'-6"				
3P608	21	7'-6"	237	1	1'-6"	6'-2"					
3P609	7	8'-2"	86	18	5'-6"	1'-6"	1'-6"				
3P610	76	13'-5"	1532	18	4'-3"	4'-9"	4'-9"				
3P611	18	14'-1"	381	6	4'-6"	3'-11"	5'-2"	0'-8"	0'-4"		
3P612	6	15'-11"	143	6	5'-5"	3'-11"	6'-1"	0'-8"	0'-4"		
3P613	28	17'-3"	725	6	6'-4"	4'-1"	6'-8"	0'-4"	0'-2"		
3P614	24	16'-11"	610	6	5'-11"	3'-11"	6'-7"	0'-8"	0'-4"		
3P615	5	19'-1"	143	7	6'-4"	5'-10"	0'-2"	0'-4"			
3P616	5	15'-4"	115	18	6'-2"	4'-9"	4'-9"				
3P801	8	31'-7"	675	STR							
3P802	2	21'-1"	113	STR							
3P803	2	8'-7"	46	STR							
Δ 3SP501	1	21'-8"	1388	15	7'-0"	0'-4 1/2"					
3SP502	1	56'-0"	3724	15	5'-6"	0'-3 1/4"					
		TOTAL	30431								

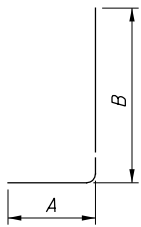


TYPE 1

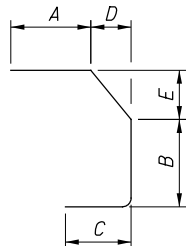


TYPE 6

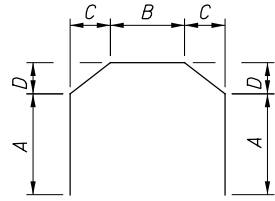

TYPE 7

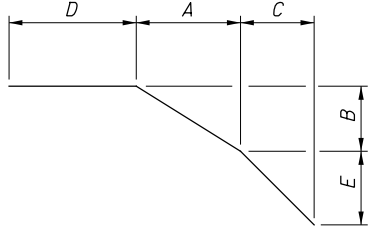

TYPE 11

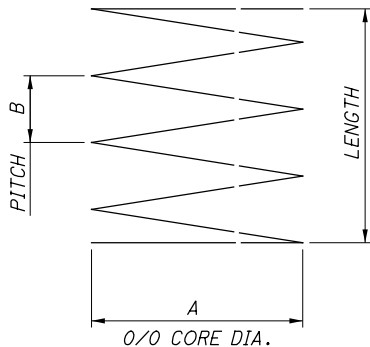


TYPE 15

REINFORCING STEEL LIST - PIER 4											
MARK	NO.	LENGTH	WEIGHT	TYPE	DIM. A	DIM. B	DIM. C	DIM. D	DIM. E/RAD.	INCR.	
Δ 4DS1001	36	15'-0"	2324	STR							
Δ 4DS1101	42	15'-1"	3366	STR							
Δ 4DS401	24	8'-2"	131	38	2'-0"	1'-11"					
4P1001	5	27'-7"	593	STR							
4P1002	36	30'-0"	4647	STR							
4P1003	36	16'-3"	2517	STR							
4P1101	7	14'-11"	555	40	9'-5"	4'-0"	0'-3"				
4P1102	7	23'-8"	880	1	22'-0"	2'-0"					
4P401	21	8'-2"	115	38	2'-0"	1'-11"					
4P402	342	1'-6"	343	21	0'-4"	0'-8"					
4P403	9	5'-1"	31	39A	1'-4 3/4"	0'-9 3/4"	0'-10 1/2"	0'-6"			
4P404	2	12'-5"	17	STR							
4P405	6	31'-7"	127	STR							
4P406	2	24'-0"	32	STR							
4P407	2	15'-3"	20	STR							
4P408	2	31'-8"	42	26	1'-6"	11'-3"	9'-0"	11'-3"	1'-6"		
4P409	4	10'-4"	28	STR							
4P501	18	30'-0"	563	STR							
4P502	14	7'-0"	102	1	6'-3"	0'-10"					
4P503	7	7'-0"	51	18	5'-7"	0'-10"	0'-10"				
4P504	5	5'-5"	28	90	1'-9"						
4P505	5	6'-8"	35	90	3'-0"						
4P506	7	5'-7"	41	18	4'-6"	0'-8"	0'-8"				
4P507	20	9'-9"	203	18	4'-8"	2'-8"	2'-8"				
4P508	14	8'-4"	122	18	3'-3"	2'-8"	2'-8"				
4P509	2	8'-1"	17	18	4'-8"	1'-10"	1'-10"				
4P510	1	8'-10"	9	7	1'-9"	3'-10 1/2"	0'-4 1/4"	0'-8 1/2"			
4P511	1	9'-7"	10	7	1'-10"	3'-5"	0'-7"	1'-2"			
4P512	8	9'-4"	78	6	1'-10"	2'-7"	3'-5"	1'-7"	0'-7"		
	1	10'-5"			2'-3"	3'-9"	0'-5"	1'-1"			
4P513	S.O.	TO	33	7	TO	TO	TO	TO		0'-2"	
	3	10'-9"			2'-8"	3'-11"	0'-4"	0'-9"			
	1	11'-10"			3'-2"	4'-0"	0'-3 1/2"	0'-9"			
4P514	S.O.	TO	37	7	TO	TO	TO	TO		0'-1"	
	3	12'-0"			3'-6"	4'-2"	0'-2 1/2"	0'-5"			
4P515	20	10'-0"	209	18	3'-3"	3'-6"	3'-6"				
4P516	20	10'-3"	214	6	3'-3"	3'-1"	3'-8"	0'-4 1/2"	0'-2"		
	1	12'-11"			3'-10"	4'-1"	0'-3"	0'-7"			
4P517	S.O.	TO	27	7	TO	TO	TO	TO		0'-1"	
	2	13'-0"			4'-0"	4'-2"	0'-2 1/2"	0'-5"			
	1	12'-7"			3'-4"	3'-9"	0'-5"	1'-1"			
4P518	S.O.	TO	40	7	TO	TO	TO	TO		0'-1 1/2"	
	3	12'-10"			3'-9"	3'-11"	0'-4"	0'-8 1/2"			
4P519	6	12'-2"	76	6	3'-3"	2'-7"	4'-10"	1'-7"	0'-7"		
4P520	1	12'-11"	13	7	3'-2"	3'-6"	0'-6 1/2"	1'-6"			
4P521	1	12'-4"	13	7	2'-9"	3'-10"	0'-4 1/2"	1'-6"			
4P522	1	11'-7"	12	7	3'-1"	3'-10"	0'-4 1/2"	0'-9"			
4P523	2	10'-4"	22	7	2'-1"	3'-7"	0'-6"	1'-3"			
4P524	2	12'-0"	25	7	3'-6"	4'-3 1/2"	0'-2 1/4"	0'-4 1/2"			
4P525	2	13'-4"	28	7	3'-7"	3'-7"	0'-6"	1'-3"			
4P526	2	5'-1"	11	18	4'-0"	0'-8"	0'-8"				
4P527	18	9'-6"	178	STR							
4P528	4	3'-8"	15	STR							
4P601	10	4'-4"	65	1	2'-11 1/2"	1'-7"					
4P602	6	14'-6"	131	35	3'-8"	3'-0"	1'-0"	1'-0"			
4P901				NOT USED							
4P902				NOT USED							
4P903	10	4'-3"	144	1	2'-11 1/2"	1'-7"					
Δ 4SP401	3	15'-1"	944	15	3'-6"	0'-4 1/2"					
4SP501	3	36'-7"	3605	15	2'-6"	0'-3"					
		TOTAL	16104								

NOTES:


1. SEE SHEET 56 / 60 FOR NOTES AND LEGEND.

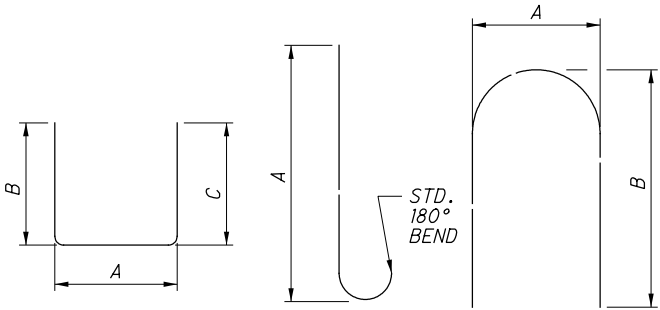


TYPE 18

TYPE 19


TYPE 21

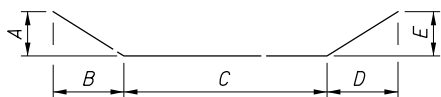


TYPE 26

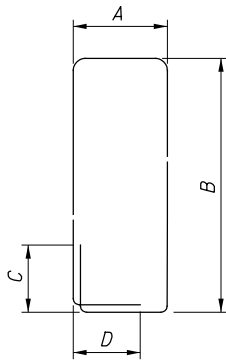


TYPE 35

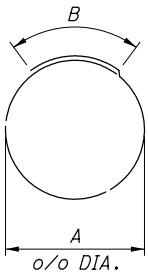


TYPE 38

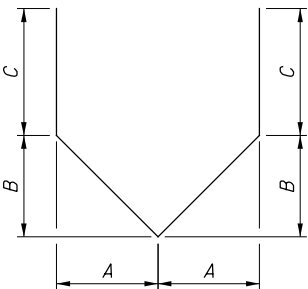


TYPE 39

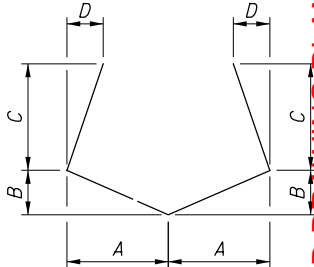

TYPE 39A

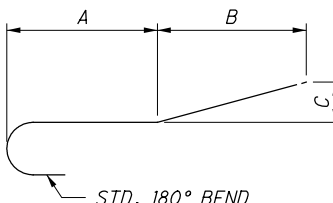

TYPE 40

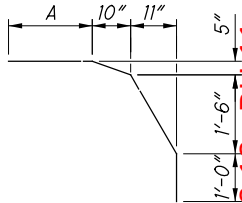

TYPE 90

2025-03-13 - BU-11 - RECORD DRAWING PLANS

DESIGN AGENCY
BURGESS & NIPLE
Engineers ■ Architects ■ Planners
5045 REED ROAD, COLUMBUS, OHIO 43220

DATE
4/29/19

REVIEWED
JCS

DRAWN
AAA

DESIGNED
JHL

STRUCTURE FILE NUMBER
7705973

CHECKED
BES

REVISED

REINFORCING STEEL LIST - 4

SUM-76-1152N

RAMP N OVER RAMP S, LANE O, IR-76 EB, SR-8 NB/SB, LANE M

SUM-76/77/8-
8.24/9.74/0.00

PID No. 102329

59/60

60
61

