


ISSUE RECORD:		
NO.	DATE	DESCRIPTION
AB	3/18/25	RW 77-1 ELIMINATED

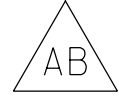

2025-03-18 - BU-18A - RECORD DRAWING PLANS

1

2

2

10

SUM-8/76/77-
0.63/9.74/8.42
PID No. 102329

RETAINING WALL 77-1 PLAN

DESIGNED
JRE

CHECKED
KDC

DRAWN
JRE

REVIEWED
TES


DATE
06/06/23

STRUCTURE FILE NUMBER



ISSUE RECORD:		
NO.	DATE	DESCRIPTION
AB	3/18/25	RW 77-1 ELIMINATED



ISSUE RECORD		DESCRIPTION
NO.	DATE	

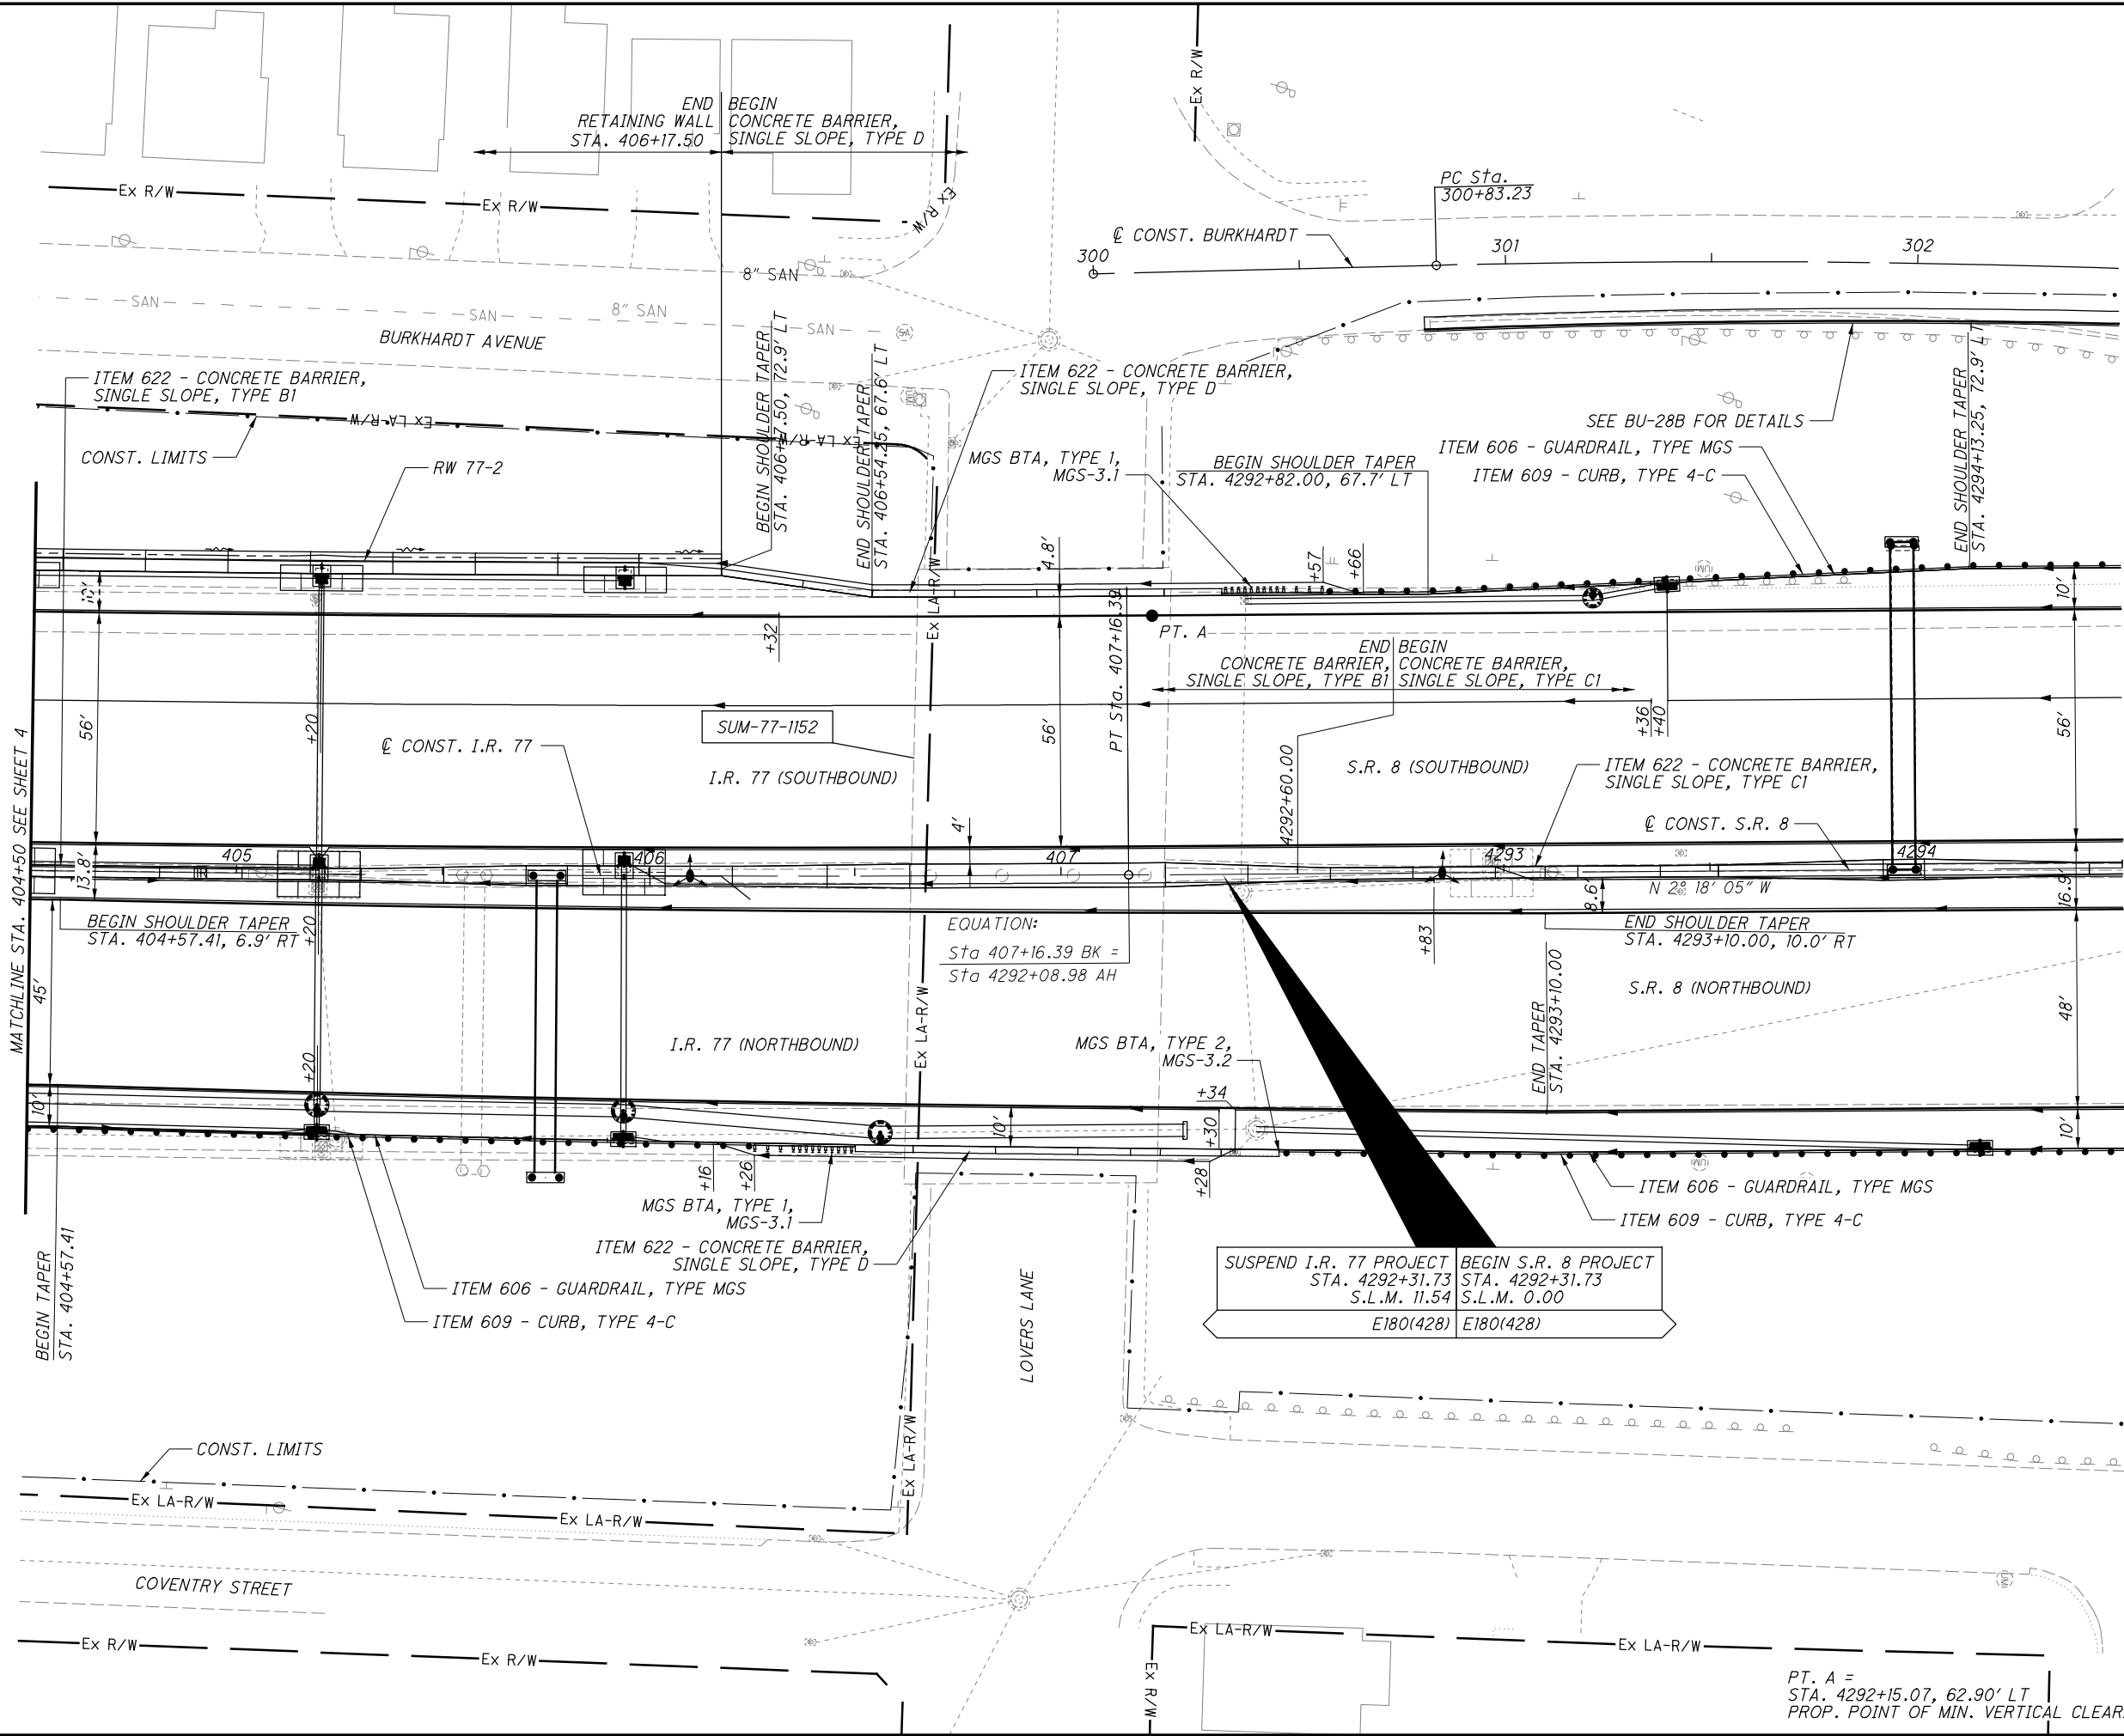


ISSUE RECORD		DESCRIPTION
NO.	DATE	

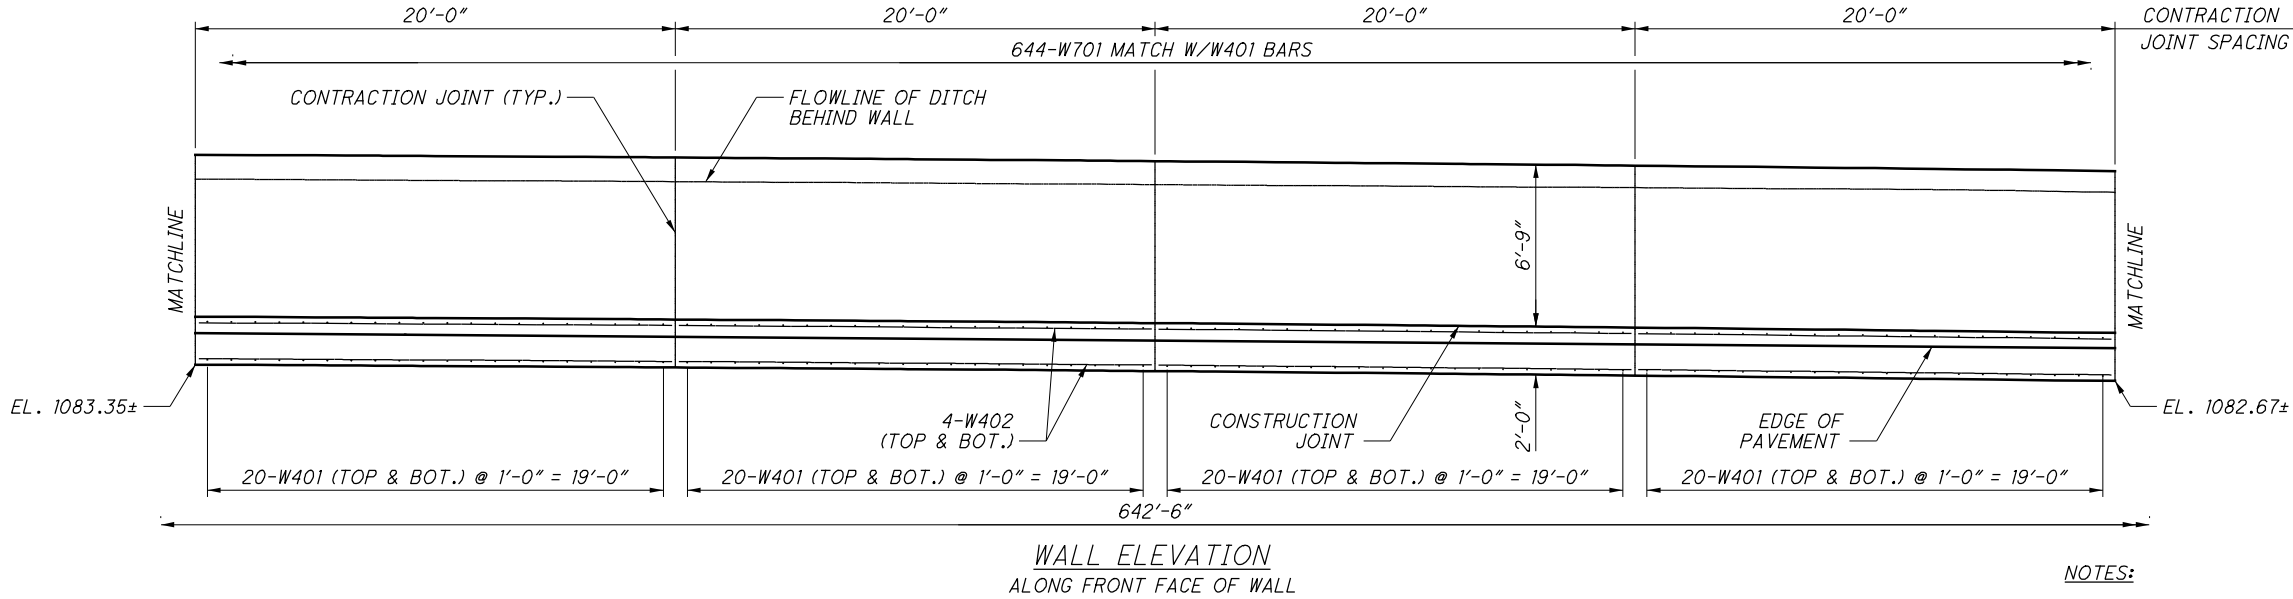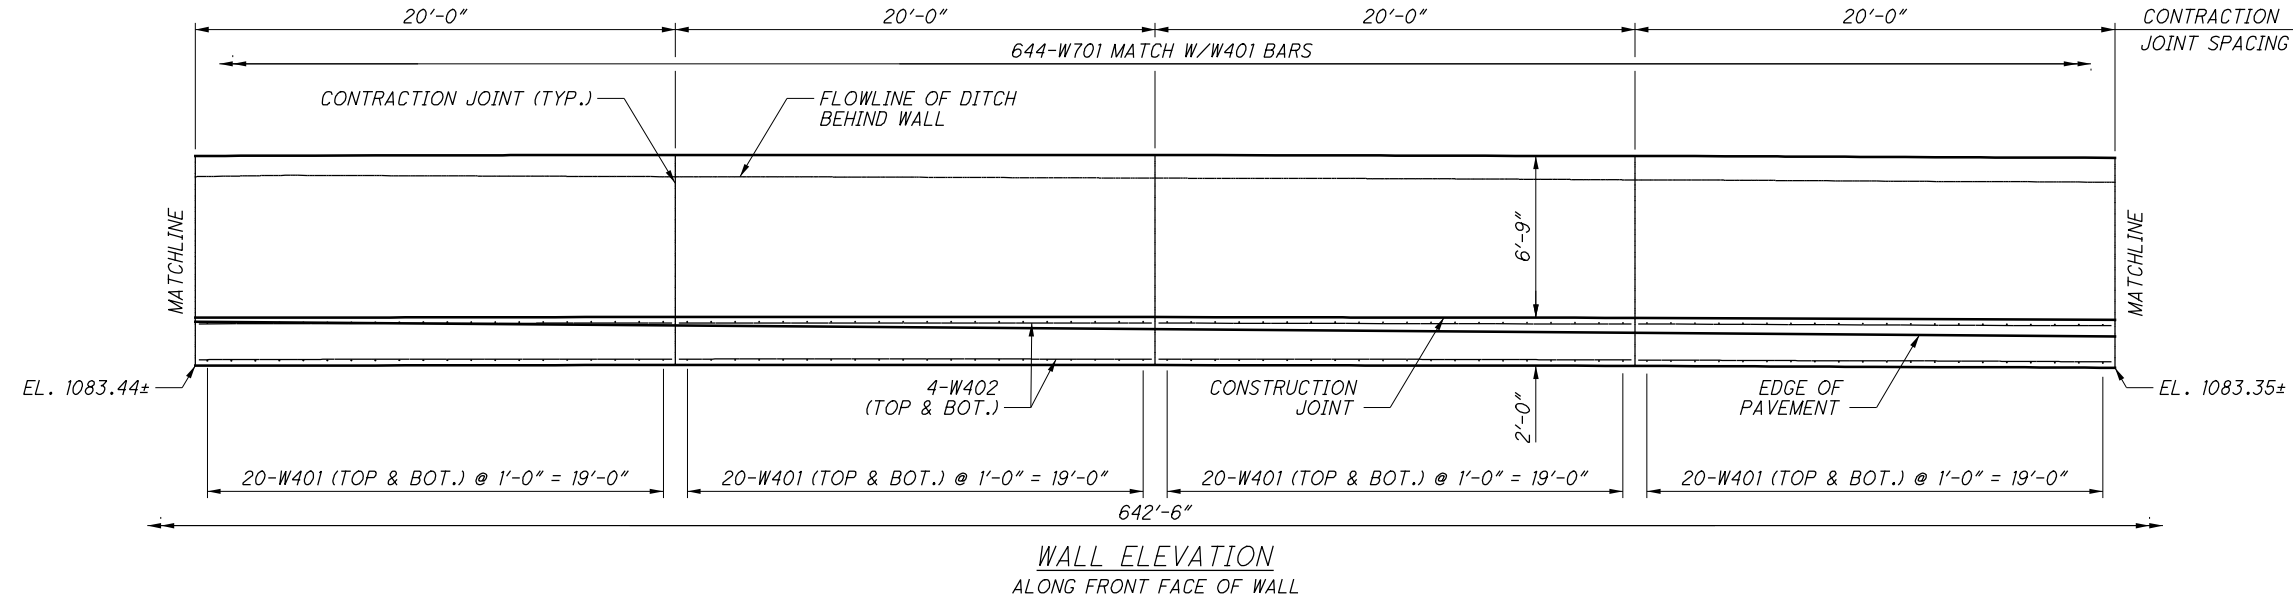


- NOTES:
- ALL STATIONS, ELEVATIONS, AND DIMENSIONS ARE GIVEN AT THE TOE OF THE FRONT FACE OF THE WALL.

ISSUE RECORD		DESCRIPTION
NO.	DATE	

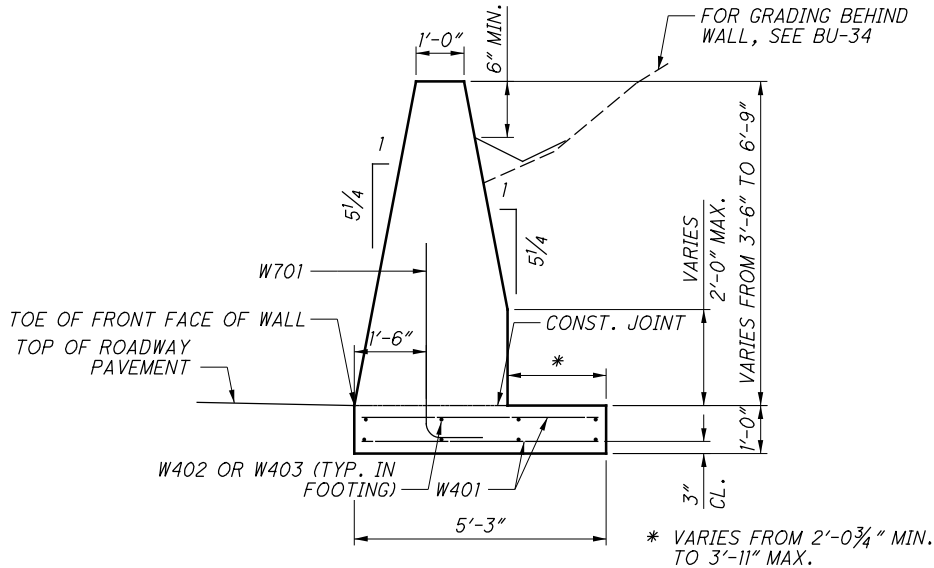

RETAINING WALL SECTION
STA. 399+75.00 TO STA. 401+15.00 AND
STA. 403+97.50 TO STA. 406+17.50


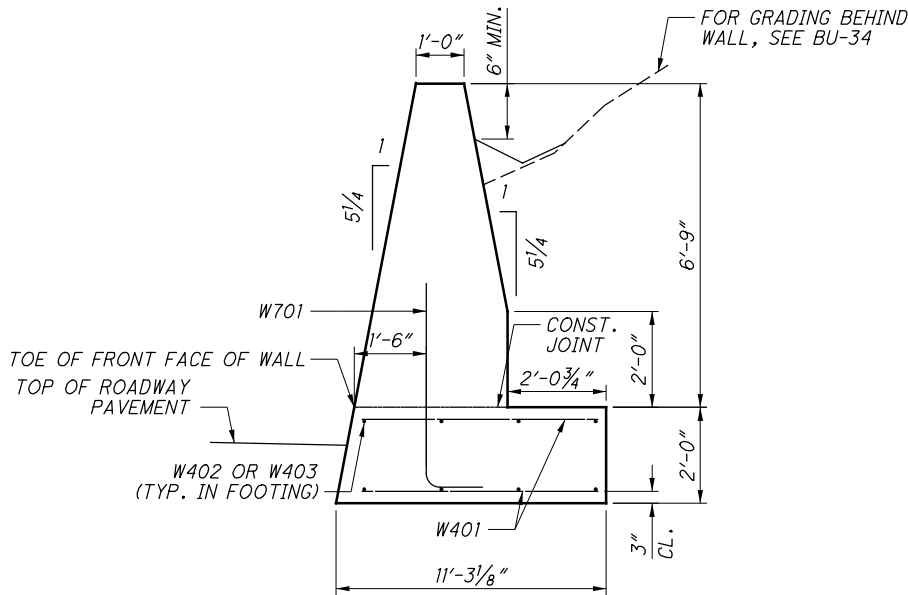


RETAINING WALL SECTION
STA. 401+15.00 TO STA. 403+97.50

NOTES:

- FOR ADDITIONAL WALL INFORMATION, SEE ODOT STANDARD DRAWING SCD RM-4.3.
- EXCEPT FOR THE W701 BAR, BARRIER SECTION DOES NOT REQUIRE REINFORCING.

MARK	NUMBER	LENGTH	WEIGHT	TYPE	DIMENSIONS						
	TOTAL				A	B	C	D	E	R	INC
RETAINING WALL ALONG I.R. 77											
W401	1288	4'-11"	4231	STR							
W402	248	19'-8"	3258	STR							
W403	16	10'-11"	117	STR							
W701	644	5'-3"	6911	1	1'-2"	4'-3"					
SUBTOTAL			14517								
TOTAL WEIGHT			14517								

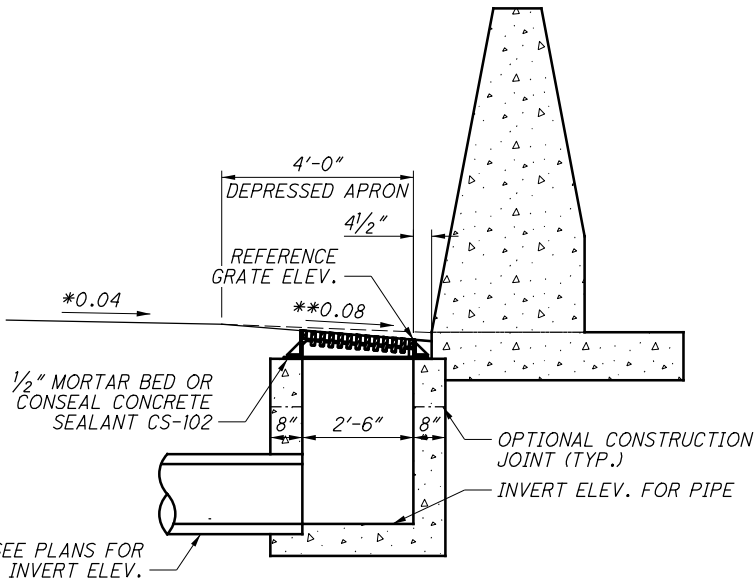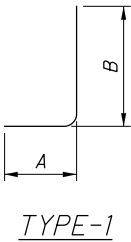

RETAINING WALL SECTION
AT INLET LOCATIONS

REINFORCING NOTES:

- THE BAR SIZE NUMBER IS SPECIFIED ON THE PLANS IN THE BAR MARK COLUMN. THE FIRST DIGIT WHERE THREE DIGITS ARE USED, AND THE FIRST TWO DIGITS WHERE FOUR ARE USED INDICATES THE BAR SIZE NUMBER. FOR EXAMPLE, M601:

M: LOCATION OF THE BAR IN THE STRUCTURE (MOMENT SLAB)
6: BAR SIZE DIMENSION NO. 6
01: SEQUENCE NUMBER
- BAR DIMENSIONS SHOWN ARE OUT TO OUT UNLESS OTHERWISE NOTED. STRAIGHT BARS ARE INDICATED BY "STR".
- ALL REINFORCING IS TO BE EPOXY COATED.