

ISSUE RECORD:		
NO.	DATE	DESCRIPTION

PROJECT DESCRIPTION

PAVEMENT REPLACEMENT OVER SUM - I.R. 76 FROM S.L.M. 8.24 TO 10.00, SUM - 77 FROM S.L.M. 9.74 TO 11.54, AND SUM - 8 FROM S.L.M. 0.00 TO 1.75. COVERS THE "SOUTH LEG" AND "WEST LEG", INCLUDES REHABILITATION OF SEVERAL STRUCTURES IN THE CITY OF AKRON, SUMMIT COUNTY, OHIO.

LIMITED ACCESS

THIS IMPROVEMENT IS ESPECIALLY DESIGNED FOR THROUGH TRAFFIC AND HAS BEEN DECLARED A LIMITED ACCESS HIGHWAY OR FREEWAY BY ACTION OF THE DIRECTOR IN ACCORDANCE WITH THE PROVISIONS OF SECTION 5511.02 OF THE OHIO REVISED CODE.

2019 SPECIFICATIONS

THE STANDARD SPECIFICATIONS OF THE STATE OF OHIO, DEPARTMENT OF TRANSPORTATION, INCLUDING SUPPLEMENTAL SPECIFICATIONS LISTED IN THE PLANS AND CHANGES LISTED IN THE PROPOSAL SHALL GOVERN THIS IMPROVEMENT.

FEDERAL PROJECT NO.

 PID NO.

 CONSTRUCTION PROJECT NO.

E180(428)

 102329

 21-3000



AKRON BELTWAY JV

BU-24

REMOVALS

I-77 at V Odom Blvd. to
I-76/77 at East Ave.

RELEASED FOR
CONSTRUCTION
April 19, 2021

RAILROAD INVOLVEMENT

NONE


RAILROAD INVOLVEMENT

NONE

RAILROAD INVOLVEMENT

NONE

- W1 STA. 4+41.25 (RAMP N)
W2 STA. 207+88.7±, 31.5' LT
E1 STA. 12+88.10 (RAMP P)
R1 SAWCUT & REMOVE EXISTING CURBED MEDIAN (SAWCUT AT THE FACE OF CURB)
R2 REMOVE HIGH MAST LIGHTING TOWER INCLUDING FOUNDATION
R3 REMOVE HIGH MAST LIGHTING TOWER (MEDIAN BARRIER AND FOUNDATION TO REMAIN)
R4 REMOVE COBRA HEAD LIGHT POLE (MEDIAN BARRIER AND FOUNDATION TO REMAIN)
R5 REMOVE 8' OF MEDIAN BARRIER FOR NEW MEDIAN MOUNTED LIGHT POLE
R6 REMOVE COBRA HEAD LIGHT POLE AND 8' OF MEDIAN BARRIER, INCLUDING LIGHT POLE FOUNDATION, FOR NEW MEDIAN MOUNTED LIGHT POLE

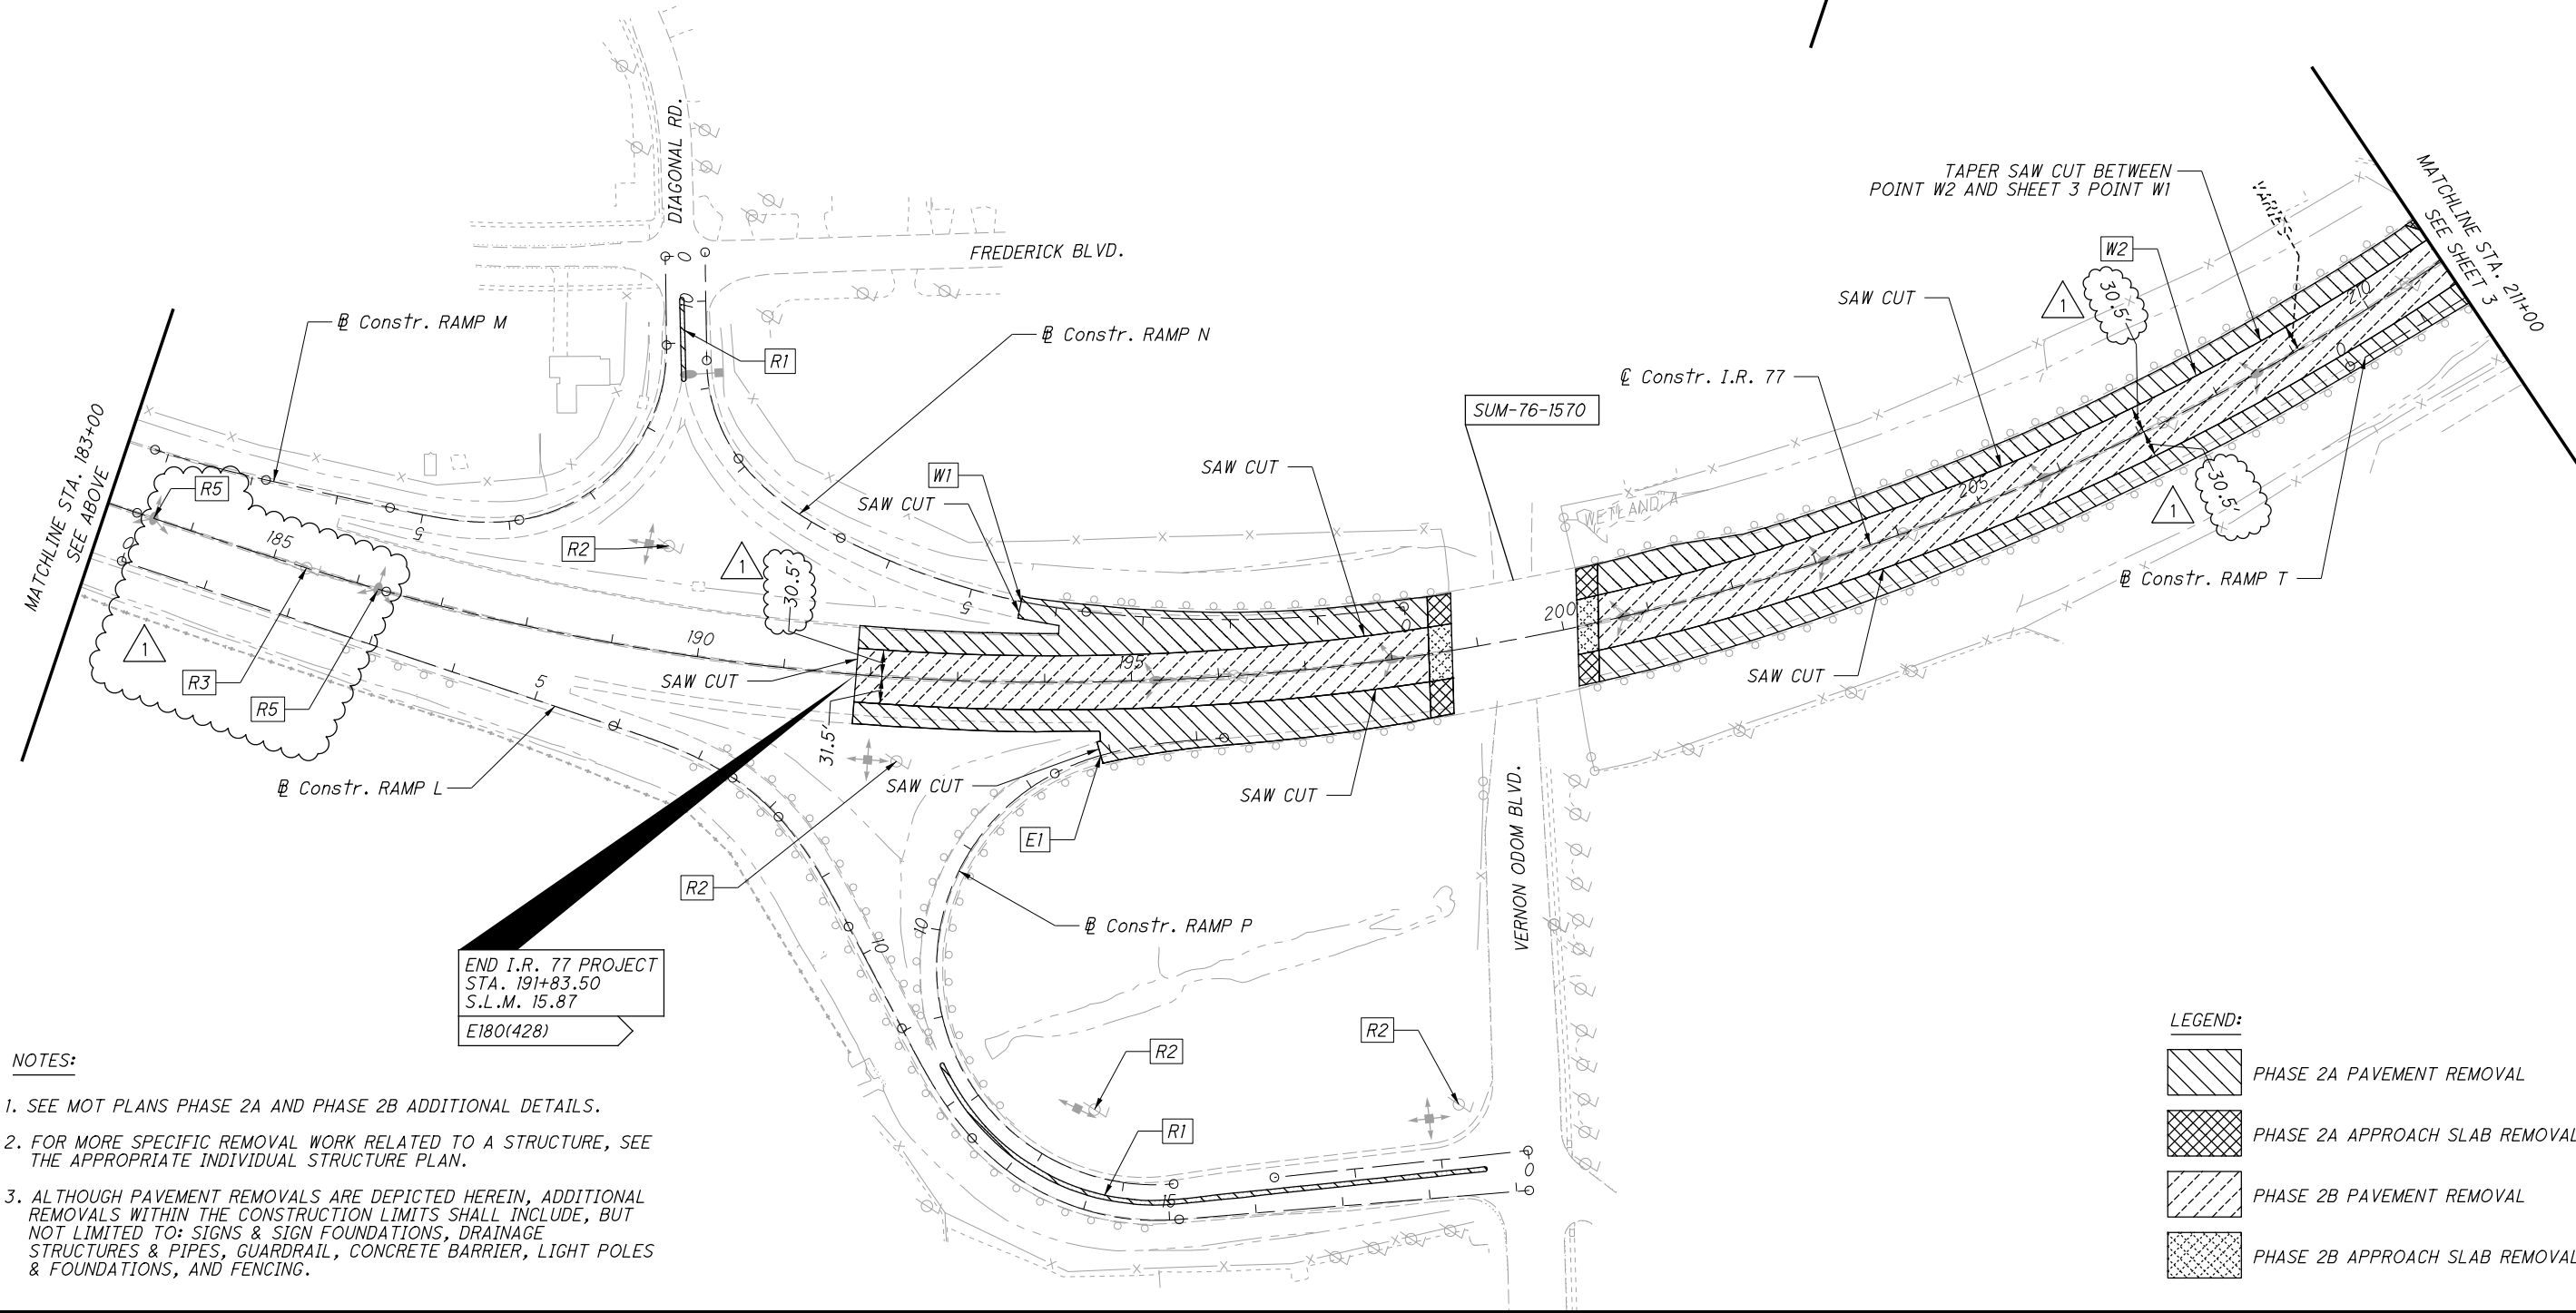

- W1

STA. 211+18.7±, 29.5' LT
- W2

STA. 218+09.1±, 29.5' LT
- W3

STA. 221+39.1±, 31.5' LT
- W4

STA. 223+93.3±
- W5

STA. 6+90.18 (RAMP W)
- W6

STA. 234+49.6±
- W7

STA. 3+94.29 (RAMP V)

E1

STA. 213+81.1±

E2

STA. 4+61.59 (RAMP T)


E3

STA. 226+25.6±

E4

STA. 17+02.36 (RAMP U)

- NOTES:
- SEE MOT PLANS PHASE 2A AND PHASE 2B FOR ADDITIONAL DETAILS.
 - FOR MORE SPECIFIC REMOVAL WORK RELATED TO A STRUCTURE, SEE THE APPROPRIATE INDIVIDUAL STRUCTURE PLAN.
 - ALTHOUGH PAVEMENT REMOVALS ARE DEPICTED HEREIN, ADDITIONAL REMOVALS WITHIN THE CONSTRUCTION LIMITS SHALL INCLUDE, BUT NOT LIMITED TO: SIGNS & SIGN FOUNDATIONS, DRAINAGE STRUCTURES & PIPES, GUARDRAIL, CONCRETE BARRIER, LIGHT POLES & FOUNDATIONS, AND FENCING.

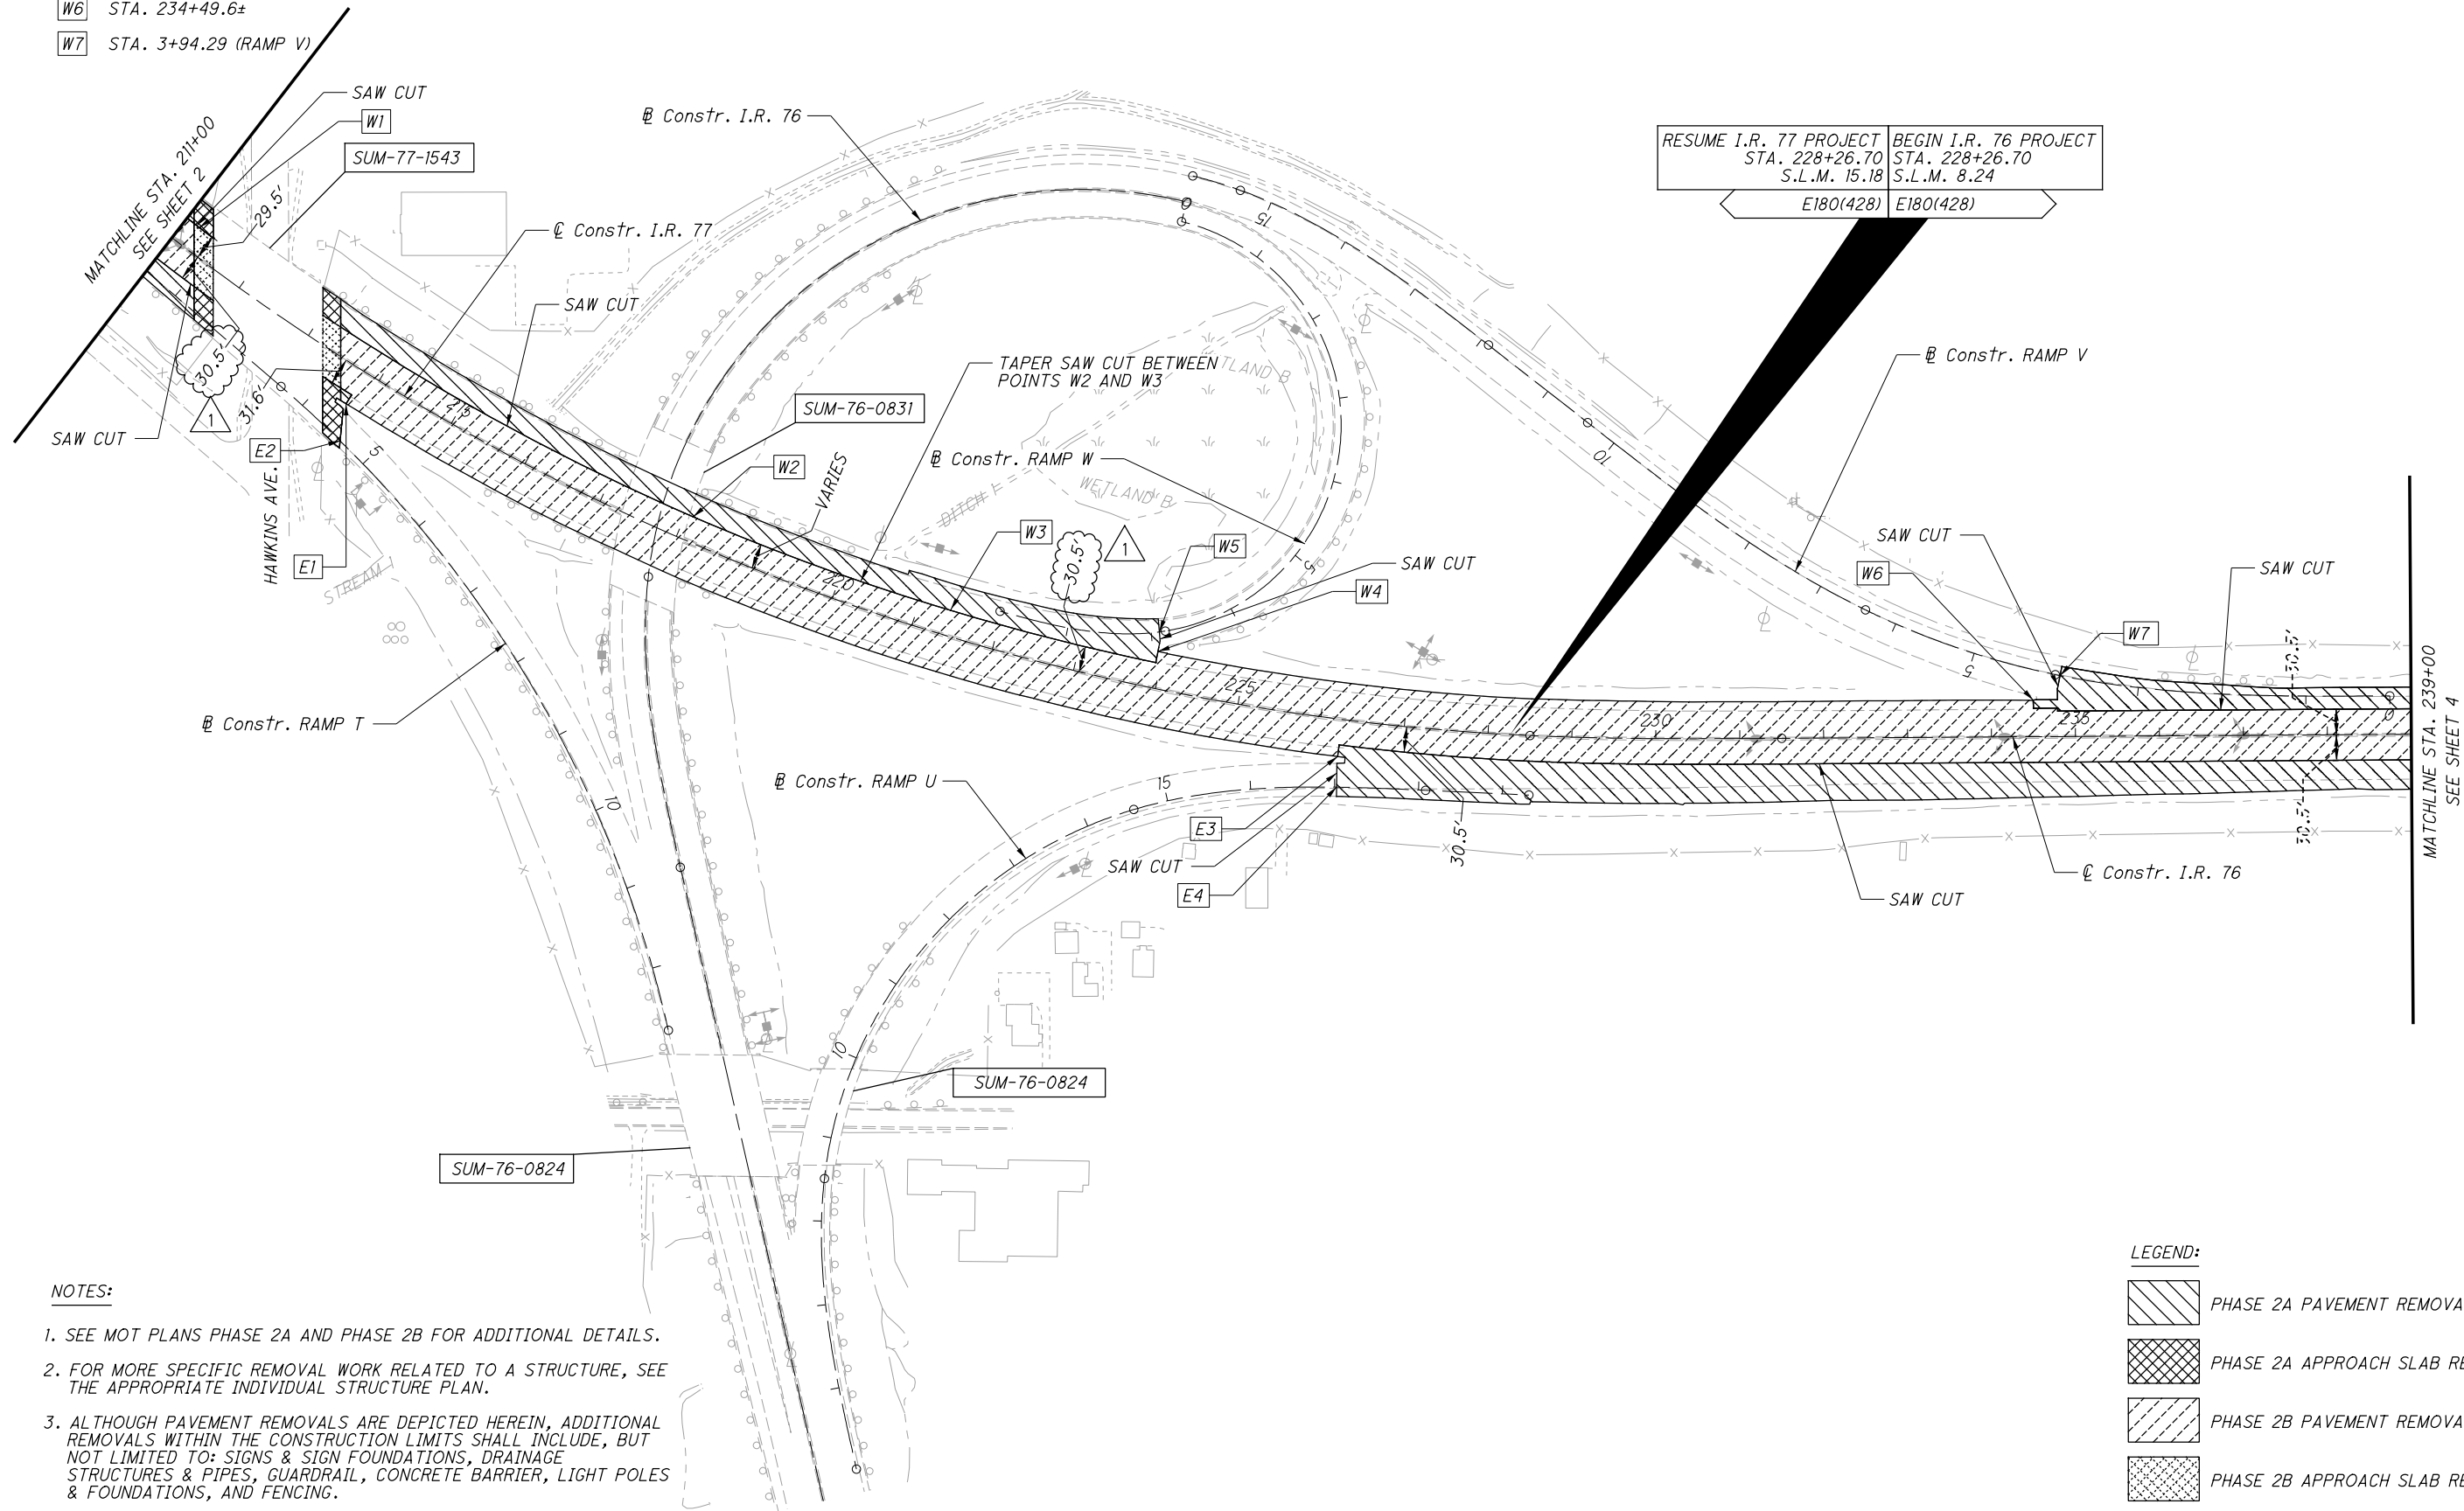

ISSUE RECORD		
NO.	DATE	DESCRIPTION
1	05/18/21	ADDITIONAL LIGHTING AND SAWCUT DIMENSION

0

100

200

HORIZONTAL SCALE IN FEET

CALCULATED

SGM

CHECKED

JD

REMOVAL PLAN - I.R. 77 / I.R. 76
STA. 211+00 TO STA. 239+00

2025-03-18 - BU-24 - RECORD DRAWING PLANS

SUM-76 / 77 / 8-
8.24 / 9.74 / 0.00

3
4

