

SCALE IN MILES



0 1 2 3 4



PORTION TO BE IMPROVED.....	_____
INTERSTATE HIGHWAY.....	_____
FEDERAL ROUTES.....	_____
STATE ROUTES.....	_____
COUNTY & TOWNSHIP ROADS.....	_____
OTHER ROADS.....	_____

SEE ROADWAY PLANS

SEE ROADWAY PLANS

UNDERGROUND UTILITIES Contact Two Working Days Before You Dig	
 OHIO811.org Before You Dig	
OHIO811, 8-1-1, or 1-800-362-2764 (Non-members must be called directly)	

PLAN PREPARED BY:



ENGINEERS SEAL:



SIGNED: [Signature]
DATE: 11/19/2021

CITY OF AKRON
SUMMIT COUNTY

TITLE	1
REMOVAL PLAN - I.R. 76 / I.R. 77	2 - 4
REMOVAL PLAN - CENTRAL INTERCHANGE	
PHASE 3A	5 - 8
PHASE 3B	9 - 12
PHASE 4A	13 - 16
PHASE 4A2	17 - 18
PHASE 4B	19 - 20
PHASE 4B2	21 - 23
PHASE 5A	24 - 27
PHASE 5B	28 - 31
PHASE 5C	32 - 33
PHASE 6A	34 - 36

RECORD DRAWING PLANS	
BU-26 - I-76/77 AT EAST AVENUE TO HOLLY CROSS BOULEVARD REMOVALS	
The undersigned hereby confirms that, to the best of their knowledge, all known field modifications made after the Released for Construction plans were sealed by the Designer are included in these drawings.	
<u>RSS JV</u> Signed: Joseph J. Buchtinec, Jr., PE	8/24/2026 Date: _____
The undersigned hereby confirms that, to the best of their knowledge, all presented field changes have been included in the Record Drawings and the Designer concurs that the changes meet the design intent of the Contract.	
<u>Parsons Transportation Group, Inc.</u> Signed: Fernando Rodriguez	
Date: _____	

[illegible][illegible]

PAVEMENT REPLACEMENT OVER SUM - I.R. 76 FROM S.L.M. 8.24 TO 10.00, SUM - 77 FROM S.L.M. 9.74 TO 11.54, AND SUM - 8 FROM S.L.M. 0.00 TO 1.75. COVERS THE "SOUTH LEG" AND "WEST LEG", INCLUDES REHABILITATION OF SEVERAL STRUCTURES IN THE CITY OF AKRON, SUMMIT COUNTY, OHIO.

THIS IMPROVEMENT IS ESPECIALLY DESIGNED FOR THROUGH TRAFFIC AND HAS BEEN DECLARED A LIMITED ACCESS HIGHWAY OR FREEWAY BY ACTION OF THE DIRECTOR IN ACCORDANCE WITH THE PROVISIONS OF SECTION 5511.02 OF THE OHIO REVISED CODE.

THE STANDARD SPECIFICATIONS OF THE STATE OF OHIO, DEPARTMENT OF TRANSPORTATION, INCLUDING SUPPLEMENTAL SPECIFICATIONS LISTED IN THE PLANS AND CHANGES LISTED IN THE PROPOSAL SHALL GOVERN THIS IMPROVEMENT.


BU - 26
REMOVALS
I-76/I-77 at East Ave.
to Holy Cross Blvd.
RELEASED FOR
CONSTRUCTION
November 19, 2021

- W1

STA. 3+54.14 (RAMP M)
- W2

STA. 12+84.31 (RAMP J)
- E1

STA. 0+00.00 (RAMP L)
- E2


STA. 0+17.70 (RAMP K)
- E3

STA. 252+59.96±, 29.25' RT
- E4

STA. 253+50.00±, 30.00' RT
- E5

STA. 258+61.21±, 30.00' RT
- E6

STA. 266+00.00±, 36.02' RT

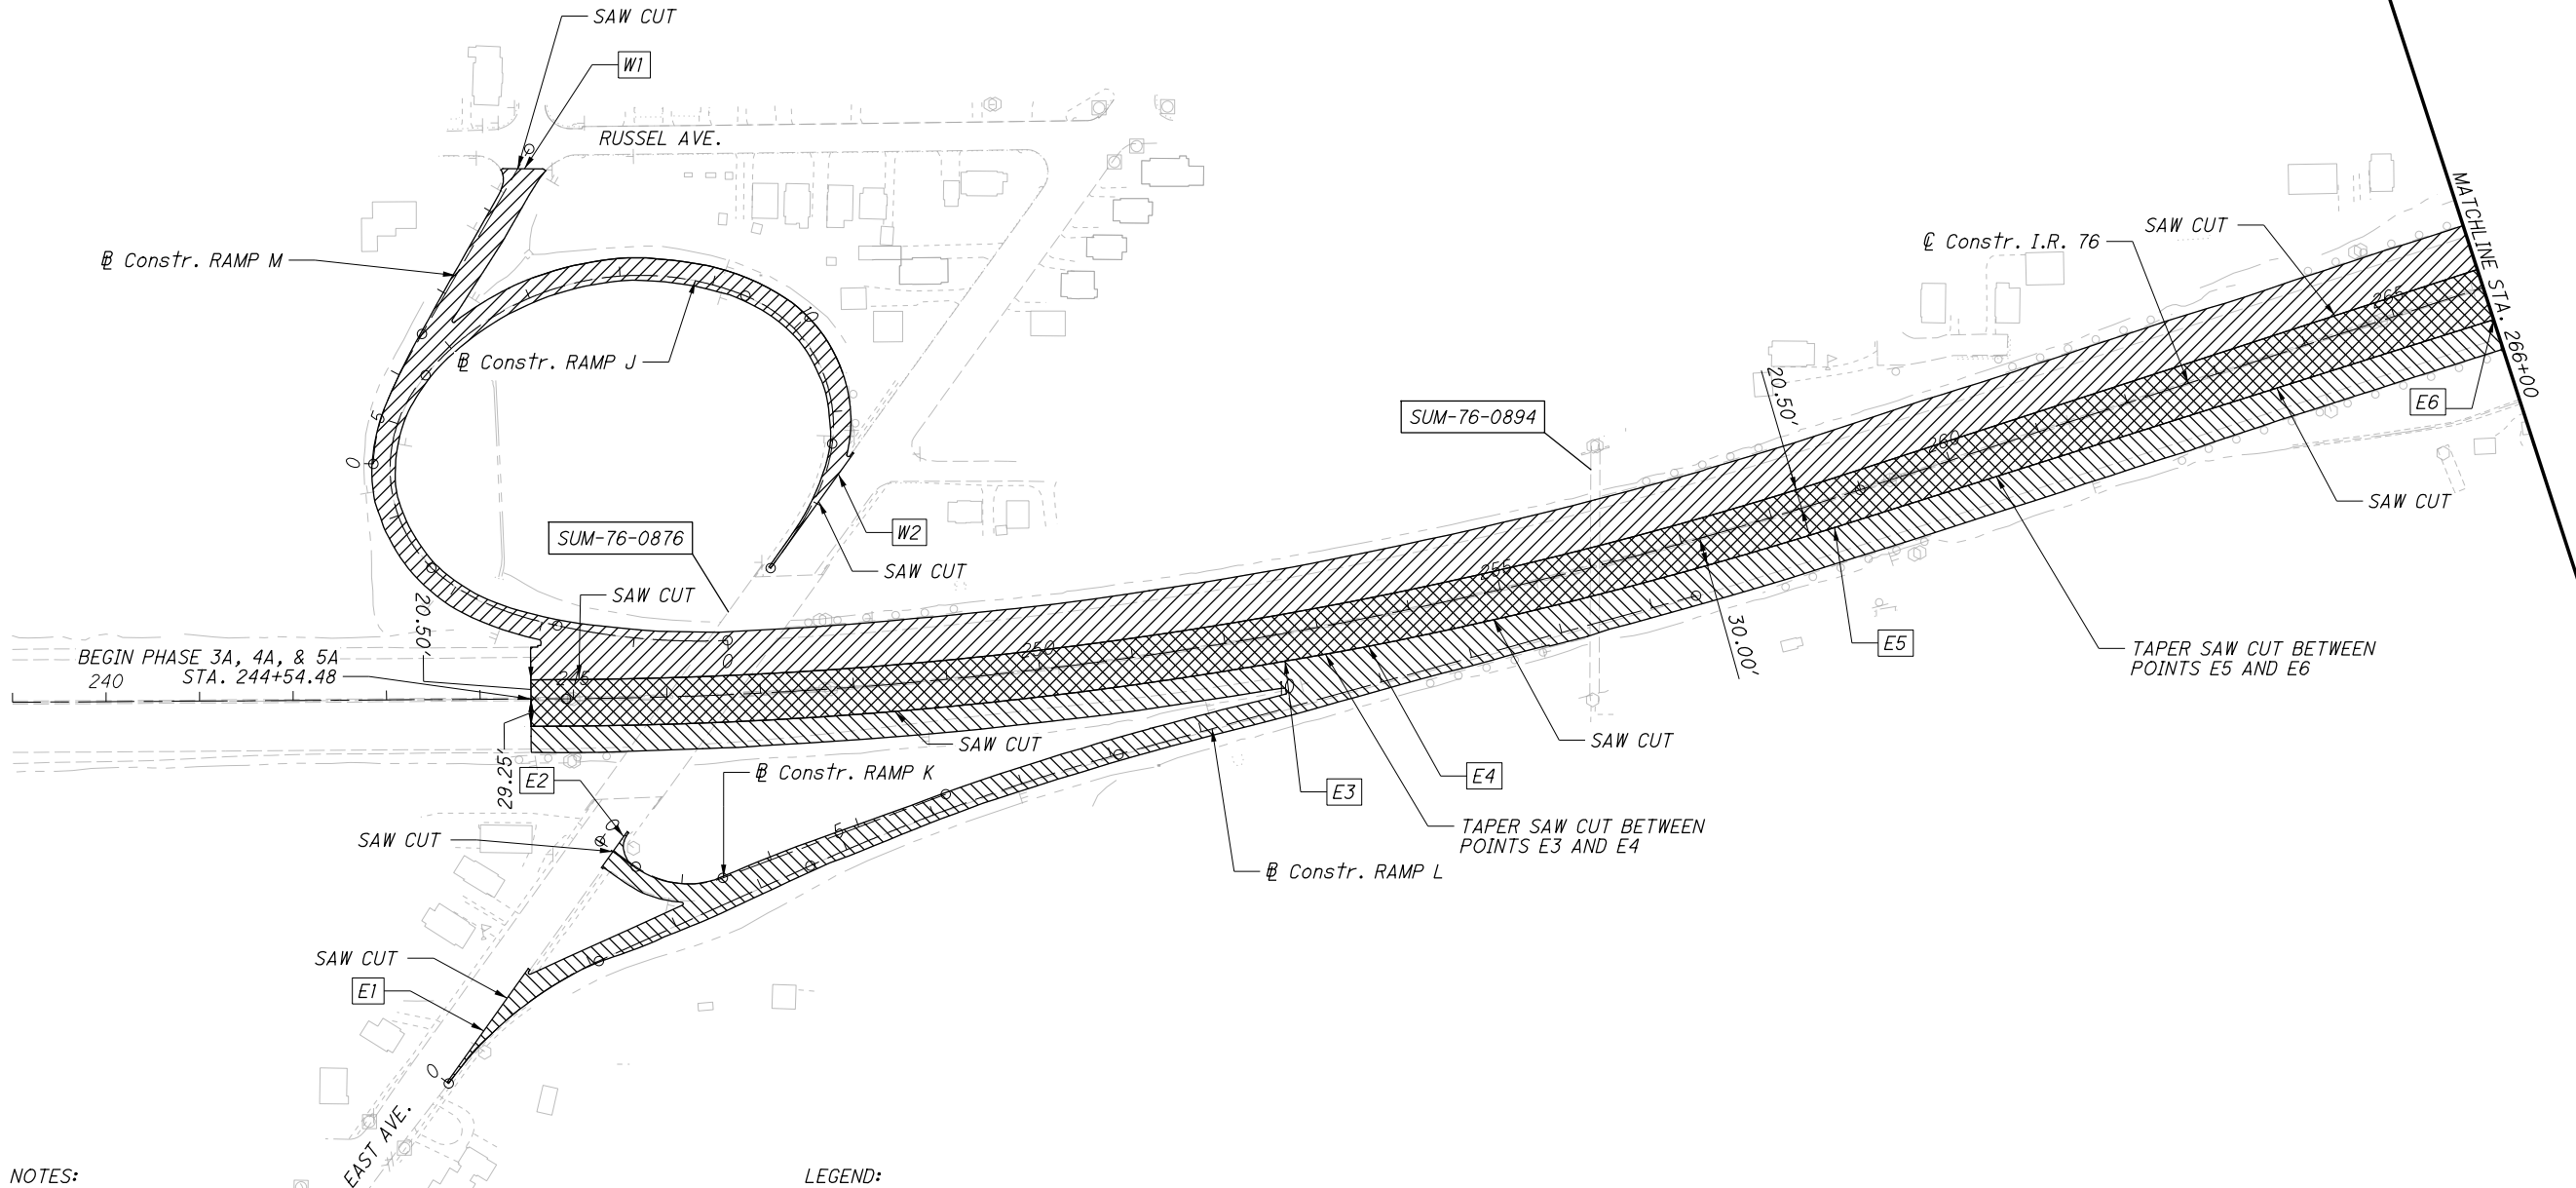

- NOTES:
1. SEE MOT PLANS PHASE 3A, 4A, & 5A FOR ADDITIONAL DETAILS.
2. FOR MORE SPECIFIC REMOVAL WORK RELATED TO A STRUCTURE, SEE THE APPROPRIATE INDIVIDUAL STRUCTURE PLAN.
3. ALTHOUGH PAVEMENT REMOVALS ARE DEPICTED HEREIN, ADDITIONAL REMOVALS WITHIN THE CONSTRUCTION LIMITS SHALL INCLUDE, BUT NOT LIMITED TO: SIGNS & SIGN FOUNDATIONS, DRAINAGE STRUCTURES & PIPES, GUARDRAIL, CONCRETE BARRIER, LIGHT POLES & FOUNDATIONS, AND FENCING.

LEGEND:

PHASE 3A PAVEMENT REMOVAL

PHASE 4A PAVEMENT REMOVAL

PHASE 5A PAVEMENT REMOVAL

ISSUE RECORD:		
NO.	DATE	DESCRIPTION

- W1

STA. 293+12.77±, 19.89' LT
- W2

STA. 293+50.00±, 19.35' LT
- E1

STA. 266+00.00±, 36.02' RT
- E2

STA. 268+20.07±, 35.25' RT
- E3

STA. 271+18.20±, 31.00' RT
- E4

SEE INTERSECTION DETAIL, BU-32
- E5

SEE INTERSECTION DETAIL, BU-32
- E6

STA. 283+54.17±, 31.00' RT
- E7

STA. 112+58.77, (RAMP EN)
- E8

STA. 288+06.96±, 29.40' RT

ISSUE RECORD:		
NO.	DATE	DESCRIPTION

CALCULATED

CAS

CHECKED

JFM

0

50


100

200

HORIZONTAL
SCALE IN FEET

↑

N

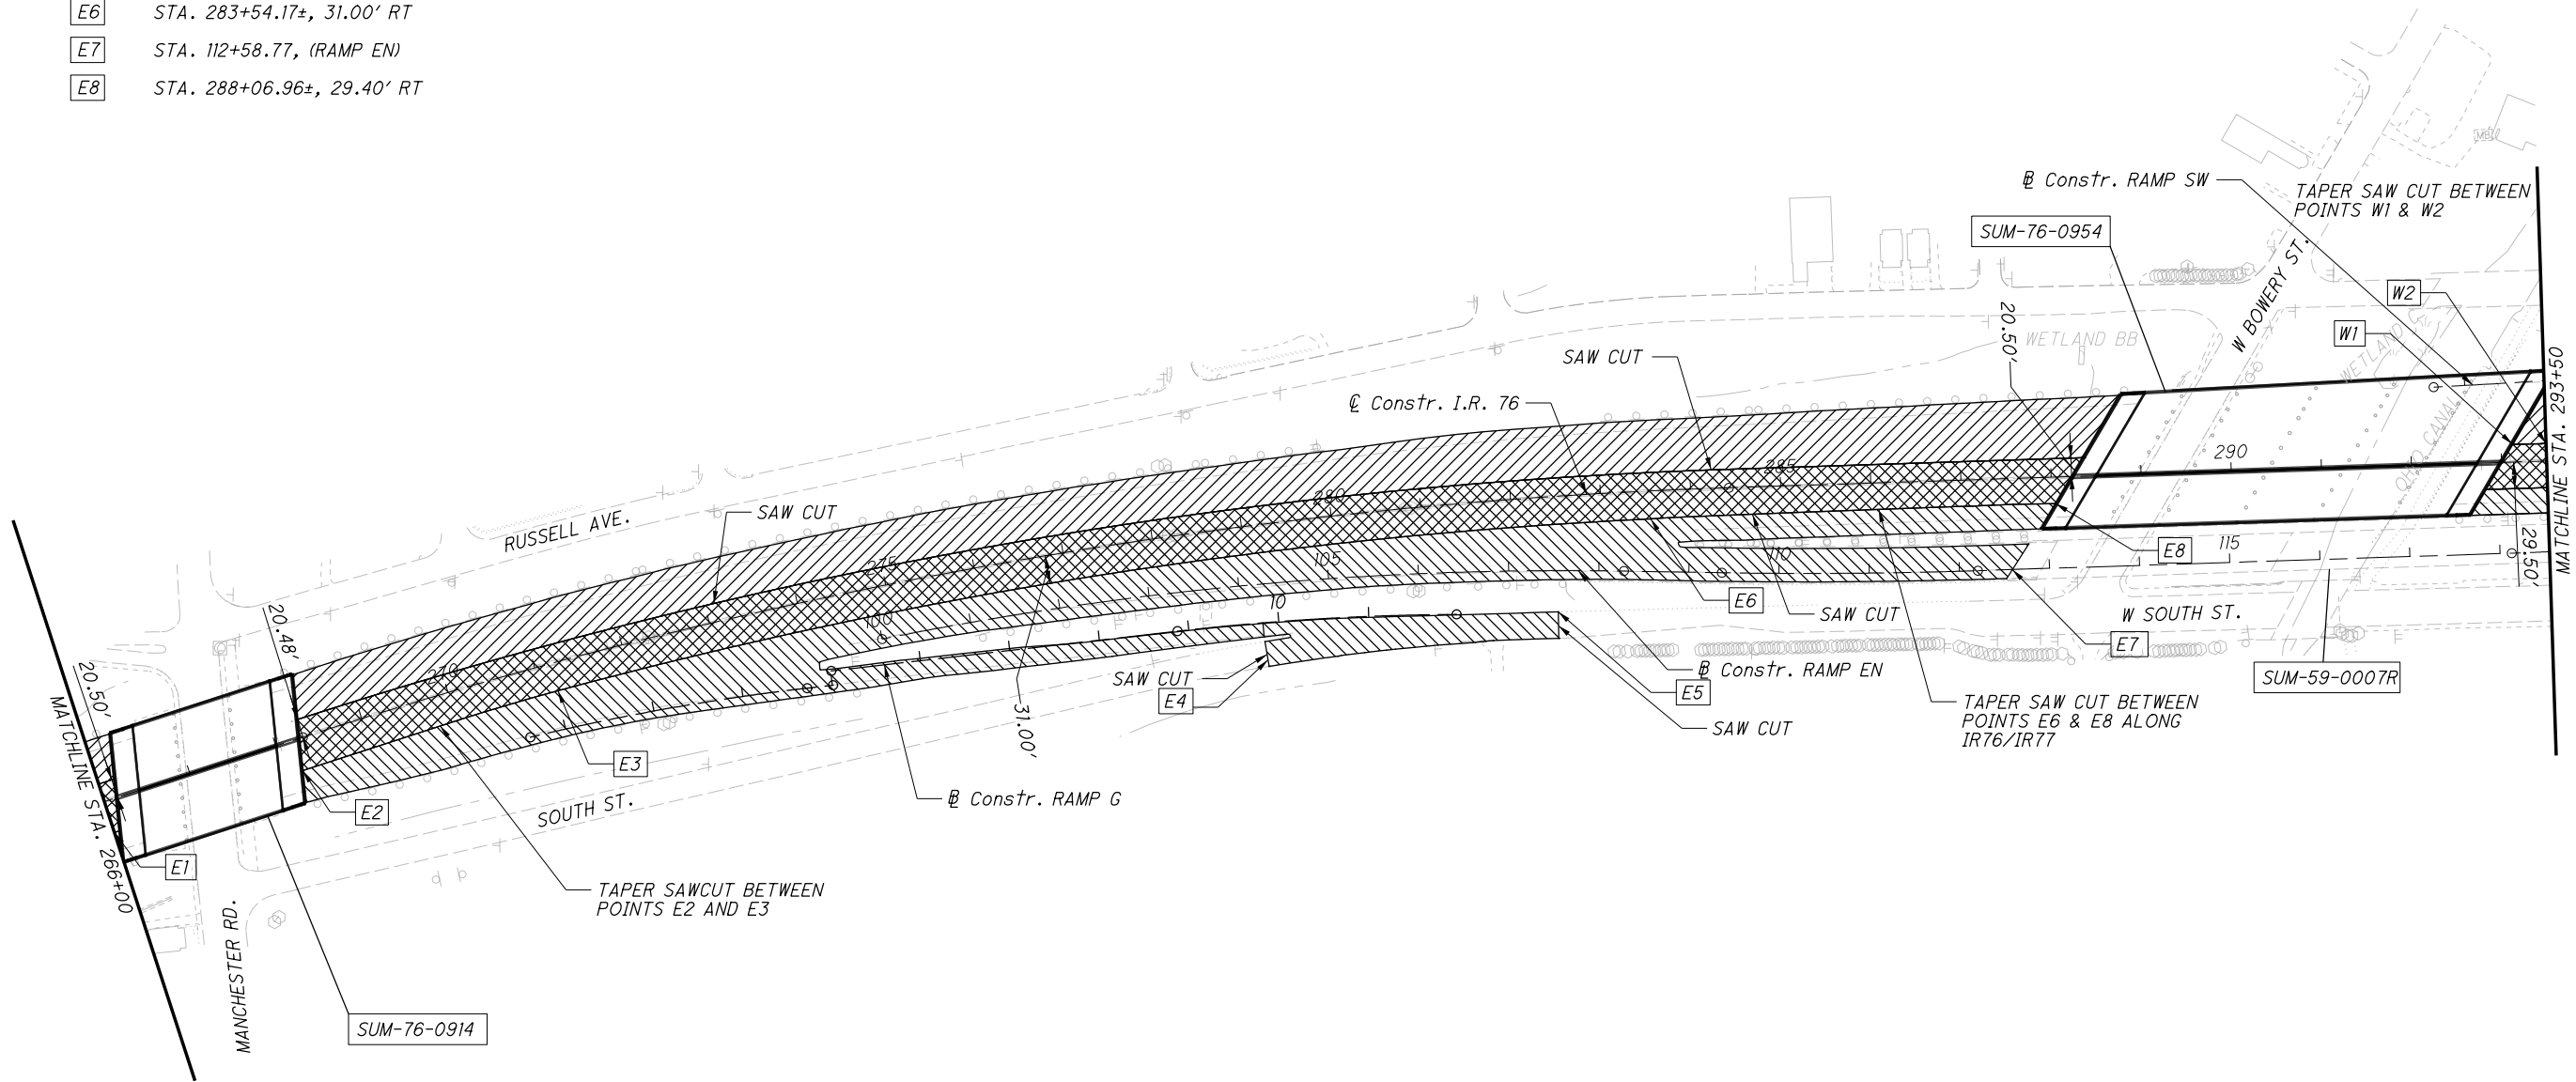


- NOTES:
- SEE MOT PLANS PHASE 3A, 4A, & 5A FOR ADDITIONAL DETAILS.
 - FOR MORE SPECIFIC REMOVAL WORK RELATED TO A STRUCTURE, SEE THE APPROPRIATE INDIVIDUAL STRUCTURE PLAN.
 - ALTHOUGH PAVEMENT REMOVALS ARE DEPICTED HEREIN, ADDITIONAL REMOVALS WITHIN THE CONSTRUCTION LIMITS SHALL INCLUDE, BUT NOT LIMITED TO: SIGNS & SIGN FOUNDATIONS, DRAINAGE STRUCTURES & PIPES, GUARDRAIL, CONCRETE BARRIER, LIGHT POLES & FOUNDATIONS, AND FENCING.

LEGEND:

PHASE 3A PAVEMENT REMOVAL

PHASE 4A PAVEMENT REMOVAL

PHASE 5A PAVEMENT REMOVAL

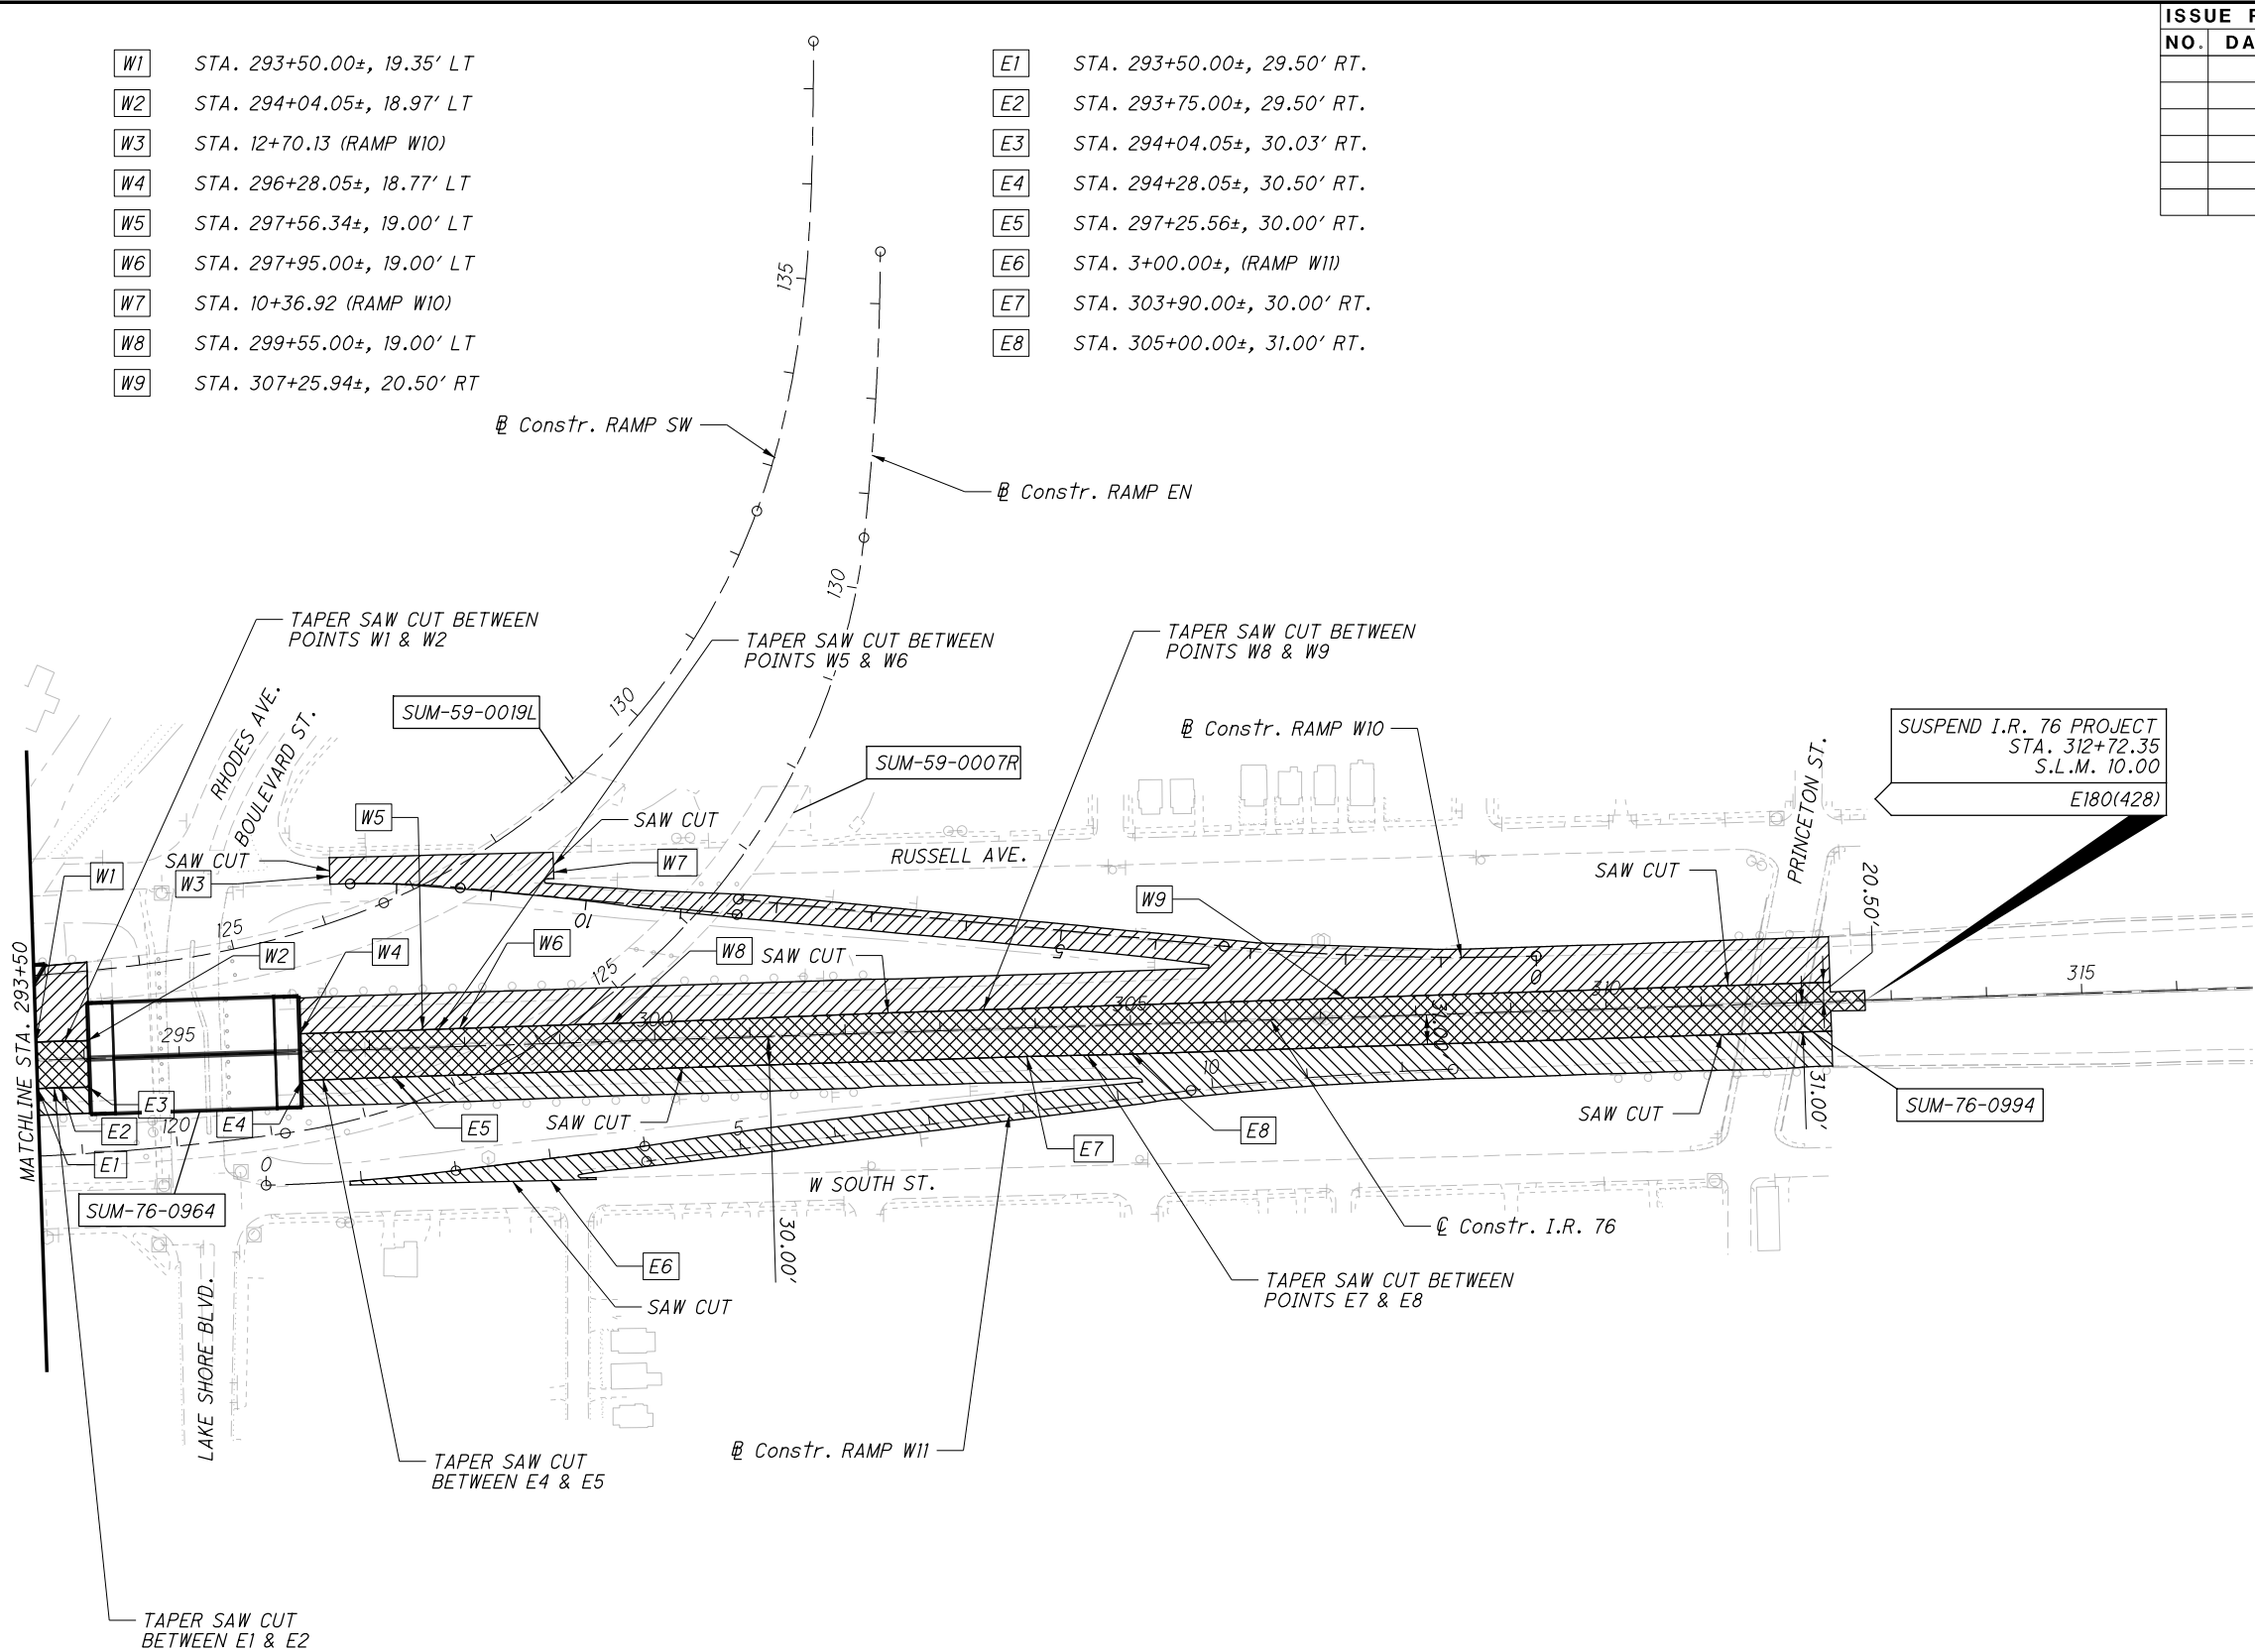

- NOTES:
- SEE MOT PLANS PHASE 3A, 4A, & 5A FOR ADDITIONAL DETAILS.
 - FOR MORE SPECIFIC REMOVAL WORK RELATED TO A STRUCTURE, SEE THE APPROPRIATE INDIVIDUAL STRUCTURE PLAN.
 - ALTHOUGH PAVEMENT REMOVALS ARE DEPICTED HEREIN, ADDITIONAL REMOVALS WITHIN THE CONSTRUCTION LIMITS SHALL INCLUDE, BUT NOT LIMITED TO: SIGNS & SIGN FOUNDATIONS, DRAINAGE STRUCTURES & PIPES, GUARDRAIL, CONCRETE BARRIER, LIGHT POLES & FOUNDATIONS, AND FENCING.

- LEGEND:
- PHASE 3A PAVEMENT REMOVAL
 - PHASE 4A PAVEMENT REMOVAL
 - PHASE 5A PAVEMENT REMOVAL

ISSUE RECORD:		
NO.	DATE	DESCRIPTION

- W1

STA. 507+65.63±, 32.00' LT
- W2

STA. 522+14.95±, 10.00' RT
- W3

STA. 524+22.82±, 10.46' LT
- W4

STA. 525+59.83±, 12.00' LT
- W5


STA. 8328+67.07±, (RAMP O)

NOTES:

1. SEE MOT PLANS PHASE 3A, 3B, 4A, 4B 5A, 5B, 5C, AND 6A FOR ADDITIONAL DETAILS.
2. FOR MORE SPECIFIC REMOVAL WORK RELATED TO A STRUCTURE, SEE THE APPROPRIATE INDIVIDUAL STRUCTURE PLAN.
3. ALTHOUGH PAVEMENT REMOVALS ARE DEPICTED HEREIN, ADDITIONAL REMOVALS WITHIN THE CONSTRUCTION LIMITS SHALL INCLUDE, BUT NOT LIMITED TO: SIGNS & SIGN FOUNDATIONS, DRAINAGE STRUCTURES & PIPES, GUARDRAIL, CONCRETE BARRIER, LIGHT POLES & FOUNDATIONS, AND FENCING.

LEGEND:

PHASE 3A PAVEMENT REMOVAL

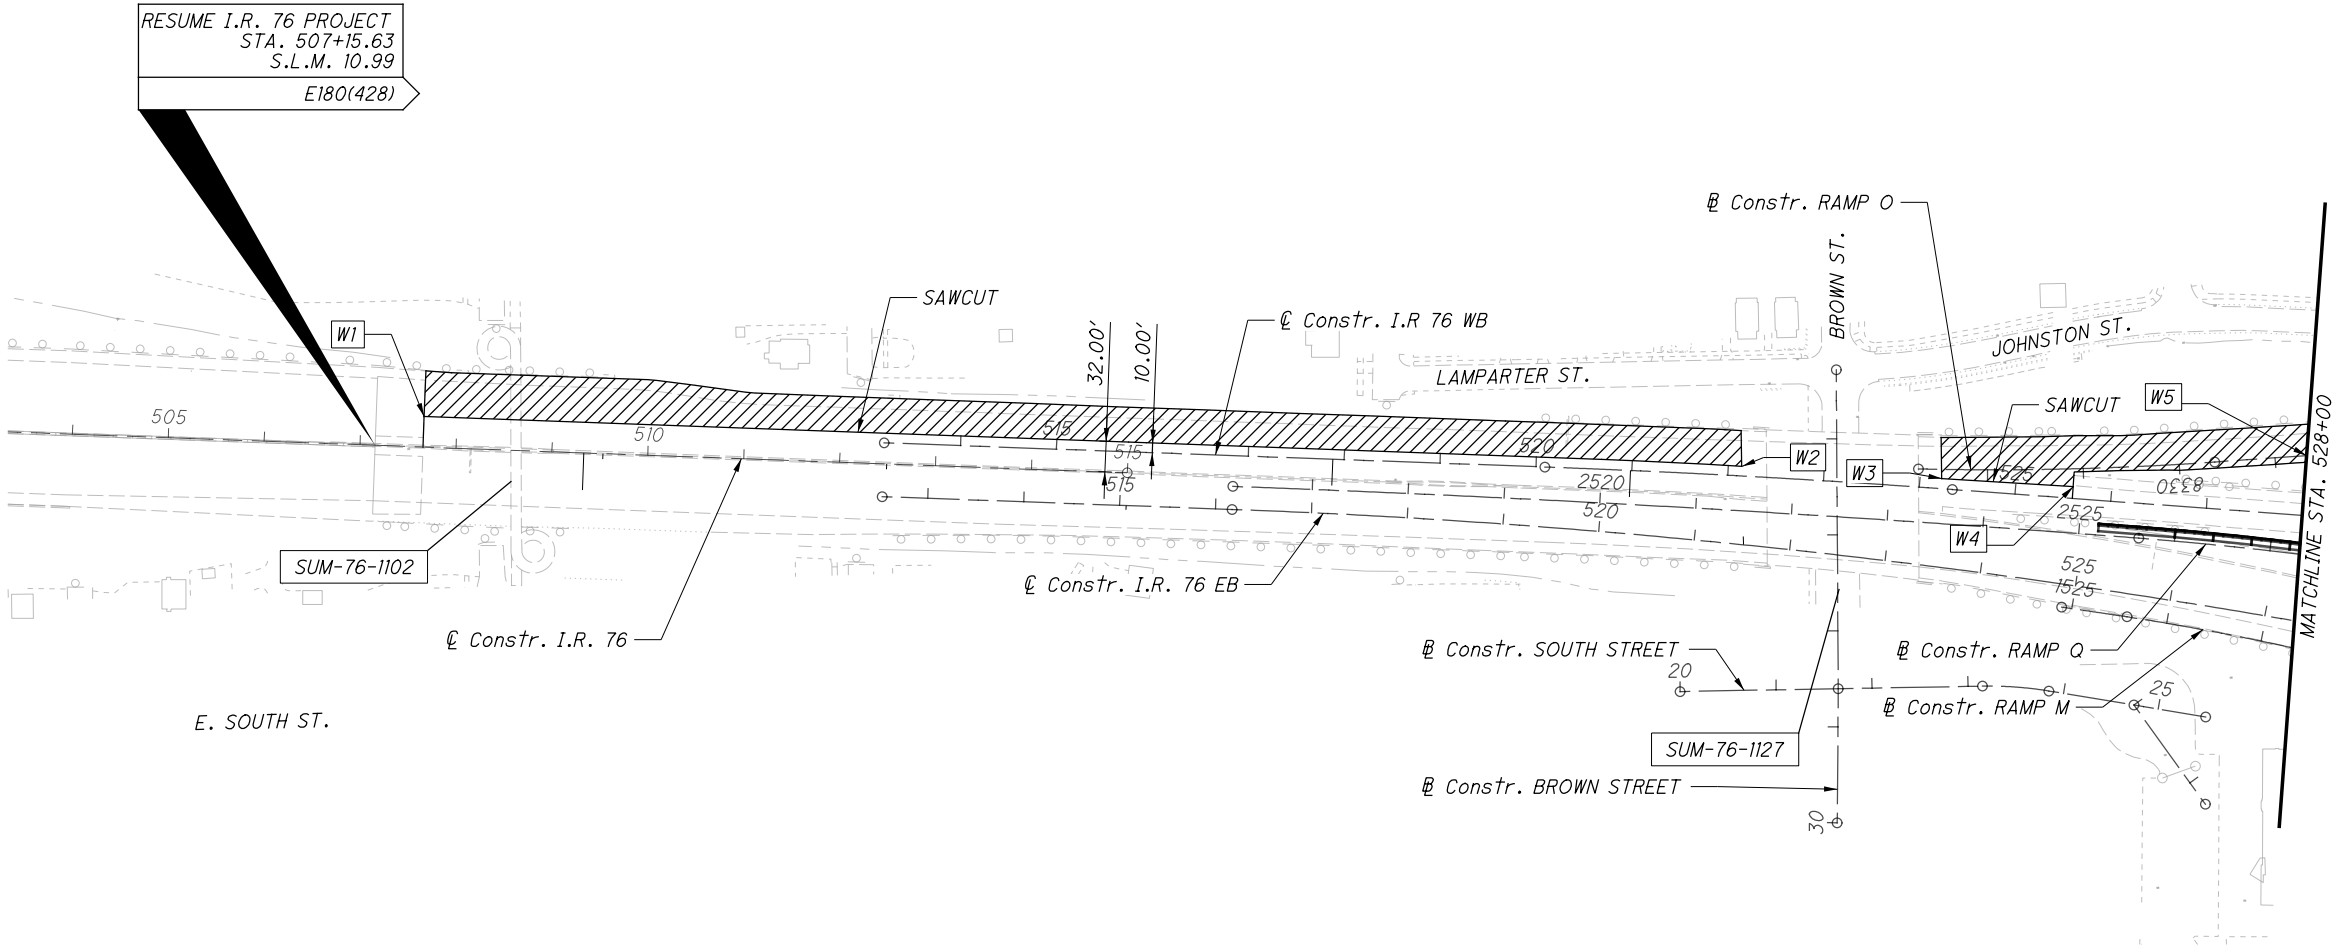

ISSUE RECORD:		
NO.	DATE	DESCRIPTION

- N1

STA. 4309+78.00±, 17.50' RT
- N2

STA. 4316+29.01±, 17.50' RT
- N3

STA. 4316+95.11±, 18.75' RT
- N4

STA. 4317+39.97±, 18.75' RT
- N5

STA. 4318+50.03±, 17.00' RT
- N6

STA. 4319+80.74±, 17.00' RT
- N7

STA. 4321+65.00±, 18.50' RT
- N8

STA. 4322+09.08±, 18.50' RT
- N9

STA. 4323+19.18±, 16.50' RT
- N10

STA. 4324+00.02±, 16.50' RT
- N11

STA. 4324+00.02±, 17.50' RT
- N12

STA. 4544+00.00±, 4.57' RT (RAMP U)
- N13

STA. 4543+11.28±, 6.00' LT/5.37 RT (RAMP U)
- N14

STA. 4542+56.65±, 6.00' LT (RAMP U)
- N15

STA. 4541+60.54±, 0.00'
- N16

STA. 8328+67.07±, (RAMP O)
- N17

STA. 5337+53.81±, 3.65 LT (RAMP P)
- N18

STA. 5337+51.82±, 11.48 LT (RAMP P)
- N19

STA. 5336+76.49±, (RAMP P)
- W1

STA. 8309+70.41±, (RAMP O)
- W2

STA. 8317+71.65±, (RAMP O)
- W3

STA. 8319+76.48±, (RAMP O)
- W4

STA. 8323+99.42±, (RAMP O)
- E1

STA. 7309+71.92±, (RAMP T)
- E2

STA. 7319+42.83±, (RAMP T)
- E3

STA. 7319+40.72±, 10.30' LT (RAMP T)
- E4

STA. 7319+42.87±, 19.84' LT (RAMP T)


TAPER SAW CUT BETWEEN:

N2 TO N3

N4 TO N5

N6 TO N7

N8 TO N9

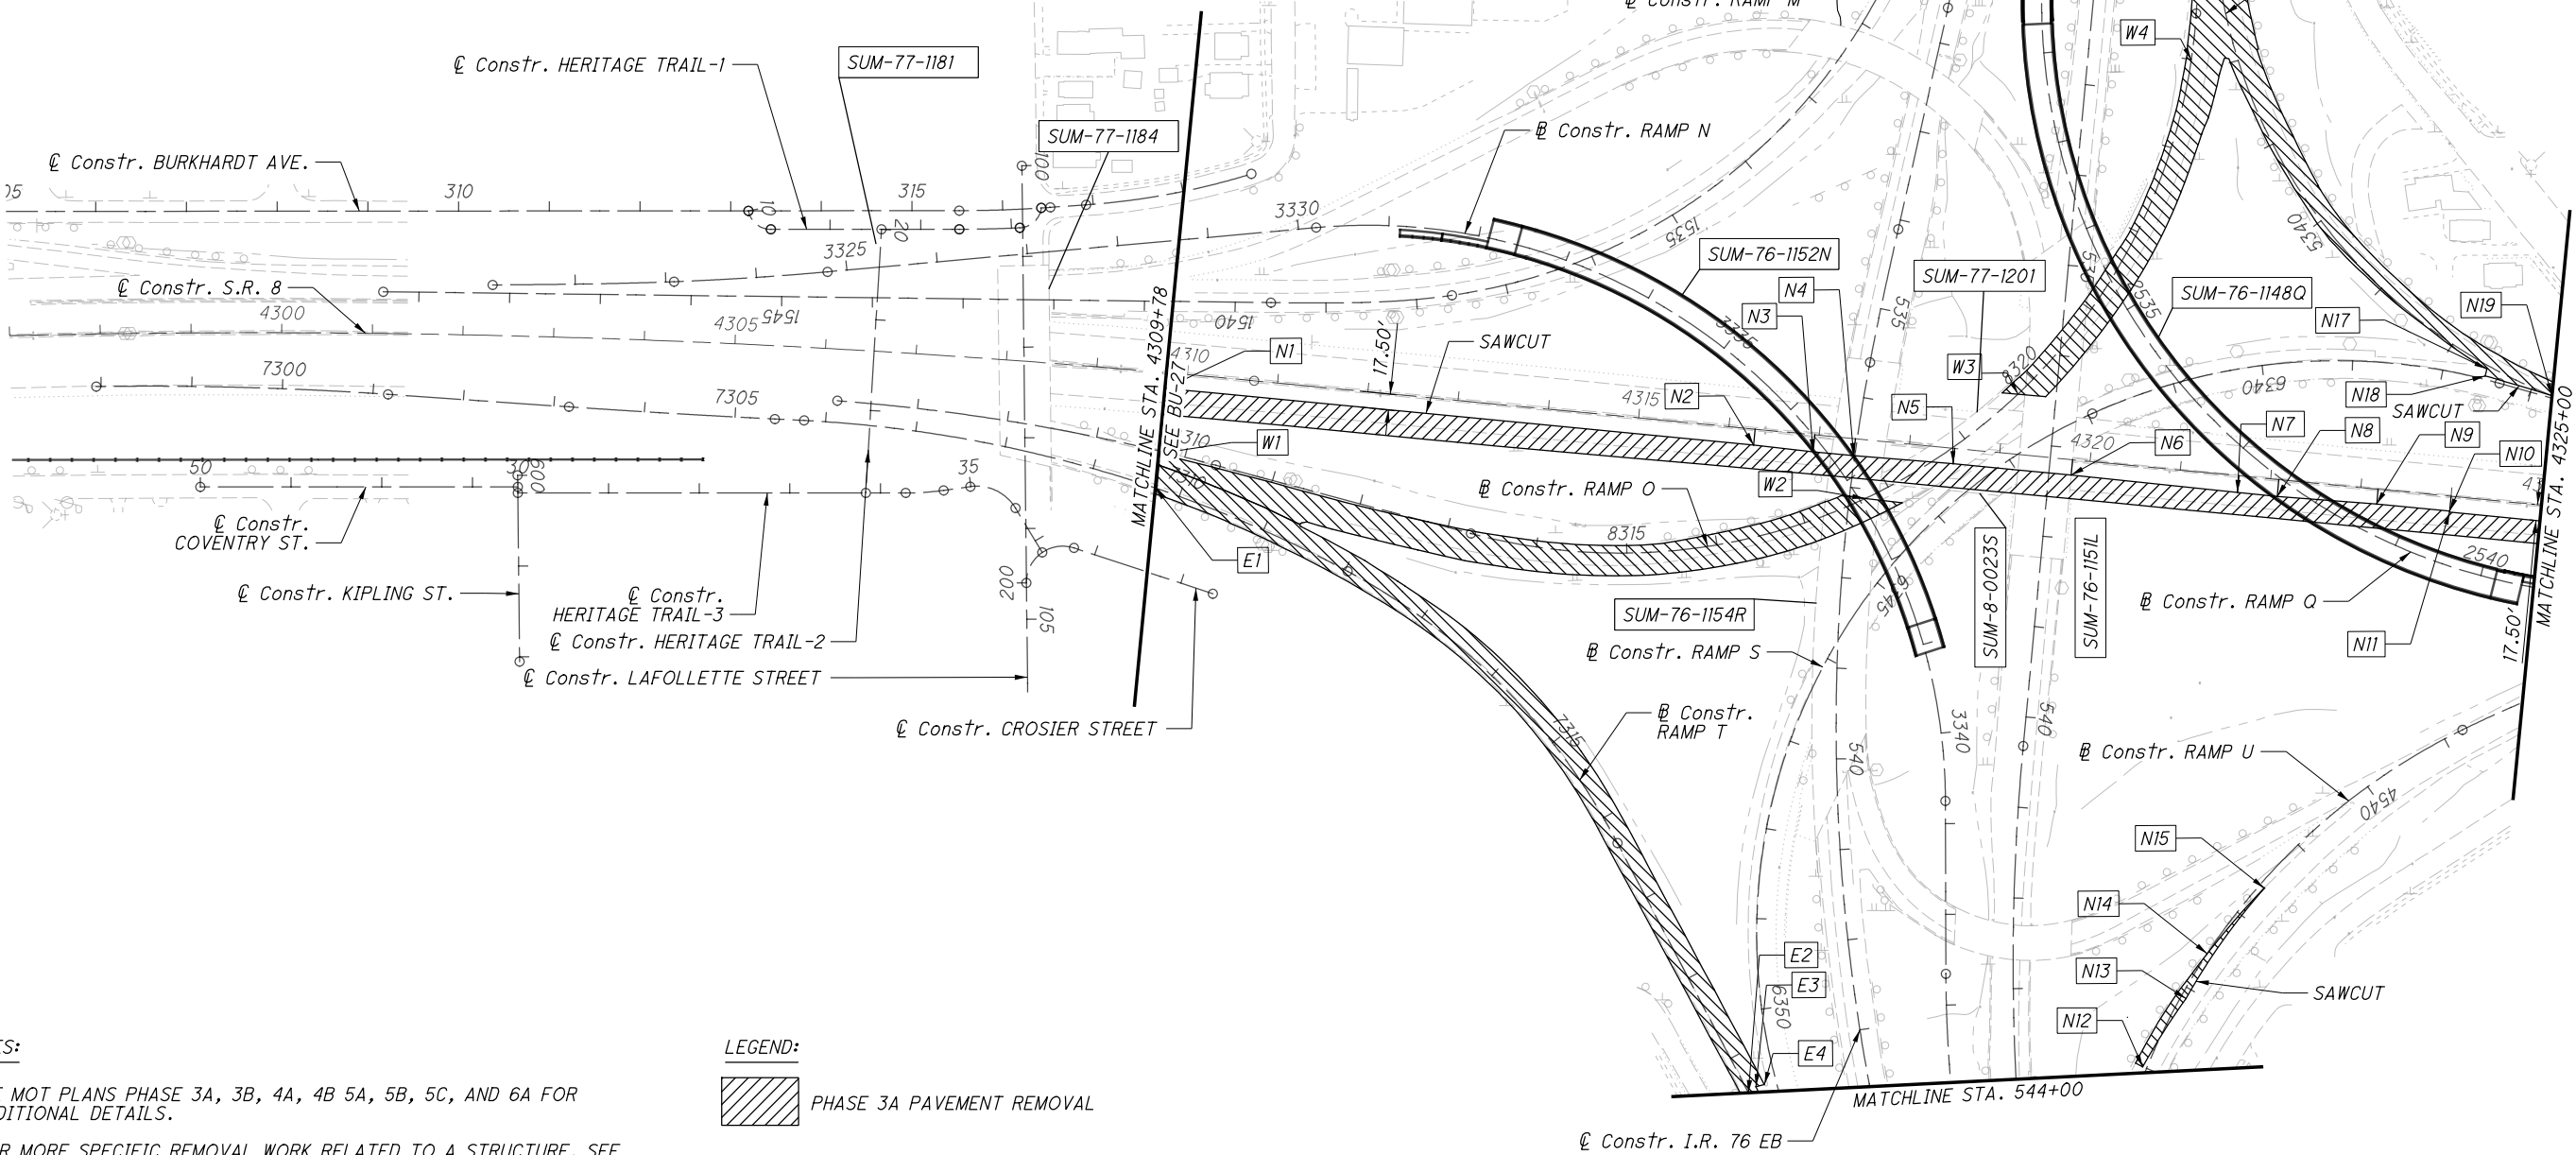

NOTES:

1. SEE MOT PLANS PHASE 3A, 3B, 4A, 4B 5A, 5B, 5C, AND 6A FOR ADDITIONAL DETAILS.
2. FOR MORE SPECIFIC REMOVAL WORK RELATED TO A STRUCTURE, SEE THE APPROPRIATE INDIVIDUAL STRUCTURE PLAN.
3. ALTHOUGH PAVEMENT REMOVALS ARE DEPICTED HEREIN, ADDITIONAL REMOVALS WITHIN THE CONSTRUCTION LIMITS SHALL INCLUDE, BUT NOT LIMITED TO: SIGNS & SIGN FOUNDATIONS, DRAINAGE STRUCTURES & PIPES, GUARDRAIL, CONCRETE BARRIER, LIGHT POLES & FOUNDATIONS, AND FENCING.

LEGEND:

PHASE 3A PAVEMENT REMOVAL

ISSUE RECORD:		
NO.	DATE	DESCRIPTION

2025-03-18 - BU-26 - RECORD DRAWING PLANS

REMOVAL PLAN - S.R. 8
STA. 4309+78 TO STA. 4325+00

SUM-76 / 77 / 8 -
8.24 / 9.74 / 0.00

6

36

CALCULATED
CAS

CHECKED
JFM

0 100 200

HORIZONTAL
SCALE IN FEET

N

1. SEE MOT PLANS PHASE 3A, 3B, 4A, 4B 5A, 5B, 5C, AND 6A FOR ADDITIONAL DETAILS.
2. FOR MORE SPECIFIC REMOVAL WORK RELATED TO A STRUCTURE, SEE THE APPROPRIATE INDIVIDUAL STRUCTURE PLAN.
3. ALTHOUGH PAVEMENT REMOVALS ARE DEPICTED HEREIN, ADDITIONAL REMOVALS WITHIN THE CONSTRUCTION LIMITS SHALL INCLUDE, BUT NOT LIMITED TO: SIGNS & SIGN FOUNDATIONS, DRAINAGE STRUCTURES & PIPES, GUARDRAIL, CONCRETE BARRIER, LIGHT POLES & FOUNDATIONS, AND FENCING.

 PHASE 3A PAVEMENT REMOVAL

CALCULATED CAS	CHECKED JFM	
		

**SUM-76 / 77 / 8-
8.24 / 9.74 / 0.00**

REMOVAL PLAN - I.R. 76
STA. 544+00 TO END I.R. 76 PROJECT

- N1

STA. 4325+00.00±, 17.50' RT
- N2


STA. 4326+78.77±, 17.50' RT
- N3

STA. 4327+28.77±, 18.00' RT
- N4

STA. 4328+88.67±, 18.00' RT
- N5

STA. 5336+76.49±, (RAMP P)
- N6

STA. 6334+69.00±, 1.42' LT (RAMP S)

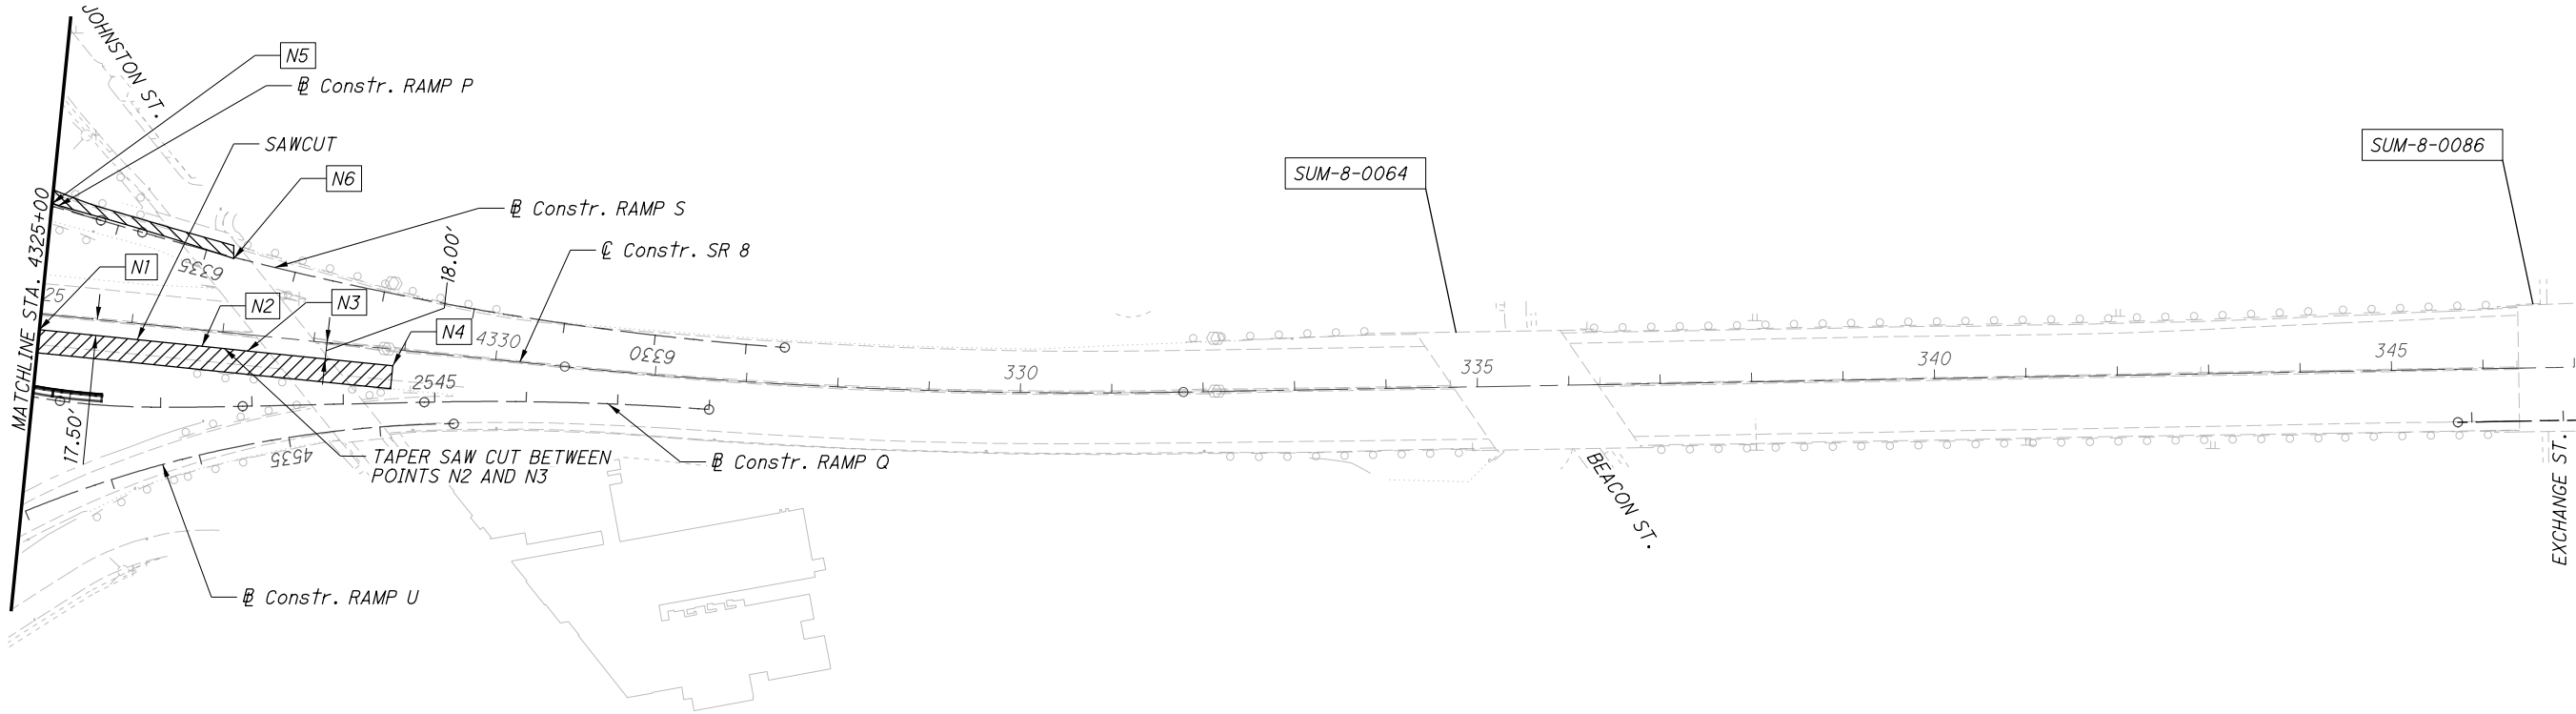

NOTES:

1. SEE MOT PLANS PHASE 3A, 3B, 4A, 4B 5A, 5B, 5C, AND 6A FOR ADDITIONAL DETAILS.
2. FOR MORE SPECIFIC REMOVAL WORK RELATED TO A STRUCTURE, SEE THE APPROPRIATE INDIVIDUAL STRUCTURE PLAN.
3. ALTHOUGH PAVEMENT REMOVALS ARE DEPICTED HEREIN, ADDITIONAL REMOVALS WITHIN THE CONSTRUCTION LIMITS SHALL INCLUDE, BUT NOT LIMITED TO: SIGNS & SIGN FOUNDATIONS, DRAINAGE STRUCTURES & PIPES, GUARDRAIL, CONCRETE BARRIER, LIGHT POLES & FOUNDATIONS, AND FENCING.

LEGEND:


PHASE 3A PAVEMENT REMOVAL

ISSUE RECORD:		
NO.	DATE	DESCRIPTION

NOTES:

- LEGEND:**

RESUME I.R. 76 PROJECT
STA. 507+15.63
S.L.M. 10.99
E180(428)

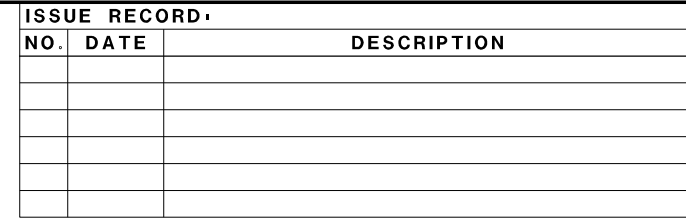

REMOVAL PLAN - I.R. 76
RESUME I.R. 76 PROJECT TO STA. 528+00

2025-03-18 - BU-26 - RECORD DRAWING PLANS

**SUM-76 / 77 / 8 -
8.24 / 9.74 / 0.00**

- N1

STA. 4309+76.90±, 5.00' RT
- N2

STA. 4319+15.67±, 5.00' RT
- N3

STA. 4544+11.65±, 14.66' RT
- N4

STA. 4543+99.08±, 13.44' RT
- N5

STA. 4544+00.00±, 4.56' RT
- N6

STA. 4543+62.09±, 0.00
- N7

STA. 4543+11.35±, 6.00' LT
- W1

STA. 544+00.00±, 12.00' LT
- W2


STA. 540+48.01±, 12.00' LT


NOTES:

1. SEE MOT PLANS PHASE 3A, 3B, 4A, 4B 5A, 5B, 5C, AND 6A FOR ADDITIONAL DETAILS.
2. FOR MORE SPECIFIC REMOVAL WORK RELATED TO A STRUCTURE, SEE THE APPROPRIATE INDIVIDUAL STRUCTURE PLAN.
3. ALTHOUGH PAVEMENT REMOVALS ARE DEPICTED HEREIN, ADDITIONAL REMOVALS WITHIN THE CONSTRUCTION LIMITS SHALL INCLUDE, BUT NOT LIMITED TO: SIGNS & SIGN FOUNDATIONS, DRAINAGE STRUCTURES & PIPES, GUARDRAIL, CONCRETE BARRIER, LIGHT POLES & FOUNDATIONS, AND FENCING.

LEGEND:

PHASE 3B PAVEMENT REMOVAL

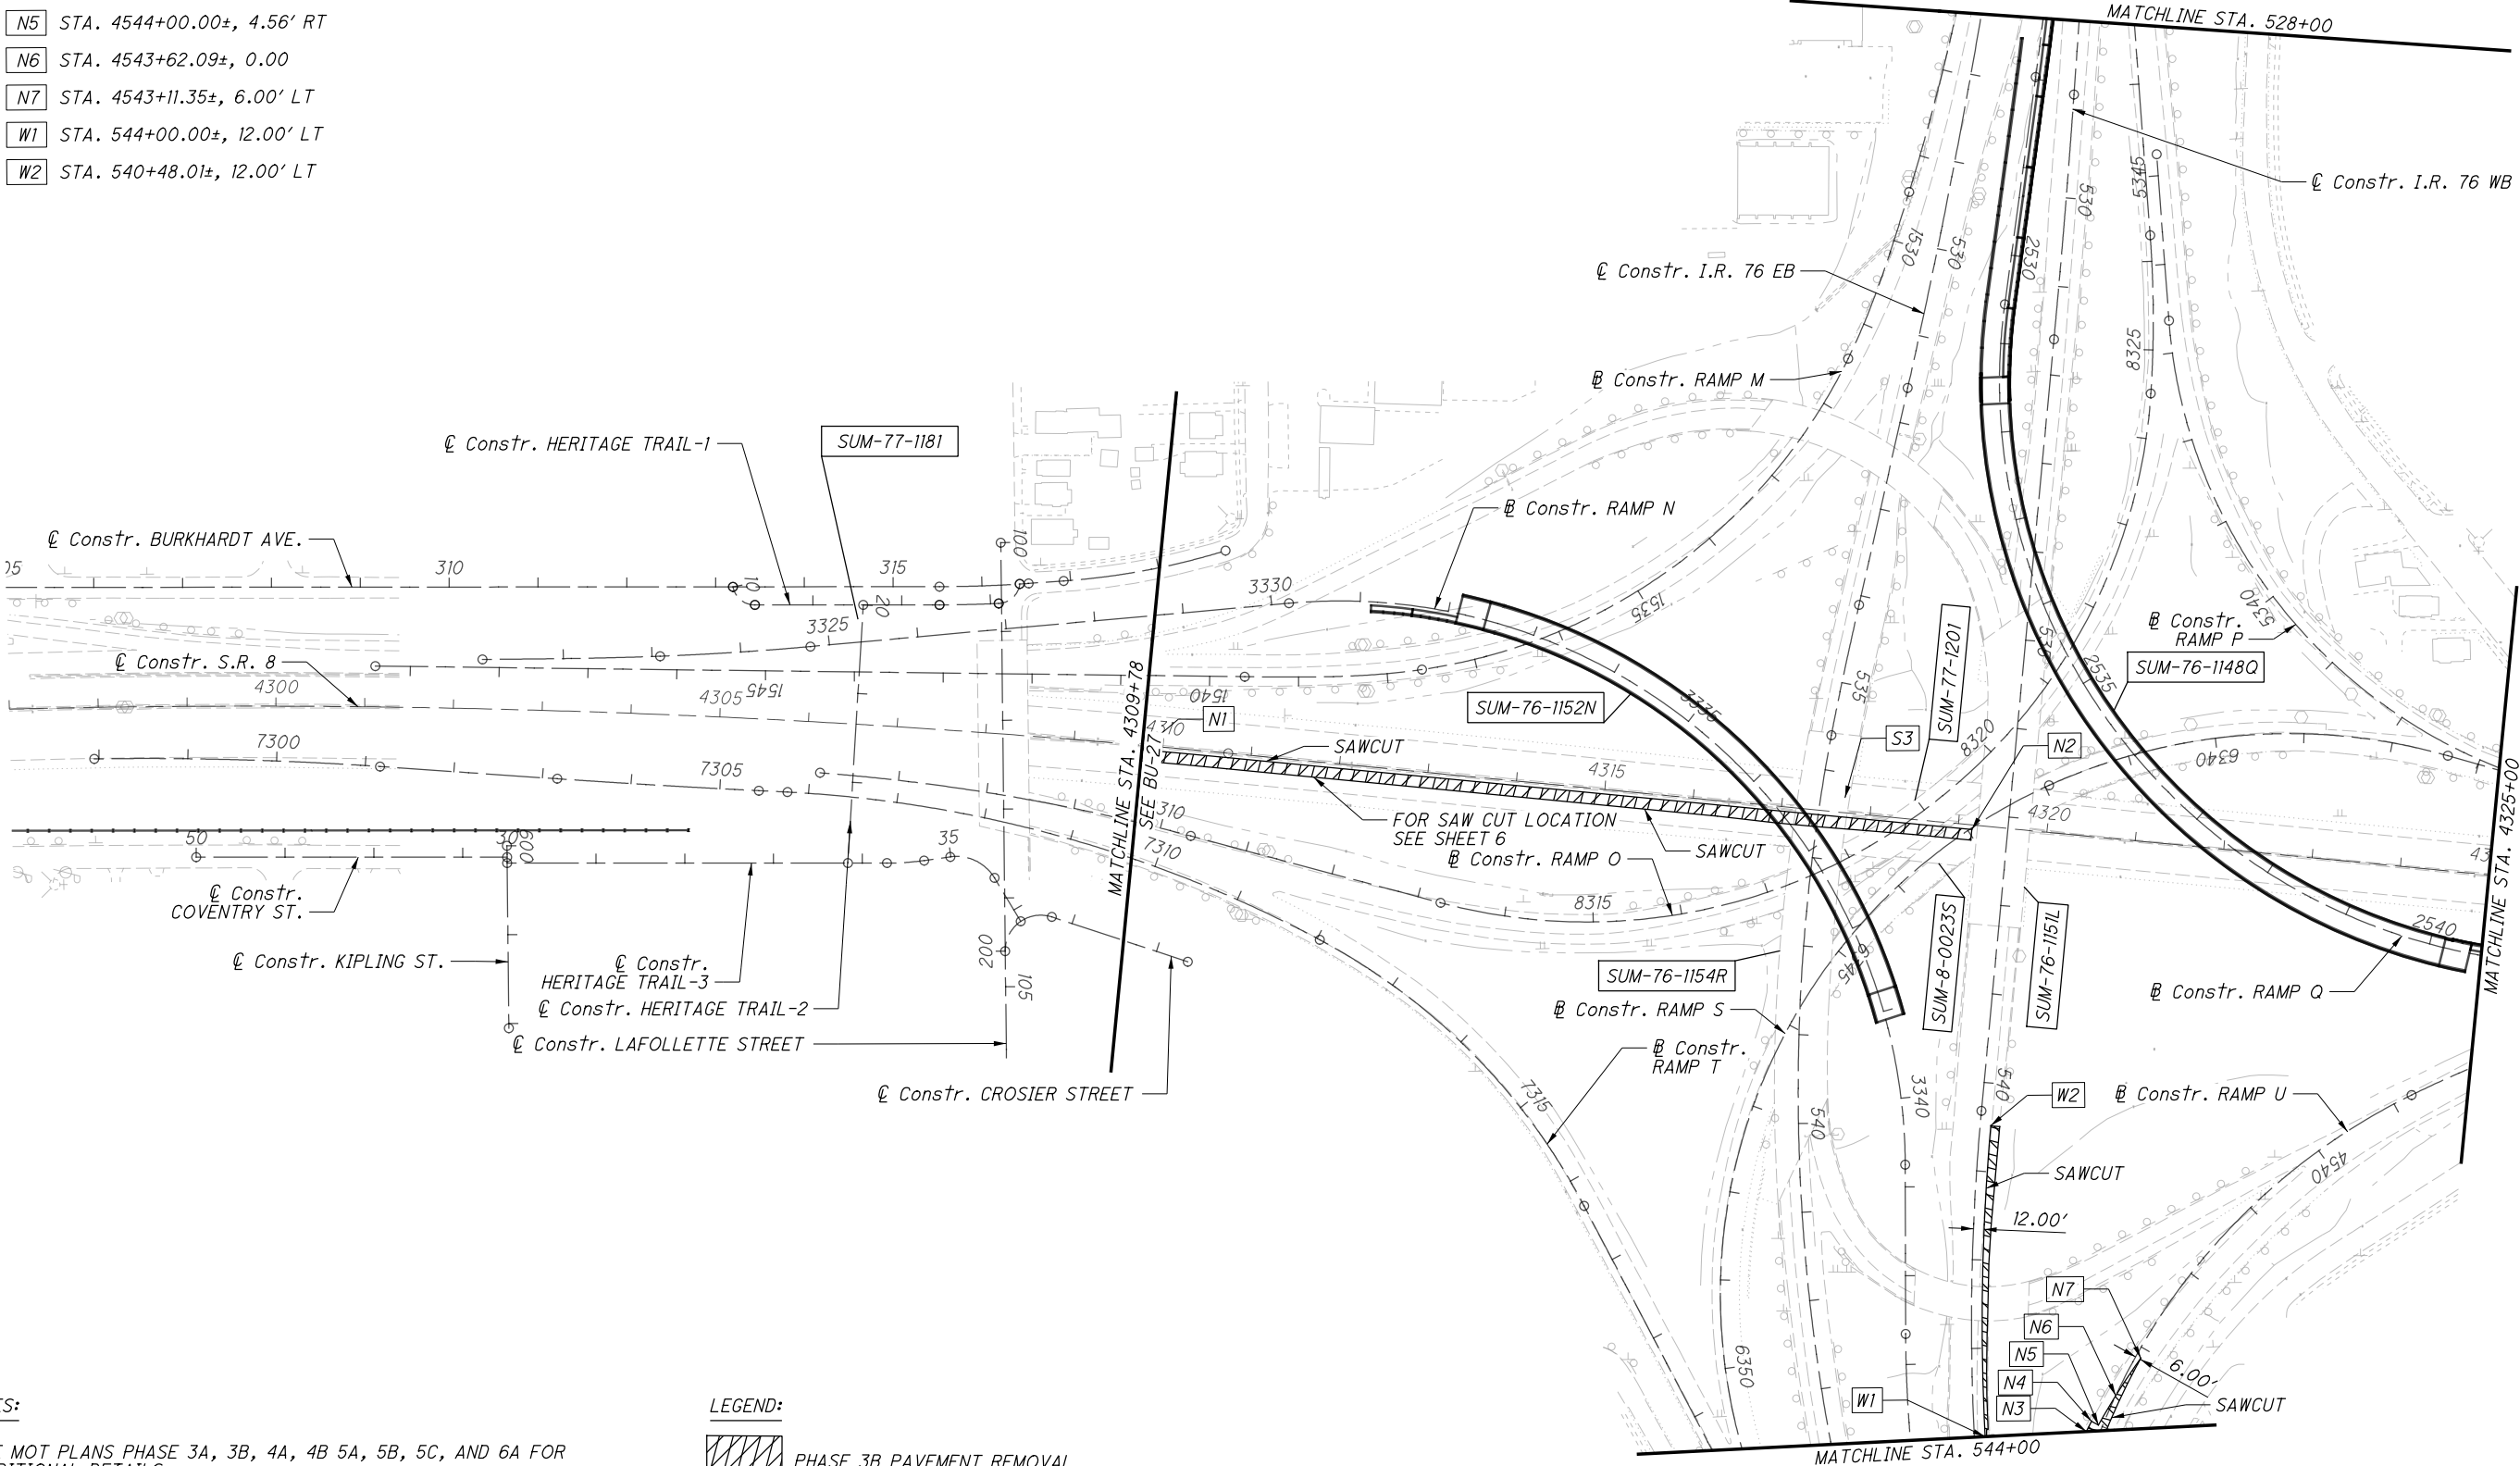

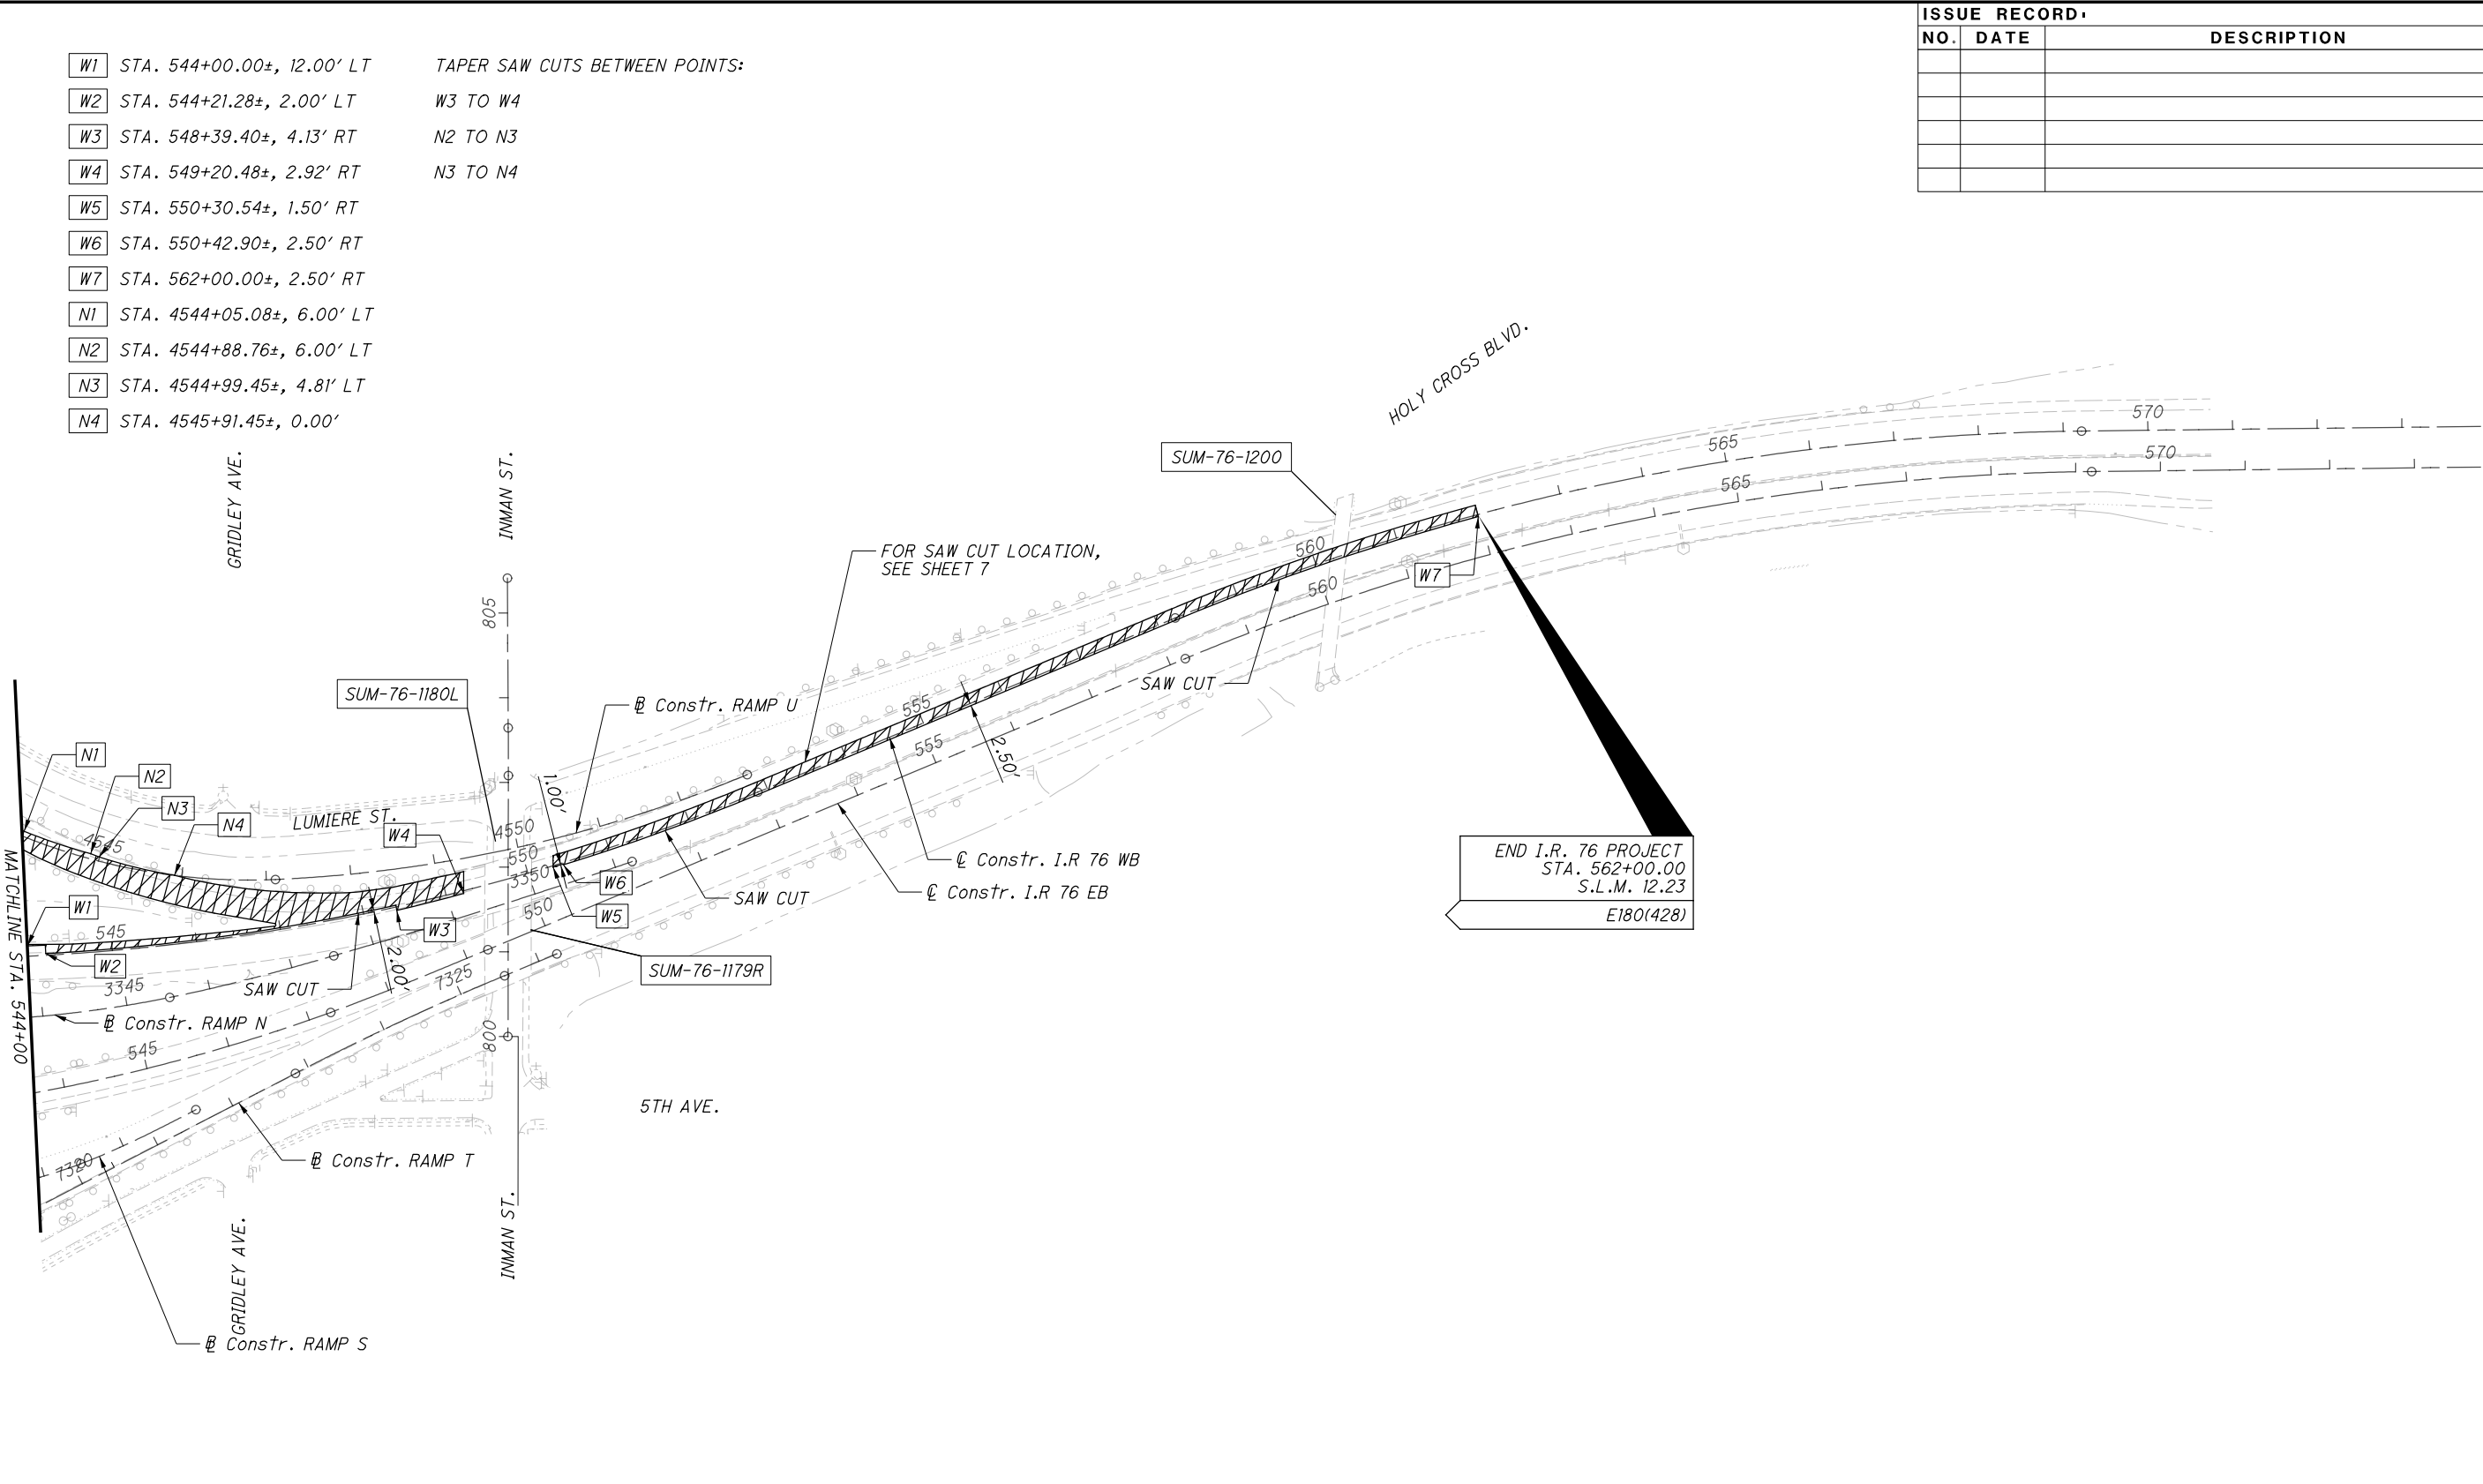

NOTES:

- SEE MOT PLANS PHASE 3A, 3B, 4A, 4B, 5A, 5B, 5C, AND 6A FOR ADDITIONAL DETAILS.
- FOR MORE SPECIFIC REMOVAL WORK RELATED TO A STRUCTURE, SEE THE APPROPRIATE INDIVIDUAL STRUCTURE PLAN.
- ALTHOUGH PAVEMENT REMOVALS ARE DEPICTED HEREIN, ADDITIONAL REMOVALS WITHIN THE CONSTRUCTION LIMITS SHALL INCLUDE, BUT NOT LIMITED TO: SIGNS & SIGN FOUNDATIONS, DRAINAGE STRUCTURES & PIPES, GUARDRAIL, CONCRETE BARRIER, LIGHT POLES & FOUNDATIONS, AND FENCING.

LEGEND:

PHASE 3B PAVEMENT REMOVAL

ISSUE RECORD:		
NO.	DATE	DESCRIPTION

- N1

STA. 4327+14.44±, 17.86' RT
- N2

STA. 4327+28.77±, 18.00' RT
- N3

STA. 4327+88.67±, 18.00' RT
- N4

STA. 4329+38.67±, 19.50' RT
- N5

STA. 334+61.46±, 19.50' RT


- NOTES:
1. SEE MOT PLANS PHASE 3A, 3B, 4A, 4B 5A, 5B, 5C, AND 6A FOR ADDITIONAL DETAILS.

2. FOR MORE SPECIFIC REMOVAL WORK RELATED TO A STRUCTURE, SEE THE APPROPRIATE INDIVIDUAL STRUCTURE PLAN.

3. ALTHOUGH PAVEMENT REMOVALS ARE DEPICTED HEREIN, ADDITIONAL REMOVALS WITHIN THE CONSTRUCTION LIMITS SHALL INCLUDE, BUT NOT LIMITED TO: SIGNS & SIGN FOUNDATIONS, DRAINAGE STRUCTURES & PIPES, GUARDRAIL, CONCRETE BARRIER, LIGHT POLES & FOUNDATIONS, AND FENCING.

LEGEND:

PHASE 3B PAVEMENT REMOVAL

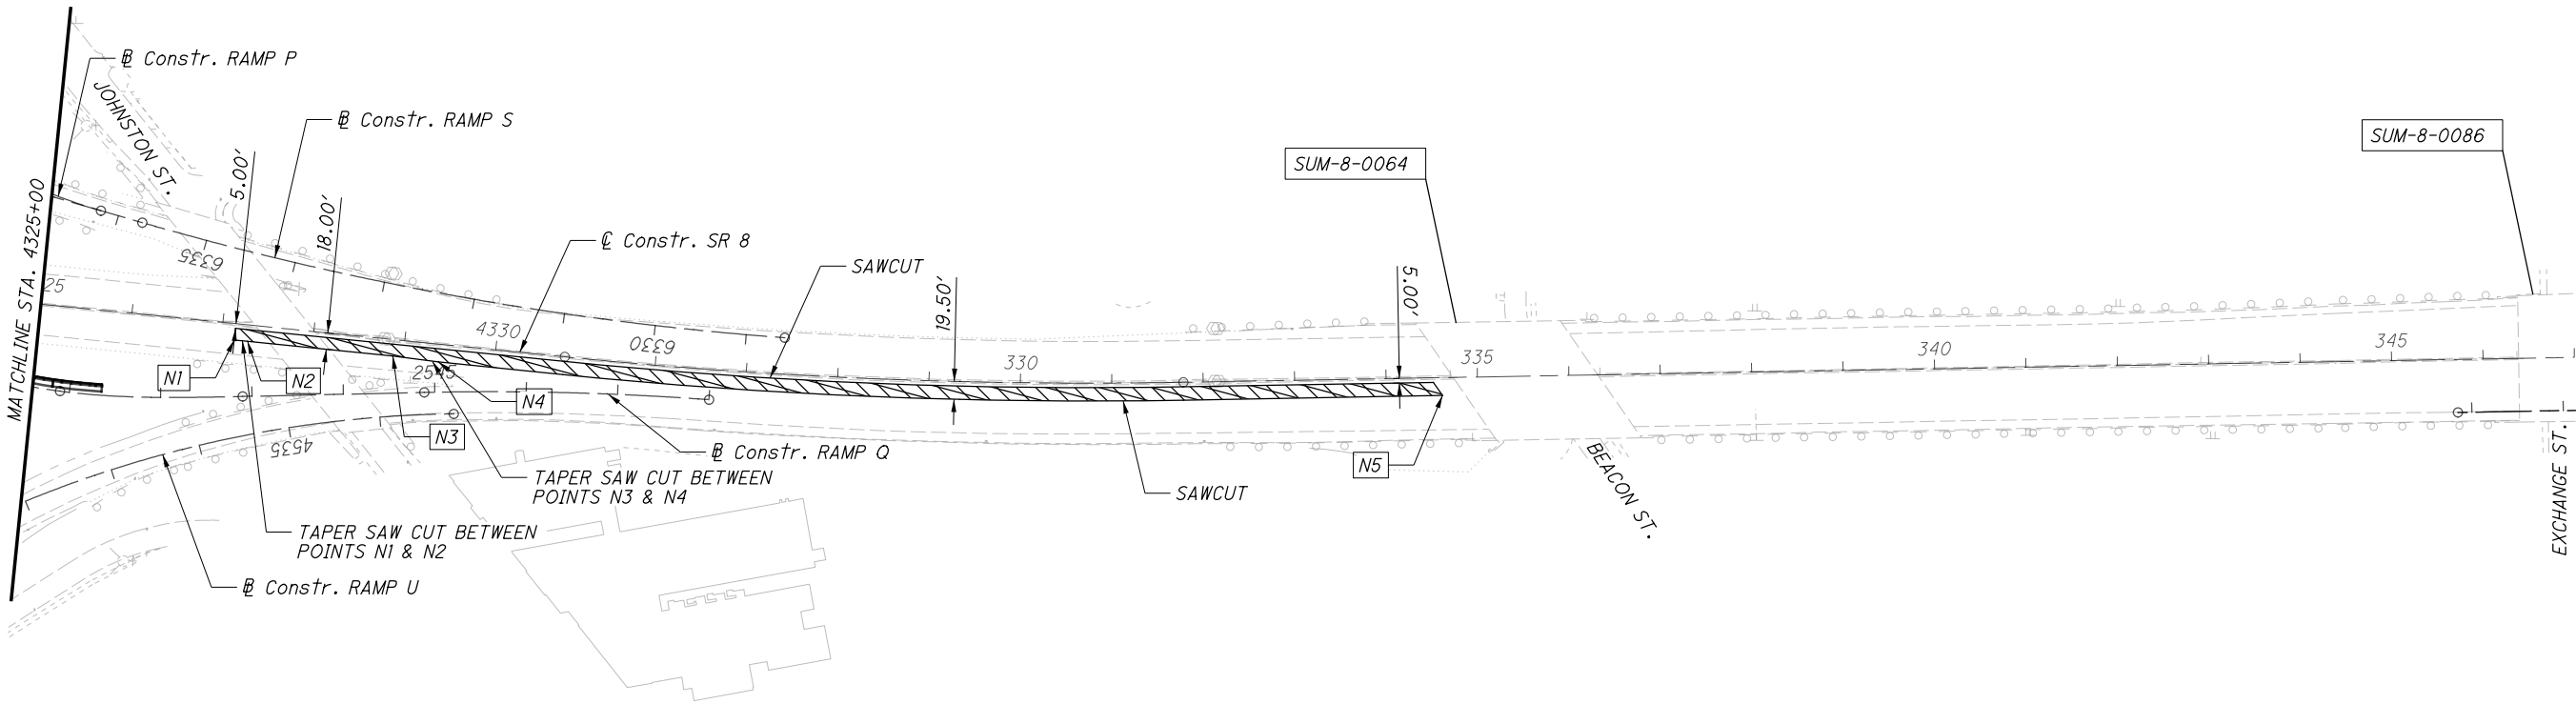

ISSUE RECORD:

NO.	DATE	DESCRIPTION

CALCULATED

CAS

CHECKED

JFM

2025-03-18 - BU-26 - RECORD DRAWING PLANS

SUM-76 / 77 / 8-8.24 / 9.74 / 0.00

12 / 36


REMOVAL PLAN - S.R 8
STA. 4325+00 TO BEACON ST.

N

0 50 100 200

HORIZONTAL SCALE IN FEET

- E1 STA. 507+65.62±, 38.80' RT
- E2 STA. 515+00.00±, 38.60' RT
- E3 STA. 518+80.82±, 0.00' (I.R. 76 EB)
- E4 STA. 521+51.40±, 8.76' LT (I.R. 76 EB)
- E5 STA. 523+60.69±, 12.40' LT (I.R. 76 EB)
- E6 STA. 527+12.49±, 7.45' RT (I.R. 76 EB)

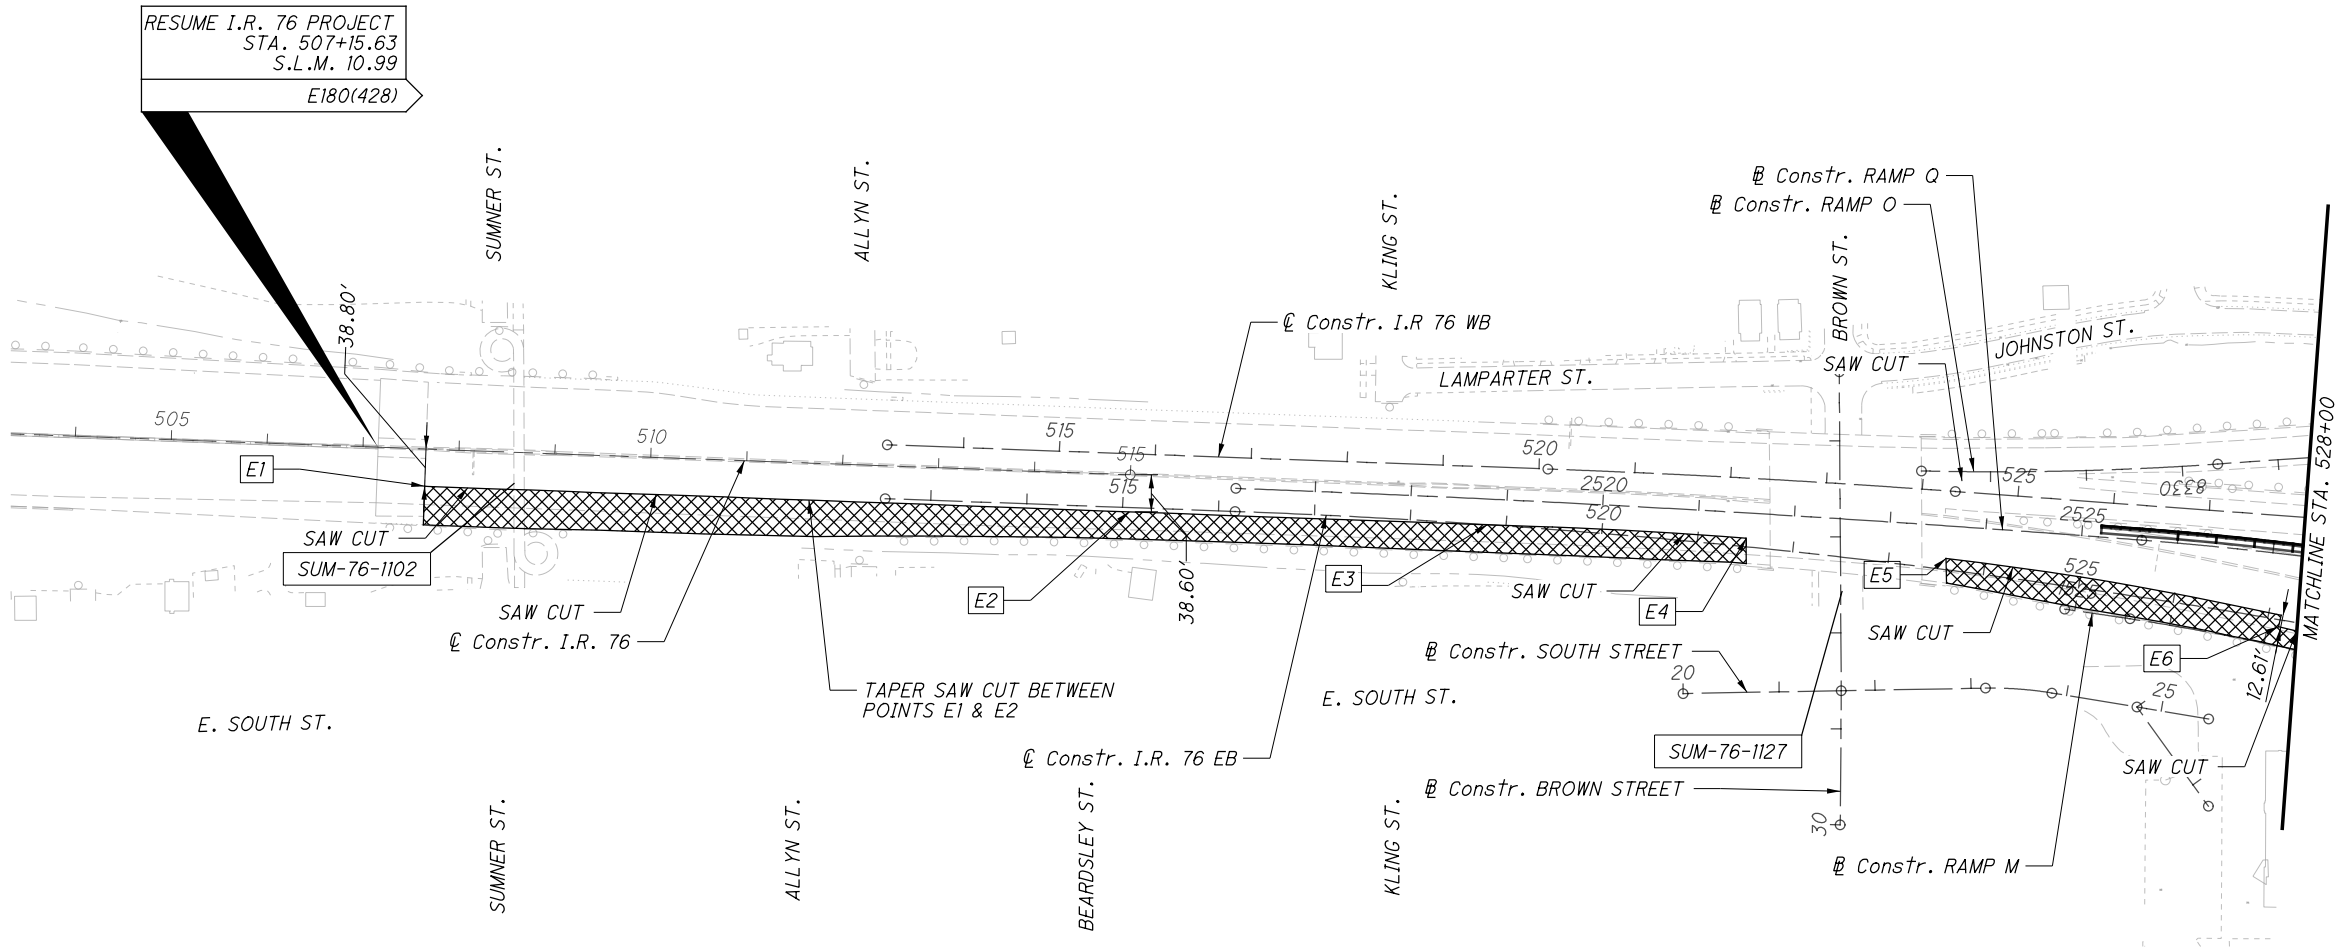

NOTES:

1. SEE MOT PLANS PHASE 3A, 3B, 4A, 4B, 5A, 5B, 5C, AND 6A FOR ADDITIONAL DETAILS.
2. FOR MORE SPECIFIC REMOVAL WORK RELATED TO A STRUCTURE, SEE THE APPROPRIATE INDIVIDUAL STRUCTURE PLAN.
3. ALTHOUGH PAVEMENT REMOVALS ARE DEPICTED HEREIN, ADDITIONAL REMOVALS WITHIN THE CONSTRUCTION LIMITS SHALL INCLUDE, BUT NOT LIMITED TO: SIGNS & SIGN FOUNDATIONS, DRAINAGE STRUCTURES & PIPES, GUARDRAIL, CONCRETE BARRIER, LIGHT POLES & FOUNDATIONS, AND FENCING.

LEGEND:

PHASE 4A PAVEMENT REMOVAL

ISSUE RECORD:		
NO.	DATE	DESCRIPTION

CALCULATED
CAS

CHECKED
JFM

0 100 200
HORIZONTAL
SCALE IN FEET

NOTES:

- LEGEND:*


[illegible]

2025-03-18 - BU-26 - RECORD DRAWING PLANS

REMOVAL PLAN - S.R. 8
STA. 4309+78 TO STA. 4325+00

SUM-76 / 77 / 8 -
8.24 / 9.74 / 0.00

W1	STA. 546+65.36±, 11.91' RT
W2	STA. 549+20.48±, 2.93' RT
W3	STA. 550+30.54±, 1.50' RT
W4	STA. 550+42.90±, 2.5' RT
W5	STA. 562+00.00±, 2.5' RT
N1	STA. 4543+98.88±, 13.25' LT, (RAMP U)
N2	STA. 4544+94.16±, 7.11' LT, (RAMP U)
N3	STA. 4544+88.77, 6.00' LT, (RAMP U)

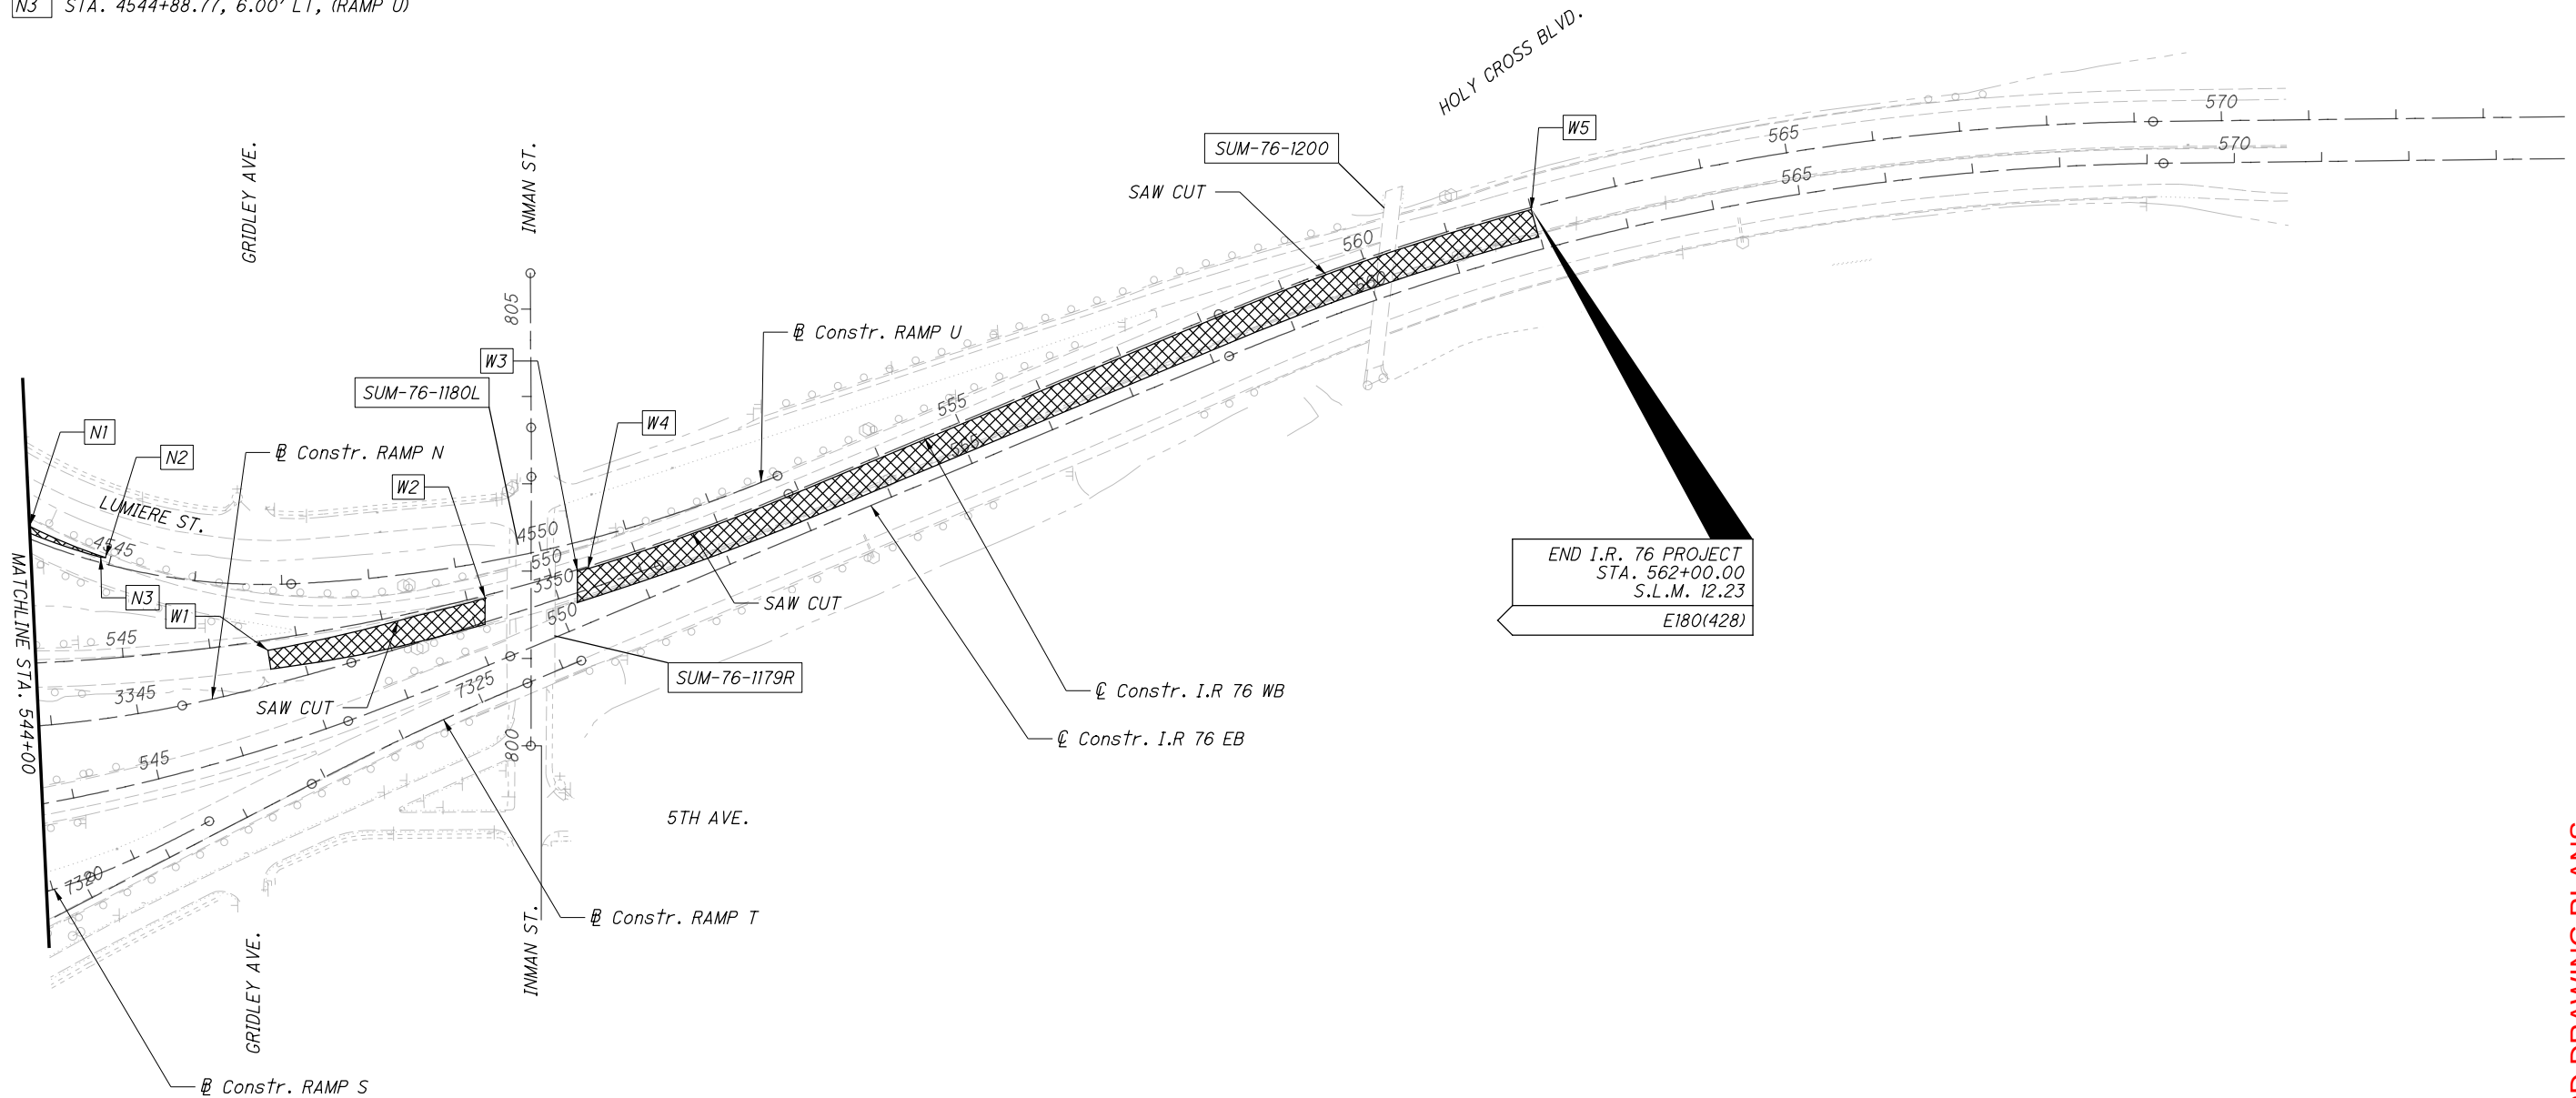

NOTES:

1. SEE MOT PLANS PHASE 3A, 3B, 4A, 4B, 5A, 5B, 5C, AND 6A FOR ADDITIONAL DETAILS.
2. FOR MORE SPECIFIC REMOVAL WORK RELATED TO A STRUCTURE, SEE THE APPROPRIATE INDIVIDUAL STRUCTURE PLAN.
3. ALTHOUGH PAVEMENT REMOVALS ARE DEPICTED HEREIN, ADDITIONAL REMOVALS WITHIN THE CONSTRUCTION LIMITS SHALL INCLUDE, BUT NOT LIMITED TO: SIGNS & SIGN FOUNDATIONS, DRAINAGE STRUCTURES & PIPES, GUARDRAIL, CONCRETE BARRIER, LIGHT POLES & FOUNDATIONS, AND FENCING.

LEGEND:



PHASE 4A PAVEMENT REMOVAL

[illegible]

REMOVAL PLAN - I.R. 76
STA. 544+00 TO END I.R. 76 PROJECT

2025-03-18 - BU-26 - RECORD DRAWING PLANS

**SUM-76 / 77 / 8 -
8.24 / 9.74 / 0.00**

- N1

STA. 4538+10.85±, 10.11' LT, (RAMP P)
- N2

STA. 4536+76.65±, 0', (RAMP P)
- N3

STA. 4536+43.40±, 1.89' RT, (RAMP P)
- N4


STA. 4534+87.23±, 7.07' RT, (RAMP P)
- N5

STA. 4533+19.07±, 10.47' RT (RAMP P)
- N6

STA. 4328+88.67±, 18.00' RT
- N7

STA. 4329+38.67±, 19.50' RT
- N8

STA. 334+86.46±, 19.50' RT

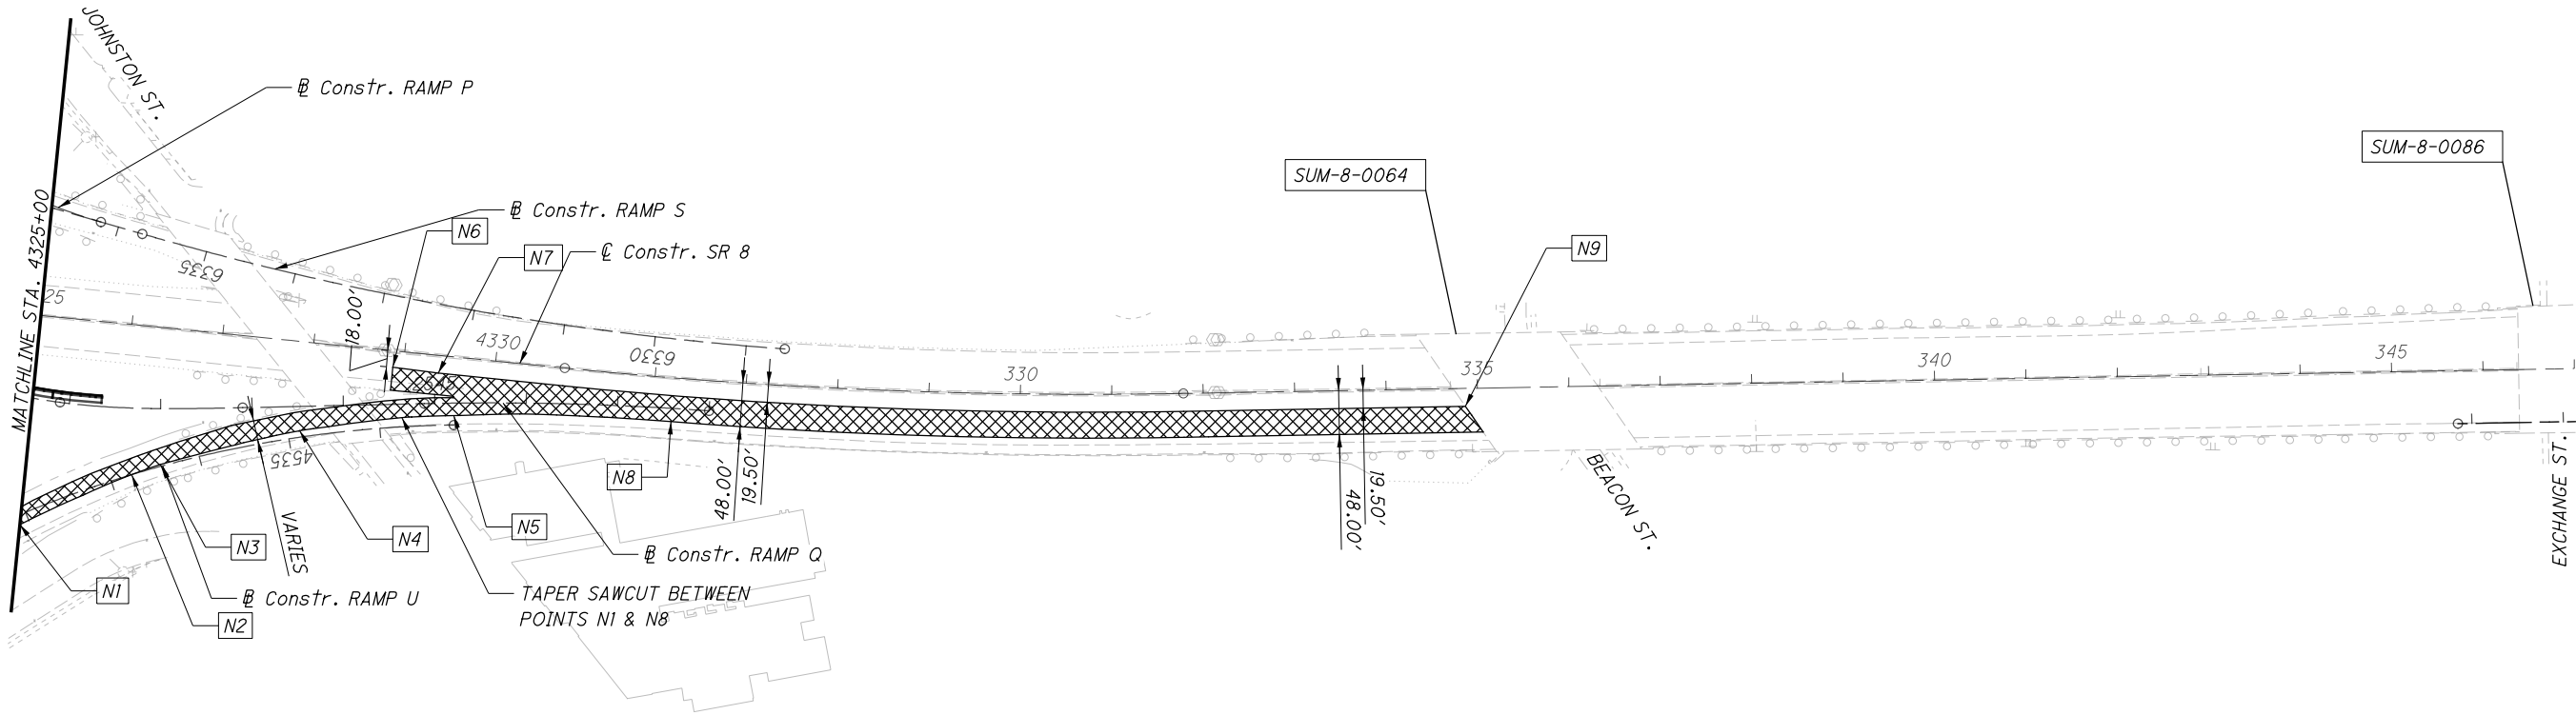

NOTES:

1. SEE MOT PLANS PHASE 3A, 3B, 4A, 4B, 5A, 5B, 5C, AND 6A FOR ADDITIONAL DETAILS.
2. FOR MORE SPECIFIC REMOVAL WORK RELATED TO A STRUCTURE, SEE THE APPROPRIATE INDIVIDUAL STRUCTURE PLAN.
3. ALTHOUGH PAVEMENT REMOVALS ARE DEPICTED HEREIN, ADDITIONAL REMOVALS WITHIN THE CONSTRUCTION LIMITS SHALL INCLUDE, BUT NOT LIMITED TO: SIGNS & SIGN FOUNDATIONS, DRAINAGE STRUCTURES & PIPES, GUARDRAIL, CONCRETE BARRIER, LIGHT POLES & FOUNDATIONS, AND FENCING.

LEGEND:

PHASE 4A PAVEMENT REMOVAL

ISSUE RECORD:		
NO.	DATE	DESCRIPTION


NOTES:

1. SEE MOT PLANS PHASE 3A, 3B, 4A, 4B, 5A, 5B, 5C, AND 6A FOR ADDITIONAL DETAILS.
2. FOR MORE SPECIFIC REMOVAL WORK RELATED TO A STRUCTURE, SEE THE APPROPRIATE INDIVIDUAL STRUCTURE PLAN.
3. ALTHOUGH PAVEMENT REMOVALS ARE DEPICTED HEREIN, ADDITIONAL REMOVALS WITHIN THE CONSTRUCTION LIMITS SHALL INCLUDE, BUT NOT LIMITED TO: SIGNS & SIGN FOUNDATIONS, DRAINAGE STRUCTURES & PIPES, GUARDRAIL, CONCRETE BARRIER, LIGHT POLES & FOUNDATIONS, AND FENCING.


LEGEND:



PHASE 4A PAVEMENT REMOVAL STEP 2

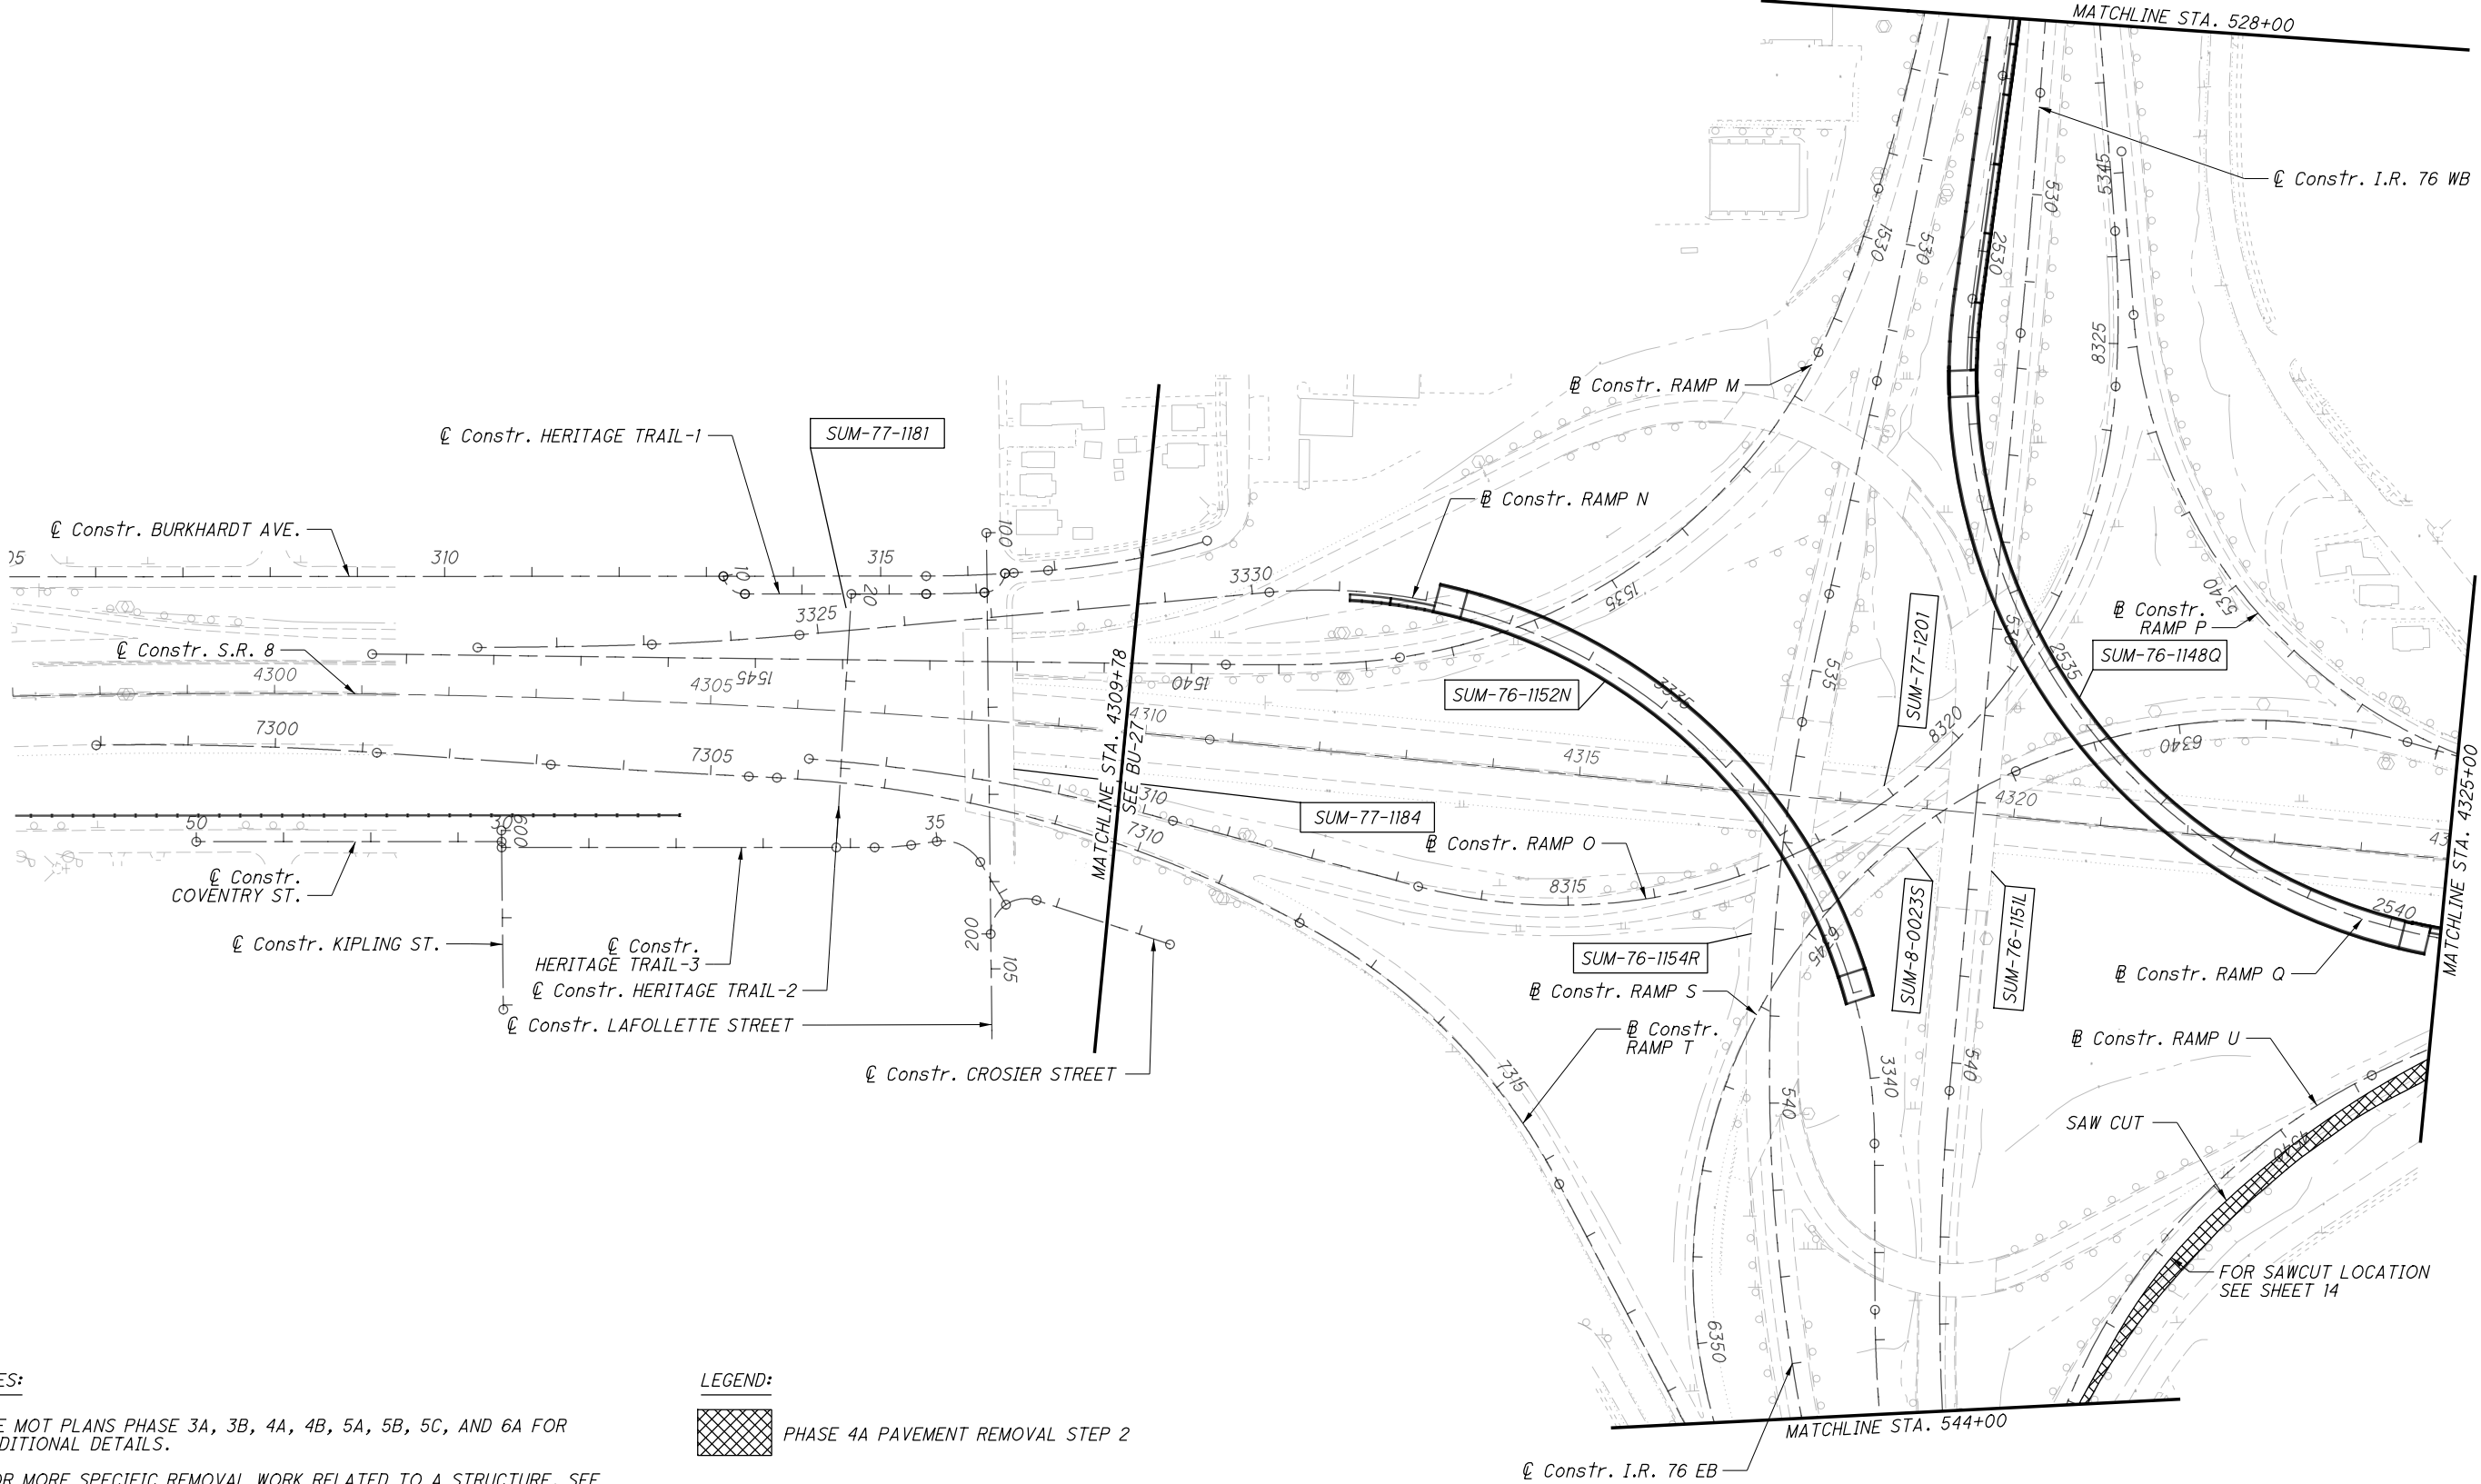

NI STA. 326+21.25, 48.0' RT (S.R. 8)

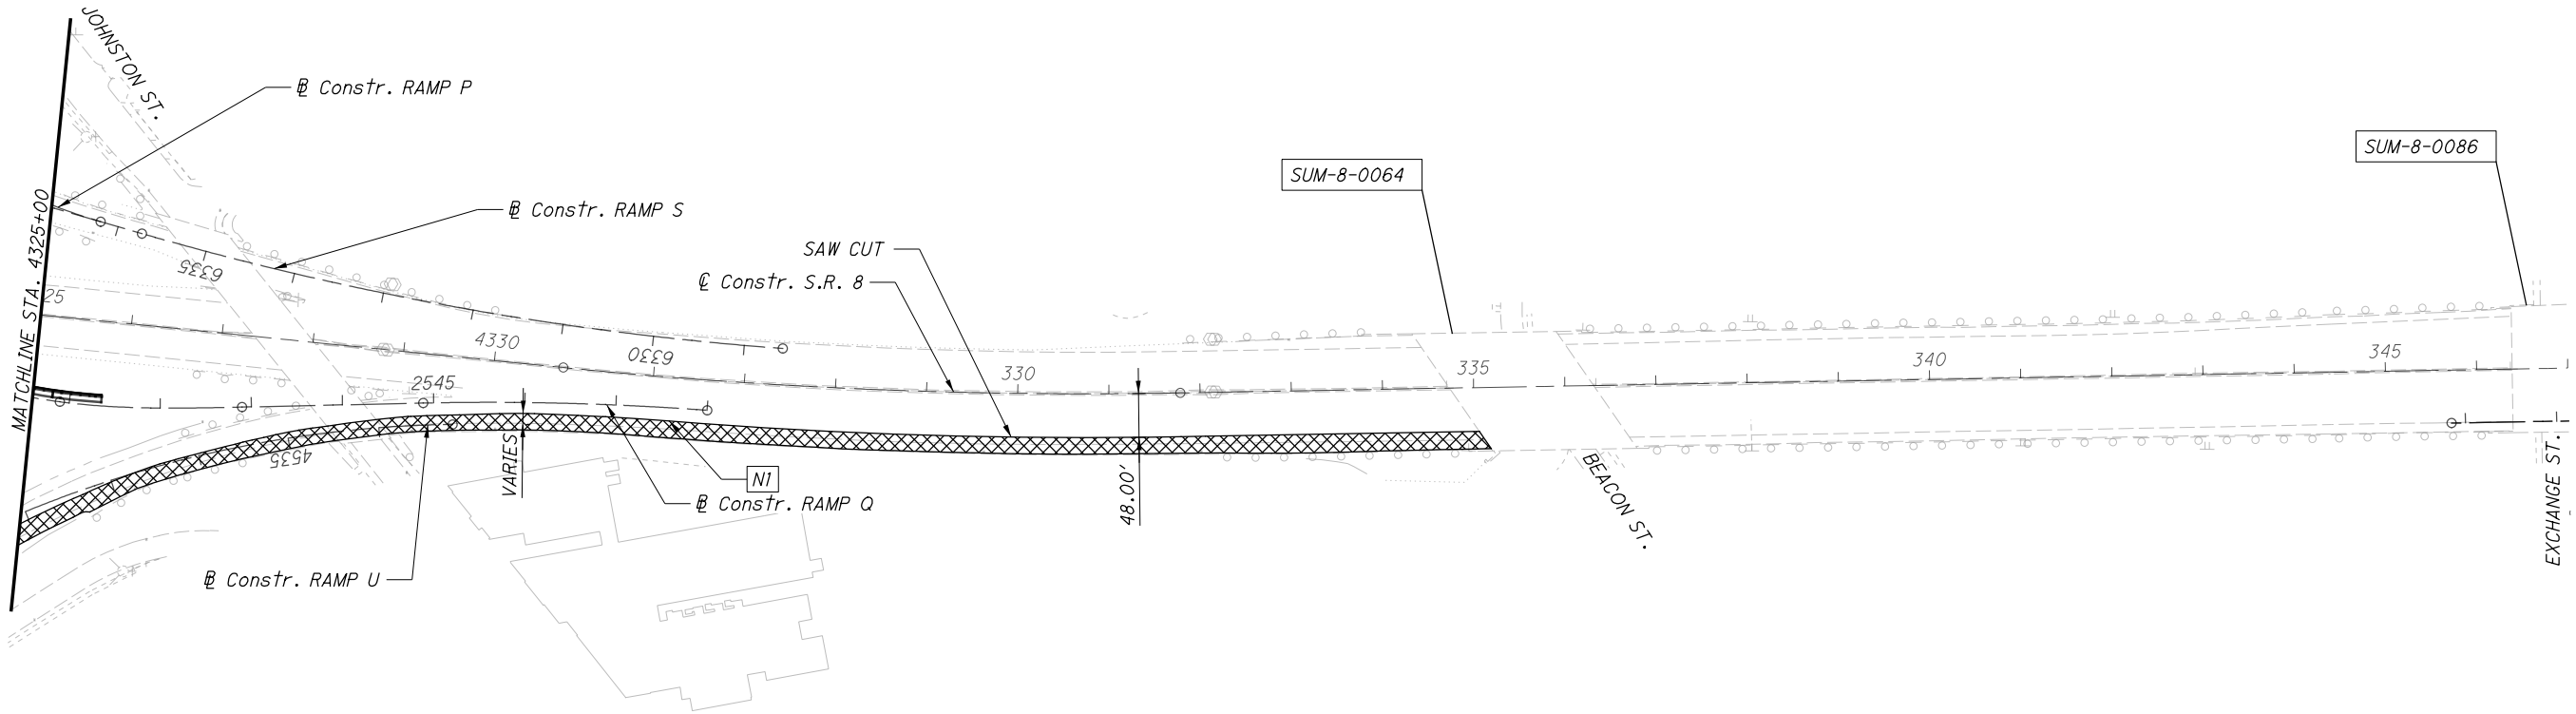

NOTES:

- SEE MOT PLANS PHASE 3A, 3B, 4A, 4B, 5A, 5B, 5C, AND 6A FOR ADDITIONAL DETAILS.
- FOR MORE SPECIFIC REMOVAL WORK RELATED TO A STRUCTURE, SEE THE APPROPRIATE INDIVIDUAL STRUCTURE PLAN.
- ALTHOUGH PAVEMENT REMOVALS ARE DEPICTED HEREIN, ADDITIONAL REMOVALS WITHIN THE CONSTRUCTION LIMITS SHALL INCLUDE, BUT NOT LIMITED TO: SIGNS & SIGN FOUNDATIONS, DRAINAGE STRUCTURES & PIPES, GUARDRAIL, CONCRETE BARRIER, LIGHT POLES & FOUNDATIONS, AND FENCING.

LEGEND:

 PHASE 4A PAVEMENT REMOVAL STEP 2

ISSUE RECORD:		
NO.	DATE	DESCRIPTION

- E1

STA. 507+65.57±, 38.8' RT (I.R. 76)
- E2

STA. 515+00.00±, 38.6' RT (I.R. 76) / 515+06.92±, 4.5' RT (I.R. 76 EB)
- E3

STA. 524+95.65, 11.7' LT (I.R. 76 EB)
- E4

STA. 524+95.42±, 28.1' LT (I.R. 76 EB)

ISSUE RECORD		
NO.	DATE	DESCRIPTION

CALCULATED
CAS

CHECKED
JFM

0

100

200

HORIZONTAL
SCALE IN FEET

↑

N

NOTES:

1. SEE MOT PLANS PHASE 3A, 3B, 4A, 4B, 5A, 5B, 5C, AND 6A FOR ADDITIONAL DETAILS.

2. FOR MORE SPECIFIC REMOVAL WORK RELATED TO A STRUCTURE, SEE THE APPROPRIATE INDIVIDUAL STRUCTURE PLAN.

3. ALTHOUGH PAVEMENT REMOVALS ARE DEPICTED HEREIN, ADDITIONAL REMOVALS WITHIN THE CONSTRUCTION LIMITS SHALL INCLUDE, BUT NOT LIMITED TO: SIGNS & SIGN FOUNDATIONS, DRAINAGE STRUCTURES & PIPES, GUARDRAIL, CONCRETE BARRIER, LIGHT POLES & FOUNDATIONS, AND FENCING.

LEGEND:

PHASE 4B PAVEMENT REMOVAL

2025-03-18 - BU-26 - RECORD DRAWING PLANS


SUM-76 / 77 / 8 -

8.24 / 9.74 / 0.00

19 / 36

REMOVAL PLAN - I.R. 76
RESUME I.R. 76 PROJECT TO STA. 528+00

E1

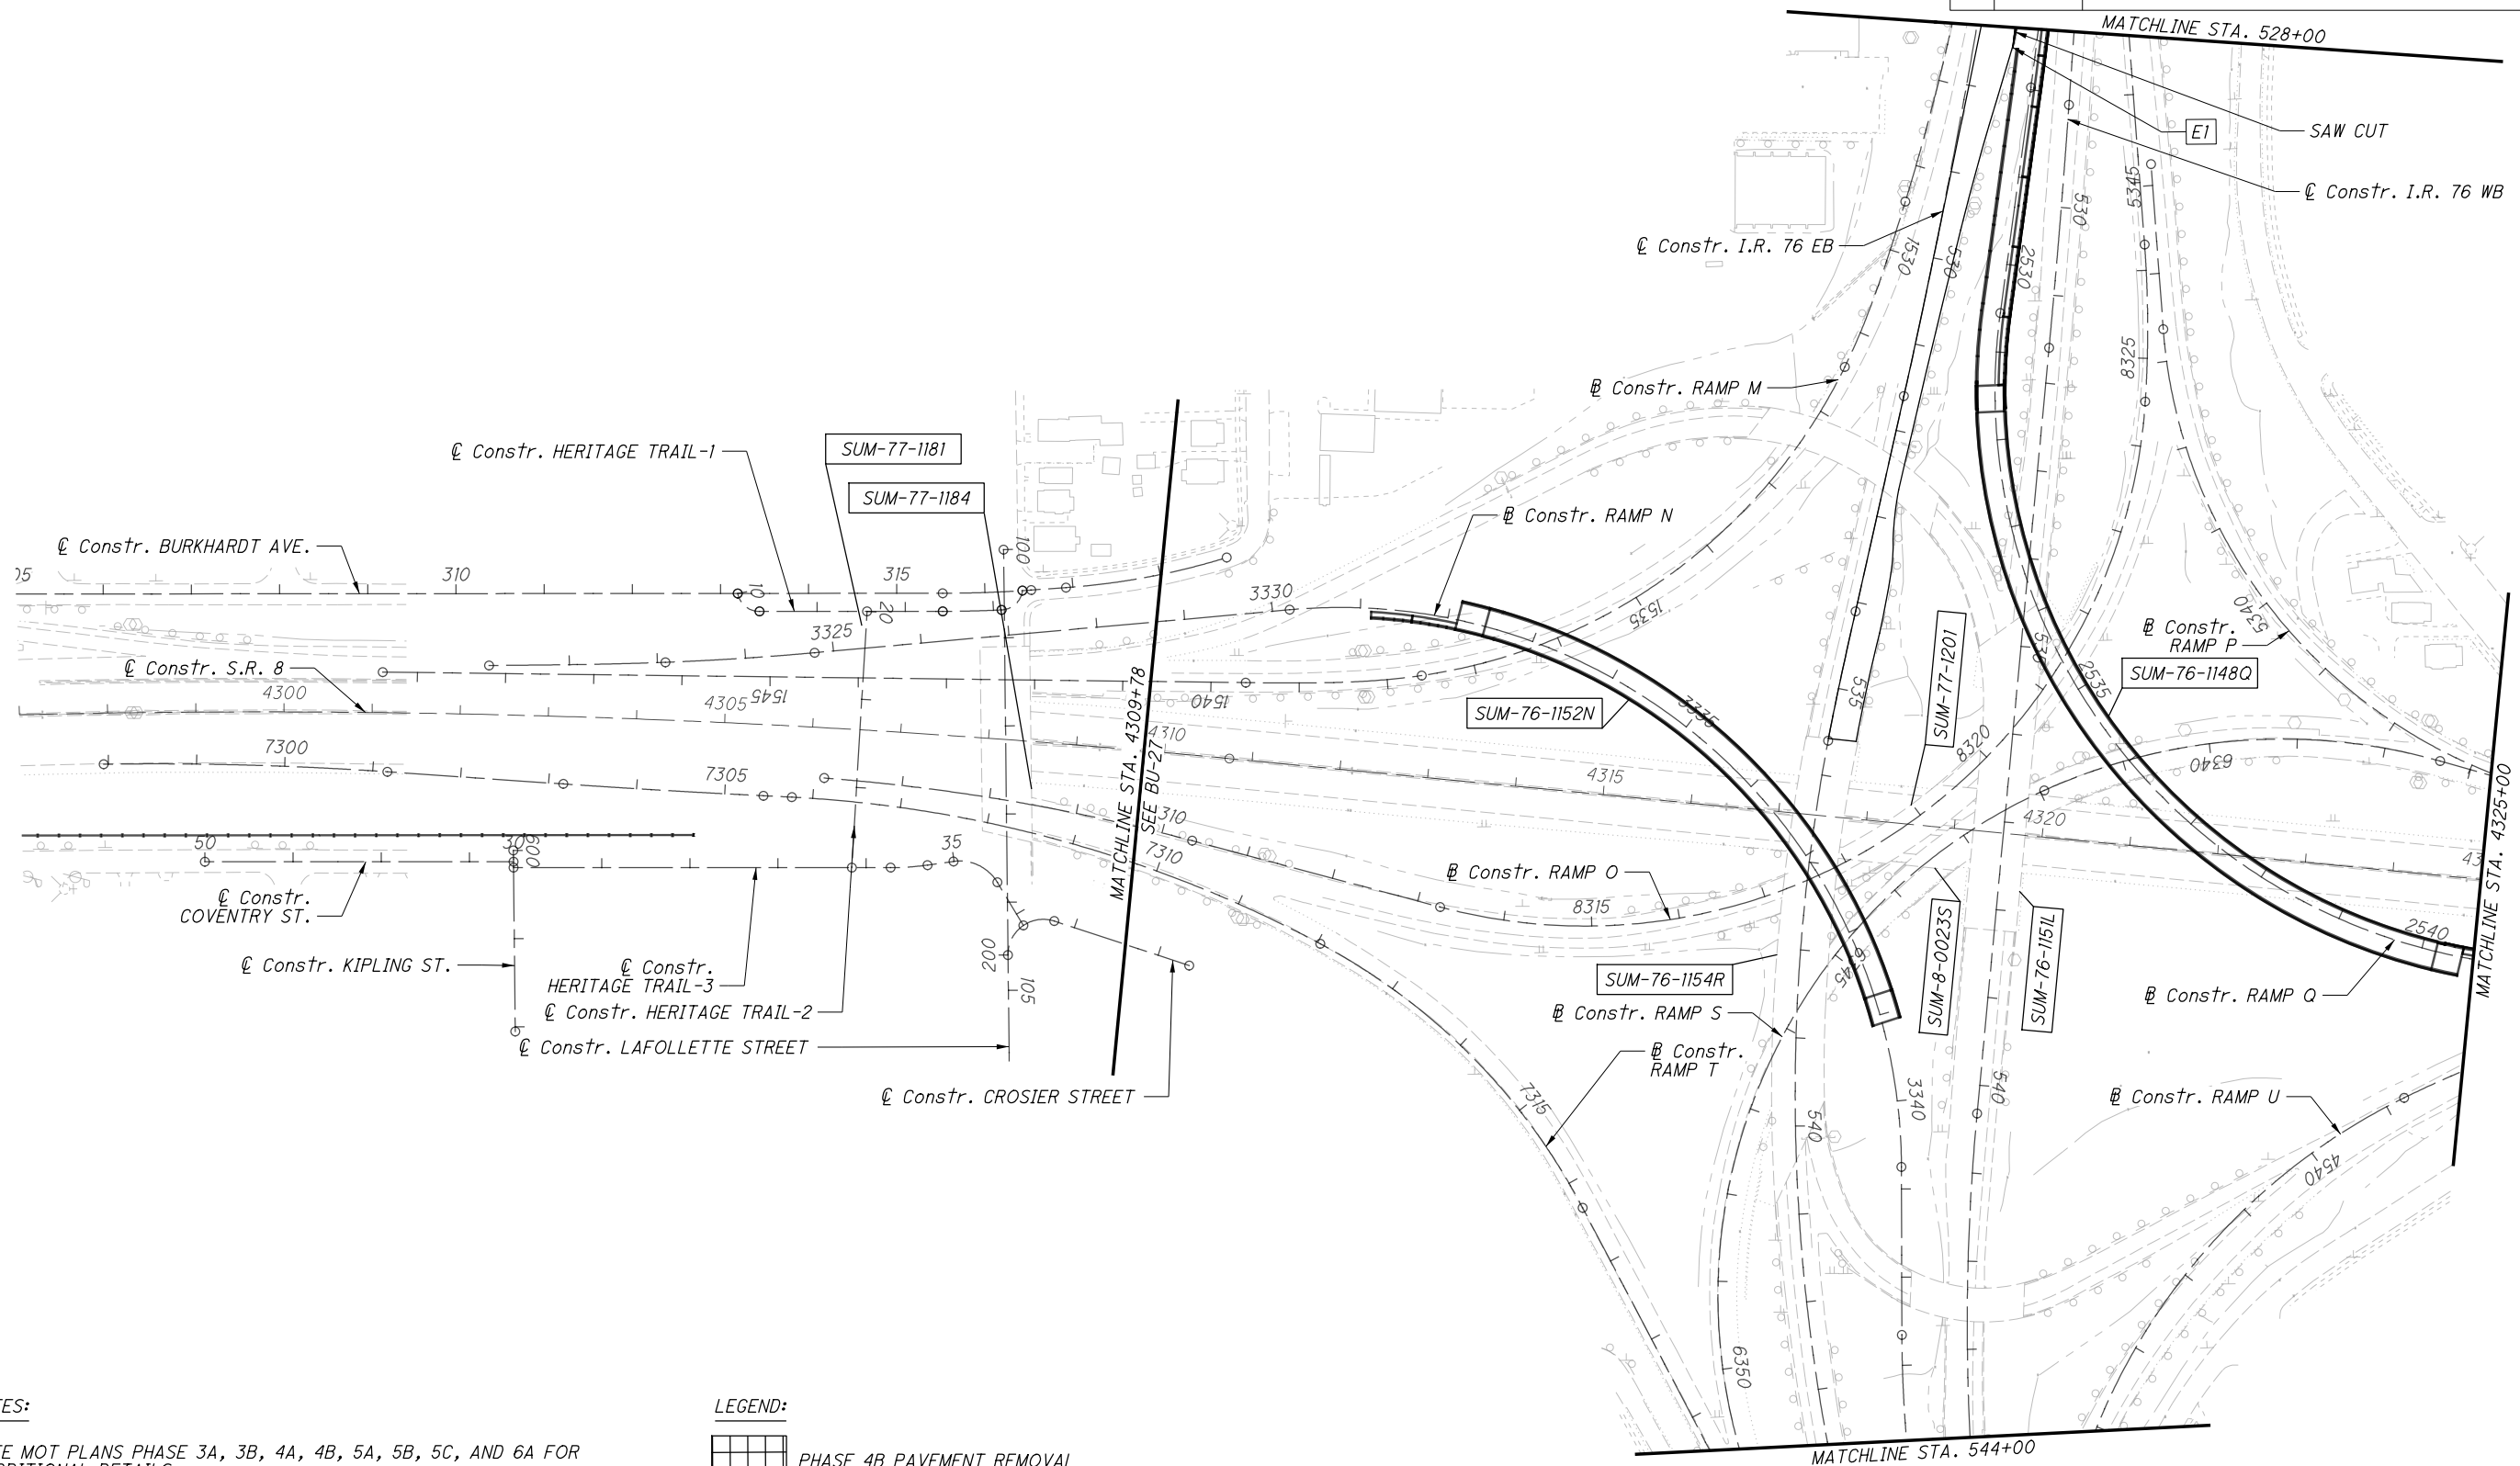
[illegible]

- NOTES:
1. SEE MOT PLANS PHASE 3A, 3B, 4A, 4B, 5A, 5B, 5C, AND 6A FOR ADDITIONAL DETAILS.
 2. FOR MORE SPECIFIC REMOVAL WORK RELATED TO A STRUCTURE, SEE THE APPROPRIATE INDIVIDUAL STRUCTURE PLAN.
 3. ALTHOUGH PAVEMENT REMOVALS ARE DEPICTED HEREIN, ADDITIONAL REMOVALS WITHIN THE CONSTRUCTION LIMITS SHALL INCLUDE, BUT NOT LIMITED TO: SIGNS & SIGN FOUNDATIONS, DRAINAGE STRUCTURES & PIPES, GUARDRAIL, CONCRETE BARRIER, LIGHT POLES & FOUNDATIONS, AND FENCING.

LEGEND:

 PHASE 4B PAVEMENT REMOVAL

E1 STA. 524+95.65±, 11.7' LT (I.R. 76 EB)

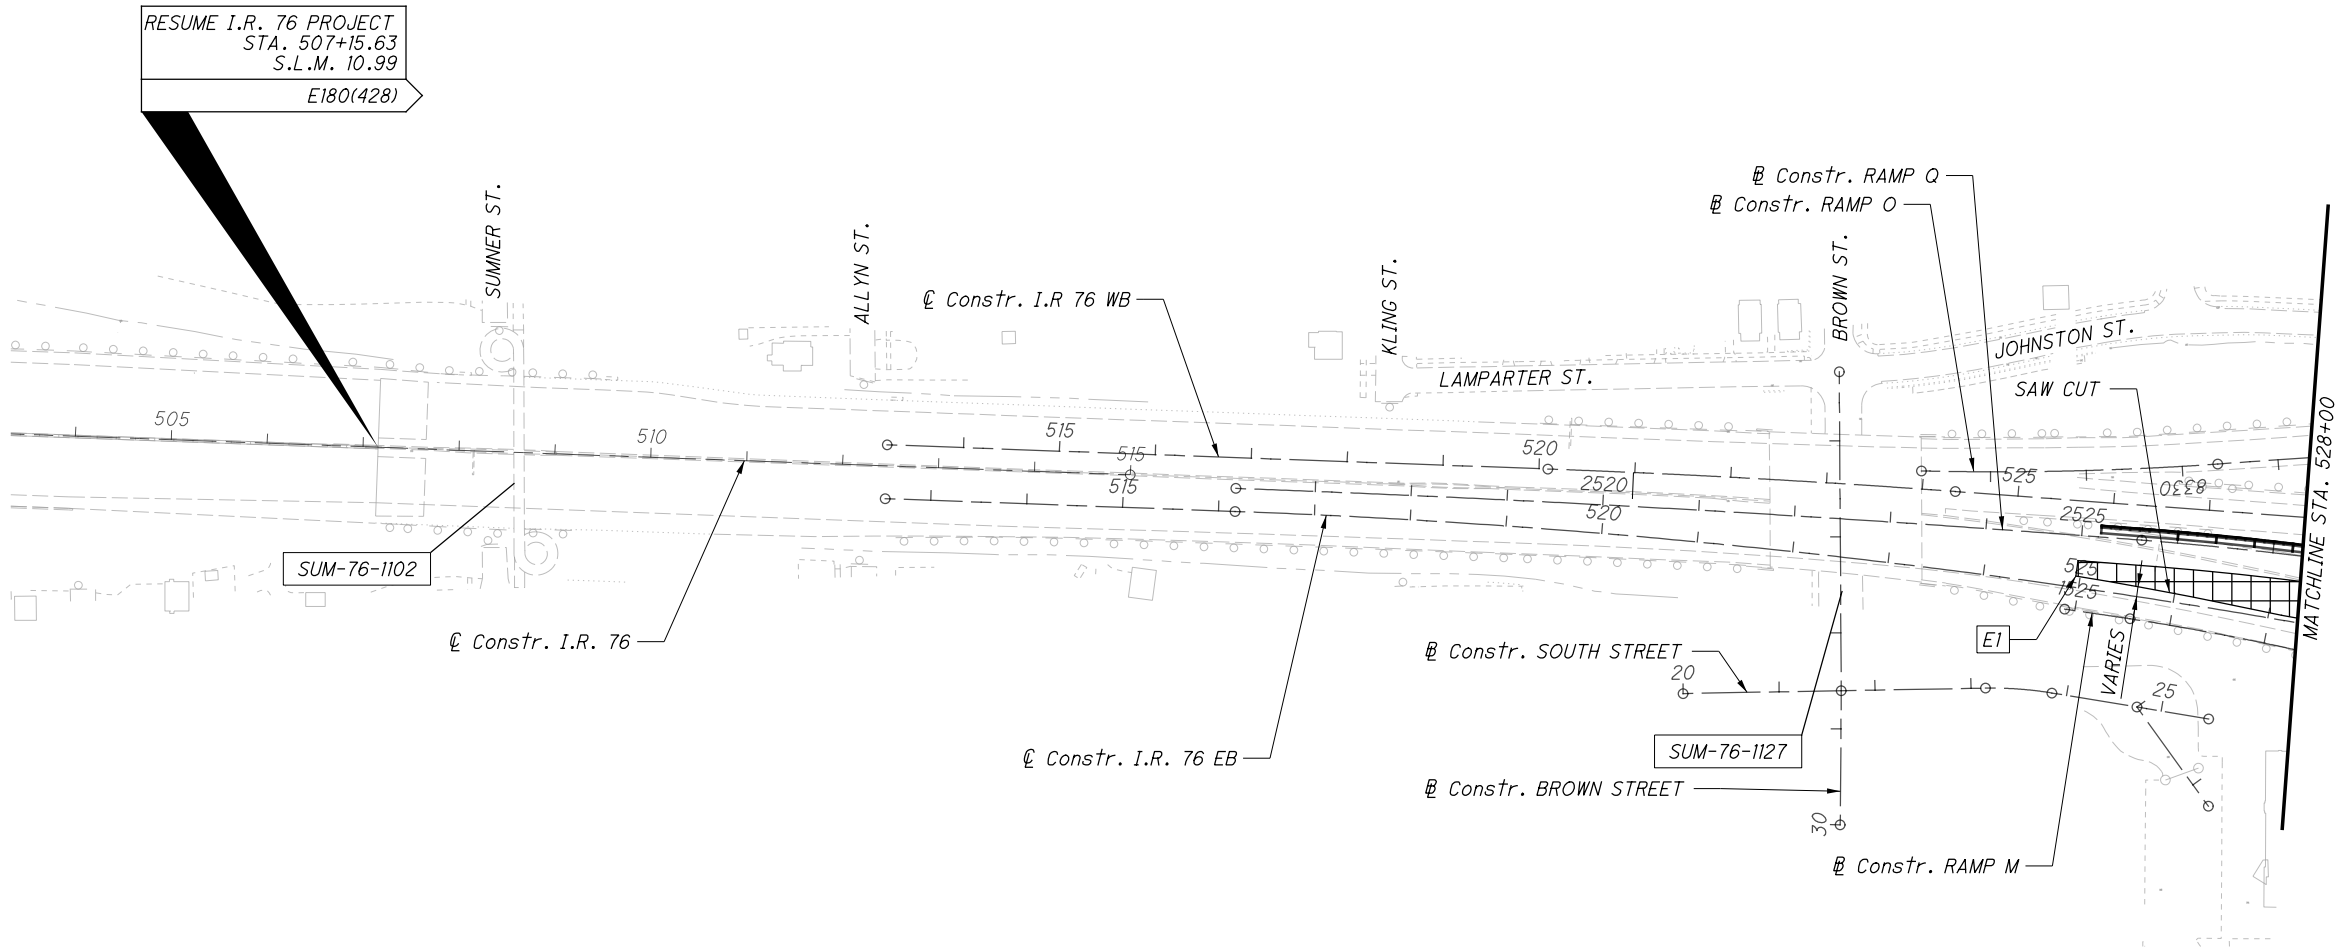

NOTES:

- SEE MOT PLANS PHASE 3A, 3B, 4A, 4B, 5A, 5B, 5C, AND 6A FOR ADDITIONAL DETAILS.
- FOR MORE SPECIFIC REMOVAL WORK RELATED TO A STRUCTURE, SEE THE APPROPRIATE INDIVIDUAL STRUCTURE PLAN.
- ALTHOUGH PAVEMENT REMOVALS ARE DEPICTED HEREIN, ADDITIONAL REMOVALS WITHIN THE CONSTRUCTION LIMITS SHALL INCLUDE, BUT NOT LIMITED TO: SIGNS & SIGN FOUNDATIONS, DRAINAGE STRUCTURES & PIPES, GUARDRAIL, CONCRETE BARRIER, LIGHT POLES & FOUNDATIONS, AND FENCING.

LEGEND:



PHASE 4B PAVEMENT REMOVAL STEP 2

ISSUE RECORD:		
NO.	DATE	DESCRIPTION

CALCULATED
CAS

CHECKED
JFM

0 100 200
HORIZONTAL
SCALE IN FEET

- E1 STA. 529+82.95±, 0.0' (I.R. 76 EB)
- E2 STA. 535+57.94±, 0.0' (I.R. 76 EB)
- E3 STA. 540+39.07±, 0.0' (I.R. 76 EB)
- NI STA. 4540+93.38±, 20.1' RT (RAMP U)

ISSUE RECORD:		
NO.	DATE	DESCRIPTION

0100200


HORIZONTAL SCALE IN FEET

CALCULATED

CAS

CHECKED

JFM

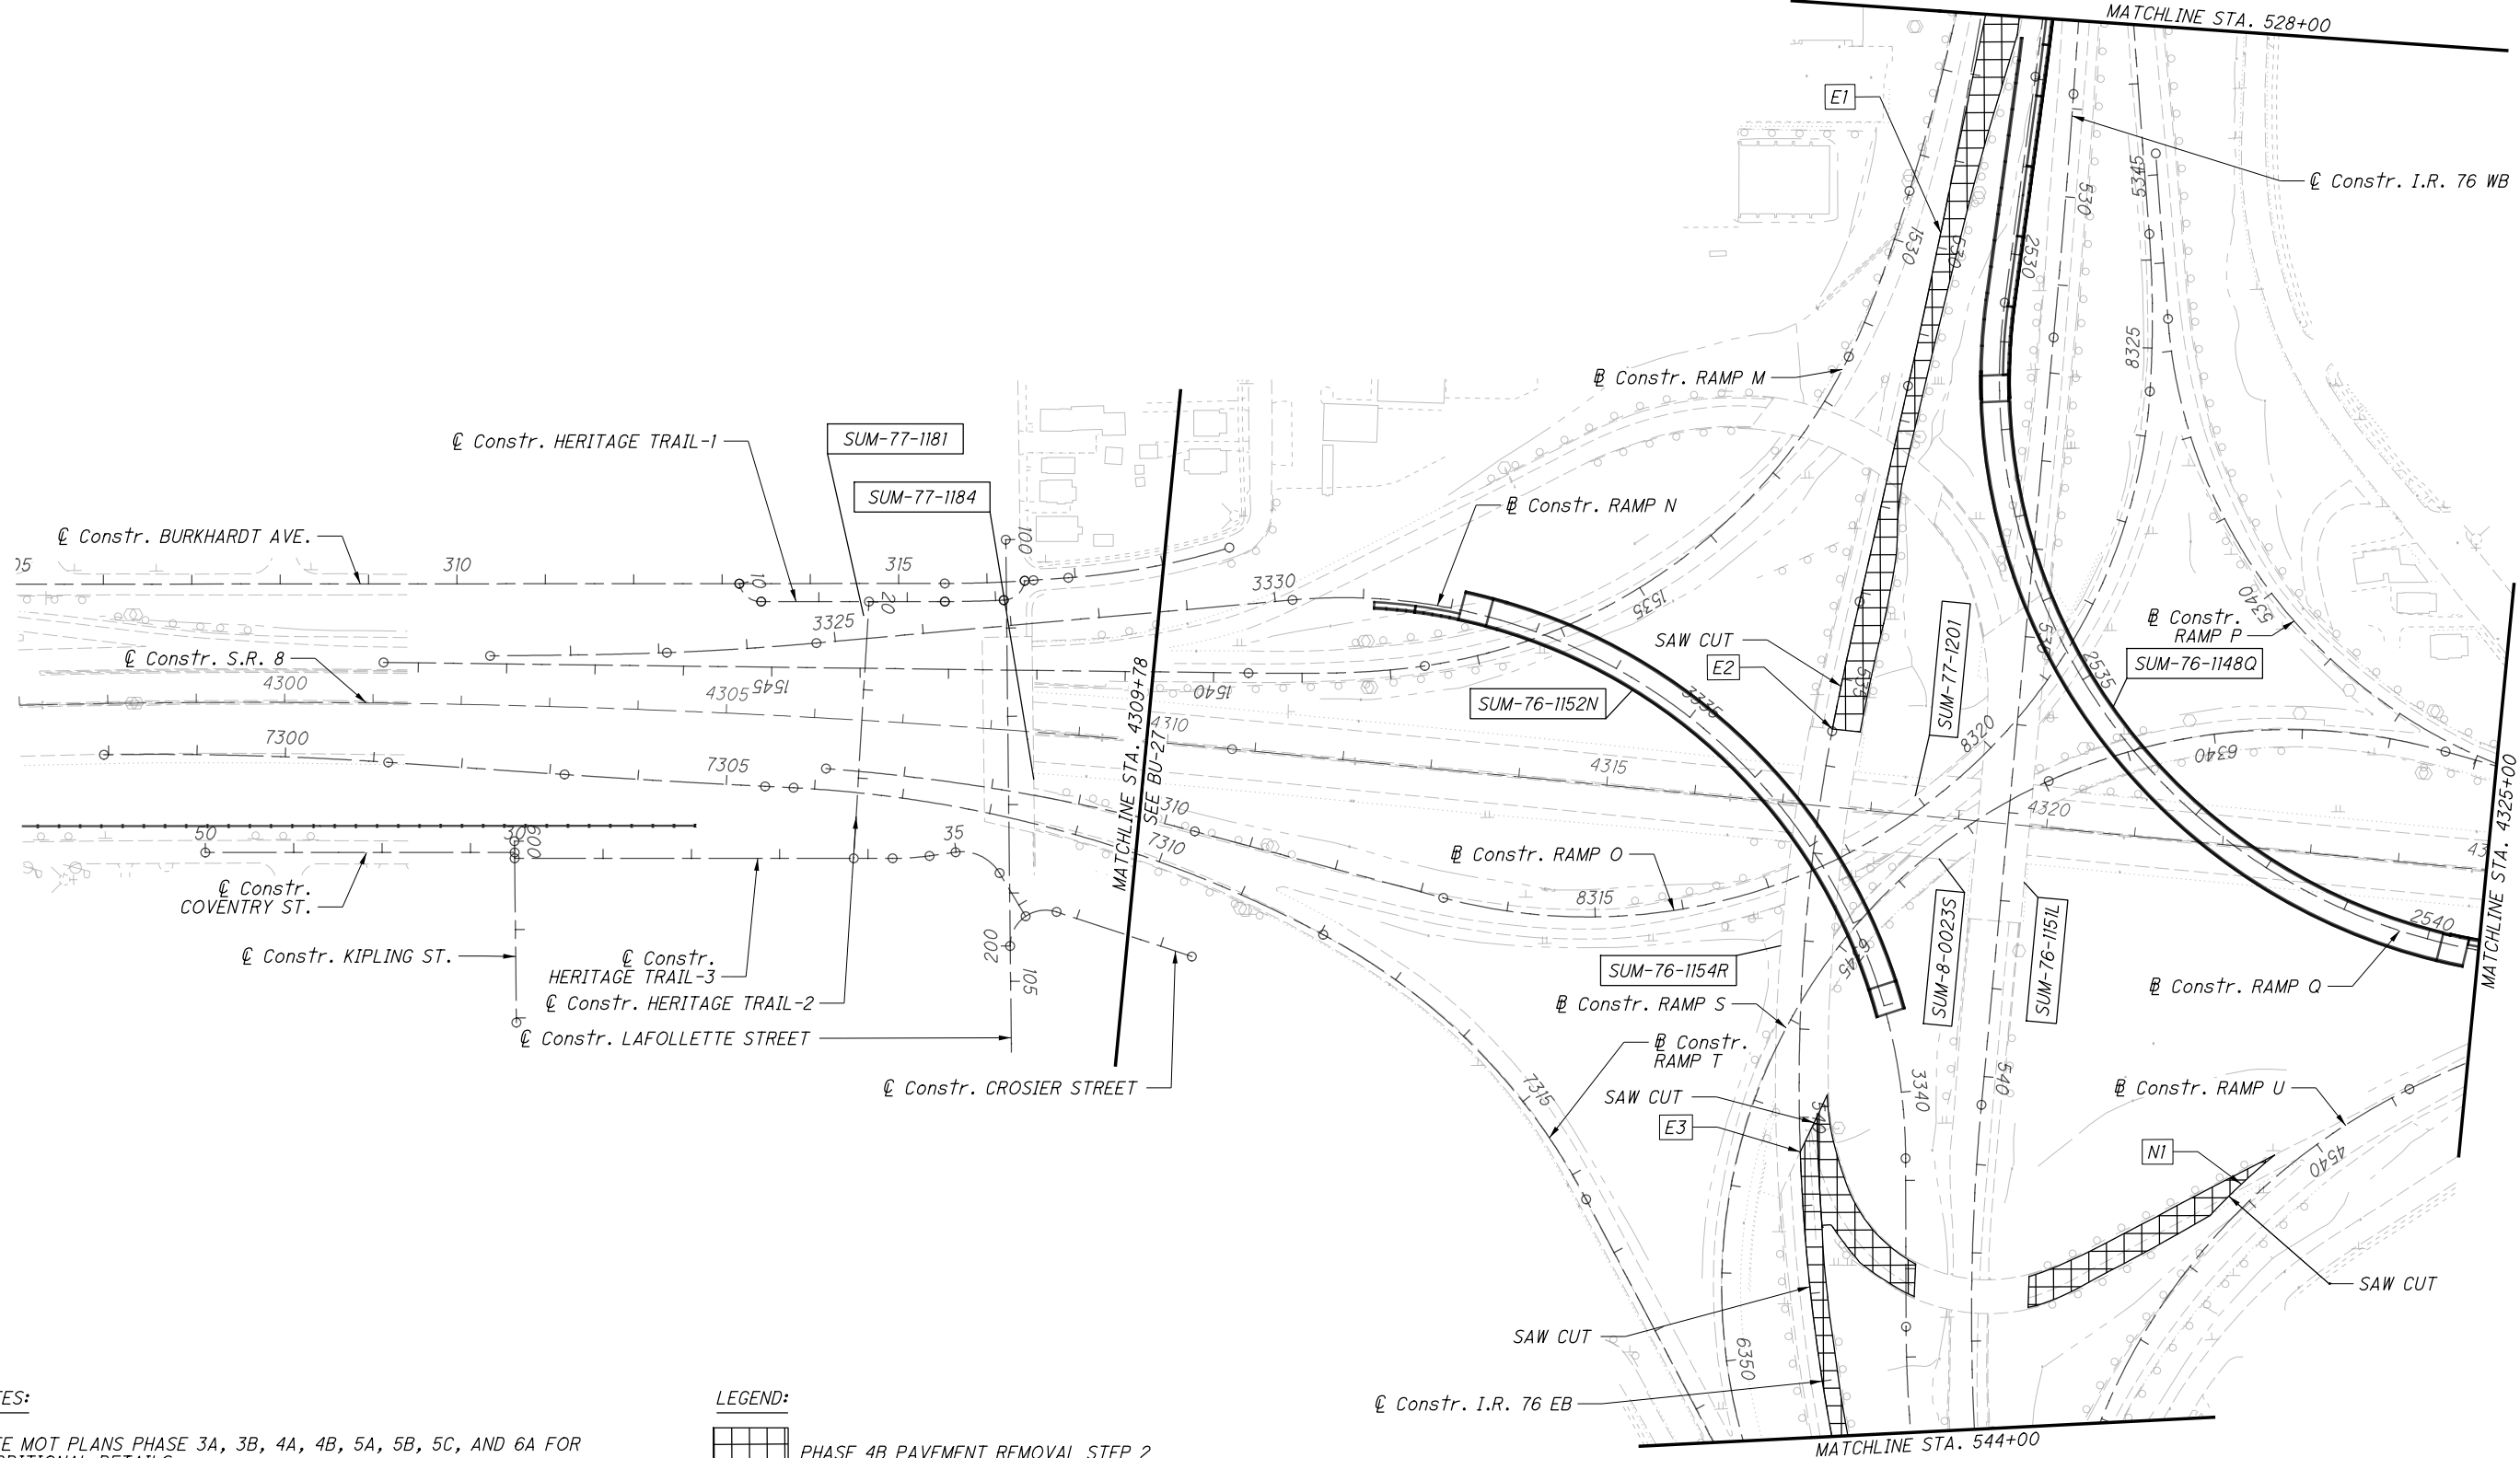


- NOTES:
1. SEE MOT PLANS PHASE 3A, 3B, 4A, 4B, 5A, 5B, 5C, AND 6A FOR ADDITIONAL DETAILS.

2. FOR MORE SPECIFIC REMOVAL WORK RELATED TO A STRUCTURE, SEE THE APPROPRIATE INDIVIDUAL STRUCTURE PLAN.

3. ALTHOUGH PAVEMENT REMOVALS ARE DEPICTED HEREIN, ADDITIONAL REMOVALS WITHIN THE CONSTRUCTION LIMITS SHALL INCLUDE, BUT NOT LIMITED TO: SIGNS & SIGN FOUNDATIONS, DRAINAGE STRUCTURES & PIPES, GUARDRAIL, CONCRETE BARRIER, LIGHT POLES & FOUNDATIONS, AND FENCING.
- LEGEND:

PHASE 4B PAVEMENT REMOVAL STEP 2


E1 STA. 549+06.51±, 0.0' (I.R. 76 EB)

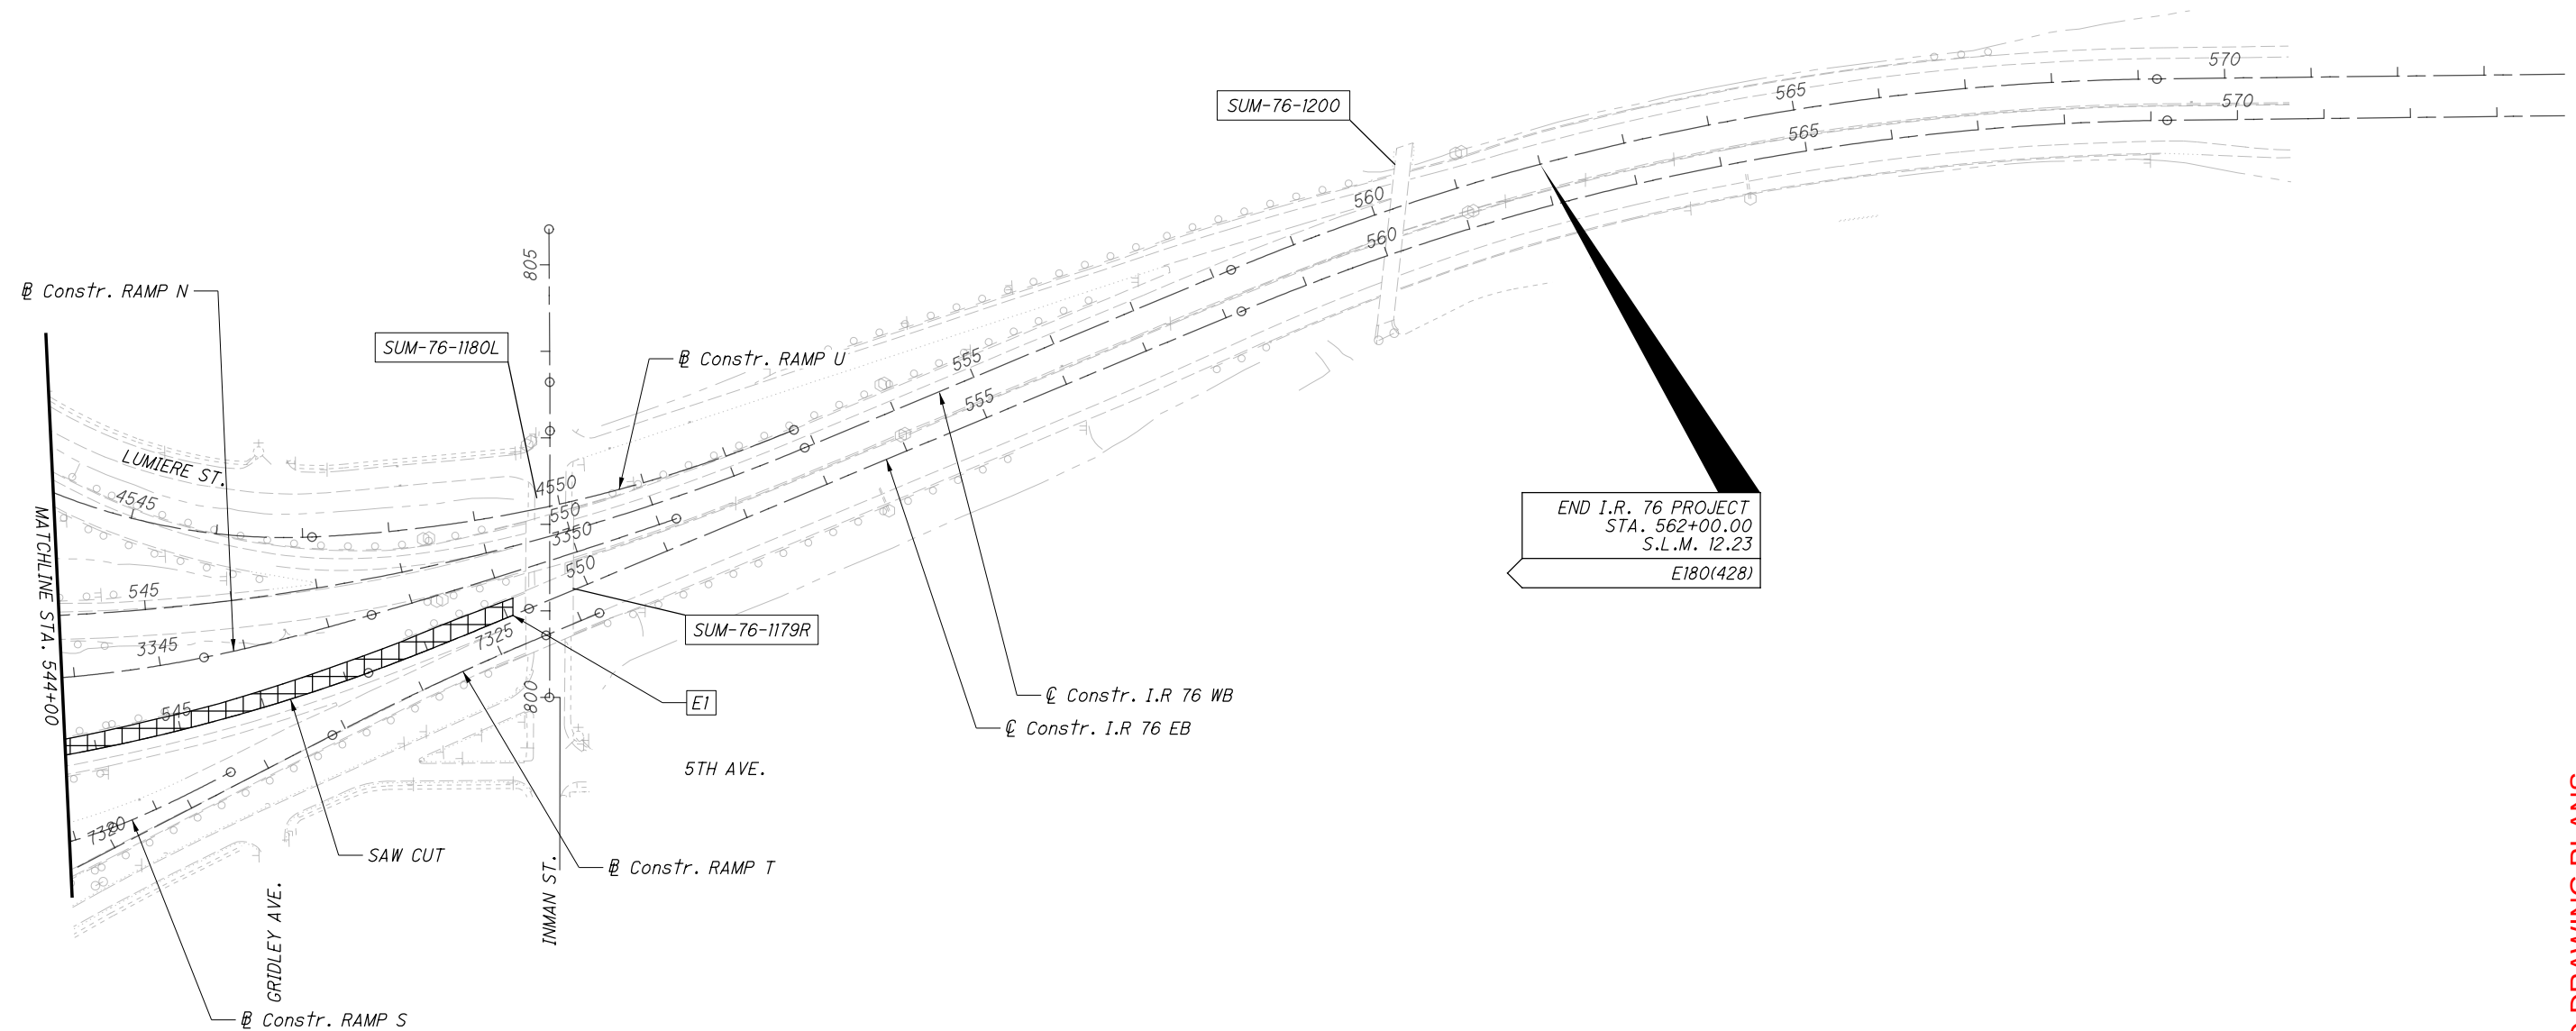

NOTES:

1. SEE MOT PLANS PHASE 3A, 3B, 4A, 4B, 5A, 5B, 5C AND 6A FOR ADDITIONAL DETAILS.
2. FOR MORE SPECIFIC REMOVAL WORK RELATED TO A STRUCTURE, SEE THE APPROPRIATE INDIVIDUAL STRUCTURE PLAN.
3. ALTHOUGH PAVEMENT REMOVALS ARE DEPICTED HEREIN, ADDITIONAL REMOVALS WITHIN THE CONSTRUCTION LIMITS SHALL INCLUDE, BUT NOT LIMITED TO: SIGNS & SIGN FOUNDATIONS, DRAINAGE STRUCTURES & PIPES, GUARDRAIL, CONCRETE BARRIER, LIGHT POLES & FOUNDATIONS, AND FENCING.

LEGEND:

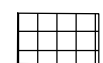

PHASE 4B PAVEMENT REMOVAL STEP 2

[illegible]

REMOVAL PLAN - I.R. 76
STA. 544+00 TO END I.R. 76 PROJECT

2025-03-18 - BU-26 - RECORD DRAWING PLANS

**SUM-16/11/8-
8.24/9.74/0.00**


- E1 STA. 527+12.89±, 5.00' LT/7.45' RT
- E2 STA. 527+31.02±, 5.00' LT/8.41' RT

ISSUE RECORD:		
NO.	DATE	DESCRIPTION

CALCULATED
CAS

CHECKED
JFM


0 100 200
HORIZONTAL
SCALE IN FEET

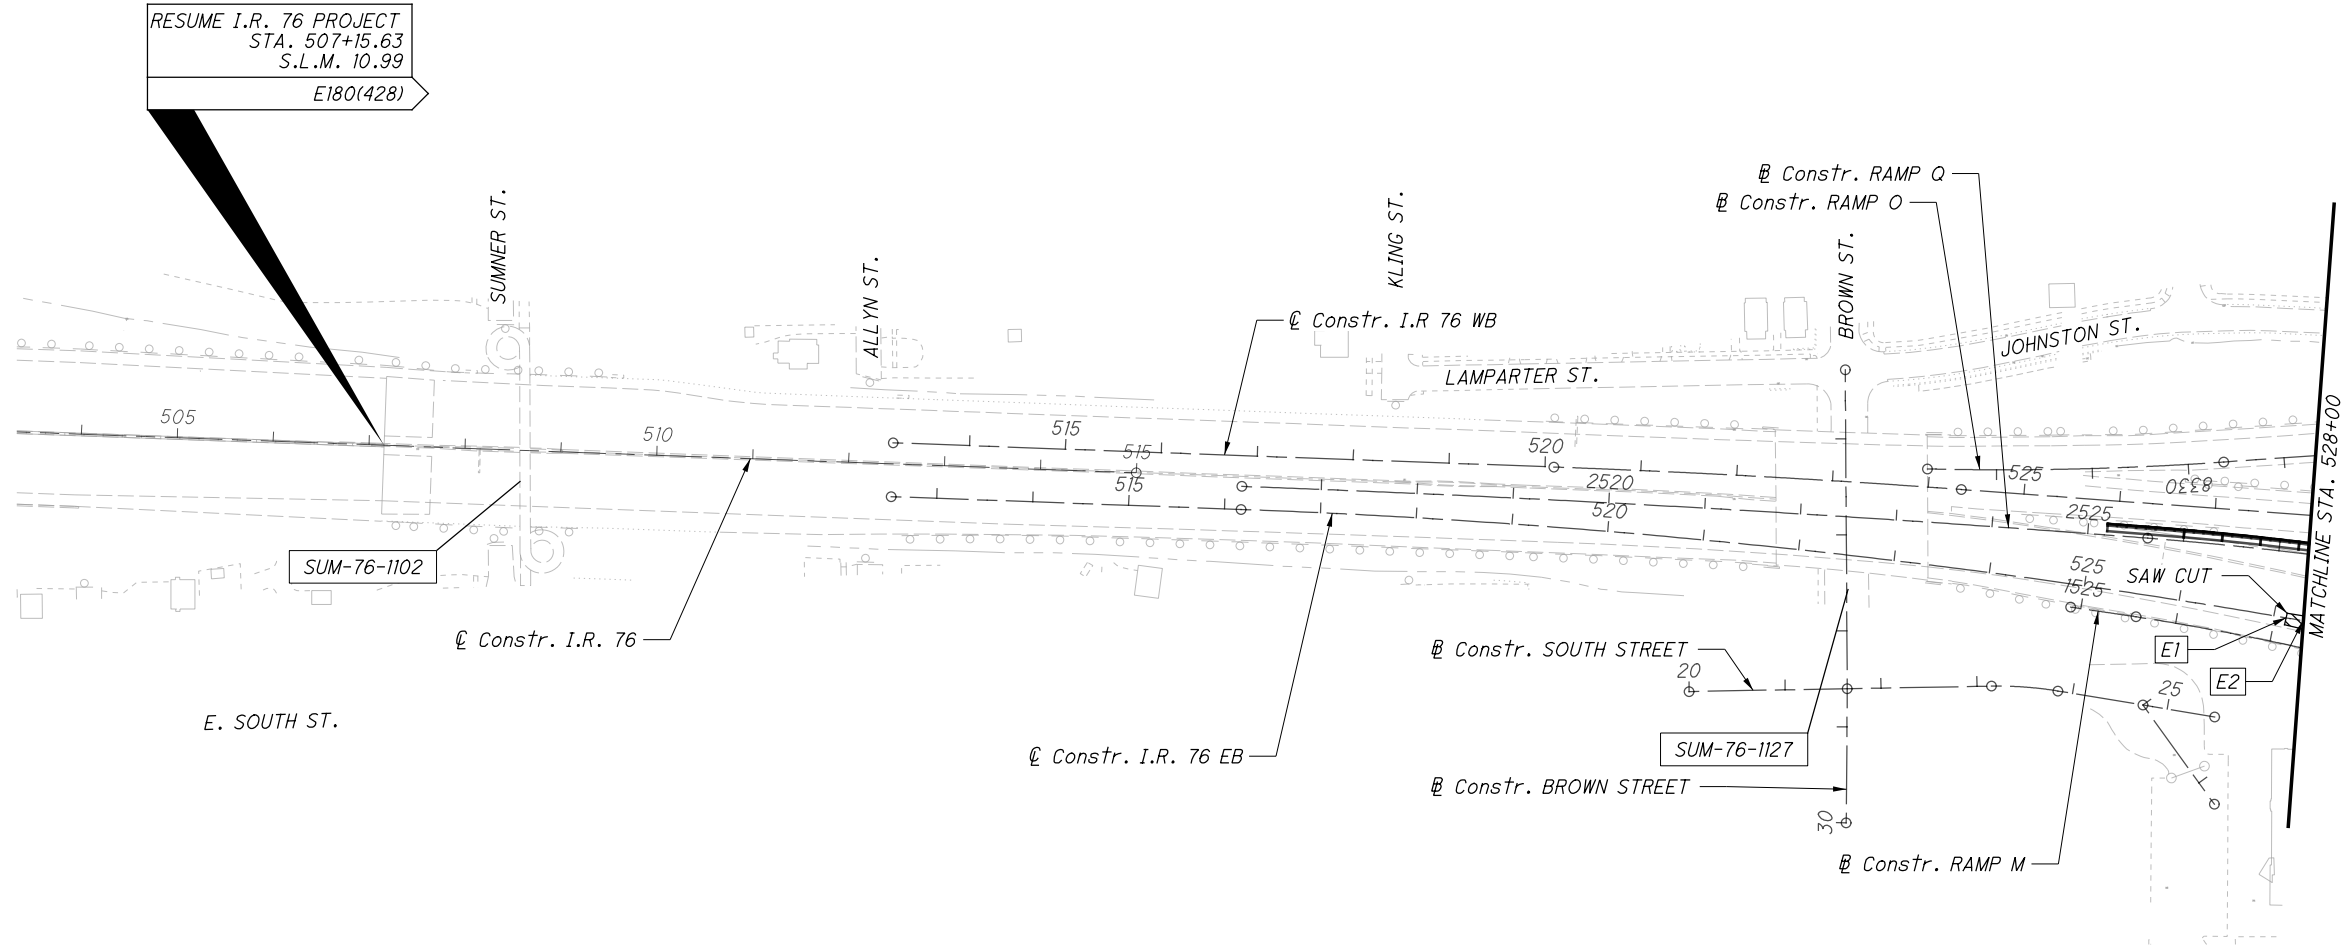

NOTES:

- SEE MOT PLANS PHASE 3A, 3B, 4A, 4B, 5A, 5B, 5C, AND 6A FOR ADDITIONAL DETAILS.
- FOR MORE SPECIFIC REMOVAL WORK RELATED TO A STRUCTURE, SEE THE APPROPRIATE INDIVIDUAL STRUCTURE PLAN.
- ALTHOUGH PAVEMENT REMOVALS ARE DEPICTED HEREIN, ADDITIONAL REMOVALS WITHIN THE CONSTRUCTION LIMITS SHALL INCLUDE, BUT NOT LIMITED TO: SIGNS & SIGN FOUNDATIONS, DRAINAGE STRUCTURES & PIPES, GUARDRAIL, CONCRETE BARRIER, LIGHT POLES & FOUNDATIONS, AND FENCING.

LEGEND:



PHASE 5A PAVEMENT REMOVAL

- E1

STA. 527+31.02±, 5.02' LT/8.49 RT
- E2

STA. 529+83.83±, 22.00' RT
- E3

STA. 529+83.52±, 28.00' RT
- E4

STA. 530+11.04±, 0.00'
- E5

STA. 535+57.94±, 0.00'
- E6

STA. 540+39.07±, 0.00'
- E7

STA. 543+63.63±, 0.00'
- E8

STA. 6336+77.97±, 2.82' RT
- E9

STA. 6337+53.17±, 11.87' RT

E10

STA. 6337+53.17±, 3.79' RT

E11

STA. 6337+69.95±, 16.97' RT

E12

STA. 6350+81.62±, 23.14' RT

E13

STA. 6350+87.72±, 21.70' RT

S1

STA. 4309+76.90±, 20.50' LT


S2

STA. 4315+58.73±, 20.50' LT

S3

STA. 4319+77.97±, 18.00' LT

S4

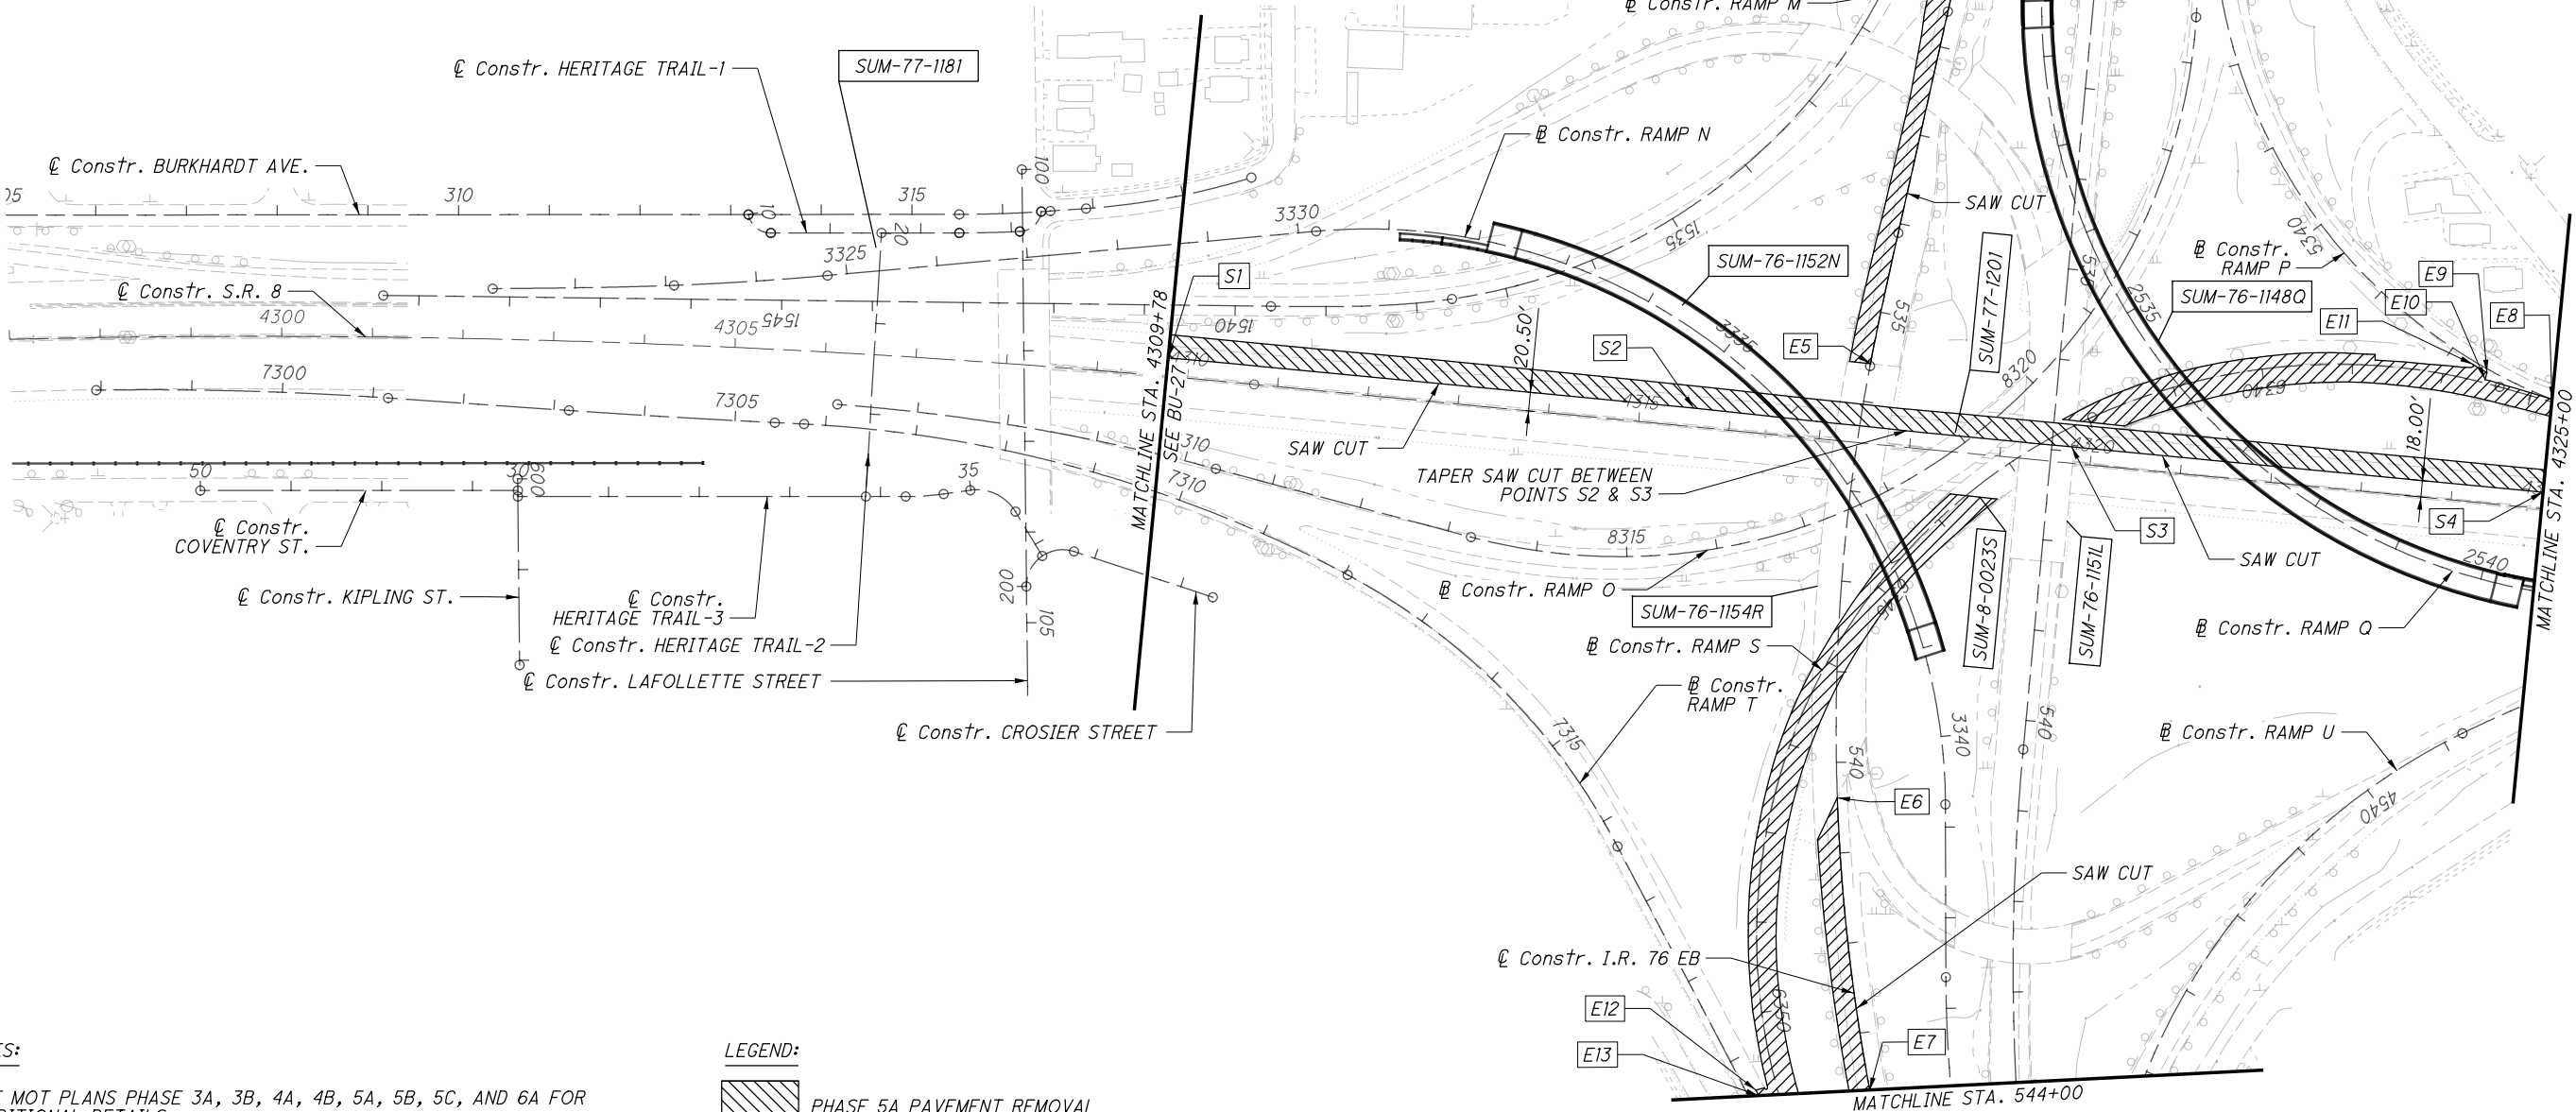STA. 4325+00.00±, 18.00' LT

NOTES:

1. SEE MOT PLANS PHASE 3A, 3B, 4A, 4B, 5A, 5B, 5C, AND 6A FOR ADDITIONAL DETAILS.
2. FOR MORE SPECIFIC REMOVAL WORK RELATED TO A STRUCTURE, SEE THE APPROPRIATE INDIVIDUAL STRUCTURE PLAN.
3. ALTHOUGH PAVEMENT REMOVALS ARE DEPICTED HEREIN, ADDITIONAL REMOVALS WITHIN THE CONSTRUCTION LIMITS SHALL INCLUDE, BUT NOT LIMITED TO: SIGNS & SIGN FOUNDATIONS, DRAINAGE STRUCTURES & PIPES, GUARDRAIL, CONCRETE BARRIER, LIGHT POLES & FOUNDATIONS, AND FENCING.

LEGEND:

PHASE 5A PAVEMENT REMOVAL

ISSUE RECORD:		
NO.	DATE	DESCRIPTION


CALCULATED

CAS

CHECKED

JFM

- E1 STA. 7319+47.57±, 10.27' LT
- E2 STA. 7322+29.67±, 6.90' LT
- E3 STA. 7323+10.41±, 7.00' LT
- E4 STA. 7324+37.96±, 7.00' LT
- E5 STA. 7325+17.26±, 7.00' LT
- E6 STA. 543+63.63±, 0.00'
- E7 STA. 546+07.75±, 0.00'
- E8 STA. 549+06.51±, 0.00'

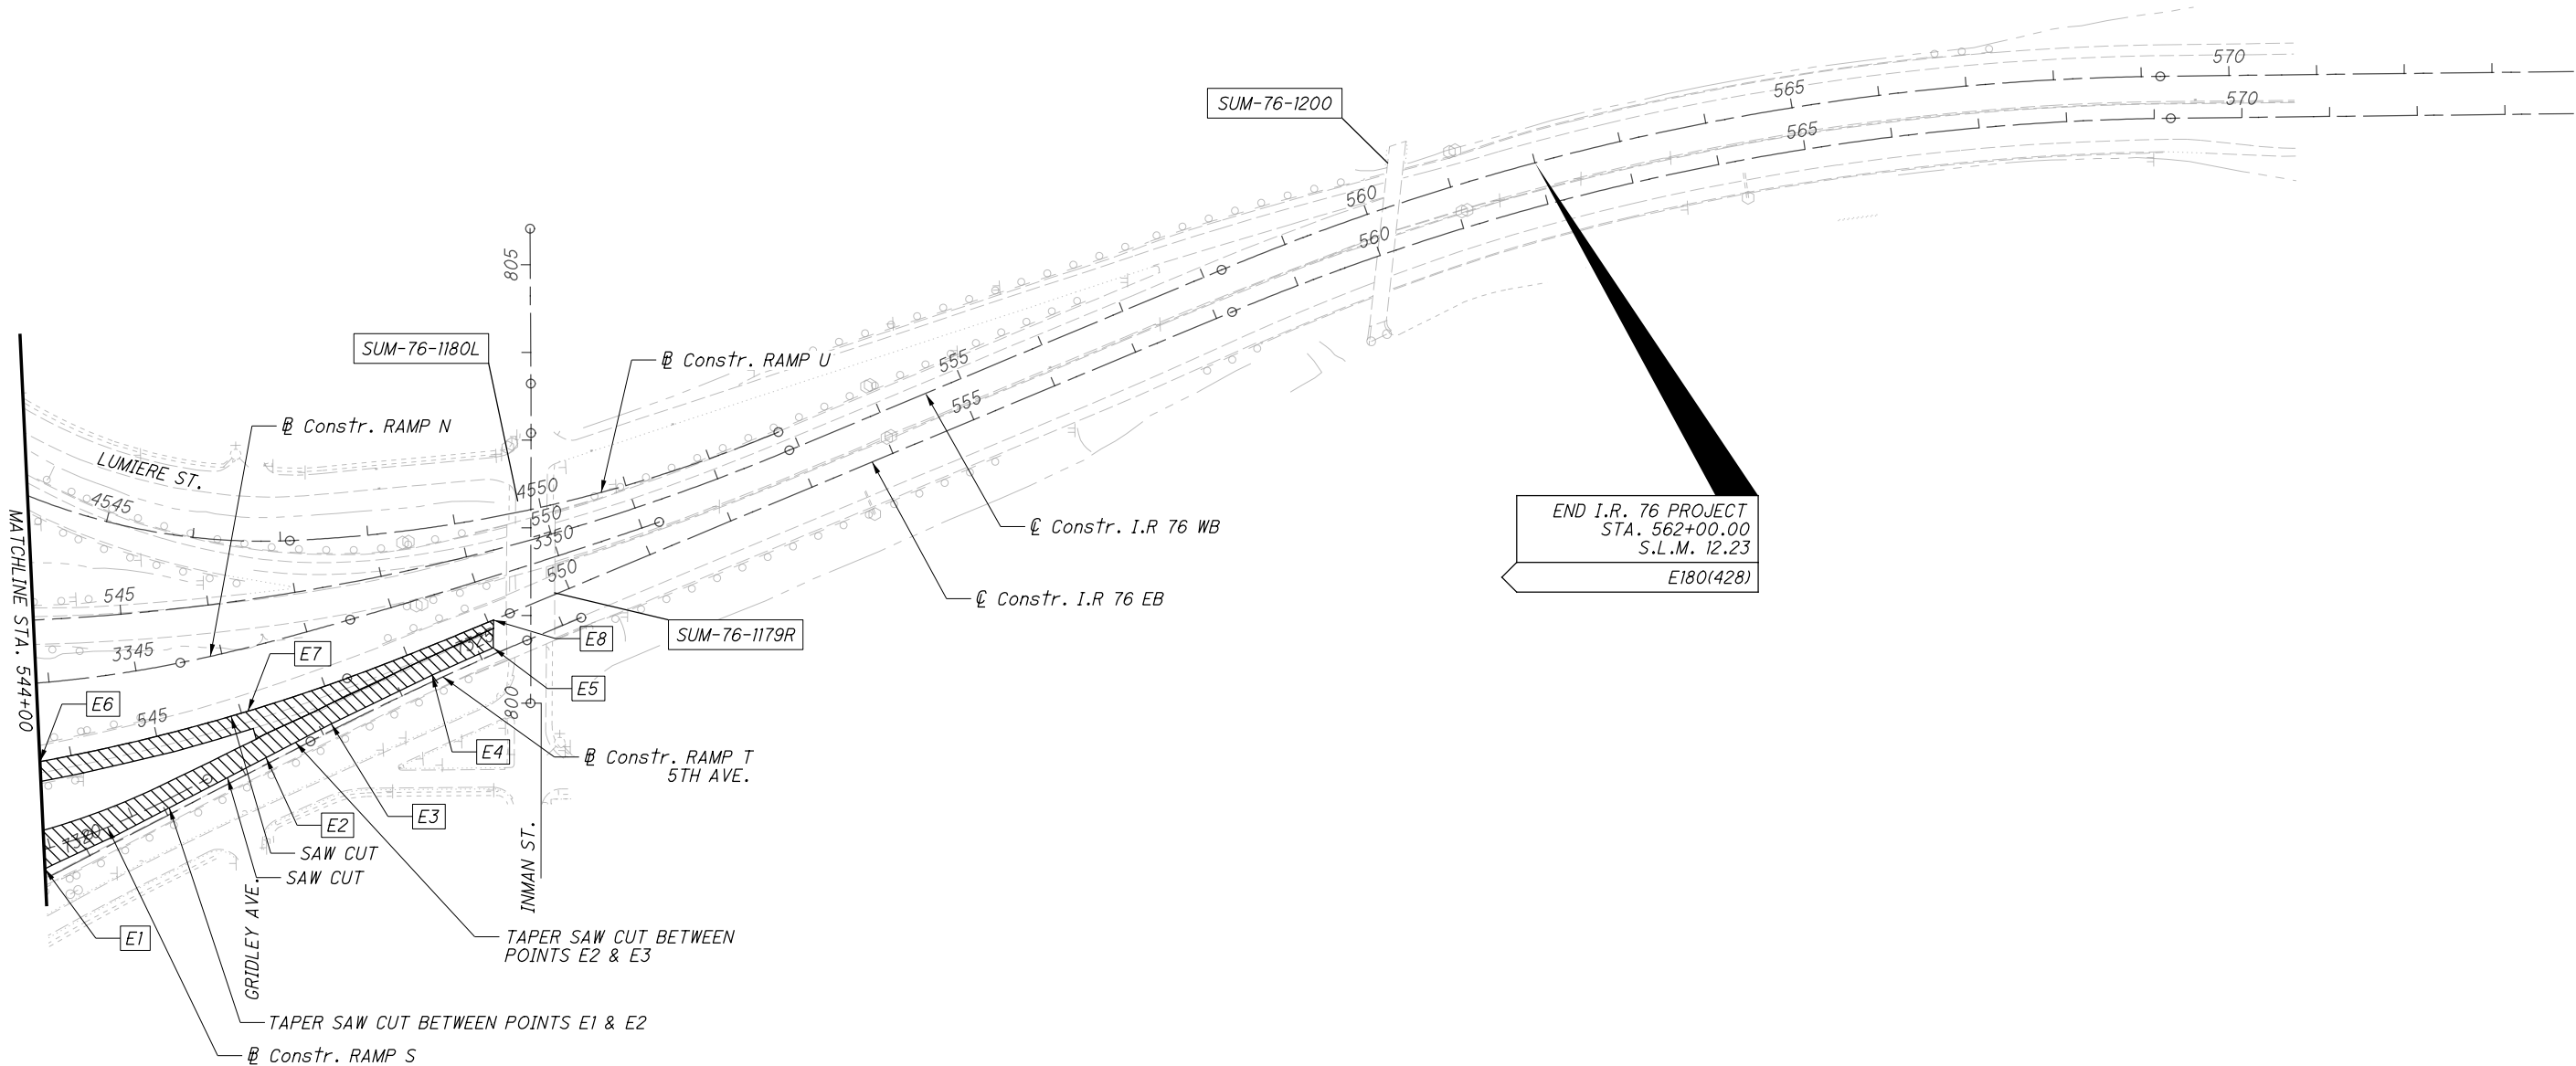

NOTES:

1. SEE MOT PLANS PHASE 3A, 3B, 4A, 4B, 5A, 5B, 5C, AND 6A FOR ADDITIONAL DETAILS.
2. FOR MORE SPECIFIC REMOVAL WORK RELATED TO A STRUCTURE, SEE THE APPROPRIATE INDIVIDUAL STRUCTURE PLAN.
3. ALTHOUGH PAVEMENT REMOVALS ARE DEPICTED HEREIN, ADDITIONAL REMOVALS WITHIN THE CONSTRUCTION LIMITS SHALL INCLUDE, BUT NOT LIMITED TO: SIGNS & SIGN FOUNDATIONS, DRAINAGE STRUCTURES & PIPES, GUARDRAIL, CONCRETE BARRIER, LIGHT POLES & FOUNDATIONS, AND FENCING.

LEGEND:

PHASE 5A PAVEMENT REMOVAL

ISSUE RECORD:		
NO.	DATE	DESCRIPTION

2025-03-18 - BU-26 - RECORD DRAWING PLANS

SUM-76 / 77 / 8 -

8.24 / 9.74 / 0.00

26

36

REMOVAL PLAN - I.R. 76

STA. 544+00 TO END I.R. 76 PROJECT

HORIZONTAL SCALE IN FEET

- S1

STA. 432+00.00±, 18.00' LT

S2

STA. 4327+00.00±, 18.50' LT

S3

STA. 4327+14.44±, 18.50' LT

S4

STA. 4327+14.44±, 21.43' LT

S5

STA. 4330+50.38±, 31.15' LT

E1

STA. 6333+50.01±, 10.00' LT

E2

STA. 6334+91.07±, 0.00'

E3


STA. 6336+75.88±, 75.88' RT
- SAW CUTS VARIES BETWEEN:

S1 TO S2

S4 TO S5

E1 TO E2

E2 TO E3

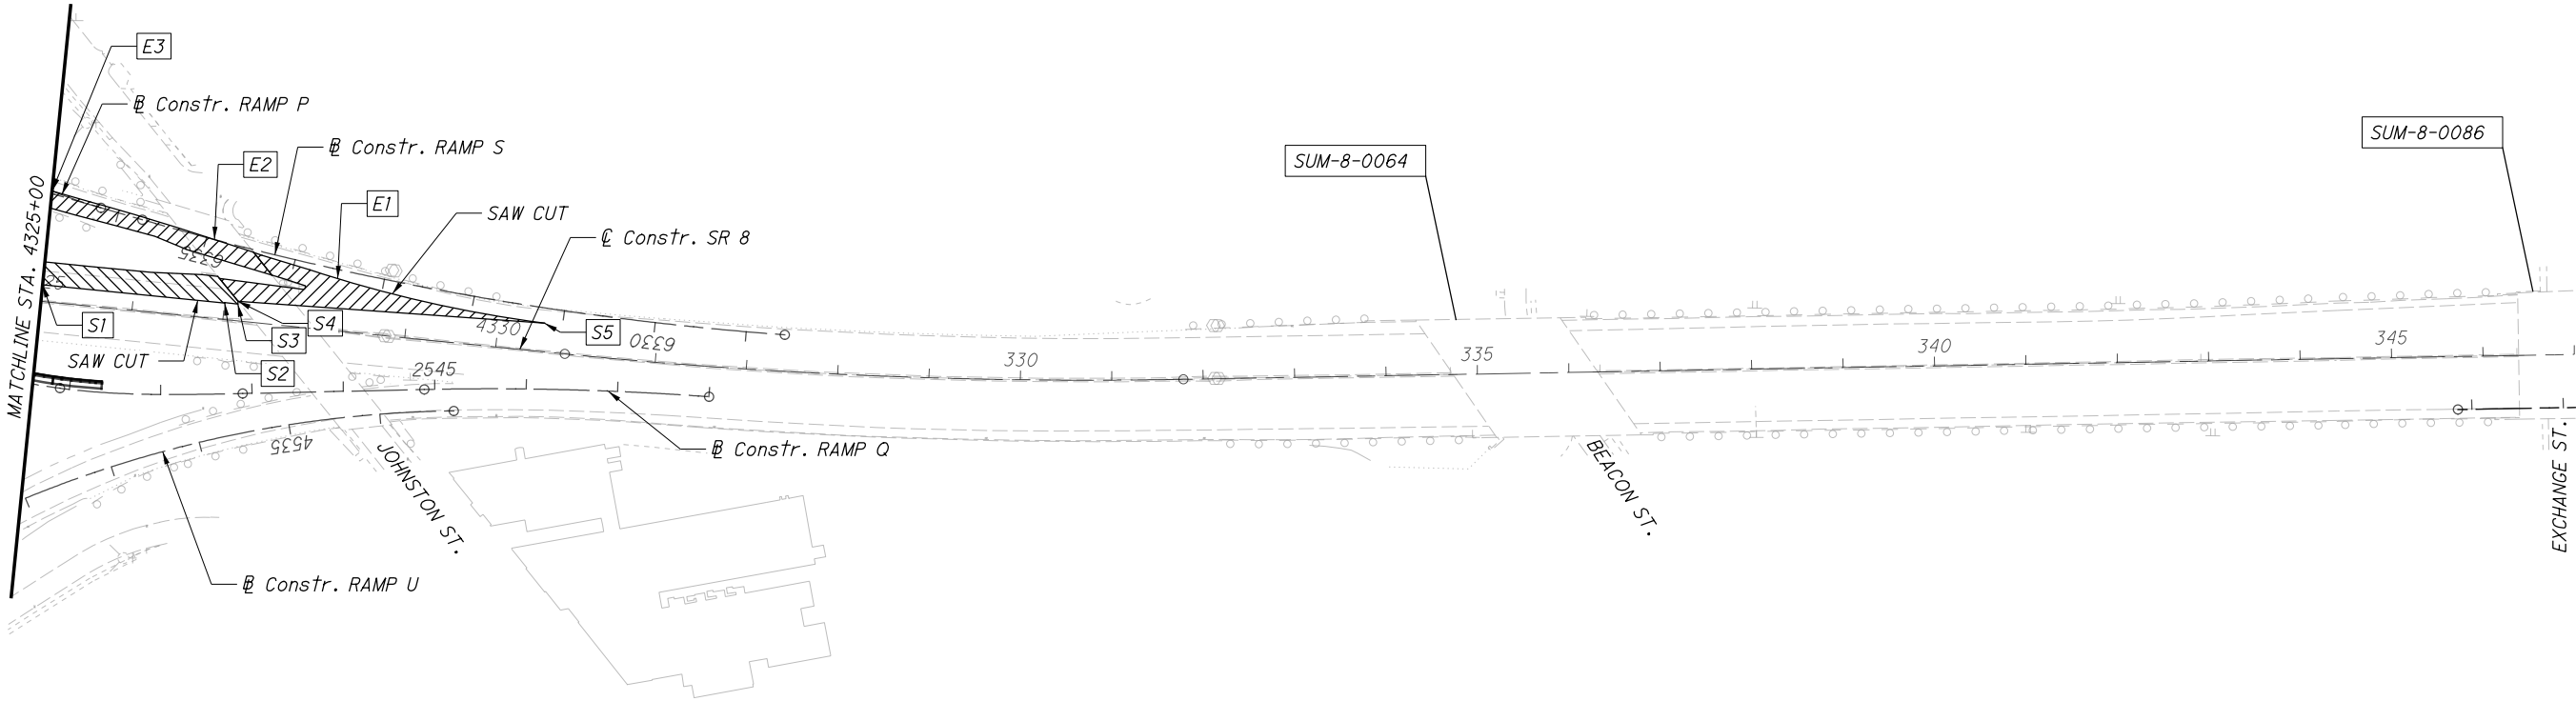

NOTES:

1. SEE MOT PLANS PHASE 3A, 3B, 4A, 4B, 5A, 5B, 5C, AND 6A FOR ADDITIONAL DETAILS.
2. FOR MORE SPECIFIC REMOVAL WORK RELATED TO A STRUCTURE, SEE THE APPROPRIATE INDIVIDUAL STRUCTURE PLAN.
3. ALTHOUGH PAVEMENT REMOVALS ARE DEPICTED HEREIN, ADDITIONAL REMOVALS WITHIN THE CONSTRUCTION LIMITS SHALL INCLUDE, BUT NOT LIMITED TO: SIGNS & SIGN FOUNDATIONS, DRAINAGE STRUCTURES & PIPES, GUARDRAIL, CONCRETE BARRIER, LIGHT POLES & FOUNDATIONS, AND FENCING.

LEGEND:

PHASE 5A PAVEMENT REMOVAL


ISSUE RECORD:		
NO.	DATE	DESCRIPTION

W1

STA. 525+59.89±, 4.50' LT

W1

STA. 528+00.00±, 3.27' LT

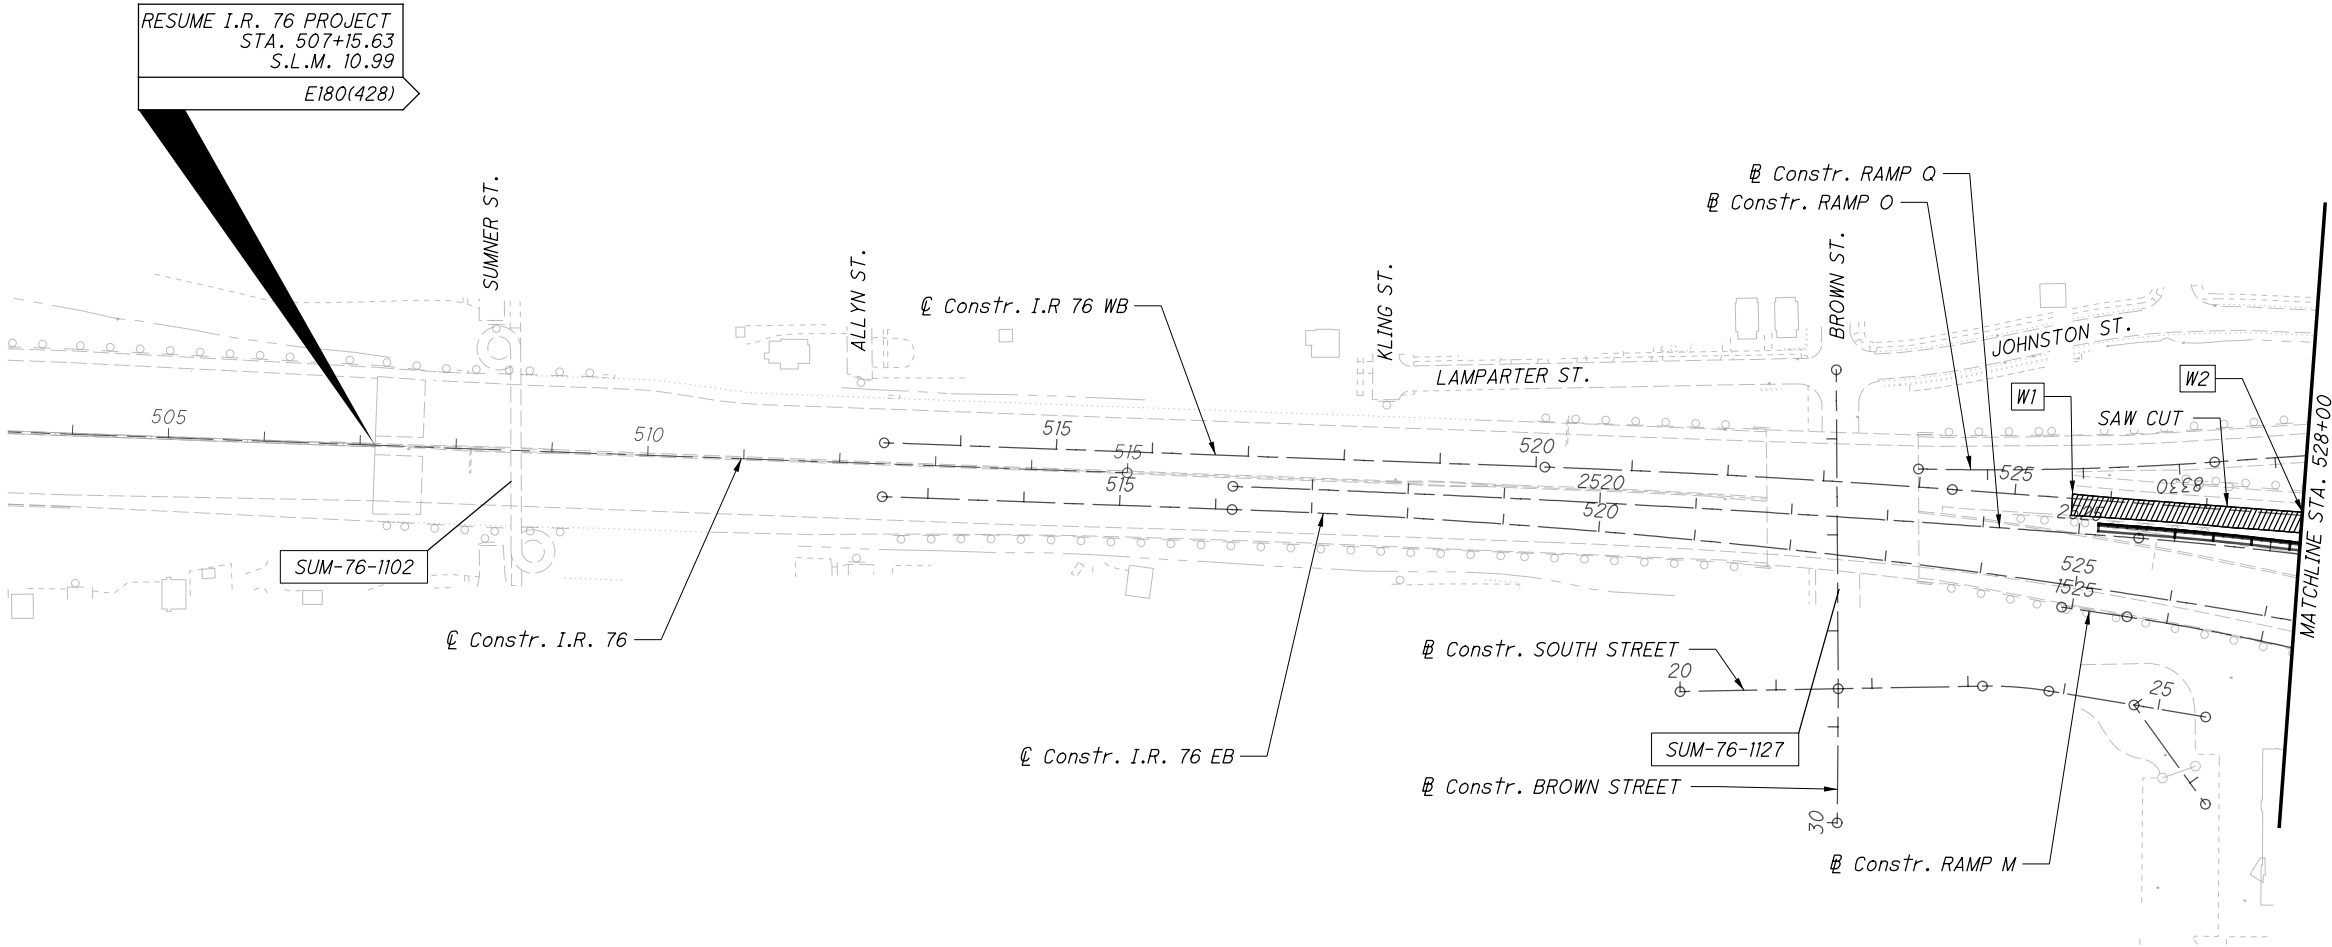

NOTES:

- SEE MOT PLANS PHASE 3A, 3B, 4A, 4B, 5A, 5B, 5C, AND 6A FOR ADDITIONAL DETAILS.
- FOR MORE SPECIFIC REMOVAL WORK RELATED TO A STRUCTURE, SEE THE APPROPRIATE INDIVIDUAL STRUCTURE PLAN.
- ALTHOUGH PAVEMENT REMOVALS ARE DEPICTED HEREIN, ADDITIONAL REMOVALS WITHIN THE CONSTRUCTION LIMITS SHALL INCLUDE, BUT NOT LIMITED TO: SIGNS & SIGN FOUNDATIONS, DRAINAGE STRUCTURES & PIPES, GUARDRAIL, CONCRETE BARRIER, LIGHT POLES & FOUNDATIONS, AND FENCING.

LEGEND:

PHASE 5B PAVEMENT REMOVAL

ISSUE RECORD:		
NO.	DATE	DESCRIPTION

- S1 STA. 4309+76.90±, 5.00' RT

S2 STA. 4315+58.87±, 20.50' LT

S3 STA. 4319+16.76±, 18.07' LT

S4 STA. 4319+16.76±, 0.00'

S5 STA. 4319+15.67±, 5.00' RT

S6 STA. 4319+15.67±, 17.00' RT

S7 STA. 4321+65.04±, 18.50' RT

S8 STA. 4322+09.02±, 18.50' RT

S9 STA. 4323+19.08±, 16.50' RT
- S10 STA. 4324+00.00±, 16.50' LT

S11 STA. 4324+00.00±, 0.00'

W1 STA. 528+00.00±, 3.27' LT

W2 STA. 530+80.63±, 3.00' LT

W3 STA. 538+23.47±, 3.00' LT


W4 STA. 541+78.28±, 3.00' LT

W5 STA. 544+00.00±, 2.23' LT

R1 REMOVE EXISTING RAMP N

R2 REMOVE EXISTING RAMP N

TAPER SAW CUTS BETWEEN:
S2 TO S3 W1 TO W2
S6 TO S7 W4 TO W5
S8 TO S9

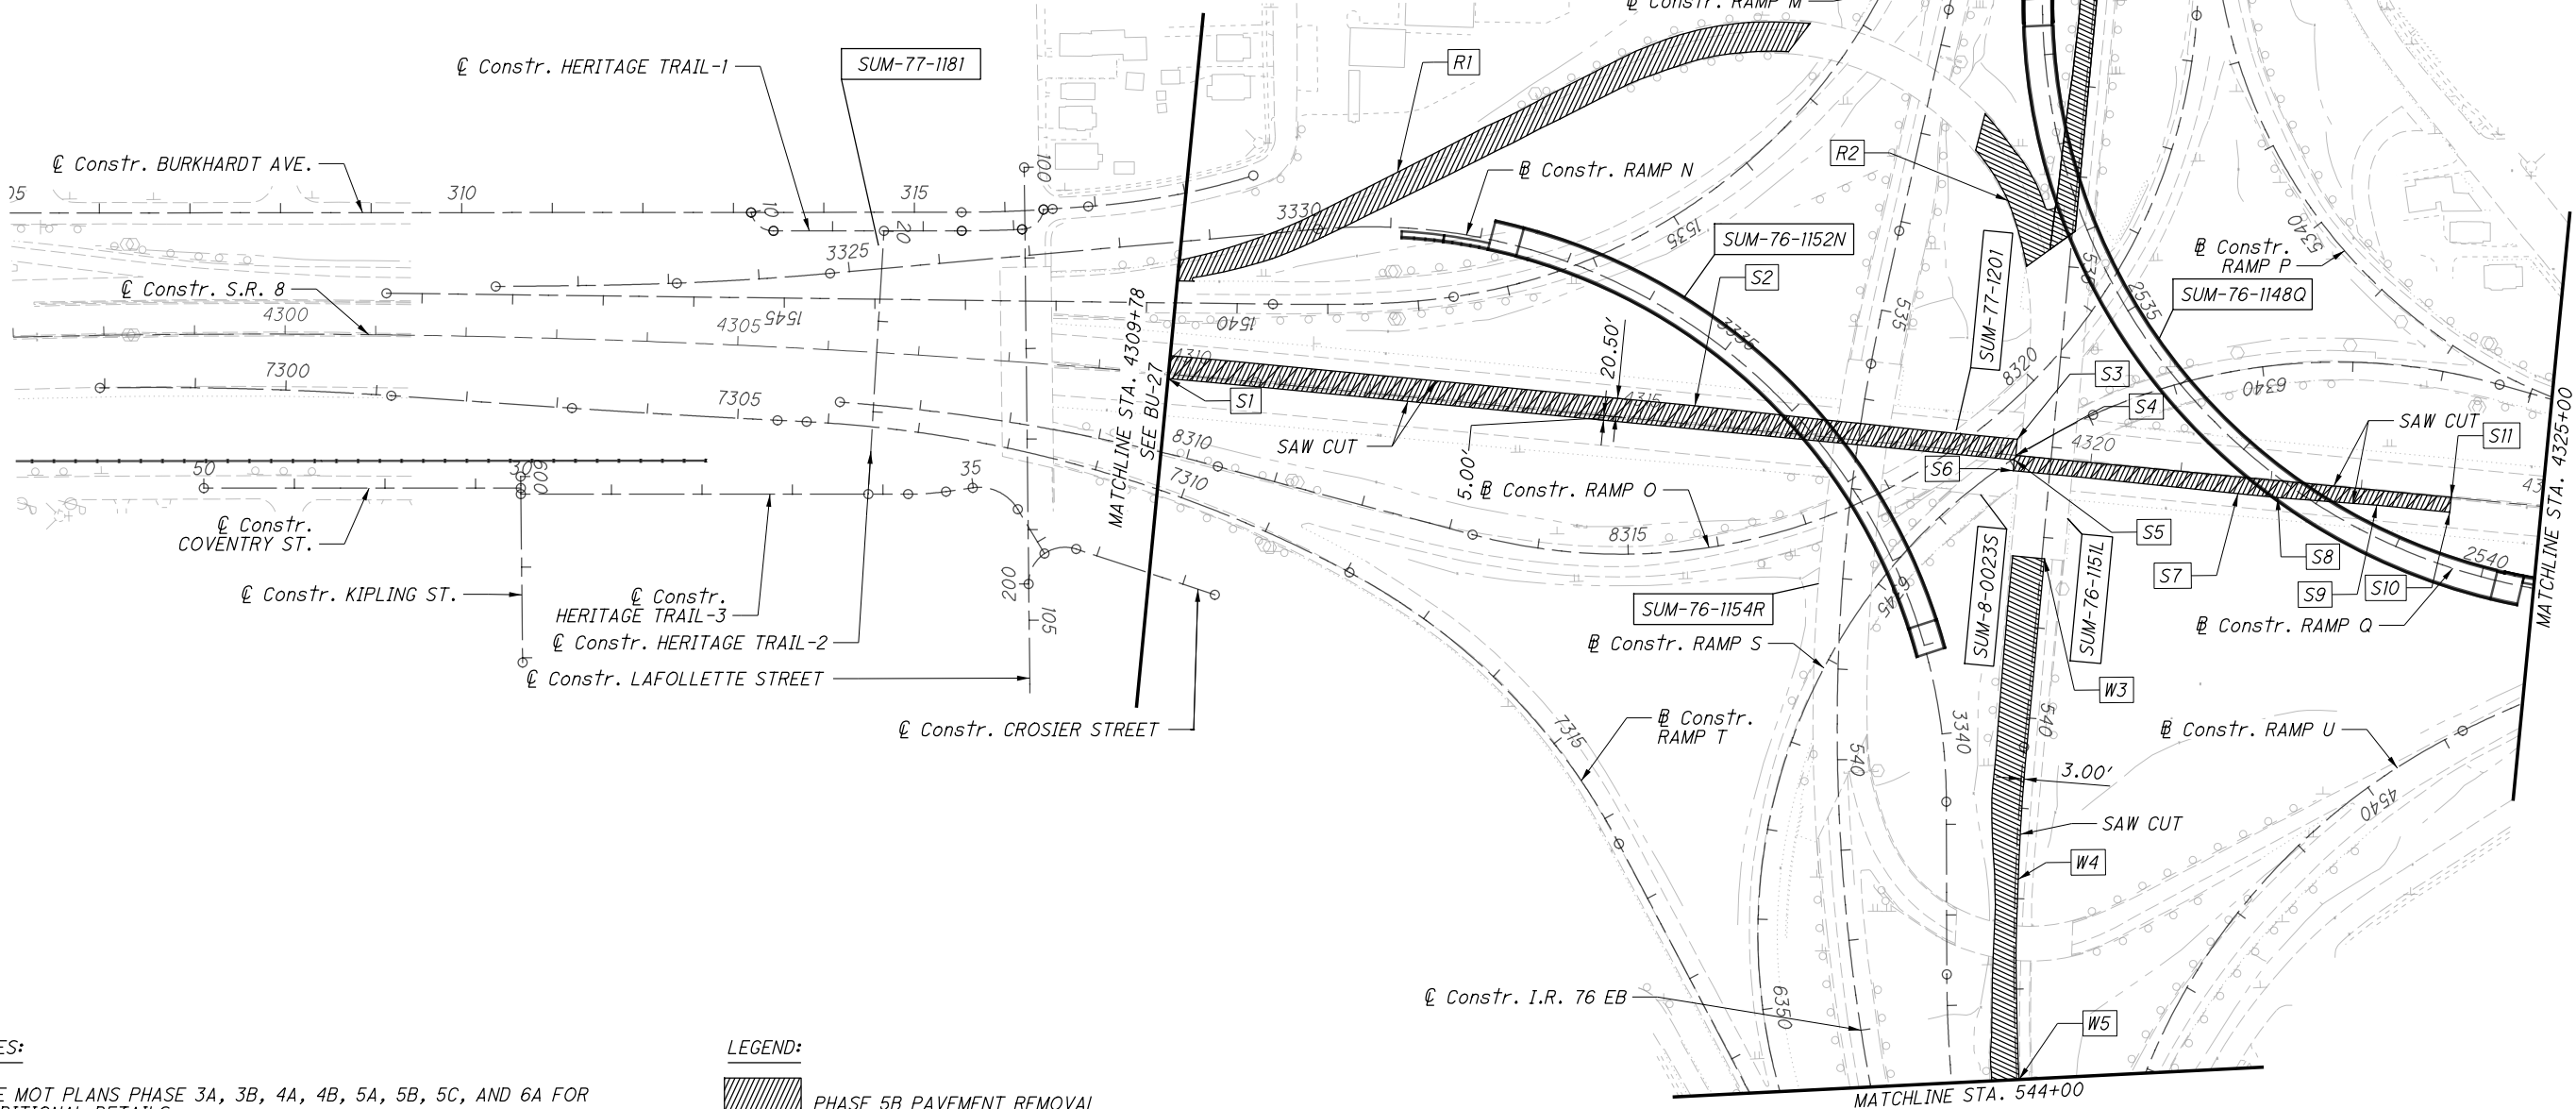

NOTES:

- SEE MOT PLANS PHASE 3A, 3B, 4A, 4B, 5A, 5B, 5C, AND 6A FOR ADDITIONAL DETAILS.
- FOR MORE SPECIFIC REMOVAL WORK RELATED TO A STRUCTURE, SEE THE APPROPRIATE INDIVIDUAL STRUCTURE PLAN.
- ALTHOUGH PAVEMENT REMOVALS ARE DEPICTED HEREIN, ADDITIONAL REMOVALS WITHIN THE CONSTRUCTION LIMITS SHALL INCLUDE, BUT NOT LIMITED TO: SIGNS & SIGN FOUNDATIONS, DRAINAGE STRUCTURES & PIPES, GUARDRAIL, CONCRETE BARRIER, LIGHT POLES & FOUNDATIONS, AND FENCING.

LEGEND:

PHASE 5B PAVEMENT REMOVAL

ISSUE RECORD:		
NO.	DATE	DESCRIPTION



- W1


STA. 544+00.00±, 2.23' LT
- W2

STA. 548+39.40±, 2.65' LT
- W3

STA. 546+65.37±, 33.33' RT
- W4

STA. 546+65.36±, 12.00' RT
- W5

STA. 548+39.40, 4.13' RT

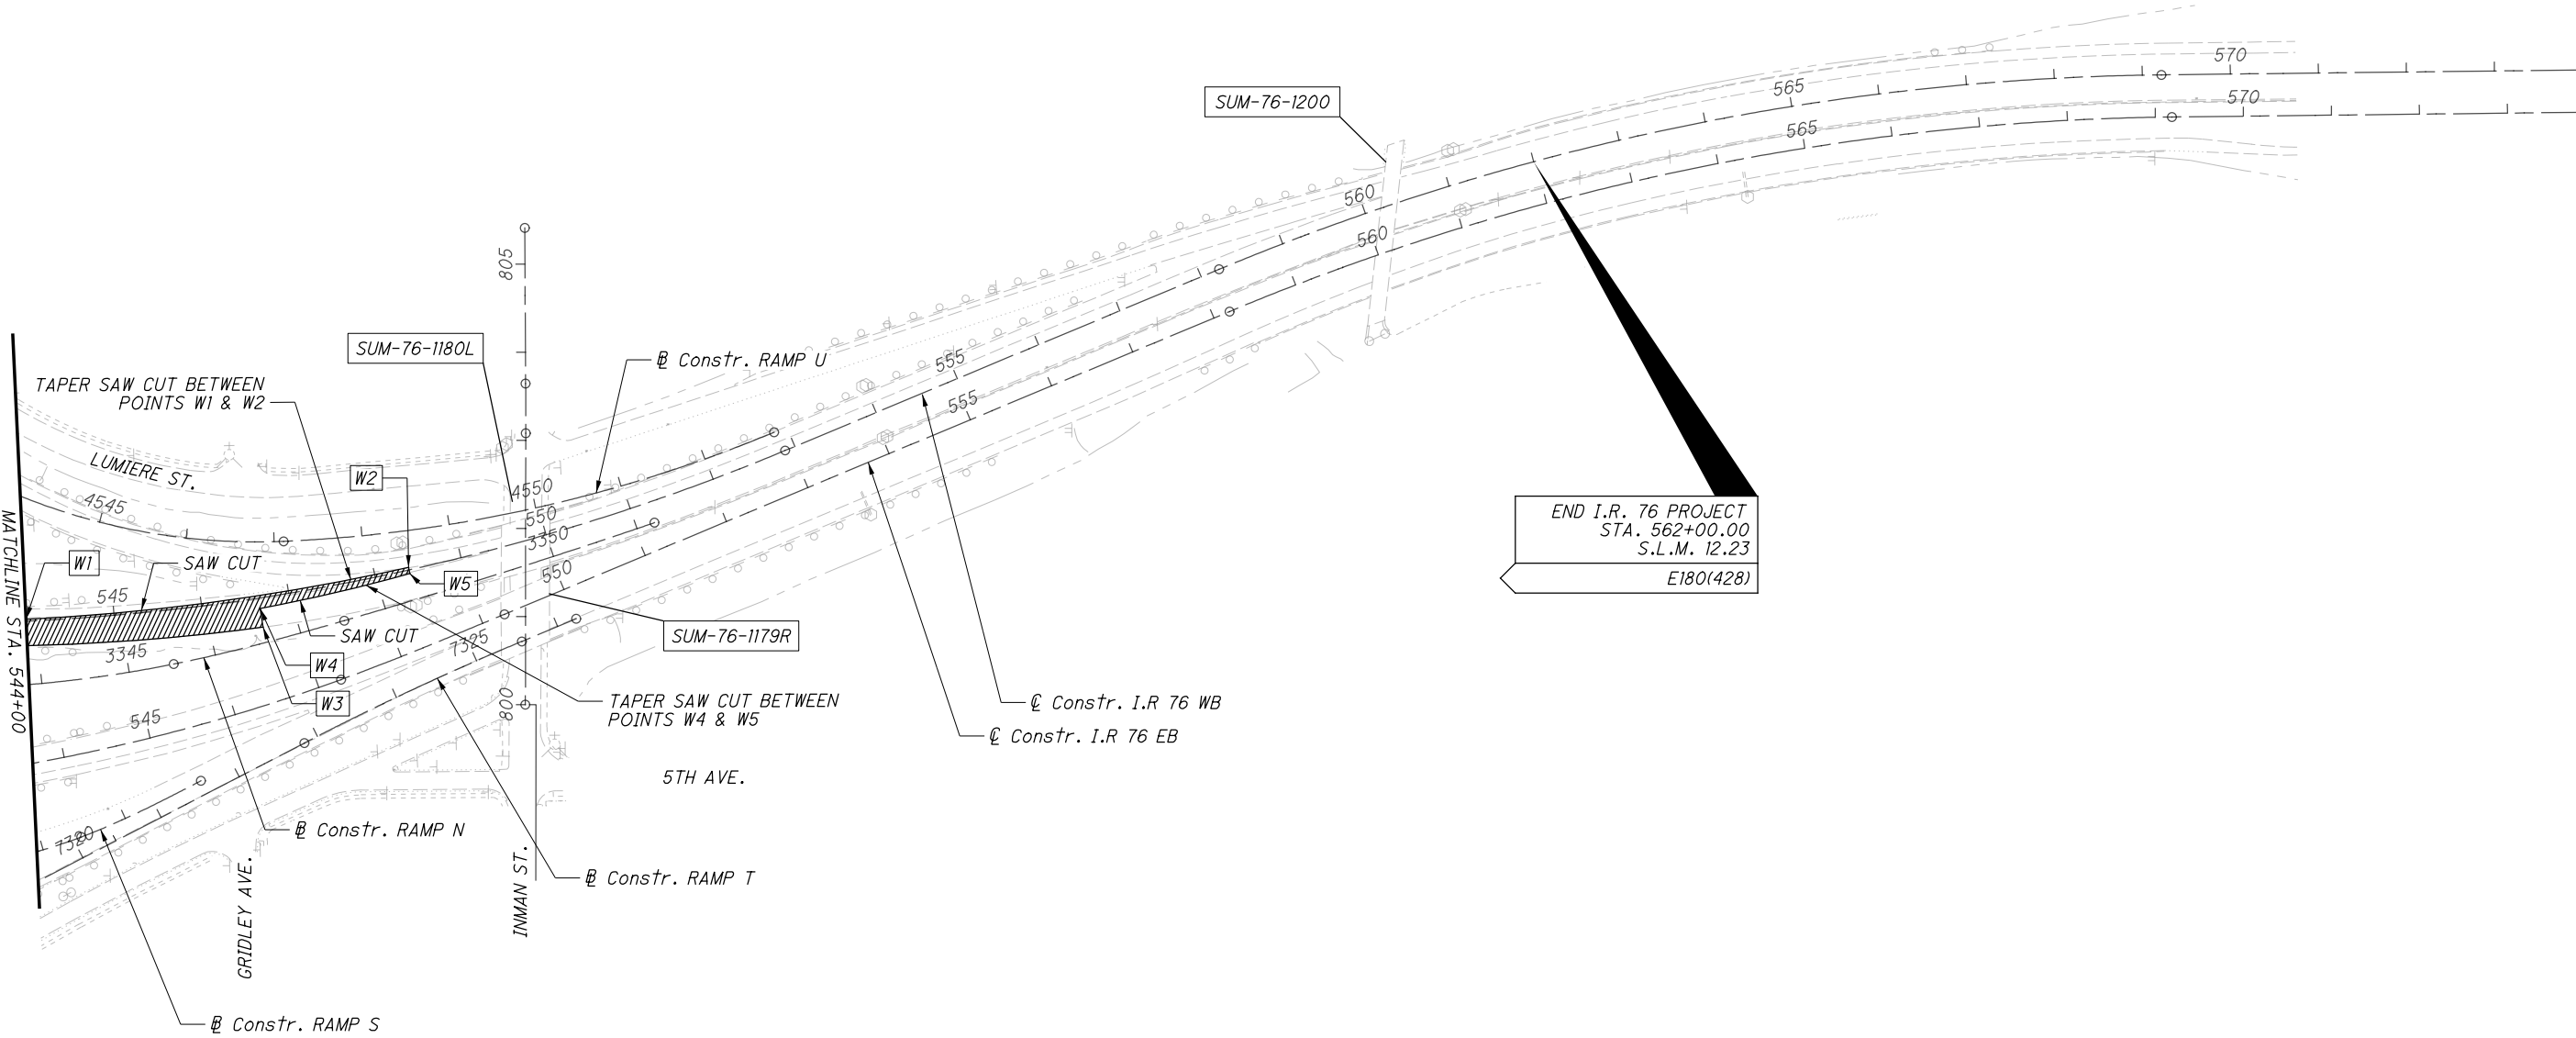

- NOTES:
1. SEE MOT PLANS PHASE 3A, 3B, 4A, 4B, 5A, 5B, 5C, AND 6A FOR ADDITIONAL DETAILS.

2. FOR MORE SPECIFIC REMOVAL WORK RELATED TO A STRUCTURE, SEE THE APPROPRIATE INDIVIDUAL STRUCTURE PLAN.

3. ALTHOUGH PAVEMENT REMOVALS ARE DEPICTED HEREIN, ADDITIONAL REMOVALS WITHIN THE CONSTRUCTION LIMITS SHALL INCLUDE, BUT NOT LIMITED TO: SIGNS & SIGN FOUNDATIONS, DRAINAGE STRUCTURES & PIPES, GUARDRAIL, CONCRETE BARRIER, LIGHT POLES & FOUNDATIONS, AND FENCING.
- LEGEND:

PHASE 5B PAVEMENT REMOVAL

ISSUE RECORD:		
NO.	DATE	DESCRIPTION

CALCULATED
CAS

CHECKED
JFM


0 100 200

HORIZONTAL
SCALE IN FEET

↑

N

- S1 STA. 4327+14.44±, 21.42' LT
- S2 STA. 4327+14.44±, 5.00' LT
- S3 STA. 4327+76.32±, 25.69' LT
- S4 STA. 4330+50.38±, 31.15' LT
- S5 STA. 325+12.31±, 30.50' LT
- S6 STA. 332+57.17±, 30.50' LT
- S7 STA. 333+12.17±, 29.50' LT

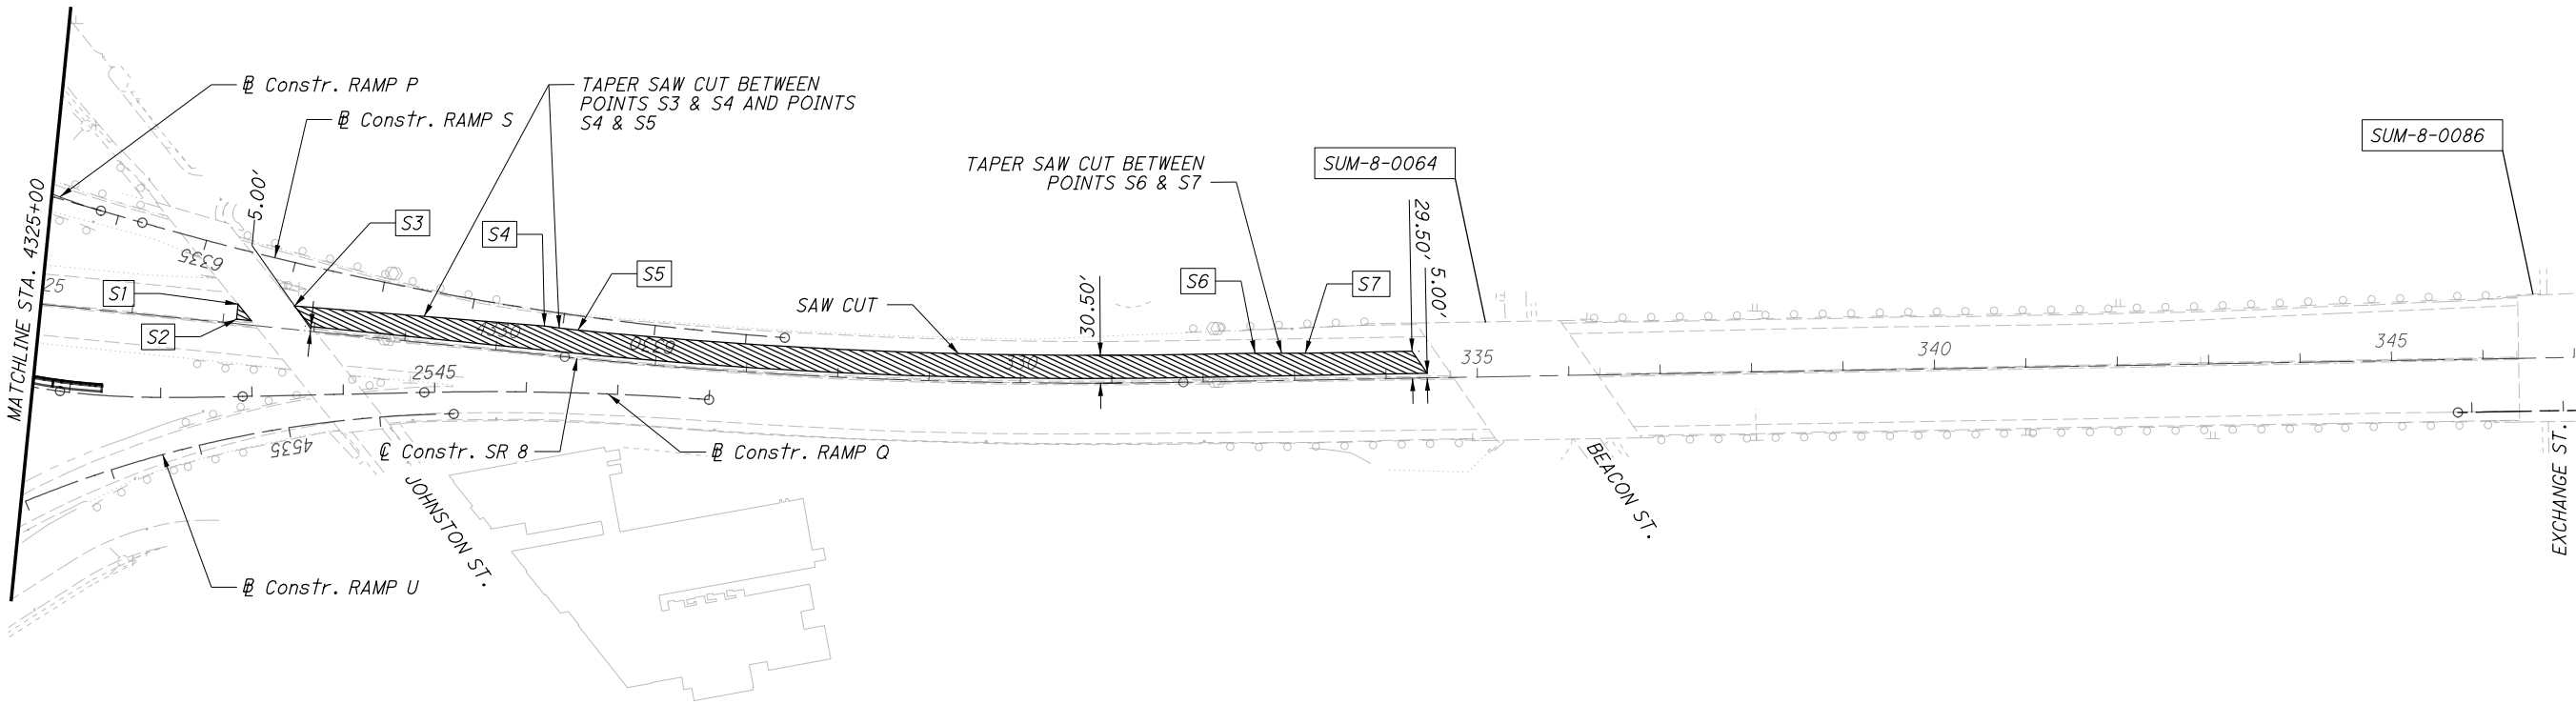

- NOTES:
1. SEE MOT PLANS PHASE 3A, 3B, 4A, 4B, 5A, 5B, 5C, AND 6A FOR ADDITIONAL DETAILS.

2. FOR MORE SPECIFIC REMOVAL WORK RELATED TO A STRUCTURE, SEE THE APPROPRIATE INDIVIDUAL STRUCTURE PLAN.

3. ALTHOUGH PAVEMENT REMOVALS ARE DEPICTED HEREIN, ADDITIONAL REMOVALS WITHIN THE CONSTRUCTION LIMITS SHALL INCLUDE, BUT NOT LIMITED TO: SIGNS & SIGN FOUNDATIONS, DRAINAGE STRUCTURES & PIPES, GUARDRAIL, CONCRETE BARRIER, LIGHT POLES & FOUNDATIONS, AND FENCING.
- LEGEND:

PHASE 5B PAVEMENT REMOVAL

ISSUE RECORD:

NO.	DATE	DESCRIPTION

CALCULATED
CAS

CHECKED
JFM

0 100 200

HORIZONTAL
SCALE IN FEET

N

2025-03-18 - BU-26 - RECORD DRAWING PLANS

SUM-76 / 77 / 8 -
8.24 / 9.74 / 0.00

31
36

REMOVAL PLAN - S.R. 8

STA. 4325+00 TO BEACON ST.

- S1

STA. 4327+00.00±, 18.0' LT (S.R. 8)
- S2

STA. 4327+00.00±, 18.5' LT (S.R. 8)
- S3

STA. 4327+14.44±, 5.0' LT (S.R. 8)
- S4

STA. 4327+14.44±, 5.0' RT (S.R. 8)
- S5


STA. 334+73.52± (S.R. 8)

NOTES:

1. SEE MOT PLANS PHASE 3A, 3B, 4A, 4B, 5A, 5B, 5C AND 6A FOR ADDITIONAL DETAILS.
2. FOR MORE SPECIFIC REMOVAL WORK RELATED TO A STRUCTURE, SEE THE APPROPRIATE INDIVIDUAL STRUCTURE PLAN.
3. ALTHOUGH PAVEMENT REMOVALS ARE DEPICTED HEREIN, ADDITIONAL REMOVALS WITHIN THE CONSTRUCTION LIMITS SHALL INCLUDE, BUT NOT LIMITED TO: SIGNS & SIGN FOUNDATIONS, DRAINAGE STRUCTURES & PIPES, GUARDRAIL, CONCRETE BARRIER, LIGHT POLES & FOUNDATIONS, AND FENCING.

LEGEND:

PHASE 5C PAVEMENT REMOVAL

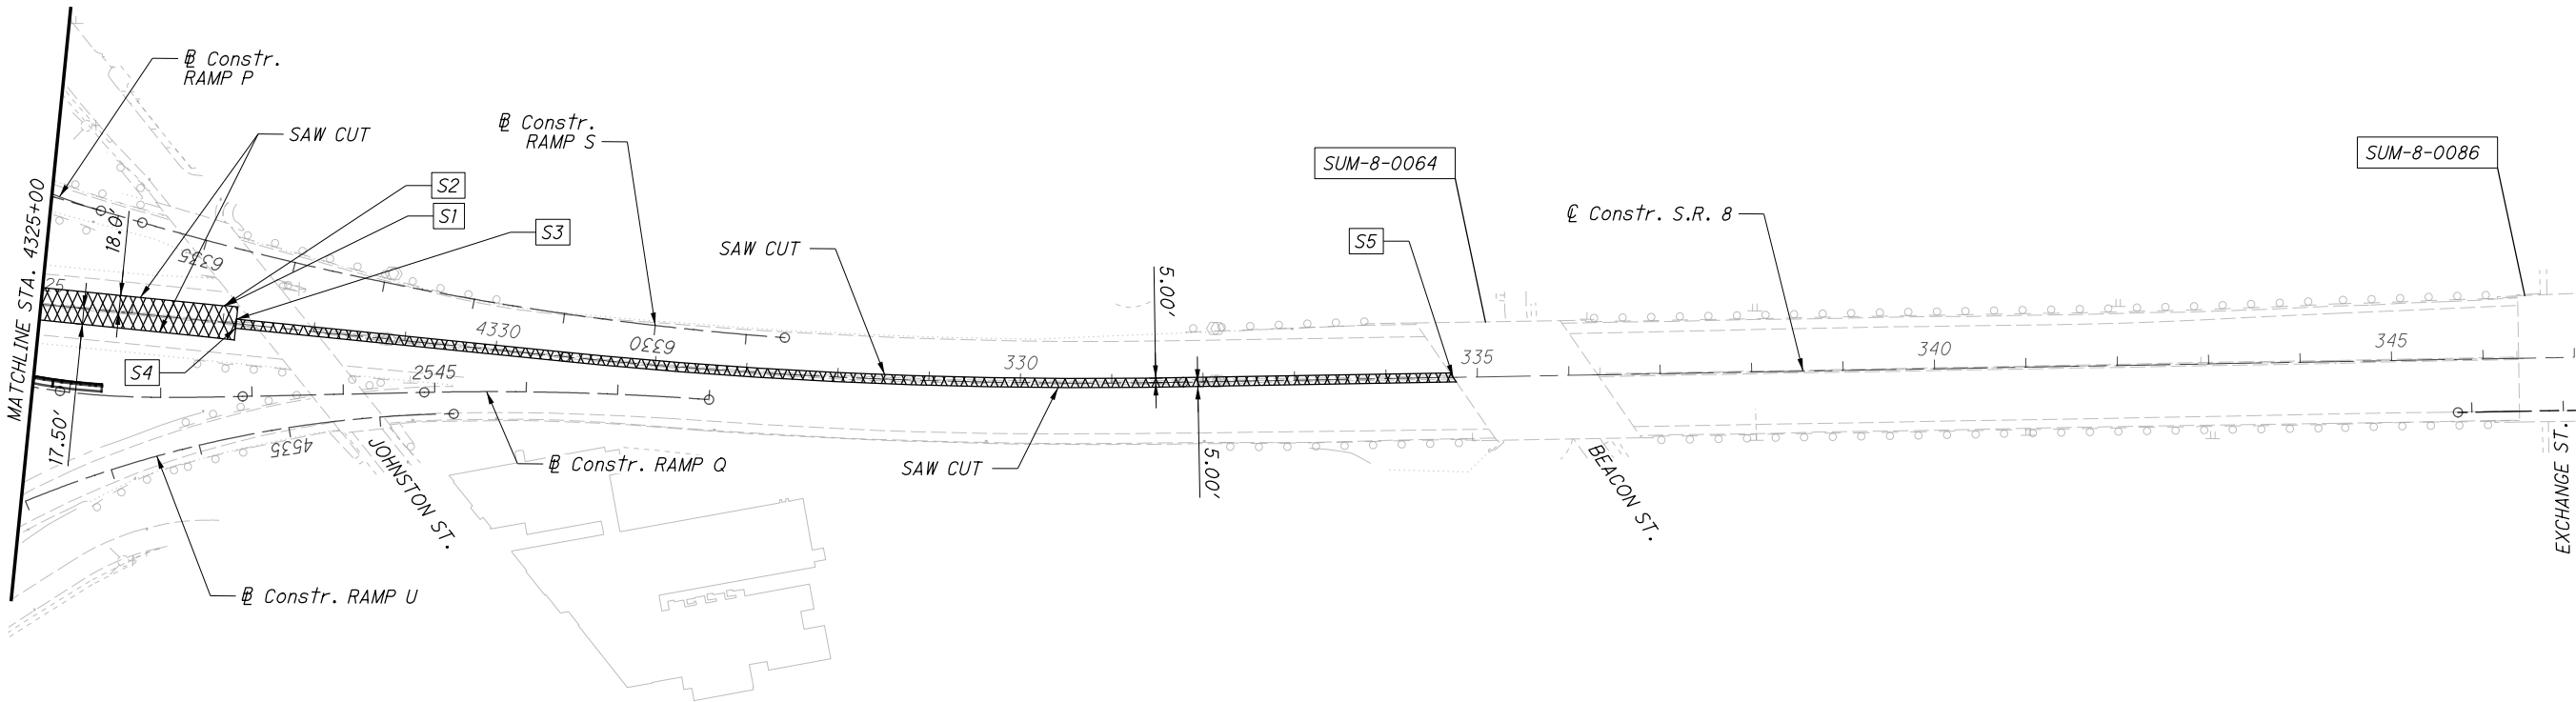

ISSUE RECORD:		
NO.	DATE	DESCRIPTION

2025-03-18 - BU-26 - RECORD DRAWING PLANS

SUM-76 / 77 / 8 -

8.24 / 9.74 / 0.00

33

36

REMOVAL PLAN - S.R. 8
STA. 4325+00 TO BEACON ST.

CALCULATED
CAS


CHECKED
JFM

0100200

HORIZONTAL
SCALE IN FEET

N

W1 STA. 525+59.87±, 4.5' LT (I.R. 76 WB)

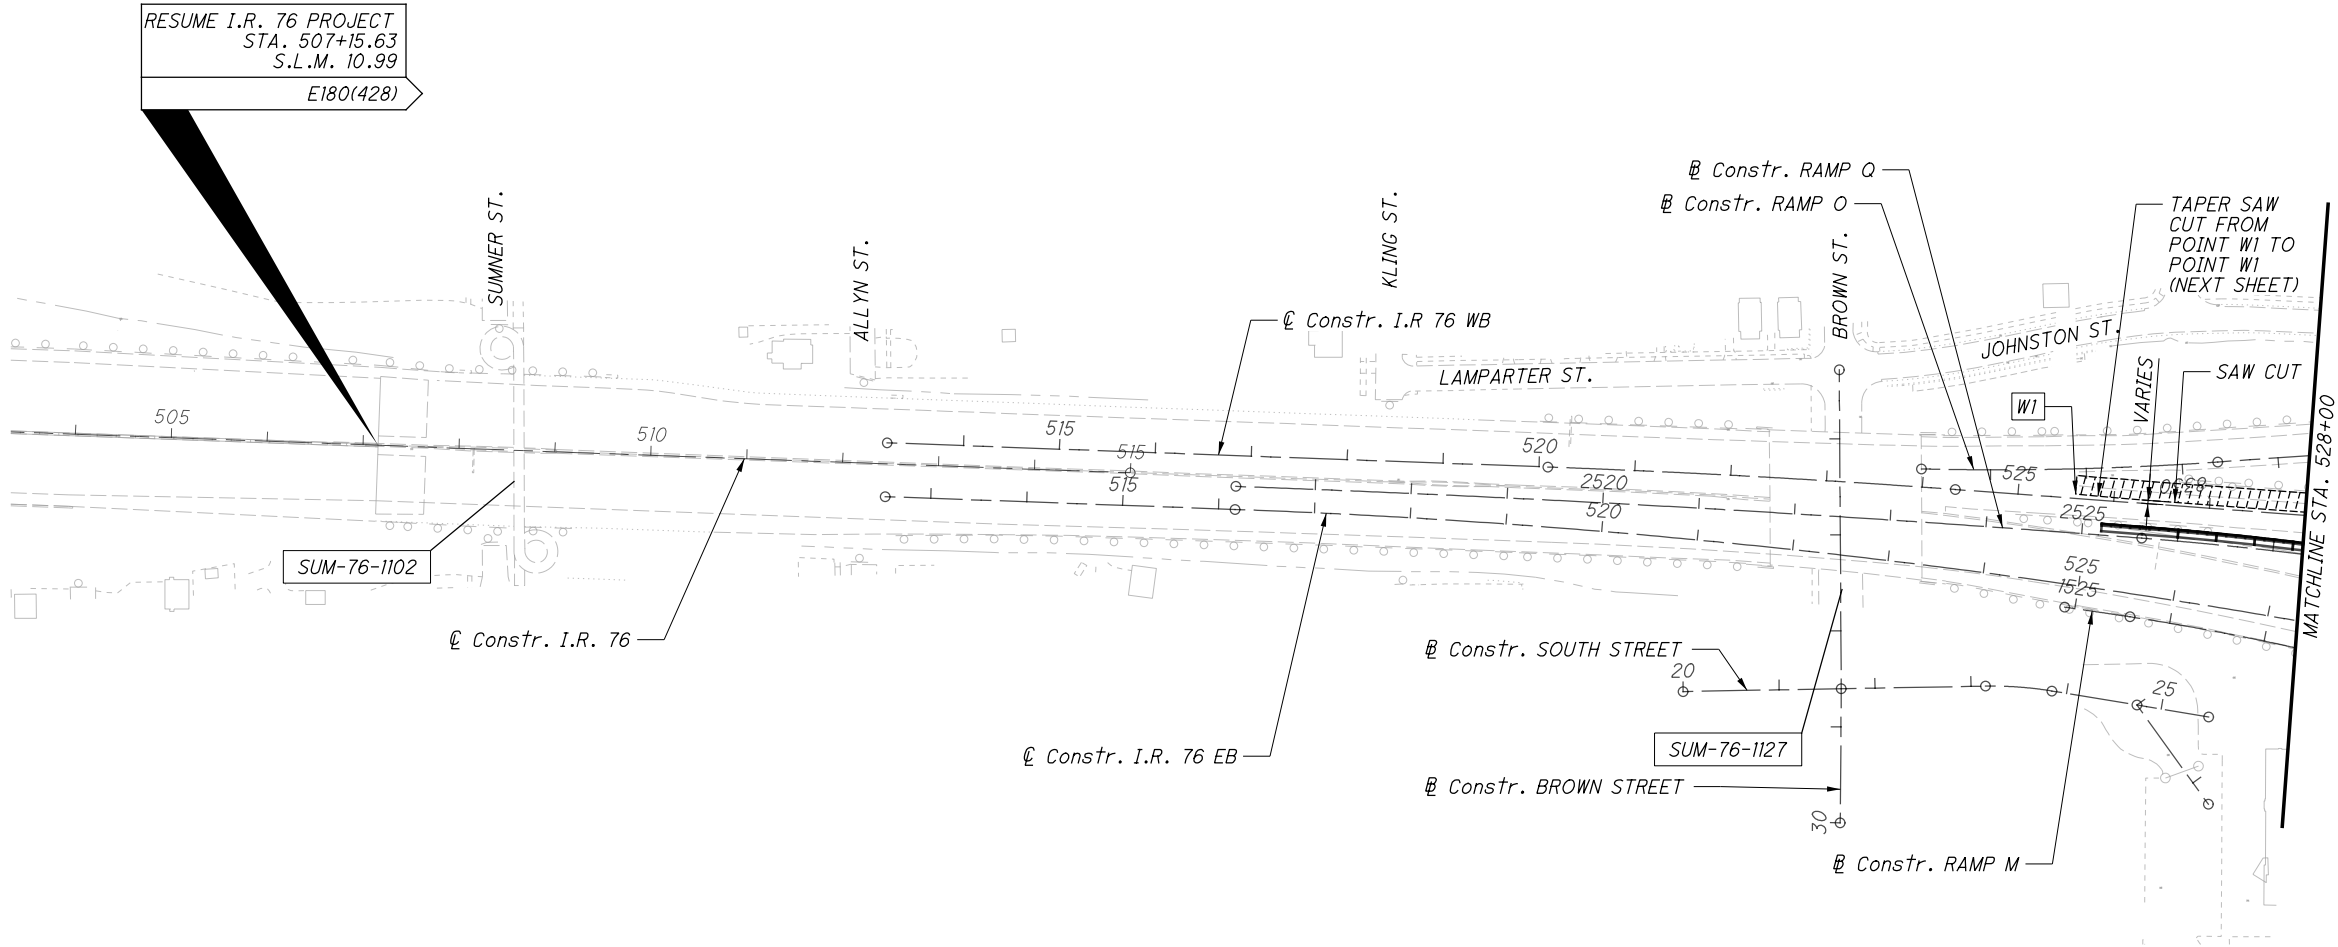

NOTES:

- SEE MOT PLANS PHASE 3A, 3B, 4A, 4B, 5A, 5B, 5C, AND 6A FOR ADDITIONAL DETAILS.
- FOR MORE SPECIFIC REMOVAL WORK RELATED TO A STRUCTURE, SEE THE APPROPRIATE INDIVIDUAL STRUCTURE PLAN.
- ALTHOUGH PAVEMENT REMOVALS ARE DEPICTED HEREIN, ADDITIONAL REMOVALS WITHIN THE CONSTRUCTION LIMITS SHALL INCLUDE, BUT NOT LIMITED TO: SIGNS & SIGN FOUNDATIONS, DRAINAGE STRUCTURES & PIPES, GUARDRAIL, CONCRETE BARRIER, LIGHT POLES & FOUNDATIONS, AND FENCING.

LEGEND:

 PHASE 6A PAVEMENT REMOVAL

ISSUE RECORD:		
NO.	DATE	DESCRIPTION

CALCULATED
CAS

CHECKED
JFM



0 100 200
HORIZONTAL
SCALE IN FEET

11/19/2021 3:17:42 PM

- Design\102329\Roadway\Sheets\BU-26\102329_BU-26_CM805.dgn Sheet

PARSONS
p:\VANVA01\PWINT01.parsons.com:Ohio State\Documents\DB-Akron Beltway Rehab\10

W1	STA. 530+80.63±, 3.0' LT (I.R. 76 WB)
W2	STA. 540+48.01±, 12.0' LT (I.R. 76 WB)
W3	STA. 541+84.92±, 3.0' LT (I.R. 76 WB)

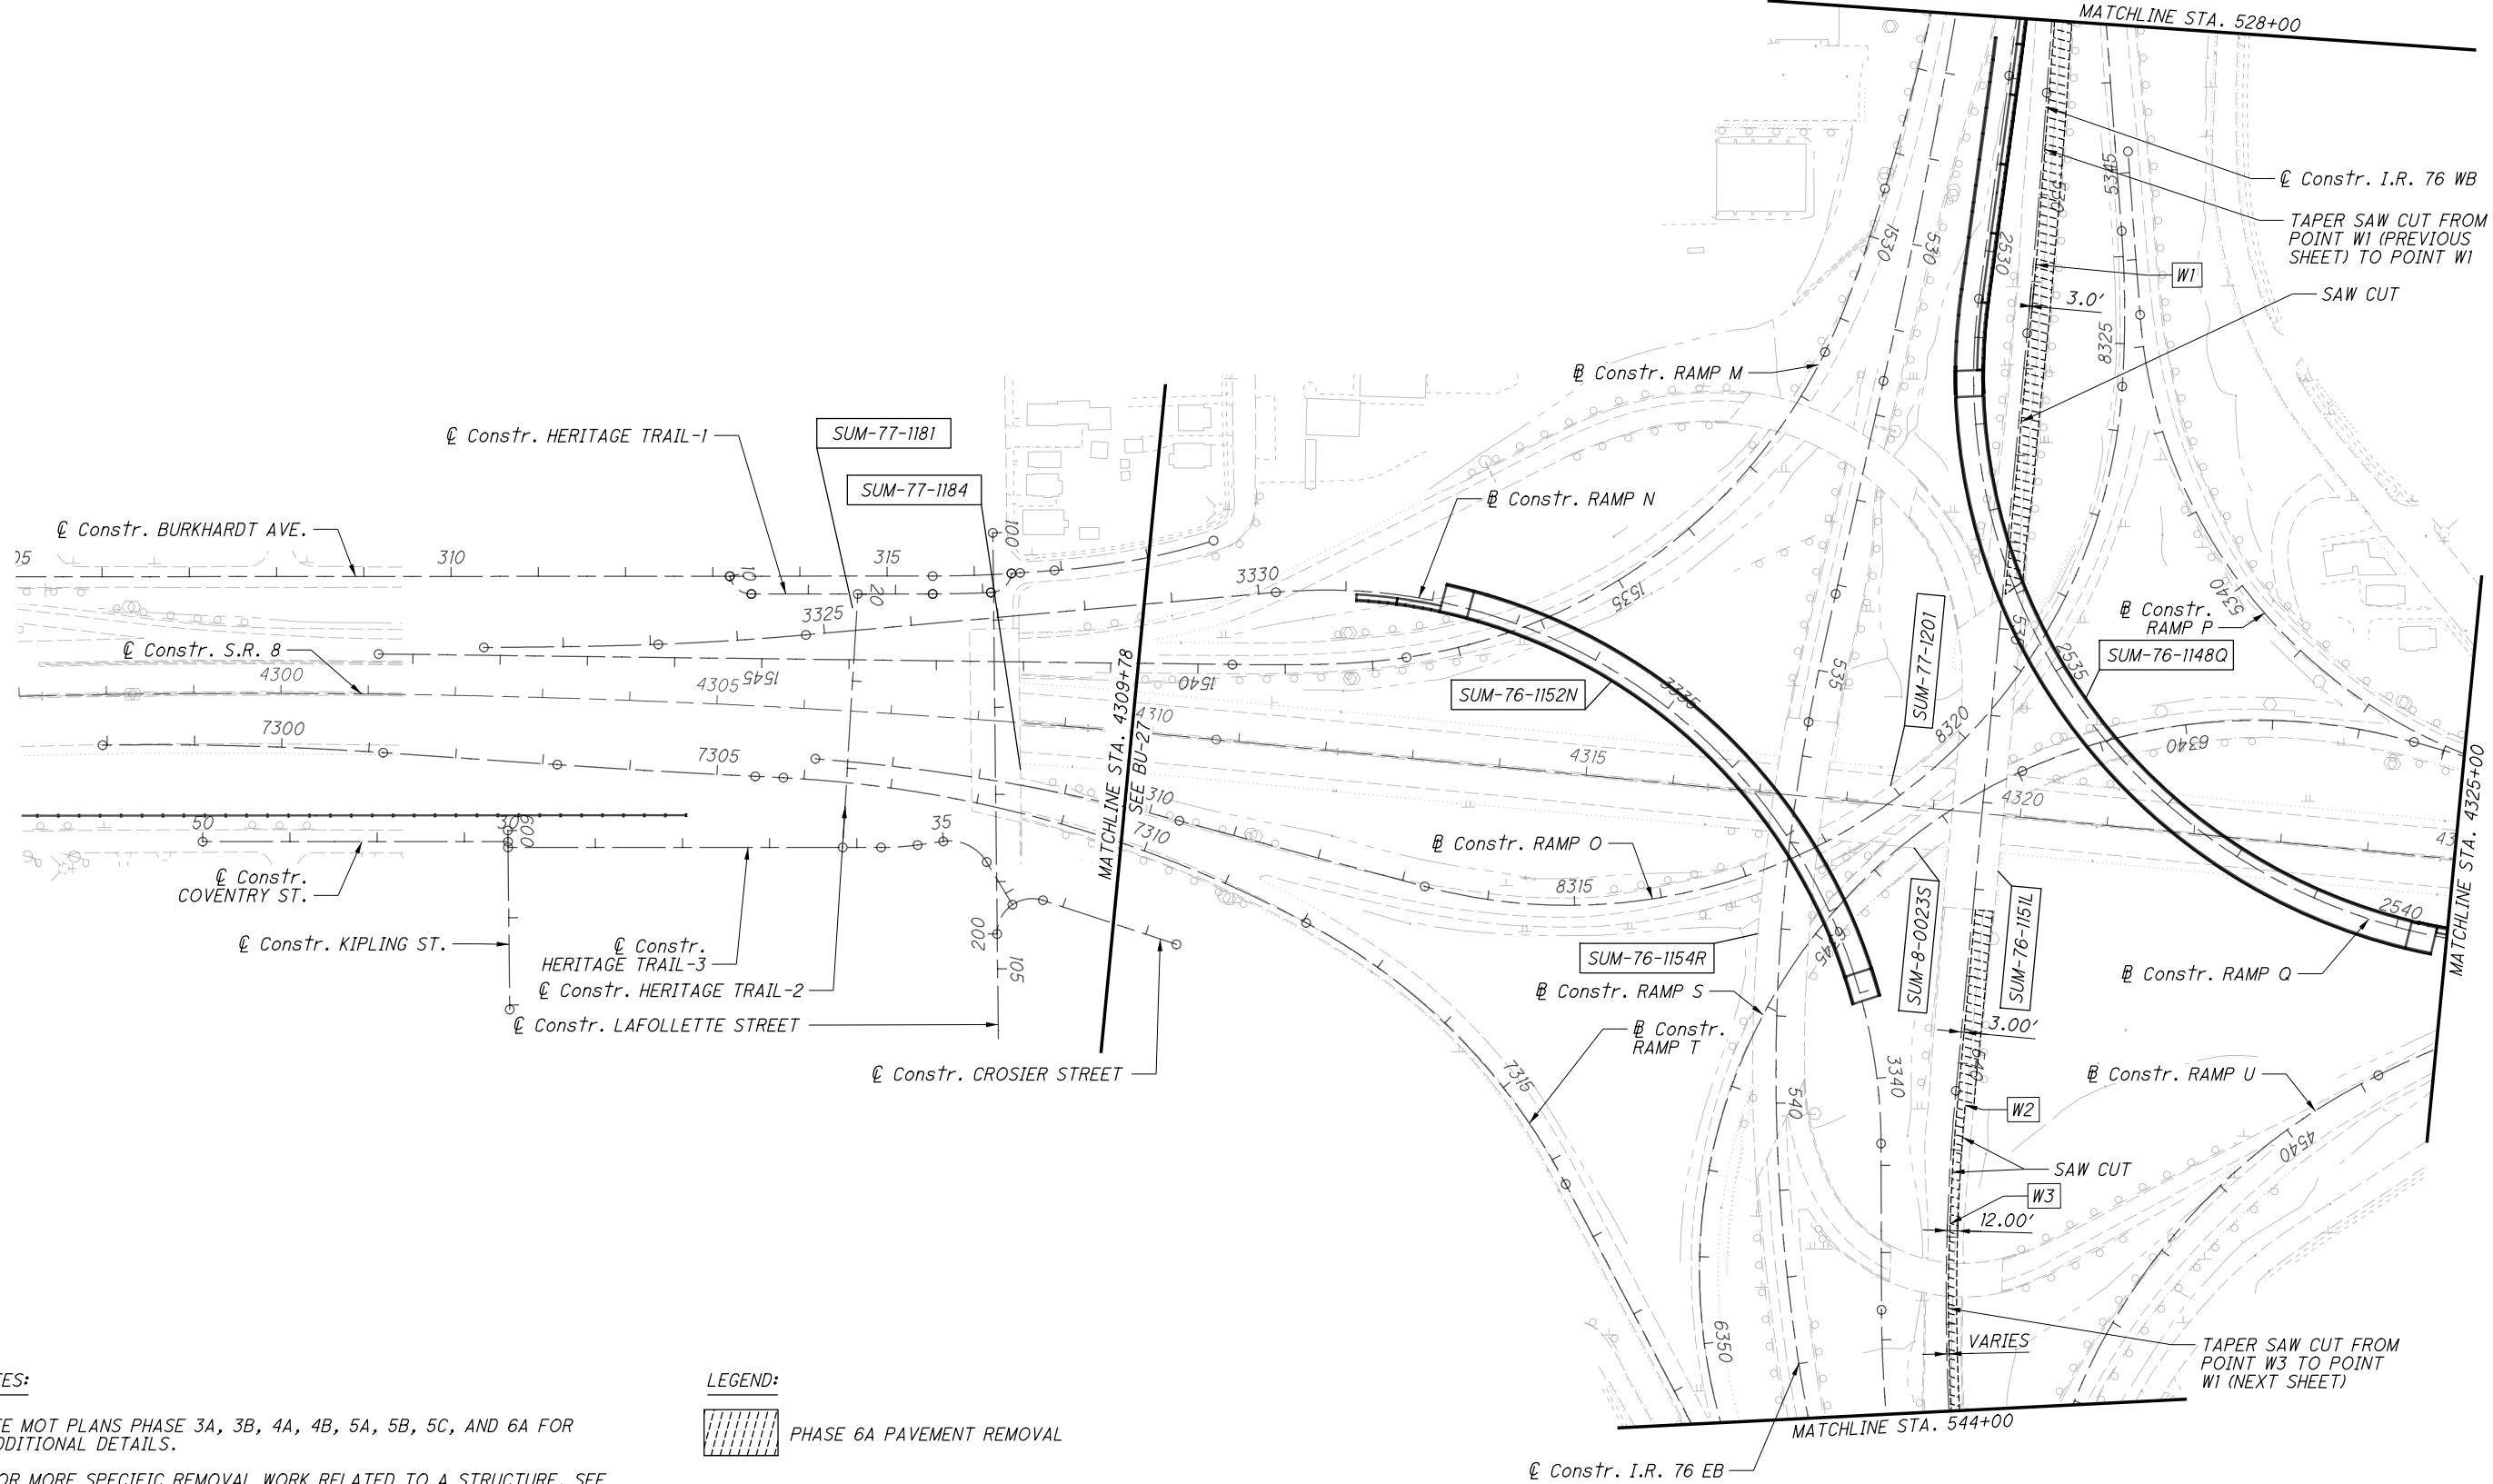[illegible]

NOTES:

1. SEE MOT PLANS PHASE 3A, 3B, 4A, 4B, 5A, 5B, 5C, AND 6A FOR ADDITIONAL DETAILS.
2. FOR MORE SPECIFIC REMOVAL WORK RELATED TO A STRUCTURE, SEE THE APPROPRIATE INDIVIDUAL STRUCTURE PLAN.
3. ALTHOUGH PAVEMENT REMOVALS ARE DEPICTED HEREIN, ADDITIONAL REMOVALS WITHIN THE CONSTRUCTION LIMITS SHALL INCLUDE, BUT NOT LIMITED TO: SIGNS & SIGN FOUNDATIONS, DRAINAGE STRUCTURES & PIPES, GUARDRAIL, CONCRETE BARRIER, LIGHT POLES & FOUNDATIONS, AND FENCING.

LEGEND:

 PHASE 6A PAVEMENT REMOVAL

2025-03-18 - BU-26 - RECORD DRAWING PLANS

**REMOVAL PLAN - S.R. 8
STA. 4309+78 TO STA. 4325+00**

**SUM-76 / 77 / 8 -
8.24 / 9.74 / 0.00**



W1

STA. 544+21.28±, 2.1' LT (I.R. 76 WB)

W2

STA. 544+21.28±, 12.0' LT (I.R. 76 WB)

ISSUE RECORD:		
NO.	DATE	DESCRIPTION

CALCULATED
CAS


CHECKED
JFM

0100200

HORIZONTAL
SCALE IN FEET

↑

N

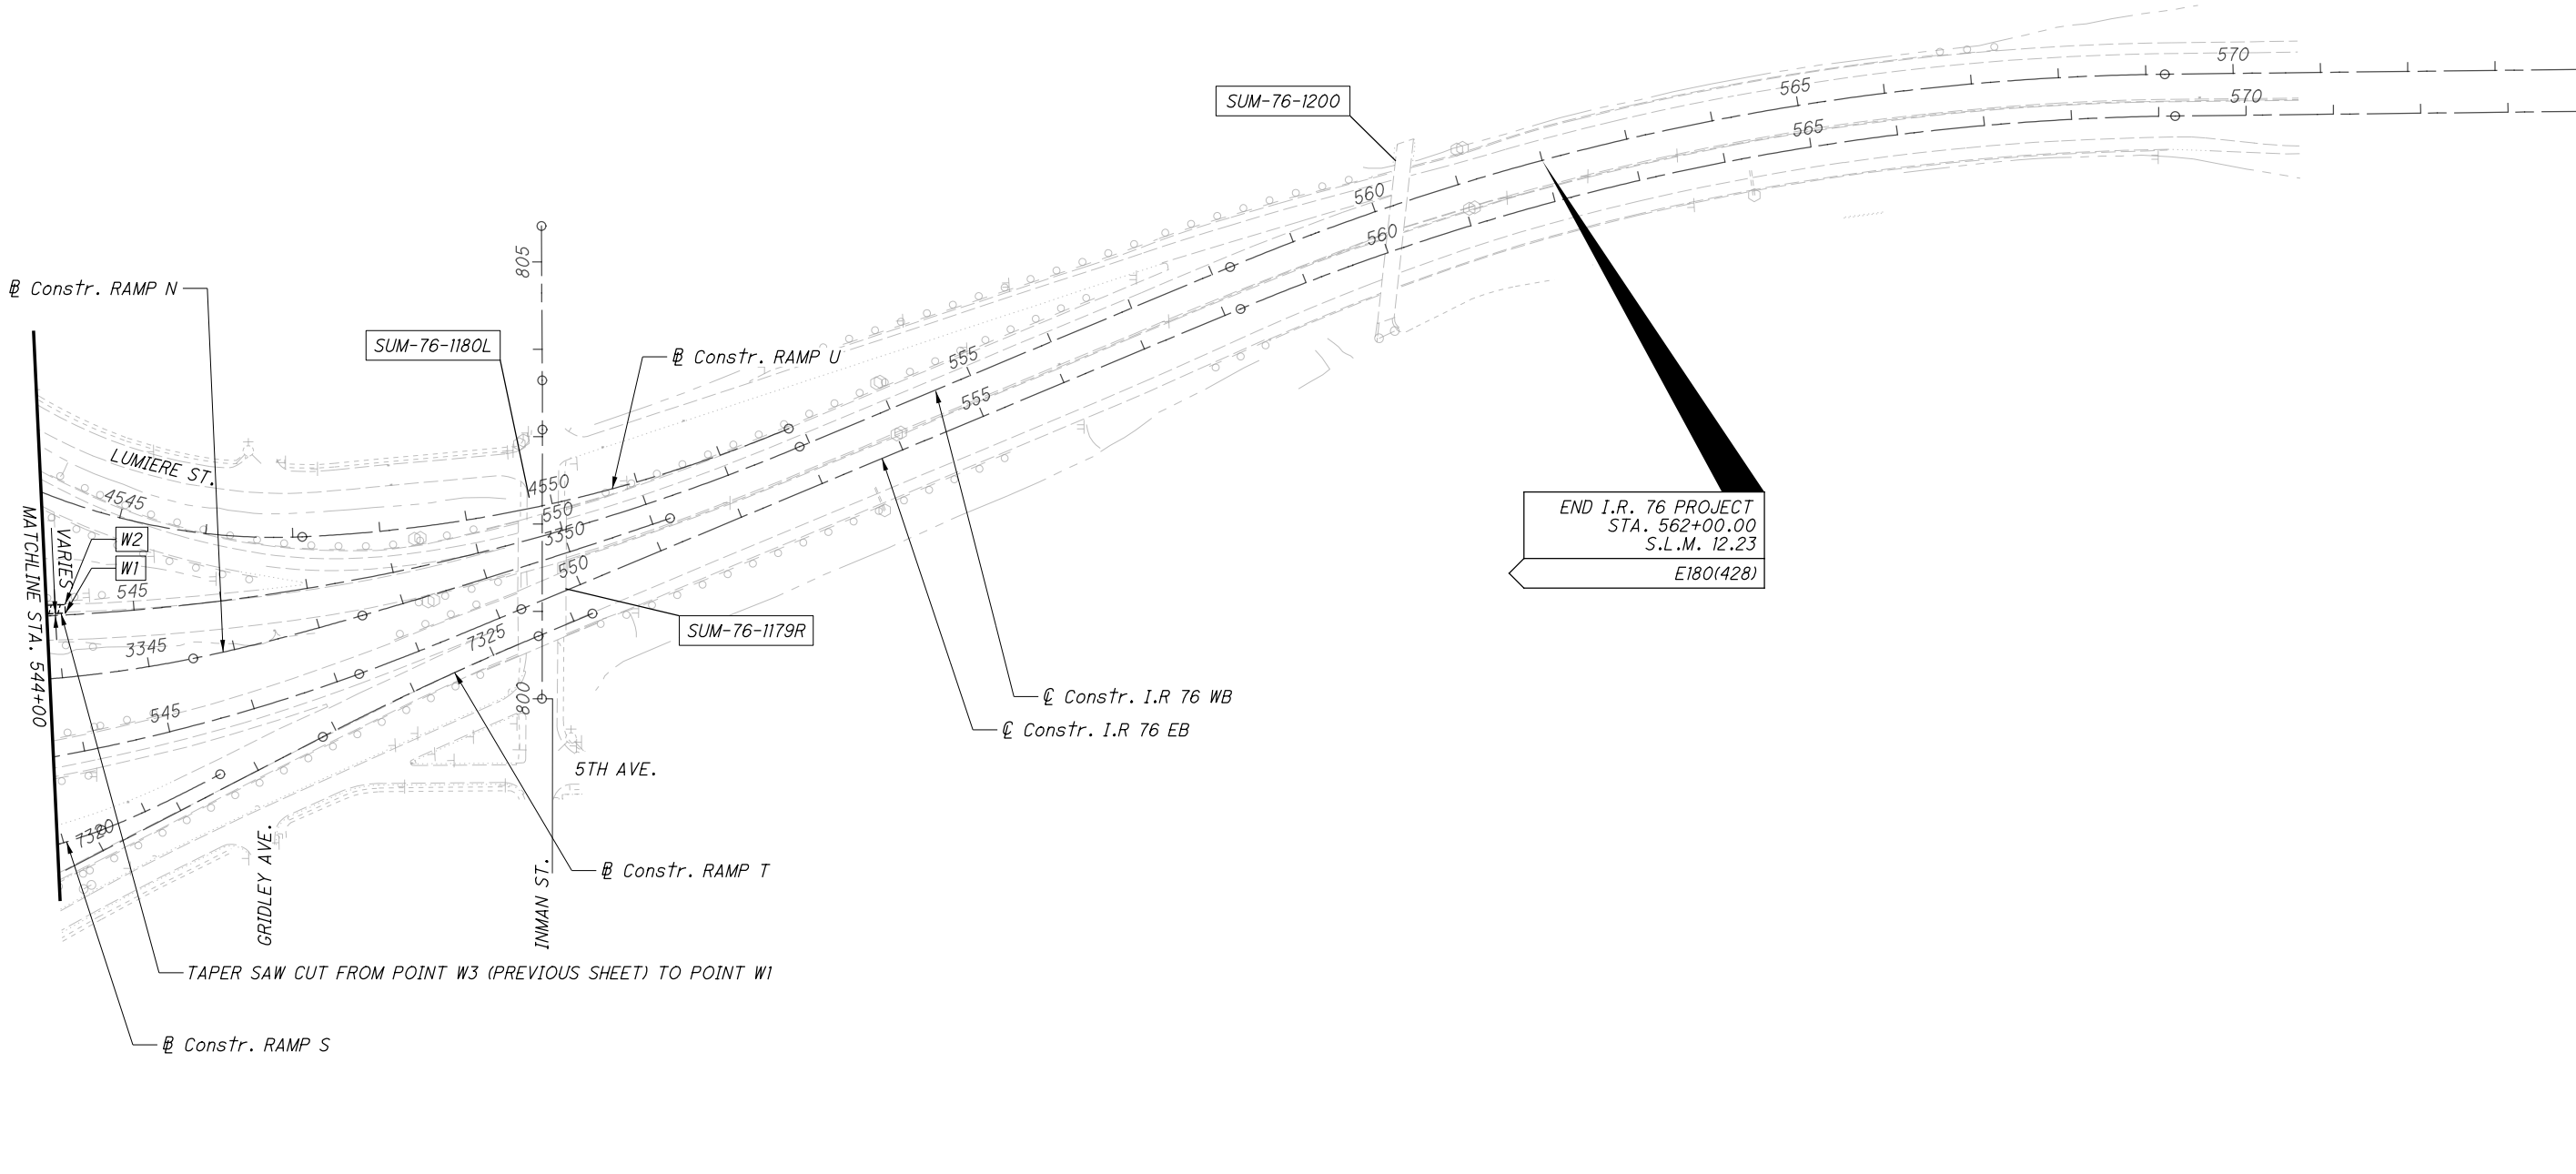

- NOTES:
1. SEE MOT PLANS PHASE 3A, 3B, 4A, 4B, 5A, 5B, 5C, AND 6A FOR ADDITIONAL DETAILS.

2. FOR MORE SPECIFIC REMOVAL WORK RELATED TO A STRUCTURE, SEE THE APPROPRIATE INDIVIDUAL STRUCTURE PLAN.

3. ALTHOUGH PAVEMENT REMOVALS ARE DEPICTED HEREIN, ADDITIONAL REMOVALS WITHIN THE CONSTRUCTION LIMITS SHALL INCLUDE, BUT NOT LIMITED TO: SIGNS & SIGN FOUNDATIONS, DRAINAGE STRUCTURES & PIPES, GUARDRAIL, CONCRETE BARRIER, LIGHT POLES & FOUNDATIONS, AND FENCING.
- LEGEND:

PHASE 6A PAVEMENT REMOVAL