

PAVEMENT MARKING LEGEND:

- ELW-#

PROPOSED EDGE LINE, WHITE 8"
- ELY-#

PROPOSED EDGE LINE, YELLOW 8"
- LL-#

PROPOSED LANE LINE, 8"
- CH-#

PROPOSED CHANNELIZING LINE, 12"
- SL-#

PROPOSED STOP LINE
- XW-#

PROPOSED CROSSWALK LINE
- A-#

PROPOSED LANE ARROW
- W-#

PROPOSED WORD ON PAVEMENT
- DL-#

PROPOSED DOTTED LINE, 6"
- TR-#

PROPOSED TRAVERSE MARKINGS
- WA-#

PROPOSED WRONG WAY ARROW

- 

TRAFFIC FLOW ARROW
- 

PROPOSED SINGLE POST SIGN
- 

PROPOSED DOUBLE POST SIGN
- 

EXISTING TRUSS SIGN SUPPORT
- 

EXISTING CANTILEVER SIGN SUPPORT
- 

PROPOSED TRUSS SIGN SUPPORT
- 

PROPOSED CANTILEVER SIGN SUPPORT
- 

PROPOSED ROADWAY RESURFACING

ISSUE RECORD:			CALCULATED AC	CHECKED REH
NO.	DATE	DESCRIPTION		


2025-03-19 - BU-38 - RECORD DRAWING PLANS

2


36

SUM-76 / 77 / 8 -
8.24 / 9.74 / 0.00


SIGNING AND PAVEMENT MARKING LEGEND

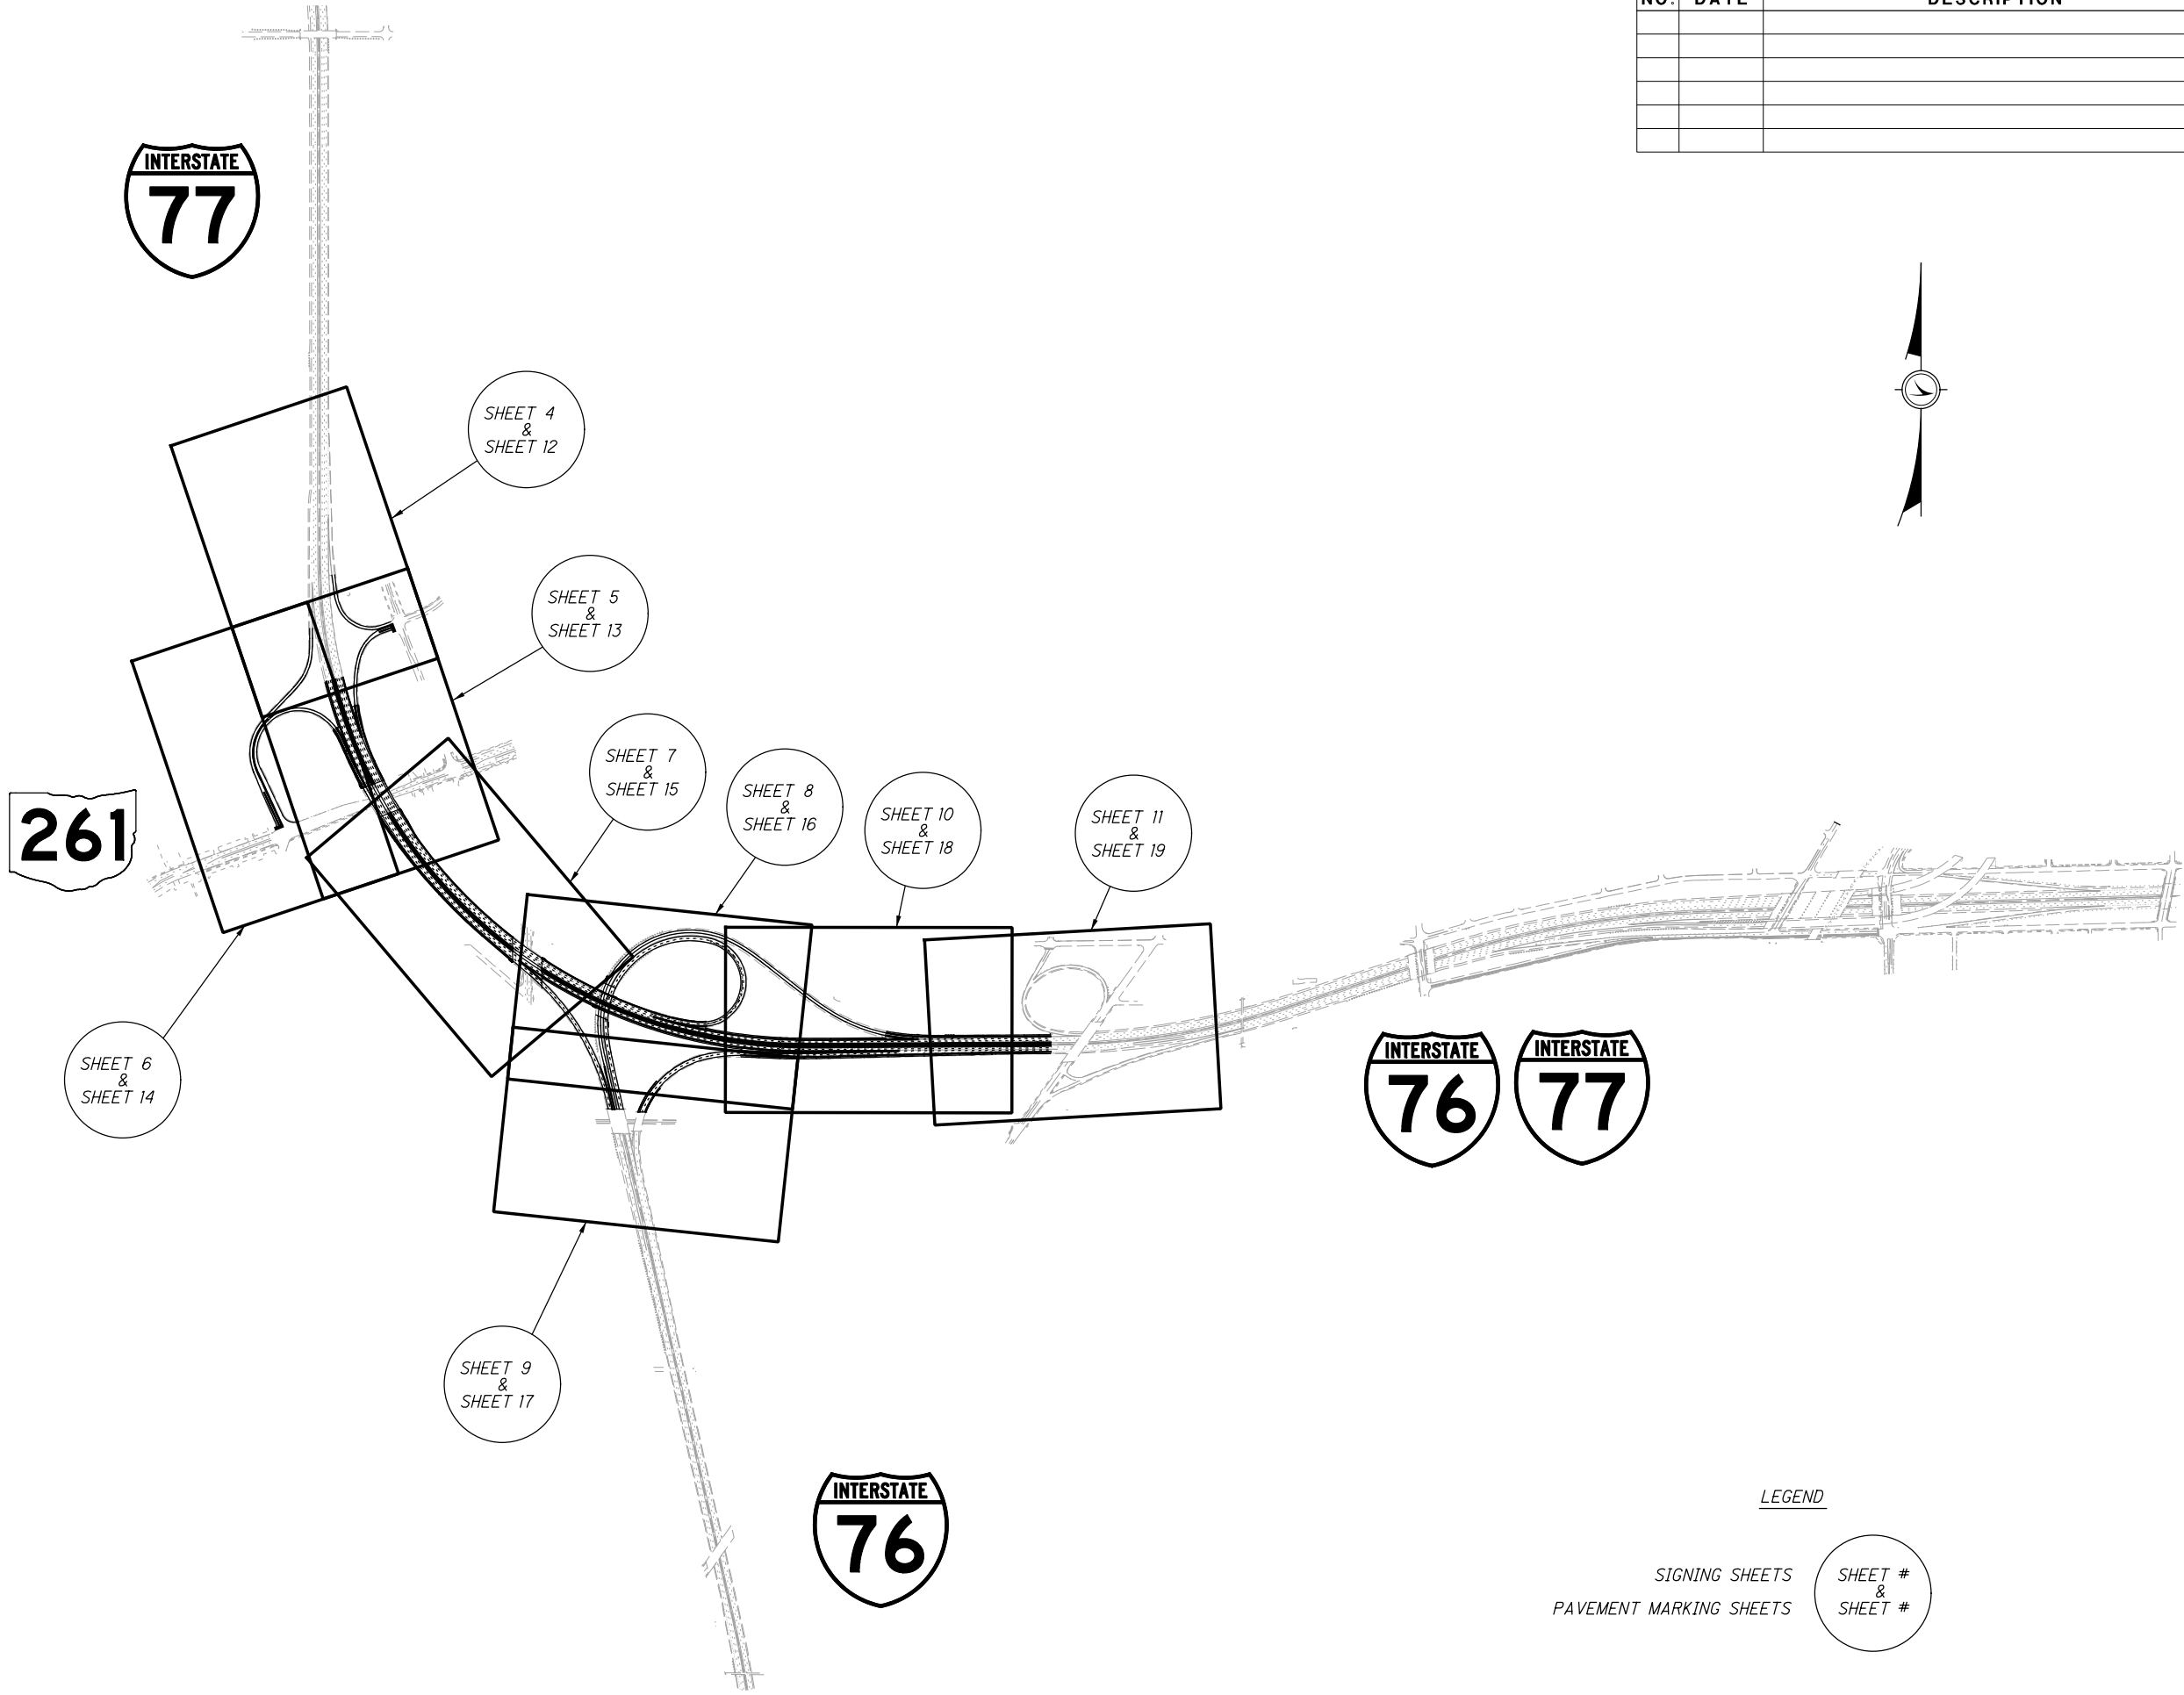

ISSUE RECORD:		
NO.	DATE	DESCRIPTION

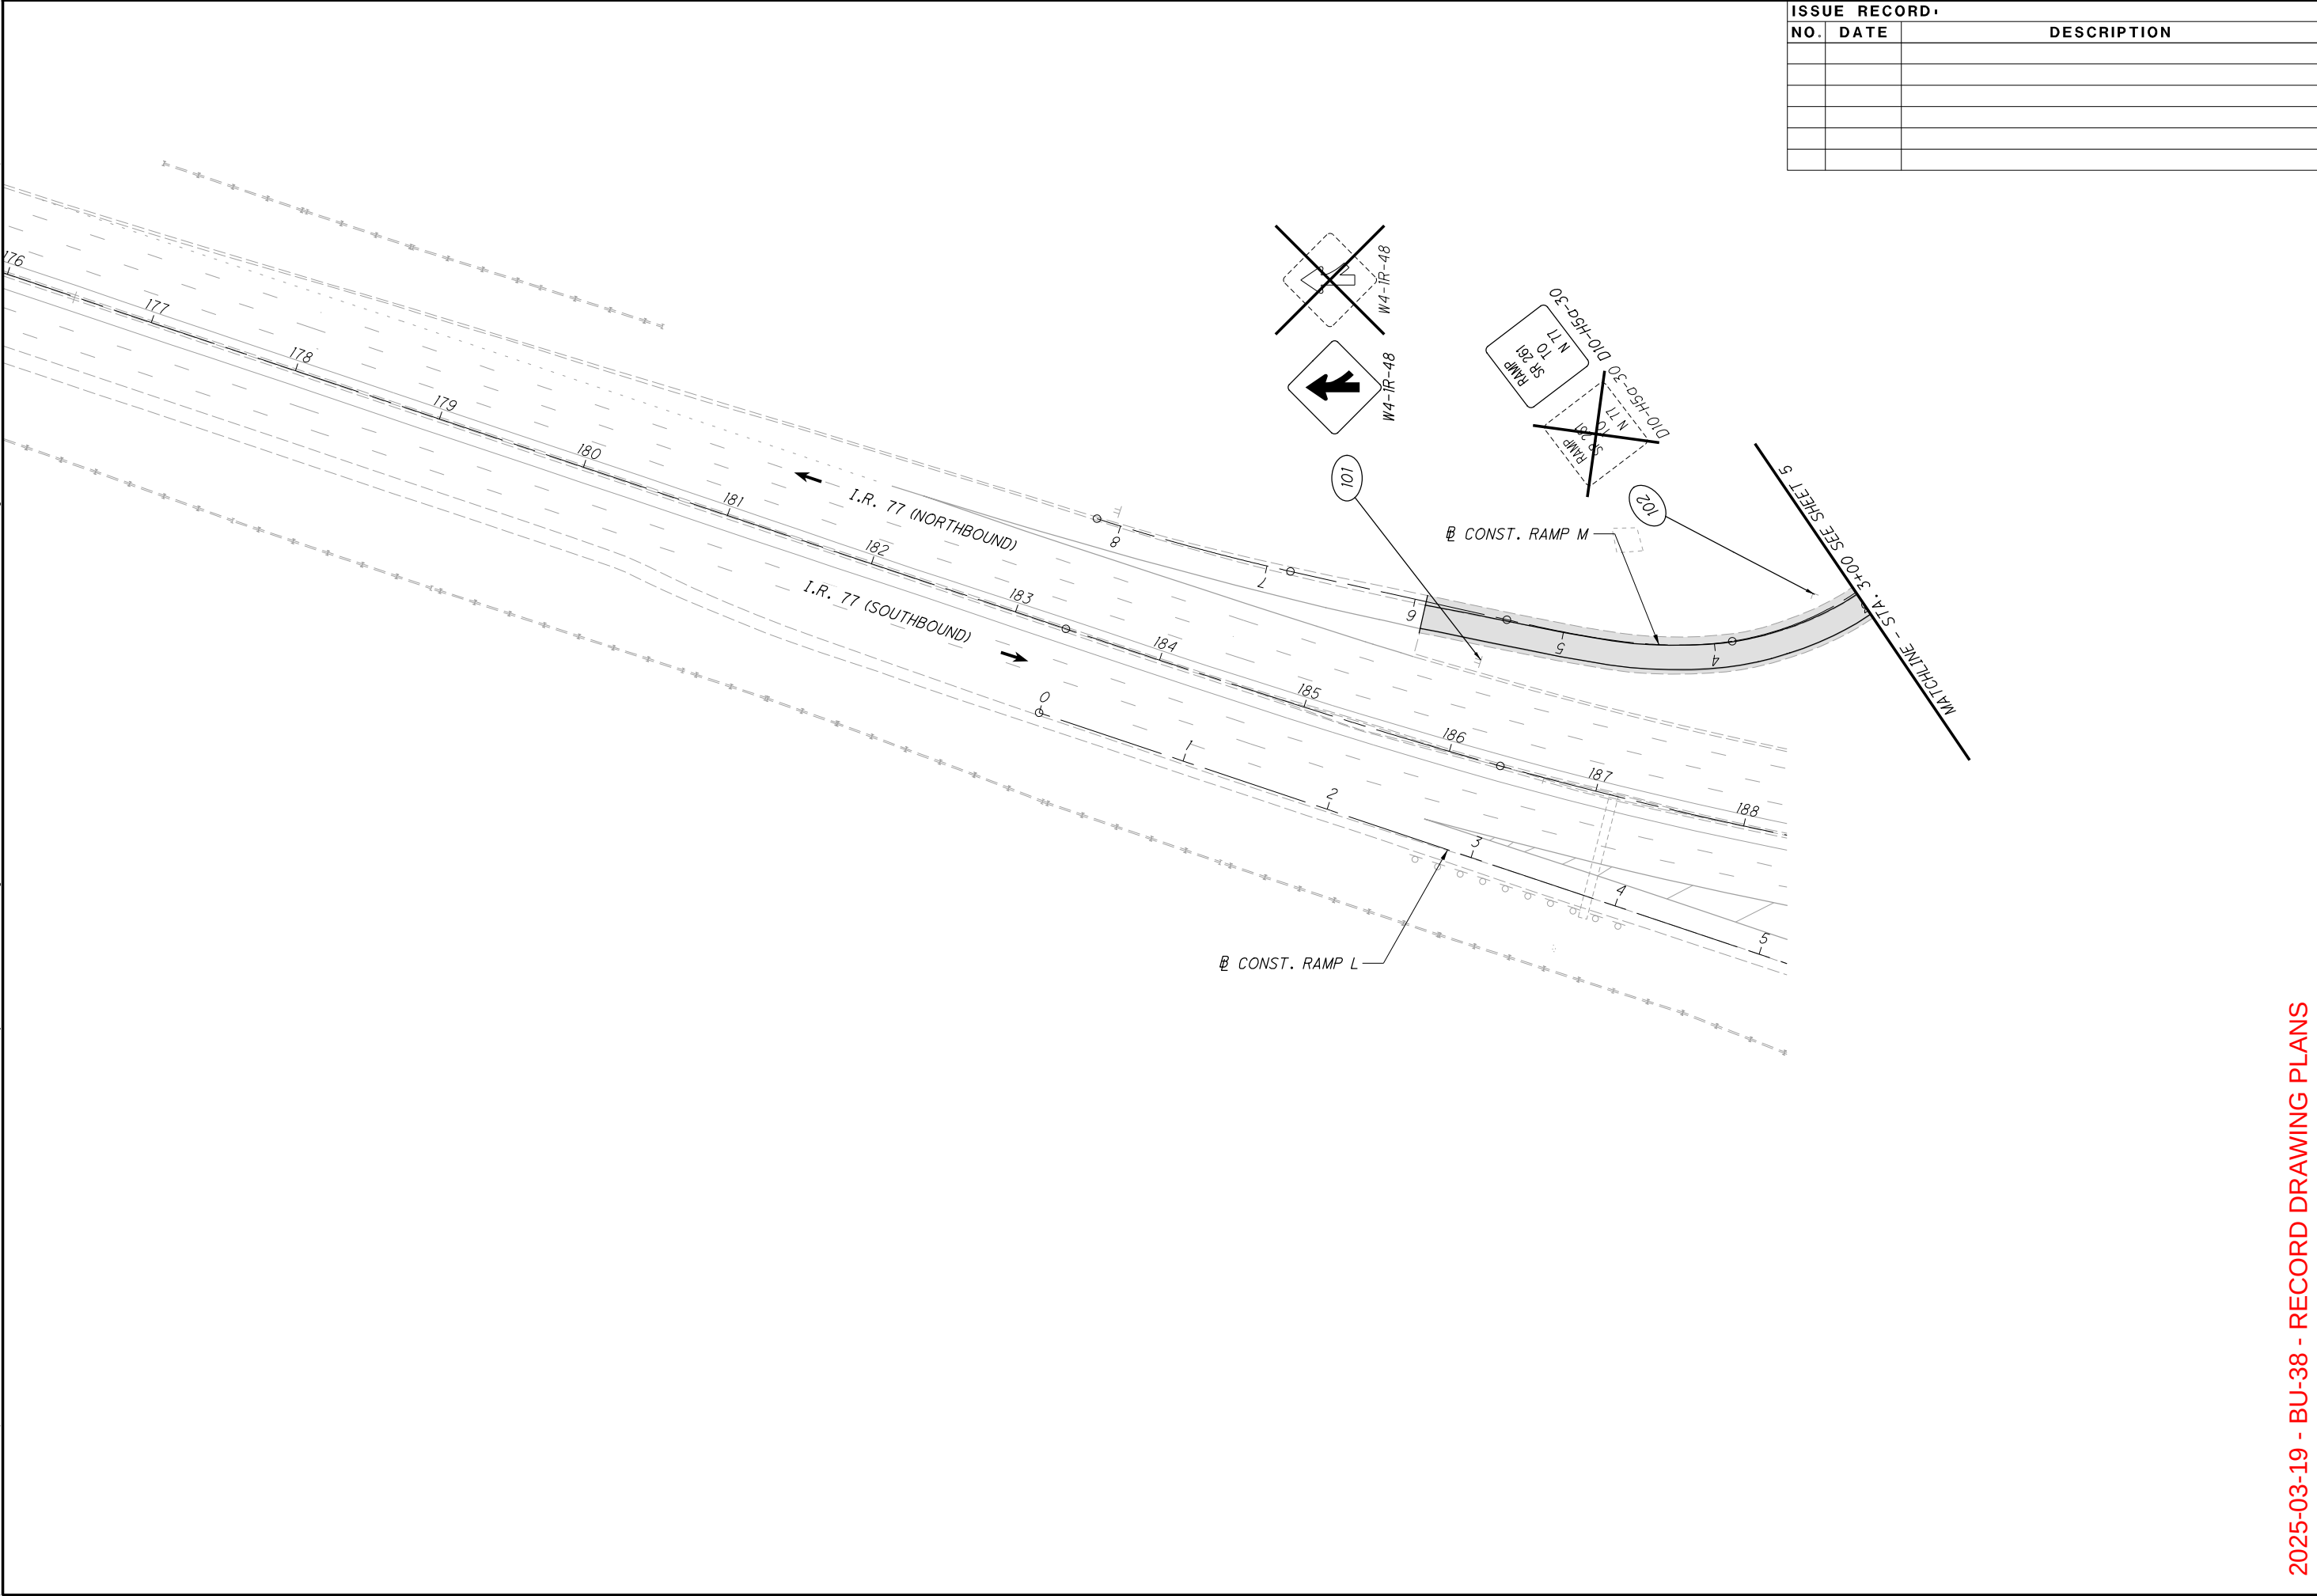

ISSUE RECORD:		
NO.	DATE	DESCRIPTION

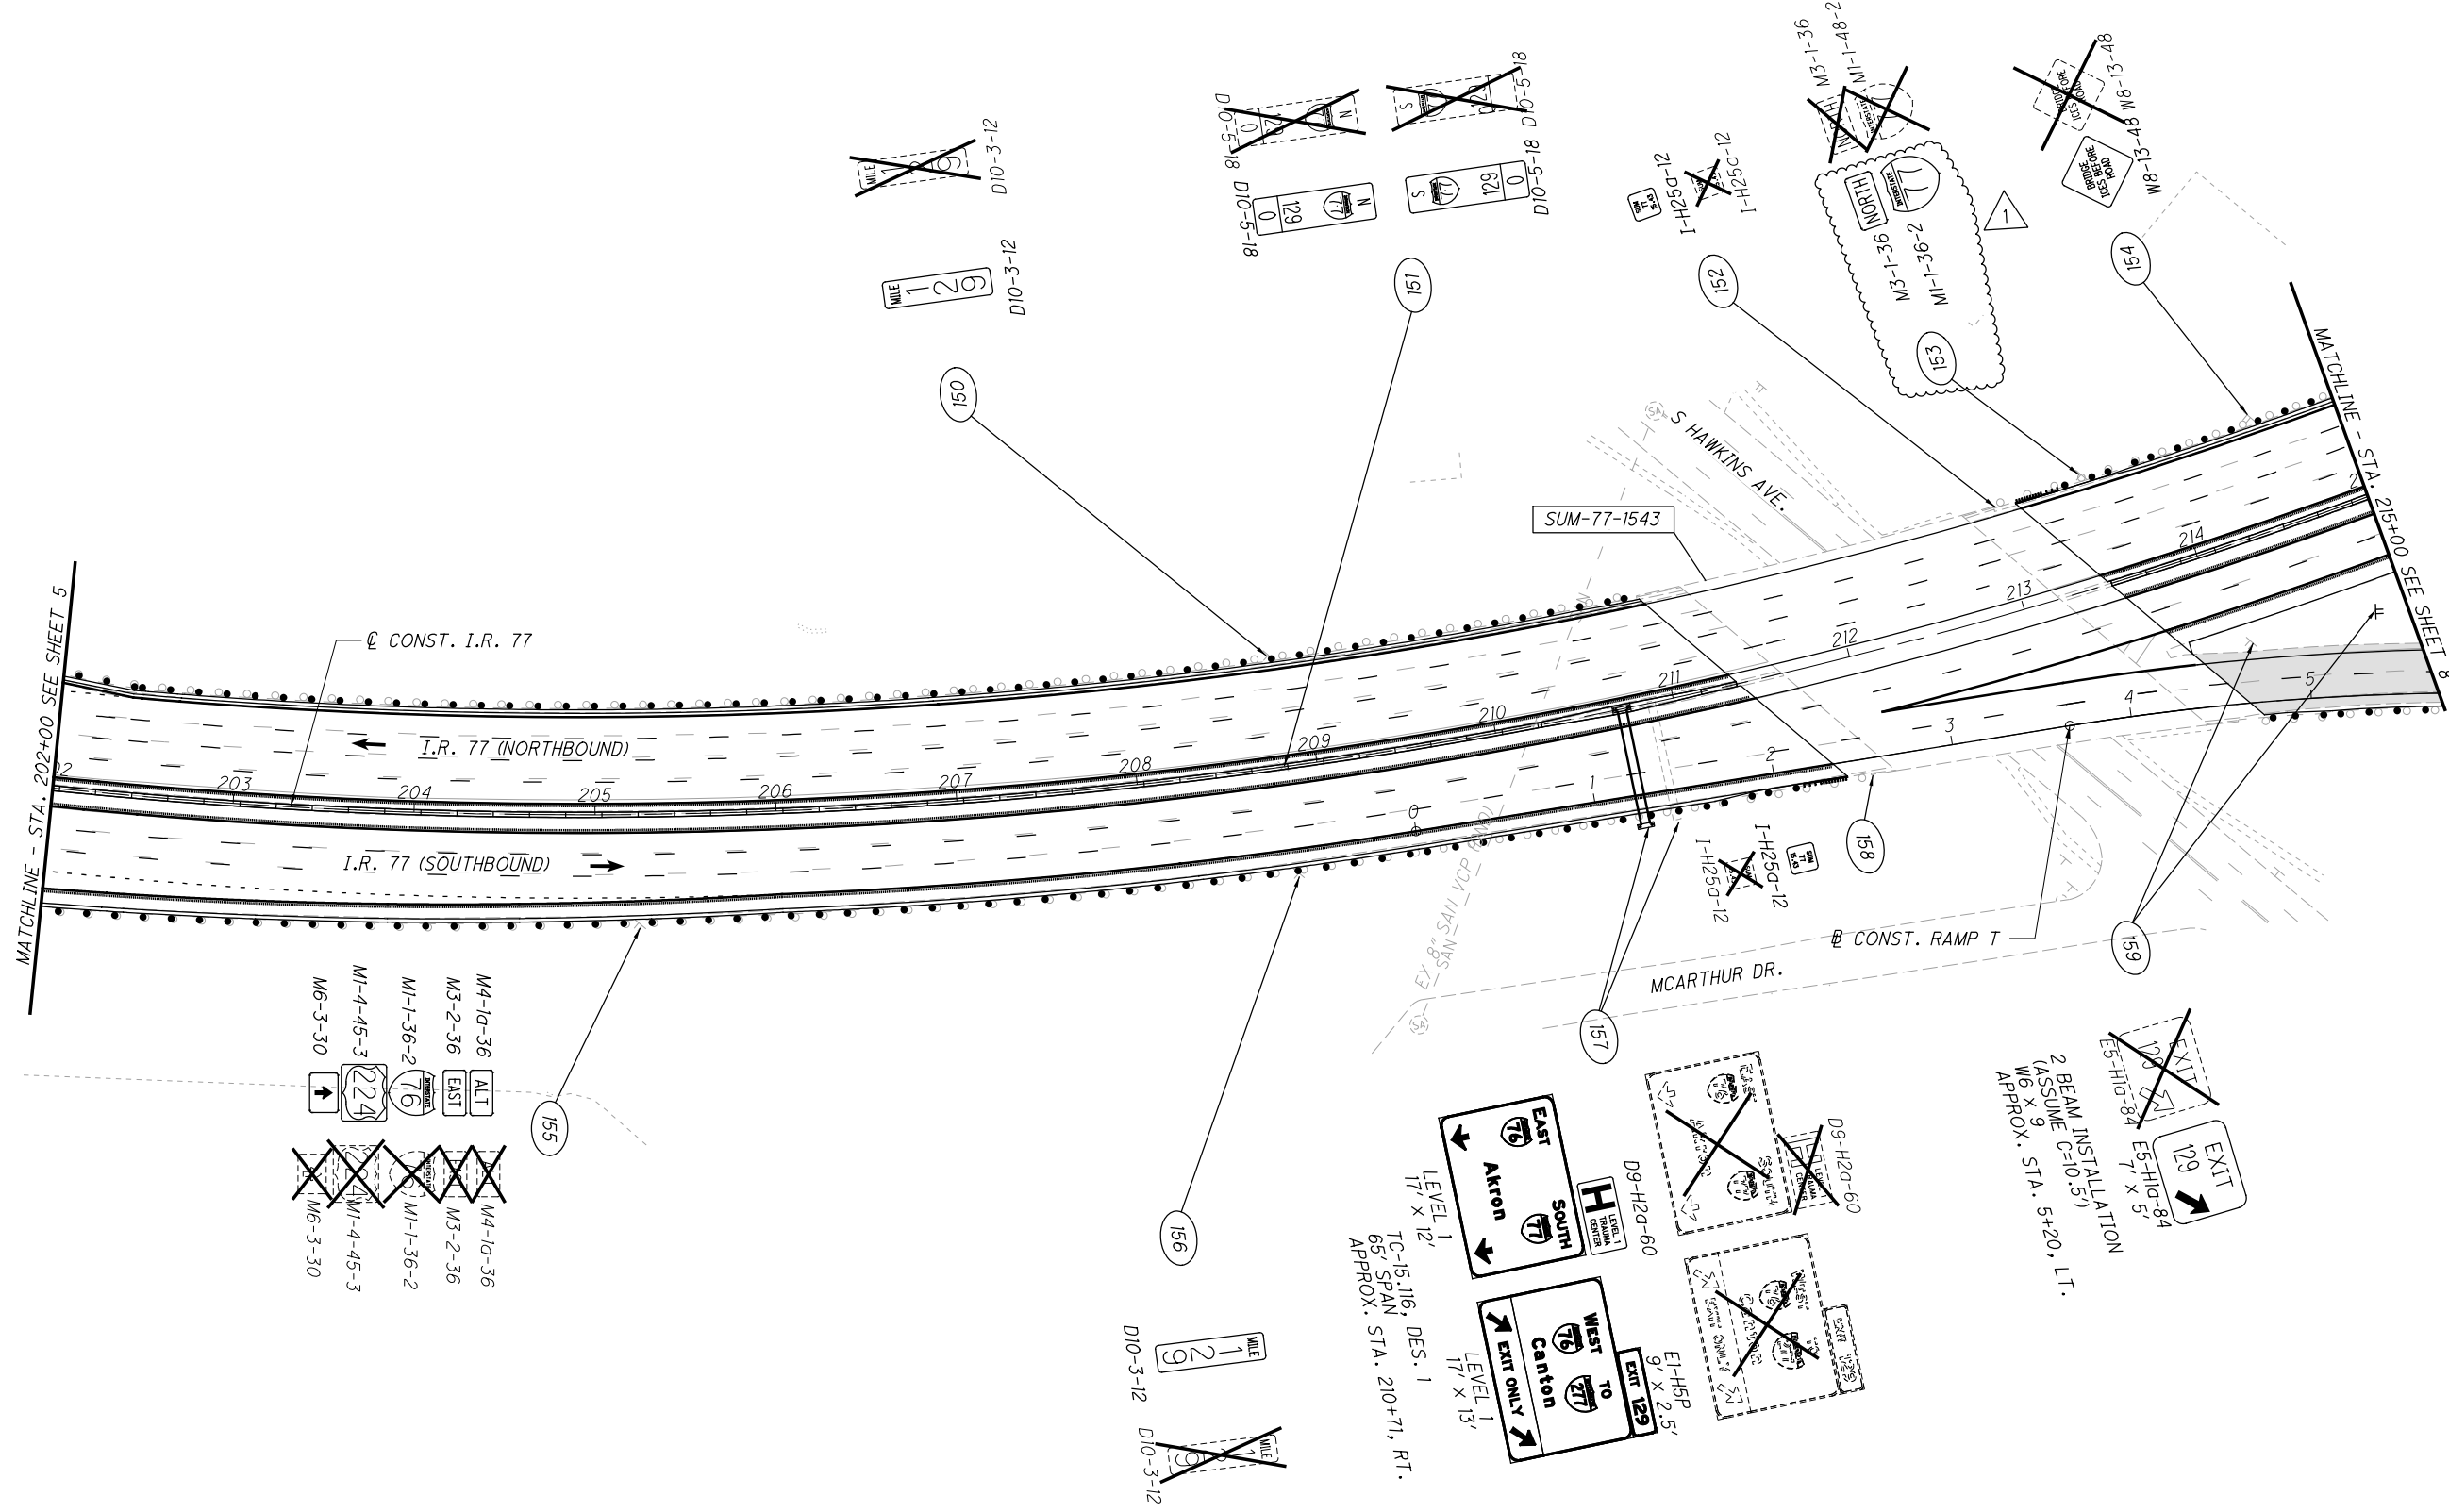


ISSUE RECORD, BU-38 TRAFFIC CONTROL		
NO.	DATE	DESCRIPTION
1	11/04/21	Revised Sign Sizes



TRAFFIC SIGNING PLAN - I.R. 77
STA. 202+00 TO STA. 215+00


**SUM-76 / 77 / 8-
8.24 / 9.74 / 0.00**

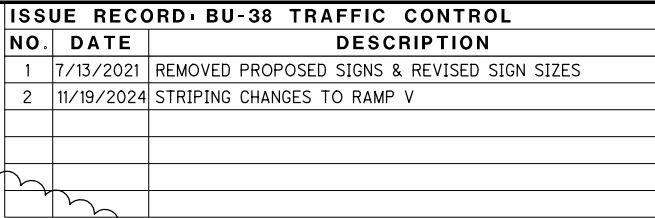

**TRAFFIC SIGNING PLAN - I.R. 77
STA. 215+00 TO STA. 228+00**

2025-03-19 - BU-38 - RECORD DRAWING PLANS


**SUM-76 / 77 / 8 -
8.24 / 9.74 / 0.00**

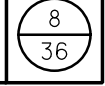




ISSUE RECORD:		
NO.	DATE	DESCRIPTION
1	11/19/2024	STRIPING CHANGES TO RAMP V



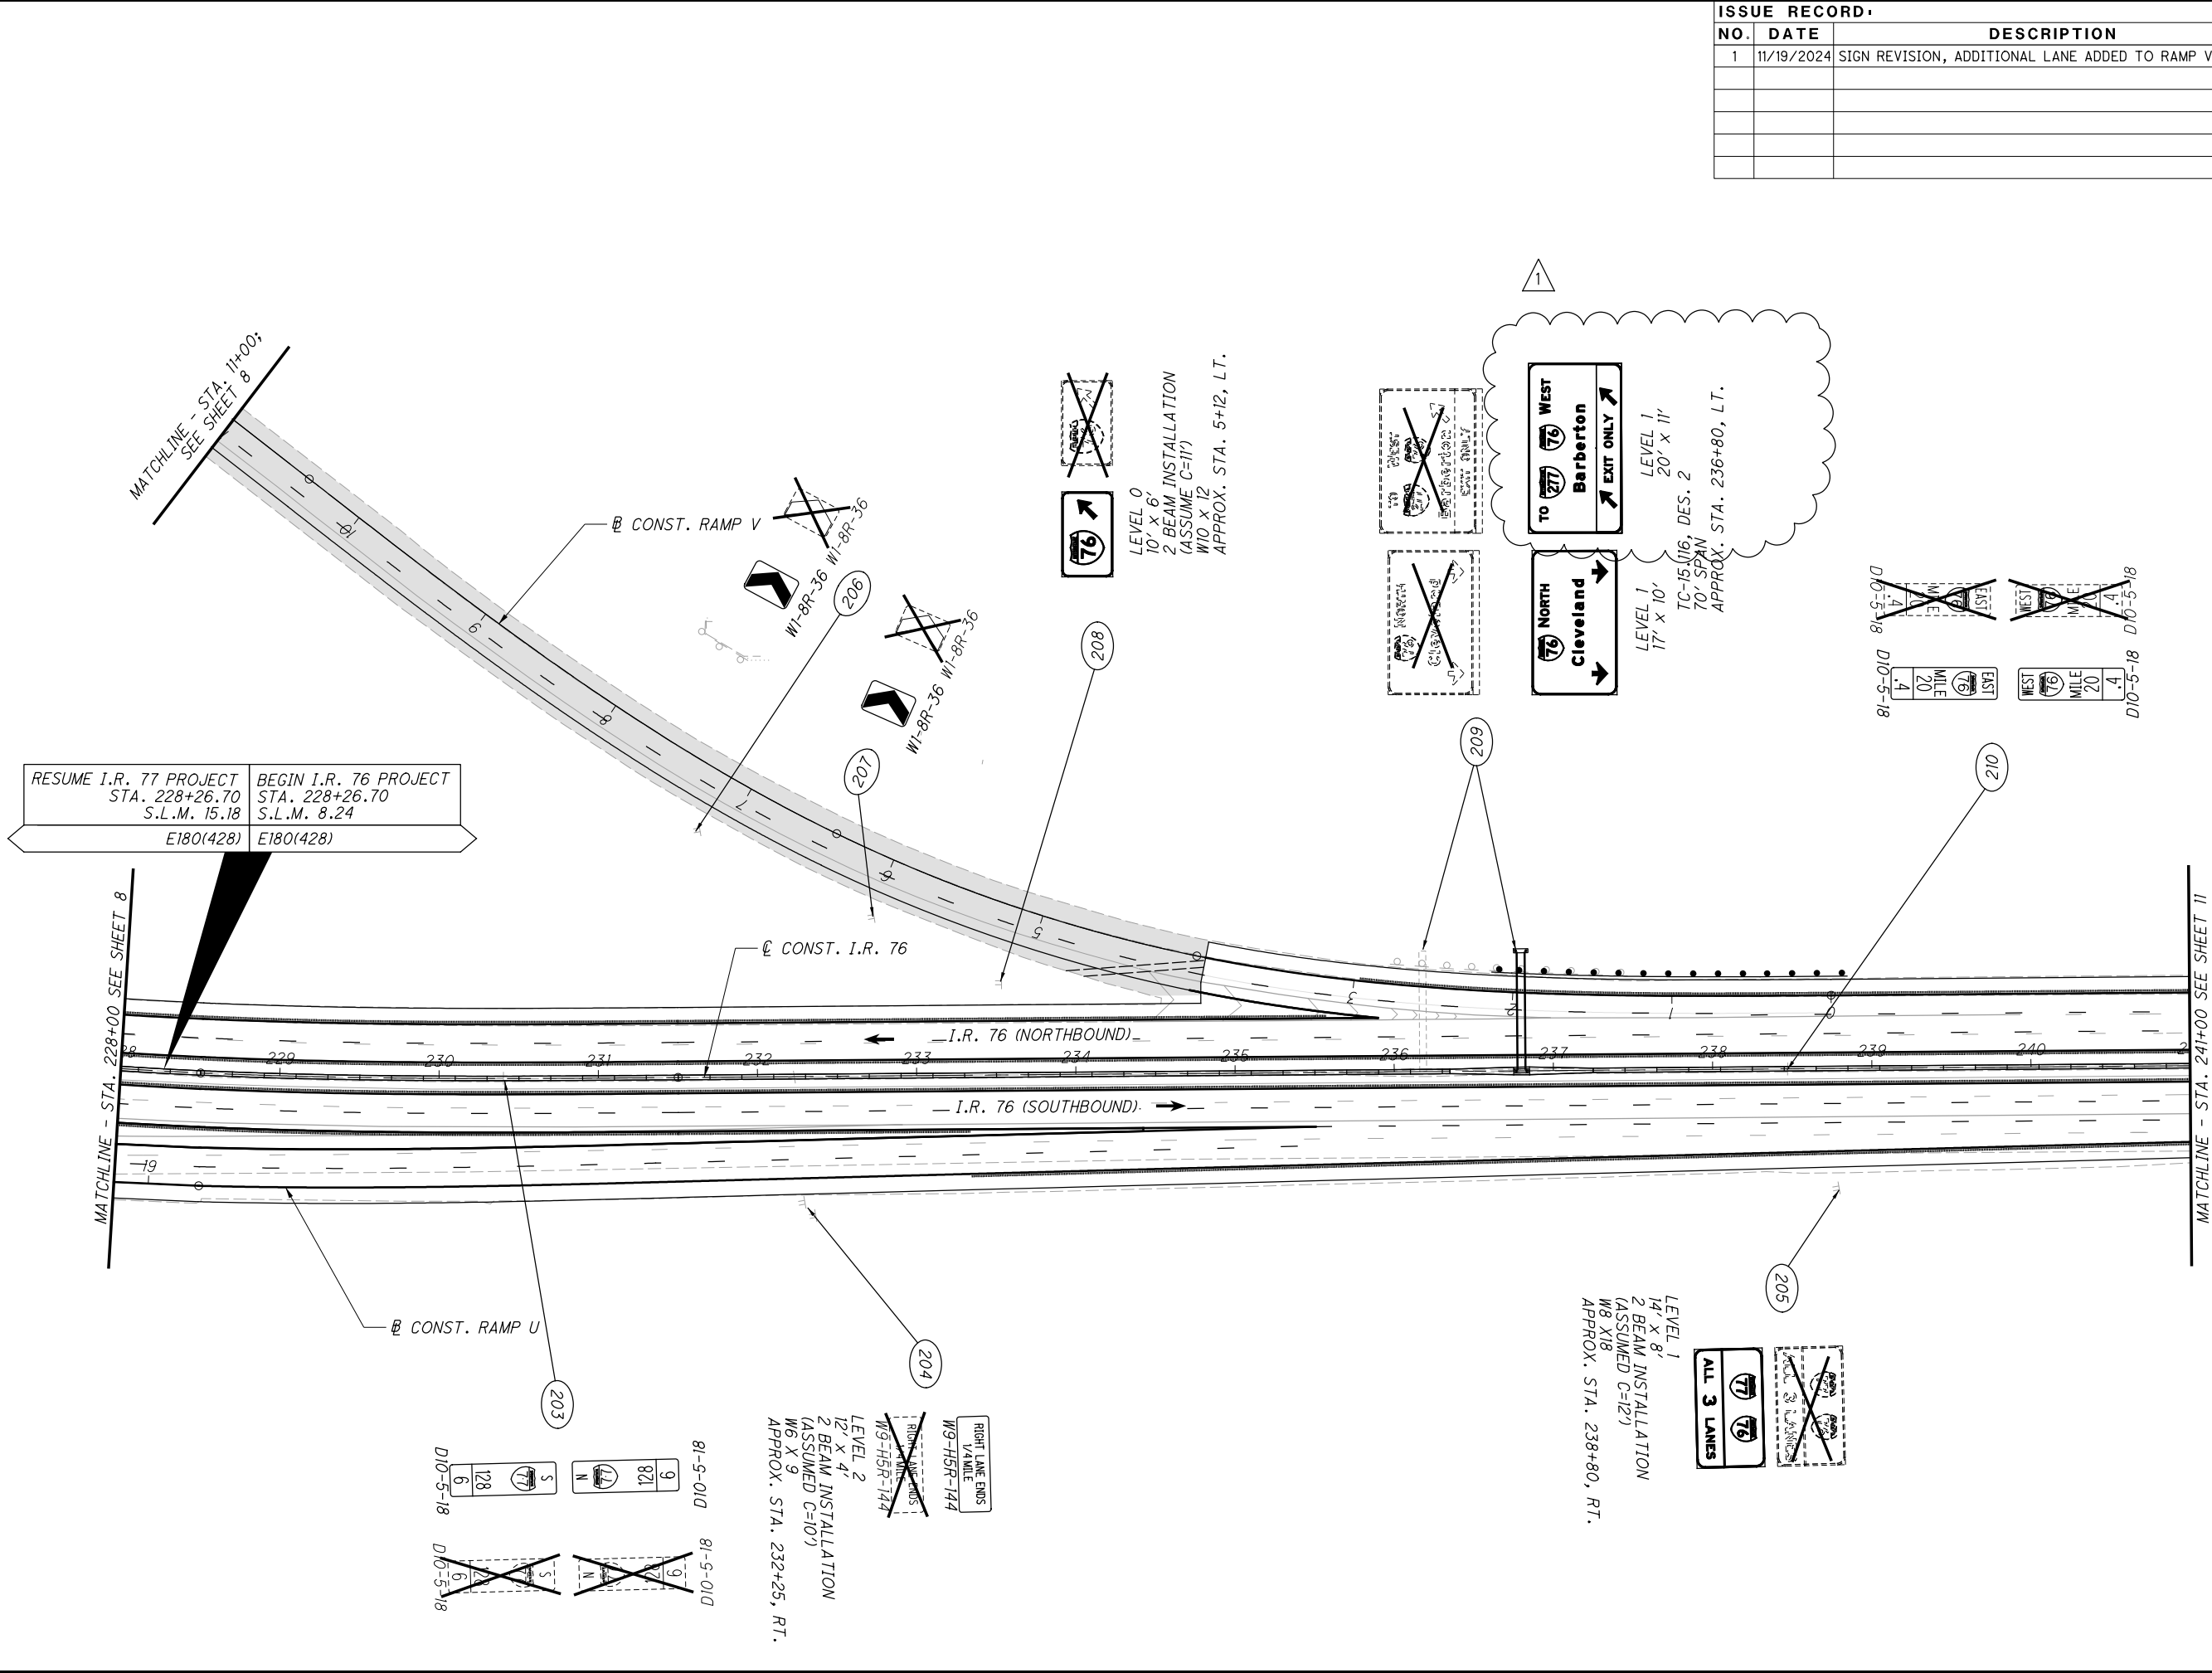

ISSUE RECORD:		
NO.	DATE	DESCRIPTION
1	11/19/2024	SIGN REVISION, ADDITIONAL LANE ADDED TO RAMP V

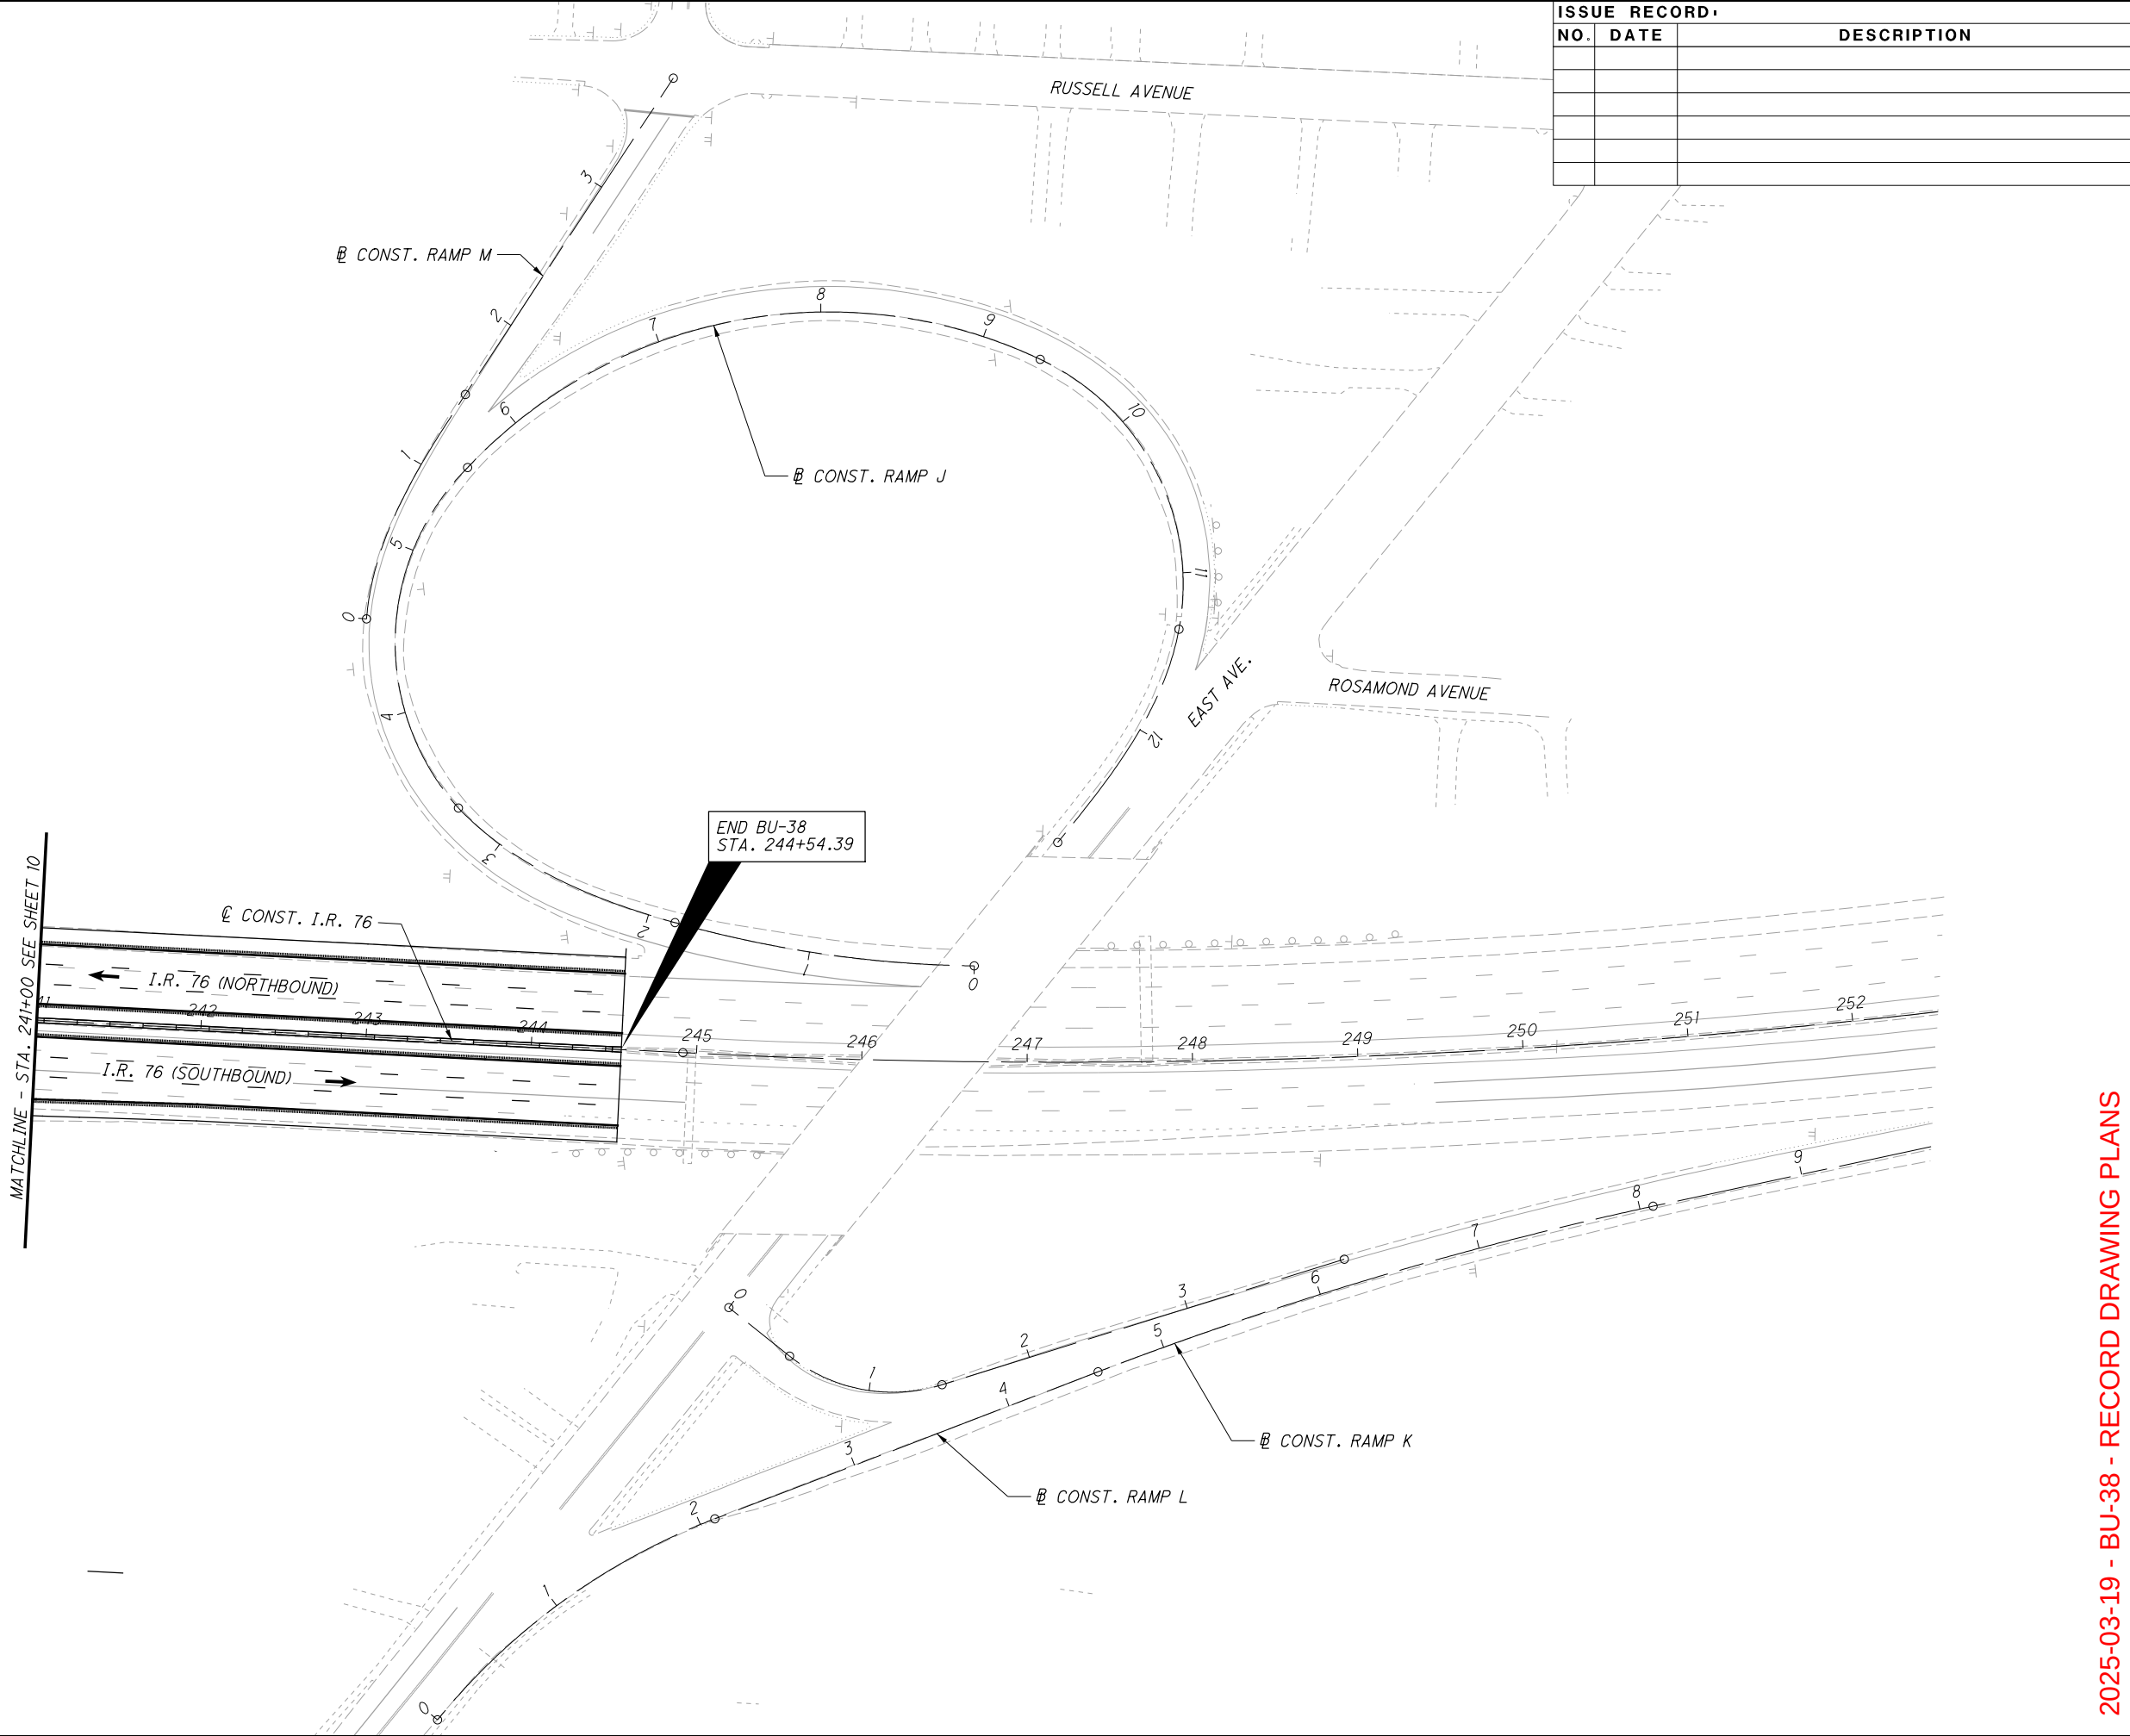

LEGEND:

- ELW-#

PROPOSED EDGE LINE, WHITE 8"
- ELY-#

PROPOSED EDGE LINE, YELLOW 8"
- LL-#

PROPOSED LANE LINE, 8"
- CH-#

PROPOSED CHANNELIZING LINE, 12"
- SL-#

PROPOSED STOP LINE
- XW-#

PROPOSED CROSSWALK LINE
- A-#

PROPOSED LANE ARROW
- W-#

PROPOSED WORD ON PAVEMENT
- DL-#

PROPOSED DOTTED LINE, 6"
- TR-#

PROPOSED TRAVERSE MARKINGS
- WA-#

PROPOSED WRONG WAY ARROW

NOTES:

1. LONG LINE PAVEMENT MARKINGS SHALL BE WET REFLECTIVE LIQUID APPLIED EPOXY PER SS 807 AND RECESSED PER SS 850, ALL OTHER PAVEMENT MARKINGS SHALL BE EPOXY.
2. PLACE BARRIER REFLECTORS ALONG THE MEDIAN BARRIER ALONG I.R. 76/I.R. 77 IN THE EB/WB & SB/NB DIRECTION.
3. PLACE RPMS ALONG PAVEMENT MARKING LINES AS PER STANDARD CONSTRUCTION DRAWINGS.

ISSUE RECORD:		
NO.	DATE	DESCRIPTION


CALCULATED
AC


CHECKED
REH

050100

HORIZONTAL
SCALE IN FEET

N

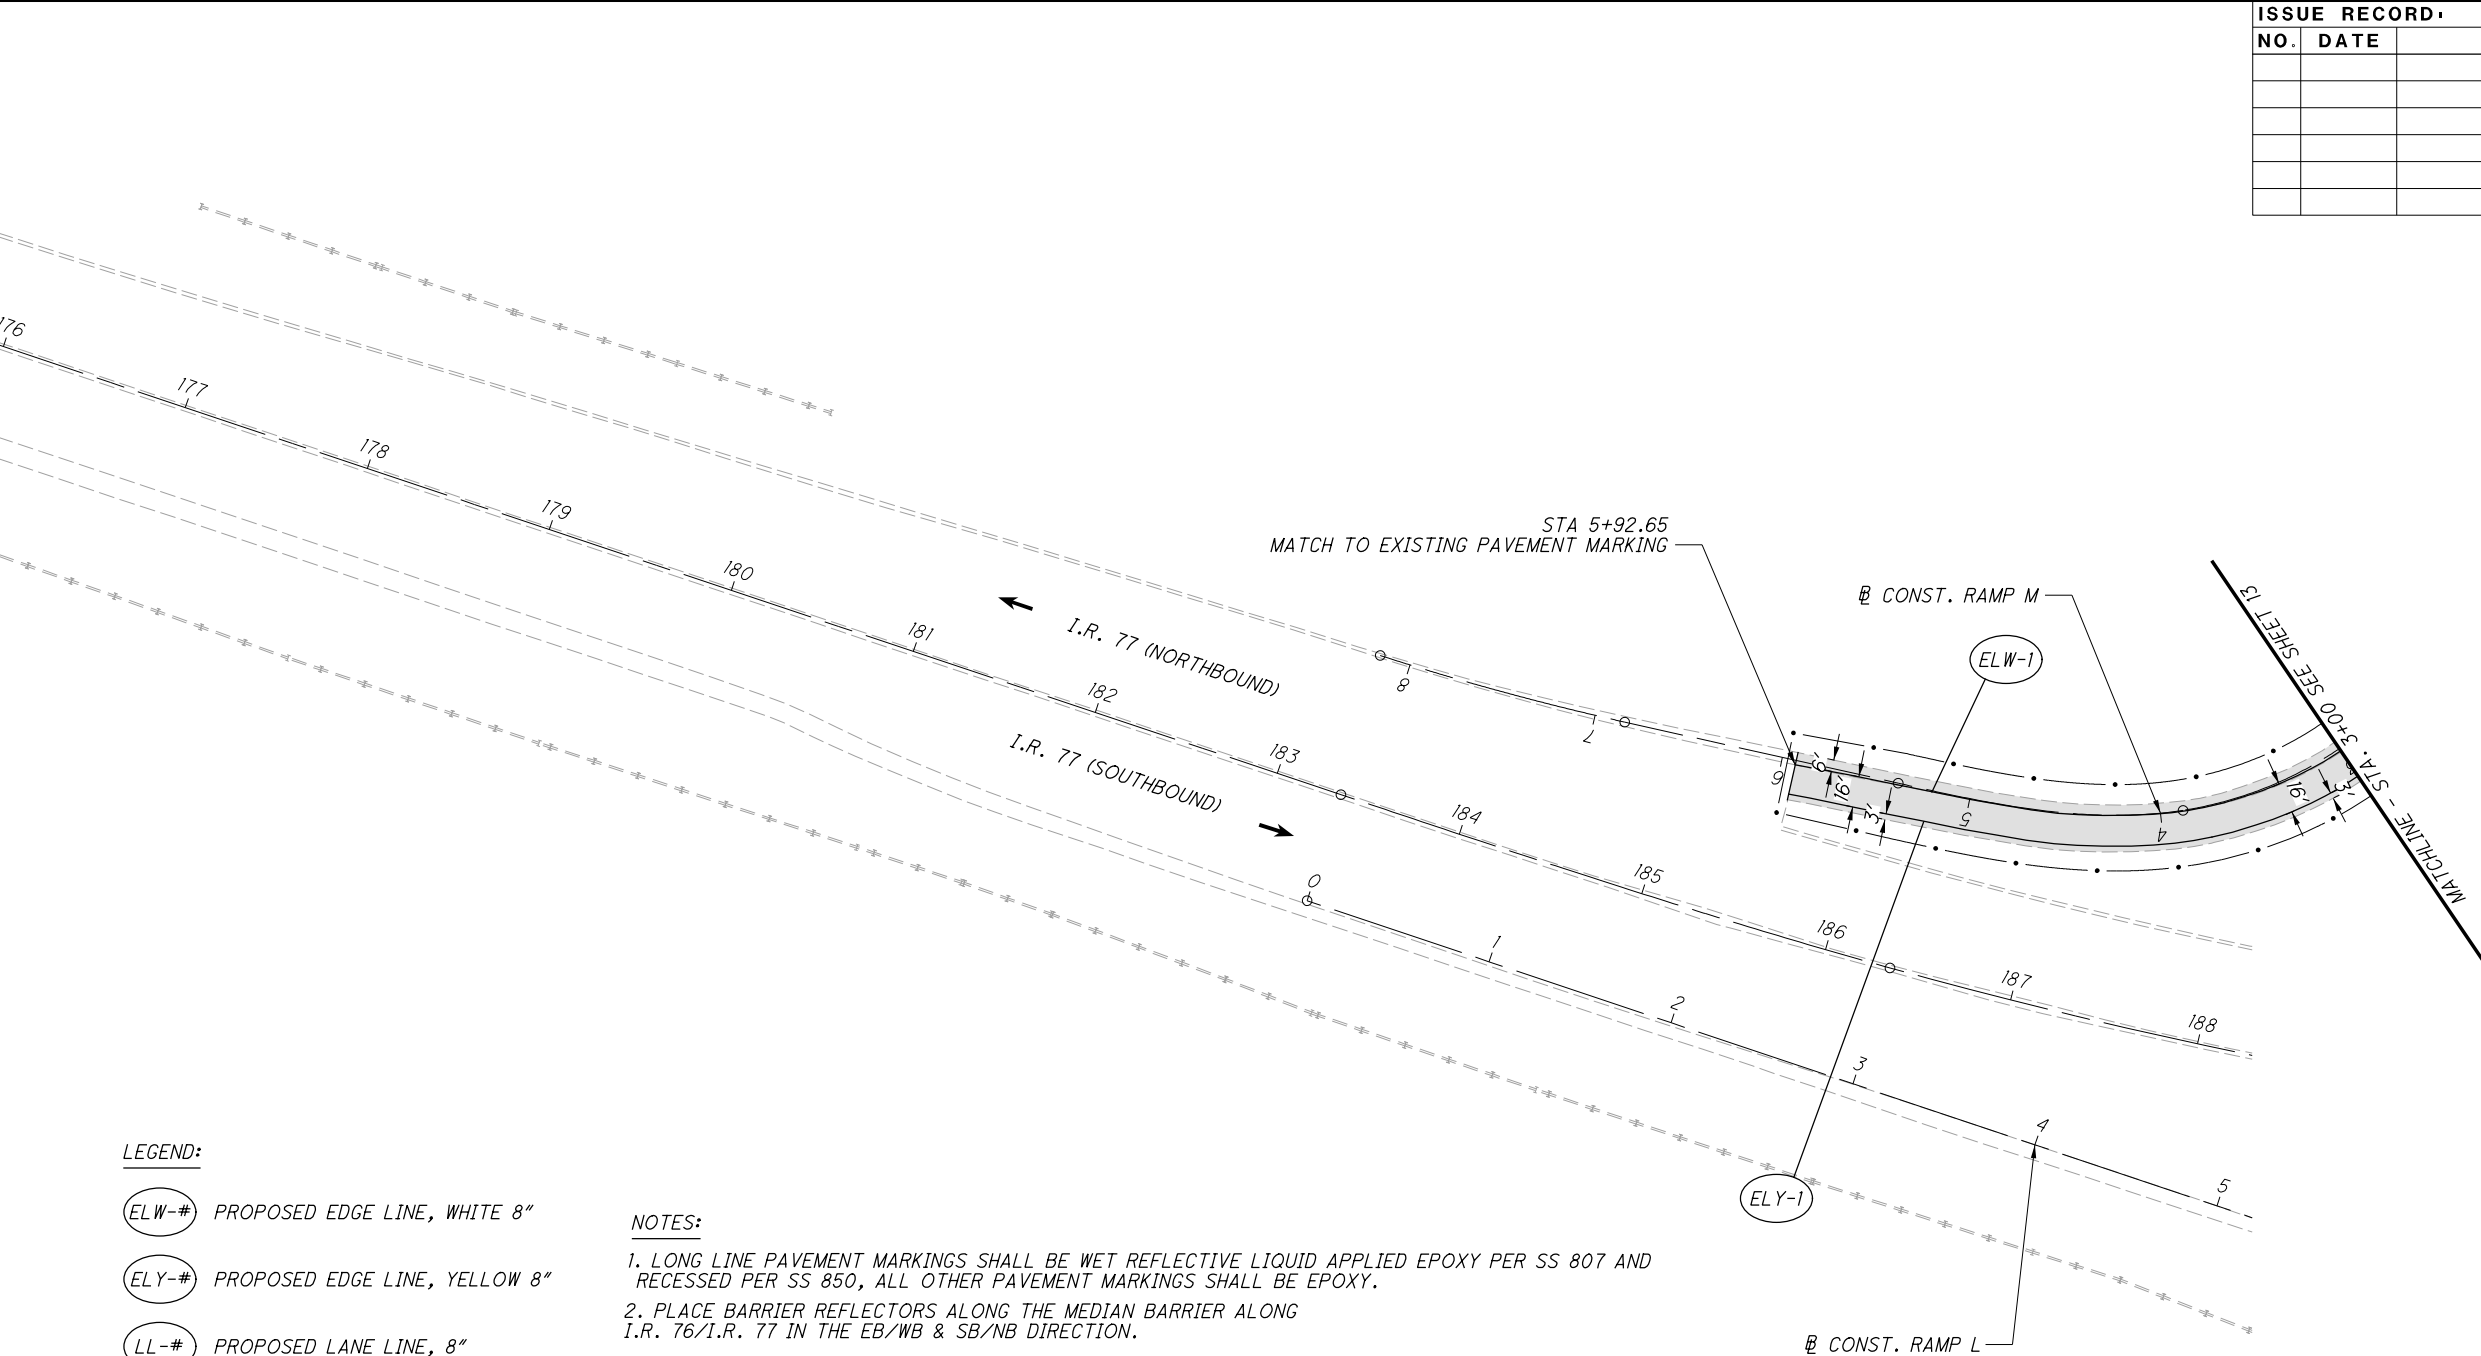

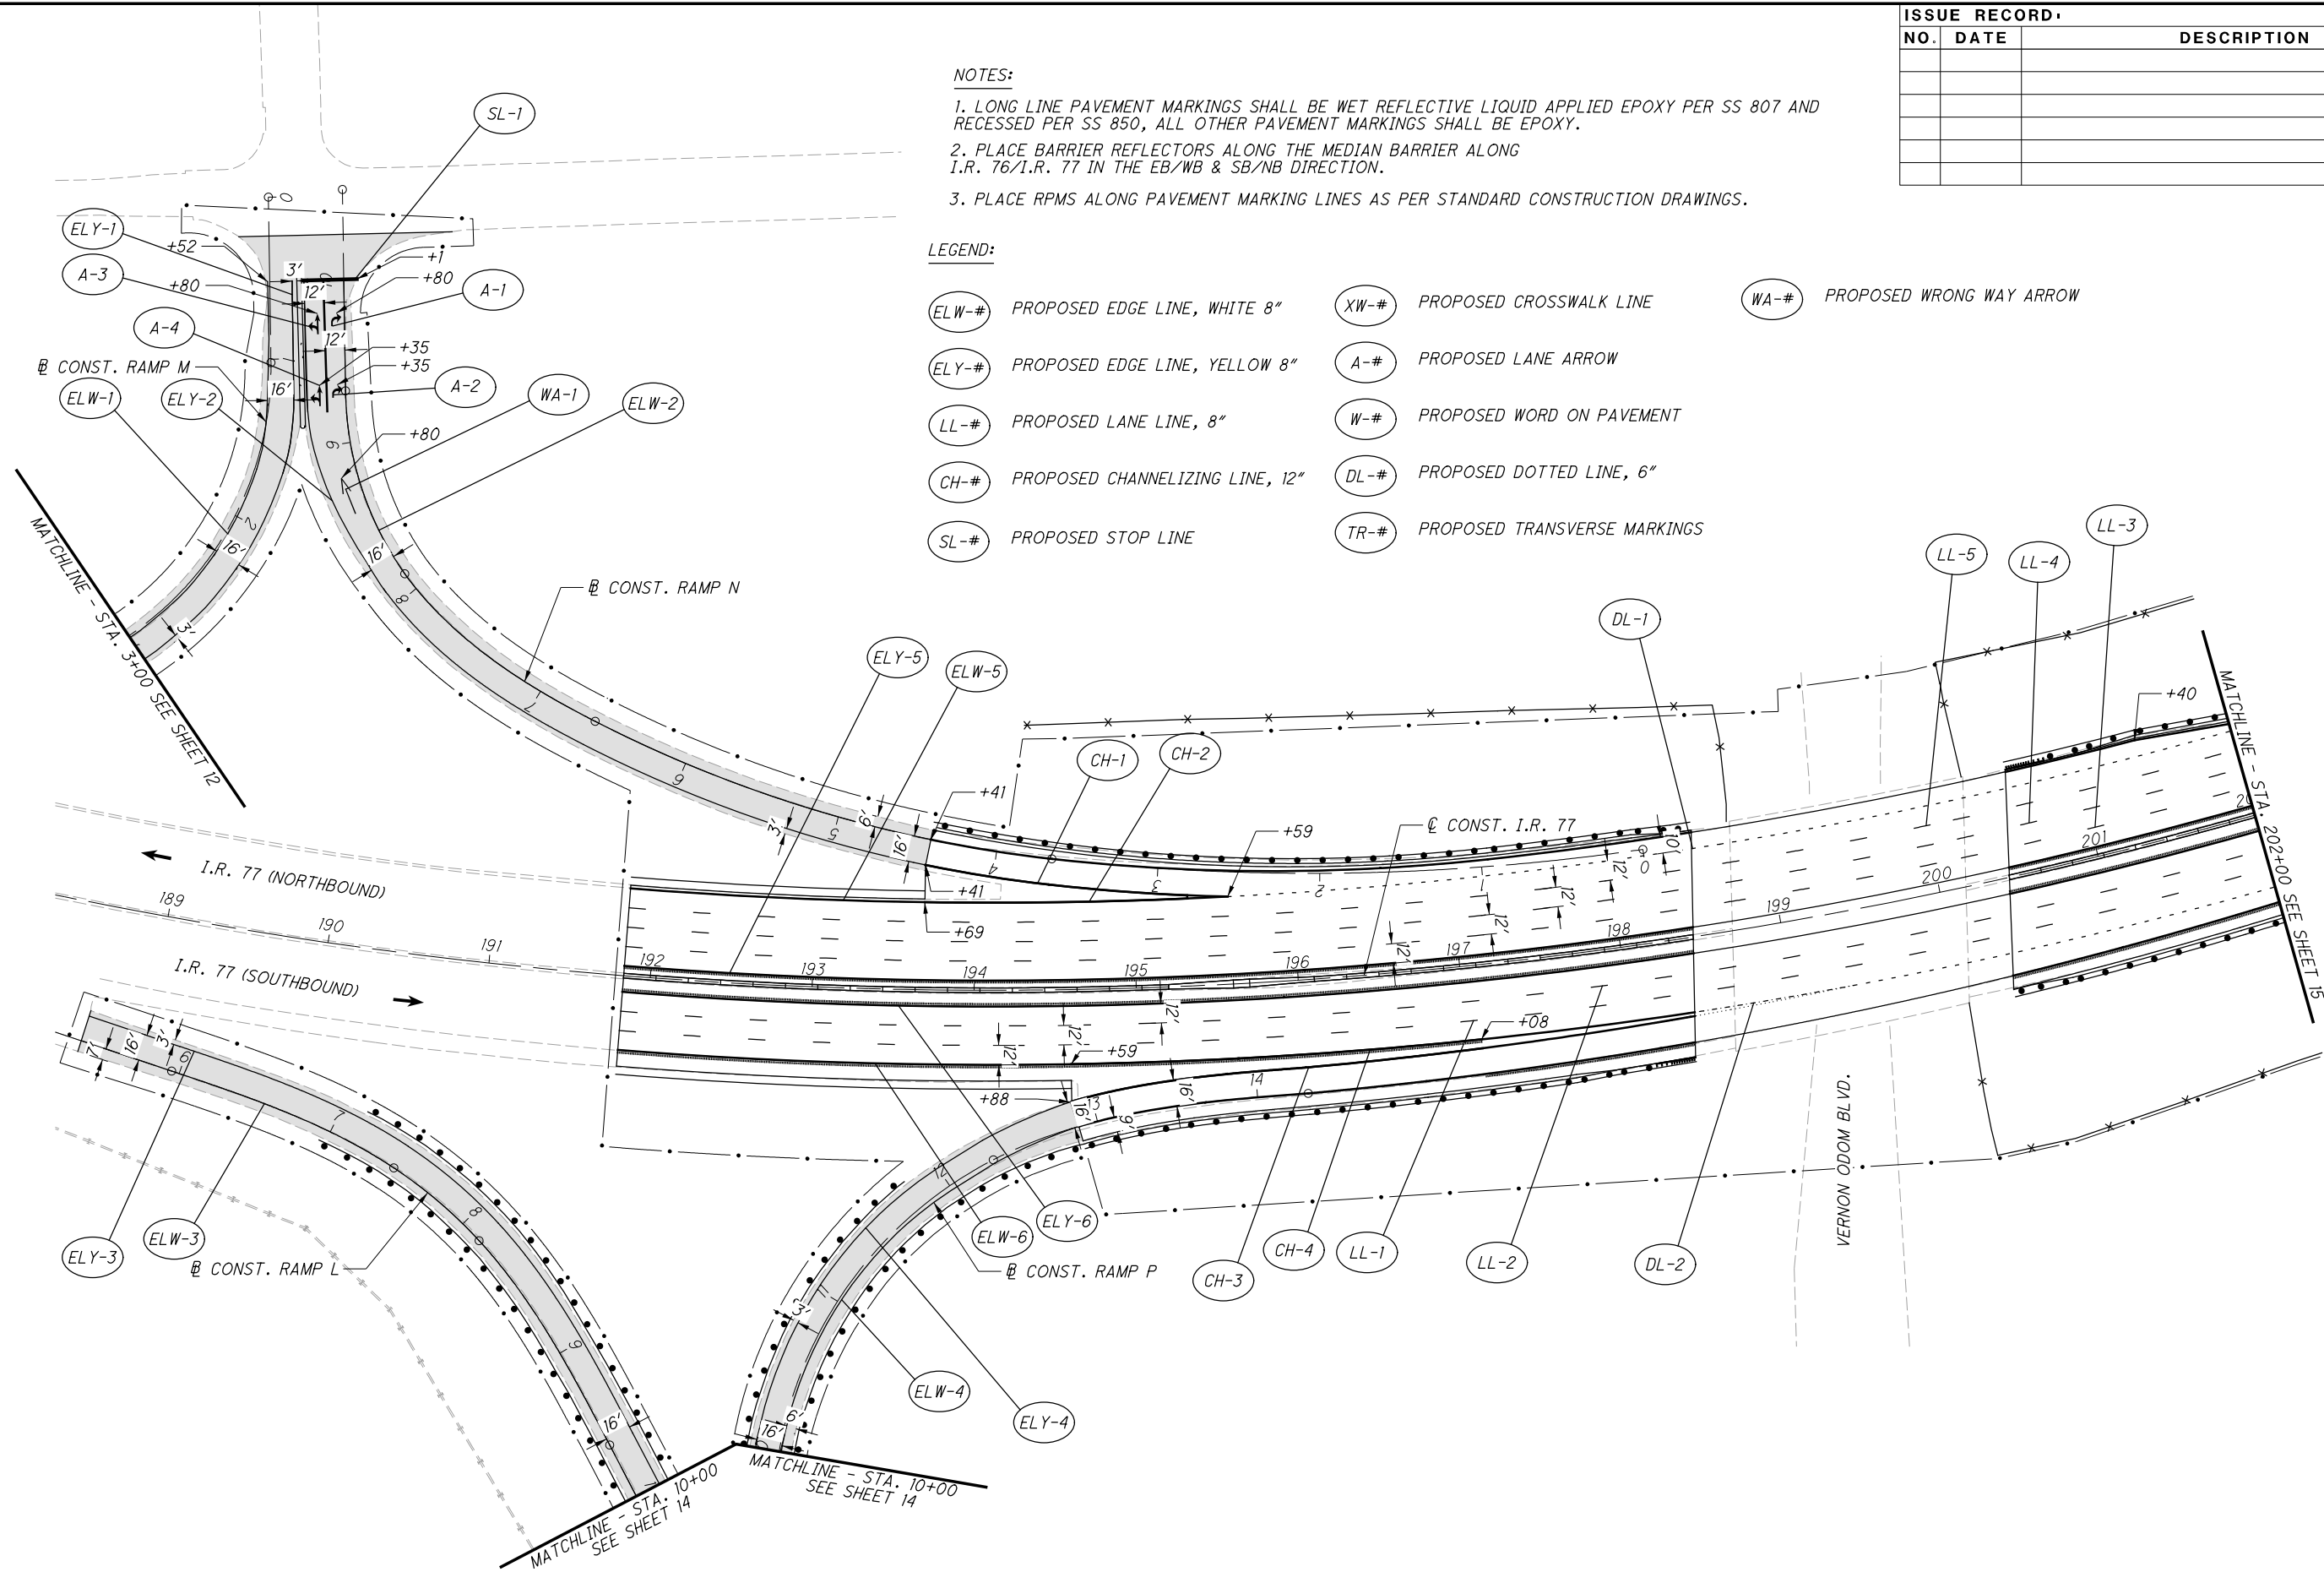[illegible]

NOTES:

1. LONG LINE PAVEMENT MARKINGS SHALL BE WET REFLECTIVE LIQUID APPLIED EPOXY PER SS 807 AND RECESSED PER SS 850, ALL OTHER PAVEMENT MARKINGS SHALL BE EPOXY.
2. PLACE BARRIER REFLECTORS ALONG THE MEDIAN BARRIER ALONG I.R. 76/I.R. 77 IN THE EB/WB & SB/NB DIRECTION.
3. PLACE RPMS ALONG PAVEMENT MARKING LINES AS PER STANDARD CONSTRUCTION DRAWINGS.

LEGEND:

- ELW-#

PROPOSED EDGE LINE, WHITE 8"
- ELY-#

PROPOSED EDGE LINE, YELLOW 8"
- LL-#

PROPOSED LANE LINE, 8"
- CH-#

PROPOSED CHANNELIZING LINE, 12"
- SL-#

PROPOSED STOP LINE
- XW-#

PROPOSED CROSSWALK LINE
- A-#


PROPOSED LANE ARROW
- W-#

PROPOSED WORD ON PAVEMENT
- DL-#

PROPOSED DOTTED LINE, 6"
- TR-#

PROPOSED TRANSVERSE MARKINGS
- WA-#

PROPOSED WRONG WAY ARROW

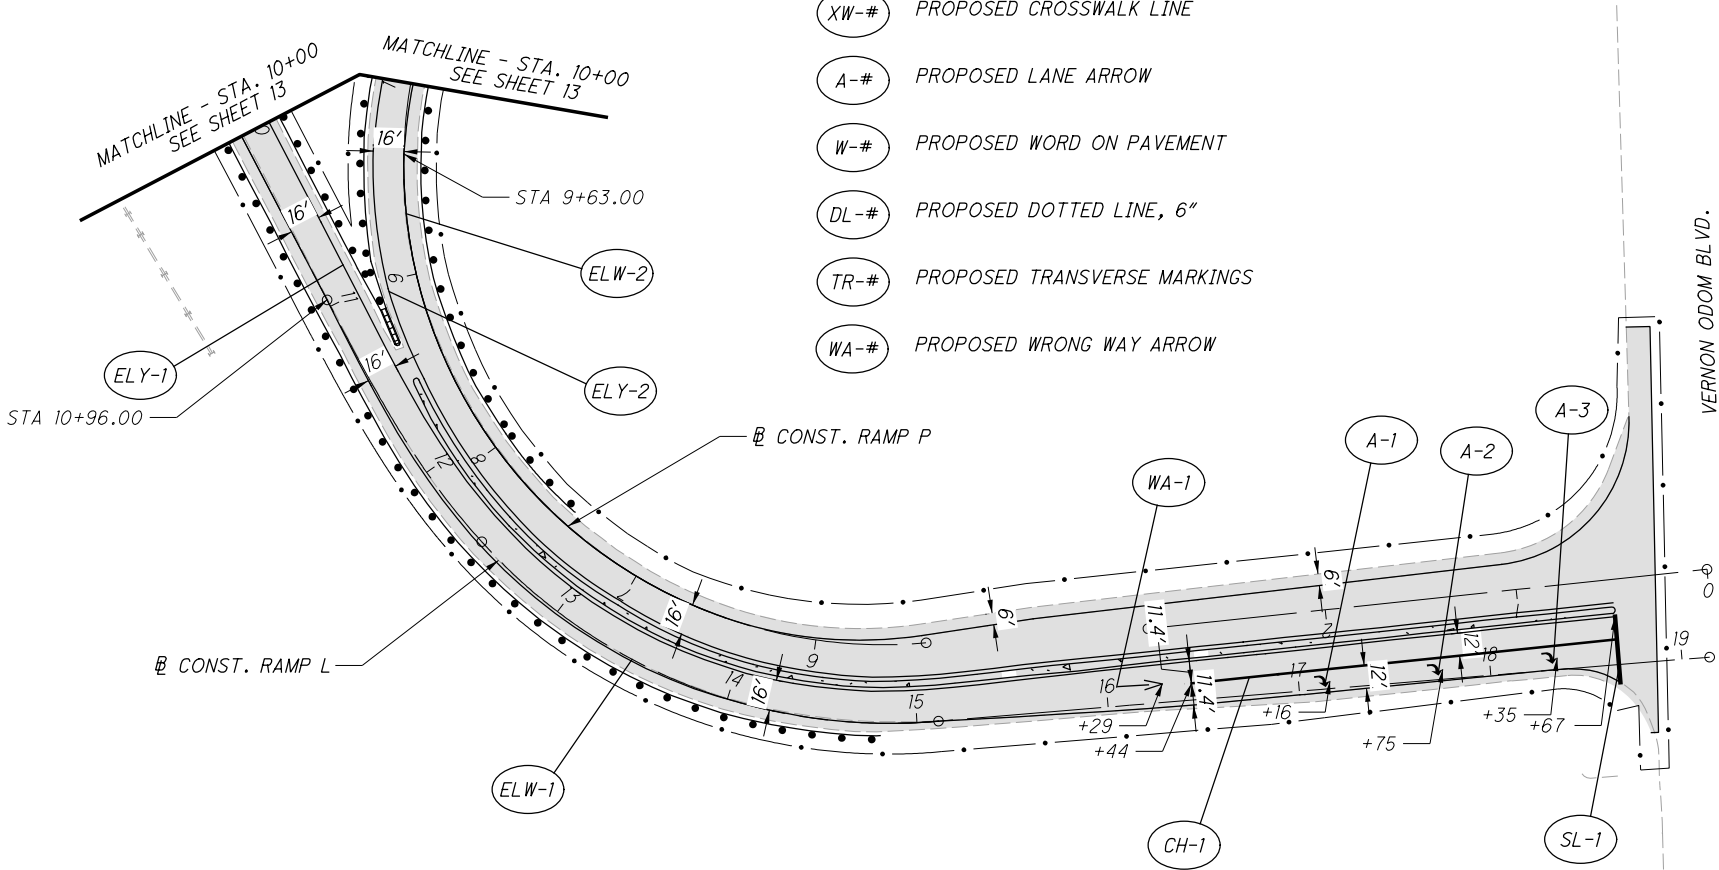

ISSUE RECORD:		
NO.	DATE	DESCRIPTION

NOTES:

1. LONG LINE PAVEMENT MARKINGS SHALL BE WET REFLECTIVE LIQUID APPLIED EPOXY PER SS 807 AND RECESSED PER SS 850, ALL OTHER PAVEMENT MARKINGS SHALL BE EPOXY.
2. PLACE BARRIER REFLECTORS ALONG THE MEDIAN BARRIER ALONG I.R. 76/I.R. 77 IN THE EB/WB & SB/NB DIRECTION.
3. PLACE RPMS ALONG PAVEMENT MARKING LINES AS PER STANDARD CONSTRUCTION DRAWINGS.

LEGEND:

- ELW-#

PROPOSED EDGE LINE, WHITE 8"
- ELY-#

PROPOSED EDGE LINE, YELLOW 8"
- LL-#

PROPOSED LANE LINE, 8"
- CH-#

PROPOSED CHANNELIZING LINE, 12"
- SL-#

PROPOSED STOP LINE
- XW-#

PROPOSED CROSSWALK LINE
- A-#

PROPOSED LANE ARROW
- W-#



PROPOSED WORD ON PAVEMENT
- DL-#

PROPOSED DOTTED LINE, 6"
- TR-#

PROPOSED TRANSVERSE MARKINGS
- WA-#

PROPOSED WRONG WAY ARROW


ISSUE RECORD:		
NO.	DATE	DESCRIPTION

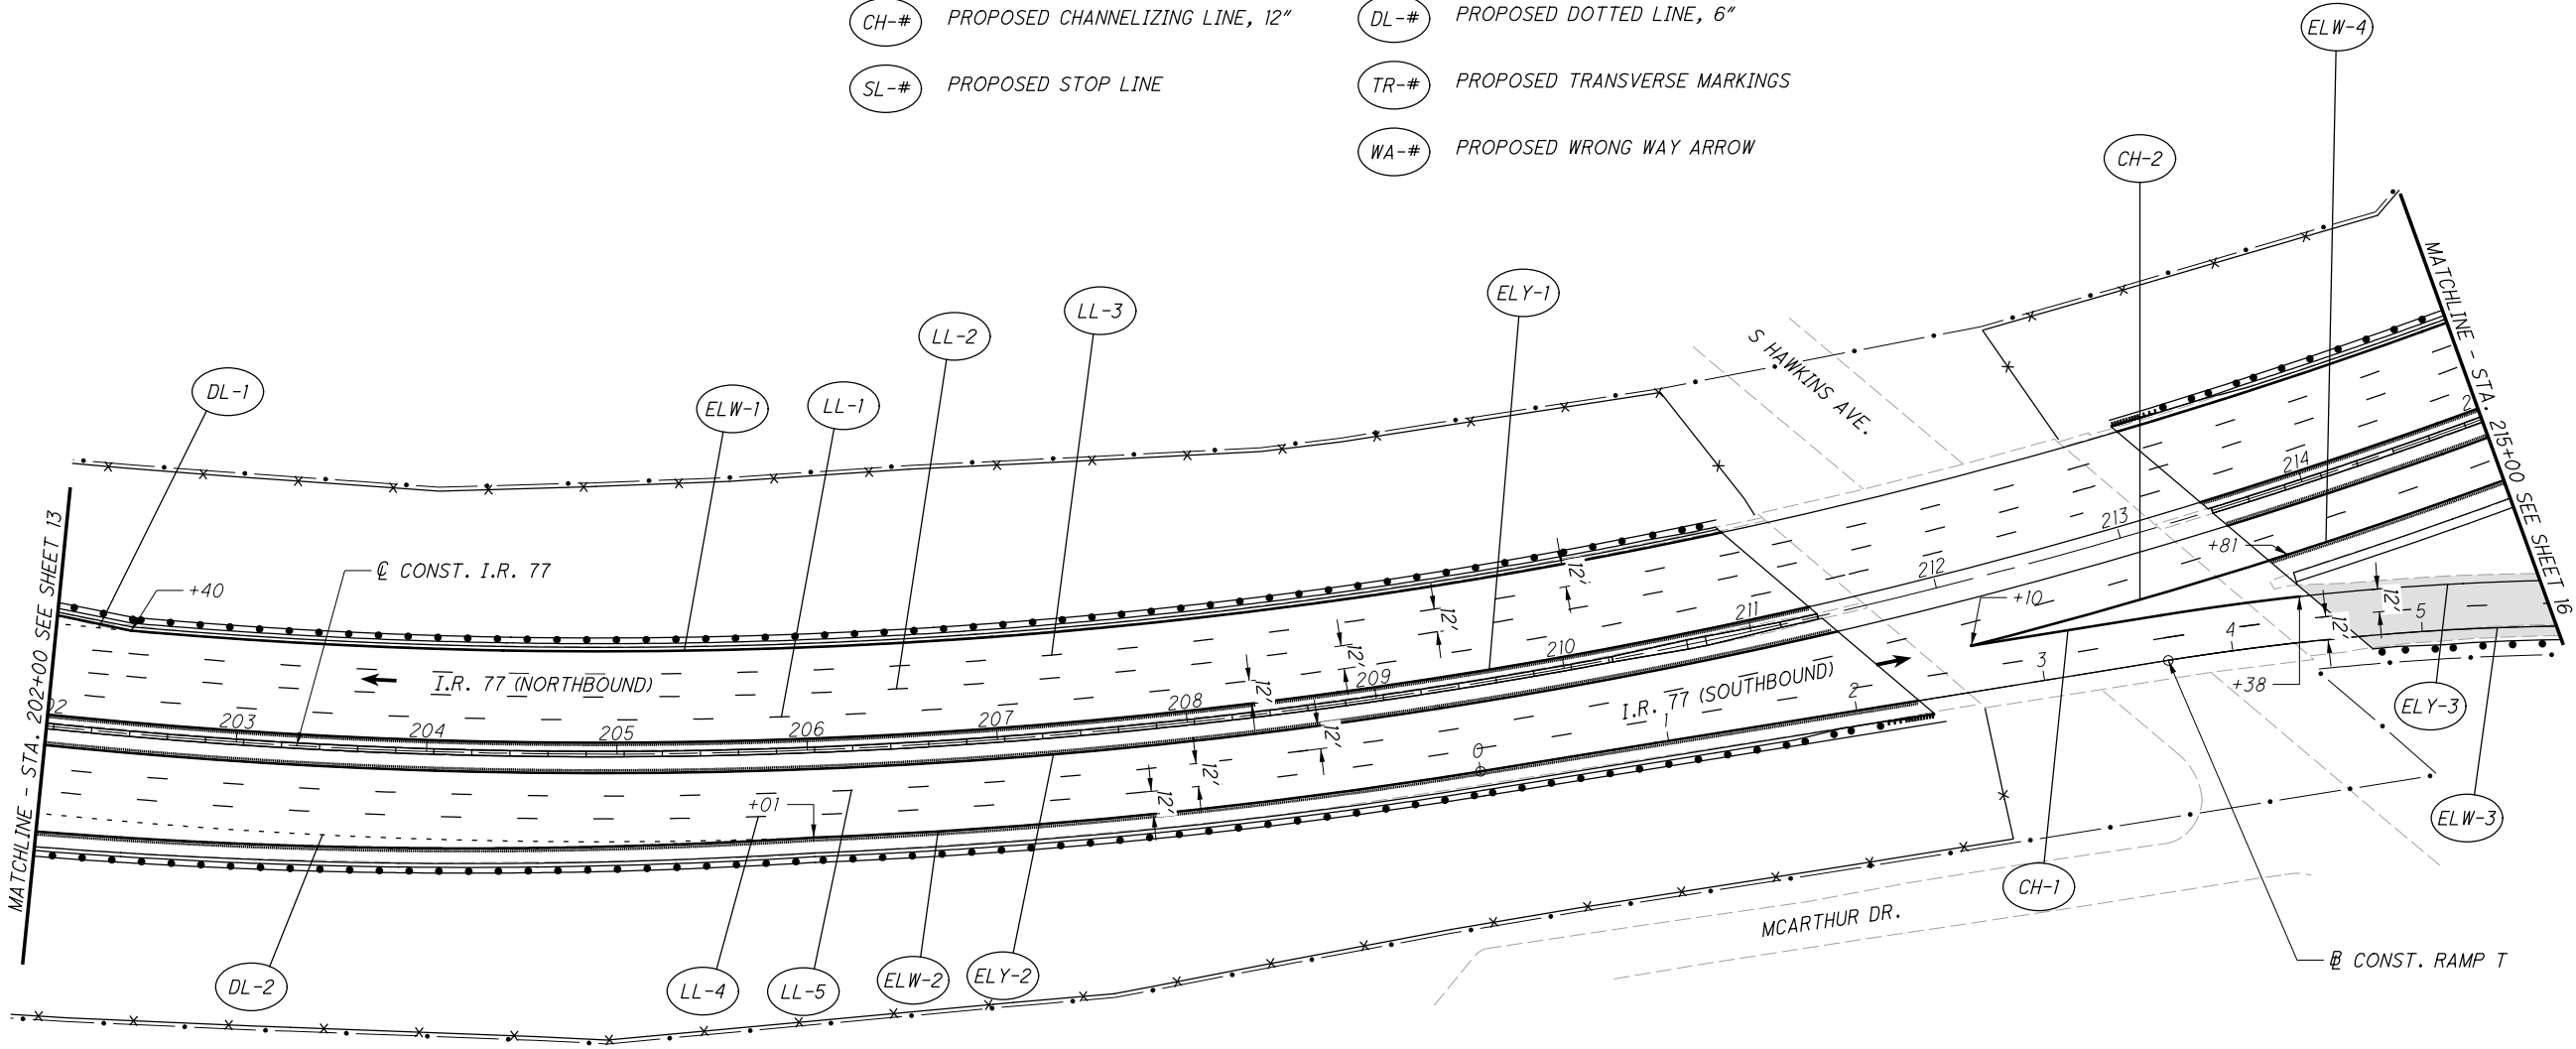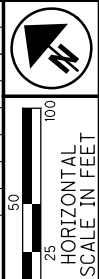

2025-03-19 - BU-38 - RECORD DRAWING PLANS

PAVEMENT MARKING PLAN - I.R. 77
STA. 202+00 TO STA. 215+00

SUM-76 / 77 / 8-
8.24 / 9.74 / 0.00

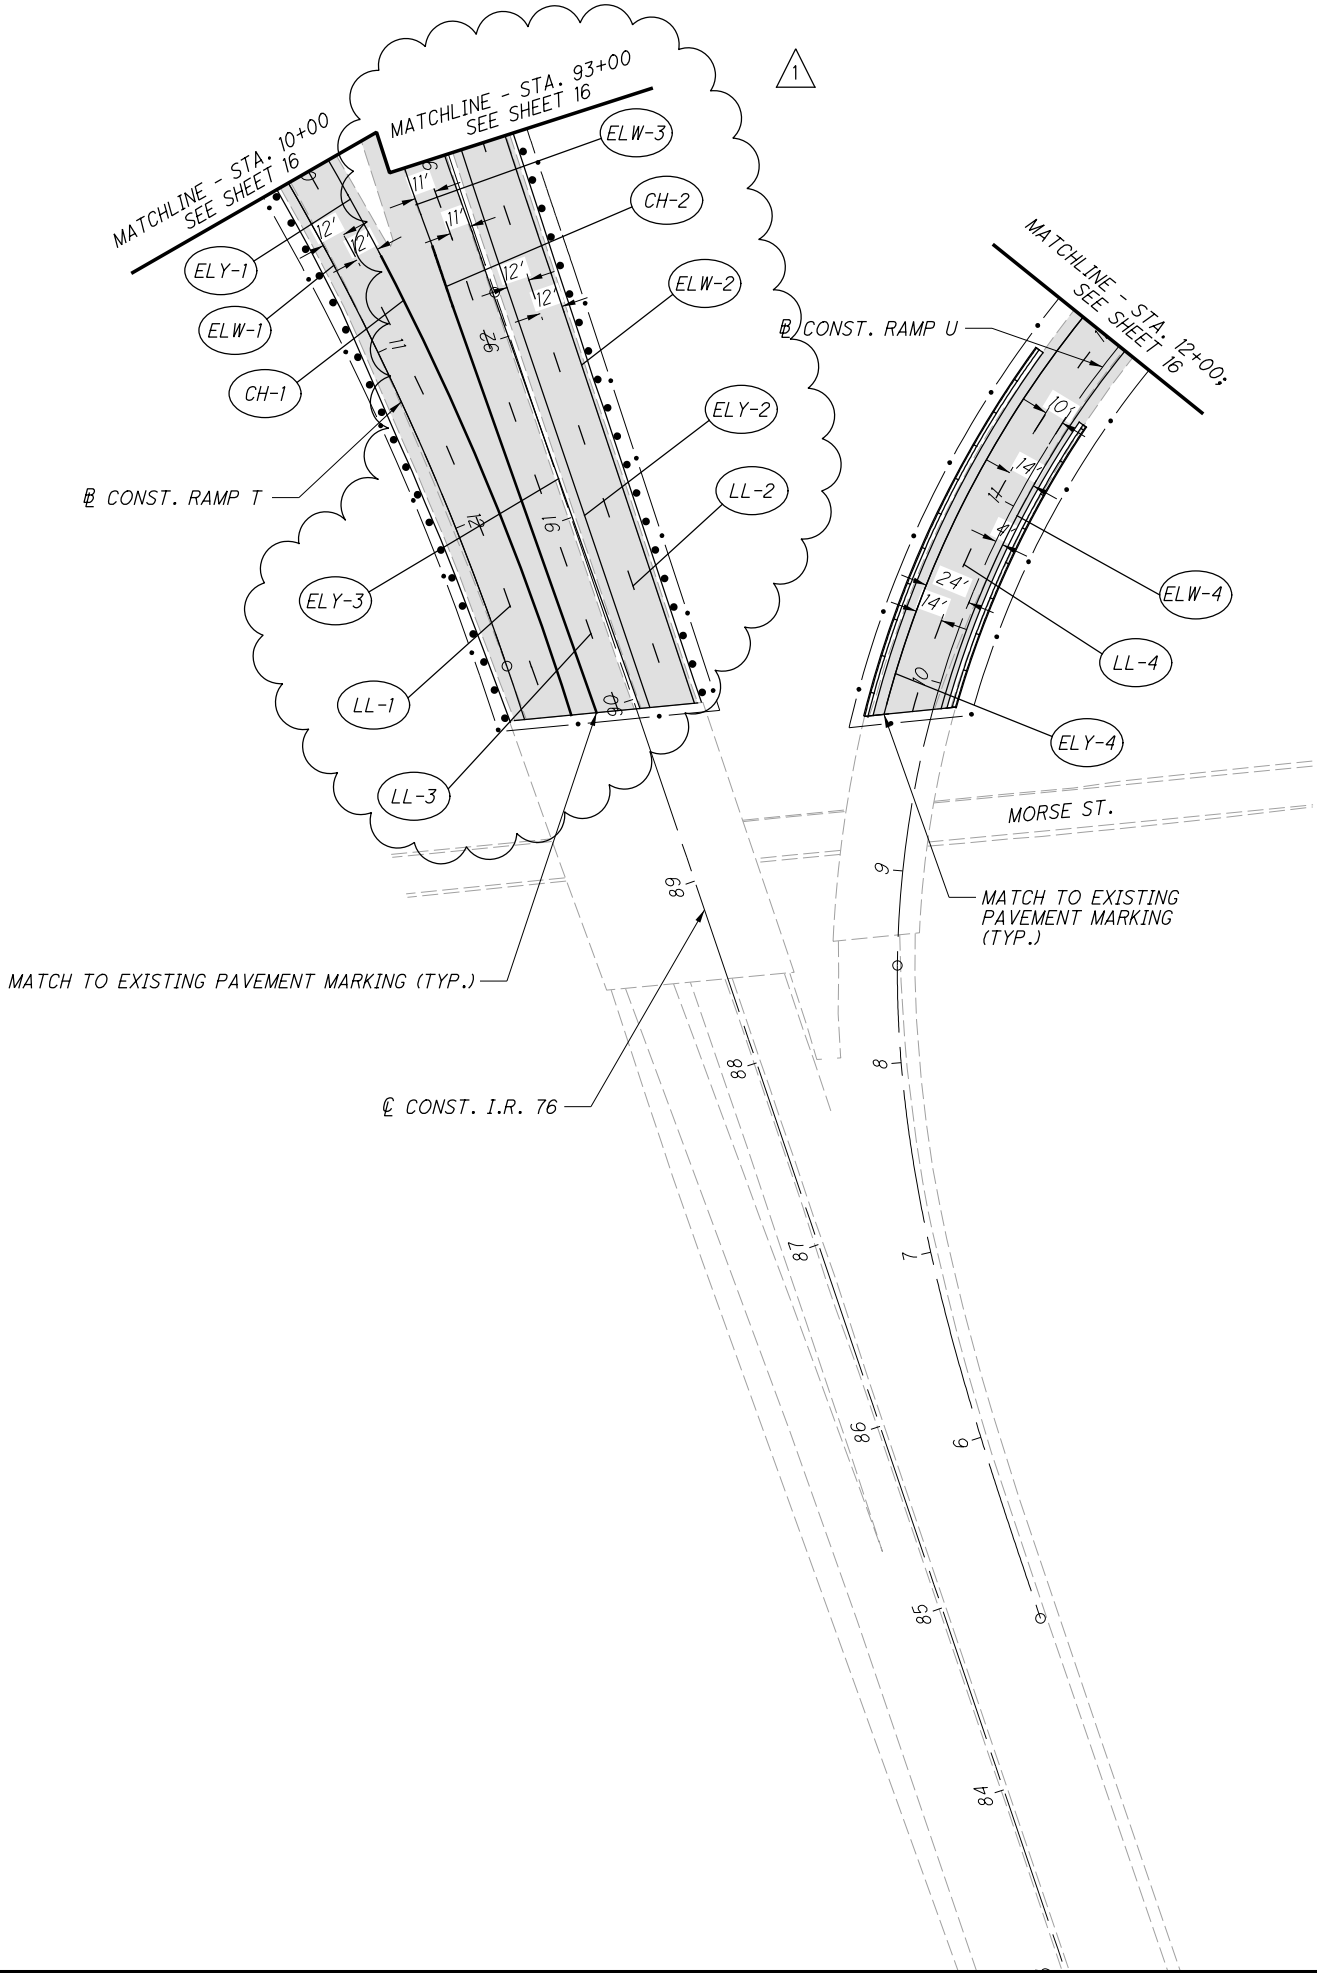

NOTES:

1. LONG LINE PAVEMENT MARKINGS SHALL BE WET REFLECTIVE LIQUID APPLIED EPOXY PER SS 807 AND RECESSED PER SS 850, ALL OTHER PAVEMENT MARKINGS SHALL BE EPOXY.
2. PLACE BARRIER REFLECTORS ALONG THE MEDIAN BARRIER ALONG I.R. 76/I.R. 77 IN THE EB/WB & SB/NB DIRECTION.
3. PLACE RPMS ALONG PAVEMENT MARKING LINES AS PER STANDARD CONSTRUCTION DRAWINGS.

LEGEND:

- ELW-# PROPOSED EDGE LINE, WHITE 8"
- ELY-# PROPOSED EDGE LINE, YELLOW 8"
- LL-# PROPOSED LANE LINE, 8"
- CH-# PROPOSED CHANNELIZING LINE, 12"
- SL-# PROPOSED STOP LINE
- XW-# PROPOSED CROSSWALK LINE
- A-# PROPOSED LANE ARROW
- W-# PROPOSED WORD ON PAVEMENT
- DL-# PROPOSED DOTTED LINE, 6"
- TR-# PROPOSED TRANSVERSE MARKINGS
- WA-# PROPOSED WRONG WAY ARROW

ISSUE RECORD:		
NO.	DATE	DESCRIPTION
1	11/19/2024	RAMP V REVISION, ADDITIONAL LANE ADDED

NOTES:


1. LONG LINE PAVEMENT MARKINGS SHALL BE WET REFLECTIVE LIQUID APPLIED EPOXY PER SS 807 AND RECESSED PER SS 850, ALL OTHER PAVEMENT MARKINGS SHALL BE EPOXY.

2. PLACE BARRIER REFLECTORS ALONG THE MEDIAN BARRIER ALONG I.R. 76/I.R. 77 IN THE EB/WB & SB/NB DIRECTION.

3. PLACE RPMS ALONG PAVEMENT MARKING LINES AS PER STANDARD CONSTRUCTION DRAWINGS.

- LEGEND:
- ELW-# PROPOSED EDGE LINE, WHITE 8"
 - ELY-# PROPOSED EDGE LINE, YELLOW 8"
 - LL-# PROPOSED LANE LINE, 8"
 - CH-# PROPOSED CHANNELIZING LINE, 12"
 - SL-# PROPOSED STOP LINE
 - XW-# PROPOSED CROSSWALK LINE
 - A-# PROPOSED LANE ARROW
 - W-# PROPOSED WORD ON PAVEMENT
 - DL-# PROPOSED DOTTED LINE, 6"
 - TR-# PROPOSED TRANSVERSE MARKINGS
 - WA-# PROPOSED WRONG WAY ARROW

ISSUE RECORD:		
NO.	DATE	DESCRIPTION
1	11/19/2024	RAMP V REVISION, ADDITIONAL LANE ADDED

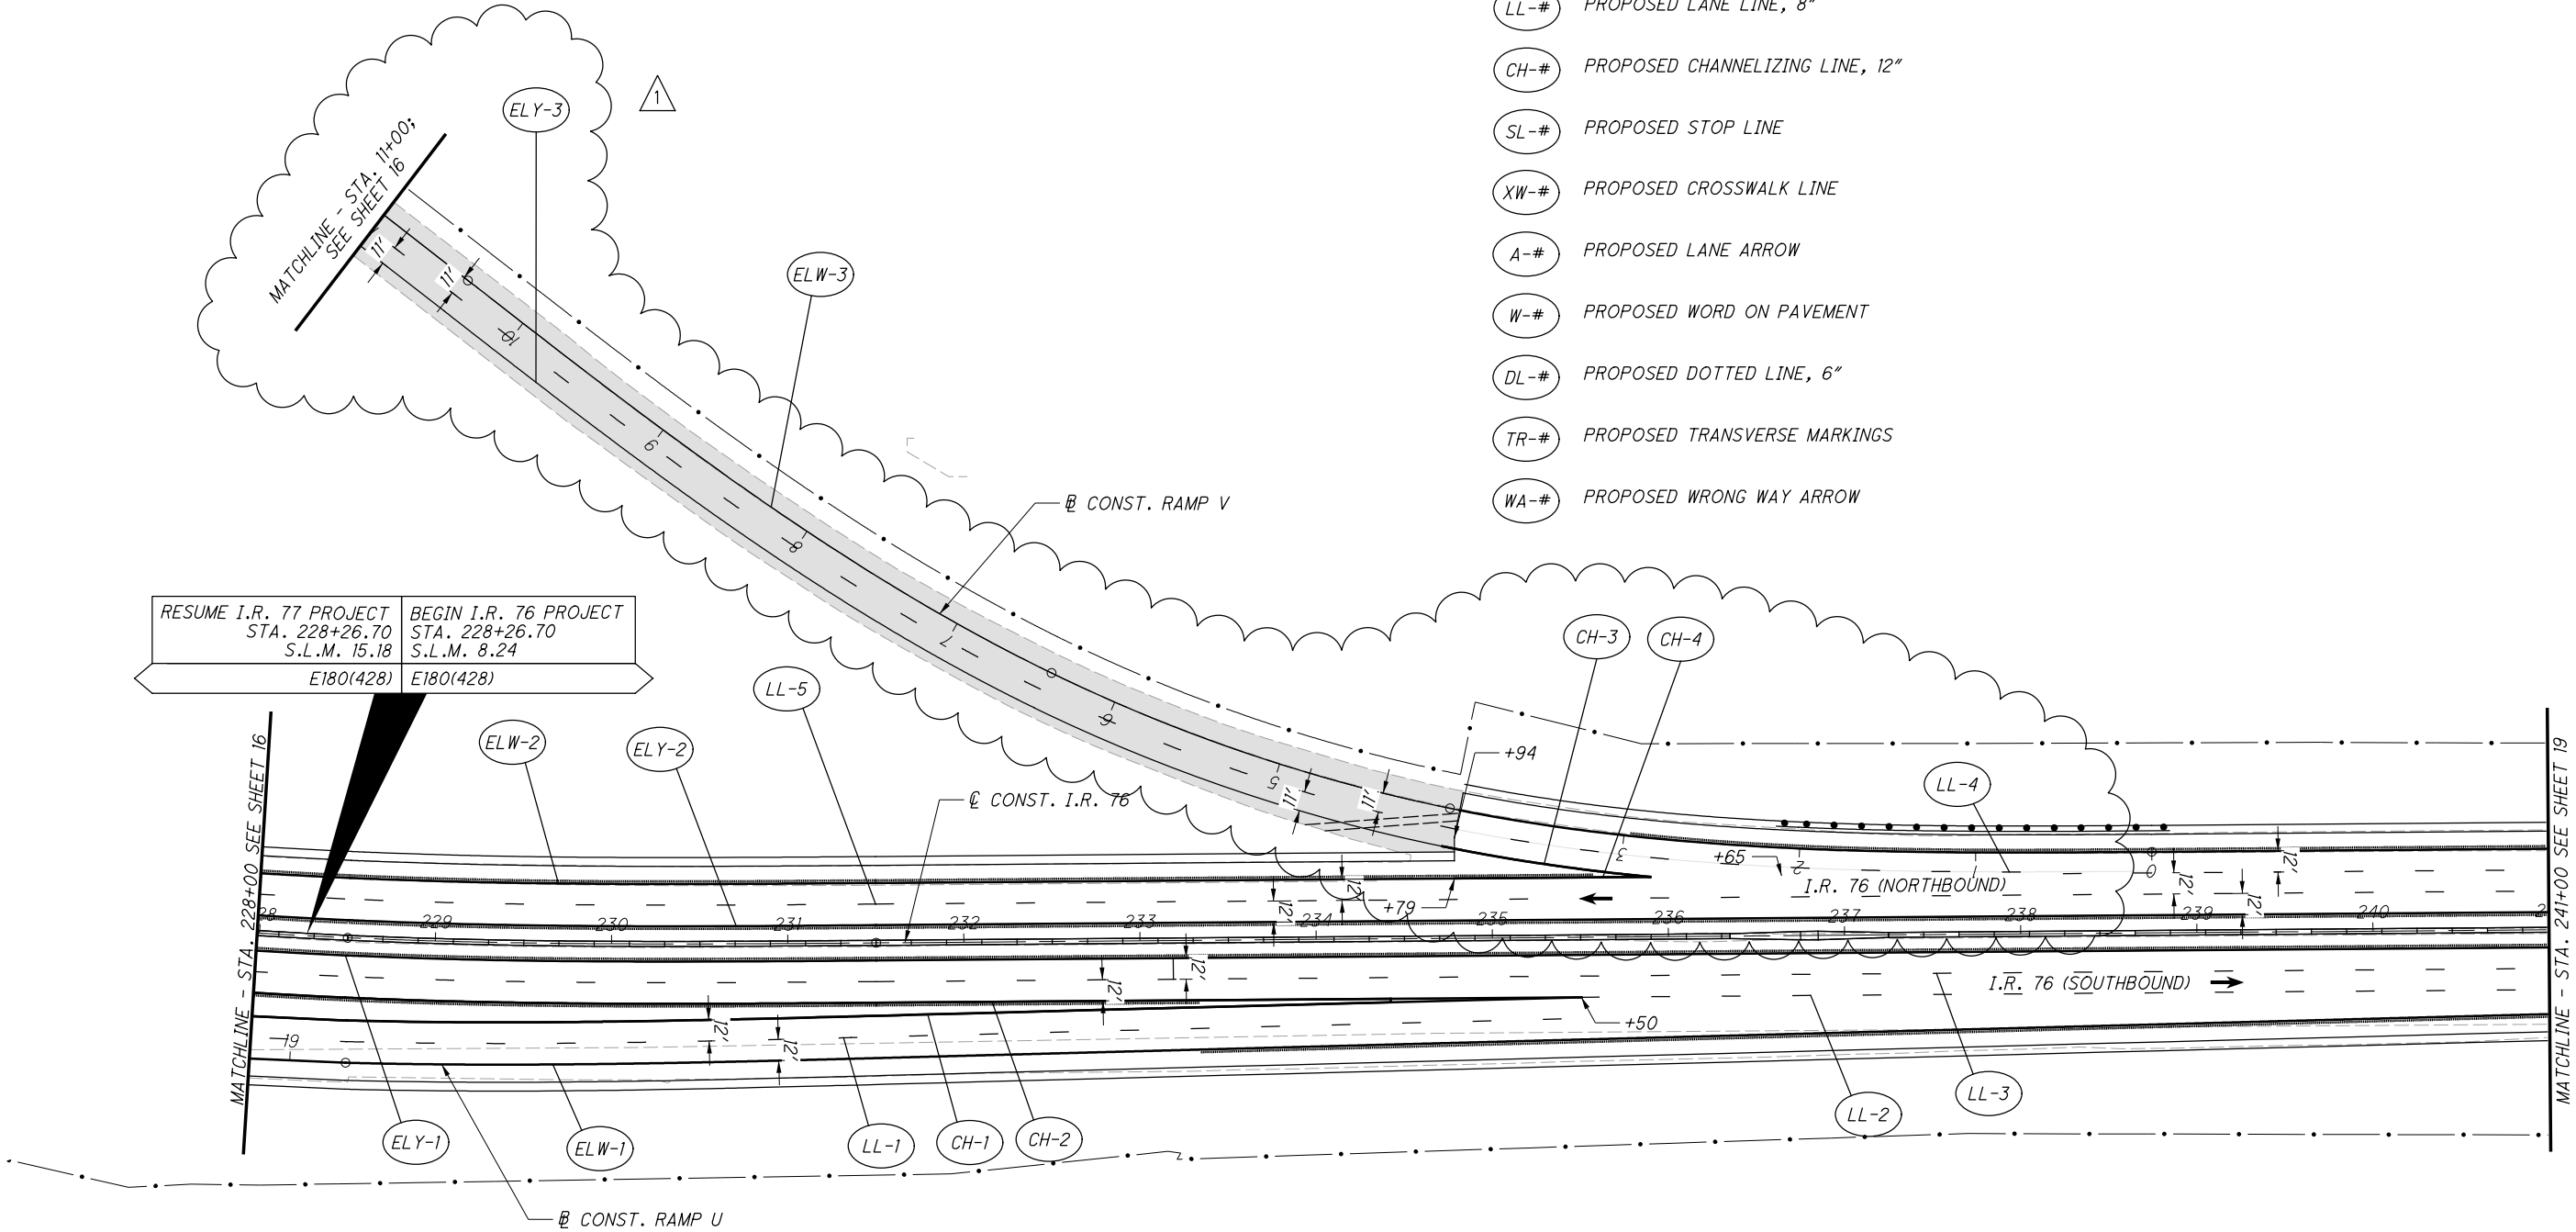

NOTES:

1. LONG LINE PAVEMENT MARKINGS SHALL BE WET REFLECTIVE LIQUID APPLIED EPOXY PER SS 807 AND RECESSED PER SS 850, ALL OTHER PAVEMENT MARKINGS SHALL BE EPOXY.
2. PLACE BARRIER REFLECTORS ALONG THE MEDIAN BARRIER ALONG I.R. 76/I.R. 77 IN THE EB/WB & SB/NB DIRECTION.
3. PLACE RPMS ALONG PAVEMENT MARKING LINES AS PER STANDARD CONSTRUCTION DRAWINGS.

LEGEND:

- ELW-#

PROPOSED EDGE LINE, WHITE 8"
- ELY-#

PROPOSED EDGE LINE, YELLOW 8"
- LL-#

PROPOSED LANE LINE, 8"
- CH-#

PROPOSED CHANNELIZING LINE, 12"
- SL-#

PROPOSED STOP LINE
- XW-#

PROPOSED CROSSWALK LINE
- A-#

PROPOSED LANE ARROW
- W-#


PROPOSED WORD ON PAVEMENT
- DL-#


PROPOSED DOTTED LINE, 6"
- TR-#

PROPOSED TRANSVERSE MARKINGS
- WA-#

PROPOSED WRONG WAY ARROW

ISSUE RECORD:		
NO.	DATE	DESCRIPTION

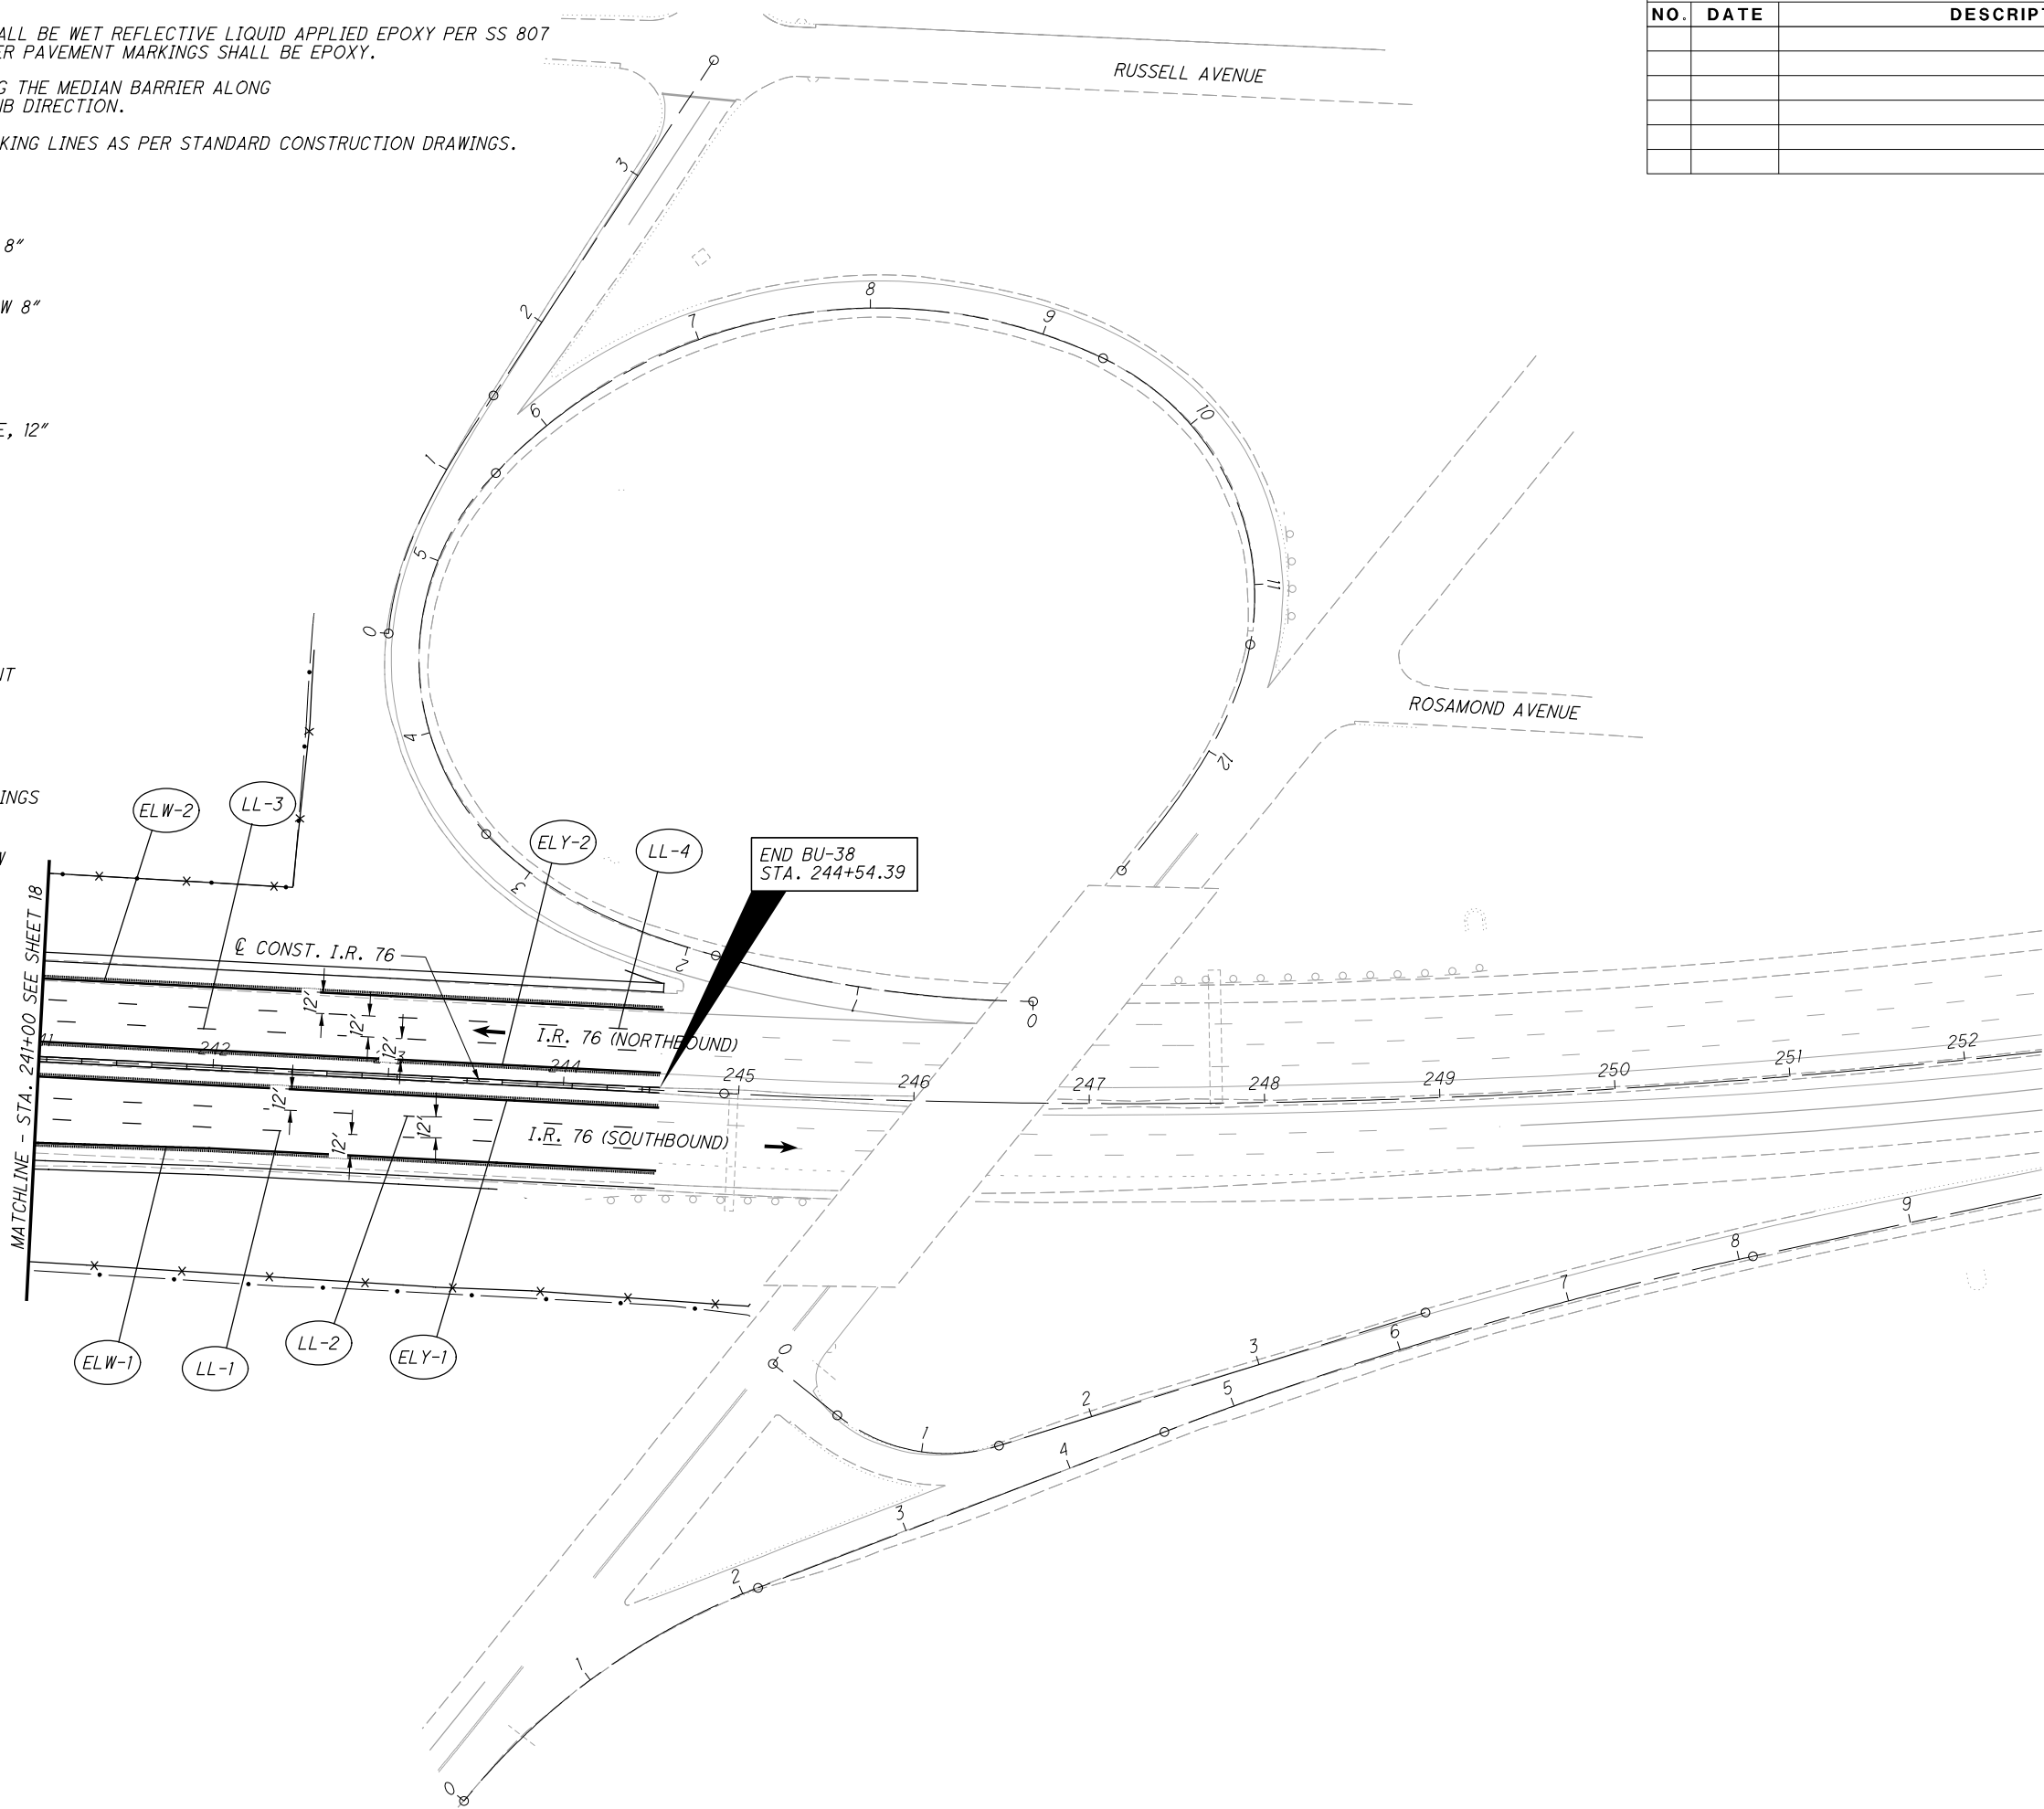

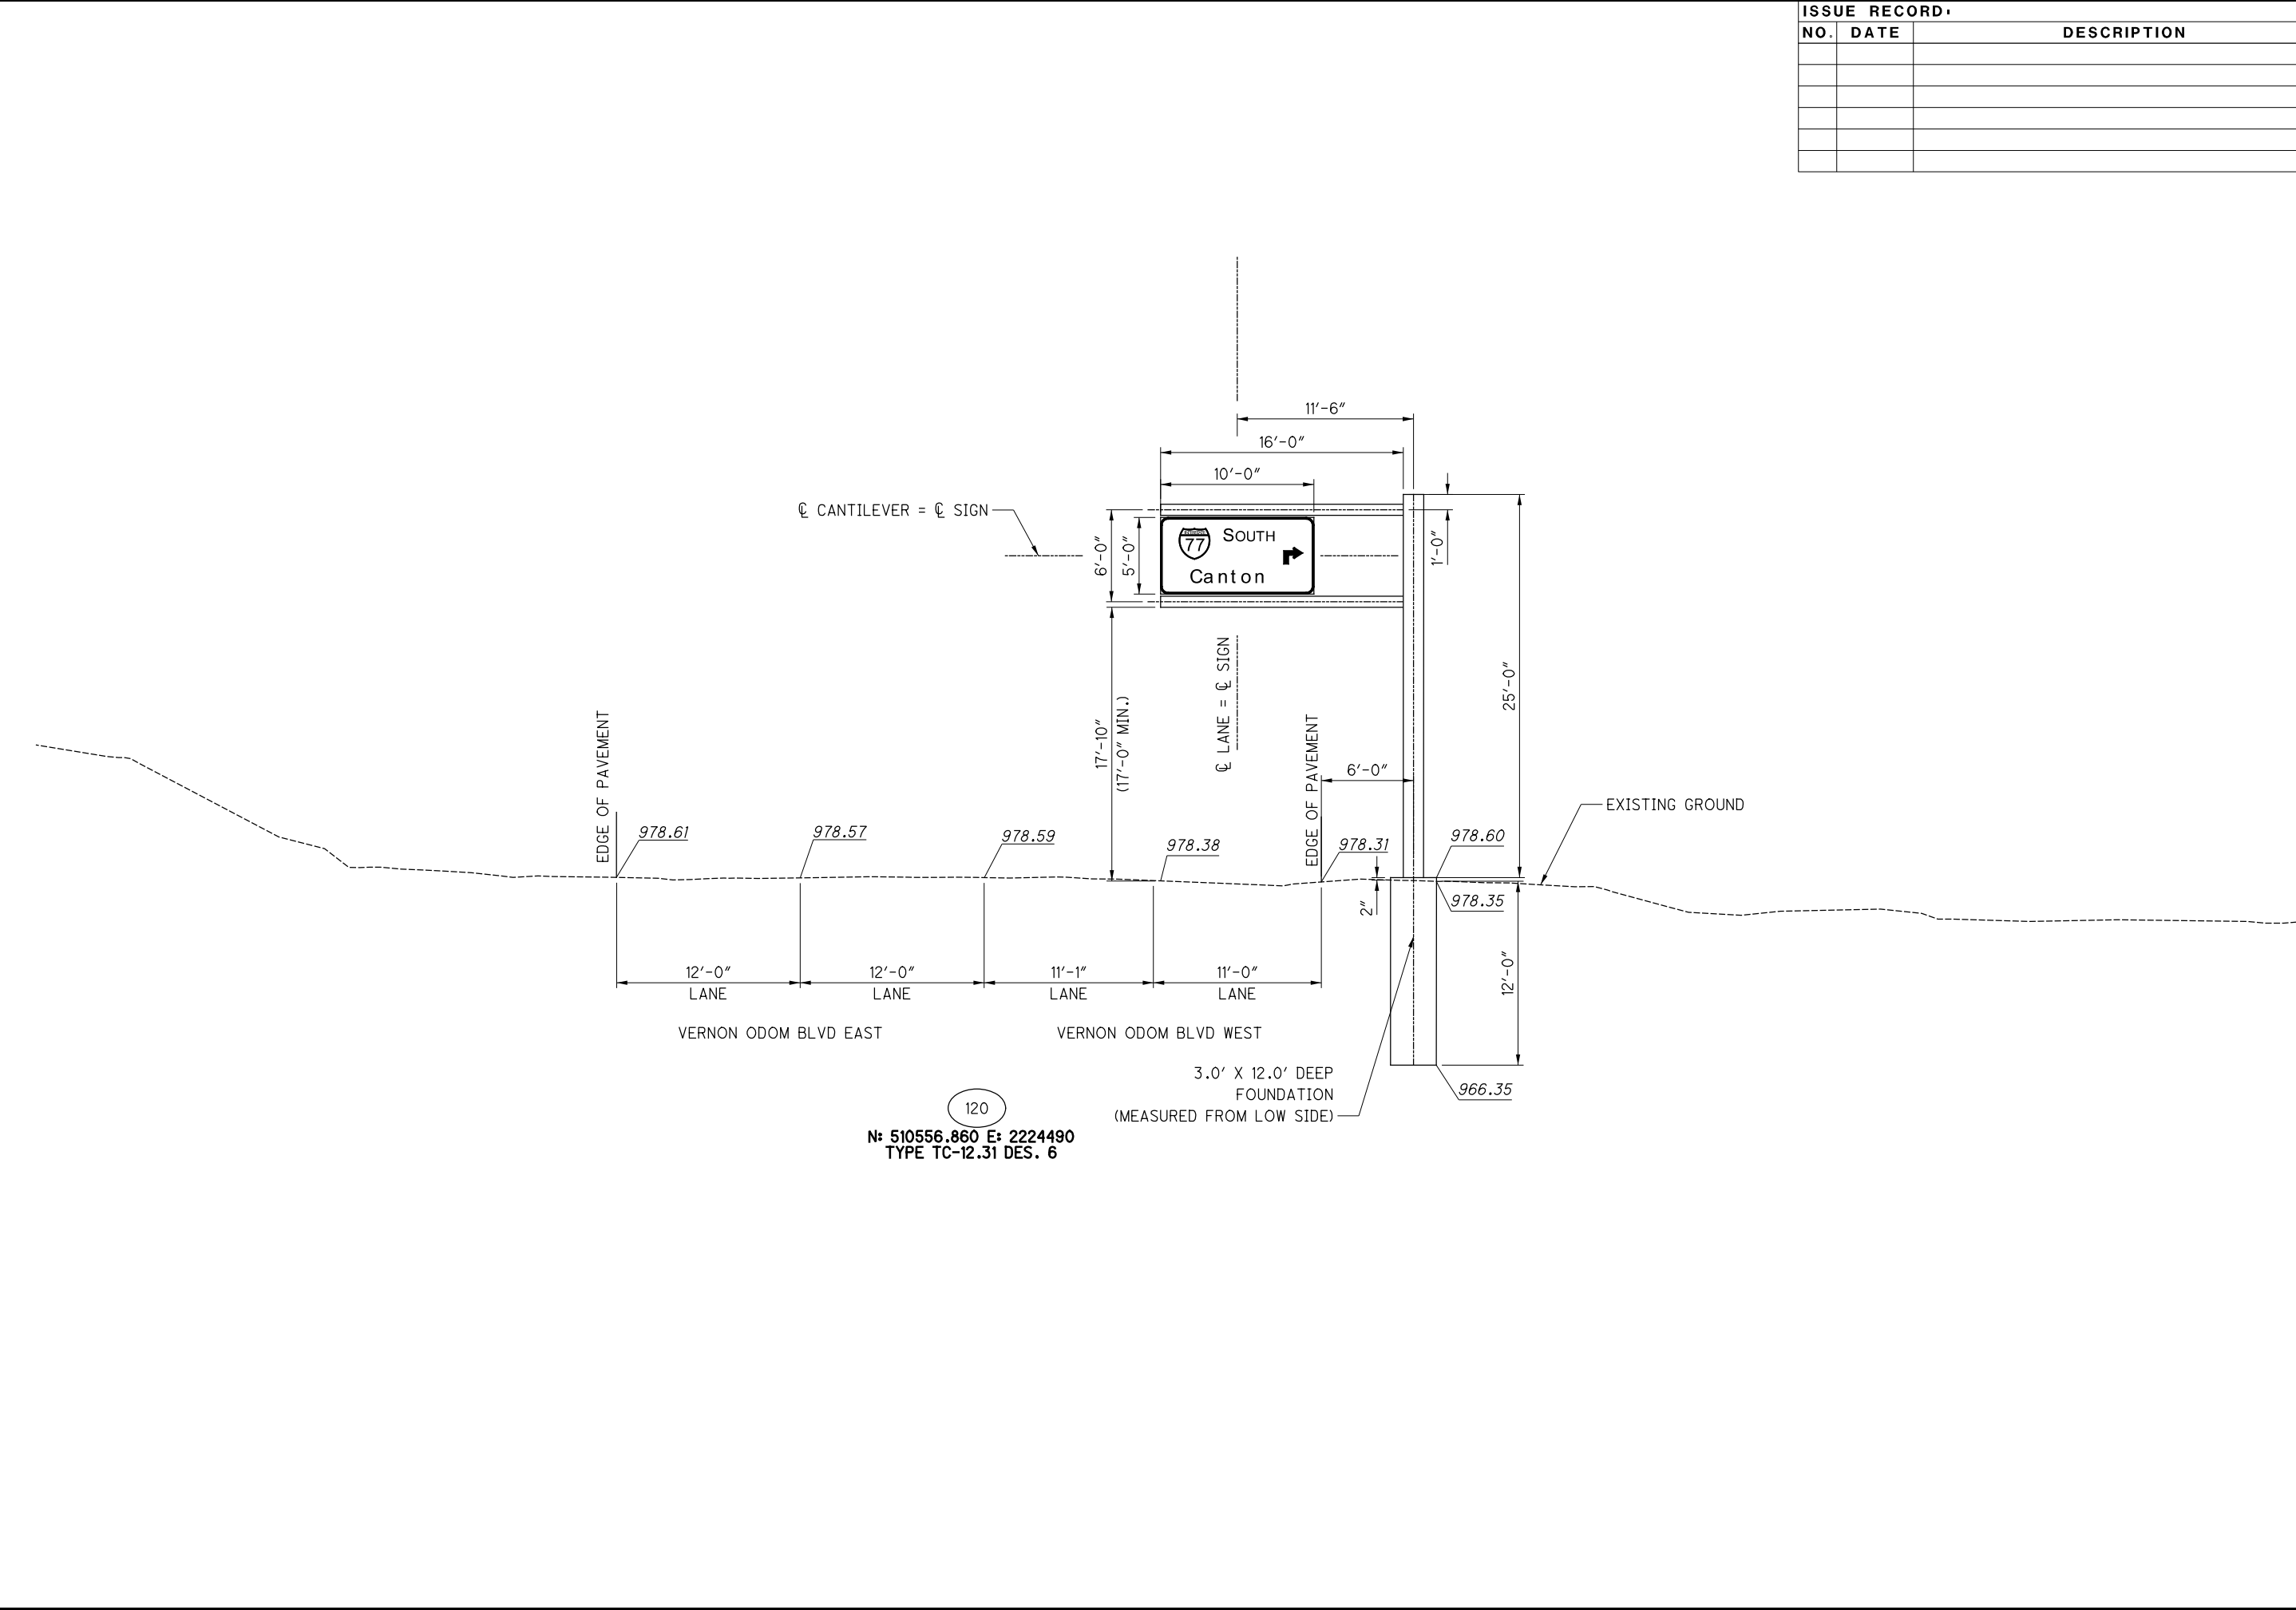

ISSUE RECORD:		
NO.	DATE	DESCRIPTION

2025-03-19 - BU-38 - RECORD DRAWING PLANS

20
36


SUM - 76 / 77 / 8 -
8.24 / 9.74 / 0.00

OVERHEAD MOUNTED SIGN ELEVATION DETAILS

CALCULATED
AC

CHECKED
RW

0 5 10
2.5'
HORIZONTAL
SCALE IN FEET

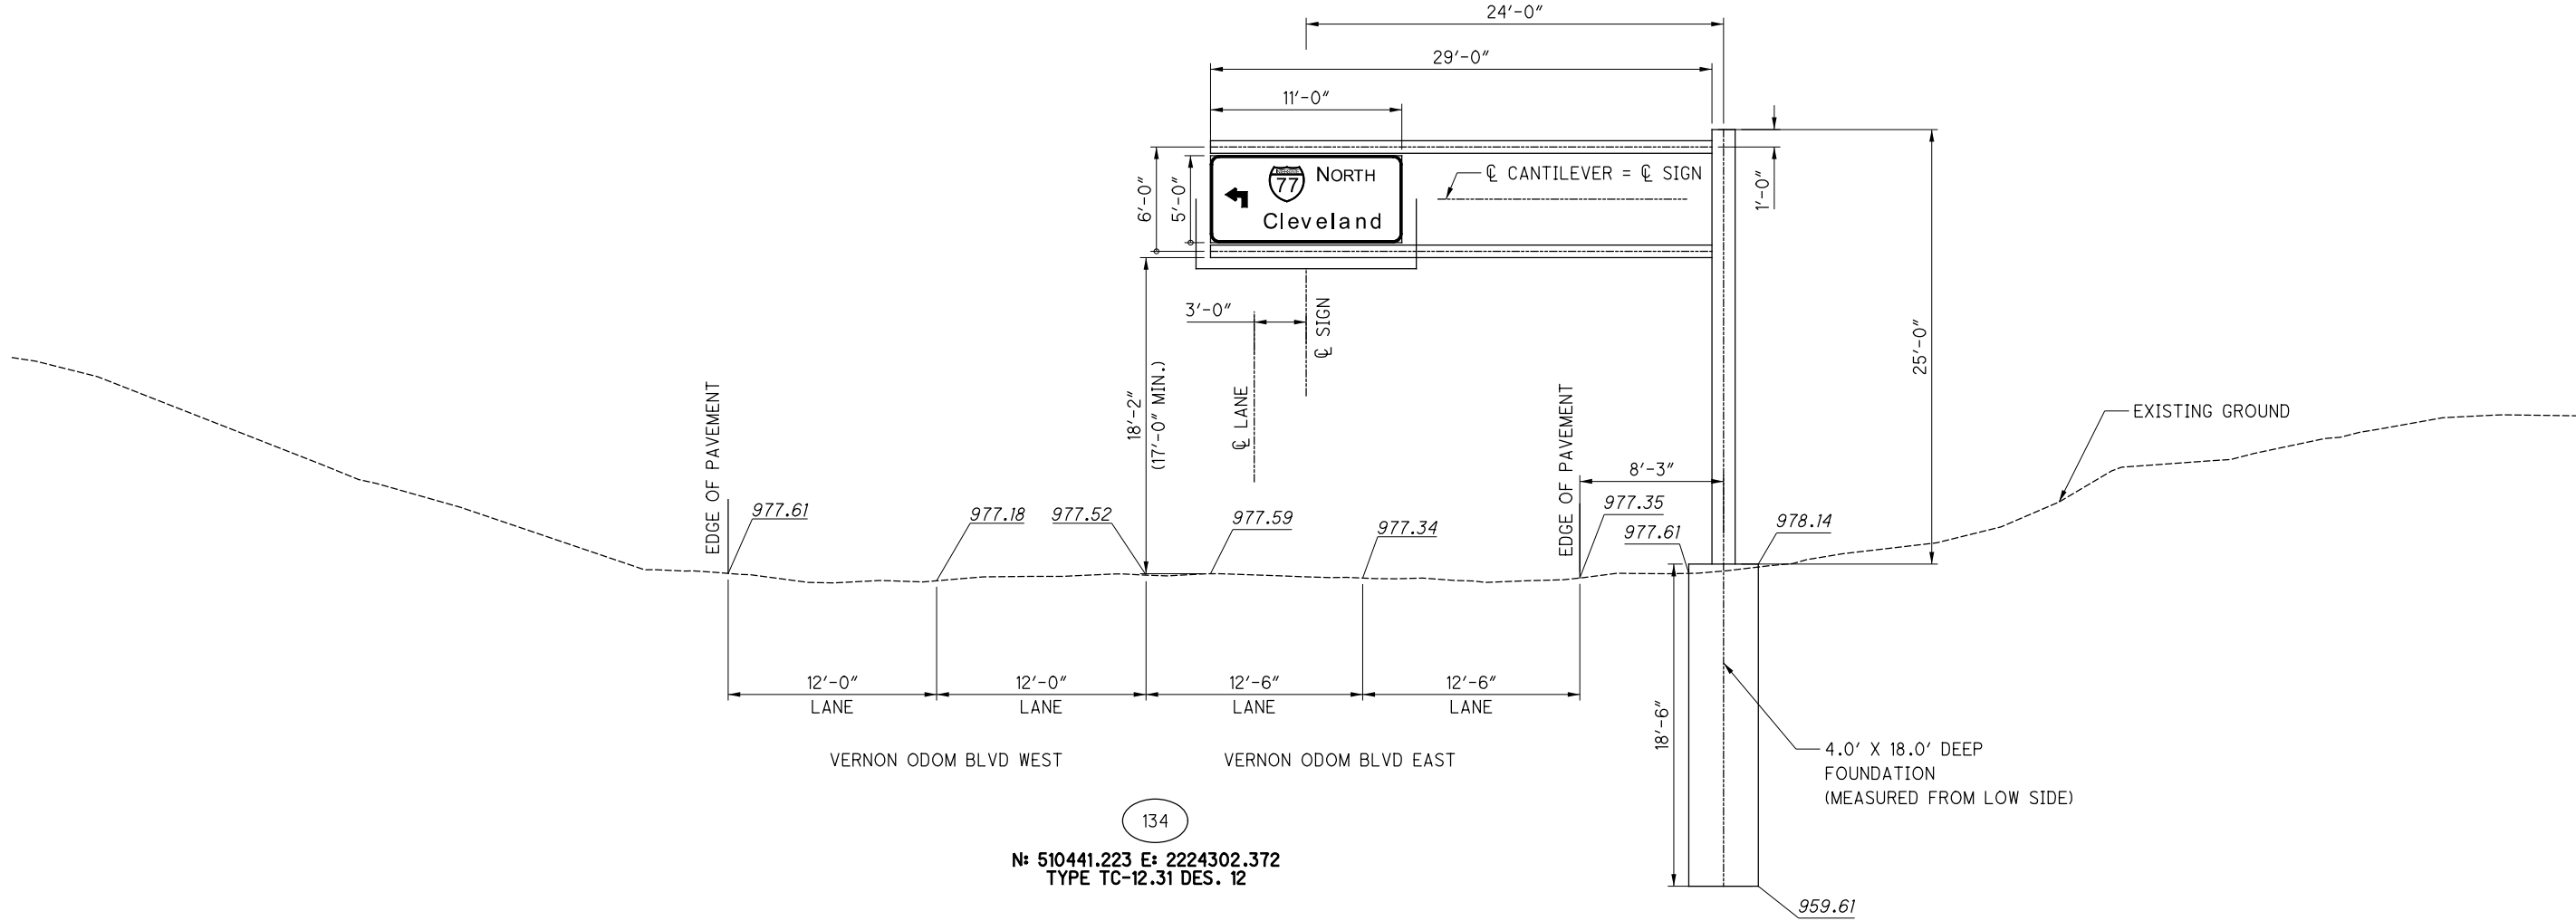

ISSUE RECORD:		
NO.	DATE	DESCRIPTION

2025-03-19 - BU-38 - RECORD DRAWING PLANS

21
36


SUM-76 / 77 / 8-
8.24 / 9.74 / 0.00


OVERHEAD MOUNTED SIGN ELEVATION DETAILS

CALCULATED
AC

CHECKED
RW

0 5 10
2.5'
HORIZONTAL
SCALE IN FEET

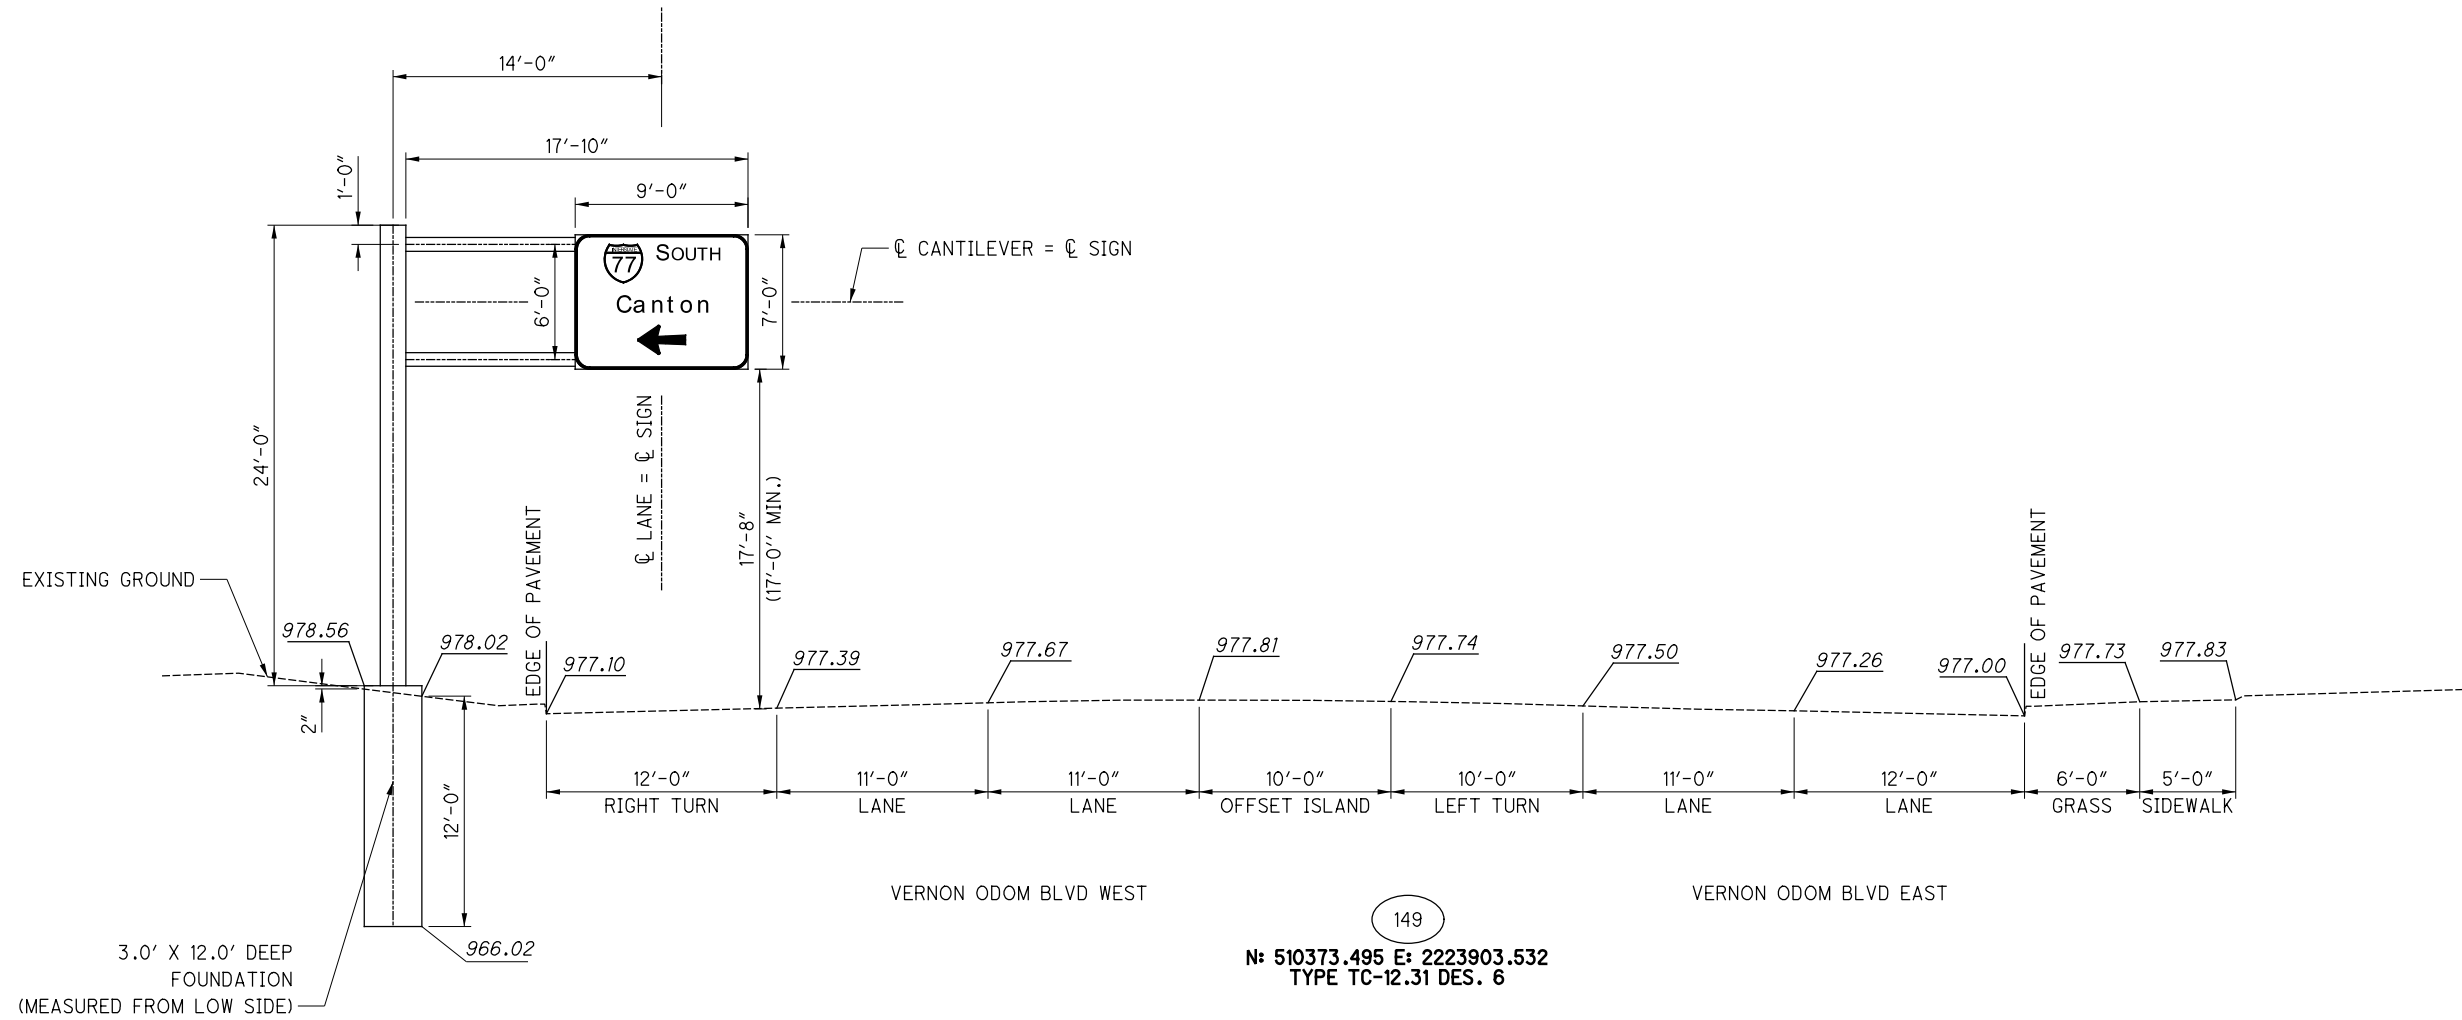[illegible]

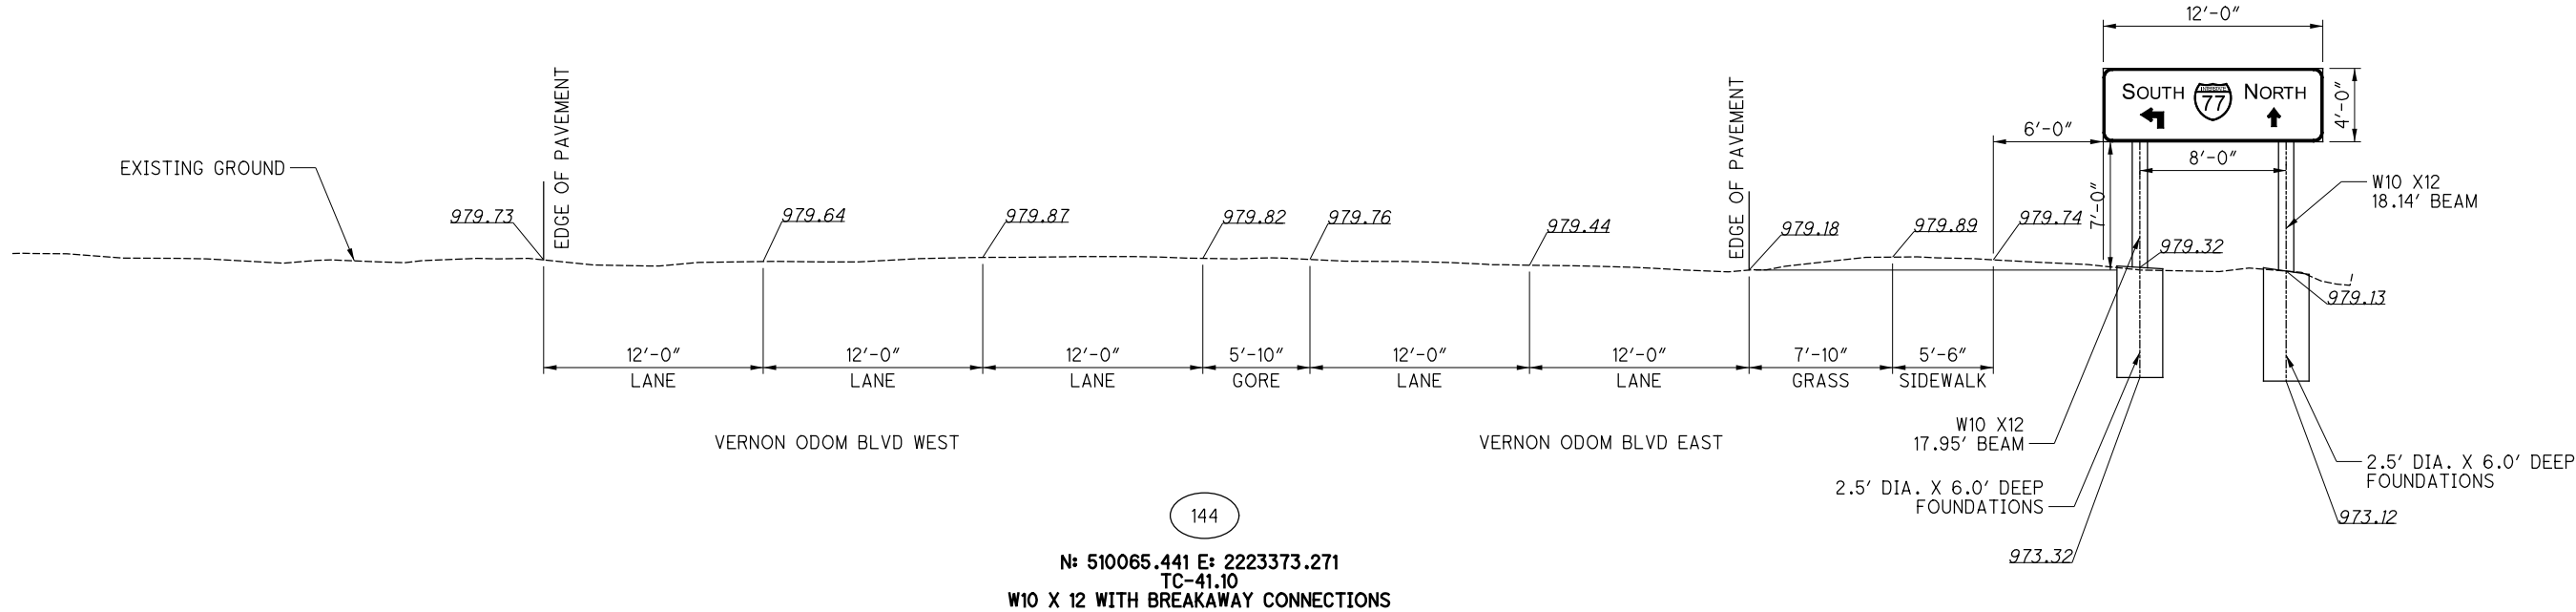

ISSUE RECORD:		
NO.	DATE	DESCRIPTION

2025-03-19 - BU-38 - RECORD DRAWING PLANS

23
36


SUM-76 / 77 / 8-
8.24 / 9.74 / 0.00


BEAM MOUNTED SIGN ELEVATION DETAILS

CALCULATED
AC
CHECKED
RW

0510

2.5'
HORIZONTAL
SCALE IN FEET

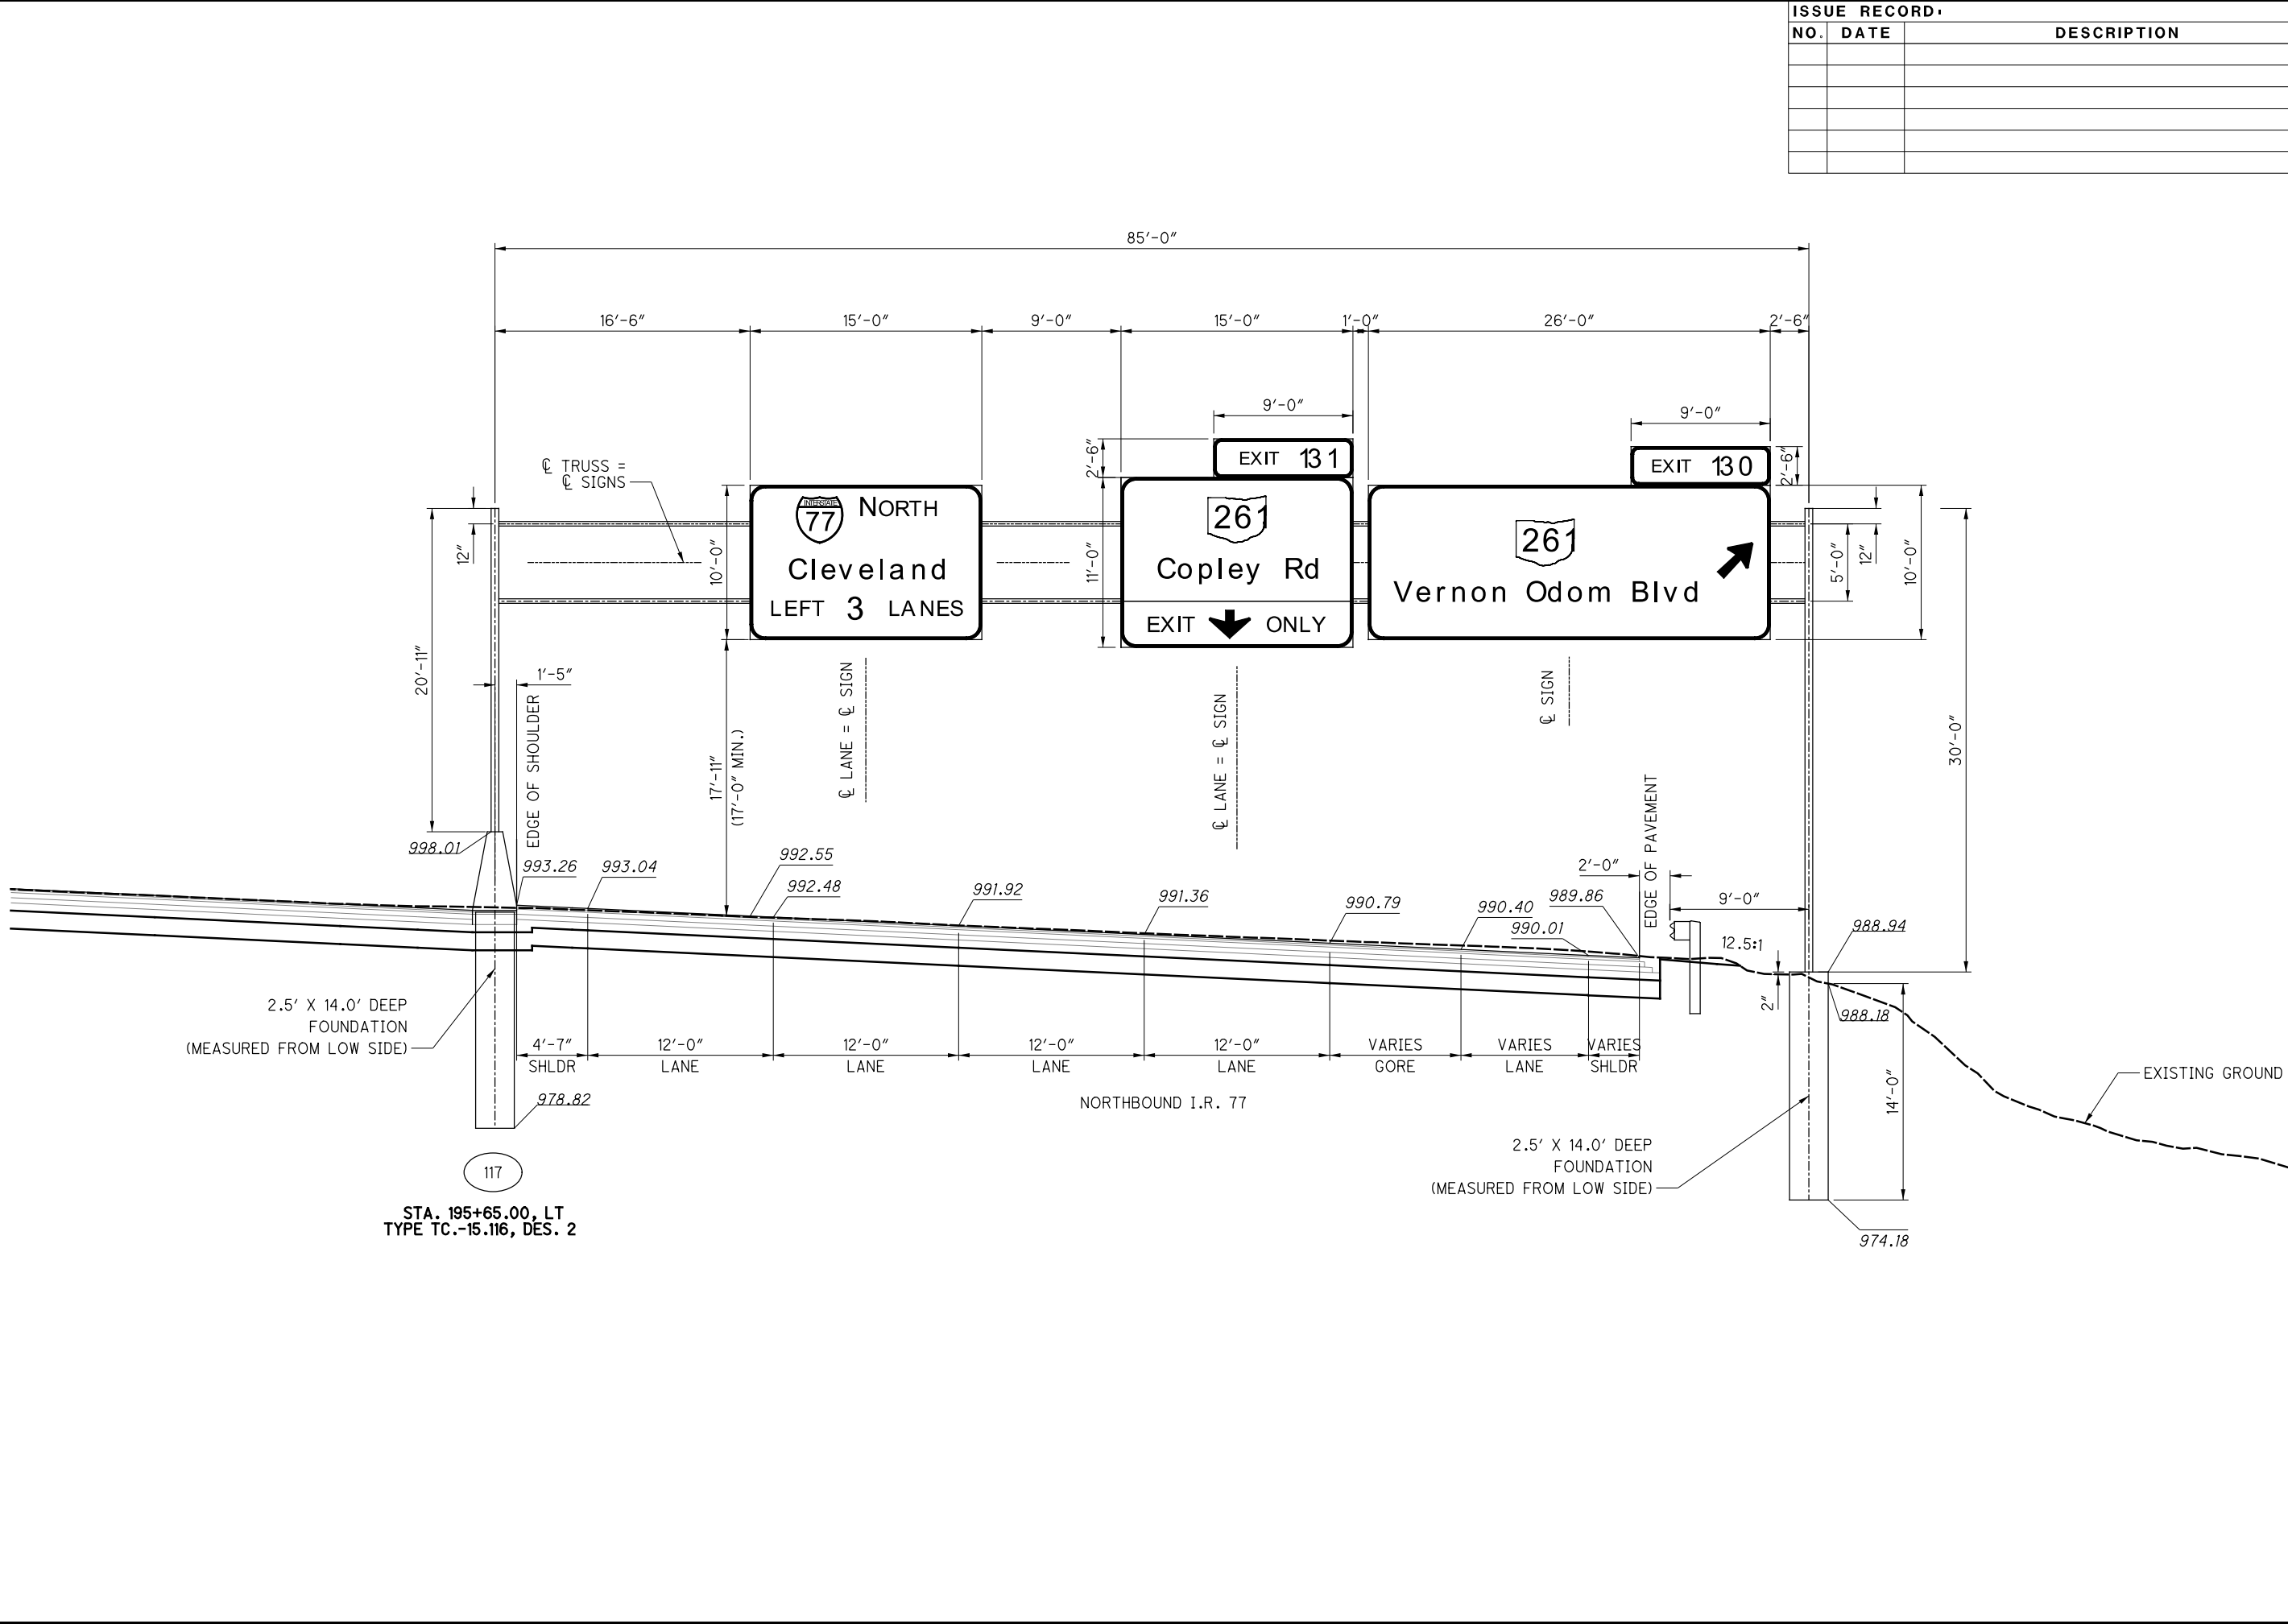

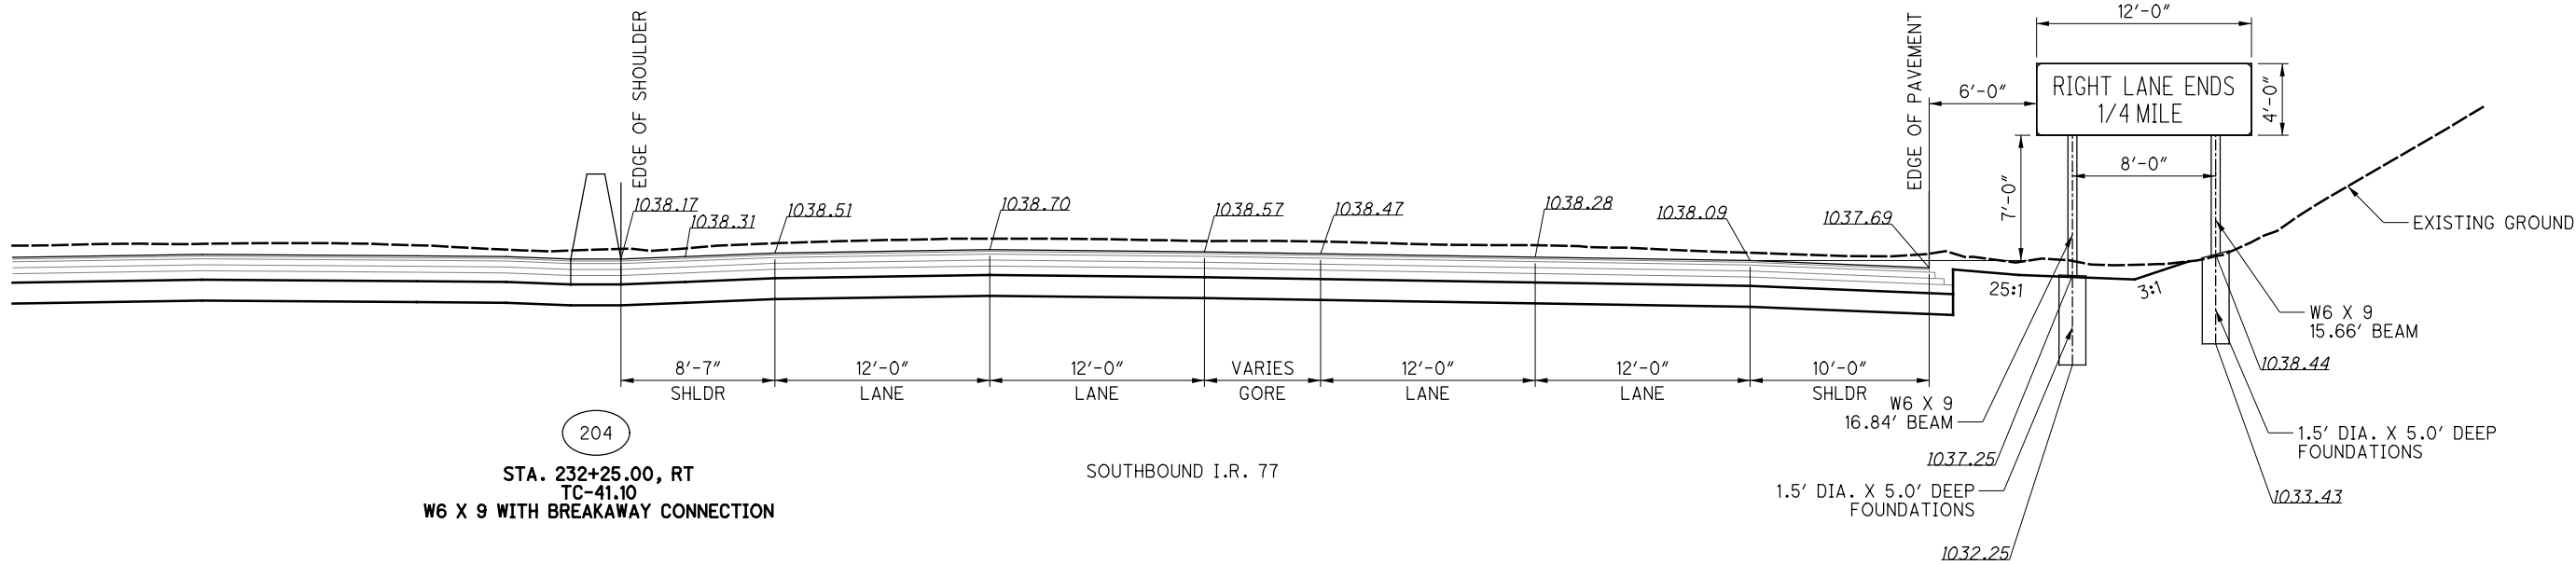

ISSUE RECORD:		
NO.	DATE	DESCRIPTION

2025-03-19 - BU-38 - RECORD DRAWING PLANS

27
36


SUM-76 / 77 / 8-
8.24 / 9.74 / 0.00

BEAM MOUNTED SIGN ELEVATION DETAILS

CALCULATED
AC
CHECKED
RW

05
2.5
10

HORIZONTAL
SCALE IN FEET

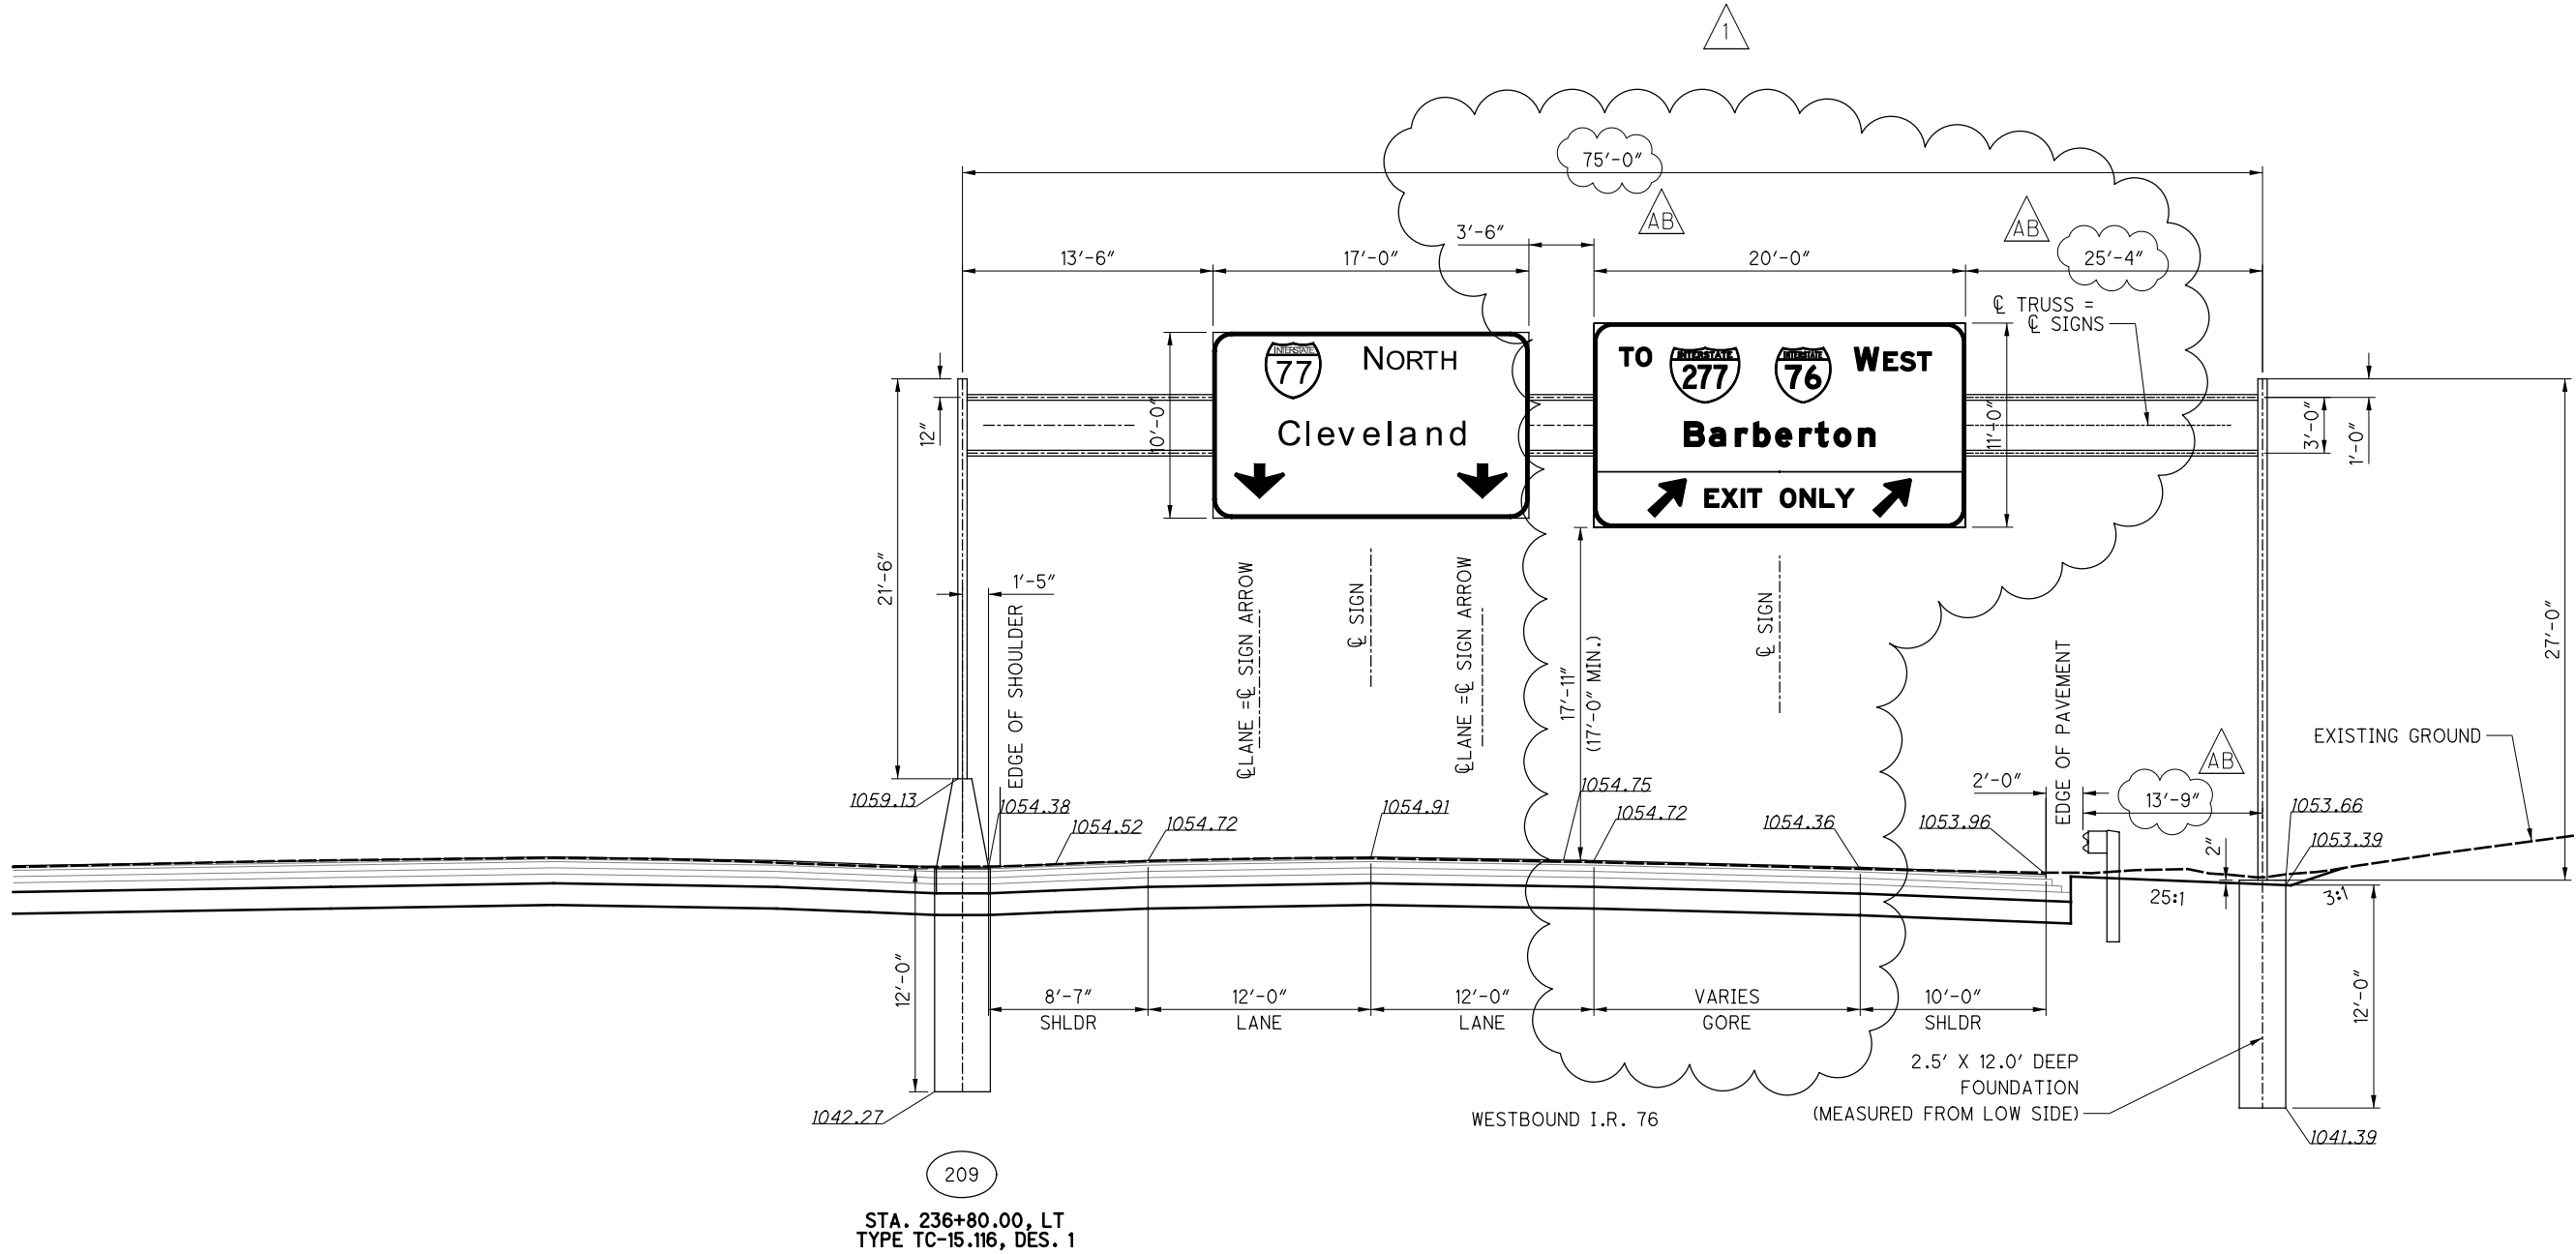

ISSUE RECORD		
NO.	DATE	DESCRIPTION
1	11/19/2024	SIGN REVISION, ADDITIONAL LANE ADDED TO RAMP V
AB	3/19/2025	DIMENSION REVISION

2025-03-19 - BU-38 - RECORD DRAWING PLANS

28
36


SUM-76 / 77 / 8-
8.24 / 9.74 / 0.00

OVERHEAD MOUNTED SIGN ELEVATION DETAILS

CALCULATED
AC
CHECKED
RW

05
10

2.5'
HORIZONTAL
SCALE IN FEET

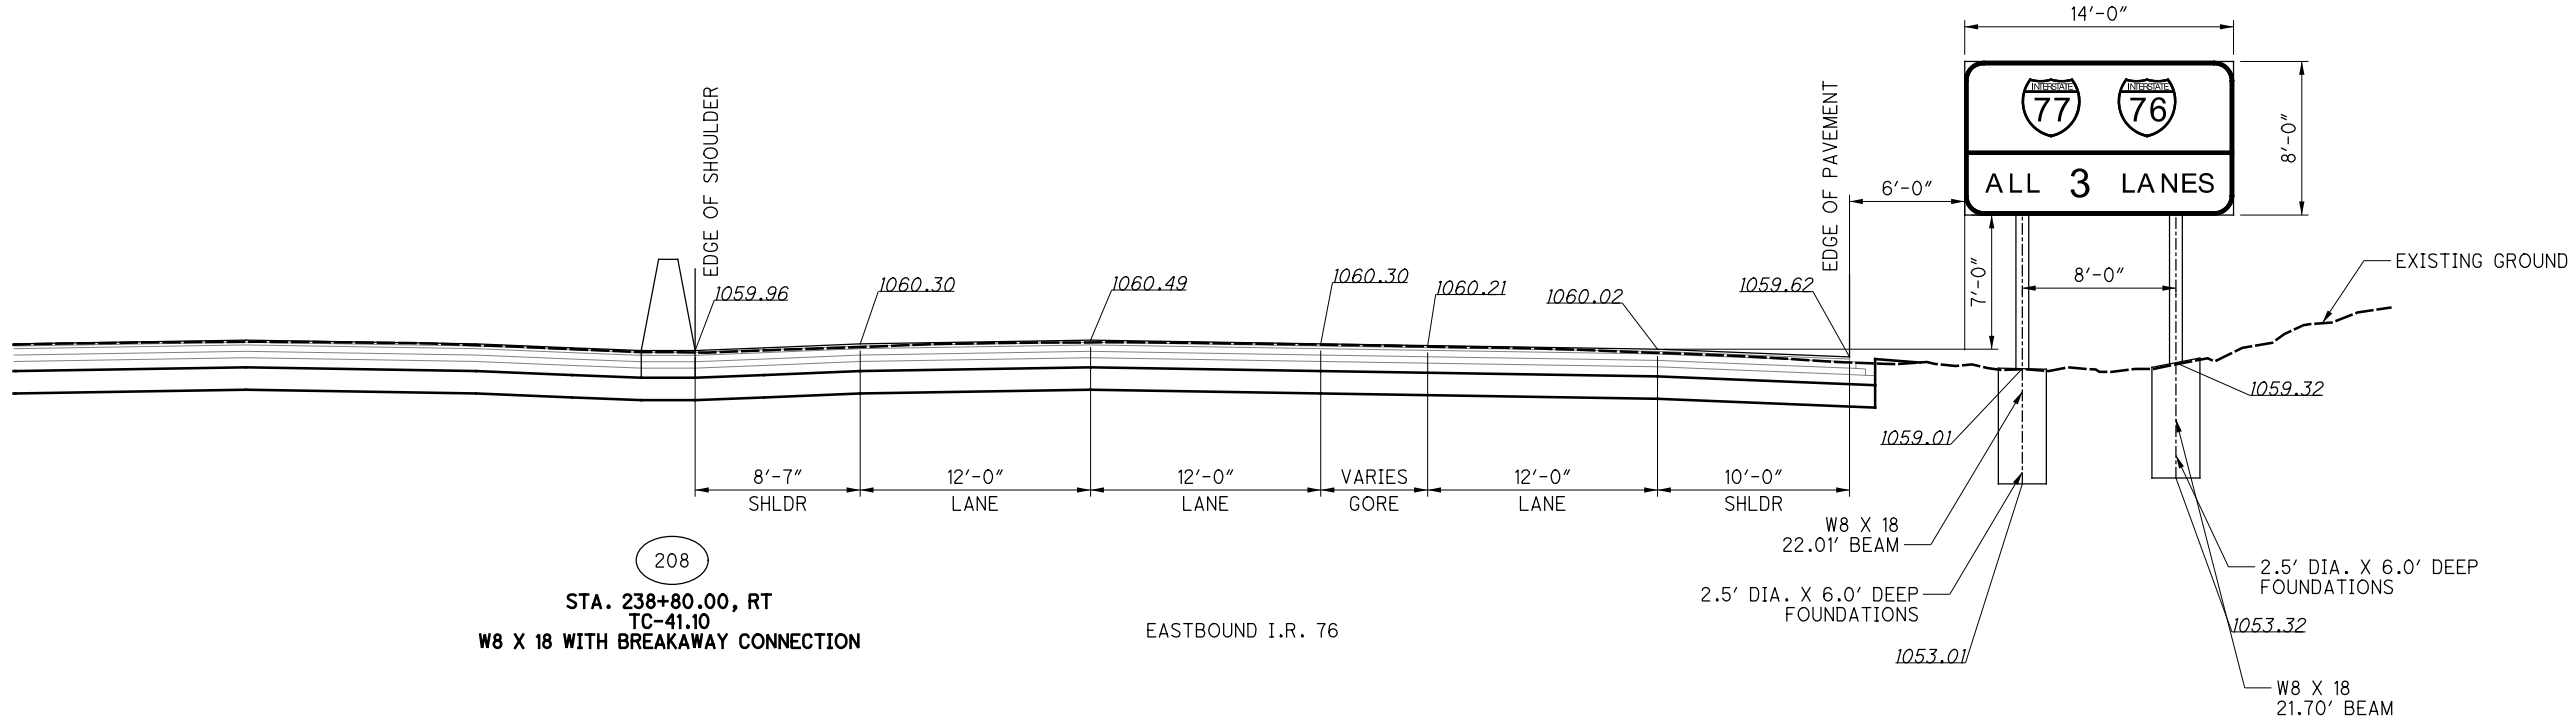


ISSUE RECORD:		
NO.	DATE	DESCRIPTION




CALCULATED	
AC	
CHECKED	
RW	


HORIZONTAL SCALE IN FEET

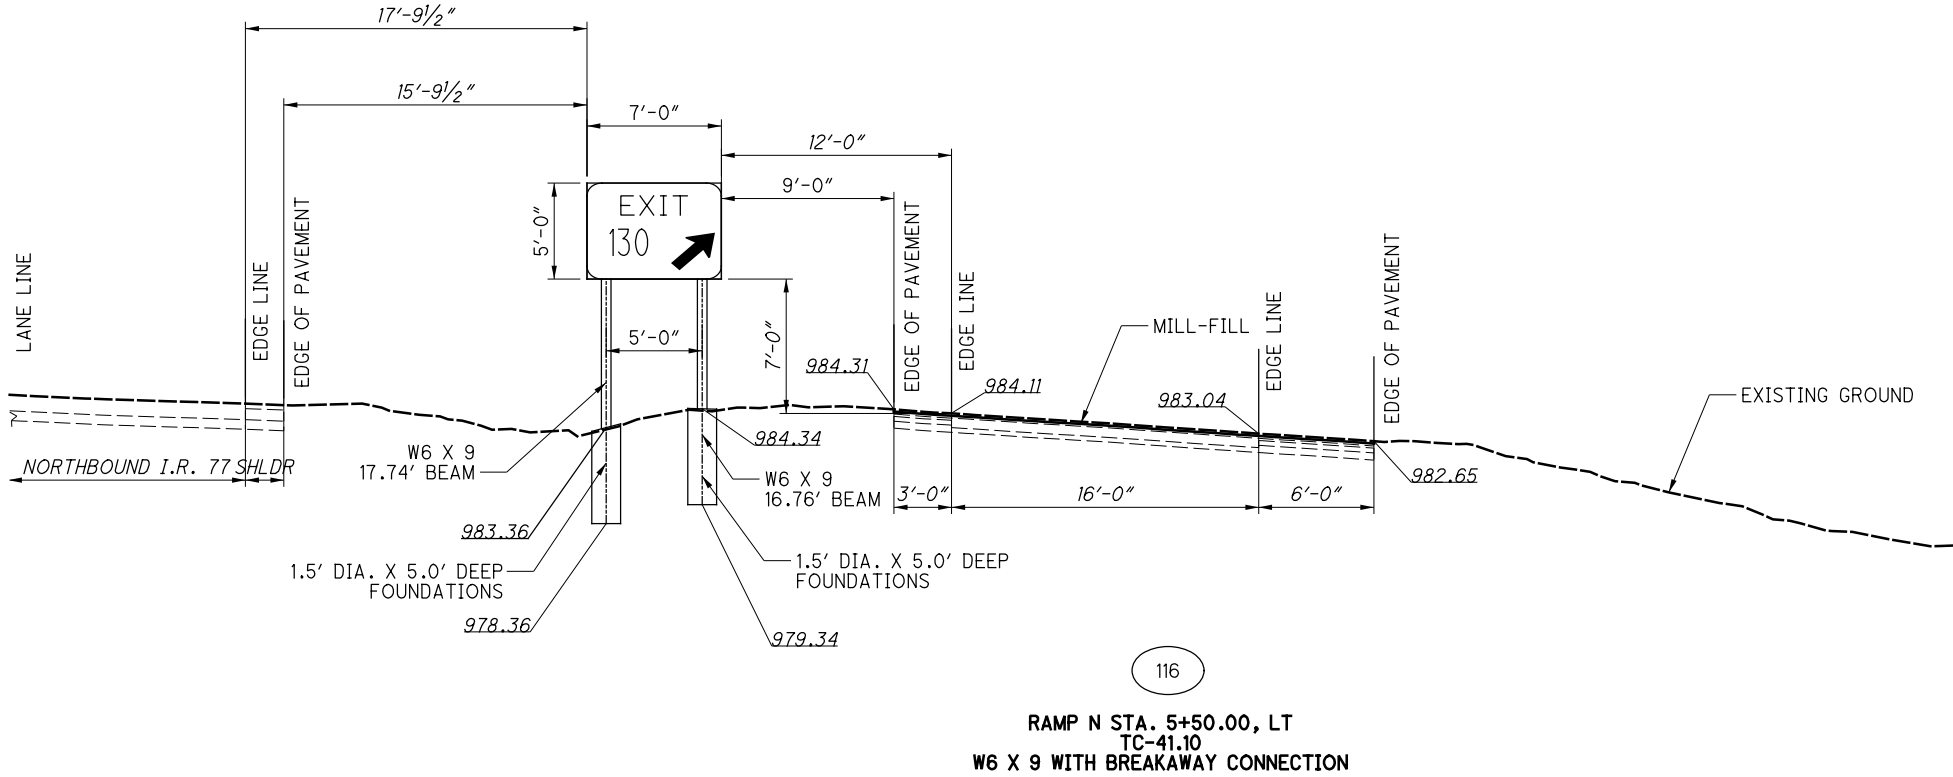

ISSUE RECORD:		
NO.	DATE	DESCRIPTION

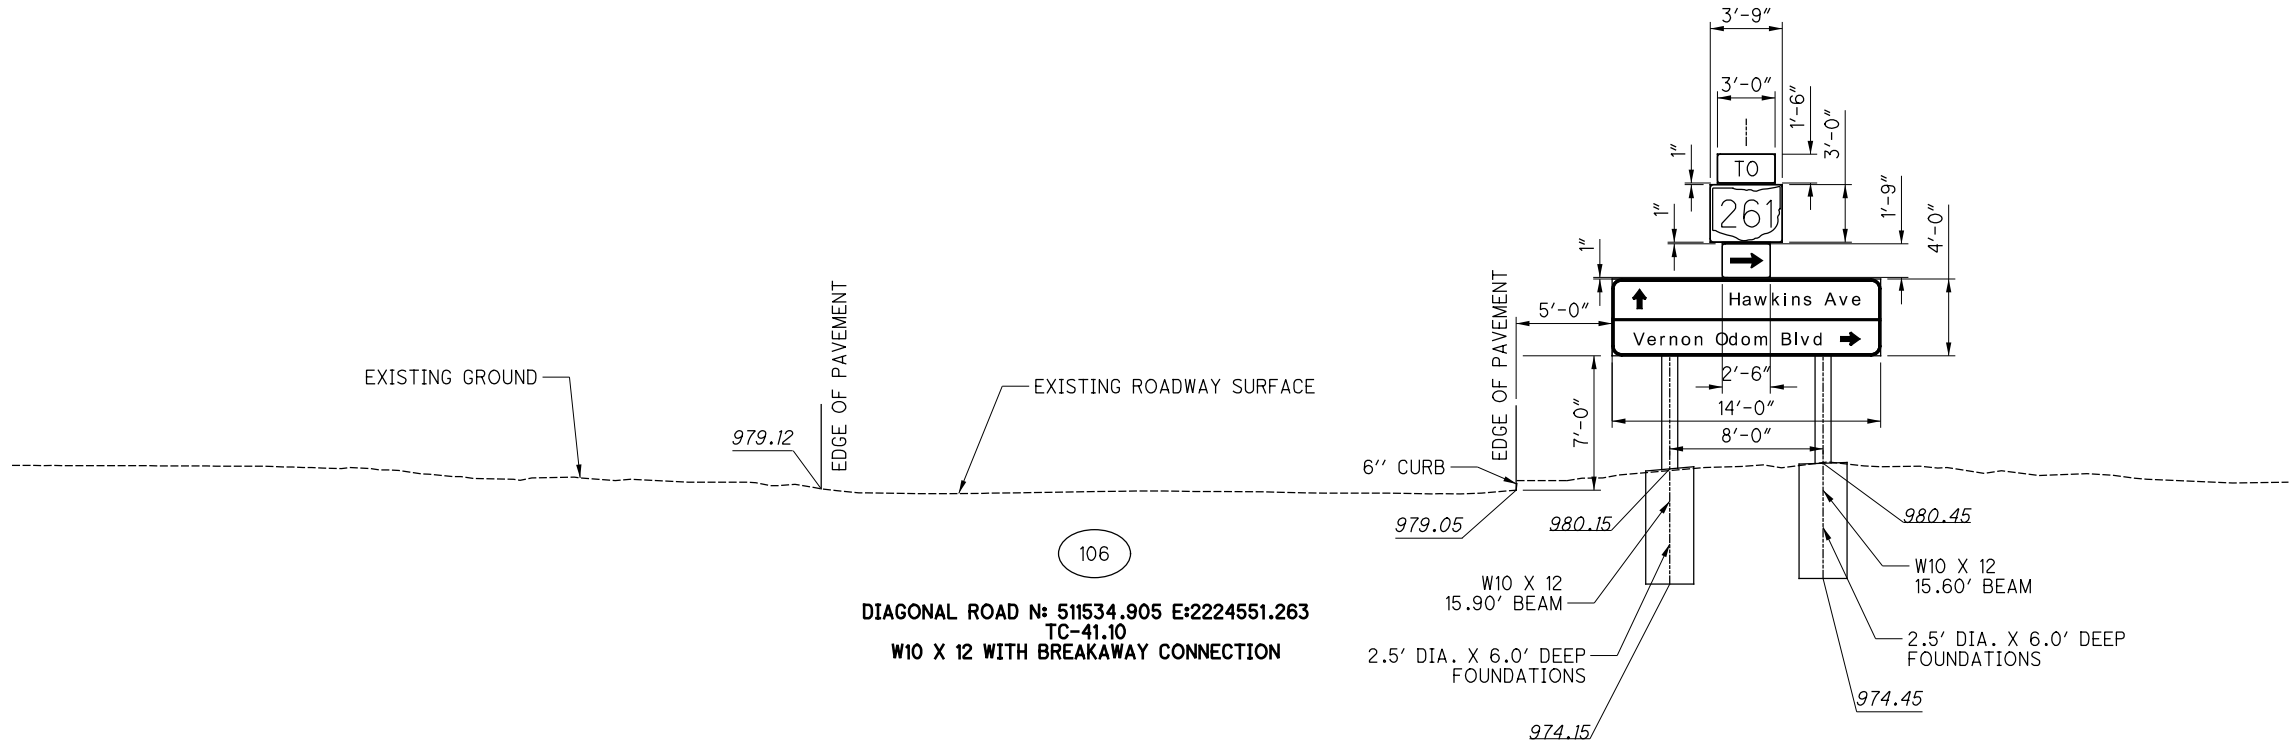

ISSUE RECORD:		
NO.	DATE	DESCRIPTION

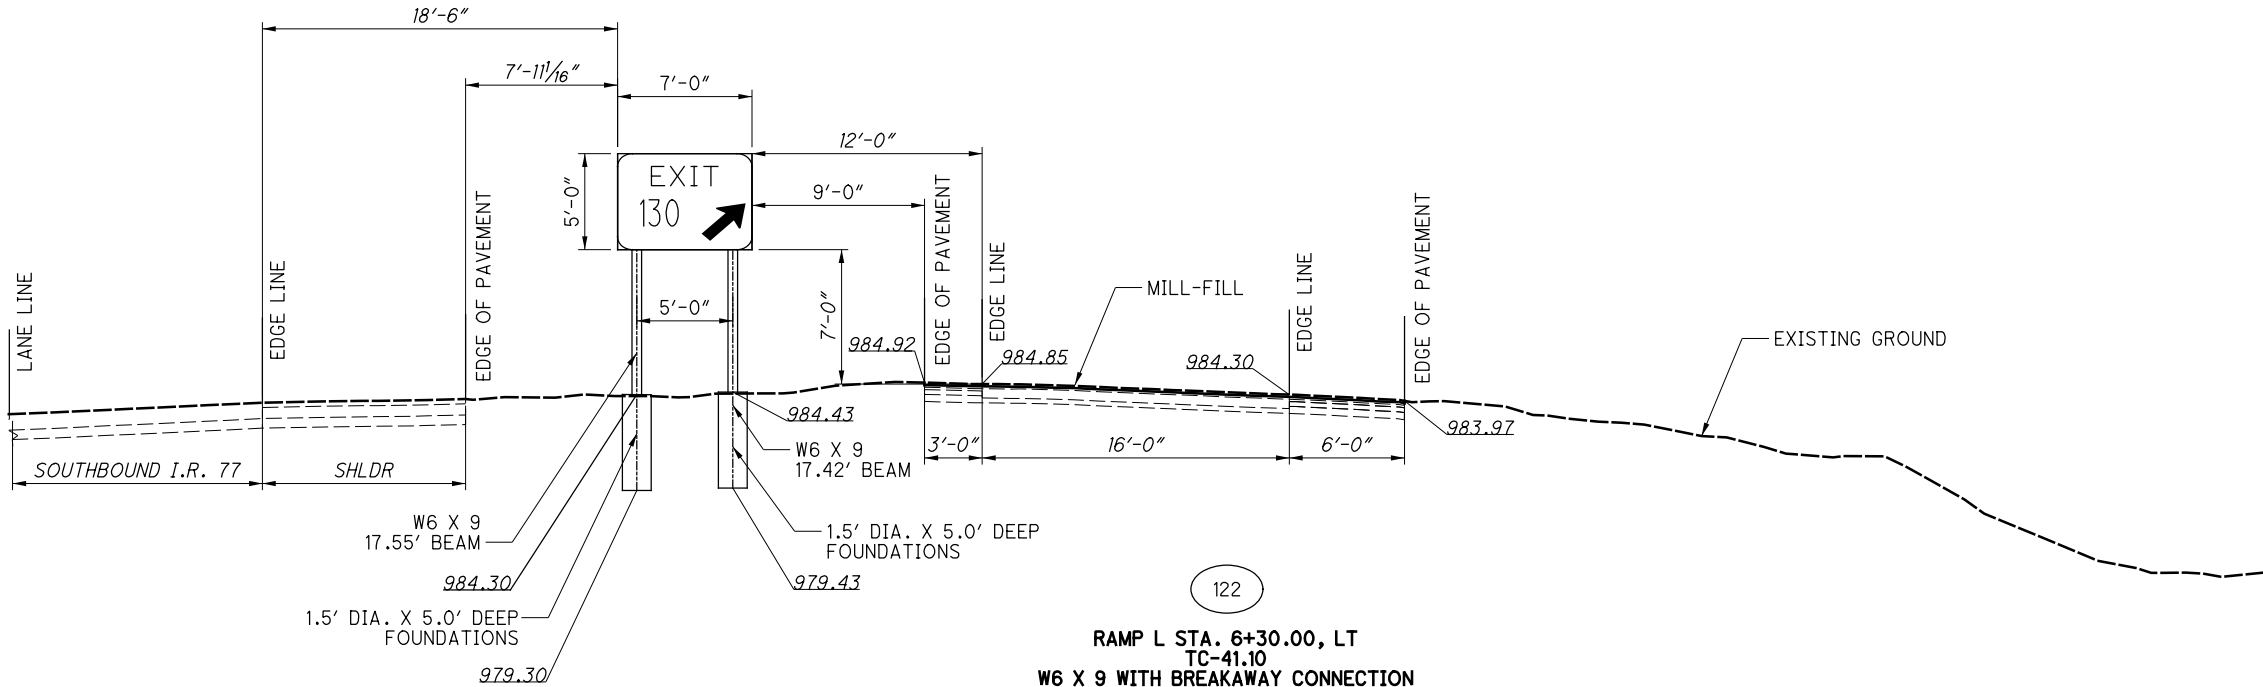

ISSUE RECORD:		
NO.	DATE	DESCRIPTION

2025-03-19 - BU-38 - RECORD DRAWING PLANS


33
36

SUM-76 / 77 / 8-
8.24 / 9.74 / 0.00


BEAM MOUNTED SIGN ELEVATION DETAILS

CALCULATED
AC
CHECKED
RW

0 5 10
2.5'
HORIZONTAL
SCALE IN FEET

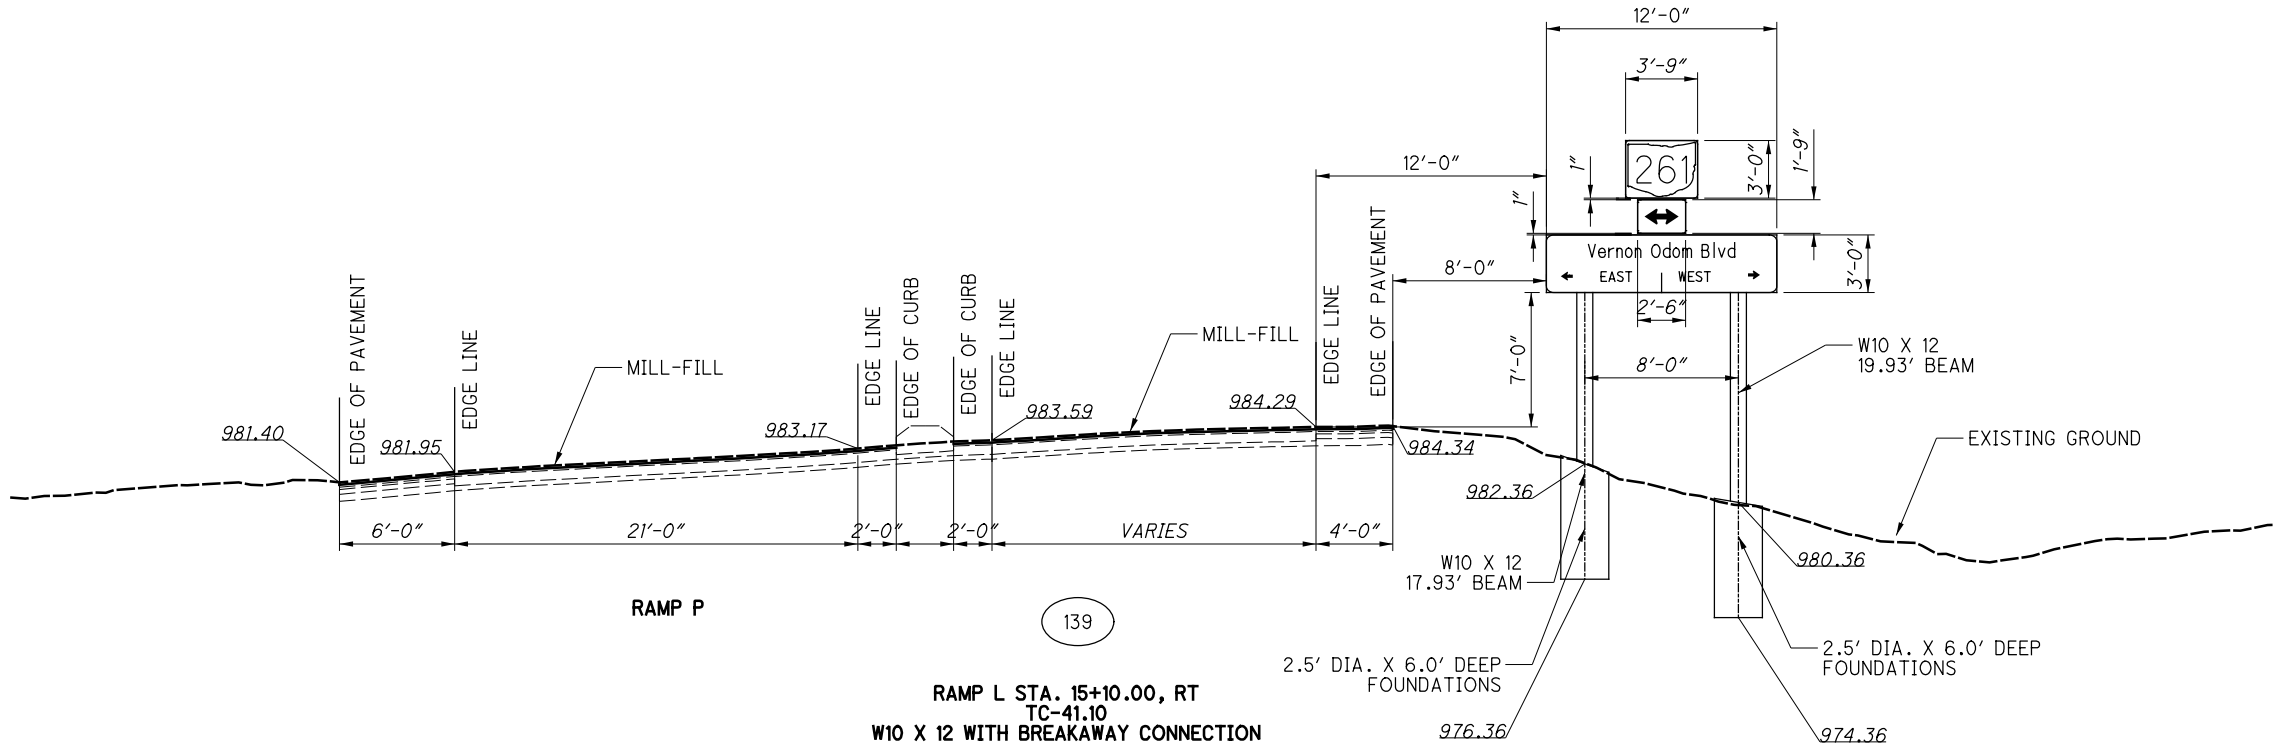

ISSUE RECORD:		
NO.	DATE	DESCRIPTION

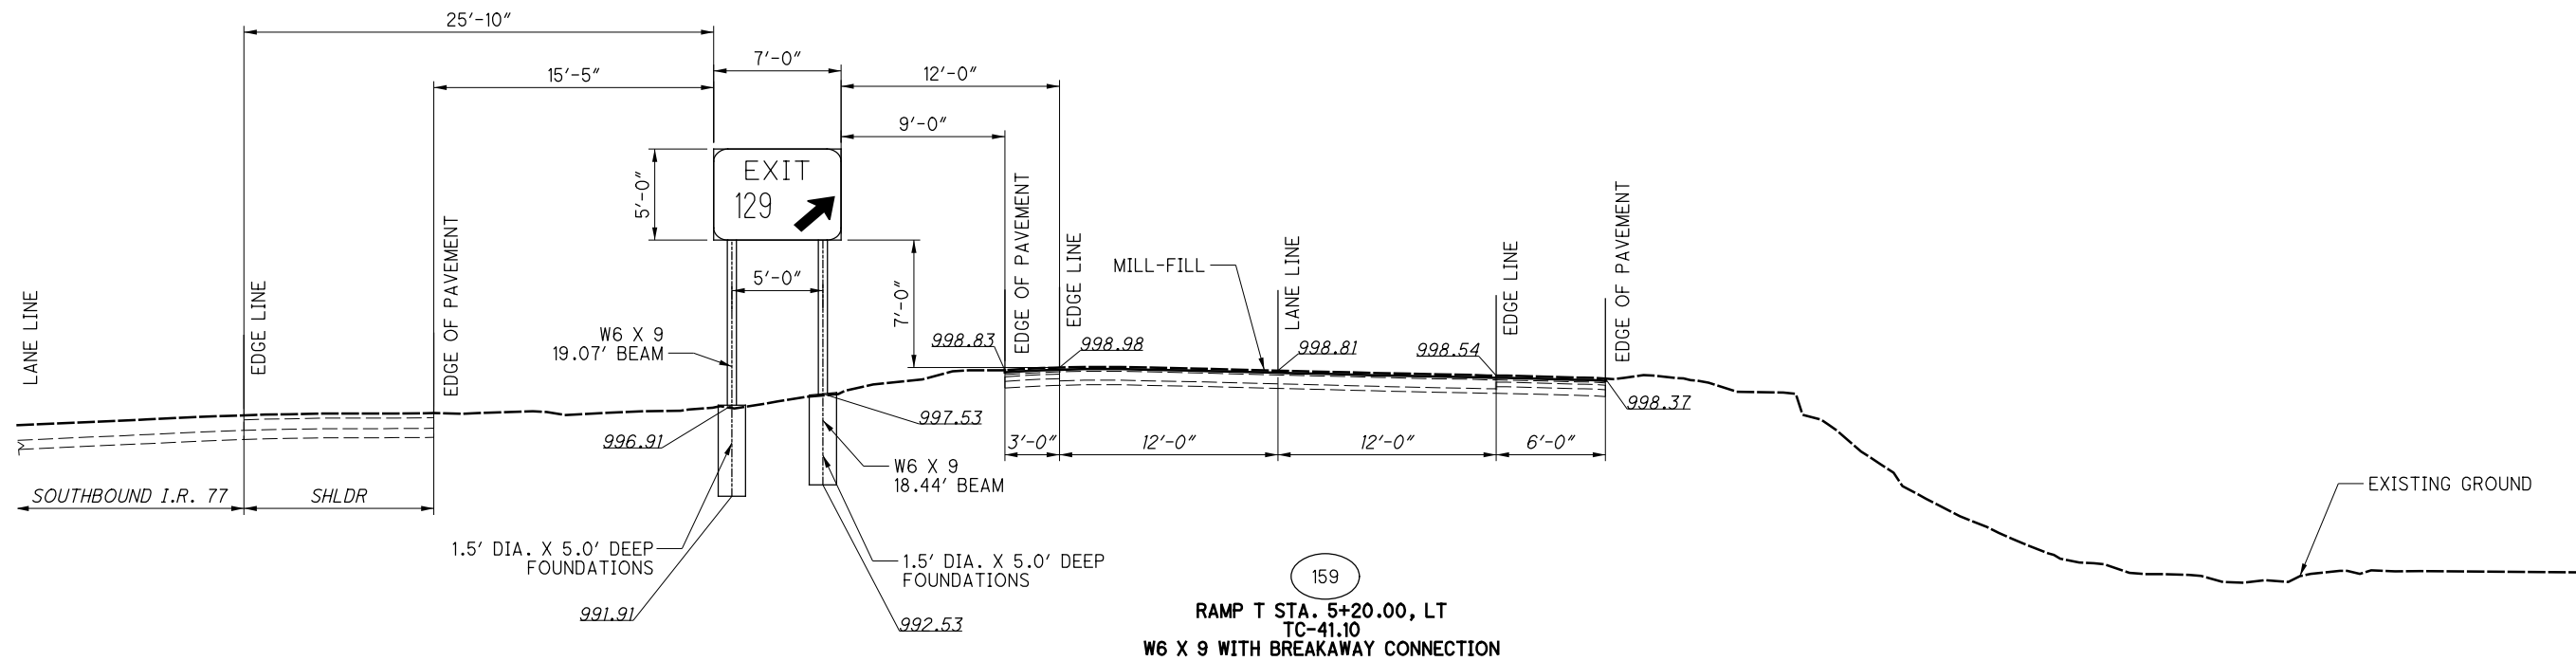
[illegible]

CALCULATED	AC	 HORIZONTAL SCALE IN FEET
CHECKED	RW	

2025-03-19 - BU-38 - RECORD DRAWING PLANS

**SUM-76/77/8-
8.24/9.74/0.00**

BEAM MOUNTED SIGN ELEVATION DETAILS

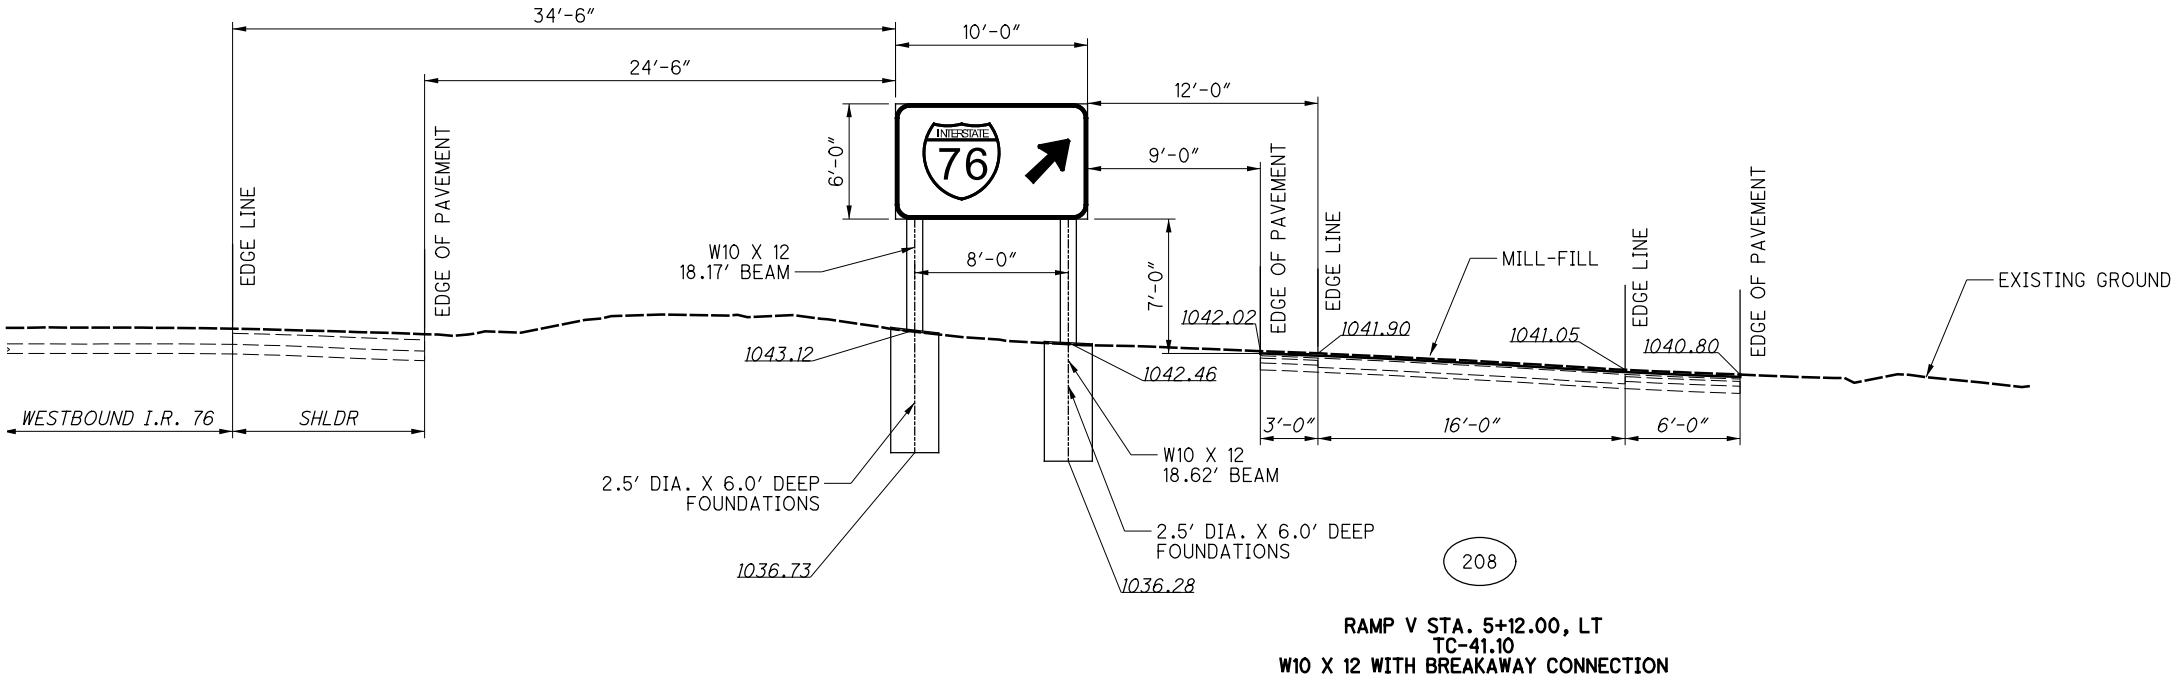

ISSUE RECORD:		
NO.	DATE	DESCRIPTION

2025-03-19 - BU-38 - RECORD DRAWING PLANS

36

36

SUM-76 / 77 / 8-
8.24 / 9.74 / 0.00

BEAM MOUNTED SIGN ELEVATION DETAILS

CALCULATED
AC

CHECKED
RW

05

10

2.5'
HORIZONTAL
SCALE IN FEET