

Legend:

- Proposed Fence
- Existing Fence
- LPEC
Line Post Encased in Concrete
- IAPA
Intermediate Anchor Post Assembly
- EPA
End Post Assembly
- AC
Abutment/Wall Connection


ISSUE RECORD:		
NO.	DATE	DESCRIPTION




FENCE PLAN - I.R. 77
END I.R. 77 PROJECT TO STA. 211+00

2025-09-02 - BU-42 - RECORD DRAWING PLANS

SUM-76 / 77 / 8-
8.24 / 9.74 / 0.00

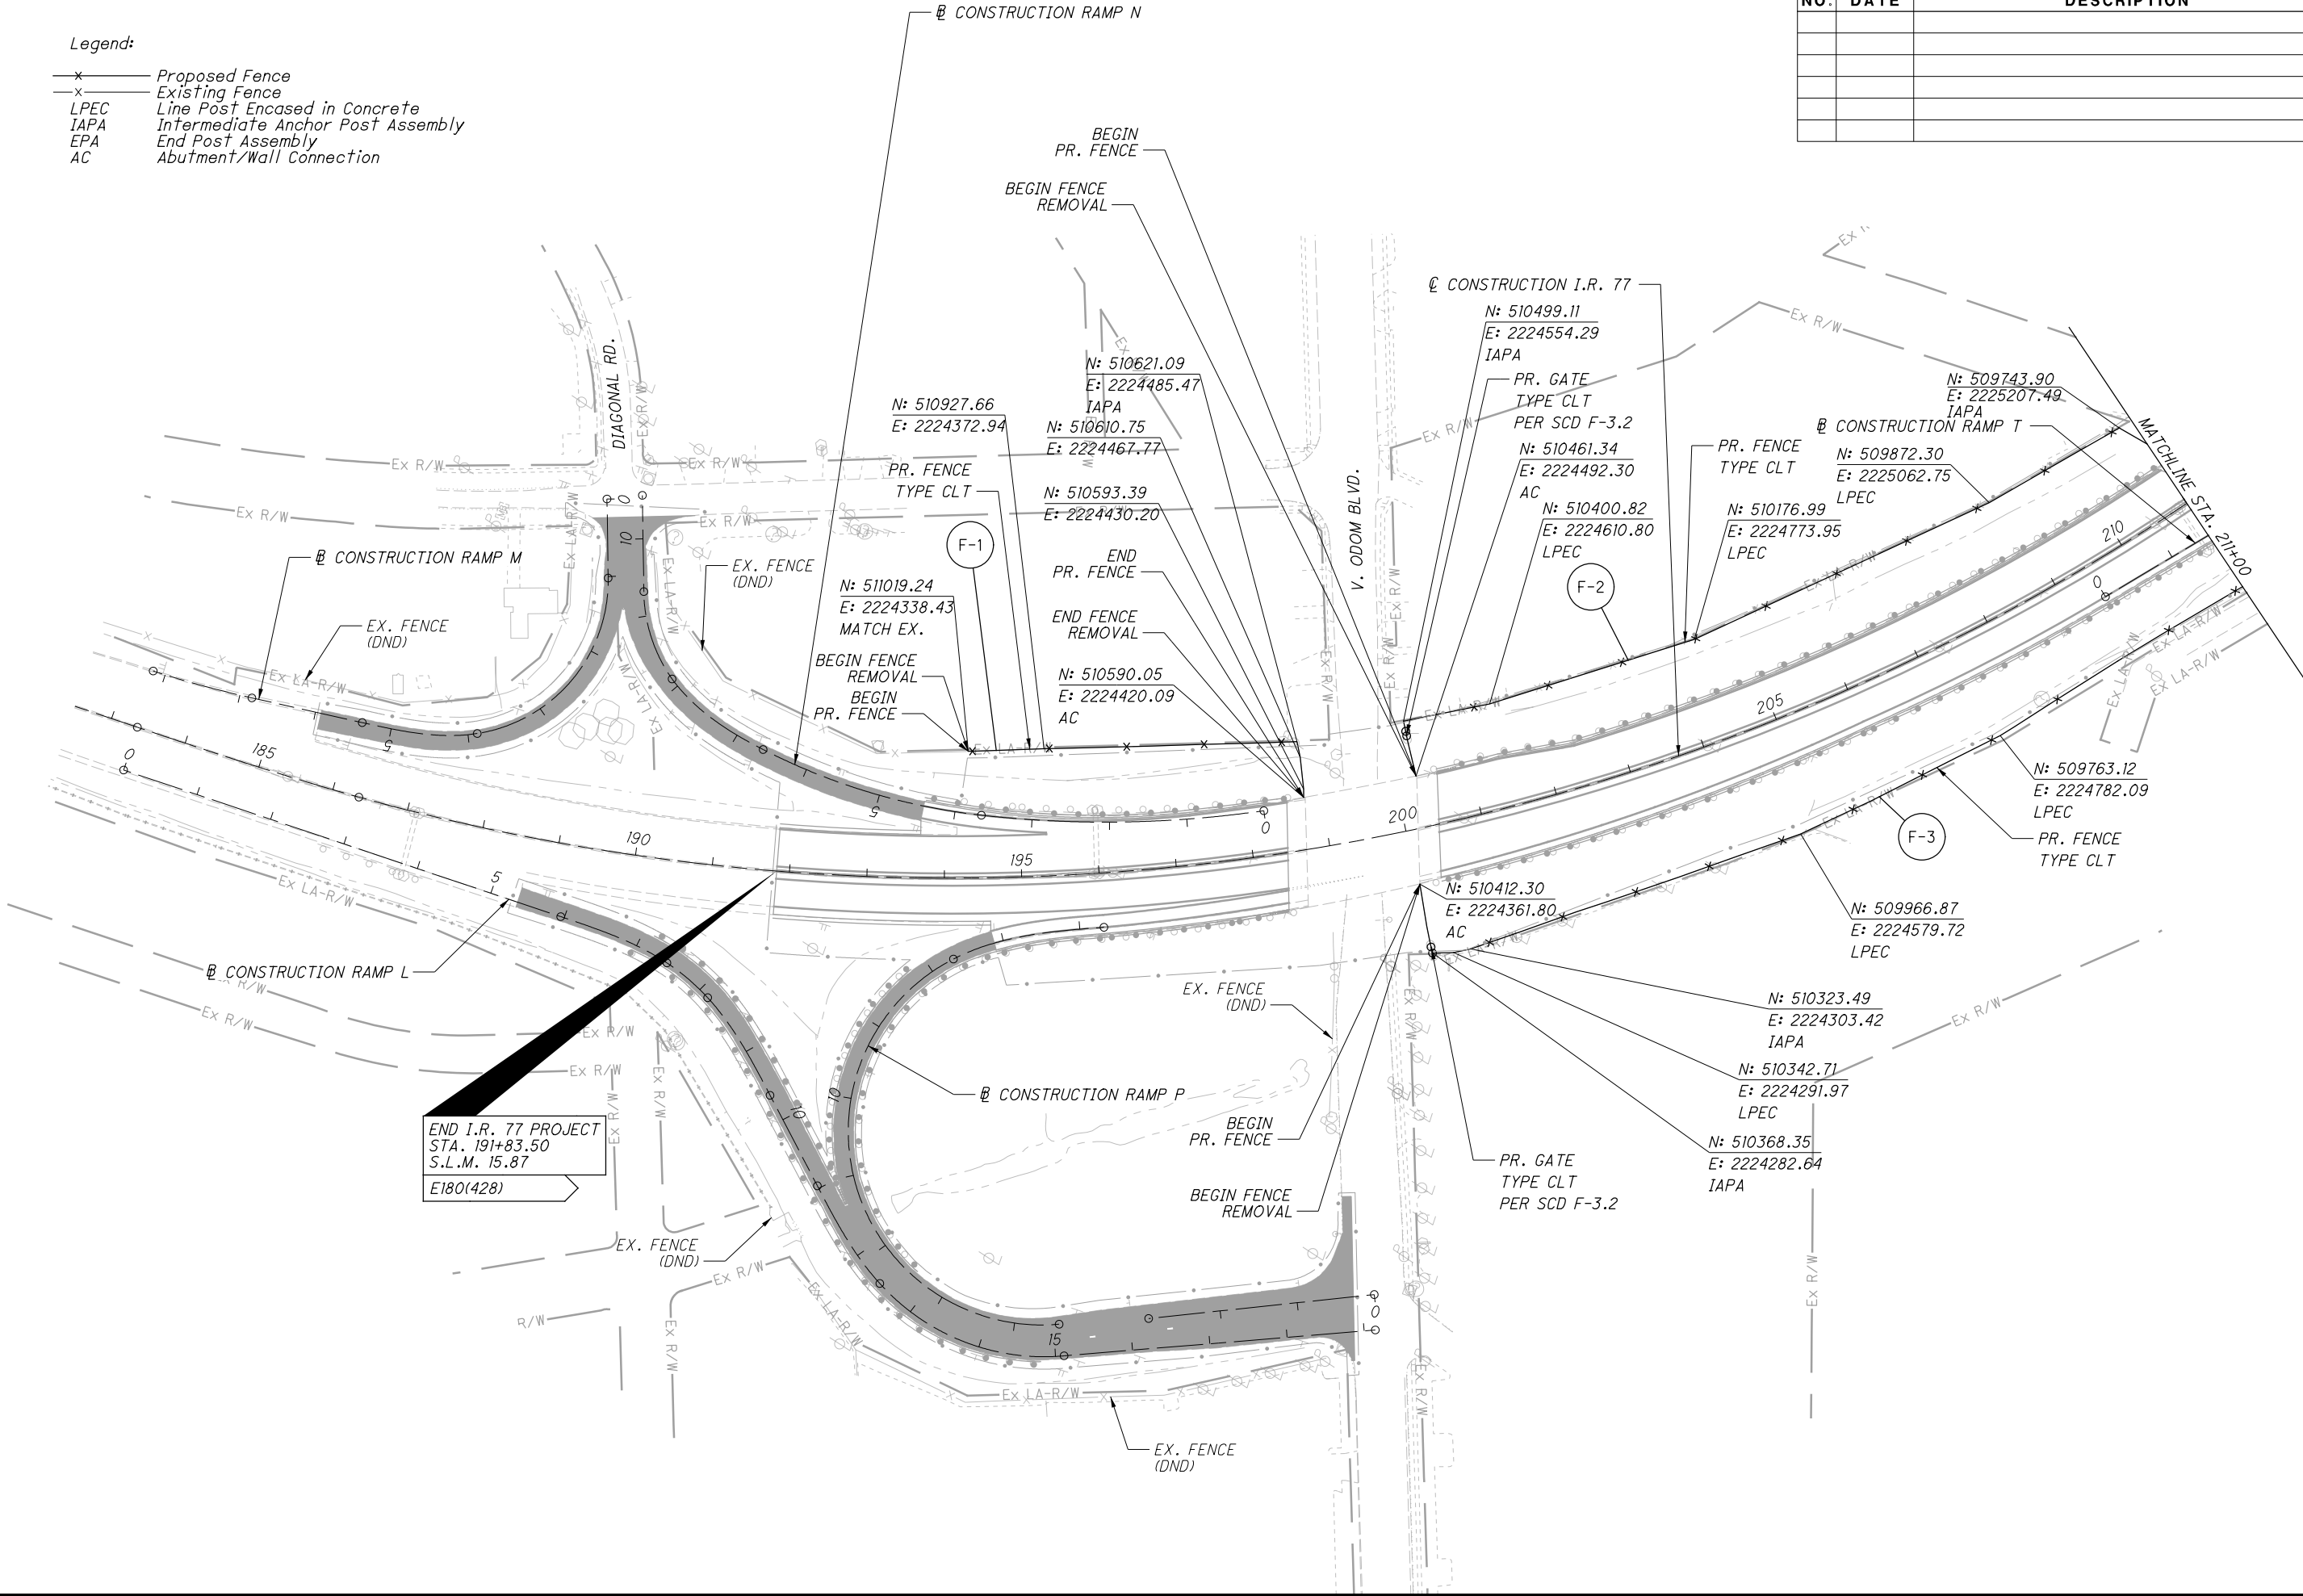

Legend:
 * Proposed Fence
 x Existing Fence
 LPEC - Line Post Encased in Concrete
 IAPA - Intermediate Anchor Post Assembly
 EPA - End Post Assembly
 AC - Abutment/Wall Connection

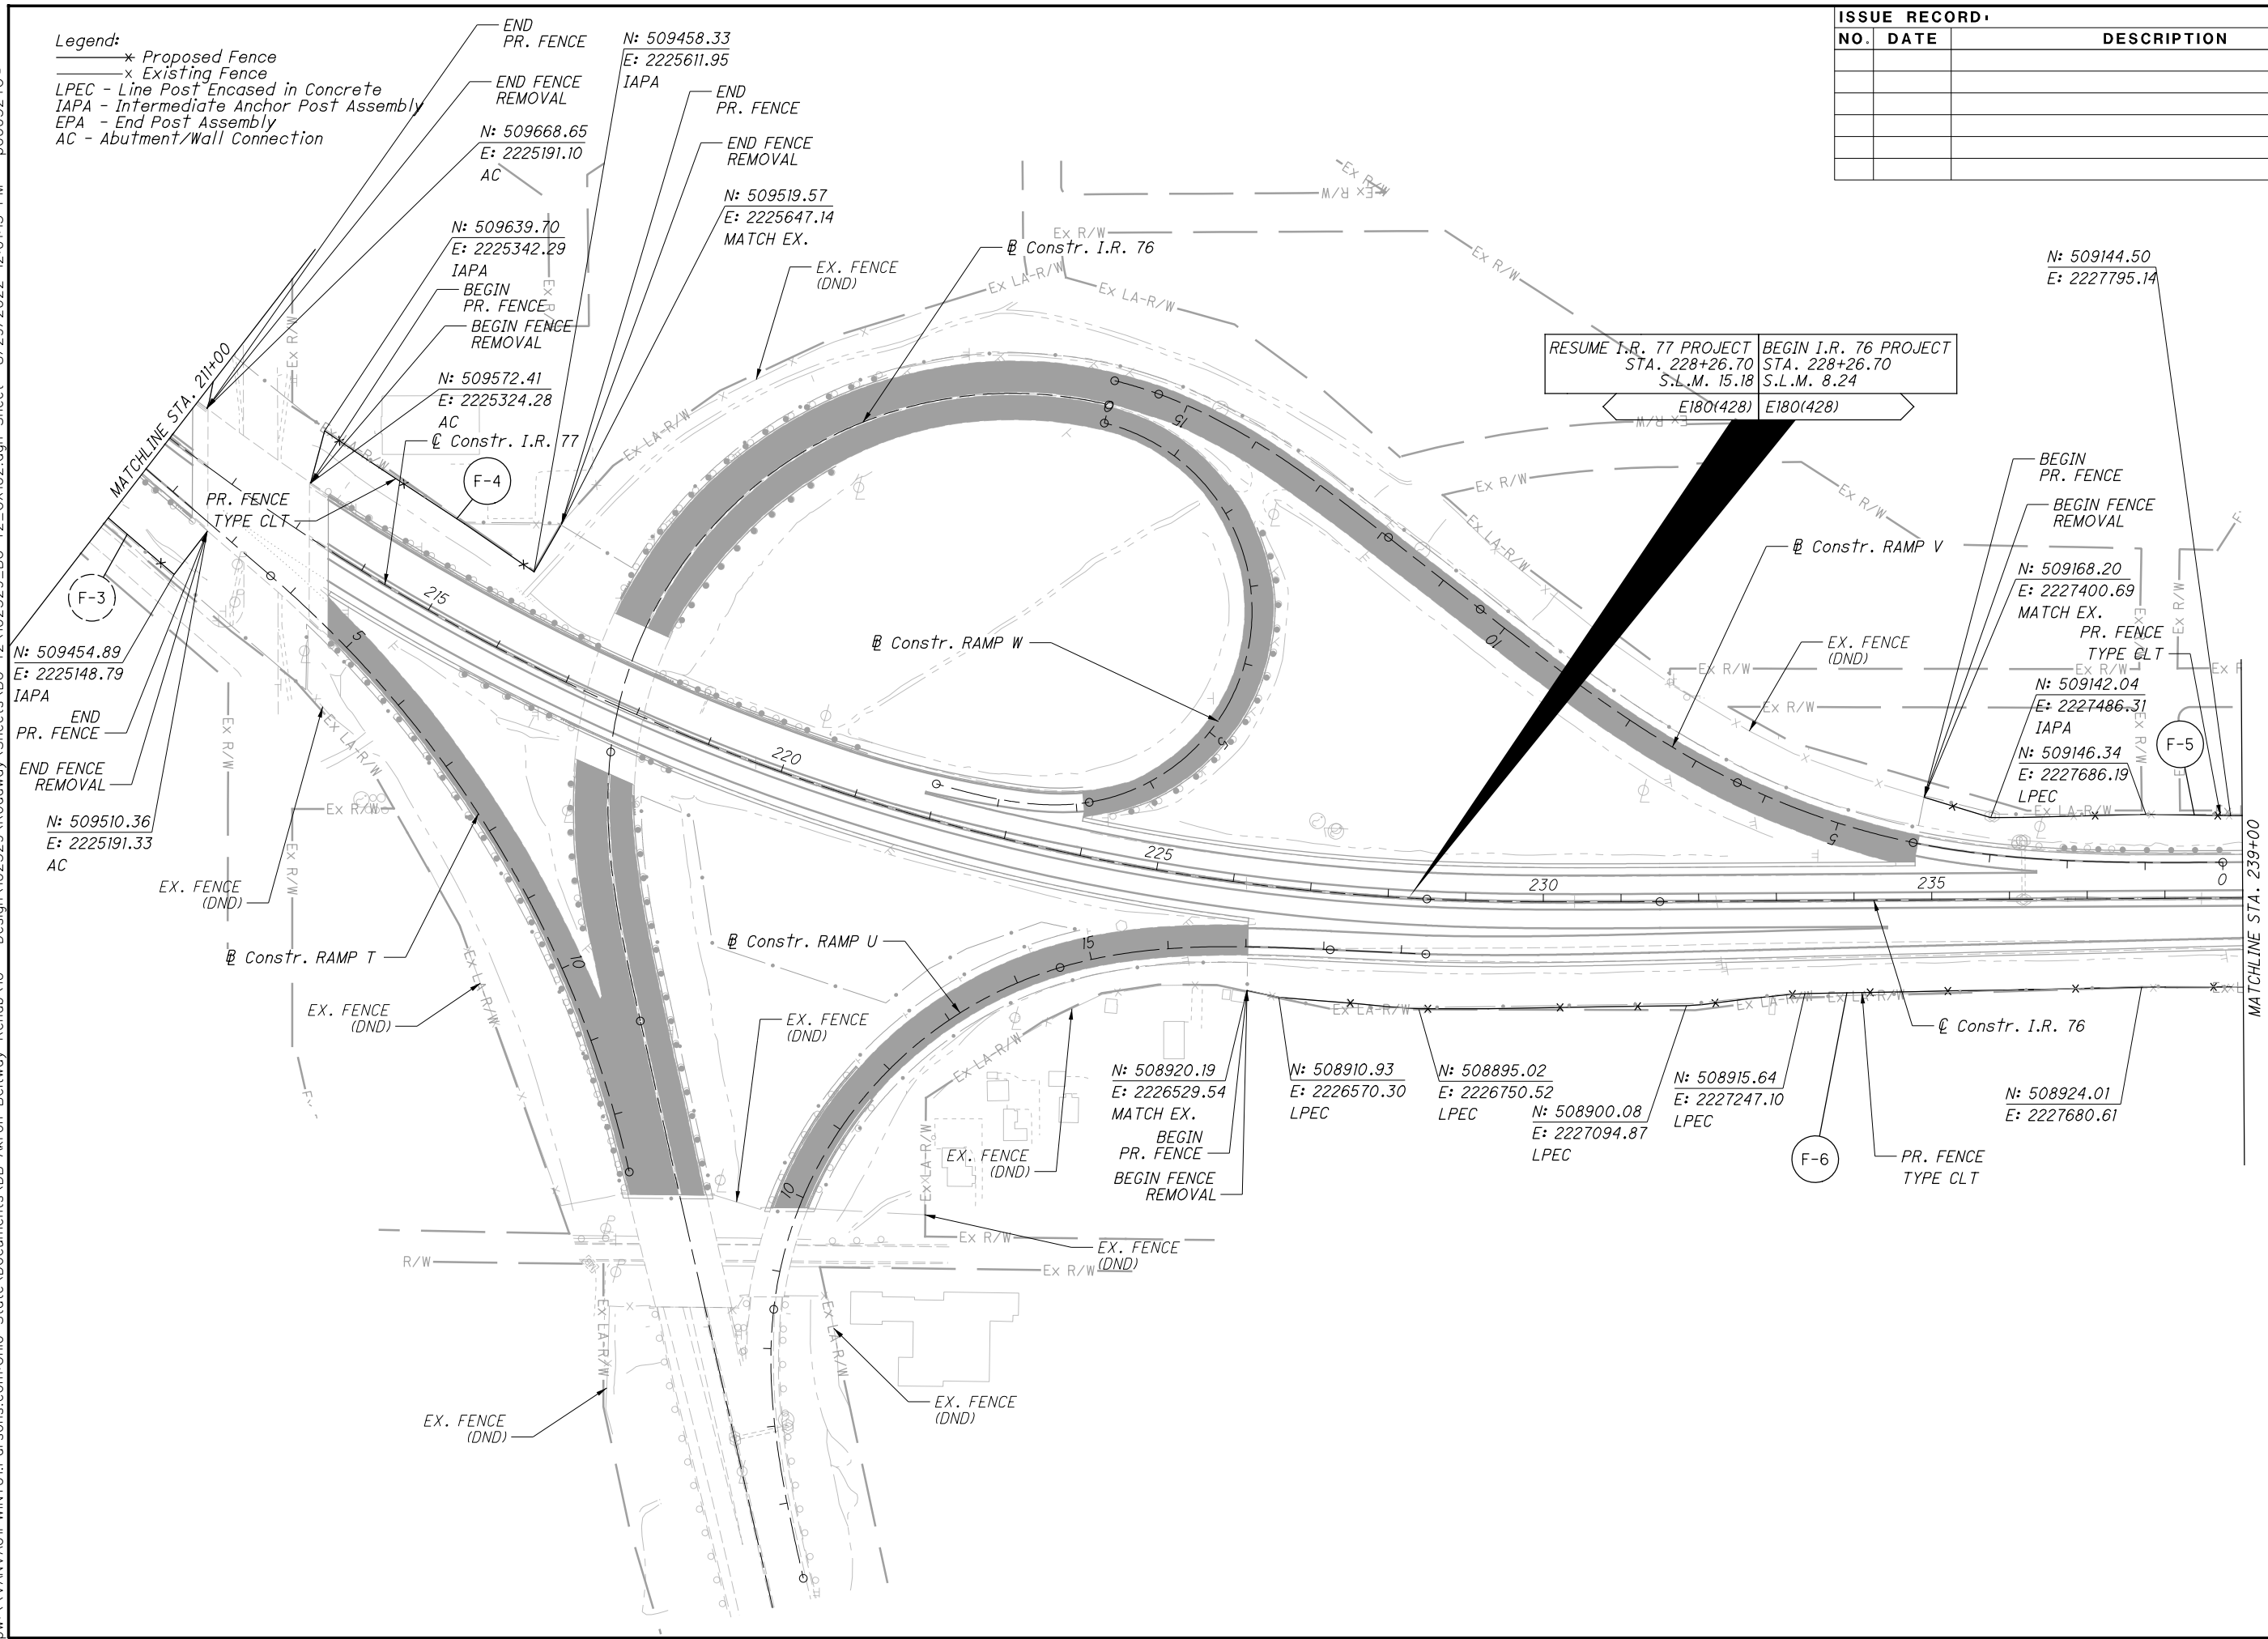
[illegible]

2025-09-02 - BU-42 - RECORD DRAWING PLANS

**FENCE PLAN - I.R. 77 / I.R. 76
STA. 211+00 TO STA. 239+00**


**SUM-76/77/8-
8.24/9.74/0.00**

Legend:
* Proposed Fence
x Existing Fence
LPEC - Line Post Encased in Concrete
IAPA - Intermediate Anchor Post Assembly
EPA - End Post Assembly
AC - Abutment/Wall Connection

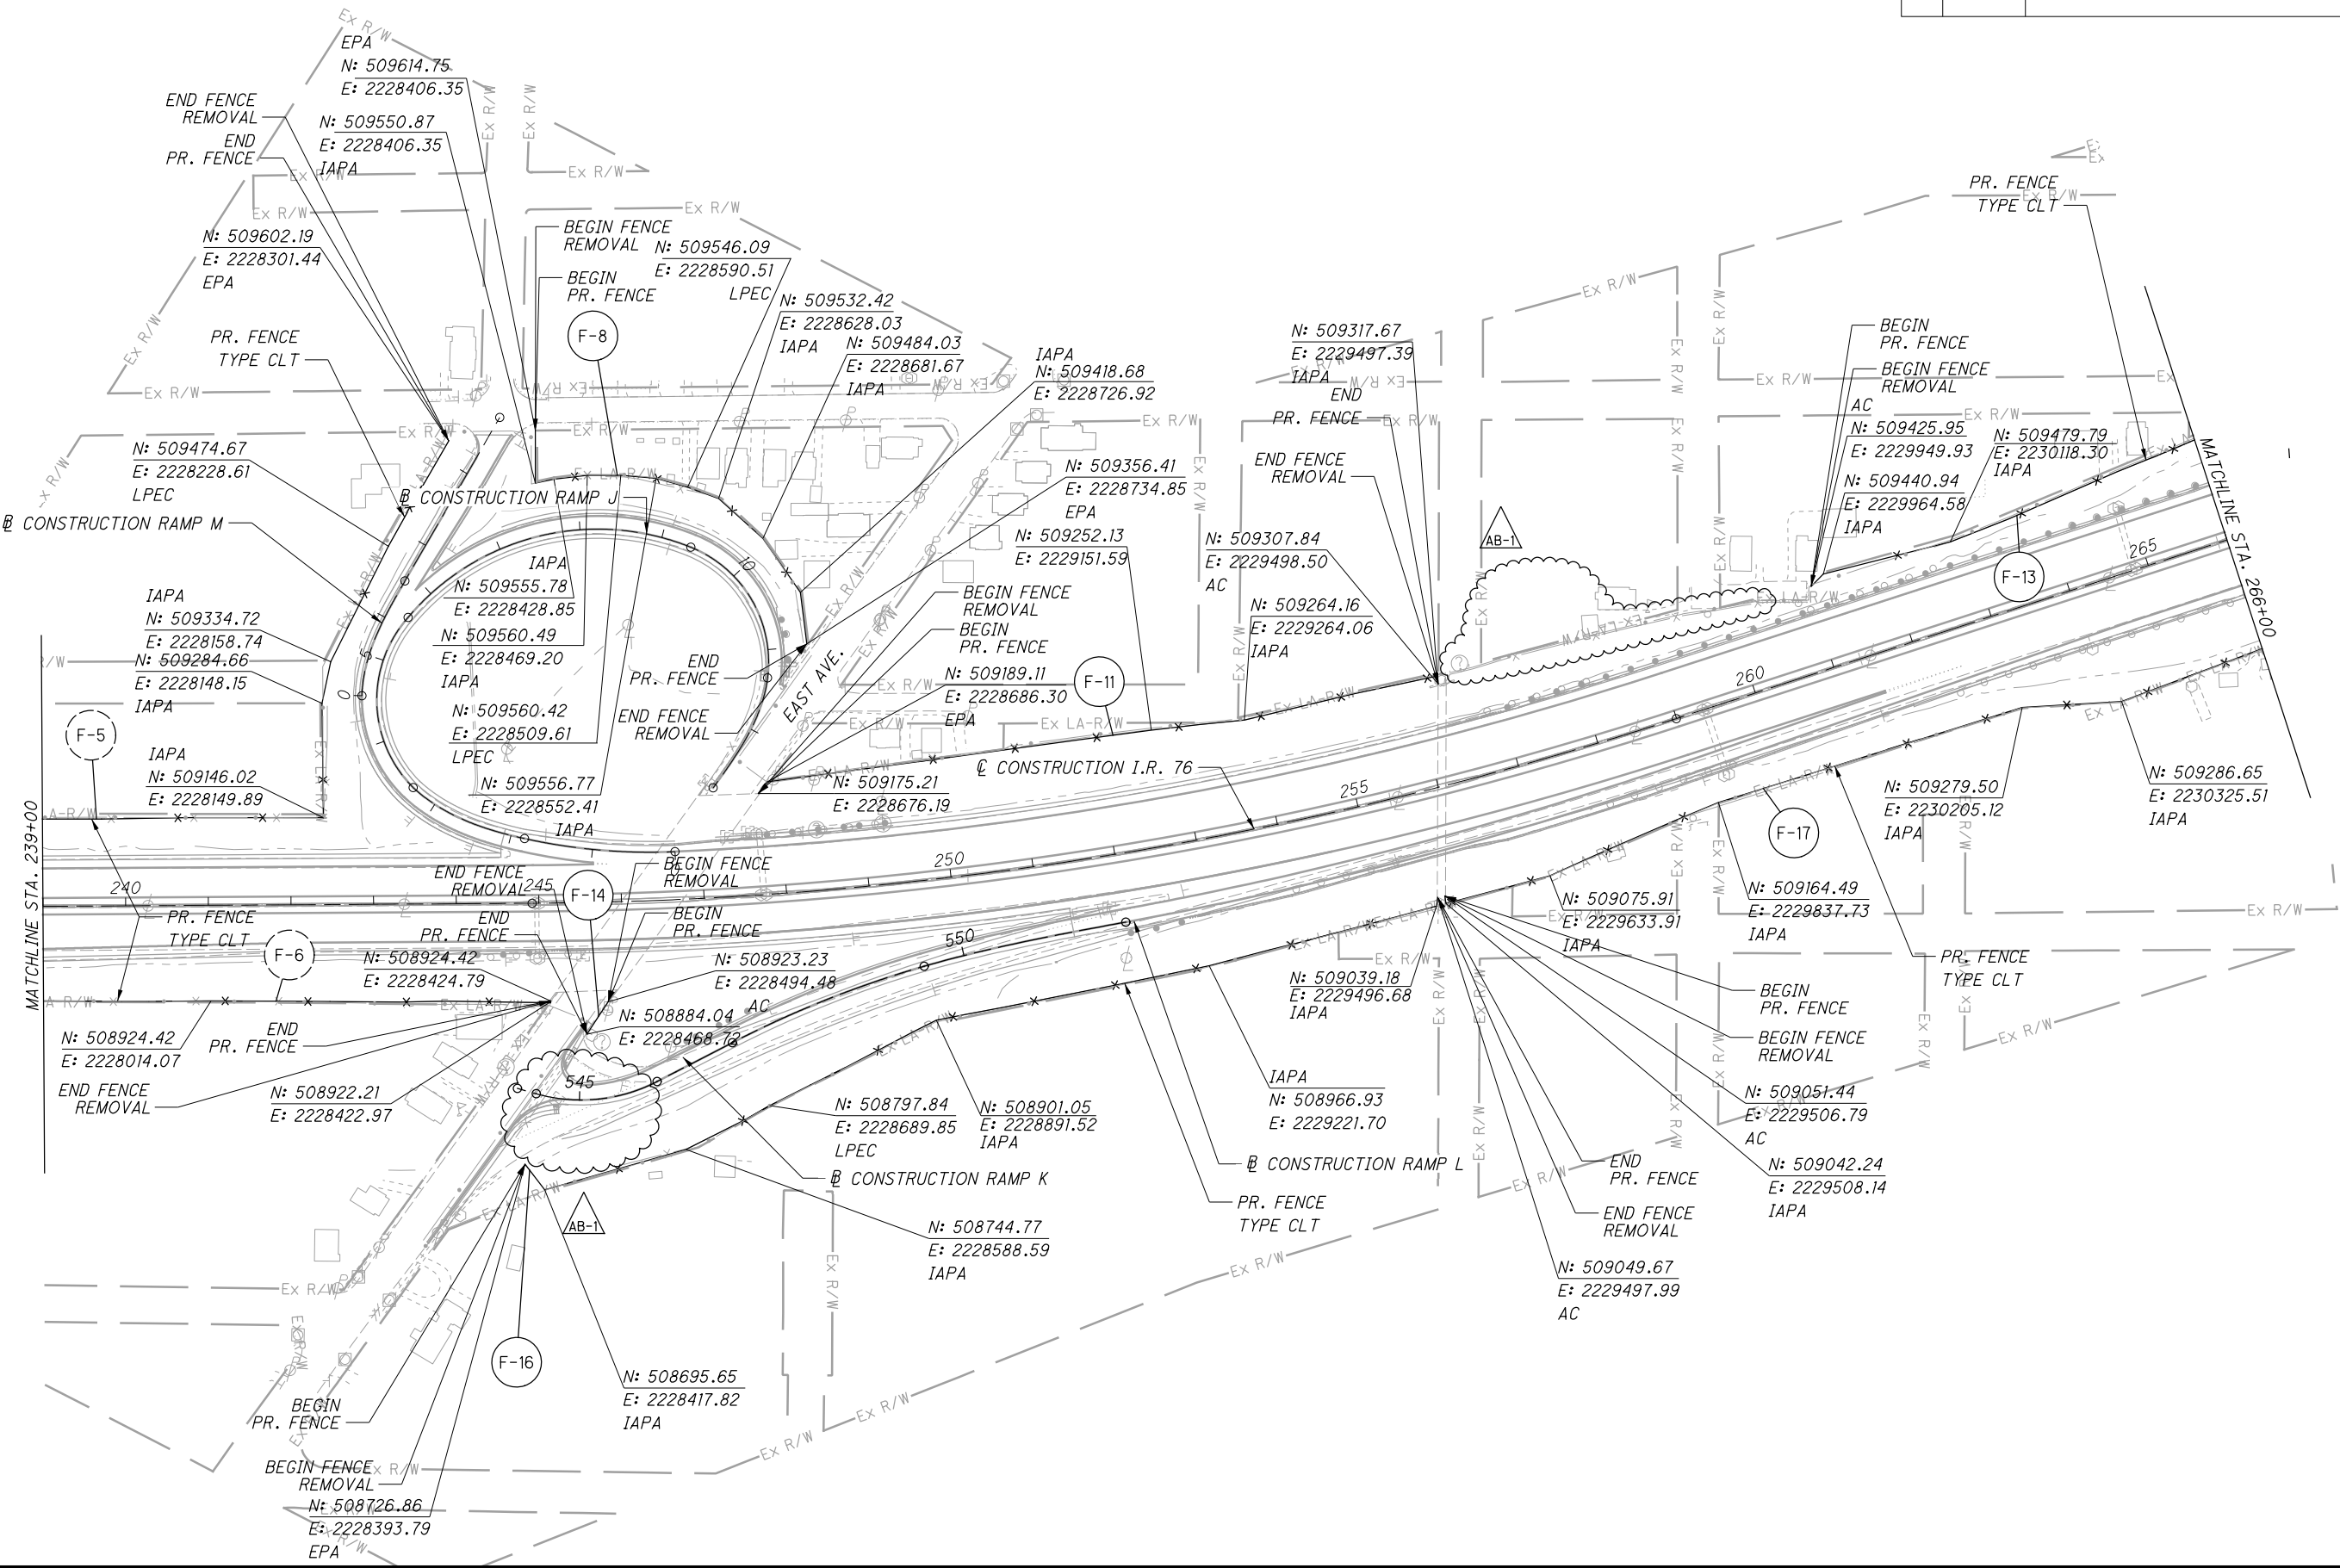


ISSUE RECORD:		
NO.	DATE	DESCRIPTION
AB-1	03/12/26	NON-PERFORMED PROP FENCING MODIFICATIONS


Legend:
* Proposed Fence
x Existing Fence
LPEC - Line Post Encased in Concrete
IAPA - Intermediate Anchor Post Assembly
EPA - End Post Assembly
AC - Abutment/Wall Connection

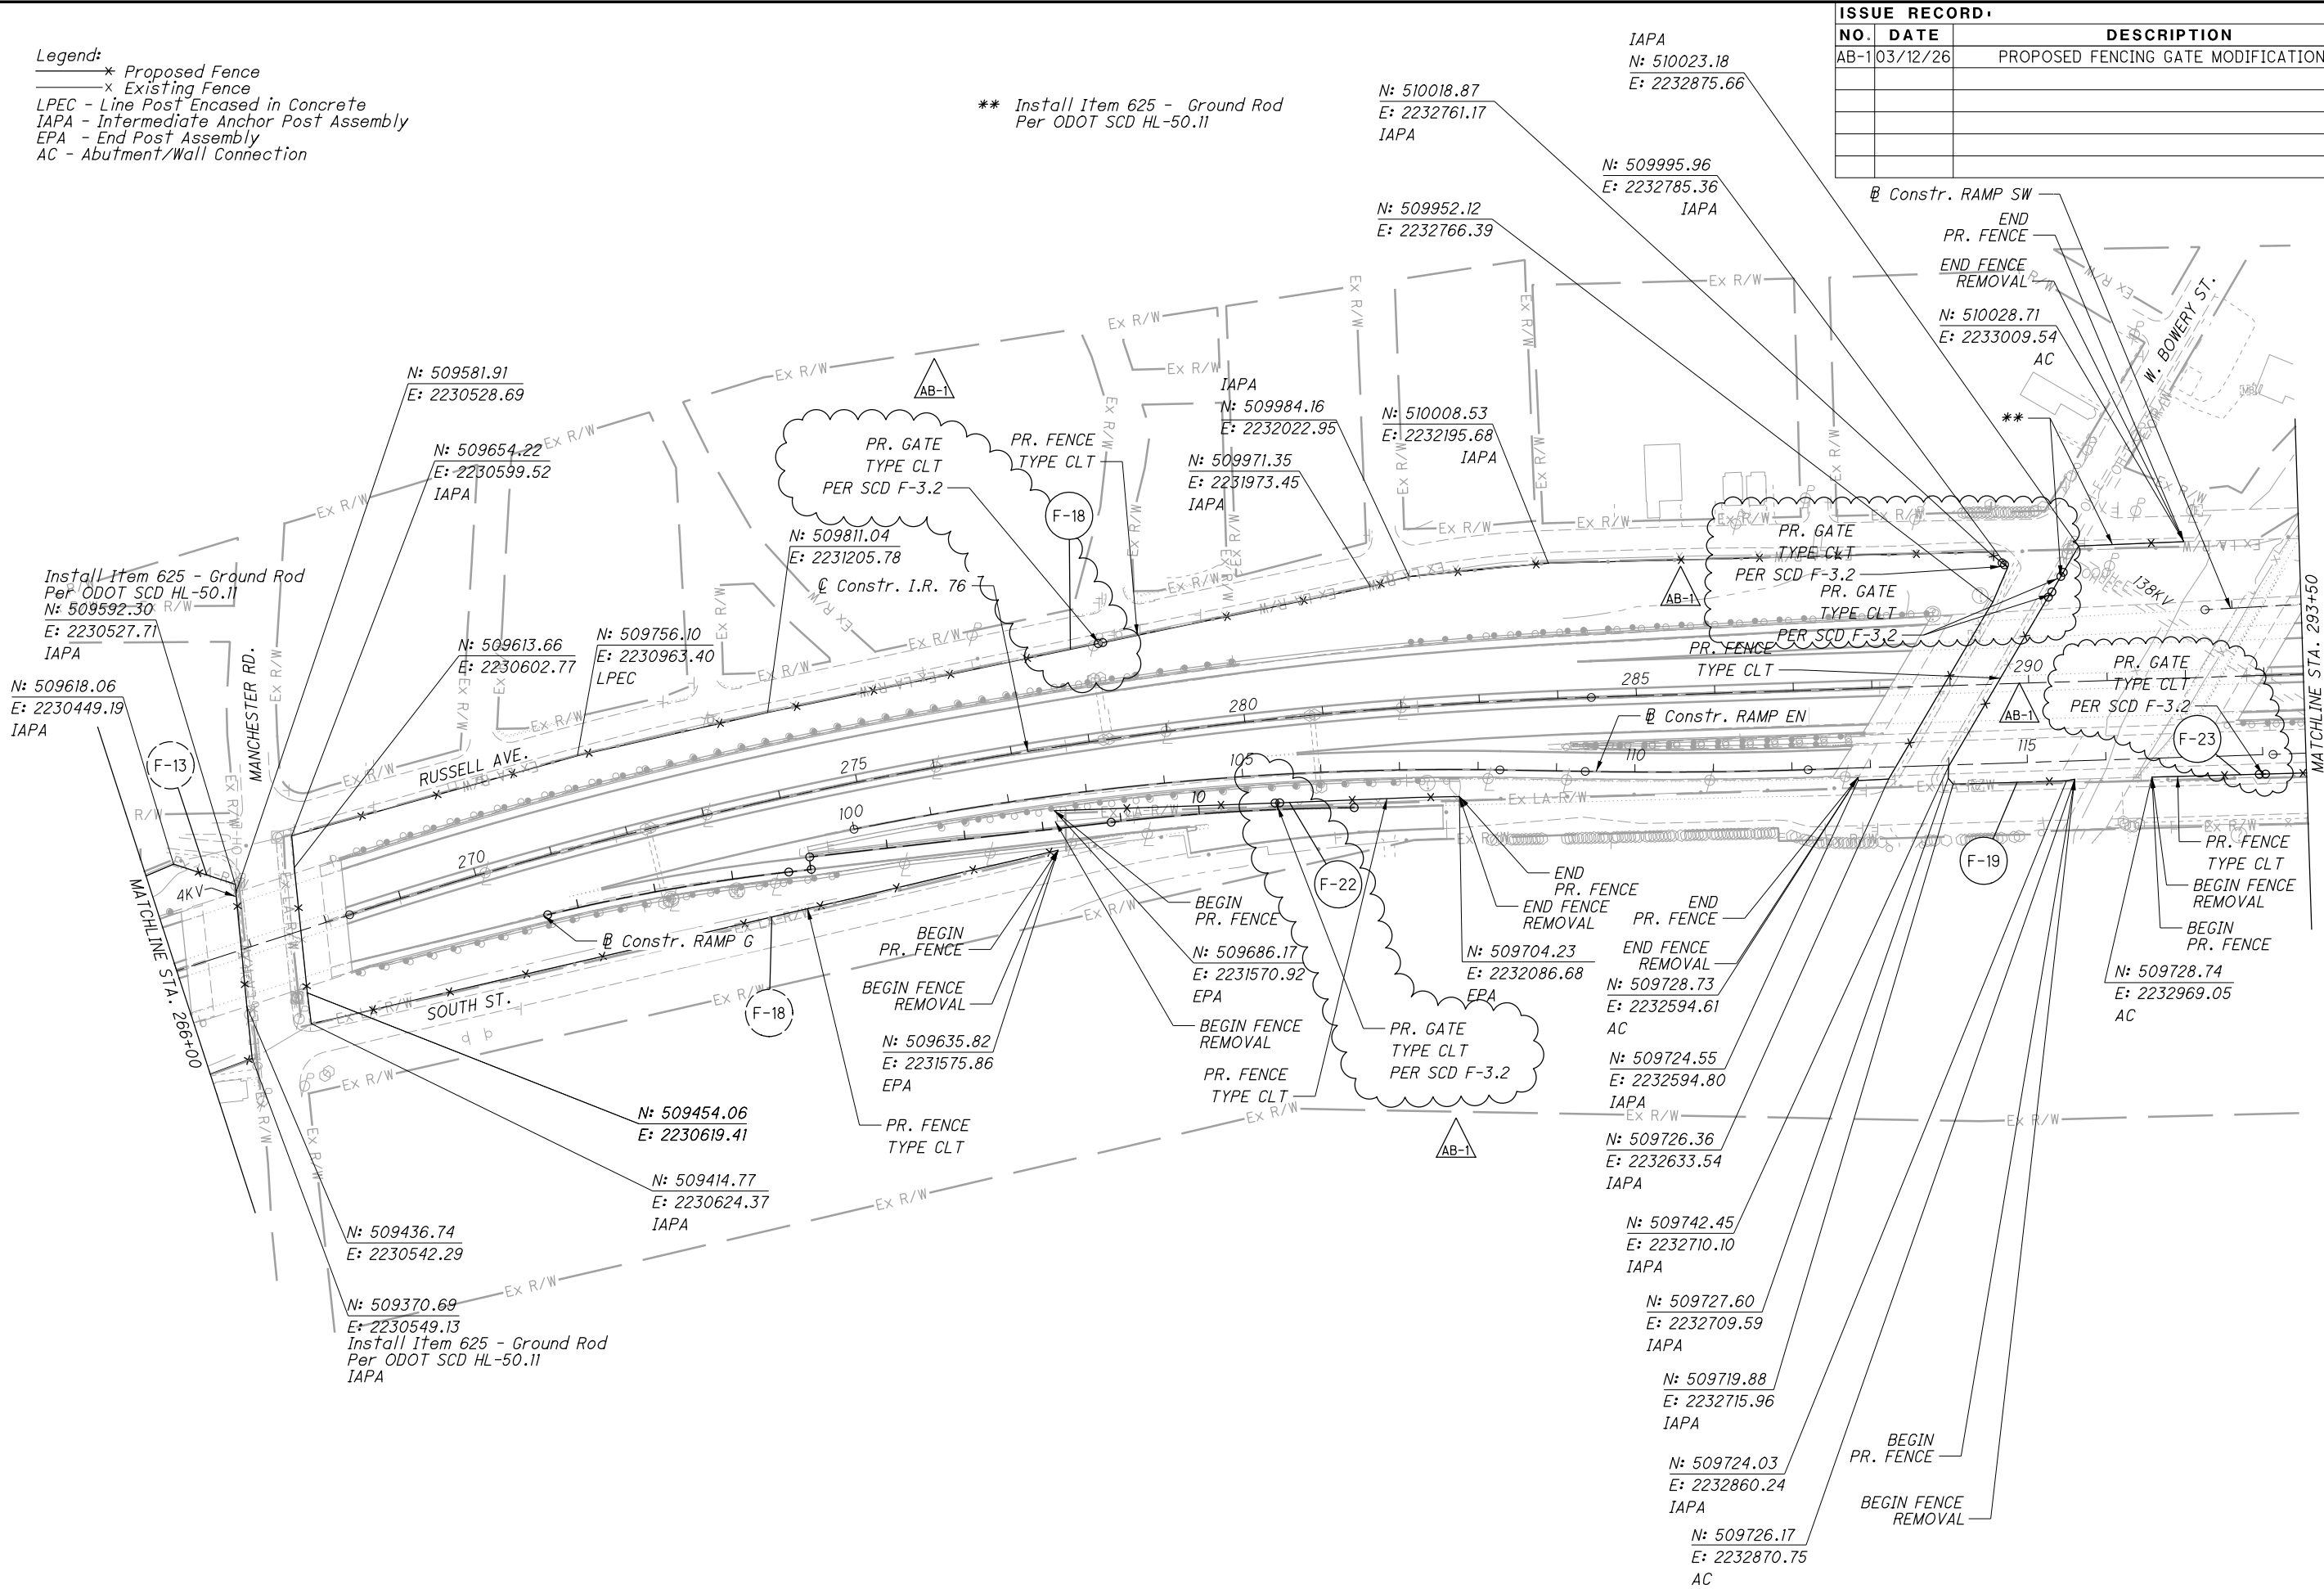

ISSUE RECORD:		
NO.	DATE	DESCRIPTION
AB-1	03/12/26	PROPOSED FENCING GATE MODIFICATIONS

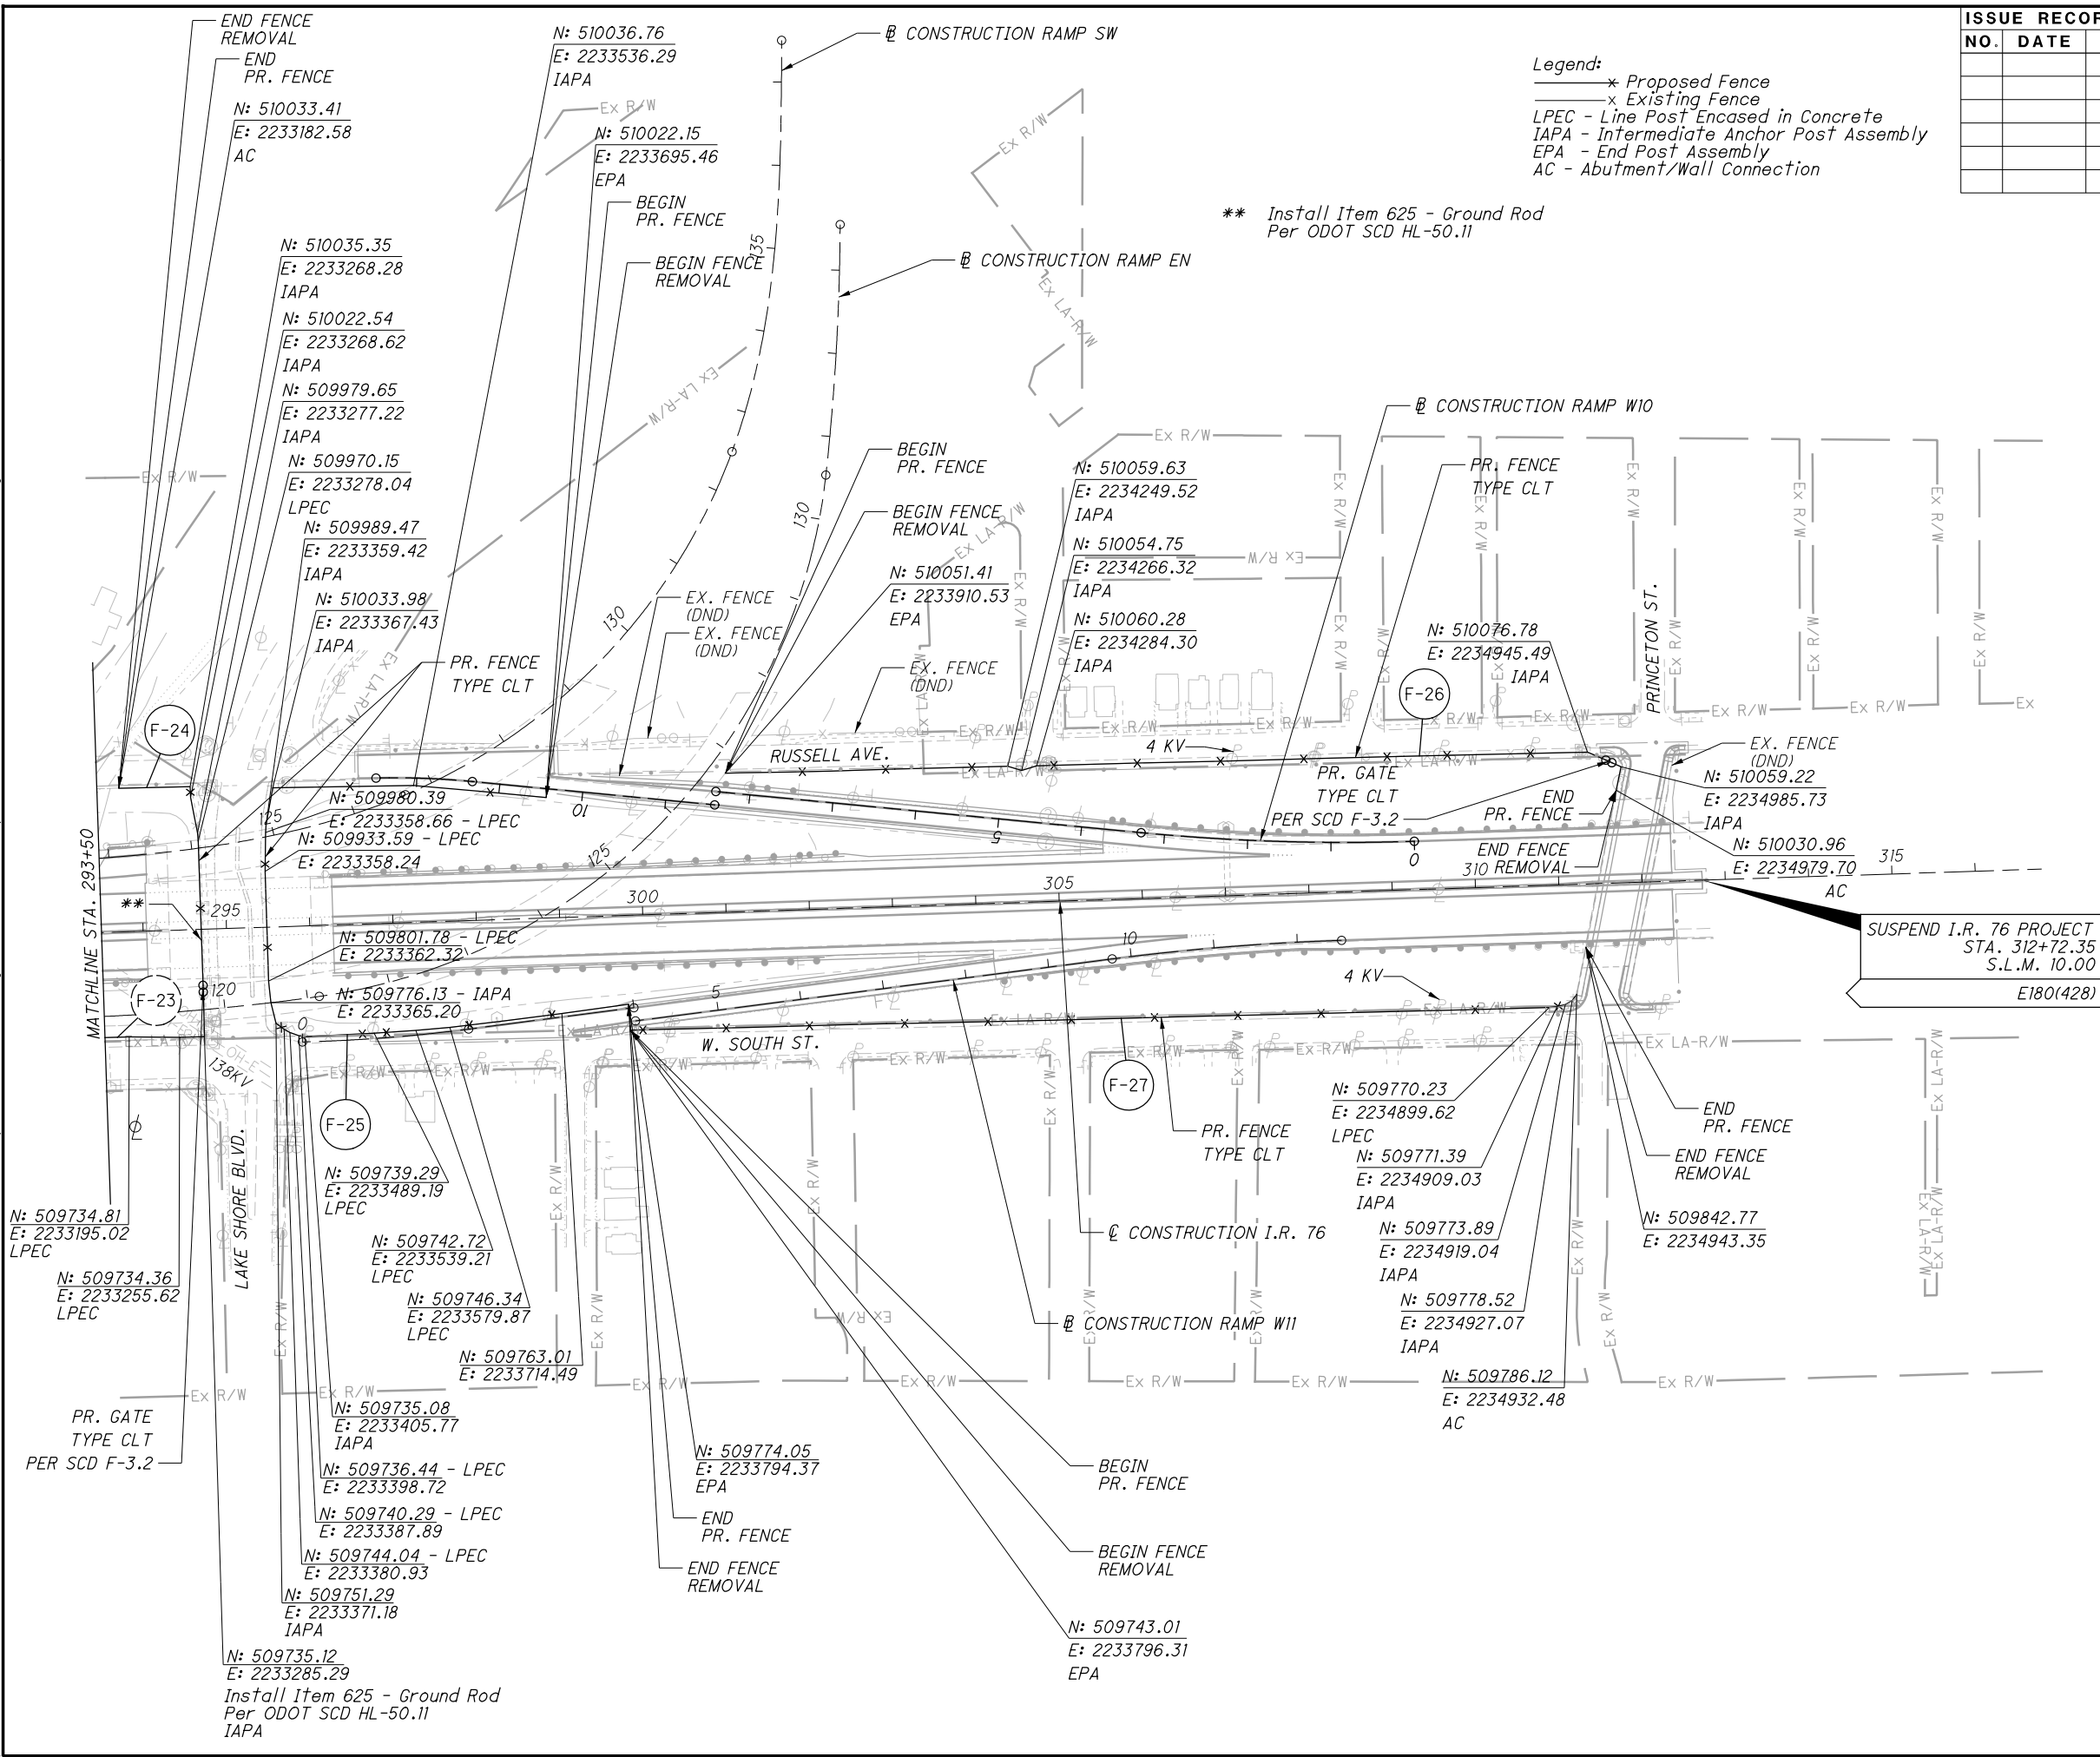[illegible]

Legend:
* Proposed Fence
x Existing Fence
LPEC - Line Post Encased in Concrete
IAPA - Intermediate Anchor Post Assembly
EPA - End Post Assembly
AC - Abutment/Wall Connection

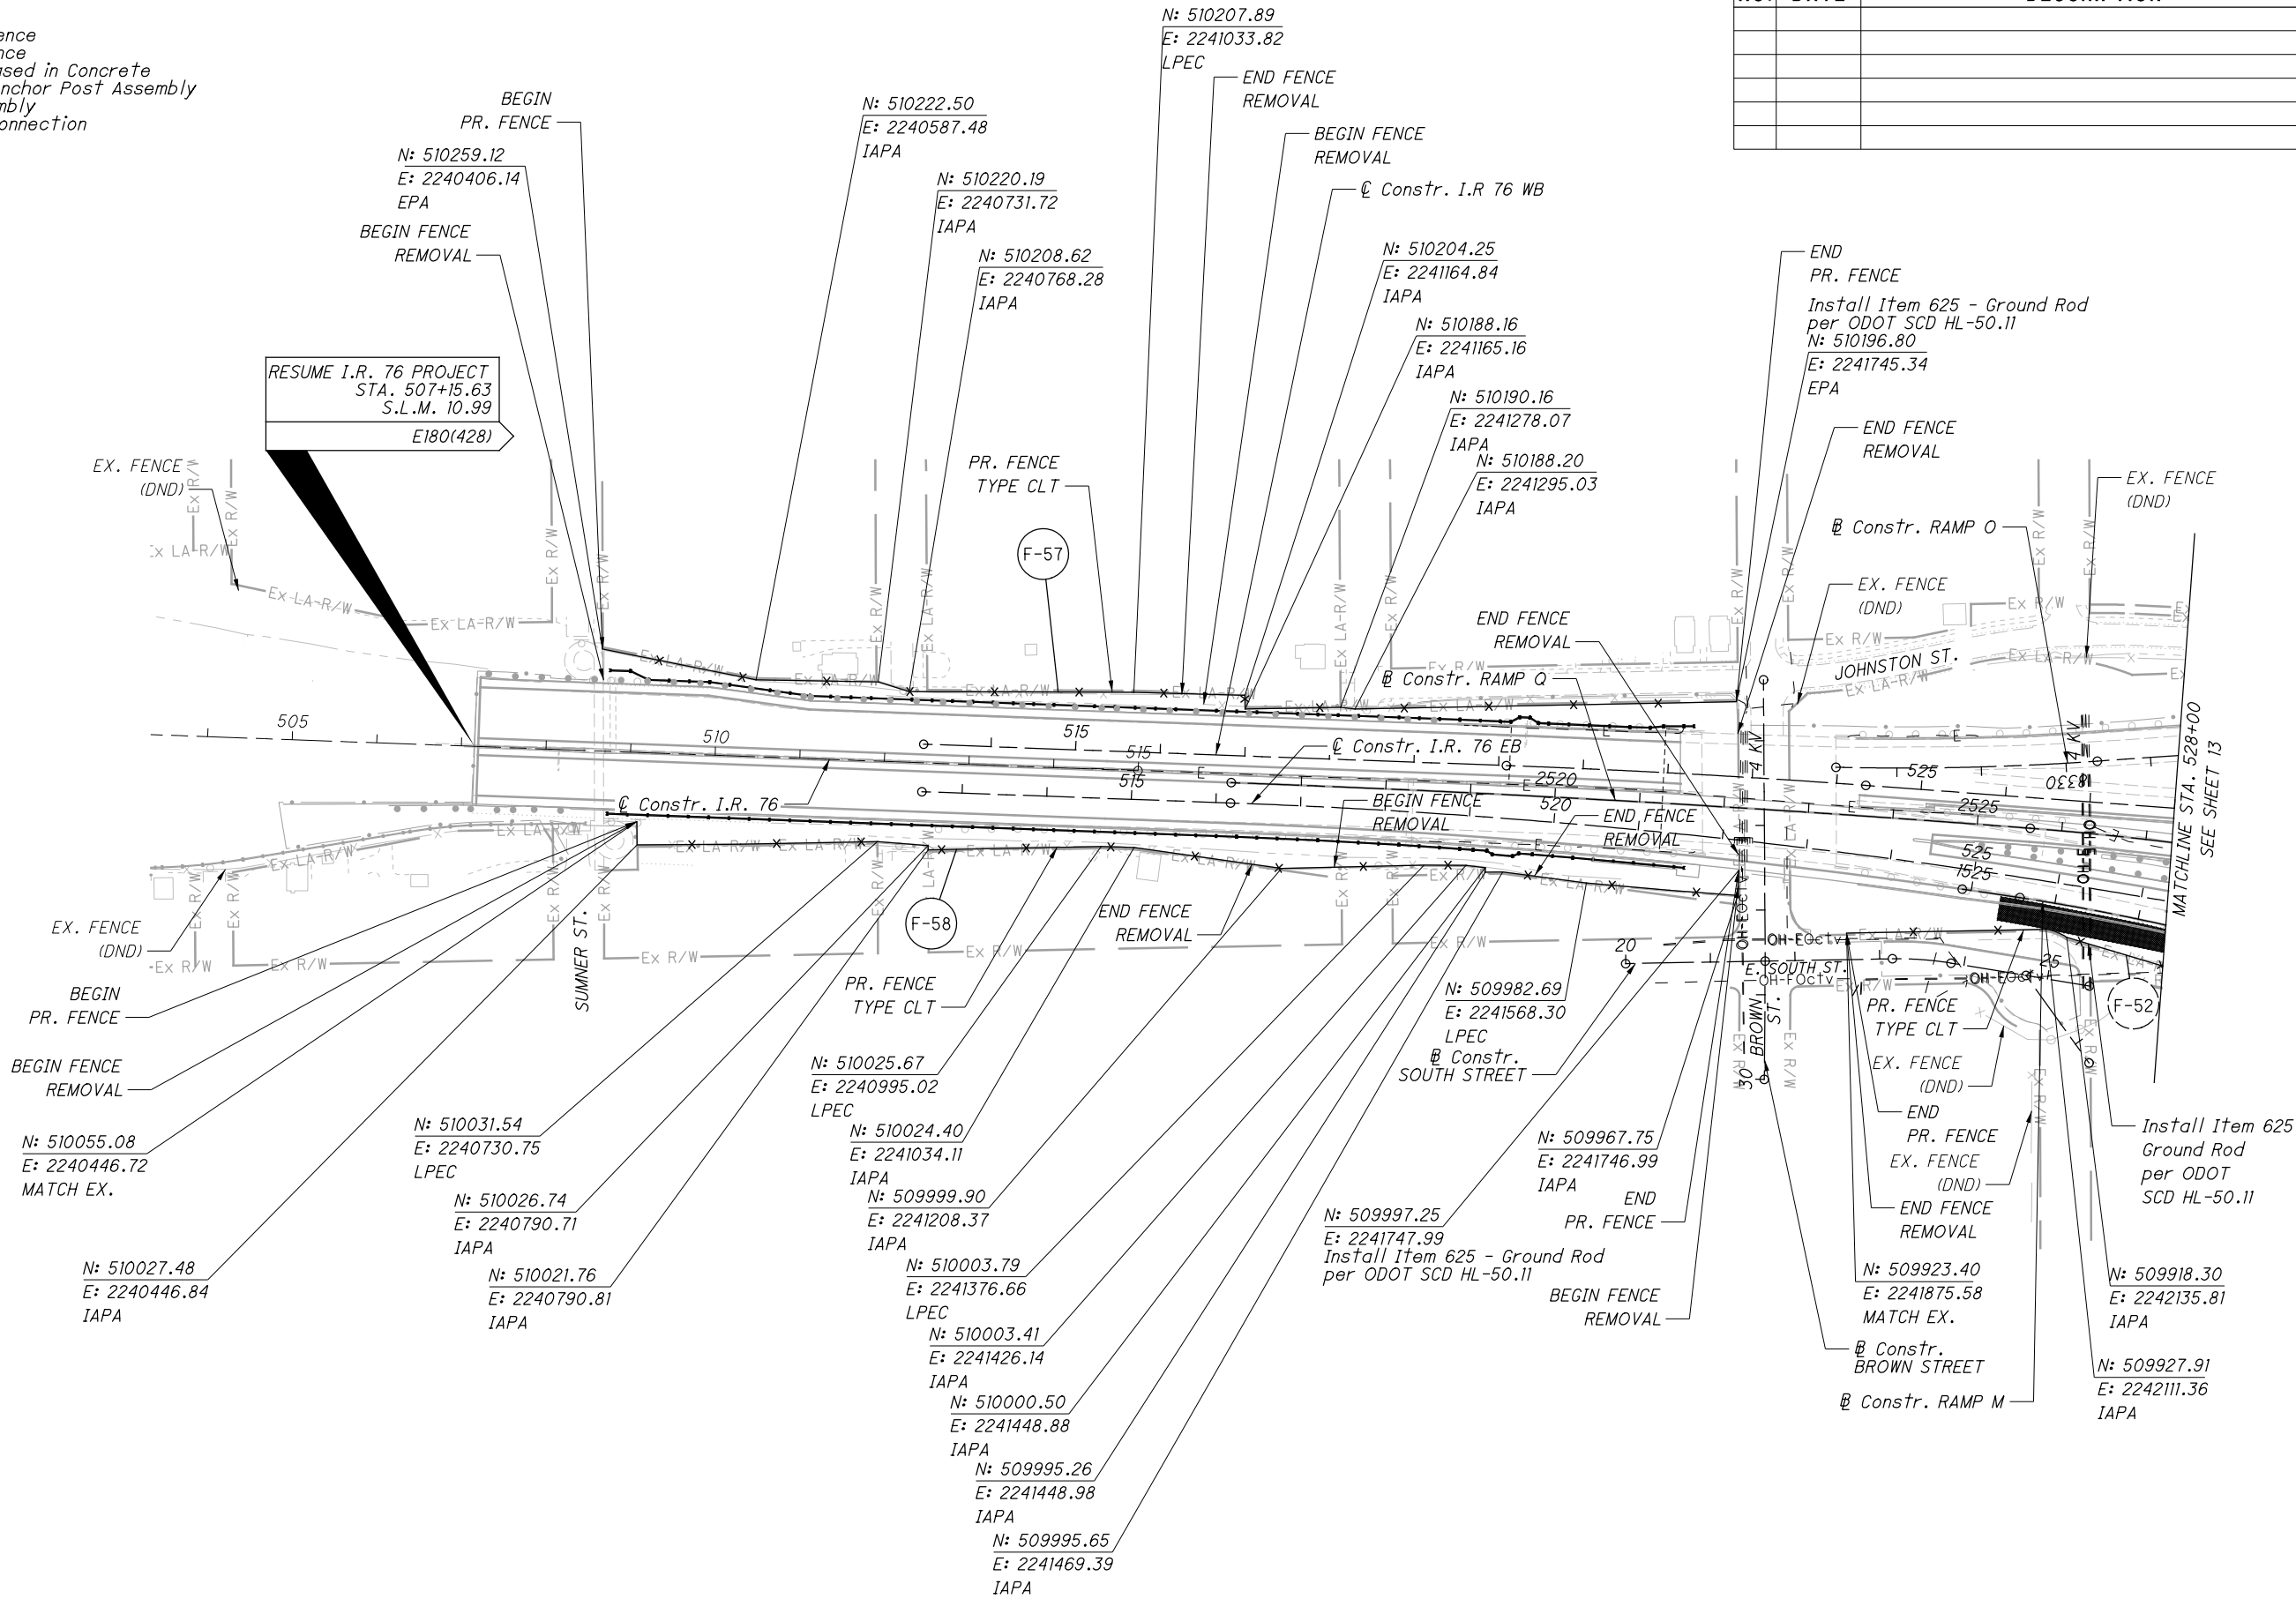


ISSUE RECORD		
NO.	DATE	DESCRIPTION

ISSUE RECORD.		
NO.	DATE	DESCRIPTION
AB-1	03/12/26	PROPOSED FENCING GATE MODIFICATIONS




FENCE PLAN - I.R. 76
STA. 544+00 TO END I.R. 76 PROJECT


SUM - 76 / 77 / 8 - 8.24 / 9.74 / 0.00

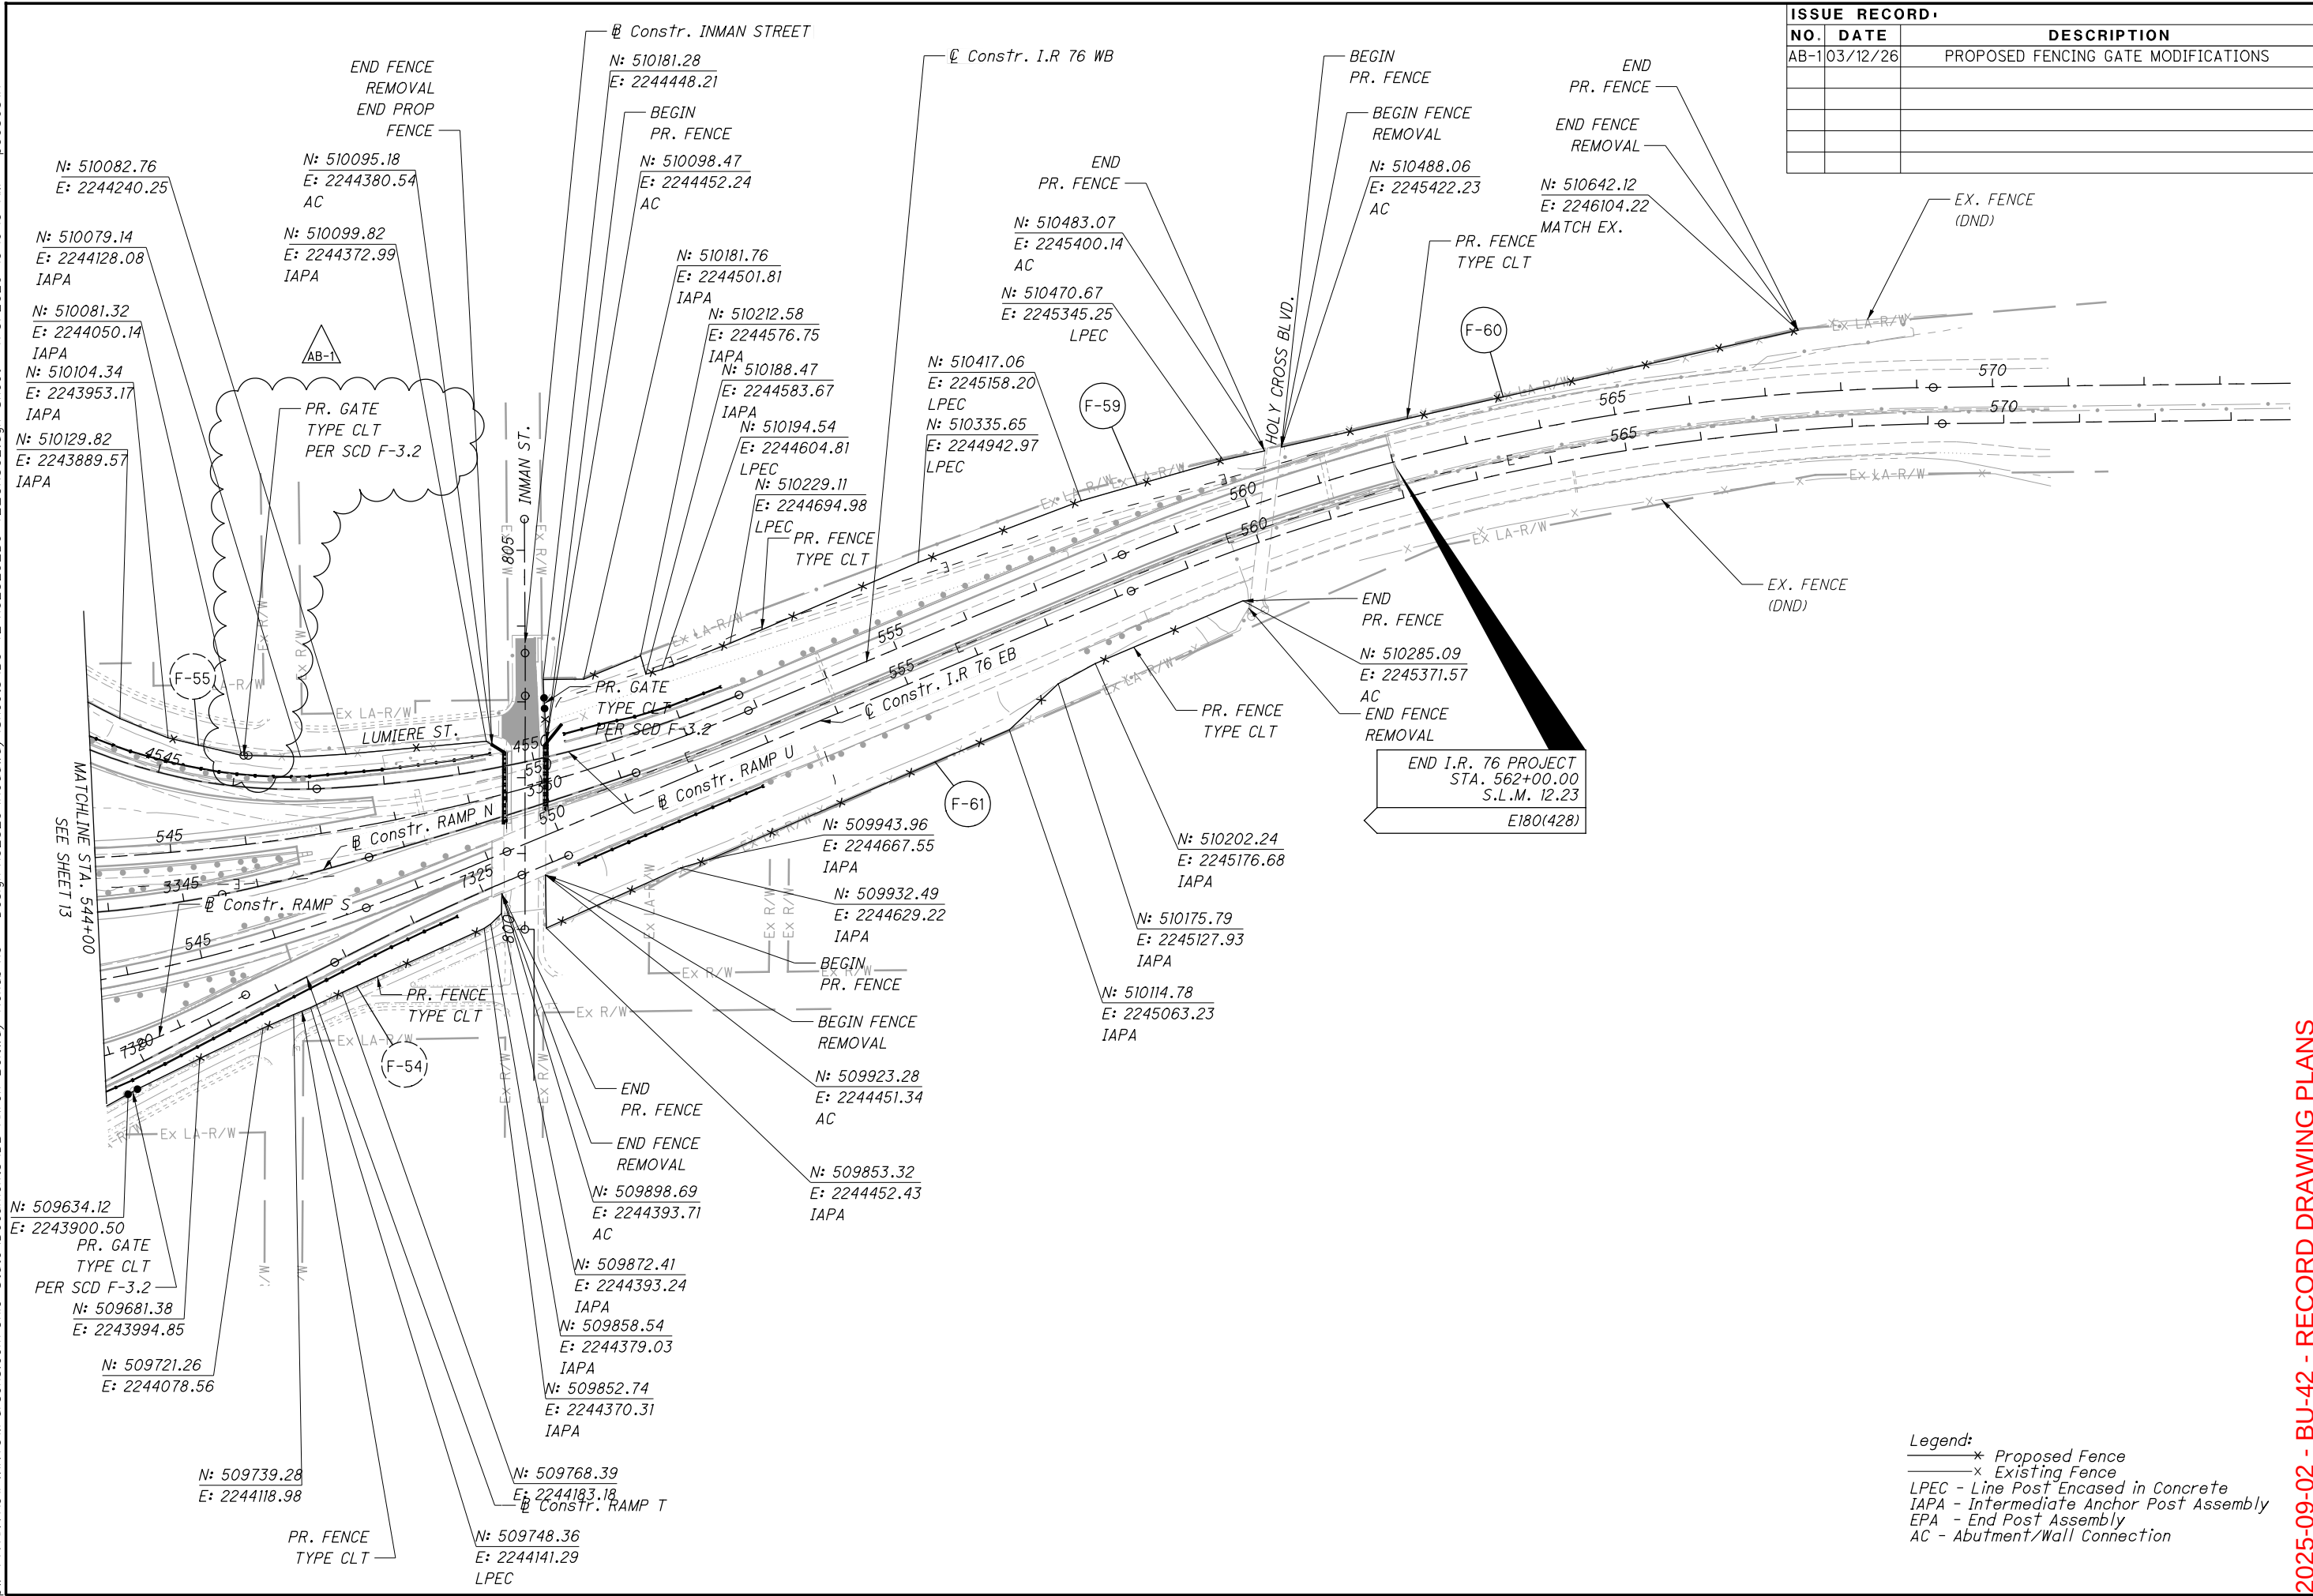

Legend:
* Proposed Fence
x Existing Fence
LPEC - Line Post Encased in Concrete
IAPA - Intermediate Anchor Post Assembly
EPA - End Post Assembly
AC - Abutment/Wall Connection

ISSUE RECORD		
NO.	DATE	DESCRIPTION
AB-1	03/12/26	NON-PERFORMED PROP FENCING MODIFICATIONS

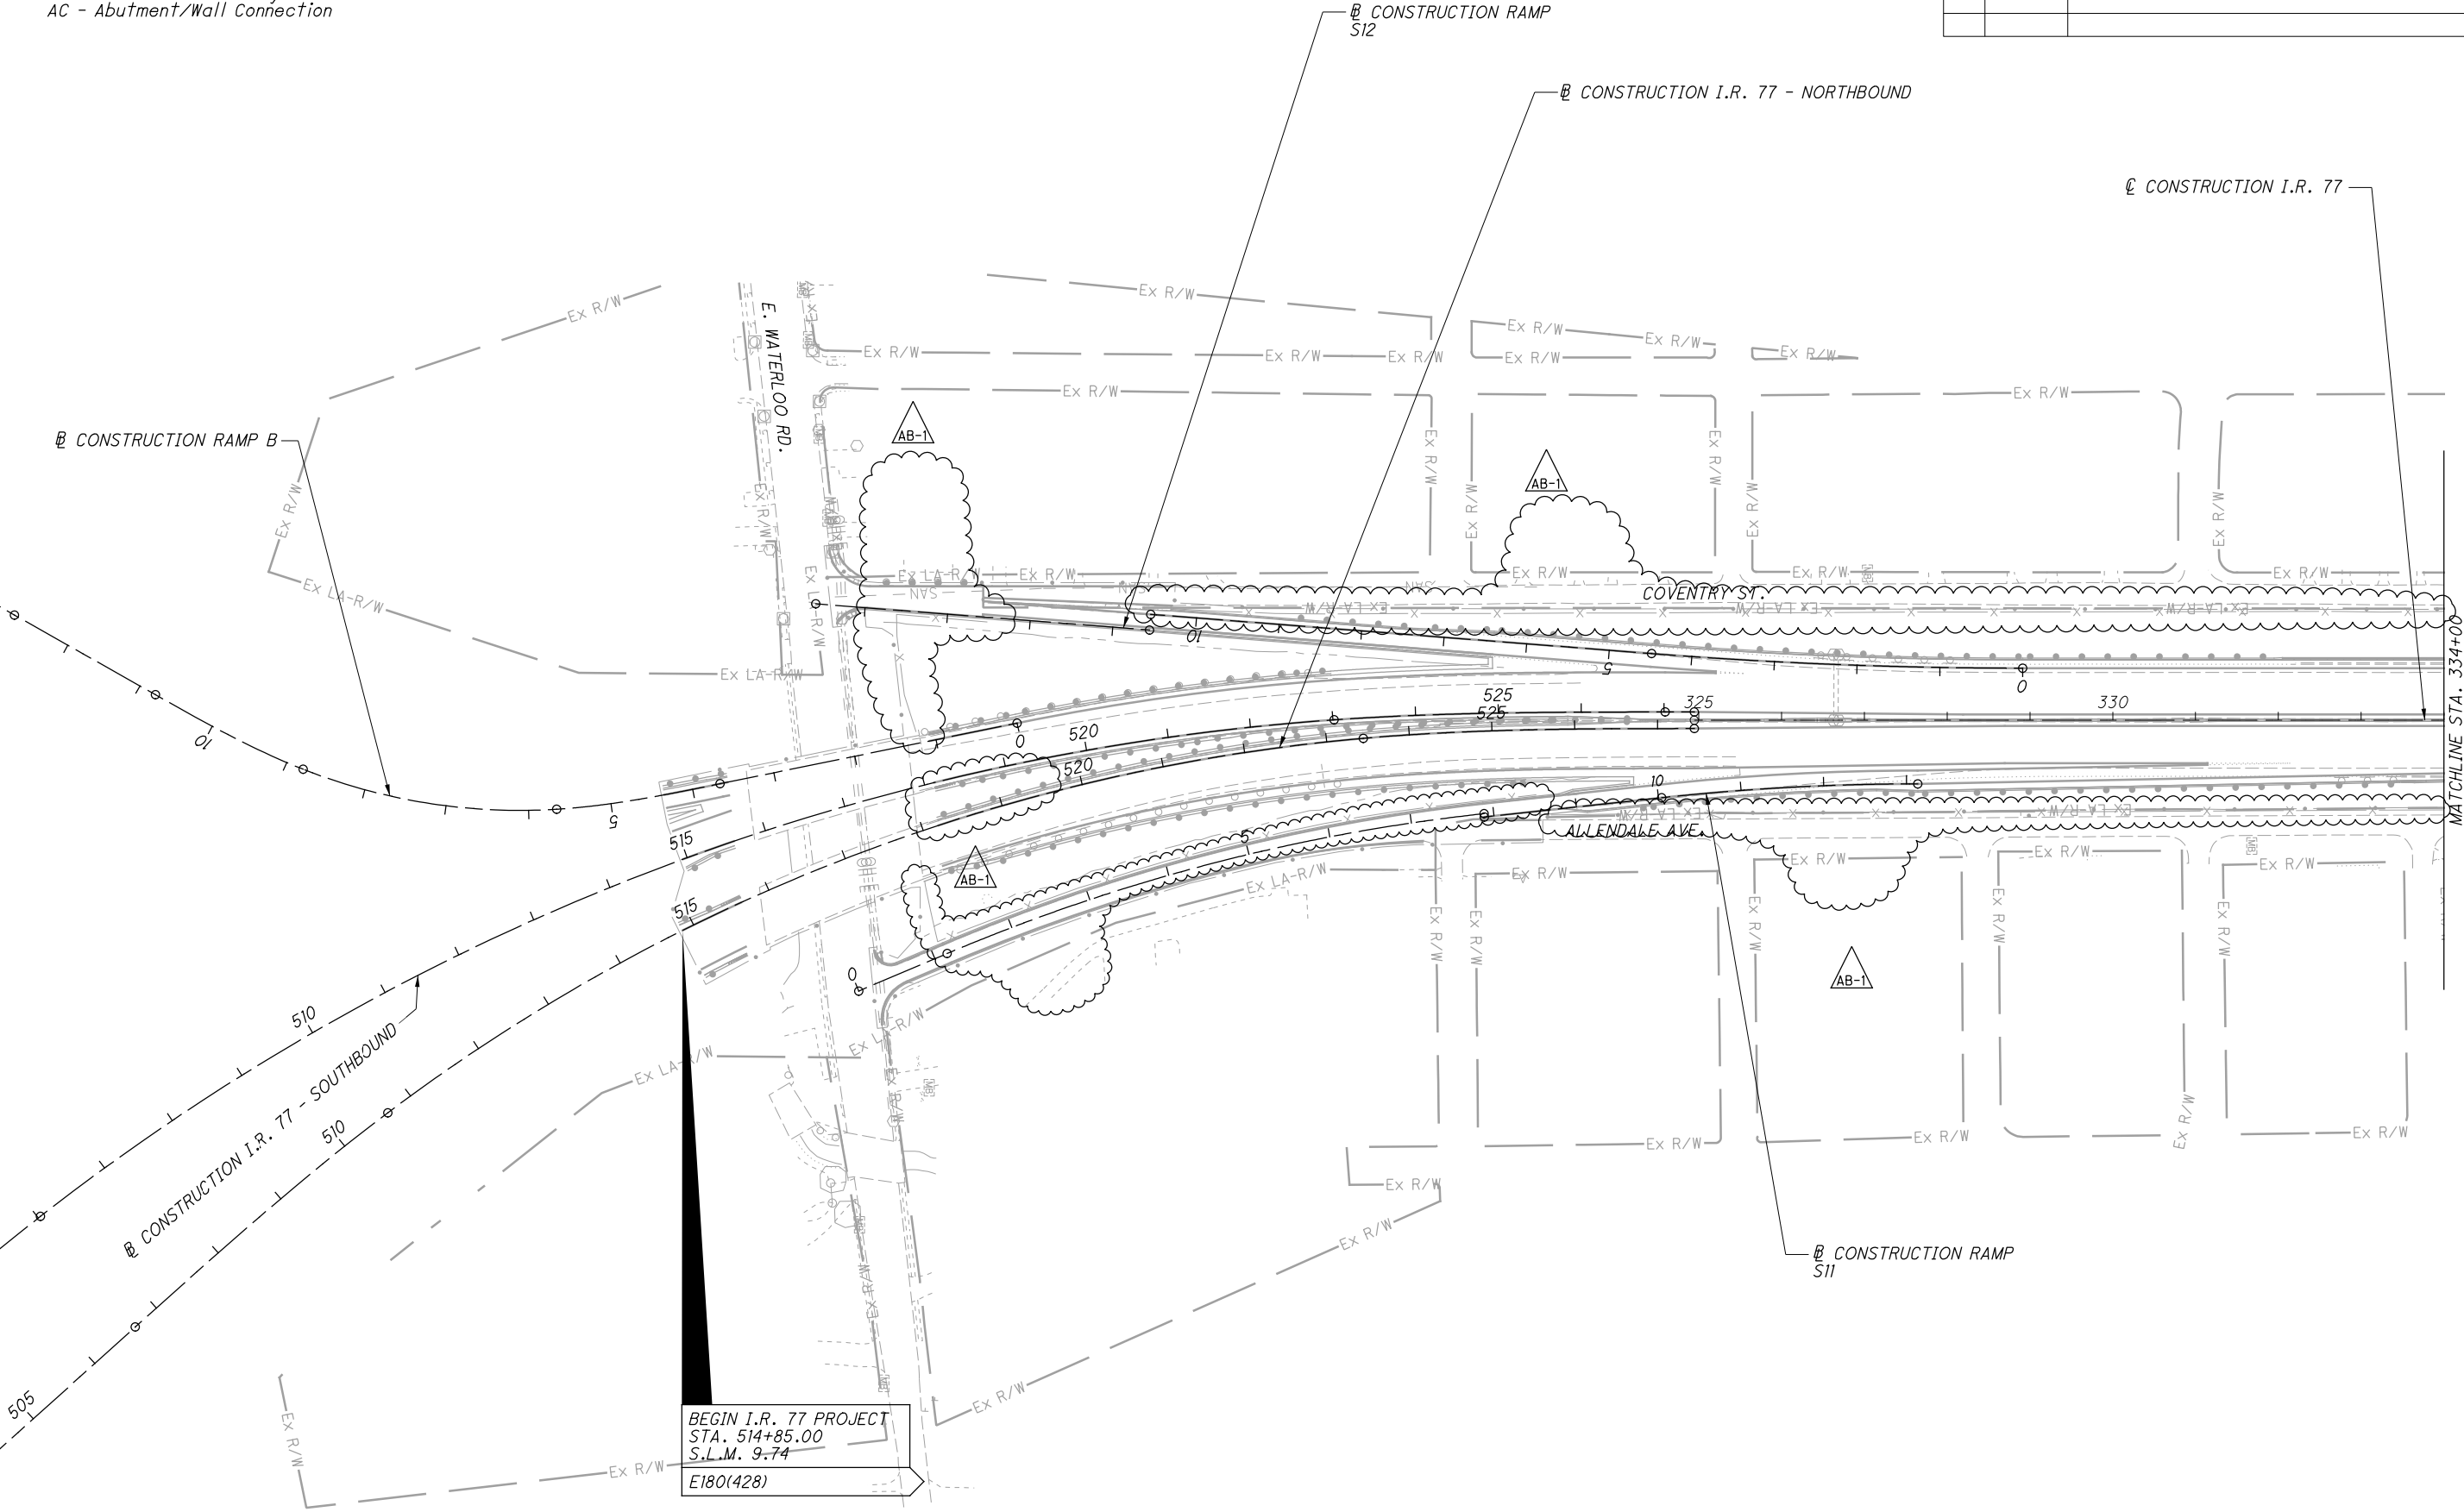


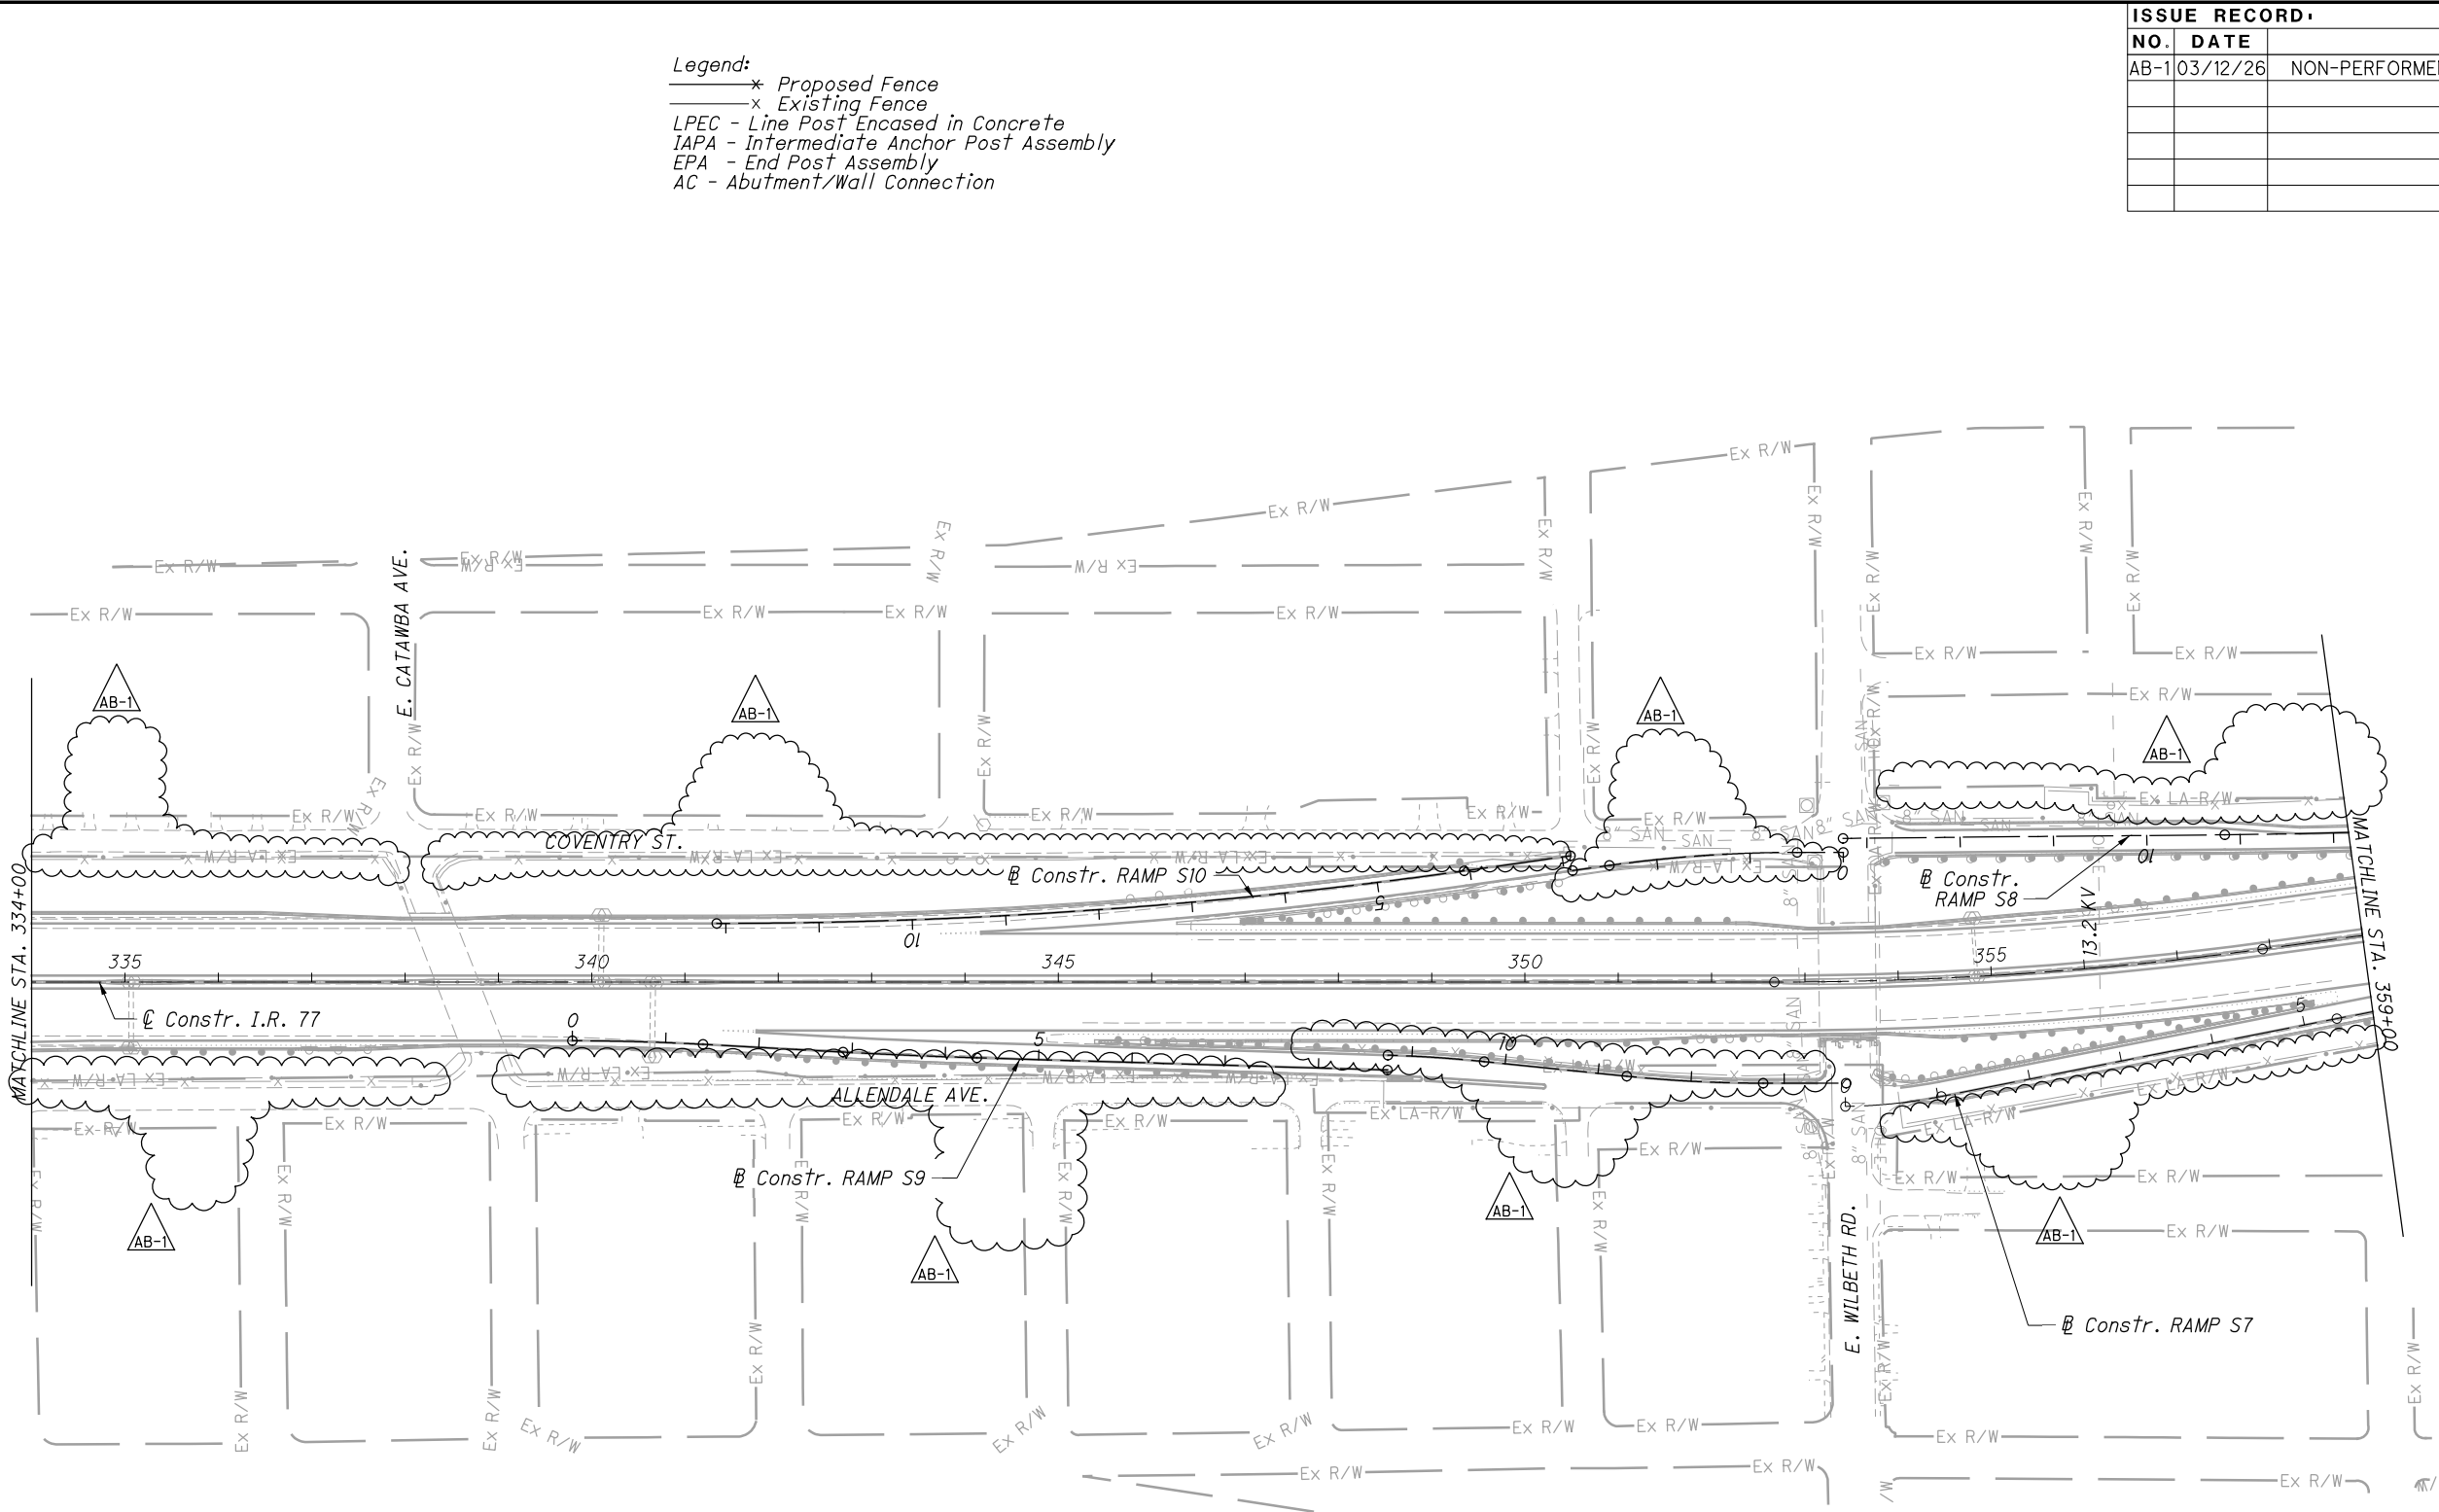

ISSUE RECORD:		
NO.	DATE	DESCRIPTION
AB-1	03/12/26	NON-PERFORMED PROP FENCING MODIFICATIONS

Legend:
* Proposed Fence
x Existing Fence
LPEC - Line Post Encased in Concrete
IAPA - Intermediate Anchor Post Assembly
EPA - End Post Assembly
AP - Abutment/Wall Connection

ISSUE RECORD		
NO.	DATE	DESCRIPTION
AB-1	03/12/26	NON-PERFORMED PROP FENCING MODIFICATIONS

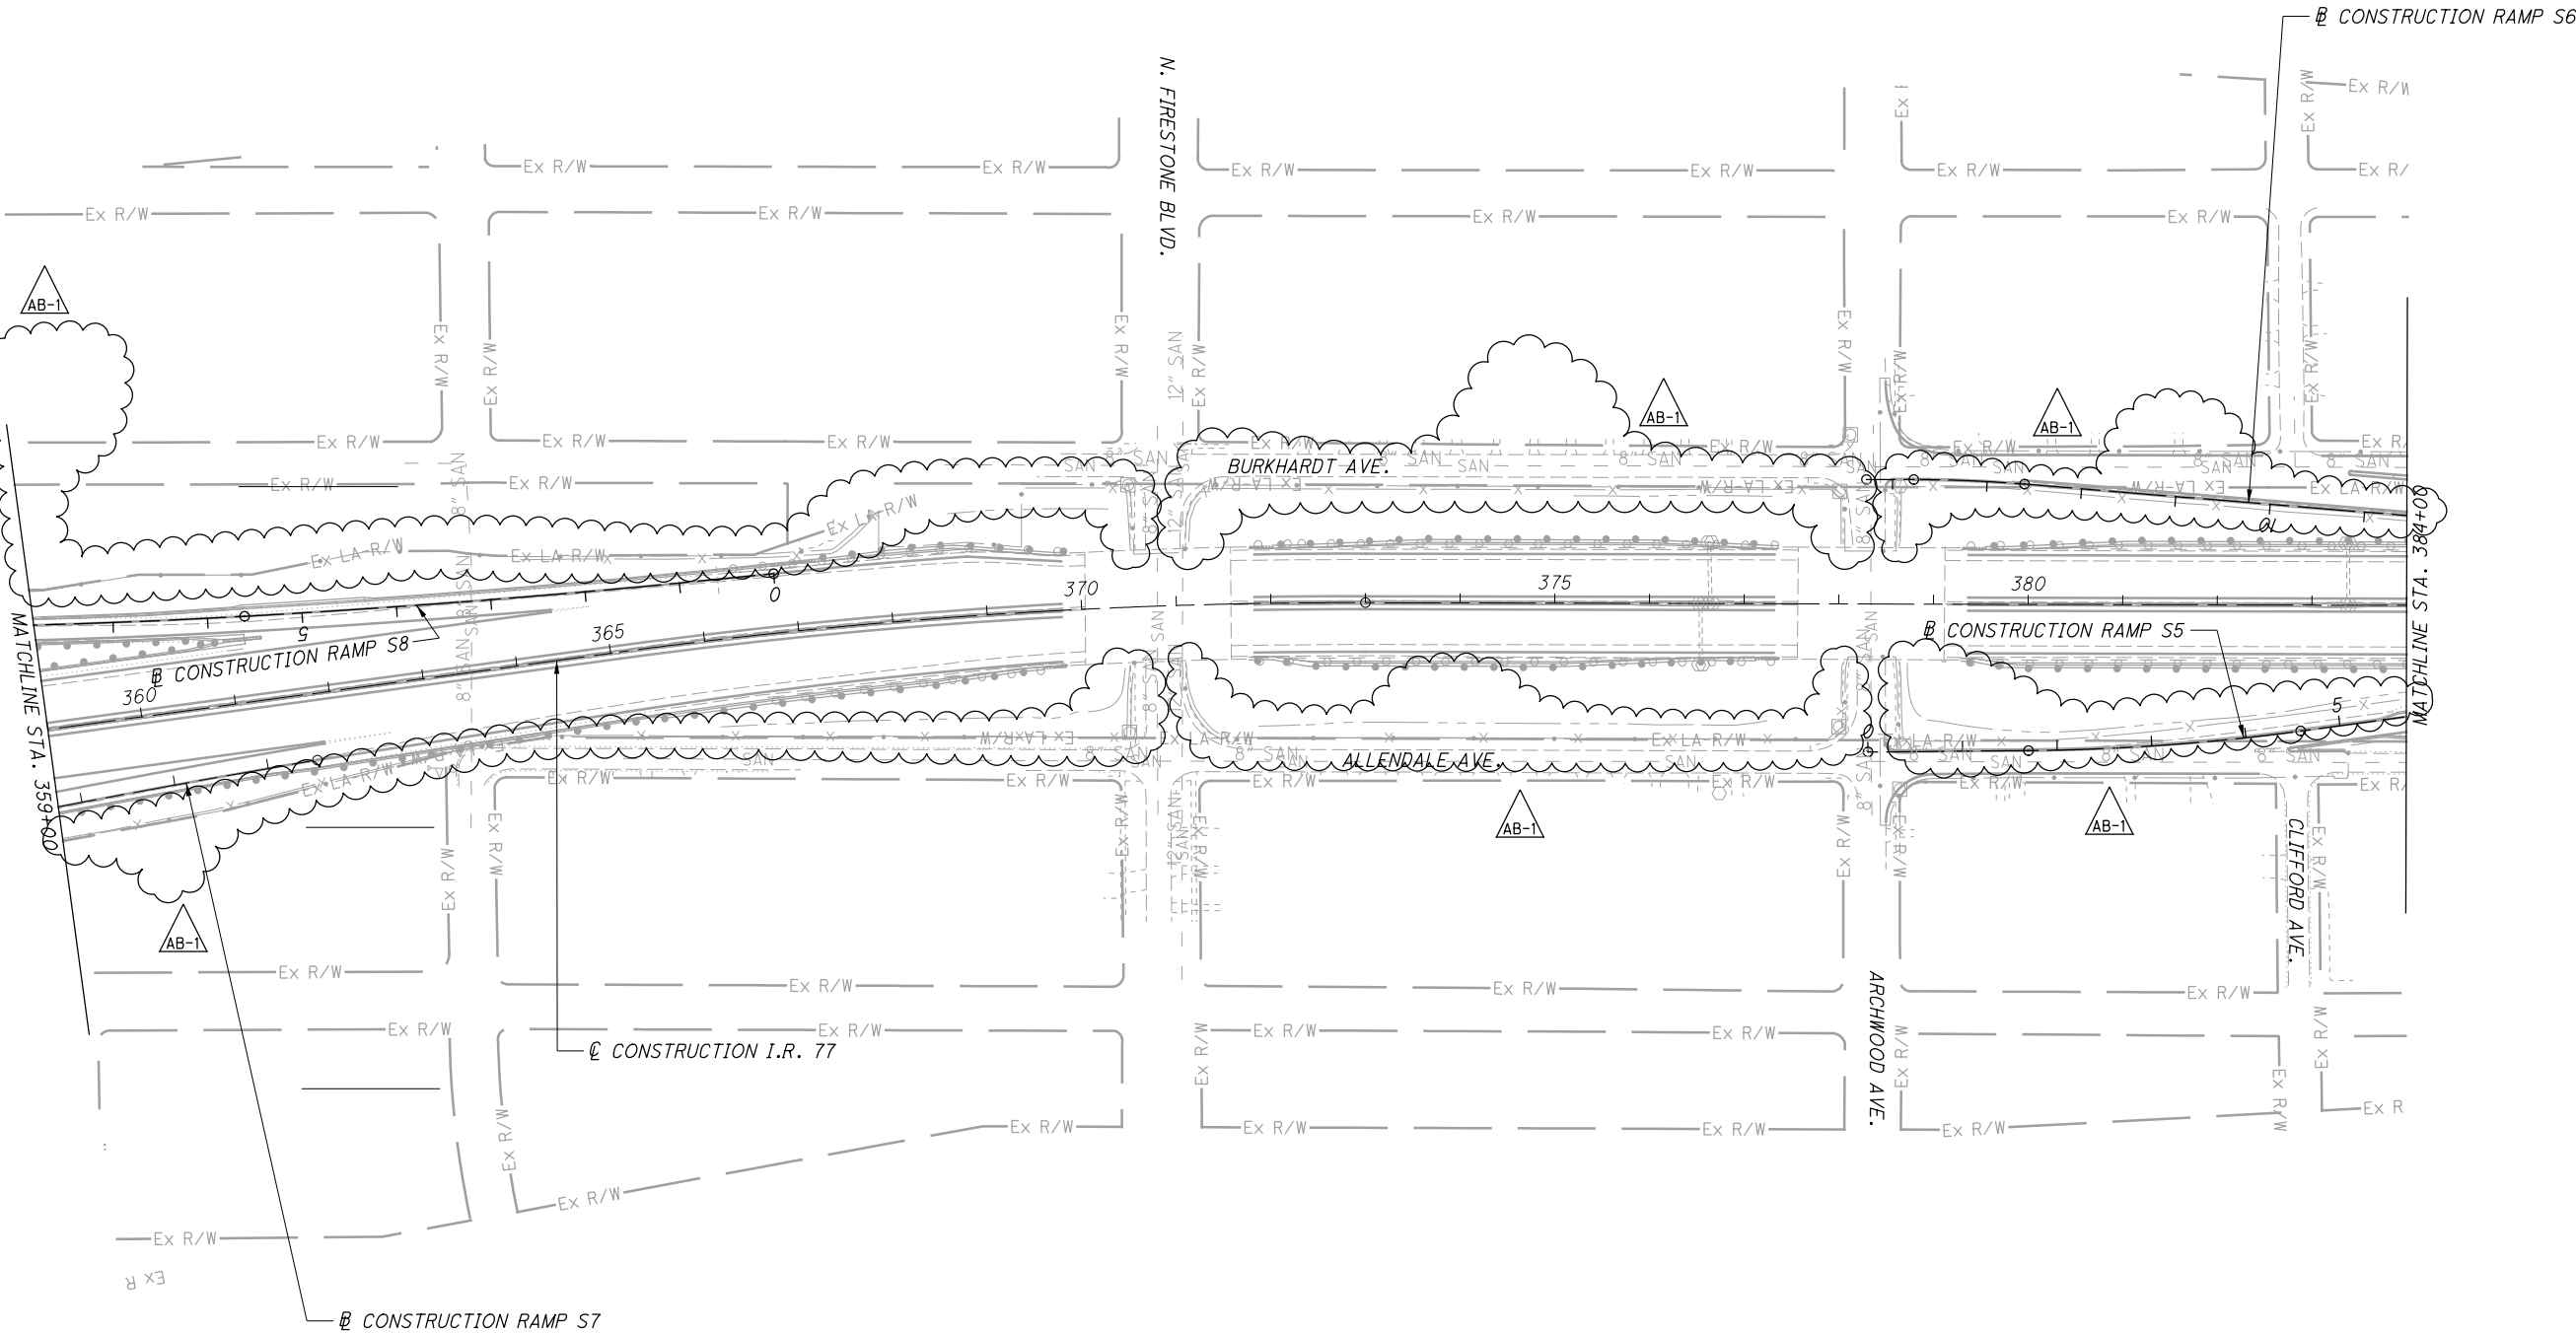

Legend:
* Proposed Fence
x Existing Fence
LPEC - Line Post Encased in Concrete
IAPA - Intermediate Anchor Post Assembly
EPA - End Post Assembly
AP - Abutment/Wall Connection

ISSUE RECORD:		
NO.	DATE	DESCRIPTION
AB-1	03/12/26	NON-PERFORMED PROP FENCING MODIFICATIONS

0100200


HORIZONTAL SCALE IN FEET

CALCULATED



AB

CHECKED

FR

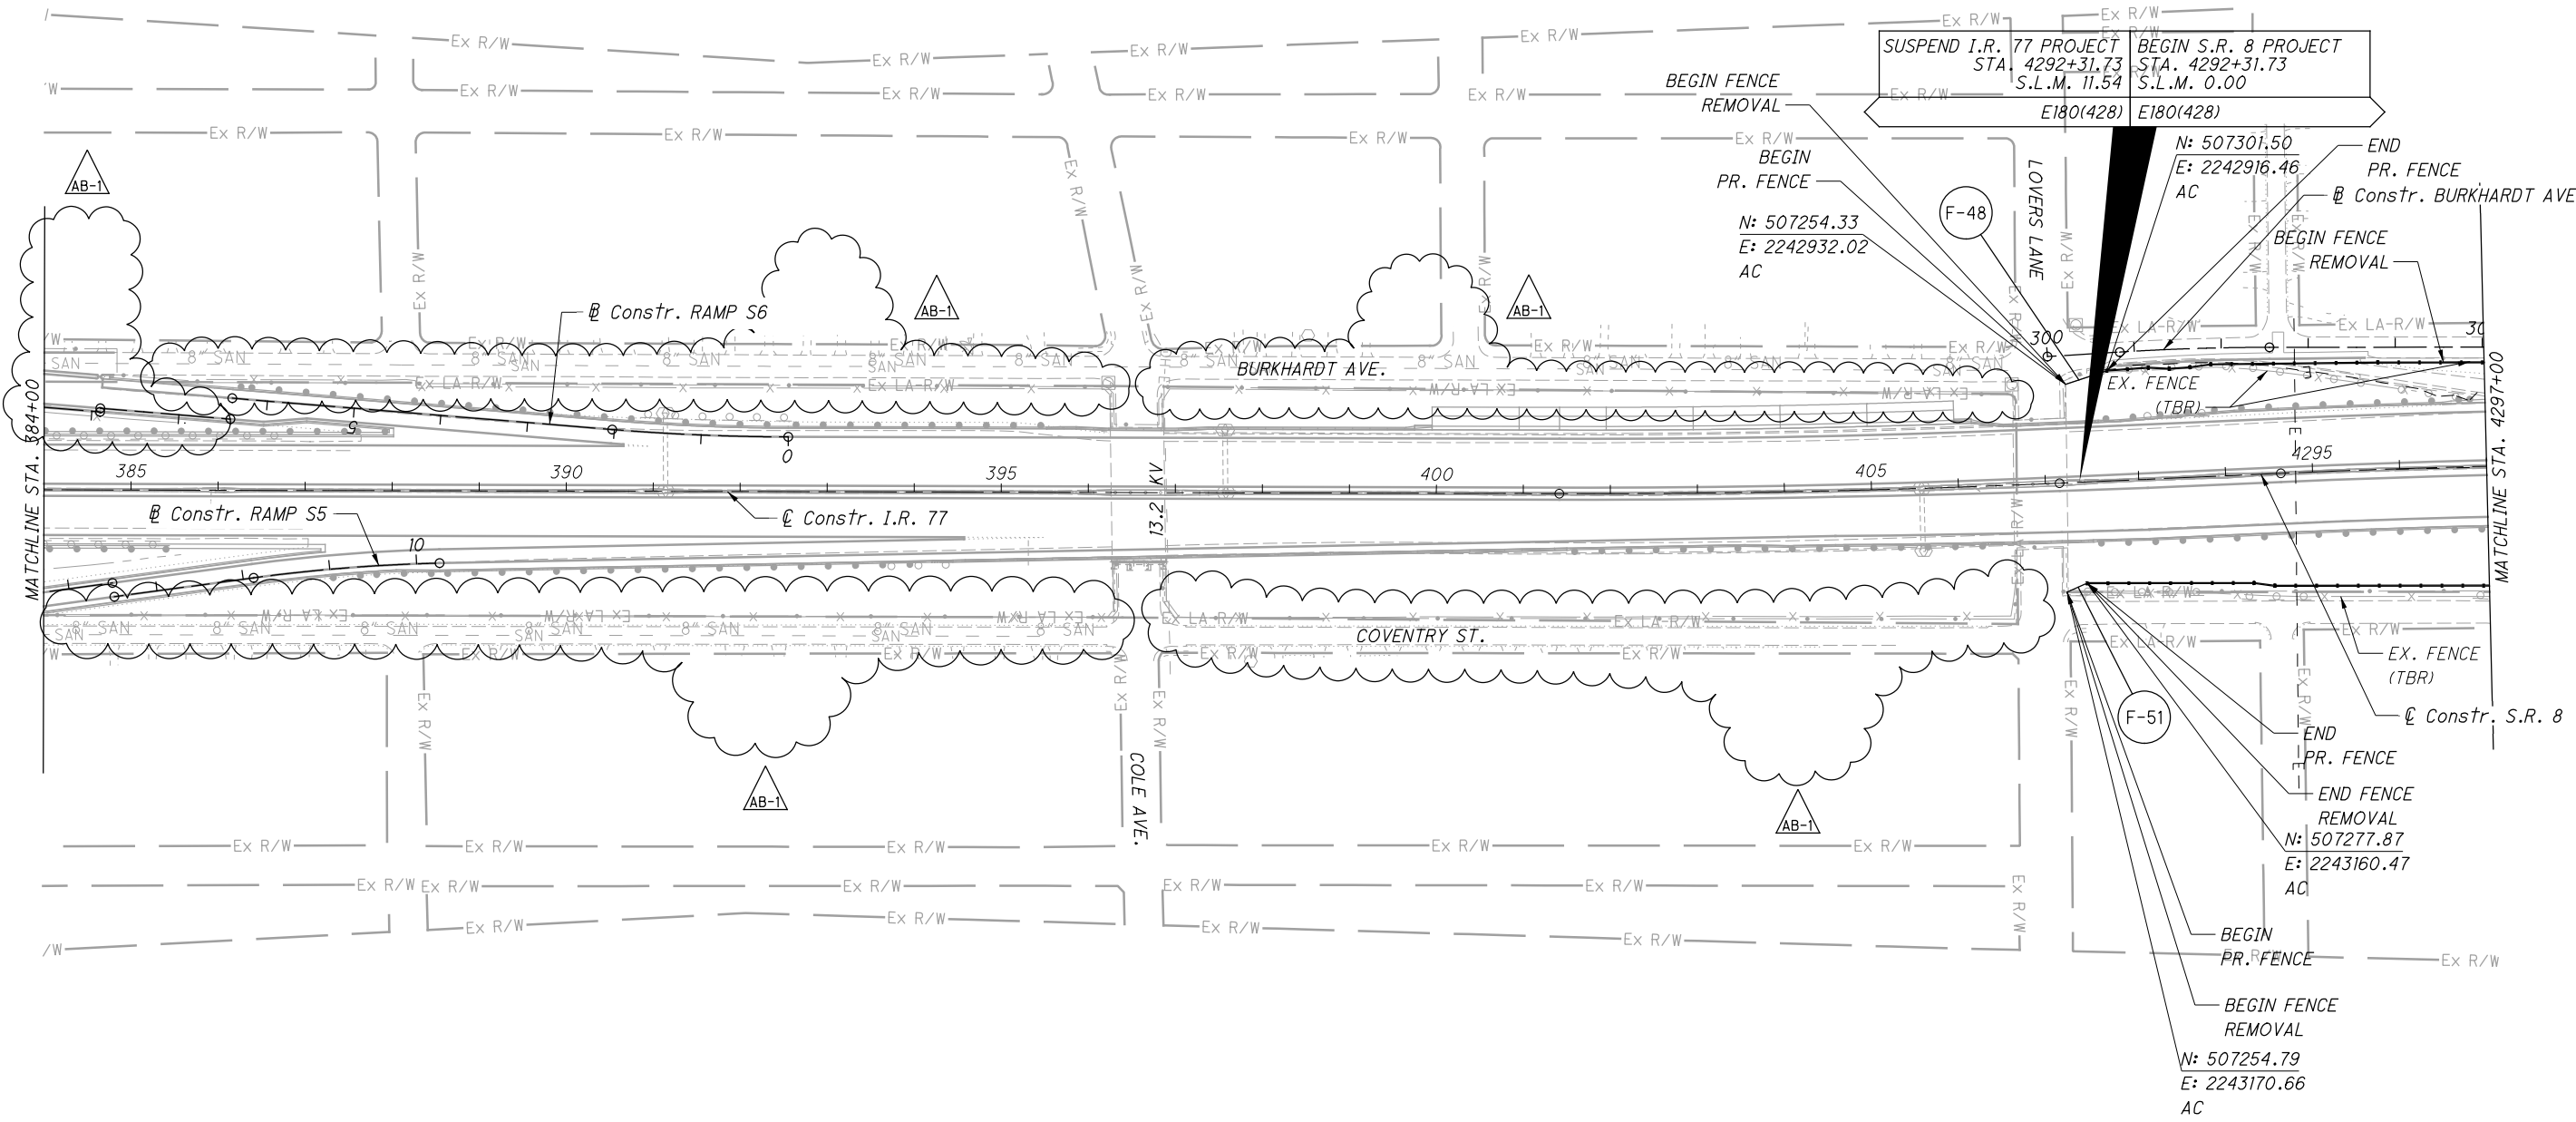

* Proposed Fence
 * Existing Fence
 LPEC - Line Post Encased in Concrete
 IAPA - Intermediate Anchor Post Assembly
 EPA - End Post Assembly
 AC - Abutment/Wall Connection

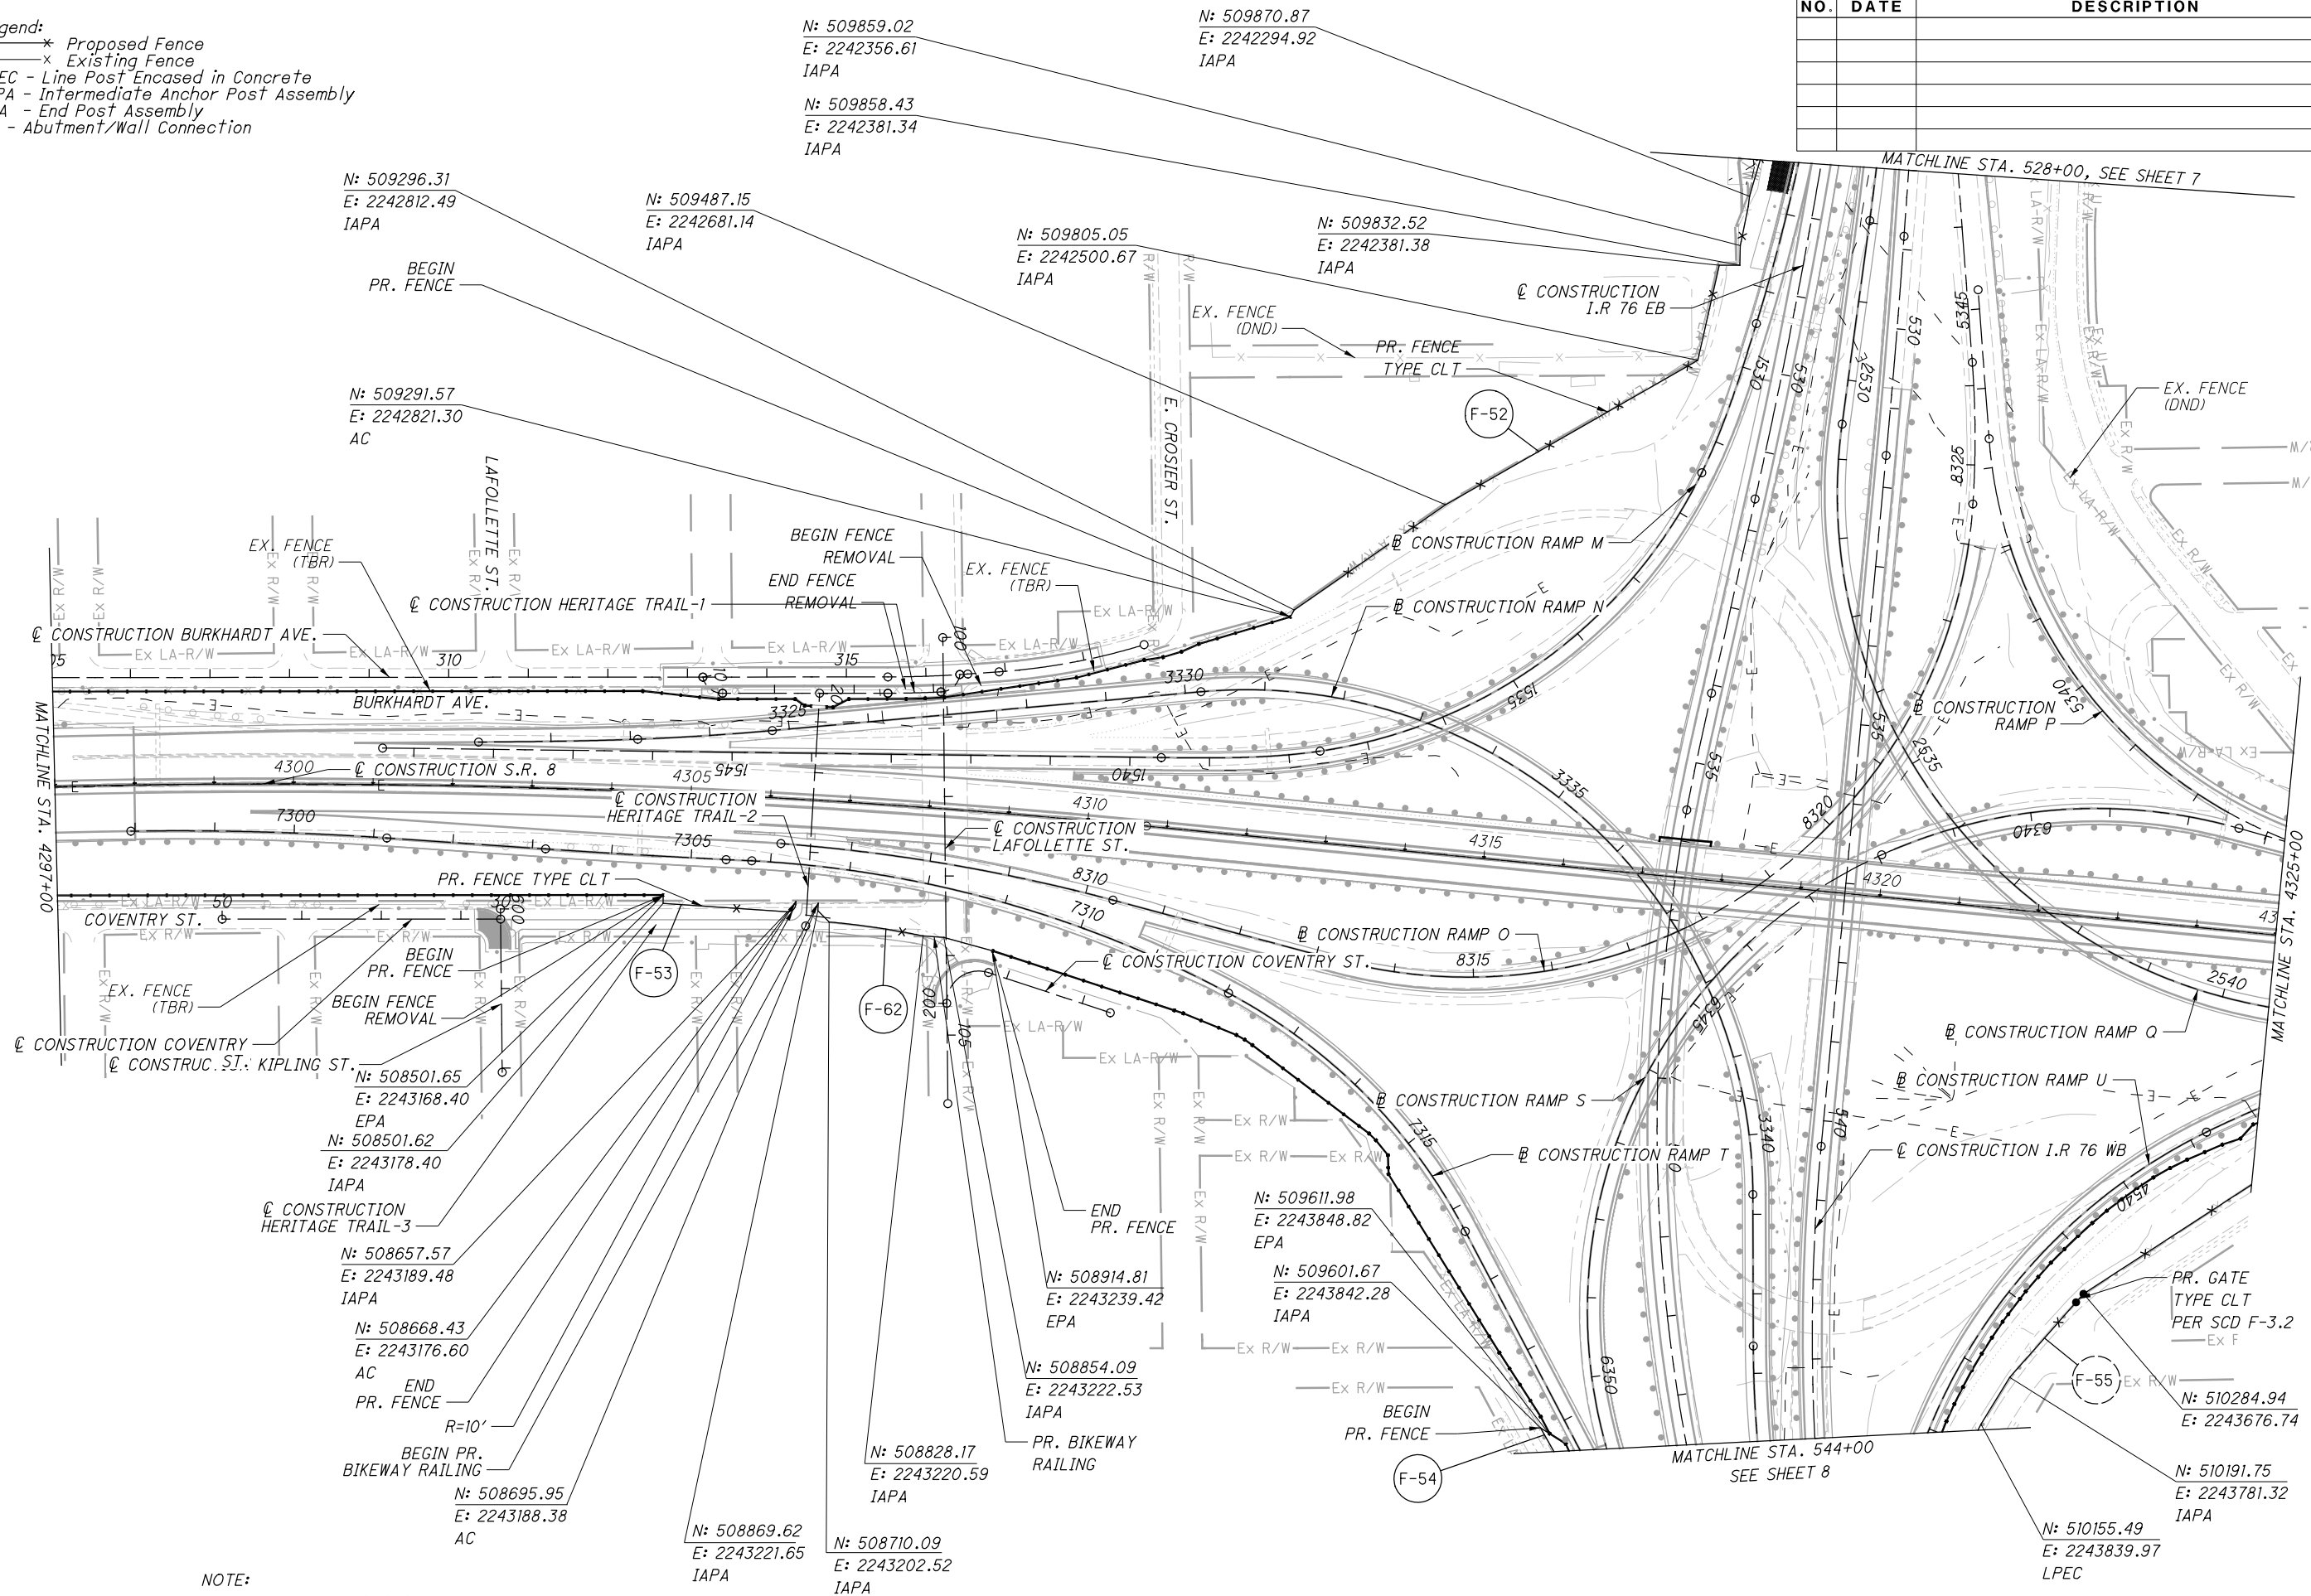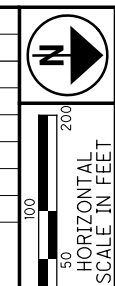[illegible]

NOTE:
SEE BU-12A FOR BIKEWAY RAILING DETAILS.

2025-09-02 - BU-42 - RECORD DRAWING PLANS

	SUM - 76 / 77 / 8 - 8.24 / 9.74 / 0.00	FENCE PLAN - S.R. 8 STA. 4297+00 TO STA. 4325+00
---	---	---

_____ × Proposed Fence
 _____ × Existing Fence
 LPEC - Line Post Encased in Concrete
 IAPA - Intermediate Anchor Post Assembly
 EPA - End Post Assembly
 AC - Abutment/Wall Connection

NO.	DATE	DESCRIPTION
AB-1	03/12/26	ADDED PROP FENCING CALLOUT

