



Ohio DOT Workspace  
SUM-8  
www.msconsultants.com



Batchplot Spec: \\msconsultants.com\files\Production\PM\60\08326\standards\plotdrv\batchplot.spc  
Pen Table: N:\PM\60\08326\standards\plotdrv\tbl.ms\_sfd.tbl  
Plot Driver: \\msconsultants.com\files\standards\usin\ohdot\18\ms\plotting\PDF.plt  
PCF: 60-08326\_PW

34" x 22"



Model: Sheet  
Printed: 4/11/2023 5:11:44 PM  
By: srfille  
View: FENCE - NEW1  
File: \\msconsultants.com\files\Production\PM\60\08326\roadway\sheet\91710\_GW001.dgn

UTILITIES

LISTED BELOW ARE ALL UTILITIES LOCATED WITHIN THE PROJECT CONSTRUCTION LIMITS TOGETHER WITH THEIR RESPECTIVE OWNERS:

AT&T  
MS. PATRICIA HARRIS  
700 HURON RD.  
CLEVELAND, OH 44115  
PHONE: (216) 822-6535  
FAX: (216) 822-6560  
E-MAIL: PH1924@ATT.COM

AT&T OHIO  
MR. PAUL THOMPSON  
50 W. BOWERY ST RM 628  
AKRON, OH 44308  
PHONE: (330) 384-9988  
FAX: (330) 384-9866

CENTURYLINK/INVOLTA  
MR. BOBBY WALTERS  
3801 ELM ROAD  
WARREN, OH 44483  
PHONE: (440) 244-8415  
E-MAIL:  
BOBBY.D.WALTERS@CENTURYLINK.COM

CITY OF AKRON  
ENGINEERING BUREAU  
MS. CHRISTINE JONKE  
166 S. HIGH ST. ROOM 701  
AKRON, OH 44308  
PHONE: (330) 375-2495  
FAX: (330) 375-2288

CITY OF AKRON  
WATER DISTRIBUTION DIVISION  
MR. TONY PUGLIA  
1460 TRIPLET BLVD.  
AKRON, OH 44306  
PHONE: (330) 375-2420  
EMAIL: TPUGLIA@AKRONOHIO.GOV

DOMINION EAST OHIO GAS  
MS. MARY J. LONG  
320 SPRINGSIDE DR.  
AKRON, OH 44333  
PHONE: (330) 664-2409  
FAX: (888) 504-0126  
E-MAIL: MARY.J.LONG@DOM.COM

FIRST ENERGY (TRANSMISSION)  
MR. DAVE KOZY  
76 S. MAIN ST.  
AKRON, OH 44308  
PHONE: (330) 384-5194

CENTURYLINK  
MR. DOUG HOLLOWAY  
1025 ELDORADO BLVD.  
SUITE 43C-402  
BROOMFIELD, CO 80021  
PHONE: (216) 906-6284  
E-MAIL:  
DOUG.HOLLOWAY@CENTURYLINK.COM

OHIO DEPARTMENT OF  
TRANSPORTATION  
DISTRICT 4 - ITS  
MS. MICHELLE CHANEY  
2088 S. ARLINGTON RD.  
AKRON, OH 44306  
PHONE: (330) 786-2267  
FAX: (330) 786-2232  
E-MAIL:  
MICHELLE.CHANEY@DOT.OHIO.GOV

OHIO EDISON  
ATTN: DAVID MILLER  
1910 W. MARKET ST. BLDG. 1  
AKRON, OH 44313  
PHONE: (330) 436-4055  
CELL: (330) 715-4340  
Millerdl@firstenergycorp.com

OHIO DEPARTMENT OF  
TRANSPORTATION  
CENTRAL OFFICE - ITS  
1606 W. BROAD STREET  
COLUMBUS, OH 43223  
PHONE: (614) 387-4113  
E-MAIL: cen.its.lab@dot.ohio.gov

CHARTER COMMUNICATIONS  
MR. JAMES LONG  
530 S. MAIN ST. STE. 1741  
AKRON, OH 44311  
PHONE: (330) 312-8845  
FAX: (330) 622-4106  
E-MAIL:  
James.Long@charter.com

SPRINT  
MR. JOSEPH J. THOMAS  
11370 ENTERPRISE PARK DR.  
SHARONVILLE, OH 45241  
PHONE: (440) 447-6163  
E-MAIL:  
JOSEPH.J.THOMAS@SPRINT.COM

WINDSTREAM BUSINESS  
MR. DWAYNE LAHMANN  
10070 RUTH DR,  
WADSWORTH, OH 44281  
PHONE: (330) 329-5495  
E-MAIL:  
DWAYNE.LAHMANN@WINDSTREAM.COM

VERIZON  
MR. AL GUEST  
120 RAVINE ST.  
AKRON, OH 44303  
PHONE: (330) 253-8267  
FAX: (918) 562-7014

ZAYO  
MR. ERIK LICIS  
4199 KINROSS LAKES PARKWAY  
SUITE #10  
RICHFIELD, OH 44286  
PHONE: (330) 237-3292  
ERIK.LICIS@ZAYO.COM  
WINDSTREAM OSP OHIO  
LEON TAYLOR  
2165 STATE ROUTE 133 SOUTH  
BLANCHESTER, OHIO, 45107  
937 725 5358

OHIO EDISON (TRANSMISSION)  
FIRST ENERGY SERVICE COMPANY  
SUPERVISOR,  
TRANSMISSION MAINTENANCE  
ATTN: RYAN GRADY  
(330) 252-6379  
(330) 413-2046 CELL  
RGRADY@FIRSTENERGYCORP.COM

DOMINION ENERGY OHIO  
ATTN: MICAH RISACHER  
320 SPRINGSIDE DRIVE, SUITE 320  
AKRON, OH 44333  
(330) 664-2638  
(440) 371-1533 CELL  
Micah.J.Risacher@dominioneenergy.com

THE LOCATION OF THE UNDERGROUND UTILITIES SHOWN ON THE PLANS ARE AS OBTAINED FROM THE OWNERS AS REQUIRED BY SECTION 153.64 O.R.C.

ODOT UTILITY COORDINATOR  
MATT STEELE  
330-786-4832

THE UNDERGROUND UTILITIES ON THIS PLAN HAVE BEEN LOCATED BY USING A SUBSURFACE UTILITY COMPANY (SUE), NATIONAL ENGINEERING& ARCHITECTURE SERVICES (NEAS). IF THERE ARE ANY DISCREPANCIES BETWEEN FIELD MARKINGS AND WHAT THE PLAN INDICATED PLEASE CONTACT THE PROJECT UTILITY COORDINATOR PRIOR TO ANY SUBSURFACE UTILITY WORK BEING INITIATED.

EXISTING PLANS

EXISTING PLANS ENTITLED SUM-8-0.63, SUM-8-1.73/1.95, SUM-8-2.23, SUM-8-1.99, SUM-8-0.38A, SUM-8-12.31, SUM-8-1.95, AND SUM-8-1.99 MAY BE INSPECTED IN THE ODOT DISTRICT 4 IN AKRON, OHIO

ENVIRONMENTAL COMMITMENTS

1. THE CONTRACTOR WILL ADVISE THE ODOT PROJECT ENGINEER A MINIMUM OF TWENTY-ONE (21) DAYS PRIOR TO THE START OF CONSTRUCTION ACTIVITIES. THE CONTRACTOR MUST ALSO PROVIDE NOTIFICATION TO THE ODOT PROJECT ENGINEER A MINIMUM OF TWENTY-ONE (21) DAYS PRIOR TO ANY LANE RESTRICTIONS/CLOSURES AND BRIDGE/RAMP CLOSURES. THE ODOT PROJECT ENGINEER WILL FORWARD THE INFORMATION TO THE ODOT-DISTRICT 4 OFFICE OF PUBLIC INFORMATION FOR USE TO NOTIFY EMERGENCY SERVICES AND COMMUNITIES A MINIMUM OF FOURTEEN (14) DAYS PRIOR TO THE START OF PROJECT CONSTRUCTION. INCLUDED IN THIS NOTIFICATION WILL BE THE PROJECTED DATES/TIMES OF THE LANE RESTRICTIONS/CLOSURES, BRIDGE/RAMP CLOSURES AND PROPOSED DETOURS.

2. PRIOR TO BRIDGE DEMOLITION ACTIVITIES, THE UNDERSIDE OF THE EXISTING BRIDGE SHALL BE CAREFULLY EXAMINED FOR THE PRESENCE OF BATS, ESPECIALLY FROM APRIL 1 TO SEPTEMBER 30. IF ANY BATS ARE FOUND ROOSTING ON THE UNDERSIDE OF THE BRIDGE, THE ECOLOGICAL STAFF OF ODOT'S OFFICE OF ENVIRONMENTAL SERVICES AND ODOT DISTRICT 4 ENVIRONMENTAL STAFF SHALL BE CONTACTED UPON IDENTIFICATION.

3. ANY AREAS DISTURBED DURING CONSTRUCTION ACTIVITIES SHALL BE RE-SEEDED/RE-VEGETATED WITH NATIVE PLANT SPECIES, INCLUDING NATIVE RIPARIAN TREE SPECIES, AND MULCHED DURING CONSTRUCTION TO ENCOURAGE ESTABLISHMENT OF NATIVE VEGETATION COVER, DECREASE EROSION AND PREVENT EROSION OF SEDIMENTS INTO WATERS OF THE U.S.

4. EXISTING RIPARIAN HABITAT ZONES SHALL BE MAINTAINED TO THE MAXIMUM EXTENT POSSIBLE.

5. CONSTRUCTION EQUIPMENT AND MATERIAL STAGING AREAS SHALL BE KEPT AWAY FROM STREAMS TO THE EXTENT PRACTICABLE. THE MECHANICAL EQUIPMENT USED TO EXECUTE THE WORK AUTHORIZED HEREIN SHALL BE OPERATED IN A MANNER TO MINIMIZE TURBIDITY THAT COULD DEGRADE WATER QUALITY AND ADVERSELY AFFECT AQUATIC PLANT AND ANIMAL LIFE.

6. THE CONTRACTOR SHALL TAKE PRECAUTIONS TO AVOID AND/OR LIMIT CONSTRUCTION AND DEMOLITION DEBRIS FROM ENTERING THE STREAM(S). ANY DEBRIS THAT DOES FALL INTO THE STREAM(S) SHALL BE REMOVED AS SOON AS POSSIBLE.

7. ACCESS TO LOOKOUT PARK AND FREEDOM TRAIL WILL BE MAINTAINED AT ALL TIMES DURING CONSTRUCTION ACTIVITIES, EXCEPT AS NEEDED TO FACILITATE BRIDGE CONSTRUCTION OVER FREEDOM TRAIL.

8. EXCEPT AS NECESSARY TO FACILITATE CONSTRUCTION ACTIVITIES, THE STAGING AND/OR STORAGE OF CONSTRUCTION EQUIPMENT WILL NOT TAKE PLACE OUTSIDE PROPOSED CONSTRUCTION LIMITS THAT ARE WITHIN THE DEFINED BOUNDARIES OF LOOKOUT PARK, ADAMS PARK AND FREEDOM TRAIL.

9. NO TREES SHALL BE REMOVED WITHIN THE PROPOSED CONSTRUCTION FOOTPRINT FROM APRIL 1 THROUGH SEPTEMBER 30. ALL NECESSARY TREE REMOVAL SHALL OCCUR FROM OCTOBER 1 THROUGH MARCH 31. THIS REQUIREMENT IS NECESSARY TO AVOID AND MINIMIZE IMPACTS TO PROTECTED BAT SPECIES AS REQUIRED BY THE ENDANGERED SPECIES ACT. FOR THE PURPOSES OF THIS NOTE, A TREE IS DEFINED AS A LIVE, DYING, OR DEAD WOODY PLANT, WITH A TRUNK THREE INCHES OR GREATER IN DIAMETER AT A HEIGHT OF 4.5 FEET ABOVE THE GROUND SURFACE, AND WITH A MINIMUM HEIGHT OF 13 FEET.

10. ANY AREAS OF DISTURBANCE THAT OCCUR WITHIN OR ADJACENT TO THE IDENTIFIED 4(F) PROPERTIES WILL BE RESTORED TO A CONDITION AS GOOD AS OR BETTER THAN EXISTING.

11. THE CONTRACTOR SHALL ABIDE BY ALL WATERWAY PERMIT CONDITIONS THROUGHOUT DURATION OF CONSTRUCTION ACTIVITIES.

12. A CO-PERMITTEE NOTICE OF INTENT (NOI) WILL BE PREPARED AND PROVIDED TO THE CONTRACTOR BY ODOT PERSONNEL AT THE PRE-CONSTRUCTION MEETING. THE CONTRACTOR SHALL BE RESPONSIBLE FOR COMPLETING THE CO-PERMITTEE NOI FOR COVERAGE UNDER OHIO EPA STORMWATER CONSTRUCTION GENERAL PERMIT AND SUBMITTING TO OHIO EPA FOR APPROVAL, ALONG WITH THE DEVELOPMENT OF A STORM WATER POLLUTION PREVENTION PLAN (SWPPP), BEFORE CONSTRUCTION ACTIVITY CAN TAKE PLACE. SPECIFICATIONS SET FORTH IN THE MOST CURRENT VERSION OF ODOT'S "CONSTRUCTION AND MATERIAL SPECIFICATIONS, LOCATION AND DESIGN MANUAL AND STANDARD DRAWINGS" SHALL BE USED TO ENSURE ADEQUATE EROSION AND SEDIMENT CONTROL, ALONG WITH ADDITIONAL PROTECTIVE MEASURES TO AVOID IMPACTS TO ADJACENT PROPERTIES, STREAMS AND WETLANDS FROM CONSTRUCTION ACTIVITIES.

13. THE CONTRACTOR SHALL RESTRICT WORK IN THE LITTLE CUYAHOGA RIVER BETWEEN DATES OF APRIL 15TH AND JUNE 30TH TO REDUCE THE IMPACTS TO INDIGENOUS AQUATIC SPECIES AND THEIR HABITAT.

14. THE CONTRACTOR SHALL MAINTAIN ACCESS TO LOOKOUT PARK AND ADAMS PARK AT ALL TIMES DURING CONSTRUCTION ACTIVITIES, EXCEPT FOR THE TIME NEEDED TO COMPLETE CERTAIN CONSTRUCTION ACTIVITIES THAT WOULD COMPROMISE SAFETY OF THE USERS OF LOOKOUT PARK.

15. THE CONTRACTOR SHALL INSTALL TEMPORARY CONSTRUCTION FENCING ALONG THE KNOWN BOUNDARIES OF LOOKOUT PARK, FREEDOM TRAIL, AND ADAMS PARK, WITHIN THE PROJECT CONSTRUCTION LIMITS PRIOR TO THE START OF CONSTRUCTION ACTIVITIES TO PROTECT THE PUBLIC AND TO MINIMIZE IMPACTS TO THE PROPERTIES. THE CONSTRUCTION FENCE SHALL BE 4'-0" (MIN.) IN HEIGHT AND SHALL BE MAINTAINED THROUGHOUT THE DURATION OF CONSTRUCTION BY THE CONTRACTOR. UNIT COST SHALL INCLUDE MATERIALS AND LABOR, INCLUDING REMOVAL OF FENCING WHEN PROJECT IS COMPLETED. THE FOLLOWING QUANTITY HAS BEEN INCLUDED FOR THIS WORK:

ITEM 607 - FENCE, MISC.:  
CONSTRUCTION FENCING (PLASTIC/NYLON) - 900 FT

16. PRIOR TO THE START OF CONSTRUCTION ACTIVITIES, THE CONTRACTOR SHALL INSTALL APPROPRIATE SIGNAGE TO ALERT USERS OF LOOKOUT PARK, FREEDOM TRAIL, AND ADAMS PARK, OF CONSTRUCTION ACTIVITIES, ANY ACCESS RESTRICTION OR CLOSURES, AND TO DIRECT USERS TO SECONDARY ACCESS POINTS.

17. THE CONTRACTOR SHALL NOT STORE OR STAGE CONSTRUCTION EQUIPMENT OR MATERIALS WITHIN THE KNOWN BOUNDARIES OF LOOKOUT PARK, FREEDOM TRAIL, AND ADAMS PARK, OUTSIDE OF THE PROPOSED CONSTRUCTION LIMITS, WITH THE EXCEPTION OF AREA(S) IDENTIFIED BY THE OFFICIAL WITH JURISDICTION TO FACILITATE THE STORAGE AND STAGING OF EQUIPMENT.

18. THE CONTRACTOR SHALL COORDINATE THE CONSTRUCTION SCHEDULE WITH ODOT (ODOT PROJECT ENGINEER), THE CITY OF AKRON (DIRECTOR OF PUBLIC SERVICE), AND SUMMIT METRO PARKS (CHIEF OF PLANNING AND DEVELOPMENT) 30 DAYS PRIOR TO THE START OF CONSTRUCTION ACTIVITIES.

19. THE CONTRACTOR SHALL LIMIT THE TEMPORARY OCCUPANCY OF ADAMS PARK AND FREEDOM TRAIL TO TWO (2) NON-CONSECUTIVE SIX (6) MONTH PERIODS. A TEMPORARY PAVED CONNECTOR PATH TO BE USED AS A HAUL ROAD FOR CONSTRUCTION PURPOSES WILL BE BUILT WITHIN ADAMS PARK, INCLUDING A TEMPORARY PATH TO THE EAST OF THE HAUL ROAD THAT WILL CONNECT TO FREEDOM TRAIL.

21. THE CONTRACTOR SHALL MAINTAIN PUBLIC ACCESS TO FREEDOM TRAIL TO ADAMS PARK VIA THE TEMPORARY PATH LOCATED TO THE EAST OF THE HAUL ROAD AND INSTALL A BARRIER TO SEPARATE THE TWO PATHS.

FREEDOM TRAIL

THE CONTRACTOR SHALL BE REQUIRED TO REPAVE ANY SECTION OF THE FREEDOM TRAIL THAT HAS BEEN DISTURBED DURING CONSTRUCTION OF ACCESS ROAD 1 PRIOR TO REOPENING THE TRAIL AFTER EACH OF THE TWO (2) SCHEDULED CLOSURES. QUANTITY HAS BEEN PROVIDED IN THE PLANS FOR AGGREGATE BASE COURSE AND ASPHALT SURFACE COURSE. THE CONTRACTOR SHALL UTILIZE THE EXISTING PLANS AND REFERENCE THE PROFILE GRADE IN THE AS-BUILT PLANS. THE CONTRACTOR SHALL INSTALL THE TRAIL AT A 1.50% CROSS SLOPE FOR THE LENGTH OF THE DISTURBANCE REGARDLESS OF THE EXISTING TRAIL CROSS SLOPE. THE CONTRACTOR SHALL TRANSITION THE CROSS SLOPE FROM THE NEWLY PAVED SECTION TO EXISTING OVER A MINIMUM LENGTH OF 15 FEET. ANY SECTION OF THE TRAIL THAT EXCEEDS 1.50% SHALL BE REMOVED AND REPLACED BY THE CONTRACTOR AT NO ADDITIONAL EXPENSE TO THE PROJECT. SEE TYPICAL SECTIONS SHEET 10. THE CONTRACTOR SHALL RECORD VIDEO PRE AND POST CONSTRUCTION FOR RECORD OF THE TRAIL CONDITION

FOR RECORD PLAN INFORMATION REGARDING THE EXISTING FREEDOM TRAIL CONTACT:  
SUMMIT METRO PARKS  
975 TREATY LINE RD.  
AKRON, OHIO 44313

ITEM SPECIAL - REMOVAL OF ELECTRICAL PLUGS

THIS ITEM OF WORK INCLUDES THE REMOVAL OF THE THREE EXISTING POLE MOUNTED RECEPTACLES USED FOR BUS MOTOR BLOCK HEATERS LOCATED CLOSEST TO THE BRIDGE. THE CONTRACTOR SHALL CONTACT DEBRA FOULK AT THE AKRON CITY SCHOOLS BUS GARAGE AT (330) 761-2805 ONE WEEK PRIOR TO PERFORMING THE WORK. THE CONTRACTOR SHALL COORDINATE THE DISCONNECT OF THE POWER PRIOR TO PERFORMING THE WORK. THIS ITEM INCLUDES THE REMOVAL OF THE RECEPTACLES, CONDUIT, CONDUCTOR, POLES, AND POLE FOUNDATIONS AS NECESSARY. THE CONTRACTOR SHALL FILL THE VOID CREATED WITH LOW STRENGTH MORTAR BACKFILL PER CMS 613. ALL MATERIAL SHALL BE RETURNED TO THE AKRON CITY SCHOOLS BUS GARAGE PERSONNEL OR DISPOSED OF PROPERLY. CONTRACTOR SHALL ENSURE THAT THE REMAINING RECEPTACLES ARE IN PROPER WORKING CONDITION UPON COMPLETION OF THE WORK. THIS WORK INCLUDES ALL LABOR, EQUIPMENT AND MATERIALS NECESSARY TO REMOVE THE PORTION OF THE EXITING SYSTEM, AND SHALL BE PAID UNDER:

ITEM SPECIAL - REMOVAL OF ELECTRICAL PLUGS

CALCULATED  
DLT  
CHECKED  
HRB

GENERAL NOTES

SUM-8-1.75

12  
801

\\msconsultants.com\files\Production\PW\60\08326\mot\sheets\91710\MS003.dgn\_Sheet1 4/11/2023 5:18:59 PM scriffle

SHEET NUM.														PART.	ITEM	ITEM	GRAND	UNIT	DESCRIPTION	SEE SHEET NO.
18	19	20	25	47	48	49	50	51	52	53	54	55	04/NHS/04	EXT	TOTAL					
		605											605	251	01010	605	CY	<b>MAINTENANCE OF TRAFFIC</b> PARTIAL DEPTH PAVEMENT REPAIR (441)		
		7,250											5,580	12,830	01000	12,830	SY	PAVEMENT PLANING, ASPHALT CONCRETE (1.5")		
		580											617	1,197	20000	1,197	GAL	NON-TRACKING TACK COAT		
50													50	410	12000	50	CY	TRAFFIC COMPACTED SURFACE, TYPE A OR B		
10													35	45	411	10000	45	CY	STABILIZED CRUSHED AGGREGATE	
		305											305	441	50000	305	CY	ASPHALT CONCRETE SURFACE COURSE, TYPE 1, (448), PG64-22		
			680										680	614	11110	680	HOUR	LAW ENFORCEMENT OFFICER WITH PATROL CAR FOR ASSISTANCE		
				100	810	848	2,953	2,784	6,279	1,670	2,140		17,584	614	11630	17,584	FT	INCREASED BARRIER DELINEATION		
15				2	6	3	3	2	5	2	2		40	614	12380	40	EACH	WORK ZONE IMPACT ATTENUATOR, 24" WIDE HAZARDS, (UNIDIRECTIONAL)		
							1		2				3	614	12390	3	EACH	WORK ZONE IMPACT ATTENUATOR, OVER 24" AND LESS THAN 36" WIDE HAZARDS, (UNIDIRECTIONAL)		
							1						1	614	12400	1	EACH	WORK ZONE IMPACT ATTENUATOR, MISC.: WORK ZONE IMPACT ATTENUATOR FOR HAZARDS WIDER THAN 36" (UNIDIRECTIONAL)	21	
	LS												LS	614	12420	LS		DETOUR SIGNING	19	
		12											12	614	12484	12	EACH	WORK ZONE INCREASED PENALTIES SIGN		
					276	552	432	616	908	897	1,488		5,169	614	12801	5,169	EACH	WORK ZONE RAISED PAVEMENT MARKER, AS PER PLAN	24	
200													1,378	1,578	614	13000	1,578	CY	ASPHALT CONCRETE FOR MAINTAINING TRAFFIC	
				45		87	88	171	240	90	87		808	614	13310	808	EACH	BARRIER REFLECTOR, TYPE 1 (ONE-WAY)		
				45		31	88	171	86	90	87		598	614	13350	598	EACH	OBJECT MARKER, ONE WAY		
						28			77				105	614	13360	105	EACH	OBJECT MARKER, TWO WAY		
		100,000											100,000	614	18000	100,000	EACH	MAINTAINING TRAFFIC, MISC.: BRIDGE DECK AND PAVEMENT PATCHING	20	

**MAINTENANCE OF TRAFFIC GENERAL SUMMARY**

**SUM - 8 - 1.75**

\\msconsultants.com\files\Production\PW\60\08326\mot\sheets\917\0MS002.dgn\_Sheet1 4/11/2023 4:45:07 PM srifle

PHASE	ROAD	DIR.	BEGIN STA.	END STA.	LENGTH	WIDTH	AREA	DEPTH	411	614	615	254	407												
									10000	13000	20000	01000	20000												
									STABILIZED CRUSHED AGGREGATE	ASPHALT CONCRETE FOR MAINTAINING TRAFFIC	PAVEMENT FOR MAINTAINING TRAFFIC, CLASS A	PAVEMENT PLANING, ASPHALT CONCRETE	NON-TRACKING TACK COAT (0.08 GAL/SY)												
								CY	CY	SY	SY	GALLON													
P-1A-1	RAMP K	SB	84+44	88+03	365	VARIES	1,950	N/A				217													
P-1A-1	S.R. 8	SB	42+95	67+00	2,405	2.00	4,850	0.125		22		539	43												
1A-1	RAMP K	SB	84+12	88+46	402	3.00	1,250	N/A			139														
P-1A-2	RAMP I	SB	11+92	17+16	525	VARIES	3,350	N/A			372														
P-1A-2	RAMP I	SB	17+25	17+50	35	VARIES	400	N/A			44														
1A-2	RAMP I	SB	12+24	14+19	200	VARIES	2,550	N/A			283														
P-1B	S.R. 8	SB	85+39	90+32	493	2.00	990	0.50	18																
P-1B	S.R. 8	SB	87+80	91+25	345	20.75	7,200	0.25		67		800	64												
P-1B	S.R. 8	SB	93+15	98+55	540	VARIES	8,950	0.25		83		994	80												
P-1B	S.R. 8	SB	58+50	67+00	850	2.00	1,700	0.125		8		189	15												
1B	RAMP I	SB	319+00	320+00	100	2.00	200	0.50	4																
1C	S.R. 8	SB	212+93	214+04	111	2.00	230	0.50	4																
1C	S.R. 8	SB	219+55	220+80	125	2.00	250	0.50	5																
1D	S.R. 8	NB	215+05	223+00	795	VARIES	19,200	0.67		474			171												
1D	S.R. 8	NB	223+00	224+65	165	VARIES	2,000	N/A			222														
1D	S.R. 8	NB	243+60	246+80	320	VARIES	3,650	0.125		17		406	32												
1D	S.R. 8	NB	246+50	261+00	1,450	VARIES	32,000	0.583		691		2,283	183												
1D	S.R. 8	SB	262+00	263+00	100	2.00	200	0.50	4																
1D	S.R. 8	NB	41+70	53+02	1,132	2.00	2,270	0.125		11		252	20												
1D	S.R. 8	NB	59+75	65+00	525	2.00	1,050	0.125		5		117	9												
2A-1	RAMP J	NB	9+13	12+05	292	VARIES	3,850	N/A			428														
2A-3	S.R. 8	NB	516+00	519+15	315	4.00	1,300	N/A			144														
SUBTOTALS THIS SHEET (CARRIED TO SHEET 46)									35	1,378	1,849	5,580	617												

55	801
SUM - 8 - 1.75	
MAINTENANCE OF TRAFFIC SUBSUMMARY	
CALCULATED	MTD
CHECKED	MTR
















REF NO.	SHEET NO.	CULVERT FILE NO. (CFN)	STATION TO STATION						611	611	611	611	611	611	611	611	611	611	611	611	611	611	611	602	601					
									15" CONDUIT, TYPE B	15" CONDUIT, TYPE C	15" CONDUIT, TYPE F	18" CONDUIT, TYPE B	18" CONDUIT, TYPE C	INLET, NO. 3 FOR SINGLE SLOPE BARRIER, TYPE D, AS PER PLAN	21" CONDUIT, TYPE C	24" CONDUIT, TYPE B	24" CONDUIT, TYPE C	24" CONDUIT, TYPE F	36" CONDUIT, TYPE B	36" CONDUIT, TYPE C	CONDUIT, MISC.: 36" CONDUIT UNDER RAILROAD	CATCH BASIN, NO. 3, AS PER PLAN	CATCH BASIN, NO. 3A, AS PER PLAN	CATCH BASIN, NO. 3	CATCH BASIN, NO. 8	INLET, NO. 3 FOR SINGLE SLOPE BARRIER, TYPE C1	INLET, NO. 3 FOR SINGLE SLOPE BARRIER, TYPE D	MANHOLE, NO. 3	CONCRETE MASONRY	ROCK CHANNEL PROTECTION, TYPE C WITH FILTER
									FT	FT	FT	FT	FT	EACH	FT	FT	FT	FT	FT	FT	FT	EACH	EACH	EACH	EACH	EACH	EACH	EACH	EACH	CY
D1	194	1988725	258+25.00	LT		258+00.00	LT	25																						
D2	194	1988728	258+00.00	LT		255+50.00	LT																							
D4	194	1988723	258+12.13	RT		258+12.13	RT	20																						
D5	192	1988699	255+50.00	LT		252+91.20	LT																							
D7	192	1988705	253+41.00	LT		252+91.20	LT	49																						
D8	192	1988701	252+91.20	LT		251+50.00	LT																							
D10	192	1988703	252+41.00	LT		252+91.20	LT	49																						
D11	190	1988702	251+50.00	LT		249+75.00	LT																							
D12	188	1988685	243+83.74	RT		243+68.91	LT																							
D13	188		546+00.00	LT		543+67.83	LT																							
D14	188		543+67.83	LT																										
D16	185	1988679	541+39.00	RT		541+50.00	RT																							
D16A	185	1988680	541+50.00	RT		541+50.00	LT	75																						
D17	185	1988681	541+39.00	LT		541+50.00	LT	11																						
D17A	185		541+50.00	LT		541+50.00	LT																							
D18	185		241+61.95	RT		241+70.28	RT																							
D19	185		241+70.28	RT		541+50.00	LT																							
D20	185		241+70.27	LT		241+70.27	LT																							
D20C	185		241+70.27	LT																										
D22	190	1988706	249+75.00	LT		249+64.63	LT																							
D22A	190		249+64.63	LT		249+50.00	LT																							
D23	190		249+50.00	LT																										
D27	175	1988657	418+00.00	RT		418+20.46	RT																							
D28	175		418+20.46	RT		420+20.00	RT																							
D29	175		420+20.00	RT		420+59.19	RT																							
D30	175		420+20.65	RT		420+20.00	RT																							
D32	175	1988658	420+59.19	RT		423+00.00	RT																							
D33	177	1988672	423+00.00	RT		524+75.08	RT																							
D34	177		524+75.08	RT		524+75.01	RT																							
D35	199		12+50.00	LT		14+00.00	LT																							
D36	200		14+00.00	LT		16+50.00	LT																							
D37	200		16+50.00	LT		17+43.71	LT																							
D37A	200		17+43.71	LT		17+91.79	LT																							
D37B	200		17+91.79	LT		224+00.88	LT																							
D39	177	1988673	524+75.00	LT		524+75.08	RT	93																						
D40	177		524+75.01	RT		524+75.01	RT																							
D42	177		524+75.01	RT		525+20.42	RT																							
D43	177		524+04.72	RT		524+75.01	RT																							
D44	177		525+20.42	RT		525+52.41	RT																							
D45	177		525+52.41	RT		525+52.15	RT																							
D46	177		525+52.15	RT		525+77.38	RT																							
TOTALS CARRIED TO GENERAL SUMMARY								322	334	98	67	807	1	241	295	428	53	814	76	63	3	4	1	13		2	12	2	6	

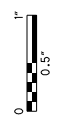

34" x 22"

REF NO.	SHEET NO.	CULVERT FILE NO. (CFN)	STATION TO STATION				611	611	611	611	611	611	611	605	611	611	611	611	611	611	611	611	611	611	611
			8" CONDUIT, TYPE C	8" CONDUIT, TYPE F	12" CONDUIT, TYPE B	12" CONDUIT, TYPE C	15" CONDUIT, TYPE B	15" CONDUIT, TYPE C	18" CONDUIT, TYPE C	CONDUIT, BORED OR JACKED 15"	AGGREGATE DRAINS	CONDUIT, BORED OR JACKED, 18"	CONDUIT, BORED OR JACKED, 36"	36" CONDUIT, TYPE C	42" CONDUIT, TYPE C	CATCH BASIN, NO. 2-2B	CATCH BASIN, NO. 3	CATCH BASIN, NO. 3, AS PER PLAN	CATCH BASIN, NO. 8	CATCH BASIN, NO. 8A	INLET, NO. 3 FOR SINGLE SLOPE BARRIER, TYPE C1	MANHOLE RECONSTRUCTED TO GRADE	MANHOLE, NO. 3		
			FT	FT	FT	FT	FT	FT	FT	FT	FT	FT	FT	FT	FT	FT	EACH	EACH	EACH	EACH	EACH	EACH	EACH	EACH	
D50	173	1988649	214+89.62	LT		214+94.31	LT																		
D53	173	1930145	515+48.04	RT		515+47.84	LT																		
D54	173	1930144	515+47.84	LT		214+92.87	LT		10																
D59	179		527+28.99	LT		527+37.00	LT																		
D61	190		551+44.28	RT																					
D59A	179		527+28.99	LT		528+08.99	LT																		
D64	179		530+32.30	RT		530+32.31	LT																		
D65	179		530+32.31	LT		530+32.31	LT																		
D66	179		530+62.23	LT		531+50.23	LT																		
D67	179		531+50.23	LT		531+50.20	RT		86																
D68	179		531+50.20	RT		531+75.20	RT																		
D70	194	1988731	560+14.23	RT		558+12.13	RT																		
D71	194	1988722	558+12.13	RT		558+12.13	LT																		
D72	194	1988730	259+64.19	LT		61+94.60	LT (RAMP B)																		
D73	194	1988729	259+64.19	LT		258+25.00	LT																		
D74	194	1988726	60+67.46	LT		560+14.23	RT																		
D75	194		560+24.41	RT		560+14.23	RT																		
D80	179		527+37.00	LT		527+81.28	LT																		
D81	179		527+81.28	LT		528+66.28	LT																		
D82	179		528+66.28	LT		529+75.00	LT																		
D83	179		529+75.00	LT		530+32.31	LT																		
D84	179		530+32.31	LT		530+62.23	LT																		
D85	177		224+79.56	LT		225+28.33	LT																		
D85A	177		225+28.33	LT		225+48.81	LT																		
D86	177		225+48.81	LT		525+52.15	RT																		
D87	179		227+68.67	LT		227+93.22	LT																		
D88	179		227+78.67	LT		227+93.22	RT																		
D89	208		628+40.33	RT		628+99.56	RT																		
D90	190		248+66.26	LT																					
D91	190		551+68.98	LT																					
D92	192		554+51.04	LT																					
D93	194		557+24.09	LT																					
D94	235		223+20.00	RT																					
D95	235		223+70.00	RT																					
D96	235		224+20.00	RT																					
D97	236		224+62.84	RT																					
D3	194	1988724	258+00.00	RT		258+00.00	LT																		
D6	192	1988700	255+50.00	RT		255+50.00	LT																		
D9	192	1988704	552+99.91	LT		252+91.20	LT																		
D26	175	1988653	518+00.02	LT		518+00.00	RT																		
TOTALS CARRIED TO GENERAL SUMMARY																									
			36	122	10	212	448	355	224	206	41	131	142	164	240	2	2	2	3	1	5	4	15		

CALCULATED  
APS  
CHECKED  
ACW

**ROADWAY SUBSUMMARY**

**SUM - 8 - 1.75**

165  
801

ms consultants, inc.

PLOT.CEL  
ms consultants, inc.  
msconsultants.com  
Ohio DOT Workspace  
SUM-8  
Batchplot Spec: \\msconsultants.com\files\Production\PM 60\06326\standards\plotdrv\batchplot.spc; CF: otdrv; Pen Table: N:\PM 60\06326\standards\plotdrv\tbl.ms; std.tbl; Plot Driver: \\msconsultants.com\files\Standards\usin\ohdot\18\ms\plotting\PDF.plt; g  
View: FENCE - NEW1  
Printed: 4/12/2023 11:30:24 PM By: srfille  
File: \\msconsultants.com\files\Production\PM 60\06326\roadway\sheet\91710\_GP002.dgn

SEE SHEETS 199 - 205  
FOR COVERAGE OF RAMPS I & J.

SEE SHEETS 161 - 169  
FOR QUANTITIES.

SEE SHEET 176  
FOR PROFILE.

SEE SHEETS 209-292  
FOR CROSS SECTIONS.

SEE SHEET 307  
FOR GORE DETAILS.

T.H. 3  
LEVEL A TEST HOLE #3  
TOP OF GROUND = 1049.28  
TOP OF PIPE = 1044.77  
2.5" UNKNOWN STEEL PIPE


**C2**  
P.I. Sta. 520+82.85  
 $\Delta = 14^\circ 12' 04''$  (RT)  
Dc = 4' 15' 00"  
R = 1,348.14'  
T = 167.93'  
L = 334.14'  
E = 10.42'  
P.C. Sta. 519+14.92  
P.T. Sta. 522+49.06  
V (des) = 60 MPH  
e (max) = 0.060

**C8**  
P.I. Sta. 98+03.68  
 $\Delta = 14^\circ 11' 40''$  (RT)  
Dc = 1' 57' 48"  
R = 2,918.12'  
T = 363.33'  
L = 722.93'  
E = 22.53'  
P.C. Sta. 94+40.35  
P.T. Sta. 101+63.28

**C1**  
P.I. Sta. 223+10.69  
 $\Delta = 14^\circ 12' 04''$  (RT)  
Dc = 4' 15' 00"  
R = 1,348.14'  
T = 167.93'  
L = 334.14'  
E = 10.42'  
PC Sta. 221+42.76  
Sta 224+76.90 BK  
V (des) = 60 MPH  
e (max) = 0.060


= PAVEMENT PLANING AND RESURFACING

(TBR) = TO BE REMOVED  
(DND) = DO NOT DISTURB

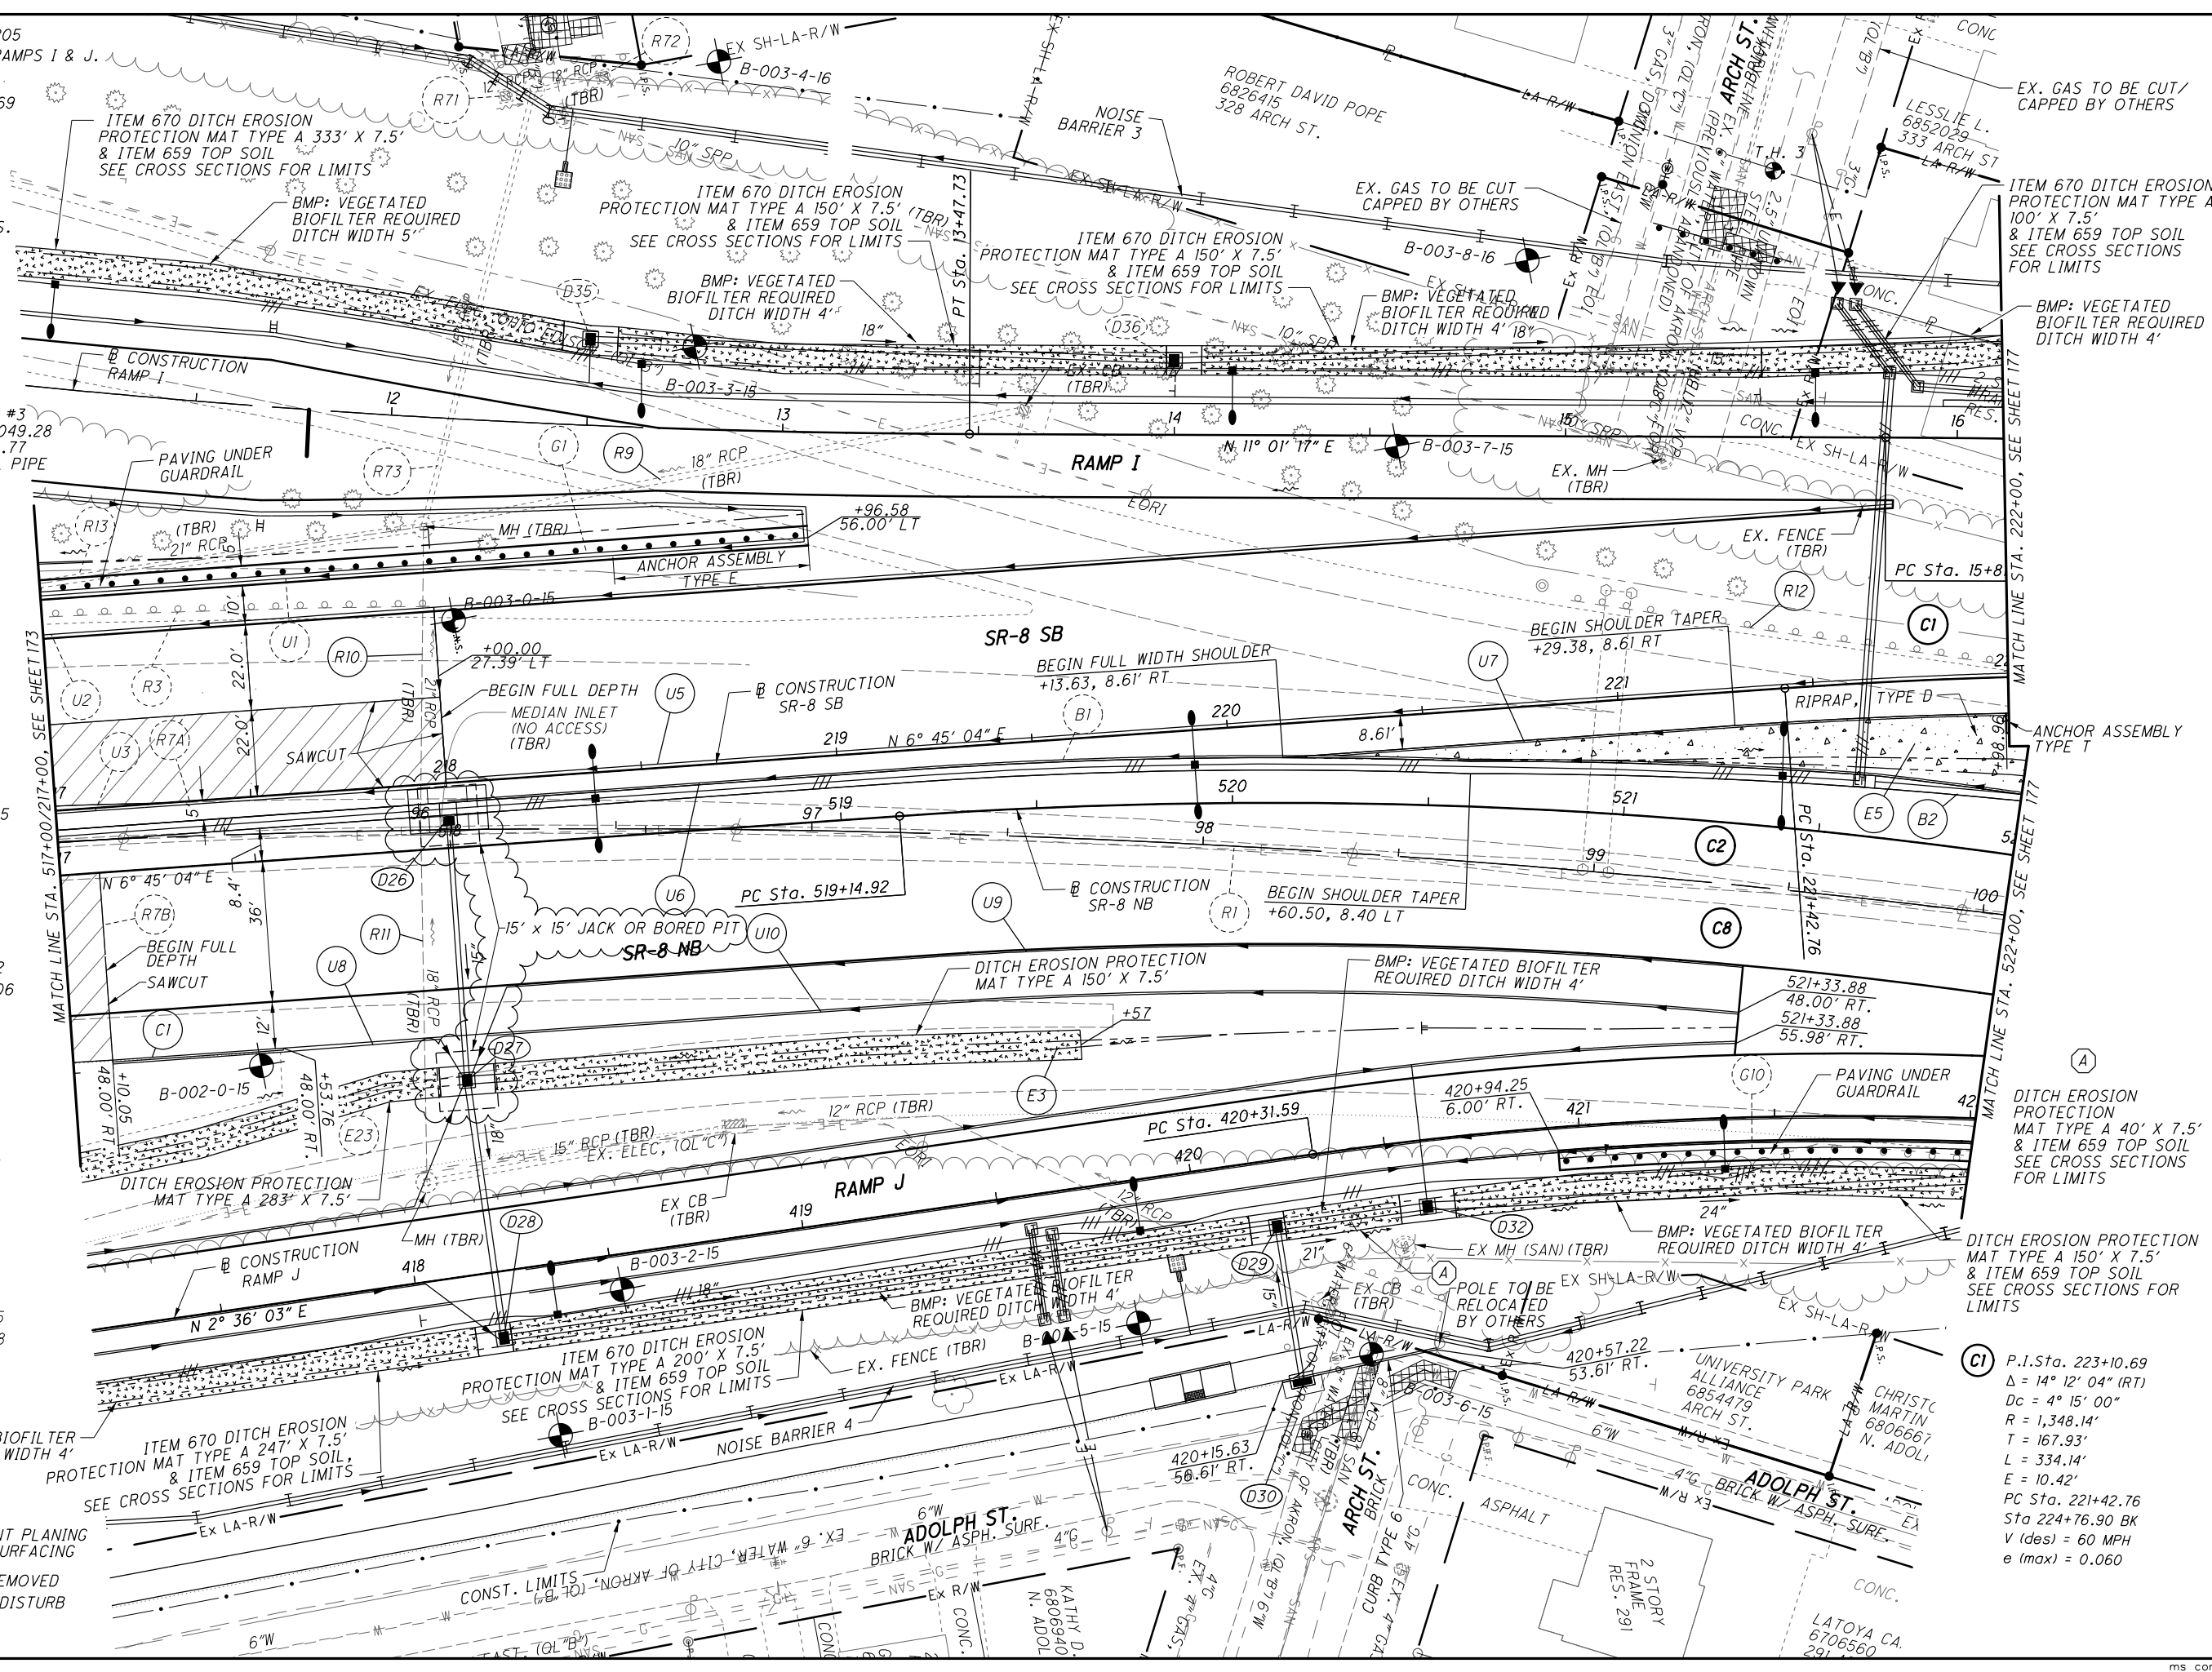

PLAN - S.R. 8 NB/SB  
STA. 517+00/217+00 TO STA. 522+00/222+00  
SUM-8-1.75  
175  
801

PLOT.CEL  
 ms consultants, inc.  
 msconsultants.com  
 Ohio DOT Workspace  
 SUM-8  
 Batchplot Spec: \\msconsultants.com\files\Production\PM 60\08326\standards\plotdrv\batchplot.spd;CF: ohio\8;  
 Pen Table: N:\PM 60\08326\standards\plotdrv\tbl.ms\_std.tbl  
 Plot Driver: \\msconsultants.com\files\standards\usin\ohdot\tbl\ms\_plotting\PDF.plt;cg  
 View: FENCE - NEW!  
 Printed: 4/13/2023 8:12:48:24 AM By: sriffle  
 File: \\msconsultants.com\files\Production\PM 60\08326\roadway\sheet\91710\_GP003.dgn  
 Model: Sheet  
 34" x 22"

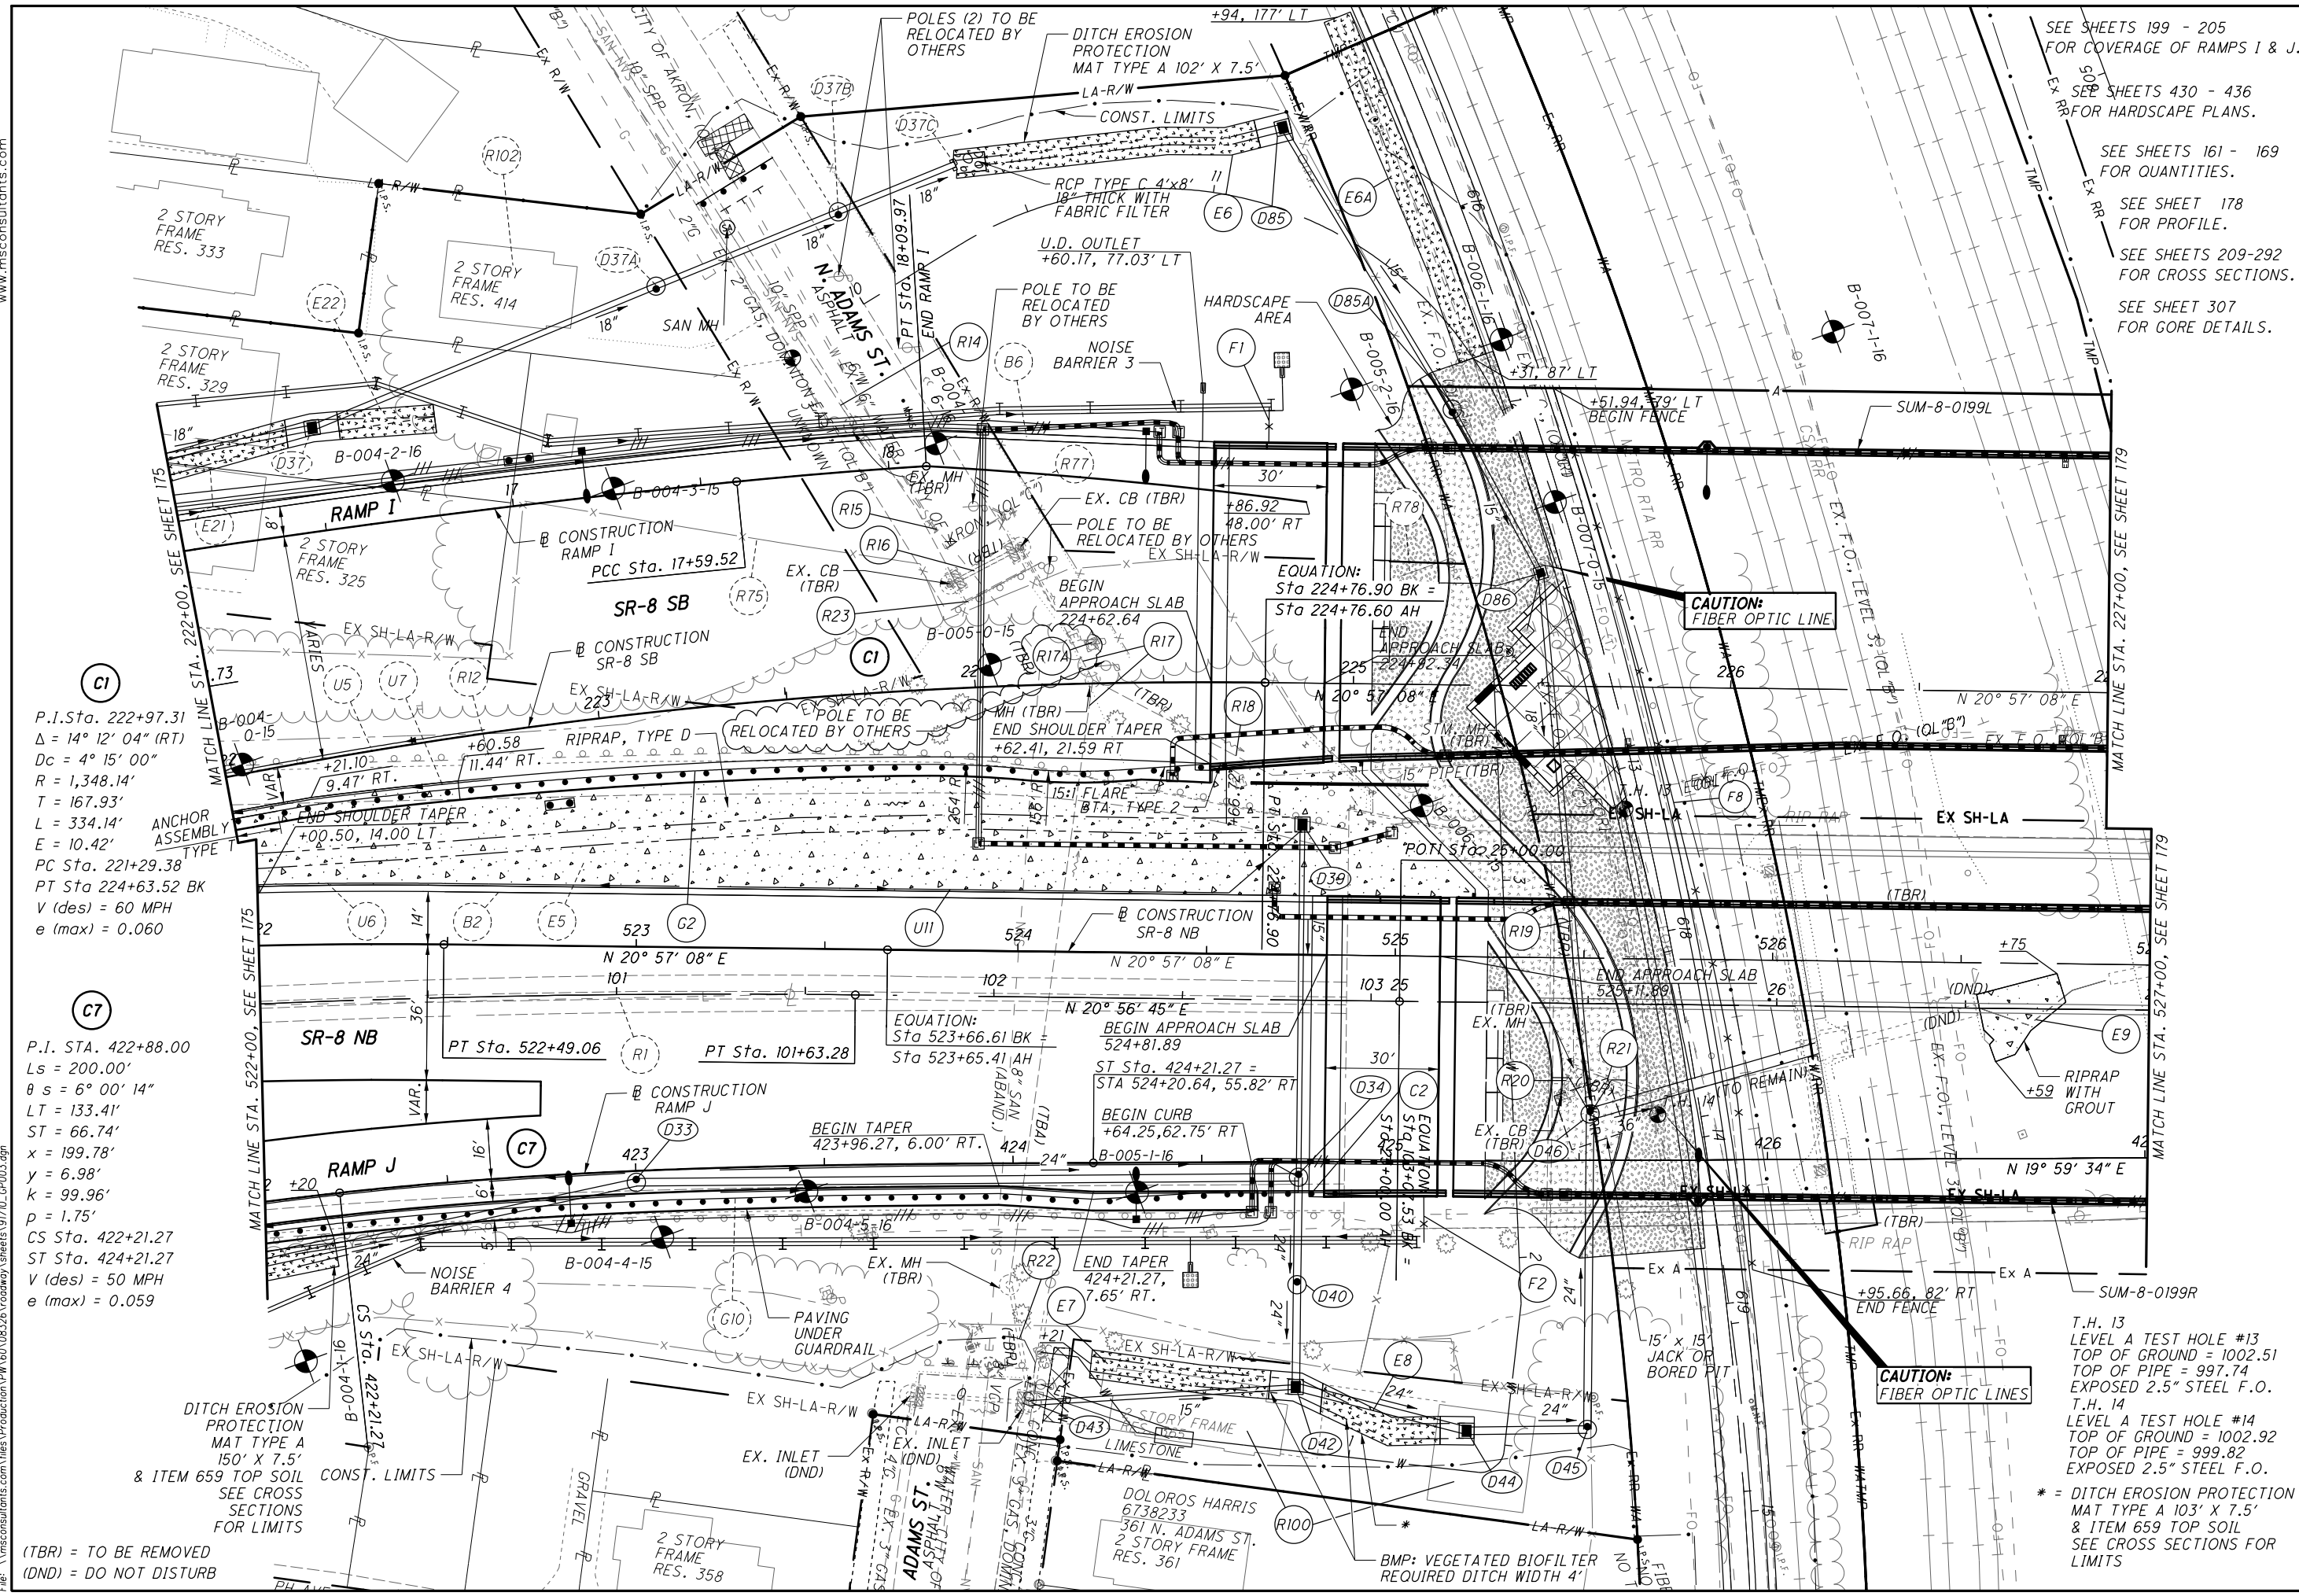

**C1**  
 P.I. Sta. 222+97.31  
 $\Delta = 14^\circ 12' 04''$  (RT)  
 $D_c = 4^\circ 15' 00''$   
 $R = 1,348.14'$   
 $T = 167.93'$   
 $L = 334.14'$   
 $E = 10.42'$   
 PC Sta. 221+29.38  
 PT Sta. 224+63.52 BK  
 $V$  (des) = 60 MPH  
 $e$  (max) = 0.060

**C7**  
 P.I. STA. 422+88.00  
 $L_s = 200.00'$   
 $\theta_s = 6^\circ 00' 14''$   
 $LT = 133.41'$   
 $ST = 66.74'$   
 $x = 199.78'$   
 $y = 6.98'$   
 $k = 99.96'$   
 $p = 1.75'$   
 CS Sta. 422+21.27  
 ST Sta. 424+21.27  
 $V$  (des) = 50 MPH  
 $e$  (max) = 0.059

(TBR) = TO BE REMOVED  
 (DND) = DO NOT DISTURB

SEE SHEETS 199 - 205  
 FOR COVERAGE OF RAMPS I & J.  
 SEE SHEETS 430 - 436  
 FOR HARDSCAPE PLANS.  
 SEE SHEETS 161 - 169  
 FOR QUANTITIES.  
 SEE SHEET 178  
 FOR PROFILE.  
 SEE SHEETS 209-292  
 FOR CROSS SECTIONS.  
 SEE SHEET 307  
 FOR GORE DETAILS.



PLAN - S.R. 8 NB/SB  
 STA. 522+00/222+00 TO STA. 527+00/227+00

SUM-8-1.75


177  
 801

PLOT.CEL  
ms consultants, inc.  
msconsultants.com  
Ohio DOT Workspace  
SUM-8  
Batchplot Spec: \\msconsultants.com\files\Production\PM 60\08326\standards\plotdrv\batchplot.spcl; CF: ohdot\8;  
Pen Table: \\msconsultants.com\files\Production\PM 60\08326\standards\plotdrv\V8L.ms\_std.tbl  
Plot Driver: \\msconsultants.com\files\Production\PM 60\08326\standards\usin\ohdot\1\8\ms\_plotting\PDF.plt; g  
View: FENCE - NEW1  
Printed: 4/12/2023 11:39:06 PM  
By: sriffle  
File: \\msconsultants.com\files\Production\PM 60\08326\roadway\sheet\9170\_GPO09.dgn


**C9**  
P.I. Sta. 248+70.39  
 $\Delta = 29^\circ 20' 09''$  (LT)  
Dc = 2° 30' 00"  
R = 2,291.83'  
T = 599.88'  
L = 1,173.43'  
E = 77.21'  
P.C. Sta. 242+70.51  
P.T. Sta. 254+43.94  
V (des) = 60 MPH  
e (max) = 0.051

**C11**  
P.I. Sta. 547+71.15  
 $\Delta = 29^\circ 20' 09''$  (LT)  
Dc = 2° 30' 00"  
R = 2,291.83'  
T = 599.88'  
L = 1,173.43'  
E = 77.21'  
P.C. Sta. 541+71.27  
P.T. Sta. 553+44.70  
V (des) = 60 MPH  
e (max) = 0.051

**C13**  
P.I. Sta. 47+28.49  
 $\Delta = 29^\circ 19' 35''$  (LT)  
Dc = 2° 30' 00"  
R = 2,291.83'  
T = 599.68'  
L = 1,173.06'  
E = 77.16'  
P.C. Sta. 41+28.81  
P.T. Sta. 53+01.87

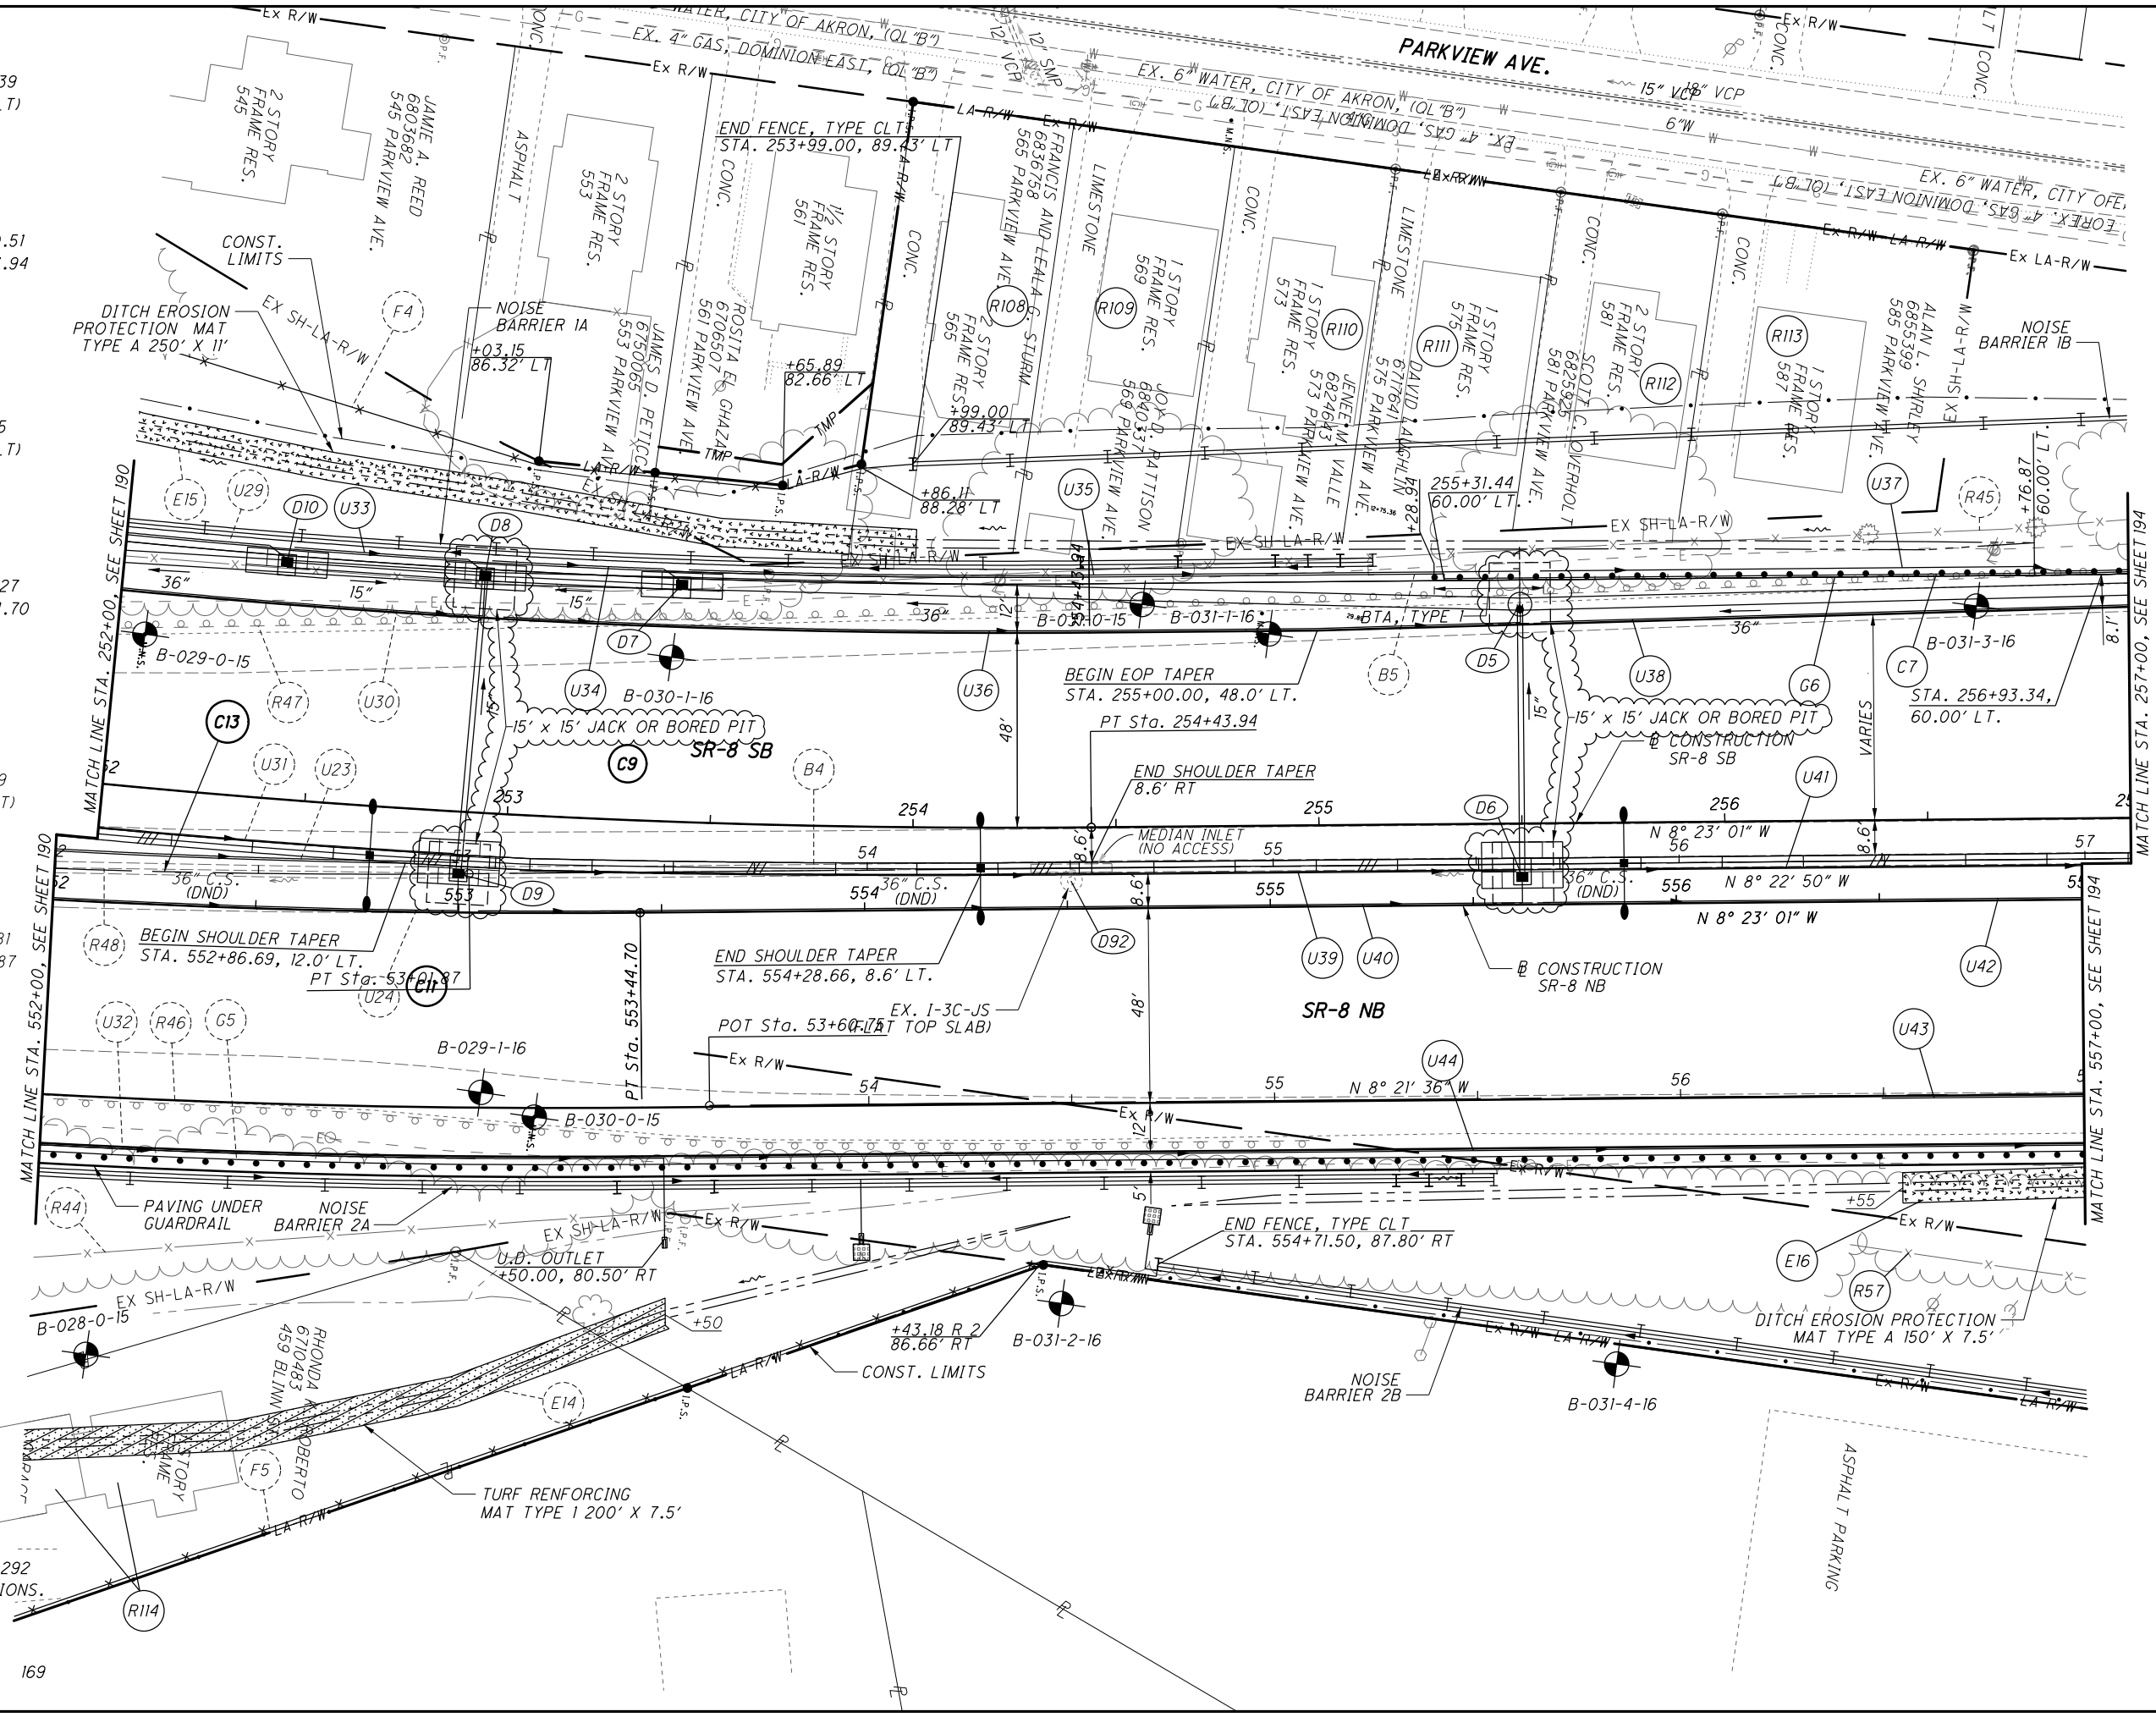

SEE SHEETS 209-292  
FOR CROSS SECTIONS.  
SEE SHEET 193  
FOR PROFILE.  
SEE SHEETS 161 - 169  
FOR QUANTITIES.

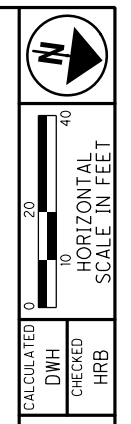

CALCULATED  
DWH  
CHECKED  
HRB



**PLAN - S.R. 8 NB / SB**  
**STA. 552+00 / 252+00 TO STA. 557+00 / 257+00**

**SUM-8-1.75**

192  
801

ms consultants, inc.

PLOT.CEL  
 ms consultants, inc.  
 msconsultants.com  
 Ohio DOT Workspace  
 SUM-8  
 www.msconsultants.com  
 Batchplot Spec: \\msconsultants.com\files\Production\PM 60\08326\standards\plotdrv\batchplot.spc; CF: ohio\8;  
 Pen Table: \\msconsultants.com\files\Production\PM 60\08326\standards\plotdrv\tbl.ms\_std.tbl  
 Plot Driver: \\msconsultants.com\files\Production\PM 60\08326\standards\usin\ohdot\8\ms\_plotting\PDF.plt;c  
 View: FENCE - NEW!  
 Printed: 4/11/2023 5:24:34 PM By: srfille  
 Model: Sheet  
 File: \\msconsultants.com\files\Production\PM 60\08326\roadway\sheet\91710\_0P014.dgn

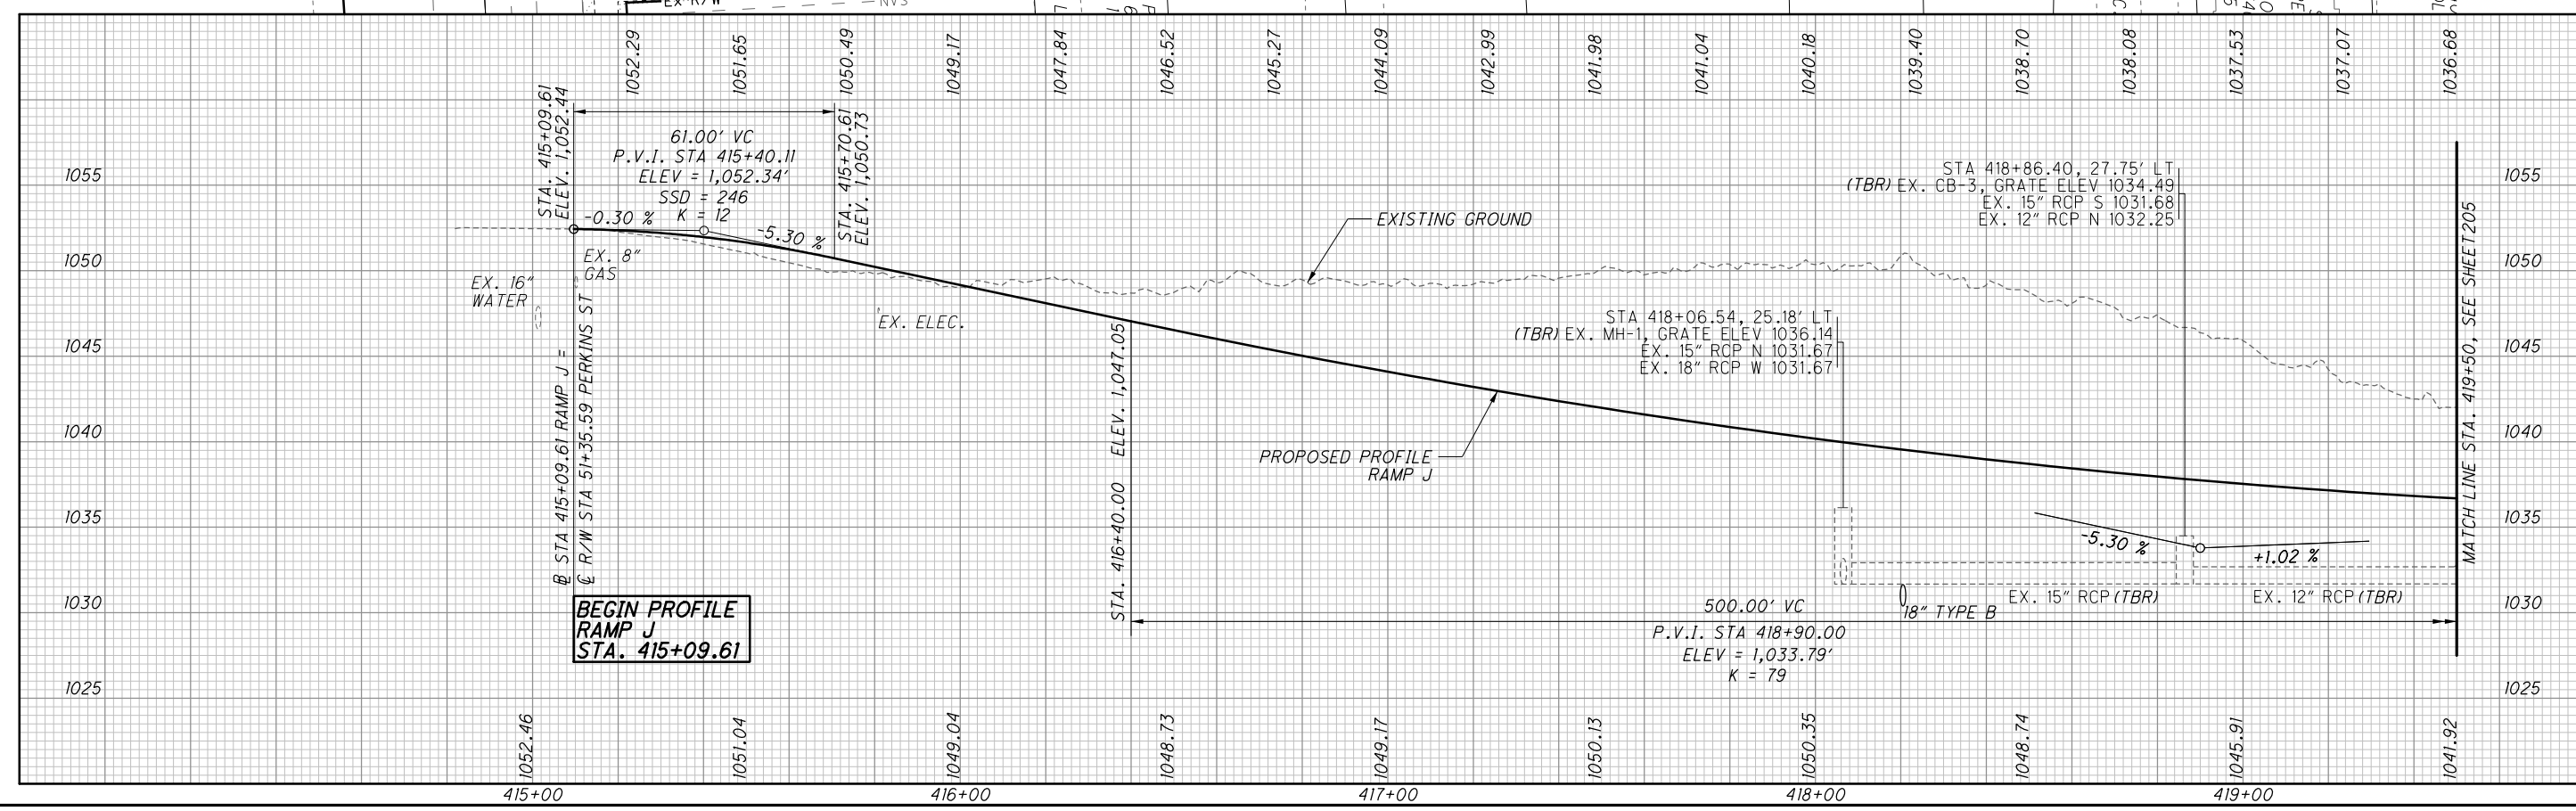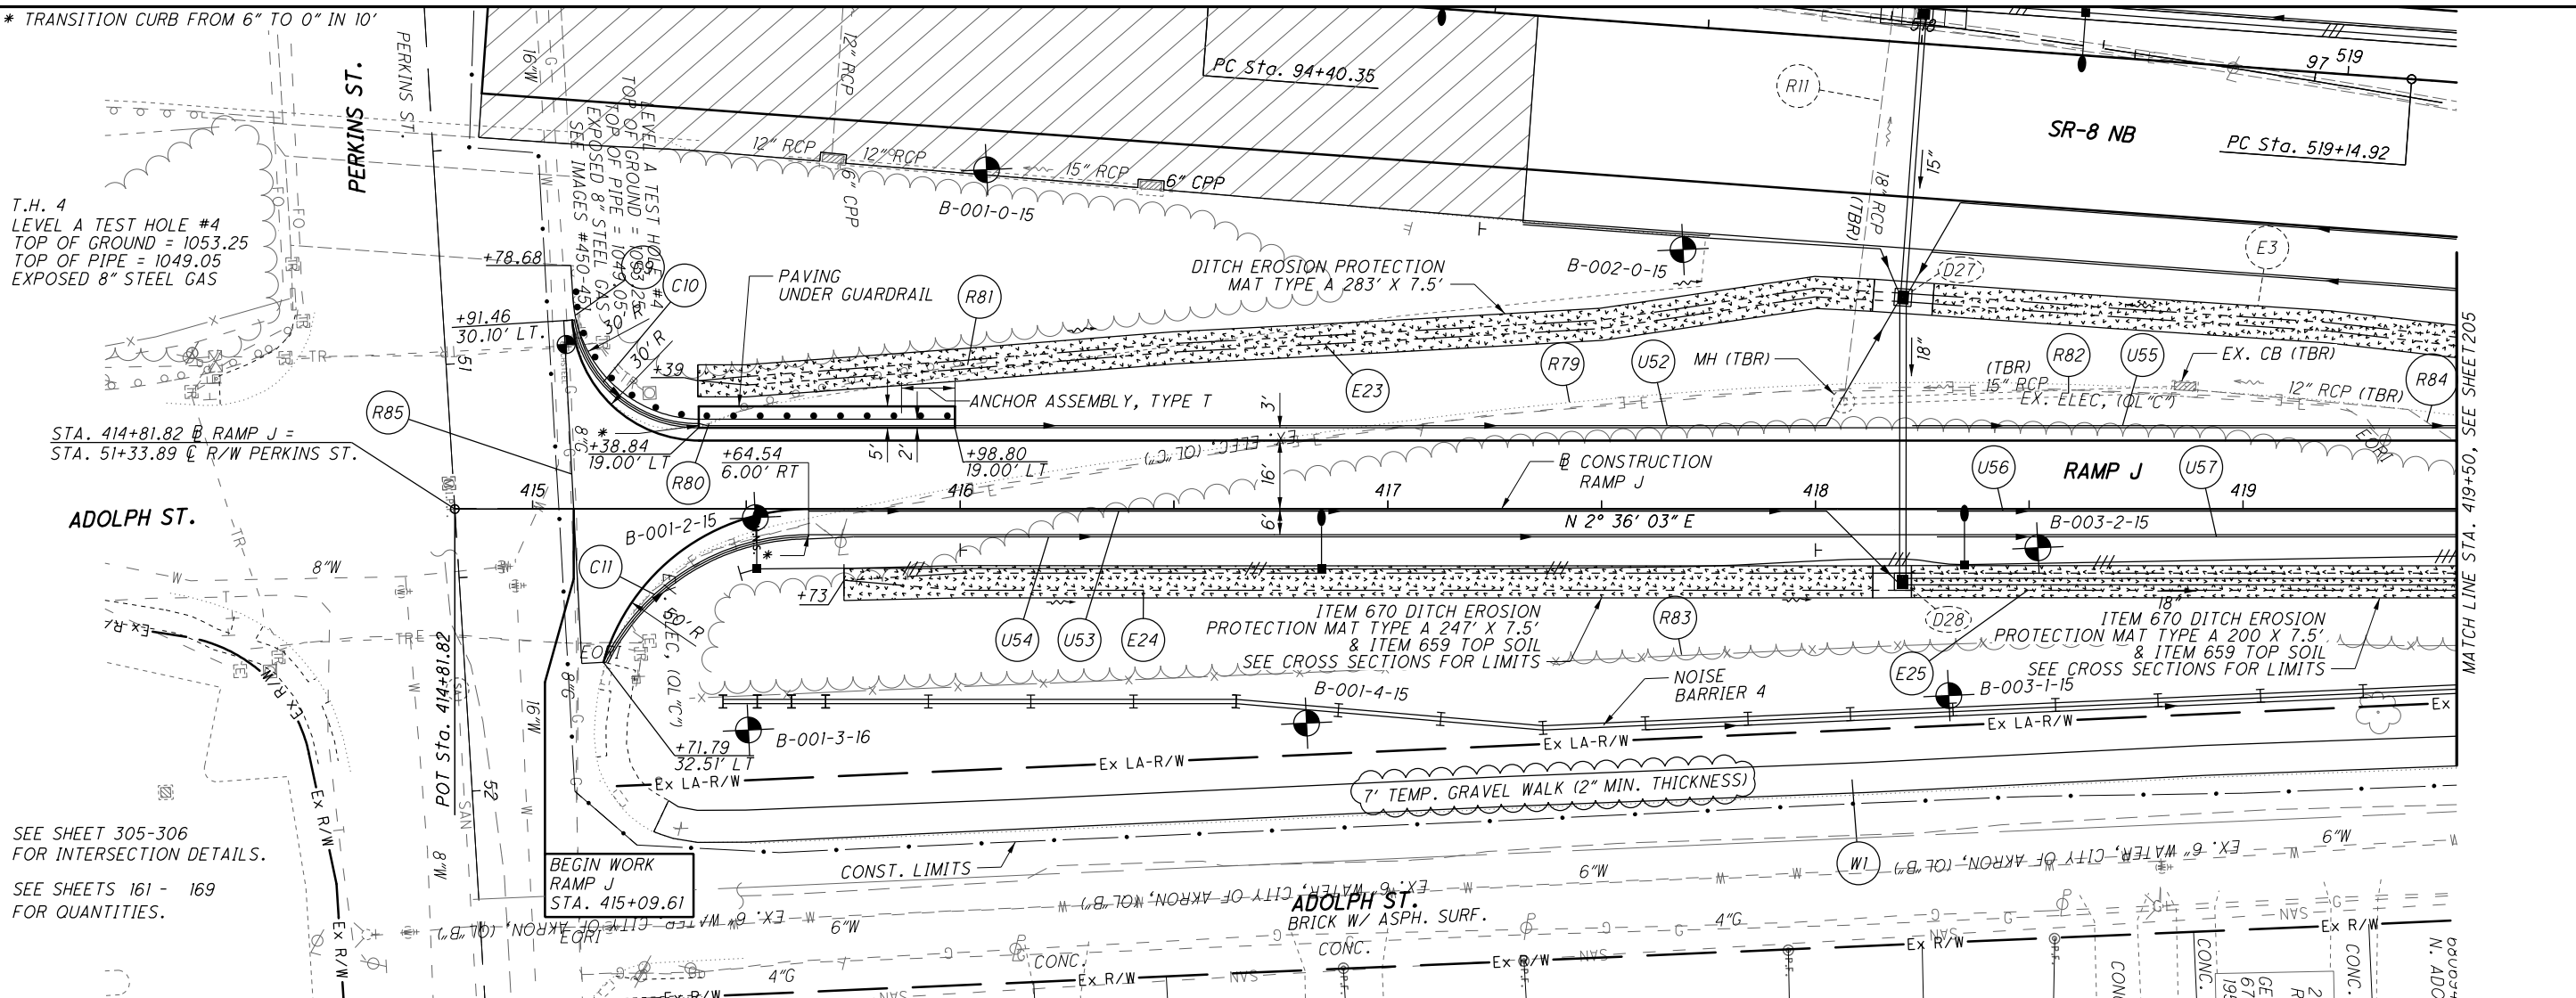

PLAN AND PROFILE - RAMP J  
 STA. 414+81.82 TO STA. 419+50

SUM-8-1.75



204  
 801

ms consultants, inc.

Ohio DOT Workspace  
SUM-8  
www.msconsultants.com

Batchplot Spec: \\msconsultants.com\files\Production\60\08326\standards\plotdrv\batchplot.sp; CF: otdrv\8;  
Pen Table: \\msconsultants.com\files\Production\60\08326\standards\tables\18.ms\_sld; CF: 60-08326\_PW  
Plot Driver: \\msconsultants.com\files\standards\user\ohio\18\ms\plotting\PDF.plt; CF: 60-08326\_PW

Model: Sheet  
Printed: 4/12/2023 @ 2:29:53 PM  
By: srfille  
File: \\msconsultants.com\files\Production\60\08326\drainage\sheet\91710\_DF004.dgn

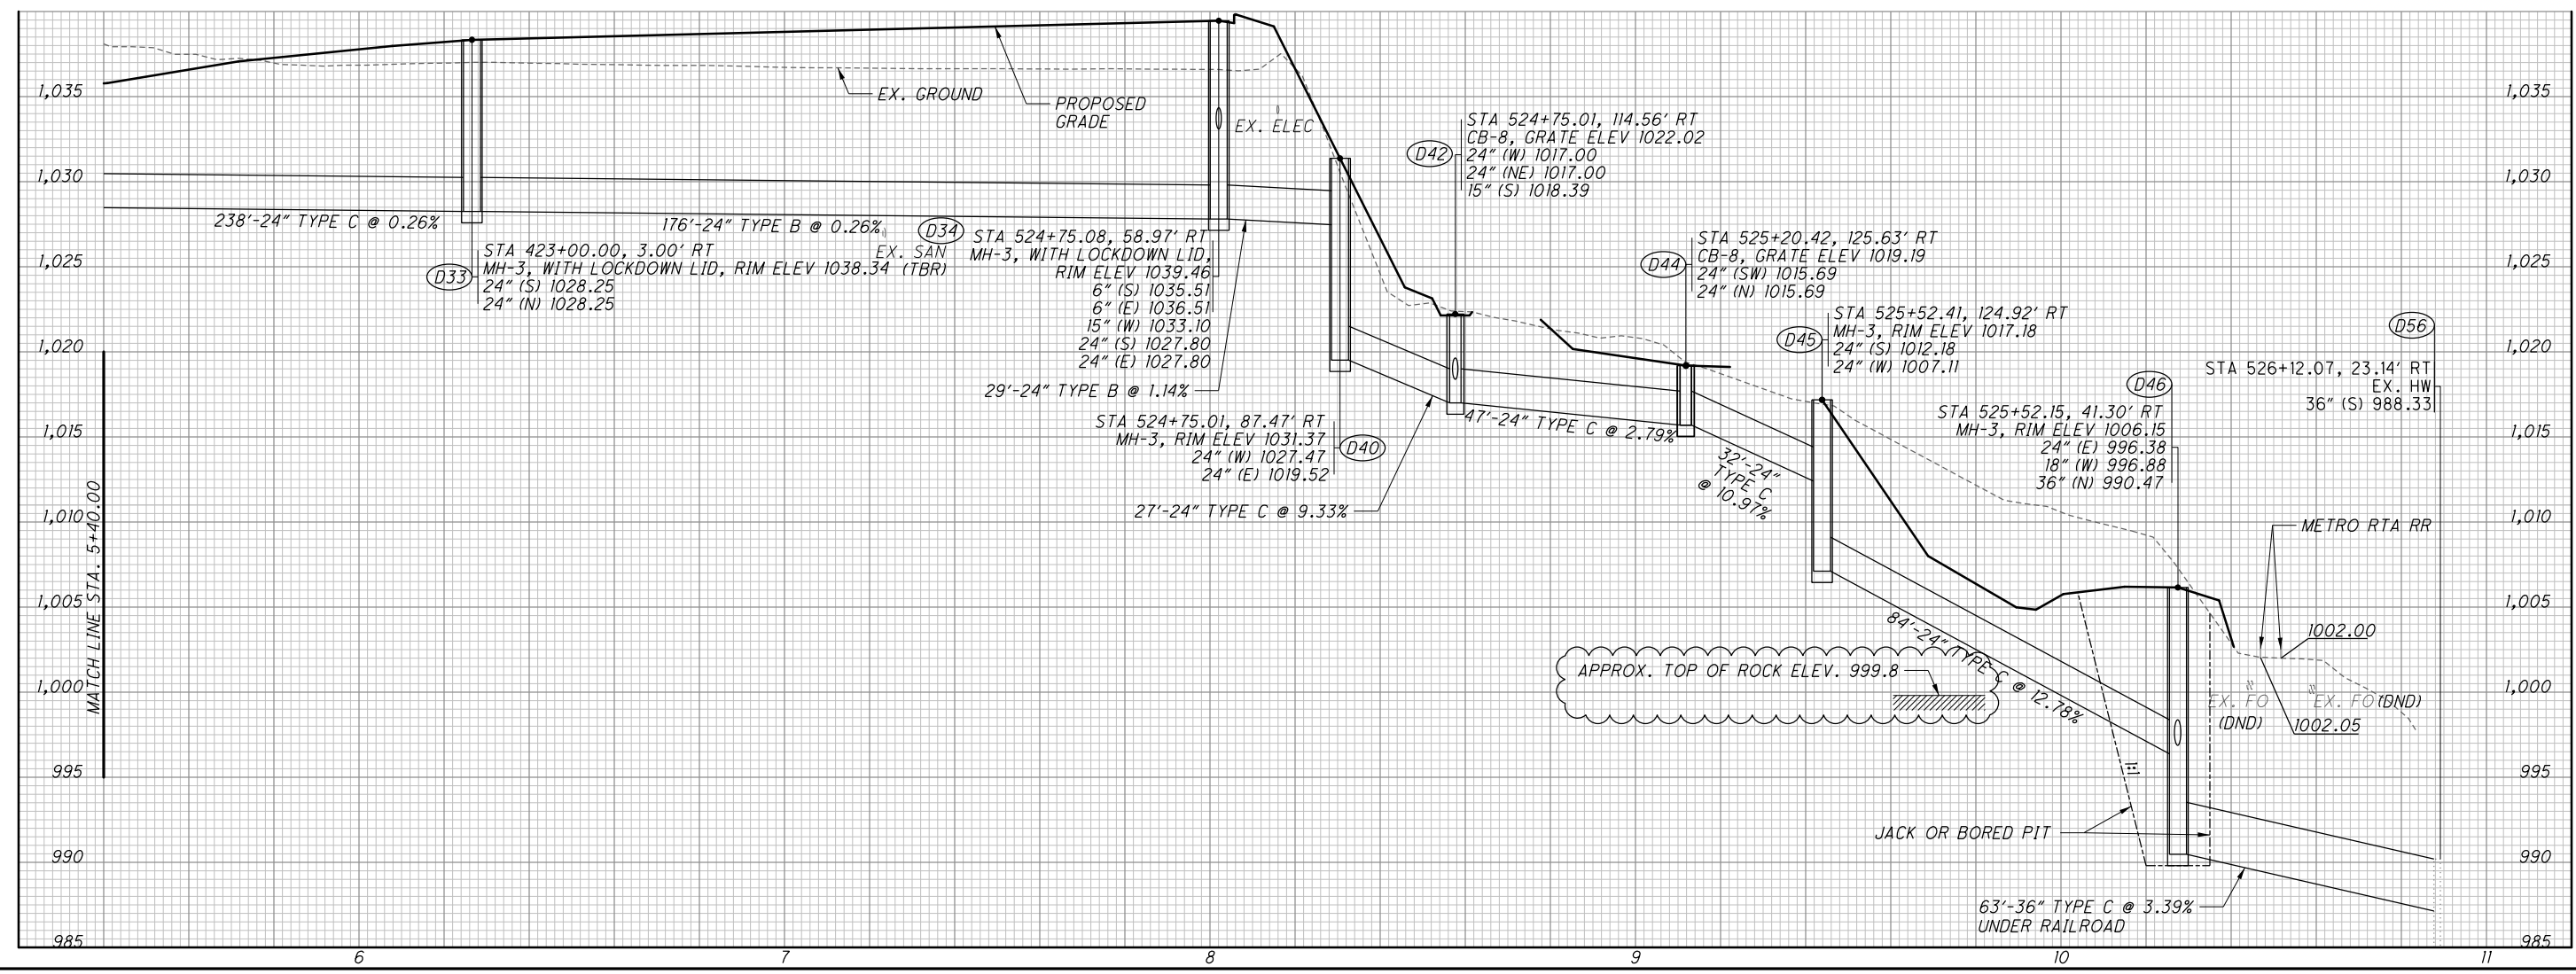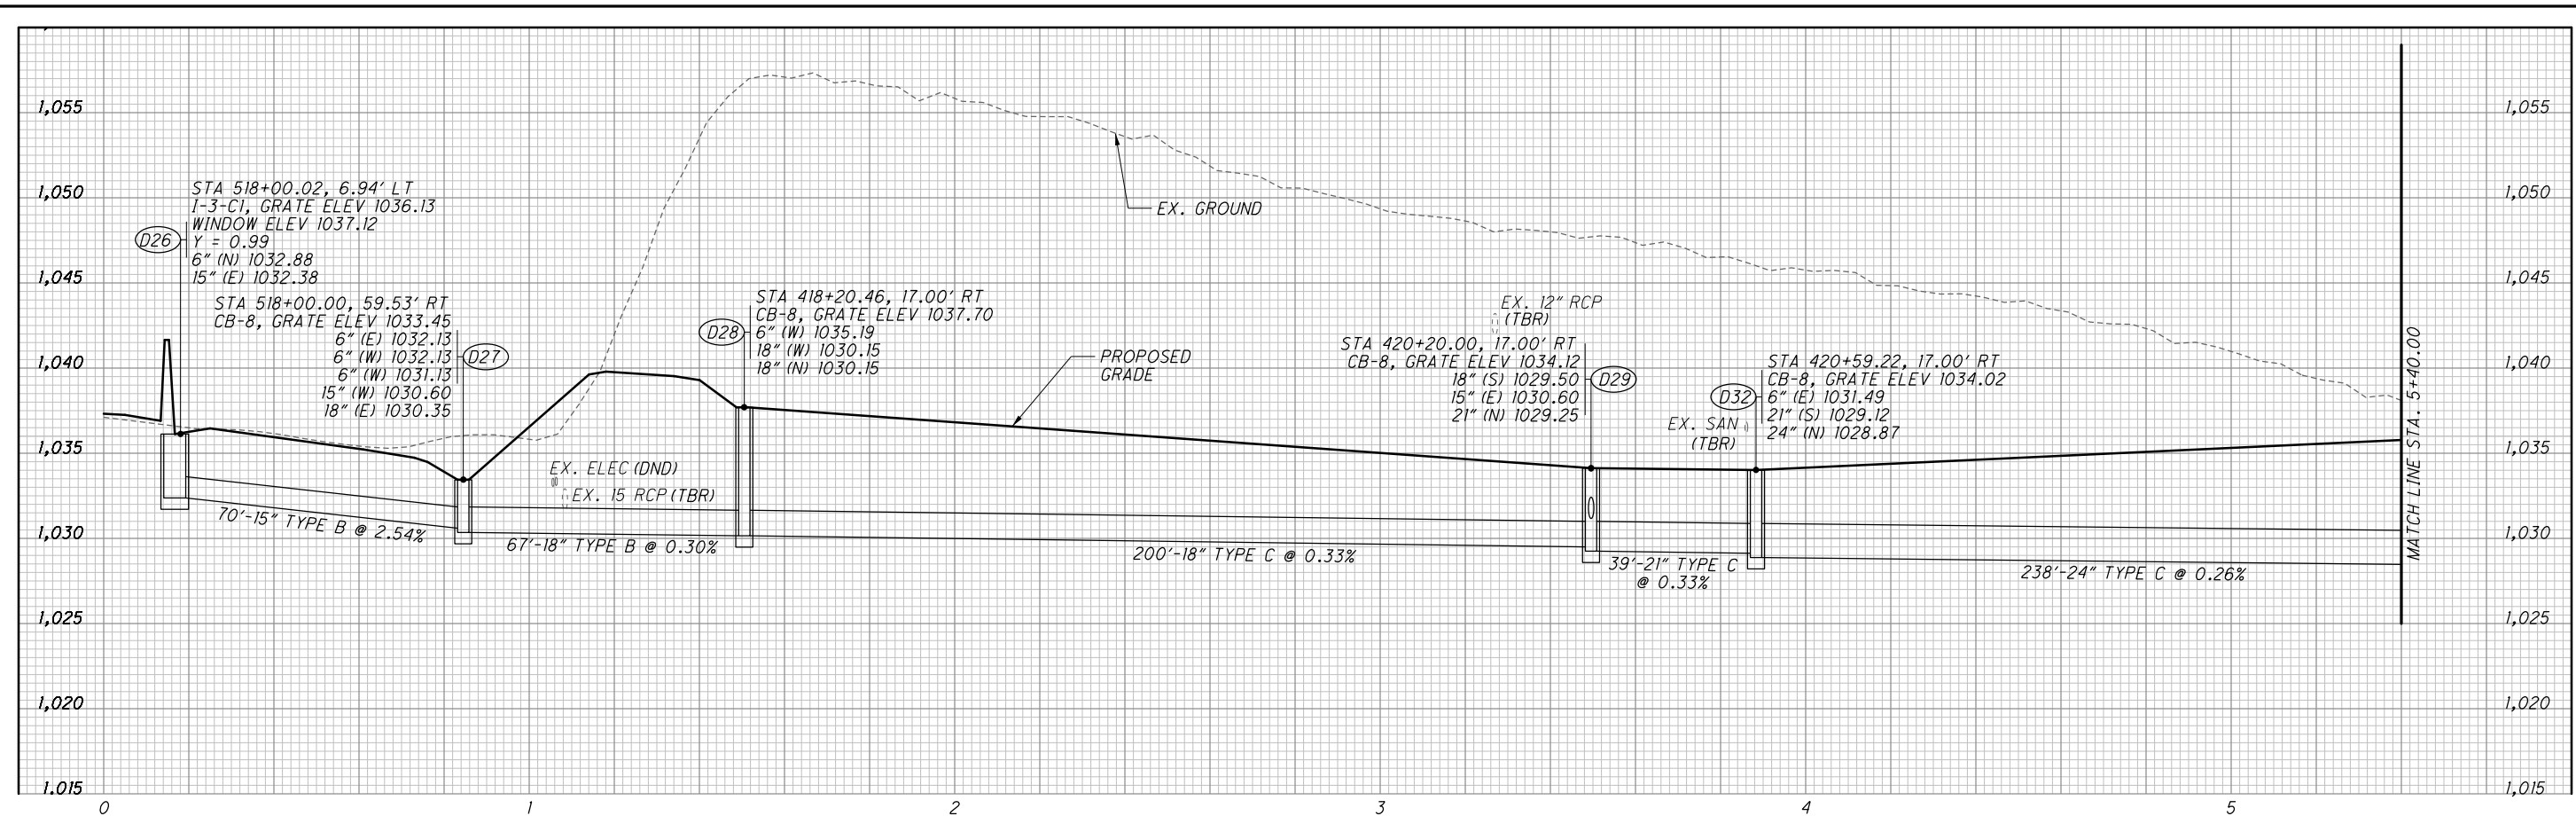



ms consultants, inc.  
msconsultants.com

Ohio DOT Workspace  
SUM-8  
www.msconsultants.com


Scale: 1" = 10'  
0 0.5 1

Batchplot Spec: \\msconsultants.com\files\Production\PM 60\08326\standards\plotdrv\batchplot.spd  
Pen Table: \\msconsultants.com\files\Production\PM 60\08326\standards\tables\18.ms\_std.plt  
Plot Driver: \\msconsultants.com\files\standards\usin\ohdot\18\ms\_plotting\PDF.plt

Model: Sheet  
Printed: 4/12/2023 @ 2:46:43 PM  
By: sriffle  
File: \\msconsultants.com\files\Production\PM 60\08326\drainage\sheet\91710\_DF007.dgn

34" x 22"

View: FENCE\_NEW1  
By: sriffle

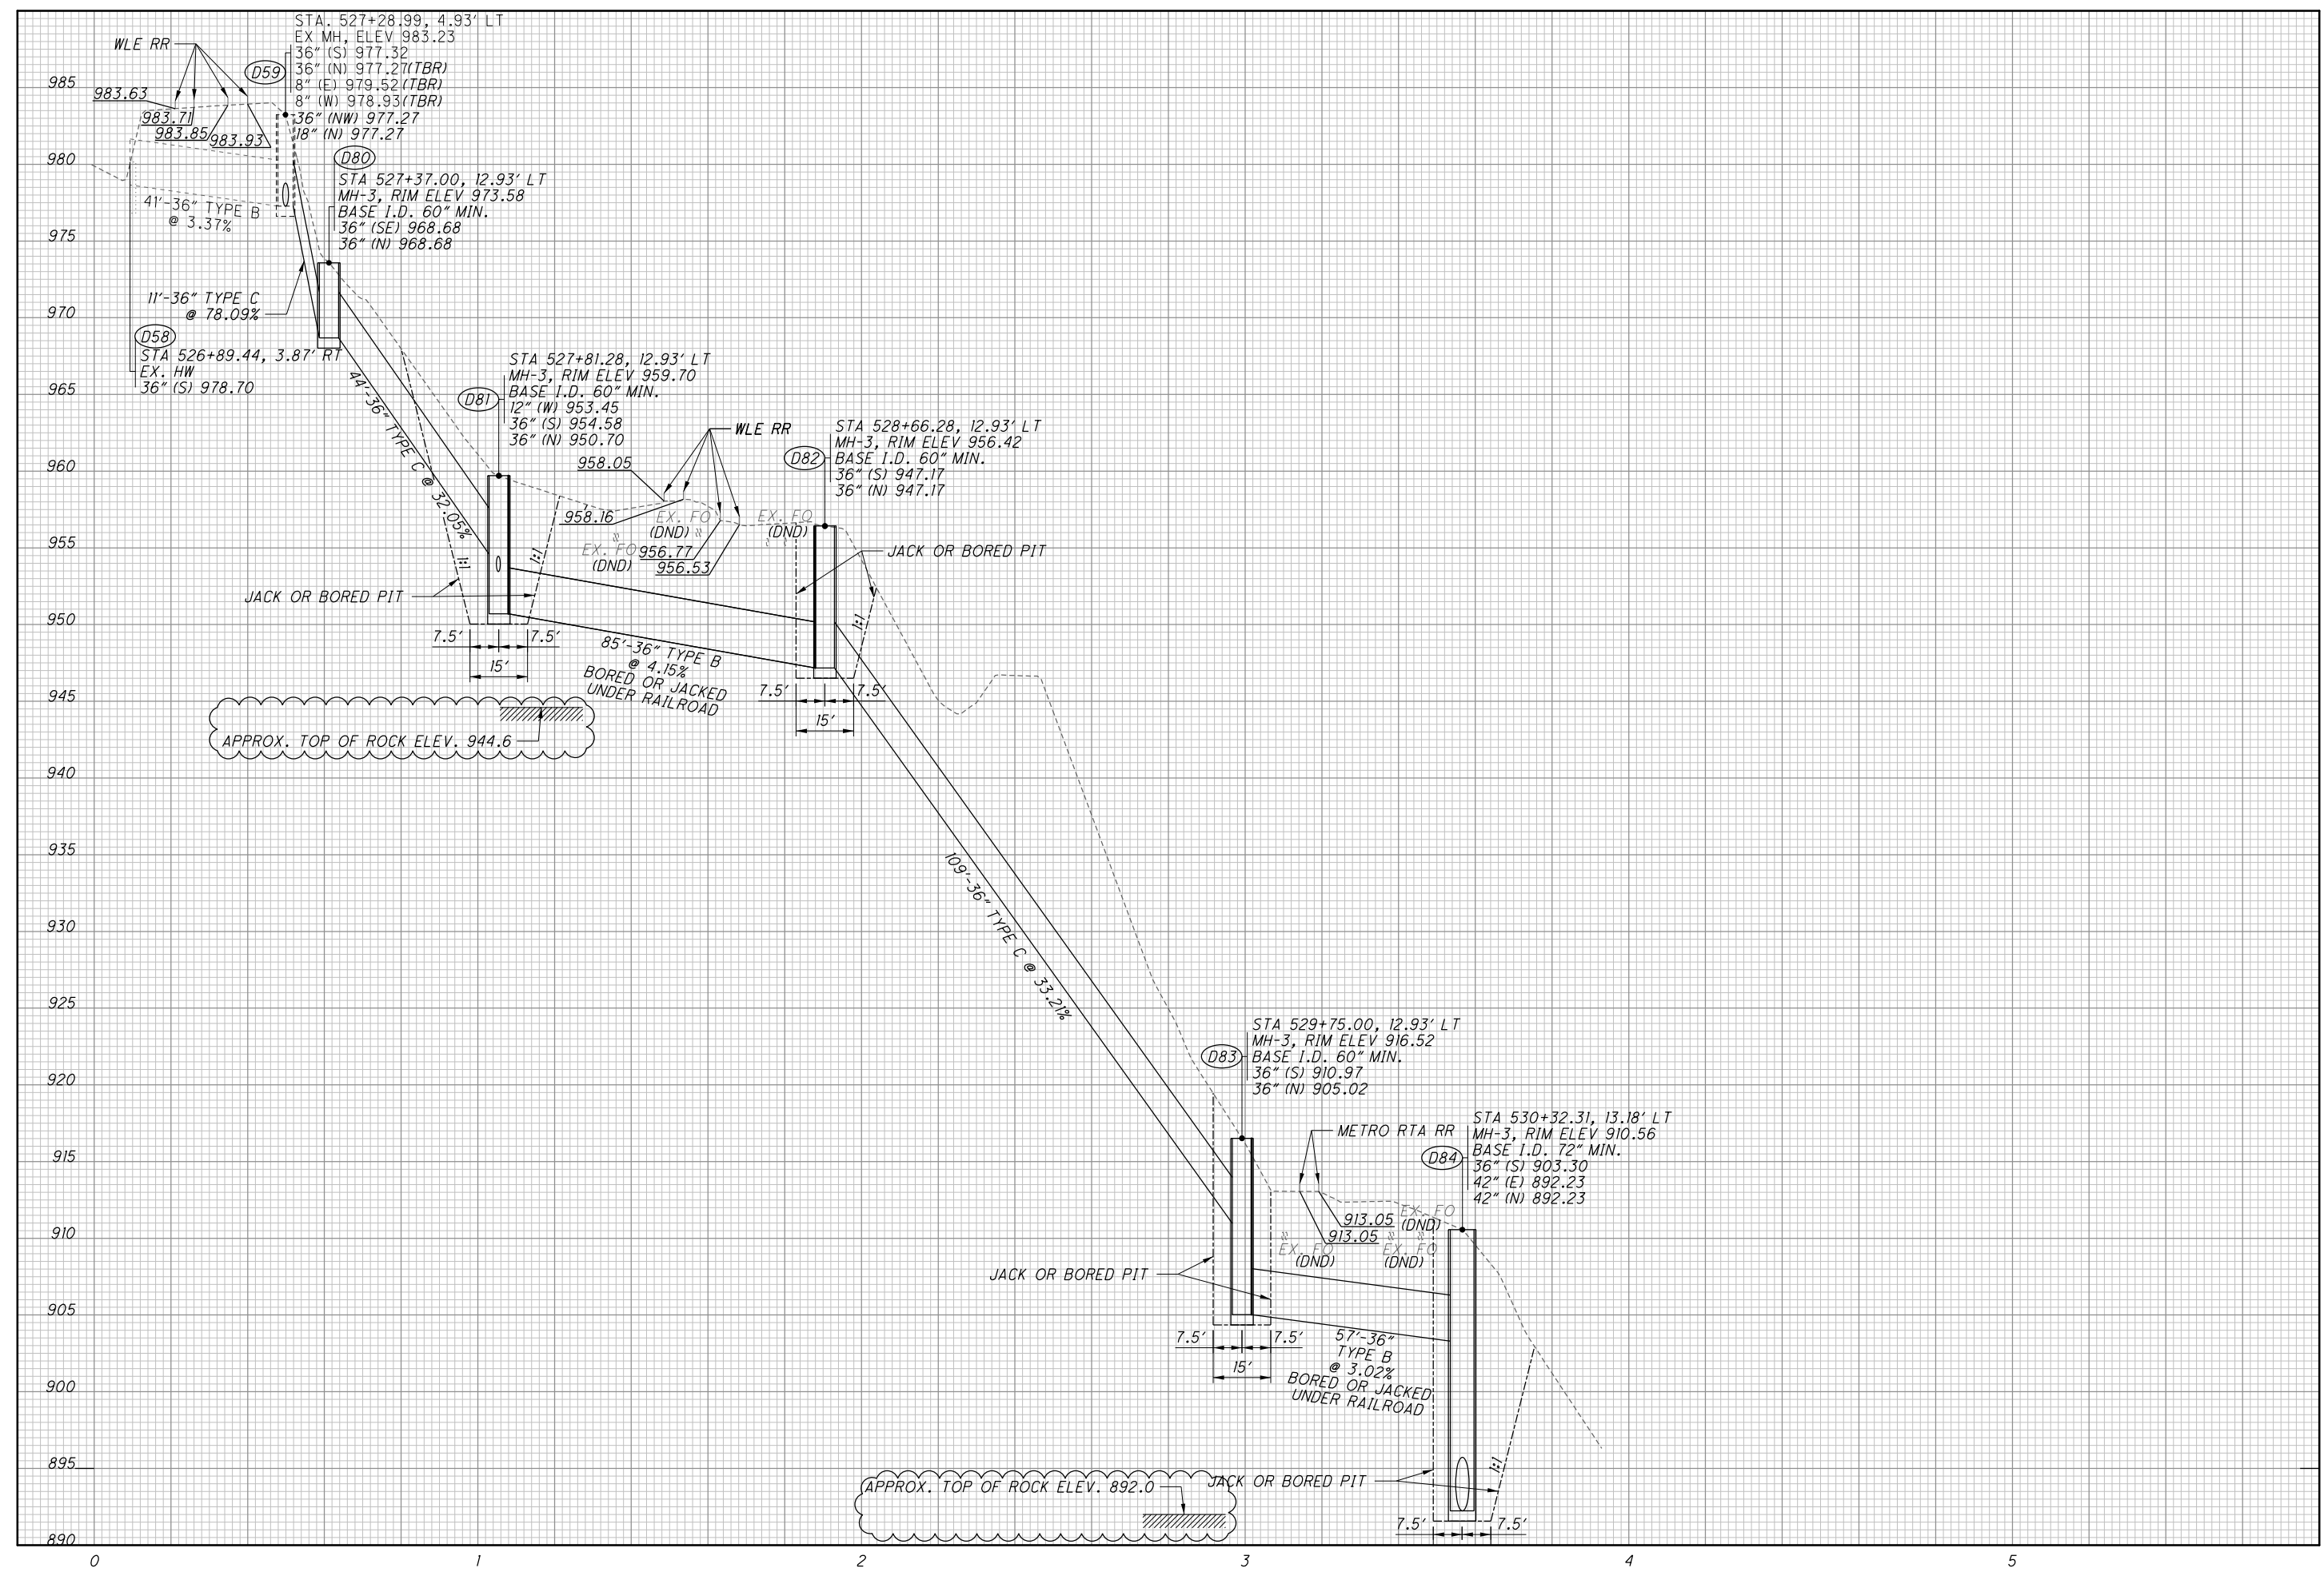

CALCULATED  
DNO  
CHECKED  
HRB


STORM SEWER PROFILES

SUM-8-1.75

318  
801





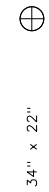

Main table with columns: SHEET NO., STATION (FROM, TO), SIDE, POLE/PULL BOX NO., and various technical specifications and quantities.

CALCULATED  
JRH  
CHECKED  
KWR

ROADWAY LIGHTING SUBSUMMARY

SUM-8-1.75

396  
801







ms consultants, inc.  
msconsultants.com

Ohio DOT Workspace  
SUM-8  
www.msconsultants.com



Batchplot Spec: ...  
Plot Driver: ...

34" x 22"


Model: Sheet  
Printed: 4/11/2023 9:00:42 AM

View: FENCE - NEW1  
By: kryan

Table with columns: SHEET NO., STATION (FROM/TO), SIDE, POLE/PULL BOX NO., and various material codes (625, FT, EACH, etc.) with descriptions like 'CONNECTION, FUSED PULL APART', 'LIGHT POLE FOUNDATION', etc.

Summary table columns: CALCULATED, JRH, CHECKED, KWR, and a large vertical title 'ROADWAY LIGHTING SUBSUMMARY' and 'SUM-8-1.75'.

399  
801

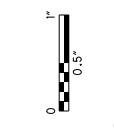

SHEET NO.	STATION	SIDE	POLE/PULL BOX NO.	625															
				CONNECTION, UNFUSED PERMANENT	NO. 6 AWG 2400 VOLT DISTRIBUTION CABLE	NO. 4 AWG 2400 VOLT DISTRIBUTION CABLE	NO. 2 AWG 2400 VOLT DISTRIBUTION CABLE	CONDUIT, 2", 725.04	CONDUIT, 3", 725.04	1-1/2" DUCT CABLE WITH THREE NO. 4 AWG 2400 VOLT CABLES	1-1/2" DUCT CABLE WITH THREE NO. 2 AWG 2400 VOLT CABLES	TRENCH, 24" DEEP	UNDERGROUND WARNING/MARKING TAPE, AS PER PLAN	JUNCTION BOX	PULL BOX, 725.08, 18"	PULL BOX, 725.08, 24"	LIGHTING, MISC.: POWER SERVICE, 240 VOLT	LIGHTING, MISC.: SERVICE TO AESTHETIC LIGHTING	
FROM	TO			EACH	FT	FT	FT	FT	FT	FT	FT	FT	FT	EACH	EACH	EACH	EACH	EACH	
406	15+74 (RAMP I)	LT	CC 'X'																
	15+74	LT	CC 'X' - PB		114	57	57		8			4	4						
	15+74	LT	PB - PB-2		216	108	108		52			26	26						
	15+90	LT	PB-2												1				
	15+90	LT	PB-2 - PB-3		1482	741	741		237			237	237						
	224+05	LT	PB-3																
	224+05	L/R	PB-3 - PB-6		360	360			110			110	110						
	223+99	RT	PB-6											1					
	223+99	RT	PB-6 - PB-9		318	318		96				96	96						
	224+95	RT	PB-9	3										1				1	
	224+95	RT	PB-9 - PB-10			78		16				16	16					1	
	225+11	RT	PB-10	3										1				1	
	224+05	LT	PB-3 - PB-5		189		189	106				53	53						
	224+54	LT	PB-5											1					
	224+54	LT	PB-5 - JB-2		255		255	150				53	53						
	225+25	LT	JB-2											1					
	225+25	LT	JB-2 - JB-3		699		699	446											
	227+48	LT	JB-3	3										1				1	
	227+48	LT	JB-3 - JB-3A					60	20										
	227+58	LT	JB-3A					60	20					1					
	227+58	LT	JB-3A - JB-3B					60	20										
	227+68	LT	JB-3B					60	20					1					
	227+68	LT	JB-3B - JB-3C					60	20										
	227+78	LT	JB-3C					60	20					1					
	227+78	LT	JB-3C - ML				111	32											
	419+58 RAMP J	RT	CC 'Y'															1	
	419+58	RT	CC 'Y' - PB			60	60		5			5	5						
	419+58	RT	PB - PB-12			99	99		23			23	23						
	419+58	RT	PB-12	6											1				
	419+58	RT	PB-12 - PB-14							520	520	122	122						
	424+68	RT	PB-14	6											1				
	424+68	RT	PB-14 - JB-7		342	342	208					64	64						
	525+46	RT	JB-7											1					
	525+46	RT	JB-7 - JB-8			699	699	446											
	527+69	RT	JB-8	3										1				1	
	527+69	RT	JB-8 - JB-8A					60	20										
	527+79	RT	JB-8A					60	20					1					
	527+79	RT	JB-8A - JB-8B					60	20										
	527+89	RT	JB-8B					60	20					1					
	527+89	RT	JB-8B - JB-8C					60	20										
	527+99	RT	JB-8C					18	2					1					
	527+99	RT	JB-8C - ML					18	2										
407	228+12 SB	LT	ML - JB-9					837	538										
	230+81	LT	JB-9	3										1				1	
	230+81	LT	JB-9 - JB-9A					20											
	230+91	LT	JB-9A					20						1					
	230+91	LT	JB-9A - JB-9B					20											
	231+01	LT	JB-9B					20						1					
	231+01	LT	JB-9B - JB9C					20											
	231+11	LT	JB-9C					20						1					
	231+11	LT	JB-9C - JB-10					620											
TOTALS CARRIED TO GENERAL SUMMARY				27	3633	2862	4575	2840	435	520	520	809	809	14	4	4	2	5	

CALCULATED  
JRH  
CHECKED  
KWR


**AESTHETIC LIGHTING SUBSUMMARY**

**SUM - 8 - 1.75**

400  
801

ms consultants, inc.

SHEET NO.	STATION		SIDE	POLE/PULL BOX NO.	625																
	FROM	TO			CONNECTION, UNFUSED PERMANENT	NO. 6 AWG 2400 VOLT DISTRIBUTION CABLE	NO. 4 AWG 2400 VOLT DISTRIBUTION CABLE	NO. 2 AWG 2400 VOLT DISTRIBUTION CABLE	CONDUIT, 2", 725.04	CONDUIT, 3", 725.04	1-1/2" DUCT CABLE WITH THREE NO. 4 AWG 2400 VOLT CABLES	1-1/2" DUCT CABLE WITH THREE NO. 2 AWG 2400 VOLT CABLES	TRENCH, 24" DEEP	UNDERGROUND WARNING/MARKING TAPE, AS PER PLAN	JUNCTION BOX	PULL BOX, 725.08, 18"	PULL BOX, 725.08, 24"	LIGHTING, MISC.: POWER SERVICE, 240 VOLT	LIGHTING, MISC.: SERVICE TO AESTHETIC LIGHTING		
					EACH	FT	FT	FT	FT	FT	FT	FT	FT	EACH	EACH	EACH	EACH	EACH			
	CC - 'Z'																				
	234+21	234+21	LT	JB-10										1							
	234+21	234+31	LT	JB-10 - JB-10A				20													
	234+31	234+31	LT	JB-10A										1							
	234+31	234+41	LT	JB-10A - JB-10B				20													
	234+41	234+41	LT	JB-10B	3									1			1				
	234+41	234+51	LT	JB-10B - JB-10C			120	20													
	234+51	234+51	LT	JB-10C										1							
	234+51	236+61	LT	JB-10C - JB-11			1320	420													
	236+61	236+61	LT	JB-11	3									1			1				
	236+61	236+71	LT	JB-11 - JB-11A			60	20													
	236+71	236+71	LT	JB-11A										1							
	236+71	236+81	LT	JB-11A - JB-11B			60	20													
	236+81	236+81	LT	JB-11B										1							
	236+81	236+91	LT	JB-11B - JB-11C			60	20													
	236+91	236+91	LT	JB-11C										1							
	236+91	238+12	LT	JB-11C - ML			378	242													
	CC - 'Y'																				
	528+00 NB	530+69	RT	ML - JB-16			822	538													
	530+69	530+69	RT	JB-16	3									1			1				
	530+69	530+79	RT	JB-16 - JB-16A				20													
	530+79	530+79	RT	JB-16A										1							
	530+79	530+89	RT	JB-16A - JB-16B				20													
	530+89	530+89	RT	JB-16B										1							
	530+89	530+99	RT	JB-16B - JB-16C				20													
	530+99	530+99	RT	JB-16C										1							
	530+99	533+34	RT	JB-16C - JB-17				470													
	533+34	533+34	RT	JB-17										1							
	533+34	533+44	RT	JB-17 - JB-17A				20													
	533+44	533+44	RT	JB-17A										1							
	533+44	533+64	RT	JB-17A - JB-17B				40													
	CC - 'Z'																				
	533+64	533+64	RT	JB-17B	3									1			1				
	533+64	533+74	RT	JB-17B - JB-17C			120	20													
	533+74	533+74	RT	JB-17C										1							
	533+74	536+19	RT	JB-17C - JB-18			1530	490													
	536+19	536+19	RT	JB-18	3									1			1				
	536+19	536+29	RT	JB-18 - JB-18A			60	20													
	536+29	536+29	RT	JB-18A										1							
	536+29	536+39	RT	JB-18A - JB-18B			60	20													
	536+39	536+39	RT	JB-18B										1							
	536+39	536+49	RT	JB-18B - JB-18C			60	20													
	536+49	536+49	RT	JB-18C										1							
	536+49	538+00	RT	JB-18C - ML			468	302													
TOTALS CARRIED TO GENERAL SUMMARY					15		4296	822	2782					20				5			

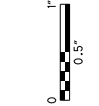

SHEET NO.	STATION		SIDE	POLE/PULL BOX NO.	625															
	FROM	TO			CONNECTION, UNFUSED PERMANENT	NO. 6 AWG 2400 VOLT DISTRIBUTION CABLE	NO. 4 AWG 2400 VOLT DISTRIBUTION CABLE	NO. 2 AWG 2400 VOLT DISTRIBUTION CABLE	CONDUIT, 2", 725.04	CONDUIT, 3", 725.04	1-1/2" DUCT CABLE WITH THREE NO. 4 AWG 2400 VOLT CABLES	1-1/2" DUCT CABLE WITH THREE NO. 2 AWG 2400 VOLT CABLES	TRENCH, 24" DEEP	UNDERGROUND WARNING/MARKING TAPE, AS PER PLAN	JUNCTION BOX	PULL BOX, 725.08, 18"	PULL BOX, 725.08, 24"	LIGHTING, MISC.: POWER SERVICE, 240 VOLT	LIGHTING, MISC.: SERVICE TO AESTHETIC LIGHTING	
					EACH	FT	FT	FT	FT	FT	FT	FT	FT	EACH	EACH	EACH	EACH	EACH		
		CC - 'Z'																		
407		234+ 07 SB	LT	CC - 'Z'														1		
	234+07	234+19	LT	CC-'Z' - PB		162	324			24			12	12						
	234+19	234+32	LT	PB - PB-16		60	120			10			10	10						
		234+32	LT	PB-16											1					
	234+32	234+41	LT	PB-16 - JB-10B		720	1440													
	234+19	533+60 NB	L/R	PB - PB-15		300	600			90			90	90						
		533+60	RT	PB-15											1					
	533+60	533+64	RT	PB-15 - JB-17B		720	1440													
408	238+12 SB	238+91	LT	ML - JB-19			231		144											
		238+91	LT	JB-19	3													1		
	238+91	239+01	LT	JB-19 - JB-19A					20											
		239+01	LT	JB-19A					20											
	239+01	239+11	LT	JB-19A - JB-19B					20											
		239+11	LT	JB-19B					20											
	239+11	239+21	LT	JB-19B - JB-19C					20											
		239+21	LT	JB-19C					318											
	239+21	240+80	LT	JB-19 - JB-20					160				47	47						
	240+80	240+80	LT	JB-20											1					
		241+51	LT	JB-20 - PB-17																
		241+51	LT	PB-17											1					
	538+00 NB	538+94	RT	ML - JB-23			297		188											
		538+94	RT	JB-23	3													1		
	538+94	540+68	RT	JB-23 - JB-24					348											
		540+68	RT	JB-24																
	540+68	541+54	RT	JB-24 - PB-21					194				64	64						
		541+54	RT	PB-21											1					
TOTALS CARRIED TO GENERAL SUMMARY					6	1962	4452		1412	124			223	223	7	4		1	2	

CALCULATED	JRH	CHECKED	KWR
<b>AESTHETIC LIGHTING SUBSUMMARY</b>			
<b>SUM - 8 - 1.75</b>			
401A 801			






Ohio DOT Workspace  
SUM-8  
www.msconsultants.com

Batchplot Spec: \msconsultants.com\files\Production\60\08326\standards\plotdrv\batchplot.spic\CF: otdot\8:  
Pen Table: N:\PW\60\08326\standards\tables\lighting\_V8.ms\_std.tbl  
Plot Driver: \msconsultants.com\files\standards\usin\ohdot\18\ms\plotting\PDF.plt:cq

34" x 22"

Model: Sheet  
Printed: 4/5/2023 8:44:40 AM By: kryan  
File: \msconsultants.com\files\Production\60\08326\lighting\sheet\91770\_LM001.dgn

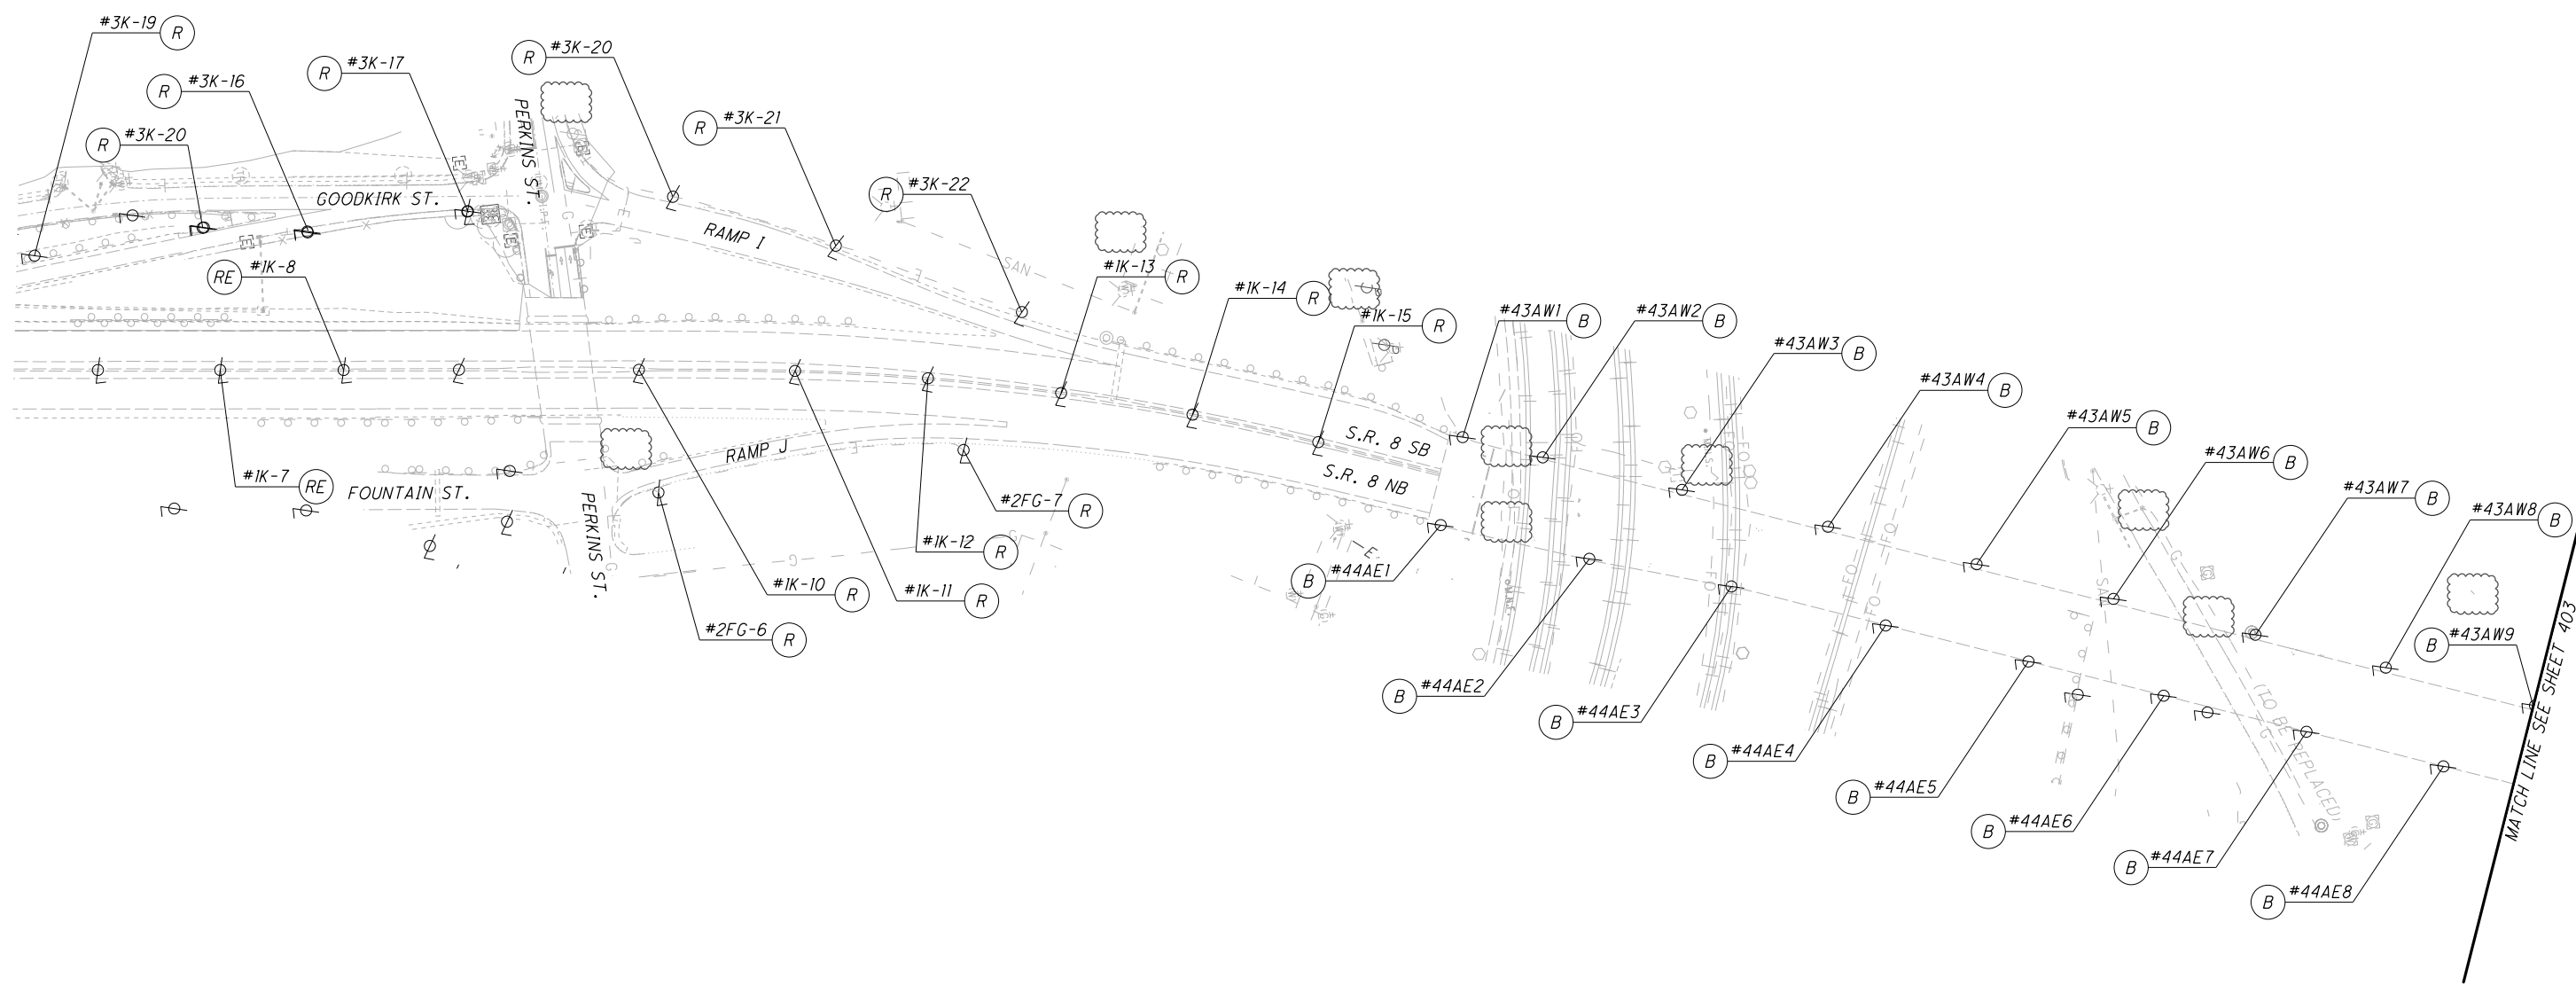

**LEGEND**

- $\phi$  EXISTING LIGHT POLE TO REMAIN
- $\phi$  LIGHT POLE AND LUMINAIRE TO BE REMOVED (R)
- $\phi$  BRIDGE MOUNTED LIGHT POLE AND LUMINAIRE TO BE REMOVED (B)
- $\phi$  LIGHT POLE AND LUMINAIRE TO BE REMOVED AND REERECTED (SEE PLAN SHEETS FOR ADDITIONAL INFORMATION) (RE)


**LIGHTING REMOVALS**

**SUM-8-1.75**

402  
801



Ohio DOT Workspace  
SUM-8  
www.msconsultants.com

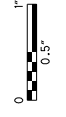

Batchplot Spec: \\msconsultants.com\files\Production\PM 60\08326\standards\plotdrv\batchplot.spclcf: otdot\8:  
Pen Table: N:\PM 60\08326\standards\tables\VB1\_ms\_std.tbl  
Plot Driver: \\msconsultants.com\files\standards\ustin\ohdot\8\ms\plotting\PDF.plt.cg PCF: 60-08326\_PW

Batchplot Spec: \\msconsultants.com\files\Production\PM 60\08326\standards\plotdrv\batchplot.spclcf: otdot\8:  
Pen Table: N:\PM 60\08326\standards\tables\VB1\_ms\_std.tbl  
Plot Driver: \\msconsultants.com\files\standards\ustin\ohdot\8\ms\plotting\PDF.plt.cg PCF: 60-08326\_PW

34" x 22"

Model: Sheet  
Printed: 4/5/2023 8:44:41 AM By: krjan  
File: \\msconsultants.com\files\Production\PM 60\08326\lighting\sheets\9770\_LM003.dgn  
View: FENCE\_VEW1  
By: krjan

PLAN LEGEND		
EXIST.	PROP.	ITEM
		LIGHT POLE, EXISTING TO REMAIN
		LIGHT POLE, 40', W/ DAVIT ARM, 10' & LED LUMINAIRE*
		LIGHT POLE, 40', W/ DOUBLE DAVIT ARMS, 10' & LED LUMINAIRES*
		LIGHT POLE, ODOT STANDARD CONVENTIONAL, AT15B40, W/ LED LUMINAIRE**
		LIGHT POLE, ODOT STANDARD CONVENTIONAL, AT12B40, W/ LED LUMINAIRE***
		LIGHT POLE, LOW MAST, 50', W/ 400 W HPS LUMINAIRE, EXISTING TO REMAIN
		LIGHT POLE, LOW MAST, REERECTED ON NEW FOUNDATION
		1 1/2" DUCT CABLE IN 24" DEEP TRENCH
		POWER SERVICE
		INDICATES CIRCUIT & NO. OF SINGLE CONDUCTORS IN CABLE OR CONDUIT (NO. 4 AWG UNLESS INDICATED OTHERWISE)
		JUNCTION BOX, IDENTIFICATION NO.
		MEDIAN JUNCTION BOX, IDENTIFICATION NO.
		PULL BOX, IDENTIFICATION NO.
		PULL BOX, EXISTING TO BE REMOVED
		(1, 2 OR 3)-3" CONDUITS, 725.04 (AS INDICATED ON THE PLANS)
		3" CONDUIT, 725.04
		STUB AND CAP CONDUIT ELL
		STRUCTURE GROUND


\* LUMINAIRE, CONVENTIONAL, LED, TYPE III, 13,500-15,000 LUMENS, DARK BRONZE, AS PER PLAN  
 \*\* LUMINAIRE, CONVENTIONAL, LED, TYPE II, 13,500-15,000 LUMENS, AS PER PLAN  
 \*\*\* LUMINAIRE, CONVENTIONAL, LED, TYPE III, 13,500-15,000 LUMENS, AS PER PLAN



**NOTE:**  
EXISTING CONTROL CENTER 'K' IS LOCATED ON THE SW CORNER OF MARKET ST. & GOODKIRK ST. (CKTS 1K & 3K ARE 480V, 2-WIRE, GROUNDED NEUTRAL CIRCUITS)

STA. 48+40  
COMBINATION SIGNAL SUPPORT  
SEE SIGNAL PLAN SHEET 382 FOR ADDITIONAL LIGHTING ITEMS

STA. 47+22  
COMBINATION SIGNAL SUPPORT  
SEE SIGNAL PLAN SHEET 382 FOR ADDITIONAL LIGHTING ITEMS

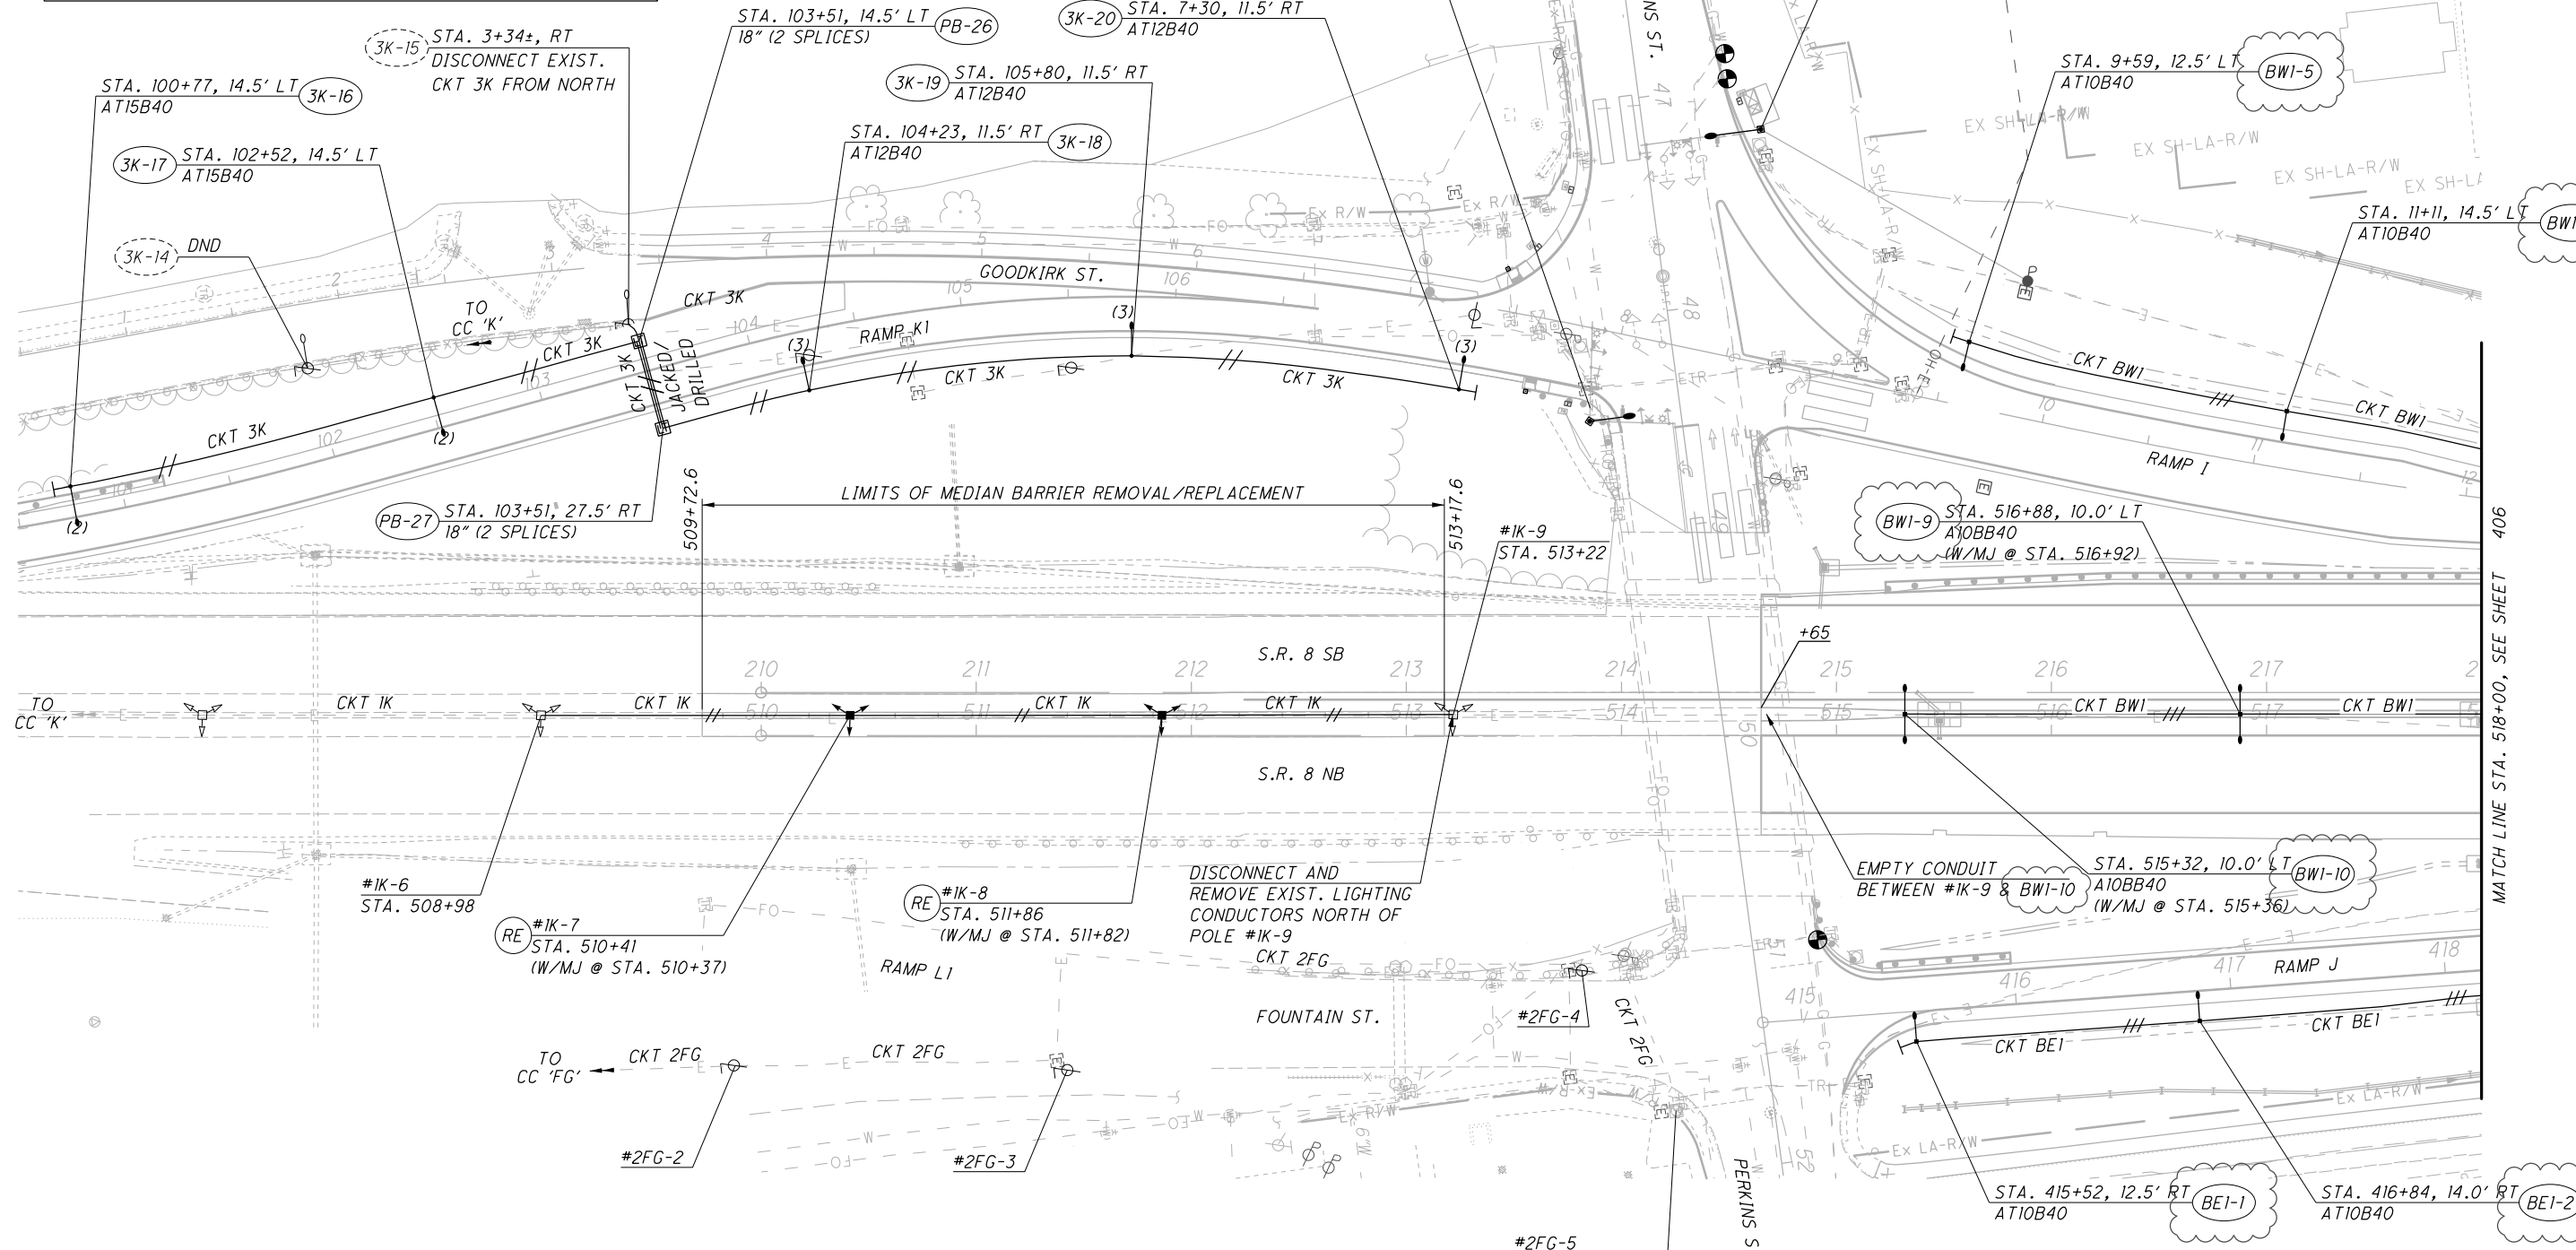

**NOTE:**  
EXISTING CONTROL CENTER 'FG' IS LOCATED ON THE NE CORNER OF FORGE ST. & FOUNTAIN ST. (CKT 2FG IS A 480V, 2-WIRE, GROUNDED NEUTRAL CIRCUIT)

#2FG-5  
DISCONNECT  
EXIST. CKT #2FG  
FROM NORTH

- NOTES:**
- 1. ALL LIGHTING MEDIAN JUNCTION BOX COVERS SHALL BE ON THE WEST SIDE OF THE SR-8 MAINLINE MEDIAN BARRIER UNLESS NOTED OTHERWISE.
  - 2. OFFSETS TO LIGHT POLES ARE FROM NEAREST EOP.
  - 3. OFFSETS TO PULL BOXES ARE FROM E.
  - 4. SEE SHEET 404 FOR PLAN LEGEND.




40  
20  
0  
HORIZONTAL SCALE IN FEET

CALCULATED  
KWR  
CHECKED  
DRB

**LIGHTING PLAN**  
**STA. 508+98 TO STA. 518+00**

**SUM-8-1.75**

405  
801

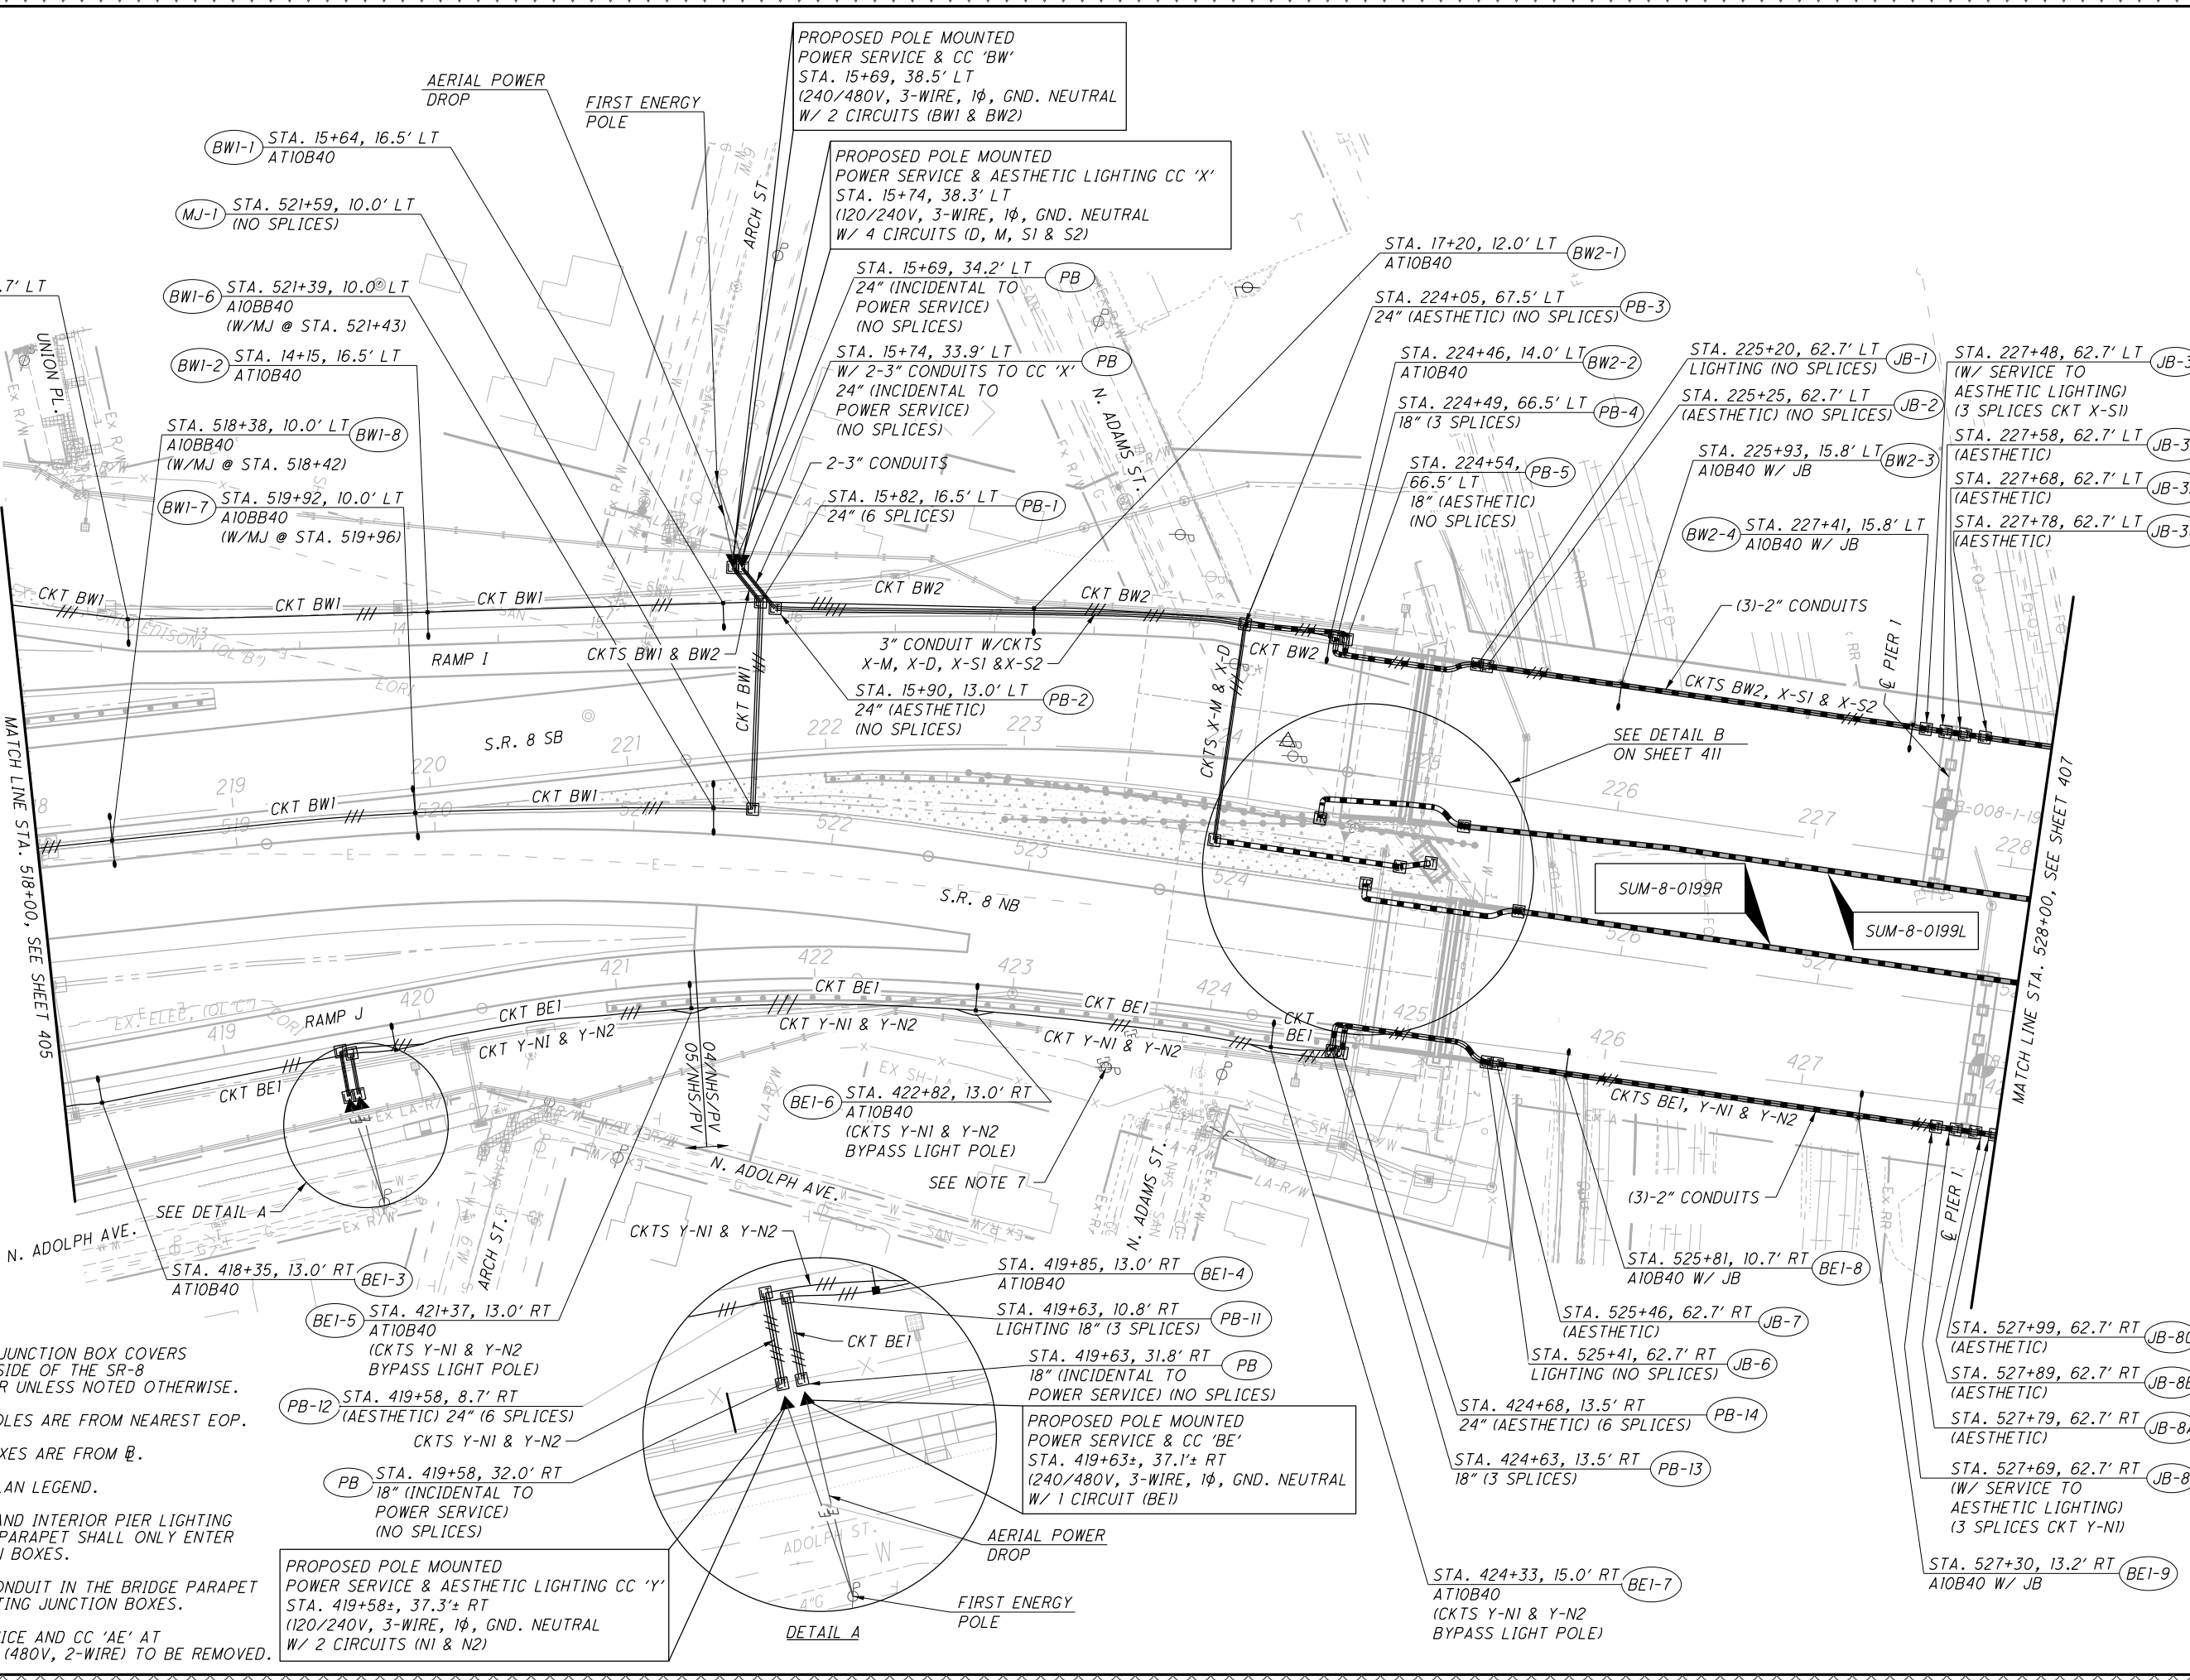

- NOTES:**
1. ALL LIGHTING MEDIAN JUNCTION BOX COVERS SHALL BE ON THE WEST SIDE OF THE SR-8 MAINLINE MEDIAN BARRIER UNLESS NOTED OTHERWISE.
  2. OFFSETS TO LIGHT POLES ARE FROM NEAREST EOP.
  3. OFFSETS TO PULL BOXES ARE FROM  $\perp$ .
  4. SEE SHEET 404 FOR PLAN LEGEND.
  5. AESTHETIC LIGHTING AND INTERIOR PIER LIGHTING CONDUIT IN THE BRIDGE PARAPET SHALL ONLY ENTER THE AESTHETIC JUNCTION BOXES.
  6. ROADWAY LIGHTING CONDUIT IN THE BRIDGE PARAPET SHALL ONLY ENTER LIGHTING JUNCTION BOXES.
  7. EXISTING POWER SERVICE AND CC 'AE' AT STA. 423+51±, 35.3'± RT (480V, 2-WIRE) TO BE REMOVED.

**PROPOSED POLE MOUNTED POWER SERVICE & AESTHETIC LIGHTING CC 'Y'**  
 STA. 419+58±, 37.3'± RT  
 (120/240V, 3-WIRE, 1 $\phi$ , GND. NEUTRAL W/ 2 CIRCUITS (NI & N2))

**PROPOSED POLE MOUNTED POWER SERVICE & CC 'BE'**  
 STA. 419+63±, 37.1'± RT  
 (240/480V, 3-WIRE, 1 $\phi$ , GND. NEUTRAL W/ 1 CIRCUIT (BE))

**PROPOSED POLE MOUNTED POWER SERVICE & CC 'BW'**  
 STA. 15+69, 38.5' LT  
 (240/480V, 3-WIRE, 1 $\phi$ , GND. NEUTRAL W/ 2 CIRCUITS (BW1 & BW2))

**PROPOSED POLE MOUNTED POWER SERVICE & AESTHETIC LIGHTING CC 'X'**  
 STA. 15+74, 38.3' LT  
 (120/240V, 3-WIRE, 1 $\phi$ , GND. NEUTRAL W/ 4 CIRCUITS (D, M, SI & S2))

STA. 15+69, 34.2' LT  
 24" (INCIDENTAL TO POWER SERVICE) (NO SPLICES)

STA. 15+74, 33.9' LT  
 W/ 2-3" CONDUITS TO CC 'X'  
 24" (INCIDENTAL TO POWER SERVICE) (NO SPLICES)

2-3" CONDUITS  
 STA. 15+82, 16.5' LT  
 24" (6 SPLICES)

3" CONDUIT W/CKTS X-M, X-D, X-S1 & X-S2  
 STA. 15+90, 13.0' LT  
 24" (AESTHETIC) (NO SPLICES)

**PROPOSED POLE MOUNTED POWER SERVICE & CC 'BE'**  
 STA. 419+63±, 37.1'± RT  
 (240/480V, 3-WIRE, 1 $\phi$ , GND. NEUTRAL W/ 1 CIRCUIT (BE))


**LIGHTING PLAN**

**STA. 518+00 TO STA. 528+00**


**SUM-8-1.75**

406  
801


ms-consultants, inc.

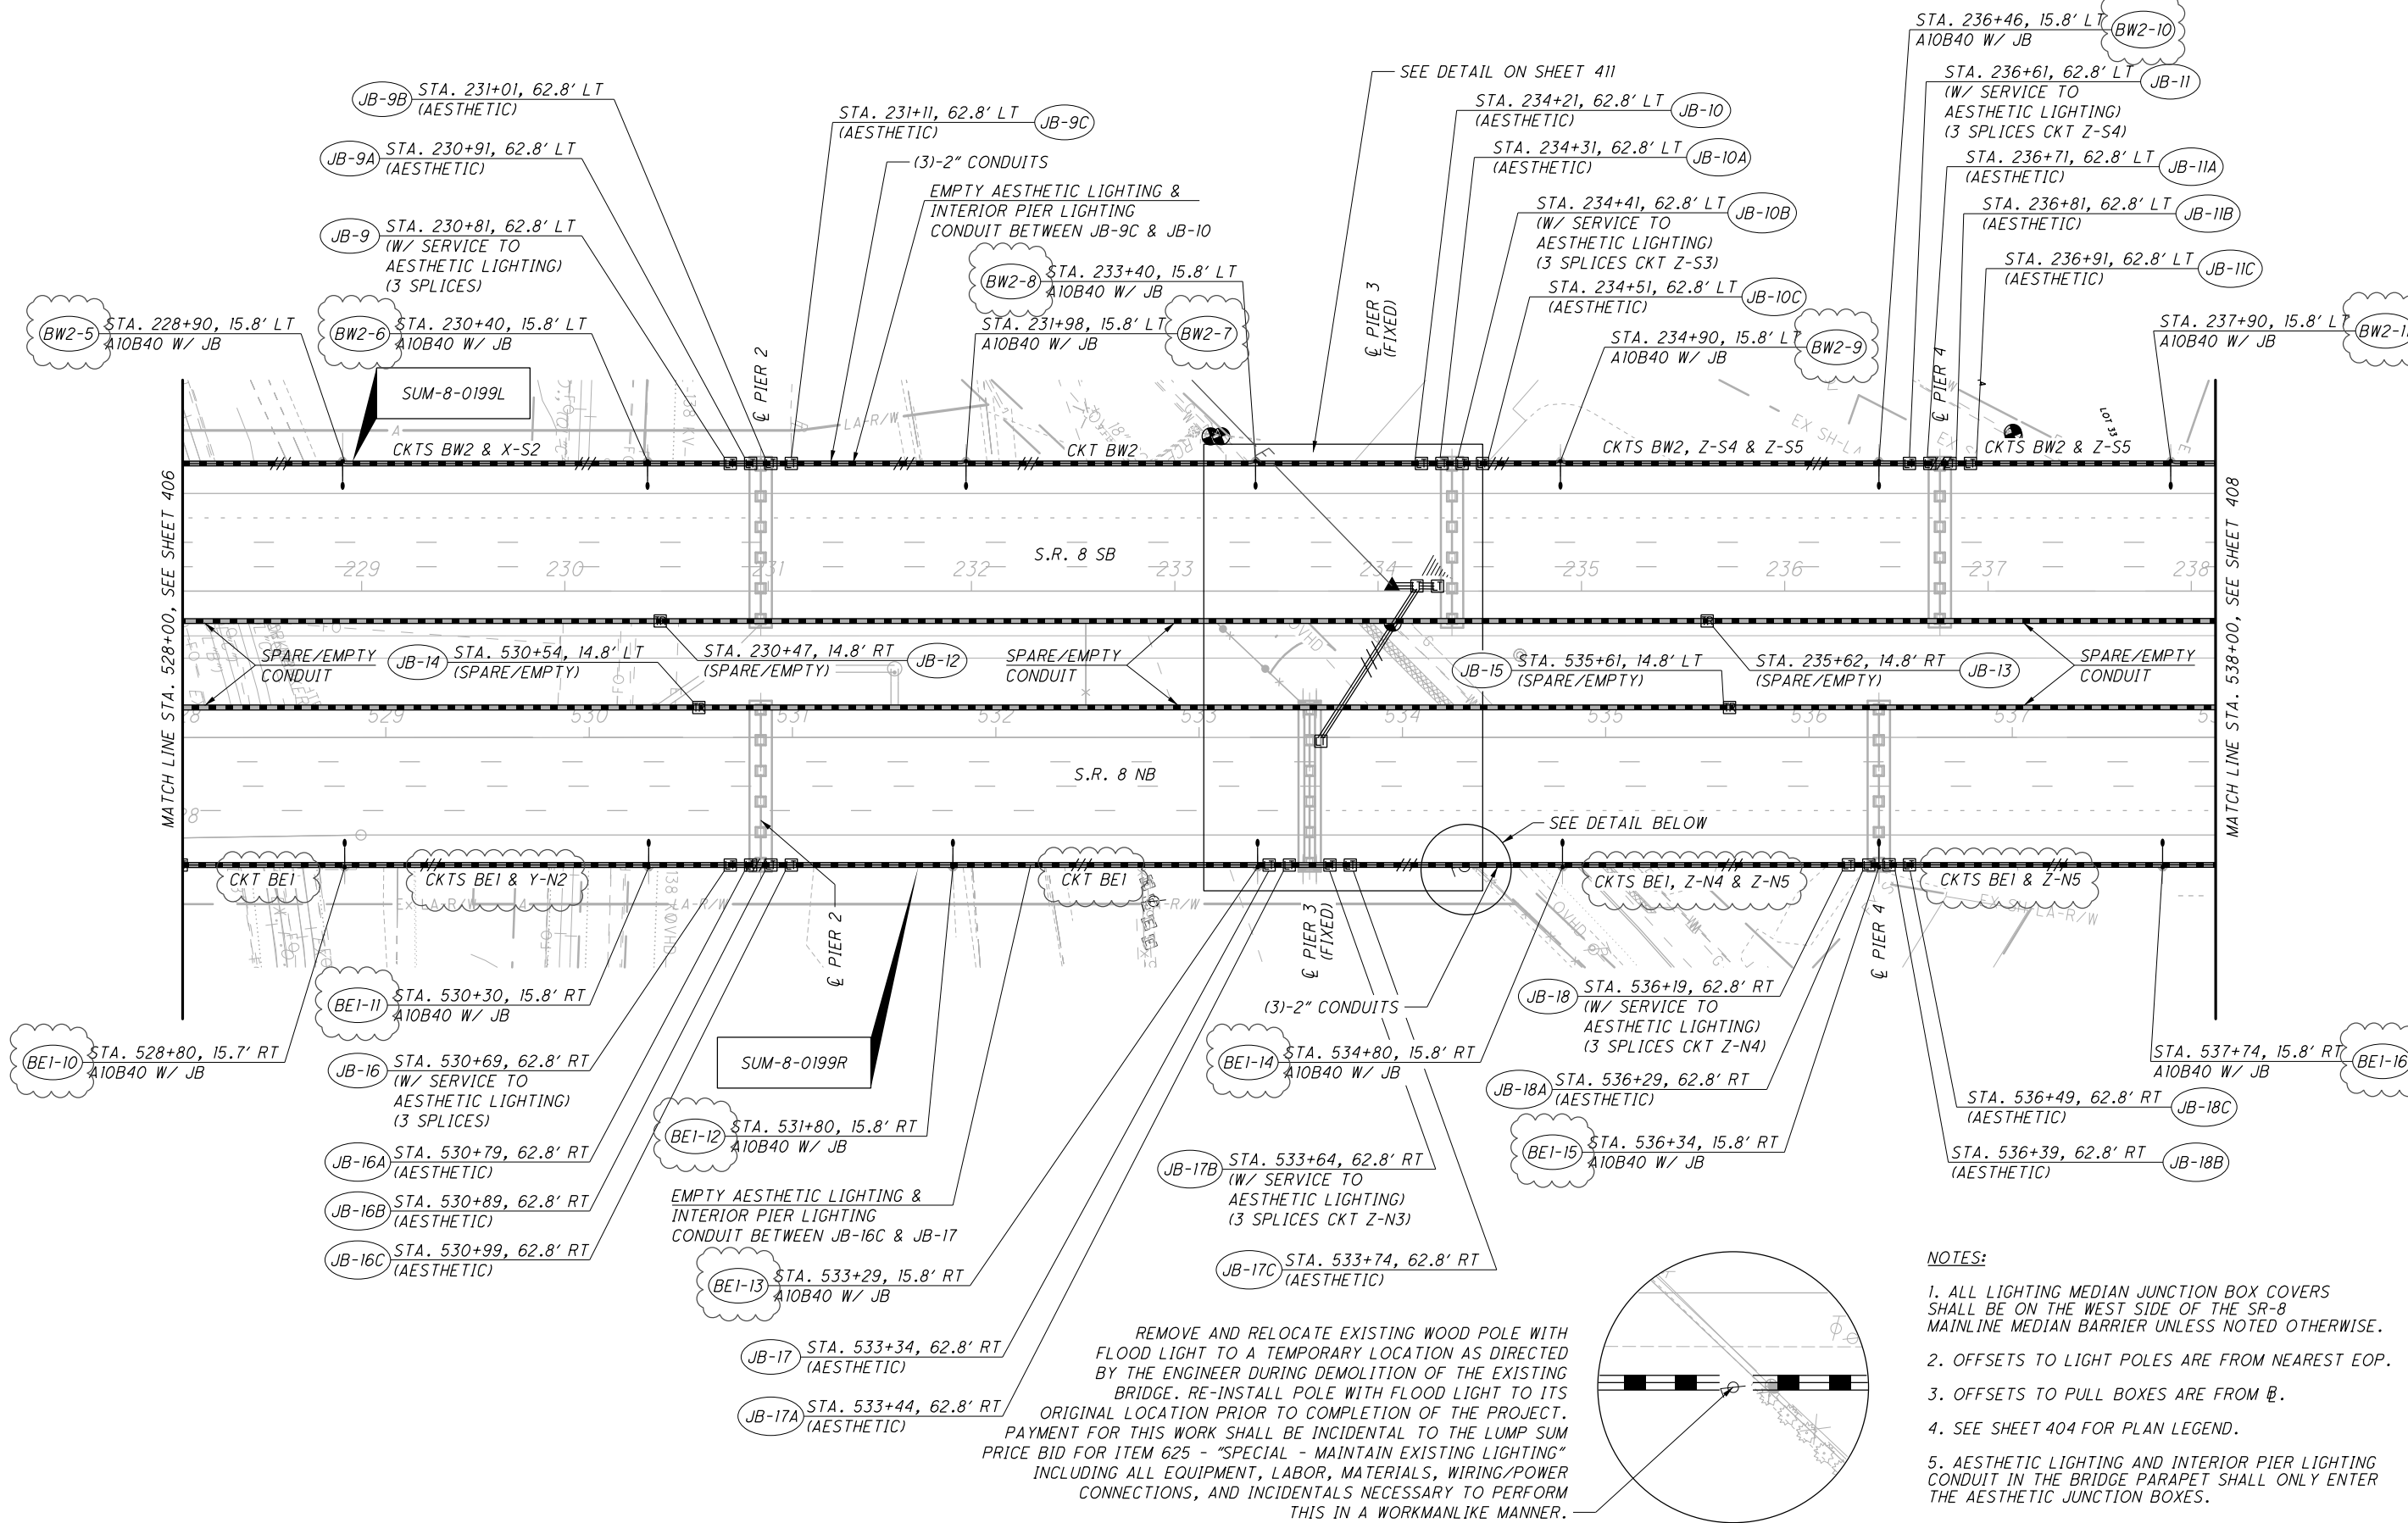





REMOVE AND RELOCATE EXISTING WOOD POLE WITH FLOOD LIGHT TO A TEMPORARY LOCATION AS DIRECTED BY THE ENGINEER DURING DEMOLITION OF THE EXISTING BRIDGE. RE-INSTALL POLE WITH FLOOD LIGHT TO ITS ORIGINAL LOCATION PRIOR TO COMPLETION OF THE PROJECT. PAYMENT FOR THIS WORK SHALL BE INCIDENTAL TO THE LUMP SUM PRICE BID FOR ITEM 625 - "SPECIAL - MAINTAIN EXISTING LIGHTING" INCLUDING ALL EQUIPMENT, LABOR, MATERIALS, WIRING/POWER CONNECTIONS, AND INCIDENTALS NECESSARY TO PERFORM THIS IN A WORKMANLIKE MANNER.

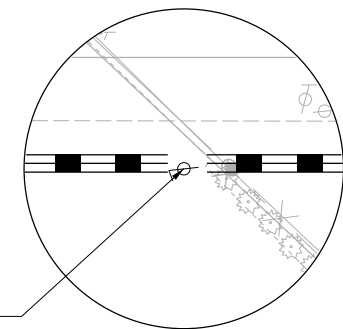

- NOTES:
1. ALL LIGHTING MEDIAN JUNCTION BOX COVERS SHALL BE ON THE WEST SIDE OF THE SR-8 MAINLINE MEDIAN BARRIER UNLESS NOTED OTHERWISE.
  2. OFFSETS TO LIGHT POLES ARE FROM NEAREST EOP.
  3. OFFSETS TO PULL BOXES ARE FROM  $\phi$ .
  4. SEE SHEET 404 FOR PLAN LEGEND.
  5. AESTHETIC LIGHTING AND INTERIOR PIER LIGHTING CONDUIT IN THE BRIDGE PARAPET SHALL ONLY ENTER THE AESTHETIC JUNCTION BOXES.
  6. ROADWAY LIGHTING CONDUIT IN THE BRIDGE PARAPET SHALL ONLY ENTER LIGHTING JUNCTION BOXES.

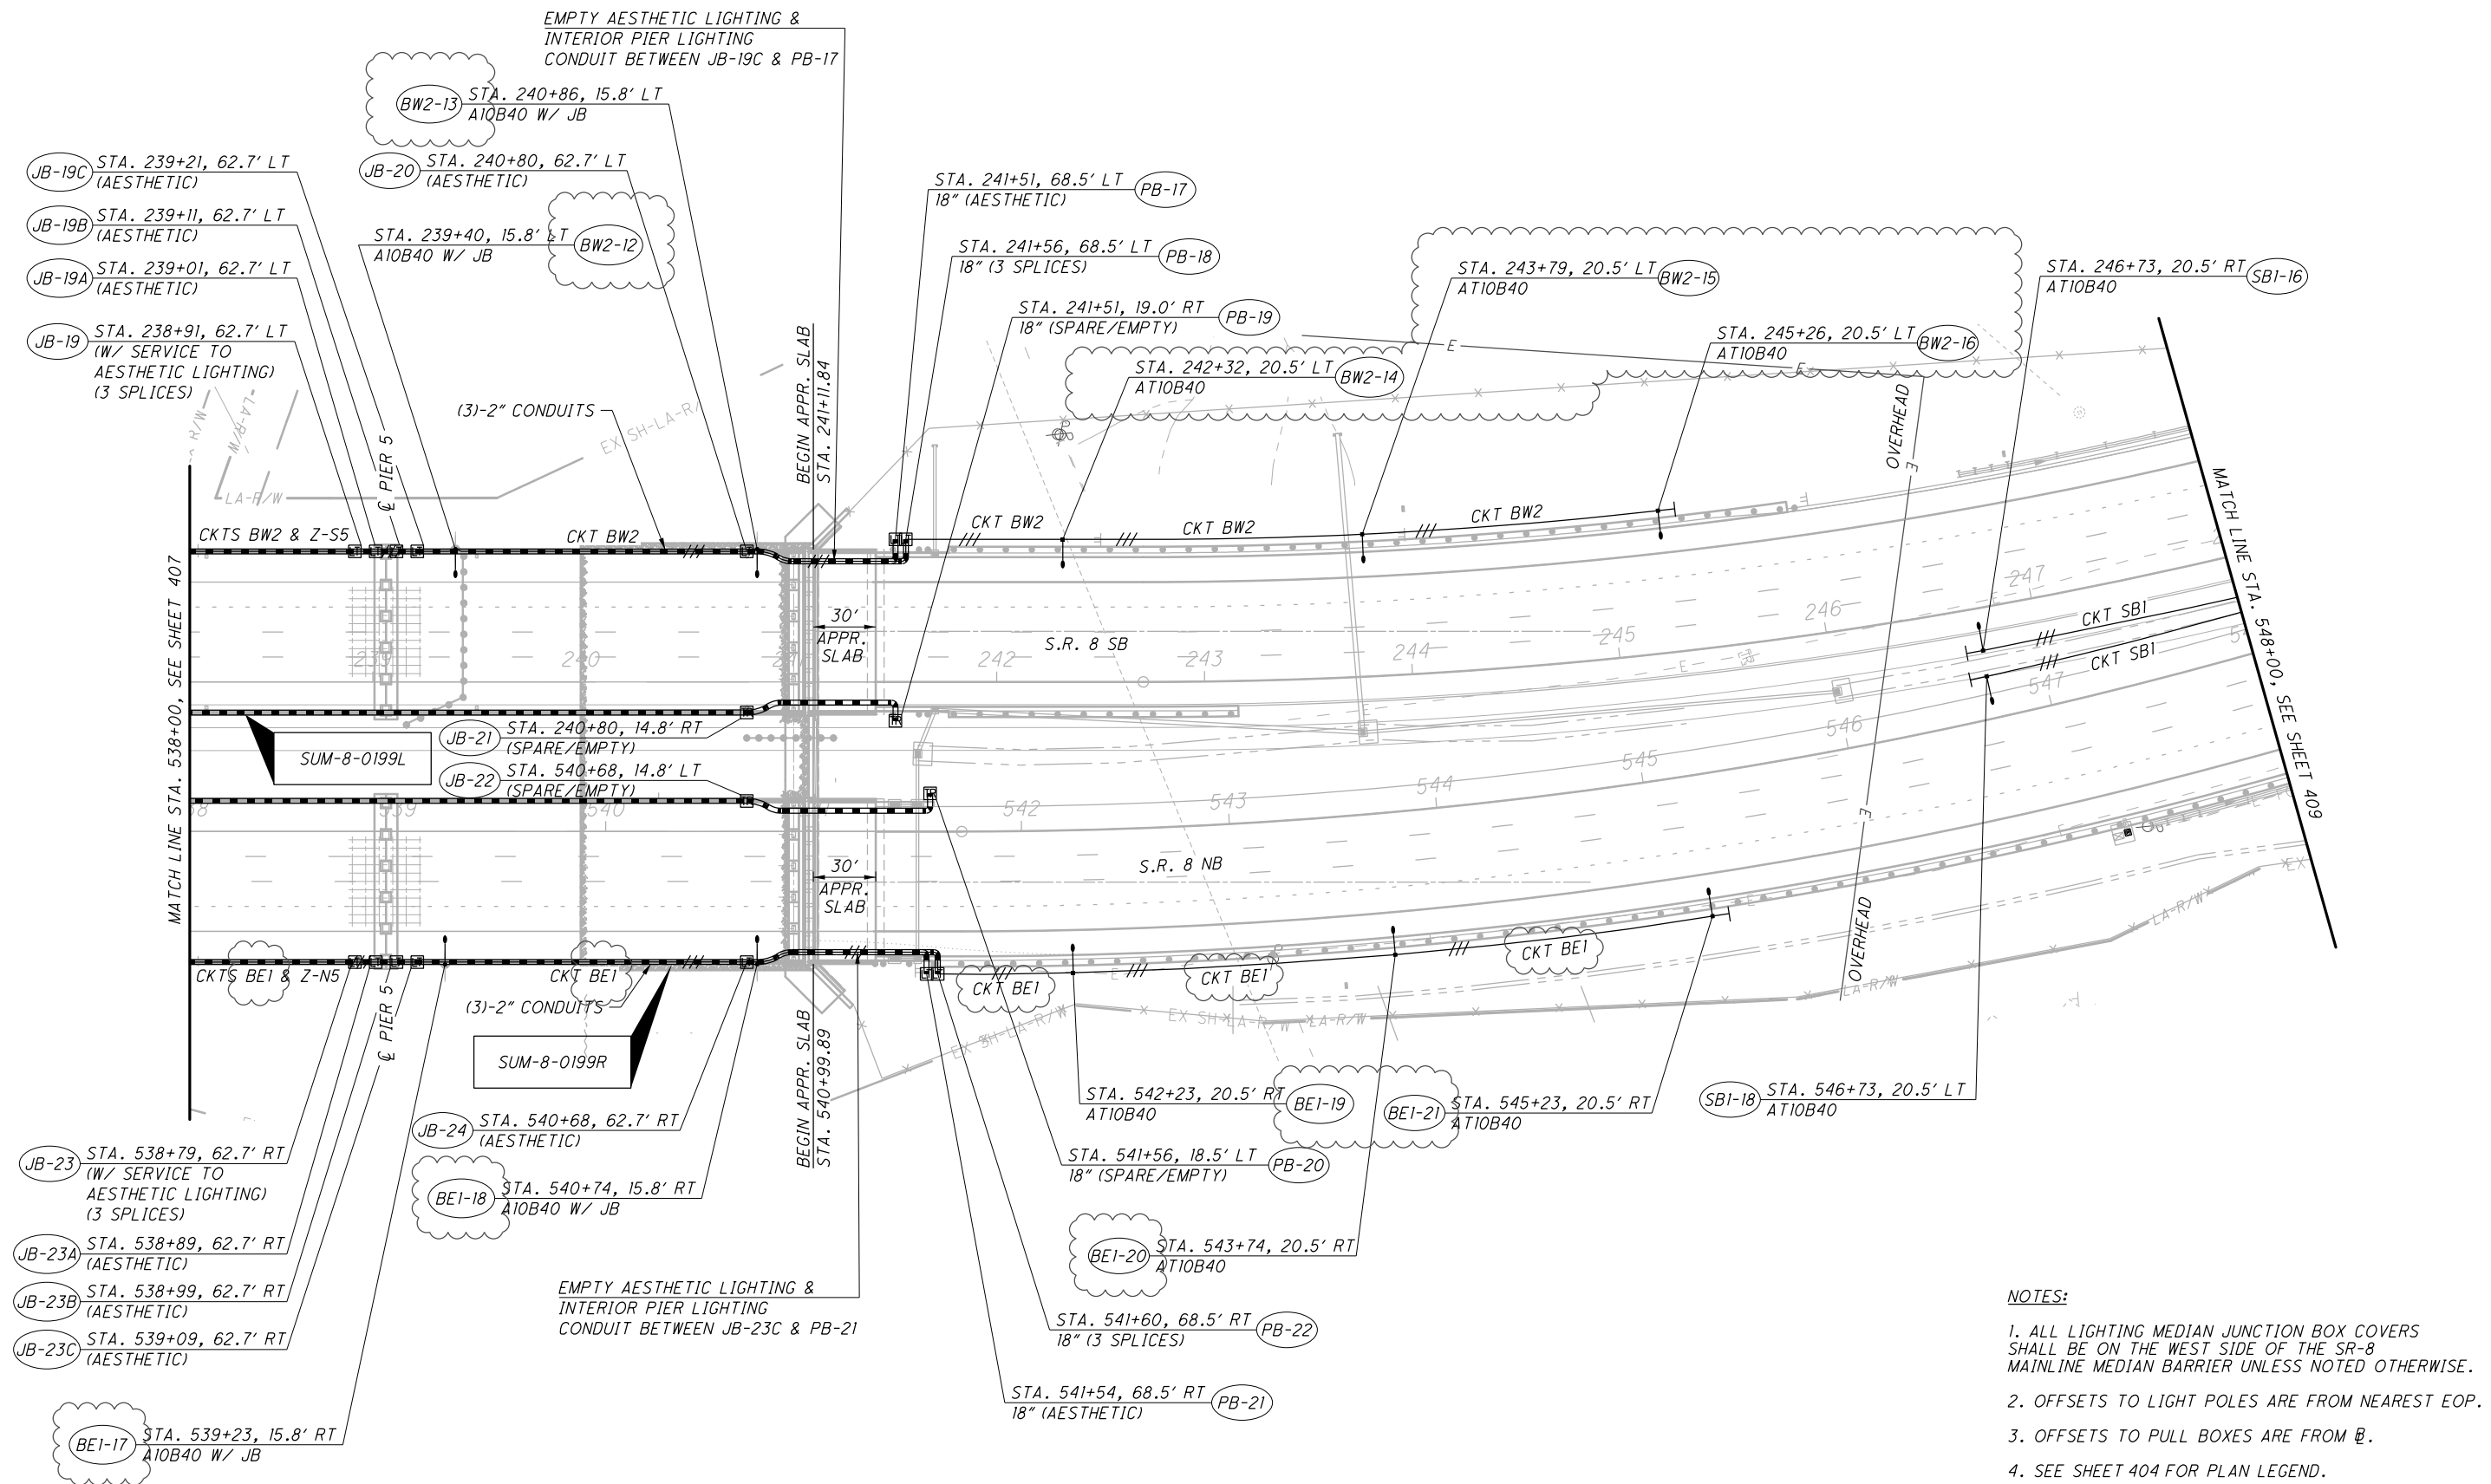

- NOTES:**
1. ALL LIGHTING MEDIAN JUNCTION BOX COVERS SHALL BE ON THE WEST SIDE OF THE SR-8 MAINLINE MEDIAN BARRIER UNLESS NOTED OTHERWISE.
  2. OFFSETS TO LIGHT POLES ARE FROM NEAREST EOP.
  3. OFFSETS TO PULL BOXES ARE FROM @.
  4. SEE SHEET 404 FOR PLAN LEGEND.
  5. AESTHETIC LIGHTING AND INTERIOR PIER LIGHTING CONDUIT IN THE BRIDGE PARAPET SHALL ONLY ENTER THE AESTHETIC JUNCTION BOXES.
  6. ROADWAY LIGHTING CONDUIT IN THE BRIDGE PARAPET SHALL ONLY ENTER LIGHTING JUNCTION BOXES.

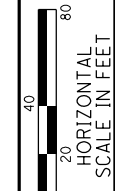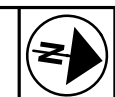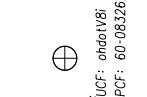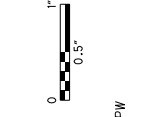


CALCULATED  
KWR  
CHECKED  
DRB

LIGHTING PLAN  
STA. 558+00 TO END PROJECT

SUM-8-1.75

410  
801

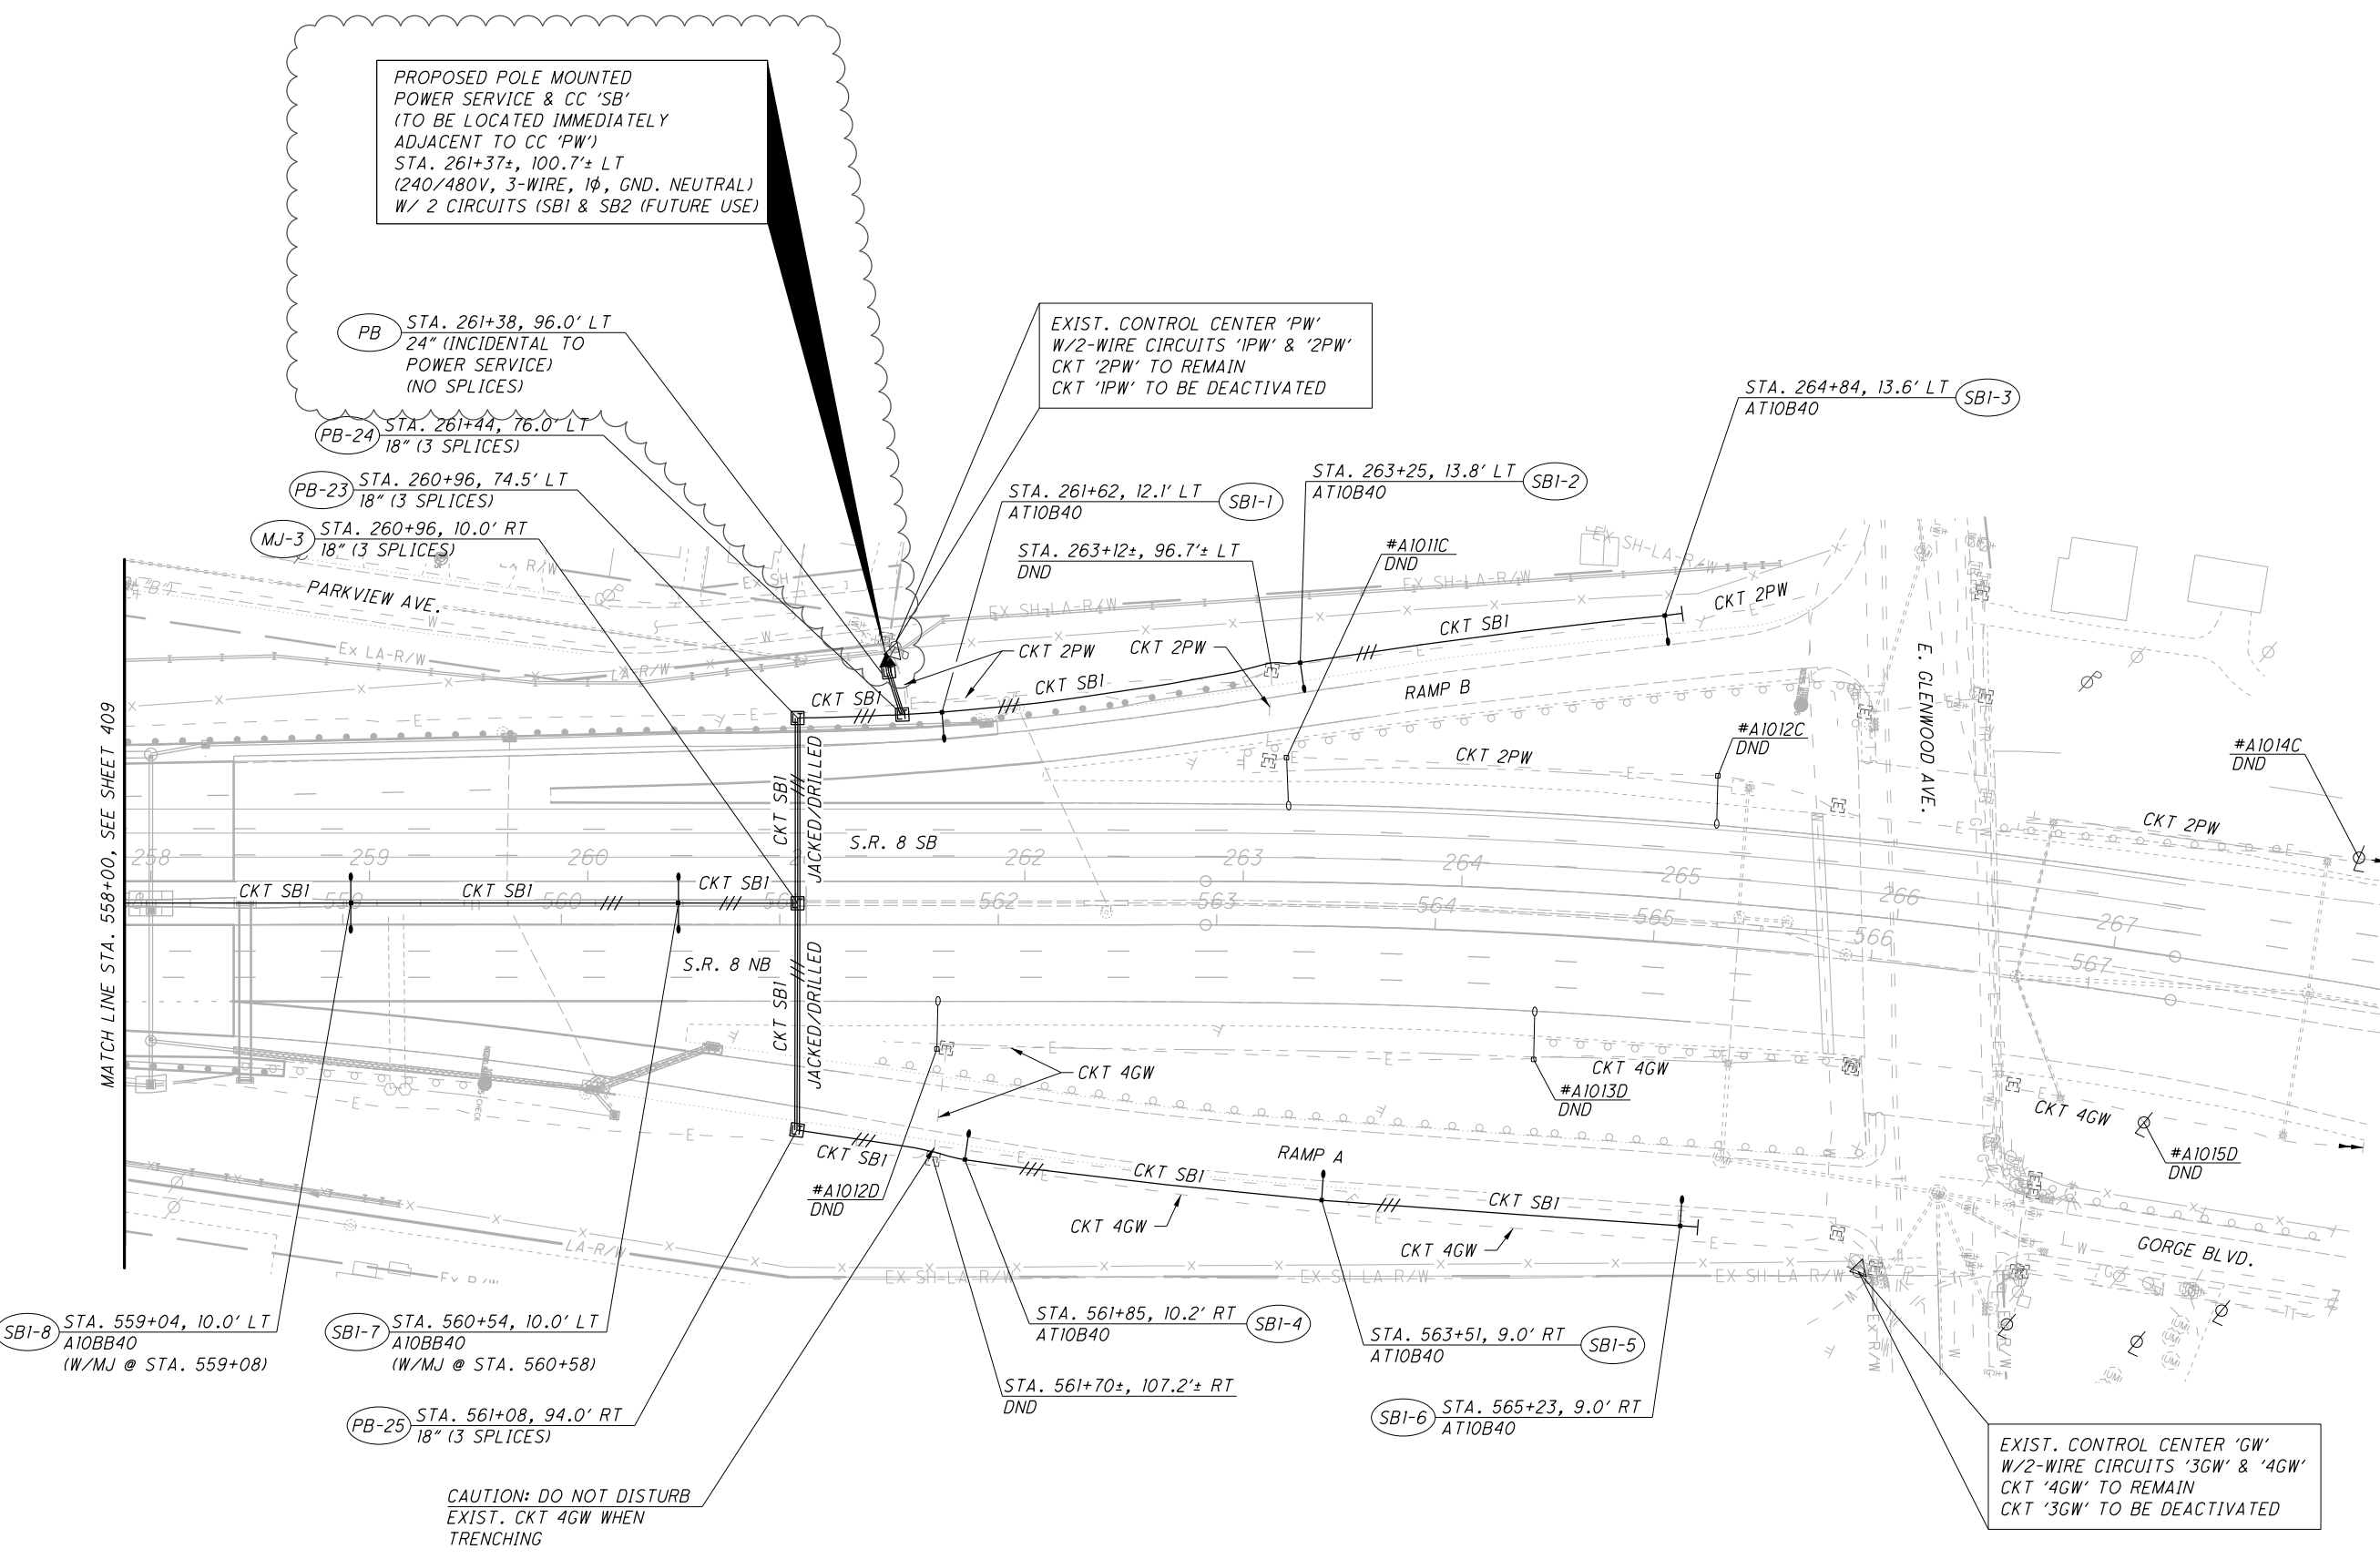



PROPOSED POLE MOUNTED  
POWER SERVICE & CC 'SB'  
(TO BE LOCATED IMMEDIATELY  
ADJACENT TO CC 'PW')  
STA. 261+37±, 100.7'± LT  
(240/480V, 3-WIRE, 1φ, GND. NEUTRAL)  
W/ 2 CIRCUITS (SBI & SB2 (FUTURE USE))

EXIST. CONTROL CENTER 'PW'  
W/2-WIRE CIRCUITS '1PW' & '2PW'  
CKT '2PW' TO REMAIN  
CKT '1PW' TO BE DEACTIVATED

EXIST. CONTROL CENTER 'GW'  
W/2-WIRE CIRCUITS '3GW' & '4GW'  
CKT '4GW' TO REMAIN  
CKT '3GW' TO BE DEACTIVATED

CAUTION: DO NOT DISTURB  
EXIST. CKT 4GW WHEN  
TRENCHING

- NOTES:
1. ALL LIGHTING MEDIAN JUNCTION BOX COVERS SHALL BE ON THE WEST SIDE OF THE SR-8 MAINLINE MEDIAN BARRIER UNLESS NOTED OTHERWISE.
  2. OFFSETS TO LIGHT POLES ARE FROM NEAREST EOP.
  3. OFFSETS TO PULL BOXES ARE FROM  $\square$ .
  4. SEE SHEET 404 FOR PLAN LEGEND.

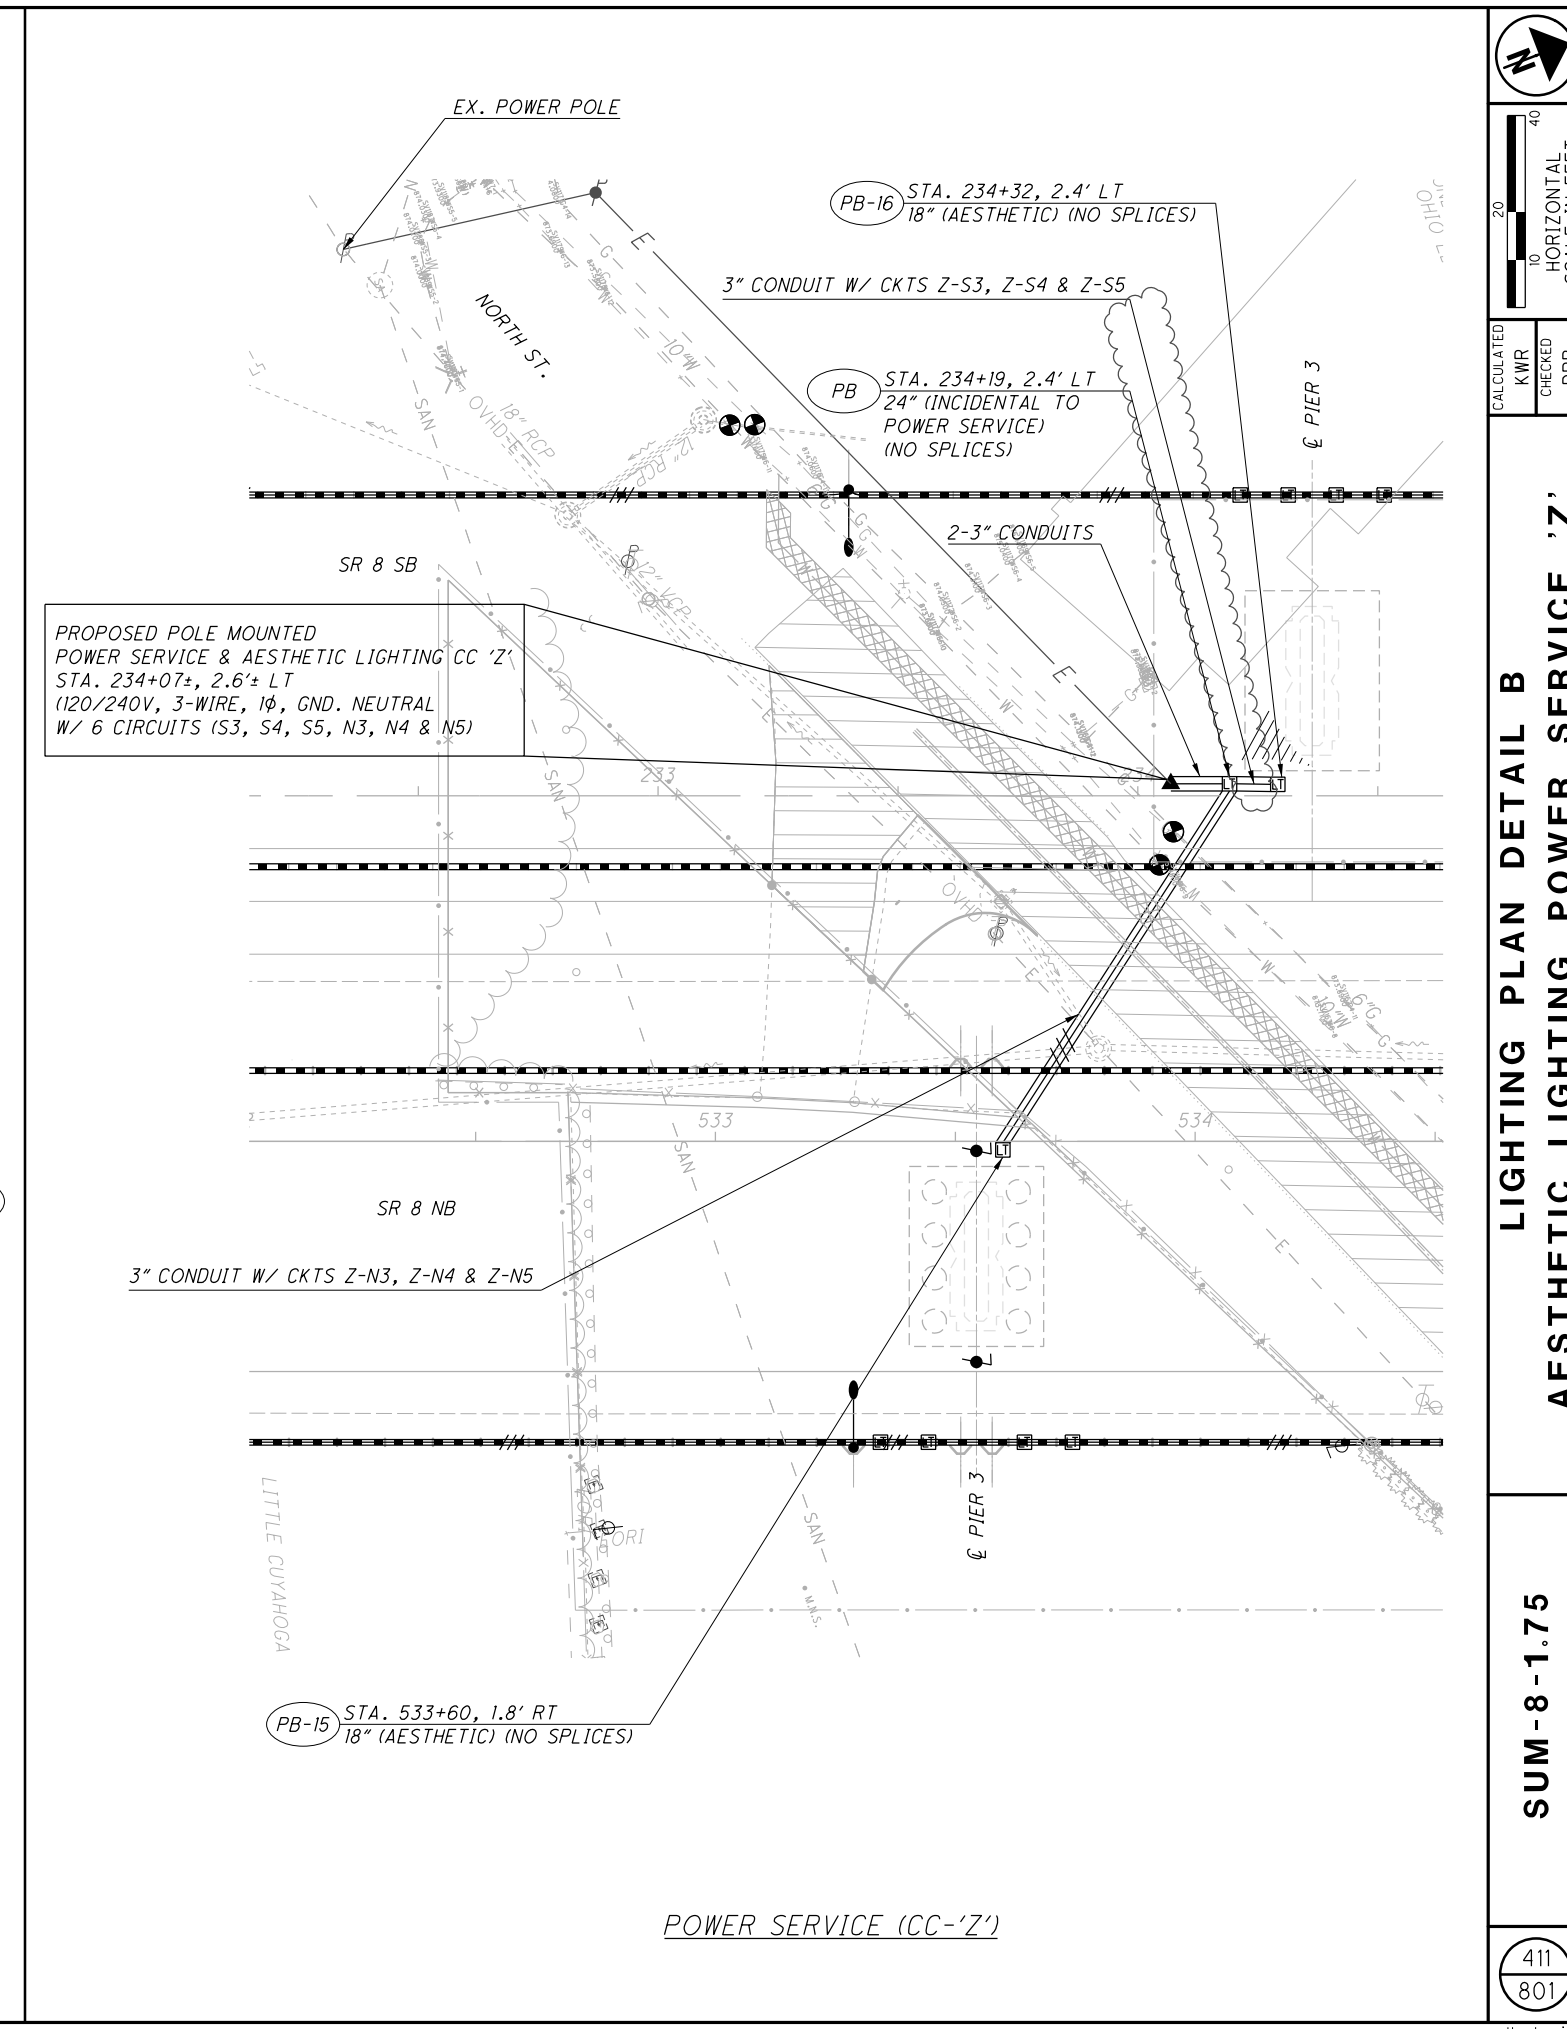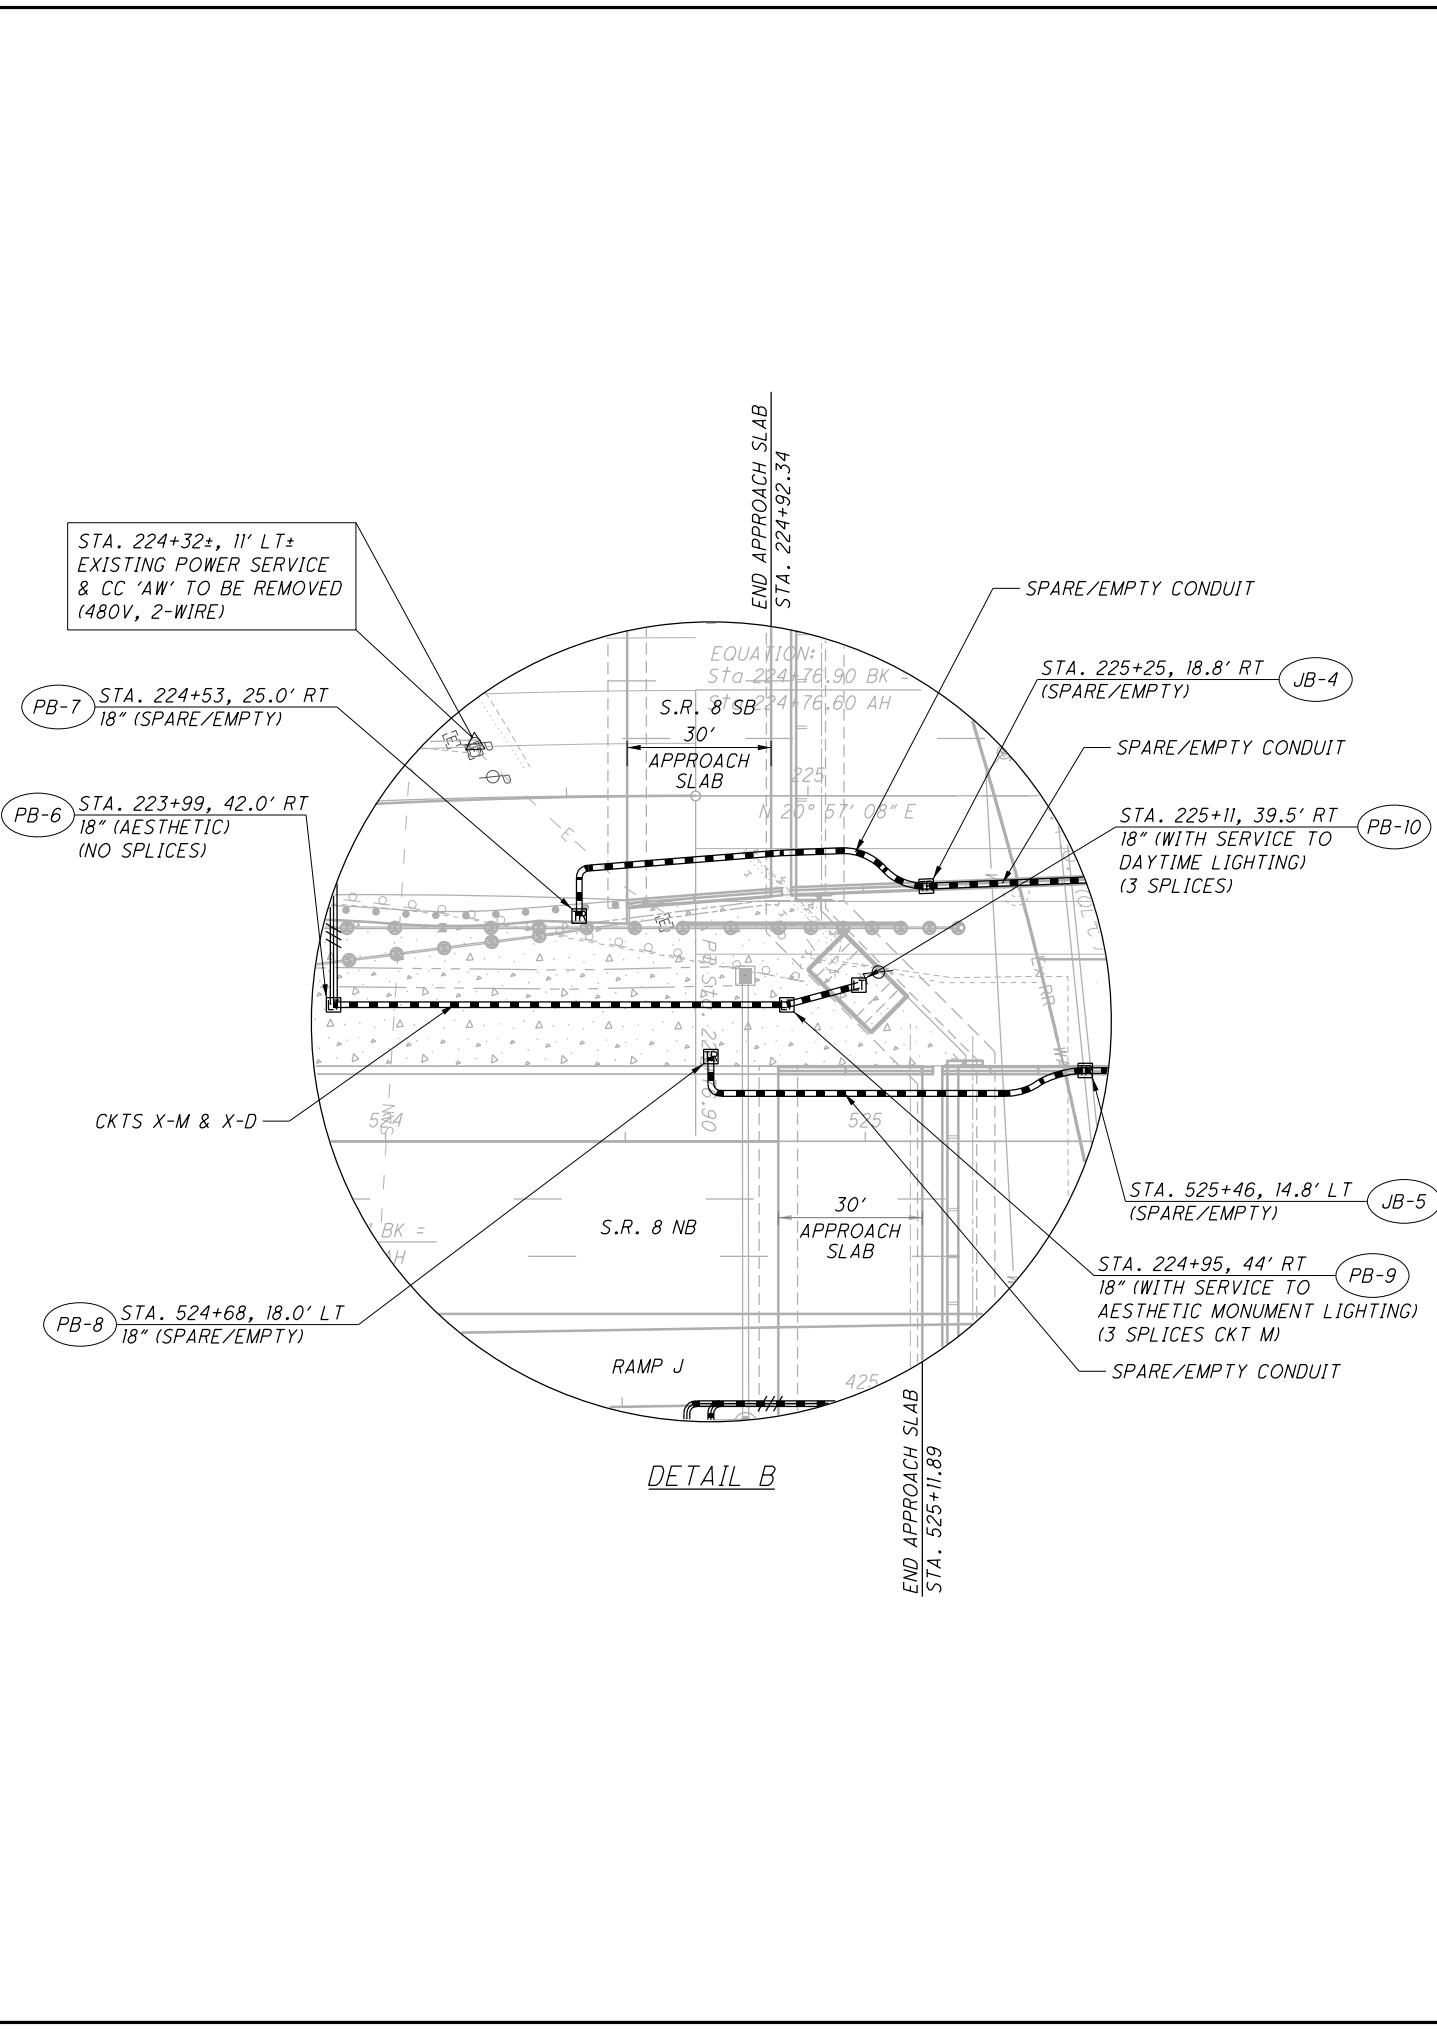




CONTROL CENTER DATA (ROADWAY)

CONTROL CENTER DESIGNATION	LINE VOLTS	CONNECTED LOAD (KVA)	SERVICE ENTRANCE CONDUCTOR SIZE - AWG	ENCLOSURE RATING (AMPS)	CIRCUIT NO.	CIRCUIT LOAD AMPS	CIRCUIT FUSE SIZE AMPS	CIRCUIT CABLE SIZE AWG	MAINTAINING AGENCY
BW	480	5.1	1/0	60	1	5.10	10	4	CITY OF AKRON
					2	5.44	10	4	
BE	480	3.4	1/0	60	1	7.14	10	4	CITY OF AKRON
SB	480	4.2	1/0	60	1	8.84	20	4	CITY OF AKRON
					2		FUTURE		

PROP.	LEGEND
—●—	LIGHT POLE W/LED LUMINAIRE
▲ PS	POWER SERVICE
□	PULL BOX WITH SPLICES *

\* ONLY PULL BOXES FOR BRANCH CIRCUITS ARE SHOWN IN CIRCUIT DIAGRAM

Ohio DOT Workspace  
 SUM-8  
 www.msconsultants.com  
 Batchplot Spec: \\msconsultants.com\files\Production\PM 60\08326\standards\plotdrv\batchplot.spic;cf: ohdot\8;  
 Pen Table: N:\PM 60\08326\standards\tables\l8.ms\_std.tbl  
 Plot Driver: \\msconsultants.com\files\standards\ustin\ohdot\l8\ms\plotting\PDF.plt;cg  
 View: FENCE - NEW1  
 By: krjan  
 8:45:05 AM  
 4/5/2023  
 Model: Sheet  
 Printed: 4/5/2023  
 File: \\msconsultants.com\files\Production\PM 60\08326\lighting\streets\9770\_0001.dgn

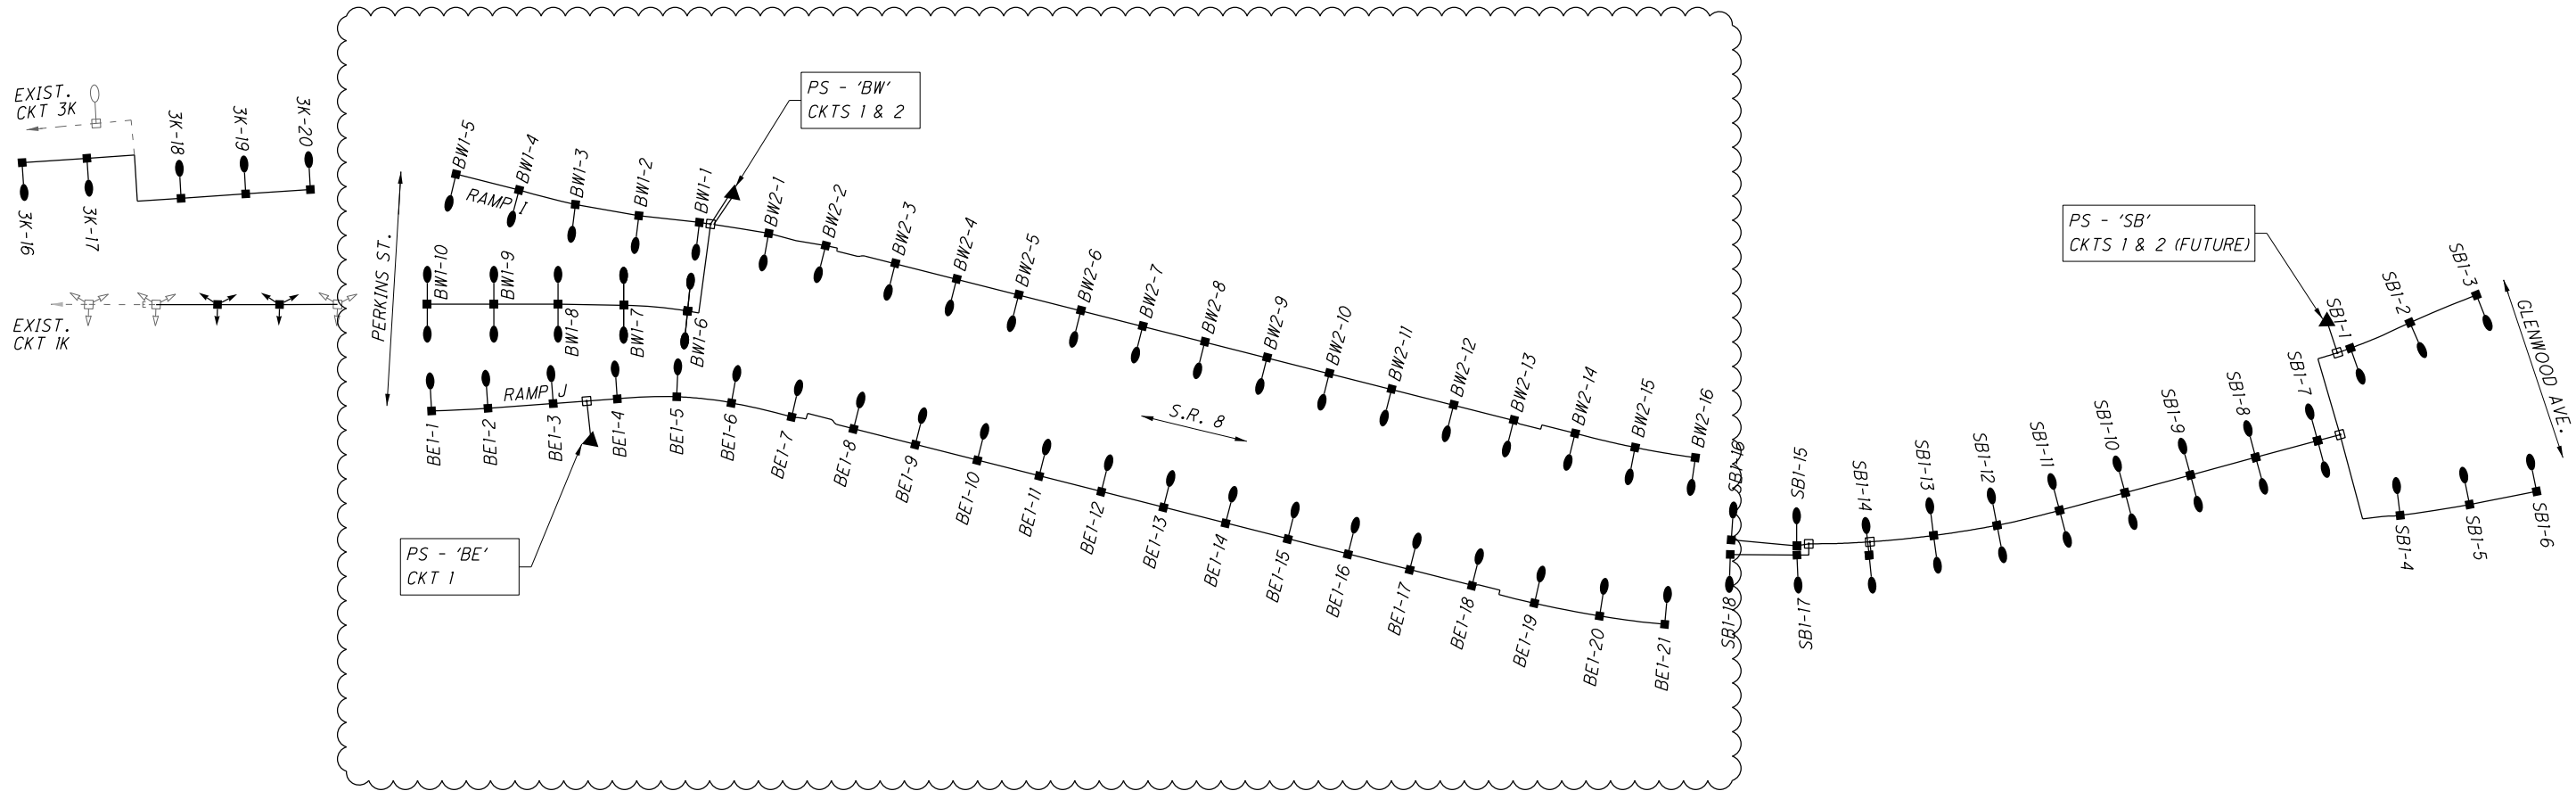

CONTROL CENTER DATA (AESTHETIC)

CONTROL CENTER DESIGNATION	LINE VOLTS	CONNECTED LOAD (KVA)	SERVICE ENTRANCE CONDUCTOR SIZE - AWG	ENCLOSURE RATING (AMPS)	CIRCUIT NO.	CIRCUIT LOAD AMPS	CIRCUIT FUSE SIZE AMPS	CIRCUIT CABLE SIZE AWG	MAINTAINING AGENCY
X	240	11.1	1/0	60	M	12.09	20	6	CITY OF AKRON
					D	34.17	50	4	
					S1	12.53	20	6	
					S2	19.69	30	2	
					N1	12.53	20	4	
Y	240	7.7	1/0	60	N2	19.69	30	2	CITY OF AKRON
					S3	19.69	30	6	
Z	240	24.9	1/0	200	S4	19.69	30	4	CITY OF AKRON
					S5	12.53	20	4	
					N3	19.69	30	6	
					N4	19.69	30	4	
					N5	12.53	20	4	

NOTE: SEE SHEET 413 FOR THE AESTHETIC LIGHTING CIRCUIT SCHEMATIC.

PLOT.CEL

ms consultants, inc.  
mconsultants.com




Ohio DOT Workspace  
SUM-8

Batchplot Spec: \\msconsultants.com\files\Production\60\08326\standards\plottdrv\batchpl.sp;CF: otdou\B; Pen Table: N:\PW\60\08326\standards\tables\VB; ms\_std.tbl Plot Driver: \\msconsultants.com\files\standards\usin\ohdot\VB\msplotting\PDF.plt;g

Model: Sheet  
Printed: 4/15/2023 8:45:06 AM By: kryan  
File: \\msconsultants.com\files\Production\60\08326\lighting\sheet\91770\_LC002.dgn

34" x 22"

www.msconsultants.com

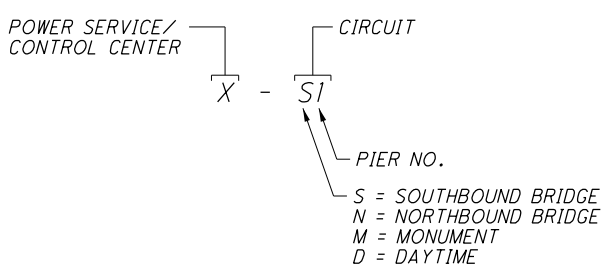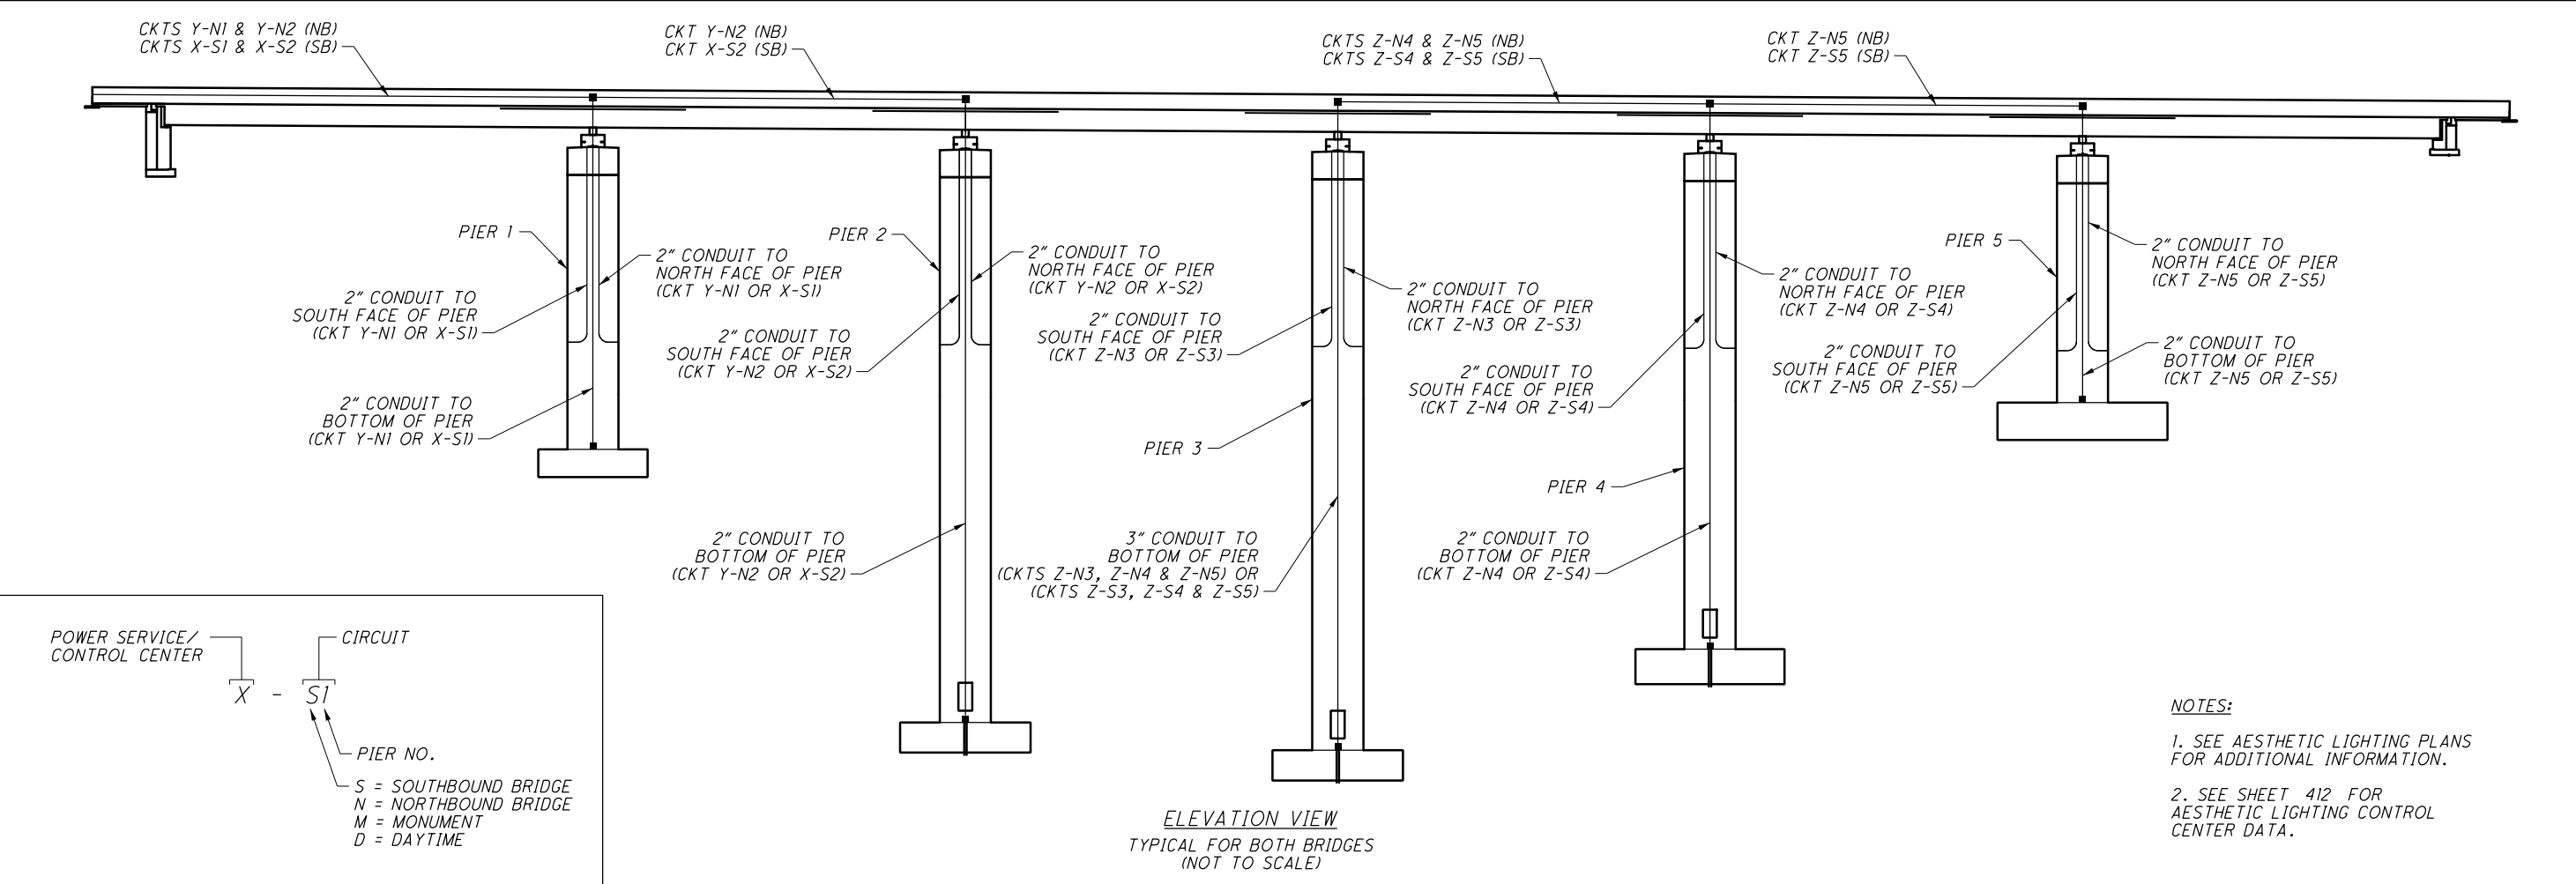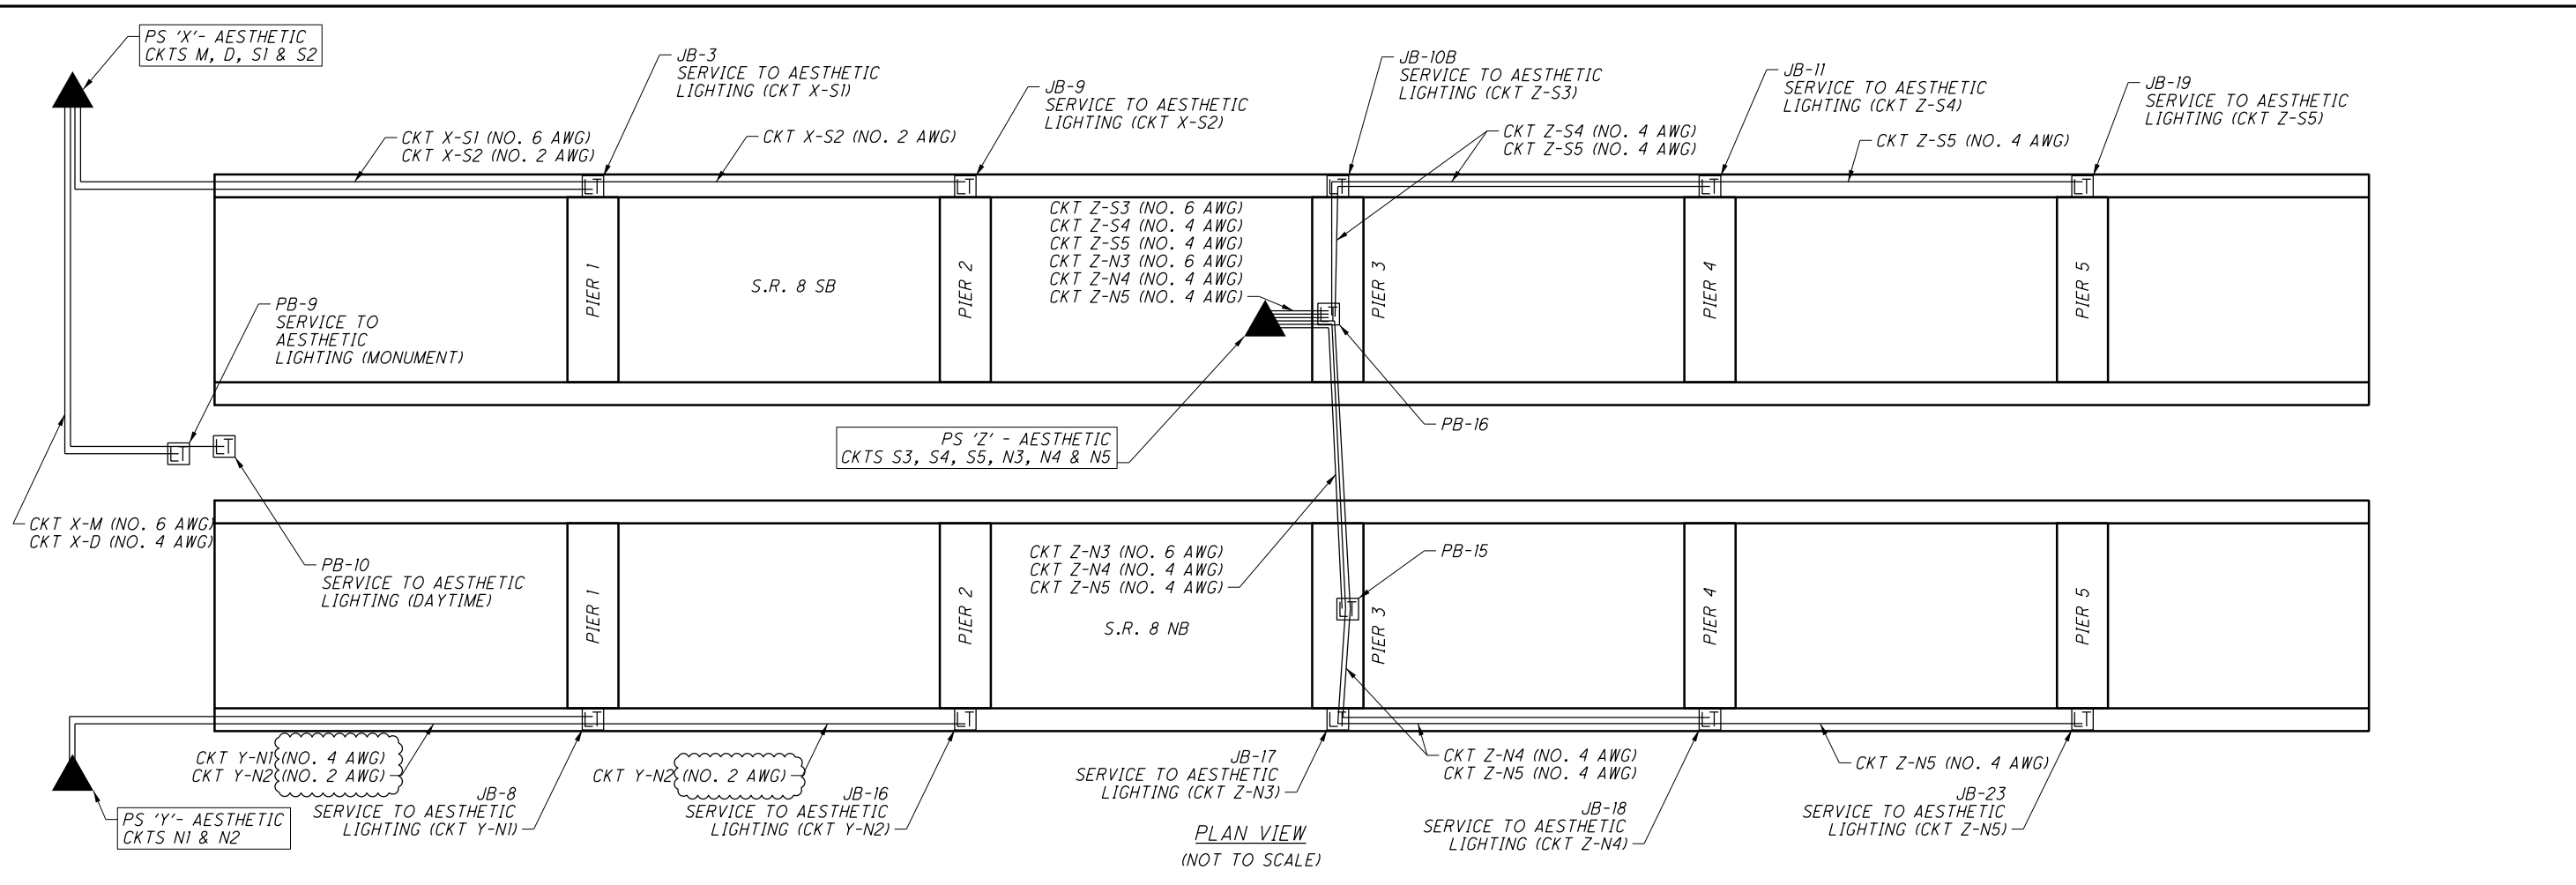

NOTES:

1. SEE AESTHETIC LIGHTING PLANS FOR ADDITIONAL INFORMATION.
2. SEE SHEET 412 FOR AESTHETIC LIGHTING CONTROL CENTER DATA.

CALCULATED  
KWR  
CHECKED  
DRB

**AESTHETIC LIGHTING CIRCUIT SCHEMATIC**


**SUM-8-1.75**

413  
801

ms consultants, inc.



Ohio DOT Workspace  
SUM-8  
www.msconsultants.com

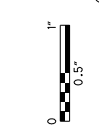

Batchplot Spec: \\msconsultants.com\files\Production\PM 60\08326\standards\plotdrv\batchplot.spc  
Pen Table: N:\PM 60\08326\standards\tables\VB1.ms\_std.tbl  
Plot Driver: \\msconsultants.com\files\standards\usin\ohdot\vb1.ms\_plotting.pdf

Batchplot Spec: \\msconsultants.com\files\Production\PM 60\08326\standards\plotdrv\batchplot.spc  
Pen Table: N:\PM 60\08326\standards\tables\VB1.ms\_std.tbl  
Plot Driver: \\msconsultants.com\files\standards\usin\ohdot\vb1.ms\_plotting.pdf

34" x 22"

Model: Sheet  
Printed: 4/5/2023 8:45:07 AM  
View: FENCE\_VEW1  
By: kryan  
File: \\msconsultants.com\files\Production\PM 60\08326\lighting\sheet\9770\_LM004.dgn

CIRCUIT 'BW1'

VOLTAGE: 480V

WIRE FACTOR USED (TWO - NO. 4 AWG WIRES): 0.62 OHMS/MFT/1000

Table with 12 columns: Section (From, To, Design Feet), Amperes (At Point, Accum.), Ampere-Feet, AWG, Voltage Drop (In Section, Accum.), % Drop, At Point. Rows include BW1-10 to BW1-1 and PB-1 to PS - 'BW'.

CIRCUIT 'BW2'

VOLTAGE: 480V

WIRE FACTOR USED (TWO - NO. 4 AWG WIRES): 0.62 OHMS/MFT/1000

Table with 12 columns: Section (From, To, Design Feet), Amperes (At Point, Accum.), Ampere-Feet, AWG, Voltage Drop (In Section, Accum.), % Drop, At Point. Rows include BW2-16 to BW2-1 and PS - 'BW'.

CIRCUIT 'BE1'

VOLTAGE: 480V

WIRE FACTOR USED (TWO - NO. 4 AWG WIRES): 0.62 OHMS/MFT/1000

Table with 12 columns: Section (From, To, Design Feet), Amperes (At Point, Accum.), Ampere-Feet, AWG, Voltage Drop (In Section, Accum.), % Drop, At Point. Rows include BE1-21 to BE1-4 and PB-II to PS - 'BE'.

CIRCUIT 'SBI'

VOLTAGE: 480V


WIRE FACTOR USED (TWO - NO. 4 AWG WIRES): 0.62 OHMS/MFT/1000

Table with 12 columns: Section (From, To, Design Feet), Amperes (At Point, Accum.), Ampere-Feet, AWG, Voltage Drop (In Section, Accum.), % Drop, At Point. Rows include SBI-18 to SBI-1 and PB-24 to PS - 'SB'.


CALCULATED  
KWR  
CHECKED  
DRB

VOLTAGE DROP CALCULATIONS


SUM - 8 - 1.75

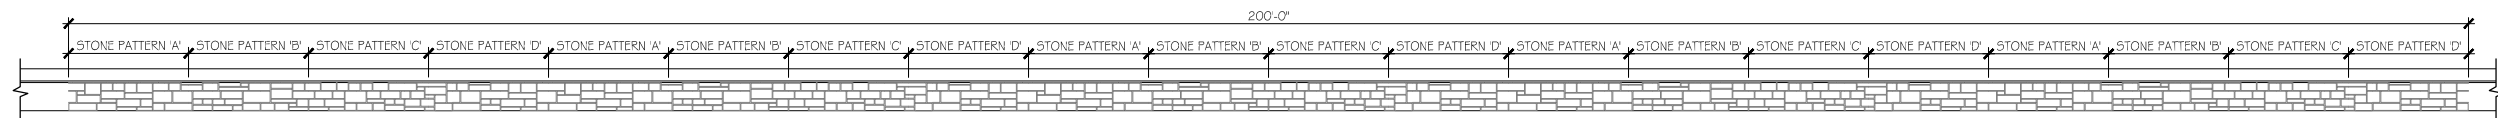


1 PARAPET ELEVATION: STONE PATTERN SEQUENCE 'A'  
A1.23 SCALE: 1/32" = 1'-0"

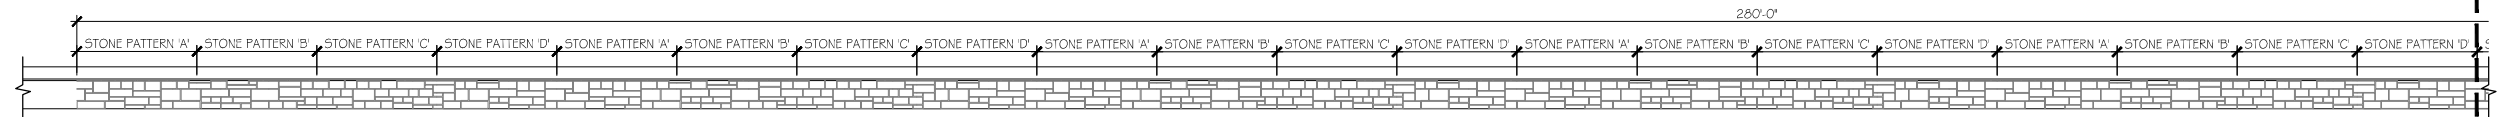

2 PARAPET ELEVATION: STONE PATTERN SEQUENCE 'B'  
A1.23 SCALE: 1/32" = 1'-0"

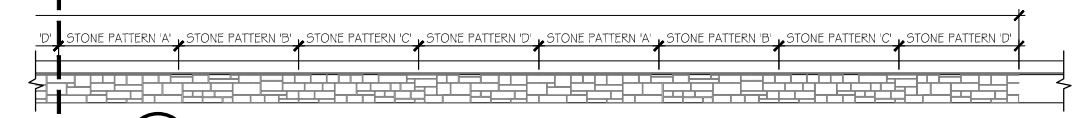

3 PARAPET ELEVATION: STONE PATTERN SEQUENCE 'B' CONTINUES  
A1.23 SCALE: 1/32" = 1'-0"

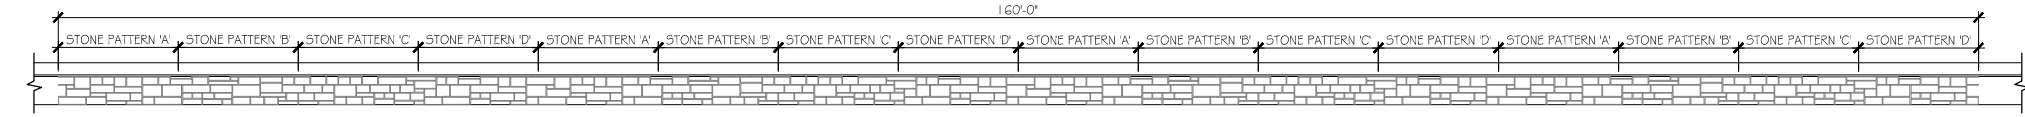

4 PARAPET ELEVATION: STONE PATTERN SEQUENCE 'C'  
A1.23 SCALE: 1/32" = 1'-0"

ACRYLIC STAIN

A. GENERAL

1. STAIN THE SIMULATED STONE SURFACES USING AN ACRYLIC RESIN-BASED STAIN AS RECOMMENDED BY THE MANUFACTURER. APPLY ONE BASE COLOR STAIN FOLLOWED BY RANDOM APPLICATION OF ONE SURFACE AND TWO ACCENT COLORS TO ACHIEVE NATURAL STONE EFFECT.

B. PRODUCTS

- PRODUCT SHALL CREATE A SURFACE FINISH THAT IS BREATHABLE (ALLOWING WATER VAPOR TRANSMISSION), AND THAT RESISTS DETERIORATION FROM WATER, ACID, ALKALI, FUNGI, SUNLIGHT OR WEATHERING.
- STAIN MIX SHALL BE A WATER BORNE, LOW VOC MATERIAL (LESS THAN 289 GRAMS/LITER), AND SHALL MEET REQUIREMENTS FOR WEATHERING RESISTANCE OF 2000 HOURS ACCELERATED EXPOSURE MEASURED IN ACCORDANCE WITH ASTM G 23. SCRUB TEST 1000 REVOLUTIONS. ABRASIVE REABRASIVE RESISTANCE (TABOR CF 10) 500 CYCLES. ADHESION ASTM D 3359 1.00MM CROSS CUTS ON GLASS PASS 3 OR HIGHER ON A SCALE OF 1 TO 5. SUPPLY INFORMATION PERTAINING TO CHEMICAL RESISTANCE ASTM D 1308 TO 87.

C. EXECUTION

- PROVIDE THE ENGINEER WITH THE MANUFACTURER'S SPECIFICATIONS FOR PRODUCT APPLICATION. APPLY THE PRODUCT IN ACCORDANCE WITH THE MANUFACTURER'S SPECIFICATIONS WITH EXCEPTIONS AS NOTED.
- CLEAN SURFACE PRIOR TO APPLICATION OF STAIN MATERIALS BY PRESSURE WASHING WITH WATER, MINIMUM 3000 PSI (A RATE OF THREE TO FOUR GALLONS PER MINUTE), USING FAN NOZZLE PERPENDICULAR TO AND AT A DISTANCE OF ONE OR TWO FEET FROM SURFACE. COMPLETE SURFACE. COMPLETED SURFACE SHALL BE FREE OF BLEMISHES, DISCOLORATION, SURFACE VOIDS AND UNNATURAL FORM WORKS. DO NOT SANDBLAST. ETCHING IS NOT REQUIRED.
- STAIN SHALL BE APPLIED AS RECOMMENDED BY THE MANUFACTURER.
- THE SIMULATED STONE STAIN SHALL CLOSELY MATCH THE SAMPLE COLOR IMAGE AS SHOWN IN SHEET A4.6.
- USE BASE STAIN SIMILAR TO THE RECOMMENDED FEDERAL COLOR NUMBER 36586. THREE ADDITIONAL RECOMMENDED COLORS FOR SURFACE AND ACCENT COLORS SHALL BE FEDERAL COLOR NUMBER 33446 (SURFACE), 34201, (ACCENT) AND 36473 (ACCENT). ACTUAL COLORS USED ARE SUBJECT TO CHANGE AT THE DIRECTION OF THE ENGINEER ON REVIEW OF THE APPEARANCE OF THE MOCKUP. USE COLOR AND TECHNIQUES AS APPROVED FOR THE FINAL MOCKUP.
- WHERE EXPOSED SOIL OR PAVEMENTS IS ADJACENT WHICH MAY SPLATTER DIRT OR SOIL FROM RAINFALL, OR WHERE SURFACE MAY BE EXPOSED TO OVERSPRAY FROM OTHER PROCESSES, PROVIDE TEMPORARY COVER OF FINISHED WORK.

D. METHOD OF MEASUREMENT AND BASIS OF PAYMENT

10. THE DEPARTMENT WILL PAY FOR THE ACCEPTED QUANTITIES AT THE CONTRACT PRICE FOR ITEM 512-SEALING OF CONCRETE SURFACES (NON-EPOXY), AS PER PLAN. QUANTITIES ARE BASED ON THE PLAN AREA, PER SQUARE FOOT, OF FORMLINER TEXTURED SURFACES, WITH NO DEDUCTIONS MADE FOR THE GROUT LINES NOT STAINED AND NO ADDITIONS FOR THE ADDITIONAL STAIN REQUIRED TO COAT THE TEXTURED SURFACES.

ITEM 512- SEALING OF CONCRETE SURFACES (NON-EPOXY), AS PER PLAN

- STAIN AND SEALER SHALL BE APPLIED AS RECOMMENDED BY THE MANUFACTURER.
- USE A CLEAR SEALER, UNLESS SPECIFIED OTHERWISE.
- VERIFY THE PRODUCT FURNISHED IS COMPATIBLE WITH THE PROPOSED STAIN PRODUCT. PROVIDE WRITTEN VERIFICATION TO THE ENGINEER.
- THE ACRYLIC STAIN AND NON-EPOXY SEALER WILL BE PAID UNDER ITEM 512-SEALING OF CONCRETE SURFACES (NON-EPOXY), AS PER PLAN.

GENERAL CONCRETE SURFACE FINISH AND COLOR

- SURFACE POINTING. ONCE CAST, TIE RECESSES, MINOR HONEYCOMBING AND BUG HOLES IN THE SURFACE OF THE CONCRETE SHALL BE REPAIRED BY POINTED WITH CONCRETE MORTAR THAT CLOSELY MATCHES THE COLOR AND CONSISTENCY OF THE BASE POUR.
- SURFACE CLEANING AND FINISHING.
  - PRESSURE WASHING WITH WATER (MINIMUM 3000 PSI) IS THE PREFERRED METHOD OF REMOVING LATENT CONCRETE FROM RAISED RELIEF OR RECESSED AESTHETIC TREATMENTS. FOLLOWING SURFACE CLEANING, THE FINAL SURFACE SHALL BE FREE OF BLEMISHES, DISCOLORATIONS, VOIDS, AND FORM MARKS, TO THE SATISFACTION OF THE ENGINEER.
  - SANDBLASTING SHALL NOT BE ALLOWED FOR CLEANING CONCRETE SURFACES WITHIN AREAS OF AESTHETIC TREATMENTS, INCLUDING BAS-RELIEFS, RECESSED TEXT, MEDALLIONS, OR STANDARD FORM LINER FINISHES, AS IT WILL COMPROMISE THE CONTRAST AND CLARITY OF THE IMAGES.
  - GROUT CLEANING AND RUBBED SURFACE FINISHING SHALL NOT BE USED WITHIN AREAS OF AESTHETIC TREATMENTS, AS THESE METHODS WILL COMPROMISE THE CONTRAST AND CLARITY OF THE IMAGES.
- SURFACE COLOR.
  - CONCRETE SEALER. A NON-EPOXY SEALER SHALL BE APPLIED TO ALL EXPOSED AREAS OF CONCRETE AS SPECIFIED IN THE FINISH ELEVATIONS FROM SHEET A4.3 THROUGH A4.7.
- THE APPROVED SAMPLE PANELS SHALL BE THE BASIS FOR DETERMINING ACCEPTABILITY OF THE COLOR/STAIN APPLICATION. ANY AREAS LACKING UNIFORM APPEARANCE OR CONSISTENCY WITH THE APPROVED SAMPLE PANELS WILL BE RECOLORED TO THE SATISFACTION OF THE ENGINEER AT NO ADDITIONAL COST TO THE CLIENT.


GENERAL SHEET NOTE

- DO NOT SCALE OFF DRAWING.
- DRAWINGS ARE ONLY A GRAPHIC REPRESENTATION. ALL REQUIRED STRUCTURAL COMPONENTS & INFORMATION ARE OMITTED AND/OR MINIMIZED FOR THE PURPOSE OF GRAPHIC CLARITY. CONTRACTOR SHALL REFER TO STRUCTURAL DRAWINGS FOR INFORMATION OF ALL STRUCTURAL COMPONENTS REQUIREMENTS.
- CONTRACTOR TO REFER TO STRUCTURAL DRAWINGS FOR ACCURATE DIMENSIONS OF BRIDGE SPAN AND ALL ASSOCIATED COMPONENTS.
- CONTRACTOR TO SEE SHEET A3.0 FOR PARAPET CONCRETE STONE PATTERN INFORMATION & DETAILS.

PLOT.CEL  
 ms consultants, inc.  
 msconsultants.com  
 Ohio DOT Workspace  
 SUM-8  
 www.msconsultants.com  
 Batchplot Spec: \\msconsultants.com\files\Production\PM 60\08326\standards\plotdrv\batchplot.dwg  
 Pen Table: \\msconsultants.com\files\Production\PM 60\08326\standards\plotters\Clean and Clouded Revisions\16.ms\_std  
 Plot Driver: \\users\blester\pwork\drv\ms11763\pdr.plt  
 Model: Sheet  
 Printed: 4/11/2023 @ 5:25:40 PM  
 File: \\msconsultants.com\files\Production\PM 60\08326\structures\sheet\91710CN003.dgn  
 View: SHEET  
 By: Blester

**ITEM 503 - UNCLASSIFIED EXCAVATION, AS PER PLAN**

THE BACKFILL MATERIAL BEHIND ABUTMENTS SHALL BE PLACED AND COMPACTED IN 6" MAXIMUM LIFTS. THE LIMITS OF UNCLASSIFIED EXCAVATION ARE AS FOLLOWS:

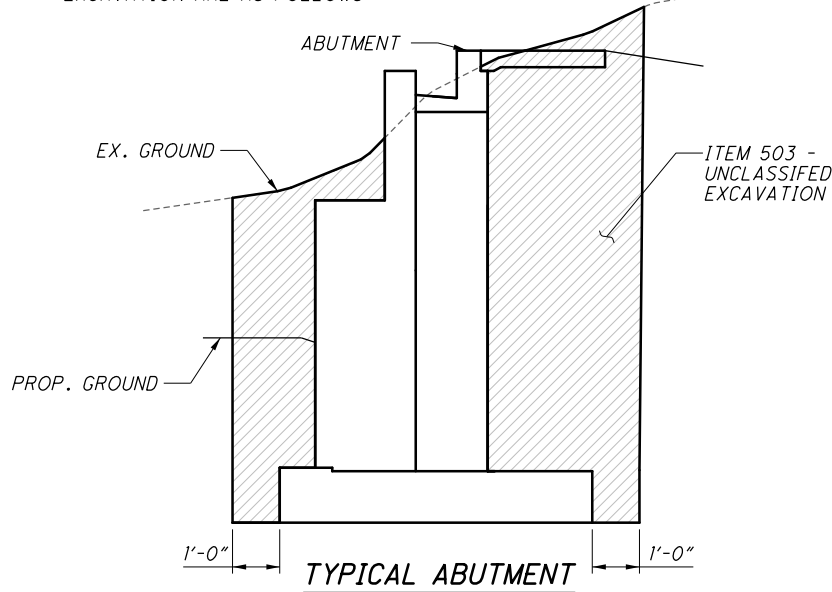

**PIER 5L CONTAMINATED SOIL**

THIS WORK SHALL CONSIST OF EXCAVATION FOR THE SUM-8-0199L (SOUTHBOUND) PIER 5 FOOTING. CONTAMINATED SOILS ARE ANTICIPATED TO EXIST AT THE FORMER ABC DEMOLITION/HARRIS STREET LANDFILL. LIMITS OF THE CONTAMINATED SOILS AS ENCOUNTERED IN BORING B-015-1-16 ARE SHOWN ON SHEET 541 OF 801. ALL REASONABLE AND FEASIBLE EXCAVATION OPTIONS SHALL BE UTILIZED BY THE CONTRACTOR TO MINIMIZE GRADING, EXCAVATION, AND SHORING TO THIS AREA. ANY HAZARDOUS/CONTAMINATED EXCAVATION MATERIAL ENCOUNTERED SHALL BE REMOVED AND DISPOSED OF ACCORDING TO THE CONTAMINATED SOIL NOTE ON PAGE [16/80] OF THE ROADWAY PLAN NOTES. FOLLOW ROADWAY PLAN NOTES FOR PAYMENT.

**ITEM 503 - STRUCTURAL EXCAVATION, MISC.: LAUNCHING PIT**

THIS WORK SHALL CONSIST OF ALL LABOR, MATERIAL AND EQUIPMENT TO CONSTRUCT THE TEMPORARY WALLS AND LAUNCHING PIT IN ACCORDANCE WITH THE PLANS AND DESIGN REQUIREMENTS SPECIFIED IN THE CONTRACT PLANS. THIS WORK SHALL BE PAID FOR AT THE CONTRACT LUMP SUM PRICE FOR ITEM 503 - STRUCTURAL EXCAVATION, MISC.: LAUNCHING PIT REFER TO THE STRUCTURAL STEEL ERECTION SPECIAL PROVISIONS FOR ADDITIONAL INFORMATION. ANY FILL MATERIAL PLACED SHALL BE COMPACTED IN 6" LIFTS.

**ITEM 503 - STRUCTURAL EXCAVATION, MISC.: RECEIVING PIT**

THIS WORK SHALL CONSIST OF ALL LABOR, MATERIAL AND EQUIPMENT TO CONSTRUCT THE TEMPORARY WALLS AND RECEIVING PIT IN ACCORDANCE WITH THE PLANS AND DESIGN REQUIREMENTS SPECIFIED IN THE CONTRACT PLANS. THIS WORK SHALL BE PAID FOR AT THE CONTRACT LUMP SUM PRICE FOR ITEM 503 - STRUCTURAL EXCAVATION, MISC.: RECEIVING PIT REFER TO THE STRUCTURAL STEEL ERECTION SPECIAL PROVISIONS FOR ADDITIONAL INFORMATION. ANY FILL MATERIAL PLACED SHALL BE COMPACTED IN 6" LIFTS.

**ITEM 503 - COFFERDAMS AND EXCAVATION BRACING, AS PER PLAN:**

THE DESIGN SHOWN ON THE PLANS FOR TEMPORARY SUPPORT OF EXCAVATION IS ONE REPRESENTATIVE DESIGN THAT MAY BE USED TO CONSTRUCT THE PROJECT. THE CONTRACTOR MAY CONSTRUCT THE DESIGN SHOWN ON THE PLANS OR PREPARE AN ALTERNATE DESIGN TO SUPPORT THE SIDES OF EXCAVATIONS. IF CONSTRUCTING AN ALTERNATE DESIGN FOR TEMPORARY SUPPORT OF EXCAVATION, PREPARE AND PROVIDE PLANS IN ACCORDANCE WITH CMS 501.05 EXCEPT AS REQUIRED FOR SHORING ADJACENT TO RAILROADS AS OUTLINED IN THE NOTE, STRUCTURE EXCAVATION AND SHORING ADJACENT TO RAILROADS, ON SHEET [20/226]. THE DEPARTMENT WILL PAY FOR THE TEMPORARY SUPPORT OF EXCAVATION AT THE CONTRACT LUMP SUM PRICE FOR COFFERDAMS AND EXCAVATION BRACING. NO ADDITIONAL PAYMENT WILL BE MADE FOR PROVIDING AN ALTERNATE DESIGN.

**ITEM 511 - CLASS QC4 MASS CONCRETE, SUBSTRUCTURE WITH QC/QA, AS PER PLAN**

CONCRETE SHALL CONFORM TO CMS 511 WITH THE EXCEPTION THAT THE CONCRETE SHALL BE 5 KSI FOR PIER CAPS AS DETAILED IN THE PLANS.

**ITEM 511 - CLASS QC1 CONCRETE, MISC.: FOOTING APRON**

THIS ITEM SHALL CONSIST OF ALL THE LABOR, MATERIAL, AND EQUIPMENT FOR THE CONCRETE APRON TO BE INSTALLED AT PIER 5 FOR BOTH NORTHBOUND AND SOUTHBOUND BRIDGES IN ACCORDANCE WITH THE PLANS AND DESIGN REQUIREMENTS SPECIFIED IN THE CONTRACT PLANS. THIS WORK SHALL BE PAID FOR AT THE CONTRACT UNIT PRICE FOR ITEM 511 - CLASS QC1 CONCRETE, MISC.: FOOTING APRON.


**ITEM 511 - CLASS QC2 CONCRETE WITH QC/QA, BRIDGE DECK, AS PER PLAN**

LOCATE THE LOWER CONTACT POINT OF THE OVERHANG FALSEWORK AT LEAST 42 INCHES ±2 IN. ABOVE THE TOP OF THE GIRDER'S BOTTOM FLANGE. THE BRACKET CONTACT POINT LOCATION REQUIREMENTS OF CMS 508 DO NOT APPLY. IN ADDITION TO THE WORK REQUIREMENTS OF 511, THE CONTRACTOR MAY EITHER PROVIDE TRADITIONAL BRIDGE FORMS, CONFORMING TO CMS 508 OR DESIGN, BUILD, PROVIDE, AND CONSTRUCT GALVANIZED STEEL STAY-IN-PLACE (SIP) FABRICATED METAL FORMS CONFORMING TO CMS 508. SUBMIT 501.06 TEST REPORTS AND WRITTEN ACCEPTANCE LETTERS TO THE ENGINEER. MATERIALS INSPECTION AND ACCEPTANCE IS PERFORMED BY THE ENGINEER AT THE PROJECT SITE. FURNISH FORM, SUPPORT MATERIALS AND HARDWARE CONFORMING TO THE FOLLOWING:

- A. FORM AND SUPPORT MATERIAL, ASTM A653 HAVING A COATING DESIGNATION OF G235, AND CONFORMING TO THE MECHANICAL PROPERTIES THE DESIGN REQUIRES.
- B. PROVIDE DECK FORMS WITH A 2-INCH MINIMUM FORM DEPTH.
- C. PROVIDE MINIMUM MATERIAL THICKNESS AS FOLLOWS: SIP FORMS (20 GAGE), SUPPORT ANGLES (20 GAGE) AND SUPPORT BARS (12 GAGE).
- D. SUPPLY ZINC COATED DECK, SELF DRILLING FASTENERS. THE HEADS OF THESE FASTENERS WILL BE A HIGHLY VISIBLE COLOR, RED OR OTHER, TO AID THE INSPECTION.

THE DEPARTMENT WILL NOT SEPARATELY PAY FOR SIP FORMS. THE COST OF THIS WORK IF CHOSEN BY THE CONTRACTOR SHALL BE INCLUDED FOR PAYMENT IN THE PRICE BID FOR ITEM 511. THE DEPARTMENT WILL NOT PAY FOR ANY ADDITIONAL CONCRETE, REINFORCING STEEL, OR STRUCTURAL STEEL THAT MAY BE REQUIRED WHEN USING SIP FORMS. ANY ADDITIONAL COST AND/OR DESIGN ASSOCIATED WITH THE USE OF SIP FORMS SHALL BE THE RESPONSIBILITY OF THE CONTRACTOR. THE ADDITIONAL DEAD LOAD OF THE SIP FORM PLUS THE WEIGHT OF THE ADDITIONAL CONCRETE WAS CALCULATED AS SPECIFIED IN THE DESIGN LOADS AND WAS INCLUDED IN THE DESIGN OF THE BRIDGE BEAMS OR GIRDERS, CAMBER DIAGRAMS, DECK SCREED TABLES, BRIDGE BEARINGS AND SUBSTRUCTURES. SHOULD THE CONTRACTOR CHANGE ANY LOAD SPECIFIED IN THE DESIGN LOADS, THE CONTRACTOR SHALL BE RESPONSIBLE FOR ANY DESIGN, FABRICATION, AND INSTALLATION MODIFICATIONS TO THE BRIDGE COMPONENTS INCLUDING THE BRIDGE BEAMS OR GIRDERS, CAMBER DIAGRAMS, DECK SCREED TABLES, BRIDGE BEARINGS, AND SUBSTRUCTURES. ALL PLAN MODIFICATIONS SHALL BE PREPARED AS PER 501.

PROVIDE TEMPORARY BLOCKING TO SUPPORT LOWER CONTACT POINT. SUGGESTED DETAIL SHOWN BELOW.

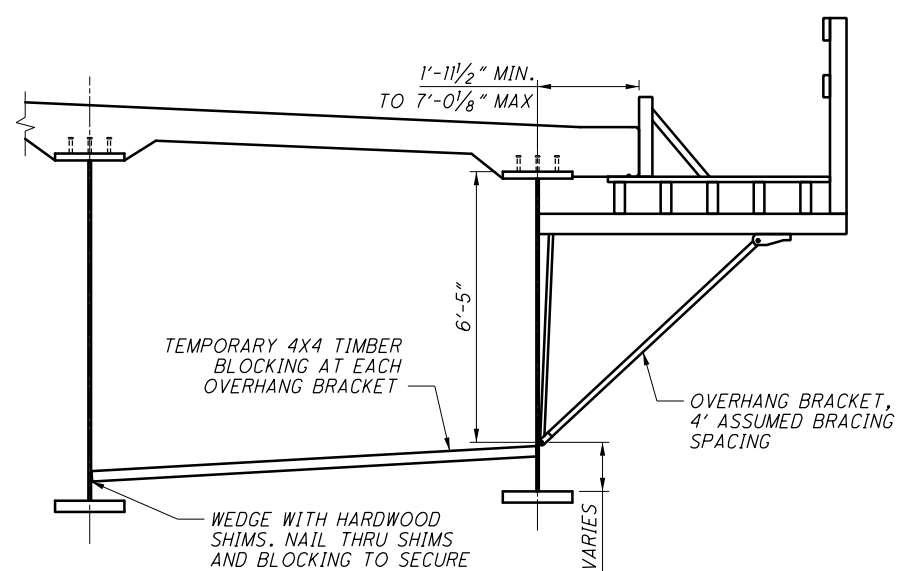


**ITEM 511 - CLASS QC1 CONCRETE, MISC.: FILL CONCRETE**

PLACE CLASS QC1 CONCRETE, MISC.: FILL CONCRETE FROM A DISTANCE OF THE BOTTOM OF REAR ABUTMENT FOOTING TO THE TOP OF BEDROCK, AS DETERMINED BY THE ENGINEER. CLASS QC1 CONCRETE, MISC.: FILL CONCRETE SHALL BE PLACED NEAT AGAINST NATIVE ROCK.

THIS ITEM CONSISTS OF FURNISHING ALL NECESSARY LABOR, MATERIALS AND EQUIPMENT REQUIRED FOR EXCAVATION TO THE TOP OF BEDROCK AS WELL AS DEWATERING AND CONCRETE PLACEMENT. NO PAYMENT WILL BE MADE FOR OVER-EXCAVATION AND PLACEMENT IN EXCESS OF THE LATERAL LIMITS LOCATED ONE FOOT BEYOND THE LIMIT OF THE PROPOSED FOOTING OR AS INDICATED ON THE PLANS. ADDITIONAL EXCAVATION AND PLACEMENT OF AREAS TO ACCOMMODATE THE CONTRACTOR'S MEANS AND METHODS WILL BE CONSIDERED INCIDENTAL TO THIS WORK.

**ITEM 511 - CLASS QC1 CONCRETE, MISC.: FILL CONCRETE (CONTINUED)**

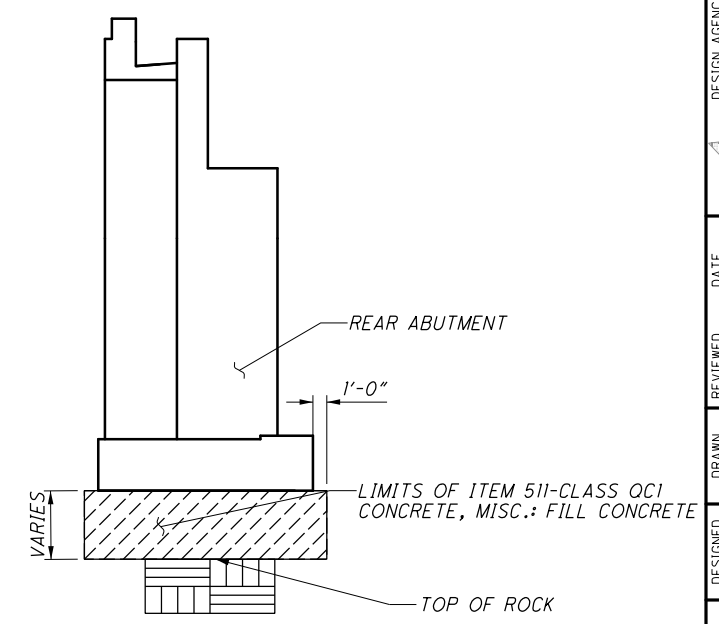

**REAR ABUTMENT SECTION**

**ITEM 512 - SEALING OF CONCRETE SURFACES, AS PER PLAN**

APPLY A PERMANENT ANTI-GRAFFITI COATING QUALIFIED ACCORDING TO SUPPLEMENT 1083 THAT IS COMPATIBLE WITH THE CONCRETE SEALER OVER WHICH IT IS APPLIED. APPLY THE ANTI-GRAFFITI COATING IN ACCORDANCE WITH THE MANUFACTURER'S PRINTED INSTRUCTIONS.

**ITEM 512 - SEALING OF CONCRETE SURFACES (NON-EPOXY), AS PER PLAN**

SEALING AND COLOR STAINING OF REAR ABUTMENT, PIERS AND PARAPETS SHALL BE IN ACCORDANCE WITH THE PIER AND AESTHETIC DETAIL SHEETS.

**ITEM 513 - STRUCTURAL STEEL, MISC.: MONUMENT**

THIS WORK SHALL CONSIST OF FURNISHING ALL NECESSARY LABOR, MATERIALS AND EQUIPMENT TO FURNISH AND ERECT THE STEEL MONUMENT. ALL PROVISIONS OF 513 SHALL APPLY.

**ITEM 513 - STRUCTURAL STEEL, MISC.: STRUCTURAL STEEL ERECTION EQUIPMENT**

THIS WORK SHALL CONSIST OF FURNISHING ALL NECESSARY LABOR, MATERIALS AND EQUIPMENT TO FURNISH AND ERECT THE LAUNCHING NOSE, LAUNCHING TAIL, KINGPOST, TEMPORARY BRACING, ROLLERS, AND ALL OTHER TEMPORARY DETAILS NECESSARY. REFER TO THE STRUCTURAL STEEL ERECTION SPECIAL PROVISIONS FOR ADDITIONAL INFORMATION.

**ITEM 513 - STRUCTURAL STEEL MEMBERS, HYBRID GIRDER, LEVEL SIX (6) FABRICATION, AS PER PLAN**

- A. DESCRIPTION
  1. THIS WORK CONSISTS OF FURNISHING ALL NECESSARY LABOR, MATERIALS AND EQUIPMENT TO FURNISH AND ERECT STRUCTURAL STEEL MEMBERS UTILIZING THE LAUNCHING METHODS SHOWN IN THESE PLANS AND AS PER SPECIAL PROVISIONS PROVIDED IN THE FINAL BID DOCUMENTS.
  2. ALL STEEL MEMBERS SHALL BE DESIGNATED AS LEVEL 6 FABRICATION.
  3. THIS WORK SHALL BE PERFORMED PER ITEM 513 STRUCTURAL STEEL MEMBER, LEVEL SIX EXCEPT AS MODIFIED BY THE STEEL BRIDGE FABRICATION GUIDE SPECIFICATIONS (AASHTO/NSBA STEEL BRIDGE COLLABORATION 2018), AND AS MODIFIED IN THESE PLAN NOTES.
- B. MATERIALS
  1. STEEL FOR GIRDER WEBS AND FLANGES SHALL BE A COMBINATION OF ASTM A709 GRADE HPS70W MANUFACTURED BY THE THERMO-MECHANICAL CONTROLLED PROCESSING (TMCP) OR QUENCHED AND TEMPERED HEAT TREATMENT PROCESSING ALONG WITH ASTM A588/709 GRADE 50W. ALL OTHER STEEL SHALL BE ASTM A709 GRADE 50W.
  2. STEEL DESIGNATED CVN SHALL BE IMPACT TESTED TO EXCEED THE TEST VALUES OF ASTM A709 TABLE S1.2 NON-FRACTURE CRITICAL IMPACT TEST REQUIREMENTS FOR ZONE 2, TEMPERATURE RANGE.

DESIGN AGENCY  
 ms consultants, inc.  
 2221 Schrock Road  
 Columbus, Ohio 43229

DATE  
 20-APR

REVIEWED  
 GLG

DRAWN  
 ABD

DESIGNED  
 ABD

CHECKED  
 ELP

STRUCTURE FILE NUMBER  
 7700370/7700371

GENERAL NOTES (3 OF 7)  
 BRIDGE NO. SUM-8-0199L/R - OVER RAILROADS  
 (CSXT, W&LE, AND METRO RTA), LITTLE CUYAHOGA RIVER, AND EAST NORTH STREET

SUM-8-1.75  
 PID No. 91710

16 / 226

514  
 801

ms consultants, inc.



**ITEM 517 - RAILING, MISC: DECORATIVE RAILING WITH CHAIN LINK FENCE, AS PER PLAN**

**DESCRIPTION:**

THIS ITEM SHALL CONSIST OF FURNISHING ALL NECESSARY LABOR, MATERIALS AND EQUIPMENT TO FABRICATE, GALVANIZE, CLEAN, APPLYING A TWO COAT SHOP PAINT SYSTEM (EPOXY/URETHANE) AND INSTALLING THE DECORATIVE RAILING WITH CHAIN LINK FENCE AS DETAILED IN THESE PLANS AND NOTES. UNLESS OTHERWISE SPECIFIED IN THE PLANS, INSTALL POSTS AND POST SLEEVES PLUMB. FOR ADDITIONAL DETAILS, SEE AESTHETIC PLANS.

**SHOP DRAWINGS DETAILING FENCE FABRICATION:**

SUBMIT SHOP DRAWINGS IN ACCORDANCE WITH 501.04 AND INCLUDE DETAILS THAT CLEARLY IDENTIFY ALL OF THE REQUIREMENTS LISTED HEREIN. PROVIDE CONNECTIONS CONSISTENT WITH CONCEPTS SHOWN ON THE DRAWING. INDICATE WELDS BY STANDARD AWS SYMBOLS, DISTINGUISHING BETWEEN SHOP AND FIELD WELDS, AND SHOW SIZE, LENGTH AND TYPE OF EACH WELD. IDENTIFY GRINDING FINISH AND PROFILE OF WELDS AS DEFINED HEREIN. INDICATE TYPE, SIZE, FINISH AND LENGTH OF BOLTS, DISTINGUISHING BETWEEN SHOP AND FIELD BOLTS. IDENTIFY HIGH STRENGTH BOLTED SLIP-CRITICAL DIRECT-TENSIONED SHEAR/BEARING CONNECTIONS. CLEARLY INDICATE WHICH SURFACES OR EDGES ARE EXPOSED AND WHAT CLASS OF SURFACE PREPARATION IS BEING USED. INDICATE SPECIAL TOLERANCES AND ERECTION REQUIREMENT AS NOTED ON THE DRAWINGS OR DEFINED HEREIN.

**SUBMIT MANUFACTURER'S COLOR CHARTS:**

SUBMIT SAMPLES OF EACH COLOR AND MATERIAL TO BE APPLIED, WITH TEXTURE TO SIMULATE ACTUAL CONDITIONS, ON REPRESENTATIVE SAMPLE, OF THE ACTUAL SUBSTRATE. PROVIDE STEPPED SAMPLES, DEFINING EACH SEPARATE COAT, INCLUDING BLOCK FILLERS AND PRIMERS. USE REPRESENTATIVE COLORS WHEN PREPARING SAMPLES FOR REVIEW. RESUBMIT UNTIL REQUIRED SHEEN, COLOR, AND TEXTURE ARE ACHIEVED. PROVIDE A LIST OF MATERIAL AND APPLICATION FOR EACH COAT OF EACH SAMPLE; LABEL EACH SAMPLE AS TO LOCATION AND APPLICATION. SUBMIT SAMPLES ON THE FOLLOWING SUBSTRATES FOR THE FIELD ENGINEER'S REVIEW OF COLOR AND TEXTURE ONLY: FERROUS METAL: TWO 8 INCH LONG SAMPLE OF SOLID METAL FOR EACH COLOR AND FINISH.

**FABRIC:**

FABRIC SHALL CONSIST OF A 1 INCH INTERCRIMP WOVEN WIRE MESH USING 0.12 INCH DIA. (11 GAGE) CRIMPED WIRE CONFORMING TO ASTM E2016 EXCEPT AS NOTED. THE PVC COATING SHALL BE BROWN IN COLOR CLOSELY APPROACHING FEDERAL COLOR STANDARD NO. 20059 UNLESS OTHERWISE SPECIFIED IN THE PLANS. HANDLE ALL PVC COATED FABRIC WITH CARE. IF THE PVC COATING IS DAMAGED, REPLACE THE DAMAGED PORTION OF THE FABRIC AT NO COST TO THE DEPARTMENT. THE INSTALLATION SHOULD BE AS PER 709.

**FABRICATION:**

FABRICATION OF THE RAILING SHALL BE IN ACCORDANCE WITH CMS 513, UF LEVEL. COATING OF THE RAILING SHALL BE IN ACCORDANCE WITH CMS 514, EXCEPT AS NOTED BELOW.

THE GALVANIZED COATING SYSTEM MAY BE APPLIED BY A GALVANIZER NOT PRE-QUALIFIED AS A FABRICATION SHOP UNDER SUPPLEMENT 1078, BUT THE PRE-QUALIFIED FABRICATOR OF THE STRUCTURAL STEEL SHALL BE RESPONSIBLE FOR THE QUALITY OF THE APPLIED GALVANIZED COATING SYSTEM AND ANY REPAIRS, RE-FABRICATION AND ADDITIONAL ASSEMBLIES REQUIRED TO ASSURE THE FABRICATED STEEL MEETS THE PLAN REQUIREMENTS.

THE TWO SHOP COATS SHALL BE APPLIED IN A STRUCTURAL STEEL FABRICATION SHOP HAVING PERMANENT BUILDINGS PER 513.04 AND PRE-QUALIFIED AT THE UF LEVEL. THE PAINT QUALITY CONTROL SPECIALIST (QCS) SHALL BE QUALIFIED AS SPECIFIED IN 514.04.

PRIOR TO GALVANIZING, ALL CORNERS OF THERMALLY CUT OR SHEARED EDGES SHALL HAVE A 1/16 INCH RADIUS OR EQUIVALENT FLAT SURFACE AT A SUITABLE ANGLE.

GALVANIZE THE FABRICATED RAILING AND HARDWARE ACCORDING TO CMS 711.02, EXCEPT THAT FABRICATED RAILING ELEMENTS SHALL NOT BE POST TREATED WITH WATER QUENCHING OR CHROMATE CONVERSION COATED.

AFTER GALVANIZATION, REMOVE ZINC HIGH SPOTS SUCH AS METAL DRIP LINE AND OTHERS THAT WOULD DETRACT FROM THE PAINT APPEARANCE BY SSPC SP2 OR SP3. TAKE CARE THAT THE BASE GALVANIZED COATING IS NOT REMOVED. CHECK REPAIRED AREAS FOR REQUIRED COATING THICKNESS.

REPAIR GALVANIZED COATINGS DAMAGED IN THE SHOP ACCORDING TO ASTM A780 METHOD A3. REPAIR GALVANIZED COATINGS DAMAGED IN THE FIELD ACCORDING TO ASTM A780 METHOD A1.

AFTER REMOVING HIGH SPOTS, CLEAN THE GALVANIZED COATING ACCORDING TO SSPC SP-1. THE CLEANING SOLUTION SHALL BE AN ALKALINE SOLUTION WITH A PH RANGING FROM A MINIMUM OF 11 TO A MAXIMUM OF 12. THIS SOLUTION CAN BE APPLIED BY IMMERSION, SPRAY OR SOFT NYLON BRUSH. FOLLOW CLEANING WITH A HOT WATER OR HOT PRESSURE WASHER RINSE. SEPARATE INDIVIDUAL PIECES AND POSITION TO FACILITATE DRAINAGE AND DRYING. THE PIECES SHALL BE COMPLETELY DRY BEFORE PROCEEDING.

AFTER CLEANING, ABRASIVE BLAST THE PIECES ACCORDING TO SSPC-SP7 BRUSH-OFF BLAST CLEANING. THE BLASTING OPERATION SHALL ROUGHEN THE GALVANIZED SURFACE TO AN ANGULAR SURFACE PROFILE OF 0.75 TO 1.00 MILLS. SELECT THE BLASTING EQUIPMENT, TECHNIQUE AND ABRASIVE MATERIAL TO PROVIDE FOR THE SPECIFIED SURFACE PROFILE WITHOUT REMOVAL OF EXCESSIVE ZINC LAYERS. THE FINAL ZINC MILAGE SHALL NOT BE LESS THAN 4.0 MILS. REMOVE ALL ABRASIVE RESIDUES WITH CLEAN COMPRESSED AIR OR OTHER METHODS ACCEPTABLE TO THE DEPARTMENT.

AFTER OBTAINING SURFACE PROFILE, SHOP APPLIES A TWO COAT PAINT SYSTEM ACCORDING TO 514 CONSISTING OF EPOXY INTERMEDIATE COAT AND A URETHANE FINISH COAT MEETING THE REQUIREMENTS OF CMS 708.02. THE FINISH COAT SHALL MATCH FEDERAL COLOR STANDARD NO. 20059. APPLY THE EPOXY COATING WITHIN 24 HOURS OF THE BRUSH-OFF BLASTING.

**FENCE POST:**

FENCE POST, TOP AND BOTTOM RAILS SHALL BE 2.5 INCH BY 2.5 INCH (OUTSIDE DIMENSION) SQUARE TUBING OR SQUARE CHANNEL CMS 707.10, GRADE 36 OR 50 STEEL TUBE GALVANIZED ACCORDING TO 711.02 WITH A WALL THICKNESS OF 0.25 INCH.

**FENCE MIDDLE RAILS:**

FENCE MIDDLE RAILS SHALL BE 1.5 INCH BY 1.5 INCH (OUTSIDE DIMENSION) SQUARE CMS 707.10, GRADE 36 OR 50 STEEL TUBE GALVANIZED ACCORDING TO 711.02 WITH A WALL THICKNESS OF 0.125 INCH.

**POST SLEEVES:**

POST SLEEVES SHALL BE 2.75 INCH BY 2.75 INCH (OUTSIDE DIMENSION) STEEL CMS 707.10, 25,000 PSI MINIMUM YIELD STRENGTH, AND 4.75 LB/FT, GALVANIZED ACCORDING TO 711.02. HEXAGON SOCKET SET SCREW SHALL BE SAE 4140 ALLOY STEEL, HEAT TREATED, WITH FLAT OR OVAL POINT.

**BASE PLATE:**

BASE PLATES SHALL BE ASTM A709 GRADE 36 OR 50 GALVANIZED ACCORDING TO 711.02.

**FASTENERS:**

THE 3/8 INCH DIA. STAINLESS STEEL BOLTS, NUTS AND WASHERS SHALL BE IN ACCORDANCE WITH C&MS 730.10.

THE 1/2 INCH DIA. THREADED ROD FOR ADHESIVE ANCHORS SHALL BE ASTM A193, GRADE B7, WITH ASTM A 563 NUTS AND ASTM F 436 WASHERS. MECHANICALLY GALVANIZE ALL ANCHOR HARDWARE ACCORDING TO ASTM B 695, CLASS 65.

USE AN ANCHOR ADHESIVE EVALUATED ACCORDING TO ICCES REPORT AC308, "ACCEPTANCE CRITERIA FOR POST INSTALLED ADHESIVE ANCHORS IN CONCRETE ELEMENTS", FOR CRACKED AND UNCRACKED CONCRETE APPLICATIONS. PUBLISHED ICCES REPORTS FOR ACCEPTABLE PRODUCT ARE AVAILABLE AT: WWW.ICC-ES.ORG/EVALUATION.REPORTS/INDEX.SHTML

**SELECT FROM ONE OF THE FOLLOWING APPROVED PRODUCTS:**

POWERS PE1000+ EPOXY ADHESIVE ANCHOR SYSTEM (ICCES REPORT ESR-2583)

CHEMFAST C-RE 385 EPOXY ADHESIVE ANCHOR SYSTEM (ICCES REPORT ESR-2538)

SIMPSON STRONG-TIE SET -XP ADHESIVE ANCHORS (ICCES REPORT ESR-2508)

WURTH WIT-PE500 EPOXY ADHESIVE ANCHORS (ICCES REPORT ESR-3051)

INSTALL ADHESIVE ANCHORS ACCORDING TO THE MANUFACTURER'S INSTALLATION INSTRUCTIONS PUBLISHED IN SECTION 4.3 OF THE ICCES REPORT LISTED ABOVE. THE MINIMUM EMBEDMENT DEPTH FOR ANCHORS SHALL BE 7 INCHES.

**FABRIC TIES AND HOG RINGS:**

FABRIC TIES AND HOG RINGS SHALL BE 0.148 INCH CORE DIAMETER GALVANIZED PVC COATED STEEL WIRE AND 0.120 INCH ANNEALED STAINLESS STEEL WIRE CONFORMING TO ASTM A478 RESPECTIVELY. TO CONNECT THE FABRIC TO THE LINE POSTS, SUPPLY ONE FABRIC TIE FOR EACH ONE FOOT OF FABRIC HEIGHT. CONNECT THE FABRIC TO THE TENSION WIRE USING HOG RINGS 2-3 INCHES ON EACH SIDE OF THE POSTS AND AT SPACINGS NOT TO EXCEED 12 INCHES BETWEEN POSTS. THE PVC COATING SHALL BE THE SAME AS THAT FOR THE STEEL FABRIC.

**FILLET WELDS:**

FILLET WELDS SHALL CONFORM TO ODOT 513.

**SHIM PLATES:**

SHIP PLATES SHALL BE MADE FROM ANY MULTI-POLYMER PLASTIC WITH A MINIMUM COMPRESSIVE STRENGTH OF 5,000 PSI IN ORDER TO INSTALL POSTS PLUMB, ENDS OF POSTS AND SLEEVES MAY BE CUT ON A BIAS.

**CAULKING COMPOUND:**

CAULKING COMPOUND SHALL CONFORM TO FEDERAL SPECIFICATION TT-S-00230 TYPE II, CLASS A, ALUMINUM GRAY. WHEN APPLYING CAULK TO THE BASE PLATE, PROVIDE A 1 INCH OPENING THROUGH THE CAULKING ON LOW SIDE OF BASE PLATE.

**SILICONE CAULK:**

SILICONE CAULK SHALL CONFORM TO ASTM C-920, TYPE -S, GRADE-NS, CLASS 25, USE NT TEST REQUIREMENTS. COLOR: CLEAR.

**CONSTRUCTION PROCEDURE:**

1. FIELD VERIFY THE PLAN LOCATIONS OF ALL BASE PLATES AND MARK PARAPET ACCORDINGLY.
2. MARK AND DRILL HOLES FOR THE 1/2 INCH HIGH STRENGTH THREADED ANCHORS OR 1/2 INCH BOLTS USING A BASE PLATE OR TEMPLATE.
3. INSTALL 1/2 IN DIAMETER HIGH STRENGTH THREADED ANCHORS OR 1/2 INCH BOLTS.
4. INSTALL POSTS AND BASE PLATES AND SHIMS WHERE REQUIRED.
5. CAULK EDGES OF BASE PLATES, SHIMS AND SLEEVES.
6. COMPLETE INSTALLATION OF THE RAIL.

INSTALL FENCING FOR EACH CONSTRUCTION PHASE PRIOR TO OPENING THAT PHASE TO VEHICULAR AND/OR PEDESTRIAN TRAFFIC.

**METHOD OF MEASUREMENT:**

THE DEPARTMENT WILL MEASURE THE QUANTITY BY THE FOOT. THE DEPARTMENT WILL MEASURE ALONG THE BOTTOM OF THE RAIL INCLUDING END POST.

**BASIS OF PAYMENT:**

THE DEPARTMENT WILL MAKE PAYMENT FOR THE COMPLETED AND ACCEPTED QUANTITIES AT CONTRACT PRICE AS FOLLOWS:

ITEM	EXT	UNIT	DESCRIPTION
517	75301	FOOT	RAILING, MISC: DECORATIVE RAILING WITH CHAIN LINK FENCE, AS PER PLAN

Model: Sheet  
 Printed: 4/12/2023 @ 10:02:58 AM  
 View: SHEET  
 By: Bl ester  
 File: \\msconsultants.com\Files\Production\60\08326\Standards\19170G0006.dgn  
 Batchplot Spec: \\msconsultants.com\Files\Production\60\08326\Standards\plotdrv\batchplot.spic  
 Pen Table: N:\PW\60\08326\Standards\plotdrv\Clean and Clouded Revisions\VB8.ms\_std - Clouded  
 Plot Driver: c:\users\blester\work\mst1763\PDF.plt  
 Ohio DOT Workspace  
 SUM-8  
 www.mscconsultants.com  
 34" x 22"

DESIGN AGENCY  
**ms consultants, inc.**  
 2221 Schrock Road  
 Columbus, Ohio 43229  
 DATE: 20-APR  
 REVIEWED: GLG  
 STRUCTURE FILE NUMBER: 7700370/7700371  
 DRAWN: ATM  
 CHECKED: ELP  
 DESIGNED: ATM  
 REVISIONS:

**GENERAL NOTES (6 OF 7)**  
 BRIDGE NO. SUM-8-0199L/R - OVER RAILROADS  
 (CSXT, W&LE, AND METRO RTA), LITTLE CUYAHOGA RIVER, AND EAST NORTH STREET

**SUM-8-1.75**  
**PID No. 91710**

19 / 226  
 517  
 801

ms consultants, inc.



Ohio DOT Workspace  
SUM-8  
www.msconsultants.com



Batchplot Spec: \msconsultants.com\files\Production\PM 60\08326\standards\plotdrv\batchplot.spj;CF: opdrv8;  
Pen Table: N:\PM 60\08326\standards\plotdrv\Clean and Clouded Revisions\VB.ms\_std - Clouded;PLOT: 60-08326-PW  
Plot Driver: c:\users\blester\work\dr\ms1763\PDF.plt;cf

Batchplot Spec: \msconsultants.com\files\Production\PM 60\08326\standards\plotdrv\batchplot.spj;CF: opdrv8;  
Pen Table: N:\PM 60\08326\standards\plotdrv\Clean and Clouded Revisions\VB.ms\_std - Clouded;PLOT: 60-08326-PW  
Plot Driver: c:\users\blester\work\dr\ms1763\PDF.plt;cf

34" x 22"

Model: Sheet  
Printed: 4/11/2023 5:25:59 PM By: Blester  
File: \msconsultants.com\files\Production\PM 60\08326\structures\sheet\91710E0001.dgn

Model: Sheet  
Printed: 4/11/2023 5:25:59 PM By: Blester  
File: \msconsultants.com\files\Production\PM 60\08326\structures\sheet\91710E0001.dgn

ESTIMATED QUANTITIES

ITEM	ITEM EXT.	TOTAL SOUTHBOUND	TOTAL NORTHBOUND	PART.				UNIT	DESCRIPTION	SOUTHBOUND				NORTHBOUND				SHEET REF.	
				01/BRO/II	02/NHS/31**	03/NH S/20	04/NH S/04			ABUT.	PIERS	SUPER.	GEN.	ABUT.	PIERS	SUPER.	GEN.		
202	11003		LUMP	LUMP															15 / 226
202	22900		521	521				SY	STRUCTURE REMOVED, OVER 20 FOOT SPAN, AS PER PLAN									521	
203	20001	12,924	1,722	14,646				CY	EMBANKMENT, AS PER PLAN*	12,924				1,722					15 / 226
203	35110	75	75	150				CY	GRANULAR MATERIAL, TYPE B*		75				75				
304	20000	130	130	260				CY	AGGREGATE BASE*		130				130				
503	11101	LUMP	LUMP	LUMP					COFFERDAMS AND EXCAVATION BRACING, AS PER PLAN										16 / 226
503	21101	4,506	7,675	12,181				CY	UNCLASSIFIED EXCAVATION, AS PER PLAN	2,015	2,491			5,854	1,821				16 / 226
503	31100		829	829				CY	ROCK EXCAVATION					664	165				
503	31500	LUMP	LUMP	LUMP					STRUCTURAL EXCAVATION, MISC.: LAUNCHING PIT										16 / 226
503	31500	LUMP	LUMP	LUMP					STRUCTURAL EXCAVATION, MISC.: RECEIVING PIT										16 / 226
505	11100	LUMP	LUMP	LUMP					PILE DRIVING EQUIPMENT MOBILIZATION										
507	00600	2,200	1,855	4,055				FT	14" CAST-IN-PLACE REINFORCED CONCRETE PILES, DRIVEN	2,200				1,855					
507	00650	2,400	2,120	4,520				FT	14" CAST-IN-PLACE REINFORCED CONCRETE PILES, FURNISHED	2,400				2,120					
507	00700	3,910	3,450	7,360				FT	16" CAST-IN-PLACE REINFORCED CONCRETE PILES, DRIVEN		3,910				3,450				
507	00750	4,140	3,680	7,820				FT	16" CAST-IN-PLACE REINFORCED CONCRETE PILES, FURNISHED		4,140				3,680				14 / 226
509	10000	3,006,458	3,016,127	6,011,568	11,017			LB	EPOXY COATED STEEL REINFORCEMENT	201,151	1,245,219	1,560,088		235,878	1,236,580	1,543,669			
509	30020	53,782	53,366	107,148				FT	NO. 4 DEFORMED GFRP REINFORCEMENT			53,782				53,366			
510	10000	612	612	1224				EACH	DOWEL HOLES WITH NONSHRINK, NONMETALLIC GROUT		612				612				
511	34447	4,414	4,349	8,763				CY	CLASS QC2 CONCRETE WITH OC/OA, BRIDGE DECK, AS PER PLAN			4,407	7		4,340	9			16 / 226
511	34450	515	506	1,021				CY	CLASS QC2 CONCRETE WITH OC/OA, BRIDGE DECK (PARAPET)			495	20		486	20			
511	42012	1,570	1,649	3,219				CY	CLASS QC1 CONCRETE WITH OC/OA, PIER ABOVE FOOTINGS		1,570				1,649				
511	42512	91	91	182				CY	CLASS QC1 CONCRETE WITH OC/OA, PIER CAP		91				91				
511	44112	495	526	1,021				CY	CLASS QC1 CONCRETE WITH OC/OA, ABUTMENT NOT INCLUDING FOOTING	495					526				
511	45602	2,074	2,071	4,145				CY	CLASS QC4 MASS CONCRETE, SUBSTRUCTURE WITH OC/OA	529	1,545			526	1,545				
511	45603	4,999	4,854	9,853				CY	CLASS QC4 MASS CONCRETE, SUBSTRUCTURE WITH OC/OA, AS PER PLAN		4,999				4,854				16 / 226
511	46012	131	406	537				CY	CLASS QC1 CONCRETE WITH OC/OA, RETAINING/WINGWALL NOT INCLUDING FOOTING	131				406					
511	46512	479	624	1,103				CY	CLASS QC1 CONCRETE WITH OC/OA, FOOTING	479				624					
511	53010	114		114				CY	CLASS QC1 CONCRETE, MISC.: FILL CONCRETE	114									16 / 226
511	53010	147		147				CY	CLASS QC1 CONCRETE, MISC.: MONUMENT				147						
511	53010	250	250	500				CY	CLASS QC1 CONCRETE, MISC.: FOOTING APRON		250				250				16 / 226
512	10001	1,808	1,957	3,765				SY	SEALING OF CONCRETE SURFACES, AS PER PLAN	420	1,388			569	1,388				16 / 226
512	10050	1,835	1,872	3,707				SY	SEALING OF CONCRETE SURFACES, (NON-EPOXY)	191		1,644		259	1,613				
512	10051	7,341	7,666	14,751	256			SY	SEALING OF CONCRETE SURFACES, (NON-EPOXY), AS PER PLAN	420	4,810	2,111		825	4,770	2,071			16 / 226
512	33000	129	156	285				SY	TYPE 2 WATERPROOFING	129				156					
513	10401	8,253,152	7,779,001	16,032,153				LB	STRUCTURAL STEEL MEMBERS, HYBRID GIRDER, LEVEL SIX (6) FABRICATION, AS PER PLAN			8,253,152			7,779,001				16 / 226
513	20000	23,330	23,248	46,578				EACH	WELDED STUD SHEAR CONNECTORS	326		23,004		316	22,932				
513	90000	35,909		35,909				LB	STRUCTURAL STEEL, MISC.: MONUMENT				35,909						16 / 226
513	95020	LUMP	LUMP	LUMP					STRUCTURAL STEEL, MISC.: STRUCTURAL STEEL ERECTION EQUIPMENT										16 / 226
514	00060	39,124	39,028	78,152				SF	FIELD PAINTING STRUCTURAL STEEL, INTERMEDIATE COAT			39,124			39,028				
514	00066	39,124	39,028	78,152				SF	FIELD PAINTING STRUCTURAL STEEL, FINISH COAT			39,124			39,028				
514	27700		3,727	3,727				SF	FIELD PAINTING, MISC.: MONUMENT DECORATIVE STEEL							3,727			18 / 226
516	12400	162	157	319				FT	SPECIAL - MODULAR EXPANSION JOINT	162				157					17 / 226
516	13600	271	344	615				SF	1" PREFORMED EXPANSION JOINT FILLER	142	129			215	129				
516	13900	102	102	204				SF	2" PREFORMED EXPANSION JOINT FILLER	102				102					

LEGEND:

- \* QUANTITY CARRIED TO GENERAL SUMMARY
- \*\* QUANTITY APPLIES TO THE REAR ABUTMENT MONUMENT

CALCULATED BY: ATM  
CHECKED BY: ELP  
DATE: 2019 SEPT.  
DATE: 2019 SEPT.

DESIGN AGENCY  
ms consultants, inc.  
2221 Schrock Road  
Columbus, Ohio 43229

DATE  
20-APR  
STRUCTURE FILE NUMBER  
7700370/7700371

DESIGNED  
ATM  
CHECKED  
ELP


ESTIMATED QUANTITIES (1 OF 2)  
BRIDGE NO. SUM-8-0199L/R - OVER RAILROADS  
(CSXT, W&LE, AND METRO RTA), LITTLE CUYAHOGA RIVER, AND EAST NORTH STREET

SUM-8-1.75  
PID No. 91710


21 / 226

519  
801


PLOT.CEL  
 ms consultants, inc.  
 www.msconsultants.com  
 Ohio DOT Workspace  
 SUM-8  
 0.5'  
 34" x 22"  
 Model: Sheet  
 Printed: 4/16/2023 5:13:33 PM  
 By: Bl ester  
 File: \\msconsultants.com\Production\60\08326\Structures\Sheets\9170SD032.dgn

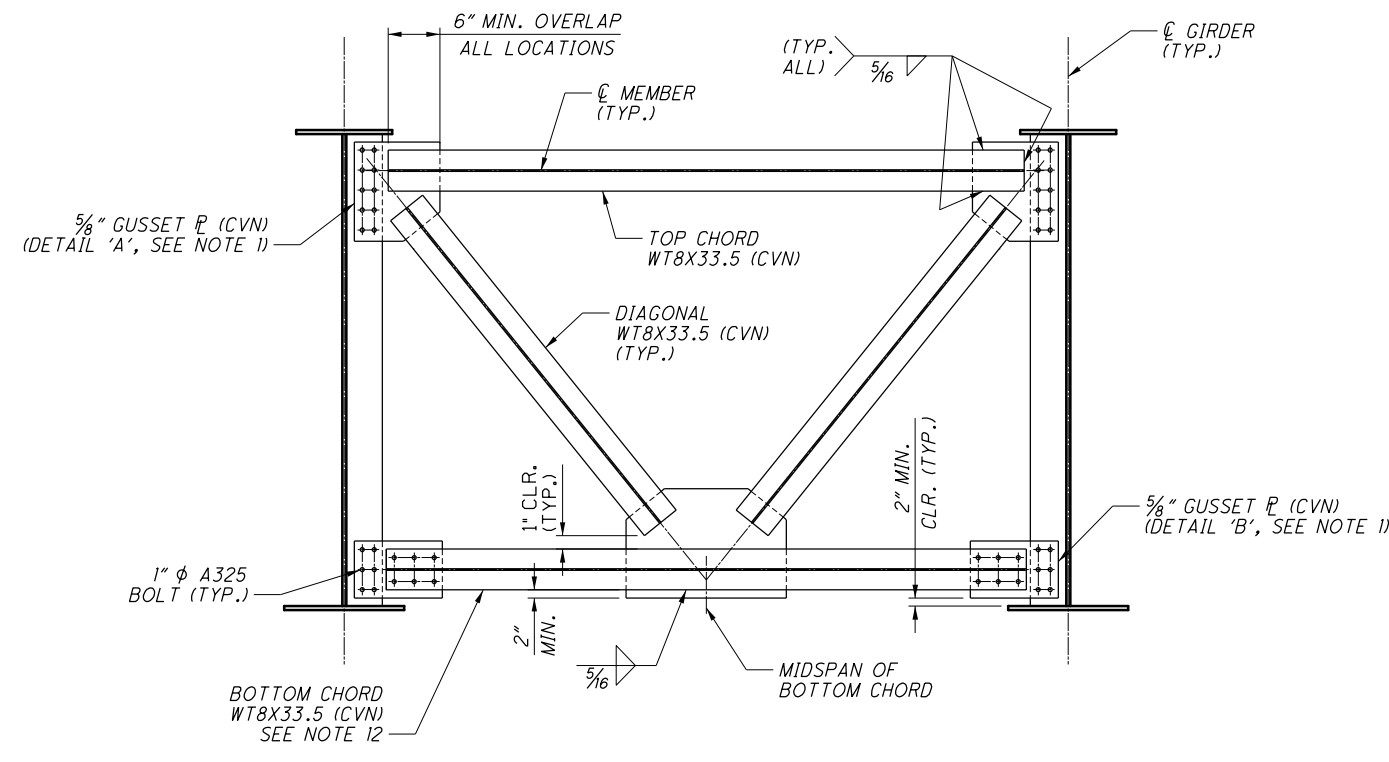


**TYPICAL INTERMEDIATE CROSSFRAME**

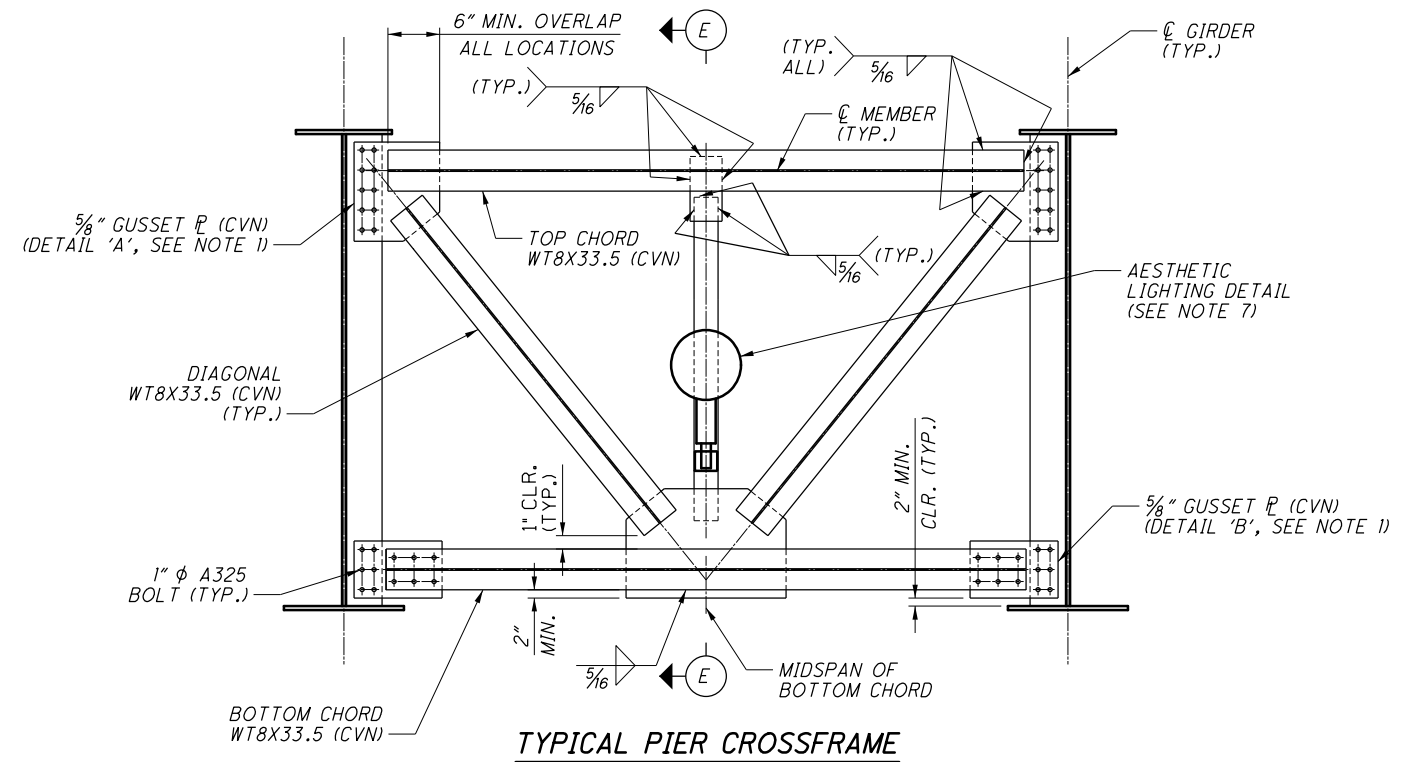

**TYPICAL PIER CROSSFRAME**

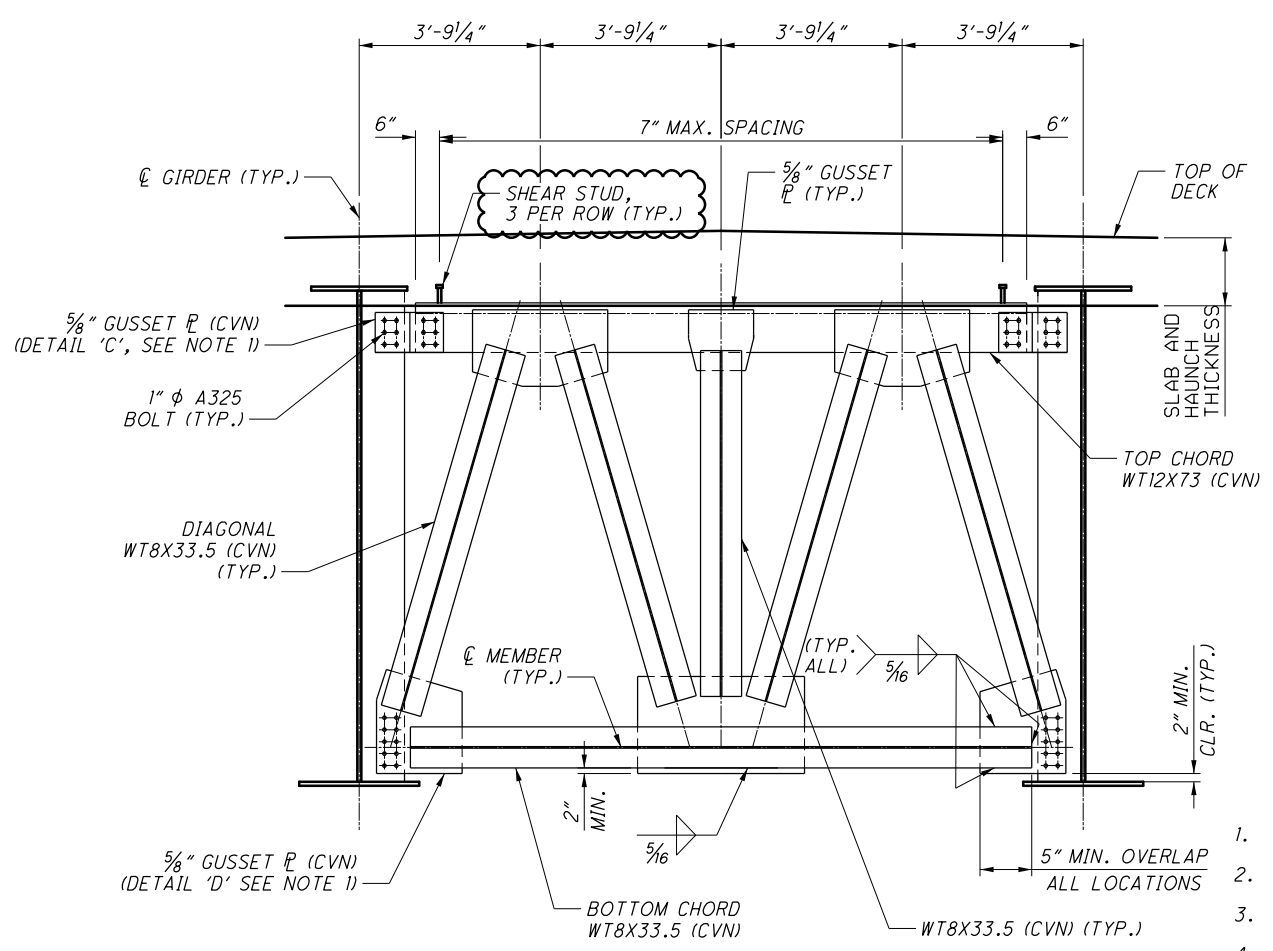

**FORWARD ABUTMENT END CROSSFRAME**

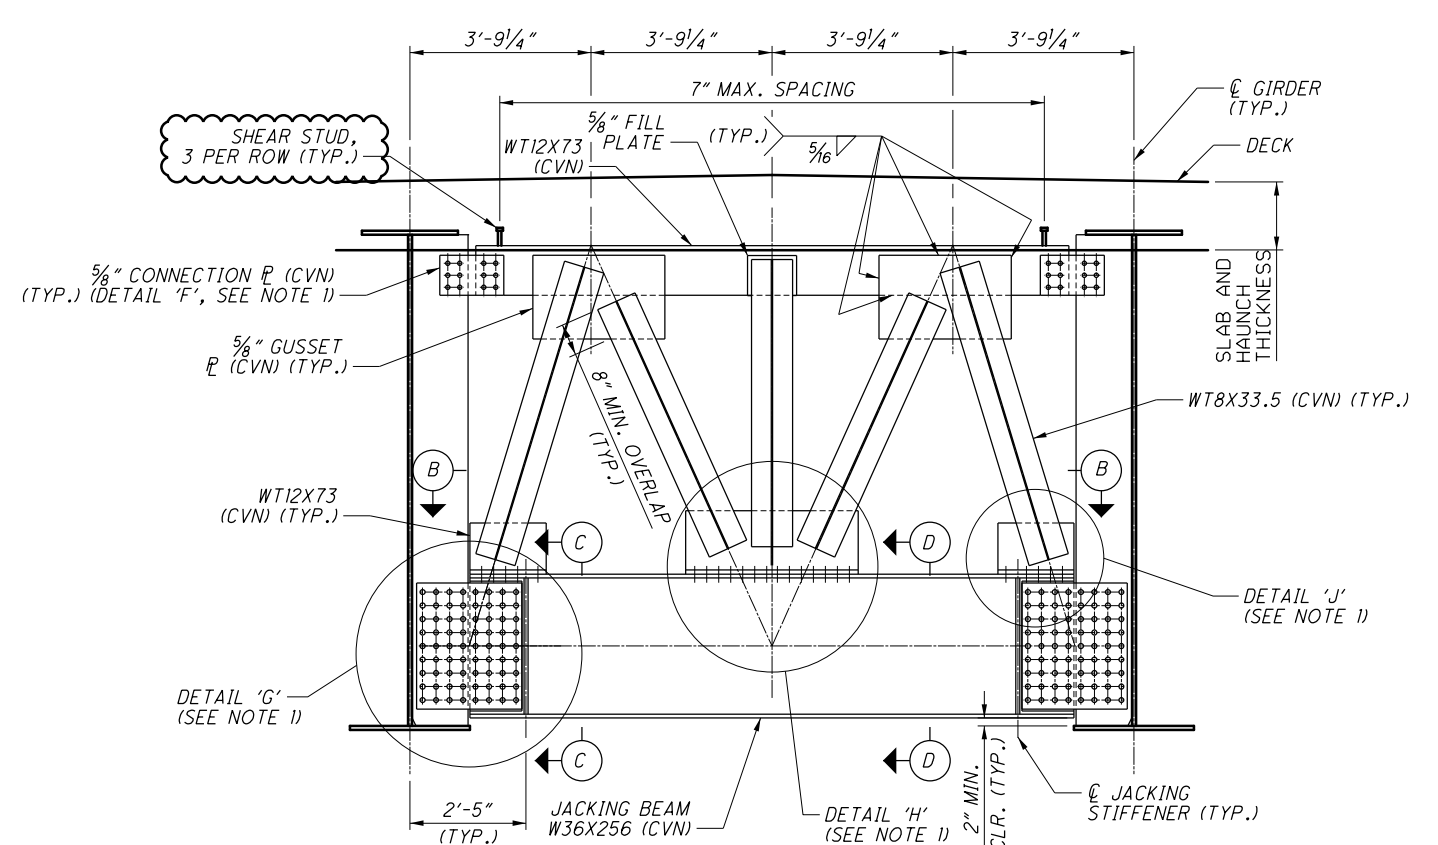

**REAR ABUTMENT END CROSSFRAME**

- NOTES:**
- FOR DETAIL 'A' THRU 'J' AND SECTIONS B-B THRU E-E, SEE SHEET 121/226.
  - FOR STRUCTURAL STEEL NOTES, SEE SHEET 107/226.
  - FOR SOUTHBOUND FRAMING PLAN, SEE SHEETS 108/226 AND 109/226.
  - FOR NORTHBOUND FRAMING PLAN, SEE SHEET 113/226 AND 114/226.
  - FOR BEARING STIFFENER DETAILS, SEE SHEET 118/226.
  - FOR DECK REINFORCING PLAN, SEE SHEETS 148/226 THRU 152/226.
  - FOR TYPICAL AESTHETIC LIGHTING DETAILS, SEE SHEET LTI/LT14.
  - HIGH STRENGTH BOLTS SHALL BE 1" ASTM A325, UNLESS OTHERWISE NOTED.
  - SHEAR STUDS SHALL BE PAID FOR UNDER ITEM 513 - WELDED STUD SHEAR CONNECTORS. FOR DETAILS, SEE SHEETS 112/226 AND 117/226.
  - ALL WELDS SHALL BE 5/16" FILLET WELDS, UNLESS OTHERWISE NOTED.
  - CROSSFRAMES, BUMPER PLATES AND ASSOCIATED HARDWARE SHALL BE PAID FOR UNDER ITEM 513 - STRUCTURAL STEEL MEMBERS, LEVEL 6.
  - FOR TYPICAL INTERMEDIATE CROSSFRAME MODIFIED BOTTOM CHORD DETAIL, SEE SHEET 121/226.

DESIGN AGENCY  
**ms consultants, inc.**  
 2221 Schrock Road  
 Columbus, Ohio 43229

DATE  
 20-APR

REVIEWED  
 GLG

DRAWN  
 KRM

DESIGNED  
 ABD

CHECKED  
 ELP

STRUCTURE FILE NUMBER  
 7700370/7700371

**TYPICAL STEEL DETAILS (3 OF 8)**

BRIDGE NO. SUM-8-0199L/R - OVER RAILROADS  
 (CSXT, W&LE, AND METRO RTA), LITTLE CUYAHOGA RIVER, AND EAST NORTH STREET

**SUM-8-1.75**  
**PID No. 91710**

120/226


618  
 801

ms consultants, inc.






34" x 22"

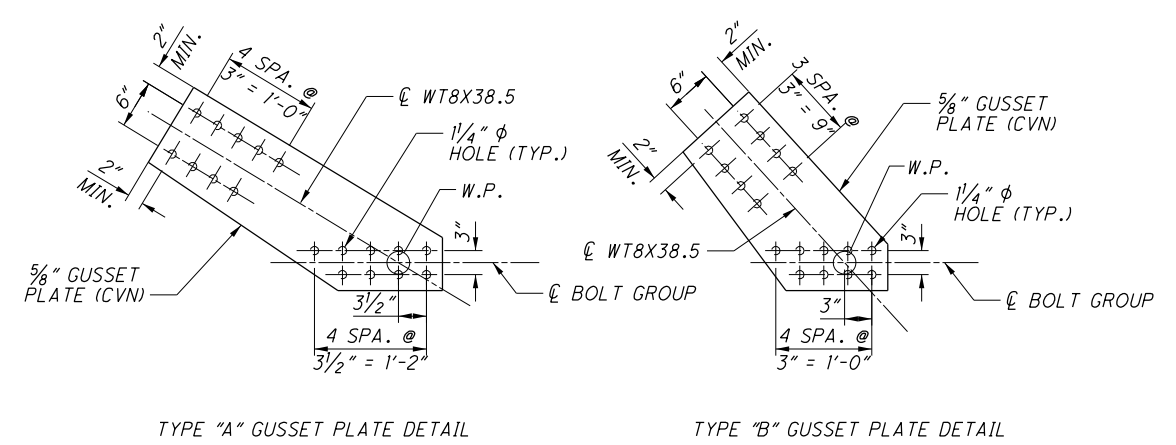


**GUSSET PLATE LATERAL BRACING PLAN VIEWS**

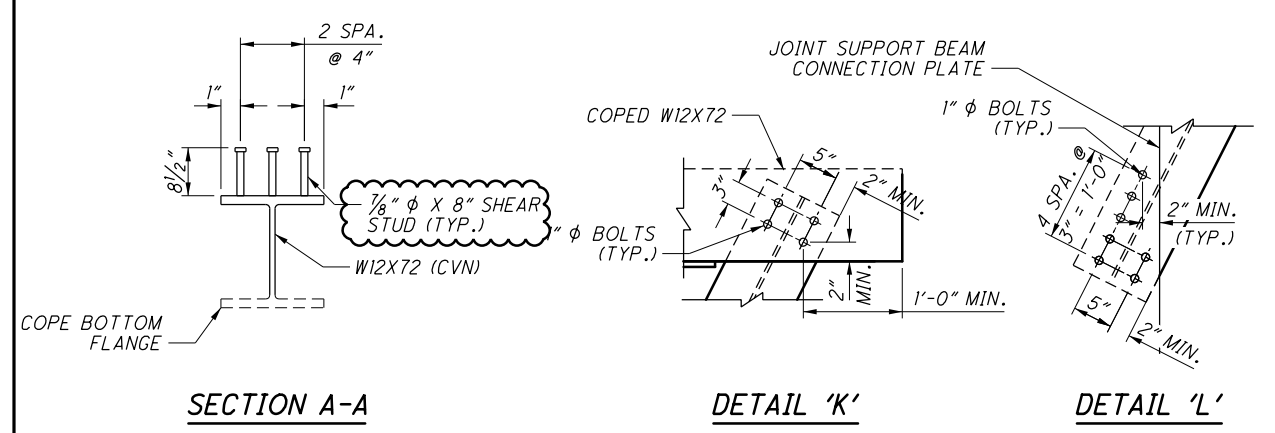


**SECTION A-A**

**DETAIL 'K'**

**DETAIL 'L'**

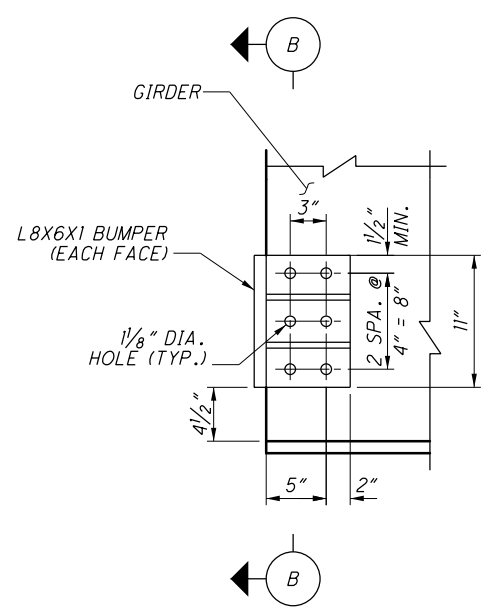

**ELEVATION**

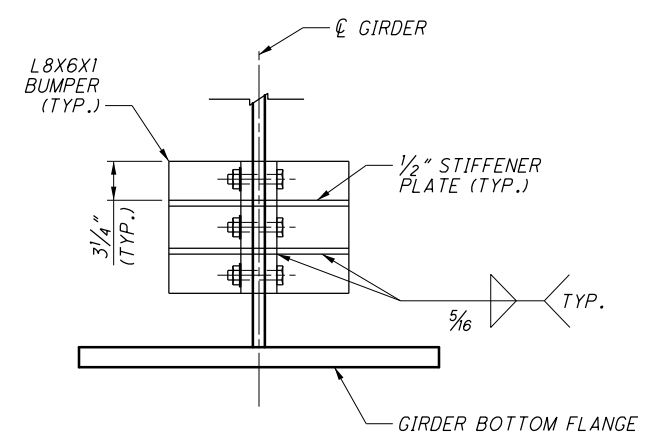


**SECTION B-B**

**BUMPER ATTACHMENT**  
TYPICAL EACH GIRDER END

**NOTES:**

- FOR ADDITIONAL LATERAL BRACING DETAILS, SEE SHEET 122/226.
- SEE SECTION A-A, THIS SHEET.

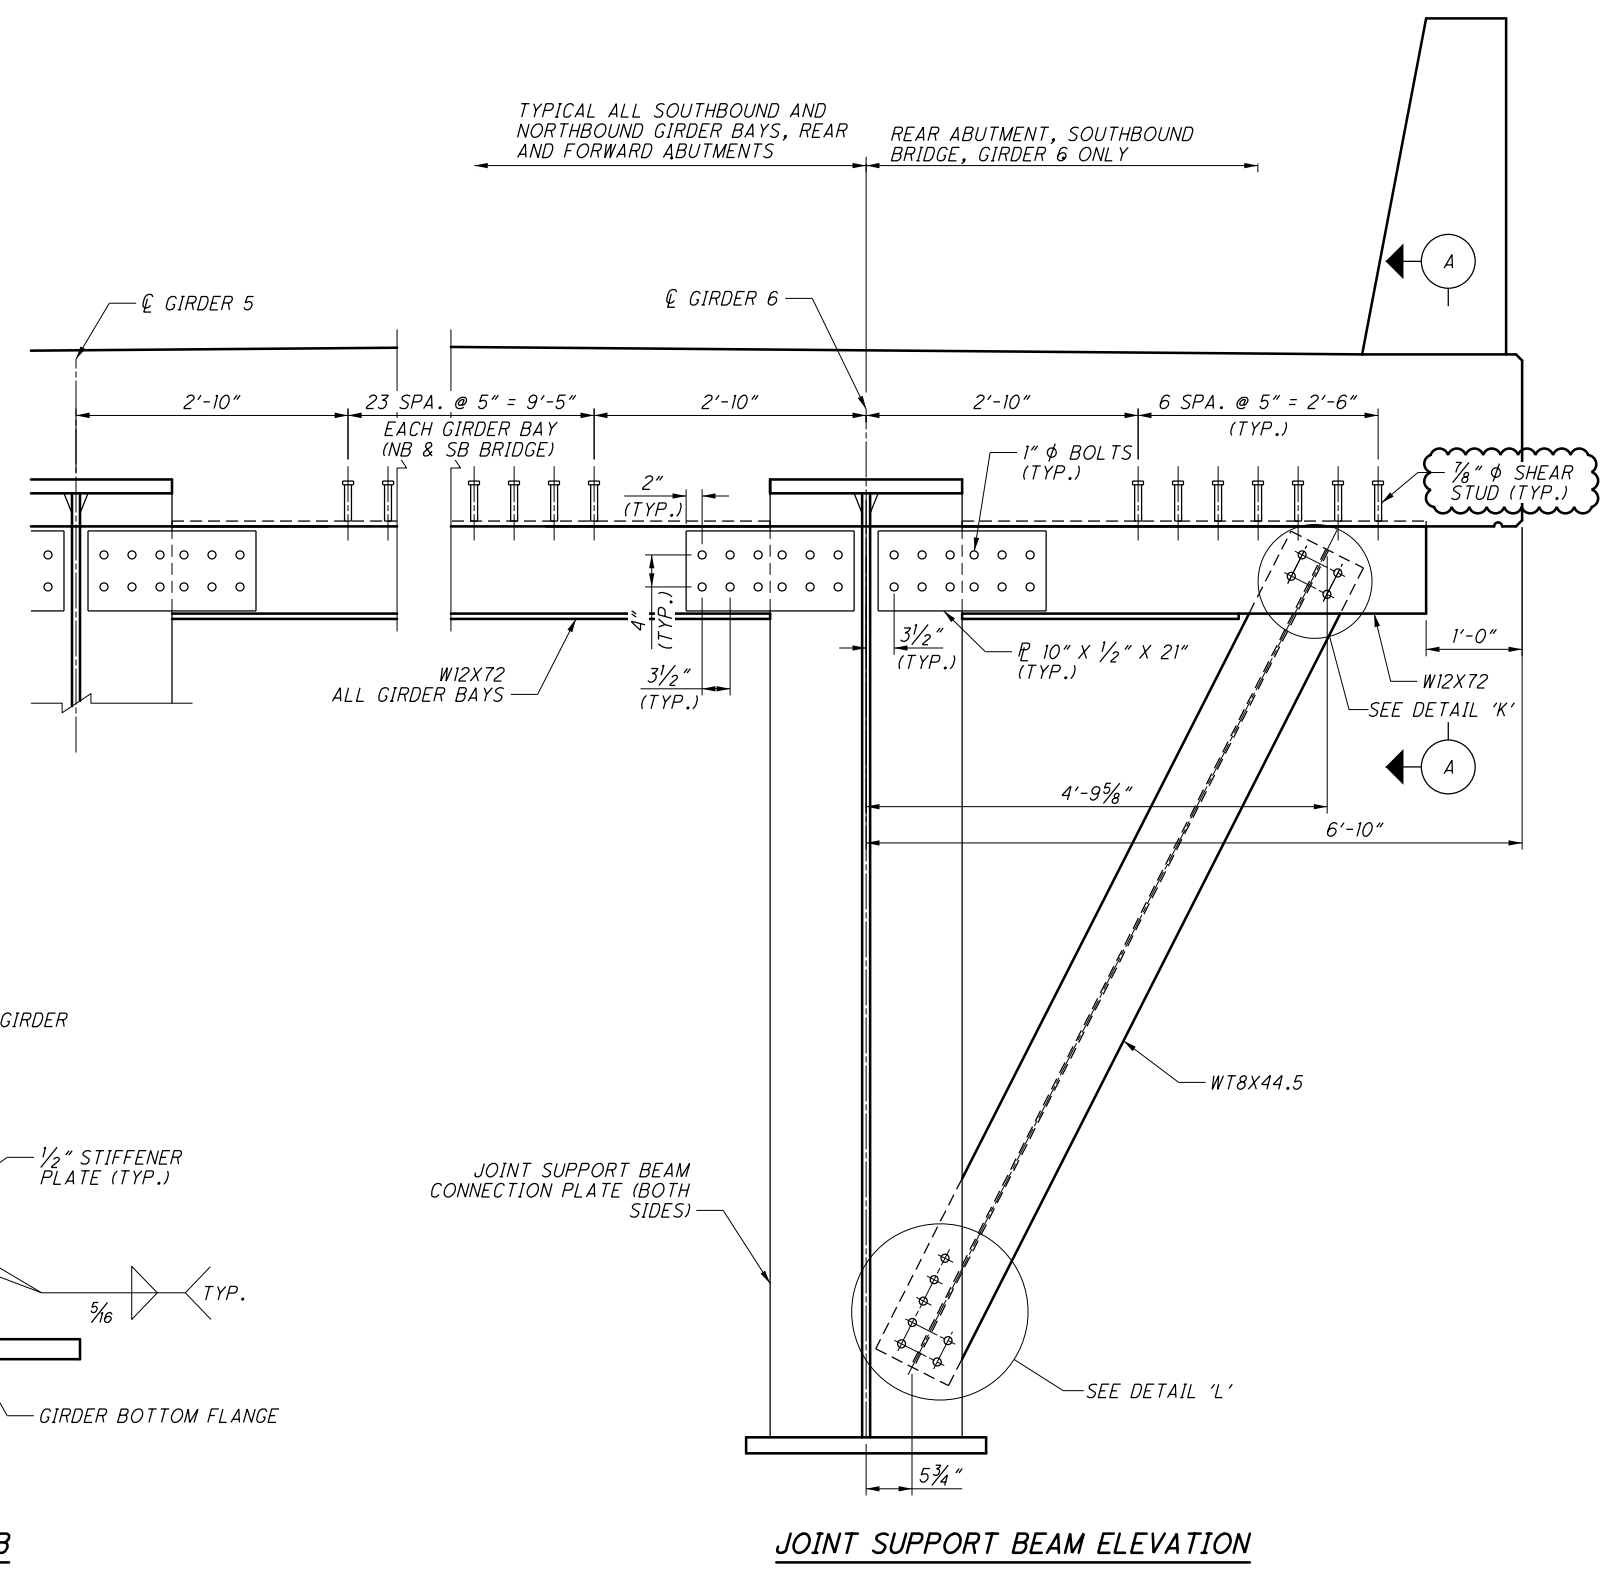

**JOINT SUPPORT BEAM ELEVATION**

DESIGNED	ATM	CHECKED	ELP
DRAWN	CDH	REVISED	
REVIEWED	GLG	DATE	20-APR
DESIGN AGENCY	ms consultants, inc.		
STRUCTURE FILE NUMBER	7700370/7700371		
DATE	20-APR		
BRIDGE NO.	SUM-8-0199L/R - OVER RAILROADS		
TYPICAL STEEL DETAILS (6 OF 8)			
BRIDGE NO. SUM-8-0199L/R - OVER RAILROADS			
(CSXT, W&LE, AND METRO RTA), LITTLE CUYAHOGA RIVER, AND EAST NORTH STREET			
PID No.	91710		
SUM-8-1.75			
123/226			
621			
801			

LOCATION	BEARING MARK	VERTICAL LOADS				TRANSVERSE LOADS (X DIR.)				LONGITUDINAL LOADS (Y DIR.)				FUTURE JACKING FORCES		MOVEMENT		ROTATION	ROTATION
		(+) LL	(-) LL	DC	DW	WL	WS	CE	EO	WL	WS	BR	TU	DL	LL	Y DIR. (in)	X DIR. (in)	STRENGTH I	SERVICE I
		KIPS	KIPS	KIPS	KIPS	KIPS	KIPS	KIP	KIPS	KIPS	KIPS	KIPS	KIPS	KIPS	KIPS			RADIANS	RADIANS
REAR ABUTMENT	RAG1	153	-37	280	71	0	0	0	0	0	0	0	0	456	199	6.99	0.27	0.010	0.008
	RAG2	187	-22	291	73	4	17	0	136	0	0	0	0	472	243	6.99	0.00	0.009	0.008
	RAG3	168	-19	294	73	3	13	0	136	0	0	0	0	477	218	6.99	0.00	0.009	0.008
	RAG4	168	-22	292	73	6	29	0	136	0	0	0	0	474	219	6.99	0.00	0.009	0.008
	RAG5	193	-25	292	73	7	53	0	136	0	0	0	0	473	250	6.99	0.00	0.010	0.008
	RAG6	153	-37	287	71	0	0	0	0	0	0	0	0	464	199	6.99	0.27	0.011	0.008
PIER 1	PIG1	283	-52	968	240	0	0	0	0	0	0	0	0	1569	368	4.18	0.27	0.031	0.021
	PIG2	328	-31	1028	251	10	49	0	476	0	0	0	0	1661	426	4.18	0.00	0.028	0.019
	PIG3	305	-27	1055	255	8	38	0	476	0	0	0	0	1703	396	4.18	0.00	0.028	0.019
	PIG4	305	-28	1057	255	7	34	0	476	0	0	0	0	1705	397	4.18	0.00	0.028	0.019
	PIG5	328	-31	1031	251	10	78	0	476	0	0	0	0	1666	427	4.18	0.00	0.029	0.020
	PIG6	283	-52	971	240	0	0	0	0	0	0	0	0	1573	368	4.18	0.27	0.034	0.022
PIER 2	P2G1	303	-56	1028	258	0	0	0	0	0	0	0	0	1671	394	1.32	0.27	0.019	0.013
	P2G2	343	-31	1089	270	8	35	0	505	0	0	0	0	1767	445	1.32	0.00	0.017	0.012
	P2G3	319	-26	1115	274	6	24	0	505	0	0	0	0	1805	414	1.32	0.00	0.016	0.012
	P2G4	319	-26	1116	274	6	27	0	505	0	0	0	0	1807	414	1.32	0.00	0.016	0.012
	P2G5	343	-31	1091	271	8	54	0	505	0	0	0	0	1769	445	1.32	0.00	0.017	0.012
	P2G6	303	-56	1026	258	0	0	0	0	0	0	0	0	1668	394	1.32	0.27	0.019	0.013
PIER 3	P3G1	284	-64	858	220	0	0	0	0	1	6	3	2	1401	369	0.00	0.27	0.027	0.018
	P3G2	326	-40	913	231	7	28	0	424	3	14	10	5	1487	423	0.00	0.00	0.023	0.016
	P3G3	305	-36	935	234	5	21	0	424	9	40	29	15	1519	397	0.00	0.00	0.022	0.015
	P3G4	305	-36	934	234	5	18	0	424	9	40	29	15	1517	396	0.00	0.00	0.022	0.015
	P3G5	326	-40	912	231	7	45	0	424	3	14	10	5	1485	423	0.00	0.00	0.023	0.016
	P3G6	284	-64	859	220	0	0	0	0	1	6	3	2	1402	369	0.00	0.27	0.027	0.018
PIER 4	P4G1	237	-69	595	156	0	0	0	0	2	12	6	2	975	308	0.00	0.27	0.046	0.030
	P4G2	290	-52	636	164	8	33	0	296	5	29	17	6	1038	377	0.00	0.00	0.040	0.026
	P4G3	269	-47	651	165	5	21	0	296	13	73	44	14	1060	349	0.00	0.00	0.039	0.025
	P4G4	269	-48	651	165	5	23	0	296	13	73	44	14	1061	349	0.00	0.00	0.039	0.025
	P4G5	290	-52	636	164	8	51	0	296	5	29	17	6	1039	377	0.00	0.00	0.041	0.026
	P4G6	237	-69	595	156	0	0	0	0	2	13	6	2	975	308	0.00	0.27	0.047	0.030
PIER 5	P5G1	225	-39	676	178	0	0	0	0	0	0	0	0	1108	292	4.83	0.27	0.038	0.025
	P5G2	283	-24	723	187	8	41	0	337	0	0	0	0	1182	367	4.83	0.00	0.034	0.022
	P5G3	263	-21	740	189	5	27	0	337	0	0	0	0	1207	341	4.83	0.00	0.032	0.022
	P5G4	263	-21	741	189	6	29	0	337	0	0	0	0	1208	341	4.83	0.00	0.032	0.022
	P5G5	283	-24	723	187	8	60	0	337	0	0	0	0	1183	367	4.83	0.00	0.034	0.022
	P5G6	225	-39	675	177	0	0	0	0	0	0	0	0	1108	292	4.83	0.27	0.038	0.025
FORWARD ABUTMENT	FAG1	131	-29	209	55	0	0	0	0	0	0	0	0	343	171	6.48	0.27	0.021	0.014
	FAG2	174	-16	218	57	4	20	0	103	0	0	0	0	357	226	6.48	0.00	0.019	0.013
	FAG3	154	-14	220	57	3	15	0	103	0	0	0	0	360	201	6.48	0.00	0.018	0.012
	FAG4	154	-14	221	57	3	15	0	103	0	0	0	0	360	201	6.48	0.00	0.018	0.012
	FAG5	174	-16	218	57	4	36	0	103	0	0	0	0	357	226	6.48	0.00	0.019	0.013
	FAG6	131	-29	209	55	0	0	0	0	0	0	0	0	342	171	6.48	0.27	0.021	0.014

**LEGEND:**

LL VEHICULAR LIVE LOAD NOT INCLUDING DYNAMIC LOAD ALLOWANCE  
 DC DEAD LOAD (DC1 + DC2)  
 DW WEARING SURFACE LOAD  
 WL WIND ON LIVE LOAD  
 WS WIND ON SUPERSTRUCTURE  
 BR VEHICULAR BRAKING FORCE  
 CE VEHICULAR CENTRIFUGAL FORCE  
 EO EARTHQUAKE  
 TU THERMAL

ALL LOADS ARE UNFACTORED. COMBINE PER AASHTO FOR WORSE CASE DESIGN REACTIONS.

**NOTES:**

- FOR COORDINATE SYSTEM DEFINITION, SEE SHEET 138/226.
- BEARING DIMENSIONS SHOWN ARE NOMINAL VALUES ONLY, AND WILL VARY WITH THE SELECTED MANUFACTURER.
- MAKE ALL NECESSARY ADJUSTMENTS TO DIMENSIONS AND ELEVATIONS AS REQUIRED TO INCORPORATE THE SPECIFIC BEARINGS SELECTED.
- THE MOVEMENT VALUES IN THE TABLES ARE IN ONE DIRECTION FOR A 90°F TEMPERATURE CHANGE.
- ROTATION VALUES IN THE TABLES INCLUDE AN ALLOWANCE OF 0.005 RADIANS FOR UNCERTAINTIES.
- ANCHORS FOR BEARINGS SHALL BE SET BY USE OF A STEEL TEMPLATE WITH A MINIMUM THICKNESS OF 1/4".
- THE PIER AND ABUTMENT BEAM SEAT ELEVATIONS ARE BASED ON BEARING HEIGHTS PROVIDED IN THE TABLE. IF THE CONTRACTOR'S SELECTED BEARING MANUFACTURER HAS A DESIGN THAT DOES NOT CONFORM TO THE HEIGHTS PROVIDED IN THE TABLE, ADJUST THE BEARING SEAT ELEVATIONS AT NO ADDITIONAL COST TO THE STATE. ADJUST THE LOCATION OF REINFORCING STEEL HORIZONTALLY AS NECESSARY TO AVOID INTERFERENCE WITH THE BEARING ANCHOR BOLTS. MAINTAIN THE MINIMUM CONCRETE COVER AND MINIMUM SPACING REQUIRED BY THE PROJECT PLANS. IF THE REINFORCING STEEL CANNOT BE MOVED TO PROVIDE THE REQUIRED POSITION FOR THE ANCHOR BOLTS, THE CONTRACTOR'S BEARING MANUFACTURER SHALL REDESIGN THE BEARINGS TO ACCOMMODATE AN ACCEPTABLE ANCHOR BOLT CONFIGURATION.
- ALL BEARINGS SHALL BE MARKED PRIOR TO SHIPPING. THE MARKS SHALL INCLUDE THE BEARING LOCATION ON THE BRIDGE AND A DIRECTION ARROW THAT POINTS UPSTATION. ALL MARKS SHALL BE PERMANENT AND VISIBLE AFTER THE BEARING IS INSTALLED.
- FUTURE JACKING FORCES FOR BEARING REPLACEMENT PROVIDED ARE PER JACK, ASSUMING A SINGLE JACK AT BEARING LOCATIONS, AND INCLUDE ADDITION OF FUTURE WEARING SURFACE.
- REFER TO SS869 FOR ADDITIONAL NOTES AND REQUIREMENTS.

DESIGN AGENCY: ms consultants, inc. 2221 Schrock Road Columbus, Ohio 43229  
 DATE: 20-APR  
 GLG: 7700370/7700371  
 STRUCTURE FILE NUMBER: 7700370/7700371  
 DESIGNED: TVB  
 CHECKED: ELP  
 SOUTHBOUND BRIDGE BEARING TABLES (1 OF 2)  
 BRIDGE NO. SUM-8-0199L/R - OVER RAILROADS (CSXT, W&LE, AND METRO RTA), LITTLE CUYAHOGA RIVER, AND EAST NORTH STREET  
 SUM-8-1-75  
 PID No. 91710  
 139/226  
 637  
 801



LOCATION	BEARING MARK	VERTICAL LOADS				TRANSVERSE LOADS (X DIR.)				LONGITUDINAL LOADS (Y DIR.)				FUTURE JACKING FORCES		MOVEMENT		ROTATION	ROTATION
		(+) LL	(-) LL	DC	DW	WL	WS	CE	EO	WL	WS	BR	TU	DL	LL	Y DIR. (in)	X DIR. (in)	STRENGTH I	SERVICE I
		KIPS	KIPS	KIPS	KIPS	KIPS	KIPS	KIP	KIPS	KIPS	KIPS	KIPS	KIPS	KIPS	KIPS			RADIANS	RADIANS
REAR ABUTMENT	RAG7	153	-36	282	73	0	0	0	0	0	0	0	0	462	198	6.23	0.27	0.014	0.011
	RAG8	189	-19	296	76	5	21	0	139	0	0	0	0	483	246	6.23	0.00	0.013	0.010
	RAG9	167	-17	298	75	4	18	0	139	0	0	0	0	485	217	6.23	0.00	0.013	0.010
	RAG10	167	-17	300	75	4	18	0	139	0	0	0	0	487	217	6.23	0.00	0.013	0.010
	RAG11	189	-19	302	76	5	38	0	139	0	0	0	0	490	246	6.23	0.00	0.013	0.010
RAG12	153	-36	295	73	0	0	0	0	0	0	0	0	479	199	6.23	0.27	0.014	0.011	
PIER 1	PIG7	270	-44	907	232	0	0	0	0	0	0	0	0	1481	351	4.03	0.27	0.011	0.009
	PIG8	316	-24	977	245	10	48	0	457	0	0	0	0	1588	410	4.03	0.00	0.010	0.008
	PIG9	297	-21	1018	250	8	40	0	457	0	0	0	0	1649	386	4.03	0.00	0.010	0.008
	PIG10	297	-21	1022	250	8	40	0	457	0	0	0	0	1653	386	4.03	0.00	0.010	0.008
	PIG11	316	-24	992	245	10	67	0	457	0	0	0	0	1607	411	4.03	0.00	0.010	0.008
PIER 2	PIG12	270	-44	938	232	0	0	0	0	0	0	0	0	1521	351	4.03	0.27	0.011	0.009
	P2G7	272	-60	817	208	0	0	0	0	0	0	0	0	1332	353	1.50	0.27	0.011	0.009
	P2G8	316	-38	878	219	7	29	0	408	0	0	0	0	1426	410	1.50	0.00	0.010	0.008
	P2G9	296	-34	913	224	6	24	0	408	0	0	0	0	1478	384	1.50	0.00	0.010	0.008
	P2G10	295	-34	913	224	6	25	0	408	0	0	0	0	1477	384	1.50	0.00	0.010	0.008
PIER 3	P2G11	316	-38	880	219	7	48	0	408	0	0	0	0	1428	410	1.50	0.00	0.010	0.008
	P2G12	272	-60	822	208	0	0	0	0	0	0	0	0	1339	353	1.50	0.27	0.011	0.009
	P3G7	261	-63	750	195	0	0	0	0	1	7	4	3	1229	339	0.00	0.27	0.011	0.009
	P3G8	307	-41	808	206	6	26	0	376	3	16	11	7	1318	399	0.00	0.00	0.010	0.008
	P3G9	287	-37	839	210	5	21	0	376	9	43	31	18	1364	373	0.00	0.00	0.010	0.008
PIER 4	P3G10	287	-37	838	210	5	21	0	376	9	42	31	18	1362	373	0.00	0.00	0.010	0.008
	P3G11	307	-41	807	206	6	43	0	376	3	15	11	7	1317	399	0.00	0.00	0.010	0.008
	P3G12	261	-63	750	196	0	0	0	0	1	7	4	2	1228	340	0.00	0.27	0.011	0.009
	P4G7	261	-53	797	204	0	0	0	0	2	9	5	2	1301	340	0.00	0.27	0.011	0.008
	P4G8	309	-32	859	216	7	33	0	400	5	25	15	6	1397	402	0.00	0.00	0.010	0.008
PIER 5	P4G9	288	-28	894	220	6	27	0	400	13	72	45	19	1448	375	0.00	0.00	0.010	0.008
	P4G10	288	-28	893	220	6	28	0	400	13	72	45	19	1447	374	0.00	0.00	0.010	0.008
	P4G11	309	-32	860	216	7	52	0	400	5	24	15	6	1398	402	0.00	0.00	0.010	0.008
	P4G12	262	-53	801	205	0	0	0	0	2	9	5	3	1306	340	0.00	0.27	0.011	0.008
	P5G7	234	-48	671	178	0	0	0	0	0	0	0	0	1103	304	5.32	0.27	0.009	0.008
FORWARD ABUTMENT	P5G8	289	-30	734	190	7	36	0	345	0	0	0	0	1201	376	5.32	0.00	0.009	0.007
	P5G9	270	-27	770	194	6	31	0	345	0	0	0	0	1253	351	5.32	0.00	0.009	0.007
	P5G10	270	-27	775	194	6	31	0	345	0	0	0	0	1260	351	5.32	0.00	0.009	0.007
	P5G11	289	-30	748	190	7	56	0	345	0	0	0	0	1219	376	5.32	0.00	0.009	0.007
	P5G12	234	-48	691	178	0	0	0	0	0	0	0	0	1130	304	5.32	0.27	0.009	0.008
FORWARD ABUTMENT	FAG7	131	-33	204	54	0	0	0	0	0	0	0	0	336	170	6.98	0.27	0.010	0.008
	FAG8	175	-20	216	56	4	20	0	103	0	0	0	0	353	228	6.98	0.00	0.009	0.008
	FAG9	154	-17	220	56	3	16	0	103	0	0	0	0	357	200	6.98	0.00	0.009	0.008
	FAG10	154	-17	224	56	4	17	0	103	0	0	0	0	363	200	6.98	0.00	0.009	0.008
	FAG11	175	-20	225	56	4	32	0	103	0	0	0	0	364	228	6.98	0.00	0.009	0.008
FAG12	131	-33	218	54	0	0	0	0	0	0	0	0	354	170	6.98	0.27	0.010	0.008	

**LEGEND:**

- LL VEHICULAR LIVE LOAD NOT INCLUDING IMPACT
- DC DEAD LOAD (DC1 + DC2)
- DW WEARING SURFACE LOAD
- WL WIND ON LIVE LOAD
- WS WIND ON SUPERSTRUCTURE
- BR VEHICULAR BRAKING FORCE
- CE VEHICULAR CENTRIFUGAL FORCE
- EO EARTHQUAKE
- TU THERMAL

ALL LOADS ARE UNFACTORED. COMBINE PER AASHTO FOR WORSE CASE DESIGN REACTIONS.

**NOTES:**

- FOR BEARING TABLE NOTES, SEE SHEET 139/226.