


ELECTRIC POWER LINES ON POLES ALONG SR800 & CR108
 TELEPHONE BURIED 12" TO 24" ALONG SR103 & SR800; ON POLES ALONG CR108
 TV CABLE BURIED 6" TO 12" ALONG SR103 & SR800
 GAS 2" PIPE BURIED 30" ±
 CONTACT 800-362-2764 RE ANY OTHER UTILITIES REFER TO 70 864

NOTIFY POWER CO. 3 DAYS IN ADVANCE OF NEED FOR POLE SUPPORT NEXT TO TRENCH
 MAINTAIN OSHA SAFE WORKING CLEARANCES FROM ENERGIZED LINES (120/240 V ALONG CR 108)

ROOF DRAINS, FOUNDATION DRAINS, AND OTHER CLEAN WATER CONNECTIONS TO THE SANITARY SEWER SYSTEM ARE PROHIBITED.

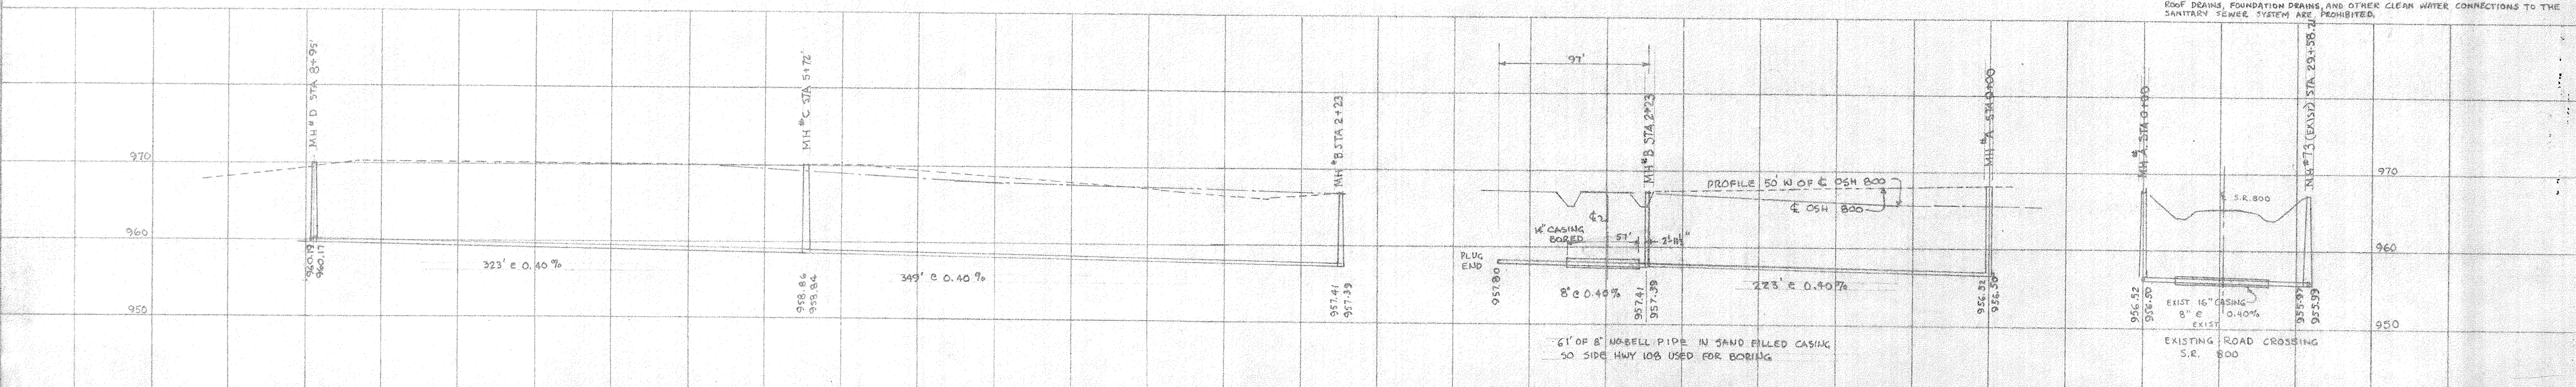

D-8
 "Record set"
 SAN. SEWER EXTENSION S.R. 800 F.S.R. 103

SCALE: 1" = 50' HORIZ. 1" = 10' VERT.
 C.G. GAUSEWITZ 2453 WESTERBROOK S.E., E. SPARTA OHIO, P.O. RT#1 MAGNOLIA, OHIO 44643 216-866-2173

EXTENSION OF SEWER 187' S.O.P. CROSSOVER AT MANHOLE # 73 (CONNECTIONS SHOWN CENTER) ALONG W. SIDE OF O.S. HWY 800 TO S. SIDE TCHWY 108 & 680' ALONG N. SIDE TCHWY 108 TO C.G. GAUSEWITZ FARMHOUSE SANDVILLE, OHIO.
 GAUSEWITZ & ASSOCIATES ARCHITECTS - ENGINEERS
 1933 TONYAWATNA TRAIL MORGANTHA, W.V. 26176
 PHONE 222-2194 AREA CODE 486

