



REVISED MONUMENT LOCATIONS
S.H. 712 SEC.P (PT)


T 15 N R 7 W
WARREN TOWNSHIP
TUSCARAWAS COUNTY
SECS 29 & 35

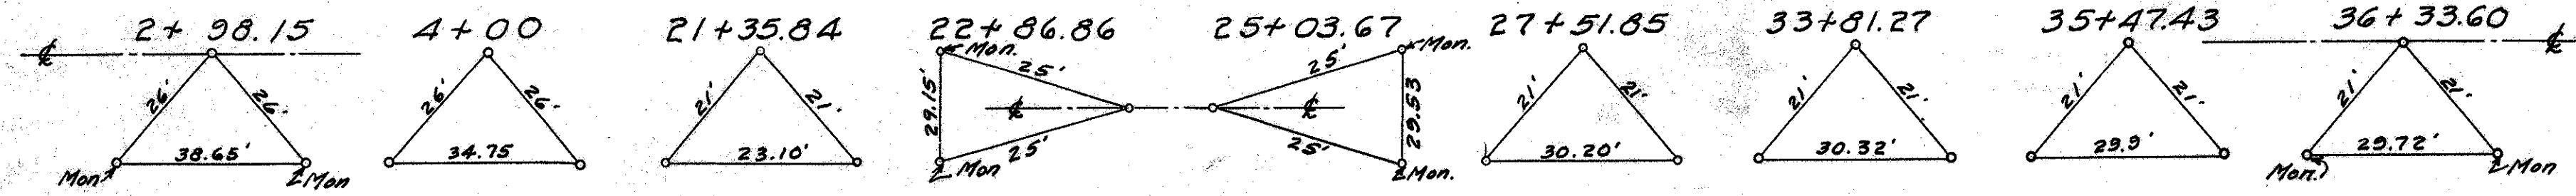


S.H. 712 SEC.N (PT)

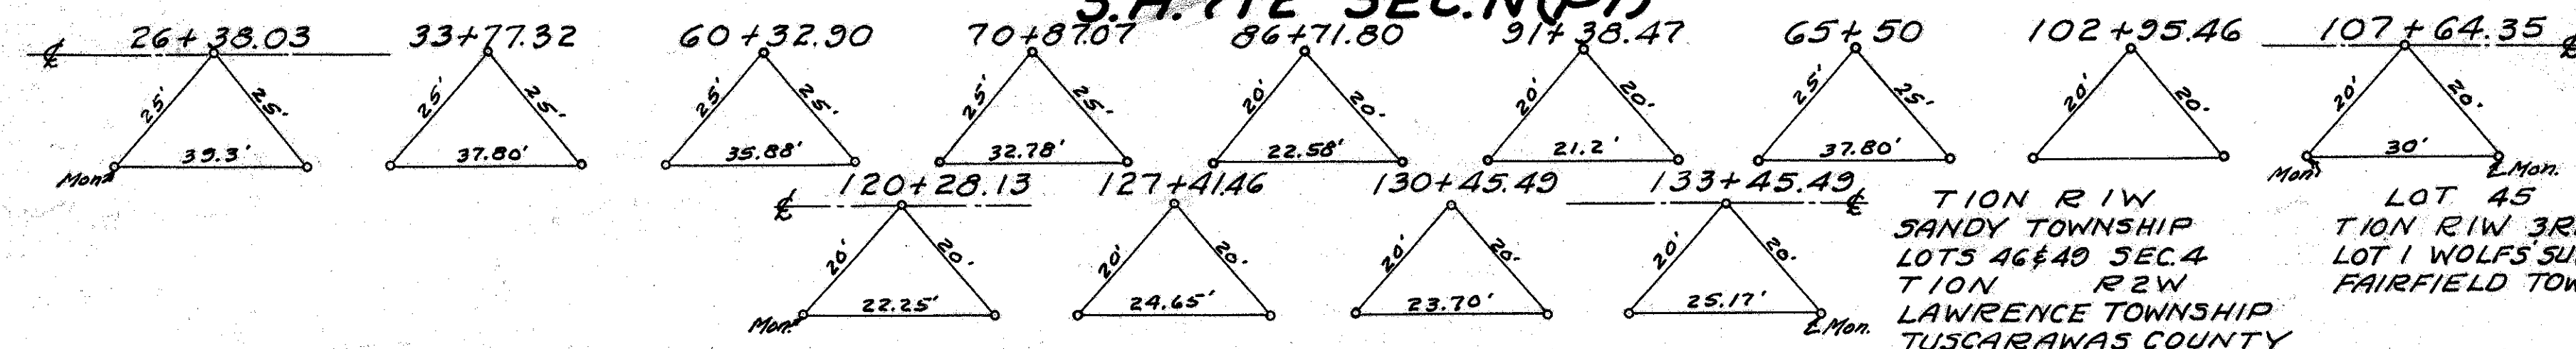


S.H. 712 SEC.O (PT)

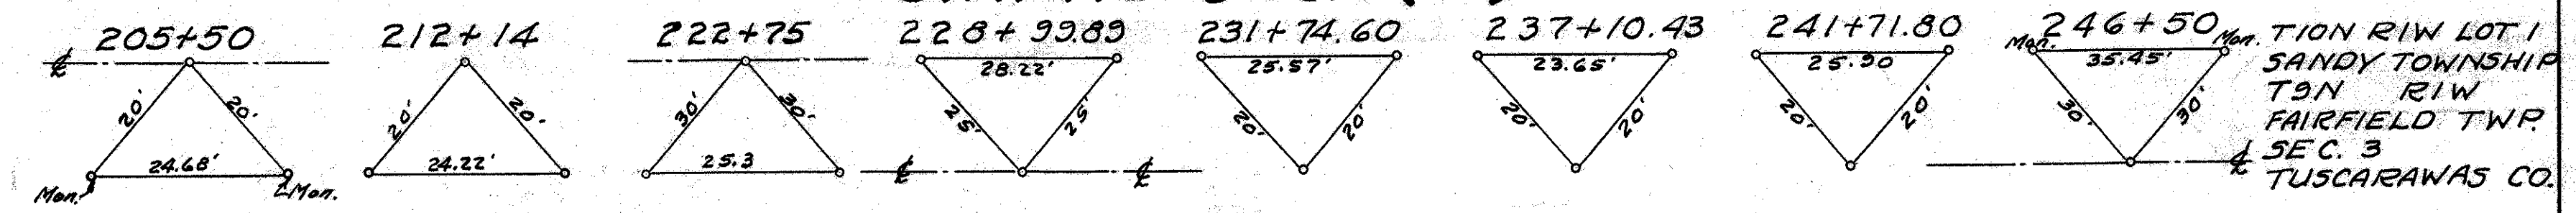

TUS-S.R. 93 - (7.32-8.09)

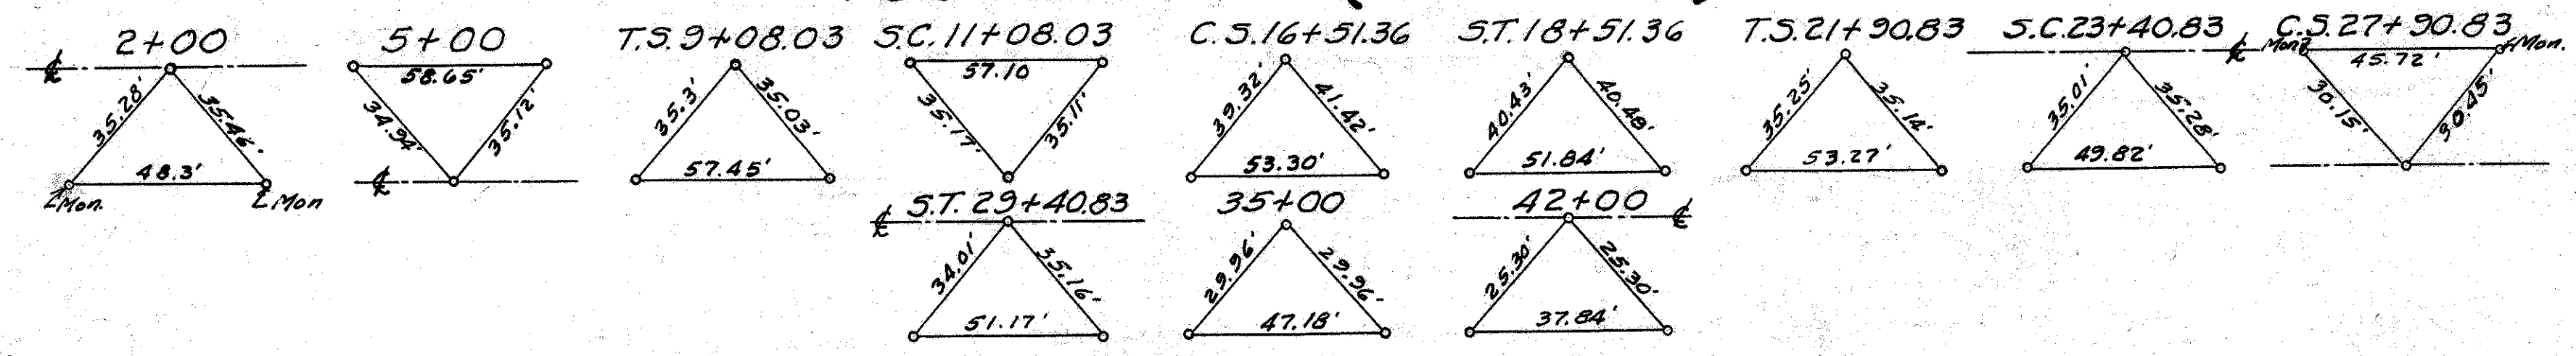

TUS - S.R. 36 - (9.16-10.04)

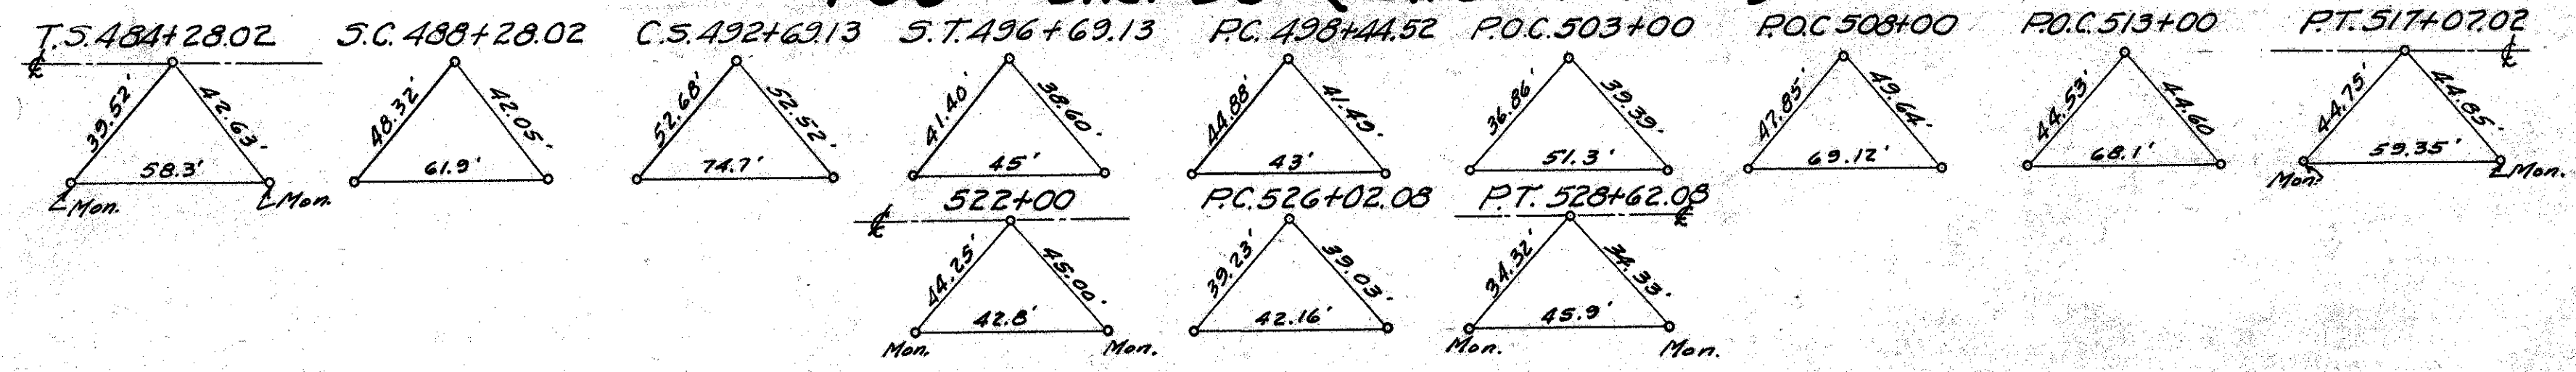


S.H. 527 SEC.E (PT)

NOTE
The above monument locations replace those shown on the original center-line plats. Original locations are now void.

12547
RECEIVED FOR RECORD
ROBERT E. MOORE, County Recorder
MAR 30 1953
Recorded Page 44 of the
Vol. 11 Records of
TUSCARAWAS COUNTY, OHIO
FEB 19 1900
M.R.

I hereby certify that this plat is correct to the best of my knowledge and belief.
Date 3-23-53
Dean R. Smith
Division Engineer.

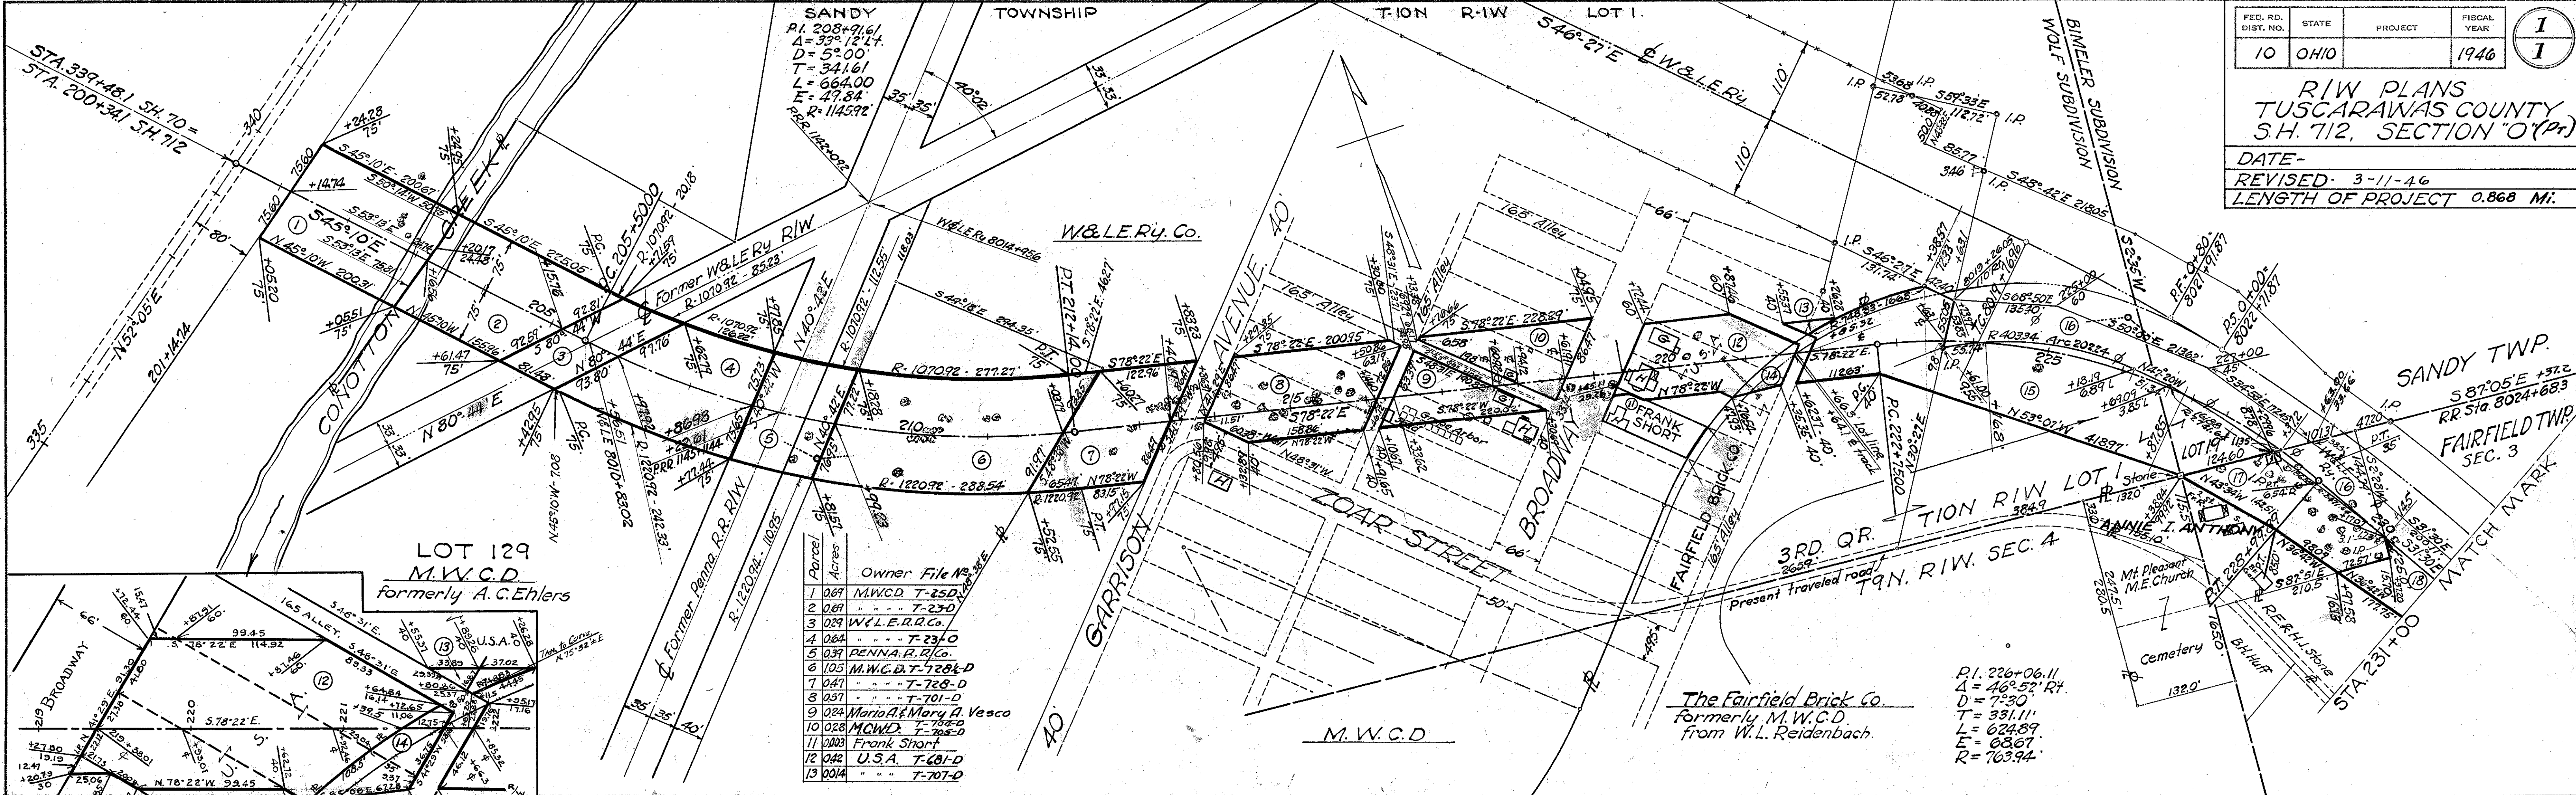

Parcel	Acres	Owner File No.
1	0.69	M.W.C.D. T-25-D
2	0.69	" " T-25-D
3	0.29	W&L E.R.R. Co.
4	0.64	" " T-23-D
5	0.39	PENNA. R.R. Co.
6	1.05	M.W.C.D. T-28-D
7	0.41	" " T-28-D
8	0.51	" " T-70-D
9	0.24	Maria & Mary A. Vesco
10	0.28	M.W.C.D. T-70-D
11	0.03	Frank Short
12	0.42	U.S.A. T-68-D
13	0.04	" " T-70-D

Parcel	Acres	Owner File No.
14	0.05	Fairfield Brick Co.
15	1.33	" " " "
17	0.41	Annie I. Anthony
18	3.71	Robt. E. Stone & H. J. Stone, PRO 048 T.A. 425
19	0.03	M.W.C.D. T-70-D

