

V. = 40 MPH

Date of Letting _____ 19____, Contract No. _____

TUSCARAWAS COUNTY
OXFORD TOWNSHIP
T5N, R3W, 1st. QTR.

FWHA
REGION
5

STATE
OHIO

STATE
PROJECT NO.
11507 (0)



17
17

TUS-258-3.89

R/W PLAN

1
1

NOTE: May 12, 1924
Tuscarawas County Commissioners
Certify 60 Feet Right of Way
Width on I.C.H. N° 352, SEC. J.
(Now State Route N° 258)

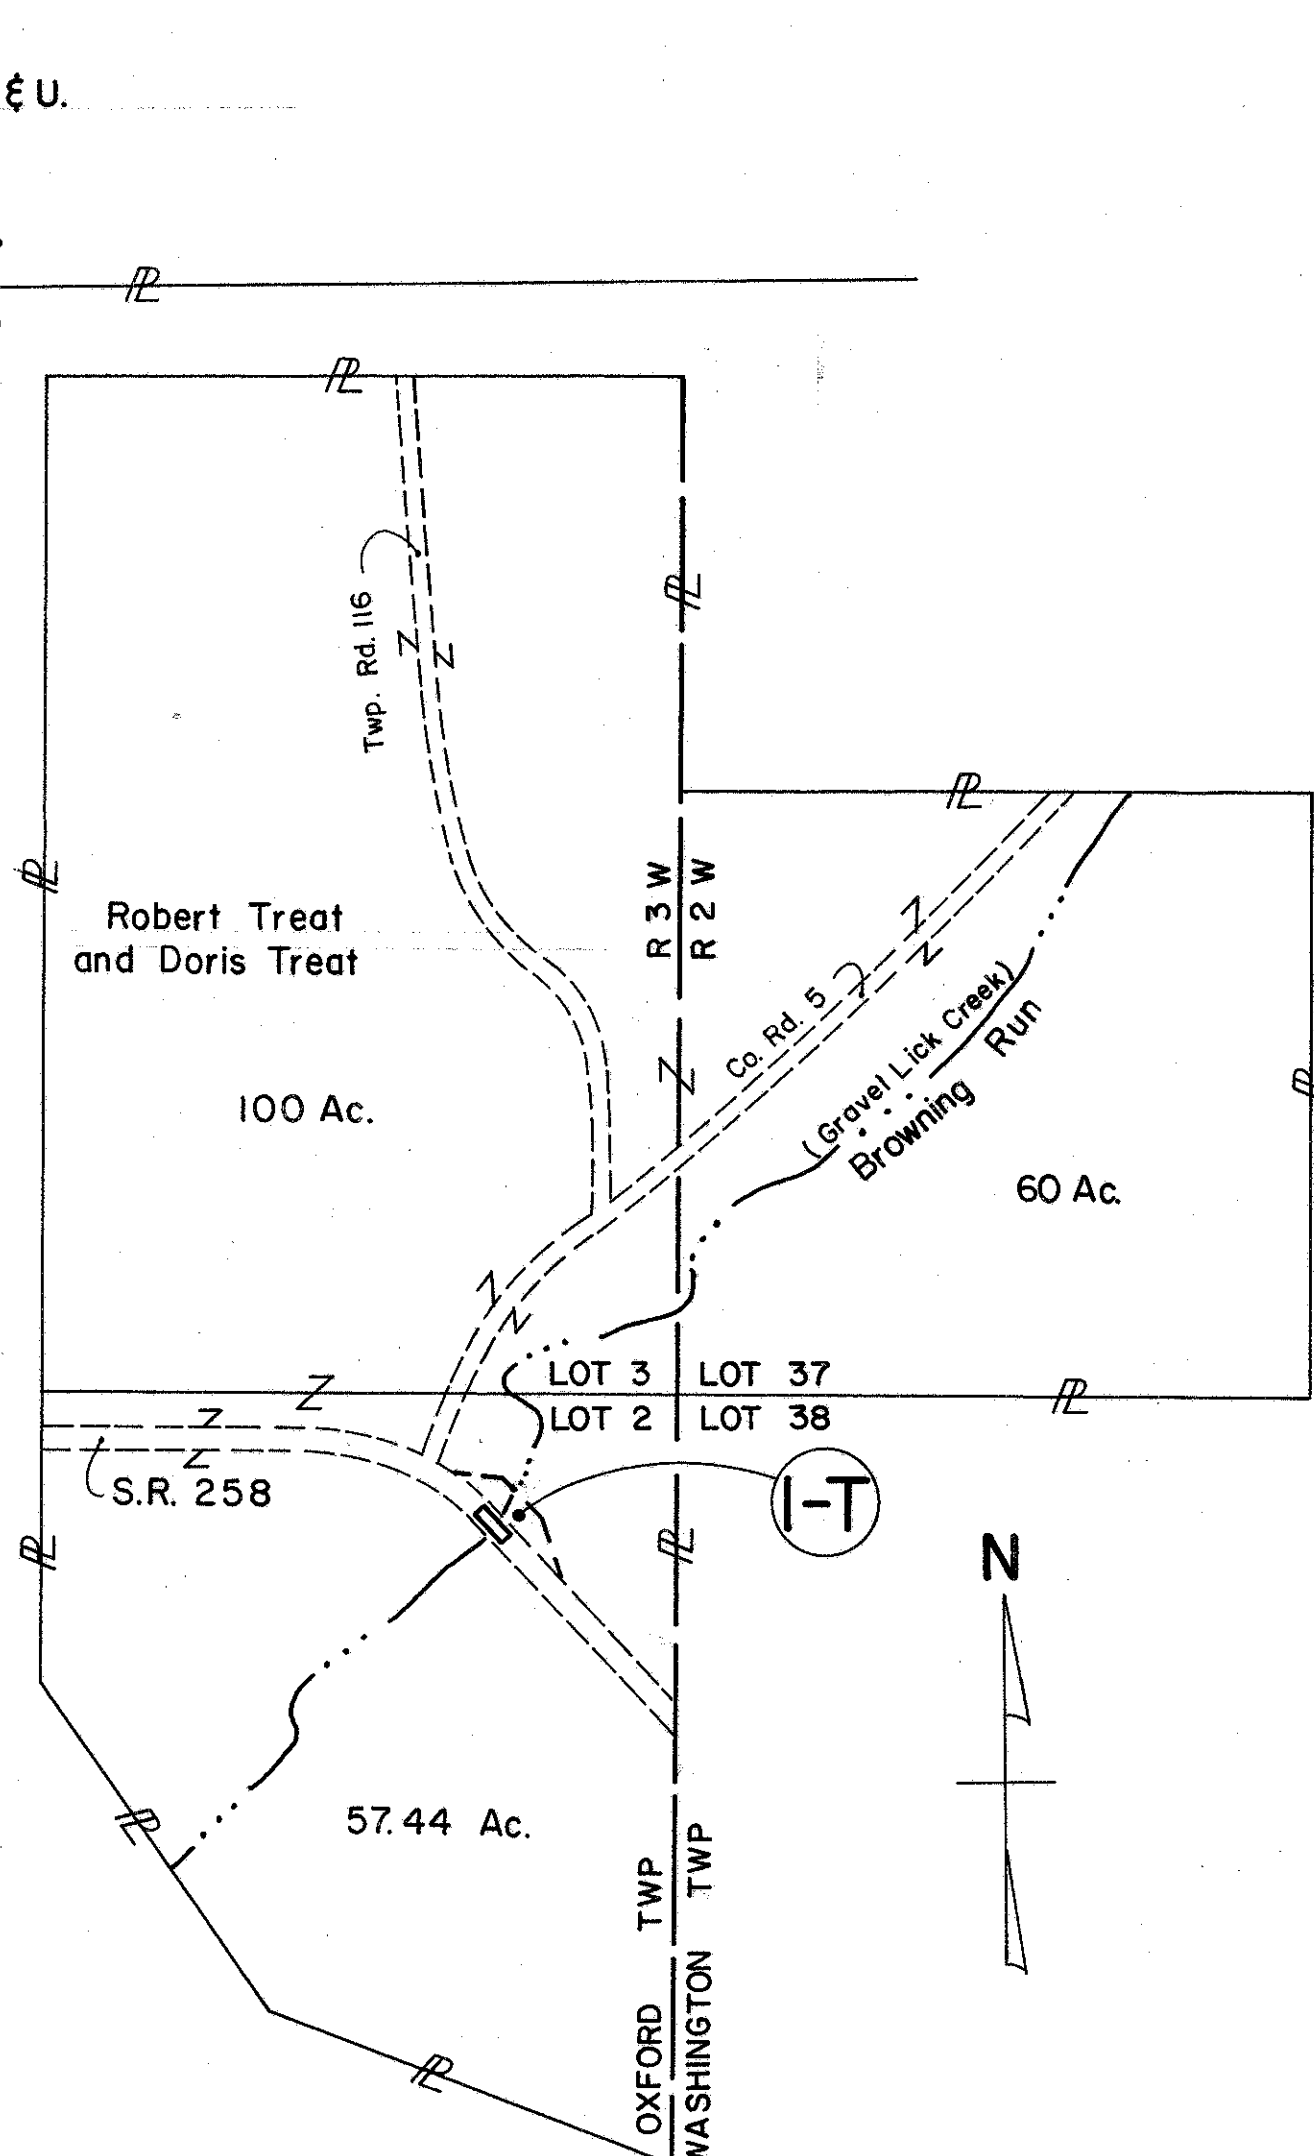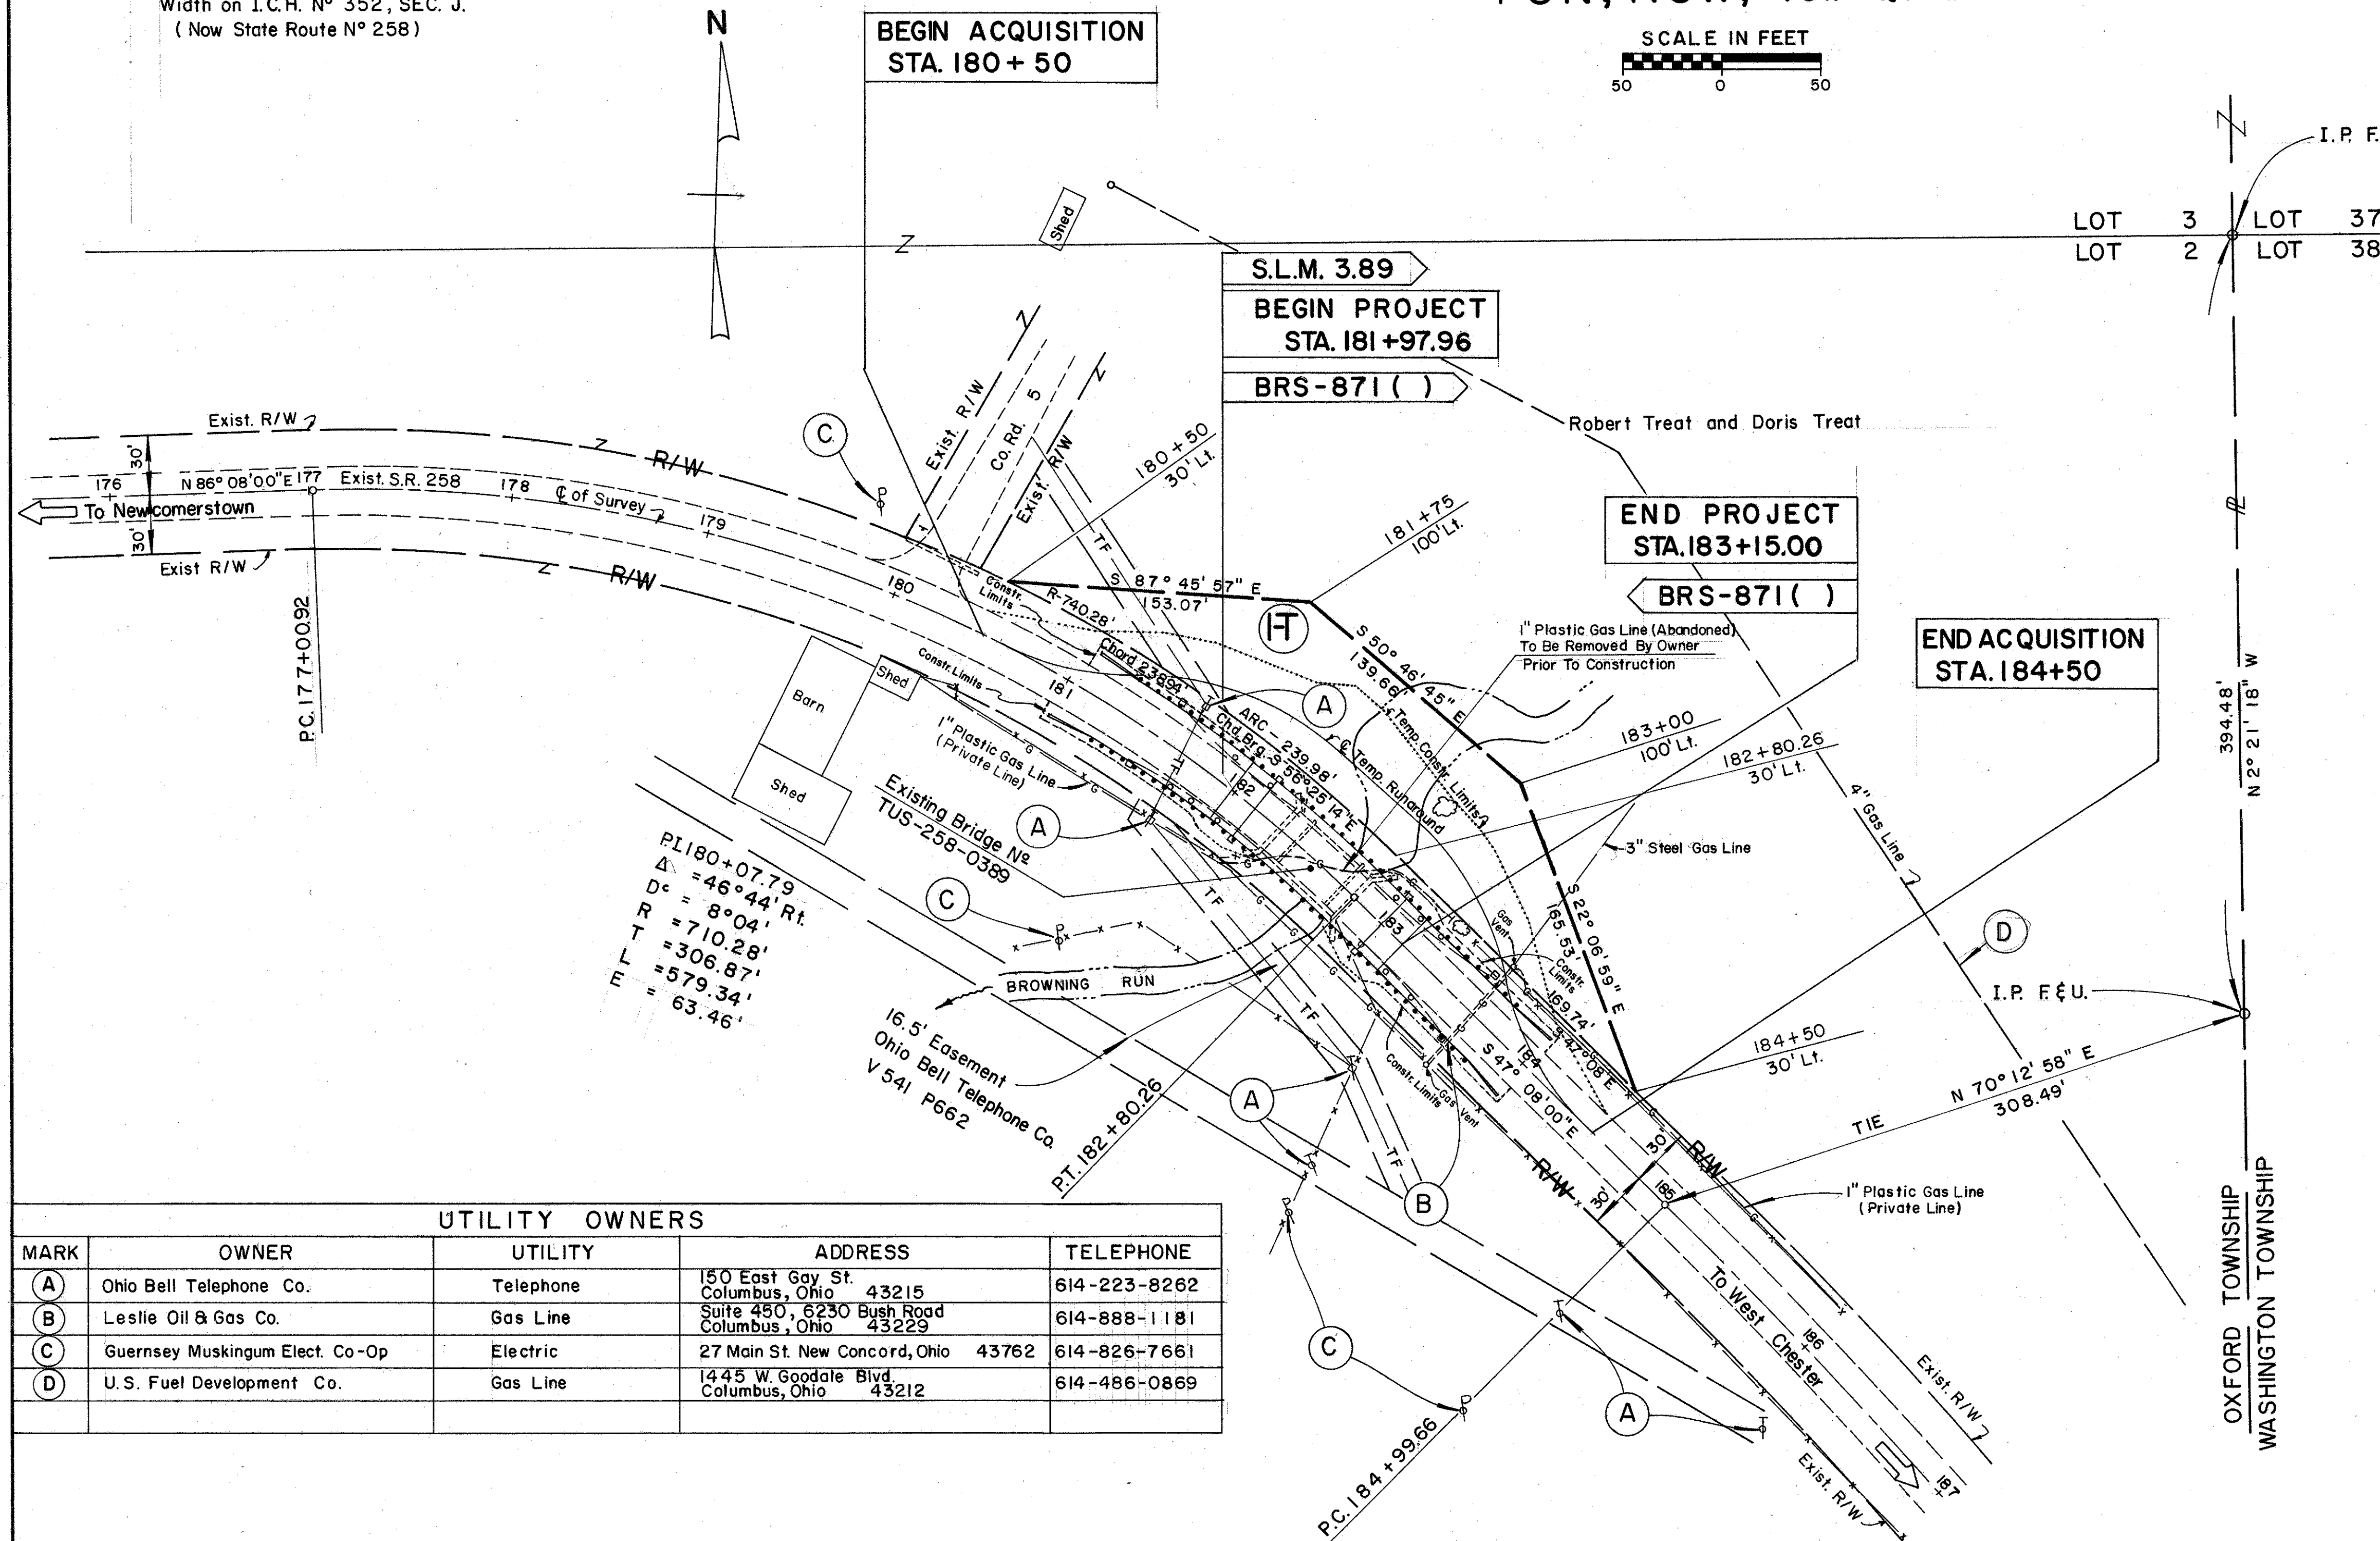

UTILITY OWNERS				
MARK	OWNER	UTILITY	ADDRESS	TELEPHONE
(A)	Ohio Bell Telephone Co.	Telephone	150 East Gay St. Columbus, Ohio 43215	614-223-8262
(B)	Leslie Oil & Gas Co.	Gas Line	Suite 450, 6230 Bush Road Columbus, Ohio 43229	614-888-1181
(C)	Guernsey Muskingum Elect. Co-Op	Electric	27 Main St. New Concord, Ohio 43762	614-826-7661
(D)	U.S. Fuel Development Co.	Gas Line	1445 W. Goodale Blvd. Columbus, Ohio 43212	614-486-0869

NOTE:
Record Area After Outsides Minus Total P.R.O.
Minus Net Take Equals Net Residue.

SUMMARY OF ADDITIONAL RIGHT OF WAY REQUIRED																	
Total No. Owners - 1			No. Total Takes - 0			Total Owners With Structures Involved-0											
PARCEL NO.	OWNER	DEED RECORD			RECORD AREA (ACRES)	TOTAL PRO (ACRES)	TOTAL TAKE (ACRES)	PRO IN TAKE (ACRES)	NET TAKE (ACRES)	NET RES. RIGHT (ACRES)	NET RES. LEFT (ACRES)	BLDGS TO BE ACQD	REMARKS	TYPE FUND			
		BOOK	PAGE	DATE													
I-T	Robert Treat and Doris Treat	230	246	1 -3 -46	57.44	2.851	0.429	0	0.429	46.094	8.495	---	LOT 2 - OXFORD Twp.	STATE	Added Location Of 1" Gas Line And Abandoned Gas Line Left of Centerline Sta. 182+50 To Sta. 186+00	Dist. 11	8-10-82
					100	2.865	0	0	0	---	97.135		LOT 3- OXFORD Twp.				
					60	1.267	0	0	0	---	58.733		LOT 37- Washington Twp.				
TOTAL - Parcel N° I-T					217.44	6.983	0.429	0	0.429	46.094	164.363	---	To Construct Temporary Runaround		REVISION	BY	DATE
															COMPLETED		7/29/82