


S:\C00\3500-3599\3599\018\Drawings\018\Drawings\roadway\sheet\107822\107822.dgn 4/23/2025 9:37:00 AM alexsch

LEGEND


- ① ITEM 442 1½" ASPHALT CONCRETE SURFACE COURSE, 12.5MM, TYPE A, (446)
- ② ITEM 407 NON-TRACKING TACK COAT (RATE PER CMS TABLE 407.06-1)
- ③ ITEM 441 1¾" ASPHALT CONCRETE INTERMEDIATE COURSE, TYPE 2 (446)
- ④ ITEM 301 7" ASPHALT CONCRETE BASE, PG64-22 (449) (PLACED IN TWO LIFTS)
- ⑤ ITEM 301 8½" ASPHALT CONCRETE BASE, PG64-22 (449) (PLACED IN TWO LIFTS)
- ⑥ ITEM 304 AGGREGATE BASE (VARIABLE DEPTH, 6" MIN.)
- ⑦ ITEM 204 SUBGRADE COMPACTION
- ⑧ ITEM 659 SEEDING AND MULCHING
- ⑨ ITEM 254 PAVEMENT PLANING, ASPHALT CONCRETE (1½" MAX.)
- ⑩ ITEM 609 CURB, TYPE 4C
- ⑪ ITEM 605 4" SHALLOW PIPE UNDERDRAINS
- ⑫ ITEM 206 CEMENT STABILIZED SUBGRADE, 12 INCHES DEEP
- ⑬ ITEM 605 4" BASE PIPE UNDERDRAINS
- ⑭ ITEM 209 PREPARING SUBGRADE FOR SHOULDER PAVING
- ⑮ ITEM 605 6" SHALLOW PIPE UNDERDRAINS

- (A) 13" EXISTING ASPHALT PAVEMENT
- (B) 4" EXISTING ASPHALT PAVEMENT
- (C) 8" EXISTING ASPHALT PAVEMENT
- (D) 4" EXISTING ASPHALT PAVEMENT,  
8" EXISTING CONCRETE PAVEMENT

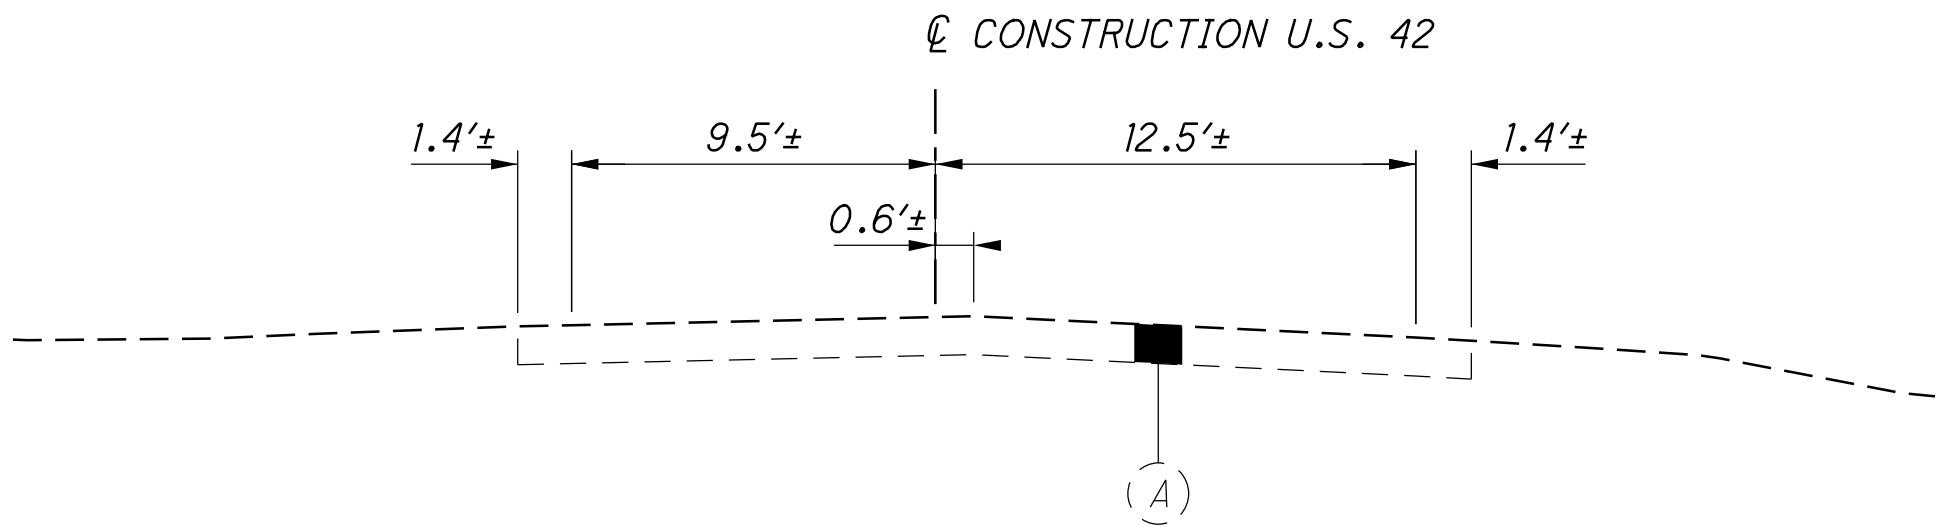


SECTION OF EXISTING ADJOINING PAVEMENT - U.S. 42

SECTION APPLIES:  
STA. 258+59.66

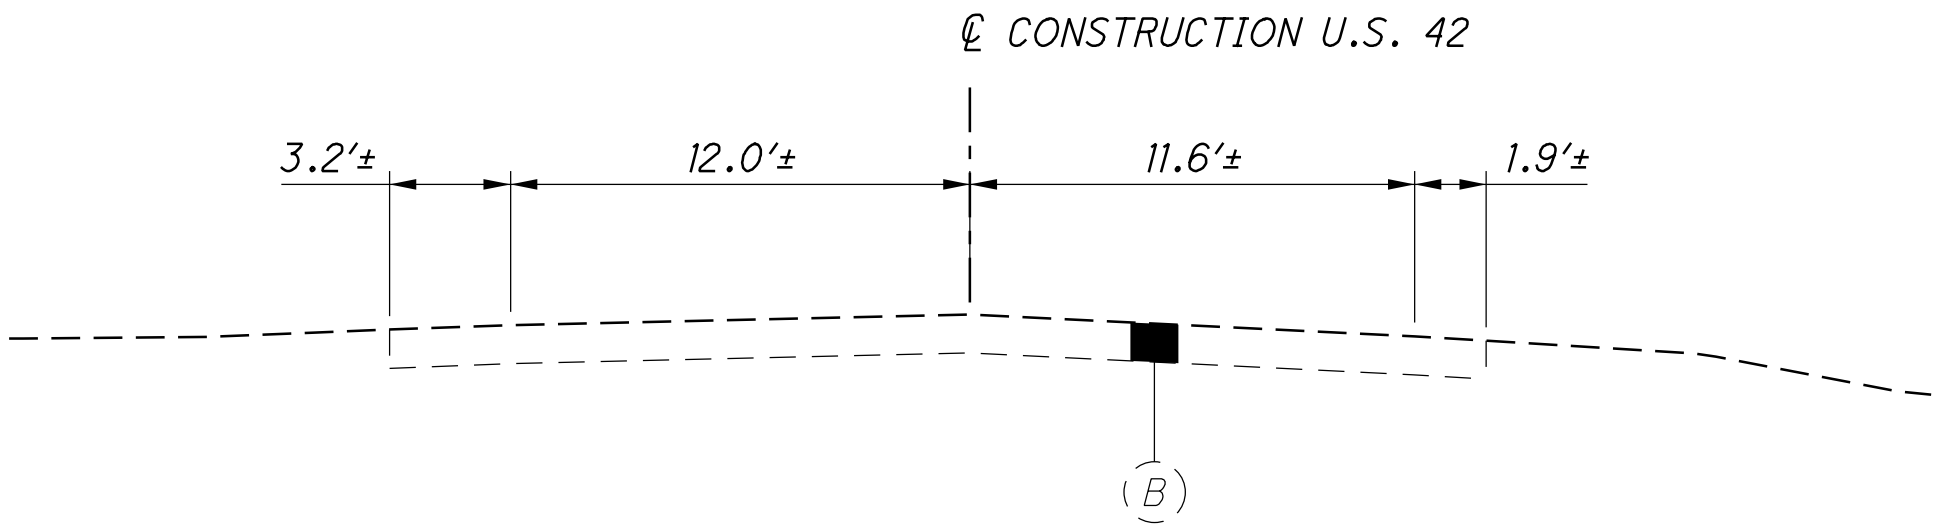


SECTION OF EXISTING ADJOINING PAVEMENT - U.S. 42

SECTION APPLIES:  
STA. 205+45.00

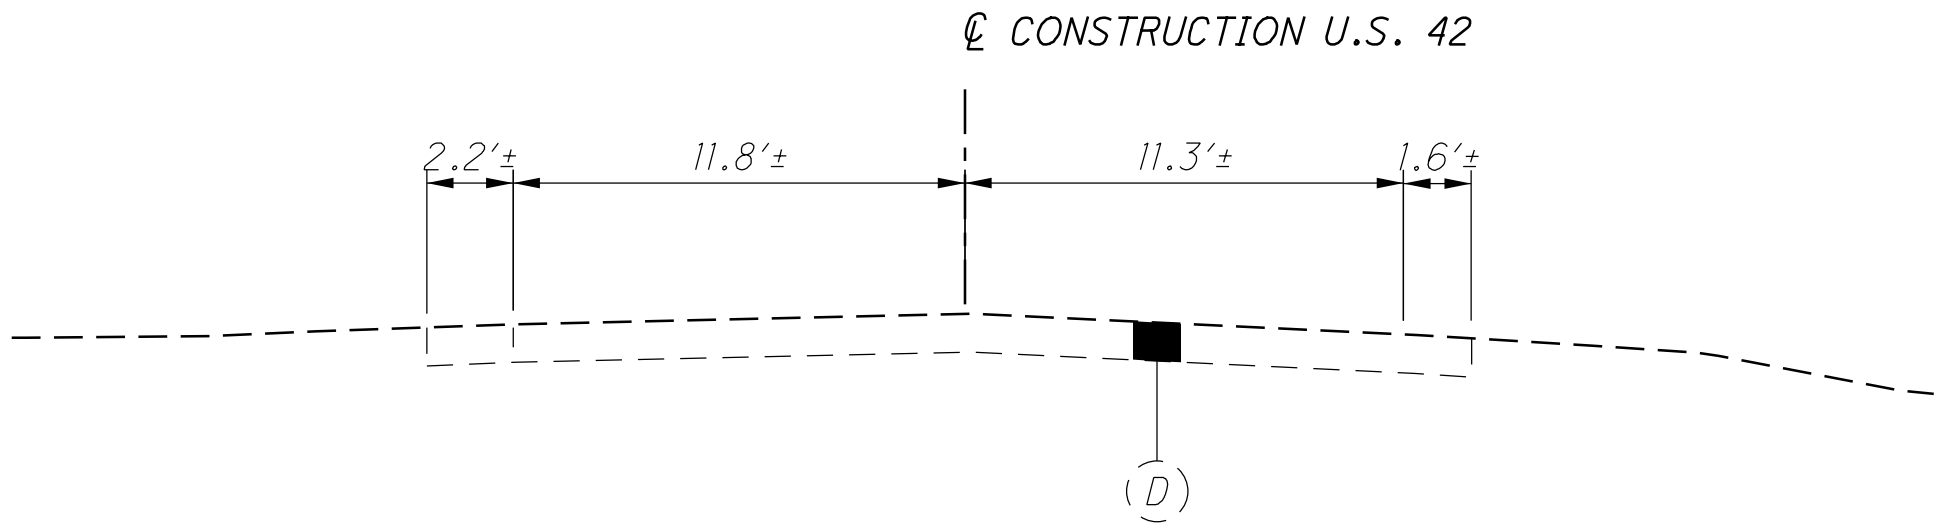


SECTION OF EXISTING ADJOINING PAVEMENT - U.S. 42

SECTION APPLIES:  
STA. 215+00.00

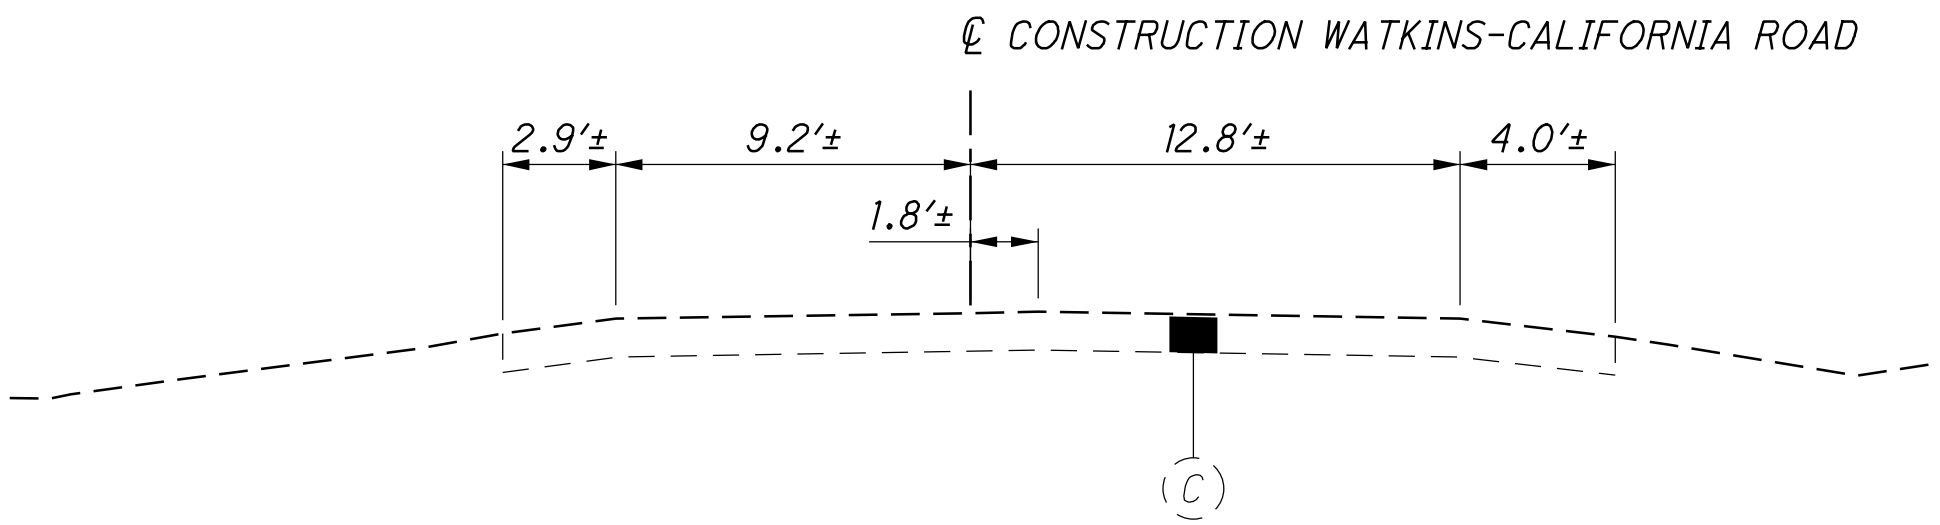


SECTION OF EXISTING ADJOINING PAVEMENT - WATKINS-CALIFORNIA ROAD

SECTION APPLIES:  
STA. 2+63.00

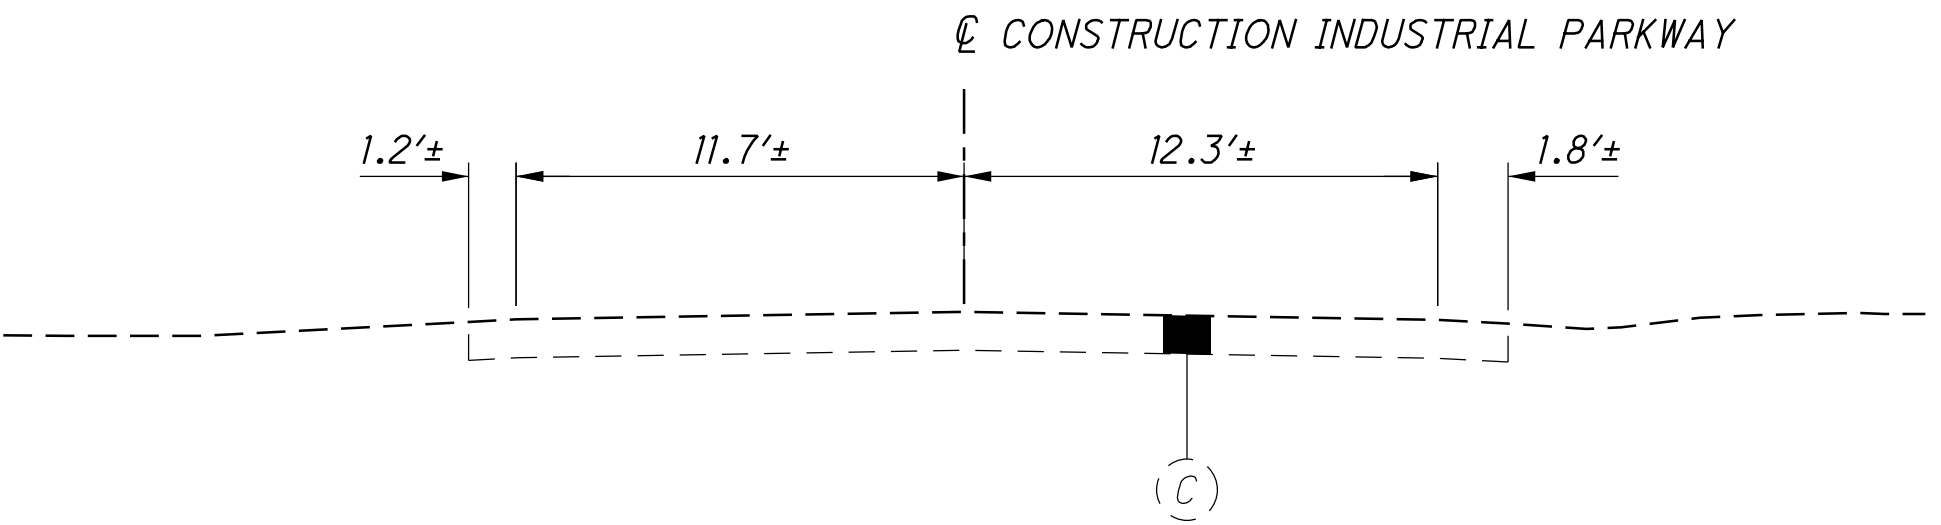

SECTION OF EXISTING ADJOINING PAVEMENT - INDUSTRIAL PARKWAY

SECTION APPLIES:  
STA. 127+33.89

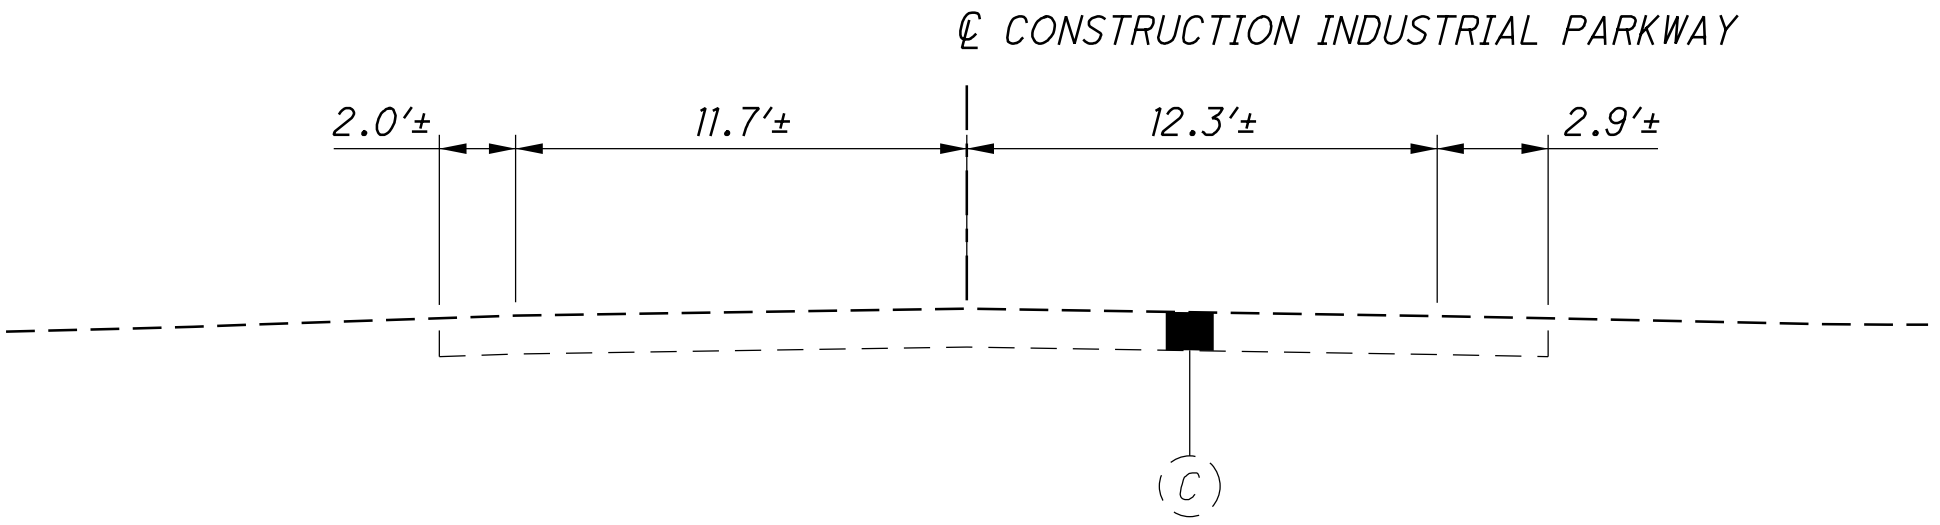

SECTION OF EXISTING ADJOINING PAVEMENT - INDUSTRIAL PARKWAY

SECTION APPLIES:  
STA. 106+26.28

S:\COO\3500--3599\3589\018\Drawings\CAD\107822\roadway\sheets\07822GS001.dgn 4/23/2025 9:37:00 AM alexsch

| REF. NO. | SHEET NO.   | LOCATION  |           |                 | DISTANCE (D) | GUARDRAIL REMOVED | PARKING BLOCK REMOVED | FENCE REMOVED | REMOVAL MISC.: BIRD BATH | REMOVAL MISC.: FLAG | REMOVAL MISC.: LANDSCAPING | 304            |     | NON-TRACKING TACK COAT | 441                                                |    | 442                                                   |    | 606 |      | CURB, TYPE 4C | LIGH POLE REMOVED | SPECIAL - MAILBOX SUPPORT | CALCULATED | ACS CHECKED | JDH |         |
|----------|-------------|-----------|-----------|-----------------|--------------|-------------------|-----------------------|---------------|--------------------------|---------------------|----------------------------|----------------|-----|------------------------|----------------------------------------------------|----|-------------------------------------------------------|----|-----|------|---------------|-------------------|---------------------------|------------|-------------|-----|---------|
|          |             |           |           |                 |              |                   |                       |               |                          |                     |                            | AGGREGATE BASE |     |                        | ASPHALT CONCRETE INTERMEDIATE COURSE, TYPE 2 (446) |    | ASPHALT CONCRETE SURFACE COURSE, 12.5MM, TYPE A (446) |    |     |      |               |                   |                           |            |             |     |         |
|          |             |           |           |                 |              |                   |                       |               |                          |                     |                            | AVG DEPTH      |     |                        | AVG DEPTH                                          |    | AVG DEPTH                                             |    |     |      |               |                   |                           |            |             |     |         |
|          |             |           |           | FT              | FT           | EACH              | FT                    | EACH          | EACH                     | SF                  | IN                         | CY             | GAL | IN                     | CY                                                 | IN | CY                                                    | FT | FT  | EACH | EACH          | FT                | GAL                       | EACH       |             |     |         |
|          |             | R-1      | P.156       | 207+00.00 |           | US 42           |              |                   |                       |               |                          | 668                 |                            |                |     |                        |                                                    |    |                                                       |    |     |      |               |                   |                           |            |             |     |         |
| R-2      | P.156       | 208+00.00 |           | US 42           |              |                   |                       |               |                          | 1305                |                            |                |     |                        |                                                    |    |                                                       |    |     |      |               |                   |                           |            |             |     |         |
| R-3      | P.156       | 209+25.00 |           | US 42           |              |                   |                       |               |                          | 1389                |                            |                |     |                        |                                                    |    |                                                       |    |     |      |               |                   |                           |            |             |     |         |
| R-4      | P.156       | 206+69.22 | 209+46.89 | US 42           | 277.67       |                   | 239.00                |               |                          | R-5      | P.156       | 207+04.36 |           | US 42           |              |                   |                       | 1             |                          |                     |                            |                |     |                        |                                                    |    |                                                       |    |     |      |               |                   |                           |            |             |     |         |
| R-6      | P.156       | 207+61.48 | 208+13.39 | US 42           | 51.91        |                   | 52.00                 |               |                          | R-7      | P.156       | 208+52.52 | 209+40.35 | US 42           | 87.83        |                   | 88.00                 |               |                          | R-8      | P.157       | 211+61.44 | 214+37.45 | US 42           | 276.01       |                   | 343.00                |               |                          | R-9      | P.157       | 211+81.52 |           | US 42           |              |                   |                       |               | 1                        |                     |                            |                |     |                        |                                                    |    |                                                       |    |     |      |               |                   |                           |            |             |     |         |
| R-10     | P.157       | 212+79.13 |           | US 42           |              |                   |                       |               | 1                        |                     |                            |                |     |                        |                                                    |    |                                                       |    |     |      |               |                   |                           |            |             |     |         |
| R-11     | P.157       | 214+00.26 |           | US 42           |              |                   |                       |               | 1                        |                     |                            |                |     |                        |                                                    |    |                                                       |    |     |      |               |                   |                           |            |             |     |         |
| R-12     | P.158       | 218+49.04 |           | US 42           |              |                   | R-13     | P.158       | 218+53.46 |           | US 42           |              |                   | 8                     |               |                          |                     |                            |                |     |                        |                                                    |    |                                                       |    |     |      |               |                   |                           |            |             |     | 1       |
| R-14     | P.158       | 219+19.56 |           | US 42           |              |                   3       |
| R-15     | P.160       | 228+60    |           | US 42           |              |                   |                       |               |                          | 679                 |                            |                |     |                        |                                                    |    |                                                       |    |     |      |               |                   |                           |            |             |     |         |
| R-16     | P.161       | 231+30.45 | 235+00.00 | US 42           | 369.55       |                   | 372.00                |               |                          | R-17     | P.162-P.163 | 237+86.19 | 240+45.41 | US 42           | 259.22       | 259.2             |                       |               | R-18     | P.163-P.164 | 243+13.00 | 246+07.00 | US 42           | 315.20       | 315.2             |                       |               | R-19     | P.169       | 111+19.80 | 112+82.20 | INDUSTRIAL      | 162.40       | 162.4             |                       |               |          |             | MB-1     | P.156       | 207+08.86 |           | US 42           |              |                   1       |
| MB-2     | P.157       | 211+24.96 |           | US 42           |              |                   1       |
| MB-3     | P.157       | 212+91.63 |           | US 42           |              |                   1       |
| MB-4     | P.168       | 109+64.00 |           | INDUSTRIAL      |              |                   1       |
|          | P.158       | 216+00.00 | 219+47.10 | US 42 (LT)      | 347.10       |                   |                       |          | P.158       | 216+00.00 | 219+37.63 | US 42 (RT)      | 337.63       |                   |                       375.22  |
|          | P.158-P.161 | 219+94.73 | 232+88.40 | US 42 (RT)      | 1293.67      |                   |                       371.3   |
|          | P.170-P.171 | 116+91.90 | 122+47.14 | INDUSTRIAL (LT) | 555.24       |                   |                       1827.41 |
|          |             873.13  |
|          |             |          |             |          |             |          |             |          |             |          |             |          |             |          |             |          |             
S:\COO\3500--3599\3589\018\Drawings\CAD\107822\roadway\sheets\07822GS001A.dgn 4/23/2025 9:37:02 AM alexsch

| REF. NO.                                   | SHEET NO.   | LOCATION                        |        |            | DISTANCE (D) | GUARDRAIL REMOVED | PARKING BLOCK REMOVED | 202           |                          |                     | 304                        |                | 407   | 441                    |                                                    | 442  |                                                       | 606  |                     |                                |                             | 609  | 625 | 609  |                             |    |
|--------------------------------------------|-------------|---------------------------------|--------|------------|--------------|-------------------|-----------------------|---------------|--------------------------|---------------------|----------------------------|----------------|-------|------------------------|----------------------------------------------------|------|-------------------------------------------------------|------|---------------------|--------------------------------|-----------------------------|------|-----|------|-----------------------------|----|
|                                            |             |                                 |        |            |              |                   |                       | FENCE REMOVED | REMOVAL MISC.: BIRD BATH | REMOVAL MISC.: FLAG | REMOVAL MISC.: LANDSCAPING | AGGREGATE BASE |       | NON-TRACKING TACK COAT | ASPHALT CONCRETE INTERMEDIATE COURSE, TYPE 2 (446) |      | ASPHALT CONCRETE SURFACE COURSE, 12.5MM, TYPE A (446) |      | GUARDRAIL, TYPE MGS | GUARDRAIL, TYPE MGS, LONG-SPAN | ANCHOR ASSEMBLY, MGS TYPE E |      |     |      | ANCHOR ASSEMBLY, MGS TYPE T |    |
|                                            |             |                                 |        |            |              |                   |                       |               |                          |                     |                            | FT             |       |                        | IN                                                 | CY   | IN                                                    | CY   |                     |                                |                             |      |     |      |                             | IN |
|                                            |             |                                 |        |            | FT           | FT                | EACH                  | FT            | EACH                     | EACH                | SF                         | IN             | CY    | GAL                    | IN                                                 | CY   | IN                                                    | CY   | FT                  | FT                             | EACH                        | EACH | FT  | GAL  | EACH                        |    |
| G-1                                        | P.157       | 213+51                          | 213+71 | US 42      |              |                   |                       |               |                          |                     |                            |                |       |                        |                                                    |      |                                                       |      | 25                  |                                |                             |      |     |      |                             |    |
| G-1A                                       | P.157       | 231+71                          | 213+83 | US 42      |              |                   |                       |               |                          |                     |                            |                |       |                        |                                                    |      |                                                       |      |                     |                                | 1                           |      |     |      |                             |    |
| G-2                                        | P.157       | 213+63                          | 214+58 | US 42      |              |                   |                       |               |                          |                     |                            |                |       |                        |                                                    |      |                                                       |      | 62.5                |                                |                             |      |     |      |                             |    |
| G-3                                        | P.157-P.158 | 214+58                          | 215+08 | US 42      |              |                   |                       |               |                          |                     |                            |                |       |                        |                                                    |      |                                                       |      |                     |                                | 1                           |      |     |      |                             |    |
| G-4                                        | P.157       | 213+79                          | 214+29 | US 42      |              |                   |                       |               |                          |                     |                            |                |       |                        |                                                    |      |                                                       |      |                     |                                | 1                           |      |     |      |                             |    |
| G-5                                        | P.157       | 214+29                          | 214+54 | US 42      |              |                   |                       |               |                          |                     |                            |                |       |                        |                                                    |      |                                                       |      | 25                  |                                |                             |      |     |      |                             |    |
| G-6                                        | P.157-P.158 | 214+54                          | 215+04 | US 42      |              |                   |                       |               |                          |                     |                            |                |       |                        |                                                    |      |                                                       |      | 25                  | 50                             |                             |      |     |      |                             |    |
| G-7                                        | P.158       | 215+04                          | 216+29 | US 42      |              |                   |                       |               |                          |                     |                            |                |       |                        |                                                    |      |                                                       |      | 125                 |                                |                             |      |     |      |                             |    |
| G-8                                        | P.158       | 216+29                          | 216+79 | US 42      |              |                   |                       |               |                          |                     |                            |                |       |                        |                                                    |      |                                                       |      |                     |                                | 1                           |      |     |      |                             |    |
| G-9                                        | P.169       | 110+95                          | 111+45 | INDUSTRIAL |              |                   |                       |               |                          |                     |                            |                |       |                        |                                                    |      |                                                       |      |                     |                                | 1                           |      |     |      |                             |    |
| G-10                                       | P.169       | 111+45                          | 111+70 | INDUSTRIAL |              |                   |                       |               |                          |                     |                            |                |       |                        |                                                    |      |                                                       |      | 25                  |                                |                             |      |     |      |                             |    |
| G-11                                       | P.169       | 111+70                          | 112+20 | INDUSTRIAL |              |                   |                       |               |                          |                     |                            |                |       |                        |                                                    |      |                                                       |      |                     | 50                             |                             |      |     |      |                             |    |
| G-12                                       | P.169       | 112+20                          | 112+45 | INDUSTRIAL |              |                   |                       |               |                          |                     |                            |                |       |                        |                                                    |      |                                                       |      | 25                  |                                |                             |      |     |      |                             |    |
| G-13                                       | P.169       | 112+45                          | 112+58 | INDUSTRIAL |              |                   |                       |               |                          |                     |                            |                |       |                        |                                                    |      |                                                       |      |                     |                                | 1                           |      |     |      |                             |    |
| DR-1                                       | P.156       | 207+22.75                       |        | US 42      |              |                   |                       |               |                          |                     |                            | 9.00           | 11.40 |                        |                                                    |      |                                                       |      |                     |                                |                             |      |     |      |                             |    |
| DR-2                                       | P.156       | 208+72.31                       |        | US 42      |              |                   |                       |               |                          |                     |                            | 9.00           | 11.19 |                        |                                                    |      | 1.50                                                  | 2.80 |                     |                                |                             |      |     |      |                             |    |
| DR-3                                       | P.157       | 210+99.18                       |        | US 42      |              |                   |                       |               |                          |                     |                            | 6.00           | 9.59  |                        |                                                    |      | 1.50                                                  | 2.40 |                     |                                |                             |      |     |      |                             |    |
| DR-4                                       | P.157       | 213.44.84                       |        | US 42      |              |                   |                       |               |                          |                     |                            | 9.00           | 17.00 |                        |                                                    |      |                                                       |      |                     |                                |                             |      |     |      |                             |    |
| DR-5                                       | P.160       | 225+39.13                       |        | US 42      |              |                   |                       |               |                          |                     |                            | 6.00           | 4.95  | 1.78                   | 1.75                                               | 1.44 | 1.50                                                  | 1.95 |                     |                                |                             |      |     |      |                             |    |
| DR-6                                       | P.160       | 226+38.39                       |        | US 42      |              |                   |                       |               |                          |                     |                            | 6.00           | 16.06 | 5.78                   | 1.75                                               | 4.68 | 1.50                                                  | 5.22 |                     |                                |                             |      |     |      |                             |    |
| DR-7                                       | P.160       | 227+13.88                       |        | US 42      |              |                   |                       |               |                          |                     |                            | 6.00           | 11.10 | 4.00                   | 1.75                                               | 3.24 | 1.50                                                  | 2.78 |                     |                                |                             |      |     |      |                             |    |
| DR-8                                       | P.160       | 228+10.75                       |        | US 42      |              |                   |                       |               |                          |                     |                            | 6.00           | 15.12 | 5.44                   | 1.75                                               | 4.41 | 1.50                                                  | 3.78 |                     |                                |                             |      |     |      |                             |    |
| DR-9                                       | P.160       | 229+12.40                       |        | US 42      |              |                   |                       |               |                          |                     |                            | 6.00           | 17.05 | 6.14                   | 1.75                                               | 4.97 | 1.50                                                  | 4.26 |                     |                                |                             |      |     |      |                             |    |
| DR-10                                      | P.160       | 229+72.27                       |        | US 42      |              |                   |                       |               |                          |                     |                            | 9.00           | 94.20 |                        |                                                    |      |                                                       |      |                     |                                |                             |      |     |      |                             |    |
|                                            | P.161       | 230+79.88 (OHIOHEALTH DRIVEWAY) |        | US 42      |              |                   |                       |               |                          |                     |                            |                | 14.19 | 5.11                   |                                                    | 4.14 |                                                       | 3.55 |                     |                                |                             |      |     |      |                             |    |
| DR-12                                      | P.165       | 253+23.73                       |        | US 42      |              |                   |                       |               |                          |                     |                            | 9.00           | 25.80 |                        |                                                    |      |                                                       |      |                     |                                |                             |      |     |      |                             |    |
| DR-13                                      | P.168       | 106+29.85                       |        | INDUSTRIAL |              |                   |                       |               |                          |                     |                            | 6.00           | 15.66 | 5.64                   | 1.75                                               | 4.57 | 1.50                                                  | 3.92 |                     |                                |                             |      |     |      |                             |    |
| DR-14                                      | P.168       | 106+60.11                       |        | INDUSTRIAL |              |                   |                       |               |                          |                     |                            | 6.00           | 21.86 | 7.87                   | 1.75                                               | 6.38 | 1.50                                                  | 5.47 |                     |                                |                             |      |     |      |                             |    |
| DR-15                                      | P.168       | 108+92.43                       |        | INDUSTRIAL |              |                   |                       |               |                          |                     |                            | 9.00           | 11.91 |                        |                                                    |      |                                                       |      |                     |                                |                             |      |     |      |                             |    |
| DR-16                                      | P.168       | 109+57.73                       |        | INDUSTRIAL |              |                   |                       |               |                          |                     |                            | 9.00           | 8.35  |                        |                                                    |      |                                                       |      |                     |                                |                             |      |     |      |                             |    |
| DR-17                                      | P.169       | 110+33.01                       |        | INDUSTRIAL |              |                   |                       |               |                          |                     |                            | 9.00           | 11.44 |                        |                                                    |      |                                                       |      |                     |                                |                             |      |     |      |                             |    |
| DR-18                                      | P.169       | 110+69.47                       |        | INDUSTRIAL |              |                   |                       |               |                          |                     |                            | 9.00           | 13.34 |                        |                                                    |      |                                                       |      |                     |                                |                             |      |     |      |                             |    |
| DR-19                                      | P.169       | 111+32.64                       |        | INDUSTRIAL |              |                   |                       |               |                          |                     |                            | 9.00           | 12.40 |                        |                                                    |      |                                                       |      |                     |                                |                             |      |     |      |                             |    |
| DR-20                                      | P.169       | 112+73.56                       |        | INDUSTRIAL |              |                   |                       |               |                          |                     |                            | 9.00           | 15.30 |                        |                                                    |      |                                                       |      |                     |                                |                             |      |     |      |                             |    |
| DR-21                                      | P.169       | 113+46.63                       |        | INDUSTRIAL |              |                   |                       |               |                          |                     |                            | 9.00           | 16.26 |                        |                                                    |      |                                                       |      |                     |                                |                             |      |     |      |                             |    |
| DR-22                                      | P.170       | 117+35.80                       |        | INDUSTRIAL |              |                   |                       |               |                          |                     |                            | 6.00           | 27.45 | 9.88                   | 1.75                                               | 8.01 | 1.50                                                  | 6.86 |                     |                                |                             |      |     |      |                             |    |
| DR-23                                      | P.170       | 118+33.55                       |        | INDUSTRIAL |              |                   |                       |               |                          |                     |                            | 6.00           | 6.33  | 2.28                   | 1.75                                               | 1.85 | 1.50                                                  | 1.58 |                     |                                |                             |      |     |      |                             |    |
| DR-24                                      | P.170       | 119+84.42                       |        | INDUSTRIAL |              |                   |                       |               |                          |                     |                            | 6.00           | 18.20 | 6.55                   | 1.75                                               | 5.31 | 1.50                                                  | 4.55 |                     |                                |                             |      |     |      |                             |    |
| DR-25                                      | P.171       | 120+22.10                       |        | INDUSTRIAL |              |                   |                       |               |                          |                     |                            | 9.00           | 23.41 |                        |                                                    |      |                                                       |      |                     |                                |                             |      |     |      |                             |    |
| DR-26                                      | P.171       | 122+16.51                       |        | INDUSTRIAL |              |                   |                       |               |                          |                     |                            | 6.00           | 7.66  | 2.76                   | 1.75                                               | 2.23 | 1.50                                                  | 1.91 |                     |                                |                             |      |     |      |                             |    |
|                                            |             |                                            |             |                                            |             |                                            |             | TOTALS FROM SUBSUMMARY SHEET P.110A        |             |                                 |        |            |              | 0                 | 0                     | 0             | 0                        | 0                   | 0                          |                | 457.2 | 63.2                   |                                                    |      | 51.2                                                  |      | 51.0                | 287.5                          | 100                         | 4    | 2   | 0    | 0                           | 0  |
| TOTALS CARRIED FROM SUBSUMMARY SHEET P.110 |             |                                 |        |            |              | 737               | 8                     | 1094          | 1                        | 3                   | 4041                       |                | 0     | 0                      |                                                    |      | 0                                                     |      | 0                   | 0                              | 0                           | 0    | 0   | 3447 | 4                           | 4  |
| TOTALS CARRIED TO GENERAL SUMMARY          |             |                                 |        |            |              | 737               | 8                     | 1094          | 1                        | 3                   | 4041                       |                | 457   | 63                     |                                                    |      | 51                                                    |      | 51                  | 287.5                          | 100                         | 4    | 2   | 3447 | 4                           | 4  |
| UNI - 42 - 3.91                            |             |                                 | P.110A<br>P.347                            |             |                                 
