


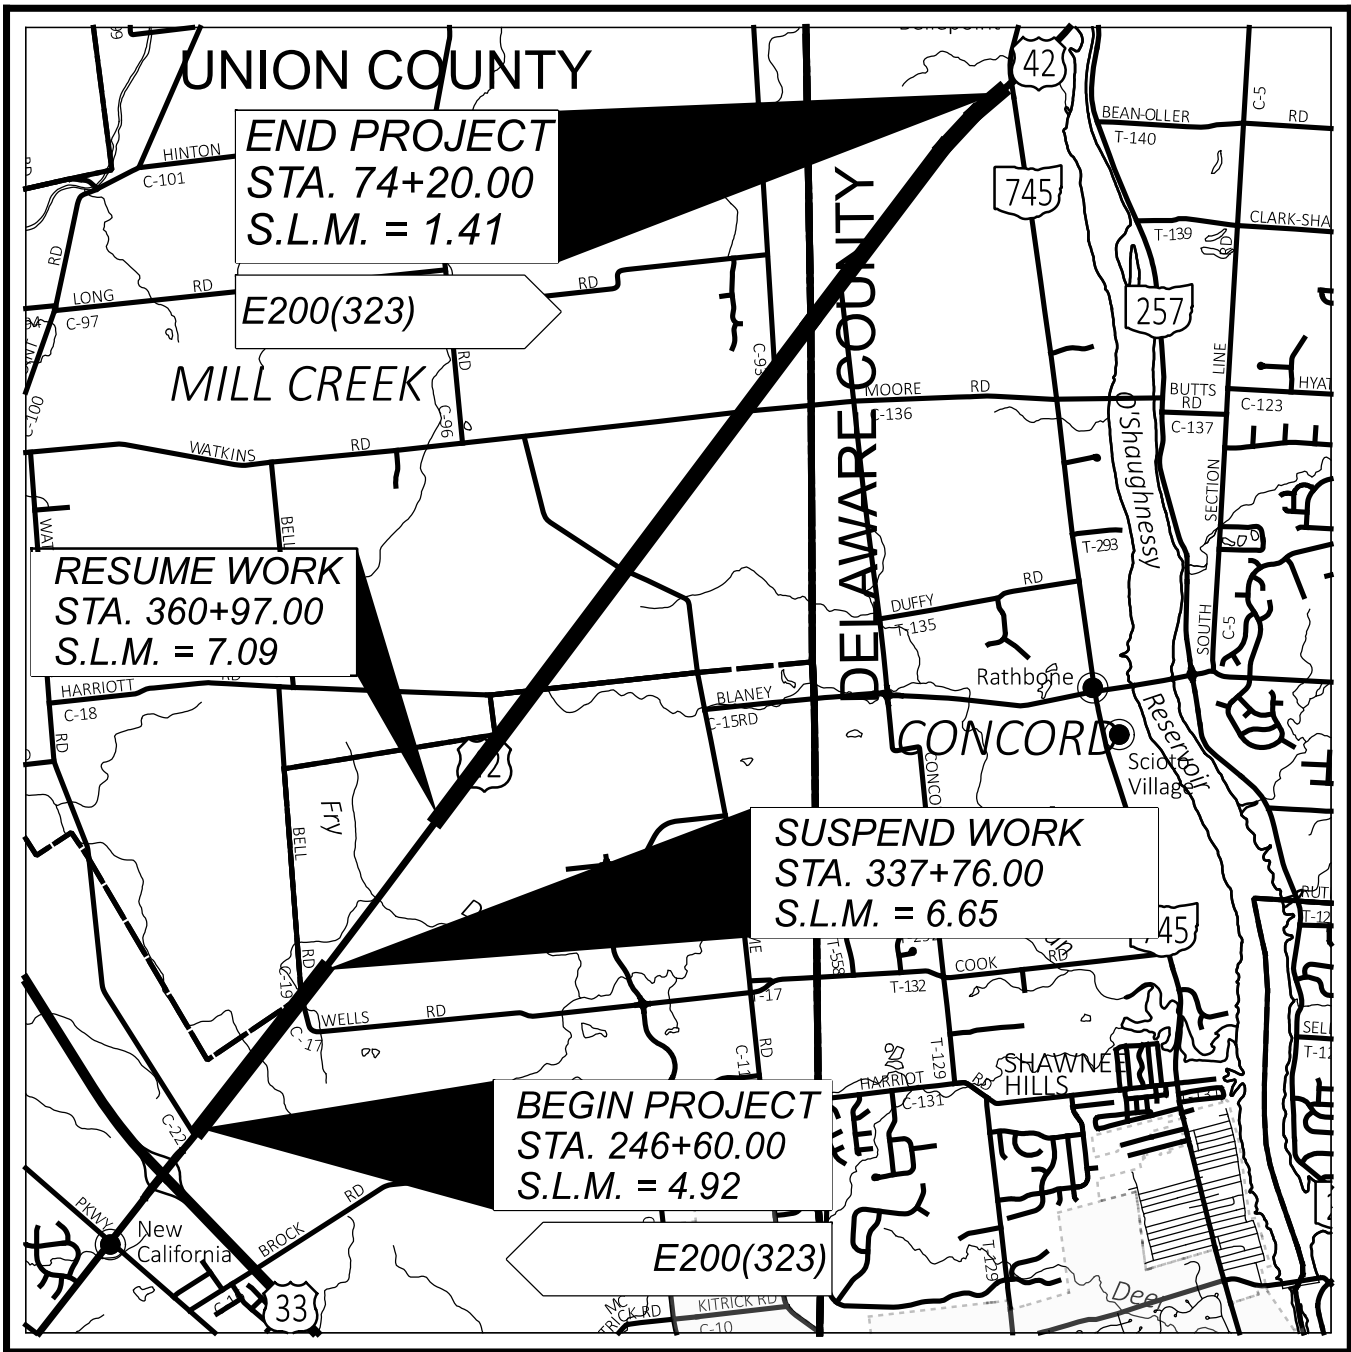

LEGEND

- ① ITEM 442 - 1 1/2" ASPHALT CONCRETE SURFACE COURSE, 12.5mm, TYPE A (446)
② ITEM 442 - 1 3/4" ASPHALT CONCRETE INTERMEDIATE COURSE, 19.0mm, TYPE A (446) SEE NOTE [D]
③ ITEM 407 - NON-TRACKING TACK COAT (RATE AS PER CMS TABLE 407.06-1)
④ ITEM 301 - 8" ASPHALT CONCRETE BASE, PG64-22, (449), (2 EQUAL L

LEGEND

- ①

ITEM 442 - 1 1/2" ASPHALT CONCRETE SURFACE COURSE, 12.5mm, TYPE A (446)
- ②

ITEM 442 - 1 3/4" ASPHALT CONCRETE INTERMEDIATE COURSE, 19.0mm, TYPE A (446). SEE NOTE [D]
- ③

ITEM 407 - NON-TRACKING TACK COAT (RATE AS PER CMS TABLE 407.06-1)

LEGEND

- 1

ITEM 442 - 1 1/2" ASPHALT CONCRETE SURFACE COURSE, 12.5mm, TYPE A (446)

2

ITEM 442 - 1 3/4" ASPHALT CONCRETE INTERMEDIATE COURSE, 19.0mm, TYPE A (446)

3

ITEM 407 - NON-TRACKING TACK COAT (RATE AS PER CMS TABLE 407.06-1)

4

ITEM 301 - 8" ASP

