


UNI-31-15.55, UNI-347-3.89

MODEL: 121080_GG101 PAPERSIZE: 34x22 (in.) DATE: 12/18/2025 TIME: 9:23:42 AM PLTDRY: OHDOT_PDF.pltctg PENTBL: OHDOT_Pen.tbl USER: David.Rankin@dot.ohio.gov WORKSPACE: OHDOTCEv02 WORKSET: 121080_PRODUCT: OpenRoadsDesigner 24.00.00.2005
pww:\ohiodot-pw.bentley.com:ohiodot-pw-02\Documents\01 Active Projects\District 06\Union\121080\400-Engineering\Roadway\Sheets\121080_GG001.dgn

SHEET NUMBER										PARTICIPATION			ITEM	ITEM EXT.	GRAND TOTAL	UNIT	DESCRIPTION	SEE SHEET NO.
P.9 - P.10	P.11 - P.12	P.14	P.15	P.16	P.17	P.27	P.34	P.35	P.36	01/STR								
					40					40			202	23001	40	SY	ROADWAY PAVEMENT REMOVED, AS PER PLAN	P.9
					567					567			202	30001	567	SF	WALK REMOVED, AS PER PLAN	P.9
					587					587			608	10001	587	SF	4" CONCRETE WALK, AS PER PLAN	P.10
					423					423			608	52000	423	SF	CURB RAMP	
4										4			623	39600	4	EACH	MONUMENT ASSEMBLY RECONSTRUCTED TO GRADE	
					0.9					0.9			659	00300	0.9	CY	EROSION CONTROL TOPSOIL	
					34.3					34.3			659	10000	34.3	SY	SEEDING AND MULCHING	
					0.03					0.03			659	20000	0.03	TON	COMMERCIAL FERTILIZER	
					0.01					0.01			659	31000	0.01	ACRE	LIME	
					0.6					0.6			659	35000	0.6	MGAL	WATER	
										1000			832	30000	1000	EACH	EROSION CONTROL	
		1520								1520			605	31100	1520	FT	DRAINAGE AGGREGATE DRAINS	
4										4			611	98630	4	EACH	CATCH BASIN ADJUSTED TO GRADE	
4										4			611	99654	4	EACH	MANHOLE ADJUSTED TO GRADE	
		2403								2403			251	01040	2403	SY	PAVEMENT PARTIAL DEPTH PAVEMENT REPAIR (ASPHALT CONCRETE BASE), 4.5"	P.10
		2064								2064			253	02001	2064	CY	PAVEMENT REPAIR, AS PER PLAN, 15"	
			76756	65985						142741			254	01000	142741	SY	PAVEMENT PLANING, ASPHALT CONCRETE, 1.5"	
			6523	5609						12132			407	20000	12132	GAL	NON-TRACKING TACK COAT	
							160	140	150	450			409	30000	450	FT	SAWING AND SEALING ASPHALT CONCRETE PAVEMENT JOINTS	
			3169	2691						5860			441	10000	5860	CY	ASPHALT CONCRETE SURFACE COURSE, TYPE 1, (446), PG64-22	
			32	58						90			441	70000	90	CY	ASPHALT CONCRETE SURFACE COURSE, TYPE 1, (449), PG64-22	
			155	122						277			617	10100	277	CY	COMPACTED AGGREGATE	
			5040	4021						9061			617	20000	9061	SY	SHOULDER PREPARATION	
5										5			617	25000	5	MGAL	WATER	
			3.27							3.27			618	43000	3.27	MILE	RUMBLE STRIPES, CENTER LINE (ASPHALT CONCRETE)	
			3.27							3.27			874	21000	3.27	MILE	LONGITUDINAL JOINT PREPARATION	
4										4			638	10800	4	EACH	WATER WORK VALVE BOX ADJUSTED TO GRADE	
						612				612			621	00100	612	EACH	TRAFFIC CONTROL RPM	
					2	612				612			621	54000	612	EACH	RAISED PAVEMENT MARKER REMOVED	
						2				2			630	85100	2	EACH	REMOVAL OF GROUND MOUNTED SIGN AND REERECTION	
						17.90				17.90			644	00104	17.90	MILE	EDGE LINE, 6"	
						8.95				8.95			644	00300	8.95	MILE	CENTER LINE	
						20				20			644	00500	20	FT	STOP LINE	
						243				243			644	00630	243	FT	CROSSWALK LINE, 24"	
						2				2			644	01110	2	EACH	SCHOOL SYMBOL MARKING, 96"	

TRAFFIC CONTROL QUANTITIES

LOCATION									644 - THERMO											RAISED PAVEMENT MARKERS									621		COMMENTS																																																																																																																																																																																																																																																																																																																																																																																																																																																																																																																																																																																																																																																																																																																																																																																																																																																																																																																																																																																																																																																																																																																																																																																																											
L O C A T I O N	C O U N T Y	R O U T E	B E G S T A	E N D S T A	B E G S L M	E N D S L M	L E N G T H	L E N G T H	EDGE LINE, 6"		CENTER LINE	CHANNELIZING LINE, 12"	STOP LINE	CROSSWALK LINE, 24"	TRANSVERSE/DIAGONAL LINE	SCHOOL SYMBOL MARKING, 96"	LANE ARROW		DOTTED LINE, 6"	ONE WAY		TWO WAY						RAISED PAVEMENT MARKER REMOVED	RPM																																																																																																																																																																																																																																																																																																																																																																																																																																																																																																																																																																																																																																																																																																																																																																																																																																																																																																																																																																																																																																																																																																																																																																																																													
																				WHITE		WHITE RED		YELLOW YELLOW																																																																																																																																																																																																																																																																																																																																																																																																																																																																																																																																																																																																																																																																																																																																																																																																																																																																																																																																																																																																																																																																																																																																																																																																																		
																				RIGHT EDGE LINE		LANE LINE	LANE LINE	CHANN ELIZING	CENTER LINE																																																																																																																																																																																																																																																																																																																																																																																																																																																																																																																																																																																																																																																																																																																																																																																																																																																																																																																																																																																																																																																																																																																																																																																																																	
									40'	80'	120'	80'	40'	80'	40'	20'	EACH	EACH	FT																																																																																																																																																																																																																																																																																																																																																																																																																																																																																																																																																																																																																																																																																																																																																																																																																																																																																																																																																																																																																																																																																																																																																																																																																							
																																																																																																																																																																																																																																																																																																																																																																																																																																																																																																																																																																																																																																																																																																																																																																																																																																																																																																																																																																																																																																																																																																																																																																																																																																										</

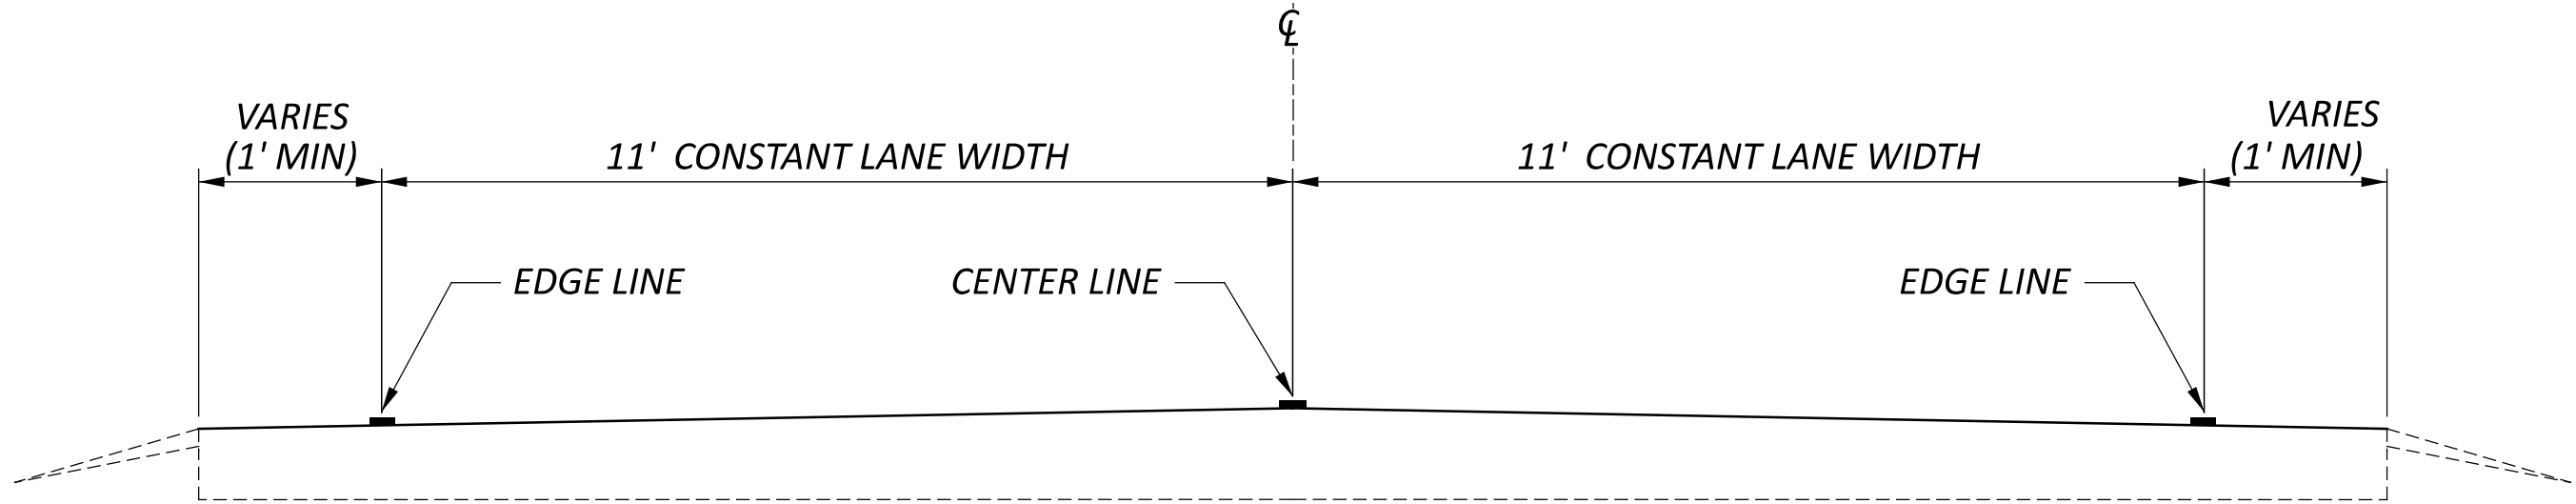

EDGE/CENTER LINE PLACEMENT DETAIL

