

WAYNE COUNTY
WAY-3-9.94

STATE OF OHIO
DEPARTMENT OF HIGHWAYS
WAY-3-9.94
WAYNE COUNTY
WOOSTER TOWNSHIP &
CITY OF WOOSTER

SEE SHEET 2 FOR DETOUR MAP

F-390(9)

FEB 21 1964
GROUND PHOTOLAB

1959 SPECIFICATIONS
LIMITED ACCESS

THIS IMPROVEMENT IS ESPECIALLY DESIGNED FOR THROUGH TRAFFIC AND HAS BEEN DECLARED A LIMITED ACCESS HIGHWAY OR FREEWAY BY ACTION OF THE DIRECTOR OF HIGHWAYS IN ACCORDANCE WITH THE PROVISIONS OF SECTION 5511.02 OF THE REVISED CODE OF OHIO.

THE STANDARD SPECIFICATIONS OF THE STATE OF OHIO, DEPARTMENT OF HIGHWAYS, INCLUDING CHANGES AND SUPPLEMENTAL SPECIFICATIONS LISTED IN THE PROPOSAL SHALL GOVERN THIS IMPROVEMENT.

THE RIGHT OF WAY FOR THIS IMPROVEMENT WILL BE PROVIDED BY THE STATE OF OHIO.

I HEREBY APPROVE THESE PLANS AND DECLARE THAT THE MAKING OF THIS IMPROVEMENT WILL NOT REQUIRE THE CLOSING OF THE HIGHWAY TO TRAFFIC, EXCEPT AS NOTED ON SHEET 12, AND THAT PROVISIONS FOR THE MAINTENANCE AND SAFETY OF TRAFFIC WILL BE AS SET FORTH ON THE PLANS AND ESTIMATES.

APPROVED: E. L. Tolson
DATE 9-30-60 DIVISION DEPUTY DIRECTOR

APPROVED: Harry E. Nepper
DATE 3-28-61 DEPUTY DIRECTOR OF PLANNING & PROGRAMMING

APPROVED: D. H. Overman
DATE 12-8-1960 ENGINEER OF BRIDGES

APPROVED: W. J. ...
DATE 12-9-60 ENGINEER OF LOCATION & DESIGN

APPROVED: C. W. McCaughey
DATE 12-9-60 DEPUTY DIRECTOR OF DESIGN & CONSTRUCTION

APPROVED: W. J. ...
DATE 3-21-61 DEPUTY DIRECTOR OF RIGHT-OF-WAY


APPROVED: W. J. Berry
DATE 3-28-61 FIRST ASSISTANT DIRECTOR

APPROVED: E. L. ...
DATE 3-28-61 DIRECTOR OF HIGHWAYS

LINE DATA		
	WORK	PROJECT
BEGIN	522+25	525+00
END	632+85.43	631+85.43
LENGTH	11,060.43 LIN. FT.	10,685.43 LIN. FT.
ADDITIONS-LOCAL ROADS *	4,812.75 LIN. FT.	
NET LENGTH	15,873.18 LIN. FT. OR 3.006 MILES	10,685.43 LIN. FT. OR 2.024 MILES


* SEE SHEET NO. 2

CONVENTIONAL SIGNS

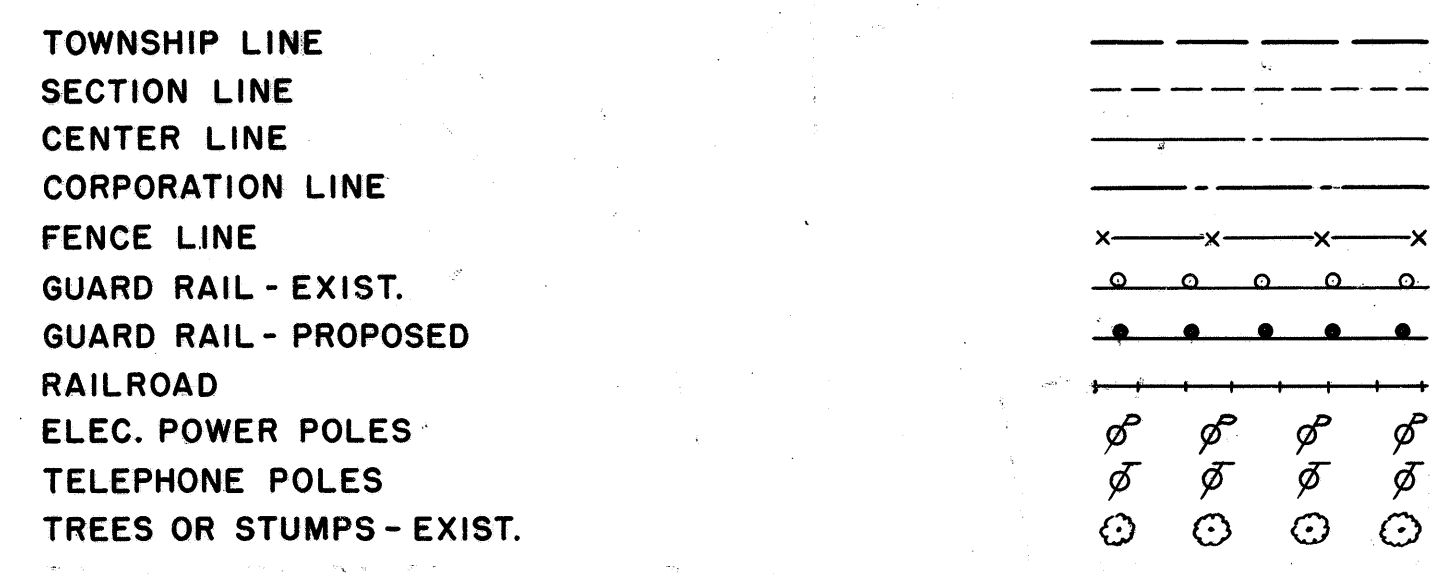

INDEX OF SHEETS

TITLE SHEET	1
SCHEMATIC PLAN	2
TYPICAL SECTIONS	3-10
GENERAL NOTES	11-12
GENERAL SUMMARY	13-14
CALCULATIONS	15-16
SUMMARY OF TABLES	17-18
SPECIAL CONST. DETAILS	19-22
PLAN & PROFILE	23-35
SUPERELEVATION TABLES	36-37
INTERSECTION DETAILS	38-42
CROSS SECTIONS	43-91
EXISTING STATE RT. 3 CONNECTION	92-99
STATE ROUTE 226 CONNECTION	100-108
STATE ROUTE 95	109-112
LOCAL ROADS	113-127
KILLBUCK CREEK CHANNEL SECTION	128
STRUCTURES 20' AND UNDER	129-131
APPROACH SLABS	132
STRUCTURES OVER 20' SPAN	133-142
R/W PLANS	143-151

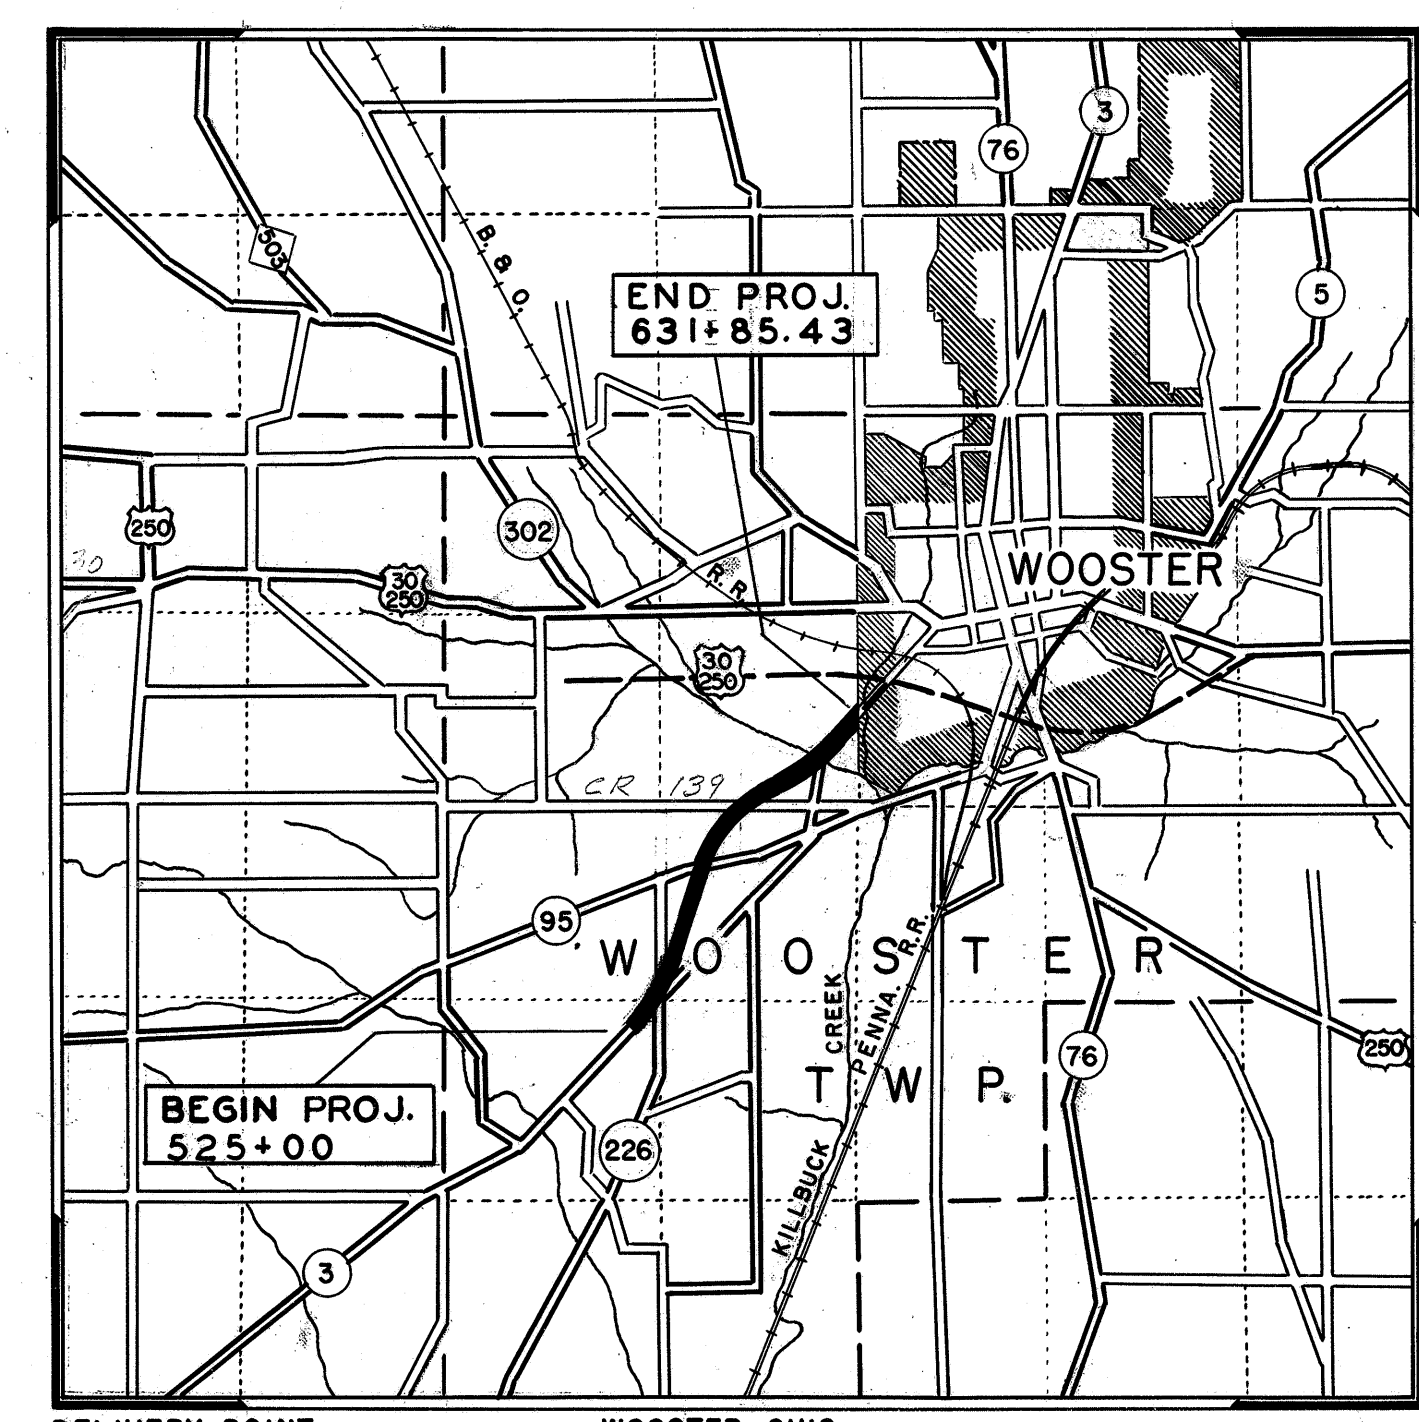

DELIVERY POINT - WOOSTER, OHIO
AVERAGE HAUL FROM SIDING - 2.0 MILES

LOCATION MAP

SCALE IN MILES

PORTION TO BE IMPROVED
STATE ROADS
OTHER ROADS

SCALES

PLAN 1" = 50'
PROFILE: HORIZONTAL 1" = 50'
PROFILE: VERTICAL 1" = 5'
CROSS SECTIONS 1" = 10'

FEB 21 1964
GROUND PHOTOLAB

SUPPLEMENTAL SPECIFICATIONS	
S-101	12-2-59
18	R. 6-15-59
S-307	8-23-60

*Sheets 136, 137, 138, 139, 140 & 142 revised 6-1-61.
Sheets 140 & 141 revised 6-28-61.
Sheets 136, 137 & 140 revised 8-22-61.*

*Revised participation in guard rail and fence as shown on sheets 2, 13 & 34.
REV. 7-18-61. R.E.G.*

SUPPLEMENTAL PRINTS OF STANDARD CONSTRUCTION DRAWINGS							
DR-1	1-3-55	1-8 M.H. NO. 1	1-26-59	L-3	4-1-50	AS-1-54	12-1-54
G-7.07	6-1-56	1-12	7-1-54	L-3-A	4-1-50	AR-1-57	2-2-59
1-1,2,3,4 & 5	4-24-58	1-14 G	1-22-52	RI-1	7-15-58	RB-1-55	2-2-59
1-8 C.B.-2-2A & B	3-2-59	1-15 NO. 1	5-21-59	S-27-P.C.-3	2-20-45	CSB-2-56	2-2-59
1-8 C.B.-2-3 & 2-4	1-26-59	1-15 NO. 2	8-17-60	S-27-P.C.-4	1-4-54	F-1	9-1-59
1-8 C.B.-NO. 6	1-26-59	1-15 NO. 2A	8-17-60	T-35	1-2-56	F-3	9-1-59
1-8 C.B.-NO. 7	3-11-60					J.P.-53	11-25-58
L-1	4-1-50	1-21-23	8-1-56				
		1-8 M.H. NO. 1-A	1-26-59				

PREPARED BY
SHAFFER, PARRETT AND ASSOCIATES
CONSULTING ENGINEERS
MANSFIELD OHIO WOOSTER

DEPARTMENT OF COMMERCE
BUREAU OF PUBLIC ROADS

APPROVED: _____
DIVISION ENGINEER DATE _____


FILE No. 231-41
WAYNE COUNTY, WAY-3-9.94
DATE OF LETTING _____
CONTRACT No. _____

REV. 3-21-61


WAYNE COUNTY
WAY-3-9.94

LINE DATA FOR APPROACHES

S.R. 3	Begin Work Sta. 534+26.98	
	End Work Sta. 548+20	
	Net Length of Work	1,393.02 Lin. Ft.
S.R. 226	Begin Work Sta. 484+50	
	End Work Sta. 493+68.22	
	Deduct S.R. 3 Pavt. 32.32 Lin. Ft.	
	Deduct Way 3 Pavt. NB. 24.20 Lin. Ft.	
	Net Length of Work	861.70 Lin. Ft.
S.R. 95	Begin Work Sta. 157+00	
	End Work Sta. 165+70	
	Deduct Way 3 Pavt. 111.02 Lin. Ft.	
	Net Length of Work	758.98 Lin. Ft.
C.R. 139	Begin Work Sta. 16+00	
	End Work Sta. 29+50	
	Deduct Way 3 Pavt. 93.82 Lin. Ft.	
	Net Length of Work	1,256.18 Lin. Ft.
C.R. 174	Begin Work Sta. 17+50	
	End Work Sta. 22+92.87	
	Net Length of Work	542.87 Lin. Ft.
	Total Length of Work	4,812.75 Lin. Ft.

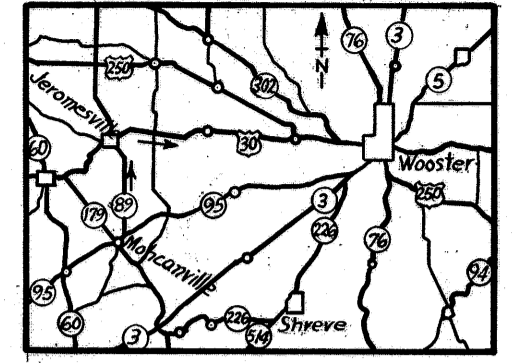

DETOUR MAP

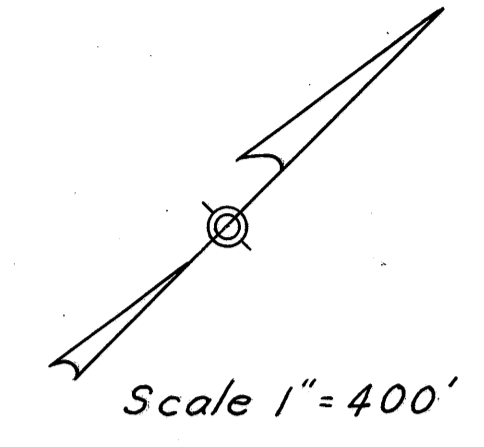


For proposed typical section of adjoining pavement at the end of this project, see upper typical section on Sheet 7.

NOTE: Marker will be furnished and erected on the left by State Forces prior to acceptance of this improvement.

End PROJECT Sta 631+85.43
End Work Sta 632+85.43
F-390(9)

NOTE: Marker will be furnished and erected on the right by State Forces prior to acceptance of this improvement.

For typical section of existing pavement adjoining the beginning of this project see Sheet 23.

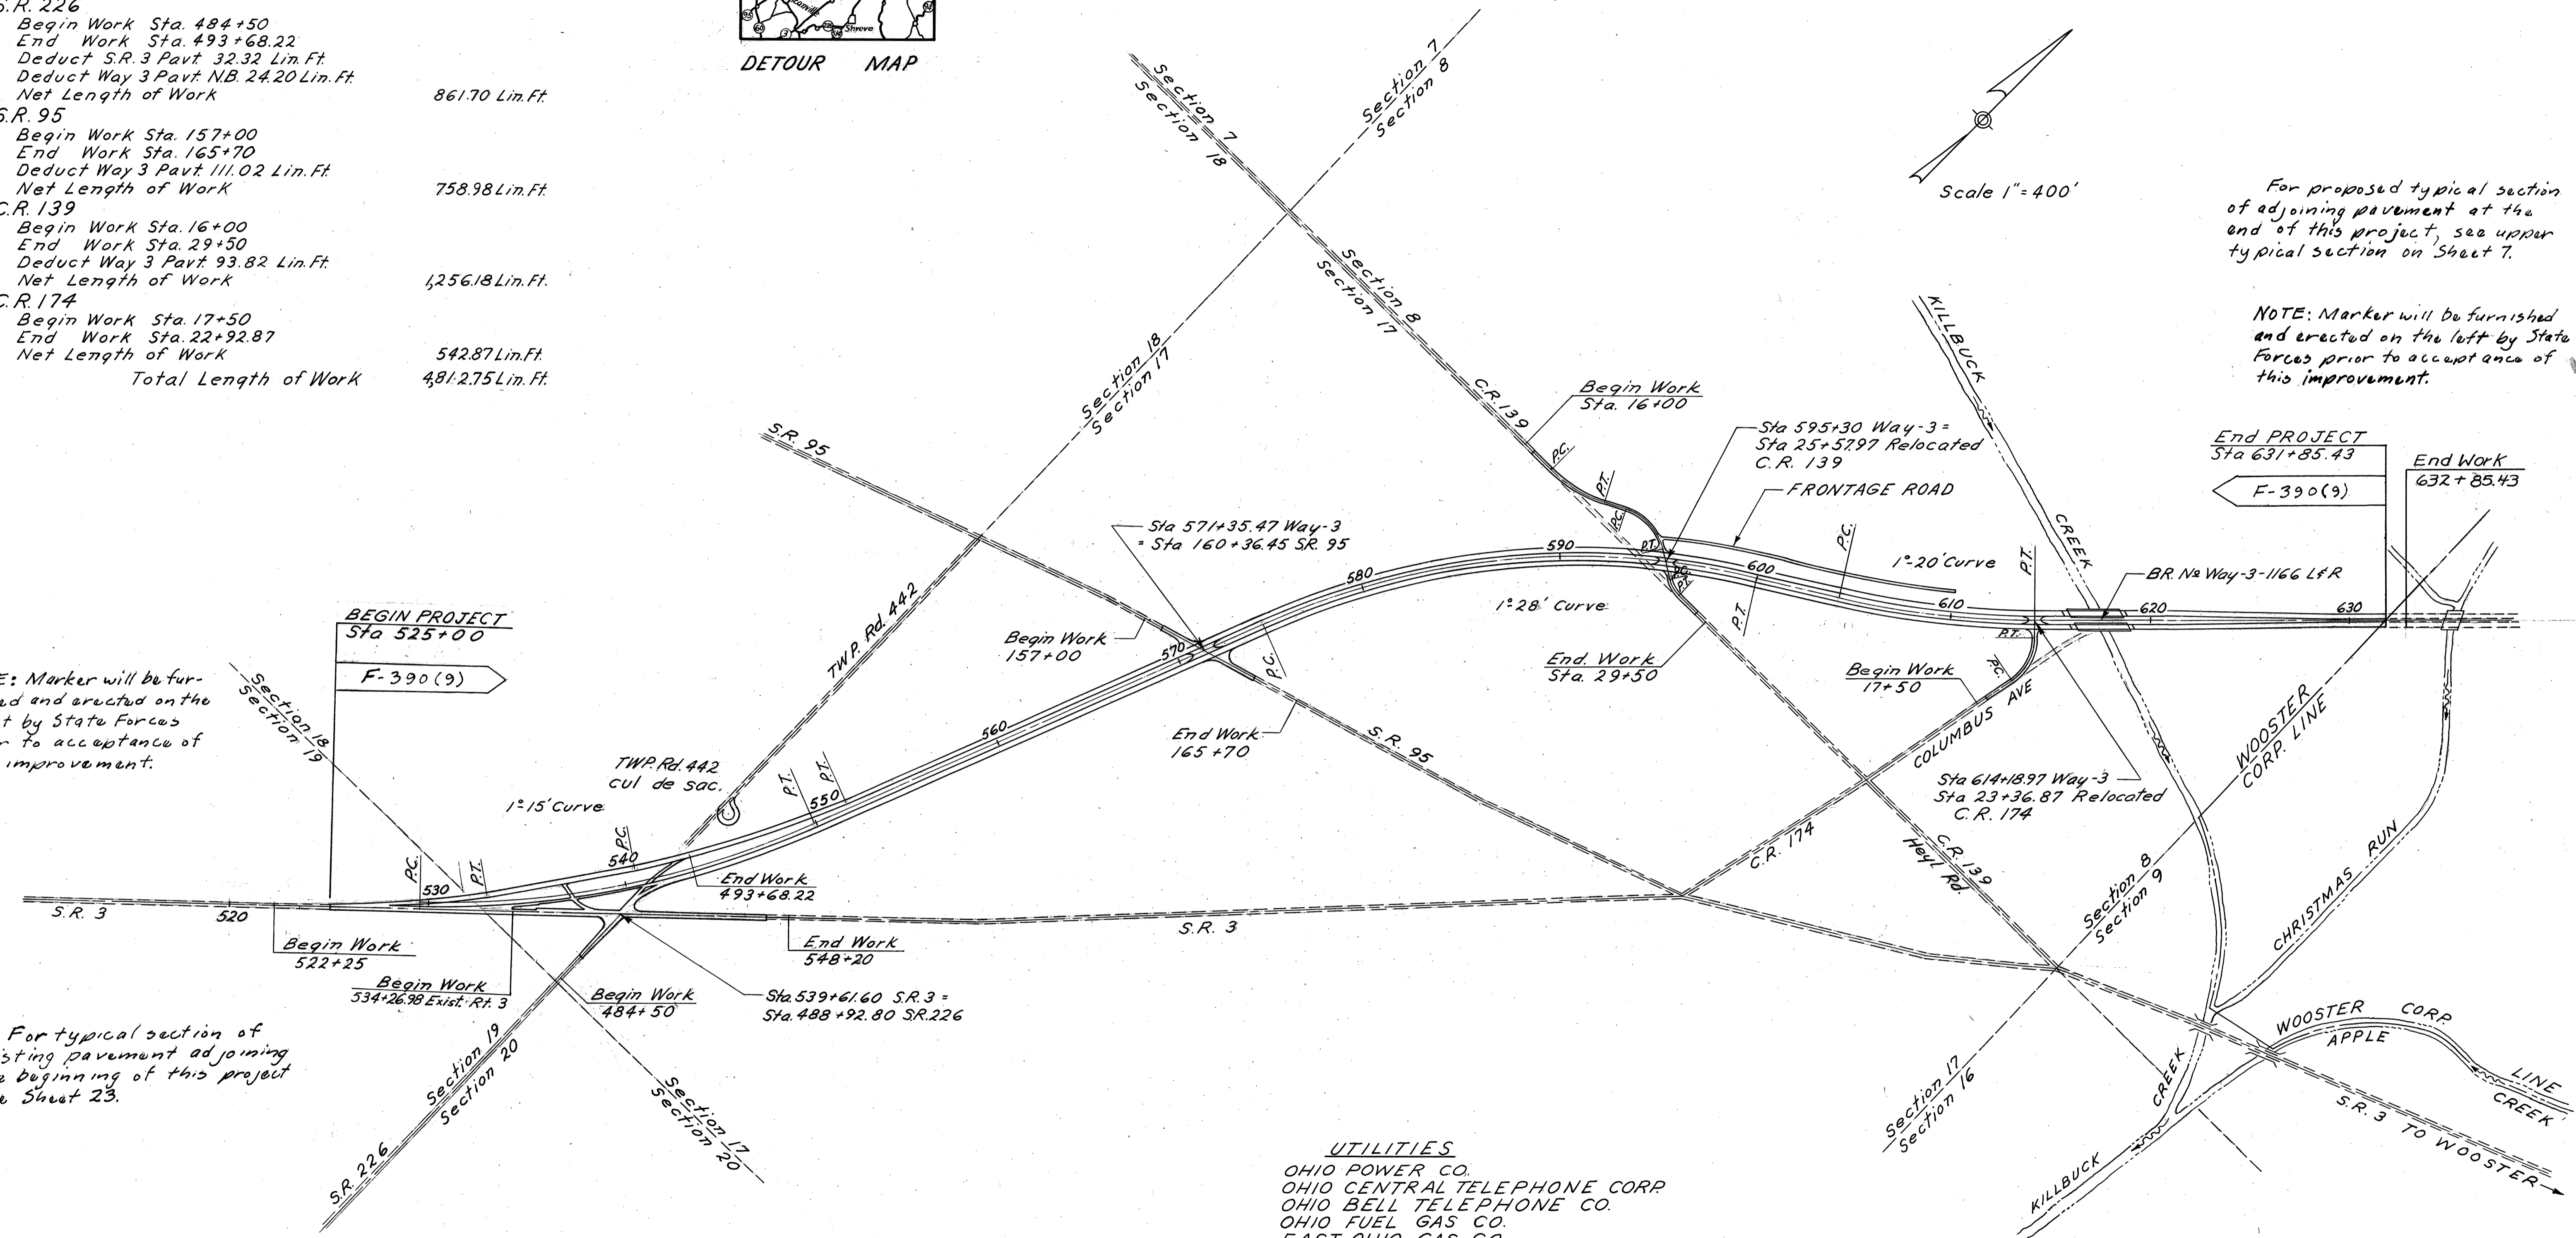

- UTILITIES**
- OHIO POWER CO.
 - OHIO CENTRAL TELEPHONE CORP.
 - OHIO BELL TELEPHONE CO.
 - OHIO FUEL GAS CO.
 - EAST OHIO GAS CO.
 - BUCKEYE PIPE LINE CO.

LIMITED FEDERAL PARTICIPATION

- Item 55-18 Fence, Federal participation limited to the following locations:
 - On the right between Sta. 563+00 and Sta. 571+25
 - On the right between Sta. 590+00 and Sta. 594+75
- Item I-15 Guard Rail, Federal participation as noted on sheet 34.

TYPICAL SECTIONS


TYPE T-35 ON B-20

FED. RD. DIVISION	STATE	PROJECT
2	OHIO	

4
151

WAYNE COUNTY
WAY-3-9.94

SCALE : $\frac{3}{16}'' = 1'-0''$

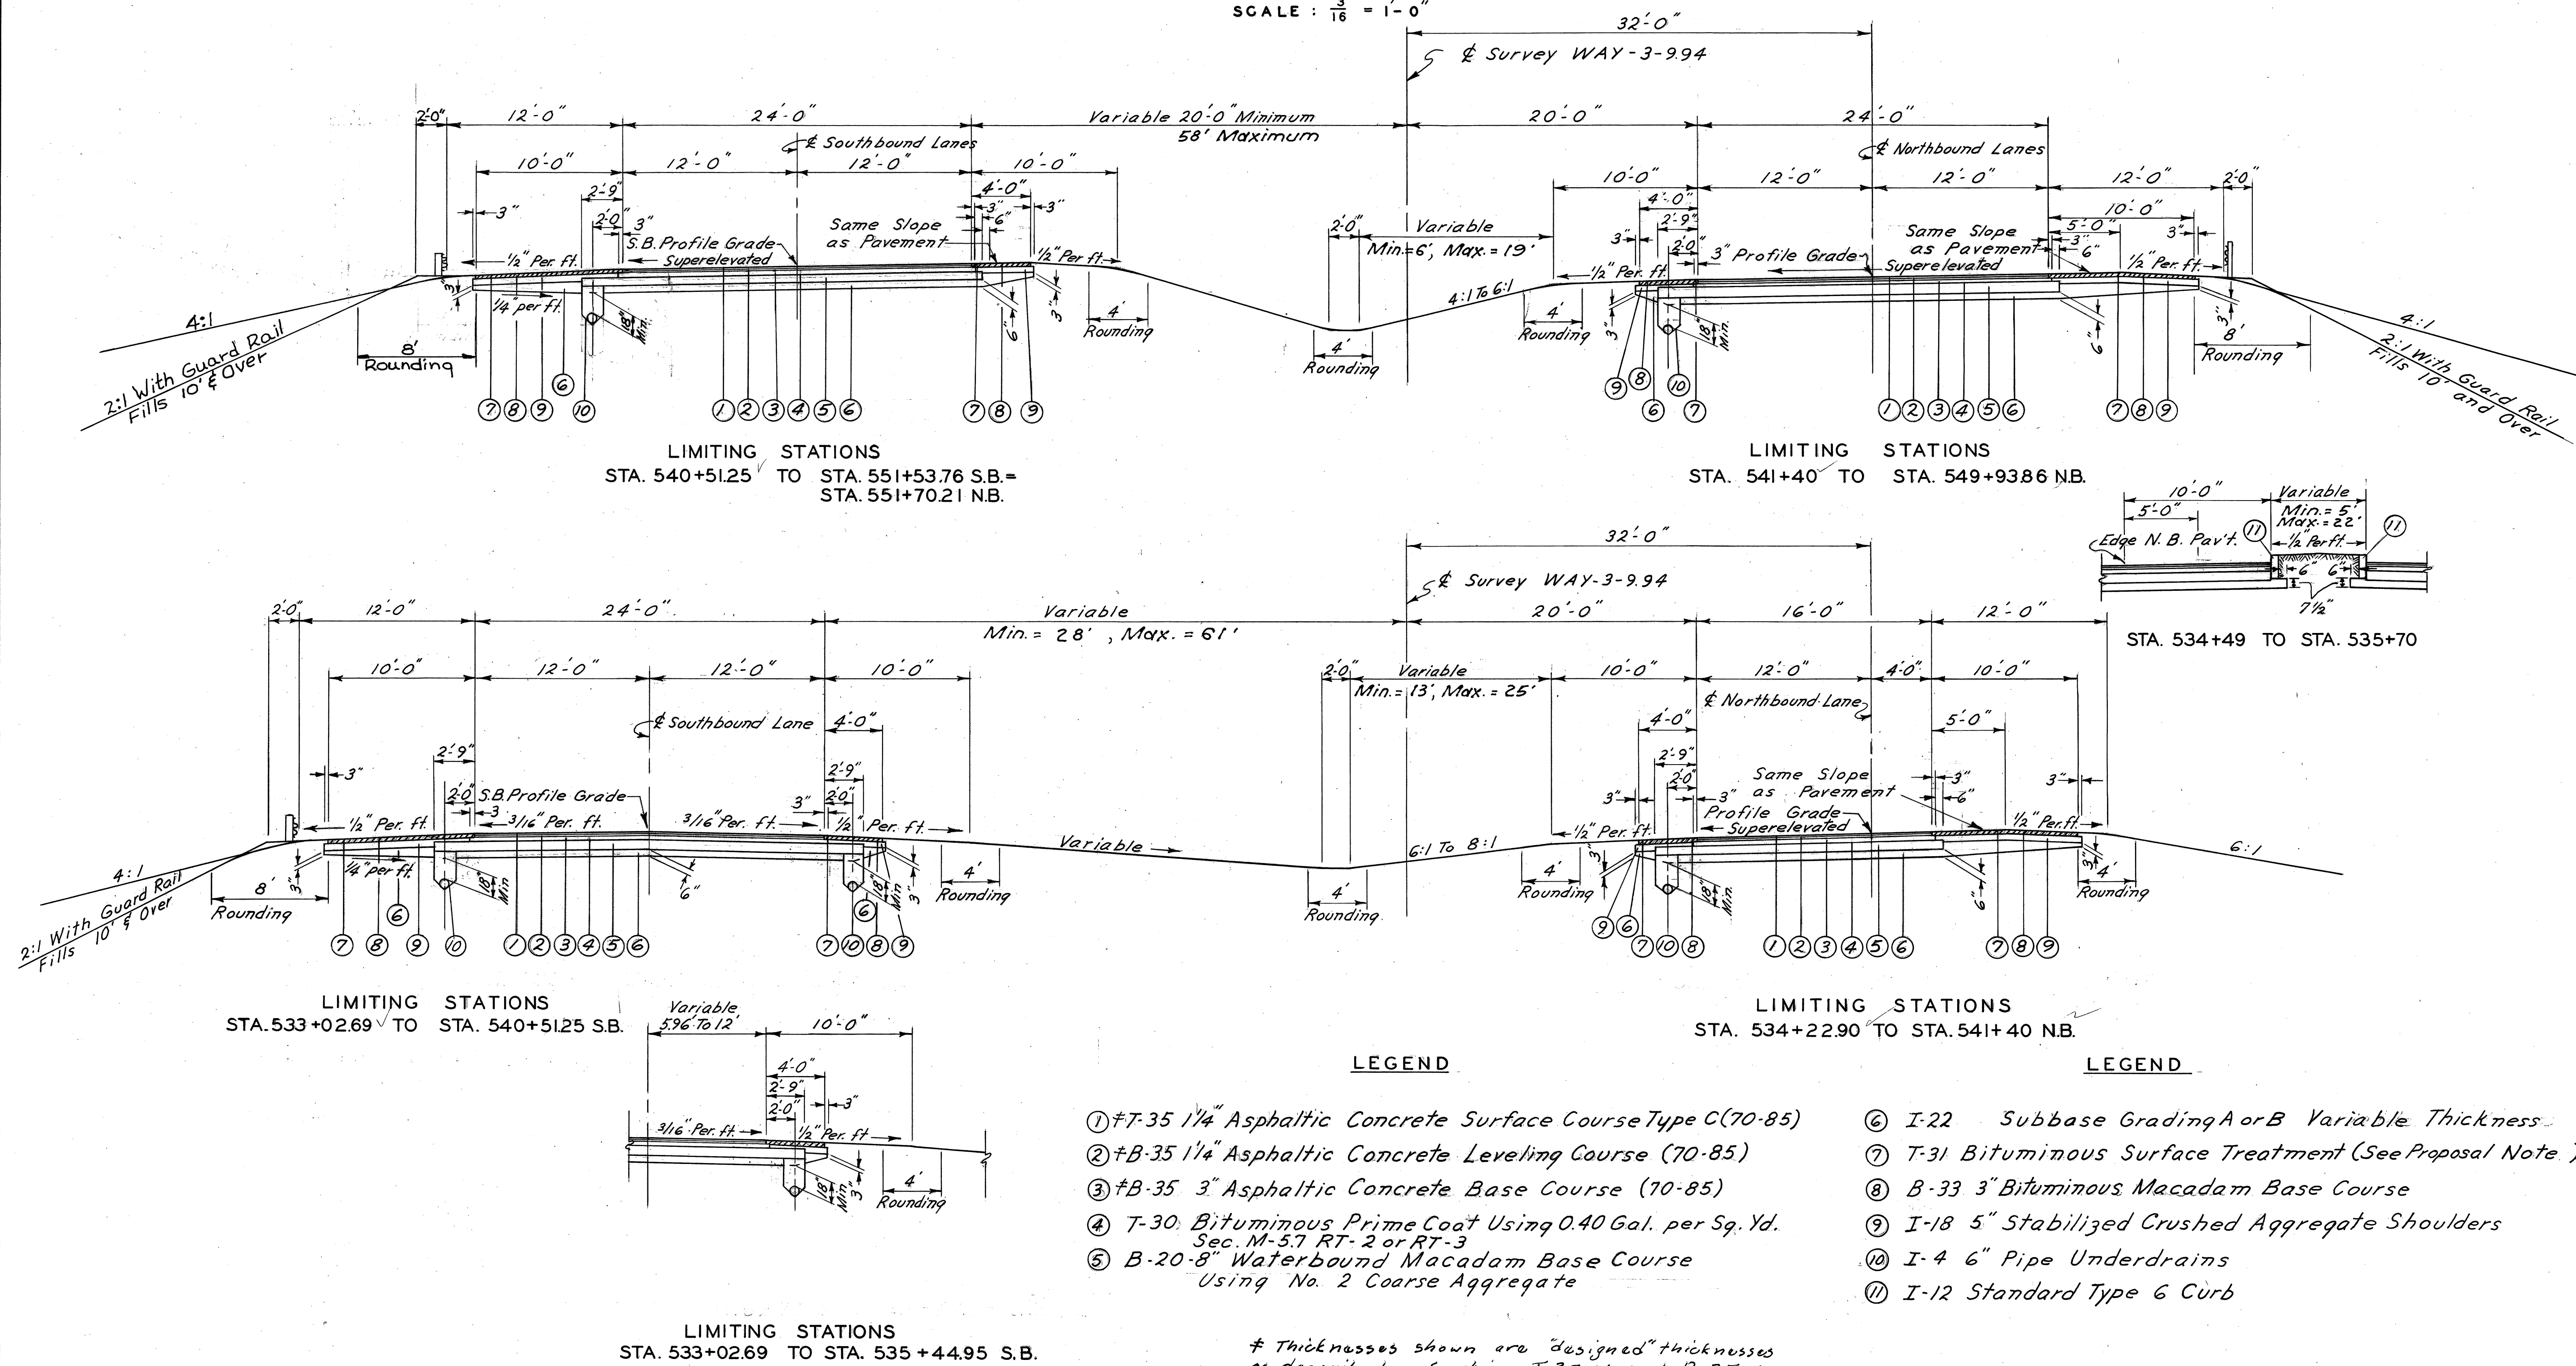

LEGEND

- ① #7-35 1 1/4" Asphaltic Concrete Surface Course Type C (70-85)
- ② #B-35 1 1/4" Asphaltic Concrete Leveling Course (70-85)
- ③ #B-35 3" Asphaltic Concrete Base Course (70-85)
- ④ T-30 Bituminous Prime Coat Using 0.40 Gal. per Sq. Yd. Sec. M-5.7 RT-2 or RT-3
- ⑤ B-20-8" Waterbound Macadam Base Course Using No. 2 Coarse Aggregate
- ⑥ I-22 Subbase Grading A or B Variable Thickness
- ⑦ T-31 Bituminous Surface Treatment (See Proposal Note)
- ⑧ B-33 3" Bituminous Macadam Base Course
- ⑨ I-18 5" Stabilized Crushed Aggregate Shoulders
- ⑩ I-4 6" Pipe Underdrains
- ⑪ I-12 Standard Type 6 Curb

* Thicknesses shown are "designed" thicknesses as described in Sections T-35.01 and B-35.01.

TYPICAL SECTIONS


TYPE T-35 ON B-20

SCALE: $\frac{3}{16}'' = 1'-0''$

FED. RD. DIVISION	STATE	PROJECT	5 151
2	OHIO		

WAYNE COUNTY
WAY-3-9.94

NOTE: For Special Toe of Slope Loading Between Sta. 617+50 and Sta. 625+75 See Sht. 22

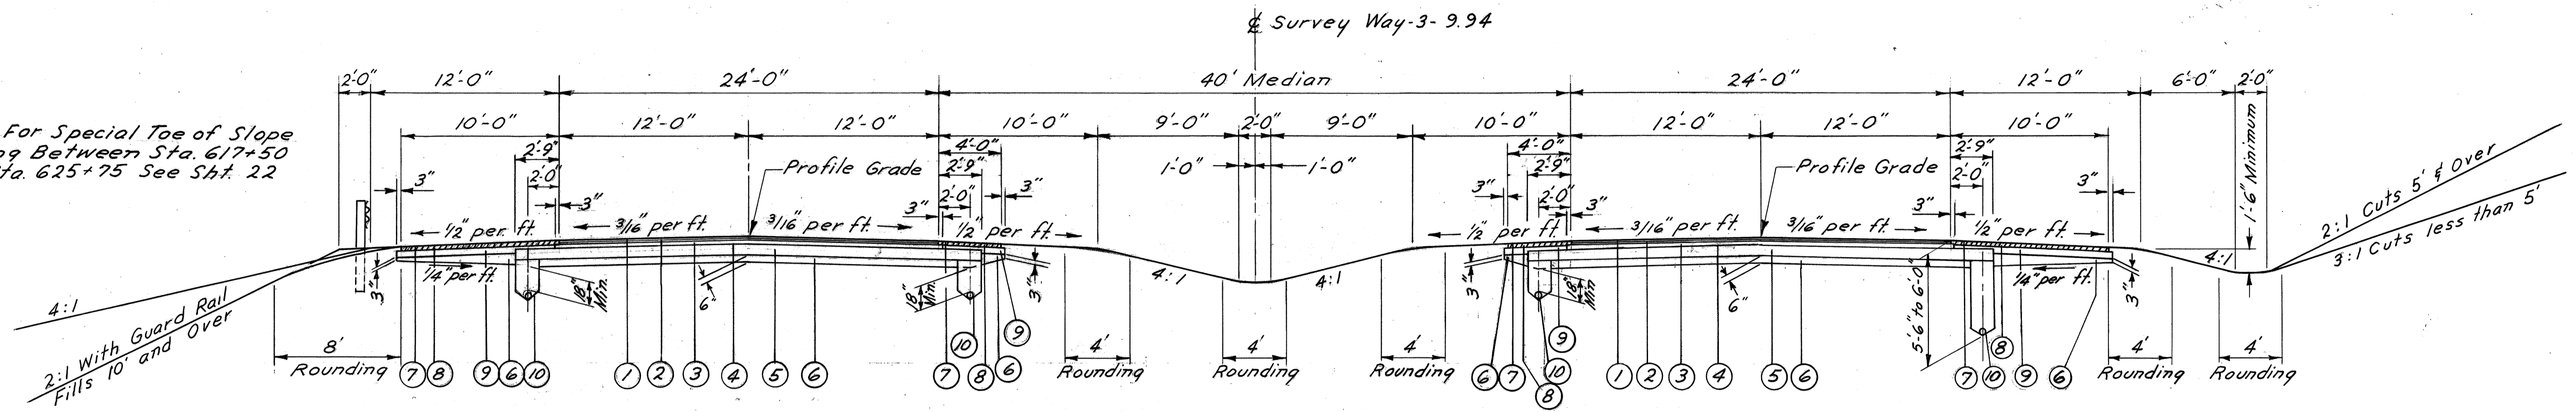



NORMAL SECTION

STATIONING SCHEDULE

STA. 562+00 TO STA. 574+58.99 ✓

STA. 599+95.92 TO STA. 604+18.76 ✓

STA. 614+18.97 TO STA. 619+54.44 ✓

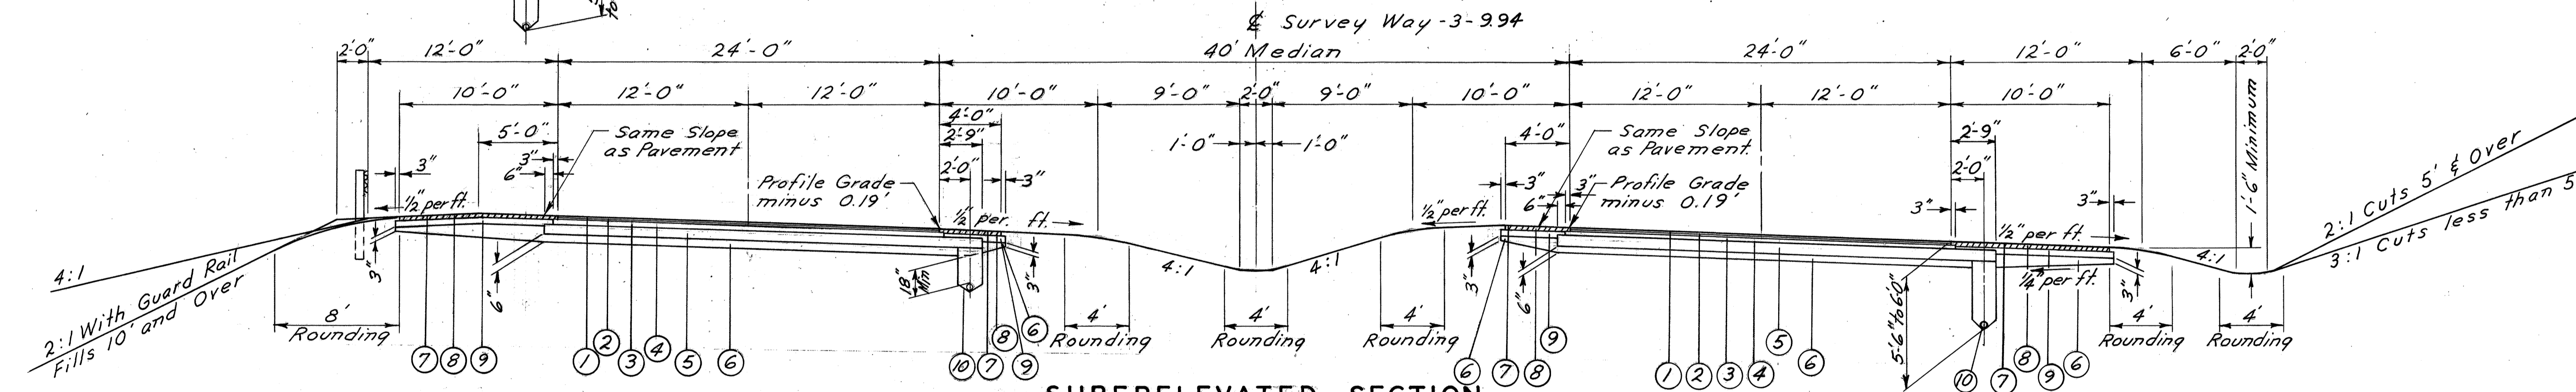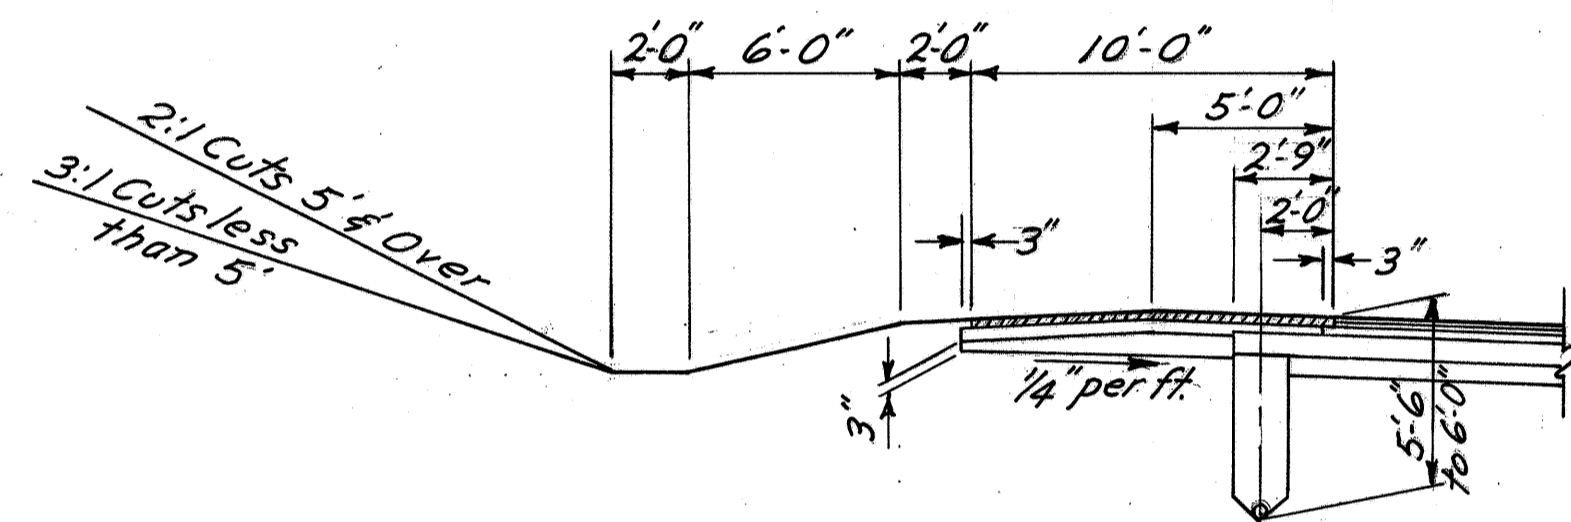

SUPERELEVATED SECTION

STATIONING SCHEDULE

STA. 574+58.99 TO STA. 576+00 ✓

STA. 595+50 TO STA. 599+95.92 ✓

STA. 604+18.76 TO STA. 614+18.97 ✓

LEGEND

- ① #7-35 1/4" Asphaltic Concrete Surface Course Type C (70-85)
- ② #B-35 1/4" Asphaltic Concrete Leveling Course (70-85)
- ③ #B-35 3" Asphaltic Concrete Base Course (70-85)
- ④ T-30 Bituminous Prime Coat Using 0.40 Gal. per Sq. Yd. Sec. M-5.7 RT-2 or RT-3
- ⑤ B-20 8" Waterbound Macadam Base Course Using No. 2 Coarse Aggregate

* Thicknesses shown are "designed" thicknesses as described in Sections T-35.01 and B-35.01.

LEGEND

- ⑥ I-22 Subbase Grading A or B Variable Thickness
- ⑦ T-31 Bituminous Surface Treatment (See Proposal Note)
- ⑧ B-33 3" Bituminous Macadam Base Course
- ⑨ I-18 5" Stabilized Crushed Aggregate Shoulders
- ⑩ I-4 6" Pipe Underdrains

TYPICAL SECTIONS


ROCK CUT TYPE T-35 ON B-20

SCALE: $\frac{3}{16}'' = 1'-0''$

FED. RD. DIVISION	STATE	PROJECT
2	OHIO	

6
151


WAYNE COUNTY
WAY-3-9.94

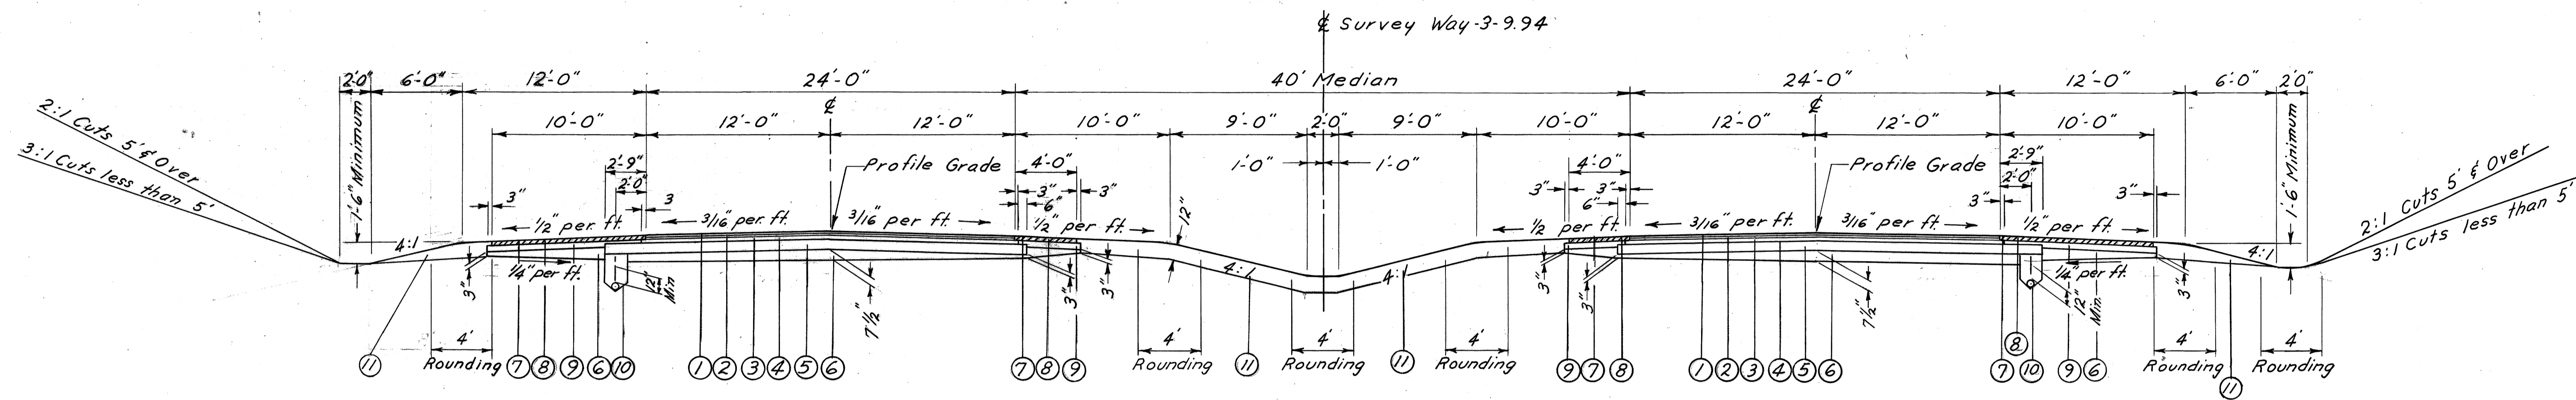

NORMAL SECTION

APPROX. STATIONING SCHEDULE

STA. 550+50 TO STA. 562+00

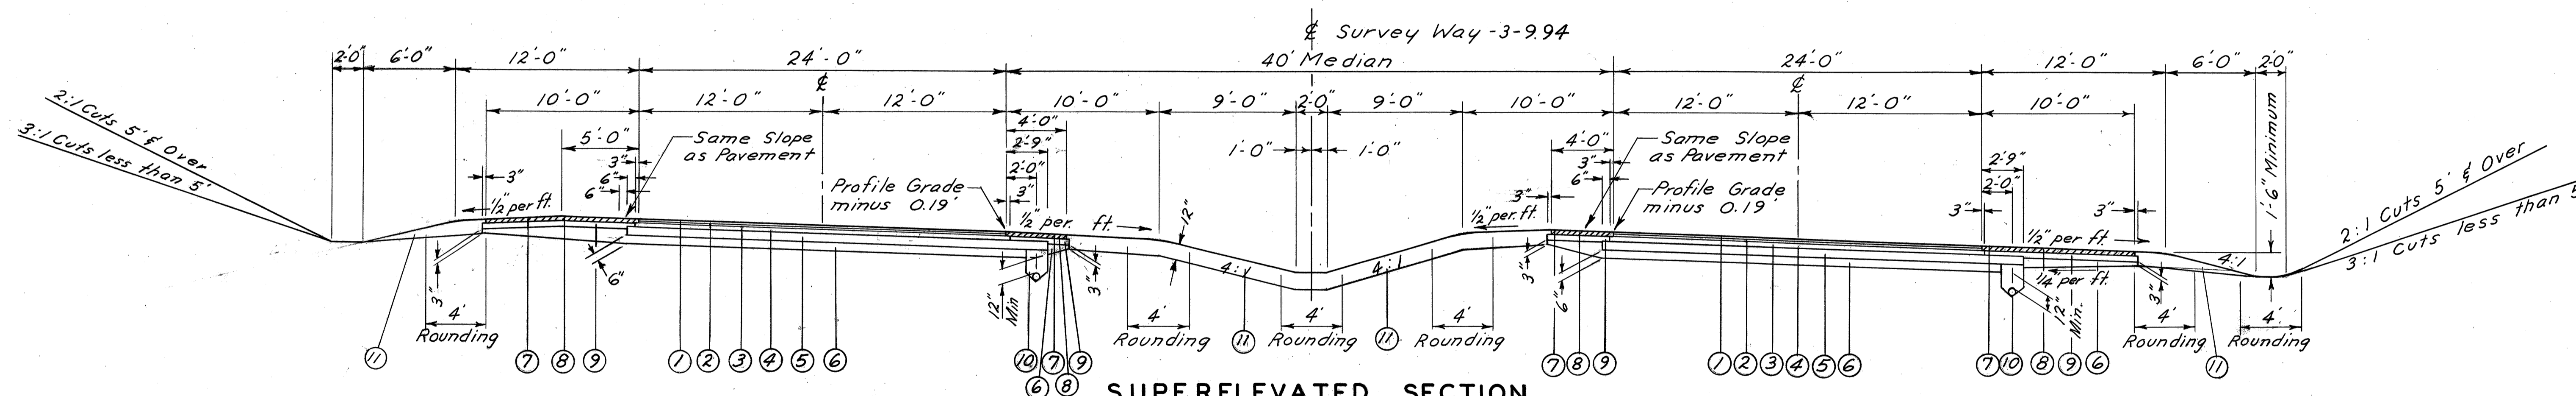

SUPERELEVATED SECTION

APPROX. STATIONING SCHEDULE

STA. 576+00 TO STA. 595+50

LEGEND

- ① #T-35 1/4" Asphaltic Concrete Surface Course Type C (70-85)
- ② #B-35 1/4" Asphaltic Concrete Leveling Course (70-85)
- ③ #B-35 3" Asphaltic Concrete Base Course (70-85)
- ④ T-30 Bituminous Prime Coat Using 0.40 Gal. per Sq. Yd. Sec. M-5.7 RT-2 Or RT-3
- ⑤ B-20 8" Waterbound Macadam Base Course Using No. 2 Coarse Aggregate

- ⑥ I-22 Subbase Grading A or B Variable Thickness
- ⑦ T-31 Bituminous Surface Treatment (See Proposal Note)
- ⑧ B-33 3" Bituminous Macadam Base Course
- ⑨ I-18 5" Stabilized Crushed Aggregate Shoulders
- ⑩ I-4 6" Pipe Underdrains
- ⑪ L-3 Placing Stockpiled Topsoil

* Thicknesses shown are "designed" thicknesses as described in Sections T-35.01 and B-35.01.

TYPICAL SECTIONS



TYPE T-35 ON B-20

SCALE: $\frac{3}{16}'' = 1'-0''$

FED. NO. DIVISION	STATE	PROJECT
2	OHIO	

7
151

WAYNE COUNTY
WAY-3-994

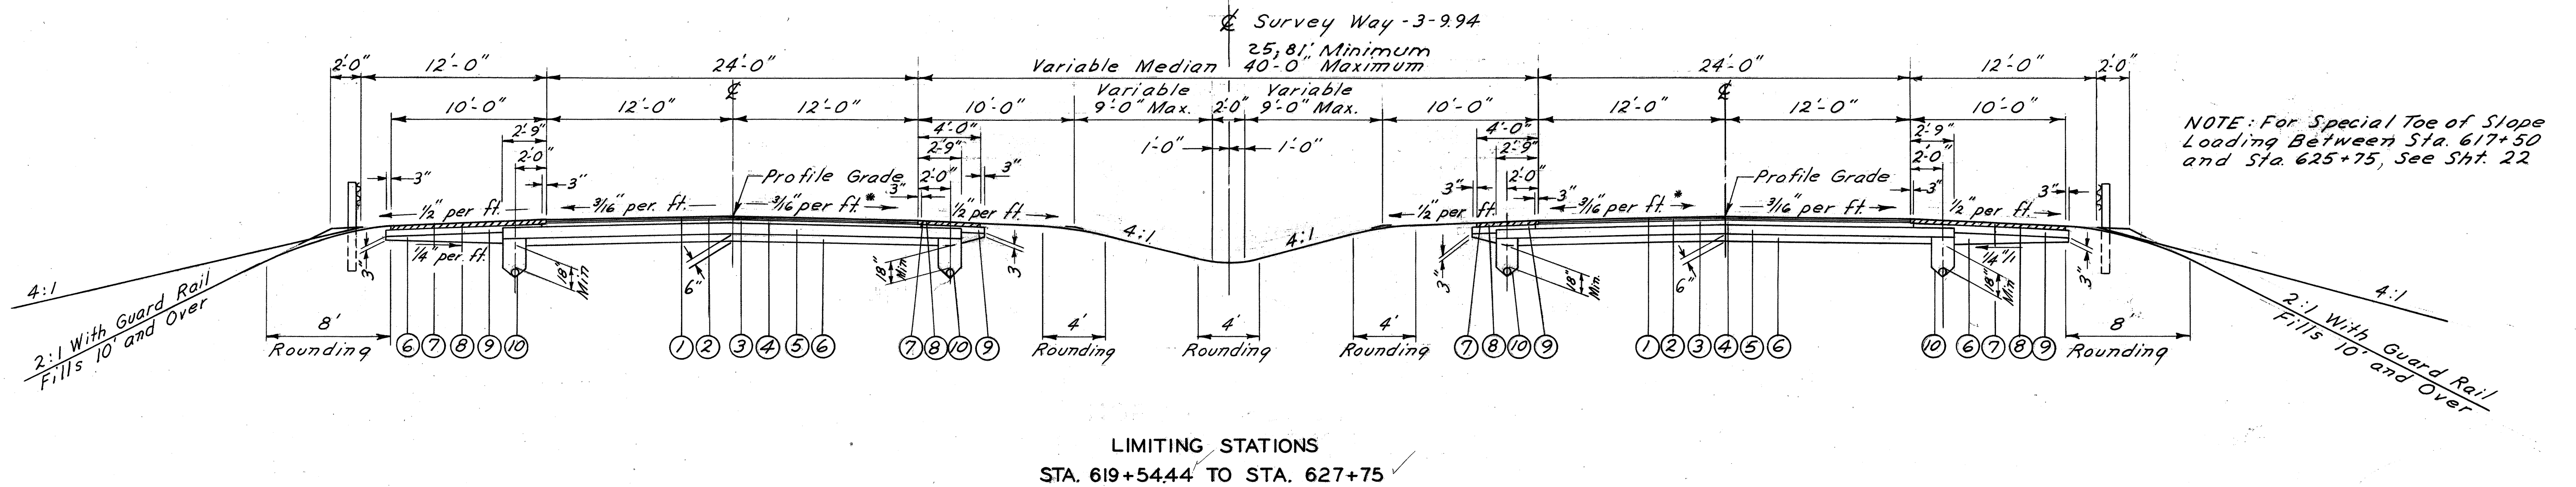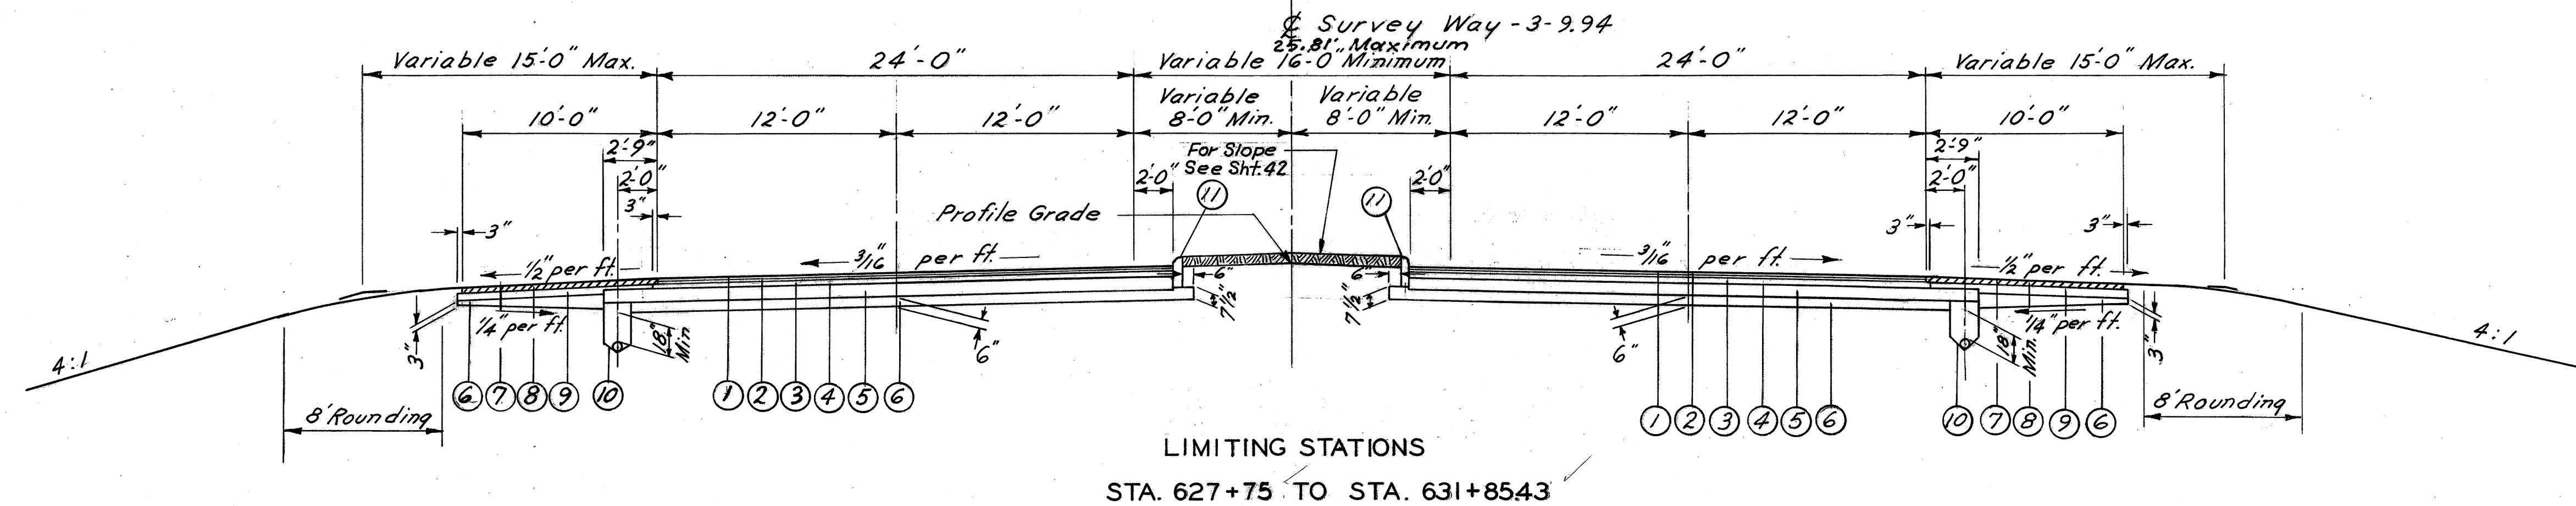

NOTE: For Special Toe of Slope Loading Between Sta. 617+50 and Sta. 625+75, See Sht. 22

* As Per Plan or - See Median Transition Detail Sheet For P't Transition elevation

LEGEND

- ① #T-35 1/4" Asphaltic Concrete Surface Course Type C (70-85)
- ② #B-35 1/4" Asphaltic Concrete Leveling Course (70-85)
- ③ #B-35 3" Asphaltic Concrete Base Course (70-85)
- ④ T-30 Bituminous Prime Coat Using 0.40 Gal. per Sq. Yd. Sec. M-5.7 RT-2 or RT-3
- ⑤ B-20 8" Waterbound Macadam Base Course Using No. 2 Coarse Aggregate
- ⑥ I-22 Subbase Grading A or B Variable Thickness
- ⑦ T-31 Bituminous Surface Treatment (See Proposal Note)
- ⑧ B-33 3" Bituminous Macadam Base Course
- ⑨ I-18 5" Stabilized Crushed Aggregate Shoulders
- ⑩ I-4 6" Pipe Underdrains
- ⑪ I-12 Standard Type 6 Curb

† Thicknesses shown are "designed" thicknesses as described in Sections T-35.01 and B-35.01.


TYPICAL SECTIONS

TYPE T-35 ON B-20


FED. RD. DIVISION	STATE	PROJECT	8
2	OHIO		151

WAYNE COUNTY
WAY-3-994


SCALE: $\frac{3}{16}'' = 1'-0''$

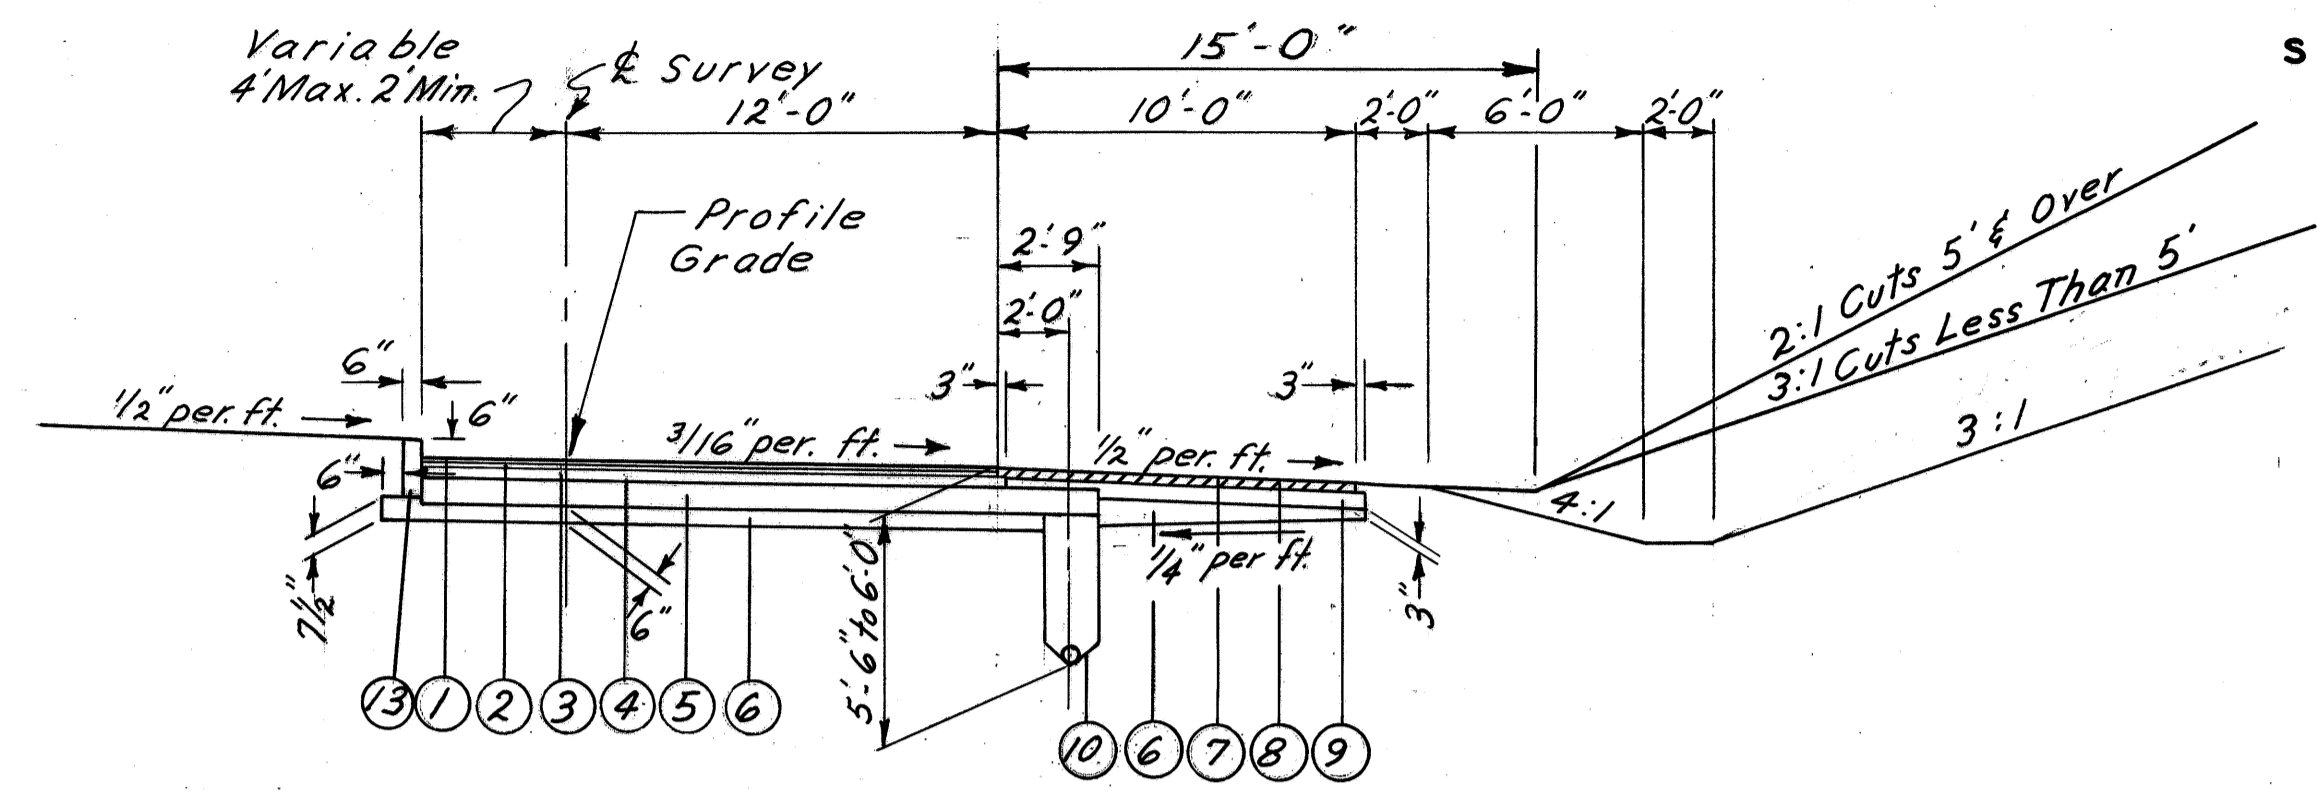


EXISTING
STATE RT. 3
LIMITING STATIONS
STA. 534+26.98 TO STA. 535+70

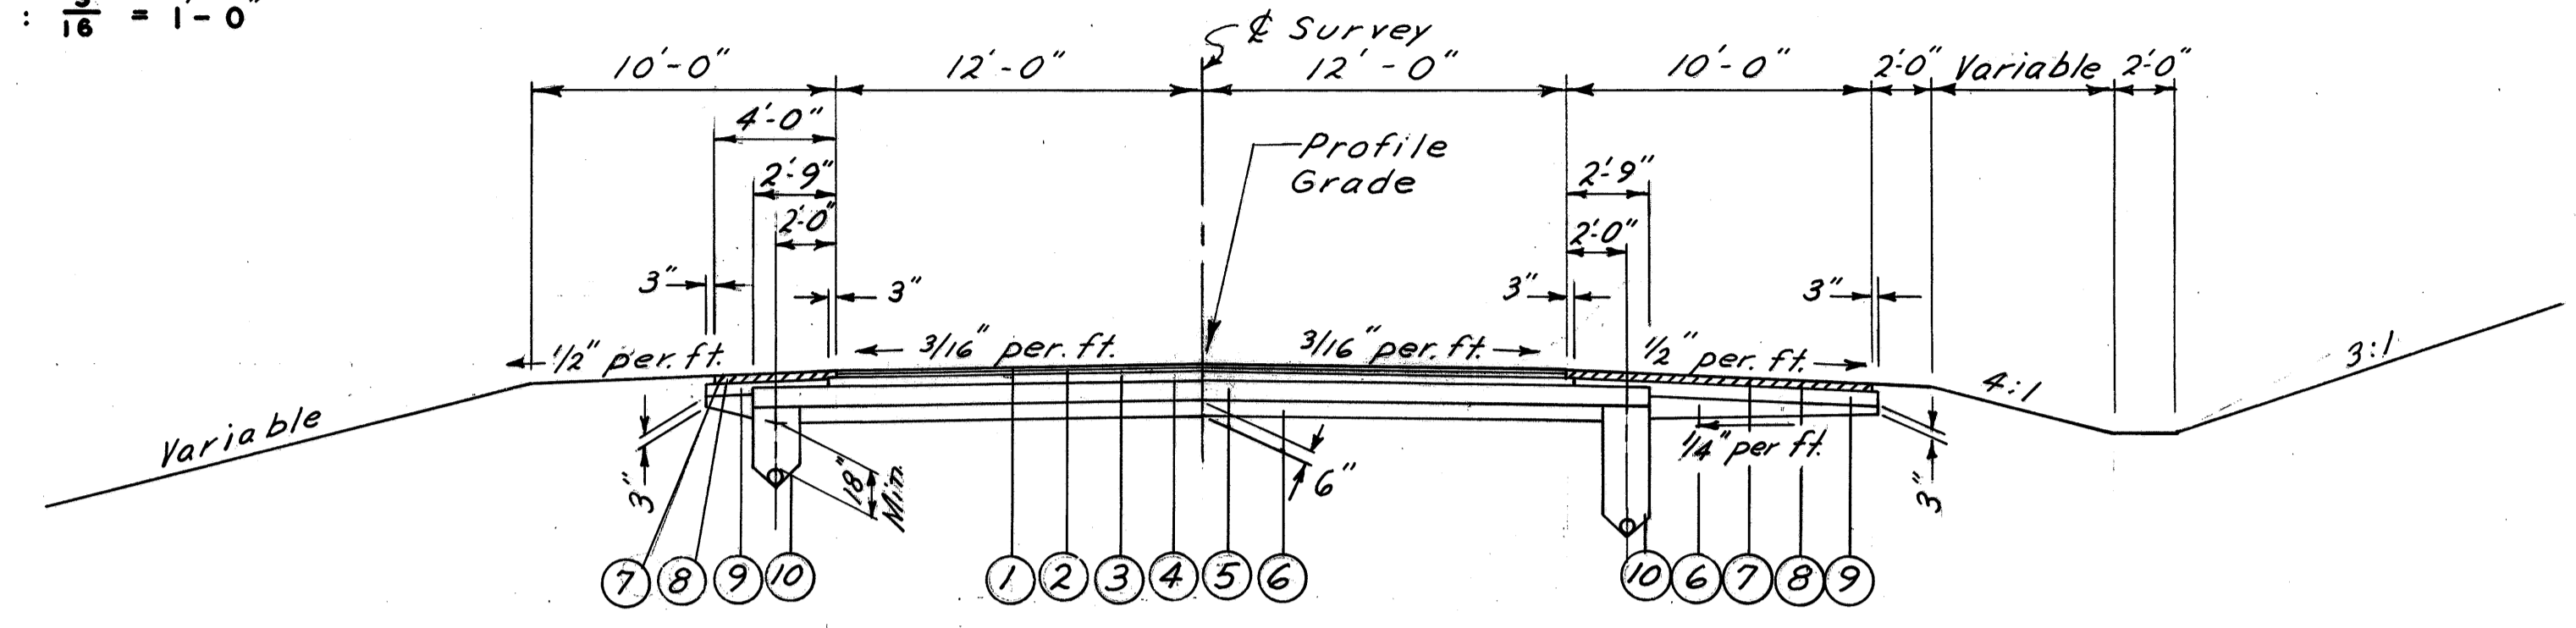

EXISTING
STATE RT. 3
LIMITING STATIONS
STA. 538+50 TO STA. 539+61.60

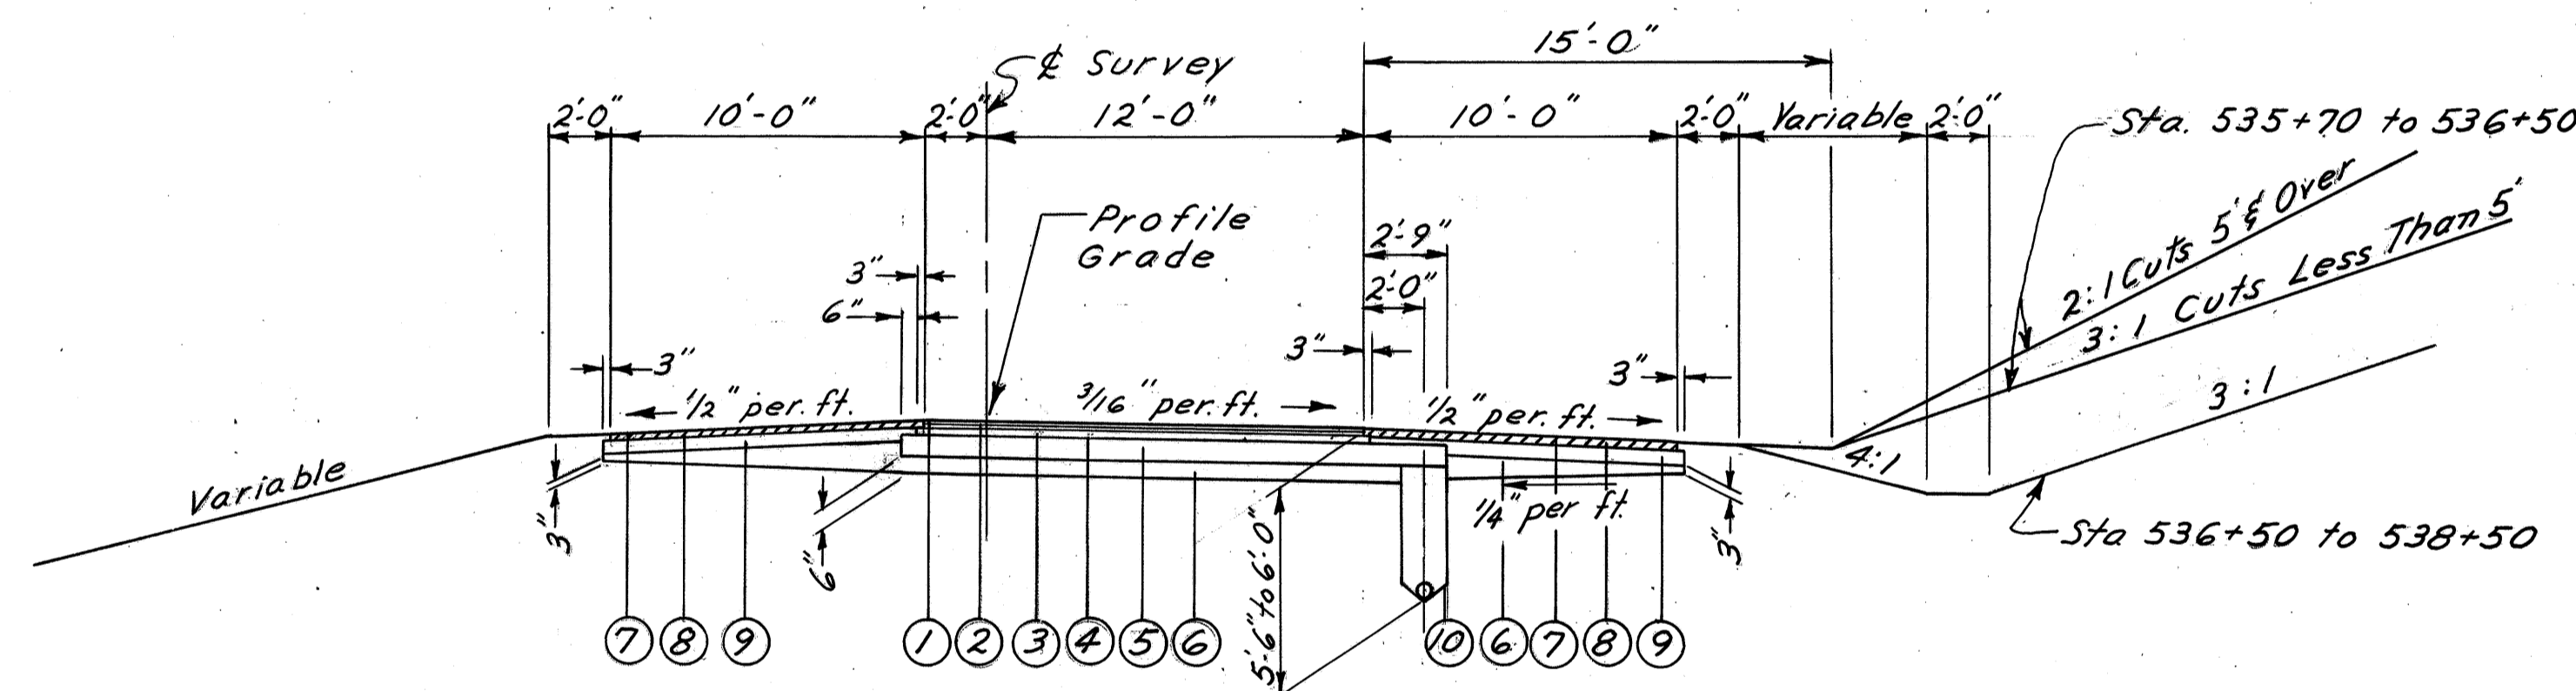

EXISTING
STATE RT. 3
LIMITING STATIONS
STA. 535+70 TO STA. 538+50

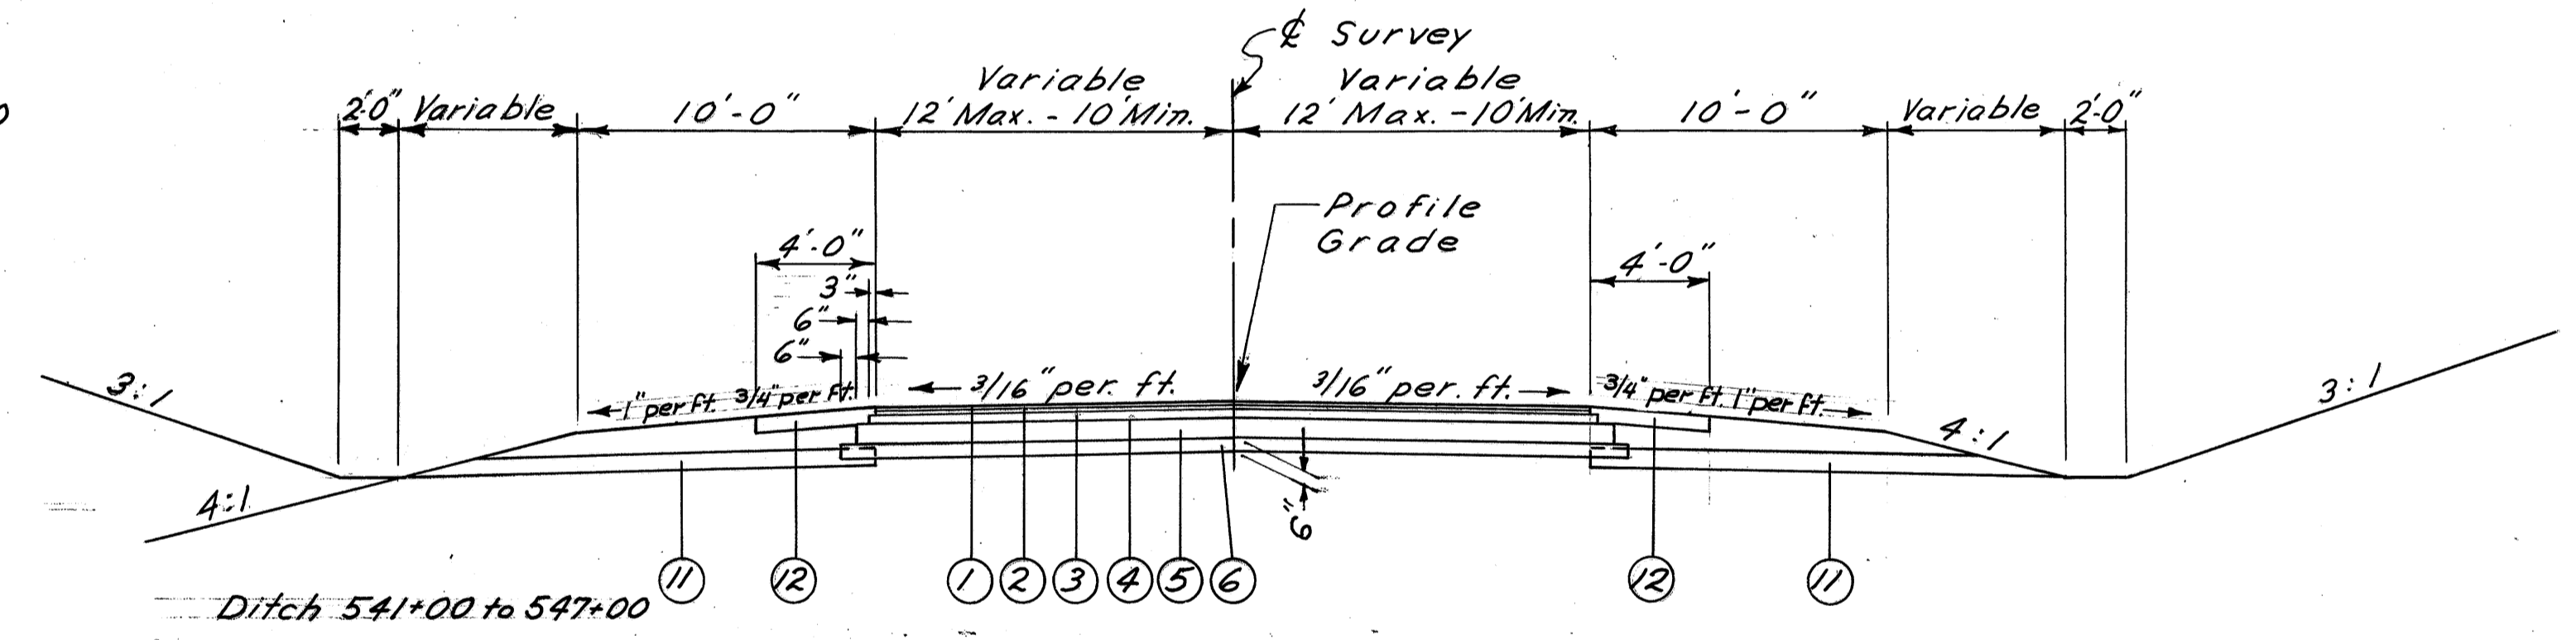

EXISTING
STATE RT. 3
LIMITING STATIONS
STA. 539+61.60 TO STA. 547+00

LEGEND

- | | |
|--|---|
| ① #T-35 1 1/4" Asphaltic Concrete Surface Course Type C (70-85) | ⑥ I-22 Subbase Grading A or B Variable Thickness |
| ② #B-35 1 1/4" Asphaltic Concrete Leveling Course (70-85) | ⑦ T-31 Bituminous Surface Treatment (See Proposal Note) |
| ③ #B-35 3" Asphaltic Concrete Base Course (70-85) | ⑧ B-33 3" Bituminous Macadam Base Course |
| ④ T-30 Bituminous Prime Coat Using 0.40 Gal. per Sq. Yd. Sec. M 5.7 RT-2 or RT-3 | ⑨ I-18 5" Stabilized Crushed Aggregate Shoulders |
| ⑤ B-20 8" Waterbound Macadam Base Course
Using No. 2 Coarse Aggregate | ⑩ I-4 6" Pipe Underdrains |
| | ⑪ I-9 Stone Underdrain (No. 2) |
| | ⑫ I-18 6" Stabilized Crushed Aggregate Shoulders |
| | ⑬ I-12 Standard Type 6 Curb |

* Thicknesses shown are "designed" thicknesses as described in Sections T-35.01 and B-35.01.

TYPICAL SECTIONS


TYPE T-35 ON B-19
TYPE T-35 ON B-20

SCALE: $\frac{3}{16}'' = 1'-0''$

FED. RD. DIVISION	STATE	PROJECT
2	OHIO	

9
151


WAYNE COUNTY
WAY-3-9.94

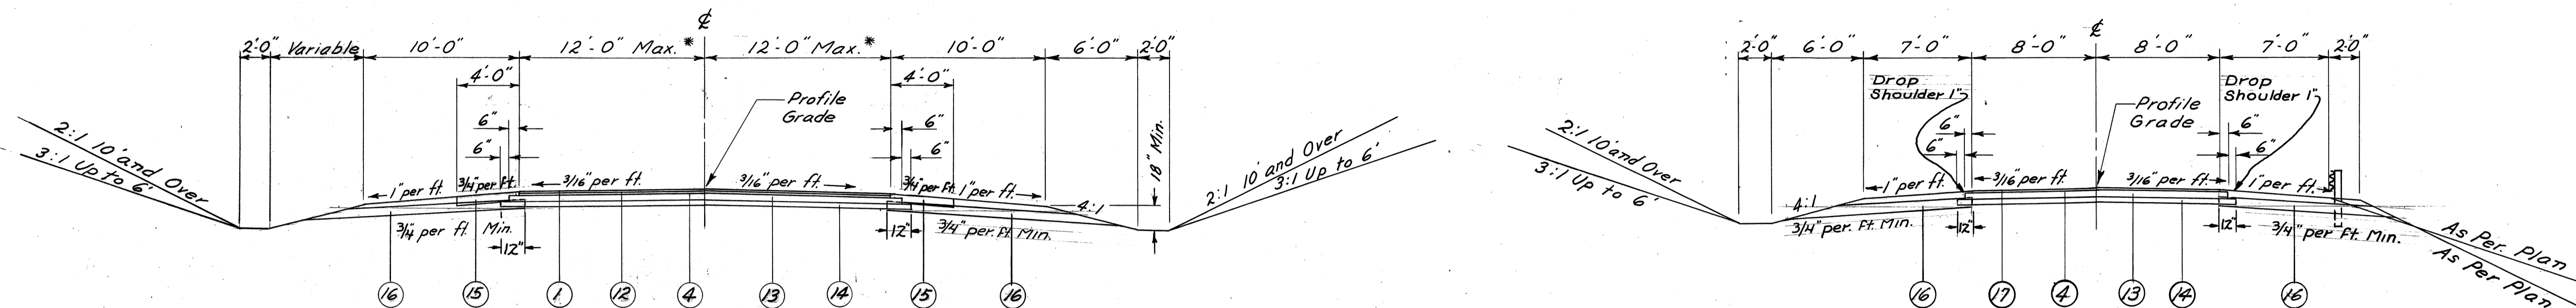


S. R. 226 & S. R. 95
LIMITING STATIONS
STA. 486+00 TO STA. 488+76.64 SR.226
STA. 158+00 TO STA. 159+80.94 SR.95
STA. 160+91.96 TO STA. 163+25 SR.95

FRONTAGE ROAD
LIMITING STATIONS
STA. 4+73.33 TO STA. 20+25


* NOTE: On S.R.#226 pavement width south of the return radii with S.R.#3 will be limited to transition taper. On S.R.#95 pavement width east & west of the return radii with S.R.#3 will be limited to existing width and transition tapers.

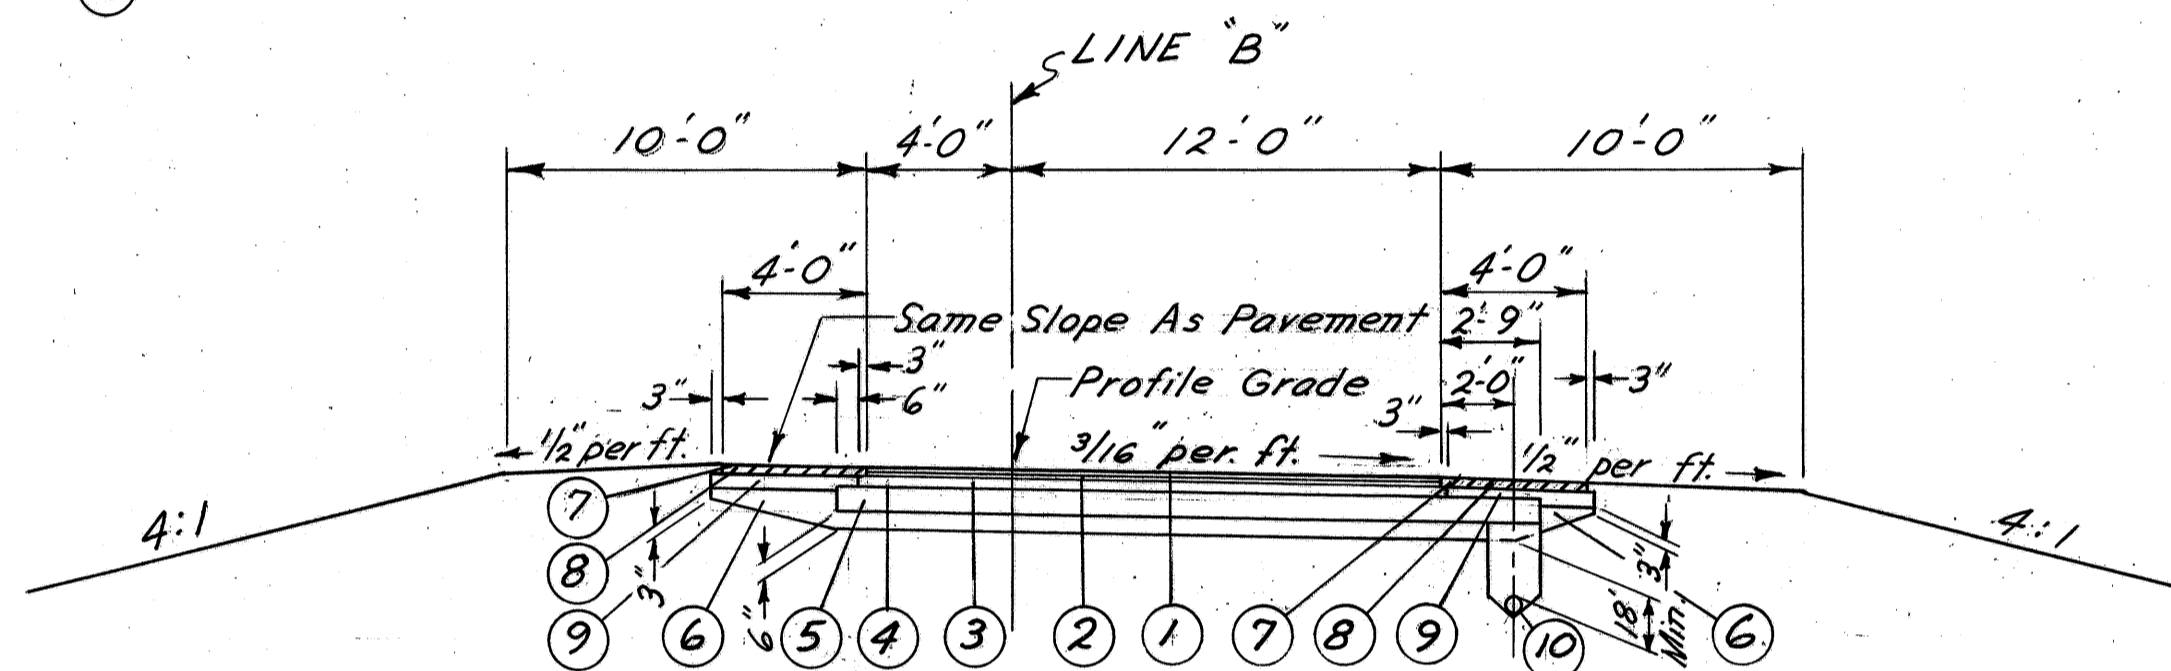

LINE "B"
LIMITING STATIONS
STA. 491+18.2 TO STA. 493+68.22

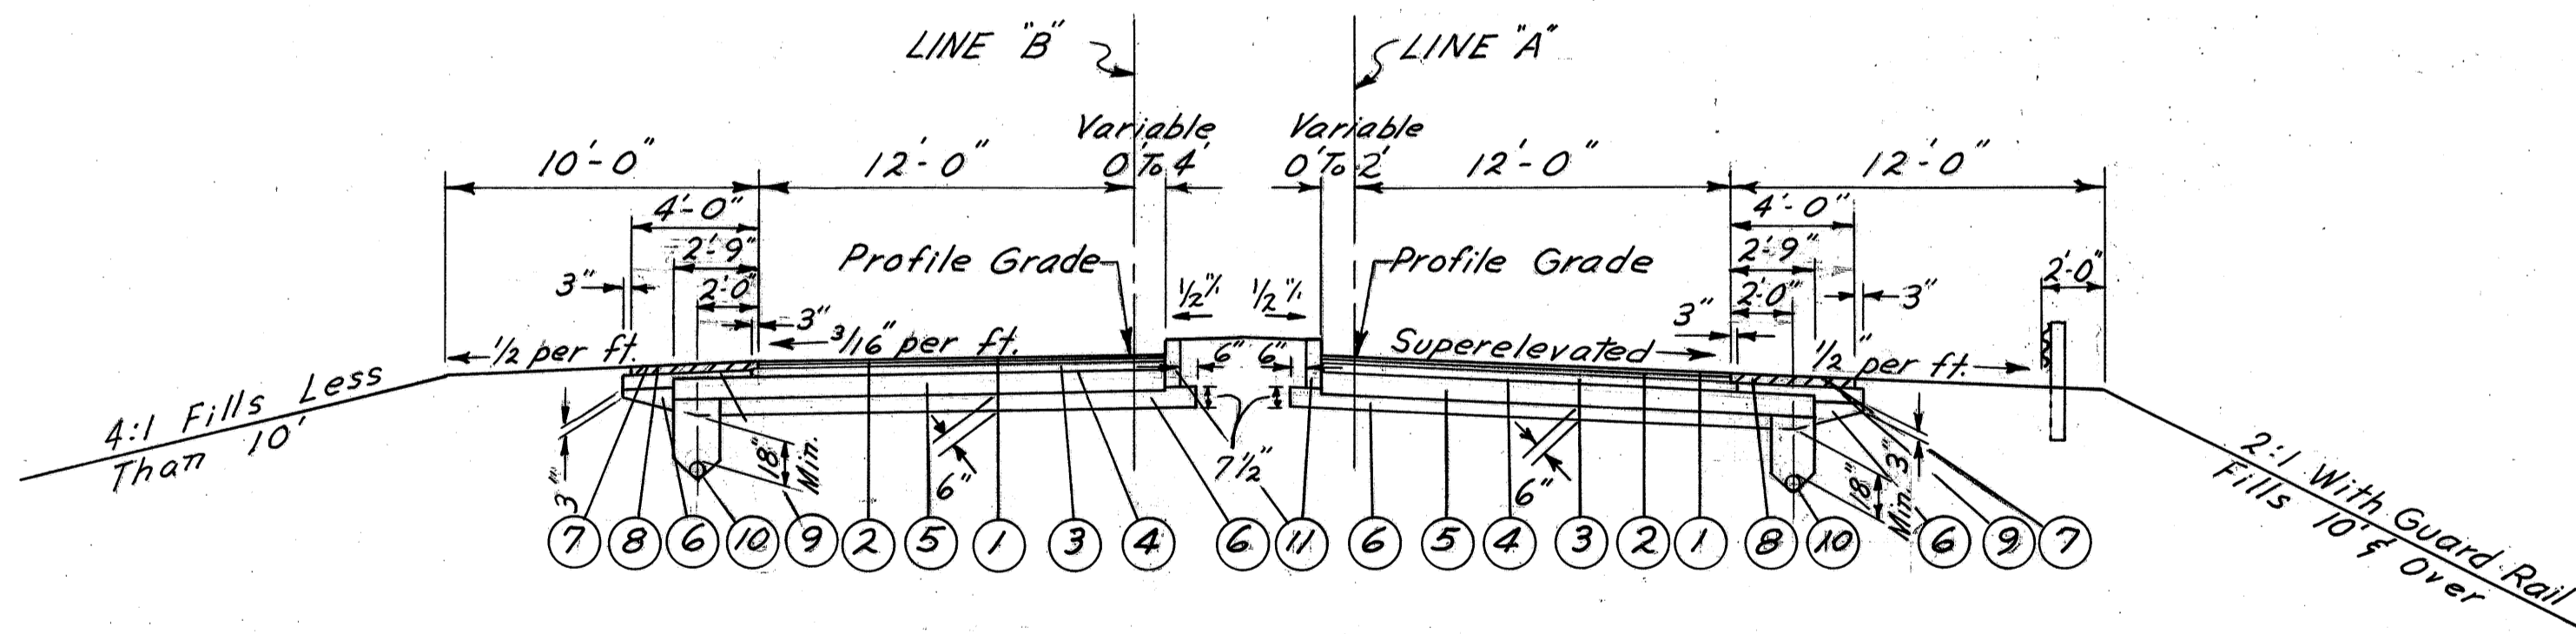

LINE "A" & LINE "B"
LIMITING STATIONS
STA. 489+08.96 TO STA. 492+38.47 "A"
STA. 489+08.96 TO STA. 490+94 "B"

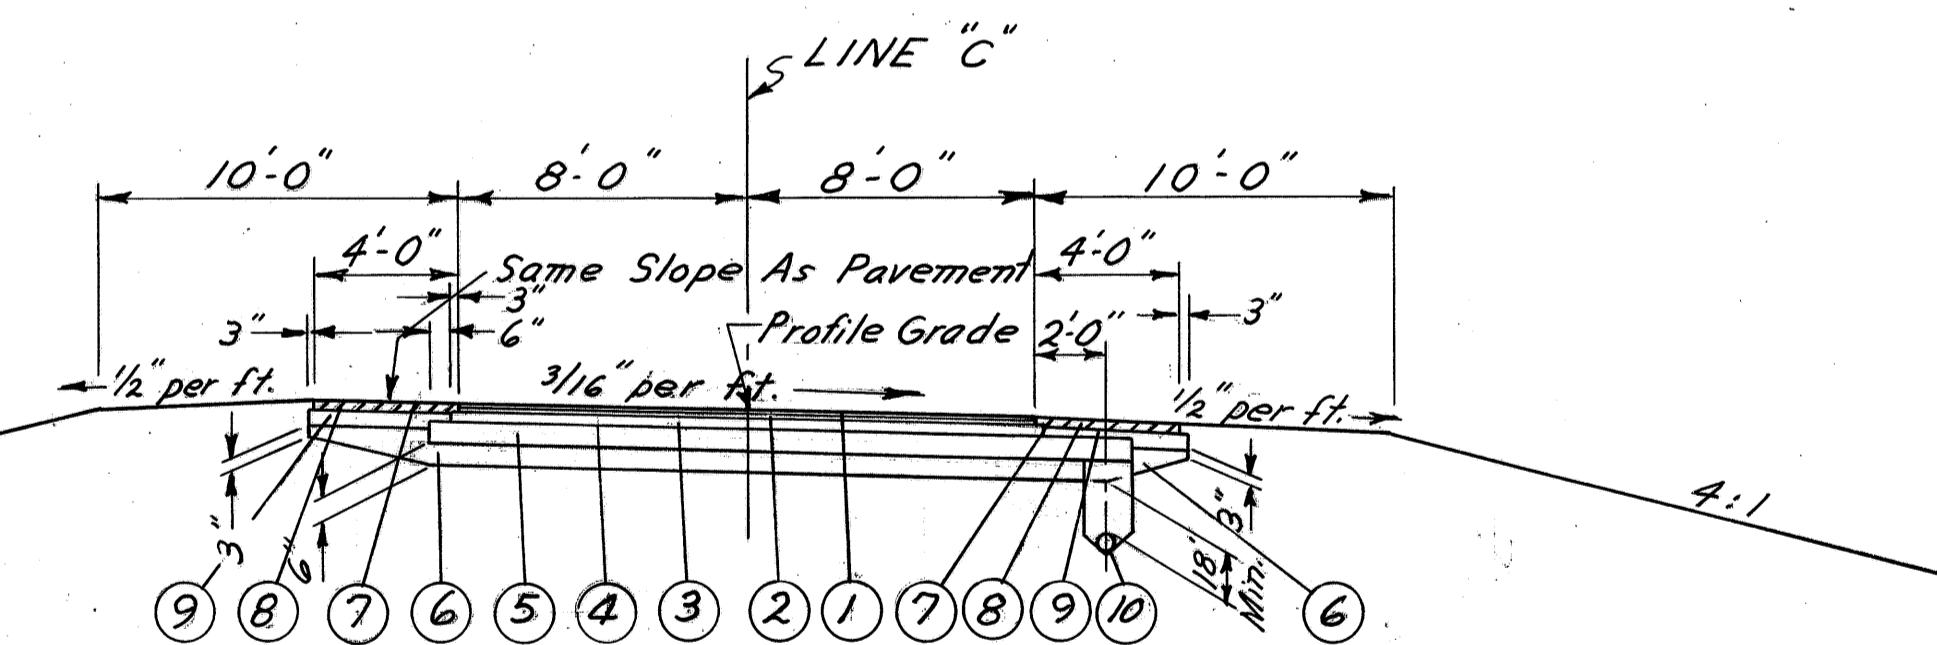

LINE "C"
LIMITING STATIONS
STA. 0+00 TO STA. 1+51
STA. 1+71 TO STA. 2+53.69

LEGEND

- ⊕ (1) T-35 1 1/4" Asphaltic Concrete Surface Course Type C (70-85)
- ⊕ (2) B-35 1 1/4" Asphaltic Concrete Leveling Course (70-85)
- ⊕ (3) B-35 3" Asphaltic Concrete Base Course (70-85)
- (4) T-30 Bituminous Prime Coat Using 0.40 Gal. per Sq. Yd. Sec. M.5.7 RT 2 or RT 3
- (5) B-20 8" Waterbound Macadam Base Course Using No. 2 Coarse Aggregate
- (6) I-22 Subbase Grading A or B Variable Thickness
- (7) T-31 Bituminous Surface Treatment (See Proposal Note)
- (8) B-33 3" Bituminous Macadam Base Course
- (9) I-18 5" Stabilized Crushed Aggregate Shoulder
- (10) I-4 6" Pipe Underdrains
- (11) I-12 Std. Type 6 Curb
- ⊕ (12) B-35 1 1/2" Asphaltic Concrete Leveling Course (70-85)
- (13) B-19 5" Aggregate Base Course
- (14) I-22 4" Subbase Grading A or B
- (15) I-18 6" Stabilized Crushed Aggregate Shoulders
- (16) I-9 Stone Underdrains (No. 2)
- ⊕ (17) T-35 1 1/2" Asphaltic Concrete Surface Course Type A (85-100)

* Thicknesses shown are "designed" thicknesses as described in Sections T-35.01 and B-35.01.

TYPICAL SECTIONS


TYPE T-35 ON B-19

FED. RD. DIVISION	STATE	PROJECT
2	OHIO	


10
157

WAYNE COUNTY
WAY-3-9.94


SCALE: $\frac{3}{16}'' = 1'-0''$

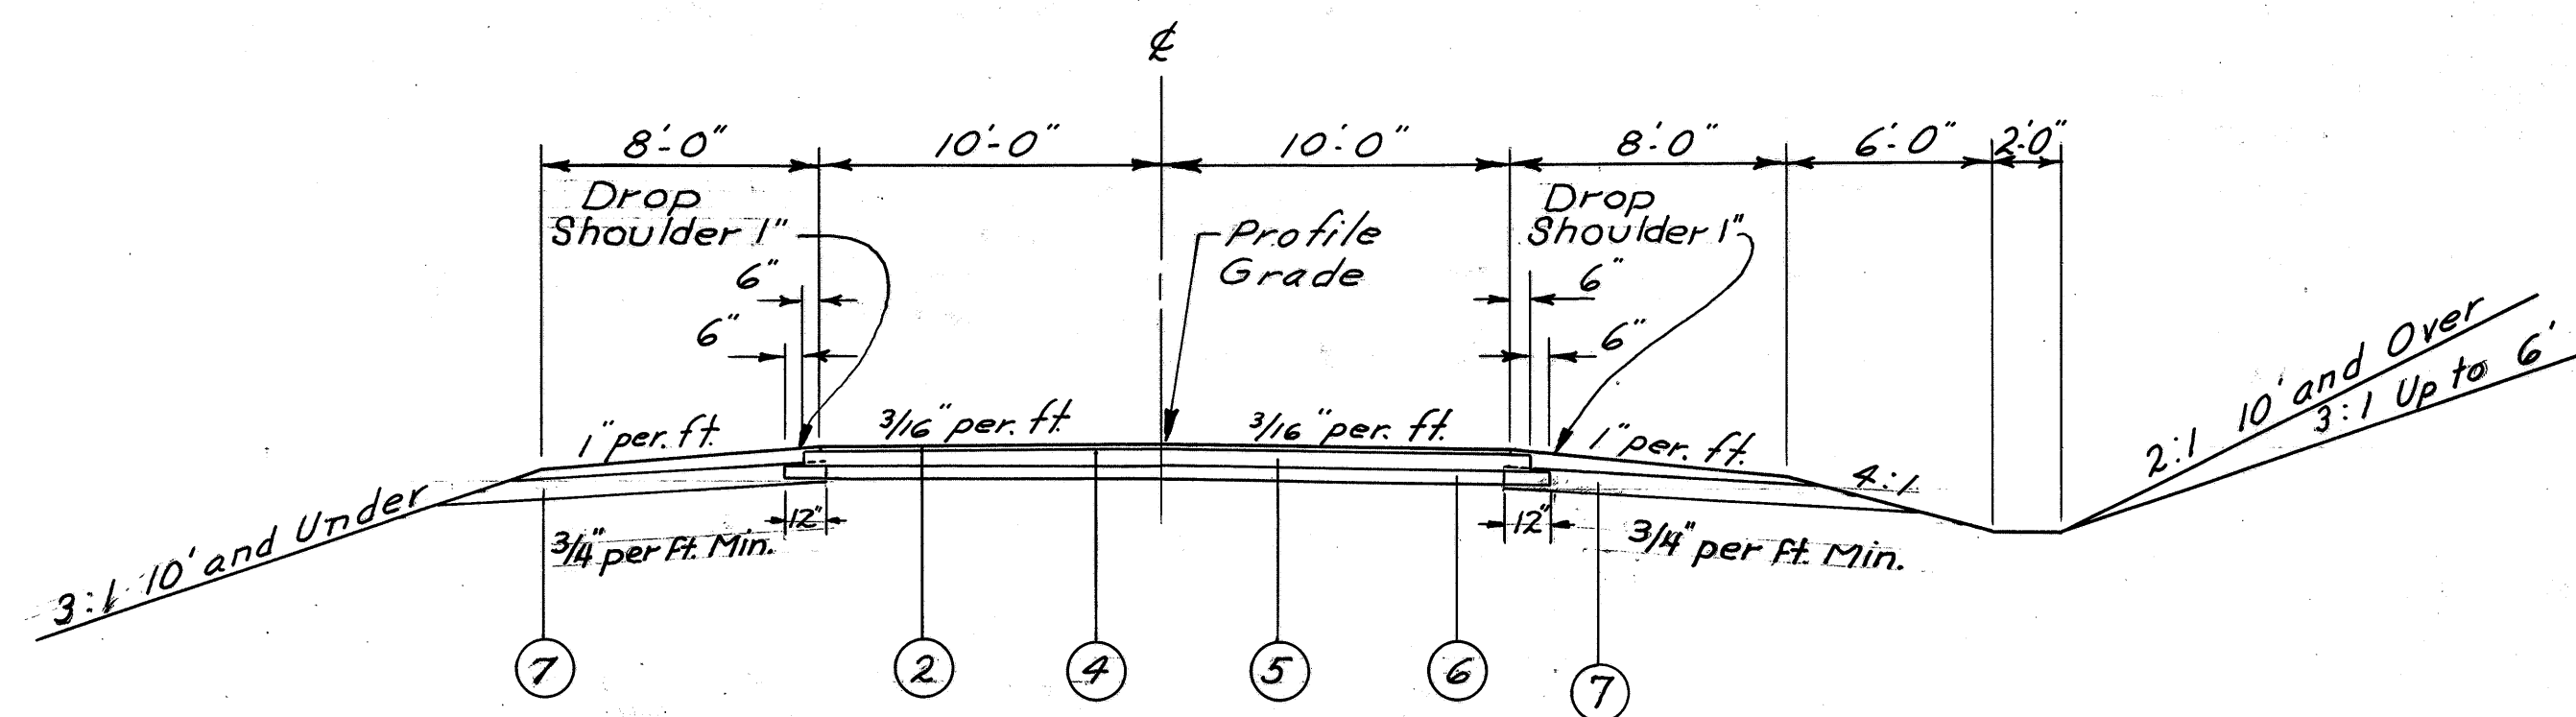


NORMAL SECTION
COUNTY RD. 139
LIMITING STATIONS
STA. 16+50 TO STA. 17+8040
STA. 20+98.21 TO STA. 22+13.52
STA. 24+98.52 TO STA. 25+11.02
STA. 26+04.84 TO STA. 26+30.79
STA. 27+59.84 TO STA. 28+60

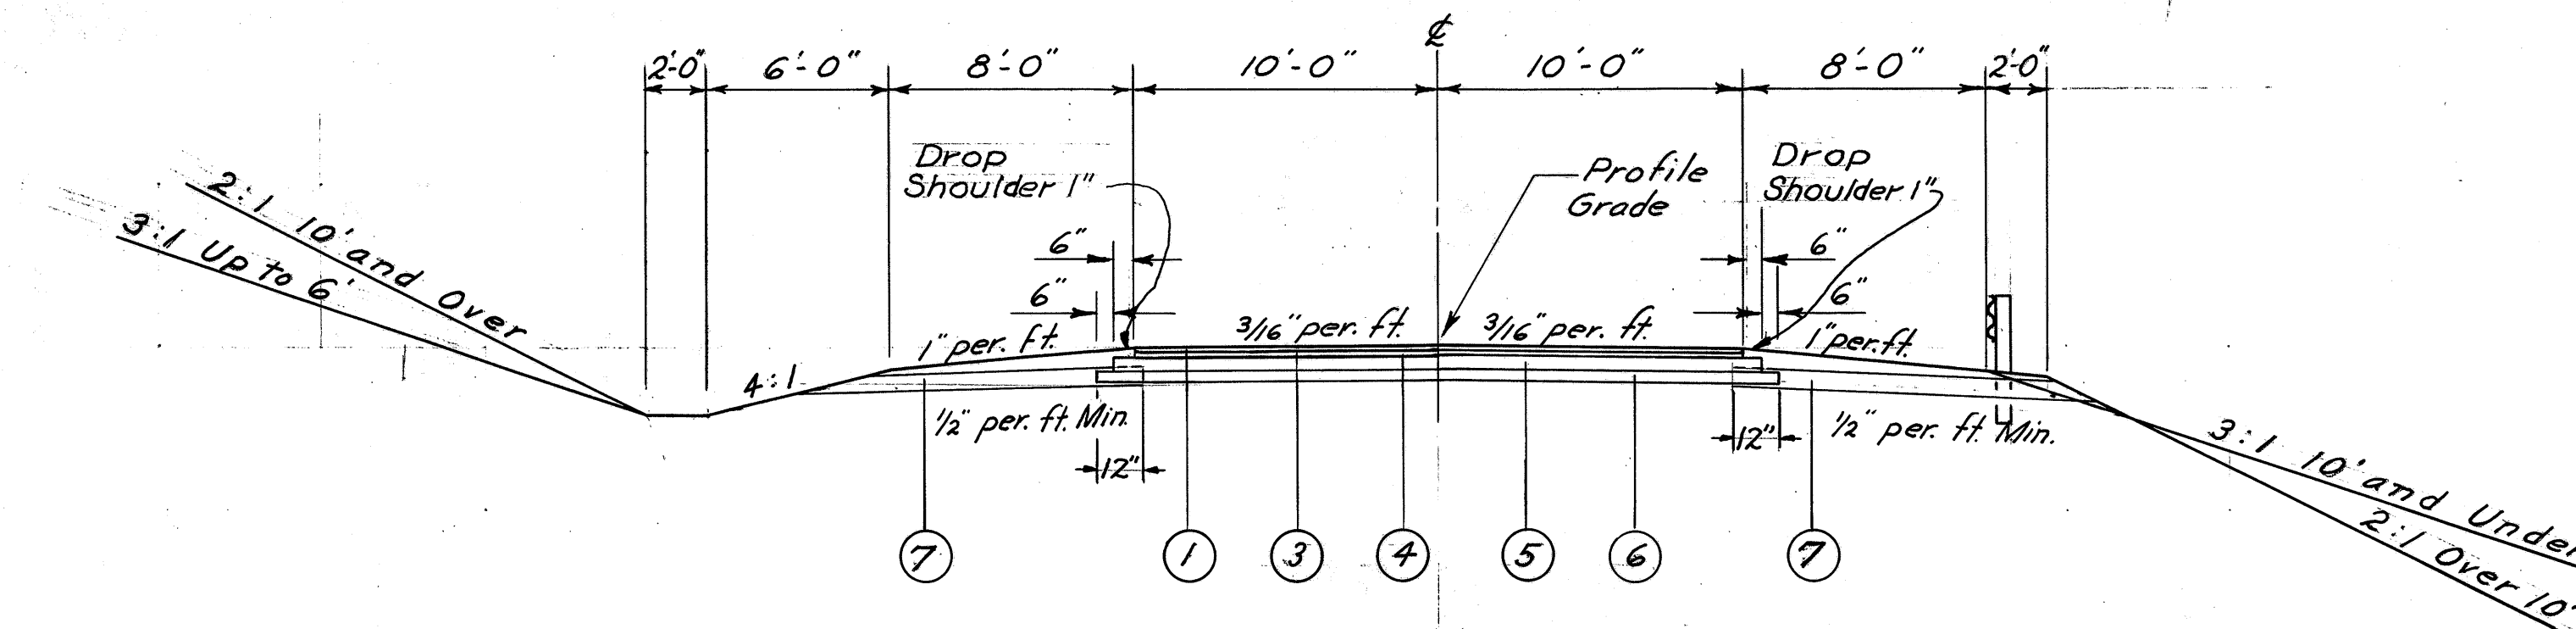

NORMAL SECTION
COUNTY RD. 174
LIMITING STATIONS
STA. 18+00 TO STA. 20+07.50
STA. 22+50.72 TO STA. 22+92.87

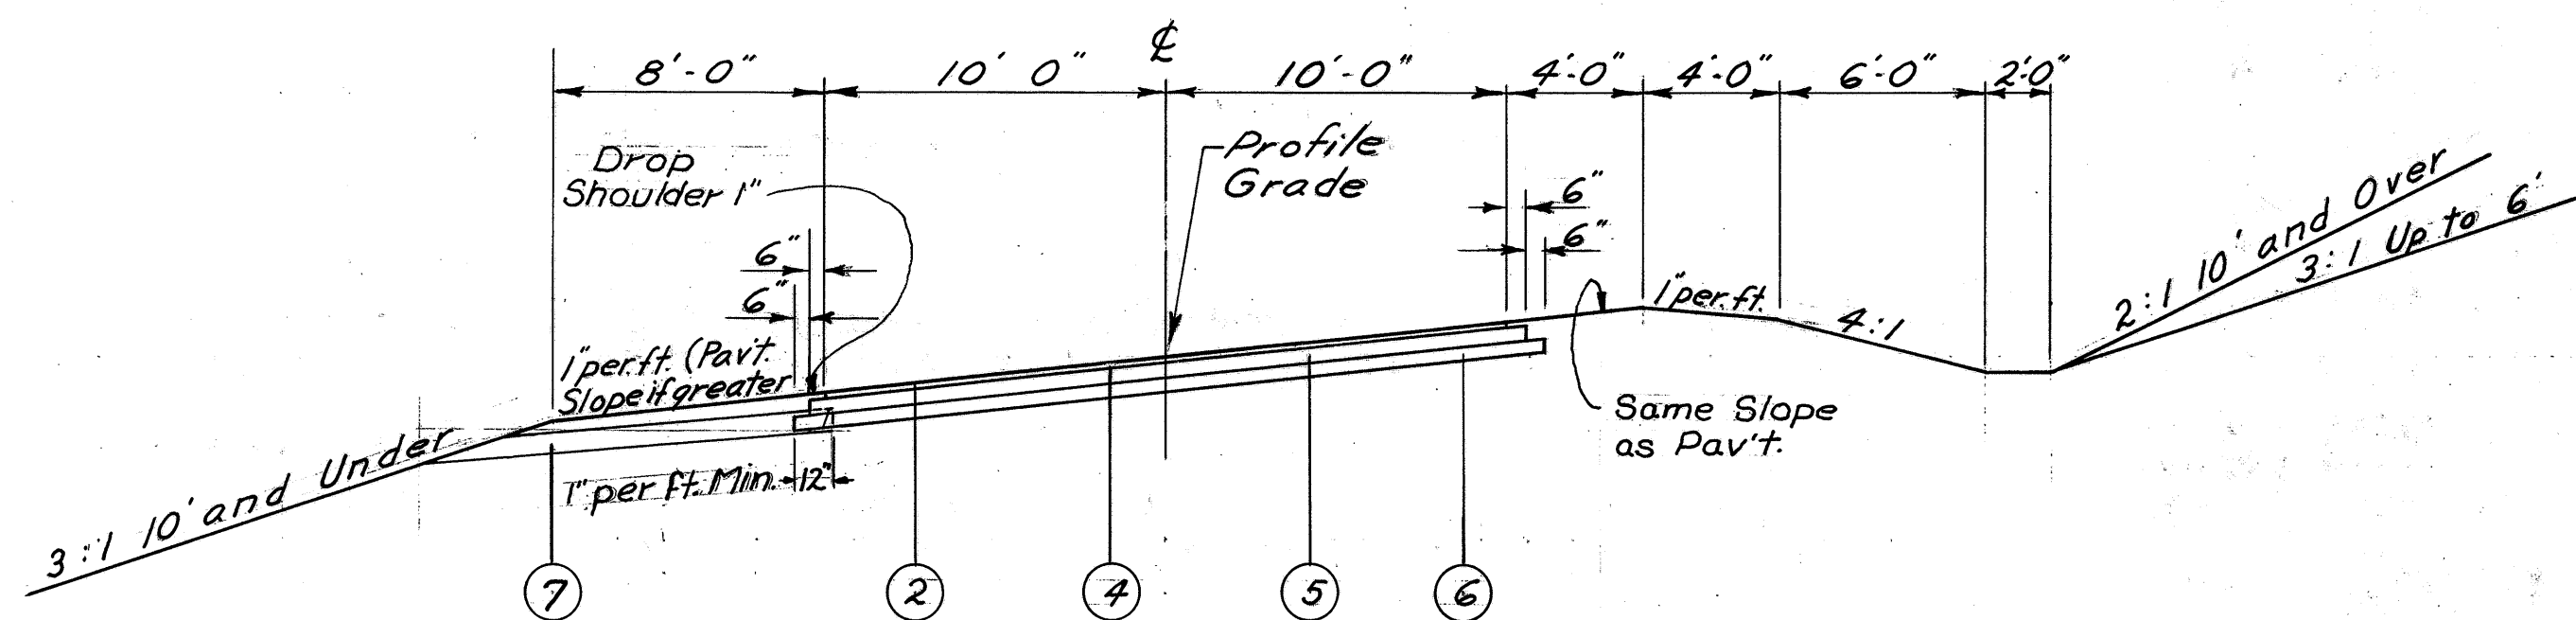

SUPERELEVATED SECTION
COUNTY RD. 139
LIMITING STATIONS
STA. 17+8040 TO STA. 20+98.21
STA. 22+13.52 TO STA. 24+98.52
STA. 26+30.79 TO STA. 27+59.84

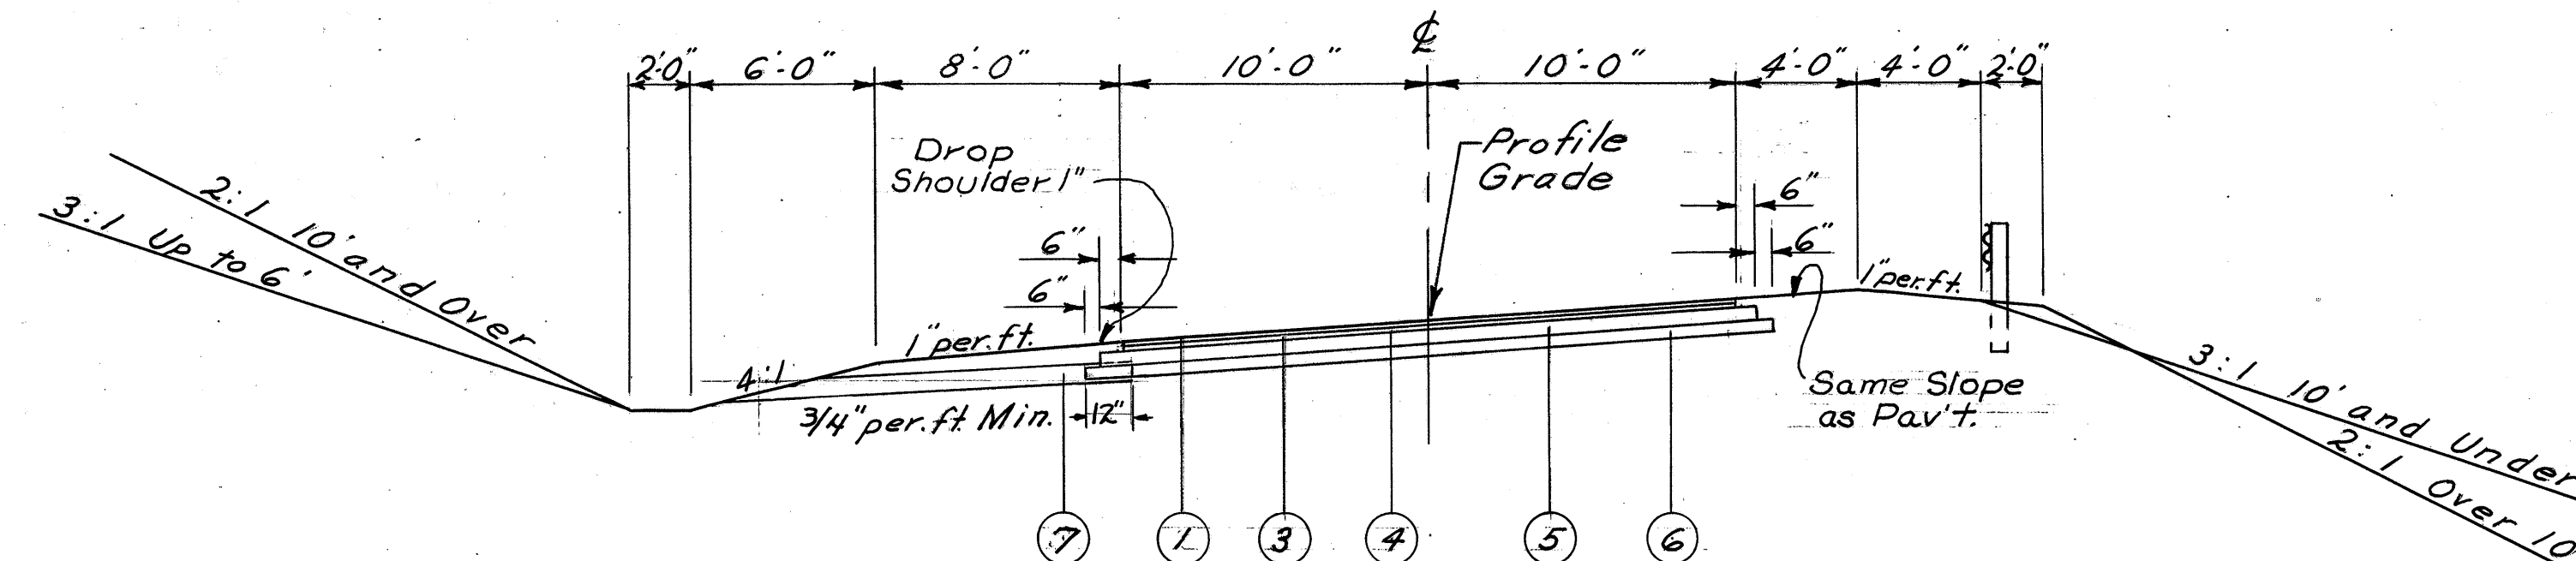

SUPERELEVATED SECTION
COUNTY RD. 174
LIMITING STATIONS
STA. 20+07.50 TO STA. 22+50.72

LEGEND

- ① # T-35 1/4 Asphaltic Concrete Surface Course Type "C" (70-85)
- ② # T-35 1/2 Asphaltic Concrete Surface Course Type "A" (85-100)
- ③ # B-35 1/2 Asphaltic Concrete Leveling Course (70-85)
- ④ T-30 Bituminous Prime Coat Using Sec. M-5.7 RT.2 or 3 Applied At The Rate of 0.4 Gal. per Sq. Yd.
- ⑤ B-19 5" Crushed Aggregate Base Course
- ⑥ I-22 4" Subbase
- ⑦ I-9 Stone Underdrain (No. 2)

* Thicknesses shown are "Designed" thicknesses as described in Sections T-35.01 and B-35.01.

GENERAL NOTES

FED. RD. DIVISION	STATE	PROJECT	
			11 151

WAYNE COUNTY
WAY-3-9.94

ROAD NAME

ALL COUNTY, TOWNSHIP, CITY OR VILLAGE ROAD OR STREET NAME SIGNS THAT WILL BE DISTURBED BY THE CONSTRUCTION SHALL BE CAREFULLY REMOVED AND STORED BY THE CONTRACTOR FOR DISPOSAL BY THEIR RESPECTIVE OWNERS. PAYMENT FOR THIS OPERATION SHALL BE INCLUDED IN THE UNIT PRICE BID FOR ROADWAY EXCAVATION. ITEM E-1

FIELD OFFICE

THE CONTRACTOR SHALL PROVIDE A SUITABLE OFFICE FOR THE EXCLUSIVE USE OF THE STATE EMPLOYEES IN ACCORDANCE WITH SEC. 5-0-01 (B), HAVING A MINIMUM OF 500 SQUARE FEET OF FLOOR SPACE. THE CONTRACTOR SHALL HAVE A TELEPHONE INSTALLED AND MAINTAINED IN THE FIELD OFFICE DURING THE CONSTRUCTION OF THIS PROJECT. THE CONTRACTOR SHALL ALSO INSTALL WIRING AND OUTLETS SUITABLE FOR CONNECTING TO OFFICE EQUIPMENT, AND PROVIDE 110 VOLT ALTERNATING CURRENT DURING THE CONSTRUCTION OF THIS PROJECT.

DESIGN SPEED

THE GEOMETRICS FOR THIS PROJECT HAVE BEEN PLANNED FOR A DESIGN SPEED OF 60 MILES PER HOUR.

UTILITIES

THE CONTRACTOR SHALL NOTIFY, AT LEAST 48 HOURS BEFORE BREAKING GROUND, ALL PUBLIC SERVICE CORPORATIONS HAVING WIRE, POLES, PIPE, CONDUITS, MANHOLES OR OTHER STRUCTURES THAT MAY BE AFFECTED BY THIS OPERATION, INCLUDING ALL STRUCTURES WHICH ARE AFFECTED AND SHOWN ON THESE PLANS. ANY AND ALL WORK REQUIRED FOR PUBLIC OR PRIVATE UTILITIES WILL BE DONE BY AND AT THE EXPENSE OF THEIR RESPECTIVE OWNERS, UNLESS OTHERWISE NOTED ON THESE PLANS.

ROUNDING OF CORNERS ON CROSS SECTIONS

THE ROUNDED CORNERS, SHOWN ON STANDARD DRAWING R-1, AS MODIFIED BY THE TYPICAL SECTIONS APPLY TO ALL CROSS SECTIONS EVEN THOUGH OTHERWISE SHOWN IN THESE PLANS.

R/W MONUMENTS, FEDERAL PROJECT MARKERS AND SECTION MARKERS

EXISTING R/W MONUMENTS, BENCH MARKS, FEDERAL PROJECTS MARKERS AND SECTION MARKERS THAT WILL BE REMOVED BY CONSTRUCTION, SHALL BE PROTECTED BY THE CONTRACTOR AS PER SECTION G-7.09 UNTIL THEY CAN BE WITNESSED, REFERENCED AND RESET BY THE CONSTRUCTION CREW.

ELEVATION DATUM

ALL ELEVATIONS ARE BASED ON U.S.G.S. DATUM.

REPLACEMENT

THE CONTRACTOR SHALL REPLACE AT HIS OWN EXPENSE ANY ITEM NOT SPECIFICALLY LISTED FOR REMOVAL THAT IS DAMAGED OR DESTROYED BY HIS OPERATION.

SUPERELEVATION

SUPERELEVATED CURVES SHALL BE BUILT WITHOUT CROWN. THE CROWN SHALL BE WORKED OUT OF THE PAVEMENT IN THE PORTION BETWEEN THE BEGINNING OF THE TRANSITION AND THE POINT WHERE THE SUPERELEVATION EQUALS TWICE THE CROWN.

NON-RIGID PAVEMENT REMOVAL

REMOVAL AND DISPOSAL OF EXISTING NON-RIGID PAVEMENT, UNLESS OTHERWISE INDICATED ON THESE PLANS, SHALL BE MEASURED AND PAID FOR AS ITEM E-1, ROADWAY EXCAVATION.

SUBGRADE COMPACTION FOR DRIVES AND MAIL BOX TURNOUTS

THE SUBGRADE UNDER B-19 MATERIAL USED ON DRIVES AND MAIL BOX TURNOUTS SHALL BE COMPACTED FOR A DEPTH OF 6 INCHES TO THE DENSITY REQUIREMENTS OF TABLE 111 IN ITEM E-1. PAYMENT FOR SUBGRADE COMPACTION AS SPECIFIED ABOVE, SHALL BE INCLUDED IN THE UNIT PRICE BID FOR ROADWAY EXCAVATION. ITEM E-1

EXCAVATION FOR ITEM B-19

EXCAVATION FOR B-19 MATERIAL USED ON SIDE ROAD APPROACHES, MAIL BOX TURNOUTS AND DRIVES HAS BEEN INCLUDED IN EARTHWORK QUANTITIES WHEN SAME IS IN "CUT". WHERE SIDE ROAD APPROACHES, MAIL BOX TURNOUTS, AND DRIVES ARE IN "FILL", EXCAVATION FOR B-19 MATERIAL SHALL BE MADE BY THE CONTRACTOR AT HIS OWN EXPENSE IF HE BUILDS THE EMBANKMENT UP TO FINISH GRADE BEFORE PLACING THE B-19 MATERIAL.

PRIVATE DRIVES

THE LOCATION OF RESIDENCE AND FIELD DRIVES MAY BE CHANGED DURING CONSTRUCTION AT THE DIRECTION OF THE ENGINEER. THE CONTRACTOR WILL BE REQUIRED TO PROVIDE TEMPORARY DRIVES, IF NEEDED, TO ALLOW ACCESS TO ALL PROPERTY OWNERS DURING CONSTRUCTION. QUANTITIES OF COMPACTED SURFACE COURSE, ITEM T-10, AND CALCIUM CHLORIDE, ITEM M-10, HAVE BEEN INCLUDED IN THE GENERAL SUMMARY FOR MAINTAINING TRAFFIC. THE COST OF PROVIDING THE TEMPORARY DRIVEWAYS SHALL BE INCLUDED IN THE ABOVE ITEMS.

GUARD RAIL REMOVAL

THE REMOVAL OF ANY GUARD RAIL POSTS LYING WITHIN THE LIMITS OF ROADWAY EXCAVATION OR EMBANKMENT (AND NOT SPECIFICALLY PAID FOR UNDER A SEPARATE ITEM) IS INCLUDED IN THE CONTRACT UNIT PRICE BID FOR ROADWAY EXCAVATION. ALL RESULTING MATERIALS SHALL BECOME THE PROPERTY OF THE CONTRACTOR AND SHALL BE DISPOSED OF BY HIM AT NO EXTRA COST TO THE STATE, EXCEPT THAT THE STEEL RAIL ON ALL EXISTING STEEL BEAM TYPE OR STEEL CABLE ON STEEL CABLE TYPE GUARD RAILS SHALL BE STORED ON THE RIGHT-OF-WAY FOR DISPOSAL BY THE OWNER.

GUARD RAIL ADJUSTMENT

THE STATIONING FOR INDIVIDUAL RUNS OF GUARD RAIL SHALL BE ADJUSTED BY THE ENGINEER AT THE TIME OF CONSTRUCTION TO ACCOMMODATE STANDARD PANEL LENGTHS.

GUARD RAIL ADJACENT TO BRIDGE PARAPET

ONE ADDITIONAL GUARD RAIL POST SHALL BE PROVIDED IN THE CENTER OF EACH PANEL OF GUARD RAIL ADJACENT TO THE PARAPET, PAYMENT FOR WHICH SHALL BE INCLUDED IN THE UNIT PRICE BID FOR ITEM I-15 GUARD RAIL.

FLARING GUARD RAIL AT BRIDGES

THE GUARD RAIL SHALL BE FLARED TO MEET THE BRIDGE RAILING IN SUCH A MANNER THAT THE CHANGE IN ALIGNMENT SHALL NOT EXCEED 1:20.

HEAVY EQUIPMENT

THE CONTRACTOR SHALL EXERCISE CARE IN THE USE OF HEAVY EQUIPMENT OVER FINISHED WORK AND WILL BE REQUIRED TO REMOVE AND REPLACE ANY COMPLETED WORK DESTROYED THEREBY. CULVERTS SHALL BE BACKFILLED TO A HEIGHT OF FOUR FEET BEFORE LOADED EARTHMOVING EQUIPMENT IS PERMITTED TO CROSS THE TRENCH. ANY ADDITIONAL FILL AND SUBSEQUENT EXCAVATION REQUIRED TO PROVIDE THIS MINIMUM COVER SHALL BE MADE AT NO ADDITIONAL COST TO THE STATE. HEAVY EQUIPMENT SHALL NOT BE OPERATED OVER ANY COMPLETED LAYER OF EMBANKMENT, COMPACTED SUBGRADE, OR SUBBASE IF SUCH OPERATION TENDS TO DESTROY THE SOIL STRUCTURE OR PIPE UNDERDRAINS; HOWEVER, IF SUCH OPERATION CANNOT BE AVOIDED, THE CONTRACTOR WILL BE REQUIRED TO REDUCE THE SIZE OF LOADS TO AN EXTENT THAT DAMAGE DOES NOT OCCUR.

UNDERGROUND UTILITIES

THE LOCATIONS OF THE UNDERGROUND UTILITIES SHOWN ON THE PLANS HAVE BEEN OBTAINED BY DILIGENT FIELD CHECKS AND SEARCHES OF AVAILABLE RECORDS. IT IS BELIEVED THAT THEY ARE ESSENTIALLY CORRECT, BUT THE STATE OF OHIO MAKES NO GUARANTEES AS TO THEIR ACCURACY OR COMPLETENESS.

CENTER LINE REFERENCE MONUMENTS

MONUMENTS SHALL BE CONSTRUCTED OF CLASS "C" CONCRETE, CAST-IN-PLACE IN A CIRCULAR HOLE 8 INCHES IN DIAMETER AND 44 INCHES IN DEPTH. TOP OF CONCRETE SHALL BE FINISHED AT A DEPTH 2 INCHES BELOW GROUND LEVEL AND THE UPPER 6 INCH PORTION OF THE CONCRETE SHALL BE FORMED. A 16-D NAIL SHALL BE EMBEDDED IN THE WET CONCRETE AS DIRECTED BY THE ENGINEER TO MARK CENTER LINE AND STATION. FOR DETAILS SEE SHEET NO. 1144.

ESTIMATED QUANTITIES

SPECIFIC LOCATIONS AND USAGE OF ESTIMATED QUANTITIES SET UP ON THIS PLAN TO BE USED "AS DIRECTED BY THE ENGINEER" SHALL BE MADE A MATTER OF RECORD BY INCORPORATION INTO THE FINAL CHANGE ORDER GOVERNING COMPLETION OF THIS PROJECT.

LOCATION AND SIZE OF PIPE

THE LOCATION, TYPE, DEPTH AND SIZE OF ALL EXISTING PIPES ARE SHOWN AS NEARLY EXACT AS THE AVAILABLE INFORMATION WILL PERMIT. THE STATE WILL NOT BE RESPONSIBLE FOR ANY VARIATIONS FOUND DURING CONSTRUCTION.

REMOVAL OF ALL EXISTING PIPE

THE REMOVAL OF ALL EXISTING PIPE DRAINS WITHIN THE LIMITS OF PROPOSED EXCAVATION ITEMS, SHALL BE INCLUDED FOR PAYMENT IN THE UNIT PRICES BID FOR THE RESPECTIVE EXCAVATION ITEMS, UNLESS OTHERWISE ITEMIZED IN THE PLANS.

PLUGGING PIPE ENDS

THE UPSTREAM ENDS OF PIPE LINES OR TILE LINES INTERCEPTED BY EARTHWORK OPERATIONS SHALL BE EFFECTIVELY BLOCKED AND COVERED. BROKEN PIECES AND PORTIONS OF PIPE OR TILE SHALL BE REMOVED UNTIL A WHOLE LENGTH IS ENCOUNTERED, WHICH SHALL BE BLOCKED WITH CONCRETE, FLAT STONE OR BRICK LAID IN MORTAR, PRECAST CLAY OR CONCRETE STOPPER. PAYMENT FOR THE ABOVE WORK SHALL BE INCLUDED IN THE PRICE BID FOR ROADWAY EXCAVATION, ITEM E-1.

SEALING OF PIPE JOINTS

WHERE CONNECTIONS ARE MADE BETWEEN RIGID AND FLEXIBLE PIPE SECTIONS OR BETWEEN PIPE SECTIONS OF DIFFERENT KIND OR TYPE OF END FABRICATION, WHETHER REQUIRED BY THE PLANS, ARISING FROM PERMISSIBLE USE OF OPTIONAL MATERIALS, OR ENCOUNTERED IN CONNECTION TO EXISTING FACILITIES, THE JOINT SHALL BE SEALED, IF SEALING IS REQUIRED BY THE SPECIFICATIONS, BY MEANS OF A CLASS "E" CONCRETE COLLAR HAVING A MINIMUM THICKNESS OF 6 INCHES AND A MINIMUM LENGTH OF 12 INCHES. PAYMENT FOR SEALING AS DESCRIBED ABOVE SHALL BE INCLUDED IN THE UNIT PRICE BID FOR THE PERTINENT PIPE ITEM.

PRIVATE SEWER TAPS

THIS PLAN MAKES NO PROVISION FOR CONNECTING, NOR SHALL THE ENGINEER OR CONTRACTOR CONNECT, ANY EXISTING OR NEW PRIVATE DRAINAGE TO THE NEW HIGHWAY DRAINAGE SYSTEM WHEN SUCH PRIVATE DRAINS CARRY EFFLUENT OR DRAINAGE FROM LEACHING BED OUTLETS, CELLAR DRAINS, OR SINK DRAINS, OR POLLUTED WATER OF ANY KIND. CONNECTIONS MAY BE MADE TO THE EXISTING OR NEW HIGHWAY DRAINAGE SYSTEM WHEN THE WATER CARRIED TO THE PROJECT DRAINAGE SYSTEM DOES NOT COME WITHIN THE CATEGORY OUTLINED ABOVE.

ACCEPTABLE WATER INCLUDES FLOW FROM ROOF DRAINS, FIELD DRAINS, AND ENCLOSED NATURAL DRAINAGE SOURCES WHICH WOULD REACH THE ROAD THROUGH NATURAL CHANNELS IF SUCH WATER WAS NOT CONDUCTED ARTIFICIALLY. EXISTING SEWER TAPS WHICH DO NOT CARRY ACCEPTABLE WATER, AS DEFINED ABOVE, SHALL BE PLUGGED AT THE RIGHT-OF-WAY LINE. PLUGGING SPECIFIED SHALL BE BY MEANS OF CLASS "E" CONCRETE, AND PAYMENT THEREFOR SHALL BE INCLUDED IN THE UNIT PRICE BID FOR ITEM E-1, ROADWAY EXCAVATION. THE FOLLOWING ESTIMATED QUANTITIES HAVE BEEN INCLUDED IN THE GENERAL SUMMARY, FOR USE AS DIRECTED BY THE ENGINEER, IN MAKING THE ABOVE DESCRIBED CONNECTIONS:

ITEM I-2	8" CLASS "B" STORM SEWERS	100 LIN. FT.
ITEM I-5	8" PIPE SPECIALS FOR CLASS "B" STORM SEWERS	5 EACH

FIELD DRAINS

ALL FARM TILES WHICH ARE ENCOUNTERED DURING CONSTRUCTION SHALL BE PROVIDED WITH UNOBSTRUCTED OUTLETS UNDER THE DIRECTION OF THE ENGINEER. EXISTING COLLECTORS WHICH ARE LOCATED BELOW THE ROADWAY DITCH ELEVATIONS AND WHICH CROSS THE ROADWAY SHALL BE REPLACED WITHIN THE RIGHT-OF-WAY LIMITS BY ITEM I-2 CLASS "B" STORM SEWERS UNDER PAVEMENT OR APPROACHES. EXISTING COLLECTORS AND ISOLATED FARM TILES WHICH ARE ENCOUNTERED ABOVE THE ELEVATION OF THE ROADWAY DITCHES SHALL BE OUTLETTED INTO THE ROADWAY DITCH. THE OPTIMUM OUTLET ELEVATION SHALL BE, IF POSSIBLE, ONE FOOT ABOVE THE FLOW-LINE ELEVATION OF THE DITCH. LATERAL TILE FIELDS WHICH CROSS THE ROADWAY SHALL BE INTERCEPTED BY ITEM I-3 ROADWAY DRAINAGE AND CARRIED IN A LONGITUDINAL DIRECTION TO AN ADEQUATE OUTLET OR ROADWAY CROSSING. THE LOCATION, TYPE, SIZE, AND GRADE OF REQUIRED REPLACEMENTS SHALL BE DETERMINED BY THE ENGINEER DURING CONSTRUCTION, AND PAYMENT SHALL BE MADE ON FINAL MEASUREMENTS. THE FOLLOWING ESTIMATED QUANTITIES HAVE BEEN INCLUDED IN THE GENERAL SUMMARY FOR THE WORK NOTED ABOVE:

I-2	8"	CLASS B STORM SEWERS UNDER PAVEMENT	500 LIN. FT.
I-2	12"	CLASS B STORM SEWERS UNDER PAVEMENT	300 LIN. FT.
I-3	8"	ROADWAY DRAINAGE	300 LIN. FT.
I-3	12"	ROADWAY DRAINAGE	300 LIN. FT.
I-3	8"	OUTLETS FOR ROADWAY DRAINAGE M 6.4 (c)	100 LIN. FT.
I-3	12"	OUTLETS FOR ROADWAY DRAINAGE M 6.4 (c)	100 LIN. FT.
I-5	8"	PIPE SPECIALS FOR I-2	5 EACH
I-5	12"	PIPE SPECIALS FOR I-2	5 EACH
I-5	8"	PIPE SPECIALS FOR I-3	5 EACH
I-5	12"	PIPE SPECIALS FOR I-3	5 EACH
I-10		DUMPED ROCK CHANNEL PROTECTION	25 CU. YD.

CONNECTIONS TO EXISTING PIPE

AT PLACES WHERE THE PLANS PROVIDE FOR PROPOSED DRAINAGE PIPE TO BE CONNECTED TO EXISTING PIPES, IT SHALL BE THE RESPONSIBILITY OF THE CONTRACTOR TO LOCATE THE EXISTING PIPE, BOTH AS TO LINE AND GRADE, BEFORE HE STARTS TO LAY THE PROPOSED PIPE. THE COST OF THIS OPERATION SHALL BE INCLUDED IN THE UNIT PRICE BID FOR THE PERTINENT PIPE ITEM.

PLACING SOD IN DITCHES

ALL SOD PLACED IN DITCHES SHALL BE LAID WITH THE LONG EDGES OF THE STRIPS PERPENDICULAR TO THE FLOW LINE OF THE DITCH. SUCCESSIVE STRIPS SHALL BE NEATLY MATCHED AND ALL JOINTS STAGGERED OR BROKEN. THE SOD SHALL BE STAKED SECURELY WITH STAKES PLACED ON MAXIMUM TWO (2) FT. CENTERS IN ROWS NOT MORE THAN TWO (2) FEET APART. STAKES IN ADJACENT ROWS SHALL BE STAGGERED. THE STAKES SHALL BE WOOD FROM 1/2" X 3/4" X 12" TO 1" X 24", AS REQUIRED TO HOLD THE SOD, AND SHALL BE DRIVEN FLUSH WITH THE TOP OF THE SOD.

EROSION CONTROL

ITEMS I-10, I-14, AND L-10 ARE PROVIDED IN THESE PLANS FOR EROSION CONTROL. ROCK OF A STABLE NATURE WILL NOT BE REMOVED IN ORDER TO PLACE ANY OF THESE ITEMS, EXCEPT AS SHOWN ON THE TYPICAL SECTIONS FOR ROCK CUT. THE ENGINEER SHALL CHECK AND NONPERFORM QUANTITIES OR ADJUST LOCATIONS AND QUANTITIES FOR THESE ITEMS, WHERE INDICATED BY FIELD CONDITIONS DURING CONSTRUCTION.

CHANNEL EXCAVATION

WHERE CHANNEL EXCAVATION IS CARRIED THROUGH A PROPOSED PIPE STRUCTURE SITE, ADDITIONAL EXCAVATION REQUIRED TO OBTAIN A STABLE FOUNDATION FOR THE STRUCTURE SHALL BE MEASURED AND PAID FOR AS ITEM E-2 STRUCTURE EXCAVATION.

PIPE FOR SUBGRADE DRAINAGE

10 LIN. FT. OF 6" HELICAL CORRUGATED METAL PIPE SEC. M.6.4 (h) IMPERFORATED SHALL BE FURNISHED AND PLACED BY THE CONTRACTOR, IN MANHOLES, CATCH BASINS AND INLETS FOR EACH SUBGRADE DRAIN, WHERE, AND AS DIRECTED BY THE ENGINEER. PAYMENT FOR EACH SHALL BE MADE AT THE PRICE BID PER LINEAL FOOT OF PIPE UNDERDRAIN OUTLETS, ITEM I-4.

GENERAL NOTES

FED. RD. DIVISION	STATE	PROJECT

12
151

WAYNE COUNTY
WAY-3-9.94

REMOVAL OF TREES AND STUMPS

ALL TREES AND STUMPS LYING WITHIN THE CONSTRUCTION LIMITS OF THIS PROJECT SHALL BE REMOVED UNDER THE LUMP SUM PRICE BID FOR ITEM E-9, REMOVAL OF TREES AND STUMPS, EXCEPT THAT THOSE TREES AND STUMPS FOR WHICH PROTECTION AND PRESERVATION WORK IS INDICATED ELSEWHERE IN THESE PLANS SHALL NOT BE REMOVED. THE FOLLOWING IS AN APPROXIMATE ESTIMATE OF THE NUMBER OF TREES AND STUMPS TO BE REMOVED.

SIZES	NO. TREES	NO. STUMPS
12" - 18"	140	10
18" - 24"	100	10
24" - 30"	70	8
30" - 36"	10	
36" - 42"	6	1
42" - 48"	1	10
OVER 48"		

THE ABOVE ESTIMATE IS APPROXIMATE AND THE STATE OF OHIO RESERVES THE RIGHT TO ORDER THE REMOVAL OF ADDITIONAL TREES OR STUMPS OUTSIDE OF THE LIMITS OF CONSTRUCTION BUT WITHIN THE RIGHT-OF-WAY AND/OR EASEMENT LINES. PAYMENT FOR THE REMOVAL OF THESE ADDITIONAL TREES OR STUMPS SHALL BE INCLUDED IN THE LUMP SUM PRICE BID FOR ITEM E-9, REMOVAL OF TREES AND STUMPS.

SCARIFICATION OF EXISTING FLEXIBLE PAVEMENT

WITHIN THE LIMITS OF CONSTRUCTION WHERE THE EXISTING FLEXIBLE PAVEMENT WILL HAVE LESS THAN 6 INCHES OF FILL PLACED UPON IT, THE PAVEMENT SHALL BE THOROUGHLY SCARIFIED FOR ITS FULL DEPTH, MIXED WITH SUFFICIENT SOIL AND PROPERLY RECOMPACTED TO INSURE THE ELIMINATION OF ANY PLANES OF SEPARATION BETWEEN IT AND THE EMBANKMENT PLACED THEREON. PAYMENT FOR SCARIFICATION AS DESCRIBED ABOVE SHALL BE INCLUDED IN THE UNIT PRICE BID FOR ITEM E-1, ROADWAY EXCAVATION.

NON-RIGID PAVEMENT REMOVAL OUTSIDE NORMAL CONSTRUCTION LIMITS

AFTER THE EXISTING PAVEMENT HAS BEEN REMOVED, THE OLD ROADWAY SHALL BE PLOWED, HARROWED, AND DRAGGED TO A SMOOTH GRADE, THE OLD DITCHES FILLED, AND THE ENTIRE AREA SLOPED TO DRAIN AND LEFT IN A NEAT CONDITION READY FOR SEEDING. PAYMENT FOR THIS WORK SHALL BE INCLUDED IN THE UNIT PRICE BID FOR EXCAVATION, ITEM E-1. SEEDING SHALL BE MEASURED AND PAID FOR IN ACCORDANCE WITH ITEM L-9.

DRILLED WELL ABANDONED

THE EXISTING CONCRETE OR STONE SLAB WELL COVER SHALL BE REMOVED AND DISPOSED OF. THE PUMP AND ALL OTHER SALVAGEABLE PARTS SHALL BECOME THE PROPERTY OF THE CONTRACTOR. THE CASING SHALL BE CUT OFF AT LEAST TWO FEET BELOW THE PROPOSED FINISHED GRADE OUTSIDE PROPOSED PAVEMENT AREAS OR AT LEAST TWO FEET BELOW THE PROPOSED SUBGRADE ELEVATION INSIDE PROPOSED PAVEMENT AREAS AND CAPPED WITH CLASS "E" CONCRETE OR A STANDARD THREADED PIPE CAP. THE UNIT PRICE BID FOR EACH "DRILLED WELL ABANDONED" SHALL INCLUDE PAYMENT FOR ALL LABOR, TOOLS, MATERIALS, AND INCIDENTALS NECESSARY TO COMPLETE THIS ITEM. AN ESTIMATED NUMBER IS LISTED BELOW.

ITEM SPECIAL, DRILLED WELLS ABANDONED 3 EACH

FILLING BASEMENTS OUTSIDE NORMAL WORK LIMITS

IN ADDITION TO THE GENERAL REMOVAL REQUIREMENTS OF SEC. E-1.03(C), ALL BASEMENTS OR PORTIONS THEREOF WITHIN THE RIGHT-OF-WAY ON THIS PROJECT BUT BEYOND THE NORMAL SLOPE LINES SHALL BE FILLED TO SURROUNDING GROUND ELEVATION AS DIRECTED BY THE ENGINEER. PRIOR TO FILLING WITHIN THIS AREA, THE BASEMENT FLOORS AND WALLS SHALL BE BROKEN UP OR REMOVED AS PROVIDED UNDER SEC. E-1.03 (C) (AND ALL HOUSE DRAINS NOT REMOVED SHALL BE PLUGGED AS PROVIDED ELSEWHERE IN THESE NOTES). WHERE BASEMENTS EXTEND BEYOND THE RIGHT-OF-WAY LINE, BUT ARE WITHIN SLOPE EASEMENT OR WORK AGREEMENT LINES, THEY SHALL BE FILLED TO THE ELEVATION OF THE SURROUNDING GROUND AS DIRECTED BY THE ENGINEER, BUT THE REQUIREMENTS OF SEC. E-1.03 (C) FOR REMOVALS BELOW THE PROPOSED FINISHED SURFACE SHALL BE WAIVED FOR THE PORTIONS EXTENDING BEYOND THE RIGHT-OF-WAY LINE. PAYMENT FOR ALL OF THE ABOVE, EXCEPT PLUGGING, SHALL BE INCLUDED IN THE UNIT PRICE BID FOR E-1 ROADWAY EXCAVATION.

DRAINAGE OF BASE MATERIAL

WHERE THE BASE MATERIAL IS DRAINED BY I-9 STONE UNDERDRAINS OR BY EXTENSIONS OF THE SUBBASE THROUGH THE SHOULDERS TO THE FILL SLOPE OR THE DITCH LINE, THE CONTRACTOR SHALL FINISH, SEED, AND MULCH THE SLOPES SO AS NOT TO IMPEDE DRAINAGE OF THE BASE MATERIAL. THE ACTUAL AREA OF THE OUTCROP OF THE SUBBASE MATERIAL OR THE I-9 UNDERDRAINS SHALL NOT BE SEEDDED.

ITEM I-9 STONE UNDERDRAINS, NO. 2

STONE UNDERDRAINS SHALL BE PLACED AT 100 FOOT INTERVALS ON EACH SIDE OF NORMAL CROWNED SECTIONS AND AT 50 FOOT INTERVALS ON THE LOW SIDE ONLY OF SUPERELEVATED SECTIONS.

PART WIDTH CONSTRUCTION

BECAUSE OF THE NECESSITY OF BUILDING A PORTION OF THIS PROJECT AND CERTAIN CROSS ROADS UNDER TRAFFIC AND CONSTRUCTING THE PAVEMENT PART AT A TIME, EXTREME CARE SHALL BE TAKEN TO PREVENT THE CONSTRUCTION OF A BUTT JOINT ON CENTERLINE IN THE BASE AND SUBBASE COURSES. THIS SHALL BE ACCOMPLISHED BY BUILDING THE BASE AND SUBBASE COURSES PLACED WITH THE FIRST PORTION OF THE PAVEMENT BUILT, AT LEAST 18 INCHES BEYOND THE CENTERLINE AND BY SURFACING NO CLOSER THAN 18 INCHES TO THE EDGE OF THE ABOVE COURSES. WHEN THE SECOND PORTION OF THE PAVEMENT IS BUILT, AT LEAST 12 INCHES OF THESE PROJECTING COURSES SHALL BE BROKEN DOWN AND THOROUGHLY KEVED IN WITH THE NEWLY PLACED CORRESPONDING COURSES IN THE SECOND PORTION OF THE PAVEMENT. PAYMENT FOR THIS OPERATION SHALL BE INCLUDED IN THE UNIT PRICES BID FOR THE PERTINENT PAVEMENT ITEMS.

I-22 UNDER APPROACH SLABS

THE AREA BETWEEN THE BOTTOM SURFACE OF THE SUBGRADE AND THE BOTTOM OF THE APPROACH SLAB SHALL BE BACKFILLED WITH ITEM I-22 SUBBASE.

SEEDING AND PROTECTION

QUANTITIES FOR SEEDING ITEM L-9 ARE CALCULATED FOR THE SOIL AREAS BETWEEN THE LINES 10 FEET OUTSIDE THE WORK LIMITS AS SHOWN ON THE CROSS-SECTIONS, OR THE RIGHT OF WAY LINE IF SUCH LINE IS LESS THAN 10 FEET FROM THE WORK LIMITS. ALL AREAS OUTSIDE THESE LIMITS WHERE THE VEGETATIVE GROWTH HAS BEEN INJURIOUSLY DISTURBED OR DESTROYED BY THE CONTRACTOR SHALL BE RE-STORED AND SEEDDED IN ACCORDANCE WITH THE PROVISIONS OF SEC. G-7.09 BY THE CONTRACTOR AT HIS OWN EXPENSE. SEED SHALL BE SOWN AT THE RATE OF 5 POUNDS PER 1,000 SQUARE FEET EXCEPT AS OTHERWISE NOTED IN THE PLANS. SEEDING FORMULA FOR ALL SEEDDED AREAS SHALL BE IN ACCORDANCE WITH THE FOLLOWING:

- 70 % KENTUCKY 31 EESCUE (FESTUEA ELATIOR, VAR. KY. 31)
- 25 % KENTUCKY BLUEGRASS (POA PRATENSIS)
- 5 % ALSIKE CLOVER (TRIFOLIUM HYBRIDUM)

L-9 COMMERCIAL FERTILIZER

ALL AREAS TO BE SEEDDED UNDER ITEM L-9 OR SODDED UNDER L-10 SHALL HAVE COMMERCIAL FERTILIZER I-12-12, APPLIED AT THE RATE OF 20 POUNDS PER 1,000 SQUARE FEET.

CONSTRUCTION LAYOUT STAKES

SEE NOTE IN PROPOSAL DESCRIBING THE WORK INCLUDED IN THIS LUMP SUM PAY ITEM.

ROCK SUBGRADE

THE CONTRACTOR SHALL BE PAID FOR THE THICKNESS OF I-22 MATERIAL SHOWN ON THE TYPICAL SECTIONS IN ROCK EXCAVATION AREAS. ANY POCKETS IN THE ROCK BELOW THE PLAN SUBGRADE ELEVATION SHALL DRAIN EITHER LONGITUDINALLY OR LATERALLY AND ALL IRREGULARITIES IN THE ROCK BELOW THIS ELEVATION SHALL BE FILLED WITH I-22 MATERIAL AT NO ADDITIONAL COST TO THE STATE.

MAINTENANCE OF TRAFFIC

S. R. 226 TRAFFIC SHALL BE MAINTAINED AT ALL TIMES. DURING CONSTRUCTION OF THE INTERSECTION OF S. R. 226 AND S. R. 3, A TEMPORARY RUN-AROUND SHALL BE PROVIDED AS SHOWN ON THE PLANS.

S. R. 95 TRAFFIC SHALL BE MAINTAINED AT ALL TIMES EXCEPT DURING ACTUAL GRADING OPERATIONS. THIS SHALL BE LIMITED TO A MAXIMUM OF SEVEN DAYS. TRAFFIC WILL BE REROUTED OVER S. R. 89 AND S. R. 30. ONE WAY TRAFFIC WILL BE PERMITTED DURING PAVING OPERATIONS. SEE DETOUR MAP ON SH'T 2.

TRAFFIC SHALL BE MAINTAINED ON S. R. 3 BY THE FOLLOWING METHOD:

WORK SHALL NOT BE STARTED ON EXISTING S. R. 3 UNTIL AT LEAST THE SOUTH BOUND LANE OF WAY 3-9.94 IS COMPLETED FROM STATION 529 + 50 TO S. R. 95, AND S. R. 95 WORK IS COMPLETED.

THE PAVEMENT OF THE SOUTH BOUND LANE SHALL BE WIDENED TO 20' BY PAVEMENT FOR CLASS "A" TEMPORARY RUN-AROUND ON THE NORTHWEST SIDE.

THE TEMPORARY RUN-AROUND ON THE SOUTHEAST SIDE OF EXISTING ROUTE 3 FROM STATION 522+25 TO 531+00 SHALL BE CONSTRUCTED.

THE INTERSECTION SHALL BE CONSTRUCTED FROM 525+00 TO 529+50, AND TRAFFIC ROUTED OVER THE SOUTH BOUND LANE TO S. R. 95, ON S. R. 95 TO ITS INTERSECTION WITH S. R. 3.

THE TEMPORARY RUN-AROUND FROM 522+25 TO 531+00 SHALL BE REMOVED.

THE USE OF THE TEMPORARY RUN-AROUND ABOVE, SHALL BE LIMITED TO A MAXIMUM OF 30 DAYS.

COUNTY ROAD 139 TRAFFIC SHALL BE MAINTAINED AT ALL TIMES EXCEPT DURING ACTUAL GRADING OPERATIONS. THIS SHALL BE LIMITED TO A MAXIMUM OF ONE MONTH. ONE WAY TRAFFIC WILL BE PERMITTED DURING PAVING OPERATIONS.

COUNTY ROAD 174 MAY BE CLOSED TO TRAFFIC DURING THE CONSTRUCTION OF THIS PROJECT.

I-22 SUBBASE GRADING "A" OR "B" AS PER PLAN
The material furnished for this item shall meet the requirements of grading A or B of section I-22.02 except that for either grading not more than 10% of the material shall pass a number 200 sieve.

LIGHTS, SIGNS, AND BARRICADES

THE CONTRACTOR SHALL, IN ADDITION TO THE GENERAL REQUIREMENTS OF SEC. G-7.07 ON THIS PROJECT, PERFORM THE FOLLOWING:

- (a) PROVIDE, ERECT, AND MAINTAIN MOVEABLE GATES ON INTERSECTING ROADS CLOSED TO TRAFFIC AT ALL POINTS, WHERE LOCAL TRAFFIC MOVEMENT TERMINATES.
- (b) PROVIDE, ERECT, AND MAINTAIN LIGHTS, SIGNS, AND BARRICADES AT THE WORK LIMITS ON ALL INTERSECTING ROADS WHICH REMAIN OPEN TO TRAFFIC.
- (c) PROVIDE, ERECT, AND MAINTAIN STANDARD 40" X 24" SIZE "ROAD CLOSED" SIGNS, SIGN SUPPORTS, AND LIGHTS AT THE FOLLOWING LOCATIONS DURING PERIODS IN WHICH THE AFFECTED ROADS ARE CLOSED TO TRAFFIC.
 1. S. R. 95 AT ITS INTERSECTION WITH S. R. 89 AND AT ITS INTERSECTION WITH EXISTING S. R. 3
 2. COUNTY ROAD 139 AT ITS INTERSECTION WITH COUNTY ROAD 174 1600' EAST OF RELOCATED S. R. 3 AND AT ITS INTERSECTION WITH TOWNSHIP ROAD 166.
 3. COUNTY ROAD 174 AT THE INTERSECTION OF COUNTY ROAD 139.

LIGHTS, BARRICADES, AND DANGER AND WARNING SIGNS SHALL BE PROVIDED AT LOCATIONS SHOWN ABOVE IN ACCORDANCE WITH SEC. G-7.07. BARRICADES AND GATES SHALL BE AS DETAILED ON STANDARD CONSTRUCTION DRAWING NO. G-7.07. SIGN SUPPORTS AND LIGHTS FOR "ROAD CLOSED" SIGNS SHALL BE AS DETAILED IN THE "OHIO MANUAL OF UNIFORM TRAFFIC CONTROL DEVICES".

PAYMENT FOR PROVIDING, ERECTING, MAINTAINING, AND REMOVING BARRICADES, GATES, LIGHTS, SIGNS, AND SIGN SUPPORTS SHALL BE INCLUDED IN THE LUMP SUM PRICE BID FOR "MAINTAINING TRAFFIC."

PAYMENT FOR TEMPORARY ROADWAYS

PAYMENT FOR CONSTRUCTION, MAINTENANCE, AND SUBSEQUENT REMOVAL, WHEREVER REQUIRED, OF TEMPORARY ROADWAYS NOT SEPARATELY ITEMIZED UNDER ITEM S-15, EXCEPT FOR FURNISHING AND PLACING OF ITEMS M-10 AND T-10, SHALL BE INCLUDED IN THE LUMP SUM PRICE BID FOR "MAINTAINING TRAFFIC."

TEMPORARY CULVERTS

PAYMENT FOR CONSTRUCTION, MAINTENANCE, AND SUBSEQUENT REMOVAL OF TEMPORARY CULVERTS AND SEWER EXTENSIONS REQUIRED FOR CONSTRUCTION OF ITEM S-15 RUN-AROUNDS SHALL BE INCLUDED IN THE LUMP SUM PRICE BID FOR RUN-AROUNDS, ITEM S-15.

ITEMS E-4, BORROW USING GRANULAR MATERIAL

MATERIAL FURNISHED FOR THESE ITEMS SHALL BE AS DEFINED IN SEC. E-1.02, EXCEPT THAT AT LEAST 75 PERCENT BY WEIGHT OF THE GRAINS OR PARTICLES SHALL BE RETAINED ON A NO. 200 SIEVE. THE MATERIAL SHALL BE PLACED BY THE END DUMPING METHOD. IN AREAS OTHER THAN WHERE UNSUITABLE MATERIAL IS TO BE EXCAVATED, NORMAL CLEARING AND GRUBBING SHALL BE PERFORMED, BUT THE REQUIREMENT OF SEC. E-1.04 FOR SCALPING AND COMPACTION SHALL BE WAIVED.

IN THE BOG AREA WHERE UNSUITABLE MATERIAL IS TO BE REMOVED, THE EXCAVATION OF THE UNSUITABLE MATERIAL AHEAD OF THE FILL AND THE END DUMPING OF GRANULAR MATERIAL ACROSS THE BOG AREA SHALL BE ADVANCED IN A MANNER WHICH WILL PRECLUDE ENTRAPMENT OF UNSUITABLE MATERIAL BENEATH ANY PORTION OF THE FILL. EXCAVATION OF UNSUITABLE MATERIAL SHALL BE INCLUDED IN THE COST OF THE GRANULAR MATERIAL REQUIRED TO BACKFILL THE EXCAVATED AREA.

- TWO ITEMS OF E-4, BORROW USING GRANULAR MATERIAL ARE REQUIRED AS FOLLOWS:
1. THE AMOUNT OF GRANULAR MATERIAL USED ABOVE THE ORIGINAL GROUND LINE, AS SHOWN ON THE PLAN CROSS SECTIONS AT THE BOG AREA, PLUS THE AMOUNT USED AT OTHER LOCATIONS ON THE PROJECT WHERE EARTHWORK IS PAID FOR AS ITEM E-1 SHALL BE MEASURED BY THE AVERAGE END AREA METHOD PLUS 5 PERCENT FOR COMPACTION, USING PROJECT CROSS SECTIONS, AND PAID FOR PER CU.YD. AS ITEM E-4, BORROW USING GRANULAR MATERIAL, AS PER PLAN.
 2. THE AMOUNT OF GRANULAR MATERIAL USED TO BACKFILL THE SPACE OCCUPIED BY THE REMOVED UNSUITABLE MATERIAL WILL BE THE AMOUNT REQUIRED TO BACKFILL TO THE ORIGINAL GROUND LINE, AS SHOWN ON SHEET 22, AND SHALL BE MEASURED IN ACCORDANCE WITH SEC. E-4.04 AS THE TOTAL QUANTITY OF E-4, BORROW USING GRANULAR MATERIAL MINUS THE QUANTITY ESTABLISHED FOR THE ITEM OF GRANULAR MATERIAL PLACED ON THE ORIGINAL GROUND AND PAID FOR PER CU.YD. AS ITEM E-4, BORROW USING GRANULAR MATERIAL, AS PER PLAN, INCLUDING EXCAVATION OF UNSUITABLE MATERIAL.

EMBANKMENT, STA. 618+61 TO STA. 632+00

BETWEEN THE ABOVE STATION LIMITS, THE FILL SHALL BE COMPLETED TO SUBGRADE ELEVATION AND BE PERMITTED TO STAND FOR A PERIOD OF SIX (6) MONTHS PRIOR TO BEGINNING WORK ON THE PAVEMENT. WOODEN HUBS APPROXIMATELY 1 1/2" X 1 1/2" X 4' SHALL BE FURNISHED AND PLACED BY THE CONTRACTOR AT 50 FT. INTERVALS IN A ROW 15 FT. RIGHT OF C, DRIVEN FLUSH WITH SURFACE OF EMBANKMENT, AND PROTECTED BY SUITABLE GUARD STAKES, TO PERMIT OBSERVATION OF THE SETTLEMENT DURING THIS WAITING PERIOD. PAYMENT FOR FURNISHING AND PLACING THE HUBS AS DESCRIBED ABOVE SHALL BE INCLUDED IN THE PRICE BID FOR ITEM E-1, ROADWAY EXCAVATION. READINGS ON HUBS WILL BE MADE BY STATE FORCES AT LEAST ONCE EVERY SEVEN DAYS.

GENERAL SUMMARY

WAYNE COUNTY
WAY-3-9.94

TYPE CODE 6201

Item	Quantities	Unit	Description	Sheet	Table	Line
ROADWAY						
E-1	332,817	CU. YDS.	ROADWAY EXCAVATION METHOD "B" AS PER PLAN	17		
E-4	9326	CU. YDS.	BORROW	17		
E-1	84,556	SQ. YDS.	COMPACTED SUBGRADE	15		
E-4	19,878	CU. YDS.	BORROW USING GRANULAR MATERIAL AS PER PLAN	17		
E-8	2,666	SQ. YDS.	REMOVAL AND DISPOSAL OF EXISTING PAVEMENT	17		
E-9	LUMP	LUMP	REMOVAL OF TREES AND STUMPS	17		
E-4	29,453	CU. YDS.	BORROW USING GRANULAR MATERIAL AS PER PLAN INCLUDING EXCAVATION OF UNSUITABLE MATERIAL	17		
E-11	1,525	M GALS.	WATER	16		
I-8	26	EACH	CENTERLINE REFERENCE MONUMENTS, AS PER PLAN	143		
I-8	14	EACH	MONUMENT ASSEMBLIES	143		
I-15	4625	LIN. FT.	GUARD RAIL, STEEL BEAM STANDARD TYPE (DEEP)	17		
I-15	* 875	LIN. FT.	GUARD RAIL, STEEL BEAM BARRIER TYPE (DEEP)	17		
I-15	528	LIN. FT.	GUARD RAIL, FLEXIBLE STEEL PLATE TENSION TYPE (STANDARD STRENGTH) OR STEEL BEAM TYPE (SHALLOW)	17		
L-1	6614	CU. YDS.	TOPSOIL STOCKPILED	16		
L-3	16,535	SQ. YDS.	PLACING STOCKPILED TOPSOIL	16		
L-9	179,088	SQ. YDS.	SEEDING AND PROTECTING AS PER PLAN	17		
L-9	1869	TONS.	COMMERCIAL FERTILIZER (12-12-12)	16		
L-10	11,806	SQ. YDS.	SODDING AS PER PLAN	17		
L-10	200	SQ. YDS.	SODDING FOR SPECIAL BERM AND SLOPE PROTECTION	17		
T-10	150	CU. YDS.	TRAFFIC COMPACTED SURFACE COURSE FOR MAINTAINING TRAFFIC	11		
SS-18	* 16859	LIN. FT.	FENCE TYPE "A" AS PER PLAN	17		
S-15	LUMP	LUMP	TEMPORARY RUN-AROUND ROAD USING CLASS "A" PAVEMENT			
SPECIAL	583	SQ. YD.	MIXING CALCIUM CHLORIDE AND CRUSHED AGGREGATE	15		
SPECIAL	3	EACH	DRILLED WELLS ABANDONED	12		
S-24	LUMP	LUMP	REMOVAL OF EXISTING STRUCTURES (PARCEL NO. 231A 1 STORY FRAME RESIDENCE AND FRAME GARAGE)			
S-24	LUMP	LUMP	REMOVAL OF EXISTING STRUCTURES (PARCEL NO. 241A 1 STORY FRAME RESIDENCE AND FRAME GARAGE)			
S-24	LUMP	LUMP	REMOVAL OF EXISTING STRUCTURES (PARCEL NO. 431A 2 STORY FRAME RESIDENCE, 1 FRAME BARN AND 6 FRAME SHEDS)			
DRAINAGE						
E-2	378	CU. YDS.	EXCAVATION FOR STRUCTURES	17		
E-3	394	CU. YDS.	CHANNEL EXCAVATION	18		
E-12	1,275	LIN. FT.	PIPE REMOVED 15" AND UNDER	18		
I-1	332	LIN. FT.	12" PIPE FOR DRIVEWAYS SEC. M-6.4 (a)	17		
I-1	118	LIN. FT.	15" PIPE FOR DRIVEWAYS SEC. M-6.4 (a)	17		
I-2	40	LIN. FT.	12" STORM SEWER SEC. M-6.4 (c)	17		
I-2	91	LIN. FT.	15" STORM SEWER SEC. M-6.4 (c)	17		
I-2	79	LIN. FT.	30" STORM SEWER UNDER PAVEMENT OR APPROACHES SEC. M-6.4 (c)	17		
I-2	82	LIN. FT.	18" CLASS A STORM SEWER UNDER PAVEMENT OR APPROACHES	17		
I-2	610	LIN. FT.	8" CLASS B STORM SEWER UNDER PAVEMENT OR APPROACHES	17		
I-2	1069	LIN. FT.	12" CLASS B STORM SEWER UNDER PAVEMENT OR APPROACHES	17		
I-2	430	LIN. FT.	15" CLASS B STORM SEWER UNDER PAVEMENT OR APPROACHES	17		
I-2	466	LIN. FT.	18" CLASS B STORM SEWER UNDER PAVEMENT OR APPROACHES	17		
I-2	100	LIN. FT.	8" CLASS B STORM SEWER	17		
I-2	300	LIN. FT.	12" STORM SEWER SEC. M-6.5 (b) OR M-6.8 (b)	17		

Item	Quantities	Unit	Description	Sheet	Table	Line
I-2	337	LIN. FT.	21" STORM SEWER UNDER PAVEMENT OR APPROACHES SEC. M-6.6 (b) OR SEC. M-6.8 (b)	17		
I-2	254	LIN. FT.	24" STORM SEWER UNDER PAVEMENT OR APPROACHES SEC. M-6.6 (b) OR SEC. M-6.8 (b)	17		
I-2	44	LIN. FT.	18" STORM SEWER SEC. M-6.5 (a) OR SEC. M-6.8 (a)	17		
I-2	96	LIN. FT.	21" STORM SEWER SEC. M-6.5 (a) OR SEC. M-6.8 (a)	17		
I-2	290	LIN. FT.	30" STORM SEWER SEC. M-6.4 (c)	17		
I-2	10	LIN. FT.	8" OUTLET FOR STORM SEWER SEC. M-6.4 (c)	17		
I-3	300	LIN. FT.	8" ROADWAY DRAINAGE	18		
I-3	1,236	LIN. FT.	12" ROADWAY DRAINAGE	18		
I-3	278	LIN. FT.	15" ROADWAY DRAINAGE	18		
I-3	197	LIN. FT.	21" ROADWAY DRAINAGE	18		
I-3	250	LIN. FT.	12" ROADWAY DRAINAGE UNDER PAVEMENT OR APPROACHES	18		
I-3	46	LIN. FT.	21" ROADWAY DRAINAGE UNDER PAVEMENT OR APPROACHES	18		
I-3	30	LIN. FT.	6" ROADWAY DRAINAGE EXTRA QUALITY DRAIN TILE SEC. M-6.7 (b)	18		
I-3	100	LIN. FT.	8" OUTLETS FOR ROADWAY DRAINAGE SEC. M-6.4 (c)	18		
I-3	110	LIN. FT.	12" OUTLETS FOR ROADWAY DRAINAGE SEC. M-6.4 (c)	18		
I-3	10	LIN. FT.	21" OUTLETS FOR ROADWAY DRAINAGE SEC. M-6.4 (c)	18		
I-4	24,321	LIN. FT.	6" UNDERDRAINS	18		
I-4	6,340	LIN. FT.	6" UNDERDRAINS HELICAL CORRUGATED METAL PIPE SEC. M-6.4 (h)	18		
I-4	360	LIN. FT.	6" PIPE OUTLETS FOR UNDERDRAINS HELICAL CORRUGATED METAL PIPE SEC. M-6.4 (h) WITHOUT PERFORATIONS	18		
I-5	43	EACH	6" PIPE SPECIALS FOR UNDERDRAINS	18		
I-5	2	EACH	8" PIPE SPECIALS FOR UNDERDRAINS	18		
I-5	5	EACH	8" PIPE SPECIALS FOR ROADWAY DRAINAGE	18		
I-5	11	EACH	12" PIPE SPECIALS FOR ROADWAY DRAINAGE	18		
I-5	2	EACH	15" PIPE SPECIALS FOR ROADWAY DRAINAGE	18		
I-5	1	EACH	21" PIPE SPECIALS FOR ROADWAY DRAINAGE	18		
I-5	12	EACH	8" PIPE SPECIALS FOR STORM SEWERS	18		
I-5	11	EACH	12" PIPE SPECIALS FOR STORM SEWERS	18		
I-5	4	EACH	15" PIPE SPECIALS FOR STORM SEWERS SEC. M-6.4 (c)	18		
I-8	1	EACH	STANDARD NO. 1 MANHOLE	18		
I-8	2	EACH	STANDARD NO. 6 CATCH BASINS	18		
I-8	13	EACH	STANDARD NO. 7 CATCH BASINS	18		
I-8	22	EACH	STANDARD NO. 2-2-A CATCH BASINS	18		
I-8	8	EACH	STANDARD NO. 2-2-B CATCH BASINS	18		
I-8	5	EACH	STANDARD NO. 2-3 CATCH BASINS MODIFIED, AS PER PLAN	18		
I-9	1083	LIN. FT.	STONE UNDERDRAINS NO. 2	17		
I-10	737	CU. YDS.	DUMPED ROCK CHANNEL PROTECTION	18		
I-14	264	LIN. FT.	STANDARD TYPE 1 PAVED GUTTER AS PER PLAN	18		
I-14	2,220	LIN. FT.	STANDARD TYPE 1 PAVED GUTTER MODIFIED, AS PER PLAN	18		
I-14	280	LIN. FT.	SPECIAL TYPE 1 PAVED GUTTER AS PER PLAN	18		
S-1	26.9	CU. YDS.	CONCRETE FOR STRUCTURES CLASS E	18		
S-24	LUMP	LUMP	REMOVAL OF EXISTING STRUCTURES	18		
S-27	108	LIN. FT.	21" PIPE FOR ROADWAY CULVERTS SEC. M-6.6 (b) OR M-6.8 (b)	18		
S-27	228	LIN. FT.	30" PIPE FOR ROADWAY CULVERTS SEC. M-6.6 (c)	18		
S-28	140	LIN. FT.	15'-6" X 9'-5" SECTIONAL CORRUGATED METAL STRUCTURES M-6.4 (g) GAGE 5-3	18		

* No Federal Participation. # Federal participation limited to 1,300 Lin.Ft. (See sheet 2)

GENERAL SUMMARY

FED. RD. DIVISION	STATE	PROJECT
2	OHIO	

14
151

WAYNE COUNTY
WAY-3-9.94

TYPE CODE 6201

Item	Quantities	Unit	Description	Sheet	Table	Line	Item	Quantities	Unit	Description	Sheet	Table	Line
PAVEMENT													
B-19	1965	CU.YD.	AGGREGATE BASE COURSE	17									
B-20	68,634	SQ.YD.	8" WATER BOUND MACADAM BASE COURSE USING NO. 2 COARSE AGGREGATE	15									
B-33	31,374	SQ.YD.	3" BITUMINOUS MACADAM BASE COURSE	15									
B-35	2,204	CU.YD.	ASPHALTIC CONCRETE LEVELING COURSE (70 - 85)	15									
B-35	4,967	CU.YD.	ASPHALTIC CONCRETE BASE COURSE (70 - 85)	15									
T-30	27,887	GAL.	BITUMINOUS PRIME COAT SEC. M-5.7, RT-2, OR RT-3	15									
T-31	15,687	GAL.	BITUMINOUS SURFACE TREATMENT - BITUMINOUS MATERIAL AS PER PLAN	15									
T-31	251	CU.YD.	BITUMINOUS SURFACE TREATMENT - NO. 46 AGGREGATE.	15									
T-31	251	CU.YD.	BITUMINOUS SURFACE TREATMENT - NO. 6 AGGREGATE.	15									
T-35	2175	CU.YD.	ASPHALTIC CONCRETE SURFACE COURSE TYPE C (70 - 85)	15									
T-35	357	CU.YD.	ASPHALTIC CONCRETE SURFACE COURSE TYPE A (85 - 100)	17									
I-7	352	SQ.YD.	REINFORCED CONCRETE APPROACH SLABS (t = 13")	17									
I-12	1,613	LIN.FT.	CONCRETE CURB - STANDARD TYPE G	17									
I-18	3,890	CU.YD.	STABILIZED CRUSHED AGGREGATE SHOULDERS AND APPROACHES	15									
M-10	3.62	TONS	FURNISHING AND APPLYING CALCIUM CHLORIDE	16									
I-21	45	SQ.YD.	4" PORTLAND CEMENT CONCRETE MEDIAN PAVEMENT STD. TYPE I	17									
I-22	15,956	CU.YD.	SUBBASE-GRADING A OR B AS PER PLAN.	15									
I-23	11	EACH	STD. PRECAST WHITE PORTLAND CEMENT CONCRETE TRAFFIC DIVIDERS	17									
	Lump	LUMP	CONSTRUCTION LAYOUT STAKES	12									
STRUCTURES OVER 20' SPAN													
STRUCTURE NO. WAY-3-1166 L & R QUANTITIES LISTED ON SHEET NO. 142													

CALCULATIONS

WAYNE COUNTY
WAY-3-9.94

Line No.	Description	Quantities	Unit	Line No.	Description	Quantities	Unit
1				72			
2				73			
3	T-35 Asphaltic Concrete Surface Course Type "C" (70-85)			74			
4	2 Lane Pavement Sta. 543+50.00 "S.B." to Sta. 551+53.76 "S.B." 803.76 Lin. Ft. on E Pav't.			75	T-31 Bituminous Surface Treatment - Bituminous Material		
5	2 Lane Pavement Sta. 542+54.61 to Sta. 549+93.86 = 739.25 Lin. Ft. on E Survey			76	"SB" Lane Sta. 543+50 to 551+53.76 = 803.76' Length 10' Paved Shldr = 803.76 x 45.66 = 4583.66 = 800.78'		
6	Length on E "N.B." Pav't = 739.25 x (4583.66 + 32) ÷ 4583.66 = 744.41 Lin. Ft.			77	"SB" Lane Sta. 543+50 to 551+53.76 = 803.76' Length 4' Paved Shldr = 803.76 x 45.97 = 66 = 4583.66 = 806.21'		
7	"N.B." Sta. 549+93.86 to Sta. 551+70.21 = 176.35 Lin. Ft.			78	"NB" Lane Sta. 542+54.61 to 549+93.86 = 739.25' Length 4' Paved Shldr = 739.25 x 46.01 = 66 = 4583.66 = 742.15'		
8	Sum of Lines 4, 6, & 7 = 1724.52 Lin. Ft. Area = 1724.52 x 24 ÷ 9 = 4598.72 Sq. Yds.			79	"NB" Lane Sta. 542+54.61 to 549+93.86 = 739.25' Length 10' Paved Shldr = 739.25 x 46.32 = 66 ÷ 4583.66 = 747.15'		
9	4 Lane Pavement Sta. 551+70.21 to Sta. 631+85.43 = 8015.22 Lin. Ft.			80	"NB" Lane Sta. 549+93.86 to 551+70.21 = 176.35' Length 4' Paved Shldr = 176.35'		
10	Deduct for Structure No 1166 Approach Slabs 306.93 Lin. Ft.			81	"NB" Lane Sta. 549+93.86 to 551+70.21 = 176.35' Length 10' Paved Shldr = 176.35'		
11	Line 9 minus Line 10 = 7708.29 Lin. Ft. Area = 7708.29 x 48 ÷ 9 = 41,110.88 Sq. Yd.			82	Sta. 551+70.21 to 627+75 E Way-3 = 7604.79 Length 4' Paved Shldr = 2 x 7604.79 = 15,209.58'		
12	Line 8 plus Line 11 Area = 45,709.60 Sq. Yds. Volume = 45,709.60 x 12.5 ÷ 36 = 1,587.14 Cu. Yd.			83	Sta. 551+70.21 to 631+85.43 E Way-3 = 8015.22' Length 10' Paved Shldr = 2 x 8,015.22 = 16,030.44'		
13	Additional Area for 2' Median Pav't Sta. 627+75 to 631+85.43 = (2 x 2 x 410.43 + 2 x 50) - 9 = 193.52 Sq. Yd.			84	Gross Length of 10' Paved Shldr = Sum of Lines 76, 78, 81 and 83 = 17,754.72 Lin. Ft.		
14	Volume for Median Pav't. = 193.52 x 1.25 ÷ 36 = 6.72 Cu. Yds.			85	Deduct 1063.86 Lin. Ft. of 10' Paved Shldr for Side Road Intersections, Str. 1166 and Approach Slabs		
15	Additional from Sheet 17 = 580.62 Cu. Yd.			86	Line 84 minus Line 85 = 16,690.86 Lin. Ft. Area = 16,690.86 x 10 ÷ 9 = 18,545.40 Sq. Yd.		
16	Sum of Lines 12, 14 and 15 = 2,174.48 Cu. Yd. use 2,175 Cu. Yd.			87	Gross Length of 4' Paved Shldr = Sum of Lines 77, 78, 80 and 82 = 16,934.29 Lin. Ft.		
17				88	Deduct 1309.86 Lin. Ft. of 4' Paved Shldr for Side Road Intersections, Bdg. 1166 Approach Slabs		
18				89	Line 87 minus Line 88 = 15,624.43' Area = 15,624.43 x 4 ÷ 9 = 6,944.19 Sq. Yds.		
19				90	Deduct for tapers into Approach Slabs A = 4 x 1/2 x 6 x 120 ÷ 9 = 160.00 Sq. Yds.		
20	B-35 Asphaltic Concrete Leveling Course (70-85)			91	Line 86 plus Line 89 minus Line 90 = 25,329.59 Sq. Yd. x 0.25 gal per Sq. Yd. x 2 applications = 12,664.80 Gal.		
21	Line 12 plus Line 14 = 1,593.86 Cu. Yd.			92	Additional from Sheet 17 = 3,022.22 Gals		
22	Additional from Sheet 17 = 609.72 Cu. Yd.			93	Sum of Lines 91 and 92 = 15,687.02 use 15,687 Gals.		
23	Sum of Line 21 and 22 = 2,203.58 Cu. Yd. use 2,204 Cu. Yd.			94			
24				95			
25				96			
26	B-35 3" Asphaltic Concrete Base Course (70-85)			97	T-31 Bituminous Surface Treatment - Aggregate		
27	From Line 12 Surface Area = 45,709.60 Sq. Yd. Area B-35 = 45,709.60 x (24.5 ÷ 24) = 46,661.88 Sq. Yd.			98	From Line 91 Area = 25,329.59 Sq. Yd. x 0.008 Cu. Yd. per Sq. Yd. = 202.64 Cu. Yd. No. 46 Aggregate		
28	Volume B-35 = 46,661.88 x 3 ÷ 36 = 3,888.49 Cu. Yd.			99	Additional from Sheet 17 = 48.34 Cu. Yd. No. 46 Aggregate		
29	Additional Area for Median Pav't Sta. 627+75 to 631+85.43 = (2 x 1.25 x 410.43 + 2 x 50) ÷ 9 = 170.72 Sq. Yd.			100	Sum of Lines 98 and 99 = 250.98 Cu. Yd. No. 46 Aggregate 251 Cu. Yd.		
30	Volume of Median Pav't = 170.72 x 3 ÷ 36 = 14.23 Cu. Yd.			101	From Line 91 Area = 25,329.59 Sq. Yd. x 0.008 Cu. Yd. per Sq. Yd. = 202.64 Cu. Yd. No. 46 Aggregate		
31	Additional from Sheet 17 = 1,063.84 Cu. Yd.			102	Additional from Sheet 17 = 48.34 Cu. Yd. No. 6 Aggregate		
32	Sum of Lines 28, 30 and 31 = 4,966.56 Cu. Yd. use 4,967 Cu. Yd.			103	Sum of Lines 101 and 102 = 250.98 Cu. Yd. No. 6 Aggregate 251. Cu. Yd.		
33				104			
34				105			
35	T-30 Bituminous Prime Coat			106			
36	Sum of Lines 27 and 29 B-35 Area = 46,832.60 Sq. Yd. Gals. Req'd = 46,832.60 x 0.4 = 18,733.04 Gals			107	B-33 Bituminous Macadam Base Course		
37	Additional from Sheet 17 = 9,153.47 Gal.			108	From Line 91 Area = 25,329.59 Sq. Yd.		
38	Sum of Lines 36 & 37 = 27,886.51 Gal. use 27,887 Gal.			109	Additional from Sheet 17 = 6,044.37 Sq. Yd.		
39				110	Sum of Lines 108 and 109 = 31,373.96 Sq. Yd. use 31,374 Sq. Yd.		
40				111			
41				112			
42	B-20 8" Waterbound Macadam Base Course			113	I-18 Stabilized Crushed Aggregate Shoulders		
43	From Line 12 T-35 Area = 45,709.60 Sq. Yd. B-20 Area = 45,709.60 x (25.5 ÷ 24) = 48,566.45 Sq. Yd.			114	5" Depth		
44	23,445.19 Lin. Ft. of I-4's Require B-20 to be extended 2' Area = 23,445.19 x 2 ÷ 9 = 5,210.04 Sq. Yd.			115	Material Req'd for Shoulders from Sta. 542+54.61 "NB" and Sta. 543+50.00 "SB" to Sta. 631+85.43		
45	Additional for Median Pav't, Sta. 627+75 to 631+85.43 Area = (2 x 1.25 x 410.43 + 50 x 2) ÷ 9 = 125.12 Sq. Yd.			116	End Area = 0.396 Sq. Yds. for 8,092.57 Lin. Ft. Volume = 0.396 x 8,092.57 ÷ 3 = 1068.22 Cu. Yd.		
46	Additional from Sheet 17 = 14,732.45 Sq. Yd.			117	End Area = 0.118 Sq. Yds. for 4,995.14 Lin. Ft. Volume = 0.118 x 4,995.14 ÷ 3 = 196.48 Cu. Yd.		
47	Sum of Lines 43, 44, 45 and 46 = 68,634.06 Sq. Yd. use 68,634 Sq. Yd.			118	End Area = 0.399 Sq. Yds. for 1,256.57 Lin. Ft. Volume = 0.399 x 1,256.57 ÷ 3 = 167.12 Cu. Yd.		
48				119	End Area = 0.451 Sq. Yds. for 2,890.04 Lin. Ft. Volume = 0.451 x 2,890.04 ÷ 3 = 434.47 Cu. Yd.		
49				120	End Area = 0.125 Sq. Yds. for 4,112.17 Lin. Ft. Volume = 0.125 x 4,112.17 ÷ 3 = 171.34 Cu. Yd.		
50	I-22 Subbase - Grading A or B			121	End Area = 0.174 Sq. Yds. for 6,552.54 Lin. Ft. Volume = 0.174 x 6,552.54 ÷ 3 = 380.05 Cu. Yd.		
51	From Line 12 T-35 Area = 45,709.60 Sq. Yd. Area I-22 = 45,709.60 x 26.5 ÷ 24 = 50,471.02 Sq. Yds.			122	End Area = 0.405 Sq. Yds. for 4,212.76 Lin. Ft. Volume = 0.405 x 4,212.76 ÷ 3 = 568.72 Cu. Yd.		
52	Volume I-22 = 50,471.02 x 6 ÷ 36 = 8,411.84 Cu. Yd.			123	Additional from Sheet 17 = 804.99 Cu. Yd.		
53	From Sta. 550+50 to Sta. 562+00 Special Rock Cut Grading Req'd for 1150 Lin. Ft.			124	Sum of Lines 116, 117, 118, 119, 120, 121, 122, and 123 = total of 5" Depth = 3,791.39 Cu. Yd.		
54	Additional End Area Req'd for Special Grading = 0.068 Sq. Yd.			125			
55	Volume I-22 for Special Grading = 0.068 x 1150 ÷ 3 = 26.07 Cu. Yd.			126	6" Depth		
56	Additional Volume Under Approach Slabs = 6.5/12 x 26.5 x 50 ÷ 27 = 26.58 Cu. Yd.			127	From Sheet 17 = 97.15 Cu. Yd.		
57	Additional I-22 Req'd for Shoulders;			128	Sum of Lines 124 and 127 = 3,888.54 Cu. Yd. use 3,890 Cu. Yd.		
58	End Area = 0.404 Sq. Yds. for 12,305.33 Lin. Ft. Volume = 0.404 x 12,305.33 ÷ 3 = 1,605.12 Cu. Yd.			129			
59	End Area = 0.078 Sq. Yds. for 9,107.31 Lin. Ft. Volume = 0.078 x 9,107.31 ÷ 3 = 236.79 Cu. Yd.			130	Special Mixing Calcium Chloride and Crushed Aggregate - Line 127. Area = 97.15 x 6 = 582.90 use 583 Sq. Yd.		
60	End Area = 0.382 Sq. Yds. for 1,256.57 Lin. Ft. Volume = 0.382 x 1,256.57 ÷ 3 = 160.00 Cu. Yd.			131			
61	End Area = 0.702 Sq. Yds. for 2,890.04 Lin. Ft. Volume = 0.702 x 2,890.04 ÷ 3 = 676.27 Cu. Yd.			132			
62	End Area = 0.207 Sq. Yds. for 4,278.75 Lin. Ft. Volume = 0.207 x 4,278.75 ÷ 3 = 295.23 Cu. Yd.			133	E-1 Compacted Subgrade		
63	End Area = 0.186 Sq. Yds. for 2,279.79 Lin. Ft. Volume = 0.186 x 2,279.79 ÷ 3 = 141.35 Cu. Yd.			134	From Line 16 Area of T-35 Type C = 2,174 x (36 ÷ 125) = 62,611.20 Sq. Yd.		
64	Additional Req'd for Median Pav't Sta. 627+75 to 631+85.43 = 410.43 Lin. Ft.			135	From Sheet 17 Area of T-35 Type A = 356.34 x (36 ÷ 1.50) = 8,552.16 Sq. Yd.		
65	End Area = 0.222 Sq. Yds. for 410.43 Lin. Ft. Volume = 0.222 x 410.43 ÷ 3 = 30.37 Cu. Yd.			136	From Line 93 Area of T-31 = 15,687 ÷ 0.4 = 39,218 Sq. Yds.		
66	Additional from Sheet 17 = 4,346.07 Cu. Yd.			137	From Sheet 17 Area of I-7 = 351.90 Sq. Yds.		
67	Sum of Lines 52, 55, 56, 58, 59, 60, 61, 62, 63, 65, and 66 = 15,955.89 Cu. Yd. use 15,956 Cu. Yd.			138	Sum of Lines 134, 135, 136, and 137 = 110,733.76 Sq. Yds.		
68				139	Deduct Area in Rock Cut 3700 Lin. Ft. x 76 ÷ 9 = 26,177.8 Sq. Yds.		
69				140	Line 138 minus Line 139 = 84,555.46 Sq. Yds. use 84,556 Sq. Yd.		
70				141			
71				142			

SUMMARY OF TABLES

WAYNE COUNTY
WAY-3-994

Carried from Sheet No.	E-1	E-2	E-4	E-8	E-8	L-9	L-10	I-15			I-7	I-12	I-1	L-10	I - 2										
	Roadway Excavation	Embankment	Granular Borrow As Per Plan	Excavation for Structures	Granular Borrow as per plan. Including Existing Excavation	Removal and Disposal of Existing Pavement	Seeding and Sodding Roadway Areas	Sodding	Guard Rail, Steel Beam Type (Deep)	Barrier Rail, Steel Beam Type (Deep)	Guard Rail	Reinforced Concrete Approach Slab T=13"			Concrete Curb Type 6	Pipe for Drives Lin Ft.	Special Berm & Slope Protection	Storm Sewer Sec. M-64(c) Lin. Ft.	Storm Sewer Under Pav't Sec. M-6.4(c) Lin. Ft.	Class "A" Storm Sewer Under Pavement Lin. Ft.	Class "B" Storm Sewer Under Pavement Lin. Ft.	Class "B" Storm Sewer Lin. Ft.	Storm Sewer Under Pavement Sec. M-6.8(a) & M-6.8(b) Lin. Ft.	Storm Sewer Sec. M-6.5(b) or Sec. M-6.8(a) Lin. Ft.	Storm Sewer Sec. M-6.5(a) & 6.8(a) Lin. Ft.
	Cu. Yds.	Cu. Yds.	Cu. Yds.	Cu. Yds.	Cu. Yds.	Sq. Yds.	Sq. Yds.	Sq. Yds.	Lin. Ft.	Lin. Ft.	Lin. Ft.	Sq. Yds.	Lin. Ft.		12" 15"	12" 15" 30"	30"	12" 15" 18"	8" 12" 15" 18"	8"	21" 24"	12"	18" 21"		
11																									
18				362				84																	
21	6,569	6,569																							
22					29,453																				
23				1		222		100						54											
24	14,680	4,527		1		2,444	11,957	78	100					36										75	
26	892	94,233		3			21,025	906	1600.02															225	
28	89,974	4,145					17,013	387	78.89																
29	21,018	9,932		1			13,270	1289																	
30	44,922	1,415		1			13,331	34																	
31	52,194	0					12,064	1616																	
32	15,655	11,458		3			14,718	1835																	
33	69,551	2,482					16,387	1711	51.8																
34	656	113,562	13,493	4			19,473	455	1821.8	87.5	351.90														
35	530	19,112	6,385	1			9,364	6	504.3			820.86													
92	1,784	6,865					11,203	134																	
93								335																	
104	276	782					3,867		246.09																
109	811	144					1,891	359						40											
110								67																	
113								860						54											
114	10,344	176					5,903	277						54											
120	2,841	4,334					5,010	469	122.1					64											44
124	119	709					2612		75					96											
126								613						52											
127				1			191	25		528															
Totals	332,817	280,445	19,878	378	29,453	2,666	179,088	11,806	4,625.0	87.5	528	351.90	820.86		332	118									

Embankment + 22% = 342,143 Cu. Yd.
Excavation = 332,817 " "
E-4, Borrow = 9326 Cu. Yd. To General Summary

Carried from Sheet No.	Sheet Name	T-35	T-35	B-35	B-35	T-30	B-20	I-22	T-31 Bituminous Surface Treatment			I-23	I-18		I-12	I-21	B-33	B-19	I-9	
		Asph. Conc. Surf. Course Type C (70-85)	Asph. Conc. Surf. Course Type A (85-100)	Asph. Conc. Leveling Course (70-85)	3" Asph. Conc. Base Course (70-85)	Bituminous Prime Coat	Gals.	8" Water bound Macadam Base Course	Subbase Grading A or B	No. 46 Aggregate	No. 6 Bituminous Aggregate	Bituminous Material	Gals.	Traffic Dividers	5"	6"	Standard Type 6 Curb	P.C. Concrete Median Pavement 4" Type 1	3" Bituminous Macadam Base Course	Aggregate Base Course
		Cu. Yds.	Cu. Yds.	Cu. Yds.	Cu. Yds.	Gals.	Sq. Yds.	Cu. Yds.	Cu. Yds.	Cu. Yds.	Gals.	Each	Cu. Yds.	Cu. Yds.	Lin. Ft.	Sq. Yds.	Sq. Yds.	Cu. Yds.	Lin. Ft.	
17	Sum of Tables															820.86				
18	Sum of Tables		111.69																525.79	
25	South Bound	193.85		193.85	473.56	2273.53	6623.06	1423.90	24.72	24.72	1545.80	11	359.66		513.08	24.52	3091.58			
27	South Bound	133.24		133.24	326.70	1569.80	4578.86	980.06	15.95	15.95	996.98		231.27		278.54	20.38	1993.93			
93	S.R. - 3	93.35		93.35	229.44	1101.42	3038.89	662.51	6.34	6.34	396.29		193.45				792.57		205.50	
100	Line C	13.92		13.92	34.14	164.90	491.64	96.14	1.33	1.33	83.15		20.61				166.29			
103	S.R. - 226	26.40		31.68		317.11									38.74			109.33	82.20	
109	S.R. - 95	67.86		81.27		779.18									58.41			266.49	108.00	
114	C.R. - 139		128.69			1235.30												439.12	240.00	
120	C.R. - 174	52.00		62.41		599.10												214.65	122.00	
126	Frontage Rd.		115.96			1113.13												409.81	325.00	
Totals		580.62	356.34	609.72	1063.84	9153.47	14,732.45	4,346.07	48.34	48.34	3022.22	11	804.99	97.15	16,12.48	44.90	6044.37	1965.19	1082.70	

R/W FENCE	
From Sheet No	Type A Fence Lin. Ft.
2	1662.97
3	3002.26
4	5664.89
5	2660.17
6	2178.62
7	704.00
Totals	15872.91

SUMMARY OF TABLES

WAYNE COUNTY
WAY-3-9.94

Carried from Sheet No.	I-3									I-4		I-5 Pipe Specials for													I-8					I-14		I-10	T-35	B-19	E-12	S-1	S-24														
	Pipe for Roadway Drainage Under Pavement Lin. Ft.			Pipe for Roadway Drainage Lin. Ft.			Outlet Pipe for Roadway Drainage Lin. Ft.	Extra Quality Drain Tile Sec. M-6.7(b) Lin. Ft.	6" Pipe for Underdrains Sec. M-6.4(b) Lin. Ft.	6" Pipe Outlets for Underdrains Sec. M-6.4(b) Lin. Ft.	6" 90° Bend	6" 45° Bend	6" 45° Wye	6" Tees	I-4				I-3					Stand. and No. Man-hole Each	Catch Basins Each					Paved Gutter Type 1 Lin. Ft.	Paved Gutter Special Lin. Ft.	Dumped Rock Channel Protection Cu. Yds.	2" Asphaltic Concrete Surface Course Type A Cu. Yds.	Aggregate Base Course For Drives 5" 6" 7" Cu. Yds.	Pipe Removal 15" and Under Lin. Ft.	Concrete for Structures Class E Cu. Yds.	Removal of Existing Structures Lump														
	12"	18"	21"	8"	12"	15"	21"	8"	12"	21"					6"	Deep	Shallow	6" 12"	6" 18"	6" 24"	6" 36"	6" 48"	6" 60"		6" 72"	8" 12"	8" 18"	8" 24"	8" 36"									8" 48"	8" 60"	8" 72"	8" 84"	No. 6	No. 7	2-2A	2-2B	Mod.	Stand.	Modif.			
11				300	300			100	100													5	5	Each													25														
18																																							9				22.77								
23								250							20		2																										5.03	24.55	54	0.23					
24	178			630				1948	1554					40		1	2																										50.36	153.26	425	0.28					
26								2600																																											
28								358	371					1700	20		2																																		
29								446	2620					730	50		2	2																																	
30								924	1337					1000	40		3	1		2																															
31									2200																																										
32								978	1368					710	50		3	2																																	
33							30	2091	1309					30	1	3		1																																	
34									3057					60	1	2	3																																		
35									1900					40		2		2																																	
92								200	218					10		1																																			
93																																																			
100									213									1																																	
104									579								2	1	2																																
109																																																			
110																																																			
113																																																			
114	72																																																		
120																																																			
124																																																			
126																																																			
127																																																			
Totals	250	46		300	236	278	197	100	110	10	30	7195	17126	6340	360	2	20	12	8	1	2	5	5	6	2	1	14	1	2	4	5	5	5	5	1	2	13	22	8	5		264	2220	280		73.7	111.69	525.79	12.75	26.89	Lump


STRUCTURE TABLE 20' SPAN & UNDER

Carried from Sheet No.	Structure No.	Station	Type	Size	Length Lin. Ft.	E-2	E-3	S-1	S-27	S-28	I-10	L-10
						Excavation for Structures Cu. Yds.	Channel Excavation Cu. Yds.	Concrete for Structures Class "E" or M-6.8(b) Cu. Yds.	Pipe for Roadway Culvert Sec. M-6.6(b) or M-6.8(b) Lin. Ft.	Pipe for Roadway Culvert Arch Sec. M-6.6(b) or Sec. M-6.4(g) 15' 6" x 9' 5" Lin. Ft.	Sectional Plate Pipe Arch Sec. M-6.4(g) 15' 6" x 9' 5" Lin. Ft.	Dumped Rock Channel Protection Cu. Yds.
130	Way-3-1185	625+85	Pipe Arch	15' 6" x 9' 5"	140	193	306	21.03		140		58
130	Way-3-1028	543+00	Pipe	30"	228	112	44	1.02	228		5	15
131	S.R-3-1027	542+00	Pipe	21"	108	57	44	0.72	108		4	11
Totals						362	394	22.77	108	228	9	84


FED. RD. DIVISION	STATE	PROJECT	
2	OHIO		

19
157


WAYNE COUNTY
WAY-3-994

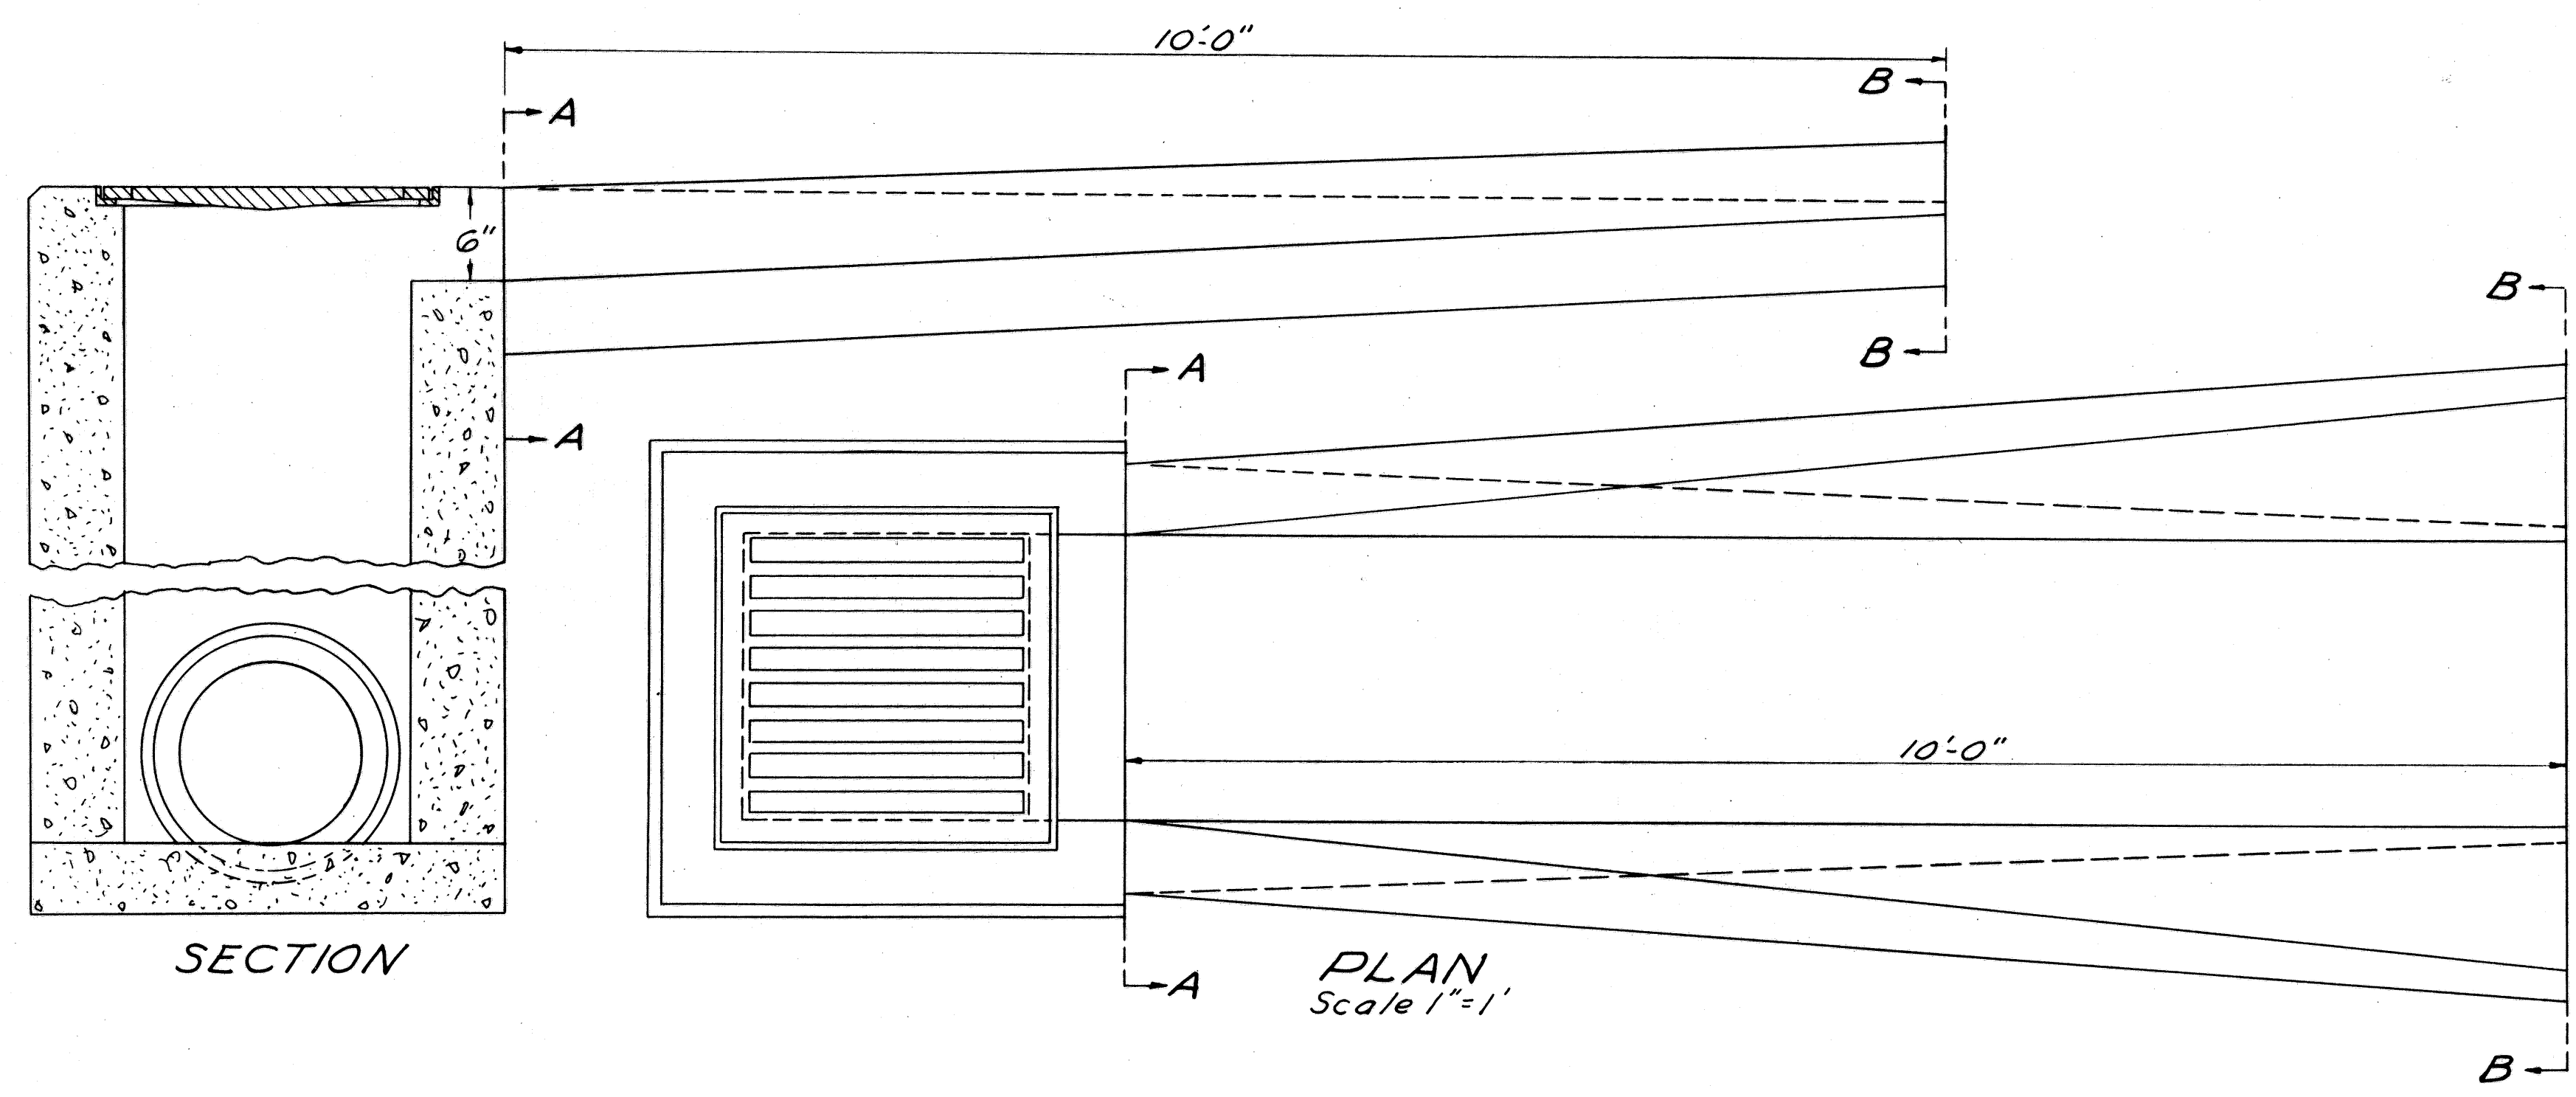


2-2-A Catch Basin with Item I-14 Paved Gutter Special

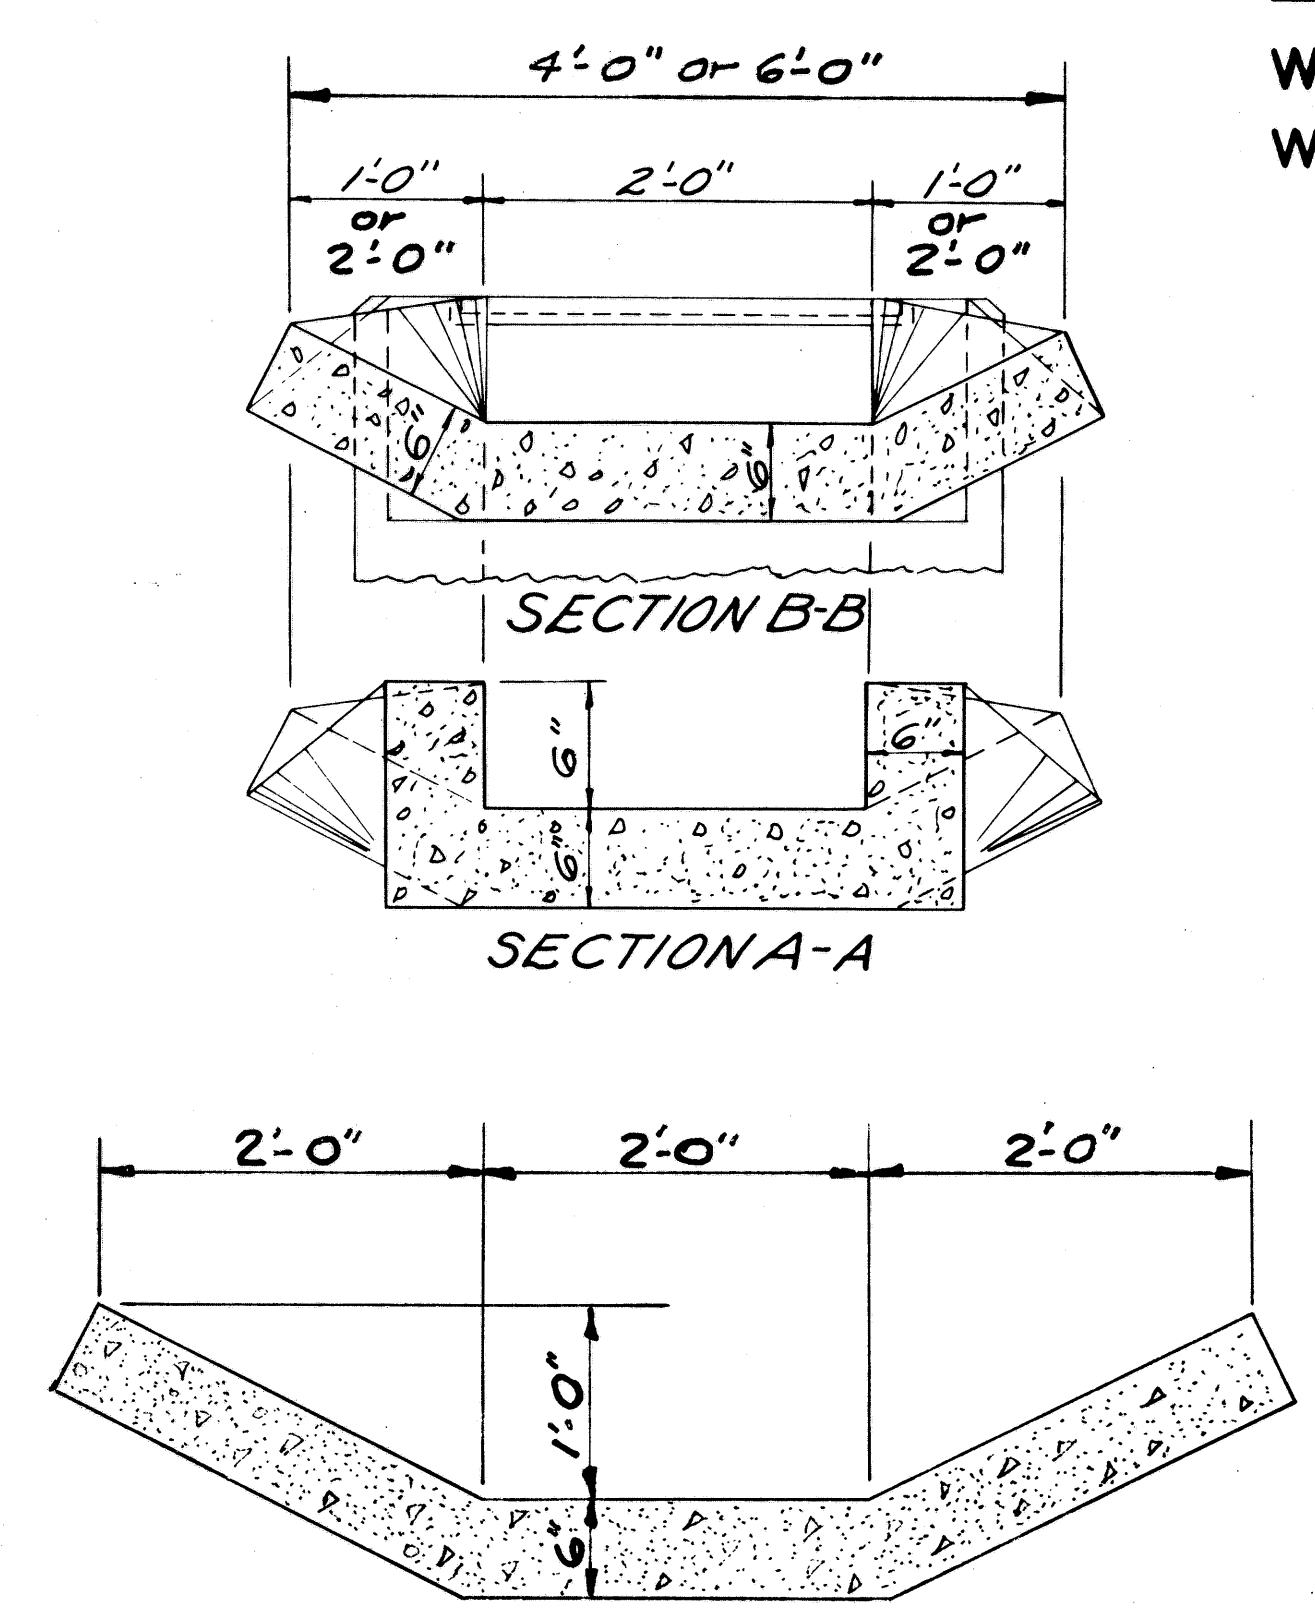

MODIFIED TYPE I PAVED GUTTER

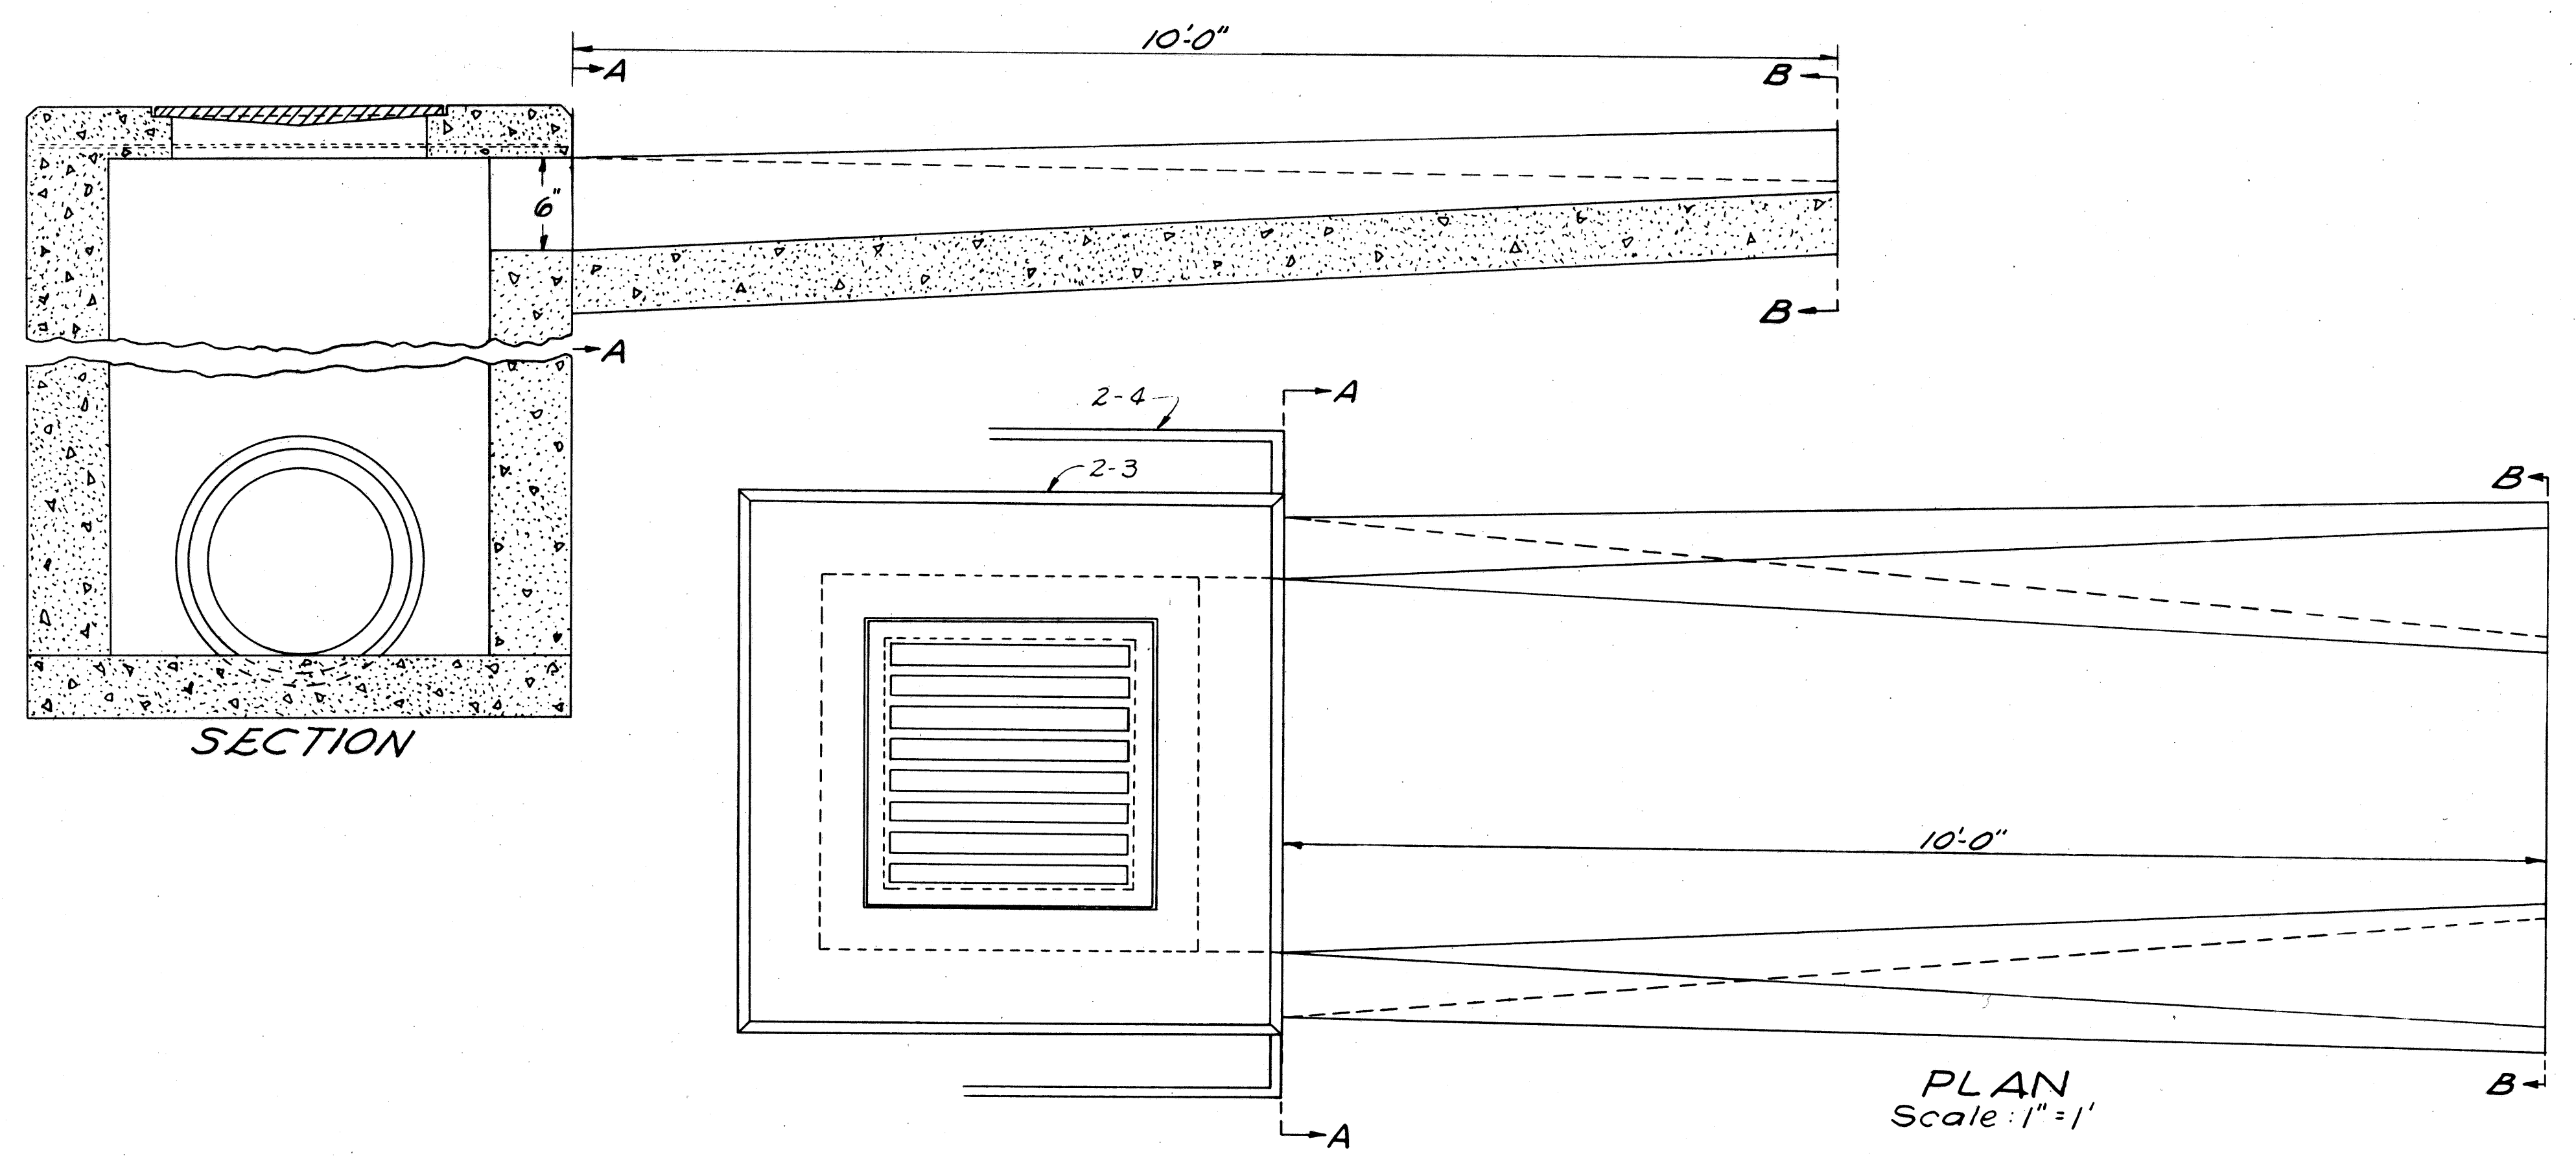

Modified 2-3 & 2-4 Catch Basin with Item I-14 Paved Gutter Special

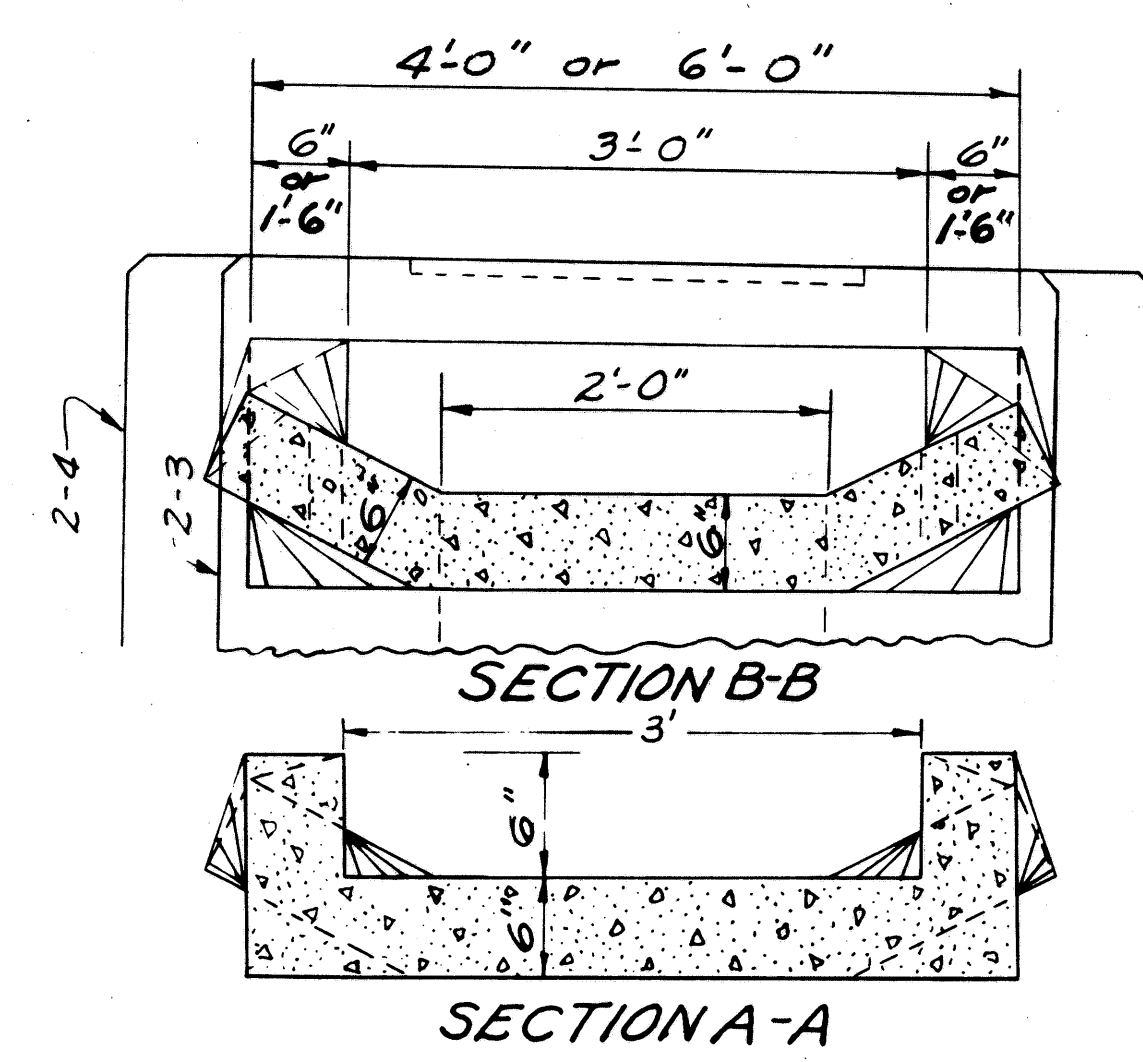


For Dimensions not shown see
Standard Drawing I-8 C.B. 2-3 & 2-4

Note: Modification of the No 2-3 & 2-4
Catch Basins consists of providing
windows as required, without bars,
dimensioned as shown in Section A-A.

GUARD RAIL PROTECTION

FOUR LANE DIVIDED, 40' MEDIAN, AT TWIN STRUCTURES

WAYNE COUNTY
WAY-3-9.94

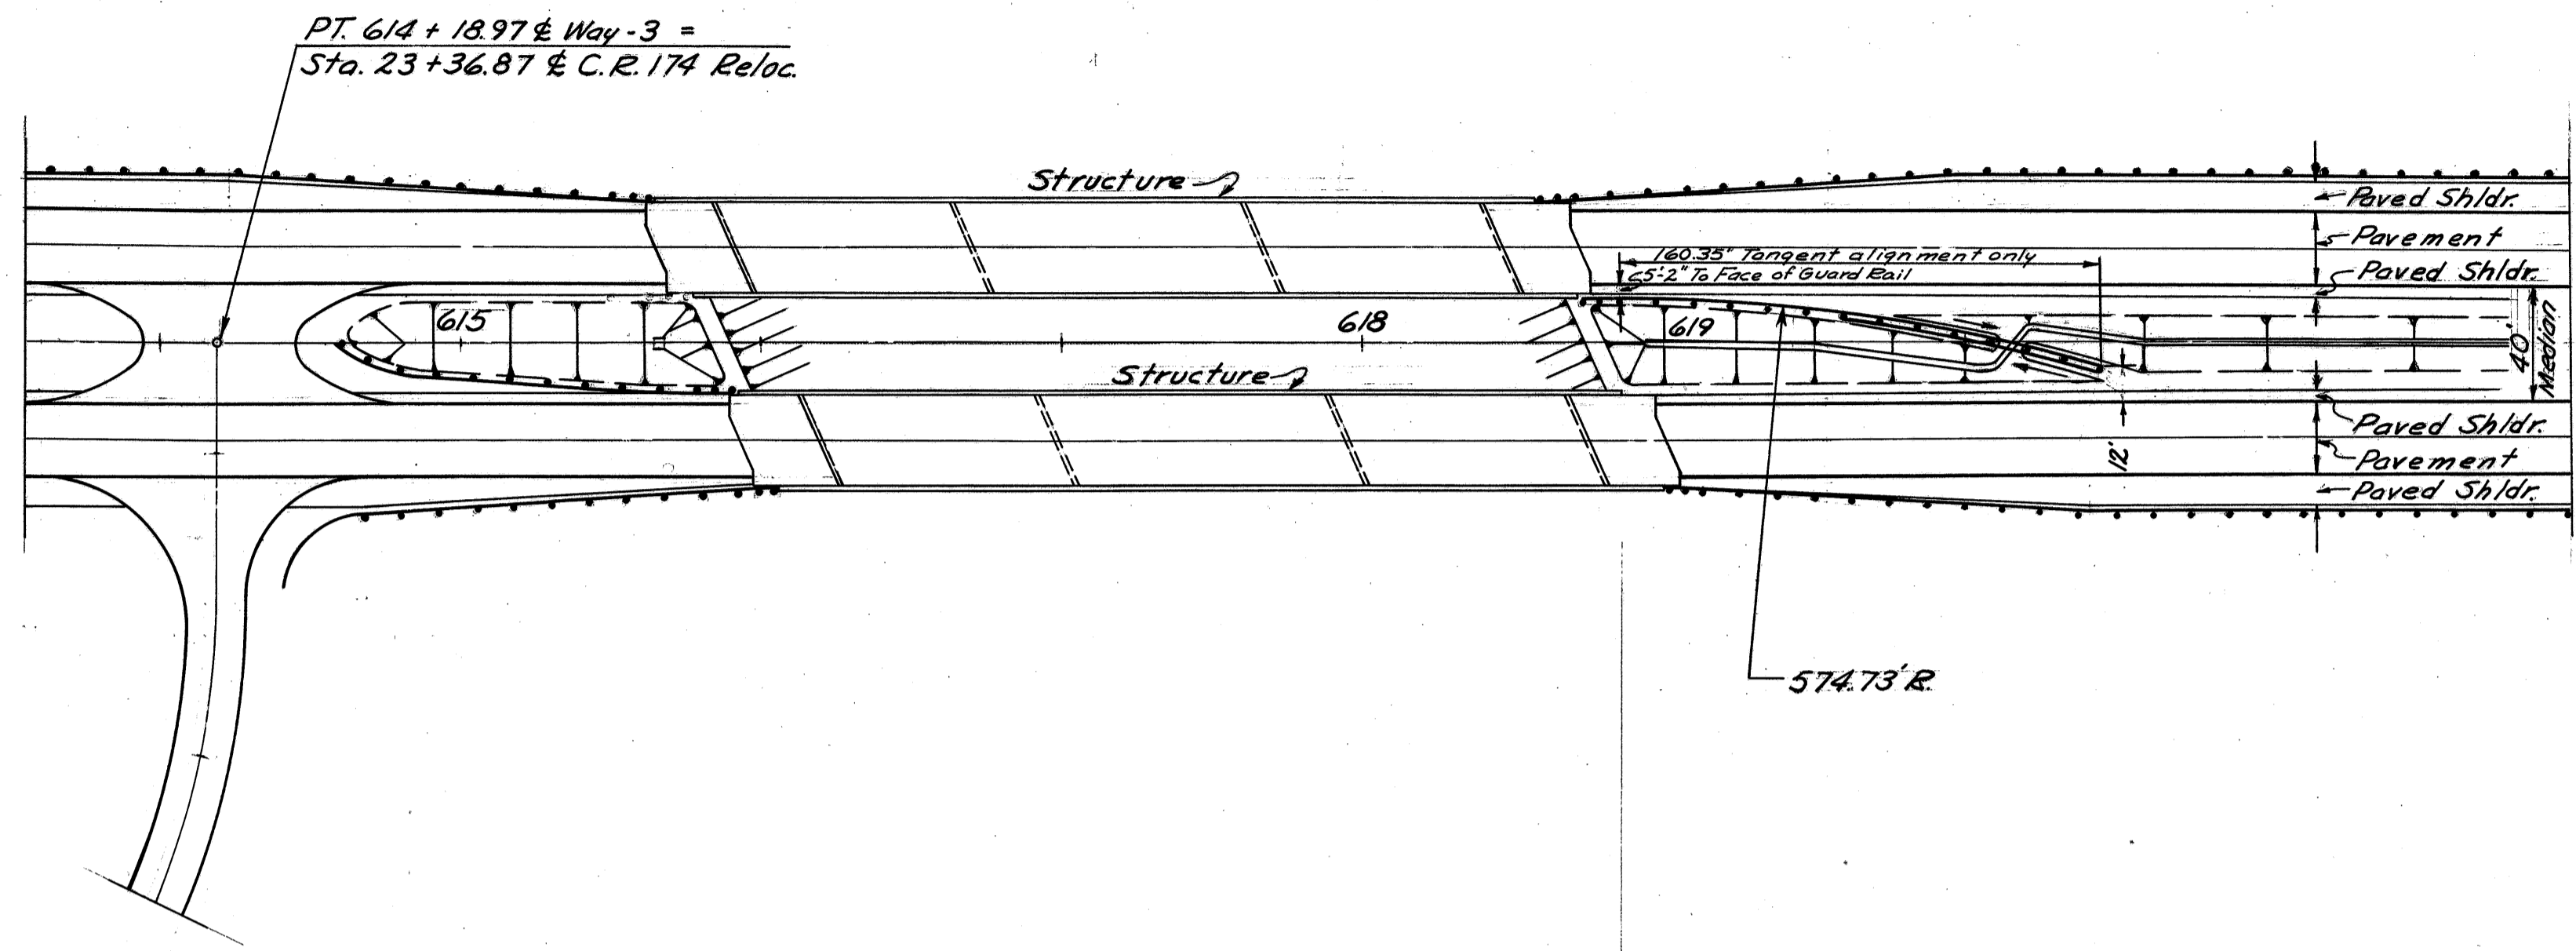

NOTES


GENERAL: Design details shown hereon shall govern the construction of guard rail at structures unless otherwise shown on the plans.

DIKE shall be provided at each end of each pair of structures.

OFFSETS for guard rail are based on the use of 5ft.-2in. offset to median parapet and 2ft. width outside shoulder. If other shoulder widths are used, the offsets shall be adjusted accordingly.


POST OFFSET	POST OFFSET	POST OFFSET	POST OFFSET
0	5.17	7	10.03
1/2	5.17	8	11.82
1	5.17	9	13.84
2	5.31	10	16.15
3	5.71	11	18.72
4	6.39	12	22.02
5	7.34	13	24.63
6	8.57	14	28.00

SEE SHEET NO. 8
FOR PAVEMENT TYPE

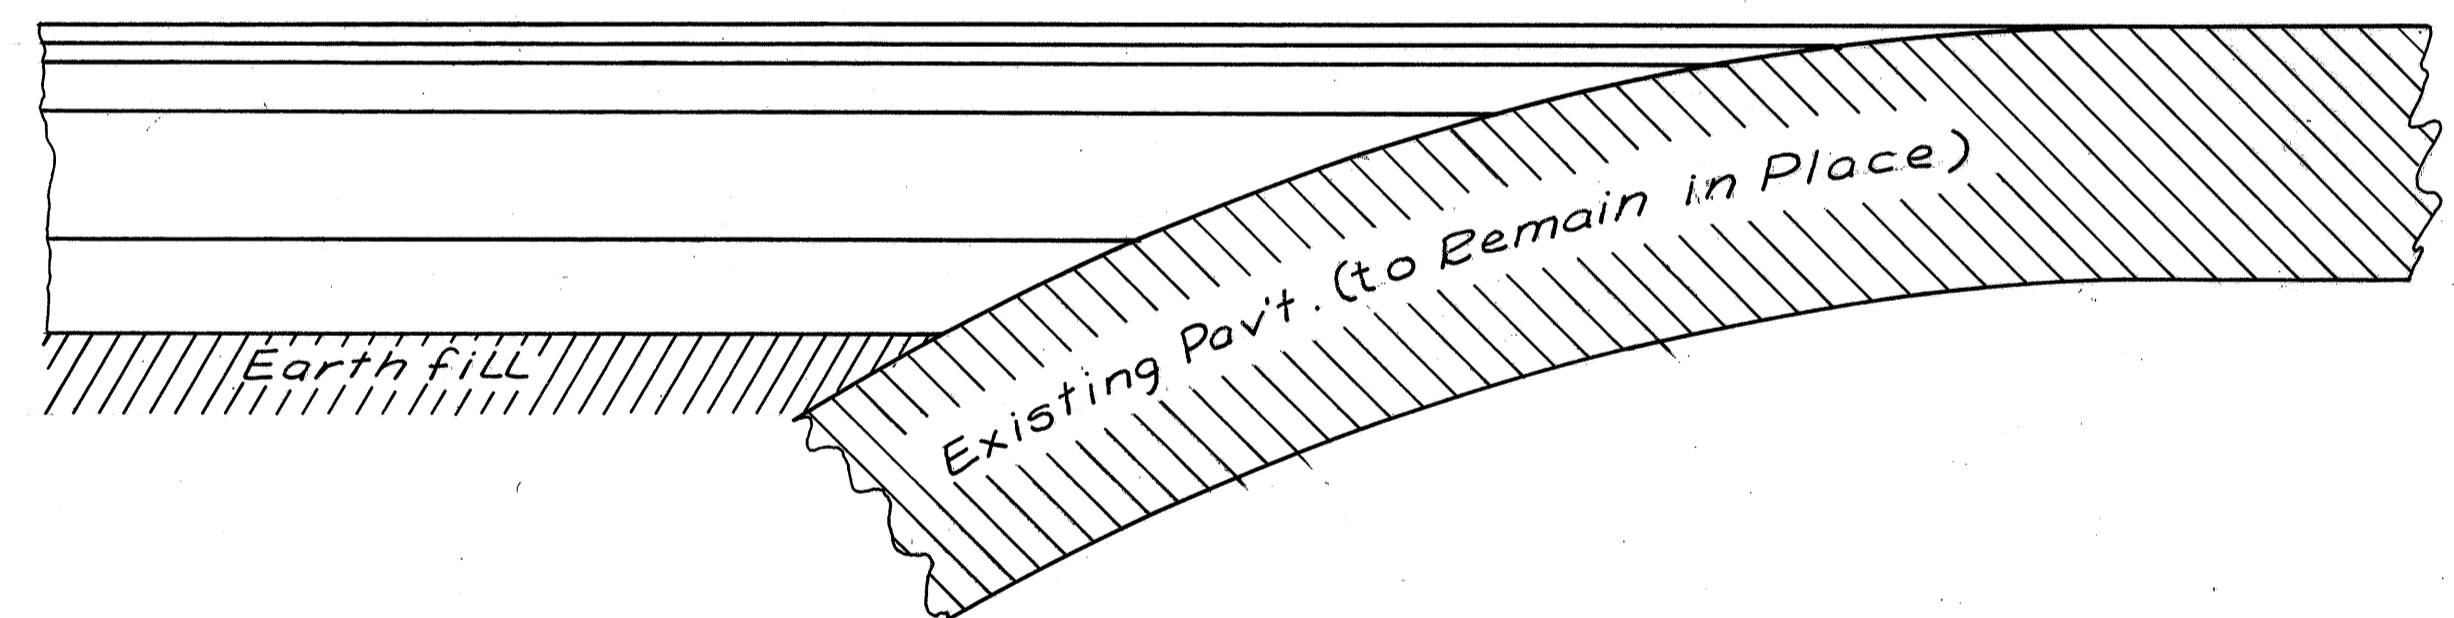


EXISTING S.R. 3 MERGER OF NEW FILL PAV'T. WITH EXISTING PAV'T.


SEE SHEET NO. 9
FOR PAVEMENT TYPE

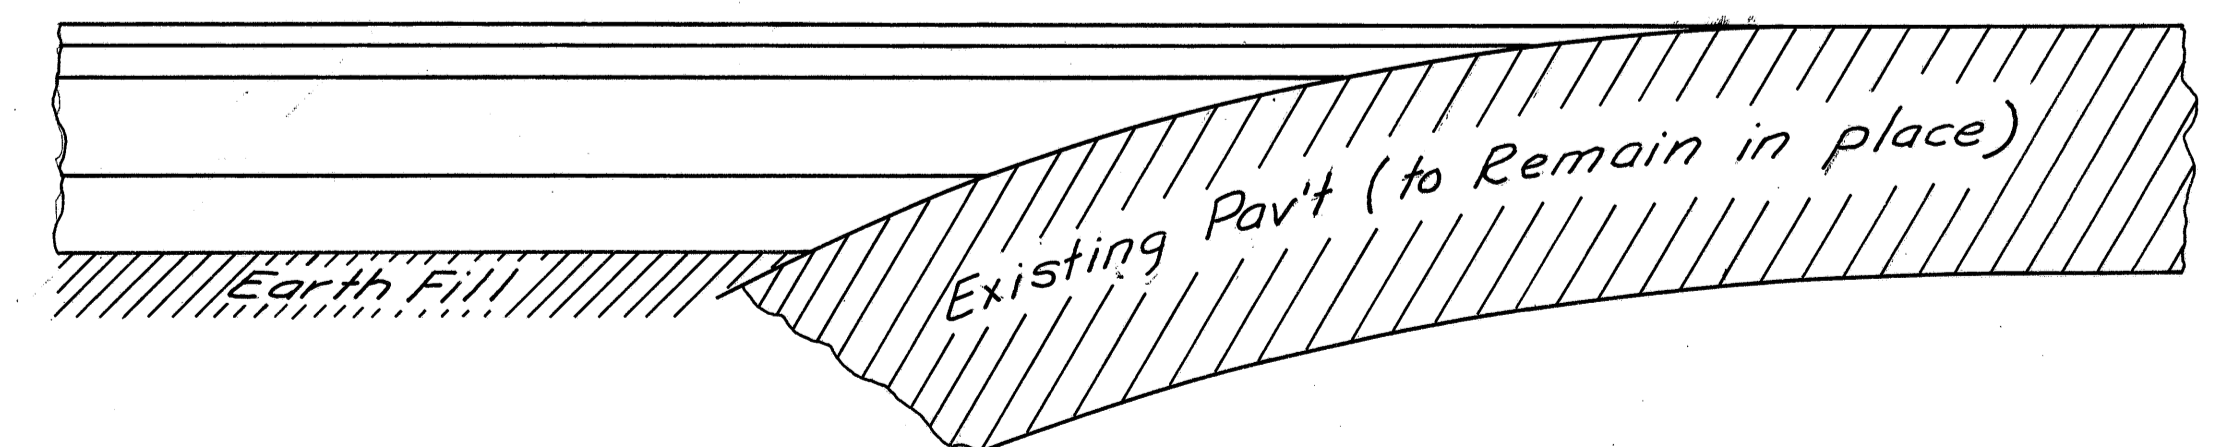

S.R. 226 MERGER OF NEW FILL PAV'T WITH EXISTING PAV'T.



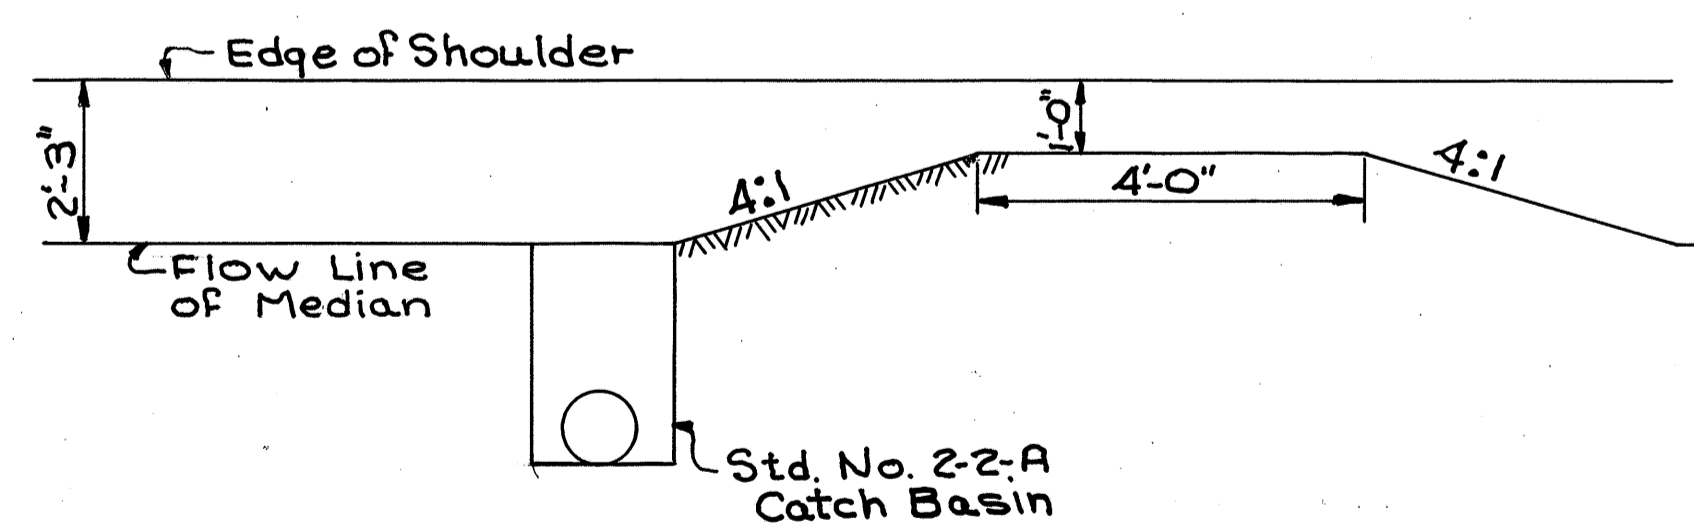


Detail of dike on continuous Grade @ Sta. 566+50 & Sta. 602+50, Sta. 624+75 Top of dike 0.5' Below Edge of Shoulder


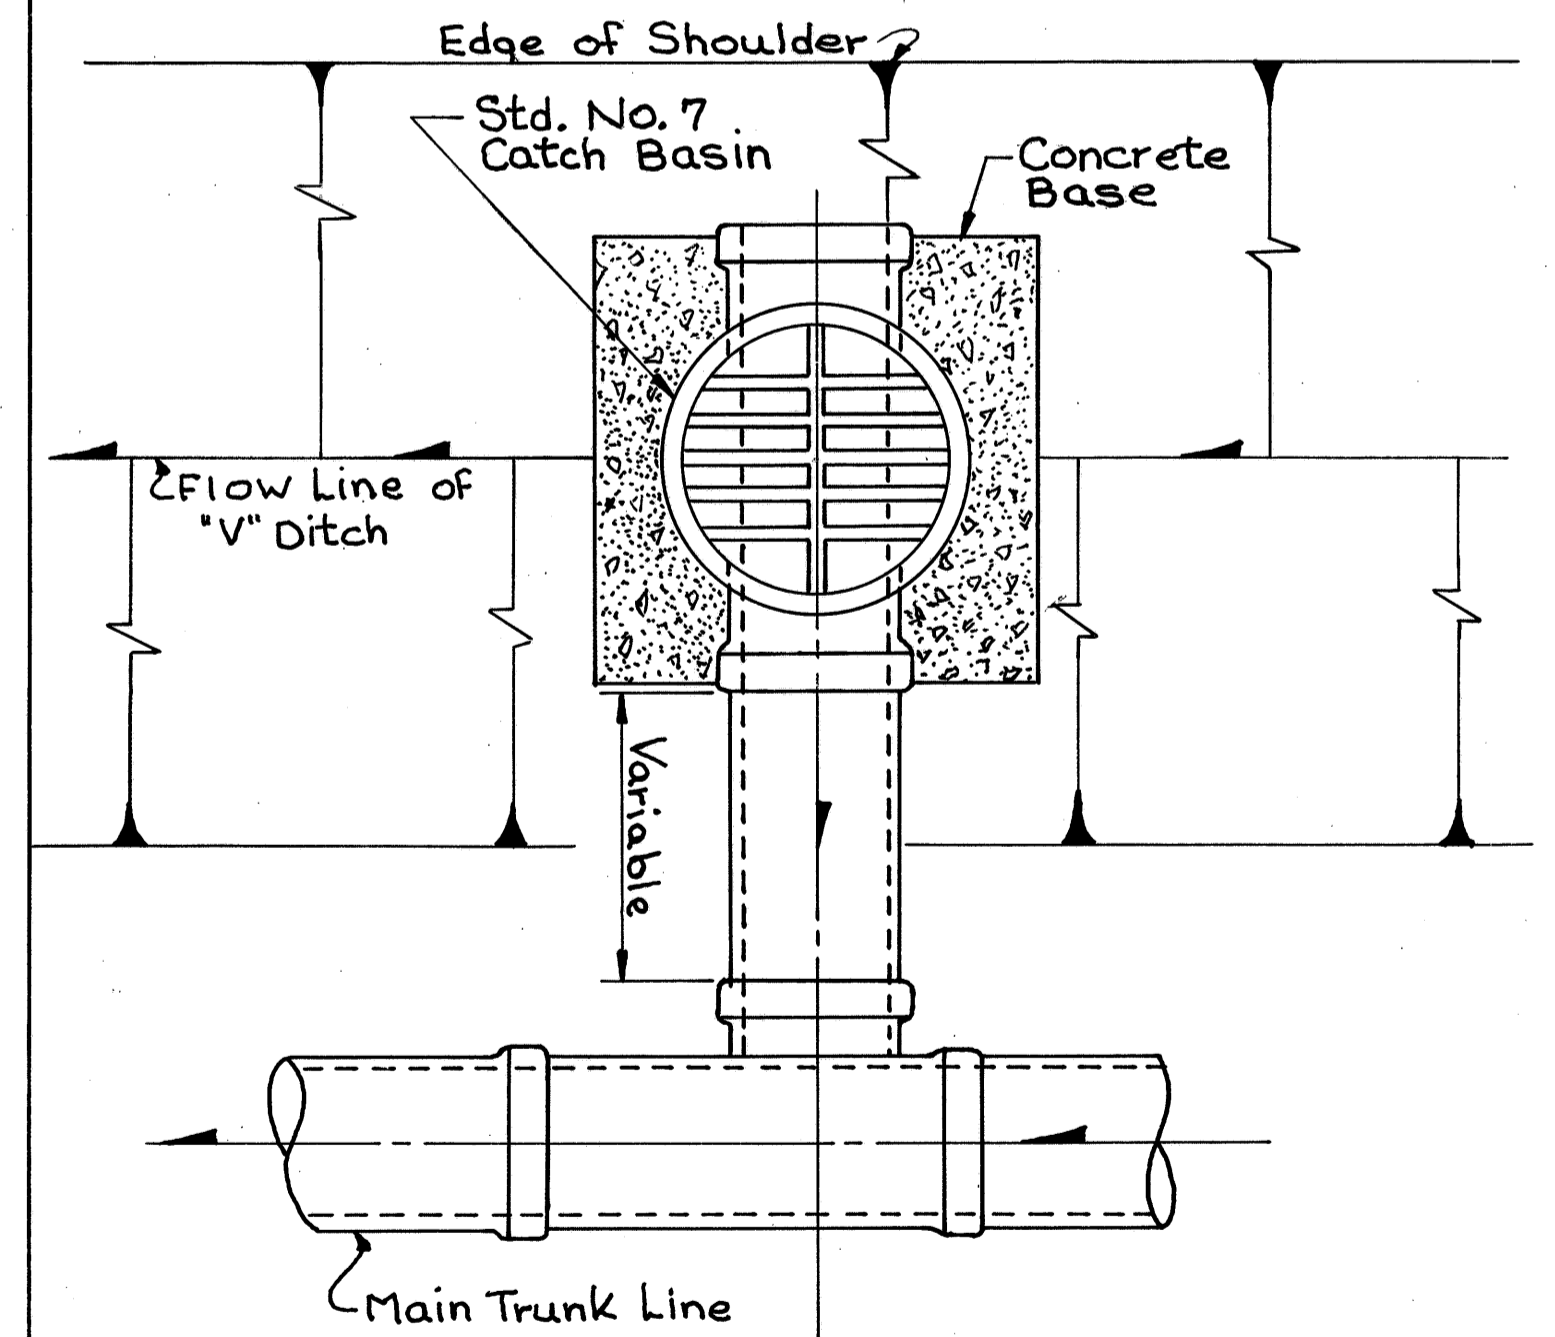


Detail for Offsetting No. 7 Catch Basin

WAYNE COUNTY
WAY-3-9.94

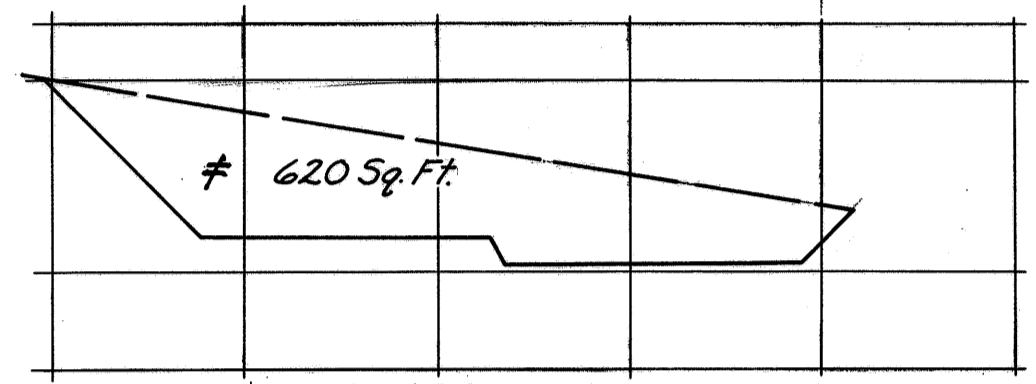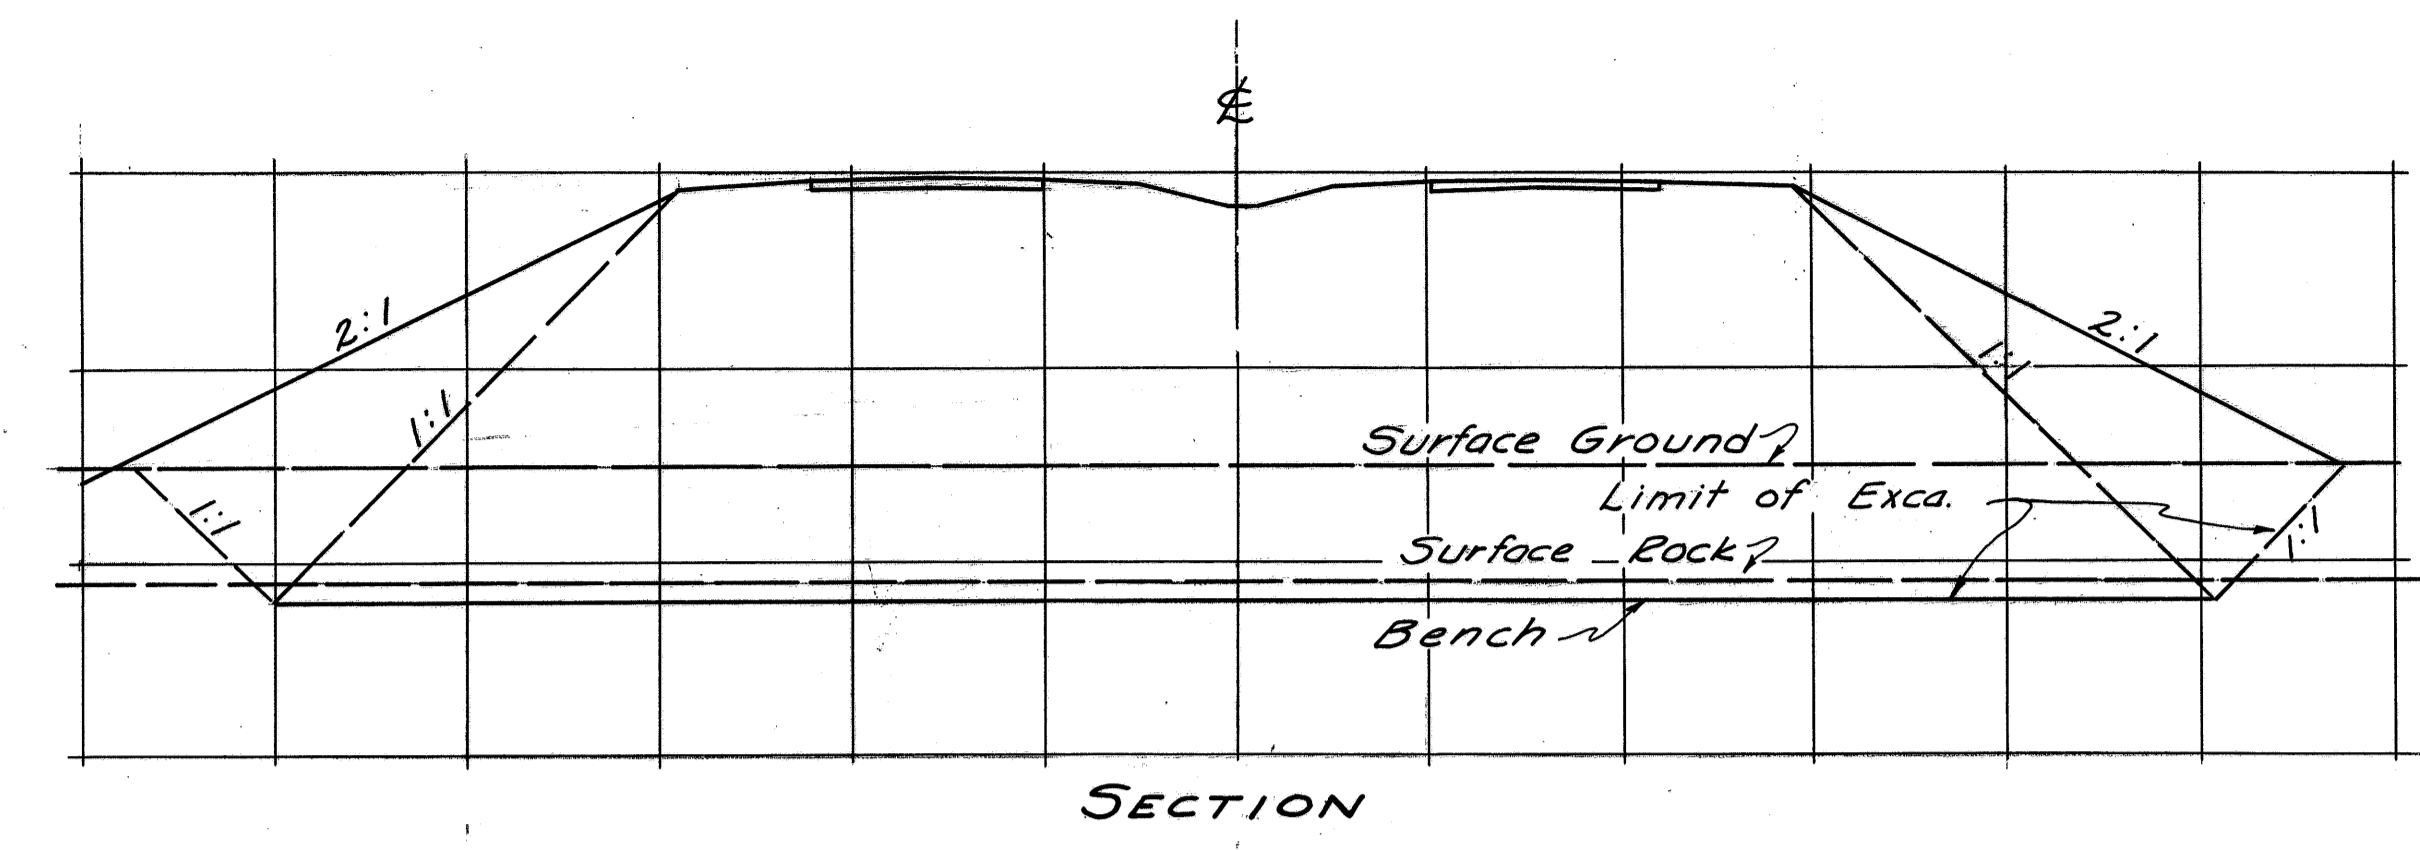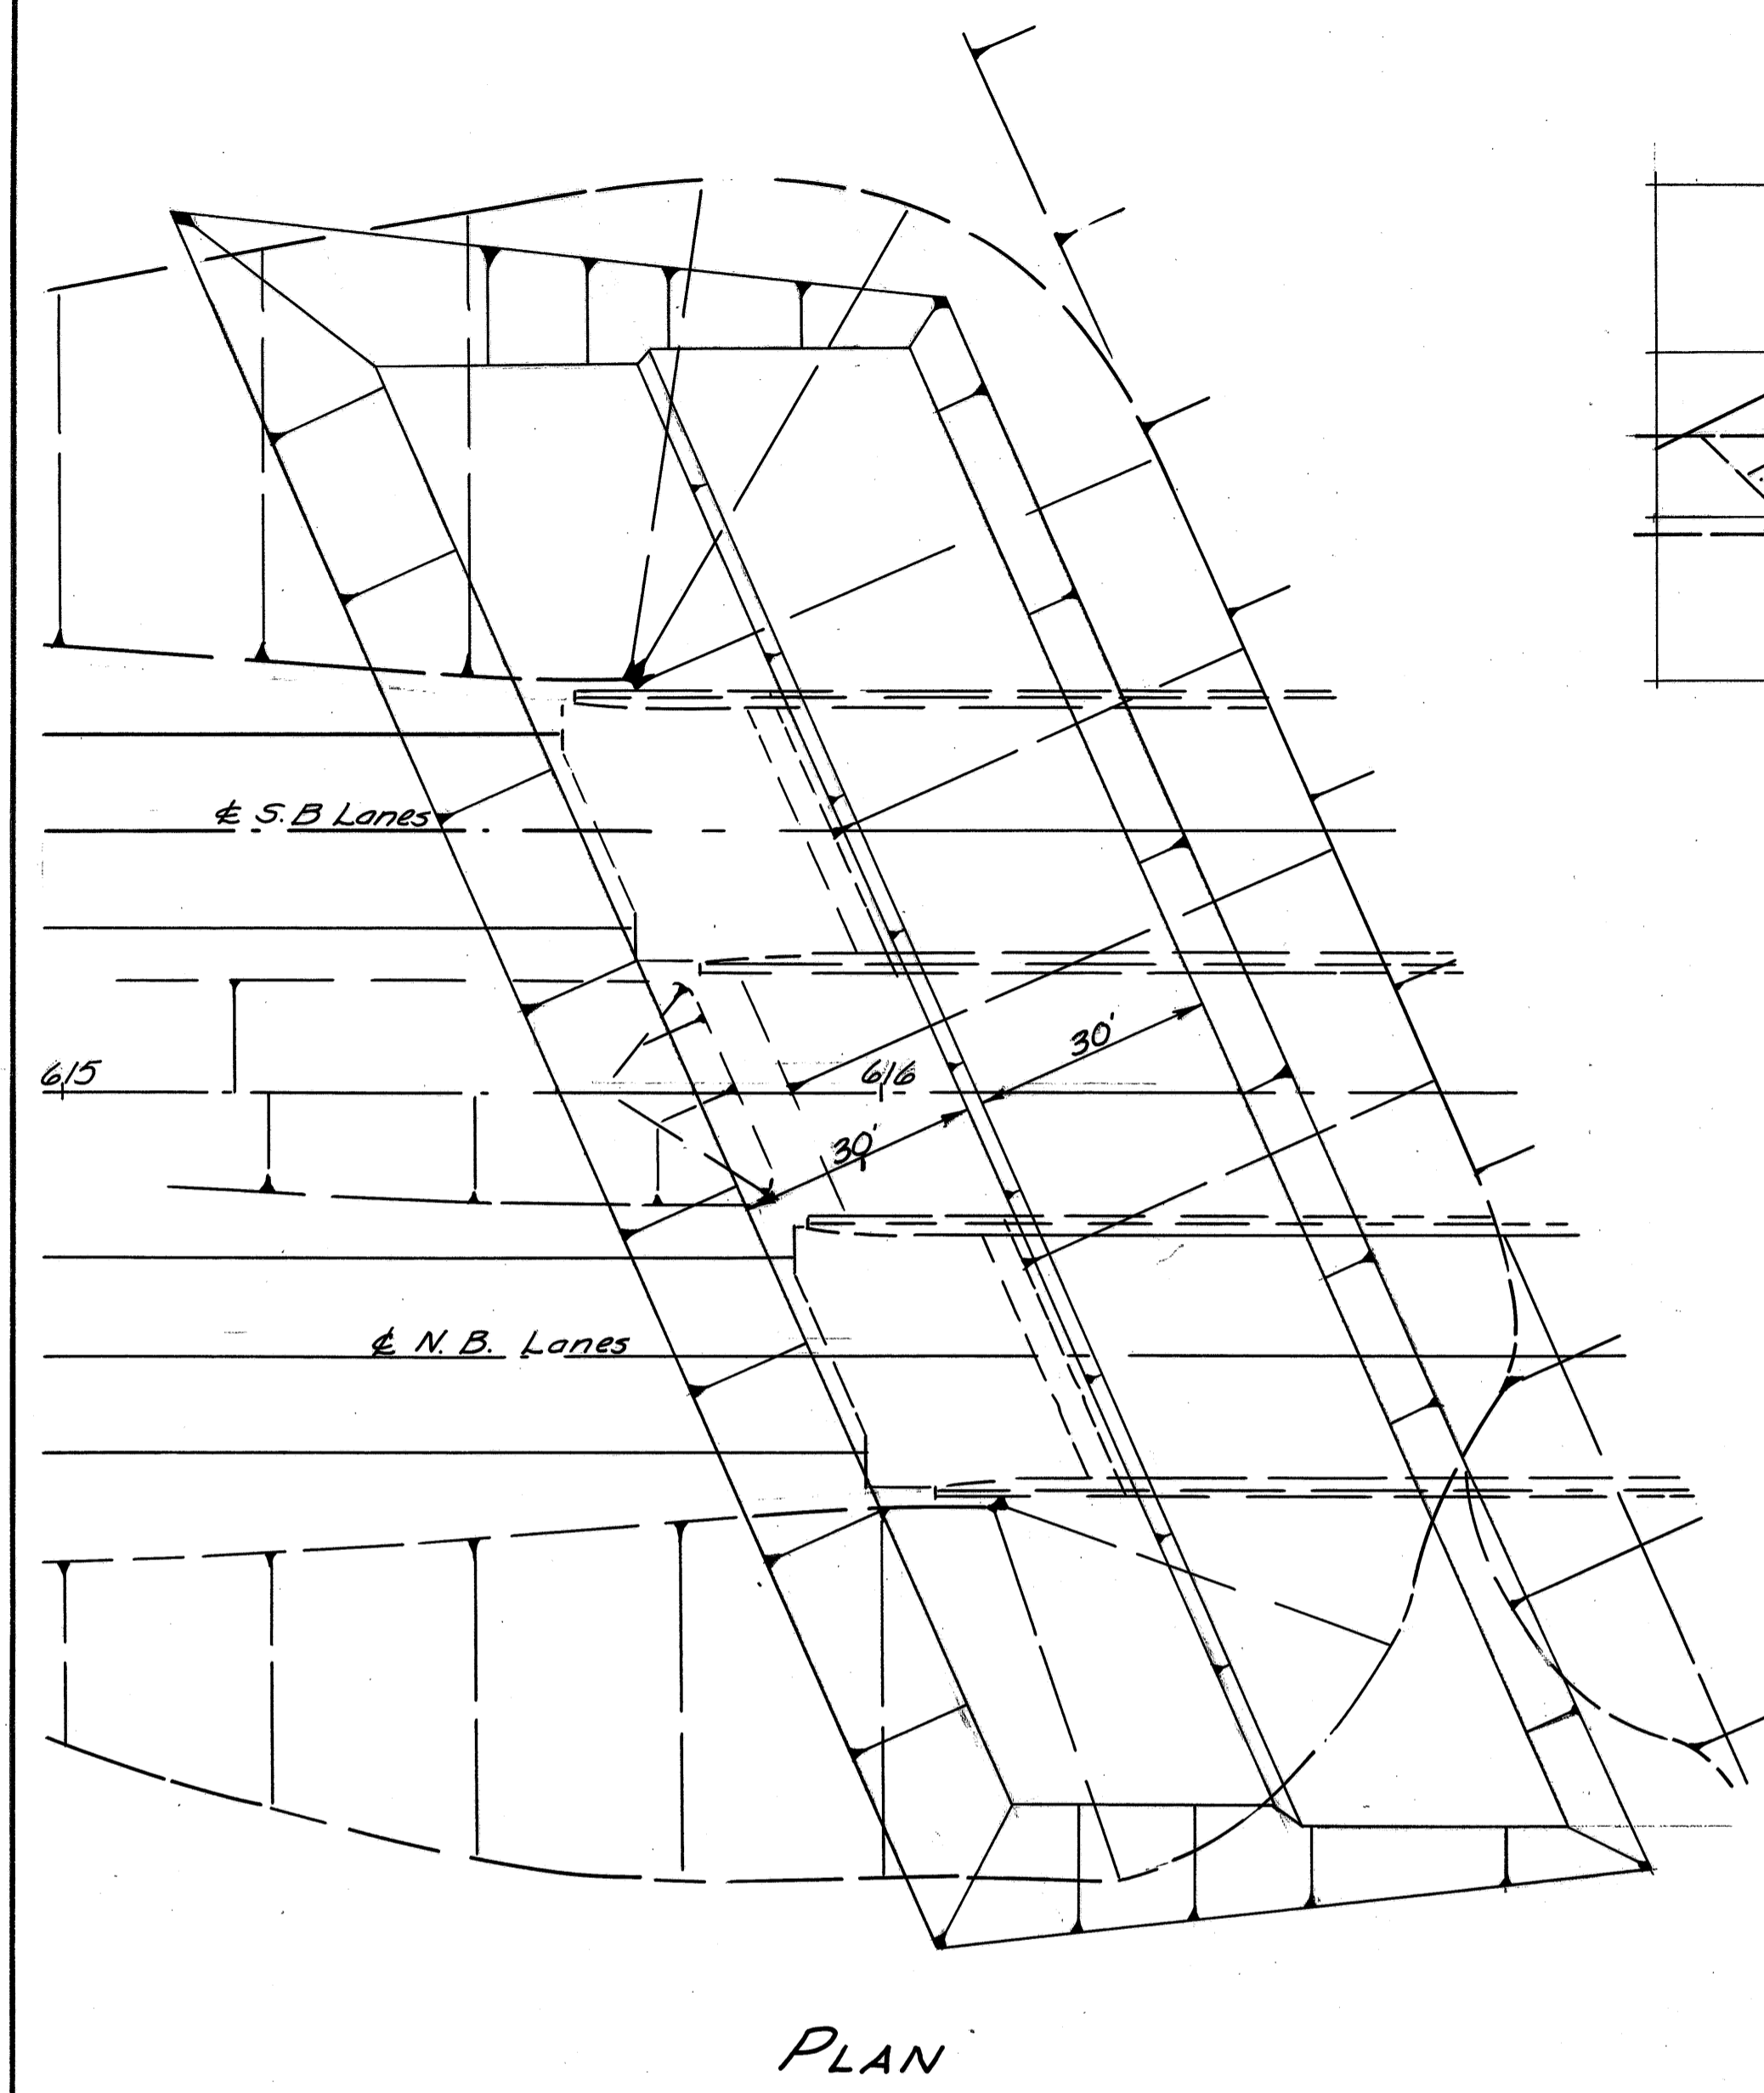


Sta.	Excavation End Area	Cu. Yds.
1+38 Lt.	0	182
110 Lt.	350	449
# 85 Lt.	620	5504
# 82 Rt.	620	404
110 Rt.	160	30
120 Rt.	0	30
Total Excavation & Embankment		6569

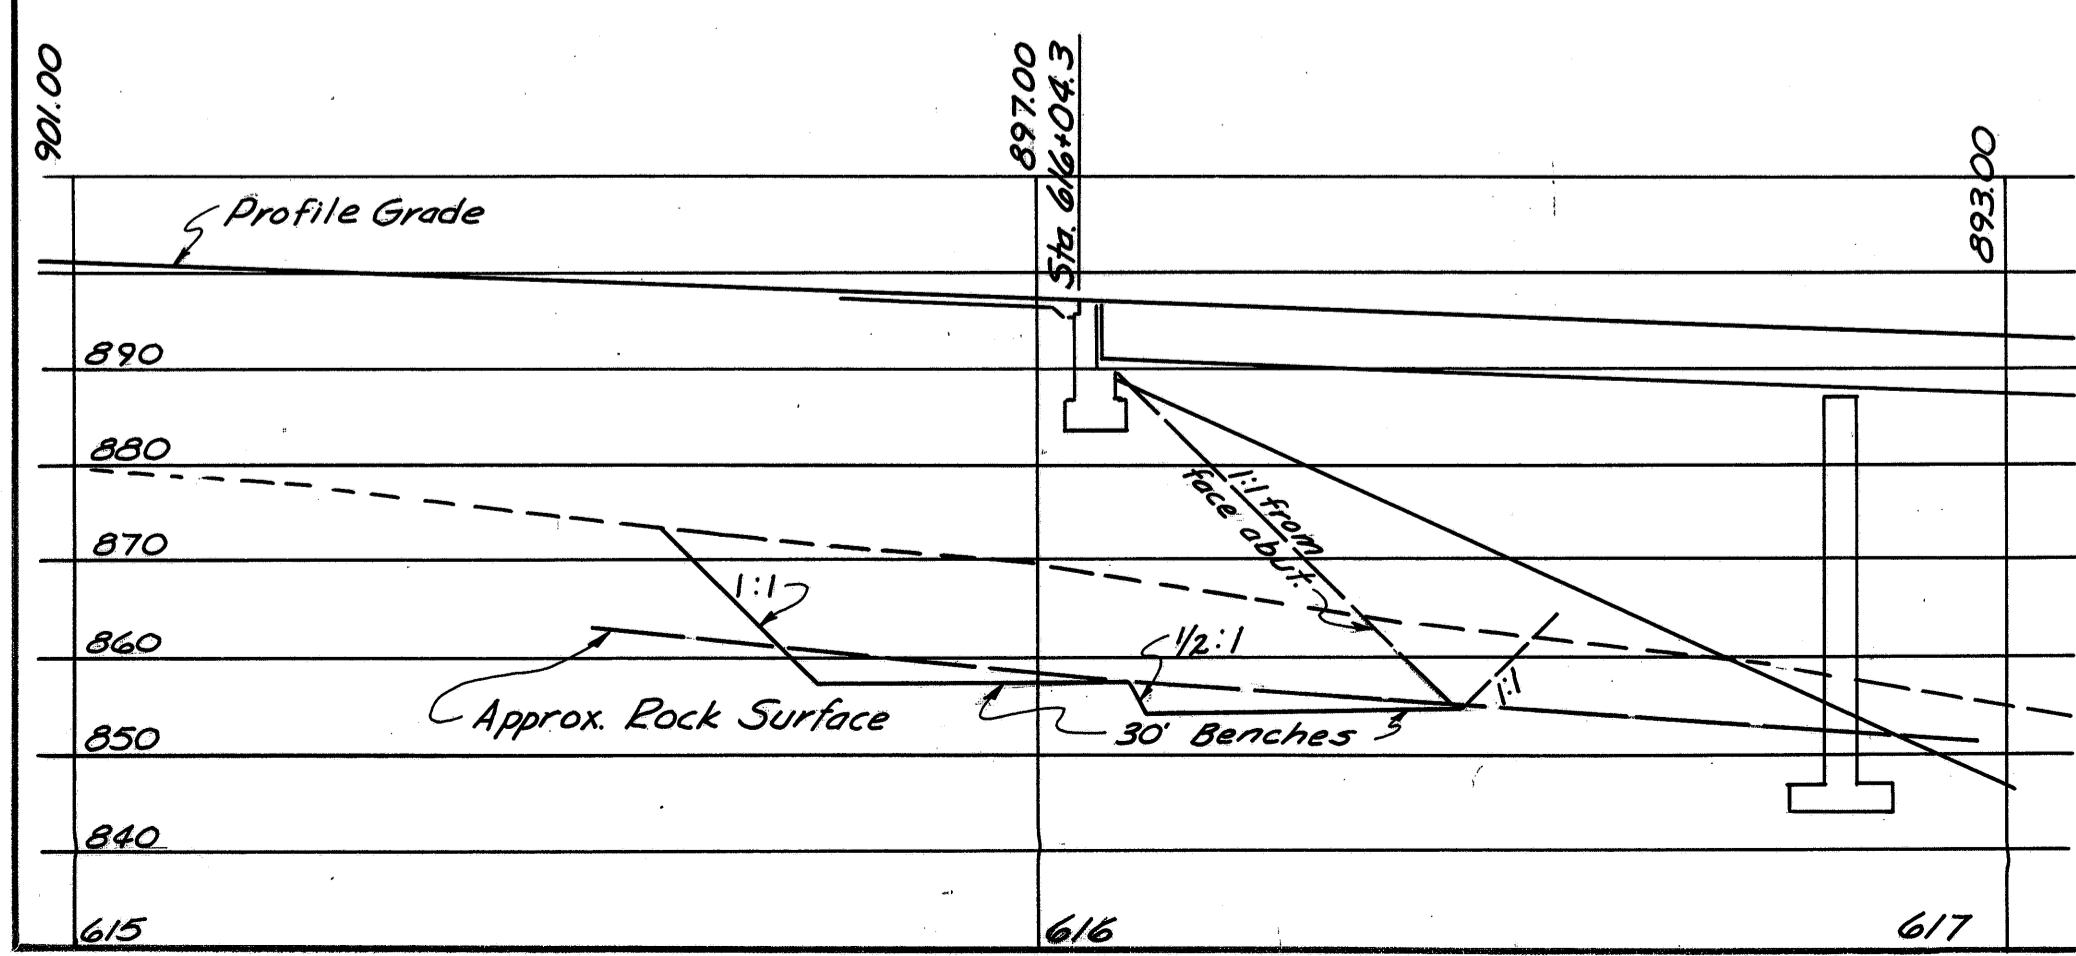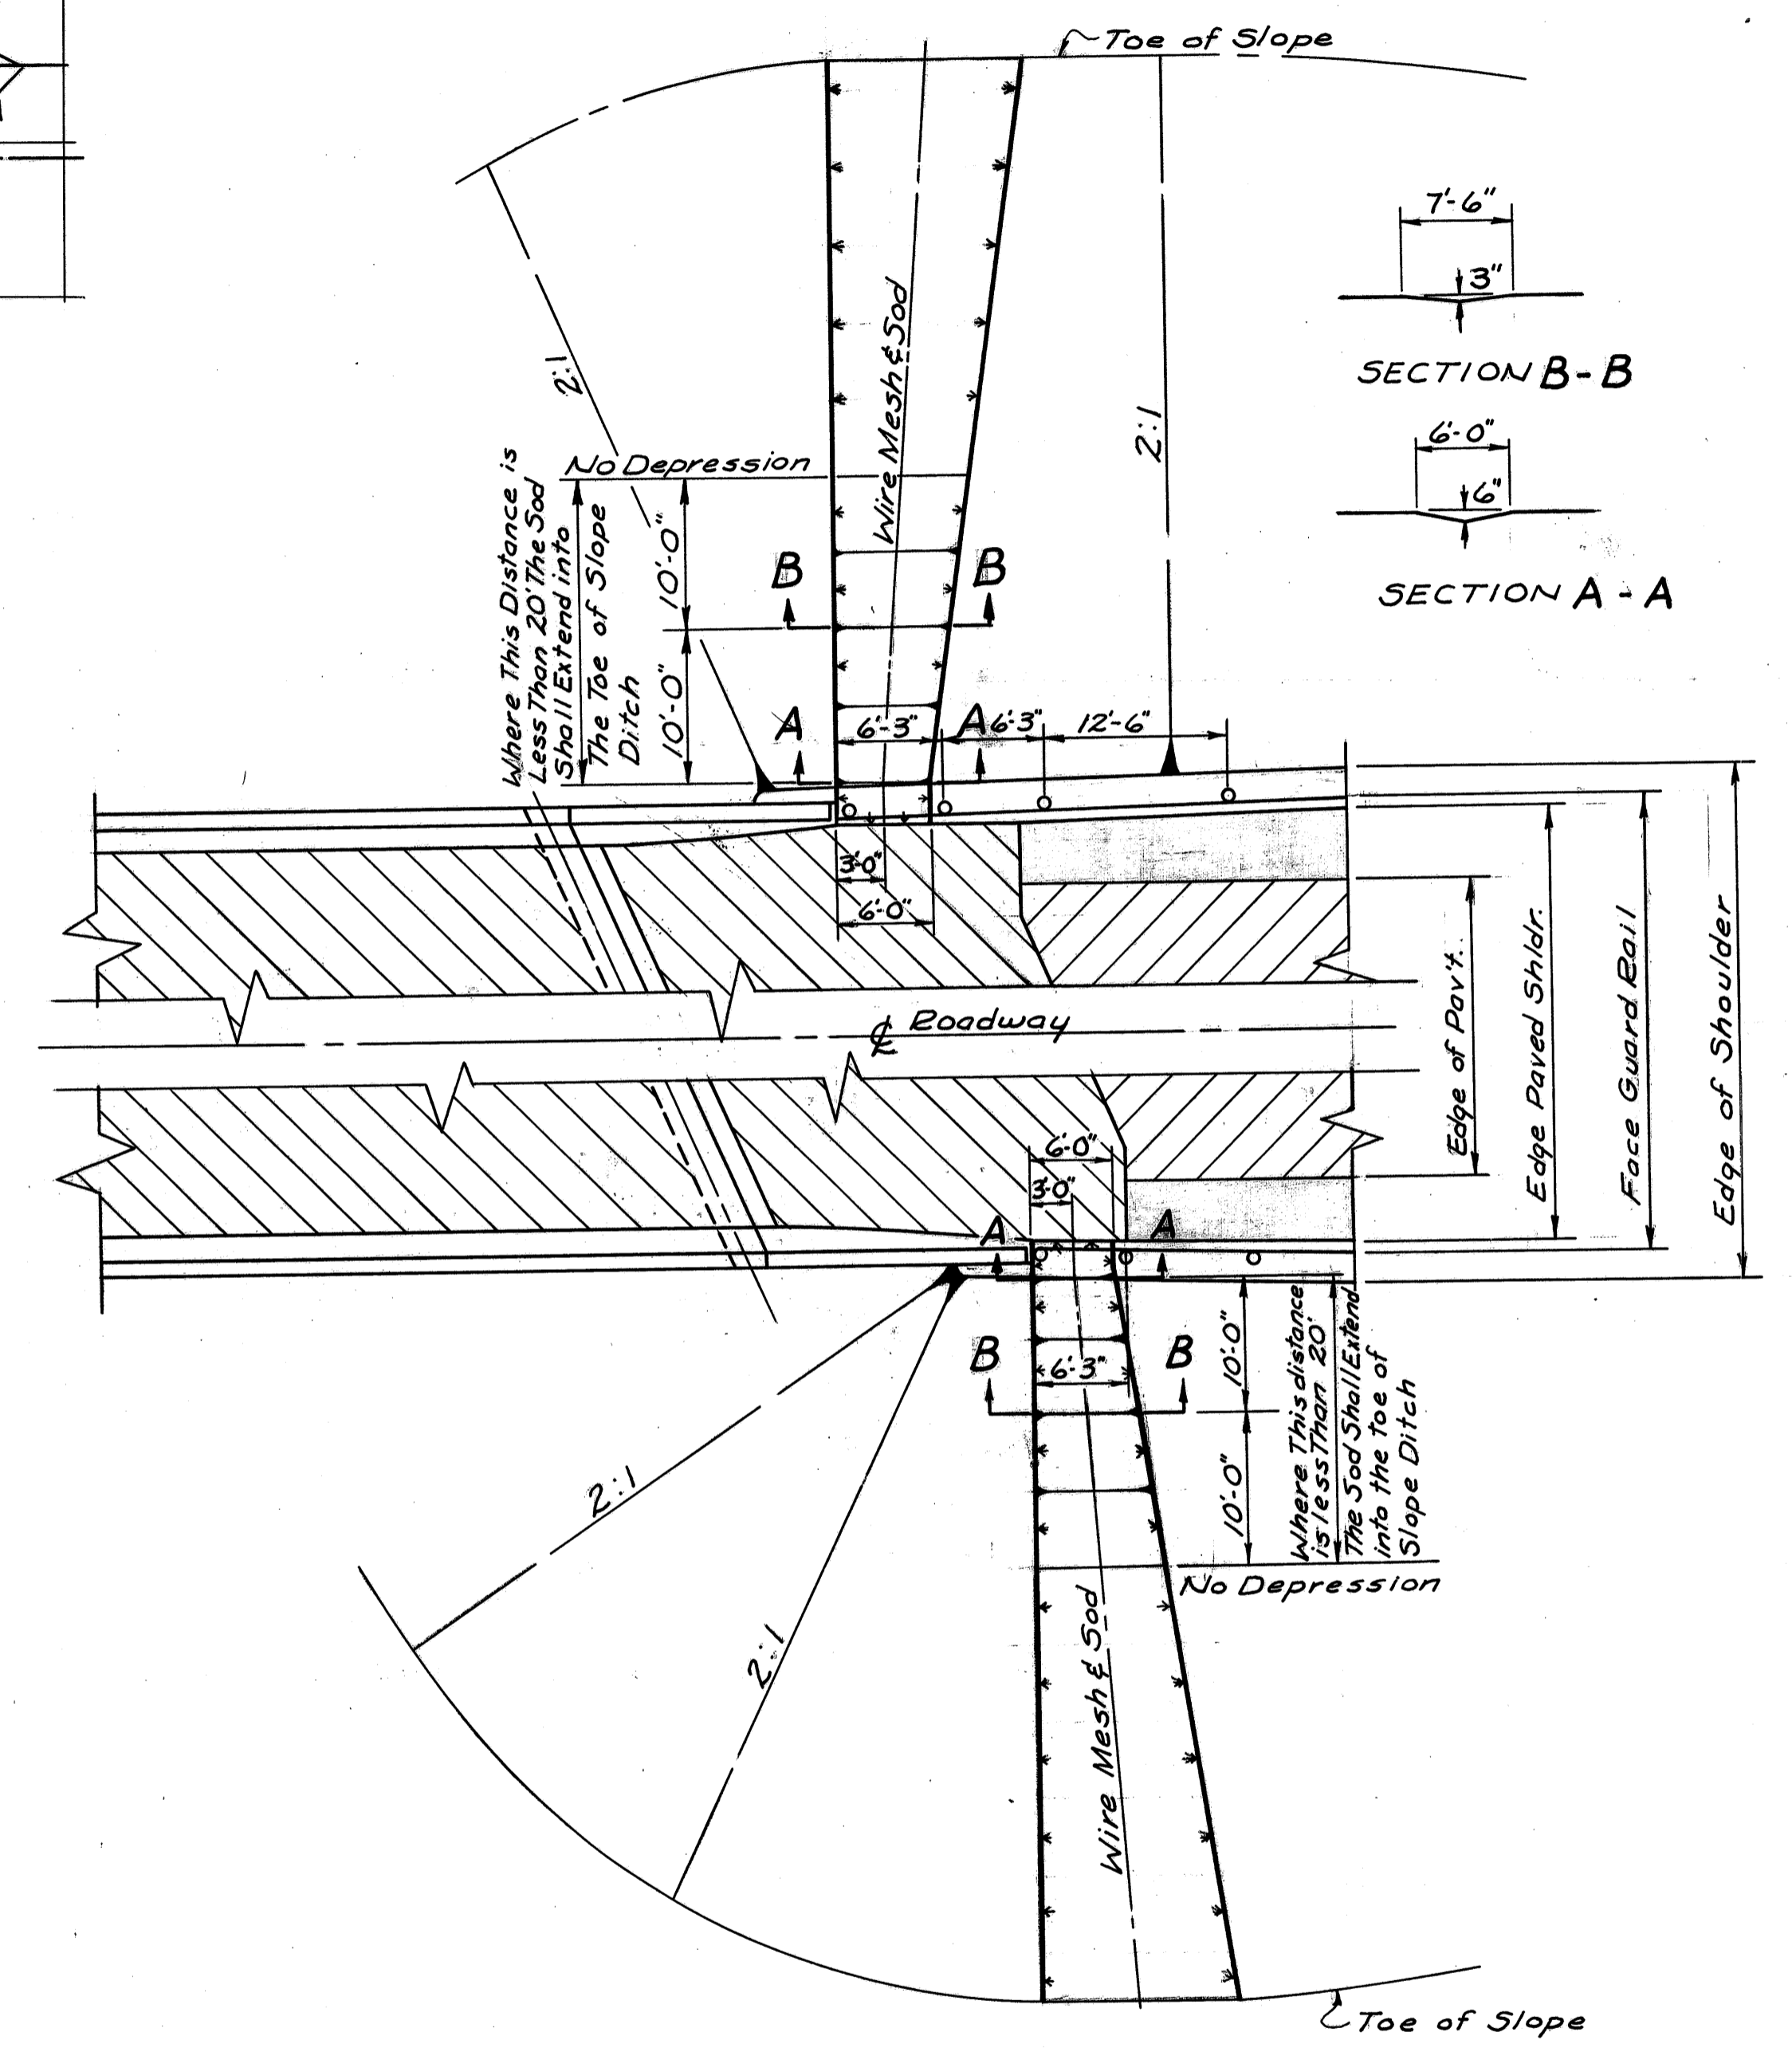

WAYNE COUNTY
WAY - 3 - 9.94

Scale: 1" = 20'

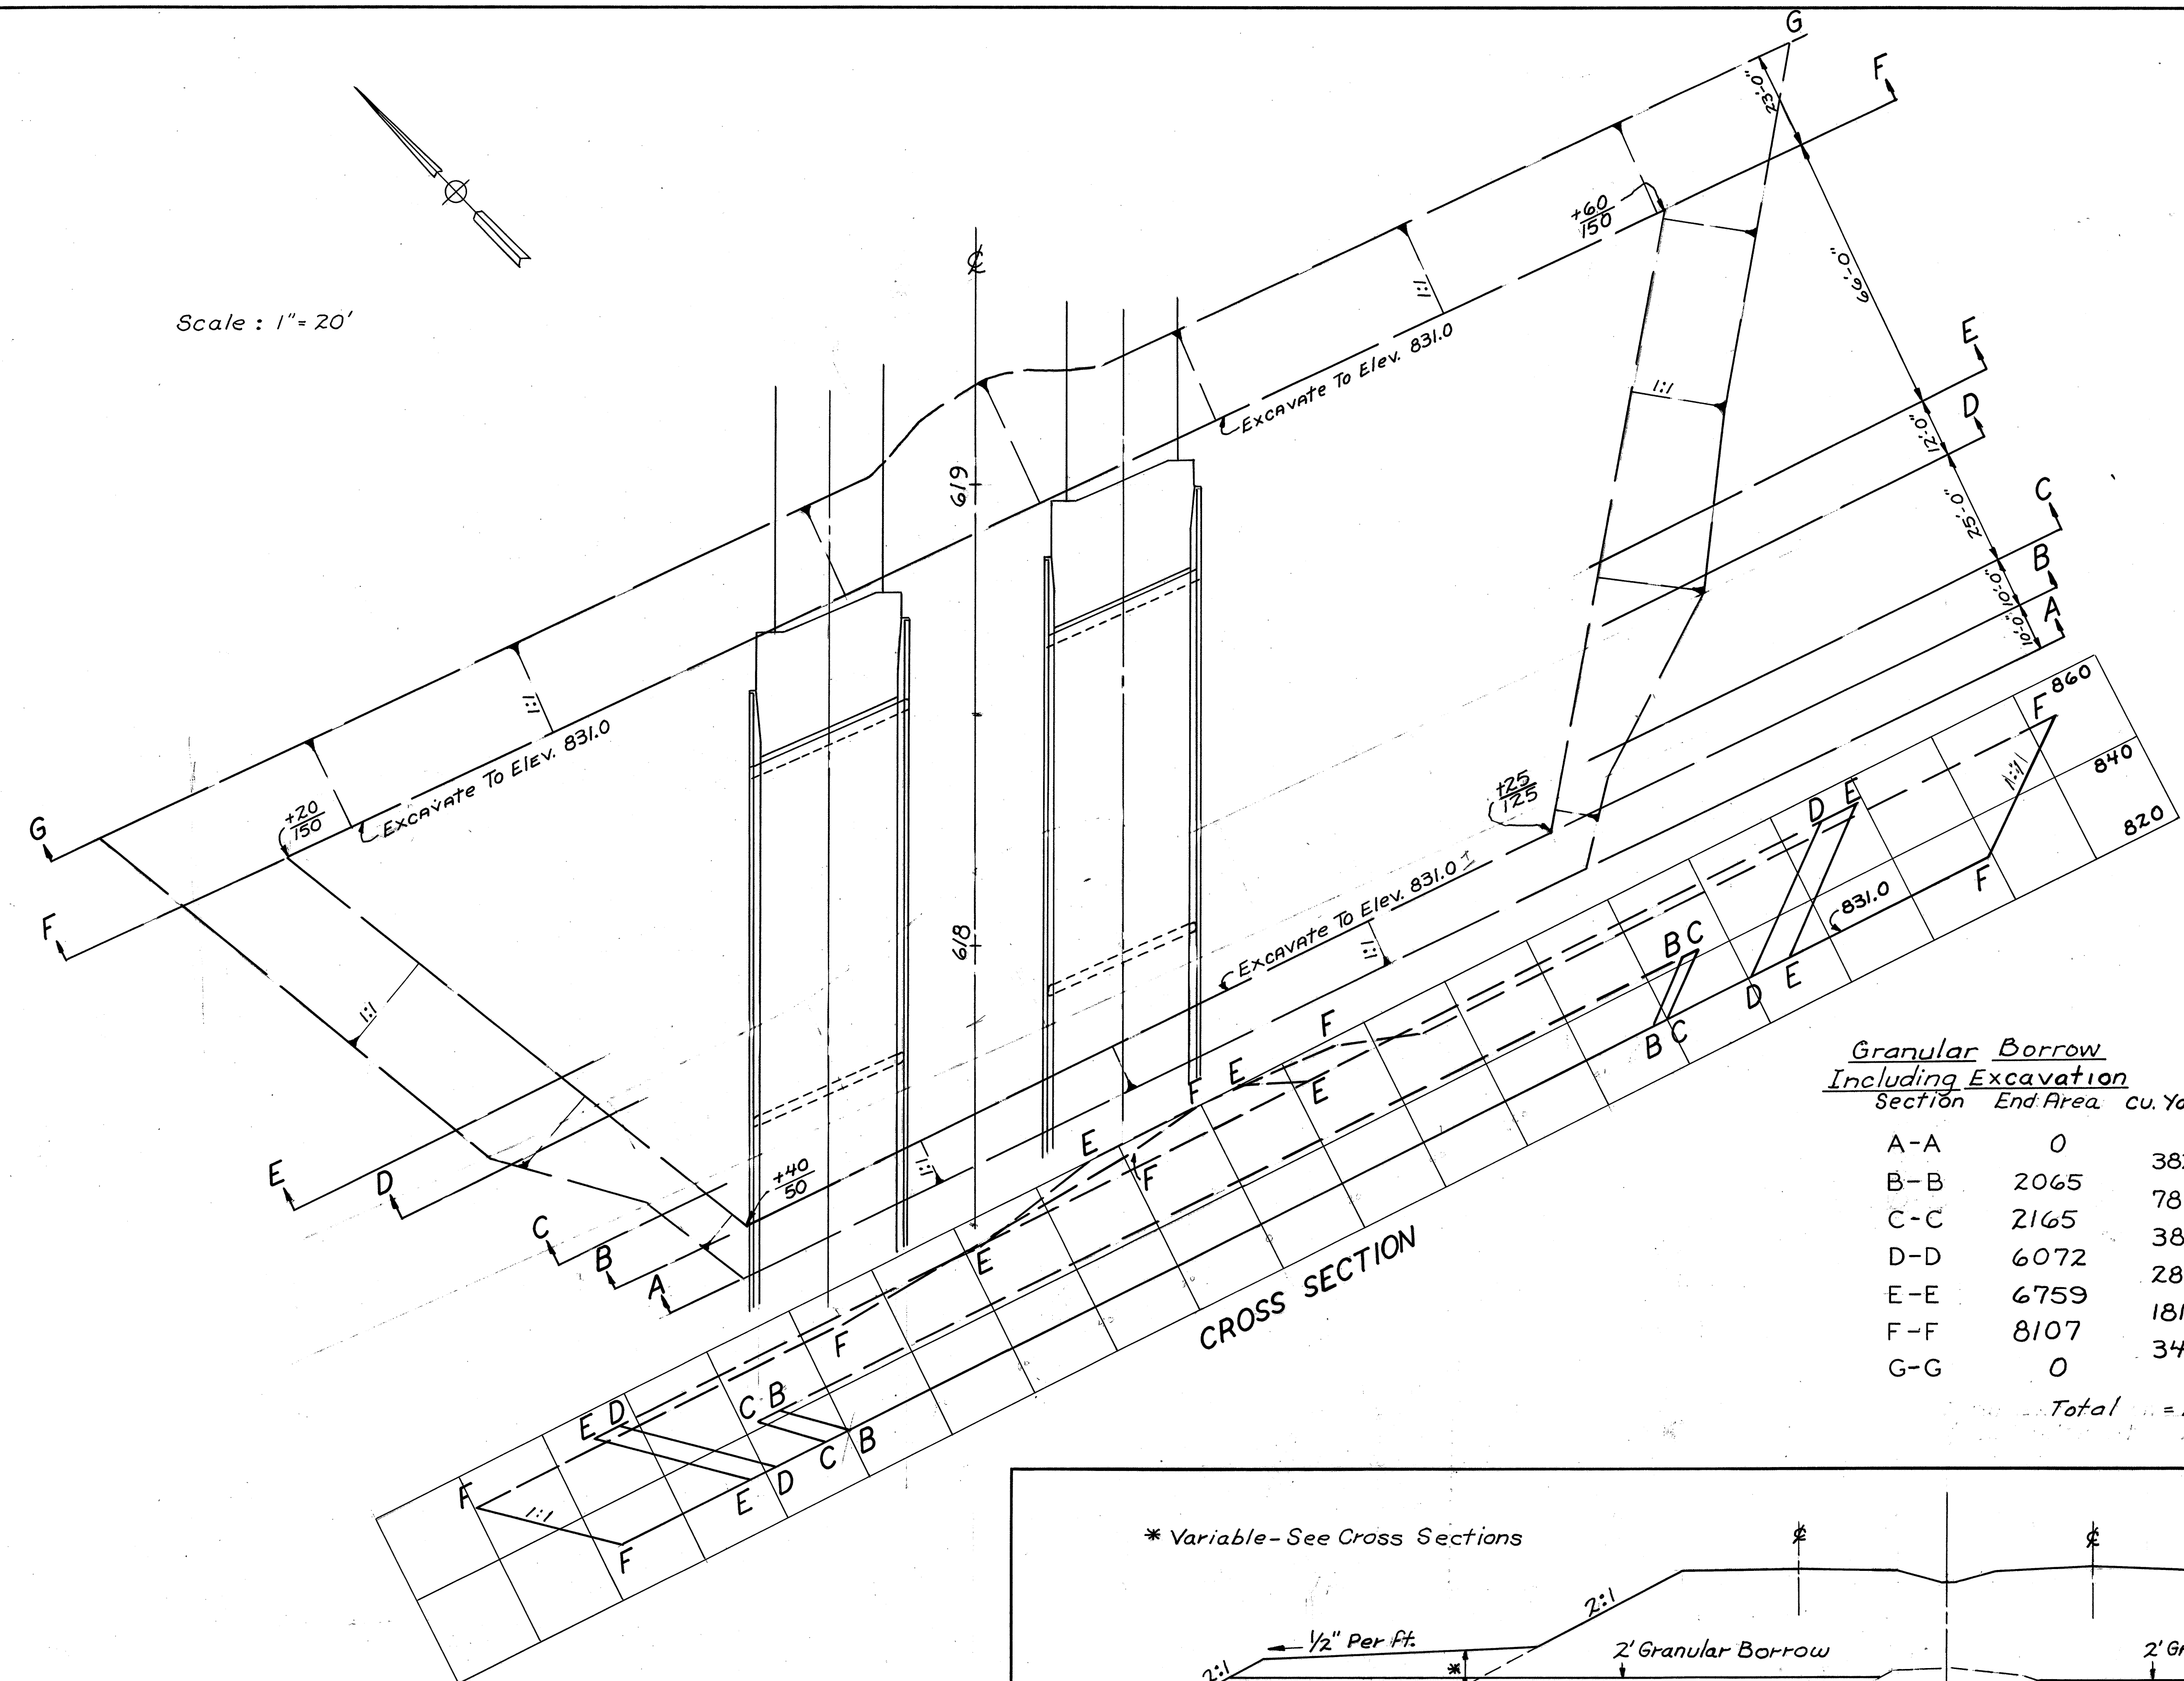


Note: Total Excavation of unsuitable material will be required in the vicinity of the forward abutment of the bridge over Killbuck Creek to the depth and limits as shown in this detail.
The space occupied by the excavated material shall be backfilled with Item E-4 Borrow Using Granular Material, as per plan, including the cost of excavation of the unsuitable material.
See General Notes on Sheet No. 12.

Granular Borrow Including Excavation		
Section	End Area	cu. Yards
A-A	0	382
B-B	2065	783
C-C	2165	3814
D-D	6072	2851
E-E	6759	18170
F-F	8107	3453
G-G	0	

Total = 29,453 Cu. Yd.

Backfill

E-4 Borrow Using Granular Material as per plan including the cost of excavation of the unsuitable material... 29,453 Cu. Yds.

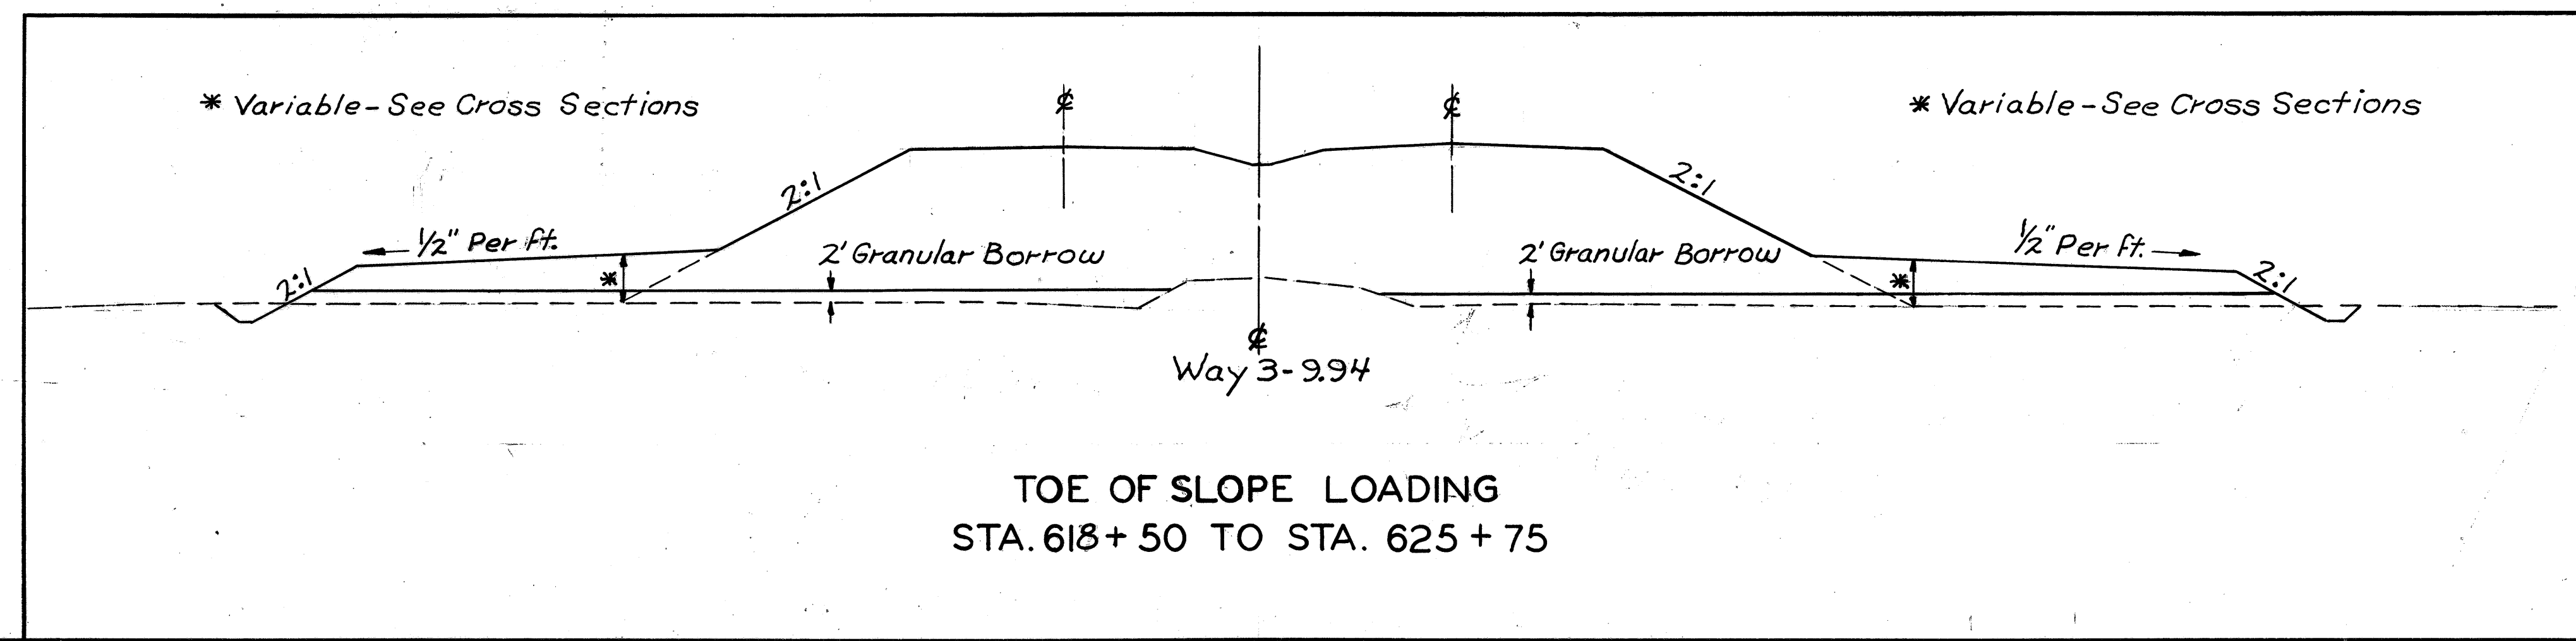


TOE OF SLOPE LOADING
STA. 618+50 TO STA. 625+75

**WAYNE COUNTY
WAY-3-9.94**


U-390 (9)
S.L.M. 9.94
**BEGIN PROJECT STA. 524+18 ON F.A.P. 390-F =
STA. 525+00 ON U-390 (9)**

Curve Data S.B. Lane
P.I. Sta. 529+10.00
 $\Delta = 11^\circ 41' 27''$
 $D = 1^\circ 29' 00''$
 $R = 3862.64'$
 $T = 395.46'$
 $L = 788.15'$
 $E = 20.19'$

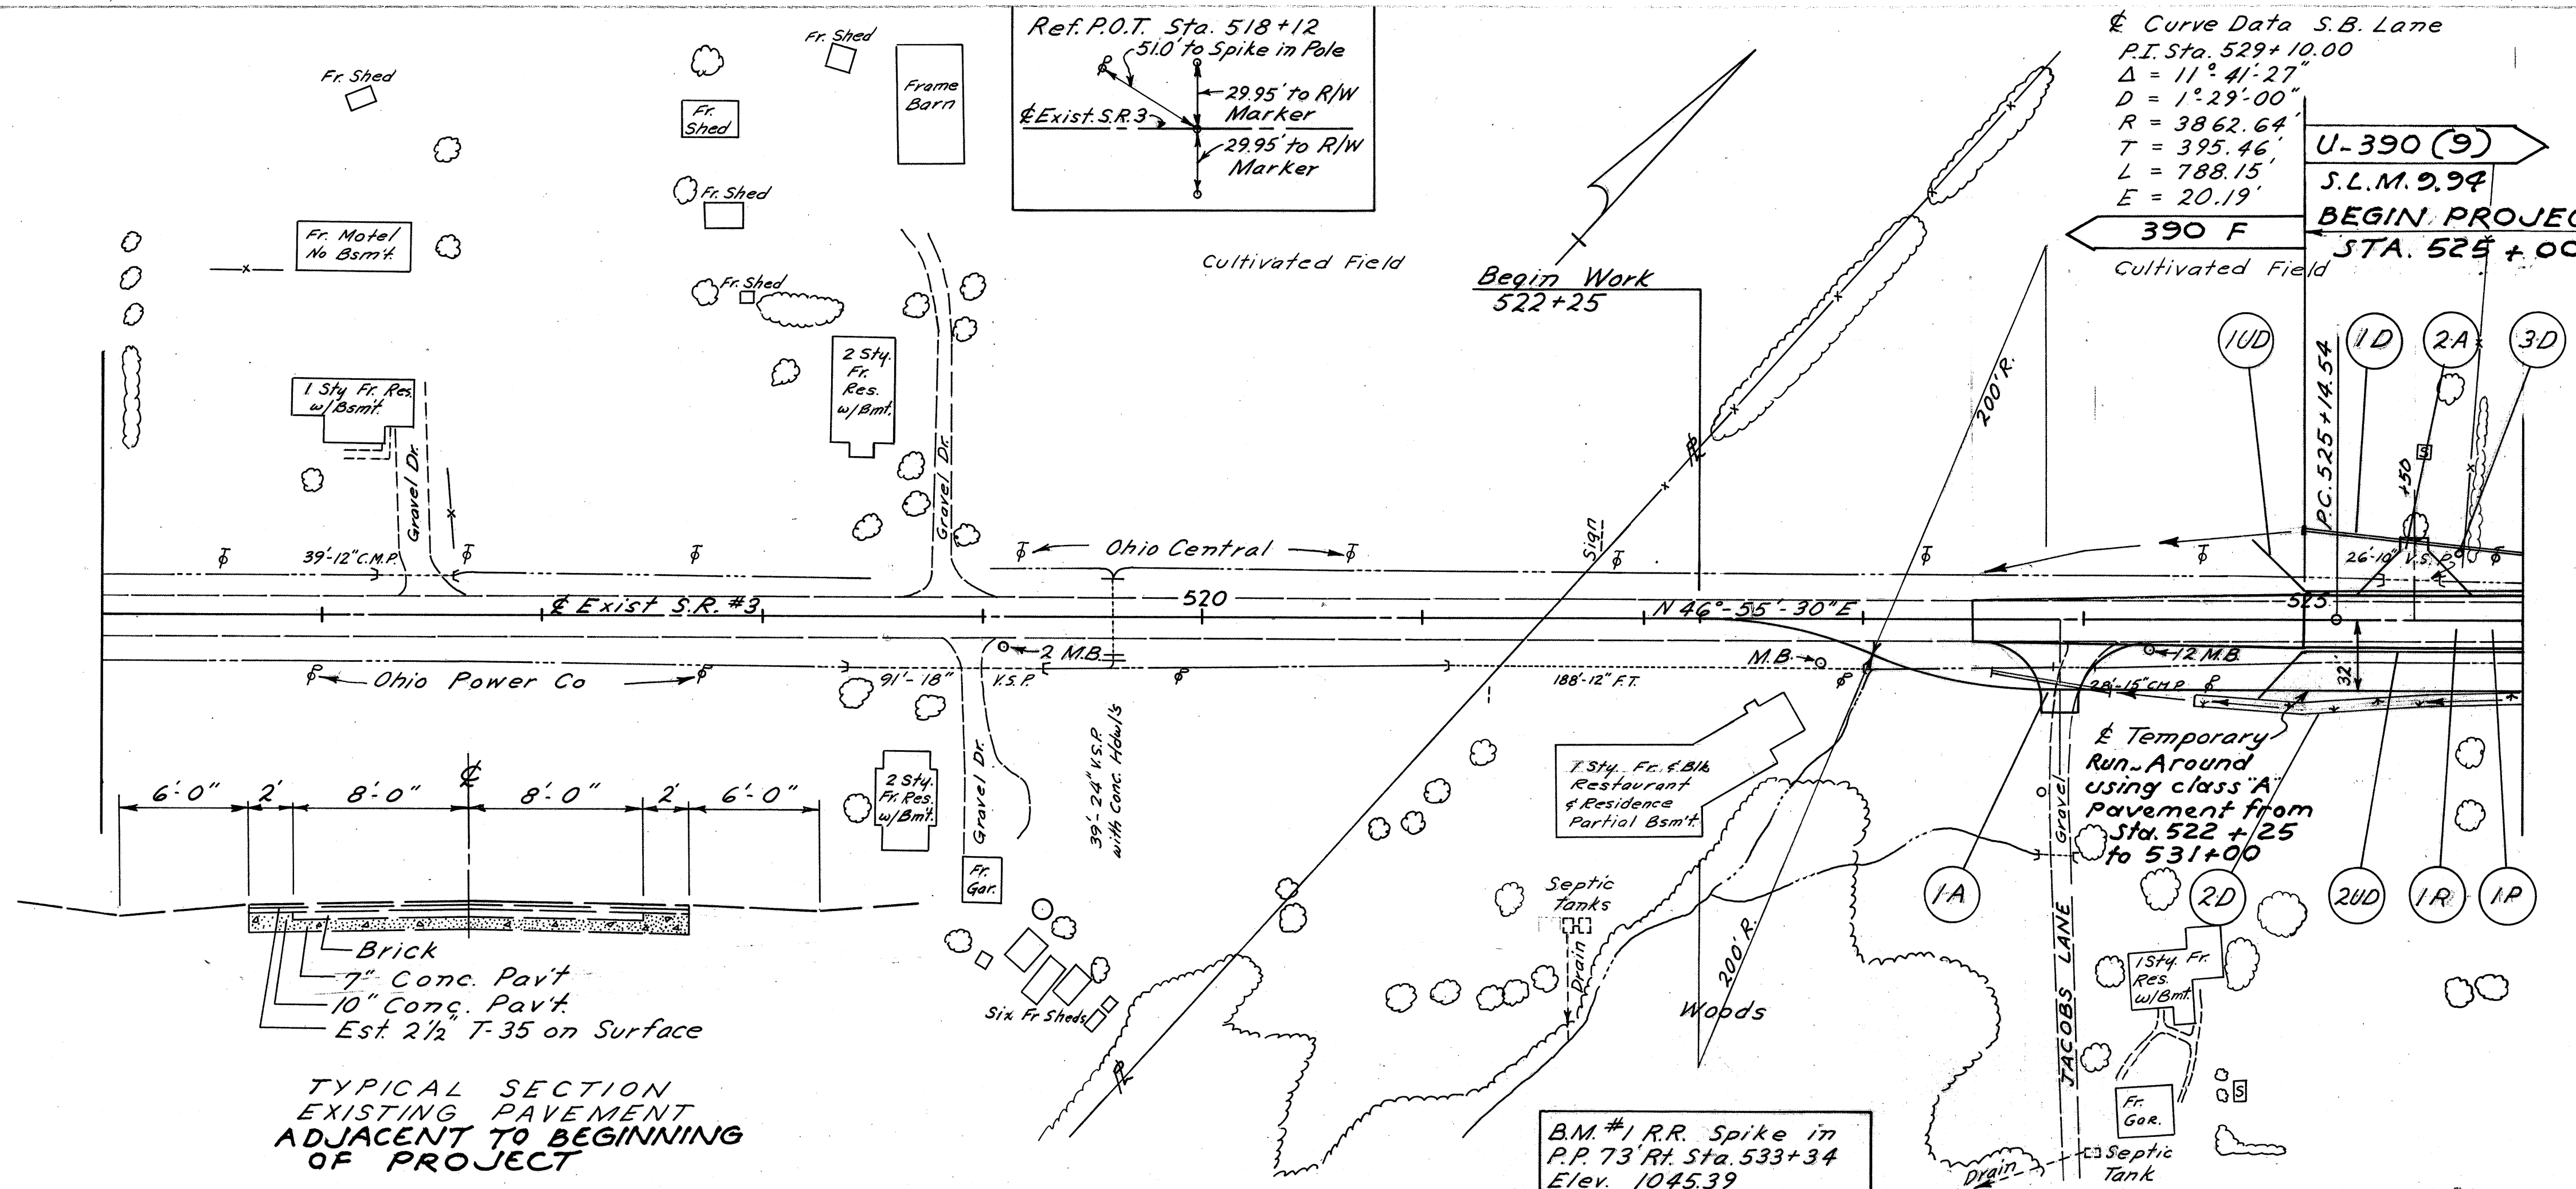

**TYPICAL SECTION
EXISTING PAVEMENT
ADJACENT TO BEGINNING
OF PROJECT**

Note: For Profile of Temporary Run-Around, See Sheet No. 94.

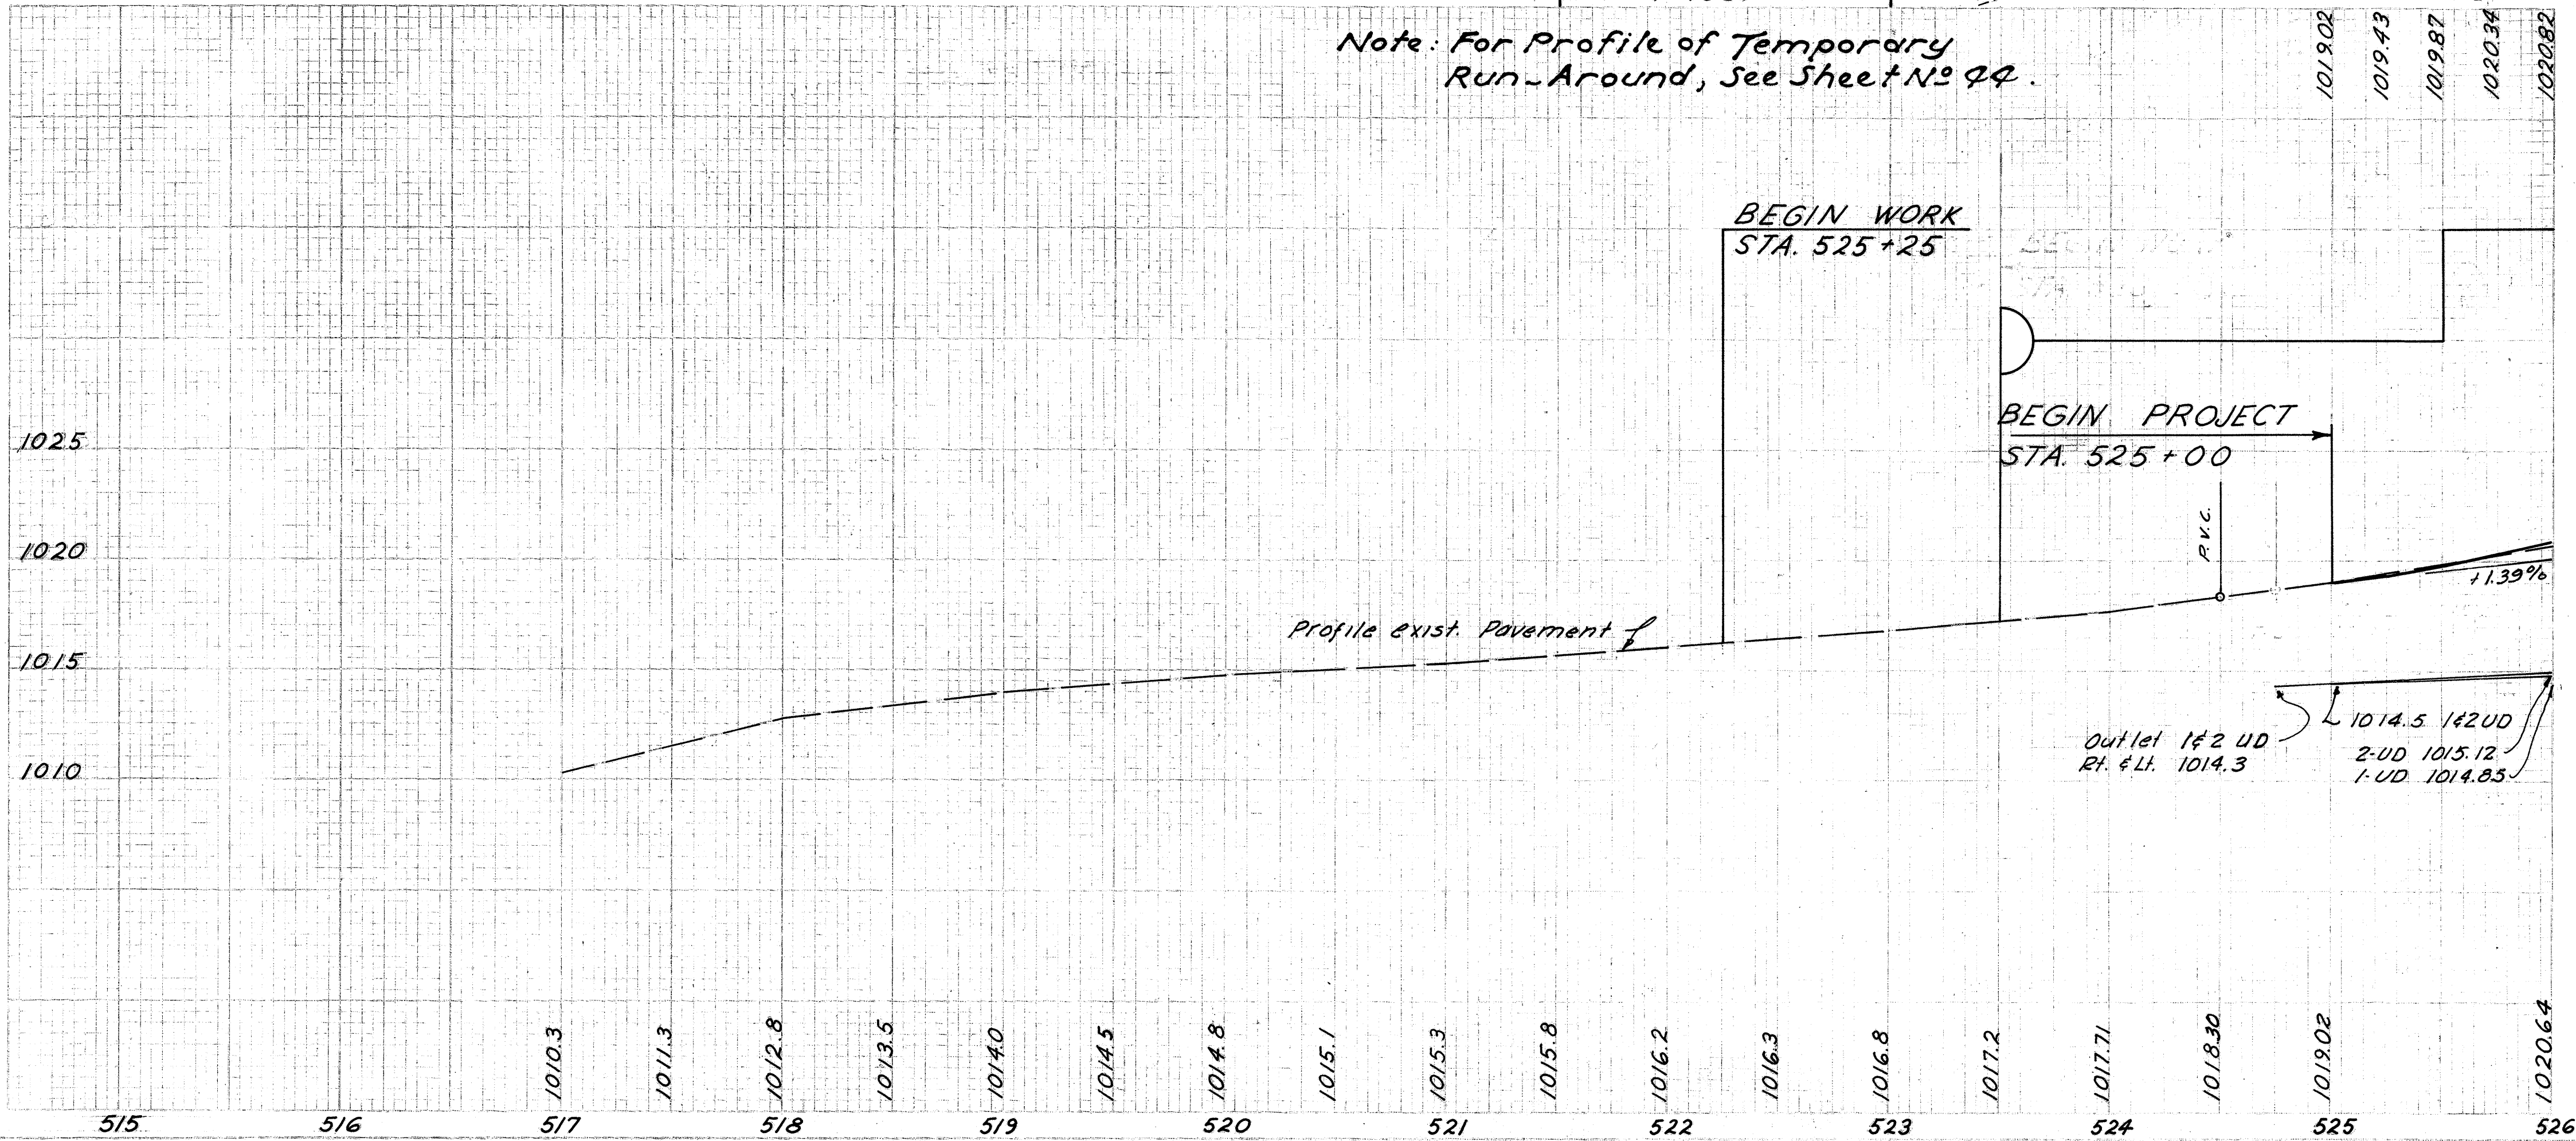

Item No.	Station	Side	L-10 Sodding		I-2 Storm Sewer		S-1	E-8	I-8	I-5
			Width	Lin. Ft.	Class	Under P't	Removal of Existing Pavement	Catch Basin No. 7	Pipe Special 12" Tee	
1-D	525+00	Lt.	12"	72	12"	24	0.23			
2-D	524+50	Rt.	6"	100						
3-D	525+70	Lt.		3					1	1
1-R	525+00						222			
Totals			100	75	24		0.23	222	1	1

Item No.	Station	Side	I-4		I-5
			6" Pipe Underdrain Deep	6" Pipe Outlet For Underdrain Bend	Pipe Special 45°
1UD	524+75	Lt.	125	10	1
2UD	524+75	Rt.	125	10	1
Totals			250	20	2

Item No.	Station	Side	B-19		T-35	I-1	E-12
			Crushed Aggregate Base Course	Asphaltic Concrete Surface Course	Pipe For Drives 15" Under	Pipe Removed 15" Under	
1-A	523+90	Rt.	16	31	18.77	5.03	54
2-A	525+50	Lt.		28	5.78		26
Totals				18.77	5.78	5.03	54

For Pavement Quantities See Sheet No. 25

Ref. P.O.T. Sta. 526+06
Spike in P
34.95'
300' to R/W
Marker
Exist SR.3
Spike in P
29.66'

Ref. P.C. Sta. 529+56.08
81.25' to N.W.
Cor. of Chimney
Way-3
Exist SR.3
72.10' to Spike
in 24" Oak
59.50' to Spike
in Pole


Ref. P.O.C. Sta. 532+73.17
Way-3
28.47' to 90°
10.96' to Tan
Exist SR.3
89.57'
66.60'
Distance to Spike in Poles

For Pavement Quantities
See Sheet No. 25
For Intersection Details
See Sheet No. 38
For Storm Sewer Details
See Sheet No. 129


Curve Data & Survey Way-3
P.I. Sta. 539+92.09
 $\Delta = 25^\circ 28' 20''$
 $D = 1^\circ 15' 00''$
 $R = 4583.66'$
 $L = 2037.78'$
 $T = 1036.01'$
 $E = 115.62'$

See Sheet 38 For Driveway
Details Not Standard

WAYNE COUNTY
WAY-3-9.94

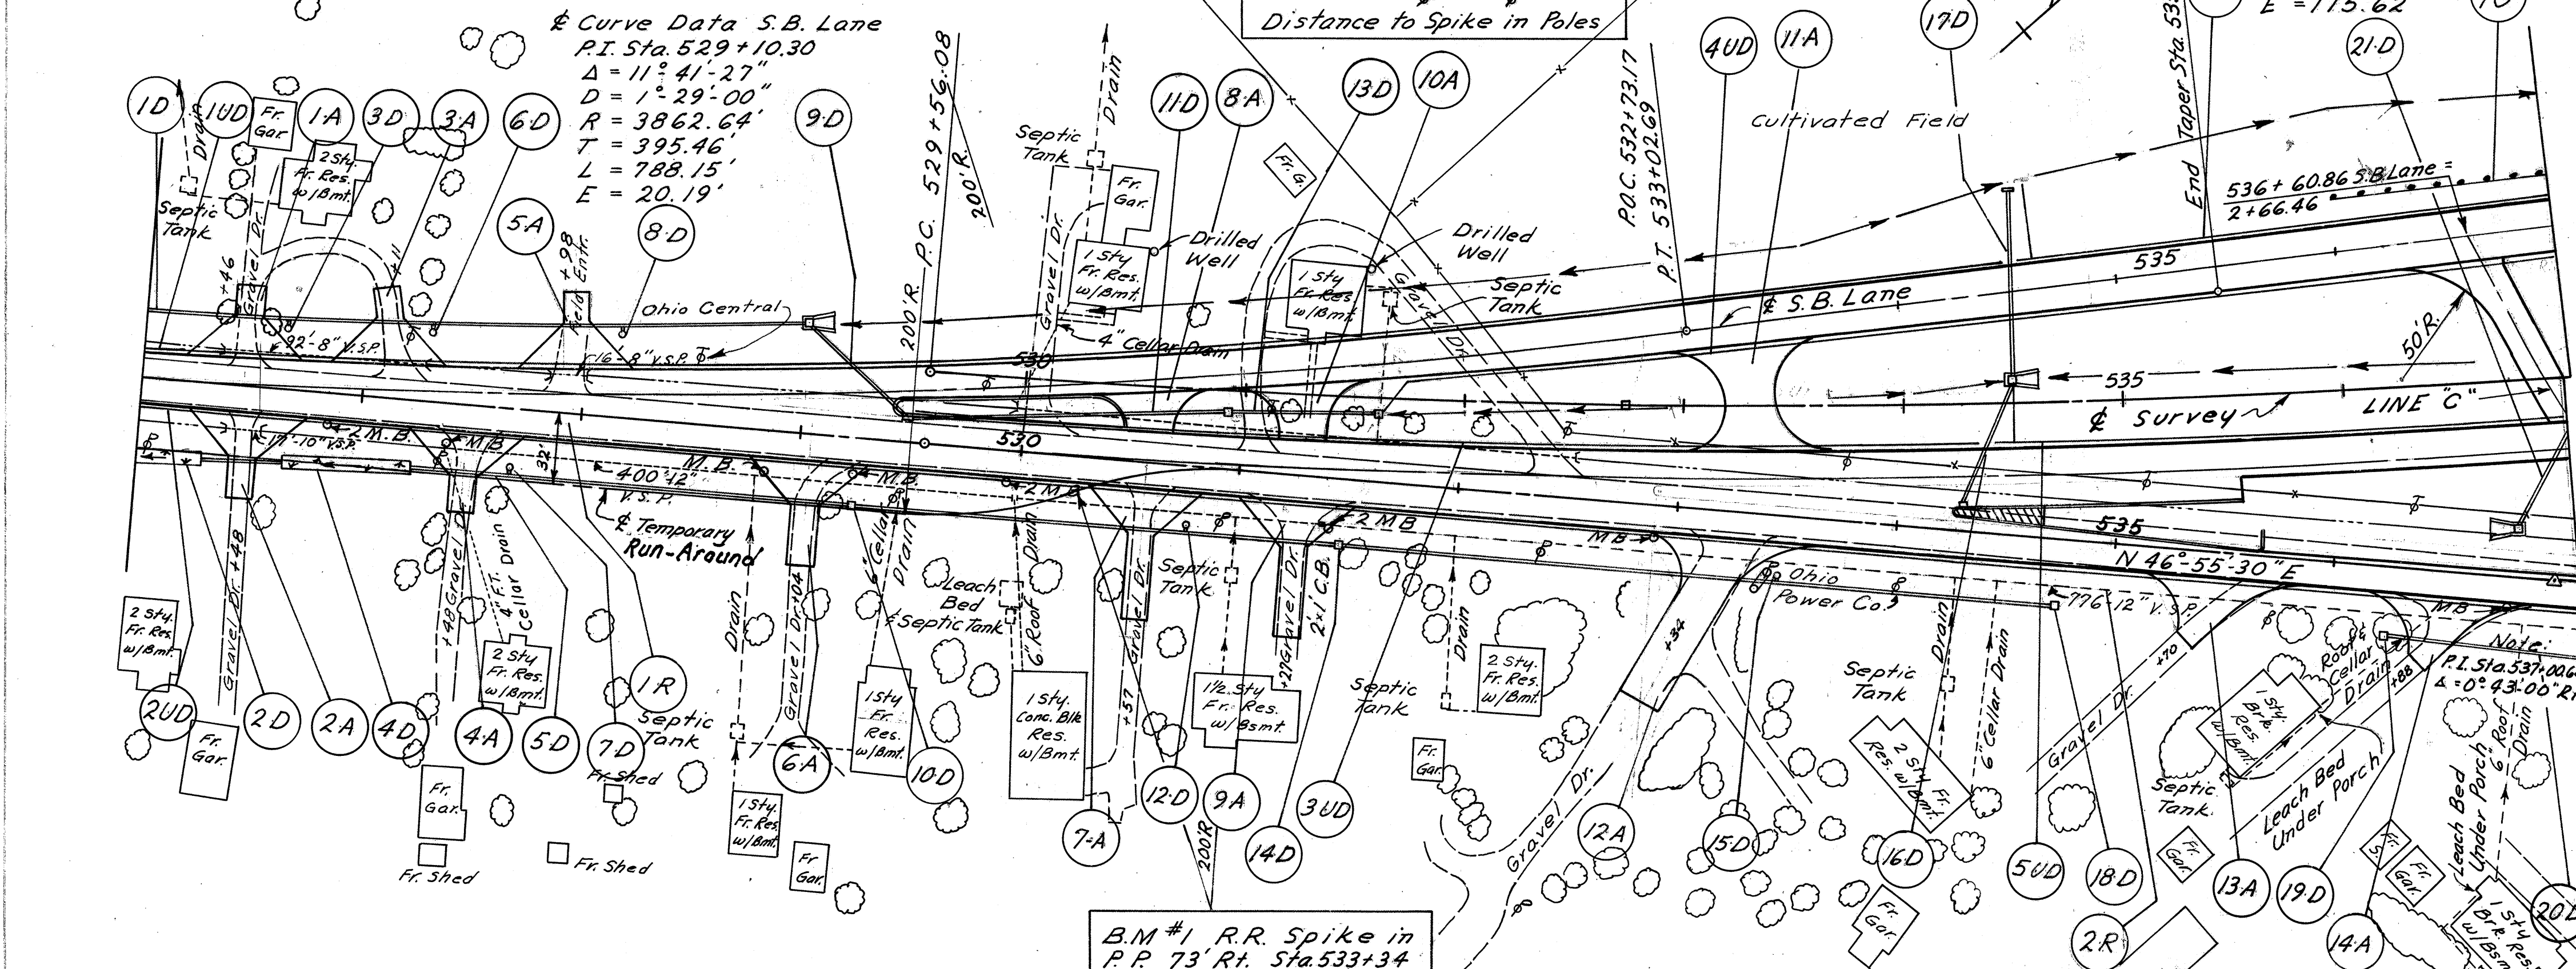

Item No.	Station	Side	L-10 Sodding		I-8 Catch Basins		I-3 Roadway Drainage		I-3 Outlet for Rdw. Drain		I-14 Paved Gutter Special		I-2 Storm Sewer		S-1 Conc. Pipe		I-5 Conc. Pipe			
			Width	So. Yds.	No. 7	No. 2-2A	No. 6	No. 2-2B	Lin. Ft.	Lin. Ft.	Lin. Ft.	Lin. Ft.	Lin. Ft.	Lin. Ft.	Lin. Ft.	Lin. Ft.	Lin. Ft.	Lin. Ft.	Lin. Ft.	
1-D	526+00	529+00	Lt.																	
2-D	526+00	526+30	Rt.	6	20															
3-D	526+65		Lt.																	
4-D	526+66	527+25	Rt.	6	40															
5-D	527+25	534+75	Rt.					580	144	10								3		
6-D	527+30		Lt.																	
7-D	527+70		Lt.																	
8-D	528+15		Lt.																	
9-D	529+00	529+50	Lt.	1.5	6								10					62		
10-D	529+25		Rt.																	
11-D	529+50	530+93	Ctr.															142		
12-D	530+78		Rt.																	
13-D	530+93	531+60	Ctr.															66		
14-D	531+50		Rt.																	
15-D	533+48		Rt.																	
16-D	534+26	534+50	Ctr.															60		
17-D	534+50		Lt.	1.5	6								10					86 0.28		
18-D	534+75		Rt.																	
19-D	536+25		Rt.																	
20-D	536+25	537+00	Rt.																	
21-D	536+75	537+25	Ctr.	1.5	6													95		
Totals								78	6	3	2	6	630	178	10	30	225	497	86 0.28	6

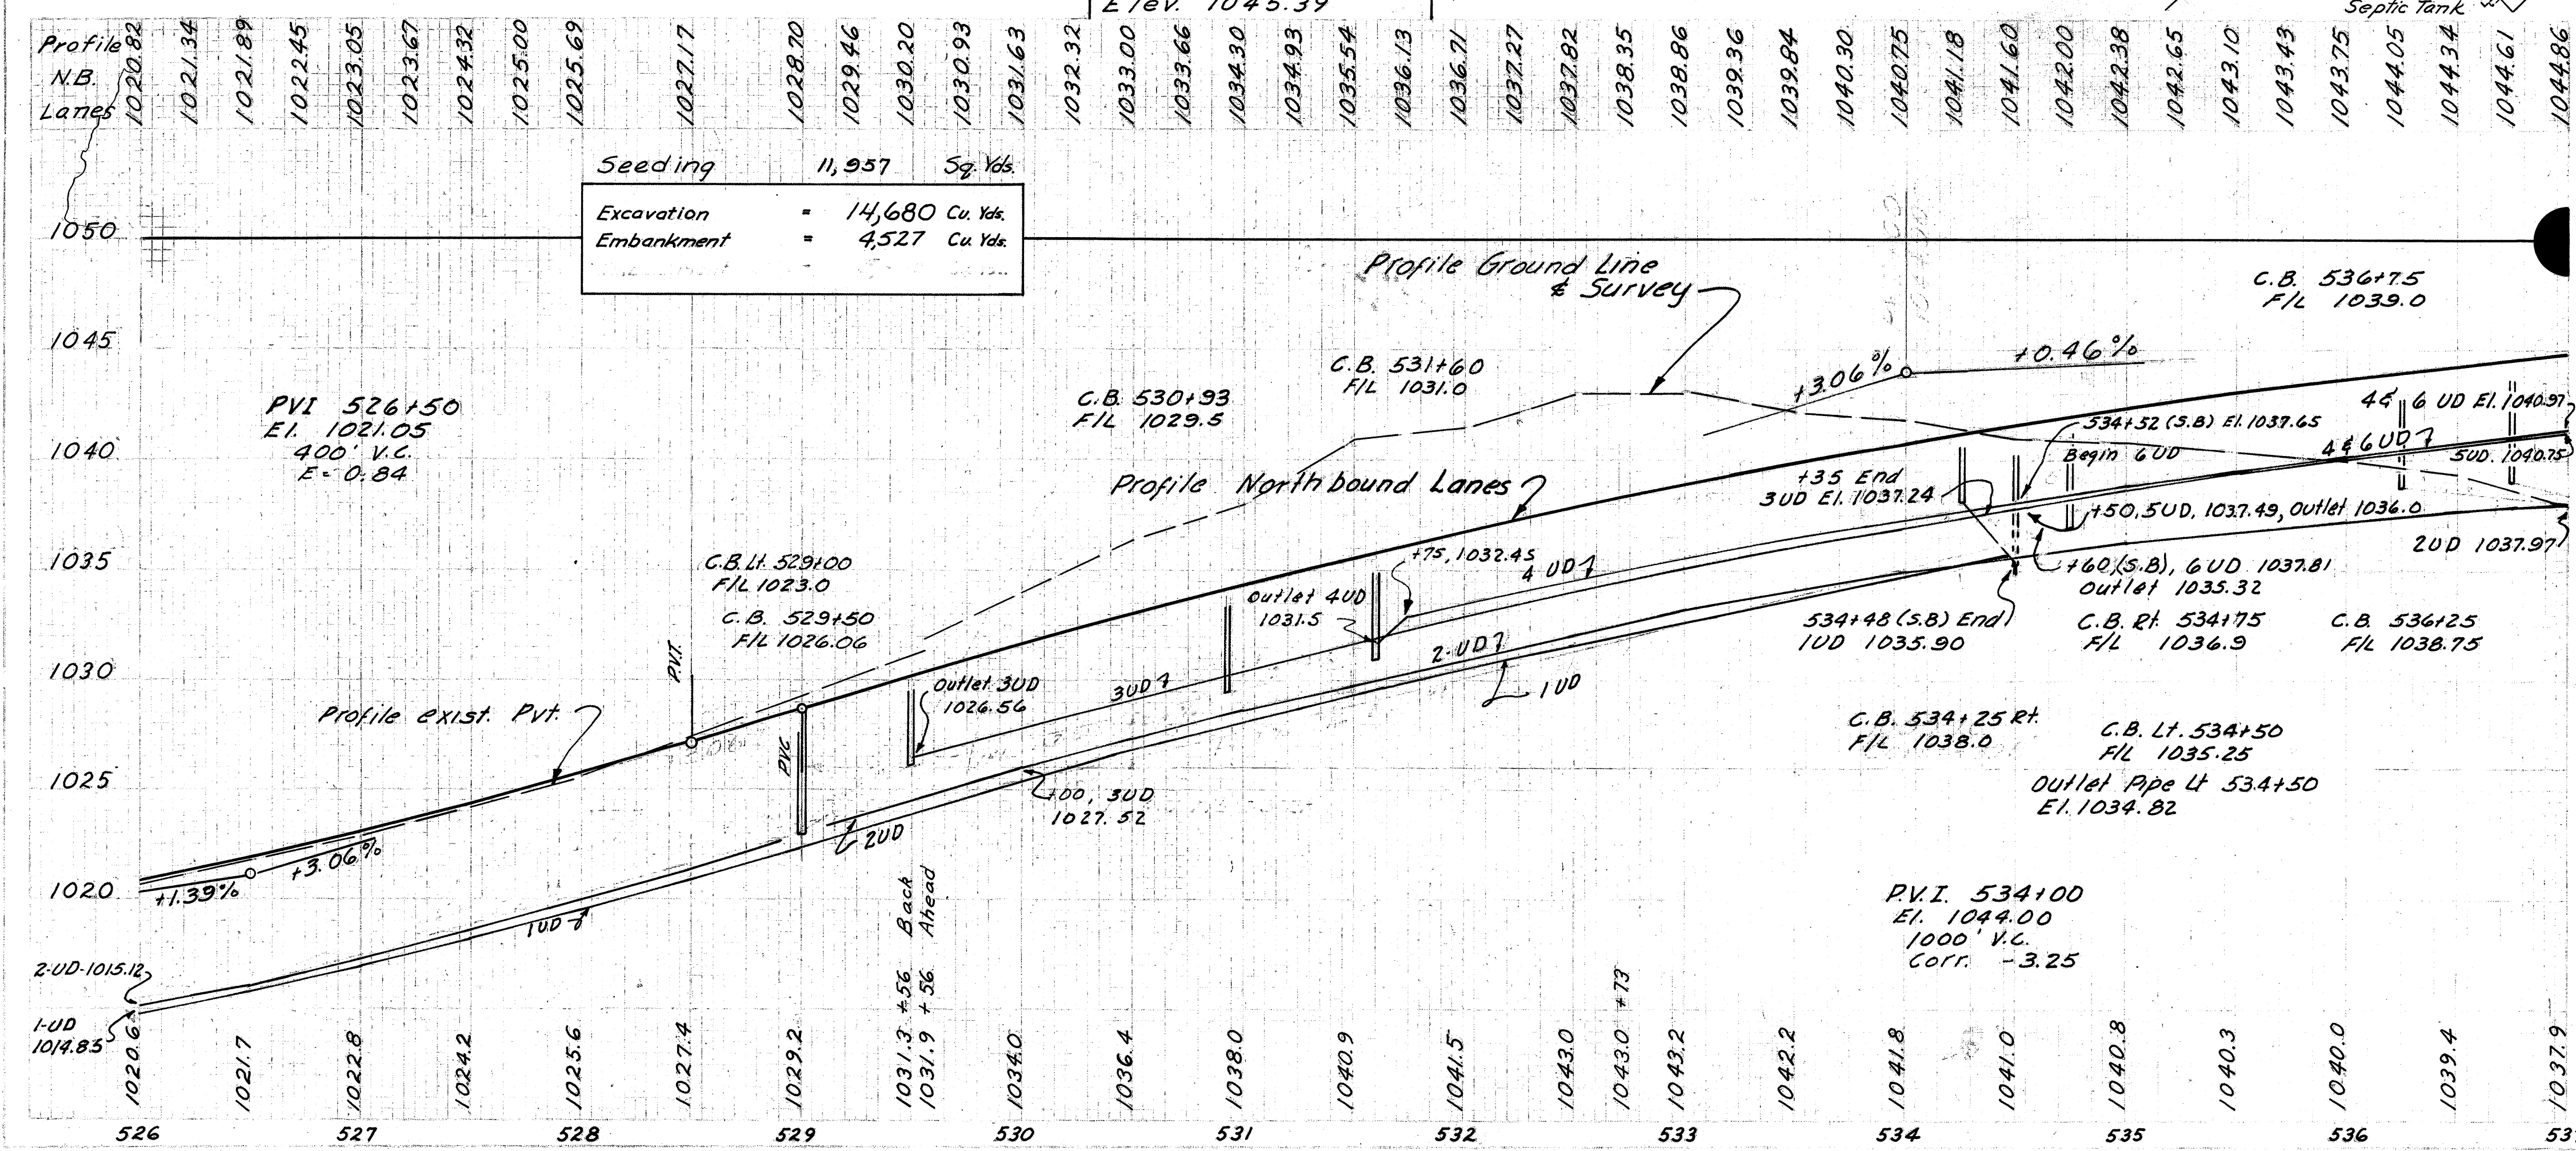


Item No.	Station	Side	I-4 6" Pipe Underdrain Shallow		I-4 6" Pipe Underdrain Deep		I-4 6" Pipe Outlet For Underdrain 45° Bend		I-5 Pipe Specials		I-15 Guard Rail Steel Beam Type Deep	
			Lin. Ft.	Lin. Ft.	Lin. Ft.	Lin. Ft.	Ea.	Ea.	Lin. Ft.	Lin. Ft.		
1UD	526+00	534+48	Lt.									
2UD	526+00	537+00	Rt.									
3UD	529+50	534+35	Rt.									
4UD	531+60	537+00	Lt.									
5UD	534+40	537+00	Rt.									
6UD	534+52	537+00	Lt.									
Totals												

Item No.	Station	Side	Skew		B-19 Crushed Aggregate Base Course		T-35 Asphaltic Concrete Base Course		I-1 Pipe For Drives		E-12 Pipe Removed 15' Underfoot		E-8 Removal & Disposal of Existing	
			Width	Length	7"	5"	6"	2"	12"	Lin. Ft.	Lin. Ft.	Lin. Ft.	Seq. Yds.	
1-A	526+46	Lt.	33											
2-A	526+48	Rt.	38											
3-A	527+11	Lt.	28											
4-A	527+48	Rt.	38											
5-A	527+98	Lt.	32											
6-A	529+04	Rt.	48											
7-A	530+57	Rt.	60											
8-A	530+57	Ctr.												
9-A	531+27	Rt.	65											
10-A	531+27	Ctr.												
11-A	533+30	Ctr.												
12-A	533+34	Rt.	20	88	24									
13-A	535+70	Rt.	41	45										
14-A	536+88	Rt.	43	45										
Totals														

Sta. 526+00 to Sta. 537+00


Curve Data S.B. Lane
 P.I. Sta. 529+10.00
 $\Delta = 11^\circ 41' 27''$
 $D = 1^\circ 29' 00''$
 $R = 3862.64'$
 $T = 395.46'$
 $L = 788.15'$
 $E = 20.19'$

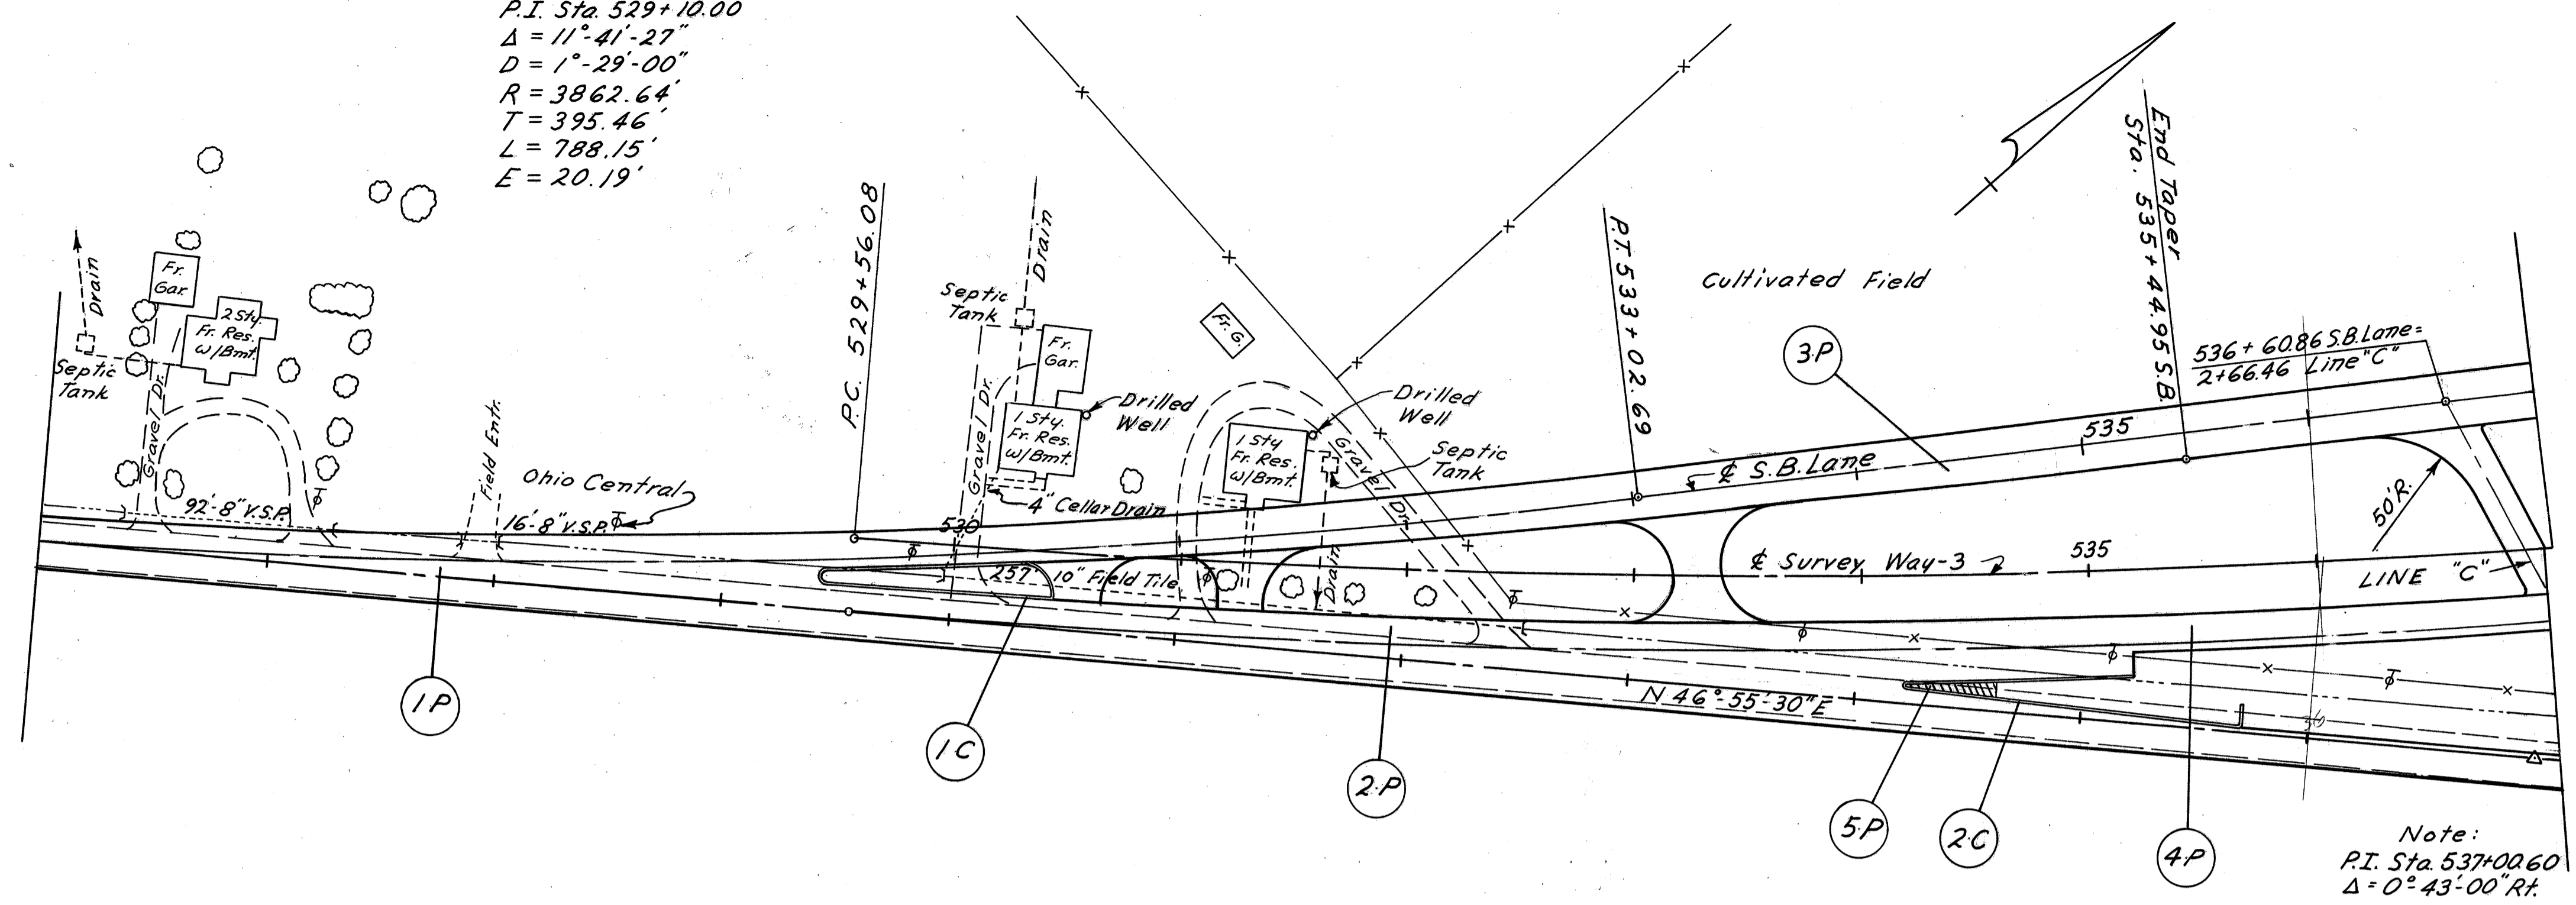

Note:
 P.I. Sta. 537+00.60
 $\Delta = 0^\circ 43' 00''$ Rt.


Curve Data & Survey Way-3
 P.I. 539+92.09
 $\Delta = 25^\circ 28' 20''$
 $D = 1^\circ 15' 00''$
 $R = 4583.66'$
 $L = 2037.78'$
 $T = 1036.01'$
 $E = 115.62'$

BM #1 R.R. Spike in
 P.P. 73' Rt. Sta. 533+34
 Elev. 1045.39

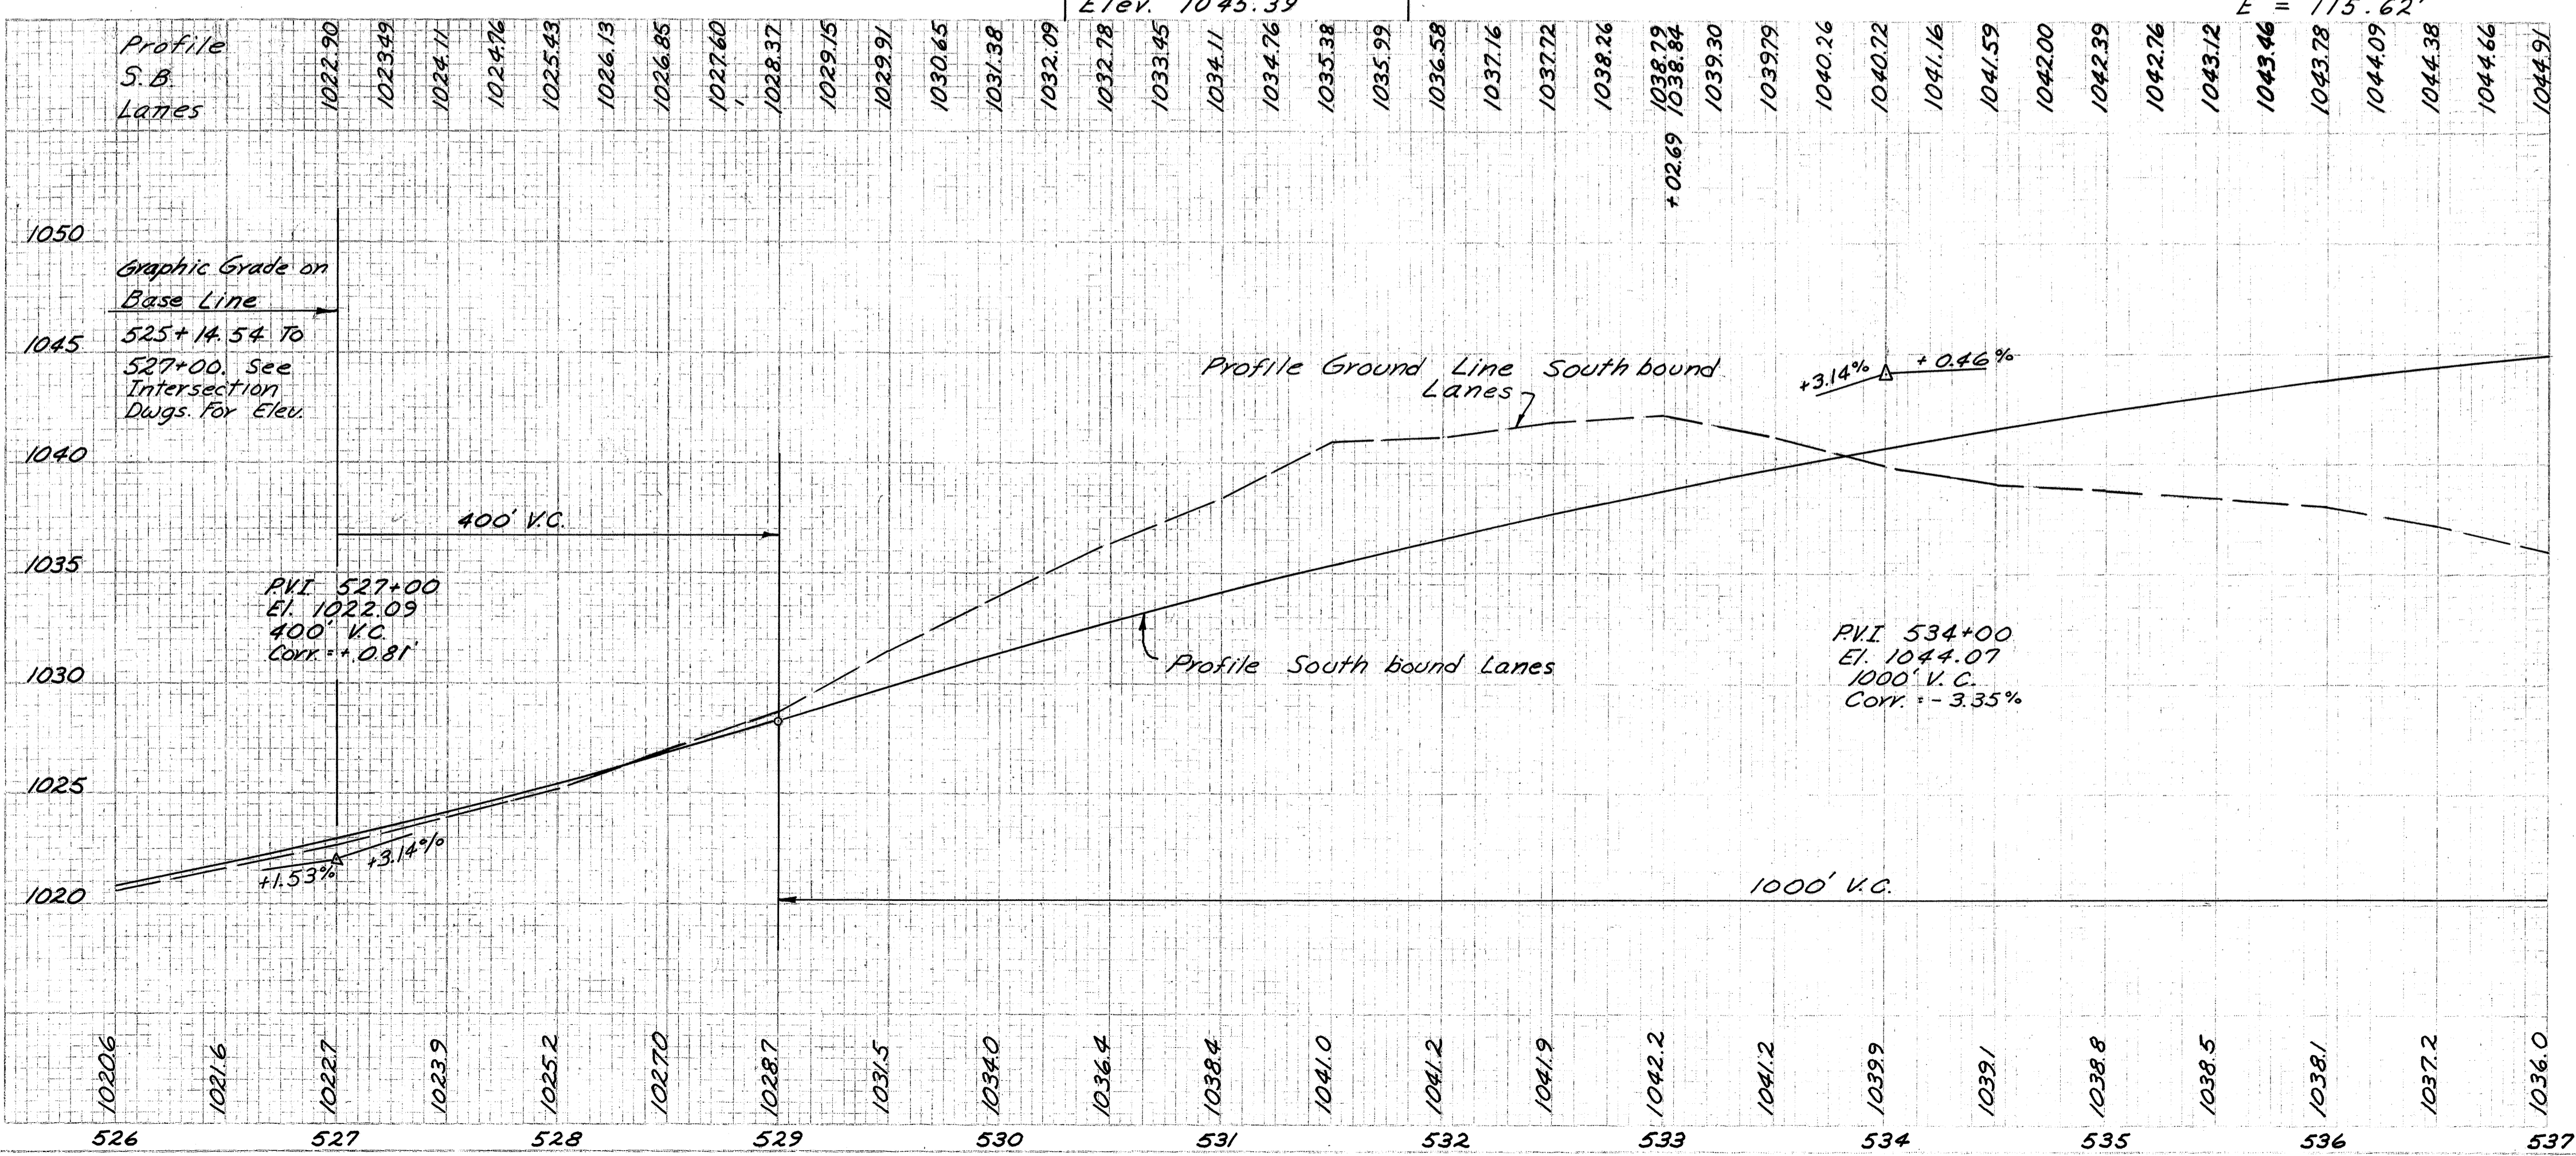


Item No.	Station	Side		Material	Sp. Yd.	Cu. Yd.	Gals.	Notes
		From	To					
I-23				Traffic Dividers				Each
I-12				Concrete Curbs				Lim Ft.
I-21				P.C. Concrete Median Part				Sp. Yd.
T-31				No. 46 Aggregate				Cu. Yd.
B-33				Bit. Material				Gal.
I-18				Stabilized Gravel				Cu. Yd.
I-22				Subbase				Cu. Yd.
B-20				Waterbound Mac. Base				Sp. Yd.
T-30				Bituminous Prime Coat				Gal.
B-35				Asphaltic Conc. Base Course				Cu. Yd.
B-35				Asphaltic Conc. Base Course				Cu. Yd.
T-35				Asphaltic Conc. Surface Course				Cu. Yd.
1-P	525+00 to 529+484			Asphaltic Conc. Surface Course	54.29	132.34	635.33	1835.46
2-P	529+484 to 534+2290 N.B.			Asphaltic Conc. Surface Course	59.09	143.81	690.33	1965.55
3-P	529+484 to 537+00 S.B.			Asphaltic Conc. Surface Course	58.31	143.22	687.74	2086.25
4-P	534+2290 to 537+00 N.B.			Asphaltic Conc. Surface Course	22.16	54.19	260.13	735.80
5-P	534+21 to 534+61			Asphaltic Conc. Surface Course				
1-C	529+40 to 530+47			Concrete				
2-C	534+23 to 535+50			Concrete				
Totals					193.85	473.56	2273.53	6623.06
						24.72	1545.80	24.52
								228.65
								284.43
								573.09

**WAYNE COUNTY
WAY-3-9.94**

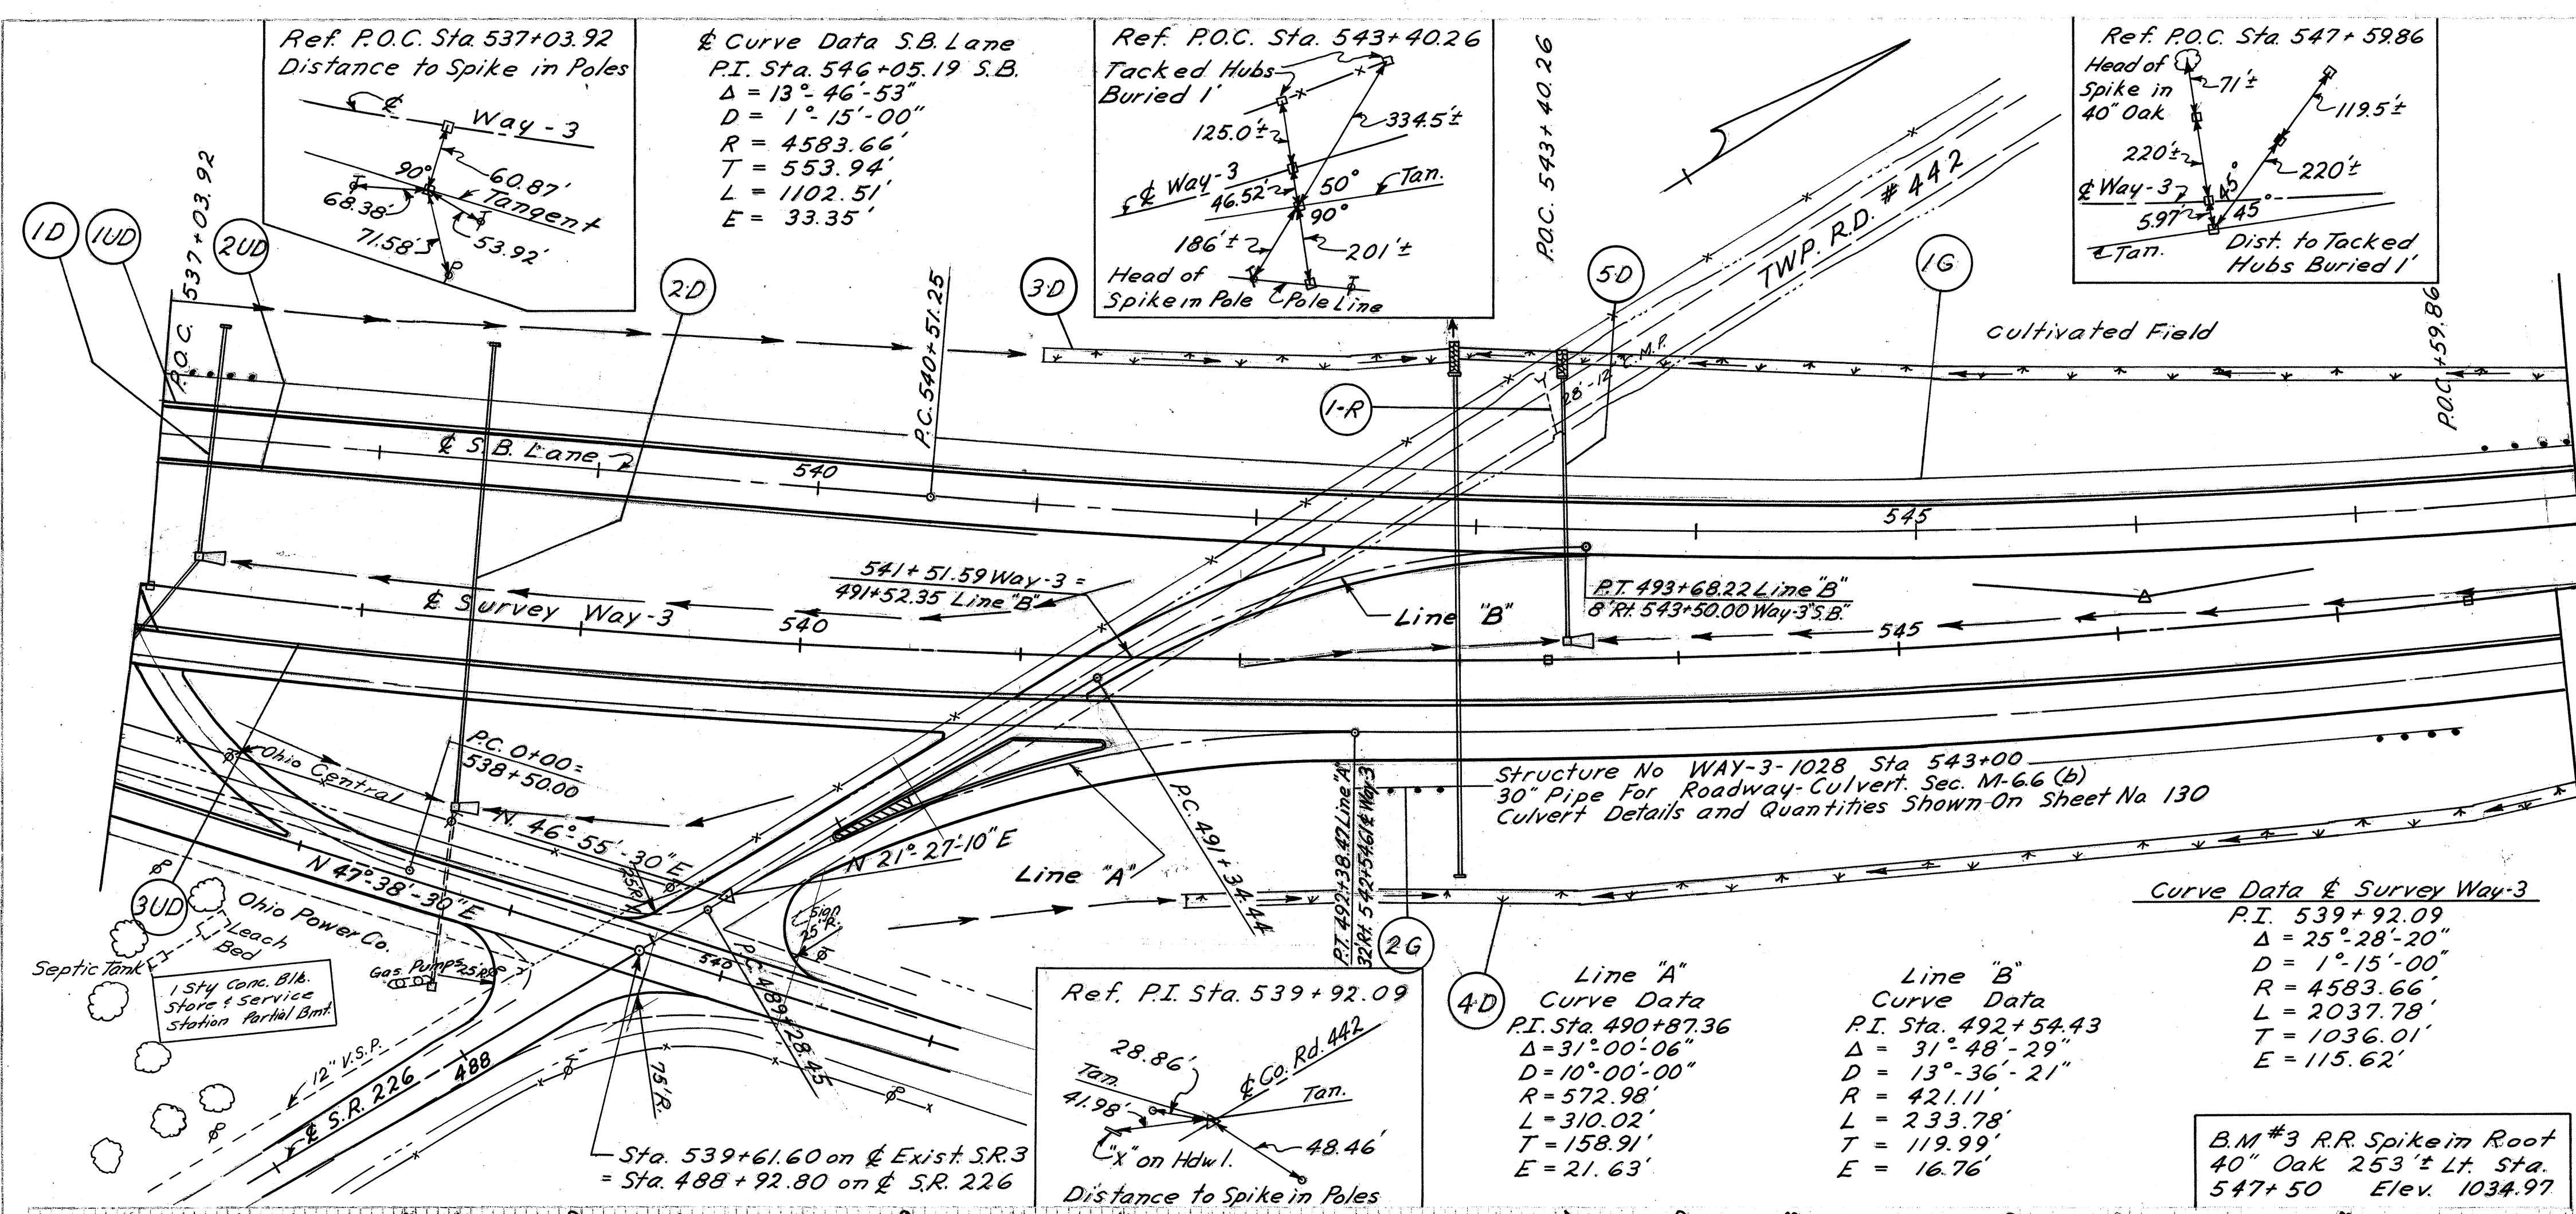

Item No.	Station	Side	L-10 Sodding		I-8 Catch Basins No. 22A	I-2 Class B Storm Sewer Under Pit	I-2 Storm Sewer	I-5 Pipe Spec. 15" Dia.	I-14 Concrete Structures	S-1 Concrete For	I-10 Dumped Rock Chamber Protection		
			Width	Length								Lin. Ft.	Sec. 15"
1-D	537+25	Lt.	1.5	6	1	104		10	0.23				
2-D	538+50	Lt.	1.5	6	1	210		10	0.30				
3-D	541+00	Lt.	6	469									
4-D	541+75	Rt.	6	419									
5-D	543+50	Lt.	1.5	6	1	78	36	2	10	0.26	30		
Totals				906	3	104	78	210	36	2	30	0.79	33

Item No.	Station	Side	I-4 6" Pipe Underdrain		I-15 Guard Rail Steel Beam		E-12 Pipe Removal	
			Shallow	Deep	Type	Beam	15" and Under	Under
1-UD	537+00	Lt.	1100					
2-UD	537+00	Lt.	400					
3-UD	537+00	Rt.	1100					
1-R	543+40	Lt.					28	
1-G	537+00	Lt.			1096.11			
2-G	542+54.61	Rt.			50391			
Totals			2600	1600.02			28	

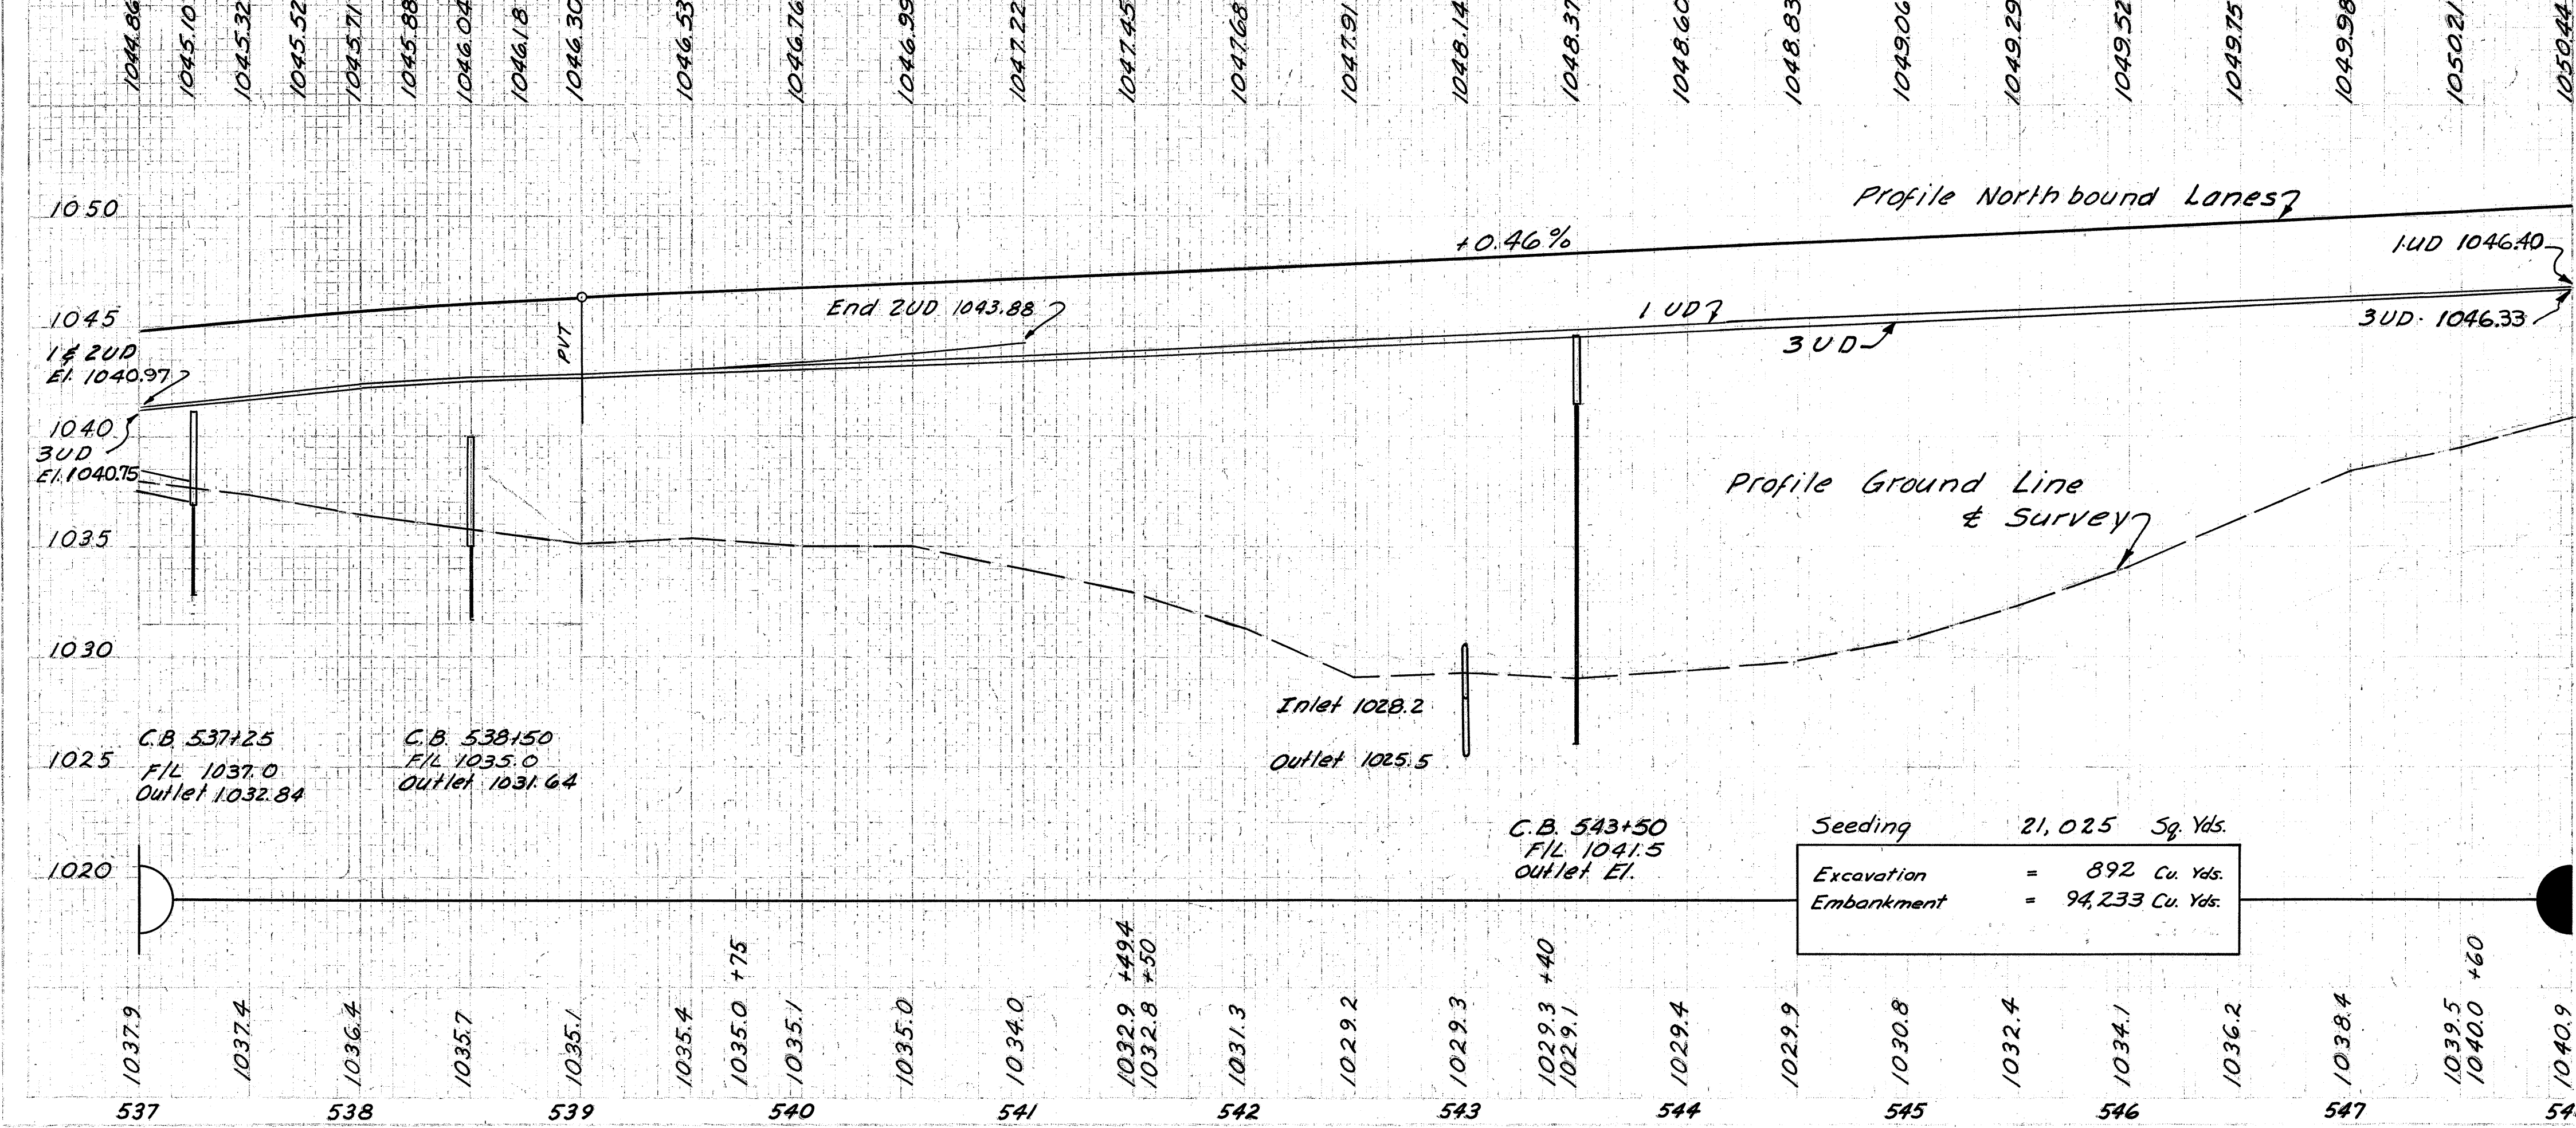


For Pavement Quantities See Sheet No. 27
For Intersection Detail See Sheet No. 39

WAYNE COUNTY
WAY-3-9.94

Line "C"
Curve Data
P.I. Sta. 1+09.93
Δ = 57° 35' 33"
D = 28° 38' 52"
R = 200.00'
T = 109.93'
L = 201.04'
E = 28.22'

Curve Data S.B.
P.I. Sta. 546+05.19 S.B.
Δ = 13° 46' 53"
D = 1° 15' 00"
R = 4583.66'
T = 553.94'
L = 1102.51'
E = 33.35'

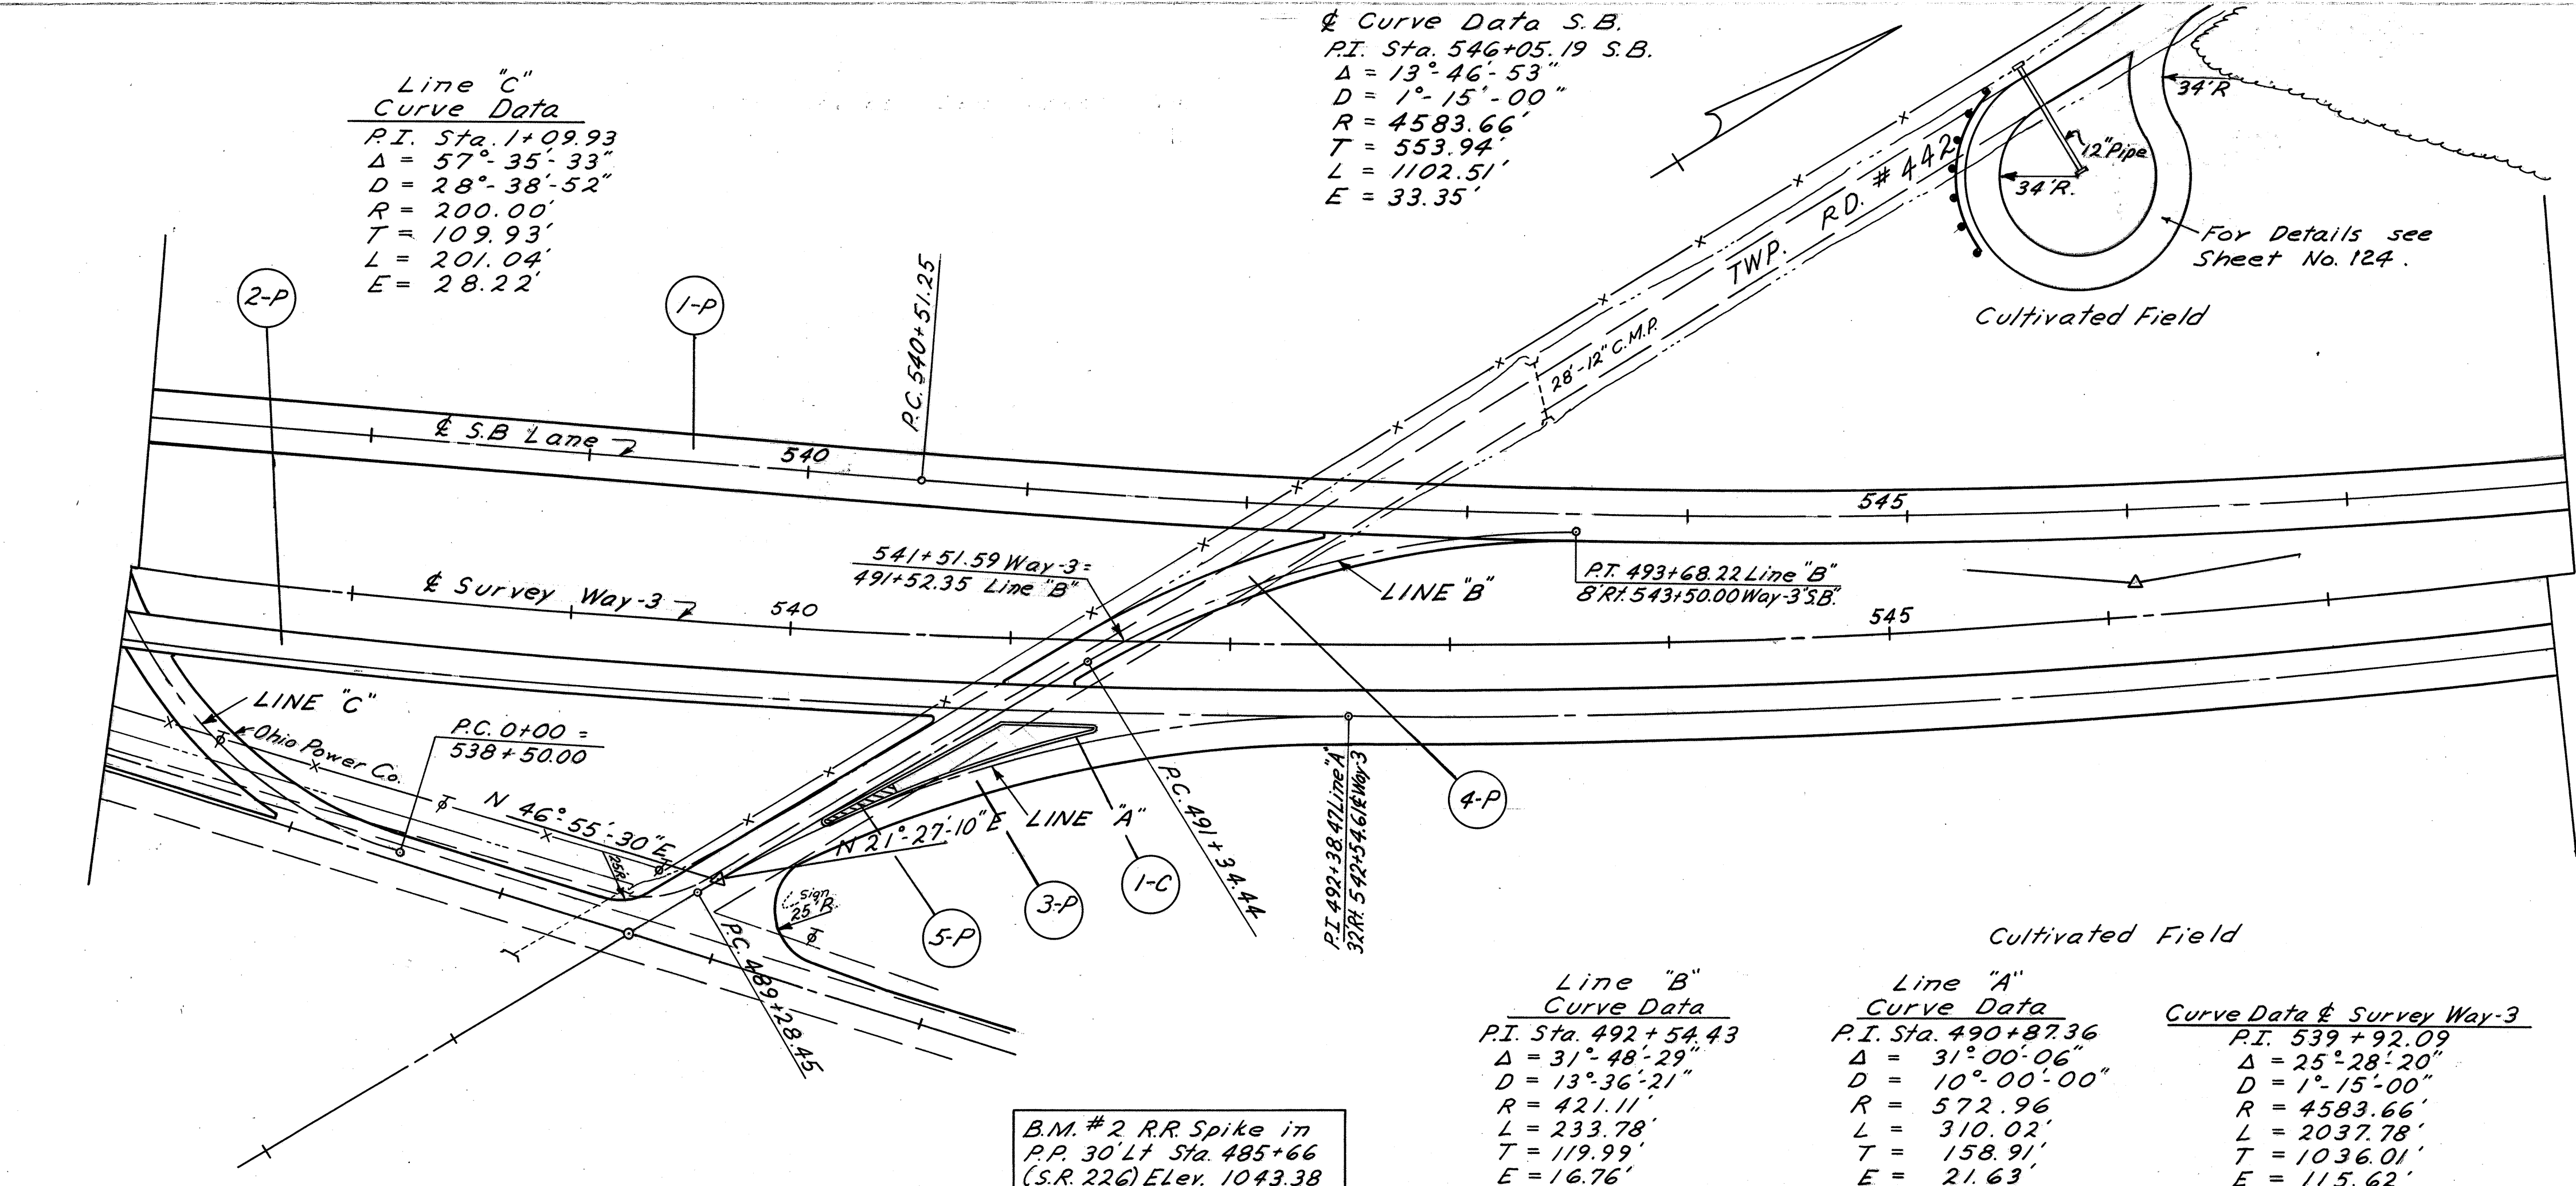


Line "B"
Curve Data
P.I. Sta. 492+54.43
Δ = 31° 48' 29"
D = 13° 36' 21"
R = 421.11'
T = 233.78'
L = 119.99'
E = 16.76'

Line "A"
Curve Data
P.I. Sta. 490+87.36
Δ = 31° 00' 06"
D = 10° 00' 00"
R = 572.96'
T = 310.02'
L = 158.91'
E = 21.63'

Curve Data & Survey Way 3
P.I. 539+92.09
Δ = 25° 28' 20"
D = 1° 15' 00"
R = 4583.66'
T = 2037.78'
L = 1036.01'
E = 115.62'

B.M. #2 R.R. Spike in
P.P. 30 Lt Sta. 485+66
(S.R. 226) Elev. 1043.38

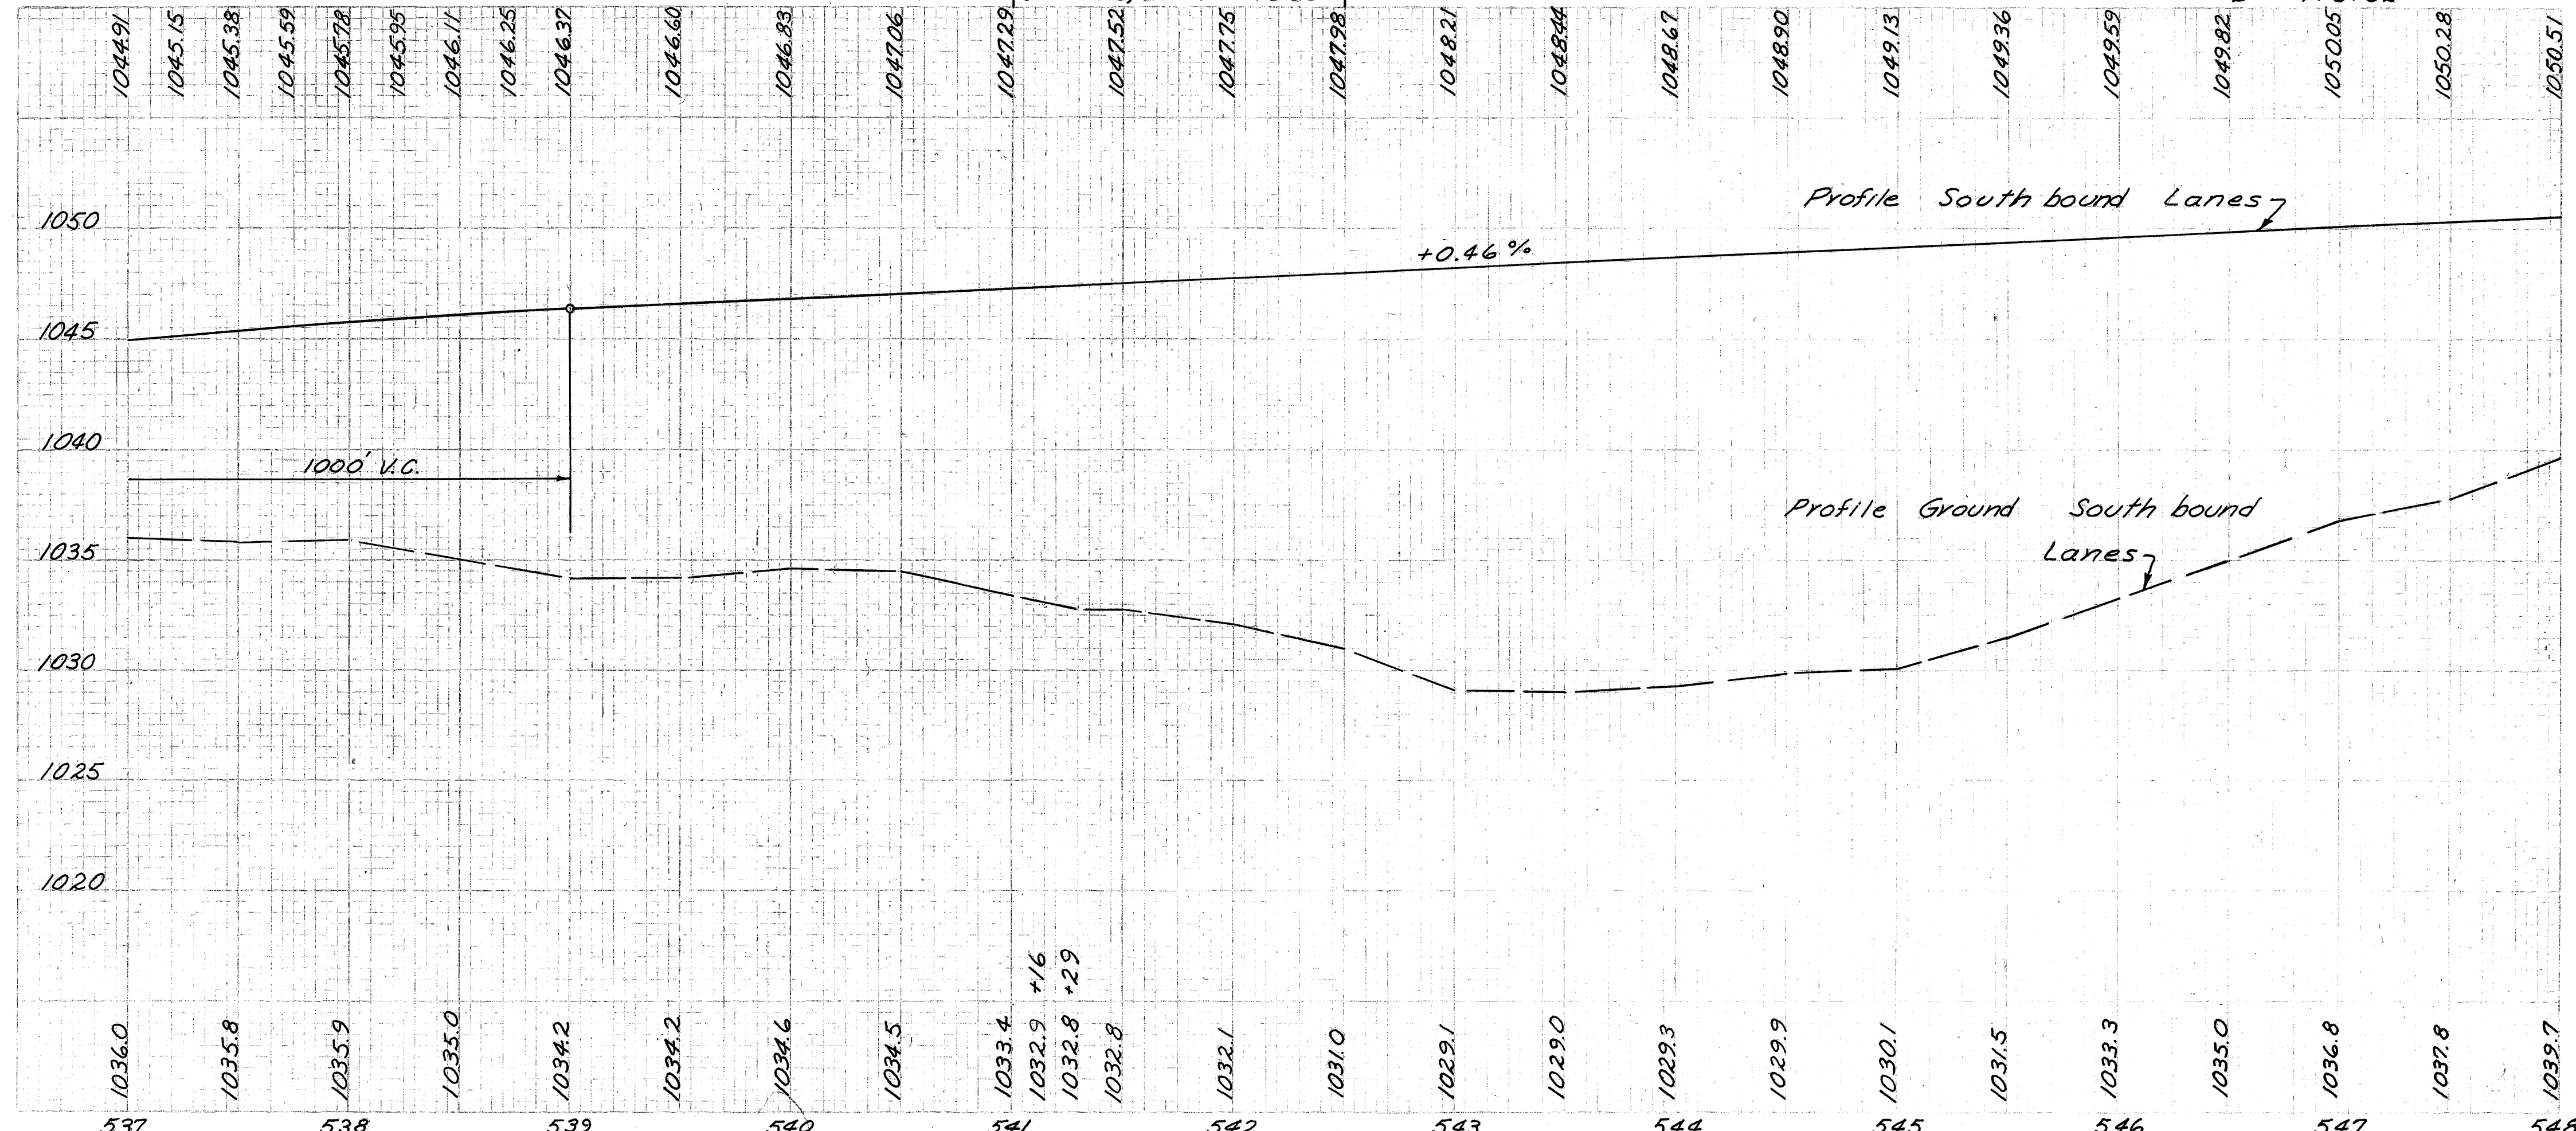

Item No.	Station		Side	T-35			B-35			B-30			B-20			I-22			I-18			B-33			T-31			I-21			I-12		
	From	To		Cu. Yd.	Cu. Yd.	Cu. Yd.	Sp. Yd.	Sp. Yd.	Sp. Yd.	Cu. Yd.	Cu. Yd.	Sp. Yd.	Sp. Yd.	Sp. Yd.	Cu. Yd.	Cu. Yd.	Sp. Yd.	Cu. Yd.	Cu. Yd.	Sp. Yd.	Cu. Yd.	Sp. Yd.	Cu. Yd.	Cu. Yd.	Sp. Yd.	Cu. Yd.	Sp. Yd.	Cu. Yd.	Sp. Yd.	Cu. Yd.	Sp. Yd.		
1-P	537+00	543+50	SB	60.19	47.45	707.78	2075.22	422.53	109.75	954.76	7.64	7.64	477.38																				
2-P	537+00	542+54	NB	33.92	83.55	401.10	1178.51	315.02	78.00	646.33	5.17	5.17	323.17																				
3-P	489+08	490+65	A/B	27.40	66.89	321.12	920.50	153.87	216.3	213.93	1.71	1.71	106.97																				
4-P	491+14	493+68	A	11.73	28.81	139.80	404.63	88.64	218.9	178.91	1.43	1.43	89.46																				
5-P	489+96	490+40																															
1-C	489+96	491+28																															
		Totals		133.24	133.24	326.70	4578.86	980.06	231.27	1993.93	15.95	15.95	996.98	20.38	20.38	278.54																	

Due to the changes listed below:
 (a) Change the flow line Elevations of the following Catch Basins:
 LOCATION PLAN ELEV. PROP. ELEV.
 Sta. 570+05 Lt. 1014.00 1014.15
 Sta. 570+50 & 1012.64 1013.83
 Sta. 572+25 & 1013.60 1013.13
 Sta. 572+25 Lt. 1014.30 1013.40

(b) Reverse the direction of flow of the I-4 Under drains on the Lt. Side from Sta. 570+25 to Sta. 572+25. The revised I-4 to have 0.4% Grade and to enter C.B. at Sta. 572+25 Lt. at Elev. 1013.80

Add from C.B. to C.B. 173 L.F. of 15" Class "B" I-2 under pavt.

Additions at location shown:
 2 Cu. Yds. B-19 Aggregate Base Course
 1 Each I-8 Std. No. 2-2-B Catch Basin
 110 Lin. Ft. 21" I-3 Roadway Drainage
 60 Lin. Ft. 21" I-3 Roadway Drainage Under Pavt. & Approach
 10 Lin. Ft. 21" I-3 Bitum. Coated Corr. Pipe Sec. M-6.4 (c) outlet for Rdwy. Drainage

Non-perform all 8' wide Sodding (306 Sq. Yds. L-10) and add at location shown 100 Sq. Yds. L-10 6' wide Sodding.
 Non-perform deep ditch. (See Cross Sections)

Non-perform 96' of 21" I-2 Storm Sewer Sec. M-6.5(a) or M-6.8(a), 1-I-8 Std. No. 1 Manhole, 1-I-5 21" x 12" Pipe Special, 197' 21" I-3 Roadway Drainage, 46' 21" I-3 Roadway Drainage Under Pavement, 10' 21" I-3 outlet for Roadway Drainage and replace at same location (see revised grade) with 293' of 12" I-3 Roadway Drainage Pipe, 46' of 12" I-3 Roadway Drainage Under Pavement, 10' of 12" I-3 outlet pipe for Roadway Drainage, 1-12" x 12" I-5 Pipe Special and 1-I-8 Std. No. 2-2-B Catch Basin at Manhole location.

Non-perform 176' of 18" I-2 Class "B" Storm Sewer under Pavt. & Appr. 1-I-8 Std. No. 2-2-A Catch Basin and 10' I-14 Std. Type 1 Paved Gutter as per plan and add 82 Lin. Ft. of 15" I-2 Class "B" Storm Sewer under Pavement & Approaches.

Sta. 566+50: Add 72' of 15" I-2 Class "B" Storm Sewer under Pavt. & Appr. (Lt. of &) 0.26 Cu. Yds. S-1 Concrete (Class "E") for PC-4 Endwalls. (See Cross Sections)

Addition: Ditch Cleanout (See Cross Sections)


Replace Exist. Pavt. with 3" B-35 2" T-35 (Type "A") 8" B-19

Do Not Disturb Exist. 12" Culvert.

Sta. 173+50:
 Additional 48' of 21" S-27 reinforced Concrete pipe Sec. M-6.6(b) or extra-strength Vitrified sewer pipe Sec. M-6.8(b) for Roadway Culverts and 0.72 Cu. Yds. Class "E" Conc. for Structures for PC-4 Endwalls and 4 Cu. Yds. I-10 Dumped Rock Channel Protection at outlet end. Place S-27 on 15" R.F. Skew (See Cross Sections).




NOTE: Additional quantities of L-9 Items are provided for seeding & fertilizing additional work areas along S.R. 95

Proj. Ref. No.	Item	Quantities		Unit	Description
		Additions	Non-Perform		
1	E-1	38		Cu. Yds.	Roadway Excavation, Method "B", as per plan
16	L-9	900		Sq. Yds.	Seeding and Protecting as per plan
17	L-9	0.08		Tons	Commercial Fertilizer (12-12-12)
18	L-10		206	Sq. Yds.	Sodding, as per plan
29	E-2	18		Cu. Yds.	Excavation for Structures
40	I-2	327		Lin. Ft.	15" Class "B" Storm Sewers under pavement or approaches
41	I-2		176	Lin. Ft.	18" Class "B" Storm Sewers under pavement or approaches
47	I-2		96	Lin. Ft.	21" Standard-Strength plain cement concrete pipe Sec. M-6.5 (a) or Standard-Strength vitrified Sewer Pipe Sec. M-6.8 (a) for Storm Sewers.
51	I-3	293		Lin. Ft.	12" Roadway Drainage
53	I-3		87	Lin. Ft.	21" Roadway Drainage
54	I-3	46		Lin. Ft.	12" Roadway Drainage under pavement or approaches
55	I-3	14		Lin. Ft.	21" Roadway Drainage under pavement or approaches
58	I-3	10		Lin. Ft.	12" Bituminous Coated Corrugated Metal Pipe Sec. M-6.4 (c) for outlets for Roadway Drainage
66	I-5	1		Each	12" Pipe Special for Roadway Drainage
68	I-5	1		Each	21" Pipe Special for Roadway Drainage
72	I-8	1		Each	Standard No. 1 Manhole
75	I-8	1		Each	Standard No. 2-2-A Catch Basin
76	I-8	2		Each	Standard No. 2-2-B Catch Basin
79	I-10	4		Cu. Yds.	Dumped Rock Channel Protection
80	I-14	10		Lin. Ft.	Standard Type 1 Paved Gutter as per plan
83	S-1	0.98		Cu. Yds.	Concrete for Structures, Class "E"
85	S-27	48		Lin. Ft.	21" Reinforced Concrete Pipe Sec. M-6.6 (b) or extra-strength vitrified Sewer Pipe Sec. M-6.8 (b) for Roadway Culverts
89	B-19	3.0		Cu. Yds.	Aggregate Base Course
93	B-35	1.0		Cu. Yds.	Asphaltic Concrete Base Course (70-85)
99	T-35	0.7		Cu. Yds.	Asphaltic Concrete Surface Course Type "A" (85-100)

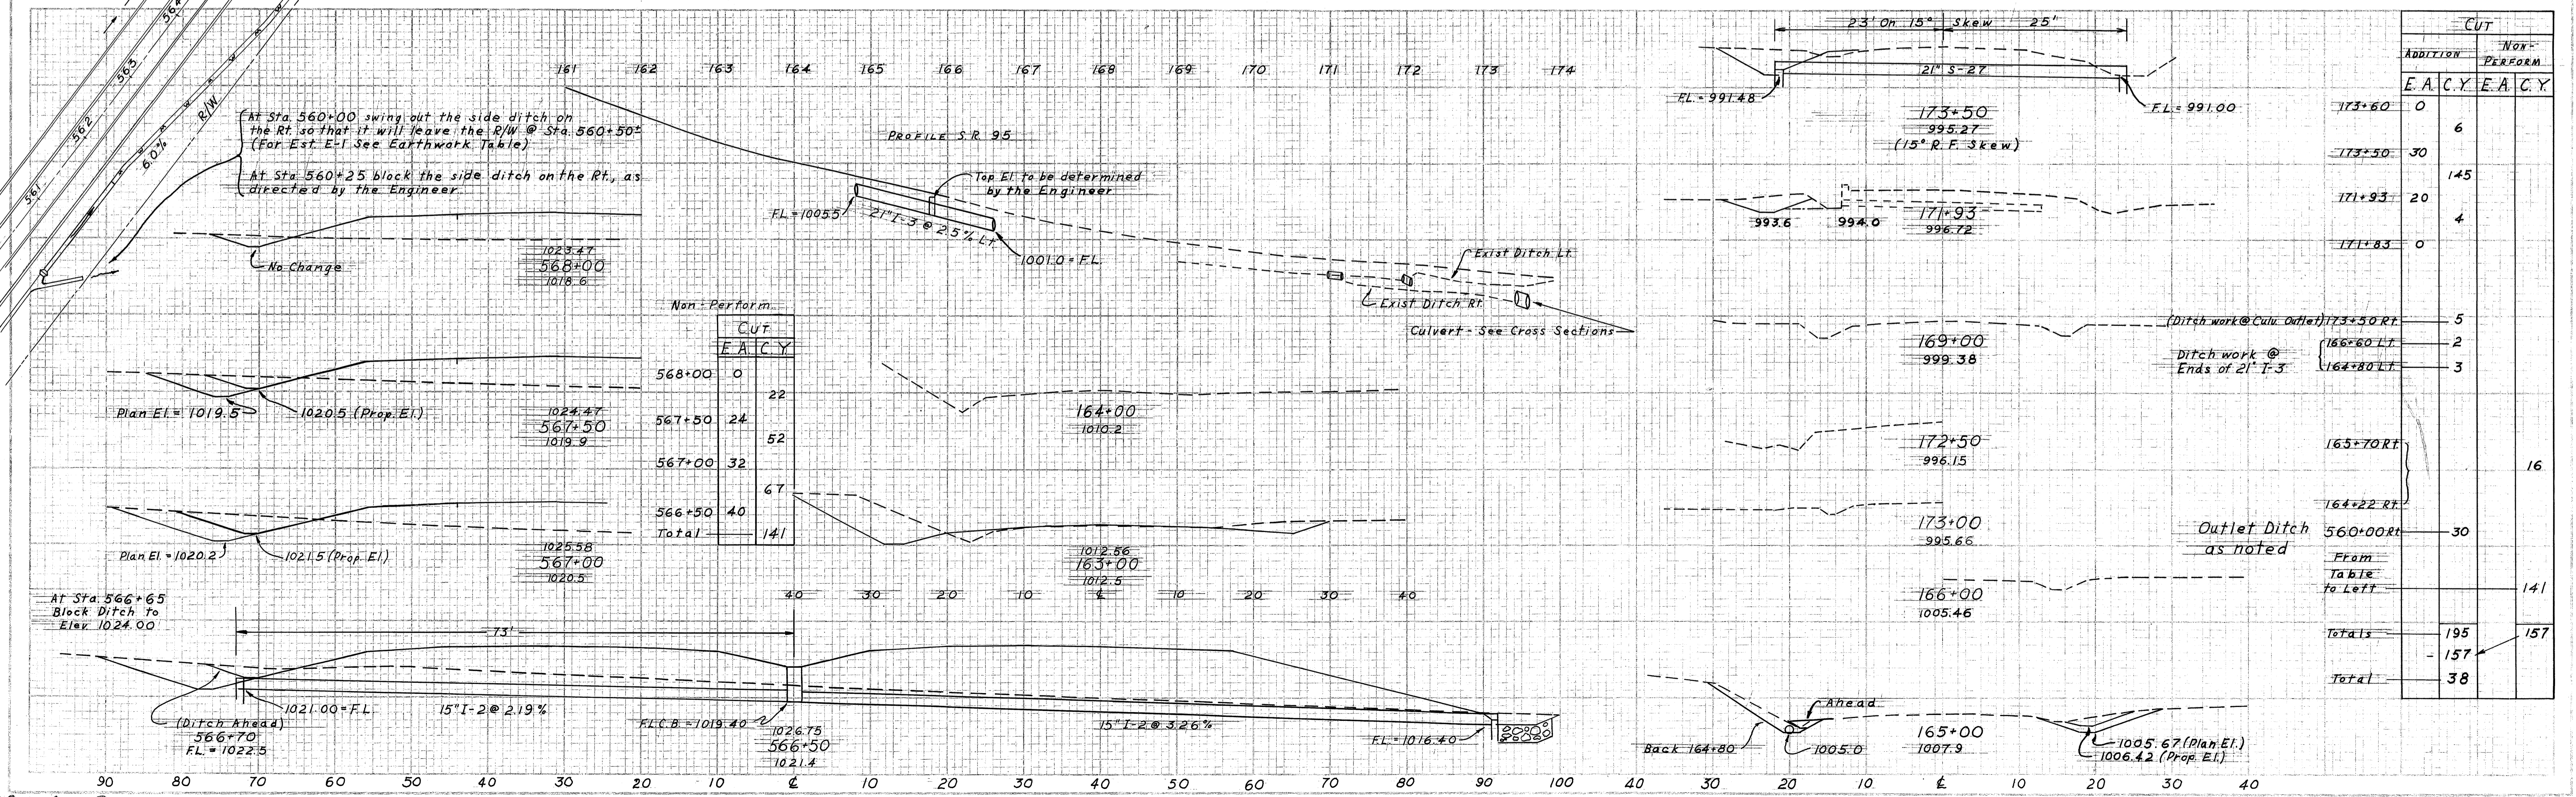

WAYNE COUNTY
WAY-3-9.94


Curve Data S.B. Lane
P.I. Sta. 546+05.19
Δ = 13°46'53"
D = 1°-15'-00"
R = 4583.66'
T = 553.94'
L = 1102.51'
E = 33.35'

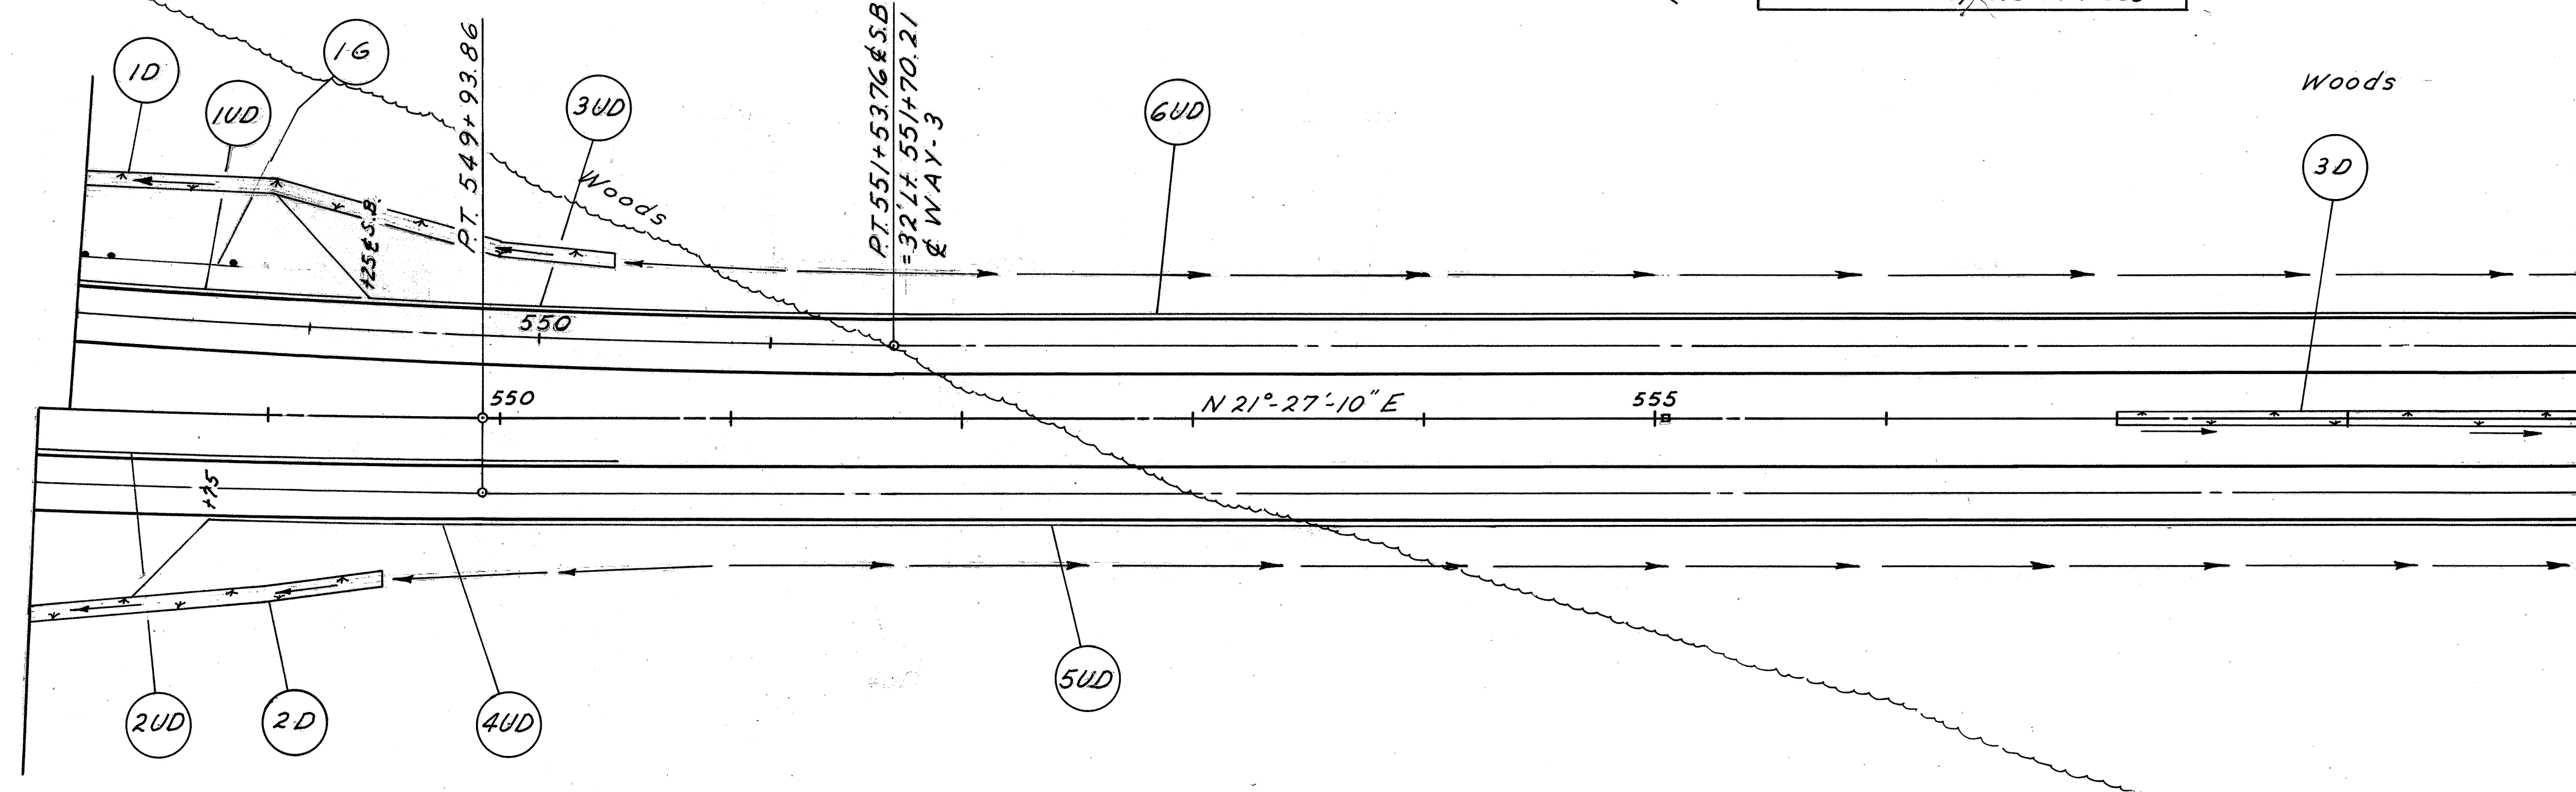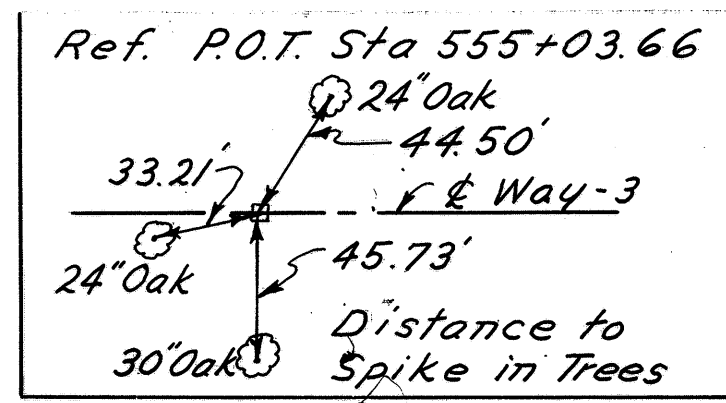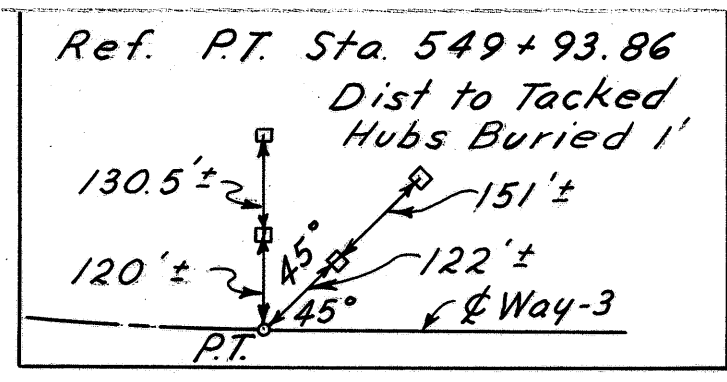

Curve Data & Survey Way-3
P.I. 539+92.05
Δ = 25°28'20"
D = 1°-15'-00"
R = 4583.66'
T = 2037.78'
L = 1036.01'
E = 115.62'

Cultivated Field

Cultivated Field

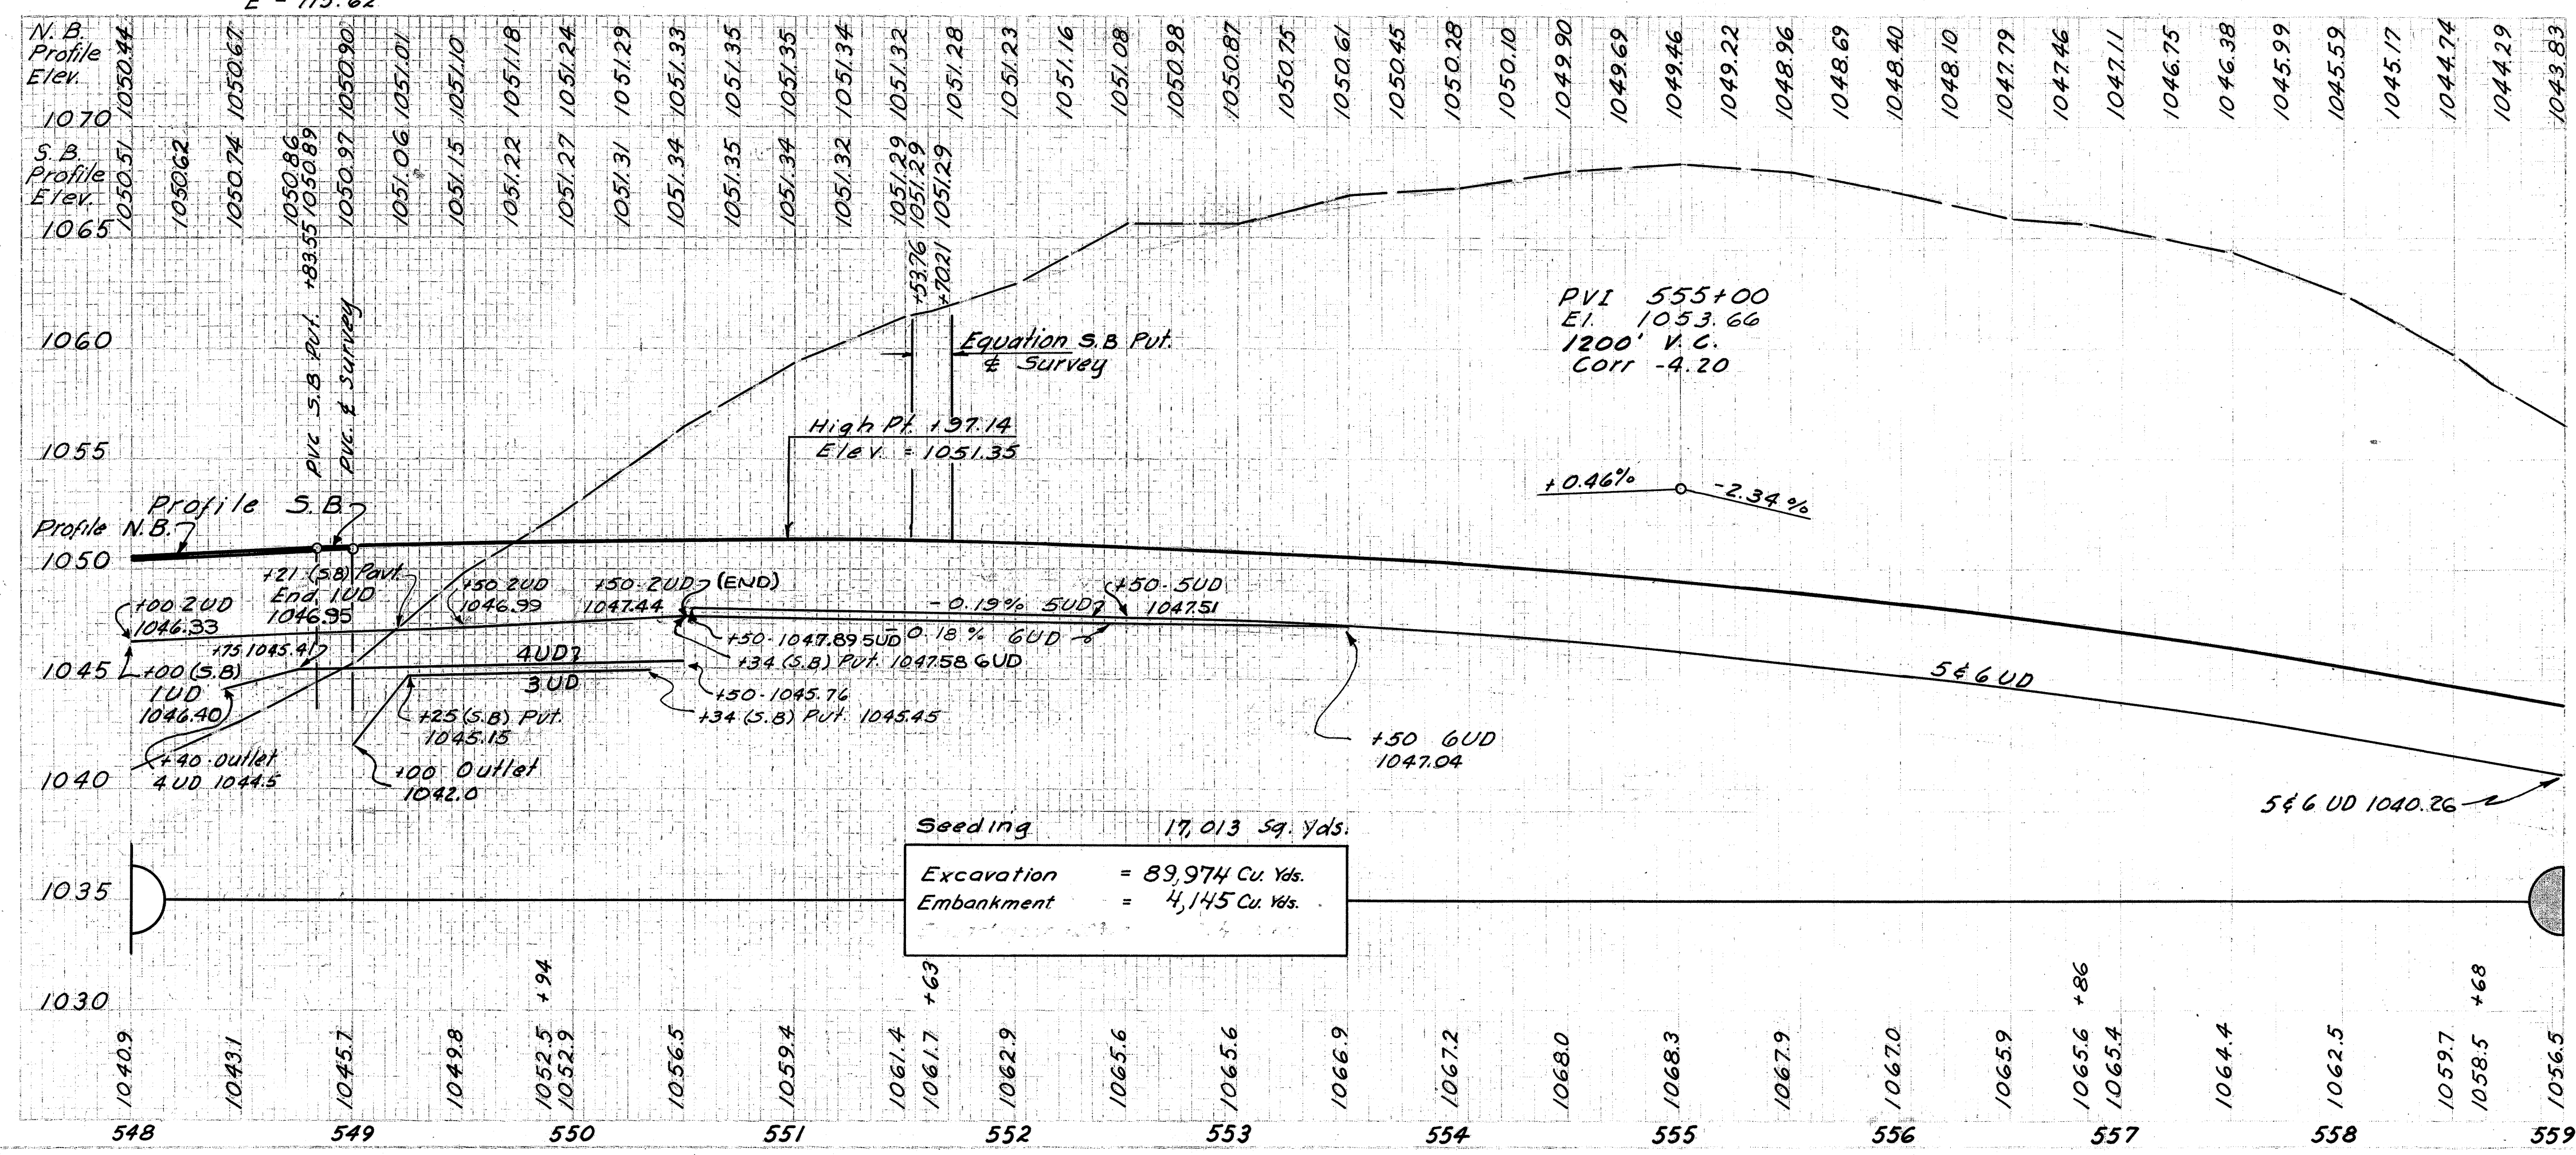


Seeding 17,013 Sq. Yds.
Excavation = 89,974 Cu. Yds.
Embankment = 4,145 Cu. Yds.

Item No.	Station		Side	L-10 Sodding		I-15 Guard Rail Steel Beam Type (Deep)	
	From	To		Lin. Ft.	Sq. Yds.	Lin. Ft.	
1-D	548+00	550+30	Lt.	6	154		
2-D	548+00	549+50	Rt.	6	100		
3-D	557+00	559+00	Rt.	6	133		
1-G	548+00	549+95.3	Lt.			78.89	
Totals					387	78.89	

Item No.	Station		Side	I-4	I-4	I-4	I-5	I-4
	From	To		6" Pipe Underdrain (Shallow)	6" Pipe Underdrain (Deep)	Pipe Outlet For Underdrain	Pipe Specials 45° Bend	6" Pipe Underdrain (Shallow) Sec. M64(b)
				Lin. Ft.	Lin. Ft.	Lin. Ft.	Ea.	Lin. Ft.
1UD	548+00	549+21	Lt.	121				
2UD	548+00	550+50	Rt.	250				
3UD	549+00	550+34	Lt.		151	10	1	
4UD	548+40	550+50	Rt.		207	10	1	
5UD	550+50	559+00	Rt.					850
6UD	550+34	559+00	Lt.					850
Totals				371	358	20	2	1700

**WAYNE COUNTY
WAY-3-9.94**

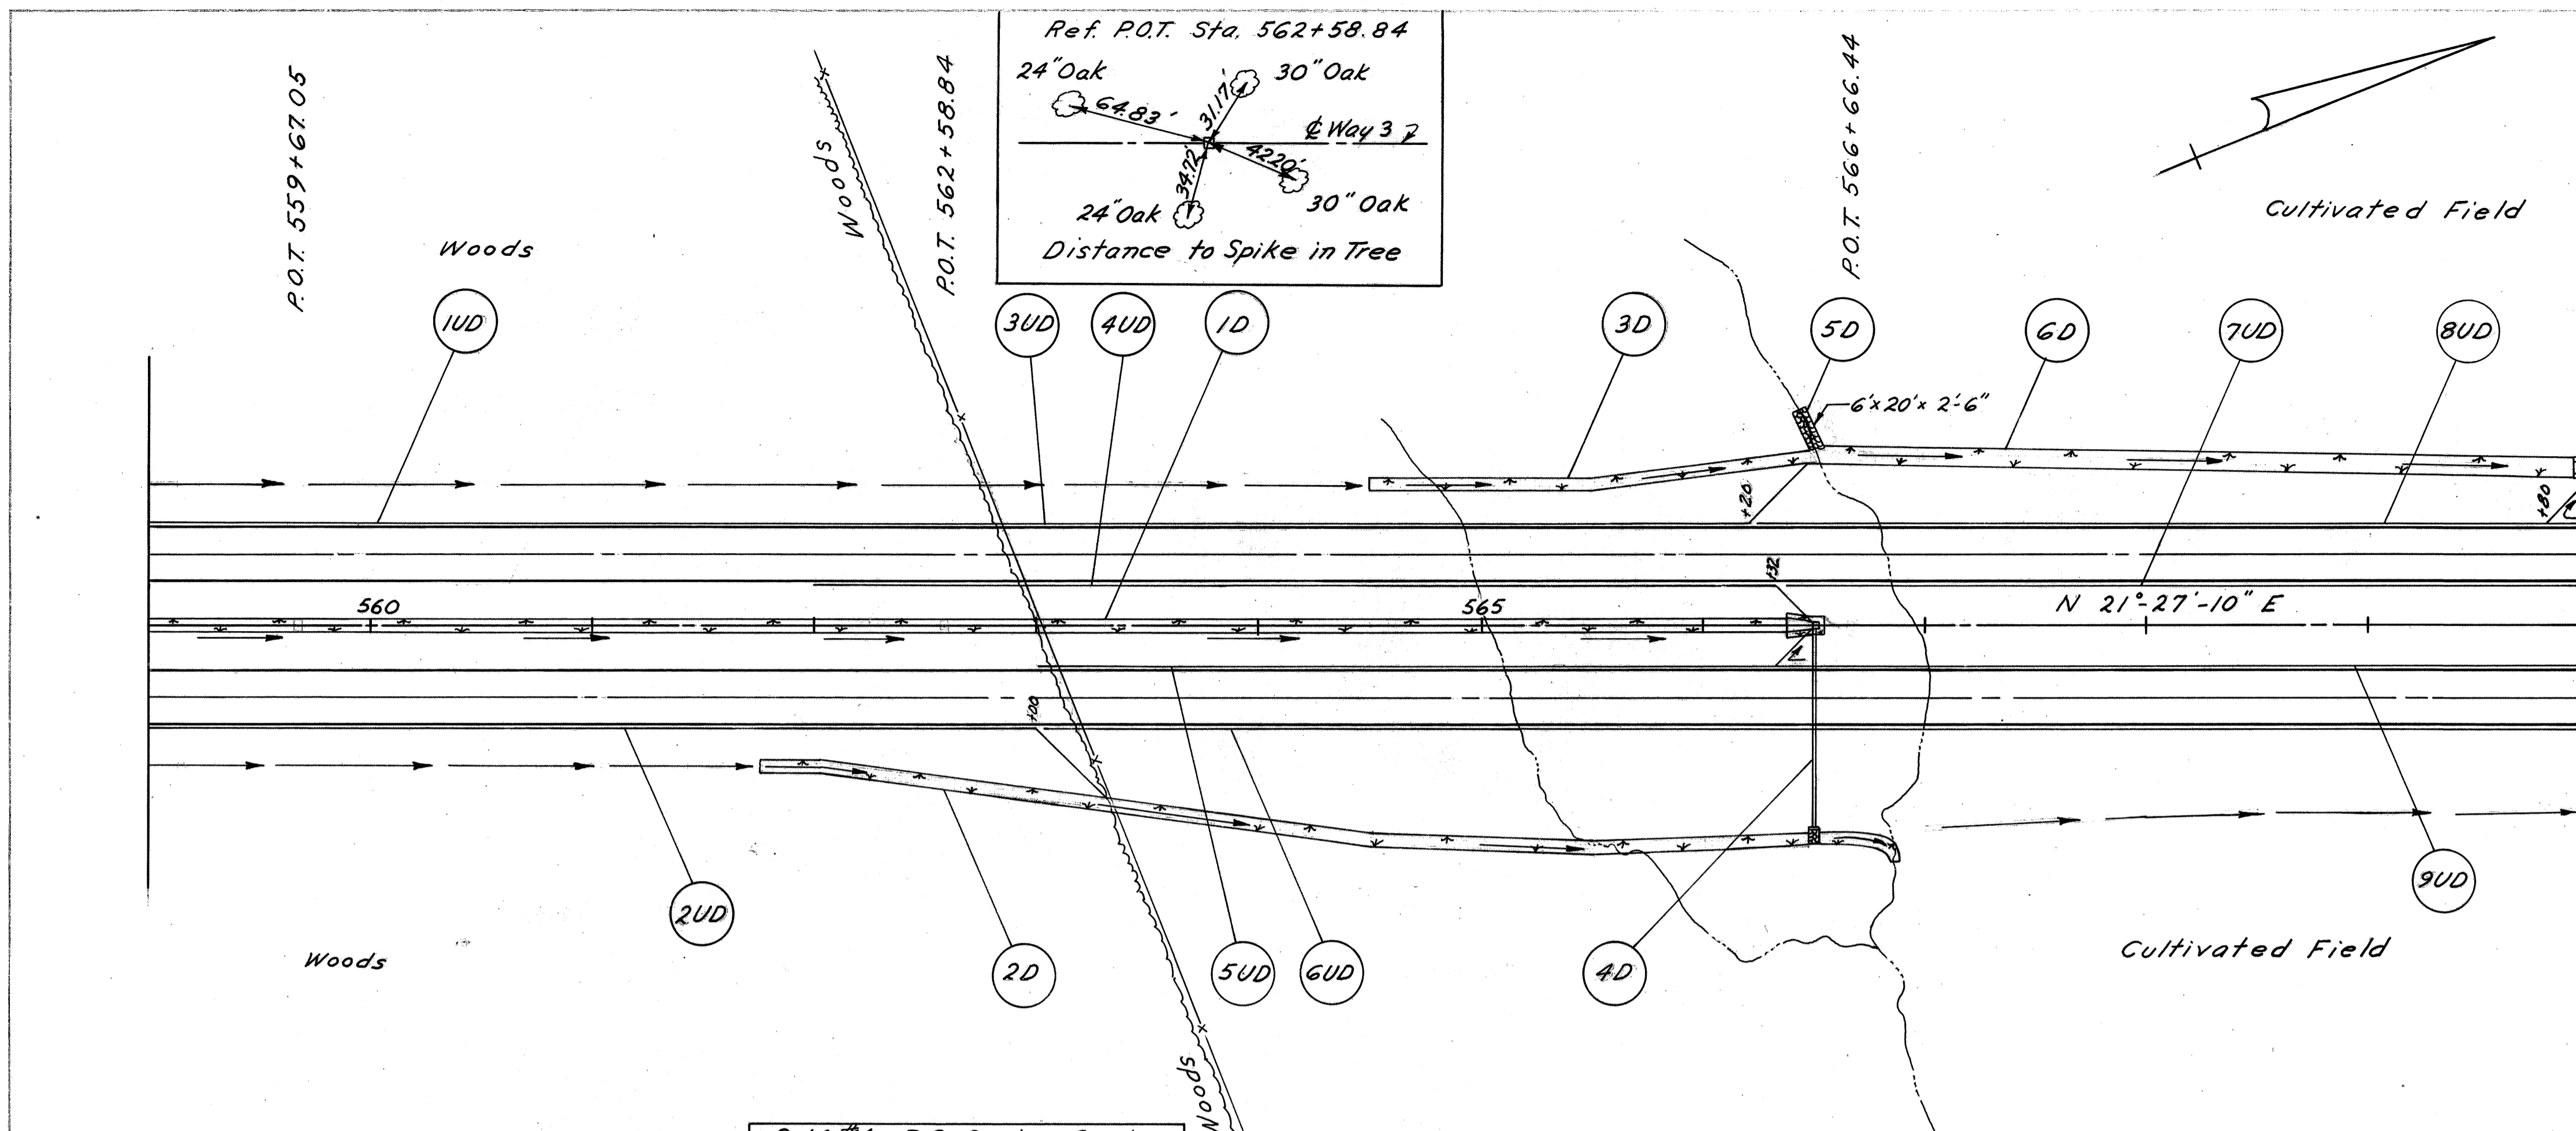


Item No.	Station		Side	L-10 Sodding Width	I-14 Paved Gutter (Special)	I-8 No 2-2-A Catch Basin	I-2 Class B Storm Sewer Under Pt.	I-10 Dumped Rock Channel Protection	S-1 Conc. For Structures Class E	
	From	To								
1-D	559+00	566+38.3	Lt.	6	492					
2-D	561+75	566+85	Rt.	6	351					
3-D	564+50	566+50	Lt.	6	134					
4-D	566+50		Lt.	1.5	6	10	1	91	30	
5-D	566+50		Lt.					30	11.1	
6-D	566+50	569+93	Lt.	8	306					
Totals					1289	10	1	91	14.1	0.26

B.M. #4 R.R. Spike Root
24" Oak 62' Lt Sta 562+51
Elev. 1040.99


Excavation = 2,018 Cu. Yds.
Embankment = 9,932 Cu. Yds.
Seeding 13,270 Sq. Yds.

P.V.I. 570+00
E.I. 1018.56
e = + 2.10
600' V.C.

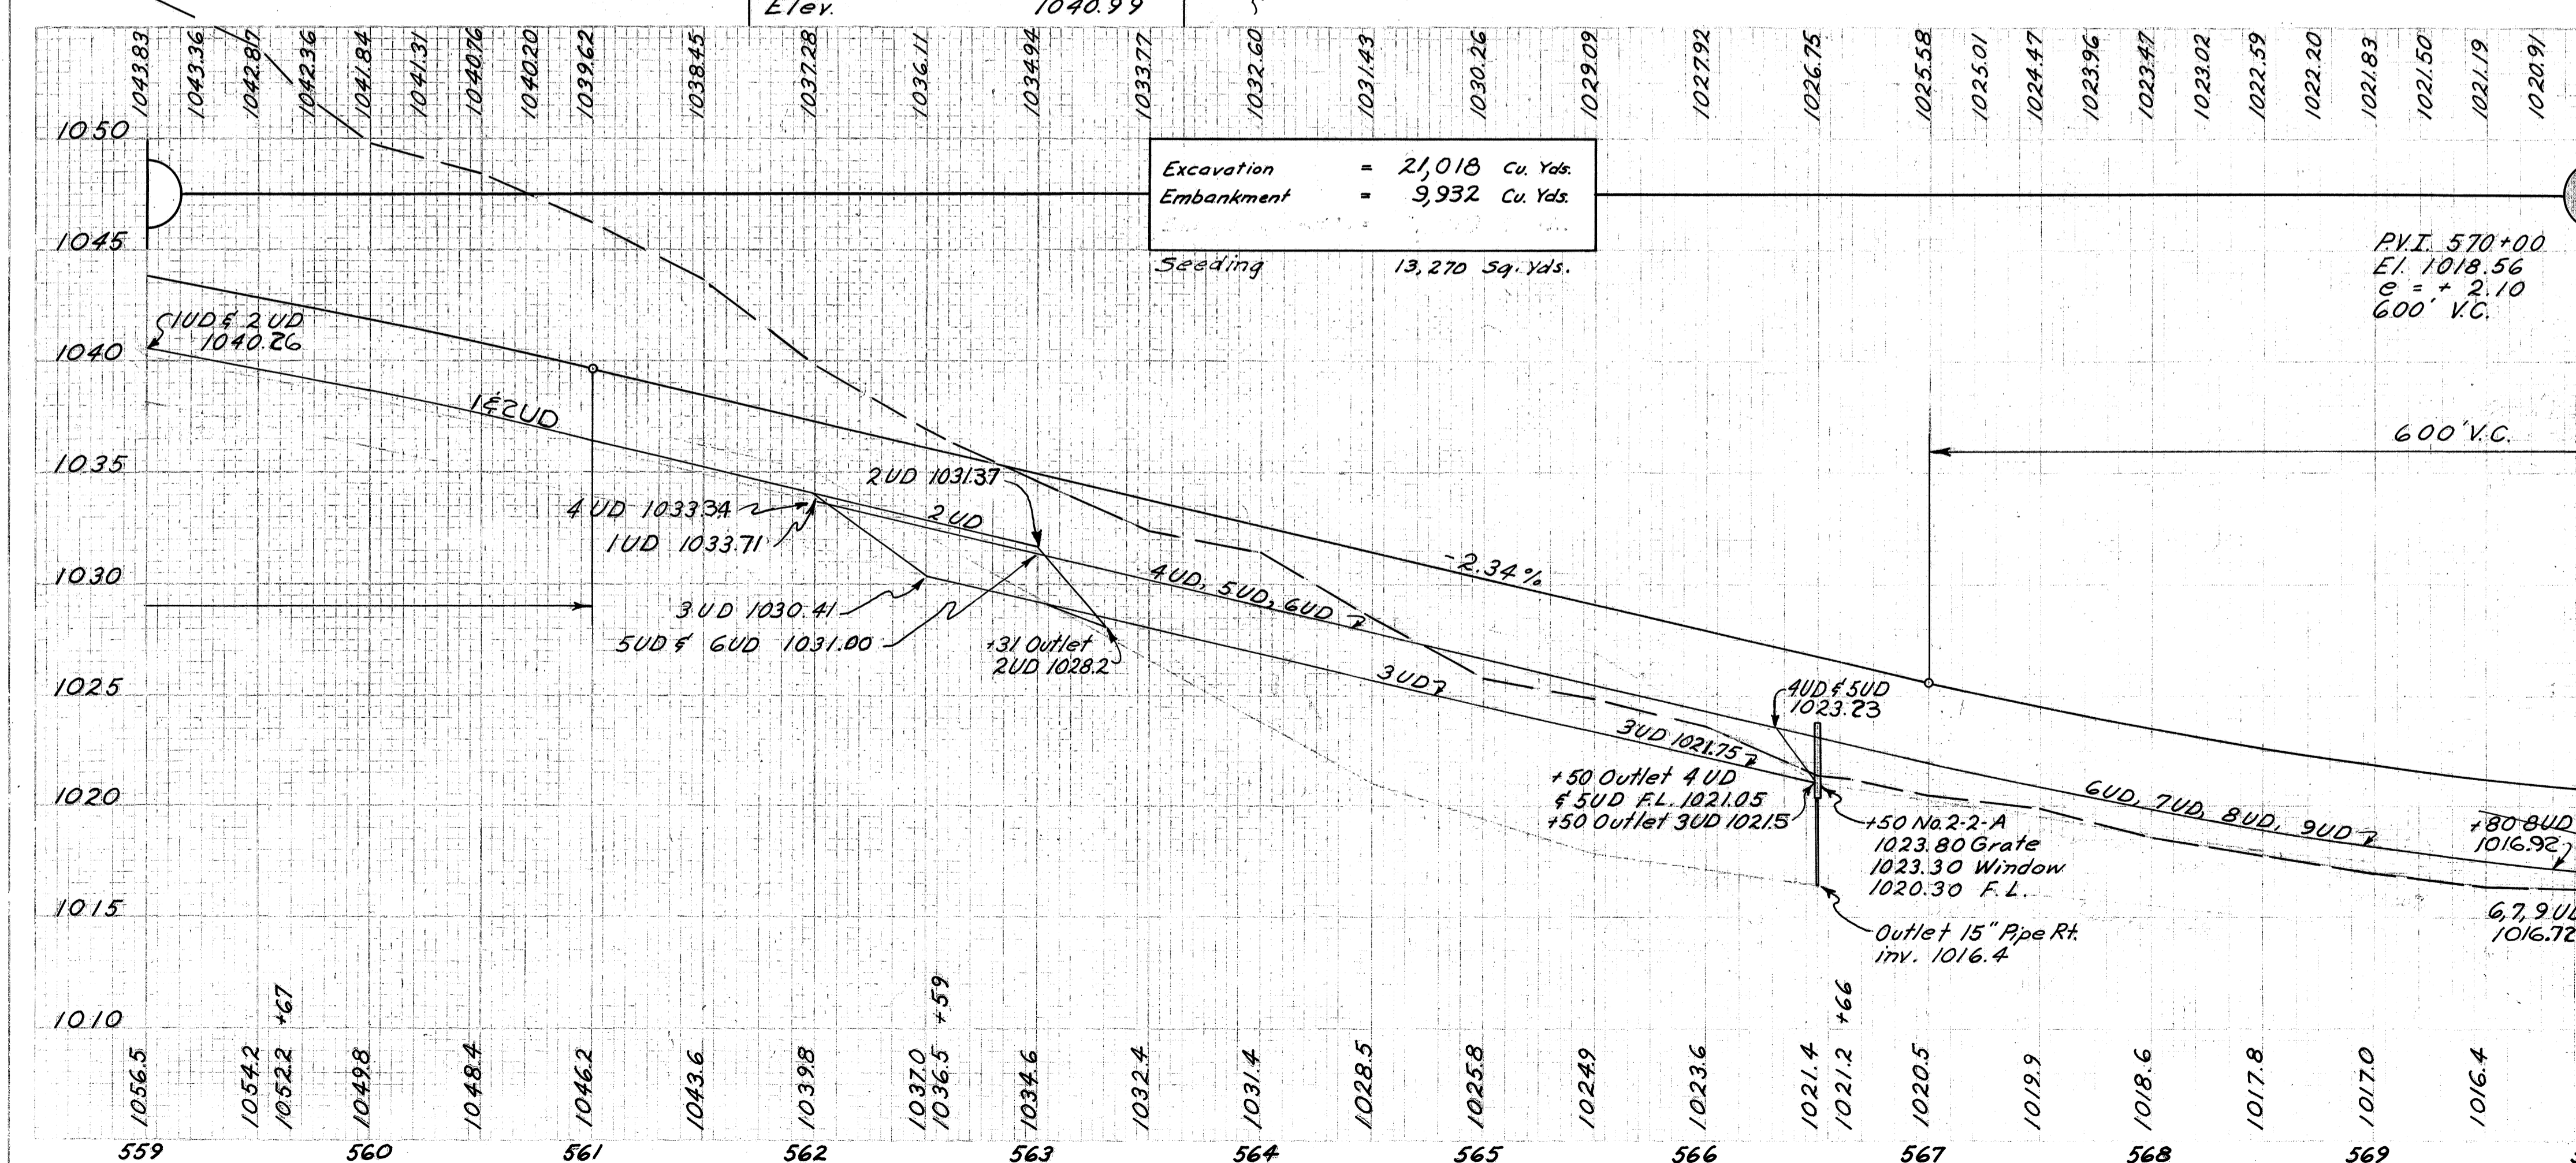

Item No.	Station		Side	I-4 6" Pipe Underdrain (Shallow)	I-4 6" Pipe Underdrain (Deep)	I-4 Pipe Outlet For Underdrain	I-5 Pipe Specials		I-4 6" Pipe Underdrain (Shallow)
	From	To					6" 45° Bend	6" 45° Wye	
1UD	559+00	562+00	Lt.						300
2UD	559+00	563+31	Rt.				10	1	430
3UD	562+00	566+50	Lt.		446		10	1	
4UD	562+00	566+49	Lt.	442					
5UD	563+00	566+49	Rt.	359				1	
6UD	563+04	570+00	Rt.	696					
7UD	566+36	570+00	Lt.	364					
8UD	566+24	570+15	Lt.	411			10	1	
9UD	566+52	570+00	Rt.	348					
Totals				2620	446	50	3	2	730


WAYNE COUNTY WAY-3-9.94

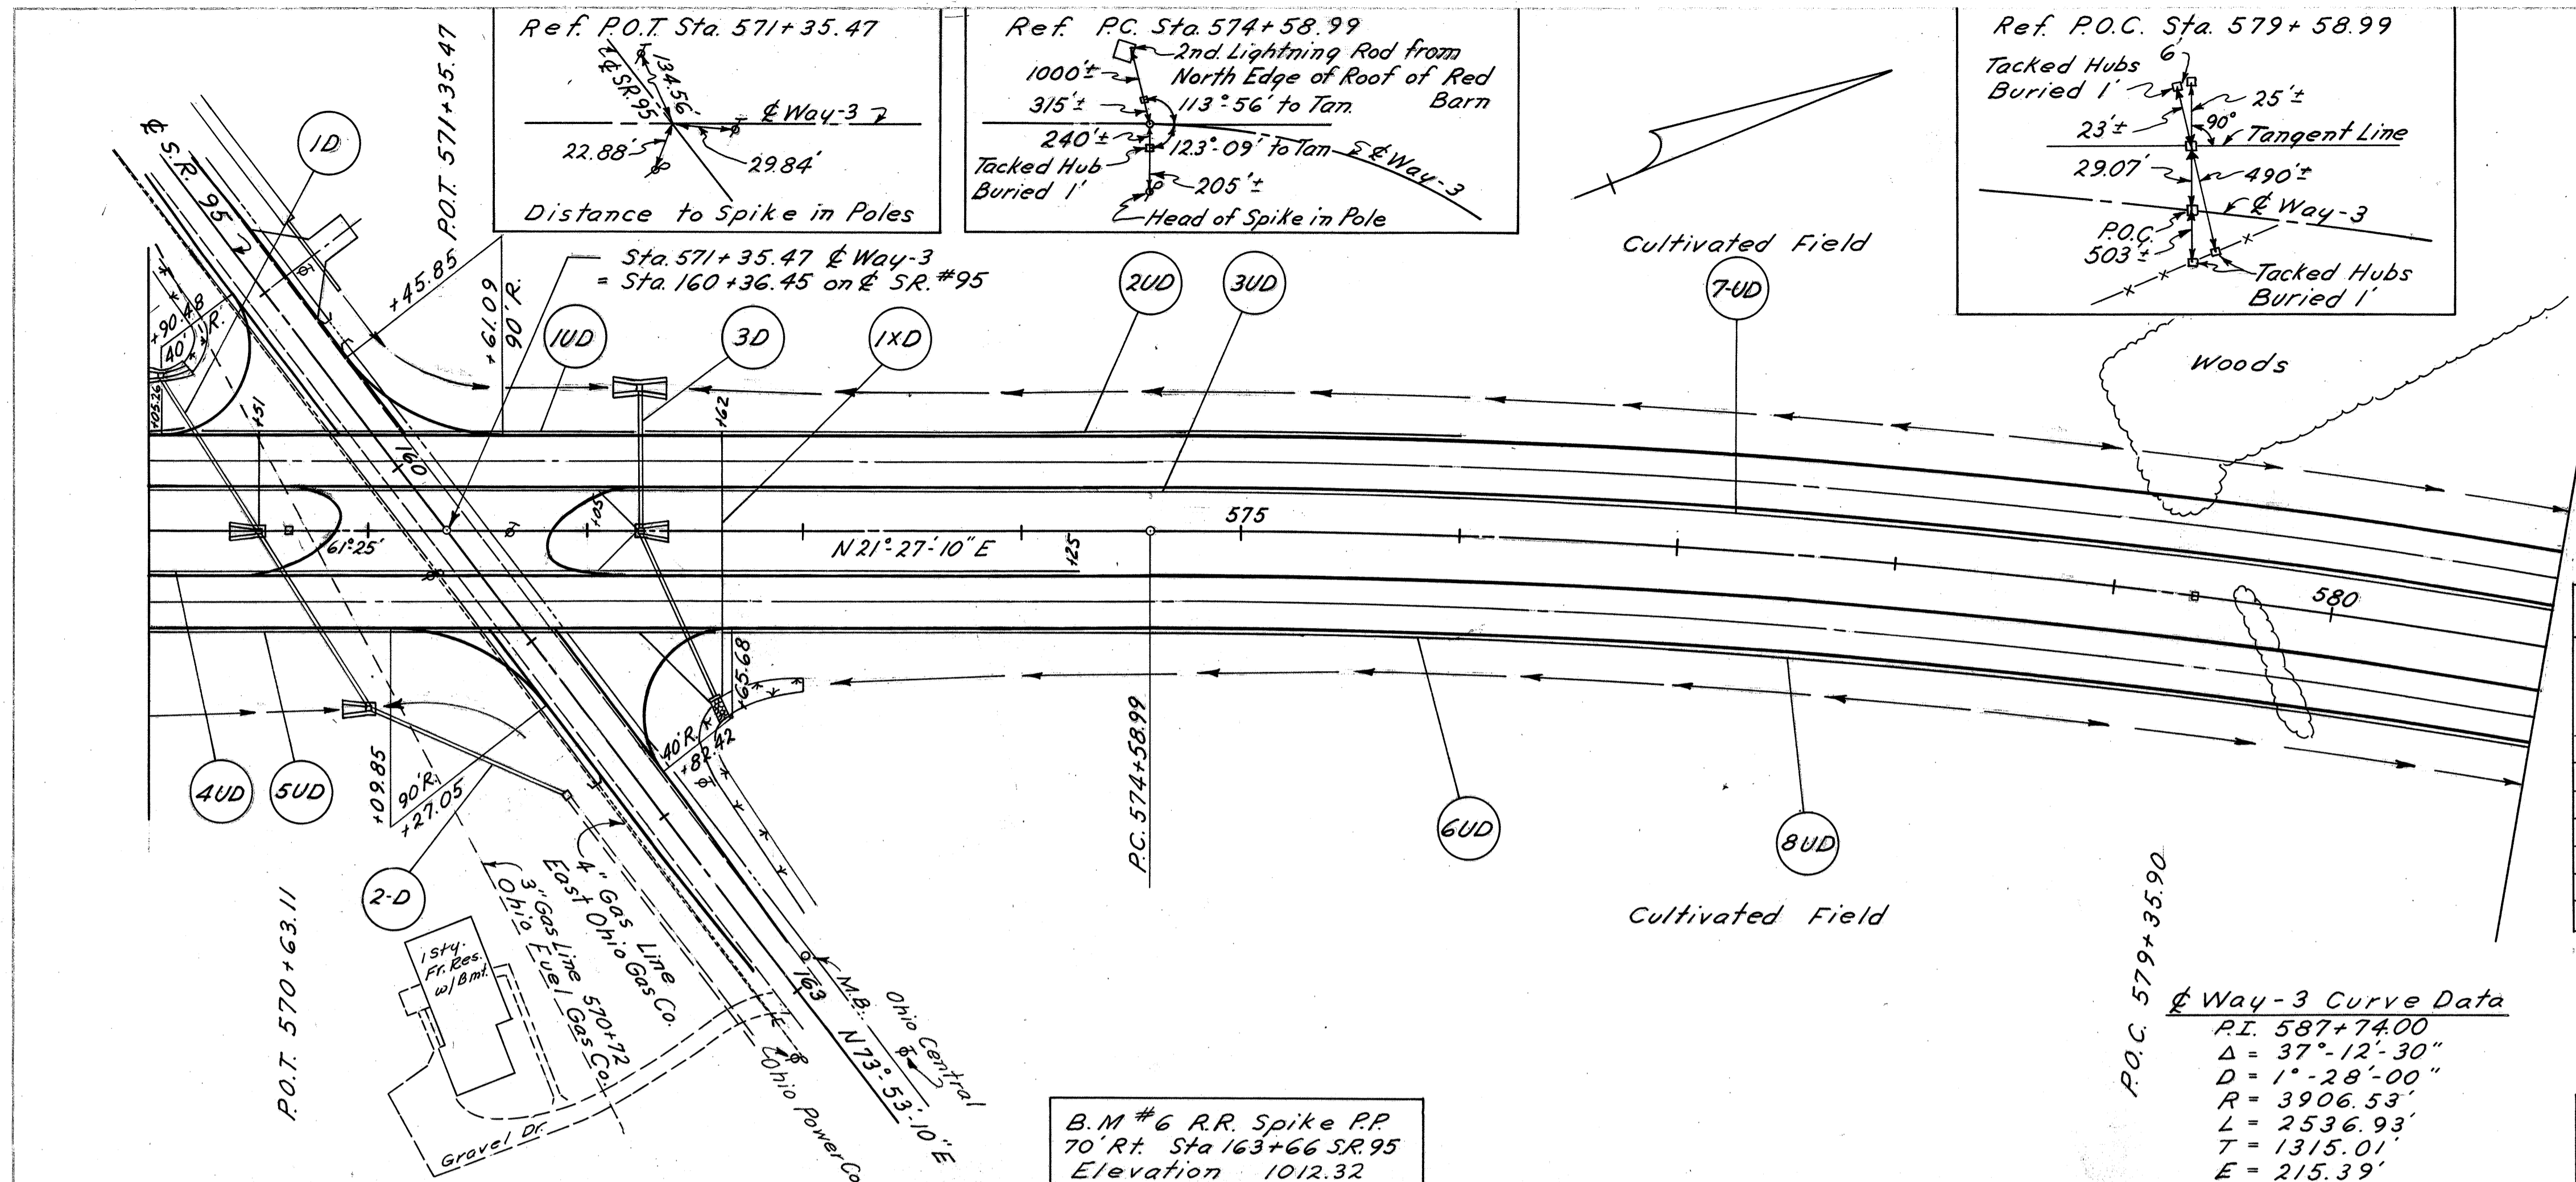

Item No.	Station		Side	L-10 Sodding Width	I-14 Paved Gutter Special Type II Modified	I-8 No. 2-2A Catch Basins	I-2 Storm Sewer Under Pavt. Class M.6.4(a)	I-2 Storm Sewer Under Pavt. Sec. M.6.5(a)	S-1 Conc. For. Structure Class E	I-10 Dumped Rock Channel Protection Depth	
	From	To		Lin. Ft.	Sq. Yds.	Lin. Ft.	Each	18" 21"	Lin. Ft.	Cu. Yds.	in
1-D	570+05	571+00	Lt. Rt.	15	20	40	3	176			
2-D	571+00	571+90	Rt.					96			
3-D	572+75	572+60	Lt. Rt.	15	14	30	2	147	0.36	30	2.6
Totals				34	70	5	176	147	96	0.36	2.6

Way-3 Curve Data
 P.I. 587+74.00
 $\Delta = 37^\circ-12'-30''$
 $D = 1^\circ-28'-00''$
 $R = 3906.53'$
 $L = 2536.93'$
 $T = 1315.01'$
 $E = 215.39'$


B.M. #6 R.R. Spike P.P.
 70' Rt. Sta. 163+66 SR.95
 Elevation 1012.32

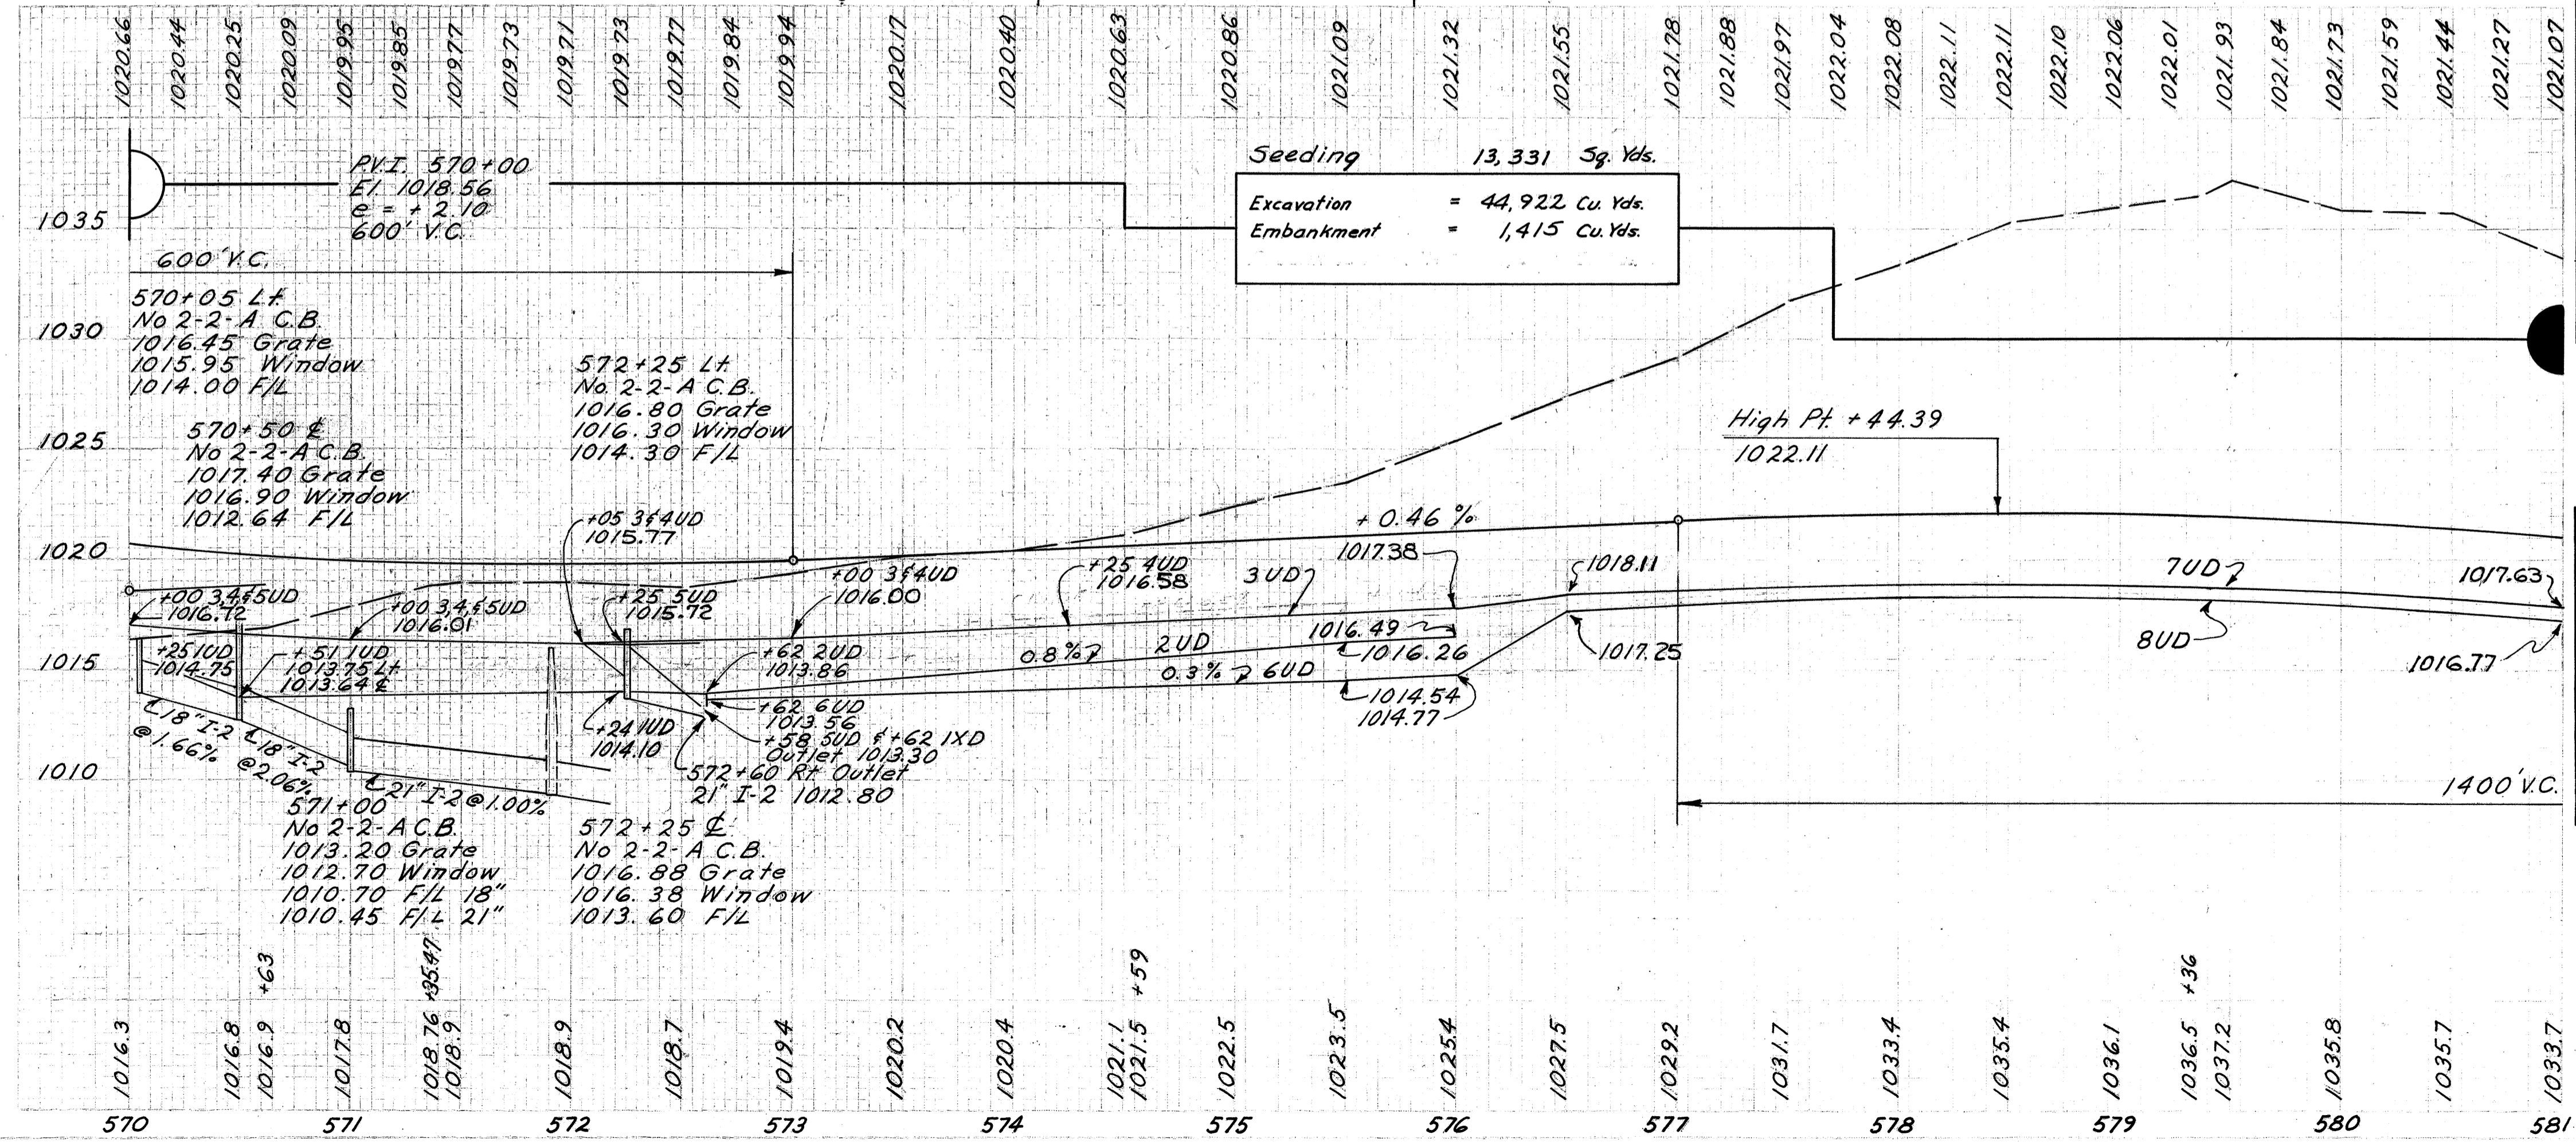

Item No.	Station		Side	I-4 6" Pipe Underdrain Shallow	I-4 6" Pipe Underdrain Deep	I-4 Pipe Outlet For Underdrain	I-5 Pipe Specials 6x8 Tee	I-5 Pipe Specials 6" Wye	I-4 6" Pipe Underdrain Shallow	
	From	To		Lin. Ft.	Lin. Ft.	Each	Ea.	Ea.	Lin. Ft.	
1UD	570+25	572+21	Lt.		227	10		1		
2UD	572+29	576+00	Lt.		359		2			
3UD	570+00	576+00	Lt.	611		10		1		
4UD	570+00	574+25	Rt.	436		10		1		
5UD	570+00	572+58	Rt.	290		10		1		
6UD	572+62	576+00	Rt.		338					
7UD	576+00	581+00	Lt.						500	
8UD	576+00	581+00	Rt.						500	
Totals				1337	924	40	2	3	1	1000


Item No.	Station		Side	I-2 Storm Sewer Under Pavt. Class B	I-2 Pipe Outlet For 8" Storm Sewer Sec. M. 6.4(c)	I-5 8x8 Tee	I-5 8x6 Tee
	From	To		Lin. Ft.	Lin. Ft.	Ea.	Ea.
1XD	572+62		Lt. Rt.	110	10	1	1
Totals				110	10	1	1

**WAYNE COUNTY
WAY-3-9.94**

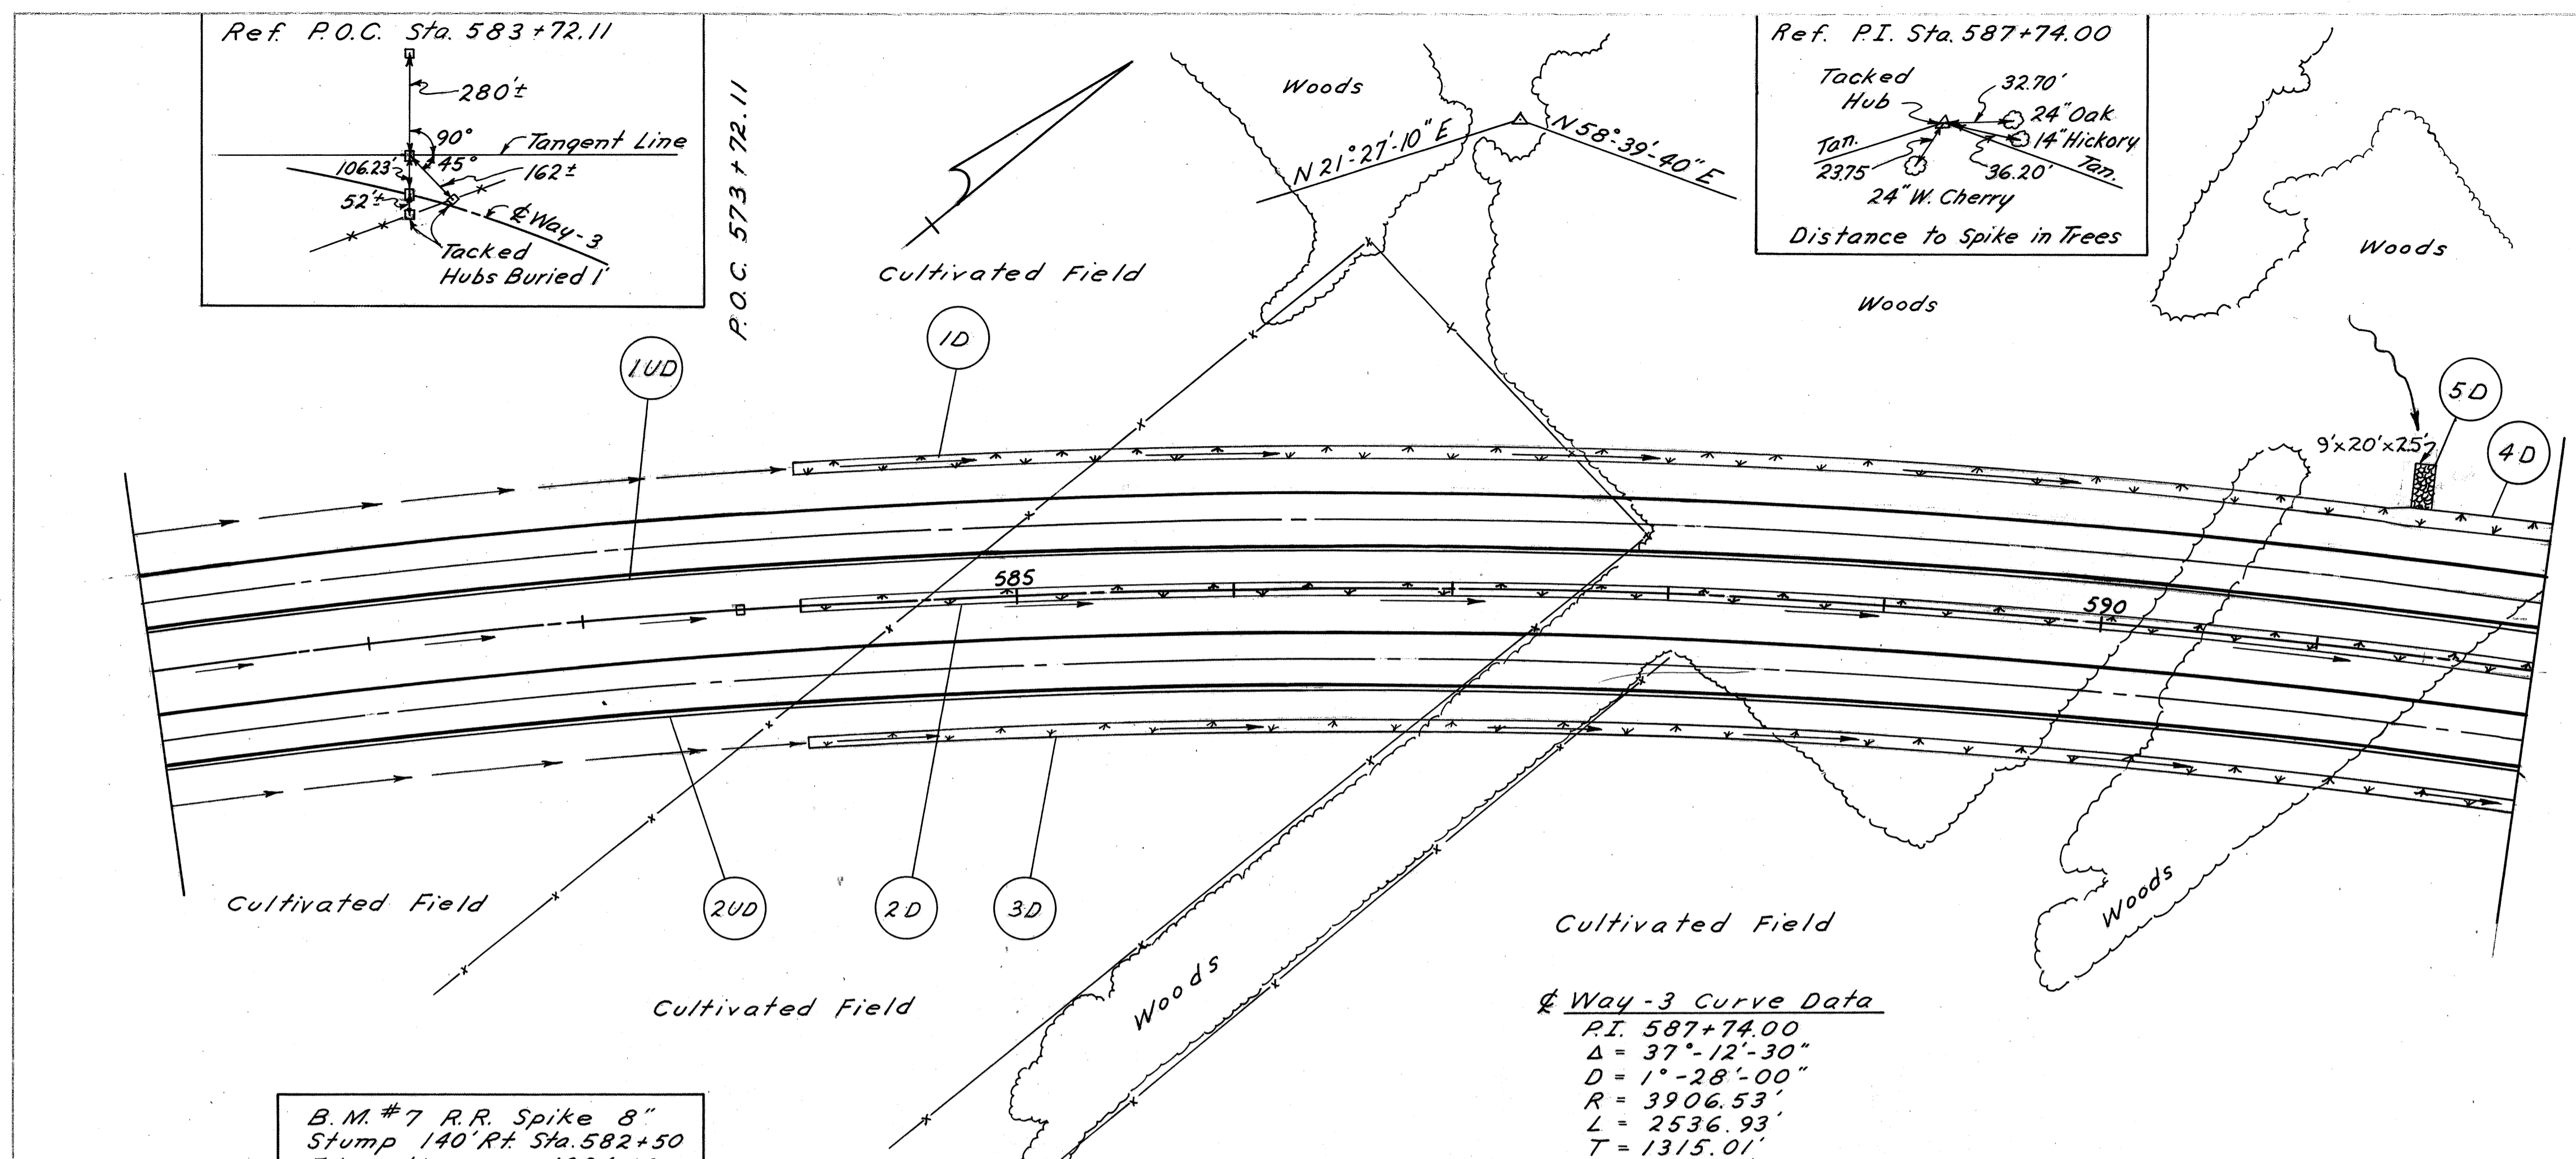


Item No	Station		Side	L-10 Sodding		I-10 Dumped Rock Channel Protection	
	From	To		Width	Depth	Depth	Width
1-D	584+00	591+40	Lt.	6	4.94		
2-D	584+00	592+00	Et.	6	5.34		
3-D	584+00	592+00	Rt.	6	5.34		
4-D	591+40	592+00	Lt.	8	5.4		
5-D	591+40		Lt.			30	16.7
Totals					1616		16.7


Item No.	Station		Side	I-4 6" Pipe Underdrain (Shallow)		I-4 6" Pipe Underdrain (Deep)	
	From	To		Lin. Ft.	Lin. Ft.		
1-UD	581+00	592+00	Lt.	1100			
2-UD	581+00	592+00	Lt.	1100			
Totals				2200			

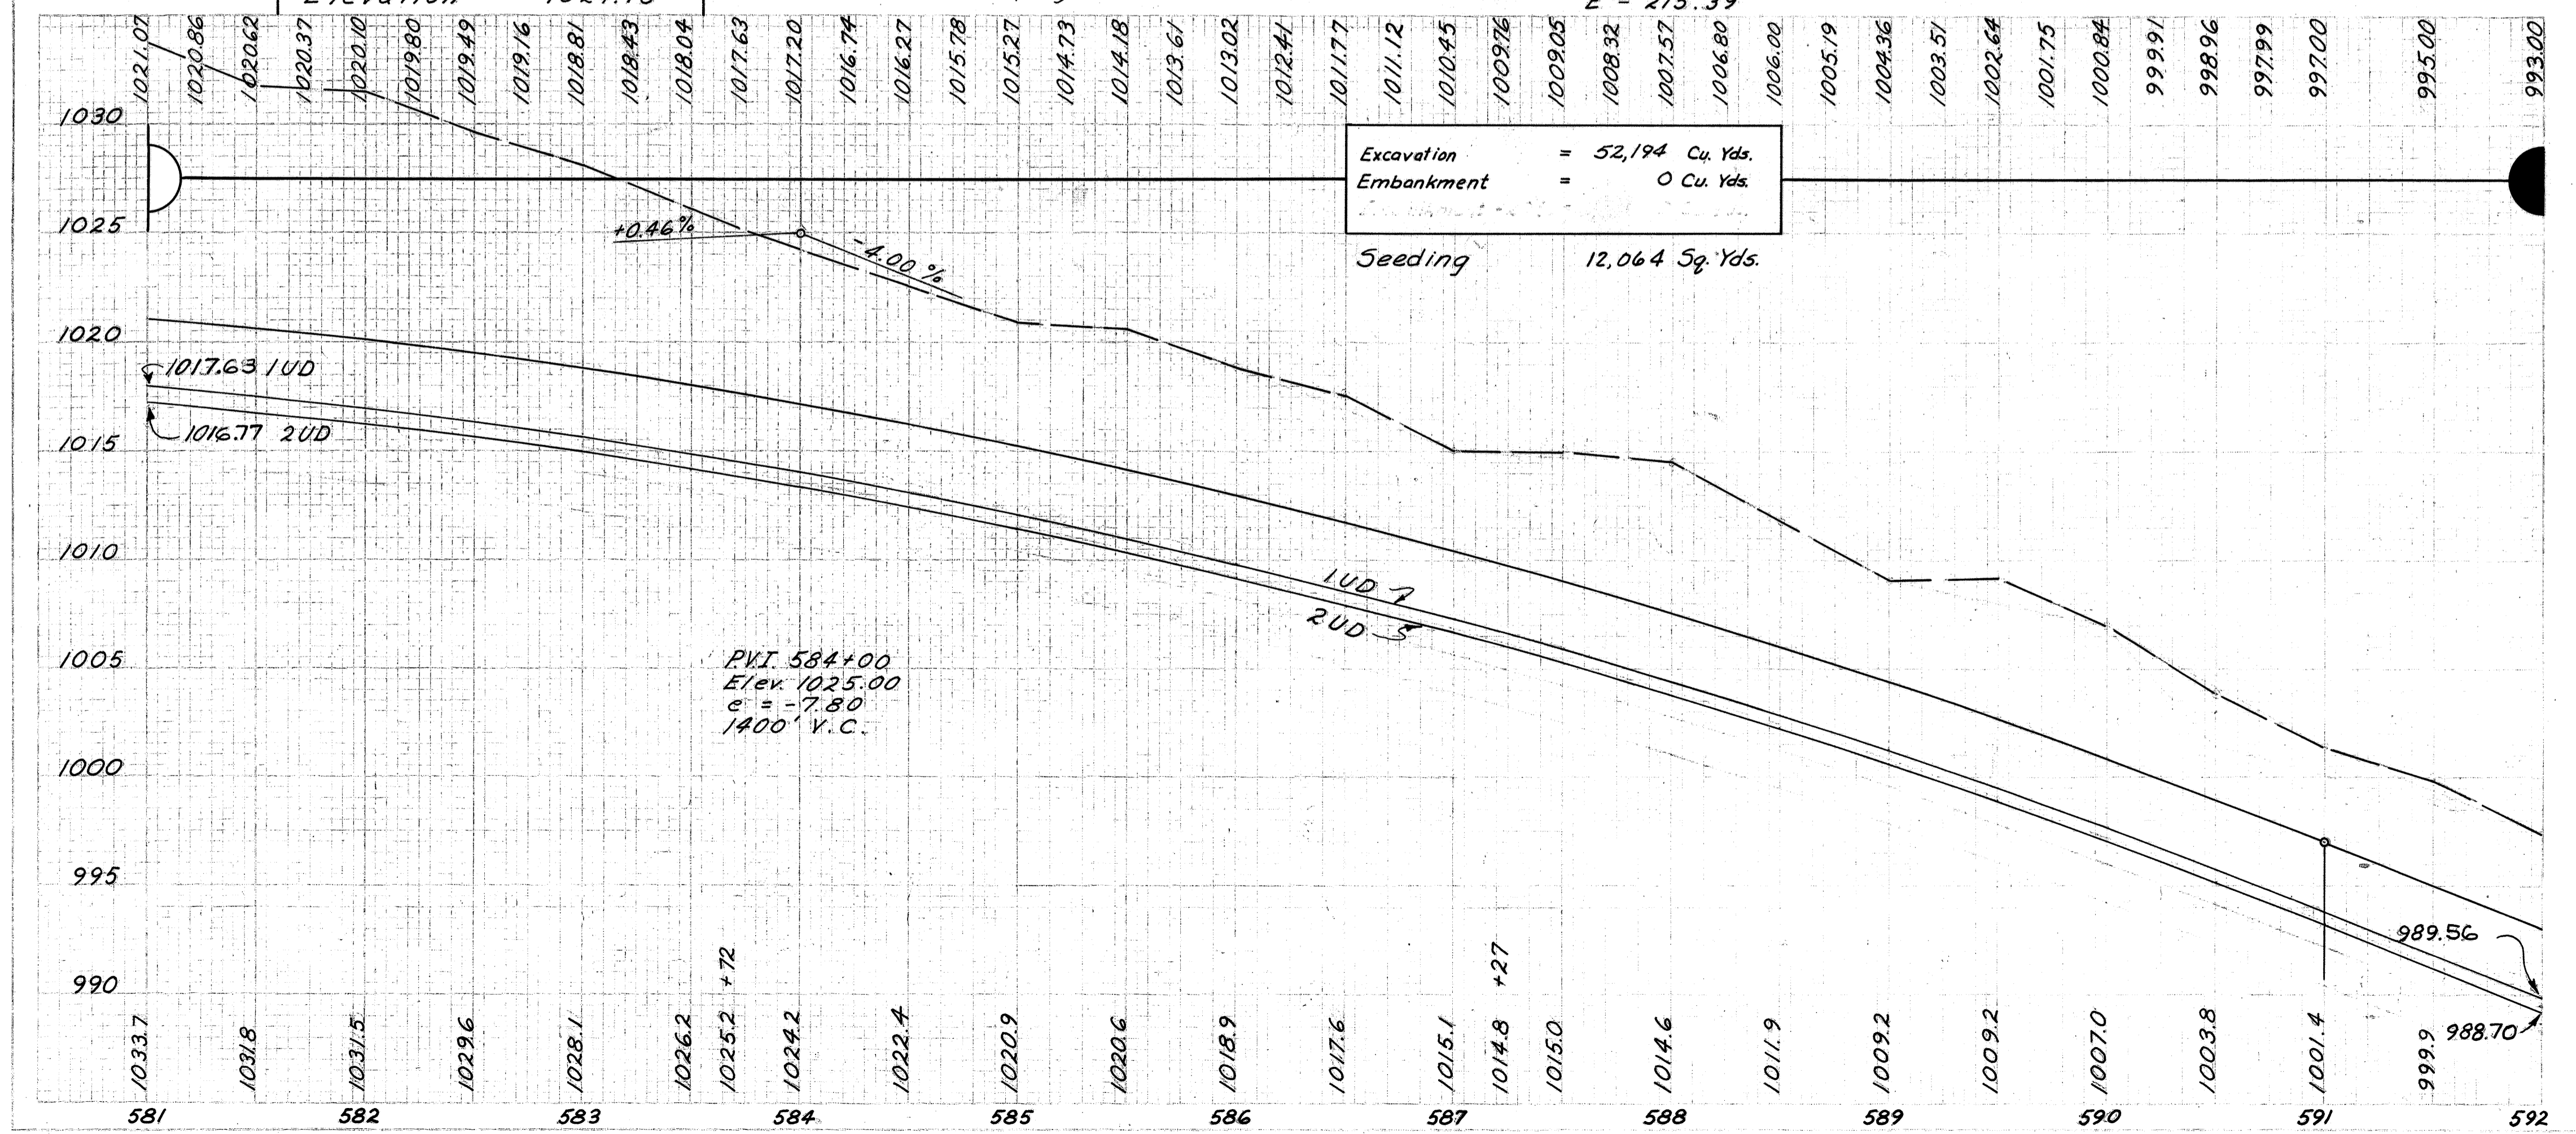

**WAYNE COUNTY
WAY-3-9.94**

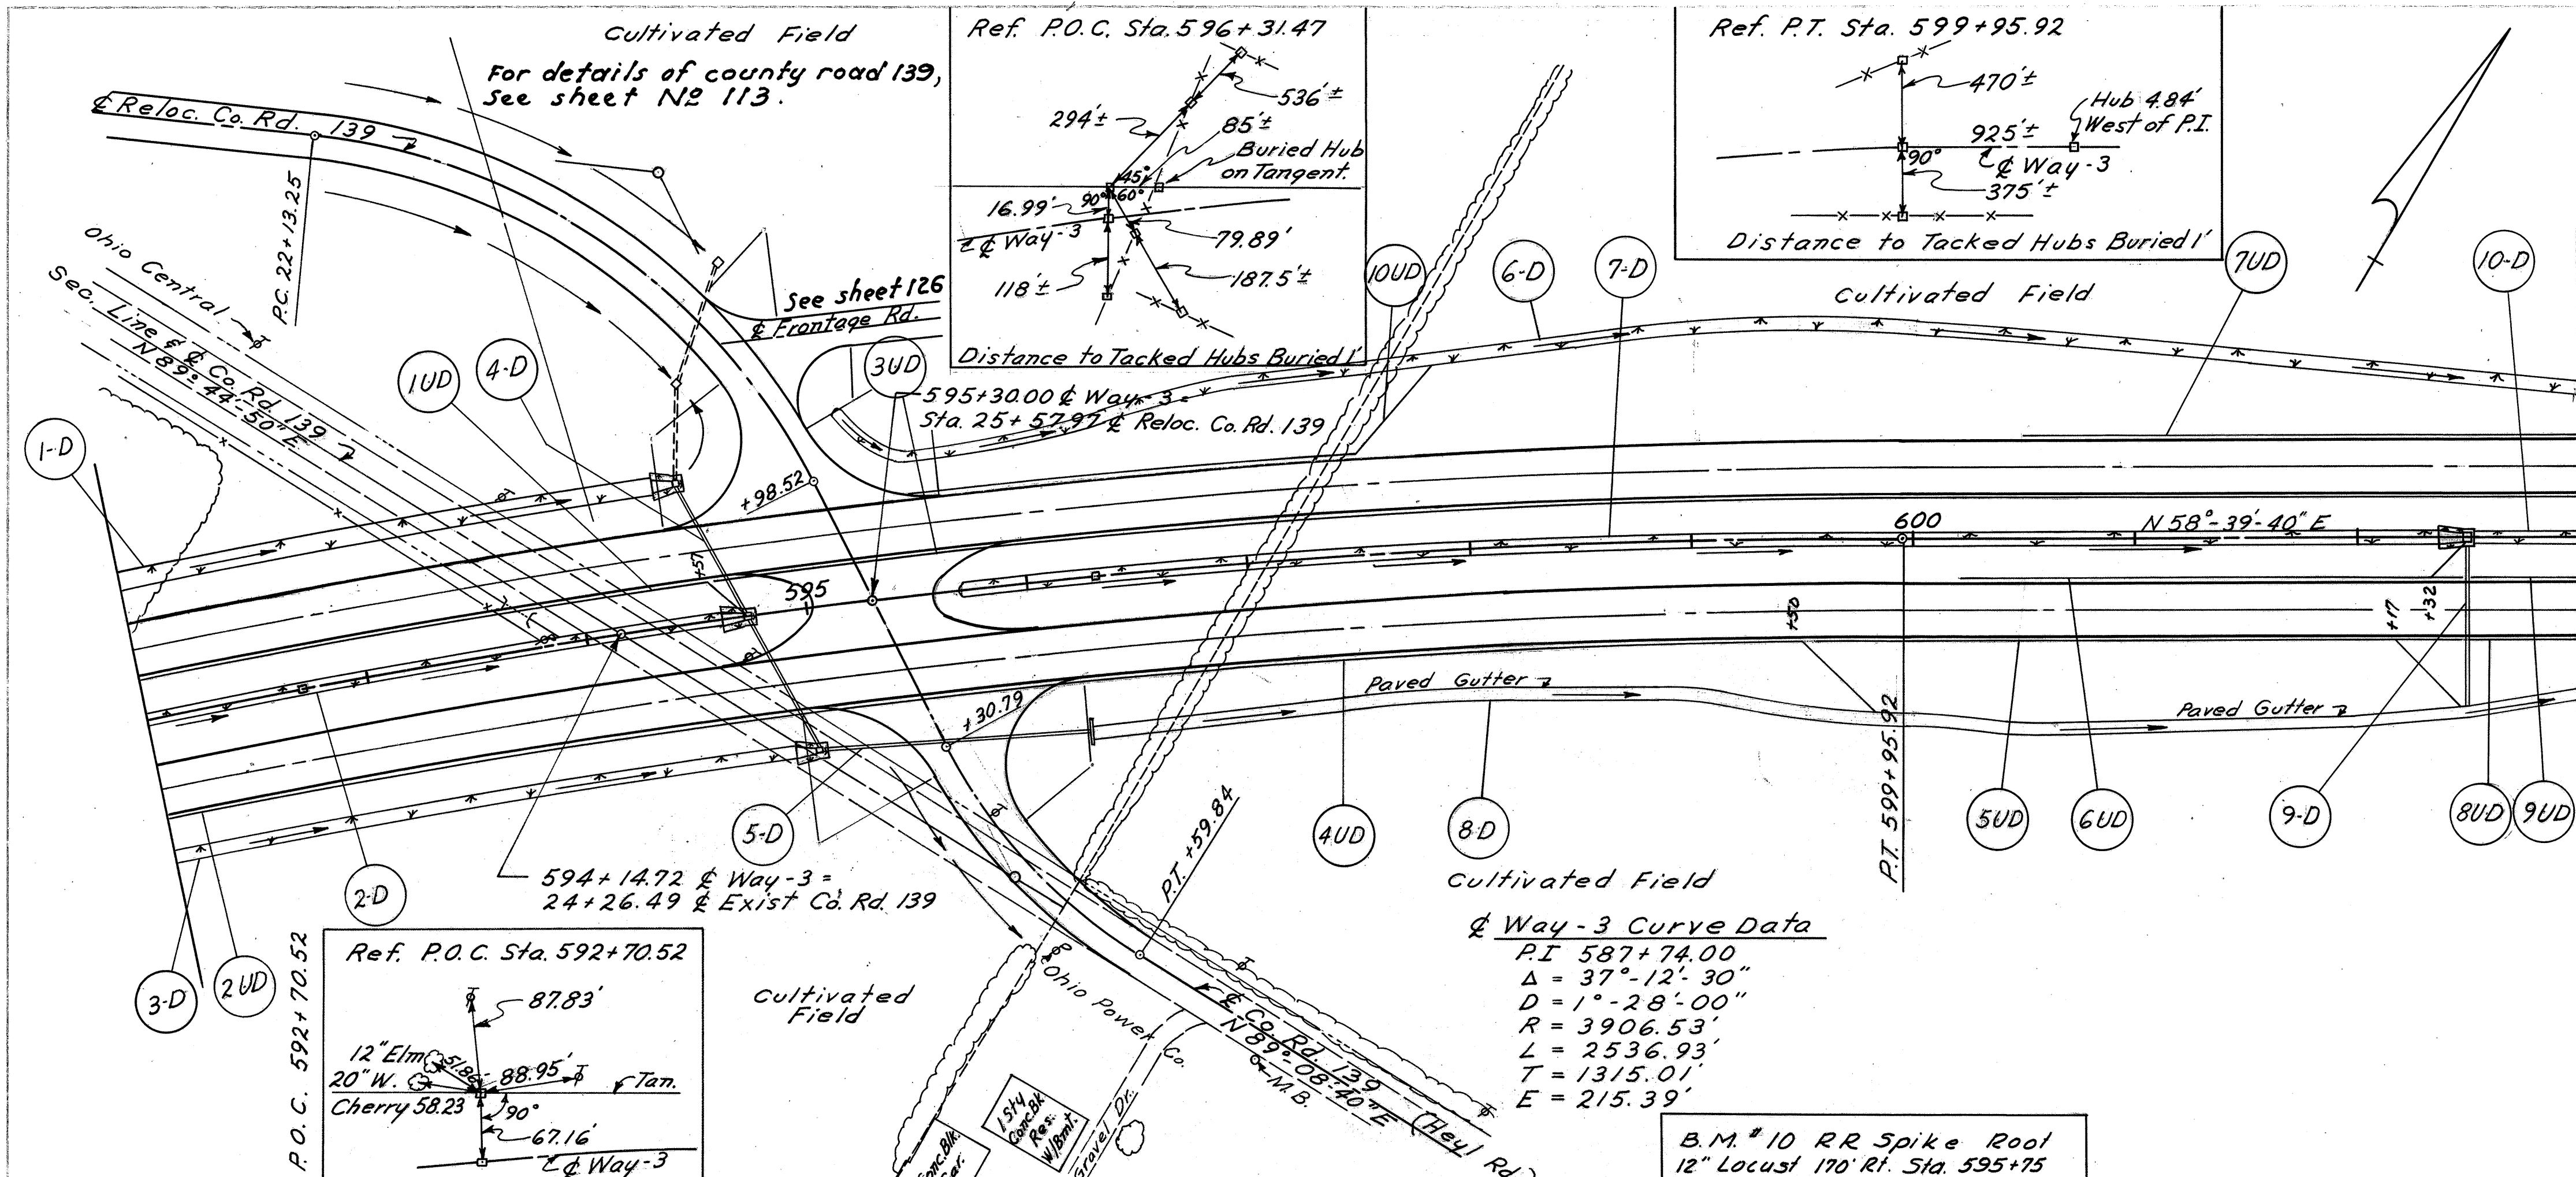

Item No.	Station		Side	L-10 Sodding		I-14 Paved Gutter		I-8 Catch Basin		I-2 Class B Storm Sewer		I-2 Storm Sewer Under P.V.		S-1 Concrete Structures		
	From	To		Width	Sp. Yd.	Lin. Ft.	Each	Each	Lin. Ft.	Lin. Ft.	Sec. M-6.6(b) 24"	Sec. M-6.8(b) 24"	Class E.	Cu. Yd.		
1-D	592+00	594+40	Lt.	8	214											
2-D	592+00	594+65	Ctr.	6	177											
3-D	592+00	594+90	Et.	6	194											
4-D	594+50	595+00	Lt.	1.5	18	30		3				136				
5-D	595+00	596+20	Et.									118	0.41			
6-D	595+25	603+00	Lt.	6	519											
7-D	595+70	602+40	Ctr.	6	450											
8-D	596+20	603+00	Et.	1.5	224		680									
9-D	602+50		Et.	1.5	6	10			1	72			0.26			
10-D	602+50	603+00	Ctr.	6	33											
Totals					835	40	680	3	1	72	254	0.67				

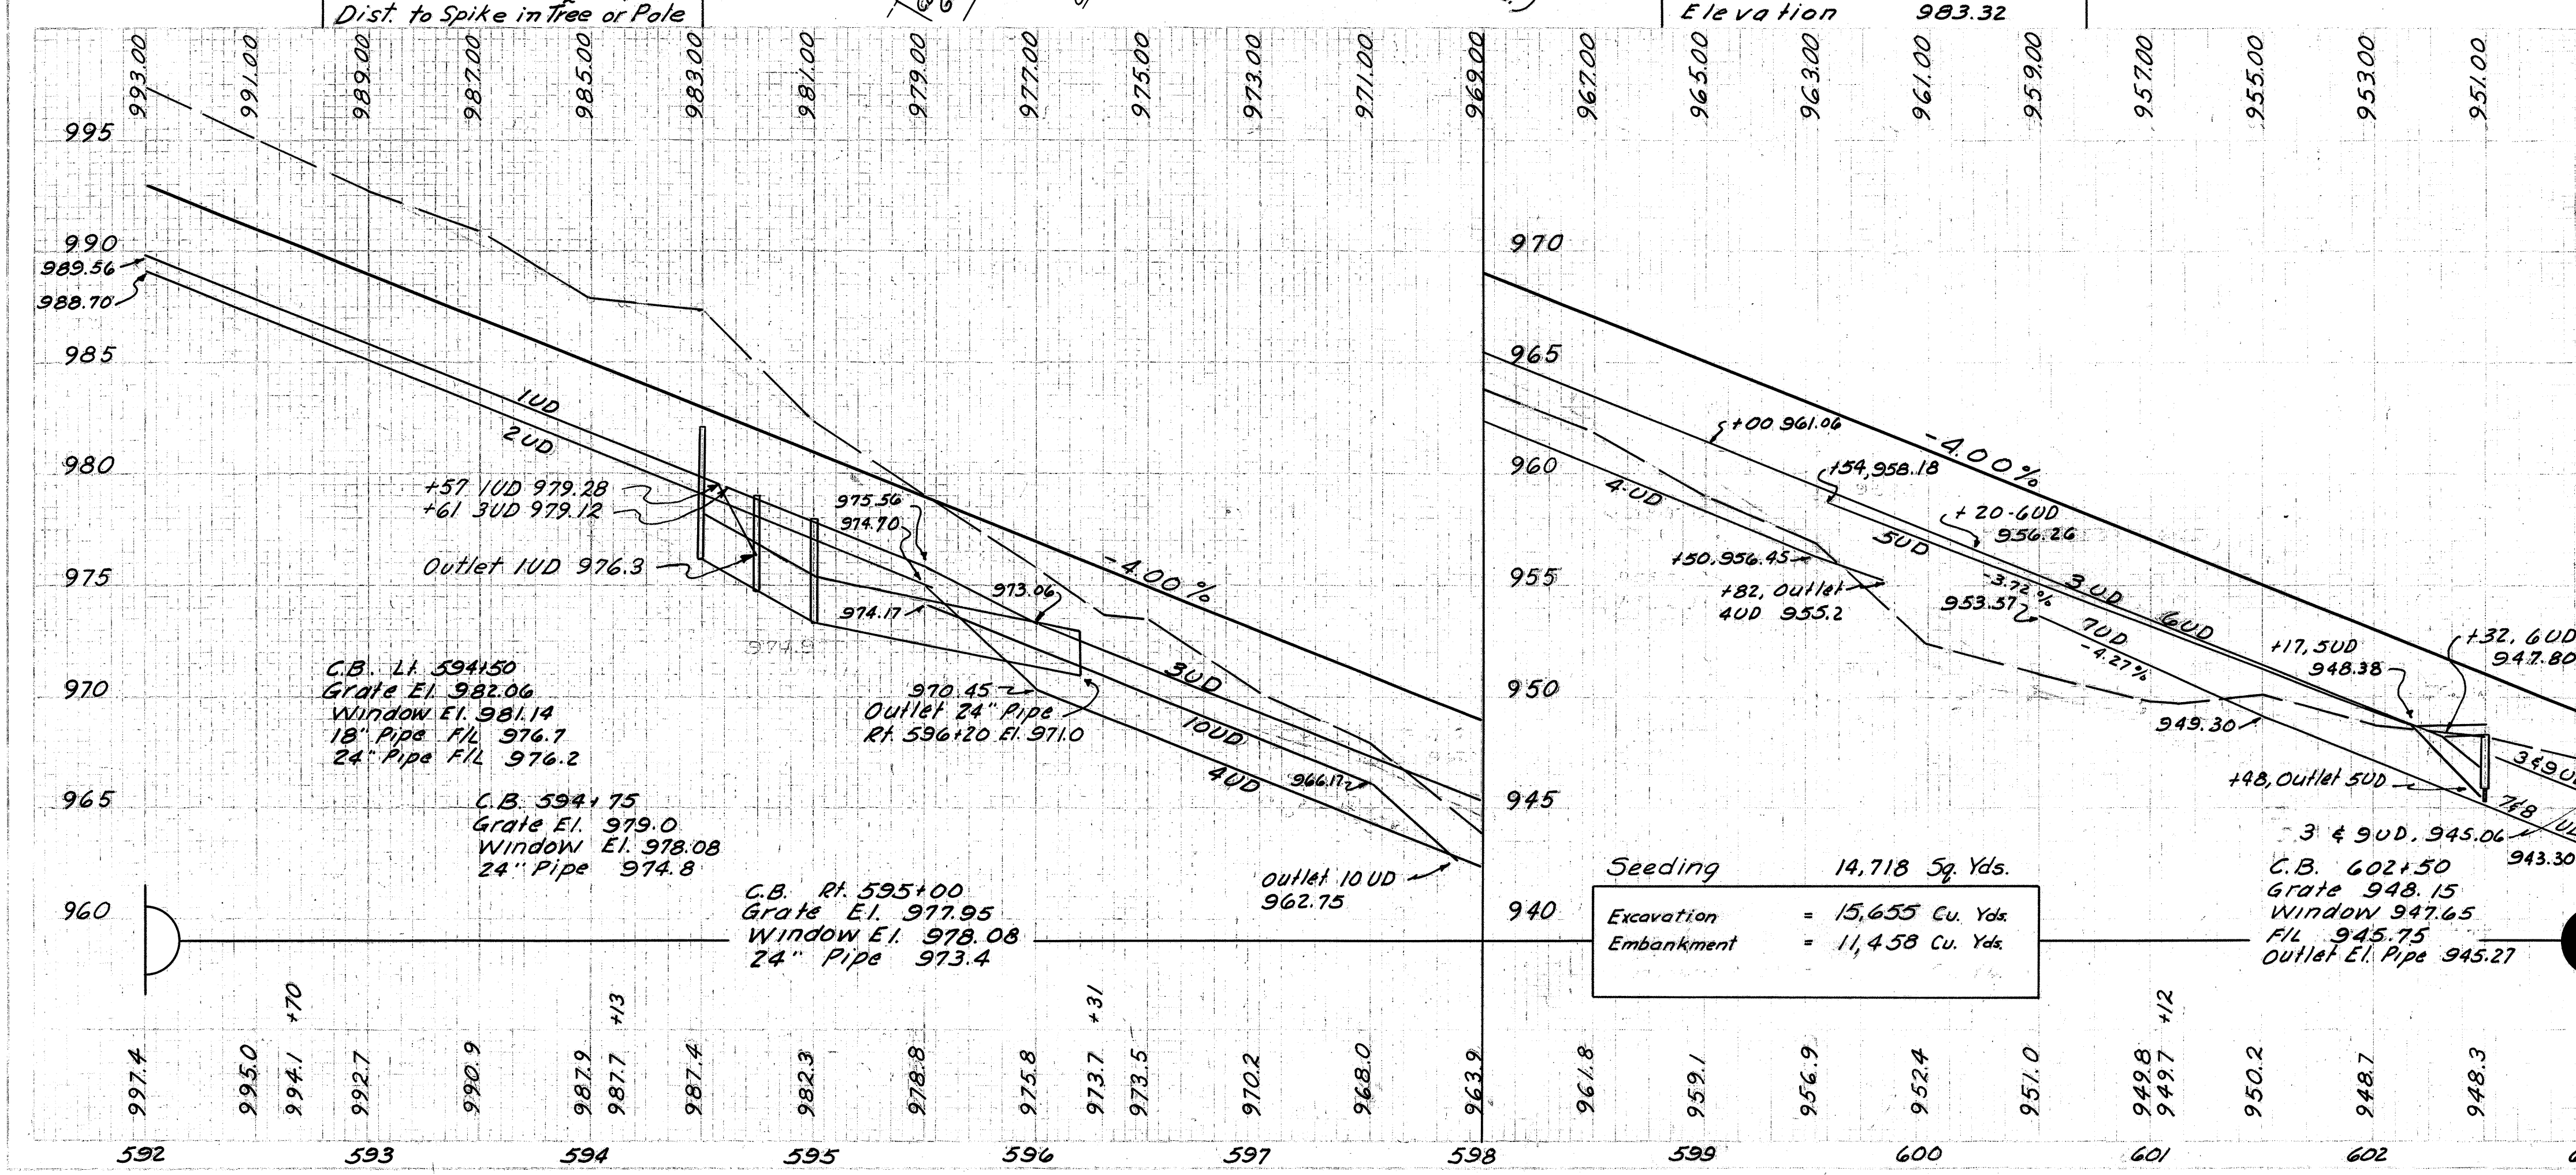


Item No.	Station		Side	I-4 6" Pipe Underdrain		I-4 6" Pipe Underdrain		I-5 Pipe Specials		I-4 6" Pipe Underdrain	
	From	To		Shallow	Deep	For Underdrain	45° Wye Bend	Each	Each	Shallow	M 6.4(h)
1UD	592+00	594+57	Lt.			10		1			271
2UD	592+00	595+50	Lt.								350
3UD	594+61	603+00	Lt.	750							89
4UD	595+50	599+82	Et.		436	10		1			
5UD	599+54	602+48	Et.	328		10		1			
6UD	600+20	602+50	Et.	242		10		1			
7UD	600+50	603+00	Lt.		250						
8UD	602+52	603+00	Et.		48						
9UD	602+52	603+00	Et.	48							
10UD	595+50	597+88	Lt.		244	10		1			
Totals				1368	978	50	3	2	710		



B.M. #11 S.W. Cor. of Lower Step on Front Porch of C.A. Barnes Residence Elevation 952.94

Way-3 Curve Data
 P.I. 609+21.13
 $\Delta = 13^\circ 20' - 10''$
 $D = 1^\circ - 20'$
 $R = 4297.18'$
 $L = 1000.21'$
 $T = 502.37'$
 $E = 29.27'$

WAYNE COUNTY
 WAY-3-9.94

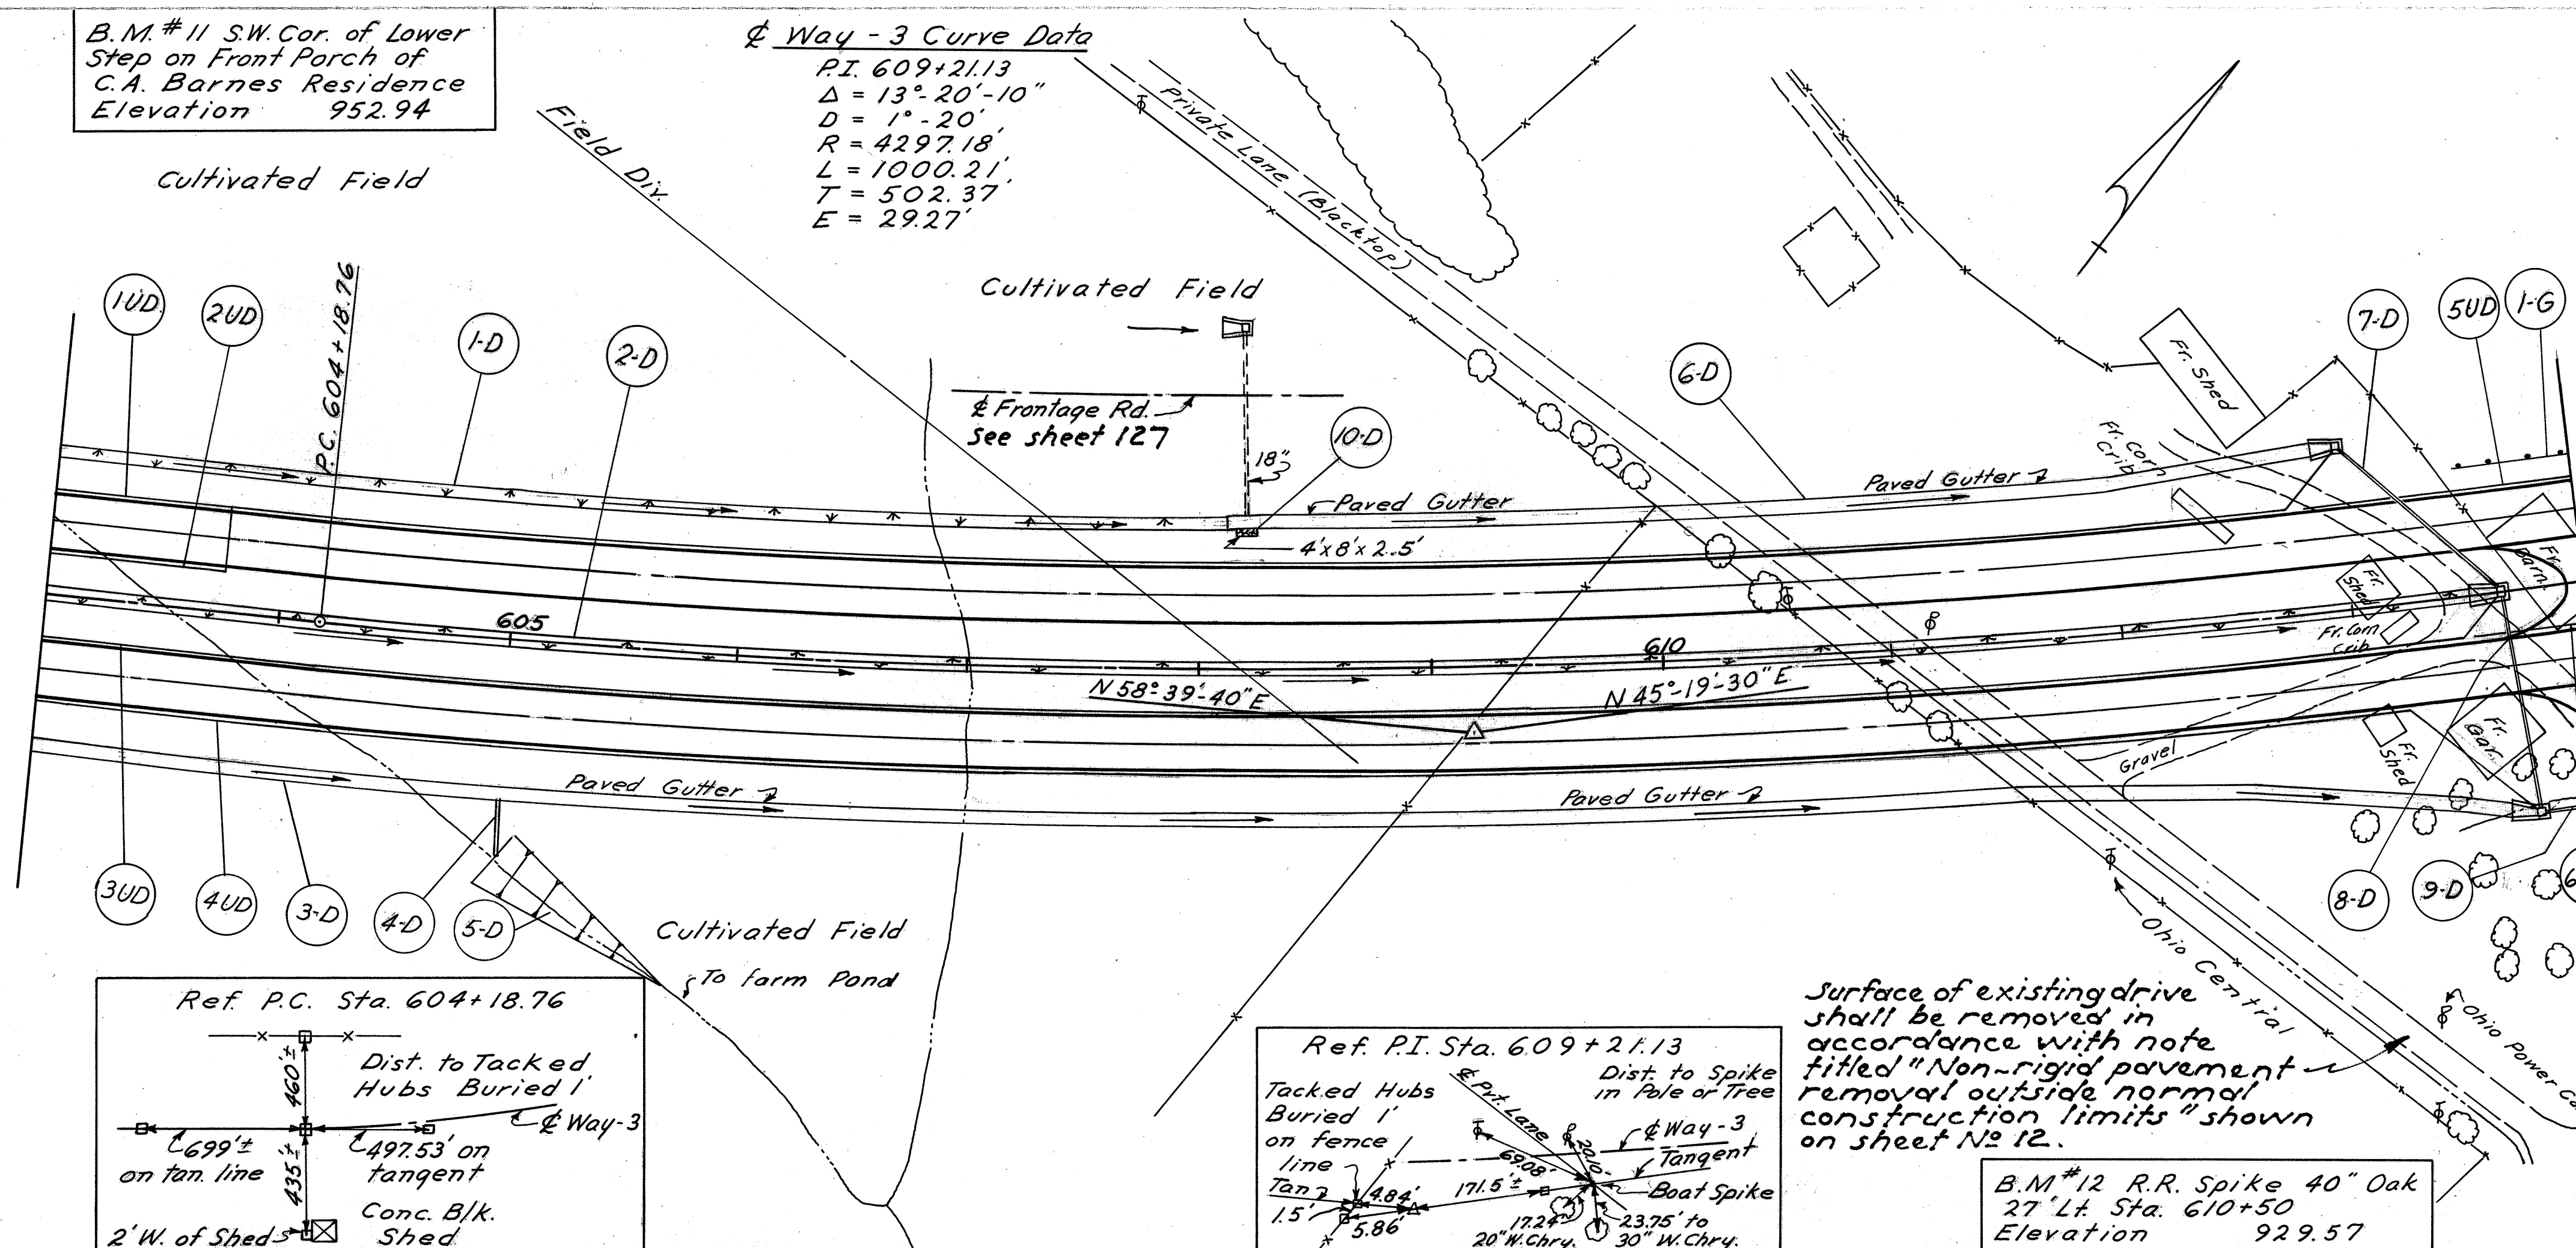


Item No.	Station	Side	L-10		I-14		I-8		I-2		I-3		I-10	
			Sodding Width	Paved Gutter	Catch Basins	Storm Sewer	Extra Qual.	Dumped	Rock Chann.					
From	To		Lin. Ft.	Sec. Yd.	Lin. Ft.	Lin. Ft.	Ea.	Ea.	21"	30"	6"	Lin. Ft.	Depth	
1-D	603+00	608+10	Lt.	6	342									
2-D	603+00	613+55	Ctr.	6	906									
3-D	603+00	613+70	Rt.	1.5	351	10	1060							
4-D	605+00		Rt.									30		
5-D	605+00	605+75	Rt.		140									
6-D	608+10	613+00	Lt.	1.5	160	10	480							
7-D	613+00	613+65	Rt.		6			1	96					
8-D	613+65	613+70	Rt.	1.5	6	10		1	94					
9-D	613+65	614+00	Rt.					1		29				
10-D	608+18		Lt.									30	3.0	
Totals					1711	30	1540	1	2	190	29	30		3.0

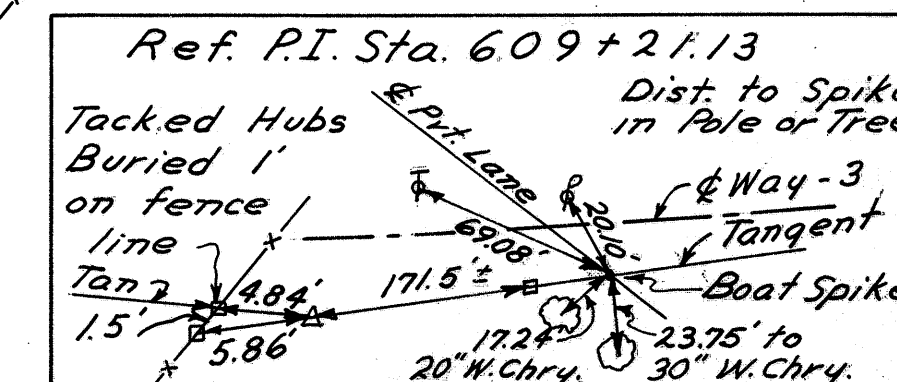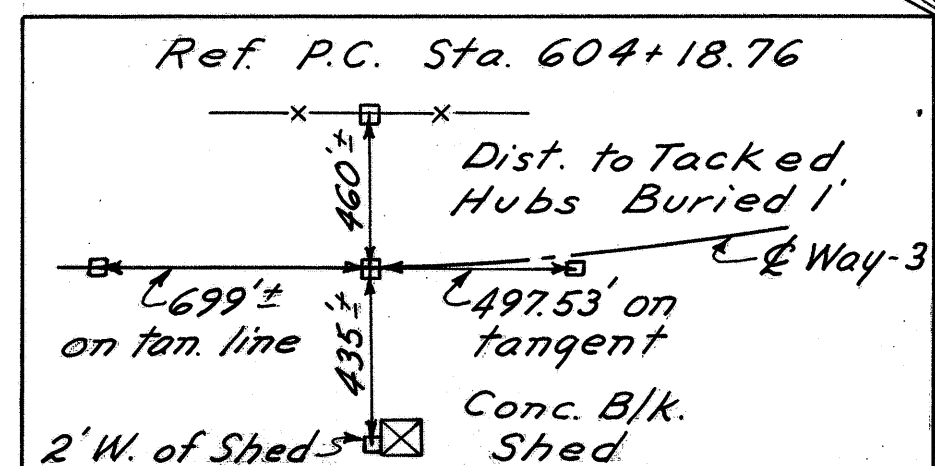

Surface of existing drive shall be removed in accordance with note titled "Non-rigid pavement removal outside normal construction limits" shown on sheet No 12.

B.M. #12 R.R. Spike 40" Oak
 27" Lt. Sta. 610+50
 Elevation 929.57

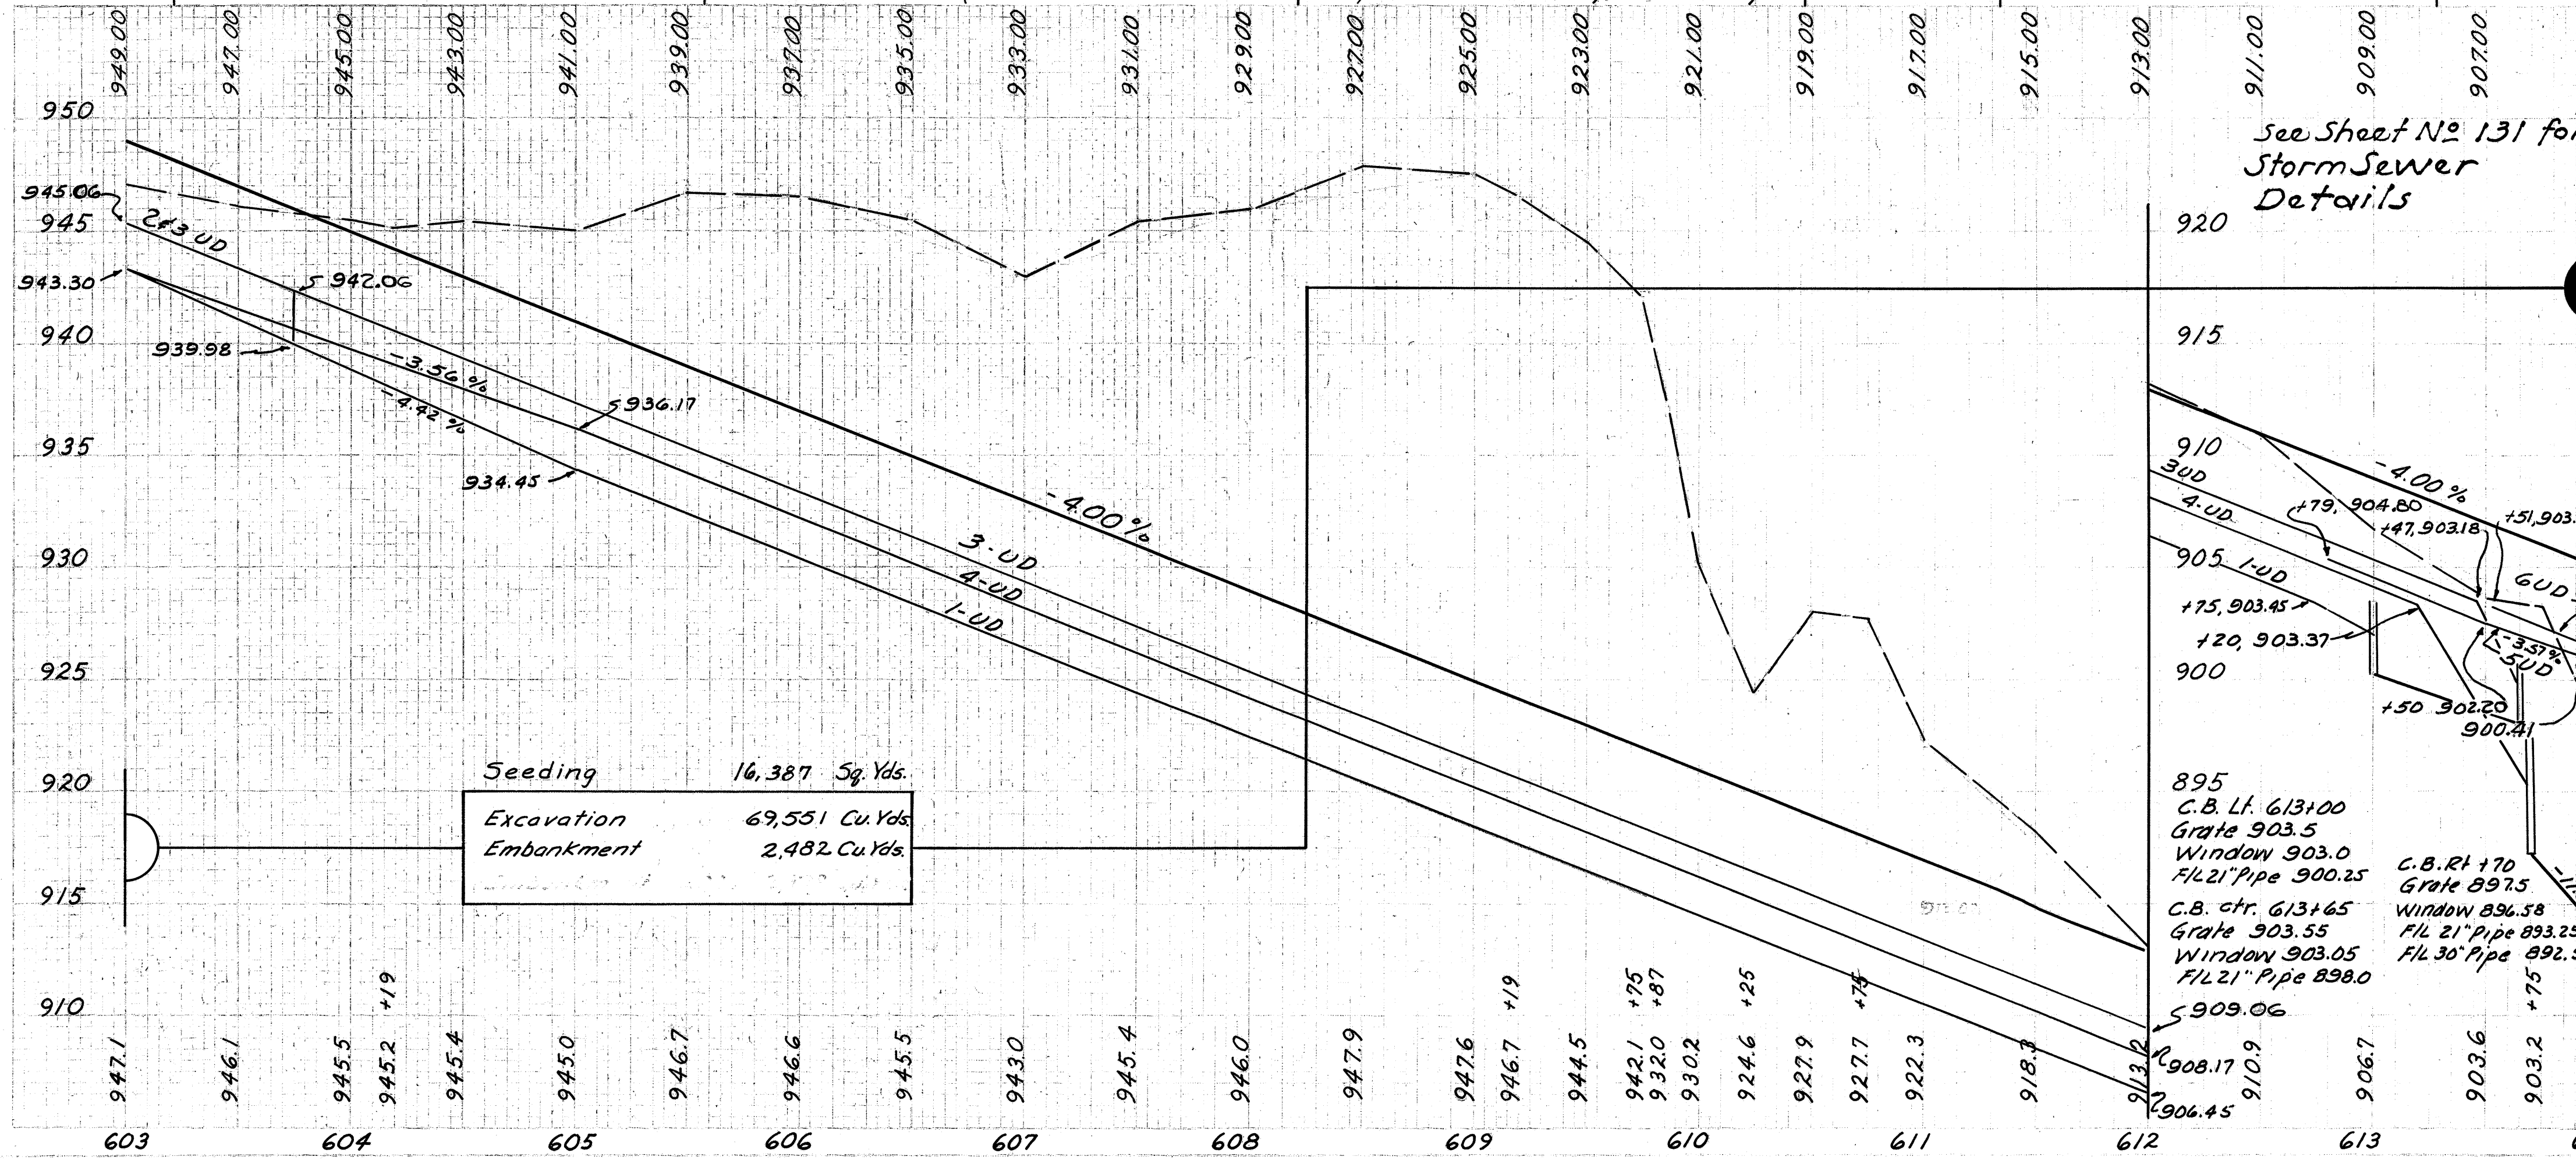


See Sheet No 131 for Storm Sewer Details

Item No.	Station	Side	I-4		I-4		I-5		I-15	
			6" Pipe Underdrain Shallow	6" Pipe Underdrain Deep	Pipe Outlet For Underdrain	Pipe Specials 45° Wye Bend	Pipe Specials 90° Tee Bend	Guard Rail Steel Beam Type (Deep)		
From	To	Lin. Ft.	Lin. Ft.	Lin. Ft.	Ea.	Ea.	Ea.	Ea.	Lin. Ft.	
1-UD	603+00	613+00	Lt.		1000	10	1			
2-UD	603+00	603+75	Lt.	81	14				1	1
3-UD	603+00	613+65	Rt.	1058		10	1			
4-UD	603+00	613+70	Rt.		1077	10	1			
5-UD	612+79	614+00	Lt.	121						
6-UD	613+51	614+00	Rt.	49						
1-G	613+48.2	614+00	Lt.							51.8
Totals				1309	2091	30	3	1	1	51.8


WAYNE COUNTY
WAY-3-9.94

Note: For Existing Structure (over Killbuck Creek) Data, See Sheet No 133.

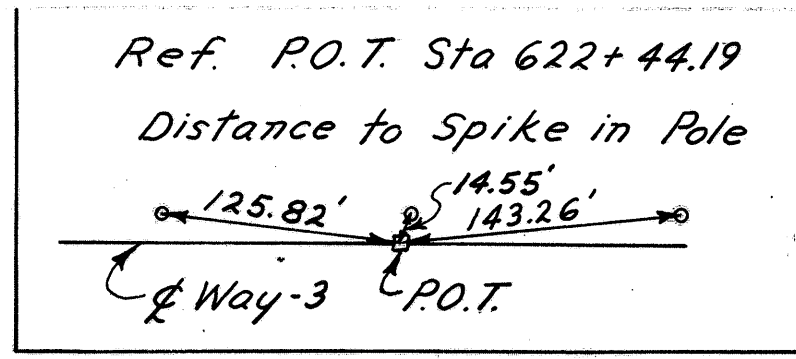

PROPOSED STRUCTURE
 STRUCTURE NO WAY-3-1166
 TYPE: Twin Continuous Steel Girder With
 rem. Conc. Deck & Sub. Structure
 SPANS: 77'-6"-97'-0", 77'-6"
 ROADWAY: 30'-0" between 2'-2" Safety Curbs
 LOAD FREQUENCY: CF 400 (57)
 WEARING SURFACE: 1" Monolithic Concrete
 APPROACH SLABS: AS-1-54 Modified (25' Long)
 ALIGNMENT: Tangent
 SKEW: 24° R.F.
 A.D.T.: 1875 (1980)

Uncultivated Field
 NOTE: For Data on Existing Structure See Sheet No. 133

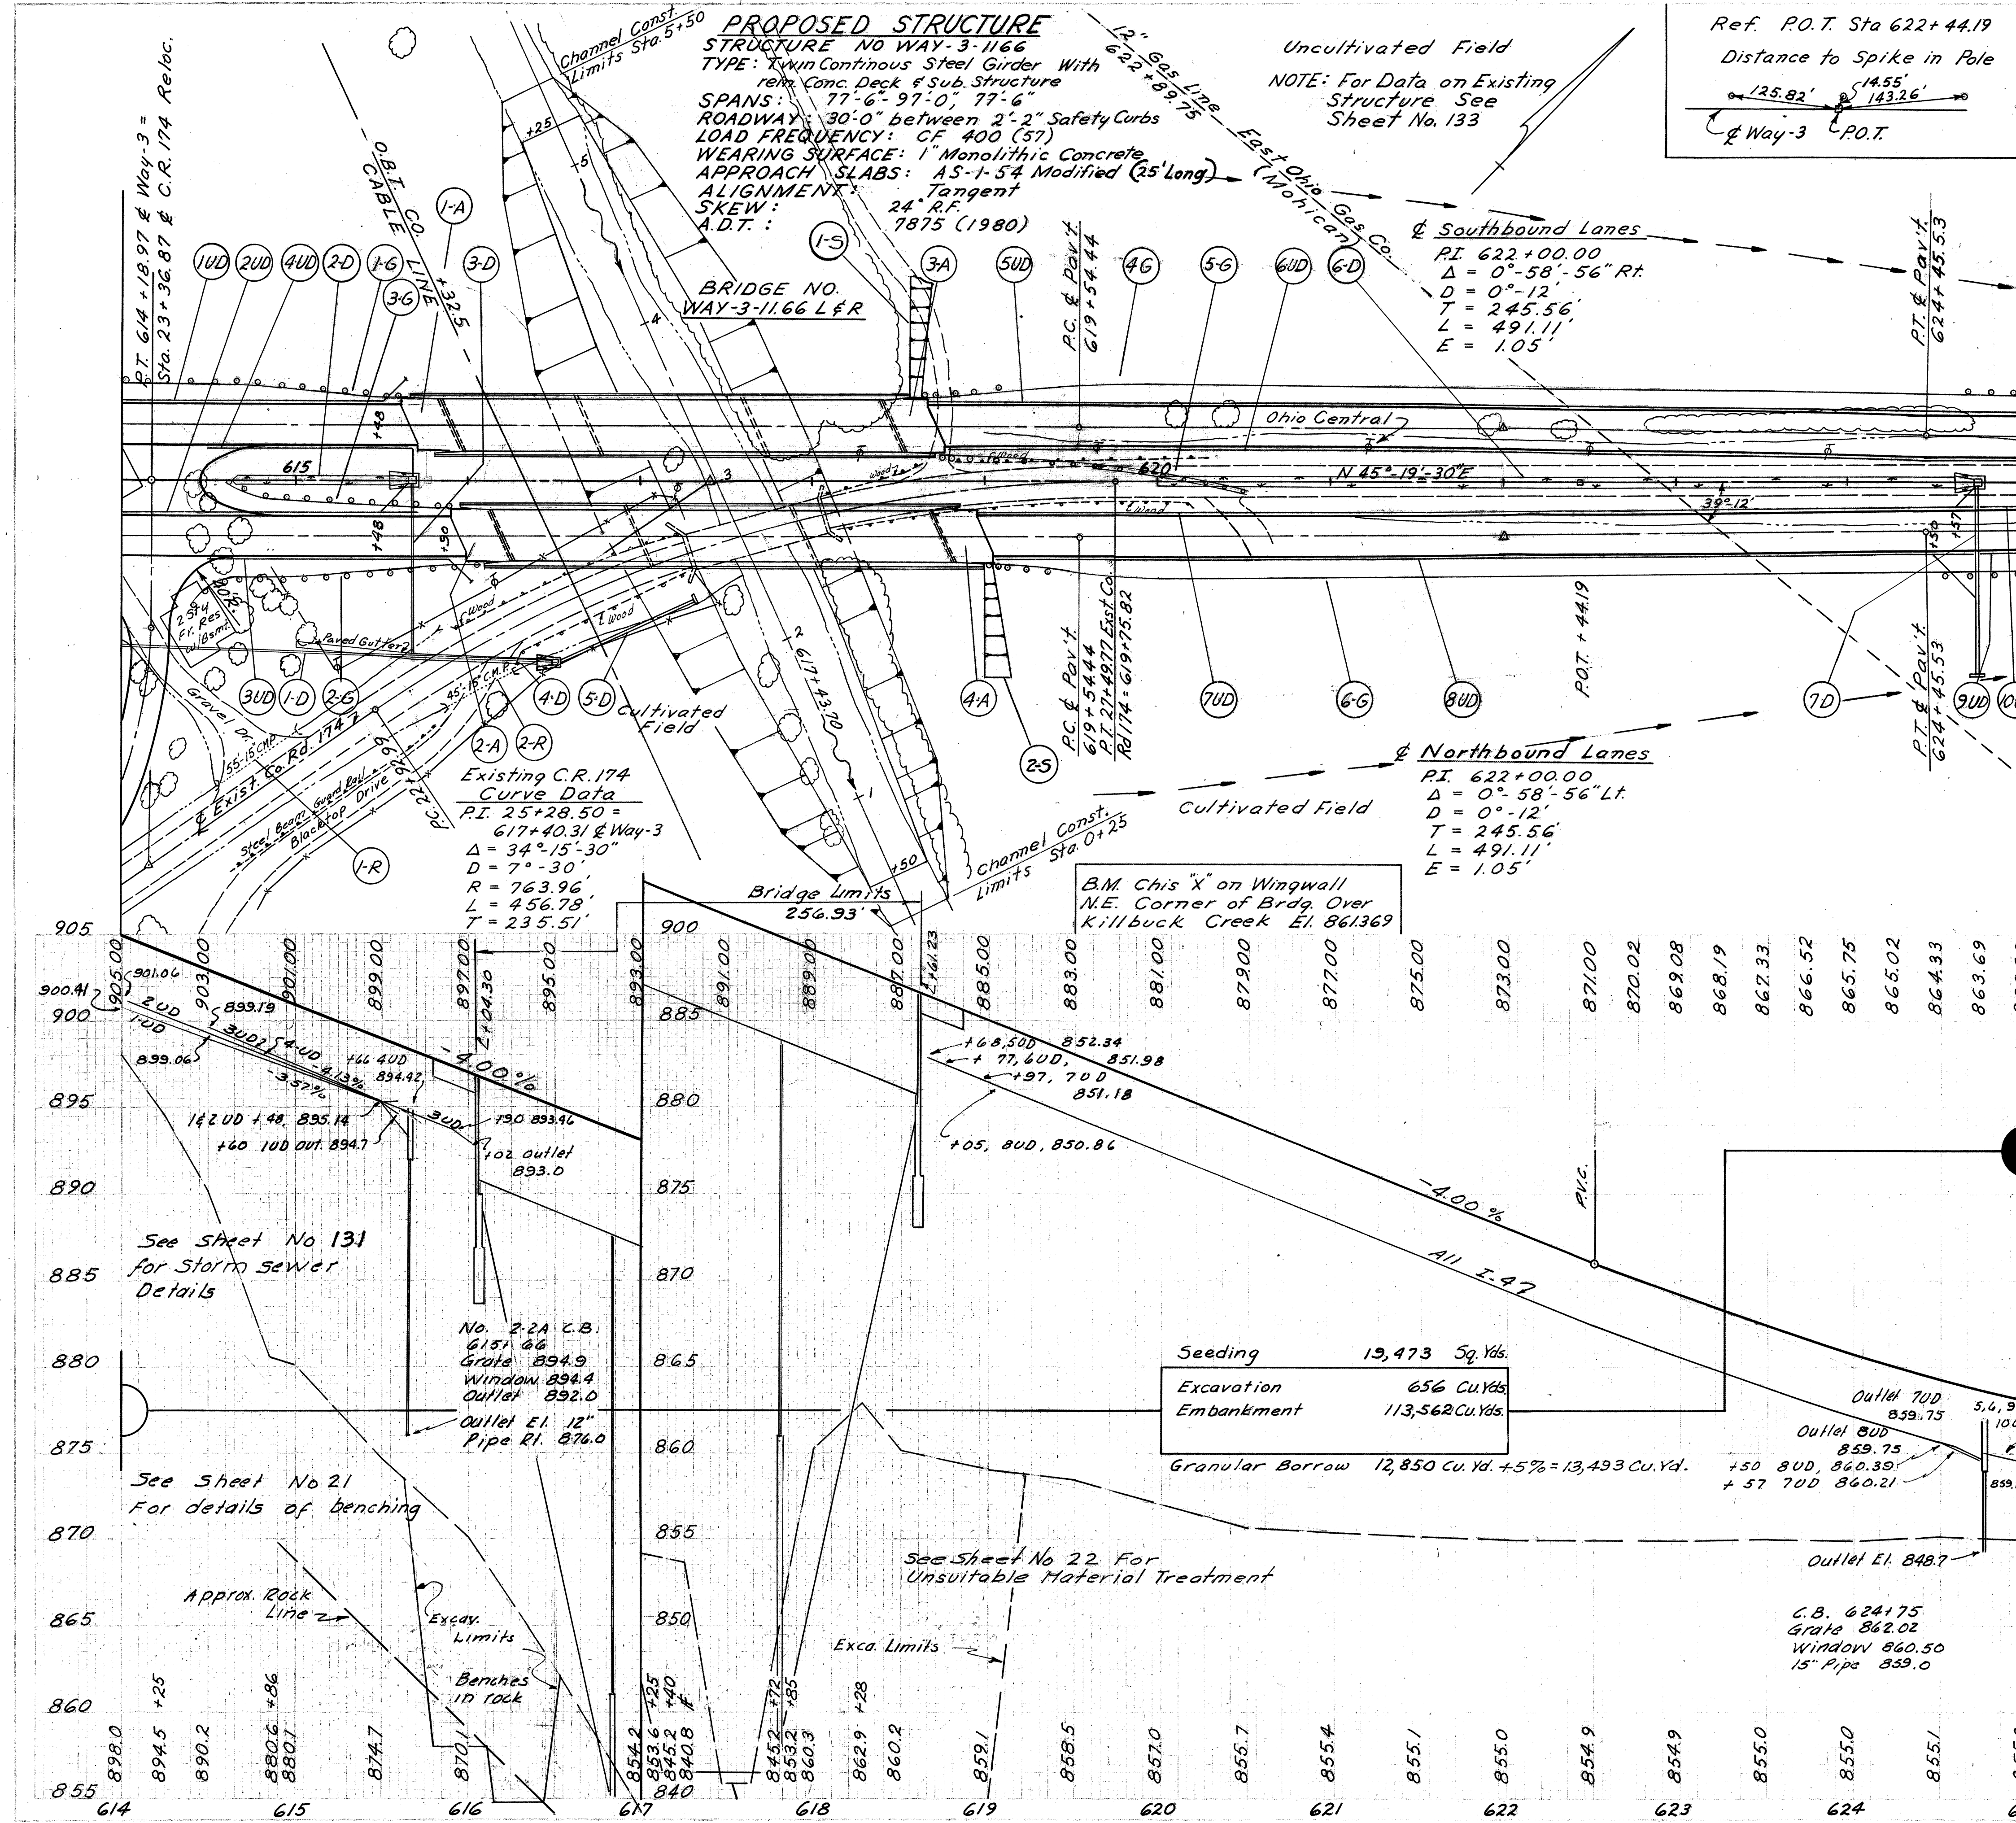

Item No	Station	Side	L-10 Sodding		I-14 Paved Gutter		I-8 Catch Basins		I-2 Storm Sewers		S-1 Concrete For Structures		I-5 Pipe Specials			
			Width	Lin. Ft.	Special	Type I	No.	2-2A	Under Pvt. 12" 15" 30" 12" 15" 30"	M.G. 4 (c)	Class E	25° Bend	12" 15"			
1-D	614+00	Rt.	6	61					50	200						
2-D	614+65	Rt.	1.5	6	10			57	40		0.23	2				
3-D	615+66	Rt.	1.5	47	10	140										
4-D	615+00	Rt.	1.5	6	10			49	55		0.26	2				
7-D	624+75	Rt.														
Totals				120	30	140	2	57	49	50	40	55	200	0.49	2	2



Item No	Station	Side	L-10 Sodding		I-8 Catch Basins		I-2 Storm Sewer		S-1 Conc. For Structures		I-10 Rip Rap		E-12 Pipe Removal		I-5 Pipe Specials	
			Width	Lin. Ft.	No. 2-2A	Mod. 6.8 (b)	Sec. M 6.5 (b)	Sec. 6.4 (c)	6.4 (c)	Class E	15' Over Under 15"	25° Bends	12" 15"			
5-D	616+50	Rt.							90	0.51						
6-D	620+00	Rt.	6	335												
1-E	614+50	Rt.											55			
2-E	615+80	Rt.											45			
Totals				335		1			90	0.51			100			

Item No	Station	Side	I-4 6" Pipe Underdrain Shallow		I-4 6" Pipe Underdrain Deep		I-4 6" Pipe Outlet For Underdrain Bend Wye		I-5 Pipe Specials			L-10 Special Berm & Slope Protection
			Lin. Ft.	Lin. Ft.	Lin. Ft.	Lin. Ft.	60°	45°	45°	Sq. Yds.		
1UD	614+00	Lt.	151				10		1			
2UD	614+00	Rt.	175				10					
3UD	614+50	Rt.	143				10		1			
4UD	614+50	Lt.	119				10	1				
5UD	618+68	Lt.	632									
6UD	618+77	Lt.	623									
7UD	618+97	Rt.	582				10			1		
8UD	619+05	Rt.	586				10			1		
9UD	624+77	Rt.	23									
10UD	624+77	Rt.	23									
1-5	618+60	Lt.										104
2-5	619+00	Rt.										96
Totals			3057				60	1	2	3		200


Item No.	Station	Side	I-15 Guard Rail Steel Beam Type (Deep)		I-15 Barrier Rail Steel Beam Type (Deep)		I-7 Reinforced Concrete Appr. Slab 7'-13"	
			Lin. Ft.	Lin. Ft.	Lin. Ft.	Sq. Yds.	Lin. Ft.	Sq. Yds.
1-G	614+00	Lt.	160.7					
2-G	22+52.9	Rt.	190.4					
3-G	614+64.2	Rt.	137.5					
4-G	618+55.4	Lt.	644.6					
5-G	618+70.5	Lt.	87.5		87.5			
6-G	618+98.9	Rt.	601.10					
1-A	615+65.05	Lt.					86.91	
2-A	615+93.55	Rt.					89.04	
3-A	616+47.00	Lt.					86.91	
4-A	618+75.50	Rt.					89.04	
Totals			1821.8	87.5			351.90	

NOTE: Federal Funds will not participate in the Barrier Guard Rail shown on this sheet.

WAYNE COUNTY WAY-3-9.94

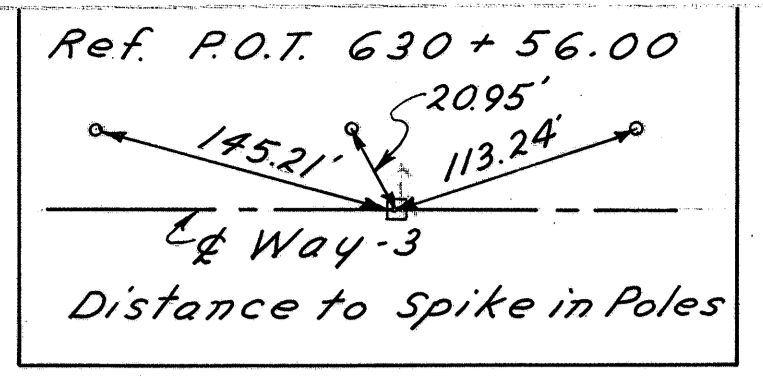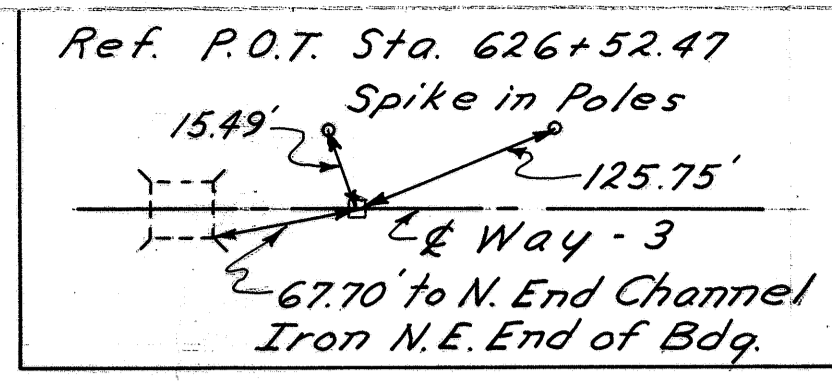

END PROJECT STA. 631+85.43
U-390 (9)
S.L.M. 11.96

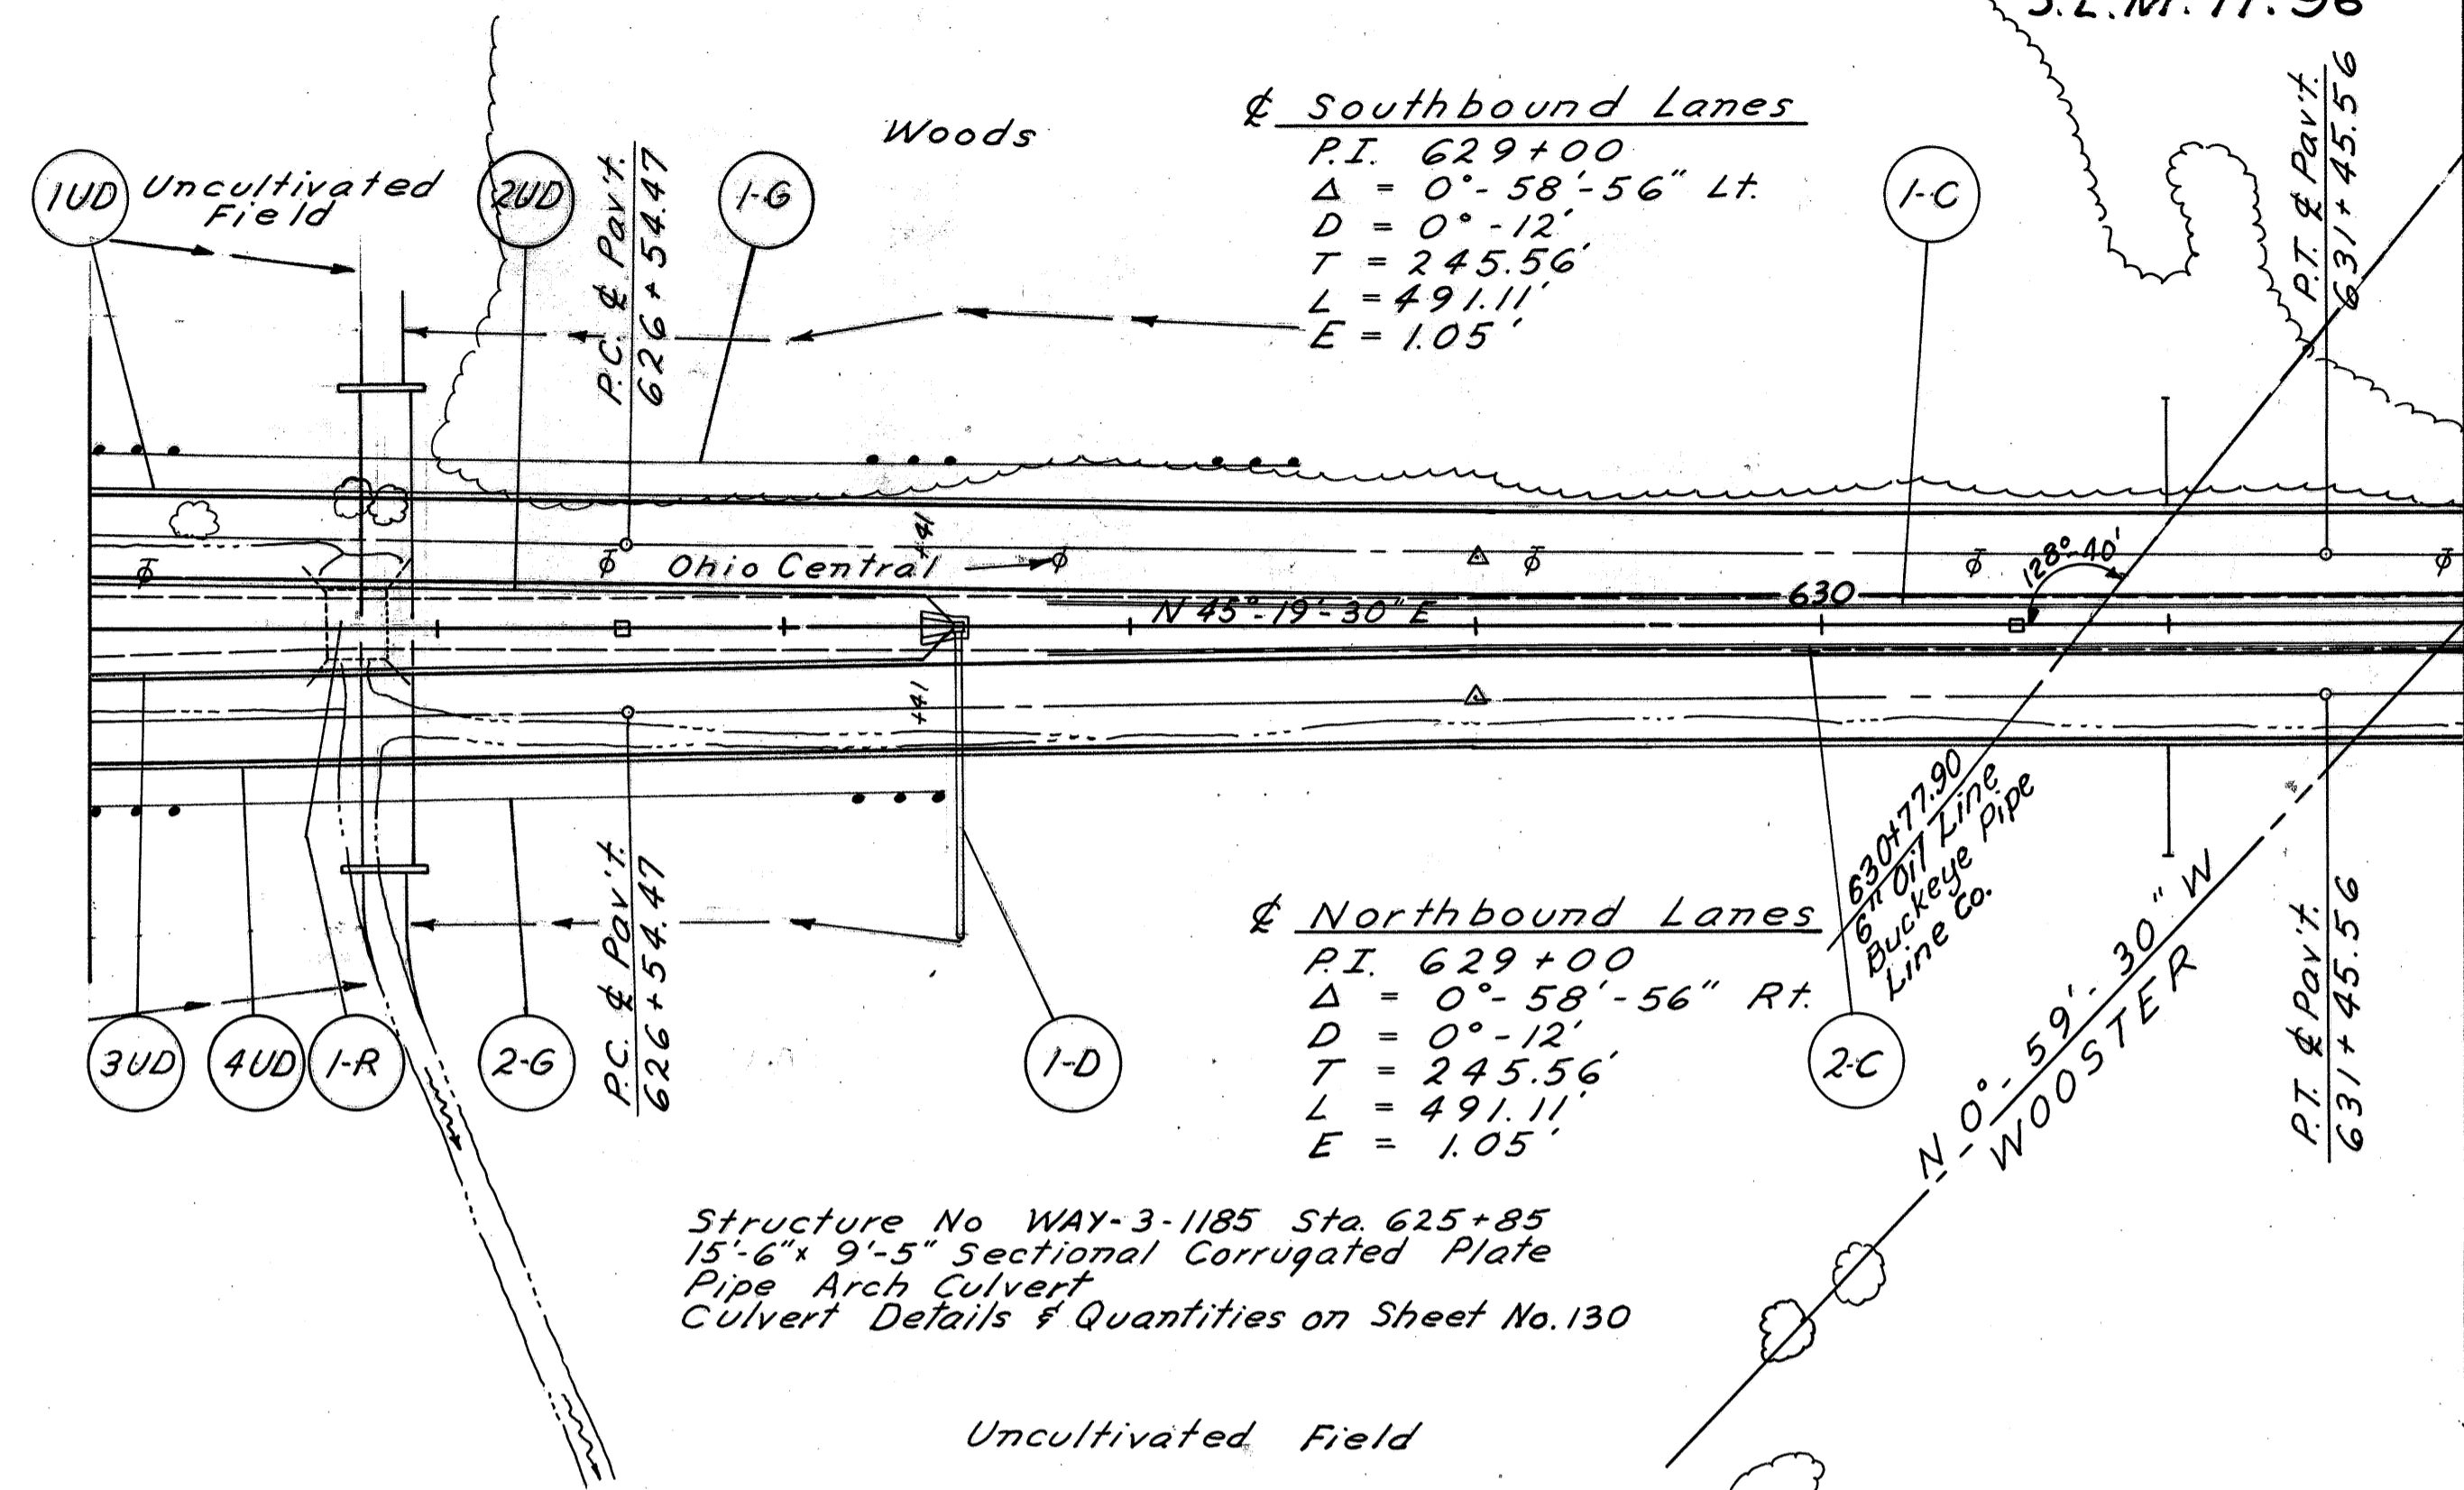

Southbound Lanes
P.I. 629+00
Δ = 0°-58'-56" Lt.
D = 0°-12'
T = 245.56'
L = 491.11'
E = 1.05'

Northbound Lanes
P.I. 629+00
Δ = 0°-58'-56" Rt.
D = 0°-12'
T = 245.56'
L = 491.11'
E = 1.05'



Structure No WAY-3-1185 Sta. 625+85
15'-6" x 9'-5" Sectional Corrugated Plate
Pipe Arch Culvert
Culvert Details & Quantities on Sheet No. 130

Note: Typical section of adjoining pavement at end of project is the same as typical section for Sta. 631+85.43 shown on sheet No. 7.

PROJECT U-1072 (3)

Item No.	Station		Side	L-10 Sodding Width Lin. Ft. Sq. Yds.	I-8 Catch Basin No. 2-2-A Each	I-2 Class B Storm Sewer under Pk. Lin. Ft. 12"	S-1 Concrete For Structures Class E. Cu. Yds.	S-24 Removal of Existing Structures	I-14 Paved Gutter Special Lin. Ft.
	From	To							
I-D	627+50		Rt.	1.5	6	1	87	0.23	10
I-R	625+75		Ctr.					Lump	
Totals				6	1	87	0.23	Lump	10

Item No.	Station		Side	I-4 6" Pipe Under-drains Shallow Lin. Ft.	I-4 6" Pipe Outlets For Under-drains Lin. Ft.	I-5 Pipe Specials			I-12 Conc Curb Type 6 Lin. Ft.	I-15 Guard Rail Steel Beam Type Deep Lin. Ft.
	From	To				6" 45° Bend Ea	6" 90° Bend Ea	6" Tees Ea		
1-UD	625+00	631+85.43	Lt.	701	10			1		
2-UD	625+00	627+50	Lt.	249	10	1				
3-UD	625+00	627+50	Rt.	249	10	1				
4-UD	625+00	631+85.43	Rt.	701	10			1		
1-G	625+00	627+55.4	Lt.							255.4
2-G	625+00	627+48.9	Rt.							248.9
1-C	627+75	631+85.43	Lt.							410.43
2-C	627+75	631+85.43	Rt.							410.43
Totals				1900	40	2	2	820.86		504.3

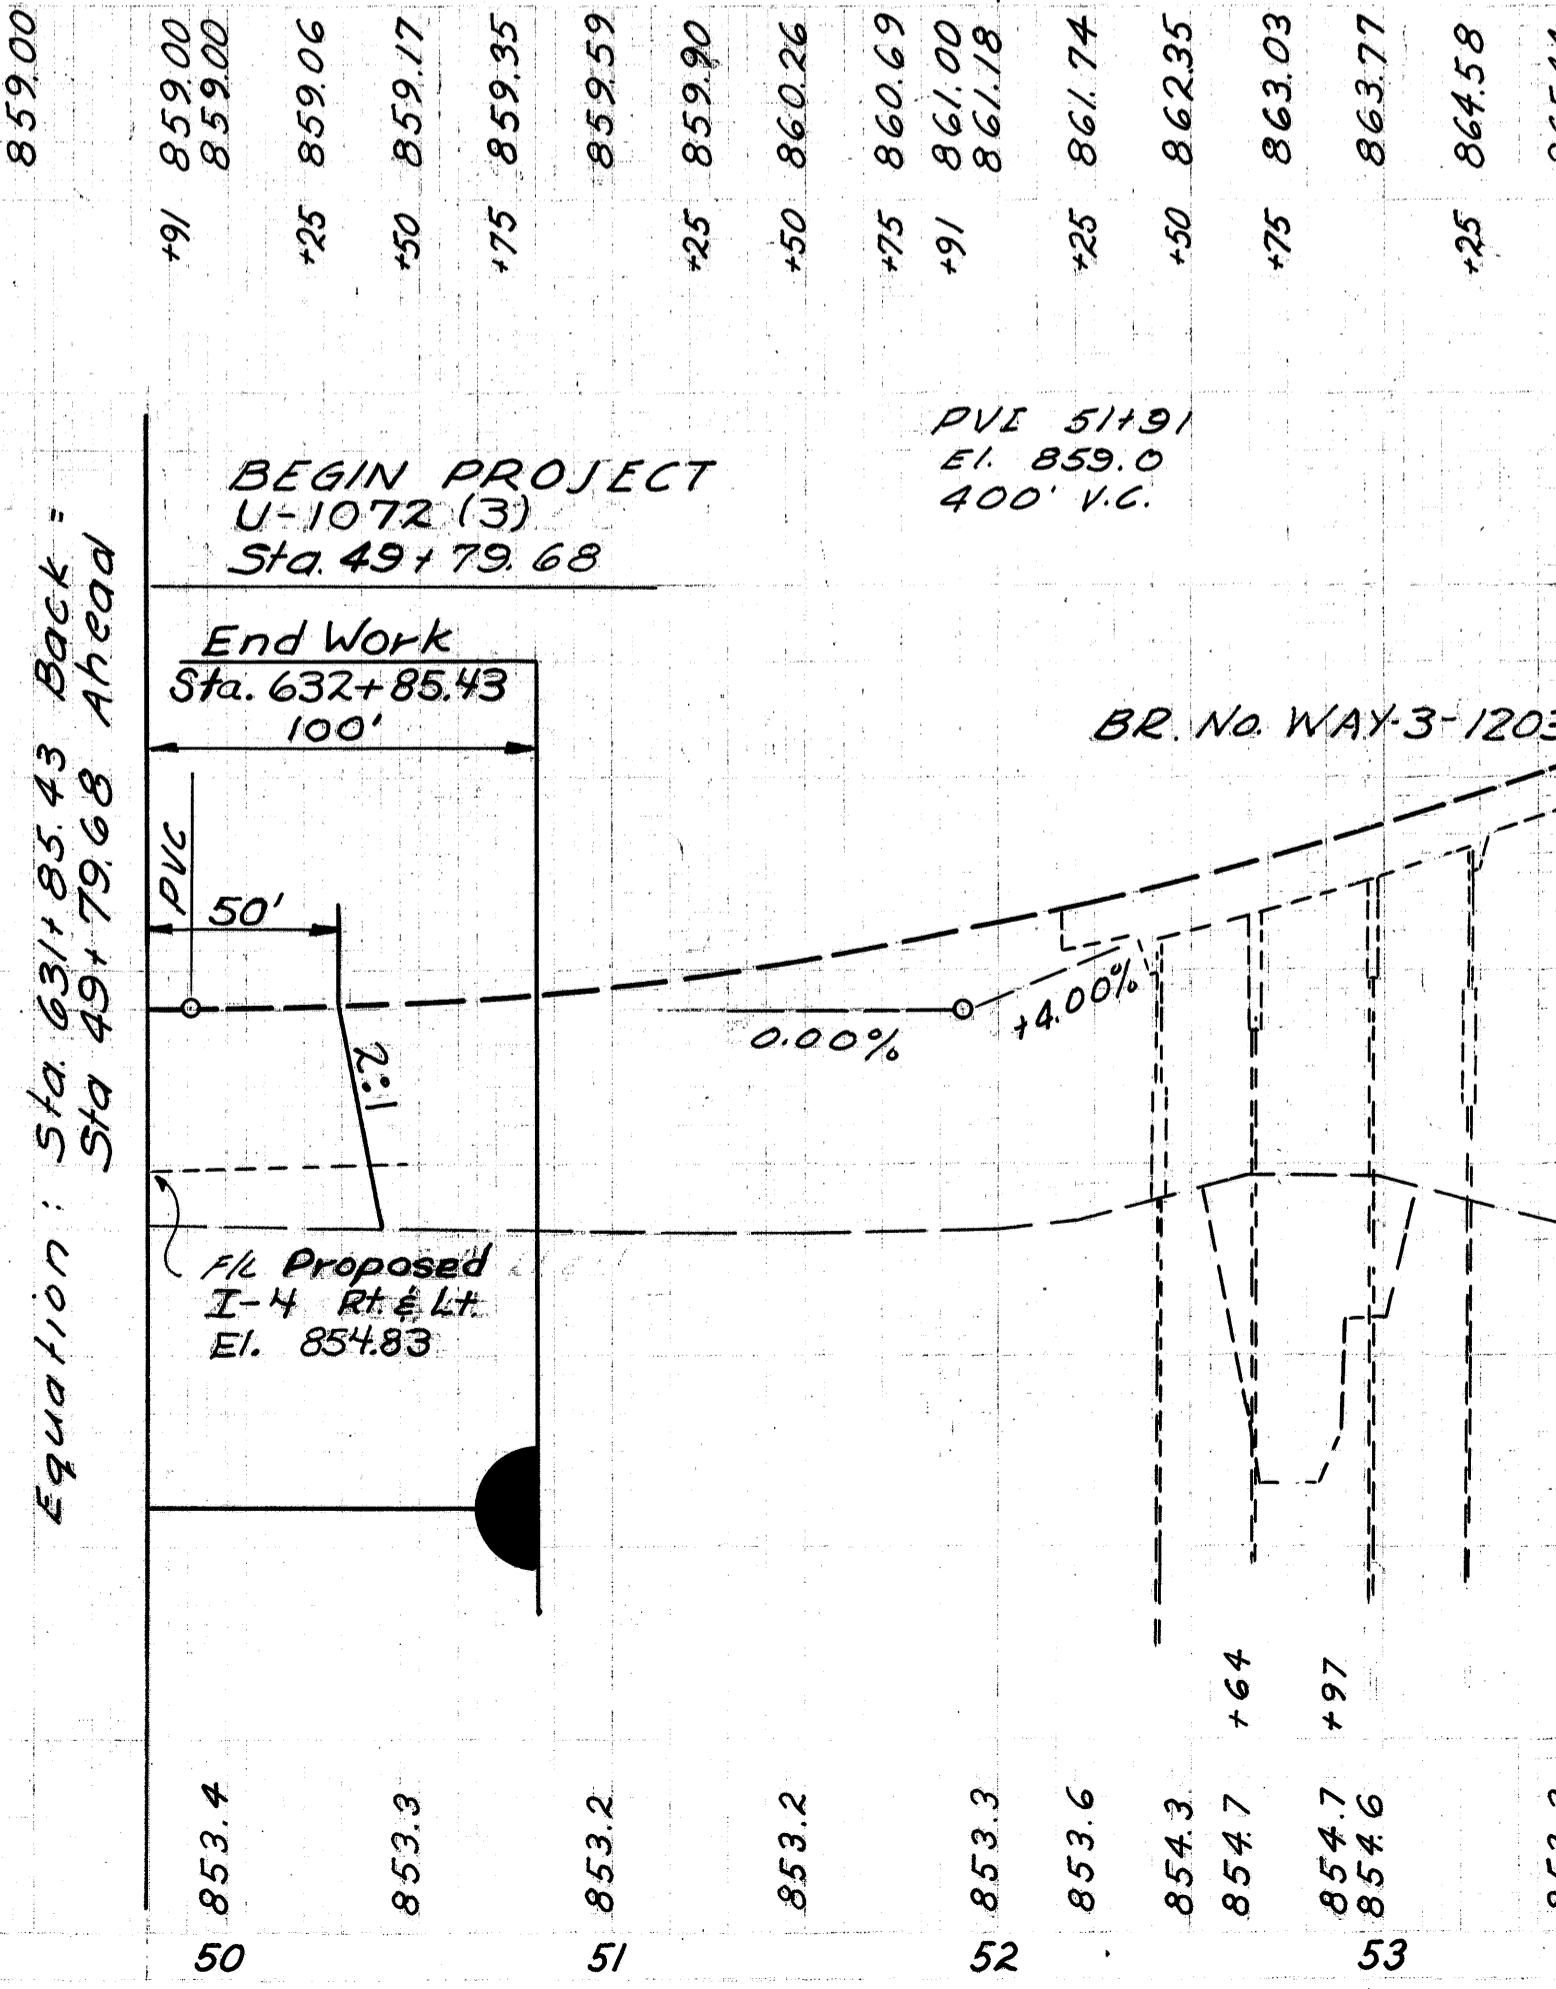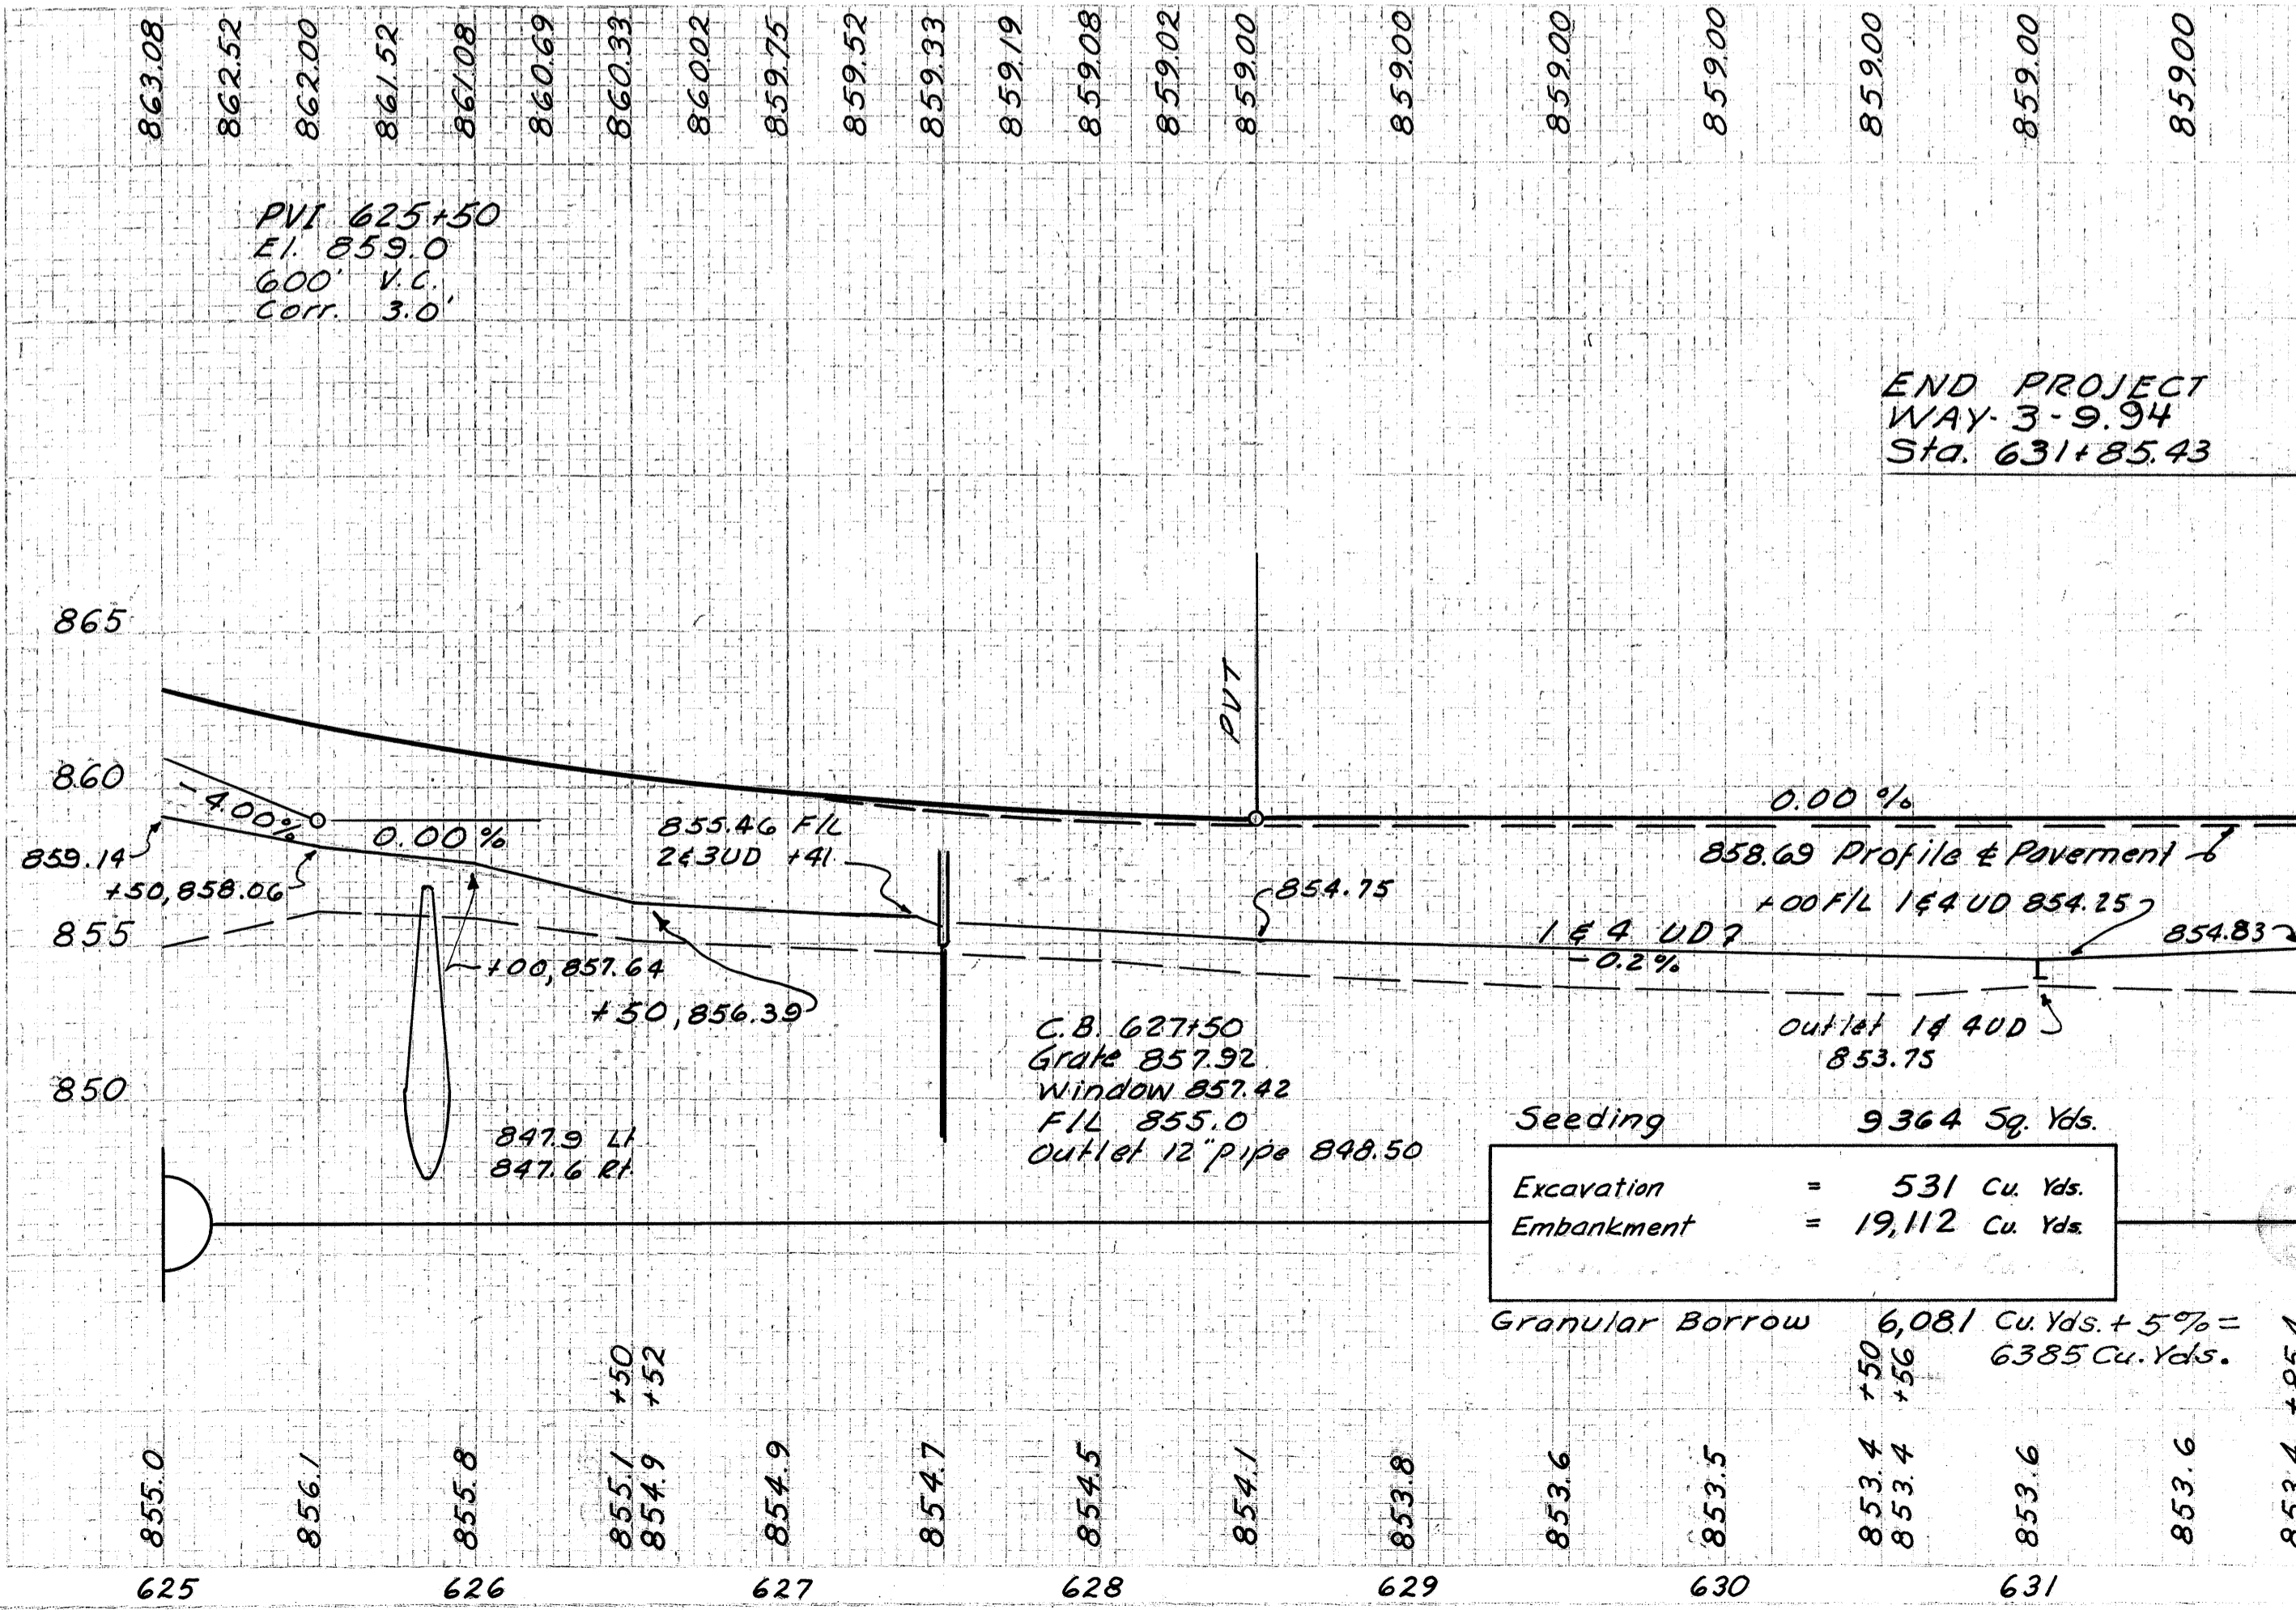

SUPERELEVATION TABLES

FED. RD. DIVISION	STATE	PROJECT	
2	OHIO		

36
157

WAYNE COUNTY WAY-3-994

STATION	PROFILE	SOUTHBOUND LANES			NORTHBOUND LANES		
		LEFT EDGE	☎	RIGHT EDGE	LEFT EDGE	☎	RIGHT EDGE
573+00	1019.94	1019.75	1019.94	1019.75	1019.75	1019.94	1019.75
+09	1019.98	1019.79	1019.98	1019.79	1019.79	1019.98	1019.79
+25	1020.06	1019.91	1020.06	1019.87	1019.87	1020.02	1019.83
+50	1020.17	1020.08	1020.17	1019.98	1019.98	1020.07	1019.88
+75	1020.29	1020.27	1020.29	1020.10	1020.10	1020.12	1019.93
574+00	1020.40	1020.47	1020.40	1020.21	1020.21	1020.17	1019.95
+25	1020.52	1020.74	1020.52	1020.33	1020.33	1020.21	1019.96
+50	1020.63	1020.92	1020.69	1020.44	1020.44	1020.25	1019.96
+75	1020.75	1021.16	1020.86	1020.56	1020.56	1020.30	1019.96
575+00	1020.86	1021.38	1021.03	1020.67	1020.67	1020.34	1019.96
+25	1020.98	1021.62	1021.20	1020.79	1020.79	1020.39	1019.96
+50	1021.09	1021.76	1021.33	1020.90	1020.90	1020.47	1020.04
+75	1021.21	1021.88	1021.45	1021.02	1021.02	1020.59	1020.16
576+00	1021.32	1021.99	1021.56	1021.13	1021.13	1020.51	1020.08
+25	1021.44	1022.11	1021.68	1021.25	1021.25	1020.82	1020.39
+50	1021.55	1022.22	1021.79	1021.36	1021.36	1020.93	1020.50
+75	1021.67	1022.34	1021.99	1021.48	1021.48	1021.05	1020.62
577+00	1021.78	1022.45	1022.02	1021.59	1021.59	1021.16	1020.73
+25	1021.88	1022.55	1022.12	1021.69	1021.69	1021.26	1020.83
+50	1021.97	1022.64	1022.21	1021.78	1021.78	1021.35	1020.92
+75	1022.04	1022.71	1022.28	1021.85	1021.85	1021.42	1020.99
578+00	1022.08	1022.75	1022.32	1021.89	1021.89	1021.46	1021.03
+25	1022.11	1022.78	1022.35	1021.92	1021.92	1021.49	1021.06
+50	1022.11	1022.78	1022.35	1021.92	1021.92	1021.49	1021.06
+75	1022.10	1022.77	1022.34	1021.91	1021.91	1021.48	1021.05
579+00	1022.06	1022.73	1022.30	1021.87	1021.87	1021.44	1021.01
+25	1022.01	1022.68	1022.25	1021.82	1021.82	1021.39	1020.96
+50	1021.93	1022.60	1022.17	1021.74	1021.74	1021.31	1020.88
+75	1021.84	1022.51	1022.08	1021.65	1021.65	1021.22	1020.79
580+00	1021.73	1022.40	1021.97	1021.54	1021.54	1021.11	1020.68
+25	1021.59	1022.26	1021.83	1021.40	1021.40	1020.97	1020.54
+50	1021.44	1022.11	1021.68	1021.25	1021.25	1020.82	1020.39
+75	1021.27	1021.94	1021.51	1021.08	1021.08	1020.65	1020.22
581+00	1021.07	1021.74	1021.31	1020.88	1020.88	1020.45	1020.02
+25	1020.86	1021.53	1021.10	1020.67	1020.67	1020.24	1019.81
+50	1020.62	1021.29	1020.86	1020.43	1020.43	1020.00	1019.57
+75	1020.37	1021.04	1020.61	1020.18	1020.18	1019.75	1019.32
582+00	1020.10	1020.77	1020.34	1019.91	1019.91	1019.48	1019.05
+25	1019.80	1020.47	1020.04	1019.61	1019.61	1019.18	1018.75
+50	1019.49	1020.16	1019.73	1019.30	1019.30	1018.87	1018.44
+75	1019.16	1019.83	1019.40	1018.97	1018.97	1018.54	1018.11
583+00	1018.81	1019.48	1019.05	1018.62	1018.62	1018.19	1017.76
+25	1018.43	1019.10	1018.67	1018.24	1018.24	1017.81	1017.38
+50	1018.04	1018.71	1018.28	1017.85	1017.85	1017.42	1016.99
+75	1017.63	1018.30	1017.87	1017.44	1017.44	1017.01	1016.58
584+00	1017.20	1017.87	1017.44	1017.01	1017.01	1016.58	1016.15
+25	1016.74	1017.41	1016.98	1016.55	1016.55	1016.12	1015.69
+50	1016.27	1016.91	1016.51	1016.08	1016.08	1015.65	1015.22
+75	1015.78	1016.45	1016.02	1015.59	1015.59	1015.16	1014.73
585+00	1015.27	1015.94	1015.51	1015.08	1015.08	1014.65	1014.22
+25	1014.73	1015.40	1014.97	1014.54	1014.54	1014.11	1013.68
+50	1014.18	1014.85	1014.42	1013.99	1013.99	1013.56	1013.13
+75	1013.61	1014.28	1013.85	1013.42	1013.42	1012.99	1012.56
586+00	1013.02	1013.69	1013.26	1012.83	1012.83	1012.40	1011.97
+25	1012.41	1013.08	1012.65	1012.22	1012.22	1011.79	1011.36
+50	1011.77	1012.44	1012.01	1011.58	1011.58	1011.15	1010.72
+75	1011.12	1011.79	1011.36	1010.93	1010.93	1010.50	1010.07
587+00	1010.45	1011.12	1010.69	1010.26	1010.26	1009.83	1009.40
+25	1009.76	1010.43	1010.00	1009.57	1009.57	1009.14	1008.71
+50	1009.05	1009.72	1009.29	1008.86	1008.86	1008.43	1008.00
+75	1008.32	1008.99	1008.56	1008.13	1008.13	1007.70	1007.27
588+00	1007.57	1008.24	1007.81	1007.38	1007.38	1006.95	1006.52
+25	1006.60	1007.47	1007.04	1006.61	1006.61	1006.18	1005.75
+50	1006.00	1006.67	1006.24	1005.81	1005.81	1005.38	1004.95
+75	1005.19	1005.86	1005.43	1005.00	1005.00	1004.57	1004.14

STATION	PROFILE	SOUTHBOUND LANES			NORTHBOUND LANES		
		LEFT EDGE	☎	RIGHT EDGE	LEFT EDGE	☎	RIGHT EDGE
589+00	1004.36	1005.03	1004.60	1004.17	1004.17	1003.74	1003.31
+25	1003.51	1004.18	1003.75	1003.32	1003.32	1002.89	1002.46
+50	1002.64	1003.31	1002.88	1002.45	1002.45	1002.02	1001.59
+75	1001.75	1002.42	1001.99	1001.56	1001.56	1001.13	1000.70
590+00	1000.84	1001.51	1001.08	1000.65	1000.65	1000.22	999.79
+25	999.91	1000.58	1000.15	999.72	999.72	999.29	998.86
+50	998.96	999.63	999.20	998.77	998.77	998.34	997.91
+75	997.99	998.66	998.23	997.80	997.80	997.37	996.94
591+00	997.00	997.67	997.24	996.81	996.81	996.38	995.95
+25	996.00	996.67	996.24	995.81	995.81	995.38	994.95
+50	995.00	995.67	995.24	994.81	994.81	994.38	993.95
+75	994.00	994.67	994.24	993.81	993.81	993.38	992.95
592+00	993.00	993.67	993.24	992.81	992.81	992.38	991.95
+25	992.00	992.67	992.24	991.81	991.81	991.38	990.95
+50	991.00	991.67	991.24	990.81	990.81	990.38	989.95
+75	990.00	990.67	990.24	989.81	989.81	989.38	988.95
593+00	989.00	989.67	989.24	988.81	988.81	988.38	987.95
+25	988.00	988.67	988.24	987.81	987.81	987.38	986.95
+50	987.00	987.67	987.24	986.81	986.81	986.38	985.95
+75	986.00	986.67	986.24	985.81	985.81	985.38	984.95
594+00	985.00	985.67	985.24	984.81	984.81	984.38	983.95
+25	984.00	984.67	984.24	983.81	983.81	983.38	982.95
+50	983.00	983.67	983.24	982.81	982.81	982.38	981.95
+75	982.00	982.67	982.24	981.81	981.81	981.38	980.95
595+00	981.00	981.67	981.24	980.81	980.81	980.38	979.95
+25	980.00	980.67	980.24	979.81	979.81	979.38	978.95
+50	979.00	979.67	979.24	978.81	978.81	978.38	977.95
+75	978.00	978.67	978.24	977.81	977.81	977.38	976.95
596+00	977.00	977.67	977.24	976.81	976.81	976.38	975.95
+25	976.00	976.67	976.24	975.81	975.81	975.38	974.95
+50	975.00	975.67	975.24	974.81	974.81	974.38	973.95
+75	974.00	974.67	974.24	973.81	973.81	973.38	972.95
597+00	973.00	973.67	973.24	972.81	972.81	972.38	971.95
+25	972.00	972.67	972.24	971.81	971.81	971.38	970.95
+50	971.00	971.67	971.24	970.81	970.81	970.38	969.95
+75	970.00	970.67	970.24	969.81	969.81	969.38	968.95
598+00	969.00	969.67	969.24	968.81	968.81	968.38	967.95
+25	968.00	968.67	968.24	967.81	967.81	967.38	966.95
+50	967.00	967.67	967.24	966.81	966.81	966.38	965.95
+75	966.00	966.67	966.24	965.81	965.81	965.38	964.95
599+00	965.00	965.67	965.24	964.81	964.81	964.38	963.95
+20	964.25	964.92	964.49	964.06	964.06	963.63	963.20
+25	964.00	964.65	964.23	963.81	963.81	963.39	962.97
+50	963.00	963.54	963.18	962.81	962.81	962.46	962.08
+75	962.00	962.42	962.12	961.81	961.81	961.54	961.20
600+00	961.00	961.31	961.07	960.81	960.81	960.61	960.31
+25	960.00	960.20	961.02	959.81	959.81	959.66	959.42
+50	959.00	959.08	959.00	958.81	958.81	958.75	958.54
+75	958.00	957.99	958.00	957.81	957.81	957.82	957.63
601+00	957.00	956.92	957.00	956.81	956.81	956.89	956.70
+25	956.00	955.87	956.00	955.81	955.81	955.95	955.76
+50	955.00	954.81	955.00	954.81	954.81	955.00	954.81

STATION	PROFILE	SOUTHBOUND LANES			NORTHBOUND LANES		
		LEFT EDGE	☎	RIGHT EDGE	LEFT EDGE	☎	RIGHT EDGE
602+50	951.00	950.81	951.00	950.81	950.81	951.00	950.81
+70	950.20	950.01	950.20	950.01	950.01	950.20	950.01
+75	950.00	949.80	949.99	949.81	949.81	950.00	949.82
603+00	949.00	948.73	948.92	948.81	948.81	949.00	948.85
+25	948.00	947.67	947.86	947.81	947.81	948.00	947.95
+50	947.00	946.60	946.80	946.81	946.81	947.00	947.02
+75	946.00	945.49	945.72	945.81	945.81	946.00	946.13
604+00	945.00	944.37	944.65	944.81	944.81	945.00	945.25
+25	944.00	943.26	943.58	943.81	943.81	944.00	944.36
+50	943.00	942.15	942.51	942.81</			

SUPERELEVATION TABLES

WAYNE COUNTY
WAY-3-9.94

STATION S. R. LANES	SOUTHBOUND LANE		
	LEFT EDGE	PROFILE & PAV'T	RIGHT EDGE
543+00	1047.85	1048.21	1048.57
+25	1047.96	1048.32	1048.71
+50	1048.08	1048.44	1048.80
+75	1048.20	1048.56	1048.92
544+00	1048.31	1048.67	1049.03
+25	1048.42	1048.78	1049.14
+50	1048.54	1048.90	1049.26
+75	1048.66	1049.02	1049.38
545+00	1048.77	1049.13	1049.49
+25	1048.88	1049.24	1049.60
+50	1049.00	1049.36	1049.72
+75	1049.12	1049.48	1049.84
546+00	1049.23	1049.59	1049.95
+25	1049.34	1049.70	1050.06
+50	1049.46	1049.82	1050.18
+75	1049.58	1049.94	1050.30
547+00	1049.69	1050.05	1050.41
+25	1049.80	1050.16	1050.52
+50	1049.92	1050.28	1050.64
+75	1050.04	1050.40	1050.76
548+00	1050.15	1050.51	1050.87
+25	1050.26	1050.62	1050.98
+50	1050.38	1050.74	1051.10
+75	1050.50	1050.86	1051.22
549+00	1050.61	1050.97	1051.33
+25	1050.70	1051.06	1051.42
+50	1050.79	1051.15	1051.51
+75	1050.86	1051.22	1051.58
550+00	1050.91	1051.27	1051.63
+25	1050.95	1051.31	1051.67
+50	1050.98	1051.34	1051.70
+75	1050.99	1051.35	1051.71
551+00	1051.02	1051.34	1051.70
+25	1051.08	1051.32	1051.56
+50	1051.10	1051.29	1051.41
551+53.76 S.B.			
=551+70.21			
WAY-3			
551+75	1051.09	1051.28	1051.36
552+00	1051.04	1051.23	1051.21
+25	1050.97	1051.16	1051.07
+50	1050.89	1051.08	1050.93
+66.45	1050.83	1051.02	1050.83
+75	1049.79	1050.98	1049.79

STATION	NORTHBOUND LANE		
	LEFT EDGE	PROFILE & PAV'T	RIGHT EDGE
543+00	1047.78	1048.14	1048.38
+25	1047.90	1048.26	1048.62
+50	1048.01	1048.37	1048.73
+75	1048.12	1048.48	1048.84
544+00	1048.24	1048.60	1048.96
+25	1048.36	1048.72	1049.08
+50	1048.47	1048.83	1049.19
+75	1048.58	1048.94	1049.30
545+00	1048.70	1049.06	1049.42
+25	1048.82	1049.18	1049.54
+50	1048.96	1049.29	1049.65
+75	1049.04	1049.40	1049.76
546+00	1049.16	1049.52	1049.88
+25	1049.28	1049.64	1050.00
+50	1049.39	1049.75	1050.11
+75	1049.50	1049.86	1050.22
547+00	1049.62	1049.98	1050.34
+25	1049.74	1050.10	1050.46
+50	1049.85	1050.21	1050.57
+75	1049.96	1050.32	1050.68
548+00	1050.08	1050.44	1050.80
+25	1050.20	1050.56	1050.92
+50	1051.31	1050.67	1051.03
+75	1050.42	1050.78	1051.14
549+00	1050.54	1050.90	1051.26
+25	1050.65	1051.01	1051.37
+50	1050.74	1051.10	1051.46
+75	1050.83	1051.17	1051.41
550+00	1051.05	1051.24	1051.36
+25	1051.11	1051.30	1051.30
+50	1051.12	1051.33	1051.27
+75	1051.15	1051.34	1051.21
551+00	1051.16	1051.35	1051.16

STATION	COUNTY ROAD #139		
	LEFT EDGE	PROFILE & PAV'T	RIGHT EDGE
16+50	1016.94	1017.10	1016.94
+75	1016.31	1016.47	1016.37
17+00	1015.63	1015.79	1015.75
+25	1015.88	1015.04	1015.11
+50	1014.02	1014.21	1014.41
+75	1012.89	1013.21	1013.53
+60.40	1012.64	1012.98	1013.33
18+00	1011.68	1012.13	1012.58
+25	1010.41	1010.98	1011.55
+50	1009.07	1009.77	1010.47
19+00	1006.32	1007.27	1008.22
+50	1003.97	1004.77	1005.57
20+00	1001.72	1002.27	1002.82
+50	999.47	999.77	1000.07
21+00	997.11	997.27	997.32
+50	994.61	994.77	994.67
22+00	992.20	992.27	992.11
+50	989.86	989.77	989.61
23+00	987.62	987.27	986.92
+50	985.23	984.77	984.31
+75	984.02	983.70	983.38
24+00	983.15	982.97	982.80
+25	982.64	982.60	982.54
+50	982.53	982.57	982.41
+75	982.24	982.40	
25+00	981.44	981.60	981.44
26+04.84		978.10	
+15		977.64	
+25		977.23	
+40		976.76	976.60
+50		976.55	976.42
+65		976.36	976.31
+75		976.30	976.30
27+00	975.99	976.15	976.29
+20	976.01	976.27	976.53
+50	975.54	975.85	976.16
+60	974.54	975.79	976.04
+75	974.49	975.66	975.83
28+00	975.11	975.27	975.30
+10	974.91	975.07	975.04
+25	974.52	974.68	974.57
+50	973.69	973.85	973.69
+60	973.30	973.46	973.30


STATION	COUNTY ROAD #174		
	LEFT EDGE	PROFILE & PAV'T	RIGHT EDGE
18+75	912.61	912.77	912.61
19+00	911.54	911.70	912.57
+25	910.55	910.71	910.64
+50	909.66	909.82	909.82
+75	908.86	909.02	909.16
20+00	908.02	908.30	908.58
+25	907.25	907.67	908.09
+50	906.57	907.13	907.69
+75	905.98	906.67	907.36
21+00	905.74	906.30	906.86
+25	905.60	906.02	906.44
+50	905.55	905.83	906.11
22+00	905.37	905.53	905.67
+25	905.22	905.38	905.22
+50	905.07	905.23	905.07
+75	904.65	904.90	904.65

WAYNE COUNTY
WAY-3-9.94

"S.B." CURVE DATA


PI Sta. 529+10.00
 $\Delta = 11^\circ 41' 27''$
 $D = 1^\circ 29' 00''$
 $R = 3862.64'$
 $T = 395.46'$
 $L = 788.15'$
 $E = 20.19'$

Scale: 1" = 20'

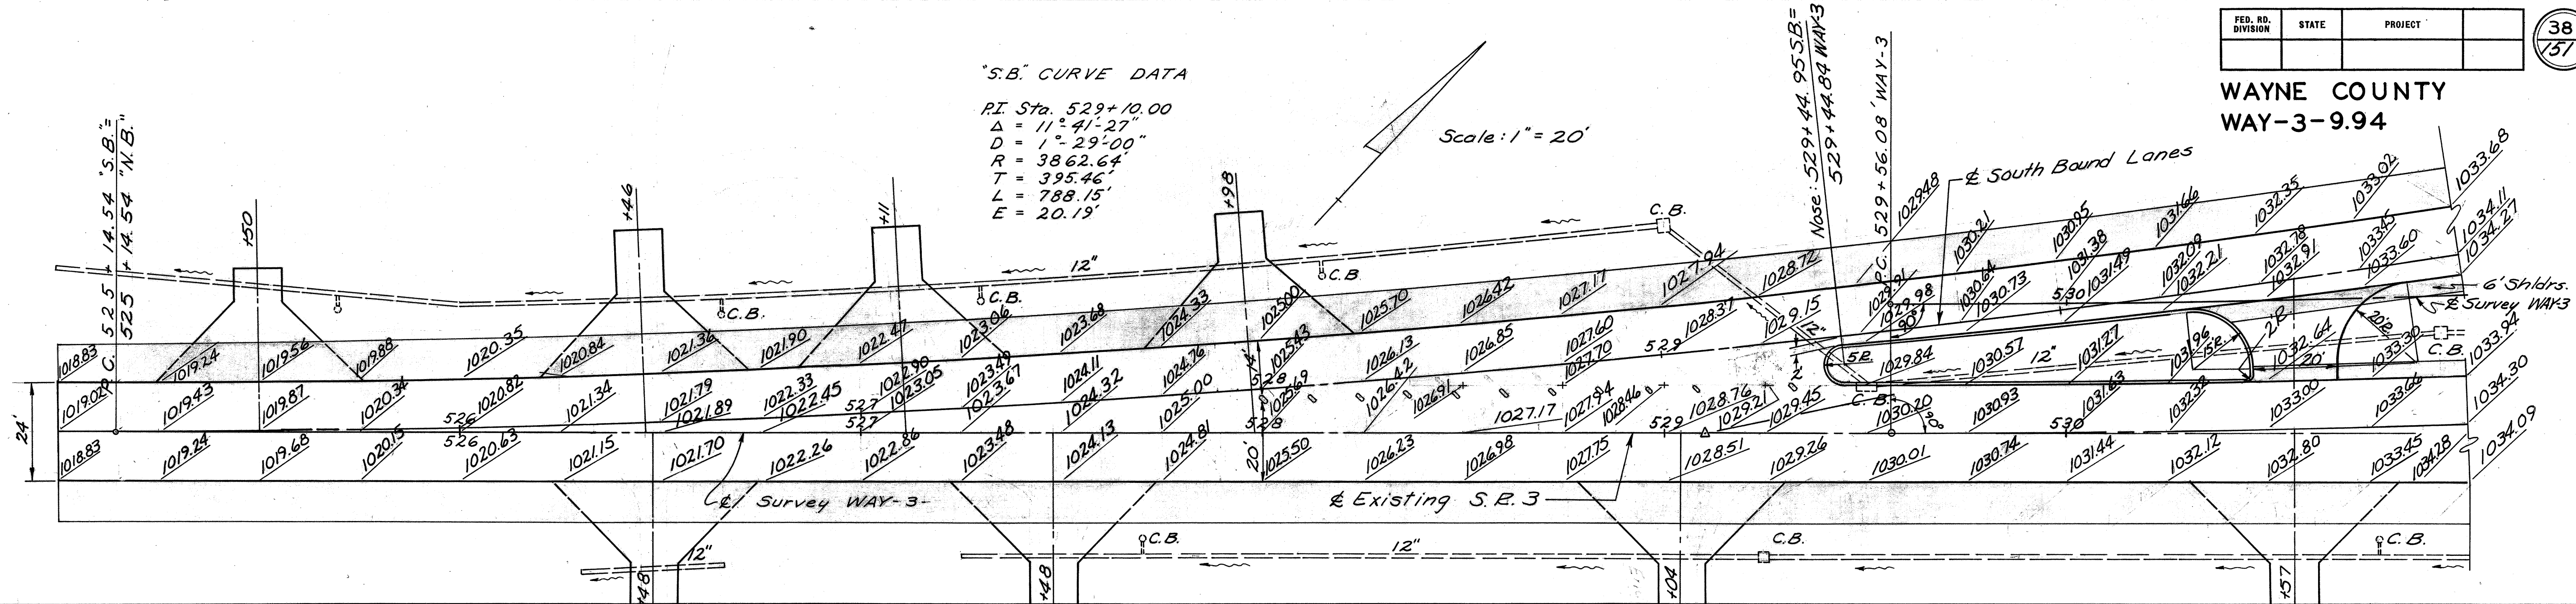

CURVE DATA & SURVEY WAY-3


PI Sta. 539+92.09
 $\Delta = 25^\circ 28' 20''$
 $D = 1^\circ 15' 00''$
 $R = 4583.66'$
 $T = 2037.78'$
 $L = 1036.01'$
 $E = 115.62'$

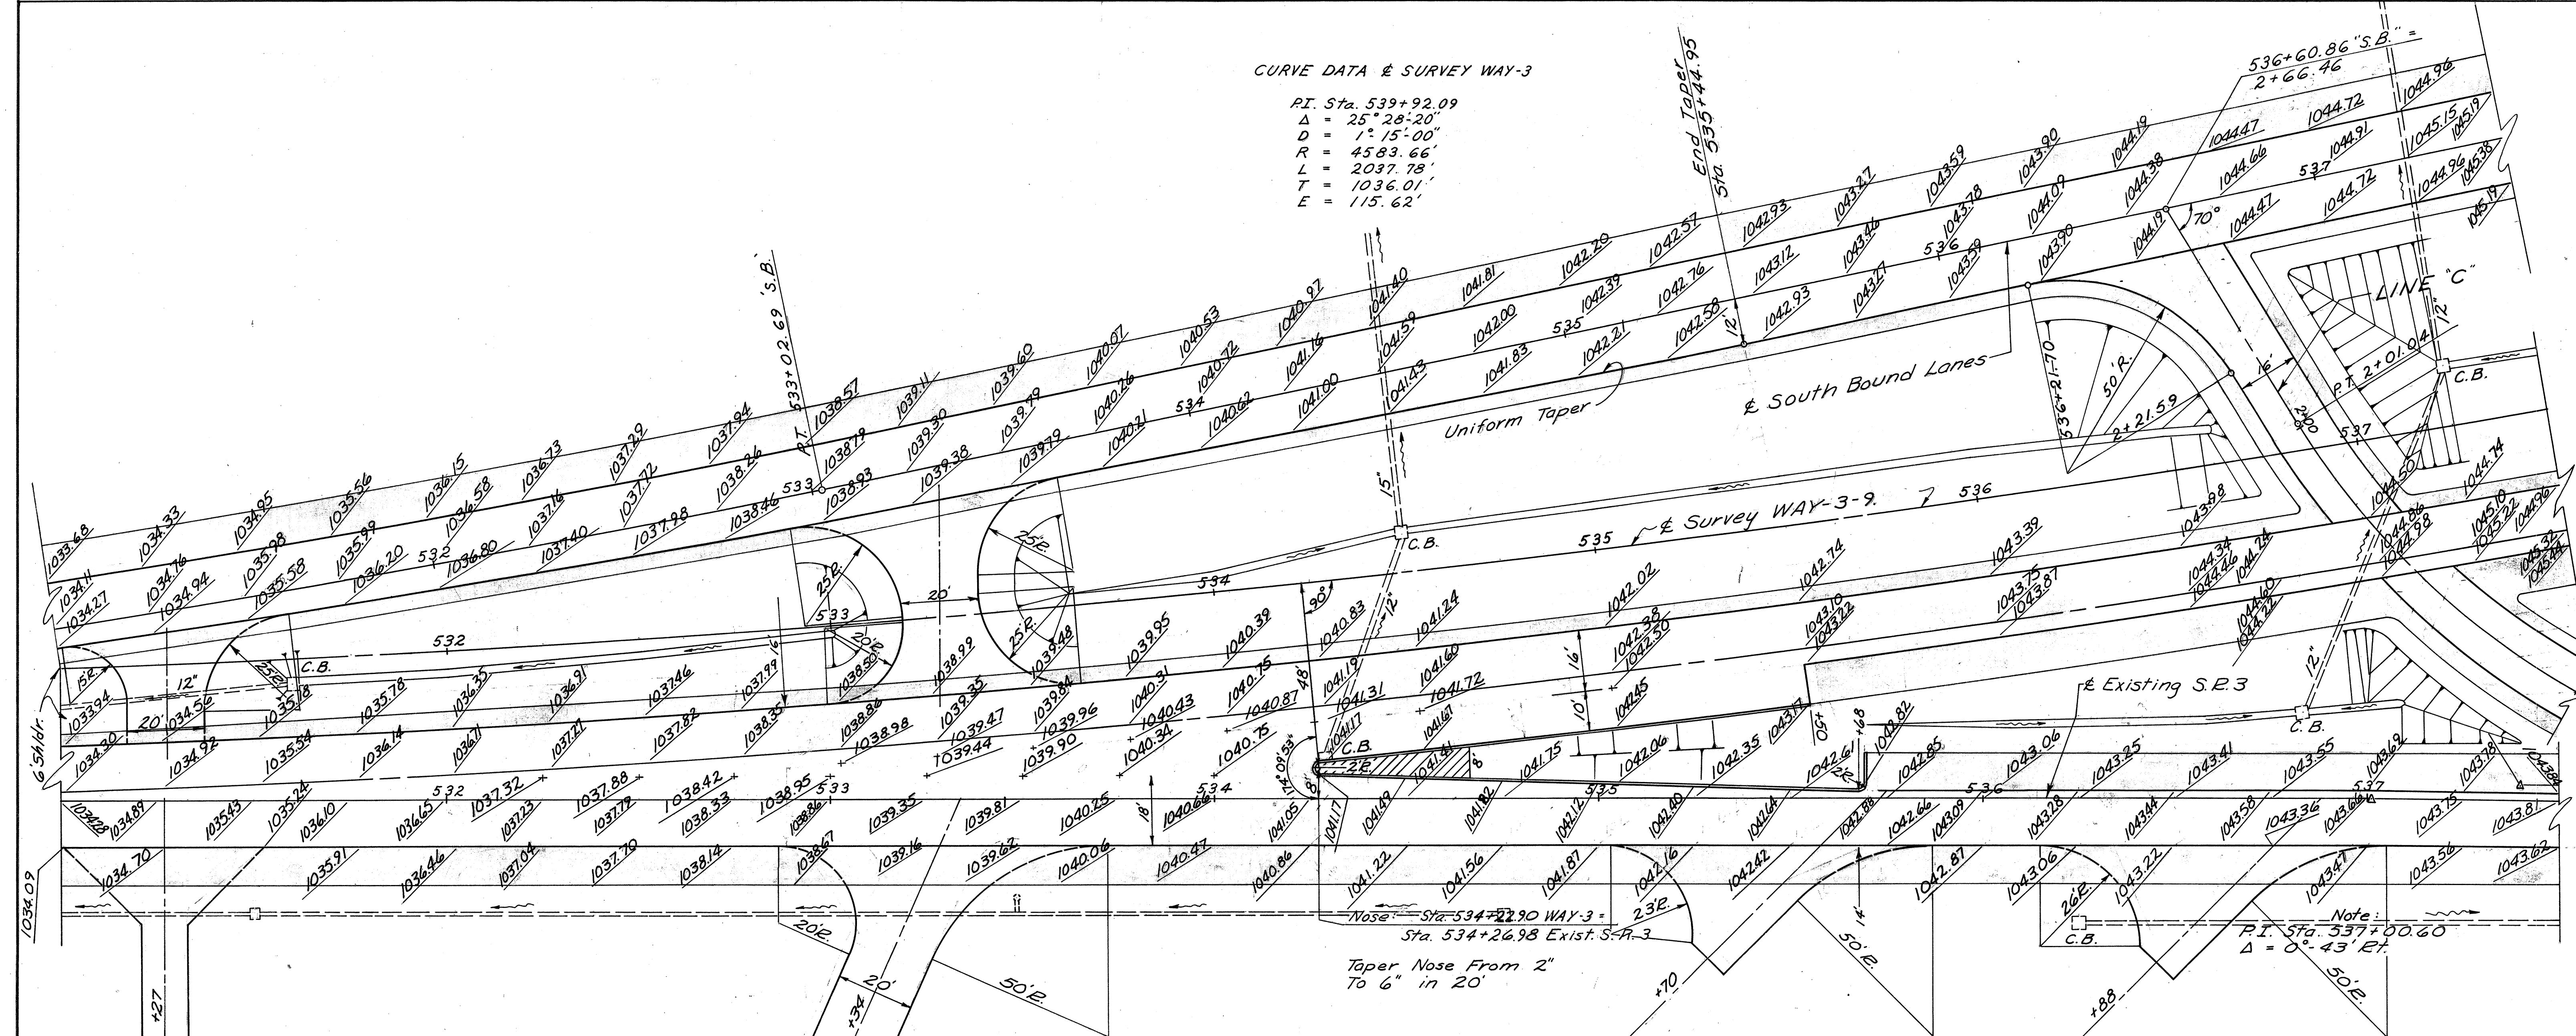

Note:
PI Sta. 537+00.60
 $\Delta = 0^\circ 43' 21''$

Nose Sta. 534+22.90 WAY-3 =
Sta. 534+26.98 Exist. S.R.3
Taper Nose From 2"
To 6" in 20'

WAYNE COUNTY
WAY-3-9.94

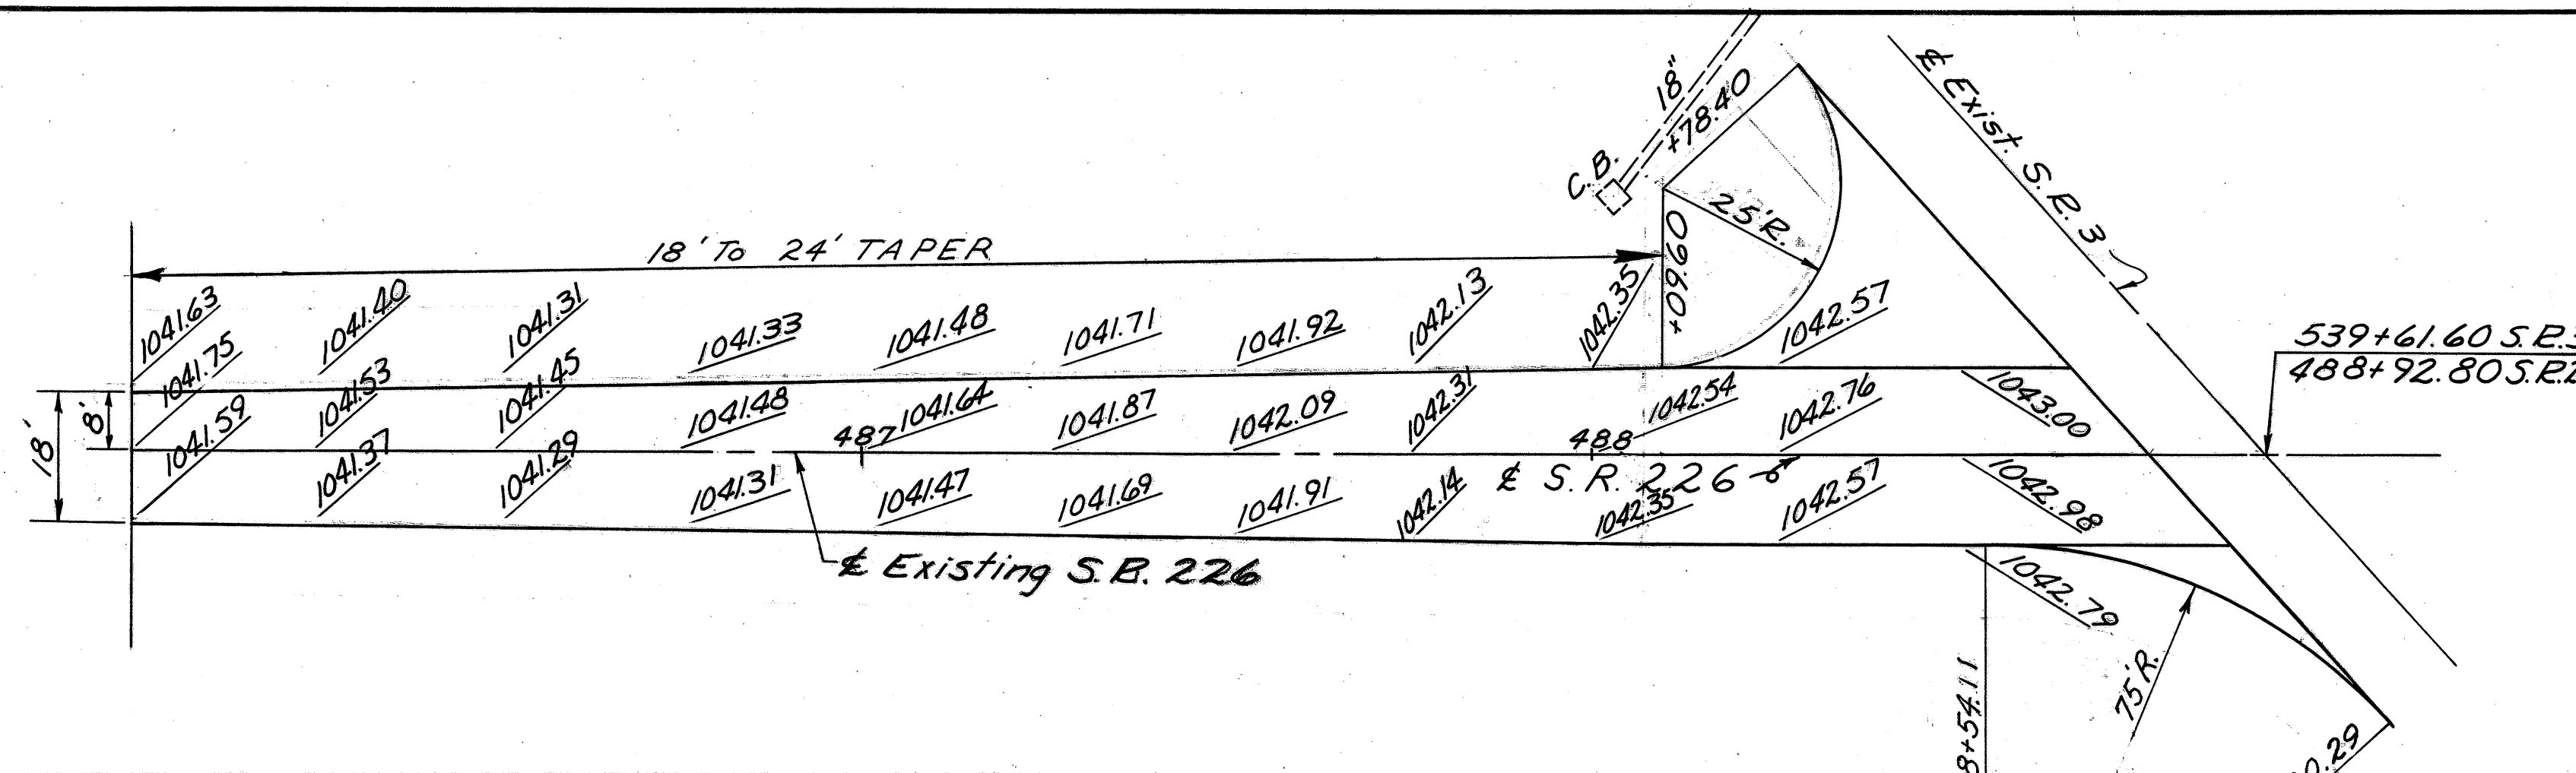

ES.B. LANES
CURVE DATA
P.I. Sta. 546 + 05.19
 $\Delta = 13^\circ 46' 53''$
 $D = 1^\circ 15' 00''$
 $R = 4583.66'$
 $L = 1102.51'$
 $T = 553.94'$
 $E = 33.35'$

Scale: 1" = 20'


WAY-3 CURVE DATA
P.I. Sta. 539 + 92.05
 $\Delta = 25^\circ 28' 20''$
 $D = 1^\circ 15' 00''$
 $R = 4583.66'$
 $L = 2037.78'$
 $T = 1036.01'$
 $E = 115.62'$

LINE "C"
CURVE DATA
 $\Delta = 57^\circ 35' 33''$
 $D = 28^\circ 38' 52''$
 $R = 200.00'$
 $L = 109.93'$
 $T = 201.04'$
 $E = 28.22'$

LINE "B"
CURVE DATA
P.I. Sta. 492 + 54.43
 $\Delta = 51^\circ 48' 29''$
 $D = 13^\circ 36' 21''$
 $R = 421.11'$
 $L = 233.78'$
 $T = 119.99'$
 $E = 16.76'$


LINE "A"
CURVE DATA
P.I. Sta. 490 + 87.36
 $\Delta = 31^\circ 00' 06''$
 $D = 10^\circ 00' 00''$
 $R = 572.96'$
 $L = 310.02'$
 $T = 158.91'$
 $E = 21.63'$

P.I. Sta. 542+30.24 P.O.C. & S.B. 9.57 RT.
P.I. Sta. 542+30.58 P.O.S.T. S.B. 6.06 RT.

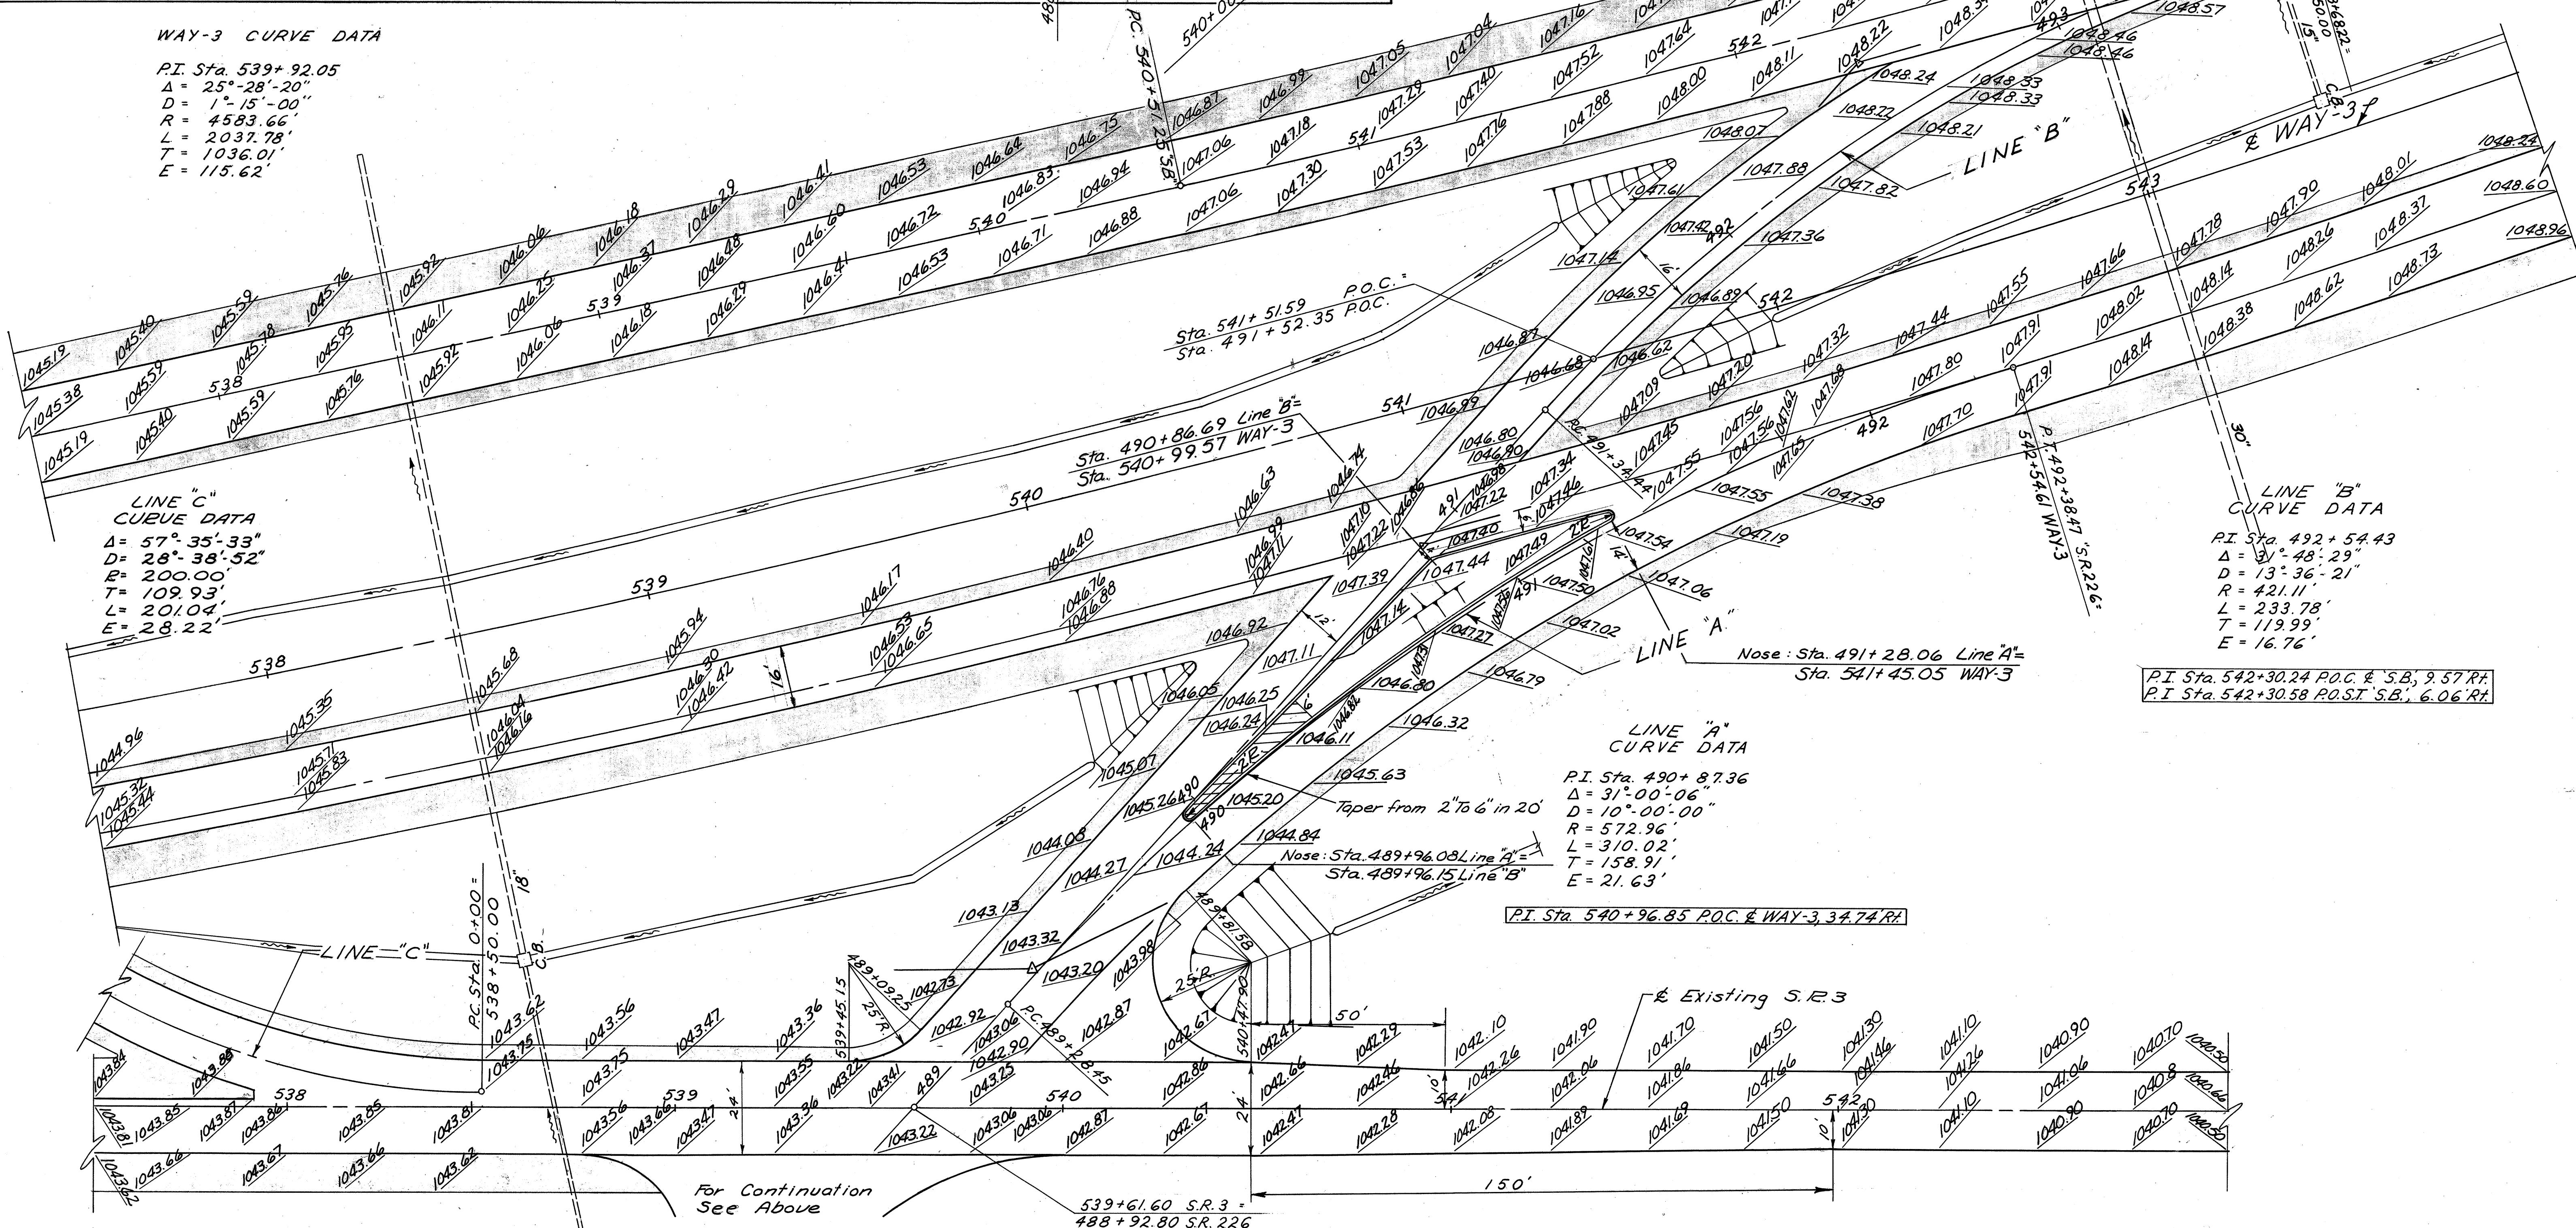

For Continuation
See Above

FED. RD. DIVISION	STATE	PROJECT	
2	OHIO		

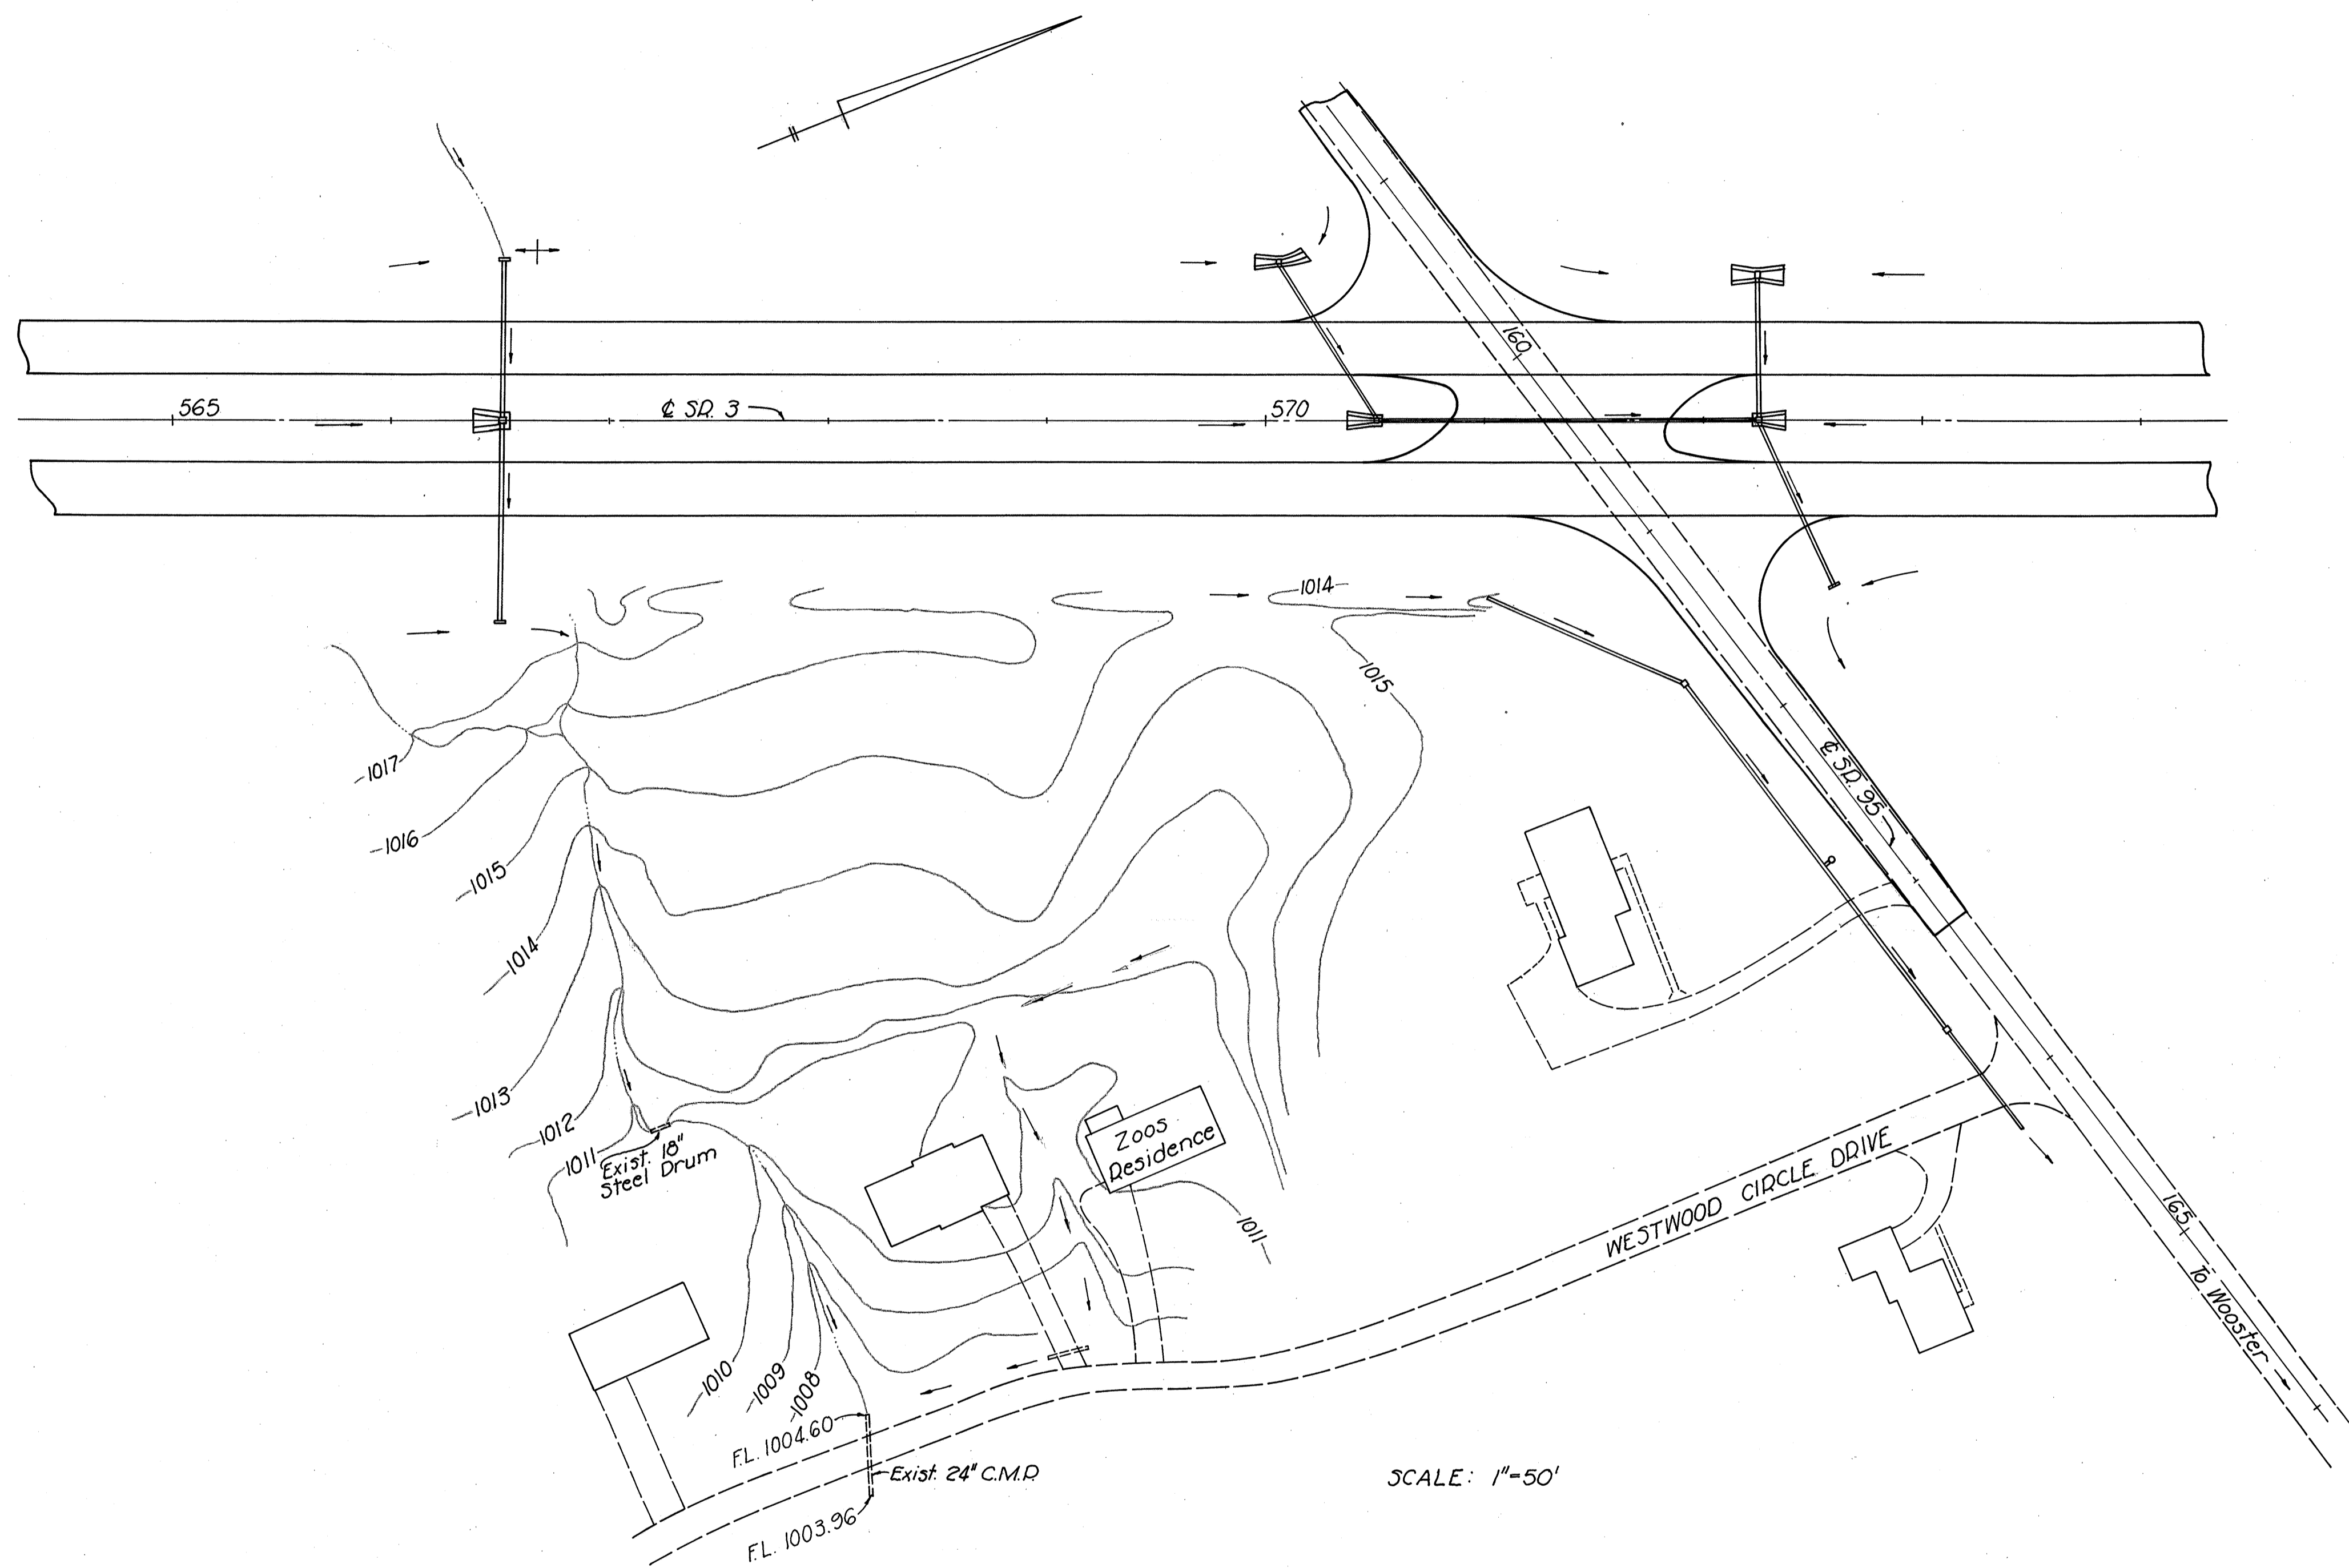

COMPLAINT OF RICHARD ZOOS
 WAYNE COUNTY, PROJECT 265 (1961), SR 3 - 9,94

WAYNE COUNTY
WAY-3-9.94


Curve Data Frontage Rd.

Sta. P.I. 17+28.57
 $\Delta = 8^{\circ} 8' 59''$
 $D = 1^{\circ} 22' 20''$
 $R = 4175.18'$
 $T = 297.45'$
 $L = 593.88'$
 $E = 10.58'$



Curve Data Private Lane

Sta. P.I. 2+00.58
 $\Delta = 53^{\circ} 00' 00''$
 $D = 114^{\circ} 35' 30''$
 $R = 50.00'$
 $T = 24.93'$
 $L = 46.25'$
 $E = 5.87'$

Scale 1" = 20'

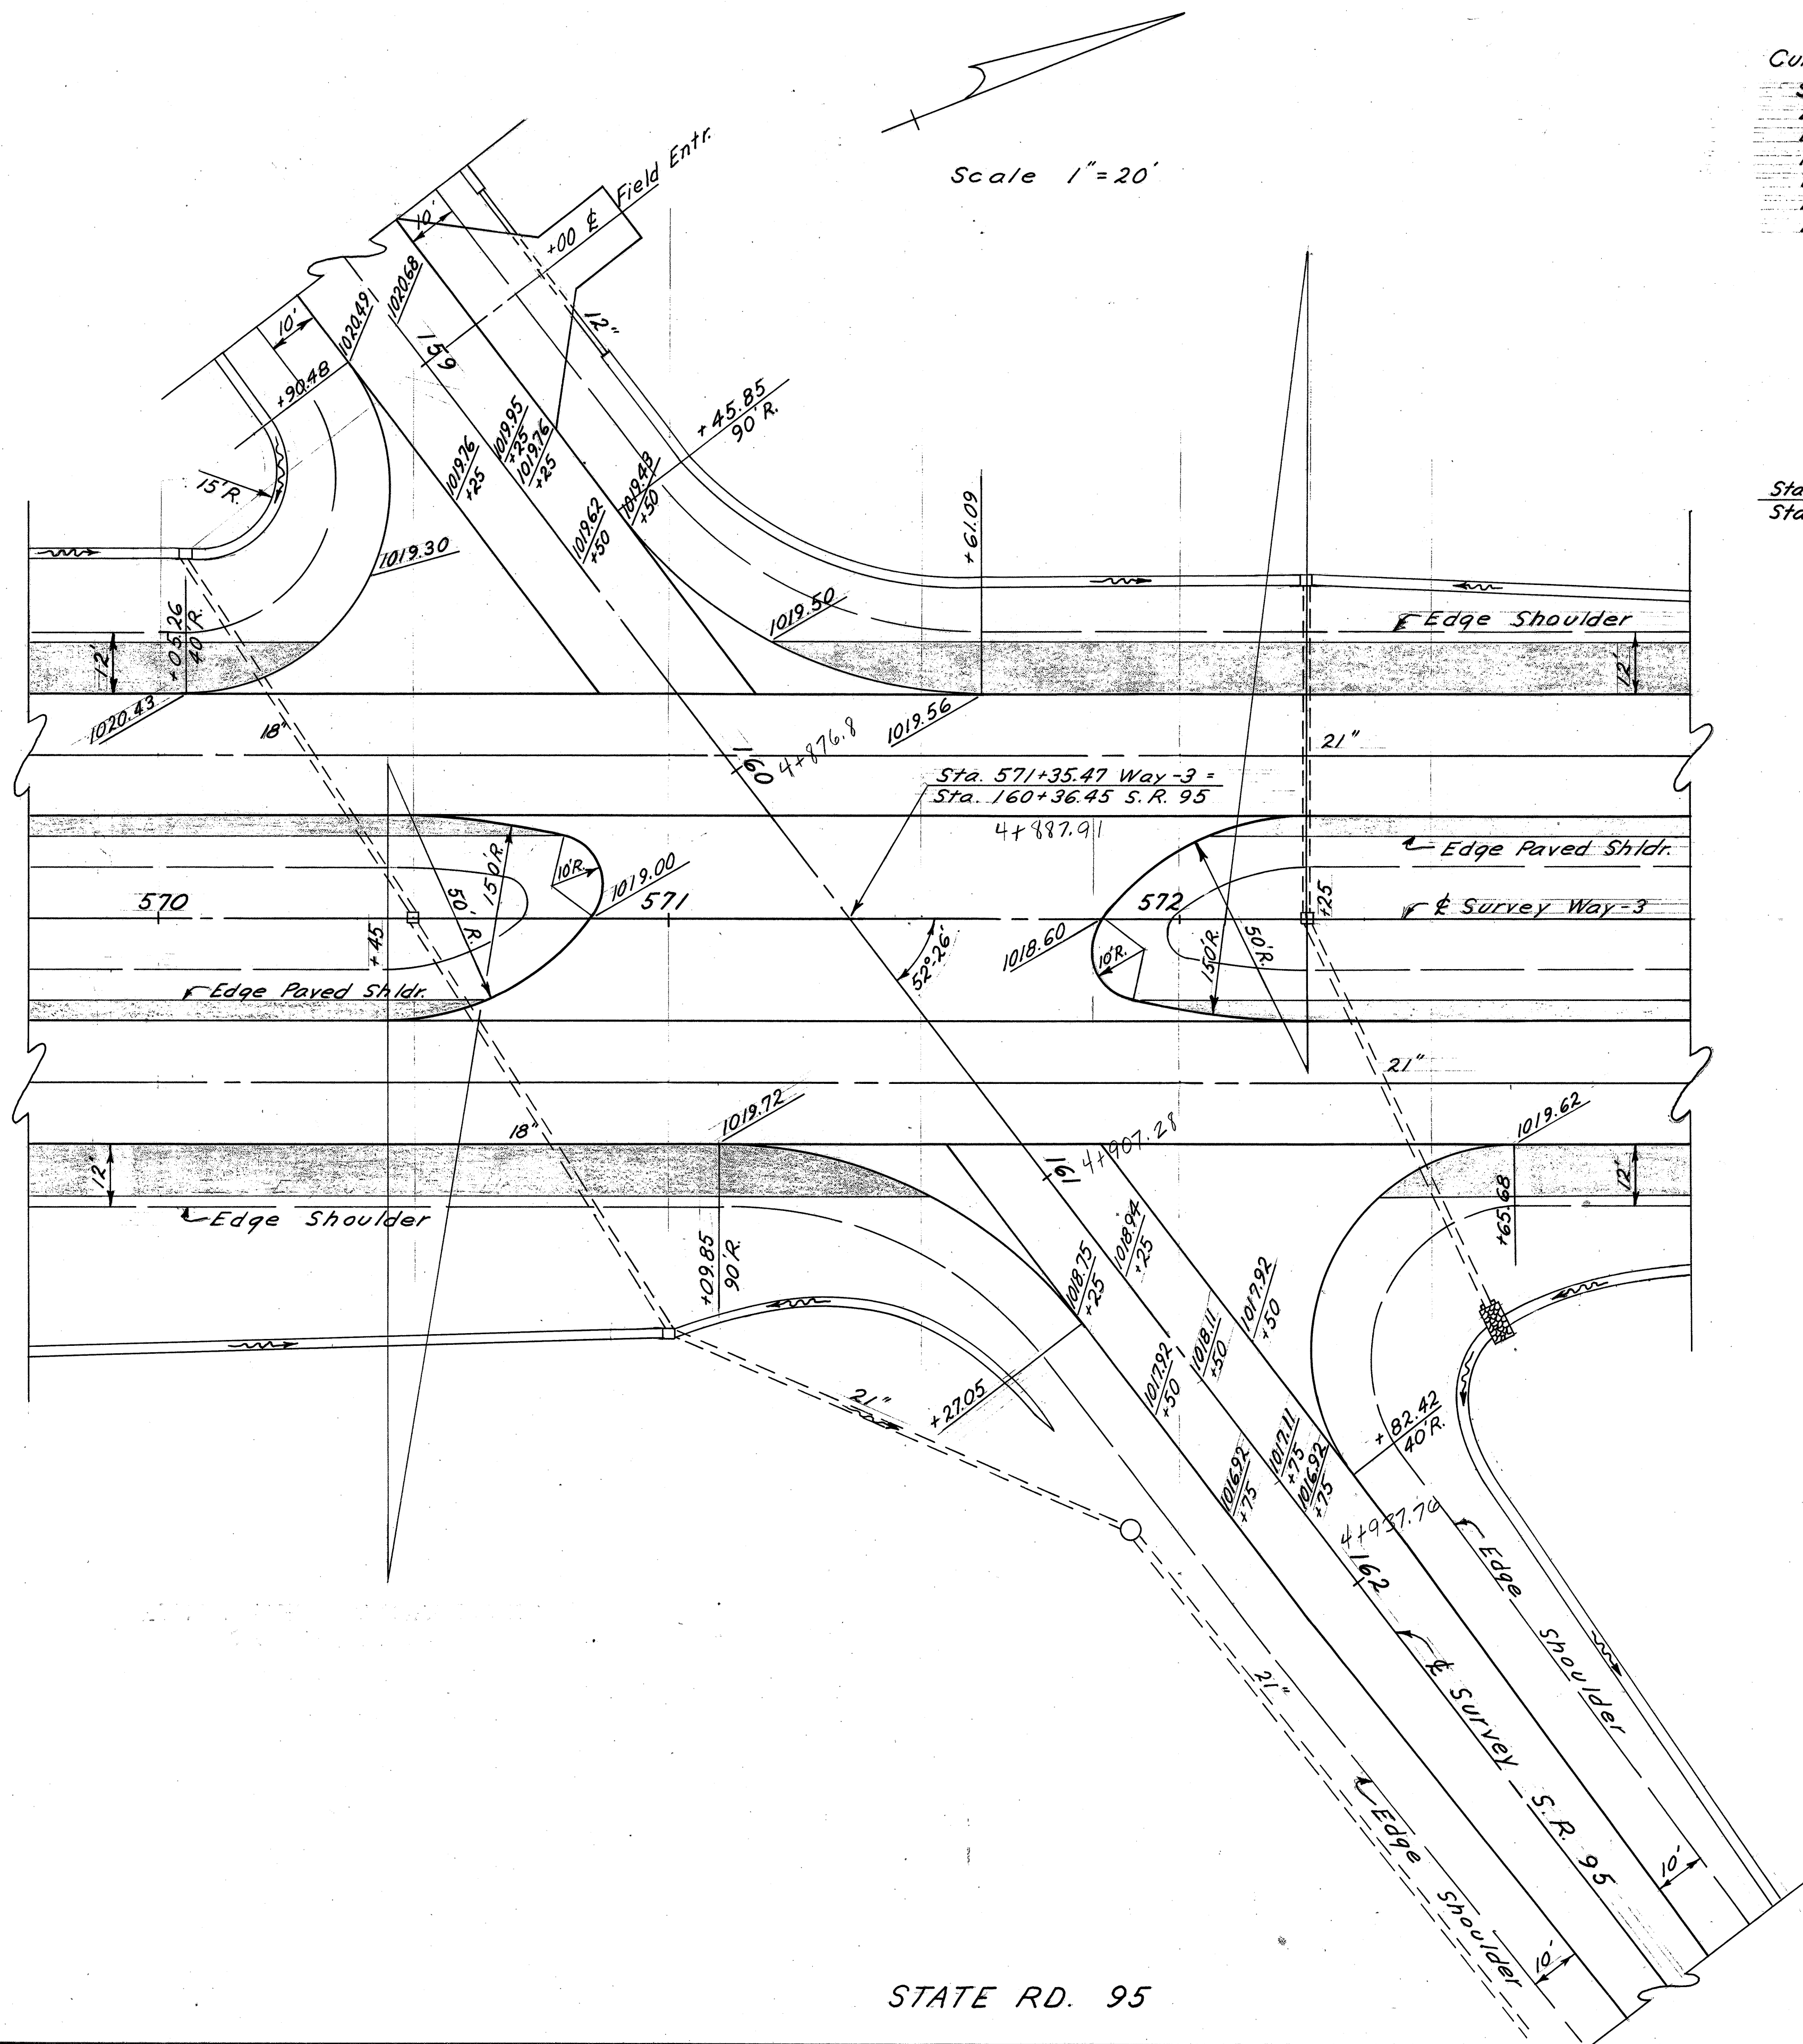



Sta. 18+50.12 Fr. Rd =
 Sta. 1+22 Private Lane

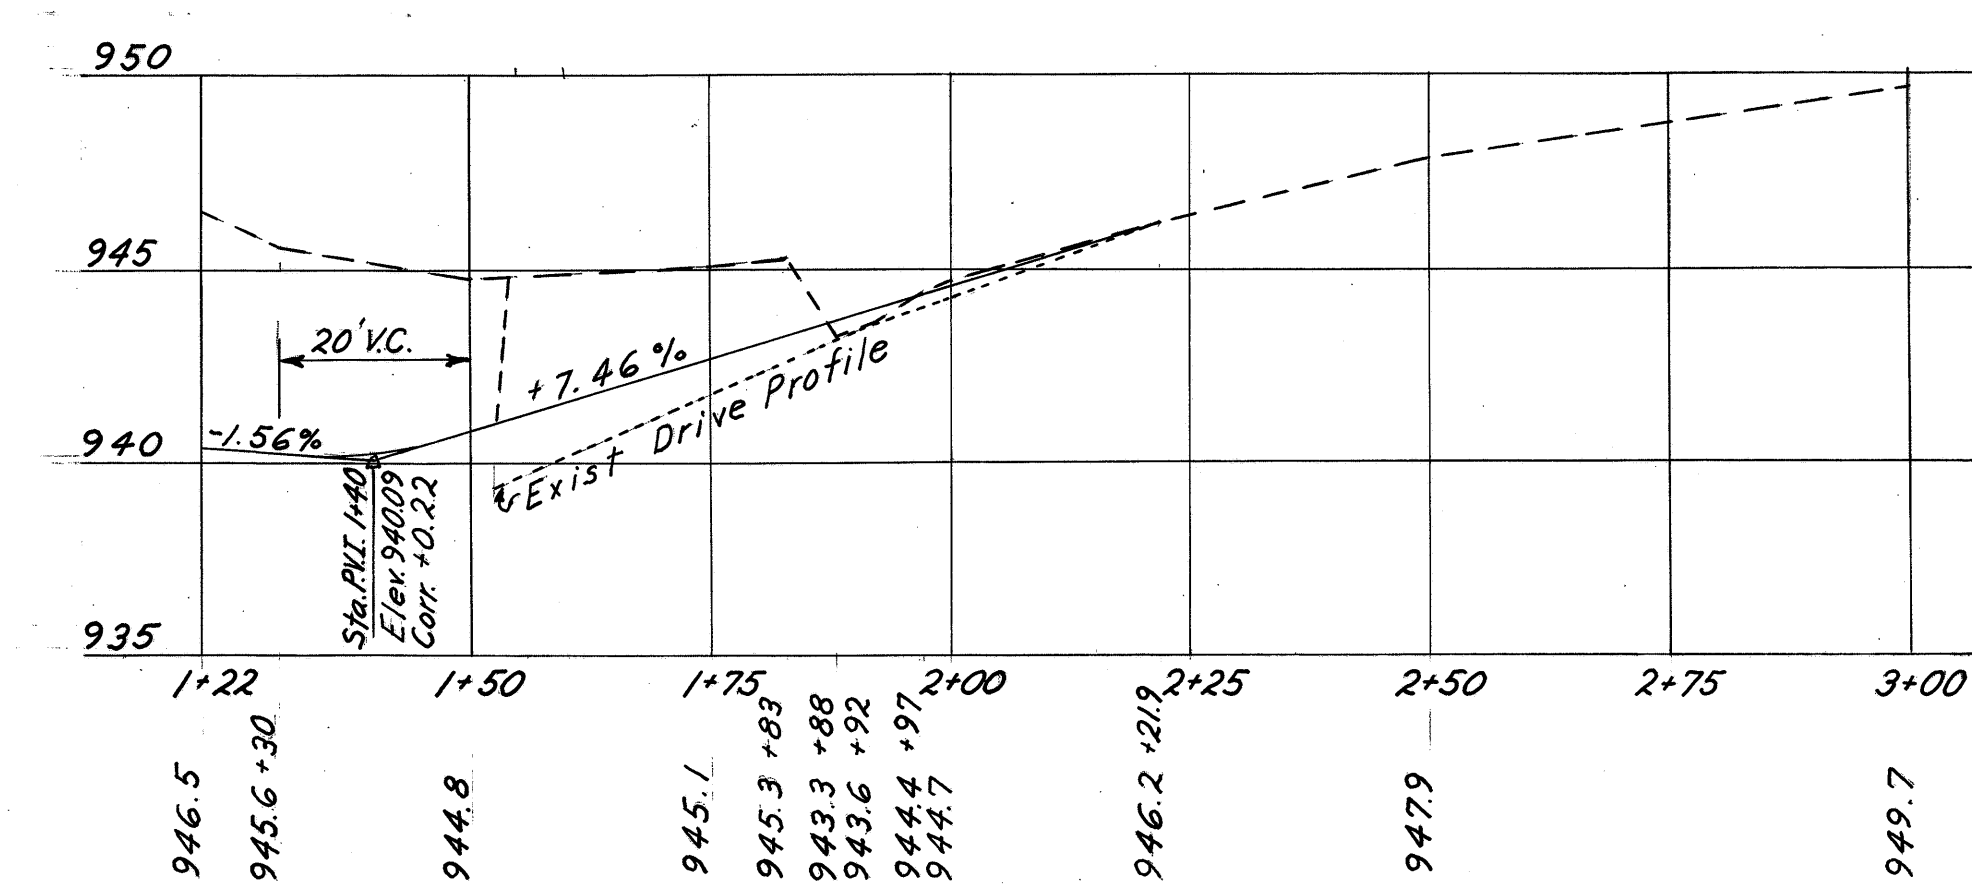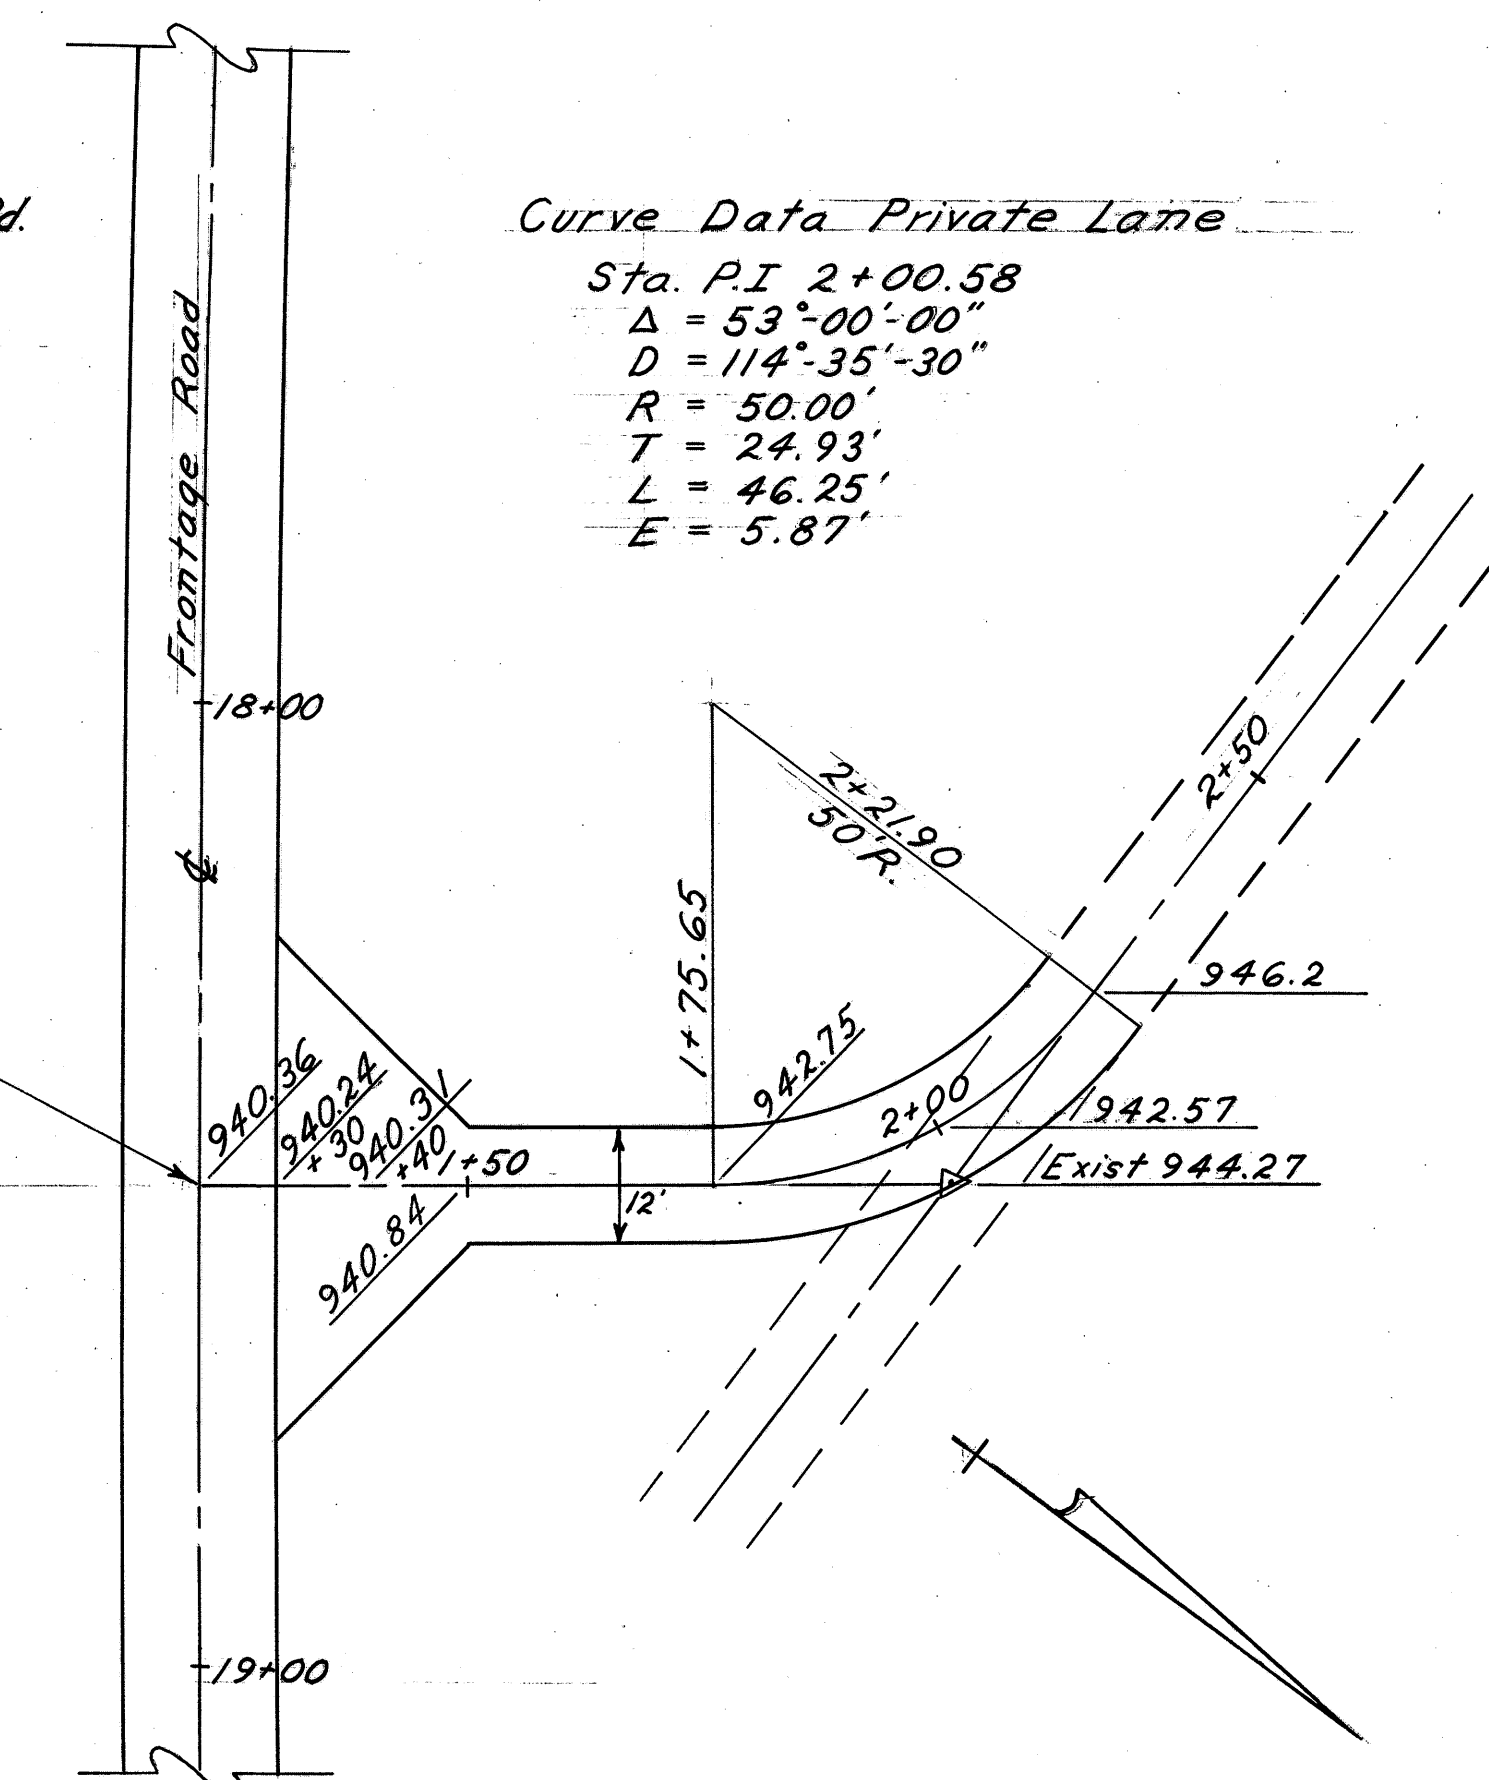

PRIVATE DRIVE
 Lt. 18+50.12
 Frontage Rd.

STATE RD. 95

WAYNE COUNTY
WAY-3-994

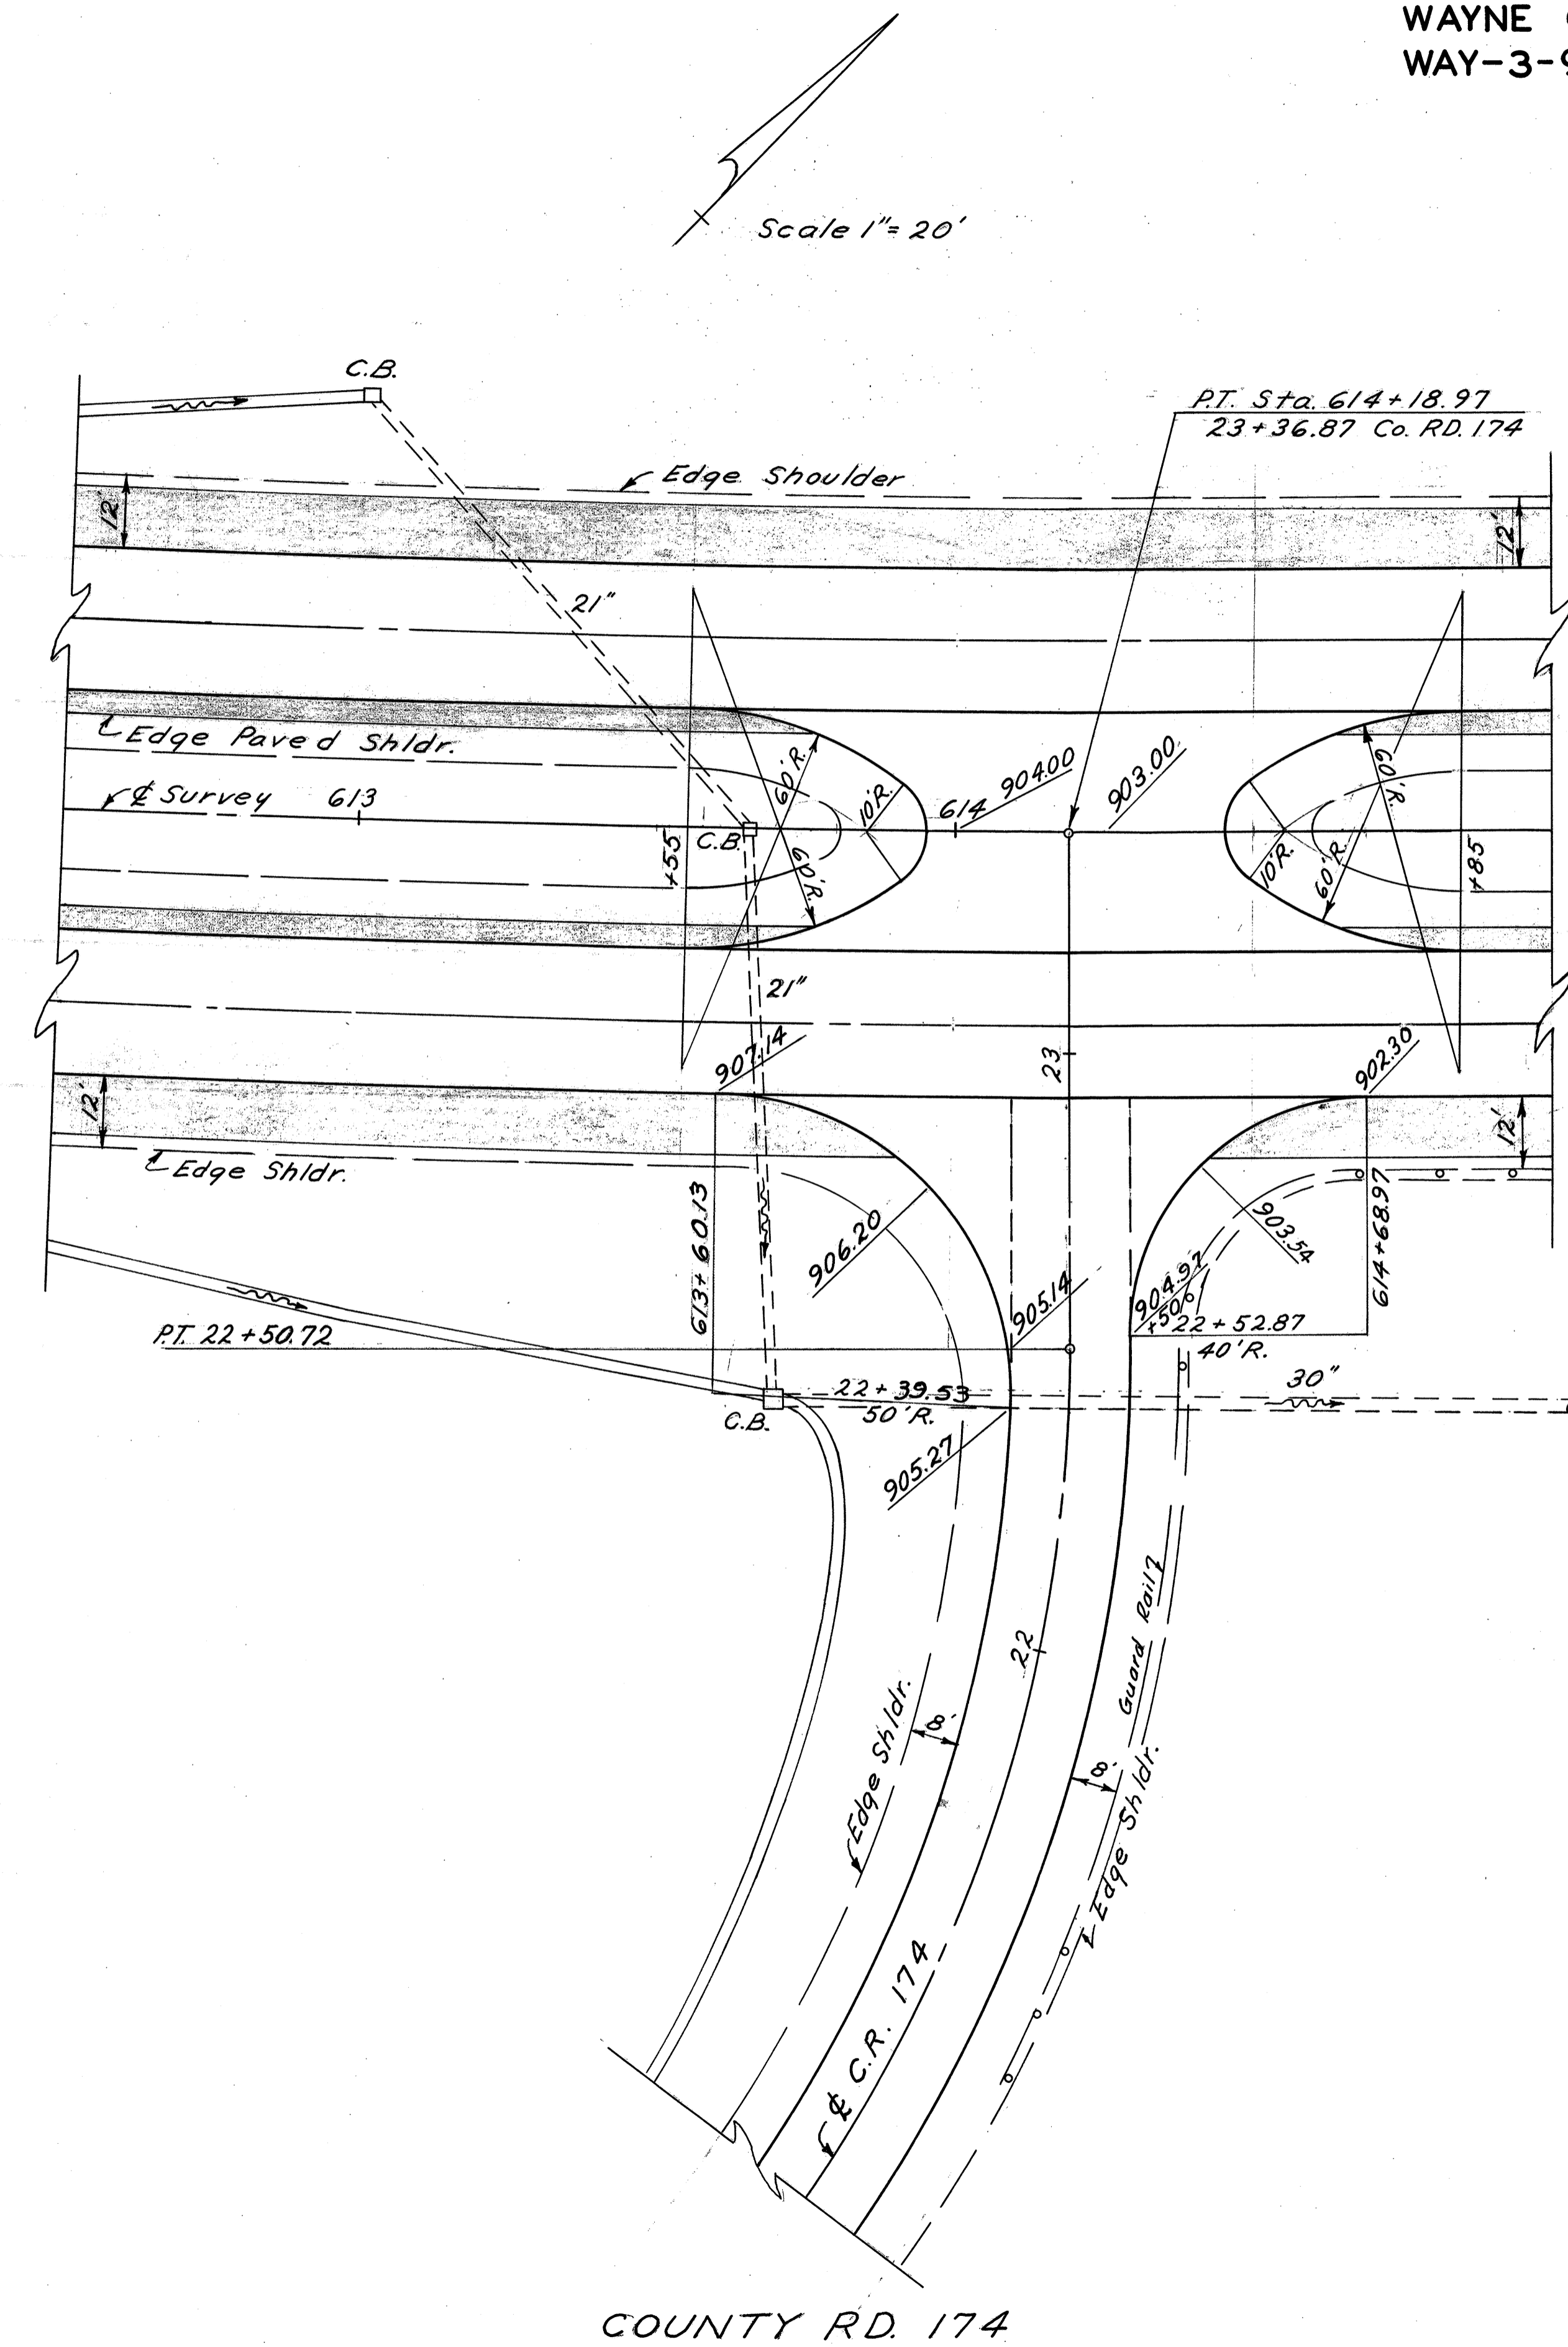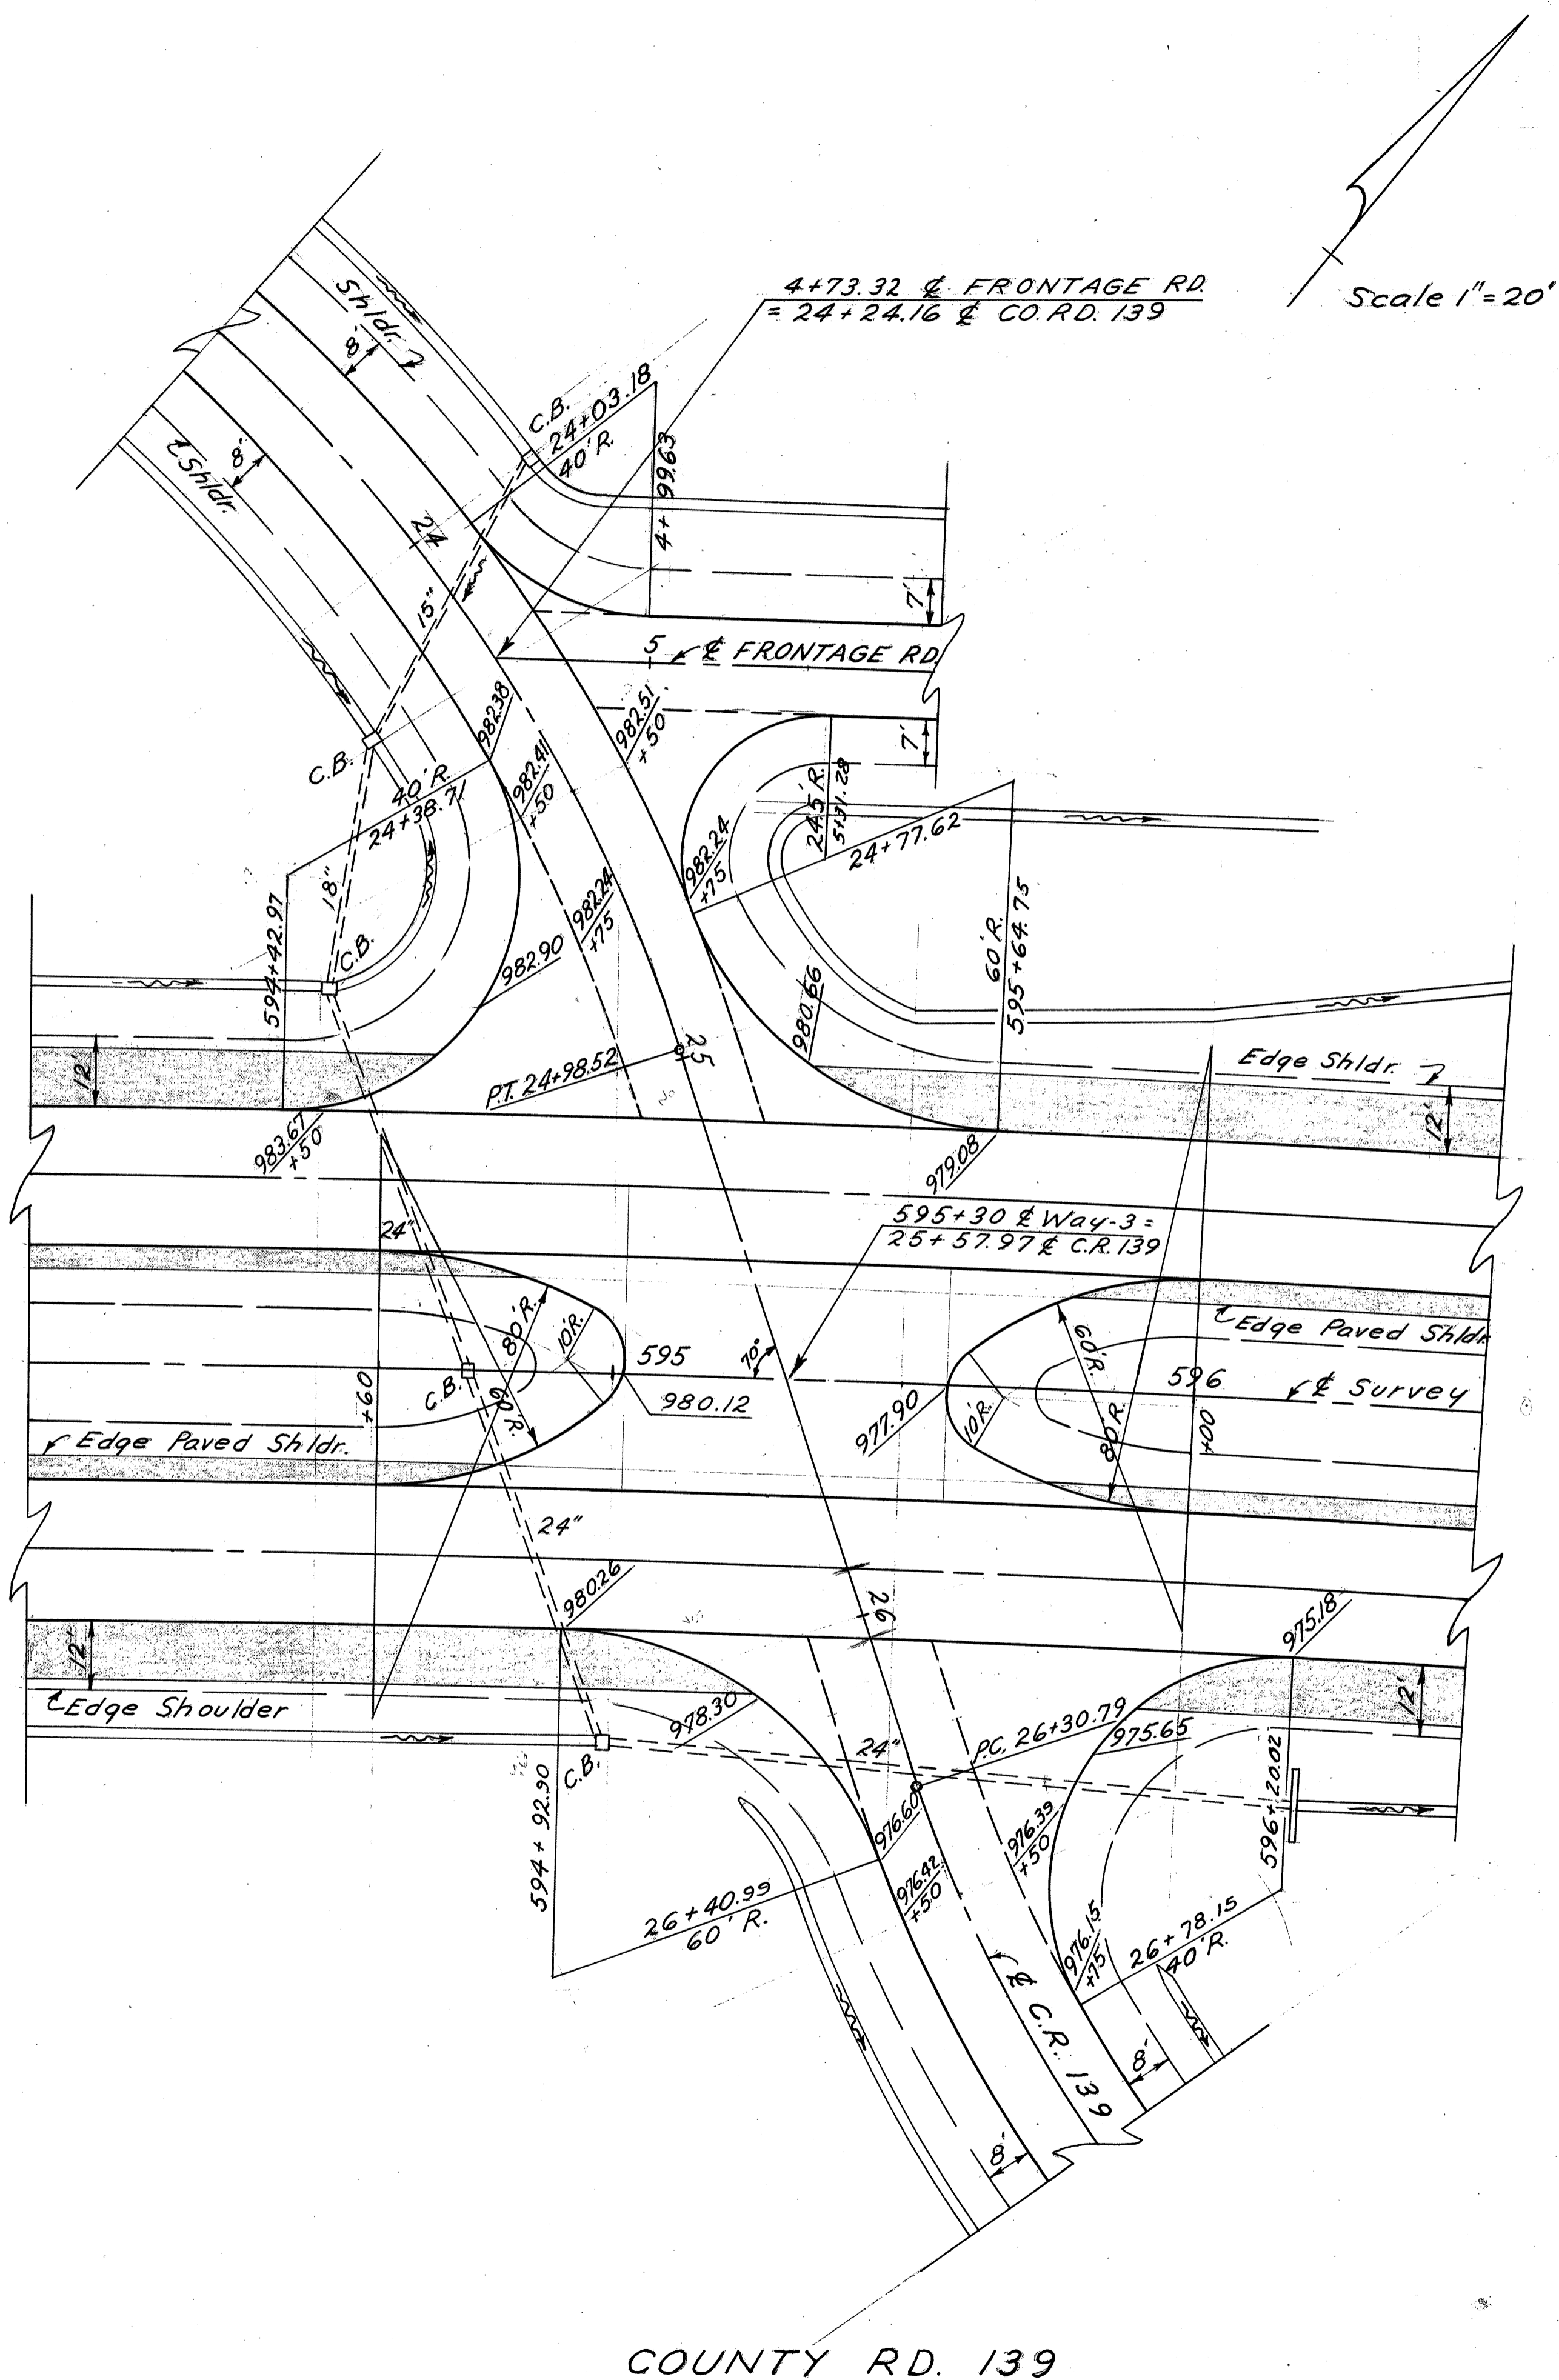

WAYNE COUNTY
WAY-3-994


P.I. Southbound Lanes 622+00
 $\Delta = 0^\circ 56' 58''$ Rt.
 $D = 0^\circ 12'$
 $T = 245.56'$
 $R = 28,647.89'$
 $L = 491.11'$
 $E = 1.05'$

P.I. Northbound Lanes 622+00
 $\Delta = 0^\circ 56' 58''$ Lt.
 $D = 0^\circ 12'$
 $T = 245.56'$
 $R = 28,647.89'$
 $L = 491.11'$
 $E = 1.05'$


P.I. Southbound Lanes 629+00
 $\Delta = 0^\circ 56' 58''$ Lt.
 $D = 0^\circ 12'$
 $T = 245.56'$
 $R = 28,647.89'$
 $L = 491.11'$
 $E = 1.05'$

P.I. Northbound Lanes 629+00
 $\Delta = 0^\circ 56' 58''$ Rt.
 $D = 0^\circ 12'$
 $T = 245.56'$
 $R = 28,647.89'$
 $L = 491.11'$
 $E = 1.05'$

Curb Transition 2" to 6" in 20'
 Sta. 627+75 to Sta. 627+95

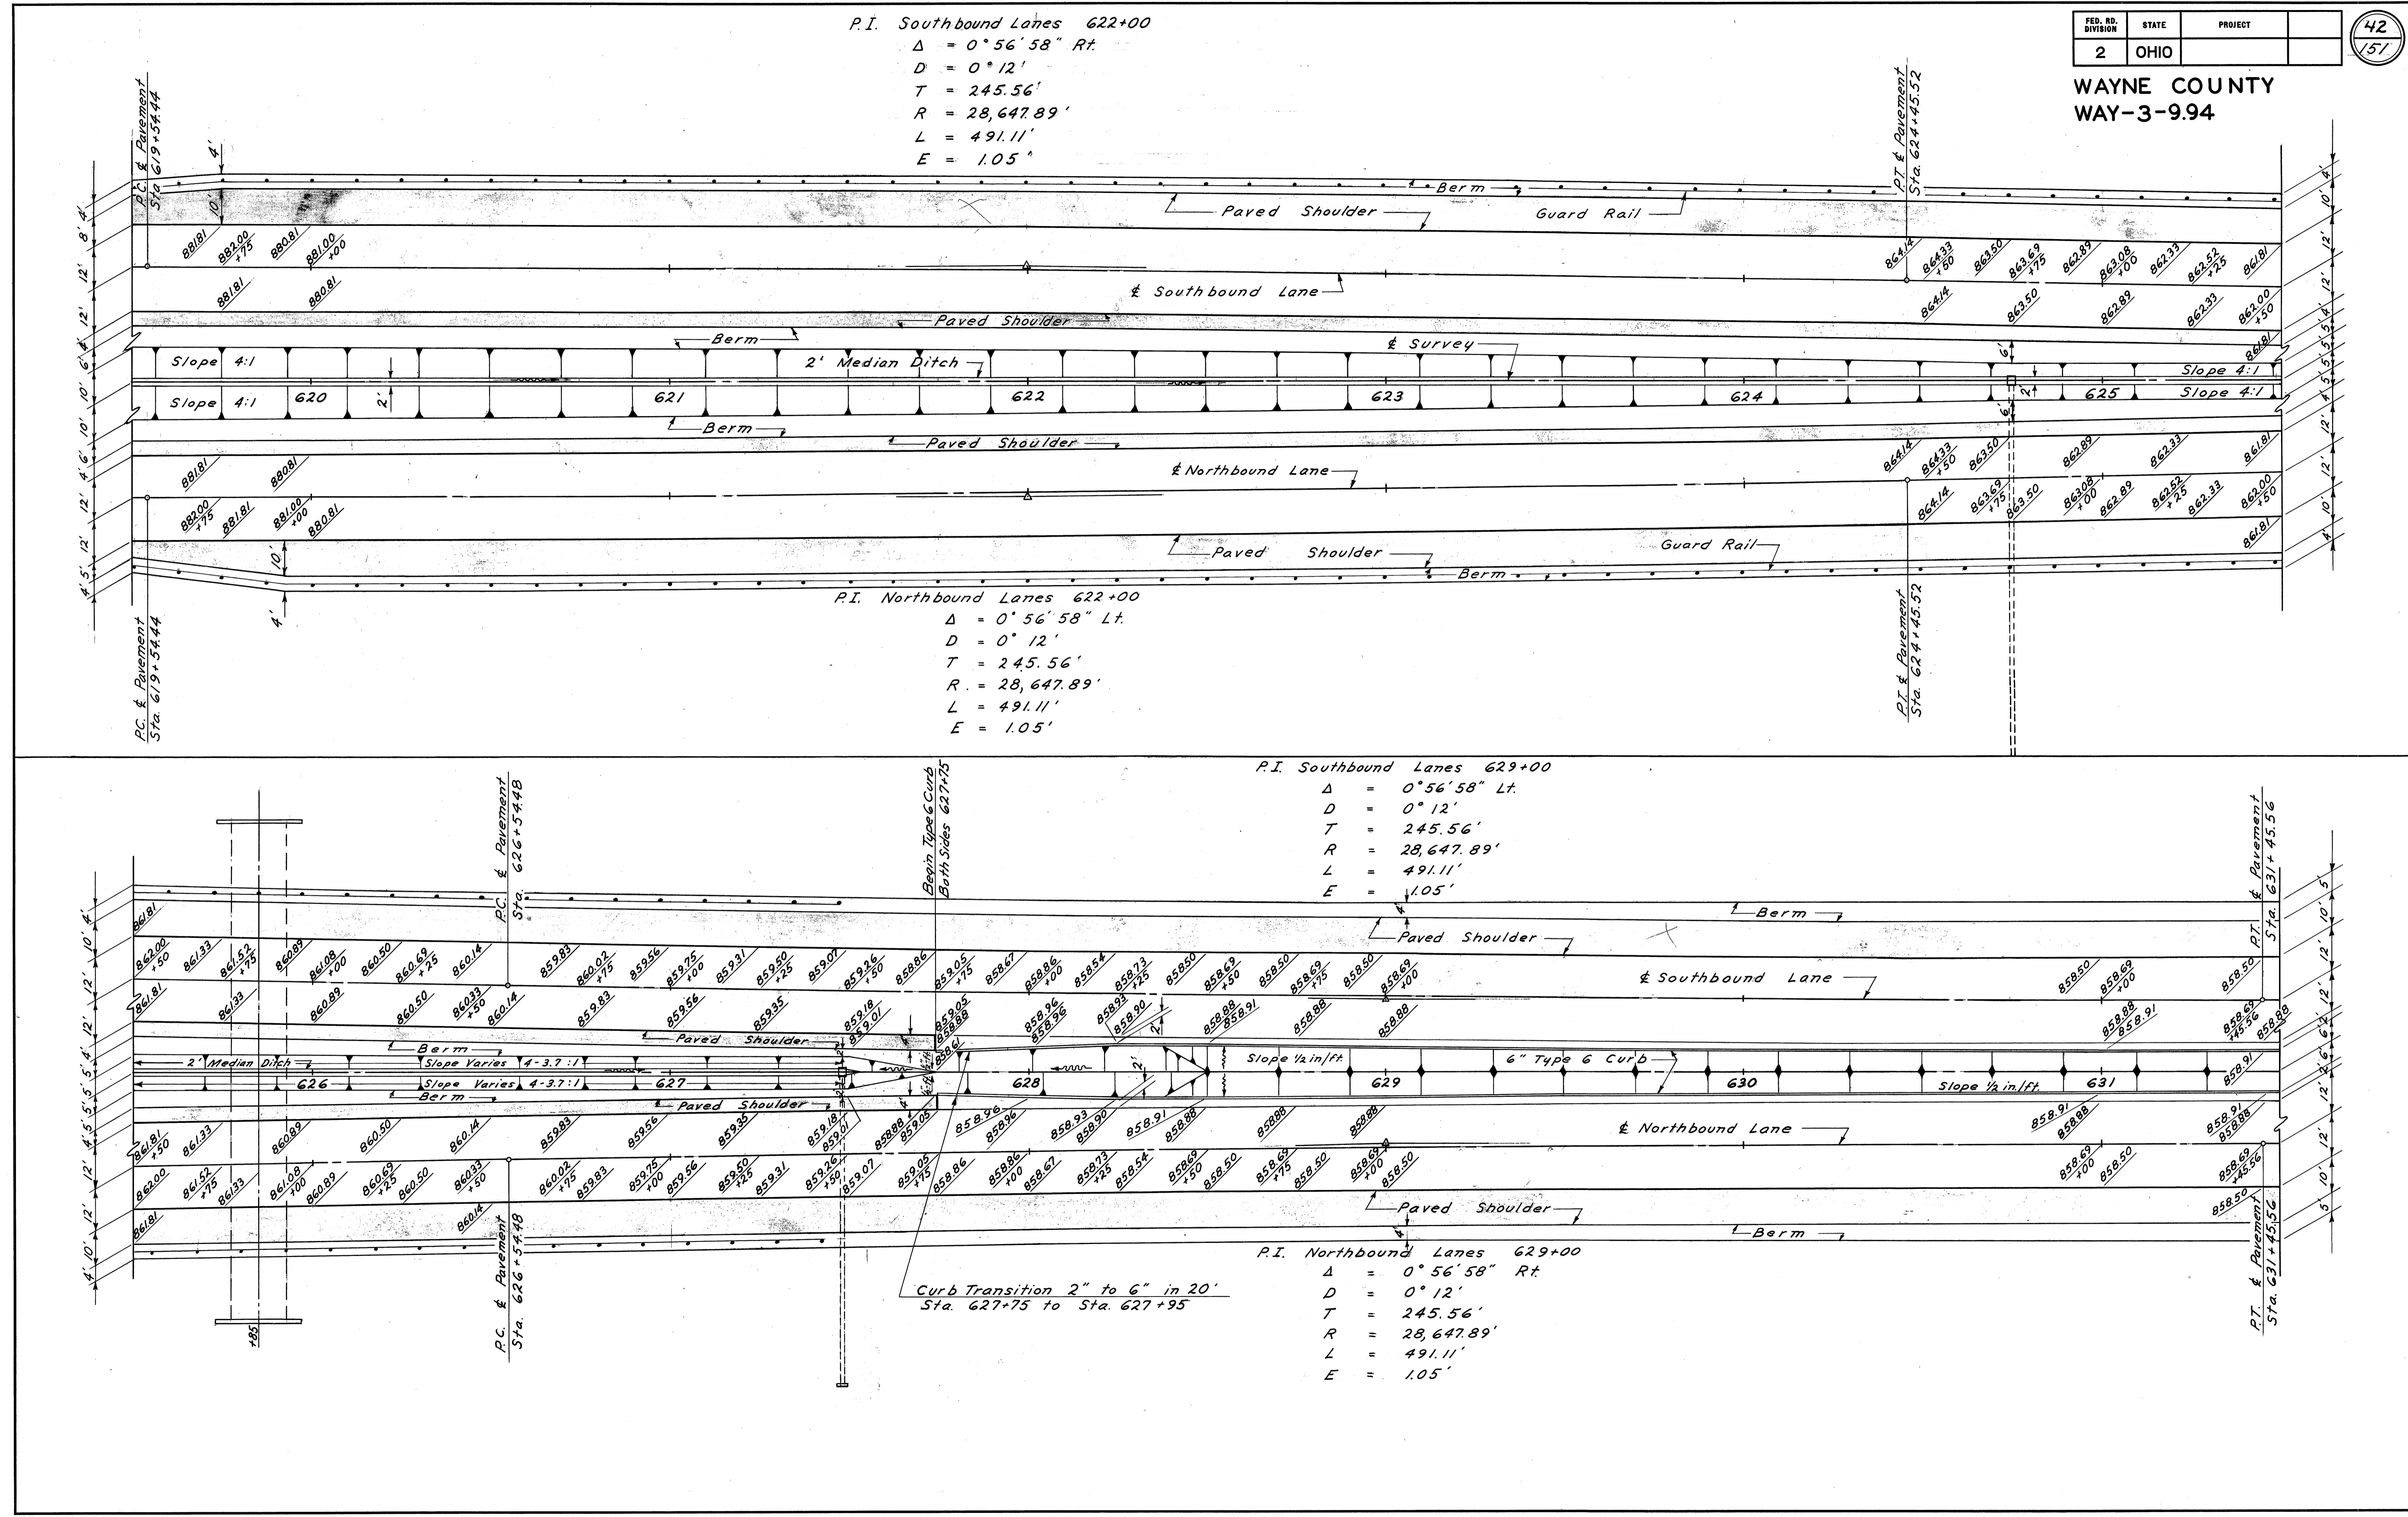


WAYNE COUNTY
WAY-3-9.94

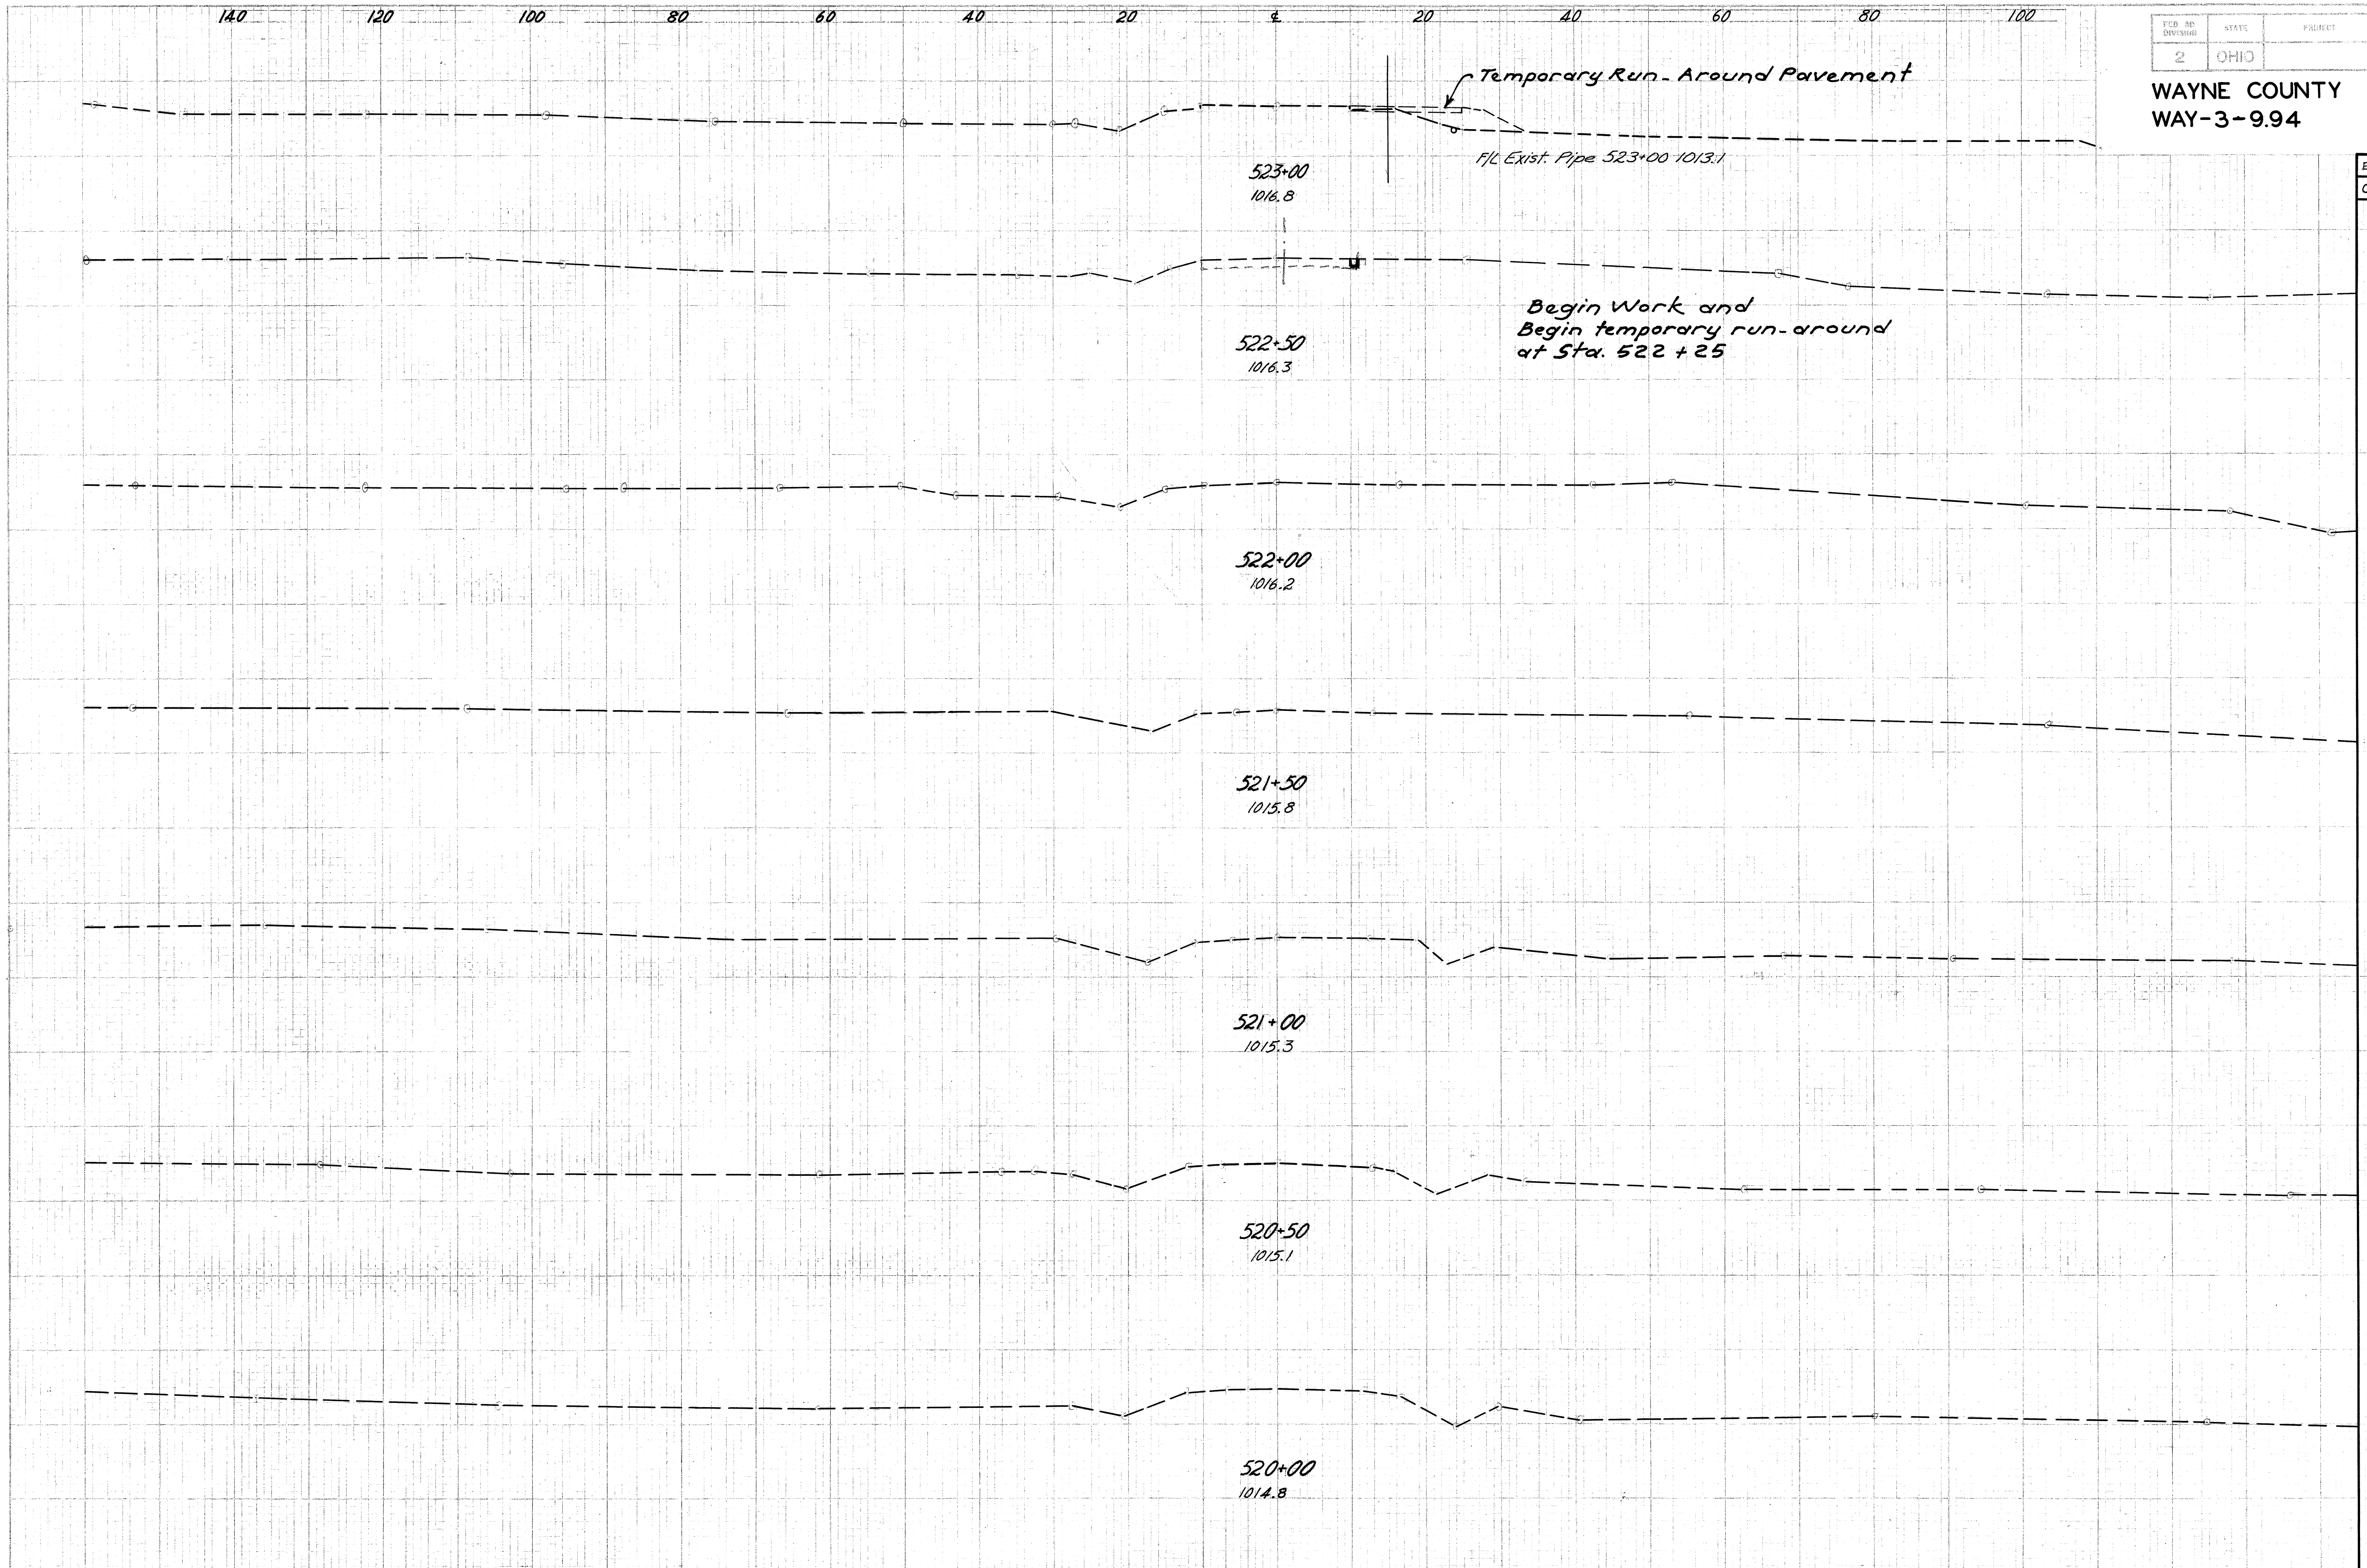

END AREA		CU. YARDS	
CUT	FILL	CUT	FILL


WAYNE COUNTY
WAY-3-994

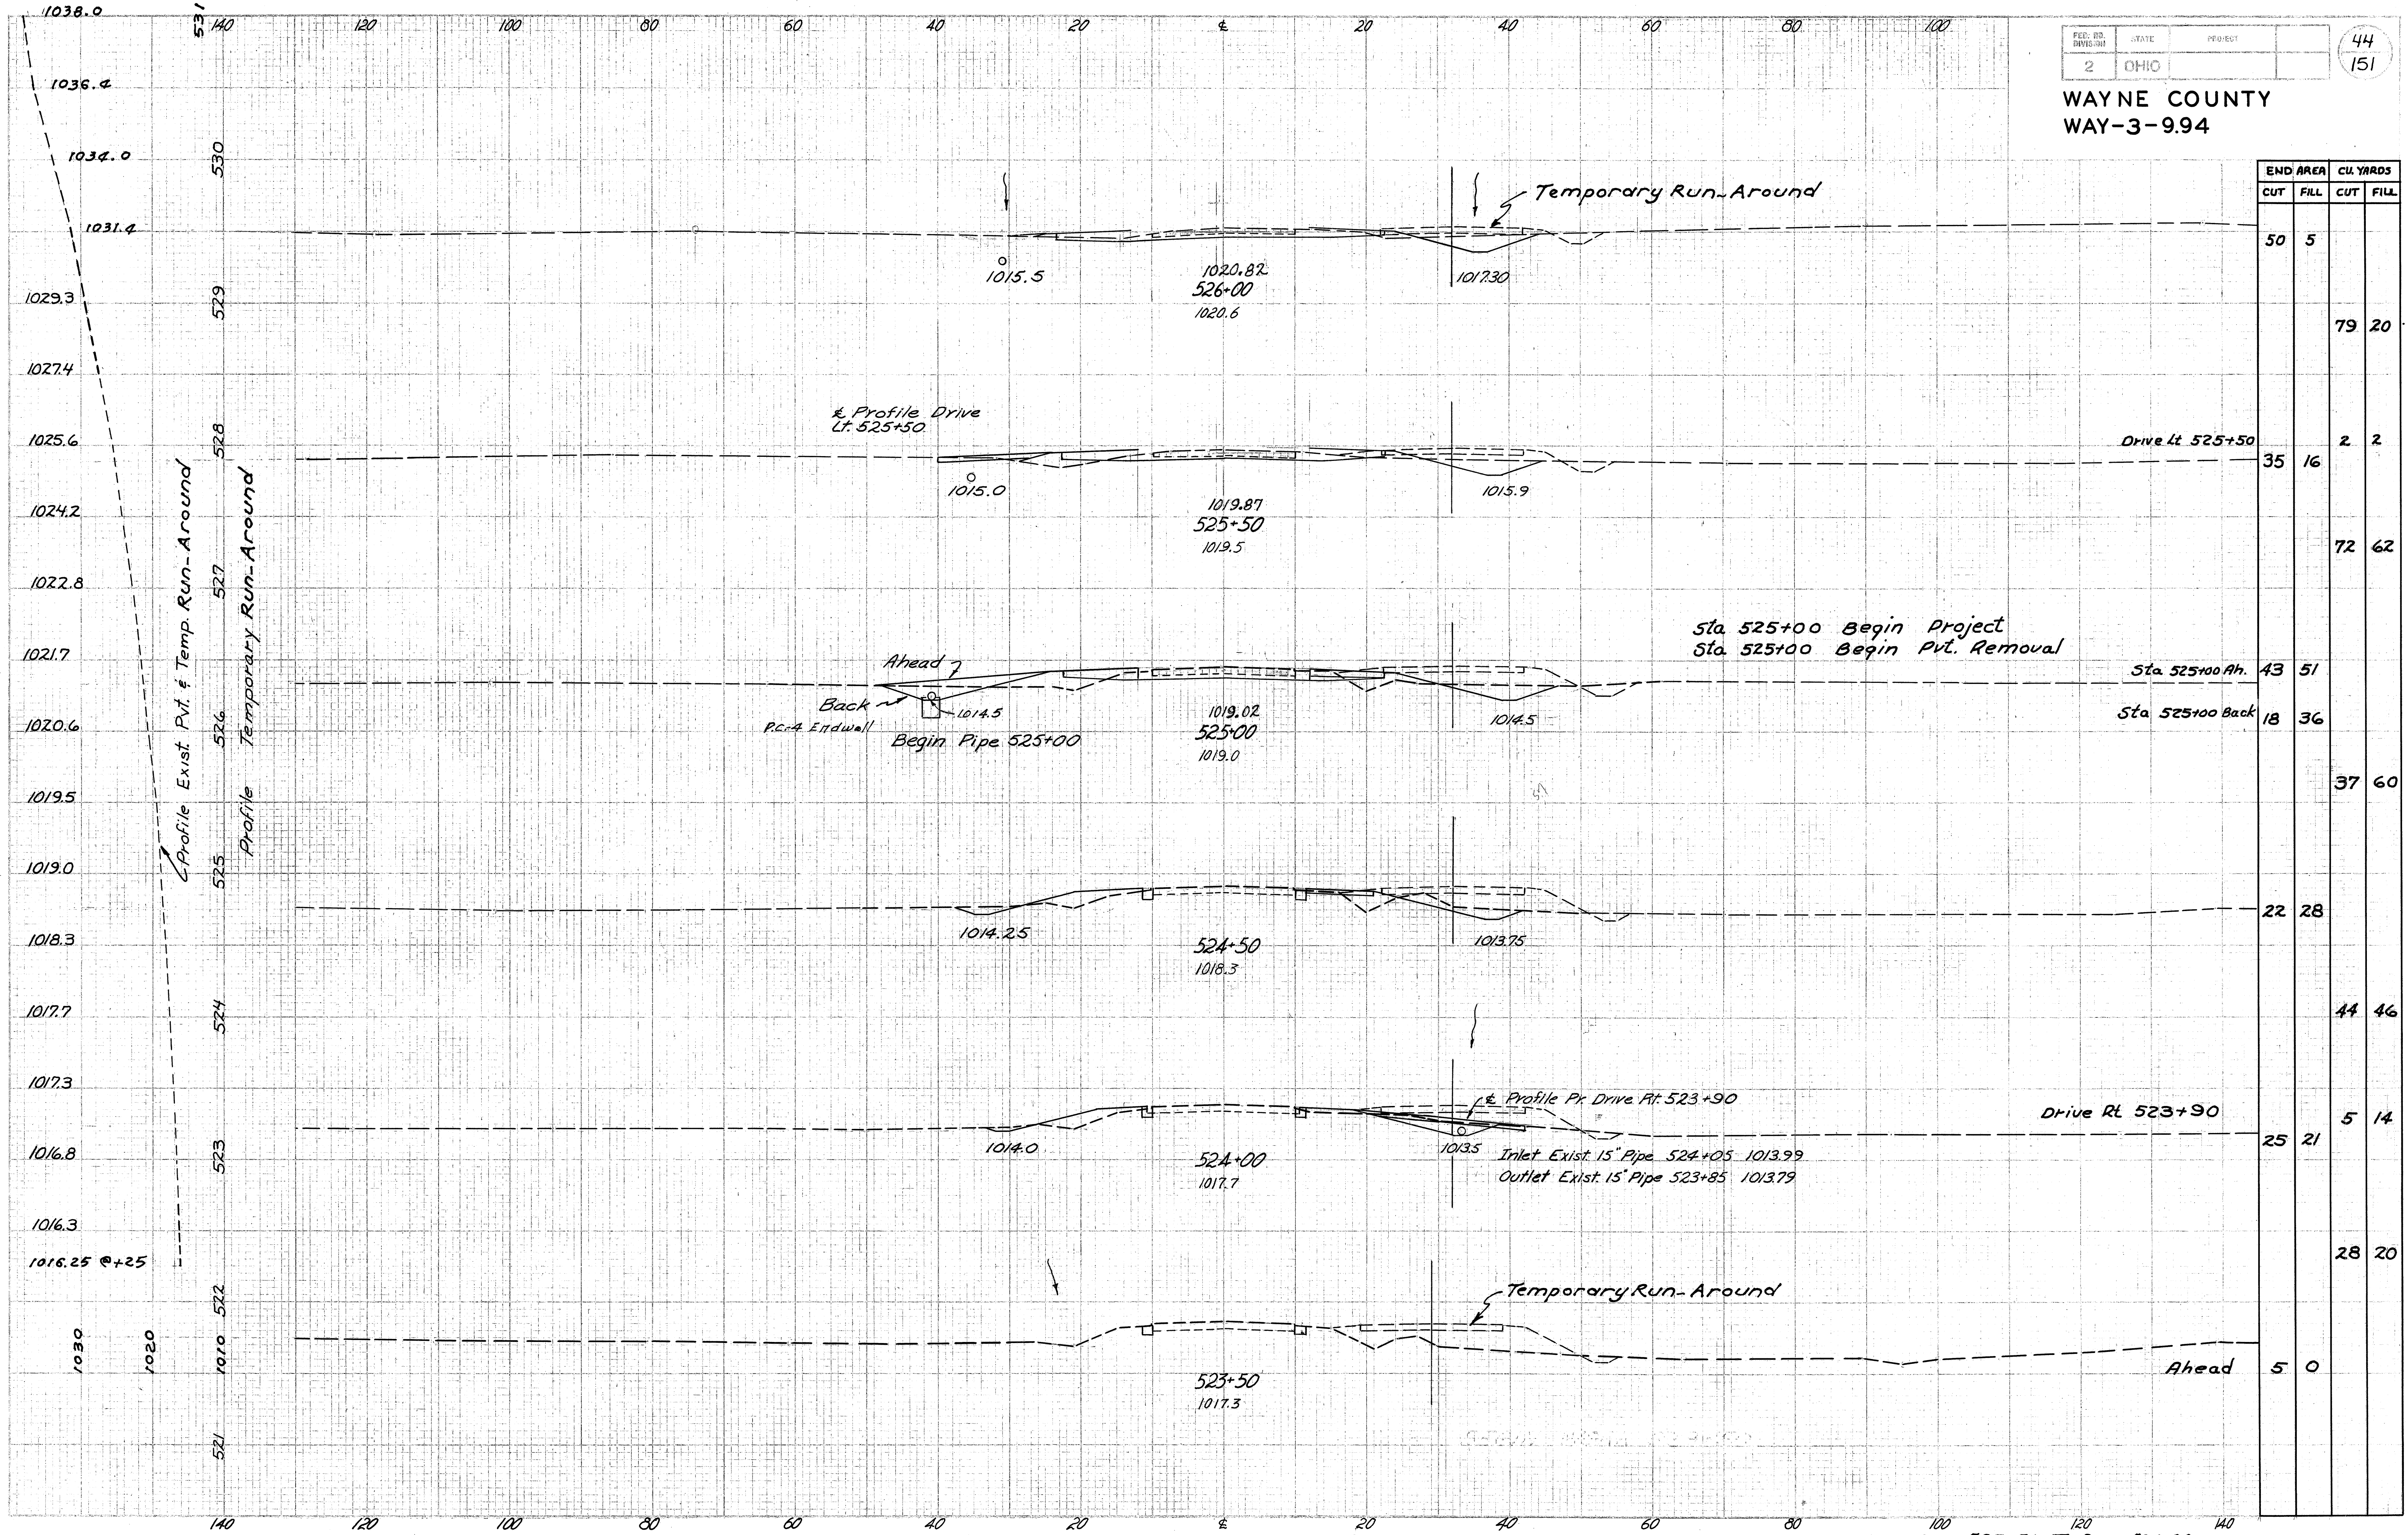

END AREA	CU. YARDS	
	CUT	FILL
50	5	
		79 20
35	16	2 2
		72 62
43	51	
18	36	
		37 60
22	28	
		44 46
25	21	5 14
		28 20
5	0	

Sta. 523+50 To Sta. 526+00


WAYNE COUNTY
WAY-3-9.94

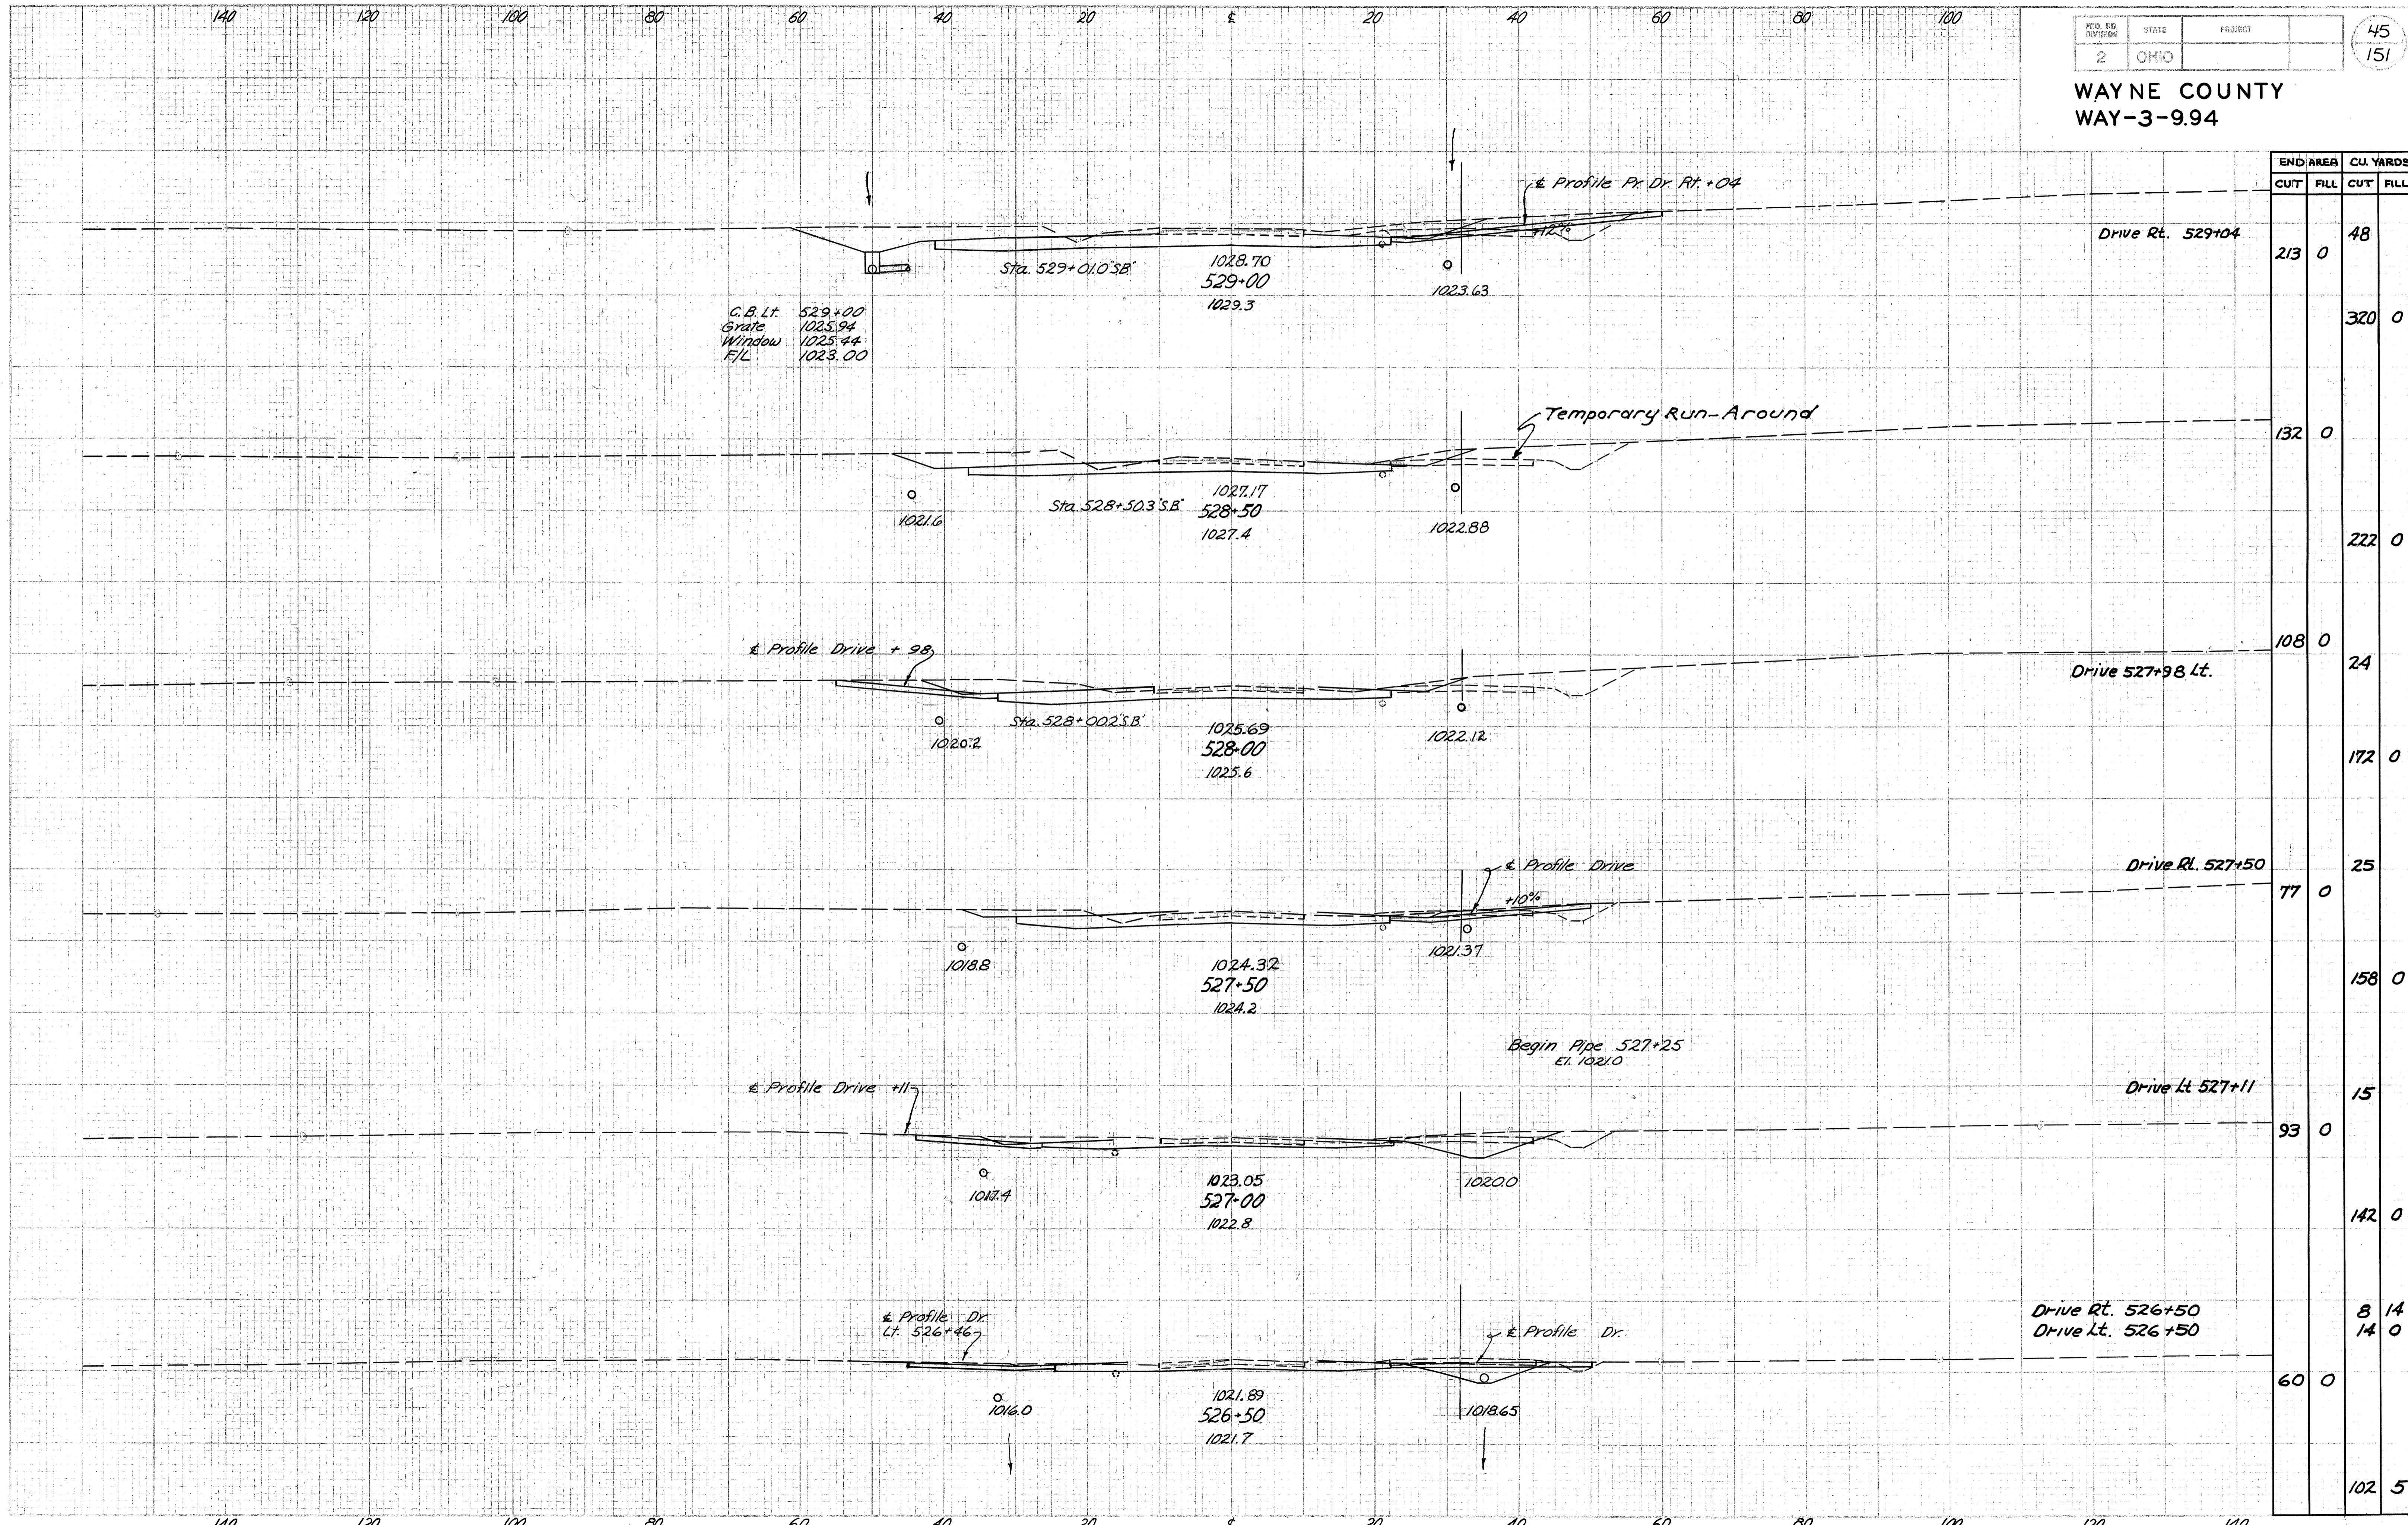

END AREA	CU. YARDS	
	CUT	FILL
213 0	0	48
		320 0
132 0	0	
		222 0
108 0	0	
		24
		172 0
77 0	0	
		25
		158 0
93 0	0	
		15
		142 0
60 0	0	
		8 14
		14 0
		102 5

100 120 140
Sta. 526+50 To Sta. 529+00


WAYNE COUNTY
WAY-3-994

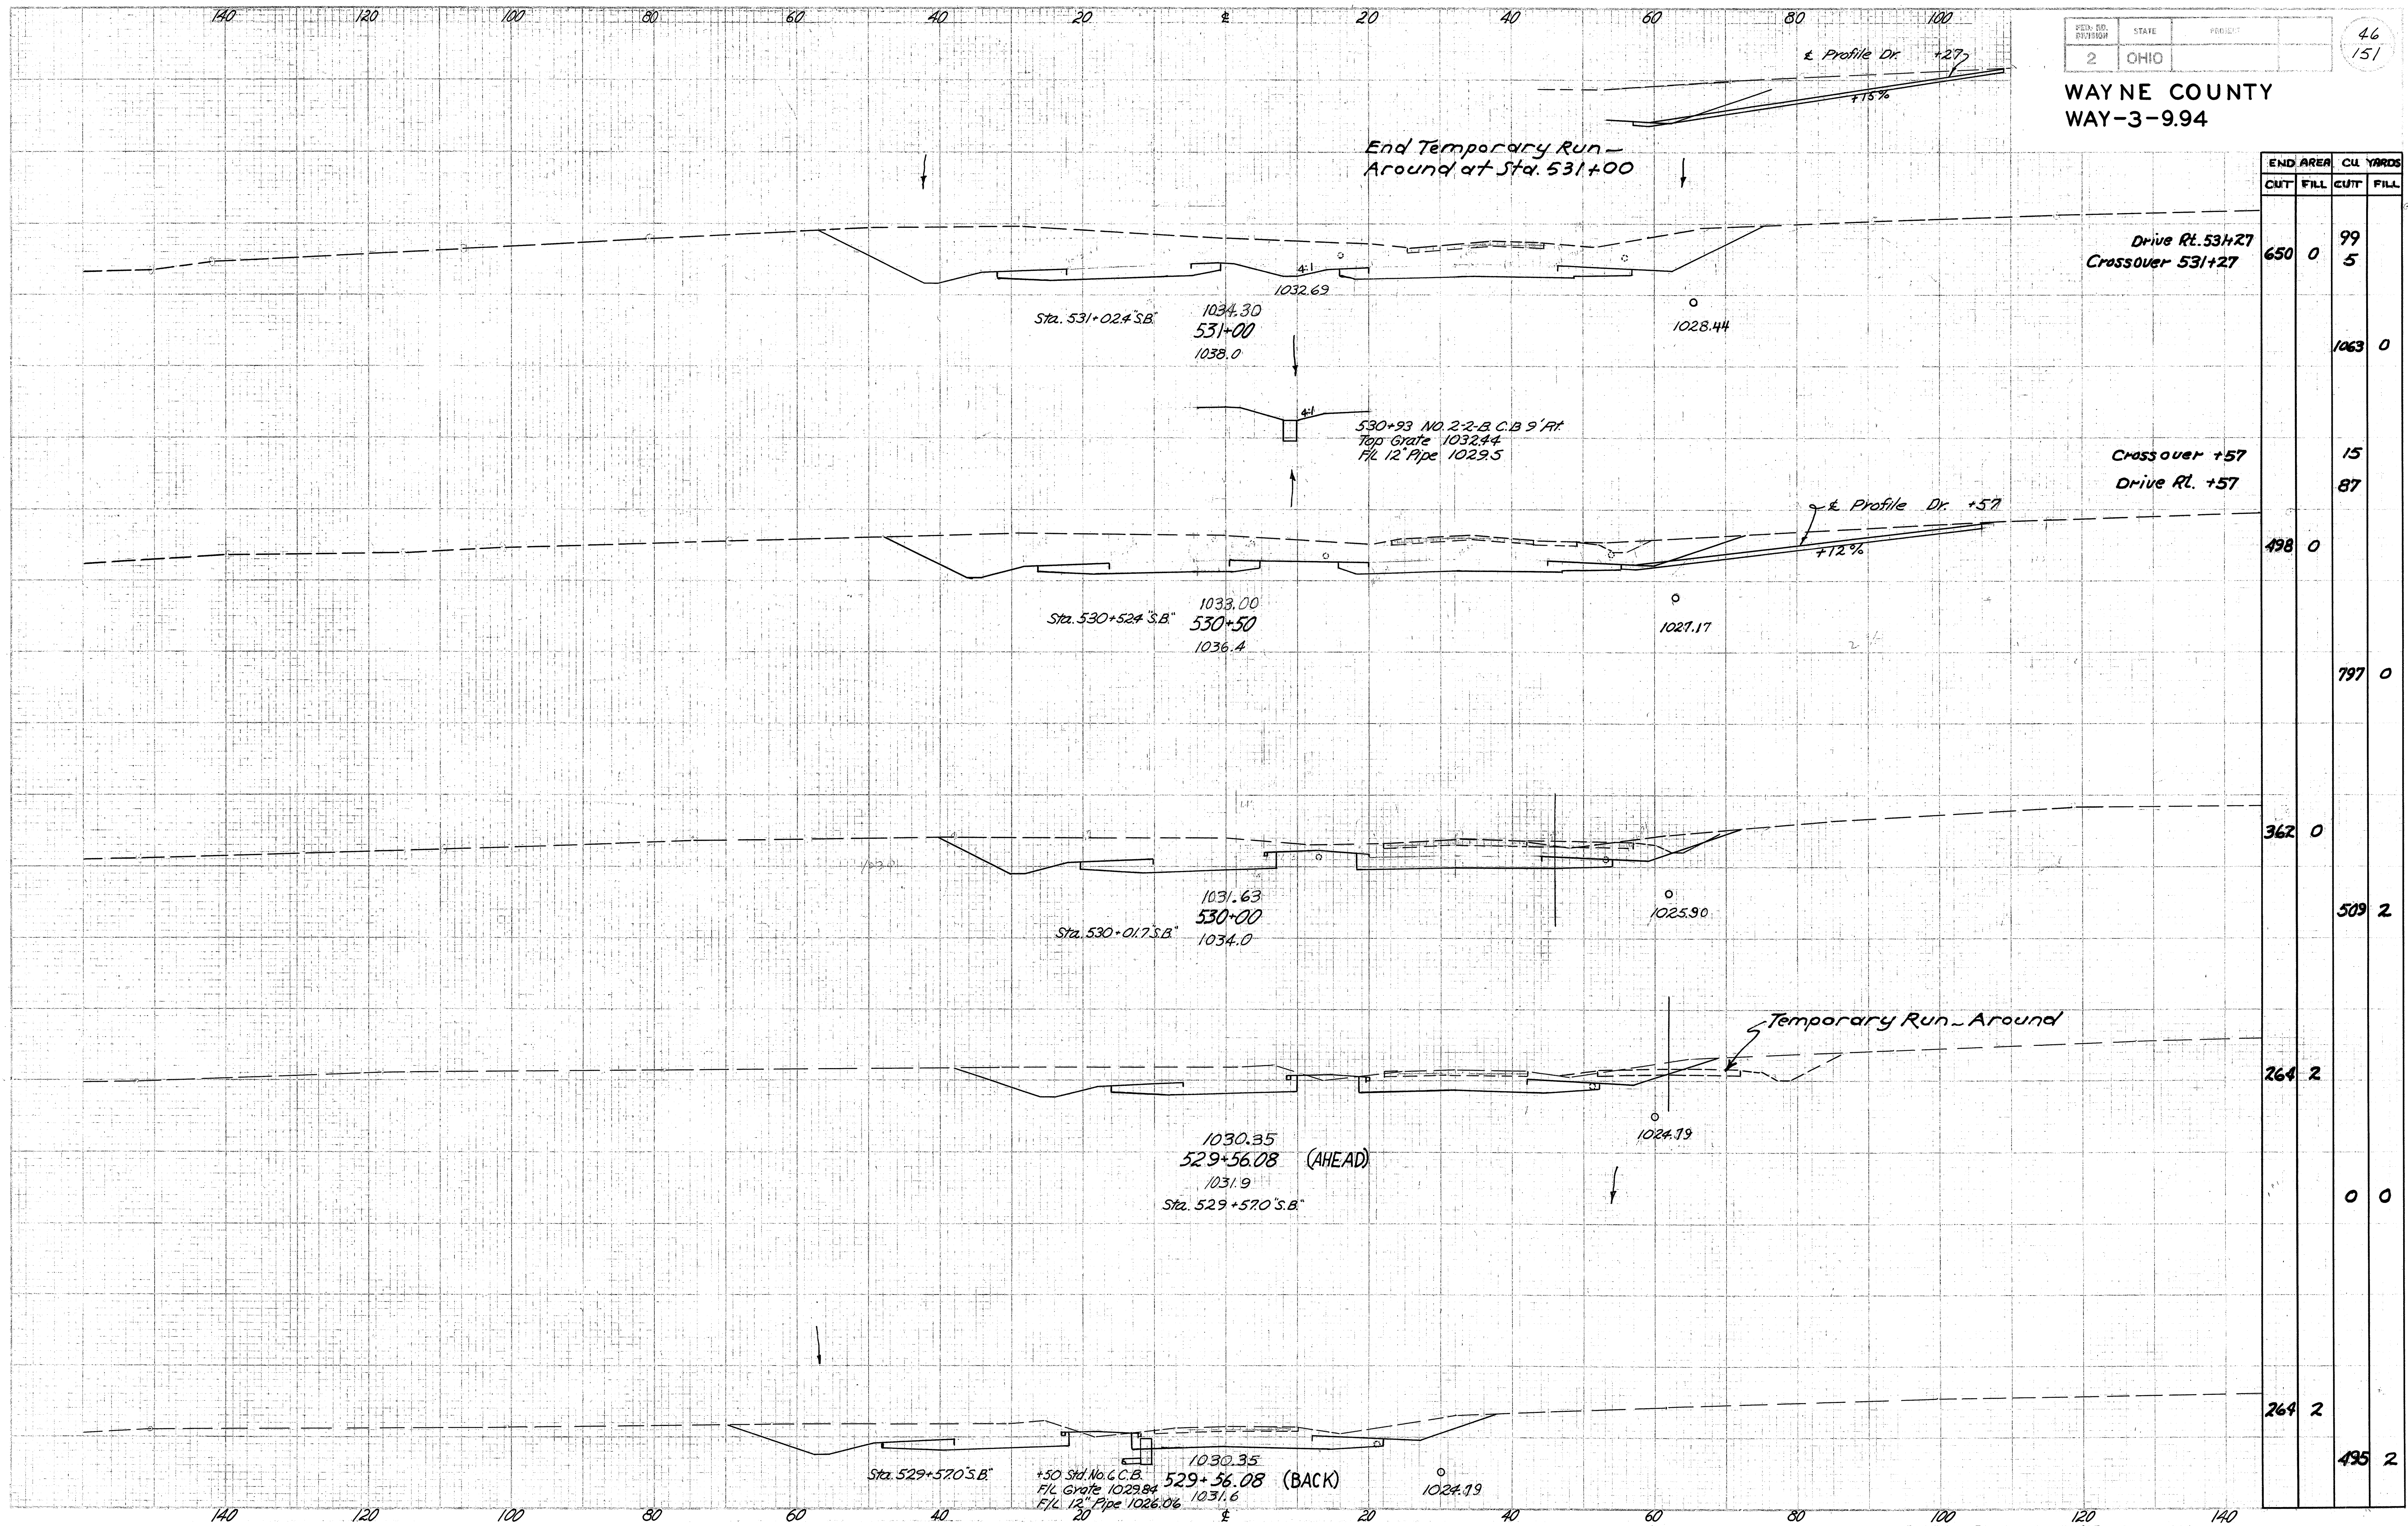

END AREA		CU YARDS	
CUT	FILL	CUT	FILL
650	0	99	5
		1063	0
		15	87
498	0		
		797	0
		362	0
		509	2
		264	2
		0	0
		264	2
		495	2

Sta. 529+56.08 To Sta. 531+00

WAYNE COUNTY
WAY-3-94

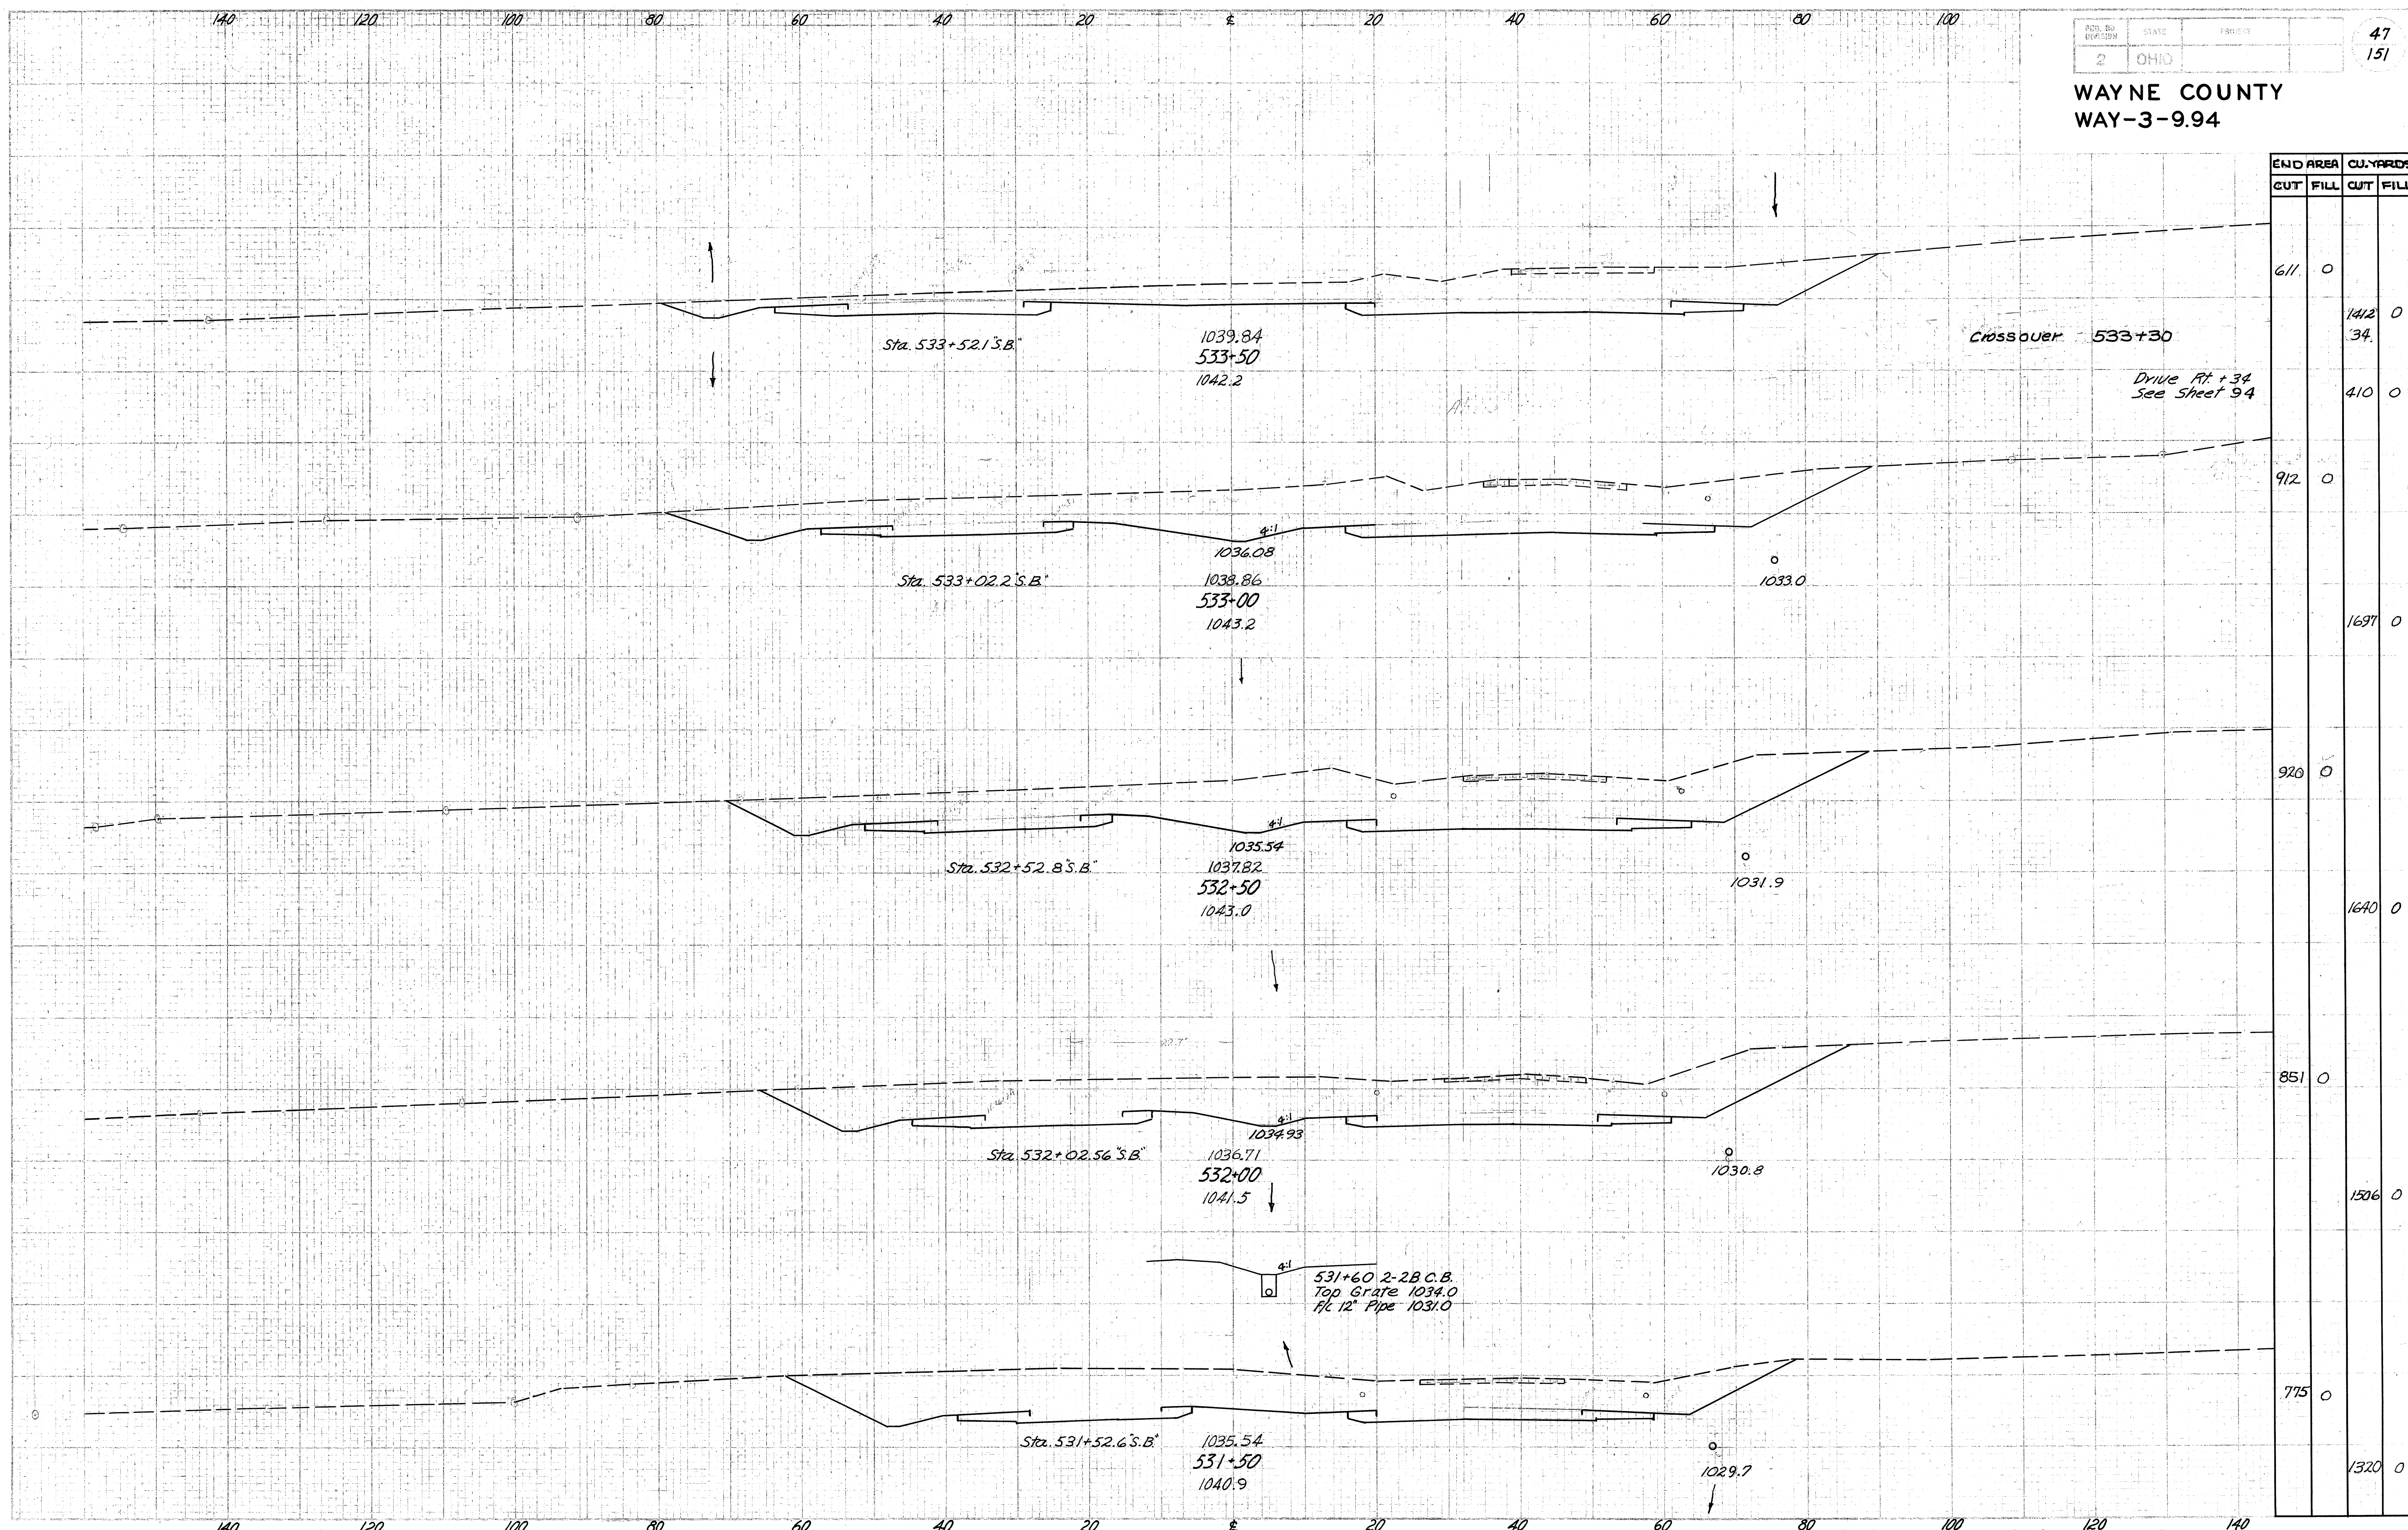


END AREA		CU. YARDS	
CUT	FILL	CUT	FILL
611	0	1412	0
		34	
		410	0
912	0	1697	0
920	0	1640	0
851	0	1506	0
775	0	1320	0

CROSSOVER 533+30
Drive Rt. +34
See Sheet 94

531+60 2-2 B.C.B.
Top Grate 1034.0
Flt 12" Pipe 1031.0

100 120 140
Sta. 531+50 To Sta. 533+50


WAYNE COUNTY
WAY-3-9.94

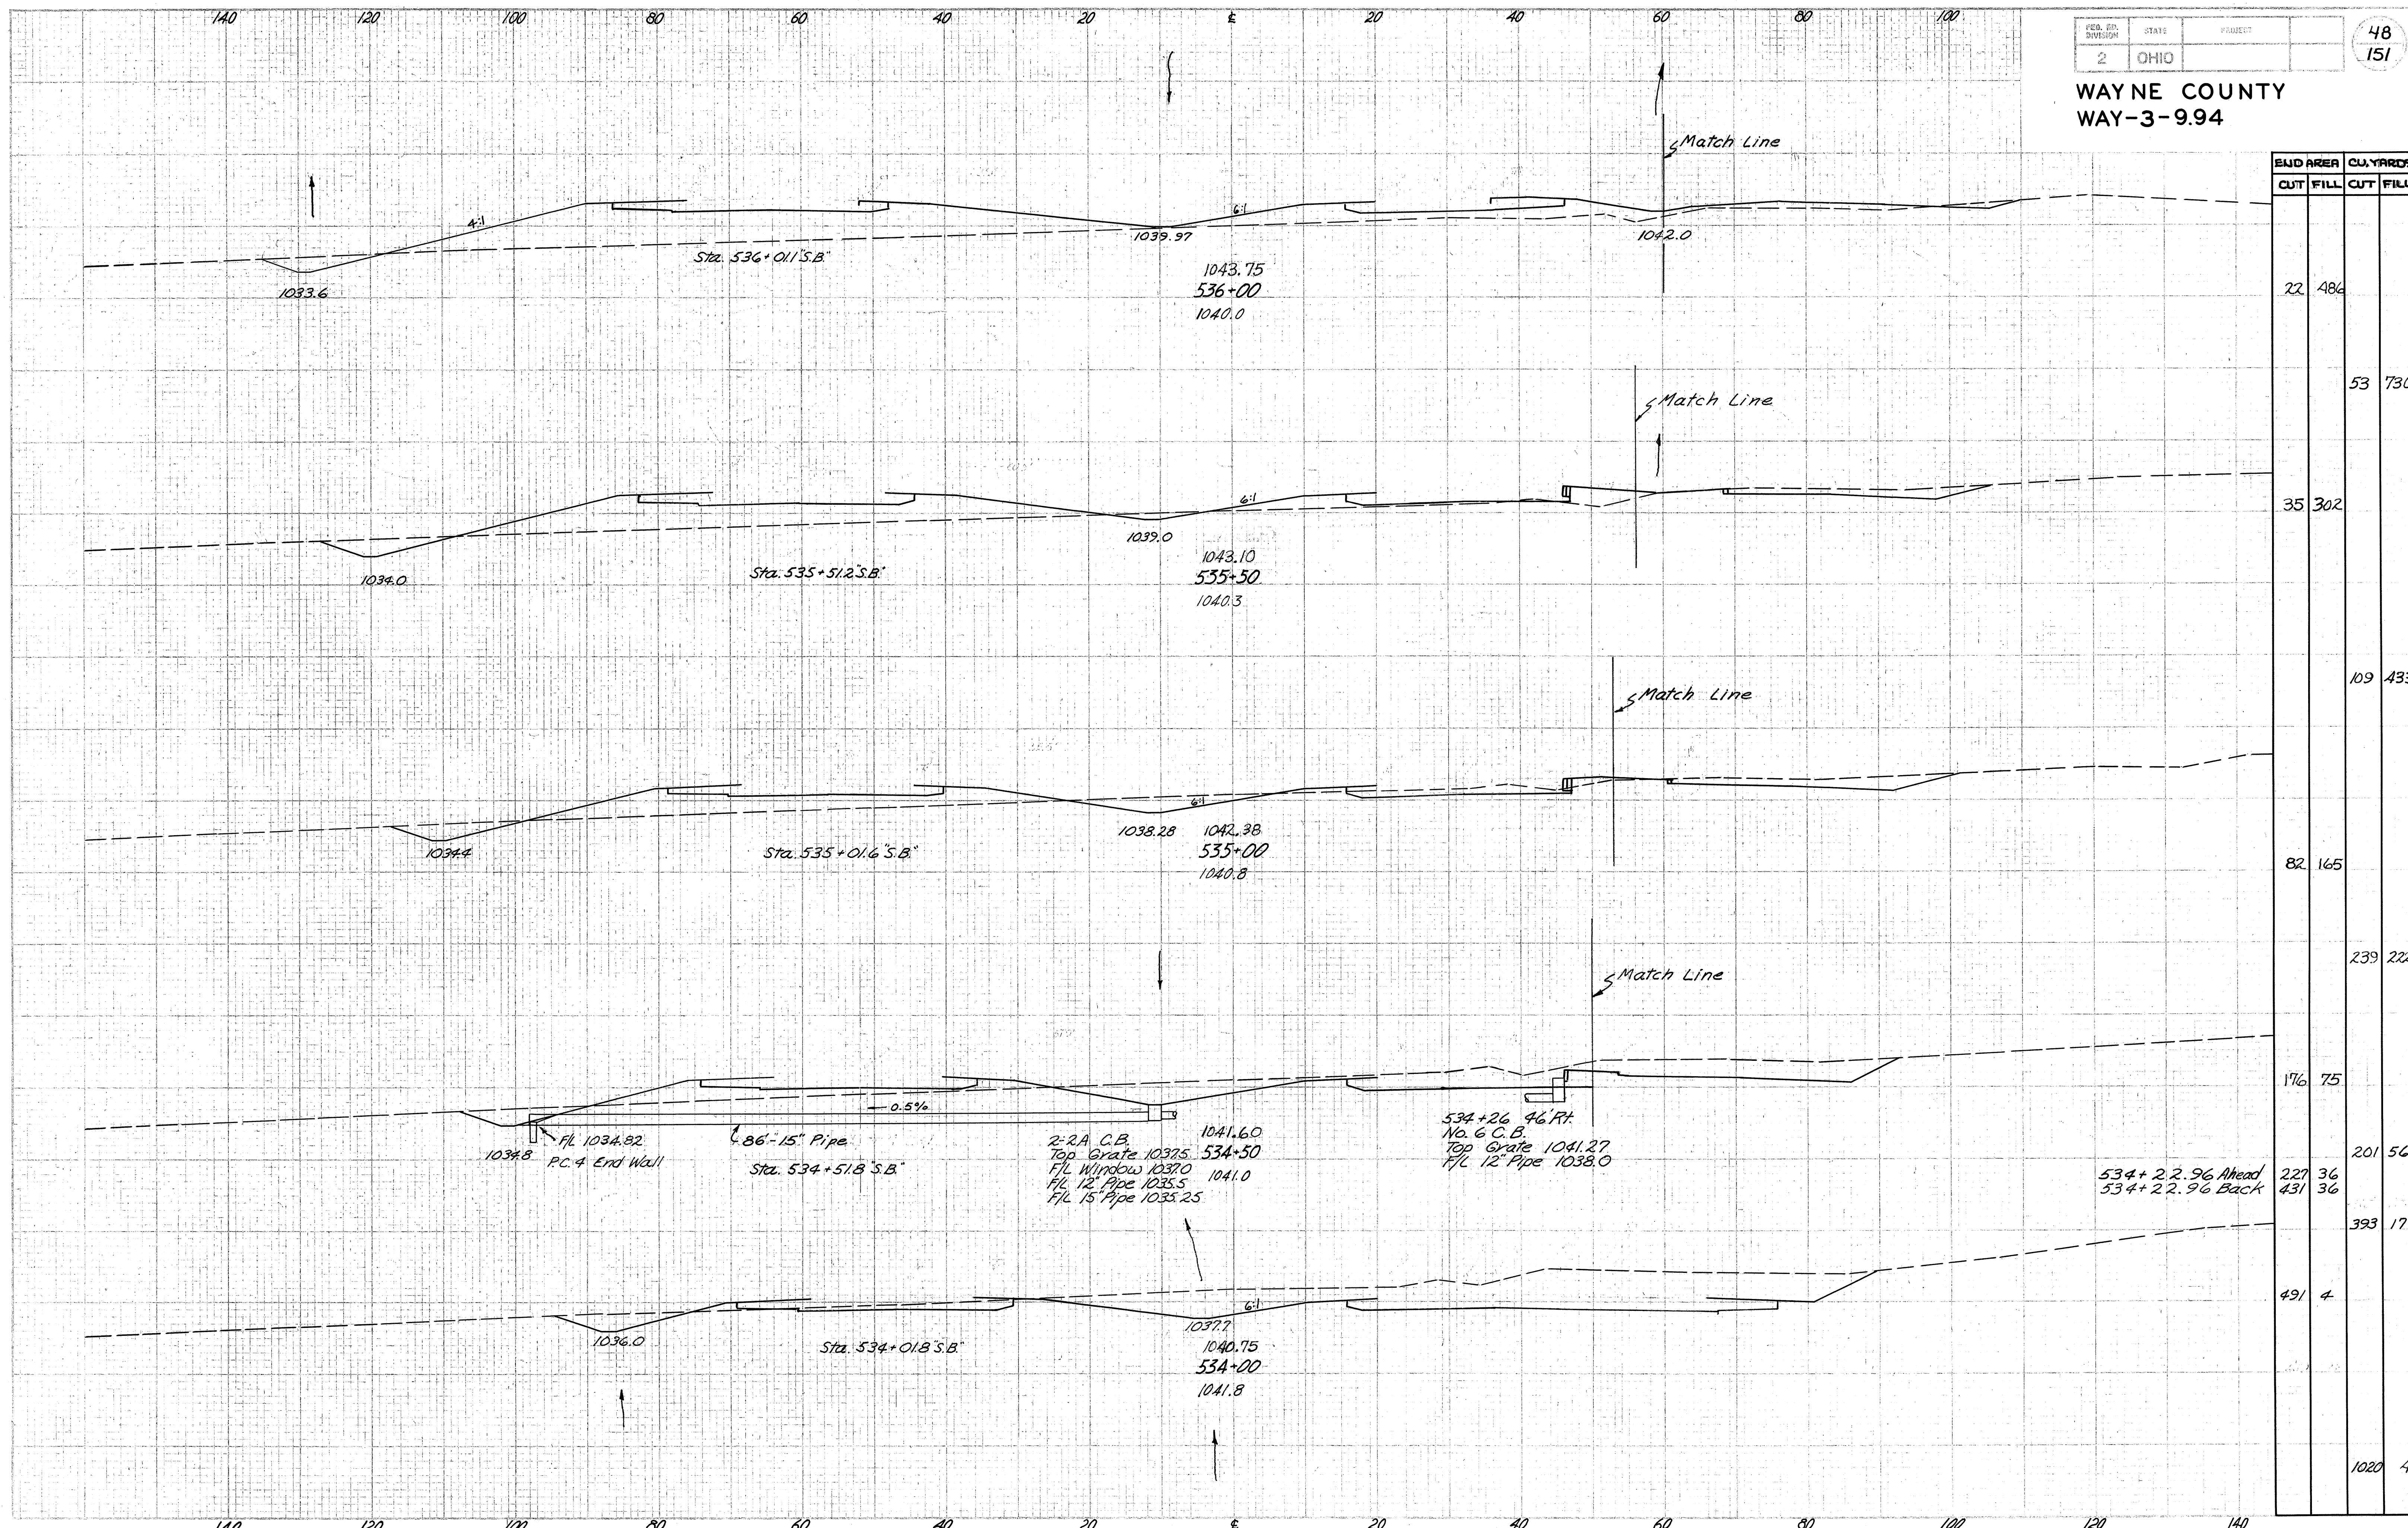

END AREA		CU. YARDS	
CUT	FILL	CUT	FILL
22	486		
		53	730
35	302		
		109	433
82	165		
		239	222
176	75		
		201	56
227	36		
431	36		
		393	17
491	4		
		1020	4

Sta. 534+00 to Sta. 536+00


WAYNE COUNTY
WAY-3-994

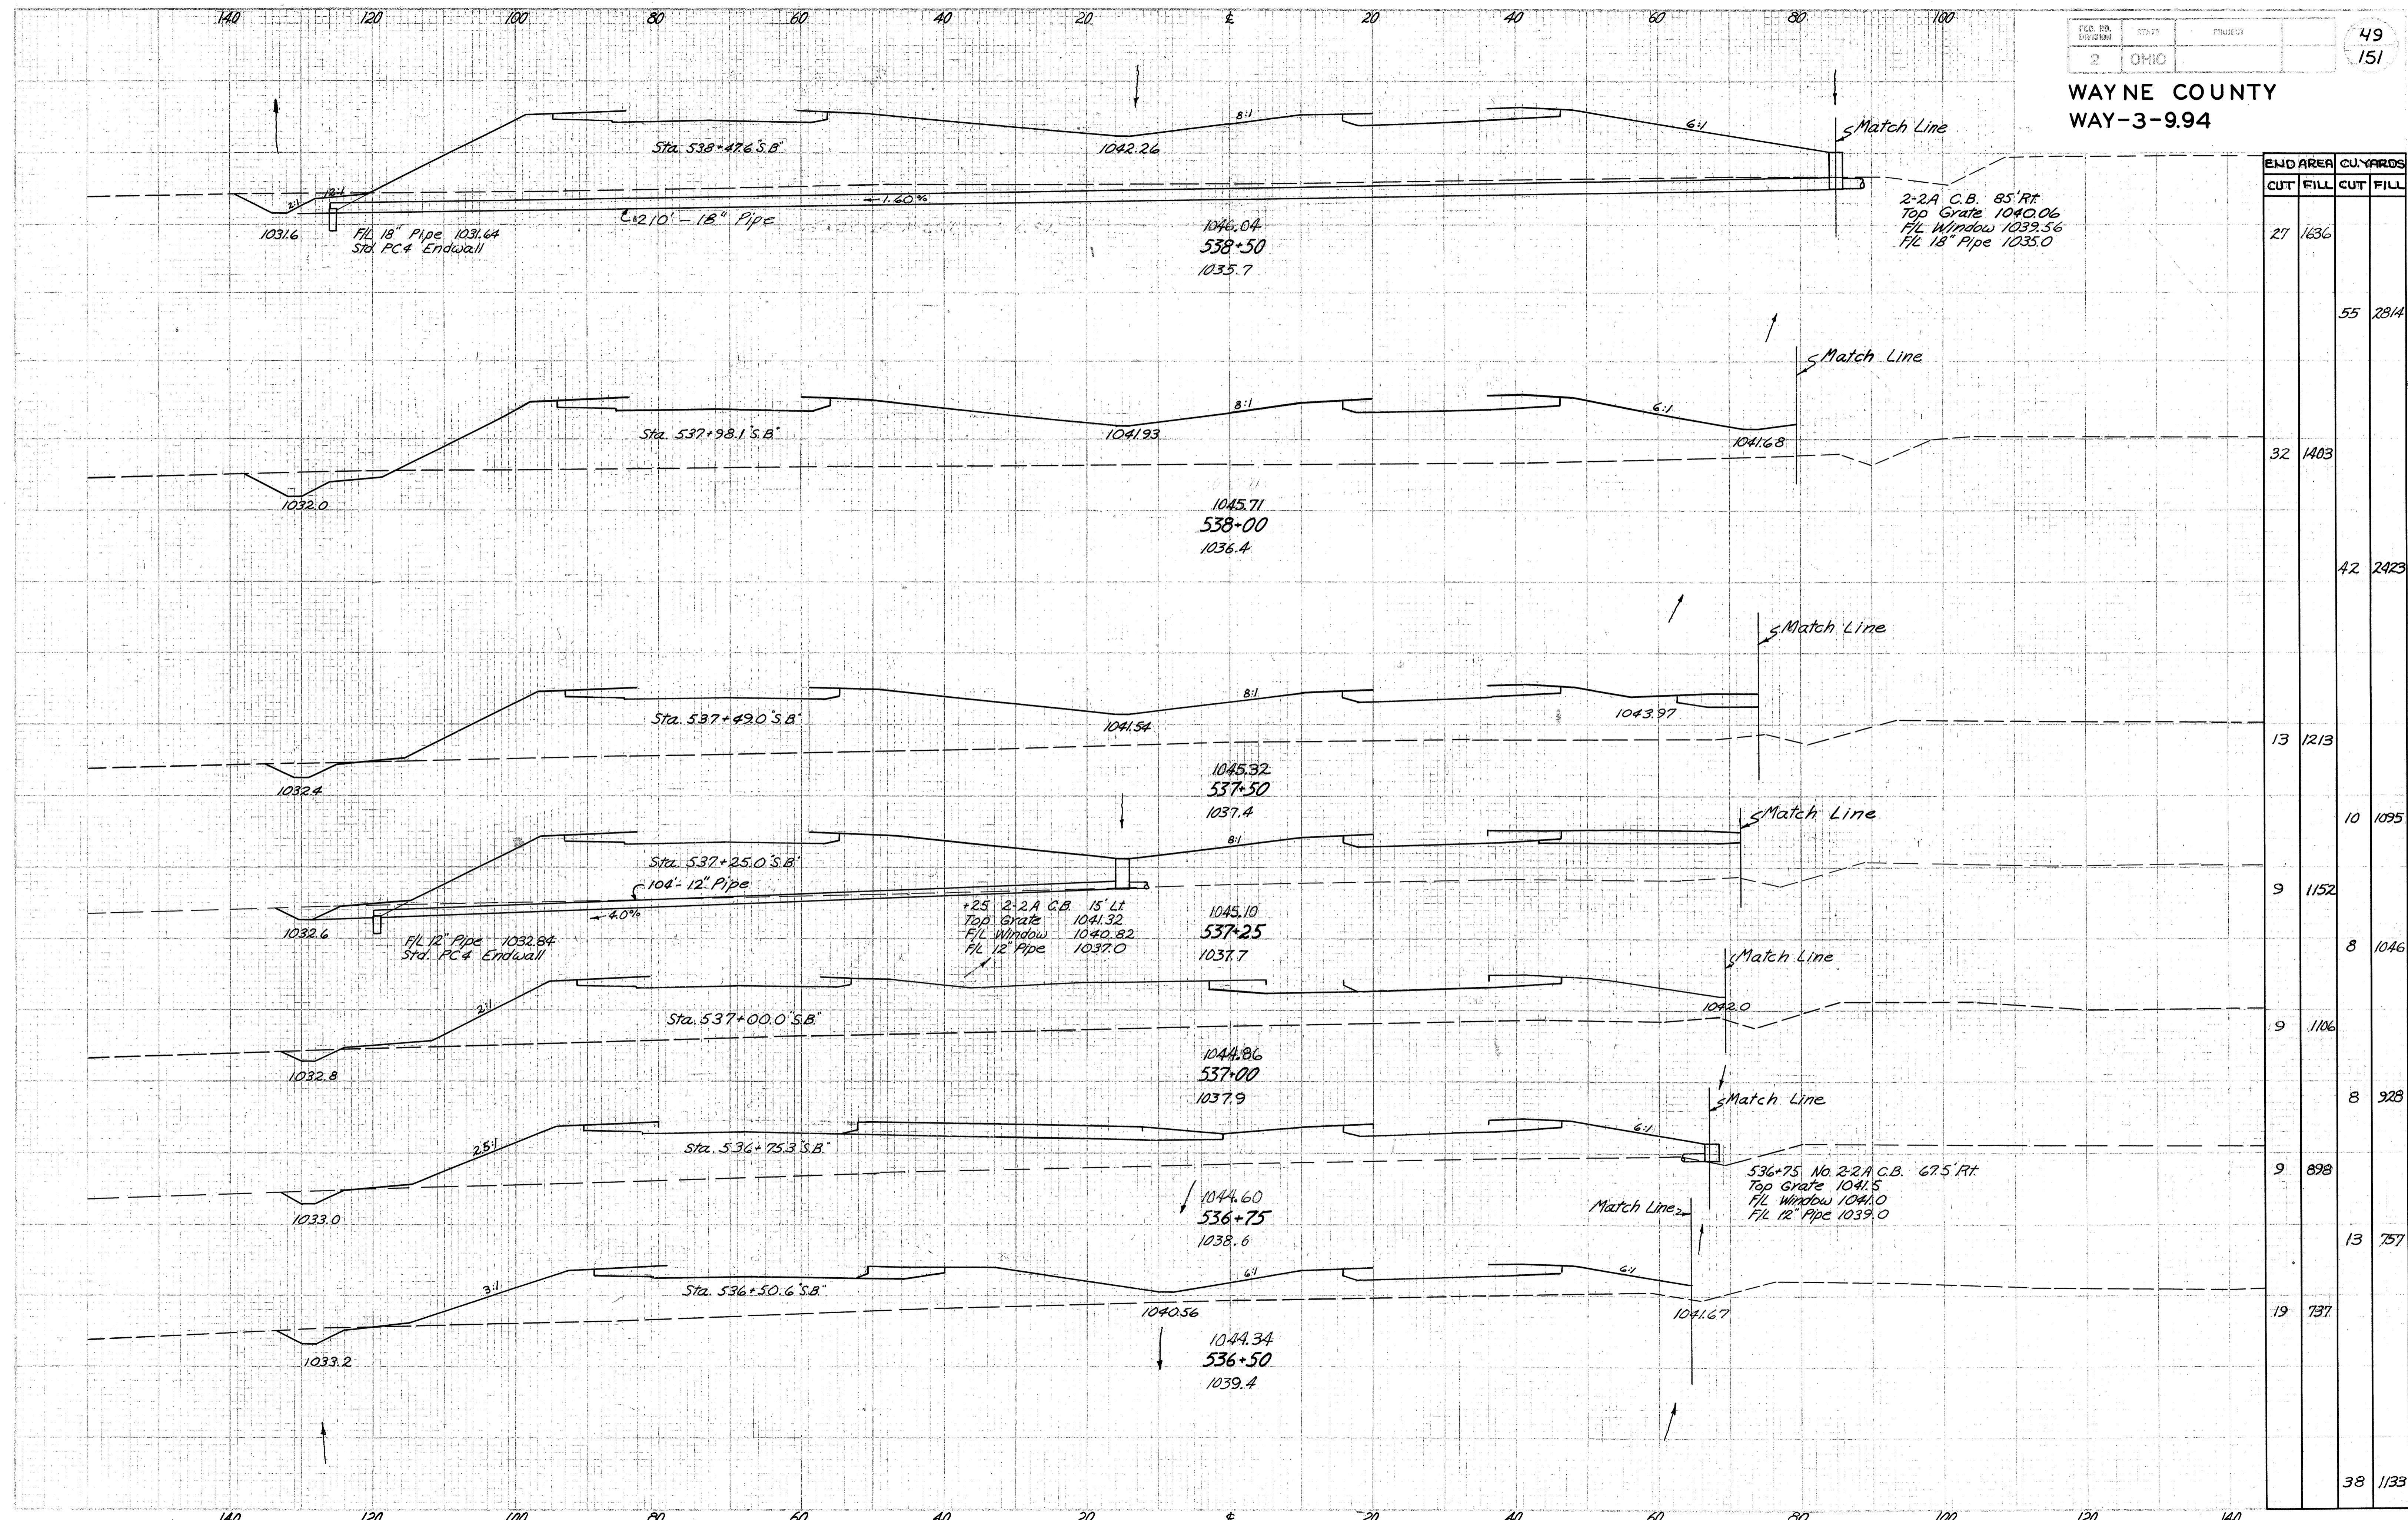

END AREA	CU. YARDS	
	CUT	FILL
27	1636	
		55 2814
32	1403	
		42 2423
13	1213	
		10 1095
9	1152	
		8 1046
9	1106	
		8 928
9	898	
		13 757
19	737	
		38 1133

Sta. 536+50 To Sta. 538+50


WAYNE COUNTY
WAY-3-994

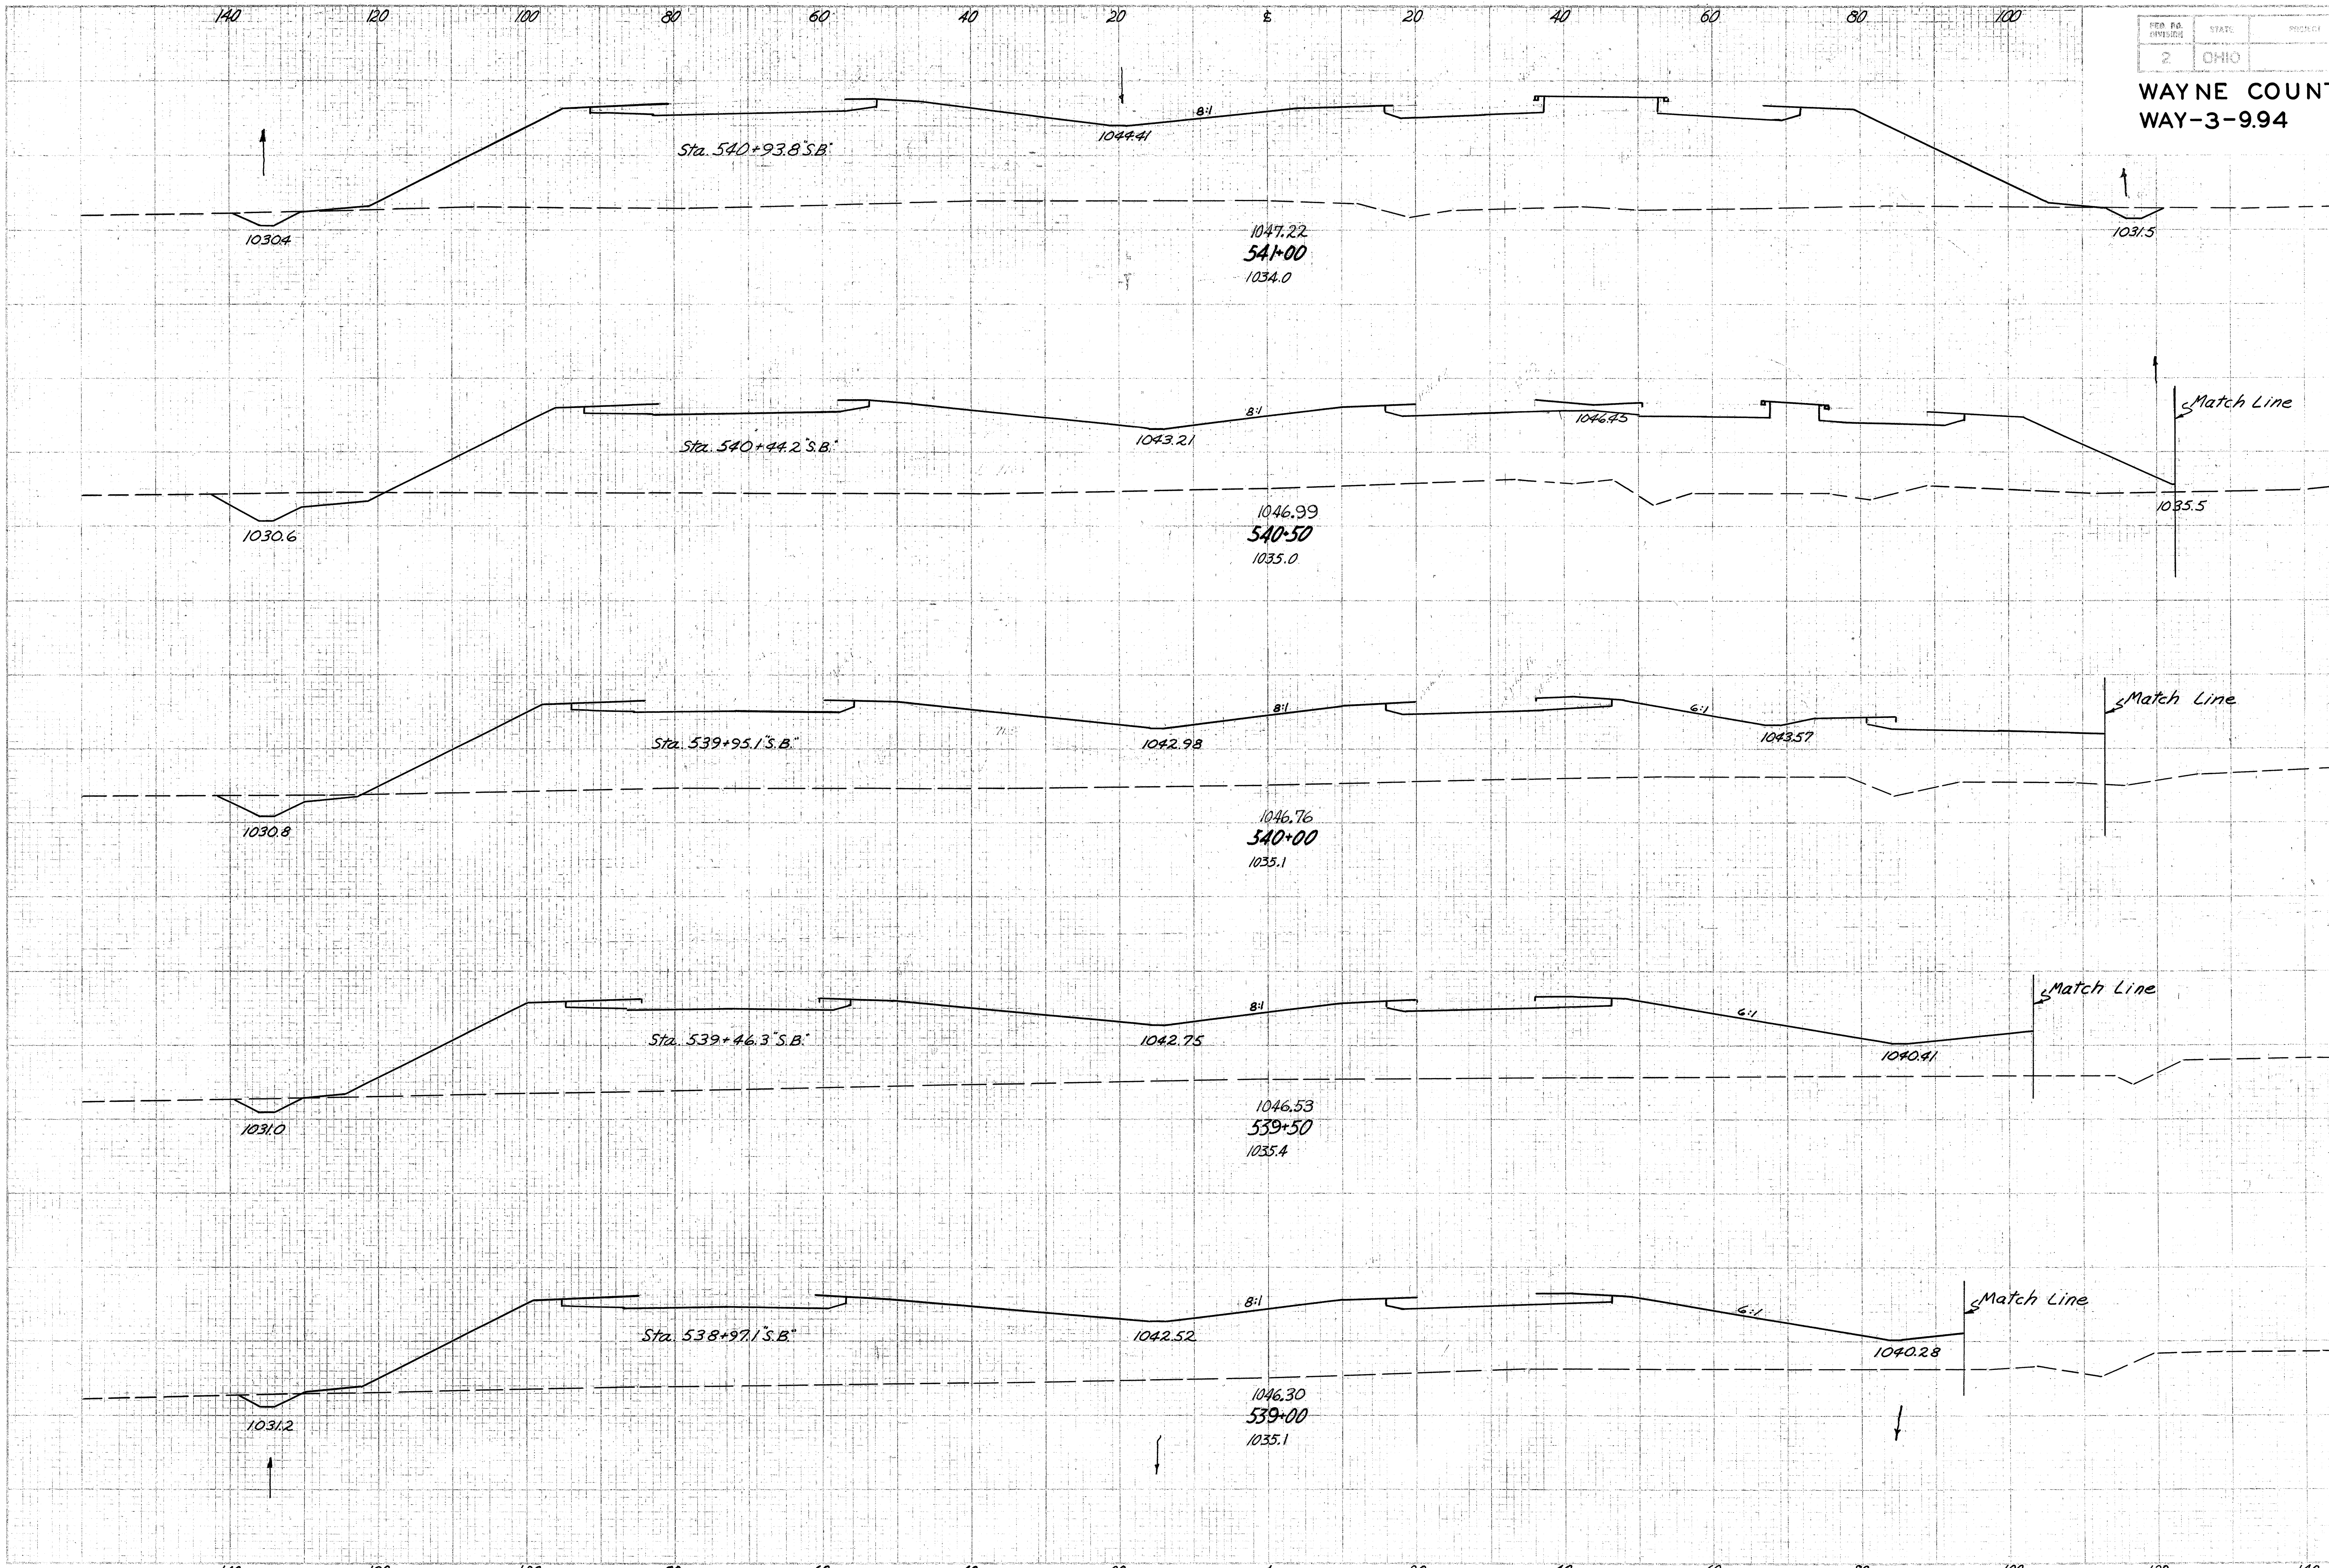

END AREA	CU. YARDS	
	CUT	FILL
17	2586	
57		4526
44	2302	
64		4094
25	2120	
34		3852
11	2040	
20		3666
10	1919	
35		3292

Sta. 539+00 To Sta. 541+00


WAYNE COUNTY
WAY-3-9.94

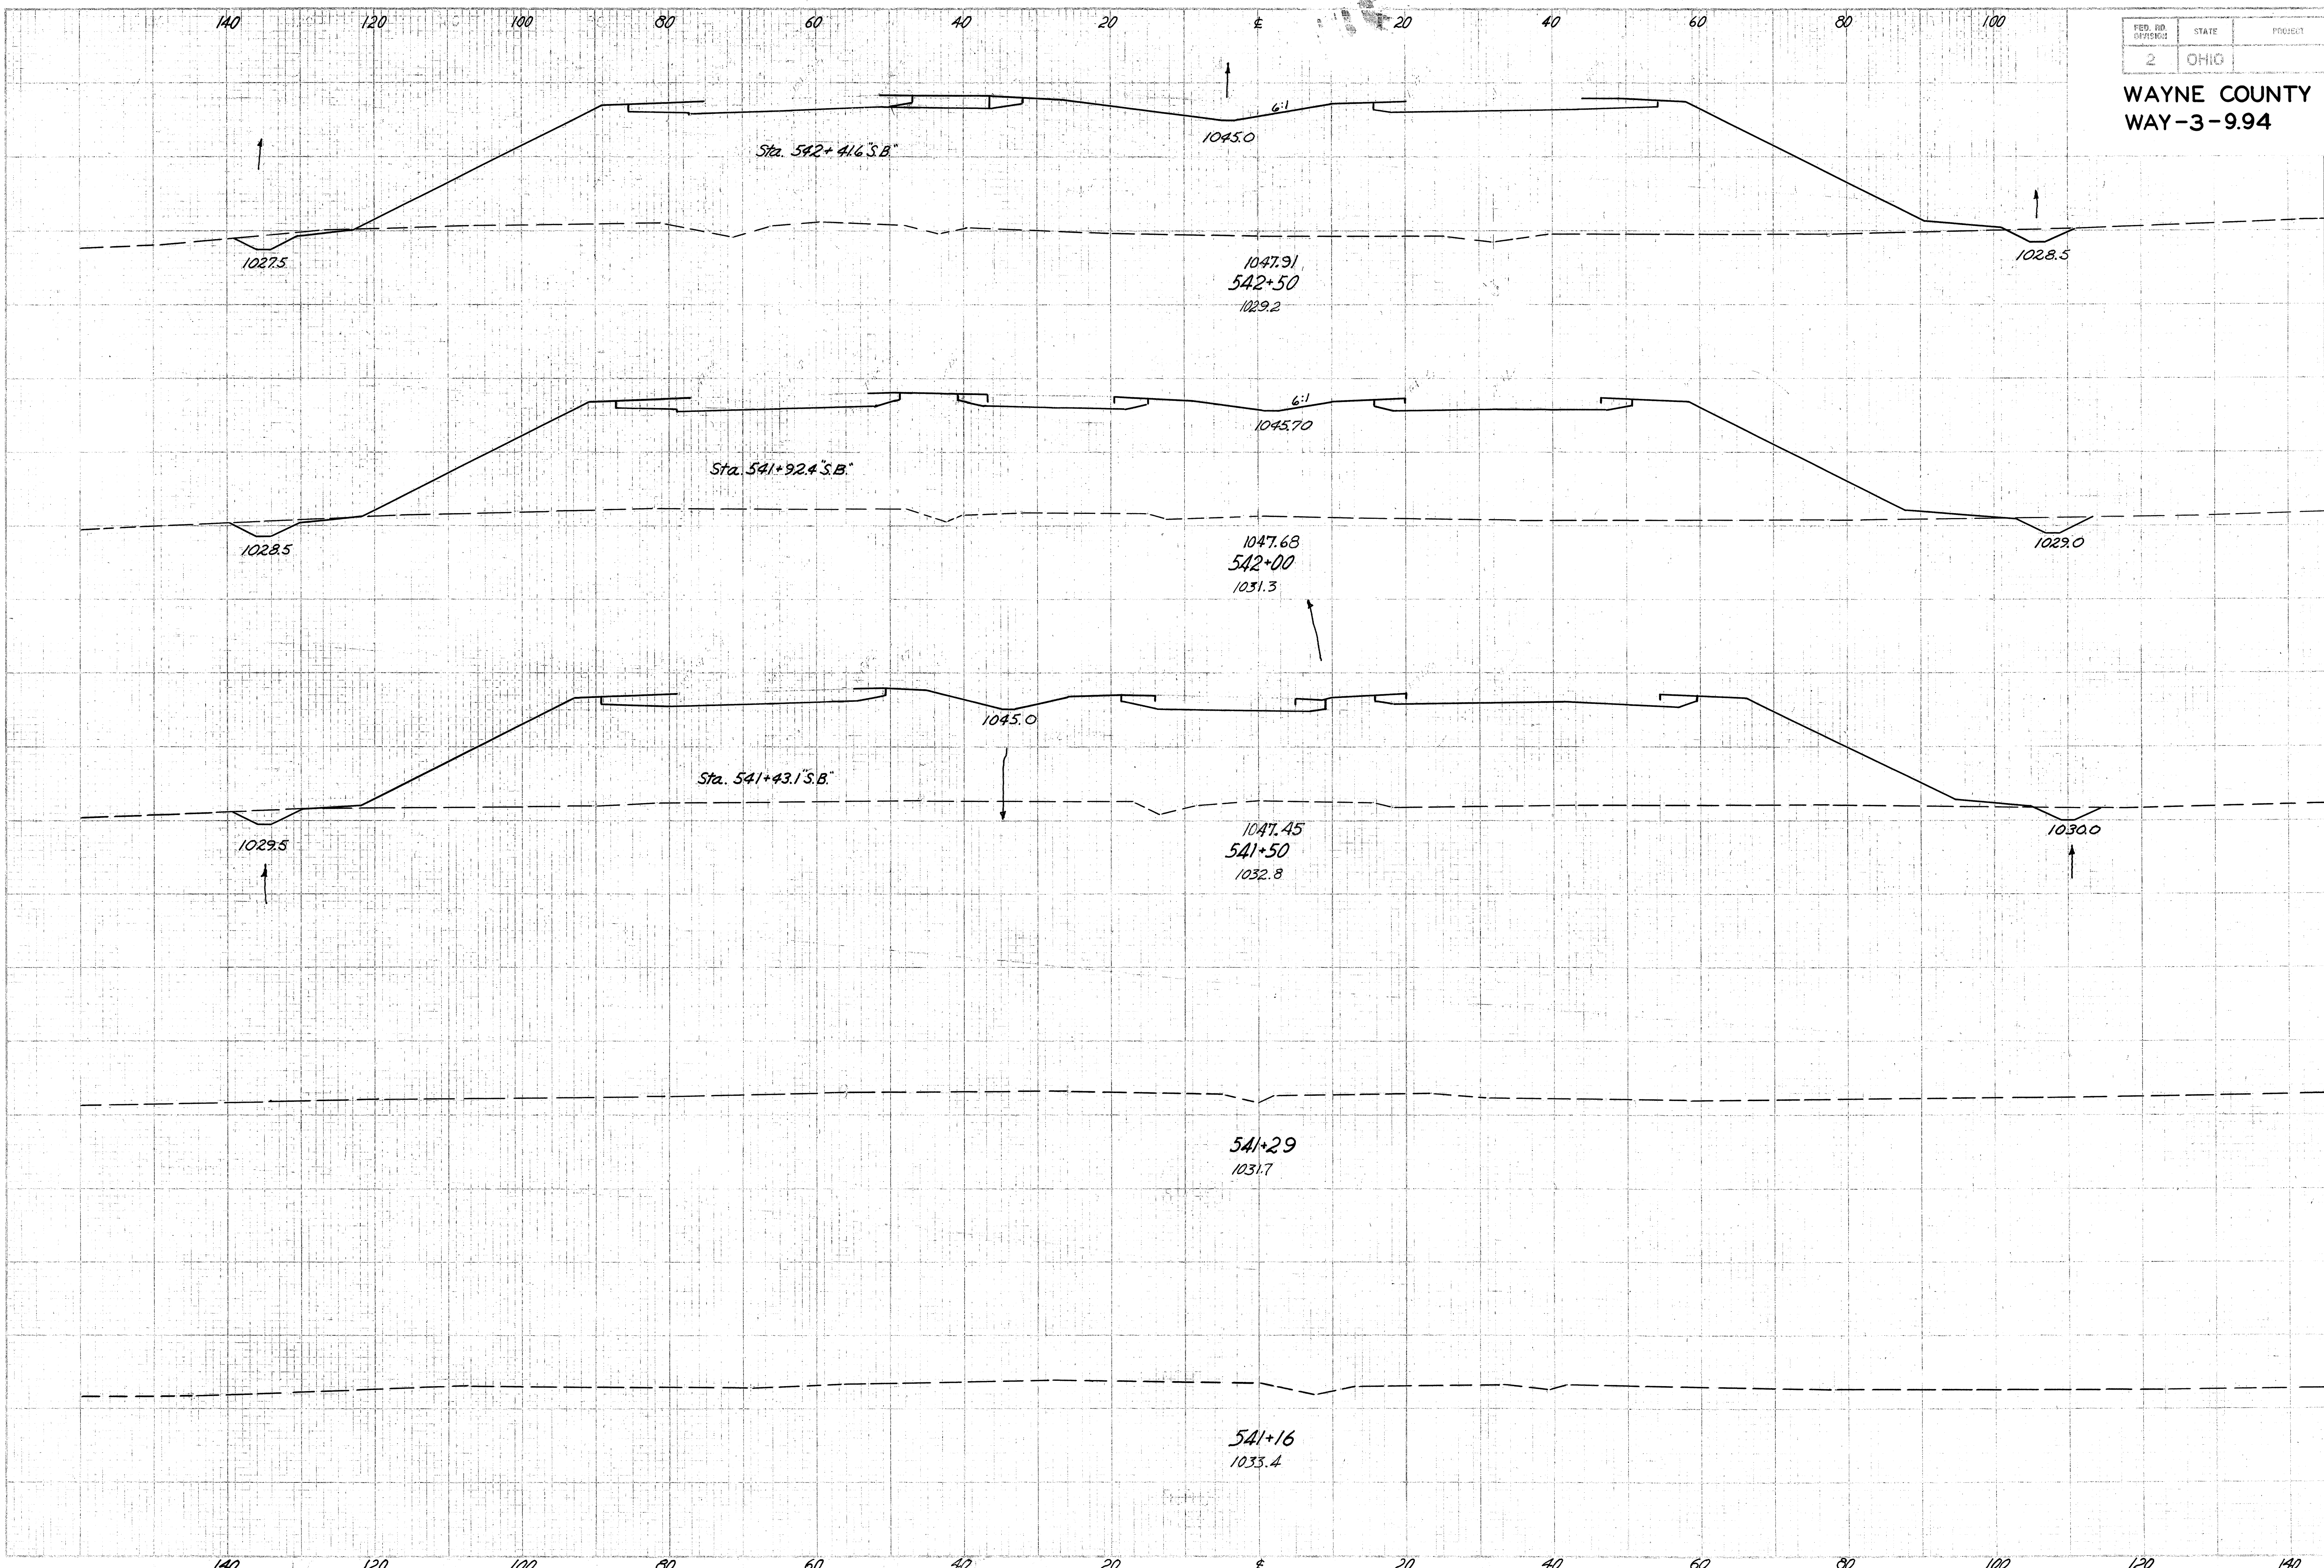

STATION	CUT AREA		FILL AREA	
	CUT	FILL	CUT	FILL
542+50	21	3046		
542+00	25	2699	43	5320
541+50	20	2647	42	4950
541+16			35	4845

Sta. 541+16 To Sta. 542+50


WAYNE COUNTY
WAY-3-9.94

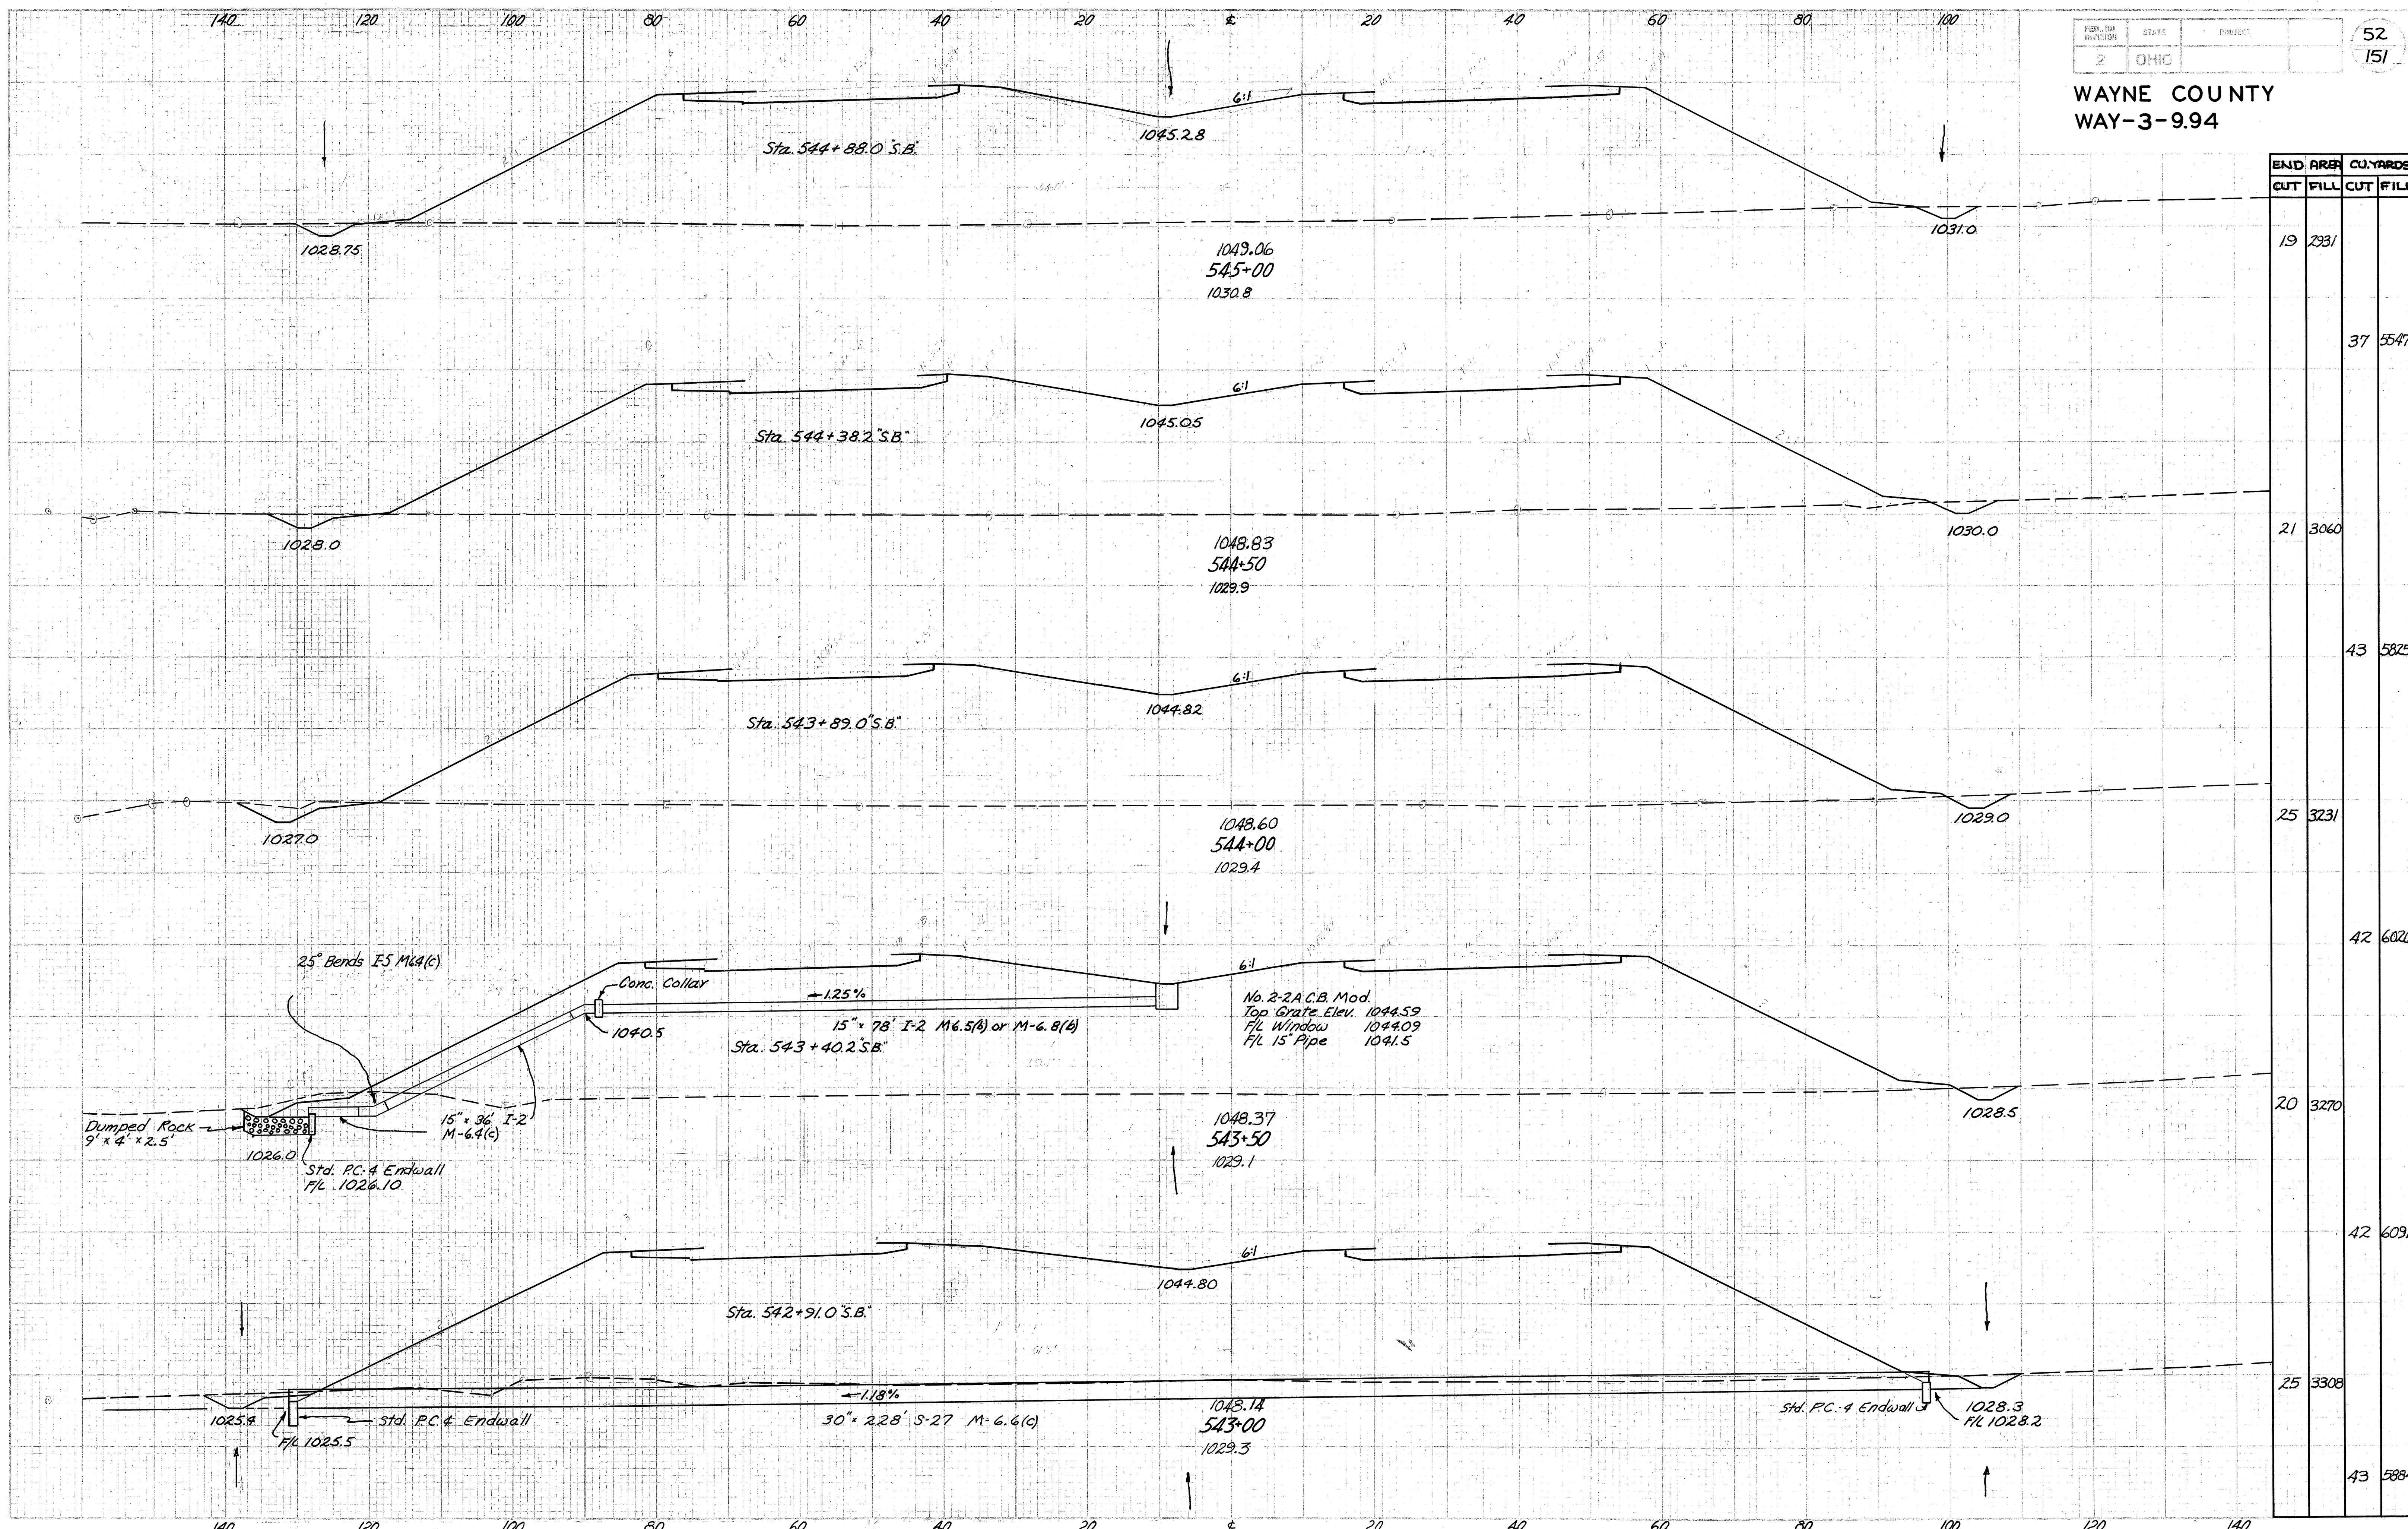

END STA.	AREA		CU. YARDS	
	CUT	FILL	CUT	FILL
19		2931		
			37	5547
21		3060		
			43	5825
25		3231		
			42	6020
20		3270		
			42	6091
25		3308		
			43	5884

Sta. 543+00 to Sta. 545+00


WAYNE COUNTY
WAY-3-9.94

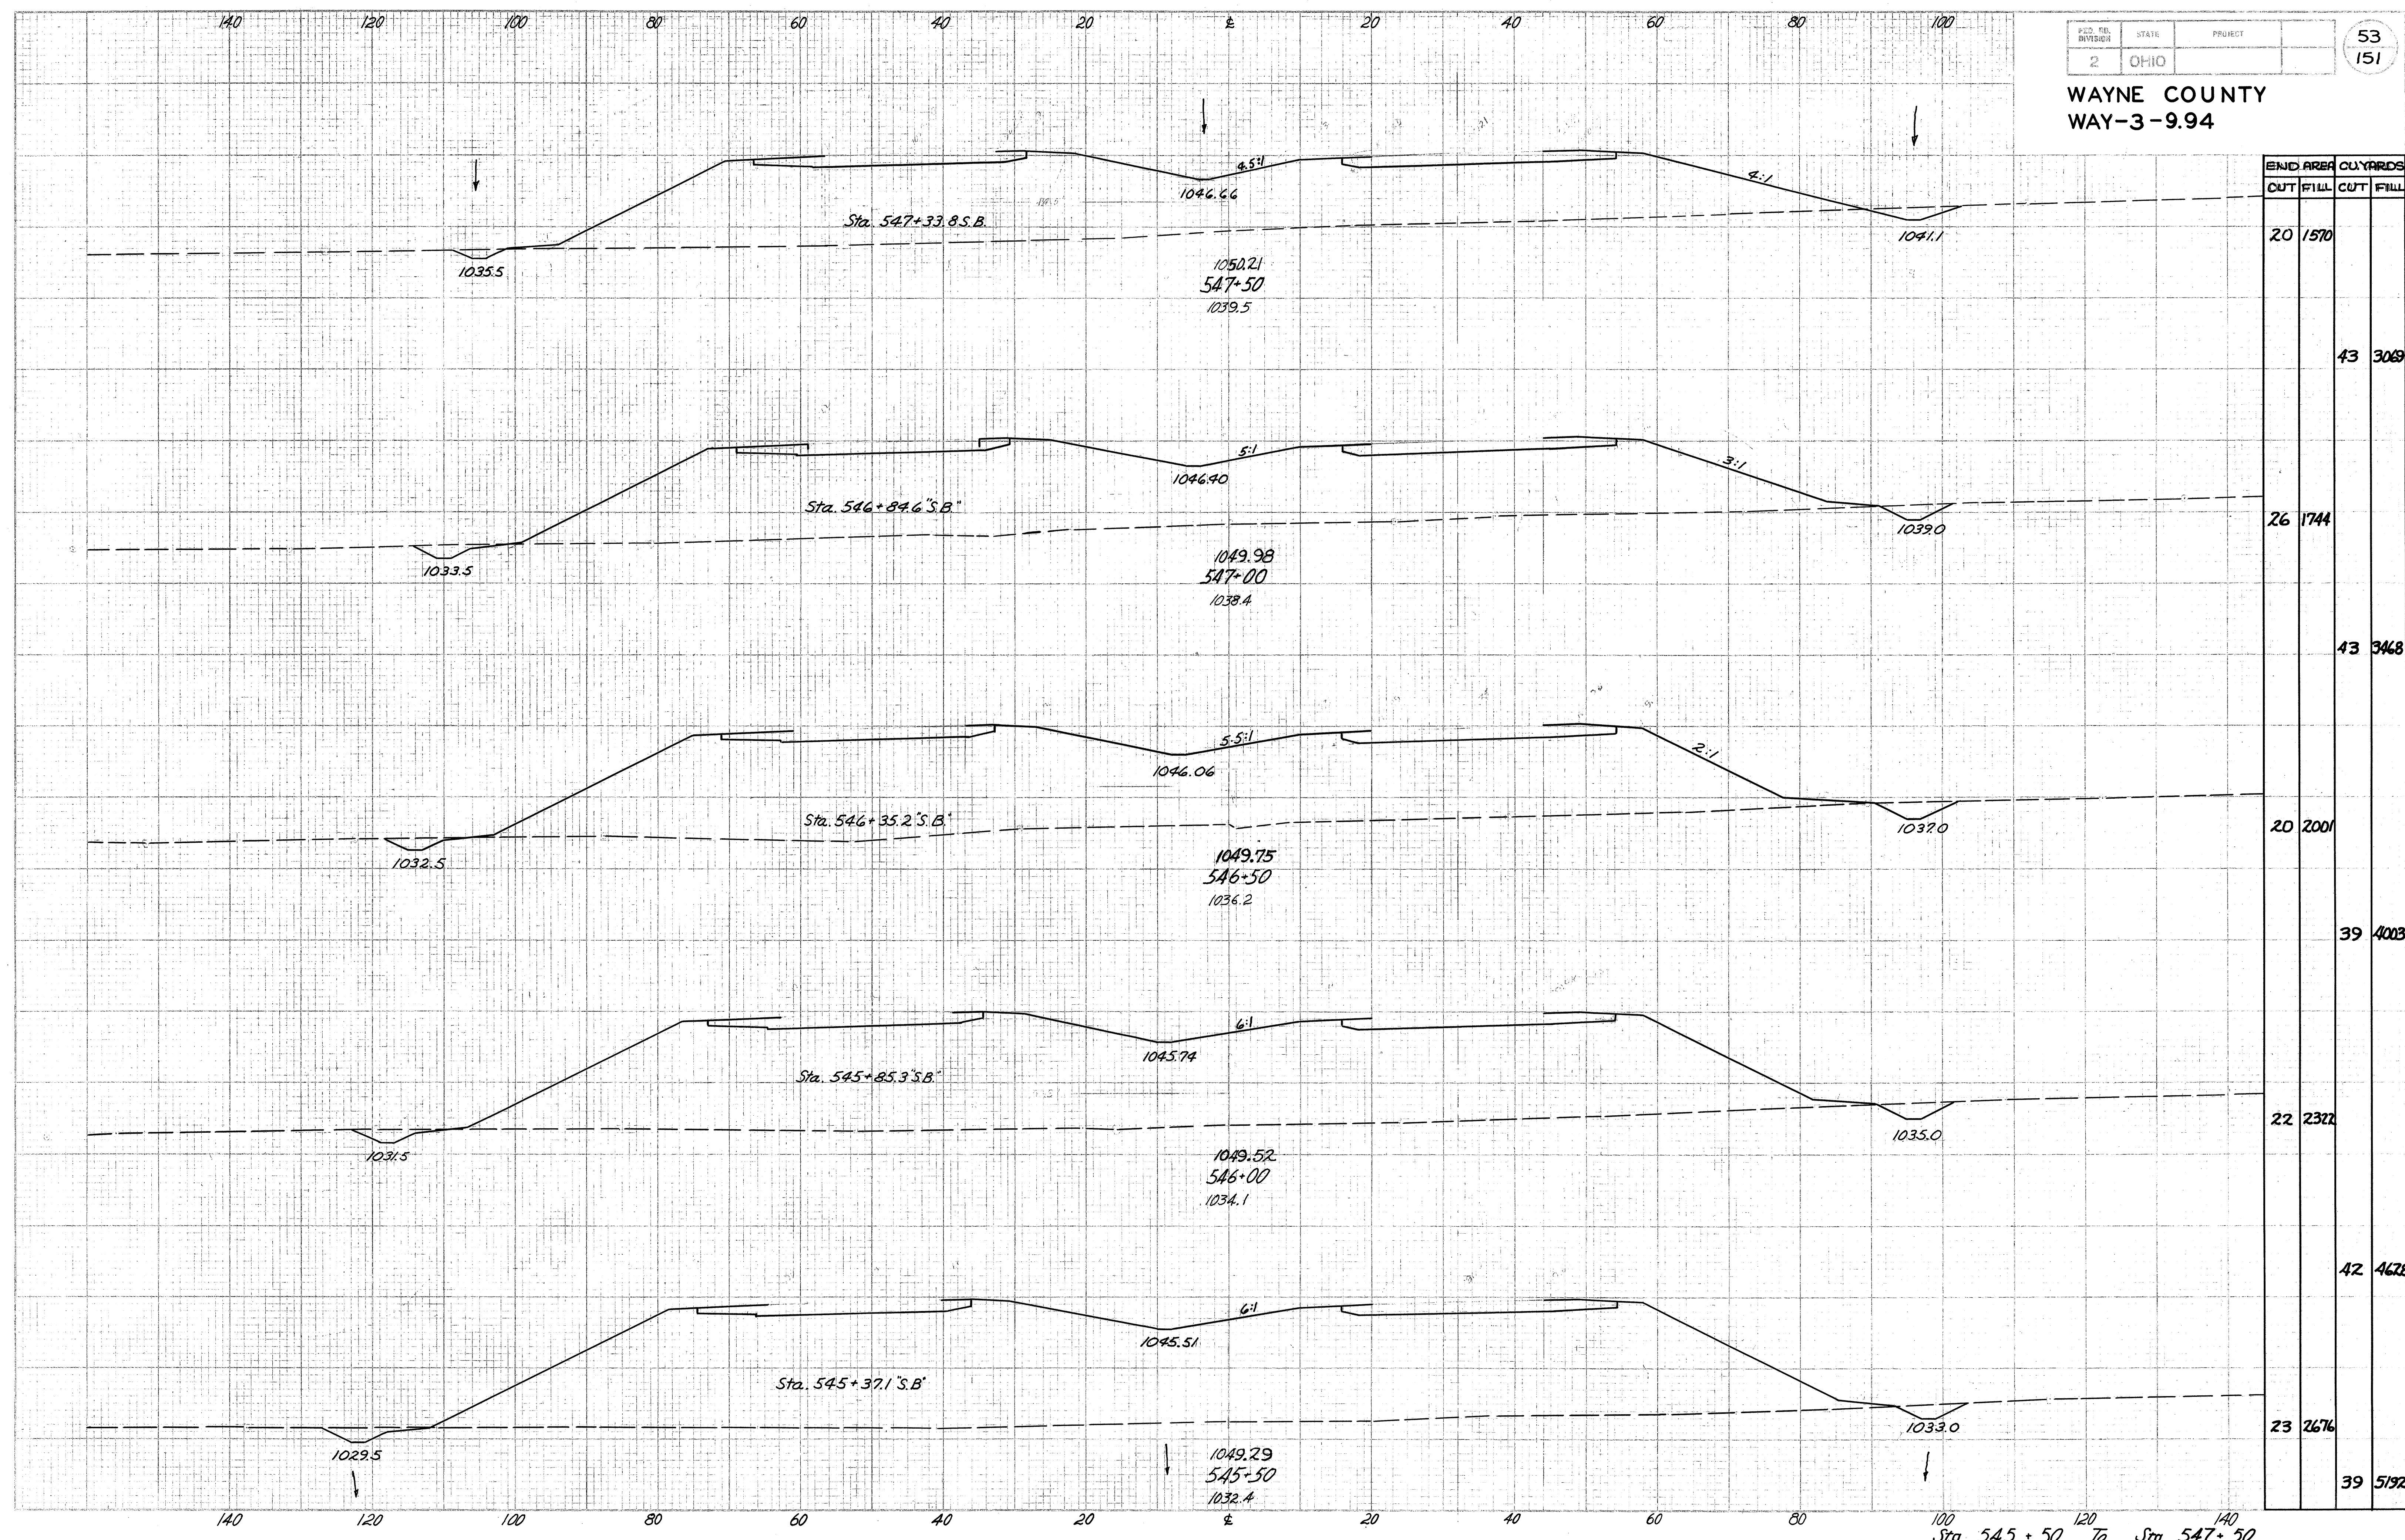

END AREA	CU YARDS	
	CUT	FILL
20	1570	
		43 3069
26	1744	
		43 3468
20	2001	
		39 4003
22	2372	
		42 4628
23	2676	
		39 5192


Sta. 545+50 to Sta. 547+50

WAYNE COUNTY
WAY-3-9.94

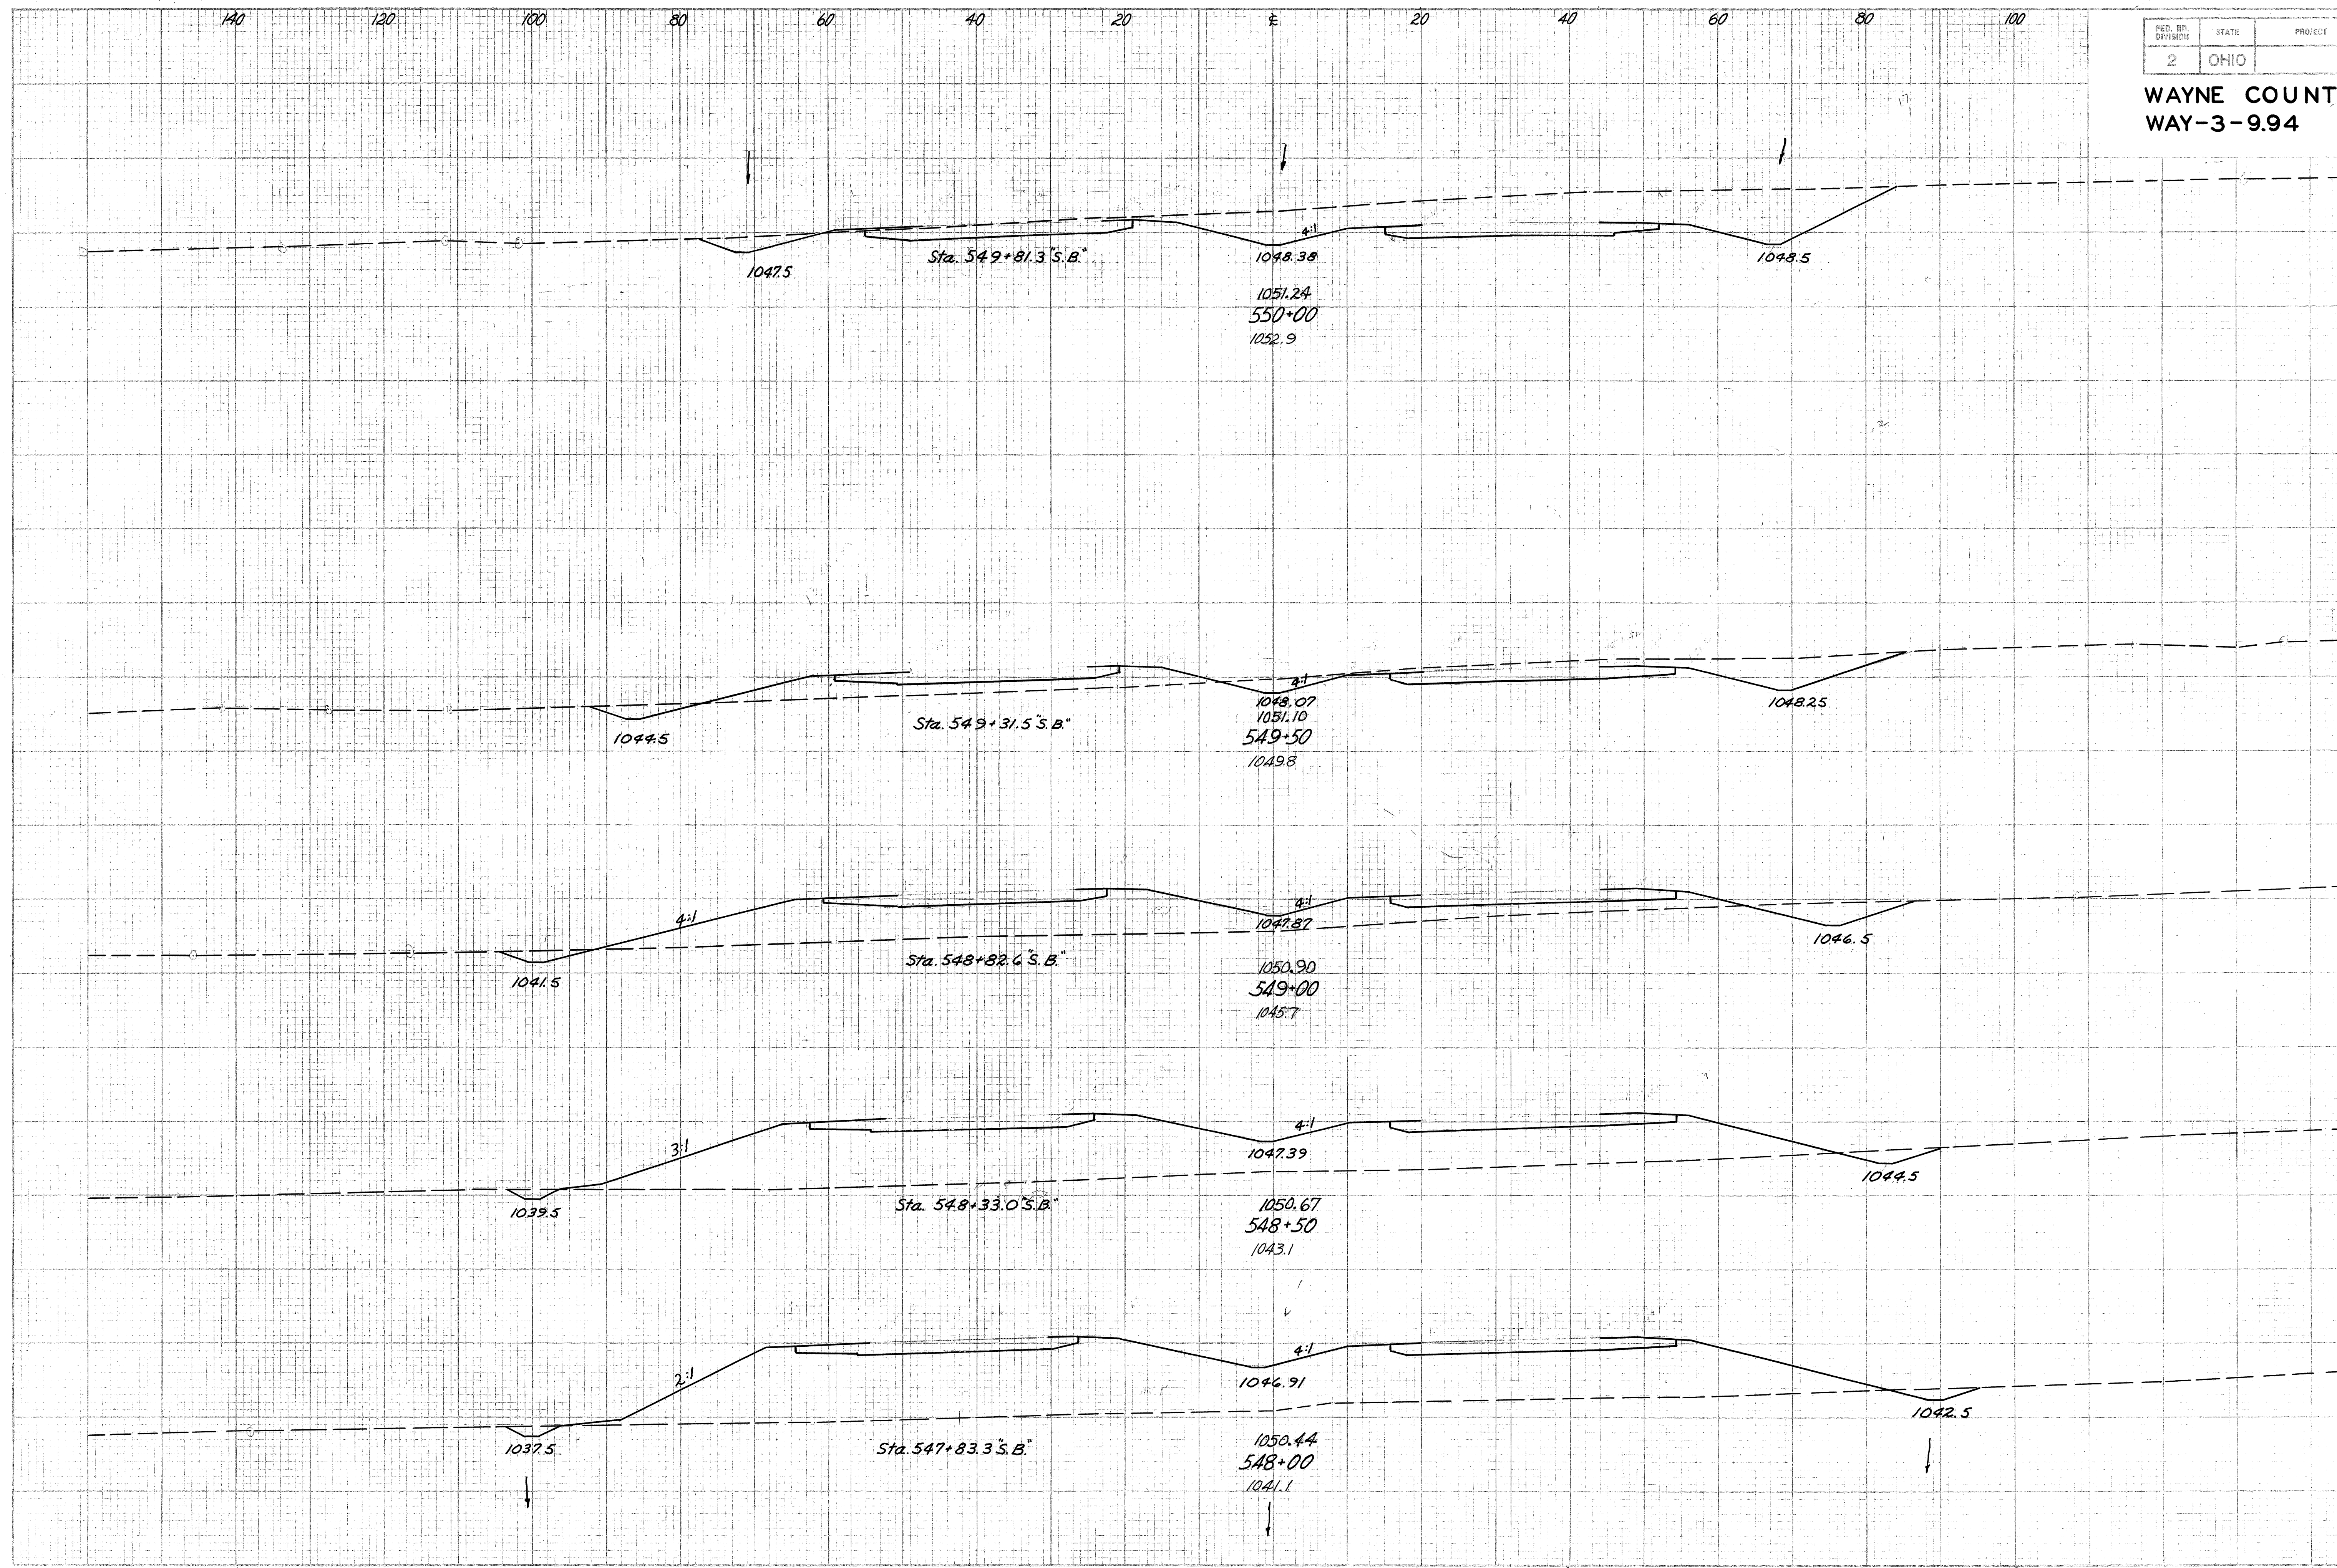

END AREA		CU YARDS	
CUT	FILL	CUT	FILL
533	1		
		685	121
207	129		
		237	561
49	498		
		64	1387
20	1000		
		34	2055
16	1219		
		34	2583


WAYNE COUNTY
WAY-3-9.94

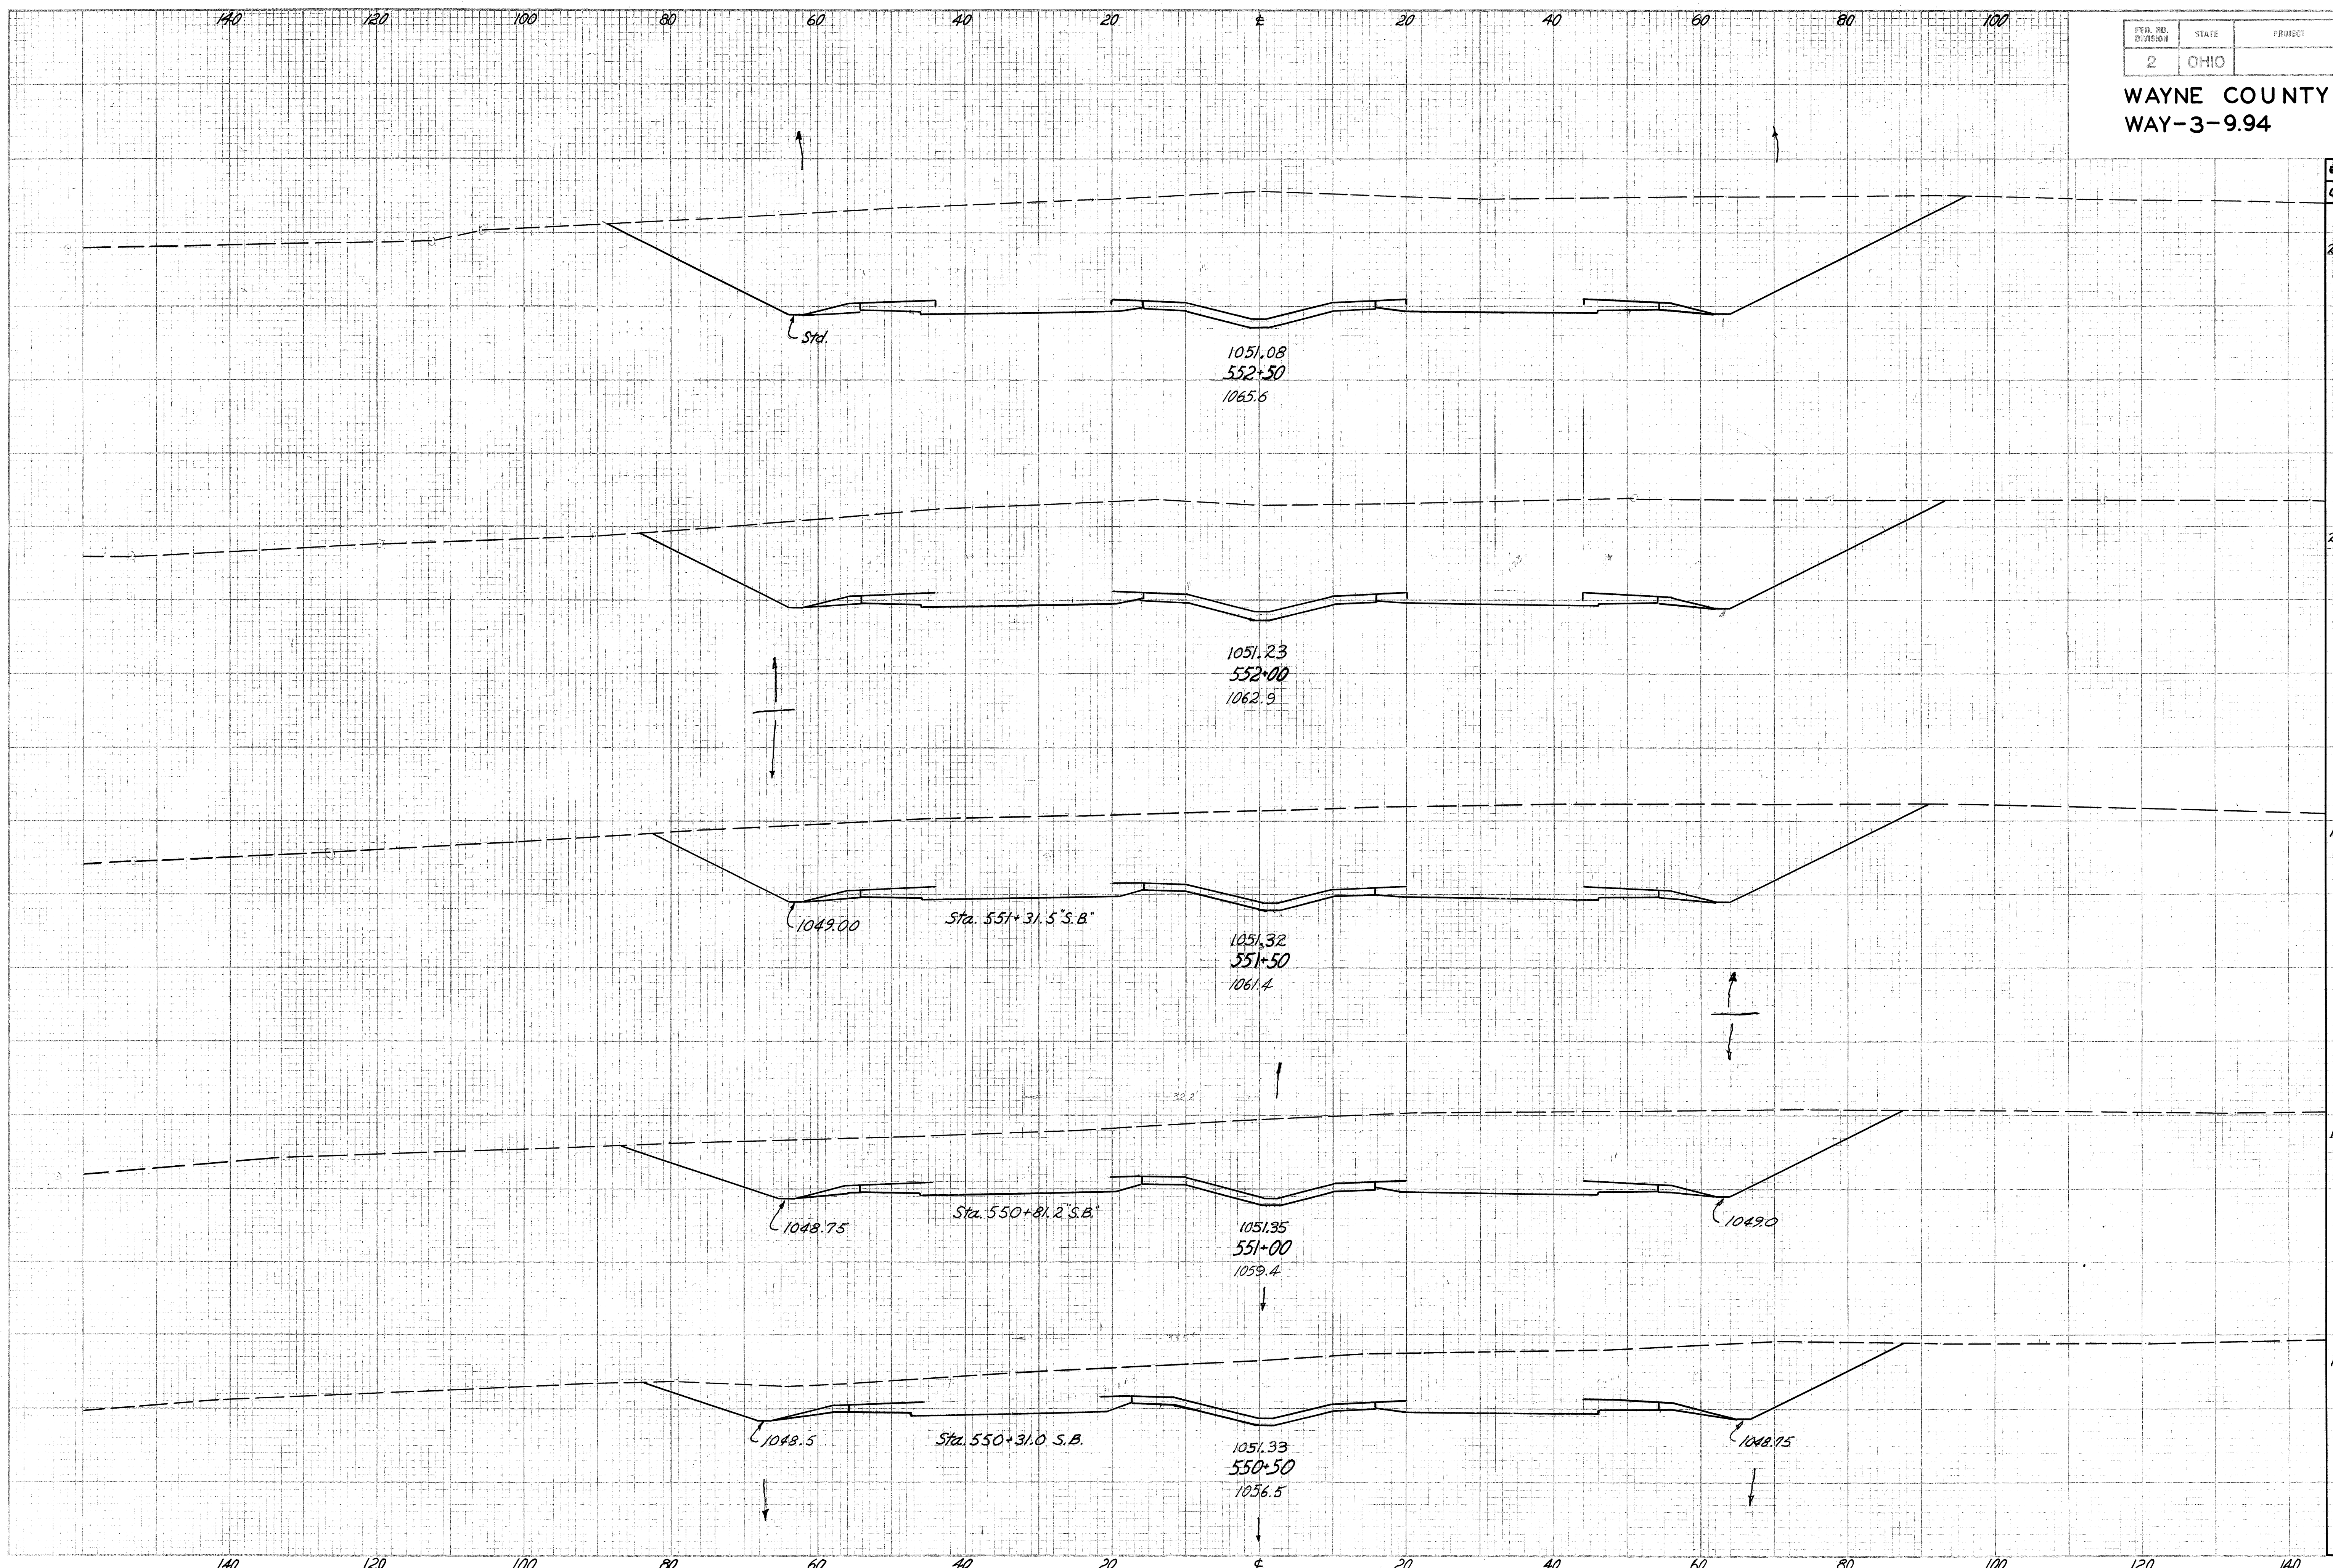

END AREA		CU. YARDS	
CUT	FILL	CUT	FILL
2428	0		
		4180	0
2086	0		
		3617	0
1820	0		
		3059	0
1483	0		
		2343	0
1047	0		
		1463	0


100 120 140
Sta. 550+50 To Sta. 552+50

WAYNE COUNTY
WAY-3-9.94

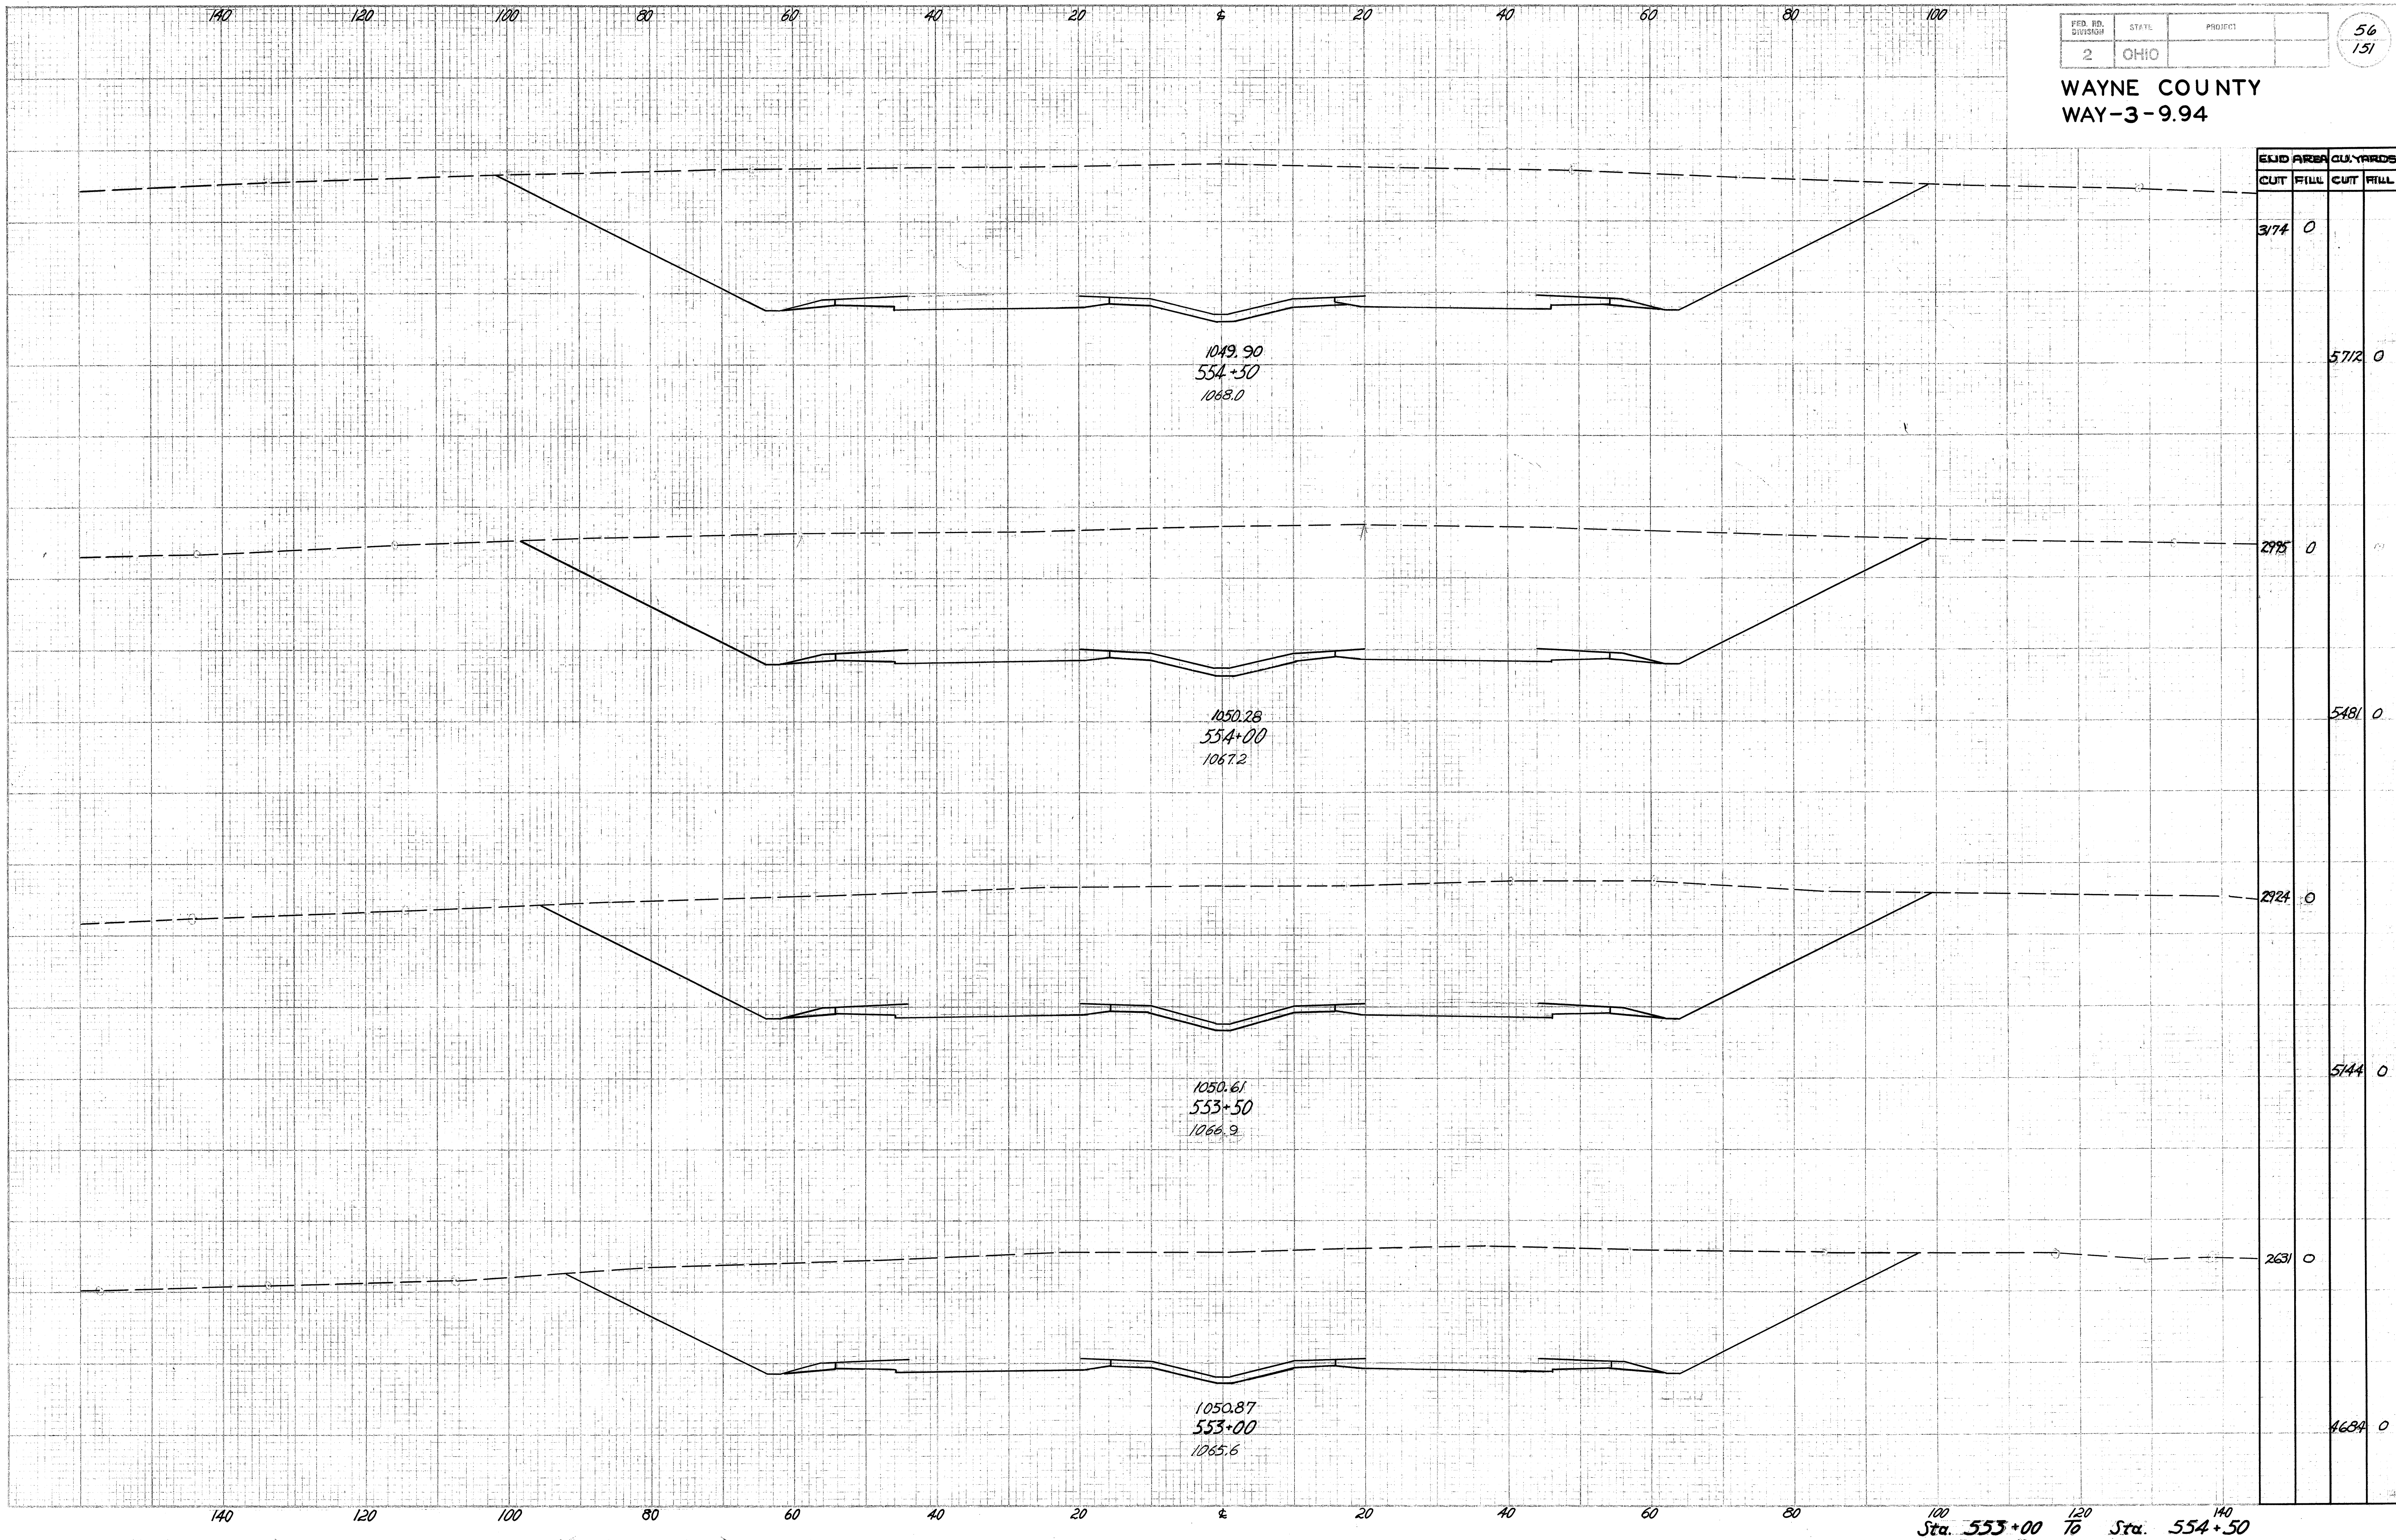

Sta. 553+00 1/16 Sta. 554+50


WAYNE COUNTY
WAY-3-9.94

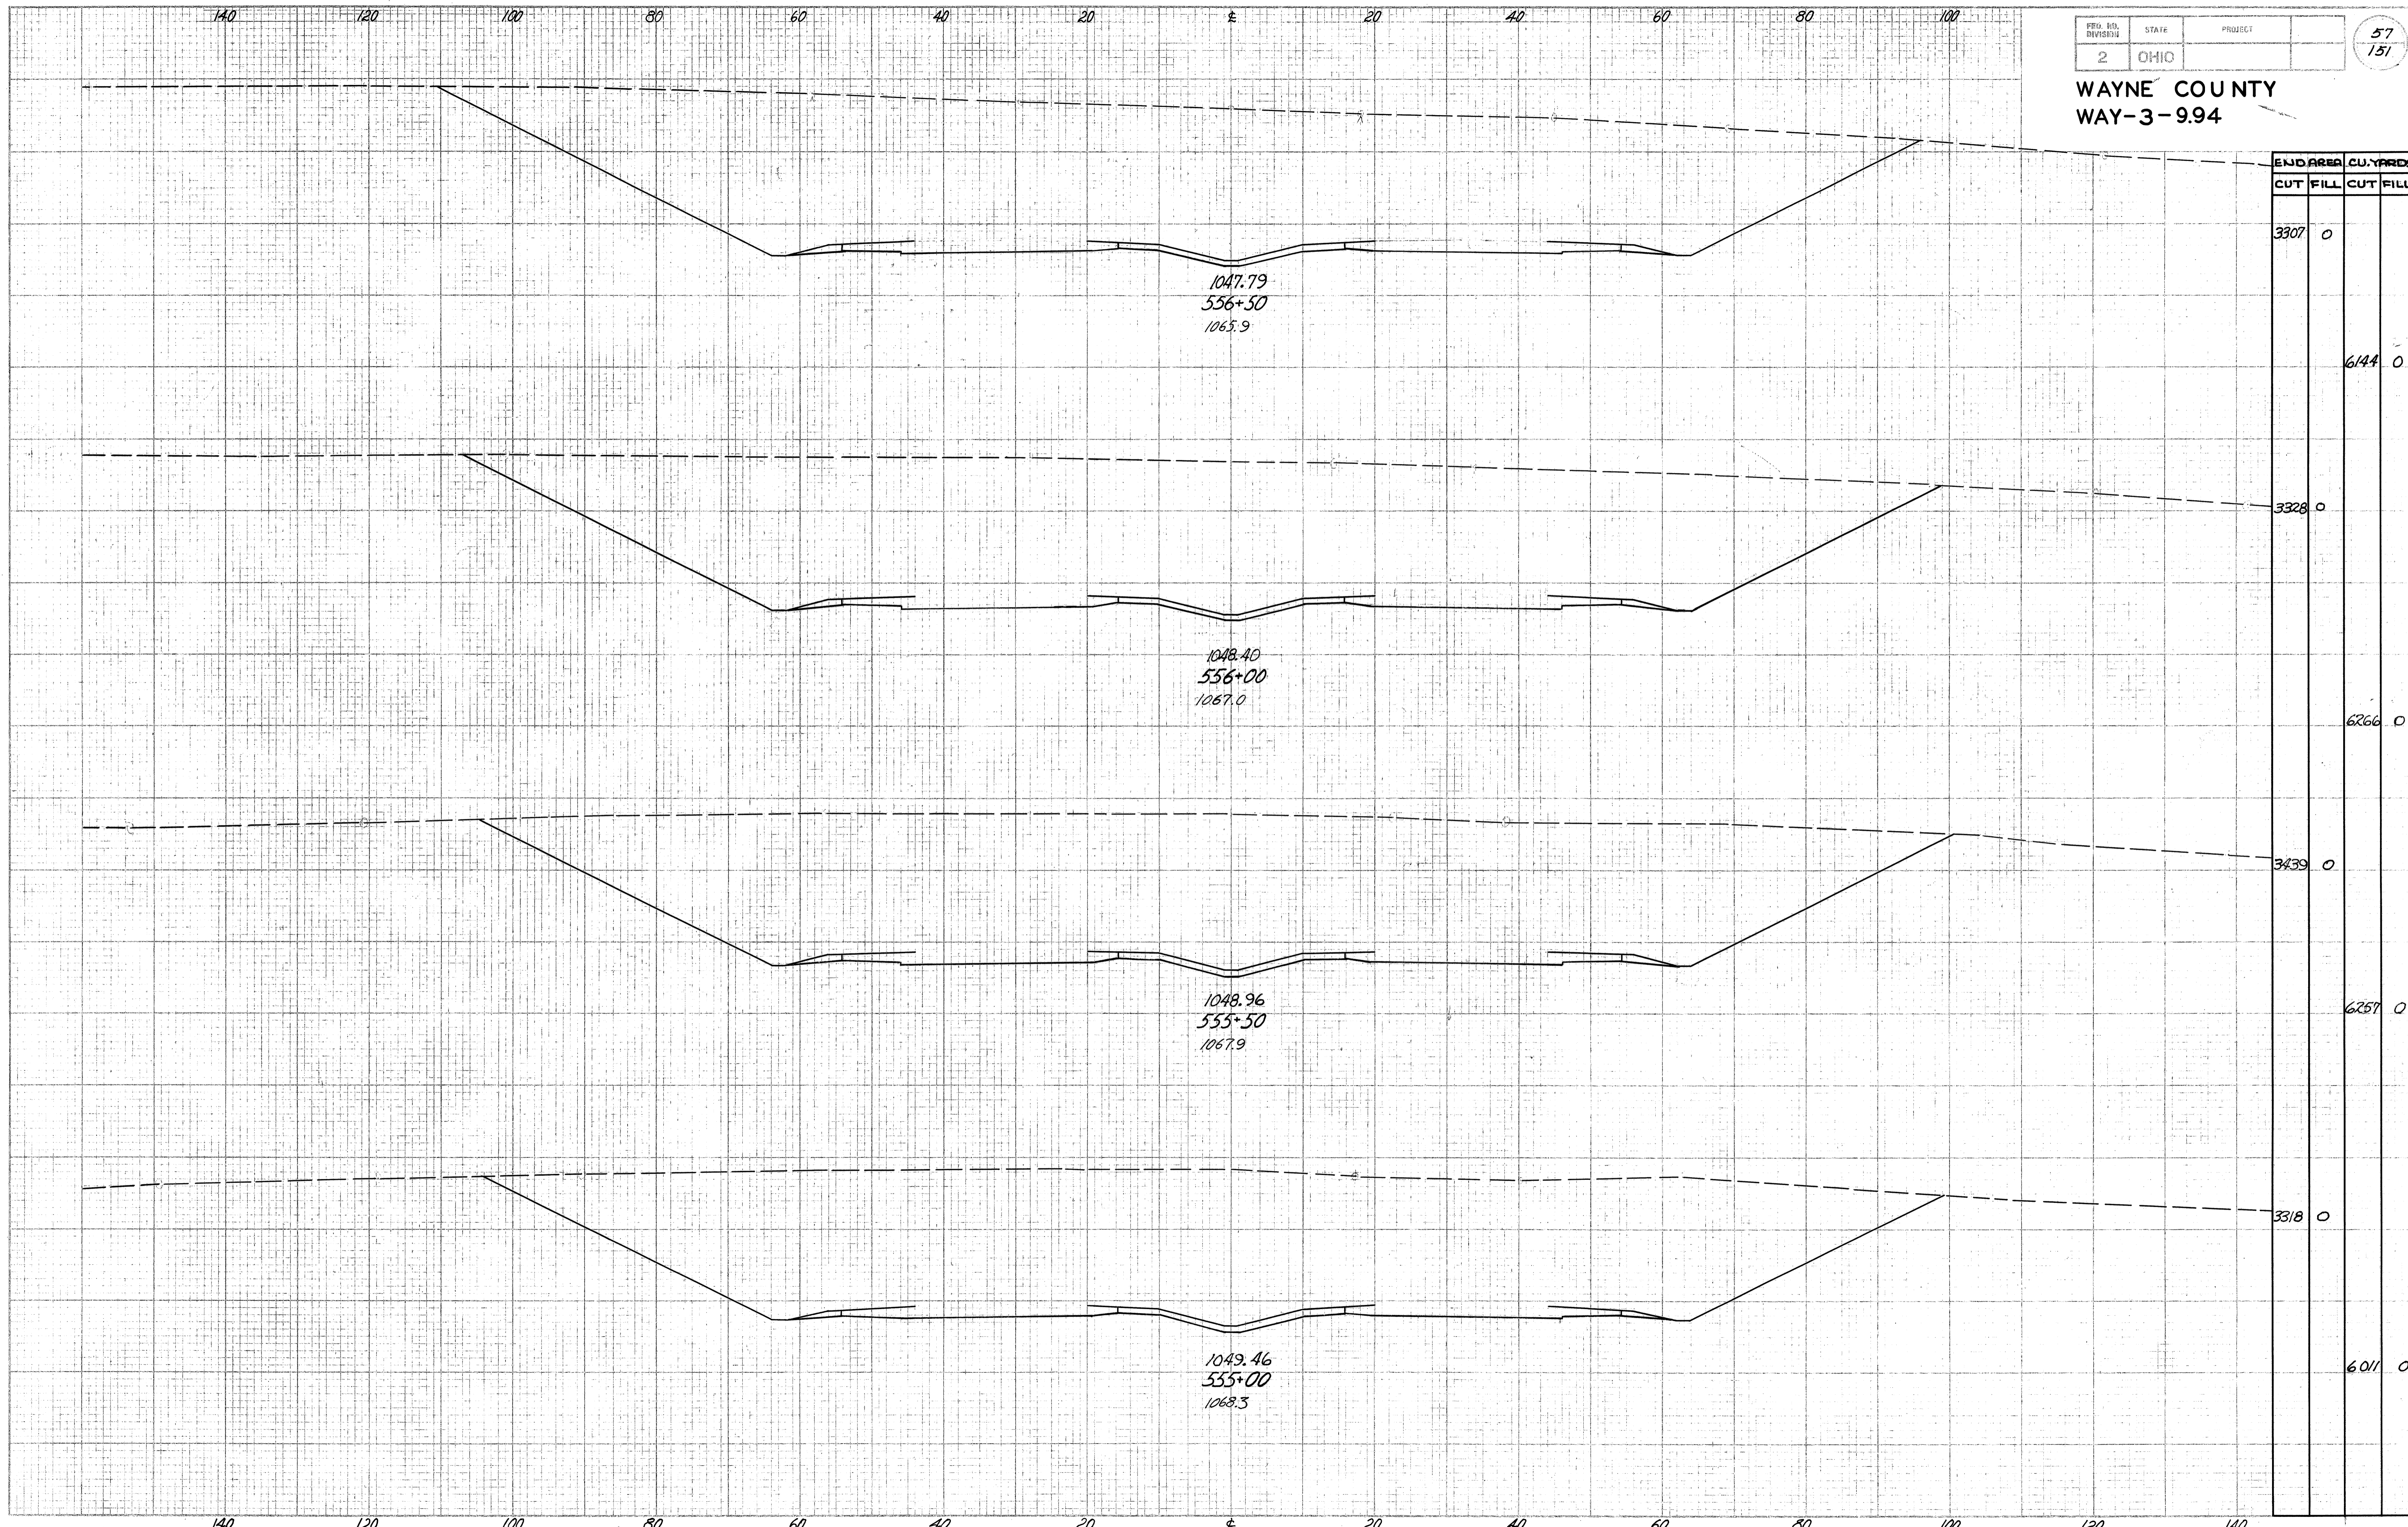

END AREA	CU. YARDS	
	CUT	FILL
3307	0	6144
3328	0	6266
3439	0	6257
3318	0	6011

Sta. 555+00 To Sta. 556+50


WAYNE COUNTY
WAY-3-9.94

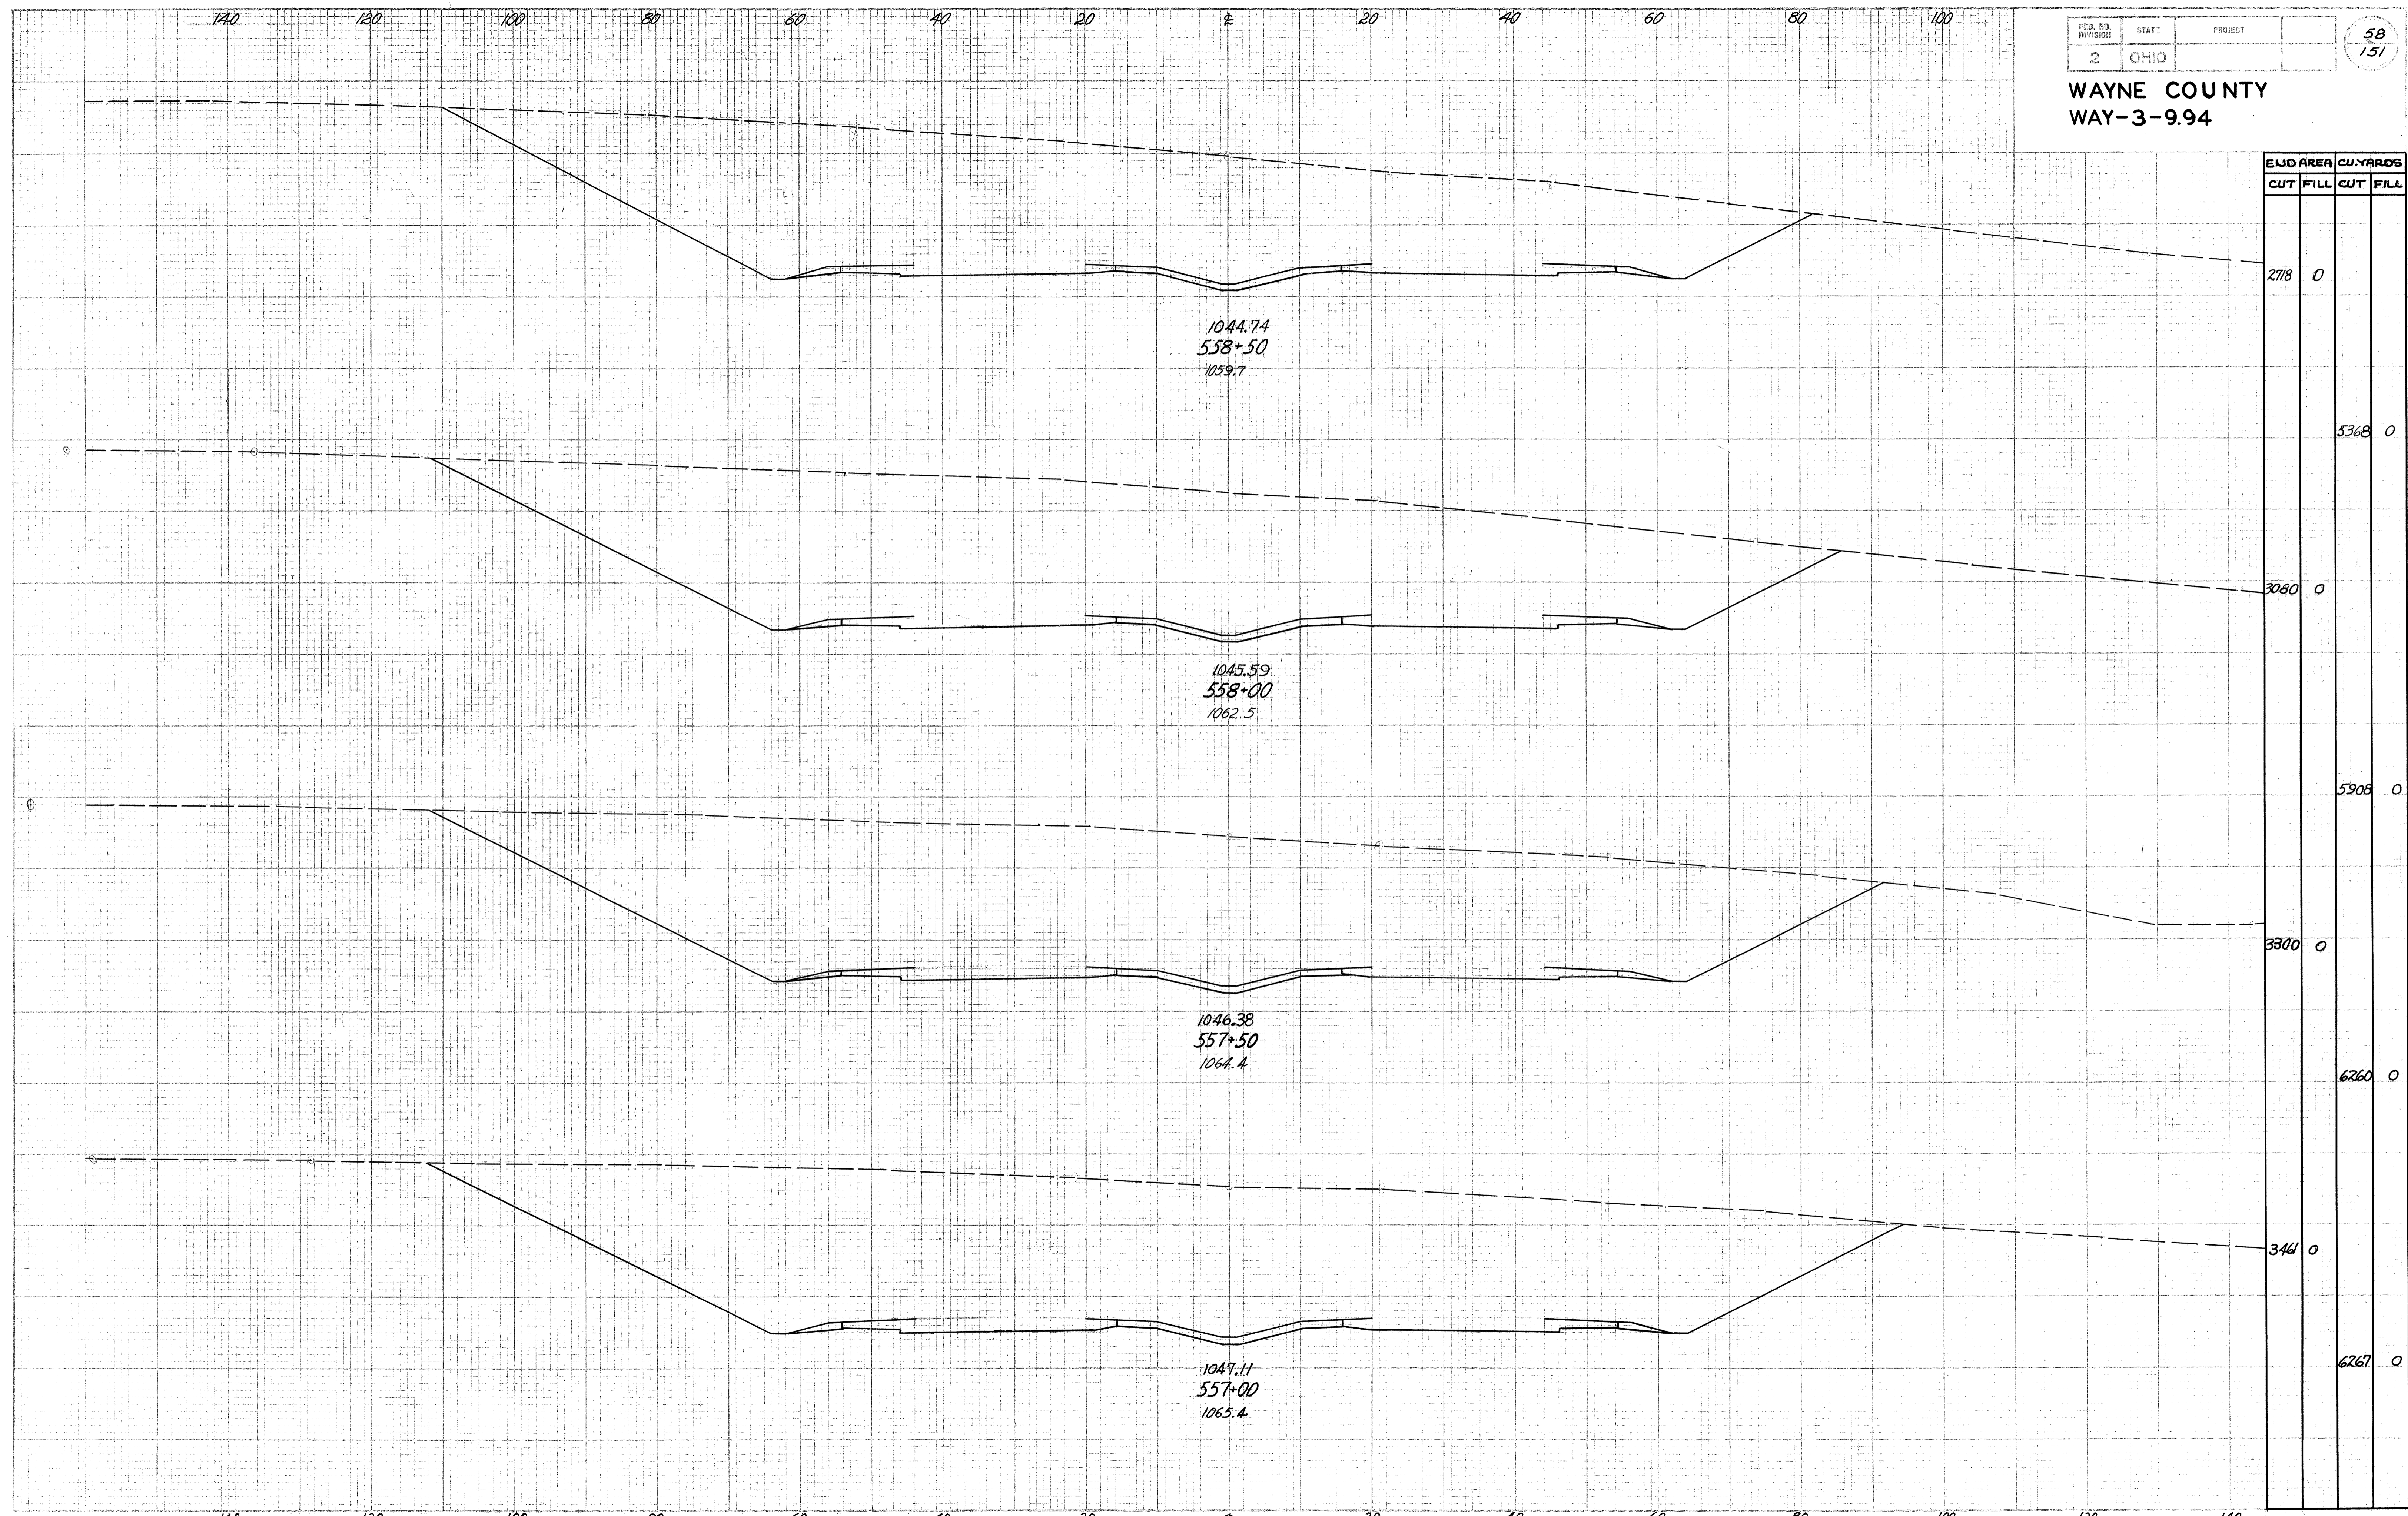

FED. RD. DIVISION	STATE	PROJECT
2	OHIO	


39
151

WAYNE COUNTY
WAY-3-9.94

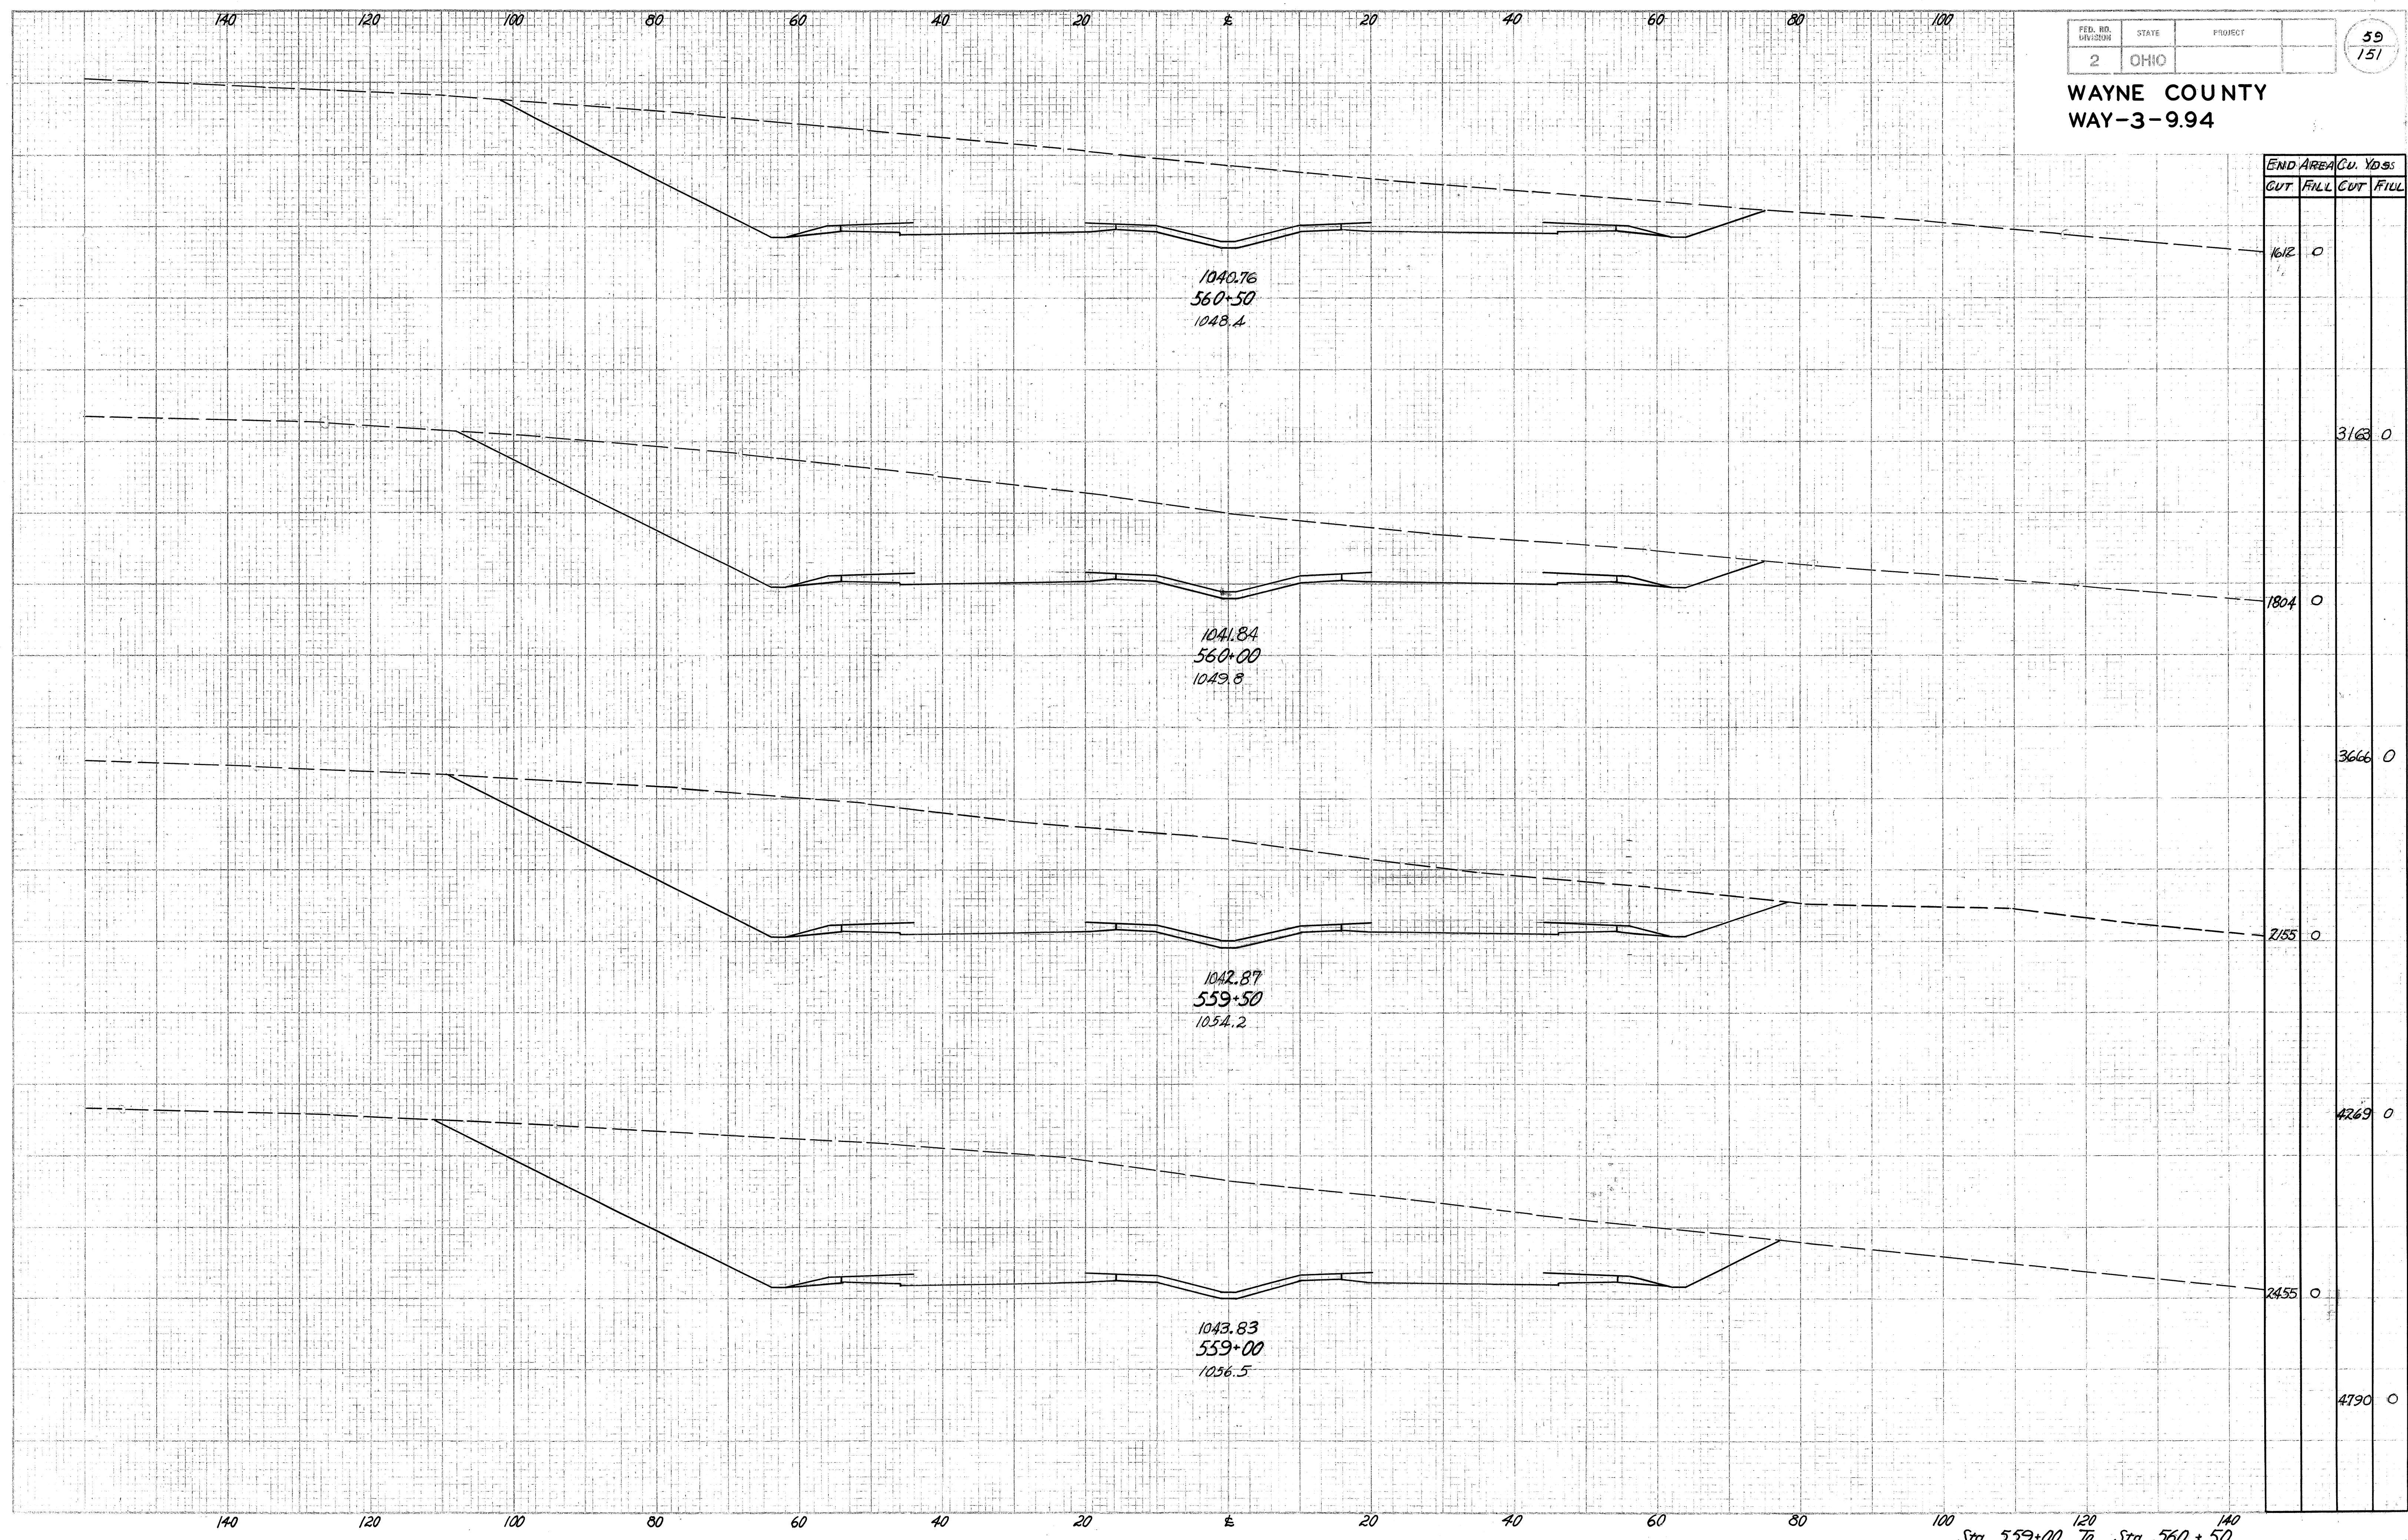

Sta. 559+00 To Sta. 560+50

WAYNE COUNTY
WAY-3-9.94

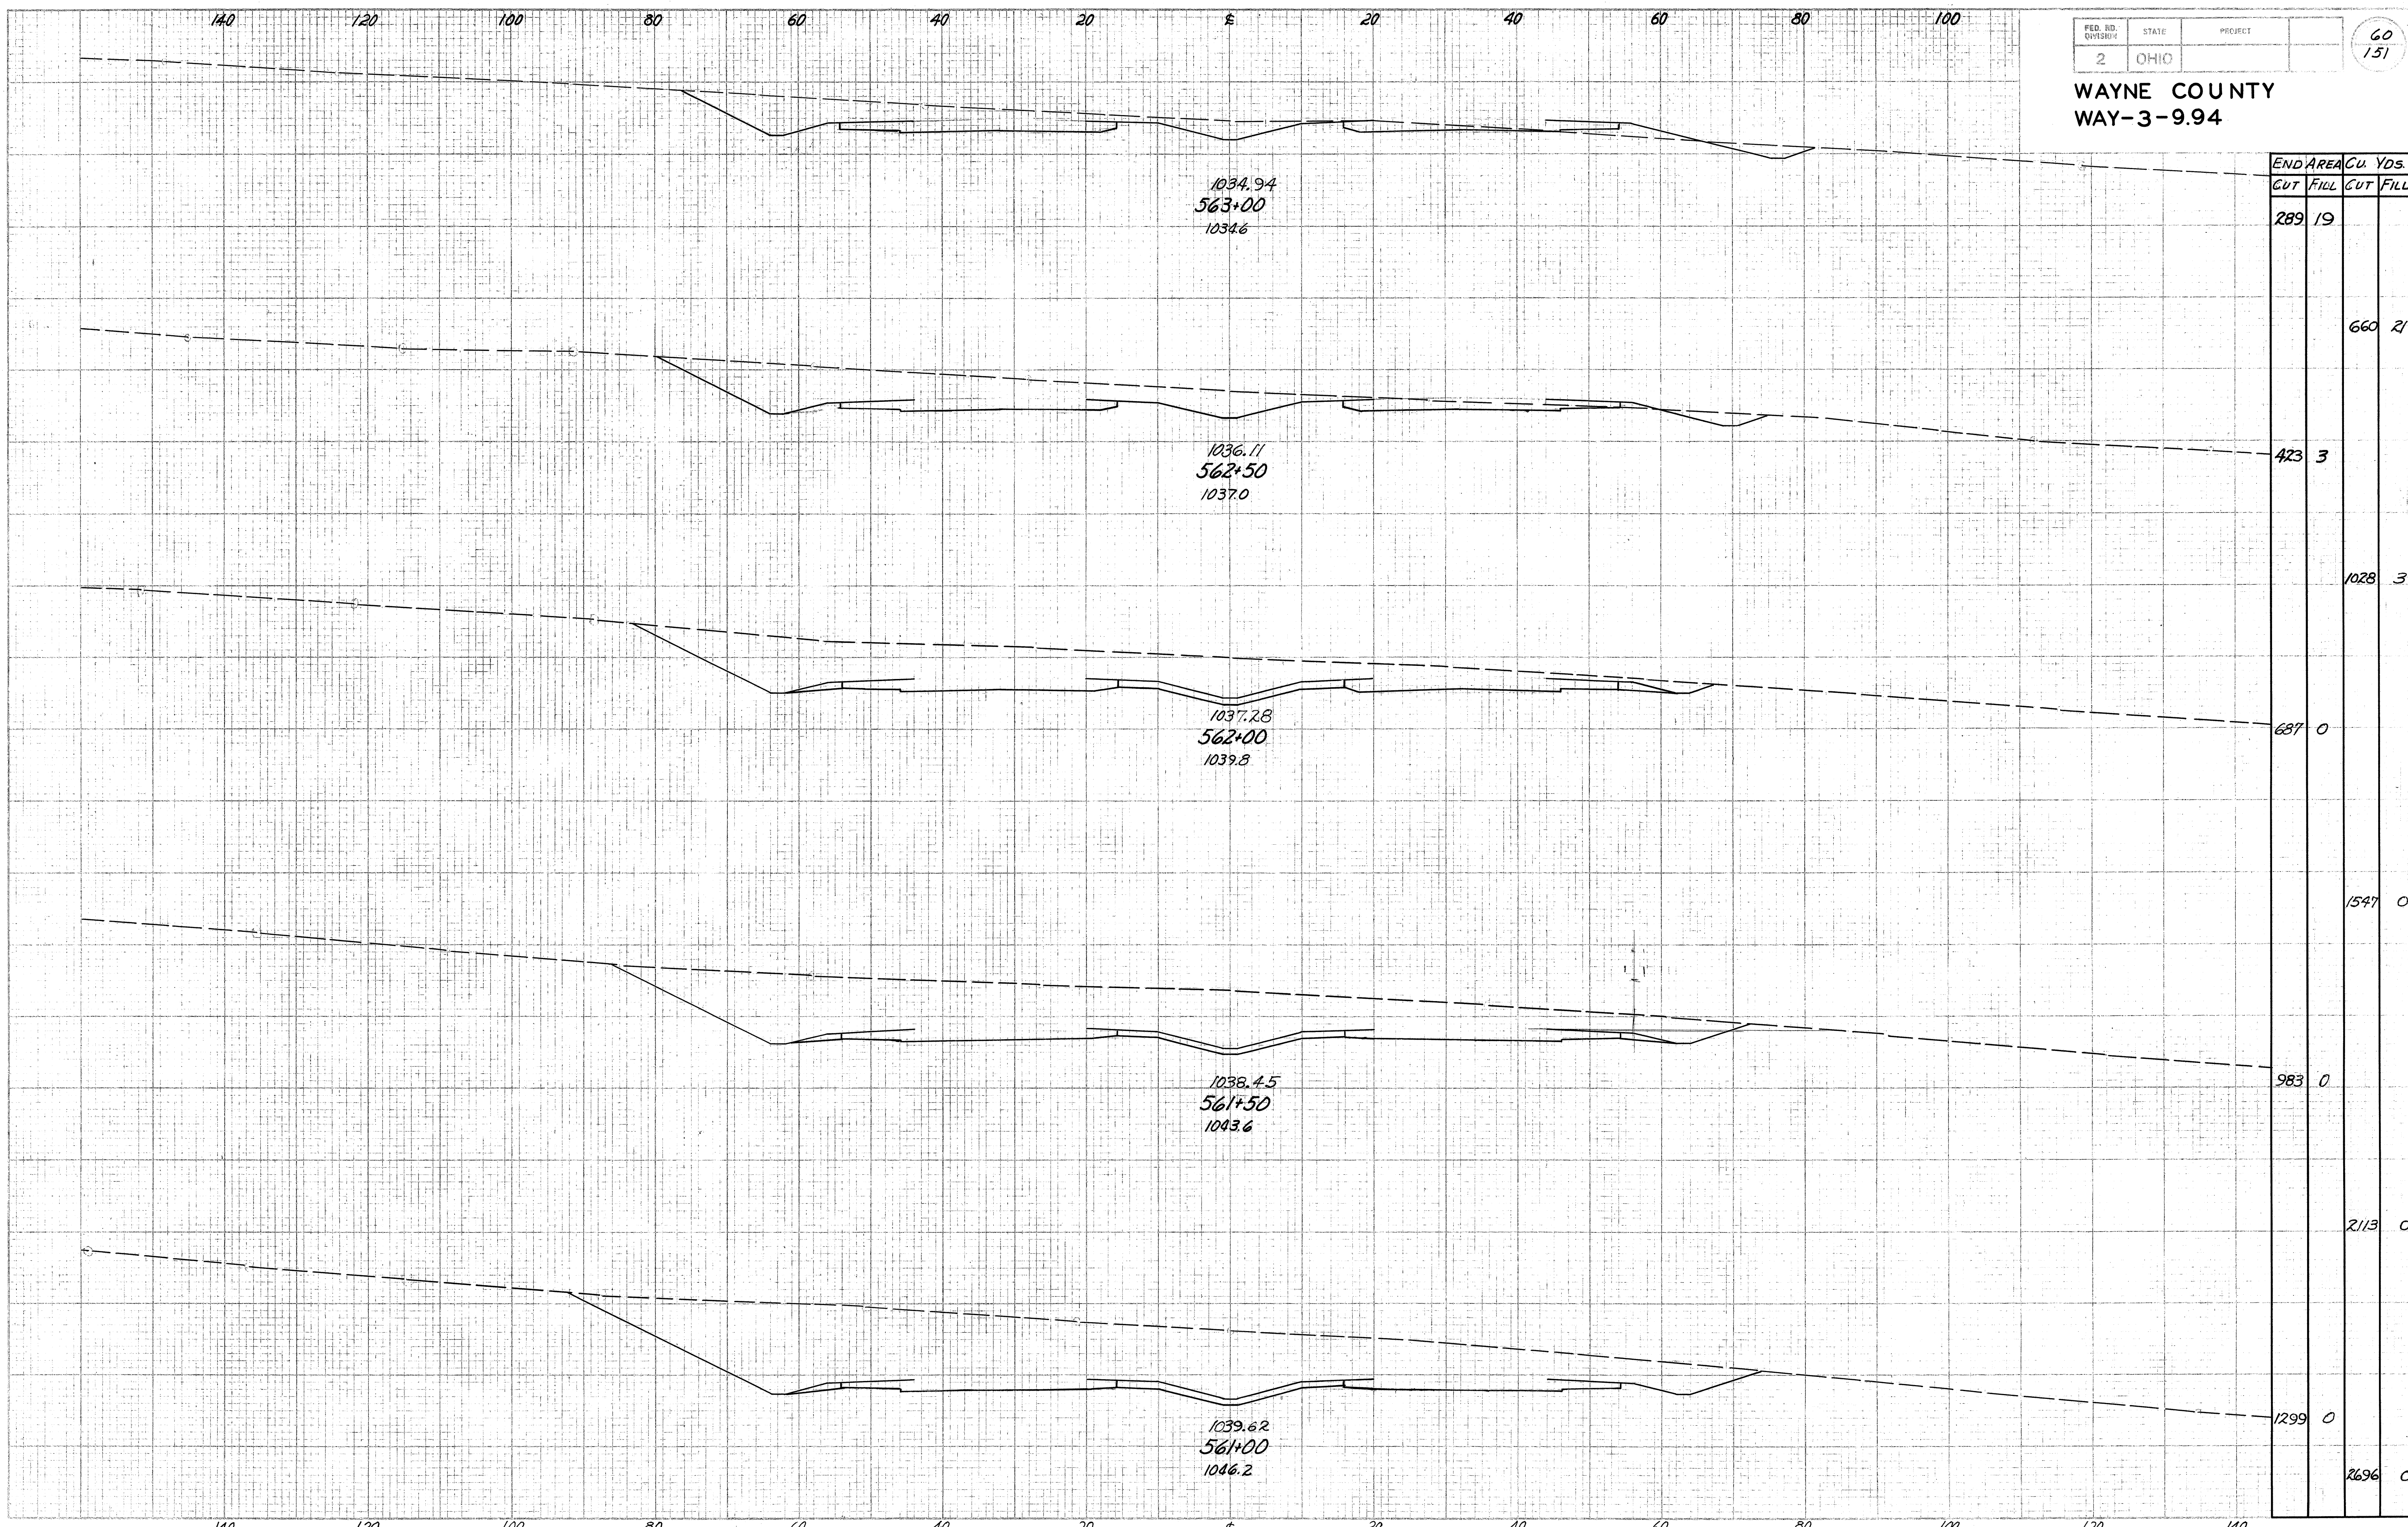

END AREA	Cu. Yds.	
	CUT	FILL
289	19	
		660 21
423	3	
		1028 3
687	0	
		1547 0
983	0	
		2113 0
1299	0	
		2696 0

1034.94
563+00
1034.6

1036.11
562+50
1037.0

1037.28
562+00
1039.8


1038.45
561+50
1043.6

1039.62
561+00
1046.2

FED. RD. DIVISION	STATE	PROJECT
2	OHIO	

61
151


WAYNE COUNTY
WAY-3-9.94

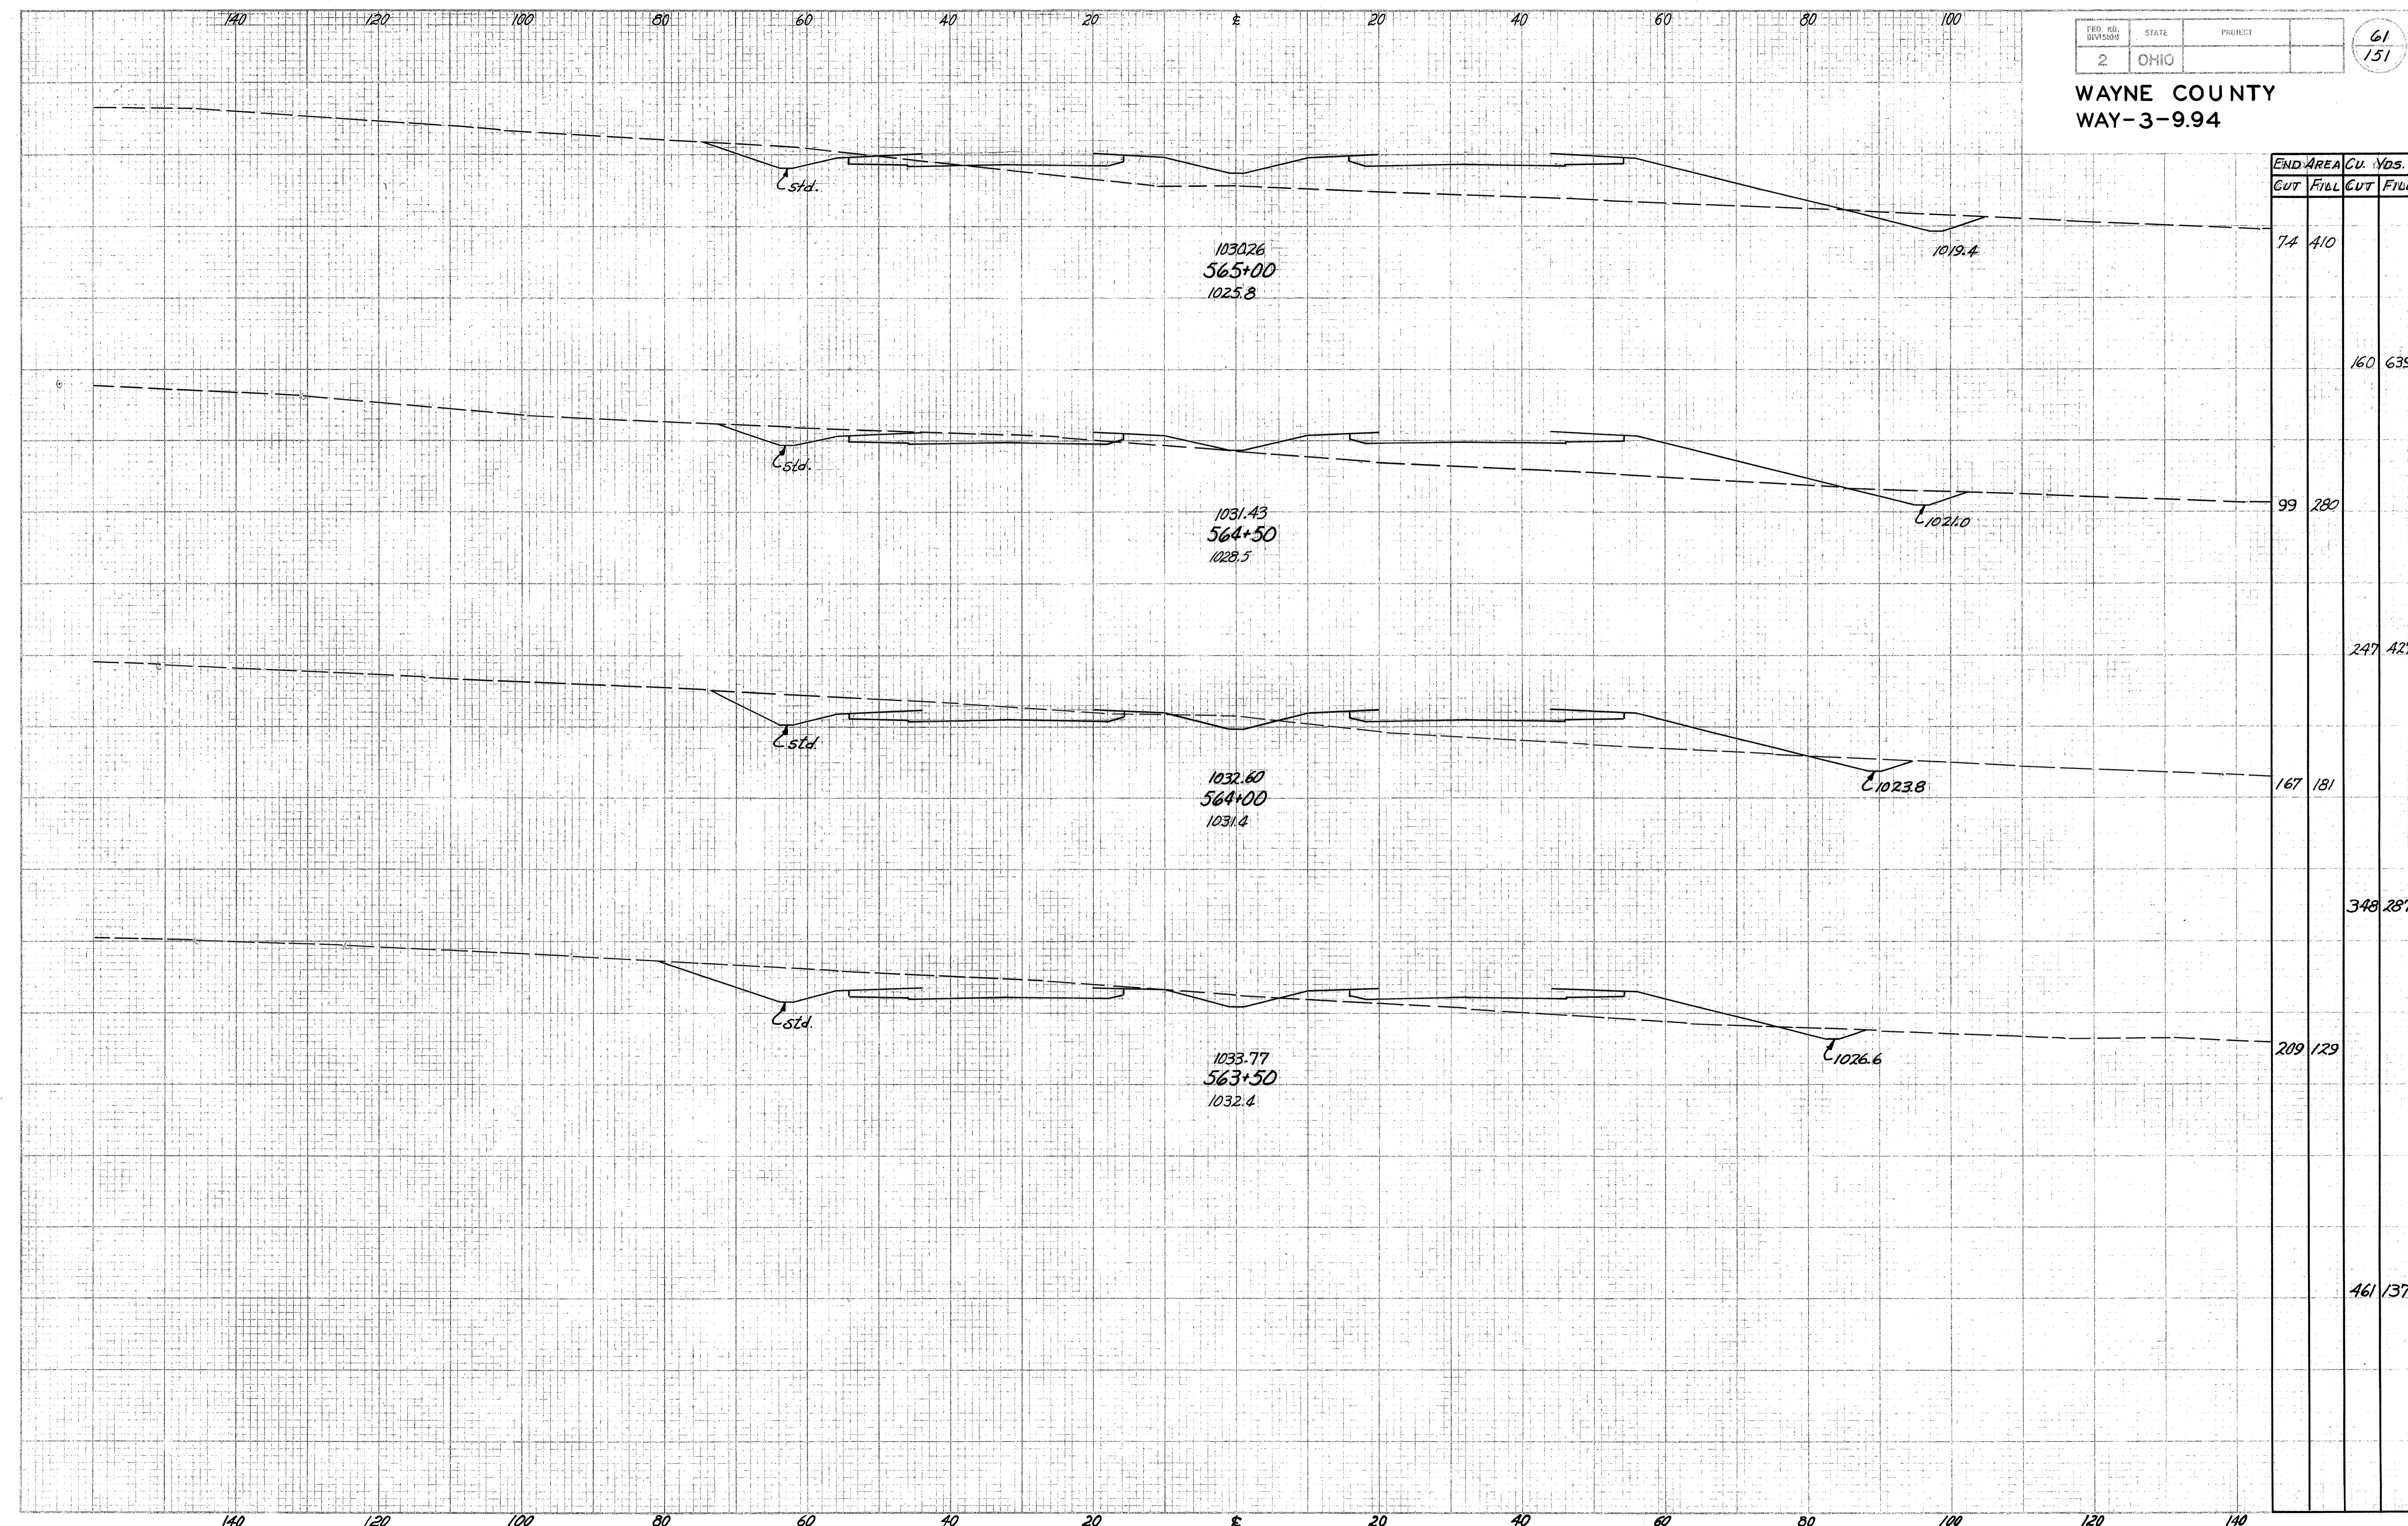

END AREA		Cu. Yds.	
CUT	FILL	CUT	FILL
74	410		
		160	639
99	280		
		247	427
167	181		
		348	287
209	129		
		461	137

100
Sta. 563+50 To Sta. 565+00


WAYNE COUNTY
WAY-3-9.94

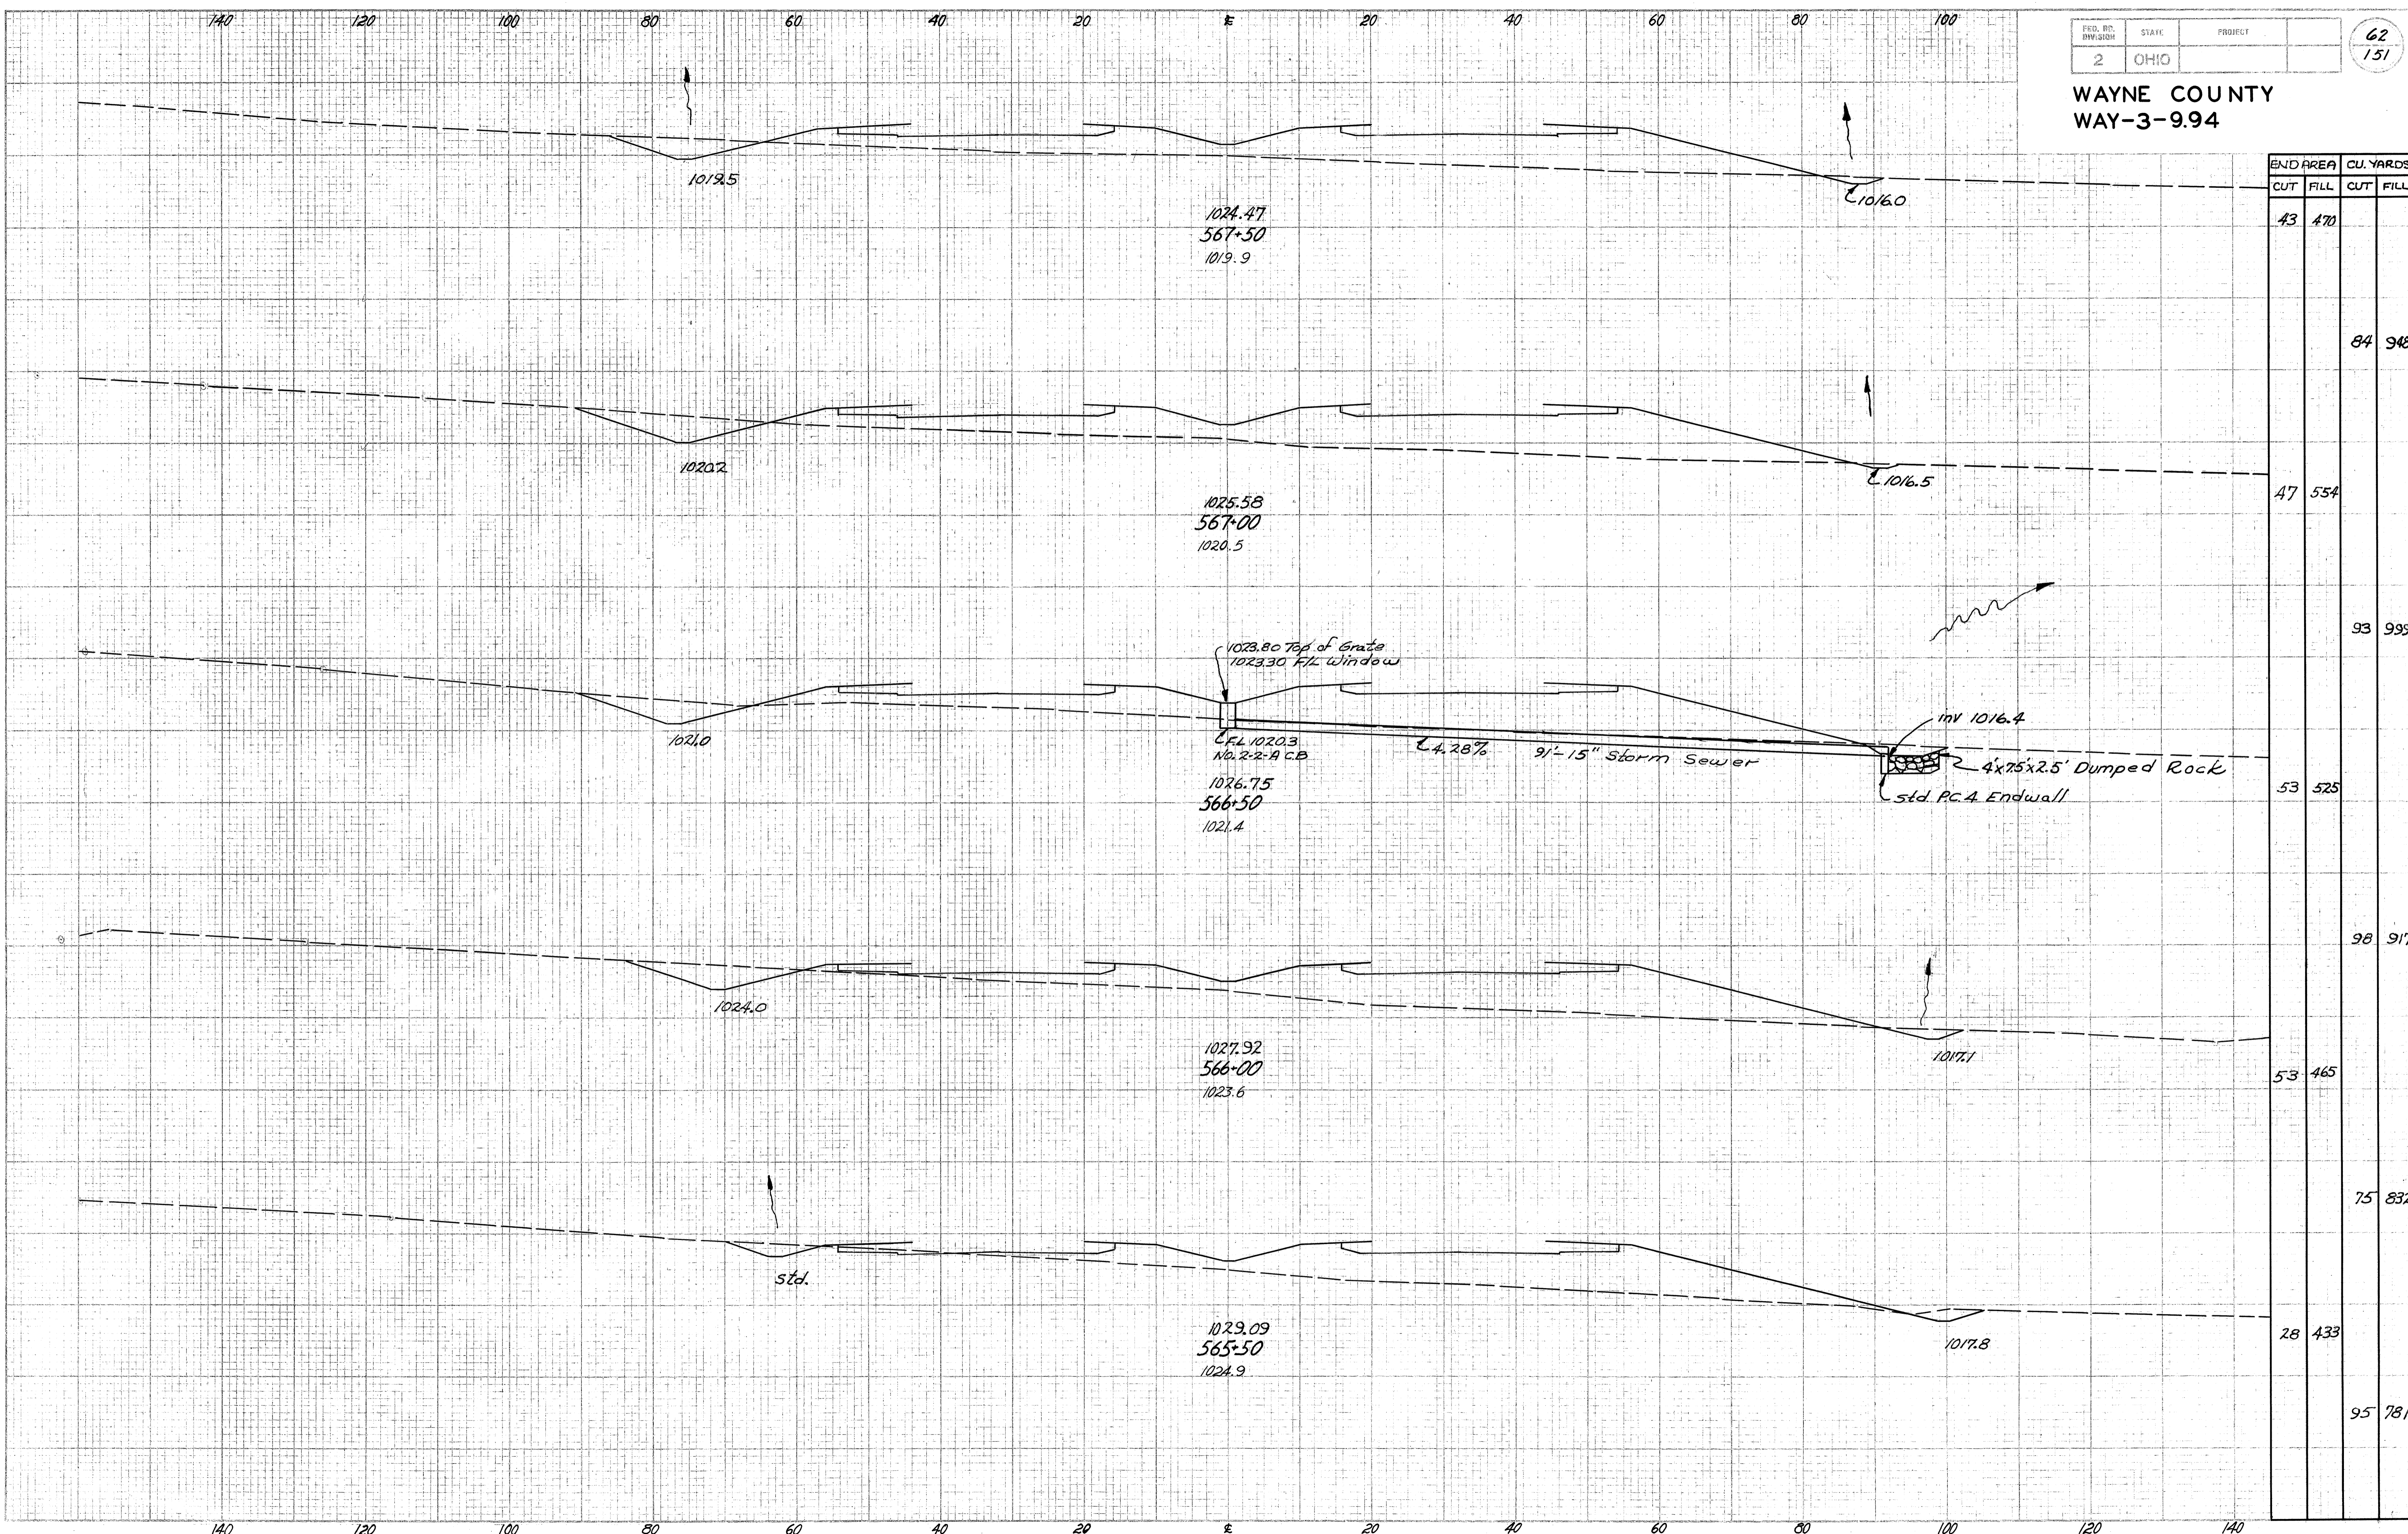

END AREA	CU. YARDS	
	CUT	FILL
43	470	
		84 948
47	554	
		93 999
53	525	
		98 917
53	465	
		75 832
28	433	
		95 781

Sta. 565+50 To Sta. 567+50


WAYNE COUNTY
WAY-3-994

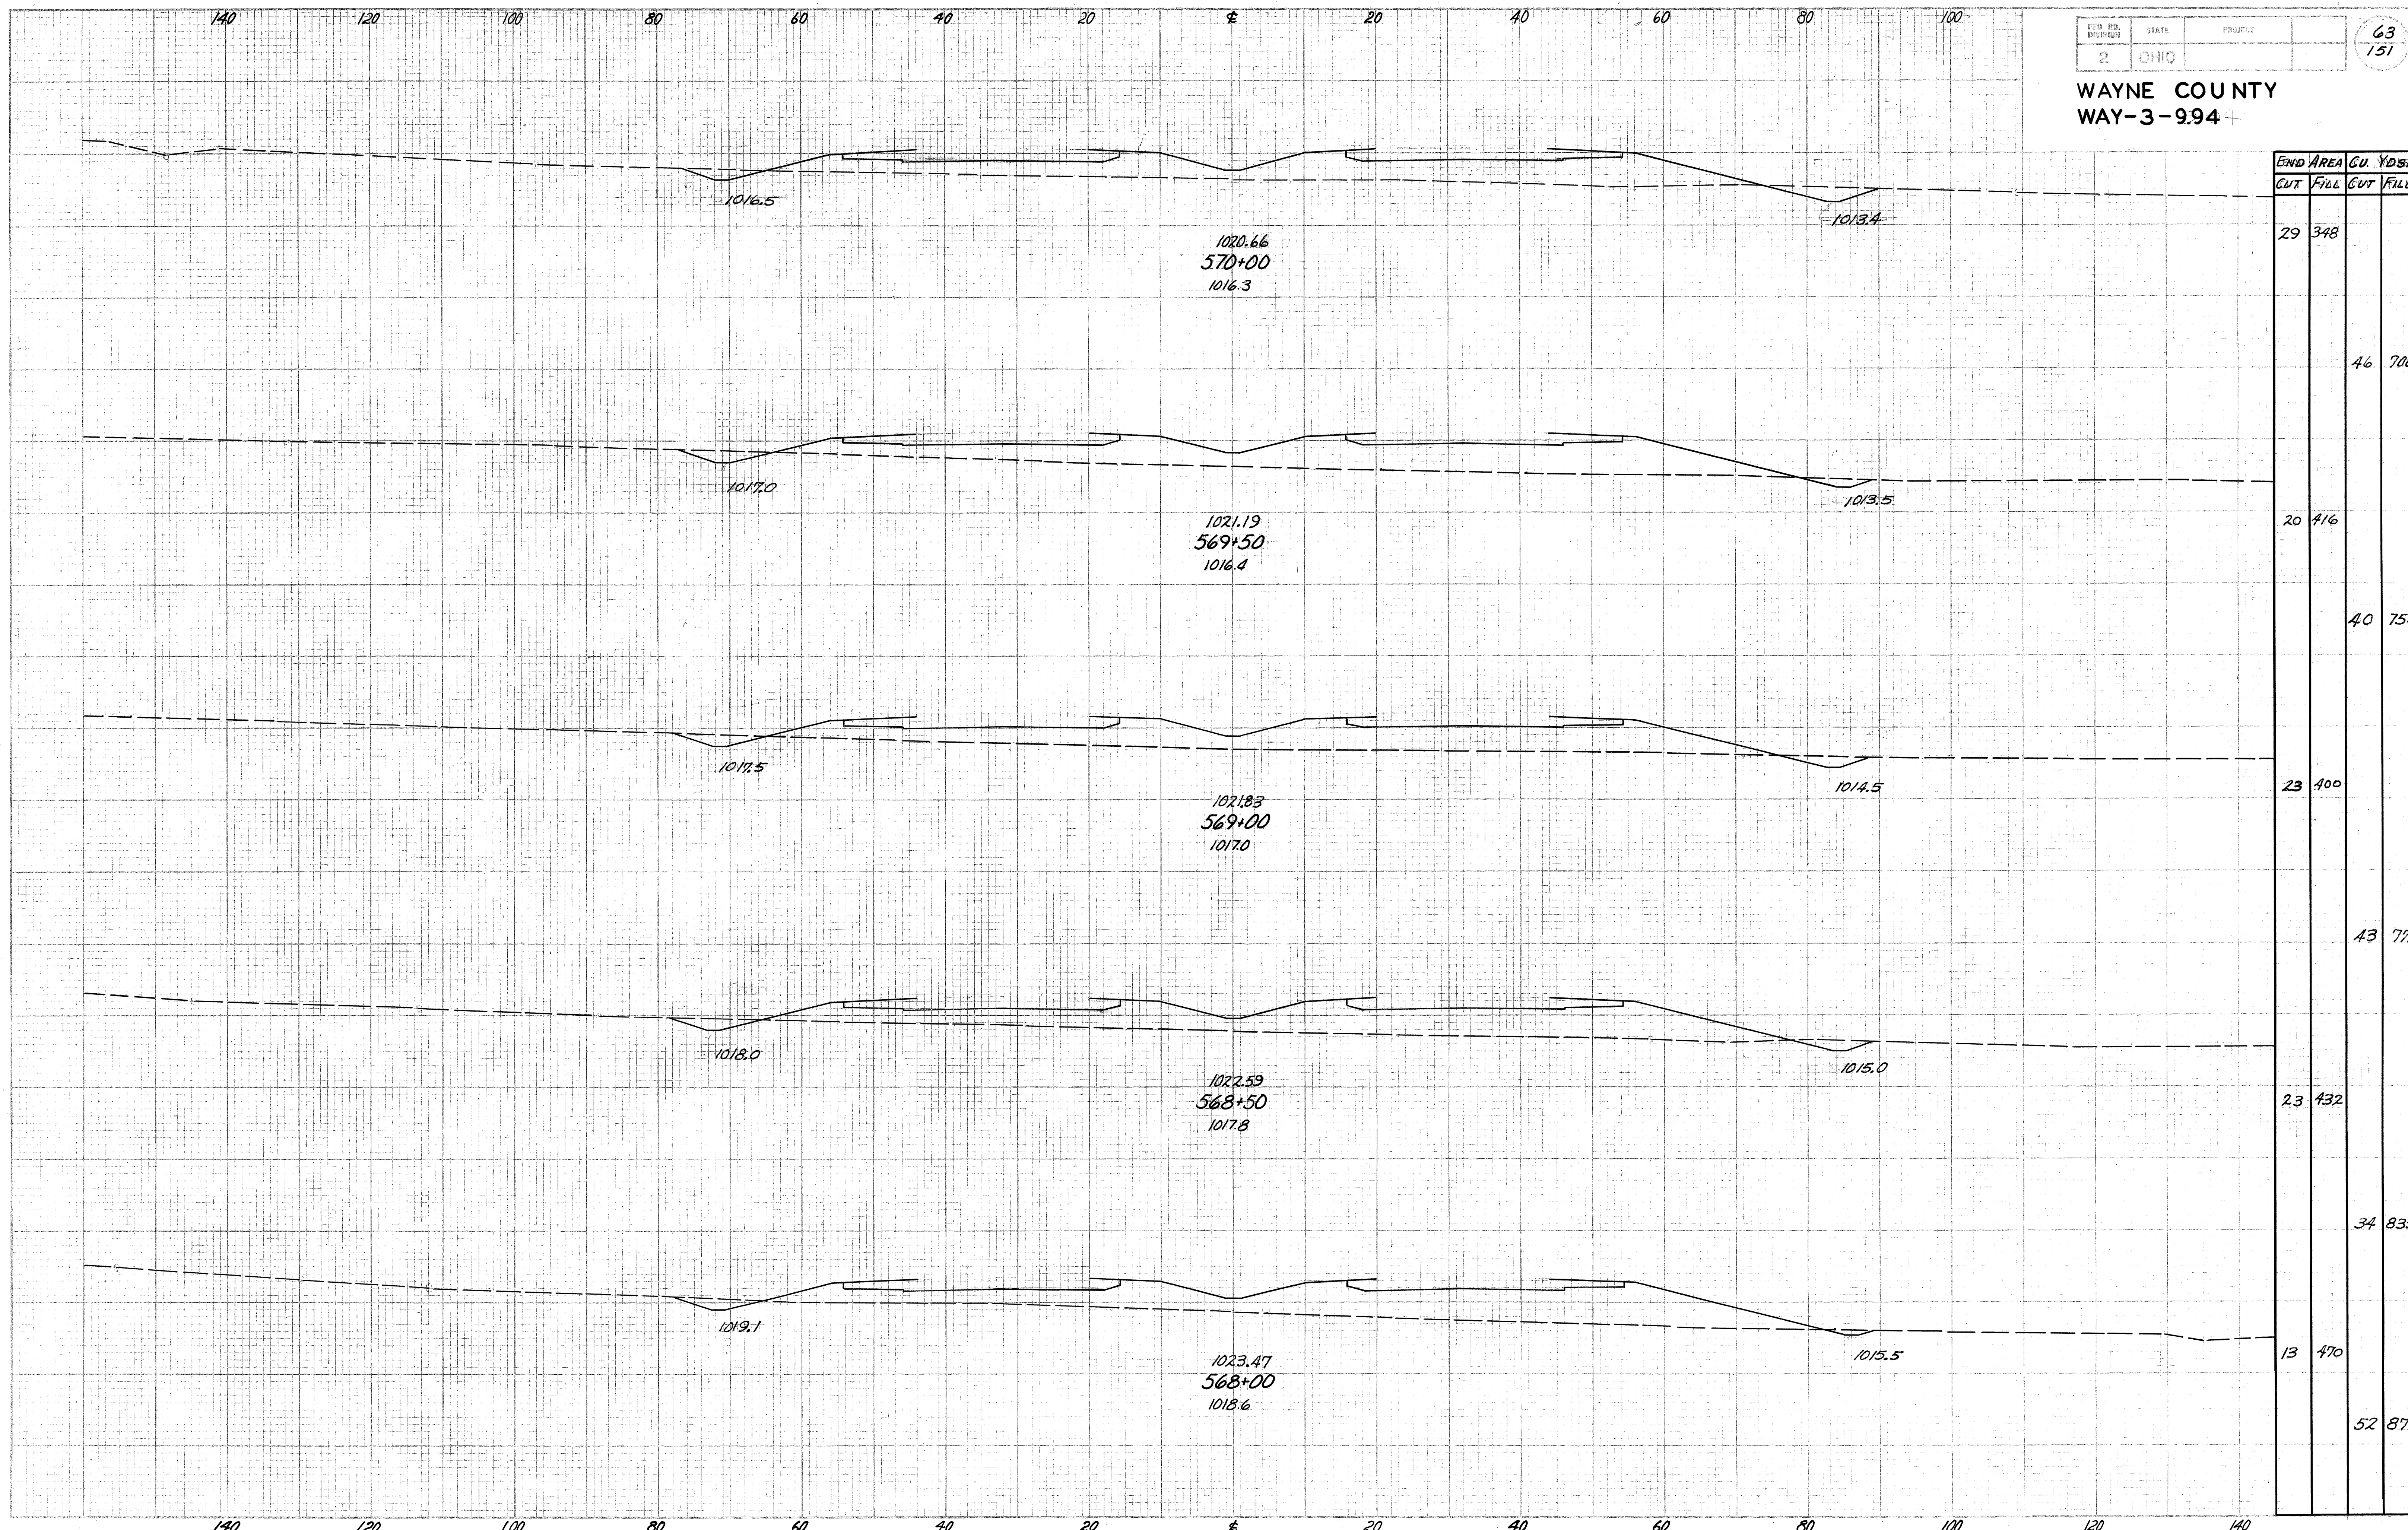

END AREA	Cu. Yds.	
	CUT	FILL
29	348	
		46 708
20	416	
		40 756
23	400	
		43 771
23	432	
		34 835
13	470	
		52 871

100 Sta. 568+00 To Sta. 570+00 140


WAYNE COUNTY
WAY-3-994

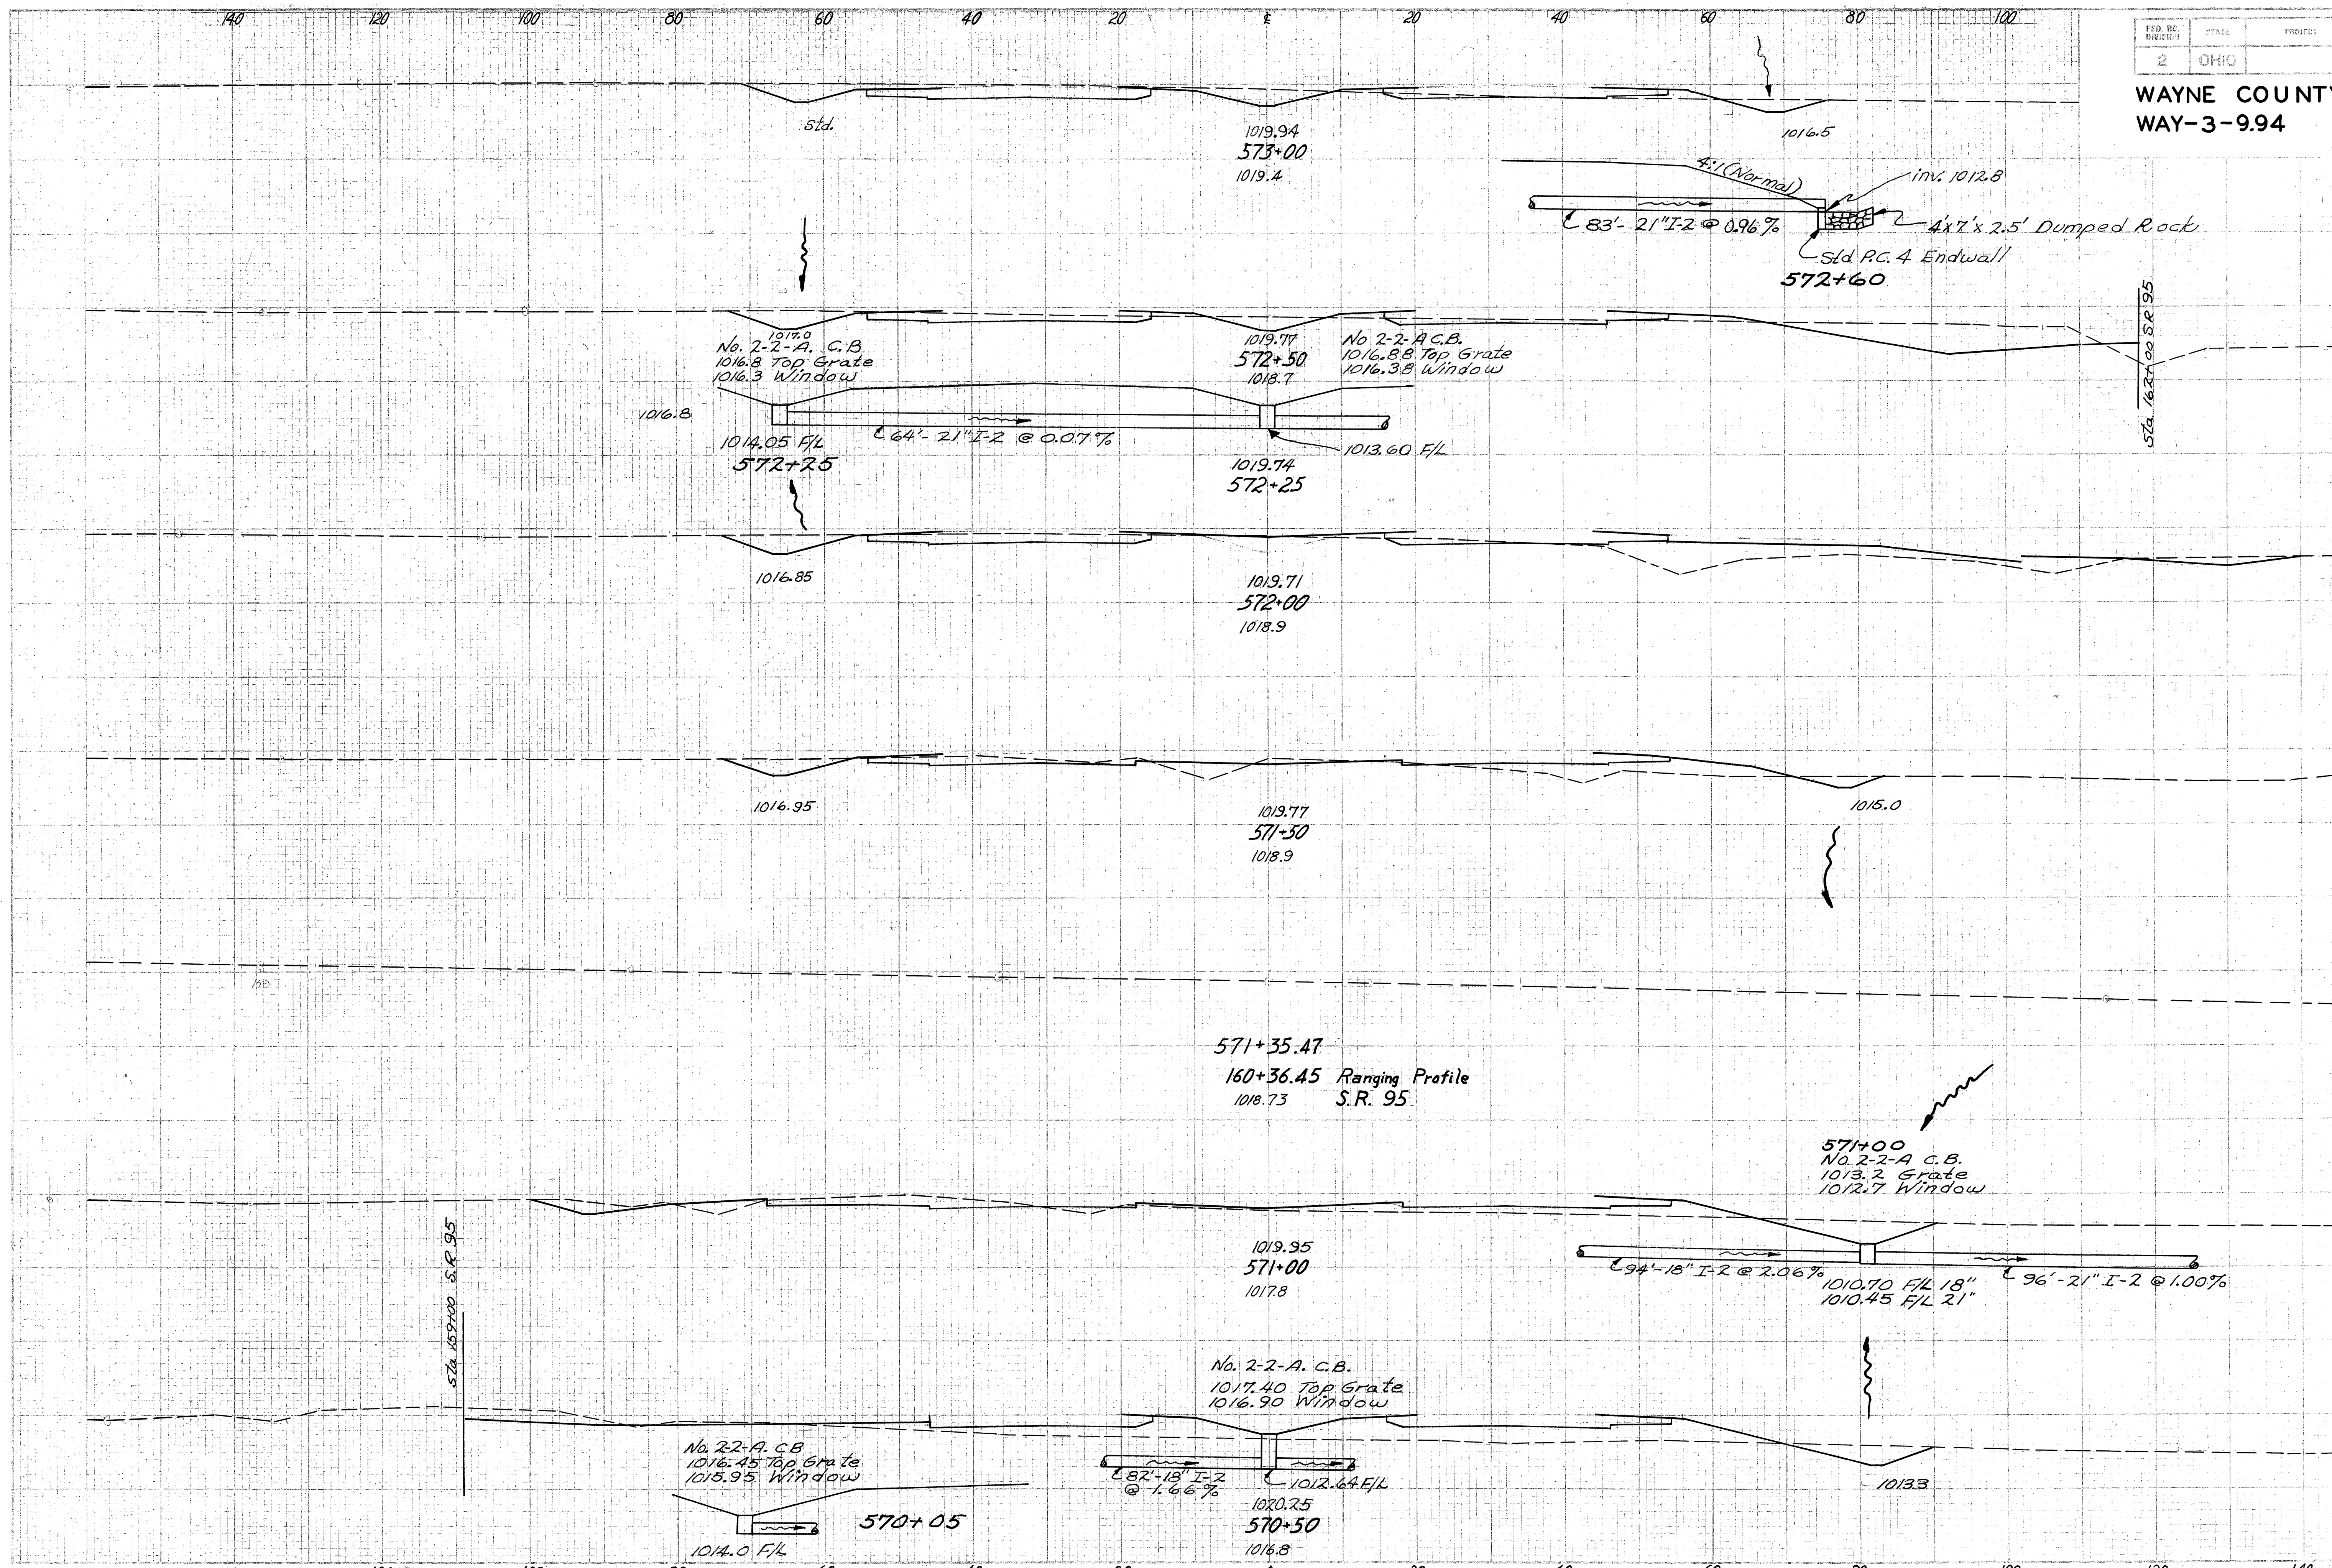

END AREA		CU. YARDS	
CUT	FILL	CUT	FILL
155	10		
		339	33
211	25		
		295	147
107	133		
		160	199
65	82		
		153	171
100	102		
		145	310
56	233		
		79	538

Sta. 570+50 To Sta. 573+00


WAYNE COUNTY
WAY-3-9.94

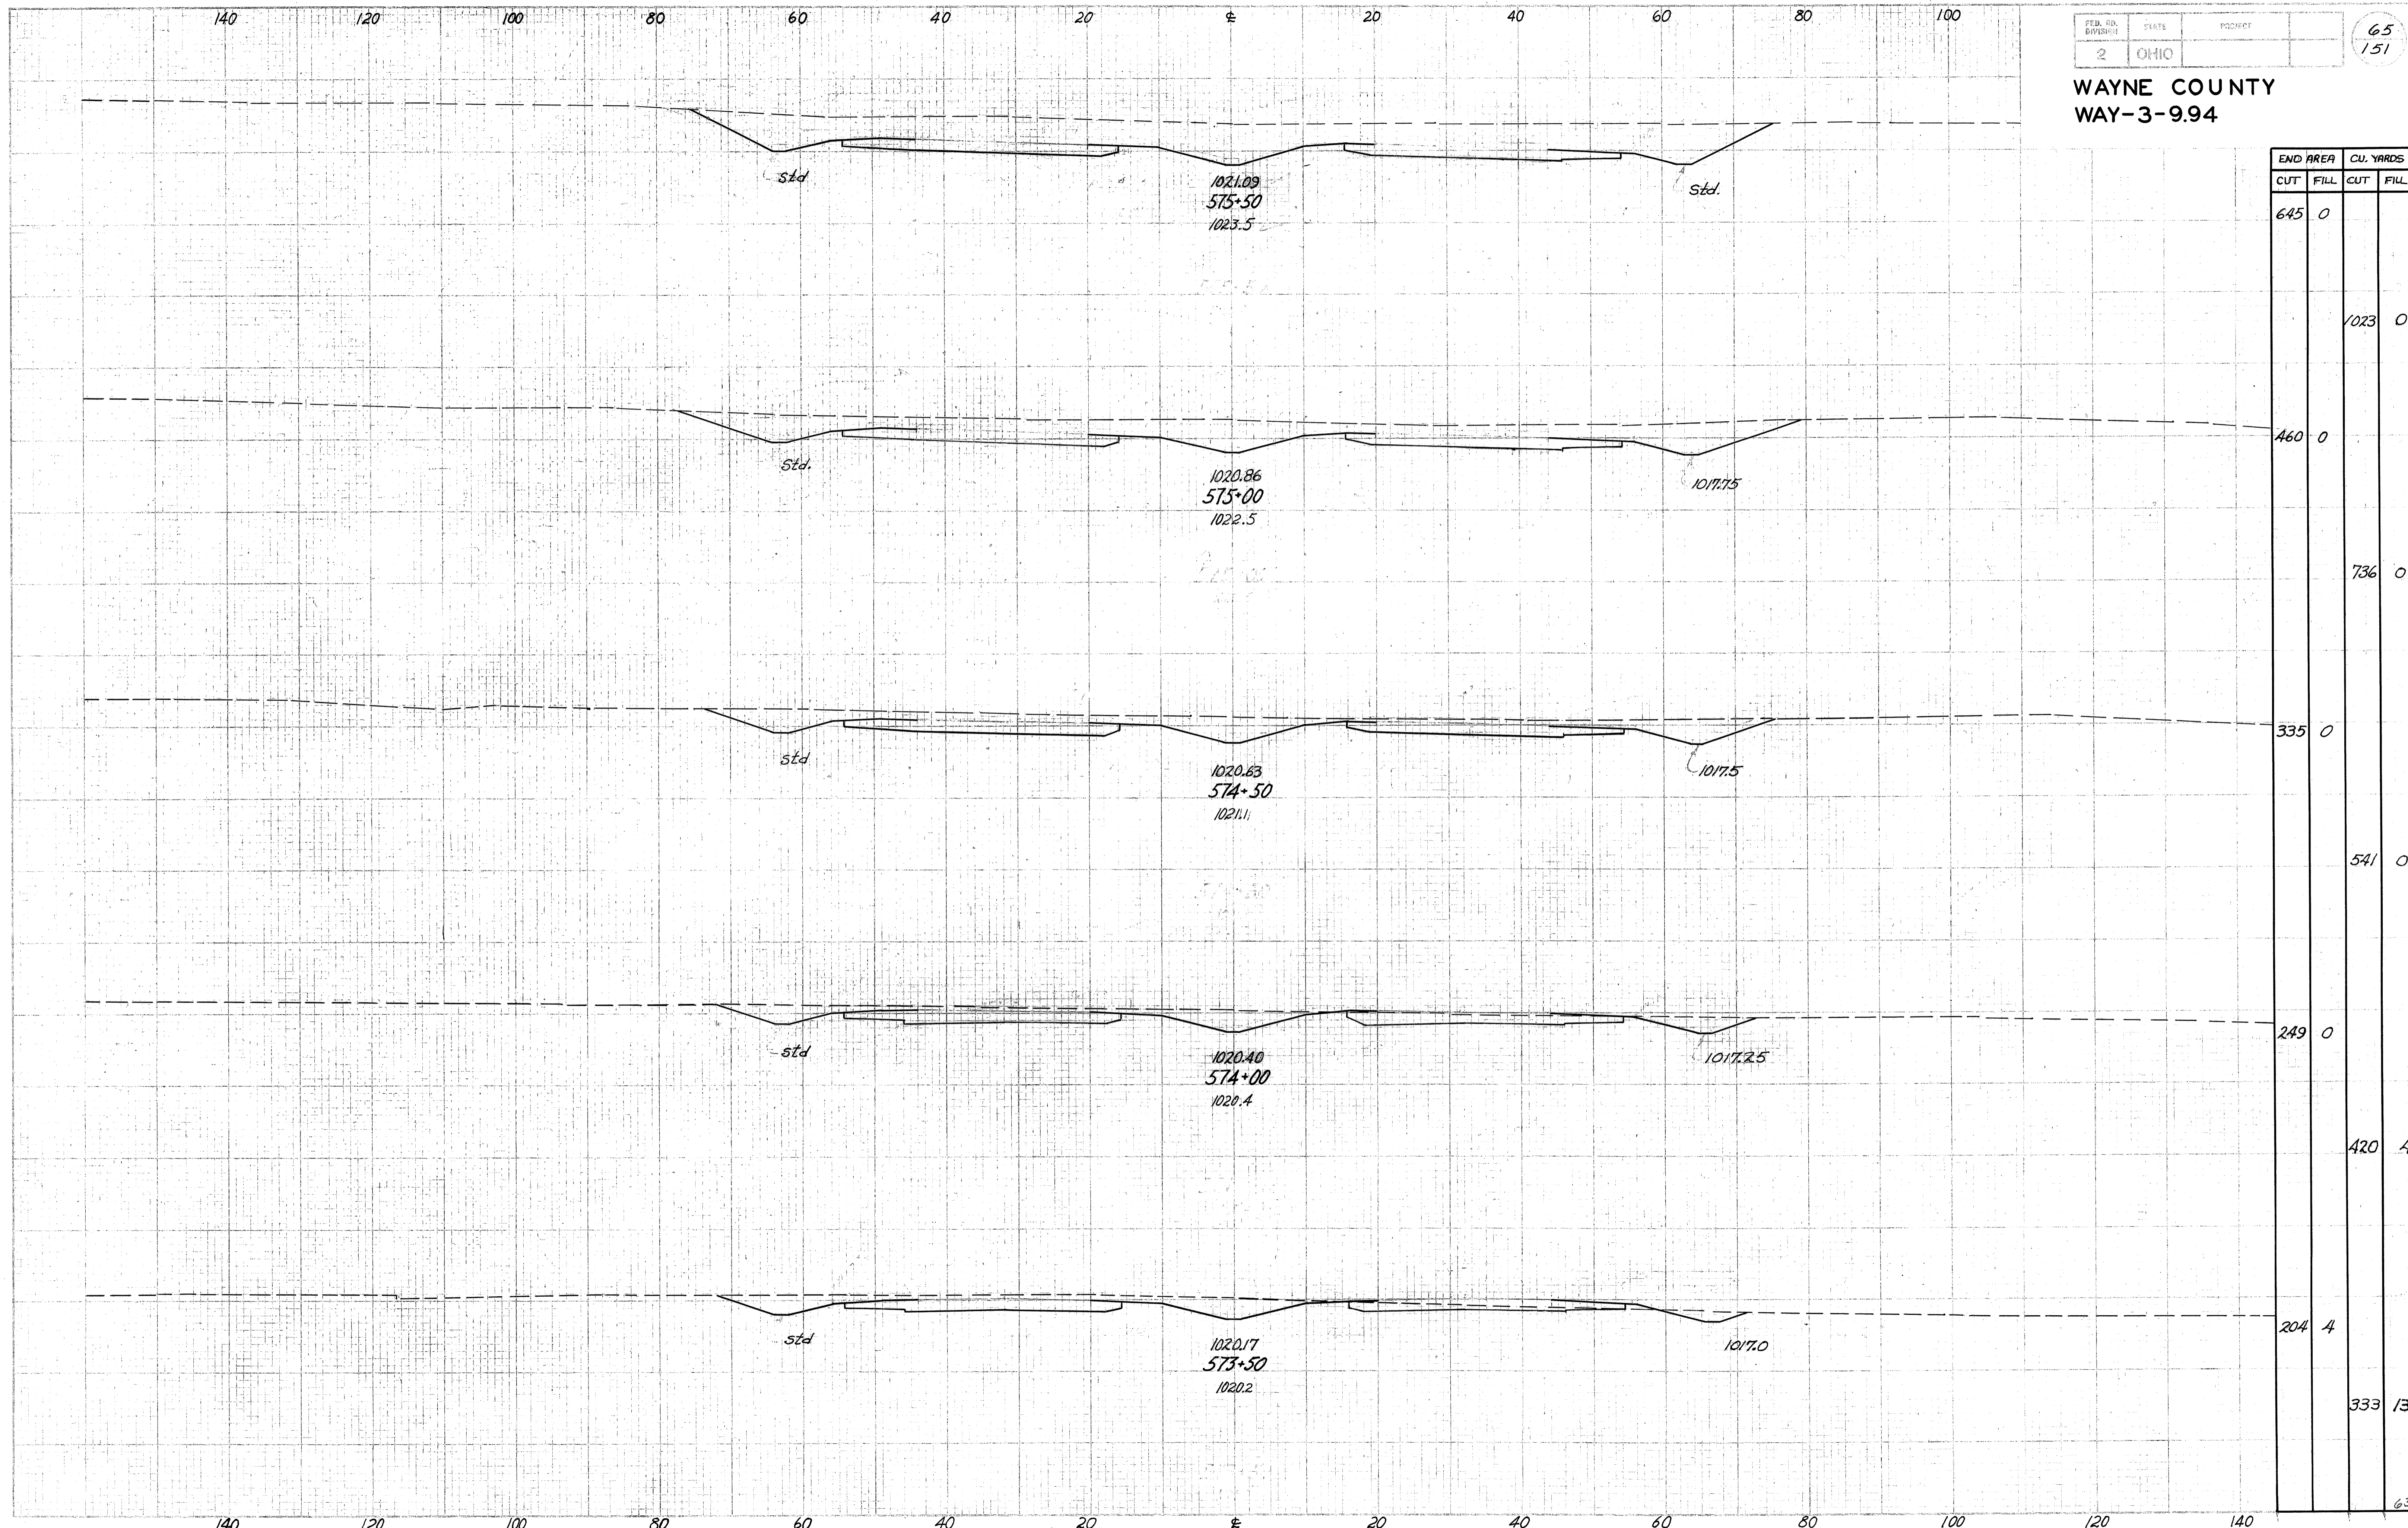

END AREA	CU. YARDS	
	CUT	FILL
645	0	
		1023
460	0	
		736
335	0	
		541
249	0	
		420
204	4	
		333
		63

Sta. 573+50 To Sta. 575+50


WAYNE COUNTY
WAY-3-9.94

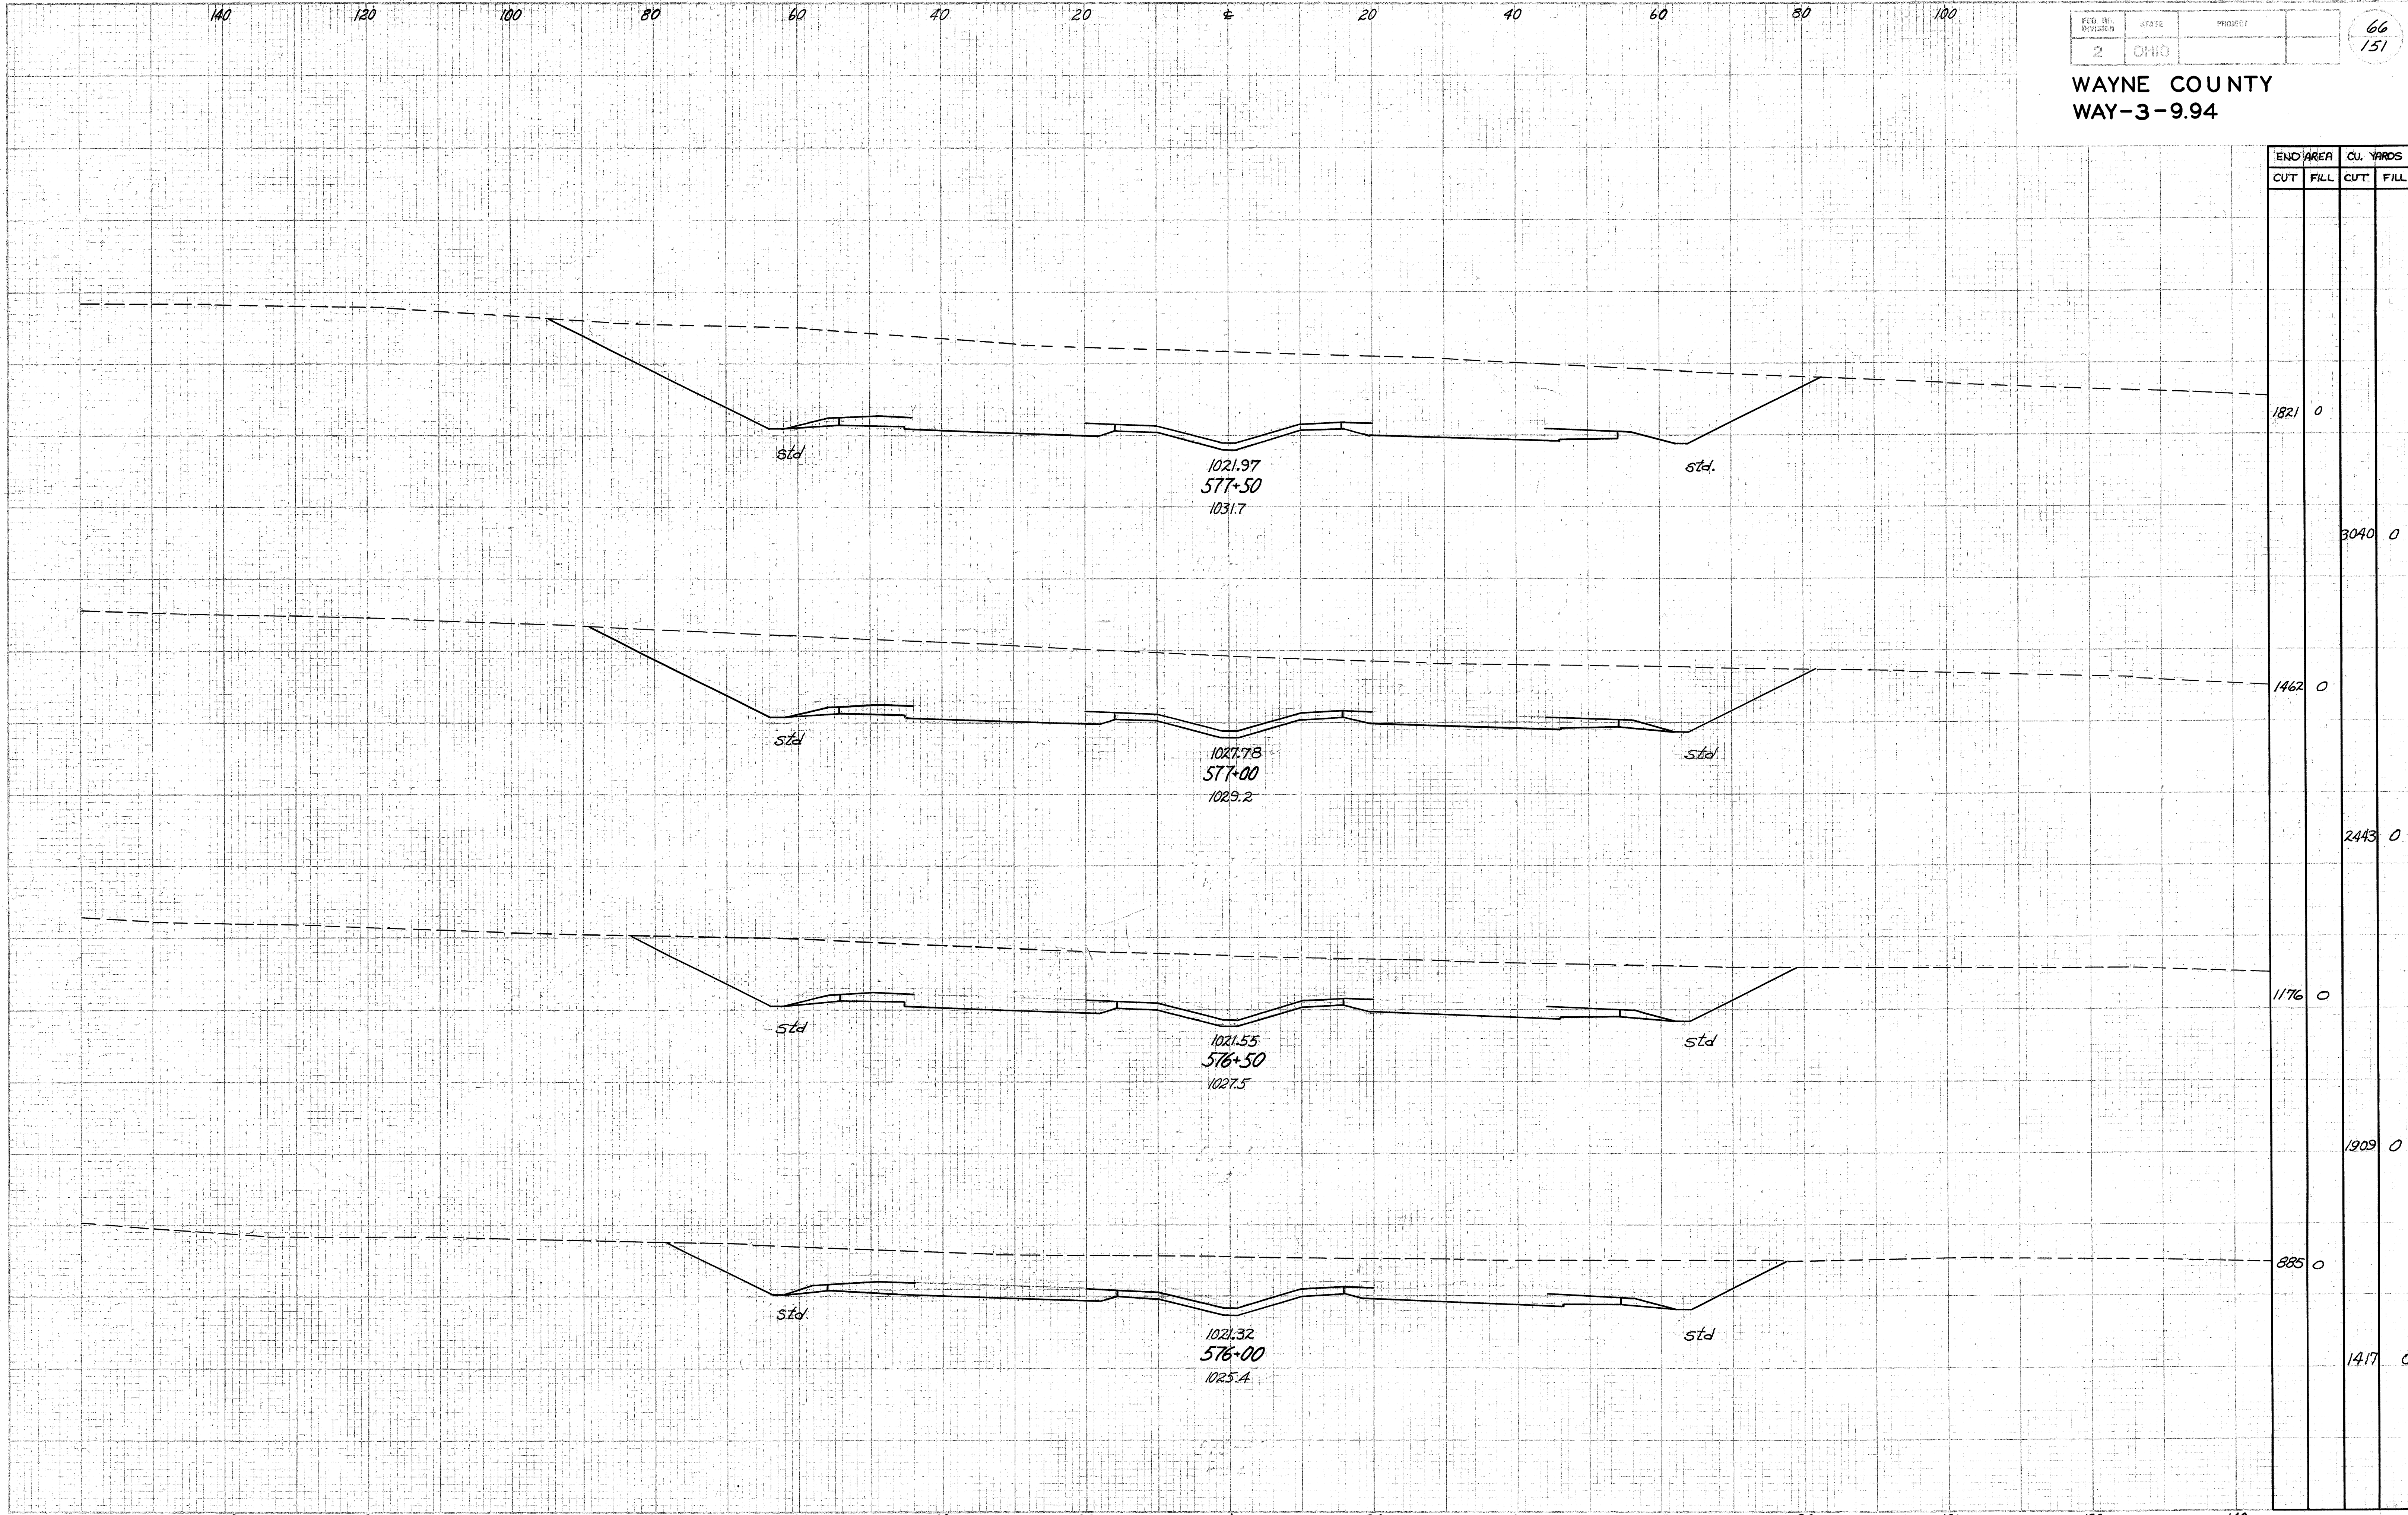

END AREA		CU. YARDS	
CUT	FILL	CUT	FILL
1821	0		
		3040	0
1462	0		
		2443	0
1176	0		
		1909	0
885	0		
		1417	0

Sta. 576+00 To Sta. 577+50


WAYNE COUNTY
WAY-3-9.94

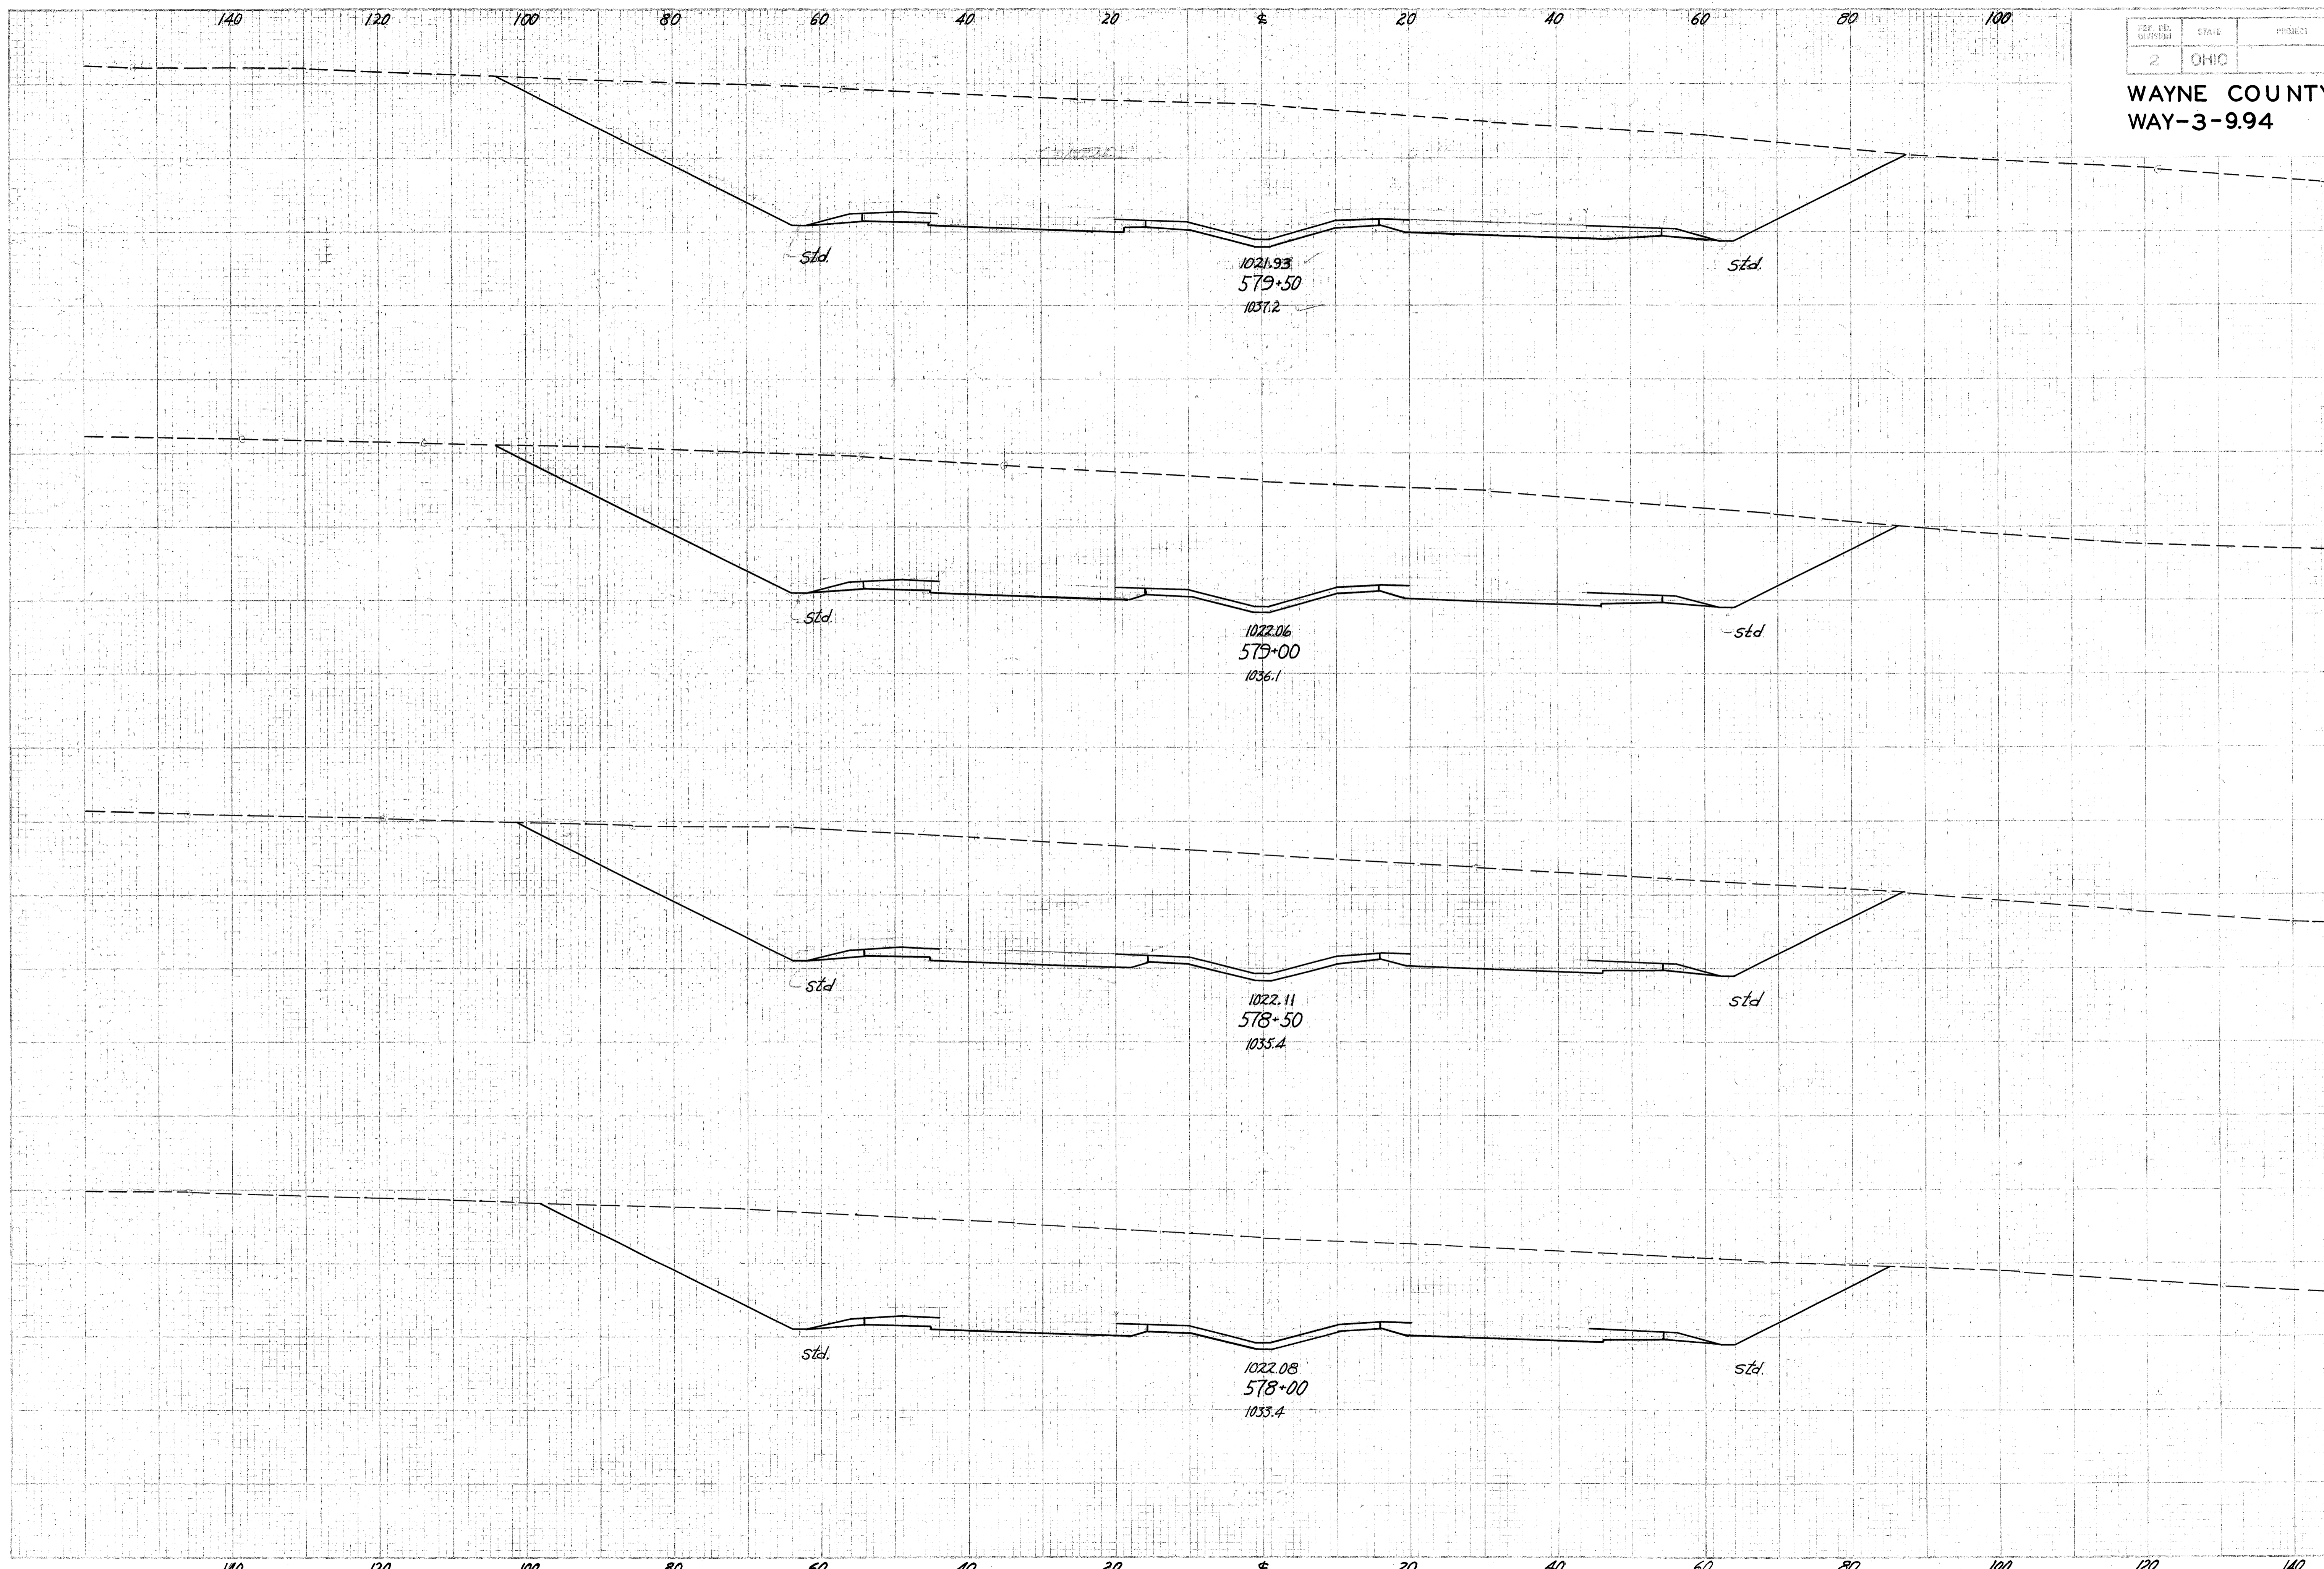

END AREA		CU. YARDS	
CUT	FILL	CUT	FILL
2677	0		
		4894	0
2608	0		
		4681	0
2447	0		
		4251	0
2144	0		
		3672	0

100 Sta. 578+00 To Sta. 579+50

WAYNE COUNTY
WAY-3-9.94

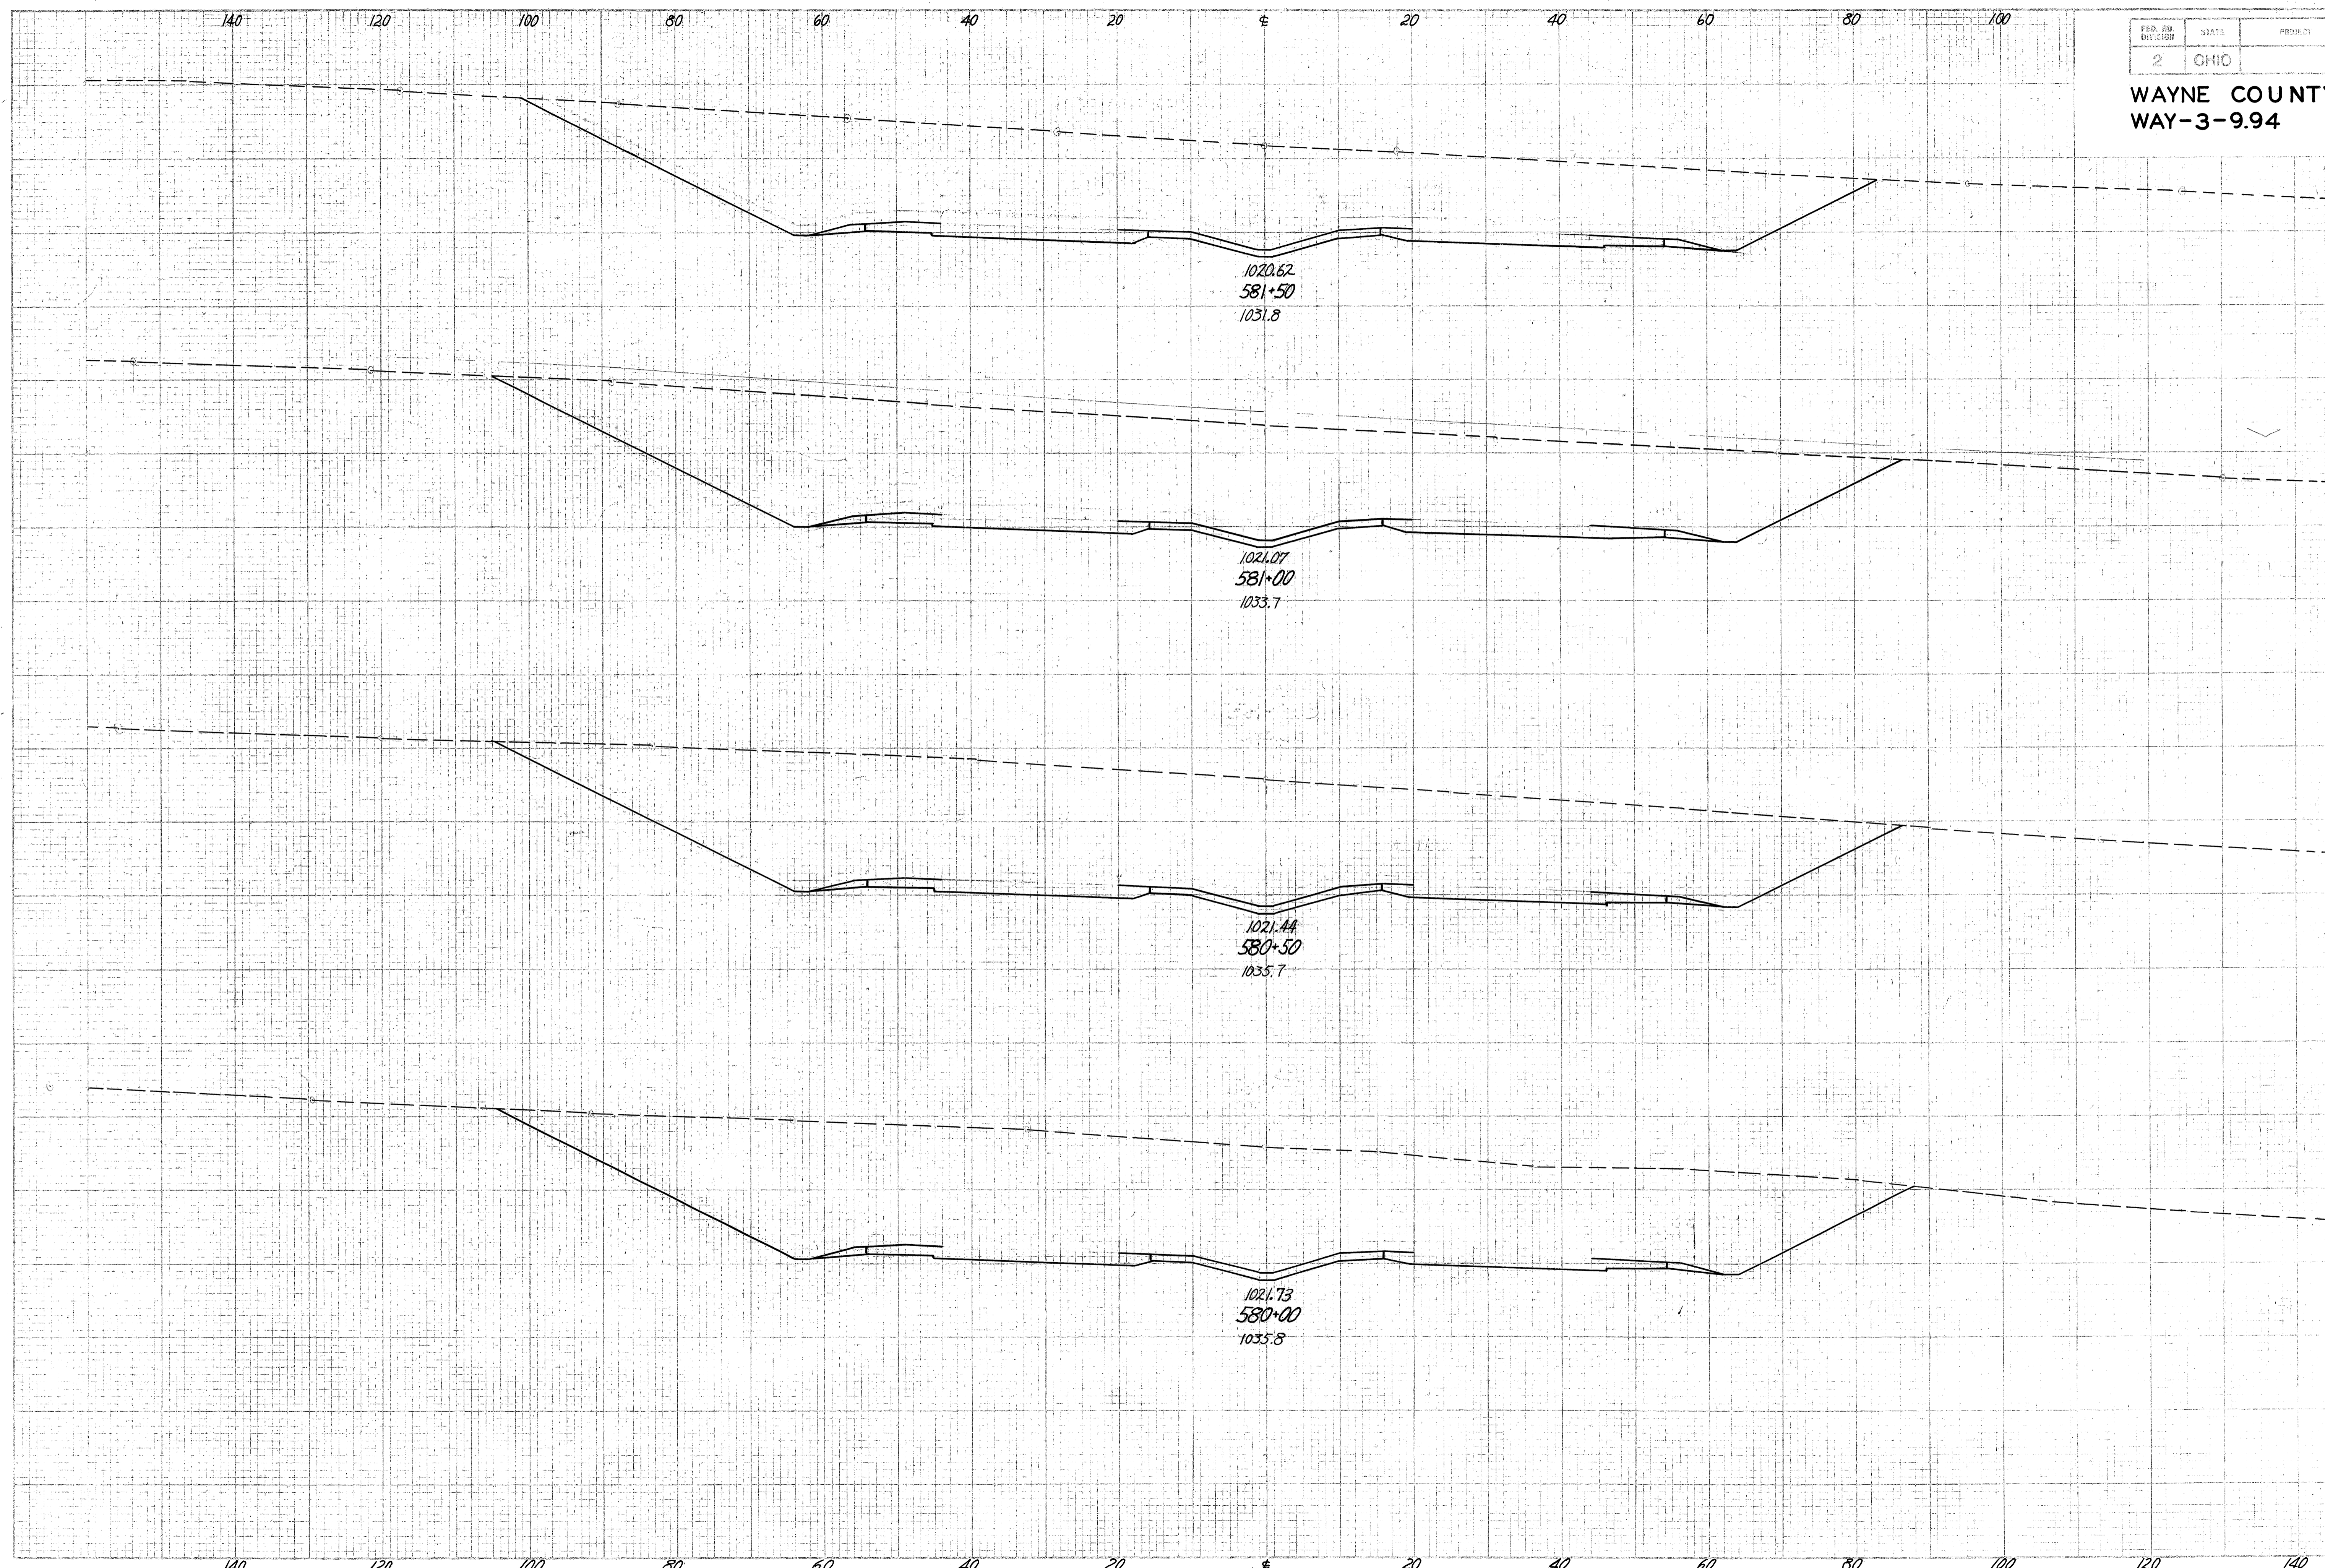

END AREA		Cu. Yds.	
CUT	FILL	CUT	FILL
2097	0		
		4174	0
2411	0		
		4650	0
2611	0		
		4840	0
2616	0		
		4901	0


1020.62
581+50
1031.8

1021.07
581+00
1033.7

1021.44
580+50
1035.7


1021.73
580+00
1035.8

WAYNE COUNTY
WAY-3-9.94

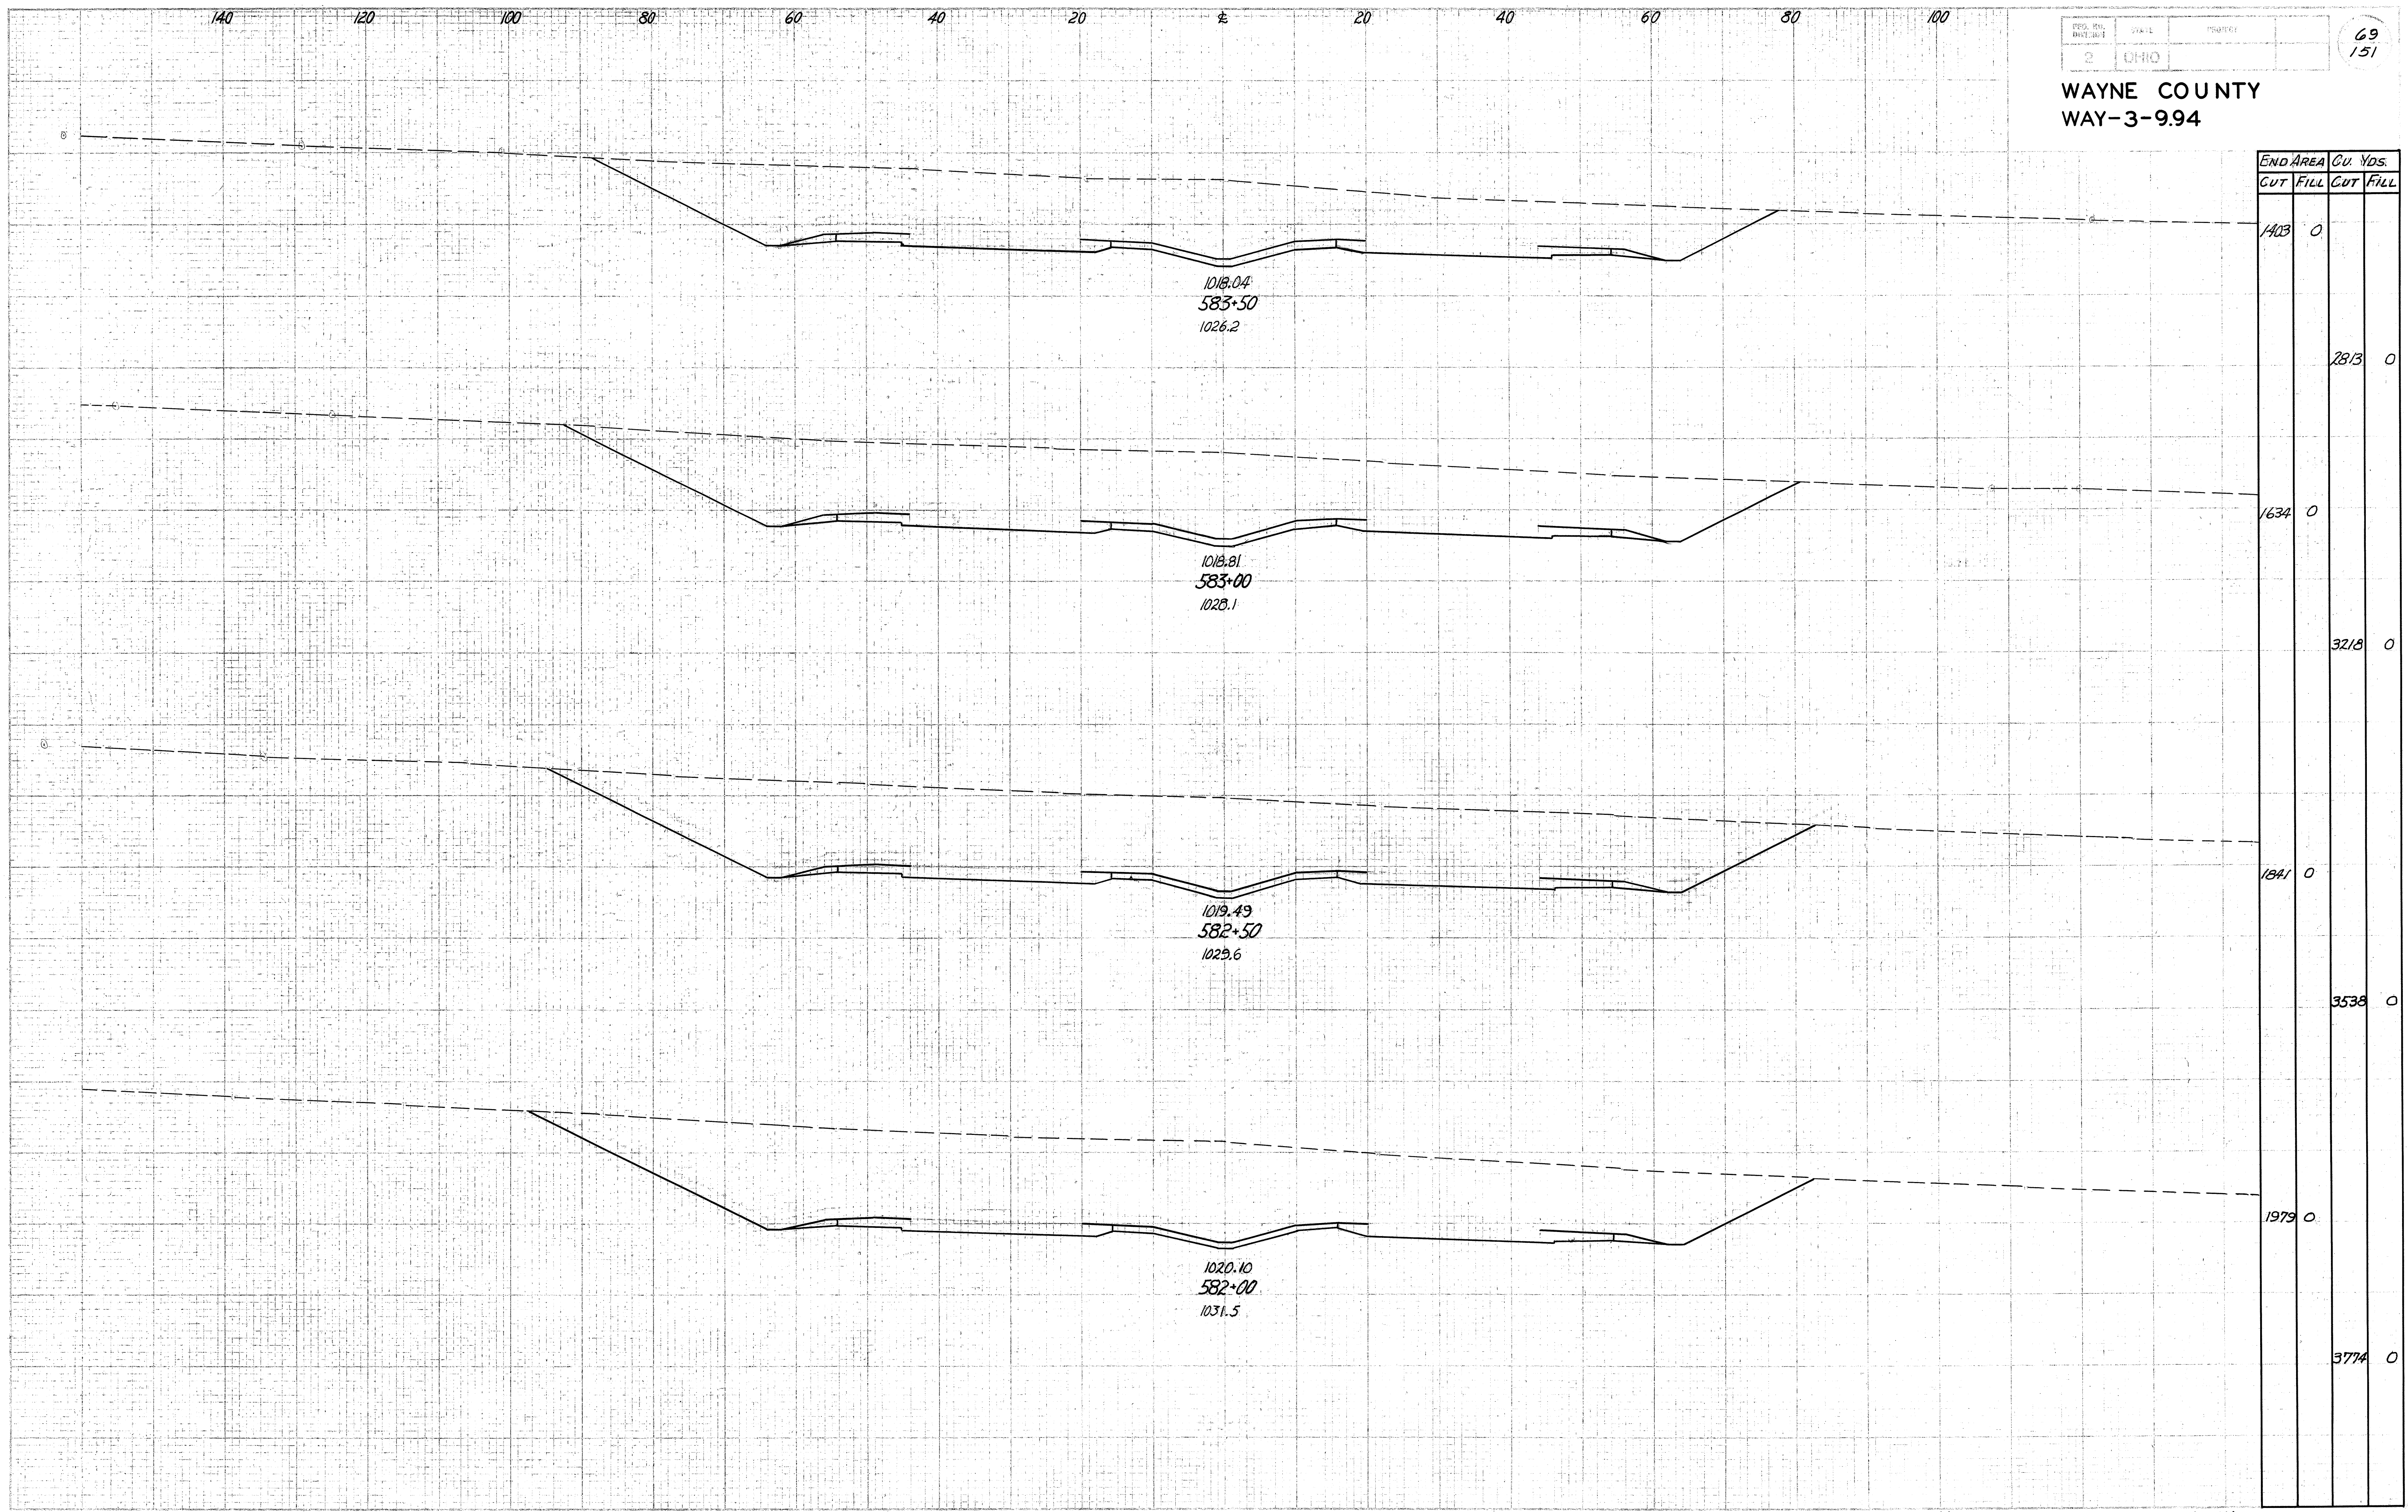

END AREA	Cu. Yds.	
CUT	FILL	
1403	0	
		283 0
1634	0	
		3218 0
1841	0	
		3538 0
1979	0	
		3774 0

WAYNE COUNTY
WAY-3-9.94

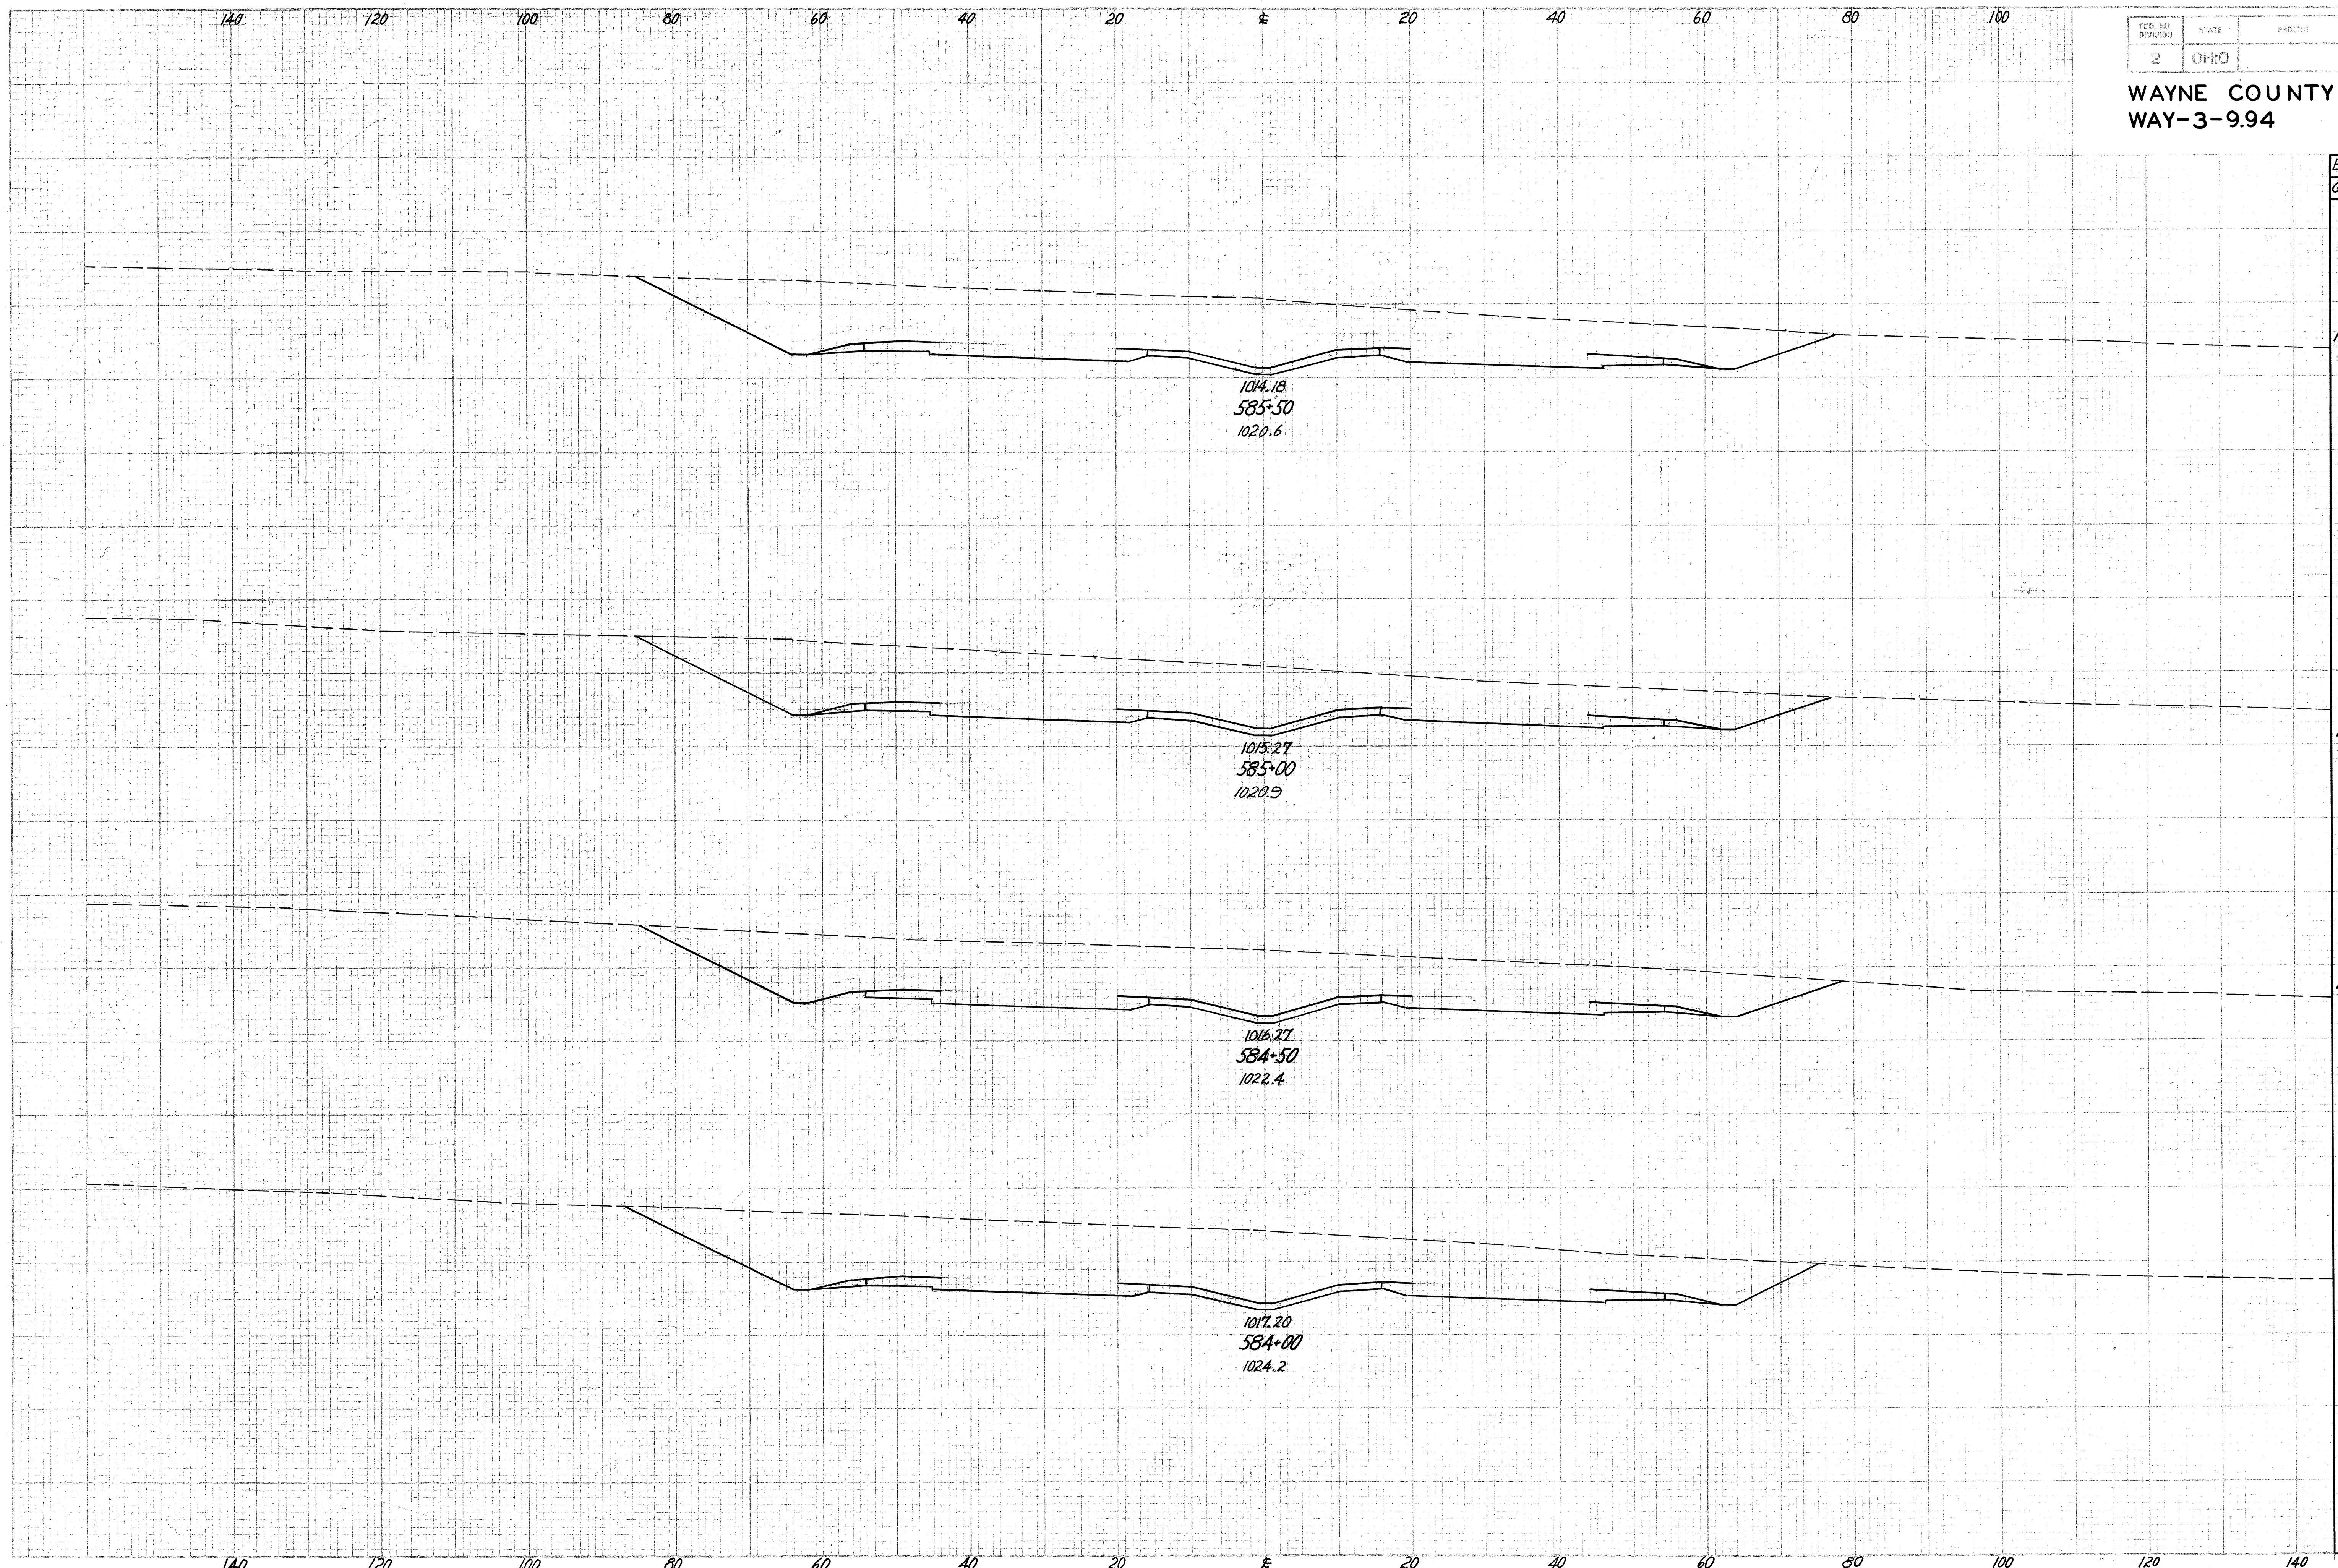

END AREA		CU. YDS.	
CUT	FILL	CUT	FILL
1167	0		
		2095	0
1095	0		
		2070	0
1140	0		
		2221	0
1258	0		
		2464	0


1014.18
585+30
1020.6

1015.27
585+00
1020.9

1016.27
584+30
1022.4

1017.20
584+00
1024.2

WAYNE COUNTY
WAY-3-9.94

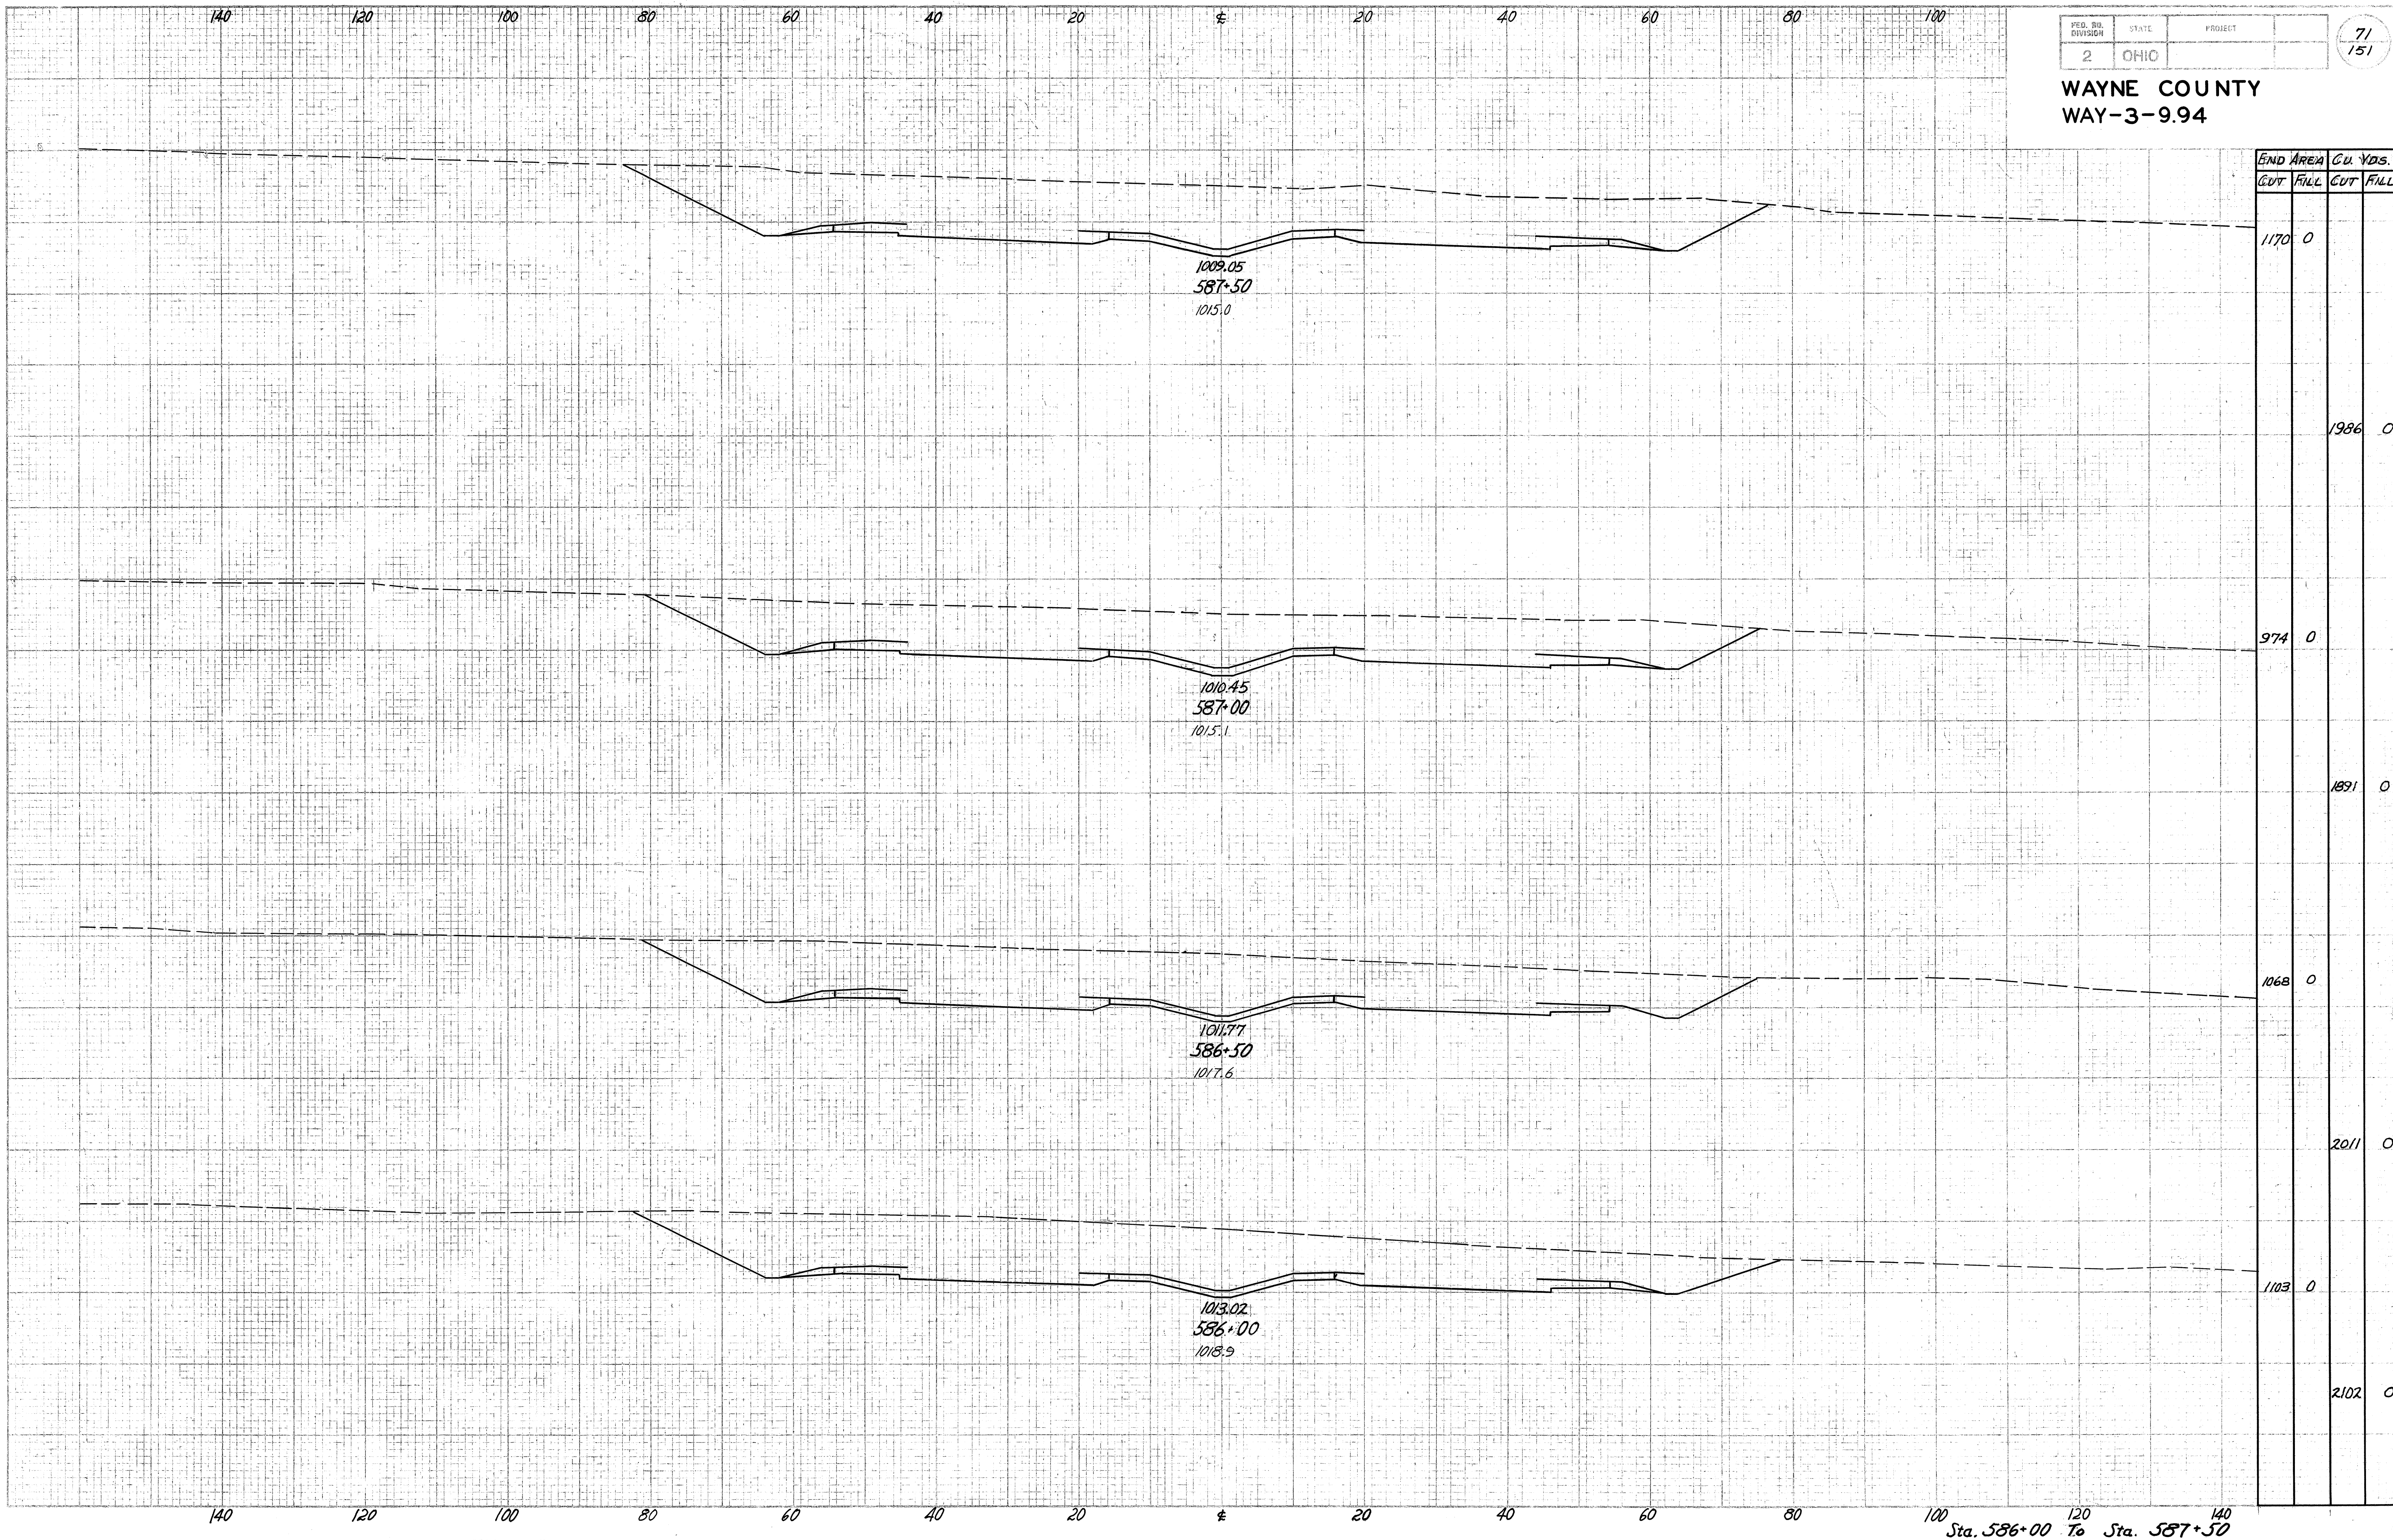


1009.05
587+50
1015.0

1010.45
587+00
1015.1


1011.77
586+50
1017.6

1013.02
586+00
1018.9


WAYNE COUNTY
WAY-3-9.94

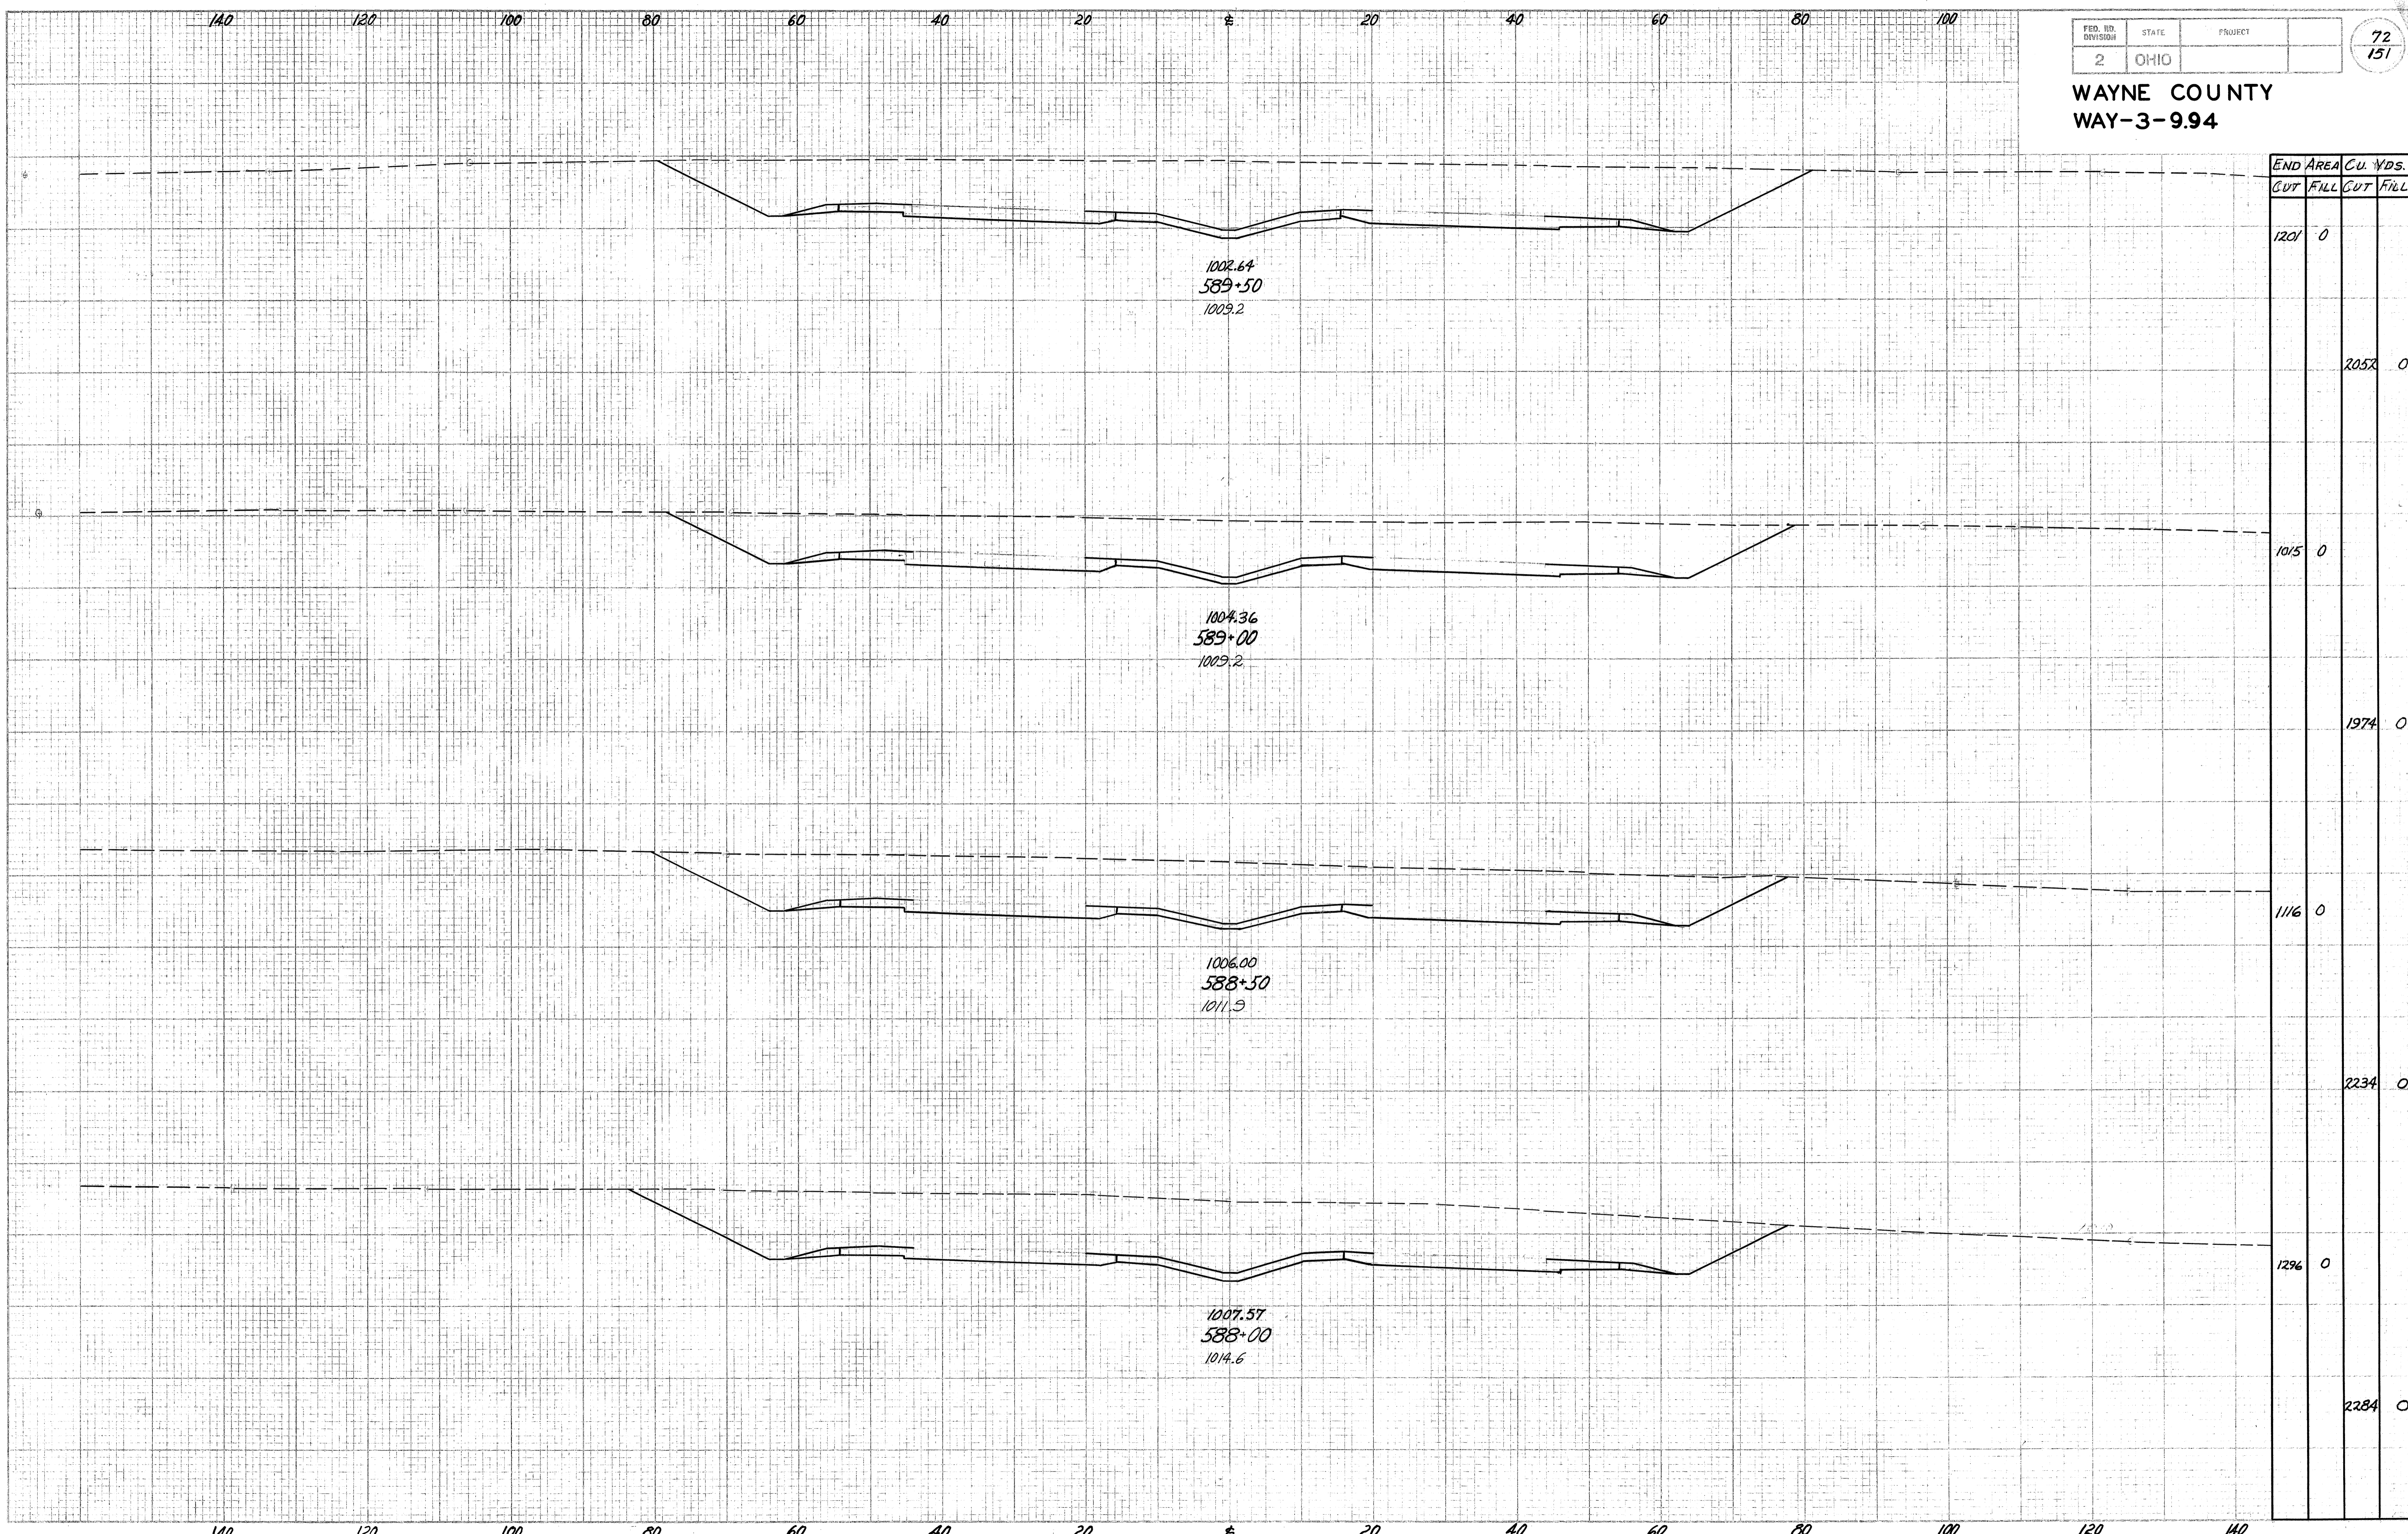

WAYNE COUNTY
WAY-3-9.94

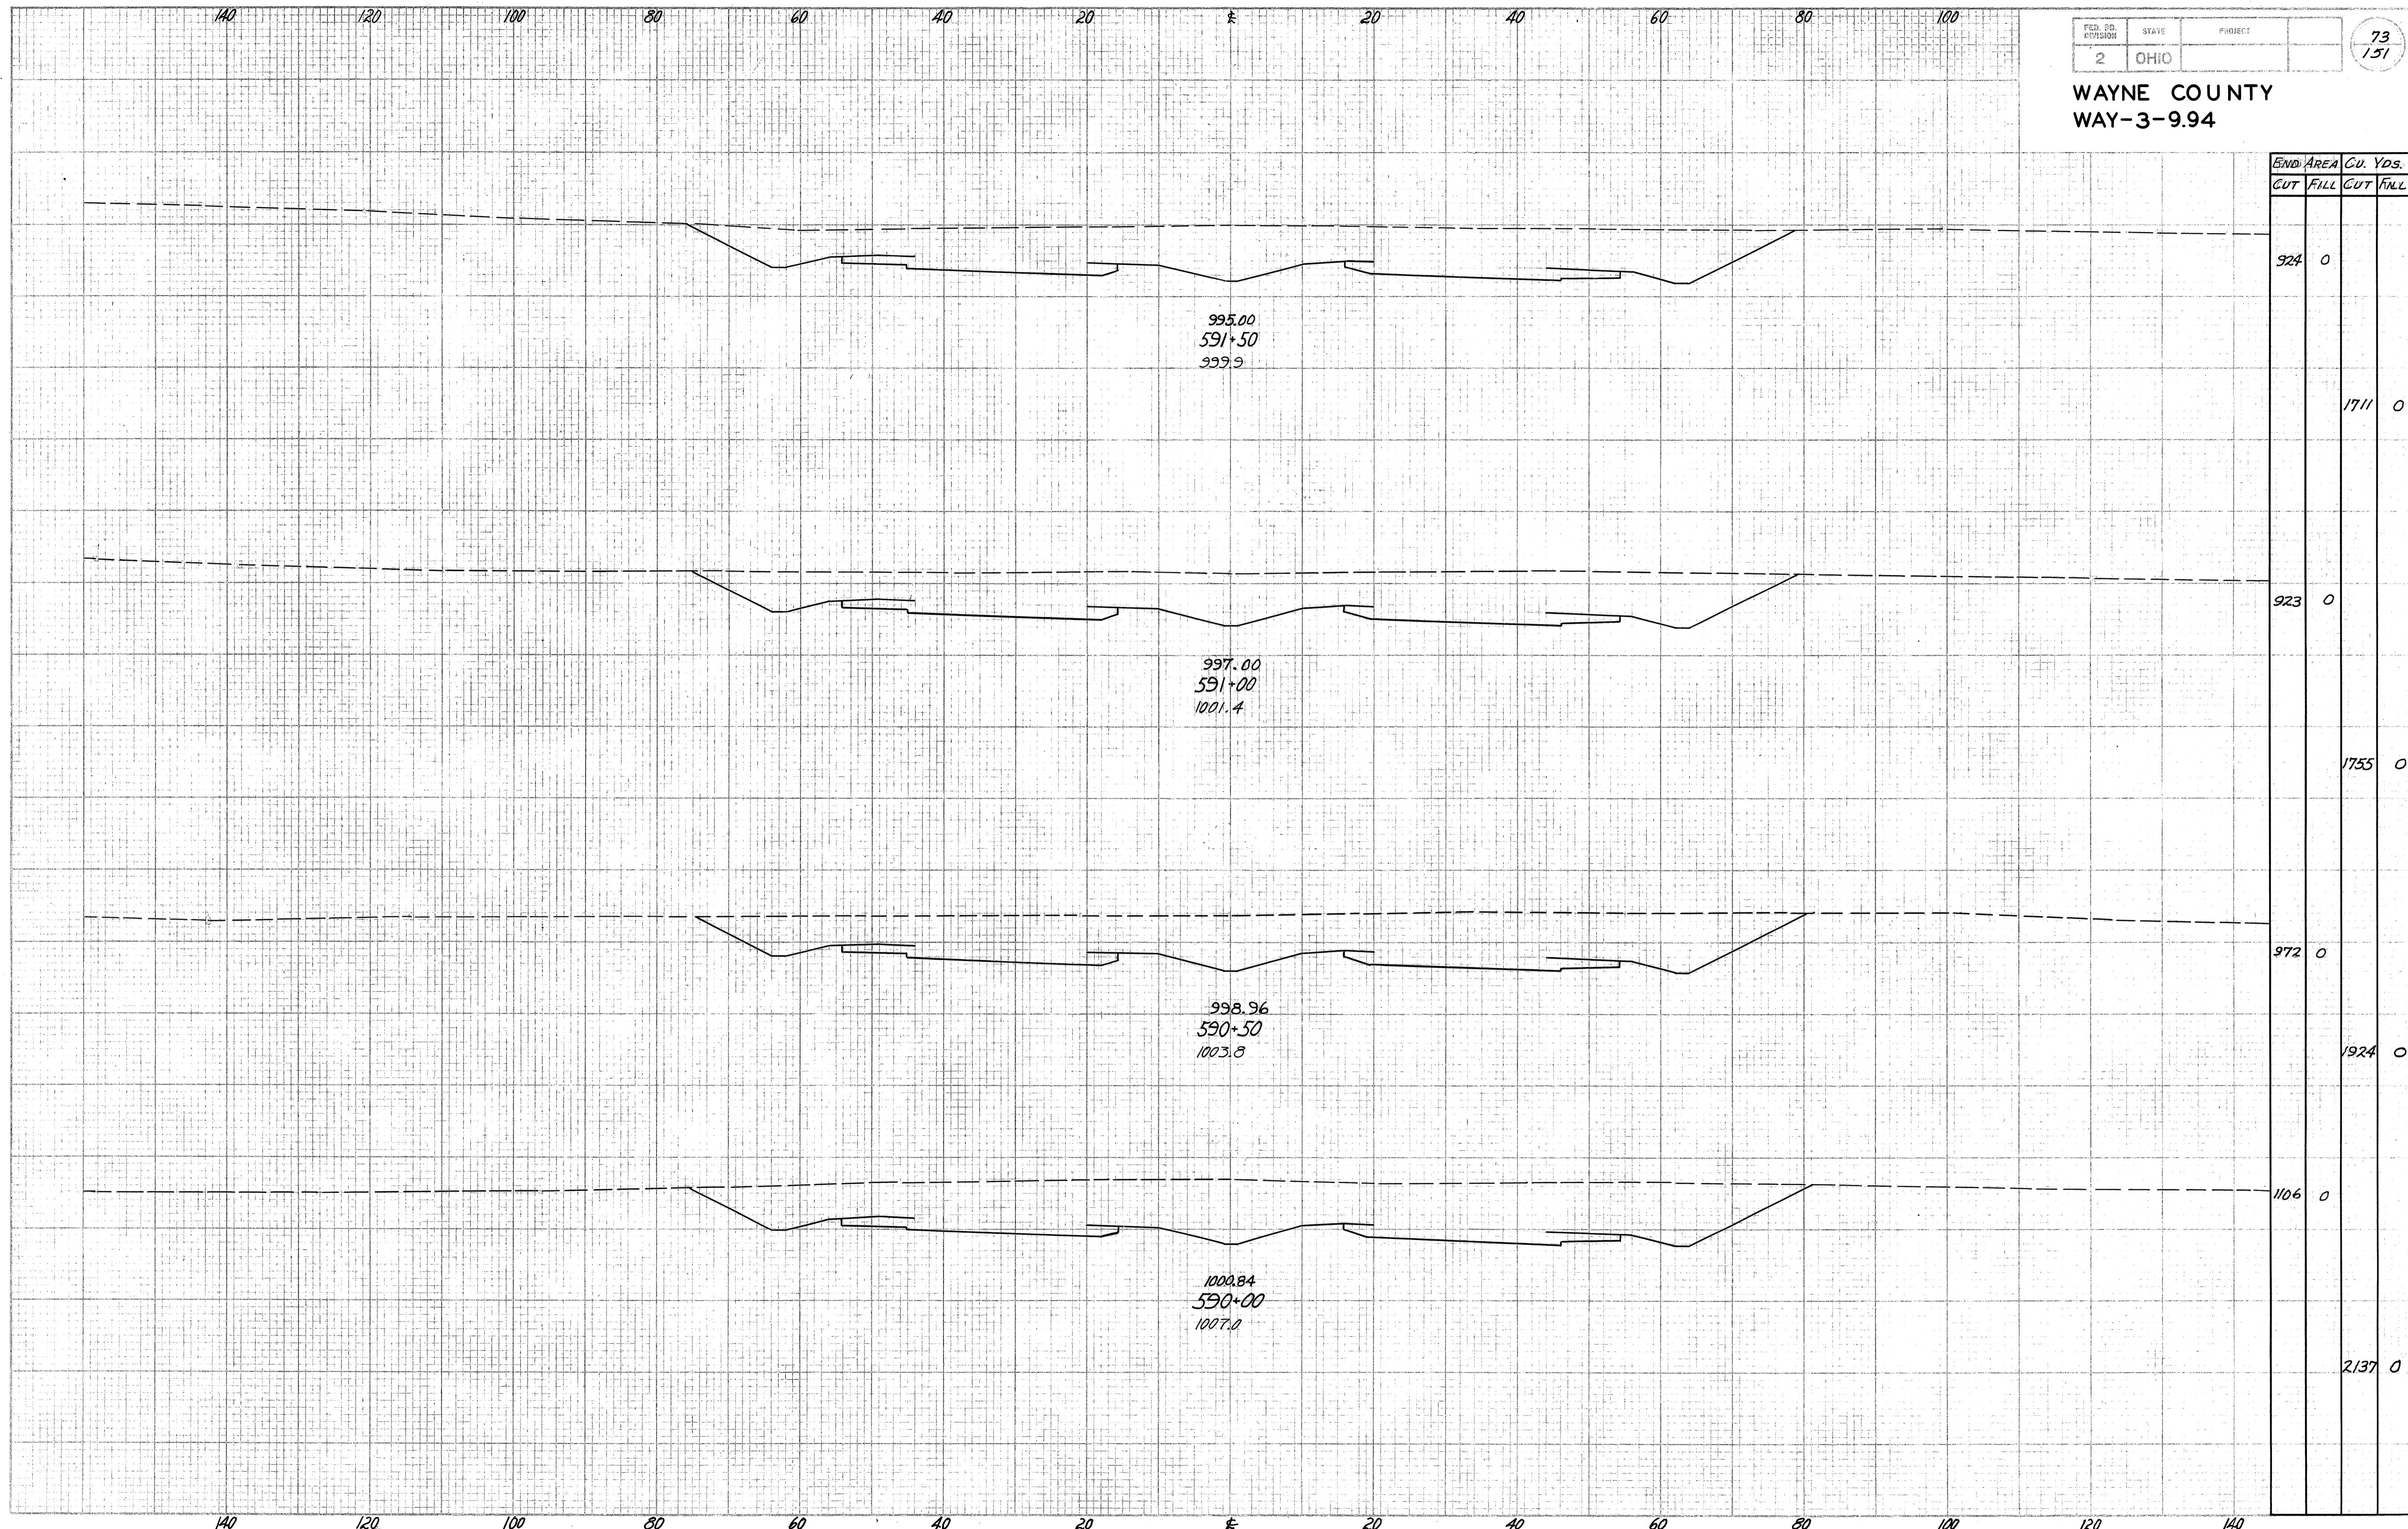

WAYNE COUNTY
WAY-3-9.94

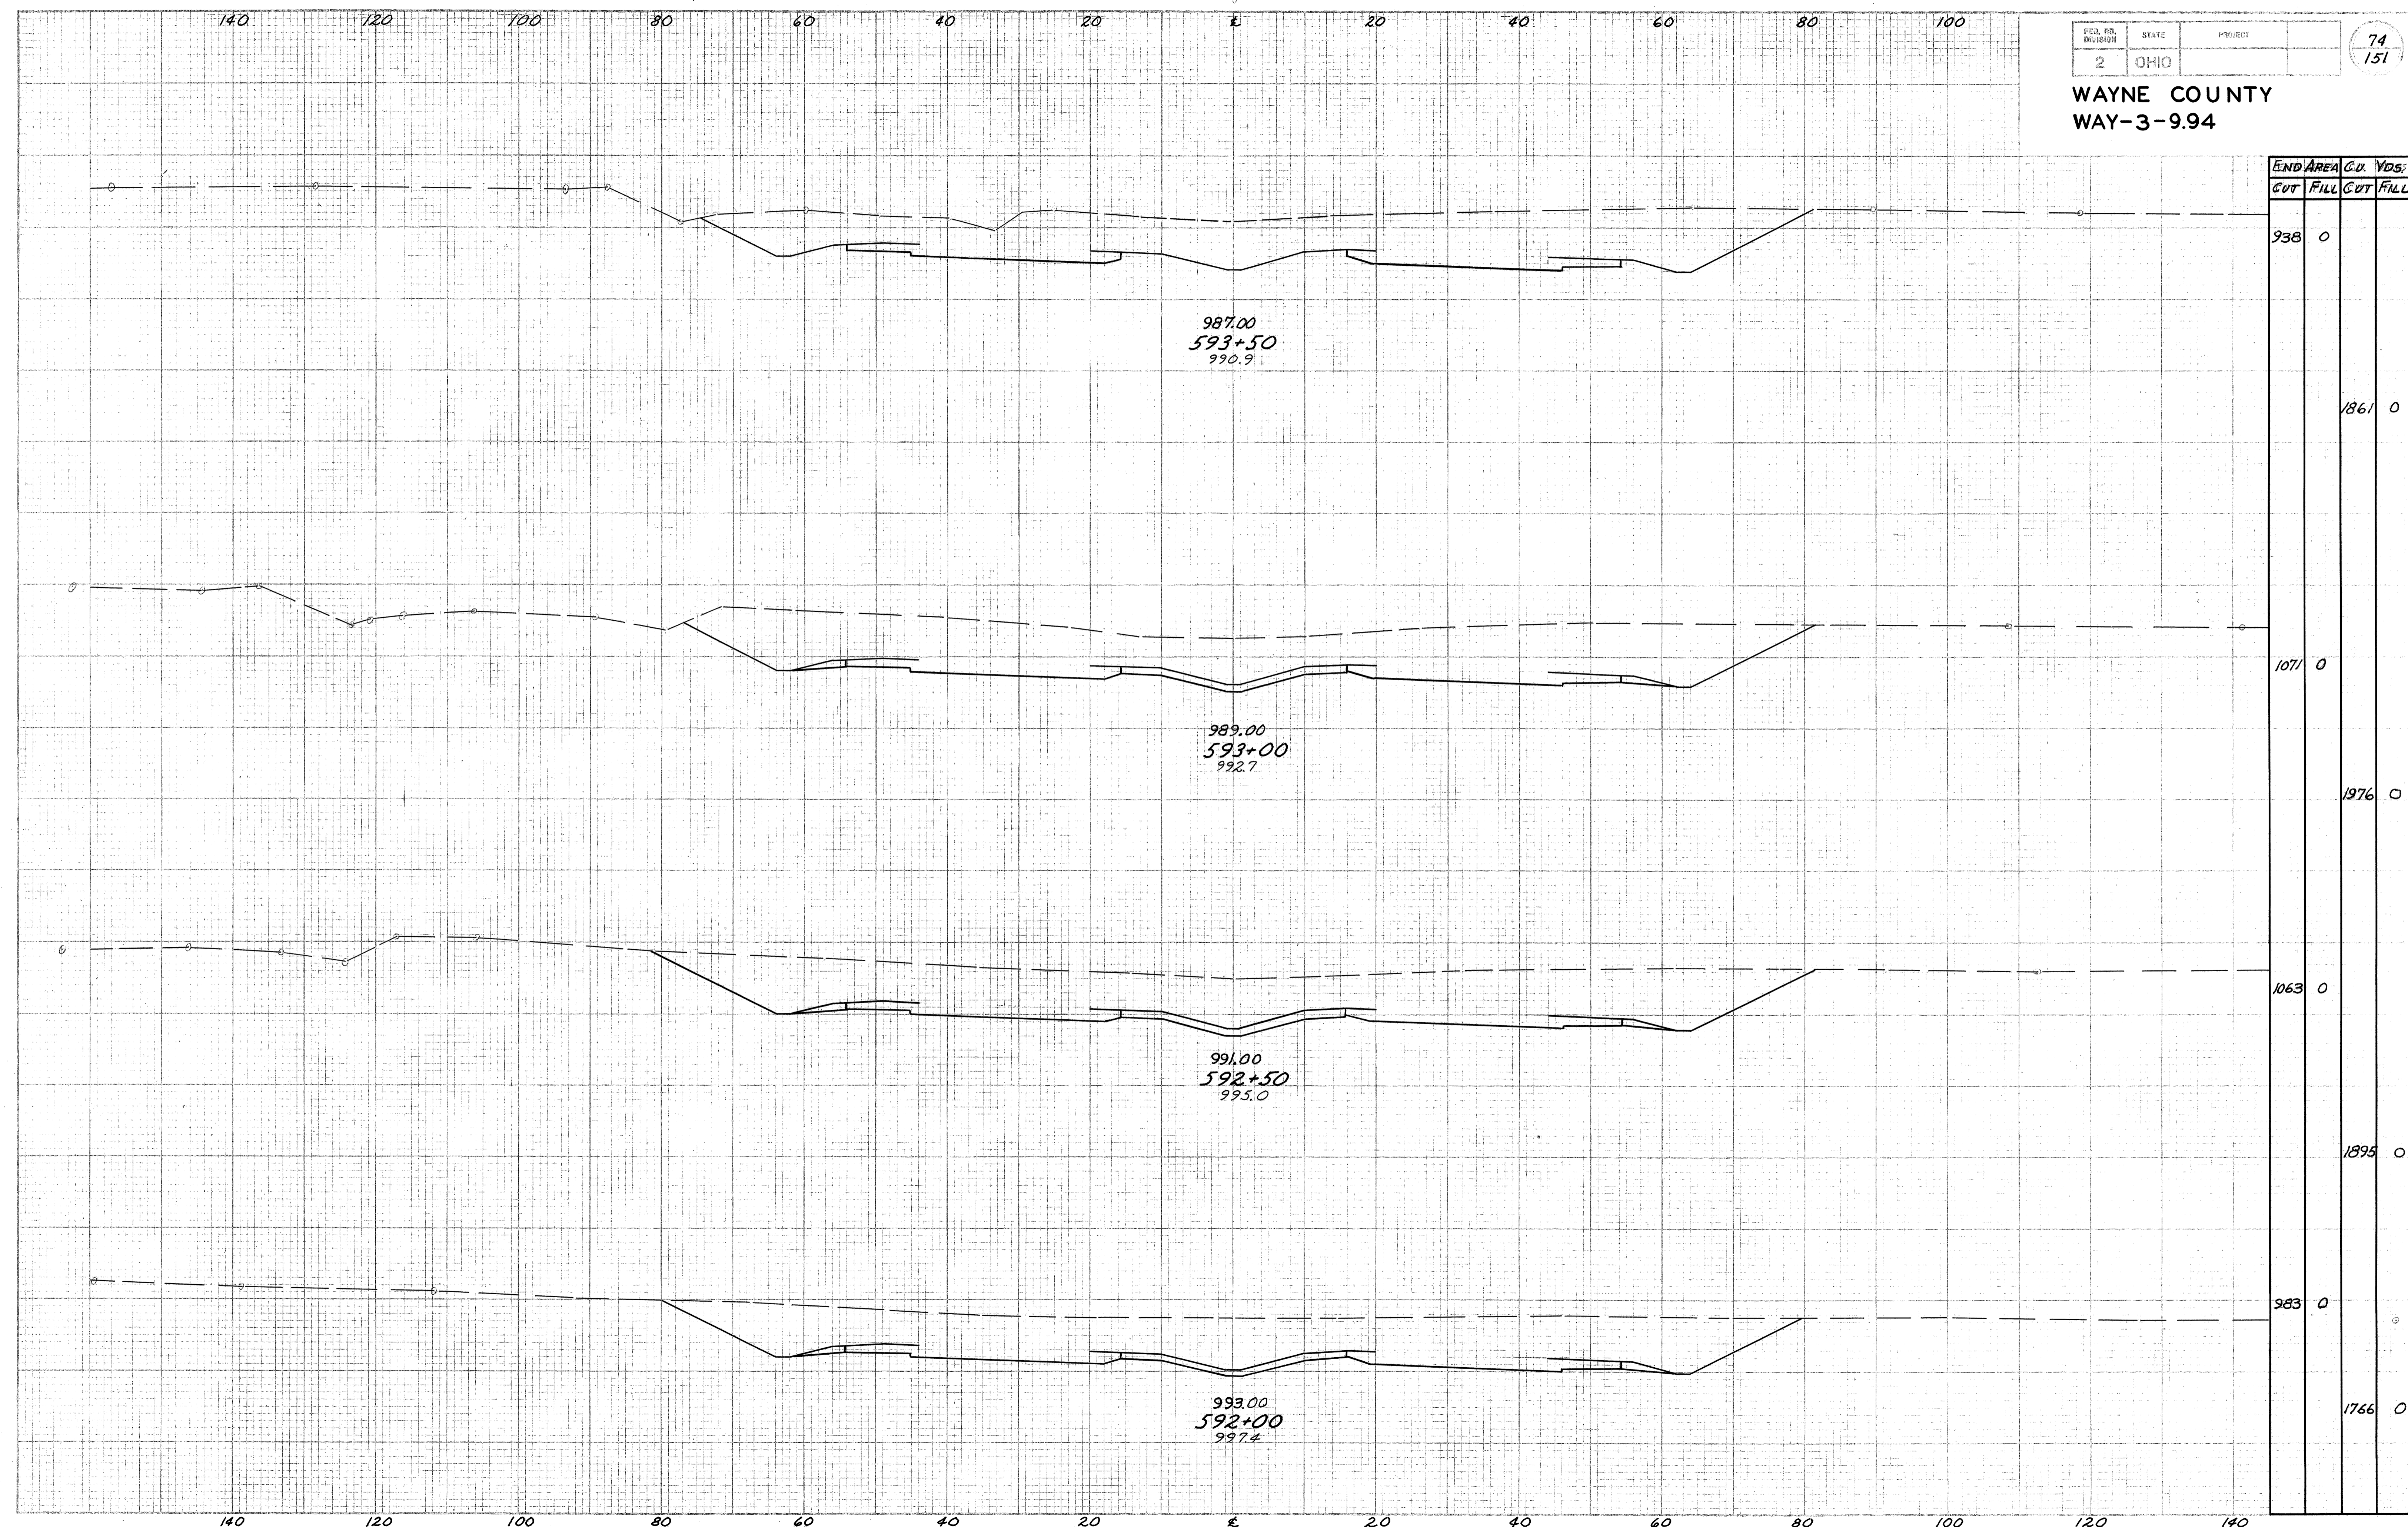

END AREA	C.U. YDS.	
	CUT	FILL
938	0	
		1861
1071	0	
		1976
1063	0	
		1895
983	0	
		1766


987.00
593+50
990.9

989.00
593+00
992.7

991.00
592+50
995.0


993.00
592+00
997.4

WAYNE COUNTY
WAY-3-994

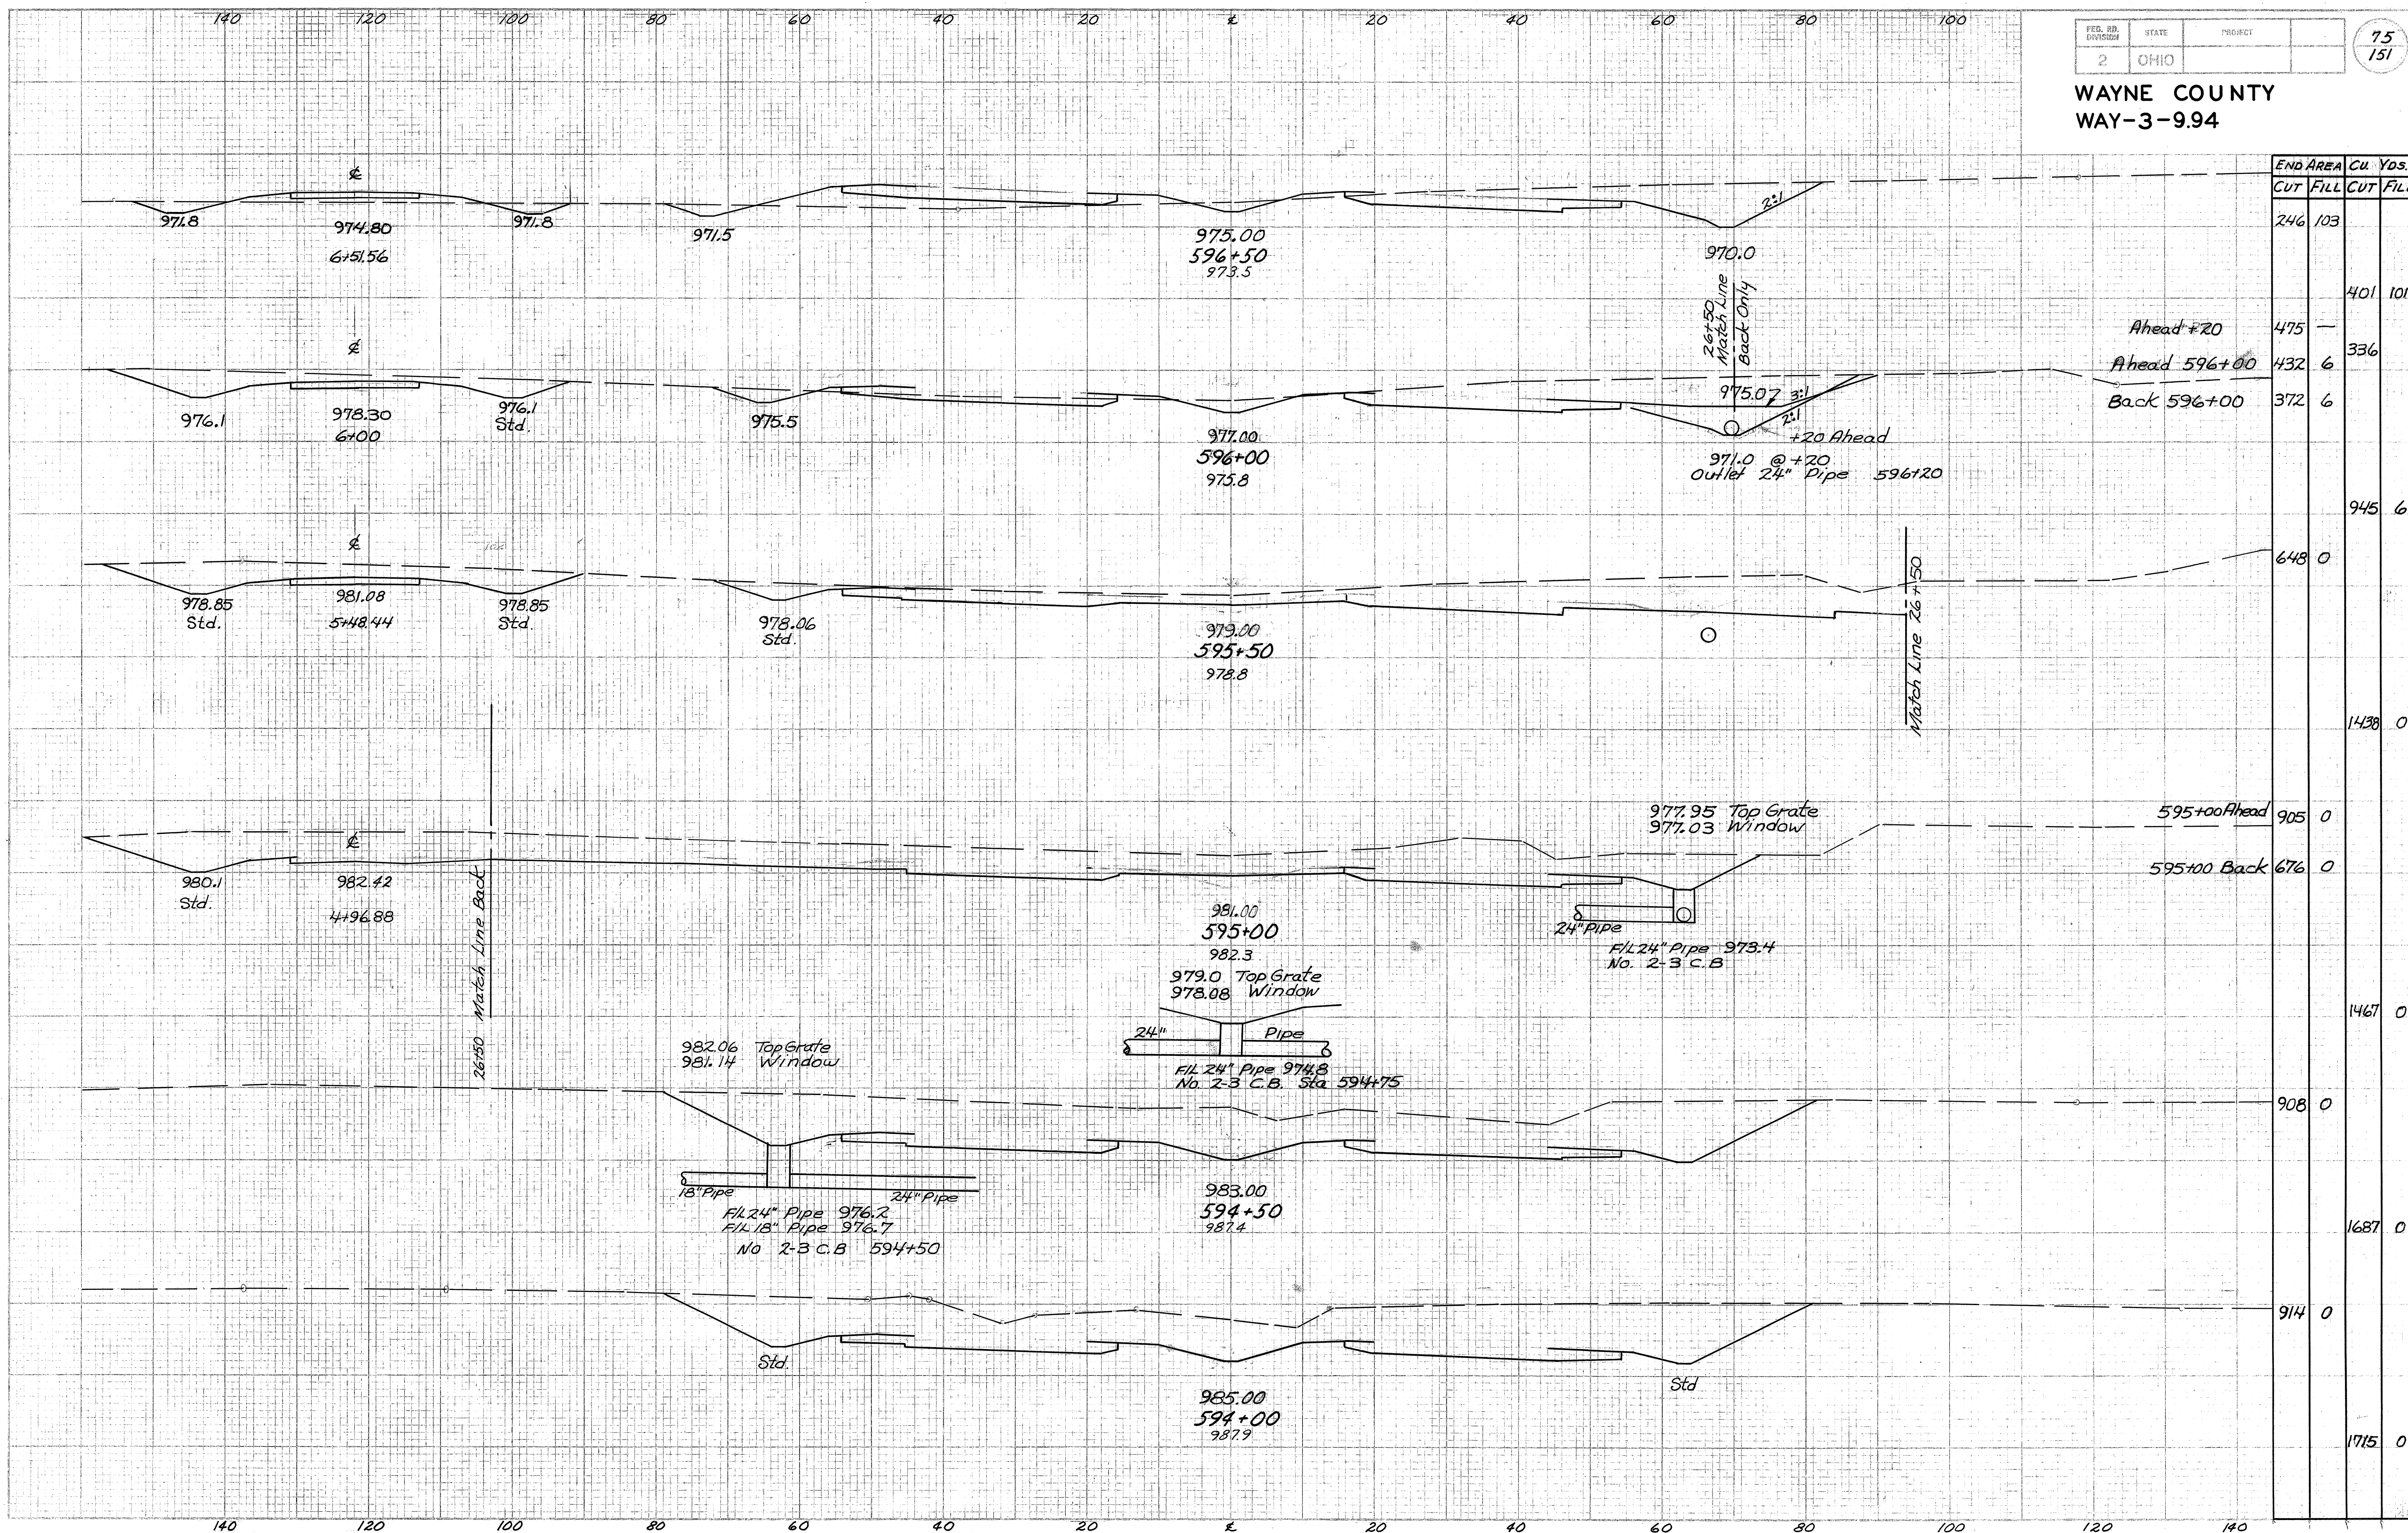

END AREA	Cu. Yds.	
	CUT	FILL
246	103	
		401 101
Ahead +20	475	—
Ahead 596+00	432	6
Back 596+00	372	6
		945 6
648	0	
		1438 0
595+00 Ahead	905	0
595+00 Back	676	0
		1467 0
908	0	
		1687 0
914	0	
		1715 0


WAYNE COUNTY
WAY-3-994

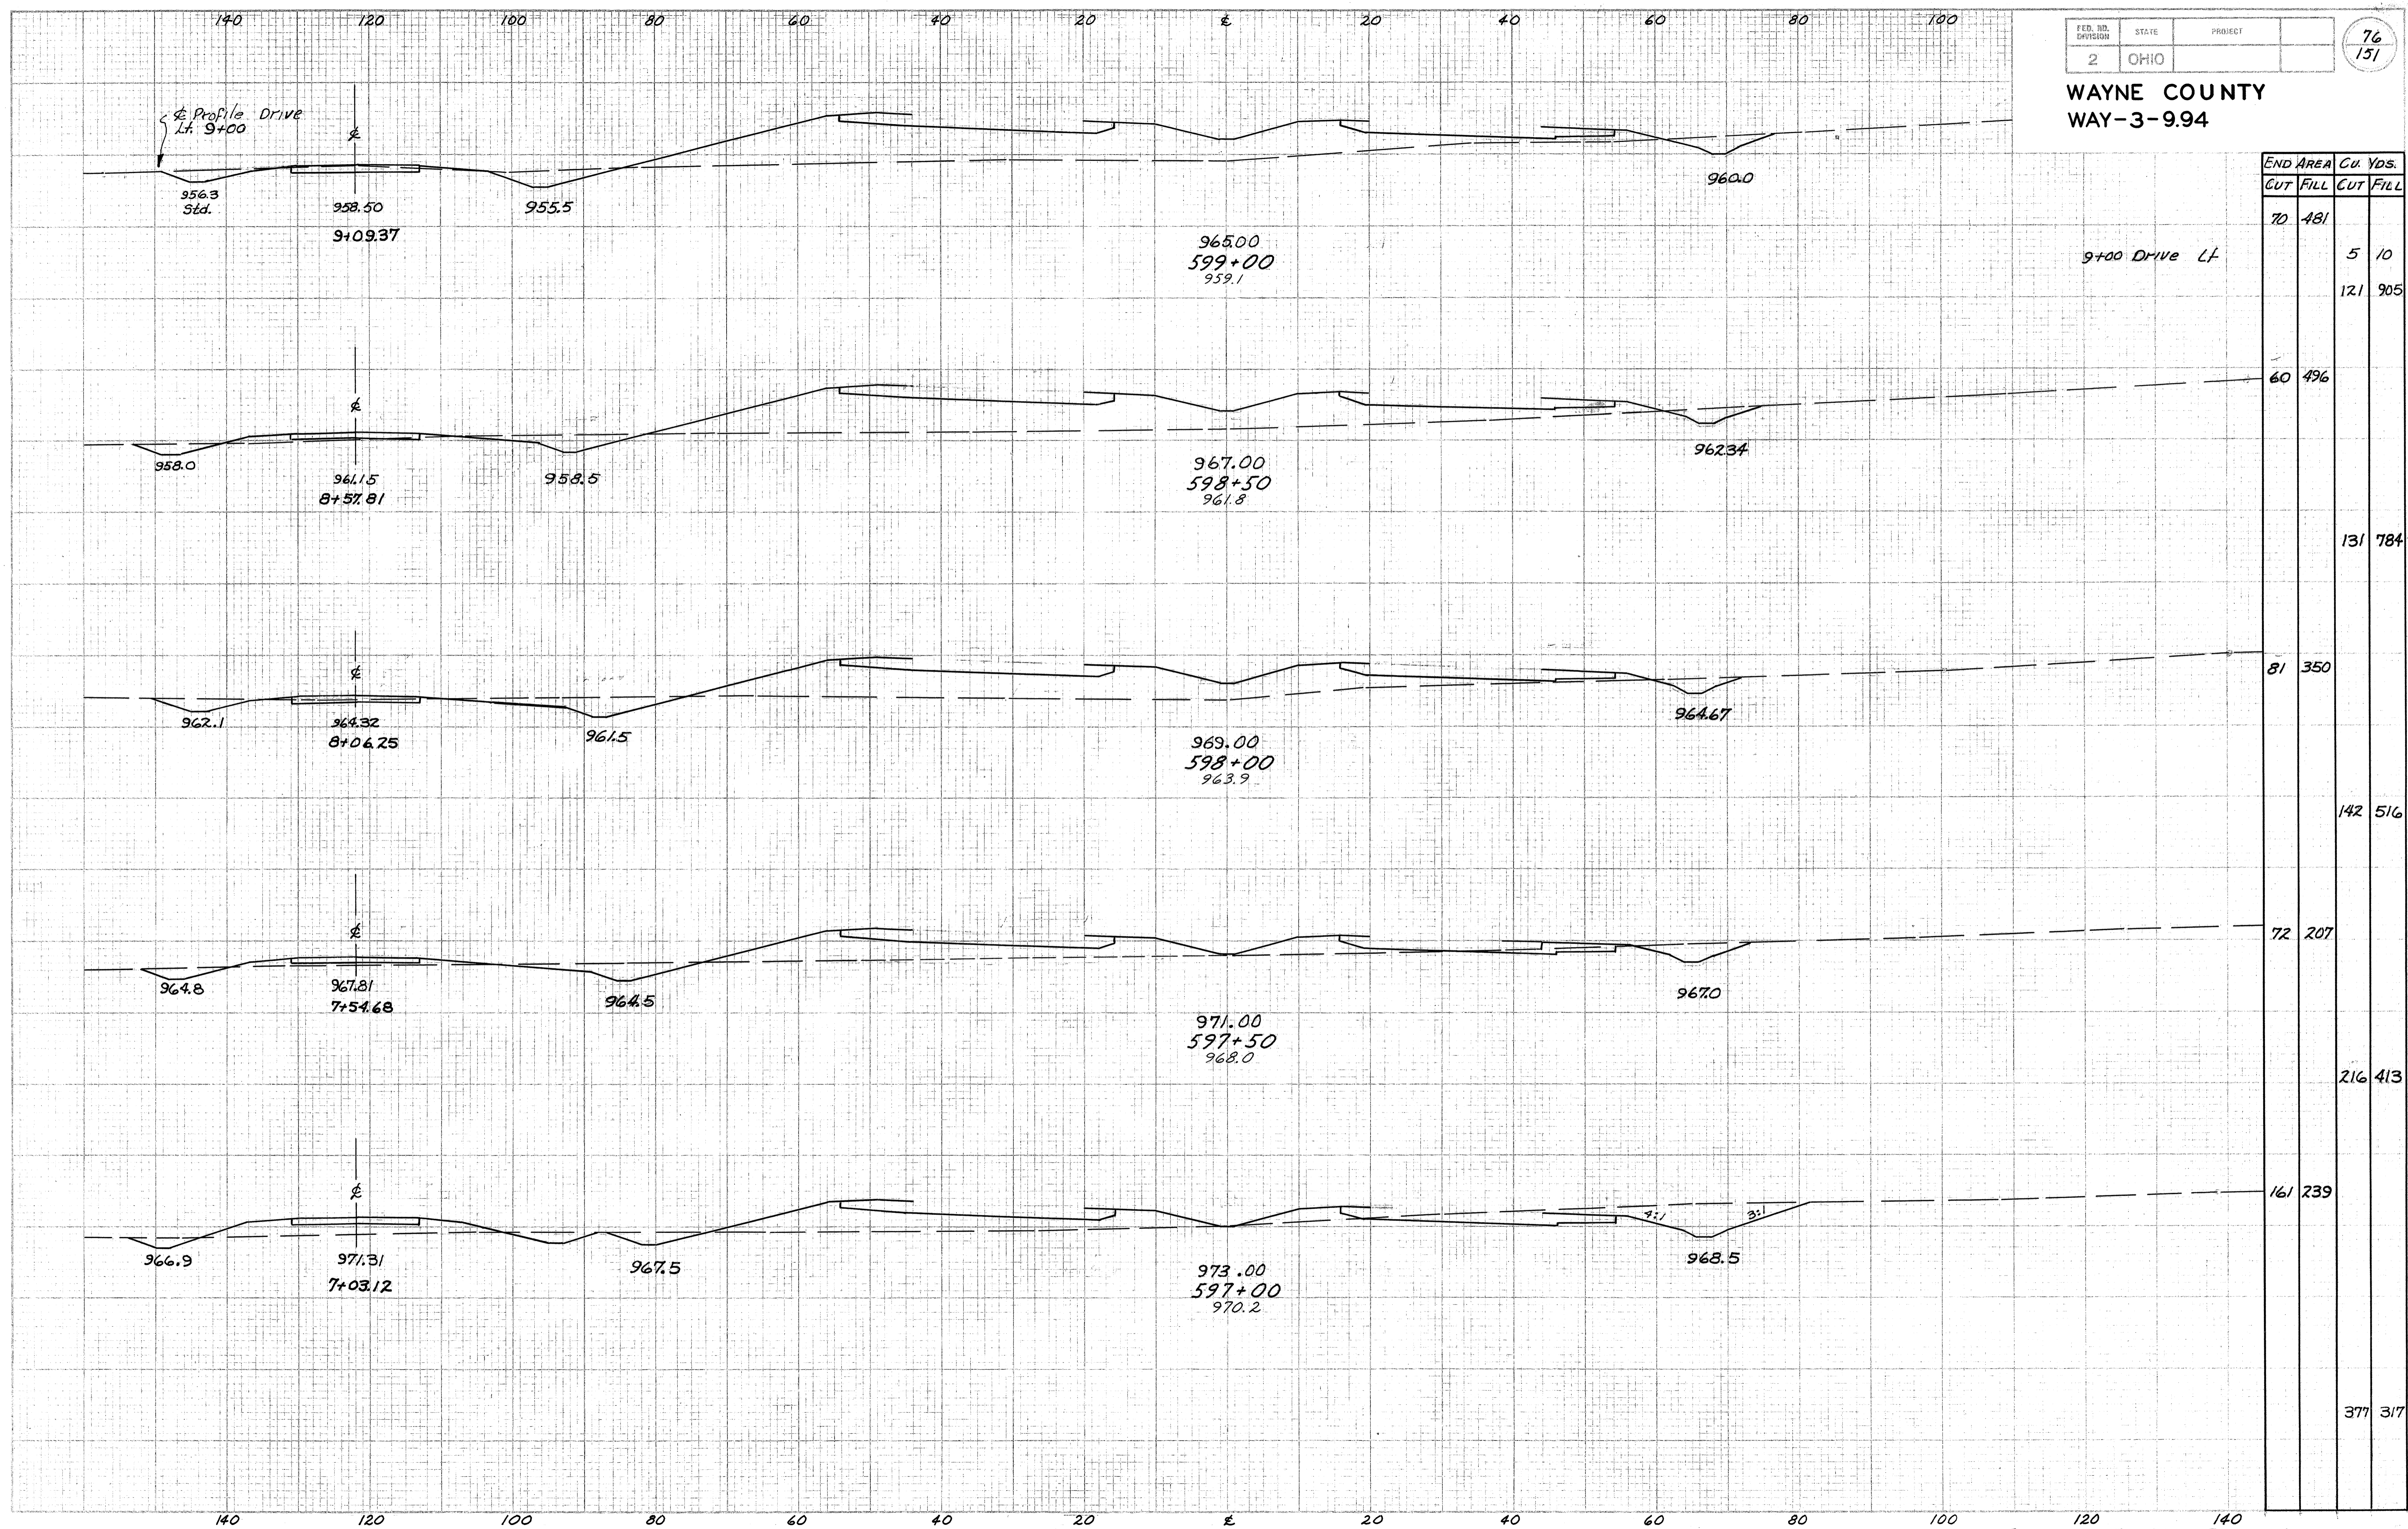

END AREA	Cu. Yds.	
	CUT	FILL
70	481	
		5 10
		121 905
60	496	
		131 784
81	350	
		142 516
72	207	
		216 413
161	239	
		371 317

Sta. 597+00 To Sta. 599+00


WAYNE COUNTY
WAY-3-9.94

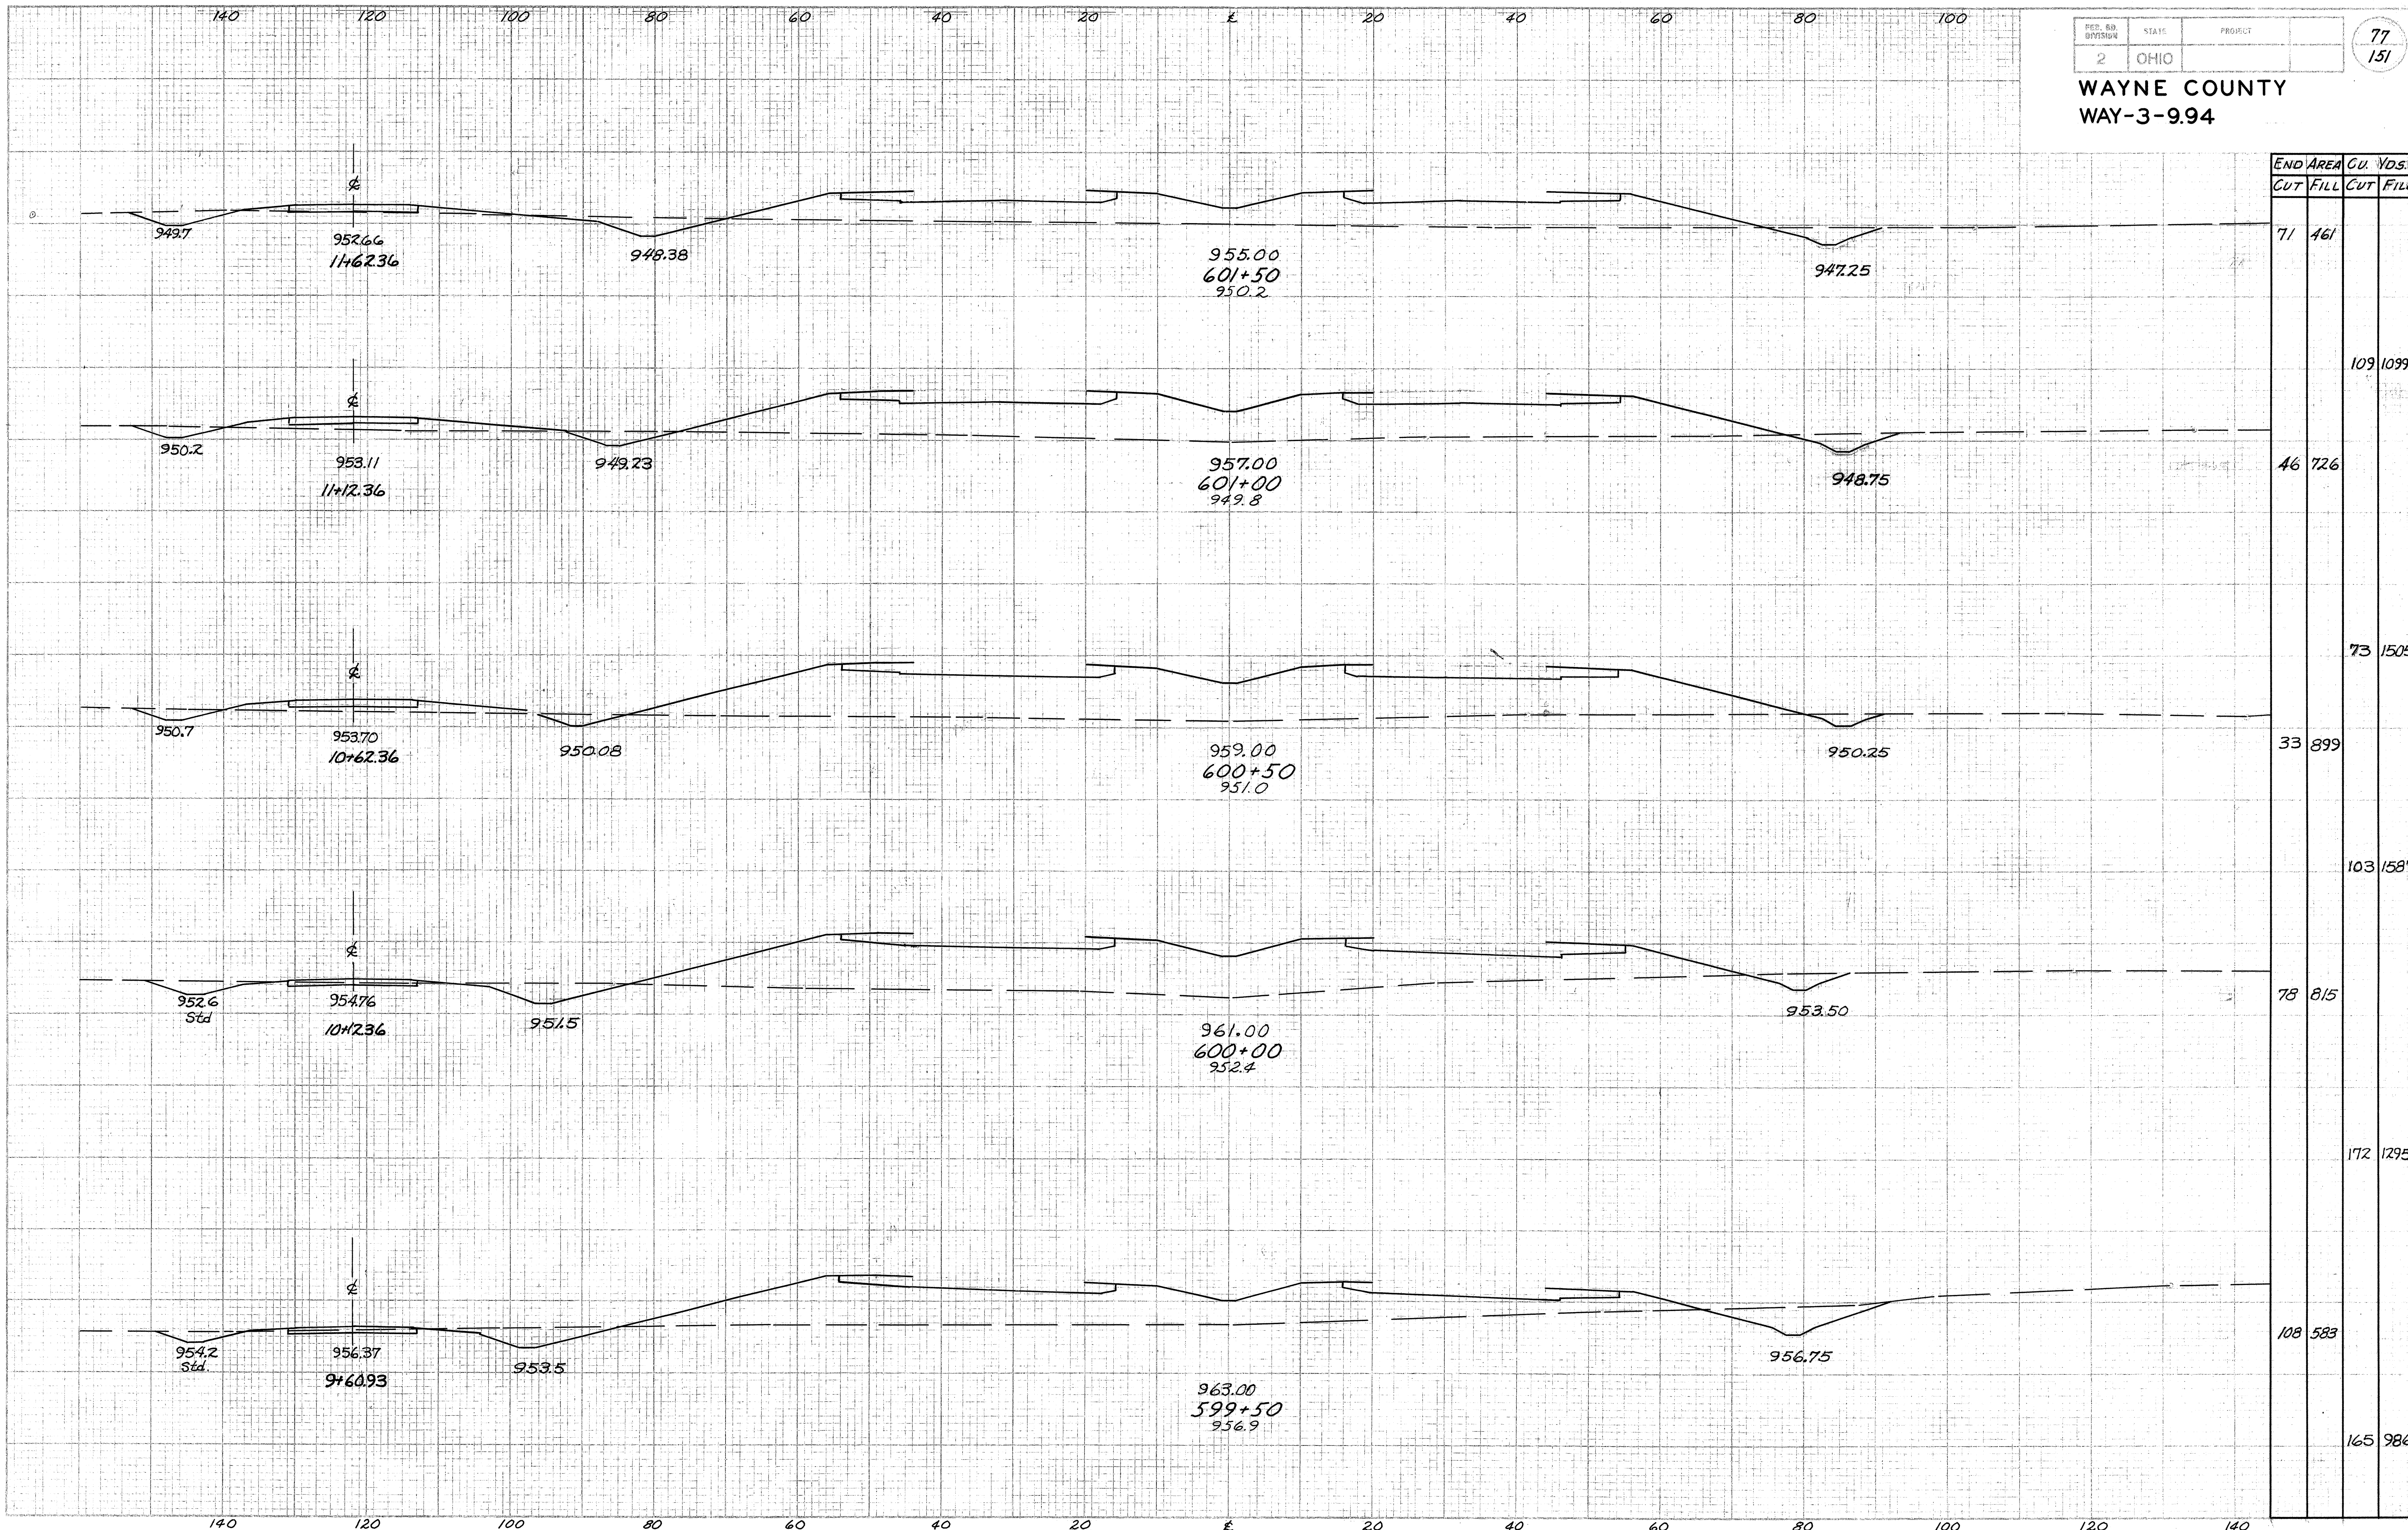

END STA.	AREA		CU. YDS.	
	CUT	FILL	CUT	FILL
71	461			
			109	1099
46	726			
			73	1505
33	899			
			103	1587
78	815			
			172	1295
108	583			
			165	986

Sta. 599+50 To Sta. 601+50


WAYNE COUNTY
WAY-3-9.94

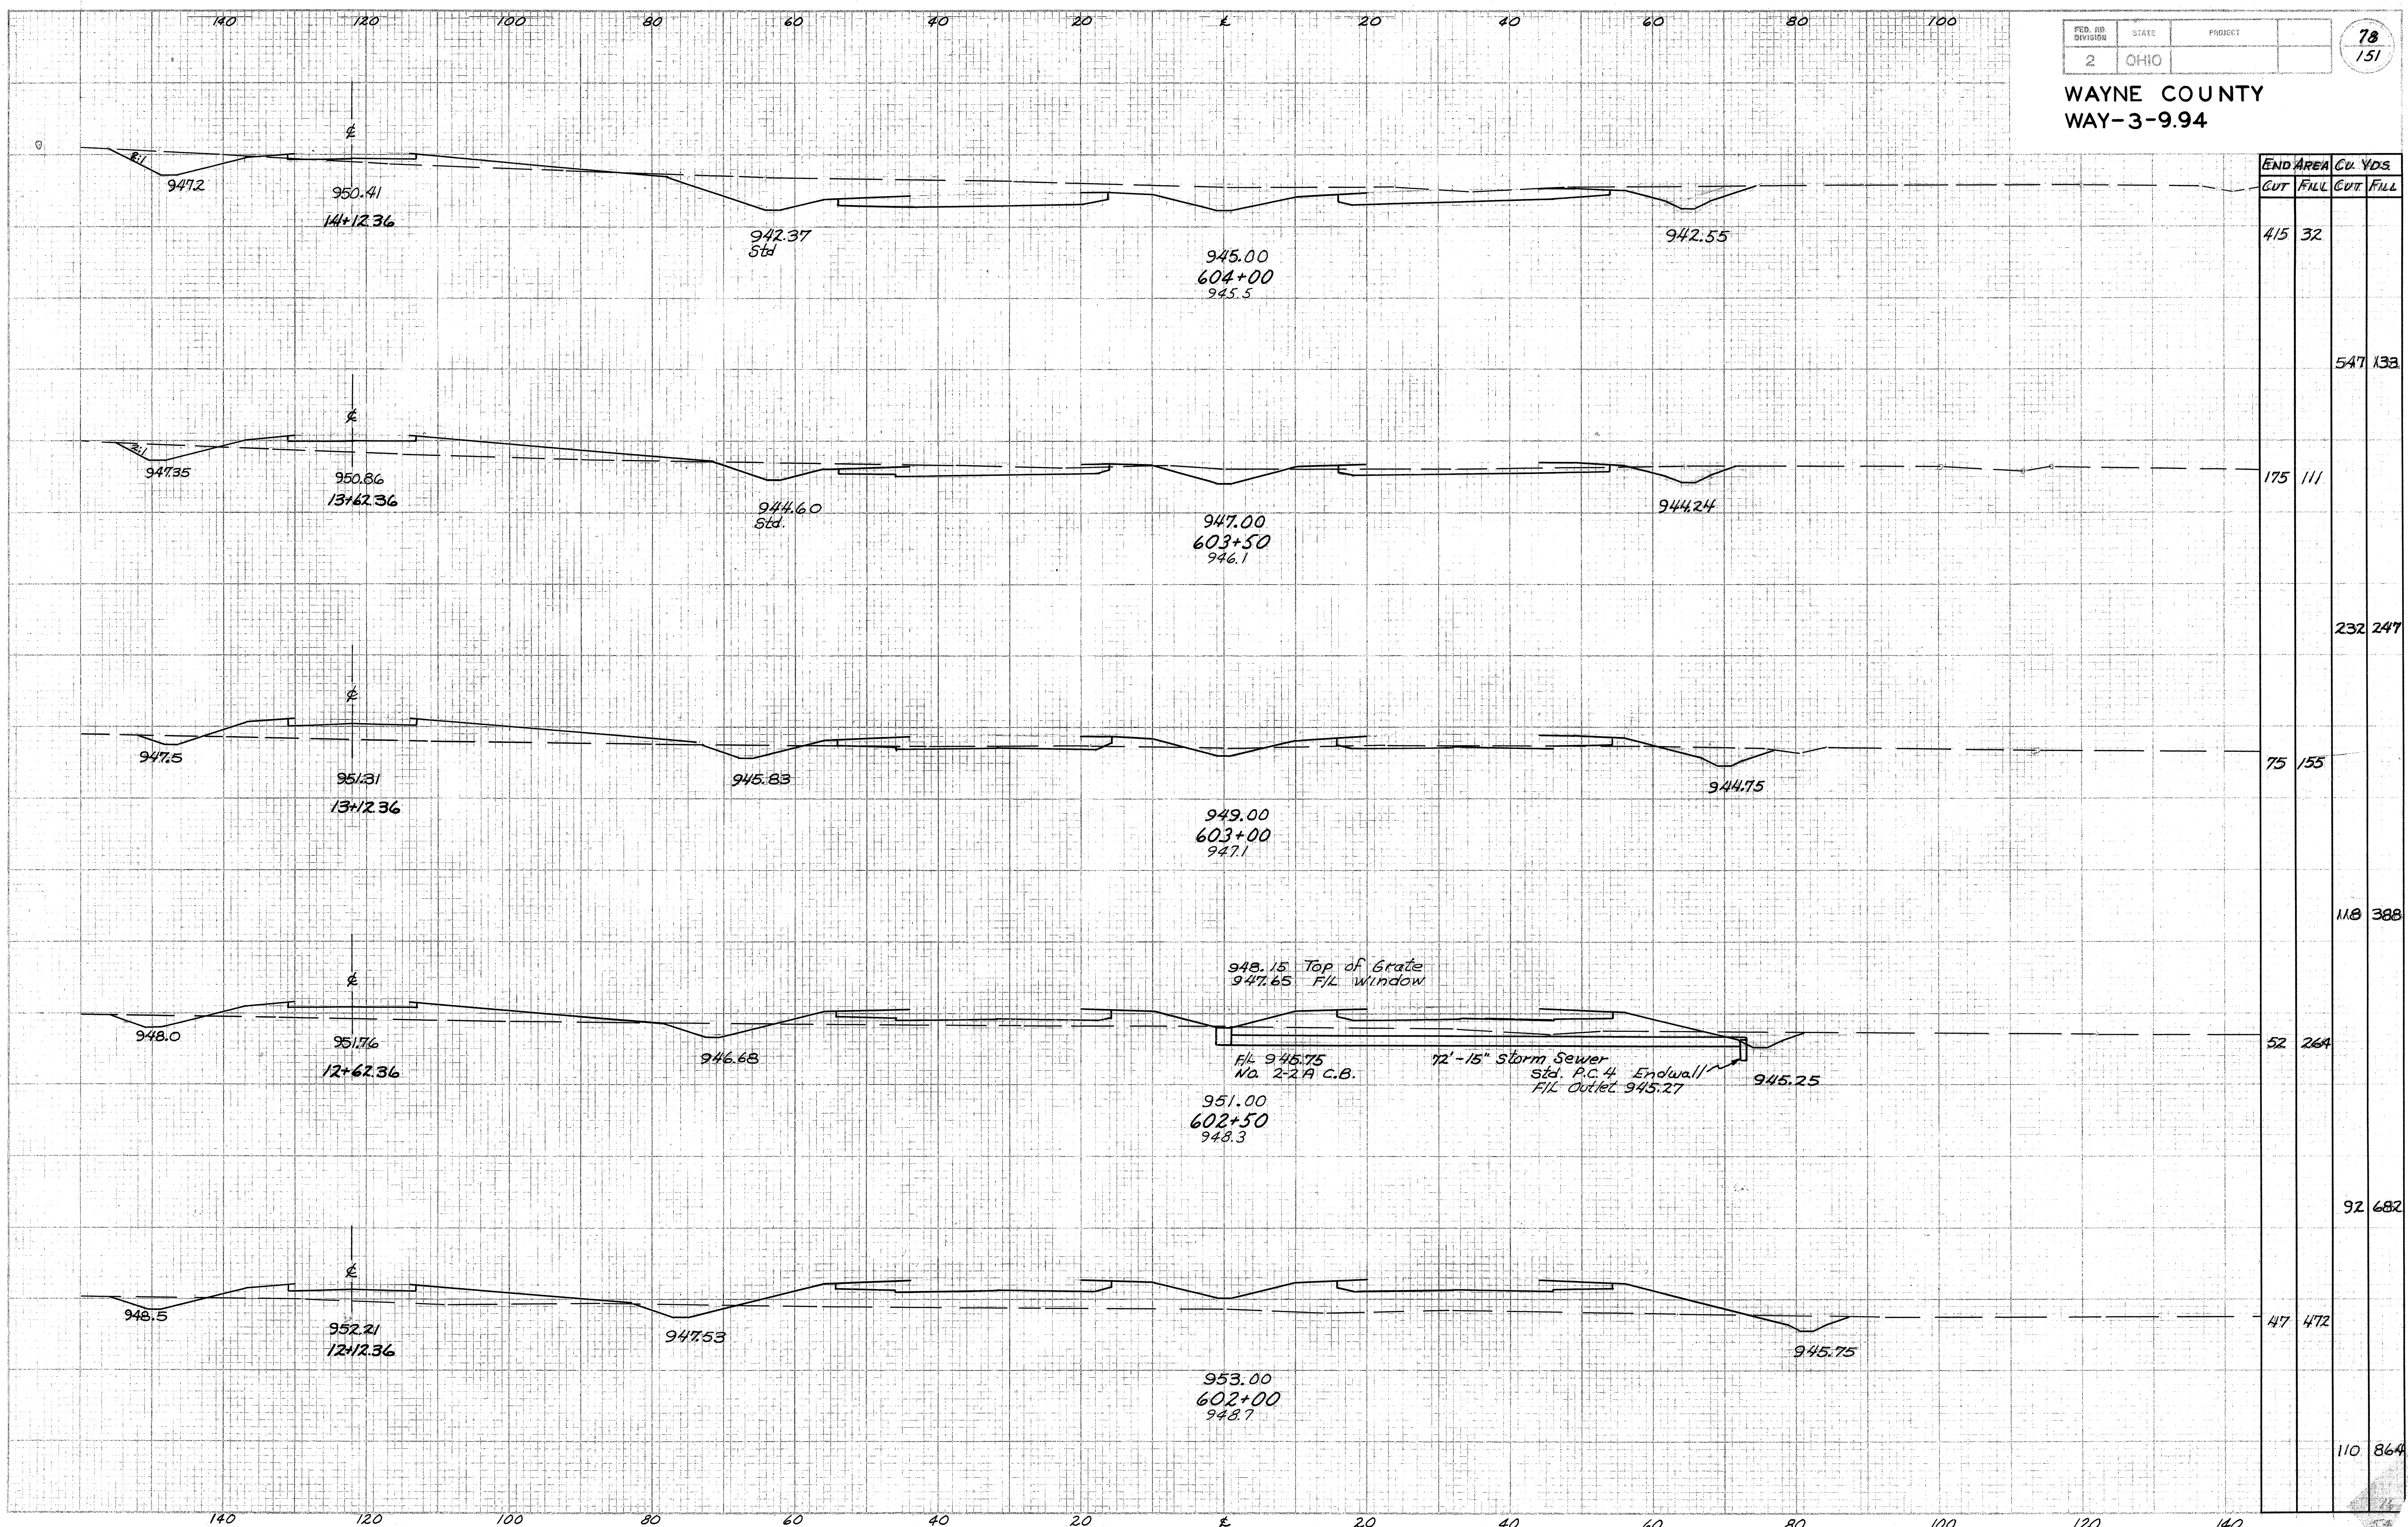

END STA.	AREA		CU. YDS.	
	CUT	FILL	CUT	FILL
604+00	415	32		
603+50			547	138
603+00	175	111		
602+50			232	247
602+00	75	155		
601+50			118	388
601+00	52	264		
600+50			92	682
600+00	47	472		
599+50			110	864


100 Sta. 602+00 To Sta. 604+00

WAYNE COUNTY
WAY-3-9.94

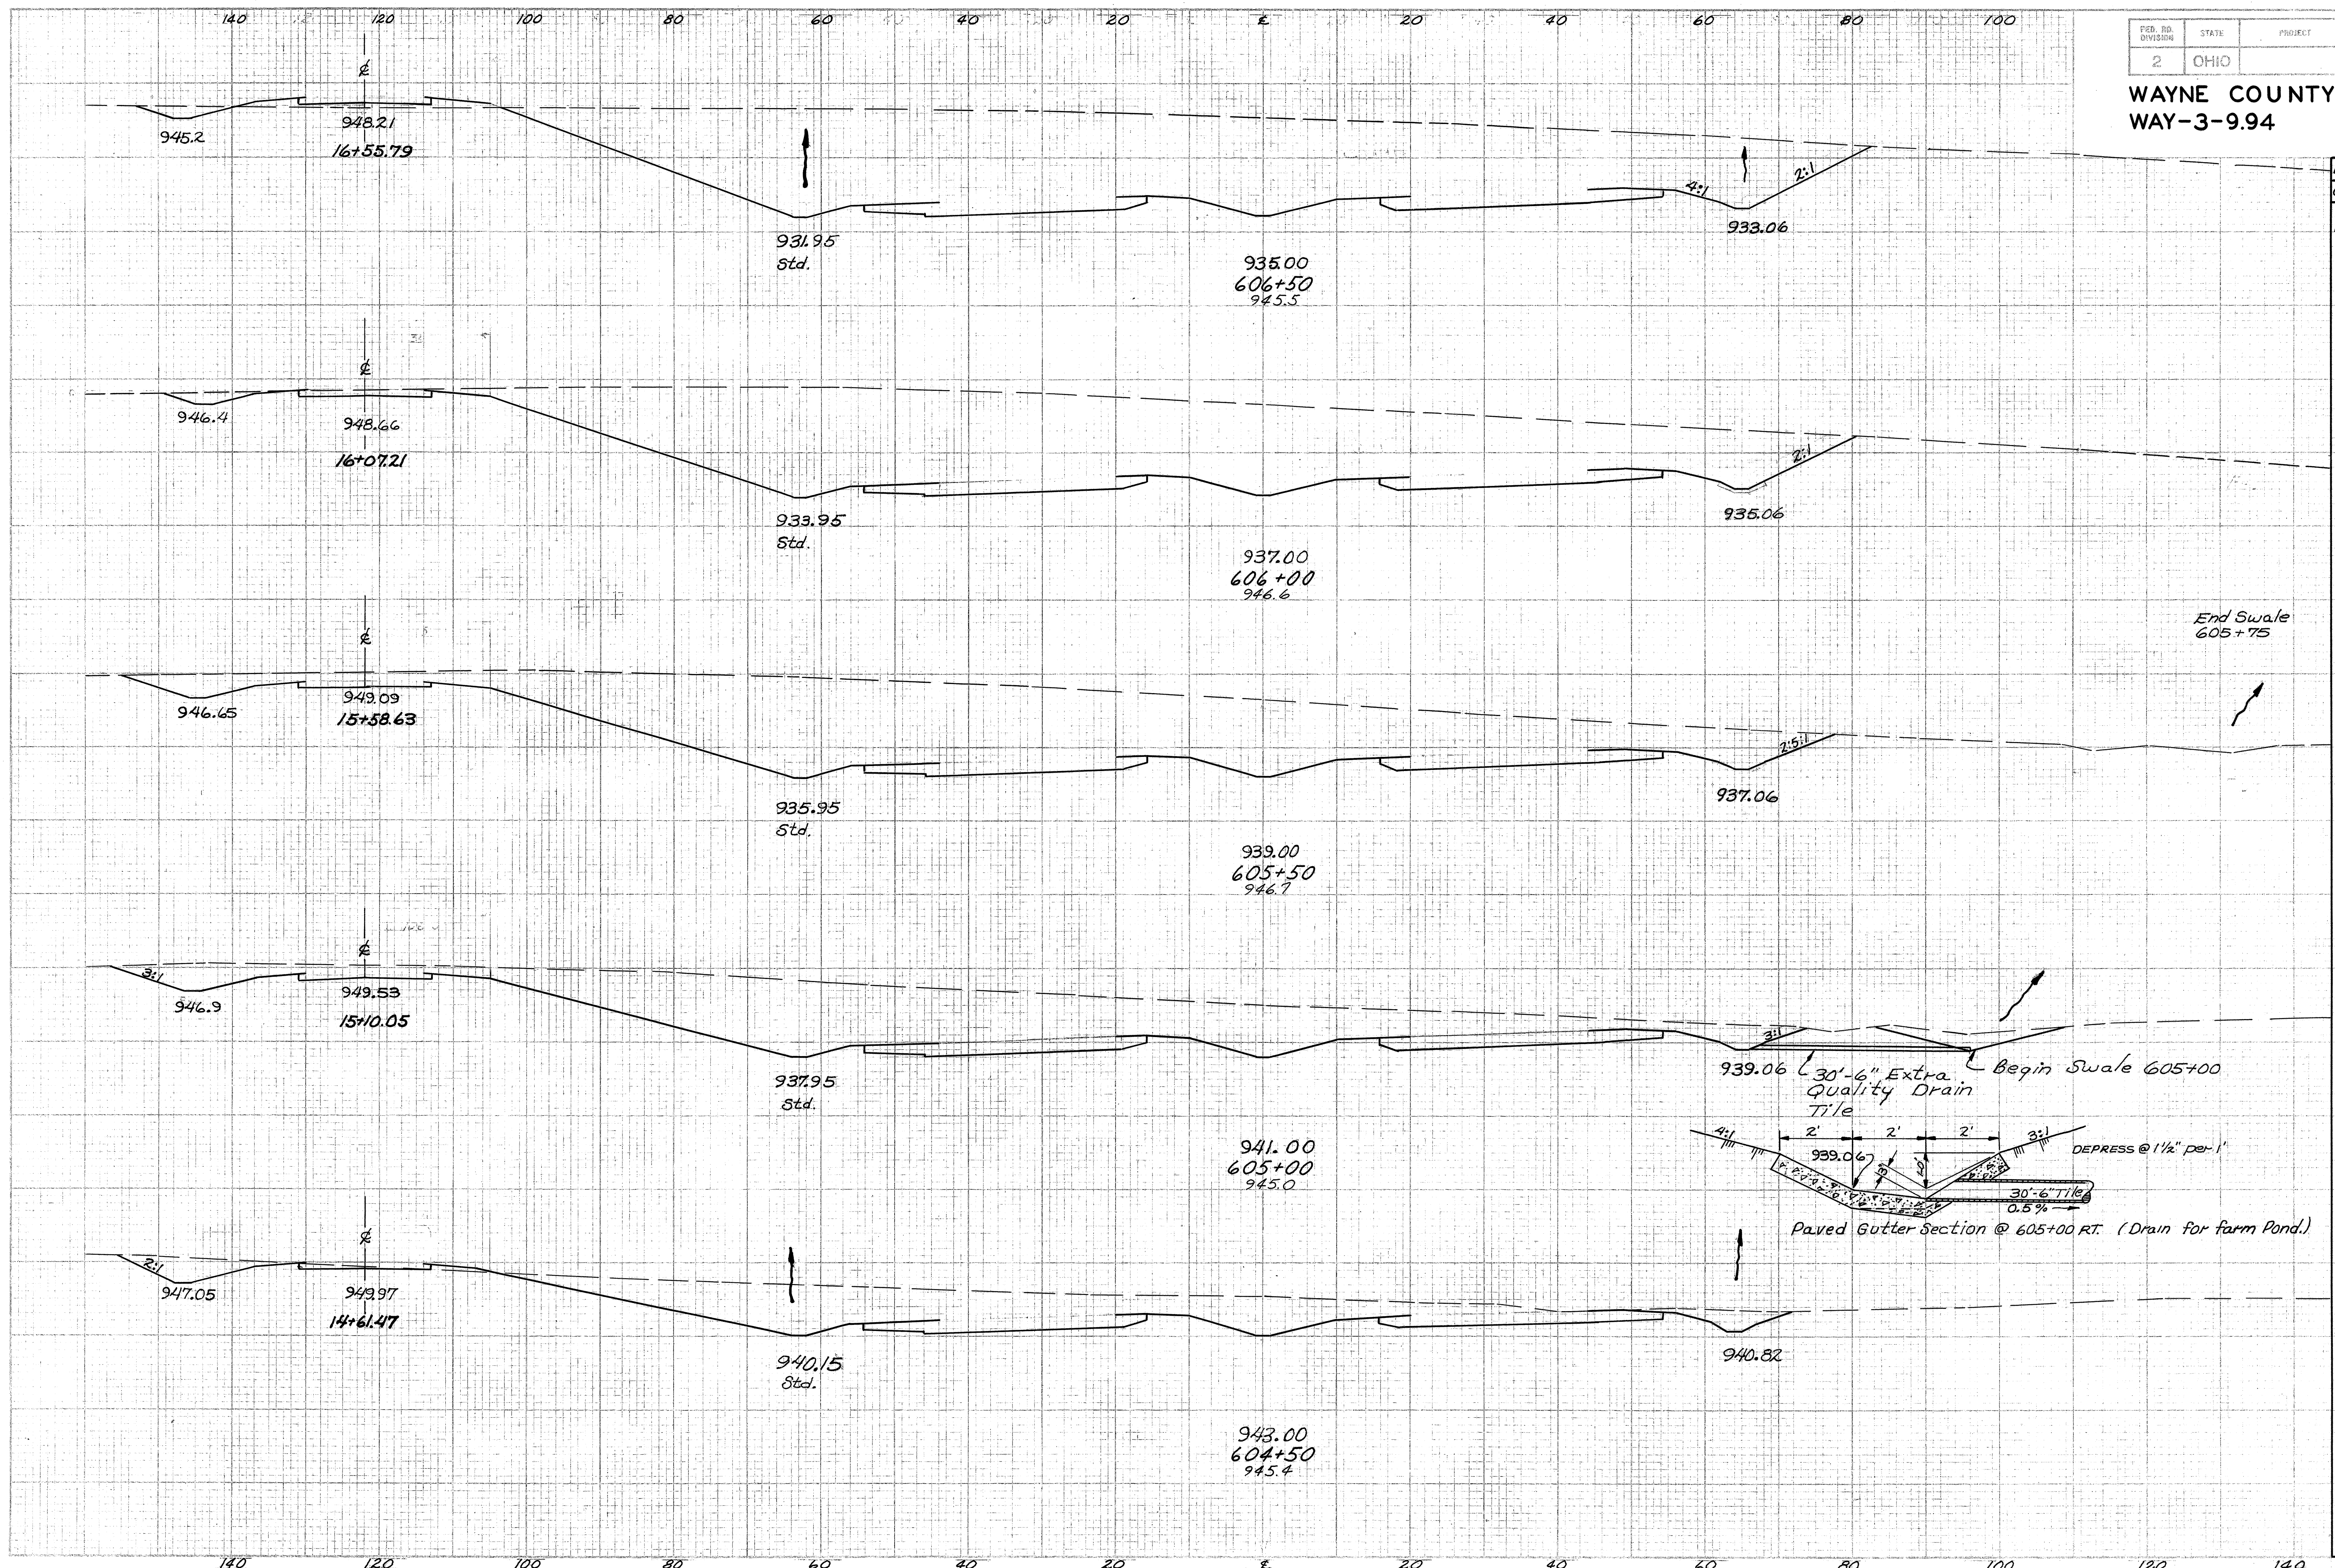

END STA	AREA		CU. YDS	
	CUT	FILL	CUT	FILL
1932		28		
			3525	26
1874		0		
			3252	0
1638		0		
			2592	0
1161		0		
			1722	4
698		4		
			1032	34


WAYNE COUNTY
WAY-3-9.94

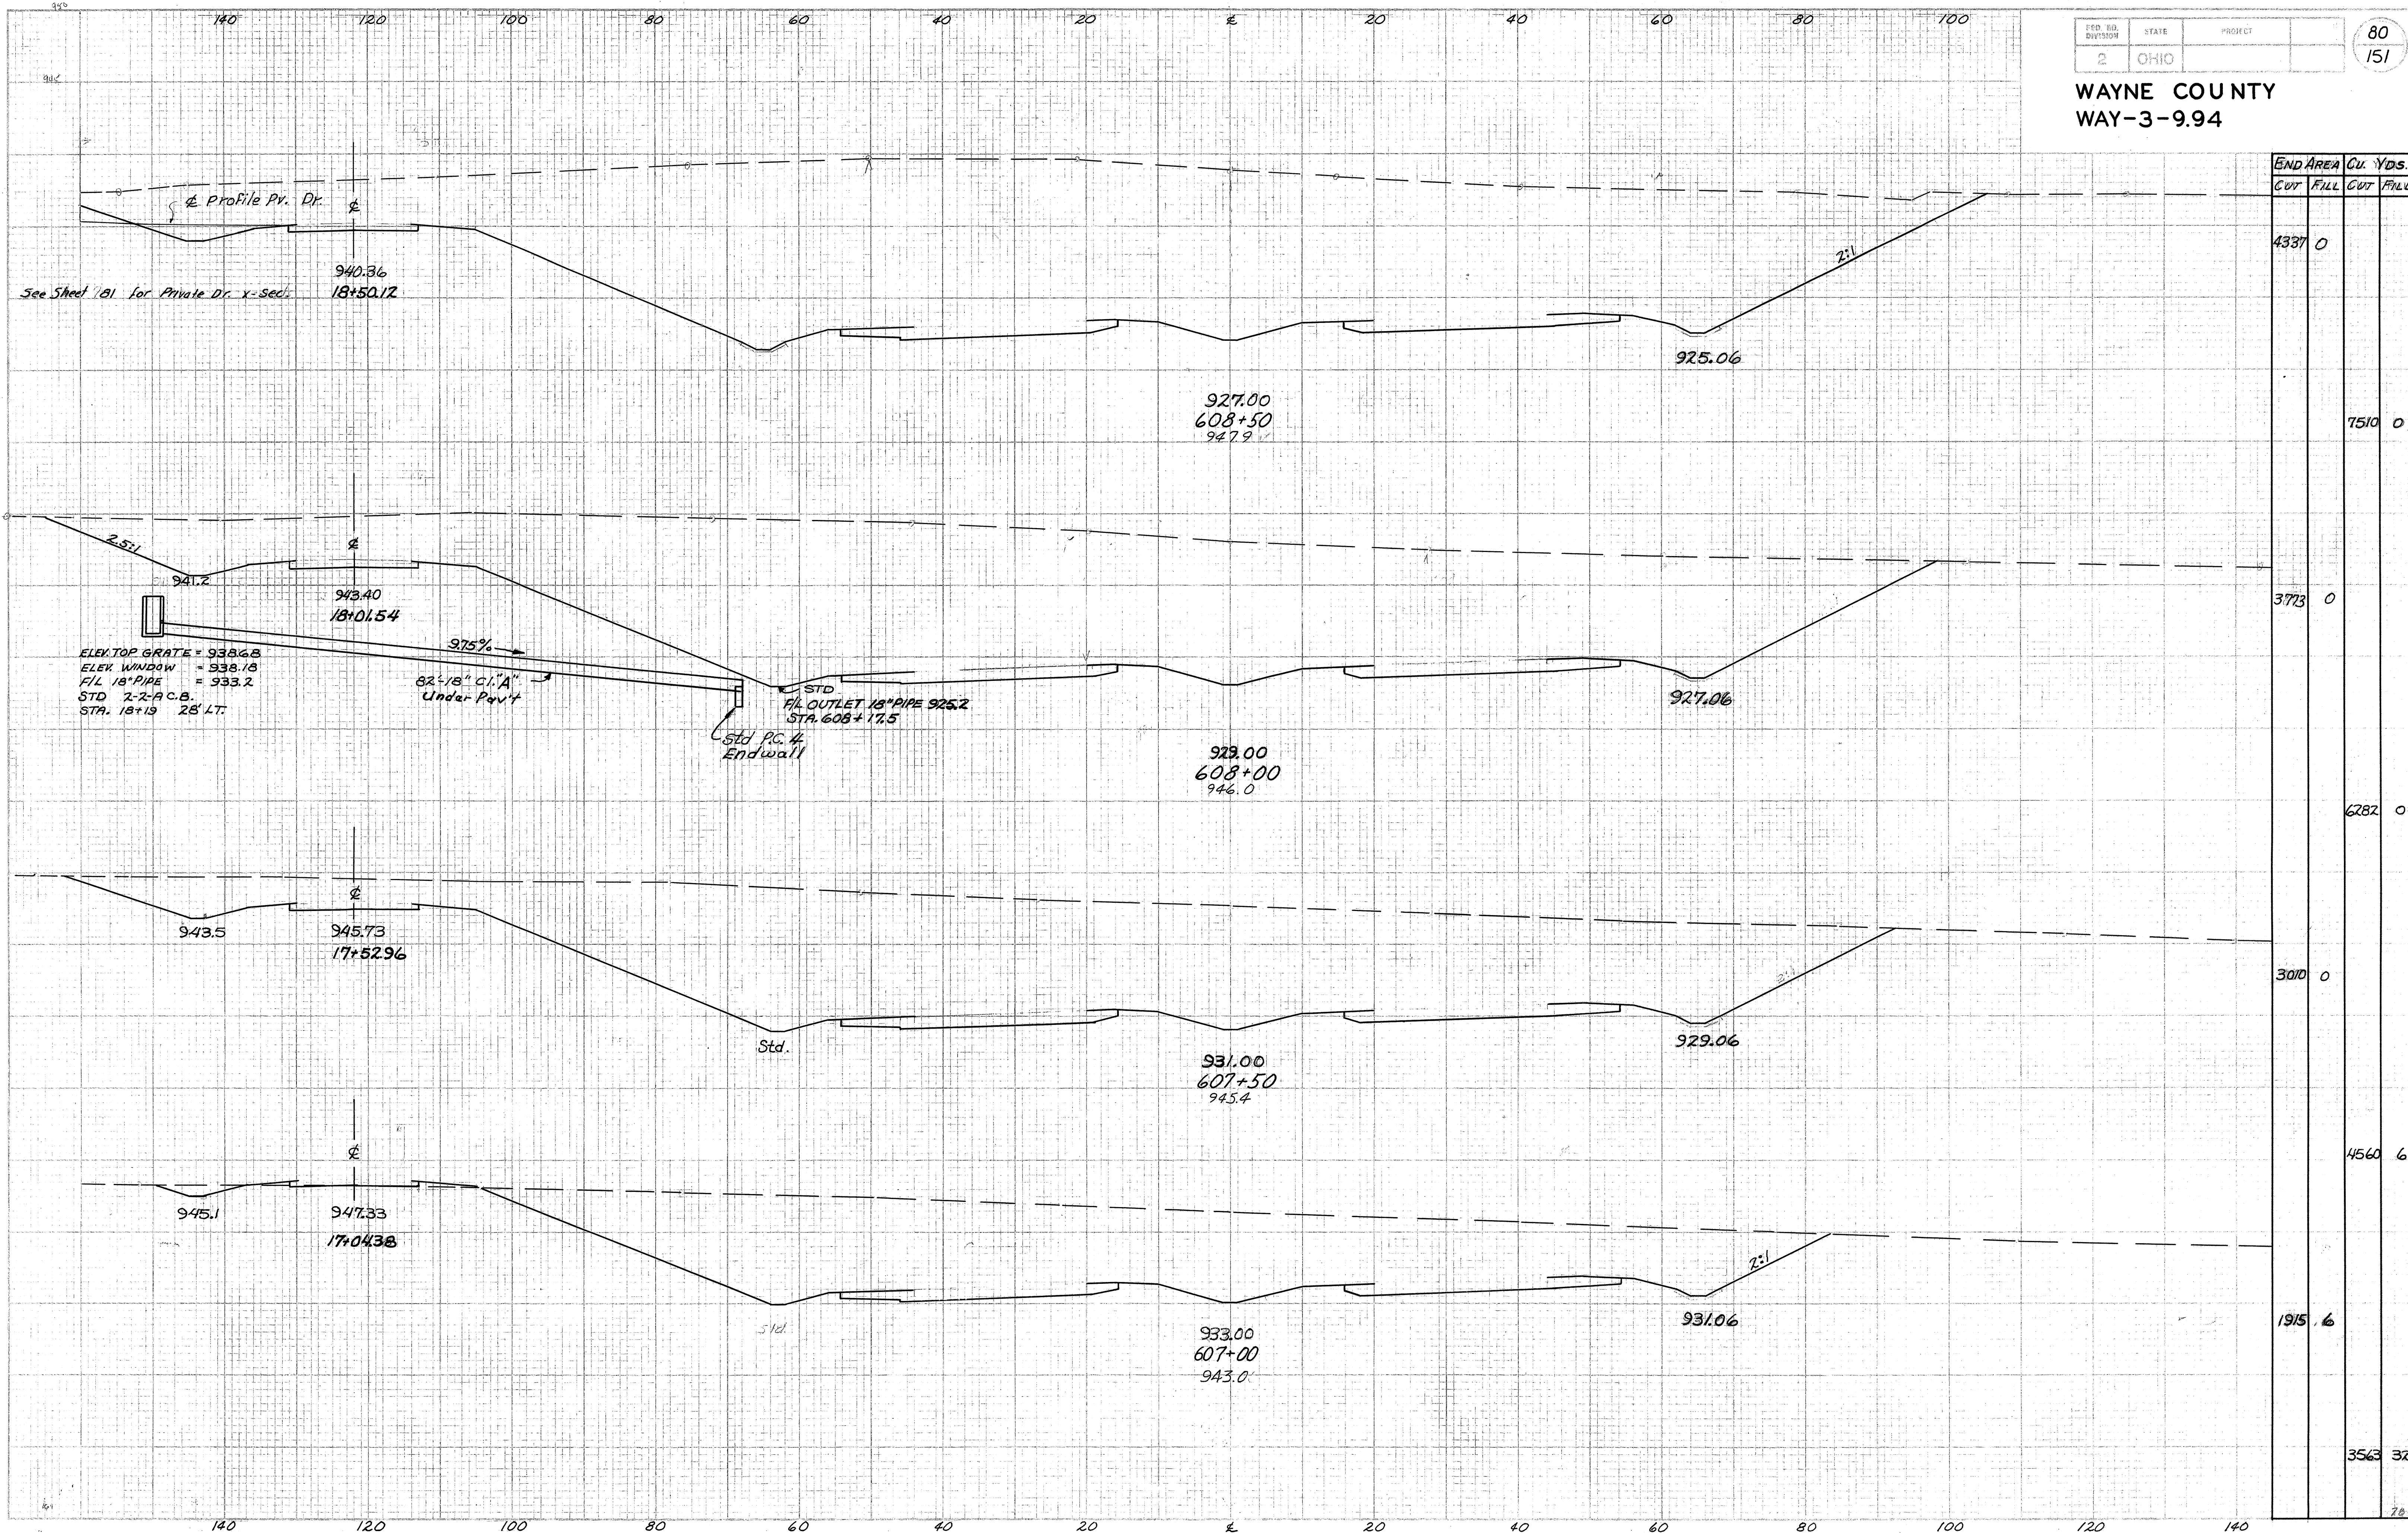

END AREA		Cu. Yds.	
CUT	FILL	CUT	FILL
4337	0		
		7510	0
3773	0		
		6282	0
3010	0		
		4560	6
1915	6		
		3563	32

Sta. 607+00 To Sta. 608+50

WAYNE COUNTY
WAY-3-9.94

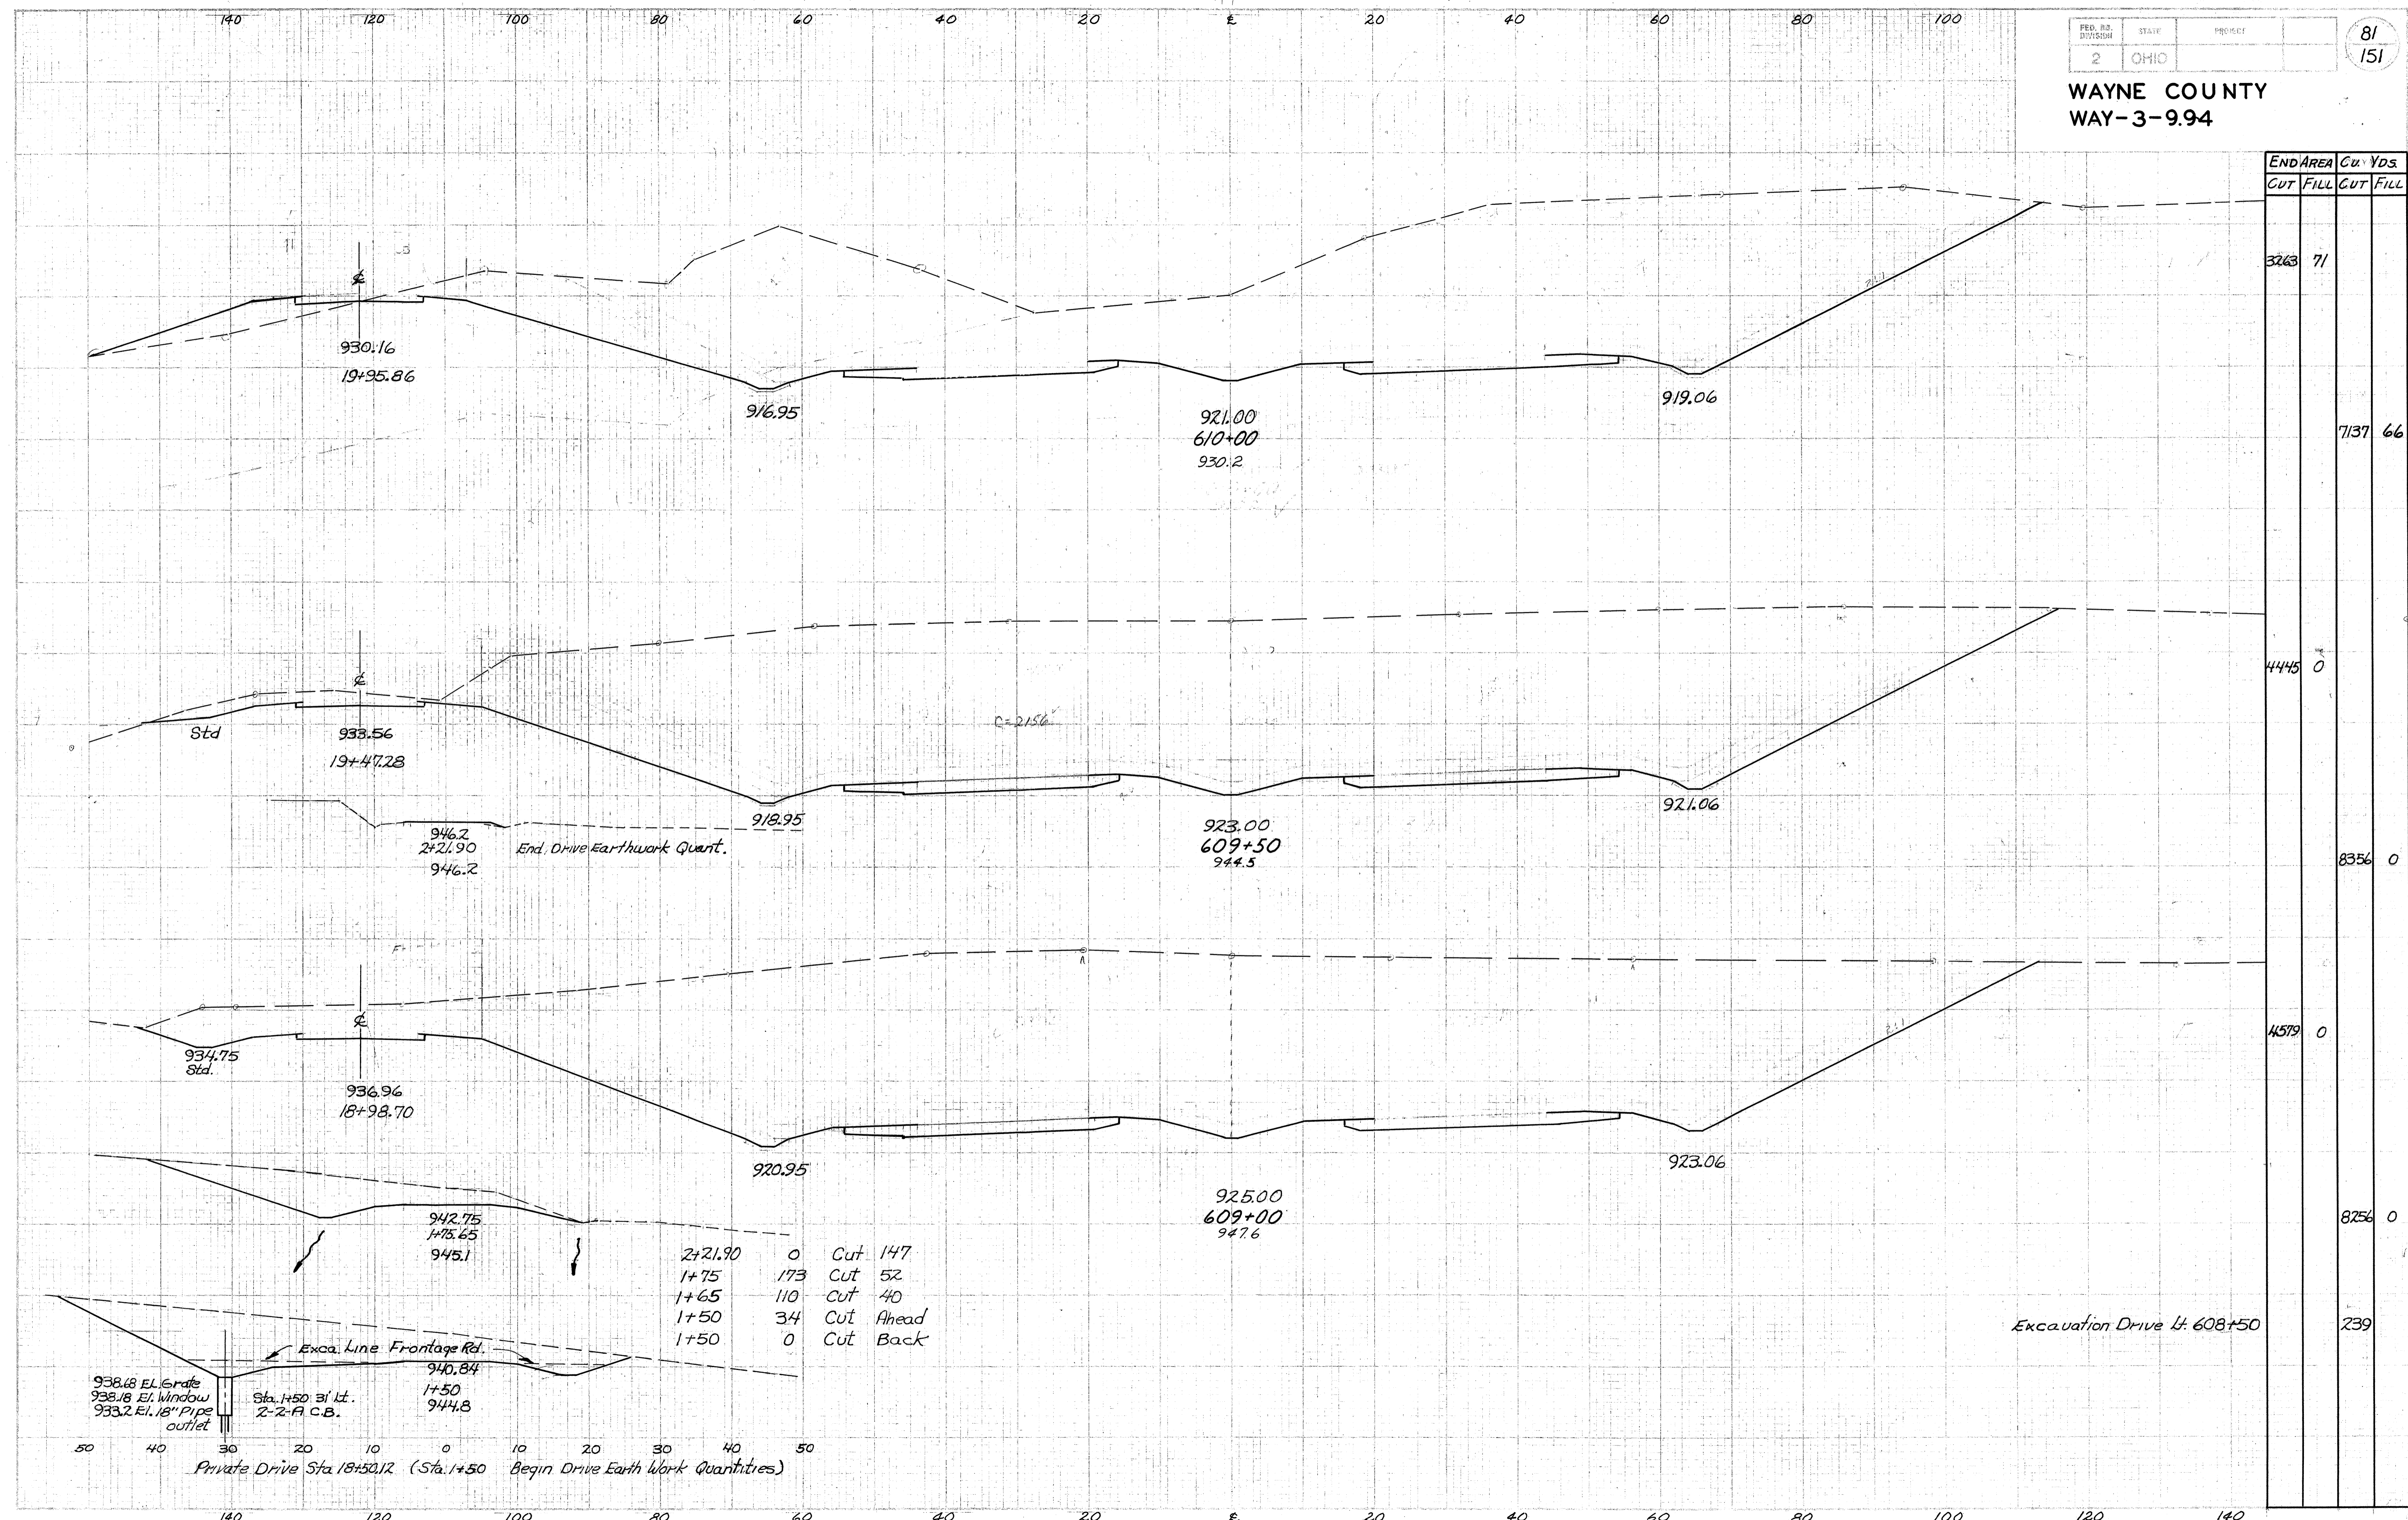

END AREA		Cu. Yds.	
CUT	FILL	CUT	FILL
3263	71		
		7137	66
4445	0		
		8356	0
4579	0		
		8256	0
			239

2+21.90	0	Cut	147
1+75	173	Cut	52
1+65	110	Cut	40
1+50	34	Cut	Ahead
1+50	0	Cut	Back


938.68 EL. Grate
938.18 EL. Window
933.2 EL. 18" Pipe outlet

Private Drive Sta. 18+50.12 (Sta. 1+50 Begin Drive Earth Work Quantities)

Excavation Drive Lt. 608+50

Sta. 609+00 To Sta. 610+00

WAYNE COUNTY
WAY-3-9.94

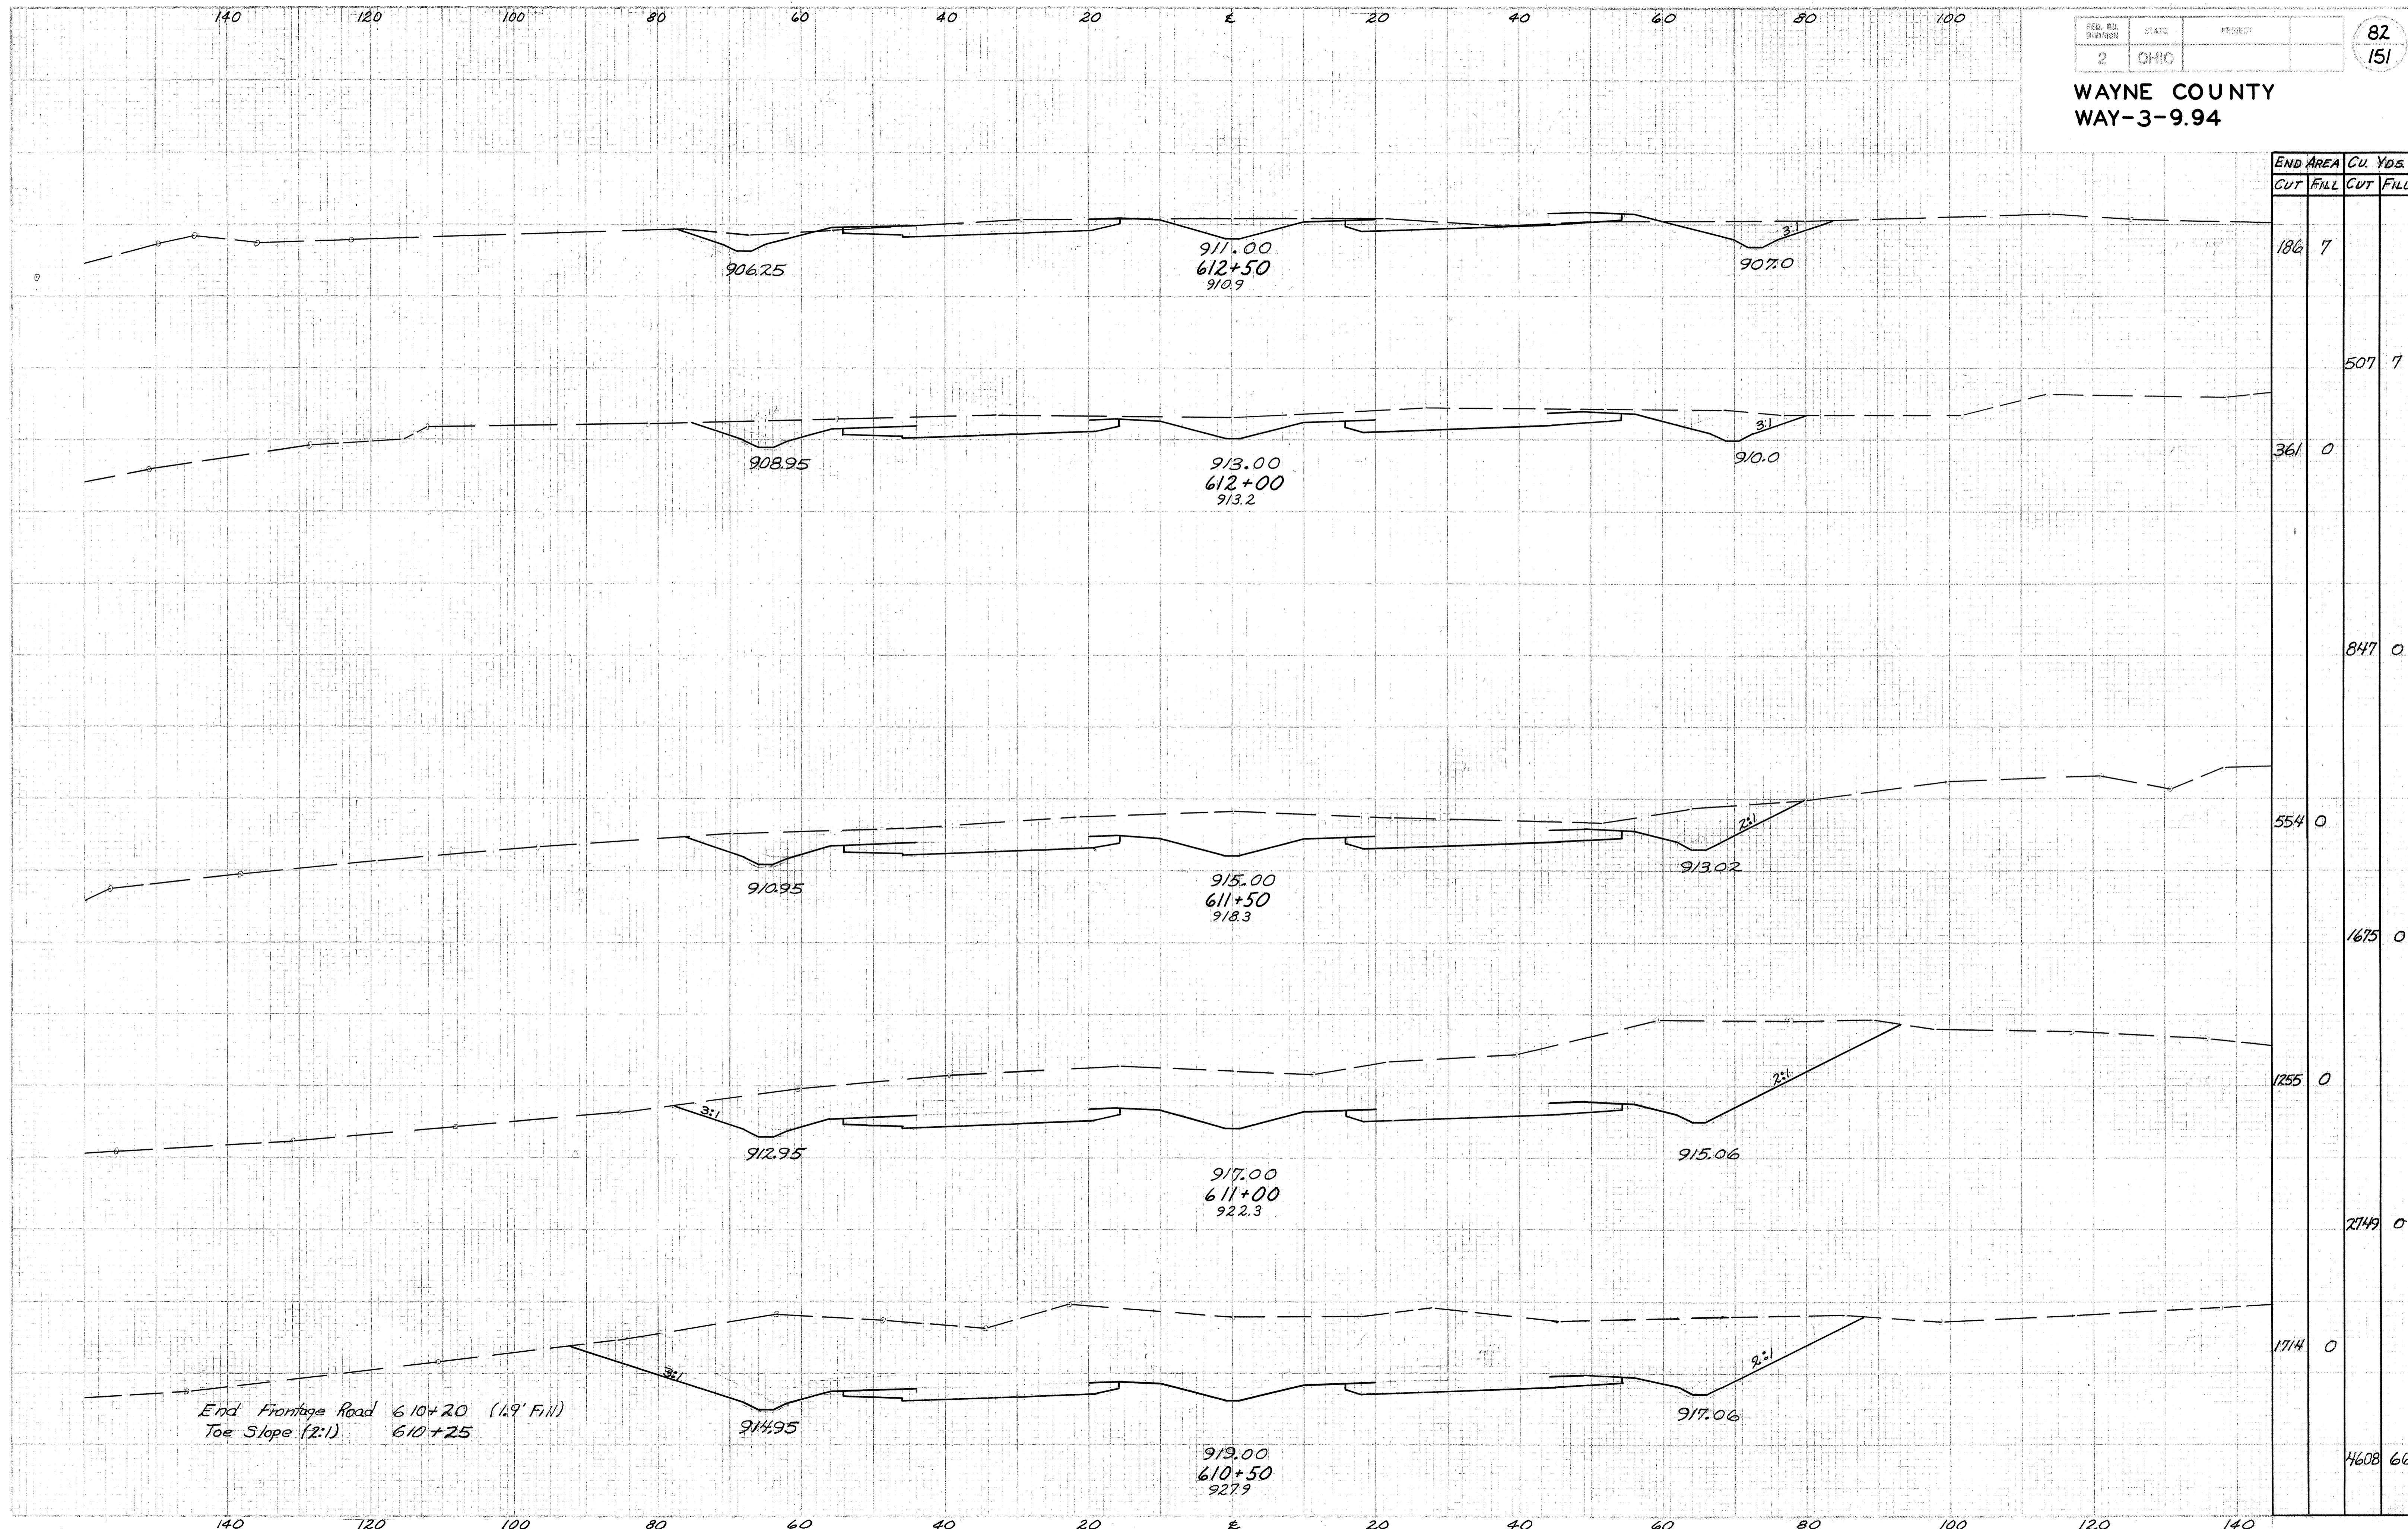


END AREA		Cu. Yds.	
CUT	FILL	CUT	FILL
186	7		
		507	7
361	0		
		847	0
554	0		
		1675	0
1255	0		
		2749	0
1714	0		
		4608	66

End Frontage Road 610+20 (1.9' Fill)
Toe Slope (2:1) 610+25

Sta. 610+50 To Sta. 612+50


WAYNE COUNTY
WAY-3-994

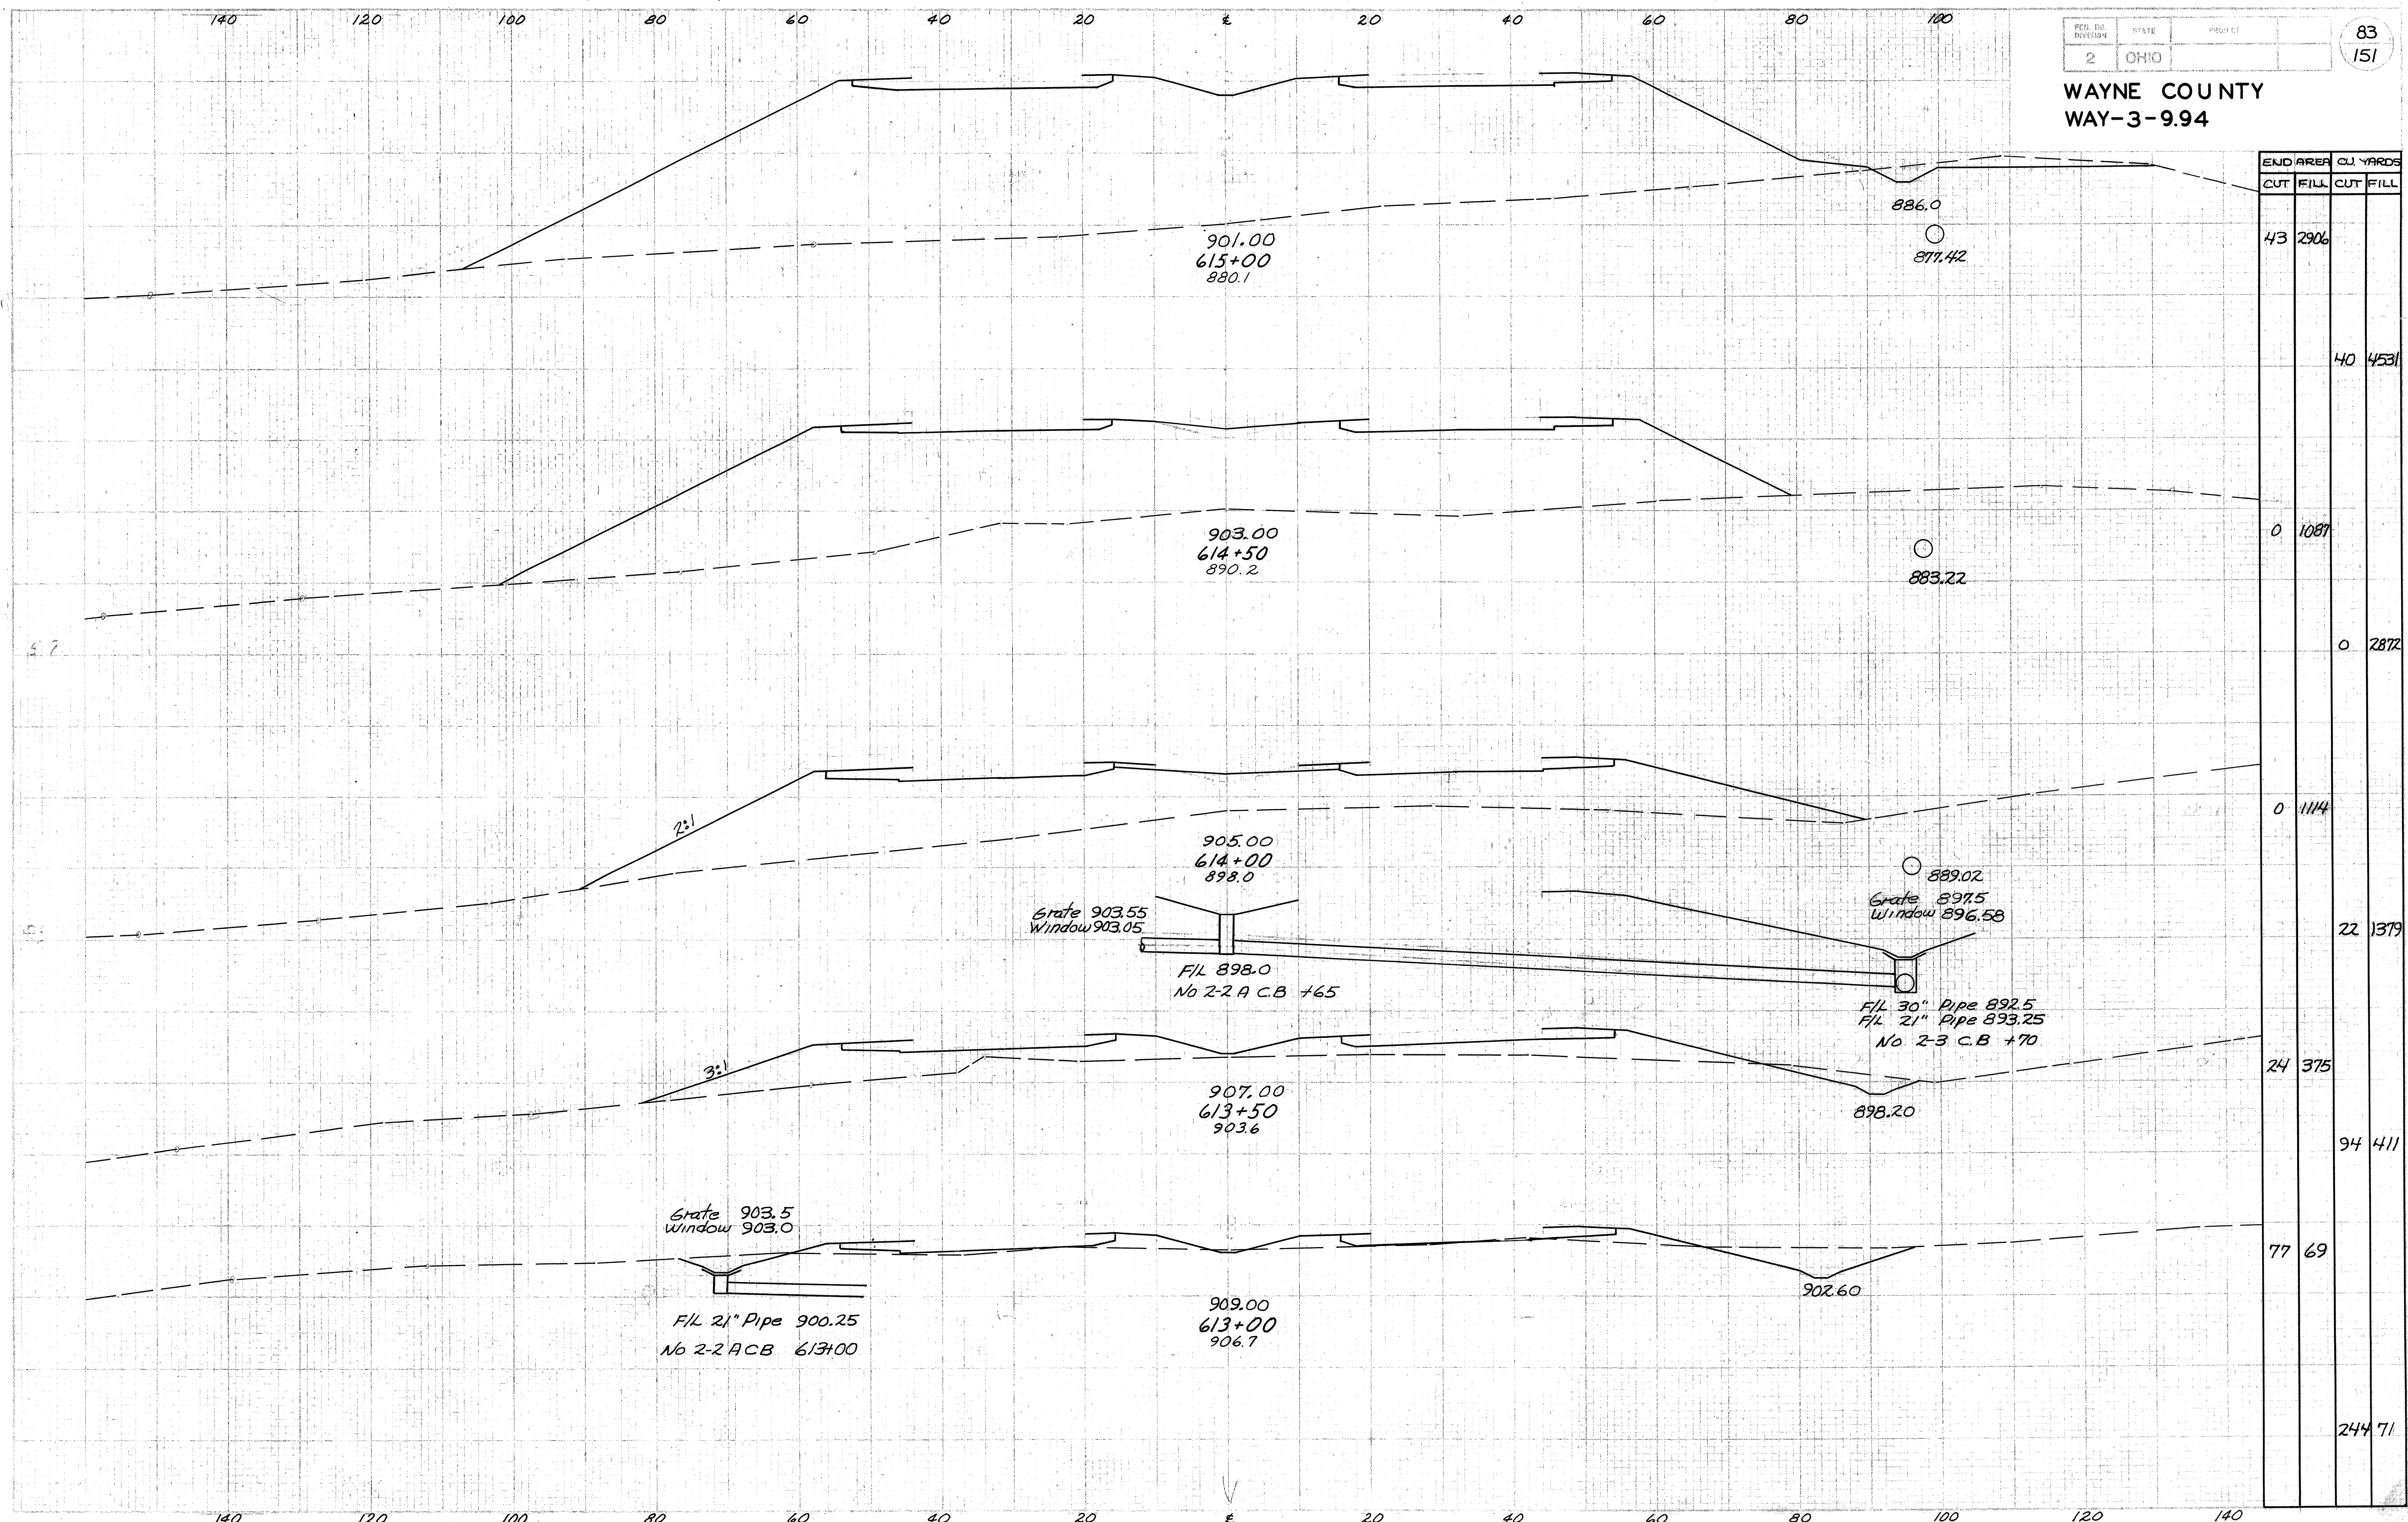

END AREA	CU. YARDS	
	CUT	FILL
43	2906	
		40 4531
0	1087	
		0 2872
0	1114	
		22 1379
24	375	
		94 411
77	69	
		244 71

Sta. 613+00 To Sta. 615+00


WAYNE COUNTY
WAY-3-9.94

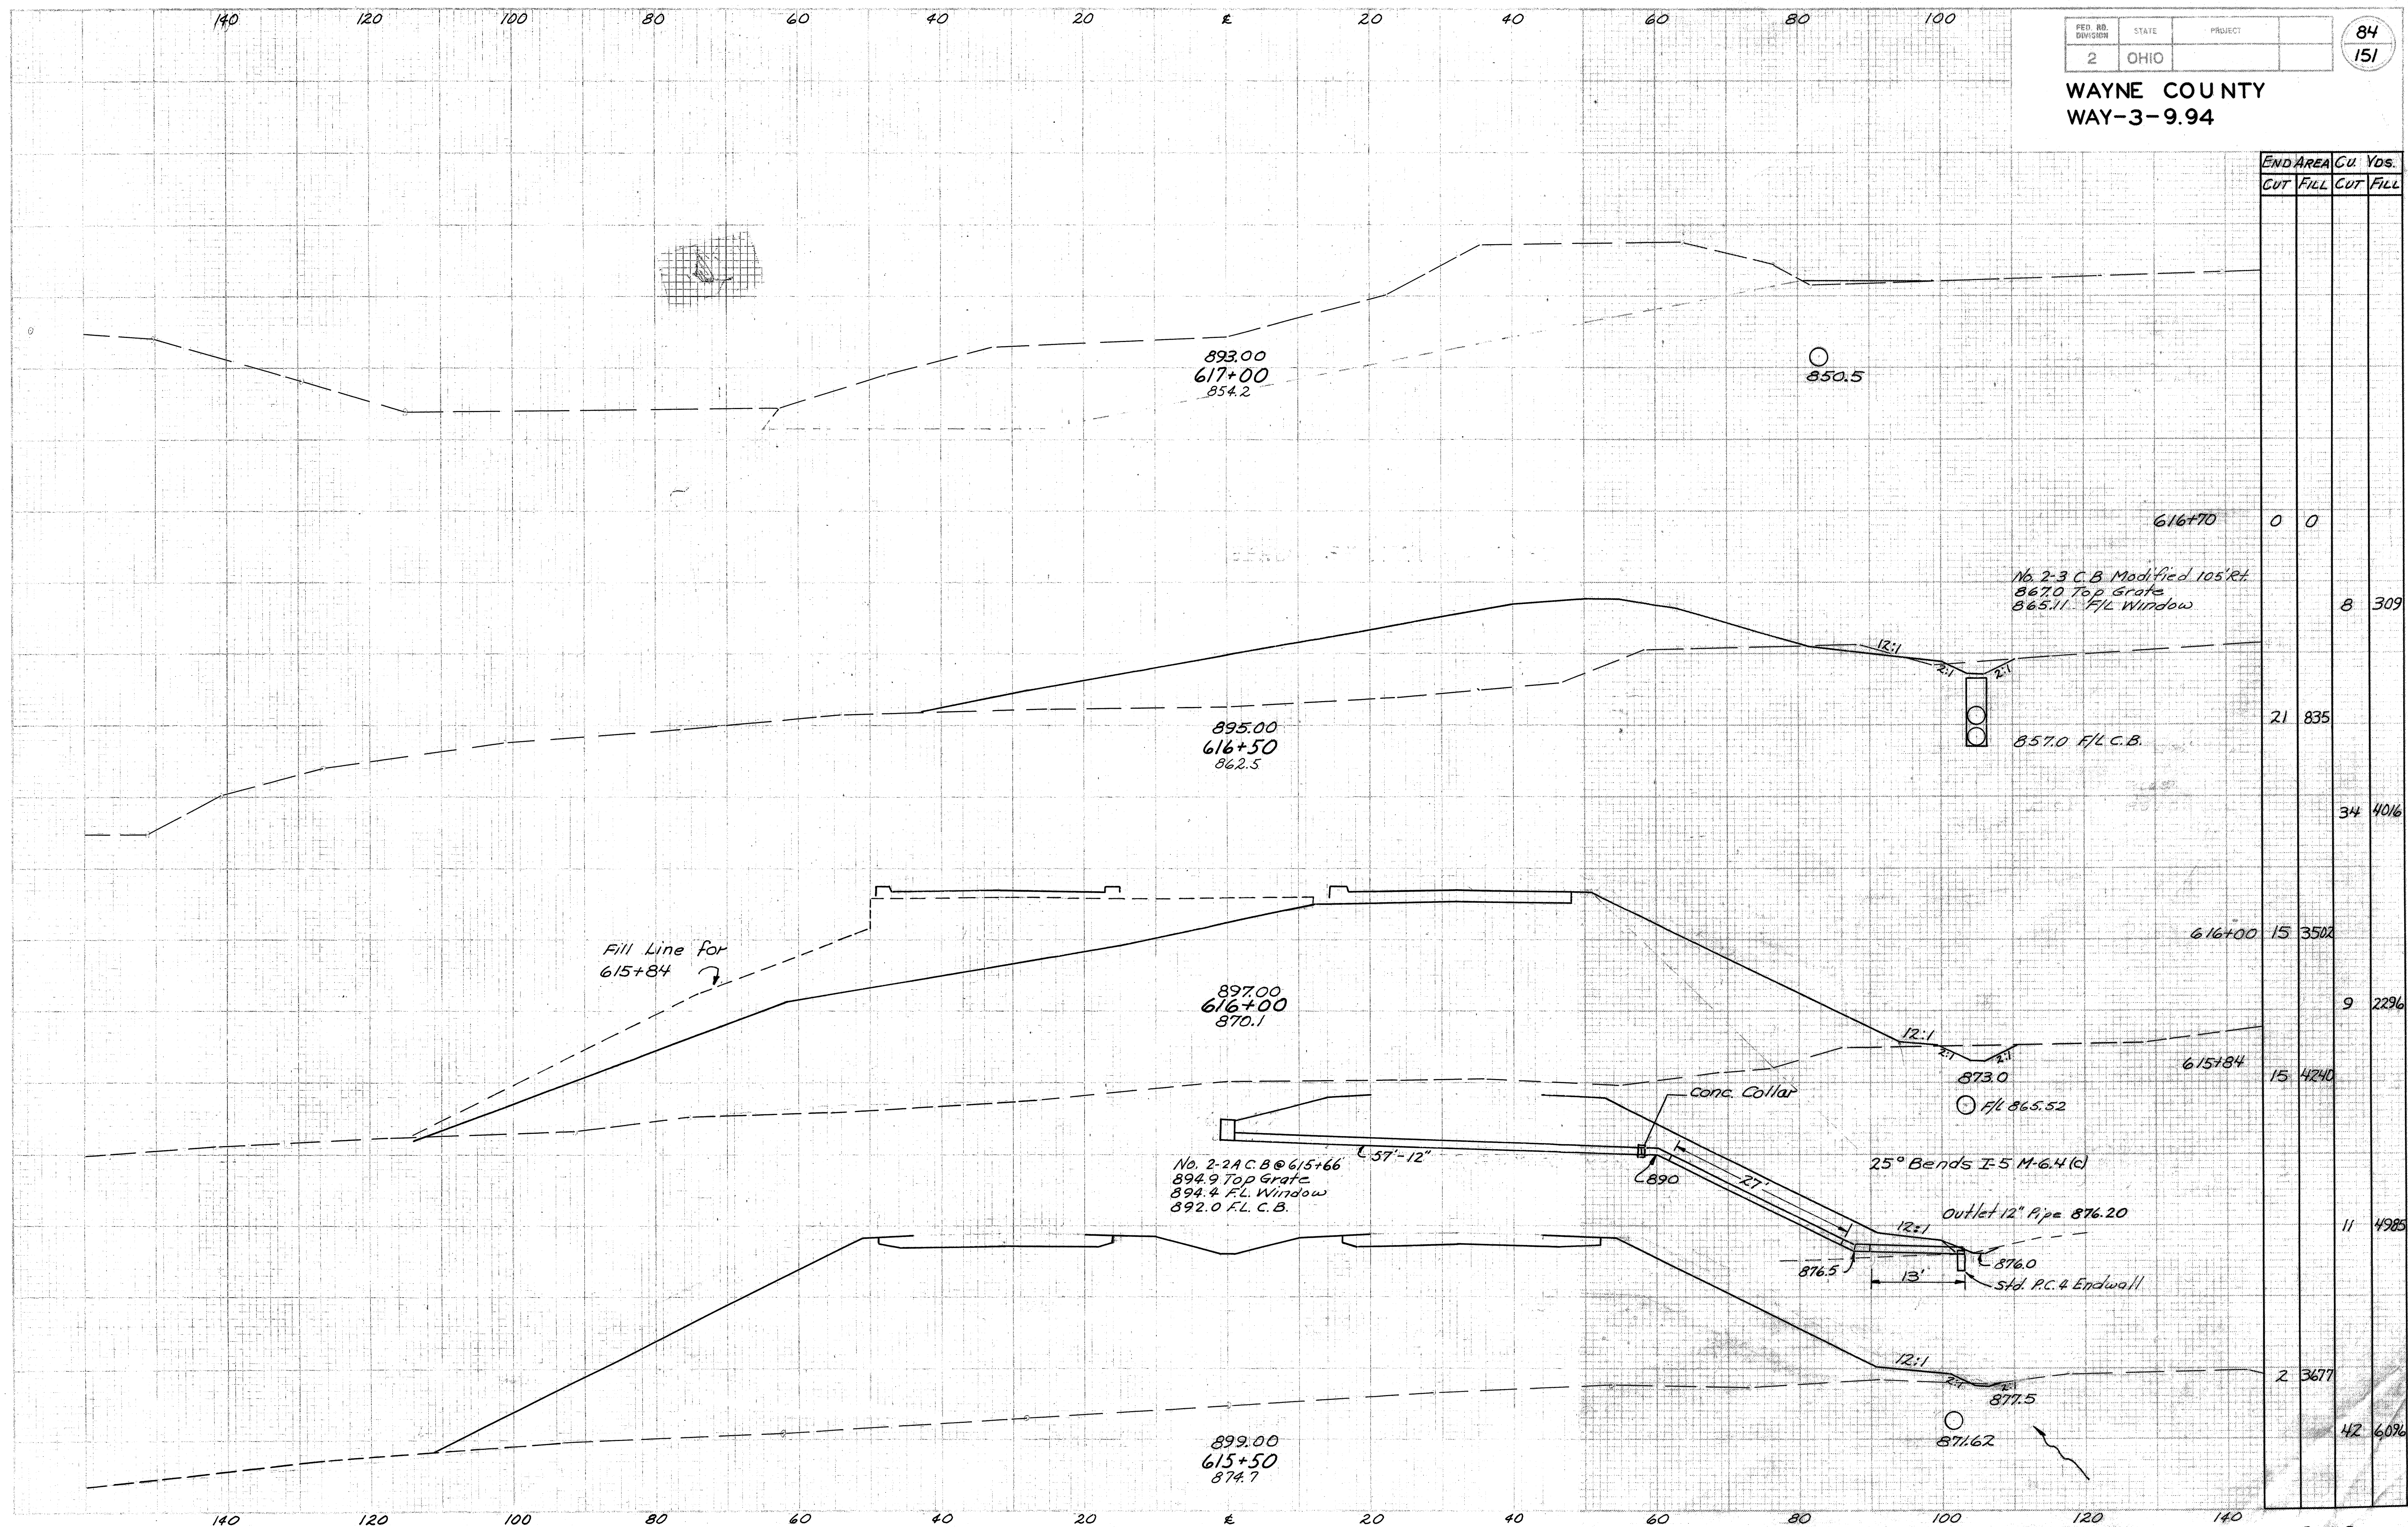

END AREA	Cu. Yds.	
	CUT	FILL
616+70	0	0
		8 309
	21	835
		34 4016
616+00	15	3502
		9 2296
615+84	15	4240
		11 4985
	2	3677
		42 6076

Sta. 615+50 To Sta. 617+00


WAYNE COUNTY
WAY-3-9.94

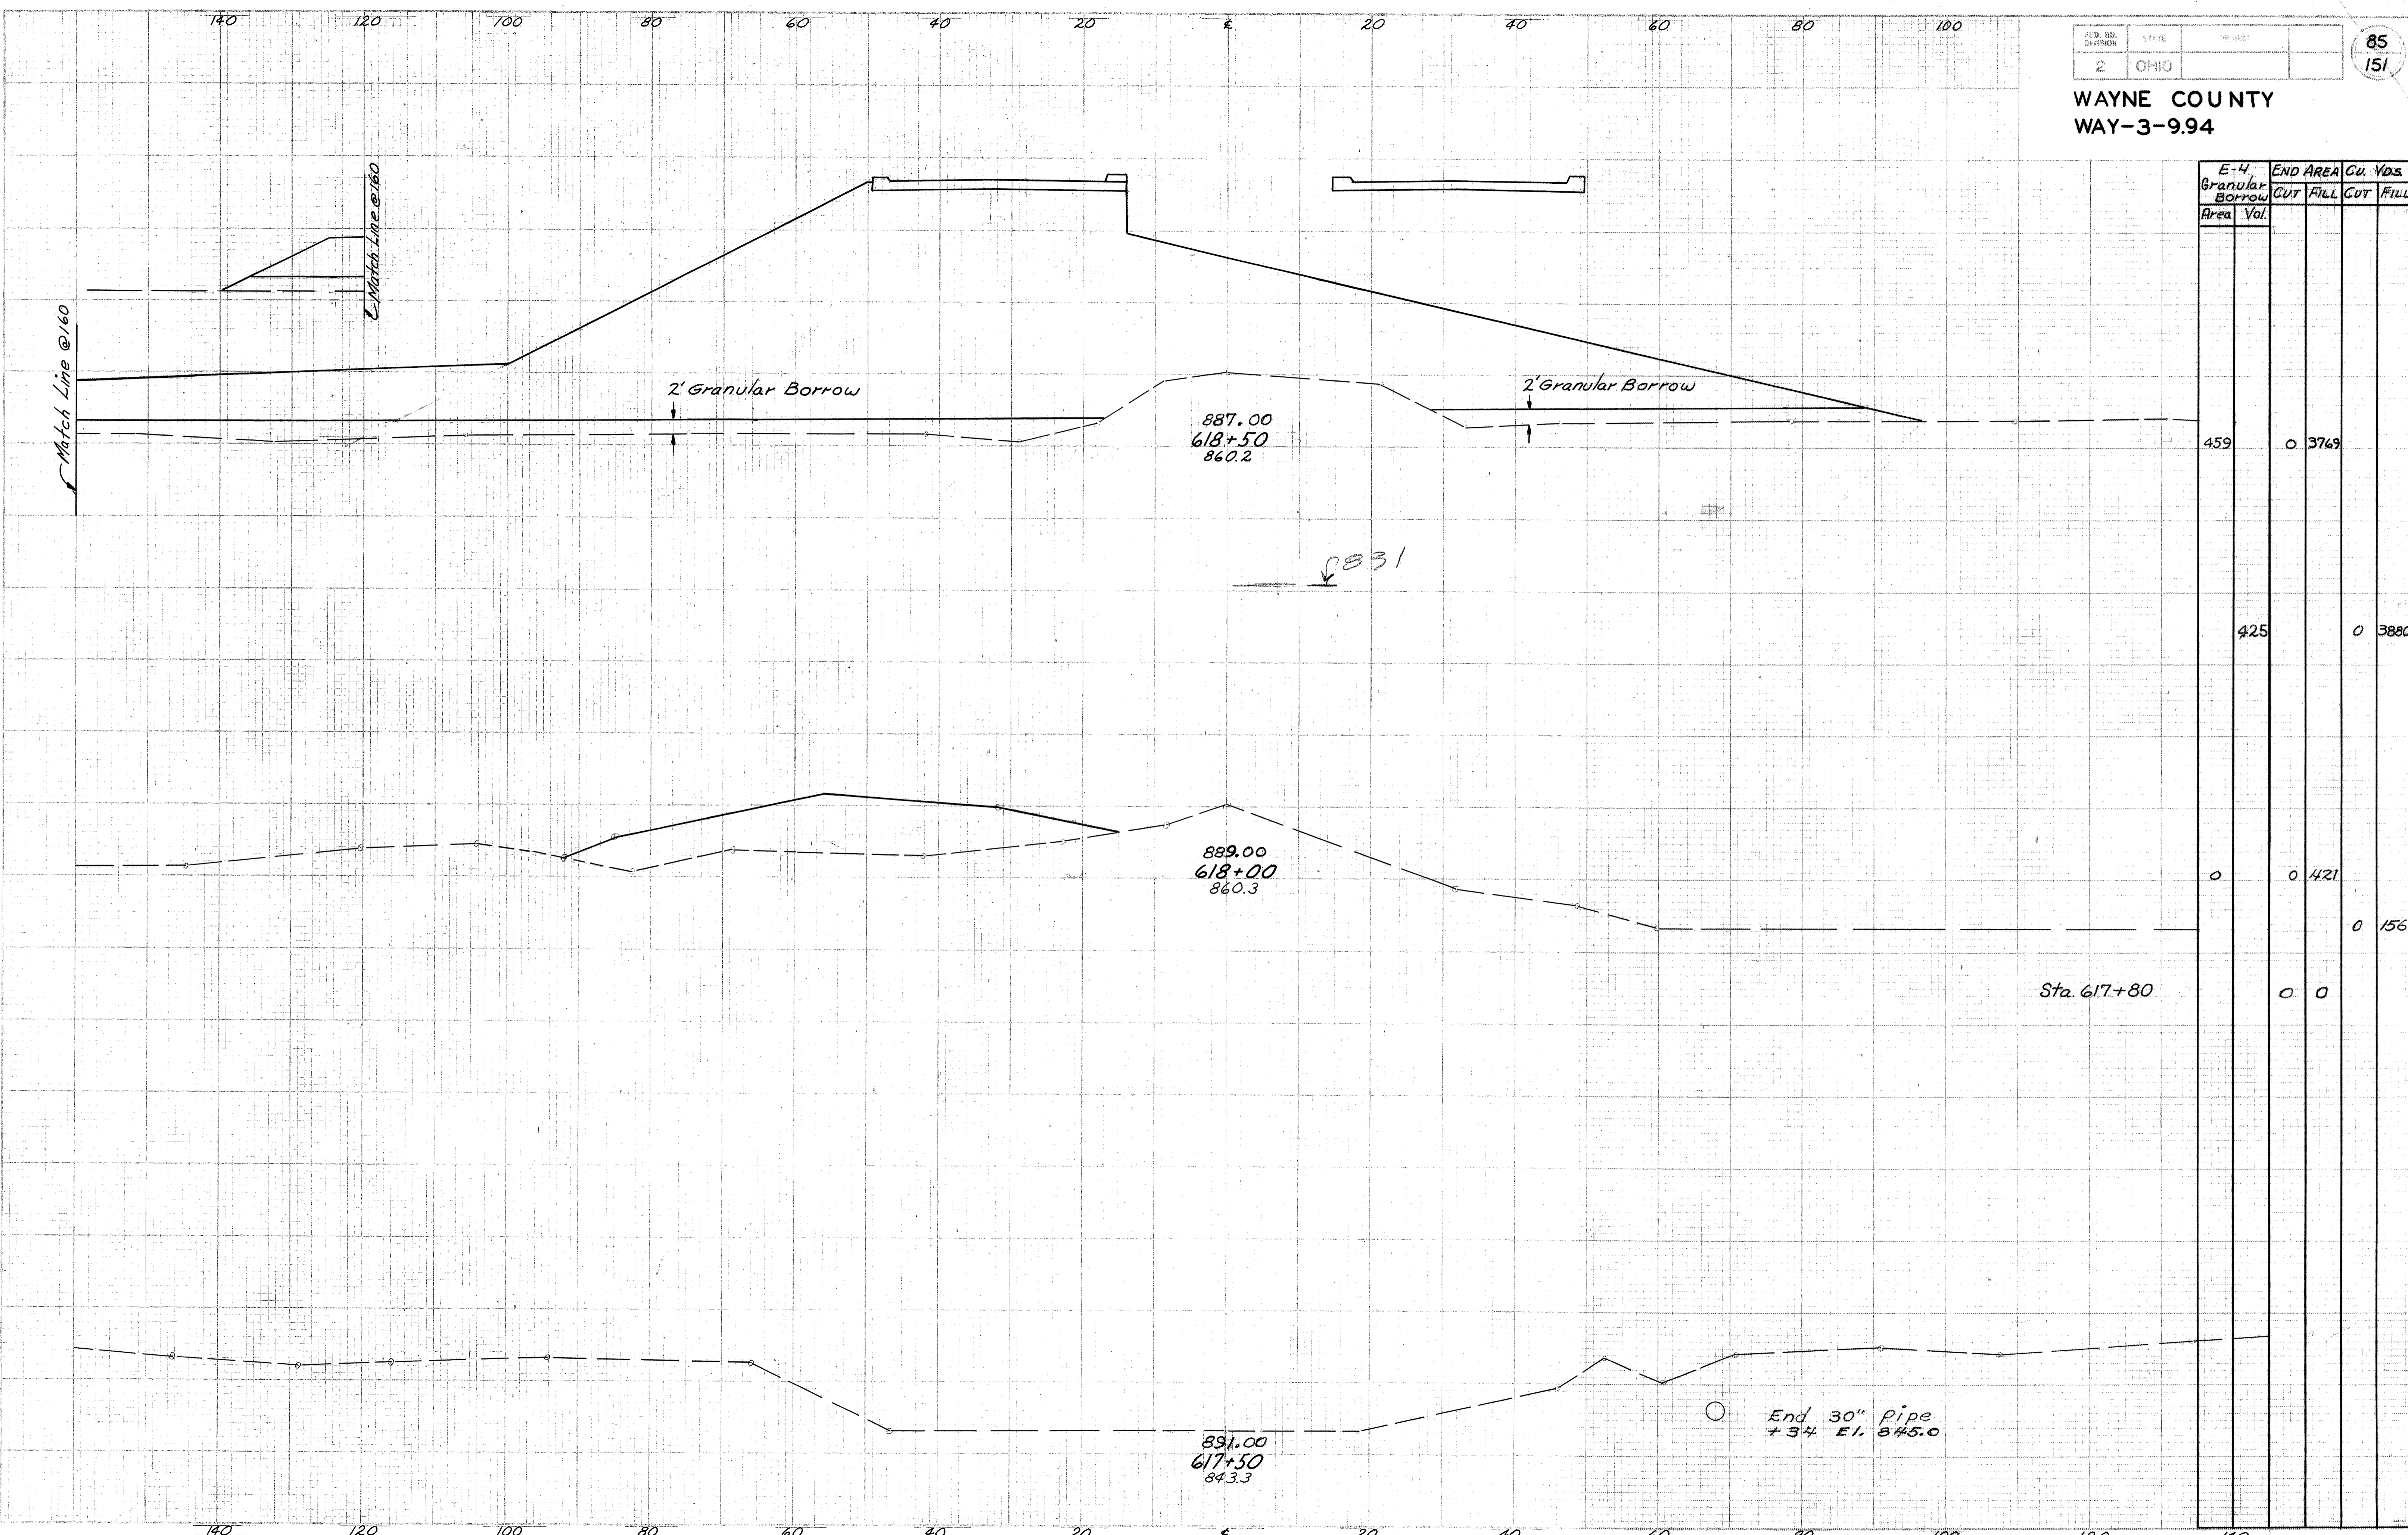

E-4 Granular Borrow Area	END AREA Vol.	Cu. Yds.	
		CUT	FILL
459	0	3769	
425	0	3880	
0	0	421	156
0	0	0	0

Sta. 617+50 To Sta. 618+50


WAYNE COUNTY
WAY-3-9.94

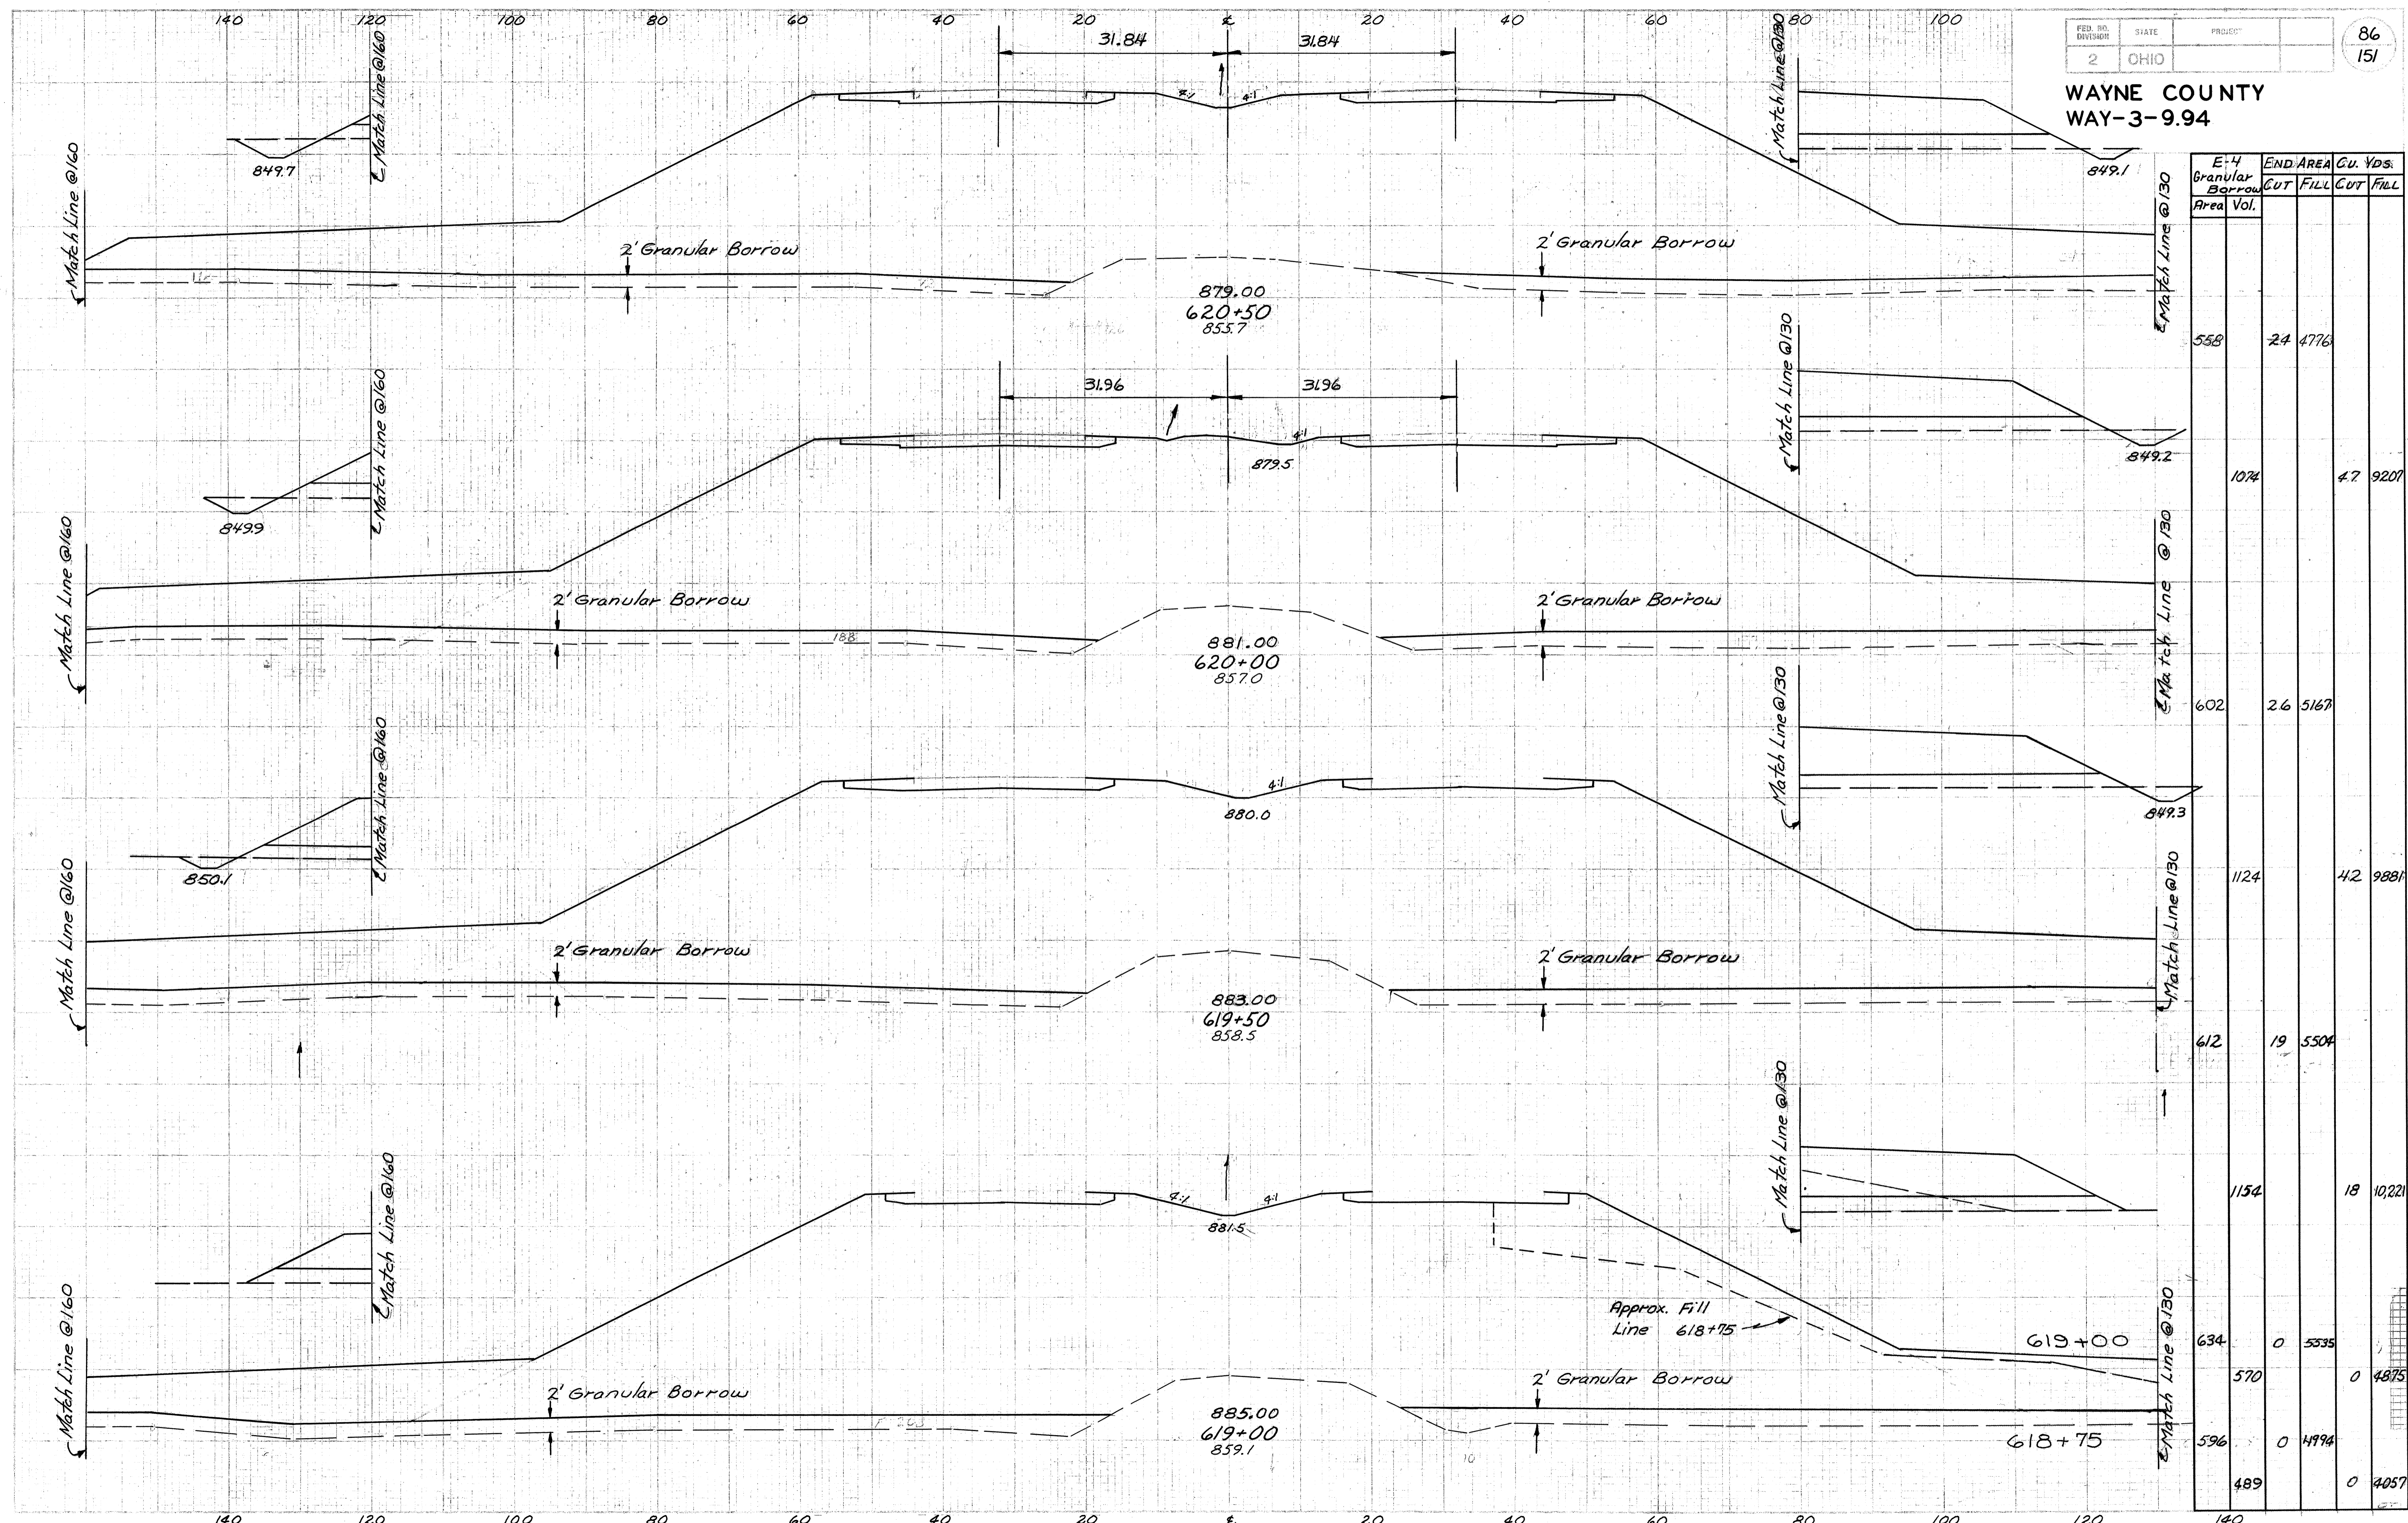

E+4 Granular Borrow Area Vol.	END AREA		Cu. Yds.	
	CUT	FILL	CUT	FILL
558	24	4776		
1074			4.7	9207
602	2.6	5167		
1124			4.2	9881
612	19	5504		
1154			18	10,221
634	0	5535		
570	0	4875		
596	0	4994		
489	0	4057		

Sta. 619+00 To Sta. 620+50


WAYNE COUNTY
WAY-3-9.94

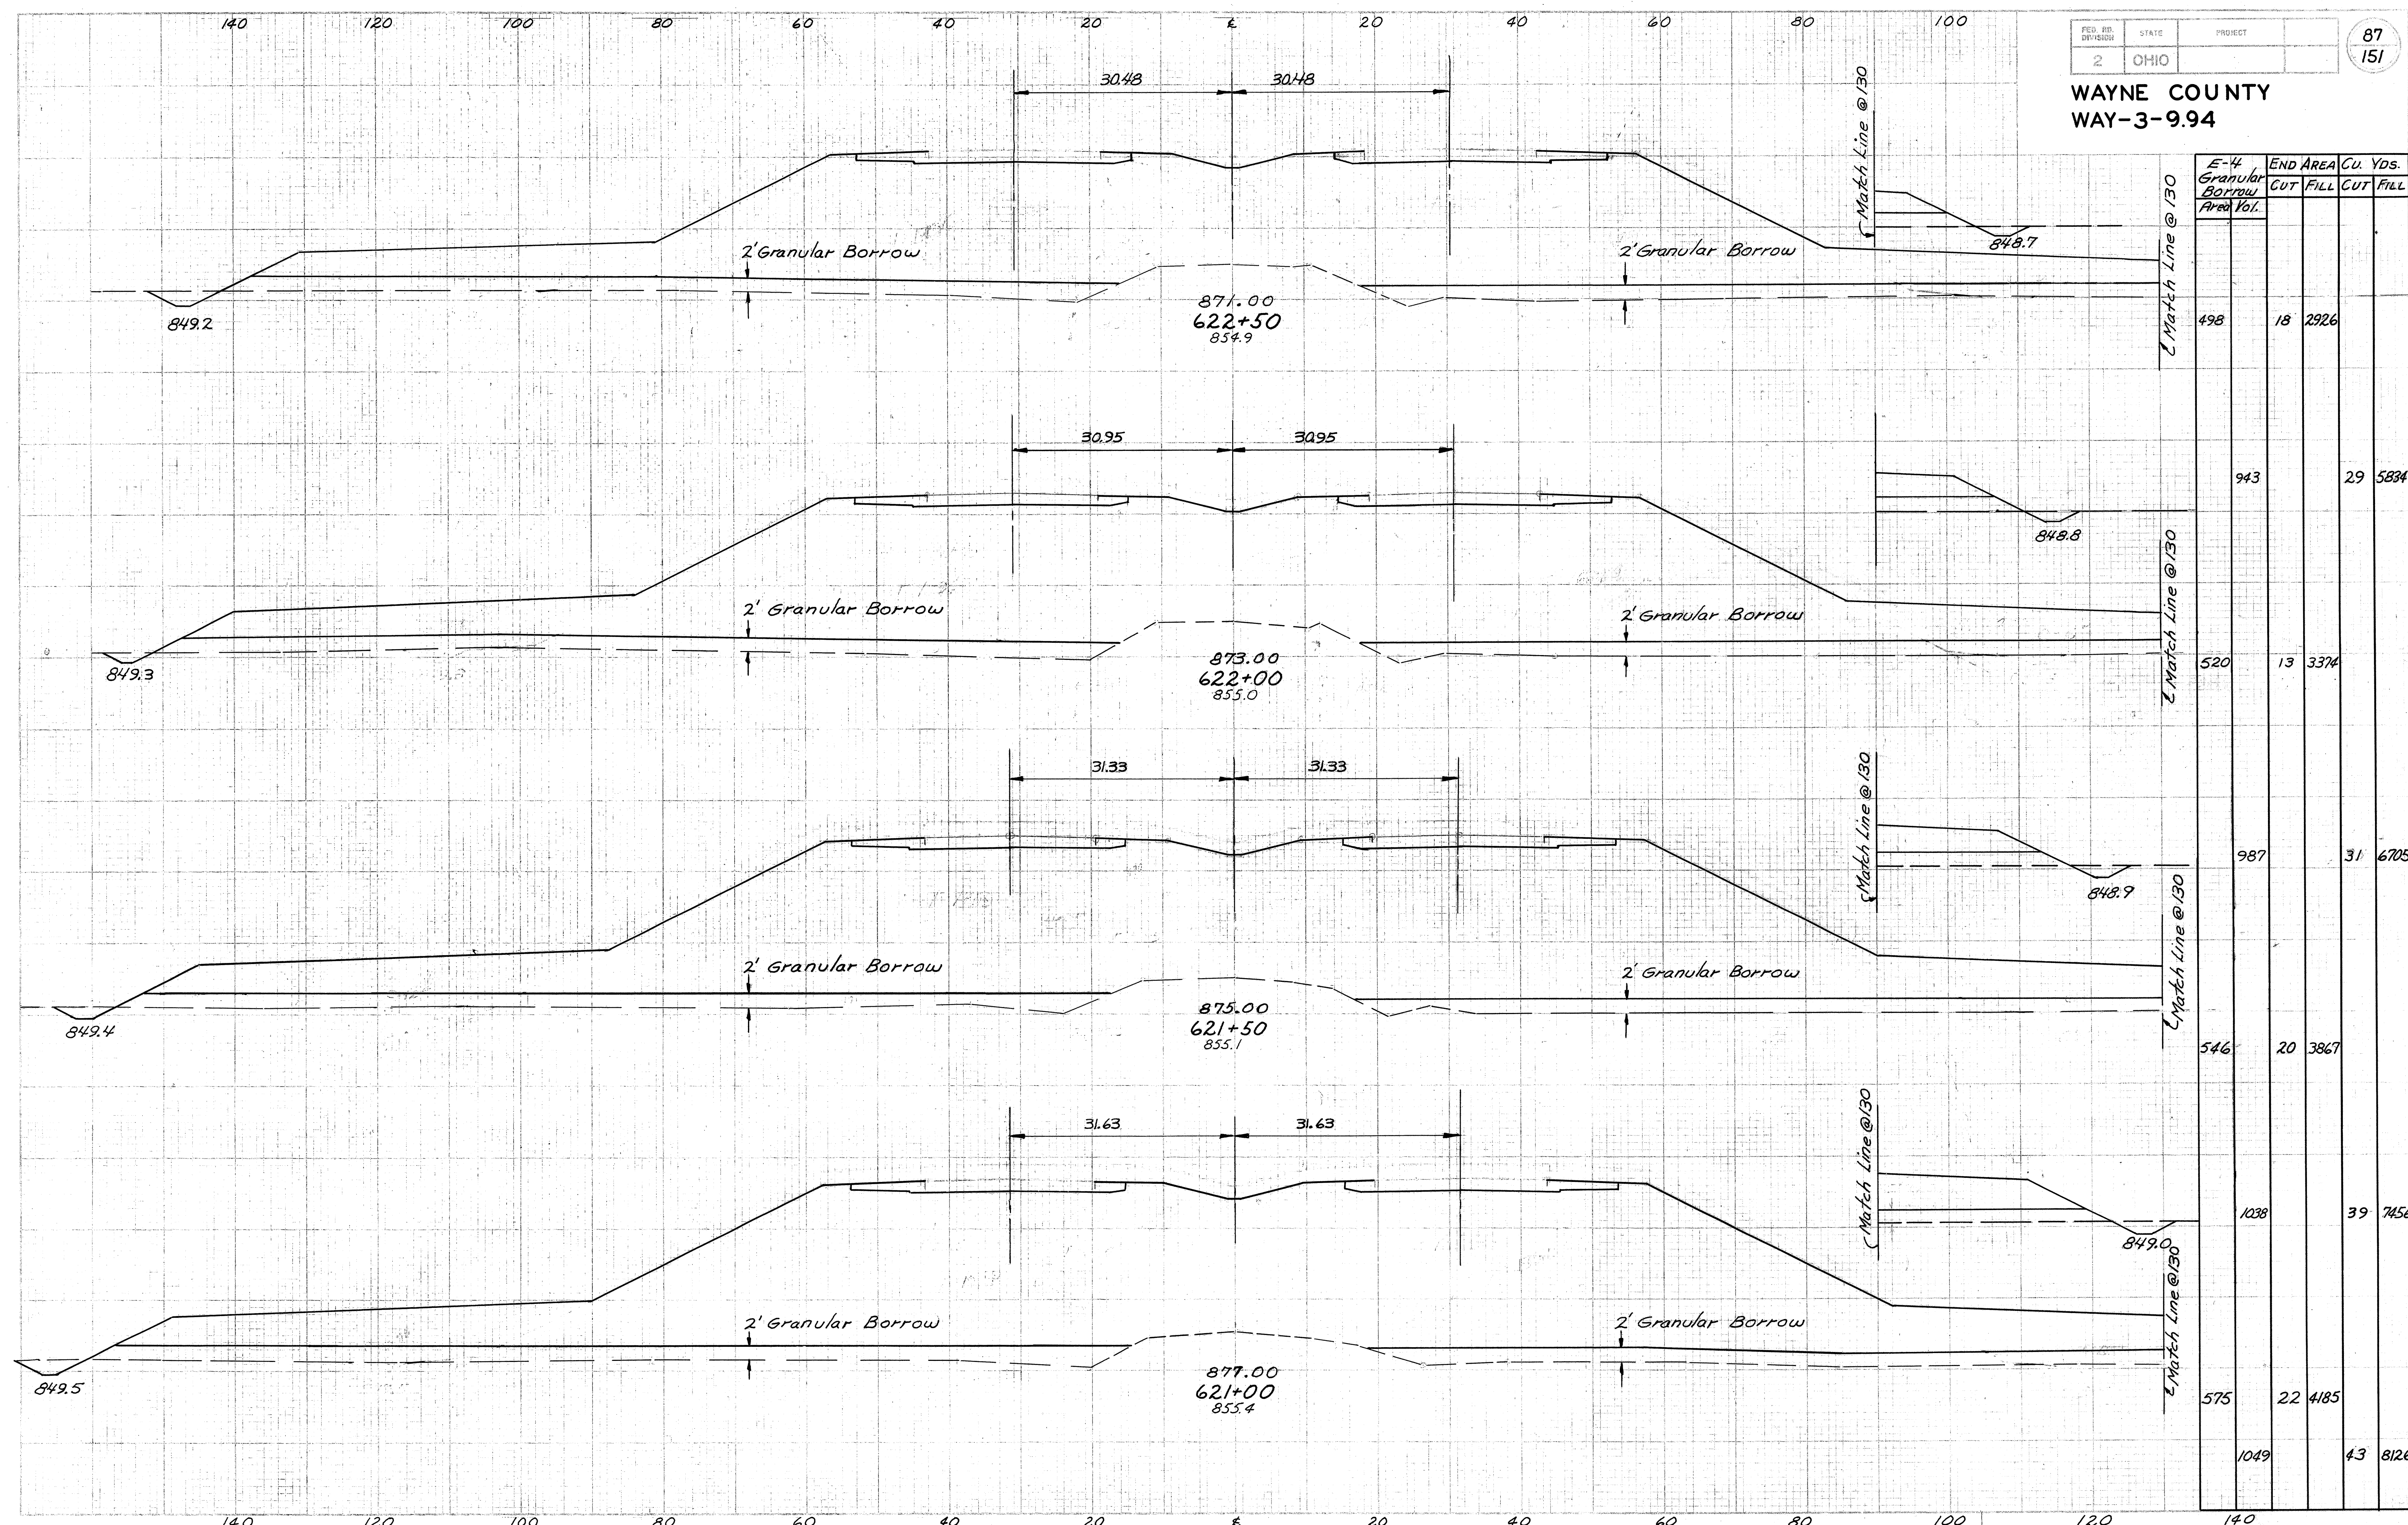

E-4 Granular Borrow Area Vol.	END AREA		Cu. Yds.	
	CUT	FILL	CUT	FILL
498	18	2926		
943			29	5834
520	13	3374		
987			31	6705
546	20	3867		
1038			39	7456
575	22	4185		
1049			43	8126


Sta. 621+00 To Sta. 622+50

WAYNE COUNTY
WAY-3-9.94

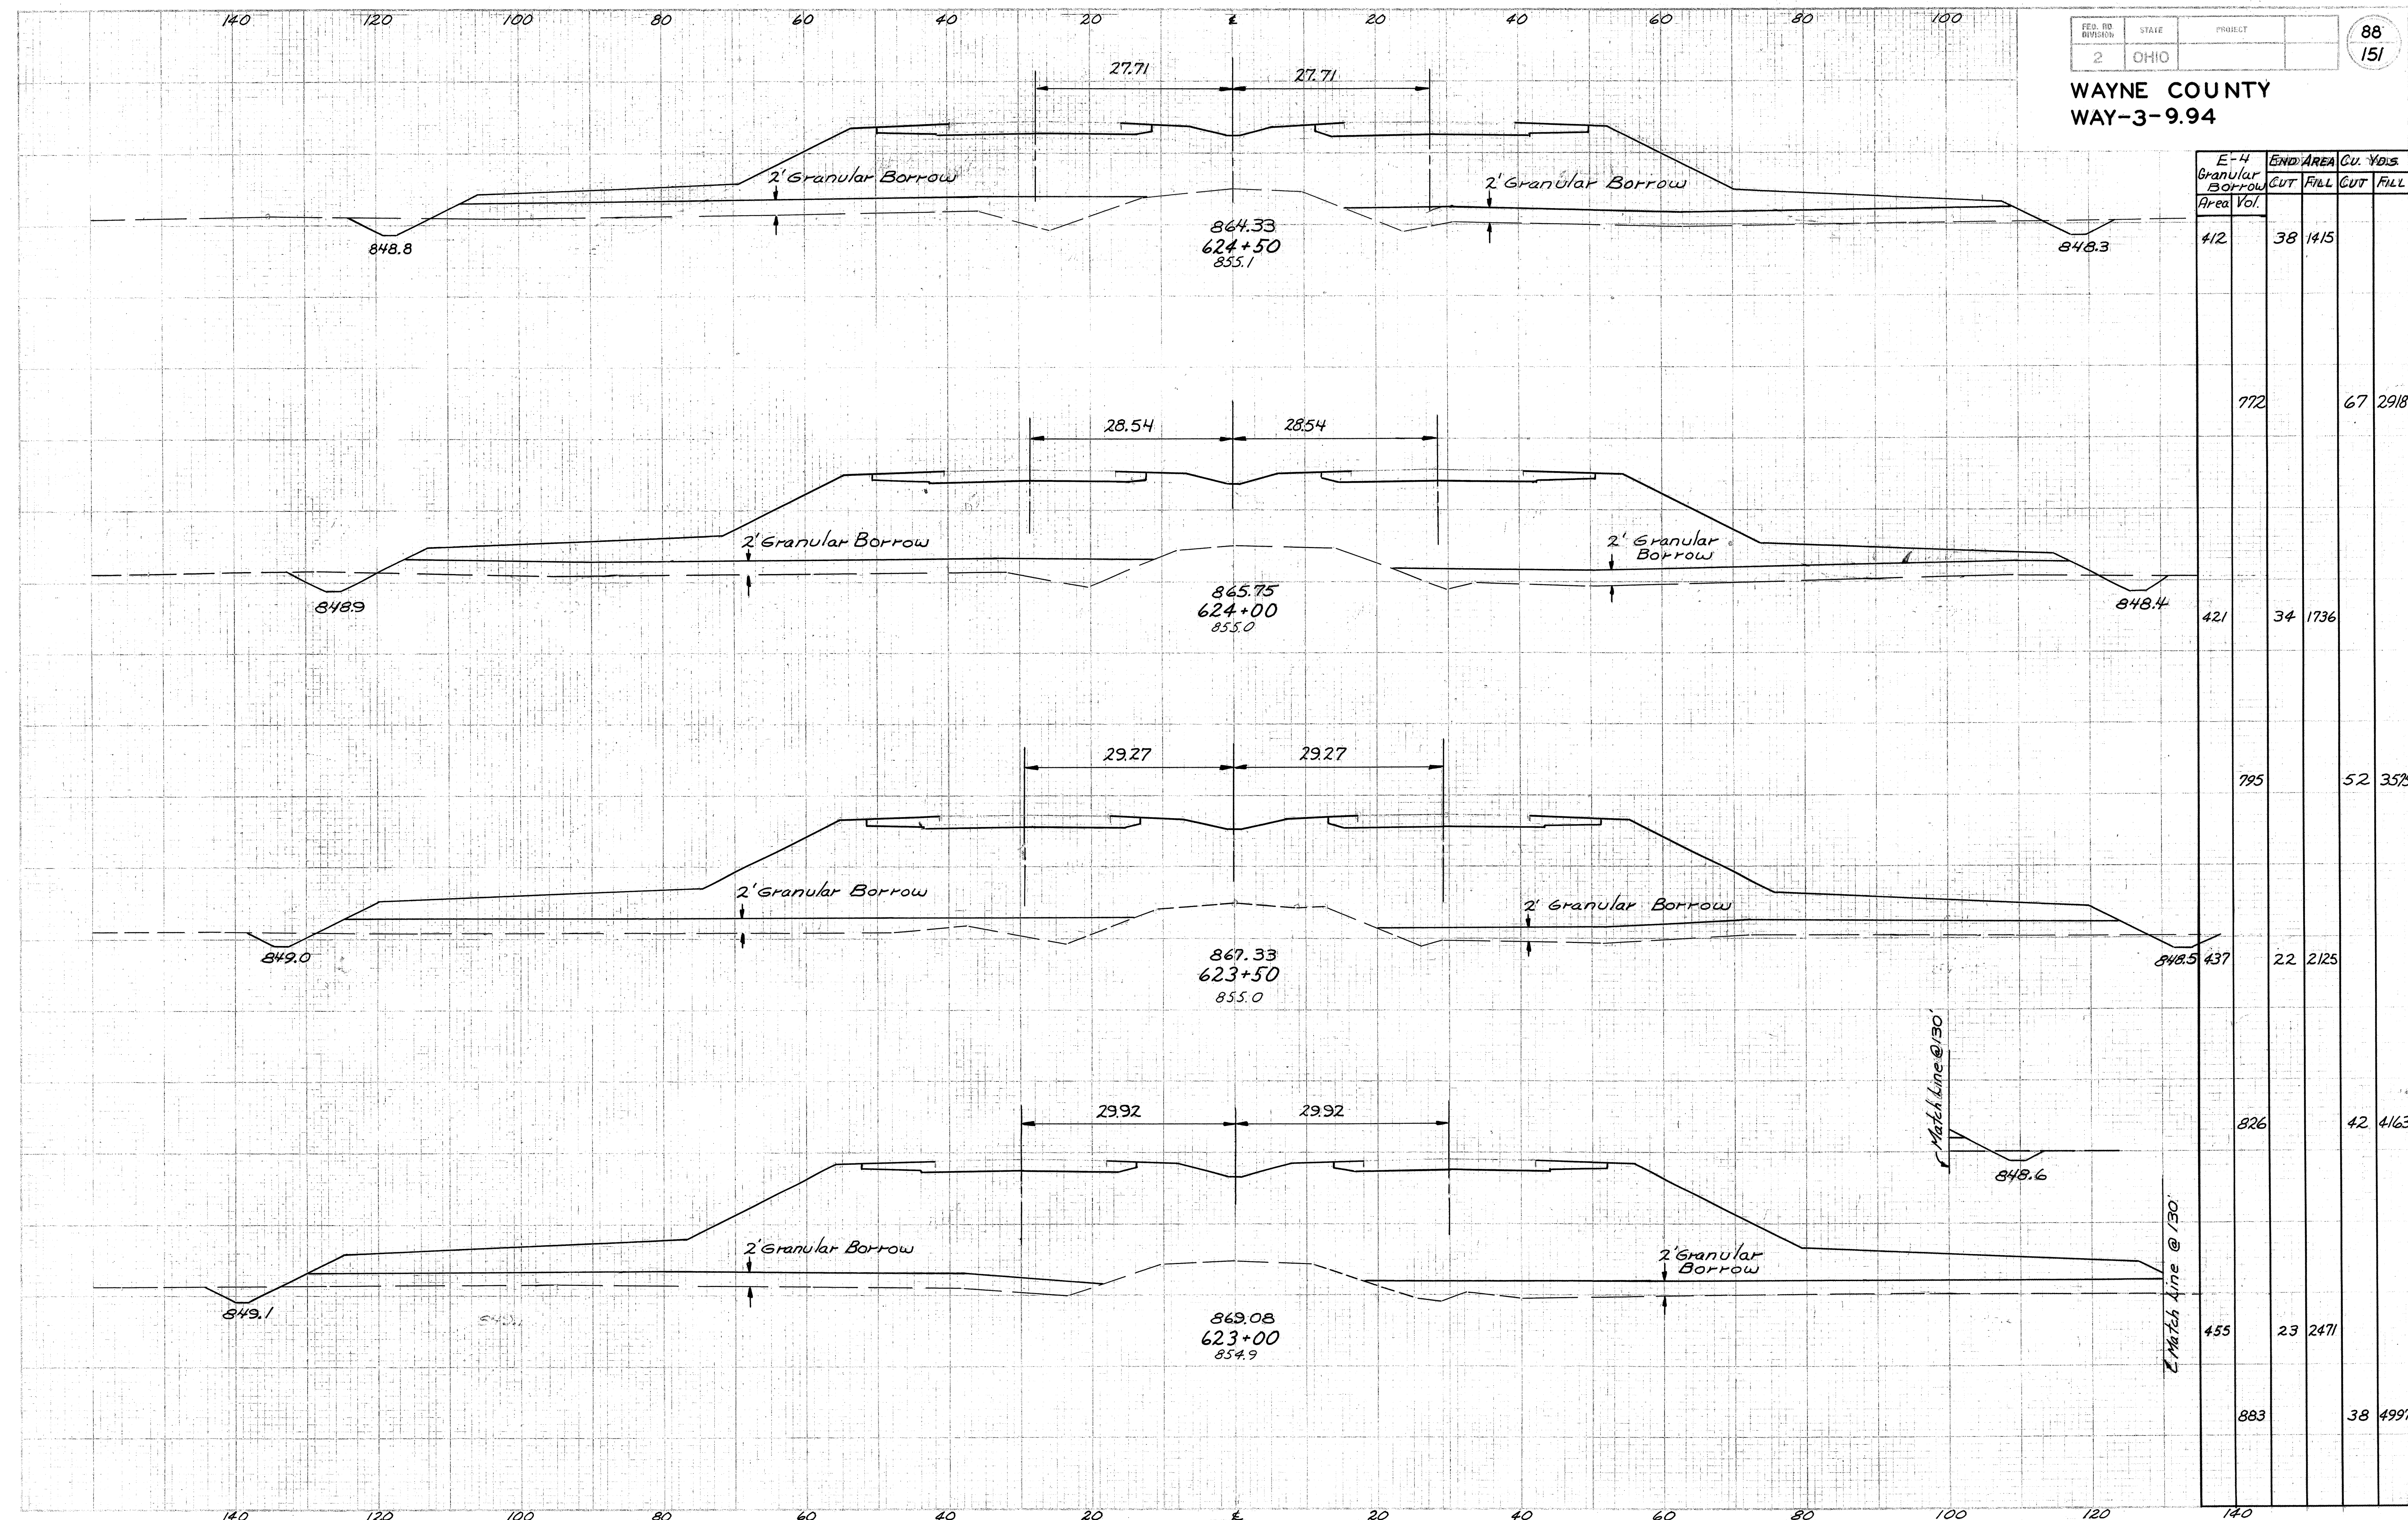

E-4 Granular Borrow Area Vol.	END AREA		Cu. Yds.	
	CUT	FILL	CUT	FILL
412	38	1415		
772			67	2918
421	34	1736		
795			52	3578
437	22	2125		
826			42	4163
455	23	2471		
883			38	4997


WAYNE COUNTY
WAY-3-9.94

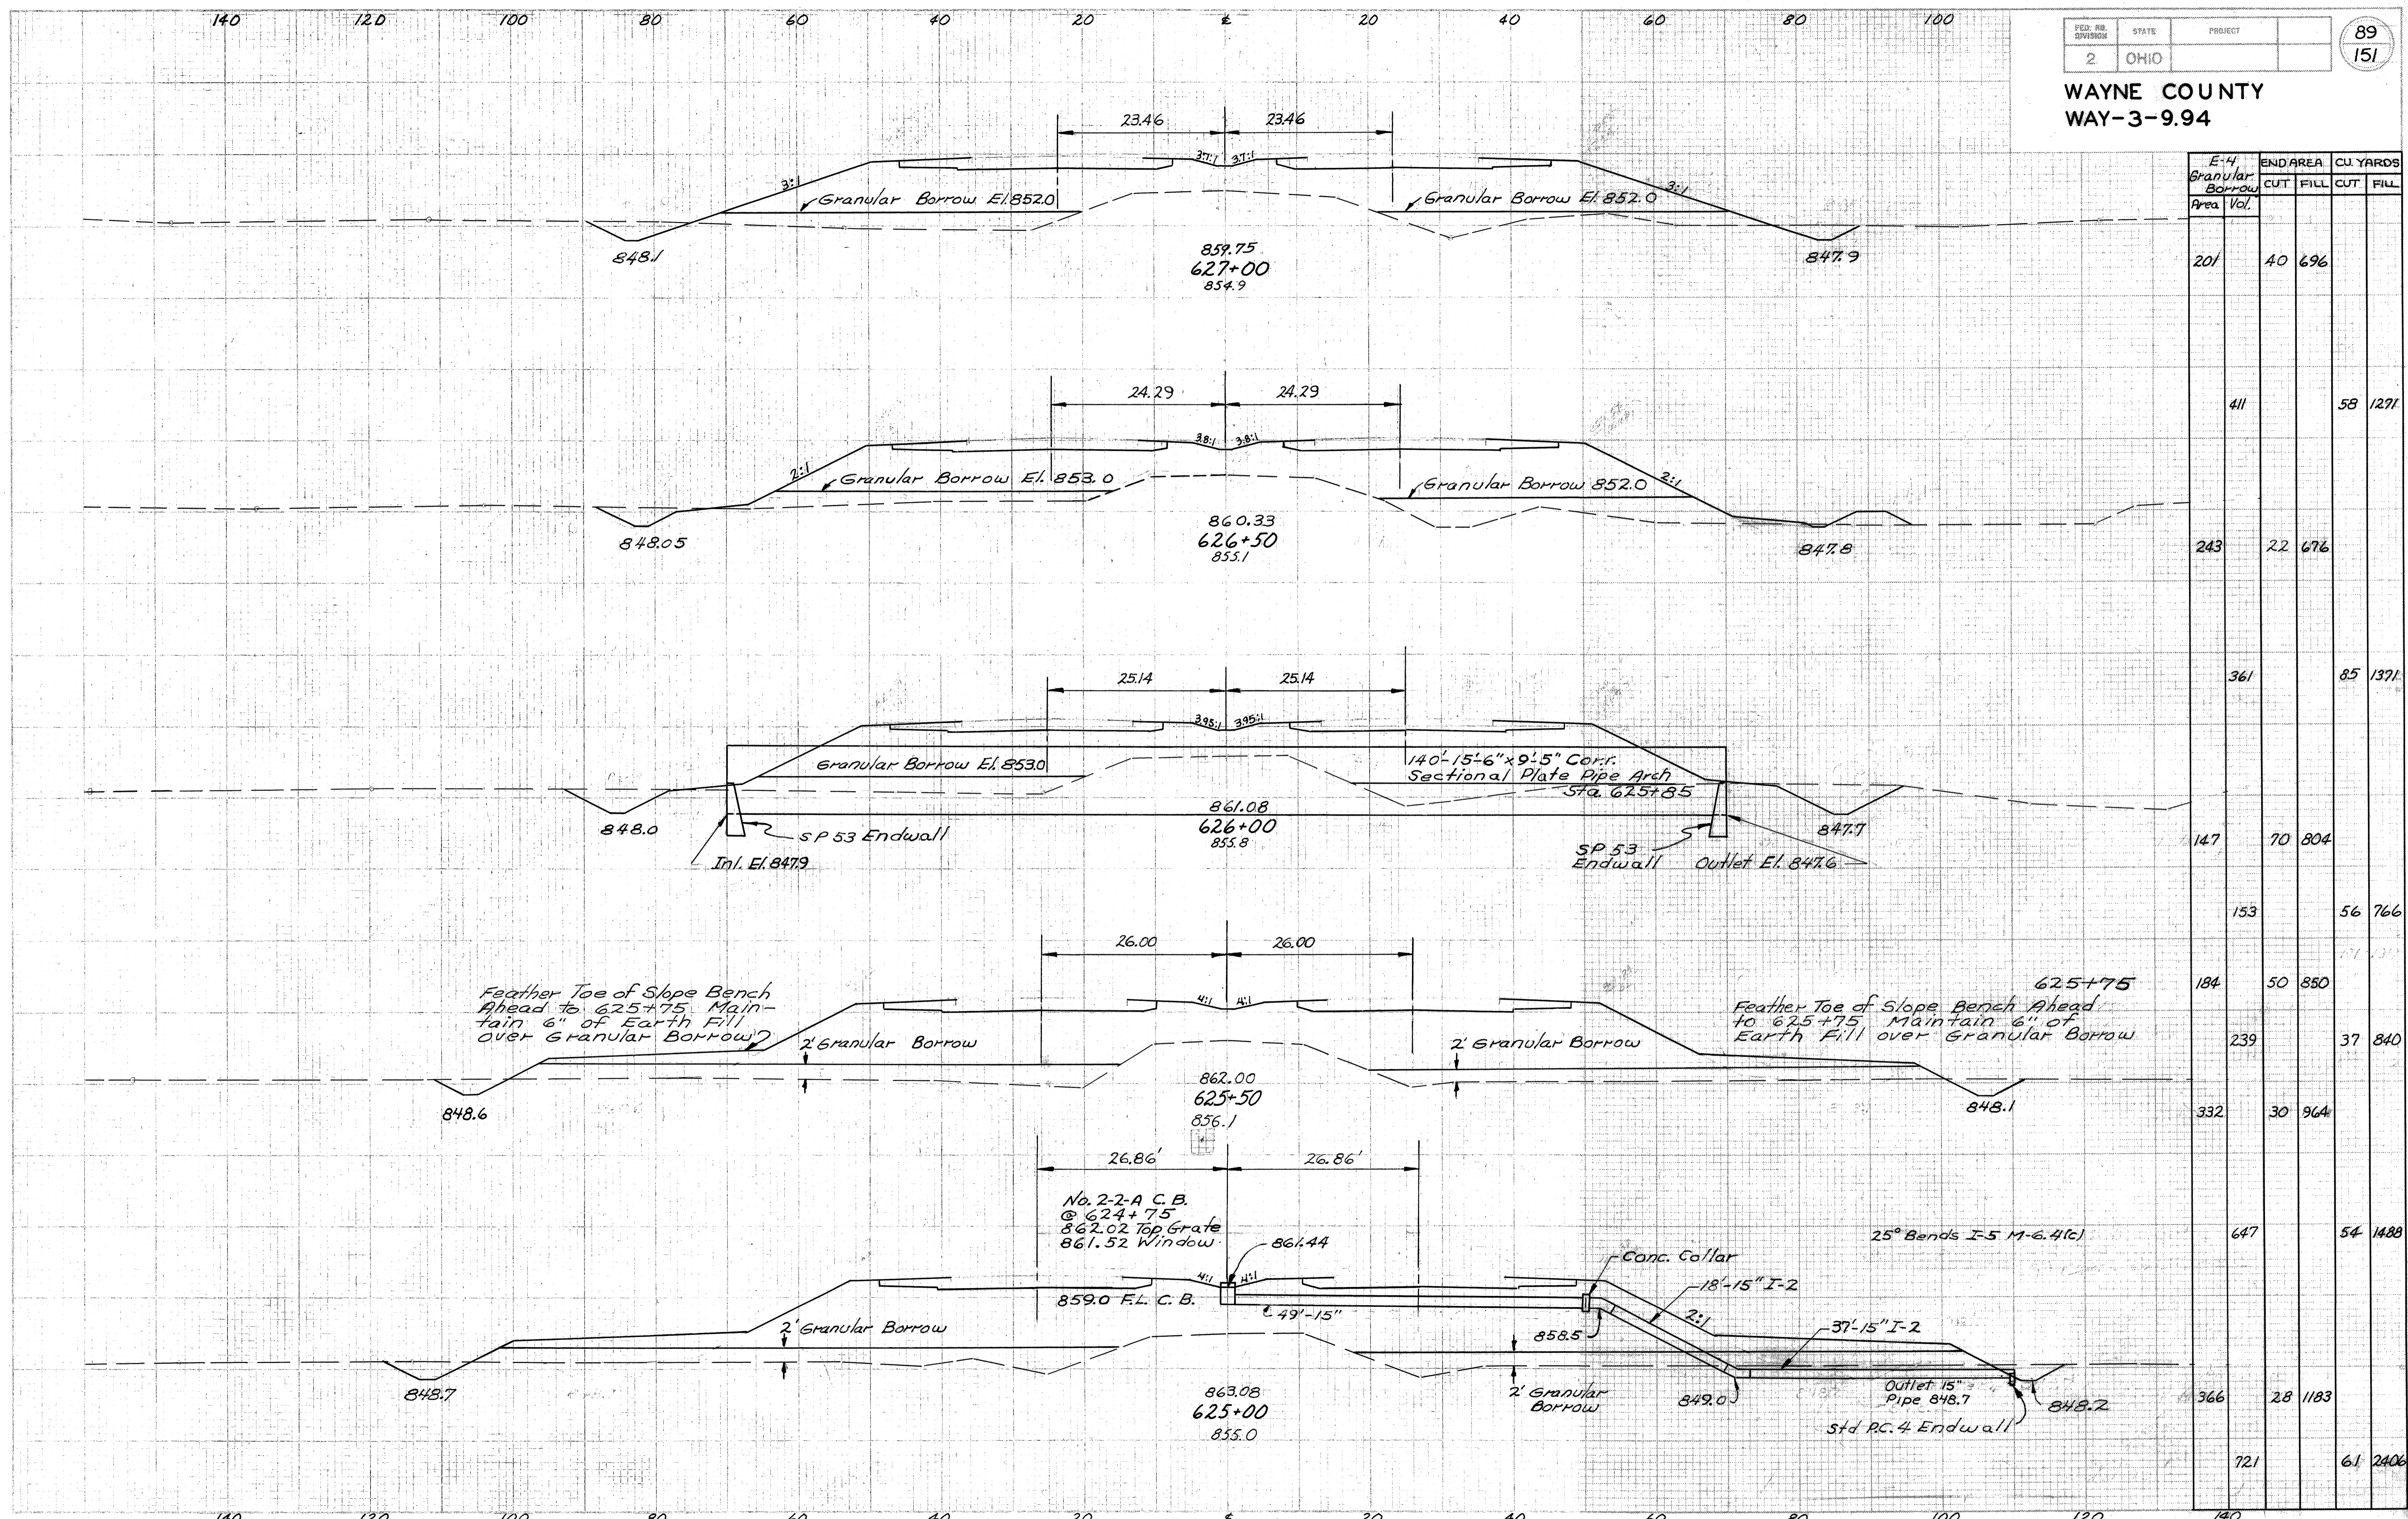

E-4 Granular Borrow Area Vol.	END AREA		CU. YARDS	
	CUT	FILL	CUT	FILL
201	40	696		
411			58	1271
243	22	676		
361			85	1371
147	70	804		
153			56	766
184	50	850		
239			37	840
332	30	964		
647			54	1488
366	28	1183		
721			61	2406

Sta. 625+00 to Sta. 627+00


WAYNE COUNTY
WAY-3-9.94

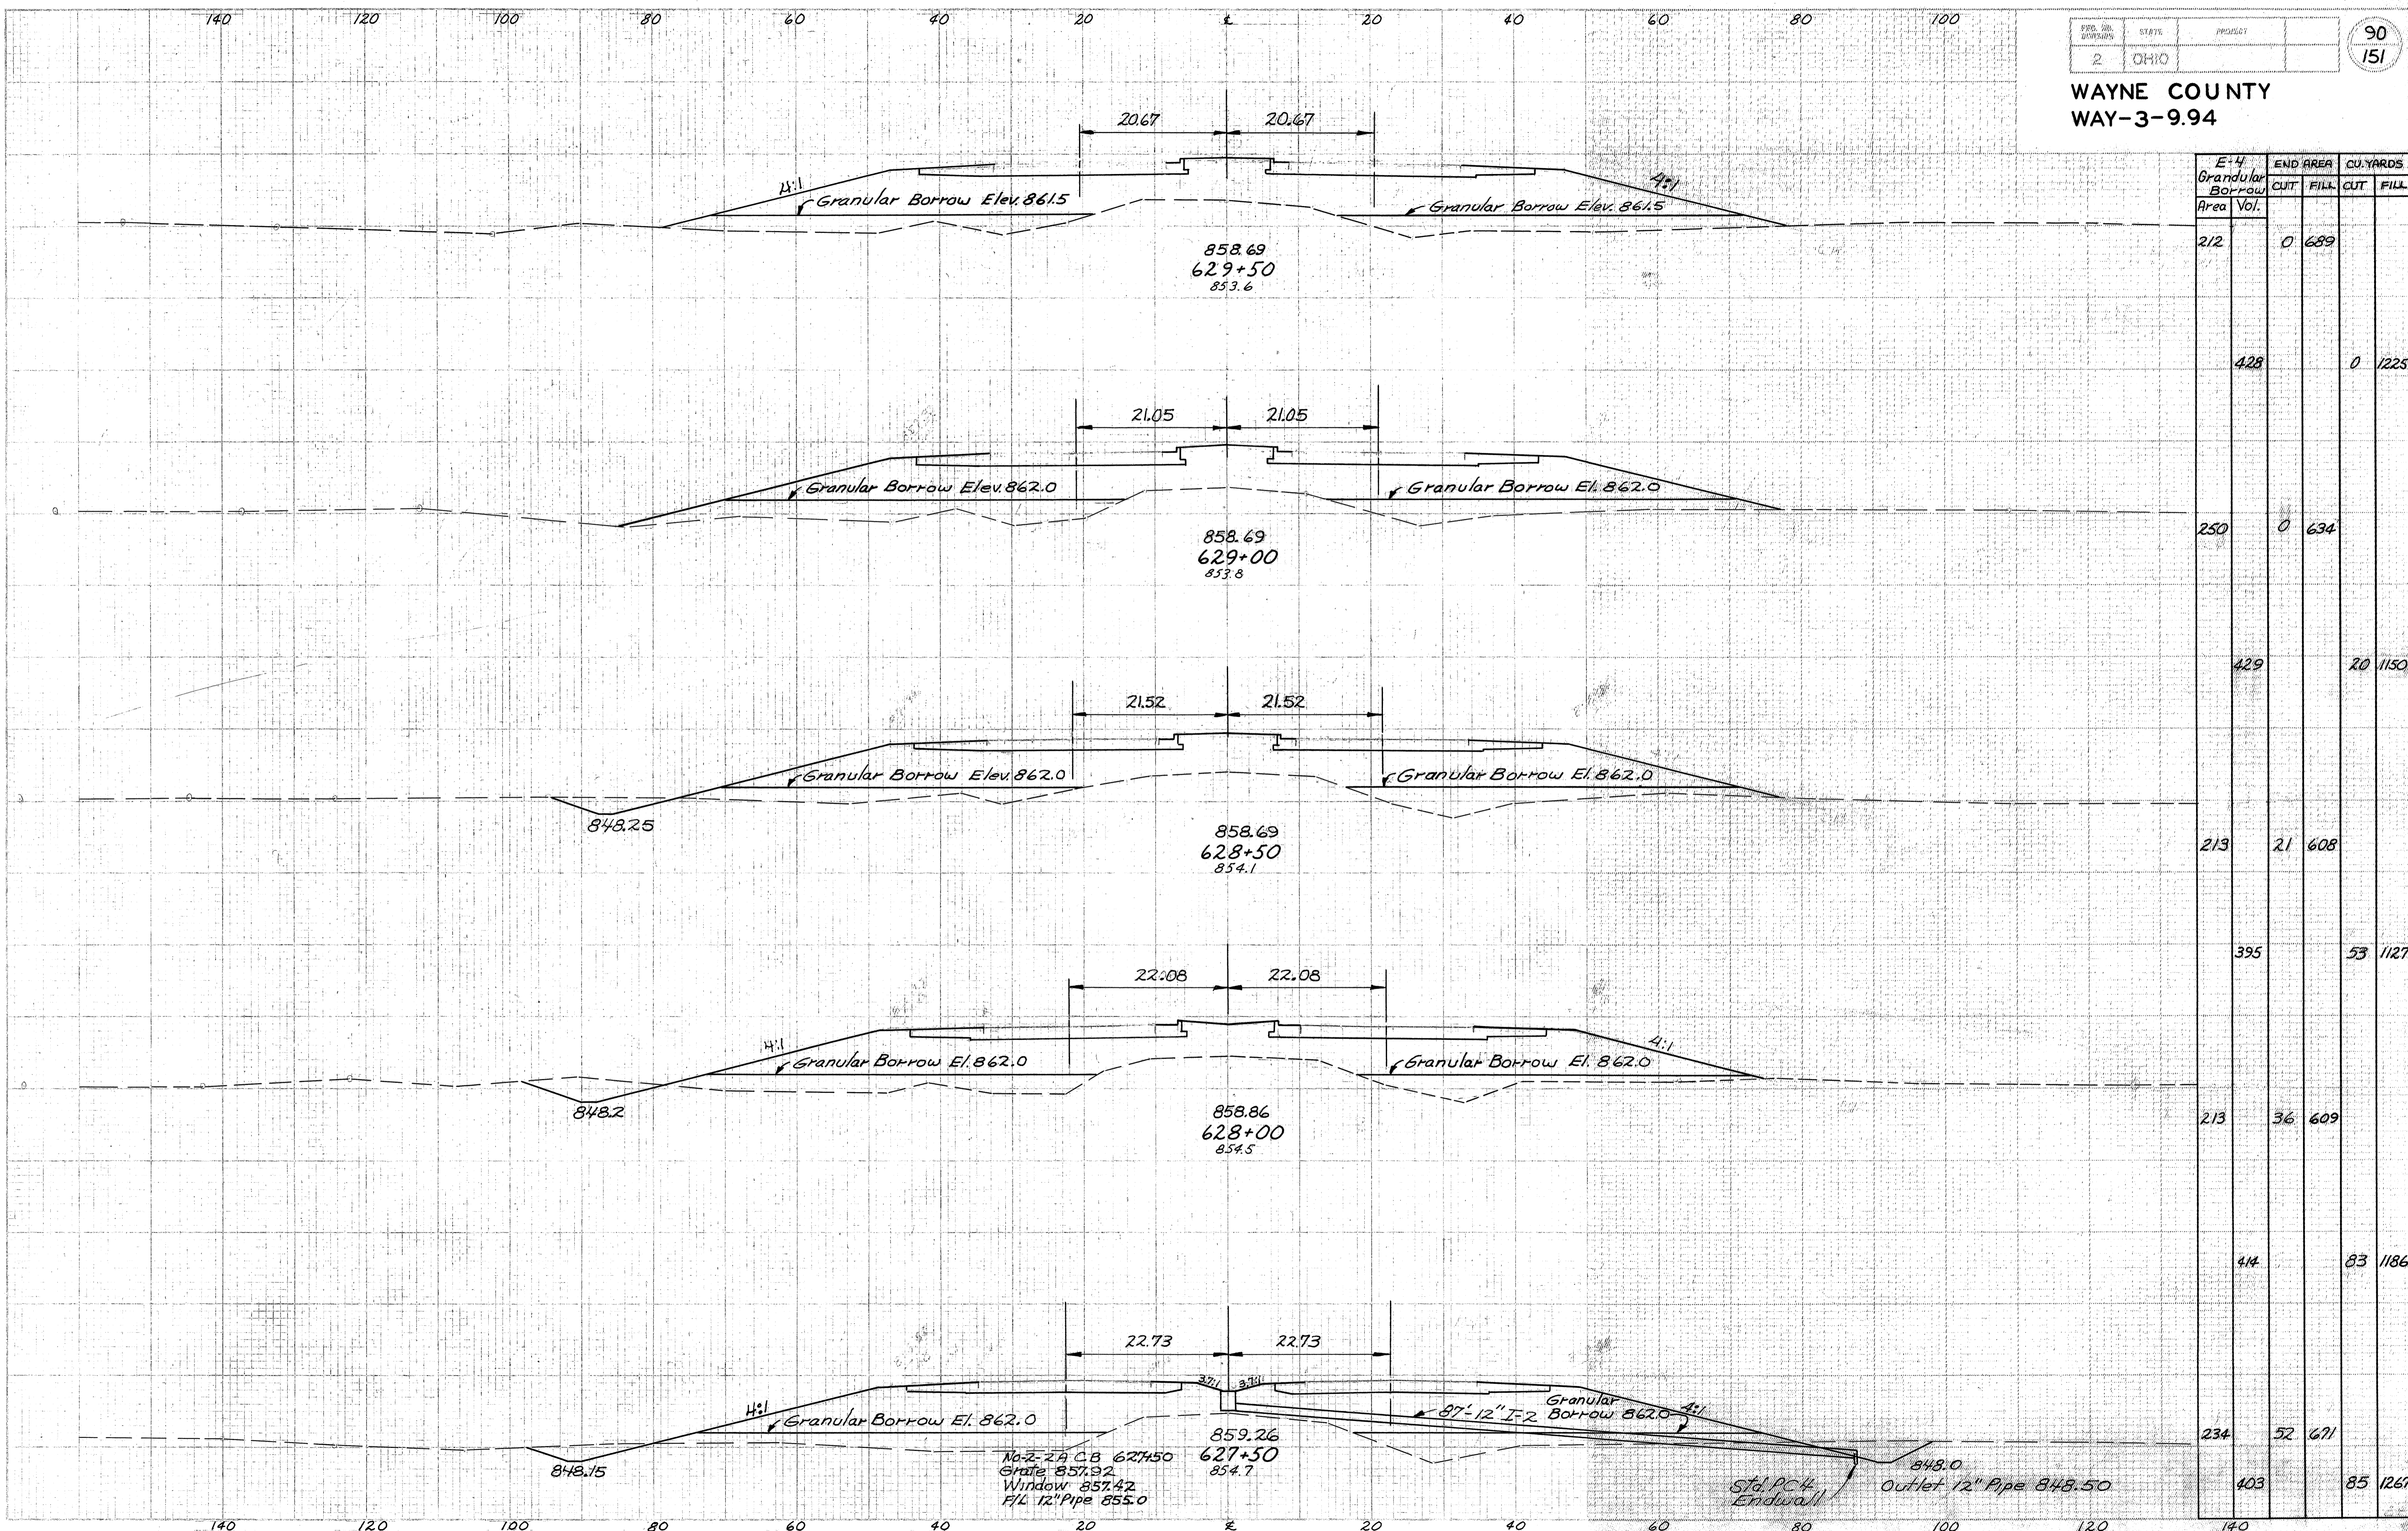

E-4 Granular Borrow Area	Vol.	END AREA		CU. YARDS	
		CUT	FILL	CUT	FILL
212		0	689		
428				0	1225
250		0	634		
429				20	1150
213		21	608		
395				53	1127
213		36	609		
414				83	1186
234		52	671		
403				85	1267

Sta. 627+50 To Sta. 629+50


WAYNE COUNTY
WAY-3-9.94

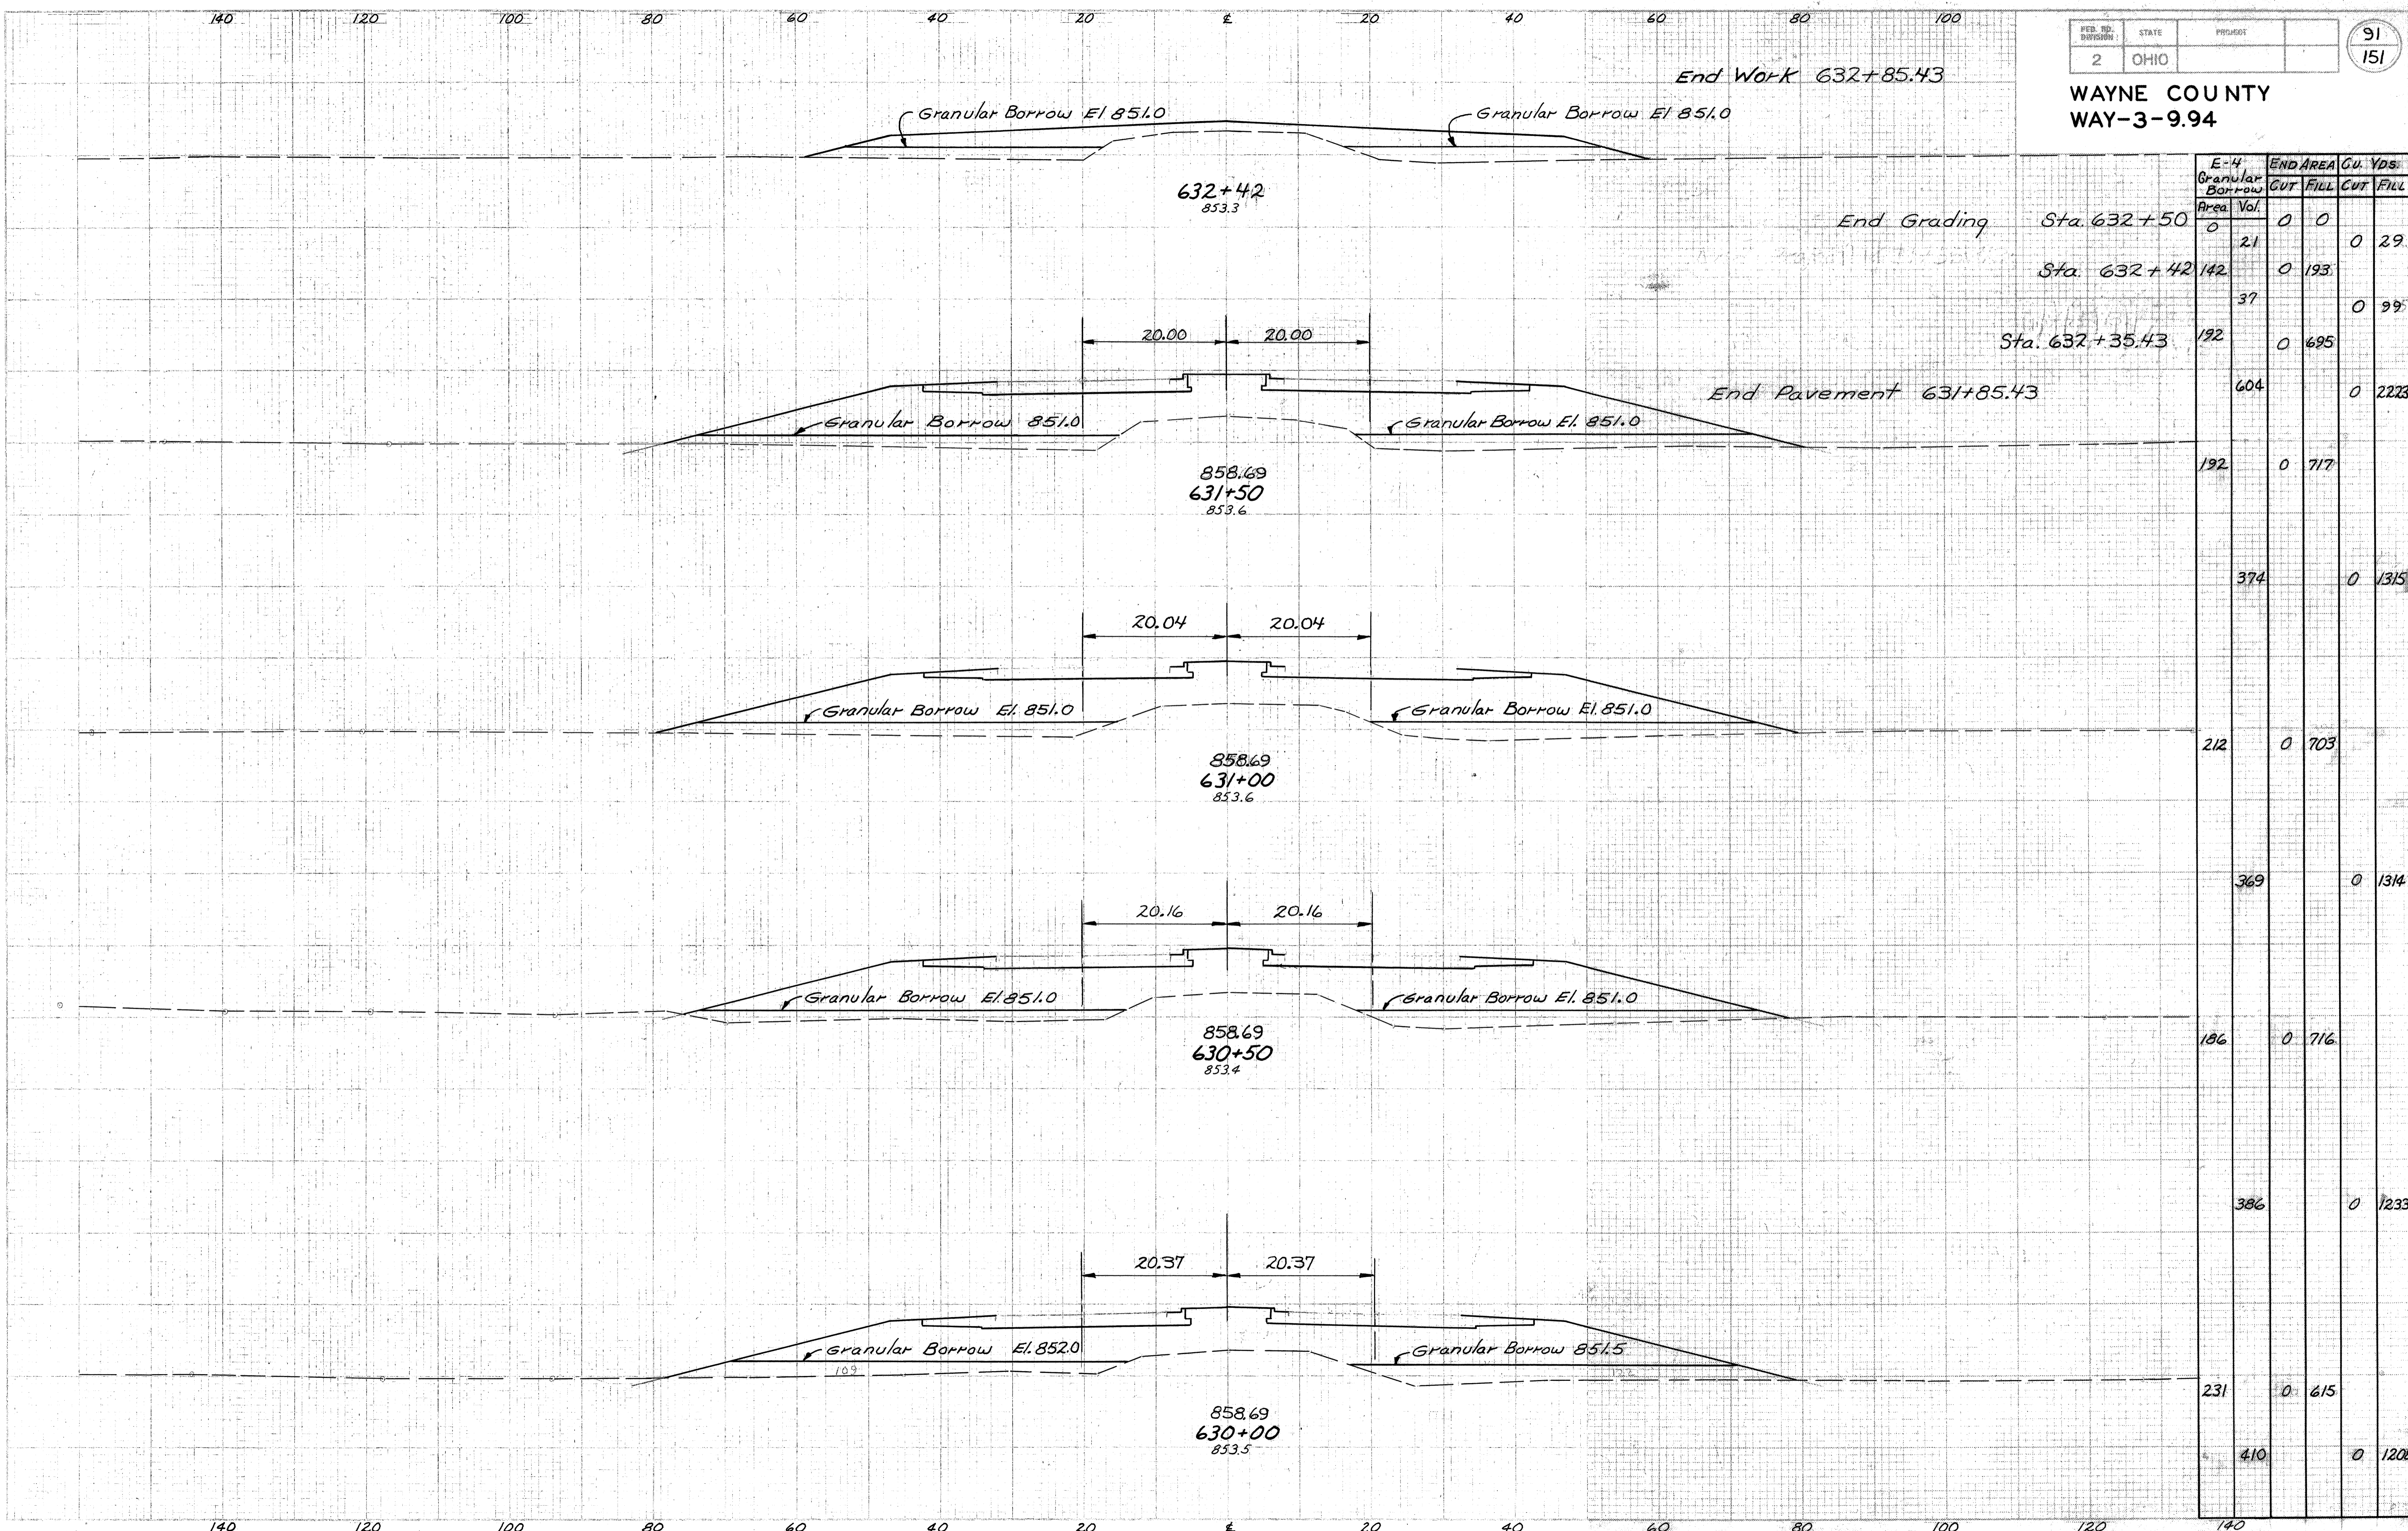

E-4 Granular Borrow Area	Vol.	END AREA		Cu. Yds.	
		CUT	FILL	CUT	FILL
0		0	0	0	0
21				0	29
142		0	193		
37				0	99
192		0	695		
604				0	2223
192		0	717		
374				0	1315
212		0	703		
369				0	1314
186		0	716		
386				0	1233
231		0	615		
410				0	1208


Sta. 630+00 To Sta. 632+00

WAYNE COUNTY
WAY-3-9.94

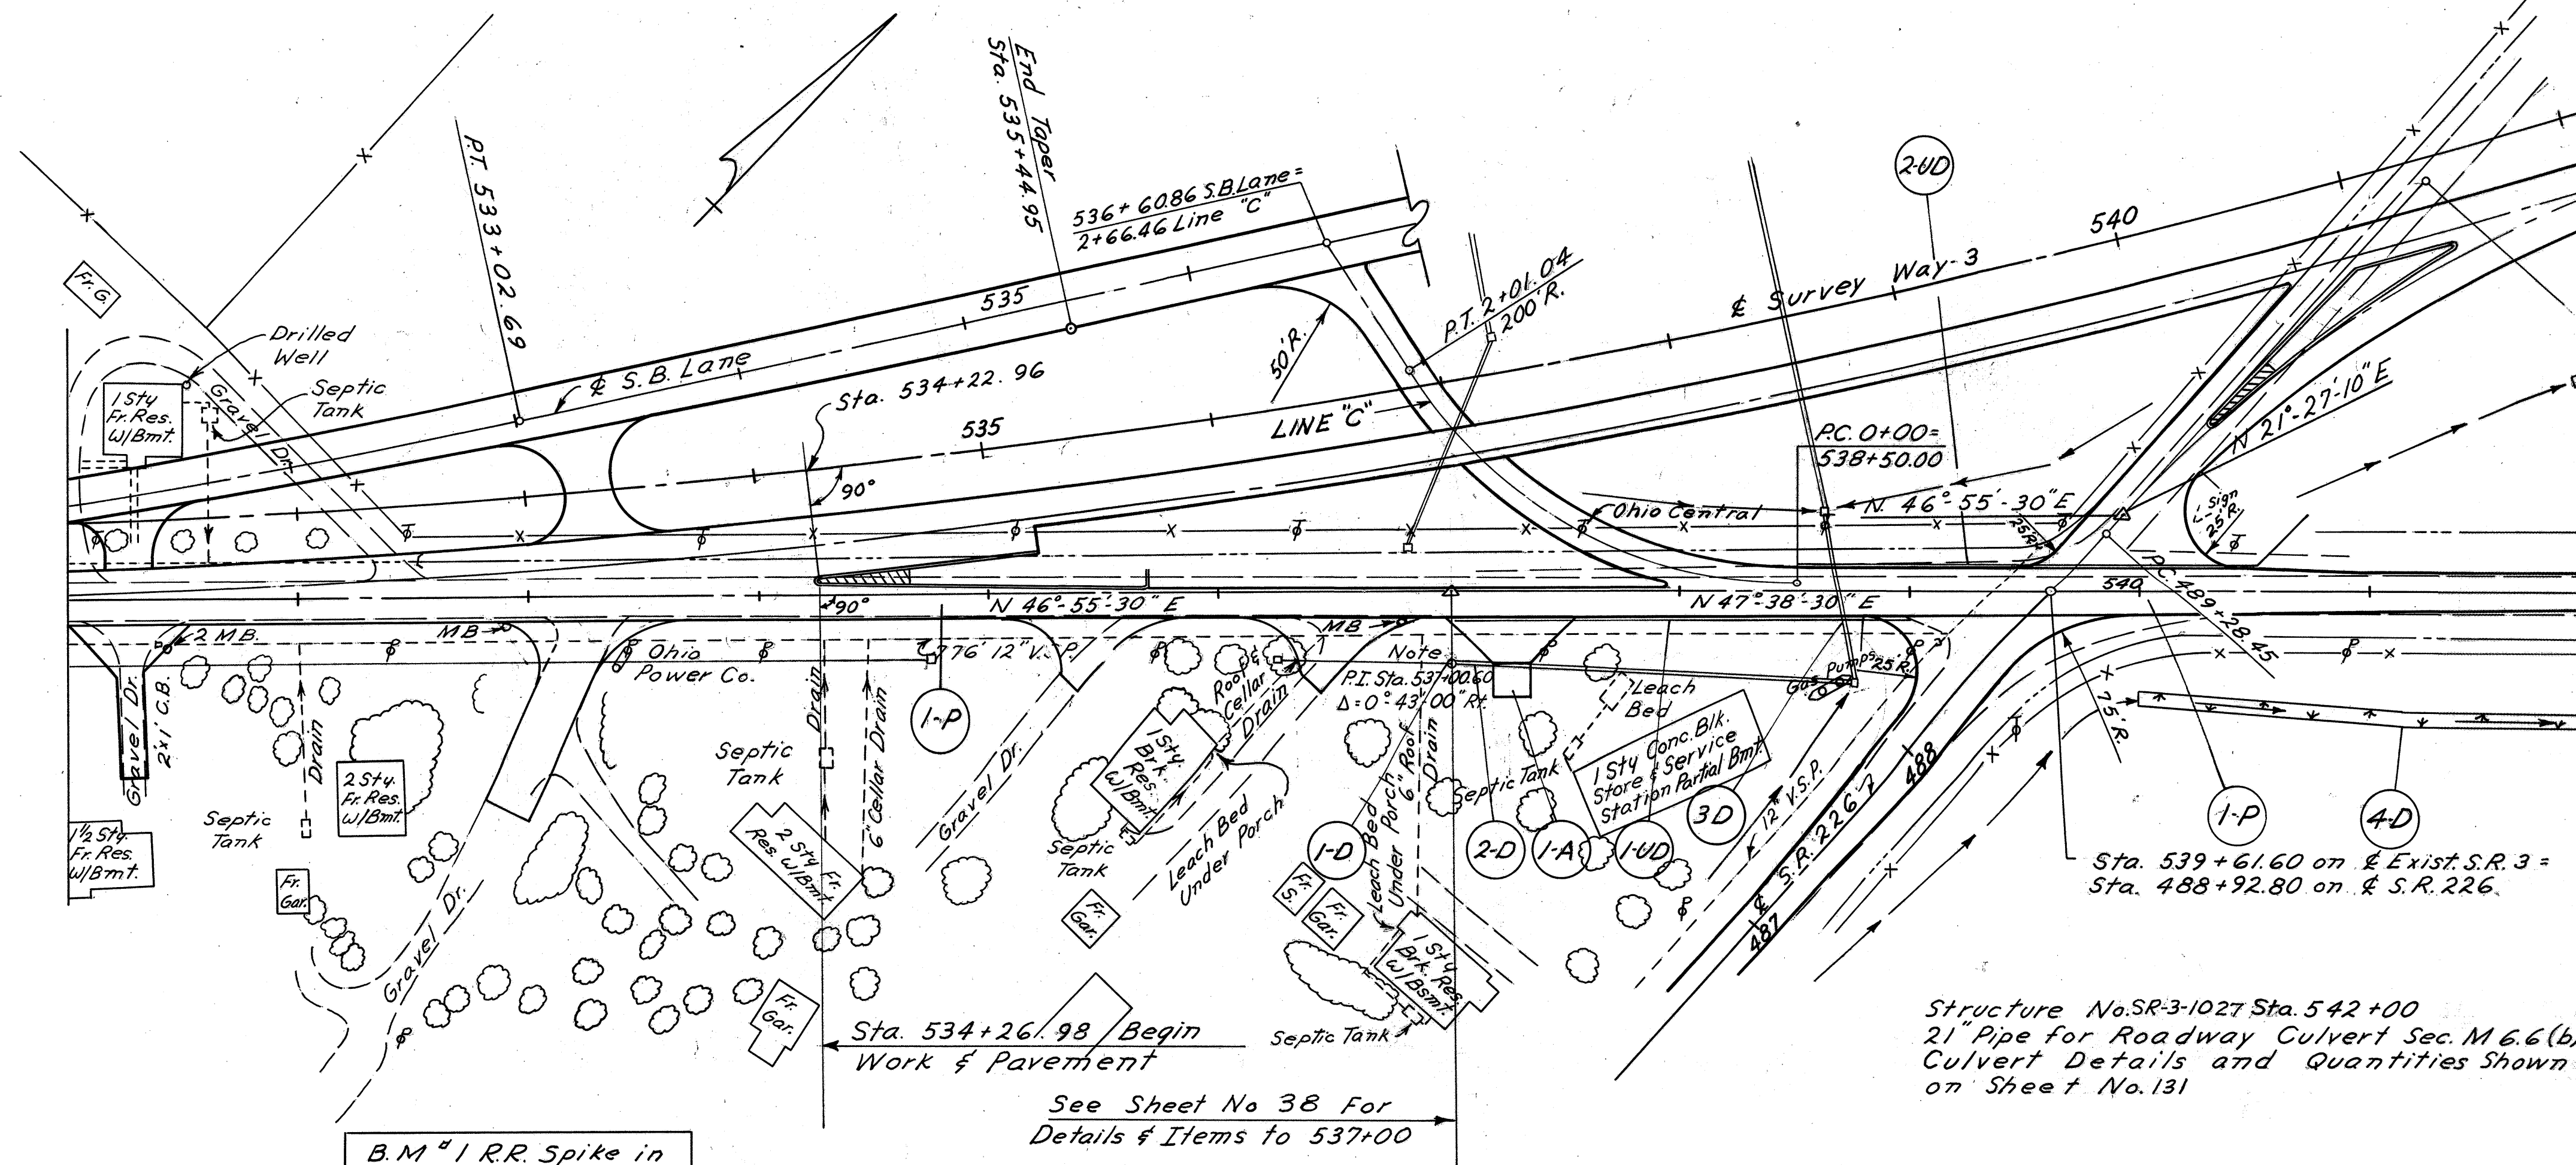

Item No.	Station		Side	Sodding Width	Catch Basin No. 2-2B	Class. B. Storm Sewer Under	Pipe Specials 12" Tee Each	Pipe For Roadway Drainage		
	From	To								
1-D	537+00		RT		1			3		
2-D	537+00	538+75	RT		1		1	169		
3-D	538+62	538+75				80				
4-D	540+00	542+00	RT	6	134					
Total					134	1	1	80	1	172


Item No.	Station		Side	1-4 6" Pipe Underdrain Deep	I-4 6" Pipe Underdrain Shallow	I-4 6" Pipe Outlet For Underdrain	I-5 Pipe Specials 6" 45° Bend	Length	Width	B-19 Crushed Aggregate Base Course Cu. Yds.	T-35 Asphaltic Concrete Surface Course Cu. Yds.
	From	To									
1-UD	537+00	539+00		200							
2-UD	538+50	540+75			218	10	1				
1-A	537+25		RT					36	16	15.86	4.42
Totals				200	218	10	1			15.86	4.42

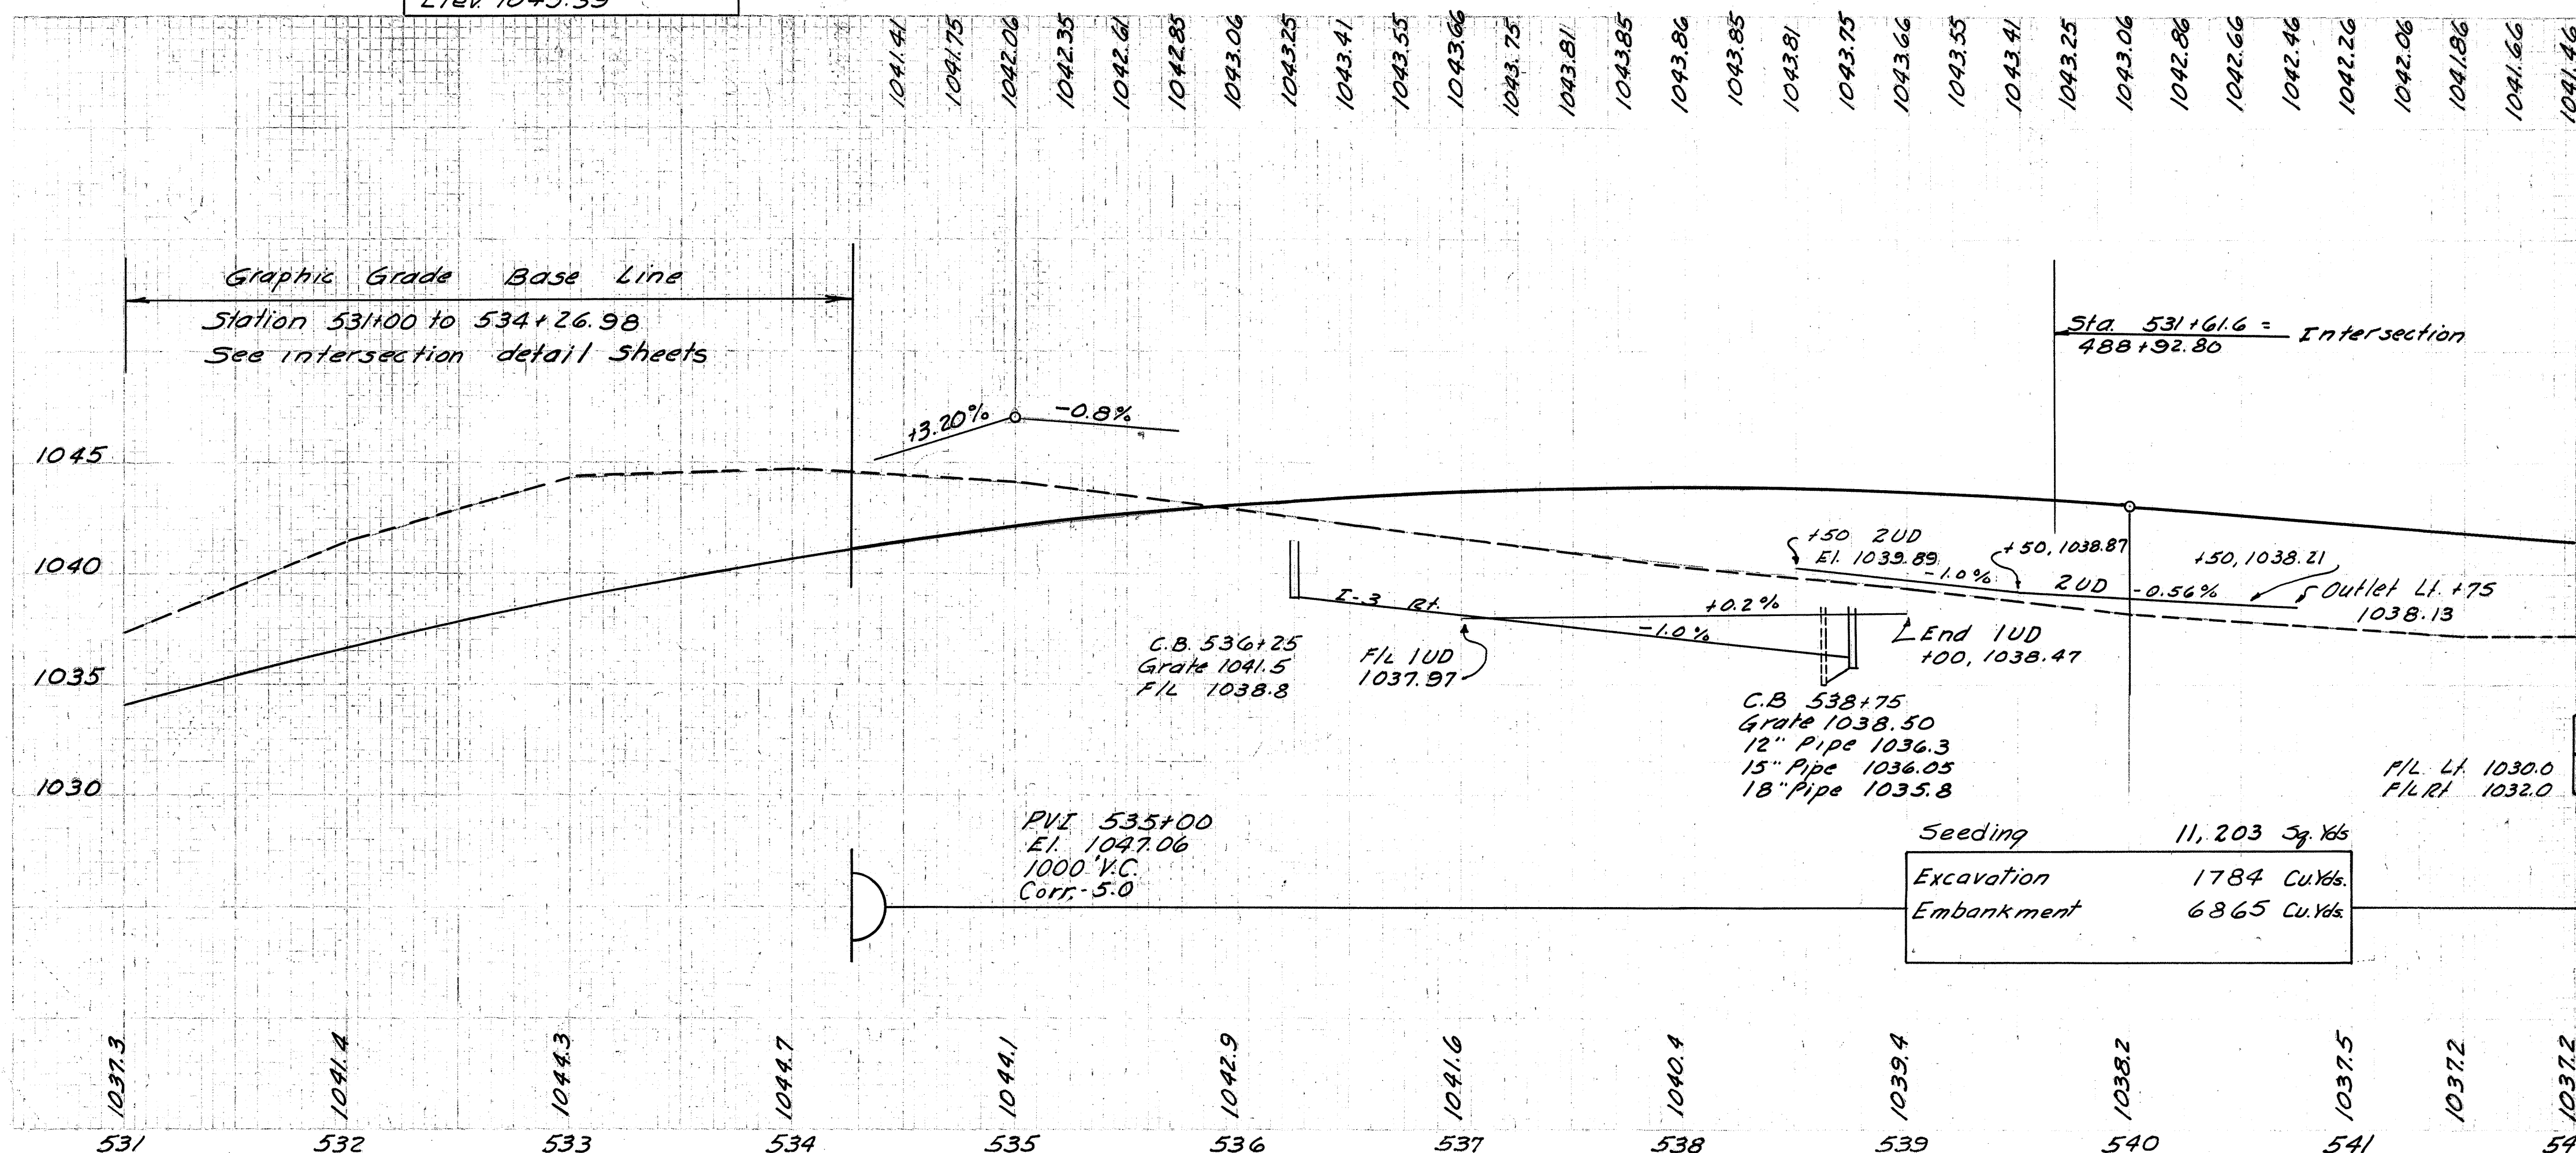

For Pavement Quantities See Sheet No. 93


EXIST. S.R.-3, Sta 531+00 to Sta. 542+00

WAYNE COUNTY
WAY-3-9.94

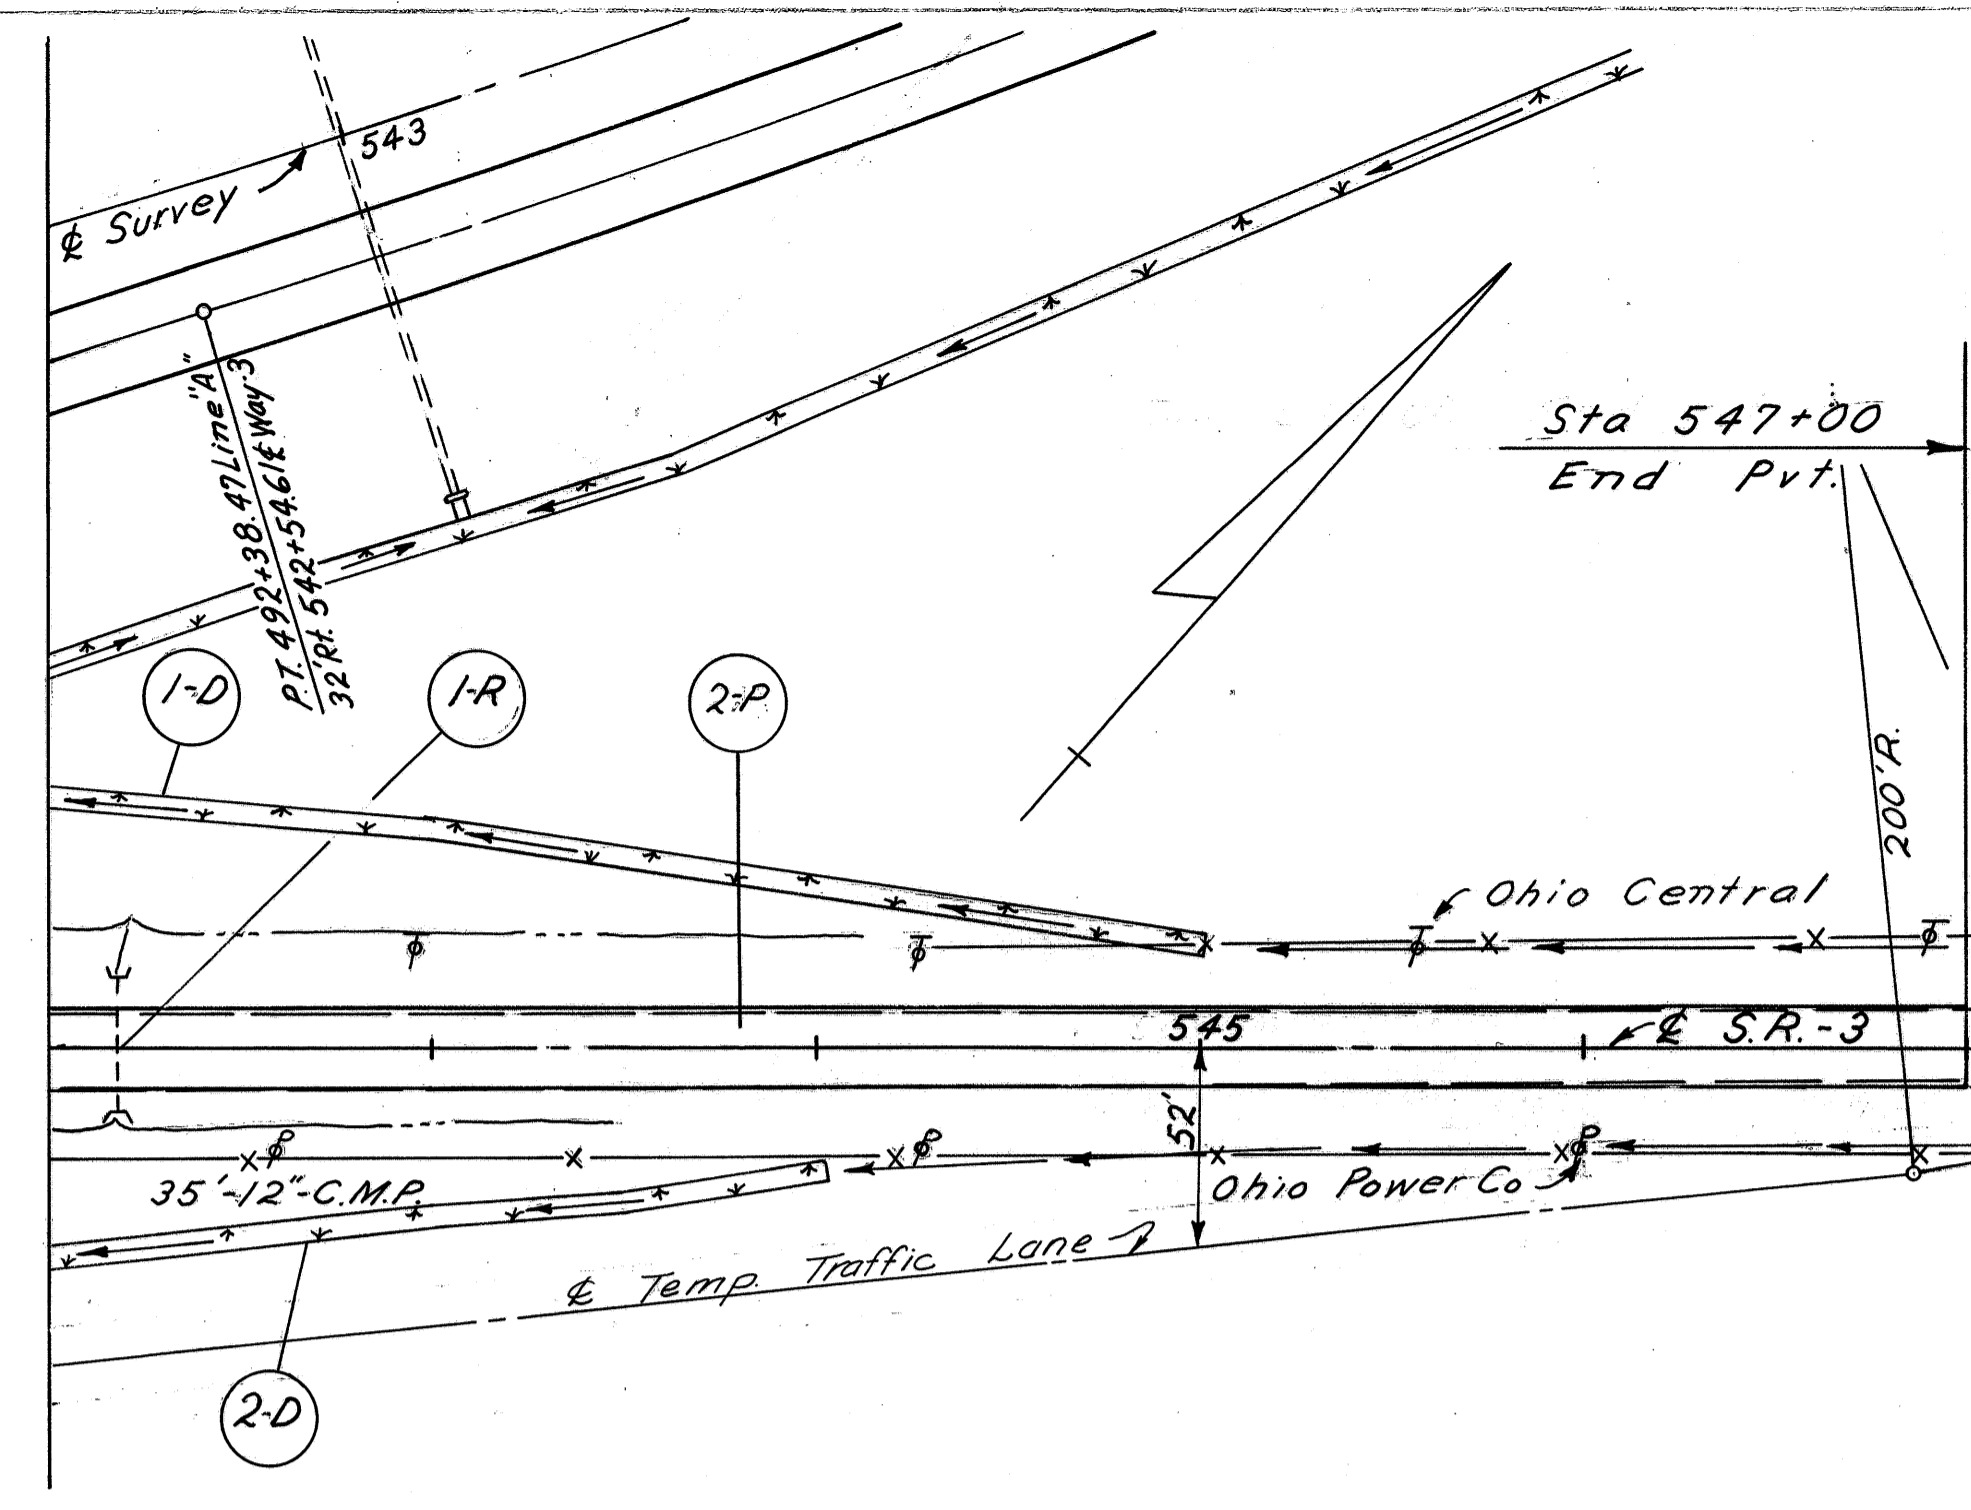


Item No.	Station		Side	T-35	B-35	B-35	T-30	B-20	I-22	I-18	B-33	T-31		I-9	
	From	To		Asphaltic Conc. Surface Course 1 1/2\" Type C	Asphaltic Conc. Leveling Course 1 1/4\" (70-85)	Asphaltic Conc. Base Course 3\" (70-85)	Bituminous Prime Coat 4 Gal/Sq. Yd.	Water bound Mac. Base Course 8\"	Subbase Grading A or B 6\"	Stabilized Crushed App. Shldr. 5\"	Bituminous Mac. Base Course 3\"	No. 6 Aggregate .008 Cu. Yd. Per Sq. Yd.	No. 46 Aggregate .008 Cu. Yd. Per Sq. Yd.	Bit. Material 2 Applications .25 Gal. Per Sq. Yd.	Stone Underdrain No. 2
P-1	534+26.98	542+00		54.77	54.77	134.53	645.86	1844.78	408.32	122.12	792.57	6.34	6.34	396.29	54.80
P-2	542+00	547+00		38.58	38.58	94.91	455.56	1194.11	254.19	71.33					150.70
Totals				93.35	93.35	229.44	1101.42	3038.89	662.51	193.45	792.57	6.34	6.34	396.29	205.50

Item No.	Station		Side	L-10	E-12
	From	To		Sodding Width	Pipe Removal 15' Under
1-D	542+00	545+00	Lt.	6	201
2-D	542+00	544+00	Rt.	6	134
1-R	542+18		Ctr.		35
Totals				335	35

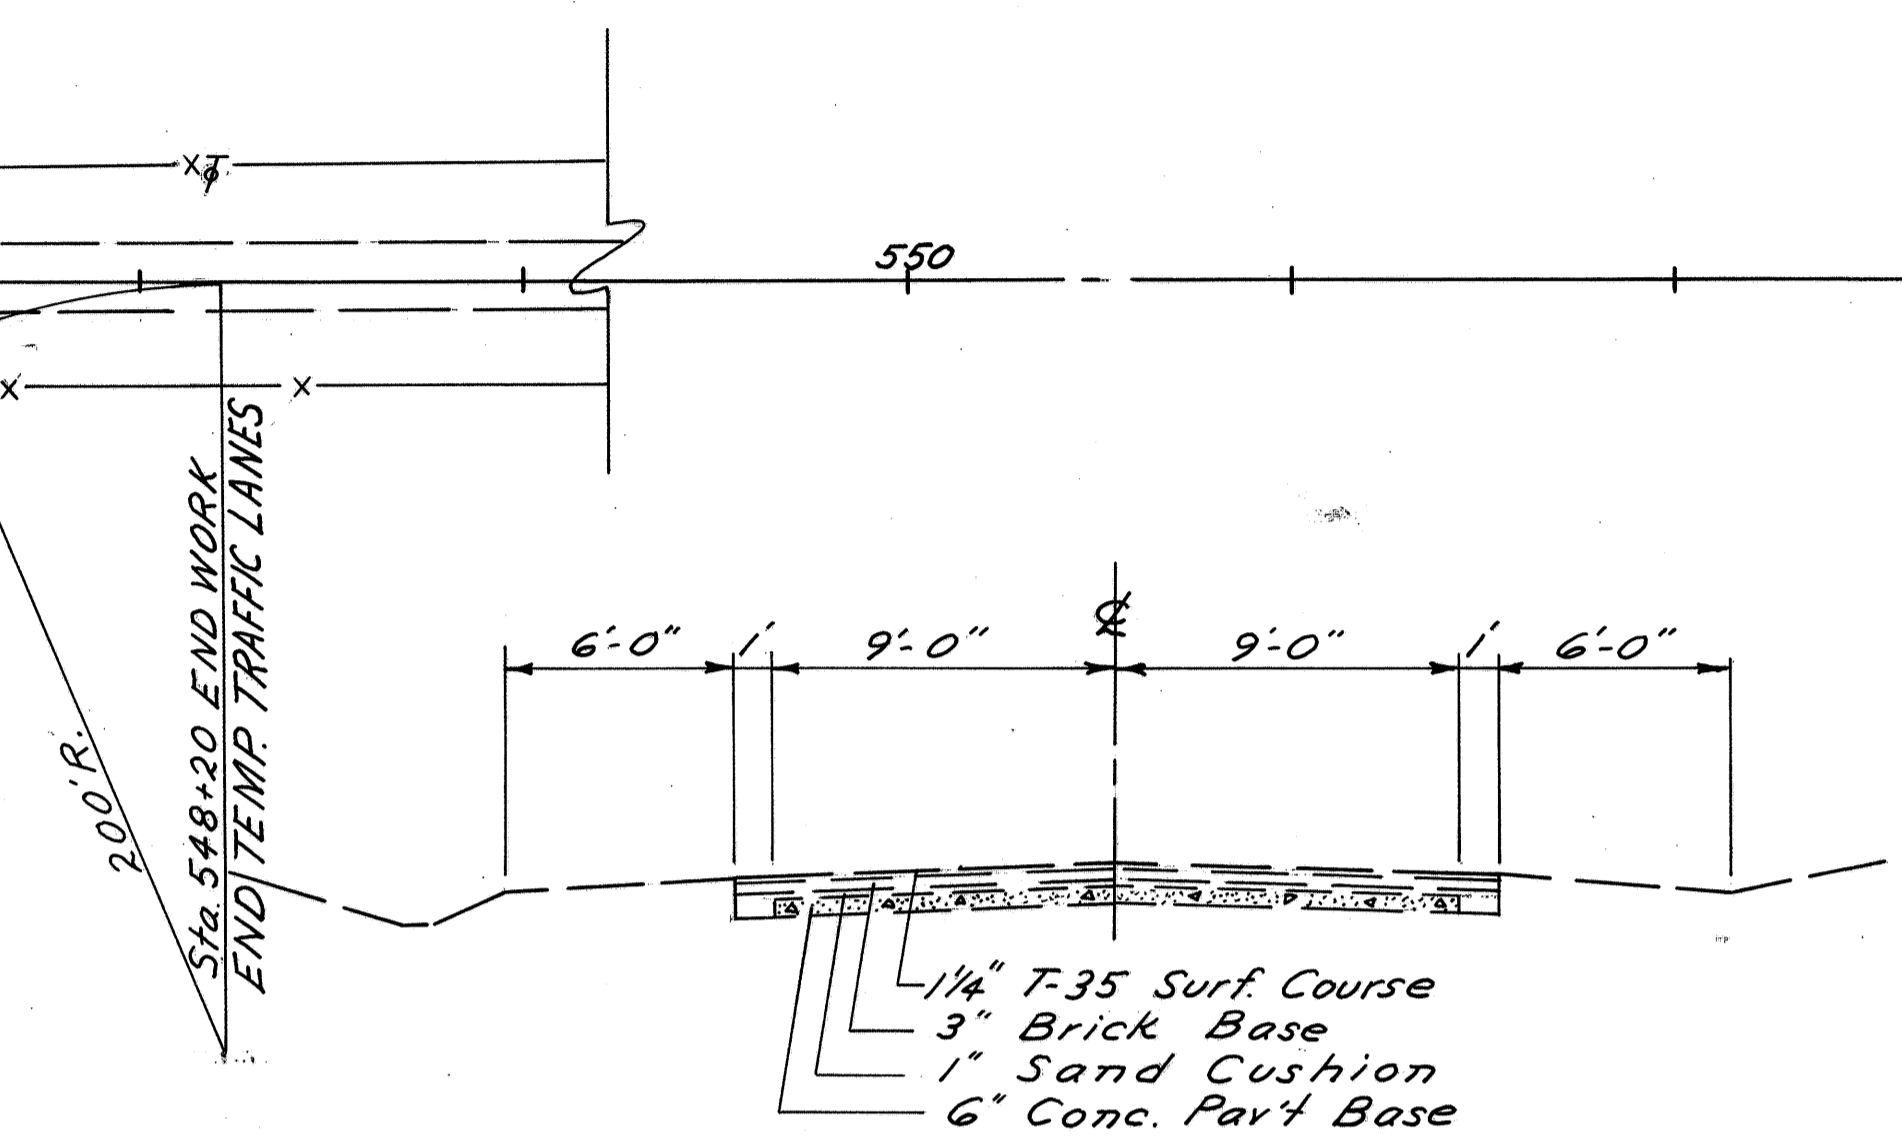


TYPICAL SECTION EXISTING PAVEMENT

B.M. #2 RR. Spike in P.P. 30 Lt. Sta. 485+66 (S.R. 226) Elev. 1043.38

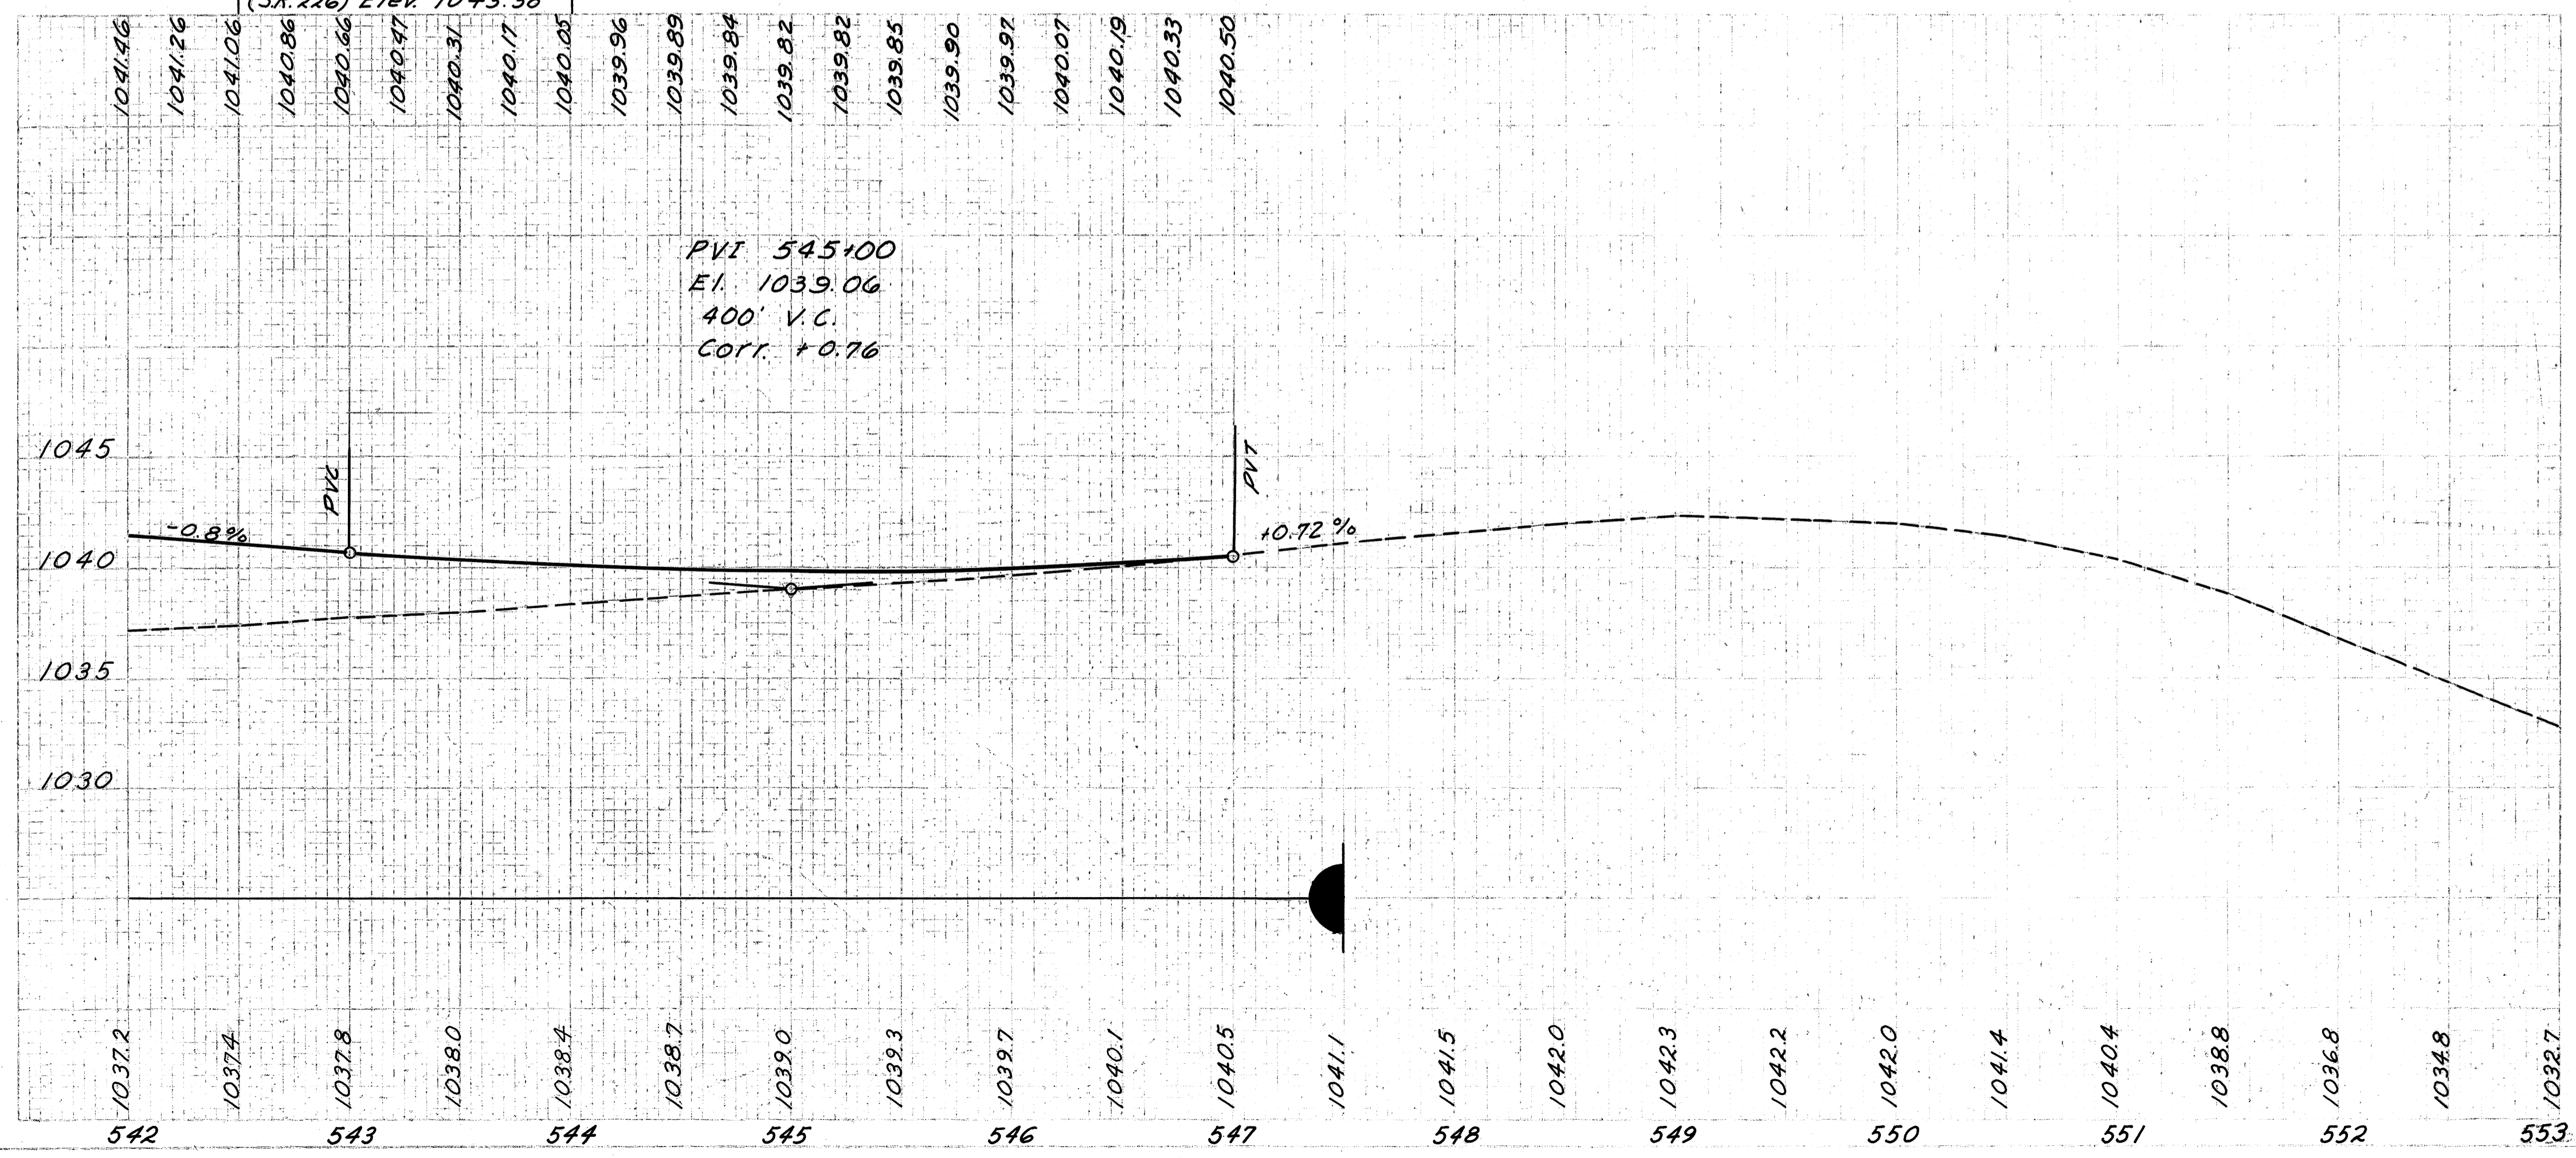

EXIST. S.R.-3, Sta. 542+00 to Sta 553+00

WAYNE COUNTY
WAY-3-9.94

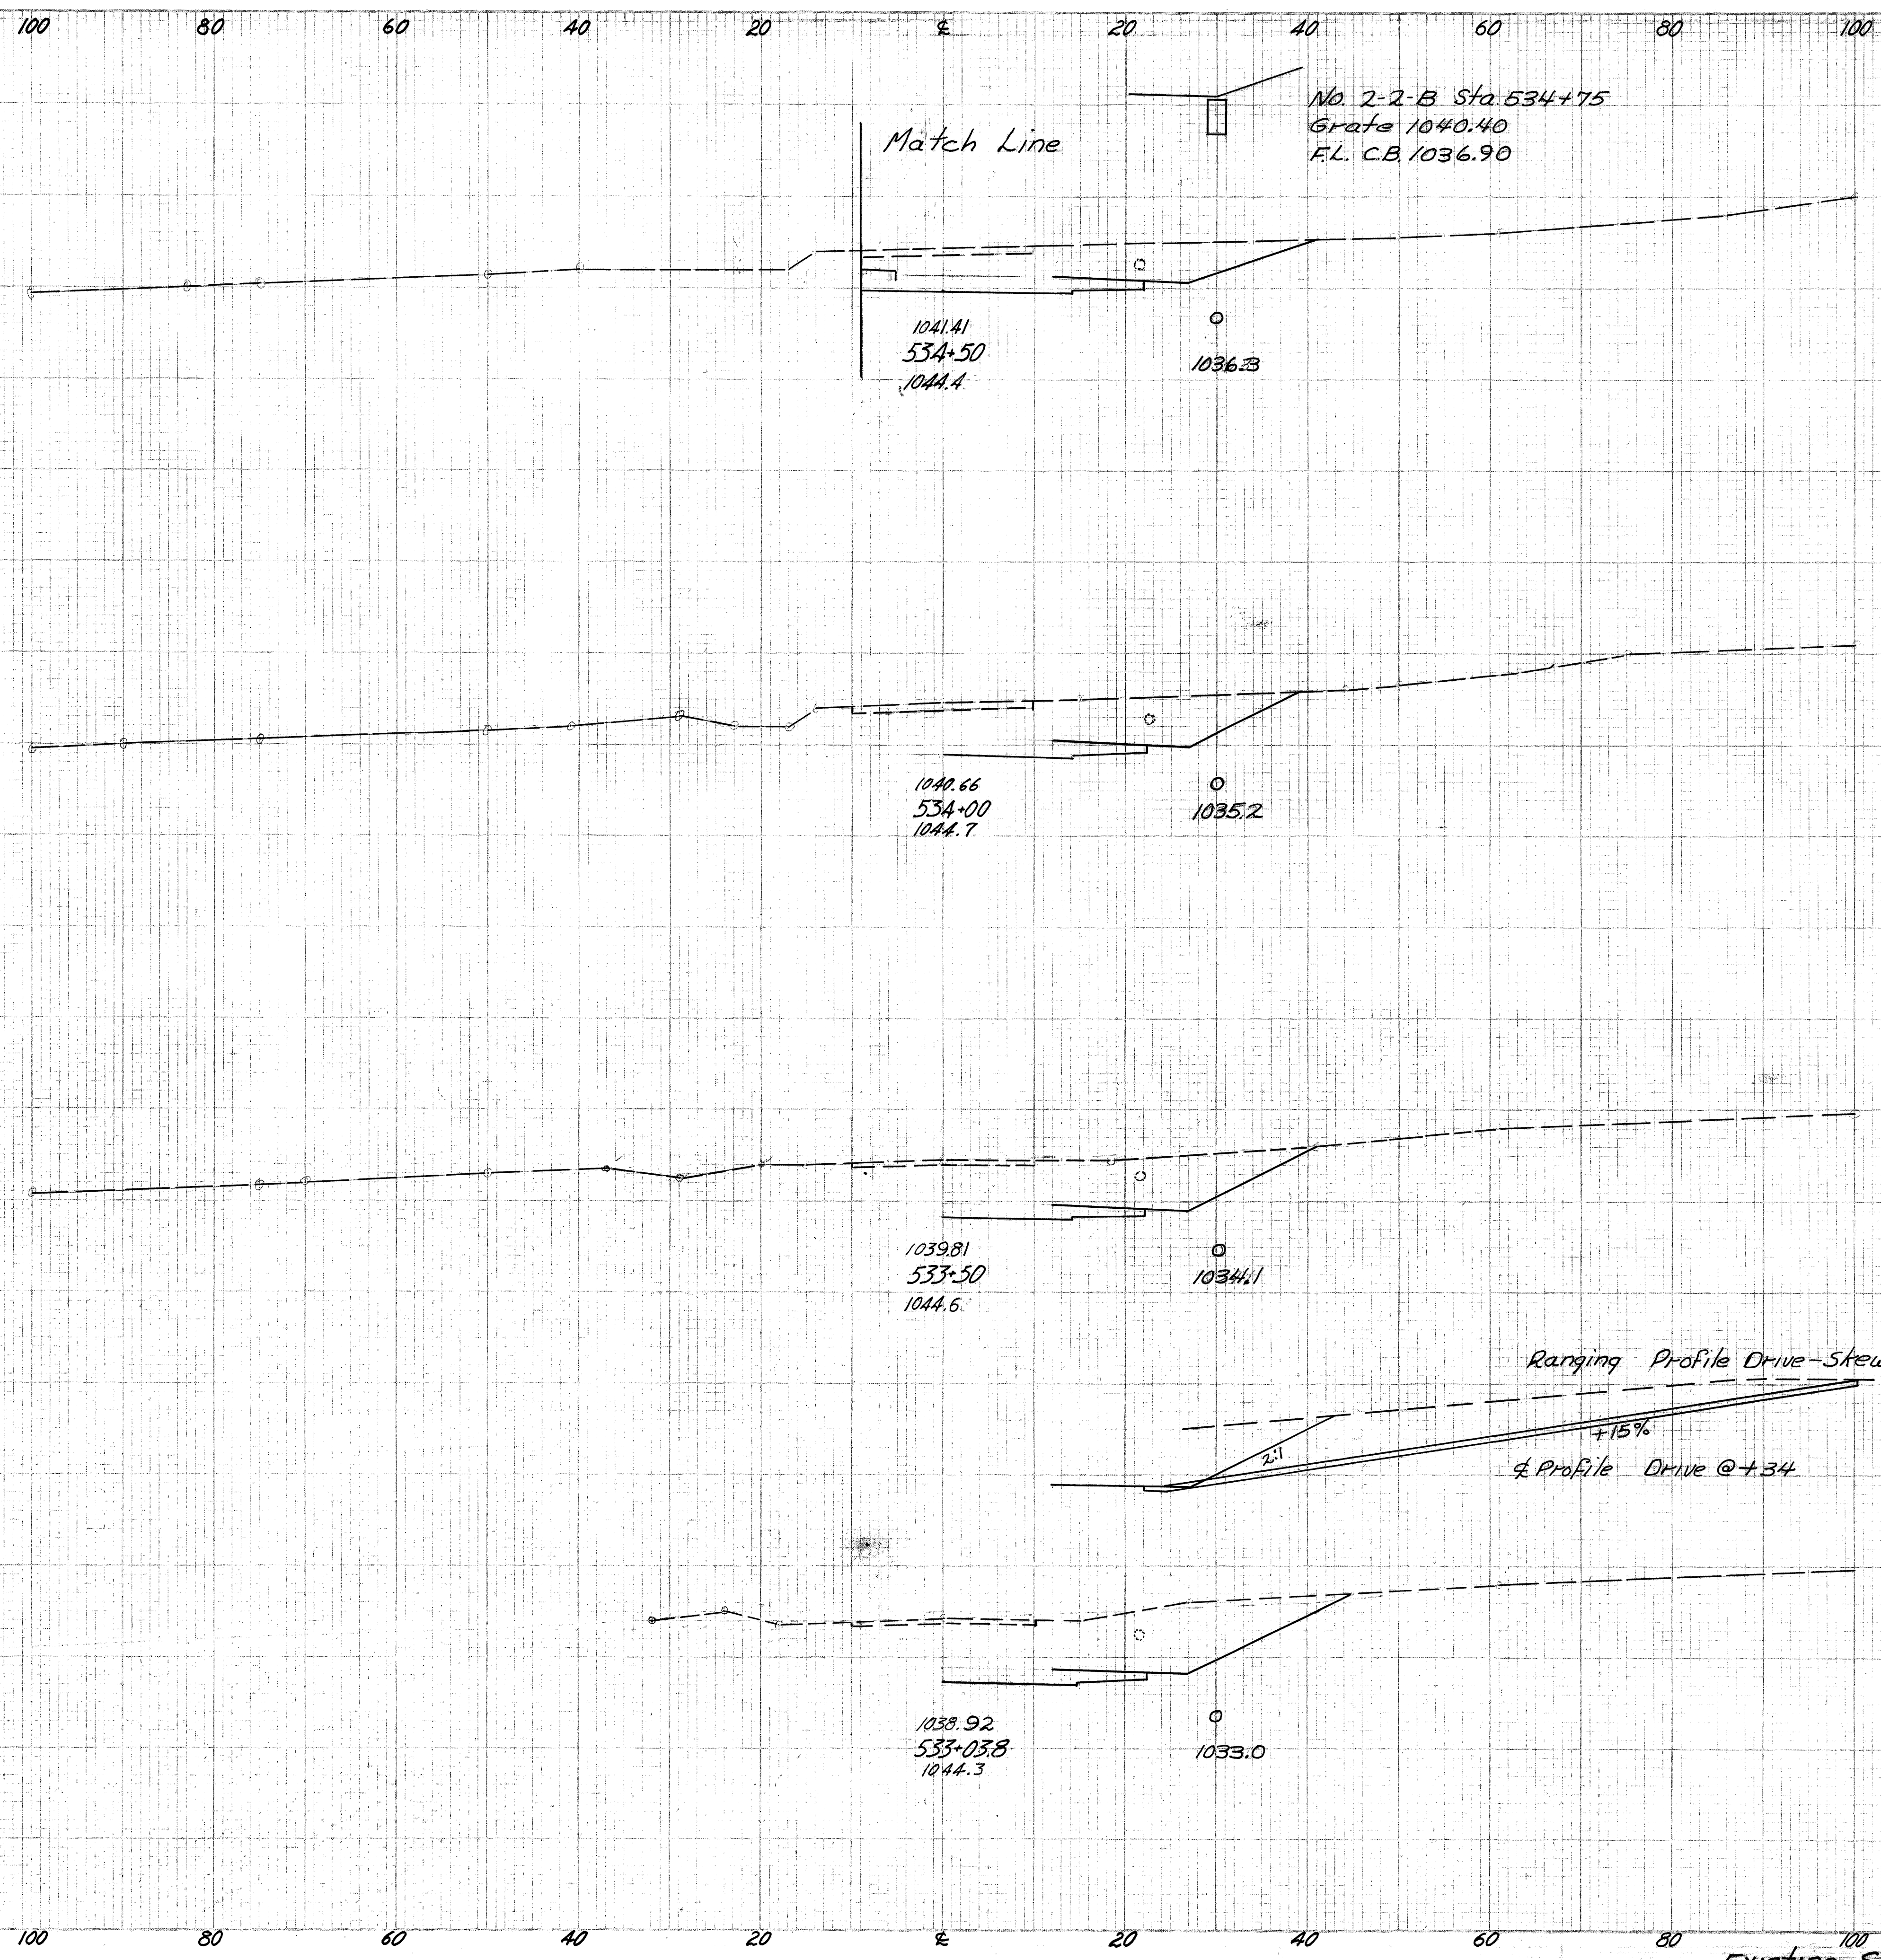

END AREA	CU. YARDS	
	CUT	FILL
190	0	
		168
534+26.98 Ahead	204	0
534+26.98 Back	0	0


WAYNE COUNTY
WAY-3-9.94

100 80 60 40 20 0 20 40 60 80 100

9" Profile Dr @ +88

Ranging Profile Exist Dr @ +88

Match Line 2

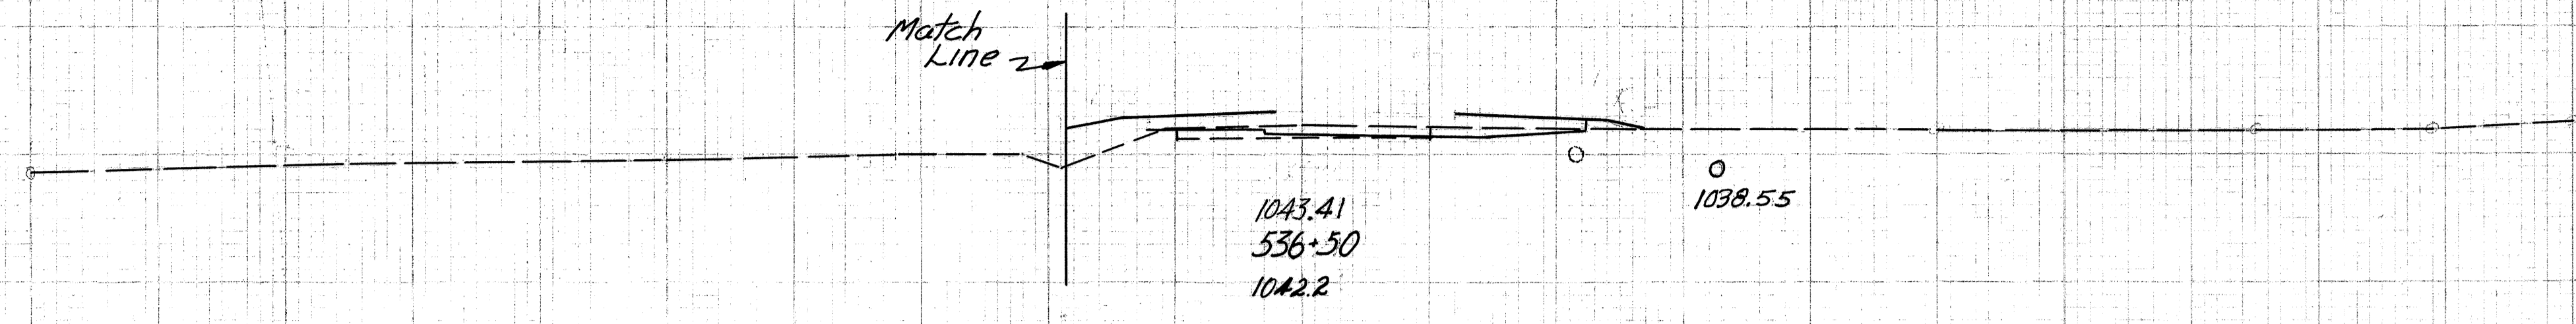

1043.41
536+50
1042.2


1038.55

Sta. 536+25 No 22B C.B.
Grate E.I. 1041.5
FIL 12" Pipe 1038.8

Drive Rl 536+88

END AREA		CU. YARDS	
CUT	FILL	CUT	FILL
			5 5
6	25		
		51	28
49	5		
		107	10
		30	
66	6		
		170	6
117	0		
		285	0

Match Line 2

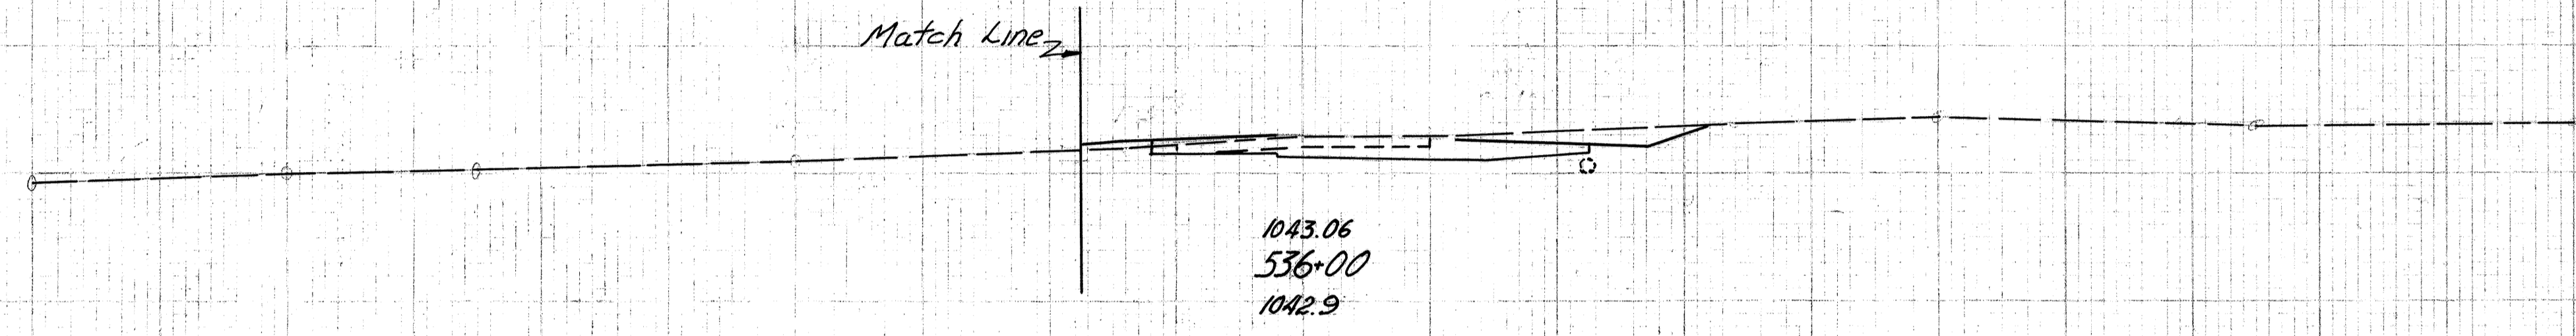


1043.06
536+00
1042.9

9" Profile Dr @ +70

Ranging Profile Drive @ +70


Drive 535+70 Rt

Match Line 2

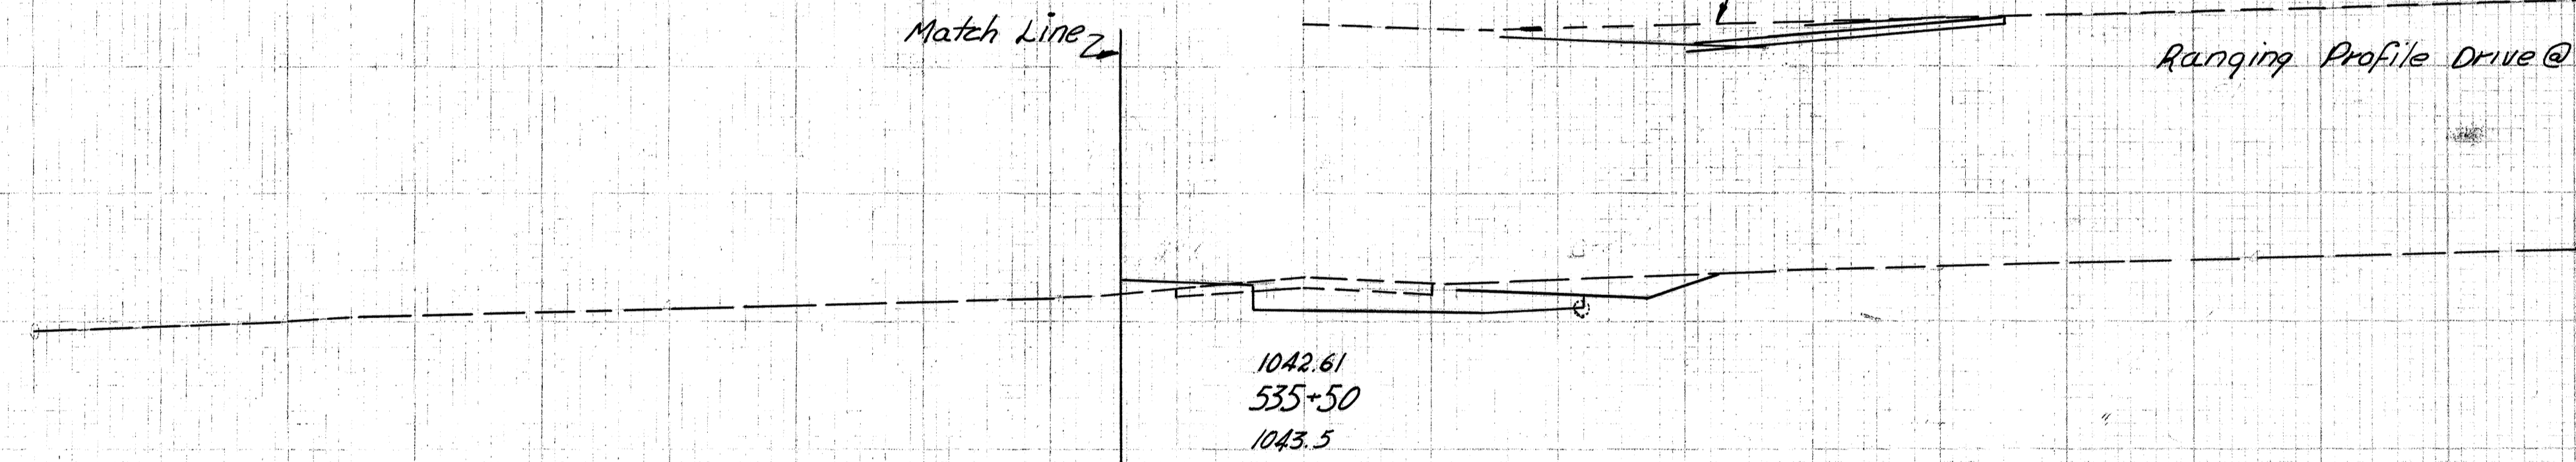

1042.61
535+50
1043.5

Match Line 2

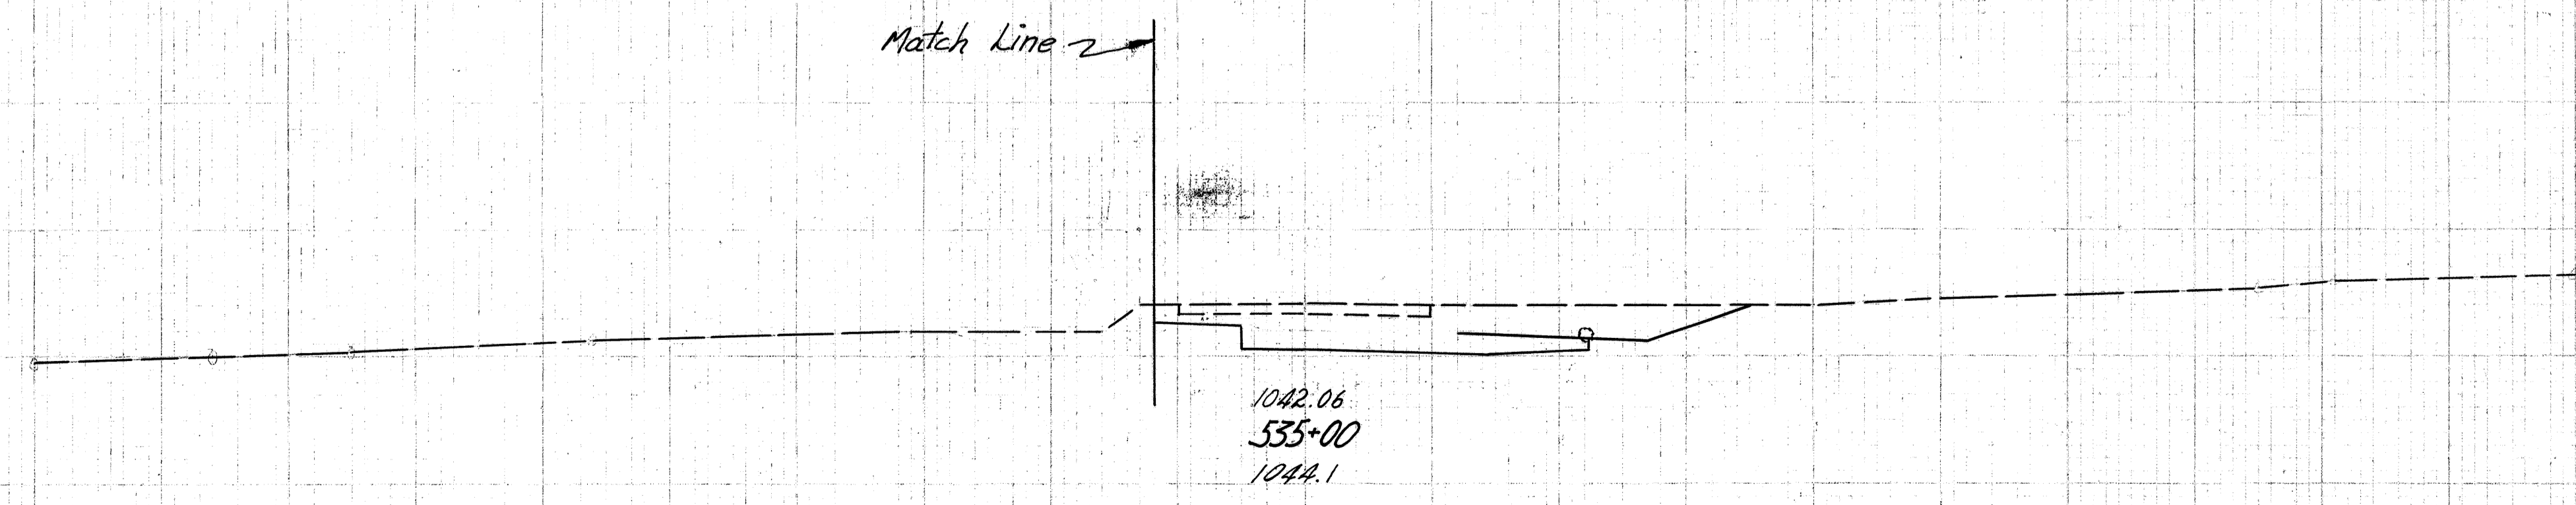


1042.06
535+00
1044.1

100 80 60 40 20 0 20 40 60 80 100

WAYNE COUNTY
WAY-3-9.94

100 80 60 40 20 0 20 40 60 80 100




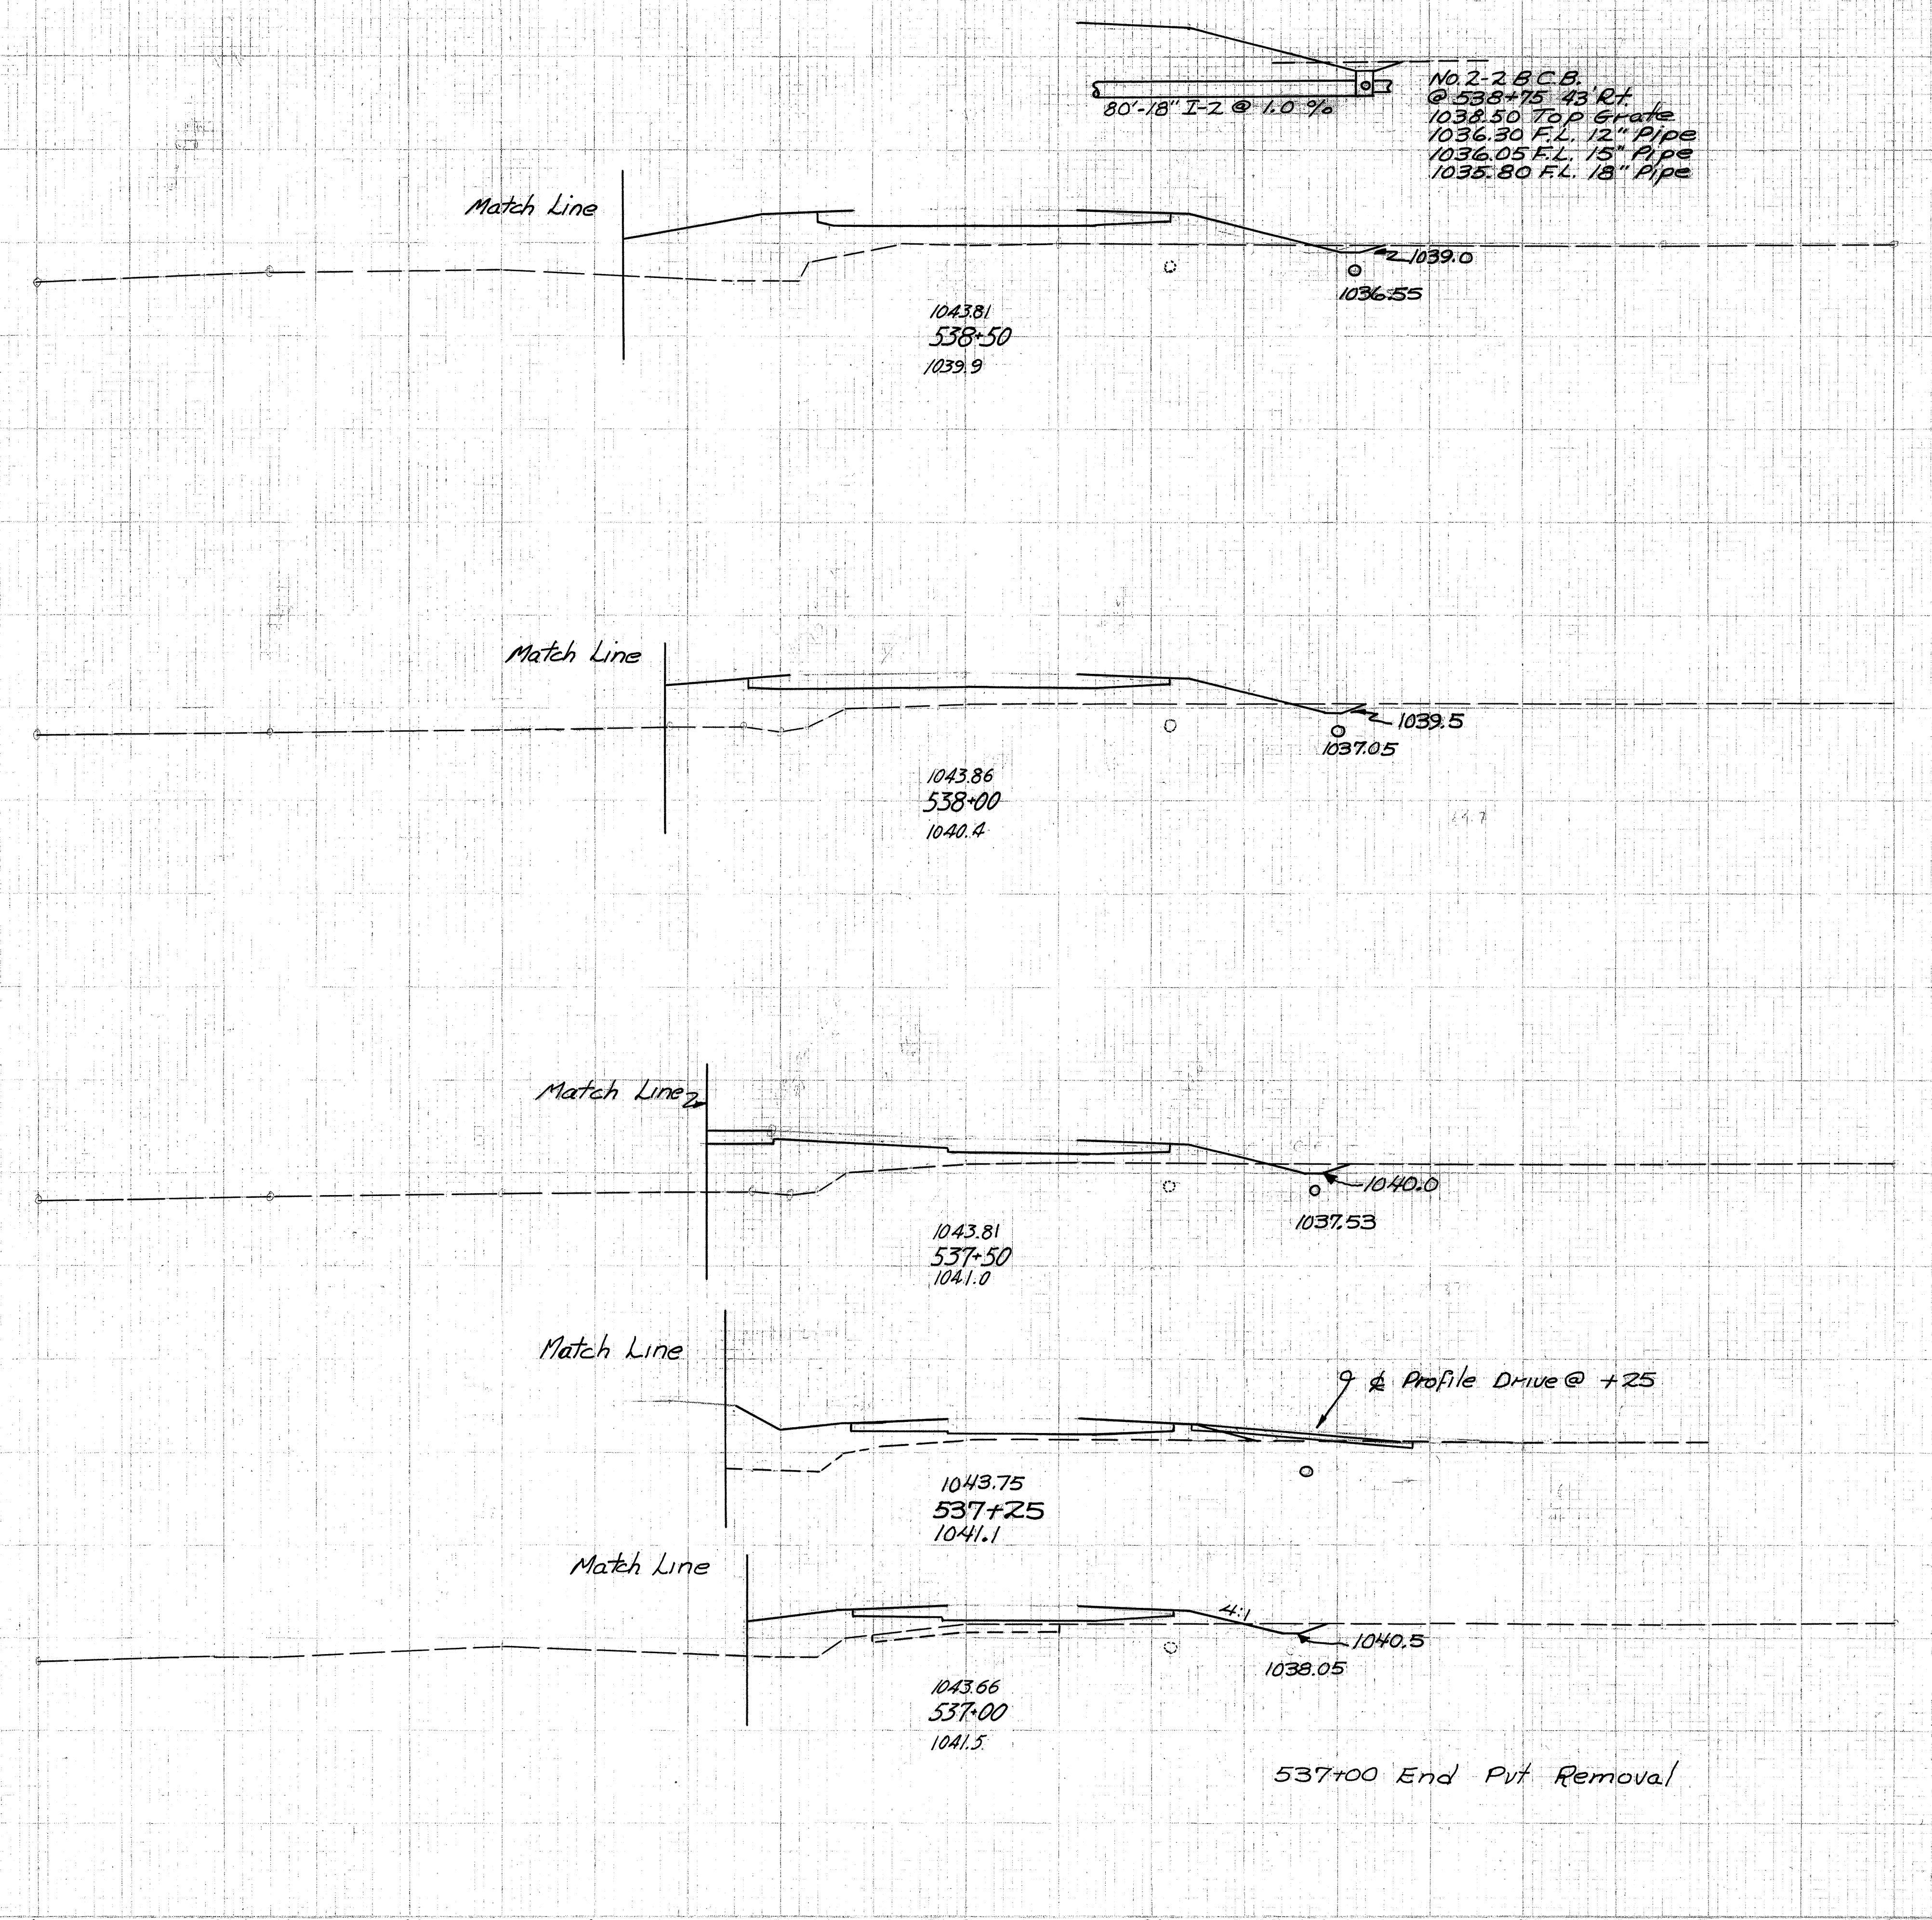


END AREA	CU. YARDS	
	CUT	FILL
4	241	
		10 388
6	178	
		11 306
6	152	
0	108	12 218 10 2
7	83	
7	104	
		12 120

100 80 60 40 20 0 20 40 60 80 100

WAYNE COUNTY
WAY-3-9.94

100 80 60 40 20 ± 20 40 60 80 100

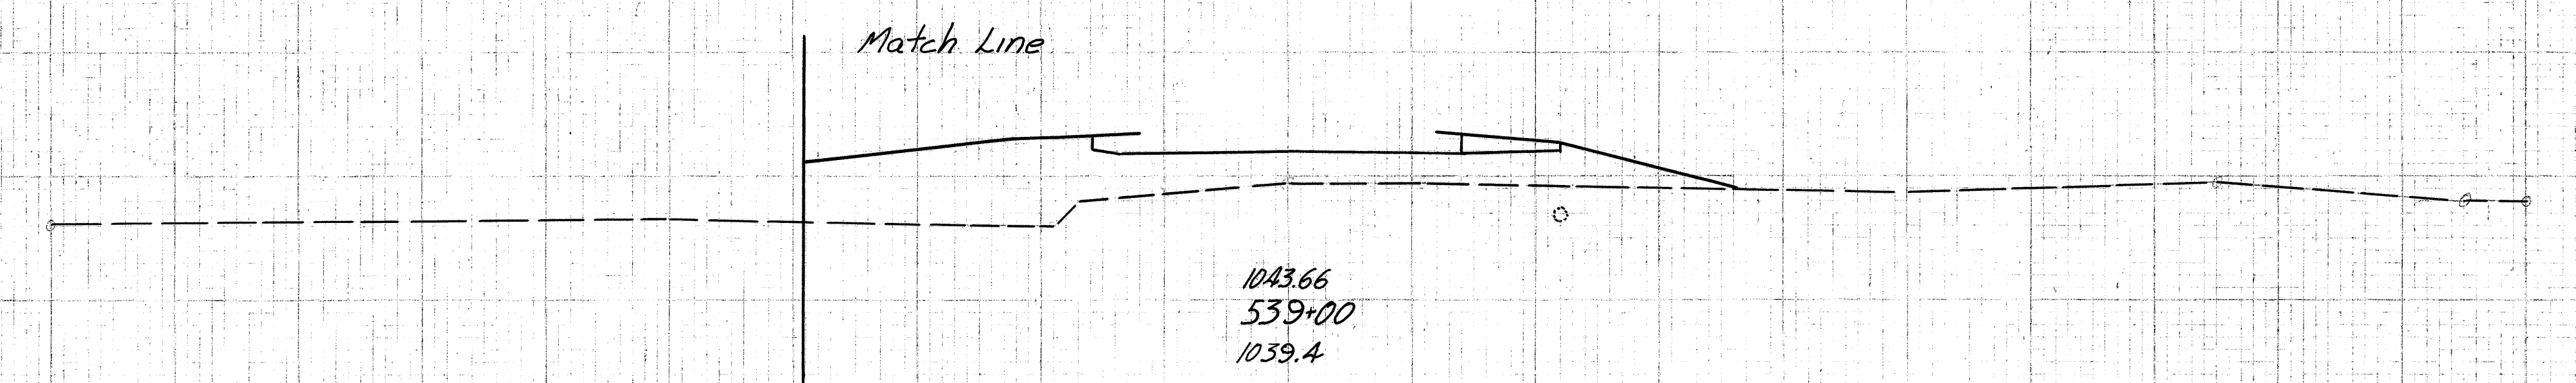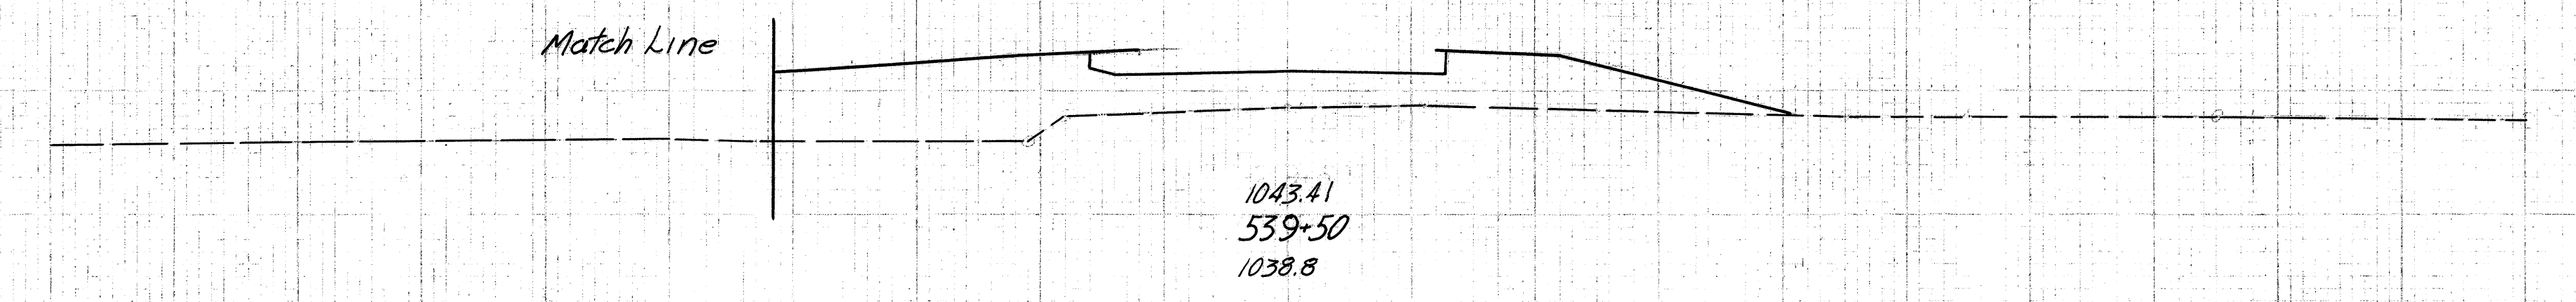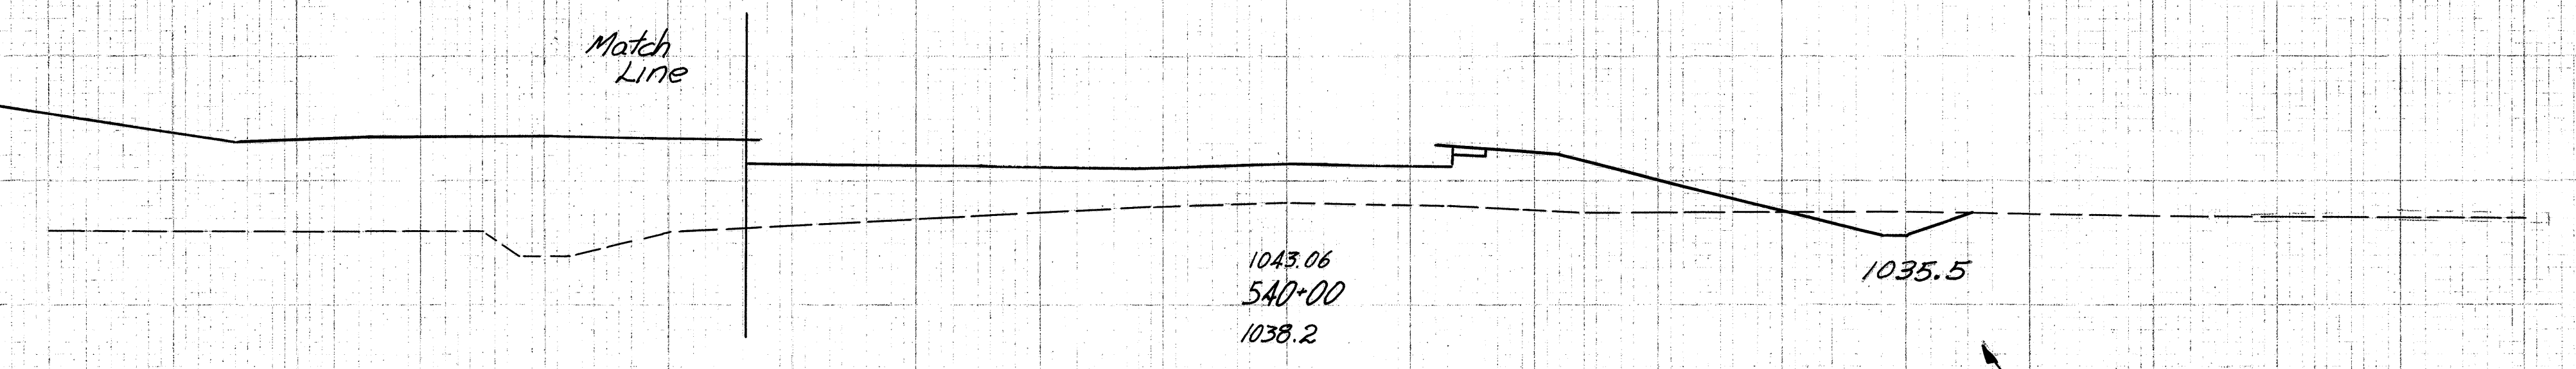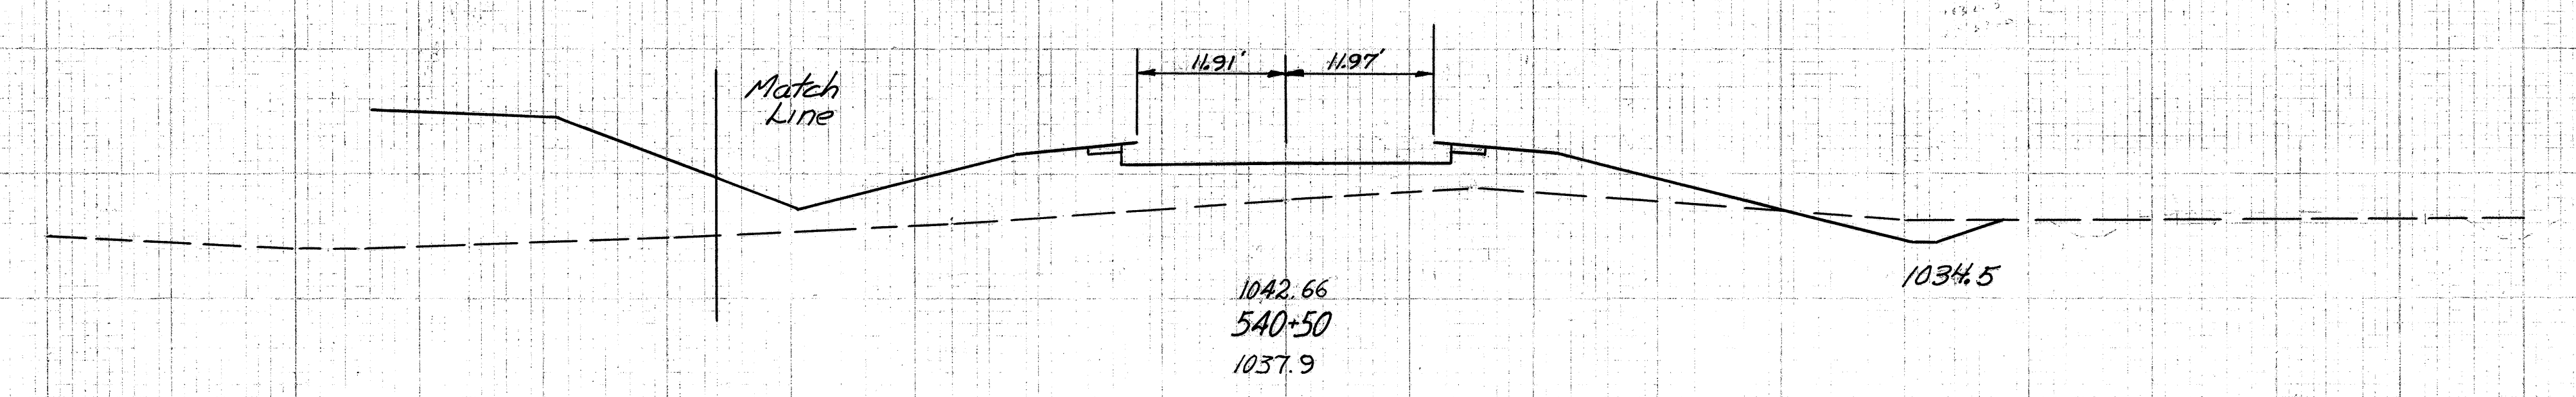


END AREA	CU YARDS	
	CUT	FILL
15	271	
		29 519
16	289	
		15 576
0	333	
		0 578
0	291	
0	283	
		4 485

Ahead 539+00
Back 539+00


100 80 60 40 20 ± 20 40 60 80 100

WAYNE COUNTY
WAY-3-994

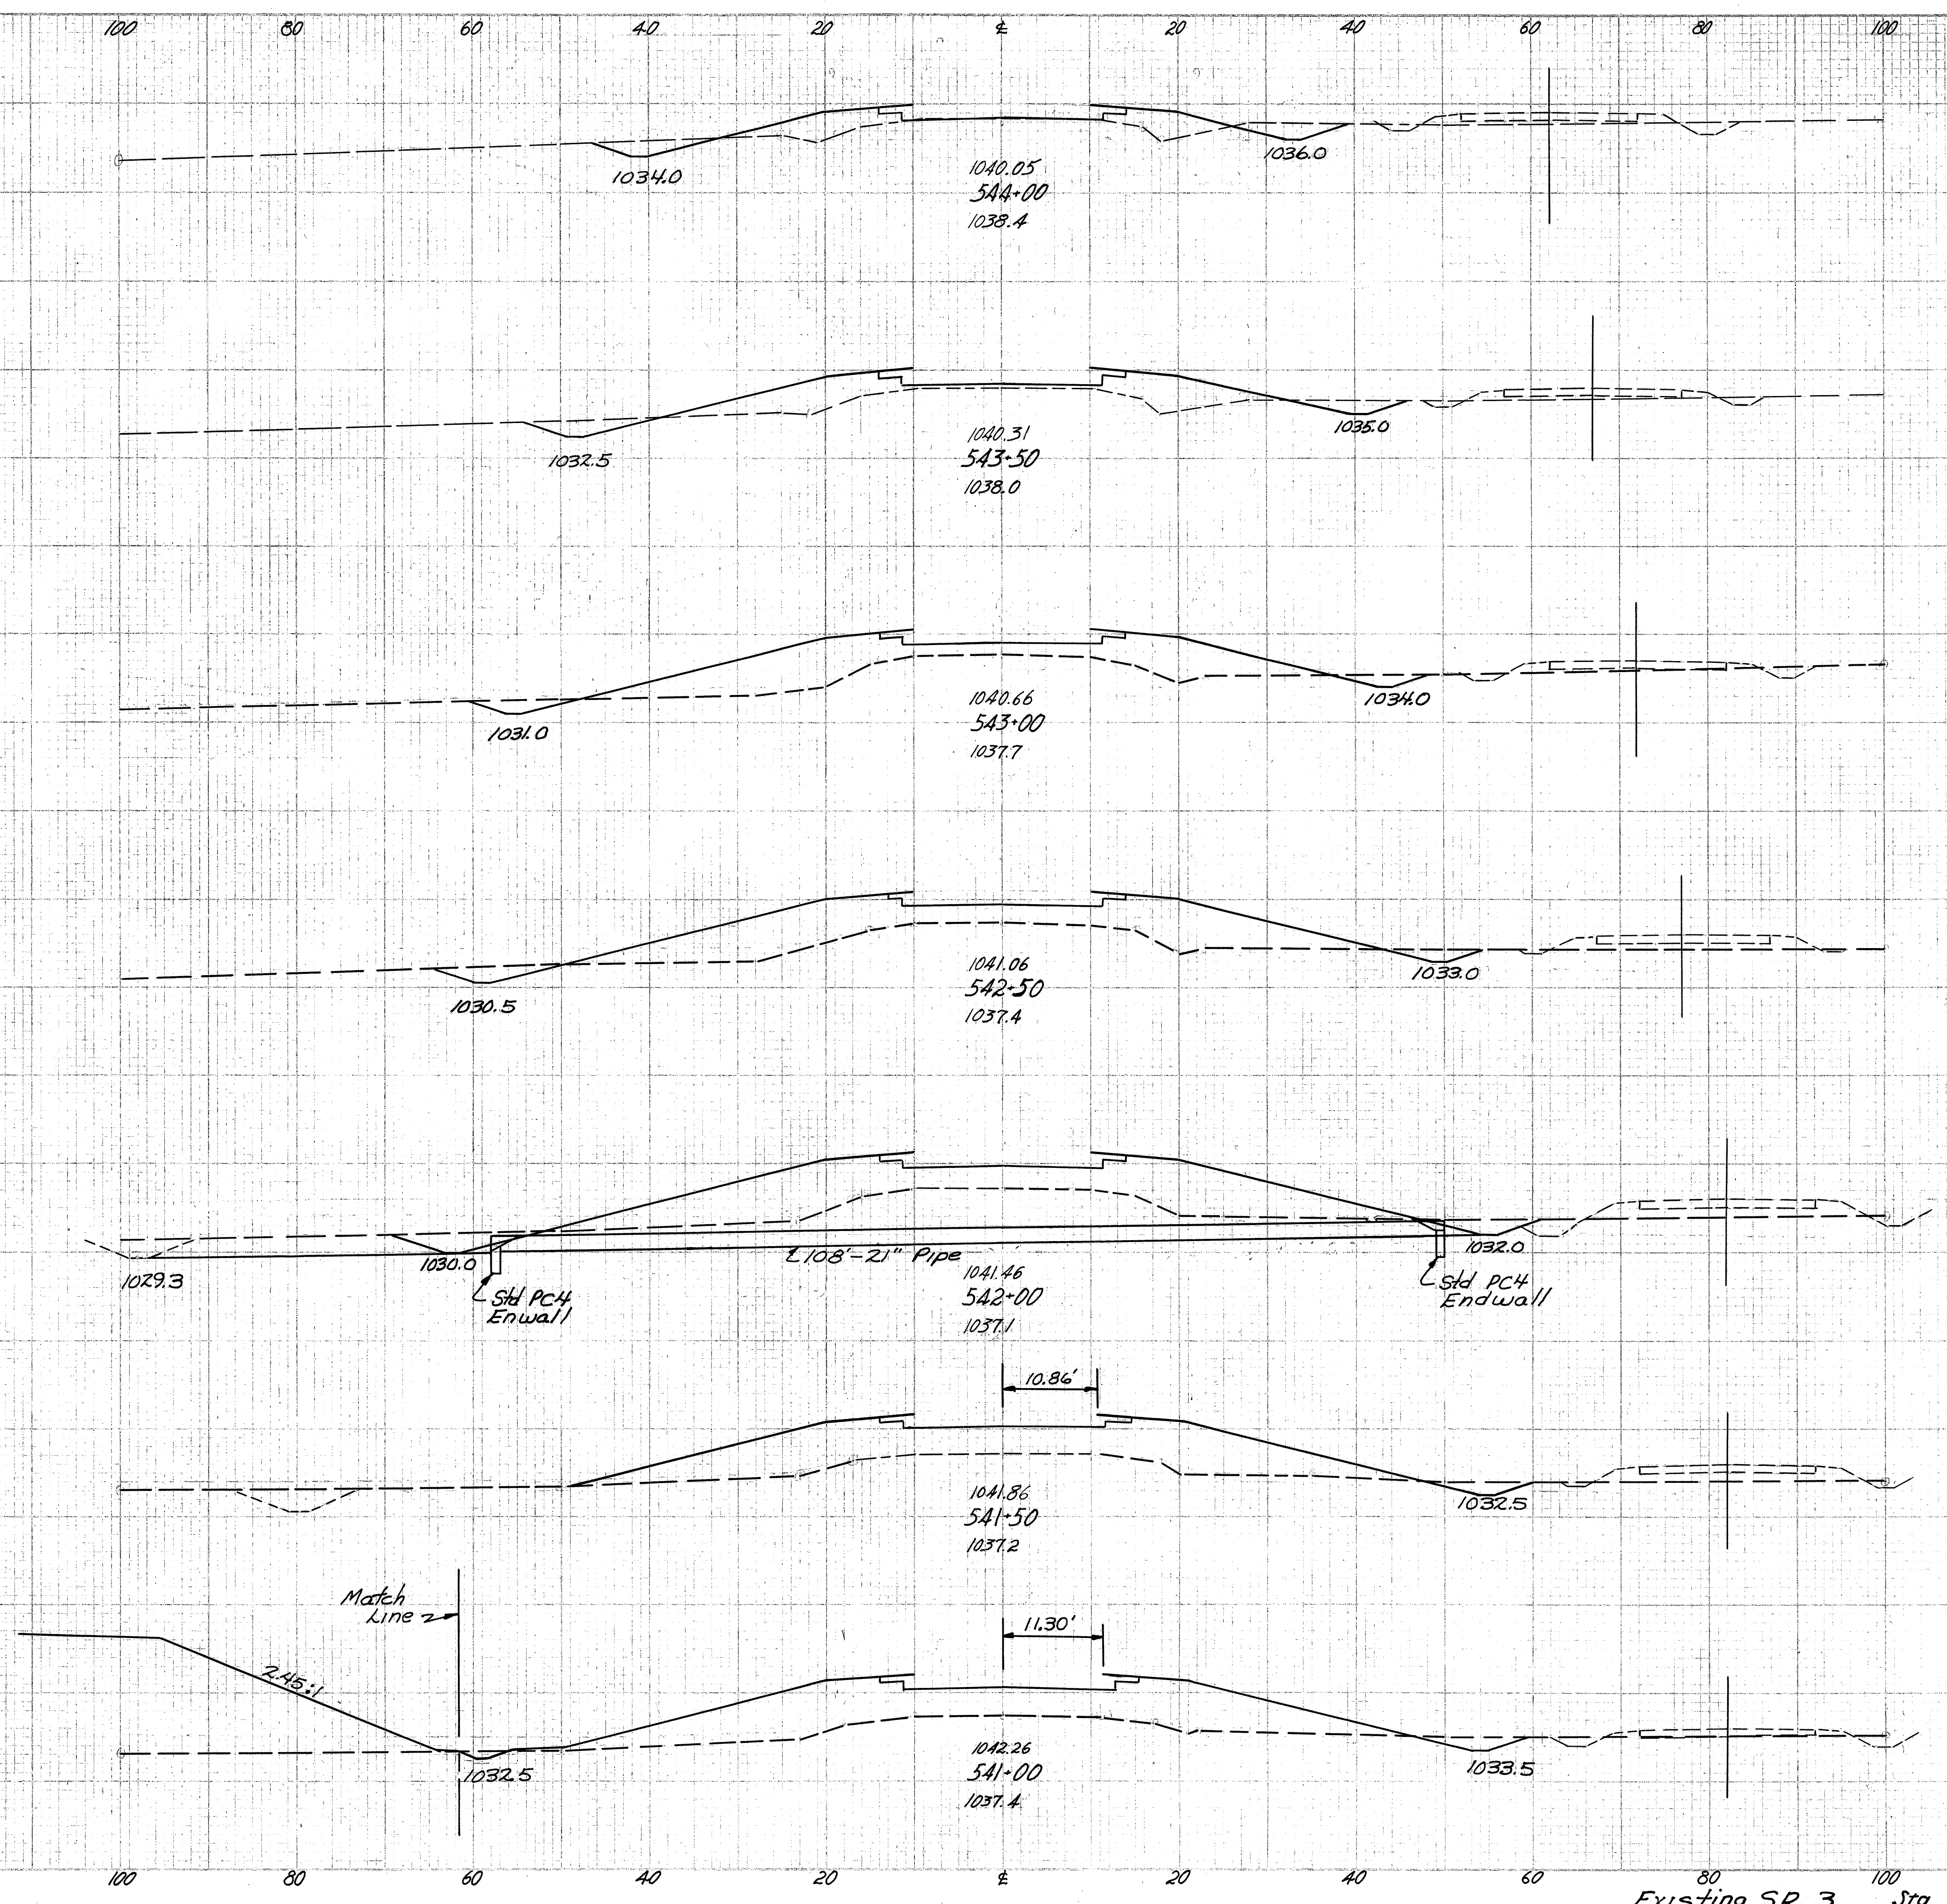

END STA	AREA		CU. YARDS	
	CUT	FILL	CUT	FILL
30	63			
			53	175
27	126			
			42	325
18	225			
			37	473
22	286			
			50	572
31	332			
			38	619
10	336			
			22	647
14	362			
			27	586

WAYNE COUNTY
WAY-3-9.94

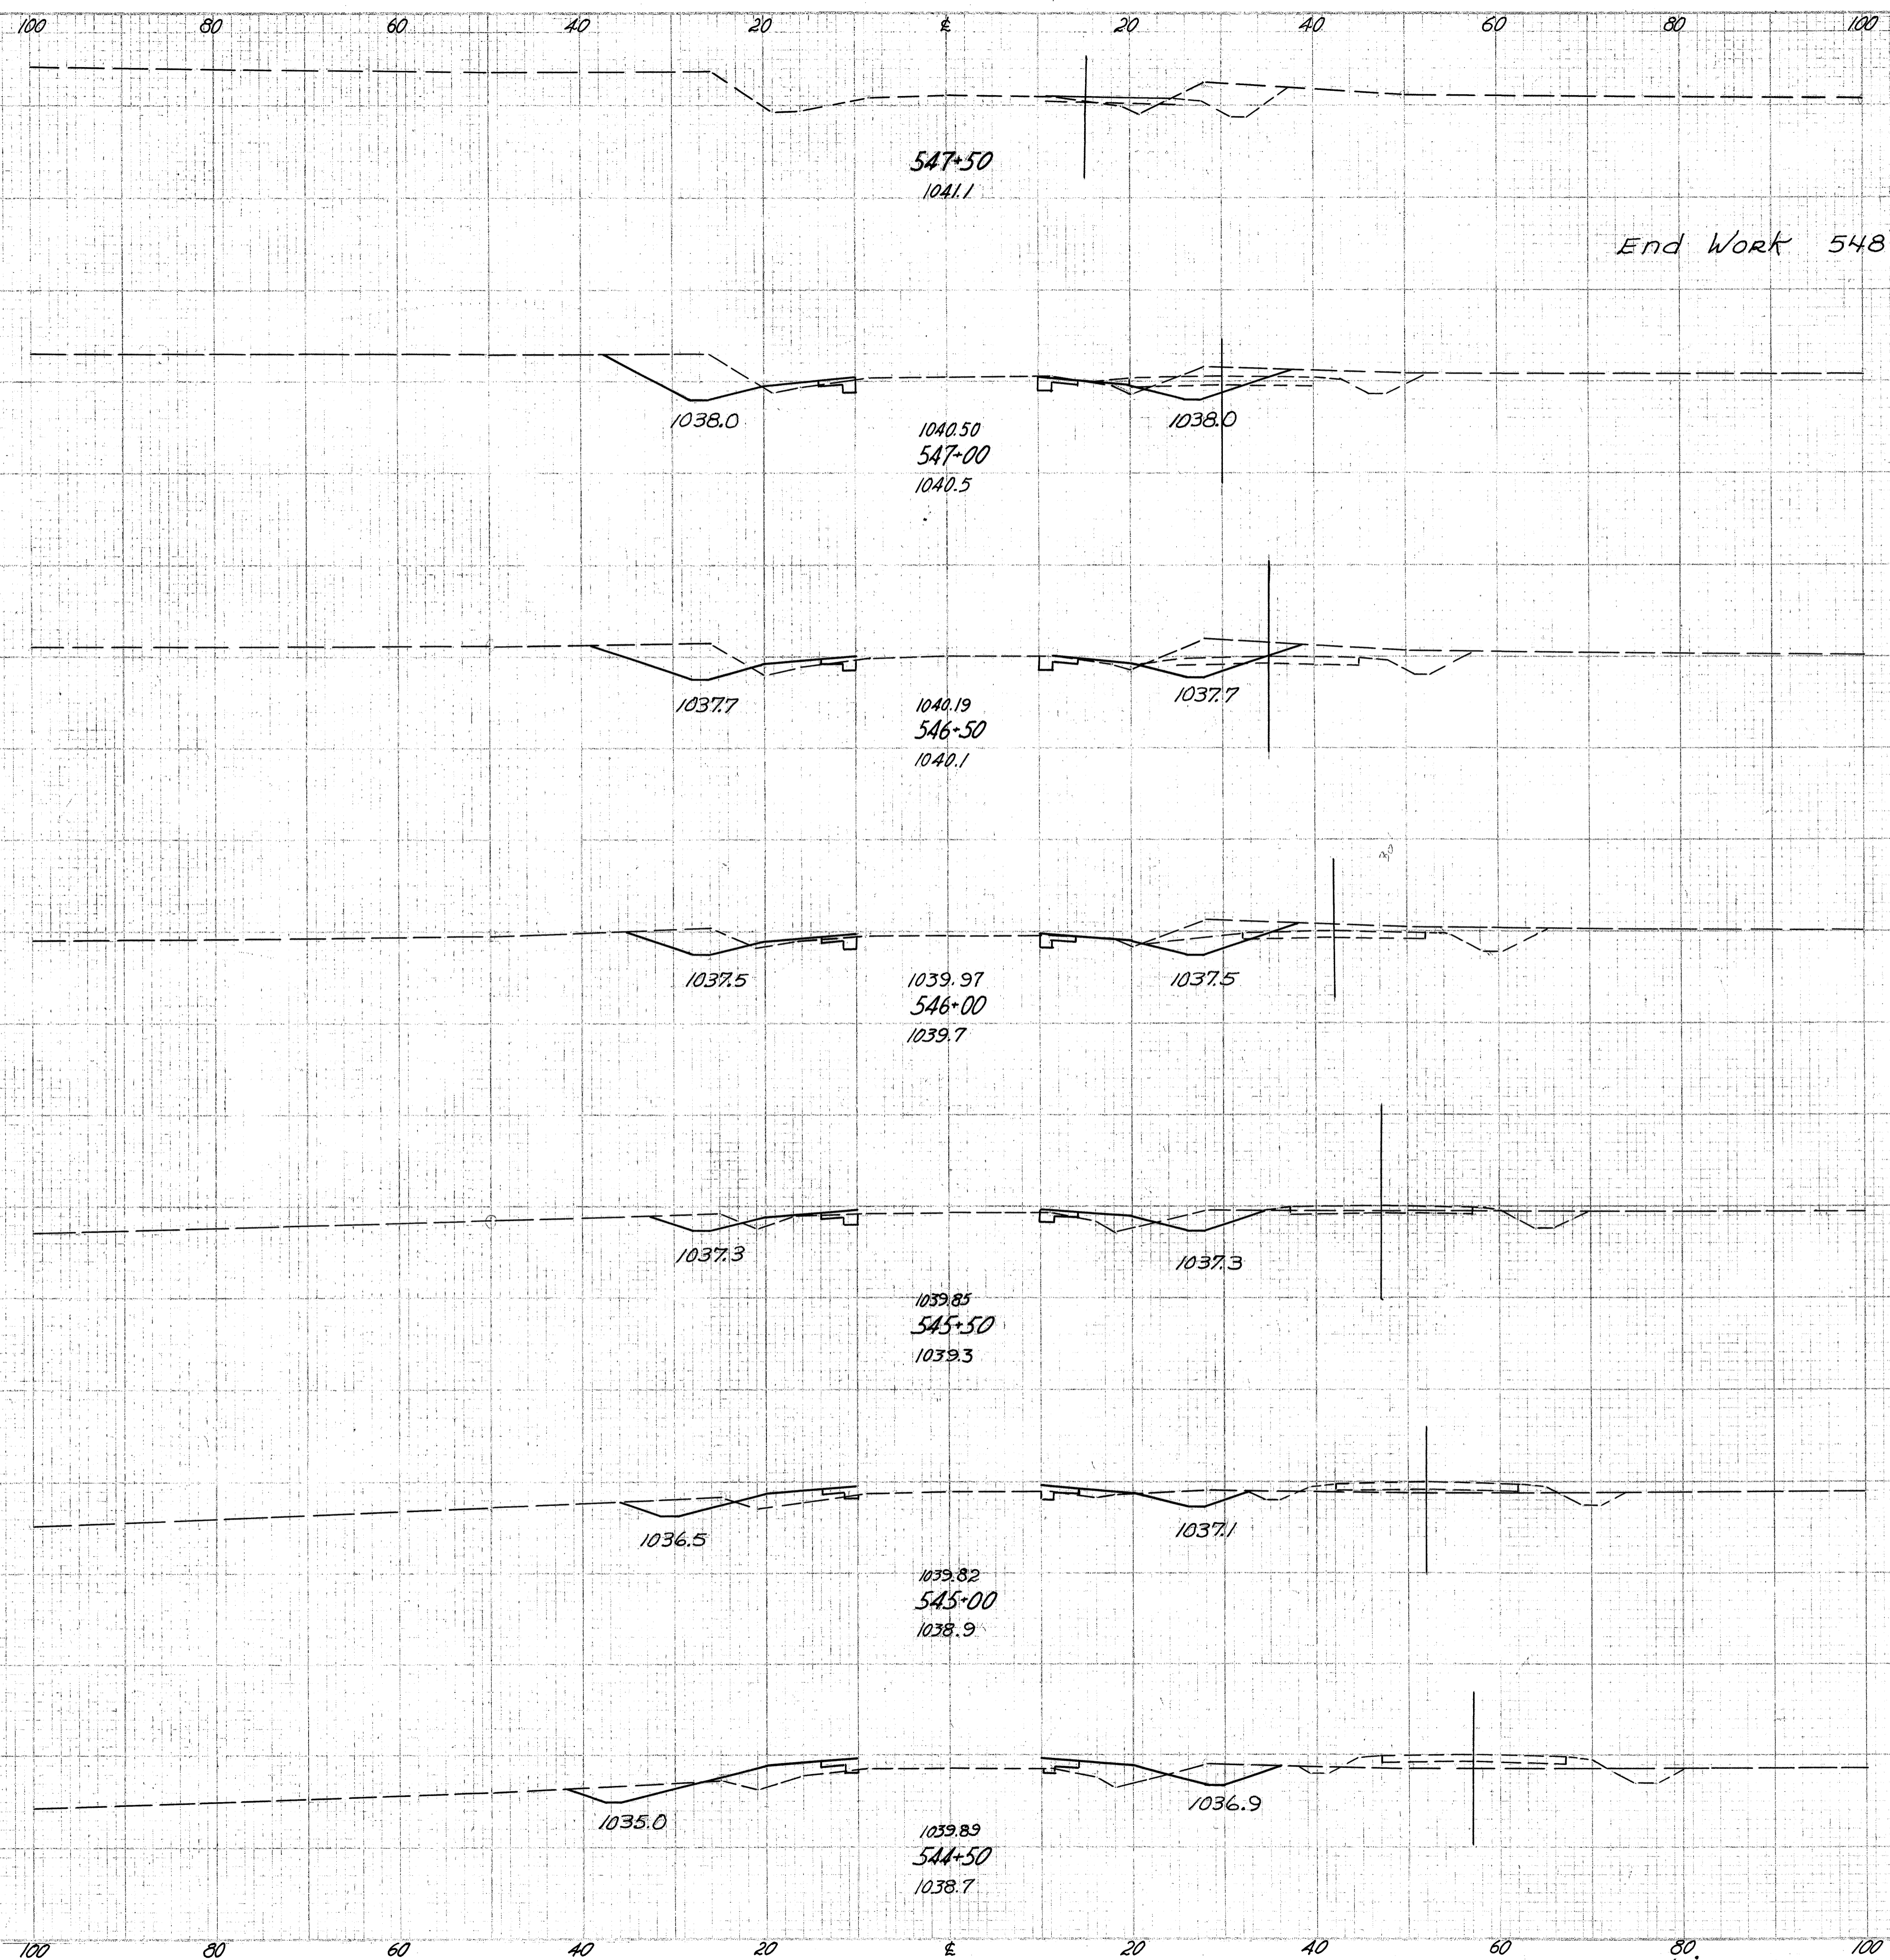

End Work 548+20

547+50


547+00 Ahead
547+00 Back

END AREA		CU. YARDS	
CUT	FILL	CUT	FILL
0	0		
		73	7
79	7		
85	7		
		154	15
		81	9
		133	13
62	5		
		84	18
28	14		
		48	27
24	15		
		49	51
29	40		
		55	96


WAYNE COUNTY
WAY-3-9.94

CURVE DATA

P.I. Sta. 1+09.93
 $\Delta = 57^{\circ} 35' 33''$
 $D = 28^{\circ} 38' 52''$
 $R = 200.00'$
 $T = 109.93'$
 $L = 201.04'$
 $E = 28.22'$

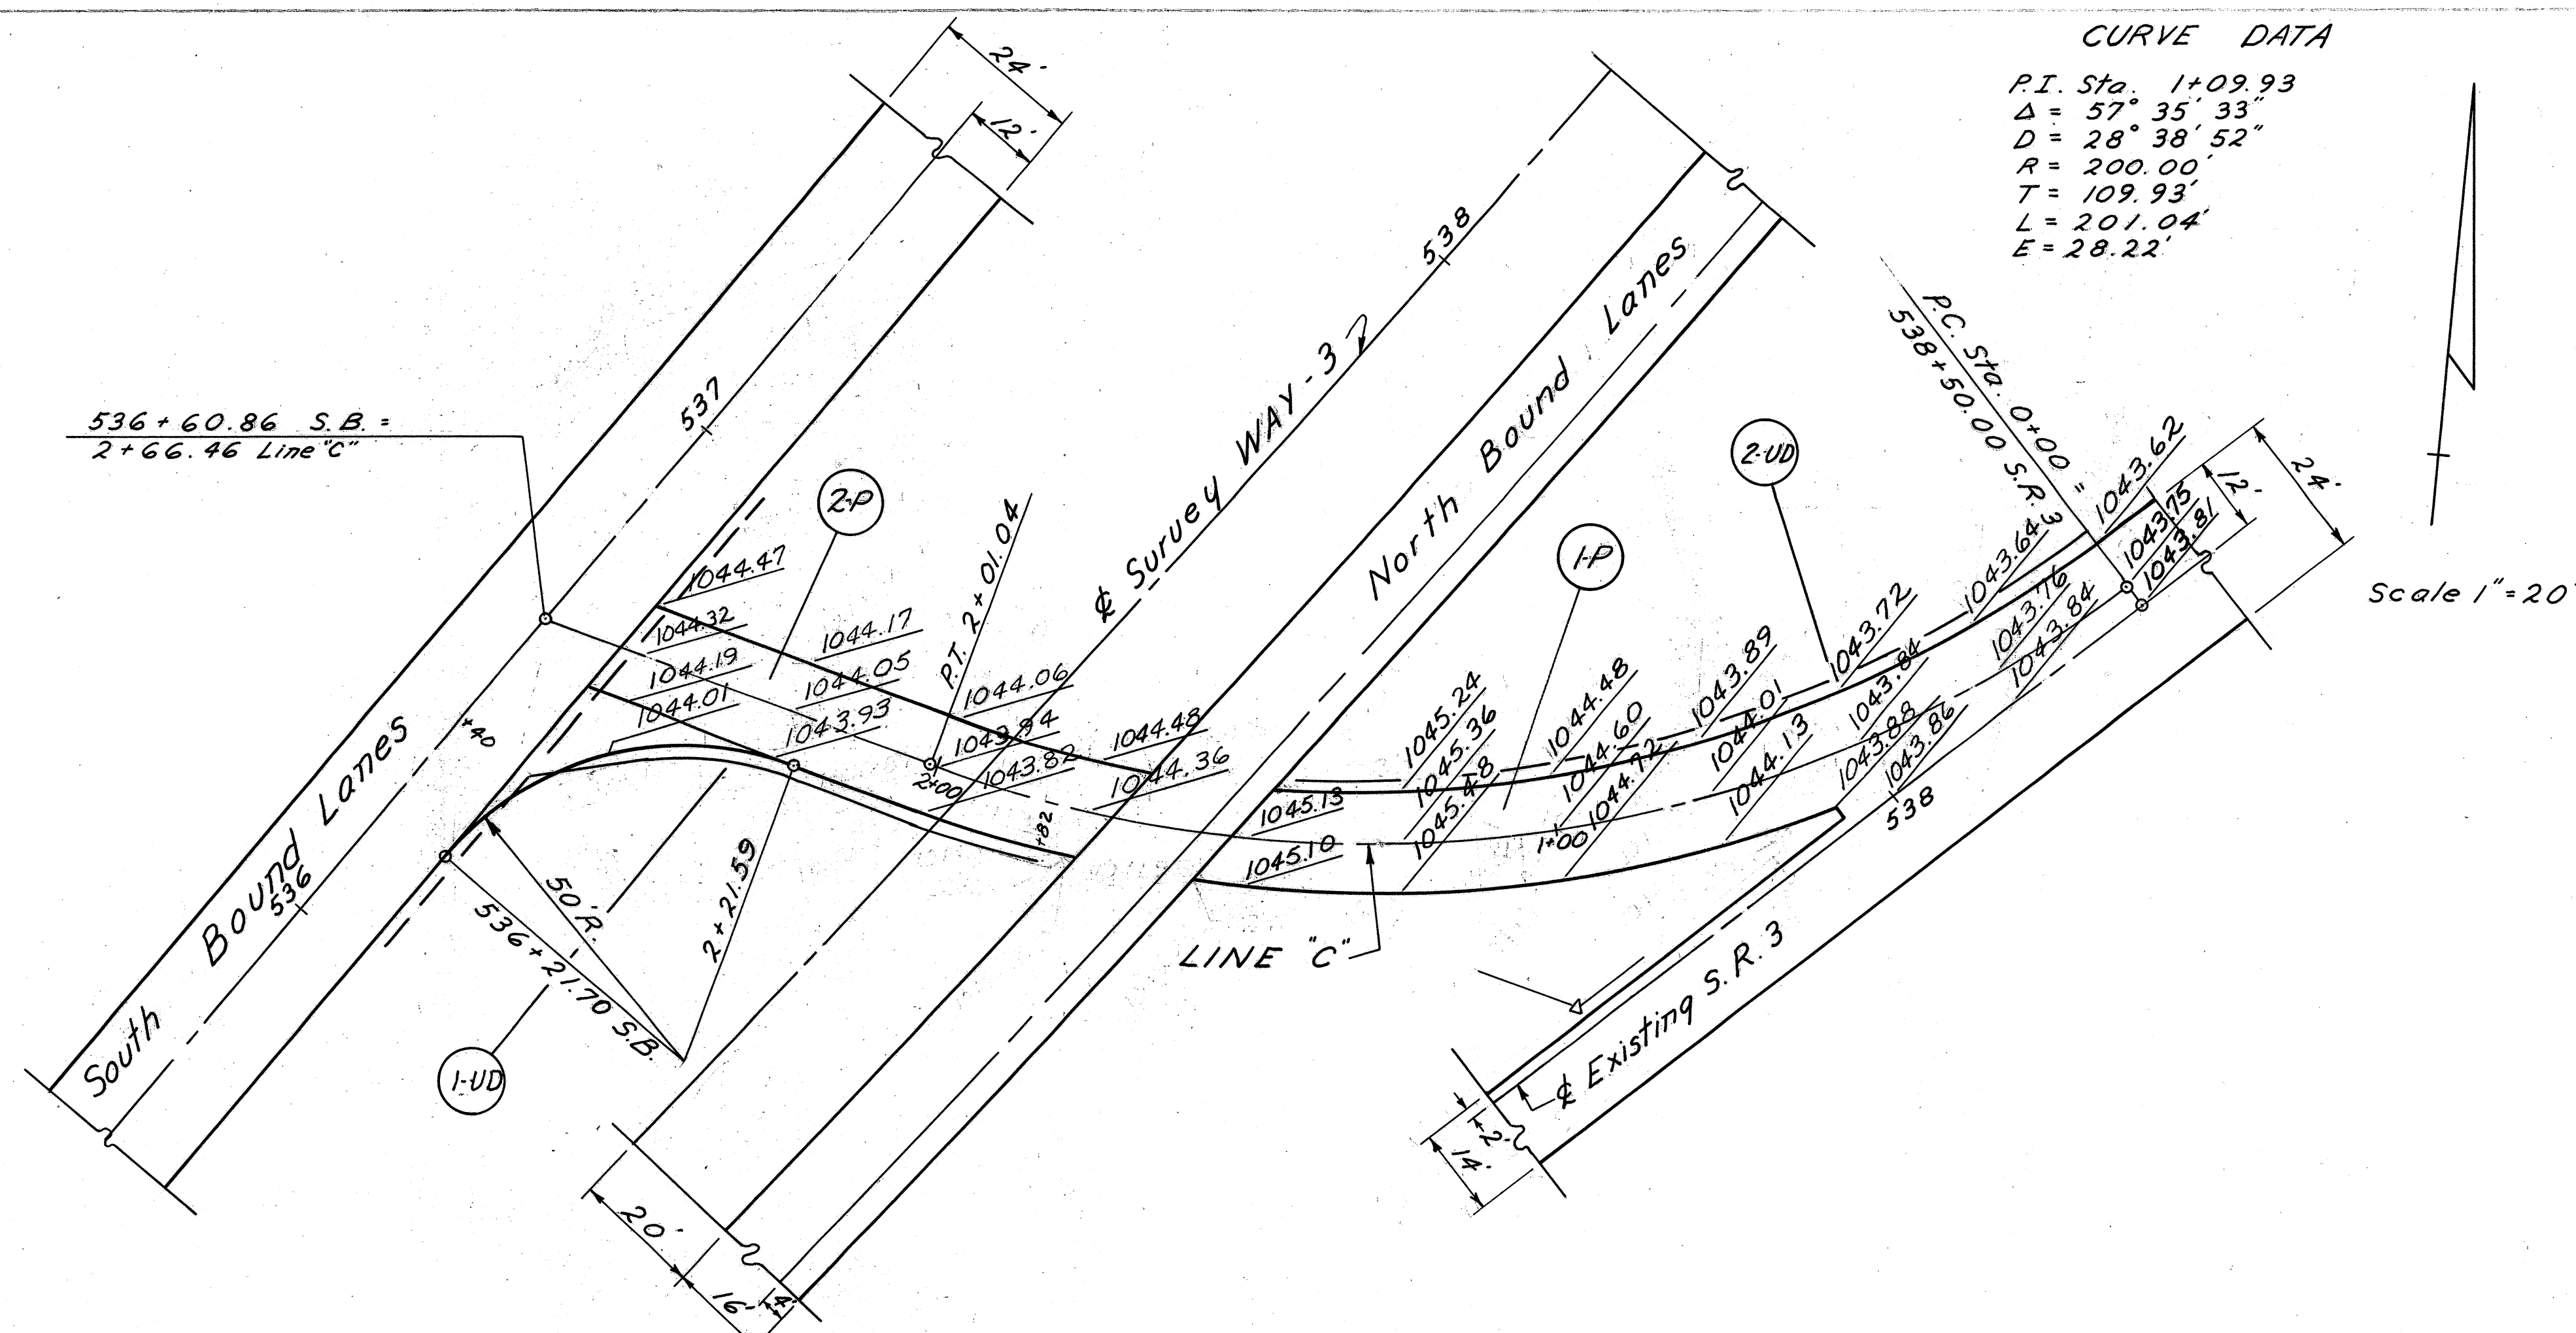

Item No.	Station		Side	I-4	I-5
	From	To		6" Pipe Underdrain Shallow	Pipe Special 6" 45" Wye
1UD	536+40	1+82	Lt.	78	1
2UD	0+00	1+40	Et.	135	
Totals				213	1

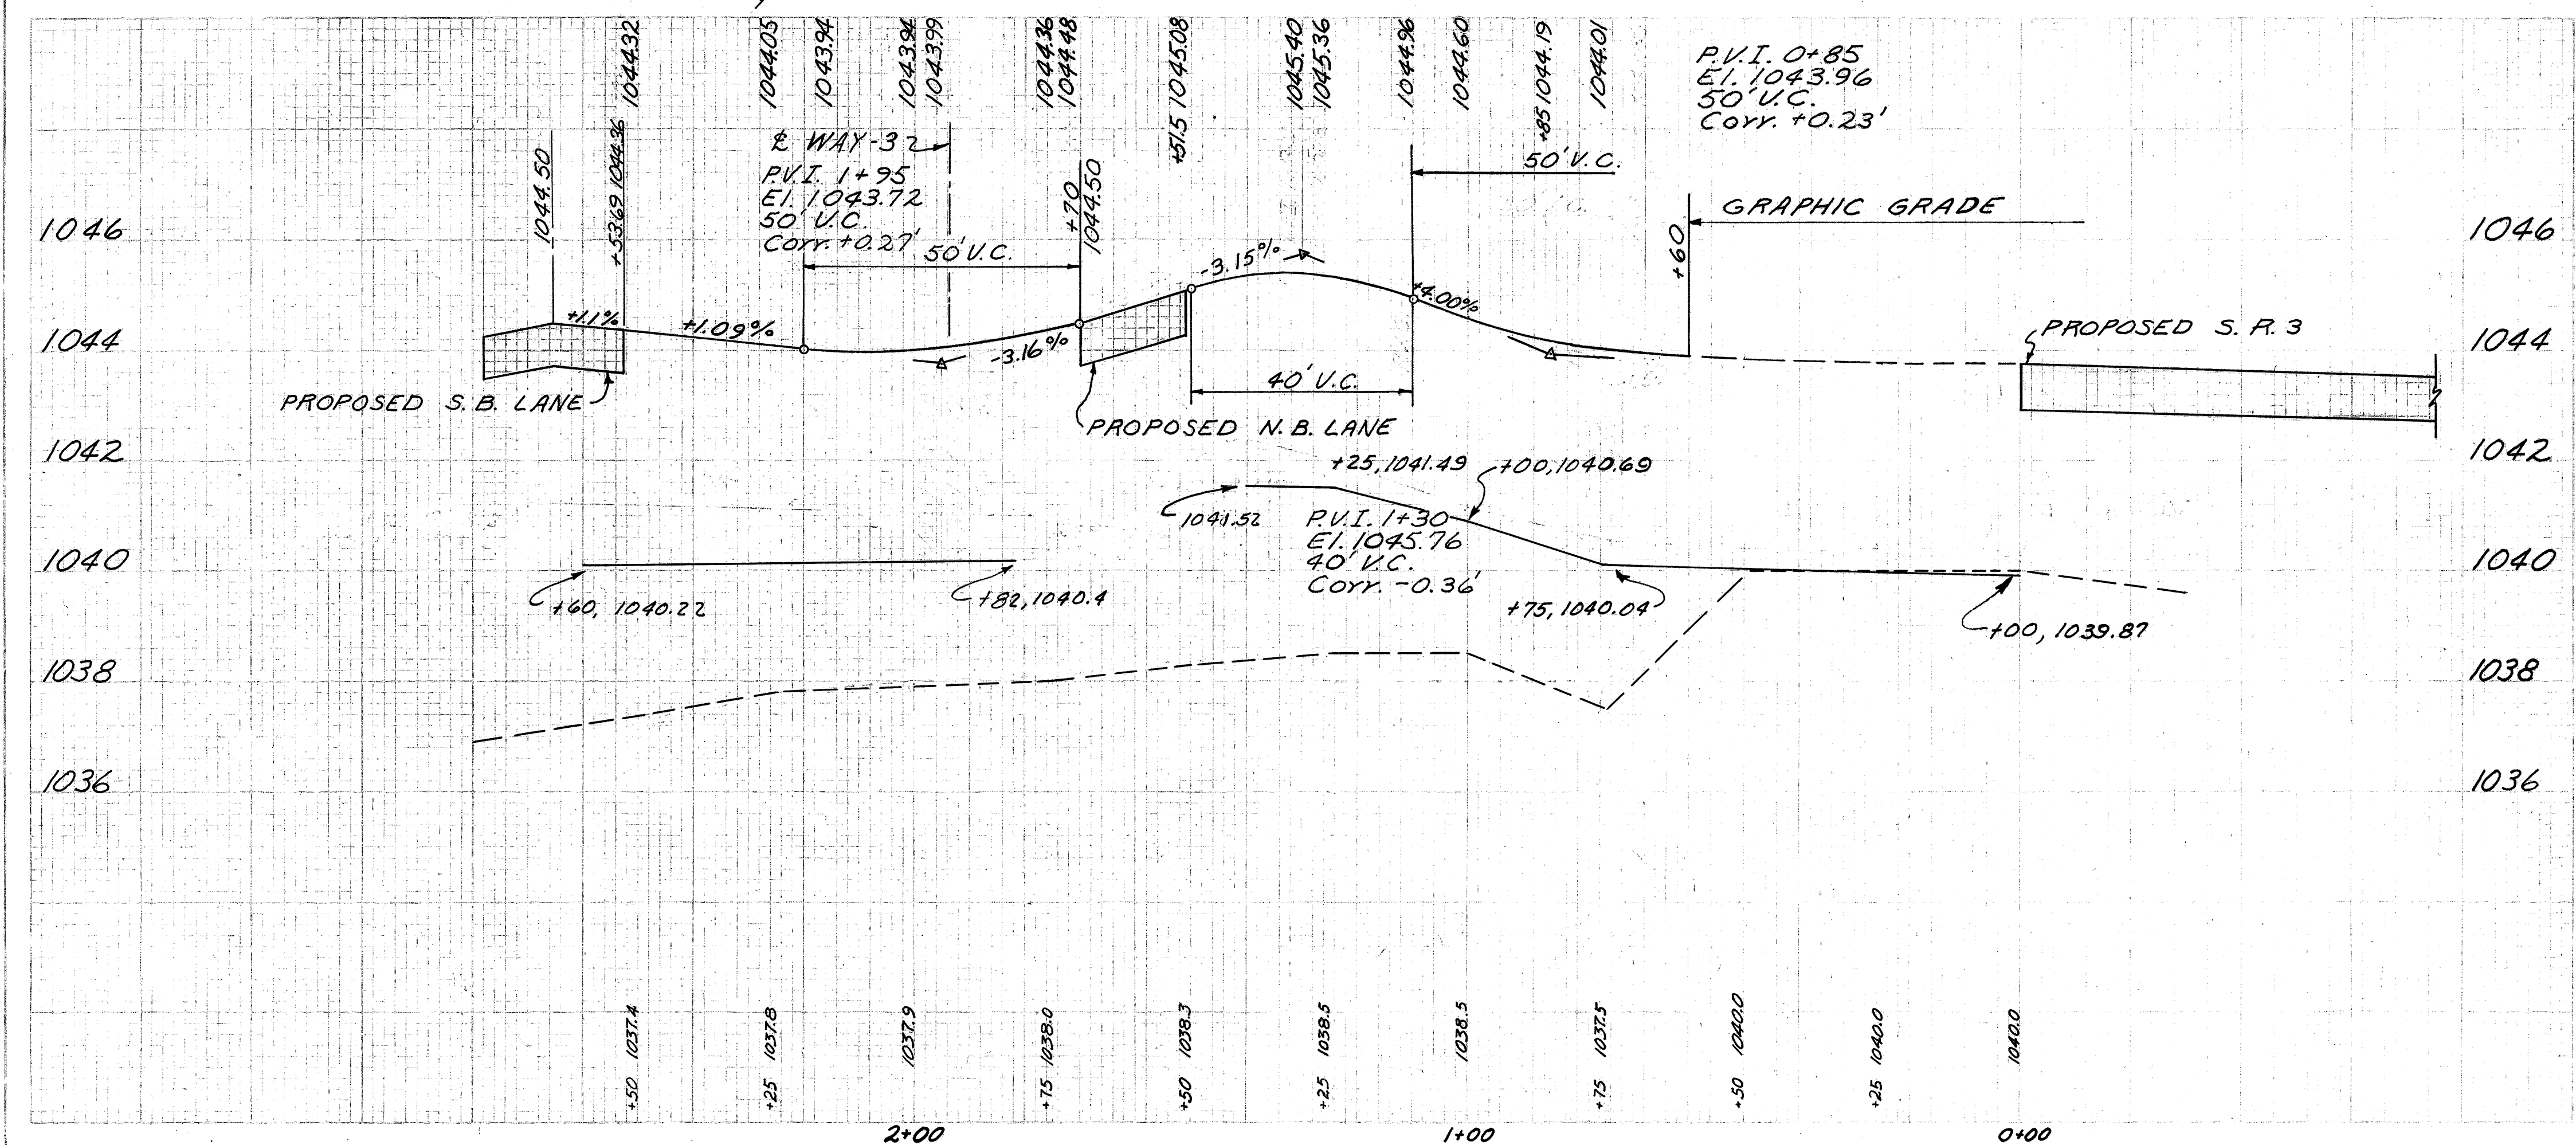

Item No.	Station	Side	T-31		B-33		I-18		I-22		B-20		T-30		B-35		B-35		T-35		
			No. 6 Aggregate Per Sq. Yd.	No. 46 Aggregate Per Sq. Yd.	Bituminous Mac. Base Course	Stabilized Crushed Chert	Subbase Grading	Water Bound Mac. Base Course	Prime Coat	Asphaltic Conc. Surface	Asphaltic Conc. Surface	Asphaltic Conc. Surface	Asphaltic Conc. Surface	Asphaltic Conc. Surface	Asphaltic Conc. Surface	Asphaltic Conc. Surface	Asphaltic Conc. Surface	Asphaltic Conc. Surface	Asphaltic Conc. Surface	Asphaltic Conc. Surface	Asphaltic Conc. Surface
1-P	0																				
2-P	1+71	2+53.69																			
Totals			1.33	1.33	1.33	1.33	1.33	1.33	1.33	1.33	1.33	1.33	1.33	1.33	1.33	1.33	1.33	1.33	1.33	1.33	1.33


LINE "C"

FILE NO. DIVISION	STATE	PROJECT
2	OHIO	

101
151

WAYNE COUNTY
WAY-3-994

END AREA		Cu. Yds.	
CUT	FILL	CUT	FILL

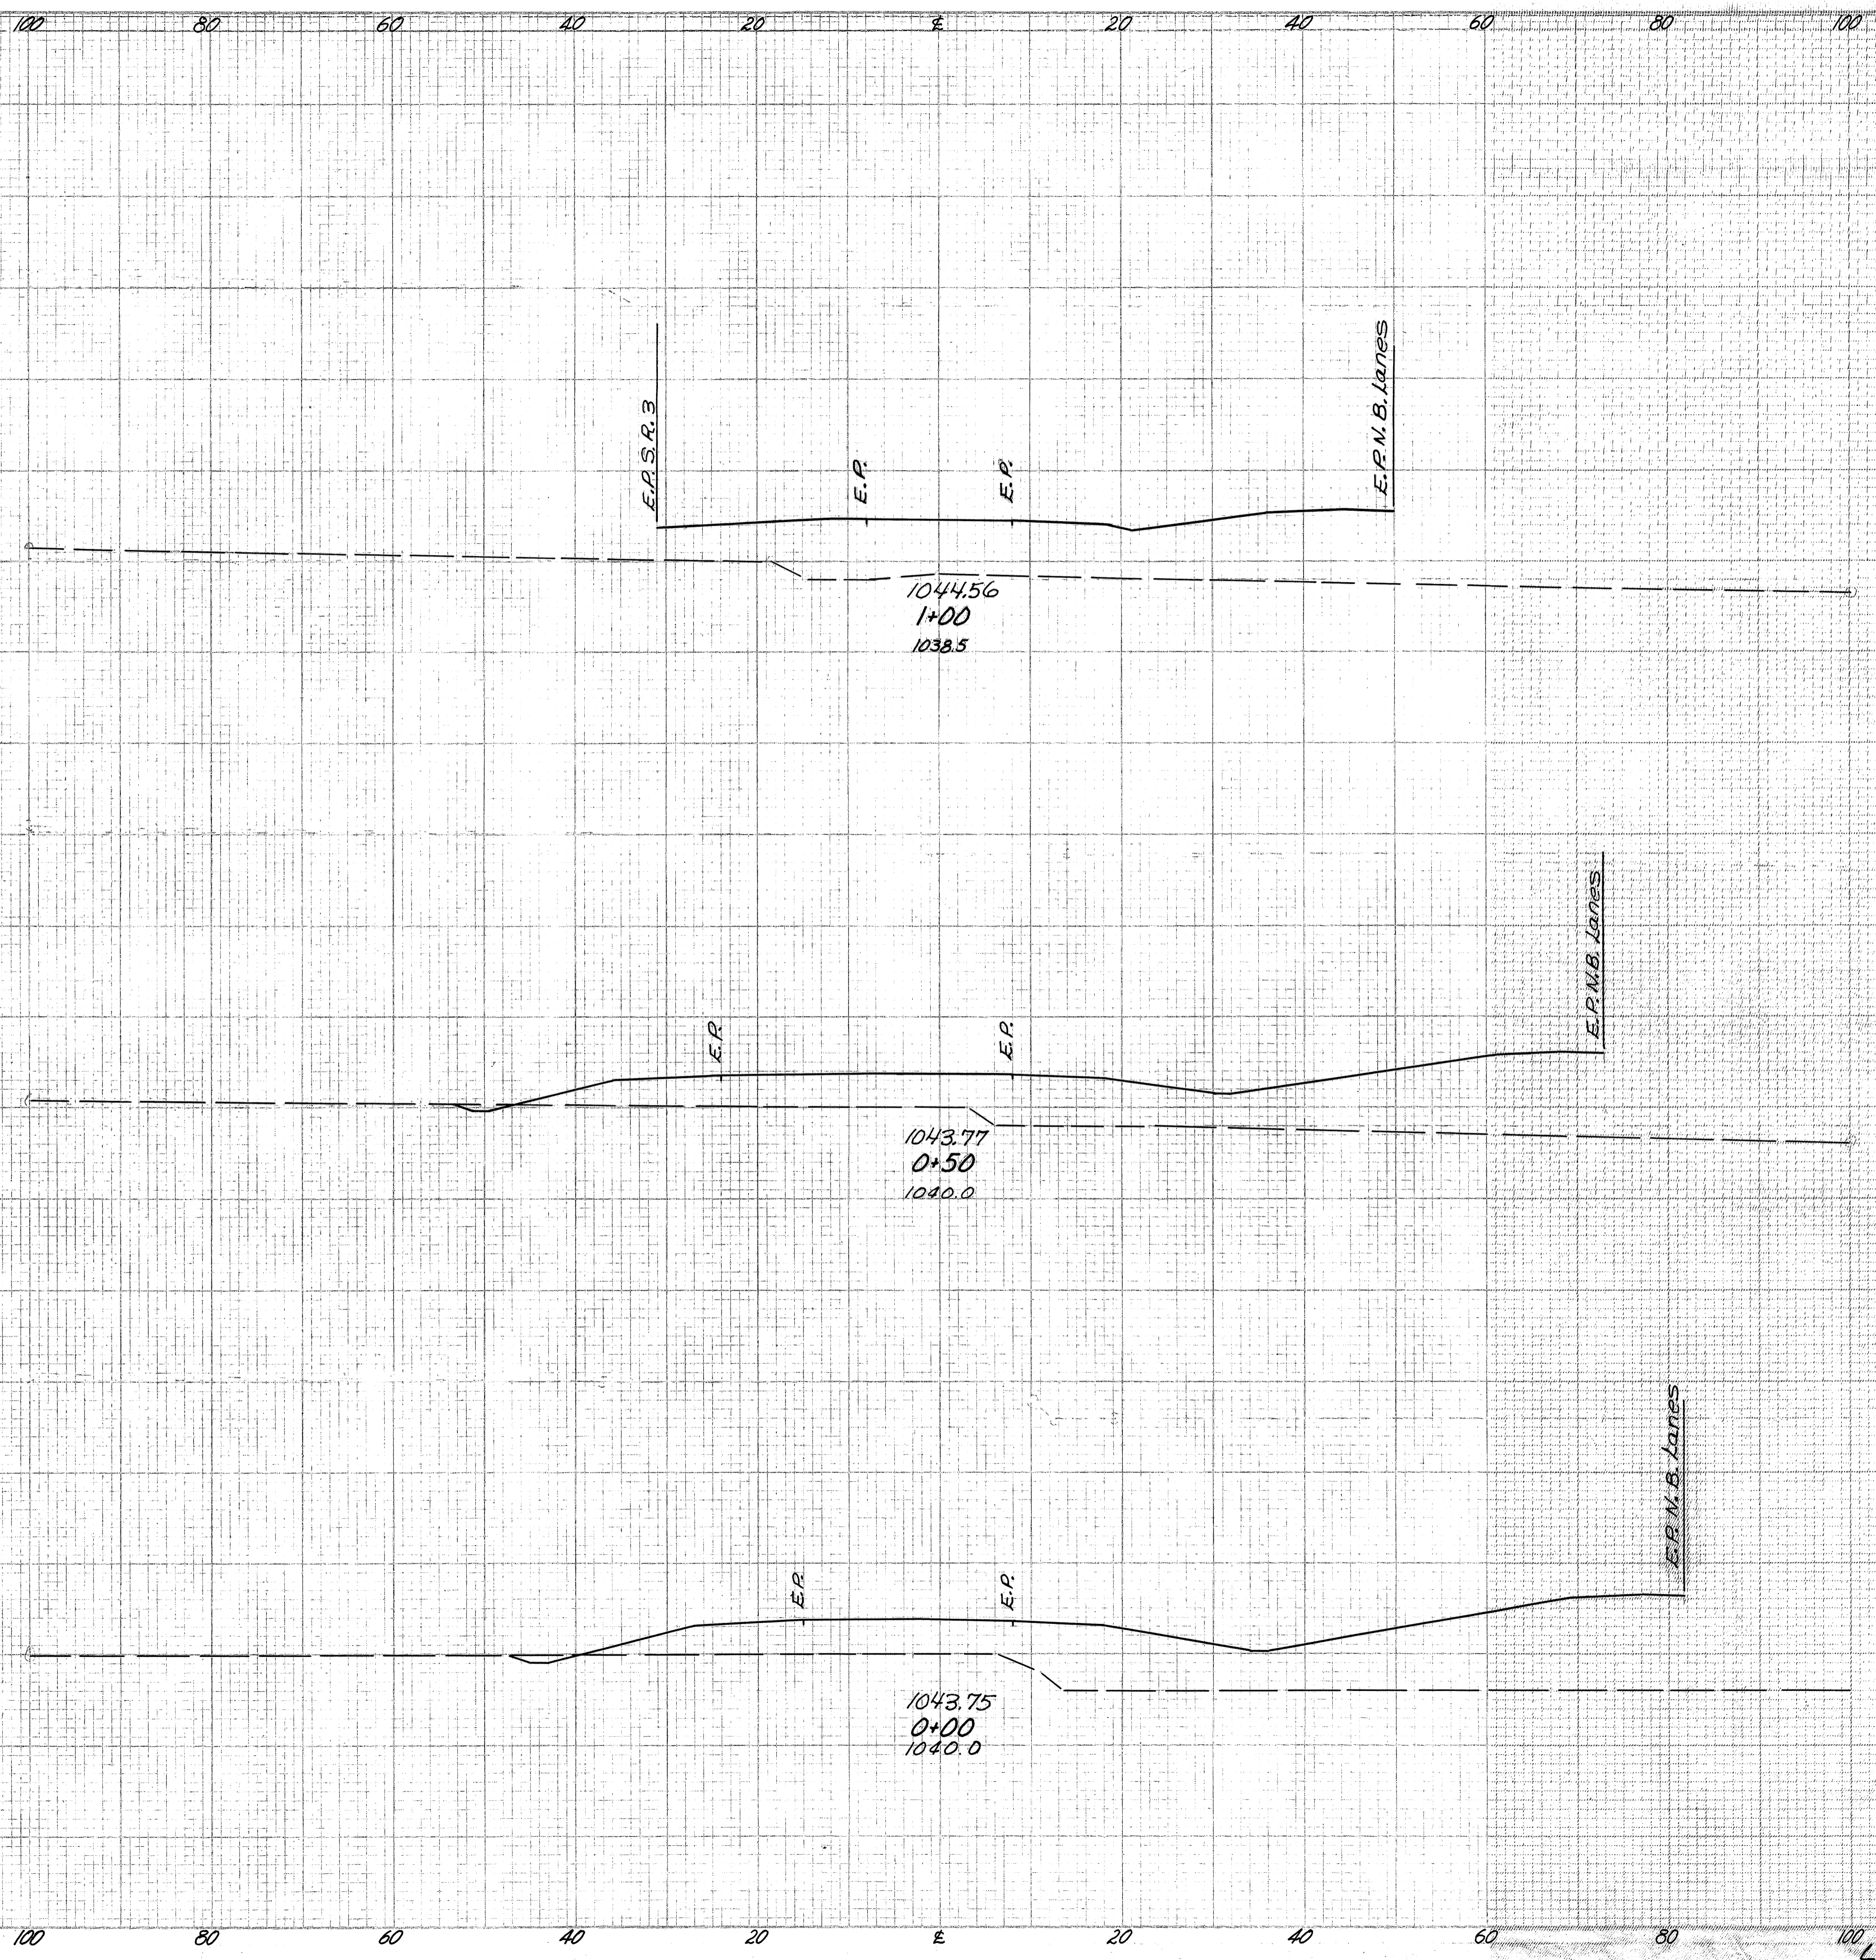


Sections Station 0+00 to
2+50 for information only
See Way 3- Cross Sections
for Earthwork quantities

WAYNE COUNTY
WAY-3-994

END AREA		CU. Yds.	
CUT	FILL	CUT	FILL

100 80 60 40 20 0 20 40 60 80 100

100 80 60 40 20 0 20 40 60 80 100

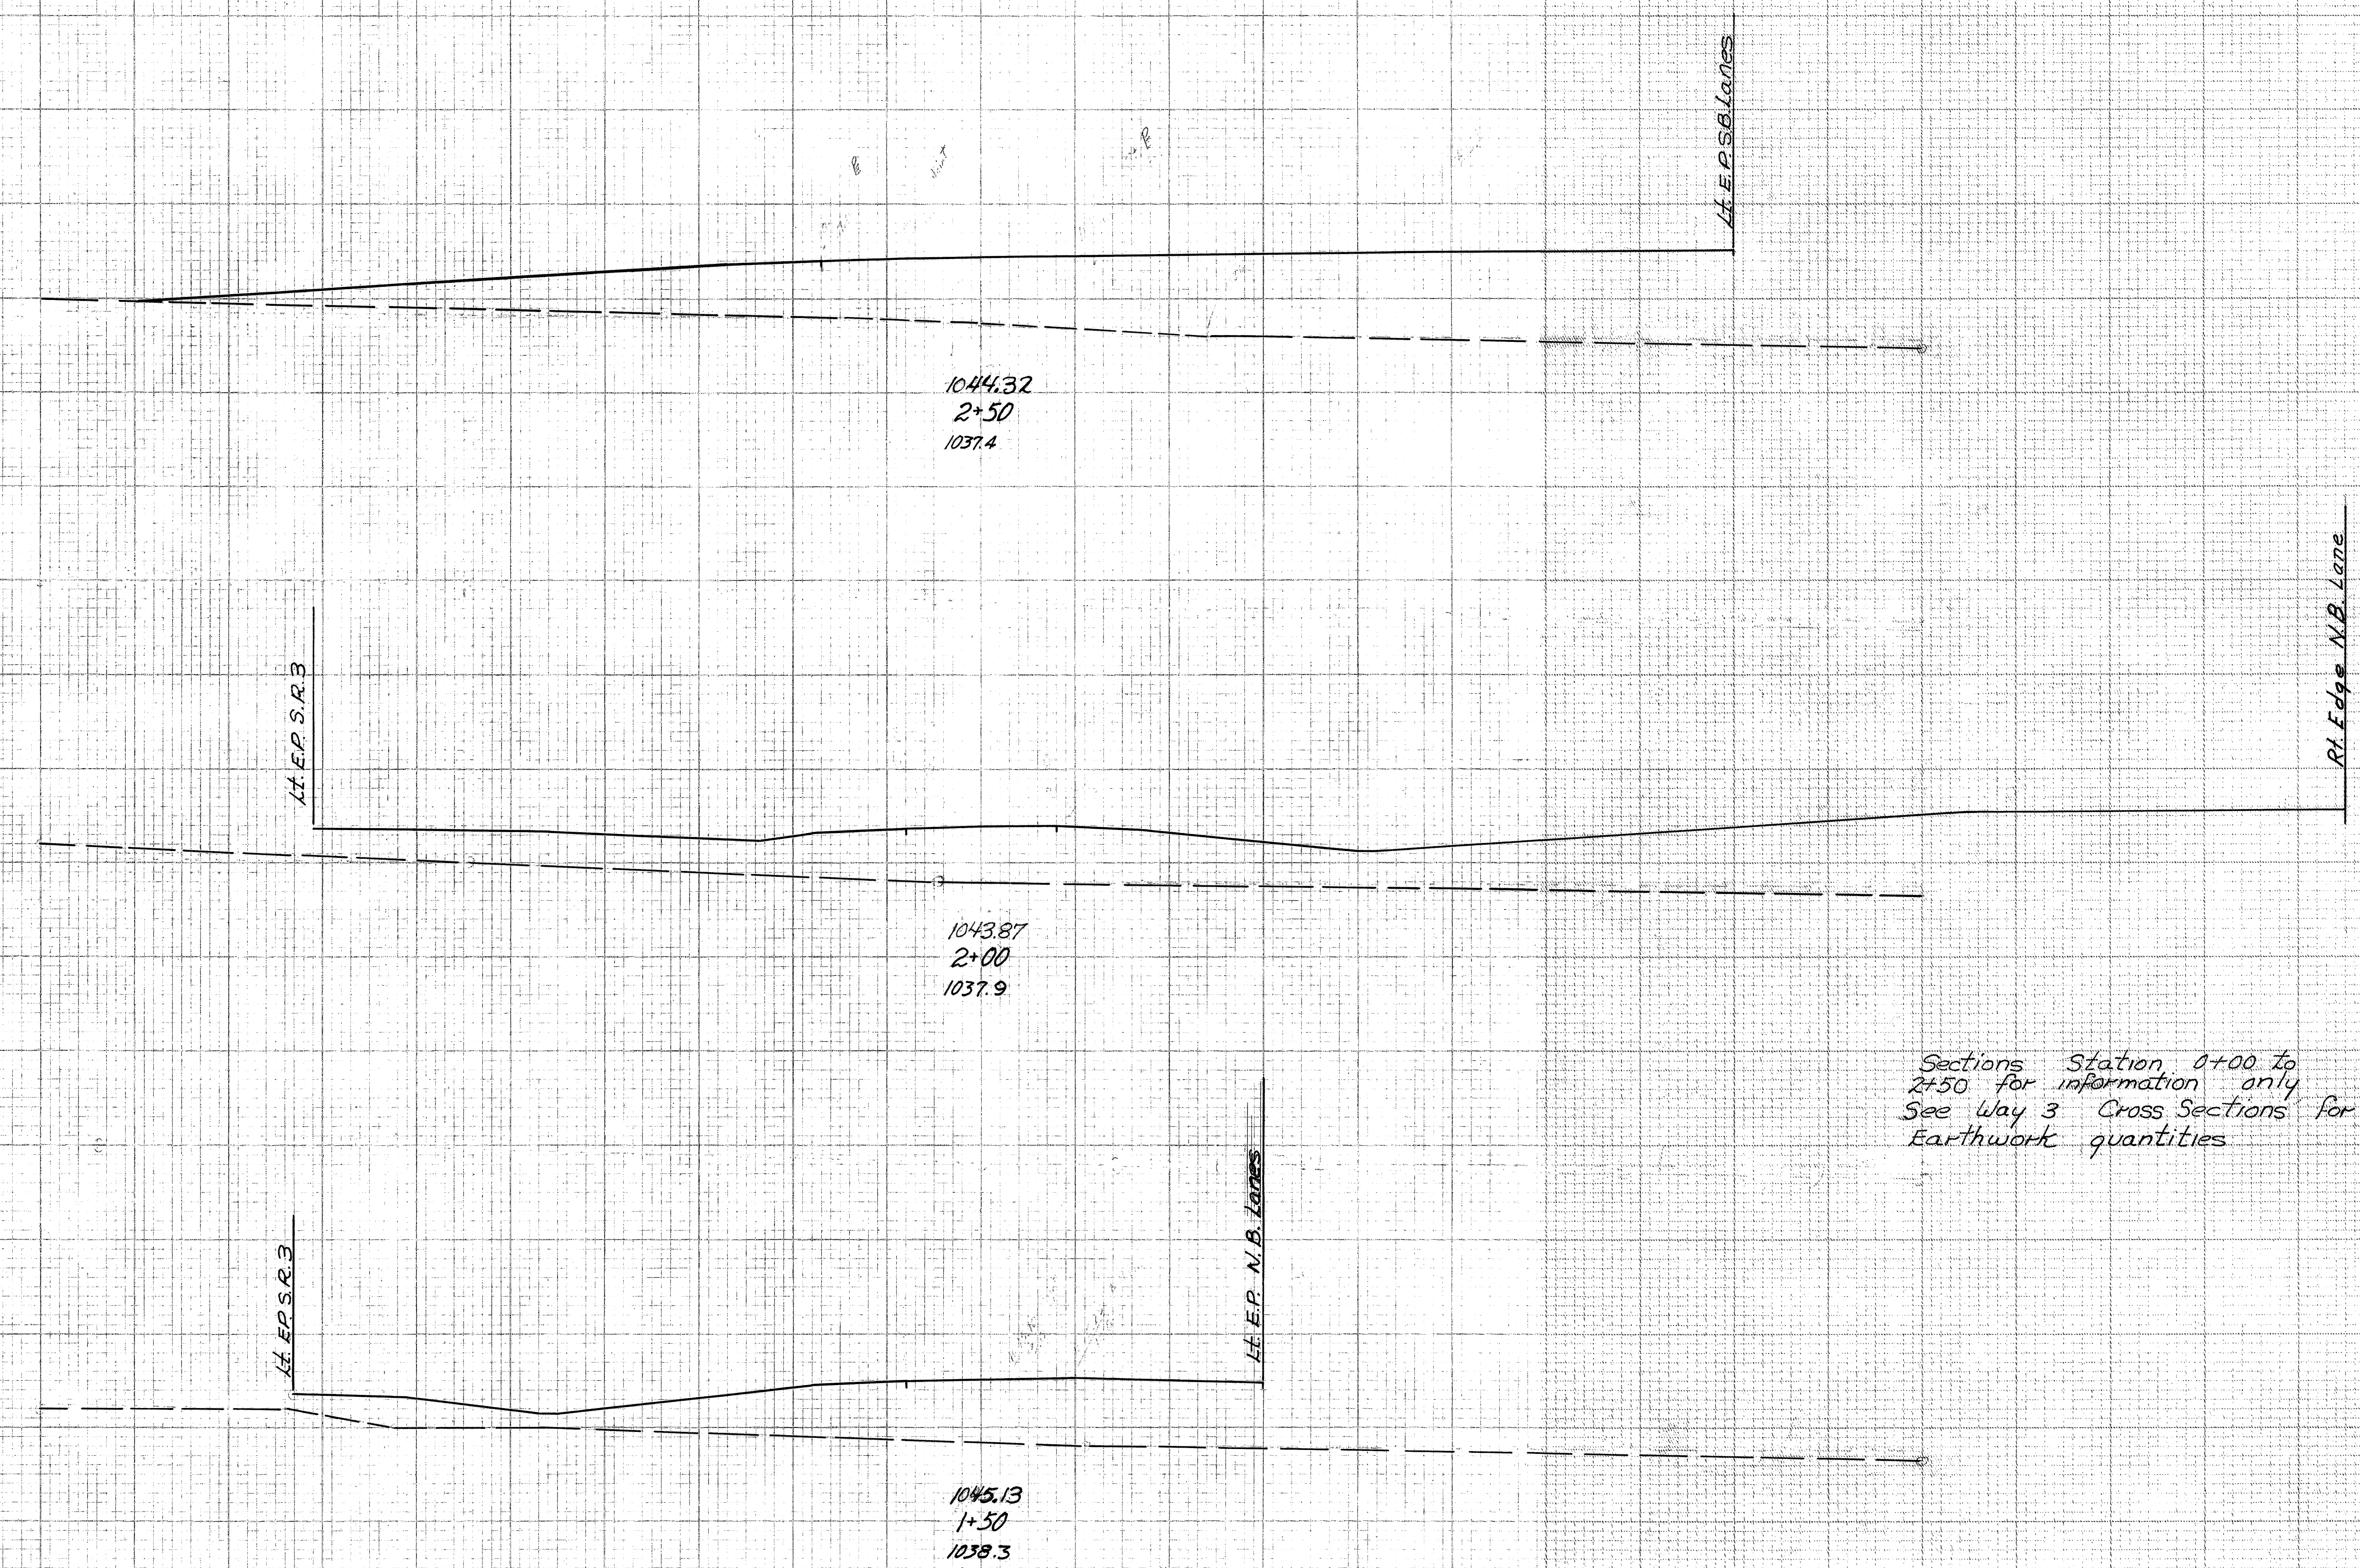



1044.32
2+50
1037.4

1043.87
2+00
1037.9

1045.13
1+50
1038.3


Sections Station 0+00 to
2+50 for information only
See Way 3 Cross Sections for
Earthwork quantities

WAYNE COUNTY
WAY-3-9.94

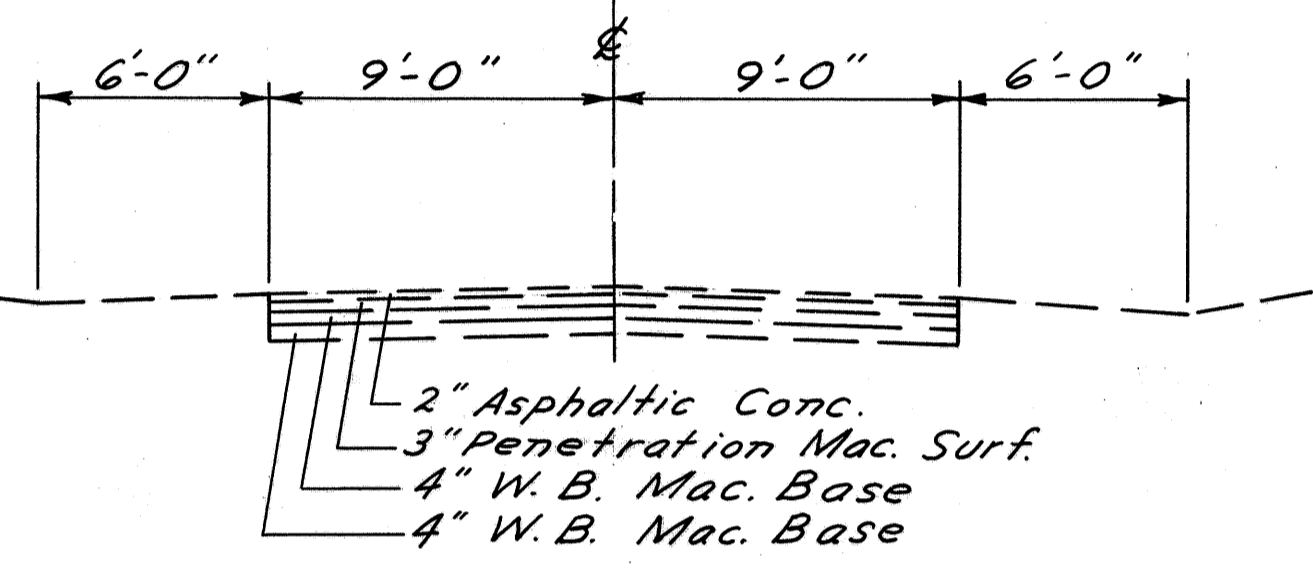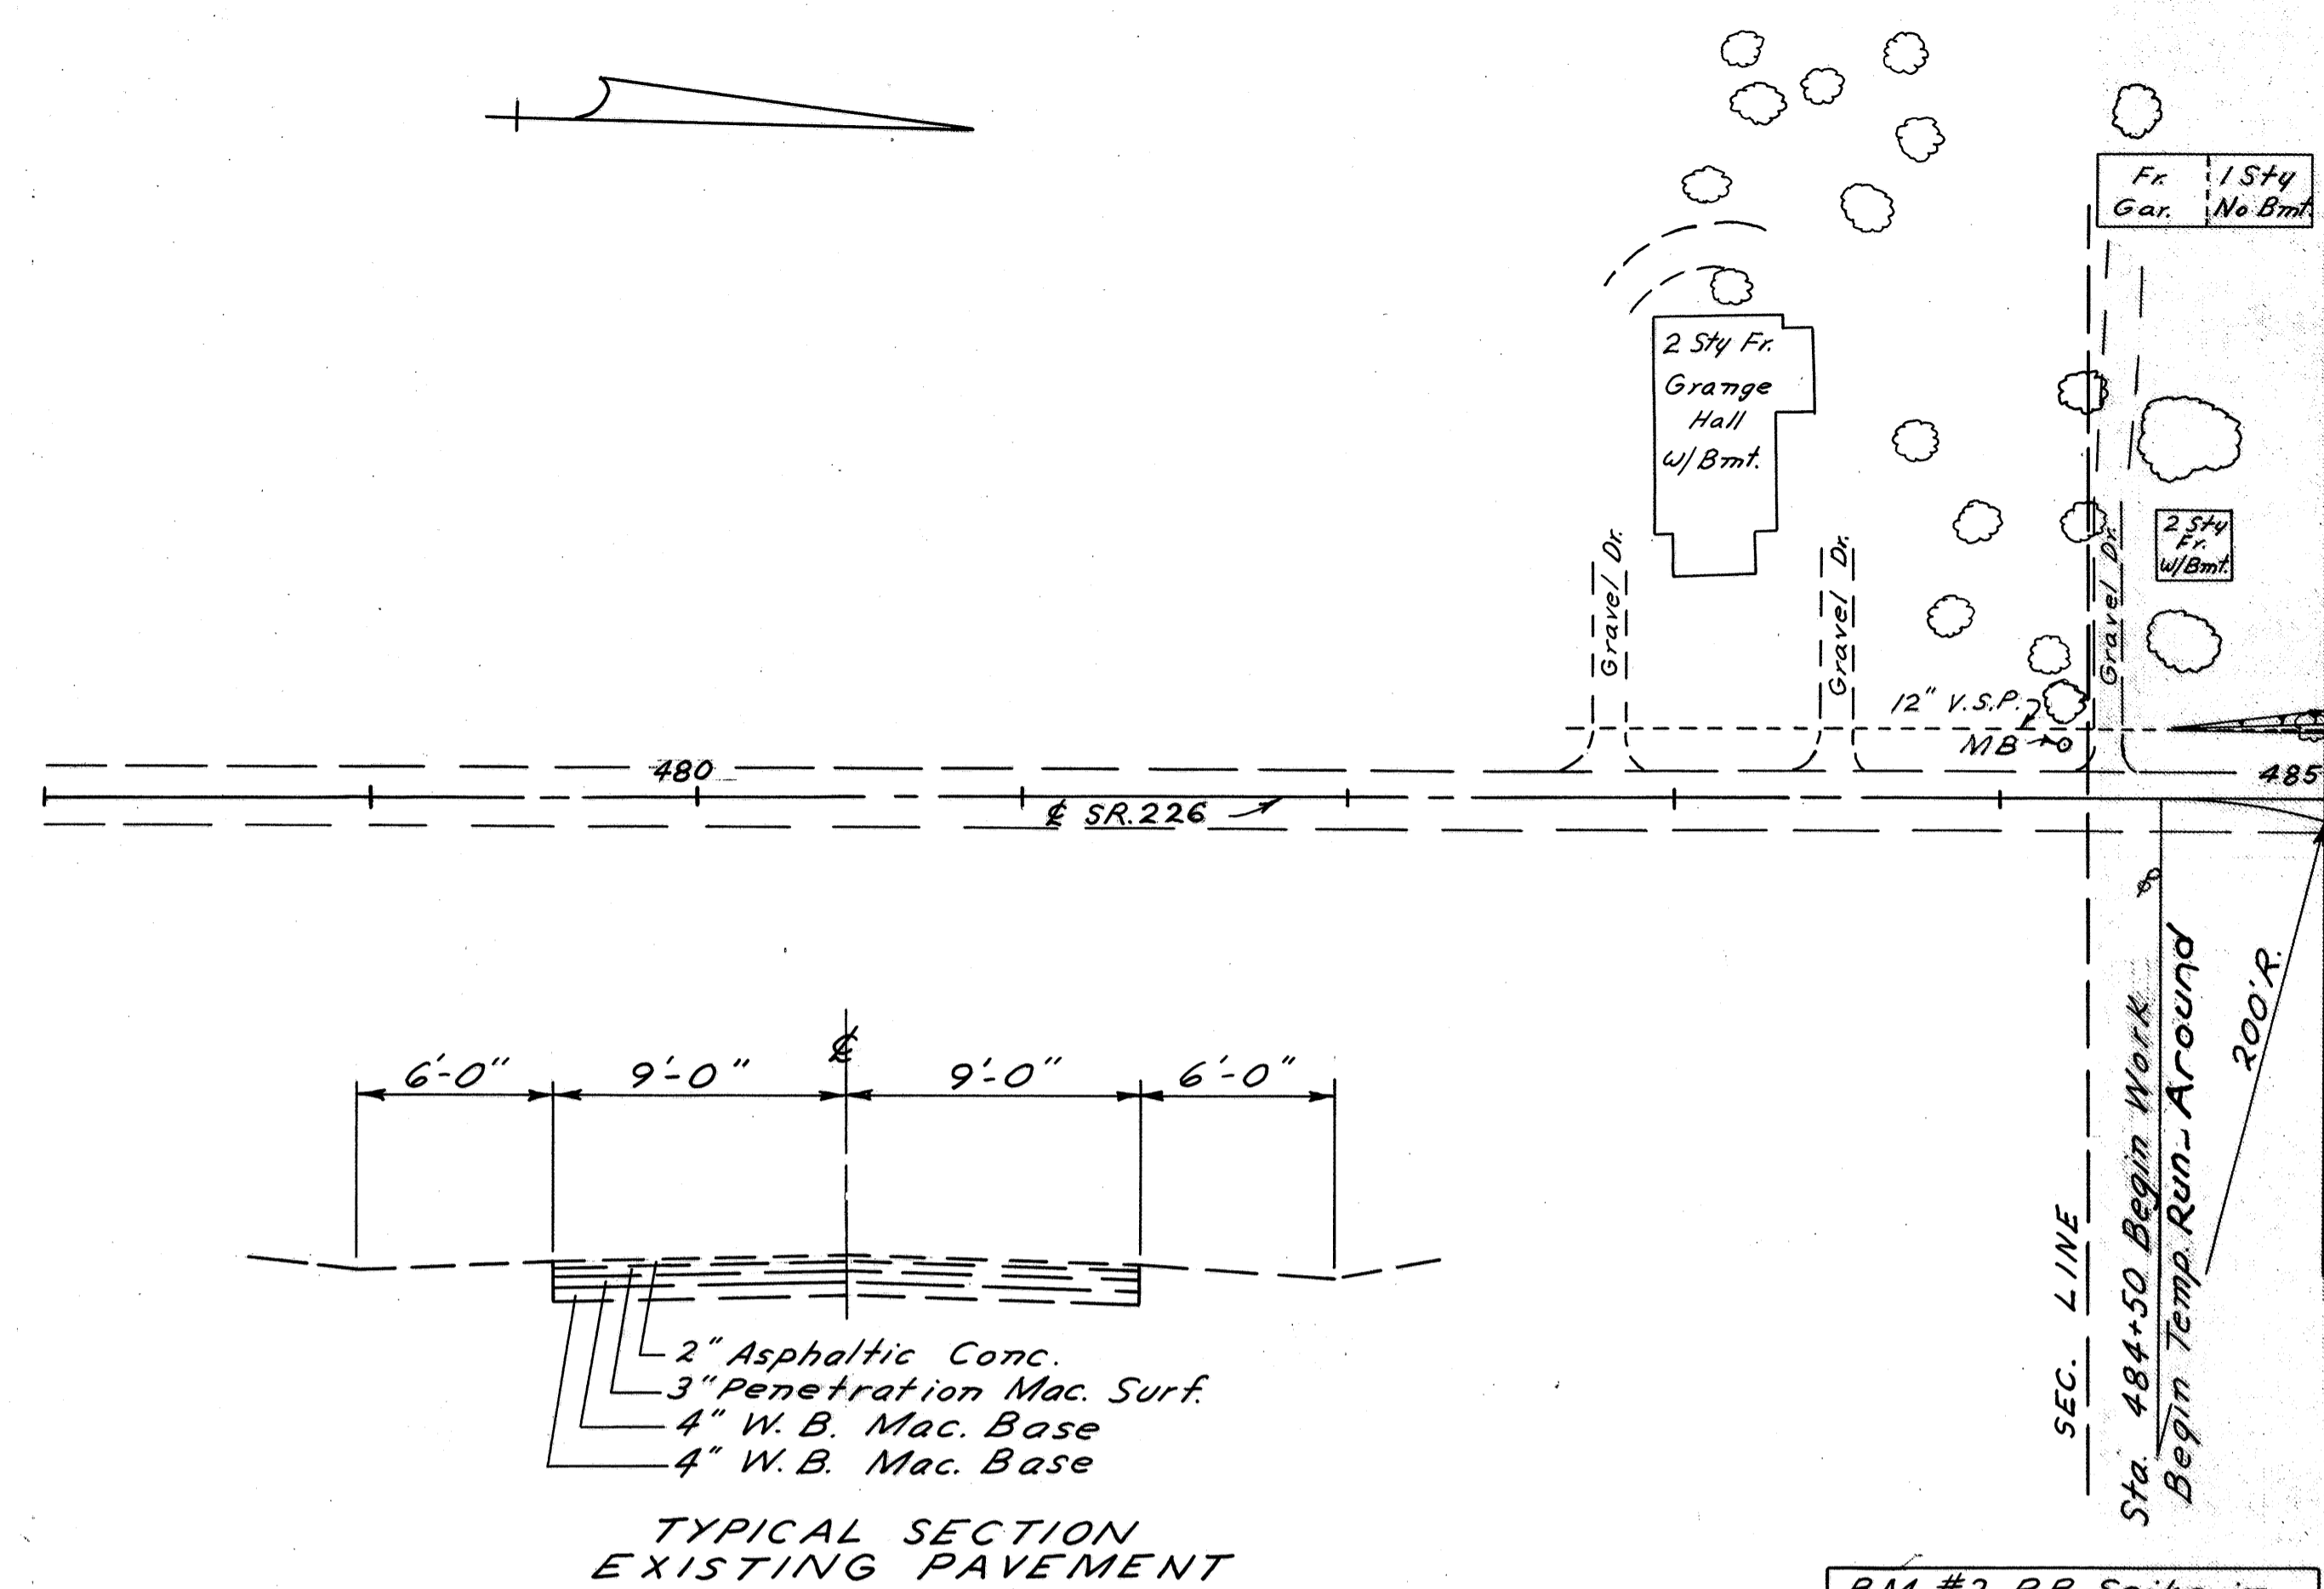

TYPICAL SECTION
EXISTING PAVEMENT

B.M. #2 R.R. Spike in
P.P. 30' LT Sta 485+66
(S.R. 226) Elev. 1043.38

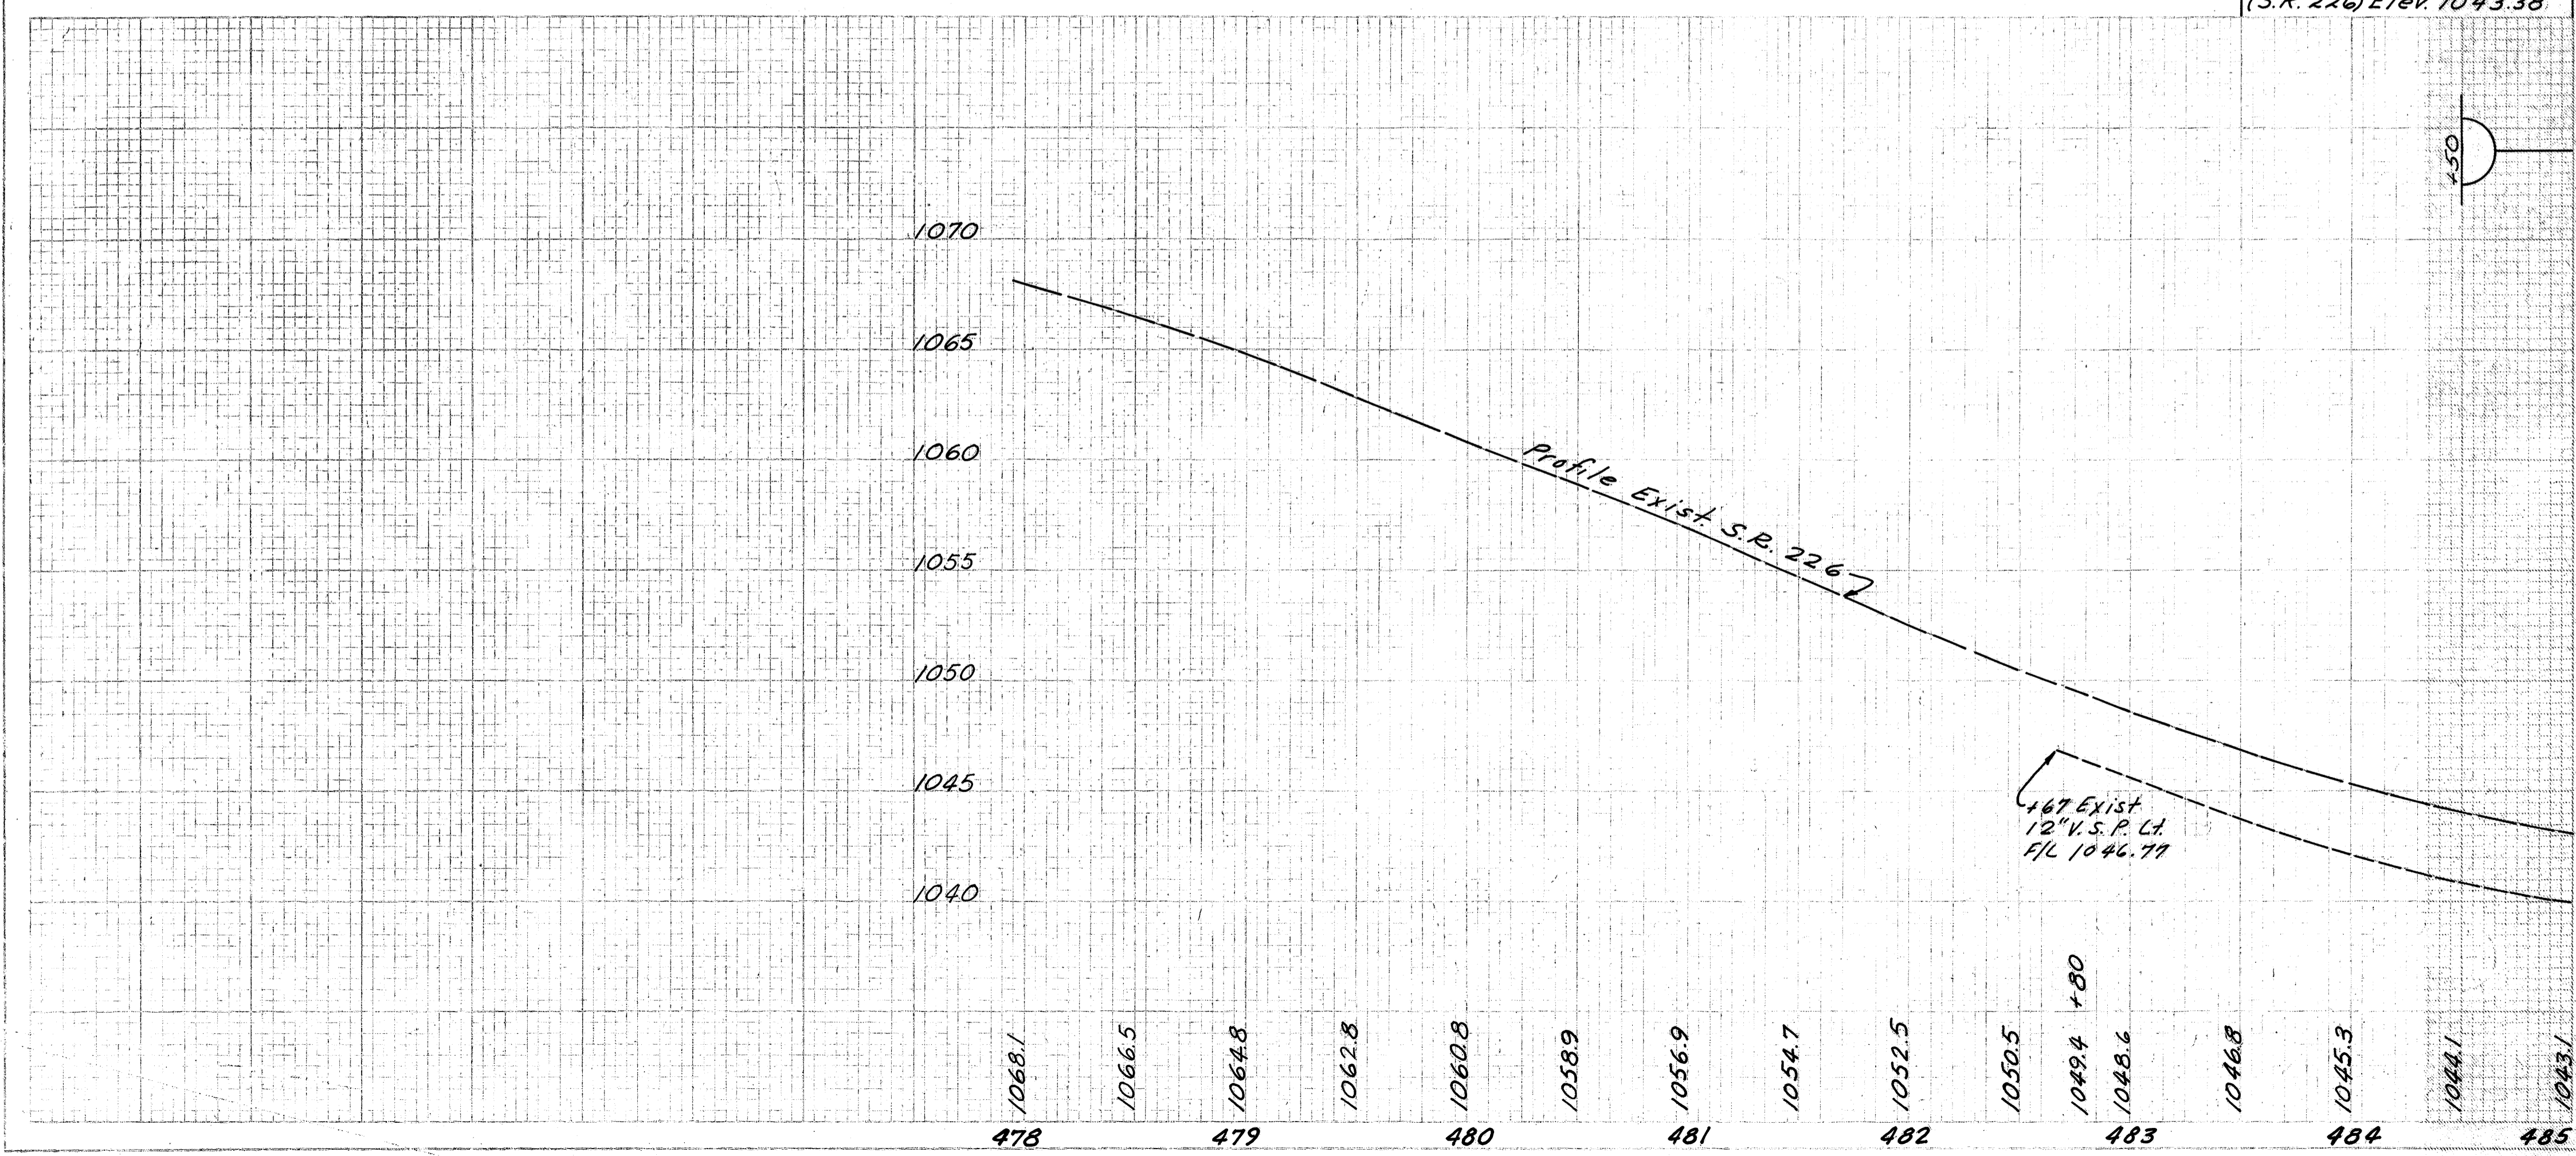


Item No.	Station	From		To		Cu. Yd.	Cu. Ft.	Lin. Ft.	Remarks
		486+00	488+64	488+64	488+64				
I-P				2640	3168	10933	31711	8220	T-35 Asphaltic Conc. 1 1/4 Type C
						10933	31711	8220	B-35 Asphaltic Conc. Leveling Course 1 1/2 (10-88)
						10933	31711	8220	B-19 Crushed Agg. Base Course 5"
						9162	3874	8220	T-30 Bituminous Prime Coat 1/2 (10-88)
						3874	8220	8220	I-22 Subbase Grading 1/2 (10-88)
									I-18 Stabilized Crushed Underlain
									I-9 Stone Underlain
				2640	3168	10933	31711	8220	Totals

**WAYNE COUNTY
WAY-3-9.94**

Curve Data S.B. Lane
 P.I. Sta 546+05.19 S.B.
 $\Delta = 13^\circ 46' 53''$
 $D = 1^\circ 15' 00''$
 $R = 4583.66'$
 $L = 553.94'$
 $E = 33.35'$

Curve Data & Survey Way-3
 P.I. 539+92.09
 $\Delta = 25^\circ 28' 20''$
 $D = 1^\circ 15' 00''$
 $R = 4583.66'$
 $L = 2037.78'$
 $T = 1036.01'$
 $E = 115.62'$

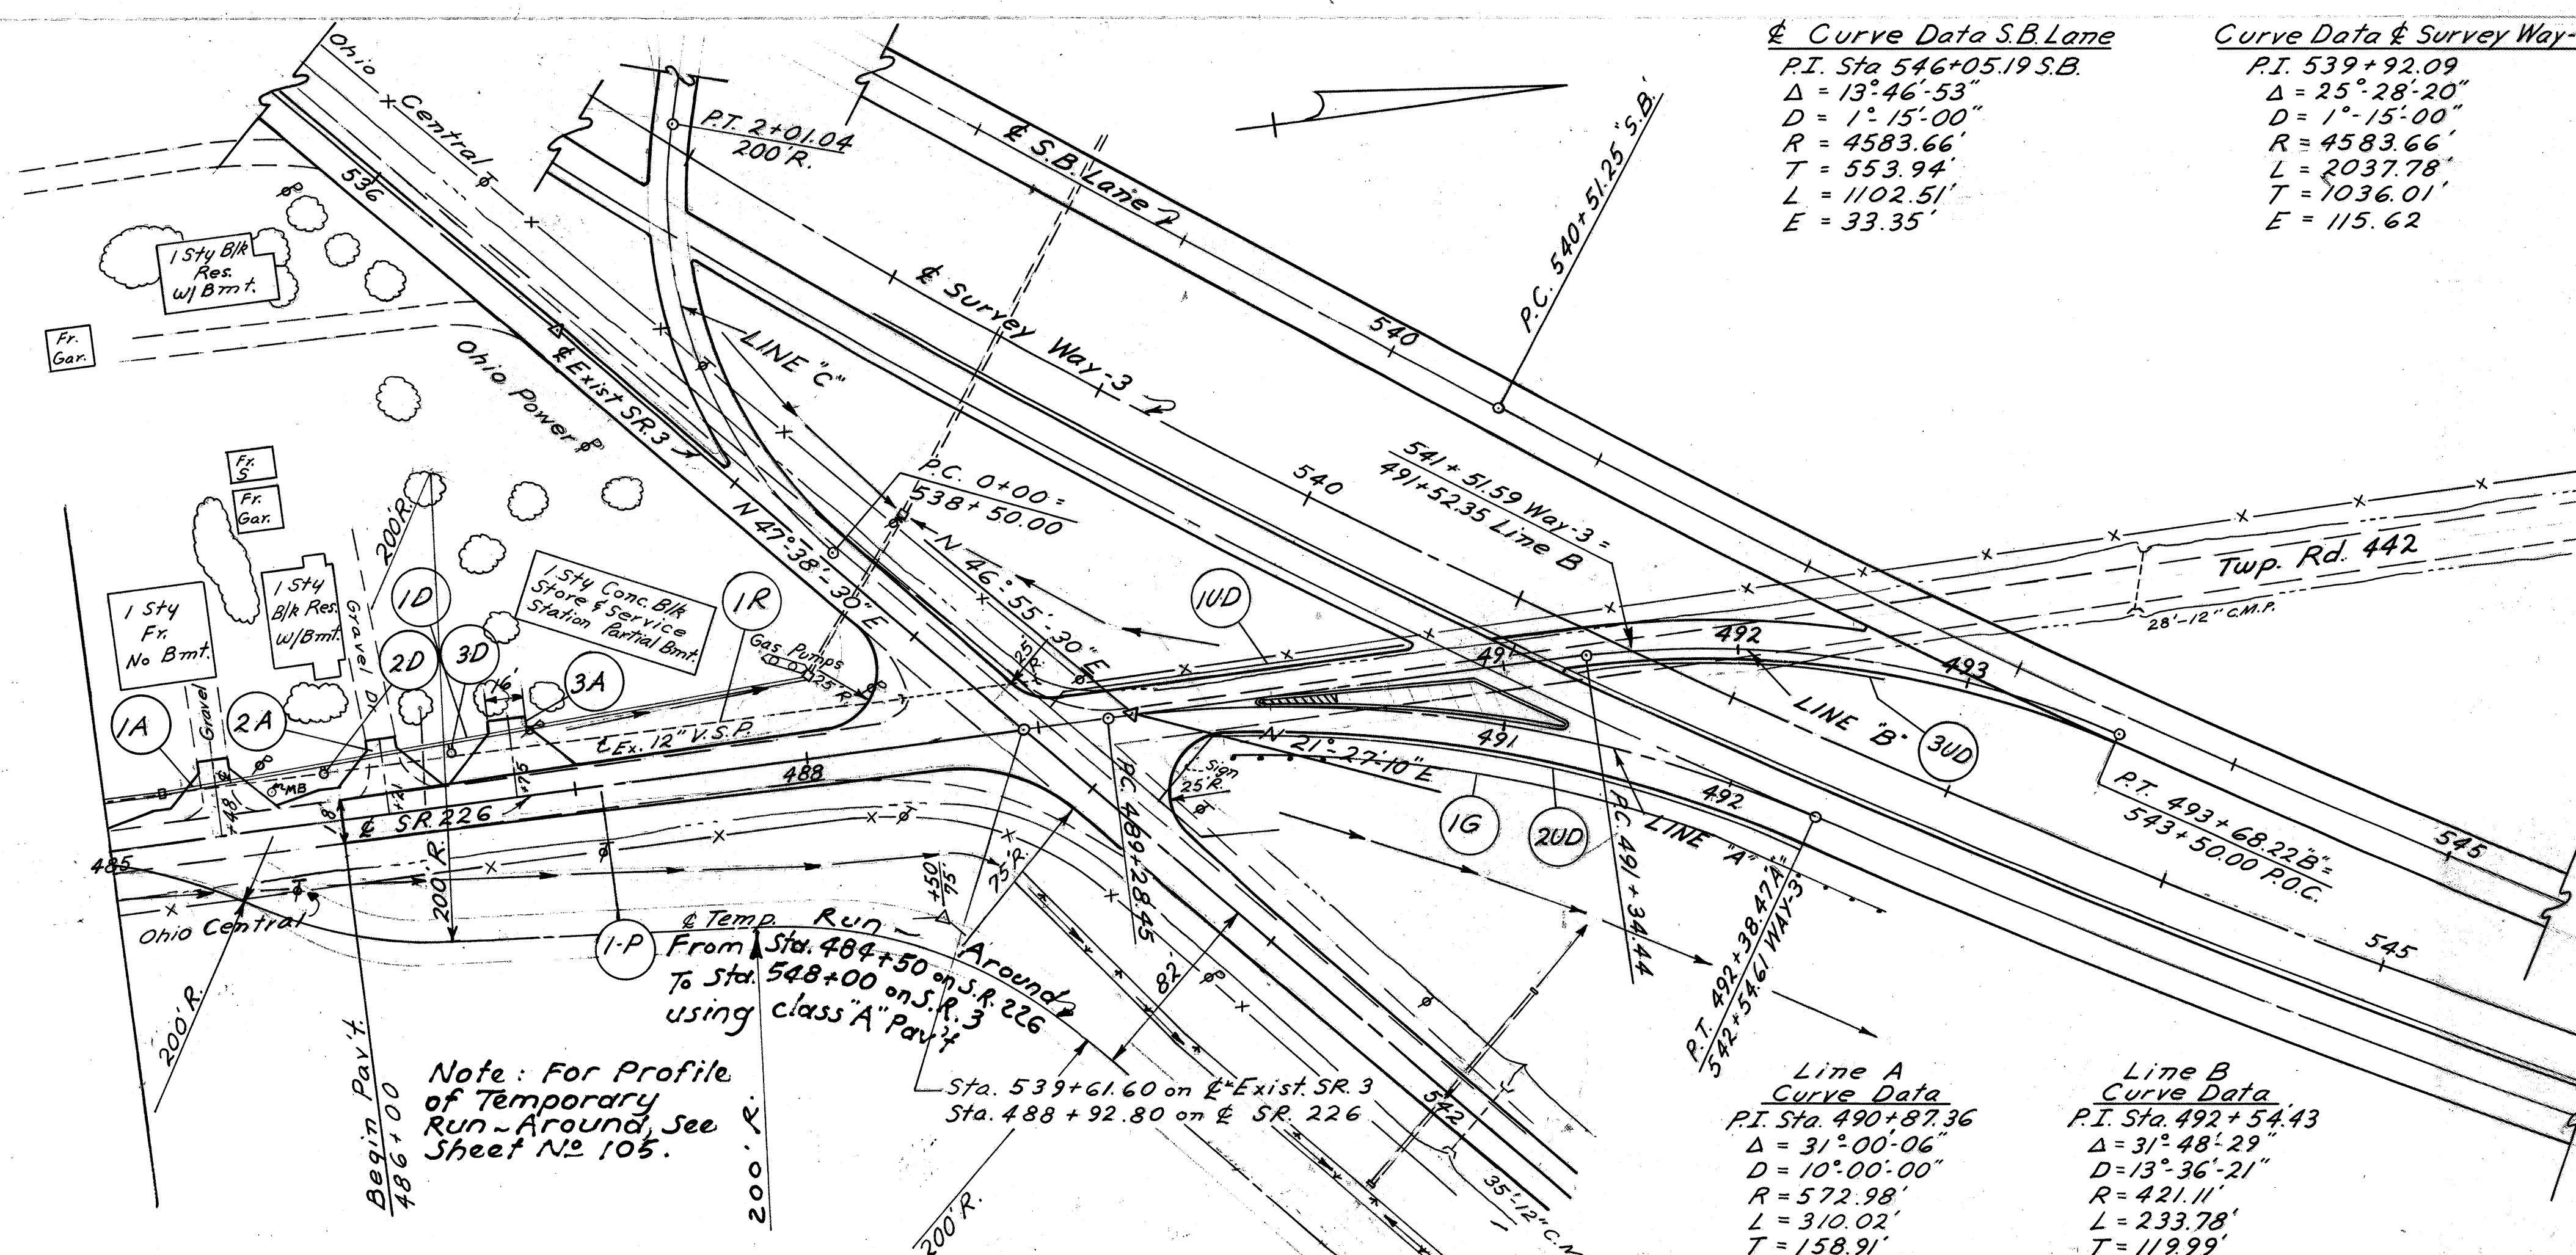


Note: For Profile of Temporary Run - Around See Sheet No 105.
 From Sta. 484+50 on S.R. 226 to Sta. 548+00 on S.R. 3 using class "A" Pavt.

Line A Curve Data
 P.I. Sta. 490+87.36
 $\Delta = 31^\circ 00' 06''$
 $D = 10^\circ 00' 00''$
 $R = 572.98'$
 $L = 310.02'$
 $T = 158.91'$
 $E = 21.63'$

Line B Curve Data
 P.I. Sta. 492+54.43
 $\Delta = 31^\circ 48' 29''$
 $D = 13^\circ 36' 21''$
 $R = 421.11'$
 $L = 233.78'$
 $T = 119.99'$
 $E = 16.76'$

Item No.	Station		Side	I-3	I-5	I-8		
	From	To		Roadway Drainage 15"	Pipe Specials 15" x 15" Tee	Catch Basins 22B	No.	No.
1-D	485+25	488+03	Lt.	272	2	1		
2-D	485+95		Lt.	3			1	
3-D	486+50		Lt.	3			1	
Totals				278	2	1	2	


Item No.	Station		Side	I-4	I-5			
	From	To		6" Pipe Underdrain Shallow	6" Pipe Specials 6" x 45" Bend Tee	6" x 45" Wye	Ea.	Ea.
1UD	489+03	490+60B	Lt.	151	1	1		
2UD	489+45A	492+38A	Rt.	292	1	1		
3UD	491+29B	492+65B	Rt.	136			1	
Totals				579	2	2	1	

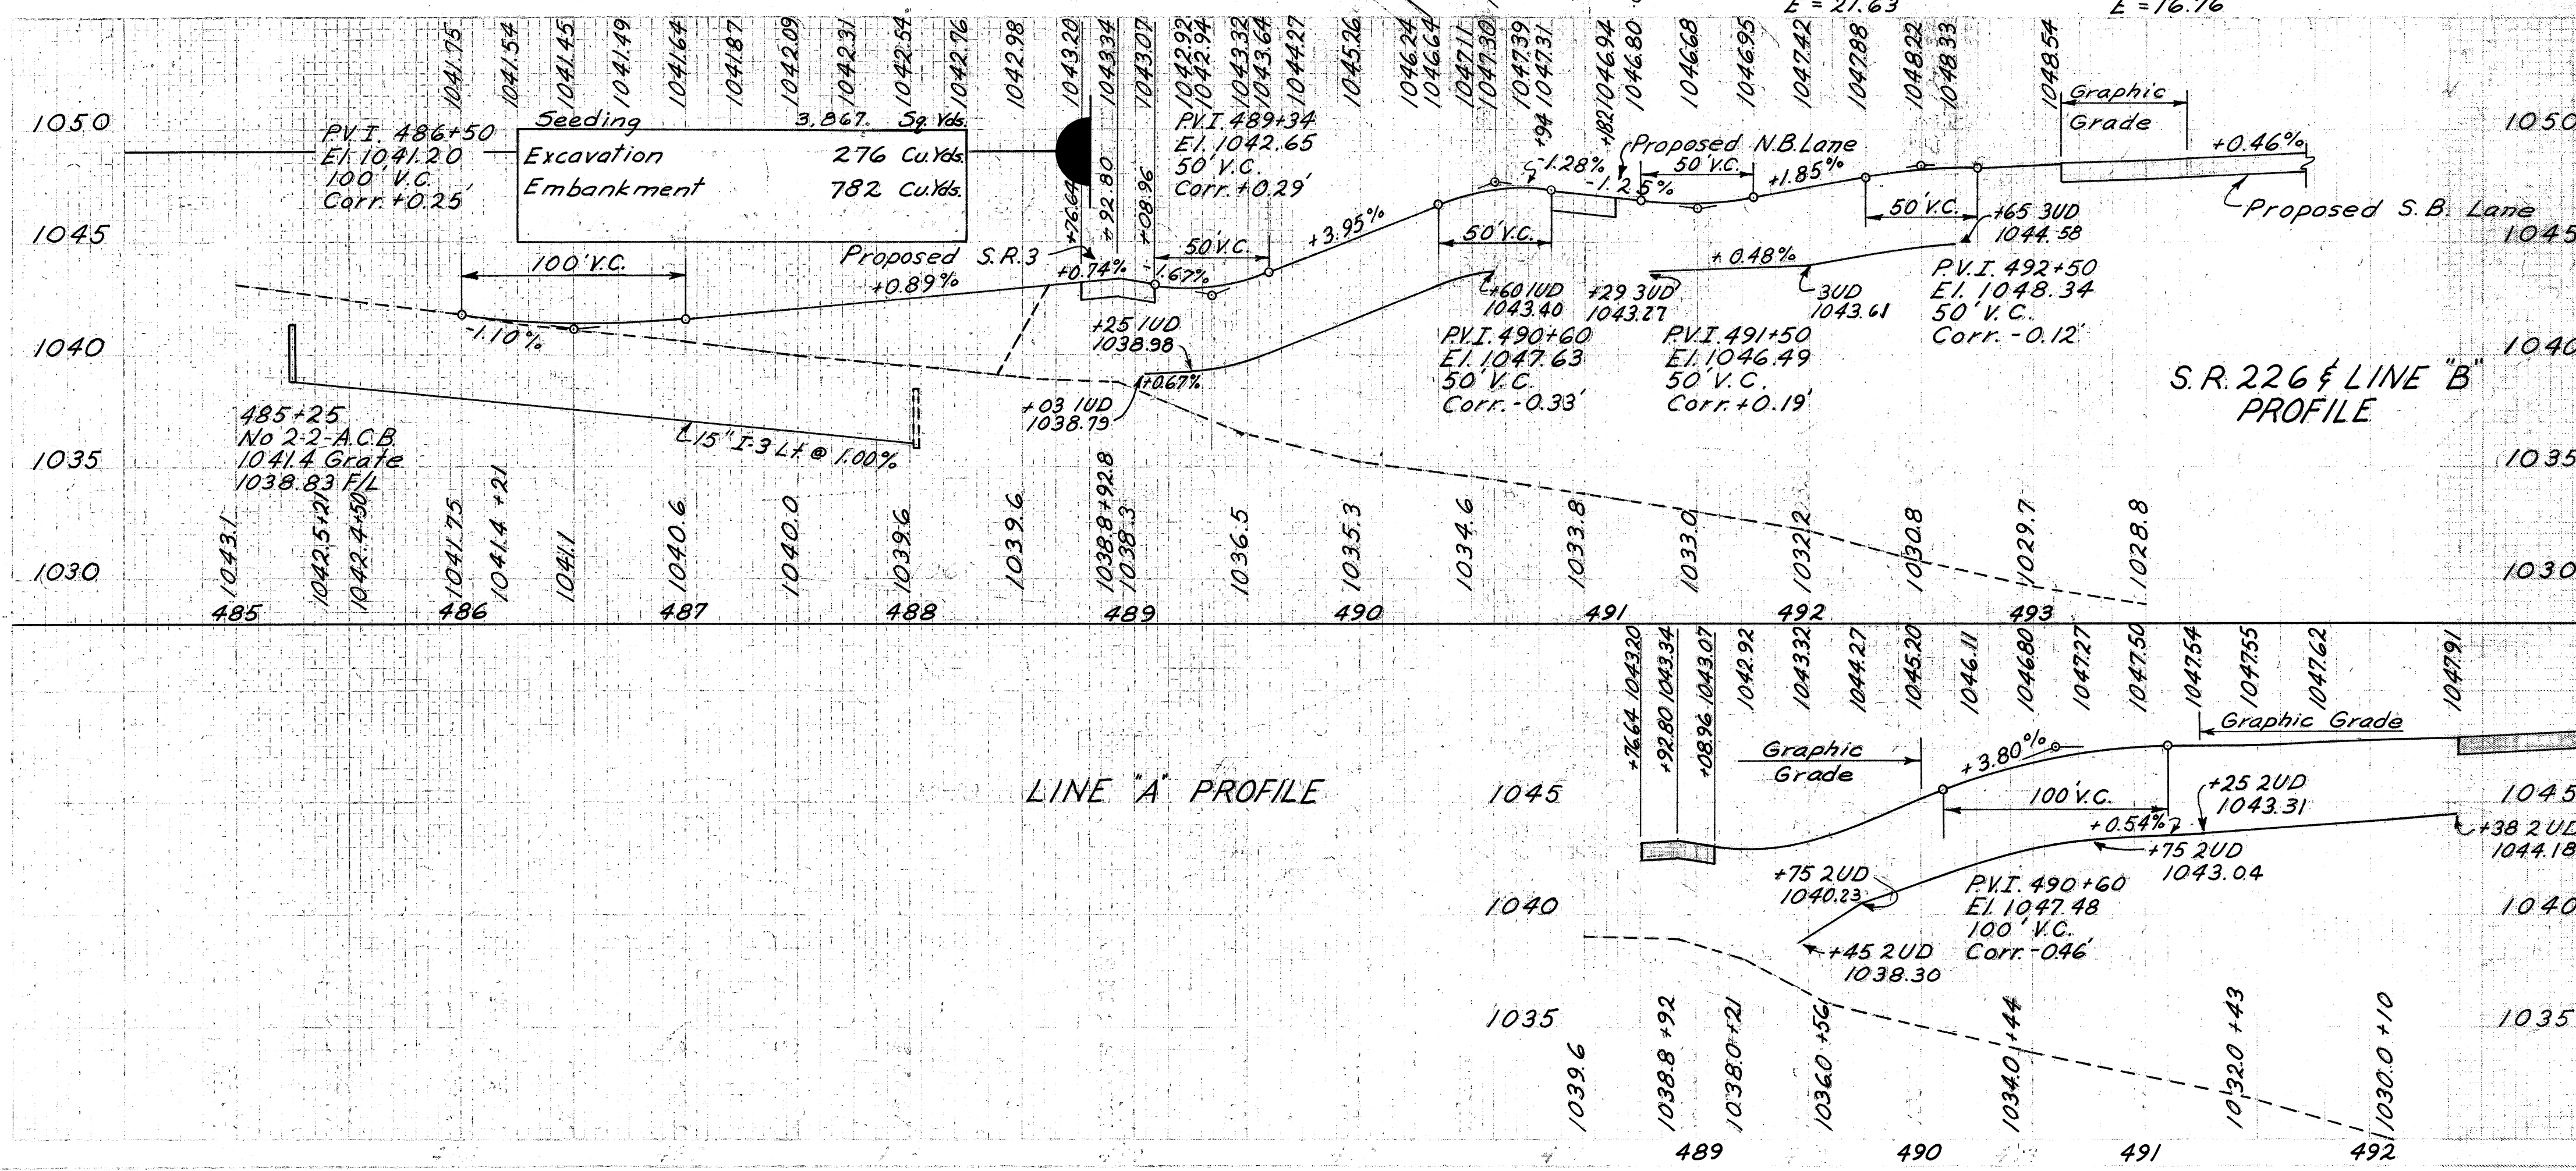


Item No.	Station		Side	Length	Width	B-19	T-35	E-12	I-15	B-19
	From	To				Crushed Aggregate Base Course 5"	Asphaltic Concrete Base Course 2"	Pipe Removed 15" & Under	Guard Rail Steel Beam Type Deep	Crushed Aggregate Base Course 7"
1A	485+48		Lt.	25	12	12.85	4.95			
2A	486+21		Lt.	25	12	12.71	4.89			
3A	486+75		Lt.	25	16		4.93			17.18
Totals						25.56	14.77	378	246.09	17.18

For Pavement Quantities Sta. 486+00 To Sta. 488+76.64 See Sheet No. 103
 For Pavement Quantities Line "A" & Line "B" See Sheet No. 27

WAYNE COUNTY
WAY-3-9.94

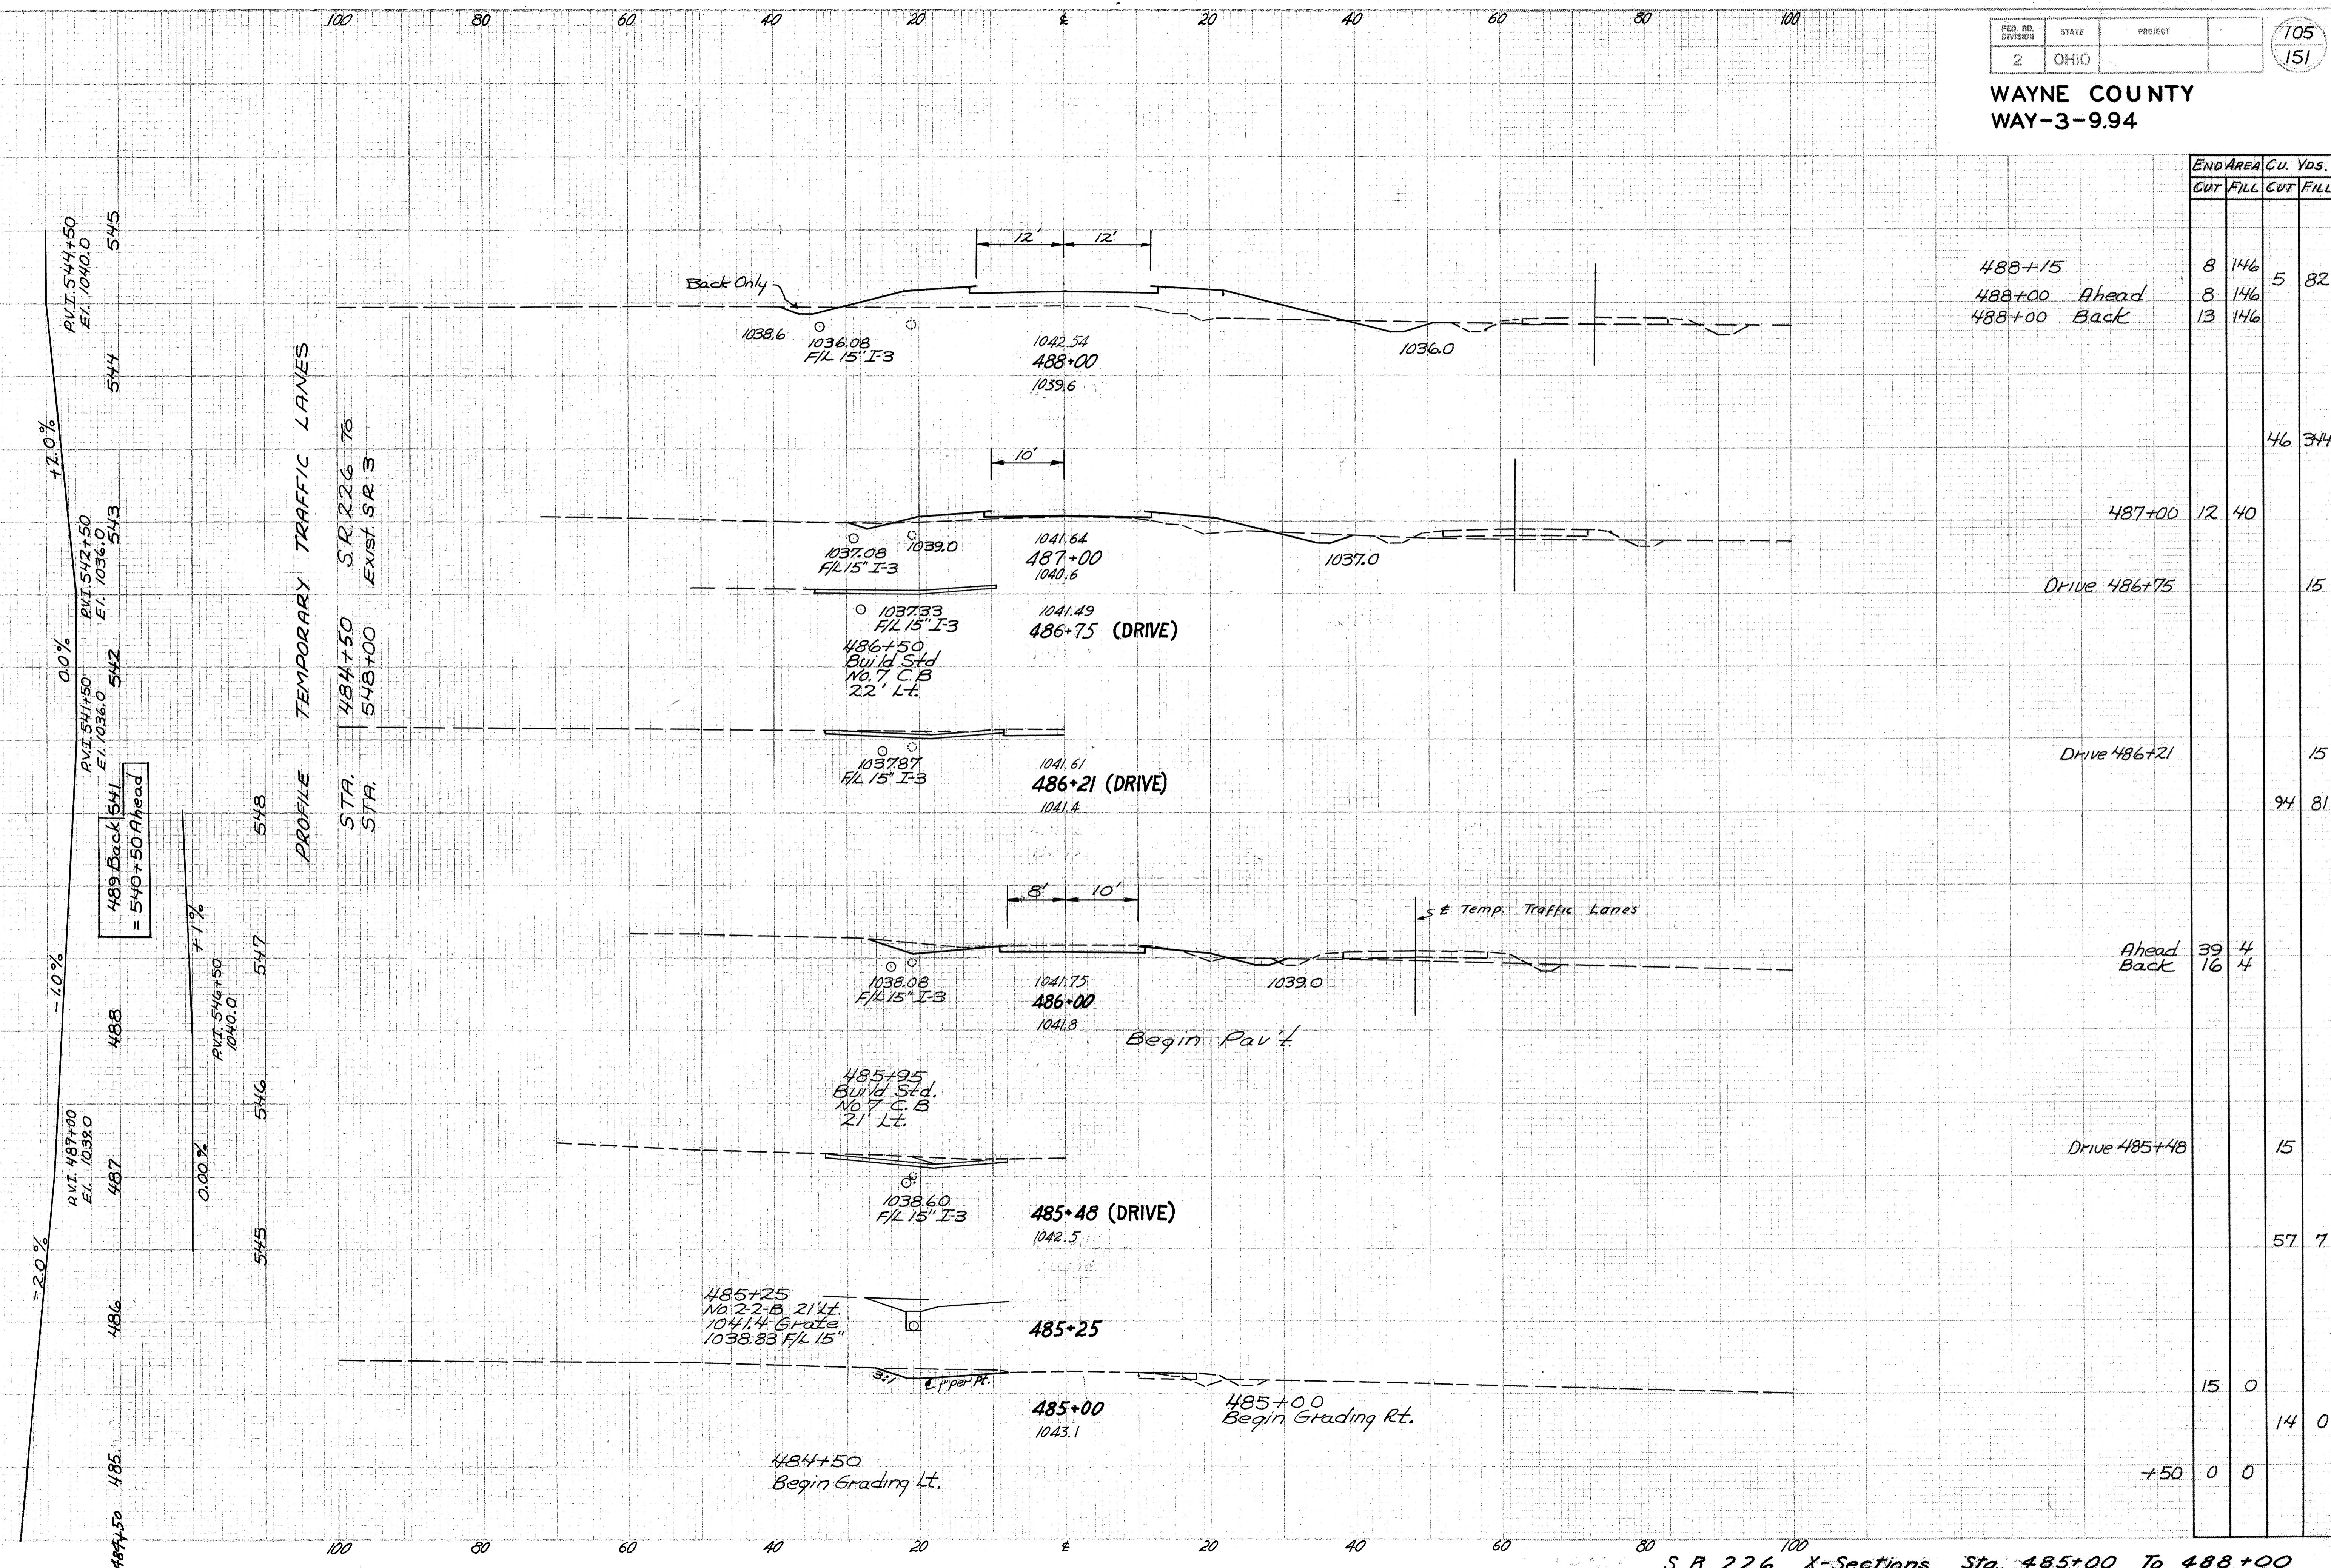

WAYNE COUNTY
WAY-3-994

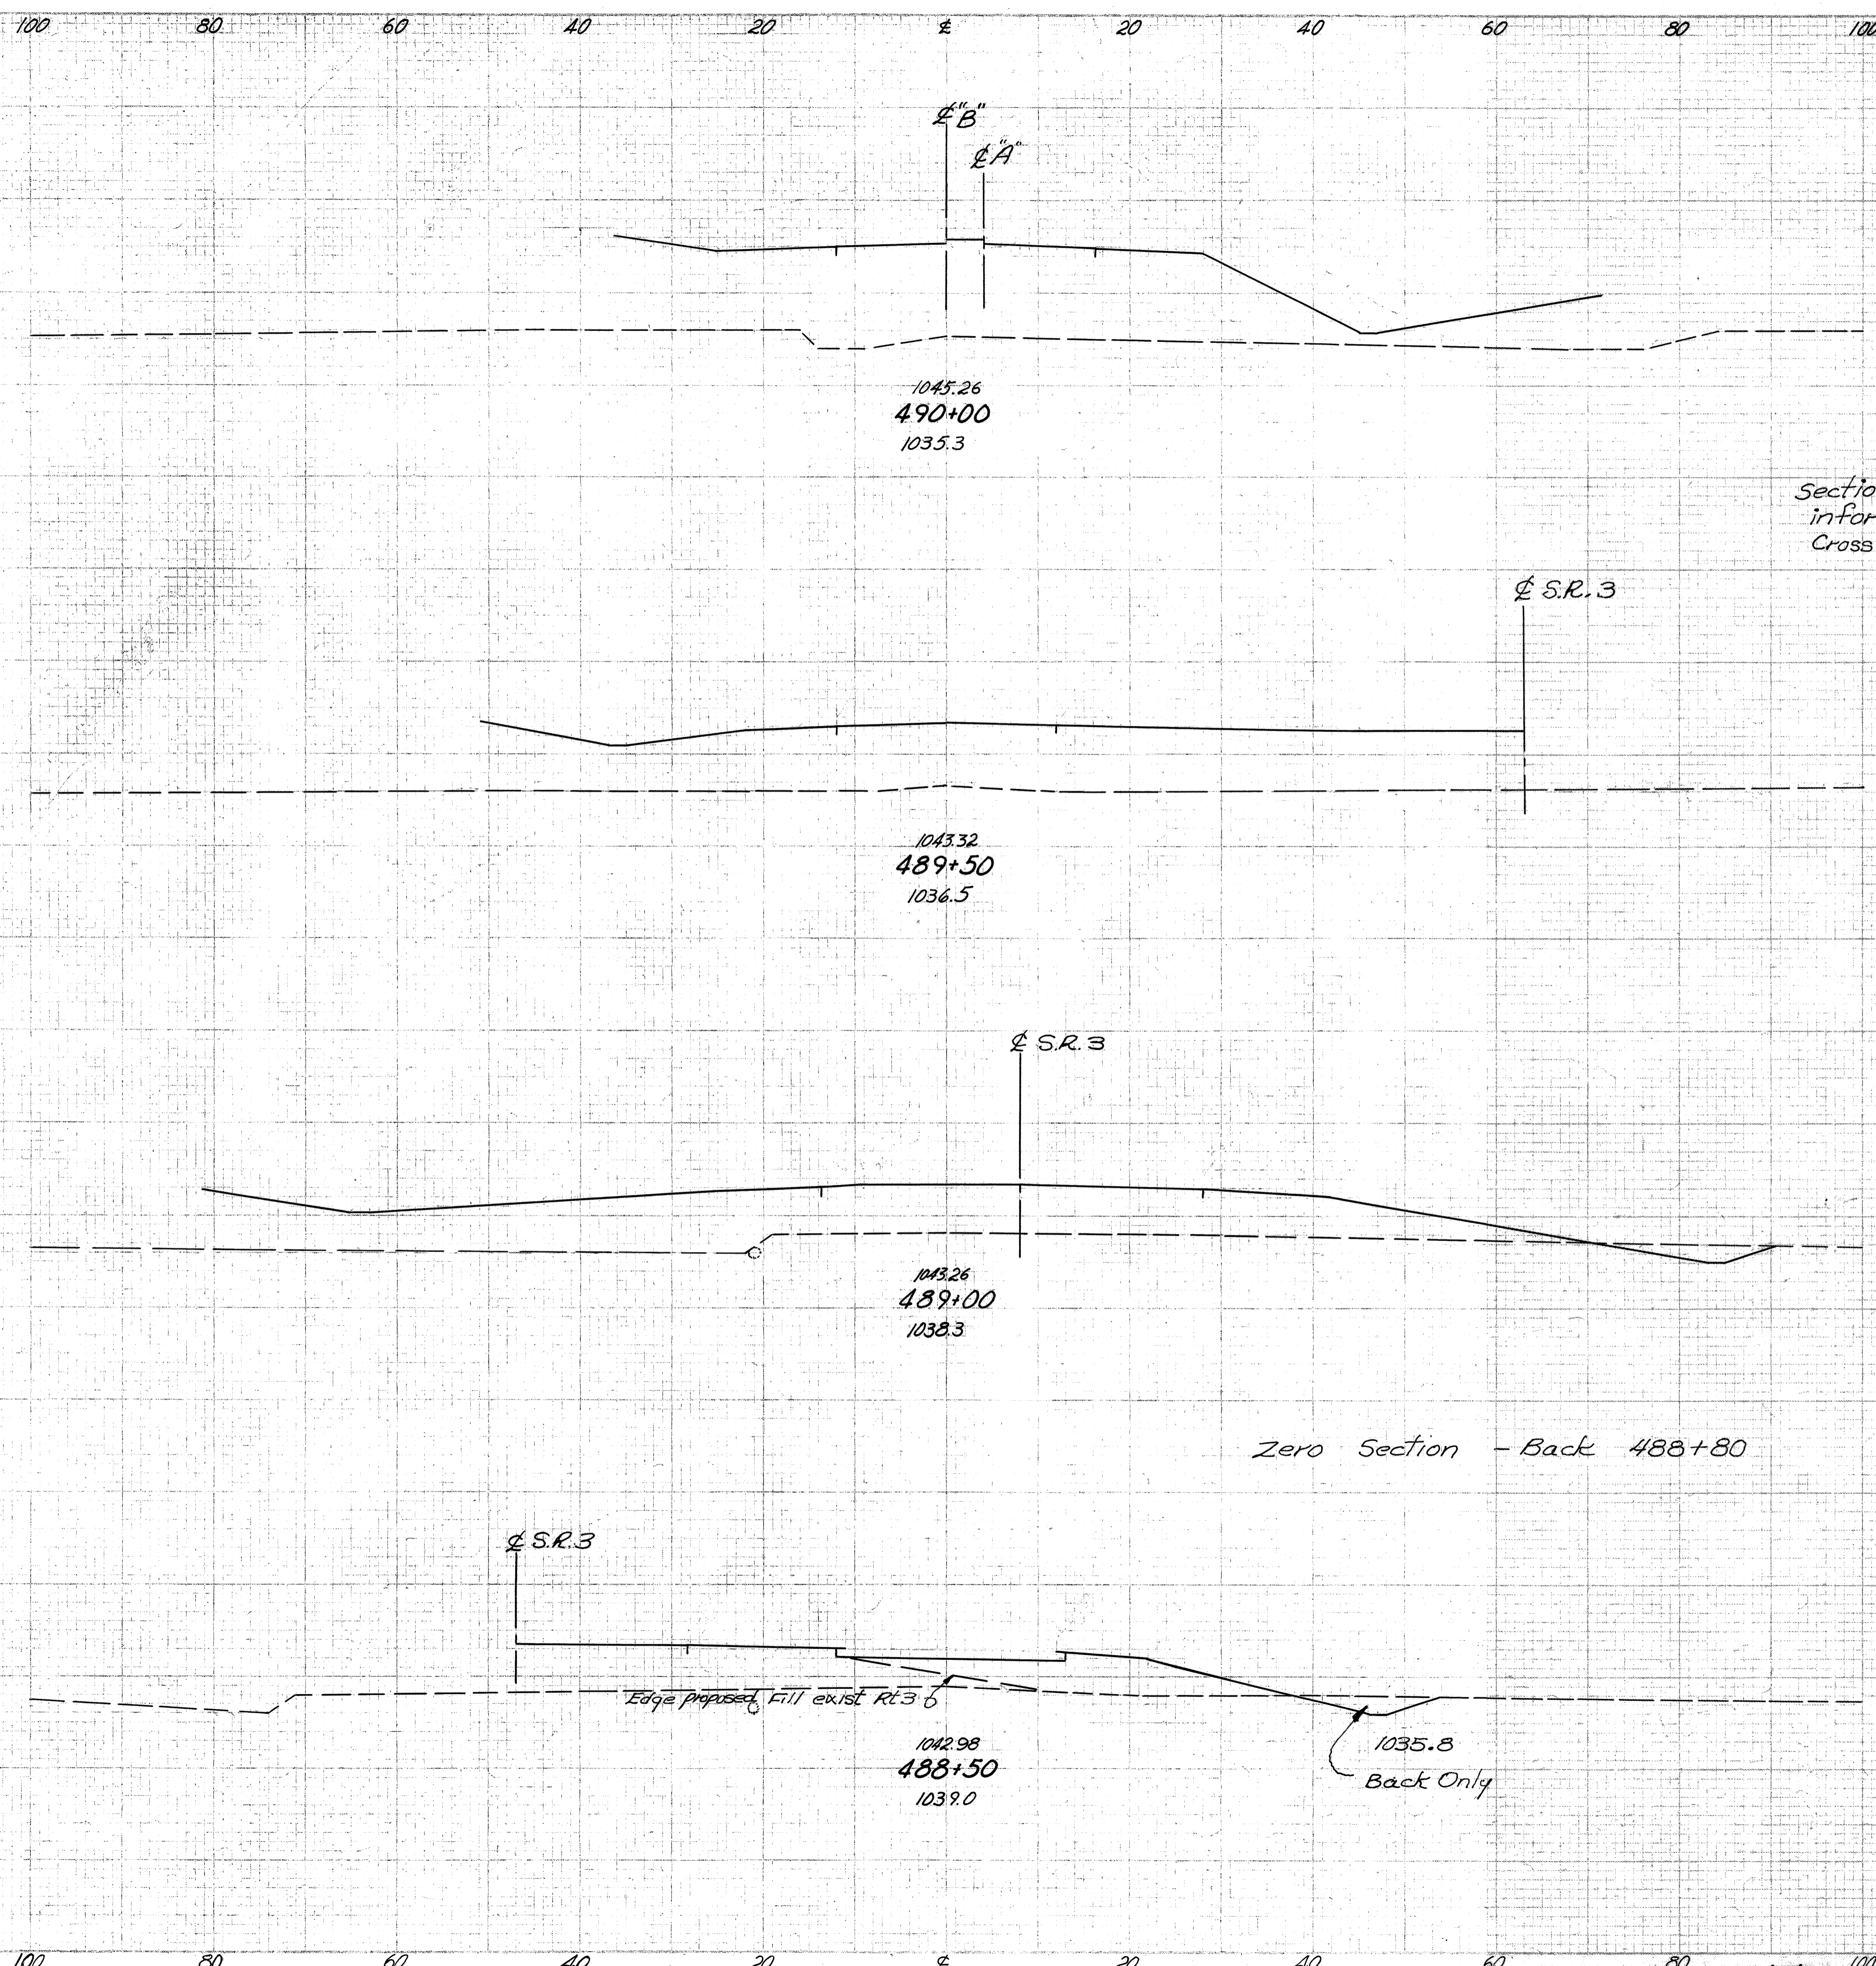

Sections 489+00 to 493+50 for information only - See Way 3 Cross Sections for Earthwork Quantities


Zero Section - Back 488+80

Excavation for ditch on Radius 488+50 to 540+00.14

488+50 Ahead 0 119
488+50 Back 16 119

END AREA	CU. YDS.	
	CUT	FILL
	0	0
	30	0
	0	66
	0	119
	16	119
	15	172

WAYNE COUNTY
WAY-3-9.94

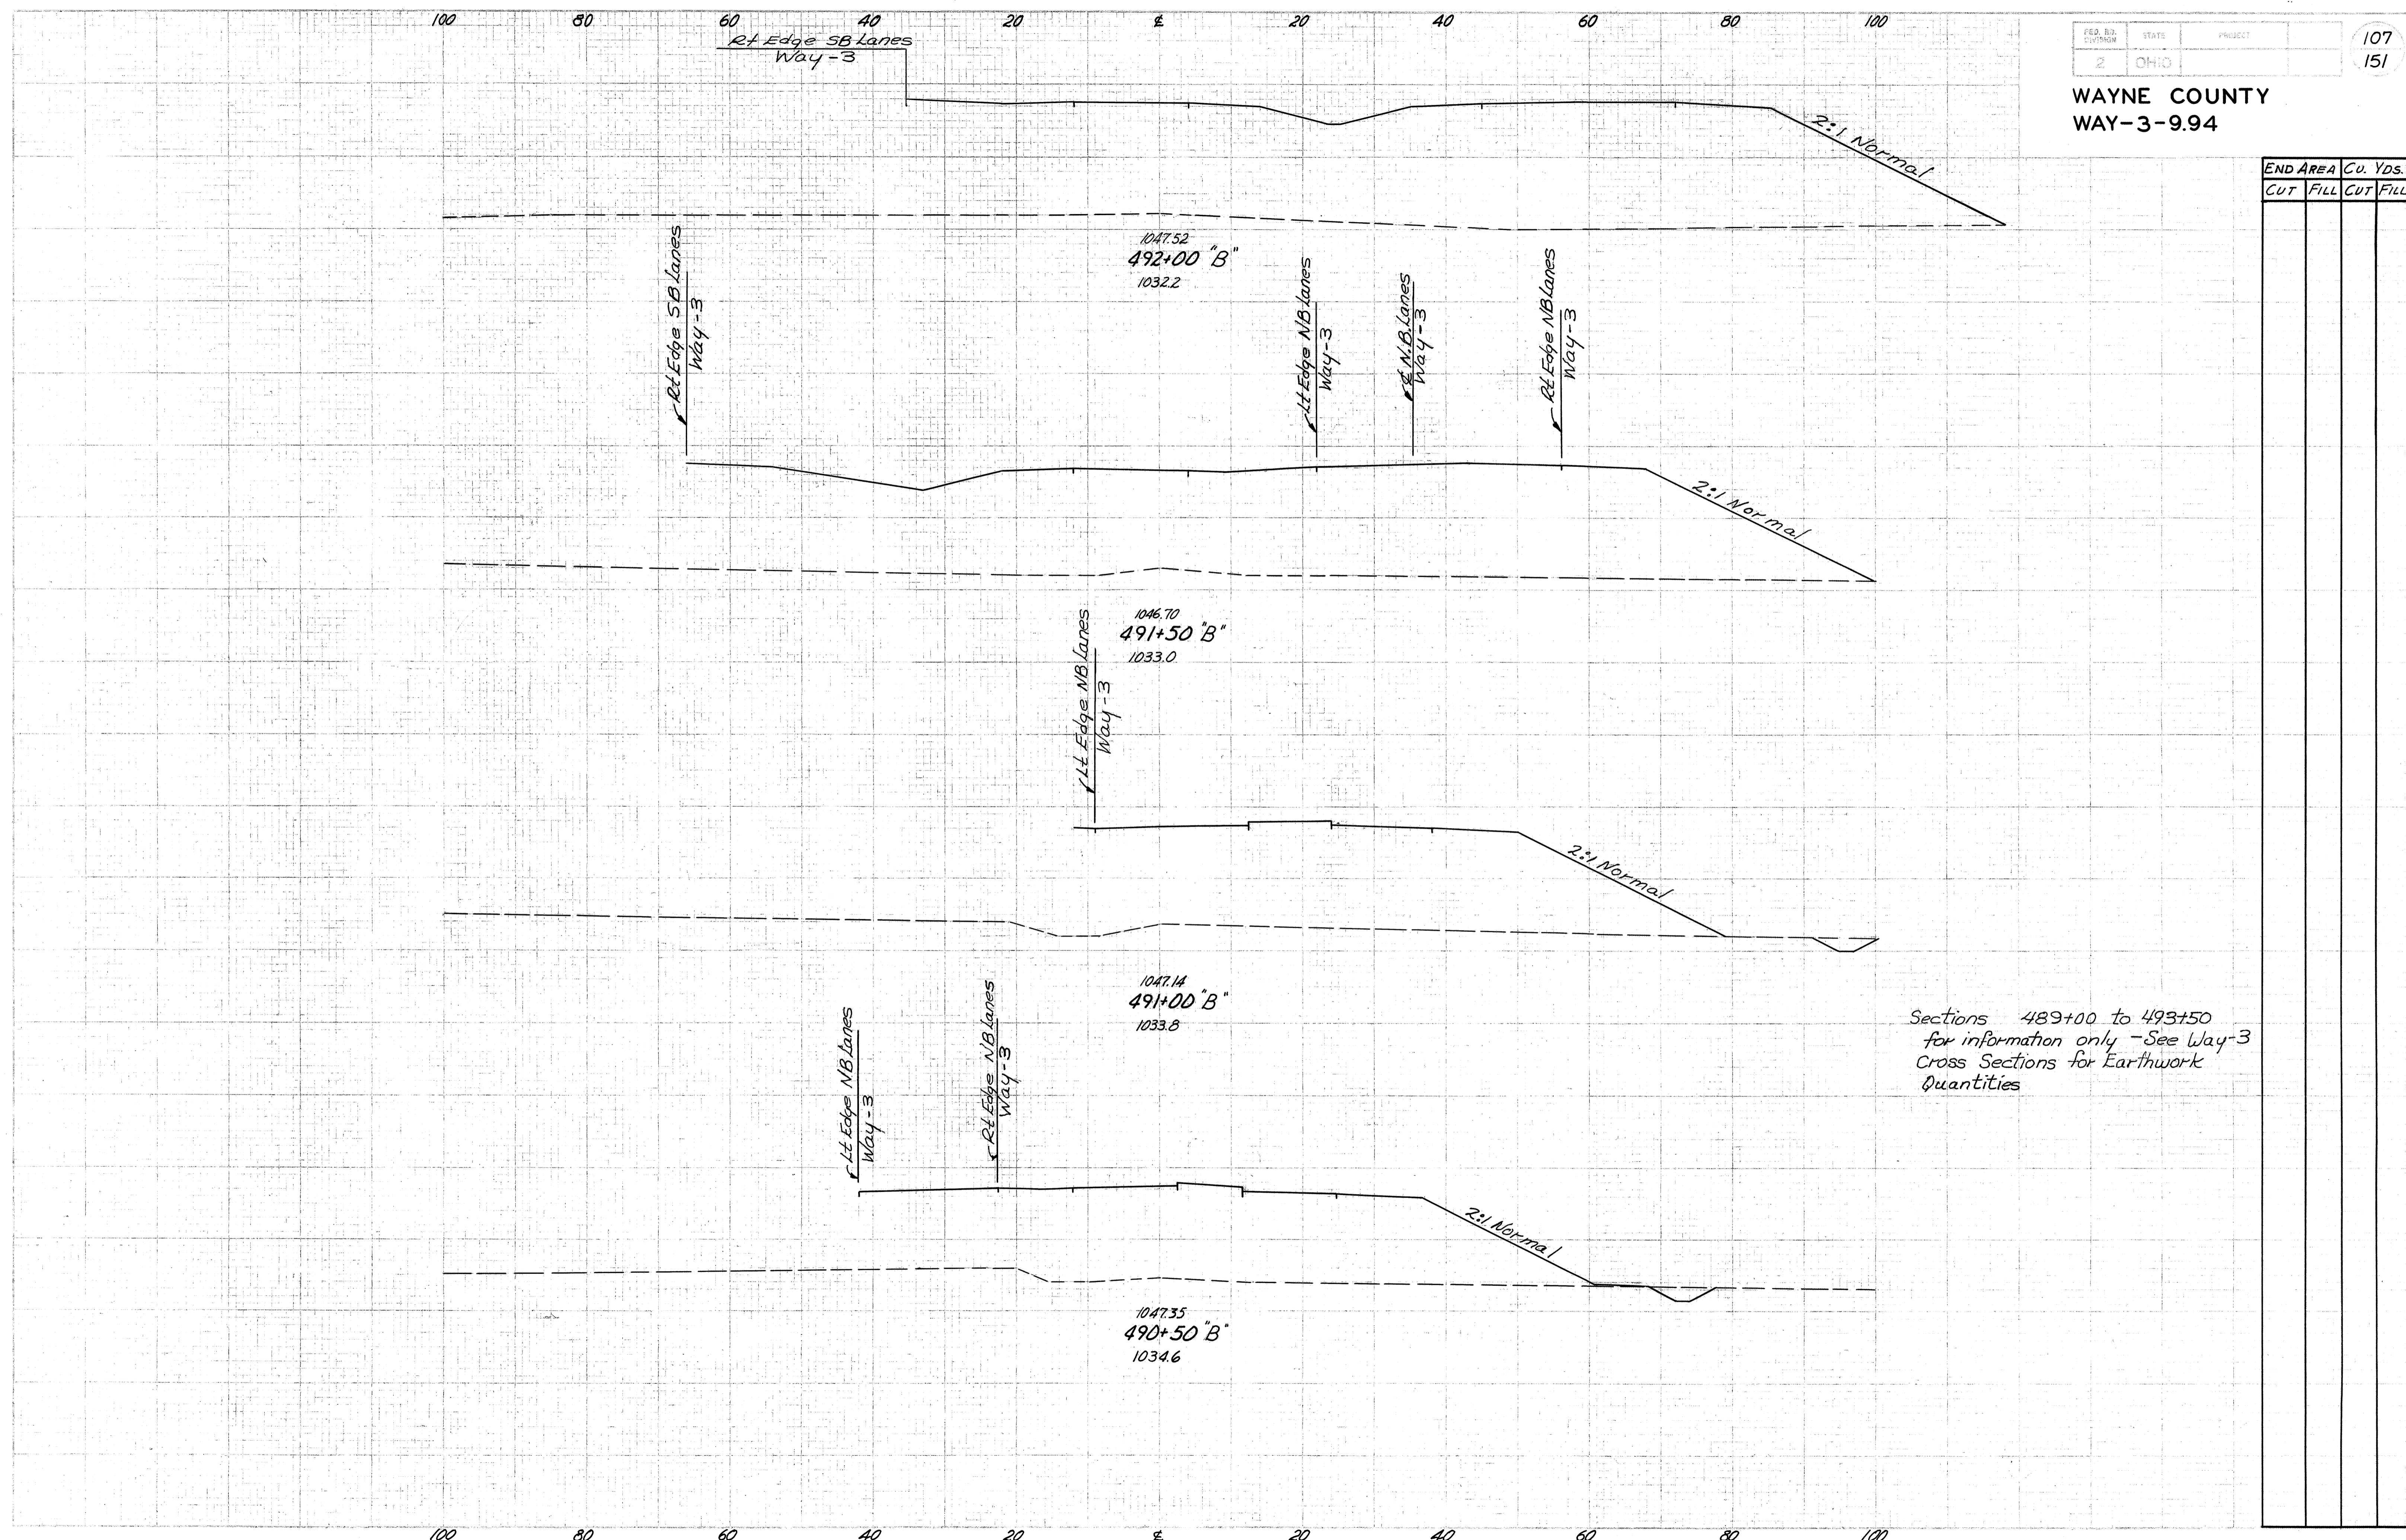


END AREA		Cu. YDS.	
CUT	FILL	CUT	FILL

Sections 489+00 to 493+50
for information only - See Way-3
Cross Sections for Earthwork
Quantities



WAYNE COUNTY
WAY-3-994

END AREA		Cu. Yds.	
CUT	FILL	CUT	FILL

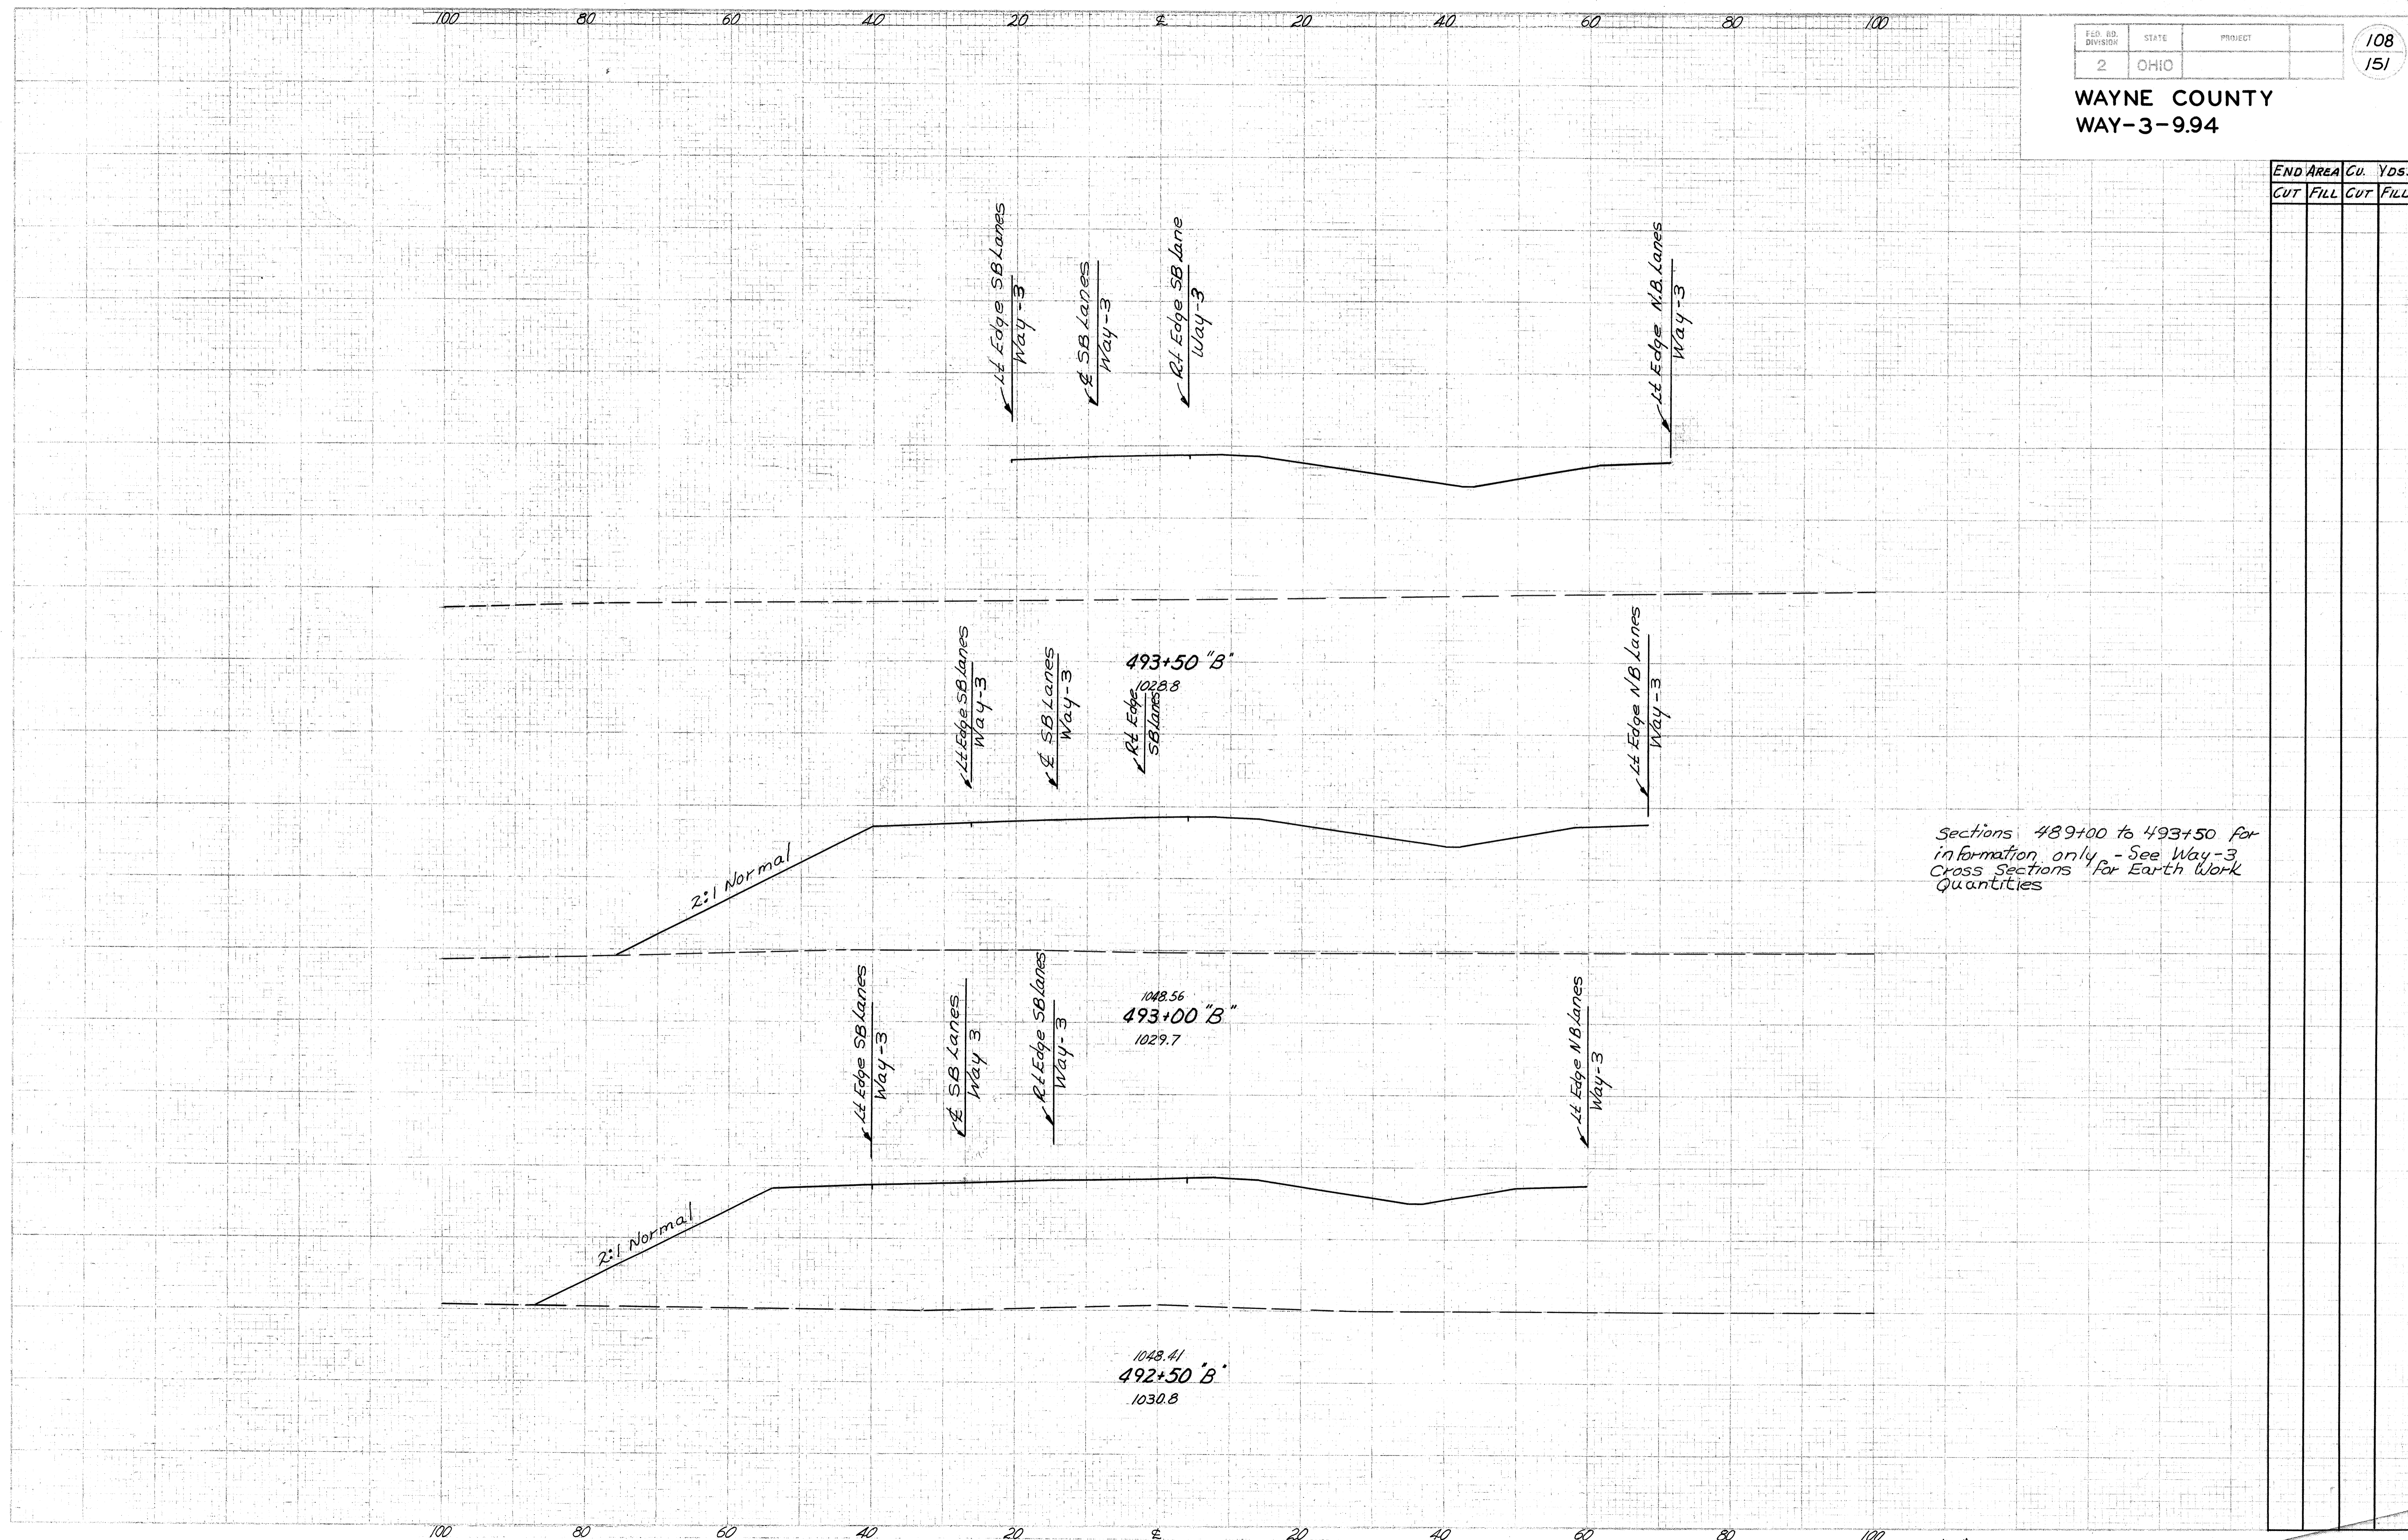

Line "B" X-Sections Sta. 492+50 To 493+50

WAYNE COUNTY
WAY-3-9.94

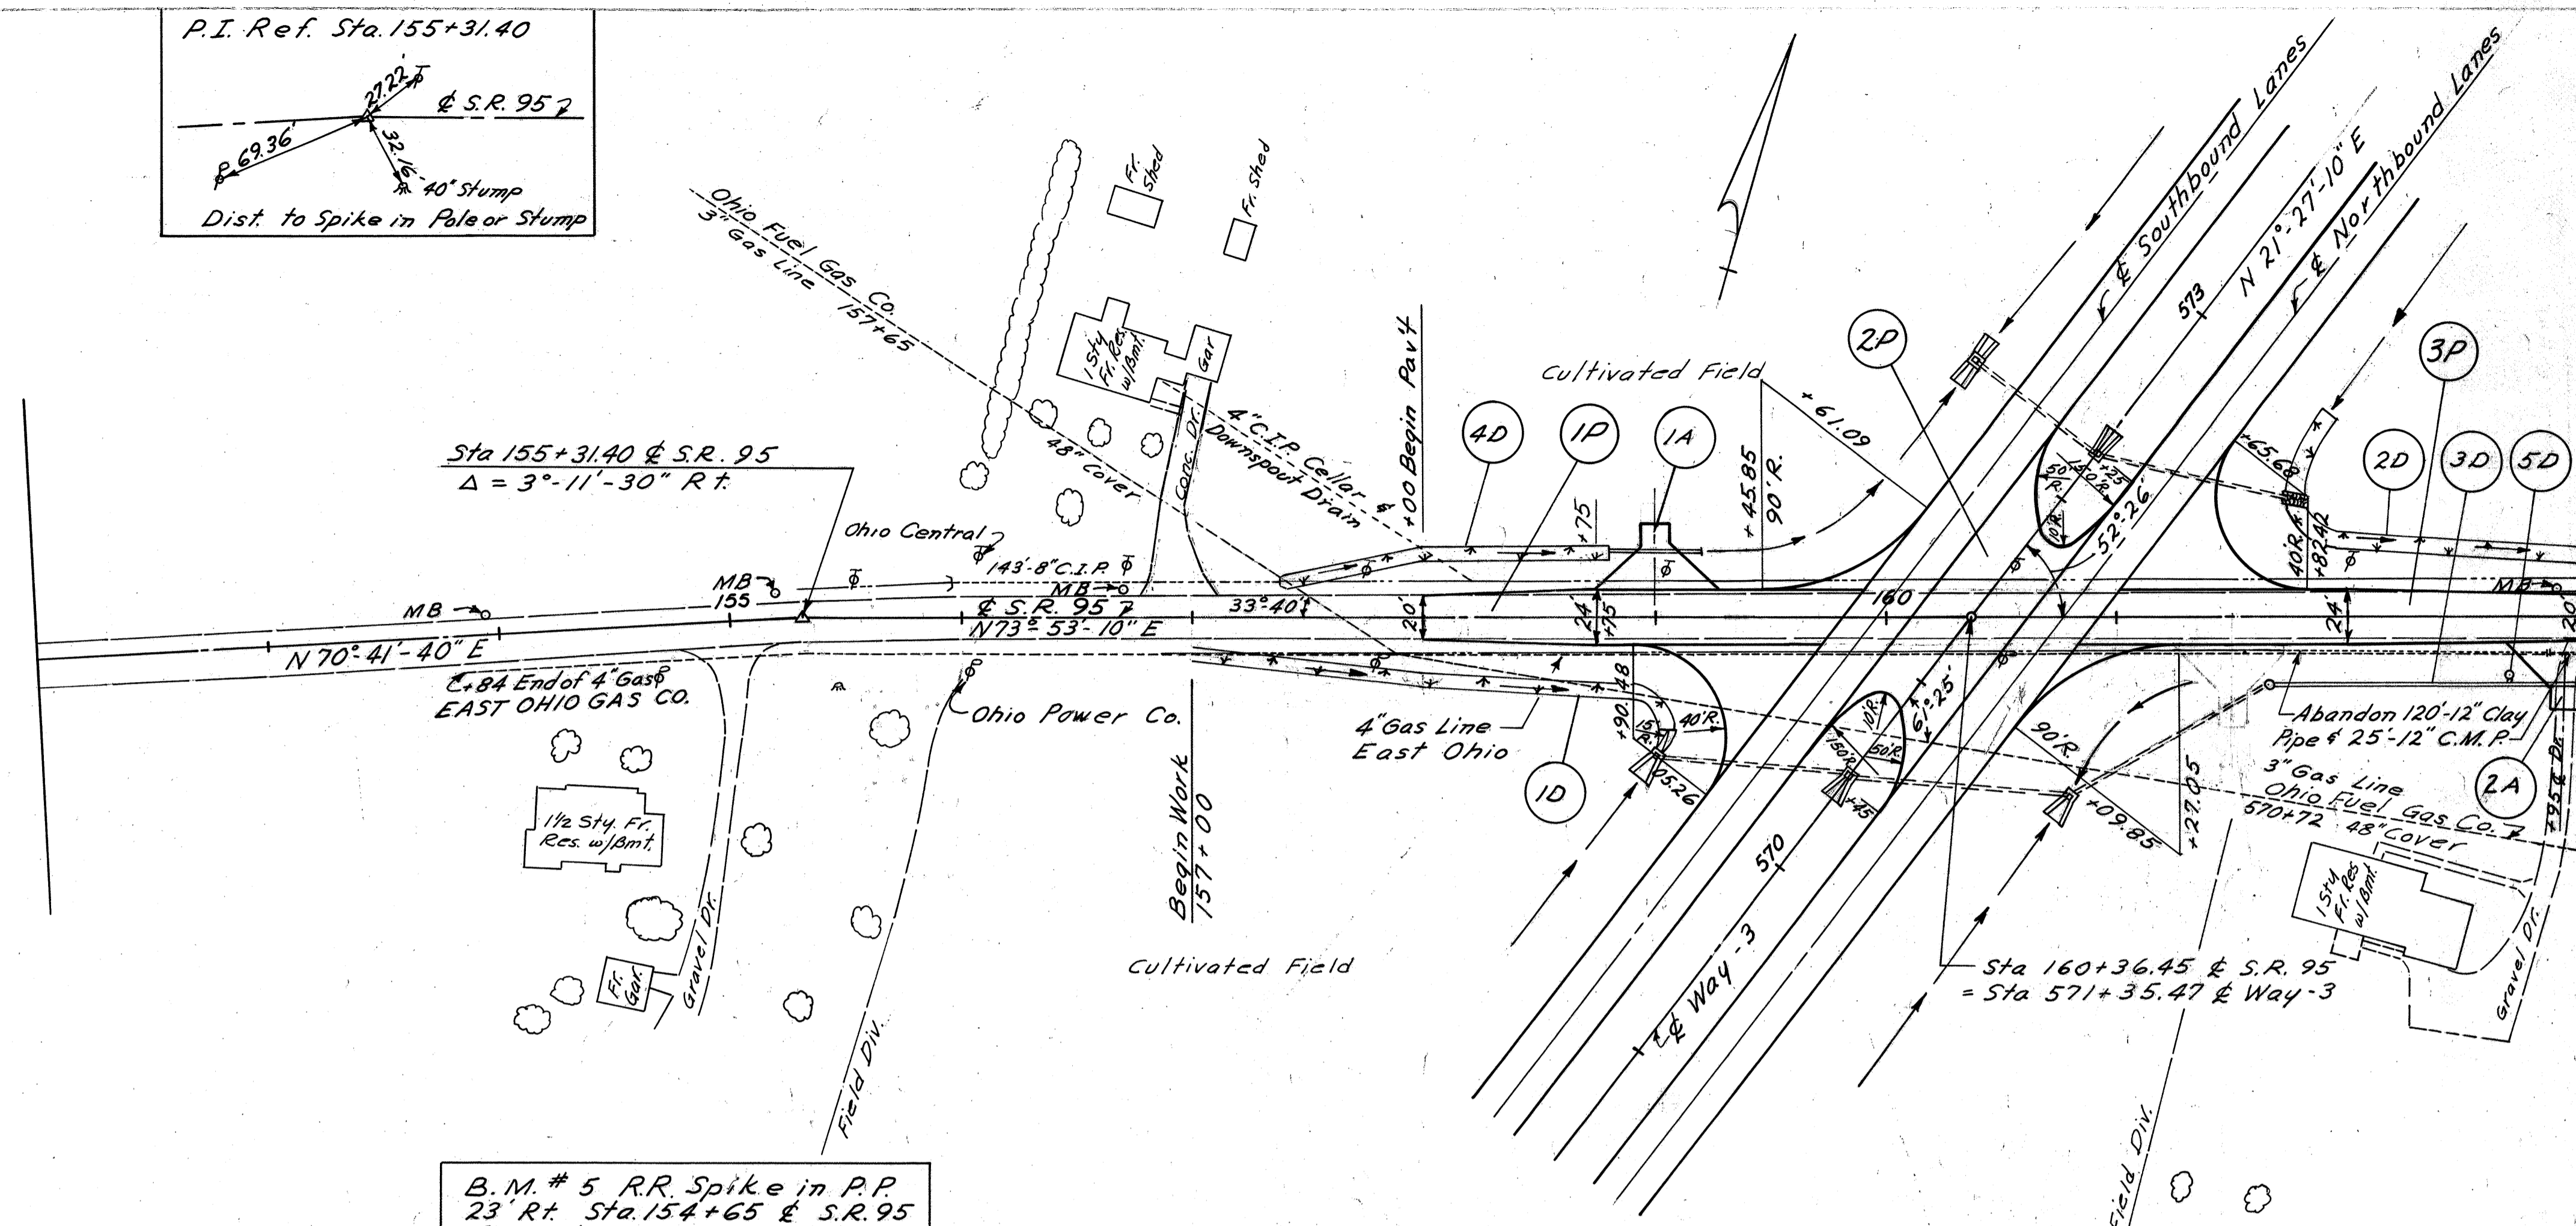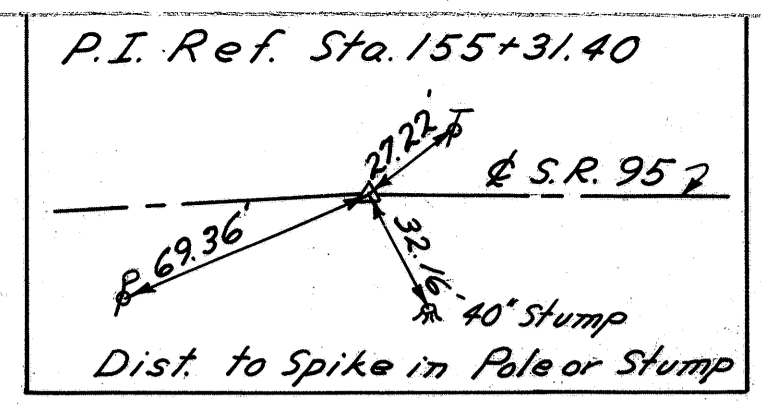


B.M. # 5 R.R. Spike in P.P.
23' Rt. Sta. 154+65 & S.R. 95
Elevation 1035.20



Item No.	Station	Side	Materials						
			Sodding Width	I-3 Roadway Drainage 21"	I-3 Roadway Drainage 12"	I-5 Pipe Special 21' x 12" Tee	I-8 Std. No. 1 Man Hole	I-8 Std. No. 7 Catch Basin	
1-D	158+00	159+10	Et.	6	150				
2-D	161+75	163+00	Lt.	6	115				
3-D	161+65	163+00	Et.			133		1	1
4-D	157+40	158+80	Lt.	6	94				
5-D	162+70		Et.			3			1
Totals				359	133	3	1	1	1

Item No.	Station	Side	Length	Materials		
				B-19 Crushed Aggregate Base Course 5"	T-35 Asphaltic Concrete Surface 6" Course 2	I-1 Pipe For Drives 12"
1A	159+00	Lt.	28		1337	40
2-A	162+95	Et.	30	1207	4.69	
Totals				1207	1337	4.69

Item No.	Station	Side	Materials						
			T-35 1 1/2" Asph. Conc. Surf. Course Type "C" 70-85	B-35 1 1/2" Asph. Conc. Level Course (70-85)	T-30 Bituminous Prime Coat	B-19 5" Agg. Base Course	I-22 4" Subbase Grading A or B	I-18 6" Stab. Crushed Aggregate Shoulders	I-9 Stone Under- drains No. 2
1P	158+00	159+80.94	22.93	27.52	264.14	92.03	73.33	22.43	40.5
2P	160+11.22	160+61.68	17.74	21.12	201.77	64.57	45.32	6.63	
3P	160+91.96	163+25	27.19	32.63	313.27	109.89	88.27	29.35	67.5
Total			67.86	81.27	779.18	266.49	206.92	58.41	108.0

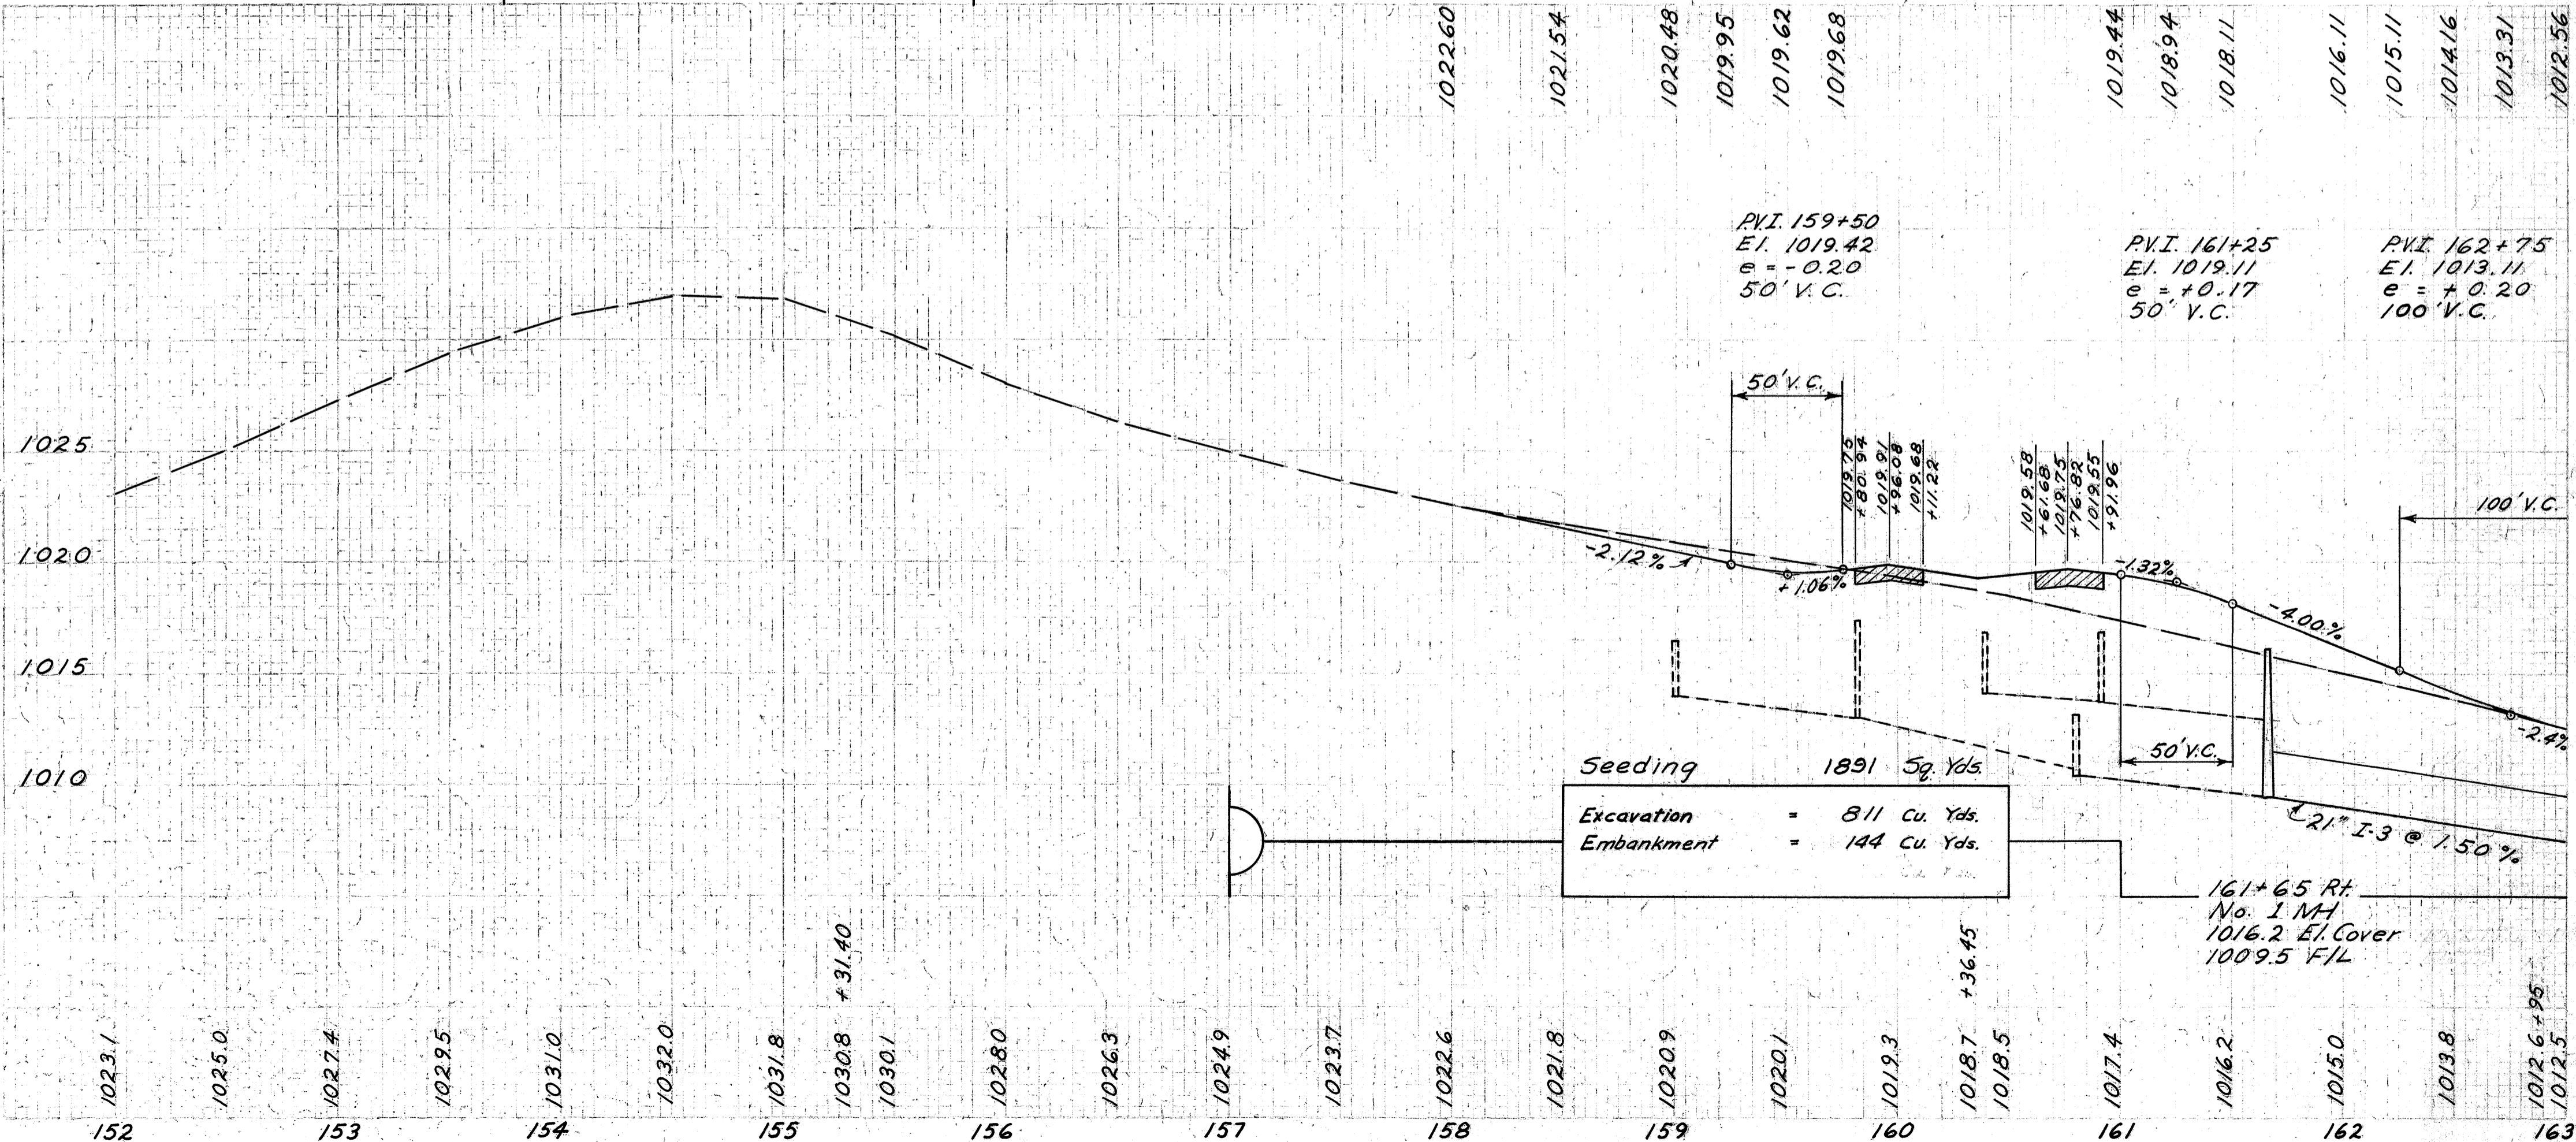

WAYNE COUNTY
WAY-3-994

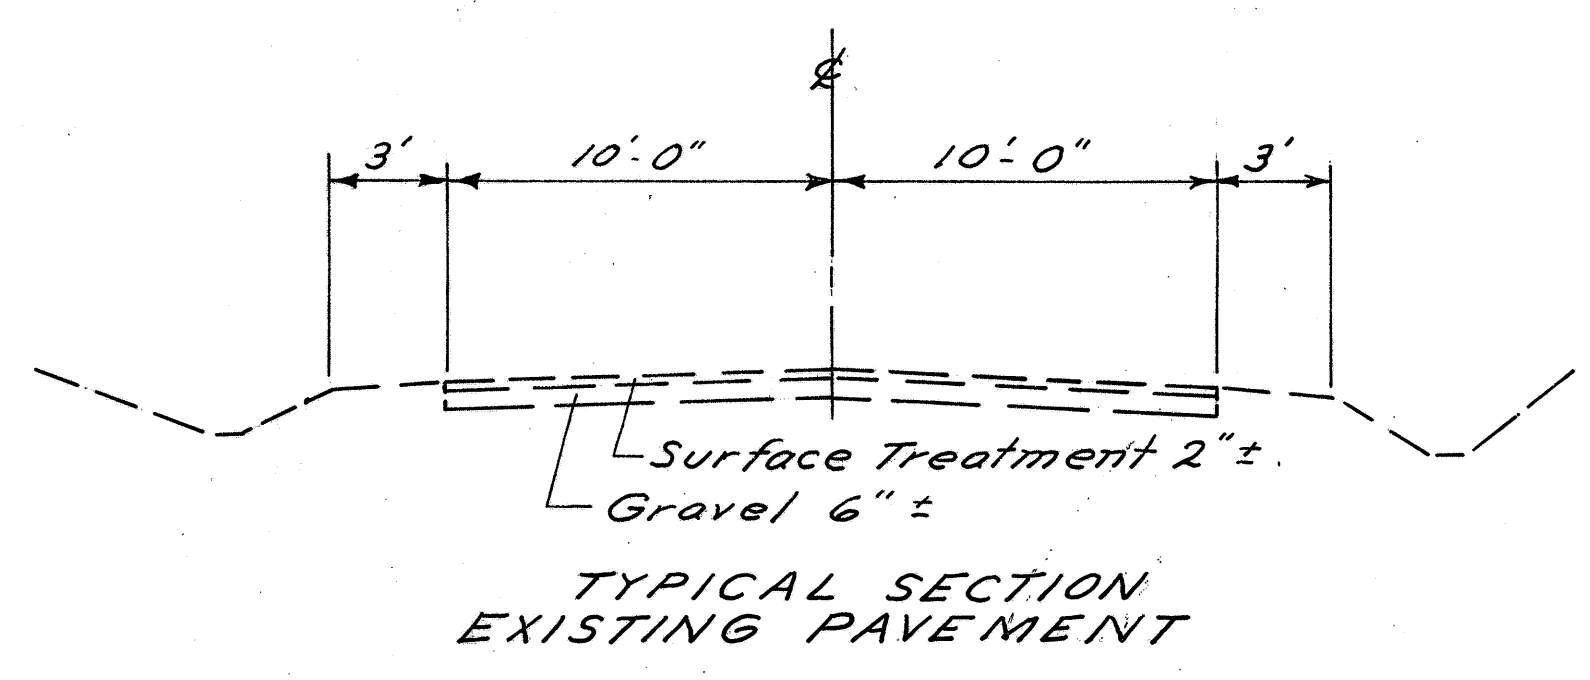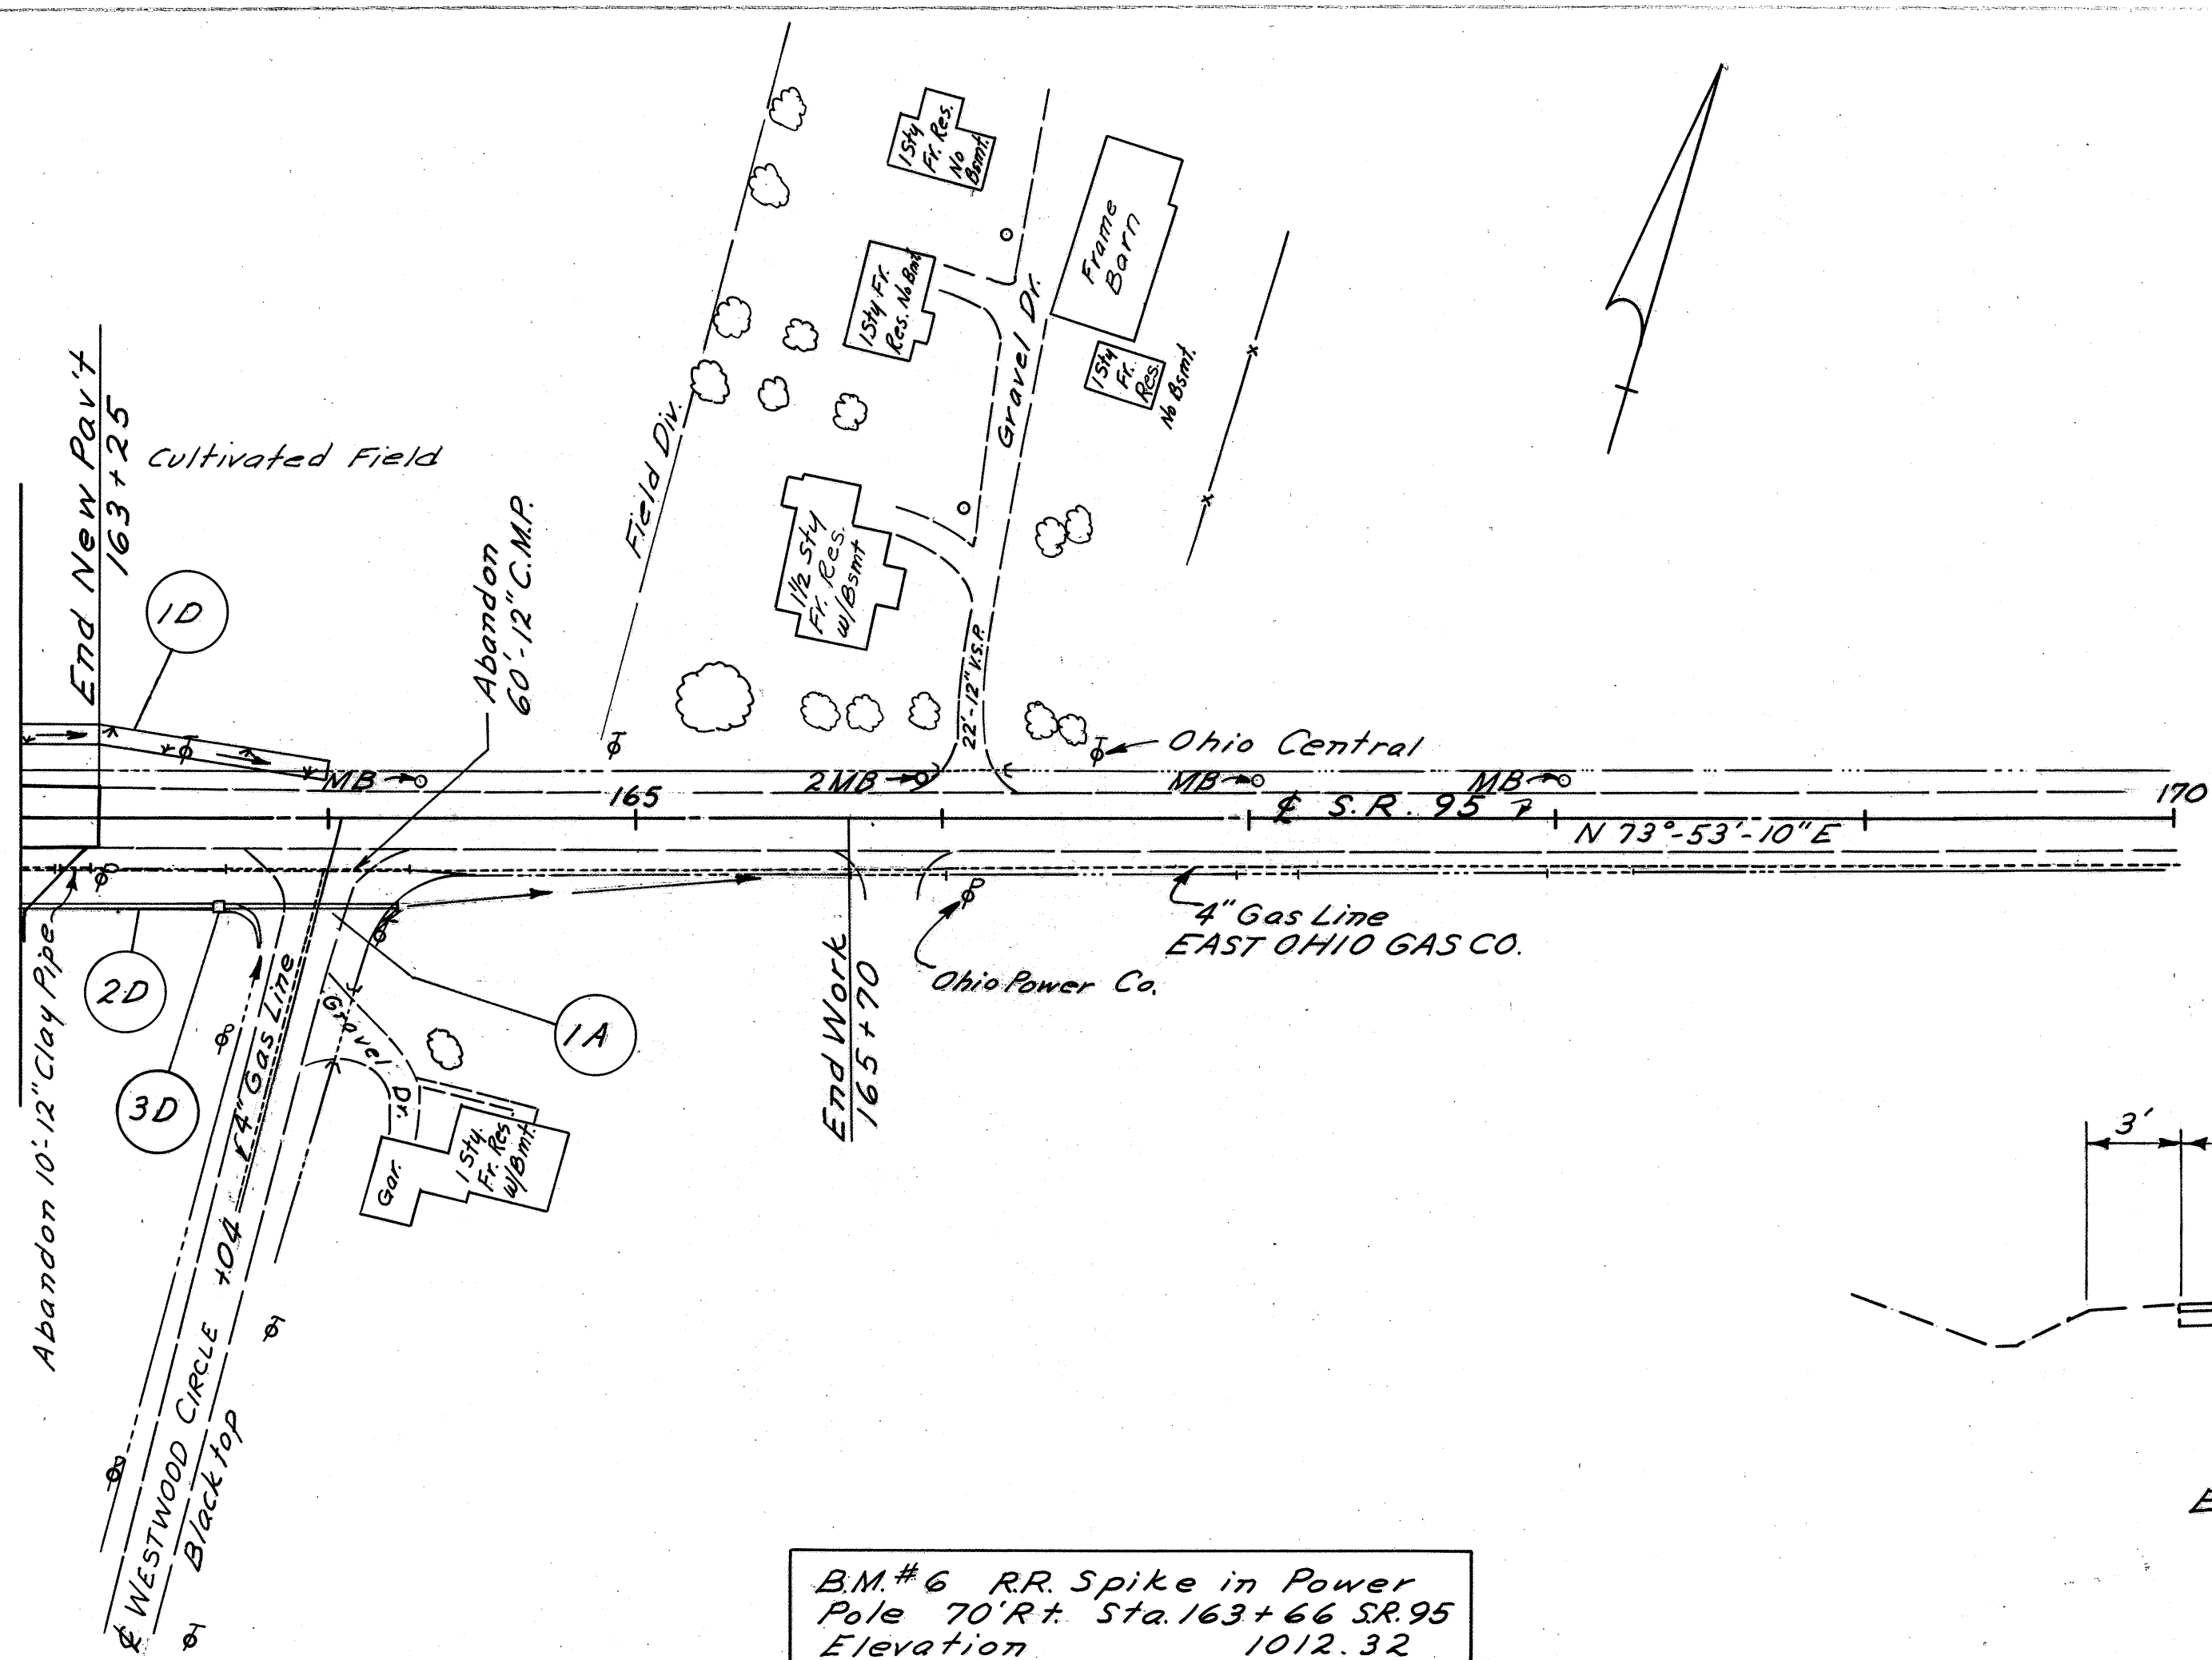


B.M.#6 RR Spike in Power Pole 70'R± Sta.163+66 SR.95 Elevation 1012.32


Item No.	Station		Side	Sodding Width	I-3 Roadway Drainage 21" Under Pavt.	I-3 Roadway Drainage 21" Under Pavt.	I-3 Outlet For Roadway Drainage 21"	I-8 No. 2-2A Catch Basin	
	From	To							
1-D	163+00	164+00	Lt.	6	67				
2-D	163+00	164+22	Rt.		64	46	10		
3-D	163+00		Rt.					1	
Totals					67	64	46	10	1

Item No.	Station		Side	Width	B-19 Crushed Aggregate Base Course 5"	T-35 Asphaltic Concrete Surface Course 2"
	From	To				
1A				4	1.25	0.50
Totals					1.25	0.50

See Preceding Sheet for Pavement Quantities

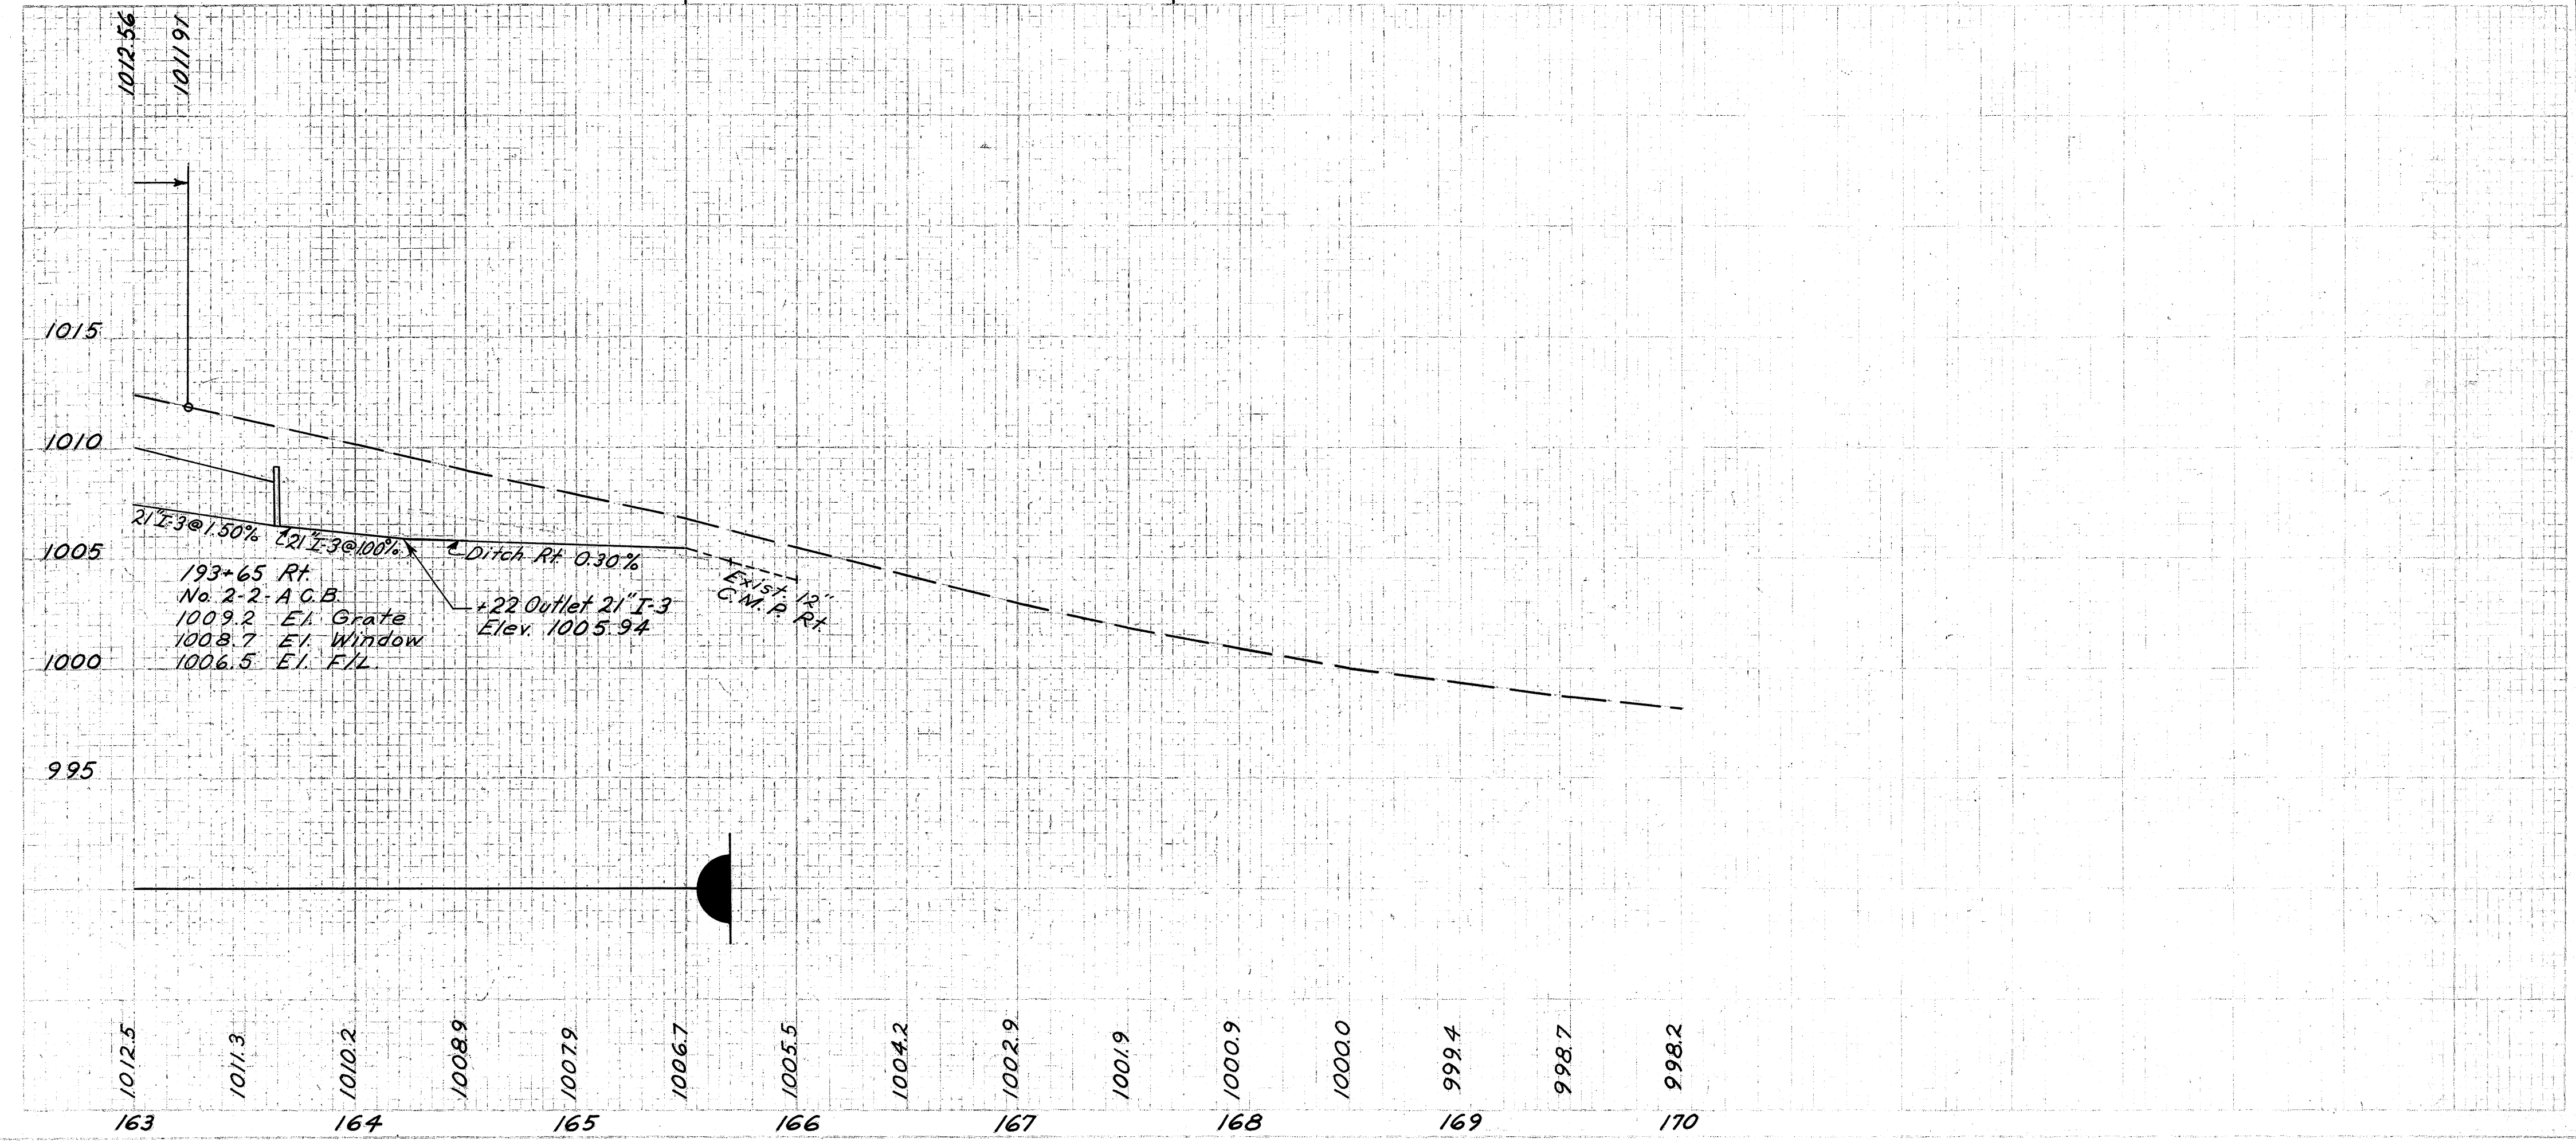


WAYNE COUNTY
WAY-3-9.94

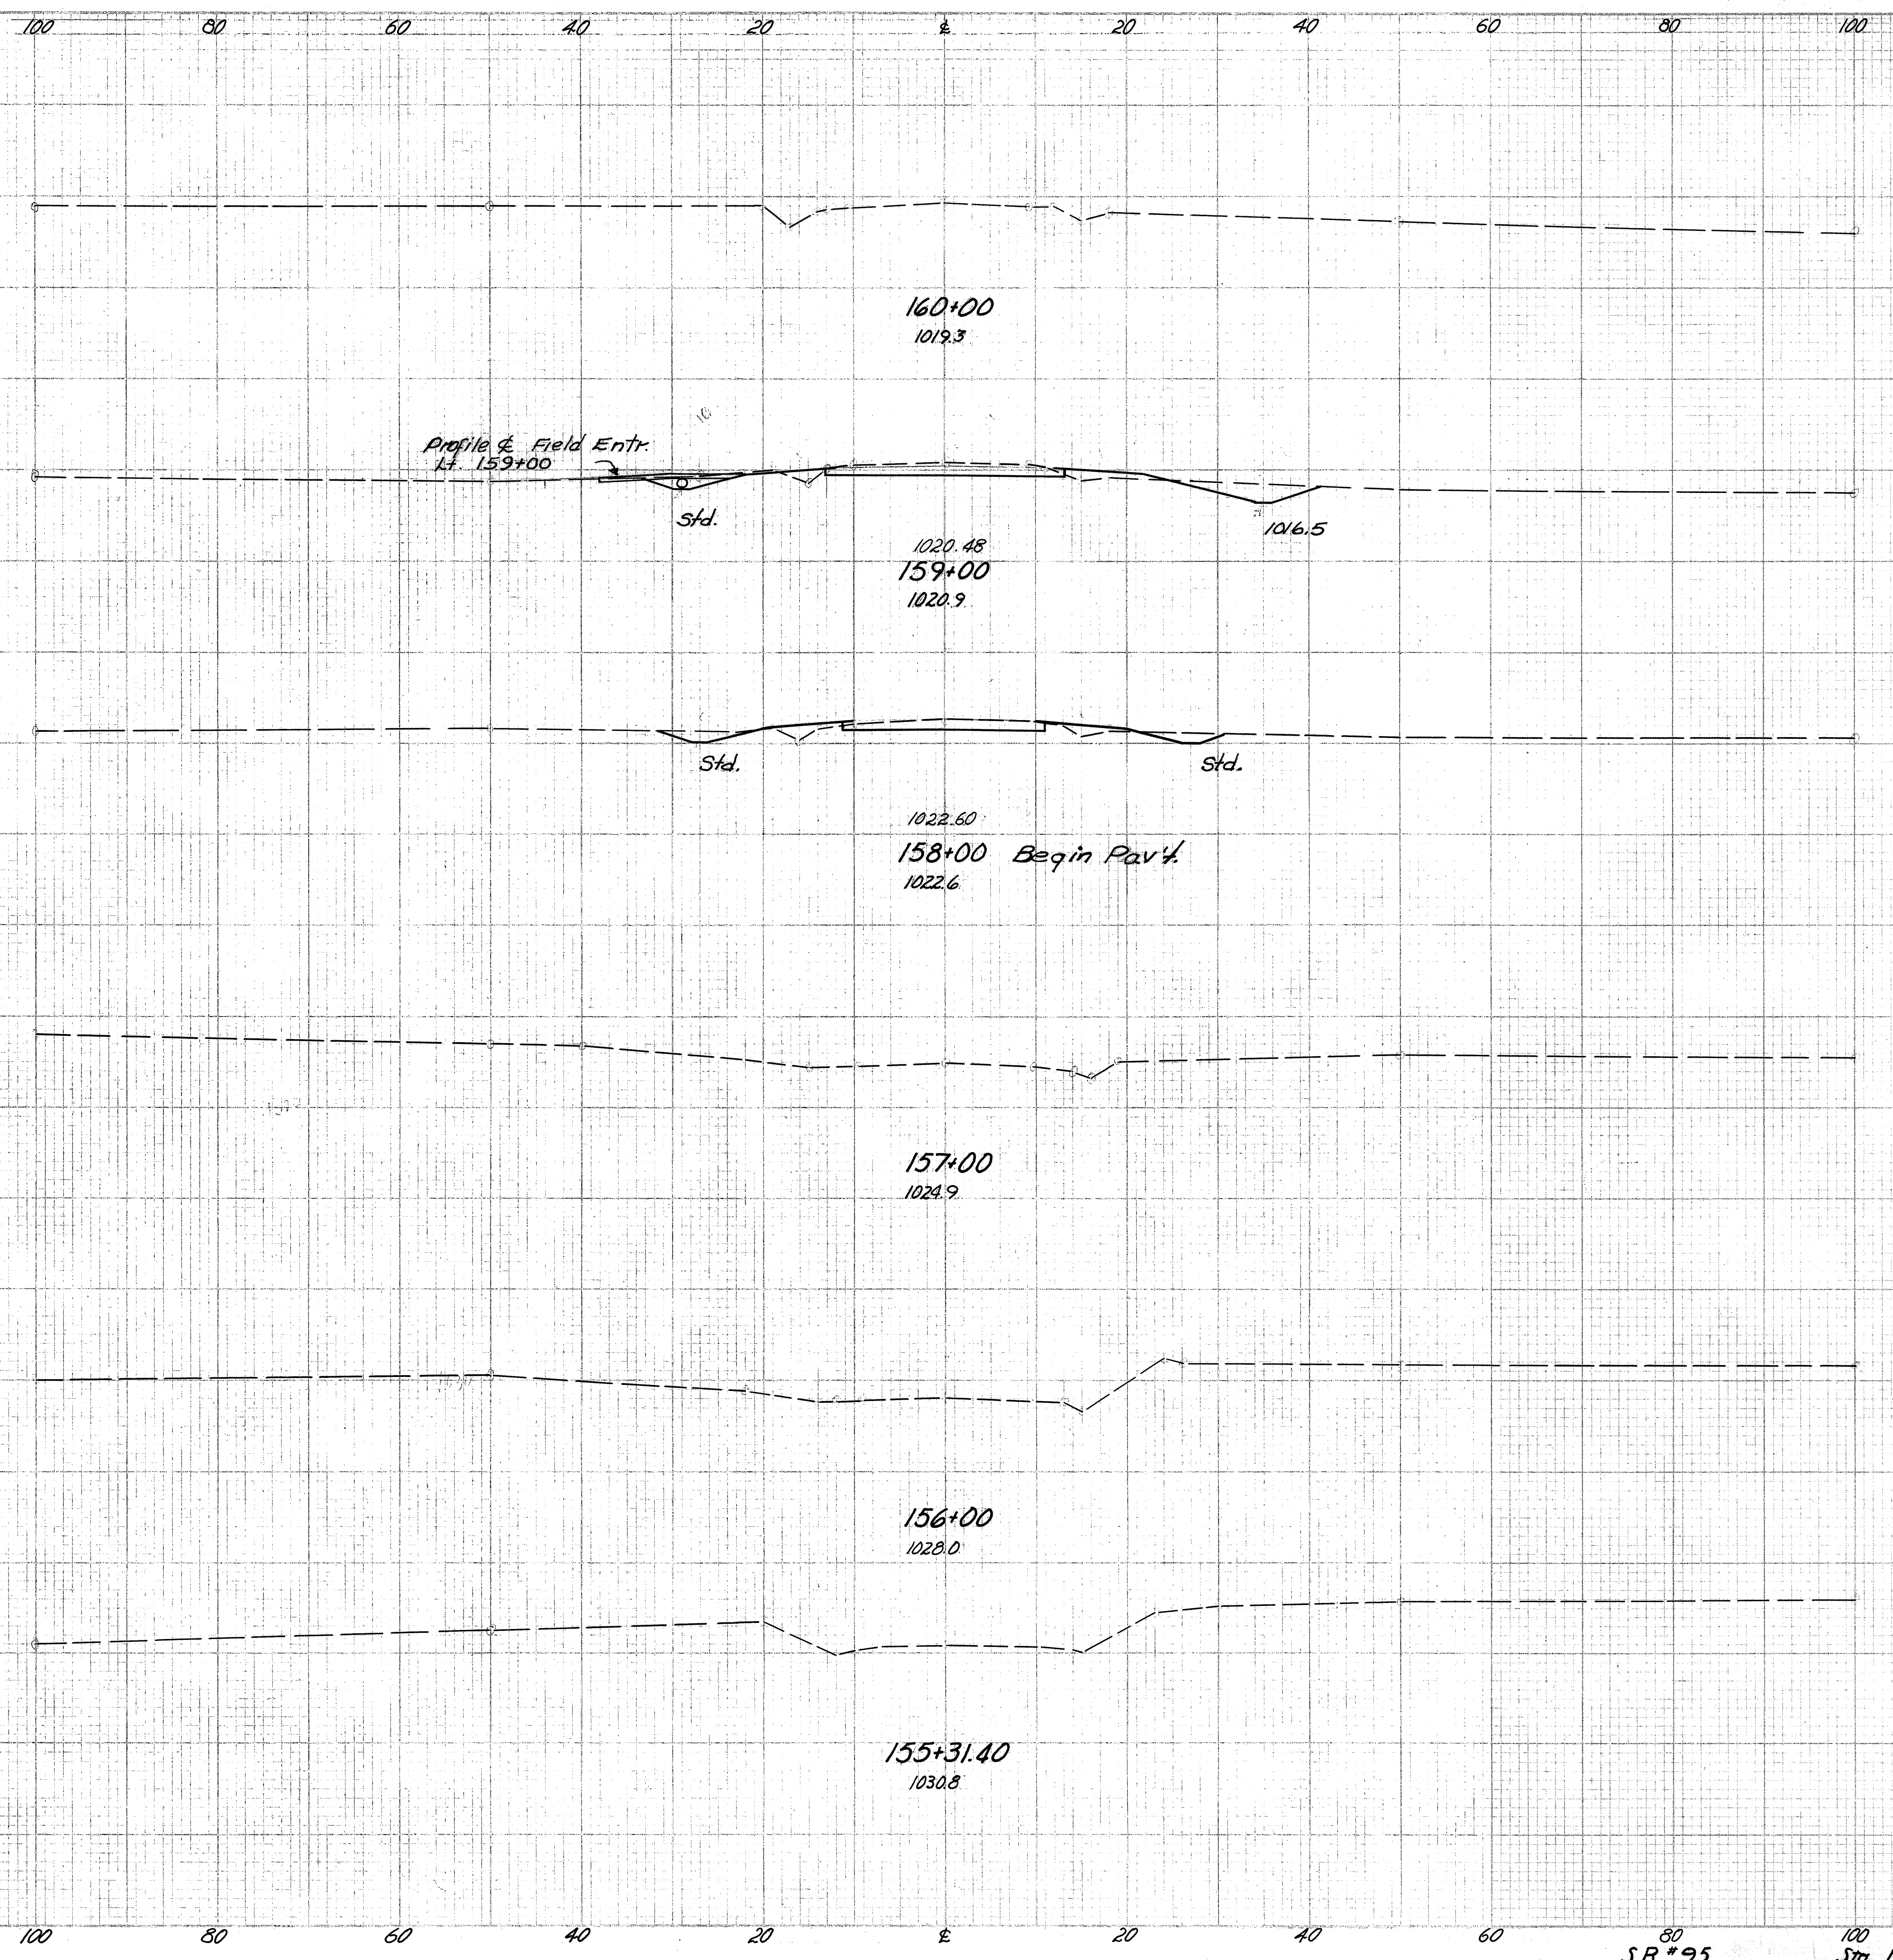

	END AREA		Cu. YDS.	
	CUT	FILL	CUT	FILL
Sta. 159+45	0	0		
Drive Lt. 159+00	58	14	3	6
				48
				12
				170
				48
158+00 Ahead	34	12		
158+00 Back	14	0		
				26
				0
Begin Work +00	0	0		

**WAYNE COUNTY
WAY-3-9.94**

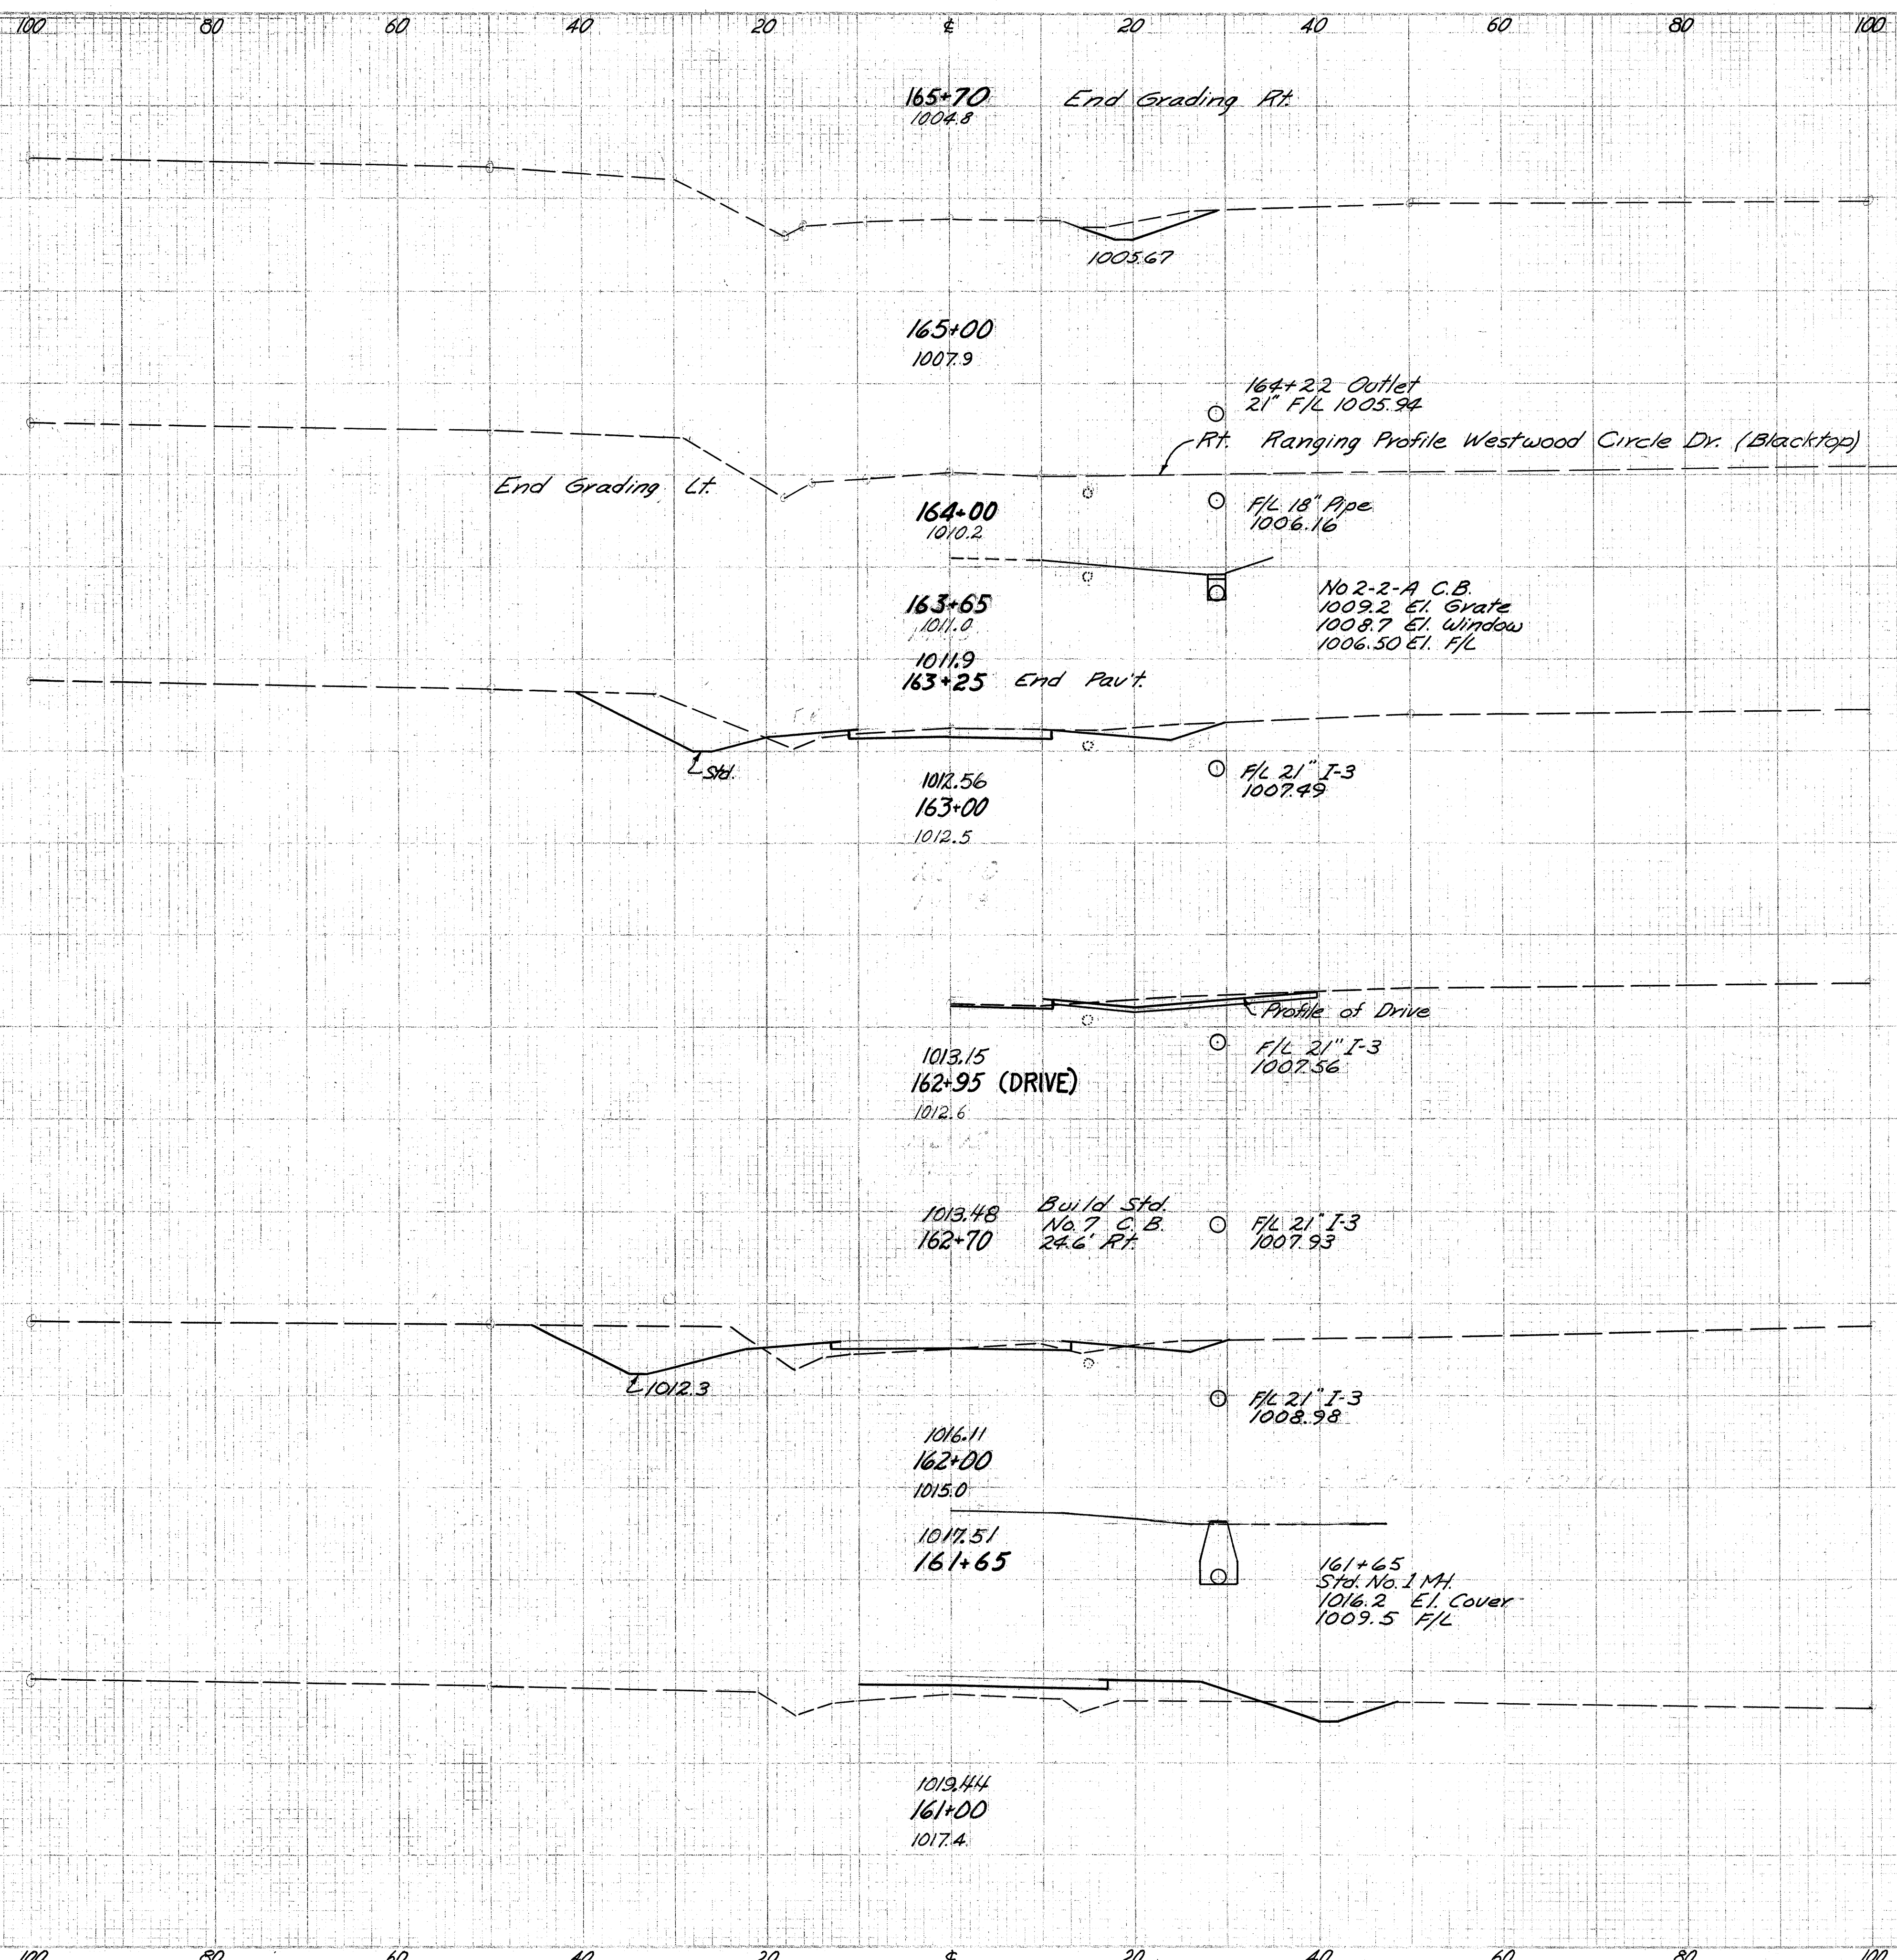

	END AREA		Cu. Yds.	
	CUT	FILL	CUT	FILL
Ahead 165+00	0	0		
Back 165+00	14	0		
			41	0
Ahead 164+22	14	0		
Back 164+22	0	0		
			0	0
164+00	0	0		
			93	8
163+25 Ahead	67	6		
163+25 Back	85	6		
			408	70
Drive Rt 162+95			22	
			91	24
162+00 Ahead				

Ref. P.O.T. Sta. 11+77.70
 R.R. Spike 24.27'
 31.55'
 Dist. to Spike in Pole


Ref. P.C. Sta 17+80.40
 79.05'
 60.58'
 24.57'
 E. Co. Rd 139

Curve Data. Reloc. C.R. 139
 $\Delta = 25^\circ - 25' - 30''$
 $D = 8^\circ - 00'$
 $R = 716.20'$
 $L = 317.81'$
 $T = 161.57'$


FED. RD. DIVISION	STATE	PROJECT	
2	OHIO		

113
151


WAYNE COUNTY
 WAY-3-9.94

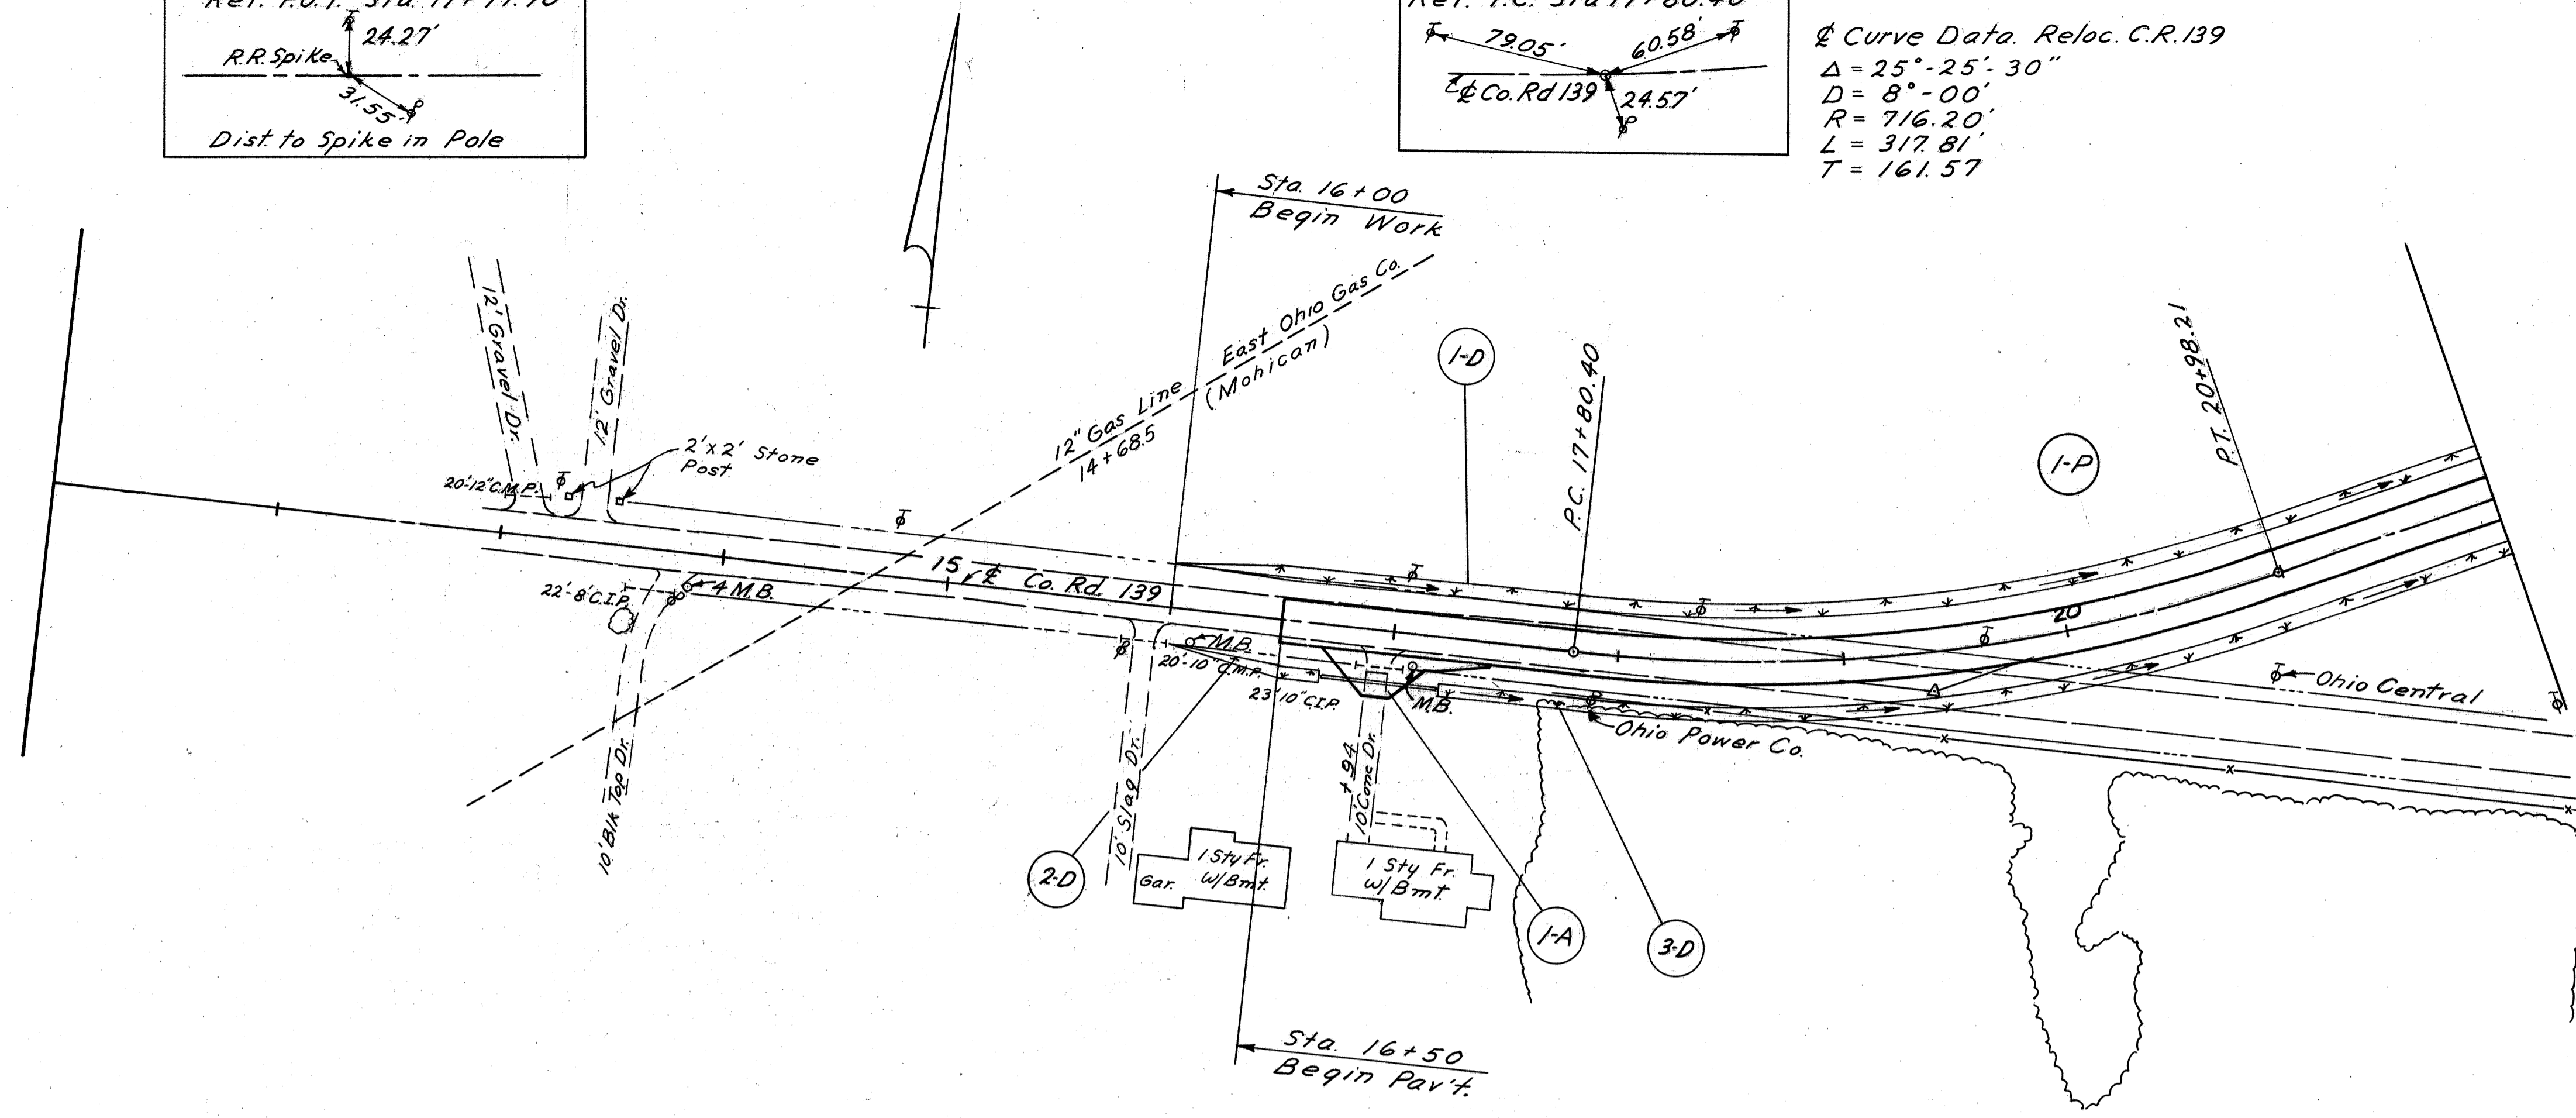

Item No.	Station		Side	L-10 Sodding	
	From	To		Lin. Ft.	Sq. Yd.
1-D	16+00	22+00	Lt.	6	450
2-D	16+00	16+68	Et.	6	52
3-D	17+22	22+00	Et.	6	358
Totals					860

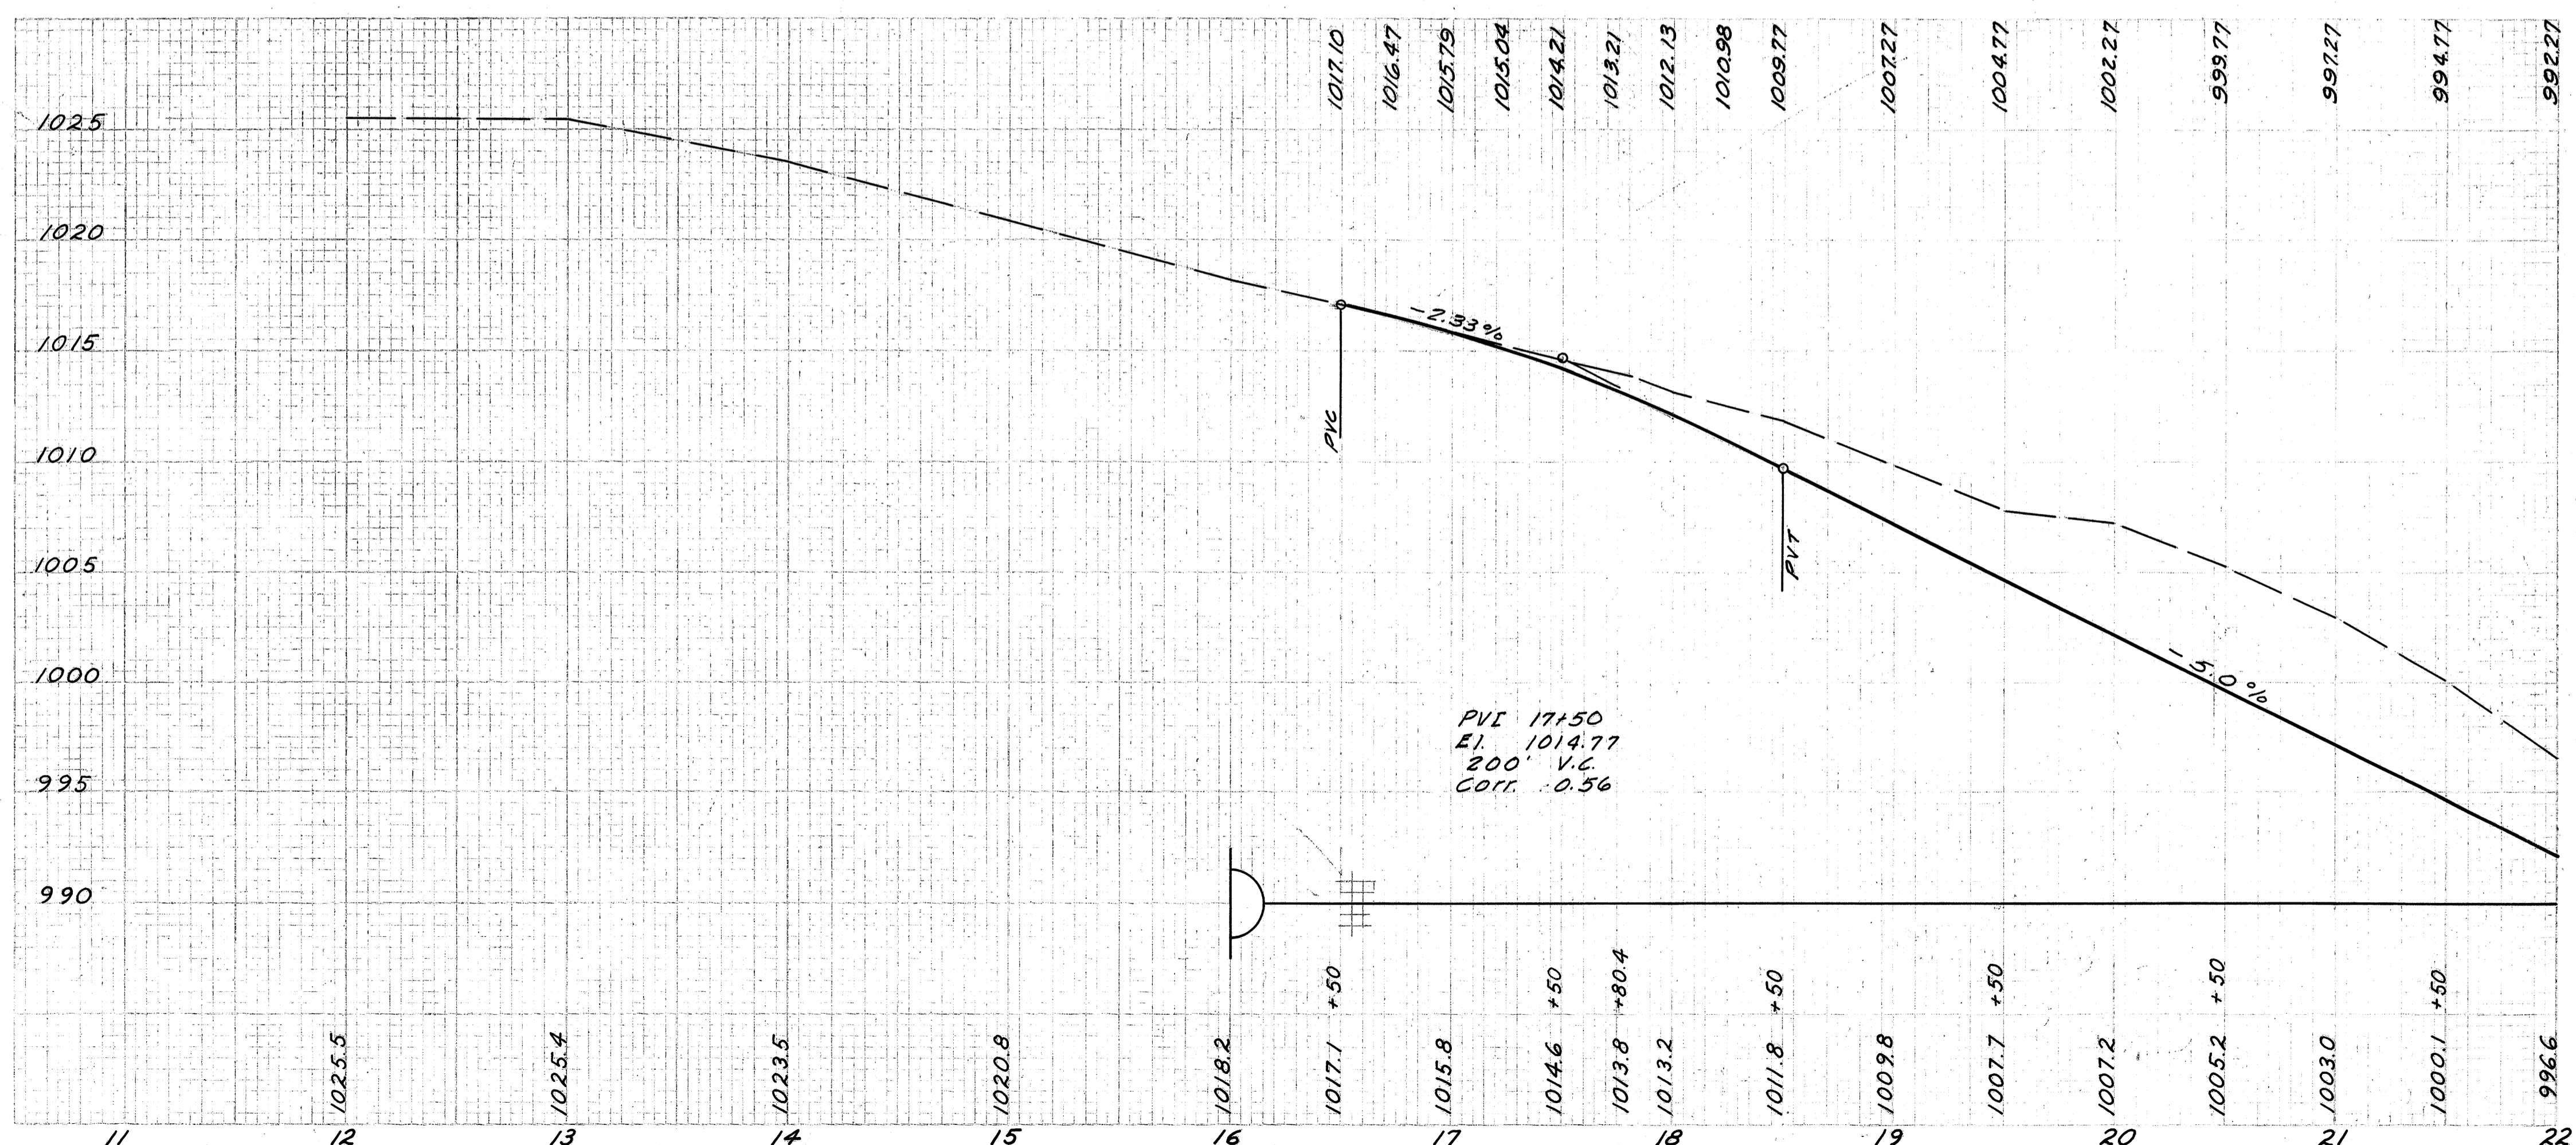

Item No.	Station		Side	Length	B-19	T-35	I-1	E-12
	From	To			Crushed Asphaltic Aggregate Base Course 5" Course 2"	Crushed Asphaltic Concrete Surface 2"	Pipe For Drives 12"	Pipe Removed 15" & Under
1-A	16+94			20	11.33	4.52	54	23
Totals					11.33	4.52	54	23

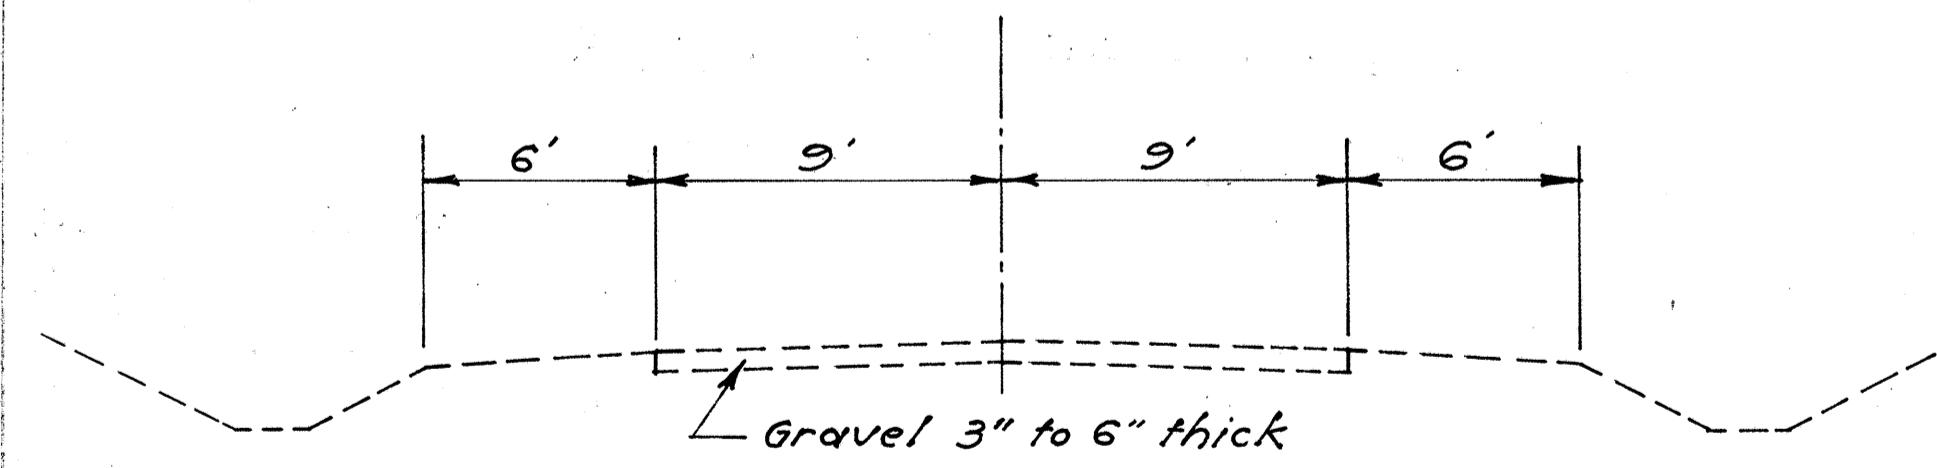


TYPICAL SECTION EXIST'G
 C.R. 139

For Pavement Quantities See Sheet No. 114

Relocated Co. Rd. 139
Curve Data
P.I. Sta 23+69.07
Δ = 57°-00'-00"
D = 20°-00'-00"
R = 286.48'
L = 285.00'
T = 155.55'
E = 39.50

Relocated Co. Rd. 139
Curve Data
P.I. Sta 26+96.92
Δ = 30°-58'-20"
D = 24°-00'
R = 238.73'
L = 129.05'
T = 66.13
E = 8.99

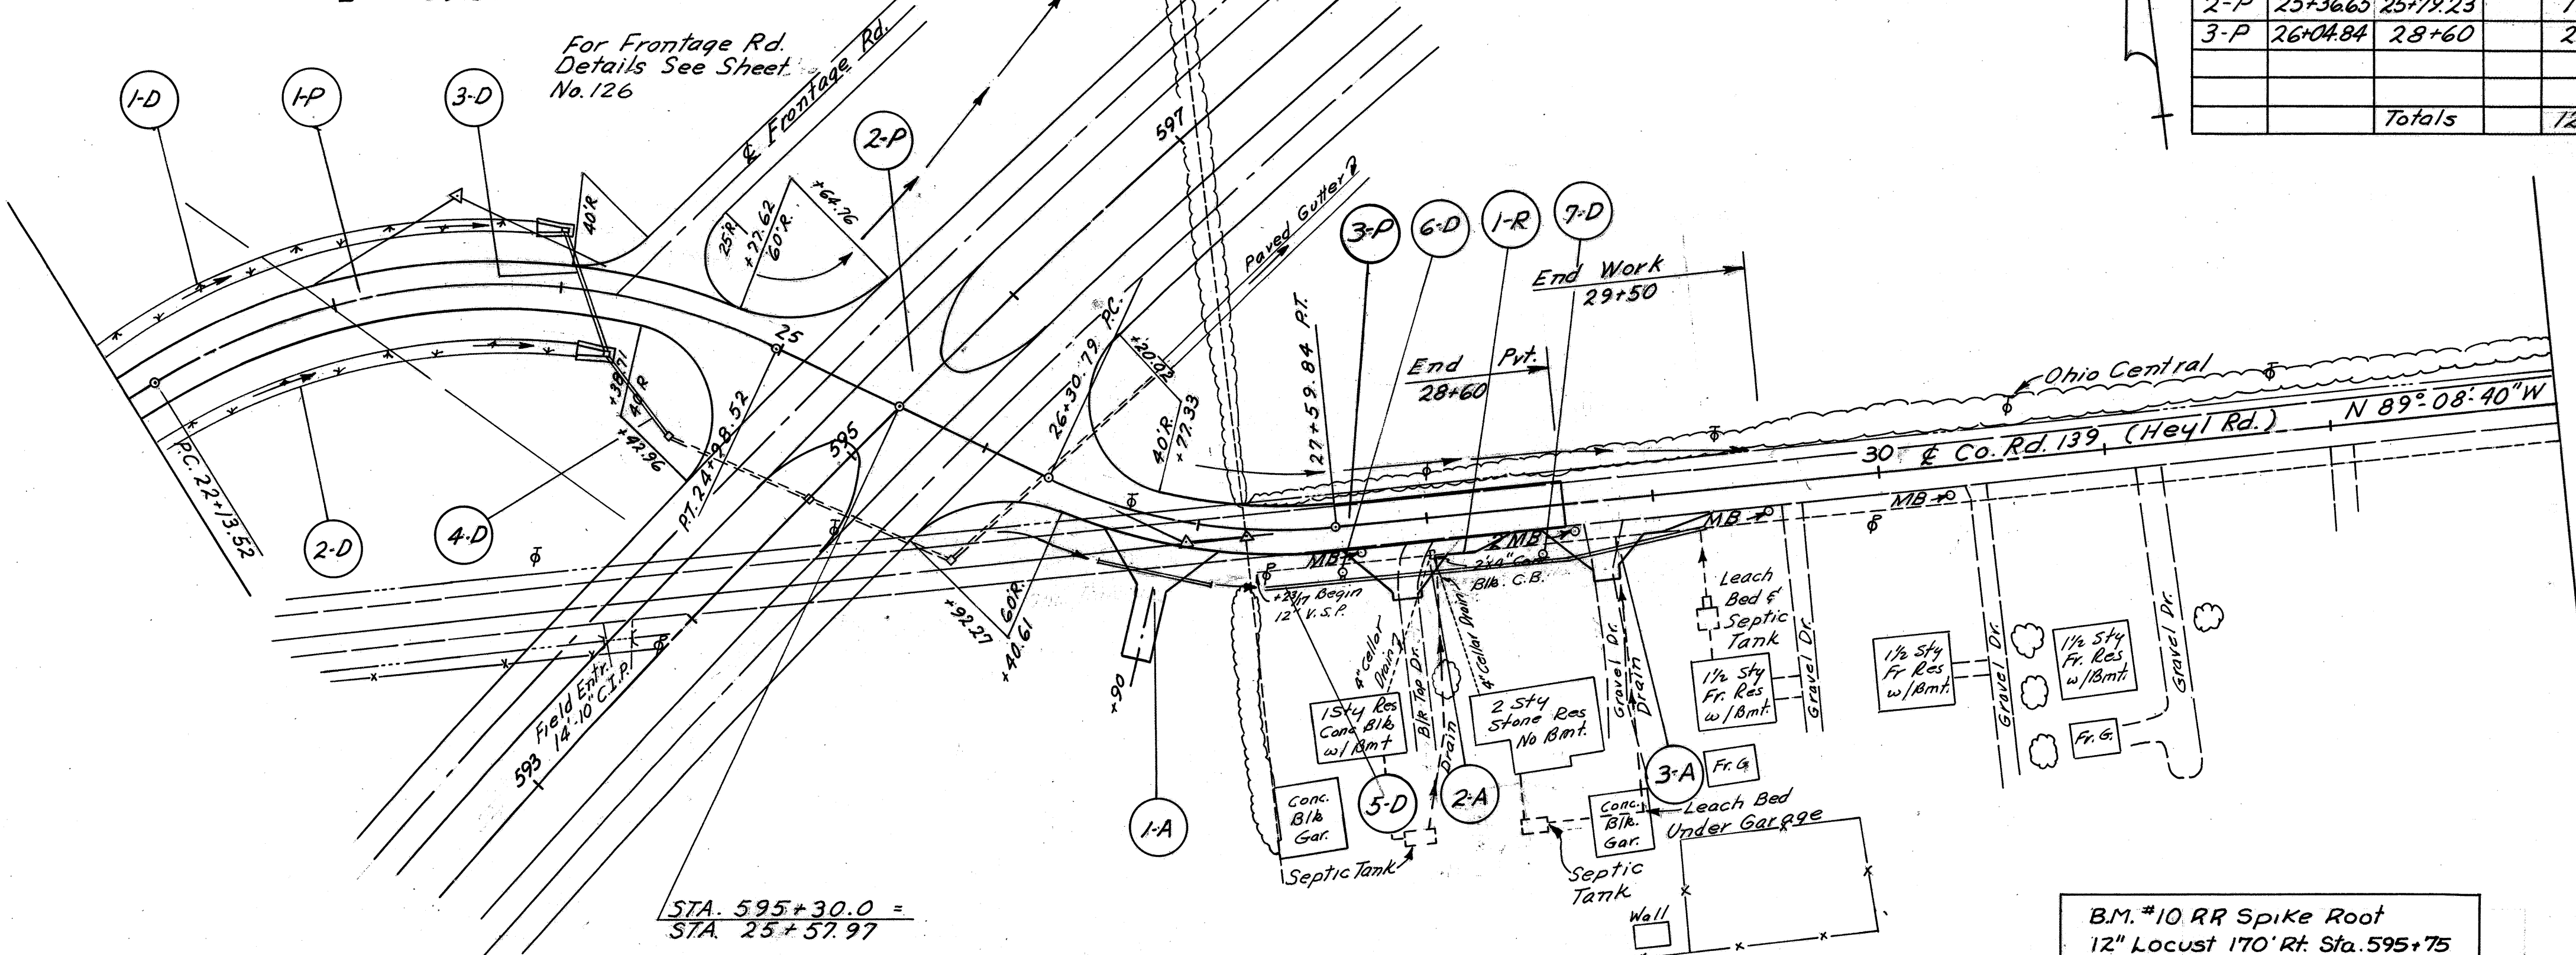


B.M. #10 RR Spike Roof
12" Locust 170' Rt. Sta. 595+75
Elevation 983.32

Item No.	Station		T-35	T-30	B-19	I-22	I-9
	From	To	Asphaltic Conc. Surface Course 1 1/2 Type A Cu. Yds.	Bituminous Prime Coat 4 gal/sq. Yd. Gal.	Crushed Agg. Base Course 5" Cu. Yd.	Subbase Grading 4" or 5" Cu. Yd.	Stone Underdrain No. 2 Lin. Ft.
1-P	16+50	25+11.02	85.52	820.9	298.21	248.88	168
2-P	25+36.65	25+79.23	13.99	134.3	40.63	33.73	
3-P	26+04.84	28+60	29.18	280.1	100.28	80.52	72
Totals			128.69	1235.3	439.12	363.13	240


Item No.	Station		Side	L-10	I-14	I-8	I-2	I-2
	From	To		Sodding Under Gutter Special Width	Paved Catch Basins No. 2-2 A	Catch Basins No. 2-2 A	Storm Sewer Under Pvt. Class 15" Lin. Ft.	Storm Sewer Sec. M. 6.5(a) 18" Lin. Ft.
1-D	22+00	23+90	Lt.	6				
2-D	22+00	24+15	Rt.	6				
3-D	24+00	24+25	Rt.	15	6	20	2	54
4-D	24+25	594+50	Rt.					44
Totals				277	20	2	54	44

Item No.	Station		Side	I-8	I-3	I-3	I-5	E-12
	From	To		Catch Basins No. 7	Pipe For Roadway Drainage Lin. Ft.	Pipe For Roadway Drainage Under Pvt. Lin. Ft.	Pipe Specials Each	Pipe Removed 15' Under Lin. Ft.
5-D	27+20	29+25	Rt.		6"	12"	125	
6-D	27+60		Rt.	1		3		
7-D	28+50		Rt.	1		3		
1-R	27+23	29+25	Rt.					232
Totals				2	131	72	2	232

Item No.	Station		Side	Length	B-19	T-35	I-1
	From	To			Crushed Aggregate Base Course Cu. Yds.	Asphaltic Concrete Surface Course Cu. Yds.	Pipe For Drives
1-A	26+90		Rt.	52	18.67	2"	54
2-A	27+89		Rt.	25	12.75	4.89	
3-A	28+76		Rt.	25	12.75	4.89	
Totals					25.50/18.67	9.78	54

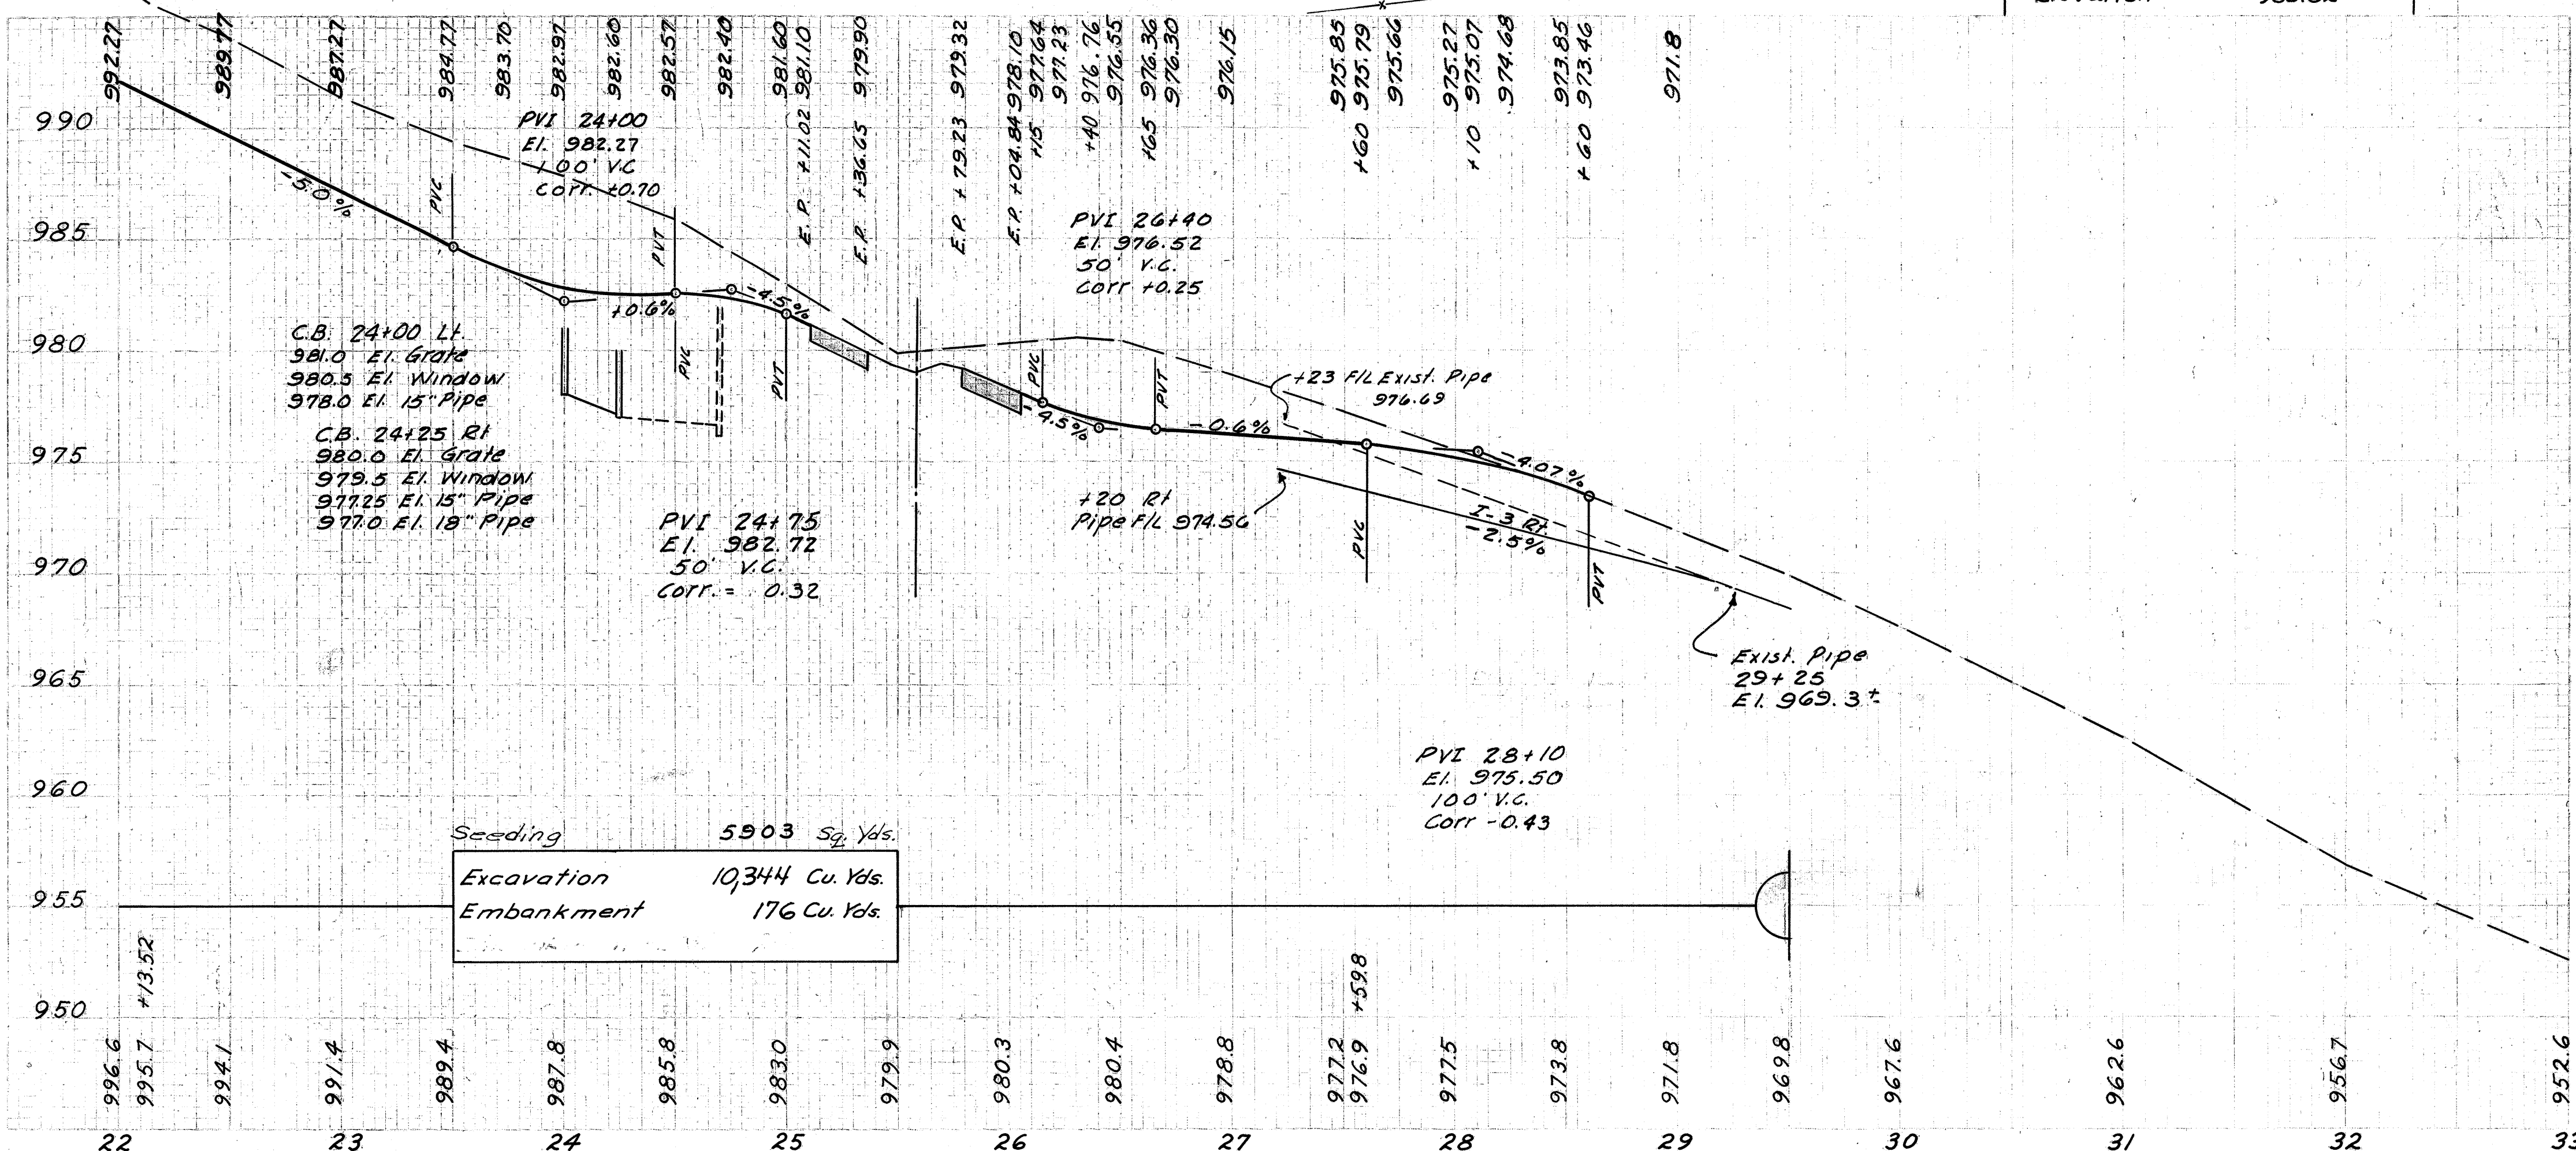

WAYNE COUNTY
WAY-3-9.94

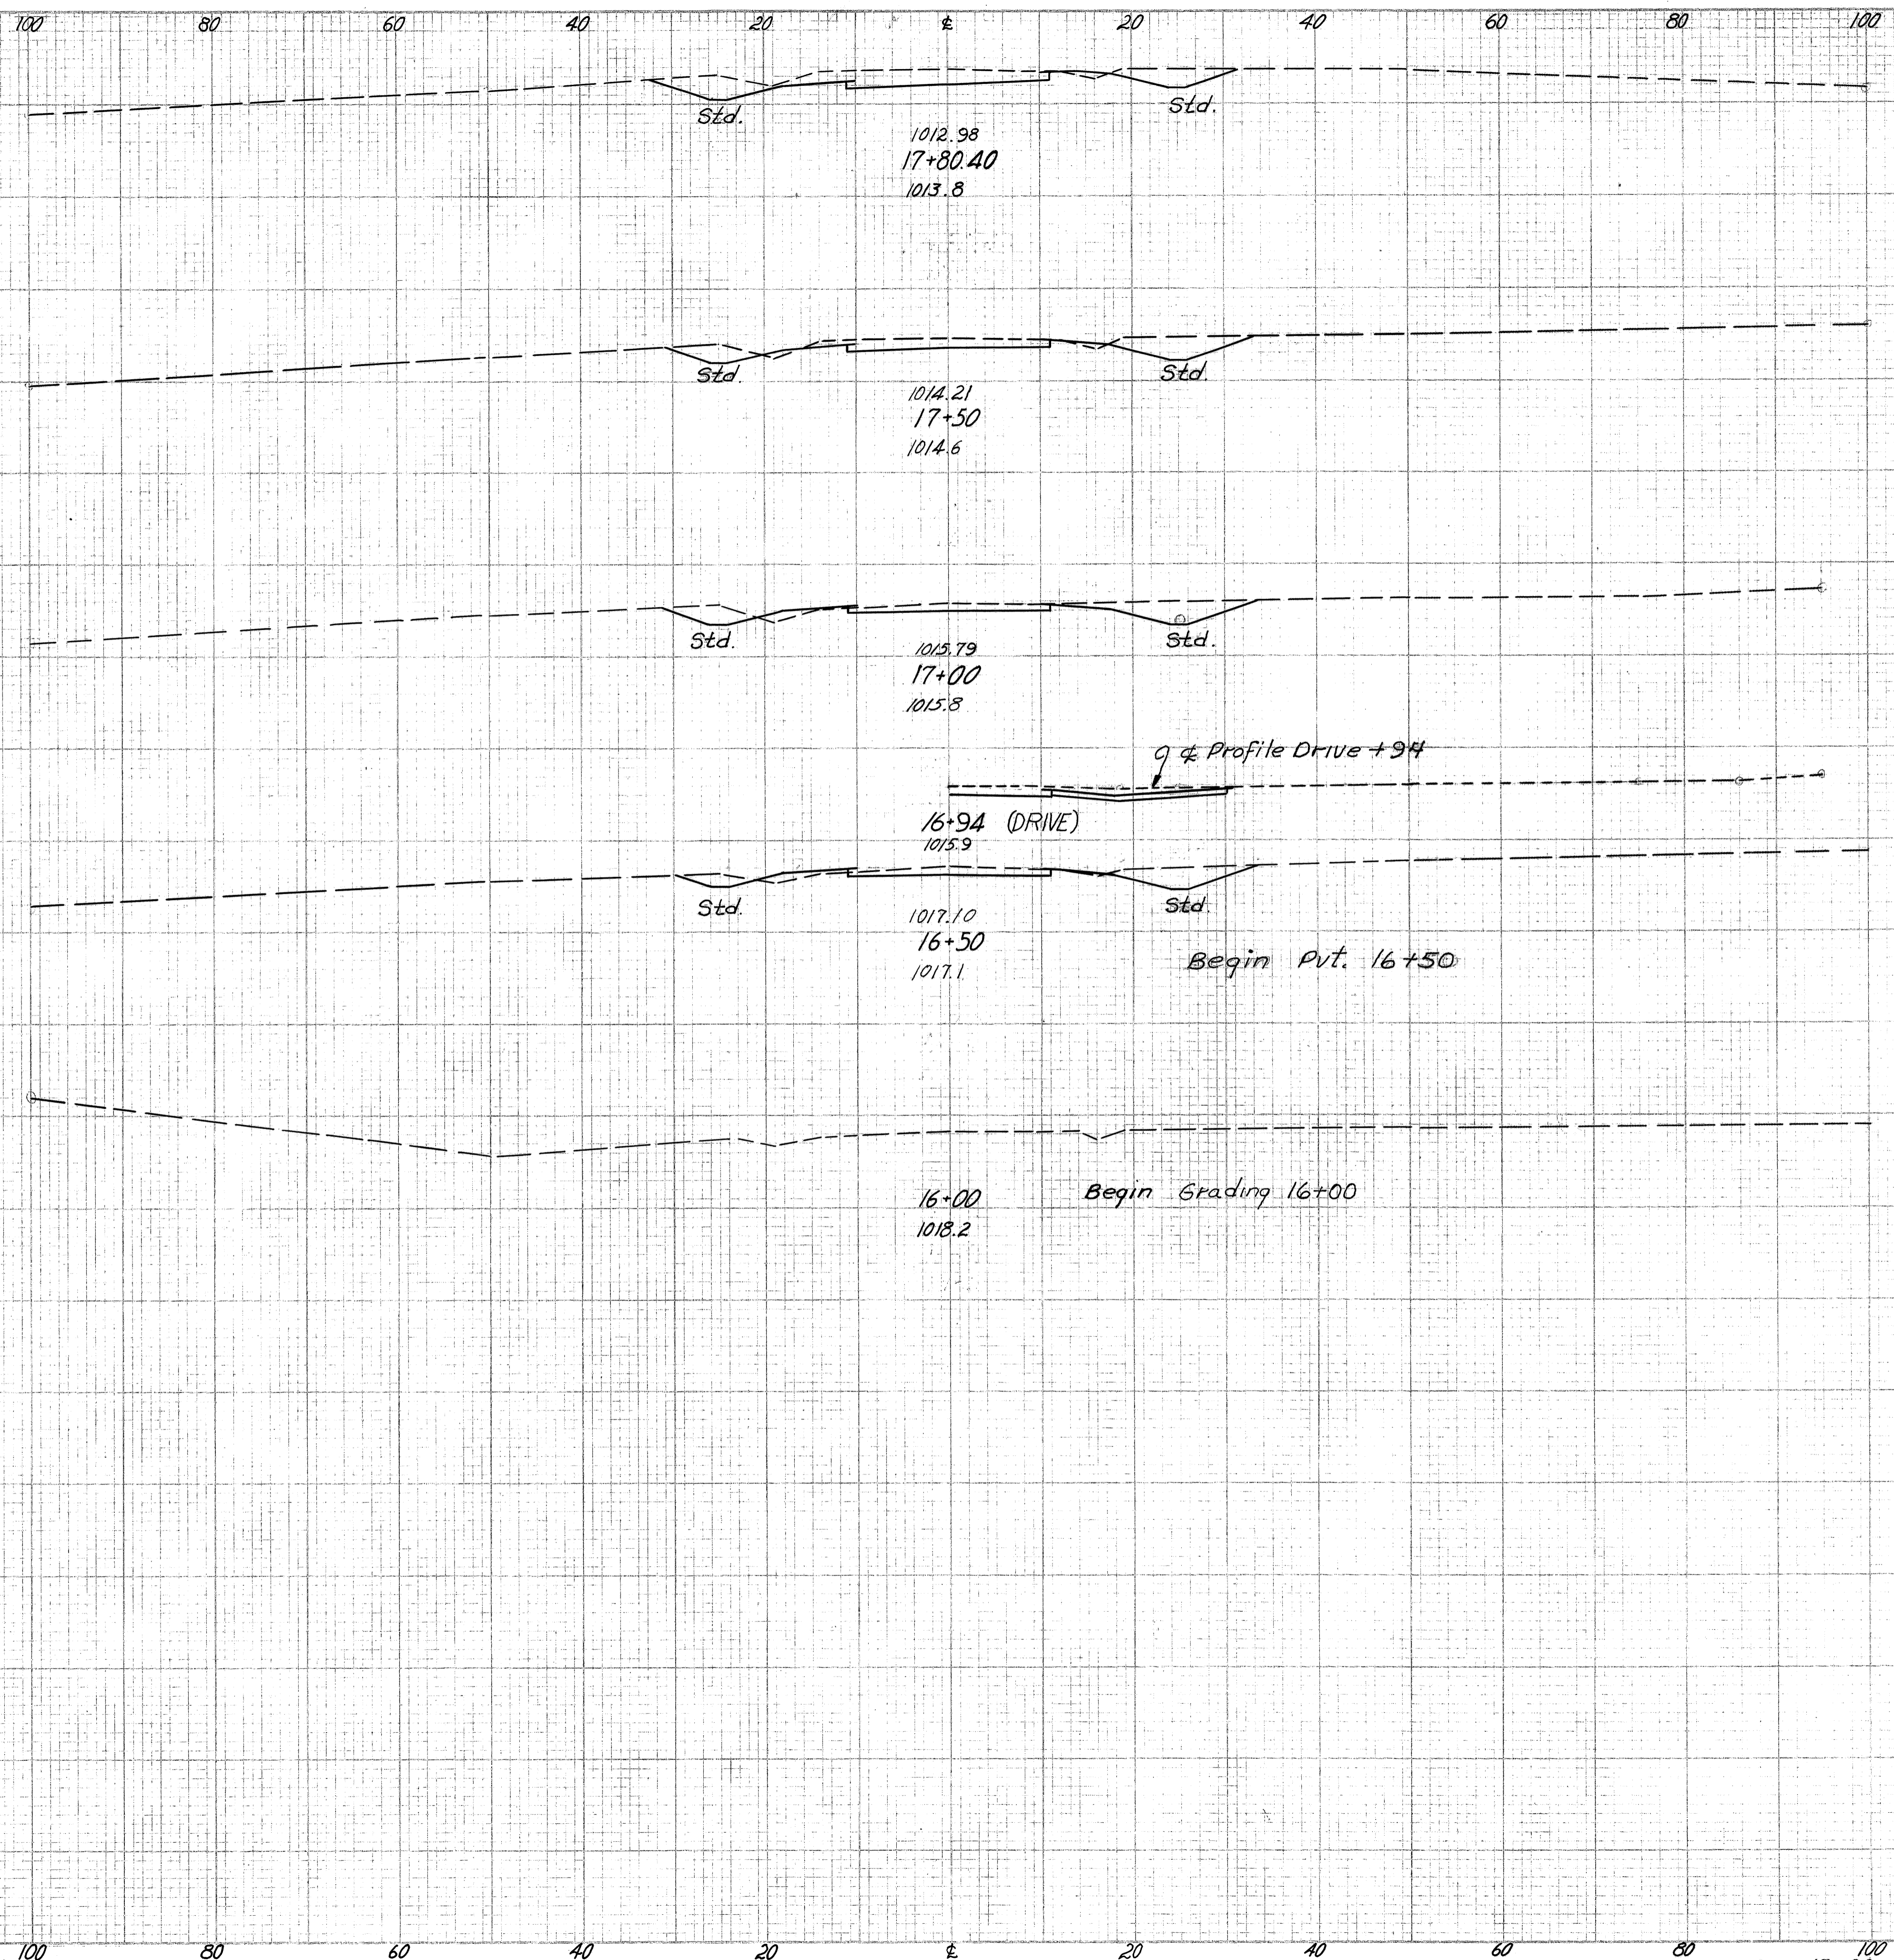

END AREA	Cu. Yds.	
	CUT	FILL
83	1	82
62	2	2
		111
		6
58	4	
		99
		10
		18
49	6	
		46
		6
0	0	

Drive Rt. 16+94

16+94 (DRIVE)
1015.9

1017.10
16+50
1017.1

16+00
1018.2

Begin Grading 16+00

Begin Pvt. 16+50

q & Profile Drive +94

Std.

1012.98
17+80.40
1013.8

Std.

1014.21
17+50
1014.6


Std.

1015.79
17+00
1015.8

Std.


1017.10
16+50
1017.1

WAYNE COUNTY
WAY-3-9.94

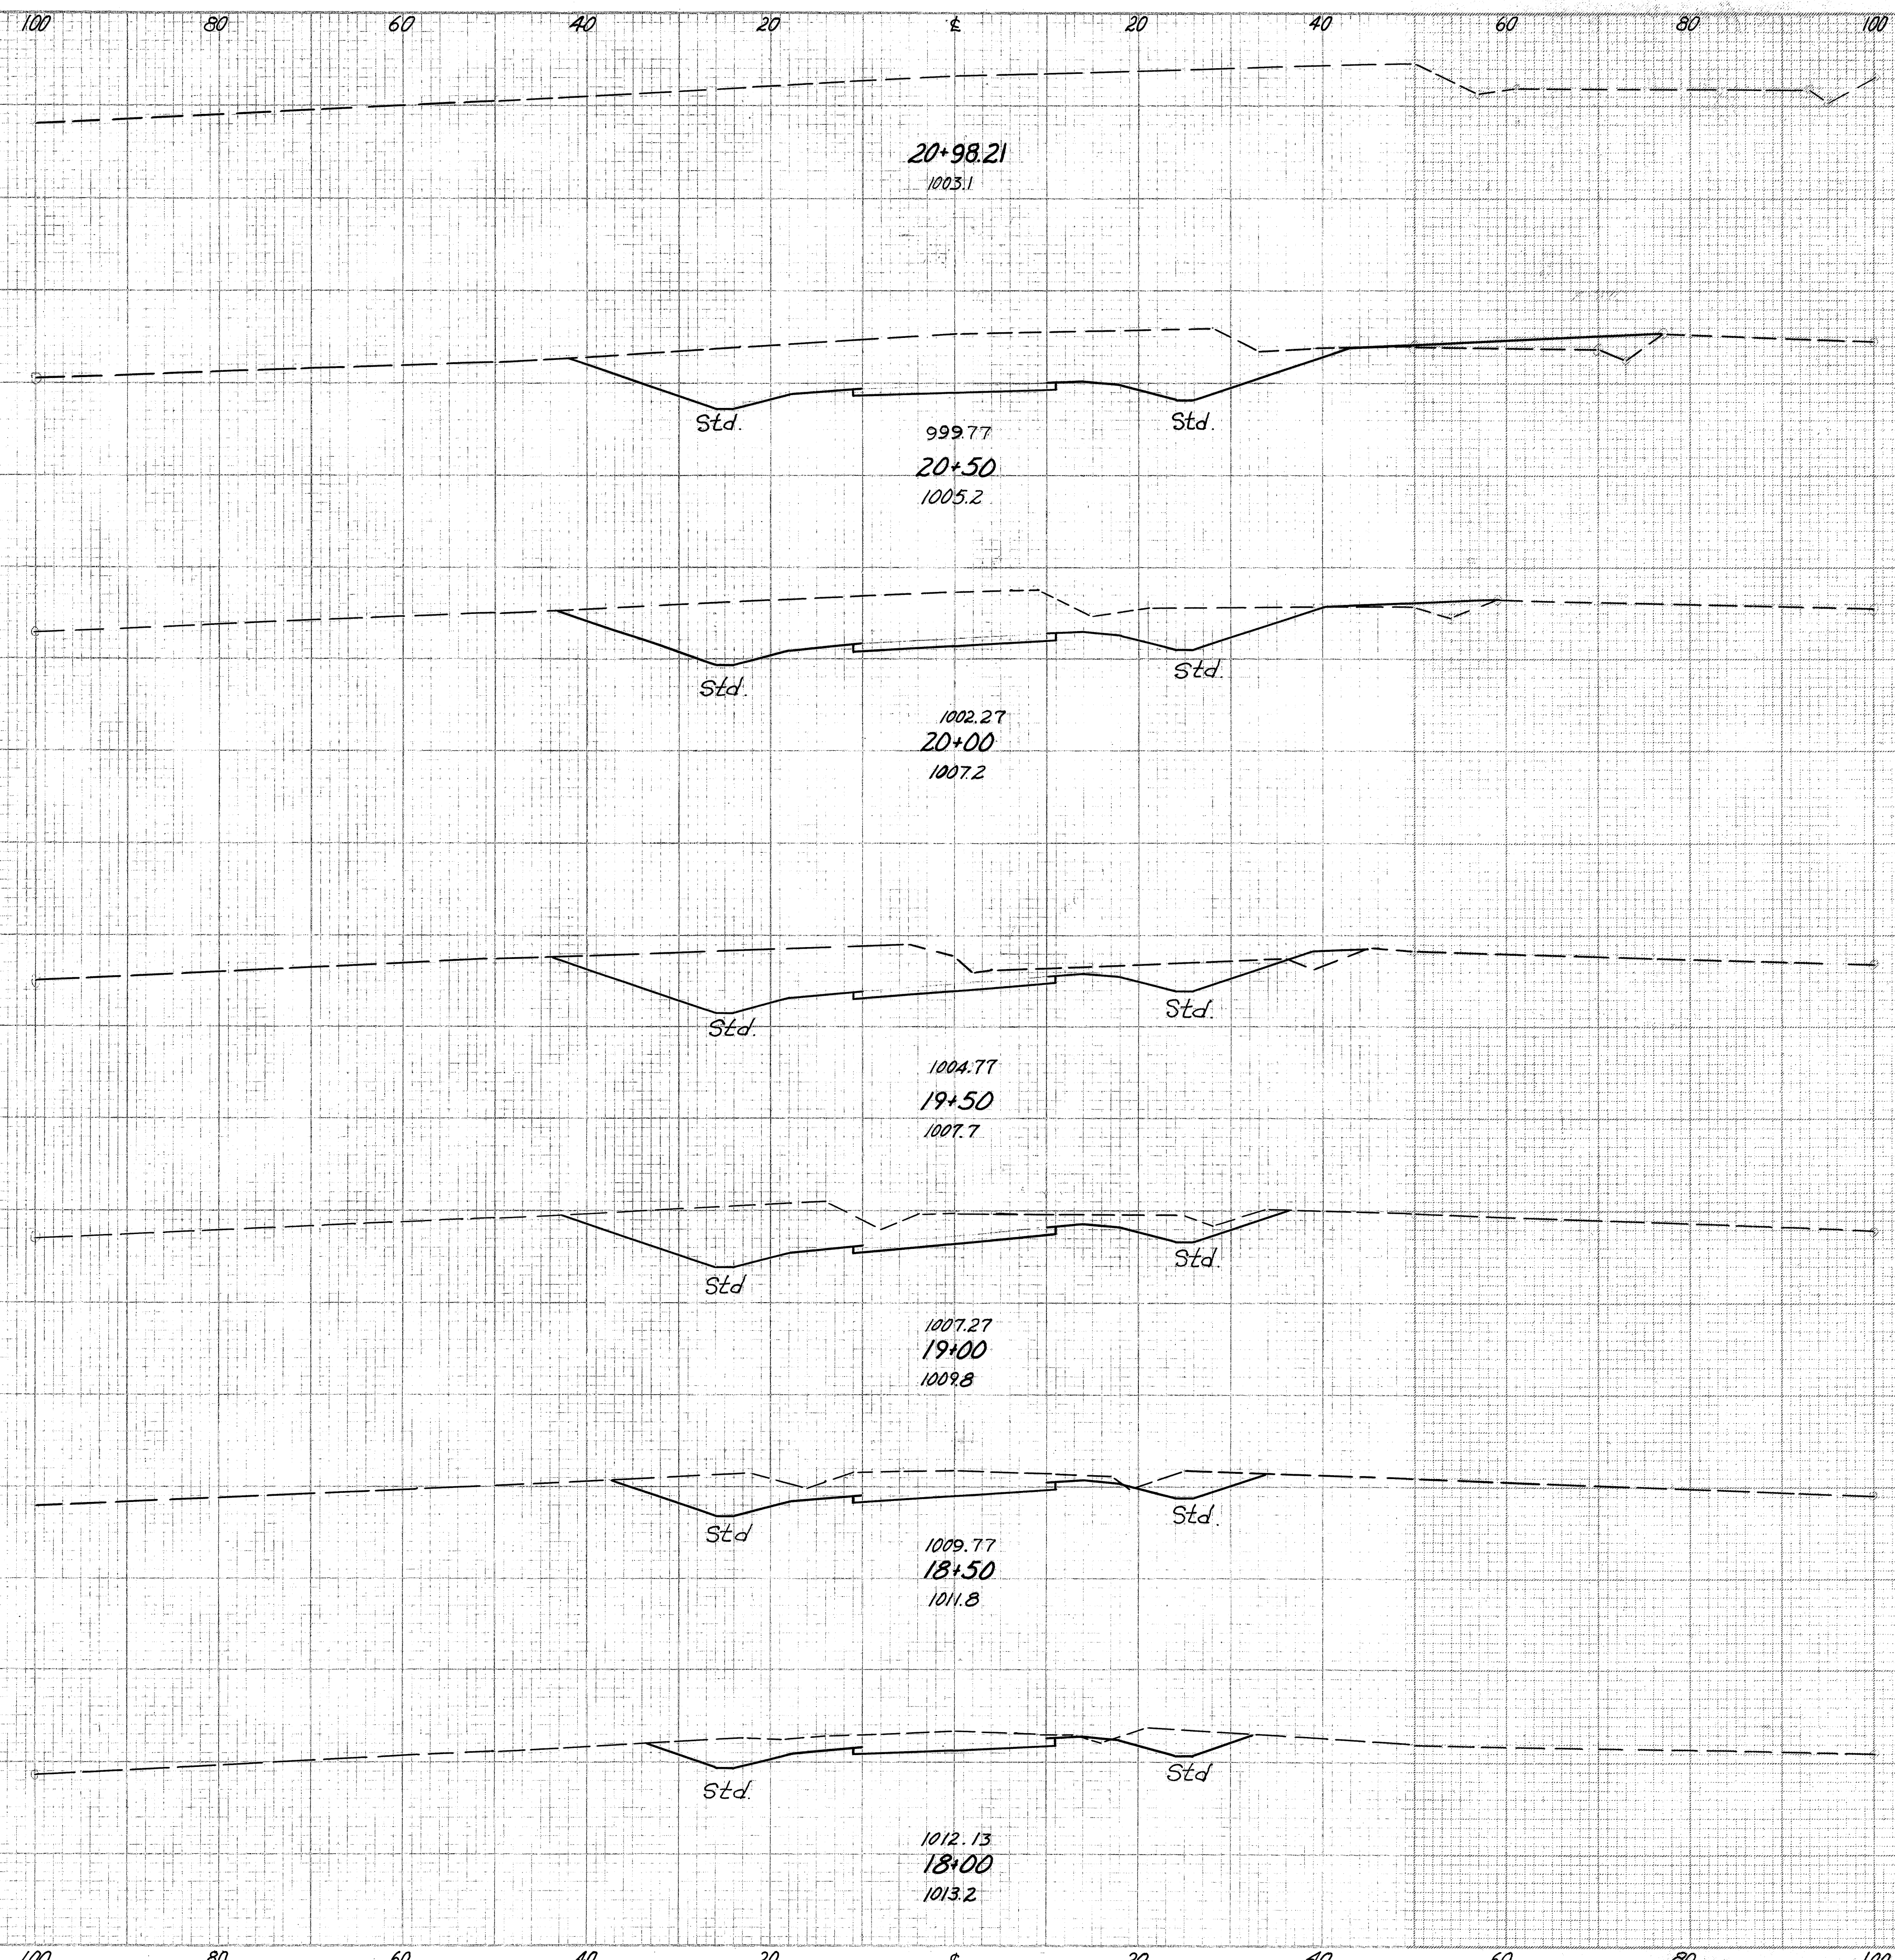


END AREA		CU. Yds.	
CUT	FILL	CUT	FILL
422	27		
		730	34
366	9		
		594	17
275	9		
		473	9
236	0		
		370	0
163	0		
		254	1
111	1		
		70	1

WAYNE COUNTY
WAY-3-9.94

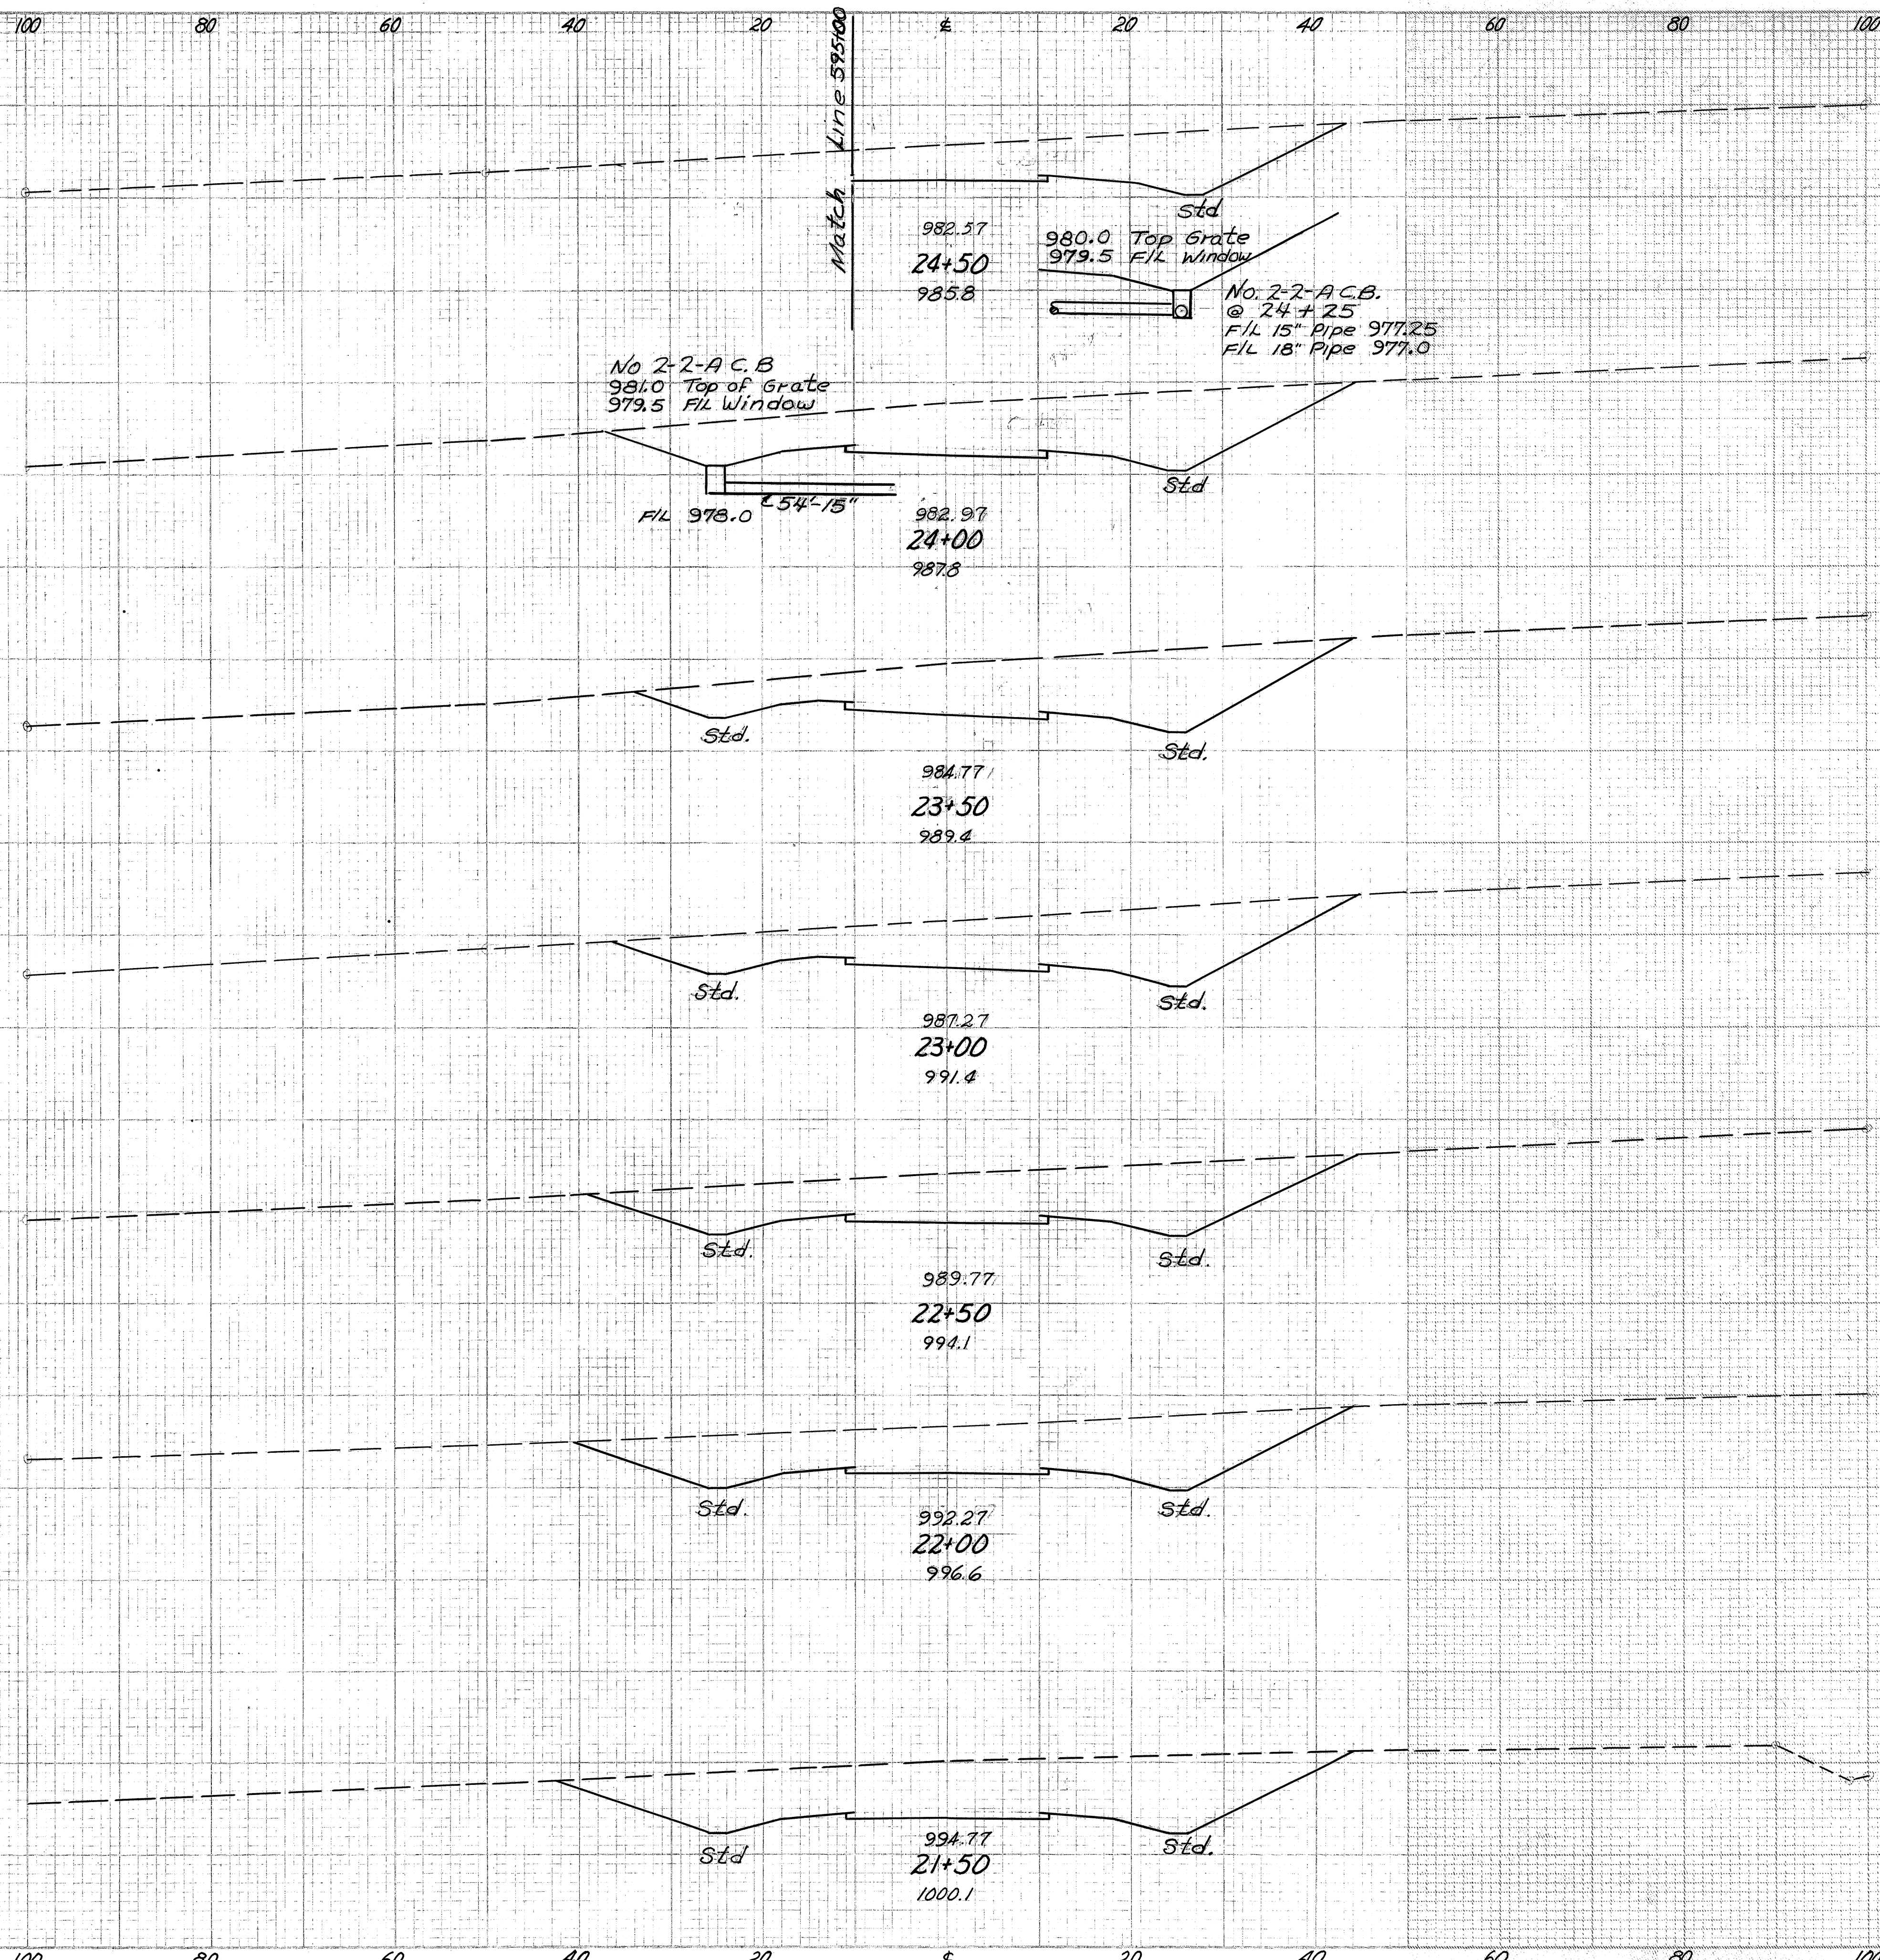

	END AREA		Cu. Yds.	
	CUT	FILL	CUT	FILL
Ahead 24+50	0	0		
Back 24+50	238	0		
24+25			600	0
24+00	410	0		
			730	0
			378	0
			704	0
			382	0
			726	0
			402	0
			742	0
			399	0
			805	0
			470	0
			1652	50

WAYNE COUNTY
WAY-3-9.94

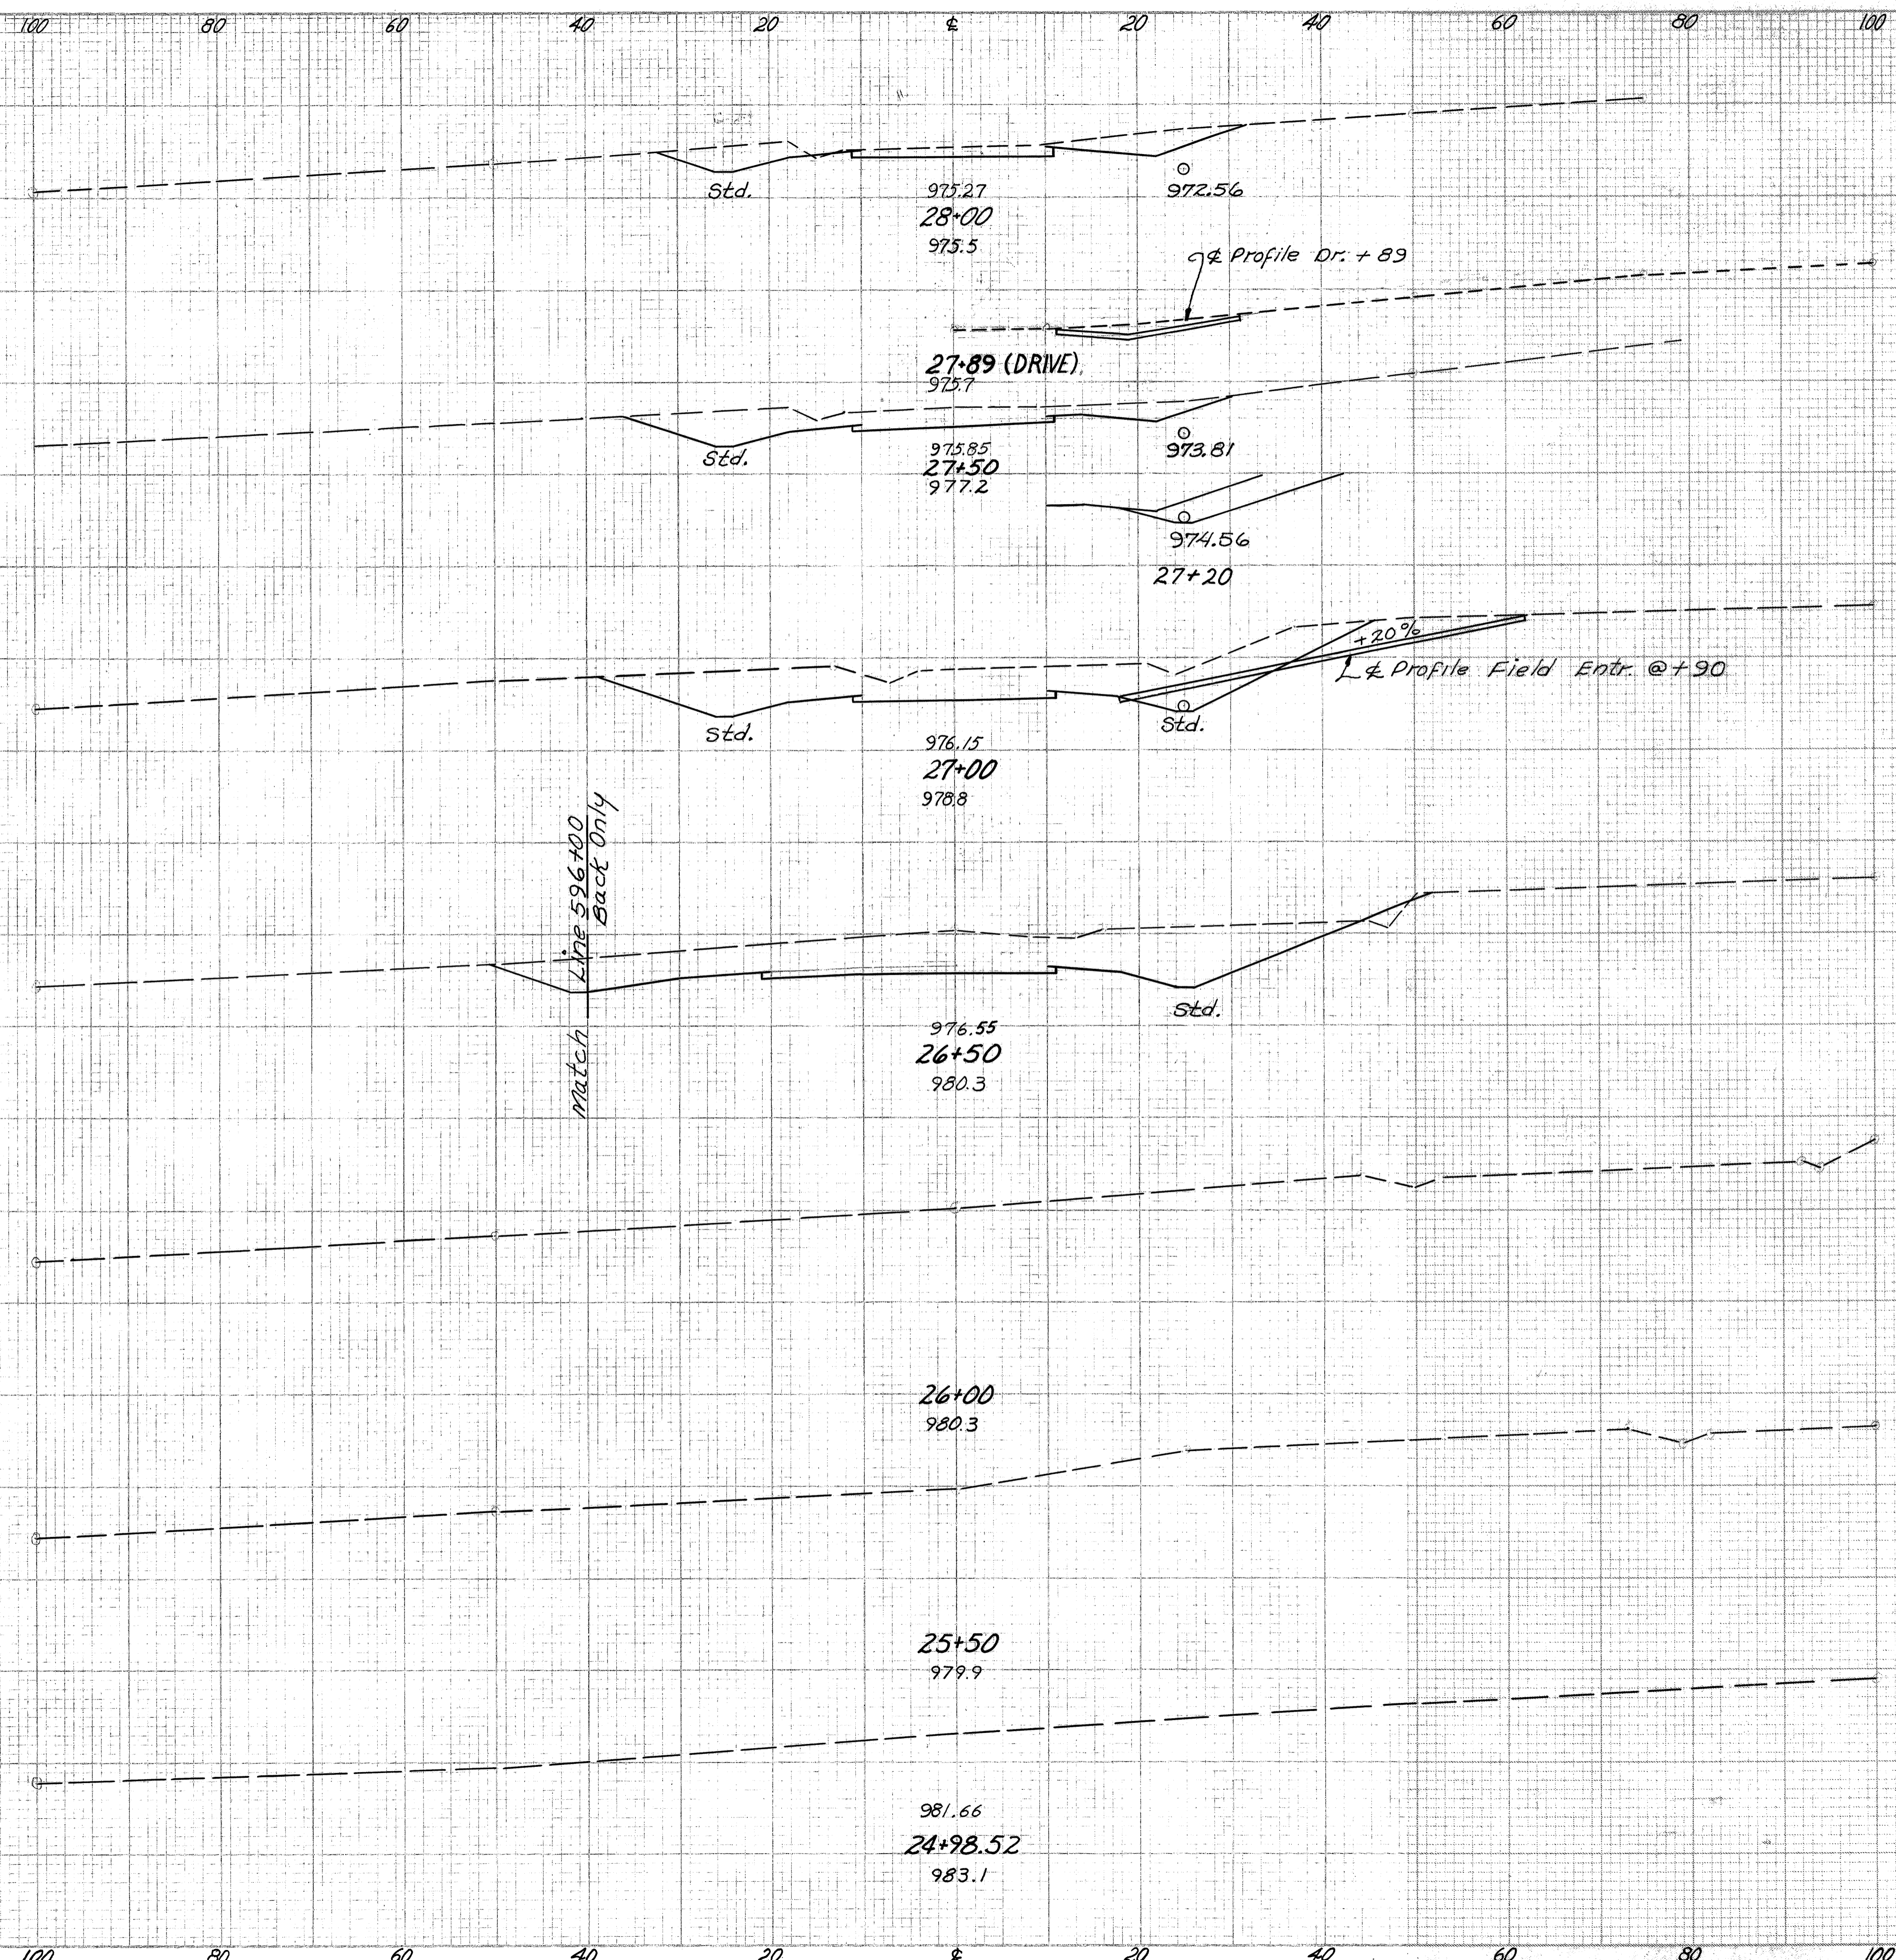


END AREA	Cu. Yds.	
	CUT	FILL
77 0	19	0
132 0	193	0
283 0	385	0
329 7	45	31
0 0	567	7

FED. RD. DIVISION	STATE	PROJECT
2	OHIO	

119
151

WAYNE COUNTY
WAY-3-9.94

END AREA		CU. YDS.	
CUT	FILL	CUT	FILL

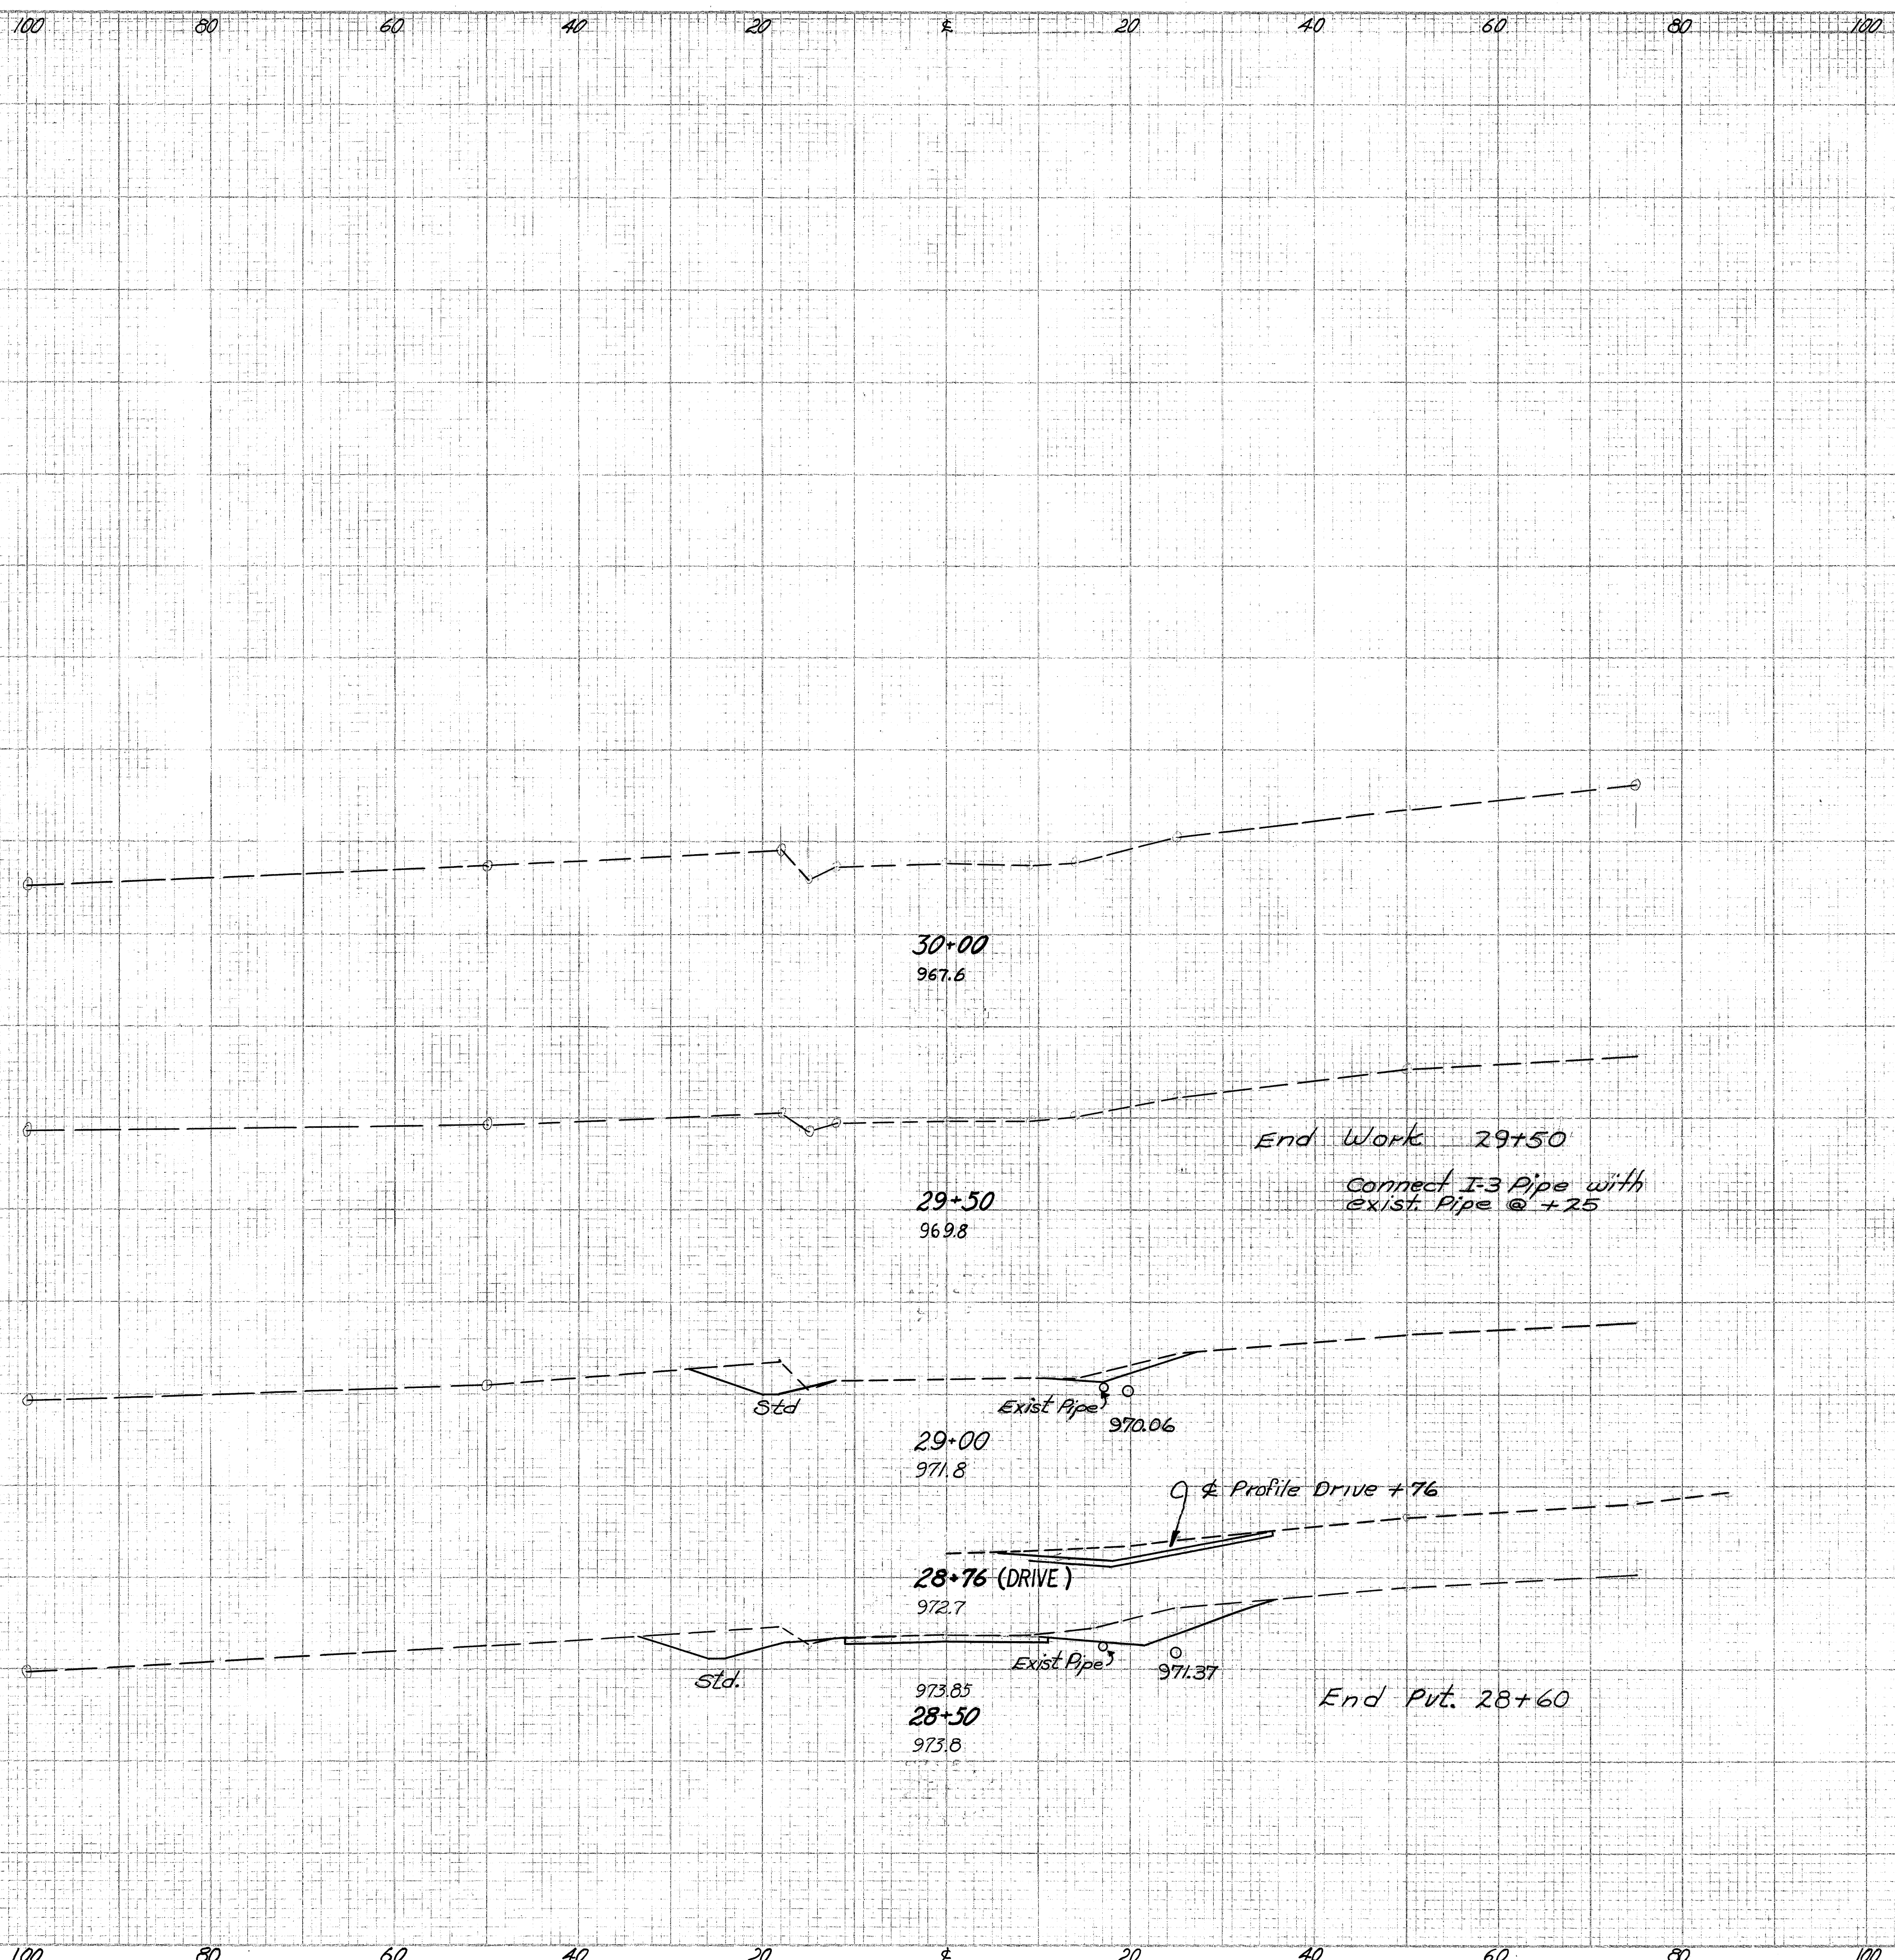


Station	CUT	FILL	CUT	FILL
29+50	0	0		
			31	1
			33	1
			119	1
			19	0
			95	0
			160	0

WAYNE COUNTY
WAY-3-9.94

Relocated C.R.174
Curve Data
P.I. 21+39.7
Δ = 55°44'30"
D = 22°55'06"
R = 250'
T = 132.21'
L = 243.22'
E = 32.80'

P.I. Sta. 16+21.48
Δ = 3°25'30" Lt.



23+36.87 C.R. #174-
P.T. 614+18.97 Way-3

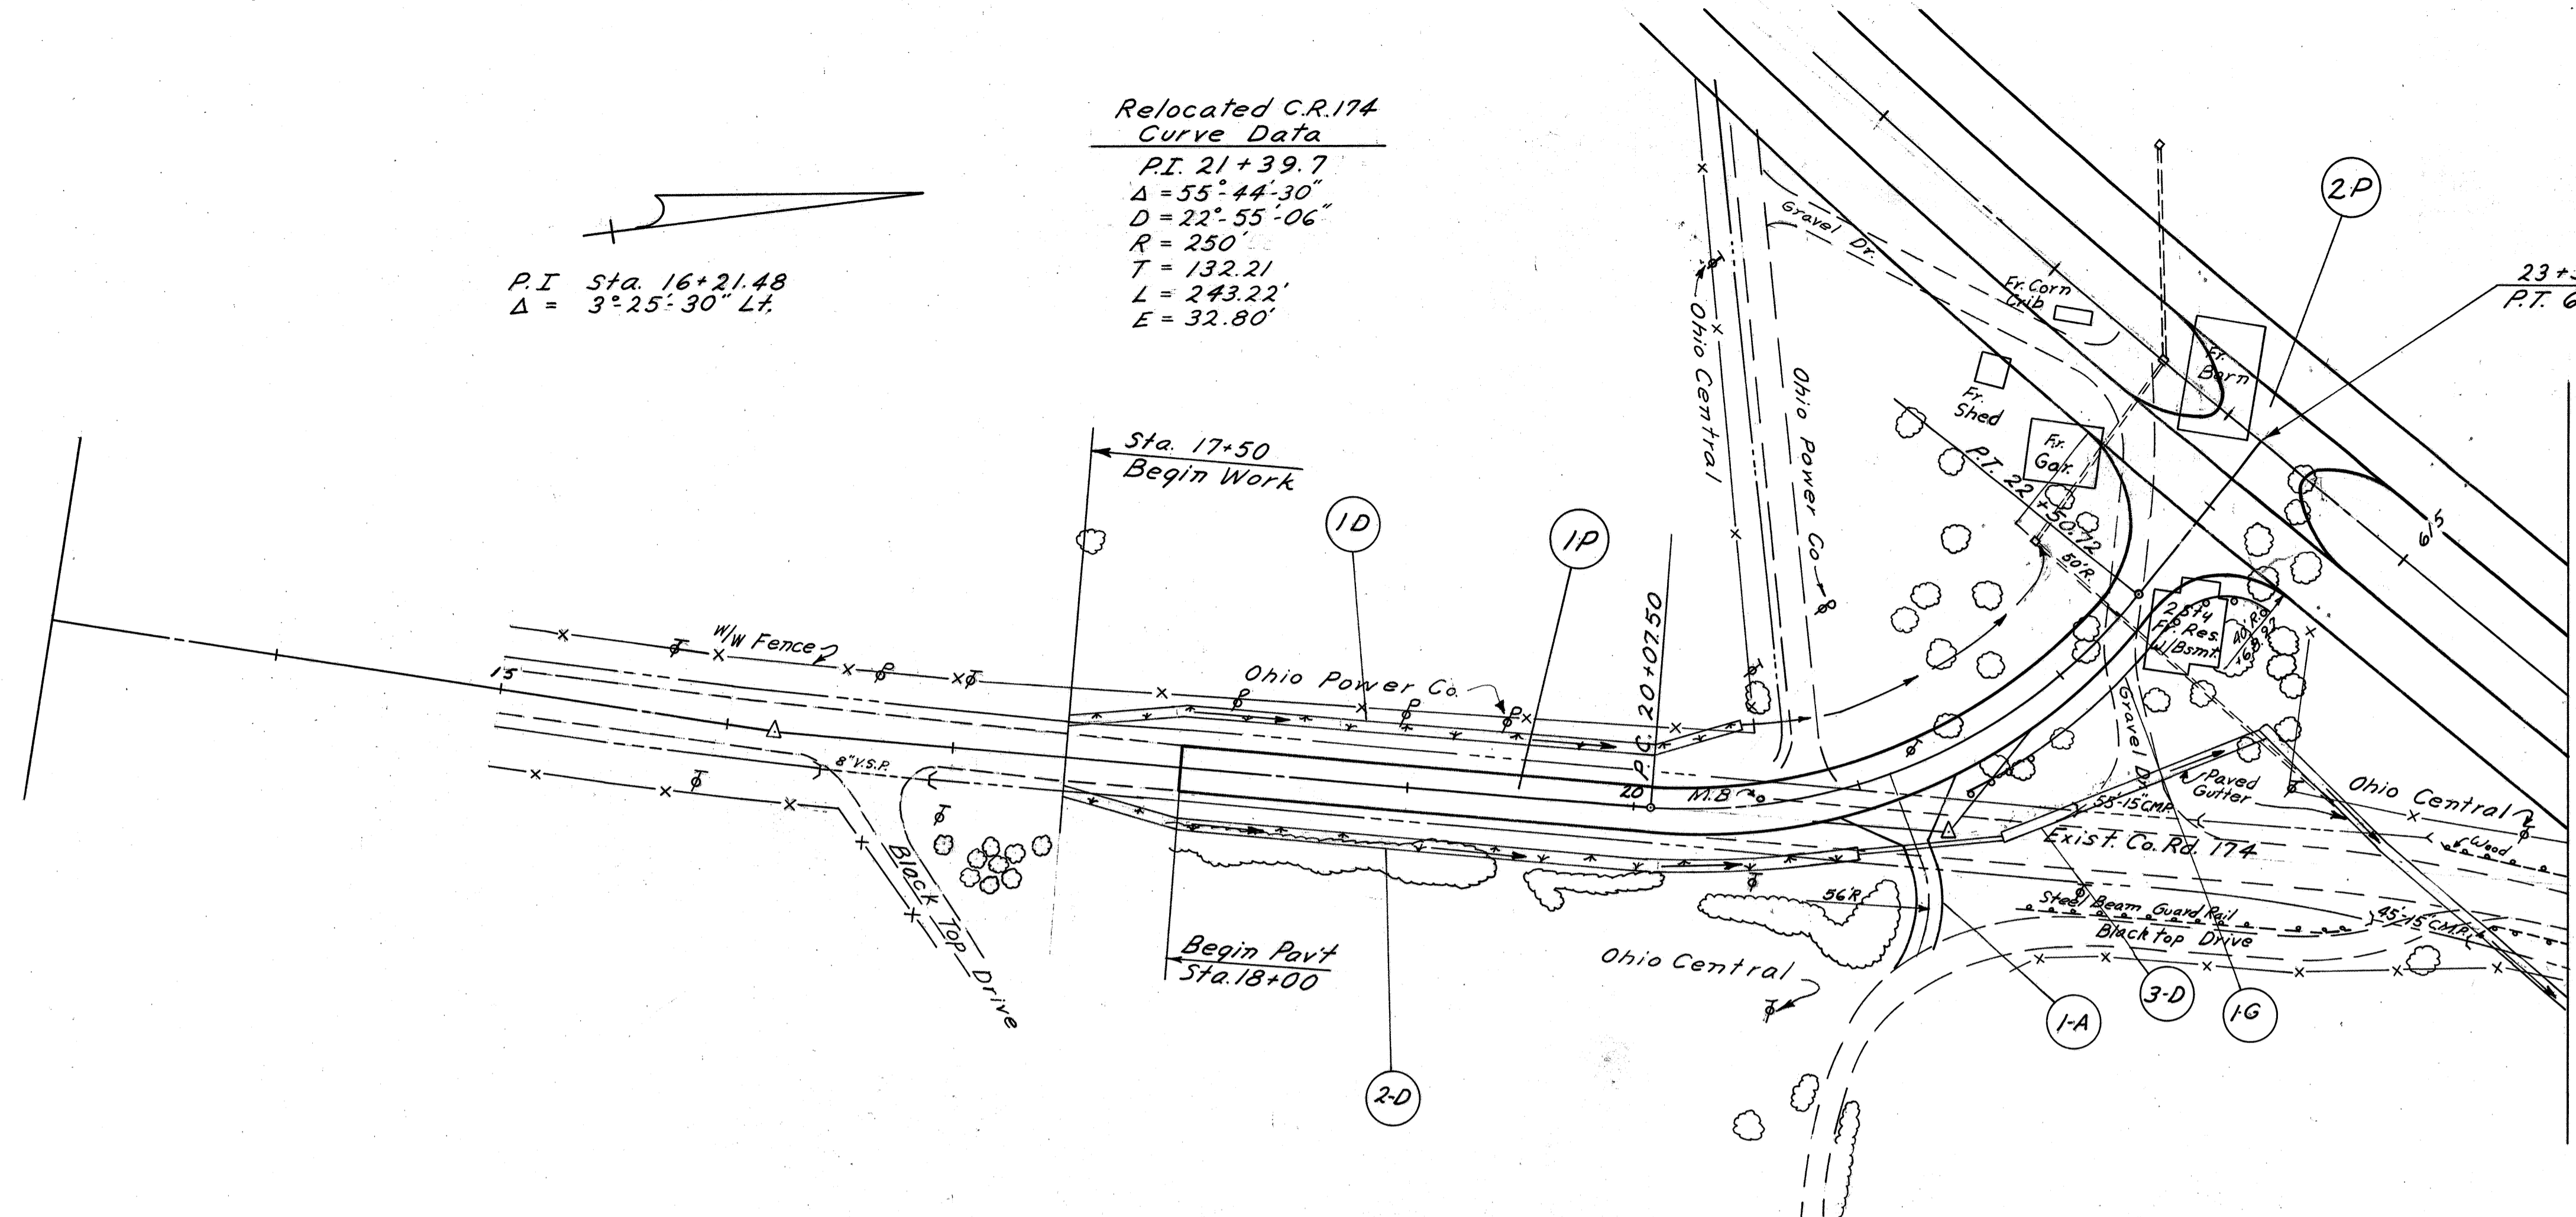

Item No.	Station		Side	L-10	I-14	I-15			
	From	To		Sodding Width	Paved Gutter Type I	Rail Steel Beam Type (Deep)			
1-D	17+50	20+50	Lt.	6	200				
2-D	17+50	20+92	Et.	6	228				
3-D	21+45	22+40	Et.	1.5	41	124			
1-G	21+38.9	22+52.9	Et.				122.1		
Totals					469	124	122.1		


Item No.	Station		Side	Length	B-19	T-35	I-1		
	From	To			Crushed Aggregate Base Course	Asphaltic Concrete Surface Course	Pipe For Drives		
1-A	21+15		Et.	80	22.10	8.39	64		
Totals					22.10	8.39	64		

Item No.	Station		Side	T-35	B-35	T-30	B-19	I-22	I-9
	From	To		Asphaltic Conc. Surface Course 1 1/2" Type C	Asphaltic Conc. Leveling Course 1 1/2" (70-85)	Bituminous Prime Coat 4 Gal/Sq. Yd.	Crushed Agg. Base Course 5"	Subbase Grading A or B 4"	Stone Underdrain No. 2
1-P	18+00	22+92.87		41.27	49.53	475.5	172.64	143.40	122.00
2-P	23+16.87	23+56.87		10.73	12.88	123.6	42.01	31.91	
Totals				52.00	62.41	599.1	214.65	175.31	122.00

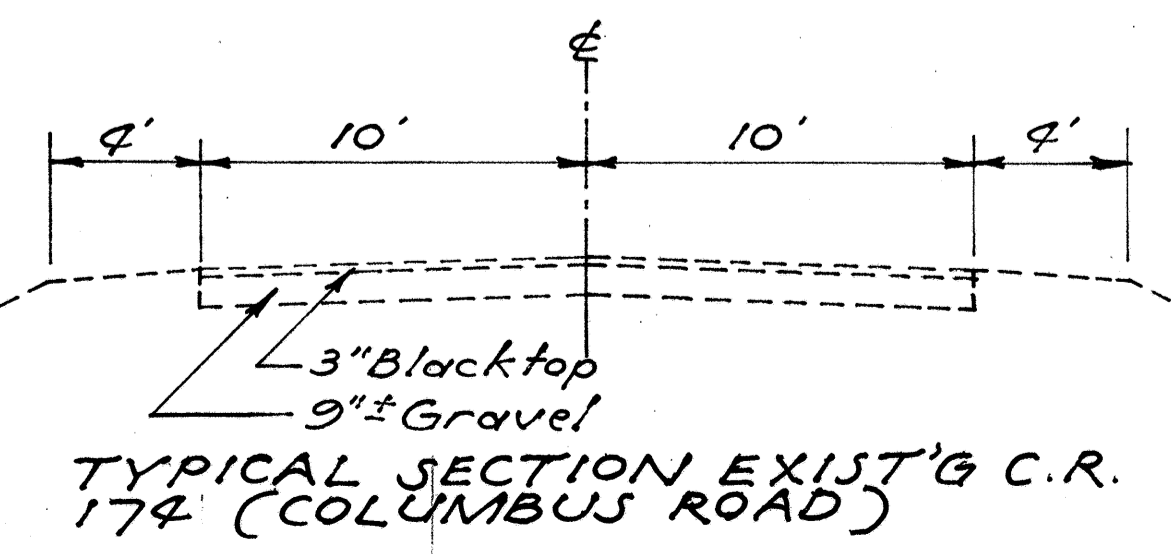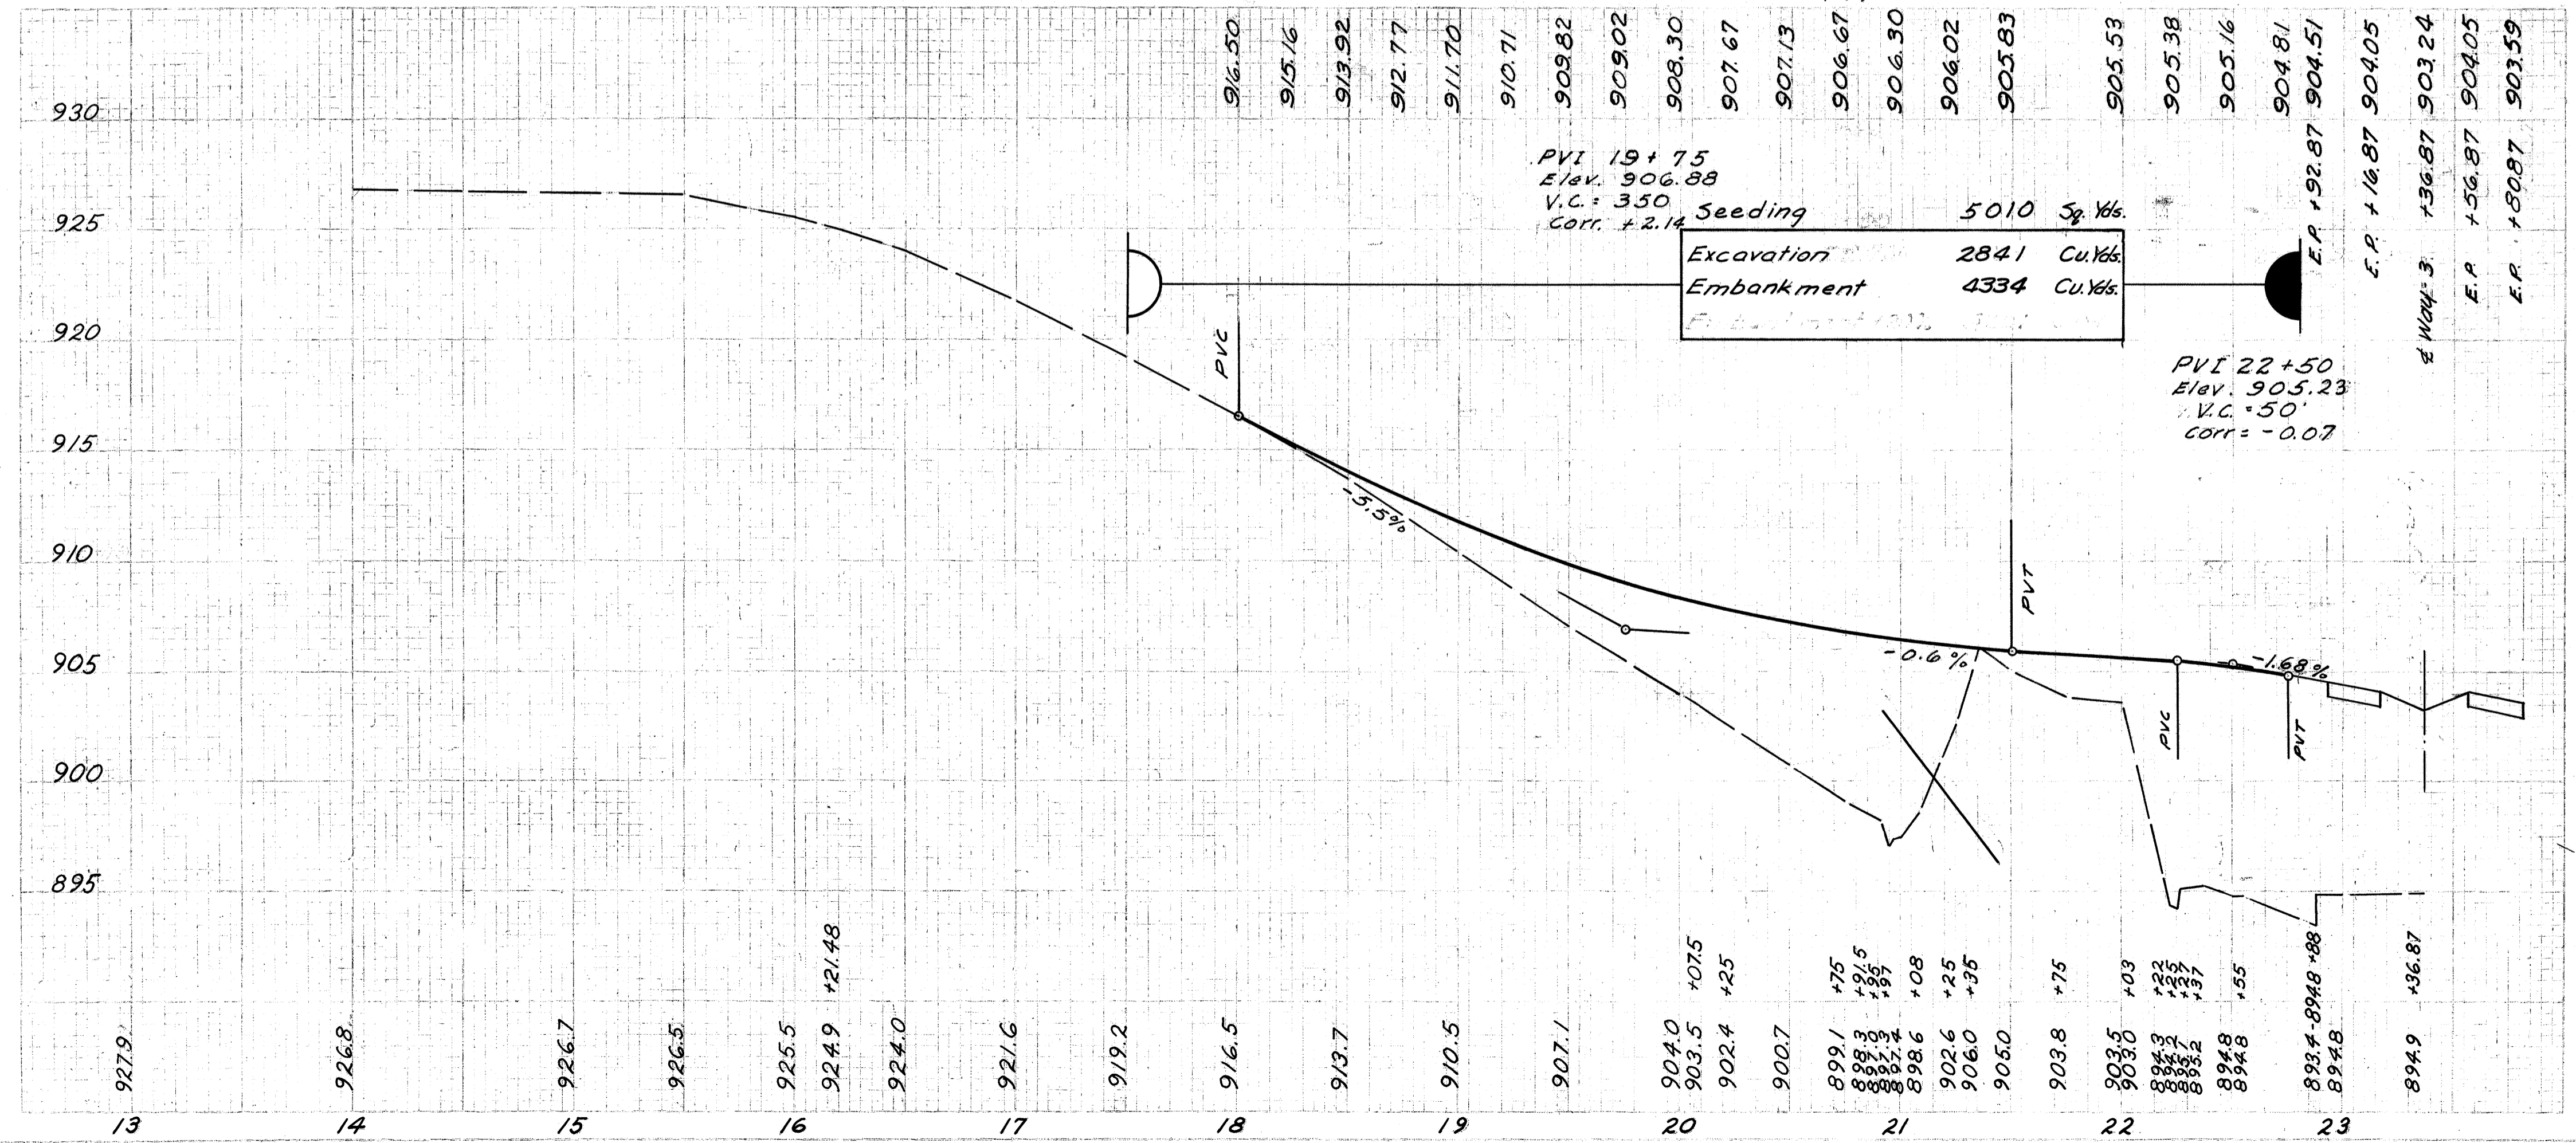


Co. Rd. 174 Sta. 14+00 to Sta. 22+92.87

WAYNE COUNTY
WAY-3-9.94

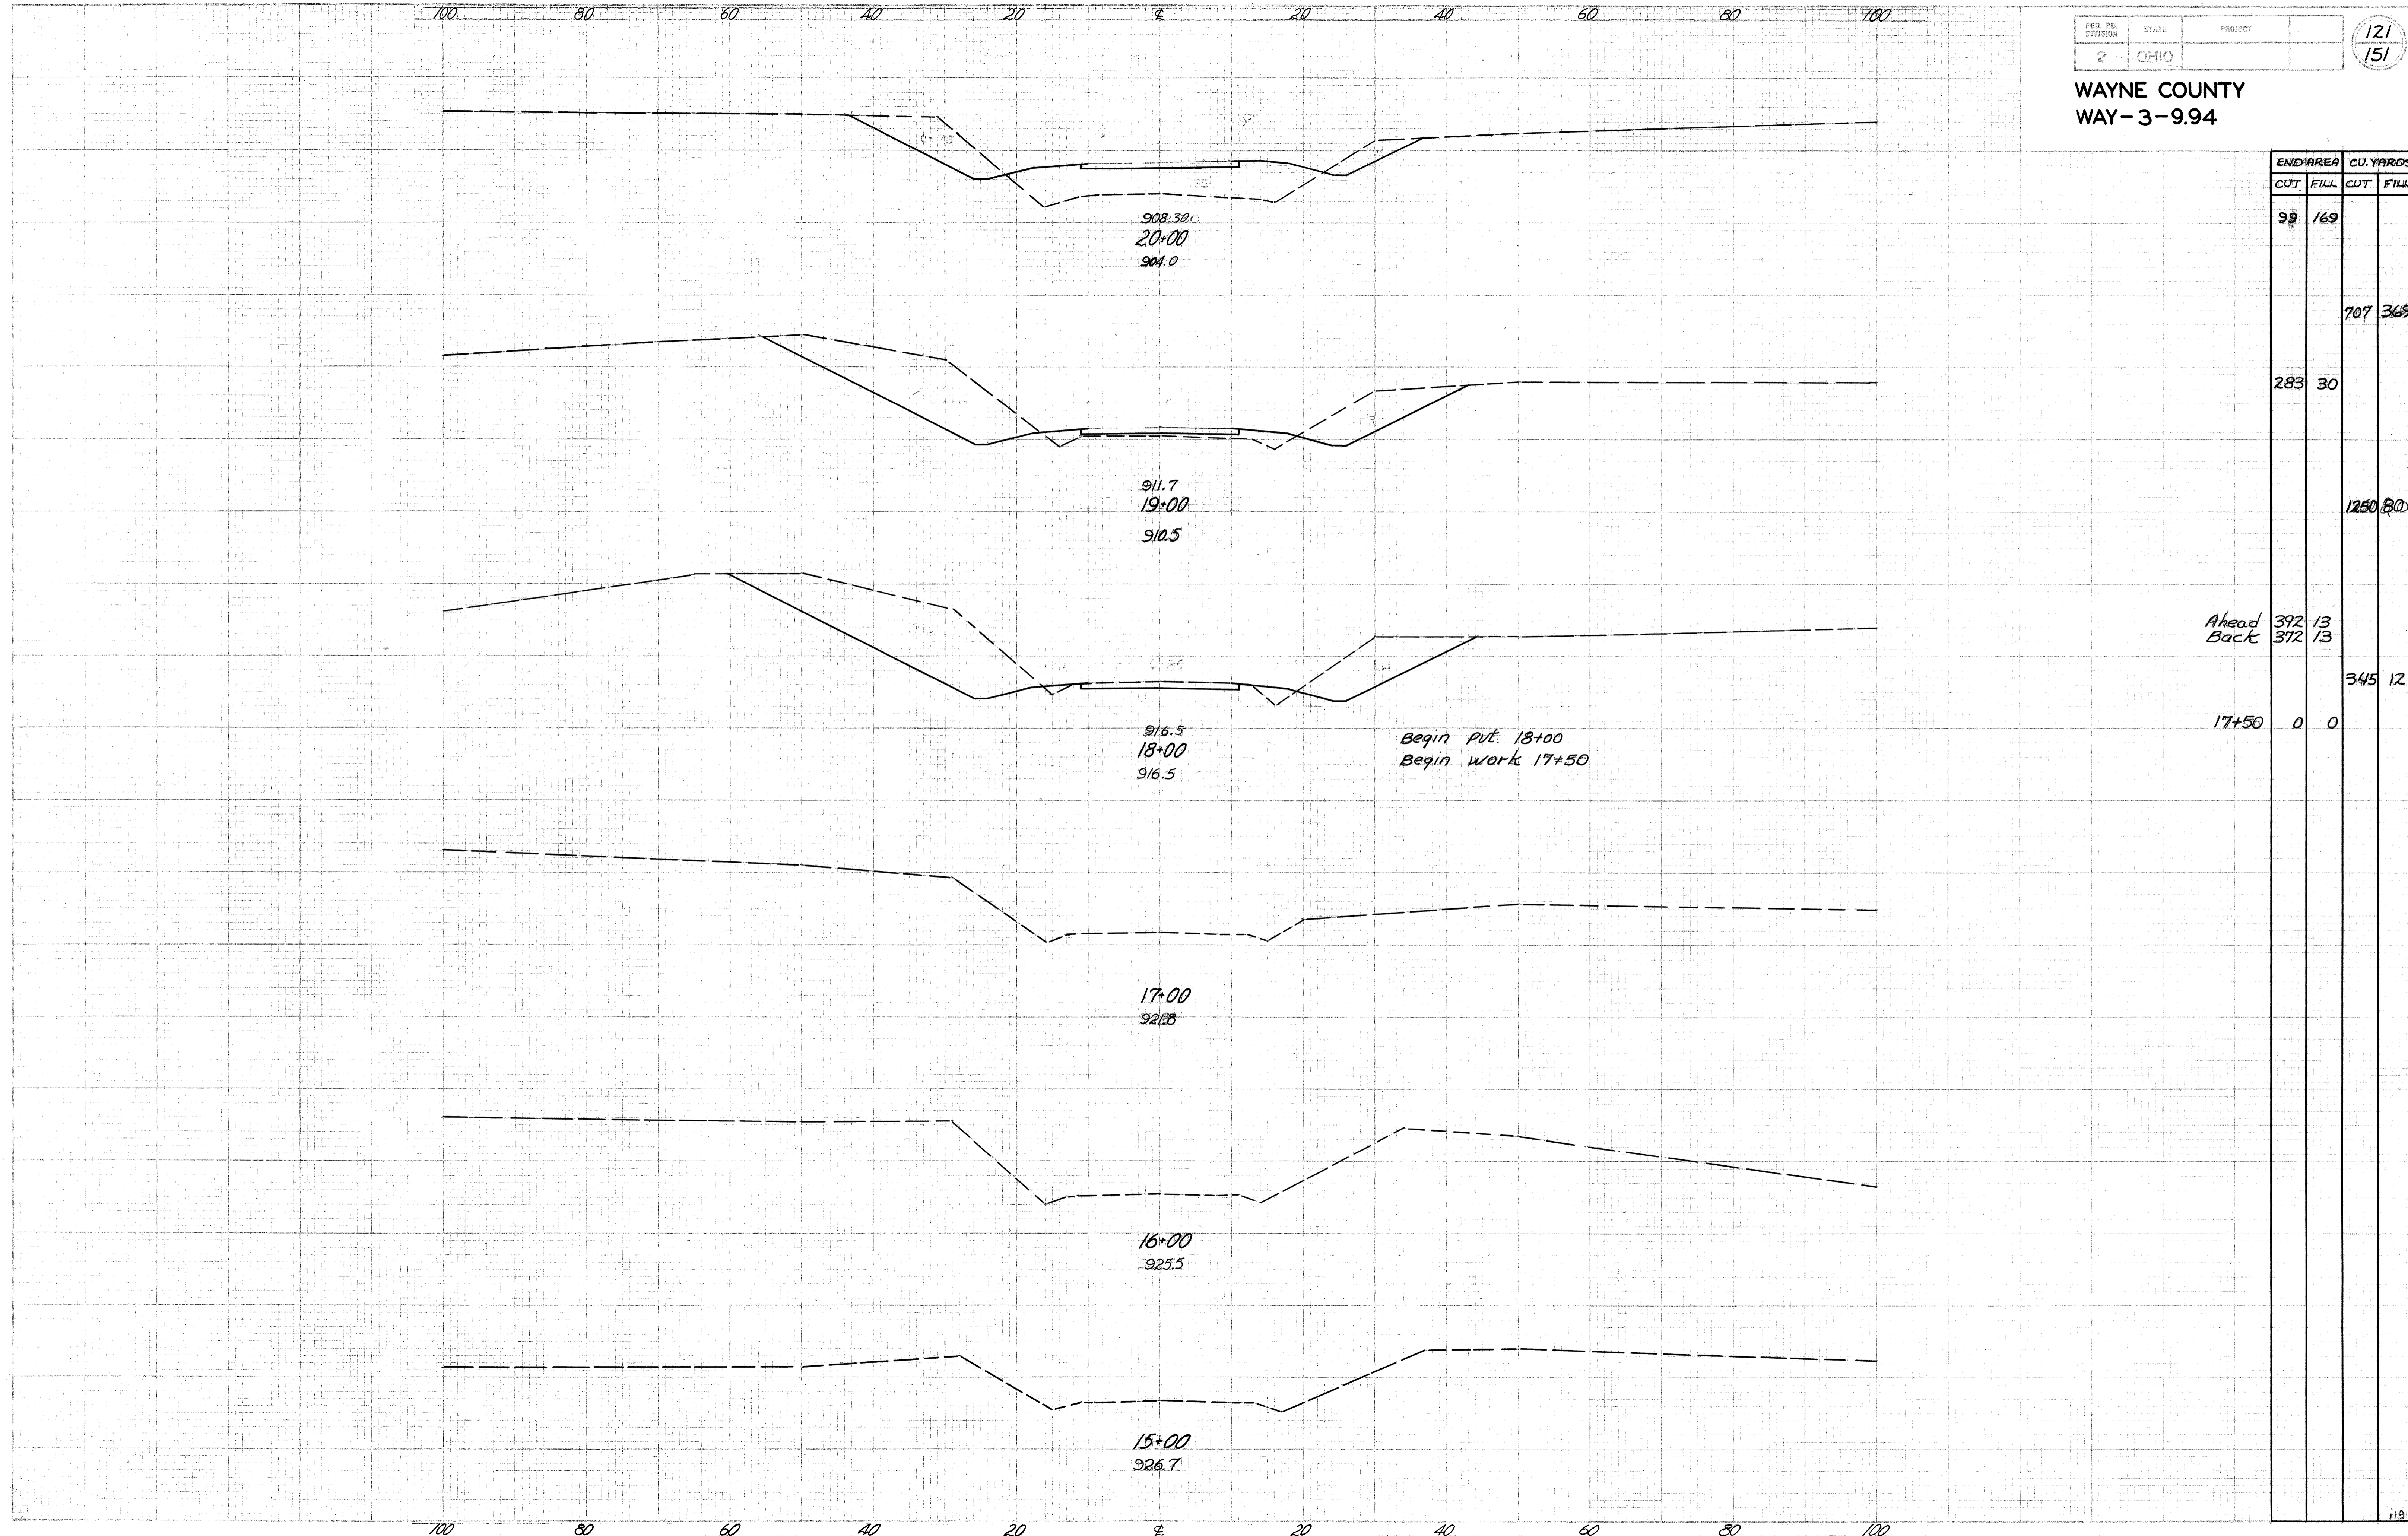

END AREA	CU. YARDS	
	CUT	FILL
99	169	
		707 369
283	30	
		1250 80
Ahead Back	392 372	13 13
		345 12
17+50	0	0

WAYNE COUNTY
WAY-3-9.94

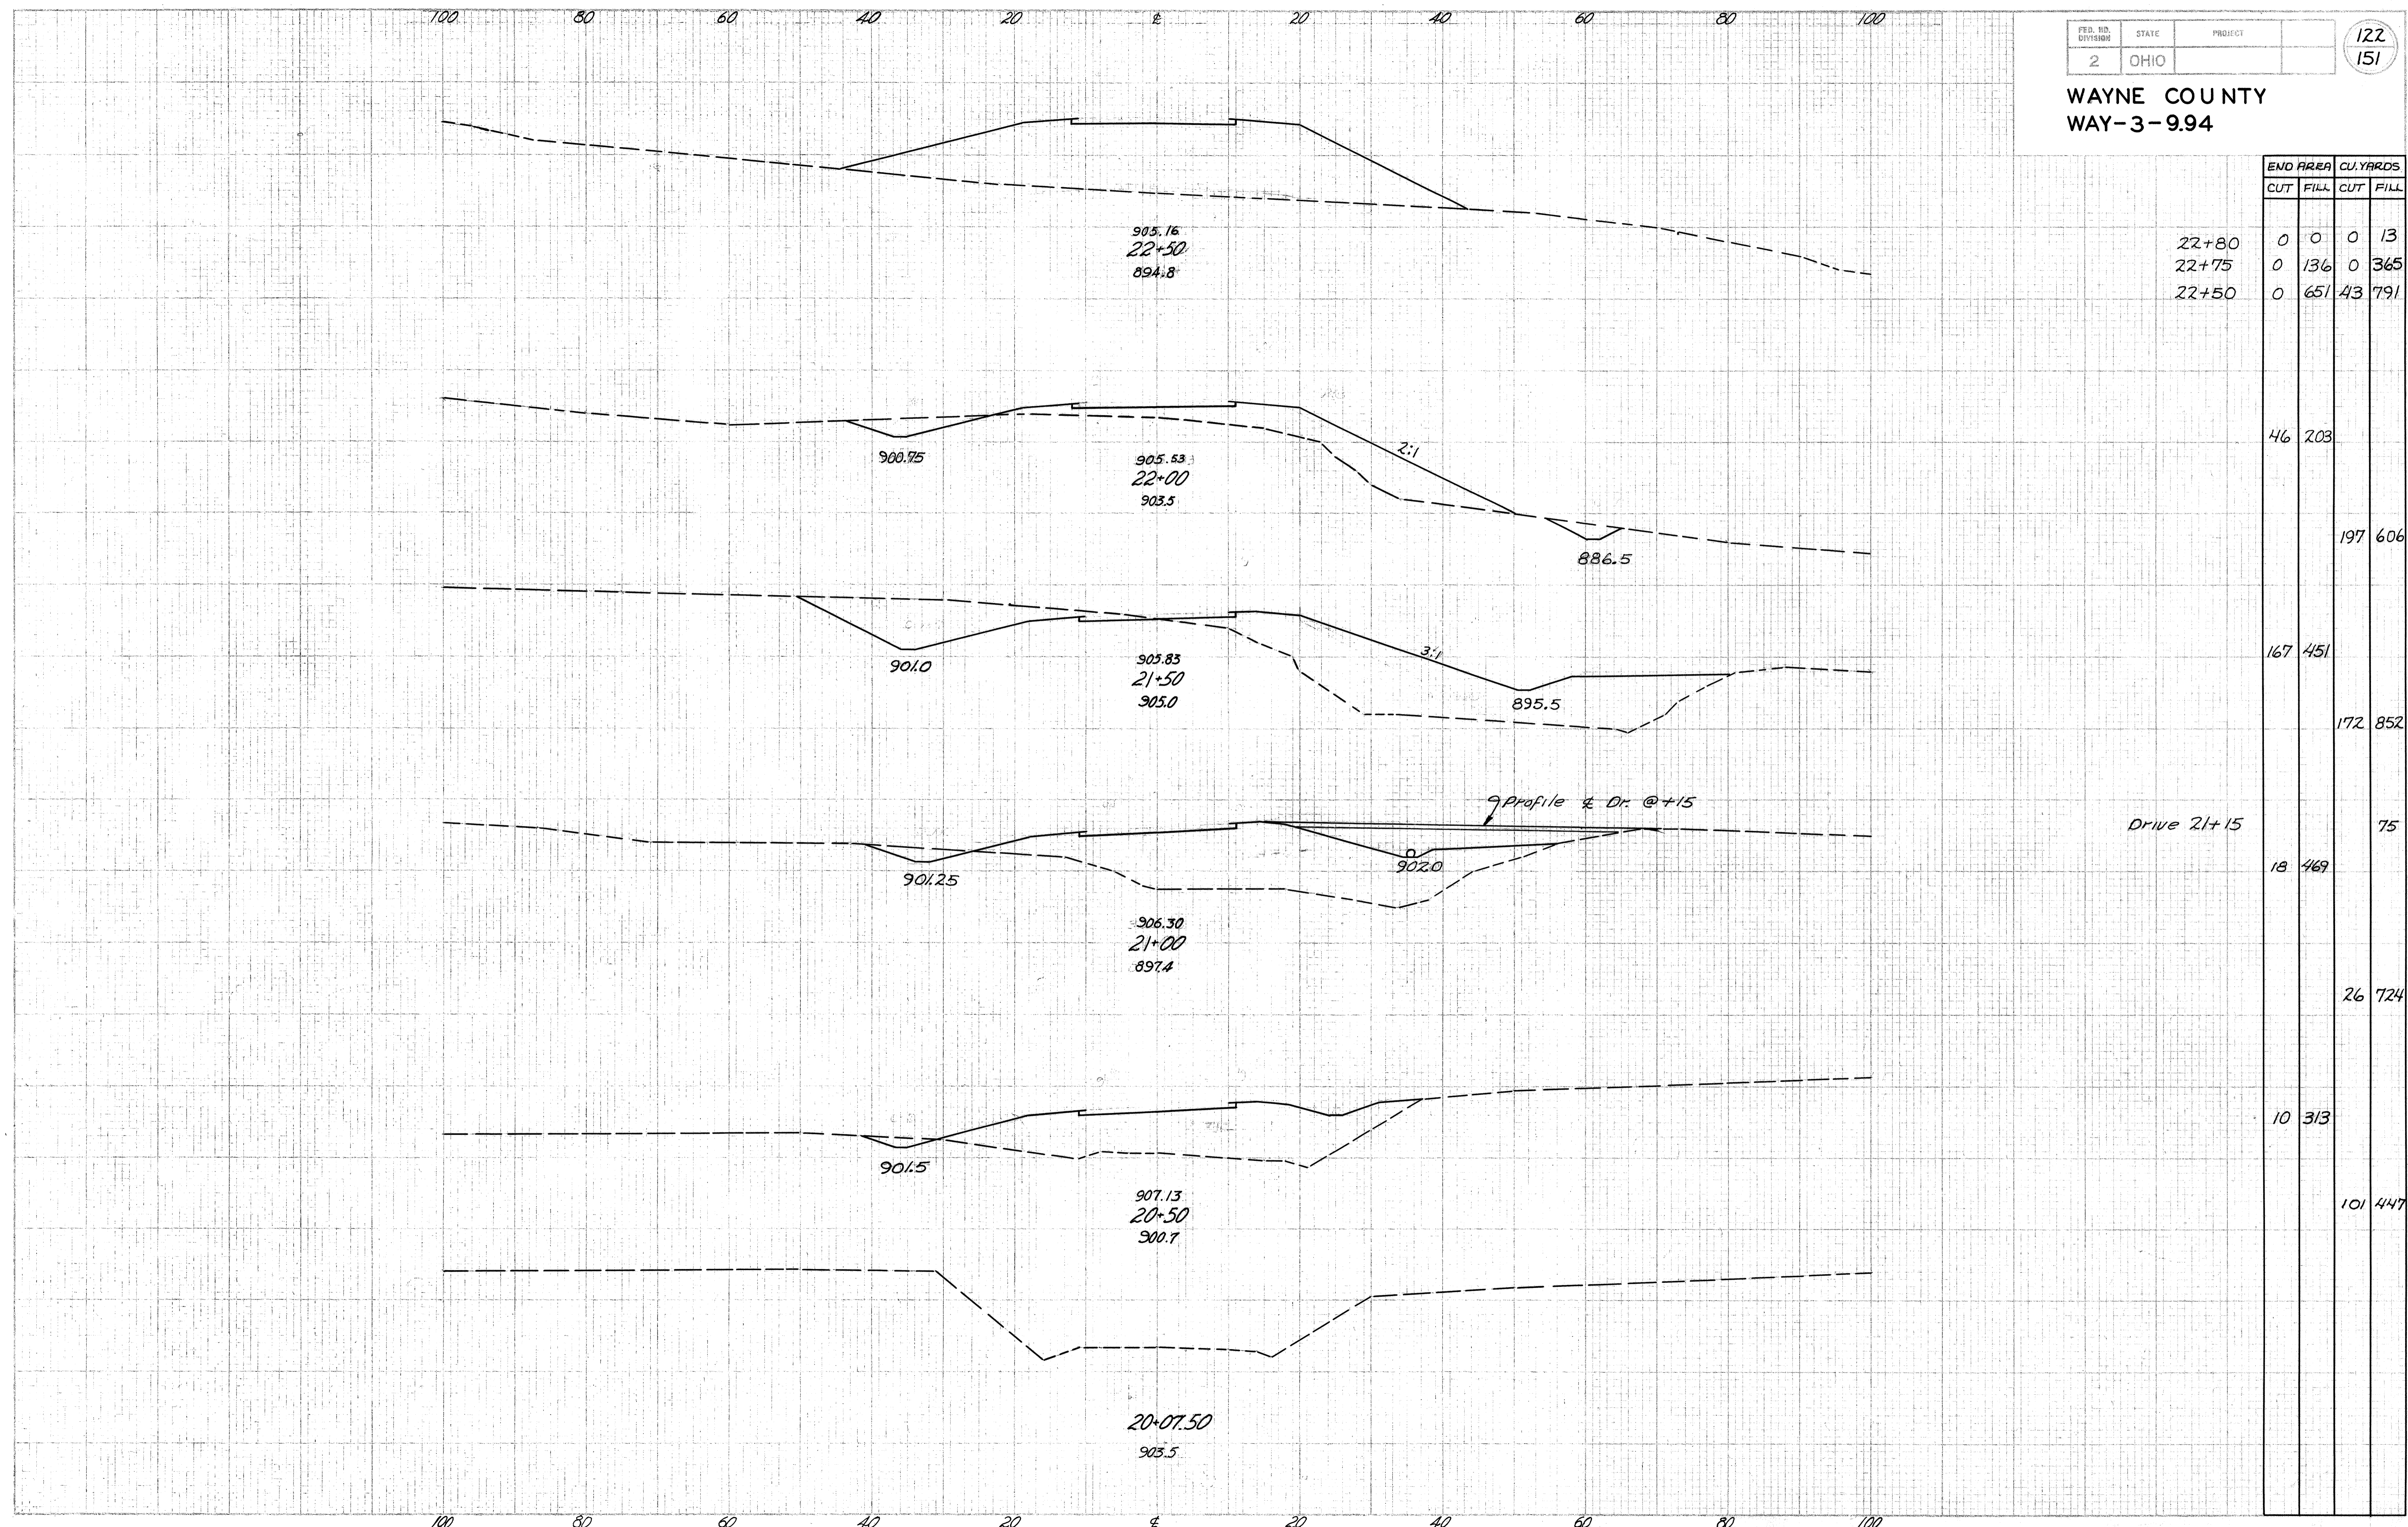

END AREA	CU. YARDS	
	CUT	FILL
22+80	0	13
22+75	0	365
22+50	0	791
	46	203
	197	606
	167	451
	172	852
	18	469
	26	724
	10	313
	101	447


100 80 60 40 20 ± 20 40 60 80 100

FED. RD. DIVISION	STATE	PROJECT
2	OHIO	

123
151

WAYNE COUNTY
WAY-3-9.94


END AREA		CU. YARDS	
CUT	FILL	CUT	FILL

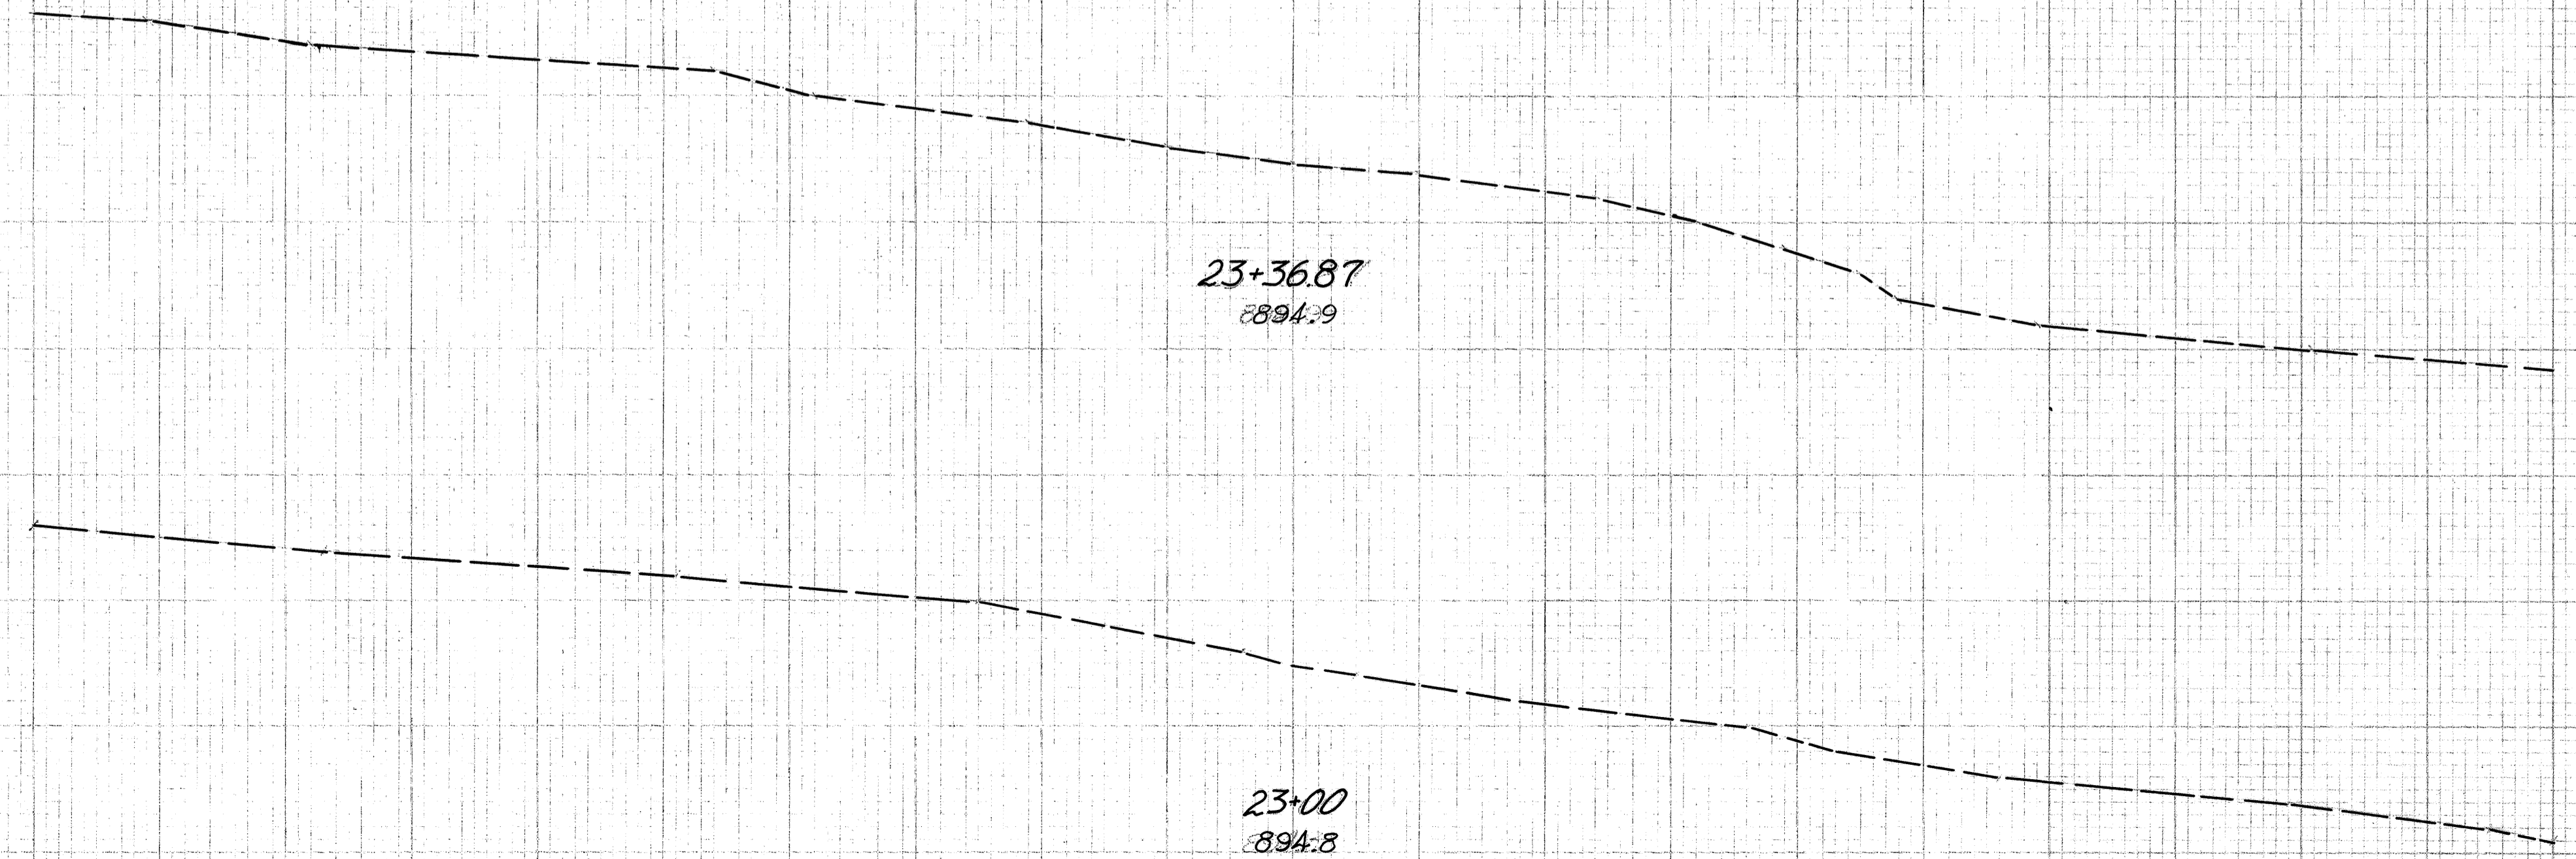

100 80 60 40 20 ± 20 40 60 80 100



Co. Rd. 174 Sta 23+00 To Sta 23+36.87

WAYNE COUNTY
WAY-3-9.94

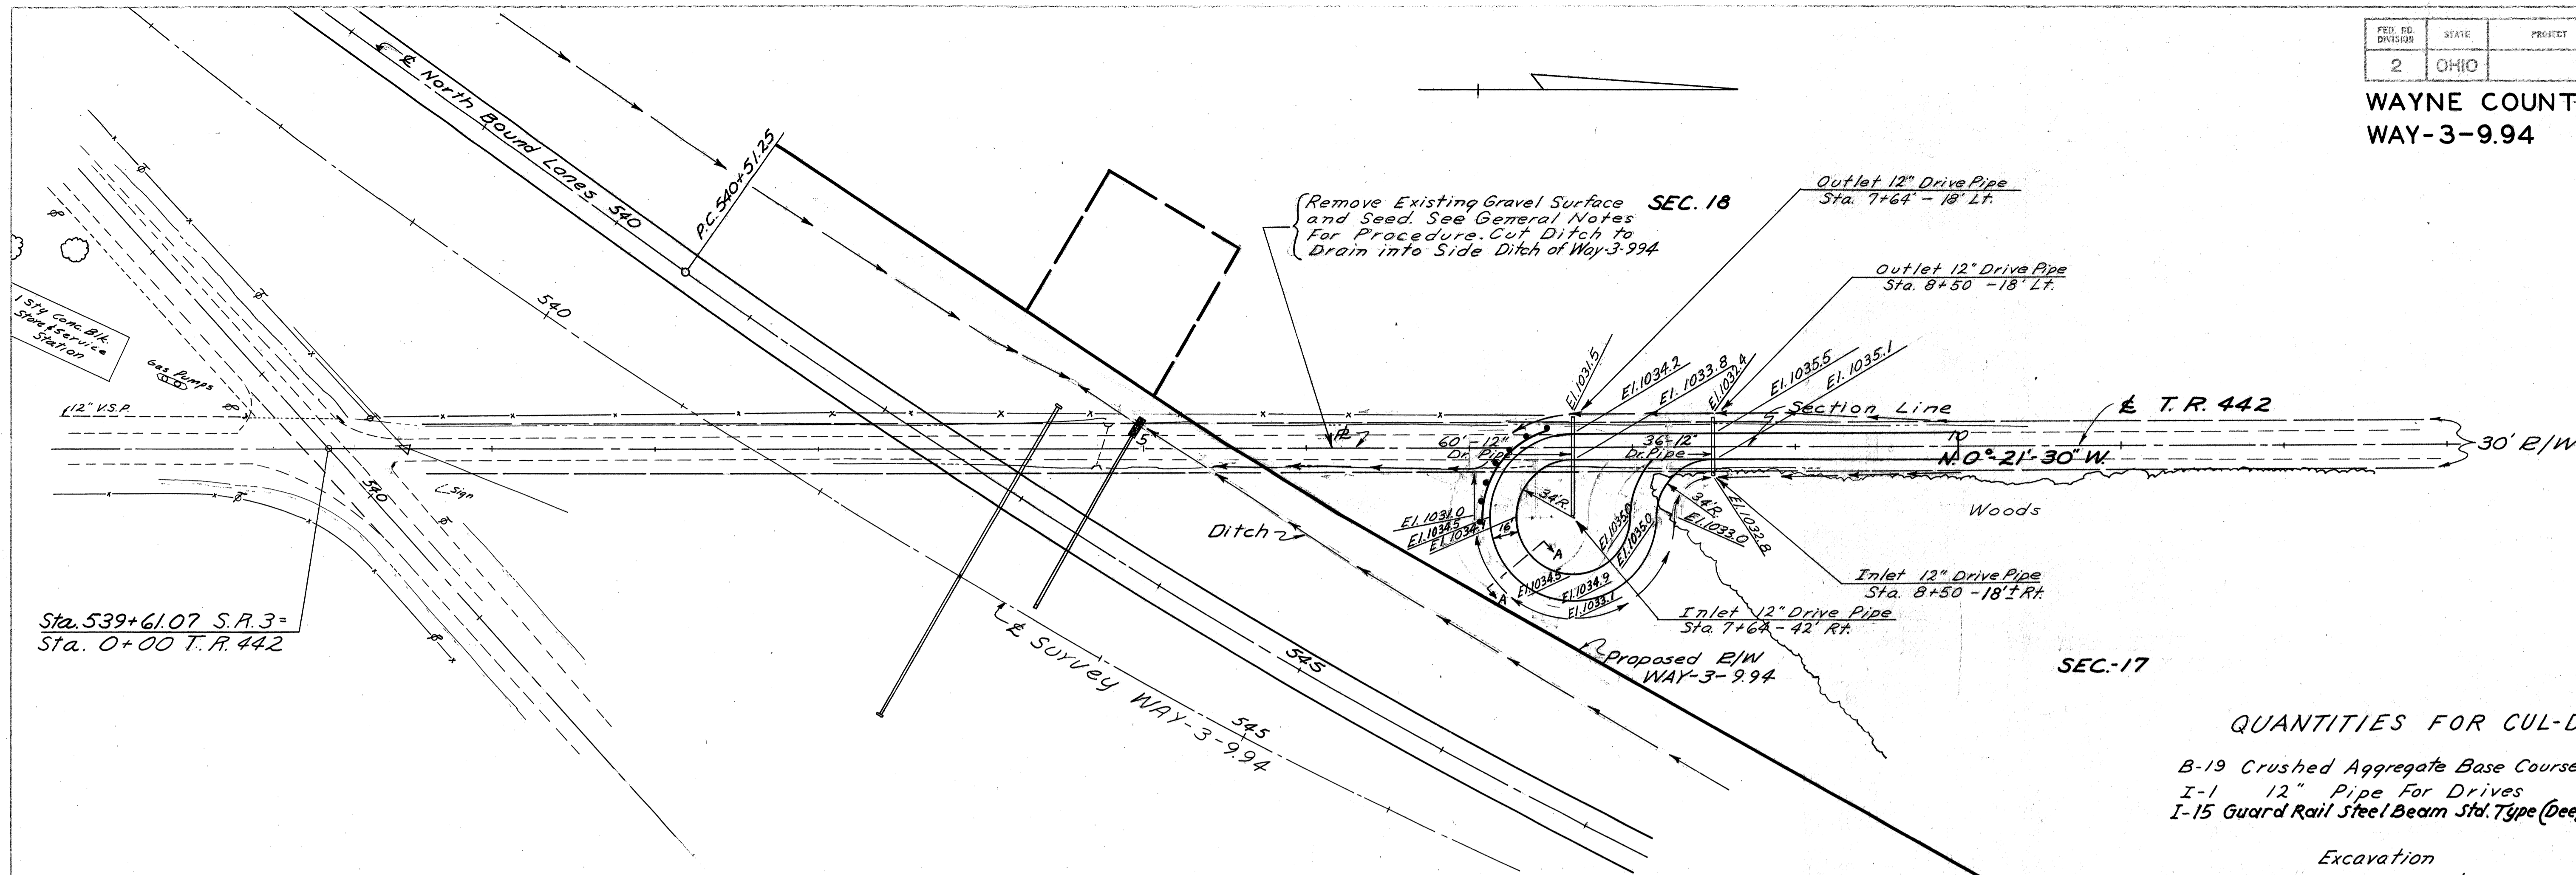

QUANTITIES FOR CUL-DE-SAC


B-19 Crushed Aggregate Base Course	148.12 Cu. Yds.
I-1 12" Pipe For Drives	96.0 Lin. Ft.
I-15 Guard Rail Steel Beam Std. Type (Deep)	75.0 Lin. Ft.
Excavation	119 Cu. Yds.
Embankment	709 Cu. Yds.
Seeding	2,612 Sq. Yds.

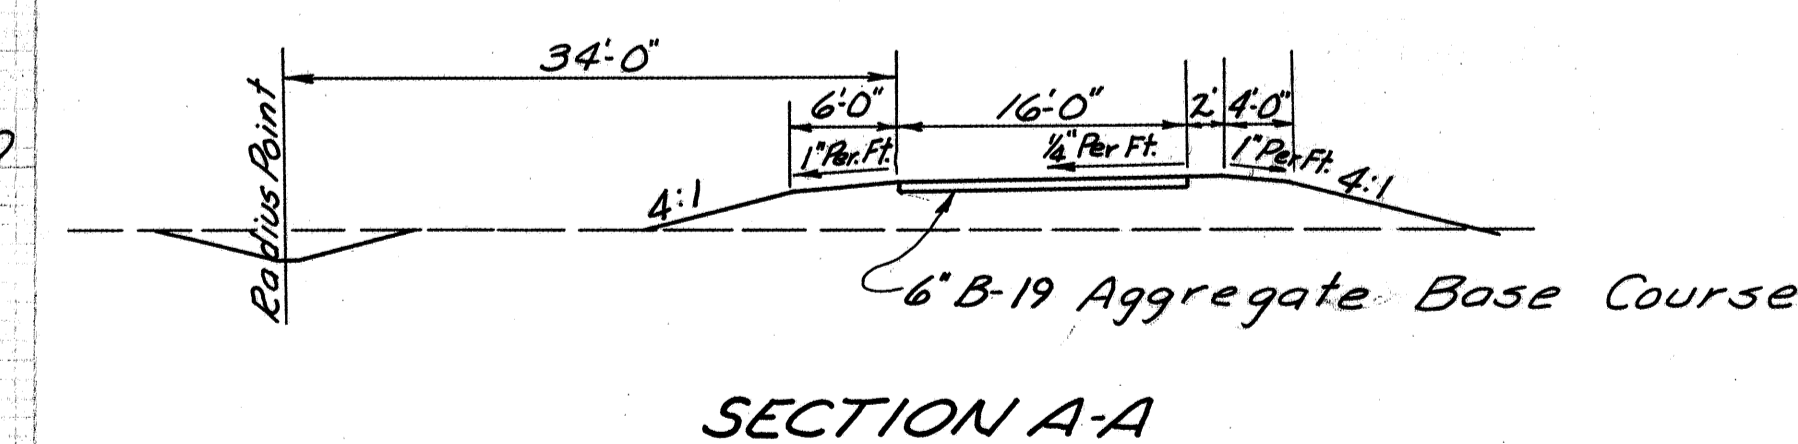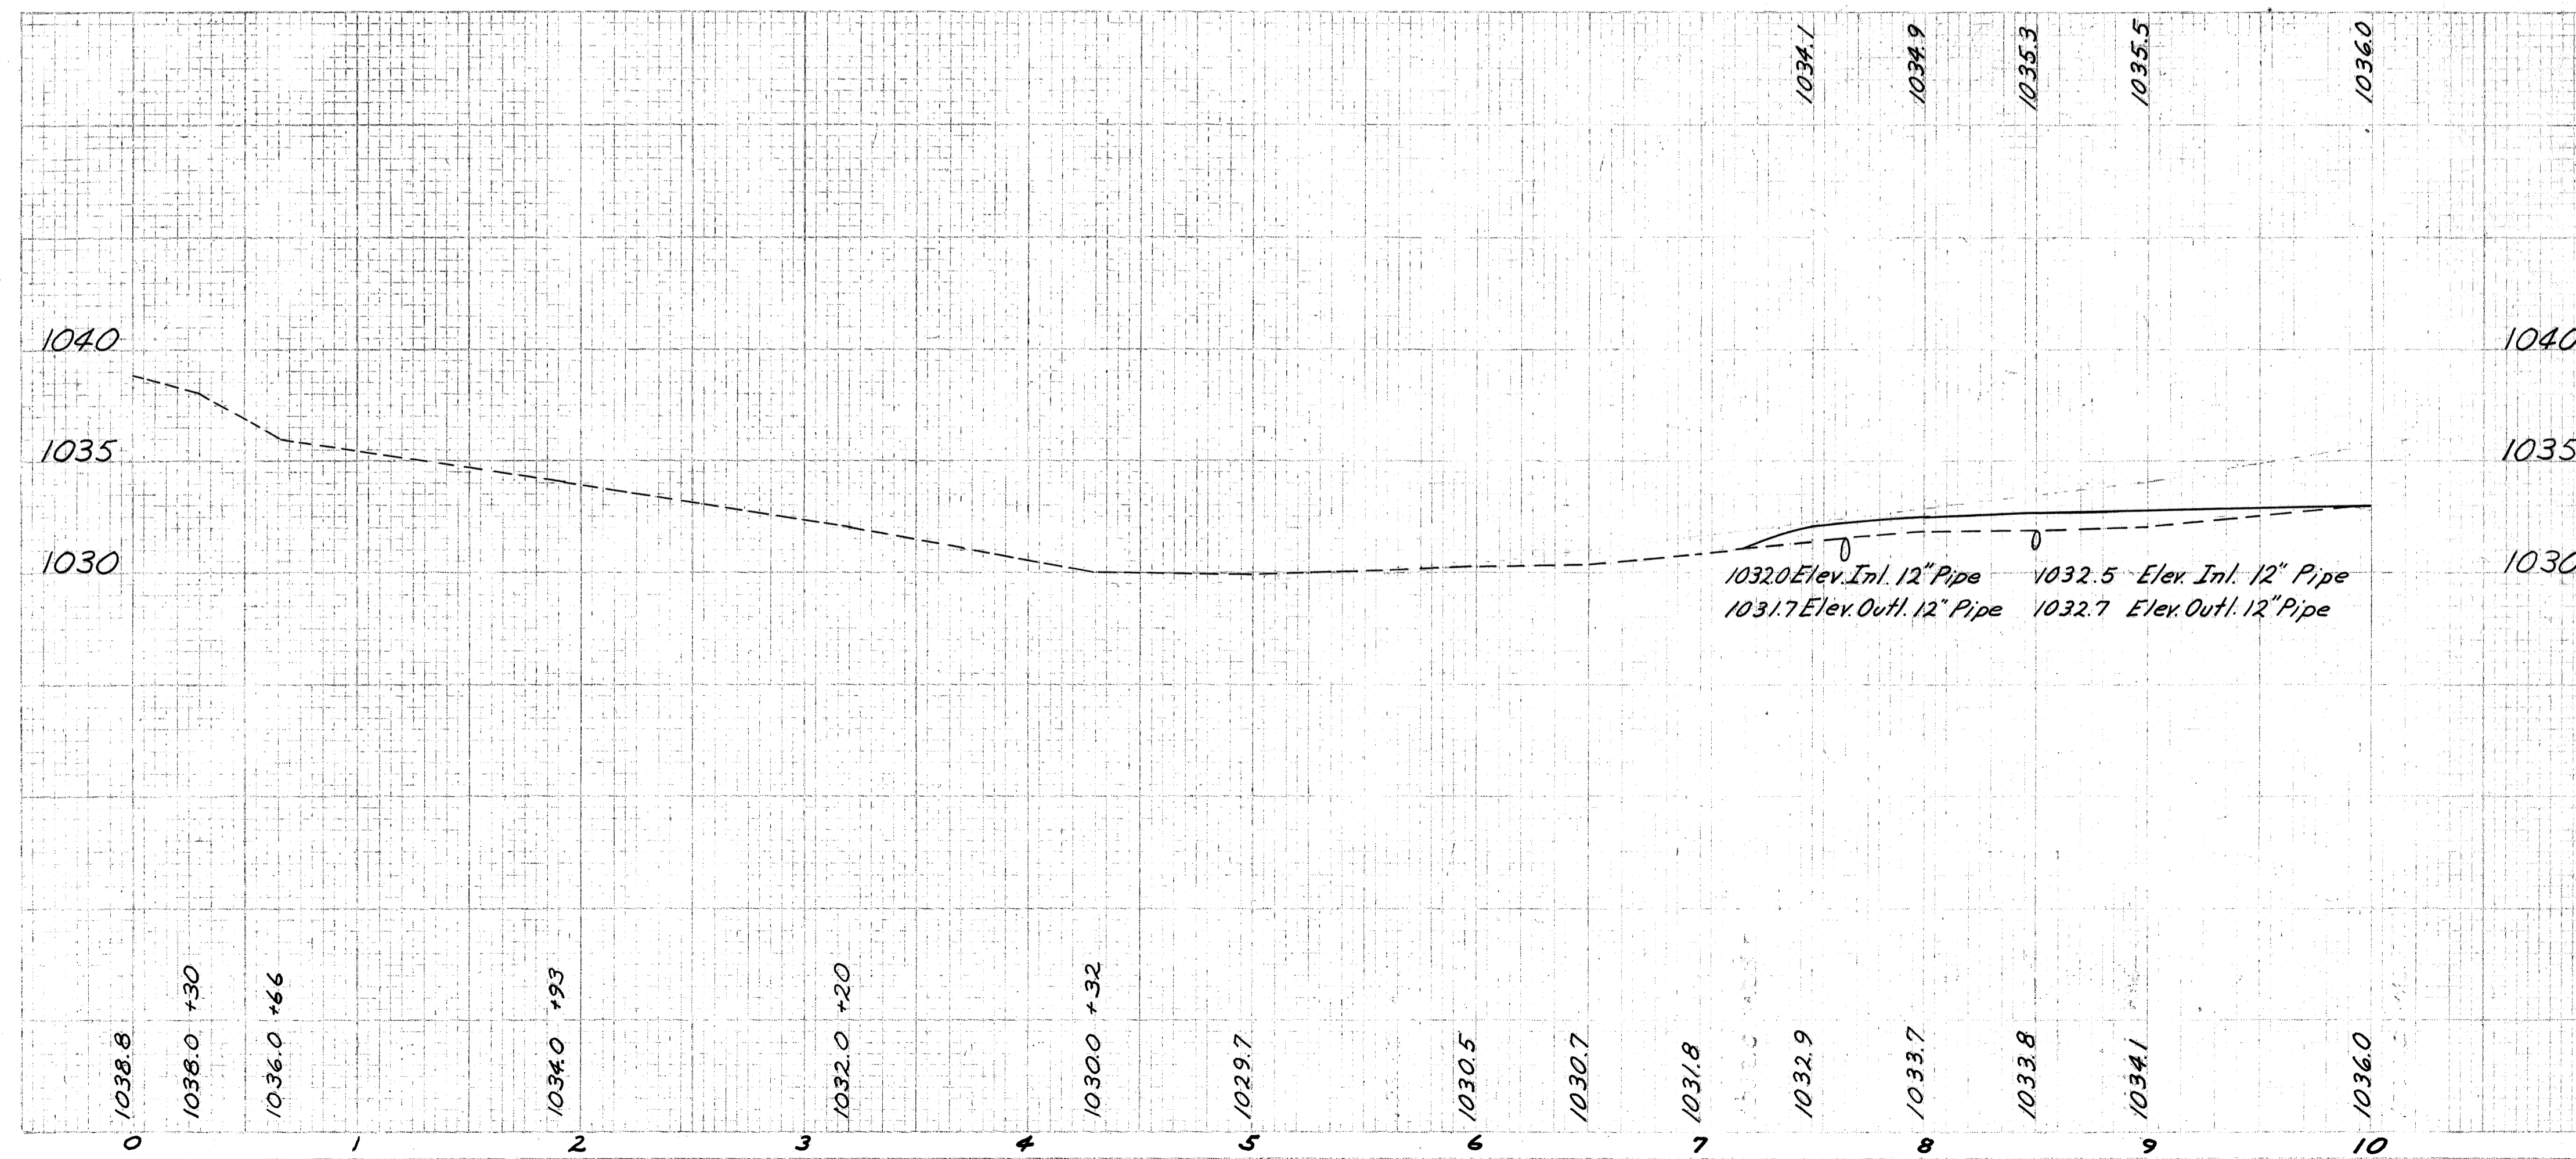

150 140 120 100 80 60 40 20 0 20 40 60 80 100

FED. RD. DIVISION	STATE	PROJECT	125 151
2	OHIO		

**WAYNE COUNTY
WAY-3-9.94**

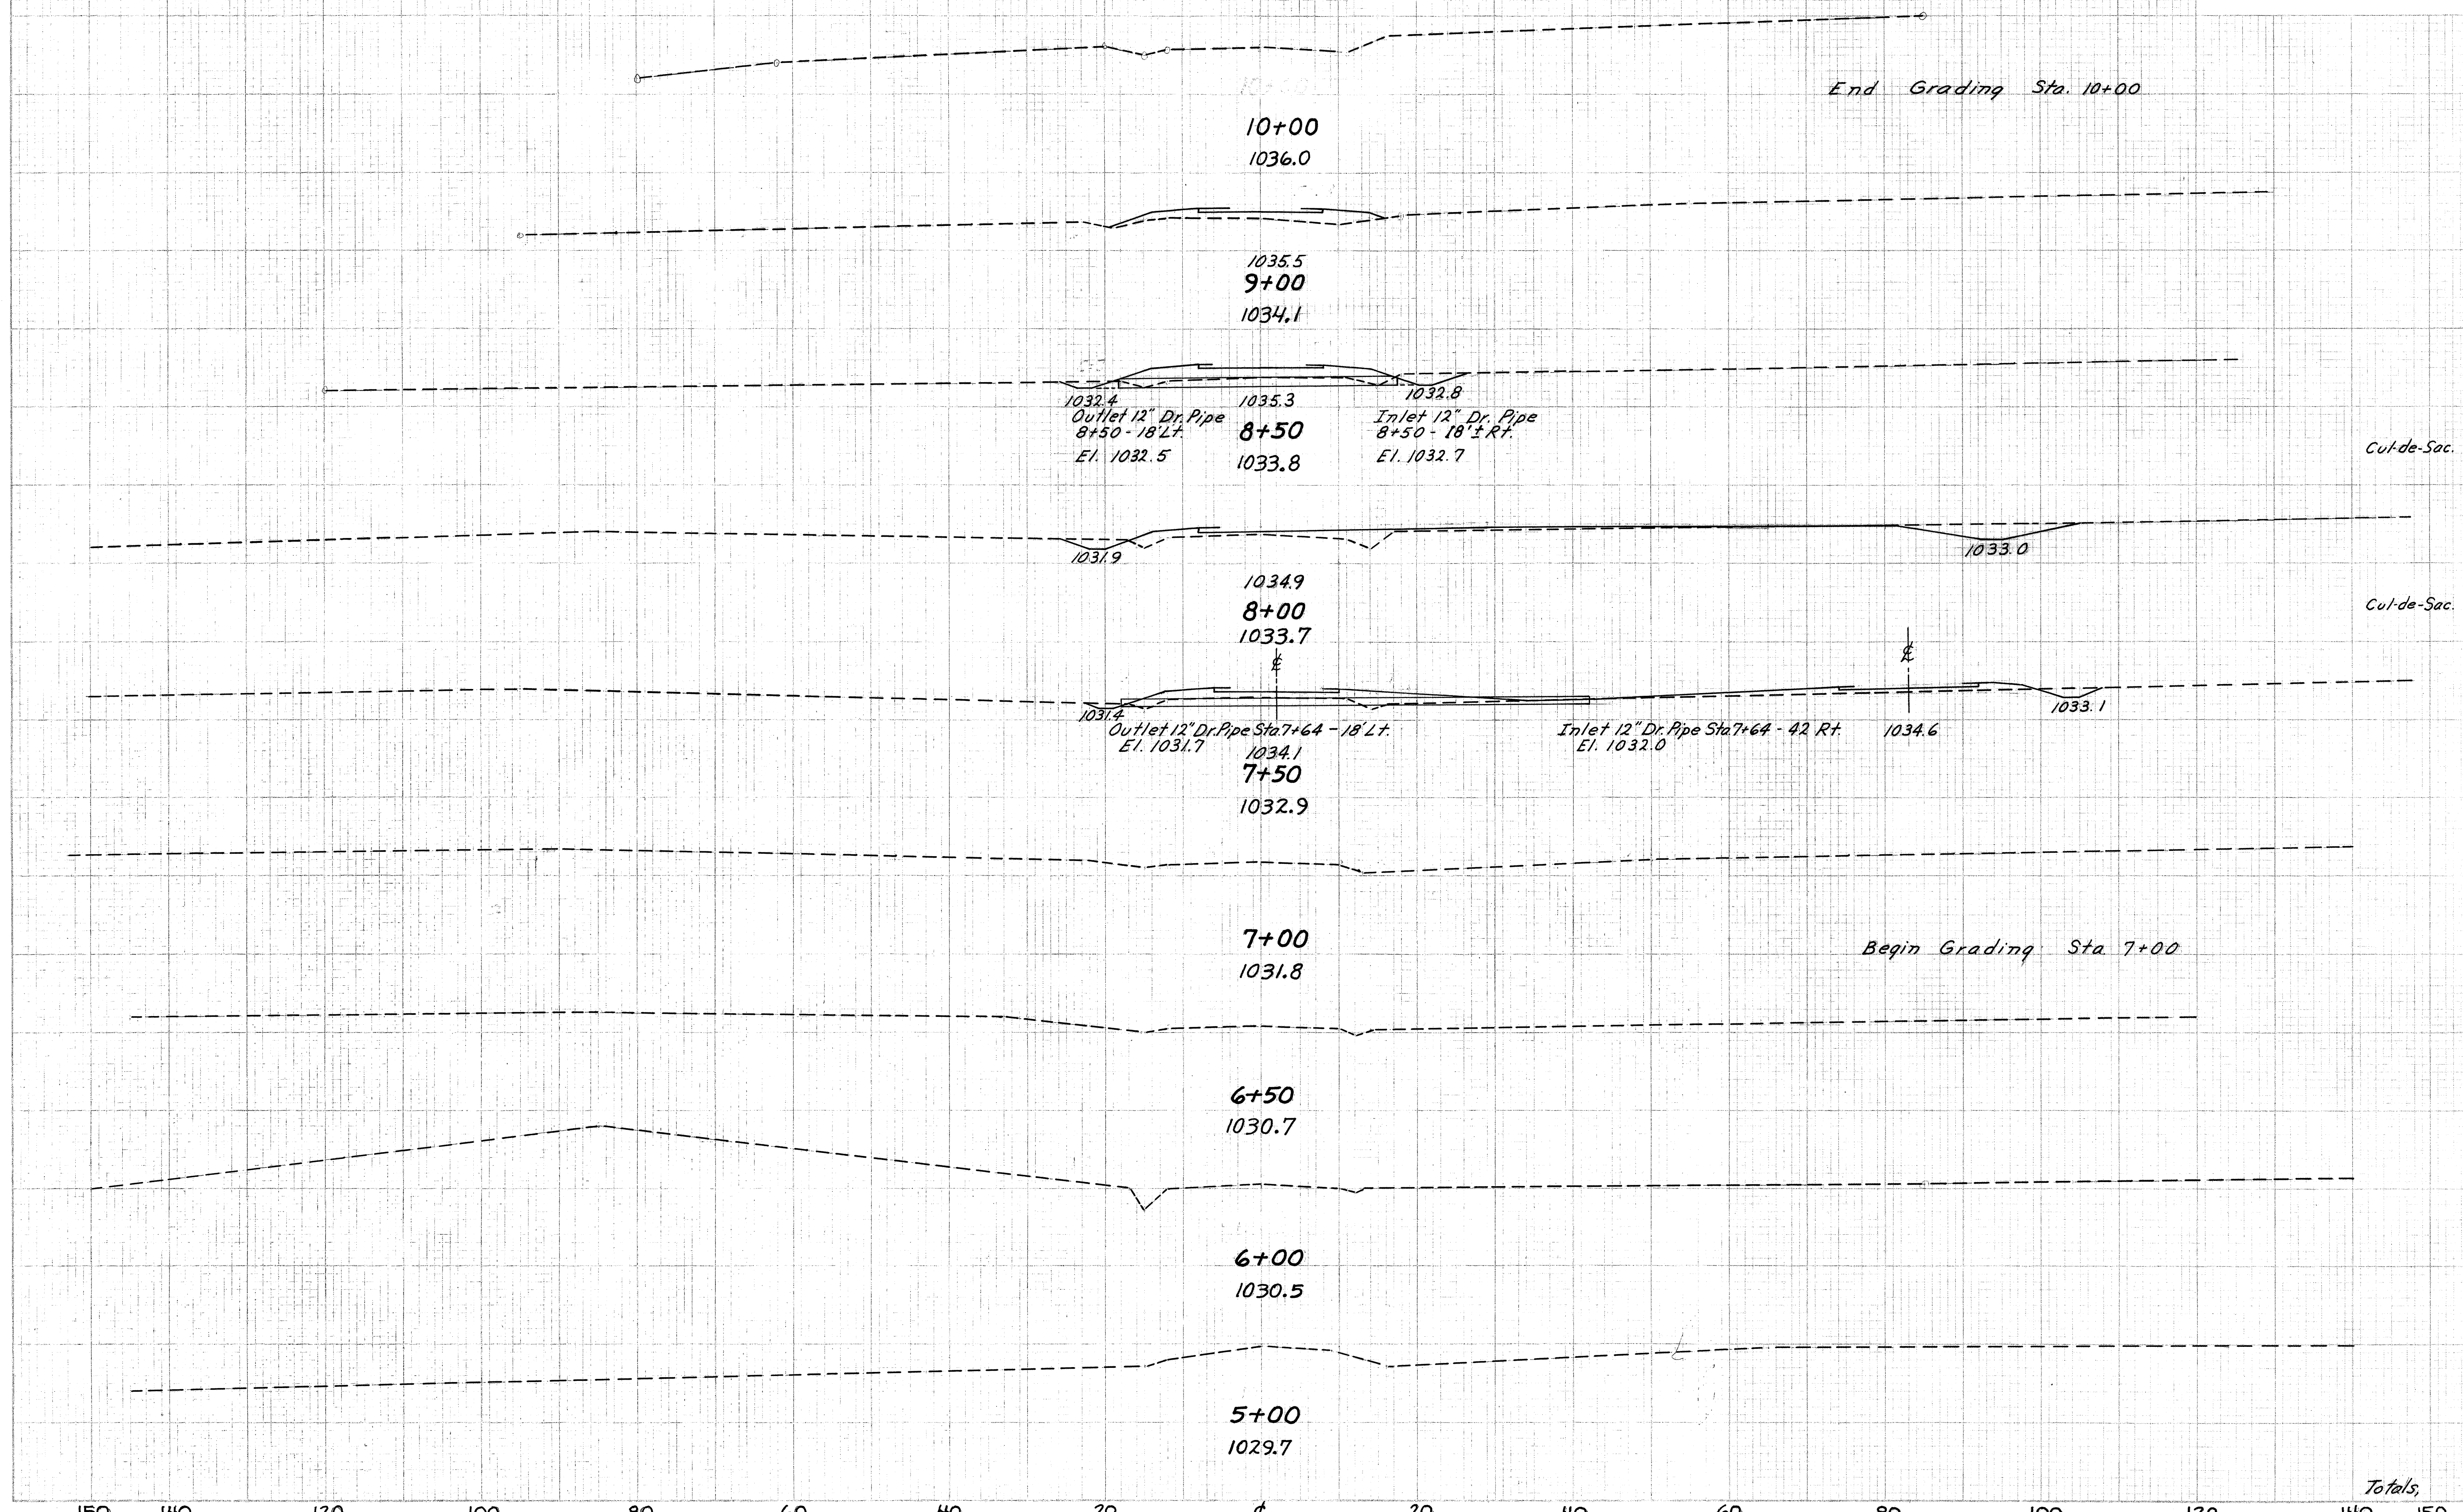


END AREA		CU. YARDS	
CUT	FILL	CUT	FILL
0	0	0	70
0	38	11	86
12	55	19	85
		35	115
8	36	10	86
		44	267
3	57		
<i>Totals</i>		119	709

150 140 120 100 80 60 40 20 0 20 40 60 80 100 120 140 150
Sta. 5+00 To Sta. 10+00

**WAYNE COUNTY
WAY-3-9.94**

Frontage Road Curve Data
 P.I. Sta. 7+41.20
 $\Delta = 7^{\circ}36'30''$
 $D = 1^{\circ}25'20''$
 $R = 4028.53'$
 $T = 267.87'$
 $L = 534.95'$
 $E = 8.90'$

**BEGIN WORK
STA. 4+85.32**

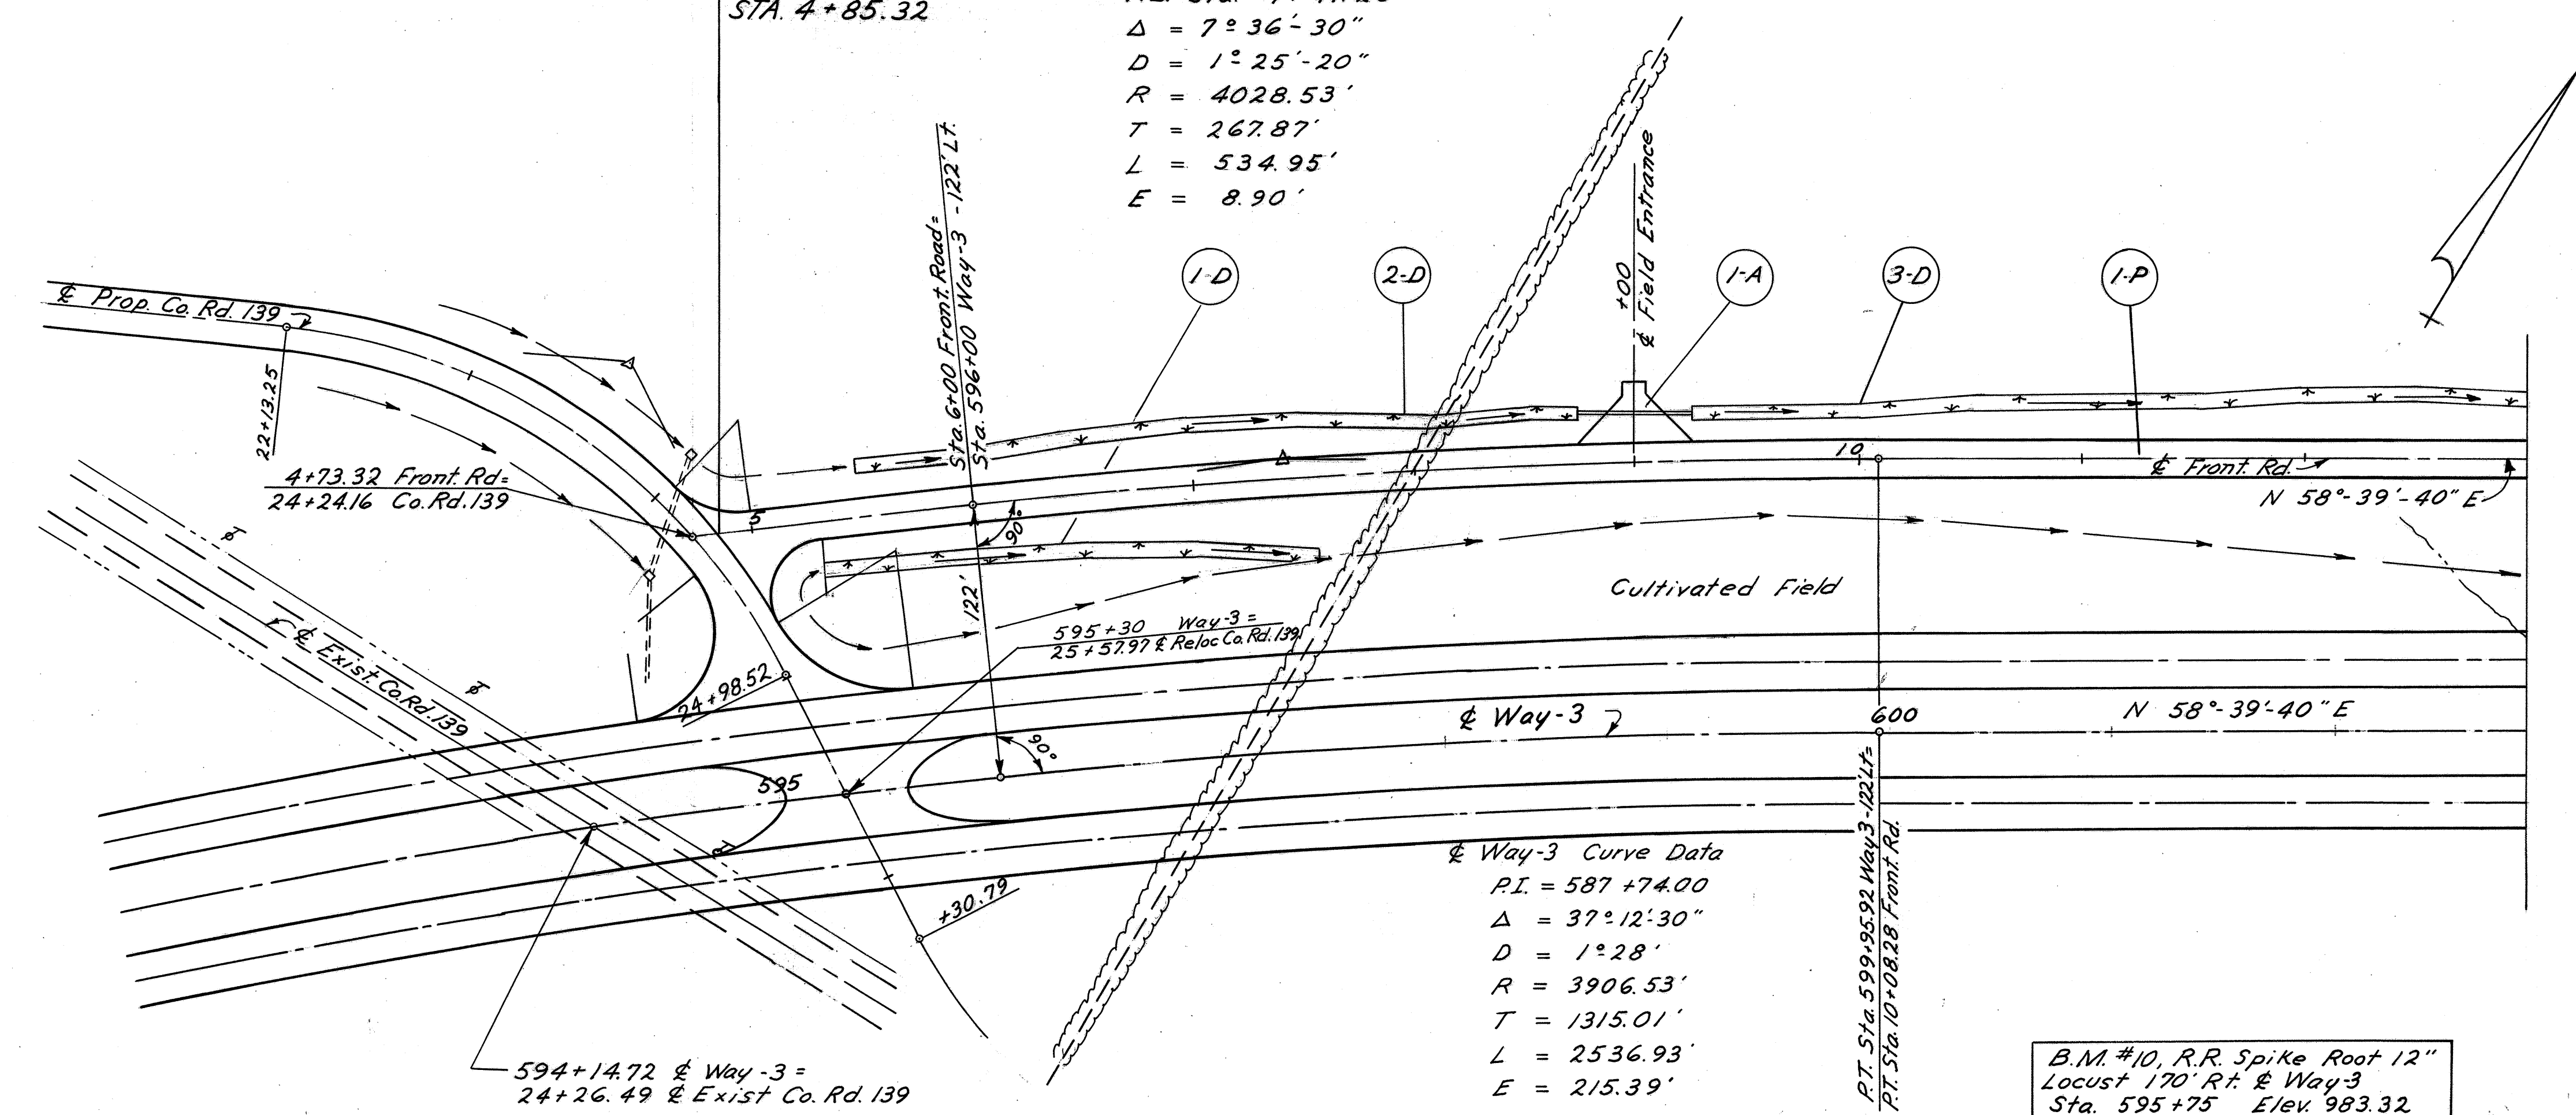


Way-3 Curve Data
 P.I. = 587+74.00
 $\Delta = 37^{\circ}12'30''$
 $D = 1^{\circ}28'$
 $R = 3906.53'$
 $T = 1315.01'$
 $L = 2536.93'$
 $E = 215.39'$

B.M. #10, R.R. Spike Root 12"
 Locust 170' R. & Way-3
 Sta. 595+75 Elev. 983.32

Item No.	Station		Side	L-10 Sodding Width		I-1 Pipe For Drives Lin. Ft.	Length	B-19 Crushed Aggregate Base Course	
	From	To		Lin. Ft.	Sq. Yds.			5"	6"
1-D	5+30	7+50	Rt.	6	147				
2-D	5+50	8+75	Lt.	6	217				
3-D	9+27	13+00	Lt.	6	249				
1-A	9+00		Lt.			52	25		1260
Totals						613	52		1260

Item No.	Station		Side	T-35 Asphaltic Conc. Surface Course 1 1/2" Type A	T-30 Bituminous Prime Coat 46 gal/sq. Yd.	B-19 Crushed Agg. Base Course 5"	I-22 Subbase Grading 4" No. 2	I-9 Stone Underdrains
	From	To		Cu. Yd.	Gal.	Cu. Yds.	Cu. Yd.	Lin. Ft.
1-P	4+85.32	20+20		115.96	1113.13	409.81	346.48	325.0
Totals				115.96	1113.13	409.81	346.48	325.00

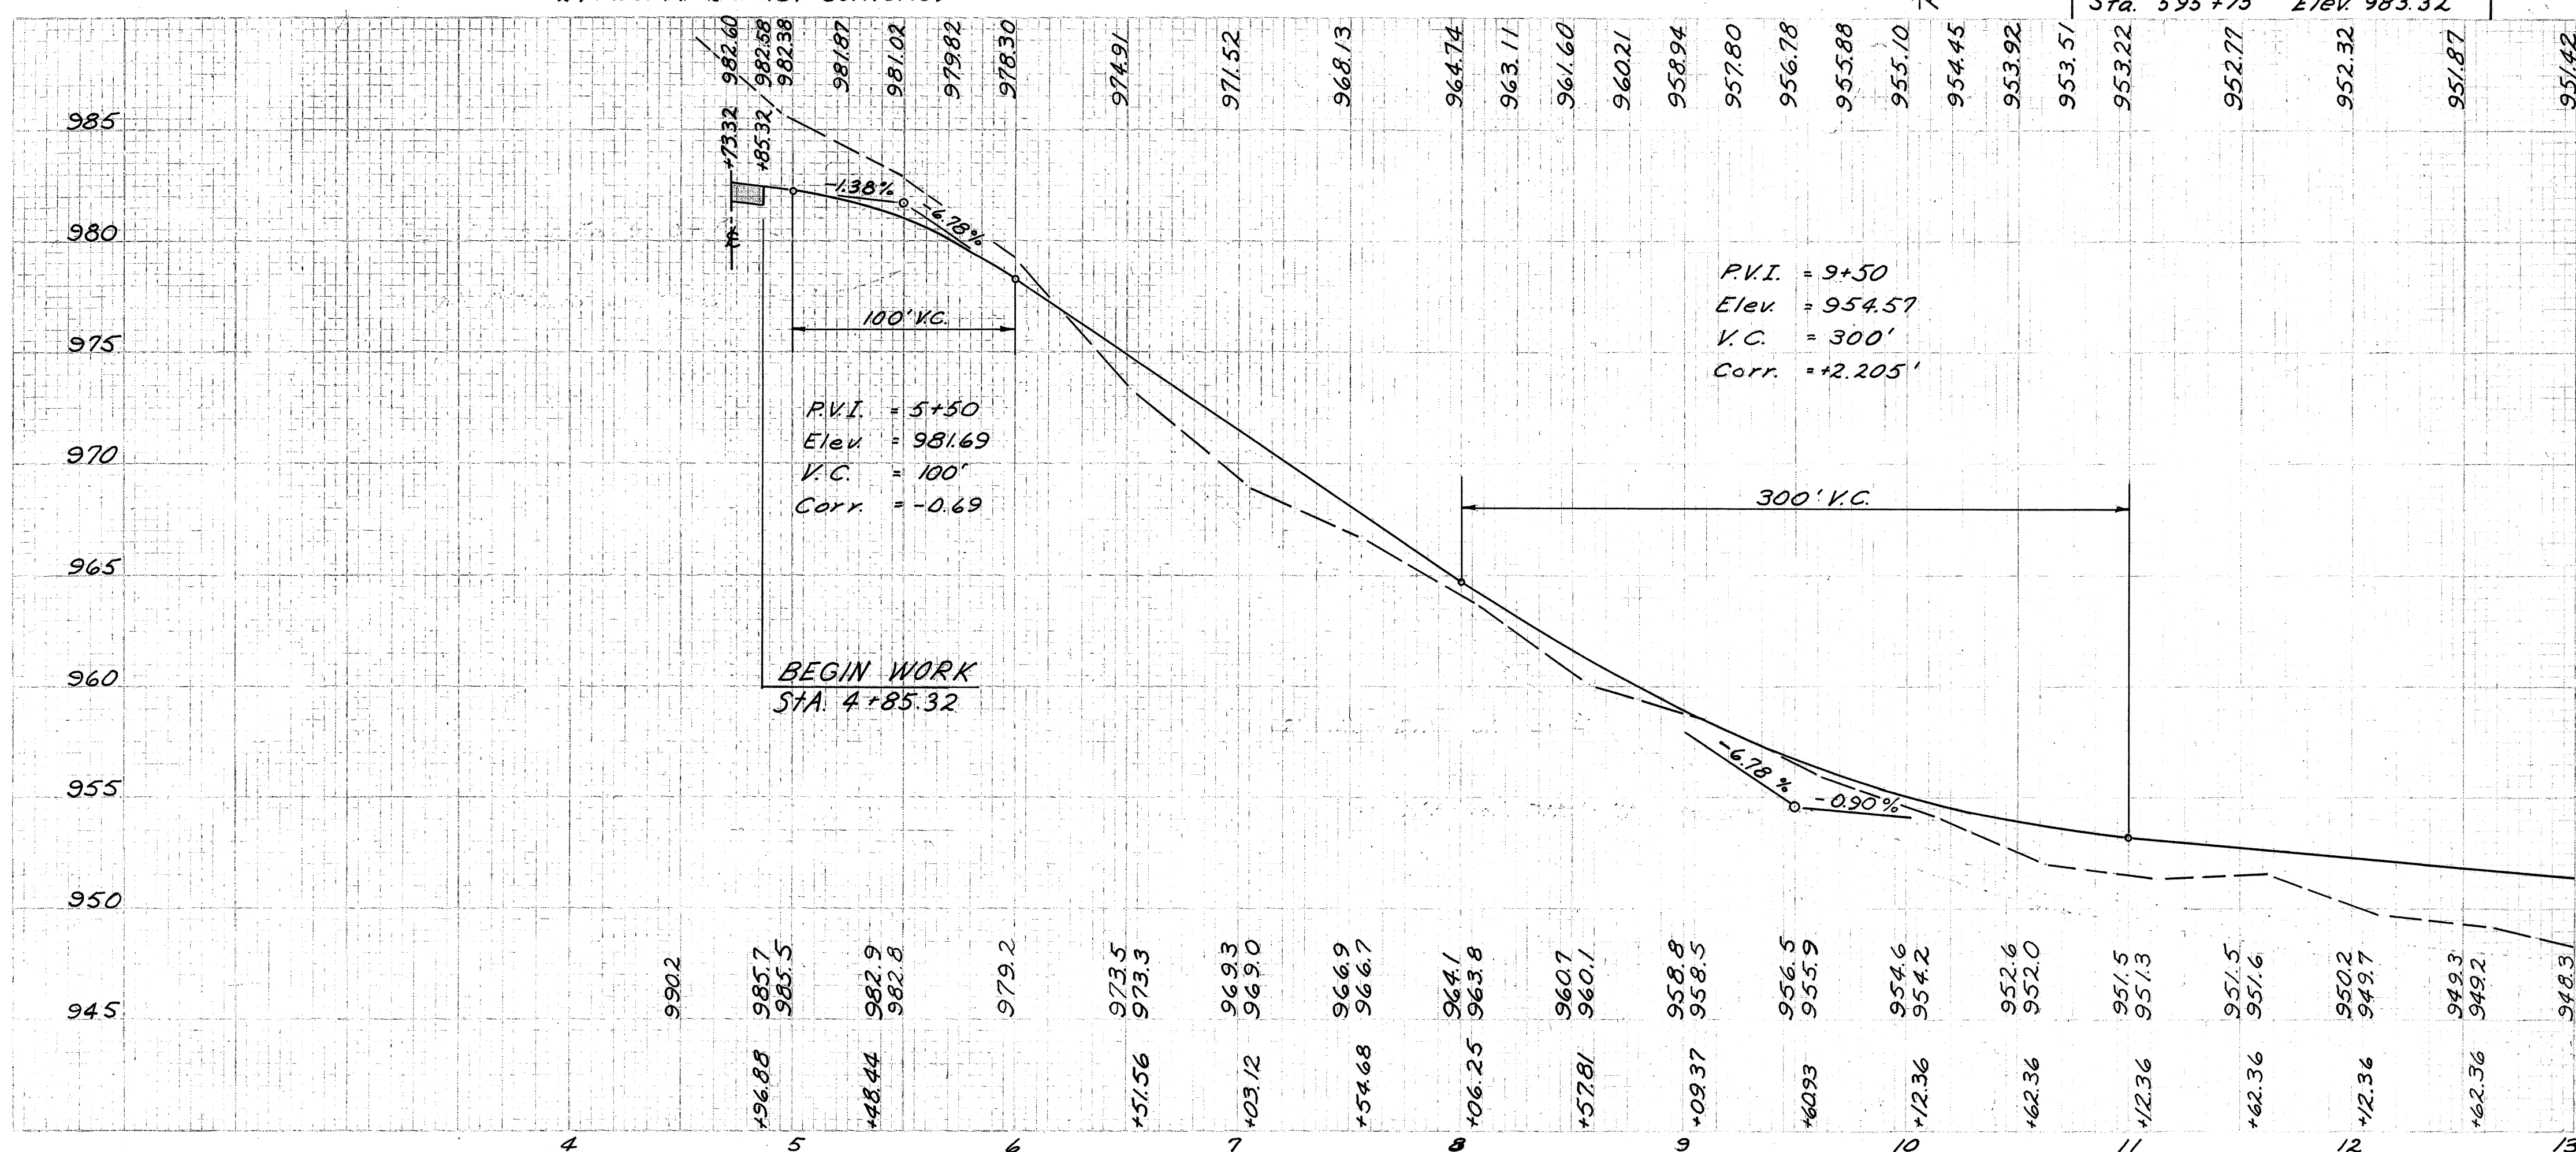


B.M. #11 S.W. Cor. of Lower Step on Front Porch of C.A. Barnes Residence Elevation 952.94

Frontage Road Curve Data
 P.I. Sta. 17+28.57
 $\Delta = 8^{\circ} 8' 59''$ Lt.
 $D = 1^{\circ} 22' 20''$
 $R = 4175.18'$
 $T = 297.45'$
 $L = 593.88'$
 $E = 10.58'$

END WORK
 STA. 20+25

For Drive Details See Sheet No. 40

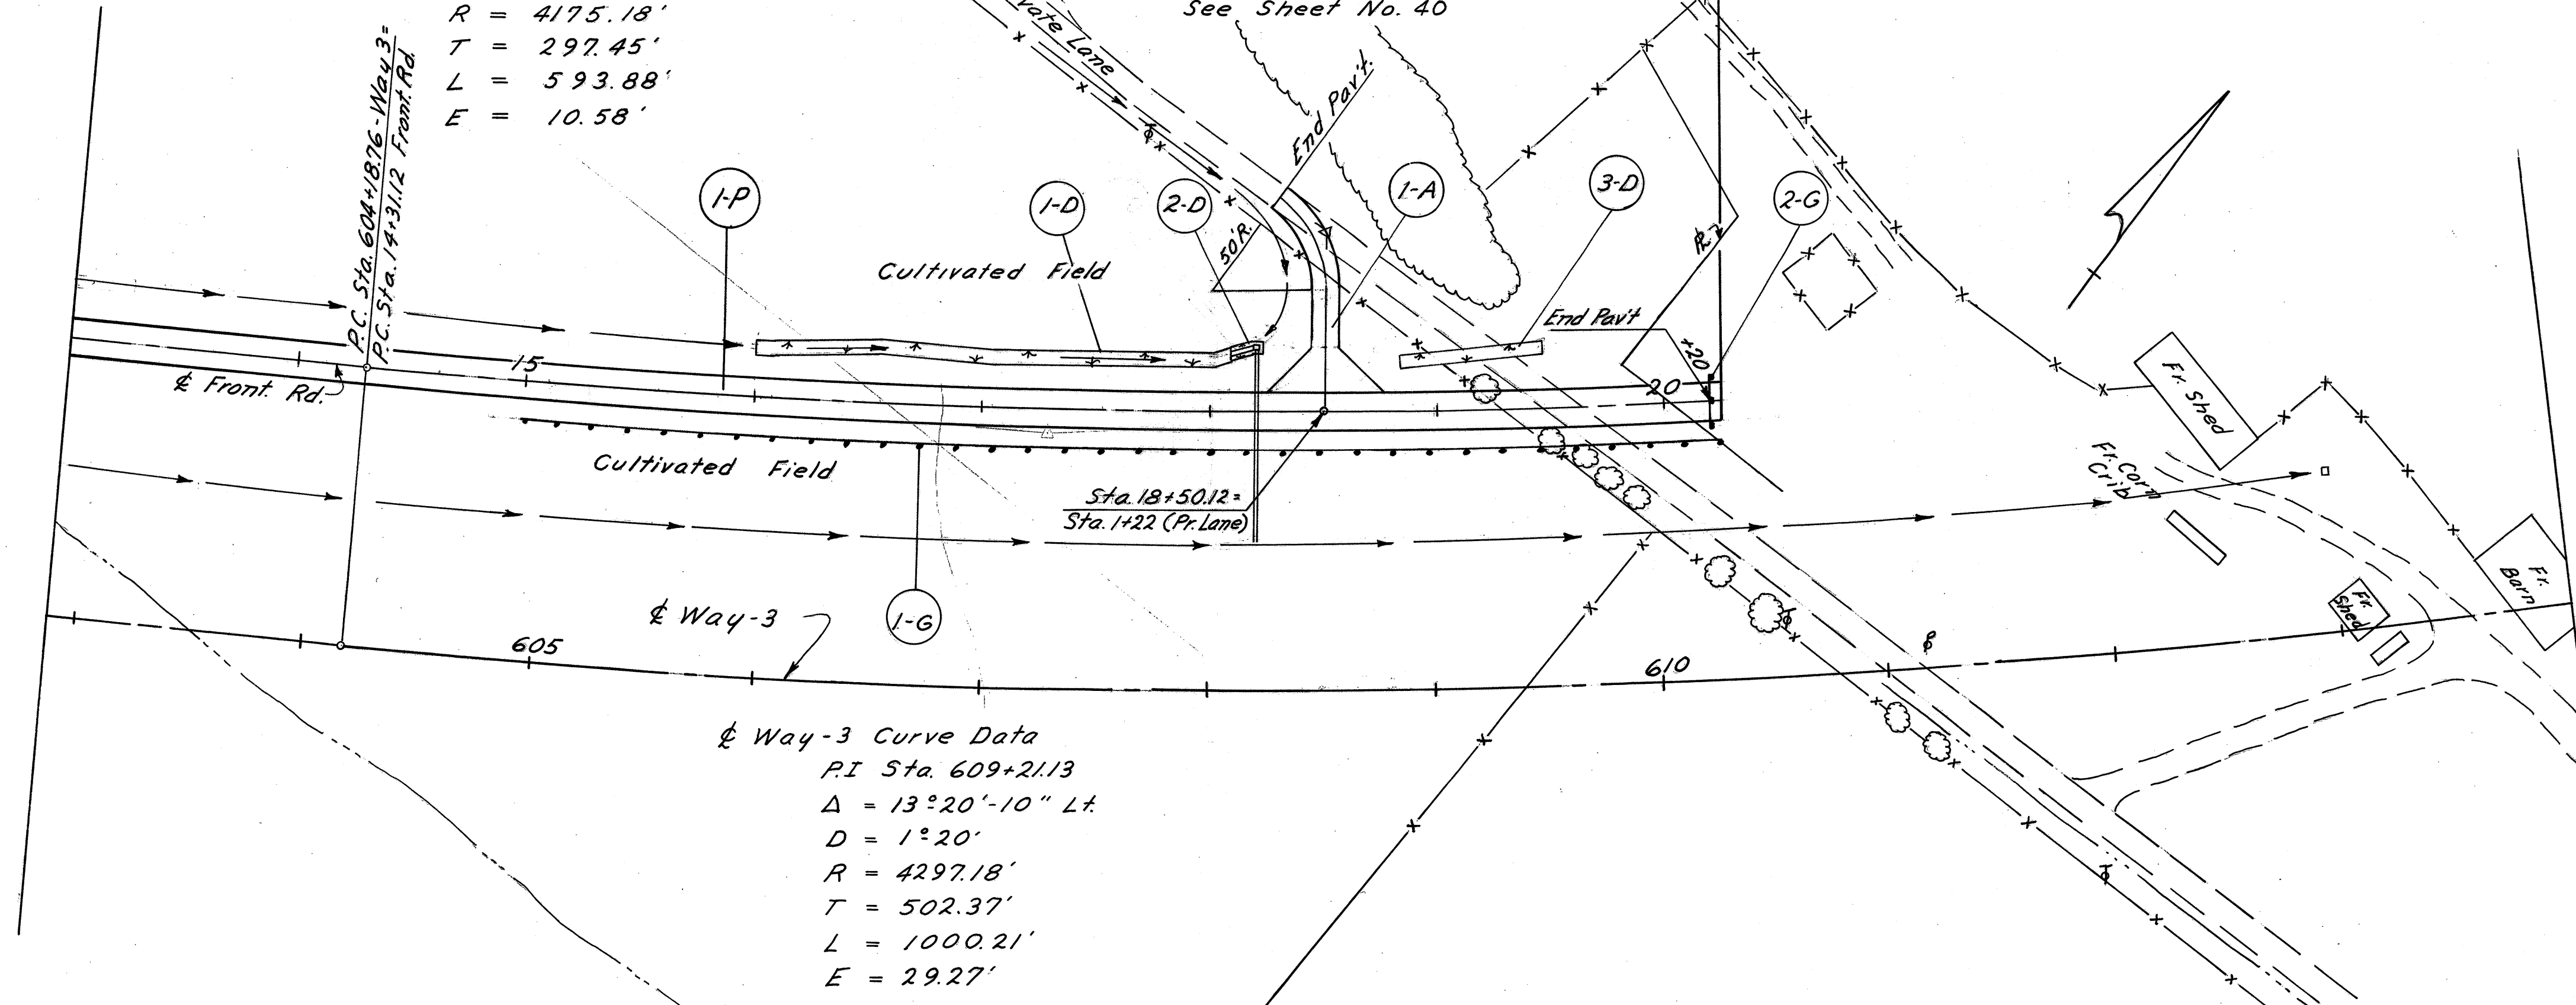


Way-3 Curve Data
 P.I. Sta. 609+21.13
 $\Delta = 13^{\circ} 20' 10''$ Lt.
 $D = 1^{\circ} 20'$
 $R = 4297.18'$
 $T = 502.37'$
 $L = 1000.21'$
 $E = 29.27'$

WAYNE COUNTY
 WAY-3-9.94


Item No.	Station		Side	L-10 Sodding Width		I-14 Paved Gutter Special	I-8 No. 2-2A Catch Basin	I-2 Class A Storm Sewer Under Pav't	I-15 Guard Rail	S-1 Concrete For Structure Class 'E' (Beam Deep)	
	From	To		Lin. Ft.	Sq. Yds.						Lin. Ft.
1-D	16+00	18+07	Lt.	6	138						
2-D	18+19		Lt.	1.5	6	10	1	82		0.3	
3-D	18+80	19+50	Lt.	6	47						
1-G	14+94	20+20	Rt.						528		
2-G	20+20								25		
Totals					191	10	1	82	528	25	0.3

Item No.	Station		Side	Length	B-19	T-35
	From	To			Crushed Aggregate Base Course	Asphaltic Conc. Surface Course
				Lin. Ft.	5" Cu. Yds.	2" Cu. Yds.
1-A	18+50.12		Lt.	91.90	24.37	9.23
Totals					24.37	9.23

For Pavement Quantities, See Sheet No. 126

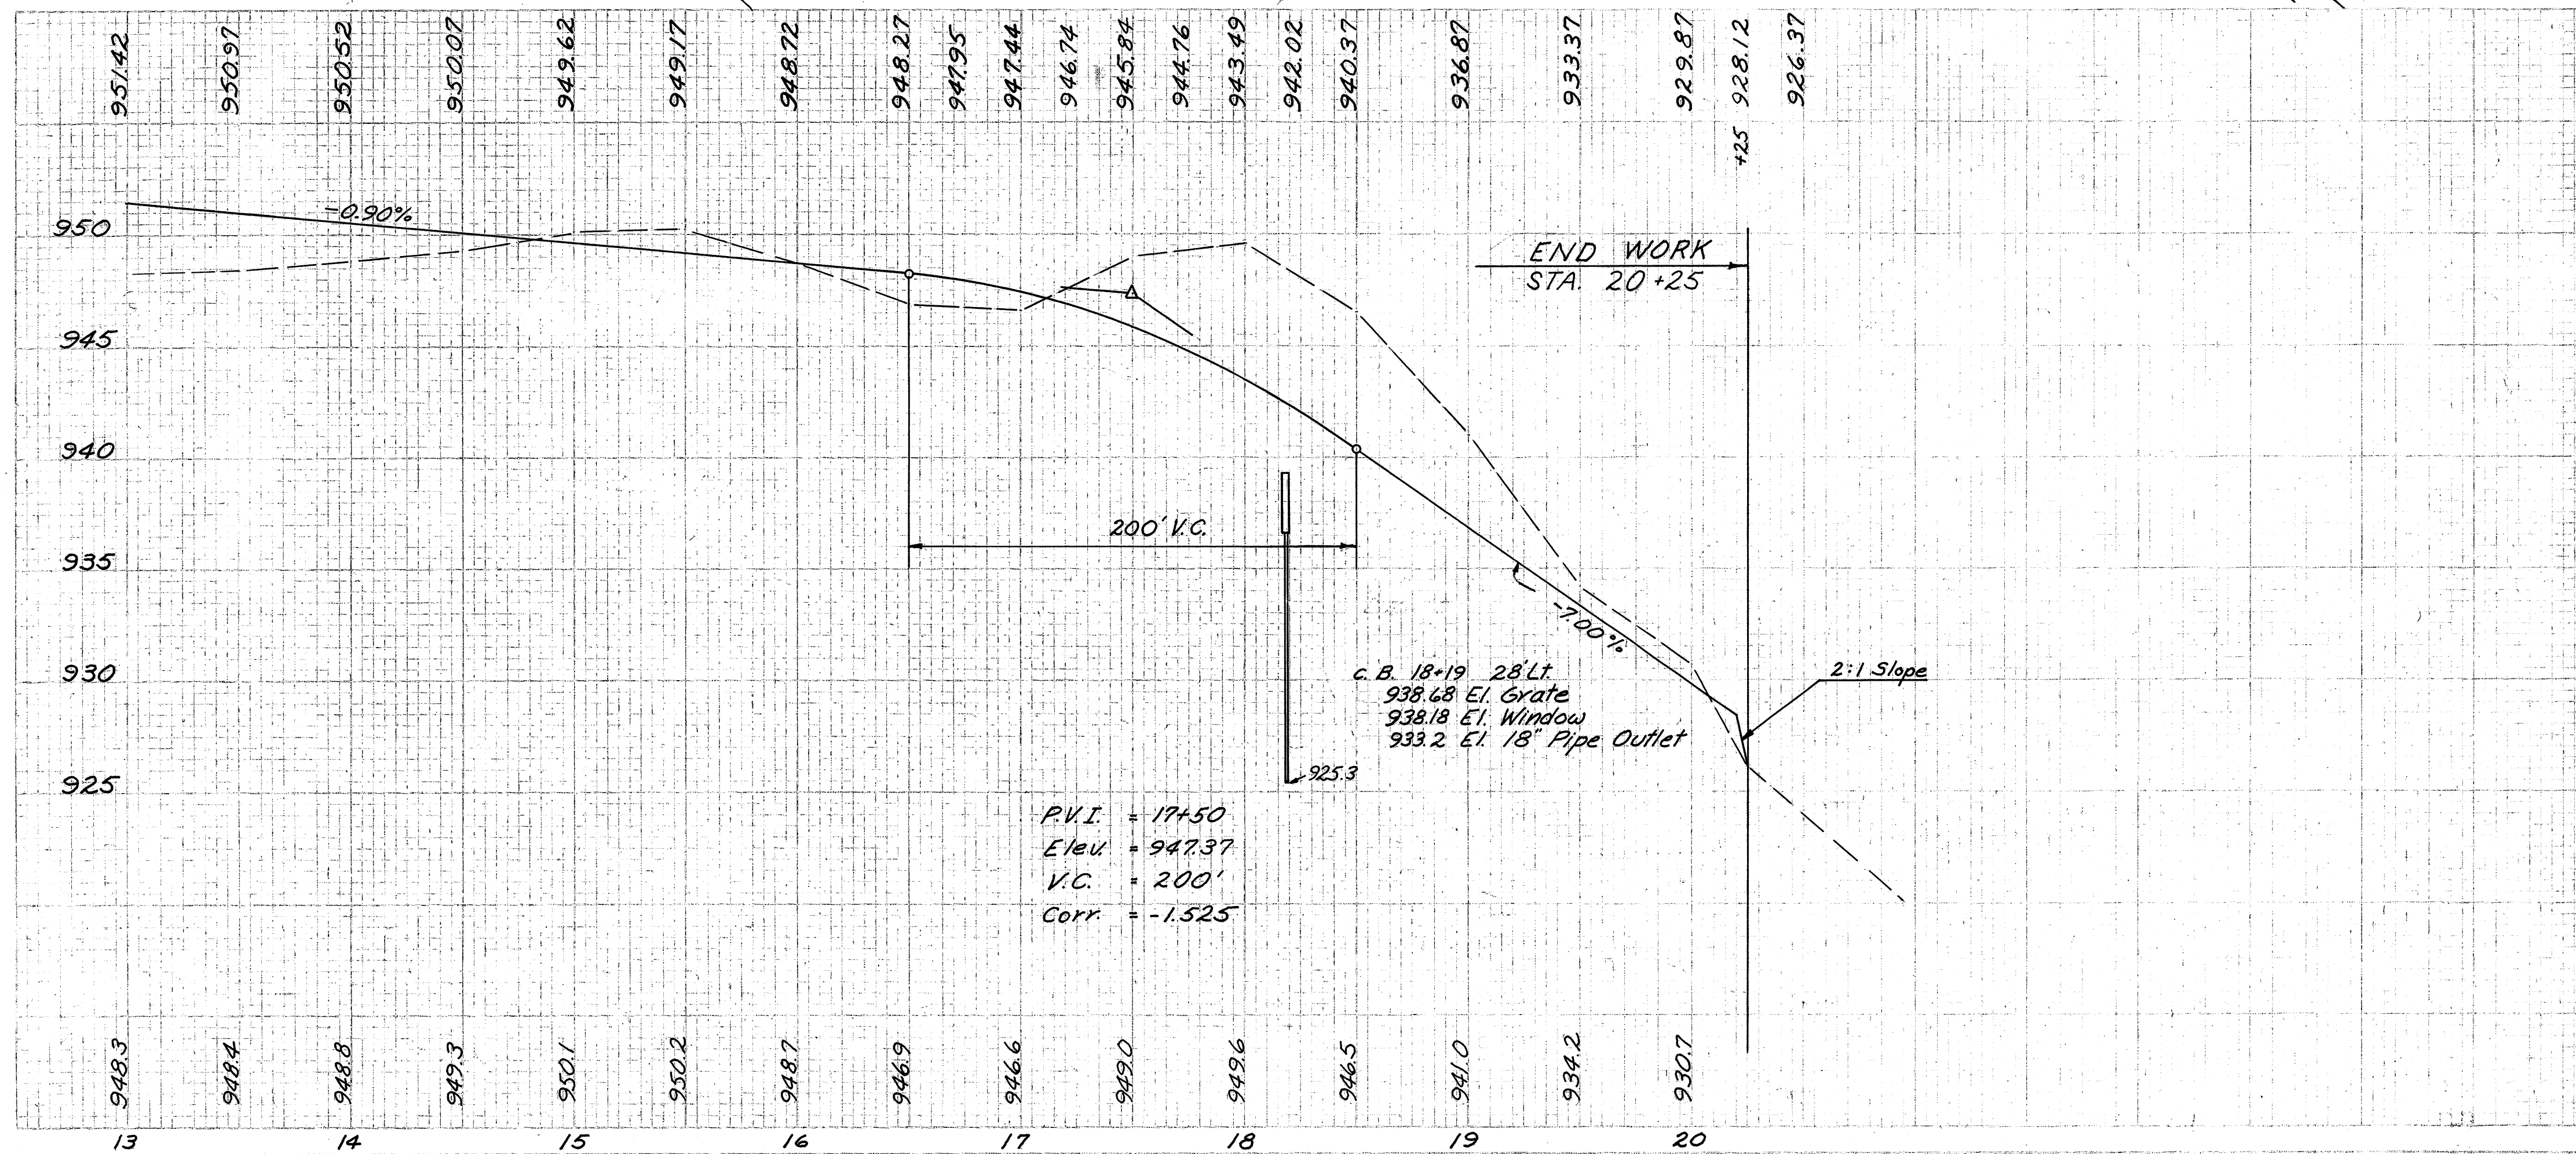

WAYNE COUNTY
WAY-3-9.94

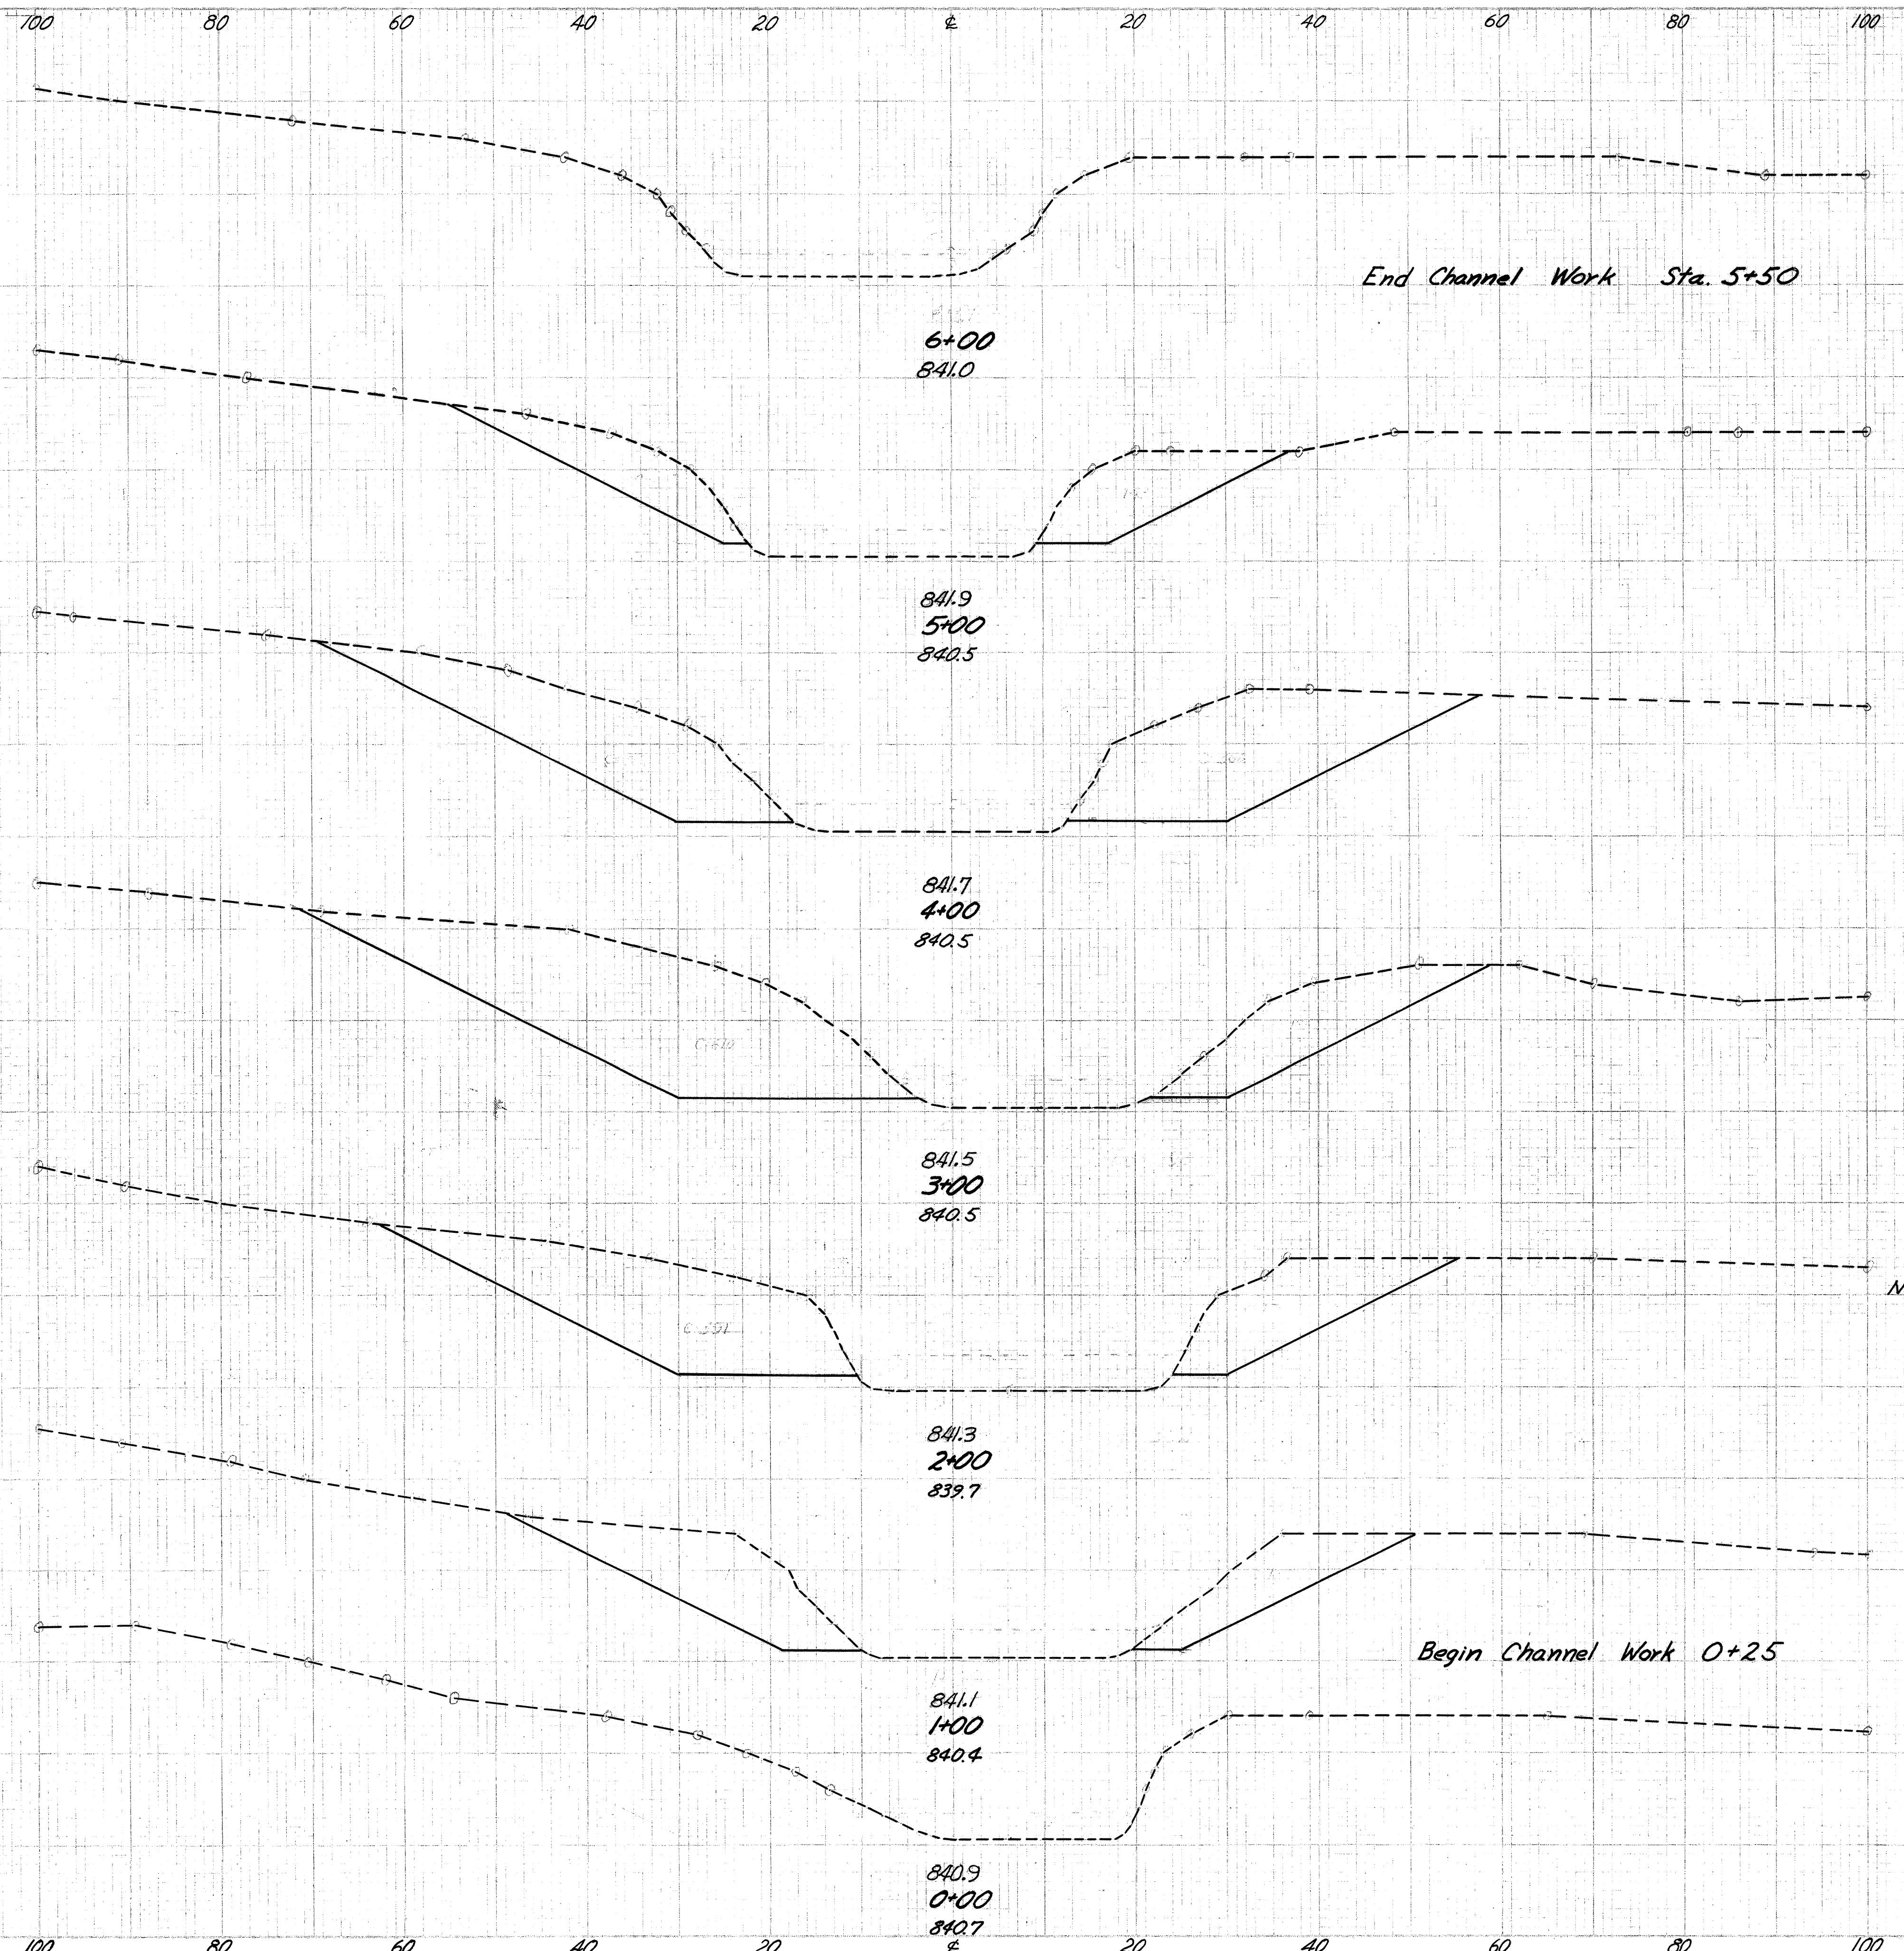

End Channel Work Sta. 5+50

Begin Channel Work 0+25


Note: If Rock is encountered in Channel Excavation as shown, excavate to the surface of the Rock only.

Total Channel Excavation = 9,586 Cu.Yd.


END AREA		CU. YARDS	
CUT	FILL	CUT	FILL
0	0		
		265	0
286	0		
		1822	0
698	0		
		2771	0
798	0		
		2537	0
572	0		
		1706	0
349	0		
		485	0
0	0		
Totals		9586	0

FED. RD. DIVISION	STATE	PROJECT	129 151
2	OHIO		

WAYNE COUNTY
WAY-3-9.94

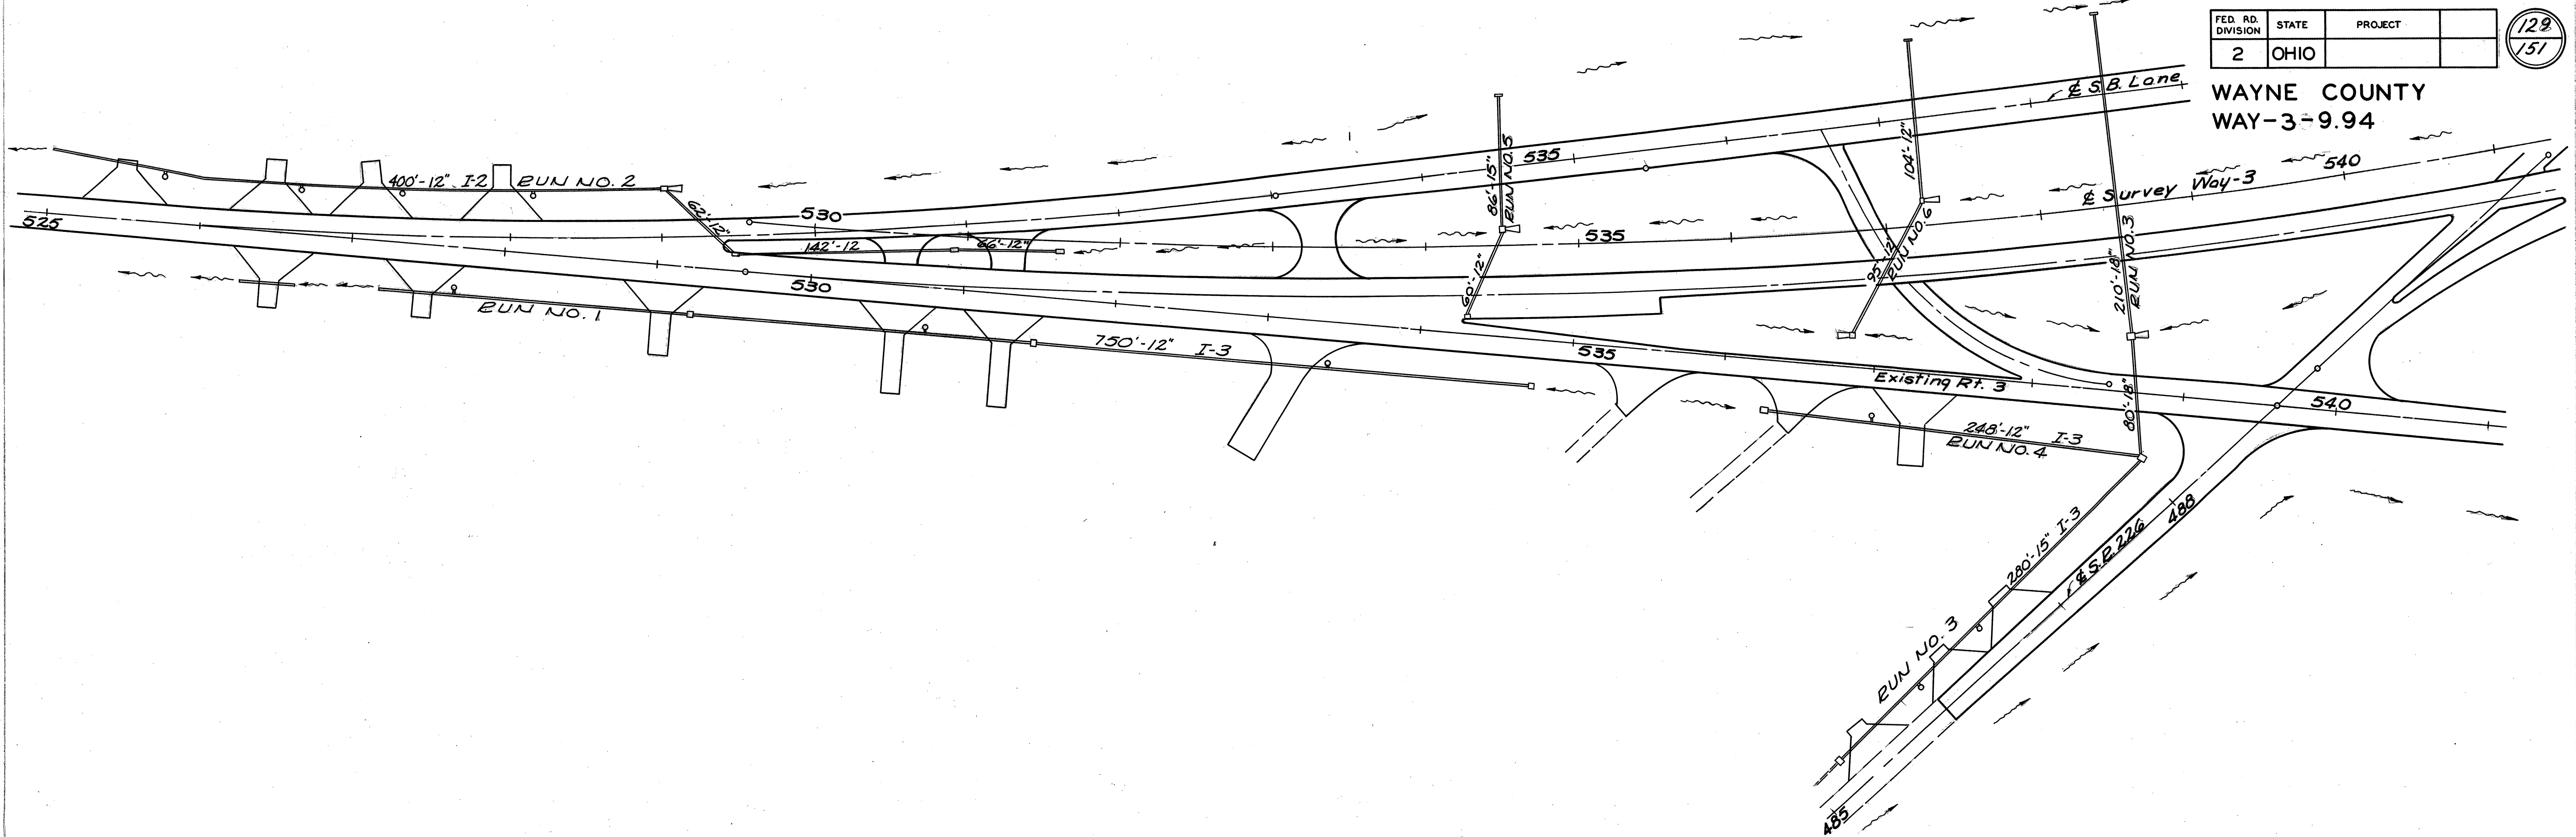

FINAL SURVEY PLANS
 DATE: 10/15/94
 BY: [Name]
 CHECKED: [Name]
 APPROVED: [Name]

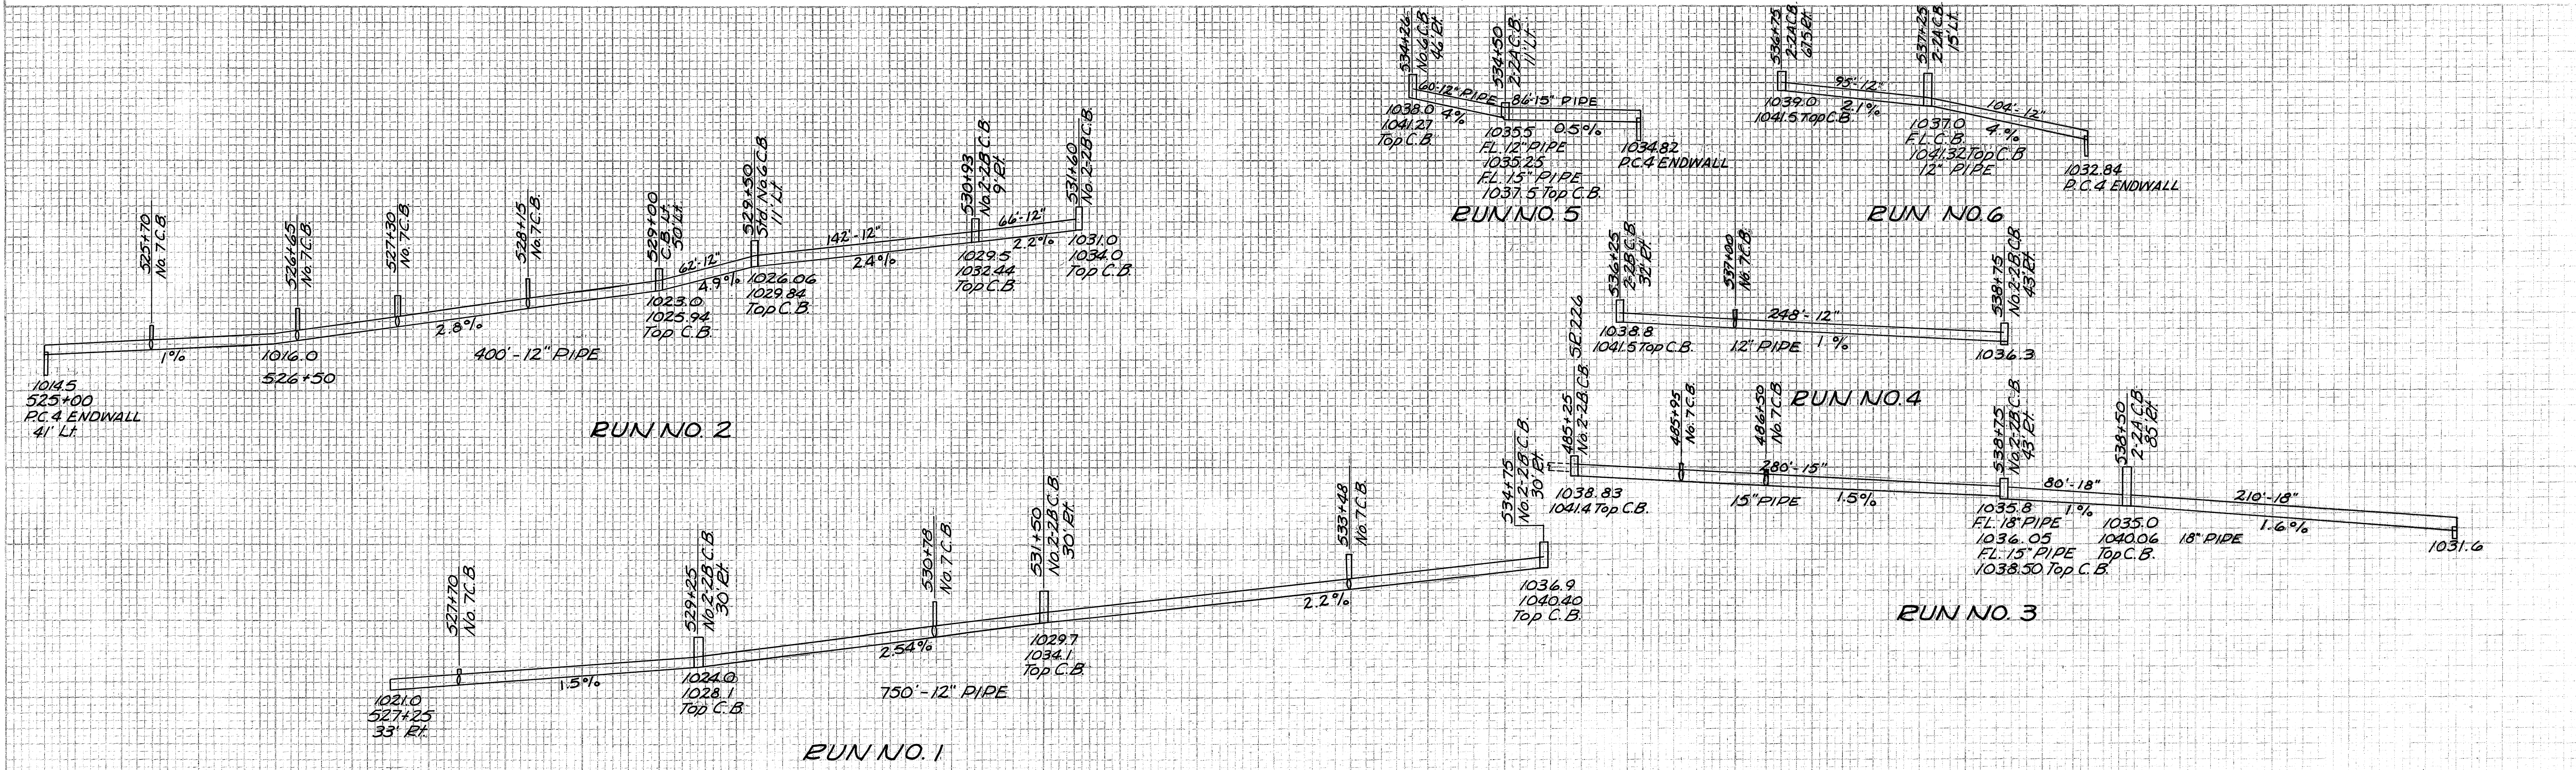

ORIGINAL SURVEY PLANS
 DATE: 10/15/94
 BY: [Name]
 CHECKED: [Name]
 APPROVED: [Name]

STORM SEWER DETAILS


**WAYNE COUNTY
WAY-3-9.94**

ESTIMATED QUANTITIES

E-2	Excavation For Structures	193 Cu.Yds.
E-3	Channel Excavation	306 Cu.Yds.
L-10	Sodding	58 Sq.Yds.
S-1	Concrete For Structures, Class "E"	21.03 Cu.Yds.
S-28	15'-6" x 9'-5" Pipe Arch For Roadway Culverts	140.0 L.F.

CULVERT DATA


TYPE: Corrugated Sectional Plate Pipe Arch Culvert, Standard Drawing SP53
 SIZE: 140' - Span 15'-6" Rise 9'-5" Section M-6.4 (g)
 WORK REQUIRED: Construct Culvert & Endwalls as Shown

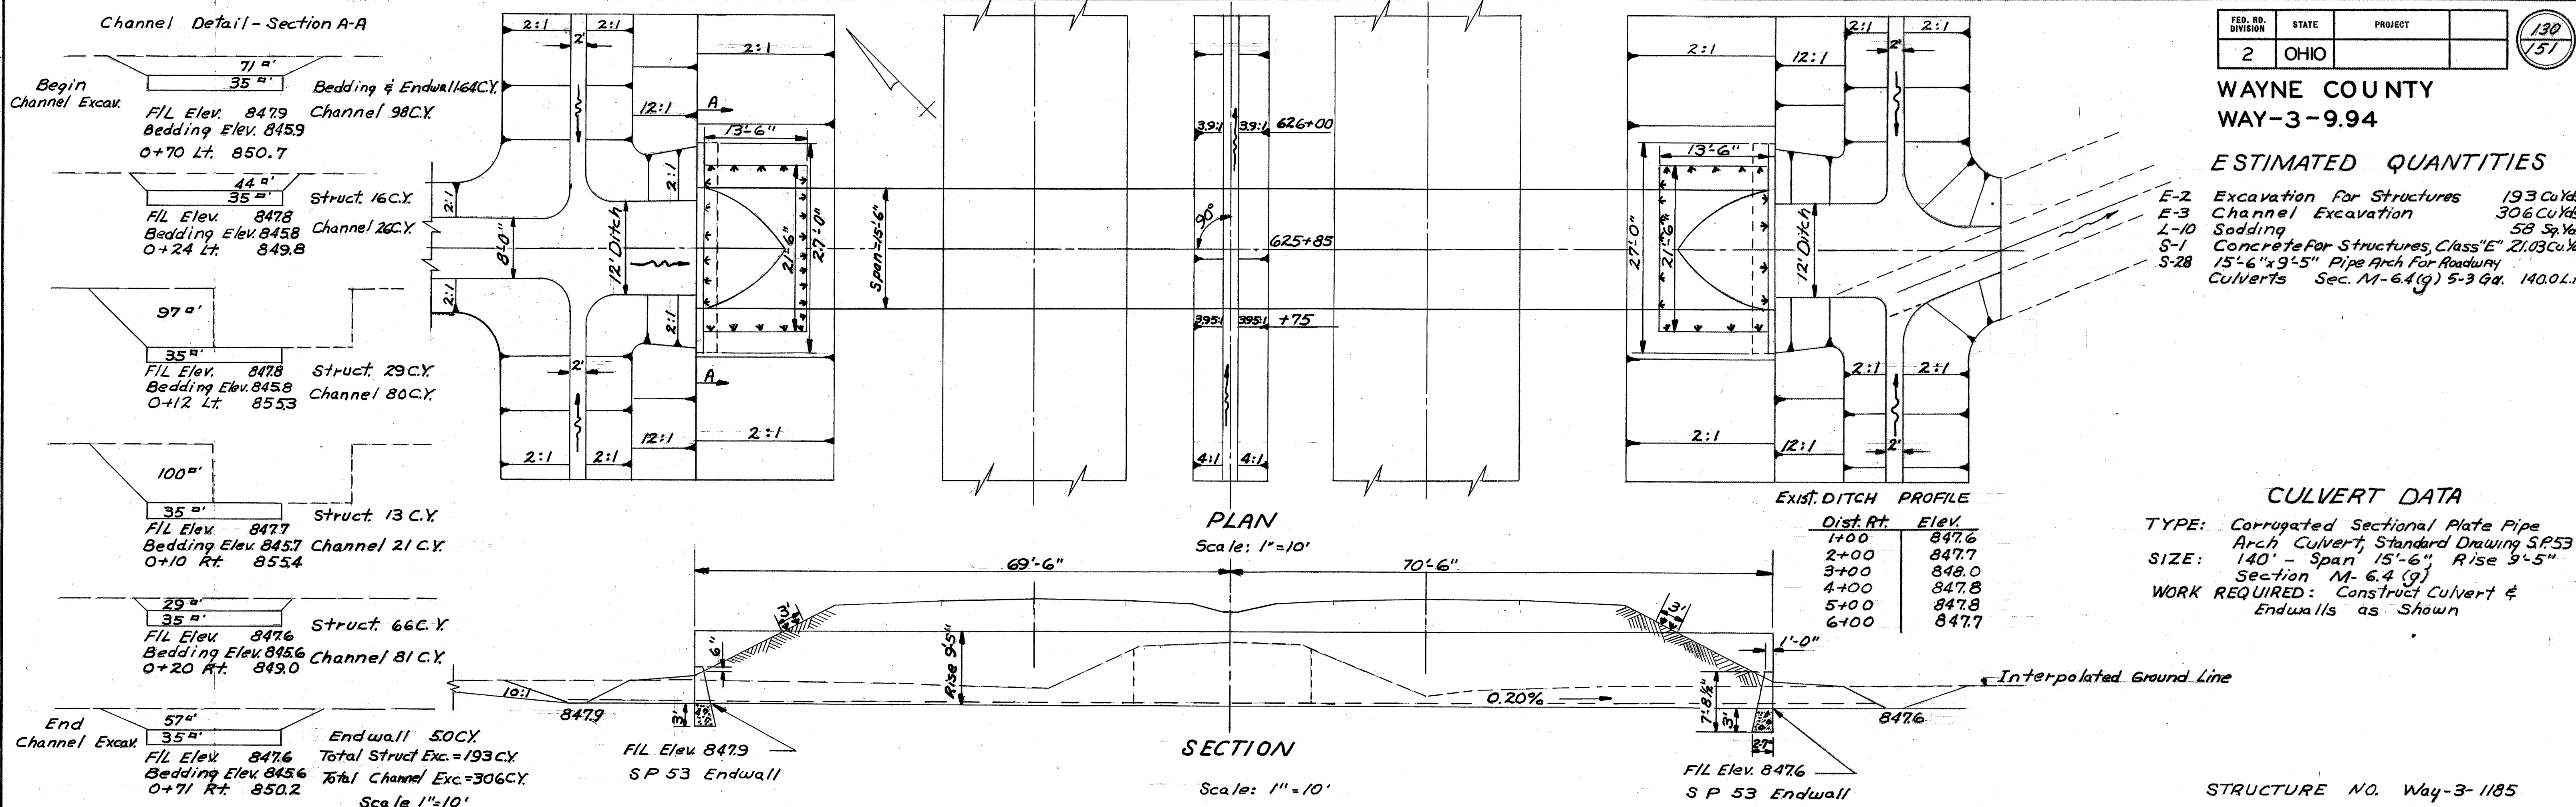

EXIST. DITCH PROFILE

Dist. Rt.	Elev.
1+00	847.6
2+00	847.7
3+00	848.0
4+00	847.8
5+00	847.8
6+00	847.7

STRUCTURE NO. Way-3-1185

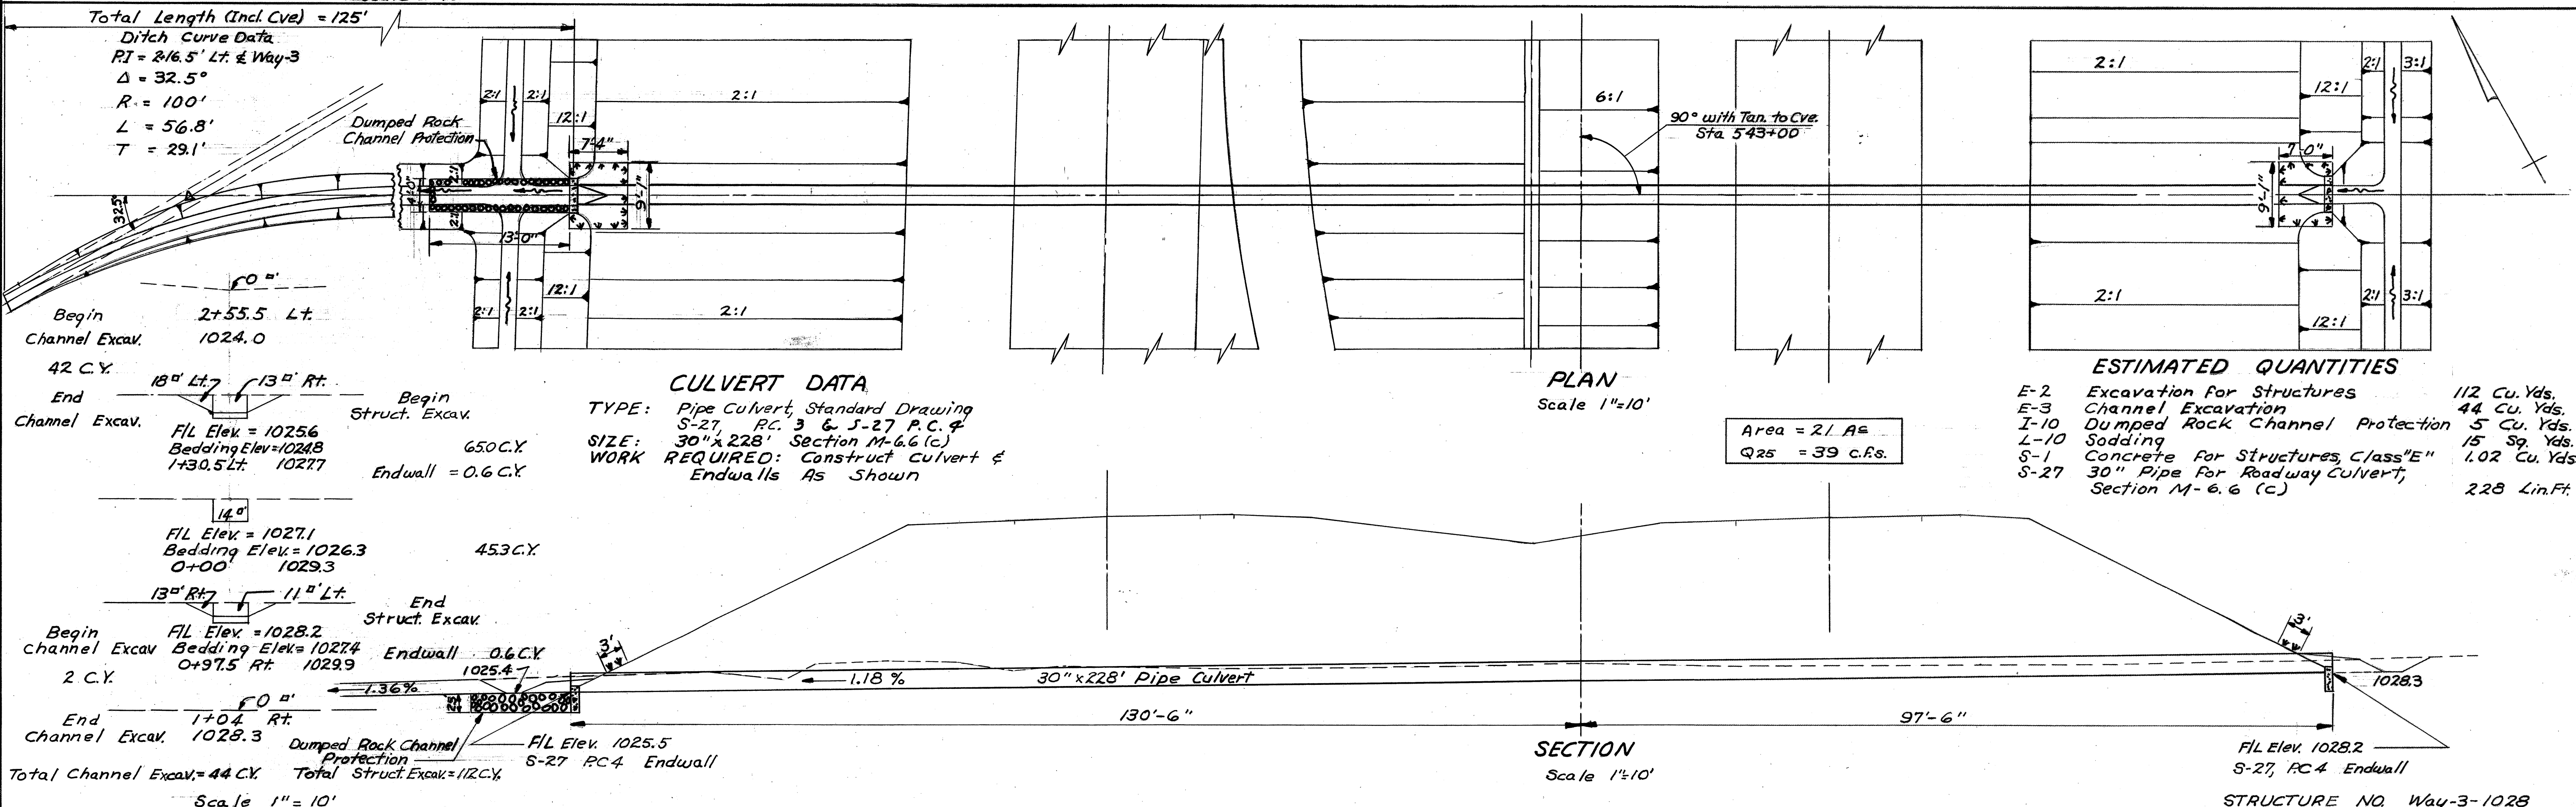

CULVERT DATA
 TYPE: Pipe Culvert, Standard Drawing S-27, P.C. 3 & S-27 P.C. 4
 SIZE: 30" x 228' Section M-6.6 (c)
 WORK REQUIRED: Construct Culvert & Endwalls As Shown

Area = 21 A.E.
 Q25 = 39 C.F.S.

ESTIMATED QUANTITIES

E-2	Excavation For Structures	112 Cu. Yds.
E-3	Channel Excavation	44 Cu. Yds.
I-10	Dumped Rock Channel Protection	5 Cu. Yds.
L-10	Sodding	15 Sq. Yds.
S-1	Concrete For Structures, Class "E"	1.02 Cu. Yds.
S-27	30" Pipe For Roadway Culvert, Section M-6.6 (c)	228 Lin.Ft.

STRUCTURE NO. Way-3-1028

**WAYNE COUNTY
WAY-3-994**

ESTIMATED QUANTITIES

E-2	Excavation for Structures	57.0 Cu.Yds.
E-3	Channel Excavation	44.0 Cu.Yds.
I-10	Dumped Rock Channel Protection	4.0 Cu.Yds.
L-10	Sodding	11.0 Sq.Yds.
S-1	Concrete for Structures, Class "E"	0.72 Cu.Yds.
S-27	21" Pipe for Roadway Culvert, Sec. M-6.6(b) 108 Lin.Ft. or Sec. M-6-8(b)	

Area = 13 AS
Q 25 = 20 c.f.s.

CULVERT DATA

TYPE: Pipe Culvert, Standard Drawing S-27, P.C. # Endwall
 SIZE: 21" x 108" Section M-6.6 (b) or 68(b)
 WORK REQUIRED: Construct Culvert & Endwalls as Shown.

Begin Channel Excav. 1029.3
 Channel Excav. = 130Y.
 0+97 Lt.

Channel Excav. = 41.6CY
 F/L Elev. 1029.4
 0+92 Lt. 1031.6

End Channel Excavation 19' Lt. 10' Rt.
 F/L Elev. 1030.06
 Bedding Elev. 1029.36
 0+58 Lt. 1032.3

Endwall = 0.4CY
 Struct. Excav. = 14CY
 F/L Elev. 1030.65
 Bedding Elev. 1029.9
 0+23 Lt. 1033.6




Struct. Excav. = 8.4CY
 F/L Elev. 1030.8
 Bedding Elev. 1030.1
 0+10 Lt. 1037.3

Struct. Excav. = 16.7 C.Y.
 F/L Elev. 1031.2
 Bedding Elev. 1030.5
 0+10 Rt. 1037.2

Struct. Excav. = 6.2 C.Y.
 F/L Elev. 1031.4
 Bedding Elev. 1030.7
 0+20 Rt. 1034.2

End Structure Excav. 8' Lt. 13' Rt.
 F/L Elev. 1031.9
 Channel Excav. 10CY Bedding Elev. 1031.2
 0+50 Rt. 1033.7





1032.0
 0+54 Rt.

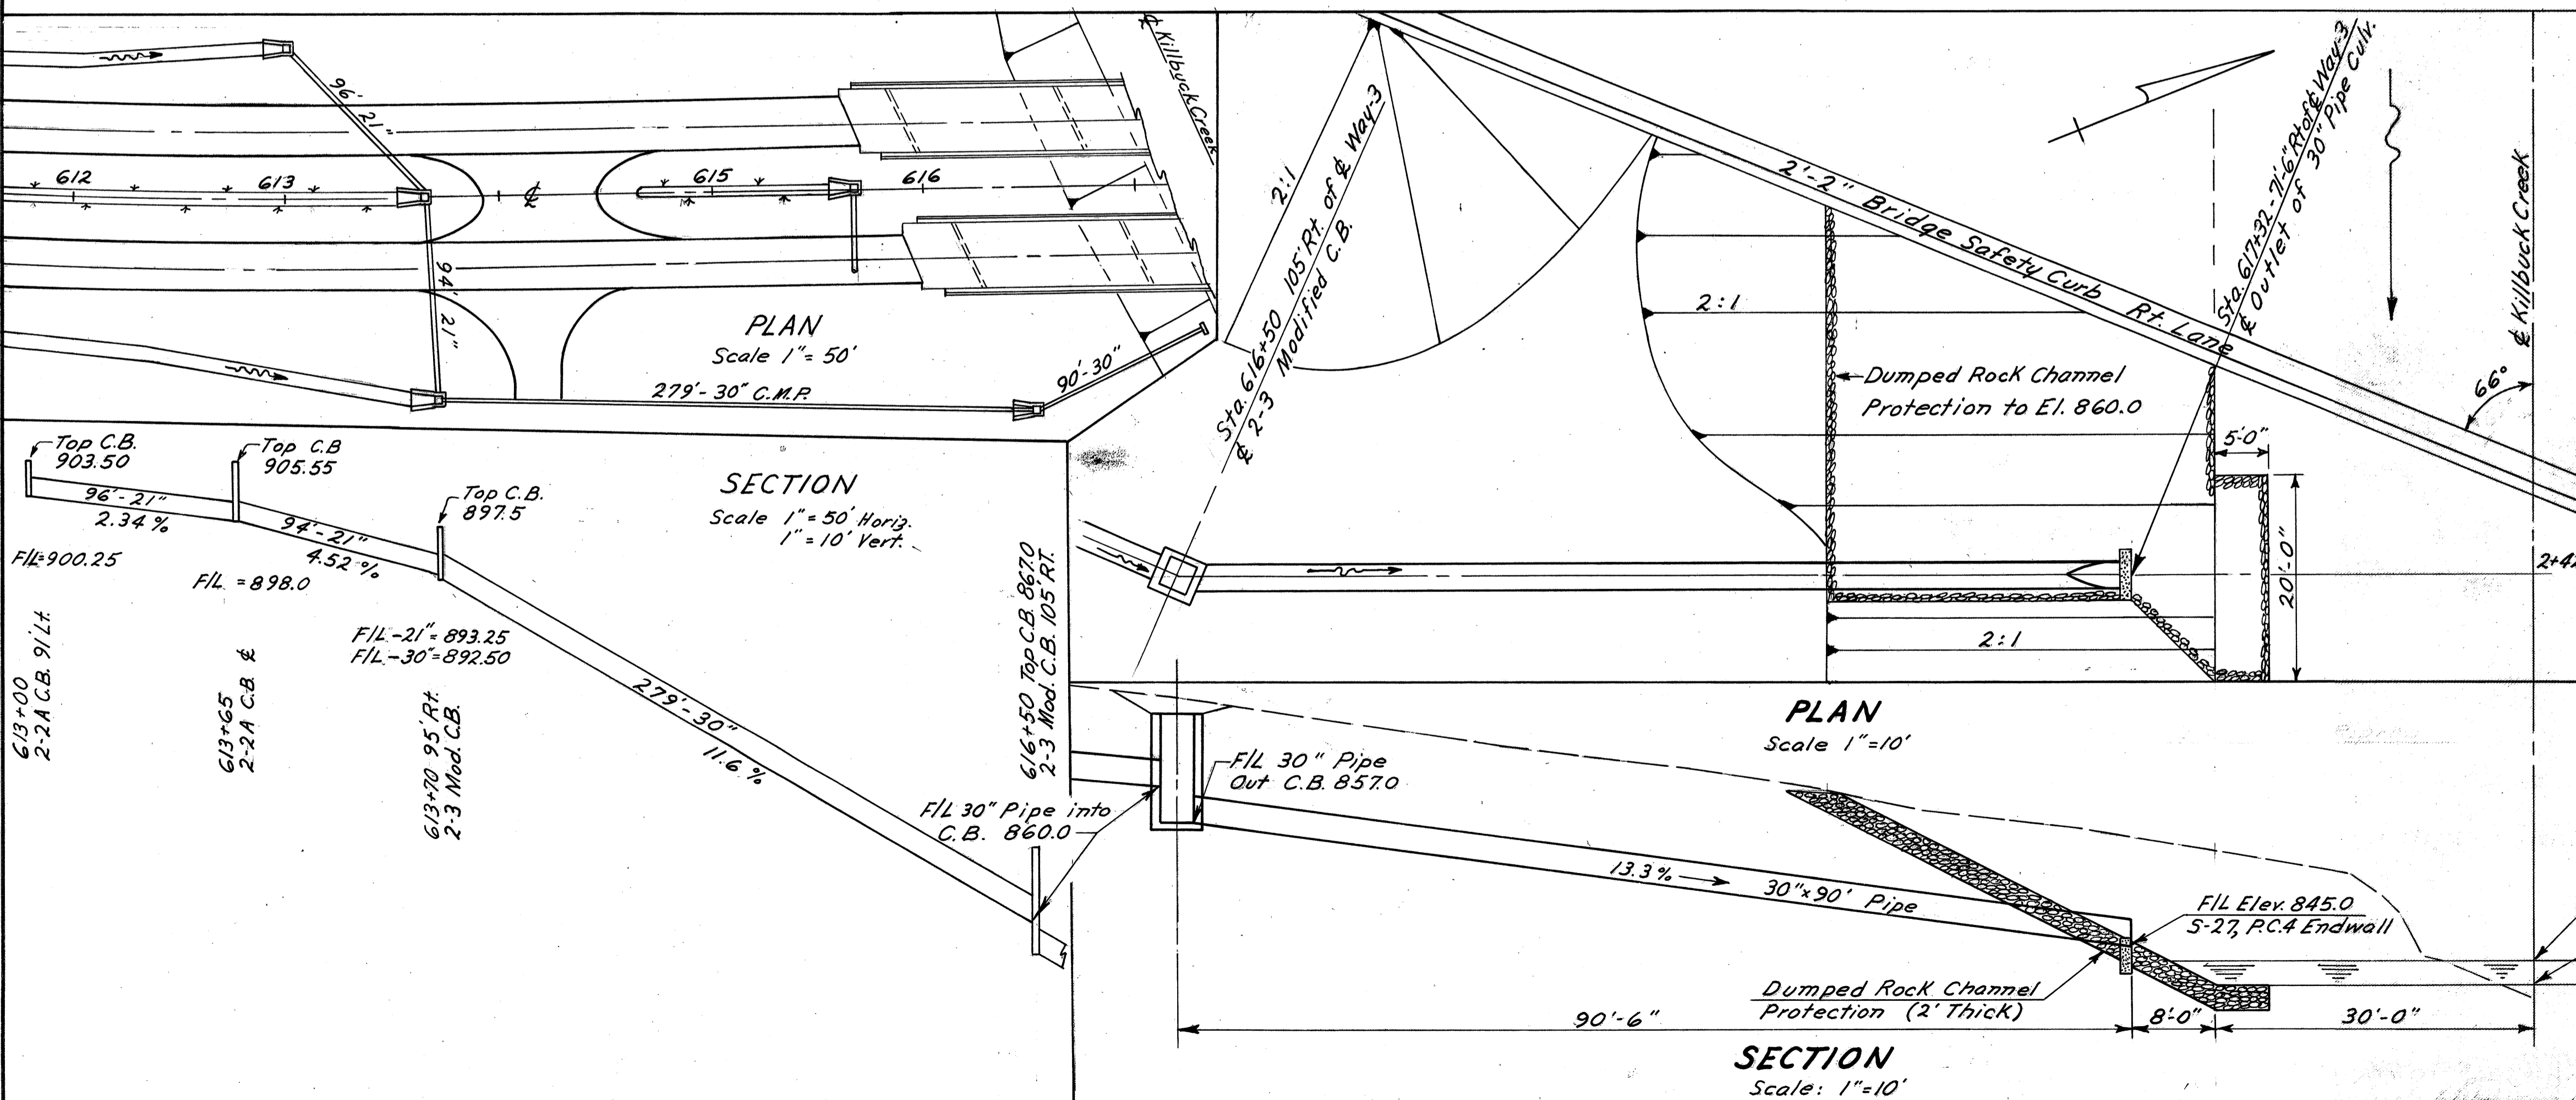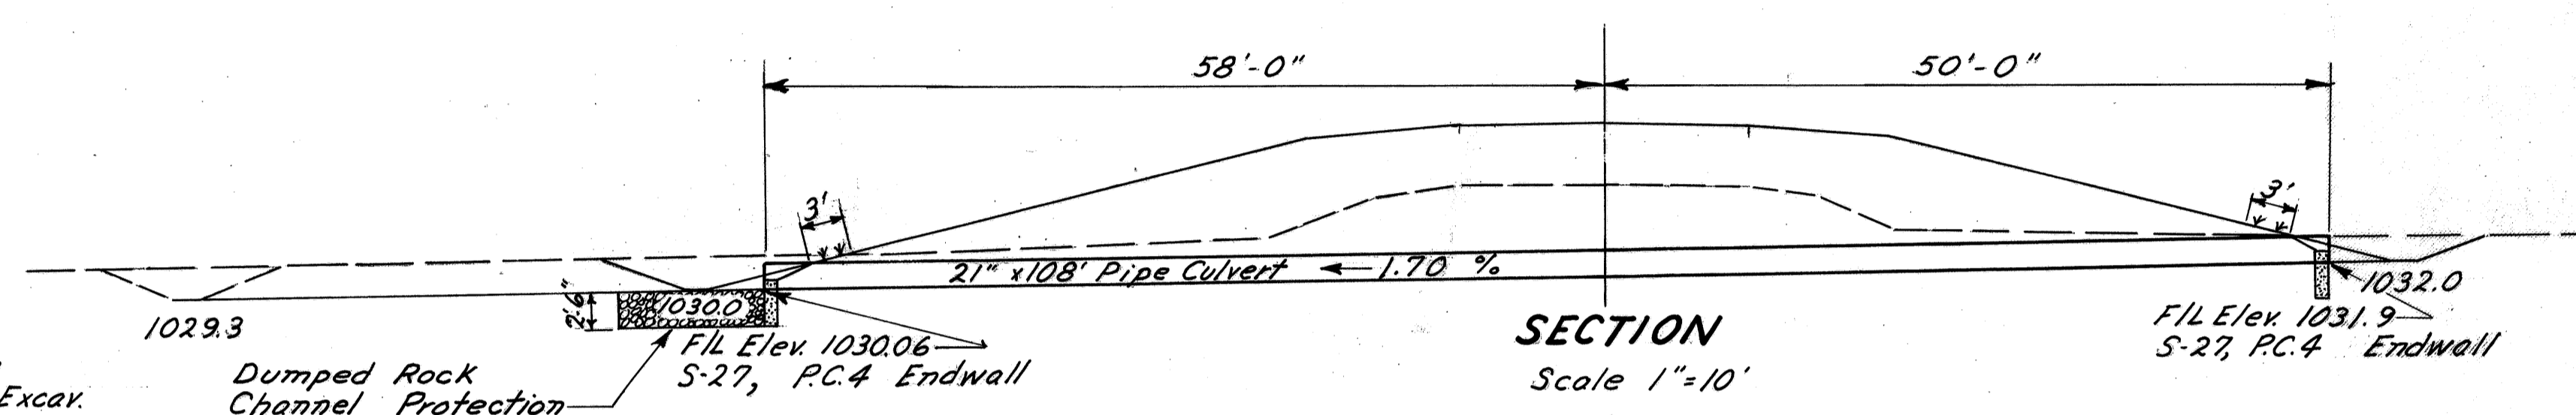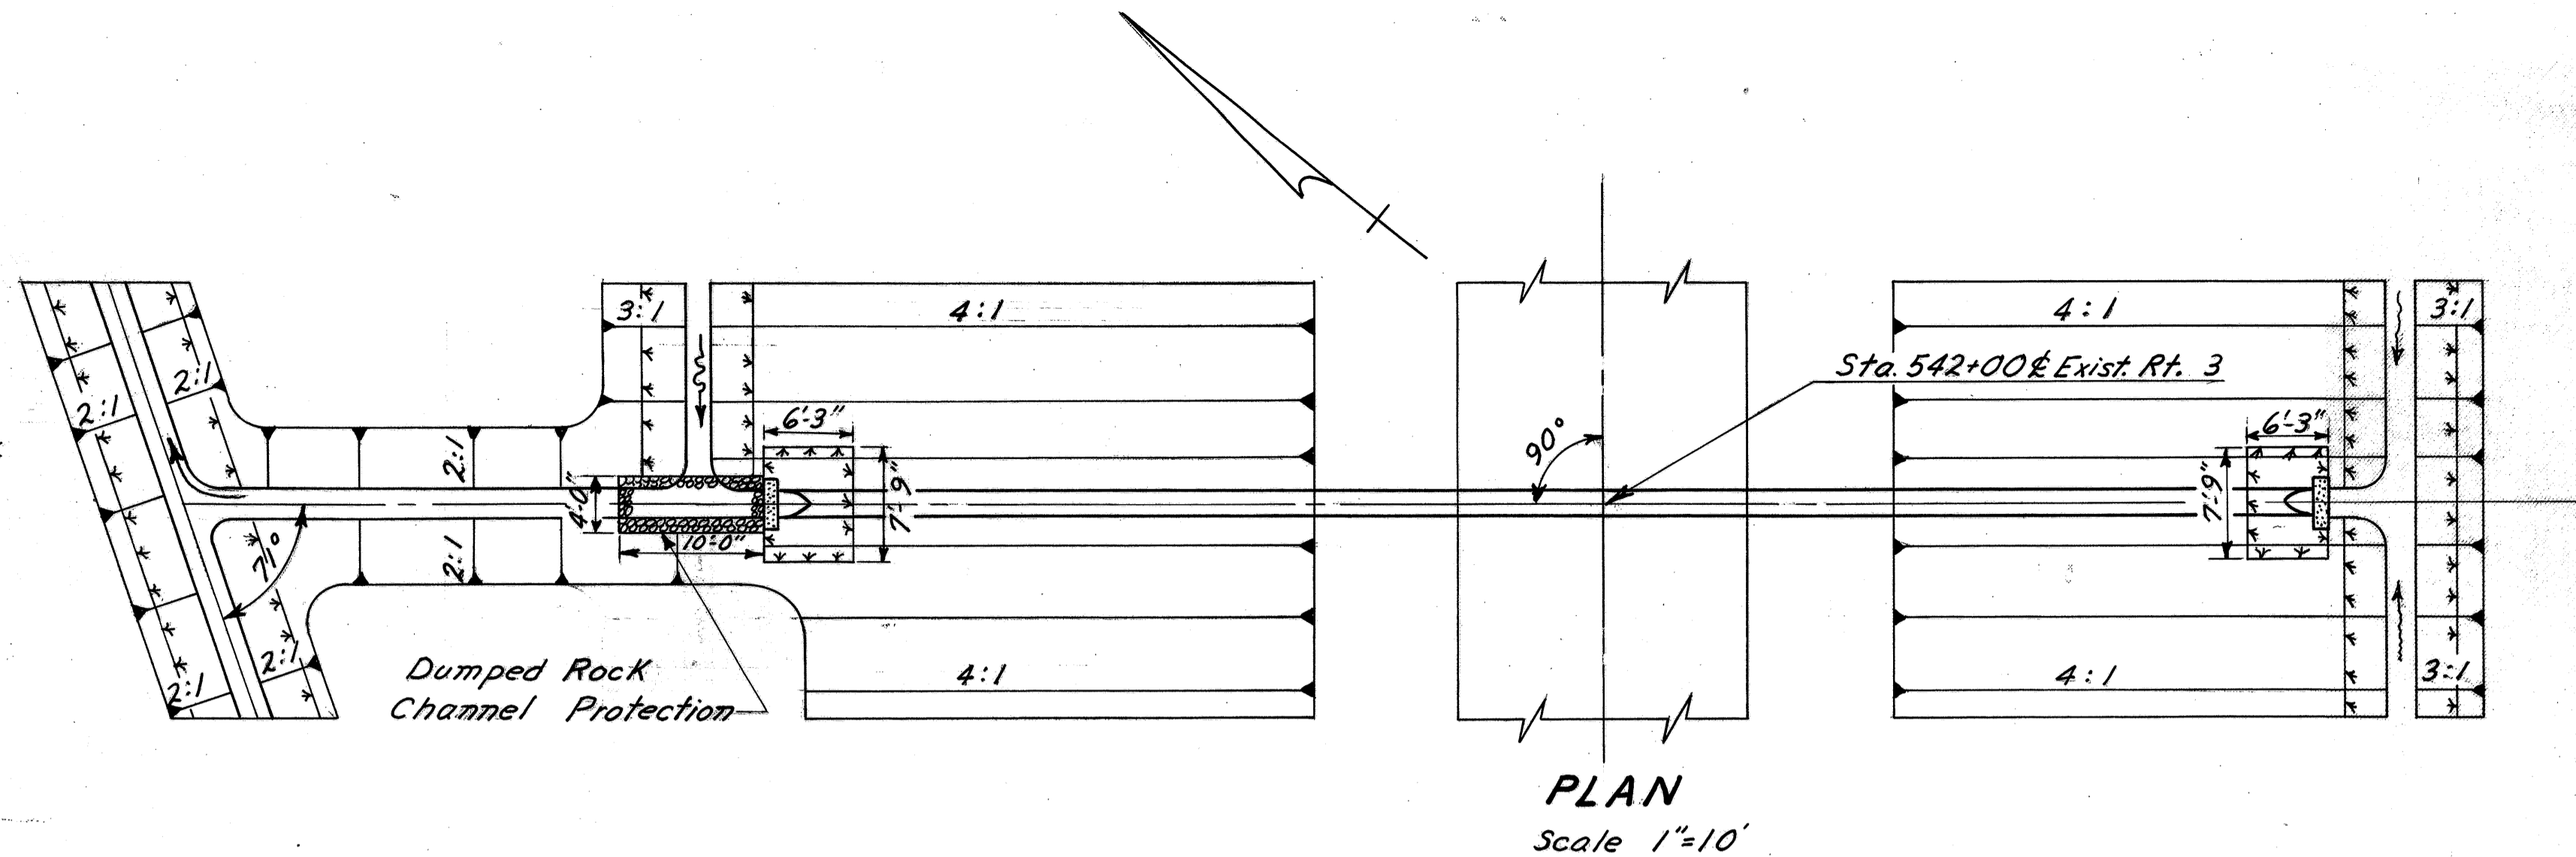

NOTE: Estimated Quantities Shown on Sheet No. 33 & 34.

30" PIPE OUTLET STA. 617+32

WAYNE COUNTY
WAY-3-9.94

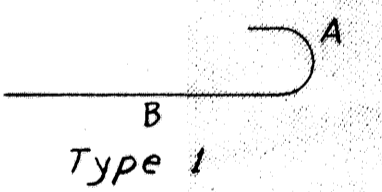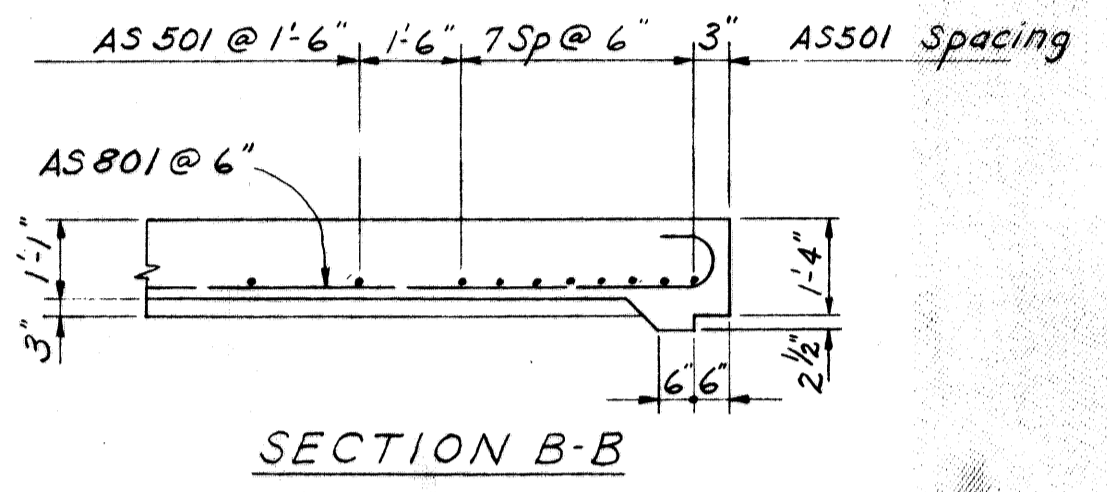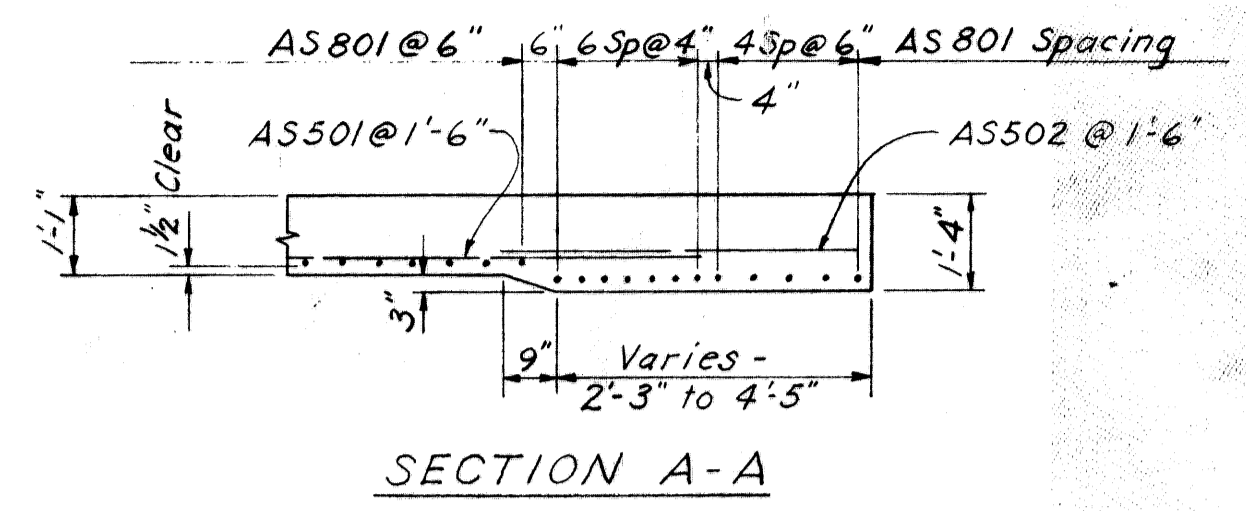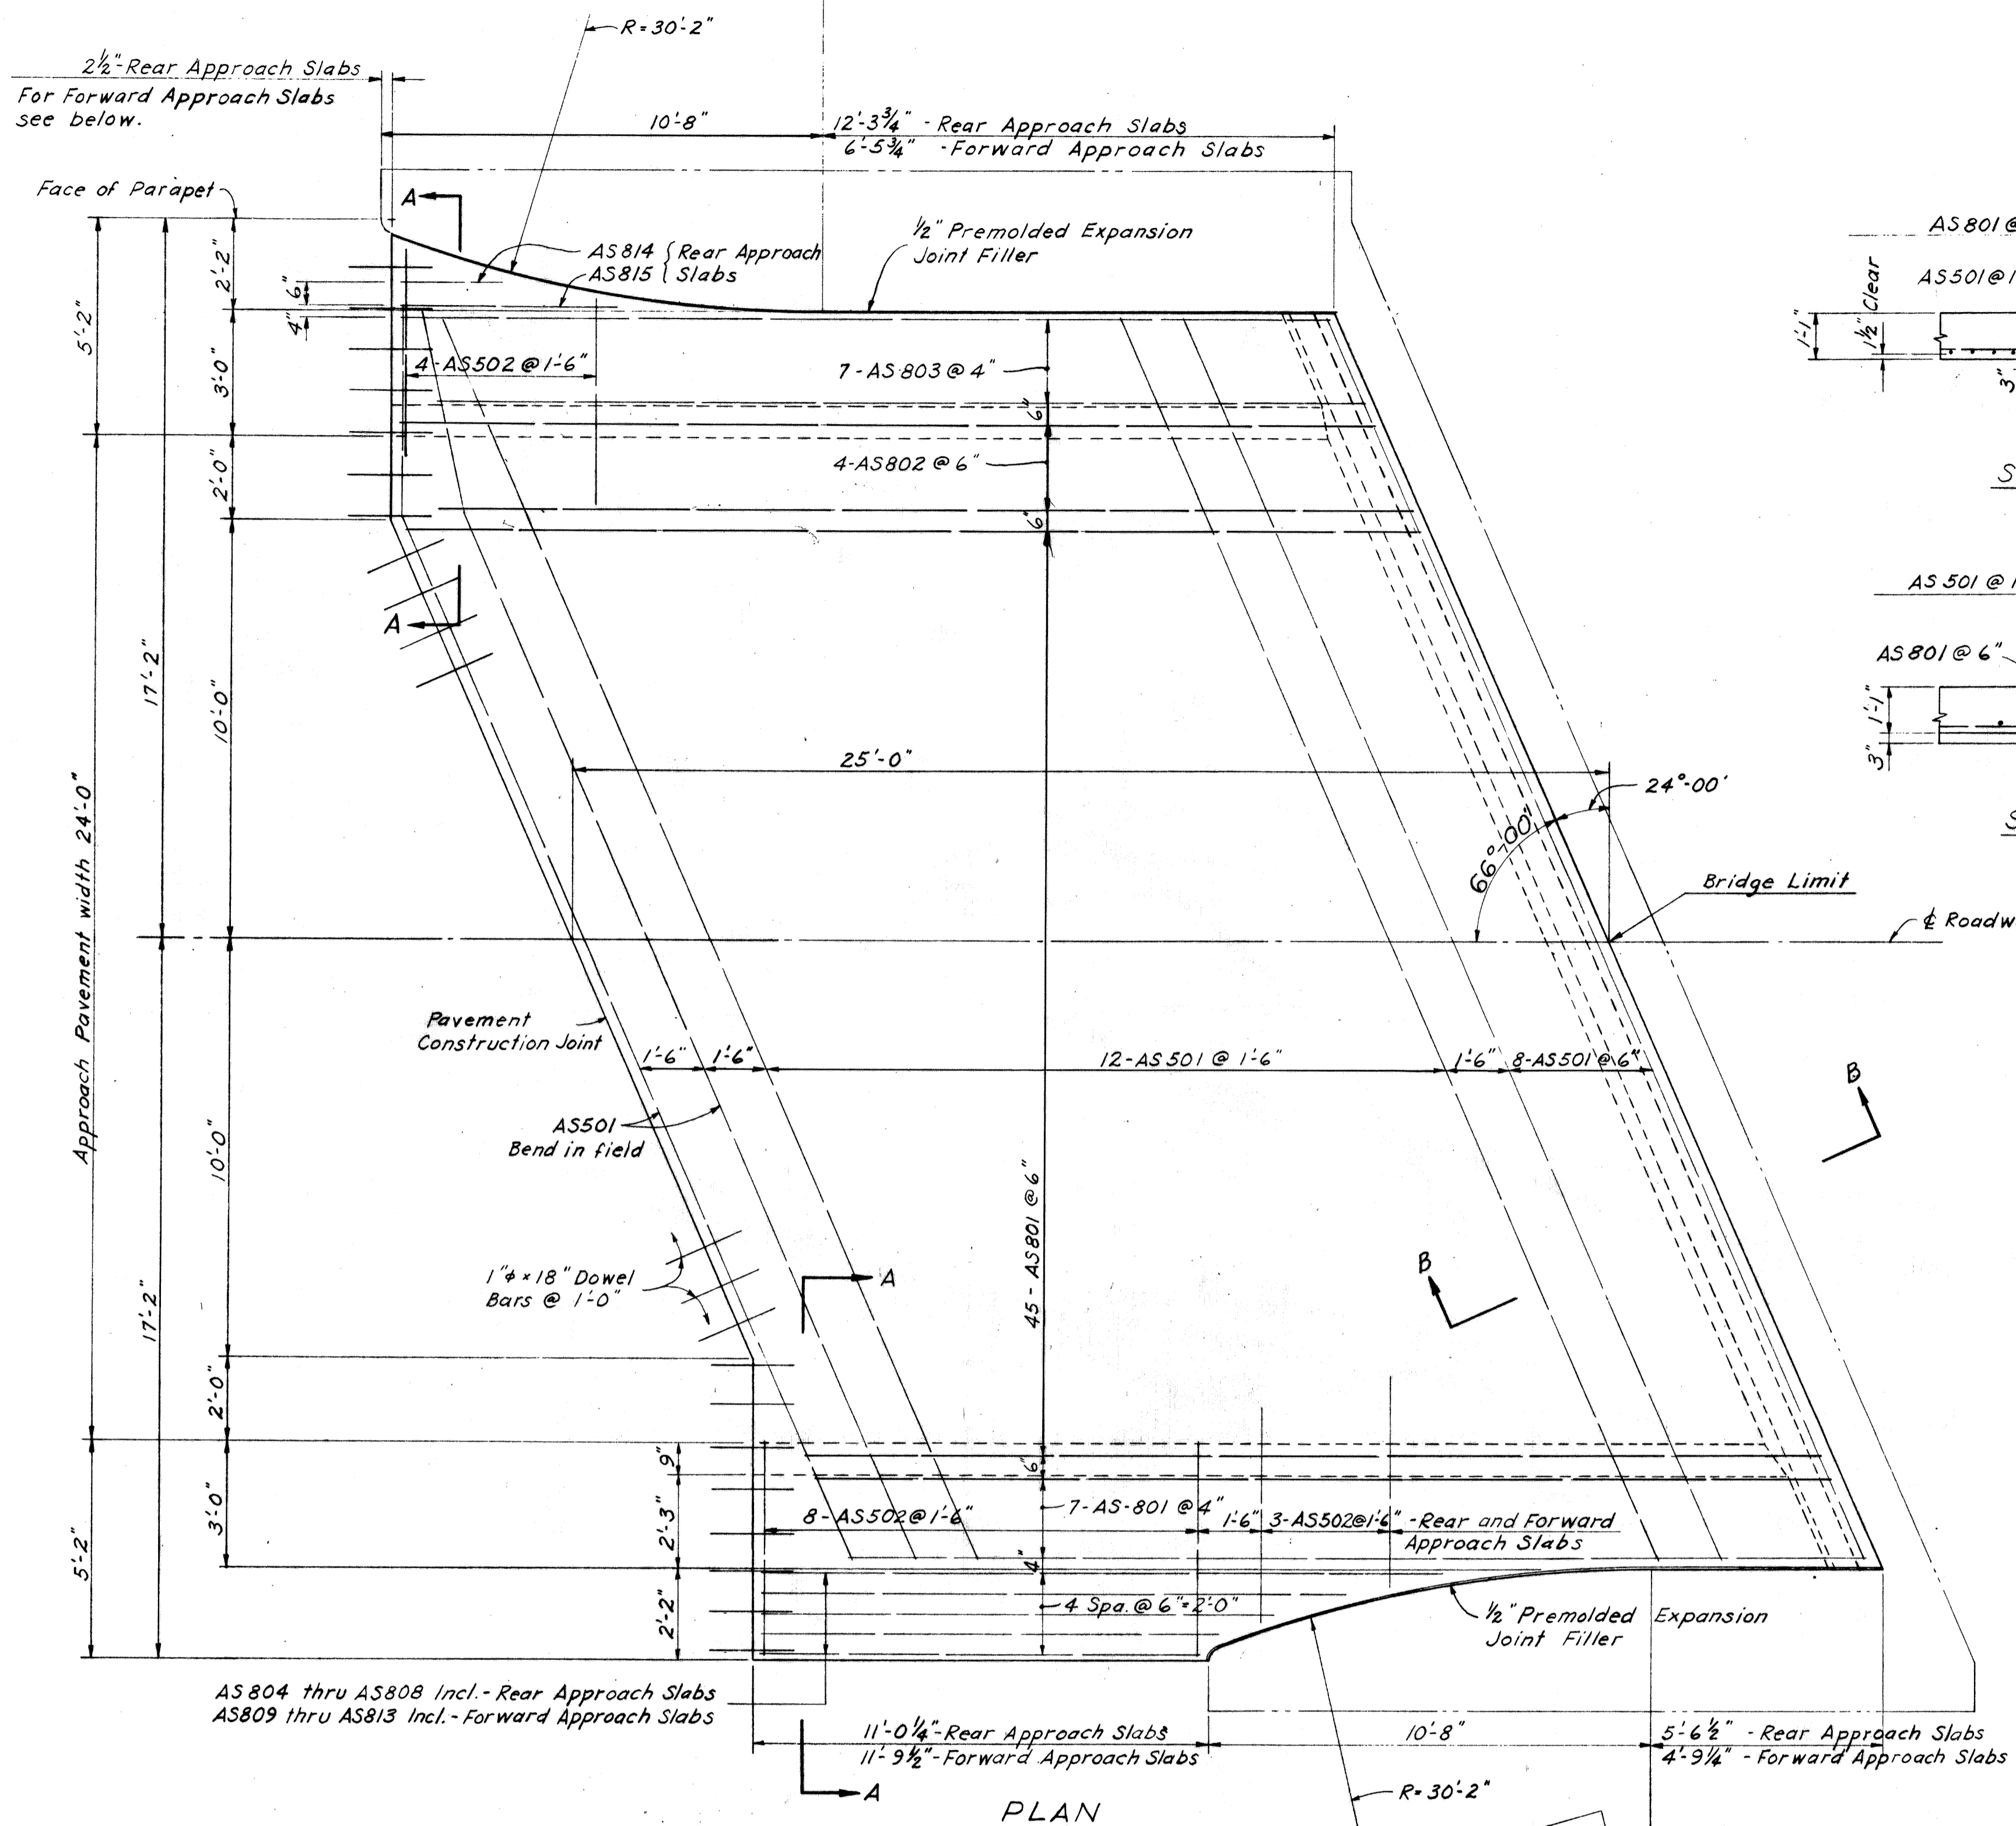

STEEL LIST						
Mark	No.	Length	Type	A	B	Weight
AS501	88	32'-3"	Str.			2960
AS502	68	5'-0"	Str.			355
AS801	208	25'-4"	1	10"	24'-6"	14,069
AS802	16	24'-4"	1	10"	23'-6"	1,040
AS803	28	23'-2"	1	10"	22'-4"	1,732
AS804	2	16'-4"	Str.			87
AS805	2	14'-0"	Str.			75
AS806	2	12'-3"	Str.			65
AS807	2	11'-0"	Str.			59
AS808	2	10'-6"	Str.			56
AS809	2	14'-7"	Str.			93
AS810	2	14'-8"	Str.			78
AS811	2	13'-2"	Str.			70
AS812	2	11'-8"	Str.			62
AS813	2	11'-3"	Str.			60
AS814	2	5'-2"	Str.			28
AS815	2	2'-5"	Str.			13
AS816	2	11'-0"	Str.			59
AS817	2	8'-5"	Str.			45
AS818	2	6'-11"	Str.			37
AS819	2	5'-3"	Str.			28
AS820	2	4'-11"	Str.			26
Total Weight						21,097 lbs.


NOTE:
Refer to Standard Drawing AS-1-54, dated 7-1-54, revised 12-1-54 for typical sections and details of Approach Slabs. Standard to be modified as necessary to accommodate reinforcing plan as shown.
Concrete shall be Class 'C'.
Steel List quantities shown are for four approach slabs.

SHAFFER, PARRETT AND ASSOCIATES
Consulting Engineers
MANSFIELD, OHIO.

APPROACH SLABS
BRIDGE No. WAY-3-1166 L & R
OVER KILLBUCK CREEK

WAYNE COUNTY S.R. 3
STA. 616 + 04.30 TO STA. 618 + 61.23


DESIGNED	DRAWN	TRACED	CHECKED	REVIEWED	DATE	REVISED
RAK	RAK	Bob	ERU			

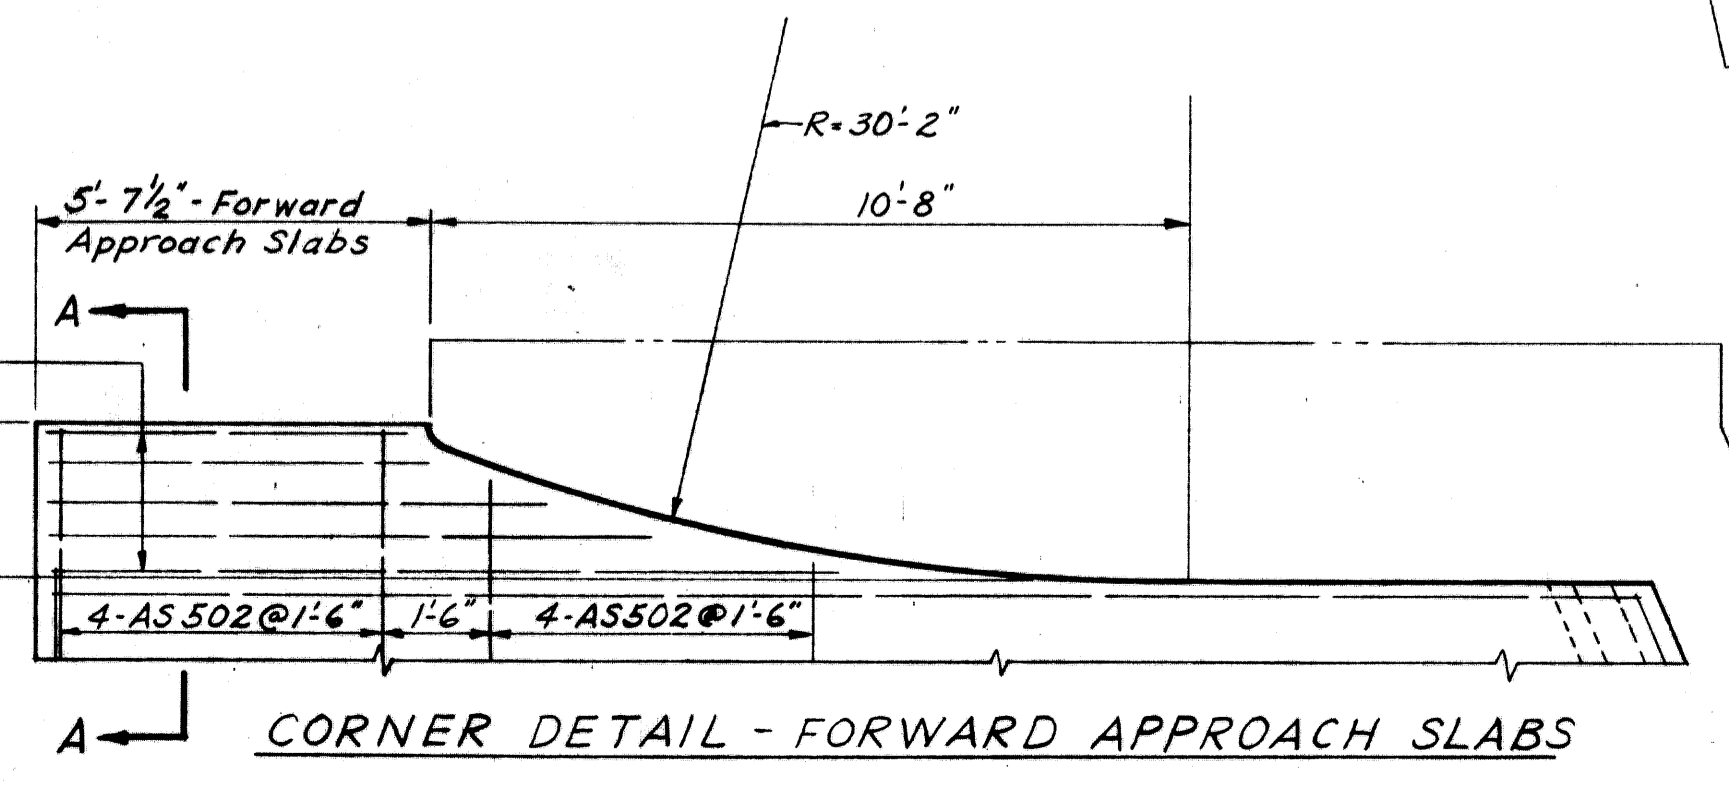

Lane Transition:
P.I. Sta. 622+00
 $\Delta = 0^{\circ}58'56''$
 $D = 0^{\circ}12'$

BORING LEGEND

- - Core boring location
- - Rod sounding location

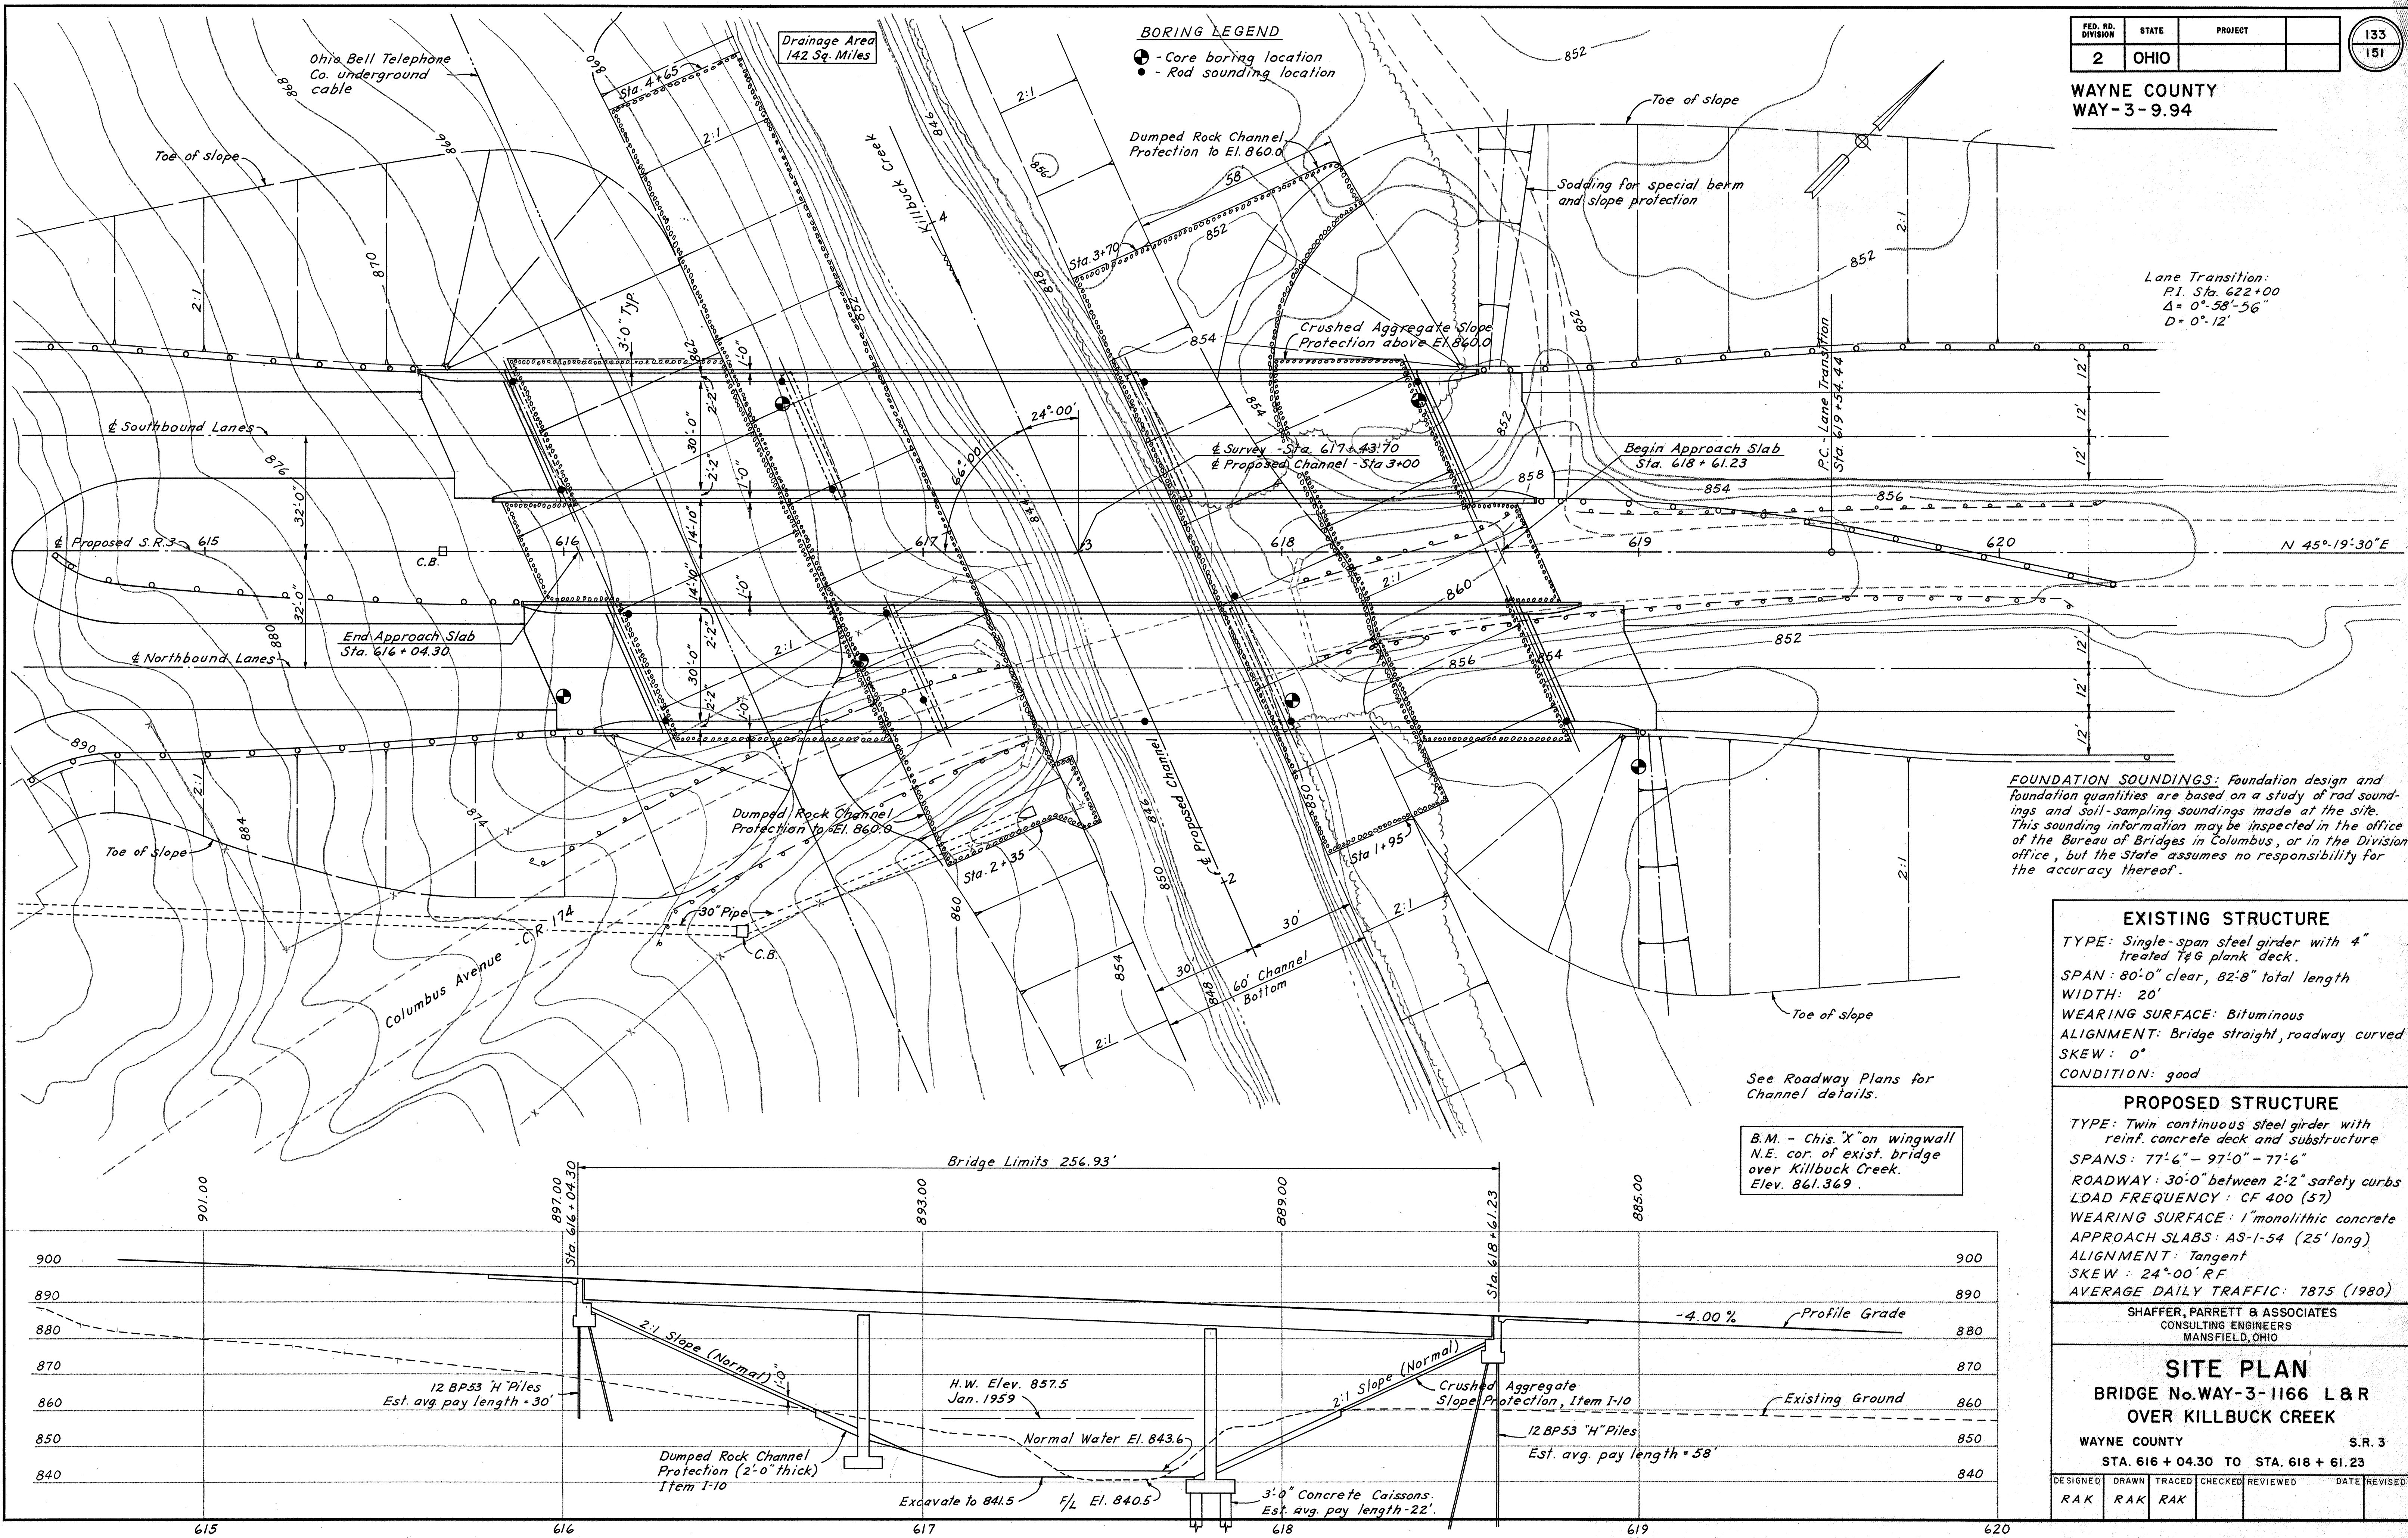

FOUNDATION SOUNDINGS: Foundation design and foundation quantities are based on a study of rod soundings and soil-sampling soundings made at the site. This sounding information may be inspected in the office of the Bureau of Bridges in Columbus, or in the Division office, but the State assumes no responsibility for the accuracy thereof.

EXISTING STRUCTURE

TYPE: Single-span steel girder with 4" treated T&G plank deck.
SPAN: 80'-0" clear, 82'-8" total length
WIDTH: 20'
WEARING SURFACE: Bituminous
ALIGNMENT: Bridge straight, roadway curved
SKEW: 0°
CONDITION: good

PROPOSED STRUCTURE

TYPE: Twin continuous steel girder with reinf. concrete deck and substructure
SPANS: 77'-6" - 97'-0" - 77'-6"
ROADWAY: 30'-0" between 2'-2" safety curbs
LOAD FREQUENCY: CF 400 (57)
WEARING SURFACE: 1" monolithic concrete
APPROACH SLABS: AS-1-54 (25' long)
ALIGNMENT: Tangent
SKEW: 24°-00' RF
AVERAGE DAILY TRAFFIC: 7875 (1980)

SHAFFER, PARRETT & ASSOCIATES
CONSULTING ENGINEERS
MANSFIELD, OHIO

SITE PLAN

BRIDGE No. WAY-3-1166 L & R
OVER KILLBUCK CREEK


WAYNE COUNTY S.R. 3
STA. 616 + 04.30 TO STA. 618 + 61.23

DESIGNED	DRAWN	TRACED	CHECKED	REVIEWED	DATE	REVISED
RAK	RAK	RAK				


See Roadway Plans for Channel details.

B.M. - This "X" on wingwall N.E. cor. of exist. bridge over Killbuck Creek. Elev. 861.369.


Bridge Limits 256.93'

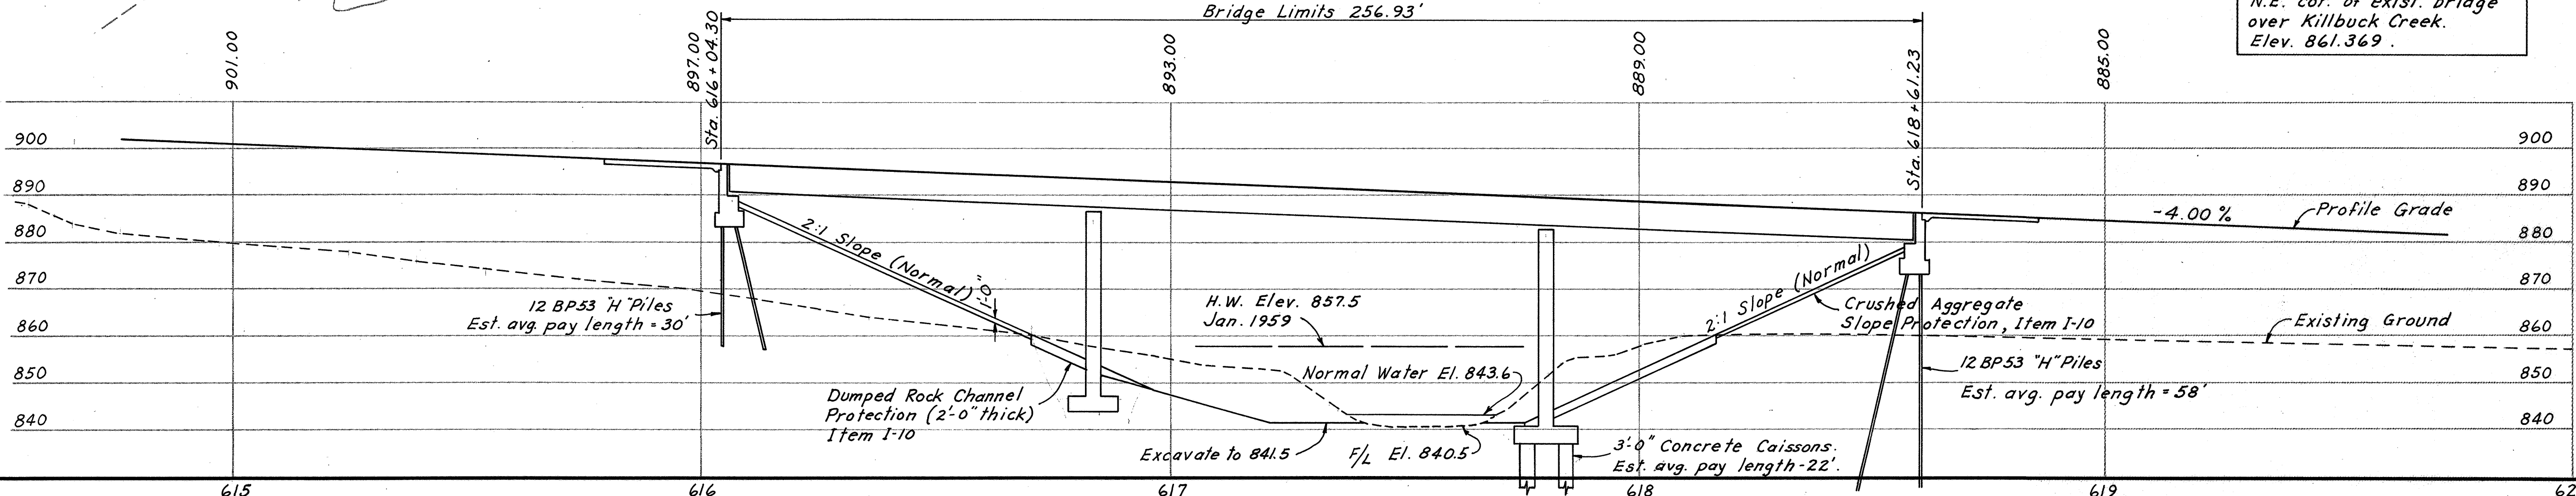

WAYNE COUNTY
WAY-3-9.94

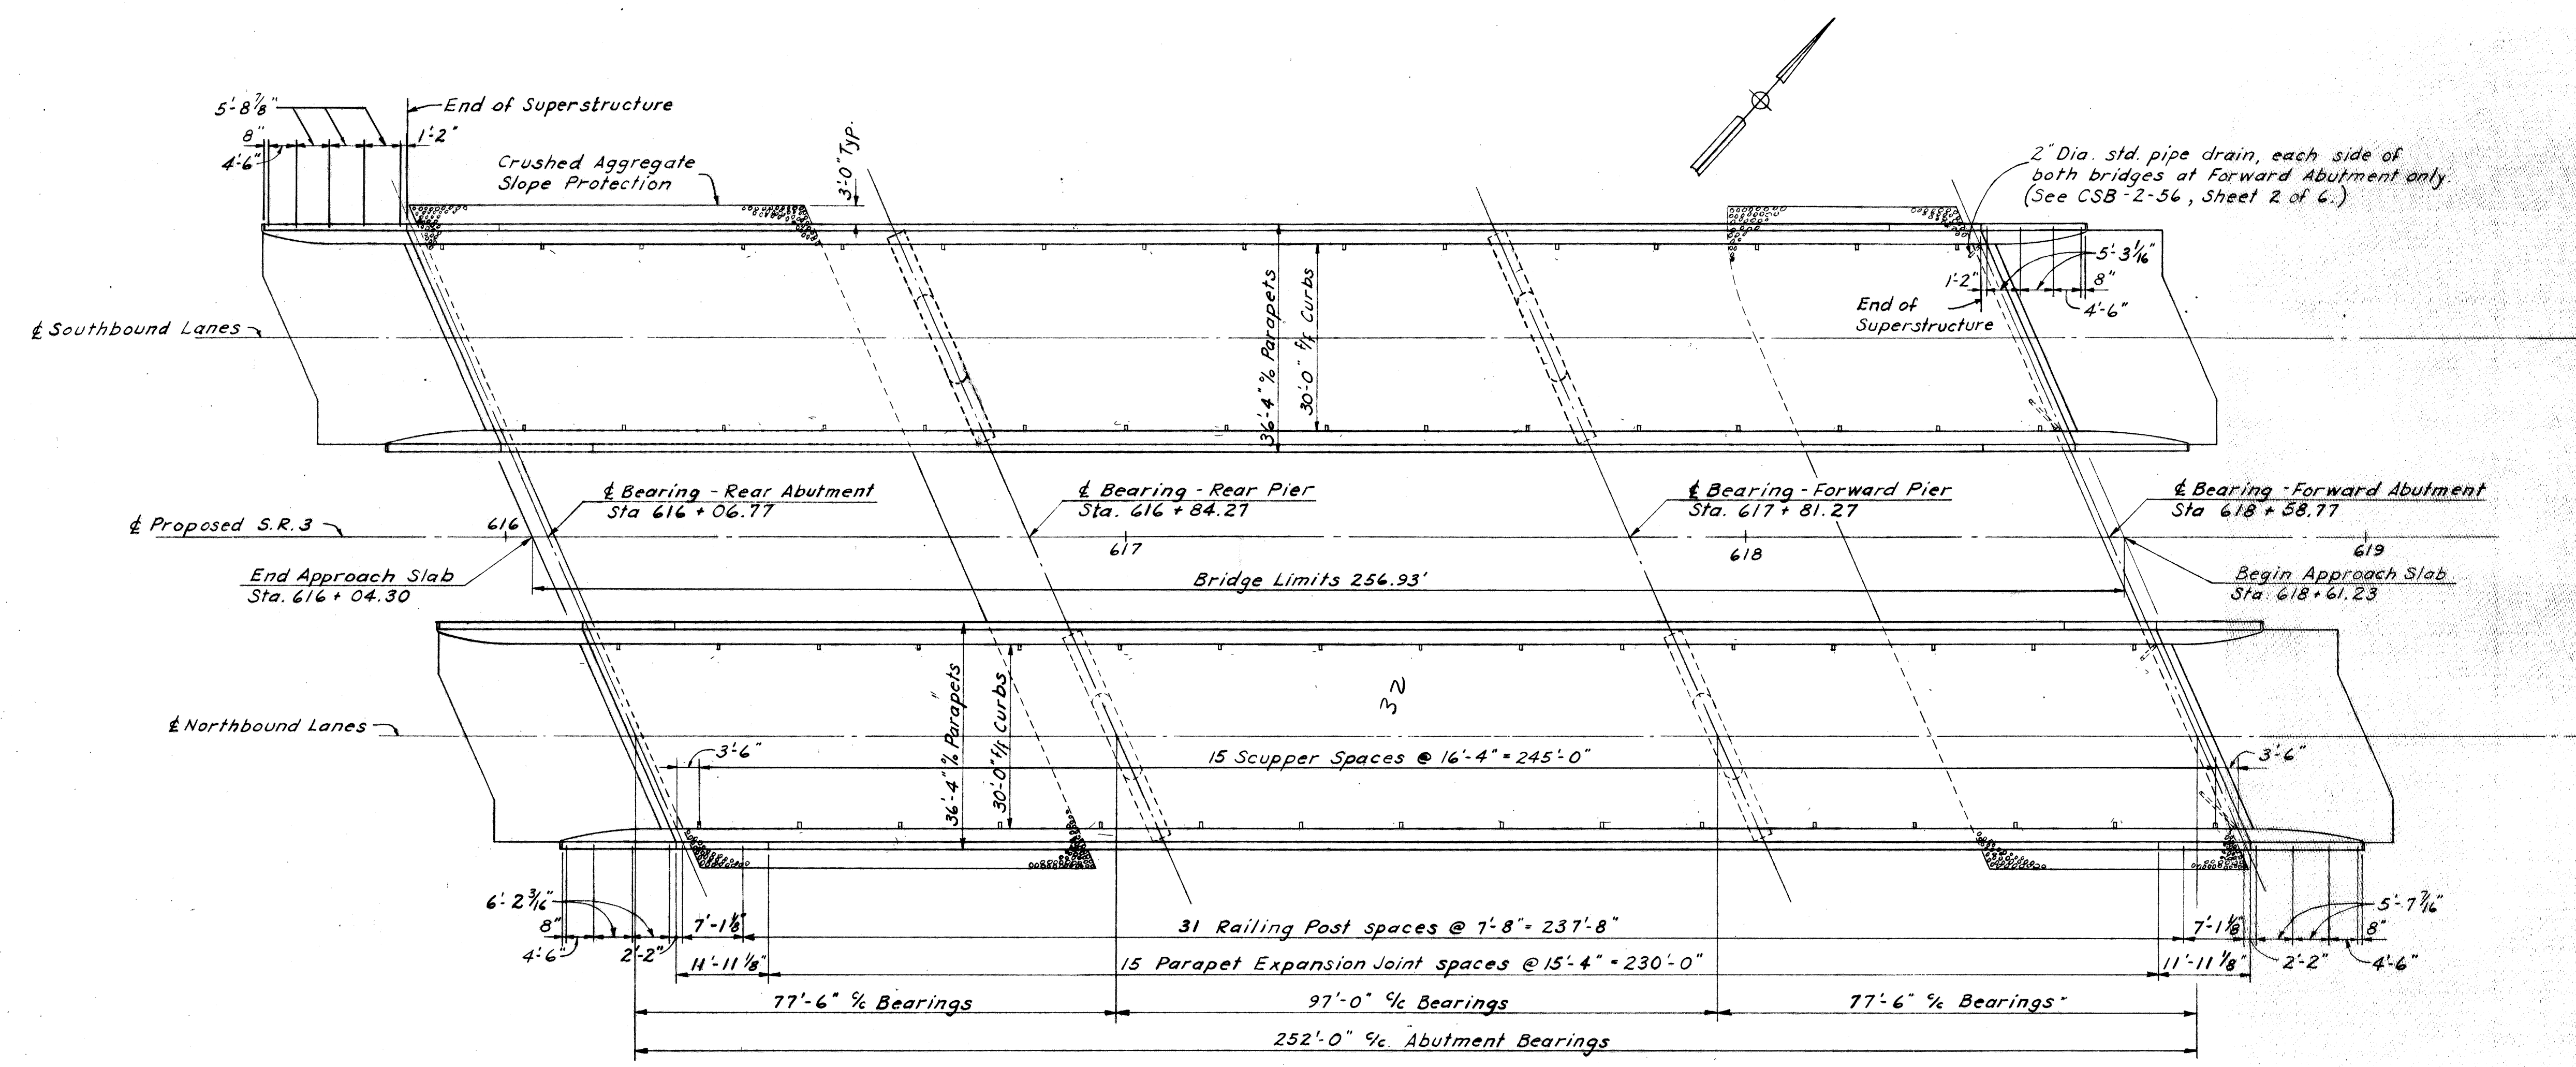

PLAN

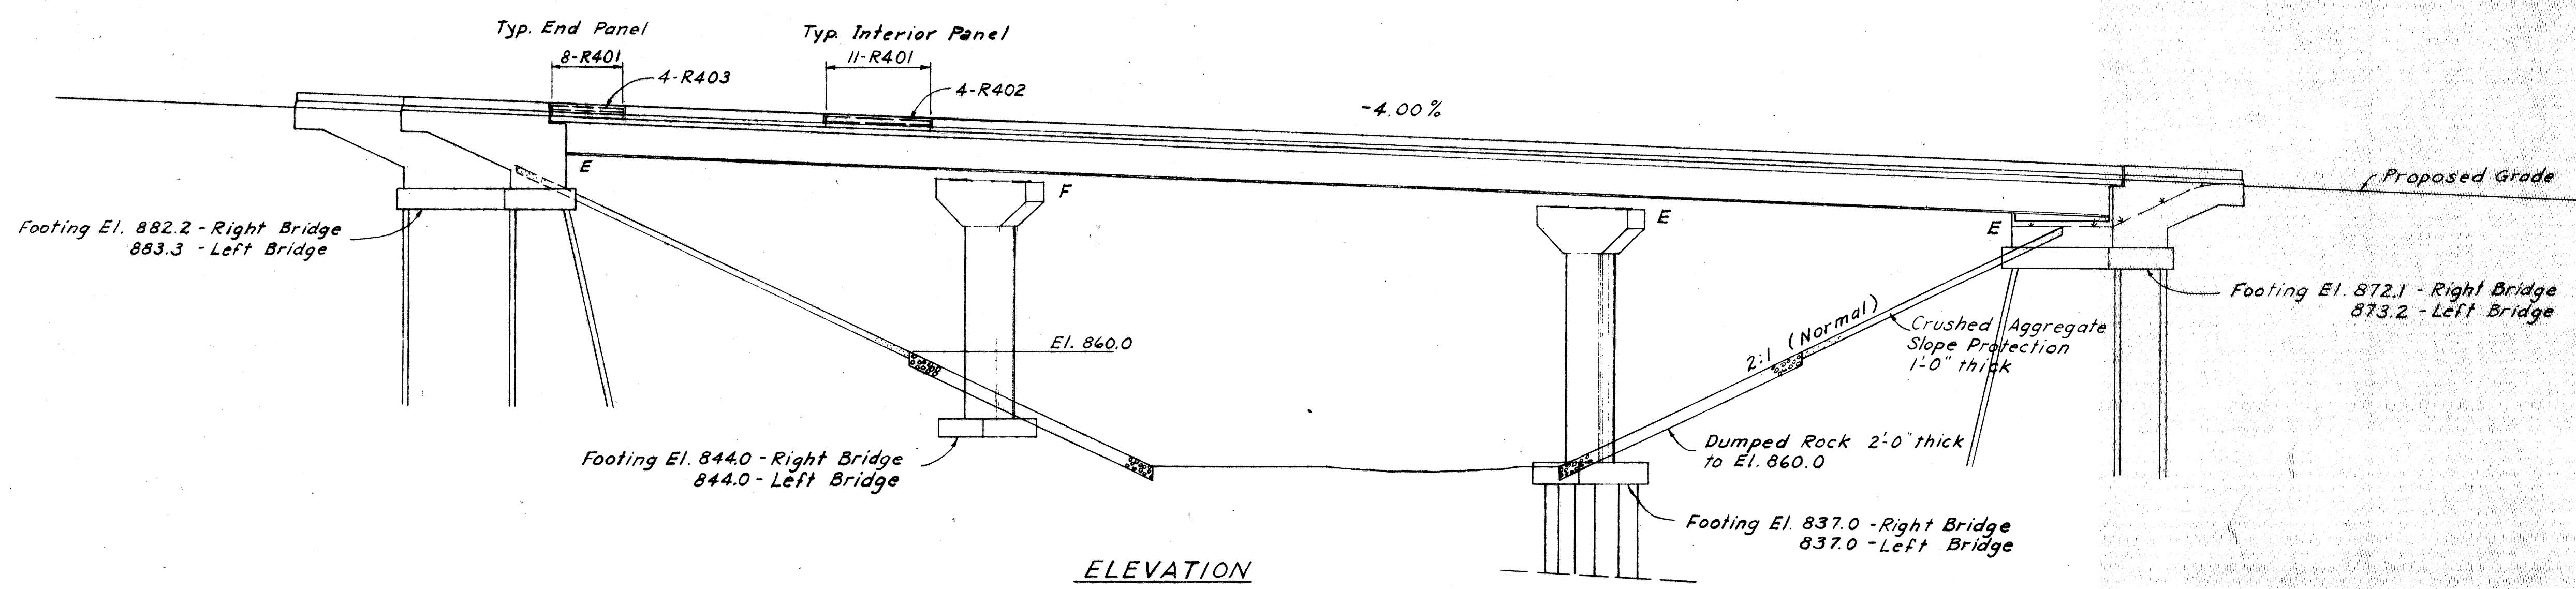

ELEVATION

NOTES:

PILES shall be driven to firm contact with bedrock using a pile hammer having an energy rating of not less than 15,000 ft. lbs. At the Contractor's option and expense, he may prebore through the embankments to obtain contact with bedrock. The design load for each pile is 30 tons.

GENERAL NOTES: See Sheet 135.

SHAFFER, PARRETT AND ASSOCIATES Consulting Engineers MANSFIELD, OHIO.						
GENERAL PLAN						
BRIDGE No. WAY-3-1166 L & R OVER KILLBUCK CREEK						
WAYNE COUNTY S.R. 3						
STA. 616 + 04.30 TO STA. 618 + 61.23						
DESIGNED	DRAWN	TRACED	CHECKED	REVIEWED	DATE	REVISED
RAK	RAK	Bob	J.M.C.			

GENERAL NOTES

FED. RD. DIVISION	STATE	PROJECT	
2	OHIO		

135
151

WAYNE COUNTY
WAY-3-9.94

DESIGN SPECIFICATIONS: This structure conforms to the requirements of "Design Specifications for Highway Structures" of the State of Ohio Department of Highways, dated 9-1-57 with revision date 2-21-58.

REFERENCE shall be made to Standard Drawing AS-1-54 (revised 12-1-54), AR-1-57 (revised 2-2-59), RB-1-55 (revised 2-2-59), CSB-2-56, sheets 1, 2 and 3 of 6 (revised 2-2-59) and to Supplemental Specifications S-101 dated 12-2-59 and S-307 dated 8-23-60.

EXCAVATION QUANTITY includes the removal of fill material between the surface of the proposed embankment and the bottom of the footings.

DRILLED CAISSONS shall penetrate 7 feet into bedrock or to the elevation shown, whichever is lower.

REAR PIER FOOTINGS shall extend a minimum of 2 ft 6 inches into firm rock or to the elevation shown, whichever is lower.

REMOVAL OF EXISTING STRUCTURE:

When no longer needed to maintain traffic, the existing structure shall be removed and shall become the property of the contractor.

CONCRETE DECK PLACING: In order to facilitate water curing of the concrete of the deck slab, the placing of concrete shall progress upgrade. The slab may be placed in sections, between transverse construction joints which are parallel to transverse reinforcing steel and are located near the center of any span.

WELDING of structural steel shall be Class "A" except as otherwise shown. Welds shown as field welds may, at the option of the Contractor, be made in the shop.

Class "B" welds are indicated on the plans as follows:



SHOP DRAWINGS for the girders shall include an overall layout with dimensions showing the relative unloaded vertical position of each girder or girder segment with respect to the others in the same girder line and with respect to a full length base or work line taking into account camber and the profile of the highway.

PILES shall be driven to firm contact with bedrock using a pile hammer having an energy rating of not less than 15,000 foot pounds. The design load for each pile is 30 tons.

If preboring is used, the holes shall be back-filled with material meeting the requirements of Sec. I-22.

PROCEDURE: The rock benching in the vicinity of the rear abutments, as shown on Sheet 21 and the excavation of unsuitable material in the vicinity of the forward abutments, as shown on Sheet 22, shall be completed and the embankment shall be placed and compacted up to the finished spill-thru slope and to the level of the subgrade for a distance of 200 feet back of the abutments, after which excavation shall be made for the abutments and for the piers.

MACHINE FINISH: The top of the bridge deck slabs shall be machine finished in accordance with the Proposal Note "Machine Finishing of Bridge Deck Slabs."

STEEL: See Proposal regarding A-373 Steel.

SHOP ASSEMBLY: At least three adjacent girder segments shall be assembled in the shop in their correct unloaded positions as shown on the shop drawing layout required in the above note, so that the faced joints for welding the segments together may be checked for proper fit-up.

CONCRETE for superstructure, abutment parapets and caissons, shall be Class "C." Concrete for pier footings, caps and stems and concrete for abutments shall be Class "E."

PARAPETS: R402 thru R407 reinforcing bars and concrete above the parapet construction joint in both the superstructure and abutments shall be included in the price per lineal foot of railing for payment.

BRIDGE SEATS: Special care must be taken in placing bars in the bridge seats of the Rear Piers so that they will not interfere with the drilling of holes for anchor bolts.

POROUS BACKFILL 2'-0" thick shall extend upward to the subgrade elevation and for the full length of the abutment.

CRUSHED AGGREGATE SLOPE PROTECTION shall be provided under the structure at all abutments.

This material shall be 1'-0" thick and shall extend from the face of the abutment down to Elev. 860.0 and transversely to 3'-0" outside the exterior faces of the superstructure.

DUMPED ROCK CHANNEL PROTECTION shall be provided under the structure, shall extend from Elev. 860.0 down to Elev. 841.5, shall be 2'-0" thick and shall be located as shown on the Site Plan.

BACKWALL concrete above bridge seat construction joint shall not be placed until after the steel work is erected, but before placing the deck slab.

SPECIAL ITEM- DRILLED CAISSONS.

Description: This item shall consist of furnishing and installing caissons of the kind and size called for on the Plans and in the following Specifications. Caissons shall be installed in accordance with these Specifications and in the location and manner and to the elevation shown on the Plans or as directed by the Director. It shall be the Contractor's responsibility to determine the proper lengths of shells or casings and caisson materials to be brought to the site and this responsibility shall not be considered in any way affected if the approximate estimated pay lengths shown on the Plans are different from that found at the site.

Materials. The materials for concrete shall be the same as for "Item S-1 Concrete for Structures." Concrete shall be Class "C." Reinforcing steel shall meet the requirements of Sec. M-7.1 and the vertical bars shall be deformed. Metal shells or casings shall be water-tight and shall be of sufficient strength to withstand earth pressure during installation and before being filled with concrete. Weld metal for splices shall be in accordance with Sec. M-7.16.

Metal Shells or Casings. Caissons shall be of a type using a metal shell or casing which may be left in place, or withdrawn, as the concrete is placed. If splices are required the Contractor shall make adequate preparation so as to reduce to a minimum the interruption of casing installation while the splice is being made. Welds shall be made at least two feet above ground.

Installation. The hole for the caisson shall be drilled through the overlying soil and into solid rock to the elevations specified on the Plans. When the proper depth has been reached, the hole shall be cleaned, dewatered, and inspected by the Engineer. Upon his approval, reinforcement may be then placed and concrete poured up to the elevation shown on the Plans.

Installation-(Cont'd) The casing may be withdrawn during the placing of the concrete. In all cases, the concrete mix, after pouring, shall fill completely the excavated space to the top of the caisson. The tops of the shells or casings shall be completely covered until the concrete is placed. Any accumulation of water or other foreign matter in the shell or casing shall be removed before placing the concrete.

Defective Caissons. A caisson shall be removed and replaced at no additional cost to the State if it is injured, or if its location differs from the specified location by more than one inch at the top.

The caissons shall be installed straight and shall not be out of plumb more than two percent. If a caisson is out of plumb more than this, the design of the caisson shall be modified accordingly.

Method of Measurement. The length of each caisson to be paid for shall be the completed and accepted length, measured along the axis of the caisson from the bottom of the drilled hole to the underside of the footing. During the installation, no jettling to aid in the penetration shall be permitted.

Basis of Payment. The quantity of caissons, measured as described above, shall be paid for at the contract unit price per linear foot bid under "Special Item- Drilled Caissons," complete in place, which price and payment shall constitute full compensation for furnishing all materials, labor and work, the use of tools and equipment and all incidentals necessary to complete this item. If reinforcing steel is required to project from within the caisson to a point above the bottom of the footing, it shall be considered as an incidental which shall be paid for in the price per foot of caissons.


SHAFFER, PARRETT AND ASSOCIATES
Consulting Engineers
MANSFIELD, OHIO.

GENERAL NOTES
BRIDGE No. WAY-3-1166 L & R
OVER KILLBUCK CREEK


WAYNE COUNTY S.R. 3
STA. 616 + 04.30 TO STA. 618 + 61.23

DESIGNED	DRAWN	TRACED	CHECKED	REVIEWED	DATE	REVISED
----------	-------	--------	---------	----------	------	---------


**WAYNE COUNTY
WAY-3-9.94**

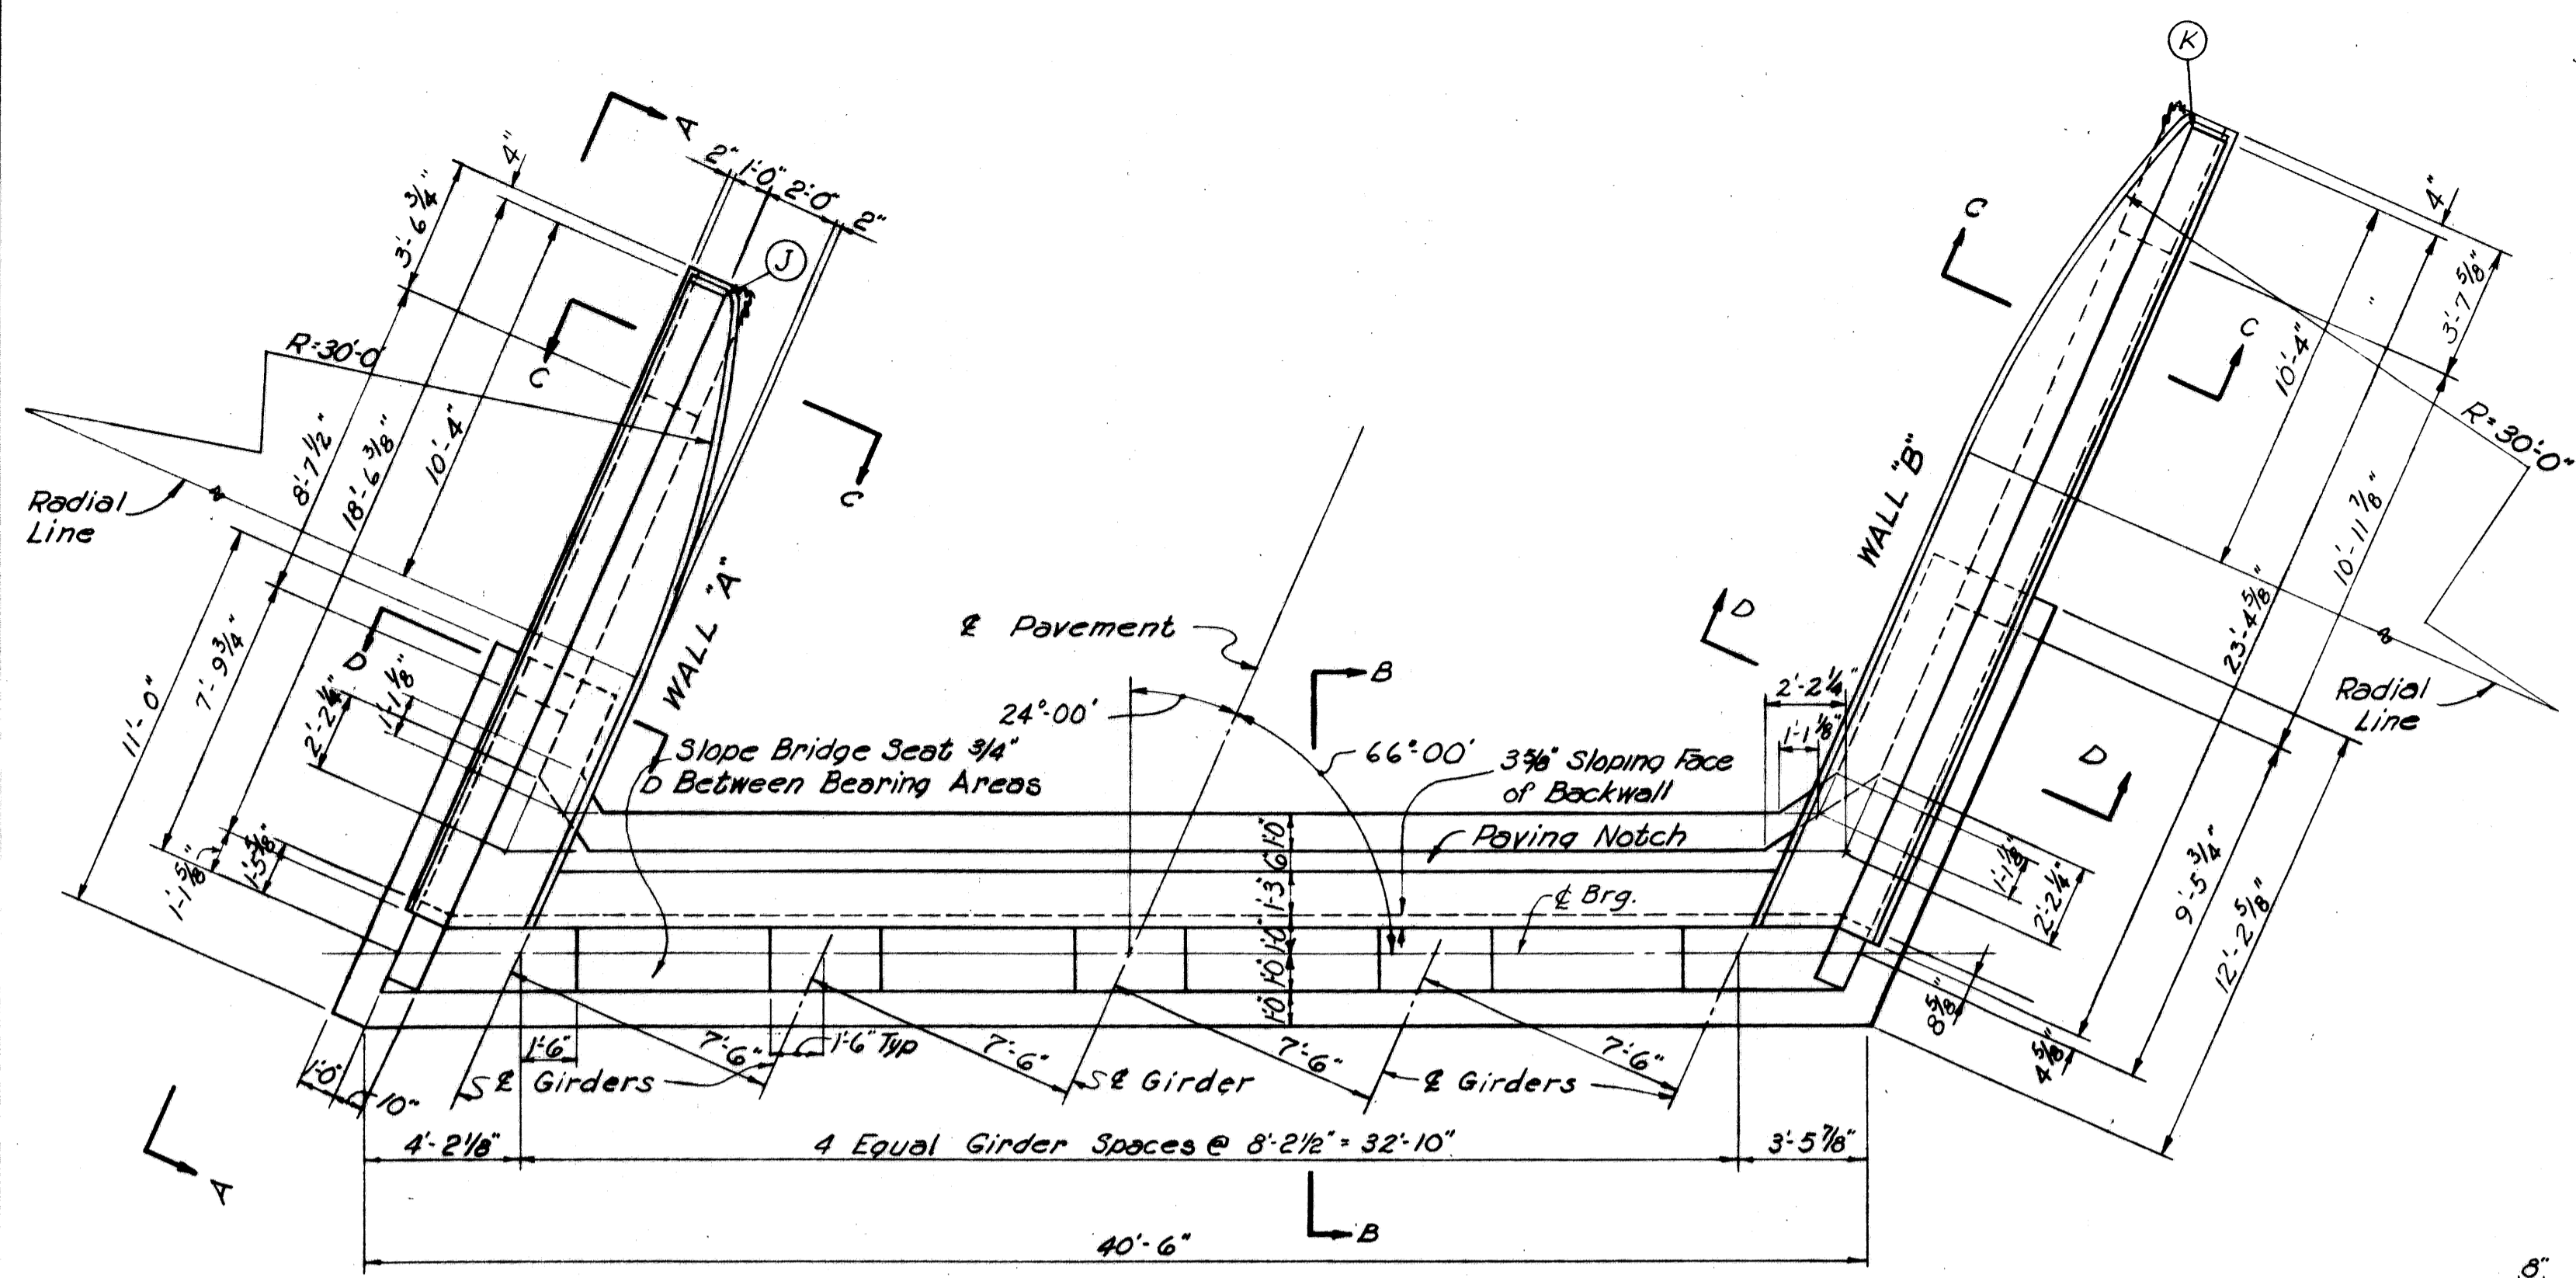


PLAN

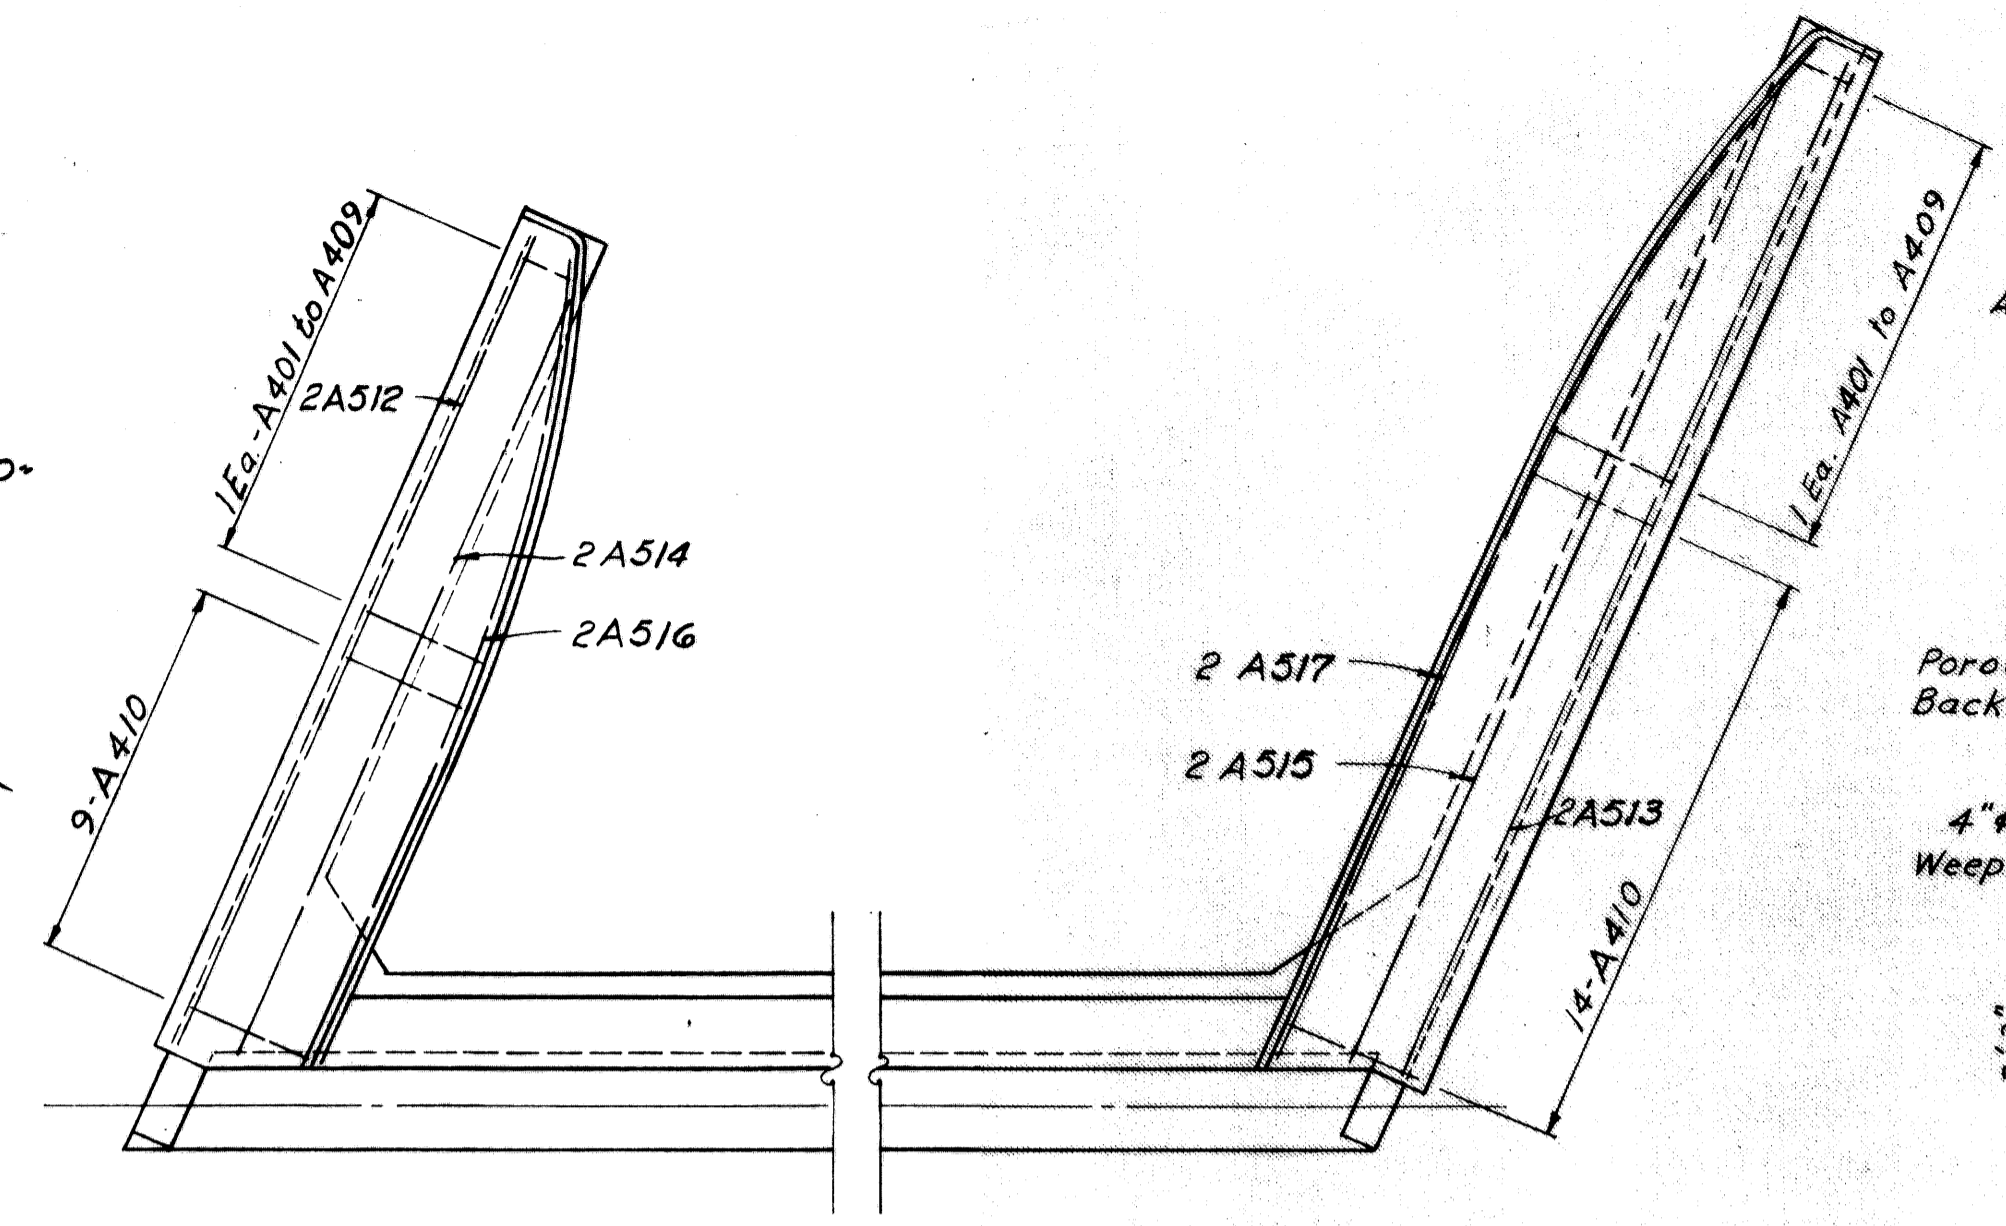


WING WALL PLAN

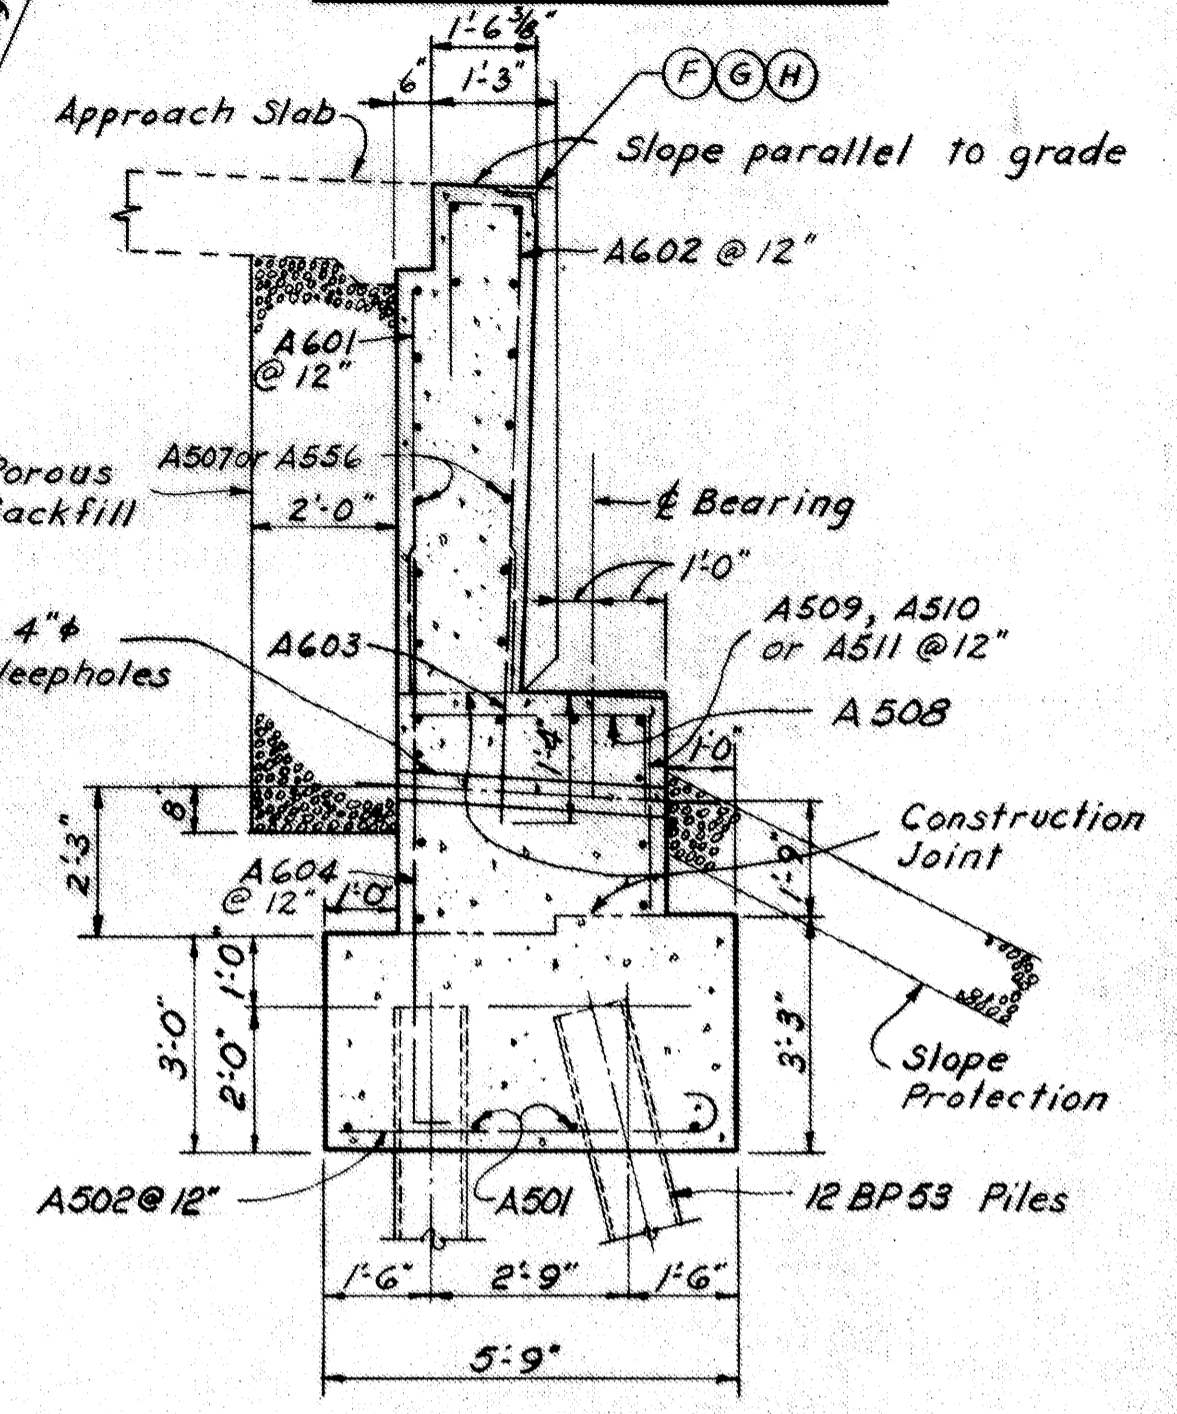


SECTION B-B

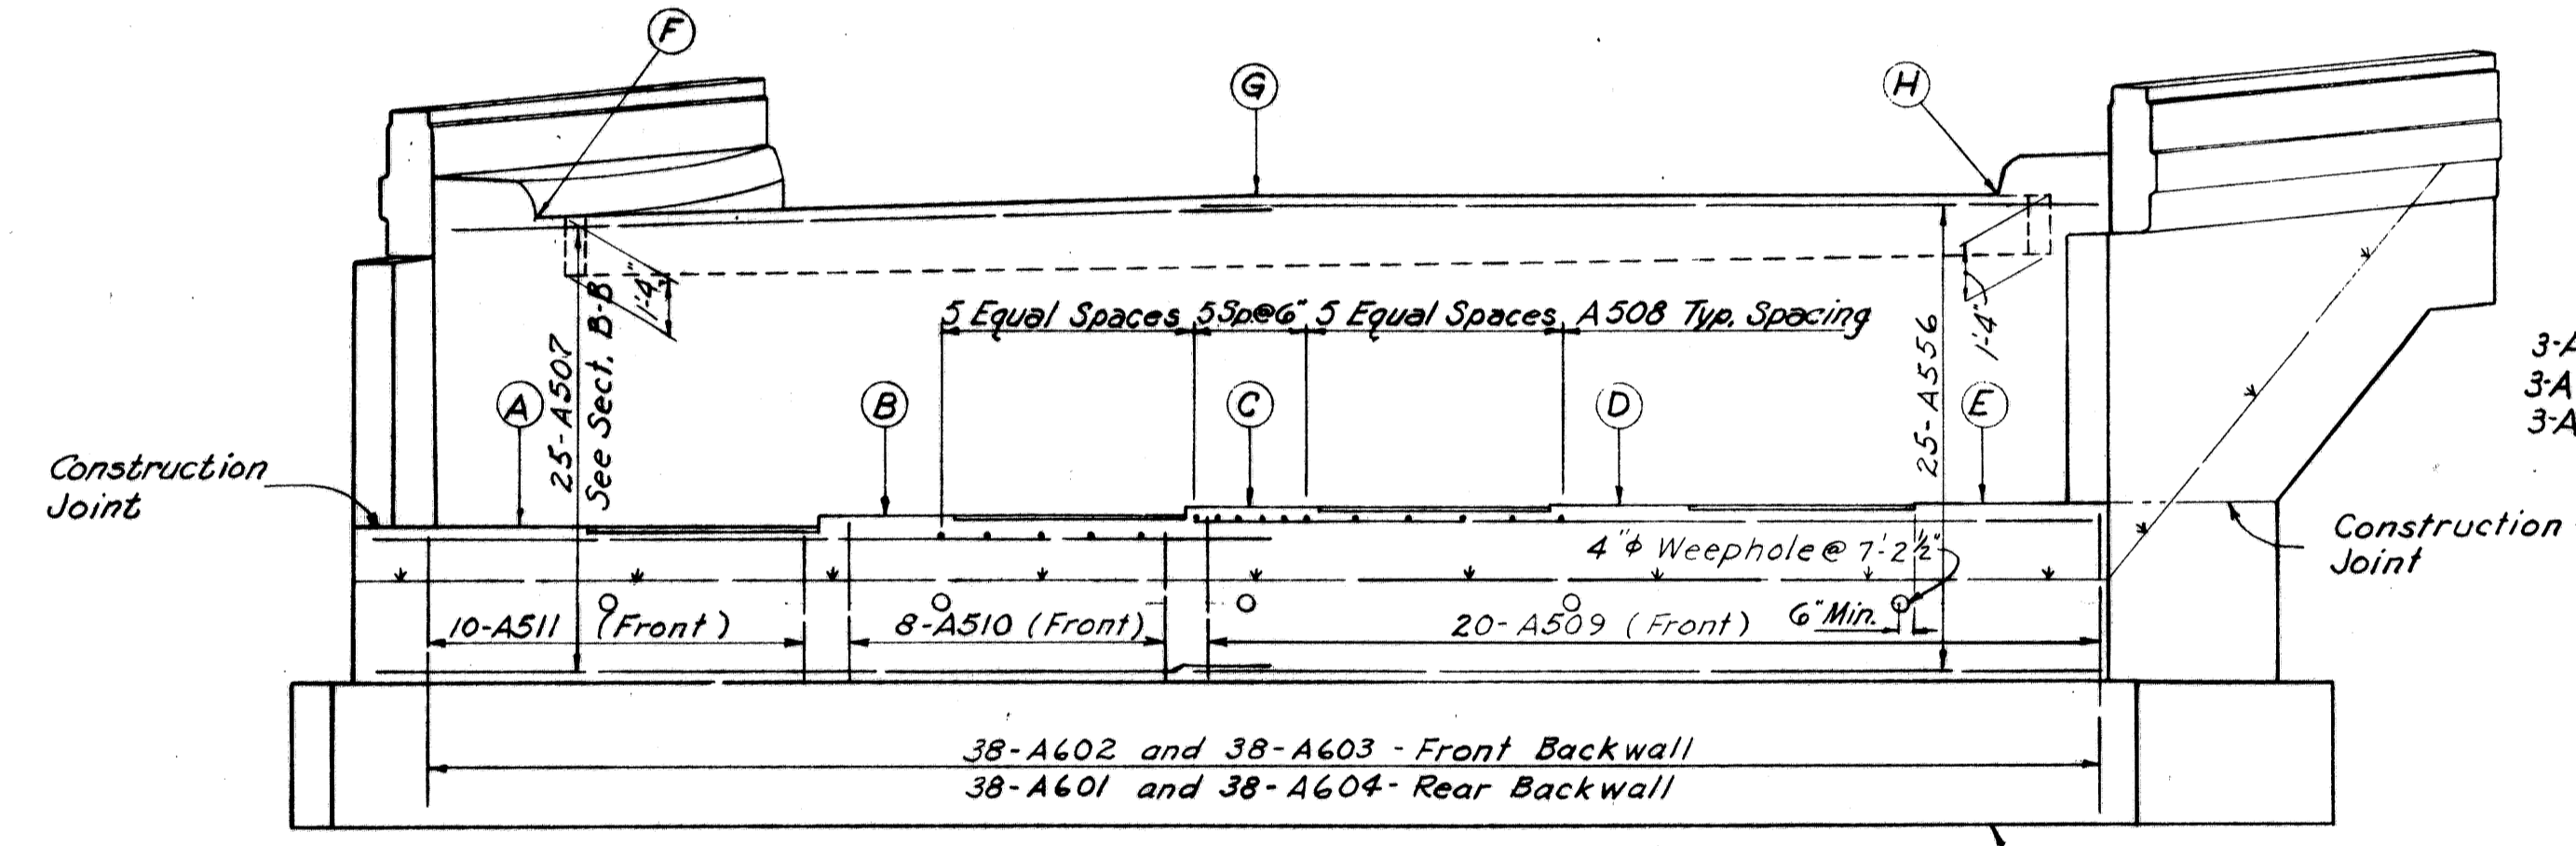


ELEVATION

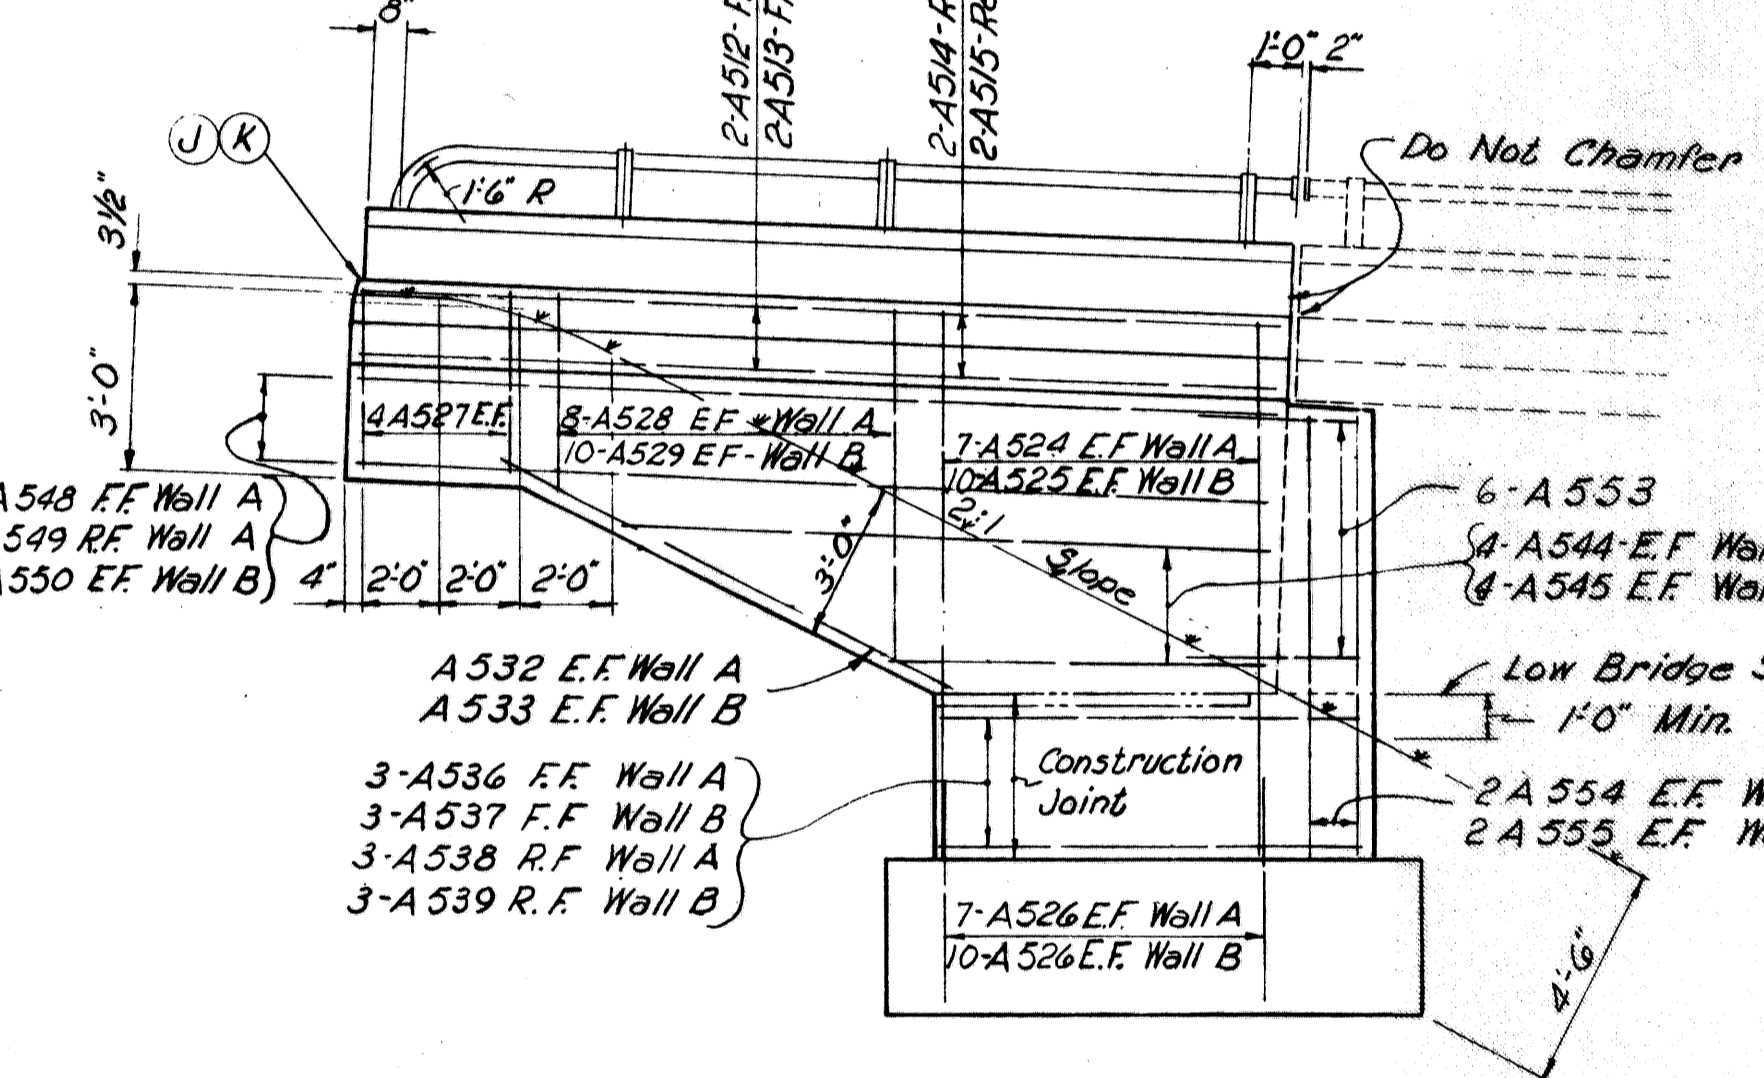

ELEVATION A-A

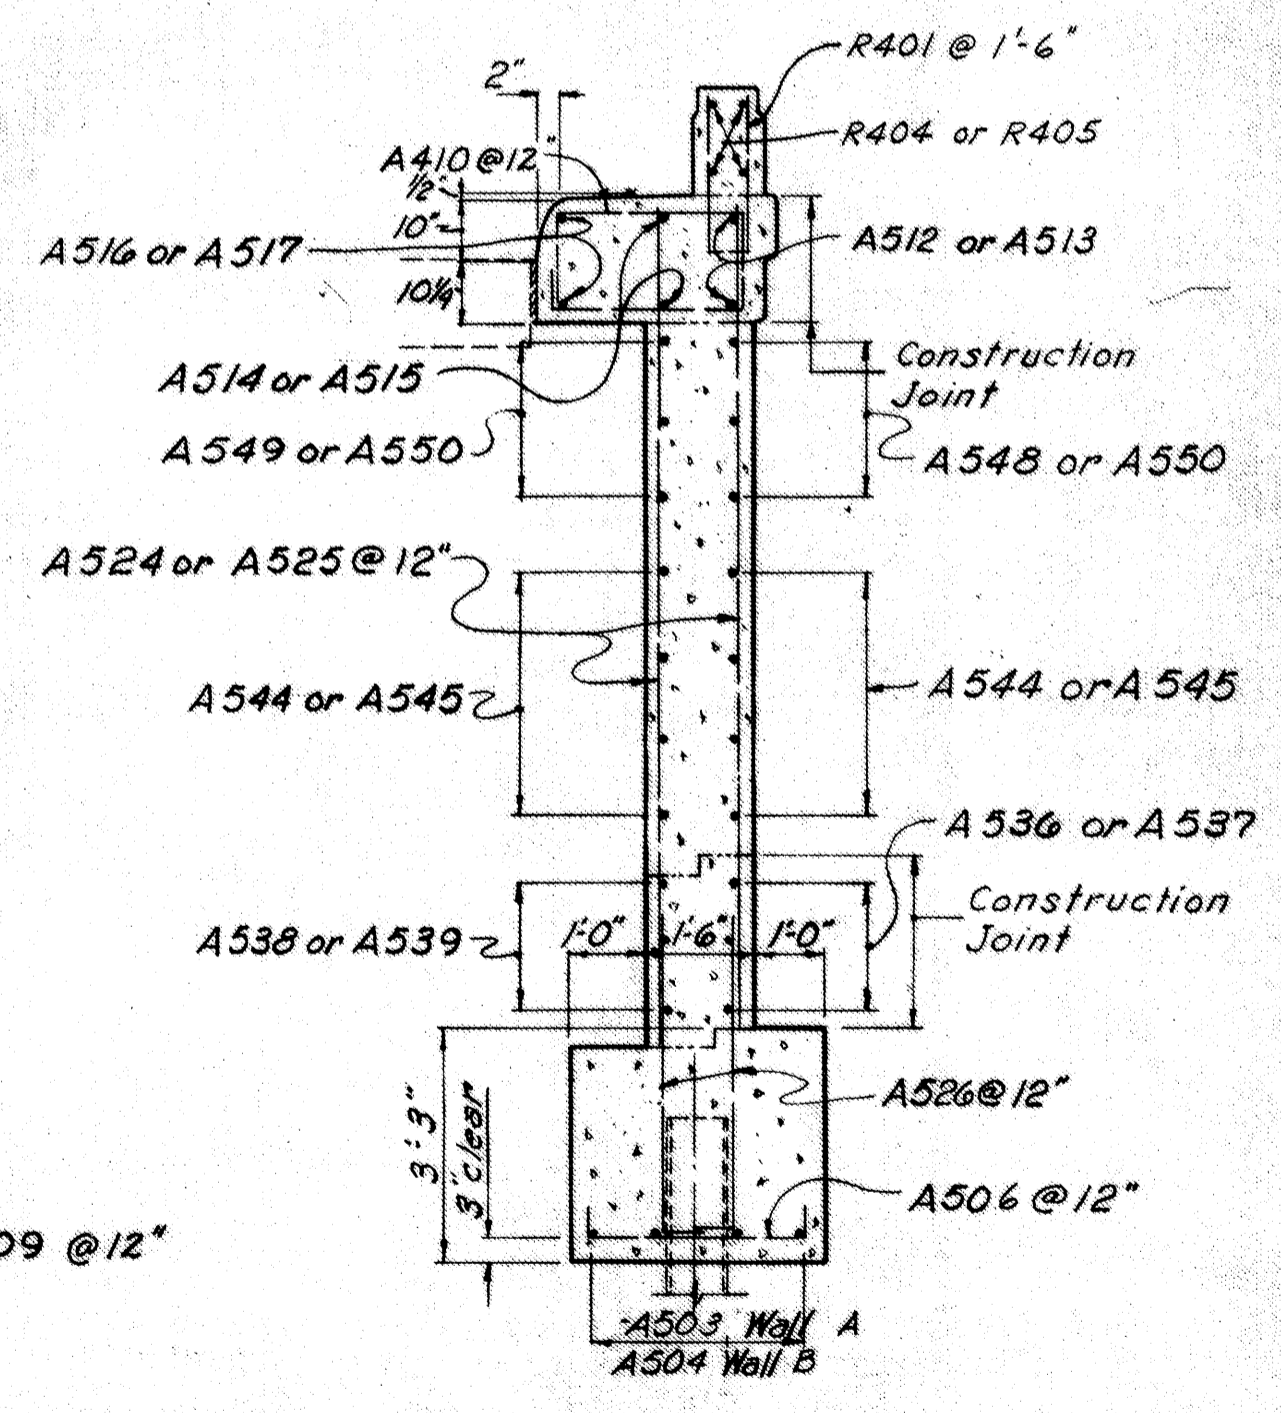


SECTION D-D

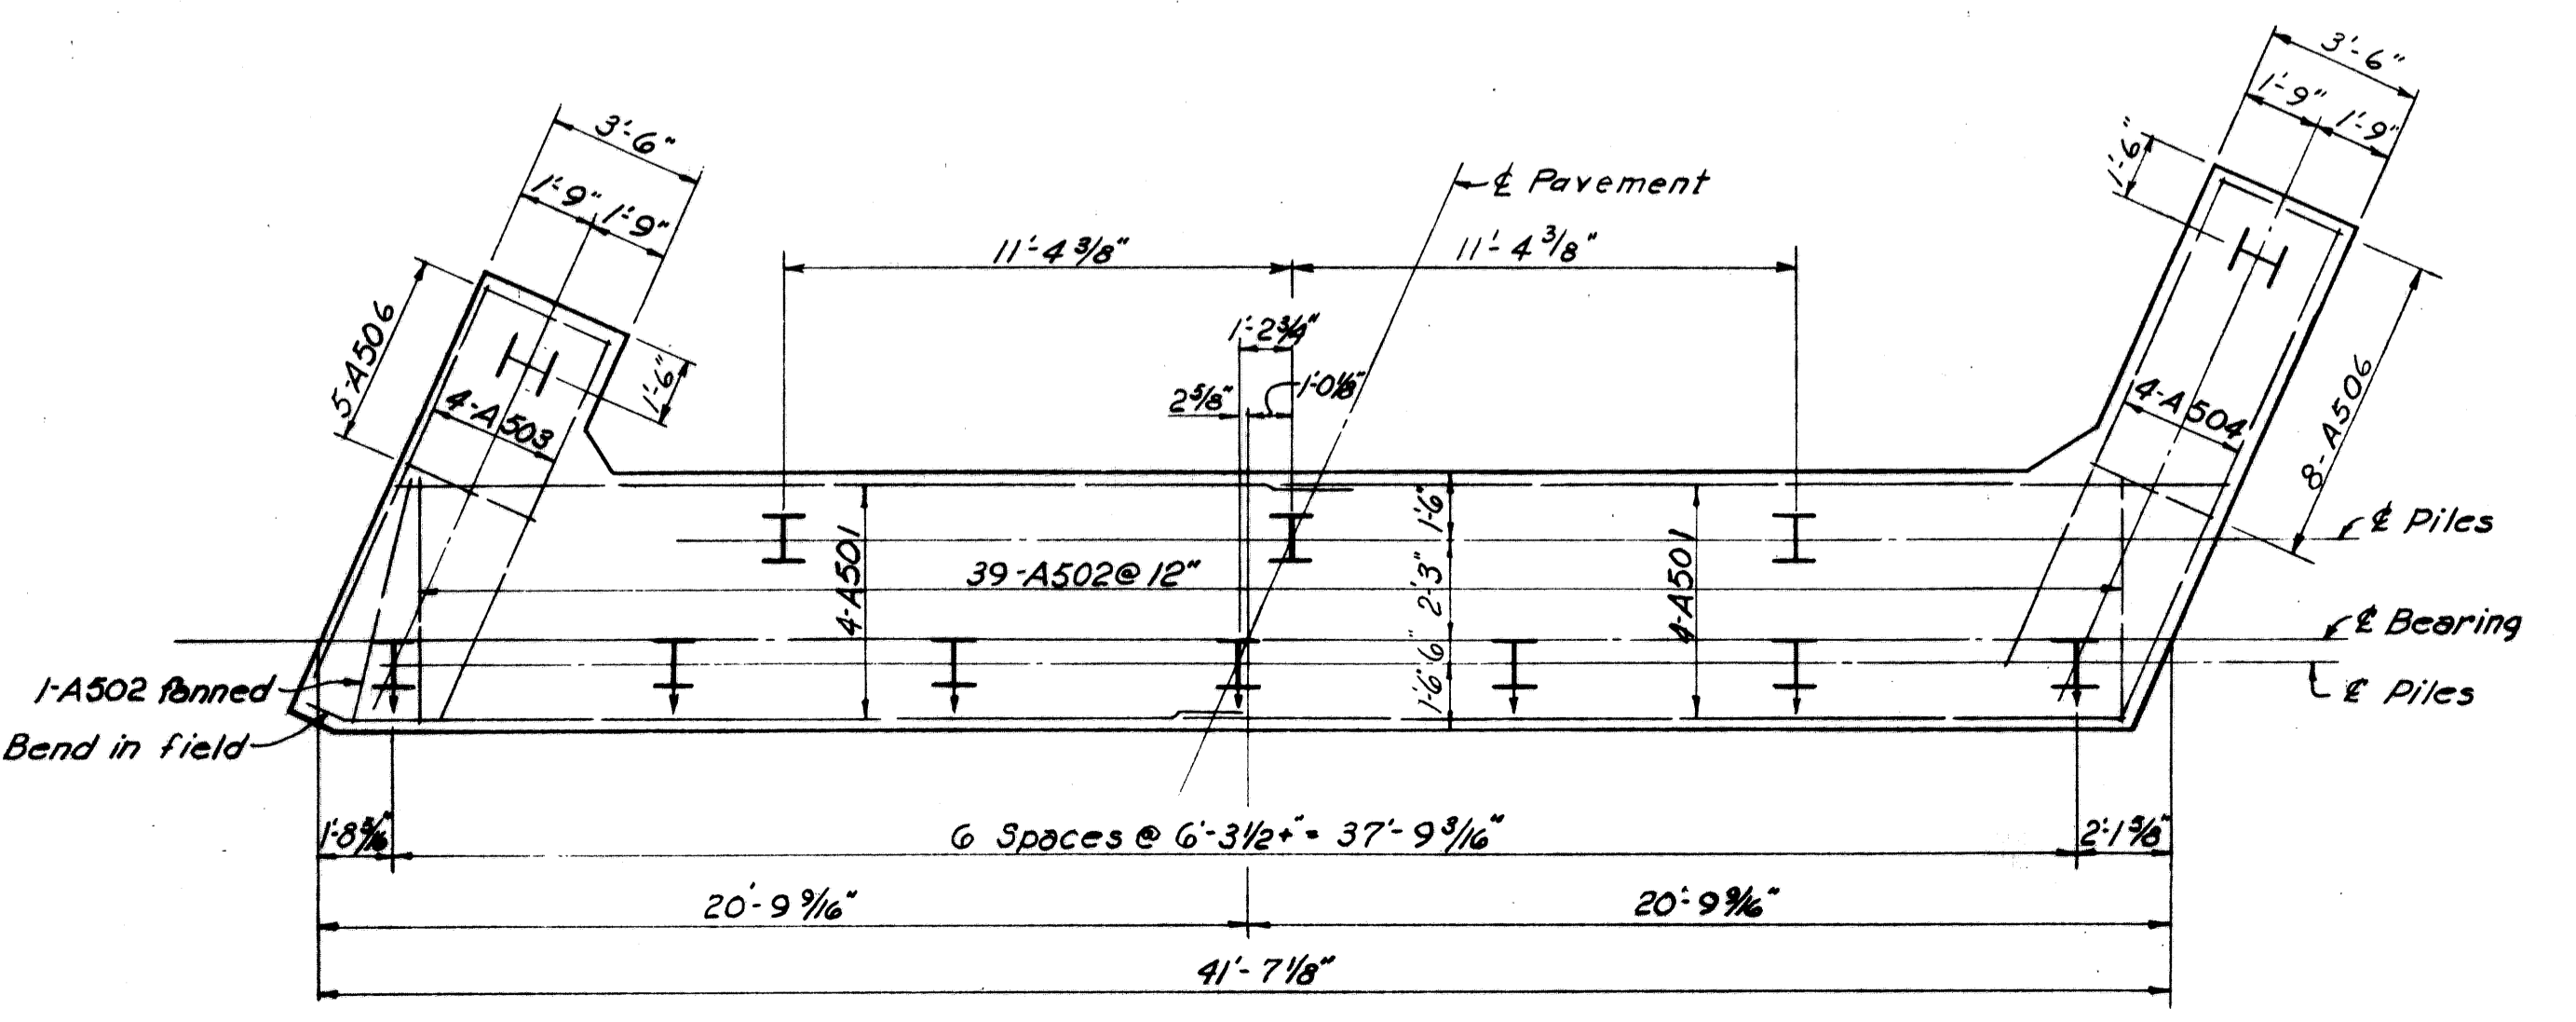

FOOTING PLAN

NOTES:
CONCRETE: All abutment concrete shall be Class "E" except parapet which shall be Class "C".
RAILING: See AR-1-57 and Sheet 2. Tubing on abutment wingwalls shall be continuous.
 I - Indicates vertical piles
 † - Indicates battered piles 1:4
 FF - Front Face
 RF - Rear Face
 EF - Each Face
GENERAL NOTES: See Sheet 135.

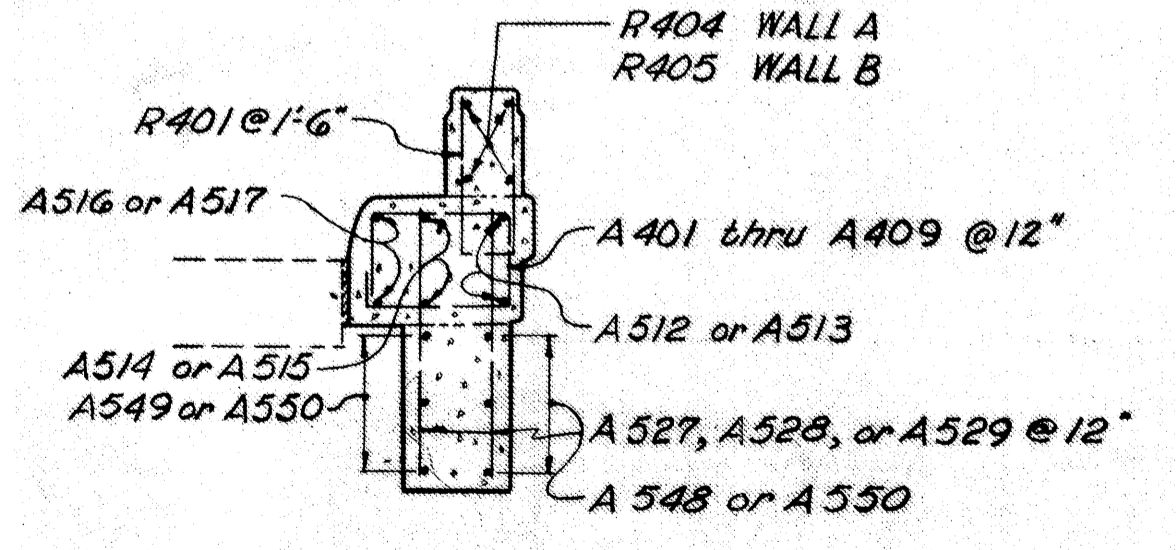

SECTION C-C

LOCATION	A	B	C	D	E	F	G	H	J	K	L
Right Bridge	888.741	888.992	889.243	889.259	889.276	895.702	896.204	896.237	897.284	897.832	882.2
Left Bridge	889.851	890.132	890.383	890.399	890.416	896.842	897.344	897.377	898.424	899.072	883.3


SHAFFER, PARRETT AND ASSOCIATES
 Consulting Engineers
 MANSFIELD, OHIO.

REAR ABUTMENTS
 BRIDGE No. WAY-3-1166 L & R
 OVER KILLBUCK CREEK


WAYNE COUNTY S.R. 3
 STA. 616 + 04.30 TO STA. 618 + 61.23

DESIGNED	DRAWN	TRACED	CHECKED	REVIEWED	DATE	REVISED
J.W.C.	J.W.C.	jack	RAK.		6-1-61	8-22-61


WAYNE COUNTY
WAY-3-9.94

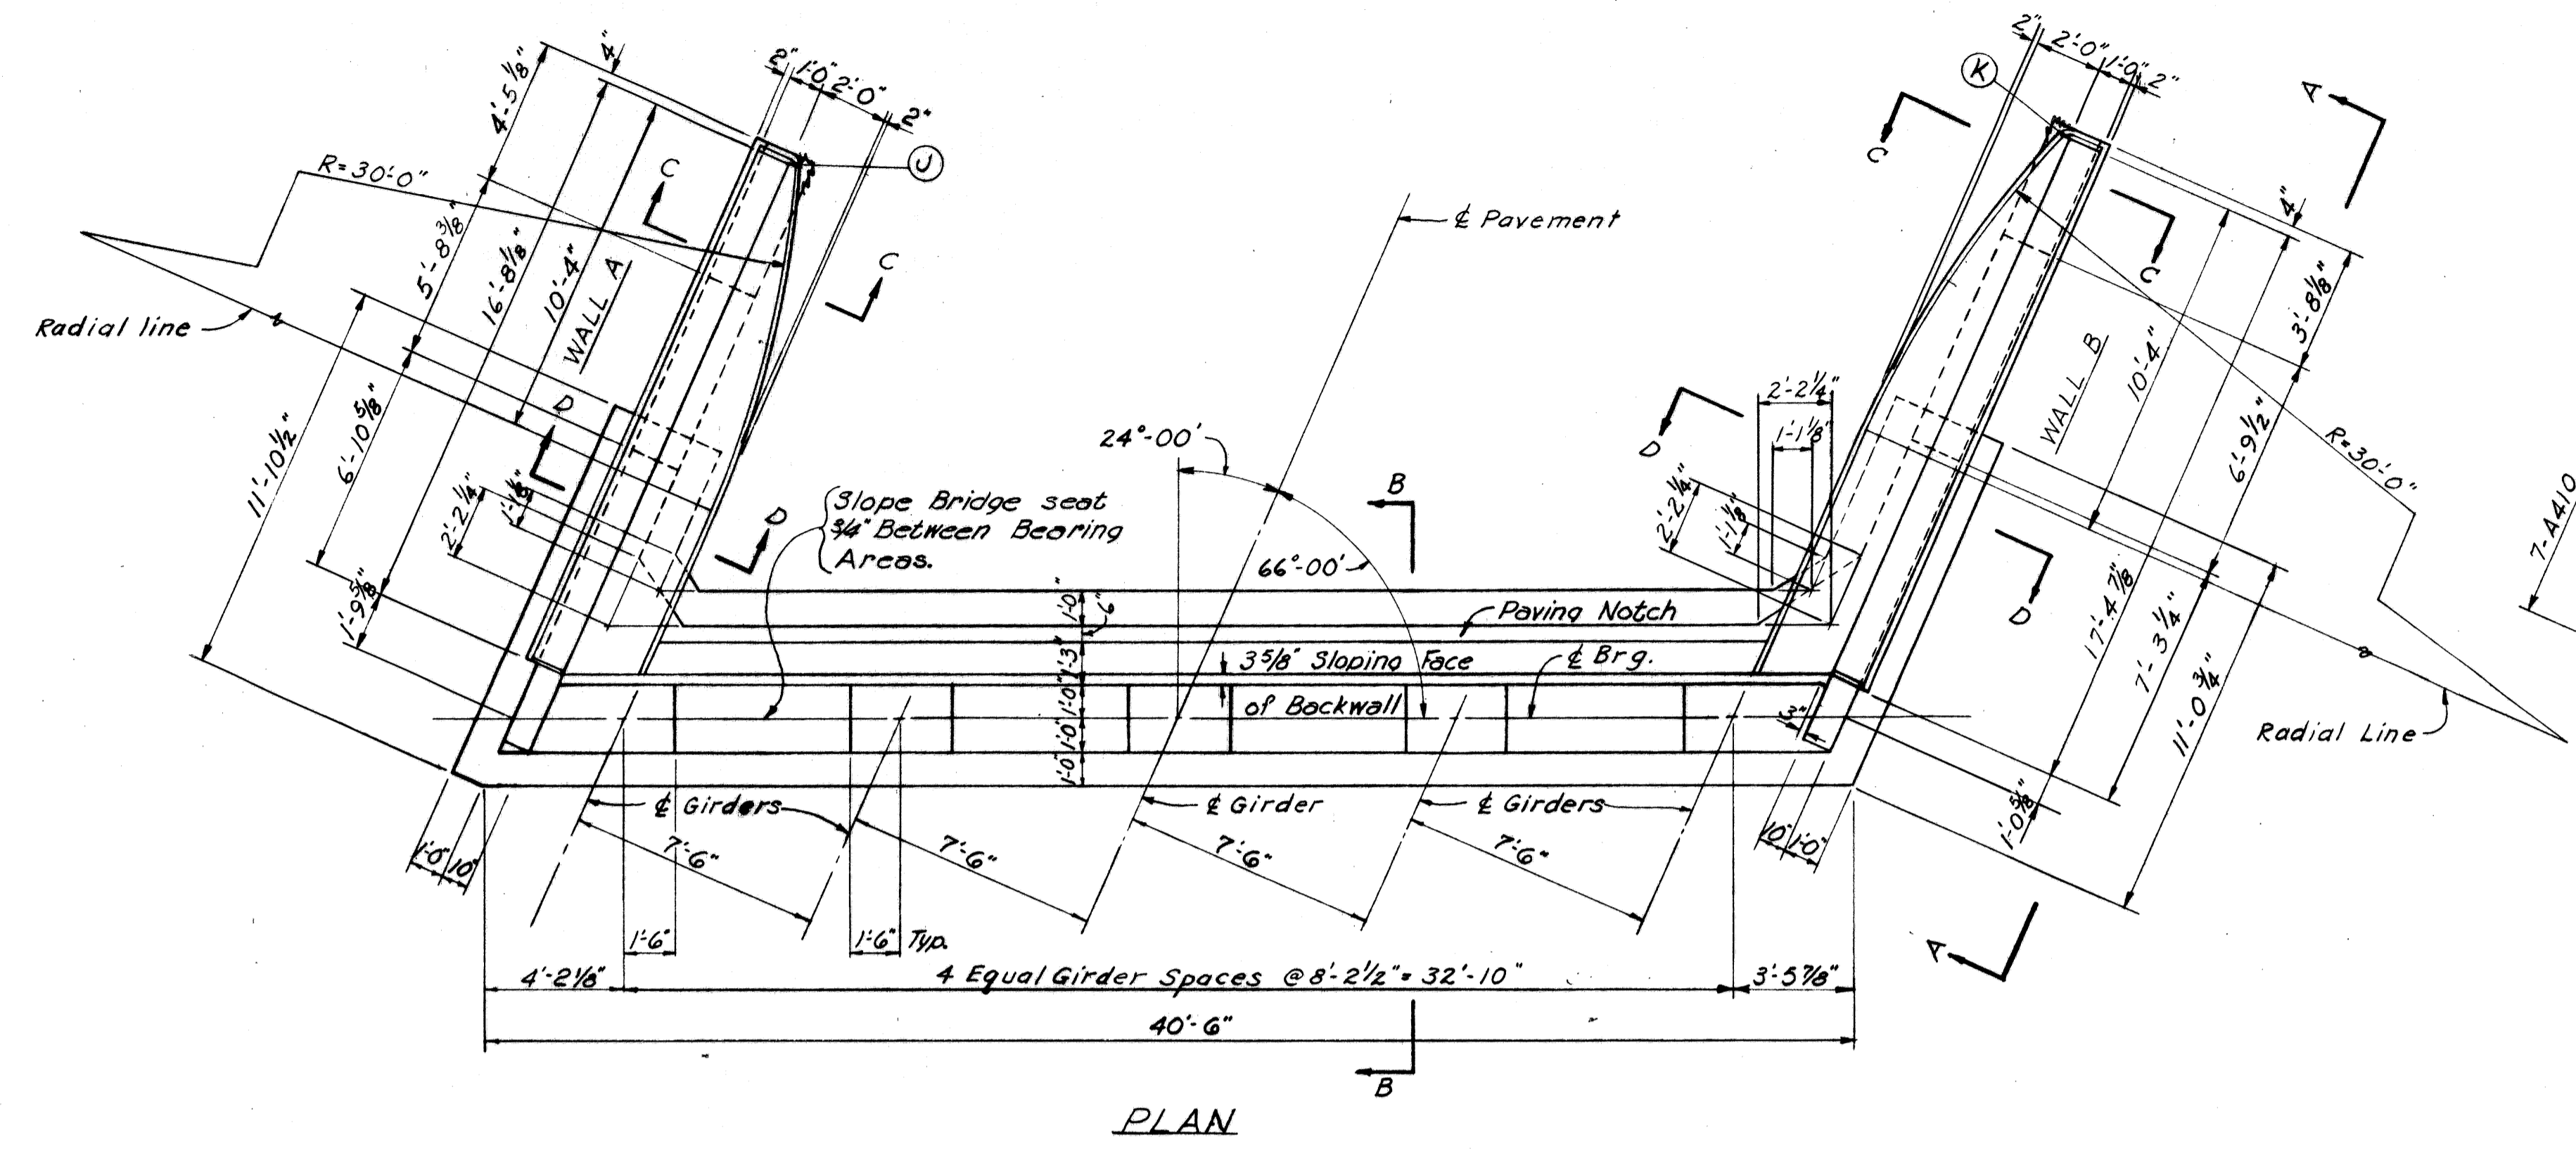


PLAN

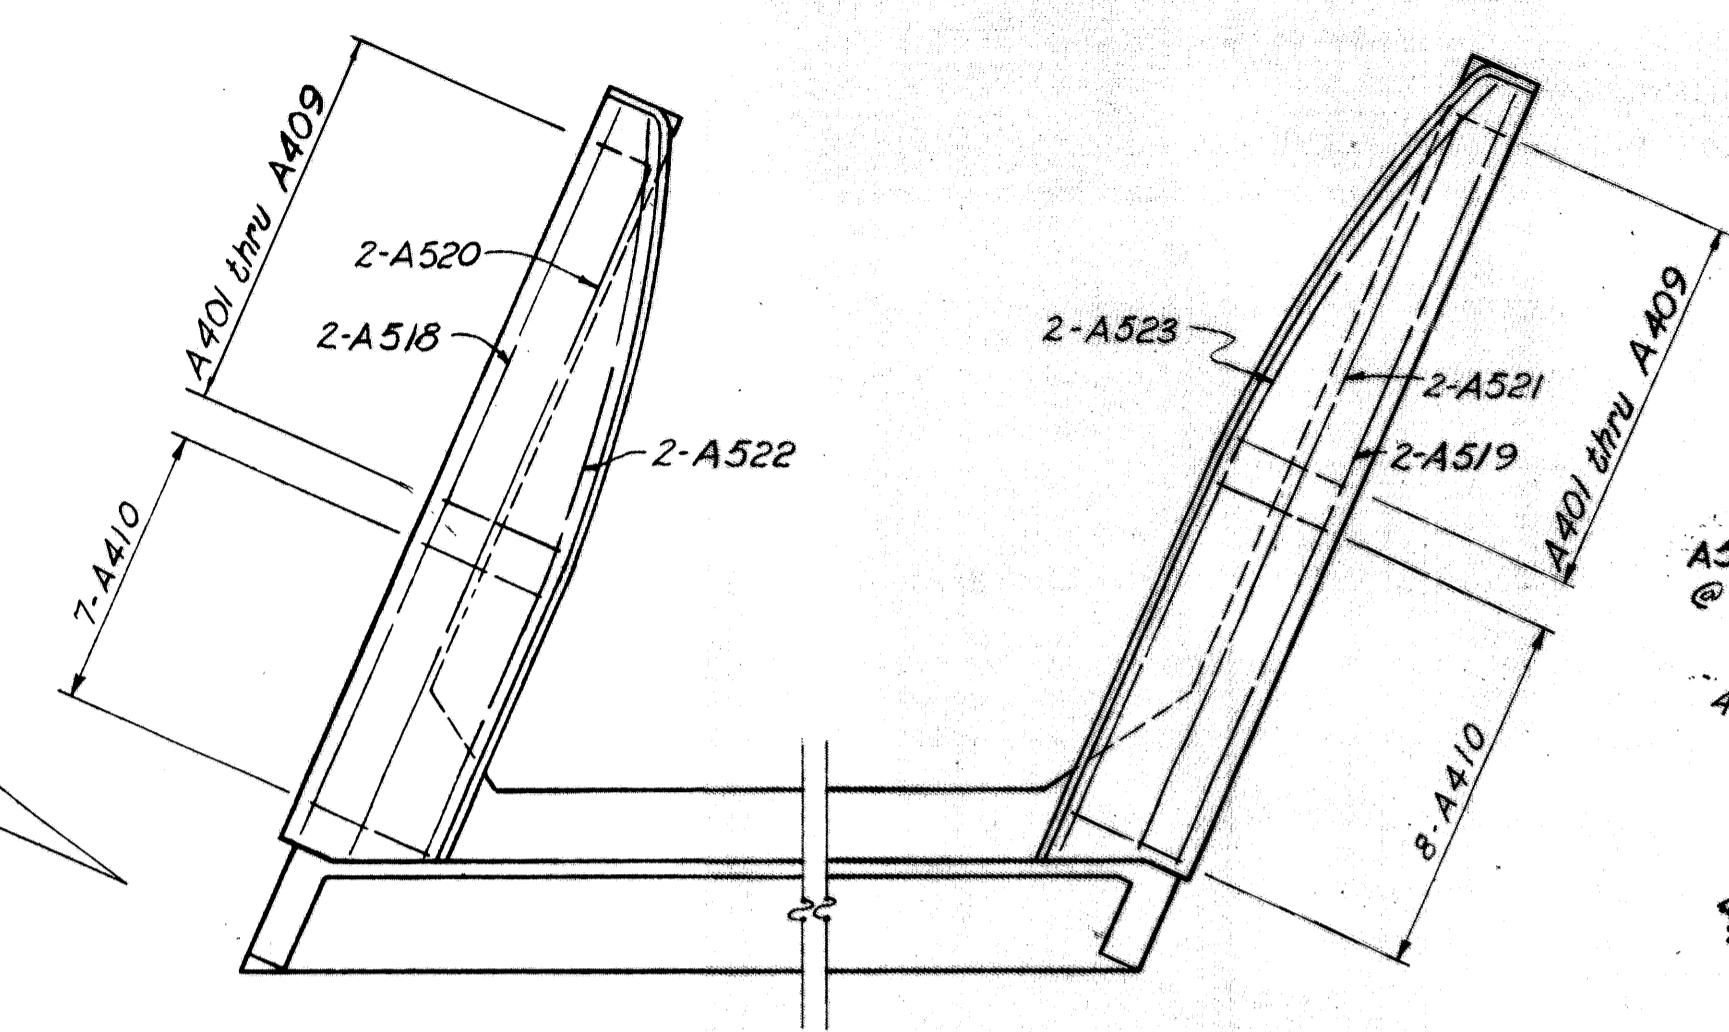


WING WALL PLAN

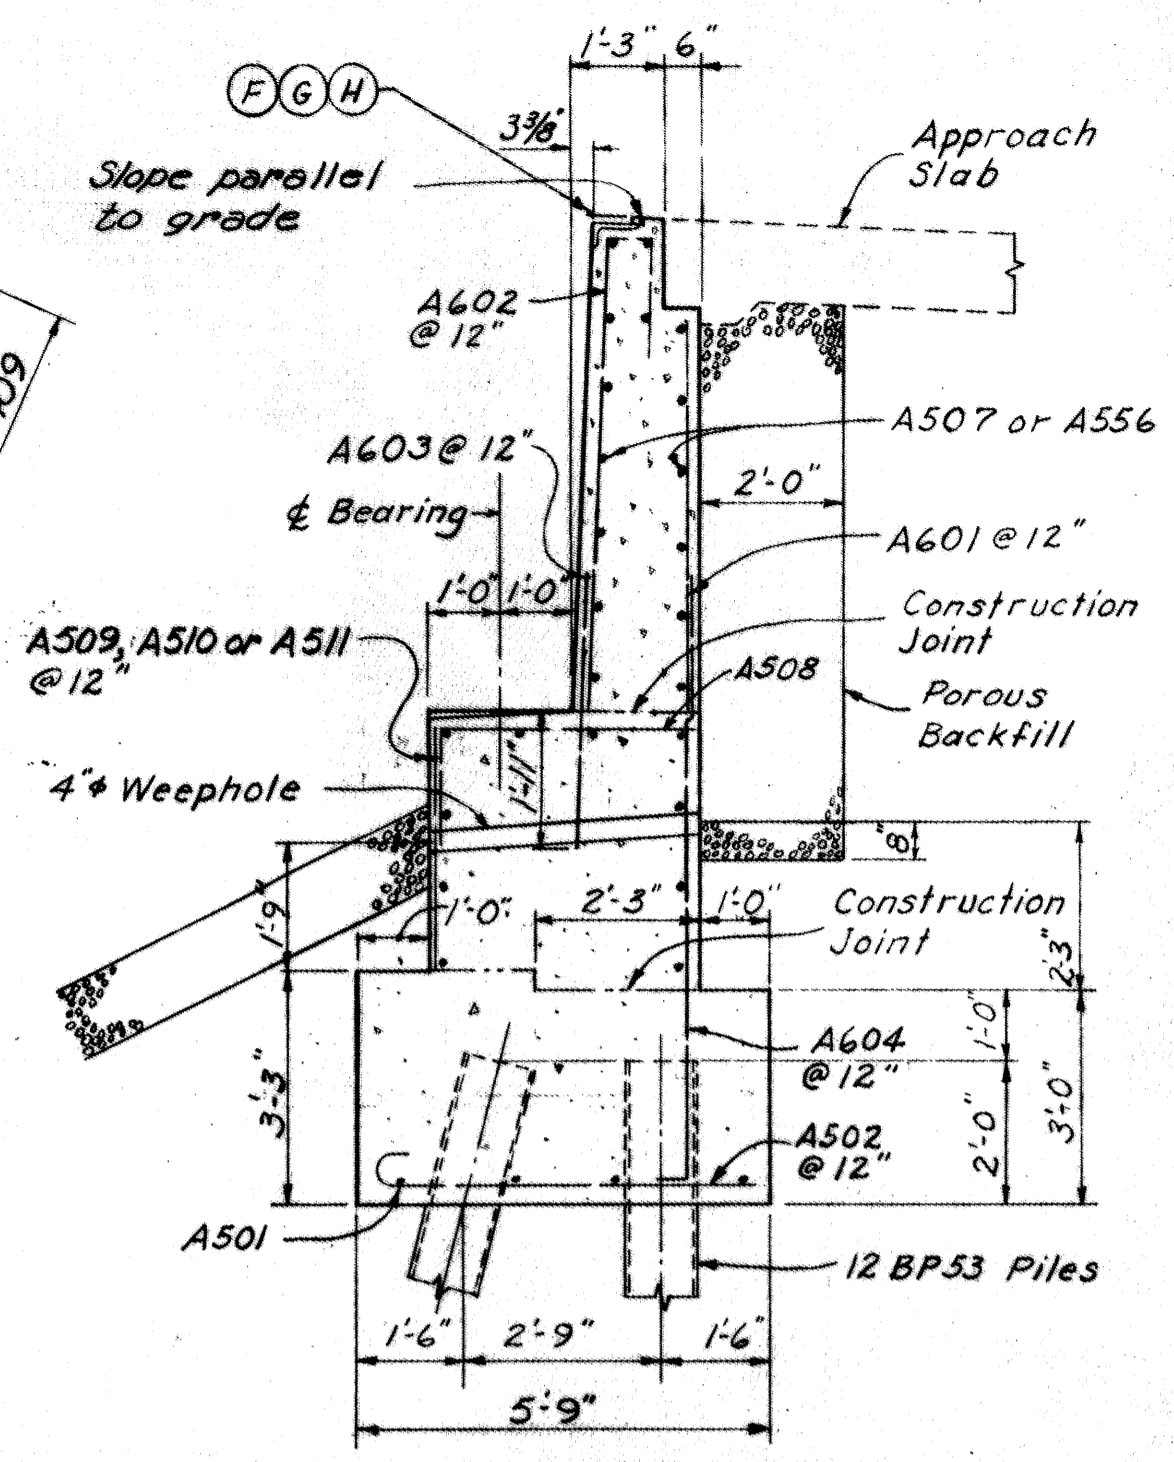


SECTION B-B

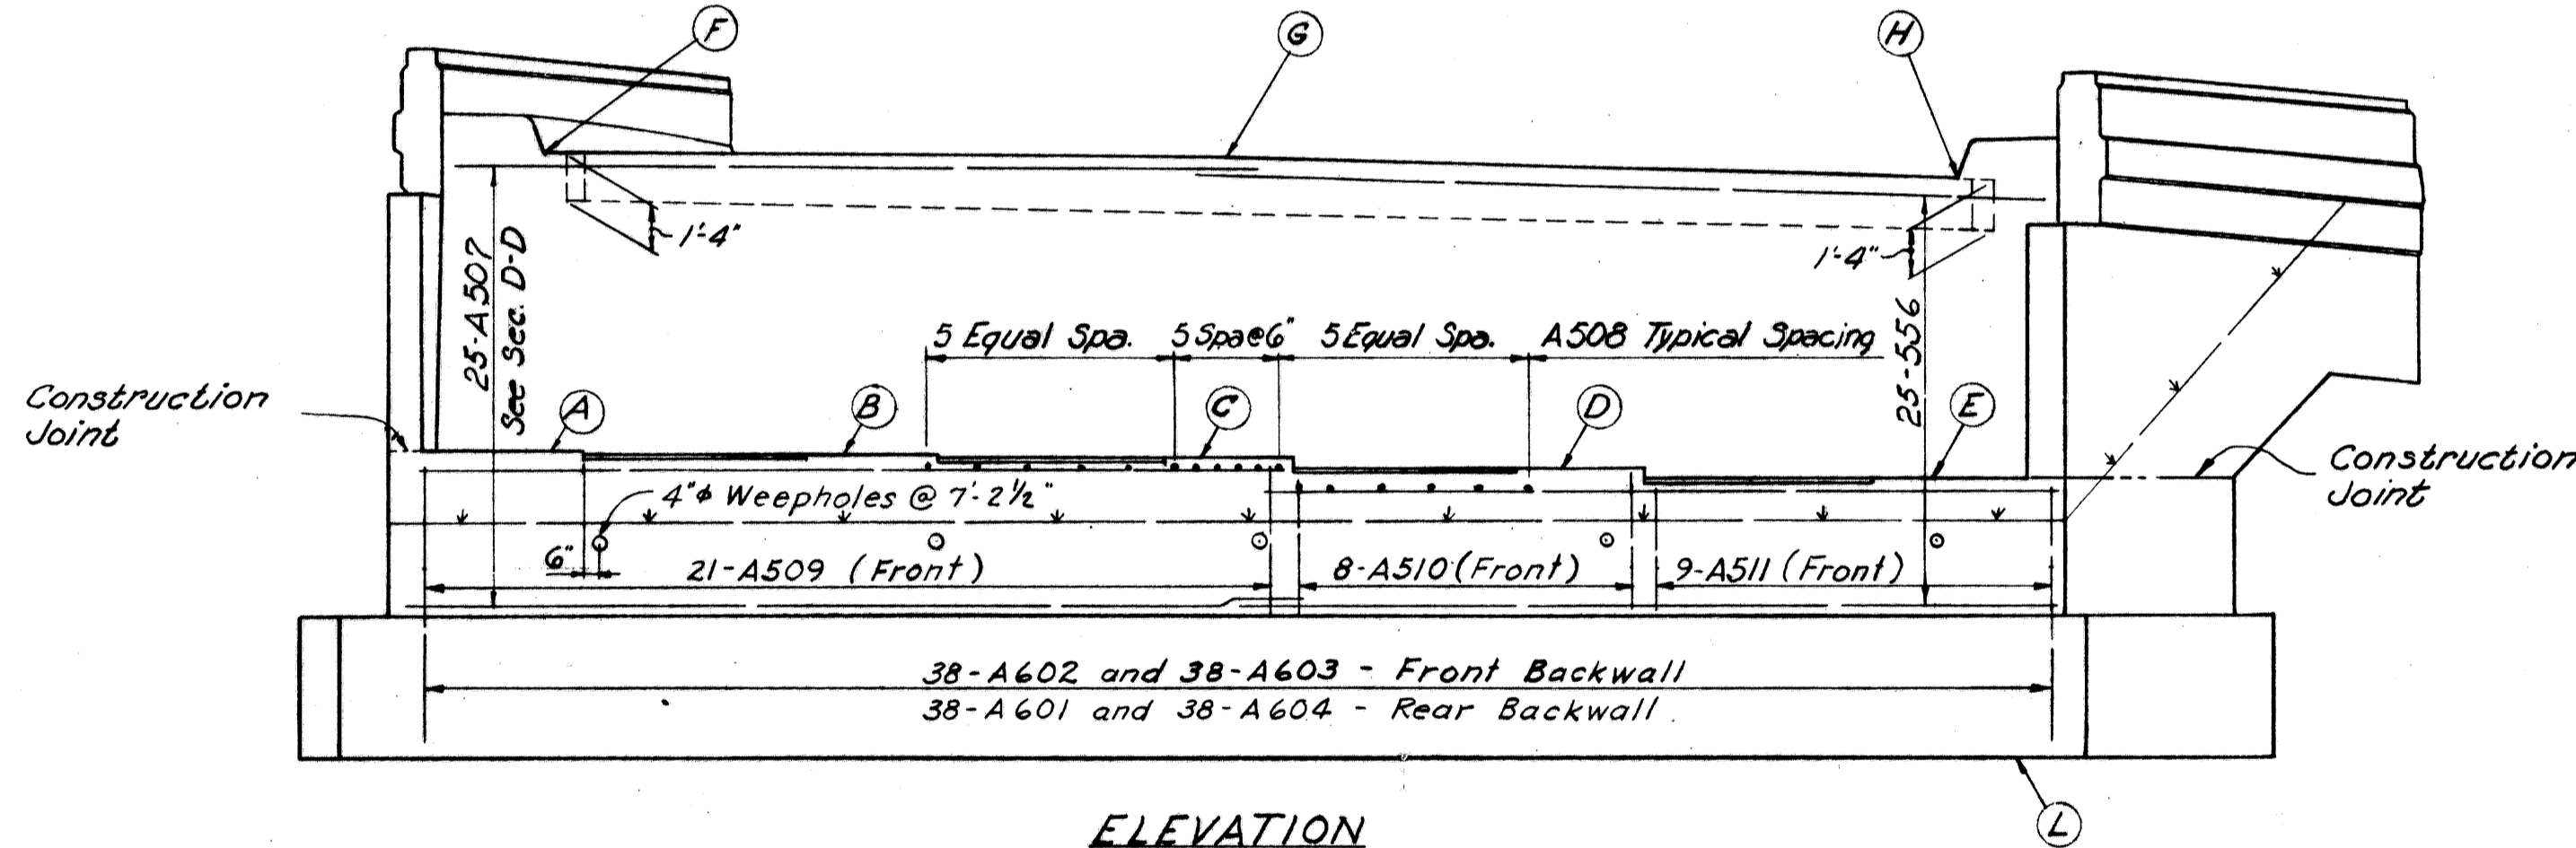

ELEVATION

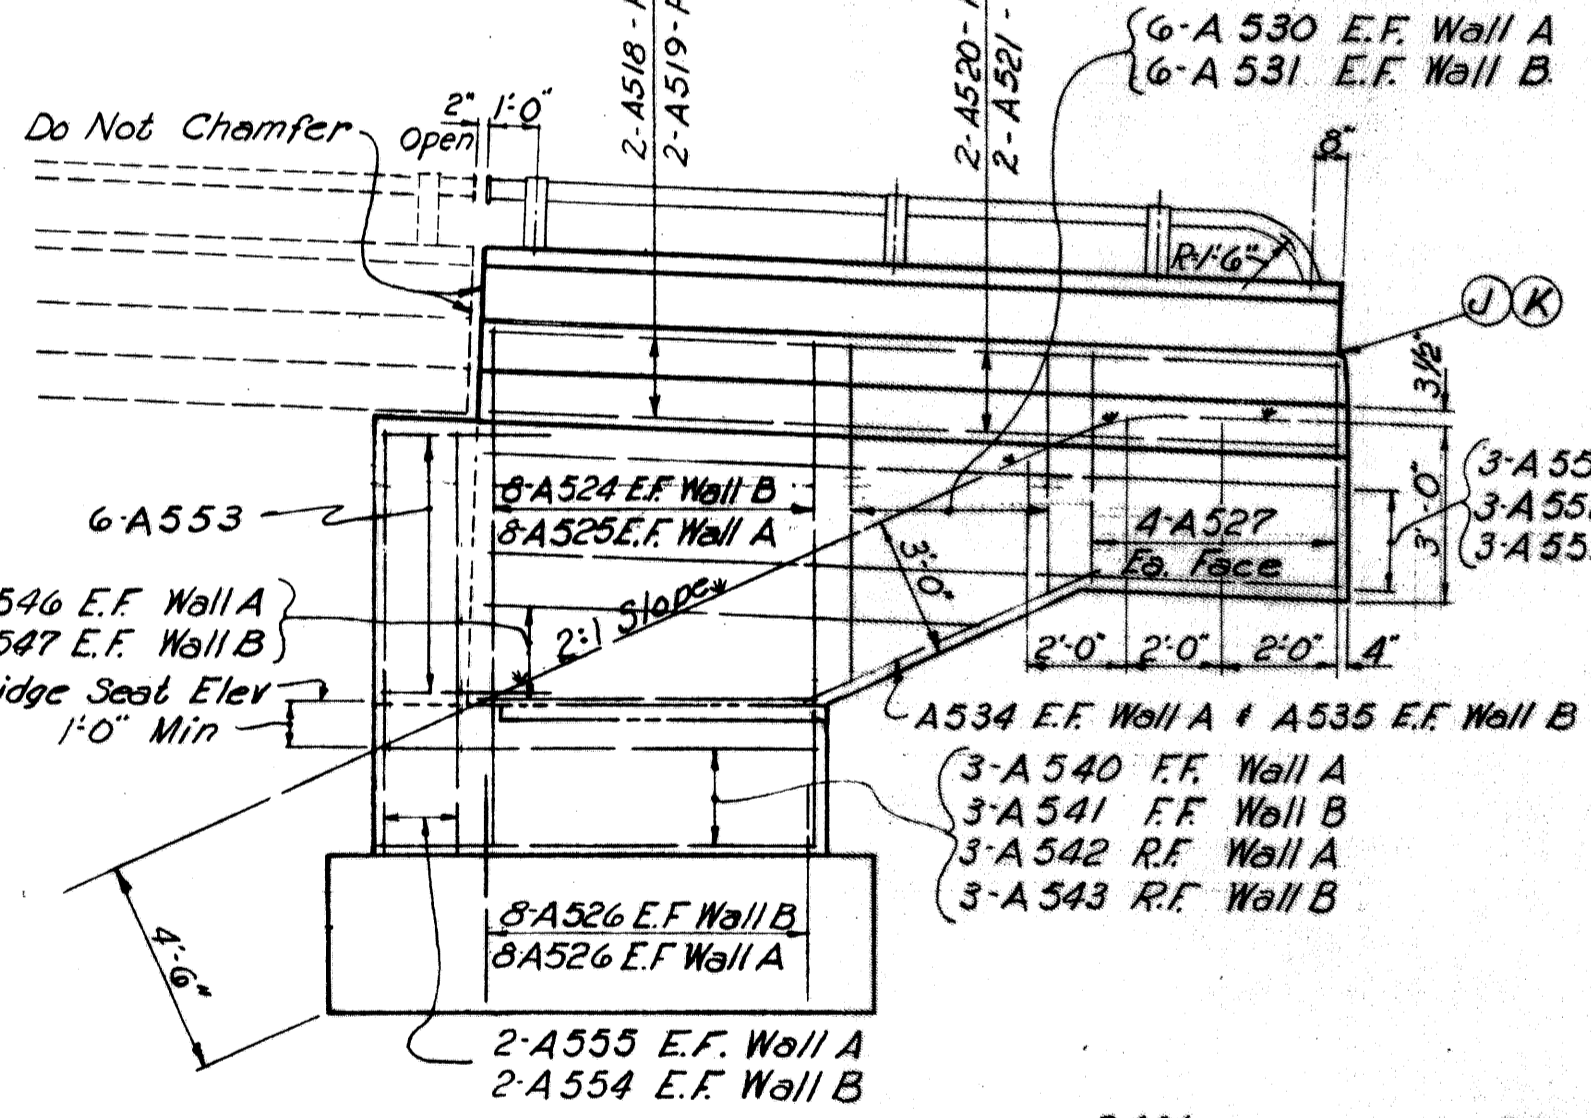

ELEVATION A-A

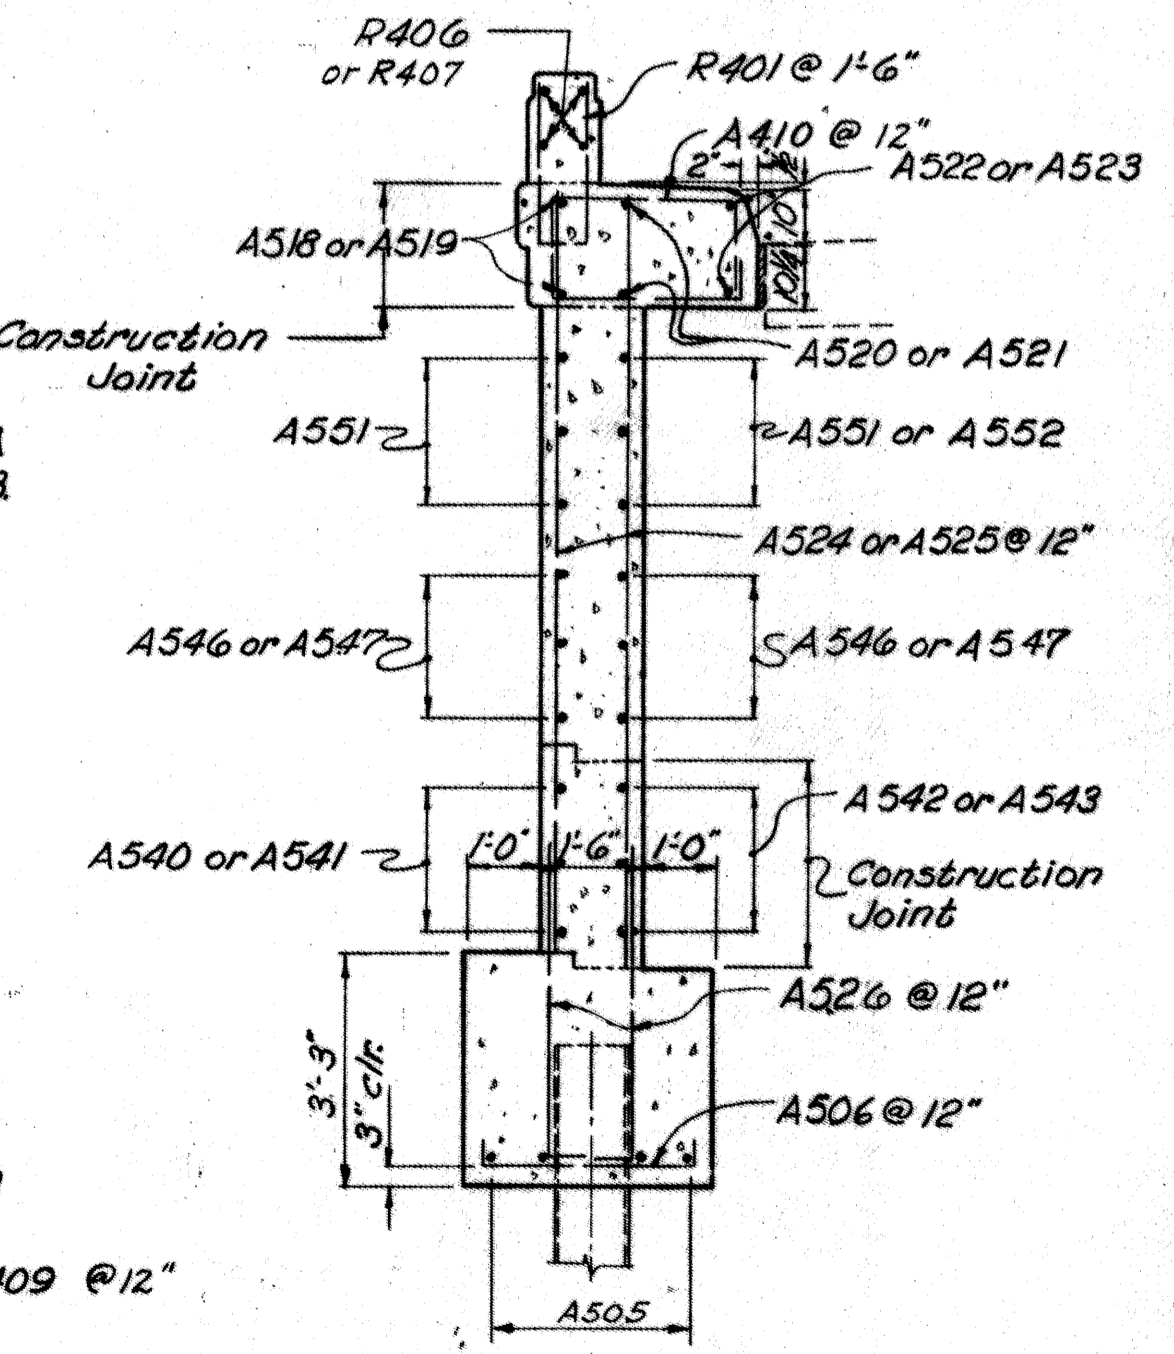


SECTION D-D

Indicates Vertical Piles
Indicates Battered Piles 1:4

NOTES:

CONCRETE: All abutment concrete shall be Class "E" except parapet which shall be Class "C".
RAILING: See AR-1-57 and Sheet 2. Tubing on abutment wingwalls shall be continuous.
GENERAL NOTES: See Sheet 135.

F.F. - Front Face
R.F. - Rear Face
E.F. - Each Face

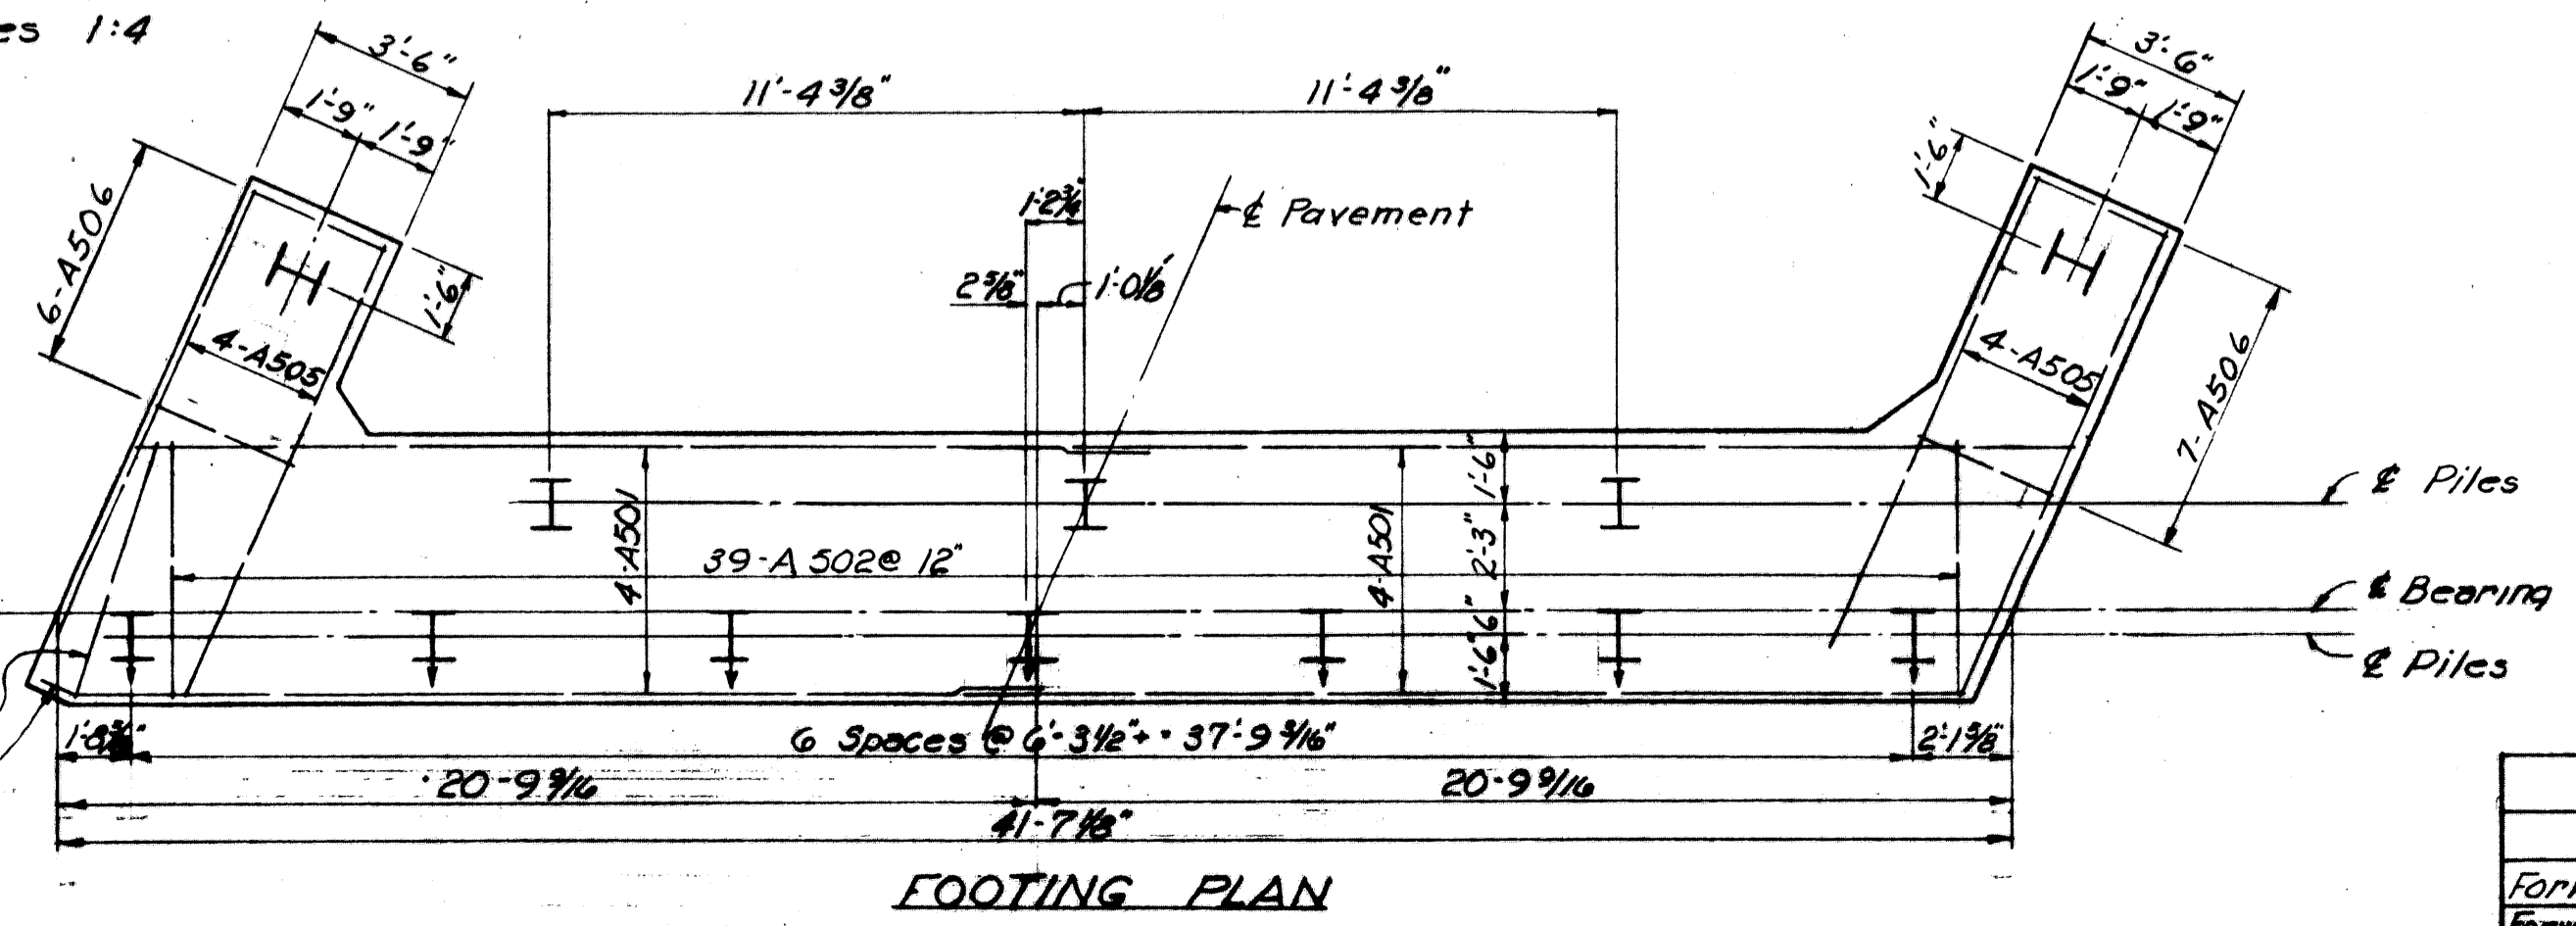

FOOTING PLAN

LOCATION	TABLE OF ELEVATIONS											
	A	B	C	D	E	F	G	H	J	K	L	
Forward Abutment - Right Bridge	879.196	879.179	879.163	878.912	878.661	886.197	886.124	885.622	886.385	885.777	872.1	
Forward Abutment - Left Bridge	880.336	880.319	880.303	880.052	879.801	887.296	887.264	886.762	887.524	886.857	873.2	

SHAFER, PARRETT AND ASSOCIATES
Consulting Engineers
MANSFIELD, OHIO.

FORWARD ABUTMENTS
BRIDGE No. WAY-3-1166 L & R
OVER KILLBUCK CREEK

WAYNE COUNTY STA. 616 + 04.30 TO STA. 618 + 61.23

DESIGNED	DRAWN	TRACED	CHECKED	REVIEWED	DATE	REVISED
RAK	JWC	jack	DHT			6-1-61 8-22-61

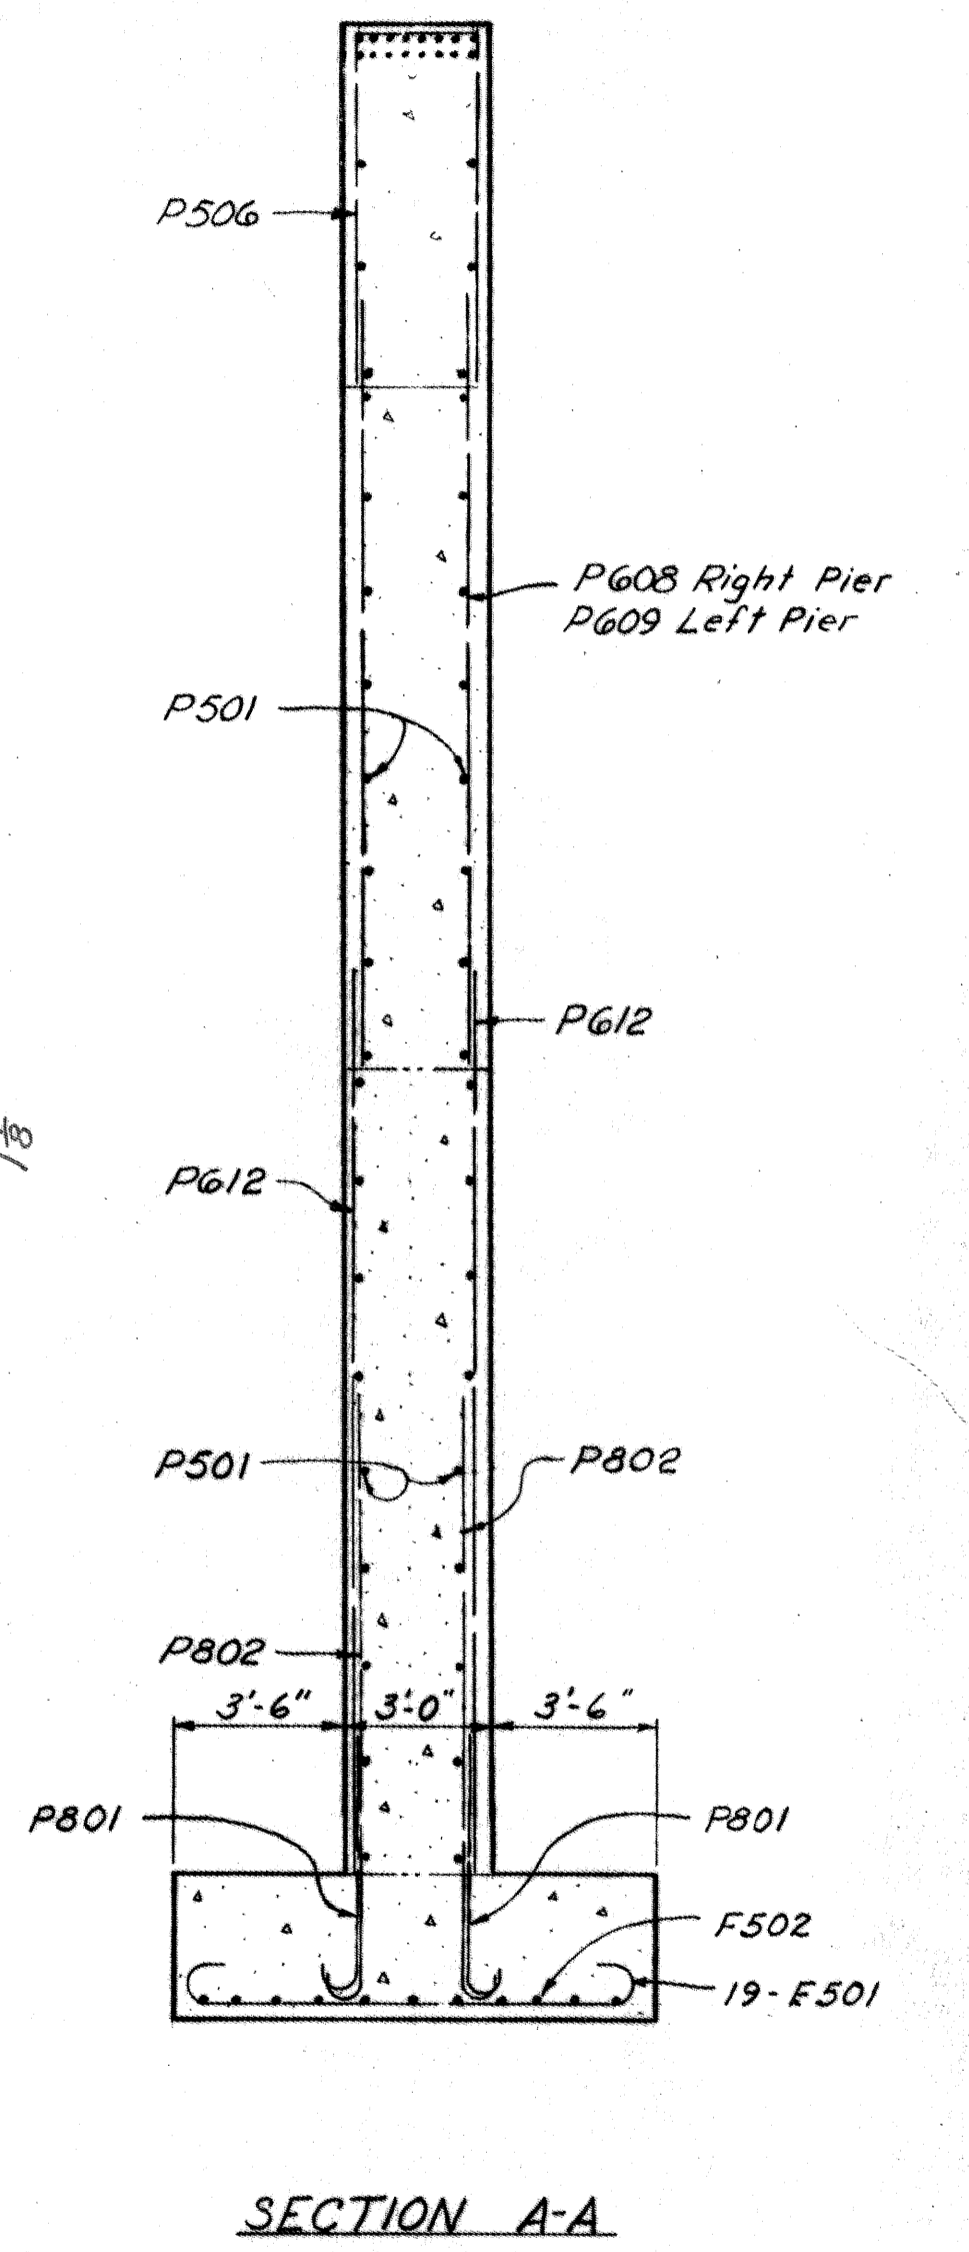
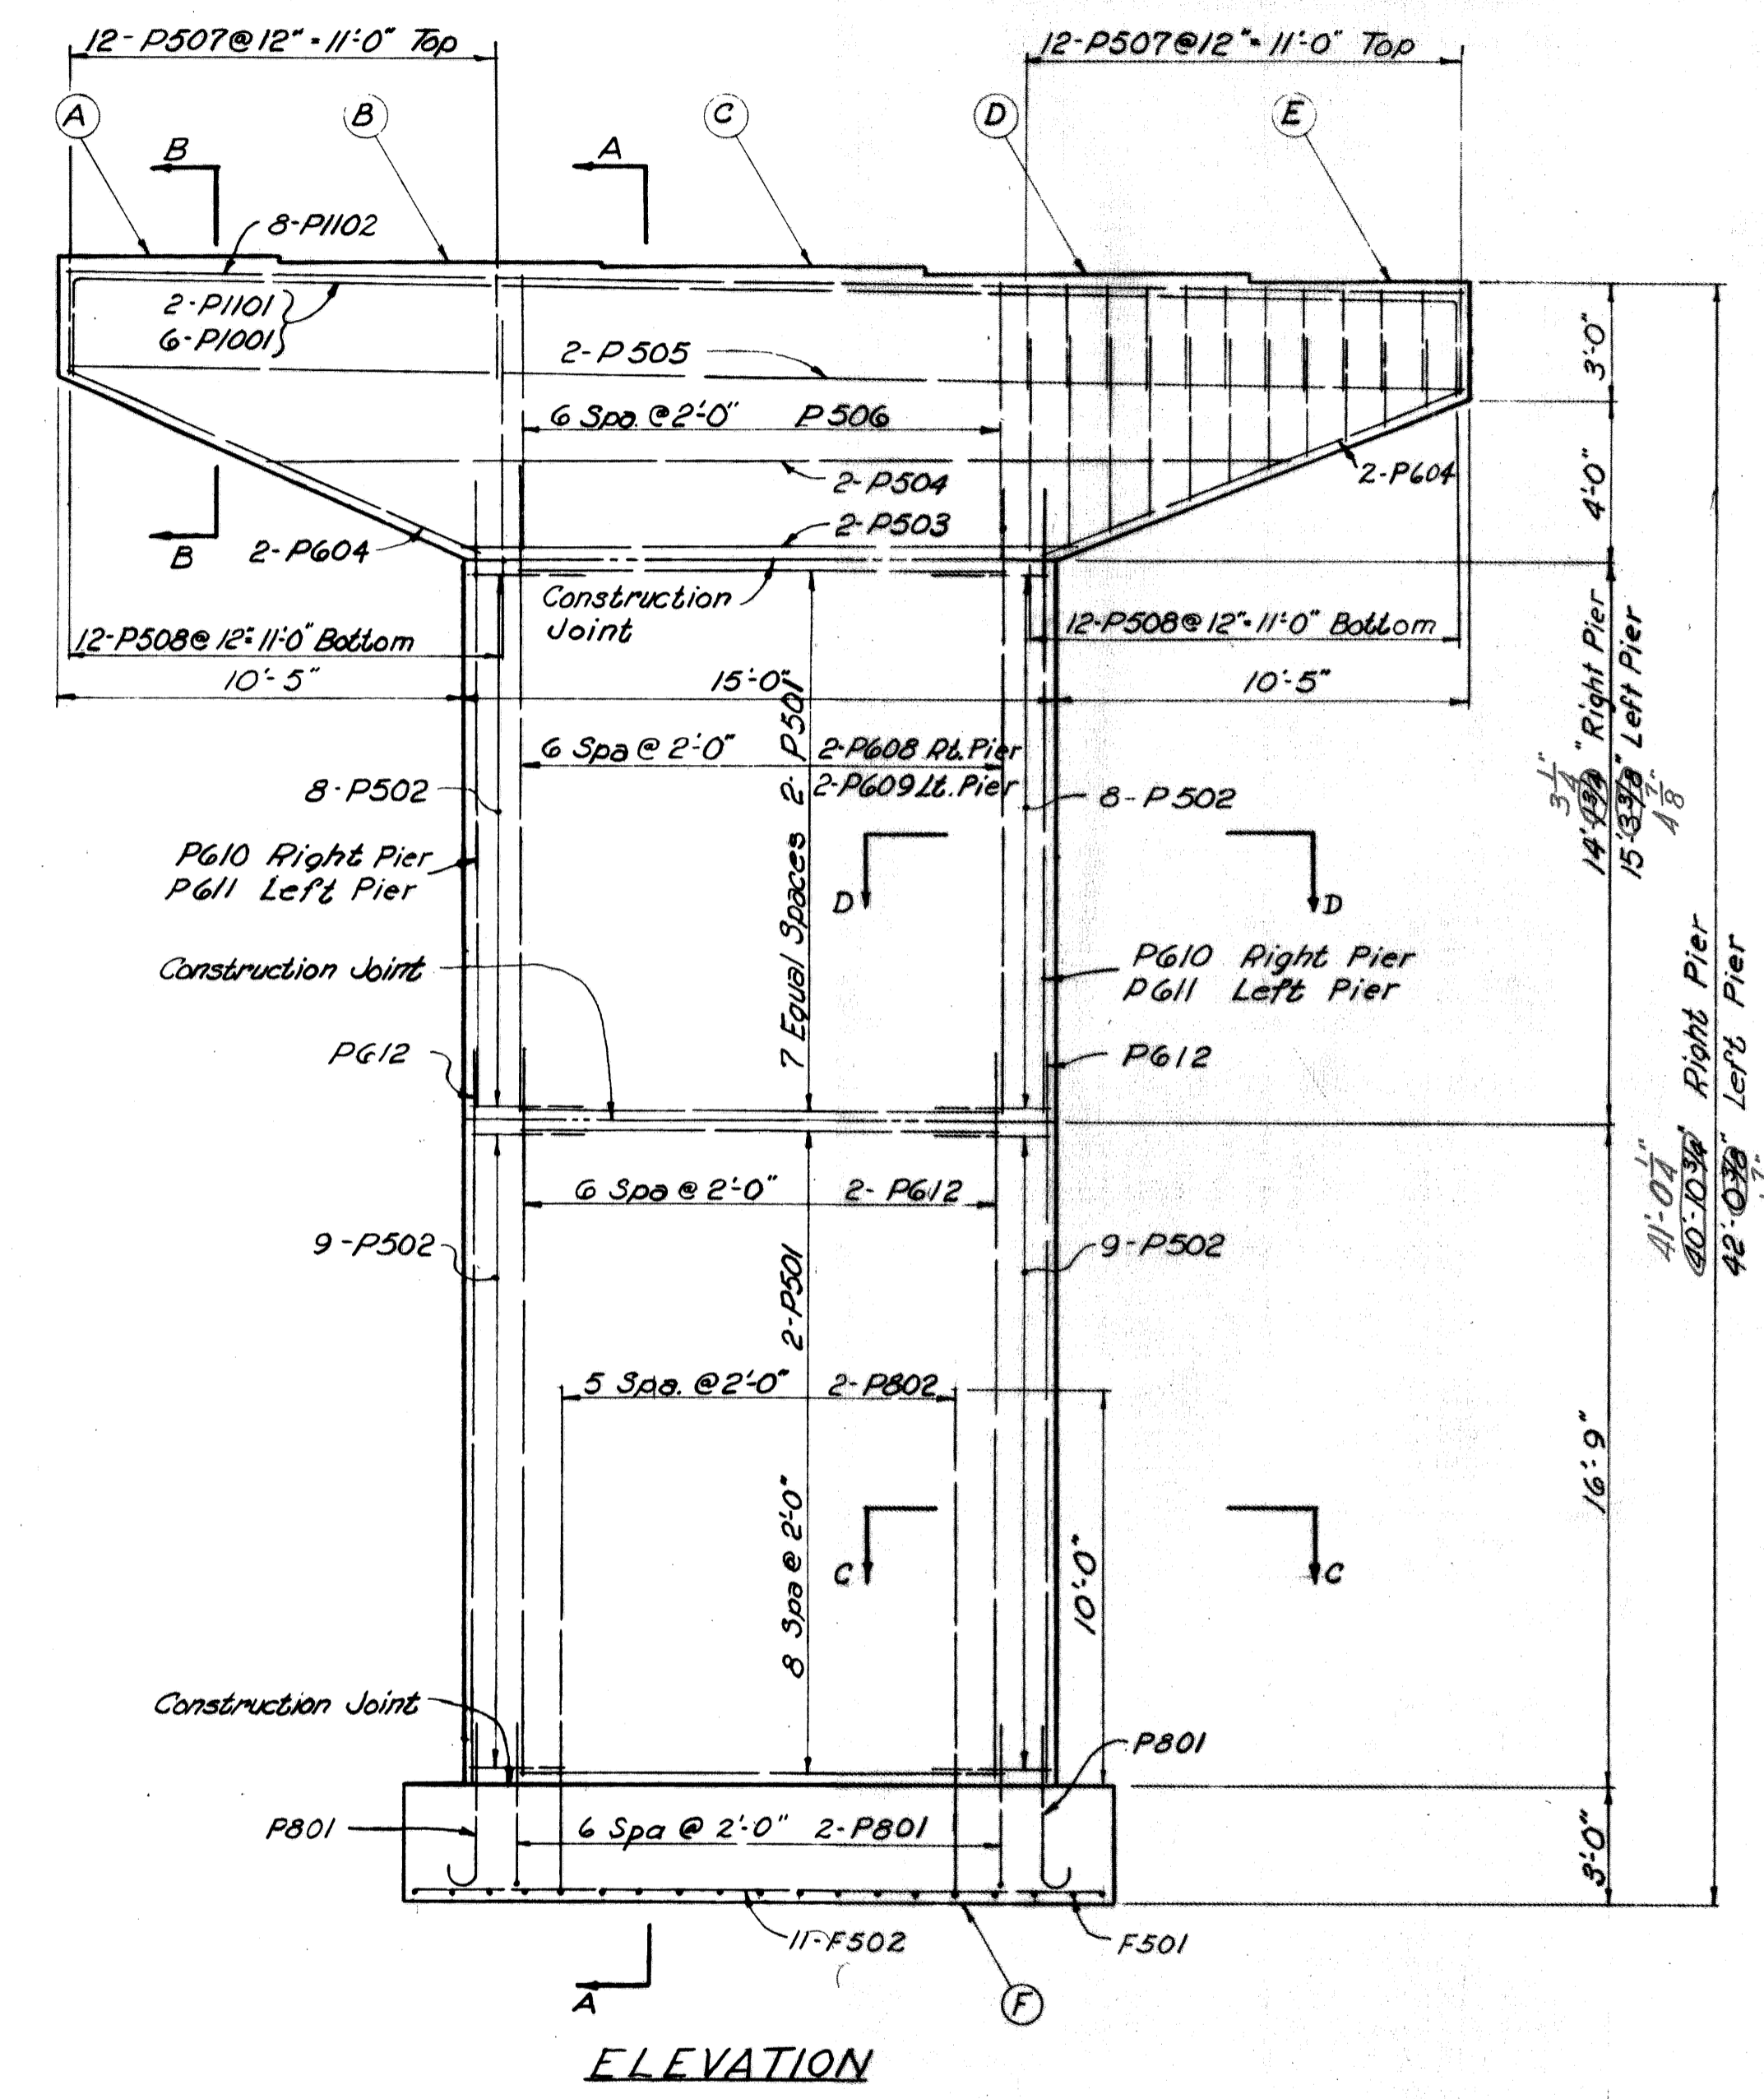
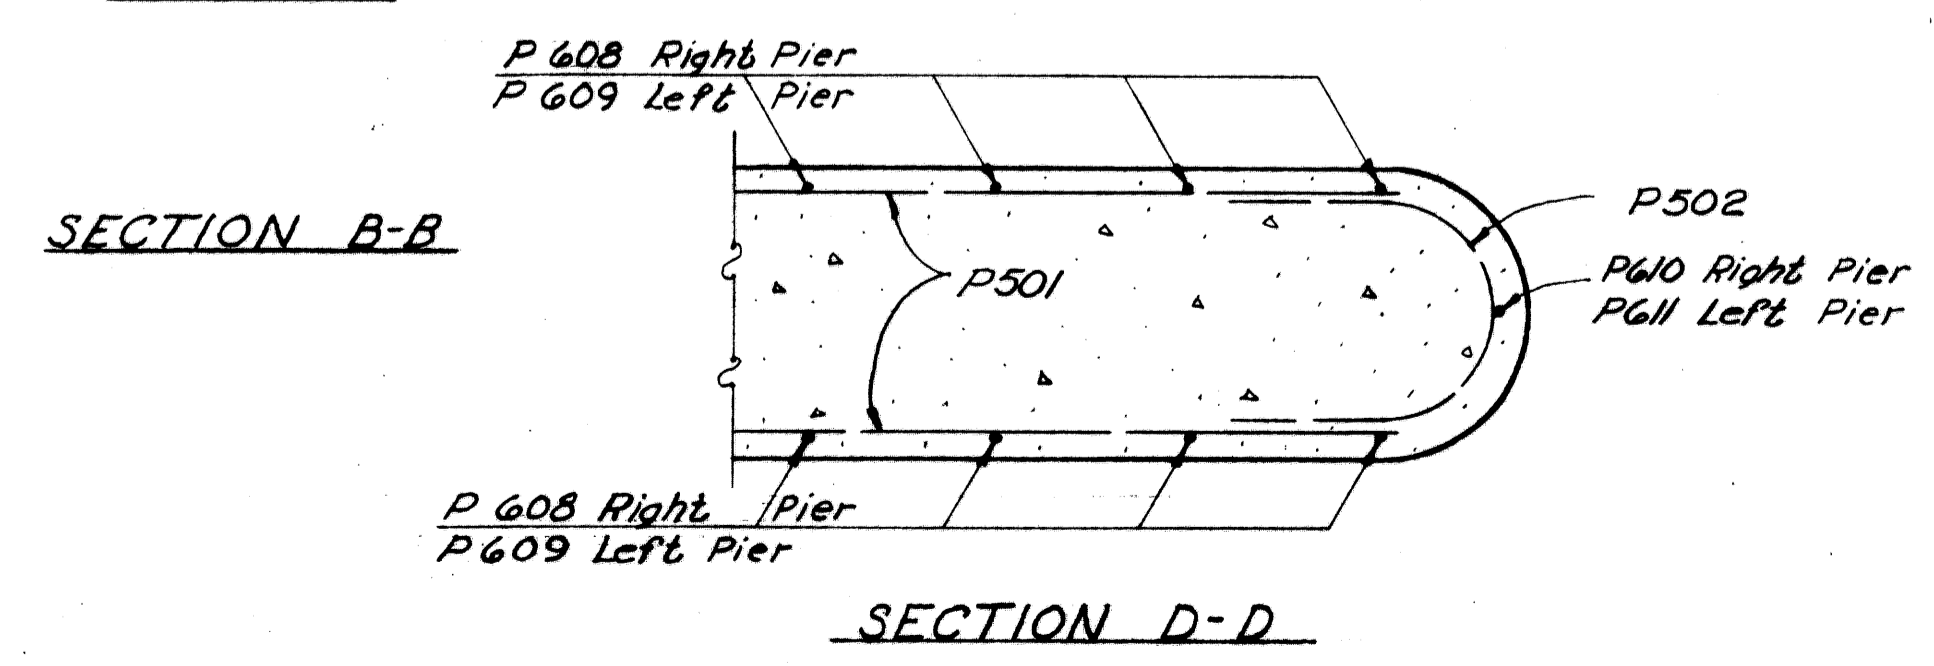
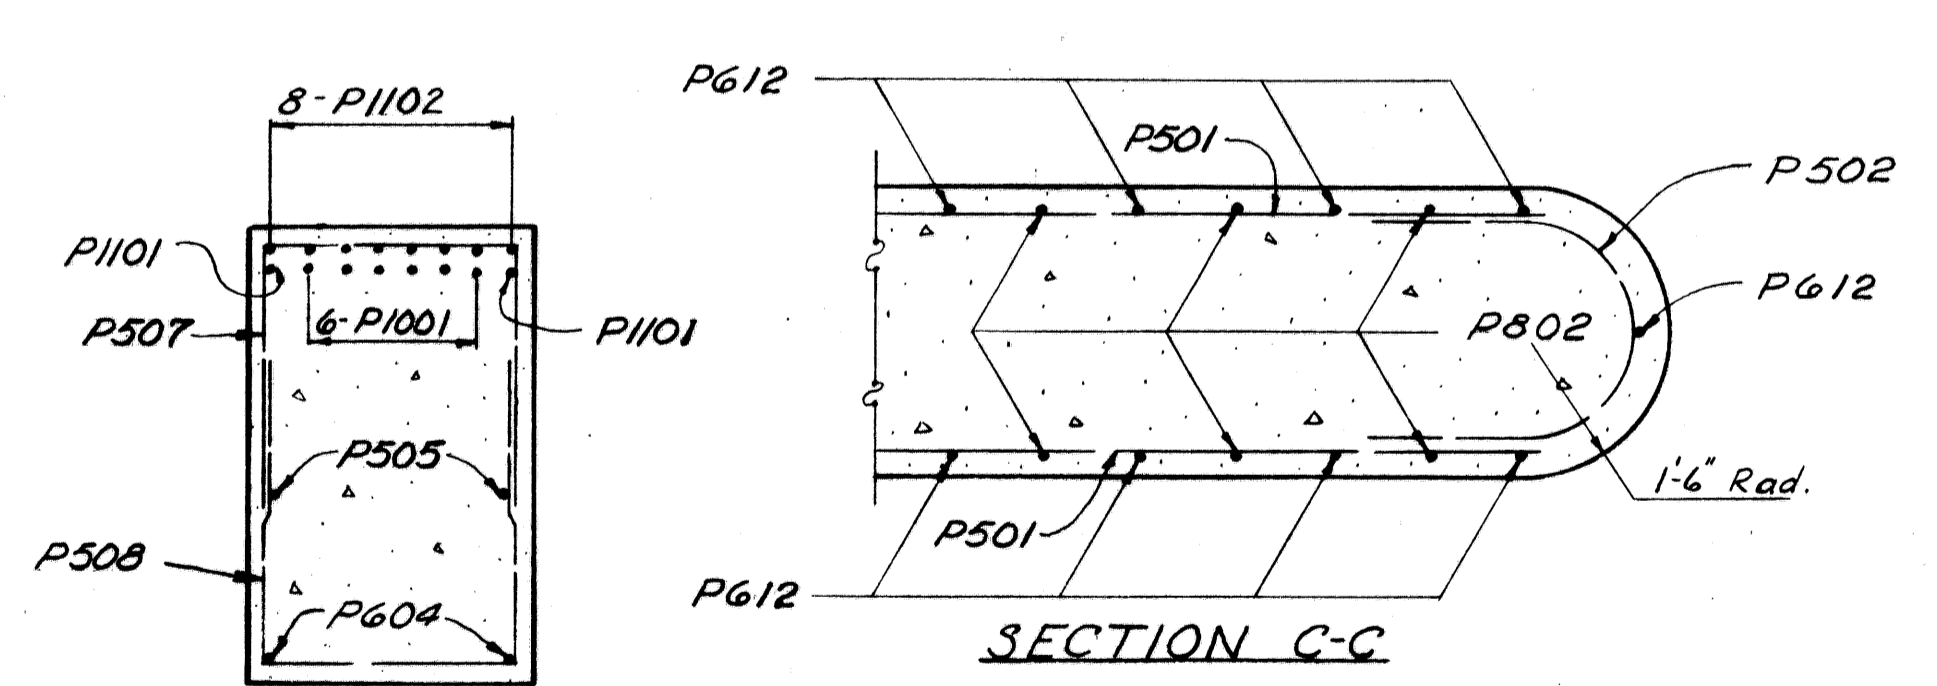
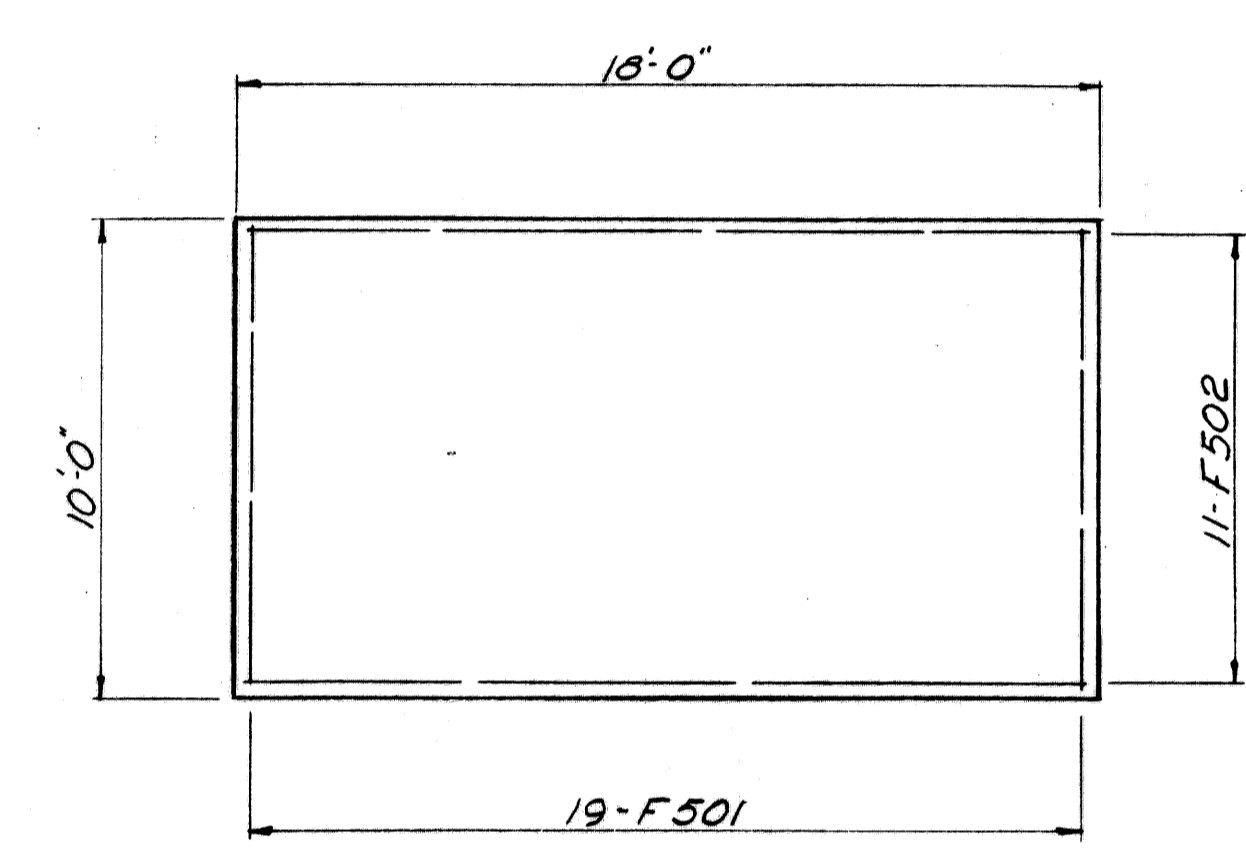
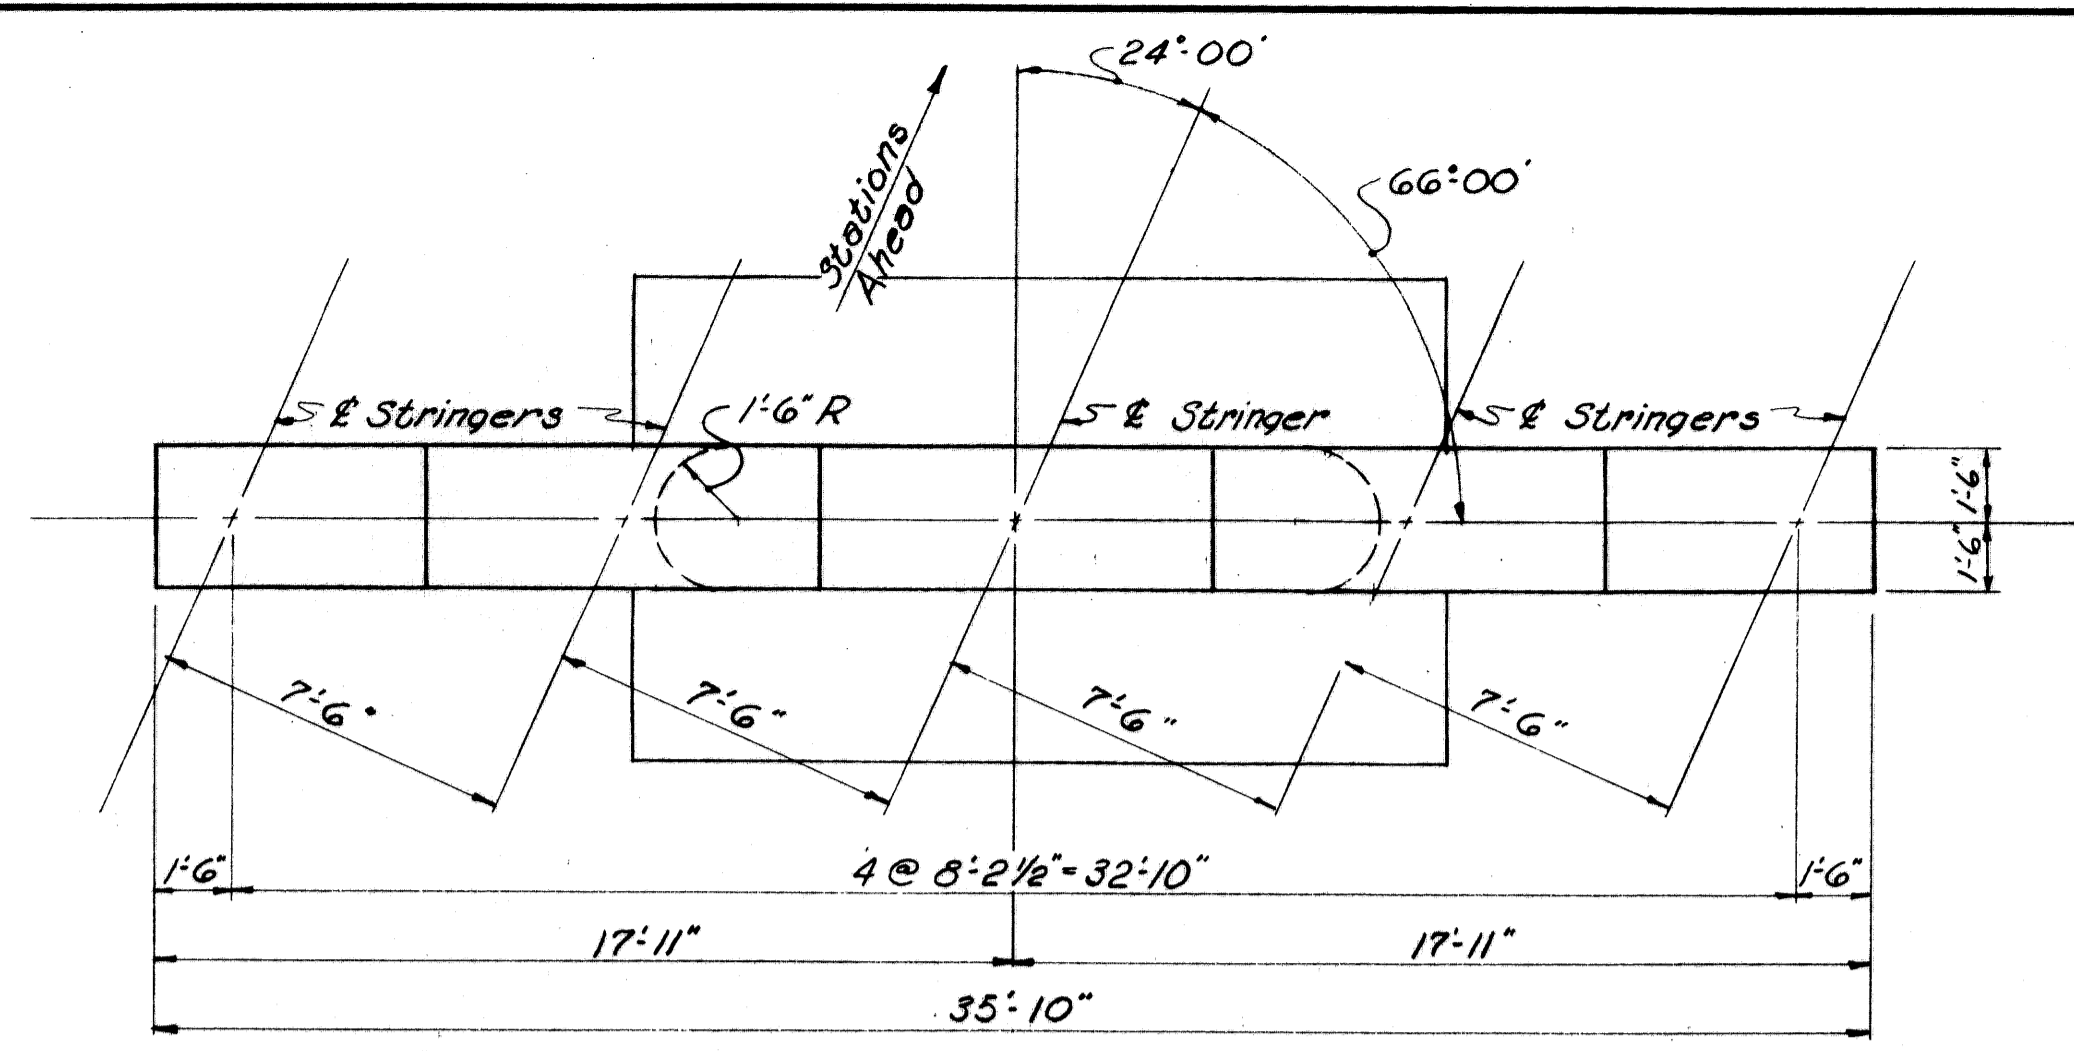


TABLE OF ELEVATIONS


	(A) ₅₅₁	(B) ₅₄₃	(C) ₅₁₈	(D) ₂₆₇	(E) ₁₅₀	(F)
Right Pier	885.62	885.47	885.45	885.22	884.93	844.0
Left Pier	886.62	886.47	886.52	886.33	886.03	844.0

NOTES:
CONCRETE: All concrete for footings, caps and stems shall be Class "E".
FOUNDATION BEARING PRESSURE: Pier footings are designed for a maximum bearing pressure of 3 tons per square foot.
GENERAL NOTES: See Sheet 135.


SHAFFER, PARRETT AND ASSOCIATES
 Consulting Engineers
 Mansfield, Ohio.

REAR PIERS
 BRIDGE No. WAY-3-1166 L & R
 OVER KILLBUCK CREEK
 WAYNE COUNTY S.R. 3
 STA. 616 + 04.30 TO STA. 618 + 61.23


DESIGNED	DRAWN	TRACED	CHECKED	REVIEWED	DATE	REVISED
RAK	RAK	jack	DHT			6-1-01

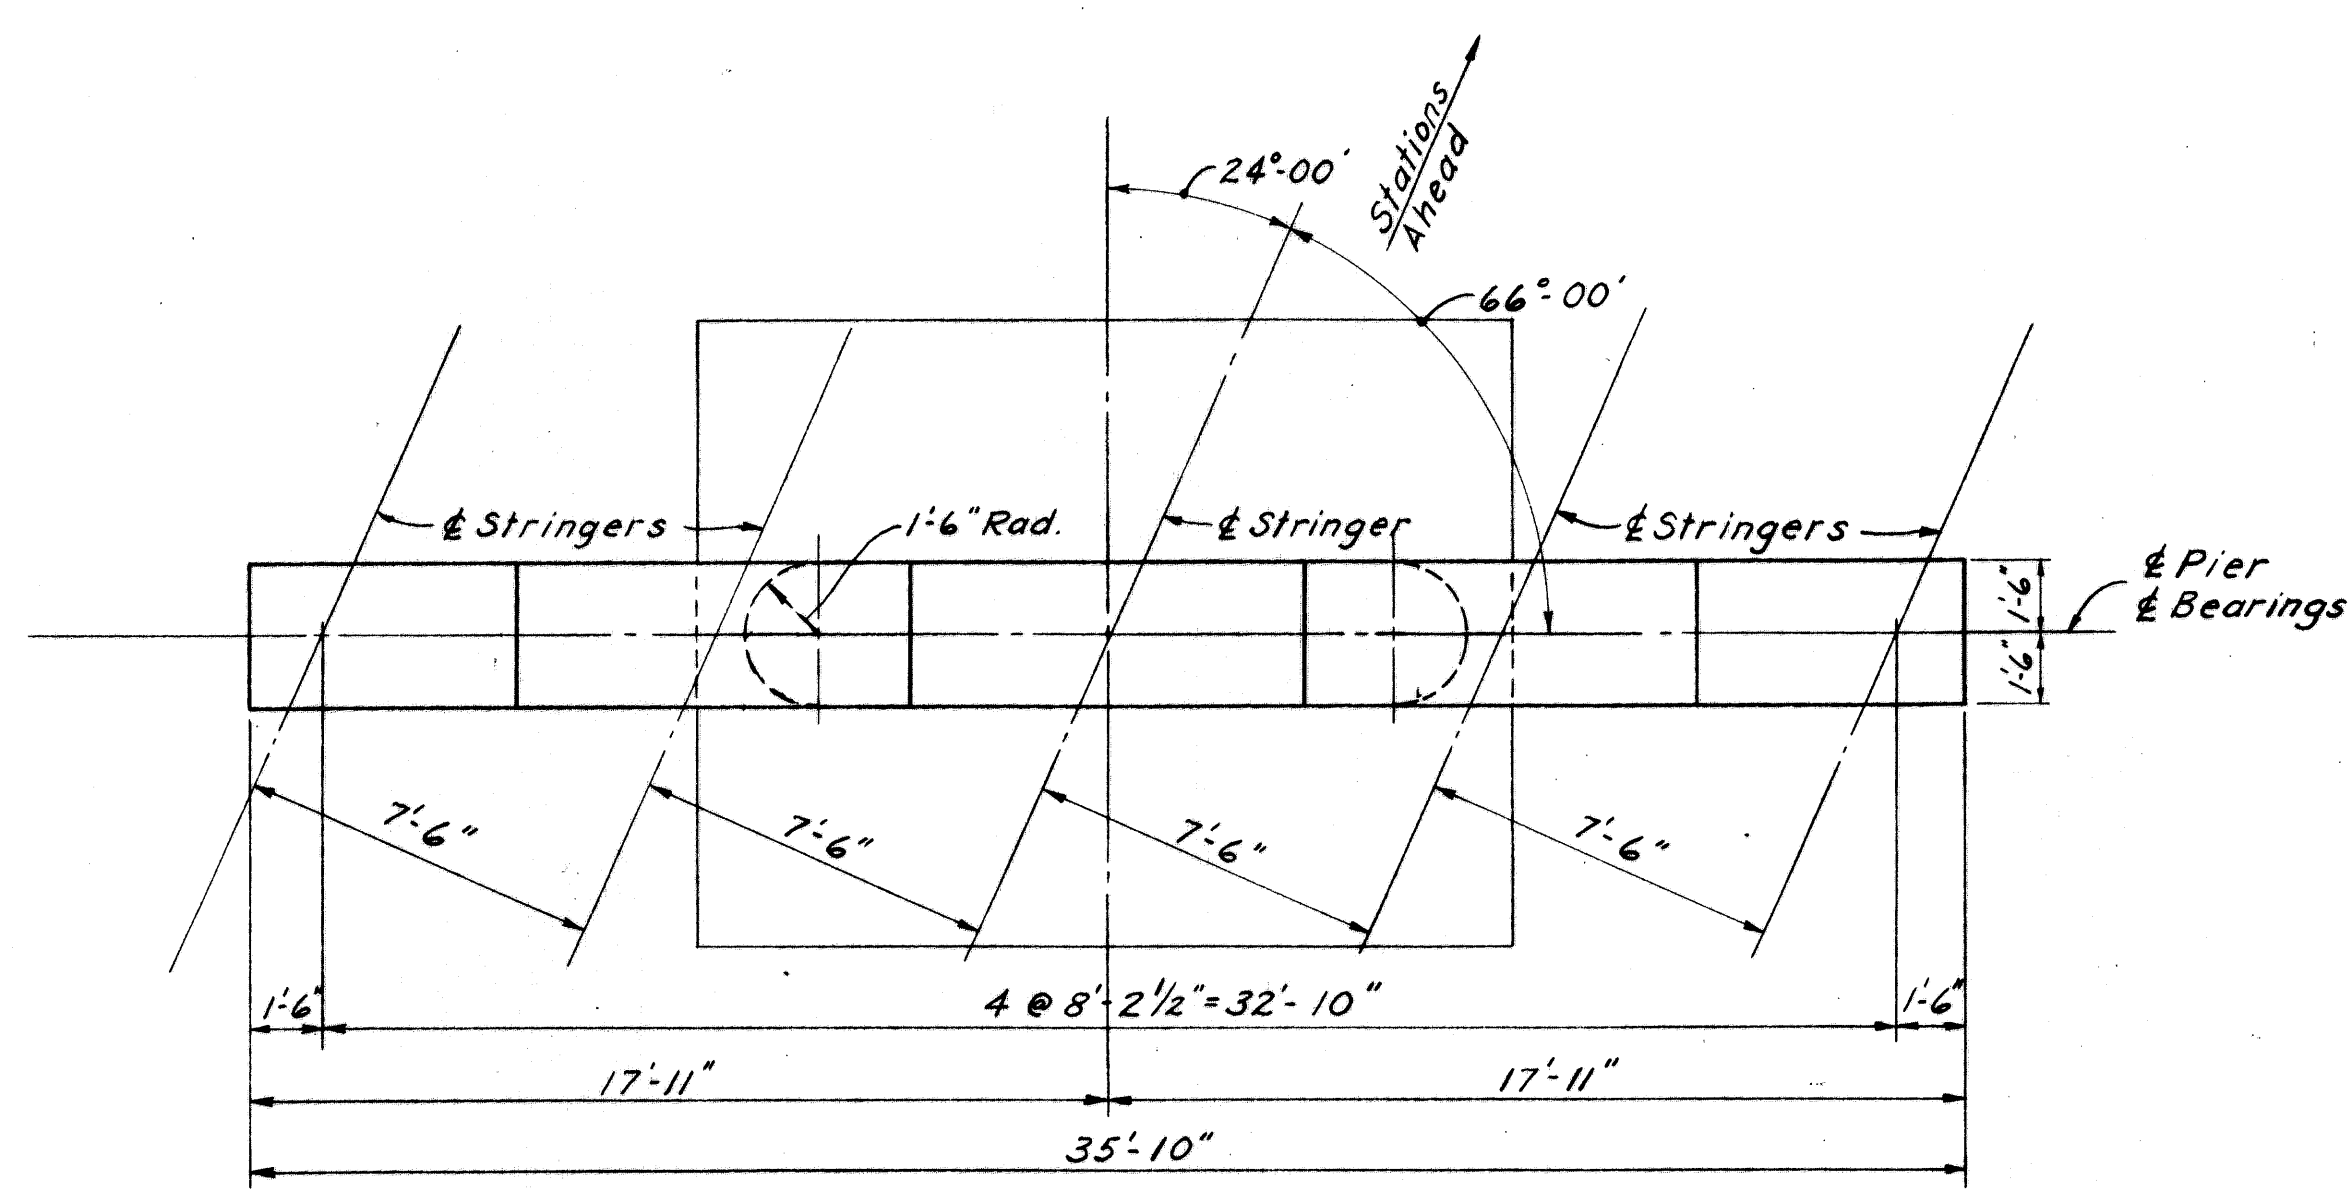


PLAN

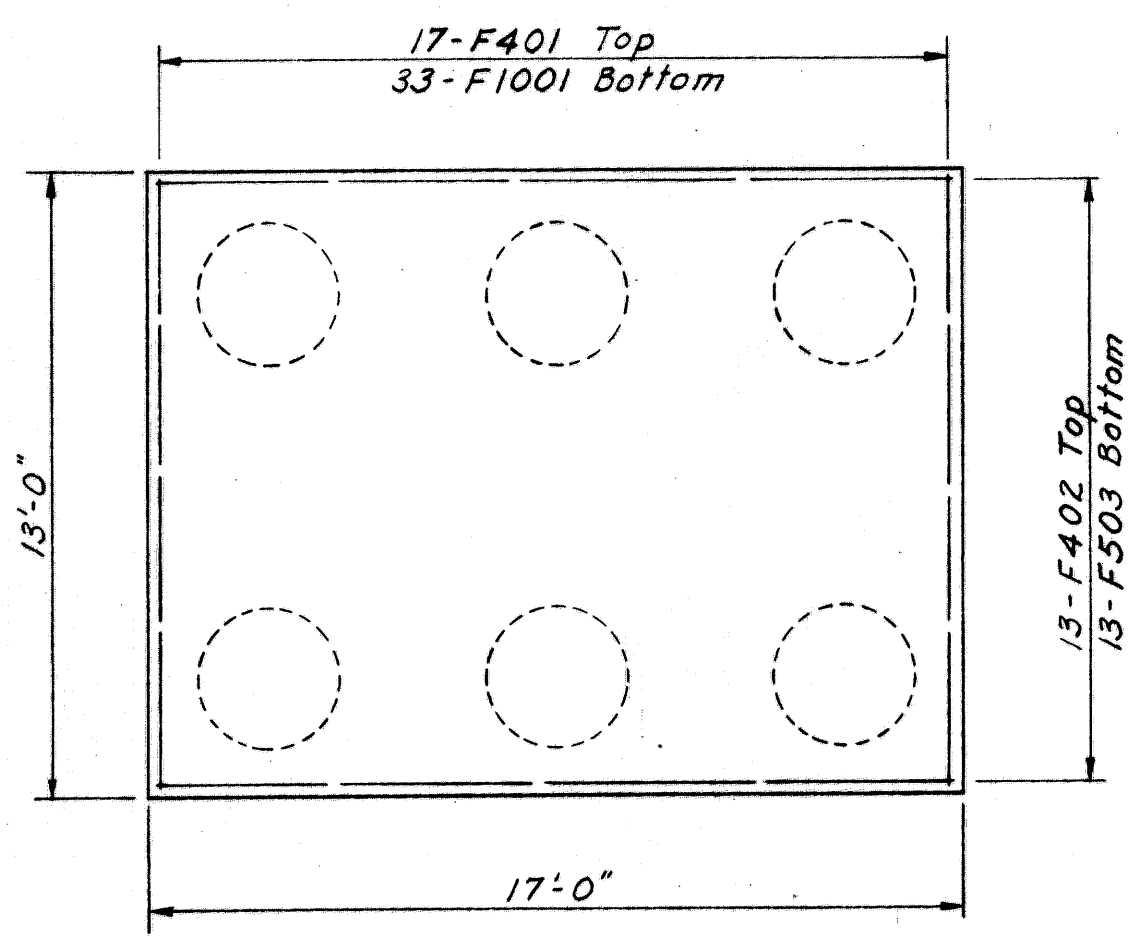


FOOTING PLAN

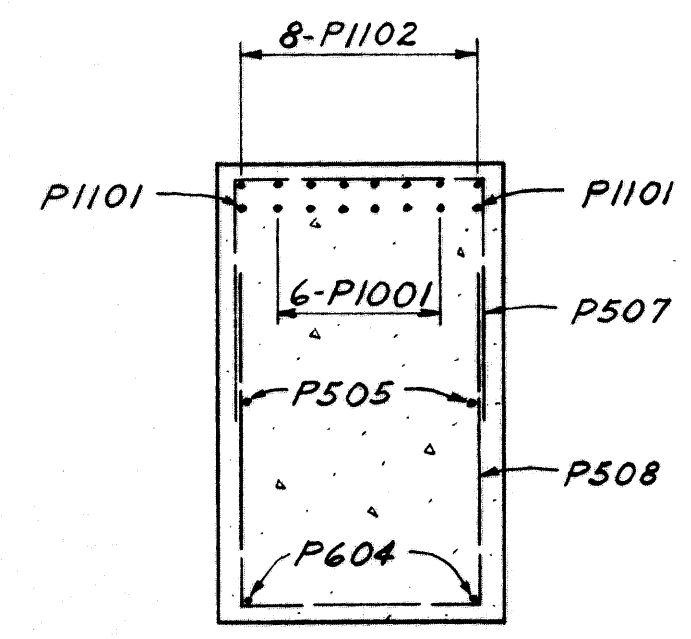


SECTION B-B

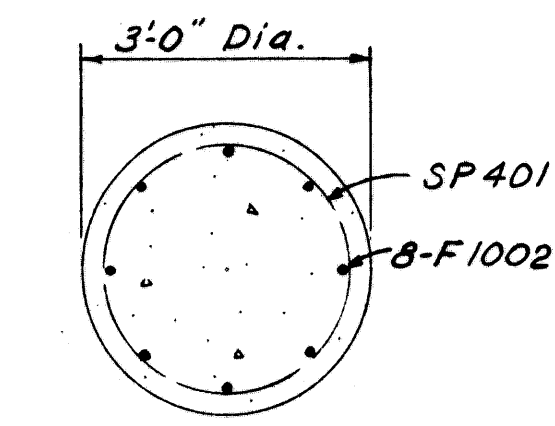


SECTION E-E

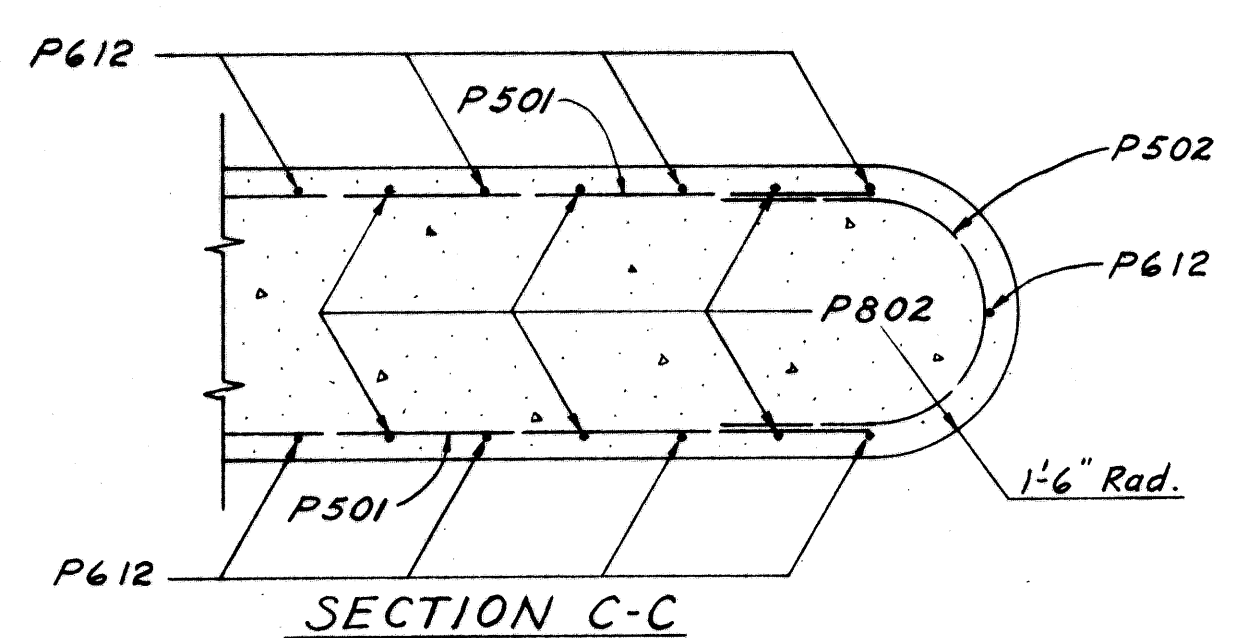


SECTION C-C

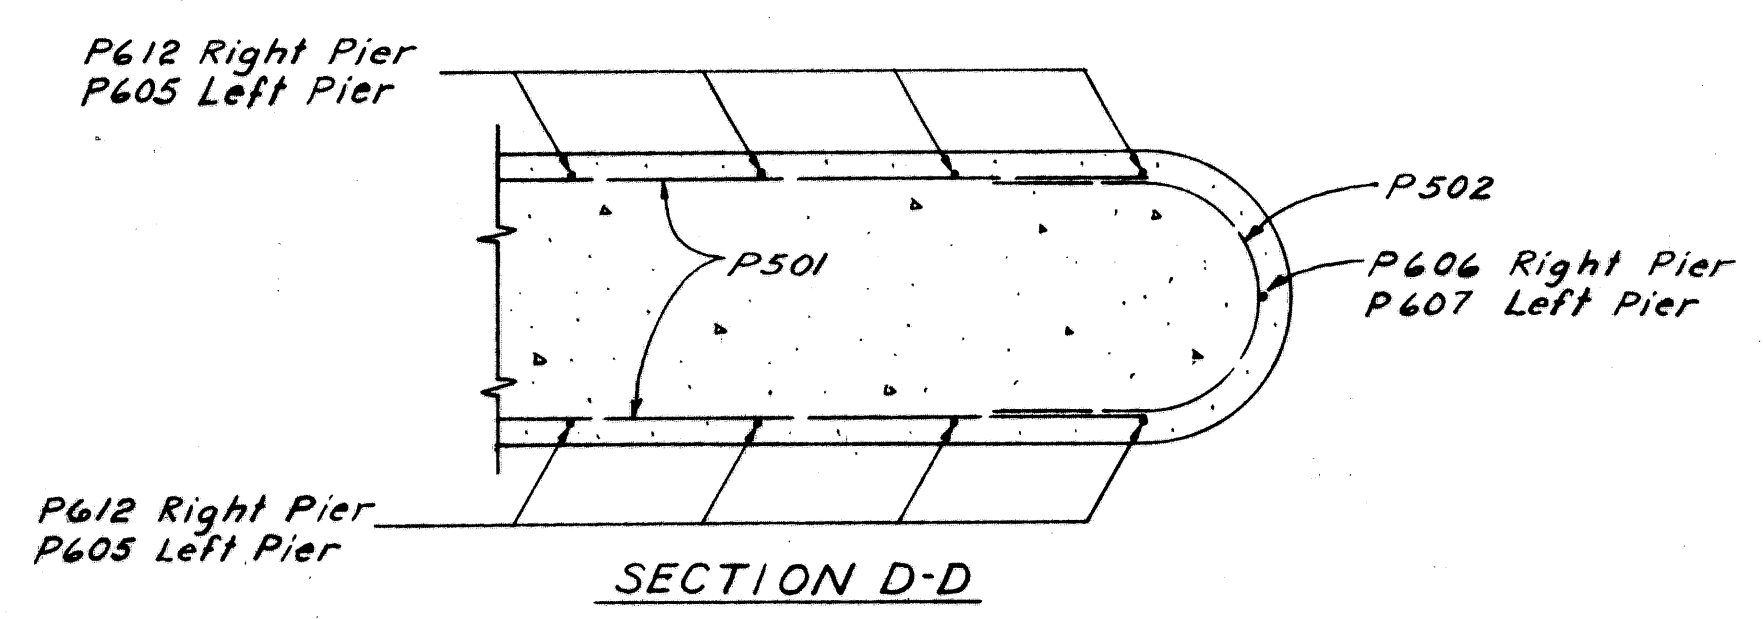

SECTION D-D

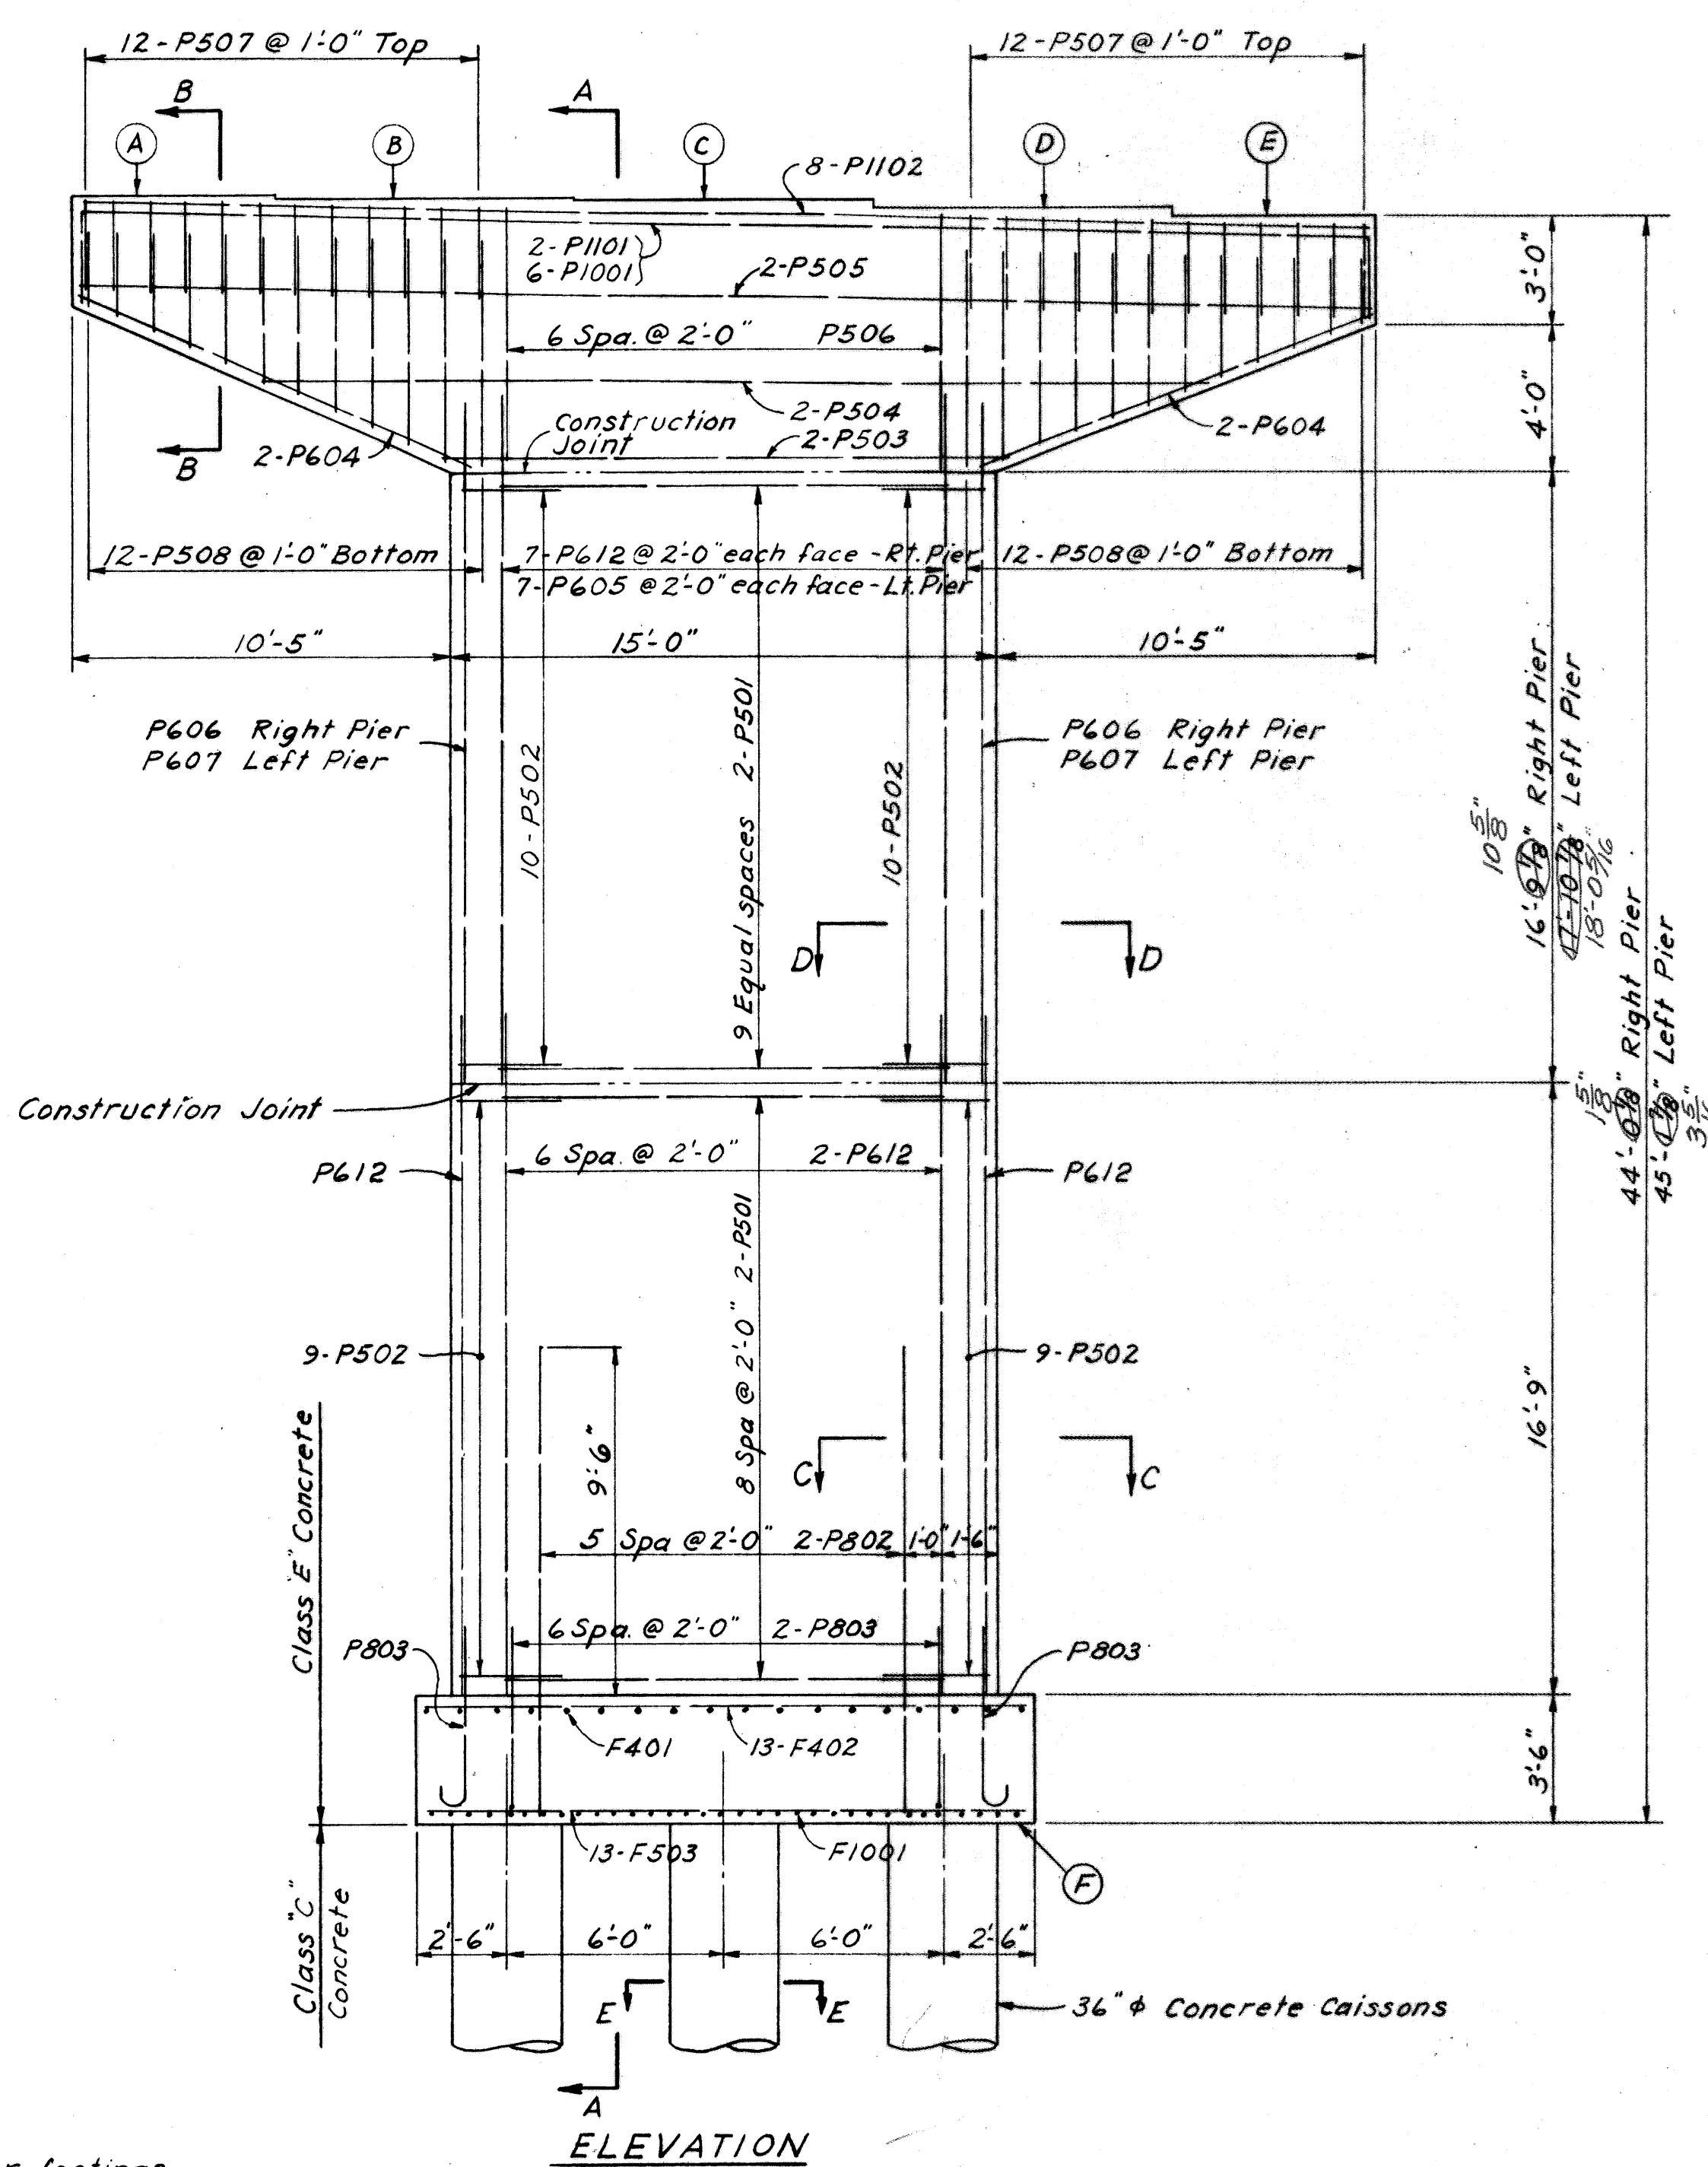

ELEVATION

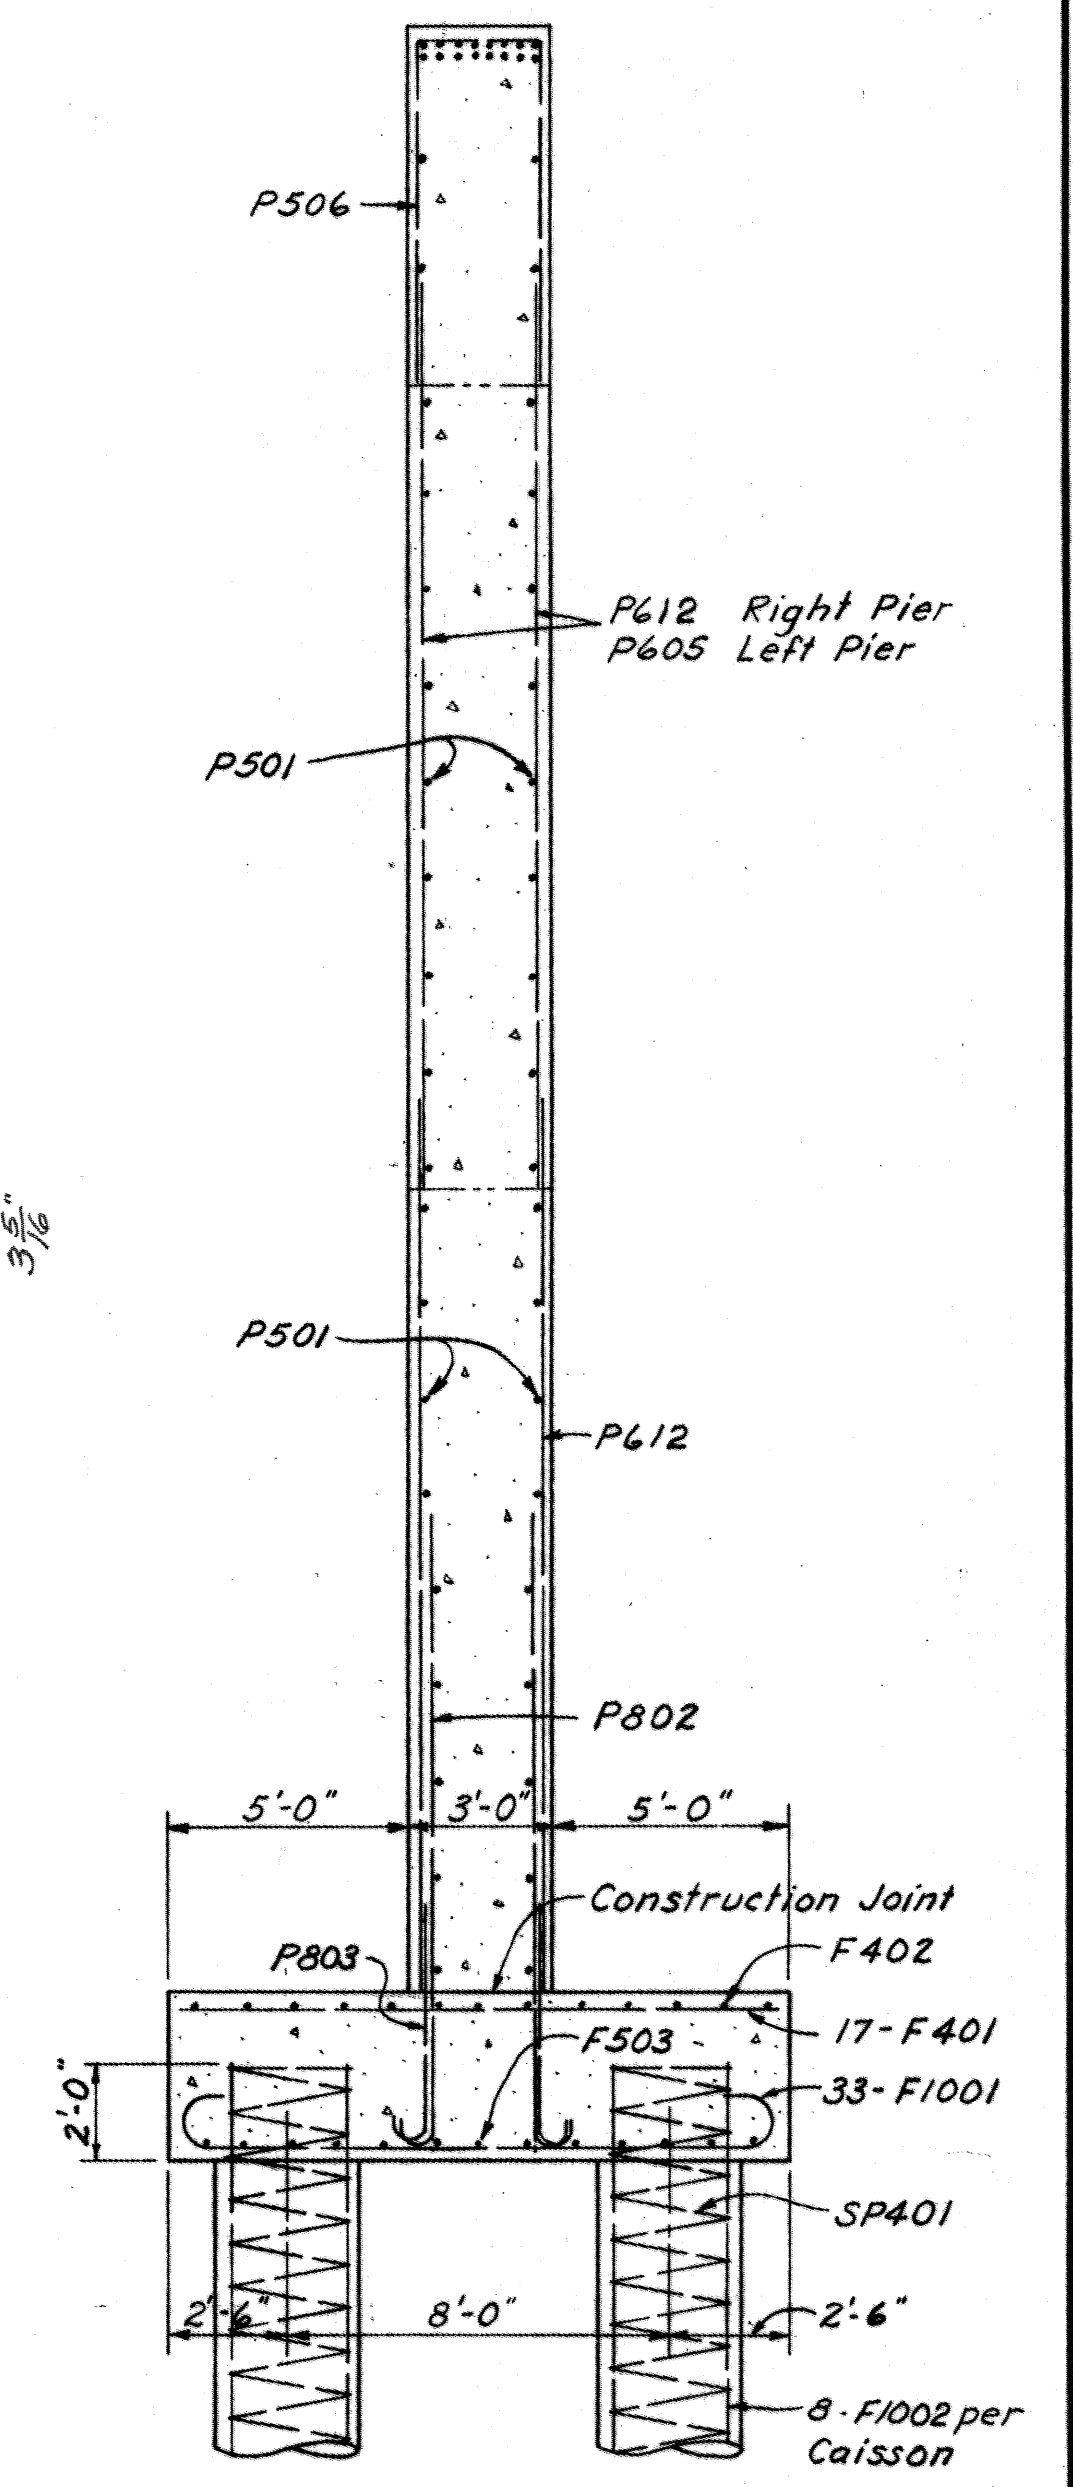

SECTION A-A

NOTES:
CONCRETE: All concrete for pier footings, caps and stems shall be Class "E". Concrete for the caissons shall be Class "C".
GENERAL NOTES: See Sheet 135.
CAISSONS shall penetrate 7 feet into bedrock or to Elev. 815.0, whichever is lower. The design load is 128 tons per caisson.

	(A) ₆₇₁	(B) ₆₅₄	(C) ₆₃₈	(D) ₆₂₁	(E) ₆₁₇	(F)
Right Pier	881.609	881.533	881.470	881.323	881.039	837.0
Left Pier	882.749	882.733	882.710	882.469	882.219	837.0
	811	794	777	527	276	


SHAFFER, PARRETT AND ASSOCIATES
 Consulting Engineers
 MANSFIELD, OHIO.

FORWARD PIERS
 BRIDGE No. WAY-3-1166 L & R
 OVER KILLBUCK CREEK

WAYNE COUNTY S.R. 3
 STA. 616 + 04.30 TO STA. 618 + 61.23

DESIGNED	DRAWN	TRACED	CHECKED	REVIEWED	DATE	REVISED
RAK	RAK	bob	JWC			6-1-01

WAYNE COUNTY
WAY-3-9.94

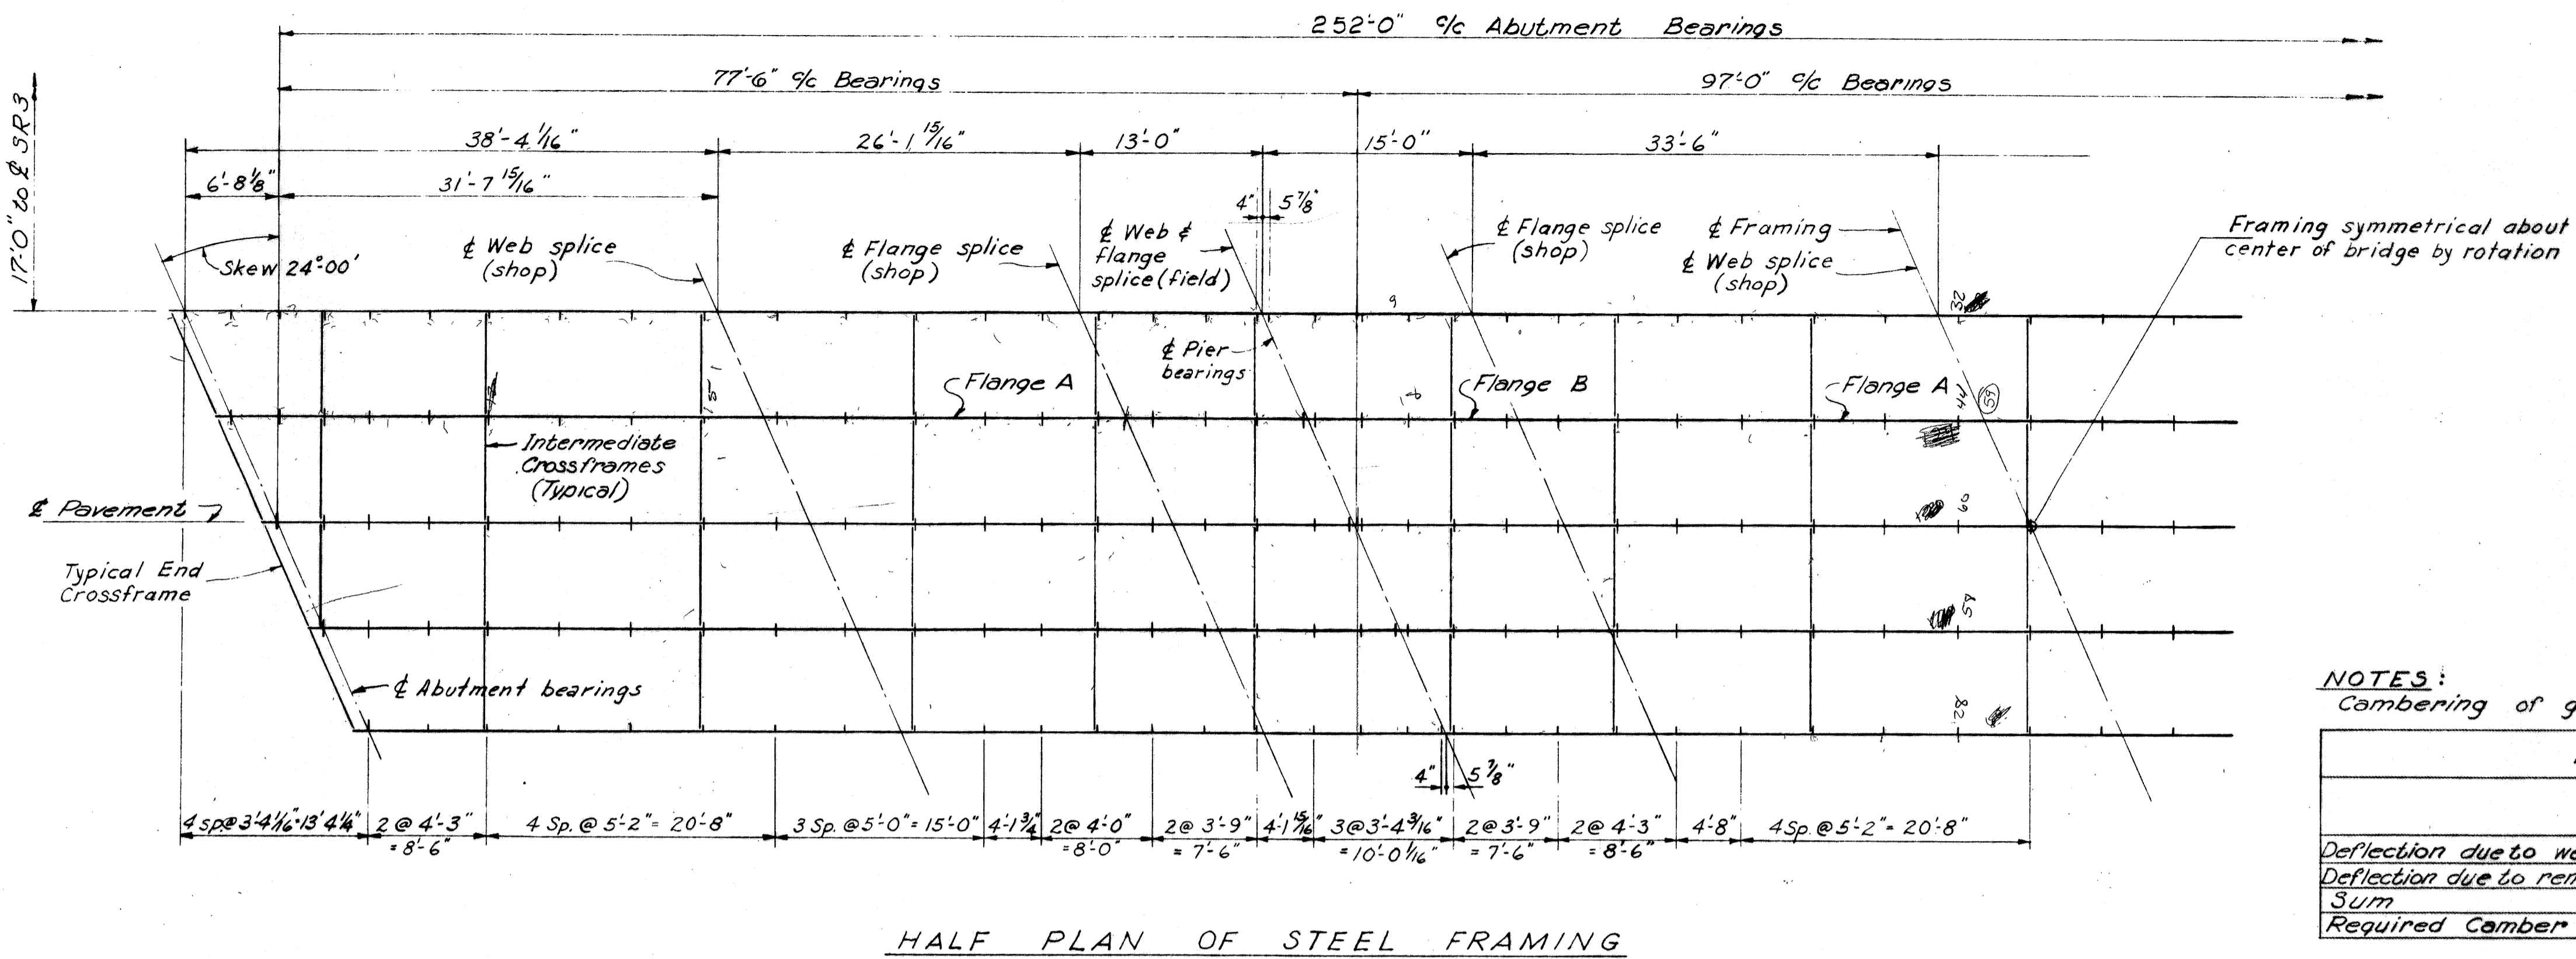

GIRDER MATERIALS	
Web	62 x 3/8
Flange A	14 x 3/4
Flange B	14 x 1 1/2
Intermediate Stiffeners	6 x 3/8
End Stiffeners	2-6 x 5/8
Pier Bearing Stiffeners	4-6 x 5/8

NOTES:
Cambering of girders is required in accordance with the following table:

	DEFLECTION AND CAMBER			
	OUTSIDE GIRDERS		INSIDE GIRDERS	
	End Spans	Middle Span	End Spans	Middle Span
Deflection due to weight of steel	3/16"	7/16"	3/16"	7/16"
Deflection due to remaining dead load	1/2"	1 3/8"	3/4"	1 5/16"
Sum	11/16"	1 3/4"	1 1/8"	2 3/16"
Required Camber	0'-1"	0'-2"	1"	2 3/16" + 2"

- GIRDER SPLICE WELDING PROCEDURE [ASSUMING MIDDLE SPAN IS IN PLACE]:**
1. Raise end of girder at forward abutment 1 1/16".
 2. Butt-weld girder flanges and web at forward pier, using the following sequence: make two passes on each flange, then two on the web; repeat using one pass at each location until welds are completed. Weld bottom plate over shoe.
 3. Make splice at rear pier in the same manner, raising the end of the girder 1 1/16" at the rear abutment.
 4. After splices are completed at the piers, lower the ends of the girders at the abutments to final positions.

BEARINGS: See RB-1-55 for the following:
R-100 Abutments
B-225 Rear Pier
R-225 Forward Pier

END CROSSFRAMES, END FINISH, GUTTERS, SCUPPERS, & CURB PLATE DETAILS: See C3B-2-56 Sheets 2 & 3 of 6

RAILING: See AR-1-57



RAILING POST, PARAPET EXPANSION JOINT & SCUPPER SPACING: See sheet 134.

CONCRETE: All superstructure concrete shall be Class "C"

GENERAL NOTES: See sheet 135.

PAINTING: After erection and after the shop coat has been cleaned and, where necessary, repainted in accordance with Sec. 8.04, an additional coat of the same paint as used in the shop shall be applied over the outside face of the outside steel girders & all sides of bottom flanges.

END DAMS: For details see sheet 141.

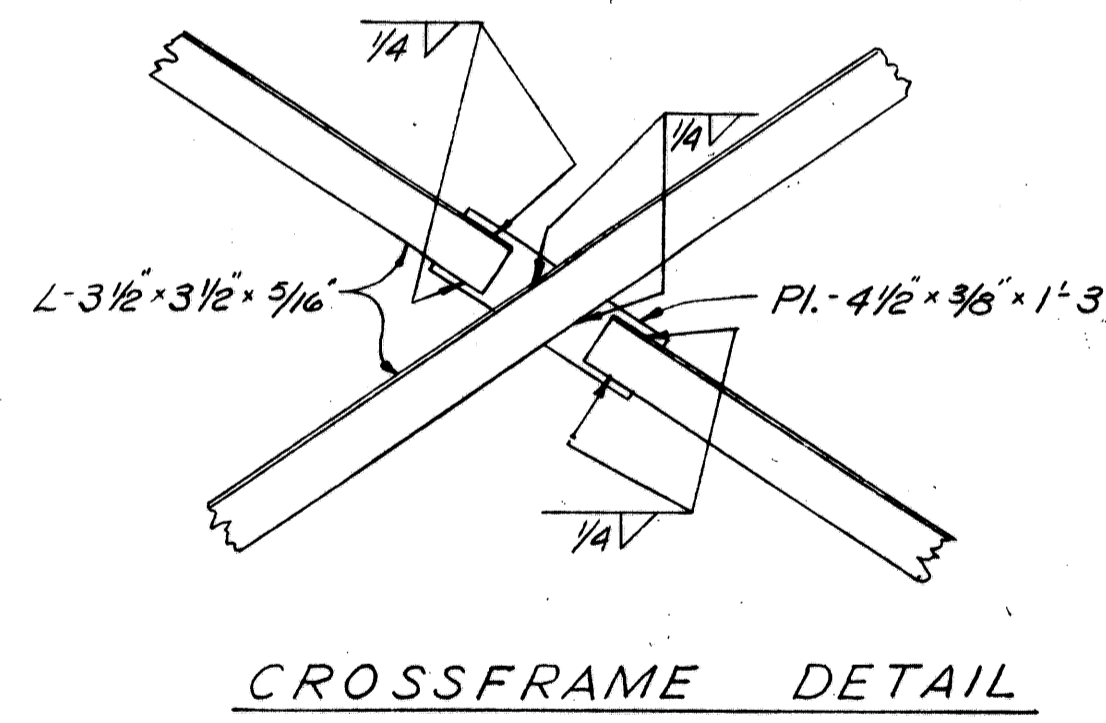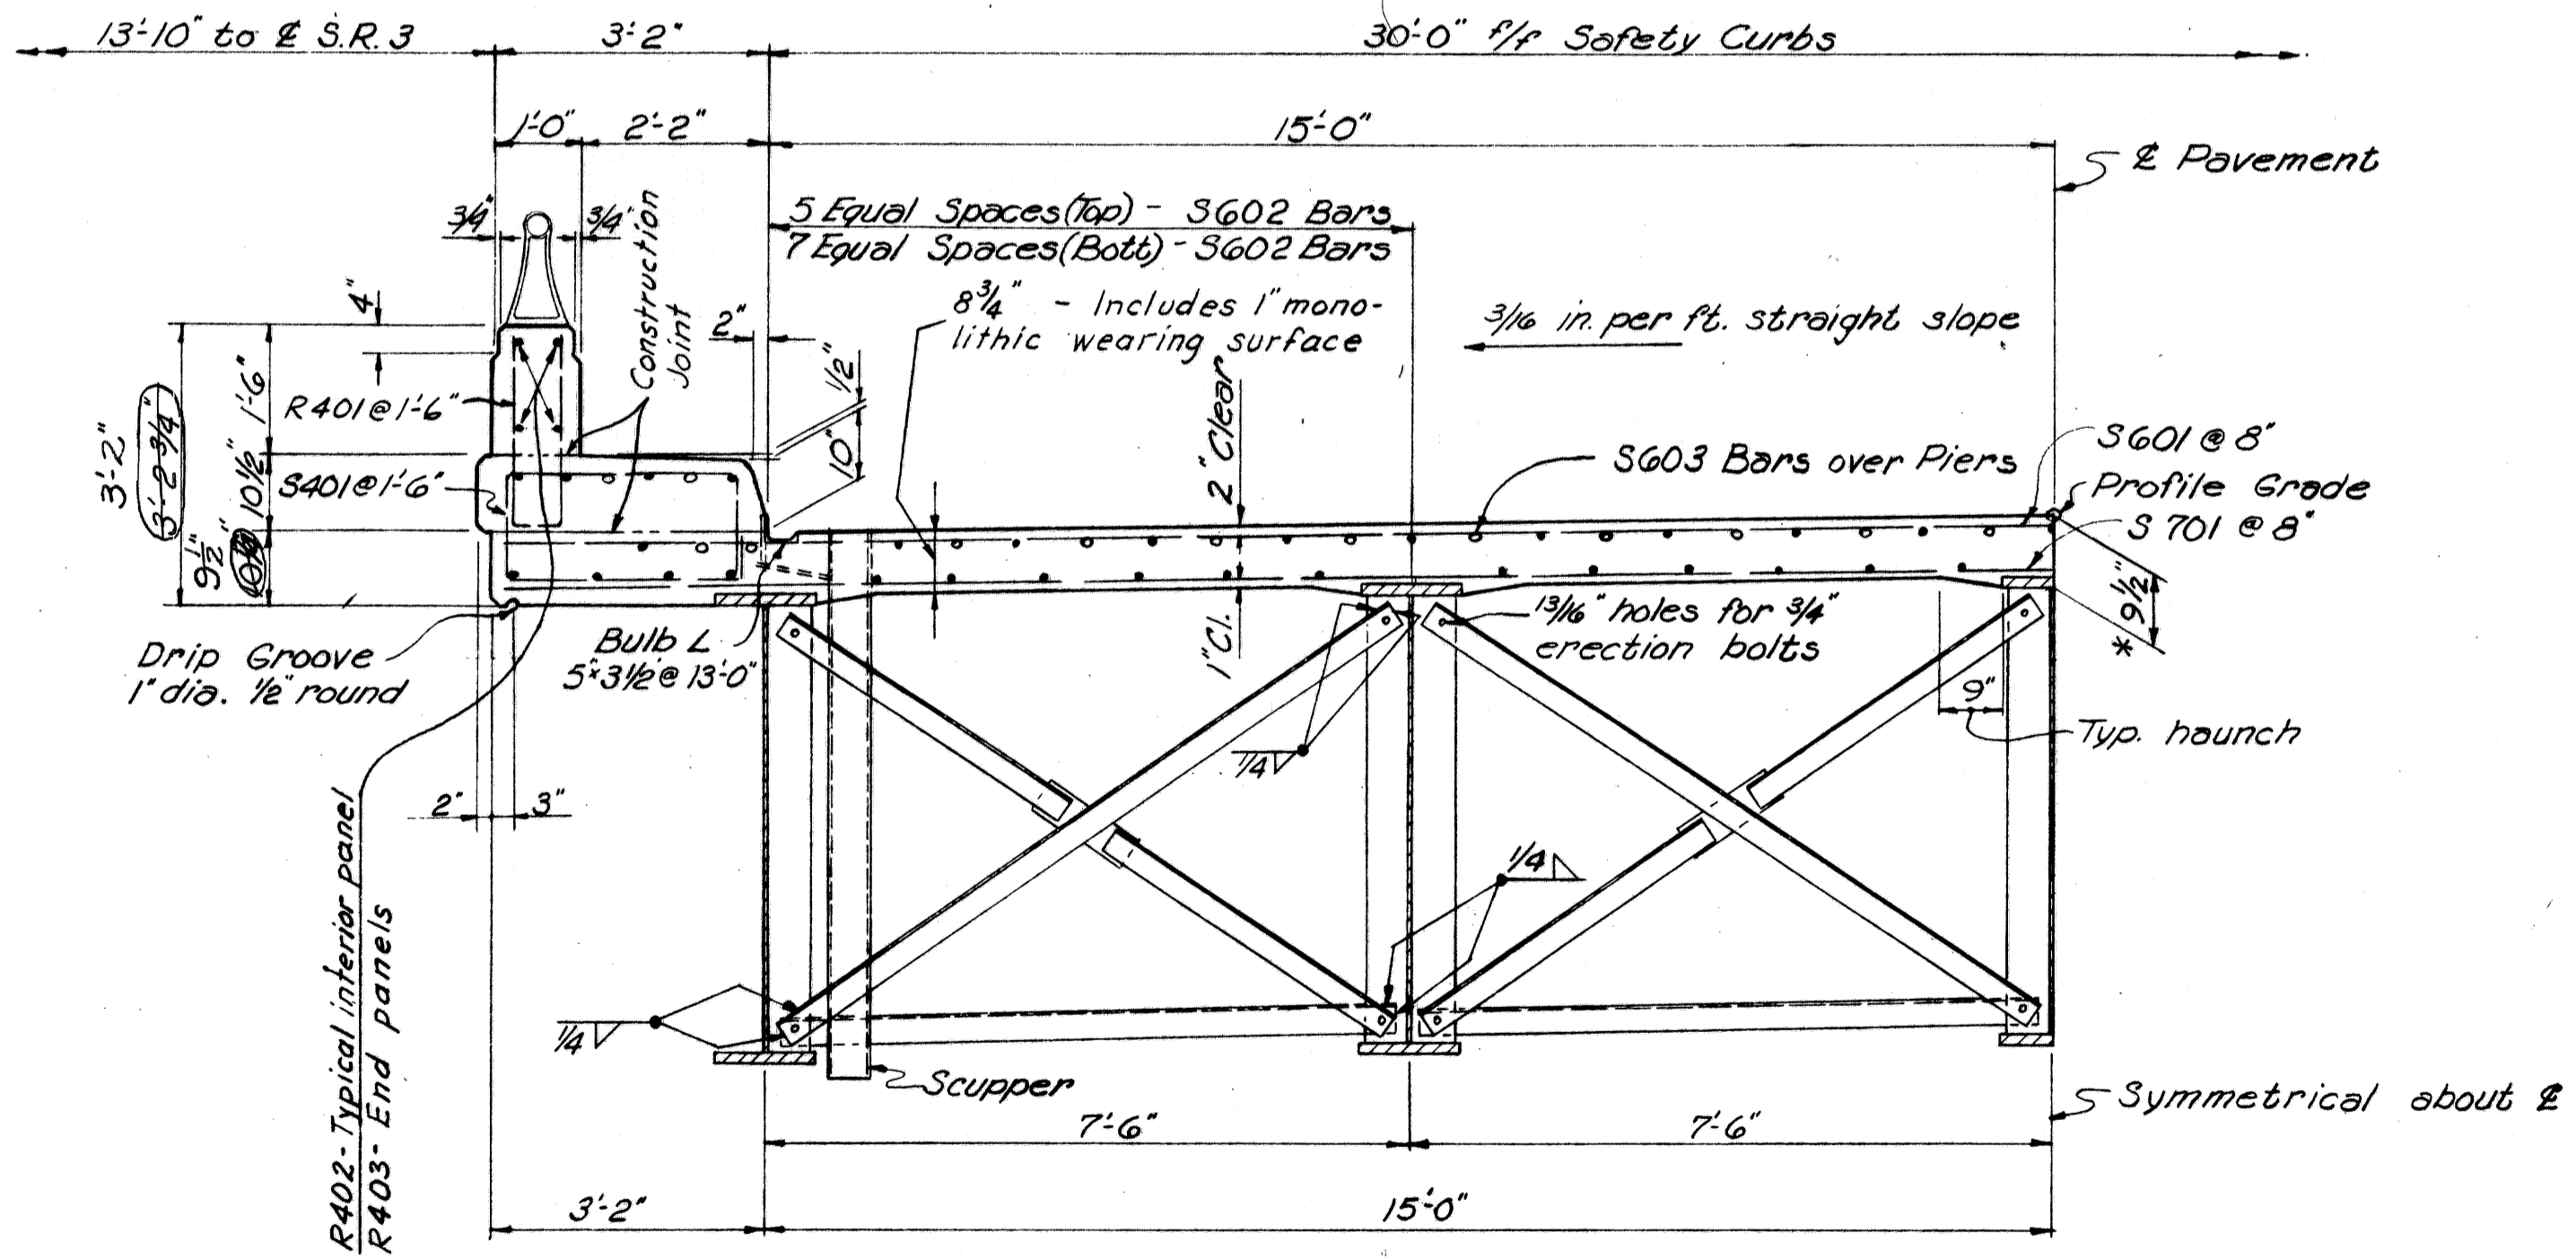

SECTION A-A

* This is the nominal dimension. The quantity of deck concrete to be paid for shall be based on this dimension, even though deviation from it may be necessary because the top flange of the beam may not have the exact camber or conformation required to place it parallel to the finished grade.

SHAFFER, PARRETT AND ASSOCIATES
Consulting Engineers
MANSFIELD, OHIO.

SUPERSTRUCTURE-1
BRIDGE No. WAY-3-1166 L & R
OVER KILLBUCK CREEK


WAYNE COUNTY
STA. 616 + 04.30 TO STA. 618 + 61.23

DESIGNED	DRAWN	TRACED	CHECKED	REVIEWED	DATE	REVISED
RAK	JWC	Jack	DHT		6-1-61	6-28-61 8-22-61


FED. RD. DIVISION	STATE	PROJECT	
2	OHIO		

141
151

WAYNE COUNTY
WAY-3-9.94

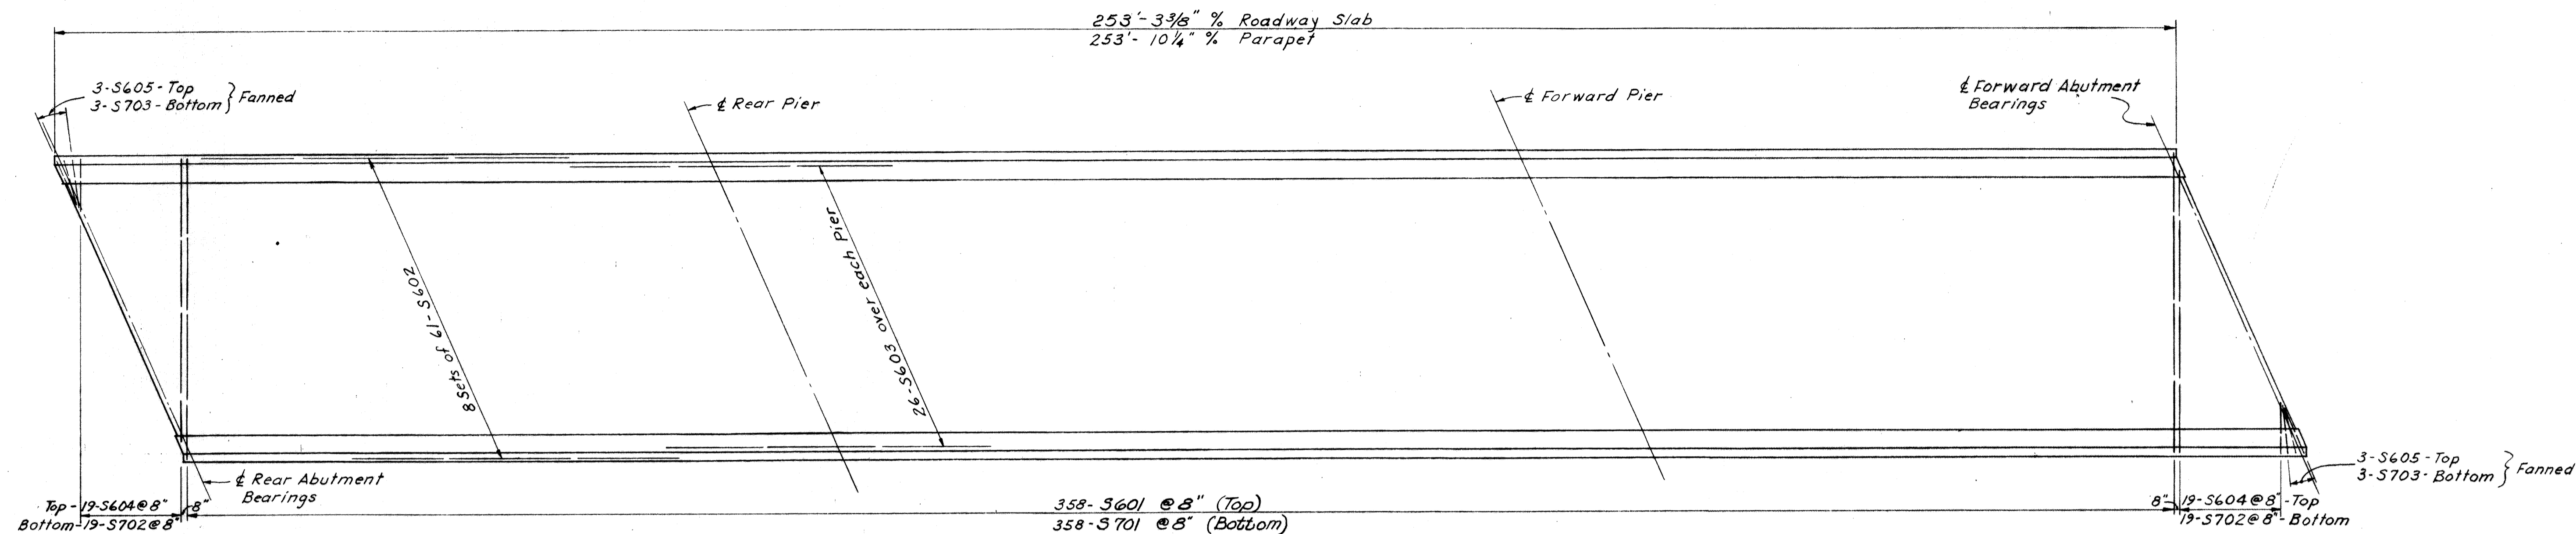

DECK SLAB PLAN

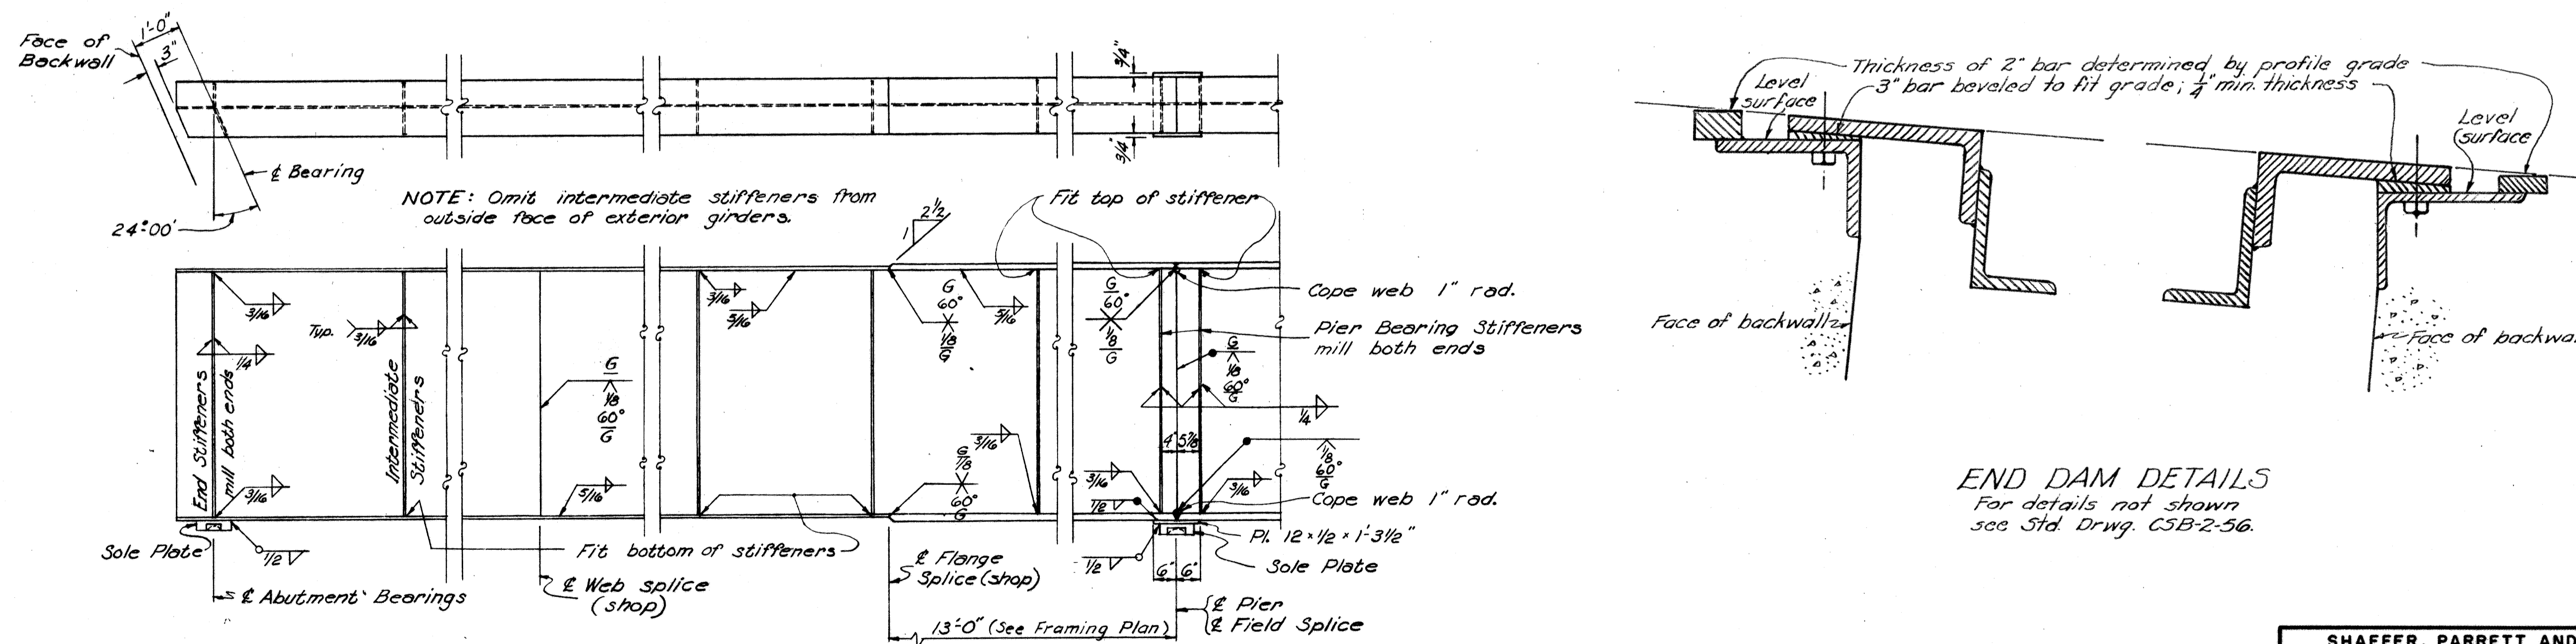


TYPICAL GIRDER DETAILS

END DAM DETAILS
For details not shown
see Std. Drwg. CSB-2-56.

SHAFFER, PARRETT AND ASSOCIATES Consulting Engineers MANSFIELD, OHIO.					
SUPERSTRUCTURE-2					
BRIDGE No. WAY-3-1166 L & R OVER KILLBUCK CREEK					
WAYNE COUNTY				S.R. 3	
STA. 616 + 04.30 TO STA. 618 + 61.23					
DESIGNED	DRAWN	TRACED	CHECKED	REVIEWED	DATE
RAK	RAK	jack	DHT		6-23-61

WAYNE COUNTY
WAY-3-9.94

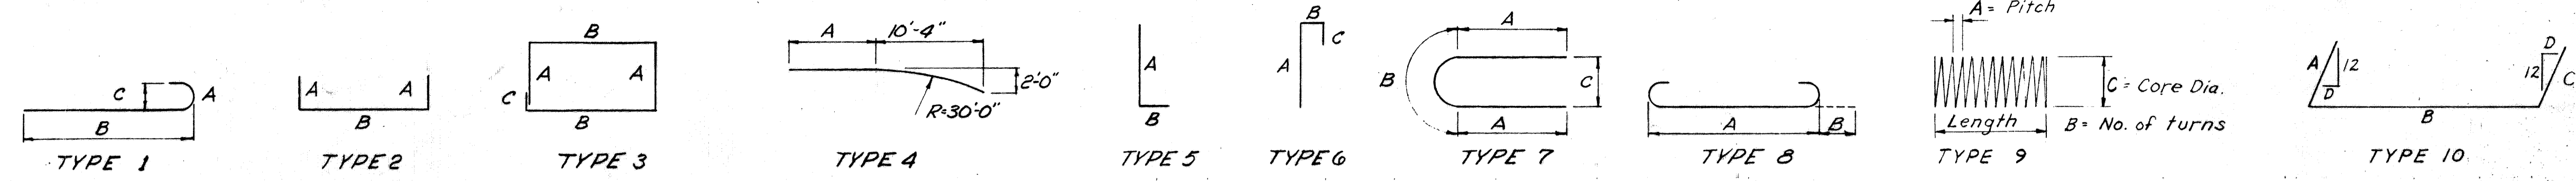

ABUTMENTS

MARK	NO.	LENGTH	TYPE	A	B	C	D	E	WEIGHT	LOCATION
R401	110	5'-4"	2	2'-4"	3'				392	Reiling Stirrups
R404	8	18'-2"	3tr.						*	Reiling Long. Rear Wall A
R405	8	23'-0"	"						*	" " " " Wall B
R406	8	16'-4"	"						*	" " " " Fwd " A
R407	8	17'-0"	"						*	" " " " " B
A401	8	8'-3"	3	1'-4"	2'-7 1/2"	4"			44	Curb Stirrups
A402	8	8'-2"	3	1'-4"	2'-7"	4"			44	" "
A403	8	8'-0"	3	1'-4"	2'-6"	4"			43	" "
A404	8	7'-10"	3	1'-4"	2'-5"	4"			42	" "
A405	8	7'-6"	3	1'-4"	2'-3"	4"			40	" "
A406	8	7'-0"	3	1'-4"	2'-0"	4"			37	" "
A407	8	6'-6"	3	1'-4"	1'-9"	4"			35	" "
A408	8	6'-0"	3	1'-4"	1'-6"	4"			32	" "
A409	8	5'-4"	3	1'-4"	1'-2"	4"			29	" "
A410	76	8'-4"	3	1'-4"	2'-8"	4"			423	Curb Stirrups
A501	32	21'-4"	Str.	Bend 4 in field as shown					712	Footing Longit.
A502	160	5'-10"	1	7'	5'-3"	5'			973	" Transv.
A503	8	9'-4"	3tr.						79	Footing Wings Rear Wall A
A504	8	11'-10"	3tr.						99	" " " " Wall B
A505	16	10'-3"	3tr.						171	" " " " Fwd Walls
A506	52	3'-8"	2	4'	3'-0"	4"			199	" " " " Transv.
A507	100	21'-9"	10	1'-6"	20'-3"	5'-3/4"			2249	Stem & Wall Longit.
A508	184	7'-6"	5	2'-4"	5'-2"				1439	Bridge Seats
A509	82	3'-8"	3tr.						314	Stem Vert Front
A510	32	3'-5"	3tr.						114	" "
A511	38	3'-2"	3tr.						126	" "
A512	4	17'-10"	3tr.						74	Front Wall A Rear Abut.
A513	4	22'-10"	3tr.						95	" " B " "
A514	4	17'-3"	3tr.						78	Rear Wall A " "
A515	4	22'-3"	3tr.						93	" " B " "
A516	4	17'-7"	4	7'-0"	10'-7"				73	Curb Wall A " "
A517	4	24'-1"	4	13'-6"	10'-7"				101	" " B " "
A518	4	16'-10"	3tr.						70	Front Wall A Fwd Abut.
A519	4	16'-8"	3tr.						69	" " B " "
A520	4	15'-10"	3tr.						66	Rear Wall A " "
A521	4	16'-6"	3tr.						69	" " B " "
A522	4	15'-8"	4	5'-1"	10'-7"				65	Curb Wall A " "
A523	4	18'-1"	4	7'-6"	10'-7"				75	" " B " "
A524	60	11'-6"	3tr.						720	Vert Wall A (E.F.) Rear Abut.
A525	72	11'-0"	3tr.						826	" " B Fwd Abut.
A526	132	4'-11"	5	4'-7"	4"				677	Footing Dowels Wings
A527	64	3'-10"	3tr.						256	Vert Wall A & B Rear & Fwd Abut.
A528	32	Varies	3tr.	4'-0" to 7'-3" Vary 4 ea. by 5/8"					189	Vert Wall A Rear Abut.
A529	40	Varies	3tr.	4'-0" to 7'-9" Vary 4 ea. by 5"					245	" " B " "
A530	24	Varies	3tr.	4'-0" to 6'-9" Vary 4 ea. by 6/16"					135	" " A Fwd " "
A531	24	Varies	3tr.	4'-0" to 6'-6" Vary 4 ea. by 6"					131	Vert Wall B " "
A532	4	10'-0"	3tr.						42	Diag. Wall A Rear " "
A533	4	11'-5"	3tr.						48	" " B " "
A534	4	7'-5"	3tr.						31	" " A Fwd " "
A535	4	7'-9"	3tr.						32	Diag. Wall B " "
A536	6	8'-2"	3tr.						51	Horiz Wall A F.F. Rear Abut.
A537	6	10'-4"	3tr.						65	" " B F.F. " "
A538	6	7'-8"	3tr.						48	" " A R.F. " "
A539	6	10'-8"	3tr.						67	" " B R.F. " "
A540	6	9'-4"	3tr.						58	" " A F.F. Fwd " "
A541	6	9'-0"	3tr.						56	" " B F.F. " "
A542	6	8'-10"	3tr.						55	" " A R.F. " "
A543	6	9'-6"	3tr.						60	" " B R.F. " "
A544	16	Varies	3tr.	6'-9" to 12'-11" Vary 4 ea. by 2'-1"					164	" " A E.F. Rear Abut.
A545	16	Varies	3tr.	8'-5" to 15'-3" Vary 4 ea. by 2'-3"					198	" " B E.F. " "
A546	12	Varies	3tr.	8'-0" to 12'-3" Vary 4 ea. by 2'-0"					125	" " A E.F. Fwd " "
A547	12	Varies	3tr.	7'-6" to 12'-0" Vary 4 ea. by 2'-3"					122	" " B E.F. " "
A548	6	18'-2"	3tr.						114	" " A F.F. Rear " "
A549	6	17'-9"	3tr.						111	" " A R.F. " "
A550	12	23'-0"	3tr.						288	" " B E.F. " "
A551	18	16'-11"	3tr.						318	" " A F.F. Fwd. " "
A552	6	16'-5"	3tr.						103	" " B E.F. " "
A553	48	7'-6"	2	3'-6"	6"				375	Curb Wall Stirrups
A554	16	9'-0"	3tr.						150	" " Vert
A555	16	9'-7"	3tr.						160	Curb Wall Vert
A556	100	21'-9"	10	-	20'-3"	1'-6"	5'-3/4"		2269	Stem and Wall Longit.
A601	132	5'-5"	3tr.						1237	Backwall Back Vert
A602	132	10'-8"	6	6'-9"	1'-2"	2'-9"			2435	Backwall Front Vert
A603	152	3'-11"	3tr.						894	Backwall Dowels
A604	152	8'-8"	5	8'-4"	4"				1979	Backwall Back Vert.
									TOTAL WEIGHT =	23,412

PIERS

MARK	NO.	LENGTH	TYPE	A	B	C	D	E	WEIGHT	LOCATION
F401	34	12'-6"	Str.						284	Footing Fwd Piers
F402	26	16'-6"	Str.						287	" " "
F501	38	10'-8"	3	9'-6"	7"				423	Footing Rear Piers
F502	22	17'-6"	3tr.						402	" " "
F503	26	16'-6"	3tr.						447	Footing Fwd Piers
F1001	66	15'-4"	3	12'-6"	17"				4355	Footing Fwd Piers
P501	144	12'-2"	3tr.						1827	Stems
P502	144	7'-4"	7	1'-7"	4'-2"	2'-8"			1101	" "
P503	8	15'-6"	3tr.						129	Caps
P504	8	24'-0"	3tr.						217	" "
P505	8	35'-6"	3tr.						294	" "
P506	28	16'-6"	2	6'-11"	2'-8"				482	" "
P507	96	7'-8"	2	2'-6"	2'-8"				768	" "
P508	96	Varies	2	*** 2'-8"					371	Caps
									*** 1'-7" to 5'-10" Vary 8 ea. by 4/4"	
P801	32	5'-7"	1	13"	4'-6"	7"			477	Stem Rear Piers
P802	48	13'-10"	1	13"	12'-9"	7"			1773	Stems
P803	32	6'-1"	1	13"	5'-0"	7"			520	Fwd Pier Stem
P604	16	11'-6"	3tr.						276	Caps
P605	14	19'-7"	3tr.						412	Lt Fwd Pier Stem
P606	2	18'-3"	3tr.						55	Rt " " "
P607	2	19'-3"	3tr.						58	Lt " " "
P608	14	16'-0"	3tr.						336	Rt Rear Pier Stem
P609	14	17'-2"	3tr.						361	Lt " " "
P610	2	15'-6"	3tr.						47	Rt " " "
P611	2	16'-9"	3tr.						50	Lt " " "
P612	78	18'-8"	3tr.						2187	Rt Fwd Pier Stem
P1001	24	35'-6"	3tr.						3666	Caps
P1101	8	35'-6"	3tr.						1509	Caps
P1102	32	39'-8"	8	35'-6"	1'-7"				6744	Caps
F1002	96	24'-0"	3tr.						**	Caisson
SP401	12	23'-10"	9	4 1/2"	66	30"			**	Caisson
									TOTAL WEIGHT	29,860

* These railing bars are included in item S-14 for payment
 ** These caisson bars included in item Special for payment

REPLACEMENT BARS

MARK	NUMBER	LENGTH
RE 400	1	5'-3"
RE 500	2	5'-7"
RE 600	6	5'-11"
RE 700	3	6'-3"
RE 1000	1	7'-3"
RE 1100	1	7'-7"

TOTAL WEIGHT OF REINFORCING STEEL = 211,881

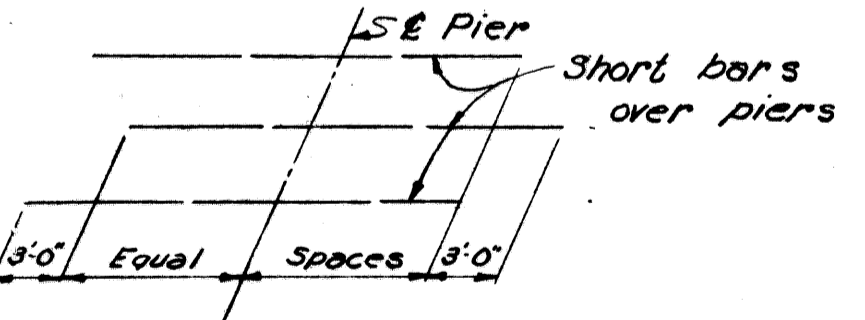


DIAGRAM SHOWING STAGGER OF SHORT BARS OVER PIERS

NOTES:
 REPLACEMENT BARS: If reinforcing bars are fabricated from stock which has been previously tested and approved by the Ohio Highway Testing Laboratory, test samples as provided in Sec. S-4.02 need not be furnished and replacement bars will not be required.
 BAR SIZE is indicated on the bar mark. The first digit where three digits are used and the first two digits where four are used, indicate the bar size number. For example, A701 is a No. 7 size bar and A1014 is a No. 10 size bar.

SUPERSTRUCTURE

MARK	NO.	LENGTH	TYPE	A	B	C	D	E	WEIGHT	LOCATION
R401	724	5'-4"	2	2'-4"	3'				2579	Reiling Stirrups
R402	240	15'-0"	3tr.						*	" " " " Longit. Interior
R403	32	11'-6"	3tr.						*	" " " " Ends
S401	680	8'-8"	3	1'-4"	2'-9"	6"			3937	Curb Stirrups
S601	714	36'-0"	3tr.						38,716	Top of Slab - Transv.
S602	976	33'-3"	3tr.						48,743	Slab Longit. - Top & Bottom
S603	104	39'-6"	3tr.						6170	" " " " Over Piers
S604	76	Varies	3tr.	6'-10" to 33'-10" Vary 4 ea. by 1'-6"					2321	Slab Top - Ends
S605	12	7'-0"	3tr.						126	" " " " (fanned)
S701	714	36'-0"	3tr.						52,684	Bottom Slab - Transv.
S702	76	Varies	3tr.	6'-10" to 33'-10" Vary 4 ea. by 1'-6"					3159	" " " " Ends
S703	12	7'-0"	3tr.						172	" " " " - Ends (fanned)
									TOTAL WEIGHT =	158,609

ESTIMATED QUANTITIES



Item	TOTAL	UNIT	DESCRIPTION	SUPER STRUCTURE	ABUTS	PIERS	GENERAL	As Built
E-2	610	Sum	Cofferdams, cribs & sheeting				lump	
E-2	610	Cu. Yds.	Unclassified excavation		483	127		
E-2	114	Cu. Yds.	Rock excavation			114		
E-3	9586	Cu. Yds.	Channel excavation				9586	
S-1	622	Cu. Yds.	Class "C" Concrete, superstructure	622				
S-1	380	Cu. Yds.	Class "E" Concrete, piers above footings			380	30.9	30.9
S-1	347	Cu. Yds.	Class "E" Concrete, abutments		347			
S-1	97	Cu. Yds.	Class "E" Concrete, pier footings			97		
S-4	211,881	Lbs.	Reinforcing steel	158,609	23,412	29,860		
S-7	429,933	Lbs.	Structural steel	539,100	429,933			
S-8	429,933	Lbs.	Field painting of structural steel as per plan	429,933				
S-14	1168	Lin Ft.	Railing (aluminum rail, supports & conc. parapets)	1016	152			
S-16	Lump	Sum	First test pile				lump	
S-18	2,112	Lin Ft.	Steel piles, 12BP 53			2,112		
S-24	Lump	Sum	Removal of existing structure				lump	
S-29	67	Cu. Yds.	Porous backfill			67		
S-29	64	Each	Scuppers			64		
I-10	1318	3/4 Tons	Crushed aggregate slope protection			1318	1642	1642
I-10	1442	Cu. Yds.	Dumped rock channel protection			1442	1016	1016
Special	264	Lin Ft.	Drilled caissons, 36" φ			264		

SHAFFER, PARRETT AND ASSOCIATES
 Consulting Engineers
 MANSFIELD, OHIO.

REINFORCING STEEL
 AND ESTIMATED QUANTITIES
 BRIDGE No. WAY-3-1166 L&R
 OVER KILLBUCK CREEK
 WAYNE COUNTY S.R. 3
 STA. 616 + 04.30 TO STA. 618 + 61.23

DESIGNED	DRAWN	TRACED	CHECKED	REVIEWED	DATE
----------	-------	--------	---------	----------	------


LOCATION PLAN
WAY-3-9.94
WOOSTER TWP SEC. 8, 17, 18, 19.
WAYNE COUNTY

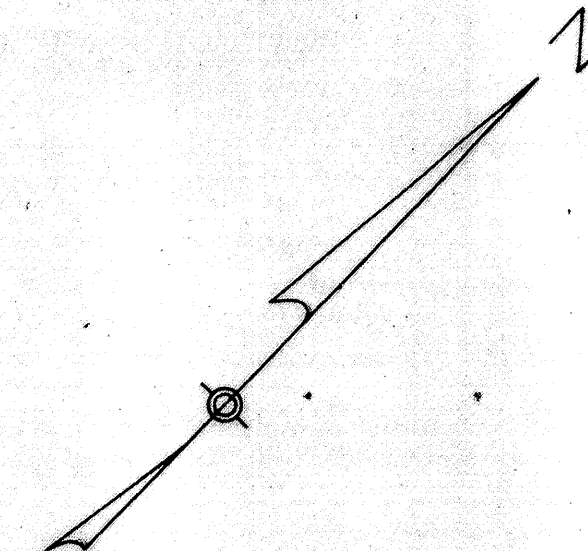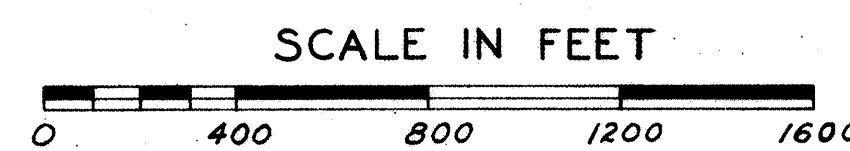

LIMITED ACCESS HIGHWAY

This improvement has been declared a limited access highway or freeway by action of the Director of Highways and Recorded in Volume 45, Page 6 of the Director's Journal in accordance with the provisions of Section 5511.02 Revised Code (1178.21), General Code of Ohio and dated Jan. 6, 1960

DETAIL OF CENTERLINE REFERENCE MONUMENT

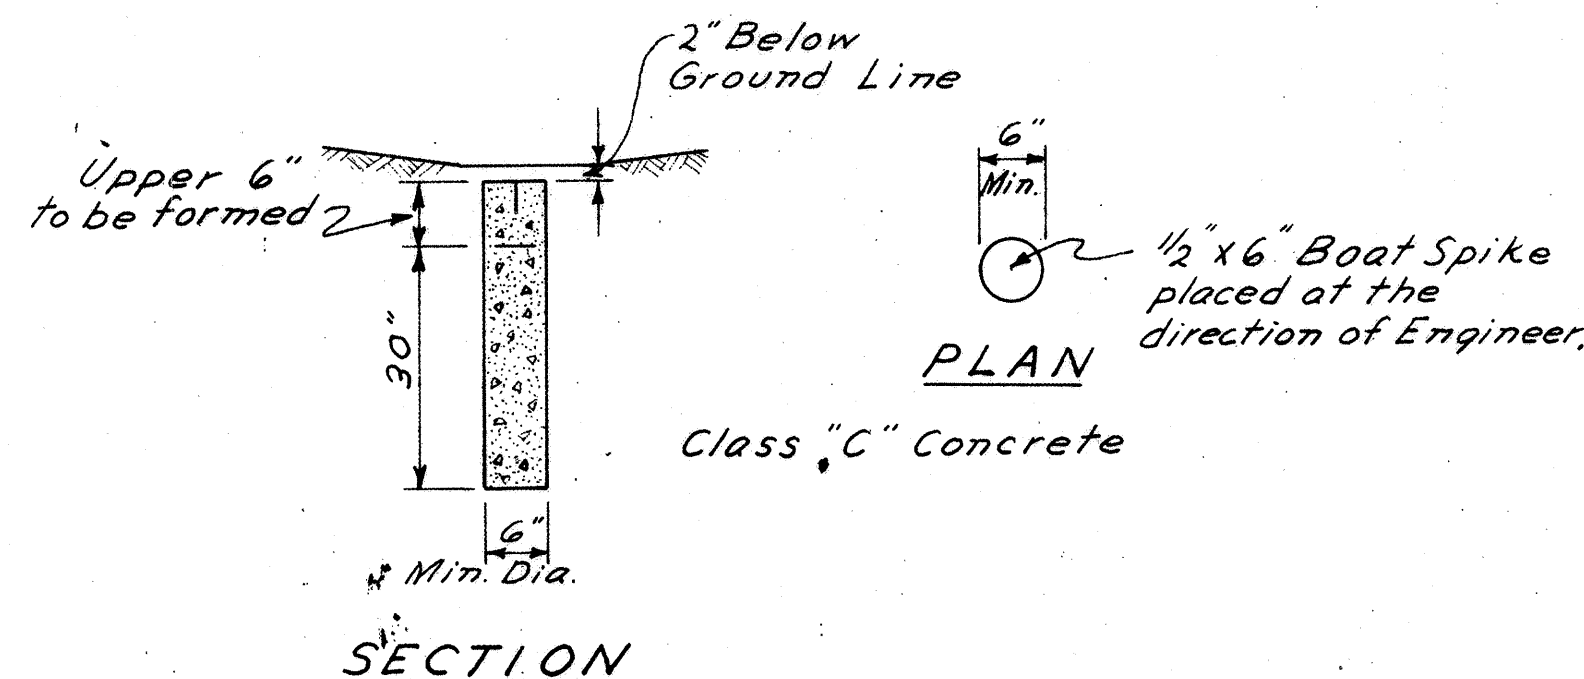

NOTE: Monuments to be placed by Contractor.

SYMBOL
● - MONUMENTS

TOTALS
26 - Reference Monuments (As per plan)
14 - Monument Assembly (See Std Const. Drwg. RT-1)

WAY-3 Curve Data
P.I. Sta 539+92.09
Δ = 25° 28' 20" Lt
D = 1° 15' 00"
R = 4583.66
L = 2037.78
T = 1036.01
E = 115.62

WAY-3 Curve Data
P.I. Sta 587+74.00
Δ = 37° 12' 30" Rt
D = 1° 28' 00"
R = 3906.53
L = 2536.93
T = 1315.01
E = 215.39

WAY-3 Curve Data
P.I. Sta 609+21.13
Δ = 13° 20' 10" Lt
D = 1° 20' 00"
R = 4297.18
L = 1000.21
T = 502.37
E = 29.27

Curve Data Relocated C.R. 174
P.C. 20+07.50
P.I. 21+39.71
P.T. 22+50.72
Δ = 55° 44' 30"
D = 22° 55' 06"
R = 250.00
L = 243.22
T = 132.21
E = 32.80

Curve Data Relocated C.R. 139		
Curve #1	Curve #2	Curve #3
P.C. 17+80.40	P.C. 22+13.52	P.C. 26+30.79
P.I. 19+47.97	P.I. 23+69.07	P.I. 26+96.92
P.T. 20+98.21	P.T. 24+98.52	P.T. 27+59.84
Δ = 25° 25' 30"	Δ = 57° 00' 00"	Δ = 30° 58' 20"
D = 8° 00' 00"	D = 20° 00' 00"	D = 24° 00' 00"
R = 716.20'	R = 286.48'	R = 238.73'
L = 317.81'	L = 285.00'	L = 129.05'
T = 161.57'	T = 155.55'	T = 66.13'
E = 18.00'	E = 39.50'	E = 8.00'

END PROJECT WAY-3-9.94 STA 631+85.43 BK
PROJECT U-1072 (3) STA 49+79.68 Ahd

FILED FOR RECORD 1960
RECORDED 1960
PLAT BOOK PAGE

WAYNE COUNTY RECORDER


FEE

I here by certify this plat to be a true delineation of a survey made by Shafter, Parrett and Associates of Mansfield and Wooster, Ohio.
Date: 9-23-60 by: *Edgar R. Johnson*

Registered Civil Engineer #16680
Registered Surveyor #3828

Approved by Division Deputy Director
Date: 10-7-60 Signed: *(Signature)*


LOCATION OF CENTERLINE REFERENCE MONUMENTS				MONUMENT ASSEMBLIES			
Station	Location	Dist. Lt.	Dist. Rt.	Station	Location	Dist. Lt.	Dist. Rt.
P.C. 529+56.08	Right Angles	42'		525+00	Right Angles	52'	50'
535+00	On &			529+56.08	Right Angles	15'	42'
539+74.97	On & Mid. Pt.			537+00 BK	Right Angles		
545+00	On &			547+00	Right Angles	40'	40'
P.T. 549+93.86	On &						
556+50	On &						
563+00	On &						
570+00	On &			23+69.07 P.I.	On Tangent		
P.C. 574+58.99	On &						
581+00	On &						
587+27.45	On & Mid. Pt.			21+39.71 P.I.	On Tangent		
594+14.92	On &						
P.T. 599+95.92	On &						
P.C. 604+18.76	On &						
609+18.86	On & Mid. Pt.						
622+00	On &						
630+00	On &						

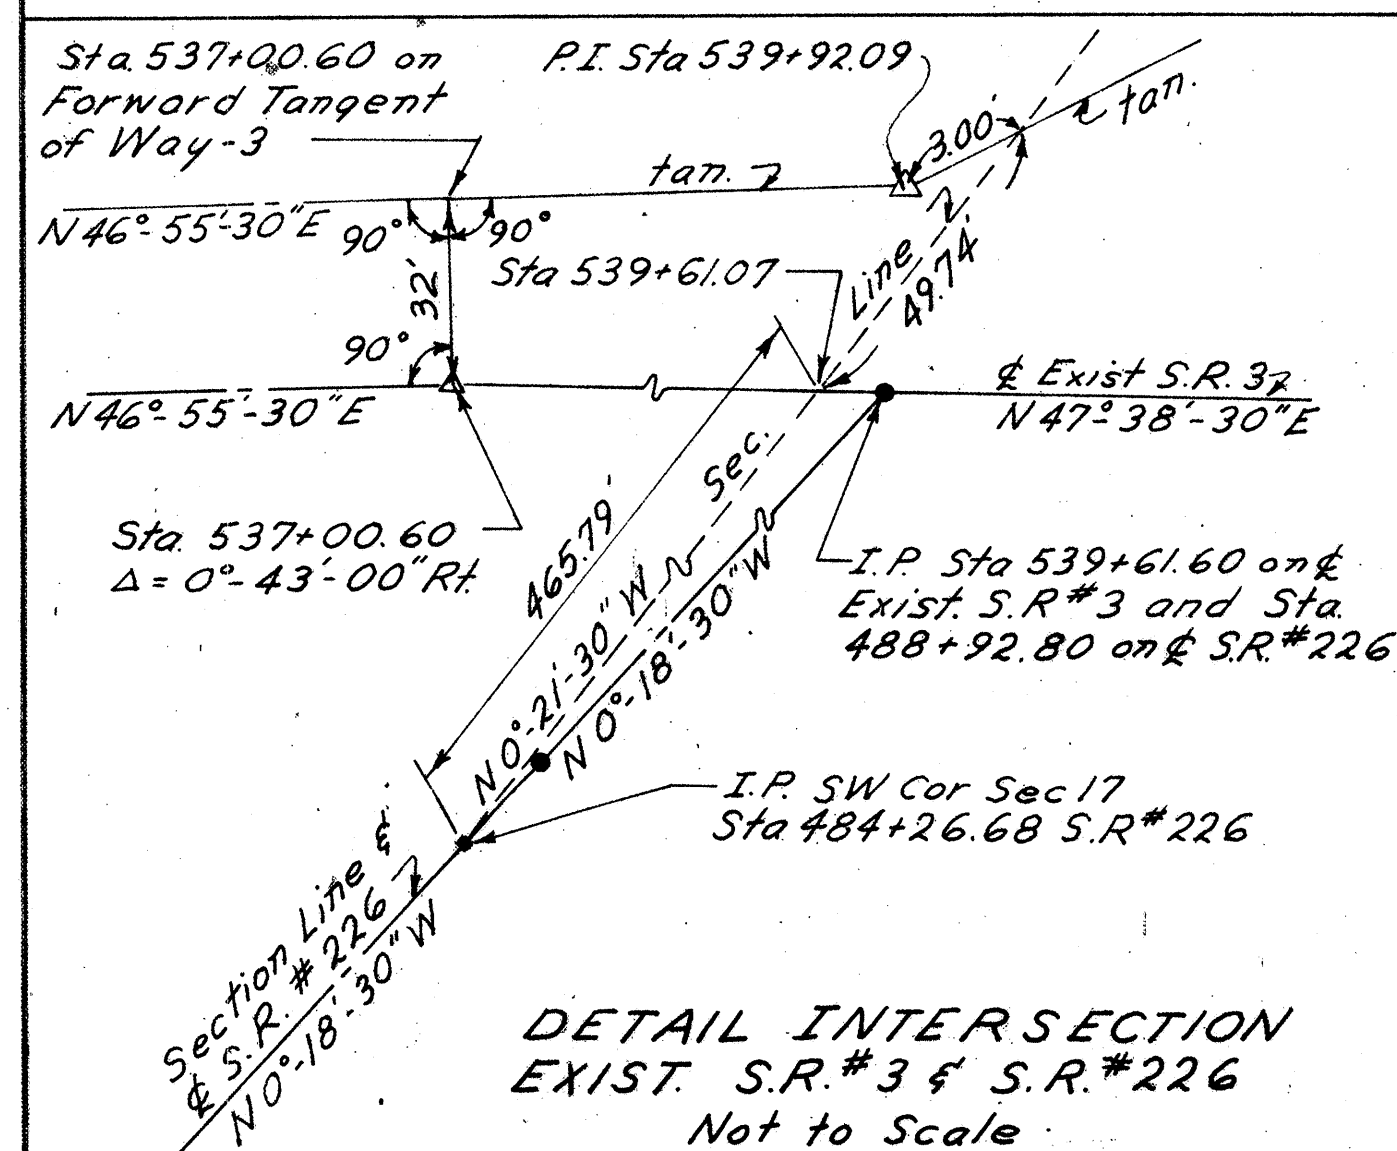

DETAIL INTERSECTION
EXIST. S.R.#3 & S.R.#226
Not to Scale

SUMMARY OF ADDITIONAL R/W REQUIRED

PARCEL NO.	OWNER	AREA ACRES	EXIST. BLDG.	SHEET NOS	REMARKS	PARCEL NO.	OWNER	AREA ACRES	EXIST. BLDG.	SHEET NOS	REMARKS	PARCEL NO.	OWNER	AREA ACRES	EXIST. BLDG.	SHEET NOS	REMARK
1	Carl H. Butdorf	0		1	Additional R/W not required	23 LA	Glenn E. & Marjorie B. Newland	0.17	Yes	2		36	Merle E. & Mary Lou Shanklin	0.02		8	
2	C. Otto & Sydna M. Slaybaugh	0.39		1		24 LA	Clifford L. & Hazel M. Aber	0.19	Yes	2		37	Donald J. & Norma J. Varns	0.02		5, 8	
4	Grace Stair Brenneman	0		1	Additional R/W not required	25 LA	Arnold C. & Blanche Calame	4.51		2		38	David M. & Joy E. Bishop	0.02		5, 8	
5	William J. Hoyer	0		1	Additional R/W not required	25-X	Arnold C. & Blanche Calame	0.23		2		39	T.E. & Myrtle Robb	0		5, 8	Additional R/W not required
6	Jack D. Bennet	0.01		1		25	Arnold C. & Blanche Calame	0.08		3		40 LA	Luther C. & Edith I. Hothem	1.12		5	
7	Hazel J. Sands Moore	0.01		1	Street	26 LA	Roberta F. Eckstein et al.	12.07		2, 3, 4		40	Luther C. & Edith I. Hothem	1.86		5, 8	
8	Jack D. Bennet	0.04		1		26	Roberta F. Eckstein et al.	0.21		2		41 LA	John J. Martin	6.48		5, 6	
9	Ephus & Hazel Daugherty	0.13		1		26 A	Roberta F. Eckstein et al.	0.78		2		41	John J. Martin	1.82		5, 6	
10	Florence N. Barr	0.03		1		27 LA	Umbert P. & Marjorie L. Noletti	4.06		4		41 A	John J. Martin	0.05		5	
11	Clara B. Marty	0.03		1		27	Umbert P. & Marjorie L. Noletti	0.05		4, 8							
11 WA	Clara B. Marty	✓		1		27 A	Umbert P. & Marjorie L. Noletti	0.01		4, 8		41 B	John J. Martin	0.27		6	
12	Norman C. & Ann C. Pinkley	0.03		1		28	Alvin W. & Bessie Lucille Swinehart	0		4, 8	Lot 10, 11, Additional R/W not required	41 WA	John J. Martin	✓		5, 6	
12 WA	Norman C. & Ann C. Pinkley	✓		1								42 LA	Clarence R. & Ruth I. Barnes	0.36		6	
13	C. Warden & Nora L. Sprowls	0.03		2		30	Warren A. & Mae M. Lawrence	0		8	Lot 9, Additional R/W not required	42 A	Clarence R. & Ruth I. Barnes	0.18		6	
13 WA	C. Warden & Nora L. Sprowls	✓		2		31	Wm. C. & Betty Ann Hissner	0		8	Lot 8 Additional R/W not required	42	Clarence R. & Ruth I. Barnes	0.18		6	
14	Richard C. & Jeanette Oberholtzer	0.05		2		32	Opal Mae Weary	0.01		8		42 WA	Clarence R. & Ruth I. Barnes	✓		6	
14 WA-1	Richard C. & Jeanette Oberholtzer	✓		2		33 LA	Fred L. & Cora M. Jennings	6.19		4		43 LA	Florence M. Barnes	6.28	Yes	6, 7	
14 WA-2	Richard C. & Jeanette Oberholtzer	✓		2		33	Fred L. & Cora M. Jennings	0.04		4, 8		43	Florence M. Barnes	0.26		6	
15	C. Warden Sprowls	0.14		2		33 A	Fred L. & Cora M. Jennings	0.10		4, 8		43 A	Florence M. Barnes	0.09		6	
15 WA	C. Warden Sprowls	✓		2		34 LA	William Cloyd Derr	4.06		4, 5		43 X	Florence M. Barnes	0.36		6	
18	Maud Shafer	0.02		2		34	William Cloyd Derr	0.01		5, 8		44 LA	Walter H. Jones	3.19		6, 7	
19	Nora C. Westfall	0		2	Additional R/W not required	34 A	William Cloyd Derr	0.01		5, 8		44	Walter H. Jones	0.16		6	
20	Raymond H. & Mildred A. Shira	0		2	Additional R/W not required	34 WA	William Cloyd Derr	✓		5, 8		44-X	Walter H. Jones	0.38		6	
21	Clifford B. & Eunice Mae Bishop	0.14	Yes	2		35	Edmond E. & Pauline M. Jacobs	0.02		8		44 WA	Walter H. Jones	✓		6	

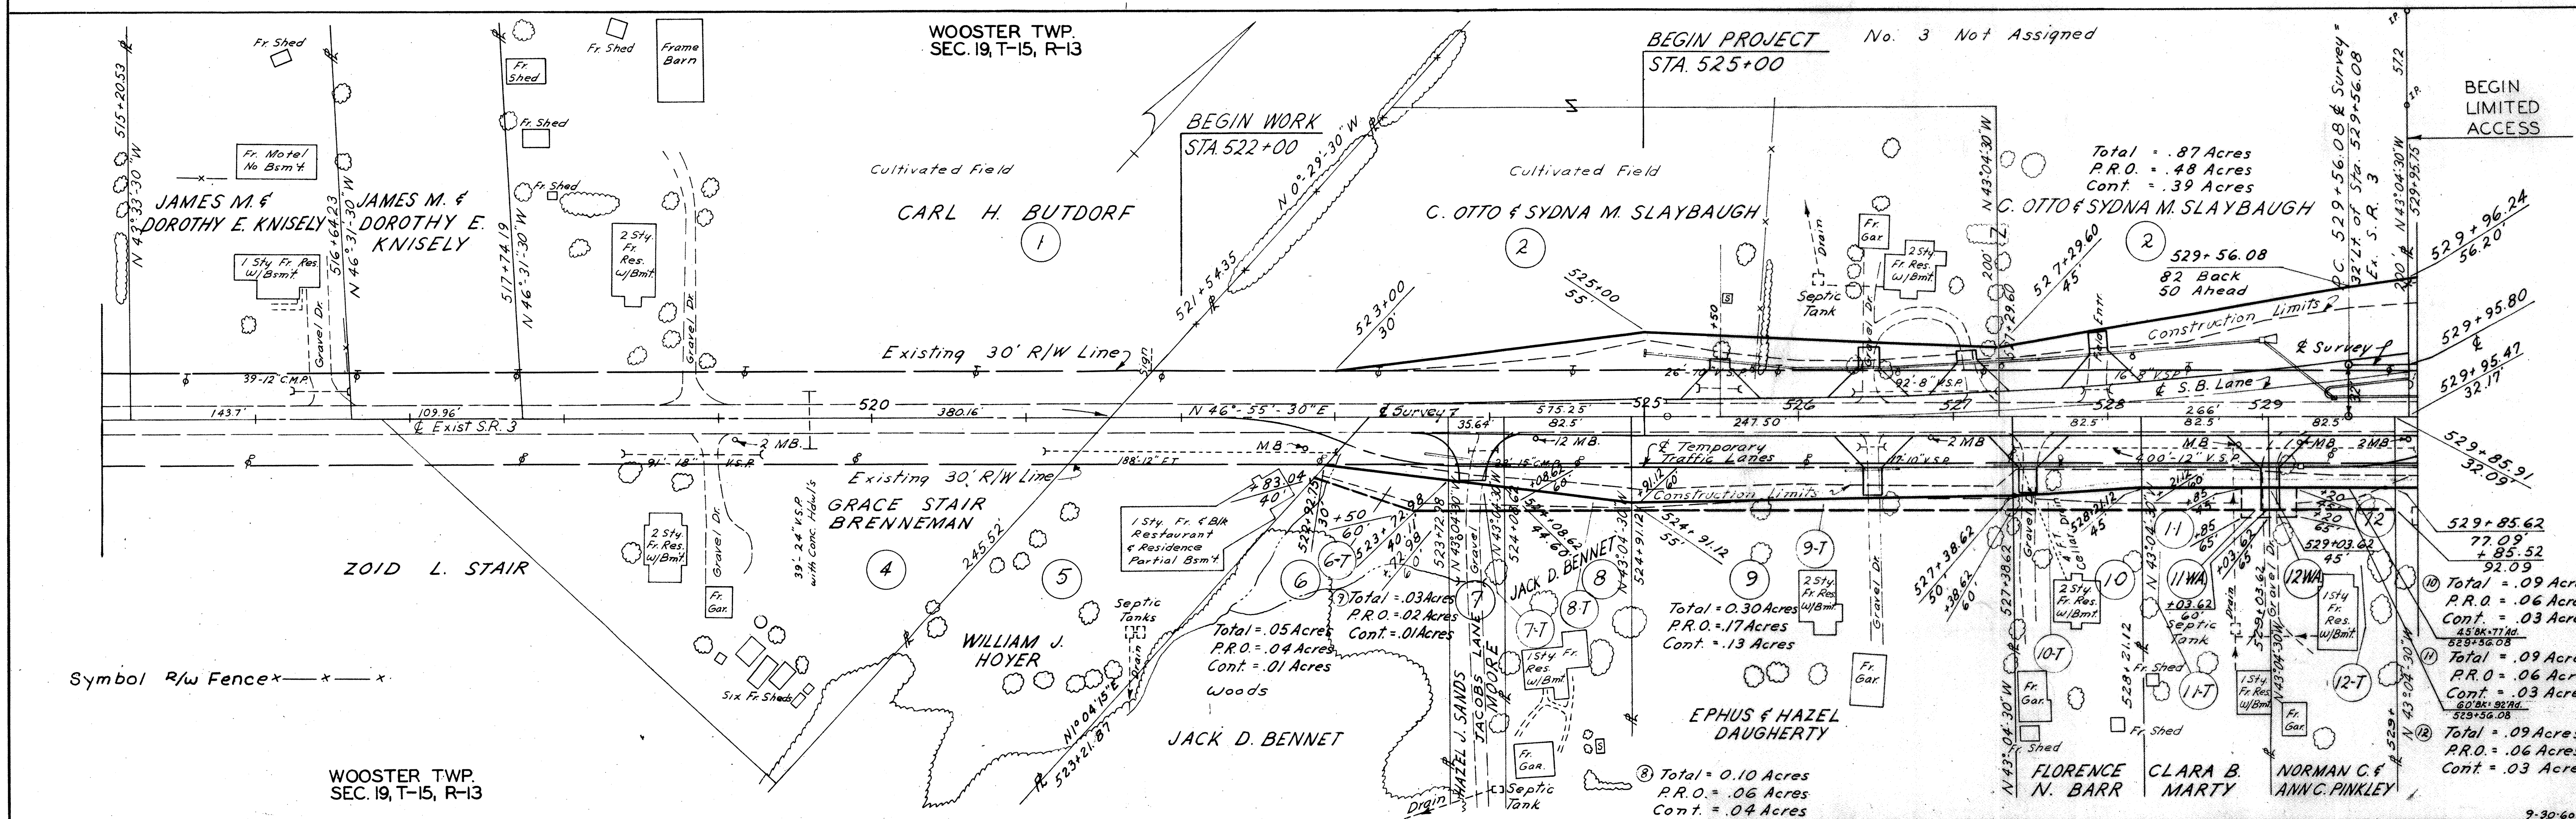

Curve Data & Survey Way-3

P.I. Sta. 539+92.09
 $\Delta = 25^{\circ}28'20''$
 $D = 1^{\circ}15'00''$
 $R = 4583.66'$
 $L = 2037.78'$
 $T = 1036.01'$
 $E = 115.62'$

ARNOLD C. & BLANCHE CALAME


Total = 0.23 AC.
 P.R.O. = 0.00 AC.
 Cont. = 0.23 AC.

ROBERTA F. ECKSTEIN ETAL.

23LA Total = 0.24 AC.
 P.R.O. = 0.07 AC.
 Cont. = 0.17 AC.

24LA Total = 0.30 AC.
 P.R.O. = 0.11 AC.
 Cont. = 0.19 AC.

25LA Total = 5.19 AC.
 P.R.O. = 0.68 AC.
 Cont. = 4.51 AC.

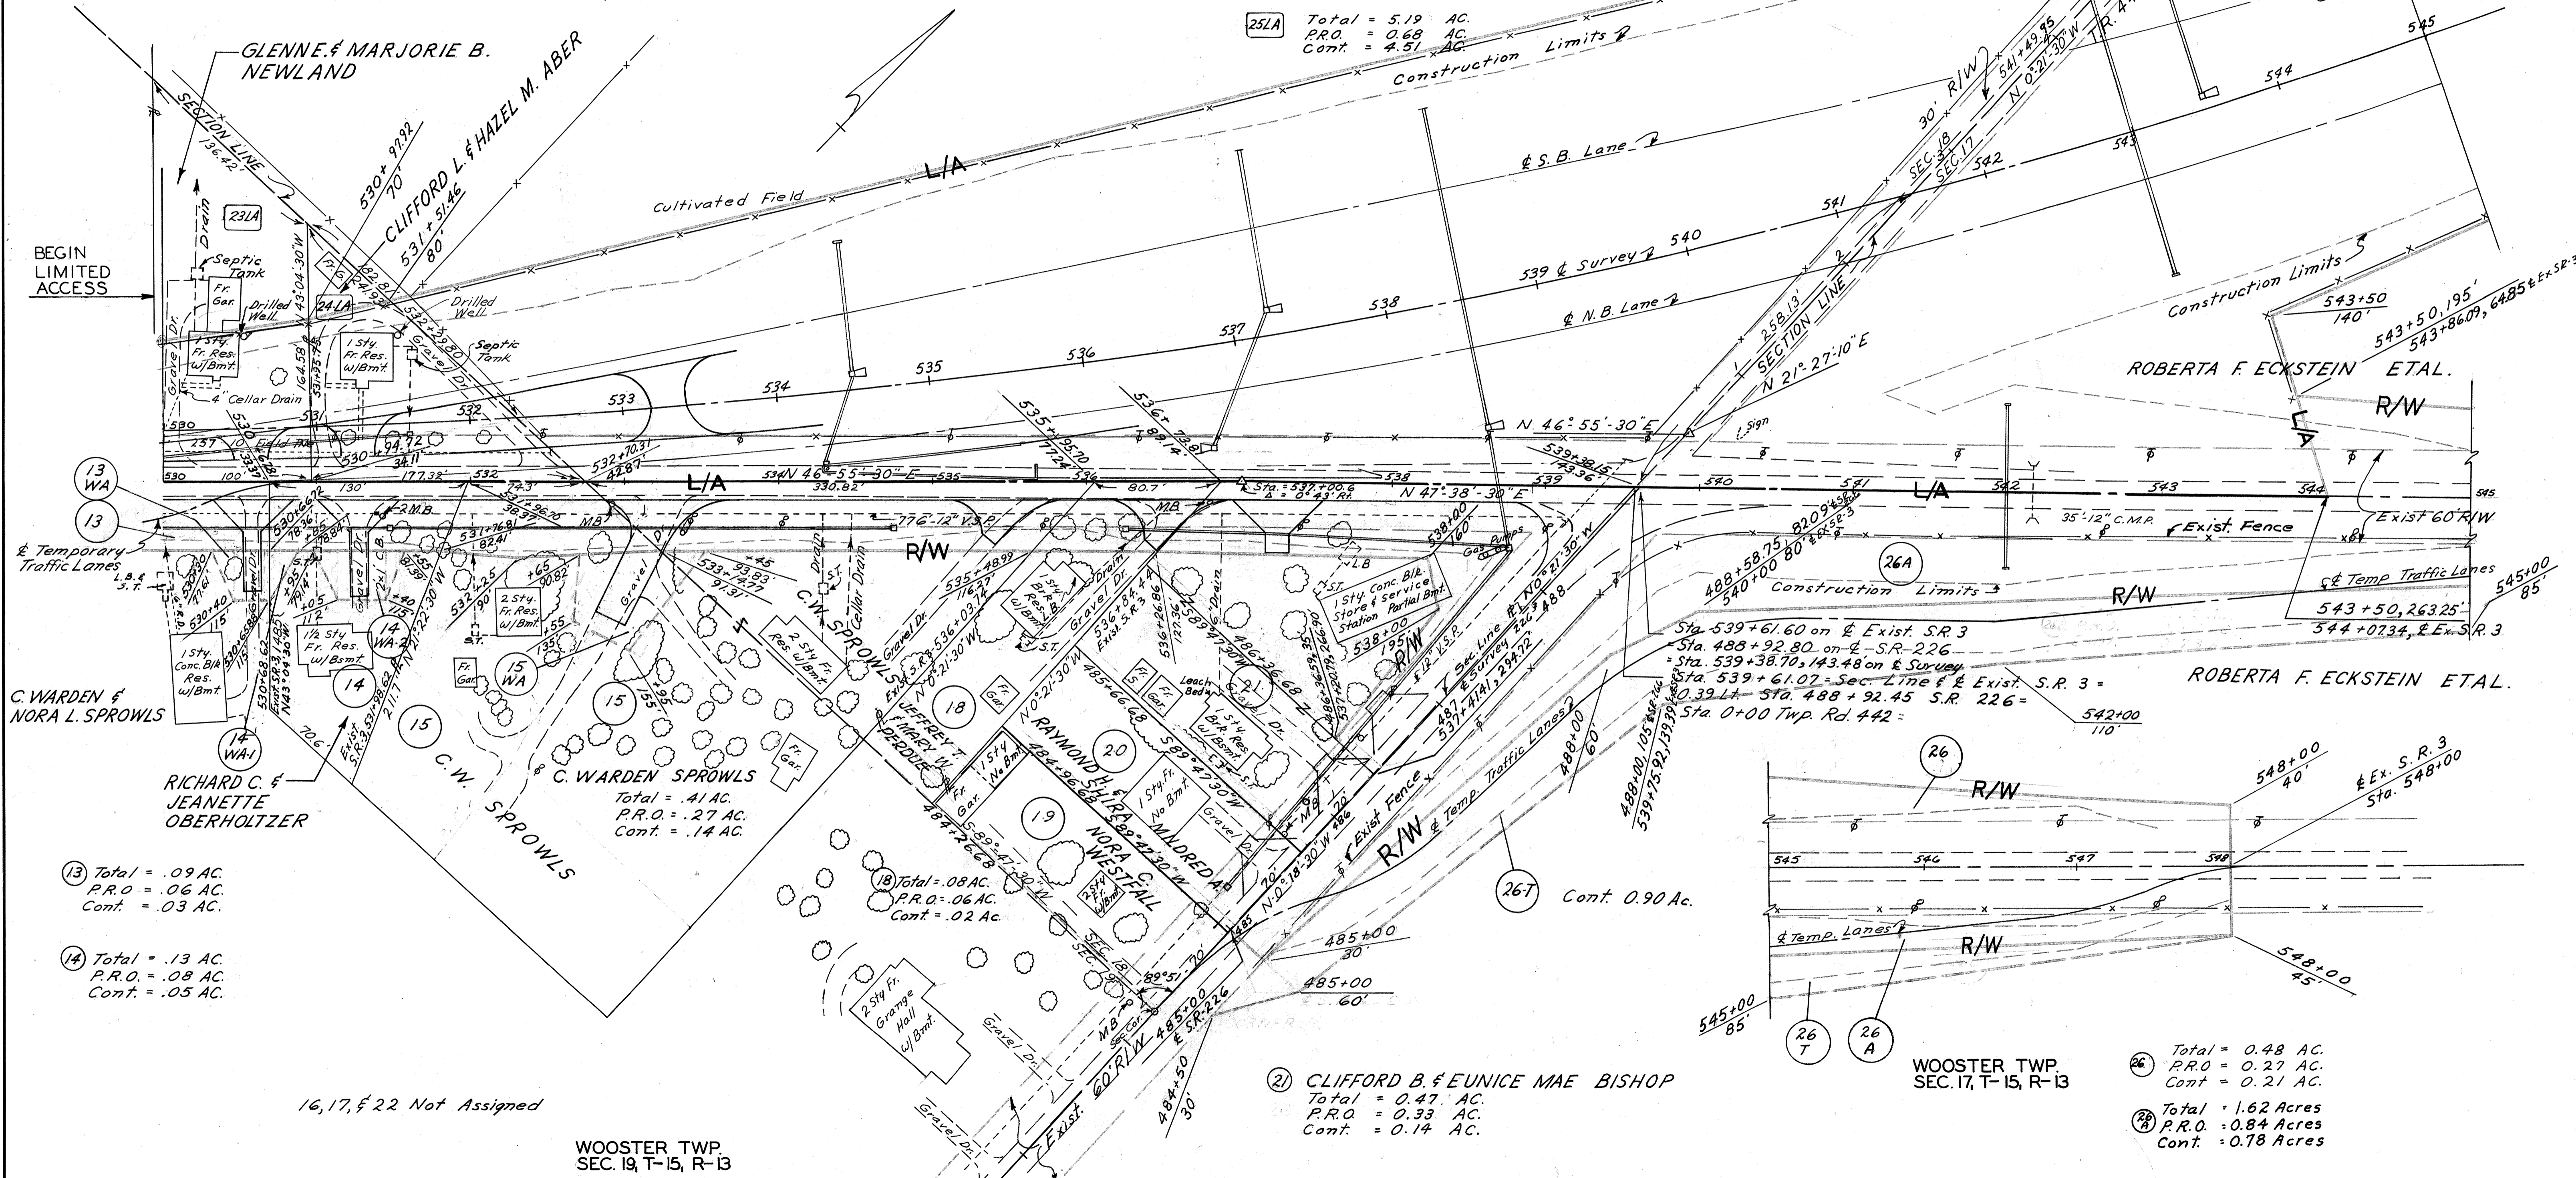

13 Total = .09 AC.
 P.R.O. = .06 AC.
 Cont. = .03 AC.

14 Total = .13 AC.
 P.R.O. = .08 AC.
 Cont. = .05 AC.

C. WARDEN & NORA L. SPROWLS
 Total = .41 AC.
 P.R.O. = .27 AC.
 Cont. = .14 AC.

18 Total = .08 AC.
 P.R.O. = .06 AC.
 Cont. = .02 AC.

21 CLIFFORD B. & EUNICE MAE BISHOP
 Total = 0.47 AC.
 P.R.O. = 0.33 AC.
 Cont. = 0.14 AC.

26T Cont. 0.90 AC.

WOOSTER TWP.
SEC. 17, T-15, R-13

26 Total = 0.48 AC.
 P.R.O. = 0.27 AC.
 Cont. = 0.21 AC.

28 Total = 1.62 Acres
 P.R.O. = 0.84 Acres
 Cont. = 0.78 Acres

16, 17, & 22 Not Assigned

WOOSTER TWP.
SEC. 19, T-15, R-13

Item SS-18 Type "A" Fence 1662.97 L.F.

FED. RD. DIVISION	STATE	PROJECT
2	OHIO	

146
157

WAYNE COUNTY
WAY-3-9.94

3
8

WOOSTER TWP.
SEC. 18, T-15, R-13


ARNOLD C. & BLANCHE CALAME

Total = 0.19 Acres
P.R.O. = 0.11 Acres
Cont. = 0.08 Acres

25

WOOSTER TWP.
SEC. 17, T-15, R-13

ROBERTA F. ECKSTEIN ETAL.

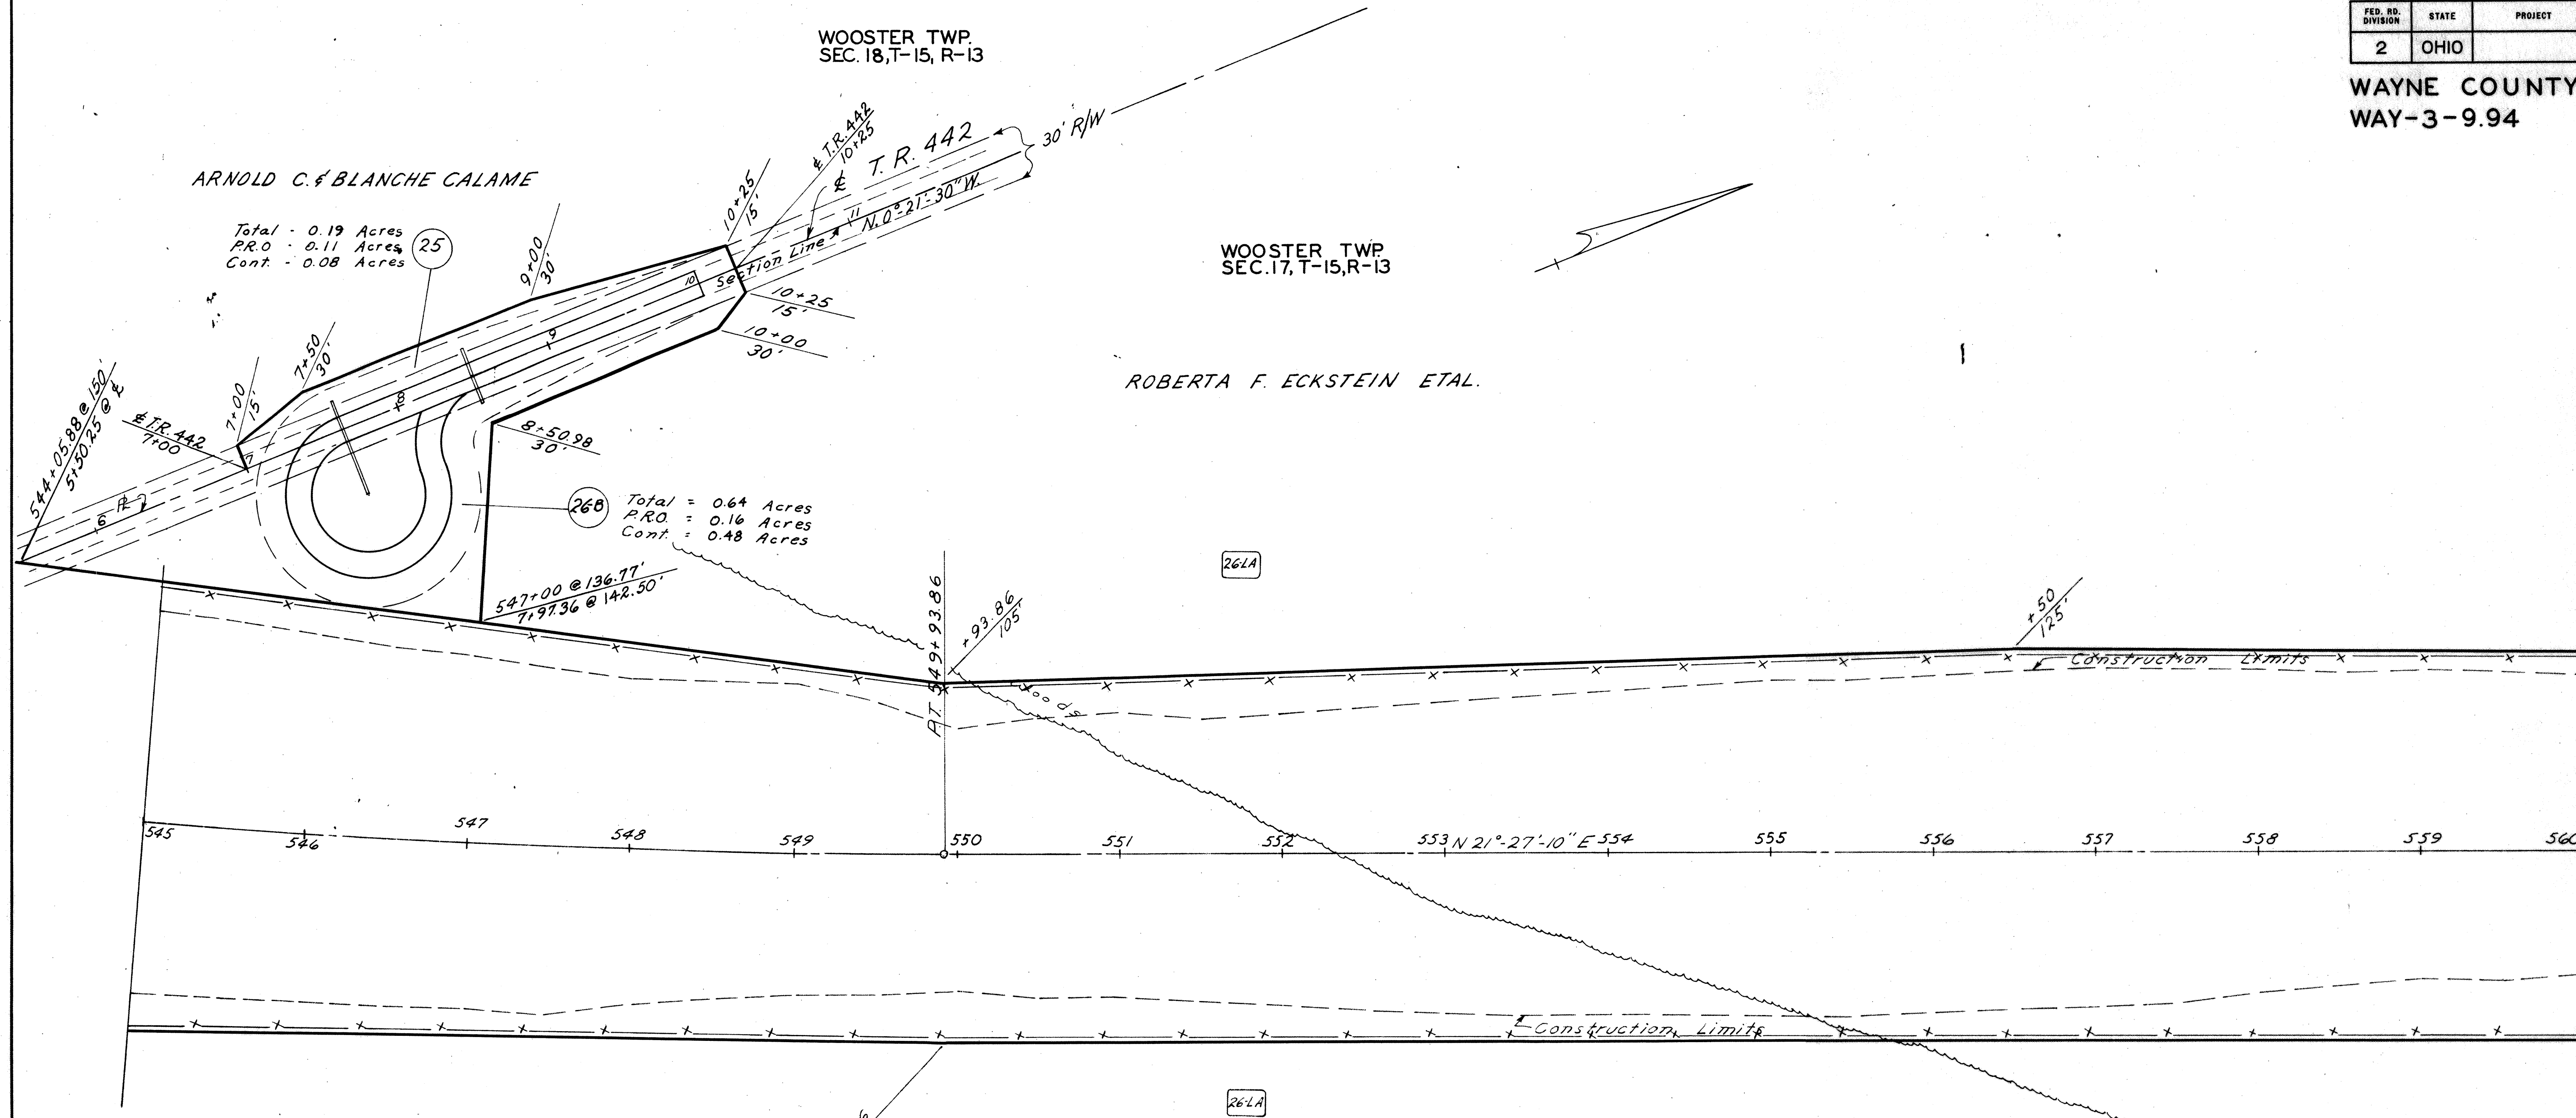

Total = 0.64 Acres
P.R.O. = 0.16 Acres
Cont. = 0.48 Acres

26A

26A

Total = 12.54 Acres
P.R.O. = 0.47 Acres
Cont. = 12.07 Acres

ROBERTA F. ECKSTEIN ETAL.

Curve Data & Survey Way-3

P.I. 539+92.09
 $\Delta = 25^{\circ}28'20''$
 $D = 1^{\circ}15'00''$
 $R = 4583.66'$
 $L = 2037.78'$
 $T = 1036.01'$
 $E = 115.62'$

WOOSTER TWP.
SEC. 17, T-15, R-13

Item 88-18 Type "A" Fence 3002.26 L.F.

Sta. 545+00 to Sta. 560+00

WOOSTER TWP.
SEC. 17, T-15, R-13

For Continuation of S.R. 95
See Sheet 8

WAYNE COUNTY
WAY-3-9.94

ROBERTA F. ECKSTEIN ETAL.

UMBERT P. & MARJORIE NOLETTI

OPAL MAE WEARY

FRED L. & CORA M. JENNINGS

ROBERTA F. ECKSTEIN ETAL.

UMBERT P. & MARJORIE NOLETTI

FRED L. & CORA M. JENNINGS

WOOSTER TWP.
SEC. 17, T-15, R-13

WOOSTER TWP.
SEC. 17, T-15, R-13

FRED L. & CORA M. JENNINGS

WILLIAM CLOYD DERR

FRED L. & CORA M. JENNINGS


WOOSTER TWP.
SEC. 17, T-15, R-13

WILLIAM CLOYD DERR

Item 88-18 Type "A" Fence 2663.39 L.F.


Sta. 560+00 to Sta. 590+00

Way-3 Curve Data
 P.I. 587+74.00
 $\Delta = 37^{\circ}-12'-30''$
 $D = 1^{\circ}-28'-00''$
 $R = 3906.53'$
 $L = 2536.93'$
 $T = 1315.01'$
 $E = 215.39'$

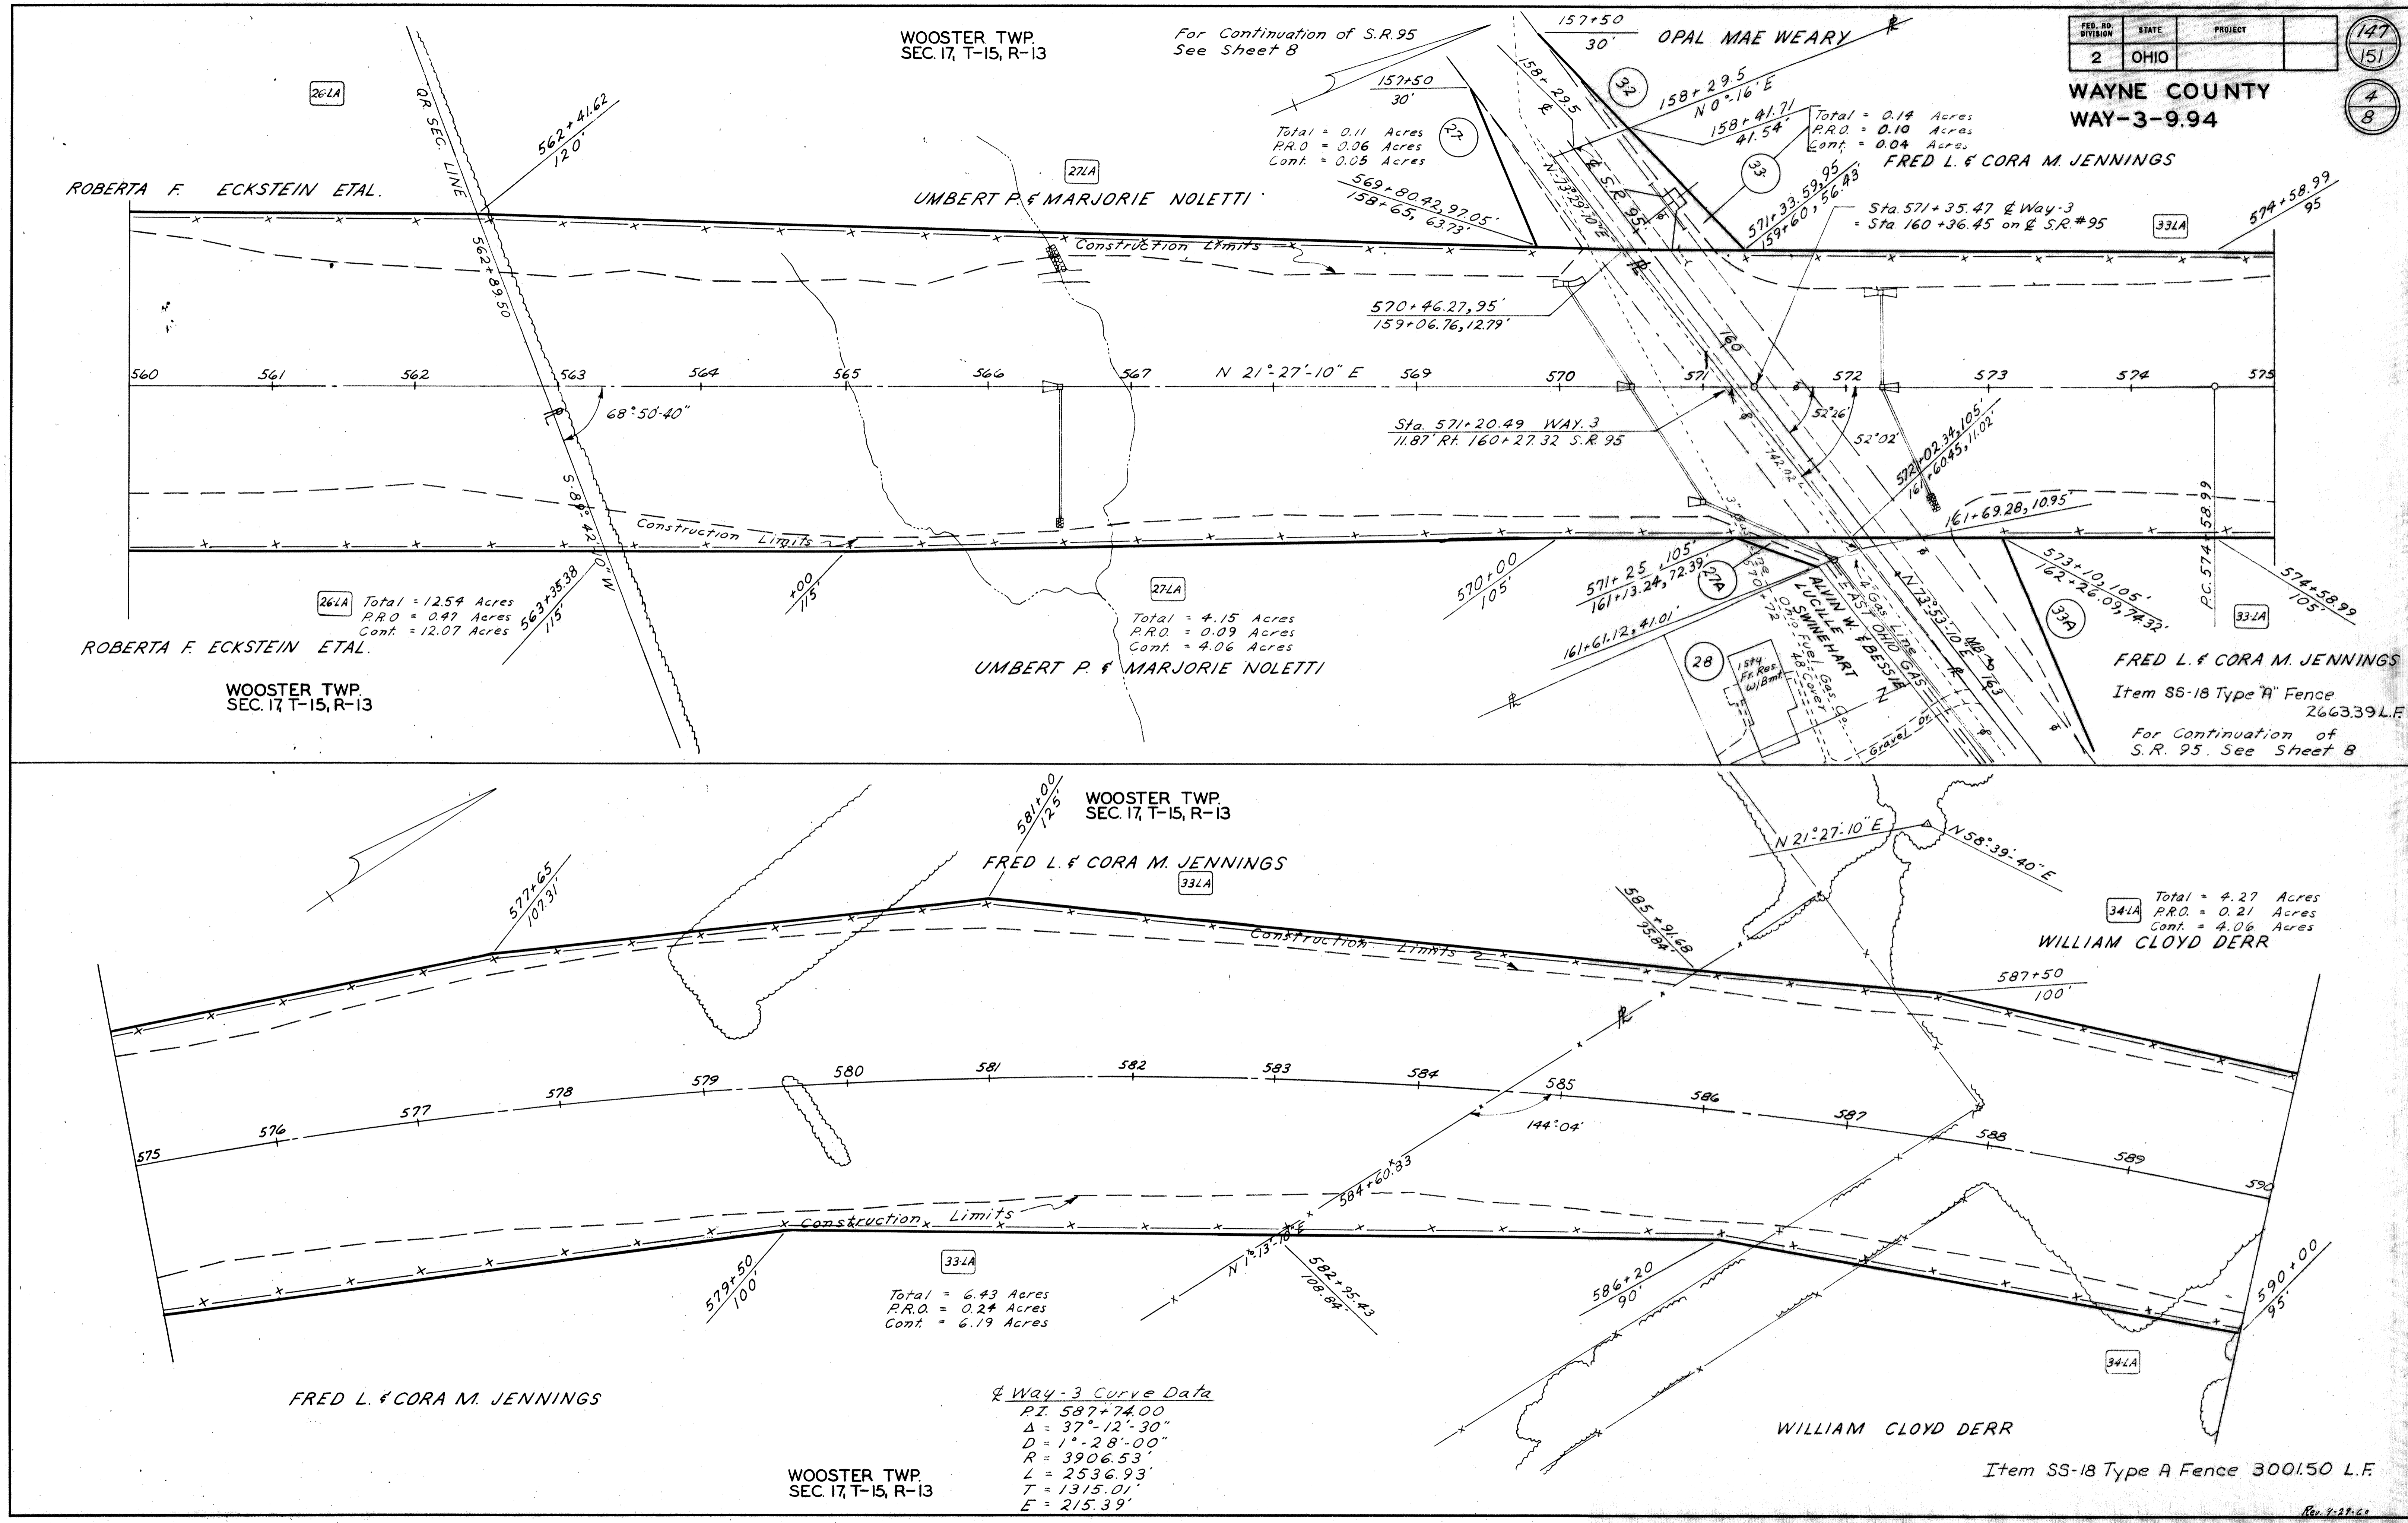


FED. RD. DIVISION	STATE	PROJECT
2	OHIO	

WAYNE COUNTY
WAY-3-9.94

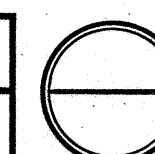

4A
8

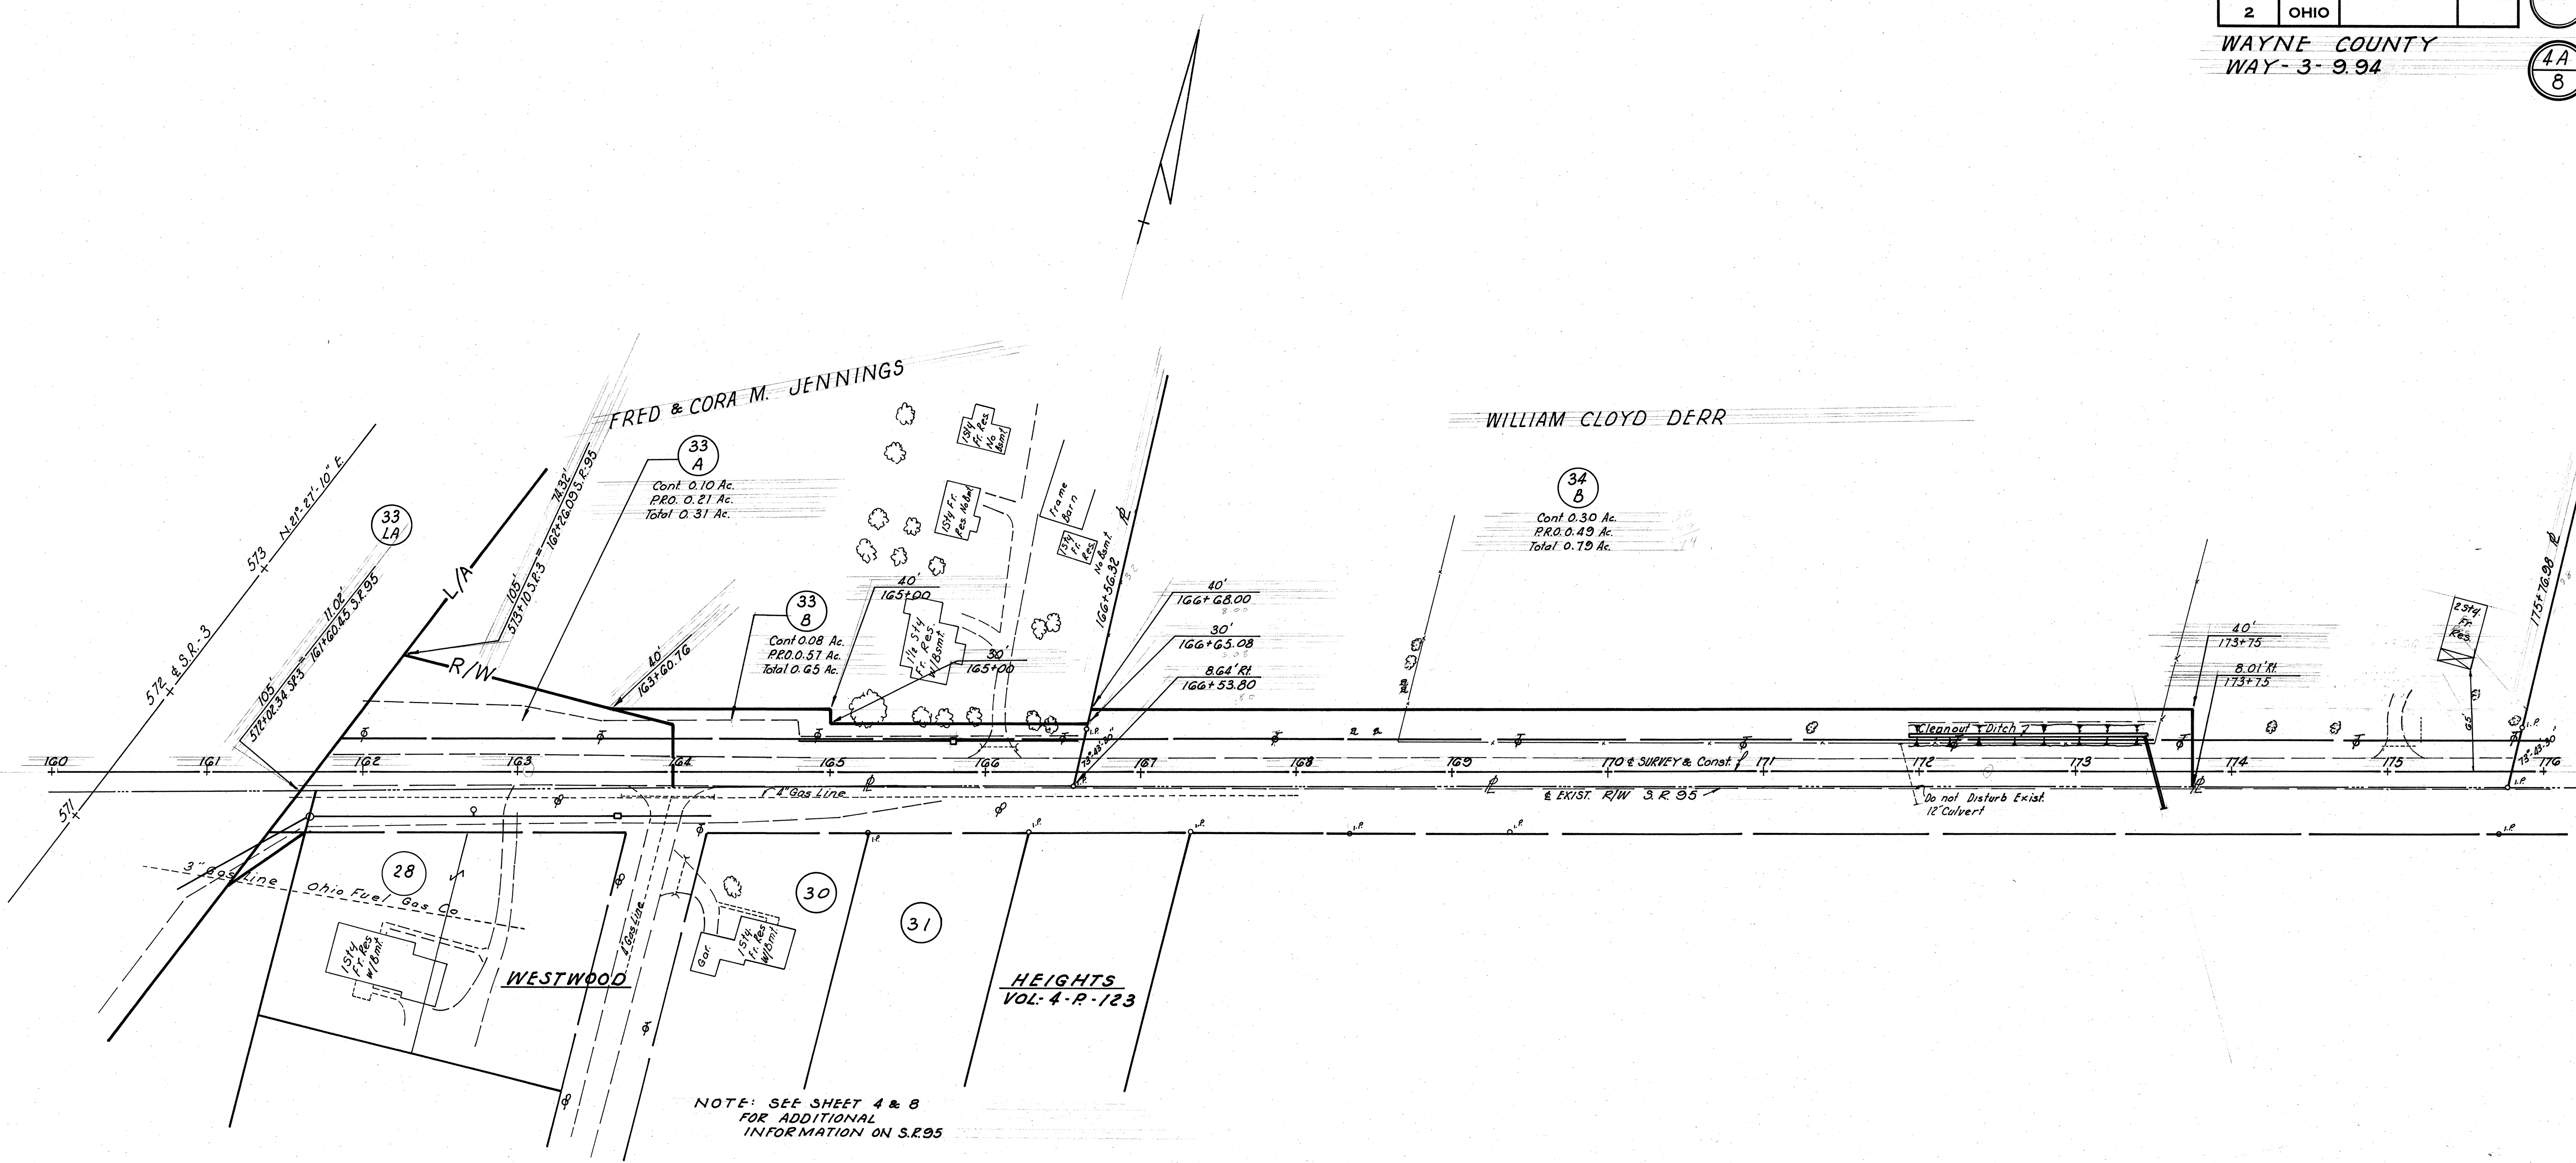


NOTE: SEE SHEET 4 & 8
FOR ADDITIONAL
INFORMATION ON S.R.95

WOOSTER TWP SEC-17 T-15N R-13W

WOOSTER TWP.
SEC. 8, T-15, R-13

Way - 3 Curve Data
 P.I. 609+21.13
 $\Delta = 13^{\circ} 20' 10''$
 $D = 1^{\circ} 20'$
 $R = 4297.18'$
 $L = 1000.21'$
 $T = 502.37'$
 $E = 29.27'$

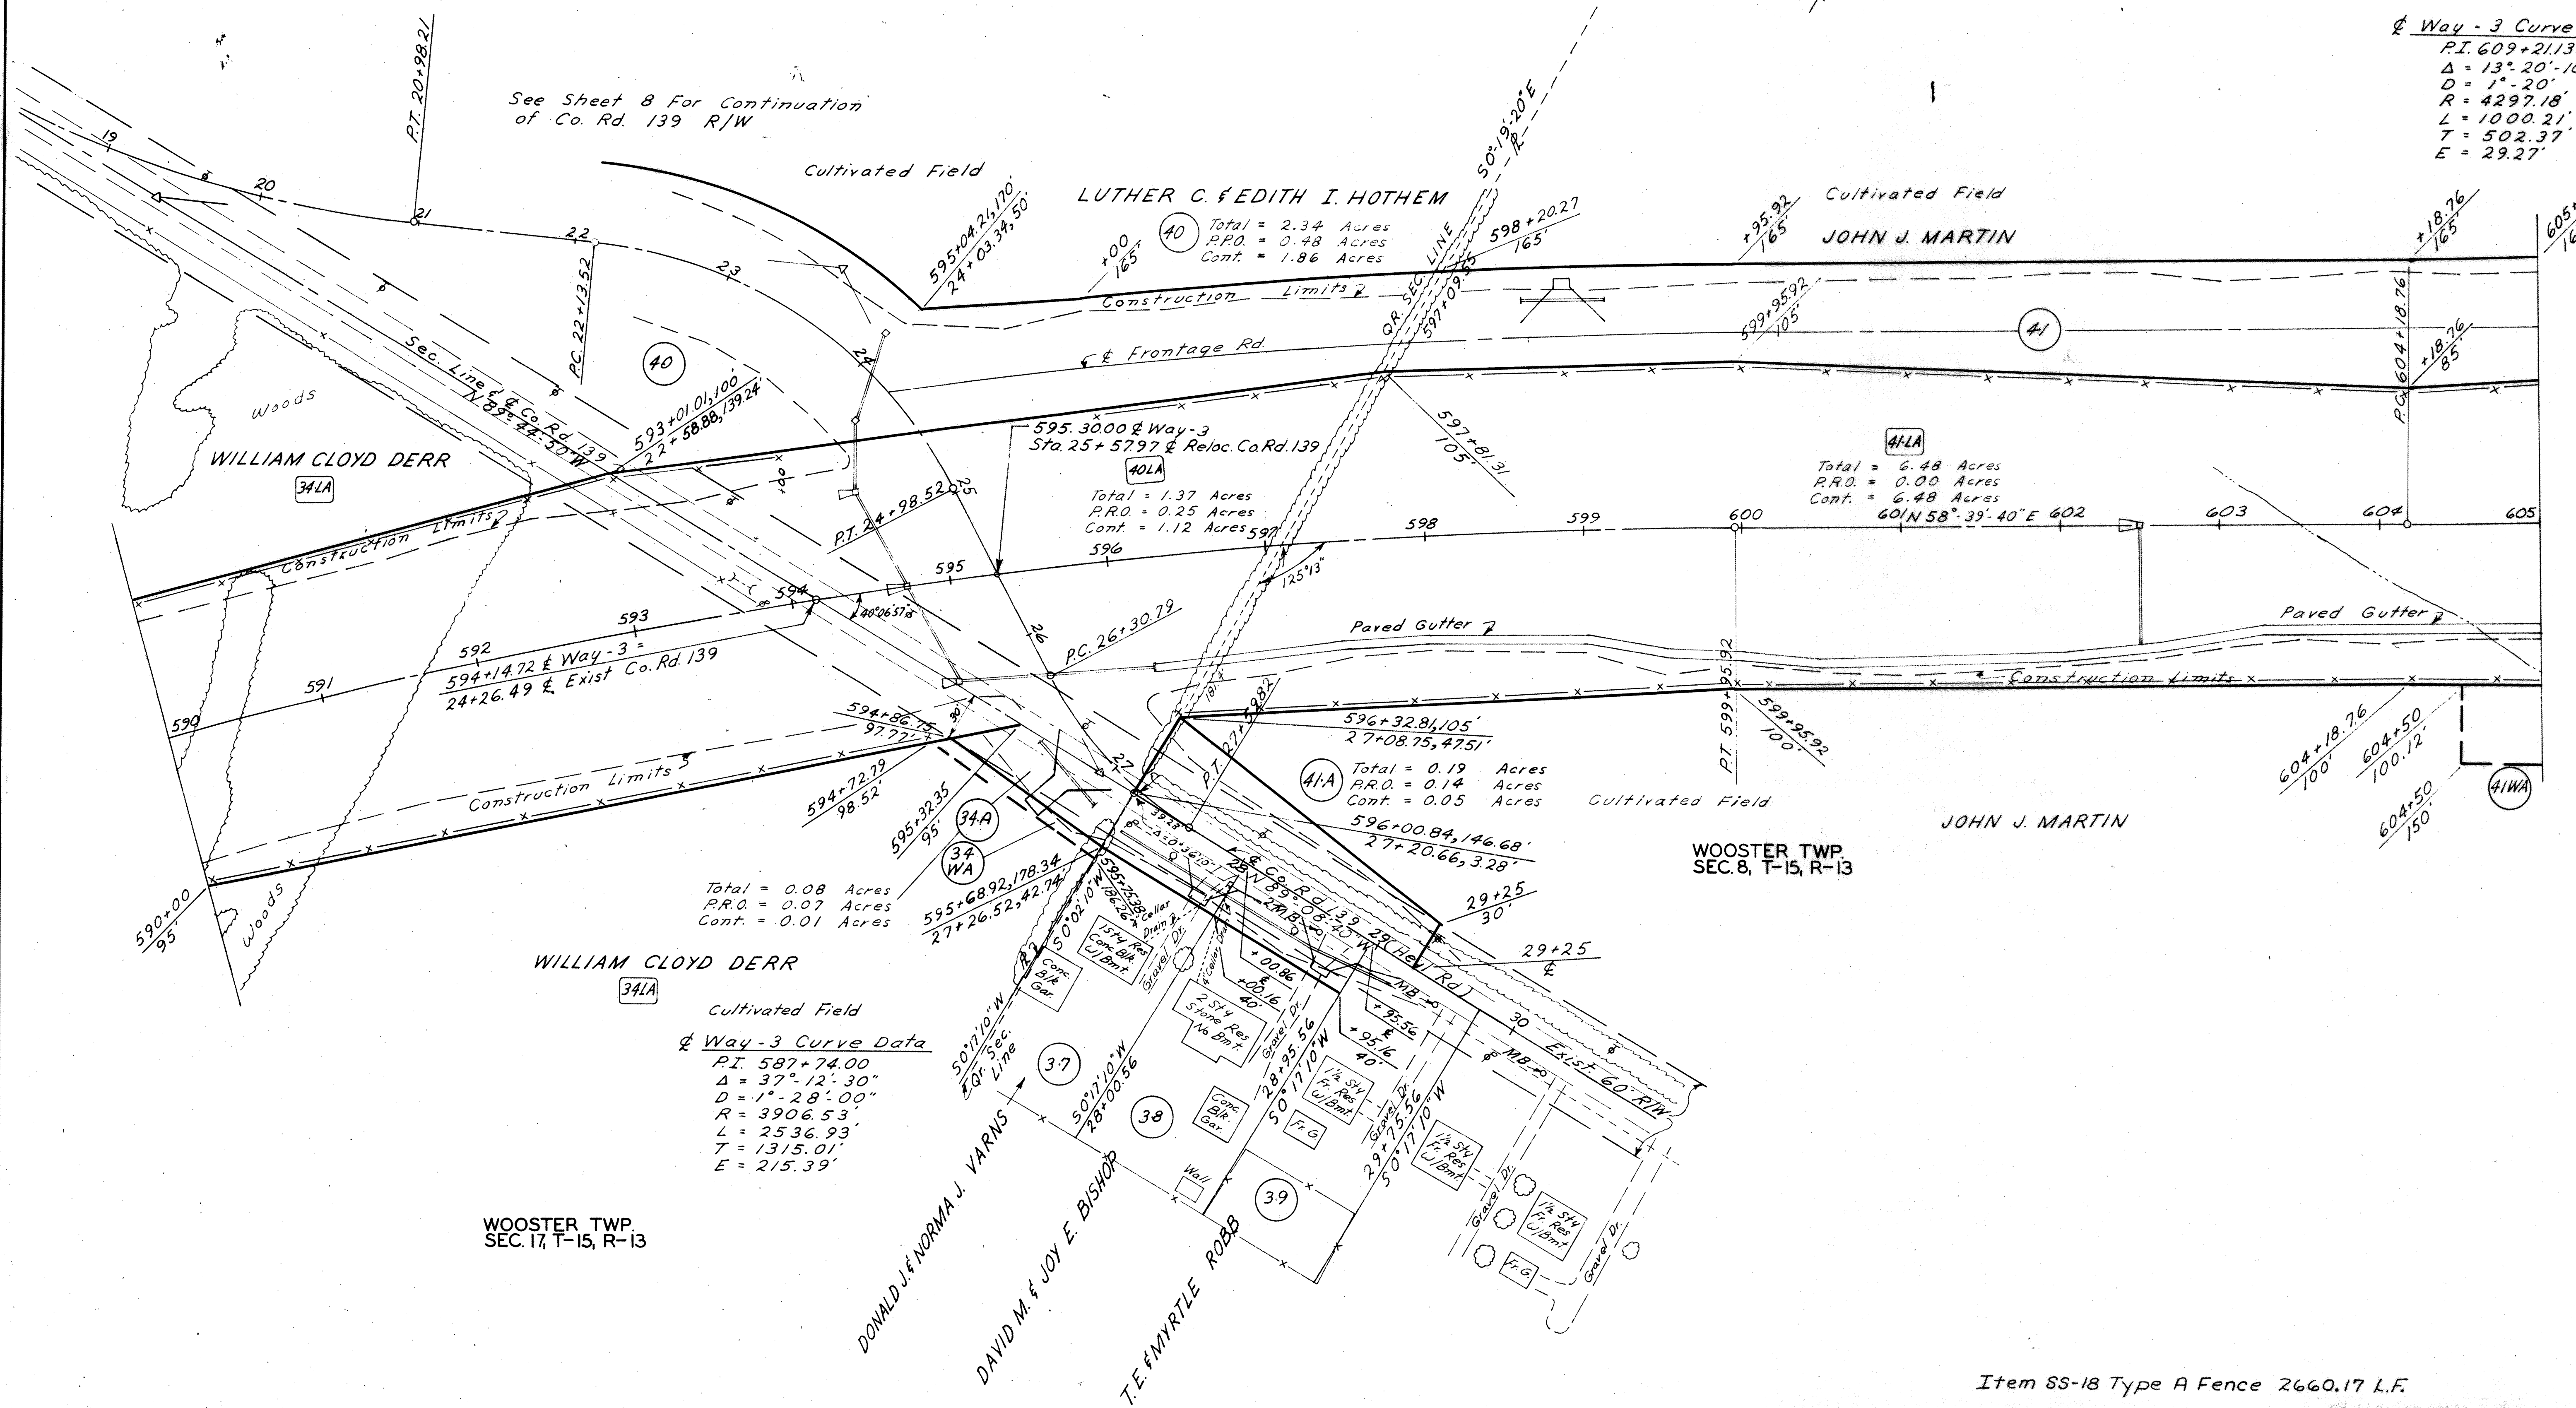

See Sheet 8 For Continuation
of Co. Rd. 139 R/W

LUTHER C. & EDITH I. HOTHM

JOHN J. MARTIN

WILLIAM CLOYD DERR

Way-3
Sta. 25+57.97 & Reloc. Co. Rd. 139

Way-3
Sta. 25+57.97 & Reloc. Co. Rd. 139

WILLIAM CLOYD DERR

JOHN J. MARTIN

WOOSTER TWP.
SEC. 8, T-15, R-13

WOOSTER TWP.
SEC. 17, T-15, R-13

Cultivated Field
 Way-3 Curve Data
 P.I. 587+74.00
 $\Delta = 37^{\circ} 12' 30''$
 $D = 1^{\circ} 28' 00''$
 $R = 3906.53'$
 $L = 2536.93'$
 $T = 1315.01'$
 $E = 215.39'$


Item 88-18 Type A Fence 2660.17 L.F.

Sta. 590+00 to Sta. 605+00

WOOSTER TWP.
SEC. 8, T-15, R-13

Way-3 Curve Data

PI 609+21.13
 $\Delta = 13^\circ 20' 10''$
 $D = 1^\circ 20'$
 $R = 4297.18'$
 $L = 1000.21'$
 $T = 502.37'$
 $E = 29.27'$

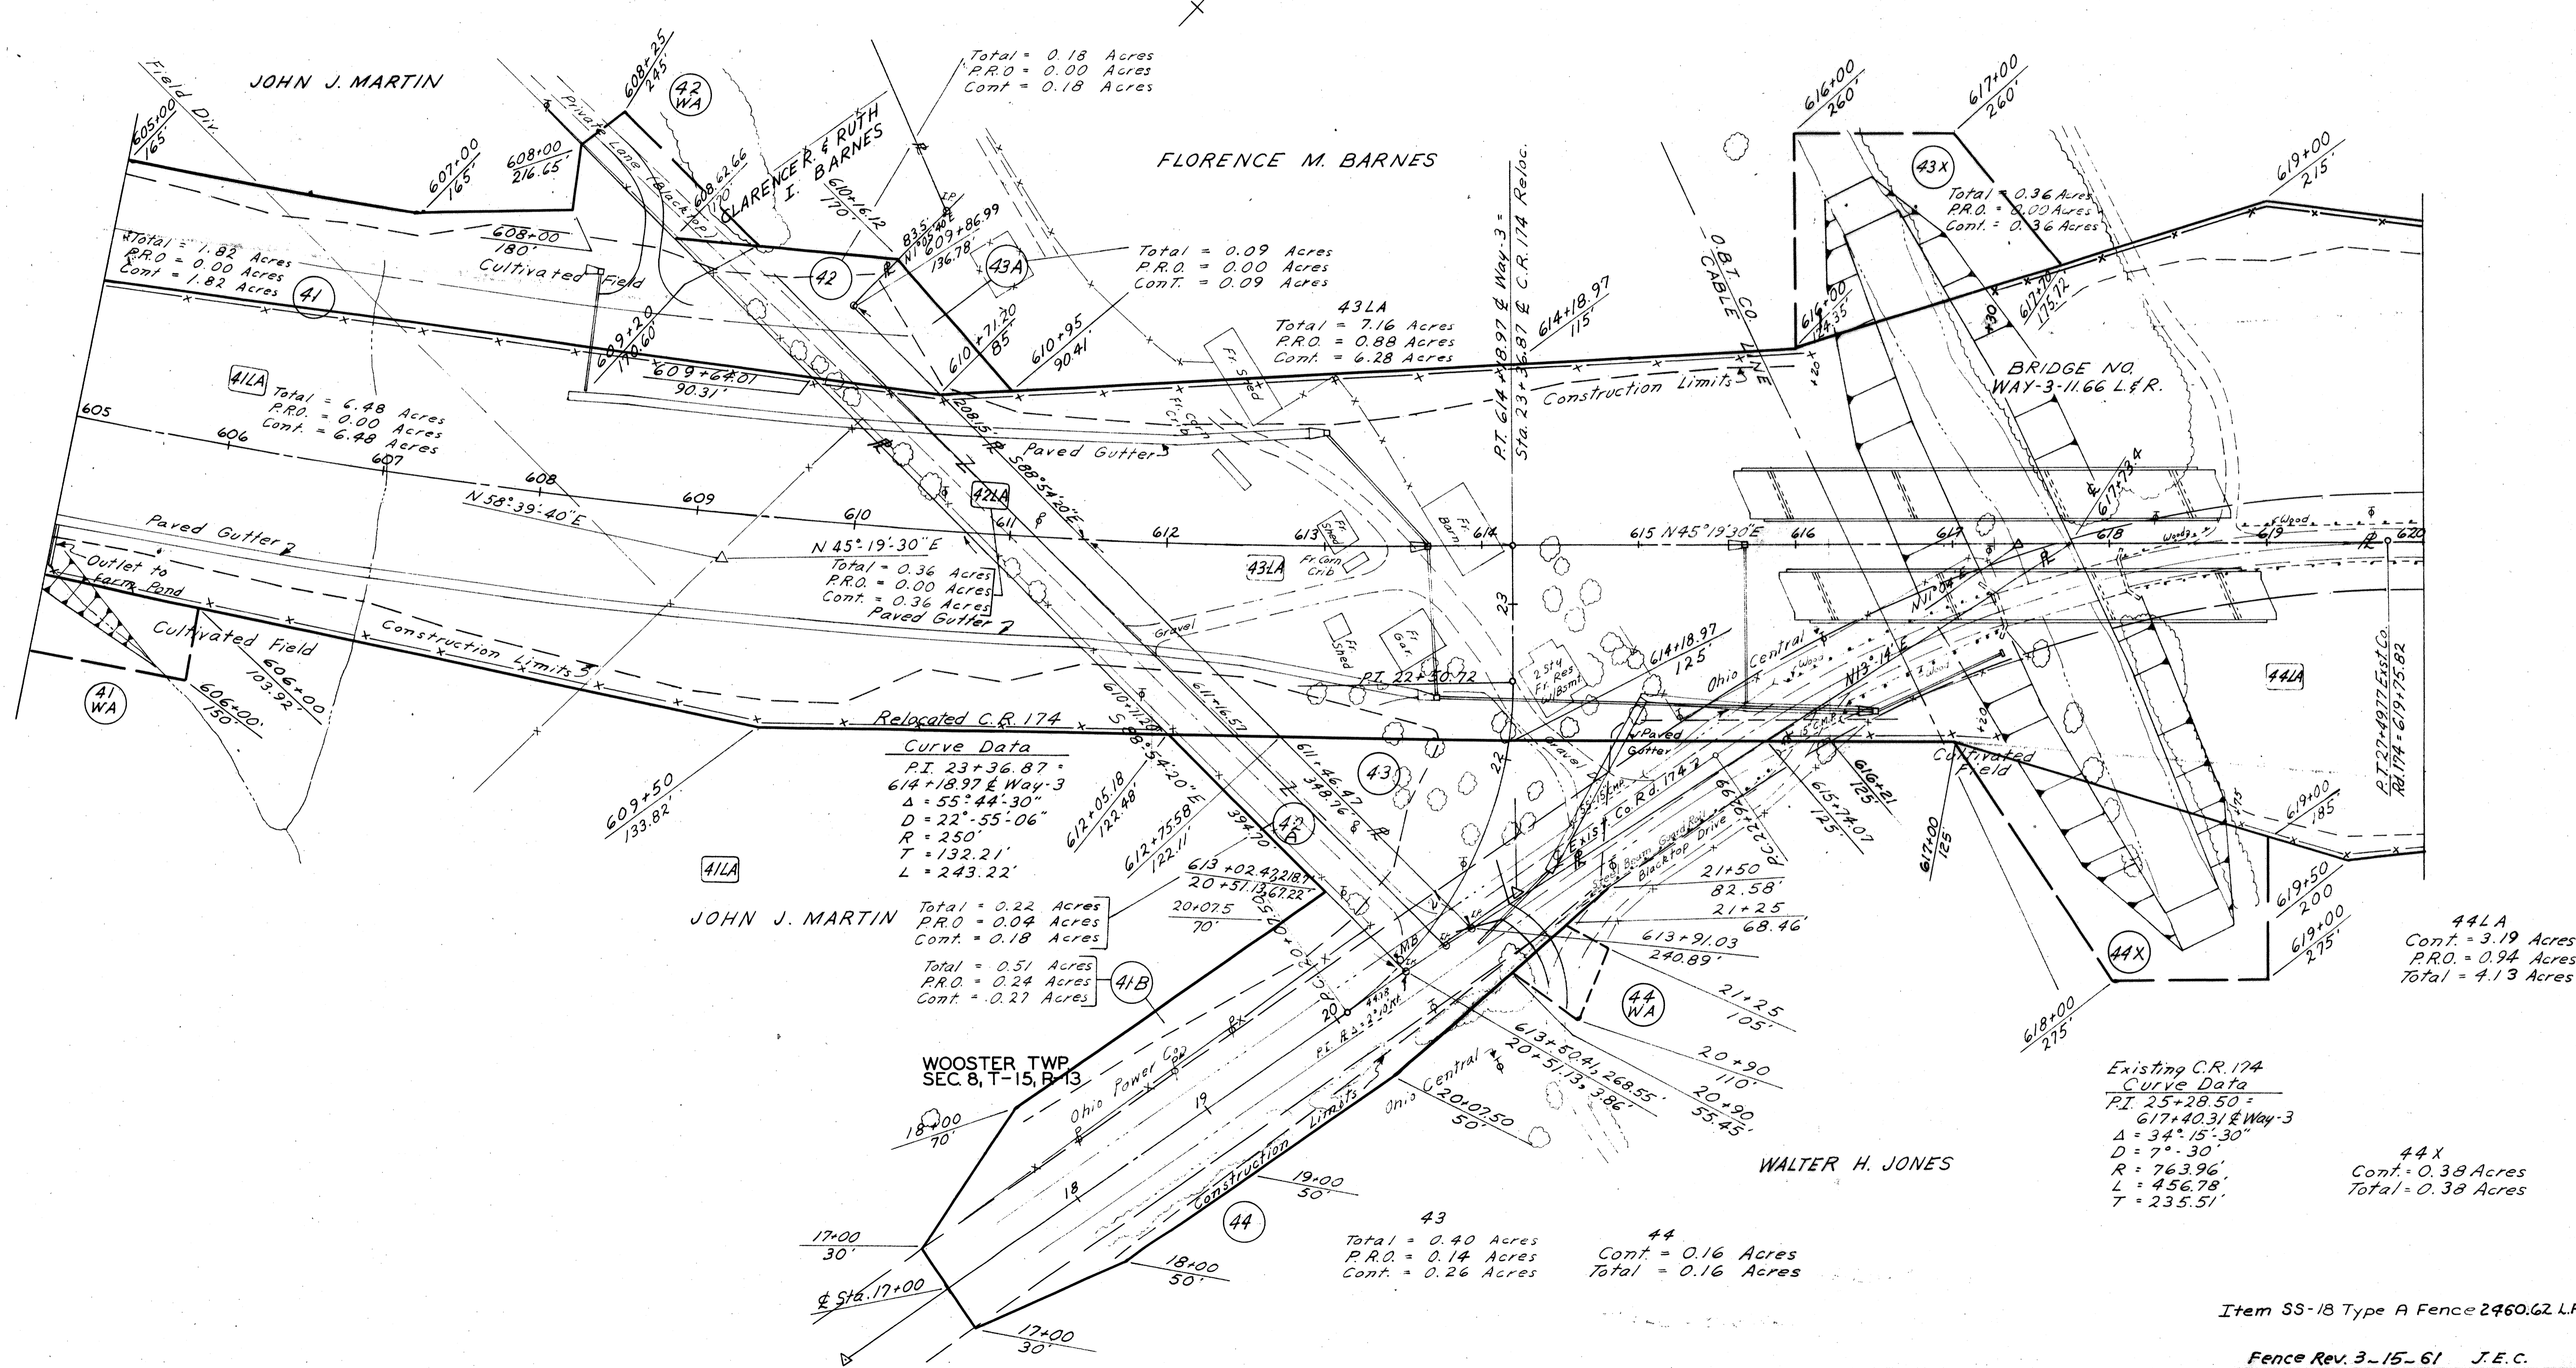

Curve Data
 PI 23+36.87'
 $\Delta = 55^\circ 44' 30''$
 $D = 22^\circ 55' 06''$
 $R = 250'$
 $T = 132.21'$
 $L = 243.22'$

Existing C.R. 174
 Curve Data
 PI 25+28.50'
 $\Delta = 34^\circ 15' 30''$
 $D = 7^\circ 30'$
 $R = 763.96'$
 $L = 456.78'$
 $T = 235.51'$

Item SS-18 Type A Fence 2460.62 L.F.

Fence Rev. 3-15-61 J.E.C.

Sta. 605+00 to Sta. 620+00

FED. RD. DIVISION	STATE	PROJECT
2	OHIO	

150
151

WAYNE COUNTY
WAY-3-9.94

7
8

WOOSTER TWP.
SEC. 8, T-15, R-13


FLORENCE M. BARNES

43LA

END PROJECT
STA. 631+85.43

END WORK
STA. 632+85.43

GR. SEC. LINE

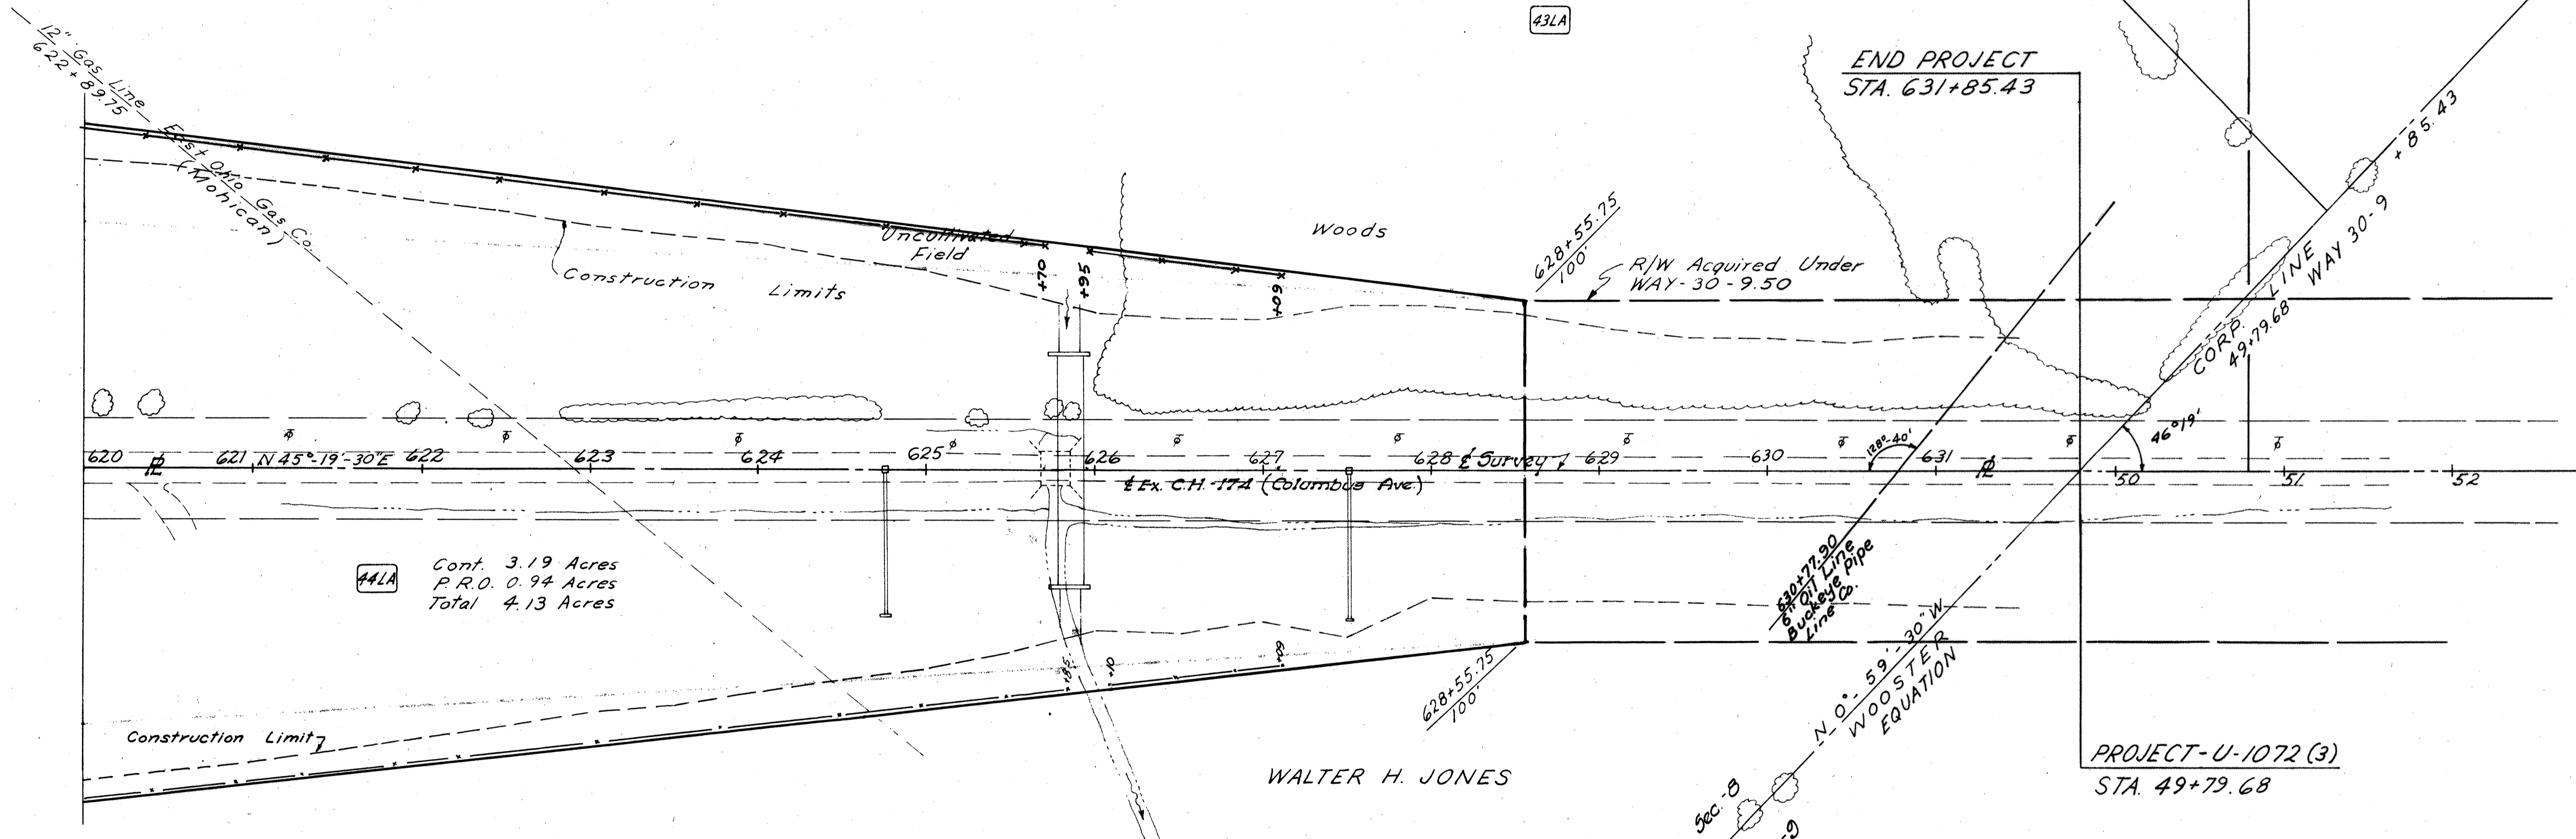

44LA
Cont. 3.19 Acres
P.R.O. 0.94 Acres
Total 4.13 Acres

WALTER H. JONES

WOOSTER TWP.
SEC. 8, T-15, R-13

Uncultivated Field

630+77.90
6\"/>

N. 0°-59'-30\"/>

PROJECT-U-1072 (3)
STA. 49+79.68


CITY OF WOOSTER

Item 55-18 Type A Fence 1408 L.F.

Fence Rev. 2-15-61 J.E.C.

Sta. 620+00 to Sta. 631+85.43

See Sheet 444A for additional information

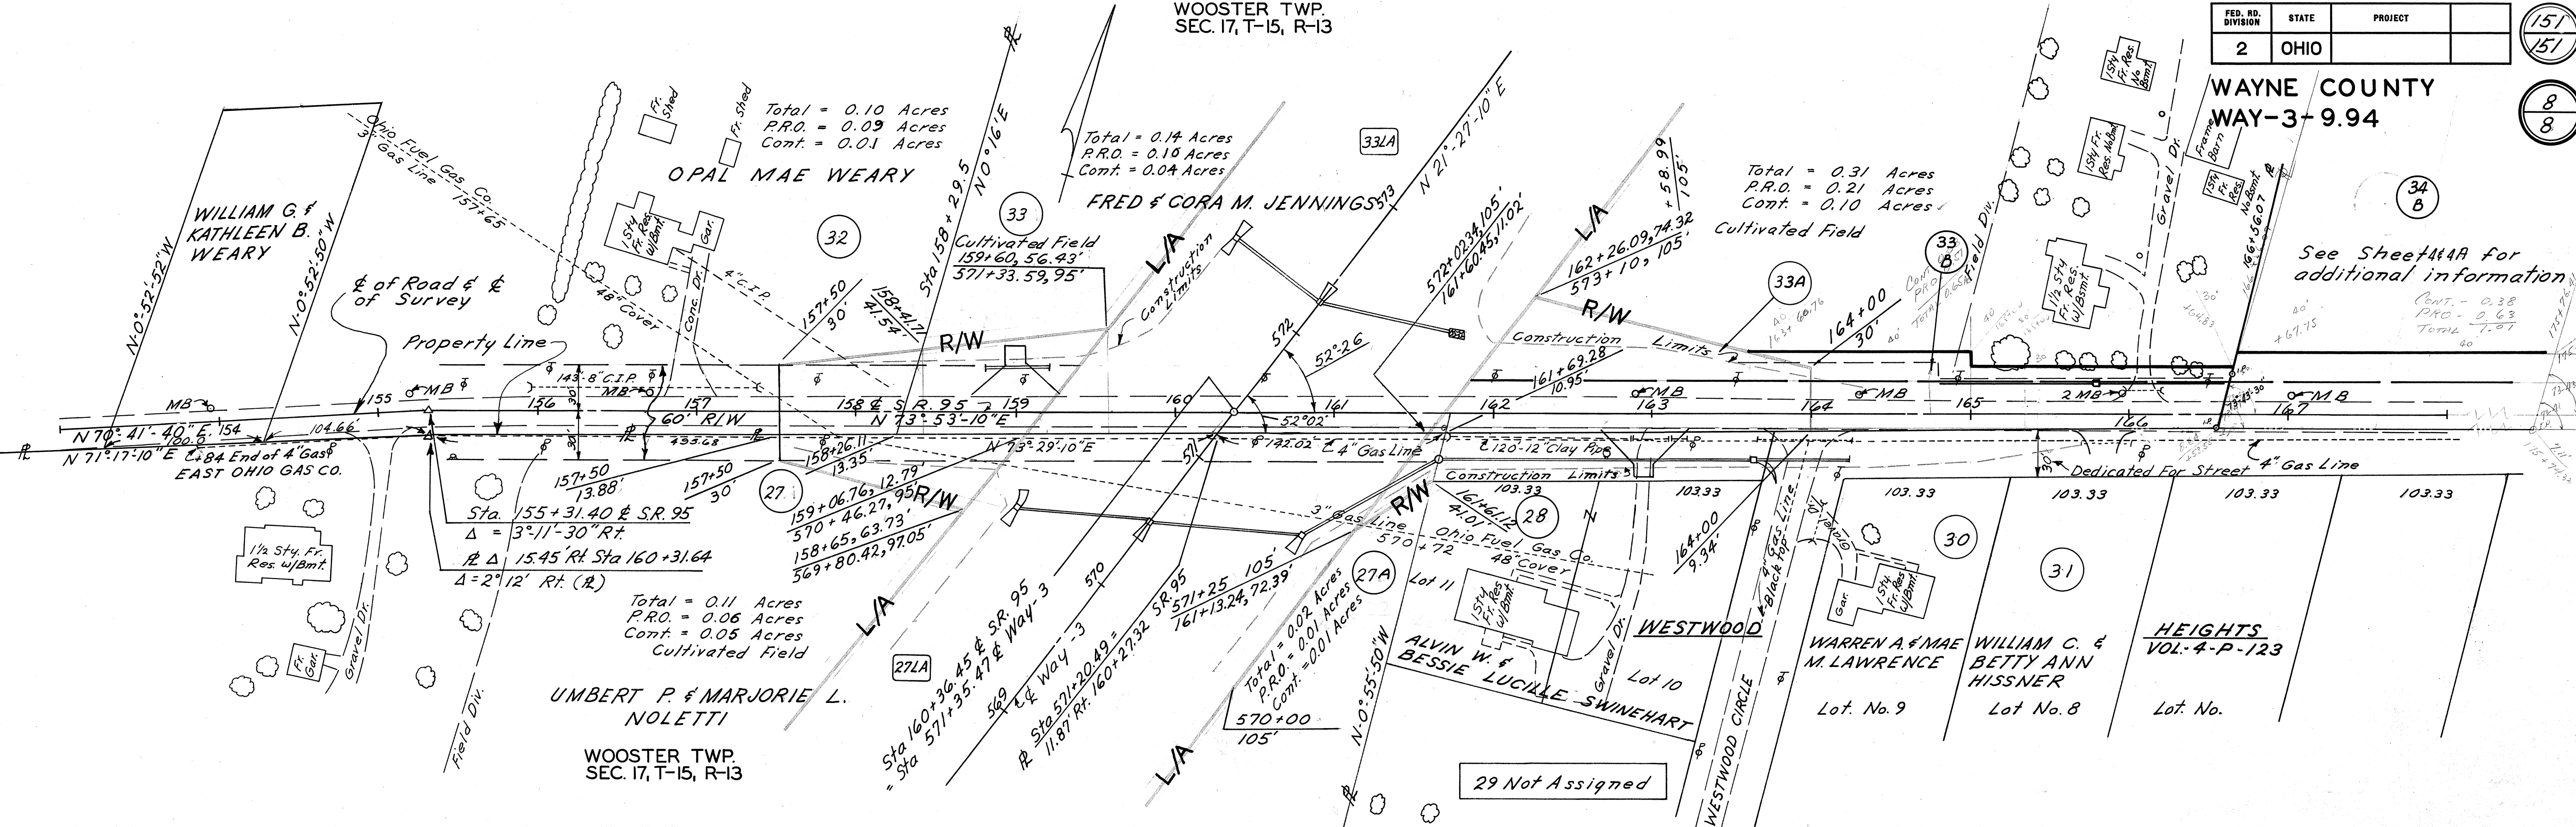

Relocated C.R. 139
Curve Data #1
P.I. 19+41.97
Δ = 25° 25' 30"
R = 716.20'
L = 317.81'
T = 161.57'


See Sheet 5 for additional information

Relocated C.R. 139
Curve Data #3
P.I. 26+96.92
Δ = 30° 58' 20"
R = 238.73'
L = 129.05'
E = 8.99'

(37) Total = .08 Acres
P.R.O. = .06 Acres
Cont. = .02 Acres

(38) Total = .09 Acres
P.R.O. = .07 Acres
Cont. = .02 Acres

Total = .19 Acres
P.R.O. = .14 Acres
Cont. = .05 Acres

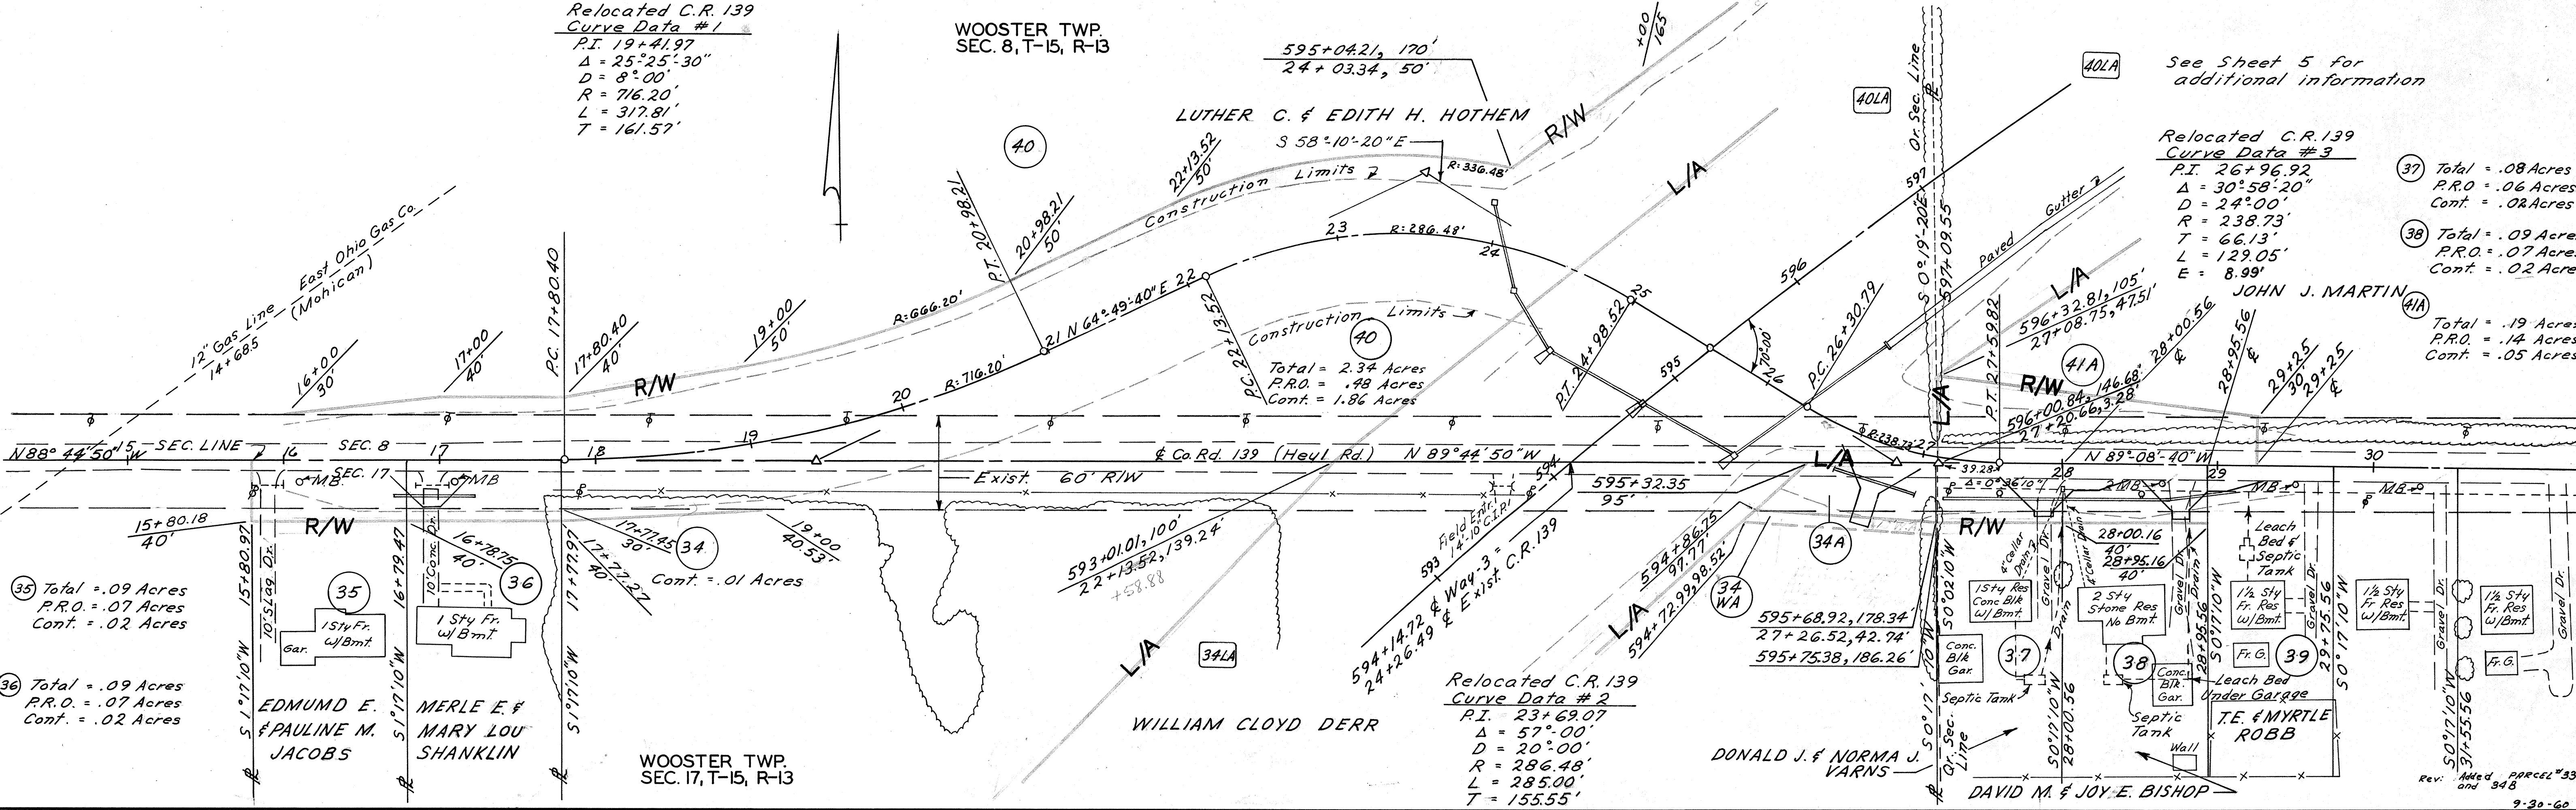

GENERAL INFORMATION

INTRODUCTION

The project consists of the major relocation of 2.2 miles of SR 3, beginning along existing SR 3 approximately 2000 feet southwest of the SR 3 - SR 226 junction and extending northeastward across open country ending at the Wooster corporation line, on Columbus Avenue, approximately 1000 feet southwest of the Columbus Avenue-Relocated USR 30 intersection. In addition to SR 3, the following improvements are to be made on these intersecting and associated roads: SR 226 (grade change), SR 95 (grade change), County Road 139 (relocation), and the relocation of Columbus Avenue (County Road 174).

The plans indicate the following regarding the proposed grade:

SR 3 - maximum depth of cut, 23 feet; fill embankment, maximum height of 34 feet (in the vicinity of the approaches to the Killbuck Creek structure), but generally less than 20 feet in height.

SR 226 - slight fill embankment - less than 2 feet in height.

SR 95 - slight cut and fill, less than 2 feet in depth and height, respectively.

County Road 139 - cut, maximum depth of 7 feet.

Columbus Avenue - maximum cut, 4 feet in depth; and fill, maximum height of 11 feet.

GEOLOGY OF THE SITE

The project is located within the boundaries of the moderately dissected Allegheny Plateau. Glacial drift in the upland portion (the first 1.8 miles) of the project ranges from 0 to in excess of 30 feet in depth. The final 1700 feet of the alignment lies on the broad flood plain of Killbuck Creek where alluvial deposits attain a thickness of at least 36 feet. Local bedrock consists of shale and sandstone, Mississippian in age.

EXPLORATION

Exploratory borings were made by means of truck mounted mechanical earth auger between April 20 and May 25, 1960 and by rotary-type drill rig between May 11 and May 13, 1960. Included with this report is information provided by two drive sample-core borings, made on May 17 and 18, 1960 in conjunction with the proposed Killbuck Creek structure investigation.

INVESTIGATIONAL FINDINGS

Borings disclose the following:

SR 3 Immediately below grade, materials consist predominantly of silts, in the A-4 classifications, as well as sandstone and shale bedrock. Frost susceptible silts were encountered within three feet of proposed grade between Stations 522+50 and 533+00, and at Stations 595+50 and 610+50. It is anticipated bedrock will be encountered in the excavations at the following locations:

Stations 550+50 to 562+00 - sandstone at grade, ditches and backslopes.

Stations 576+00 to 583+00 - either shale or sandstone at grade, ditches and backslopes (although bedrock apparently does not occur at grade at Station 584+50, it is expected this irregularity is localized and will not affect the overall assumption that bedrock will be encountered at or below grade within this interval).

In the embankment foundation areas, materials, for the most part, in the upland portion of the project, consist of dry to moist silts, in the A-4a classification and minor amounts of silt clay and clay, in the A-6a and A-7-6 classifications. In the Killbuck Creek flood plain area, the embankment foundation soils consist of generally moist to wet, compressible, silts, silt clays, clays, elastic silts and elastic clays, in the A-4, A-6, A-7-6, A-5, and A-7-5 classifications, respectively. These soils range in occurrence from ground surface to in excess of 30 feet in depth. The majority of the soils, in particular, the silts, are contaminated with organic materials.

SR 226 - materials in the embankment foundation consist of sandy silt, in the A-4a classification.

SR 95 - in the cut area, materials consist of frost susceptible silt, in the A-4b classification; in the embankment foundation, sandy silt and silty clay, in the A-4a and A-6a classifications.

County Road 139 Material below grade, in the proposed cut area consists of silt (frost susceptible) as well as shale and sandstone bedrock. It is anticipated bedrock will be encountered at or very near grade between approximately Stations 19+50 and 24+50.

Columbus Avenue Materials immediately below grade consist of sandy silt, in the A-4a classification, frost susceptible at Station 19+00.

LEGEND FOR PROJECT-AVERAGE RESULTS OF TESTS- SAMPLES TESTED


DESCRIPTION	H. R. B. CLASS	OHIO CLASS	% AGG.	% C. SAND	% F. SAND	% SILT	% CLAY	LIQUID LIMIT	PLASTICITY INDEX	WATER CONTENT	SAMPLES TESTED
Gravel and stone fragments	A-1-a (0)	A-1-a	62	19	10	6	3	NP	NP	14	21
Gravel and stone fragments with sand	A-1-b(0)	A-1-b	42	27	18	8	5	NP	NP	16	41
Fine sand	A-3 (0)	A-3	17	27	46	-10-		NP	NP	18	1
Coarse and fine sand	---	A-3a	7	23	50	-20-		NP	NP	24	21
Gravel and stone fragments with sand and silt	A-2-4(0)	A-2-4	39	14	17	22	8	NP	NP	16	13
Sandy silt	A-4 (4)	A-4a	13	7	23	39	18	27	2	27	102
Silt	A-4 (8)	A-4b	1	1	14	56	26	34	3	30	135
Elastic silt and clay with organic material unless otherwise noted	A-5 (8)	A-5	0	4	28	45	23	50	2	56	13
Silt and clay	A-6 (9)	A-6a	4	2	5	50	39	35	12	27	55
Silty clay	A-6 (11)	A-6b	3	2	5	47	43	37	17	26	8
Elastic clay without organic material unless otherwise noted	A-7-5 (14)	A-7-5	0	1	6	42	51	57	17	43	18
Clay	A-7-6 (12)	A-7-6	0	1	3	45	51	44	17	33	33
Clay bedrock											16
Weathered shale											12
Weathered sandstone											2
Shale											
Sandstone											
Wood Log											
Sod and/or Topsoil X1 - Approximate depth.											
Berm material											
Auger boring - plan view.											
Drive sample-core boring - plan view.											
Auger boring plotted to vertical scale only.											
Drive sample-core boring plotted to vertical scale only.											
Number of blows for "Standard Penetration" test. X=number of blows for the first 6 inches. Y=number of blows for the second 6 inches.											
Water content nearly equal to or greater than liquid limit.											
Indicates a non-plastic material with high water content.											
Free water											
Static water level											
Indicates broken rock interval.											
NOTE: Small vertical figures beside borings indicate loss on ignition. e.g. 15%											
NOTE: Figures beside borings indicate water content in percent. e.g. 15											

Samples Tested
Lab. Nos. So.

- 53914-54005 incl.,
- 55120-55206 incl.,
- 56547-56598 incl.,
- 57126-57127 incl.,
- 57142-57152 incl.,
- 59481-59508 incl.,
- 56610-56782 incl.


Revised
10/10/60

SOIL PROFILE
WAYNE COUNTY
WAY-3-994
OHIO STATE HIGHWAY
TESTING LABORATORY
O. S. U. CAMPUS, COLUMBUS, OHIO

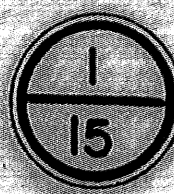

NOTE: INFORMATION SHOWN BY THIS SUBGRADE PROFILE WAS OBTAINED SOLELY FOR USE IN ESTABLISHING DESIGN CONTROLS FOR THE PROJECT. THE STATE OF OHIO DOES NOT GUARANTEE THE ACCURACY OF THIS DATA AND IT IS NOT TO BE CONSTRUED AS A PART OF THE PLANS GOVERNING CONSTRUCTION OF THE PROJECT.

Fed. No. F-

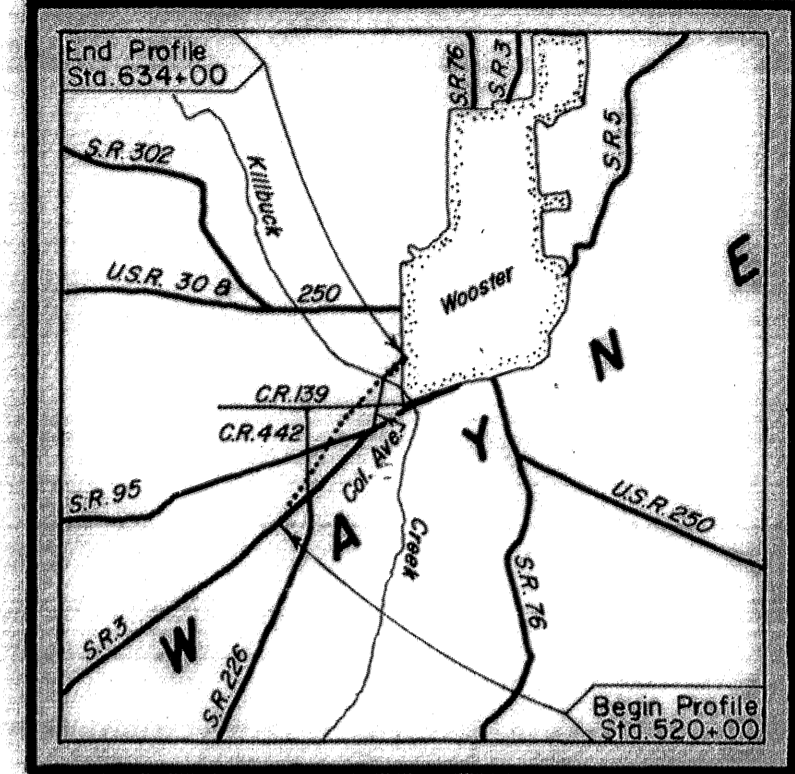

LOCATION MAP

Recon - N.P.L. - 4-14-60
Auger - J.R.G., C.E.G., J.A.G. - 4-20-10-5-25-60
Drive Sample - Core - R.L.S. - 5-11-13-60
Drafting - L.N.L., D.M. - 6-23-60
Supplemental
Auger - J.R.G. - 6-27-10-6-29-60
Drafting - R.A.W., J.B.M. - 10-10-60

Revised
10/10/60

SUMMARY OF SOIL TEST DATA

NOTE: NP shown in Liquid Limit and Plasticity Index columns indicates that the material is non-plastic.
*Denotes sample taken at or near grade.

Table with 15 columns: Station & Offset, Depth From To, % Agg, % C S, % FS, % Silt, % Clay, LL, PI, % W C, SHTL Class. The table contains multiple data entries for various soil profiles across different stations and depths.

Revised
10/10/60

SOIL PROFILE
WAYNE COUNTY
WAY-3 - 9.94
OHIO STATE HIGHWAY
TESTING LABORATORY
O. S. U. CAMPUS, COLUMBUS, OHIO

SUMMARY OF SOIL TEST DATA (Continued)



NOTE: NP shown in Liquid Limit and Plasticity Index columns indicates that the material is non-plastic.
* Denotes sample taken at or near grade.

Station & Offset	Depth From To	% Agg	% C S	% FS	% Silt	% Clay	LL	PI	% WC	SHTL Class
623+00 70*LT	1.0-3.0	0	1	4	48	47	38	14	30	A-6a
	3.0-6.0	0	1	4	62	33	38	15	29	A-6a
	6.0-7.0	0	1	10	59	30	NP	NP	32	A-4b
	7.0-10.0	0	1	25	51	23	NP	NP	31	A-4b
	10.0-13.0	0	3	30	44	23	46	NP	50	A-5
	13.0-14.0	Wood Log								Visual
	14.0-16.0	0	3	32	42	23	36	NP	43	A-4a
	16.0-19.0	0	8	67	-25-			NP	24	A-3a
	19.0-20.5	0	6	43	34	17	47	NP	50	A-5
	20.5-24.0	30	19	20	21	10	NP	NP	13	A-2-4
	24.0-26.0	26	40	25	-	9-	NP	NP	18	A-1-b
623+00 40*LT	0.0-2.0	0	1	3	42	54	47	16	31	A-7-5
	2.0-3.0	0	1	2	49	48	48	17	28	A-7-5
	3.0-8.0	0	0	2	56	42	41	16	28	A-7-6
	8.0-10.0	0	0	1	47	28	33	5	29	A-4b
	10.0-15.0	0	1	35	48	16	34	NP	65	A-4a
	15.0-19.0	0	1	35	49	15	NP	NP	29	A-4a
	19.0-21.0	0	0	16	62	22	45	16	27	A-7-6
	21.0-26.0	66	20	9	-	5-	NP	NP	16	A-1-a
623+00 35*RT	0.5-3.0	0	0	2	44	54	44	17	34	A-7-6
	3.0-5.5	0	1	3	59	37	34	10	30	A-4b
	5.5-9.0	0	0	20	59	21	NP	NP	37	A-4b
	9.0-14.0	0	2	27	53	18	NP	NP	40	A-4b
	14.0-18.0	0	6	43	37	14	35	NP	57	A-4a
	18.0-23.0	53	21	17	-	9-	NP	NP	32	A-1-a
	23.0-26.0	39	40	12	-	9-	NP	NP	14	A-1-b
623+00 70*RT	0.5-4.0	0	1	3	61	35	41	14	29	A-7-6
	4.0-6.0	0	0	7	64	29	NP	NP	34	A-4b
	6.0-11.0	0	2	23	57	18	32	NP	40	A-4b
	11.0-16.0	0	2	31	49	18	NP	NP	43	A-4a
	16.0-20.0	0	1	29	49	21	NP	NP	41	A-4a
	20.0-23.0	38	38	16	-	8-	NP	NP	17	A-1-b
	23.0-26.0	83	10	4	-	3-	NP	NP	13	A-1-a
624+00 60*LT	0.0-1.0	0	1	2	43	54	49	23	32	A-7-6
	1.0-3.0	0	2	1	65	62	33	11	27	A-6a
	3.0-8.0	0	2	4	63	33	32	6	30	A-4b
	8.0-10.0	0	1	21	50	28	NP	NP	31	A-4b
	10.0-14.0	0	2	31	38	29	47	14	47	A-7-5
	14.0-19.5	0	2	52	30	16	29	NP	38	A-4a
	19.5-24.0	39	23	10	21	7	NP	NP	14	A-2-4
	24.0-26.0	0	4	80	-	16-	NP	NP	25	A-3a
624+00 15*LT	0.5-4.0	0	6	9	62	23	NP	NP	22	A-4b
	4.0-6.0	0	2	2	43	53	45	18	34	A-7-6
	6.0-7.0	0	1	1	37	61	41	13	29	A-7-6
	7.0-11.0	0	2	2	49	47	43	20	30	A-7-6
	11.0-14.0	0	0	8	72	20	NP	NP	29	A-4b
	14.0-17.0	0	0	20	57	23	NP	NP	34	A-4b
	17.0-22.0	0	2	30	49	19	41	NP	46	A-5
	22.0-27.0	52	20	13	11	4	NP	NP	11	A-1-a
	27.0-30.0	57	13	15	11	4	NP	NP	15	A-1-a
	30.0-31.0	0	1	84	-	15-	NP	NP	28	A-3a
	31.0-33.0	54	31	10	-	5-	NP	NP	12	A-1-a
624+00 35*RT	0.5-2.0	0	1	3	31	65	48	14	41	A-7-5
	2.0-6.5	0	0	1	59	40	36	13	62	A-6a
	6.5-11.0	0	0	20	55	25	NP	NP	37	A-4b
	11.0-16.0	0	5	29	43	23	NP	NP	50	A-4a
	16.0-21.0	0	9	25	47	19	26	3	34	A-4a
	21.0-25.0	45	27	13	-	15-	NP	NP	16	A-1-b
	25.0-28.0	29	42	22	-	7-	NP	NP	13	A-1-b
624+00 65*RT	0.5-5.0	0	1	2	47	50	40	17	28	A-6b
	5.0-8.0	0	0	7	66	27	NP	NP	26	A-4b
	8.0-11.0	0	0	30	50	20	NP	NP	28	A-4b
	11.0-16.0	0	7	31	42	20	34	9	38	A-4a
	16.0-21.0	0	10	26	43	21	NP	NP	35	A-4a
	21.0-25.0	14	10	62	11	3	NP	NP	21	A-3a
	25.0-28.0	46	29	17	-	8-	NP	NP	14	A-1-b
625+00 50*LT	0.0-1.5	0	1	2	44	53	46	17	32	A-7-6
	1.5-3.0	0	1	2	46	51	51	19	30	A-7-5
	3.0-8.0	0	1	8	64	27	NP	NP	27	A-4b
	8.0-13.0	0	1	36	44	19	NP	NP	32	A-4a
	13.0-16.0	0	13	47	32	8	NP	NP	36	A-4a
	16.0-18.0	0	41	27	27	5	NP	NP	20	A-3a
	18.0-20.0	50	8	15	25	2	NP	NP	20	A-2-4
	20.0-22.0	49	15	11	19	6	NP	NP	12	A-1-b
	22.0-26.0	24	31	34	-	11-	NP	NP	17	A-1-b
625+00 50*RT	0.5-4.5	0	1	5	48	46	35	12	28	A-6a
	4.5-6.0	0	1	8	61	30	27	5	28	A-4b
	6.0-7.5	0	1	23	56	20	NP	NP	26	A-4b
	7.5-11.0	0	1	17	66	16	NP	NP	27	A-4b
	11.0-14.5	0	1	28	49	22	NP	NP	33	A-4a
	14.5-16.5	0	28	37	28	7	NP	NP	30	A-3a
	16.5-22.0	71	10	7	-	12-	NP	NP	14	A-1-a
	22.0-25.0	35	29	23	-	13-	NP	NP	18	A-1-b
625+95 53*LT	0.0-2.0	0	1	4	44	51	39	12	31	A-6a
	2.0-3.0	0	2	6	23	69	45	16	35	A-7-6
	3.0-7.0	0	1	12	58	29	28	9	29	A-4b
	7.0-9.0	0	0	25	53	22	NP	NP	30	A-4b
	9.0-13.0	0	0	24	61	15	NP	NP	32	A-4b
	13.0-19.0	0	4	27	41	18	41	NP	38	A-5
	19.0-21.0	42	18	14	18	8	NP	NP	13	A-2-4
	21.0-24.0	69	14	8	7	2	NP	NP	16	A-1-a
626+00 50*RT	0.5-3.0	0	1	2	41	56	49	24	32	A-7-6
	3.0-6.0	0	0	5	56	38	33	14	29	A-6a
	6.0-9.0	0	0	17	60	23	26	4	29	A-4b
	9.0-11.0	0	0	7	67	26	NP	NP	32	A-4b
	11.0-16.0	0	0	14	71	15	NP	NP	36	A-4b
	16.0-21.0	0	3	35	49	13	30	NP	31	A-4a
	21.0-22.0	34	16	14	30	6	NP	NP	22	A-4a
627+00 50*LT	0.0-1.5	0	1	4	28	67	44	11	41	A-7-5
	1.5-4.0	0	1	5	40	39	14	34	34	A-6a
	4.0-7.0	0	0	15	55	30	30	7	26	A-4b
	7.0-10.0	0	0	13	64	23	NP	NP	27	A-4b
	10.0-15.0	0	1	24	53	22	NP	NP	41	A-4b
	15.0-17.0	0	1	18	62	19	24	NP	62	A-5
	17.0-19.0	42	12	14	24	8	NP	NP	12	A-2-4
627+00 50*RT	0.5-4.0	0	1	2	42	55	48	21	32	A-7-6
	4.0-5.0	0	1	3	53	43	38	15	38	A-6a
	5.0-10.0	0	1	3	60	36	34	12	30	A-6a
	10.0-15.0	0	0	12	62	26	NP	NP	31	A-4b
	15.0-19.5	0	1	14	59	26	26	7	33	A-4b
	19.5-20.0	68	11	8	11	2	NP	NP	13	A-1-a
627+50 15*RT	0.5-2.0	44	10	19	17	20	NP	NP	10	A-2-4
	2.0-4.0	0	3	6	67	24	26	6	23	A-4b
	4.0-7.0	0	1	3	46	50	38	12	39	A-6a
	7.0-12.0	0	1	3	54	42	35	12	30	A-6a
	12.0-17.0	0	0	1	59	40	35	13	31	A-6a
	17.0-22.0	0	0	6	60	34	31	11	27	A-6a
	22.0-25.0	38	9	12	24	17	NP	NP	24	A-4a
	25.0-28.0	58	10	7	20	5	NP	NP	20	A-1-b
628+00 60*LT	0.3-1.0	0	1	3	40	56	41	12	34	A-7-6
	1.0-2.0	0	2	4	43	51	41	16	32	A-7-6
	2.0-6.0	0	0	2	60	38	35	14	30	A-6a
	6.0-9.0	0	1	5	62	32	28	6		



Revised
10/10/60

SOIL PROFILE
WAYNE COUNTY
WAY-3-994
 OHIO STATE HIGHWAY
 TESTING LABORATORY
 O. S. U. CAMPUS, COLUMBUS, OHIO

5
15

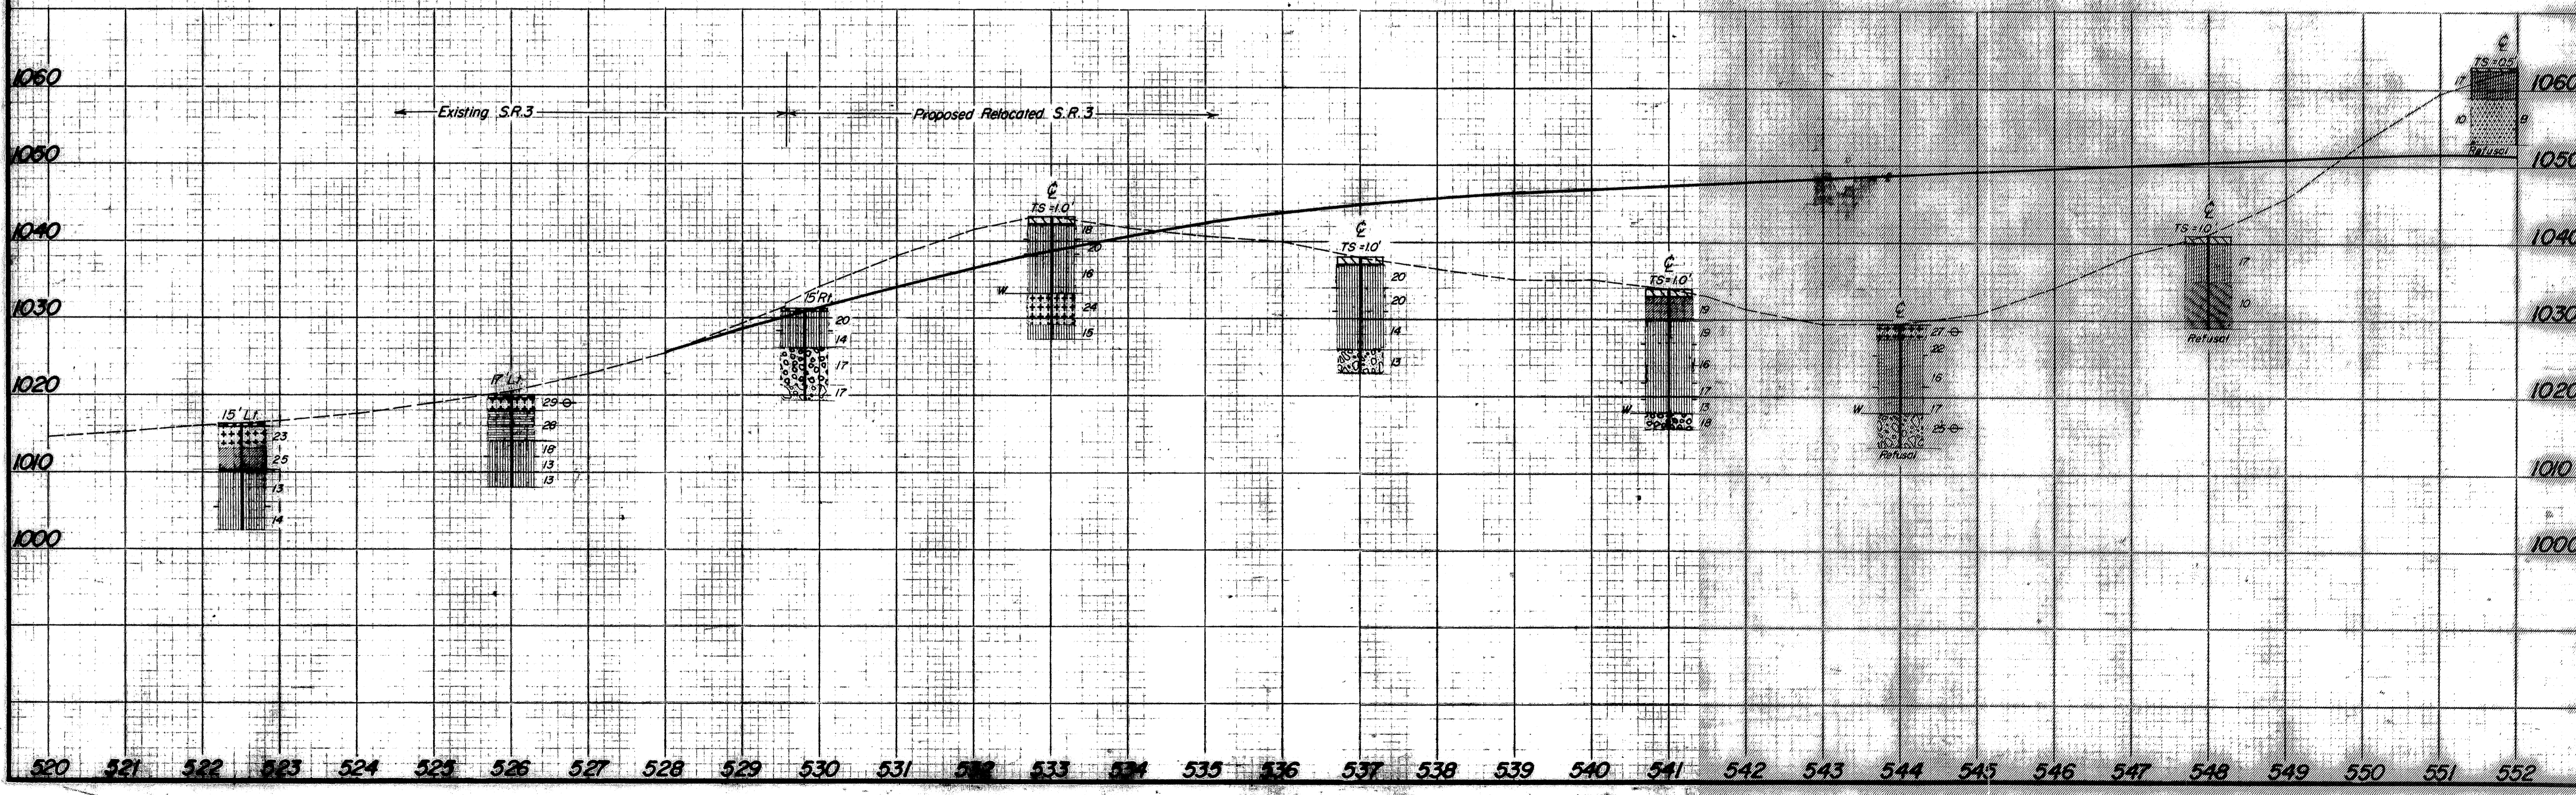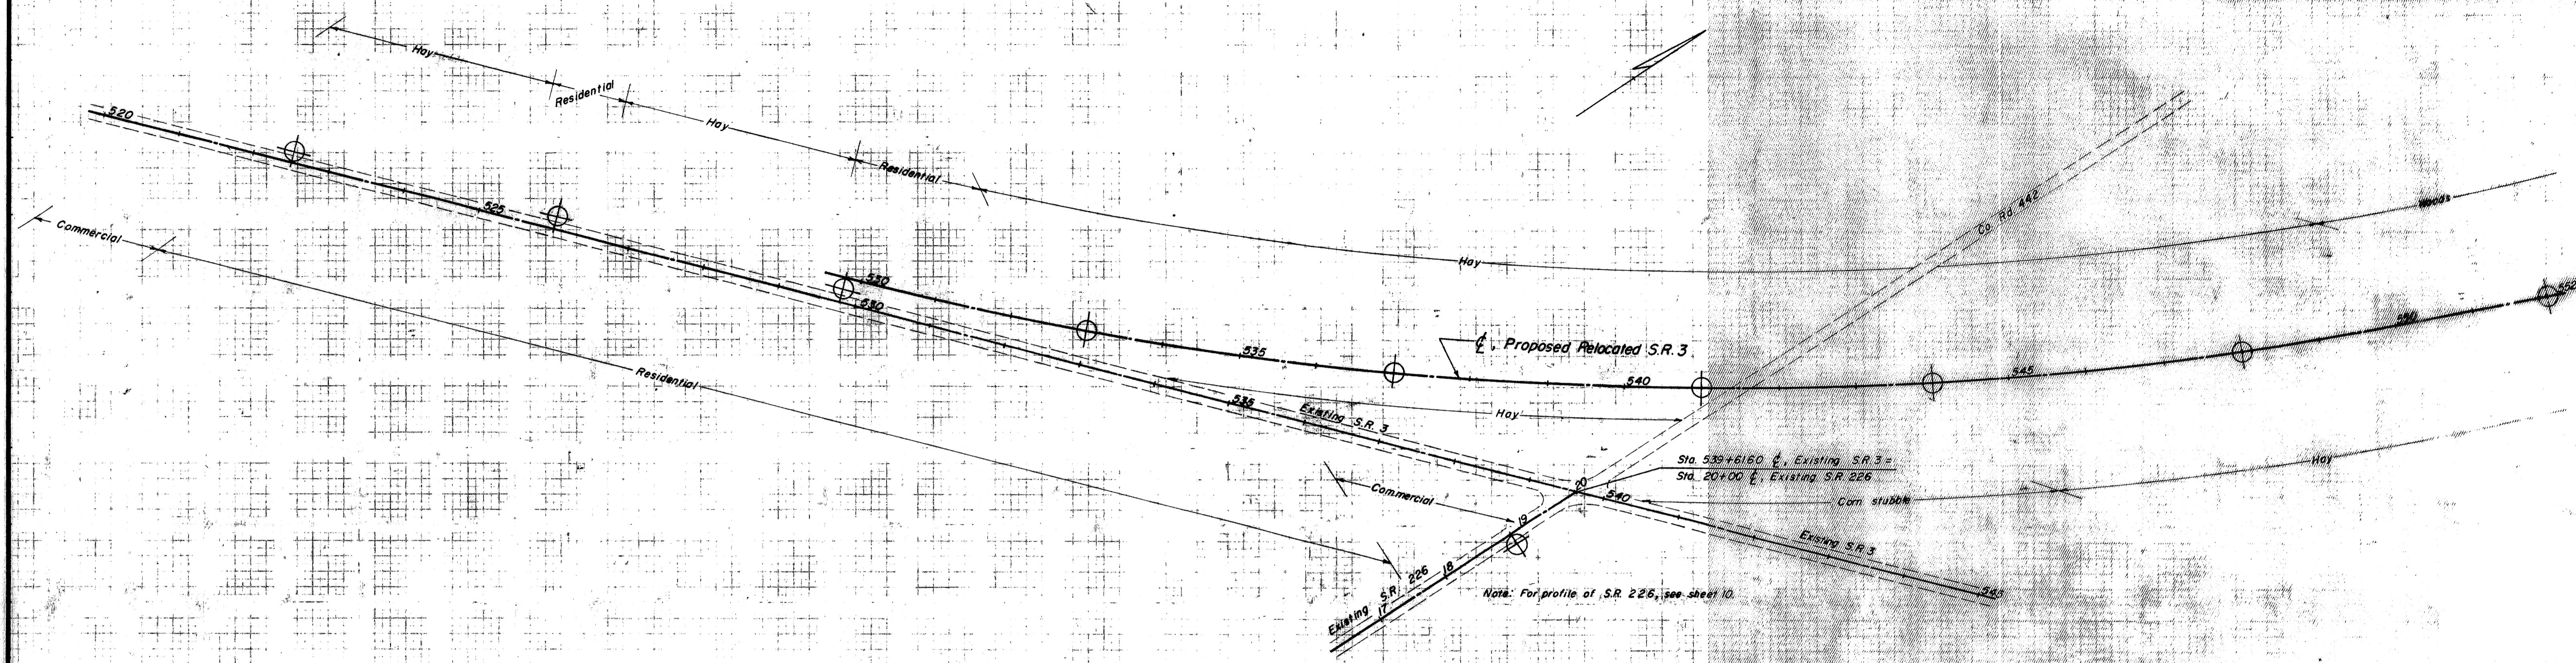


Revised
 10/10/60

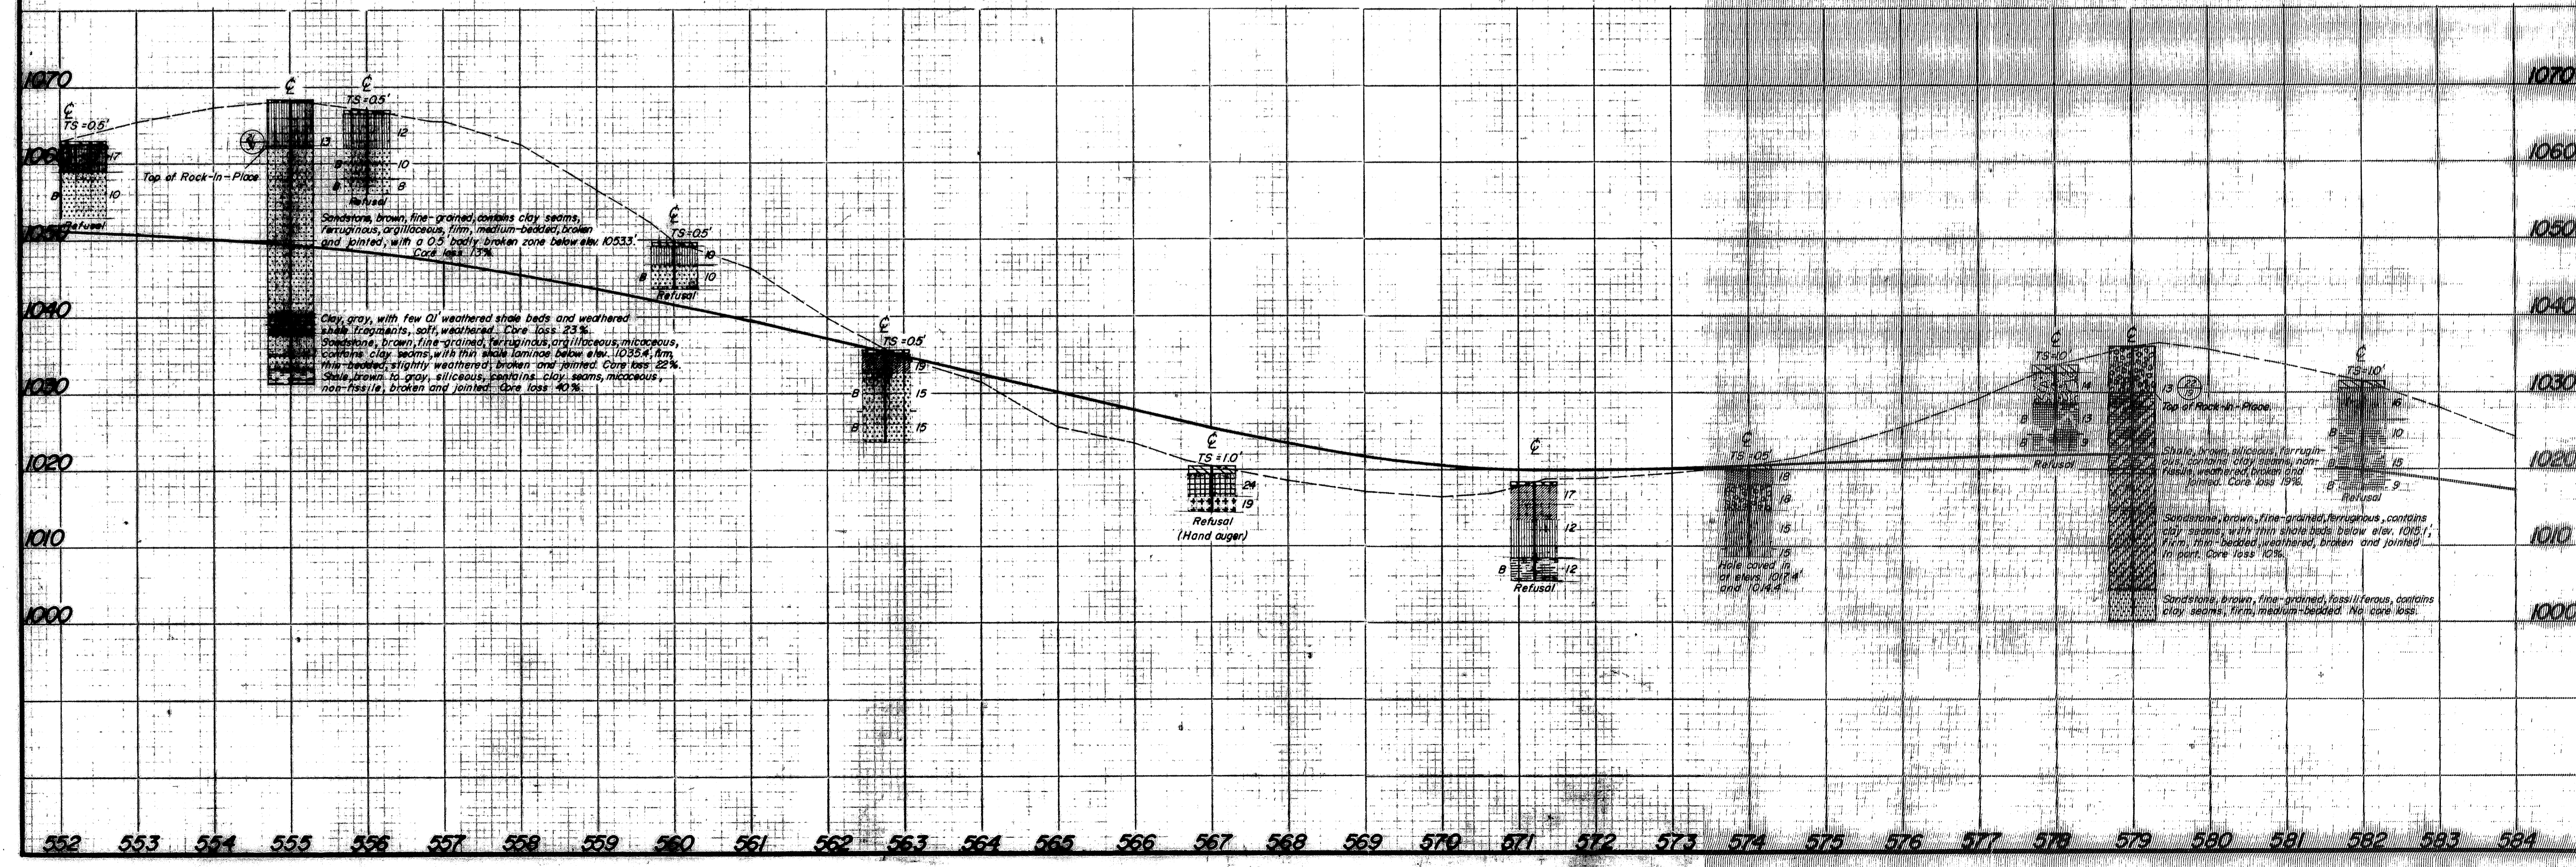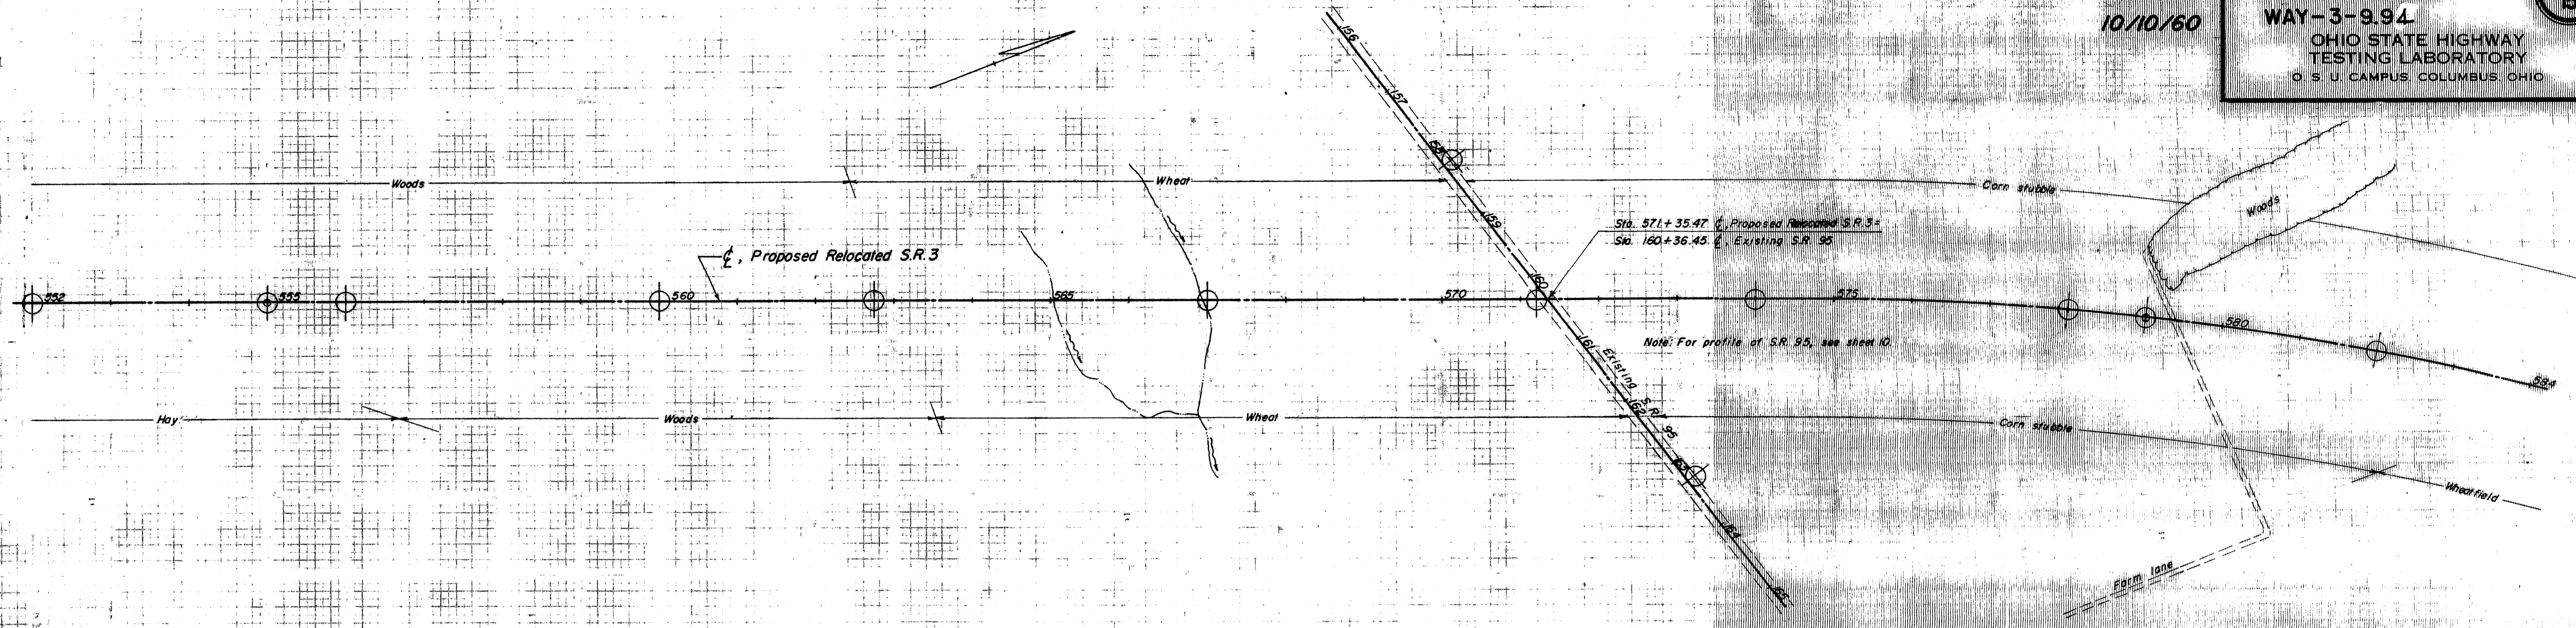

Revised
10/10/60

SOIL PROFILE
WAYNE COUNTY
WAY - 3 - 994
OHIO STATE HIGHWAY
TESTING LABORATORY
O S U CAMPUS COLUMBUS, OHIO

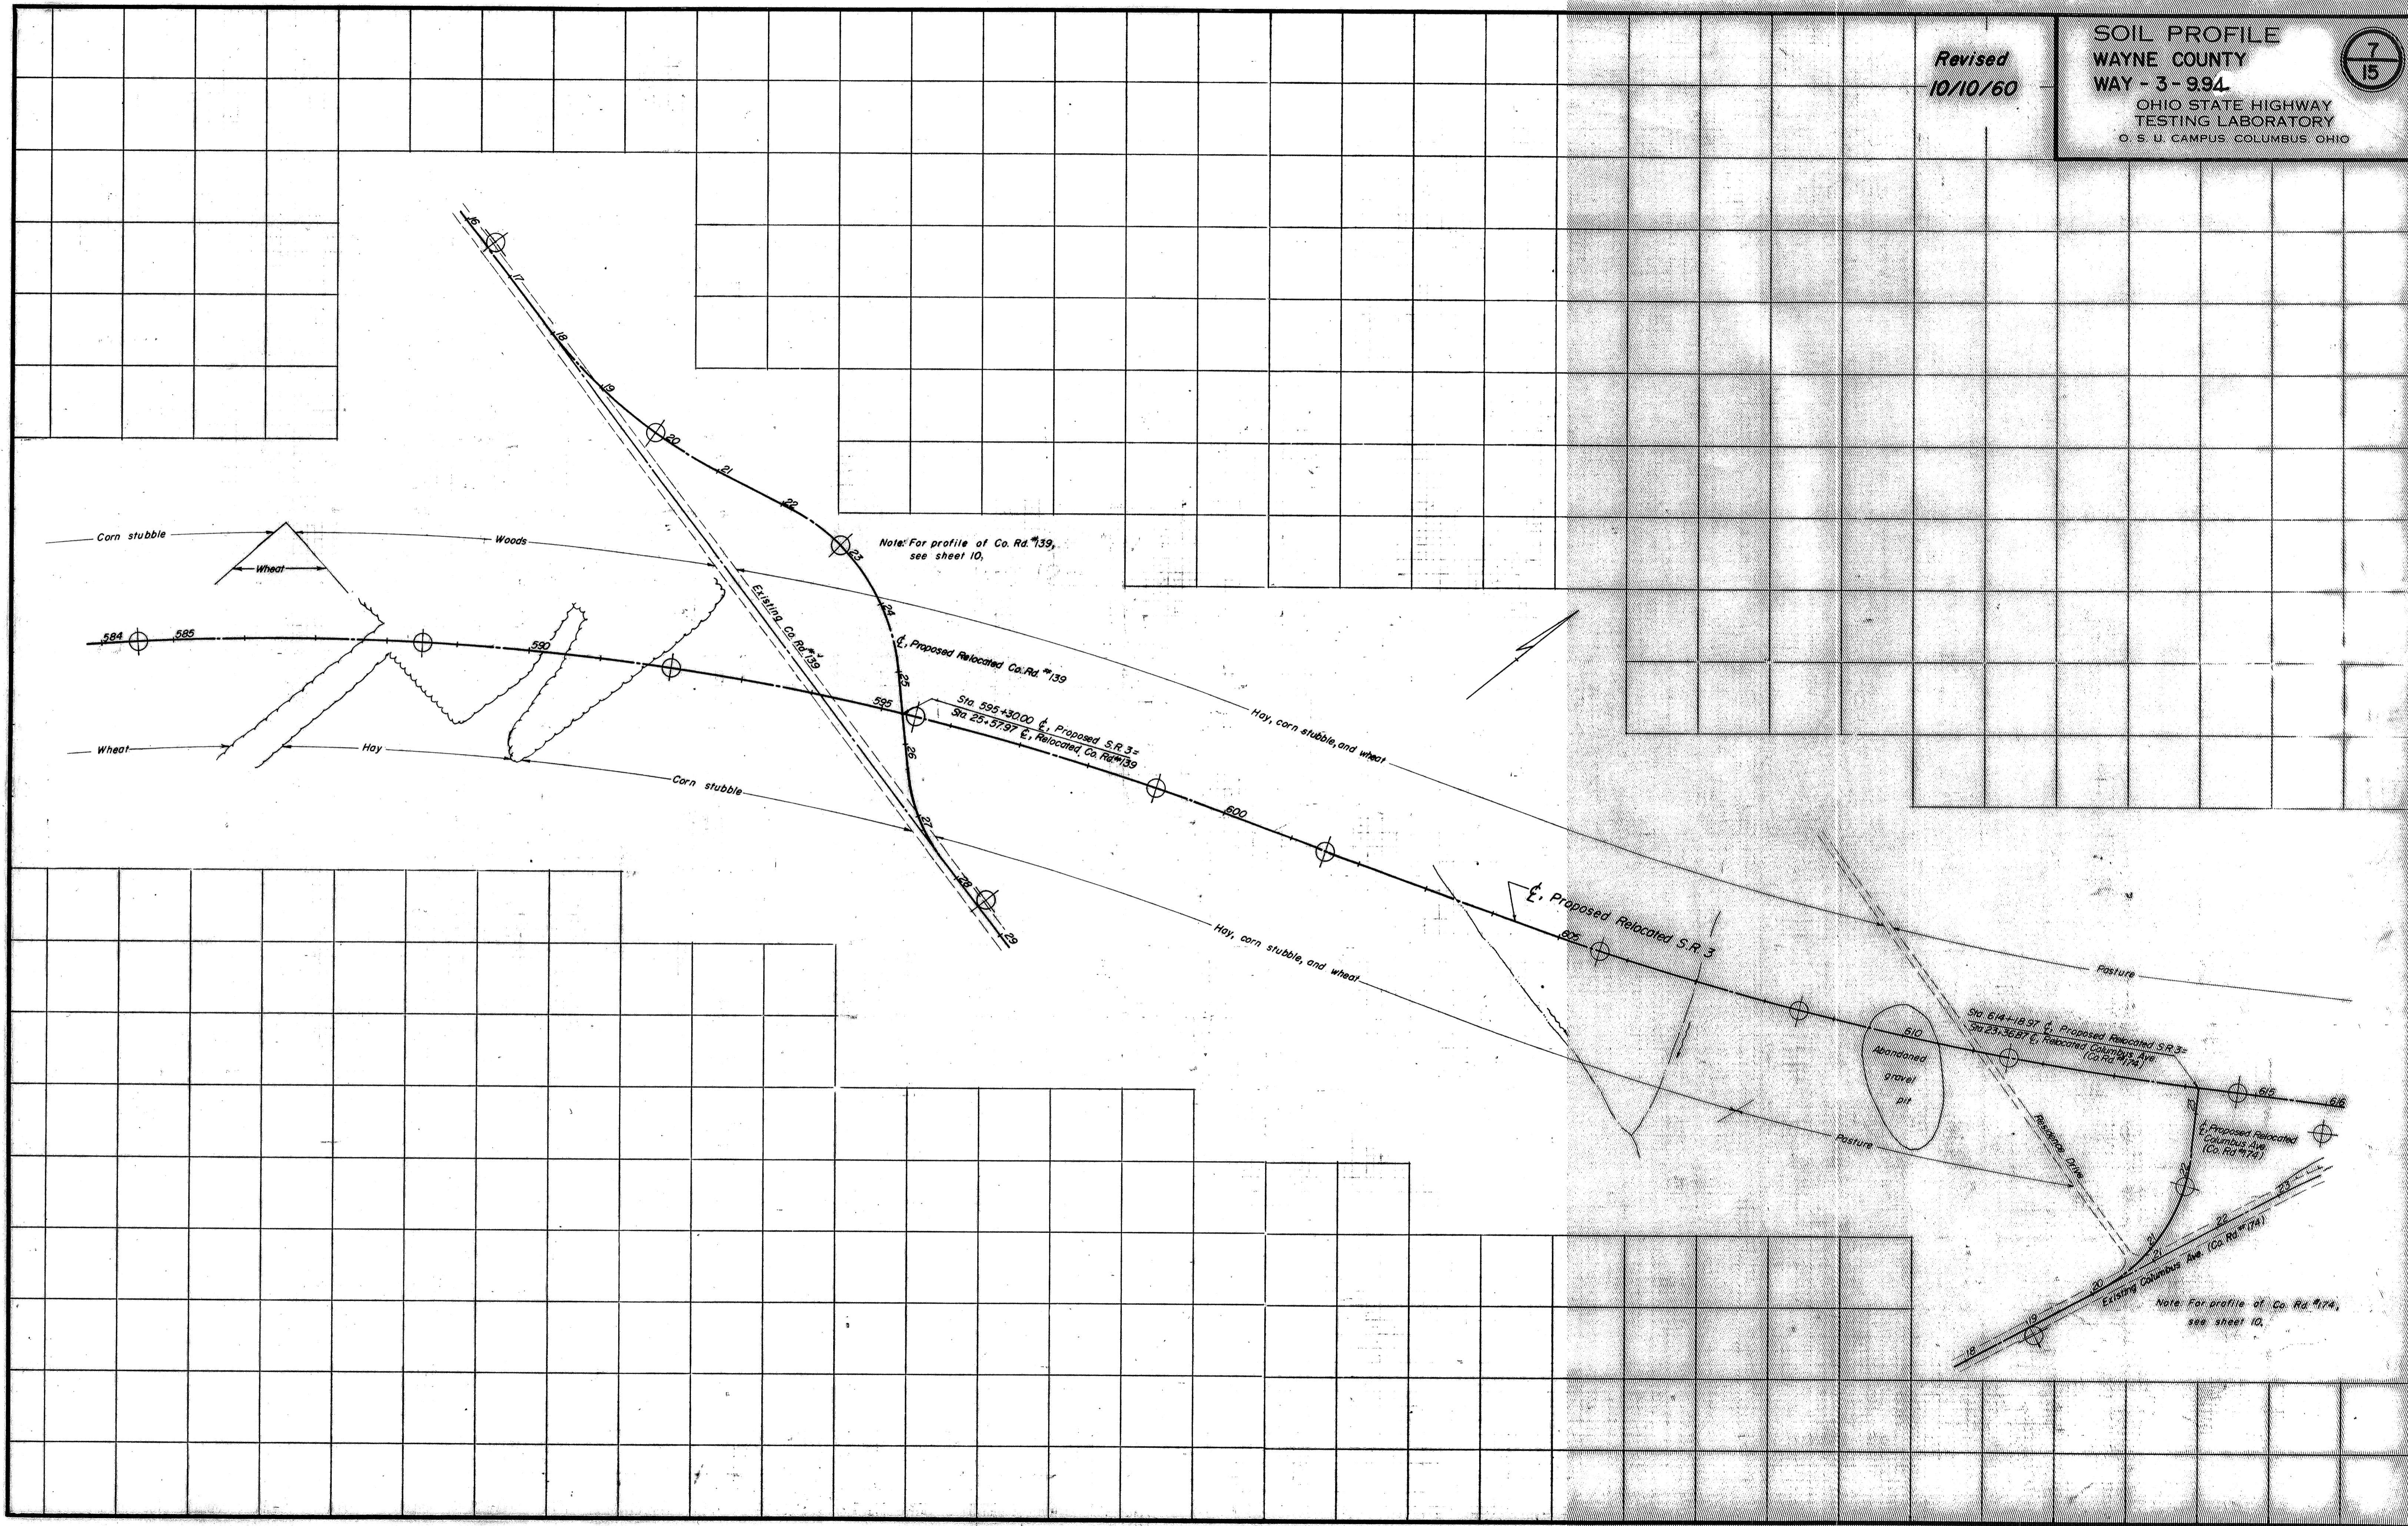


Revised
10/10/60

1020

SOIL PROFILE
WAYNE COUNTY
WAY - 3 - 994
OHIO STATE HIGHWAY
TESTING LABORATORY
O. S. U. CAMPUS, COLUMBUS, OHIO

8
15

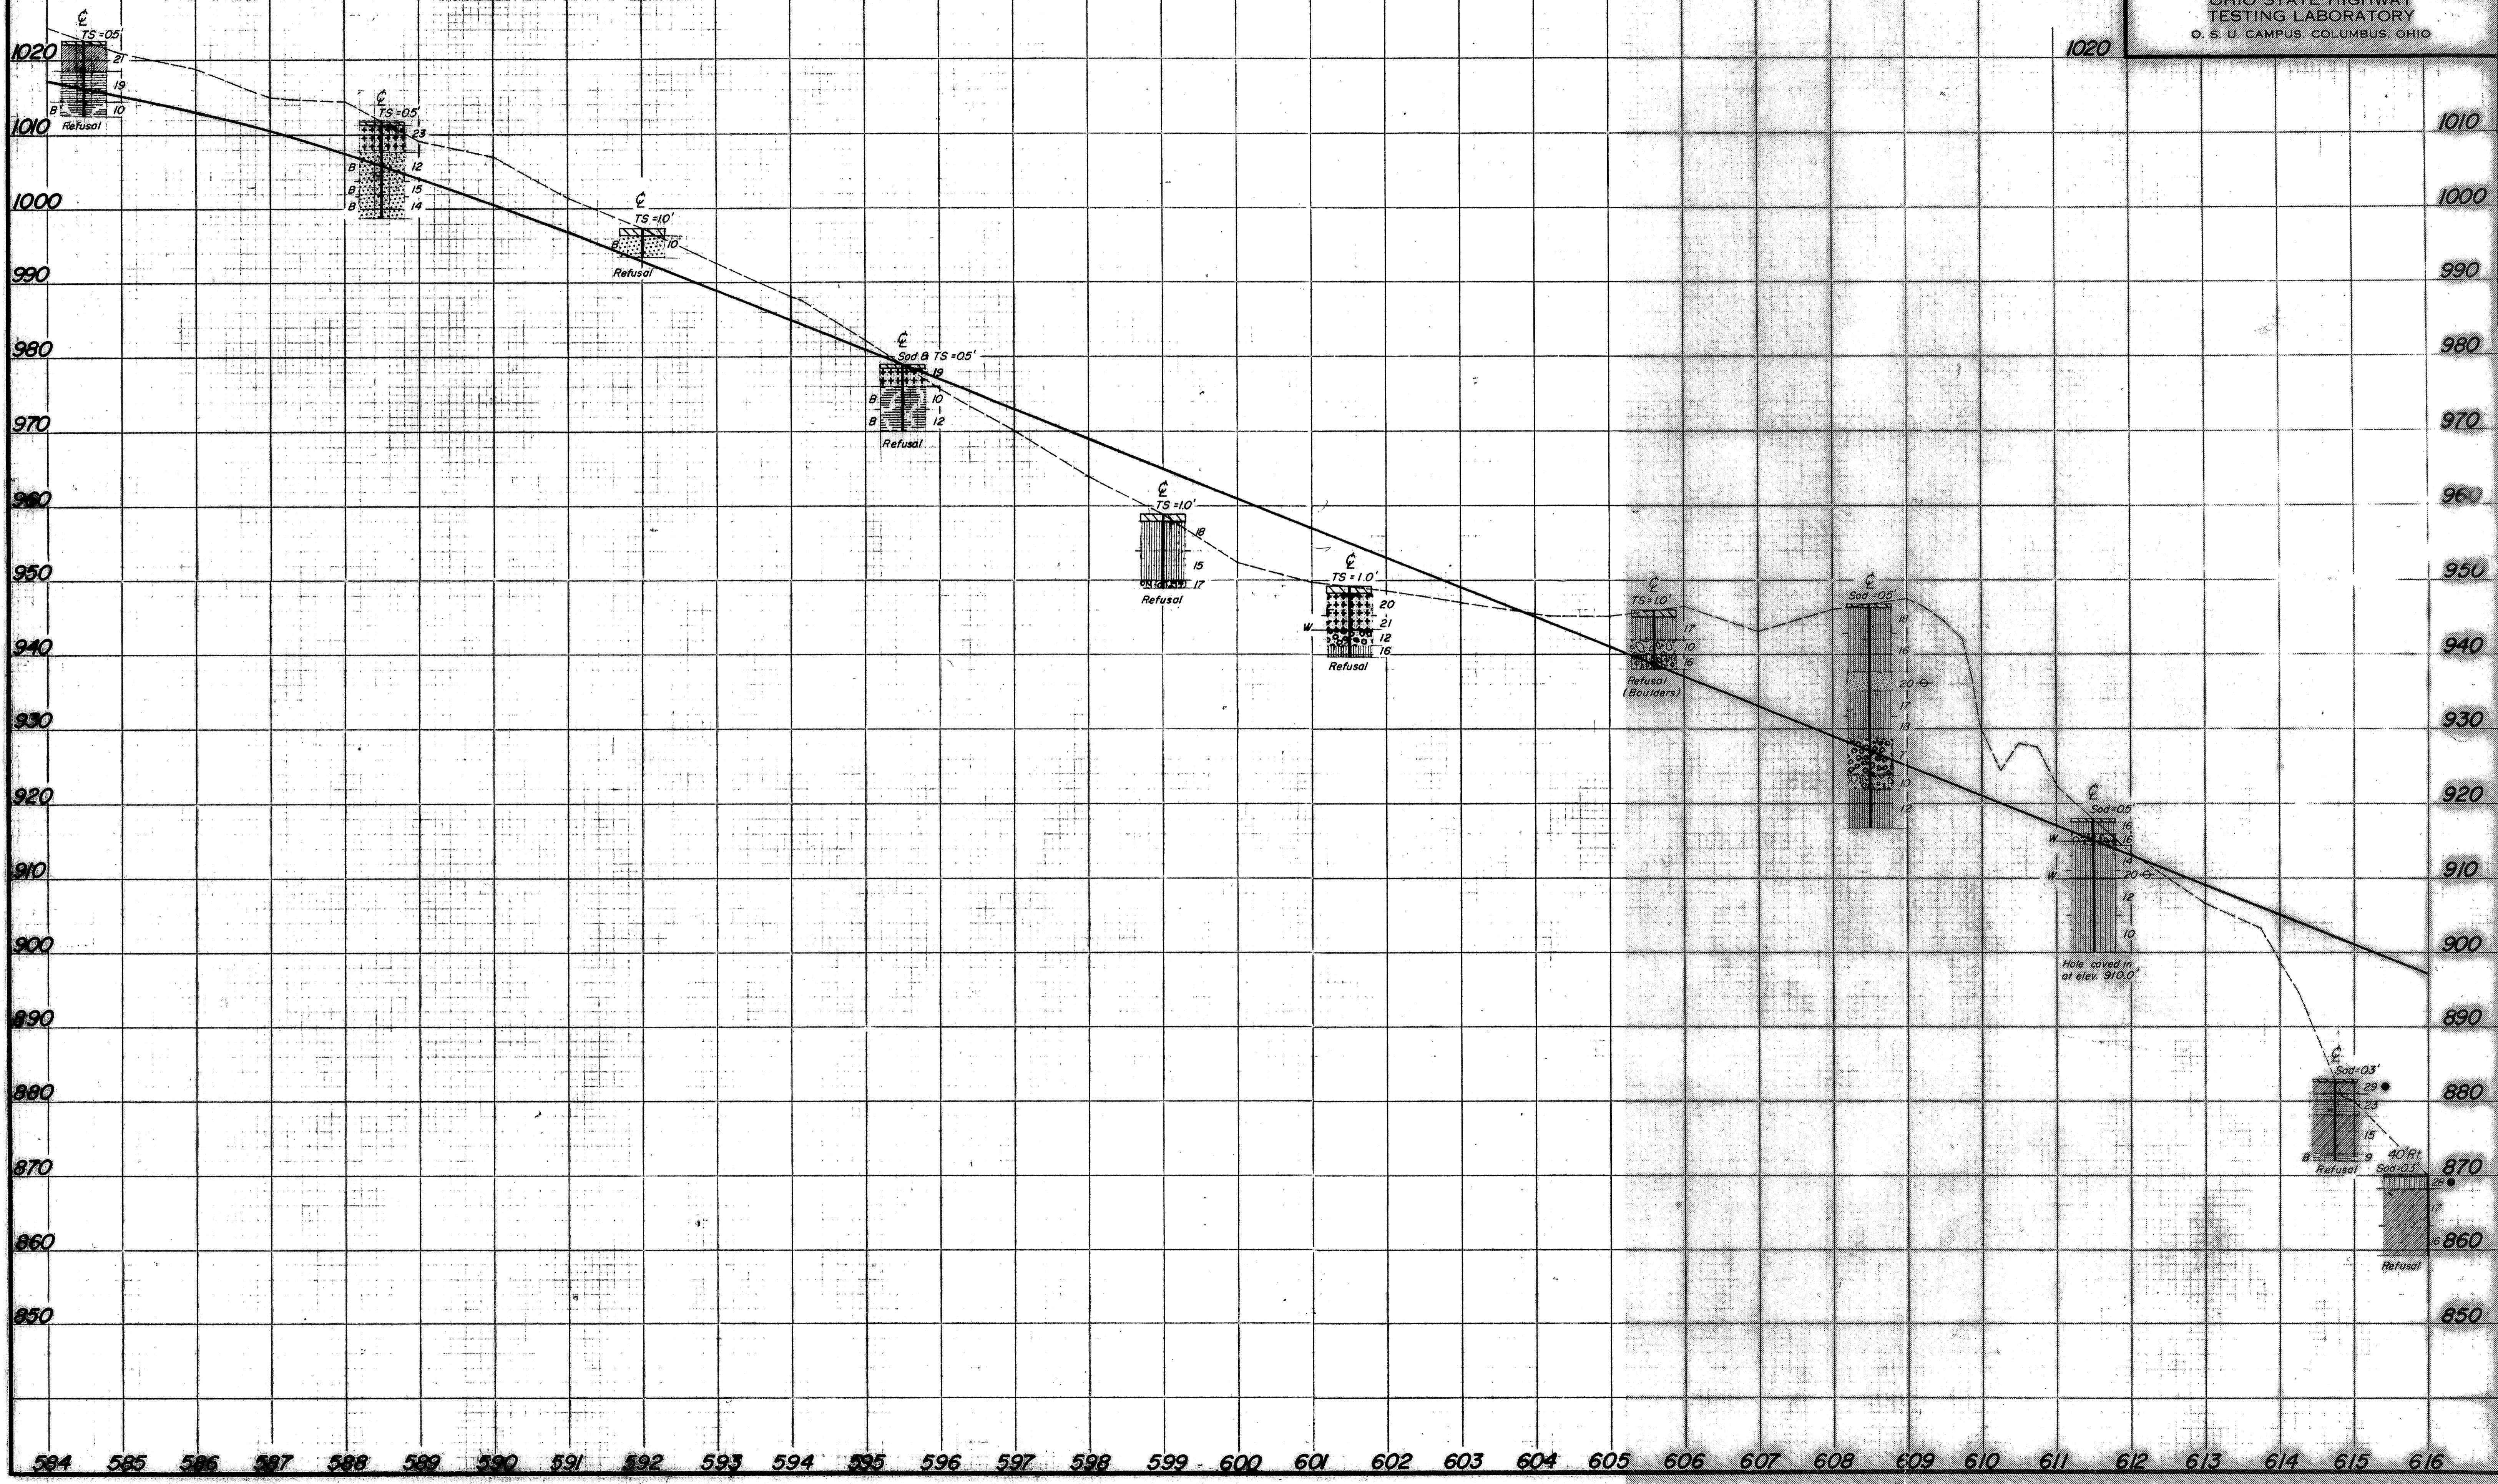



584 585 586 587 588 589 590 591 592 593 594 595 596 597 598 599 600 601 602 603 604 605 606 607 608 609 610 611 612 613 614 615 616

Revised
10/10/60


SOIL PROFILE
WAYNE COUNTY
WAY-3-9.94

9
15


OHIO STATE HIGHWAY
TESTING LABORATORY
O. S. U. CAMPUS, COLUMBUS, OHIO

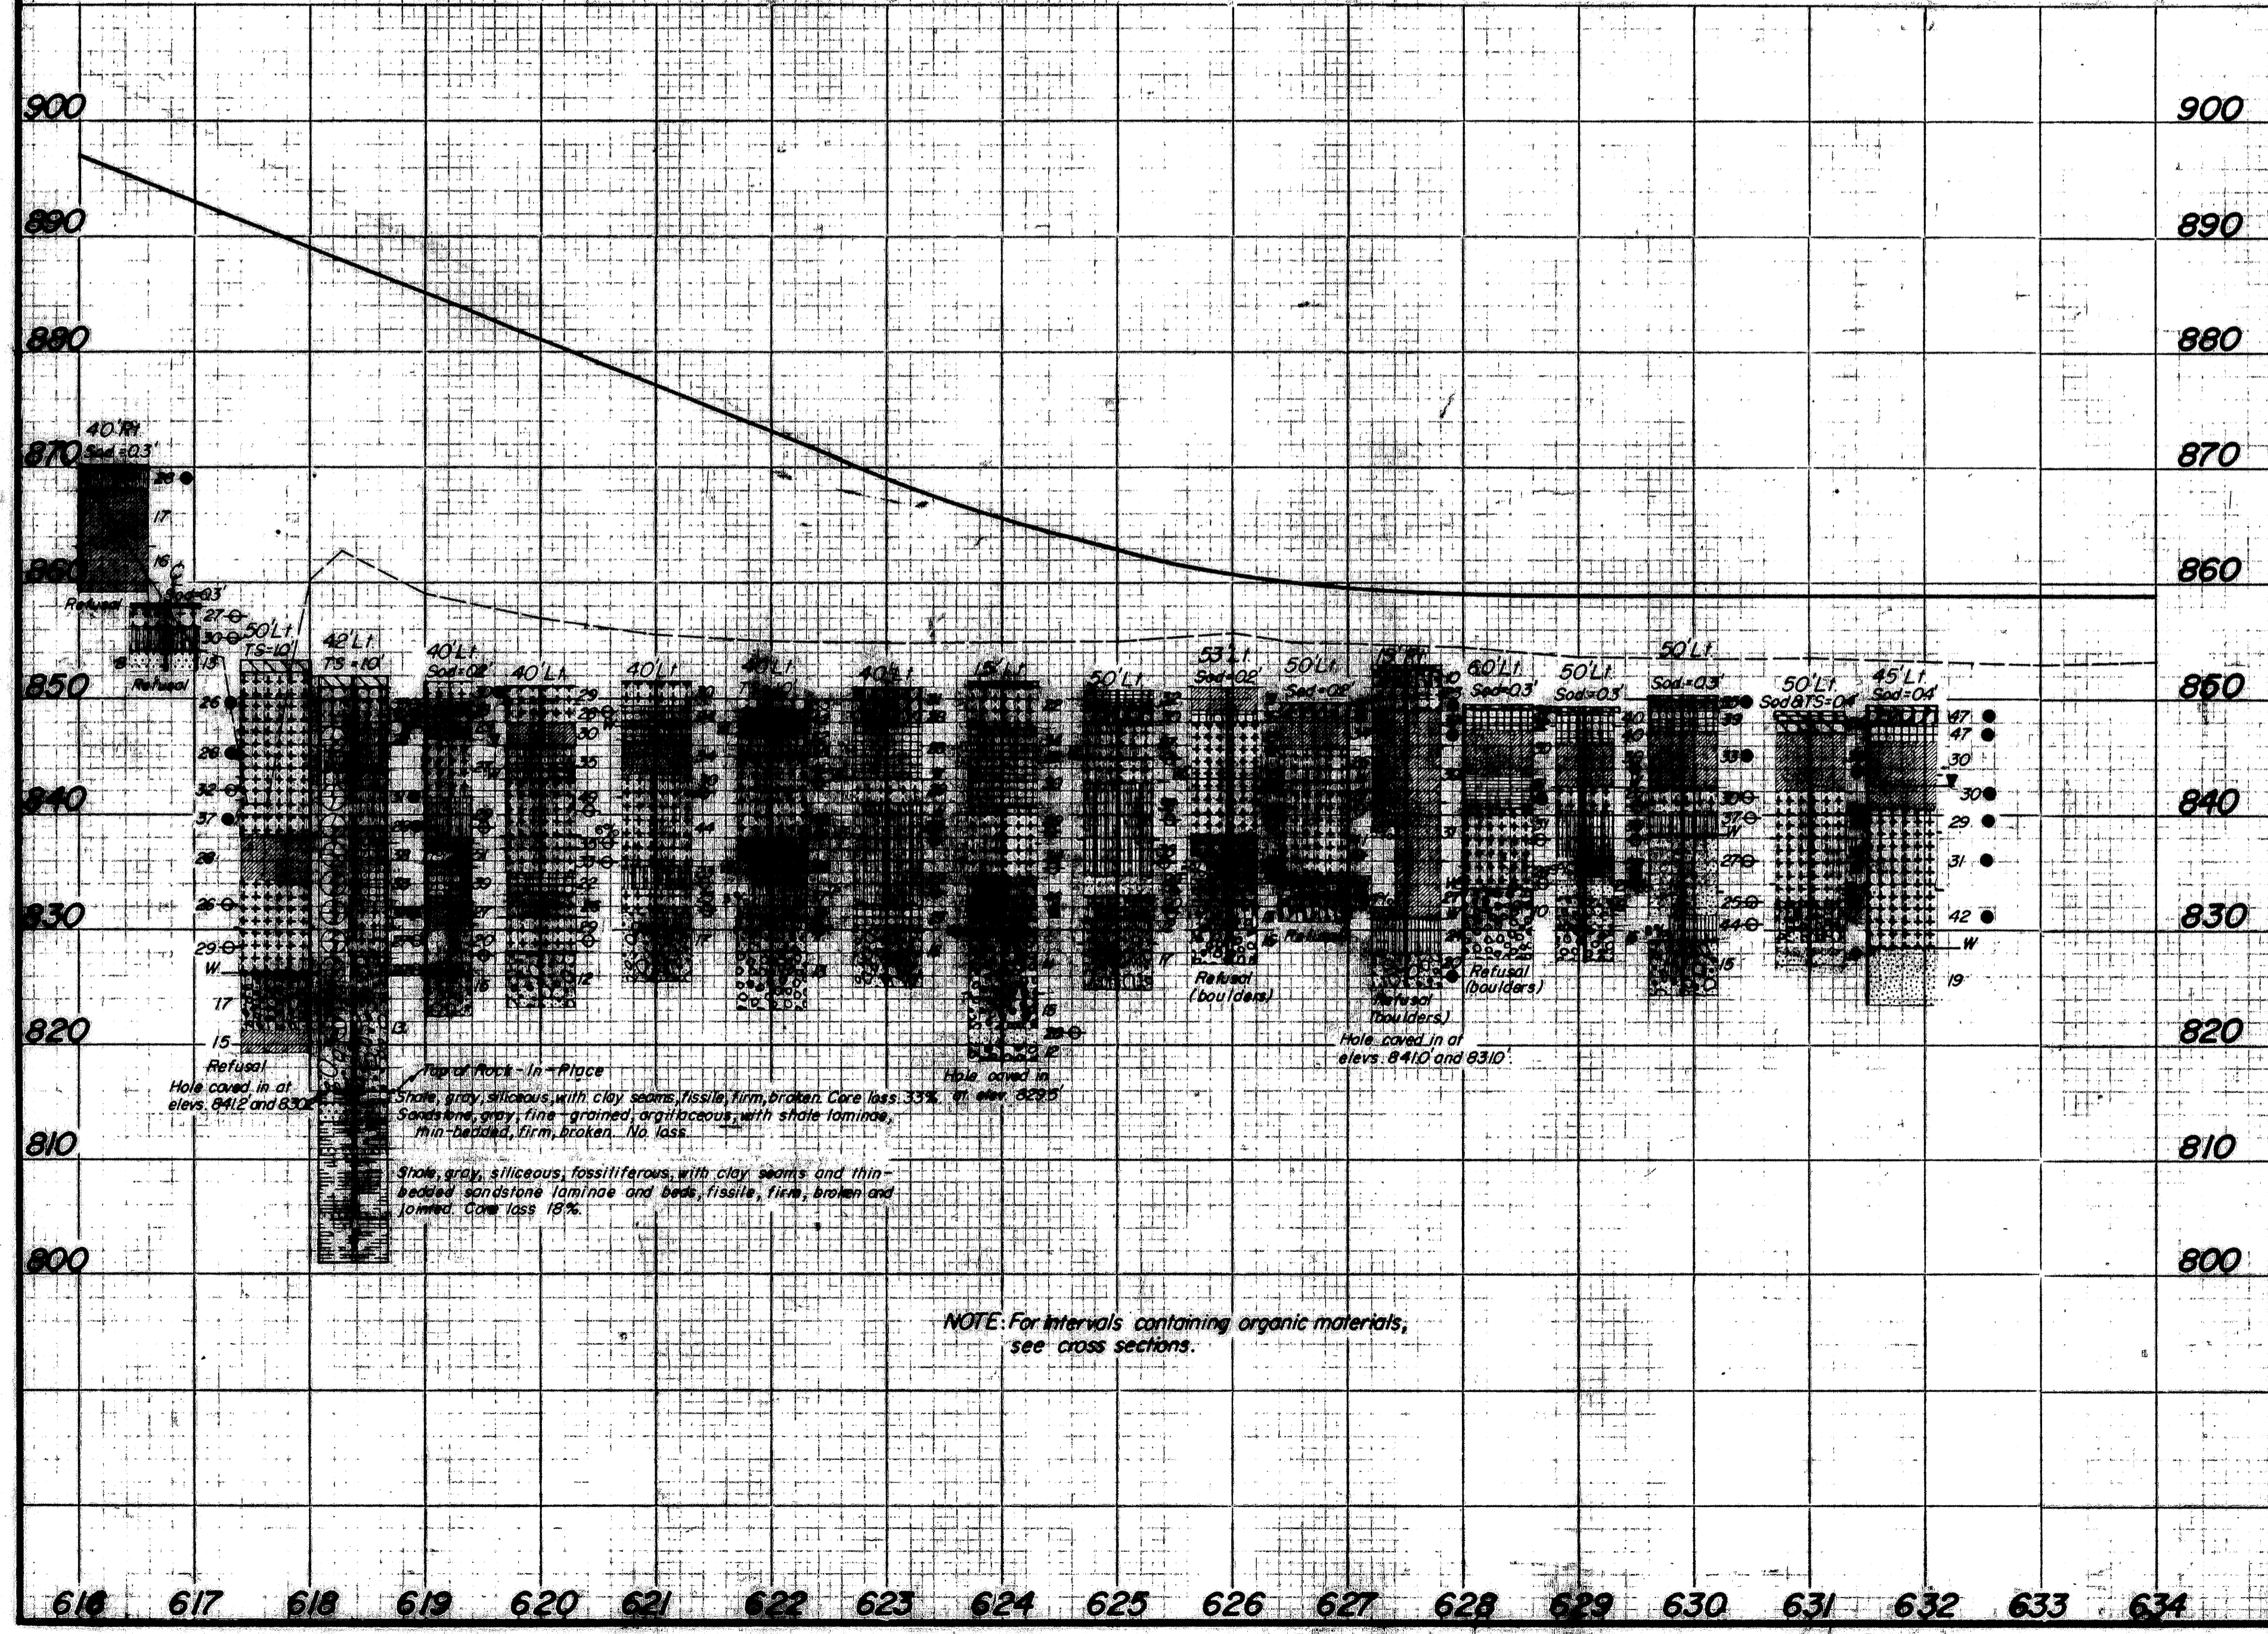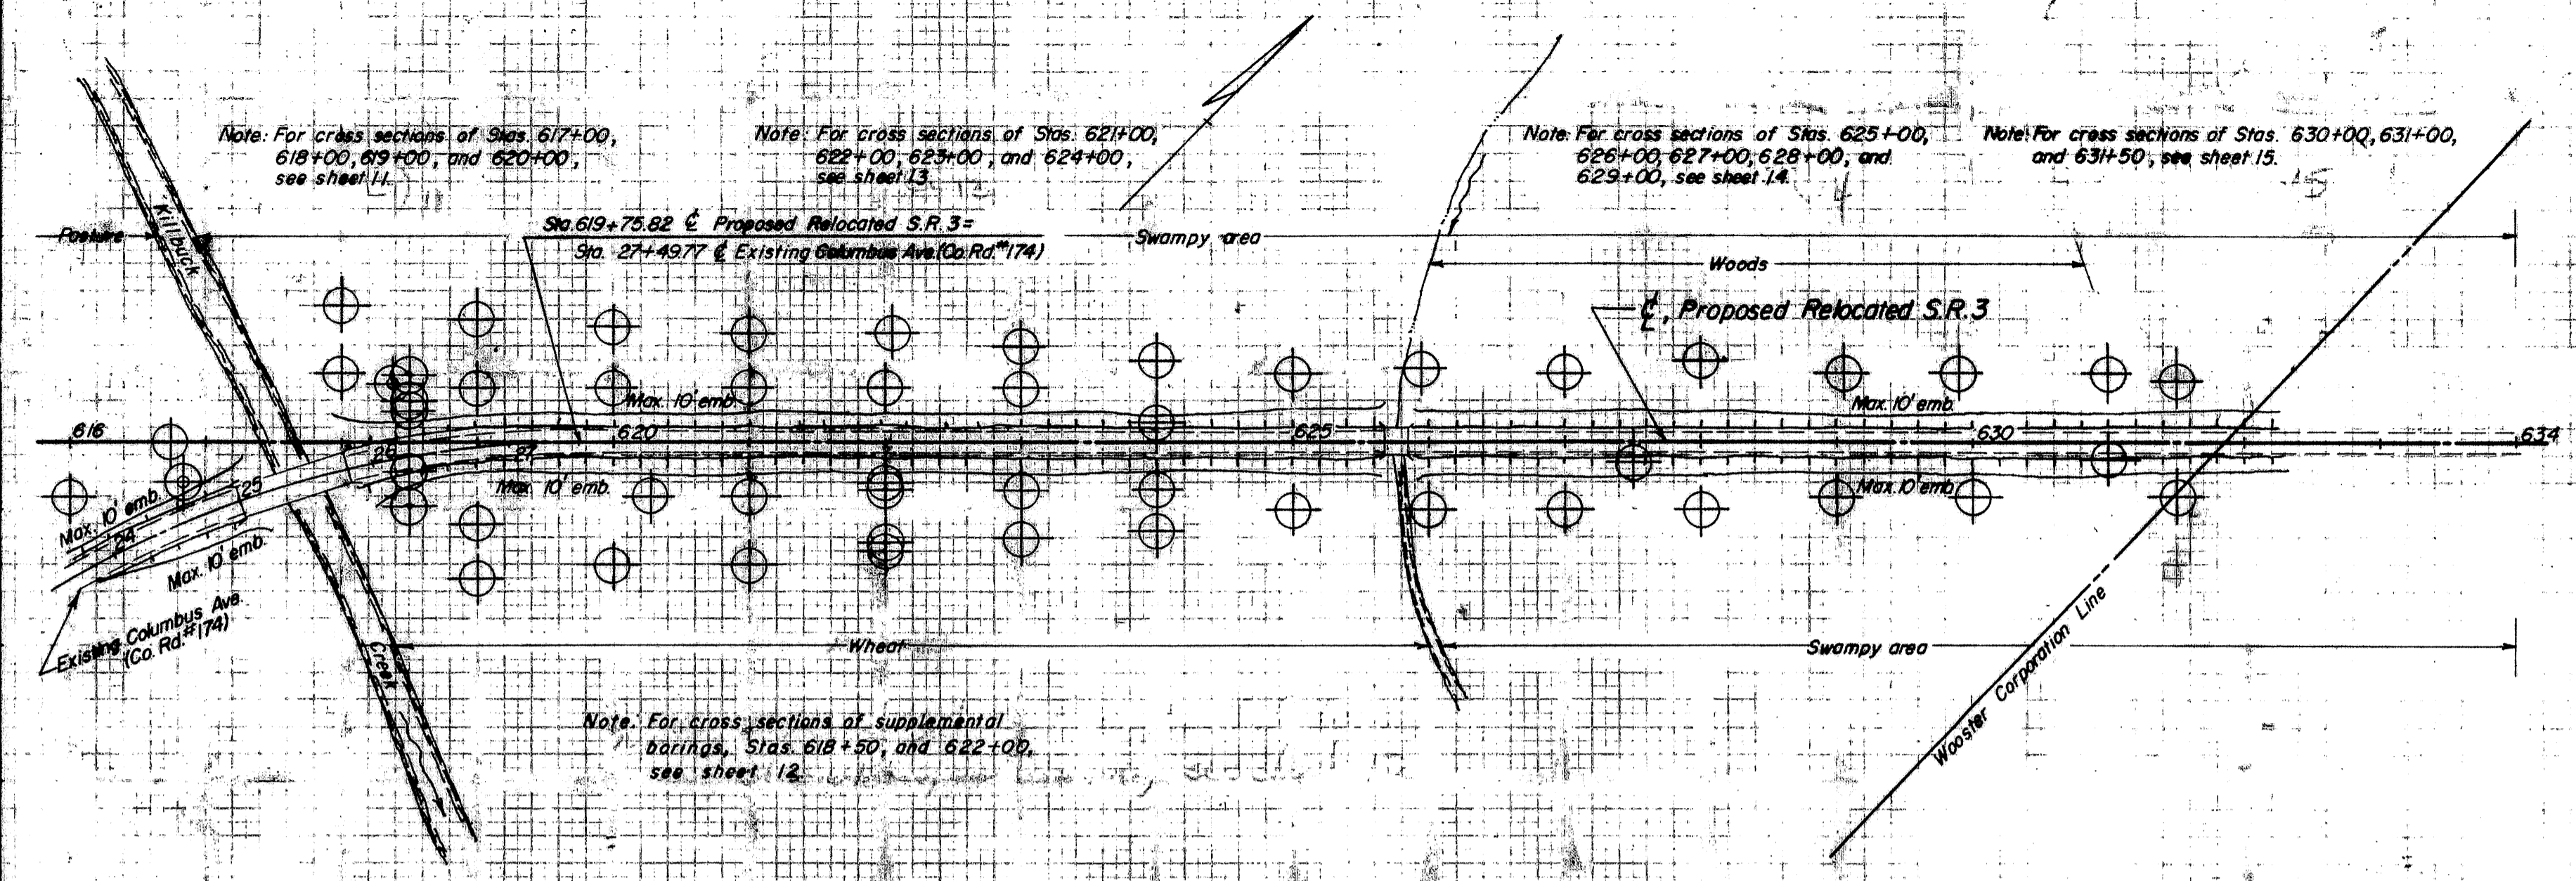


Proposed Relocated Columbus Ave. (Co. Rd. 774)

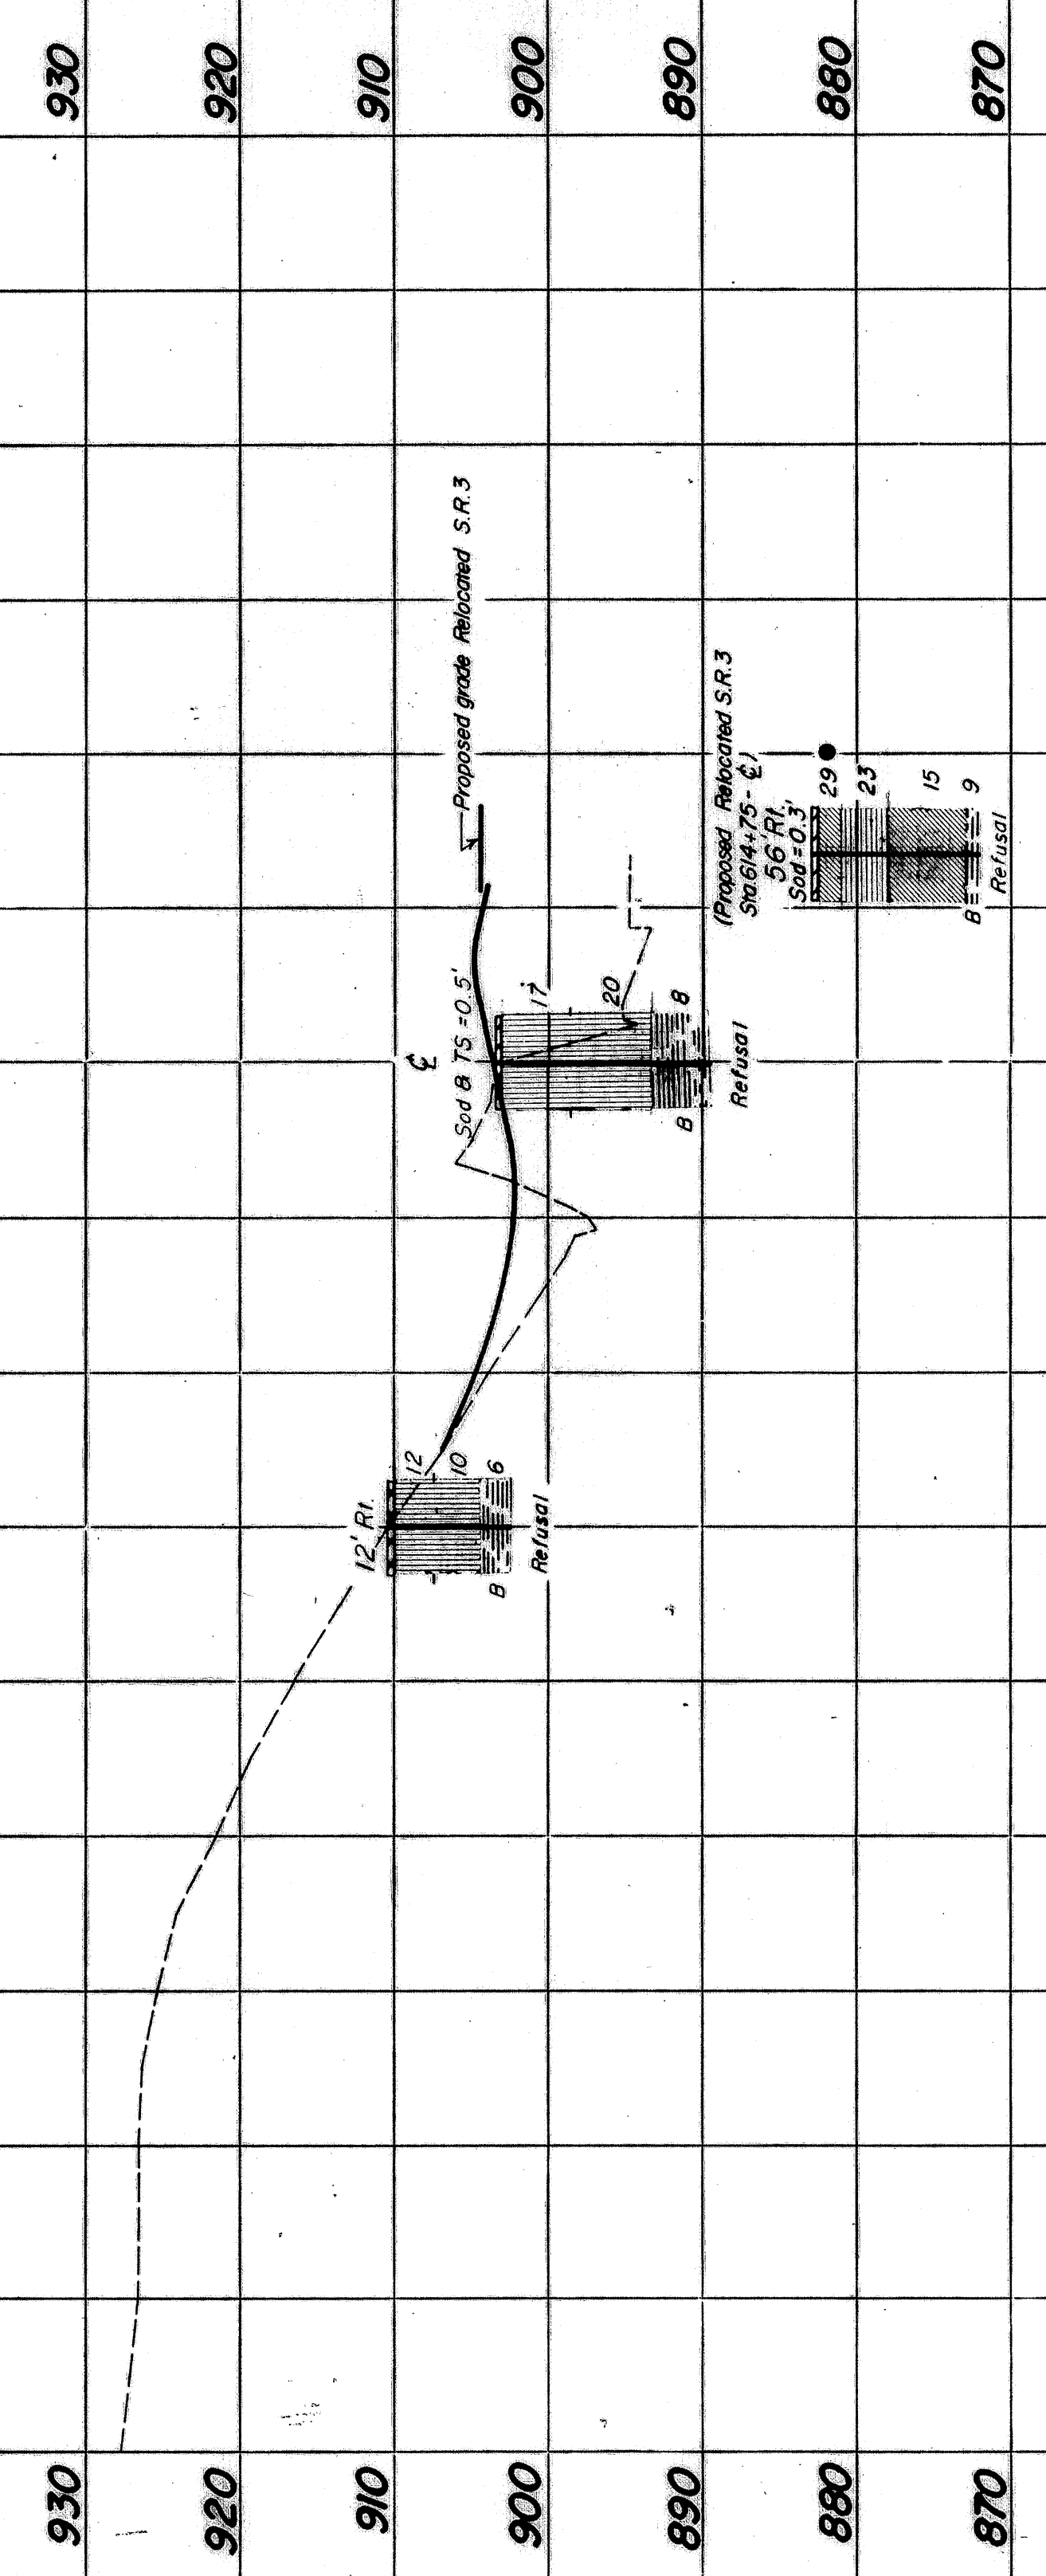


Proposed Relocated Co. Rd. 739

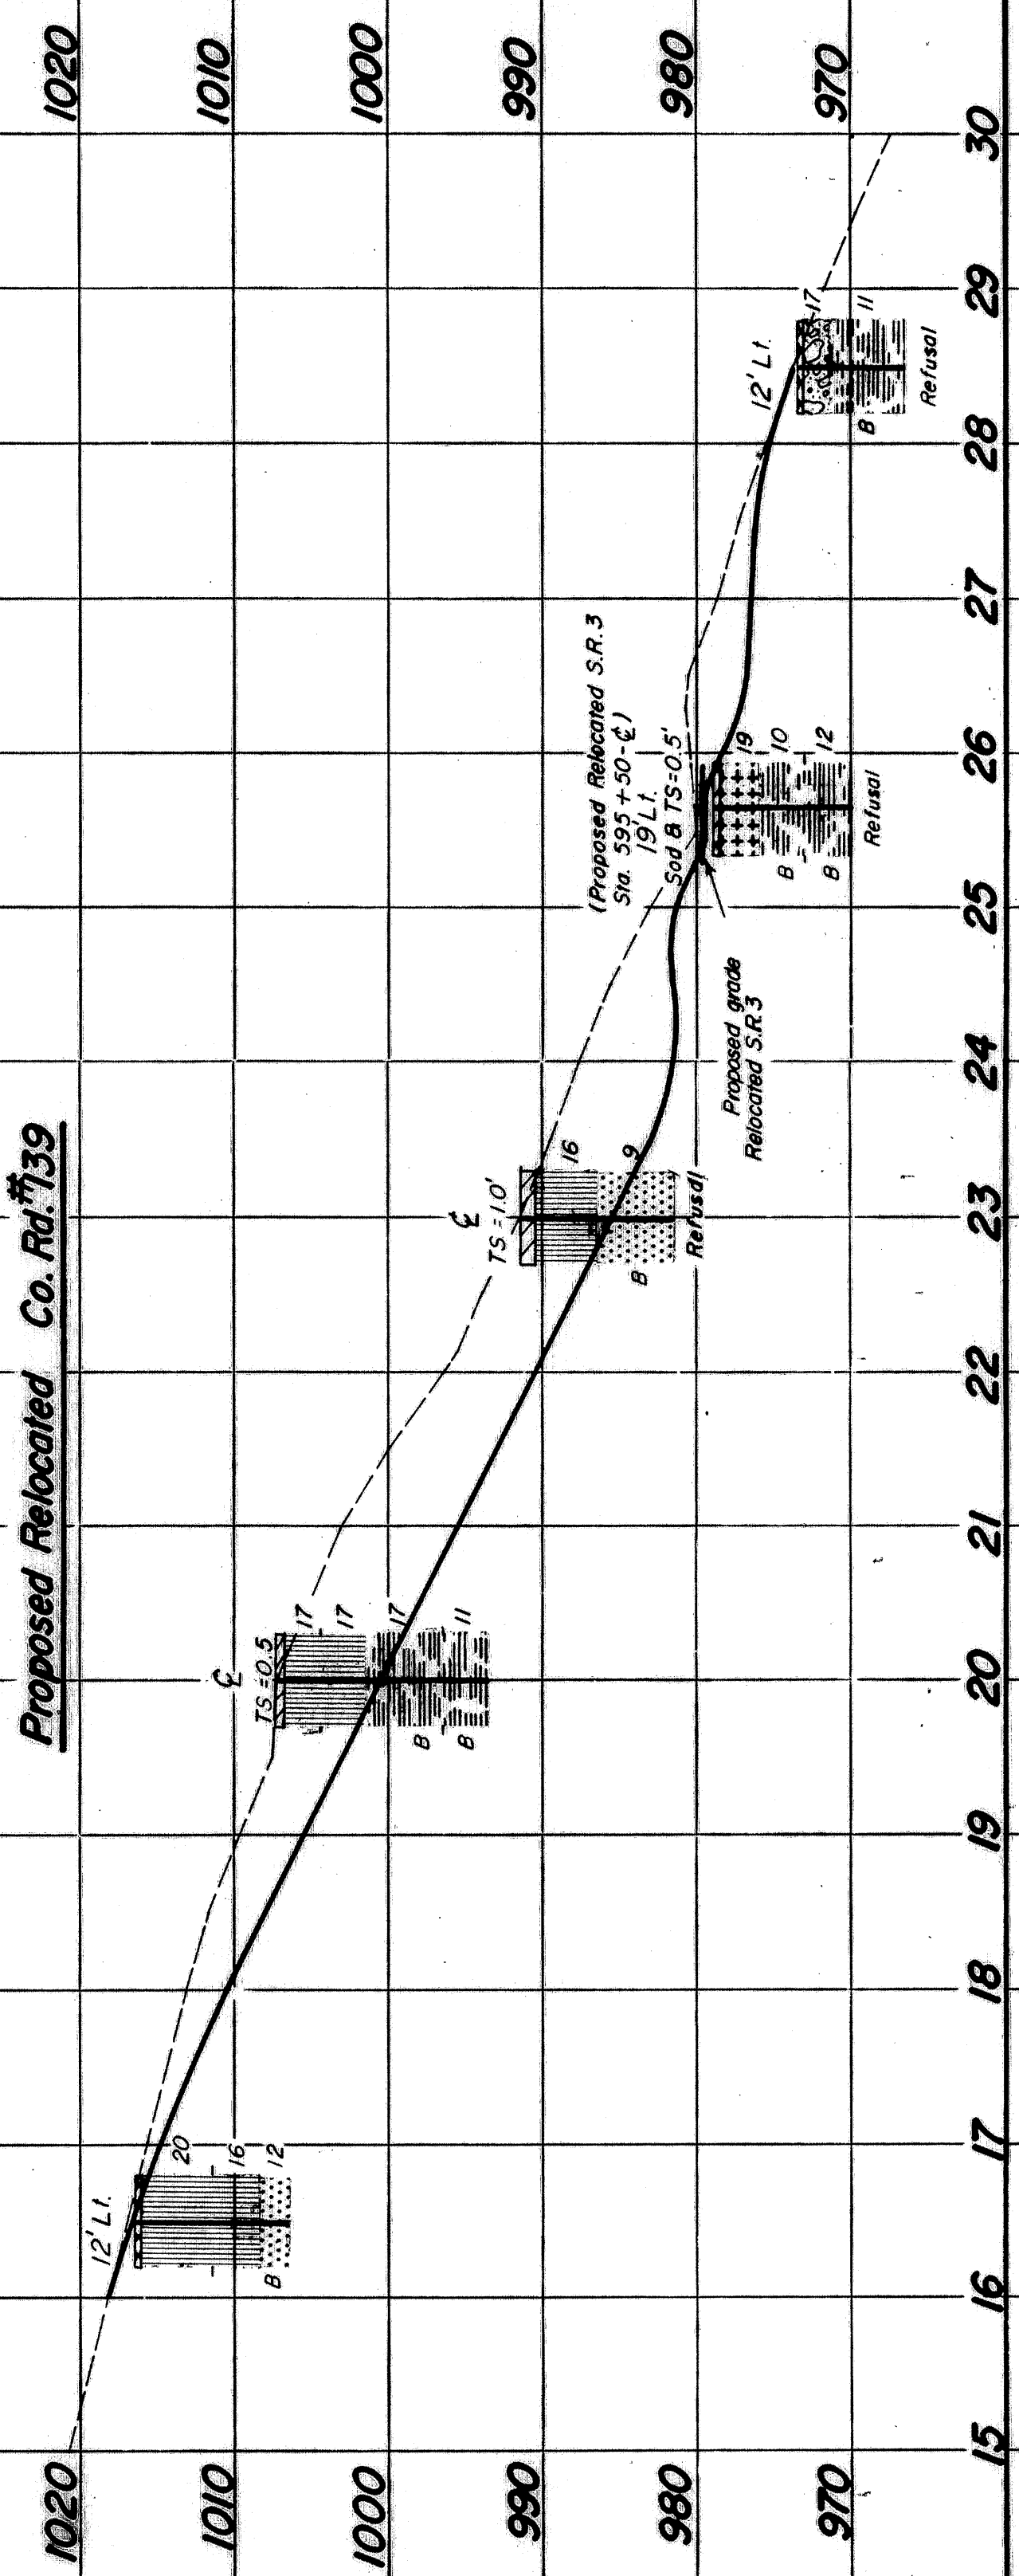

Existing S.R. 95

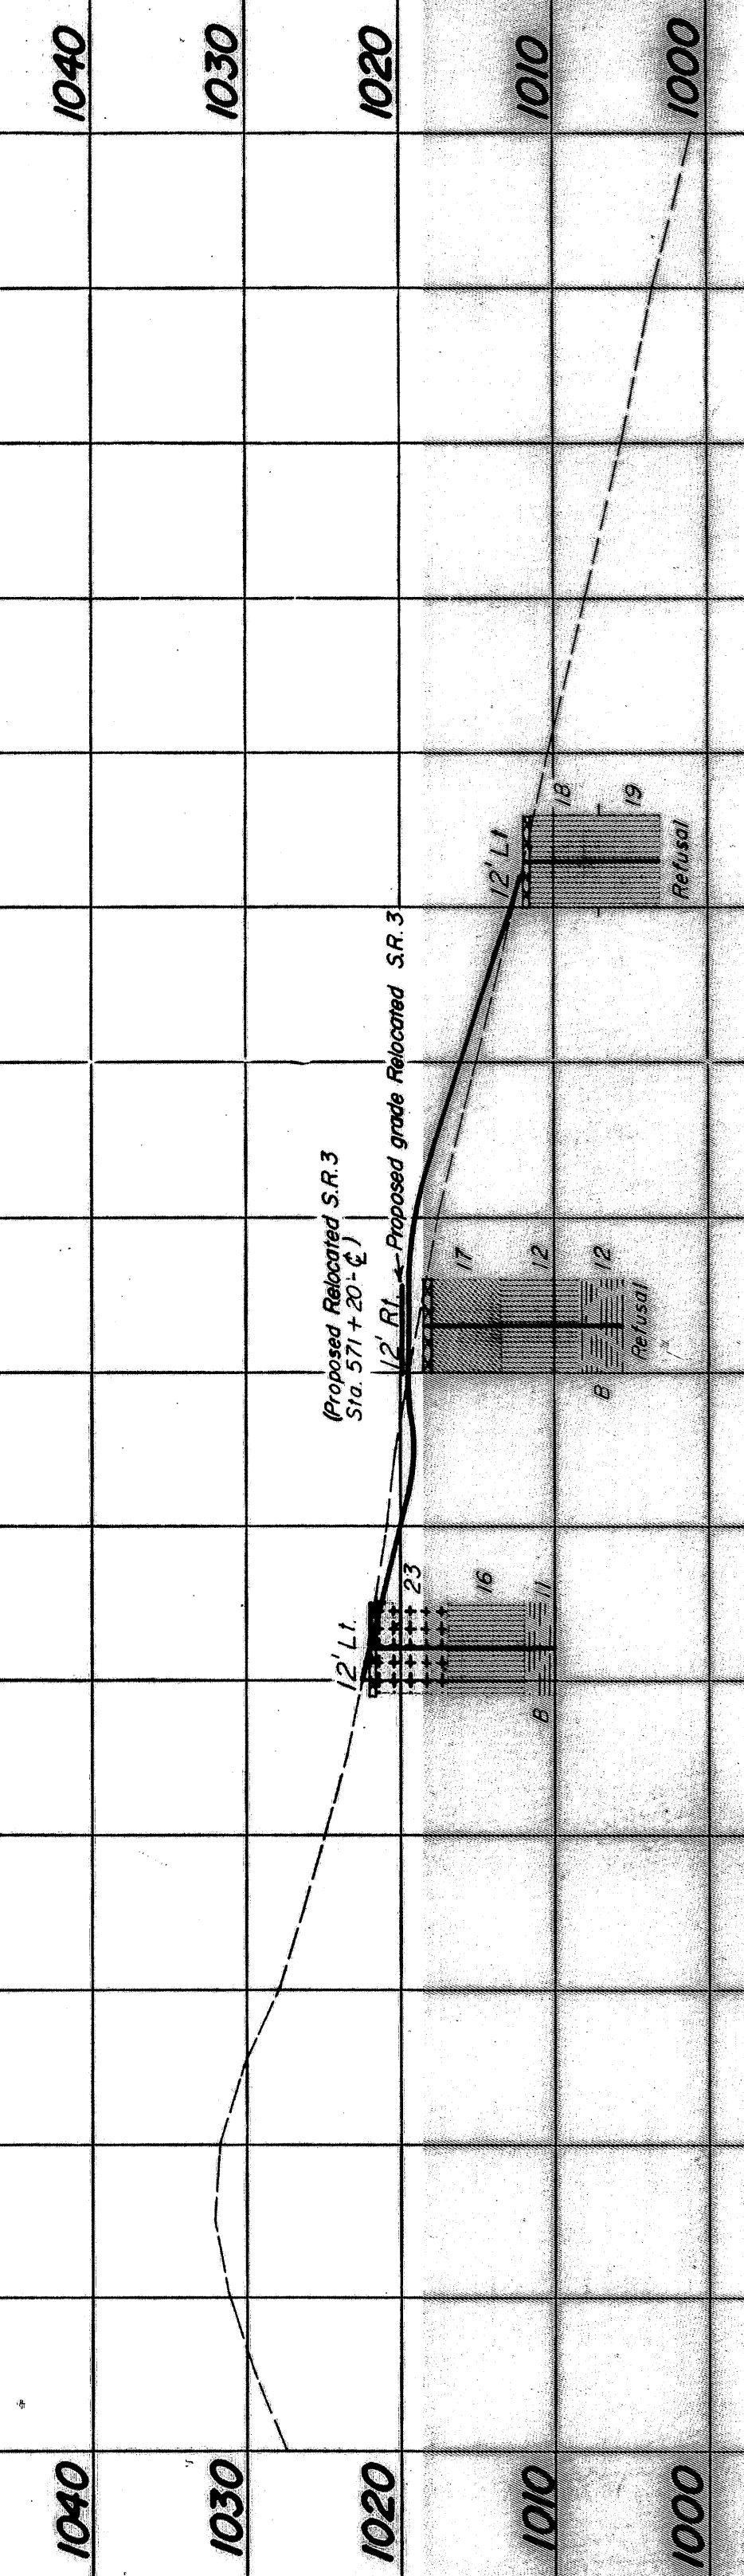


Existing S.R. 226

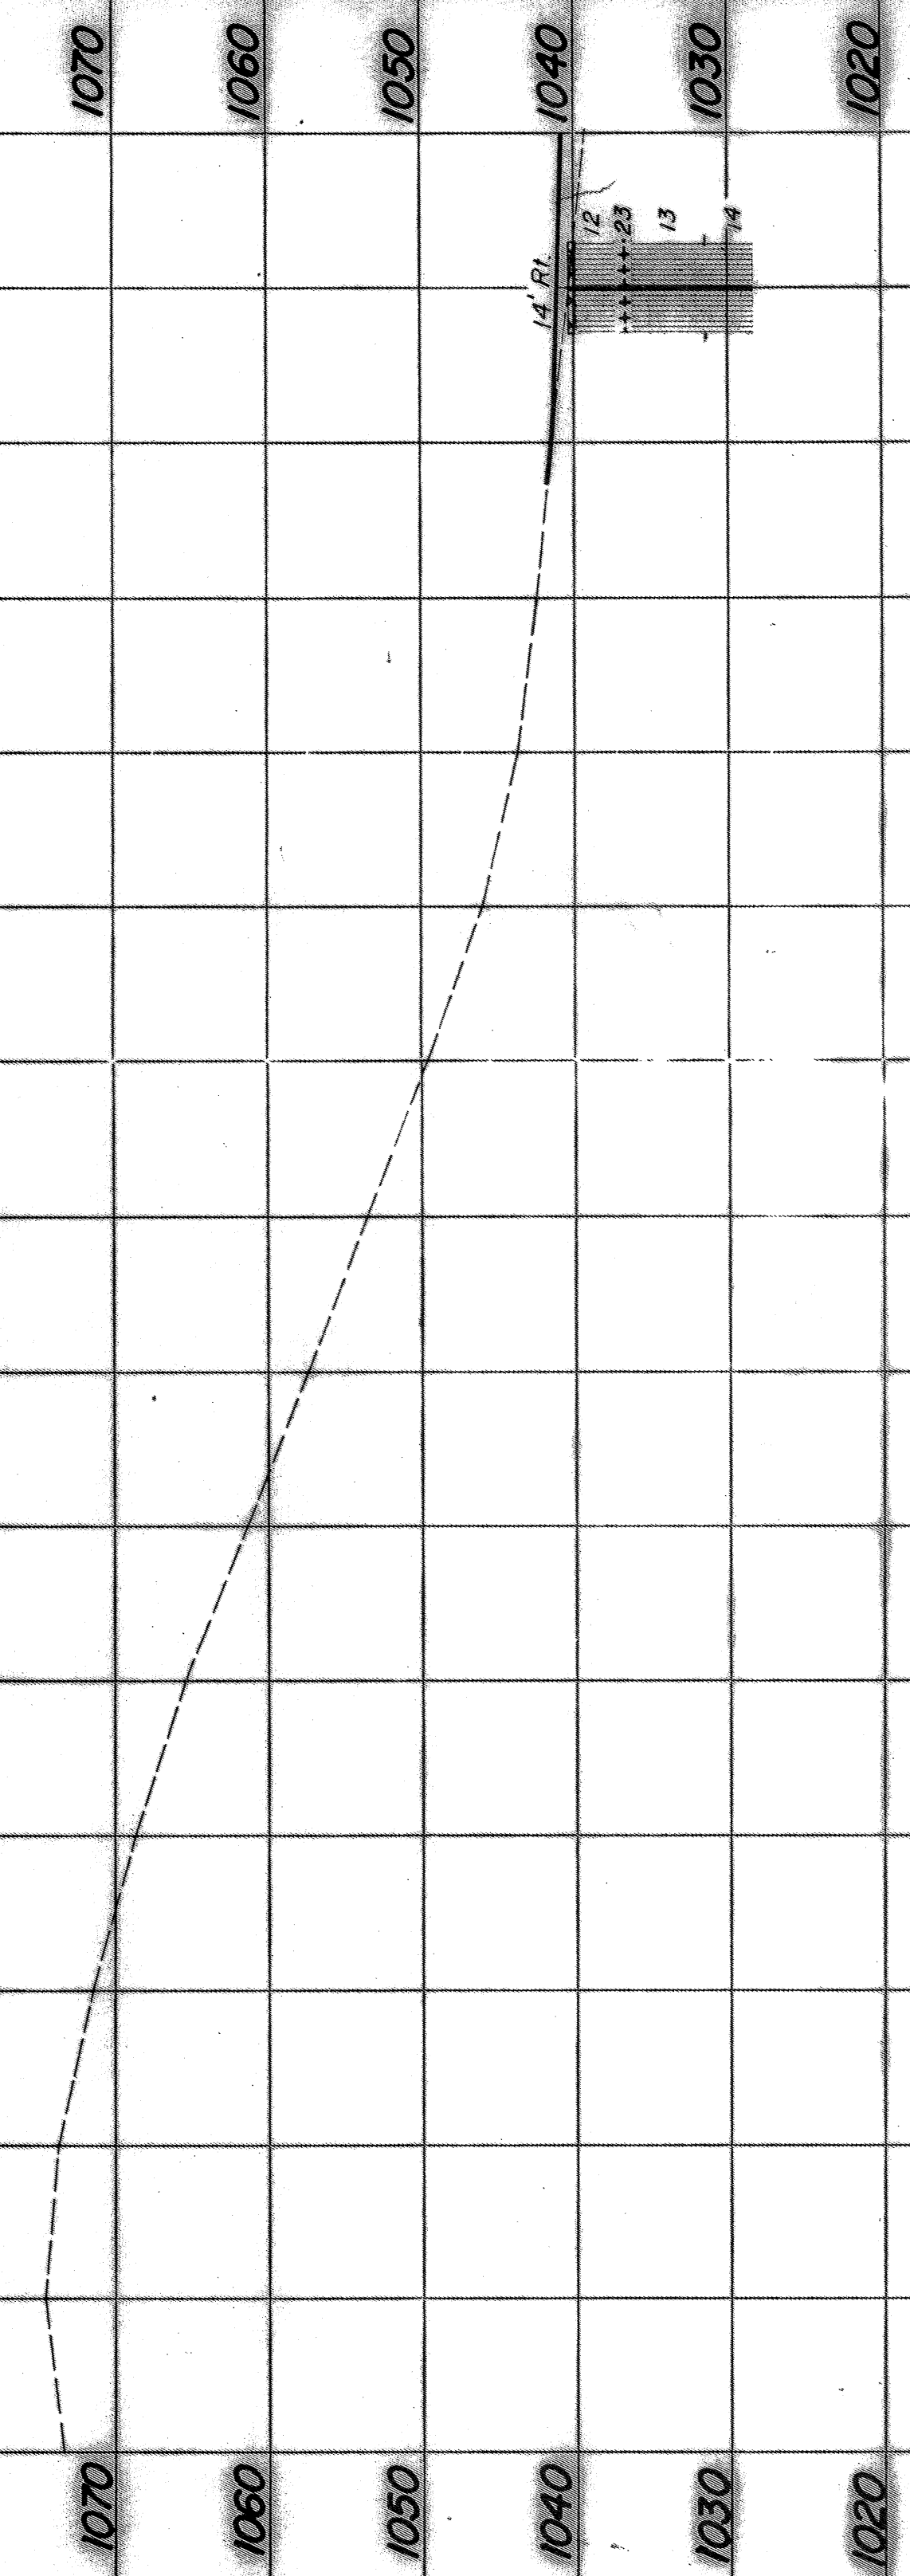

Revised
10/10/60

Revised
10/10/60

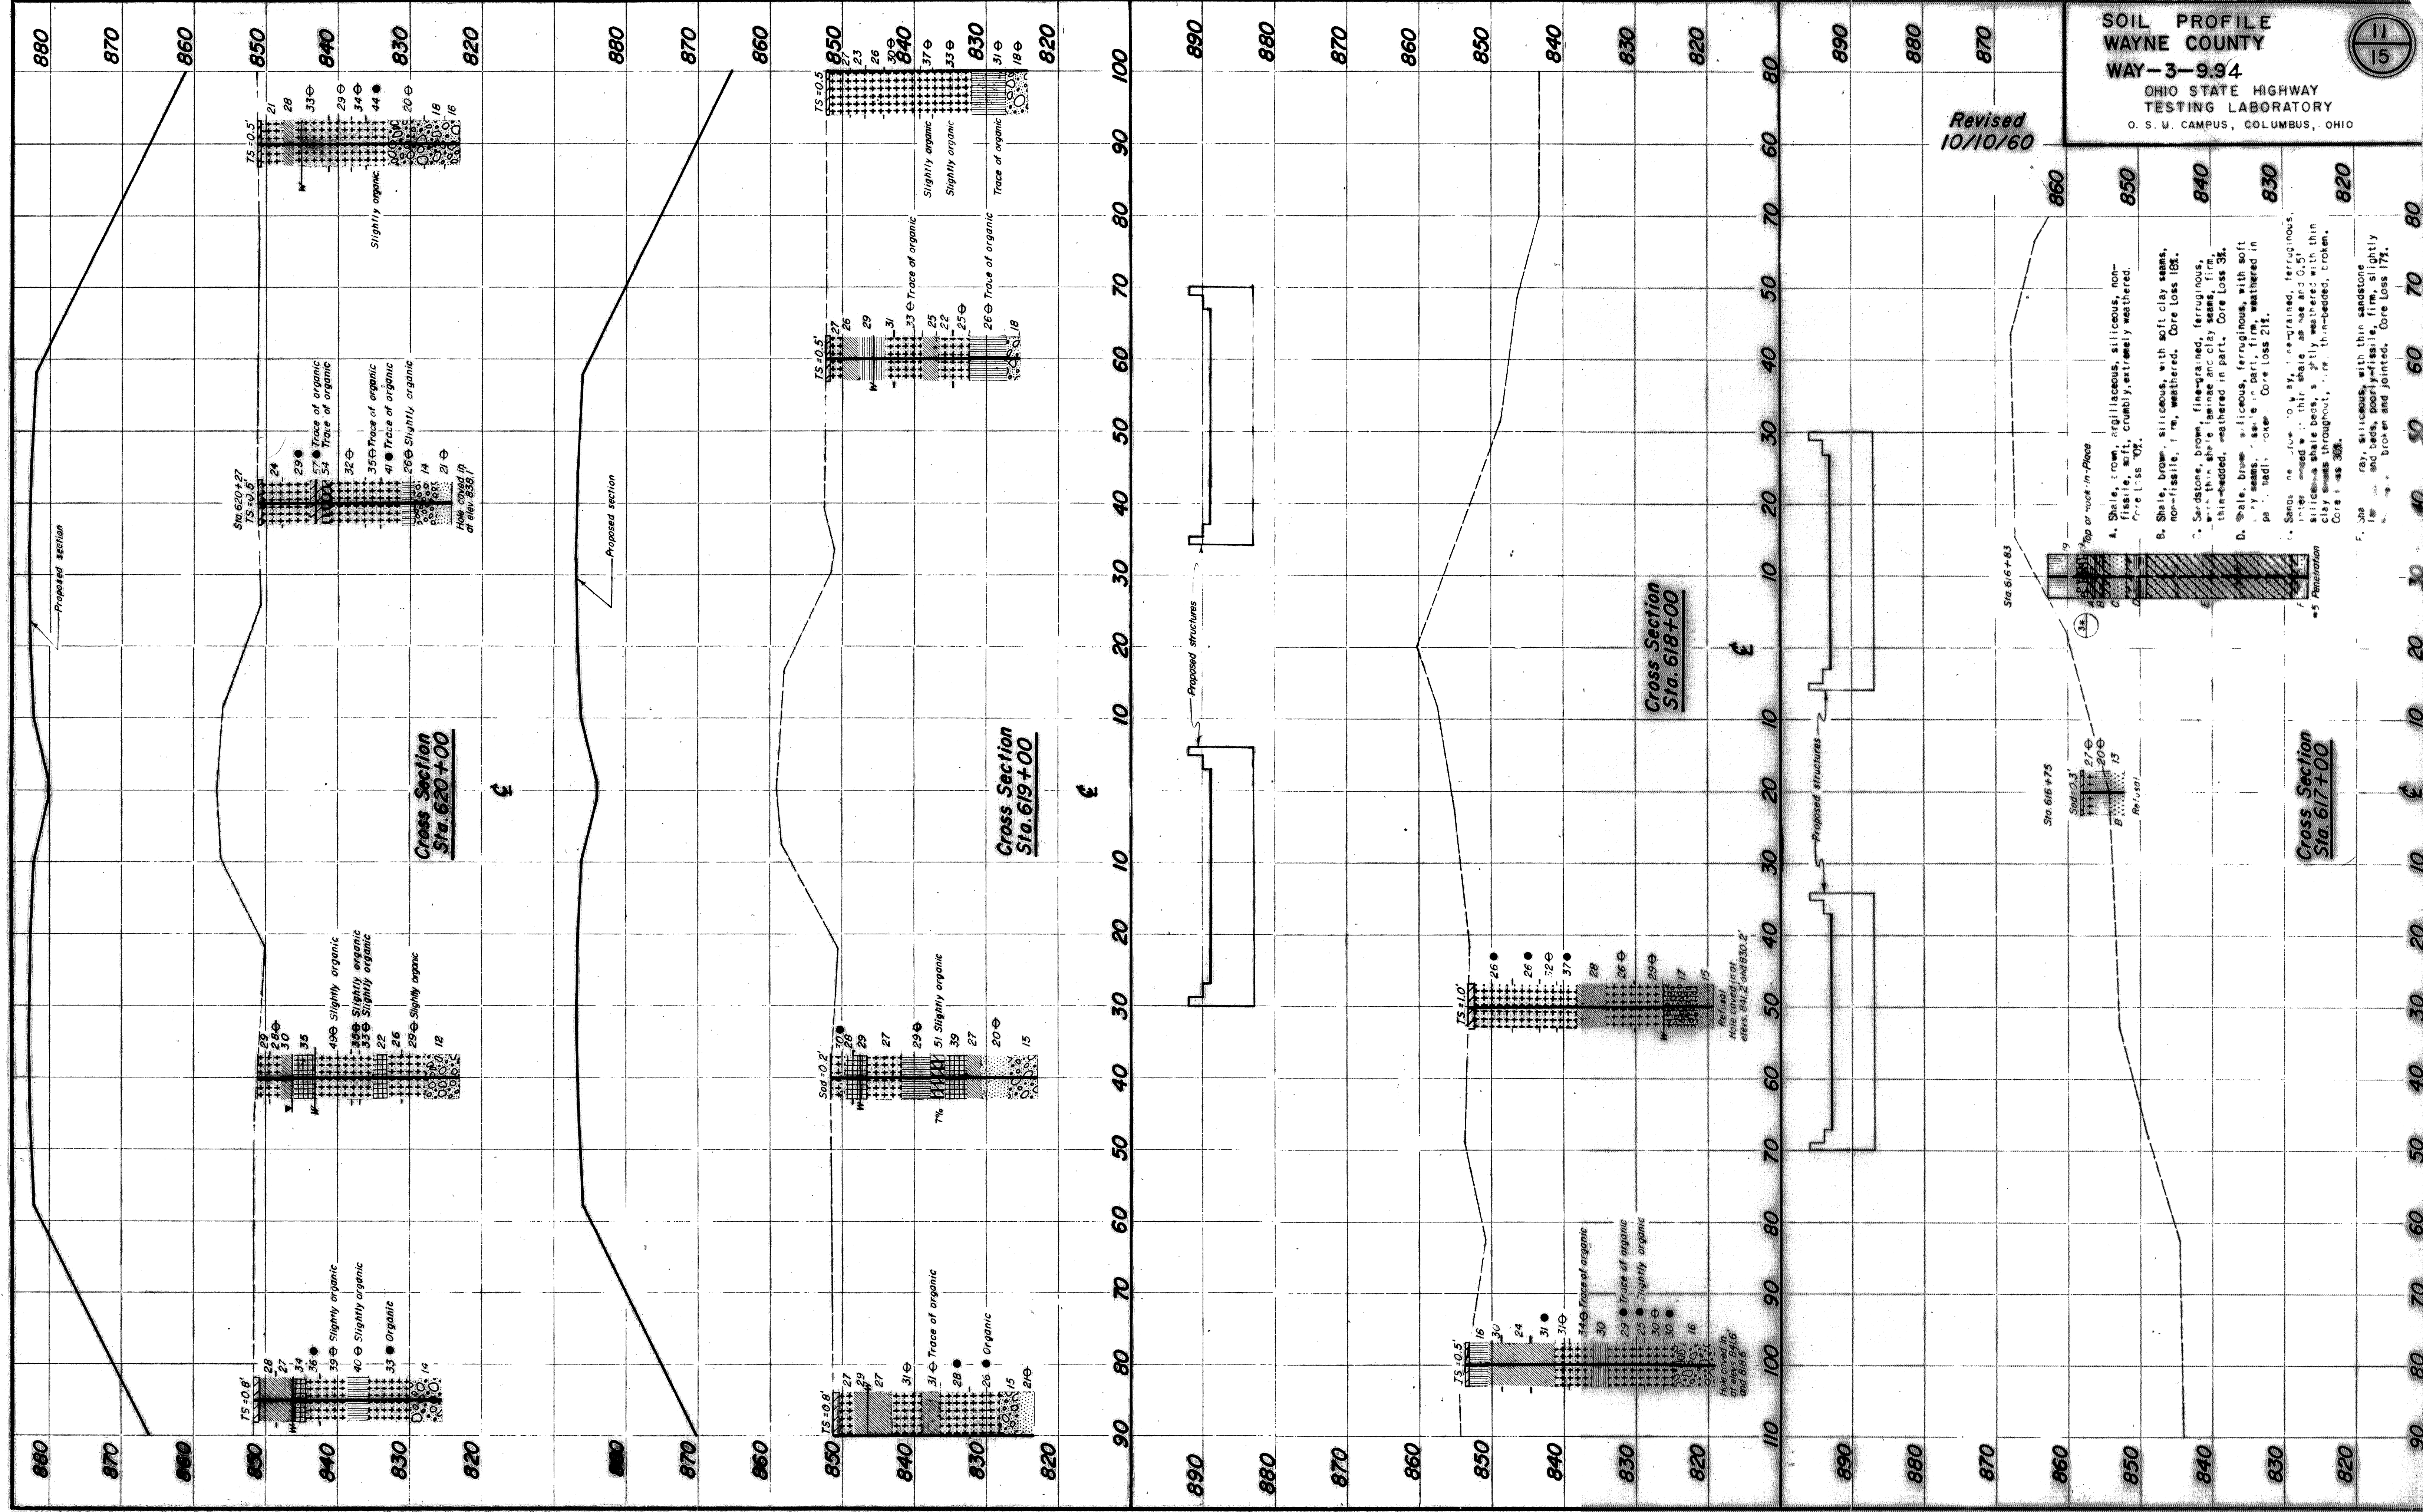

- A. Shale, brown, argillaceous, siliceous, non-fissile, soft, crumbly, extremely weathered. Core Loss 10%.
- B. Shale, brown, siliceous, with soft clay seams, non-fissile, firm, weathered. Core Loss 18%.
- C. Sandstone, brown, fine-grained, ferruginous, with thin shale laminae and clay seams, firm, thin-bedded, weathered in part. Core Loss 3%.
- D. Shale, brown, siliceous, ferruginous, with soft clay seams, in part, firm, weathered in part, bedded. Core Loss 21%.
- E. Sandstone, brown, fine-grained, ferruginous, interbedded with thin shale laminae and 0.5' siliceous shale beds, slightly weathered with thin clay seams throughout, firm, thin-bedded, broken. Core Loss 30%.
- F. Sandstone, siliceous, with thin sandstone laminae and beds, poorly-fissile, firm, slightly broken and jointed. Core Loss 17%.


Cross Section
Sta. 618+00

Cross Section
Sta. 617+00

Cross Section
Sta. 620+00

Cross Section
Sta. 619+00

Supplement
10/10/60

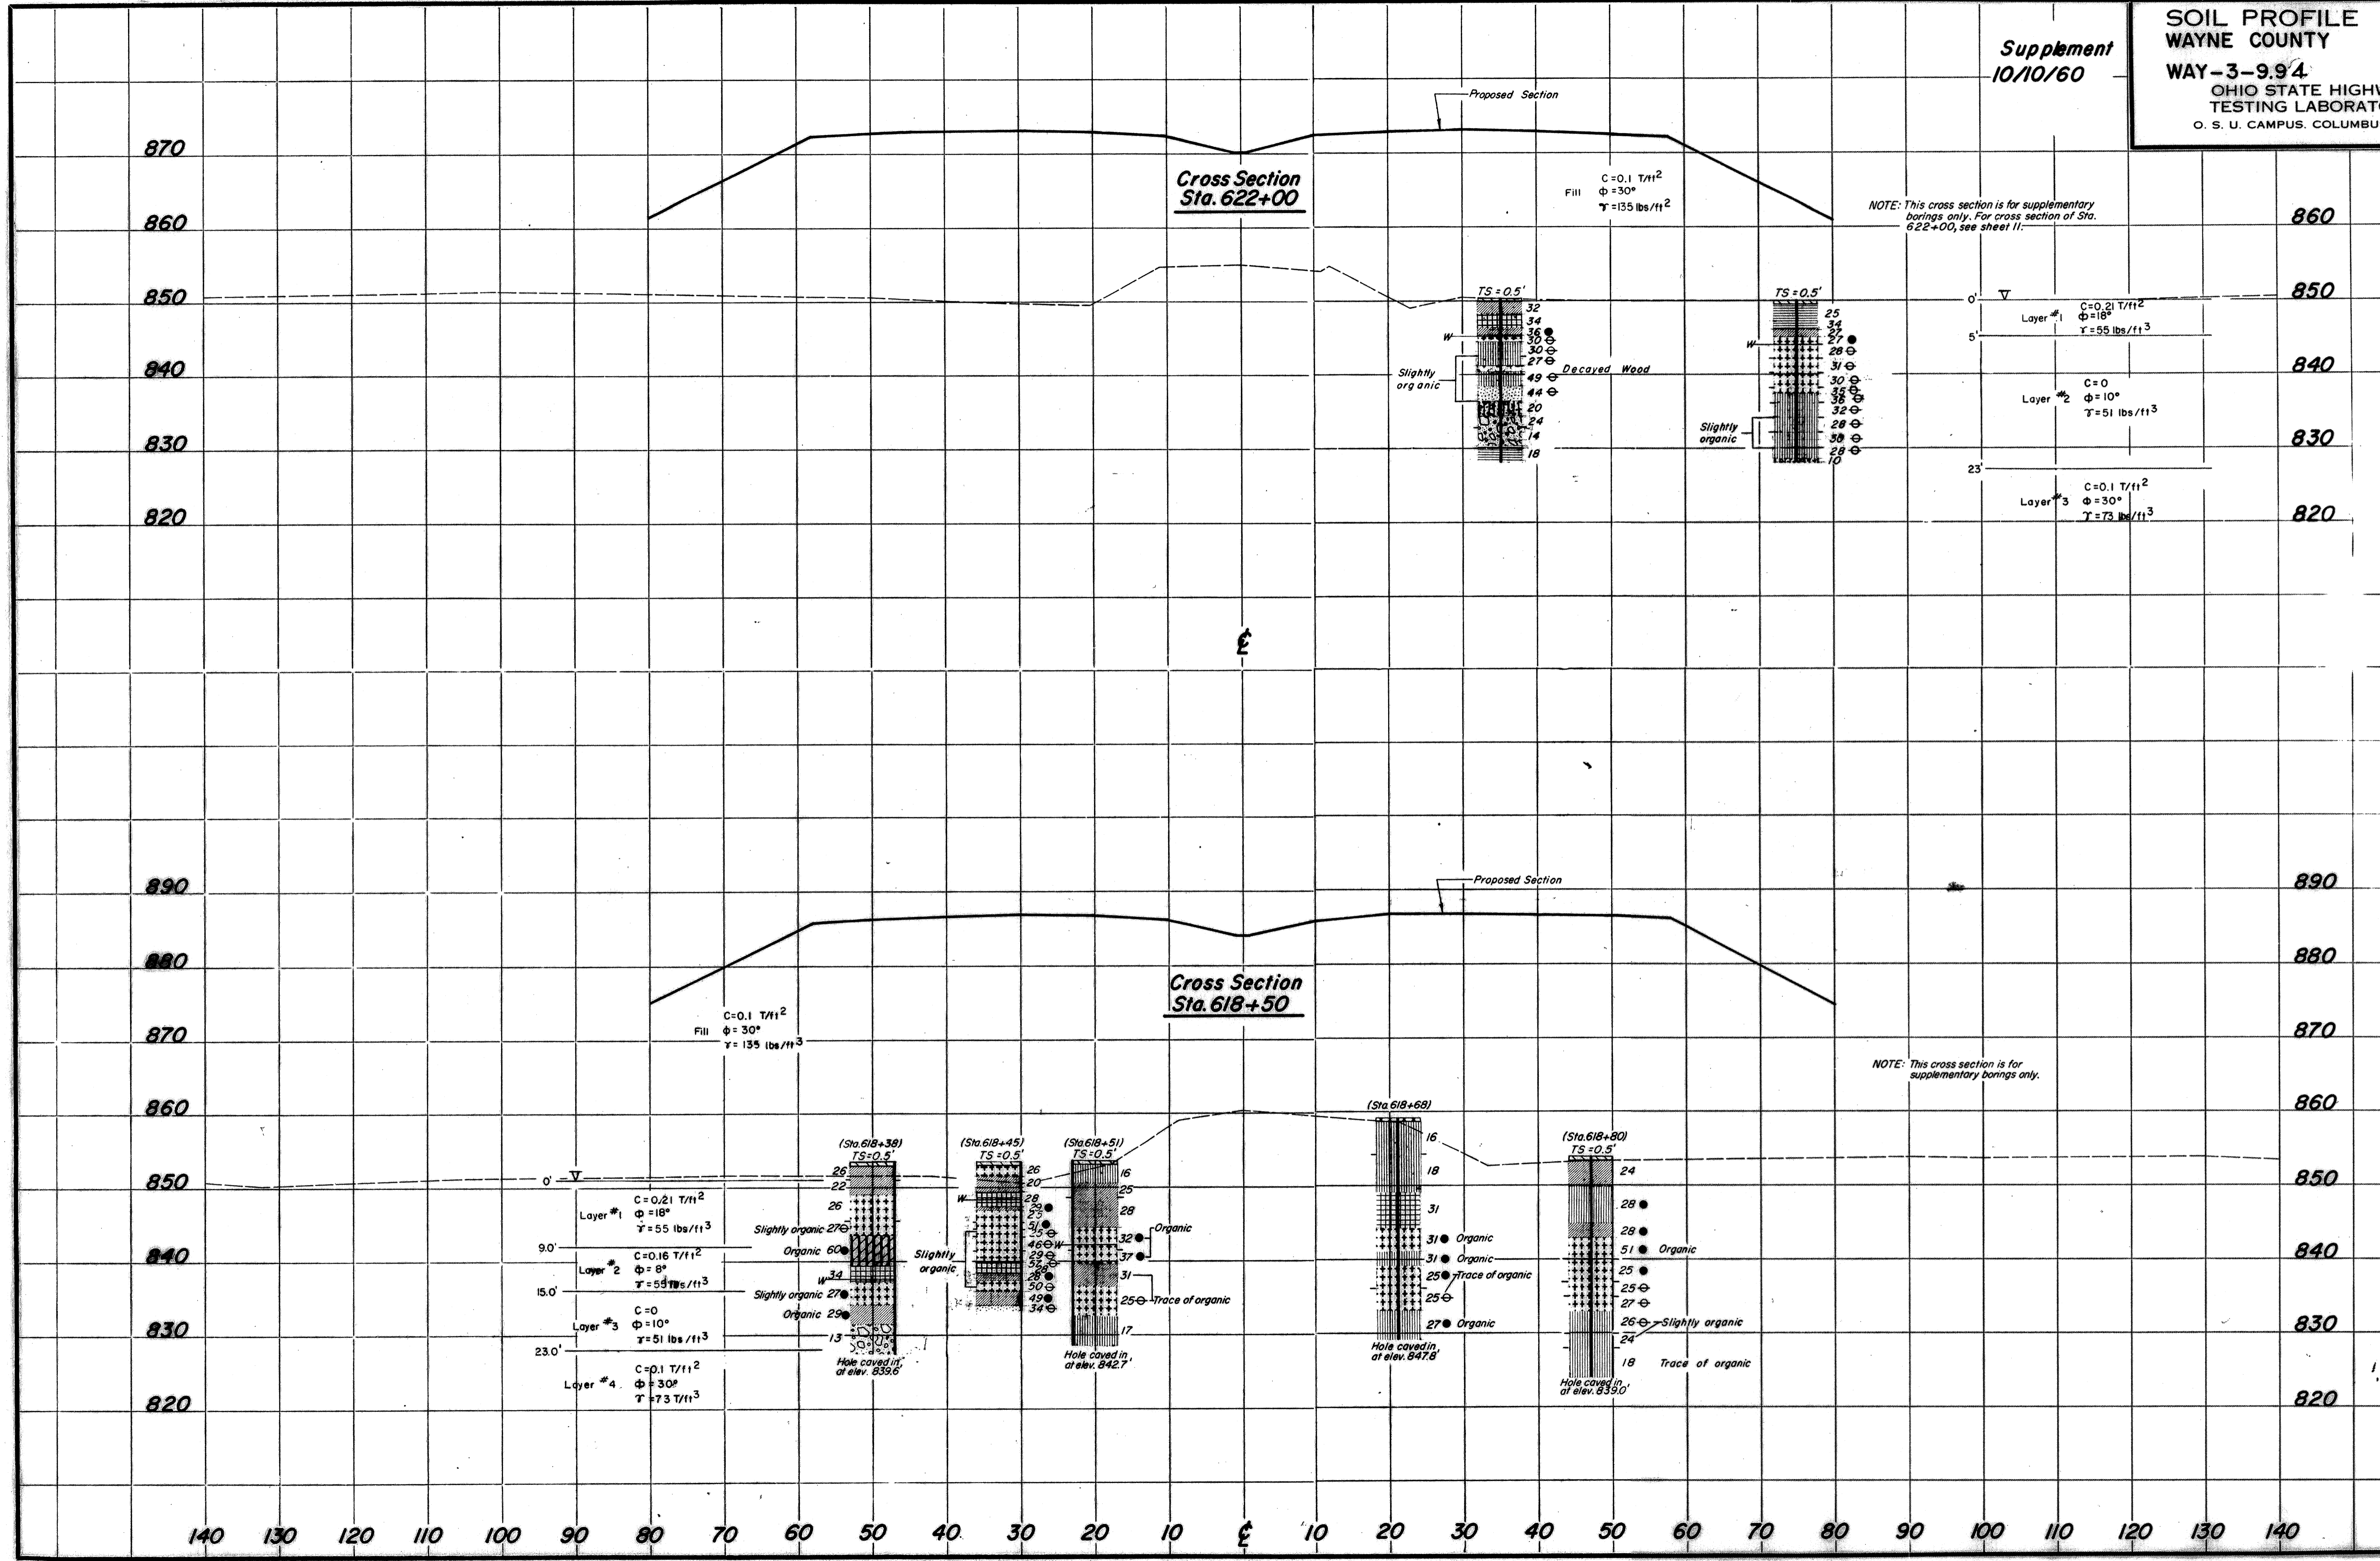

Cross Section
Sta. 622+00

Fill
 $C=0.1 T/ft^2$
 $\phi=30^\circ$
 $\gamma=135 \text{ lbs}/ft^3$

NOTE: This cross section is for supplementary borings only. For cross section of Sta. 622+00, see sheet II.

Cross Section
Sta. 618+50

Fill
 $C=0.1 T/ft^2$
 $\phi=30^\circ$
 $\gamma=135 \text{ lbs}/ft^3$

NOTE: This cross section is for supplementary borings only.

Layer #1
 $C=0.21 T/ft^2$
 $\phi=18^\circ$
 $\gamma=55 \text{ lbs}/ft^3$

Layer #2
 $C=0.16 T/ft^2$
 $\phi=8^\circ$
 $\gamma=55 \text{ lbs}/ft^3$

Layer #3
 $C=0$
 $\phi=10^\circ$
 $\gamma=51 \text{ lbs}/ft^3$

Layer #4
 $C=0.1 T/ft^2$
 $\phi=30^\circ$
 $\gamma=73 \text{ lbs}/ft^3$

(Sta. 618+38)
TS=0.5'

Slightly organic 27

Organic 60

Slightly organic 27

Organic 29

Hole caved in at elev. 839.6'

(Sta. 618+45)
TS=0.5'

Slightly organic

Organic

(Sta. 618+51)
TS=0.5'

Organic

Trace of organic

Hole caved in at elev. 842.7'

(Sta. 618+68)
TS=0.5'

Organic

Organic

Trace of organic

Organic

Hole caved in at elev. 847.8'

(Sta. 618+80)
TS=0.5'

Organic

Organic

Trace of organic


Slightly organic

Trace of organic

Hole caved in at elev. 830'

140 130 120 110 100 90 80 70 60 50 40 30 20 10 0 10 20 30 40 50 60 70 80 90 100 110 120 130 140

Revised
10/10/60

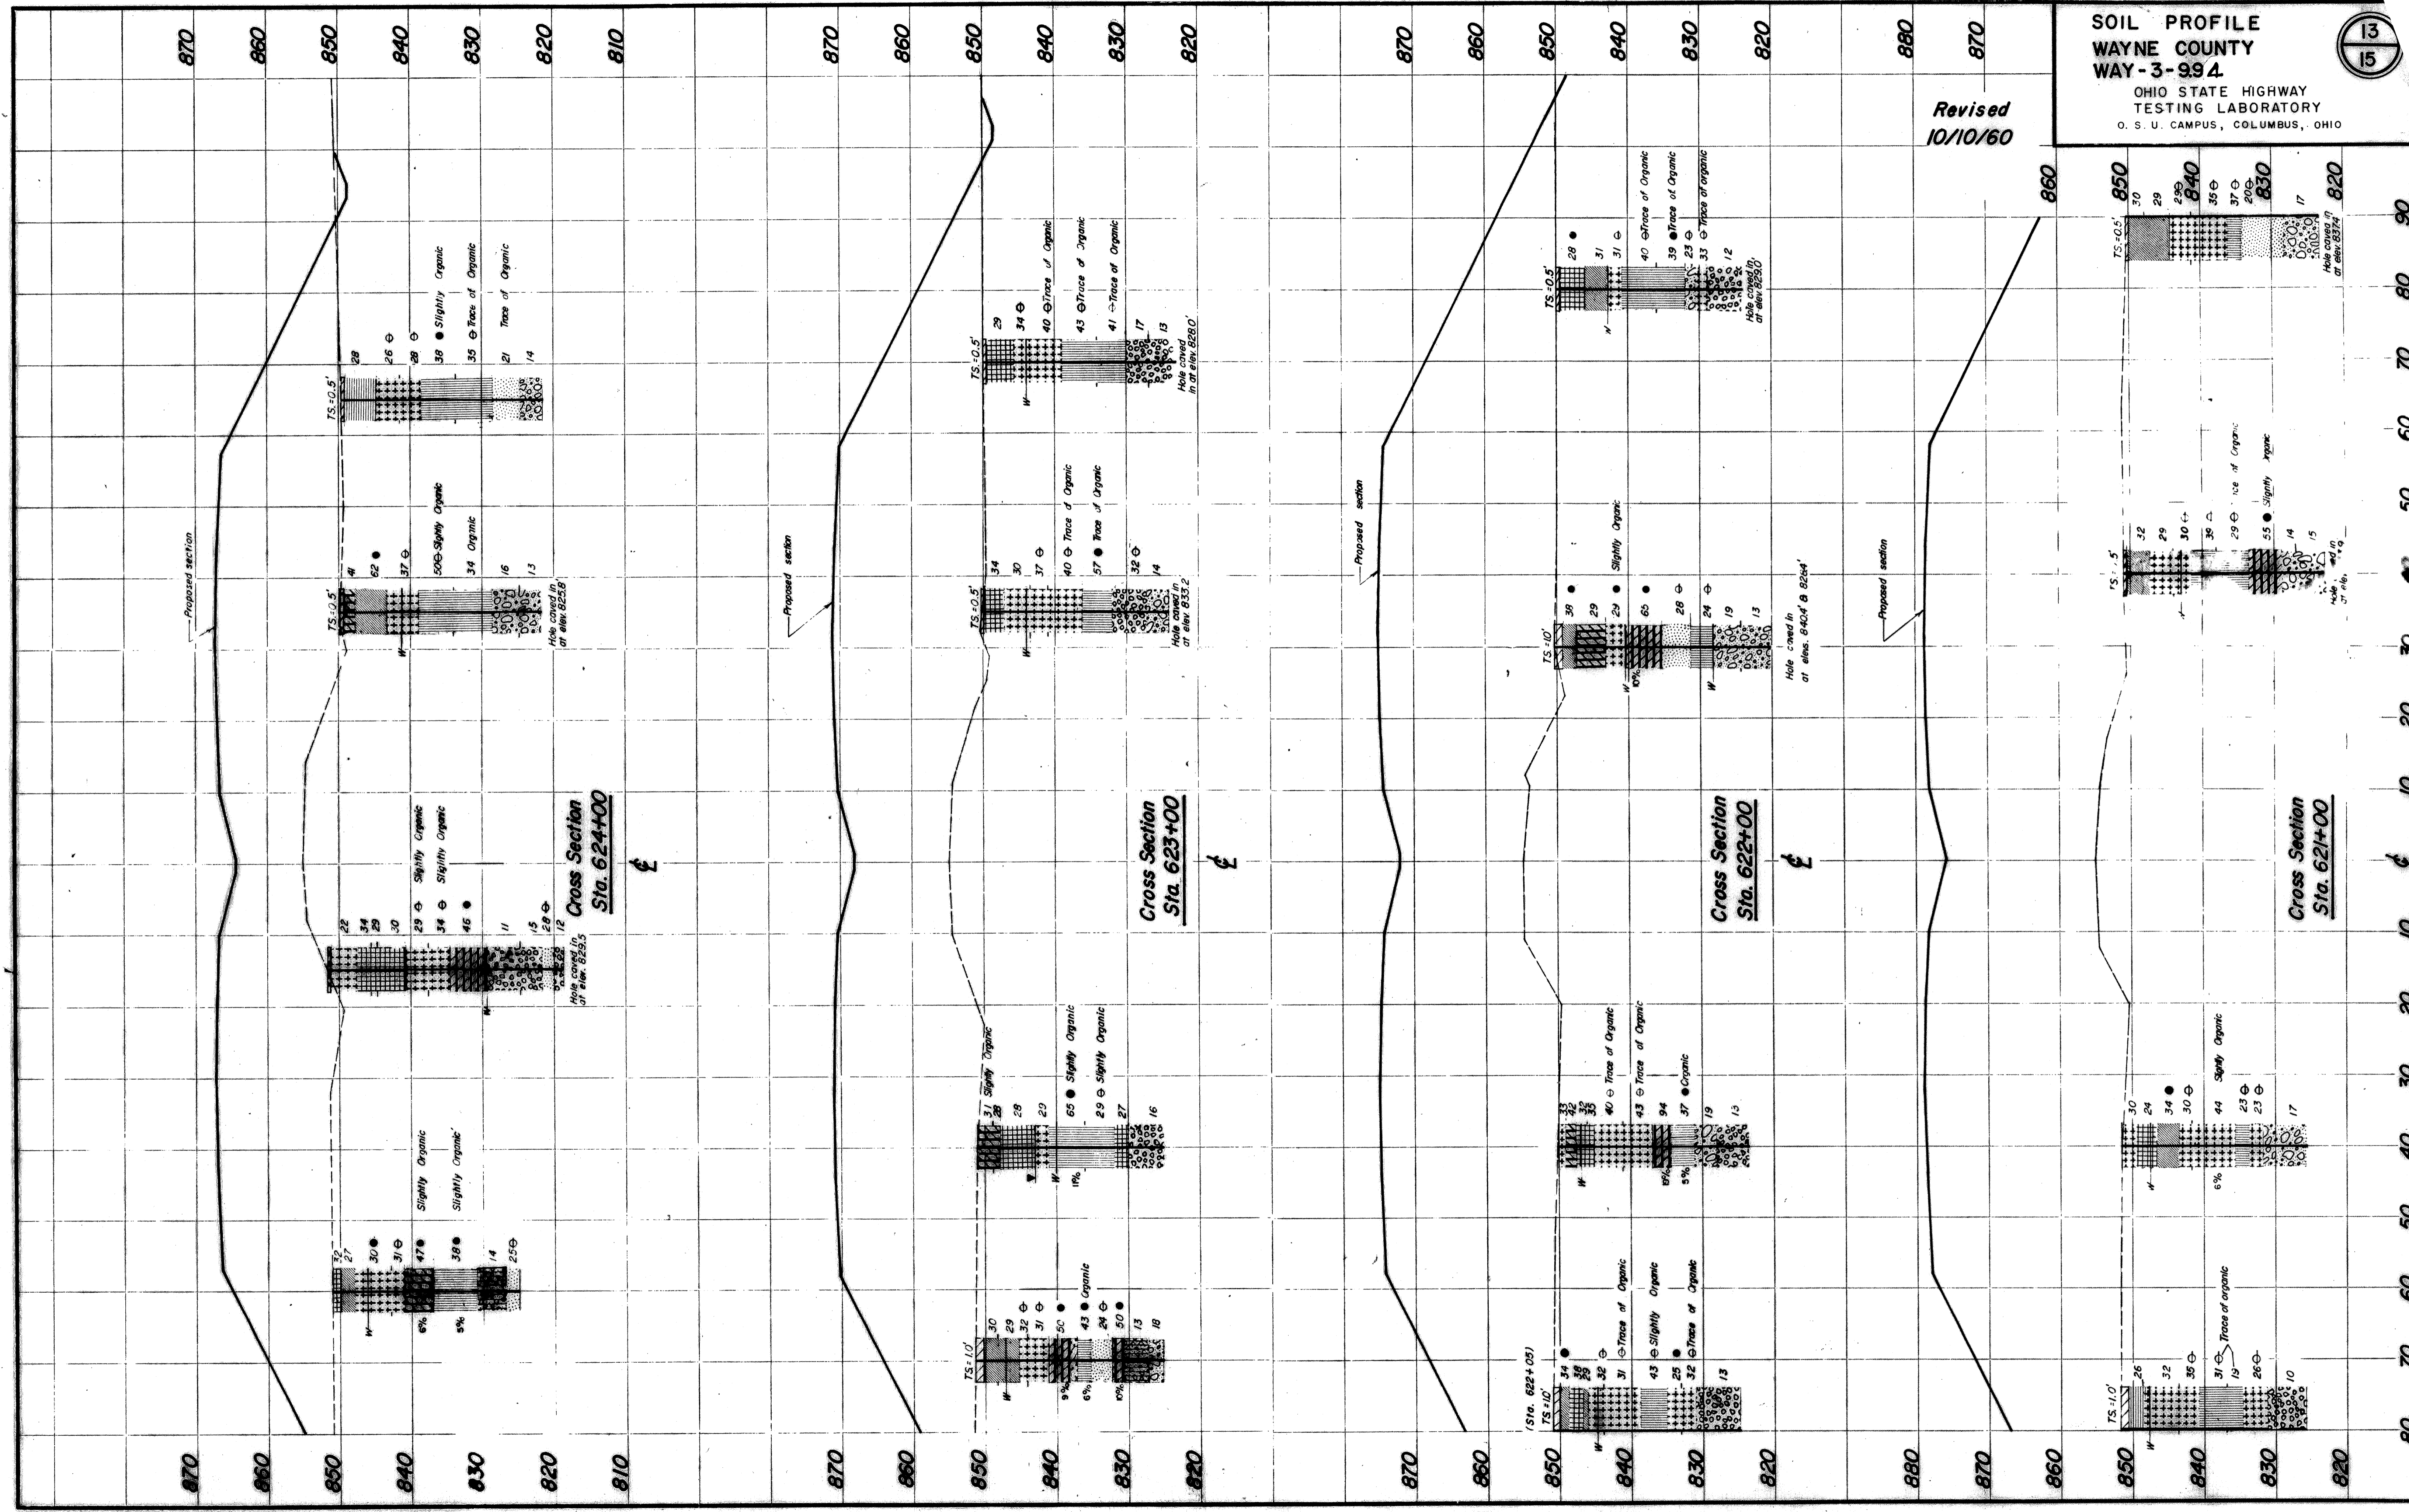

870
860
850
840
830
820
810

870
860
850
840
830
820

870
860
850
840
830
820

880
870
860

870
860
850
840
830
820
810

870
860
850
840
830
820

870
860
850
840
830
820

880
870
860

80
70
60
50
40
30
20
10


Cross Section
Sta. 624+00

Cross Section
Sta. 623+00


Cross Section
Sta. 622+00

Cross Section
Sta. 621+00

Revised
10/10/60

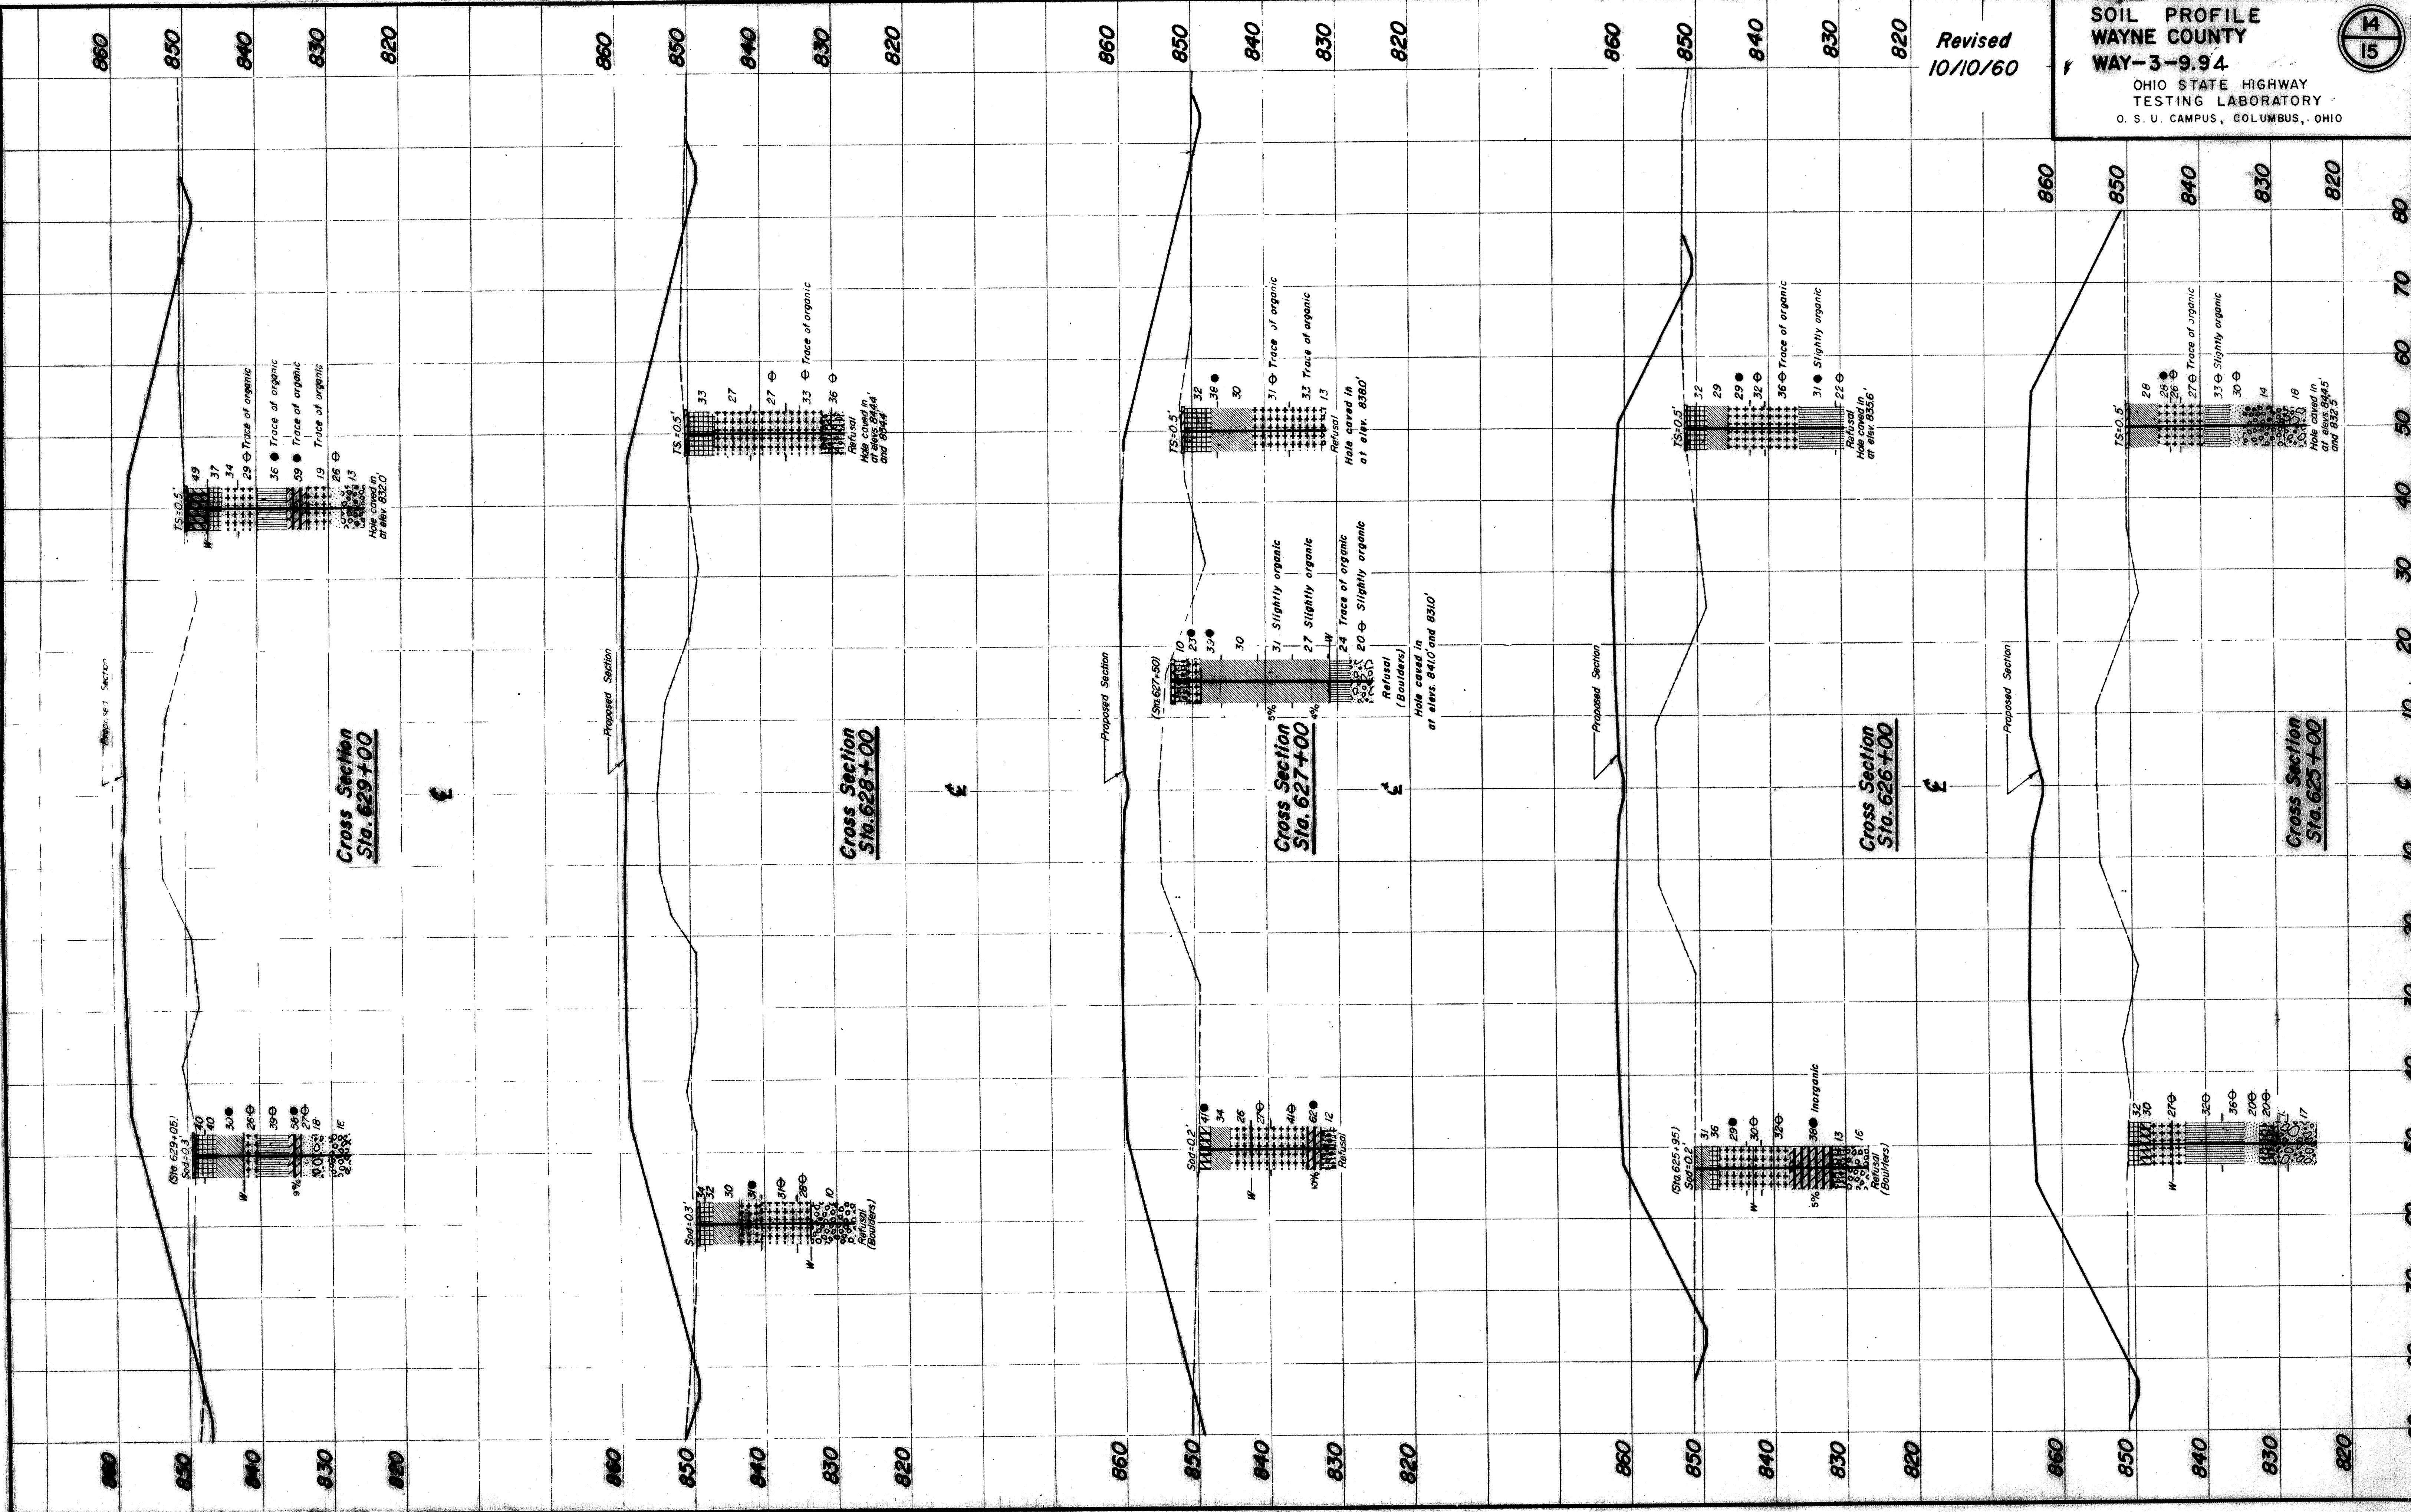

Revised
10/10/60

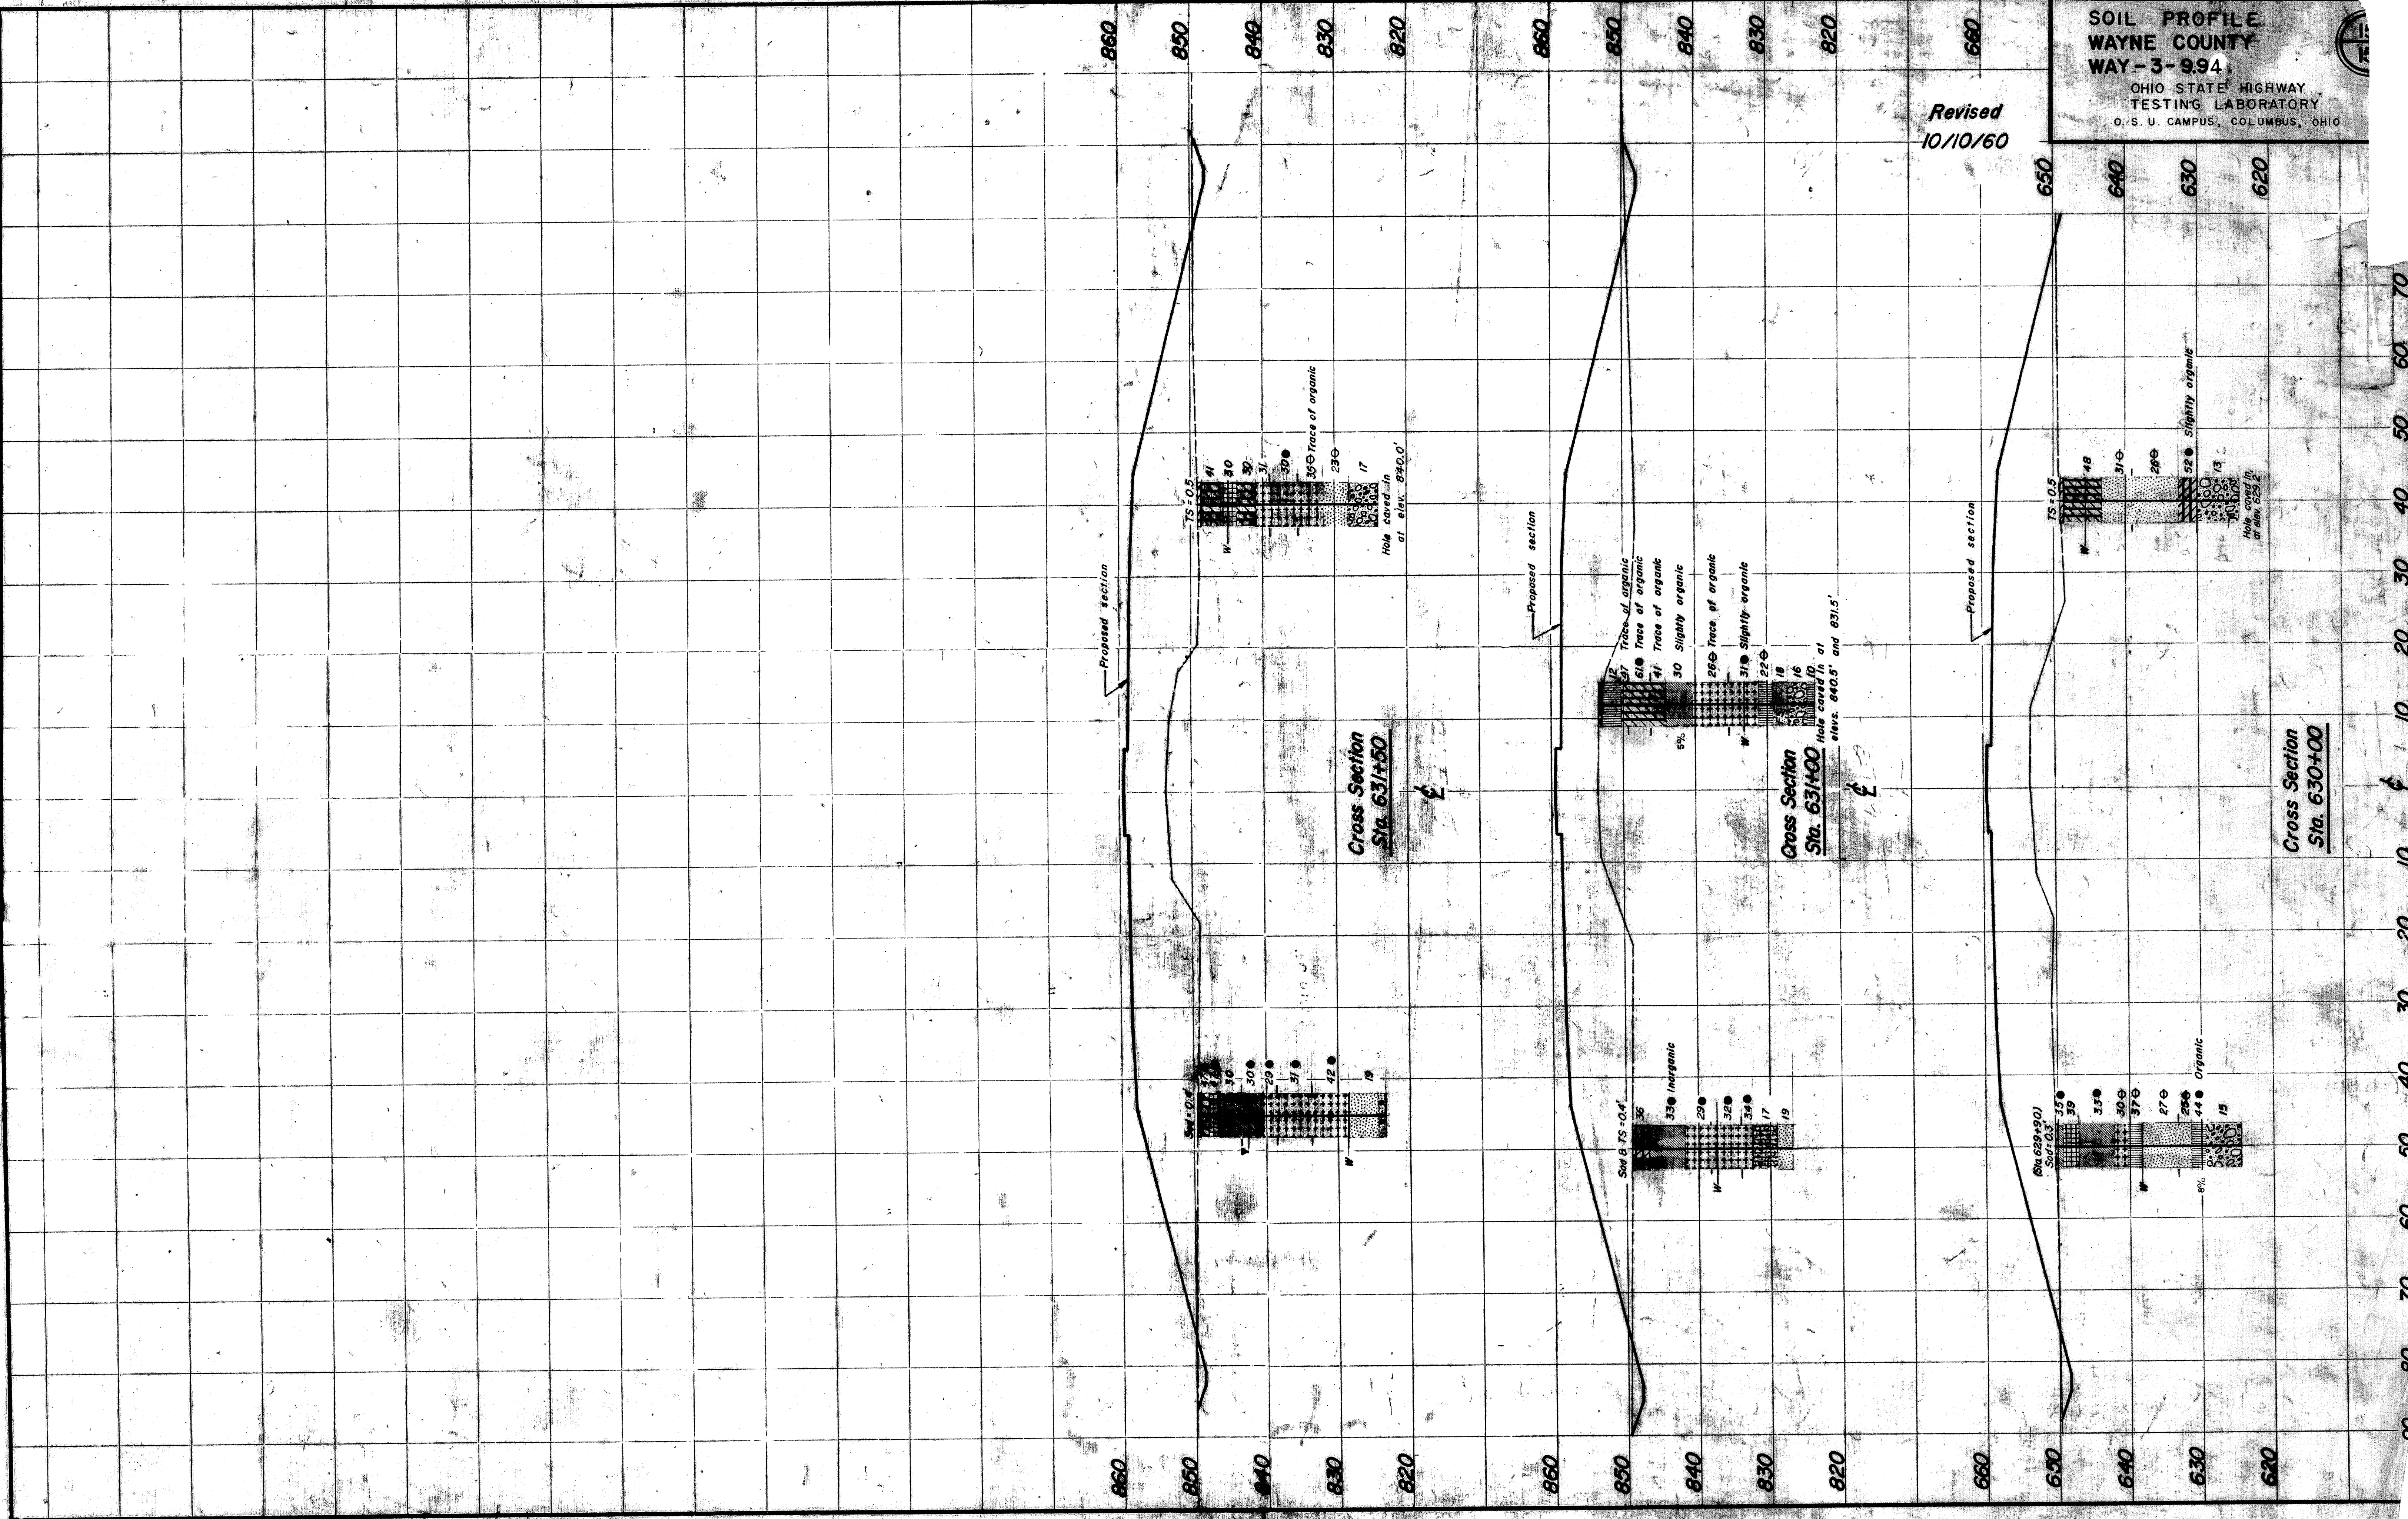

Drawn By	6-22-60
Checked By	6-22-60
Revised By	