

LOCATION MAP

LATITUDE: 40°41'27.2" LONGITUDE: 81°41'33.3"



PORTION TO BE IMPROVED .....	
INTERSTATE HIGHWAY .....	
FEDERAL ROUTES .....	
STATE ROUTES .....	
COUNTY & TOWNSHIP ROADS .....	
OTHER ROADS .....	

DESIGN DESIGNATION

CURRENT ADT (2024) .....	5,800
DESIGN YEAR ADT (2044) .....	7,200
DESIGN HOURLY VOLUME (2044) .....	650
DIRECTIONAL DISTRIBUTION .....	51%
TRUCKS (24 HOUR B&C) .....	15%
DESIGN SPEED .....	55 MPH
LEGAL SPEED .....	55 MPH
DESIGN FUNCTIONAL CLASSIFICATION:	
RURAL PRINCIPAL ARTERIAL OTHER	
NHS PROJECT .....	YES

DESIGN EXCEPTIONS

NONE

ADA DESIGN WAIVERS

NONE

UNDERGROUND UTILITIES

Contact Two Working Days  
Before You Dig

  
OHIO811.org  
Before You Dig

OHIO811, 8-1-1, or 1-800-362-2764  
(Non members must be called directly)



PLANS PREPARED BY:  
OHIO DEPARTMENT OF  
TRANSPORTATION  
DISTRICT THREE ENGINEERING

STATE OF OHIO  
DEPARTMENT OF TRANSPORTATION

WAY-250-27.50

PAINT TOWNSHIP

WAYNE COUNTY

INDEX OF SHEETS:

TITLE SHEET	1
GENERAL NOTES	2 - 3
MAINTENANCE OF TRAFFIC NOTES	4
TYPICAL SECTIONS	5
GENERAL SUMMARY	6
ROADWAY SUB-SUMMARY	7
PLAN	8
CROSS SECTIONS	9
DRAINAGE SUB-SUMMARY	10
CULVERT DETAILS	11
CHANNEL CROSS SECTIONS	12
PLAN INSERT SHEETS	13 - 14
RIGHT OF WAY	RW.1 - RW.7

STANDARD CONSTRUCTION DRAWINGS					SUPPLEMENTAL SPECIFICATIONS	SPECIAL PROVISIONS
DM-1.1	1/17/25				800-2023	1/17/25
DM-4.3	1/15/16				832	7/19/24
DM-4.4	1/15/16				902	7/19/19
HW-2.1	7/15/22					
RM-1.1	1/20/23					
MT-97.10	4/19/19					
MT-101.90	7/17/20					
MT-105.10	1/17/20					
TC-41.20	10/18/13					
TC-42.20	10/18/13					
TC-52.10	10/18/13					
TC-52.20	1/15/21					

FEDERAL PROJECT NUMBER

E240428

RAILROAD INVOLVEMENT

NONE

PROJECT DESCRIPTION

THIS PROJECT WILL INCLUDE THE REPLACEMENT OF A 30" DIAMETER CONCRETE CULVERT UNDER U.S. 250 USING THE JACK AND BORE METHOD.

EARTH DISTURBED AREAS

PROJECT EARTH DISTURBED AREA:	N/A* ACRES
ESTIMATED CONTRACTOR EARTH DISTURBED AREA:	N/A* ACRES
NOTICE OF INTENT EARTH DISTURBED AREA:	N/A* ACRES
(* = MAINTENANCE PROJECT)	

2023 SPECIFICATIONS


THE STANDARD SPECIFICATIONS OF THE STATE OF OHIO, DEPARTMENT OF TRANSPORTATION, INCLUDING SUPPLEMENTAL SPECIFICATIONS LISTED IN THE PLANS, CHANGES LISTED IN THE PROPOSAL, AND THE SUPPLEMENTAL SPECIFICATION 800 VERSION INDICATED ON THE PROPOSAL SHALL GOVERN THIS IMPROVEMENT.

I HEREBY APPROVE THESE PLANS AND DECLARE THAT THE MAKING OF THIS IMPROVEMENT WILL NOT REQUIRE THE CLOSING TO TRAFFIC OF THE HIGHWAY AND THAT PROVISIONS FOR THE MAINTENANCE AND SAFETY OF TRAFFIC WILL BE AS SET FORTH ON THE PLANS AND ESTIMATES.

  
Robert Weaver  
District 03 Deputy Director


  
Pamela Boratyn  
Director, Department of Transportation

ENGINEER'S SEAL

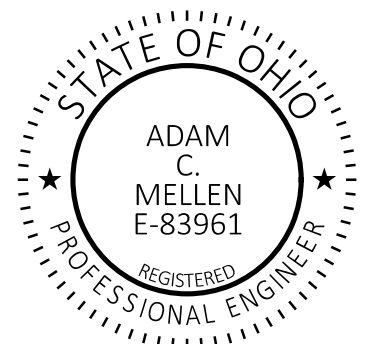

TITLE SHEET

DESIGN AGENCY  
DISTRICT 3



ENGINEERING TEAM THREE

DESIGNER  
JSR

REVIEWER  
ACM 01/27/25

PROJECT ID  
118424

SHEET  
P.1

TOTAL  
14