

*LOCATION MAP*

LATITUDE: 41°29'11"      LONGITUDE: -83°43'42"



PORTION TO BE IMPROVED	
INTERSTATE HIGHWAY	
FEDERAL ROUTES	
STATE ROUTES	
COUNTY & TOWNSHIP ROADS	
OTHER ROADS	

### DESIGN DESIGNATION


N/A

## DESIGN EXCEPTIONS

NONE REQUIRED

## ADA DESIGN WAIVER

NONE REQUIRED


<p><b>UNDERGROUND UTILITIES</b></p> <p>Contact Two Working Days Before You Dig</p>	
 <p><b>OHIO811.org</b></p> <p>Before You Dig</p>	
<p><b>OHIO811, 8-1-1, or 1-800-362-2764</b></p> <p>(Non-members must be called directly)</p>	

PLAN PREPARED BY:




DGL CONSULTING ENGINEERS, LLC  
3455 BRIARFIELD BLVD. SUITE E  
MAUMEE, OH 43537  
PHONE: 419.535.1015  
[www.dgl-ltd.com](http://www.dgl-ltd.com)

## ENGINEER'S SEAL

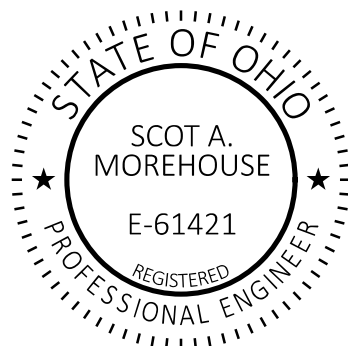

## ENGINEER'S SEAL

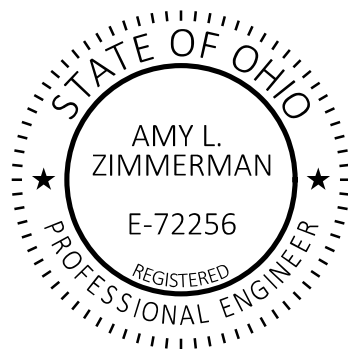

STATE OF OHIO  
DEPARTMENT OF TRANSPORTATION

# ROCHE DE BOEUF

# CITY OF WATERVILLE

# LUCAS & WOOD COUNTY

*INDEX OF SHEETS:*

TITLE SHEET	1
SCHEMATIC PLAN	2
TYPICAL SECTION	3
GENERAL NOTES	4-6
MAINTENANCE OF TRAFFIC NOTES	7
GENERAL SUMMARY	8
PROJECT SITE PLAN	9
PLAN AND PROFILE	10-15
CROSS SECTIONS	16-20
LANDSCAPING PLAN AND NOTES	21
PHOTO SUPPLEMENT	22-24
BATHYMETRIC SURVEY	25

[illegible]

## PROJECT DESCRIPTION

DEMOLITION OF 2052 FT OF THE ROCHE DE BOEUF  
BRIDGE OVER THE MAUMEE RIVER.  
MINOR EMBANKMENT REPAIRS ARE ALSO INCLUDED.

## EARTH DISTURBED AREAS


PROJECT EARTH DISTURBED AREA: 0.9 ACRES  
ESTIMATED CONTRACTOR EARTH DISTURBED AREA: 2.2 ACRES  
NOTICE OF INTENT EARTH DISTURBED AREA: 3.1 ACRES

## 2023 SPECIFICATIONS

THE STANDARD SPECIFICATIONS OF THE STATE OF OHIO, DEPARTMENT OF TRANSPORTATION, INCLUDING SUPPLEMENTAL SPECIFICATIONS LISTED IN THE PLANS AND CHANGES LISTED IN THE PROPOSAL SHALL GOVERN THIS IMPROVEMENT.

I HEREBY APPROVE THESE PLANS AND DECLARE THAT THE MAKING OF THIS IMPROVEMENT WILL NOT REQUIRE THE CLOSING TO TRAFFIC OF THE HIGHWAY EXCEPT AS NOTED ON SHEET 7, AND THAT PROVISIONS FOR THE MAINTENANCE AND SAFETY OF TRAFFIC WILL BE AS SET FORTH ON THE PLANS AND ESTIMATES.

Pat M. Colley, P.E.  
Pat McColley, P.E., S.I.  
District 02 Deputy Director

  
Pamela Boratyn  
Director, Department of Transportation

FEDERAL PROJECT NO.

**E240629**

PID NO.

107 405

CONSTRUCTION PROJECT NO.

RAILROAD INVOLVEMENT

**NONE**

**WOO - LUC  
ROCHE DE BOEUF**

$$\frac{1}{25}$$