

PORTION TO BE IMPROVED	
INTERSTATE HIGHWAY	
FEDERAL ROUTES	
STATE ROUTES	
COUNTY & TOWNSHIP ROADS	
OTHER ROADS	

# **DESIGN DESIGNATION**

	SR 65	SR 18
CURRENT ADT (2022)	4300	1500
DESIGN YEAR ADT (2034)	4300	1600
DESIGN HOURLY VOLUME (2022)	450	150
DIRECTIONAL DISTRIBUTION	52%	10%
TRUCKS (24 HOUR B&C)	5%	5%
DESIGN SPEED	Varies	Varies
LEGAL SPEED	Varies	Varies
DESIGN FUNCTIONAL CLASSIFICATION:		
Rural Major Collector		
NHS PROJECT	NO	

## **DESIGN EXCEPTIONS**

NONE

## ADA DESIGN WAIVERS

NONE

		STANDARD CONSTRUCTION DRAWINGS SUPPLEMENTAL SPECIFICATIONS PH										
UNDERGROUND UTILITIES		BP-3 1	1/17/20	DBR-3-11	7/15/11			600	7/26/21			
Contact Two Working Days		BP-4.1	7/19/13					832	10/19/18			
Before You Dig		BP-3.2	1/18/19	MT-97.10	4/19/19			874	4/17/20			
	ENGINEER'S SEAL:	BP-5.1	1/18/19	MT-97.12	1/20/17	Addec		875	1/18/19			
01110.044	ENGINEERO BEAL	BP-7.1	7/17/20	MT-99.20	4/19/19							
-OHI0811.org				MT-101.60	1/17/20							
Before You Dig	WHE OF	MGS-1.1	1/19/18	MY-10190	117/20							
110811, 8-1-1, or 1-800-362-2764	JULE 10	MGS-2.1	1/19/18	MT-105.10	1/17/20							
(Non members must be called directly)	€#/ M. 3.# €	MGS-3.1	1/19/18		$\boldsymbol{X}$							
(interine index be during an any)	子 FAHY 缶	MGS-3.2	1/18/13	TC-65.10	1/17/14							
	E 63302	MGS-4.2	7/19/13	TC-65.11	7/21/17							
PLAN PREPARED BY:	OC ATE HO	MGS-4.3	1/18/13	TC-71.10	1/19/18							
ODOT DISTRICT 2	NAL	MGS-5.2	7/15/16									
317 E POE RD	O.J. HABL	MGS-5.3	7/15/16									
	SIGNED POL	MGS-6.1	1/19/18									
BOWLING GREEN, OHIO	DATE: 16 05-200	MGS-6.2	7/19/19									

**INDEX OF SHEETS:** 

MAINTENANCE OF TRAFFIC NOTES

2-4

5

6

7.8

9-13

14-24

25-28

TITLE SHEET TYPICAL SECTIONS

SUBSUMMARY

PLAN SHEETS

CROSS SECTIONS

GENERAL NOTES

GENERAL SUMMARY

# FEDERAL PROJECT NUMBER

E150259

# RAILROAD INVOLVEMENT

TOLEDO, LAKE ERIE, WESTERN RAILWAY, CSX

## **PROJECT DESCRIPTION**

RESURFACE SR 65 FROM HENRY COUNTY LINE TO SR 235. RESURFACE SR 18 FROM SLM 18.53 TO SLM 19.48. PERFORM NECESSARY RELATED WORK.

# EARTH DISTURBED AREAS

PROJECT EARTH DISTURBED AREA: N/A ACRES ESTIMATED CONTRACTOR EARTH DISTURBED AREA: N/A ACRES NOTICE OF INTENT EARTH DISTURBED AREA! N/A ACRES

## 2019 SPECIFICATIONS

THE STANDARD SPECIFICATIONS OF THE STATE OF OHIO, DEPARTMENT OF TRANSPORTATION. INCLUDING SUPPLEMENTAL SPECIFICATIONS LISTED IN THE PLANS AND CHANGES LISTED IN THE PROPOSAL SHALL GOVERN THIS IMPROVEMENT.

I HEREBY APPROVE THESE PLANS AND DECLARE THAT THE MAKING OF THIS IMPROVEMENT WILL NOT REQUIRE THE CLOSING TO TRAFFIC OF THE HIGHWAY EXCEPT AS NOTED ON SHEET 6, AND THAT PROVISIONS FOR THE MAINTENANCE AND SAFETY OF TRAFFIC WILL BE AS SET FORTH ON THE PLANS AND ESTIMATES.

APPROVED DATE 6/25/21 DISTRICT DEPUTY DIRECTOR

Jack Marchlandes/HEQ APPROVED DATE 9-9-21 DIRECTOR, DEPARTMENT OF TRANSPORTATION

ESIGNE	R	1
	JWZ	L
RE	EVIEWER	1
	06-25-21	L
SO'EC	TID .	1
5	95796	L
ieet 1	TOTAL 28	
_	_	

DESIGN AGENCY

SHEET

Щ LIL

## ITEM 614, MAINTAINING TRAFFIC

NO WORK SHALL BE PERFORMED AND ALL EXISTING LANES SHALL BE OPEN TO TRAFFIC DURING THE FOLLOWING DESIGNATED HOLIDAYS OR EVENTS:

APPLE BUTTER FESTIVAL OCTOBER, 2022

CHRISTMAS FOURTH OF JULY NEW YEAR'S LABOR DAY MEMORIAL DAY THANKSGIVING (OTHER HOLIDAY OR EVENT)

THE PERIOD OF TIME THAT THE LANES ARE TO BE OPEN DEPENDS ON THE DAY OF THE WEEK ON WHICH THE HOLIDAY OR EVENT FALLS. THE FOLLOWING SCHEDULE SHALL BE USED TO DETERMINE THIS PERIOD:

DAY OF HOLIDAY	TIME ALL LANES
OR EVENT	MUST BE OPEN TO TRAFFIC

SUNDAY 12:00N FRIDAY THROUGH 6:00AM MONDAY ΜΟΝΠΑΥ 12:00N FRIDAY THROUGH 6:00AM TUESDAY 12:00N MONDAY THROUGH 6:00AM WEDNESDAY TUESDAY WEDNESDAY 12:00N TUESDAY THROUGH 6:00AM THURSDAY THURSDAY 12:00N WEDNESDAY THROUGH 6:00AM FRIDAY THURSDAY (THANKSGIVING ONLY)

6:00AM WEDNESDAY THROUGH 6:00AM MONDAY FRIDAY 12:00N THURSDAY THROUGH 6:00AM MONDAY SATURDAY 12:00N FRIDAY THROUGH 6:00AM MONDAY

SHOULD THE CONTRACTOR FAIL TO MEET ANY OF THESE

EQUIREMENTS, THE CONTRACTOR SHALL BE ASSESSED A DISINCENTIVE IN THE AMOUNT OF \$5000 FOR EACH DAY THE ABOVE DESCRIBED LANE CLOSURE RESTRICTIONS ARE VIOLATED

LENGTH AND DURATION OF LANE CLOSURES AND RESTRICTIONS SHALL BE AT THE APPROVAL OF THE ENGINEER. IT IS THE INTENT TO MINIMIZE THE IMPACT TO THE TRAVELING PUBLIC. LANE CLOSURES OR RESTRICTIONS OVER SEGMENTS OF THE PROJECT IN WHICH NO WORK IS ANTICIPATED WITHIN A REASONABLE TIME FRAME, AS DETERMINED BY THE ENGINEER, SHALL NOT BE PERMITTED. THE LEVEL OF UTILIZATION OF MAINTENANCE OF TRAFFIC DEVICES SHALL BE COMMENSURATE

# WHITH THE WORK IN PROGRESS

NOTICE OF CLOSURE SIGNS (W20-H13) SHALL BE ERECTED BY THE CONTRACTOR PRIOR TO THE SCHEDULED ROAD OR RAMP CLOSURE IN ACCORDANCE WITH THE NOTICE OF CLOSURE TIME TABLE BELOW .. EAT THE APPROVAL OF THE ENGINEER, PORTABLE CHANGEABLE MESSAGE SIGNS MAY BE USED IN LIEU OF THE STANDARD FLATSHEET SIGN FOR CLOSURE DURATIONS OF LESS THAN 1 WEEK.

THE SIGNS SHALL BE ERECTED ON THE RIGHT-HAND SIDE OF THE ROAD/RAMP FACING TRAFFIC. THEY SHALL BE PLACED SO AS NOT TO INTERFERE WITH THE VISIBILITY OF ANY OTHER TRAFFIC CONTROL SIGNS. ON ROADWAYS, THEY SHOULD BE ERECTED AT OR NEAR THE POINT OF CLOSURE. THE SIGNS MAY BE ERECTED ANYWHERE ON RAMPS AS LONG AS THEY ARE VISIBLE TO THE MOTORISTS USING THE RAMP. ON ENTRANCE RAMPS, THE SIGN SHALL BE ERECTED WELL IN ADVANCE OF THE MERGE AREA TO AVOID DISTRACTING MOTORISTS.

/// 010 010		
	Notice of Closure Sign Time	e Table
<u>ltem</u>	Duration of Closure	Sign Displayed to I
Ramp &	>= 2 weeks	14 calendar days p
Road	> 12 hours & < 2 weeks	7 calendar days pri
Closures	< 12 hours	2 business days pri

Ā

ഗ്

/18-0.00/18

65/

-00M

Public prior to closure rior to closure prior to closure

THE SIGN SHALL DISPLAY THE DATE OF THE CLOSURE IN MMM-DD FORMAT AND THE NUMBER OF DAYS OF THE CLOSURE. THE LAST LINE OF THE W20-H13 SIGN LISTS A PHONE NUMBER WHICH A MOTORIST MAY CALL FOR ADDITIONAL INFORMATION. THIS PHONE NUMBER SHALL BE 419-373-4428.

# ITEM 614. MAINTAINING TRAFFIC ROAD CLOSED SIGN

THE CONTRACTOR SHALL PROVIDE. ERECT AND MAINTAIN STANDARD 48 X 30 INCH ROAD CLOSED SIGNS, SIGN SUPPORTS, BARRICADES AND LIGHTS, AS DETAILED IN SCD MT-101.60 AT THE FOLLOWING LOCATIONS DURING PERIODS IN WHICH THE AFFECTED ROADS ARE CLOSED TO TRAFFIC.

ALL WORK AND TRAFFIC CONTROL DEVICES SHALL BE IN ACCORDANCE WITH CMS 614 AND OTHER APPLICABLE PORTIONS OF THE SPECIFICATIONS, AS WELL AS THE OHIO MANUAL OF UNIFORM TRAFFIC CONTROL DEVICES. PAYMENT FOR ALL LABOR, EQUIPMENT AND MATERIALS SHALL BE INCLUDED IN THE LUMP SUM CONTRACT PRICE FOR ITEM 614, MAINTAINING TRAFFIC UNLESS SEPARATELY ITEMIZED IN THE PLAN.

#### ITEM 614, REPLACEMENT SIGN

FLATSHEET SIGNS FURNISHED BY THE CONTRACTOR IN ACCOR-DANCE WITH THE REQUIREMENTS OF THE PLANS, SPECIFICA-TIONS AND PROPOSAL WHICH BECOME DAMAGED BY TRAFFIC FOR REASONS BEYOND THE CONTROL OF THE CONTRACTOR SHALL BE REPLACED IN KIND WHEN ORDERED BY THE ENGINEER. REPLACEMENT SIGNS SHALL BE NEW. OTHER MATERIALS MAY BE IN USED, BUT GOOD, CONDITION SUBJECT TO APPROVAL BY THE ENGINEER.

PAYMENT FOR THE NEW SIGNS SHALL BE MADE AT THE CONTRACT PRICE PER EACH FOR ITEM 614, REPLACEMENT SIGN, AND SHALL INCLUDE THE COST OF REMOVING AND DISPOSING OF DAMAGED SIGNS, HARDWARE AND SUPPORTS, AND PROVIDING THE NECESSARY REPLACEMENT HARDWARE, SUPPORTS, ETC.

AN ESTIMATED QUANTITY OF 5 EACH HAS BEEN PROVIDED IN THE GENERAL SUMMARY.

#### ITEM 614, REPLACEMENT DRUM

DRUMS FURNISHED BY THE CONTRACTOR IN ACCORDANCE WITH THE REQUIREMENTS OF THE PLANS, SPECIFICATIONS AND PROPOSAL WHICH BECOME DAMAGED BY TRAFFIC FOR REASONS BEYOND THE CONTROL OF THE CONTRACTOR SHALL BE REPLACED IN KIND WHEN ORDERED BY THE ENGINEER. REPLACEMENT DRUMS SHALL BE NEW.

## Added to Note

PAYMENT FOR THE NEW DRUMS SHALL BE MADE AT THE CON-TRACT PRICE PER EACH FOR ITEM 614, REPLACEMENT DRUM, AND SHALL INCLUDE THE COST OF REMOVING AND DISPOSING OF THE DAMAGED DRUM, AND PROVIDING AND MAINTAINING THE REPLACEMENT DRUM IN ACCORDANCE WITH THE CONTRACT REQUIREMENTS FOR THE ORIGINAL DRUM.

AN ESTIMATED QUANTITY OF 5 EACH HAS BEEN PROVIDED IN THE GENERAL SUMMARY.

#### PLACEMENT OF ASPHALT CONCRETE

TWO-WAY TRAFFIC SHALL BE MAINTAINED AT ALL TIMES EXCEPT THAT ONE-WAY TRAFFIC WILL BE PERMITTED FOR MINIMUM PERIODS OF TIME CONSISTENT WITH THE REQUIREMENTS OF THE SPECIFICATIONS FOR PROTECTION OF COMPLETED ASPHALT CONCRETE COURSES.

#### TEMPORARY WEDGING

ALL TEMPORARY ASPHALT WEDGING/REMOVAL OF WEDGE REQUIRED TO PROVIDE A SMOOTH TRANSITION FROM MILLED SURFACES TO EXISTING SURFACES THROUGHOUT THE PROJECT (INCLUDING DRIVE APPROACHES AND CONCRETE PAVEMENT AREAS IN GRAND RAPIDS) ARE TO BE INCLUDED IN ITEM 614 MAINTAINING TRAFFIC.

#### WORK ZONE MARKINGS AND SIGNS

Added Note

THE FOLLOWING ESTIMATED QUANTITIES HAVE BEEN CARRIED TO THE GENERAL SUMMARY FOR USE AT LOCATIONS IDENTIFIED BY THE ENGINEER FOR WORK ZONE PAVEMENT MARKINGS AND SIGNS PER THE REQUIREMENTS OF CMS 614.04 AND 614.11.

ITEM 614 - WORK ZONE MARKING SIGN 28 EACH ITEM 614 - WORK ZONE EDGE LINE, CLASS I 39 MILE ITEM 614 - WORK ZONE CENTERLINE. CLASS I 24 MILE ITEM 614 - WORK ZONE STOP LINE, CLASS III 306 FT

Moved Note from this Column, to that Column

## ODOT NOTIFICATION CONTACT INFORMATION

THE ODOT PROJECT ENGINEER SHALL FORWARD THE CONSTRUCTION NOTIFICATION INFORMATION THE FOLLOWING DEPARTMENTS WITHIN THE TIMELINE OUTLINED IN TEM PART 642-58 TO ENSURE COMPLIANCE WITH FEDERAL NOTIFICATION REQUIREMENTS:

DISTRICT PUBLIC INFORMATION OFFICER (PIO) BY PHONE AT: (419) 373-4428 OR EMAIL AT: DO2.PIO@DOT.OHIO.GOV

DISTRICT PERMIT SECTION BY PHONE AT: (419) 373-4301 OR EMAIL AT: D02.PERMITS@DOT.OHIO.GOV


#### NOTIFICATION OF TRAFFIC RESTRICTIONS

THROUGHOUT THE DURATION OF THE PROJECT, THE CONTRACTOR SHALL NOTIFY THE PROJECT ENGINEER IN WRITING OF ALL TRAFFIC RESTRICTIONS AND UPCOMING MAINTENANCE OF TRAFFIC CHANGES. THE CONTRACTOR SHALL ENSURE THE WRITING OF ALL TRAFFIC RESTRICTIONS AND UPCOMING MAINTENANCE OF TRAFFIC CHANGES. THE CONTRACTOR SHALL ENSURE THE WRITTEN NOTIFICATION IS SUBMITTED IN A TIMELY MANNER TO ALLOW THE PROJECT ENGINEER TO MEET THE REQUIRED TIME FRAMES SET FORTH IN THE TABLE BELOW TO INFORM THE SPECIAL HAULING PERMITS SECTION (HAULING.PERMITS@DOT.OHIO.GOV) AND THE DISTRICT PUBLIC INFORMATION OFFICE (PIO). THIS NOTIFICATION SHALL BE RECEIVED BY THE PROJECT ENGINEER PRIOR TO THE PHYSICAL SETUP OF ANY APPLICABLE SIGNS OR MESSAGE BOARDS.

INFORMATION SHOULD INCLUDE, BUT IS NOT LIMITED TO, ALL CONSTRUCTION ACTIVITIES THAT IMPACT OR INTERFERE WITH TRAFFIC AND SHALL LIST THE SPECIFIC LOCATION, TYPE OF WORK, ROAD STATUS, DATE AND TIME OF RESTRICTION, DURATION OF RESTRICTION, NUMBER OF LANES MAINTAINED, NUMBER OF LANES CLOSED, MINIMUM VERTICAL CLEARANCE, MINIMUM WIDTH OF DRIVABLE PAVEMENT, DETOUR ROUTES, IF APPLICABLE, AND ANY OTHER INFORMATION REQUESTED BY THE PROJECT ENGINEER.

ITEM	NOTIFICATION T DURATION OF CLOSURE	
RAMP & ROAD CLOSURES	>= 2 WEEKS	21 CALENDAR DAYS PRIOR TO CLOSURE
	> 12HOURS & < 2 WEEKS	14 CALENDAR DAYS PRIOR TO CLOSURE
	< 12 HOURS	4 CALENDAR DAYS PRIOR TO CLOSURE
LANE CLOSURES & RESTRICTIO		14 CALENDAR DAYS PRIOR TO CLOSURE
1201110110	< 2 WEEKS	5 BUSINESS DAYS PRIOR TO CLOSURE
START OF CONSTRUCT TRAFFIC PA CHANGES		14 CALENDAR DAYS PRIOR TO IMPLEMENTATION

ANY UNFORESEEN CONDITIONS NOT SPECIFIED IN THE PLANS REQUIRING TRAFFIC RESTRICTIONS SHALL ALSO BE REPORTED TO THE PROJECT ENGINEER USING THE NOTIFICATION TIME TABLE.

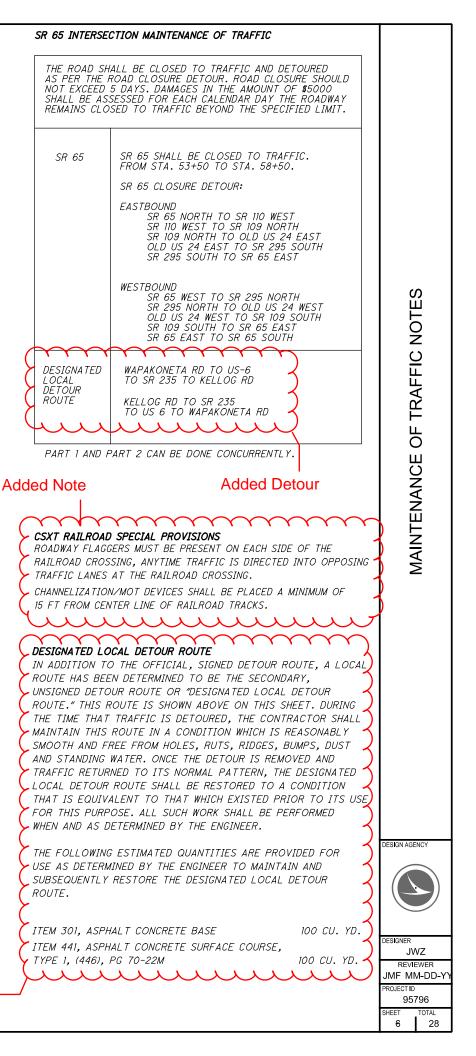


			1	1		SHEE	T NUM.				•		PA	RT.	ITEM	ITEM	GRAND	UNIT	D
	5	6	9	10	11	12	13						01/STR/PV	02/MPO/PV	1160	EXT	TOTAL	UNIT	
													LS		202	11000	LS		STRUCTURE REMOVED
			499											499	202	23000	499	SY	PAVEMENT REMOVED
							12,150						12,150		202	30000	12,150	SF	WALK REMOVED
							15						15		202	32000	15	FT	
						2,600							2,600		202	38000	2,600	FT	GUARDRAIL REMOVED
						9							9		202	42000	9	EACH	ANCHOR ASSEMBLY REMOVED, TYPE A
						3							3		202	42010	3	EACH	ANCHOR ASSEMBLY REMOVED, TYPE E
						7							7		202	42040	7	EACH	ANCHOR ASSEMBLY REMOVED, TYPE T
						3							3		202	42050	3	EACH	ANCHOR ASSEMBLY REMOVED, TYPE B
						8	4			A al al		and the s	8		202	47000	8	EACH	BRIDGE TERMINAL ASSEMBLY REMOVED
	175			<u> </u>	Added	Quant	ty			Add	ed Qua	intity –	175	,357	203	10000	532	СҮ	EXCAVATION
	200		V 357										200		203	20000	200	CY CY	EMBANKMENT
	200					36							36		203	15000	36	STA	RESHAPING UNDER GUARDRAIL
	200												200		601	20010	200	CY	CRUSHED AGGREGATE SLOPE PROTECTION
						1,563							1,563		606	15050	1,563	FT	GUARDRAIL, TYPE MGS
						988							988		606	15100	988	FT	GUARDRAIL, TYPE MGS WITH LONG POSTS
						3							3 12		606 606	26050 26150	3 12	EACH	ANCHOR ASSEMBLY, MGS TYPE B
						12 7							7		606	26150	7	EACH EACH	ANCHOR ASSEMBLY, MGS TYPE E MASH 2016 ANCHOR ASSEMBLY, MGS TYPE T
						4							4		606	35002	4	EACH	MGS BRIDGE TERMINAL ASSEMBLY, TYPE 1
													· · ·						
						4							4		606	35140	4	EACH	BRIDGE TERMINAL ASSEMBLY, TYPE 4
							8,100						8,100		608	10000	8,100	SF	4" CONCRETE WALK
							4,050						4,050		608	52000	4,050	SF	
						81	15						15 81		609 614	26000 13310	15 81	FT EACH	CURB, TYPE 6 BARRIER REFLECTOR, TYPE 1 ,BIDIRECTIONAL
						81							81		014	13310	81	EACH	BARRIER REFLECTOR, TYPE T ,BIDIRECTIONAL
																			ERC
													5,000		832	30000	5,000	EACH	EROSION CONTROL
															0.1.1	00000		<b>540</b>	
lgn	5												5		611 611	98630 98634	5	EACH EACH	CATCH BASIN ADJUSTED TO GRADE
001.d	5												5		611	90654	5	EACH	MANHOLE ADJUSTED TO GRADE
99	2												2		611	99660	2	EACH	MANHOLE RECONSTRUCTED TO GRADE
95796	1												1		623	39500	1	EACH	MONUMENT BOX ADJUSTED TO GRADE
sets/6																			
ay∖She	1												1		638	10800	1	EACH	VALVE BOX ADJUSTED TO GRADE
Roadw																			
ering/F																			
igine	10.0		12	2									14		209	60500	14	MILE	LINEAR GRADING
00-Er	12.9 2,471												12.9 2,471		209 253	72050 02000	12.9 2,471	MILE CY	PREPARING SUBGRADE FOR SHOULDER PAVING PAVEMENT REPAIR
796\4	2,771		– Adde	d Qua	ntity								2,777		200	02000	2,771		
ziems od/95									U	pdated	Quan	titv —							<ul> <li>Updated Quantity</li> </ul>
USER: jziem ct 02\Wood\9	1,422	$\frown$	85,468	17,779								<b></b>	104,669		254	01000	104,669	SY	PAVEMENT PLANING, ASPHALT CONCRETE, 3 <sup>1</sup> / <sub>4</sub> "
I USI	58	100	83											141	301	46000	241	CY	ASPHALT CONCRETE BASE, PG64-22
50 AM ADistric	117		111	0.400										228	304	20000	228	CY	AGGREGATE BASE
9:14:5 ojects	161 7.8	100	12,021	2,490 741									14,672		407 441	20000 10100	14,672 .848.8	GAL CY	NON-TRACKING TACK COAT ASPHALT CONCRETE SURFACE COURSE, TYPE 1,
TIME: 9:14:50 / ctive Projects\Di	1.0			741									848.8		441	10100	040.0		- Updated Quantity
21 TI Activ	32.1		4,183	865					U	pdated	Quant	itv —	5,052.1	28	441	10200	5,080.1	CY	ASPHALT CONCRETE INTERMEDIATE COURSE, TY
0/20;	59											1	59		441	50100	59	CY	ASPHALT CONCRETE SURFACE COURSE, TYPE 1,
. 9/3	73.8			– Adde	ed Qua	ntity							73.8		441	50300	73.8	CY	ASPHALT CONCRETE INTERMEDIATE COURSE, TY
DATE: 9/30/2021 7 2/Documents/01 Act	70.4		3,583										3,632.4	21	442	10000	3,653.4	CY	ASPHALT CONCRETE SURFACE COURSE, 12.5 MM
			1,238	136									1,374		617	10100	1,374	CY	COMPACTED AGGREGATE
7×11 (			7,708	1,234									8,942		875	10000	8,942	LB	LONGITUDINAL JOINT ADHESIVE
ZE: 1			7,700	1,204									0,042		010	10000	0,042		
PAPERSIZE: 17x11 (in.) bentley.com:ohiodot-pw-(																			TRA
PAP					320								320		621	00100	320	EACH	RPM
ot pw					365								365		621	54000	365	EACH	
) EL S					14								14		642	00104	14	MILE	EDGE LINE, 6", TYPE 1
MODEL Sheet																			
								L				1							1

WOO-65/18-0.00/18.53

DESCRIPTION	SEE SHEET NO.	
ROADWAY		
		≿
		AR AR
		Ψ
		S S
		SAL
		GENERAL SUMMARY
ROSION CONTROL		Ū
DRAINAGE		
PAVEMENT		
G		
1		
1, (446), PG70-22M		
		DESIGN AGENCY
TYPE 2, (446) 1, (448), PG70-22M		
TYPE 2, (448)		
<i>I</i> М, ТҮРЕ А (446)		
		DESIGNER
RAFFIC CONTROL		JWZ
		JMF MM-DD-YY
		PROJECT ID 95796
		SHEET TOTAL 7 28
		. 20

									000	071	407	407	440		0.17	075		$\sum_{n=1}^{\infty}$	001	001		1	 I	
								4	209	254	407	407	442	441	617	875	202	203 🗸	301	304				-
STATI	ON R	ANGE	TYPICAL SECTION	SIDE	DISTANCE (D)	AVERAGE WIDTH (W)	SURFACE AREA (A) A=D×W/9	cadd generated area	LINEAR GRADING	PAVEMENT PLANING, ASPHALT CONCRETE	NON-TRACKING TACK COAT 0.085	NON-TRACKING TACK COAT 0.055	ASPHALT CONCRETE SURFACE COURSE, 12.5 MM, TYPE A (446)	ASPHALT CONCRETE INTERMEDIATE COURSE, TYPE 2, (446)	COMPACTED AGGREGATE	LONGITUDINAL JOINT ADHESIVE	PAVEMENT REMOVED	EXCAVATION	HALT CONCRETE BASE, PG64- 22	AGGREGATE BASE				
						4		Ċ		Ъ	ION	ION	AS	INT		LC LC		א א	ASP					
					FT	FT	SY	SY	MILE	SY	GAL	GAL	CY	CY	CY	LB	SY	сү 🗸	CY	CY				-
	SR 65												10.00					<u>}</u>						
1+19.84 5+00.00	TO TO	5+00.00	_	LT/RT	380.16 500.00	23.90 24.00	1009.54 1333.33		0.14	1009.54 1333.33	85.81 113.33	55.52 73.33	42.06 55.56	49.07 64.81	15.25 20.06	95.04 125.00								-
0+00.00	TO	15+00.00		LT/RT	500.00	23.60	1311.11		0.19	1311.11	111.44	73.33	54.63	63.73	20.06	125.00								-
5+00.00	TO	20+00.00		LT/RT	500.00	36.50	2027.78		0.19	2027.78	172.36	111.53	84.49	98.57	20.06	125.00								
0+00.00	TO	31+50.00		LT/RT	1150.00	24.60	3143.33		0.44	3143.33	267.18	172.88	130.97	152.80	46.14	287.50		~ _						-
1+50.00	то	43+00.00		LT/RT	1150.00	23.50	3002.78		0.44	3002.78	255.24	165.15	125.12	145.97	46.14	287.50		א א						
3+00.00	то	53+00.00	-	LT/RT	1000.00	23.30	2588.89		0.38	2588.89	220.06	142.39	107.87	125.85	40.12	250.00		┝						-
3+00.00	TO	59+00.00		LT/RT	600.00	29.60	1973.33		0.23	1973.33	167.73	108.53	82.22	95.93	24.07	150.00		4	)					1
																		(L						]
9+00.00	TO	64+00.00	_	LT/RT	500.00	25.30	1405.56		0.19	1405.56	119.47	77.31	58.56	68.33	20.06	125.00		(^						-
4+00.00 0+00.00	TO TO	80+00.00		LT/RT	1600.00	24.60 25.90	4373.33 2877.78		0.61	4373.33 2877.78	371.73 244.61	240.53 158.28	182.22 119.91	212.59 139.89	64.20 40.12	400.00 250.00		~ _ }						-
0+00.00	10	90+00.00		LI/KI	1000.00	25.90	2011.10		0.30	2011.10	244.01	100.20	119.91	139.69	40.12	250.00		<u>}</u>	1					-
0+00.00	то	91+88.00		LT/RT	188.00	26.60	555.64		0.07	555.64	47.23	30.56	23.15	27.01	7.54	47.00		$ \downarrow  \downarrow$						-
3+65.00	TO	95+00.00		LT/RT	135.00	26.60	399.00		0.05	399.00	33.92	21.95	16.63	19.40	5.42	33.75								
5+00.00	TO	100+00.00		LT/RT	500.00	25.20	1400.00		0.19	1400.00	119.00	77.00	58.33	68.06	20.06	125.00			)					
0+00.00	TO	203+00.00		LT/RT	10300.00	23.60	27008.89		3.90	27008.89	2295.76	1485.49	1125.37	1312.93	413.27	2575.00		( ^						_
)3+00.00	то	252+00.00		LT/RT	4900.00	23.60	12848.89		1.86	12848.89	1092.16	706.69	535.37	624.60	196.60	1225.00		~}						-
52+00.00	TO	257+00.00		LT/RT	500.00	28.00	1555.56		0.19	1555.56	132.22	85.56	64.81	75.62	20.06	125.00		┟──ҳ						
57+00.00	TO	262+00.00		LT/RT	500.00	23.90	1327.78		0.19	1327.78	112.86	73.03	55.32	64.54	20.06	125.00		¥ ~						
																		ý j						
62+00.00	то	311+27.68	_	LT/RT	4927.68	23.90	13085.73		1.87	13085.73	1112.29	719.72	545.24	636.11	197.72	1231.92								_
Wide	ening SF	R 65																(. ^						-
	TO	58+25.00		RT	478.00	8.70		499.00			55.00		21.00	28.00			499.00	357.00	83.00	111.00				-
																		<u>ہ ۲</u>						
			_															<u>}</u> ∡						_
Into	ersectio	ne	_																					-
	Saylor Ln			RT	88.00	12.00		89.60		89.60	7.62	4.93	3.73	4.36										-
	Beach St			RT/LT	69.00	12.00		183.90		183.90	15.63	10.11	7.66	8.94										
	West St.			RT/LT	51.00	13.50		200.10		200.10	17.01	11.01	8.34	9.73				(^						_
	Beaver St Mill St.	t.	_	RT/LT	95.00	15.00		251.10		251.10	21.34	13.81	10.46	12.21				~}						_
	akoneta	Rd.	-	RT/LT RT	87.00 52.00	15.00 79.00		256.90 242.70		256.90 242.70	21.84 20.63	14.13 13.35	10.70 10.11	12.49 11.80				* *						1
	E. 2nd St			RT	32.00	23.00		56.50		56.50	4.80	3.11	2.35	2.75				<u>}</u> _						1
-	Front St.			LT	88.00	54.40		239.30		239.30	20.34	13.16	9.97	11.63				$\succ$						1
	Ionroe S			RT	37.00	16.00		46.20		46.20	3.93	2.54	1.93	2.25				<u>ہے ل</u>	)					-
Μ	Bridge S SR 295			RT LT	64.00 137.00	16.00 55.00	+	75.40 317.90		75.40	6.41 27.02	4.15 17.48	3.14 13.25	3.67 15.45					)					-
E,				RT	66.00	7.00		35.70		35.70	3.03	1.96	1.49	1.74				(						1
М Е,	odburn A	Rd.		RT	68.00	10.00		52.70		52.70	4.48	2.90	2.20	2.56				( ^						]
M E, Woo Syc	odburn A camore F			RT	75.00	9.00		61.20		61.20	5.20	3.37	2.55	2.98				~ _						DESIGN /
M E, Woo Syc Bens	odburn A camore F nschoter			RT	110.00	13.00		130.50		130.50	11.09	7.18	5.44	6.34				א א						-
M E, Woo Syc Bens	odburn A camore F						+											ᢣ						
M E, Woo Syc Ben:	odburn A camore F nschoter									1								X						] ([-
M E, Woo Syc Bens	odburn A camore F nschoter															I T			) – – – – – – – – – – – – – – – – – – –	I 7				
M E, Woo Syc Bens	odburn A camore F nschoter																							
M E, Woo Syc Ben:	odburn A camore F nschoter																	(^						
M E, Woo Syc Ben:	odburn A camore F nschoter																							
M E, Woo Syc Ben:	odburn A camore F nschoter																		Ad	ded Iten	n			
M E, Woo Syc Ben:	odburn A camore F nschoter																		Ad	ded Iter	n			- RE
M E, Woo Syc Bens	odburn A camore F nschoter																		Ad	ded Iter	n			- RE JMF I
M E, Woo Syc Ben:	odburn A camore F nschoter						CIR	TOTALS	11 70	85467.95	7310 77	4700.75	3582.15	4182.71	1237.01	7707.71	499.00	357.00	Ad	ded Iten	n			DESIGNEI DESIGNEI TRE JMF M PROJECT 9 SHEET

WOO-65/18-0.00/18.53

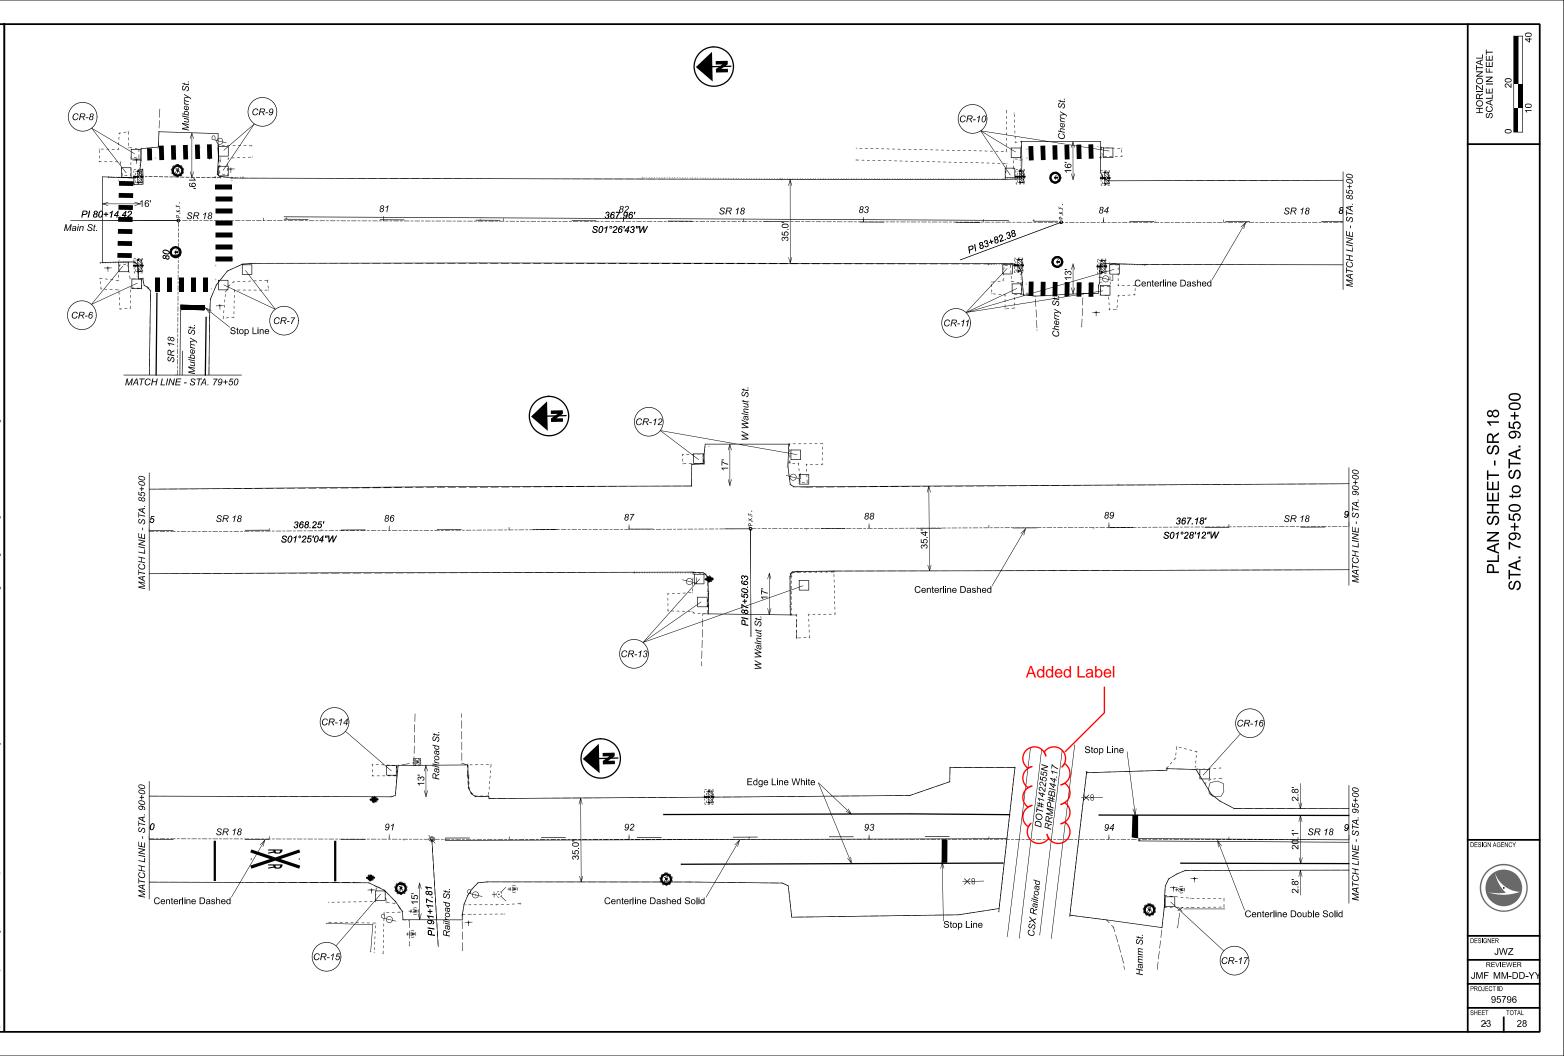

MODEL: Sneet PAPERSIZE: 17x11 (in.) DATE: 9/23/2021 TIME: 1151:20 PM USER: Jziems pw://ohiodot-pw.bentley.com:ohiodot-pw-02/Documents/OlActive Projects/DIs

WOO-65/18-0.00/18.53