



**CUY-90-14.90**

**PID 77332/85531**

---

**APPENDIX GE-14**

---

**West Bank Future (CCG2) Grading Plan  
(Contract Document)**

State of Ohio  
Department of Transportation  
Jolene M. Molitoris, Director


**Innerbelt Bridge  
Construction Contract Group 1 (CCG1)**

Revision Date: July 19, 2010



8 - Addendum No. 8 - Updated due to updates to R/W takes Abbey Road Parking Elimination and NS Access Road Addition

**GRADING PLAN FOR FUTURE  
EASTBOUND CENTRAL  
VIADUCT WITH WALL AT  
UNIVERSITY AVENUE.**

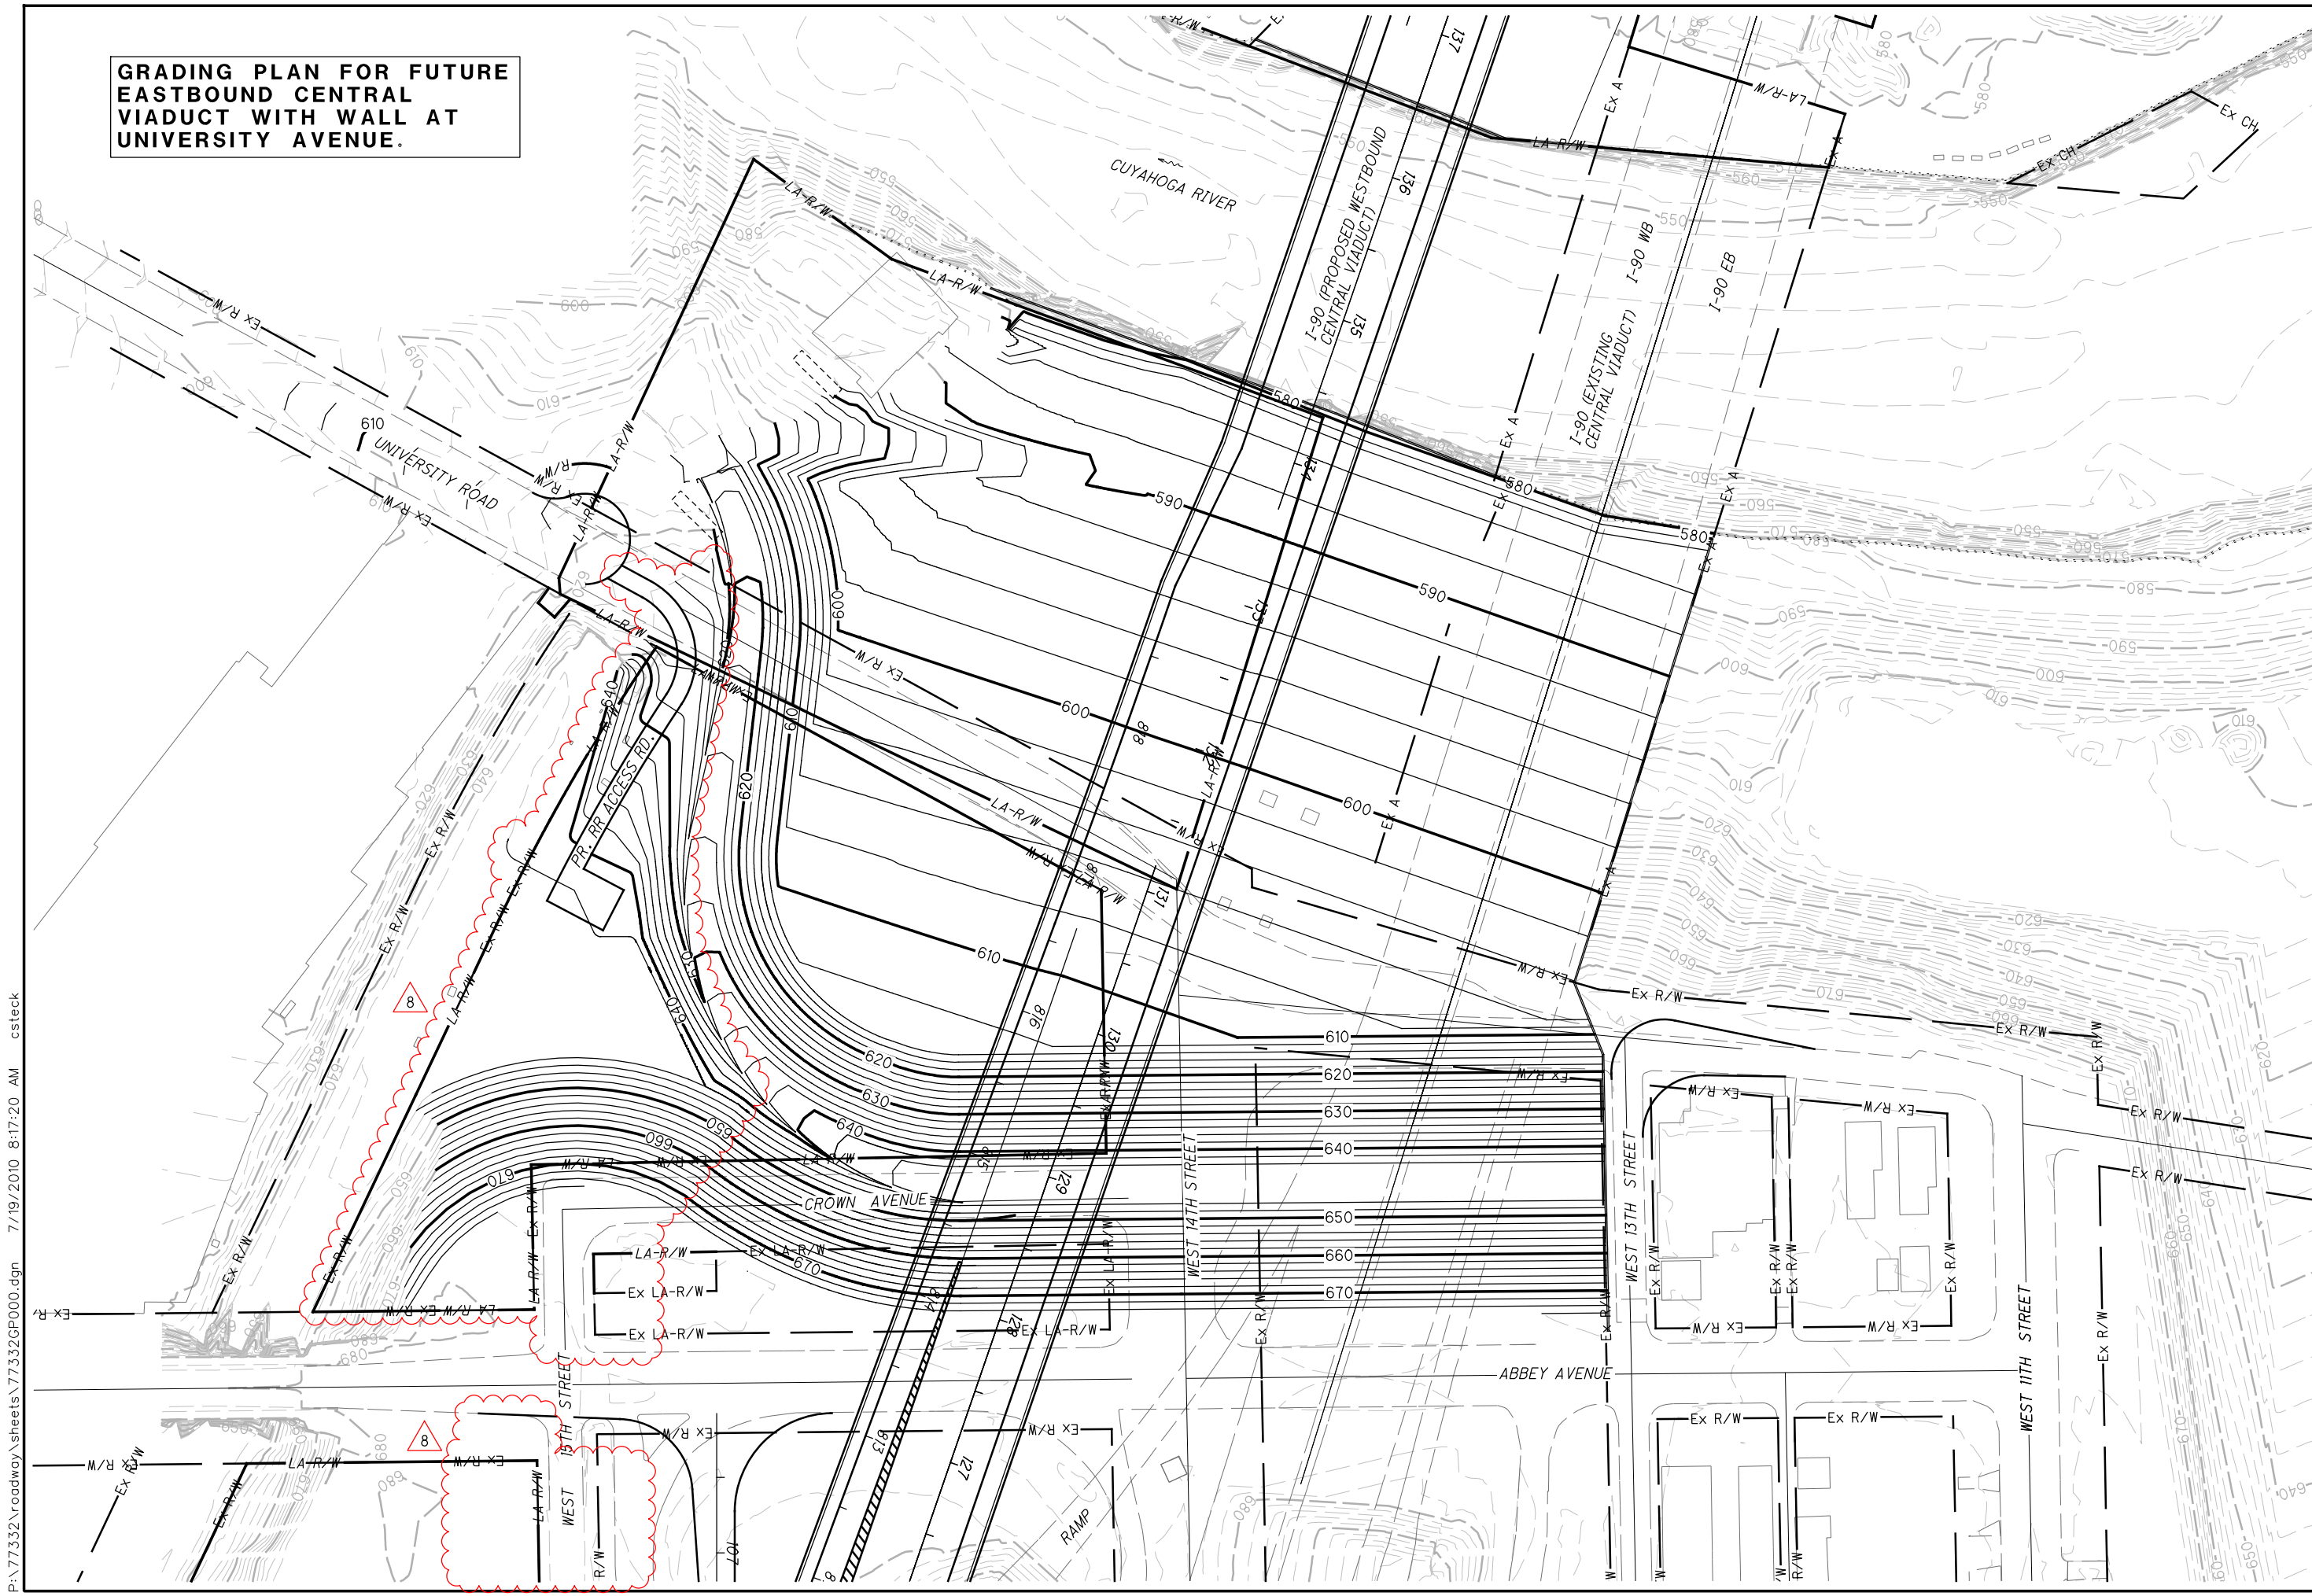

CALCULATED CDS CHECKED R/L E

0 50 100  
25  
HORIZONTAL SCALE IN FEET

**FUTURE SLOPE GRADING PLAN  
CUYAHOGA RIVER WEST BANK**

**CUY -90-14.92**



P:\77332\roadway\sheets\77332GP000.dgn 7/19/2010 8:17:20 AM csteck