



CUY-90-14.90

PID 77332/85531

APPENDIX EX-31

CUY-090-1637 PID 0.030

(Reference Document)

State of Ohio
Department of Transportation
Jolene M. Molitoris, Director

**Innerbelt Bridge
Construction Contract Group 1 (CCG1)**

210
S

THIS IMPROVEMENT IS ESPECIALLY DESIGNED FOR THROUGH TRAFFIC AND HAS BEEN DECLARED A LIMITED ACCESS HIGHWAY OR FREEWAY BY ACTION OF THE DIRECTOR OF HIGHWAYS IN ACCORDANCE WITH THE PROVISIONS OF SECTION 5511.02 REVISED CODE OF OHIO.

COMBINED LINE DATA

LENGTH OF PROJECT PART 6 [I-71-5(6)247]	= 668.53'	= 0.126 MILE
LENGTH OF PROJECT PART 7-A [I-77-5(1)162]	= 1203.24'	= 0.227 MILE
LENGTH OF PROJECT PARTS 7-A&B [I-71-5(8)248]	= 4643.78'	= 0.879 MILE
TOTAL LENGTH OF PROJECTS	= 6,515.55'	= 1.234 MILES
LENGTH OF WORK PART 6 [I-71-5(6)247]	= 3885.53'	= 0.735 MILE
LENGTH OF WORK PART 7-A [I-77-5(1)162]	= 1895.12'	= 0.358 MILE
LENGTH OF WORK PARTS 7-A&B [I-71-5(8)248]	= 10,577.65'	= 2.003 MILES
TOTAL LENGTH OF WORK	= 16,358.30'	= 3.098 MILES

INDEX OF SHEETS

SHEET NO.	TITLE SHEET	36-39	DRAINAGE PROFILES	137-144	RAMP E-10 OVER RAMP E-8
2	SCHEMATIC PLAN	40	DRAINAGE DETAILS	145-155	BR. NO. CUY - 21-1573
3-4	TYPICAL SECTIONS	41-47	LIGHTING PLANS	156-163	BR. NO. CUY - 21 - 1559
5-6	GEOMETRICS	48	LIGHTING NOTES	164-170	BR. NO. CUY - 21 - 1544
7	GENERAL NOTES	49-52	LIGHTING DETAILS	171-172	PIER CAP PLANS
8-11	QUANTITY CALCULATIONS	53-59	EXISTING UTILITIES	173	END DAM DETAILS
12,13	GENERAL SUMMARY OF QUANTITIES	60	CROSS-SECTION KEY SHEET	174	DRAINAGE DETAILS
14,14A,14-B,14-C	QUANTITIES	61-90	CROSS-SECTIONS	175	RAILING AND GUARD RAIL DETAILS
15-20	PAVEMENT DETAILS	91-97	RIGHT OF WAY	176-177	LIGHTING DETAILS
21	OMITTED	98-98A	GENERAL NOTES FOR STRUCTURES	177A-177B	SIGN BRIDGE DETAILS
22-26	ROADWAY PROFILES	99-99A	ESTIMATED QUANTITIES	178-181	OMITTED
27-31	MISCELLANEOUS DETAILS	100-113	BR. NO. CUY - 42-1843		
32-35	DRAINAGE PLANS	114-136	BR. NO. CUY - 42 - 1854		

LINE DATA

LENGTH OF PROJECT	CUY-21-15.32 (WILLOW) I-77-5(1)162	STA 30+41.98 TO STA 42+45.12	= 1,203.24' = 0.227 MILE
	CUY-42-18.42 (INNER BELT) Part 7-A	STA 64+68.53 TO STA 83+09.31	= 1,840.78'
	CUY-42-18.77 (INNER BELT) Part 7-B	STA 0+200 TO STA 26+03	= 2,803.00'
	TOTAL I-71-5(8)248		= 4,643.78' = 0.879 MILE
LENGTH OF WORK	CUY-21-15.32 (WILLOW) I-77-5(1)162	STA 23+50 TO STA 42+45.12	= 1,895.12' = 0.358 MILE
	CUY-42-18.42 (INNER BELT) Part 7-A	STA 64+68.53 TO STA 83+09.31	= 1,840.78'
	(E-18) STA 10+38 TO STA 19+88.32		= 291.03'
	(WILLOW) STA 12+52.21 TO STA 17+88.32		= 483.01'
	(WILLOW) STA 42+73.11 TO STA 42+45.12		= 67.59'
	CUY-42-18.77 (INNER BELT) Part 7-B	STA 0+200 TO STA 70+86	= 7,286.00'
	Add for Elevation	STA 27+09.87 to STA 26+61.13 RA	= 48.74'
	TOTAL I-71-5(8)248		= 10,577.65' = 2.003 MILES

PREPARED AND RECOMMENDED BY
HOWARD, NEEDLES, TAMMEN & BERGENDOFF
CONSULTING ENGINEERS
KANSAS CITY CLEVELAND NEW YORK

H.G. SOURS
ASSOCIATE
COLUMBUS

SUPPLEMENTAL SPECIFICATIONS			
NUMBER	DATE	NUMBER	DATE
S-101	12-2-59	S-207	4-28-59
M-106 (6d) Rev.	4-1-58	B-219 Rev.	3-12-59
M-206.14	7-15-49	18 Rev.	6-15-59

FILE NO.	CUYAHOGA COUNTY
	SEC. CUY-21-15.32 & CUY-42-18.42
	DATE OF LETTING
	CONTRACT NO.

STATE OF OHIO
DEPARTMENT OF HIGHWAYS
C U Y - 21 - 15.32
C U Y - 42 - 18.42
CUYAHOGA COUNTY
CITY OF CLEVELAND
WILLOW INNERBELT FREEWAY
PART 7-A

NOTE
Since the Construction Plans for PART N26, PART N27-A and PART N27-B are now Combined into ONE CONTRACT and PROJECT, the General Notes and Traffic Maintenance Notes of each of the aforesaid PARTS, shall apply in the general execution and completion of this COMBINED PROJECT.

FED. ROAD DIV. NO.	STATE	FEDERAL AID PROJECT NO.	TYPE FUNDS
2	OHIO	I-71-5(8)248 I-77-5(1)162	1 181

CUY-21-15.32
CUY-42-18.42


MAR 22 1965
GROUND PHOTOGRAPH

MICROFILMED
JUL 9 1985

I - 71 - 5 (8) 248
I - 77 - 5 (1) 162
LIMITED ACCESS

PART 7-A

For Part 6, see plans for CUY-42-18.29
For Part 7-B, see plans for CUY-42-18.77

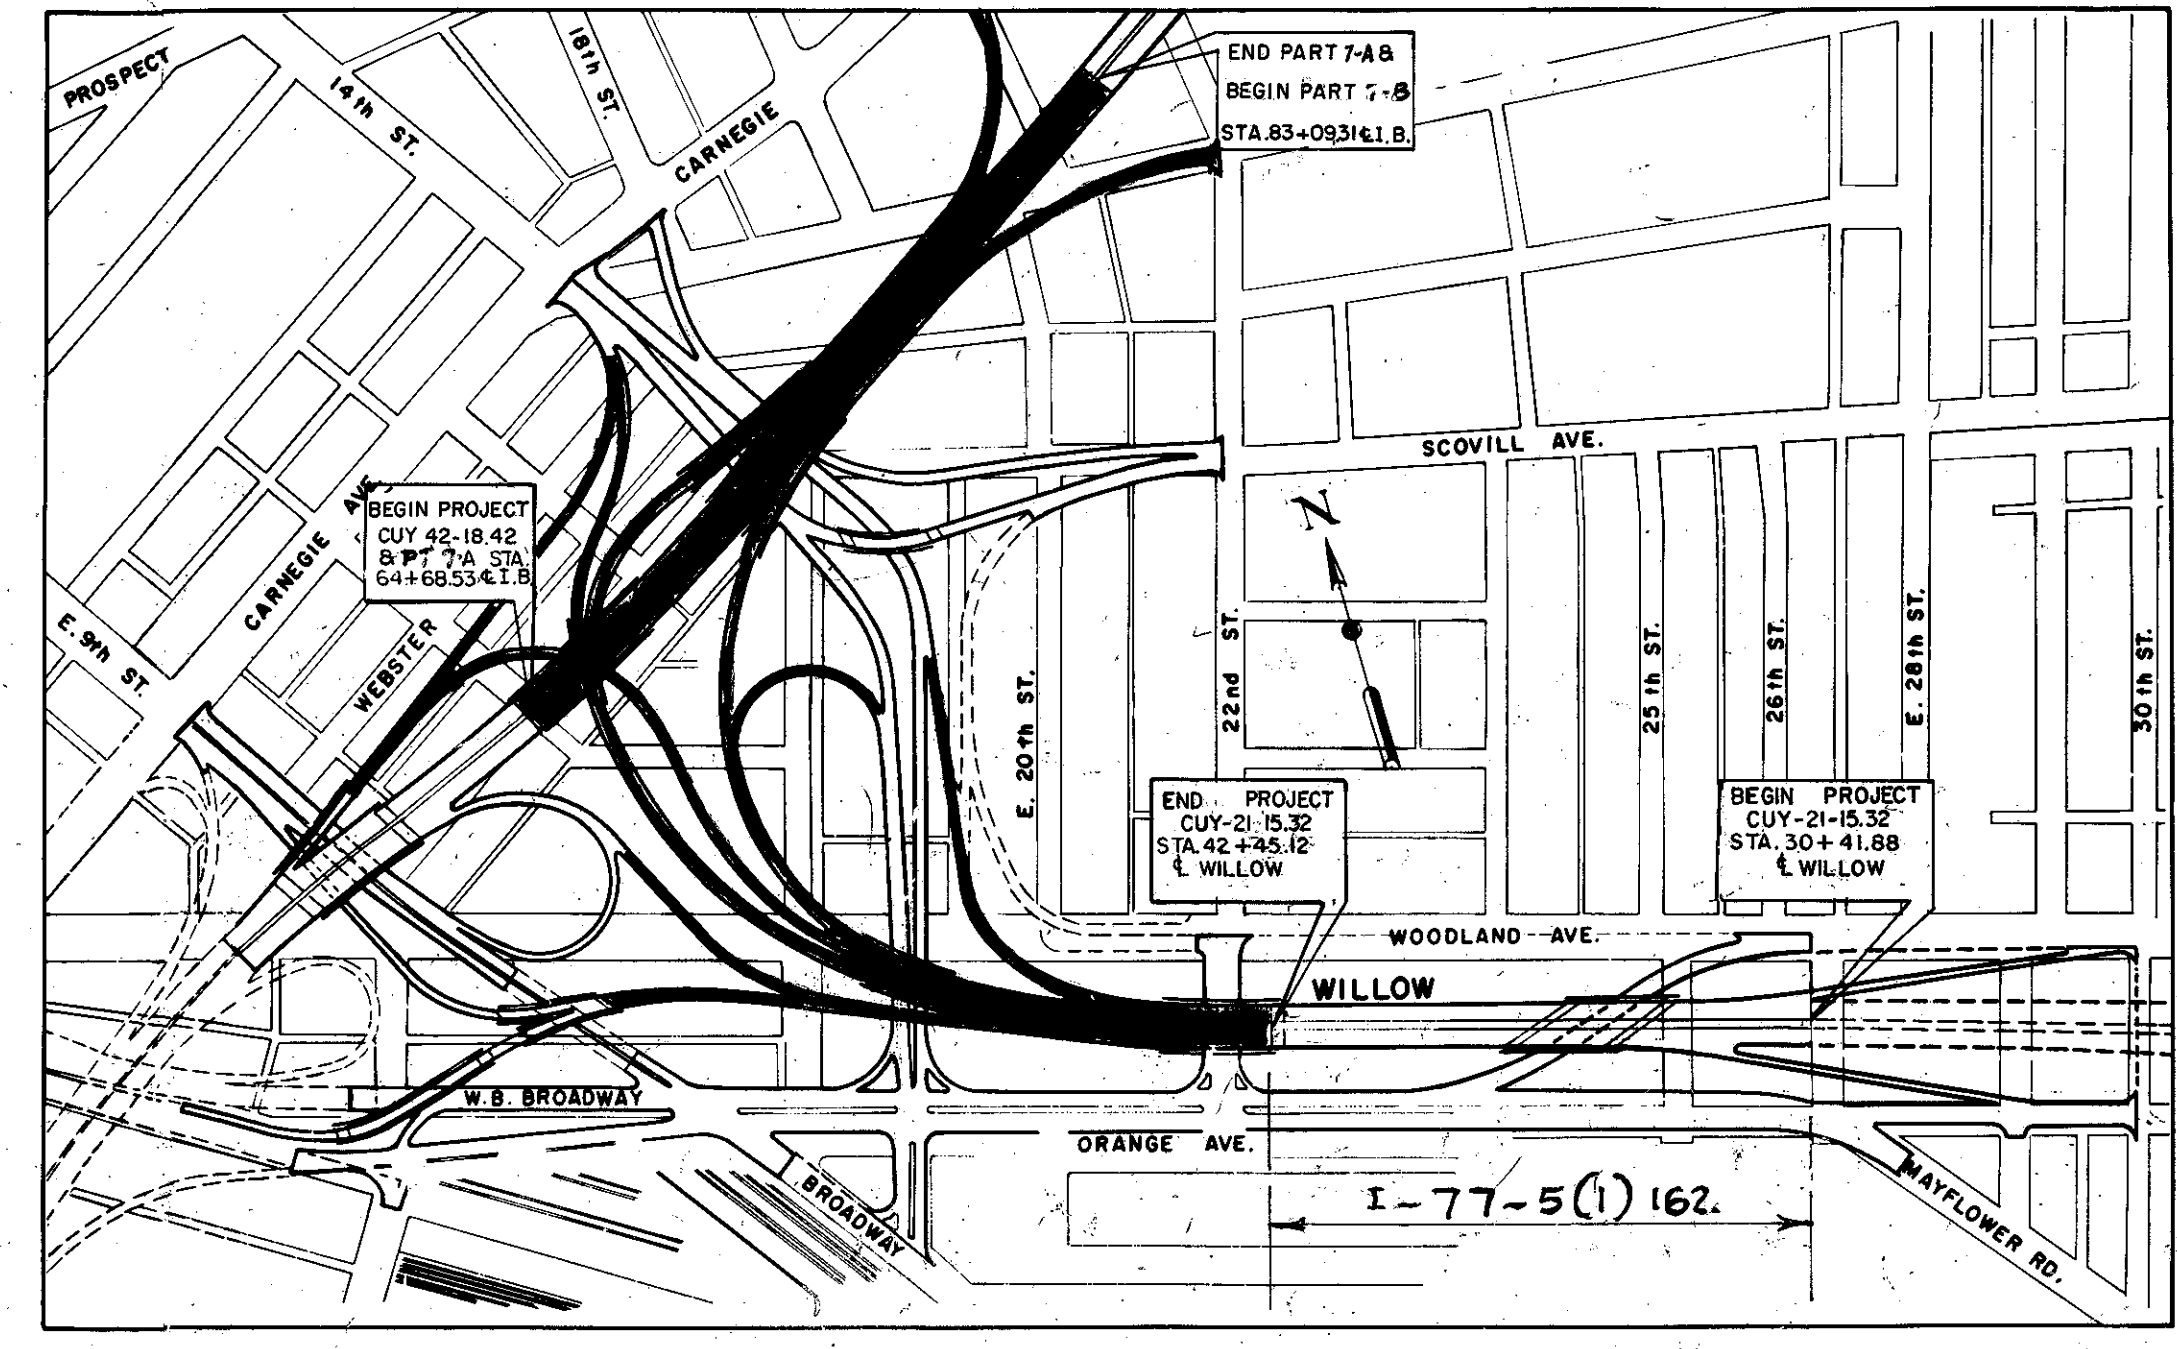


DELIVERY POINT - N.Y.C. ST.L. R.R. BROADWAY TEAM TRACKS AVERAGE HAUL 1/2 MILE

LOCATION PLAN

CONVENTIONAL SIGNS

PAVEMENT PLANS	SHEET 15
DRAINAGE PLANS	SHEET 31
LIGHTING PLANS	SHEET 43
EXISTING UTILITIES	SHEET 53

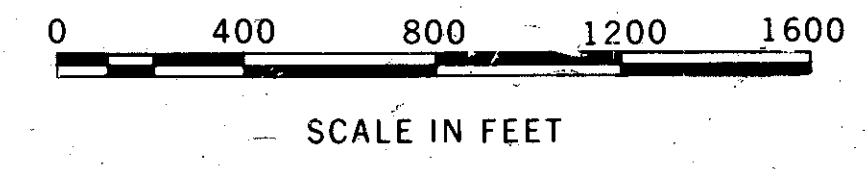

PORTION TO BE IMPROVED ■
OTHER HIGHWAYS & STREETS □

SCALES

PLAN 1" = 50'
PROFILE HORIZONTAL 1" = 100'
" VERTICAL 1" = 10'
CROSS SECTIONS 1" = 10'

STANDARD DRAWINGS			
NUMBER	DATE	NUMBER	DATE
DR-1	1-3-55	I-HS No. 1	11-3-58
AR-1-57	2-2-59	I-75 No. 6	7-1-59
		I-75 No. 1	8-21-59
L-3	4-1-50	F-3	9-1-59
L-3-A	4-1-50	I-15 NO. 2A	5-21-59
R1-1	7-15-58	BT-50-70-71 ENO	10-1-47
B-T-71 R	3-2-53	AS-1-54	12-1-54
LJ NO. 1	7-1-55	G-7.07	6-1-56
I-1, 2, 3, 4, 5	4-24-58	F-1	9-1-59
I-8CB 2-2-A&B	3-2-59	I-12	7-1-54
I-8CB NO. 9-A	1-26-59	L-1	4-1-50
I-8CB NO. 6	1-26-59	TJ	5-1-56
I-8 MH NO. 1	1-26-59	T-35	1-2-56
I-8 MH NO. 2	1-26-59	I-14G	1-22-52
I-15 NO. 1	5-21-59	I-21-23	8-1-56
I-8CB NO. 3	1-26-59	I-8CB NO. 7	3-2-59
I-8CB NO. 3-A	1-26-59	I-8 I NO. 2-A	4-23-59
I-RMH NO. 1-A	1-26-59	I-8 I NO. 2	4-23-59
I-8 2B 2-3 62-2	7-26-59		
RG-1-55	2-2-59	RN-45	8-18-47

THE STANDARD SPECIFICATIONS OF THE STATE OF OHIO DEPARTMENT OF HIGHWAYS, INCLUDING CHANGES AND SUPPLEMENTAL SPECIFICATIONS LISTED IN THE PROPOSAL SHALL GOVERN THIS IMPROVEMENT. I HEREBY APPROVE THESE PLANS AND DECLARE THAT THE MAKING OF THIS IMPROVEMENT WILL NOT REQUIRE THE CLOSING TO TRAFFIC OF THE HIGHWAY AND THAT PROVISIONS FOR THE MAINTENANCE AND SAFETY OF TRAFFIC WILL BE AS SET FORTH IN THE PLANS AND ESTIMATES. THE RIGHT OF WAY FOR THIS IMPROVEMENT WILL BE PROVIDED BY THE STATE OF OHIO.

APPROVED DATE 2/12/59
APPROVED DATE 2/12/59
APPROVED DATE 3-11-60
APPROVED DATE 3-4-60
APPROVED DATE 8-9-60
APPROVED DATE 3-9-60
APPROVED DATE 3-9-60
APPROVED DATE 3-9-60

Louis R. Drauder
DIRECTOR OF PUBLIC SERVICE, CITY OF CLEVELAND
W. B. Perry
DIVISION DEPUTY DIRECTOR
Ray E. Neenan
DEPUTY DIRECTOR OF PLANNING AND PROGRAMMING
W. J. Corman
ENGINEER OF BRIDGES
W. J. Corman
ENGINEER OF LOCATION AND DESIGN
C. W. M. Raughy
DEPUTY DIRECTOR OF DESIGN AND CONSTRUCTION
Ed. J. Berry
FIRST ASSISTANT DIRECTOR
Ed. J. Berry
DIRECTOR OF HIGHWAYS

Sheets 116, 131, 132, 133 & 175 revised 6-17-60.
Sheets 109, 110, 111, 125, 126, 127 & 128 revised 6-20-60.
Sheets 147, 153 & 171 revised 7-22-60.
Sheet 12 revised 8-22-60 REC.
Sheets 146, 147, 150, 153, 155 & 171 revised 9-21-60.
Sheet 162 revised 12-6-60.
Sheet 1AA revised 1-12-61.

MAR 22 1965
Revised As Built
GROUND PHOTOGRAPH

DEPARTMENT OF COMMERCE
BUREAU OF PUBLIC ROADS
APPROVED:
DIVISION ENGINEER
DATE






Note: Federal Aid Markers will be furnished and erected by State Forces on the Right at Beginning of each Project and on the Left at End of each Project prior to acceptance of this improvement.

CUYAHOGA COUNTY
CITY OF CLEVELAND
CUY-42-18.42
CUY-21-15.32
SCHEMATIC PLAN

Note: Typical Section of adjoining pavement is the same as the proposed construction.

MICROFILMED
JUL 3 1985

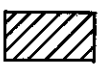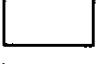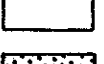LEGEND

-  Previous Contract - Part 5
-  Part 6
-  Part 7 - I-77-5(8)248
-  Part 7-I-77-5(1)162
-  Fence

CUY-42-1843
BRIDGE NUMBER 3

TYPE: Continuous welded steel girder with reinforced concrete deck and substructure.

SPANS: 90'-0", 123'-8 1/2" & 89'-9" (along E.I.B.F.)

ROADWAY: 102'-0" f./f. parapets

LOADING: CF 2000 - Adequate for A.A.S.H.O. alternate loading.

SKEW: Varies

SURFACE COURSE: 1" Monolithic Concrete

ALIGNMENT: 1°30' Curve left

APPROACH SLABS: AS-1-54 (25' Long)

SUPERELEVATION: .03' per ft.

CUY-21-1573
BRIDGE NUMBER 9

TYPE: Continuous steel beam with reinforced concrete deck and substructure.

SPANS: 37'-4 1/16", 42'-1 9/16", 53'-1 11/16", & 32'-0 7/8" along E-15.

ROADWAY: Varies

LOADING: CF 2000 - Adequate for A.A.S.H.O. alternate loading.

SKEW: 6°43'20"

SURFACE: 1" Monolithic Concrete

ALIGNMENT: Tangent

APPROACH SLABS: AS-1-54 (25' Long)

SUPERELEVATION: Varies

CUY-21-1544
BRIDGE NUMBER 11

TYPE: Continuous steel beam with reinforced concrete deck and substructure.

SPANS: 56'-0", 93'-0" & 56'-0"

ROADWAY: 112'-0" (Normal) f/f parapets

LOADING: CF 2000 - Adequate for A.A.S.H.O. alternate loading.

SURFACE COURSE: 1" Monolithic concrete

ALIGNMENT: Tangent

APPROACH SLABS: AS-1-54 (25' long)

SUPERELEVATION: None

SKEW: 56°00'

CUY-42-1854
BRIDGE NUMBER 4

TYPE: Continuous welded steel girder with reinforced concrete deck and substructure.

SPANS: 55'-0", 88'-6", 99'-0", & 60'-0" along E.I.B.

ROADWAY: Varies

LOADING: CF 2000 - Adequate for A.A.S.H.O. alternate loading.

SKEW: Varies

SURFACE: 1" Monolithic Concrete

ALIGNMENT: 1°-30' Left Tangent

APPROACH SLABS: AS-1-54 (25' Long)

SUPERELEVATION: Varies

CUY-21-1559
BRIDGE NUMBER 10

TYPE: Continuous steel beam with reinforced concrete deck and substructure.

SPANS: 56'-0", 93'-3", & 56'-0" along Willow Freeway

ROADWAY: 112'-0" (nominal) f./f. parapets.

LOADING: CF 2000 - Adequate for A.A.S.H.O. alternate loading.

SURFACE COURSE: 1" Monolithic Concrete

ALIGNMENT: Tangent to 3°00' Rt.

APPROACH SLABS: AS-1-54 (25' Long)

SUPERELEVATION: Varies

SKEW: 0°-00'

BRIDGE NUMBER 5

TYPE: Continuous steel beam with reinforced concrete deck and substructure.

SPANS: 31'-0 3/8", 48'-2 1/2", 34'-1" along E-10

ROADWAY: Varies

LOADING: CF 2000 - Adequate for A.A.S.H.O. alternate loading.

SKEW: Varies

SURFACE COURSE: 1" Monolithic Concrete

ALIGNMENT: 14°30' Curve left.

APPROACH SLABS: AS-1-54 (25' Long)

SUPERELEVATION: .08' ft. per ft.

CUY-21-1573
BRIDGE NUMBER 8

TYPE: Continuous steel beam with reinforced concrete deck and substructure.

SPANS: 38'-7 5/16", 43'-10 1/16", 55'-9 1/2", & 33'-11 3/8" along E Willow Freeway.

ROADWAY: 84'-0" (nominal) face to face parapets.

LOADING: CF 2000 - Adequate for A.A.S.H.O. alternate loading.


SKEW: Varies

SURFACE: 1" Monolithic Concrete

ALIGNMENT: 3°00'00" Rt.

APPROACH SLABS: AS-1-54 (25' Long)

SUPERELEVATION: .05' ft./ft.

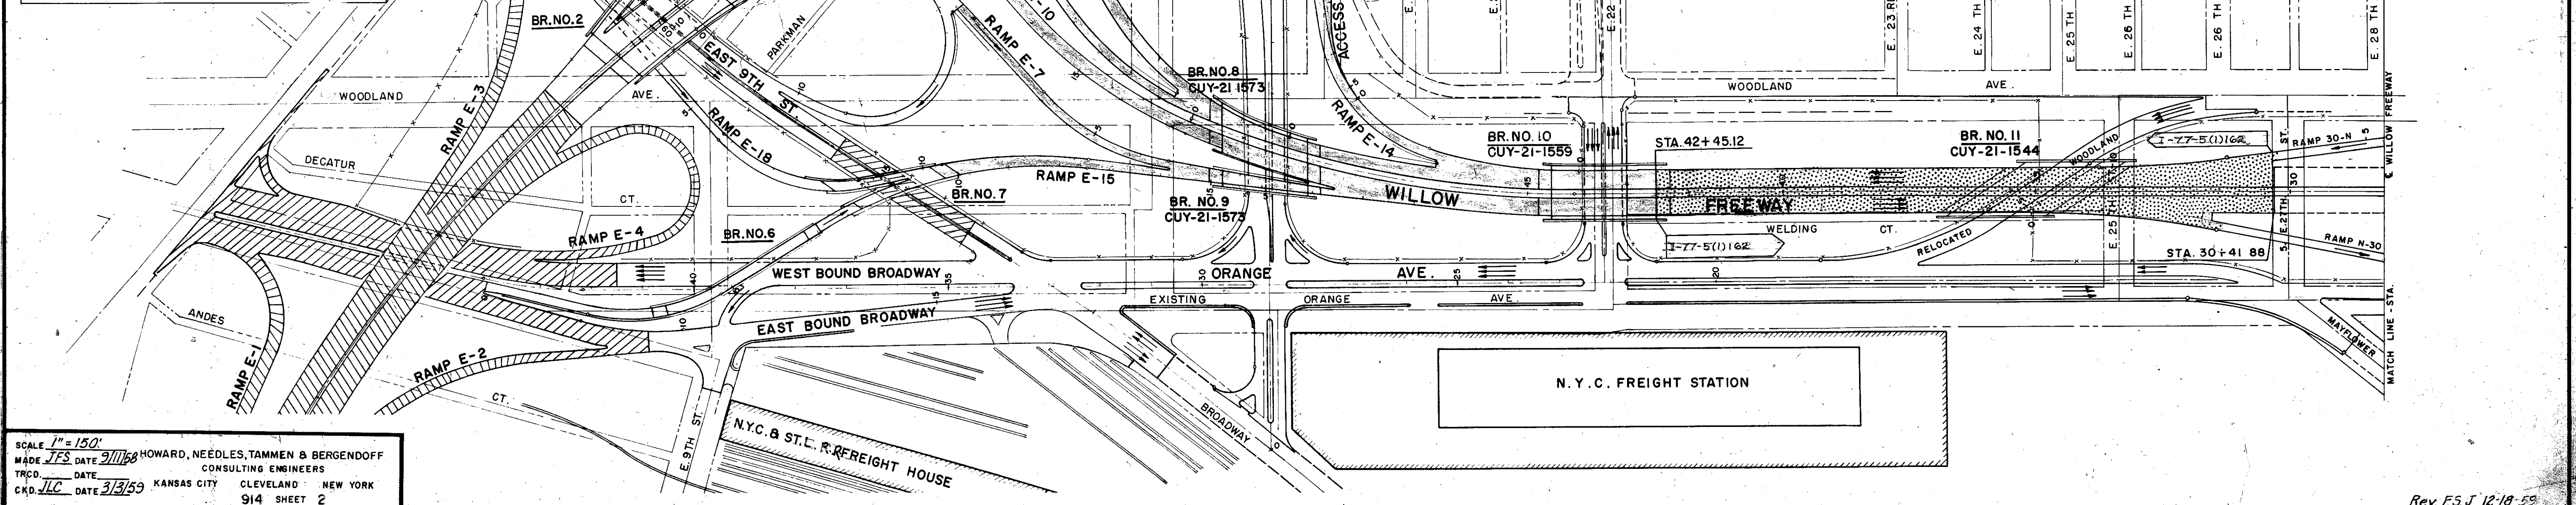


SCALE 1" = 150'
MADE JFS DATE 9/11/58 HOWARD, NEEDLES, TAMMEN & BERGENDOFF
TRCD. DATE 3/13/59 KANSAS CITY CLEVELAND NEW YORK
CND. JLC DATE 3/13/59 KANSAS CITY CLEVELAND NEW YORK
914 SHEET 2

TYPICAL SECTIONS TYPE T-71


FED. ROAD DIV. NO.	STATE	FEDERAL AID PROJECT NO.	TYPE FUNDS
2	OHIO		

3
181

CUYAHOGA COUNTY
CITY OF CLEVELAND
CUY-42-18.42
CUY-21-15.32
TYPICAL SECTIONS

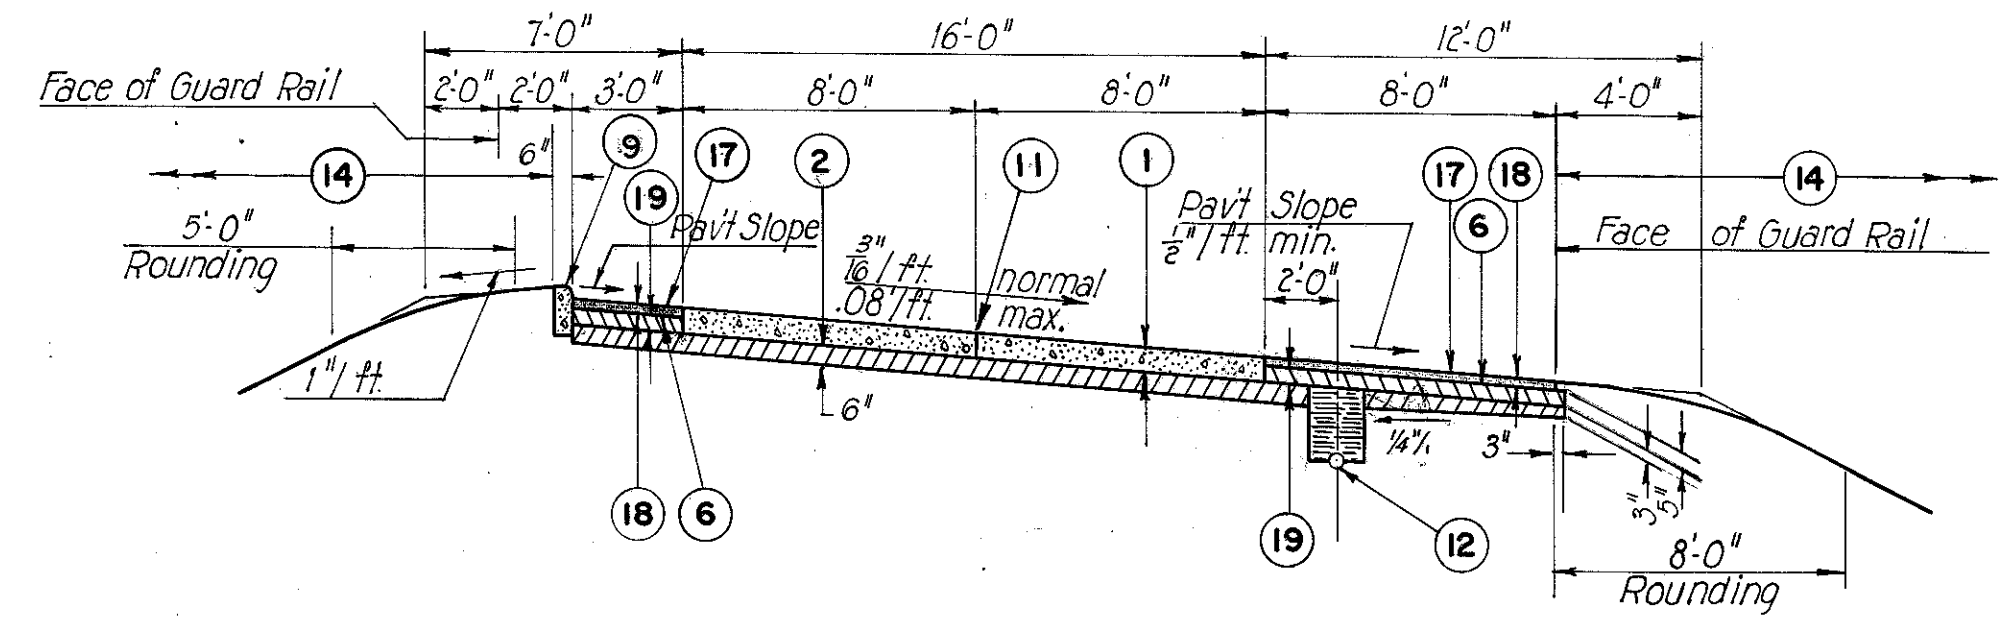


ONE LANE
NORMAL AND CURVE RIGHT

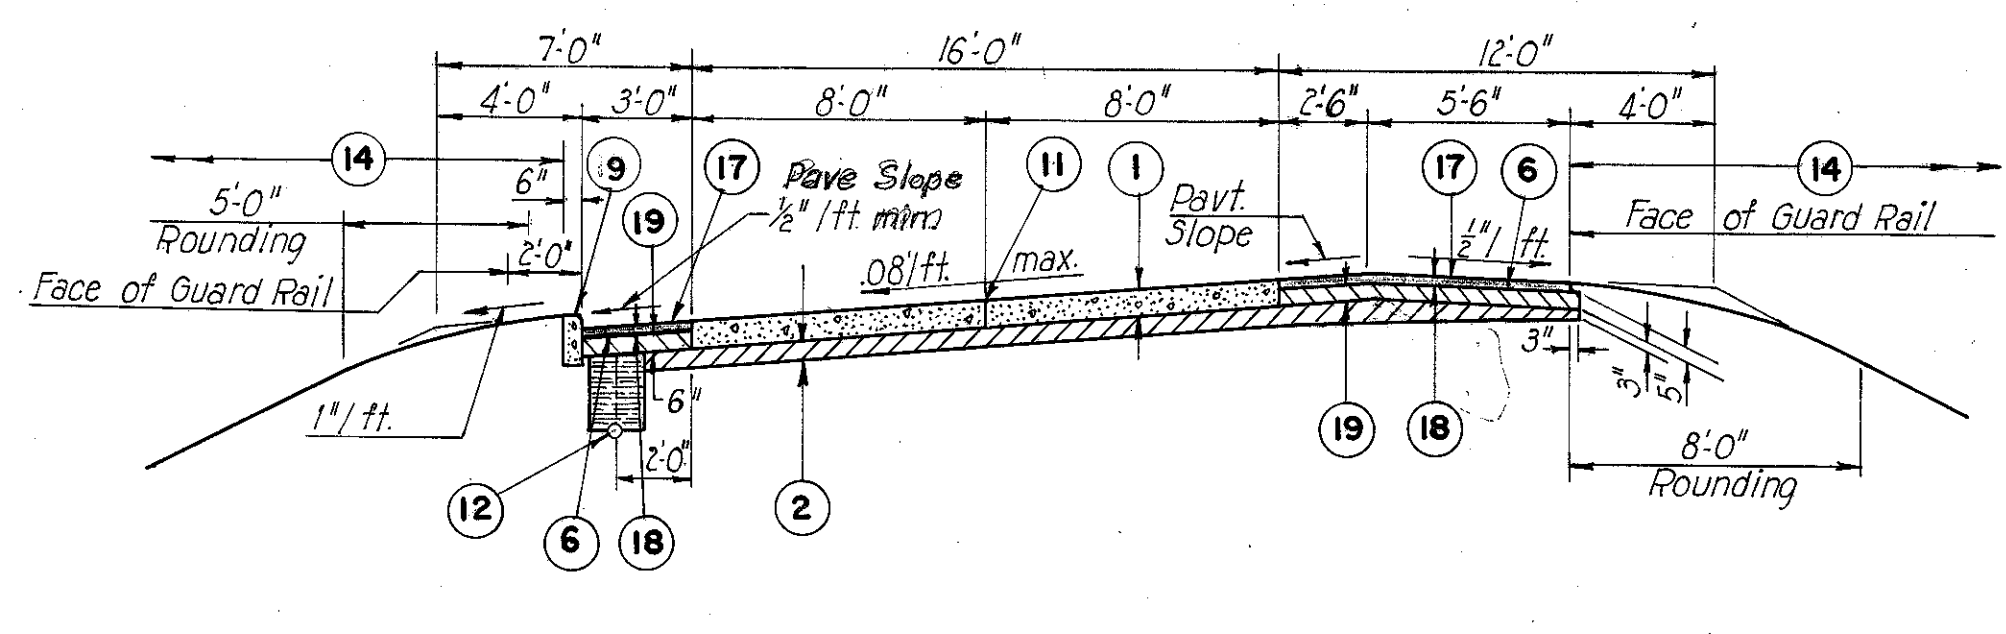


ONE LANE
CURVE LEFT

Note: Depth of I-9 = 18" from top of Pipe to bottom of I-22 unless otherwise shown.

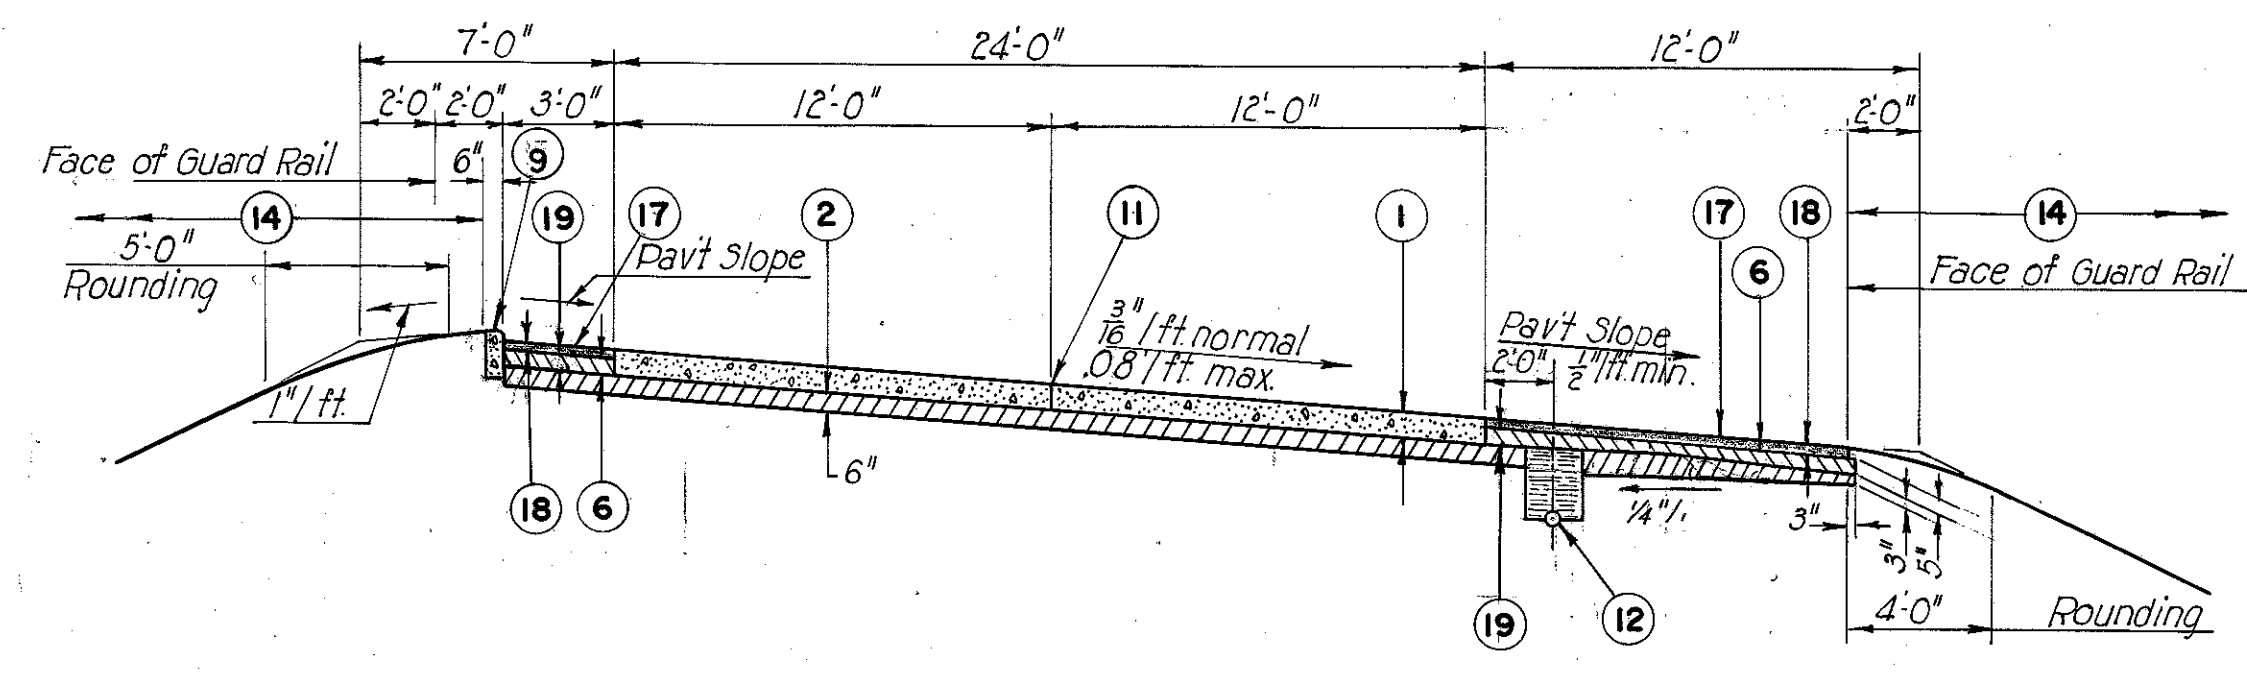

TWO LANE
NORMAL AND CURVE RIGHT

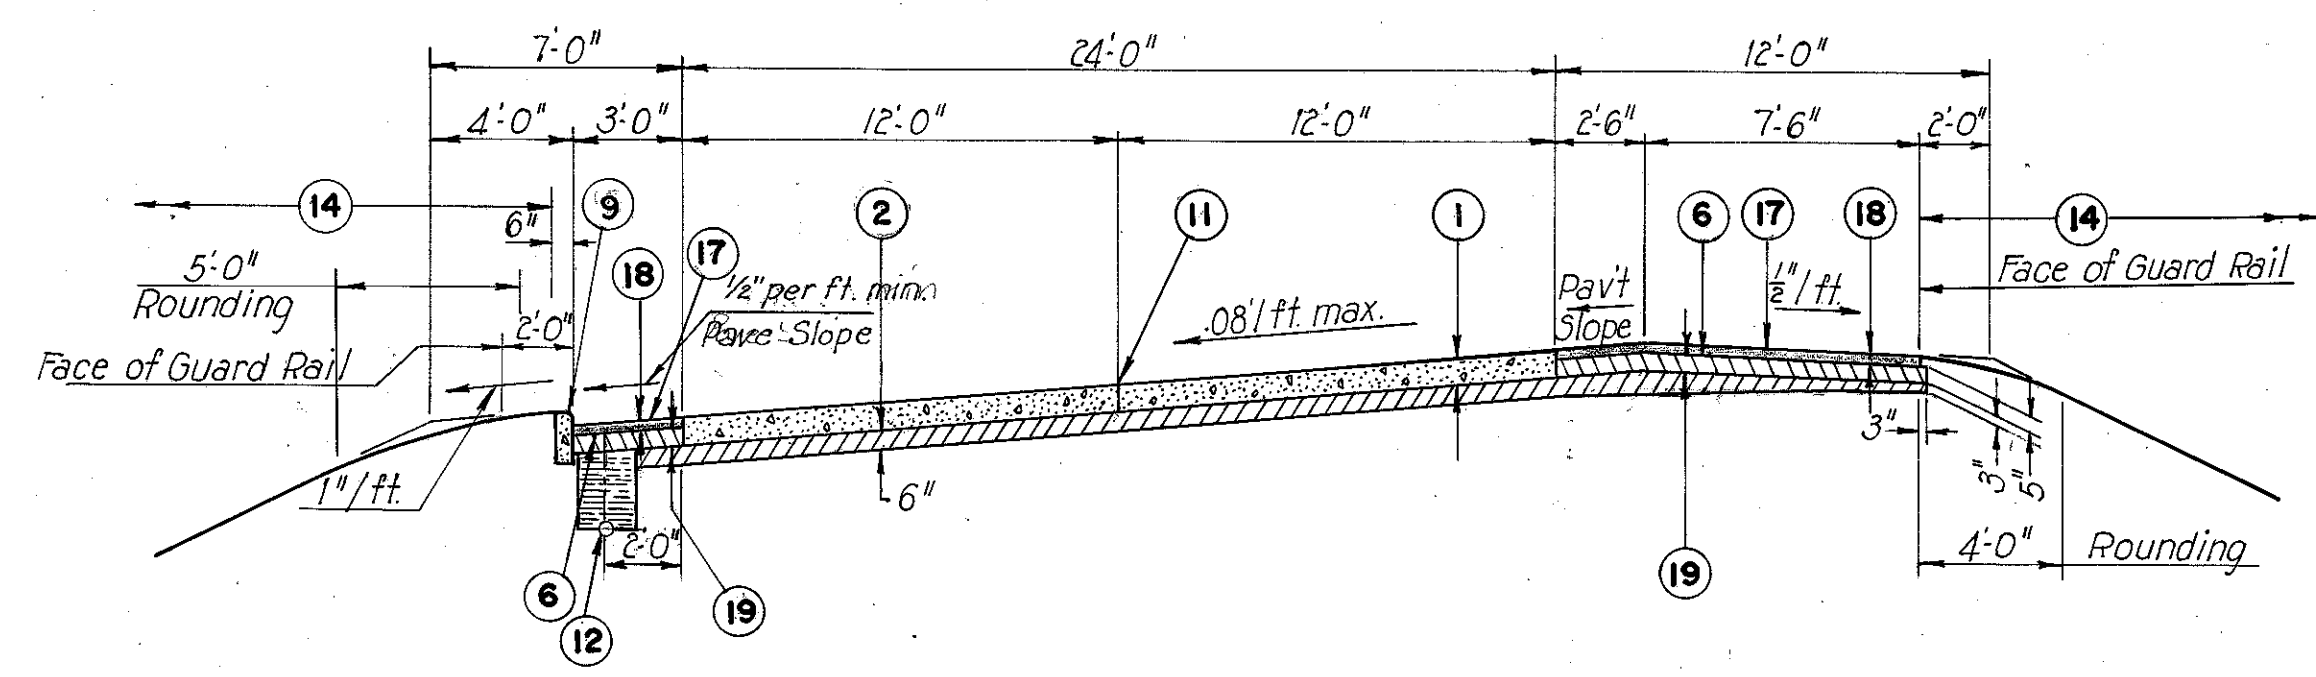

TWO LANE
CURVE LEFT

Ramp No.	One or Two Lane Ramp	Tangent		Curve Right		Curve Left		Diverging Trans.		Merging Trans.		Bridges	
		Sta.	Sta.	Sta.	Sta.	Sta.	Sta.	Sta.	Sta.	Sta.	Sta.	Sta.	Sta.
E-5	One	4+68.32	9+60.56	2+50.32	4+68.32			1+13.65	2+50.32	9+60.56	11+95±		
E-6	Two			1+98.47	4+48.29			1+09±	1+98.47				
	One			5+68.20	10+38.11			4+48.29	5+68.20				
E-7	One	1+36.63	3+73.22			3+73.22	6+50.40			6+50.40	7+43±	7+43±	8+97.35
E-8	One	4+33.14	6+17.14	0+47.96	4+33.14	6+17.14	11+60.35	0+00.00	0+47.96	11+74.52	14+10±	14+10±	14+17.67
		11+60.35	11+74.52										
E-9	One			0+93.60	4+31±			0+00.00	0+93.60			4+31±	7+50.38
E-10	Two	4+18±	5+06.54			5+06.54	7+93±	0+00.00	0+79±	9+79±	9+90.07	0+79±	4+18±
						9+90.07	17+41.98					7+93±	9+66±
E-11	Variable	6+26.30	6+55.84	1+98.46	6+26.30			0+00.00	1+98.46				
E-13	Variable	1+04.35	1+41.06	1+41.06	4+96.25			0+00.00	1+04.35	4+96.25	6+12.32		
E-14	One			2+76.73	4+72.70			0+82±	2+76.73			0+00.00	0+82±
		7+76.96	10+79.56					4+72.70	7+76.96				
E-15	One	12+57.21	14+05.74							10+06±	12+57.21		
		17+22±	17+40.32							14+05.74	15+02±	15+02±	17+22±
										17+40.32	19+80.49		
E-16	One	3+44.96	4+98.38	1+82.29	3+44.96	4+98.38	6+24±	0+38.25	1+82.29	8+09±	8+32.85	6+24±	8+09±
E-17	Two			2+31.62	6+21.14			1+63±	2+31.62			0+00.00	1+63±
								6+21.14	7+06.65				
	One			7+06.65	10+70.65								
Access	One							0+00.00	3+02.49				
N-30	One	3+66.67	9+04.20	3+53.61	3+66.67			0+75±	3+53.61	9+04.20	10+51.81	0+00	0+75±
30-N	One	1+73.65	7+16.40					0+00	1+73.65	7+16.40	9+81±	9+81±	10+52.42

LEGEND

- ① 9" Reinforced Portland Cement Concrete Pavement, Item T-71.
- ② Subbase, Item I-22.
- ⑥ Bituminous Prime Coat, Item T-30, Sec. M57 (RT-2 or RT-3). Applied at rate of 0.4 Gal. per Sq. Yd.
- ⑨ 6"x18" Sandstone Curb, Item I-11.
- ⑩ Standard Type I Median Pavement, Item I-21.
- ⑪ Standard Longitudinal Joint.
- ⑫ 6" Underdrain, Item I-4.
- ⑭ Seeding and Protecting, Item L-9.
- ⑰ Bituminous Surface Treatment using 0.008 Cu. Yd. No. 6 Aggregate and 0.25 Gal. Bituminous Material per sqyd. (See Note in Proposal), Item T-31.
- ⑱ 3" Waterproofed Aggregate Base Course Item B-219.
- ⑲ Stabilized Crushed Aggregate Shoulder, Item I-18.
- ⑳ Guard Rail, Steel Beam, Barrier Type (Deep), Item I-15.

RAMP NO.	Sta.	Sta.	INCREASE IN WIDTH
E-6	2+18.42	4+48.29	2'
E-6	4+48.29	9+03.24*	3'
E-7	3+73.22	6+57.92	1'
E-8	6+17.14	11+60.35	2'
E-10	5+06.54	9+90.07	2'
Access	0+00.00	1+61.73	2'
E-14	2+97.97	4+72.70	2'
E-16	4+98.38	6+24±	1'
E-17	6+21.14	11+14.37*	3'


SCALE 1/2" = 1'
MADE 6/11/58 DATE 9-3-58 HOWARD, NEEDLES, TAMMEN & BERGENDOFF
TRCD. R. R. DATE 10-4-58 CONSULTING ENGINEERS
CKD. J. L. C. DATE 12-3-58 KANSAS CITY CLEVELAND NEW YORK
914 SHEET 3

FED. ROAD DIV. NO.	STATE	FEDERAL AID PROJECT NO.	TYPE FUNDS
2	OHIO		

4
181

TYPICAL SECTIONS TYPE T-71


CUYAHOGA COUNTY
CITY OF CLEVELAND
INNER BELT
CUY-42-18.42
CUY-21-15.32

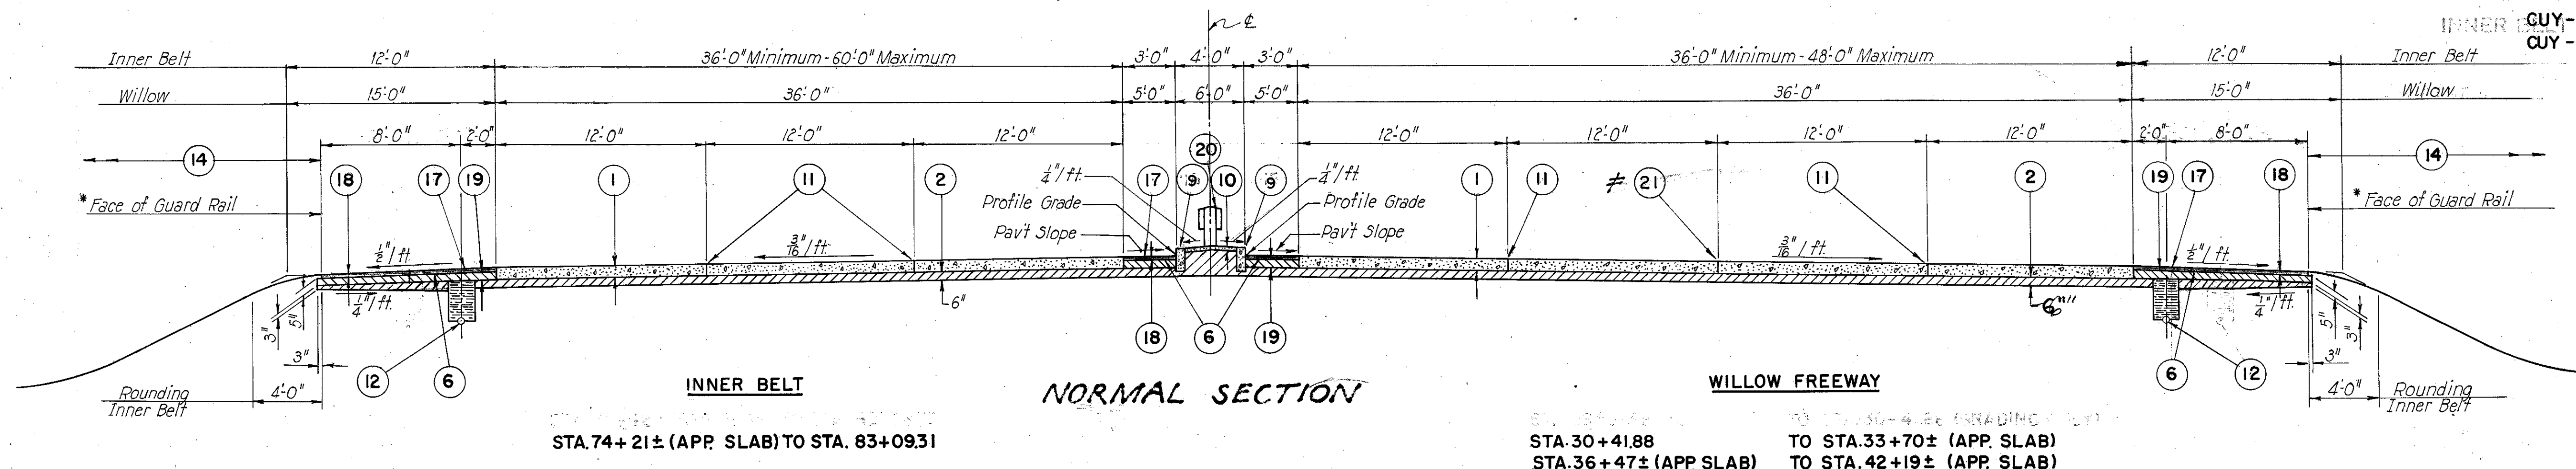

Note: Depth of I-4 = 18" from top of pipe to bottom of I-22 unless otherwise shown.


LEGEND

- ① 9" Reinforced Portland Cement Concrete Pavement, Item T-71
- ② Subbase, Item I-22.
- ⑥ Bituminous Prime Coat, Item T-30, Sec. M5.7 (RT-2 or RT-3) Applied at rate of 0.4 Gal. per Sq. Yd.
- ⑨ 6" x 18" Sandstone Curb, Item I-11.
- ⑩ Standard Type 1 Median Pavement, Item I-21.
- ⑪ Standard Longitudinal Joint.
- ⑫ 6" Underdrain, Item I-4
- ⑭ Seeding and Protecting, Item L-9.
- ⑰ Bituminous Surface Treatment Using 0.008 Cu. Yd. No. 6 Aggregate and 0.25 Gal. Bituminous Material per Sq. yd. (See Note in Proposal), Item T-31.
- ⑱ 3" Waterproofed Aggregate Base Course Item B-219.
- ⑲ Stabilized Crushed Aggregate Shoulder, Item I-18.
- ⑳ Guard Rail, Steel Beam, Barrier Type (Deep), Item I-15.
- ≠ ㉑ Standard Longitudinal Key Joint without tie bars.

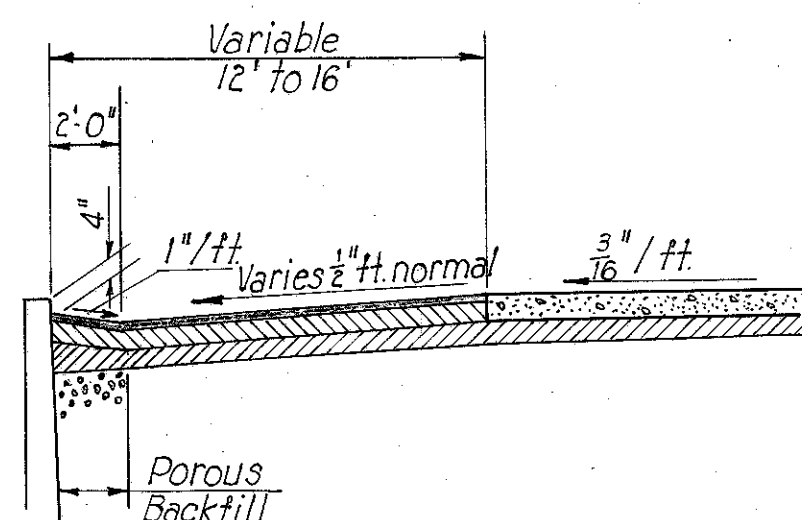

* Center joint shall be a standard Longitudinal Key Joint without Tie Bars when Pavement Width exceeds 36'-0" unless otherwise shown.


* Note:
Face of guard rail on Willow Freeway, is 12' from edge of pavement.

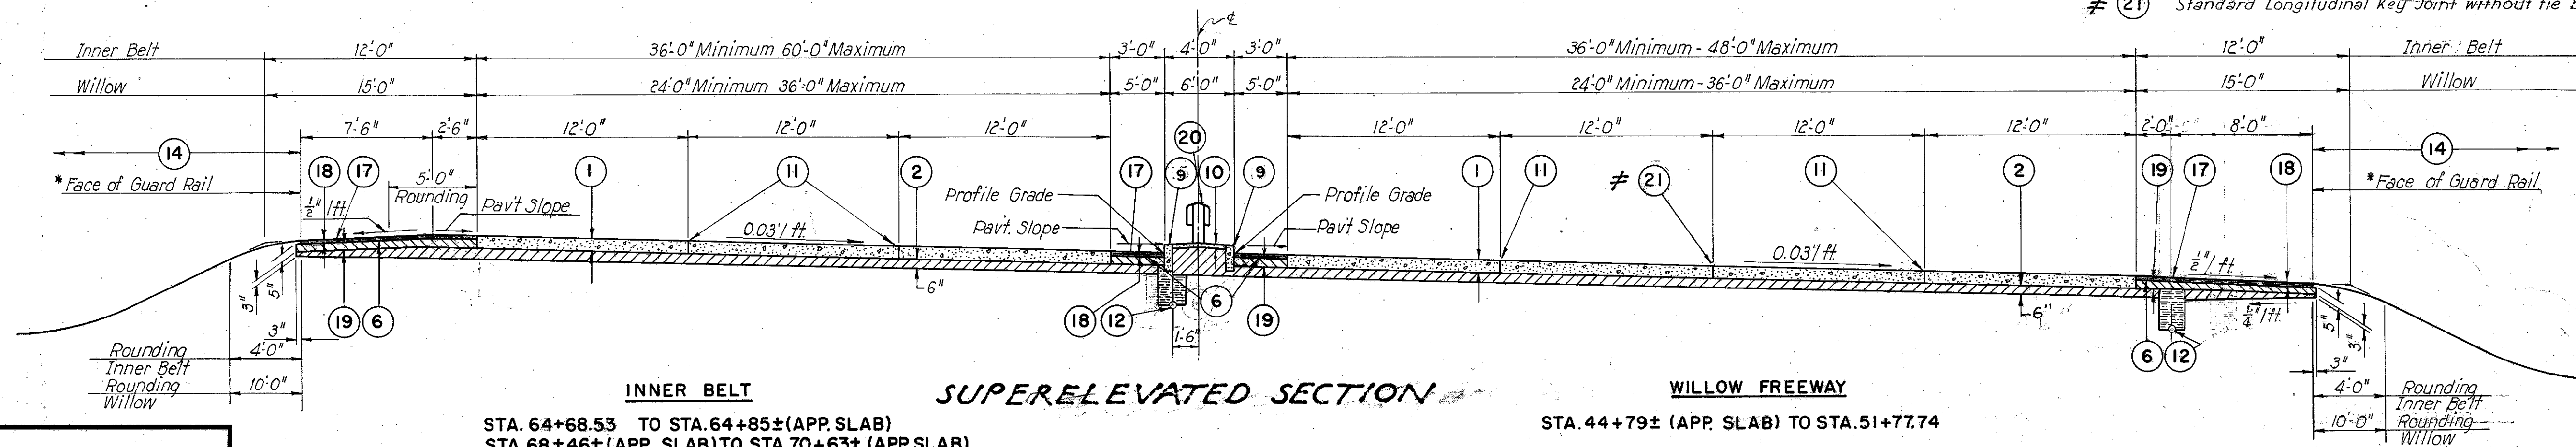

SCALE: 1" = 1'-0"
DATE: 8-4-58
HOWARD, NEEDLES, TAMMEN & BERGENDOFF
CONSULTING ENGINEERS
KANSAS CITY CLEVELAND NEW YORK
914 SHEET 4

FED. ROAD DIV. NO.	STATE	FEDERAL AID PROJECT NO.	TYPE FUNDS	5
2	OHIO			181

CUYAHOGA COUNTY
CITY OF CLEVELAND
CUY - 42-18.42
CUY - 21-15.32

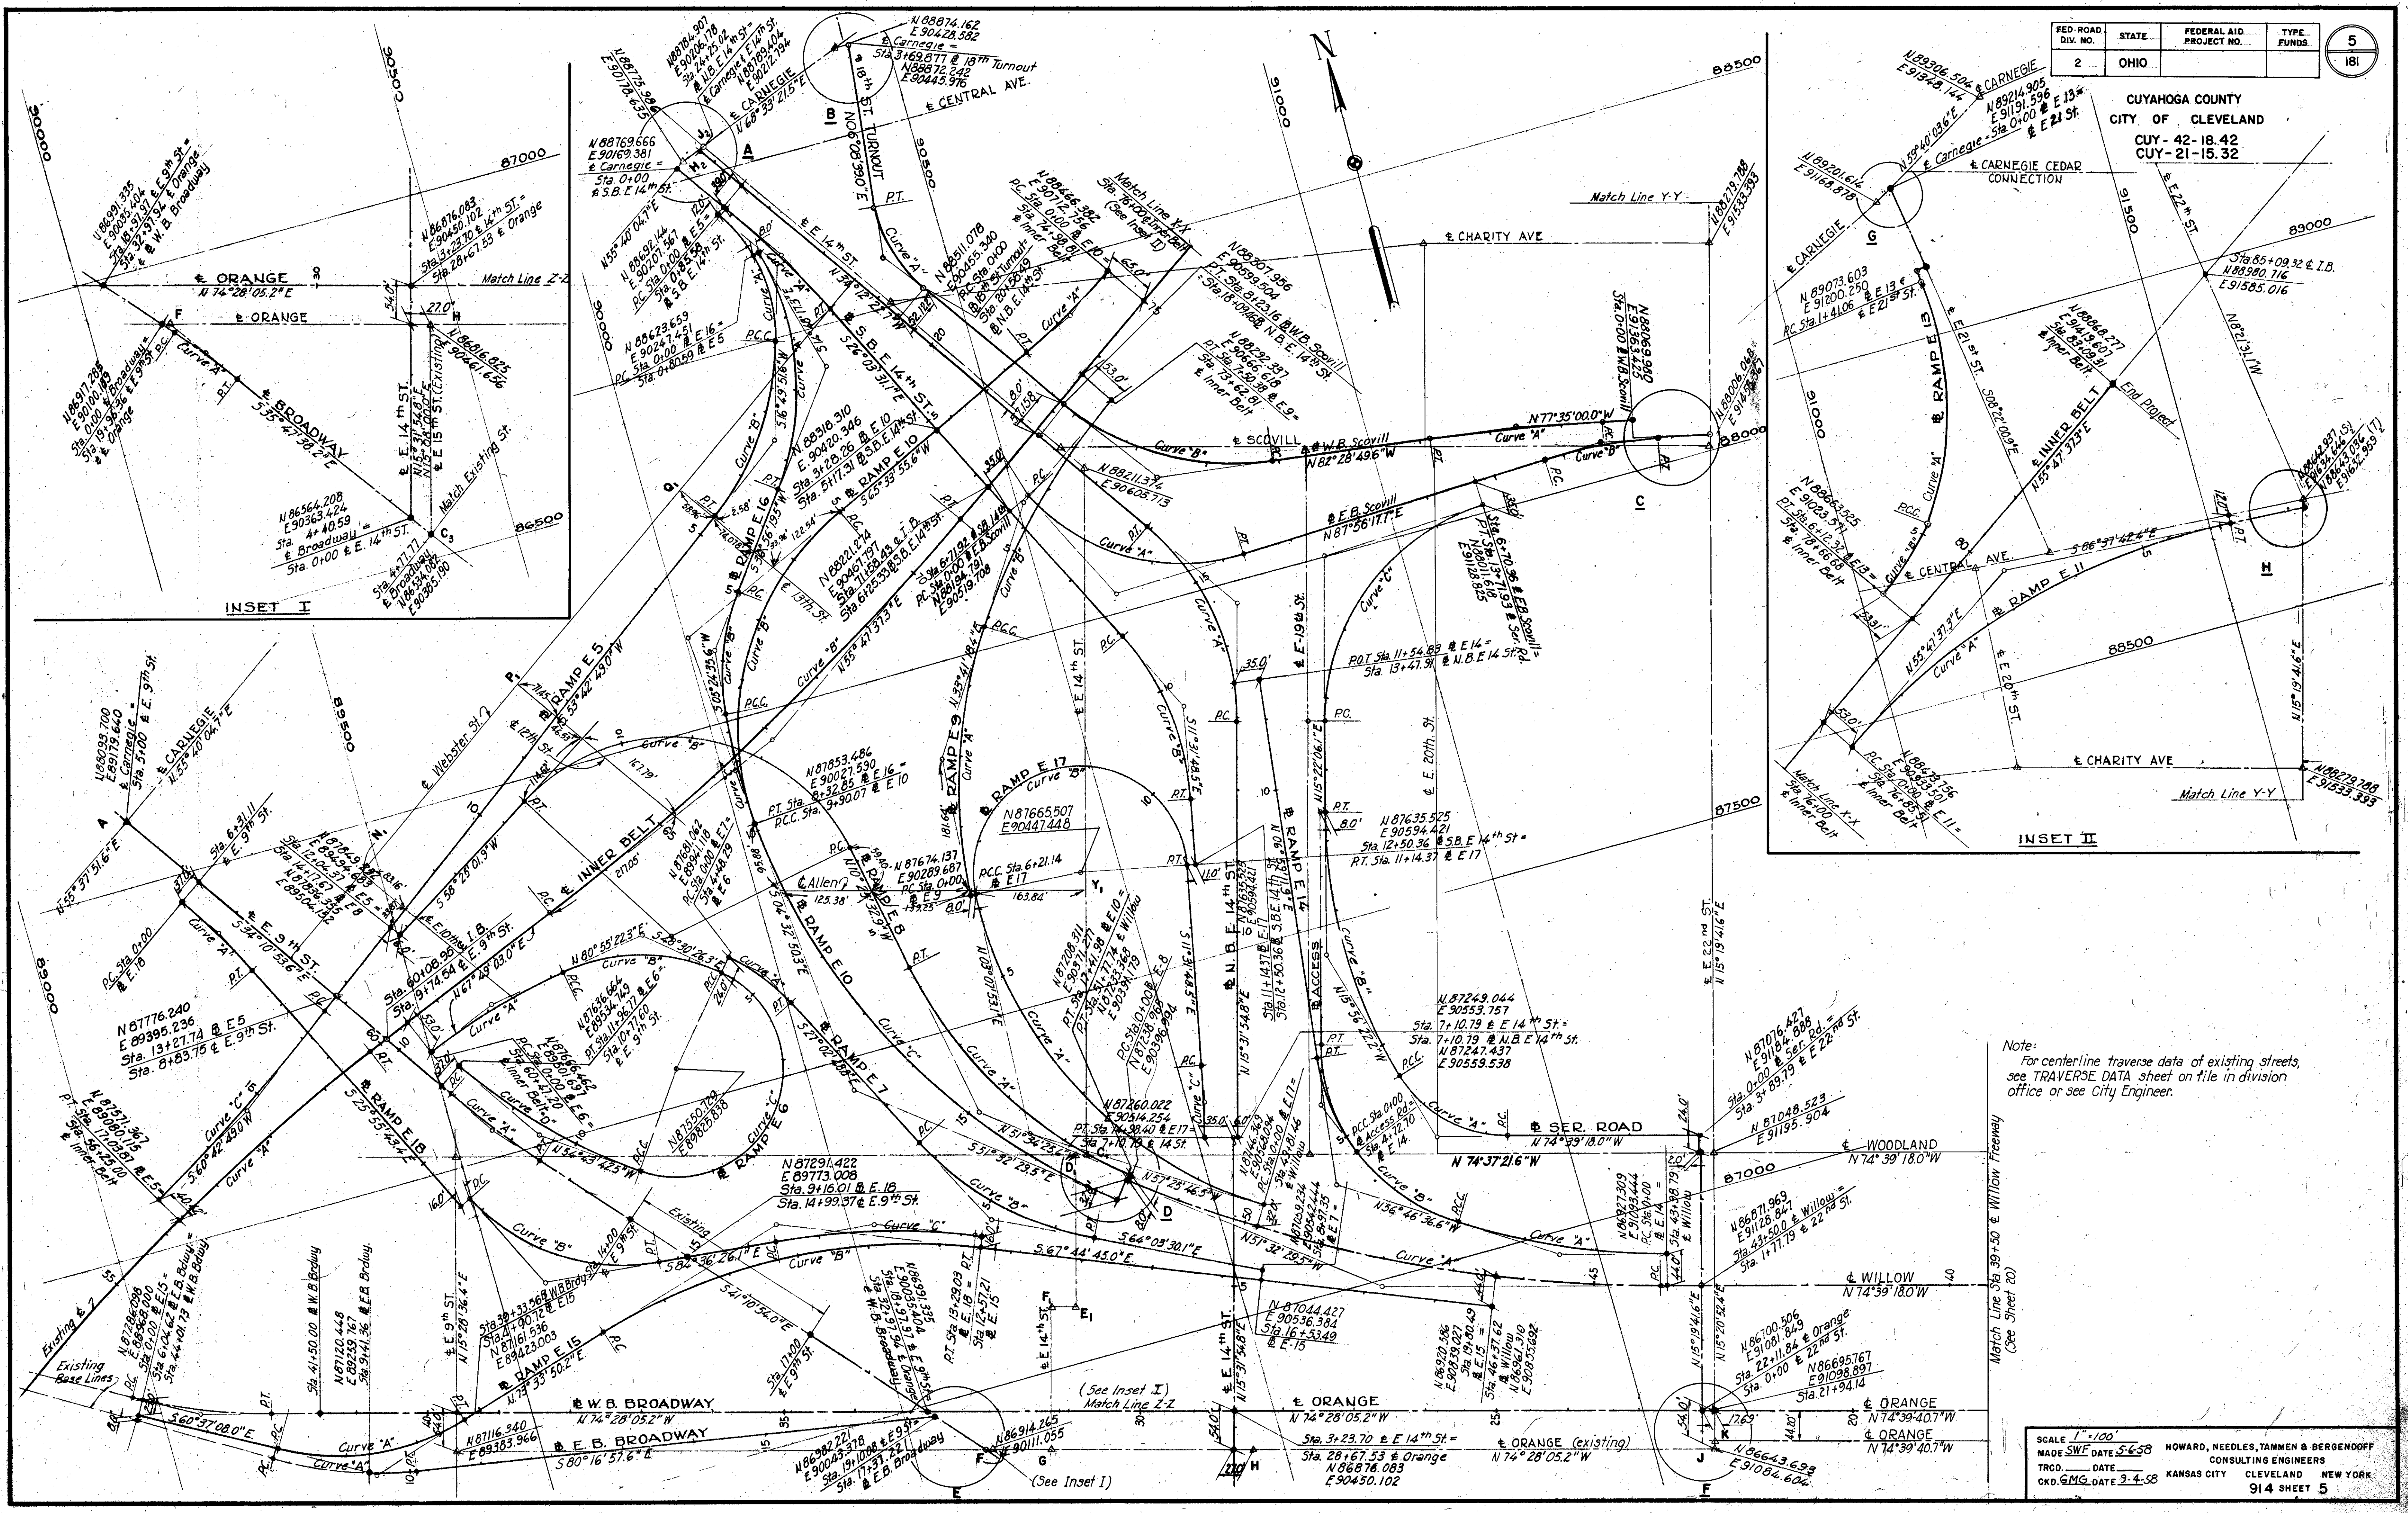

Note:
For centerline traverse data of existing streets,
see TRAVERSE DATA sheet on file in division
office or see City Engineer.

Match Line Sta 39+50 & Willow Freeway
(See Sheet 20)

SCALE 1"=100'
MADE S.W.E. DATE 5-6-58
TRCD. DATE
CKD. M.G. DATE 2-4-58
HOWARD, NEEDLES, TAMMEN & BERGENDOFF
CONSULTING ENGINEERS
KANSAS CITY CLEVELAND NEW YORK
914 SHEET 5

CUYAHOGA COUNTY
CITY OF CLEVELAND
CUY - 42-18.42
CUY - 21-15.32

CURVE DATA TABULATION

DESCRIPTION	CURVE	BEGINNING OF CURVE		P.I. OF CURVE		ENDING OF CURVE		Δ	D	R	T	L	REMARKS
		STATION	COORD.	STATION	COORD.	STATION	COORD.						
FREEWAYS													
INNER BELT	"A"	45+28.225	N 86831.706 E 88267.935	52+70.170	N 87410.112 E 88732.616	59+80.200	N 87690.243 E 89419.645	29°02'23"	2°00'	2864.789'	741.945'	1451.980'	
	"B"	62+98.330	N 87810.354 E 89714.228	67+00.601	N 87962.236 E 90086.725	70+99.918	N 88188.383 E 90419.411	12°01'25"	1'30'	3819.719'	402.271'	801.588'	
WILLOW	"A"	44+07.286	N 86887.127 E 91073.603	47+97.821	N 86990.476 E 90696.391	51+77.735	N 87233.368 E 90391.179	23°06'48"	3°00'	1909.859'	390.535'	770.499'	
RAMP													
RAMP E 5	"A"	0+00.000	N 88692.144 E 90207.567	1+09.796	N 88601.340 E 90269.292	2+04.877	N 88496.247 E 90237.501	51°02'14"	—	230.000'	109.796'	204.877'	
	"B"	2+04.877	N 88496.247 E 90237.501	3+41.346	N 88365.624 E 90197.986	4+68.324	N 88284.859 E 90081.383	36°52'57"	14°00'	409.256'	136.469'	263.447'	
	"C"	13+53.866	N 87160.715 E 89174.176	15+29.084	N 87637.039 E 89232.337	17+03.866	N 87571.367 E 89080.115	7°00'00"	2°00'	2864.789'	175.218'	350.000'	
RAMP E 6	"A"	0+00.000	N 87666.462 E 89501.697	1+09.690	N 87707.877 E 89603.268	2+18.423	N 87725.182 E 89711.585	13°06'13"	6°00'	954.930'	109.690'	218.423'	
	"B"	2+18.423	N 87725.182 E 89711.585	3+41.446	N 87744.590 E 89833.067	4+48.286	N 87663.085 E 89925.217	50°34'11"	22°00'	260.435'	123.023'	229.863'	
	"C"	4+48.286	N 87663.085 E 89925.217	—	N 87550.729 E 89825.838	9+03.238	N 87428.265 E 89739.220	173°46'43"	—	150.000'	—	454.952'	
	"D"	9+03.238	N 87428.265 E 89739.220	10+51.595	N 87513.934 E 89618.098	11+96.766	N 87636.664 E 89534.749	20°32'48"	7°00'	818.511'	148.357'	293.528'	
RAMP E 7	"A"	0+00.000	N 87645.062 E 89941.118	0+54.287	N 87645.062 E 89941.118	1+07.302	N 87536.745 E 90006.467	21°27'37"	20°00'	286.479'	54.287'	107.302'	
	"B"	3+73.218	N 87536.745 E 90006.467	5+20.736	N 87728.514 E 90178.677	6+57.922	N 87755.382 E 90178.677	37°00'41"	13°00'	440.737'	147.518'	284.704'	
RAMP E 8	"A"	0+00.000	N 87238.965 E 90396.994	2+26.383	N 87379.663 E 90219.644	4+39.137	N 87602.309 E 90178.677	41°08'52"	9°30'	603.113'	226.383'	433.137'	
	"B"	6+17.137	N 87732.262 E 90145.379	—	N 87732.262 E 90145.379	11+60.353	N 87971.121 E 89723.358	111°09'25"	—	280.000'	408.601'	543.216'	
RAMP E 9	"A"	0+00.000	N 87674.137 E 90289.687	1+95.640	N 87869.485 E 90300.374	3+81.963	N 88032.271 E 90408.891	30°33'23"	8°00'	716.197'	195.640'	381.963'	
	"B"	3+81.963	N 88032.271 E 90408.891	5+68.492	N 88187.475 E 90512.355	7+50.384	N 88292.337 E 90666.618	22°06'18"	6°00'	954.930'	186.529'	368.421'	
RAMP E 10	"A"	0+00.000	N 88466.382 E 90712.756	0+81.629	N 88420.493 E 90645.247	1+62.862	N 88386.727 E 90570.929	9°46'18"	6°00'	954.930'	81.629'	162.862'	
	"B"	5+06.536	N 88244.565 E 90258.037	7+83.798	N 88129.875 E 90025.608	9+90.072	N 87853.486 E 90027.550	70°06'45"	14°30'	395.143'	277.262'	483.536'	
	"C"	9+90.072	N 87853.486 E 90027.550	13+88.623	N 87456.189 E 90229.188	17+41.880	N 87208.911 E 90371.277	46°59'32"	6°15'	916.732'	398.551'	751.908'	
RAMP E 11	"A"	0+00.000	N 88473.756 E 90333.801	3+24.879	N 88456.394 E 91202.182	6+26.297	N 88363.288 E 91526.438	37°34'40"	6°00'	954.930'	324.879'	626.297'	
RAMP E 13	"A"	1+41.058	N 89073.803 E 91200.250	3+21.916	N 88894.610 E 91226.567	4+83.653	N 88750.281 E 91117.656	45°23'37"	13°15'00"	432.421'	180.858'	342.595'	
	"B"	4+83.653	N 88750.281 E 91117.656	5+48.689	N 88698.360 E 91078.492	6+72.323	N 88663.525 E 91023.571	20°33'13"	16°00'00"	358.099'	65.036'	128.670'	
RAMP E 14	"A"	0+00.000	N 86927.309 E 91038.444	1+50.205	N 86927.309 E 91038.444	2+97.969	N 87049.355 E 90822.942	17°52'41"	6°00'	954.930'	150.205'	297.969'	
	"B"	2+97.969	N 87049.355 E 90822.942	4+76.159	N 87146.986 E 90673.870	6+16.786	N 87323.853 E 90635.522	63°45'48"	20°00'	286.479'	178.190'	318.817'	
RAMP E 15	"A"	2+03.697	N 87786.161 E 91254.487	3+46.125	N 87786.161 E 91254.487	4+73.210	N 87553.582 E 90406.213	45°49'01"	17°00'	337.034'	142.428'	269.513'	
	"B"	7+04.496	N 87727.924 E 90628.067	9+91.858	N 87303.392 E 89903.667	12+57.214	N 87194.503 E 90163.625	38°41'24"	7°00'	818.511'	287.362'	552.718'	
RAMP E 16	"A"	0+00.000	N 88623.659 E 90247.451	1+85.243	N 88444.564 E 90234.786	3+44.957	N 88296.505 E 90183.462	51°44'36"	15°00'	381.972'	185.243'	344.957'	
	"B"	4+98.379	N 88179.878 E 90091.262	5+88.238	N 88102.058 E 90037.260	6+73.539	N 88012.536 E 90028.788	31°31'43"	18°00'	318.310'	89.859'	175.160'	
	"C"	6+73.539	N 88012.536 E 90028.788	7+53.397	N 87933.034 E 90021.259	8+32.854	N 87853.486 E 90027.550	9°57'25"	6°15'	916.732'	79.858'	159.315'	
RAMP E 17	"A"	0+00.000	N 87146.986 E 90268.037	3+43.126	N 87331.086 E 90278.391	6+21.139	N 87146.986 E 90268.037	60°33'39"	9°45'	587.649'	343.126'	621.139'	
	"B"	6+21.139	N 87146.986 E 90268.037	—	N 87663.525 E 90467.448	11+14.366	N 87635.525 E 90594.421	188°23'55"	—	150.000'	—	493.227'	
	"C"	13+98.352	N 87331.086 E 90278.391	14+48.394	N 87308.237 E 90514.254	14+98.396	N 87260.022 E 90514.254	04°00'06"	4°00'	1432.395'	50.042'	100.044'	
RAMP E 18	"A"	0+00.000	N 87964.433 E 89222.690	0+68.893	N 87907.421 E 89261.395	1+37.547	N 87845.503 E 89231.519	8°15'10"	6°00'	954.930'	68.893'	137.547'	
	"B"	5+79.017	N 87455.467 E 89494.942	7+40.040	N 87310.653 E 89569.350	8+72.410	N 87295.520 E 89729.640	58°40'42"	20°00'	286.479'	161.023'	293.393'	
	"C"	10+38.156	N 87279.343 E 89894.673	11+79.691	N 87266.641 E 90035.581	13+19.180	N 87213.040 E 90166.573	16°51'41"	6°00'	954.930'	141.535'	281.024'	
STREETS													
EAST 9 th ST.	"A"	10+93.130	N 87603.028 E 89512.868	11+71.005	N 87538.606 E 89556.620	12+48.686	N 87479.596 E 89607.896	7°00'00"	4°30'	1273.240'	77.875'	155.556'	
N. B. E. 14 th ST.	"A"	12+94.497	N 87809.828 E 90715.939	14+60.486	N 87969.753 E 90760.286	16+05.361	N 88107.031 E 90666.971	49°44'12"	16°00'	358.039'	165.989'	310.864'	
S. B. E. 14 th ST.	"A"	0+89.740	N 88695.448 E 90219.831	1+91.758	N 88671.077 E 90277.183	2+93.432	N 88578.430 E 90321.999	08°08'51"	4°00'	1432.325'	102.018'	203.692'	
	"B"	9+08.700	N 87966.706 E 90592.881	10+38.692	N 87849.928 E 90649.385	11+59.292	N 87722.559 E 90623.402	37°35'19"	15°00'	381.972'	129.992'	250.592'	
18 th ST. Turnout	"A"	0+00.000	N 88511.078 E 90455.340	72.375	N 88570.099 E 90413.451	1+38.363	N 88642.088 E 90421.197	41°30'32"	30°00'	190.986'	72.375'	138.363'	
W. B. SCOVILL	"A"	0+40.671	N 88078.725 E 91323.705	1+63.173	N 88105.063 E 91204.068	2+85.526	N 88121.094 E 91082.619	4°53'49"	2°00'	2864.789'	122.502'	244.855'	
	"B"	5+09.058	N 88150.347 E 90861.009	6+75.603	N 88172.442 E 90695.897	8+23.162	N 88307.956 E 90599.504	47°06'56"	15°00'	381.972'	166.545'	314.104'	
E. B. SCOVILL	"A"	0+00.000	N 88194.791 E 90512.788	1+86.053	N 88027.602 E 90601.439	3+30.016	N 88034.346 E 90782.951	66°00'11"	20°00'	286.479'	186.053'	330.016'	
	"B"	7+71.761	N 88053.148 E 91228.831	8+52.627	N 88053.148 E 91303.645	9+32.632	N 88035.760 E 91388.620	14°28'42"	9°00'	636.620'	80.866'	160.871'	
SERVICE ROAD	"A"	2+71.000	N 87146.986 E 90268.037	3+69.437	N 87174.195 E 90028.630	4+50.336	N 87268.847 E 90801.597	58°42'55"	—	175.000'	98.437'	179.336'	
	"B"	4+50.336	N 87268.847 E 90801.597	6+51.028	N 87421.823 E 90746.482	8+41.684	N 87655.339 E 90739.671	31°18'28"	8°00'	716.197'	200.692'	391.348'	
	"C"	9+68.761	N 87772.874 E 90893.349	12+02.454	N 88003.210 E 90893.349	13+71.927	N 88011.678 E 91129.825	72°34'11"	18°00'	318.310'	233.693'	403.166'	
ACCESS	"A"	0+00.000	N 87826.476 E 90713.970	0+83.833	N 87826.476 E 90682.795	1+61.734	N 87826.476 E 90705.013	37°11'56"	23°00'	249.112'	83.833'	161.734'	
E. B. BROADWAY	"A"	8+02.580	N 87176.590 E 89133.263	9+06.173	N 87122.896 E 89221.862	10+07.340	N 87108.410 E 89323.975	21°30'00"	10°30'	545.674'	103.539'	204.760'	
BROADWAY	"A"	0+20.760	N 86901.661 E 90113.859	0+74.677	N 86861.081 E 90149.360	1+28.514	N 86817.348 E 90180.895	5°23'15"	5°00'	1145.916'	53.917'	107.754'	

DESCRIPTION	CURVE	BEGINNING OF CURVE		P.I. OF CURVE		END OF CURVE		Δ	D	R	T	L
		STATION	COORD.	STATION	COORD.	STATION	COORD.					
Relocated Woodland	"A"	0+00.000	N 86680.887 E 92416.604	1+84.390	N 86729.676 E 92238.787	3+57.895	N 86670.695 E 92064.084	31°00'00"	9°30'	603.113'	184.390'	357.895'
	"B"	5+65.516	N 86637.444 E 91856.175	7+49.870	N 86578.475 E 91681.507	9+23.344	N 86627.241 E 91503.720	33°59'37"	9°30'	603.113'	184.354'	357.828'
RAMP N-30	"A"	0+00.000	N 86606.956 E 91928.320	1+83.898	N 86558.291 E 92105.662	3+66.667	N 86476.882 E 92270.480	11°00'00"	3°00'	1909.859'	183.898'	366.667'
	"B"	9+41.743	N 86235.81									

CUYAHOGA COUNTY
CITY OF CLEVELAND
CUY-42-18.42
CUY-21-15.32

GENERAL NOTES

GRADING TOLERANCES (COMBINED PROJECT)

FOR AREAS IN FRONT OF RESIDENCES, FOR AREAS BETWEEN CURB AND SIDEWALK AND FOR OTHER AREAS SPECIFICALLY INDICATED ON THE PLANS, THE SEED BED SHALL BE PREPARED TO PROVIDE A SMOOTH SURFACE. ALL STONES LARGER THAN ONE INCH IN DIAMETER SHALL BE REMOVED FROM THE SURFACE OF THE SEED BED. HAND RAKING WILL BE REQUIRED IN AREAS INACCESSIBLE TO MACHINES AND HAND RAKING MAY BE REQUIRED, IF DIRECTED BY THE ENGINEER, IN ALL THE AFOREMENTIONED AREAS IF MACHINES USED DO NOT PROVIDE RESULTS EQUIVALENT TO RESULTS OBTAINED BY HAND RAKING. COST OF THIS ADDITIONAL WORK SHALL BE INCLUDED IN THE UNIT PRICE BID FOR ROADWAY EXCAVATION, ITEM E-1.

DESIGN STANDARDS

THE DESIGN SPEED FOR THIS PROJECT IS 50 M.P.H.

FIELD OFFICE

THE CONTRACTOR SHALL PROVIDE A SUITABLE FIELD OFFICE IN ACCORDANCE WITH SEC. S-0.01(b) HAVING A MINIMUM OF 500 SQ. FT. OF FLOOR SPACE. THE CONTRACTOR SHALL HAVE A TELEPHONE INSTALLED AND MAINTAINED IN THE FIELD OFFICE DURING CONSTRUCTION OF THIS PROJECT.

PERMITS, LAWS AND REGULATIONS

THE CONTRACTOR SHALL SECURE, AT HIS OWN EXPENSE, ALL NECESSARY PERMITS FROM THE MUNICIPAL OR OTHER PUBLIC AUTHORITIES, SHALL GIVE ALL NOTICES REQUIRED BY LAW OR MUNICIPAL ORDINANCES, AND SHALL PAY ALL FEES AND CHARGES INCIDENT TO THE DUE AND LAWFUL PROSECUTION OF THE WORK COVERED BY THIS CONTRACT.

UTILITIES

FOLLOWING IS A LIST OF THE UTILITIES WITHIN THE LIMITS OF CONSTRUCTION.

- EAST OHIO GAS COMPANY
- CITY OF CLEVELAND WATER DEPARTMENT
- CLEVELAND ELECTRIC ILLUMINATING COMPANY
- MUNICIPAL ELECTRIC LIGHT AND POWER COMPANY
- OHIO BELL TELEPHONE COMPANY
- WESTERN UNION
- AMERICAN TELEPHONE & TELEGRAPH COMPANY

UNDERGROUND UTILITIES

THE LOCATIONS OF THE UNDERGROUND UTILITIES SHOWN ON THE PLANS HAVE BEEN OBTAINED BY DILIGENT FIELD CHECKS AND SEARCHES OF AVAILABLE RECORDS. IT IS BELIEVED THEY ARE ESSENTIALLY CORRECT, BUT THE STATE OF OHIO MAKES NO GUARANTEES AS TO THEIR ACCURACY OR COMPLETENESS.

UTILITY NOTE

ANY AND ALL WORK REQUIRED FOR REMOVING, RELOCATING AND CONSTRUCTION OF NEW FACILITIES FOR PRIVATE OR PUBLIC UTILITIES WILL BE DONE BY AND AT THE EXPENSE OF THE RESPECTIVE OWNERS UNLESS OTHERWISE NOTED ON THE PLANS.

WATER METER BOXES

THE CITY WATER DEPARTMENT WILL RELOCATE ALL PRIVATELY OWNED WATER METER BOXES AND THIS ITEM WILL NOT BE INCLUDED AS A PART OF THE WORK TO BE PERFORMED BY THE CONTRACTOR.

CONNECTIONS TO EXISTING SEWERS

AT PLACES WHERE THE PLANS PROVIDE FOR PROPOSED DRAINAGE PIPE TO BE CONNECTED TO EXISTING PIPES, IT SHALL BE THE RESPONSIBILITY OF THE CONTRACTOR TO LOCATE THE EXISTING PIPE BOTH AS TO LINE AND GRADE, BEFORE HE STARTS TO LAY THE PROPOSED SEWER. THE COST OF THIS OPERATION SHALL BE INCLUDED IN THE COST BID FOR ITEM I-2 STORM SEWERS.

THE CONTRACTOR SHALL SO CONDUCT HIS OPERATIONS THAT THE FLOW OF ALL EXISTING SEWERS WILL BE MAINTAINED AT ALL TIMES. ANY ADDITIONAL LABOR OR COST INVOLVED IN MAINTAINING THIS FLOW BY PUMPING OR BY ANY OTHER APPROVED METHOD WHICH IS NECESSARY FOR THE COMPLETION OF THIS PROJECT SHALL BE INCLUDED IN THE PRICE BID PER LINEAR FOOT OF STORM SEWERS, ITEM I-2. SEE DRAINAGE NOTE 2, SHEET 40.

WORK BY THE CITY OF CLEVELAND

THE CITY WILL PROVIDE FOR THE REMOVAL OR DISPOSAL OF ALL EXISTING BUILDINGS WITHIN THE LIMITS OF THE RIGHT OF WAY LINES AS FOLLOWS:
BUILDINGS WITH BASEMENTS - TO THE LEVEL OF EXISTING GROUND
BUILDINGS WITHOUT BASEMENTS - TO THE GROUND FLOOR
BUILDING FLOOR SLABS TO BE REMOVED BY CONTRACTOR AND PAID FOR AS ITEM E-1, ROADWAY EXCAVATION.

TRAFFIC

THE CONTRACTOR, AT ALL TIMES, MUST COOPERATE WITH THE CITY OF CLEVELAND TRAFFIC ENGINEERING AND PARKING DIVISIONS IN THE PERFORMANCE OF HIS WORK, AND SHALL PRESENT ONE WEEK IN ADVANCE A PROPOSED WORK SCHEDULE, INCLUDING TIME ESTIMATES TO THE PROJECT ENGINEER, AND SECURE WRITTEN APPROVAL OF SAME BEFORE ANY WORK IS UNDERTAKEN THAT WOULD DISRUPT NORMAL FLOW OF TRAFFIC.

WHERE ANY OF THE WORK CALLED FOR UNDER THIS CONTRACT INVOLVES THE CLOSING OF EXISTING STREETS AND/OR THE RE-ROUTING OF TRAFFIC, THE CONTRACTOR FOR THIS PROJECT SHALL PROSECUTE TO THE FULLEST EXTENT THE WORK INVOLVED SO AS TO REDUCE TO A MINIMUM THE LENGTH OF TIME THAT THE STREETS CONCERNED WILL BE CLOSED TO TRAFFIC.

IN ADDITION TO THE ABOVE, SECTION G-4.05 "MAINTENANCE OF LOCAL TRAFFIC" WILL BE IN FORCE DURING THE ENTIRE LIFE OF THE CONTRACT.

ATTENTION IS DIRECTED PARTICULARLY TO THE NEED FOR PROVIDING ADEQUATE FACILITIES TO ACCOMMODATE SCHOOL CHILDREN AND OTHER PEDESTRIAN TRAFFIC IN THE VICINITY OF THE PROJECT. THE CONTRACTOR SHALL PROVIDE AND MAINTAIN SUCH TEMPORARY BOARD WALKS, CINDER WALKS, HANDRAILS, ADJACENT TO EXCAVATIONS, ETC. AS MAY BE NECESSARY TO ACCOMMODATE IN A REASONABLE AND SAFE MANNER PEDESTRIAN TRAFFIC IN THE VICINITY OF THE PROJECT.

ALL OF THE ABOVE ARE INCLUDED IN THE LUMP SUM BID FOR "MAINTAINING TRAFFIC." AGGREGATE AND CALCIUM CHLORIDE ARE CARRIED IN THE GENERAL SUMMARY TO BE USED AS DIRECTED BY THE ENGINEER, FOR THE MAINTENANCE OF LOCAL TRAFFIC.

OVERHEAD CONSTRUCTION SHALL NOT BE CONSIDERED SUFFICIENT REASON TO CLOSE A STREET TO TRAFFIC, IF IN THE OPINION OF THE PROJECT ENGINEER THE CONSTRUCTION MAY BE ADEQUATELY ISOLATED AND TRAFFIC PROTECTED FROM FALLING OBJECTS OF WHATEVER NATURE. IN ORDER TO INSURE THAT TRAFFIC BE FULLY PROTECTED, BELOW THE STRUCTURES, FROM FALLING OBJECTS, THE CONTRACTOR SHALL PROVIDE NECESSARY PROTECTIVE NETTING OR PLATFORMS.

SURVEY DATA

FOR CENTERLINE DATA OF EXISTING STREETS, SEE SHEET SD-1 (ADJUSTED SURVEY DATA) ON FILE IN DIVISION OFFICE.

REMOVAL OF TREES AND STUMPS

THE NUMBER OF TREES INDICATED FOR REMOVAL IS APPROXIMATE AND THE STATE OF OHIO RESERVES THE RIGHT TO ORDER REMOVAL OF ADDITIONAL TREES OR STUMPS. PAYMENT FOR THE REMOVAL OF THESE ADDITIONAL TREES AND STUMPS IS INCLUDED IN THE LUMP SUM BID FOR REMOVAL OF TREES AND STUMPS, ITEM E-9.

REMOVAL OF REFUSE AND DEBRIS

ANY EXISTING REFUSE, DEBRIS OR ANY OTHER UNSUITABLE MATERIAL SHALL BE REMOVED AND DISPOSED OF BY THE CONTRACTOR IN ACCORDANCE WITH ITEM E-1. THE QUANTITY OF REFUSE OR DEBRIS, OR OTHER UNSUITABLE MATERIAL REMOVED AND DISPOSED OF WILL BE DETERMINED BY FINAL CROSS SECTIONS, AND THE YARDAGE SO DETERMINED WILL BE PAID FOR AT THE CONTRACT UNIT PRICE BID FOR ROADWAY EXCAVATION, ITEM E-1.

REMOVAL AND DISPOSAL OF EXISTING PAVEMENT


THE EXTENT OF RIGID PAVEMENT REMOVAL, SHOWN ON EXISTING UTILITIES SHEETS 54 THROUGH 60, MAY BE MODIFIED AS NECESSARY BY THE ENGINEER. RIGID PAVEMENT LOCATED WITHIN THE LIMITS OF PROPOSED CONSTRUCTION AND NOT INDICATED FOR REMOVAL, IS TO BE BROKEN UP INTO PORTIONS NOT TO EXCEED 1 SQUARE FOOT IN AREA BUT NEED NOT BE REMOVED; PAYMENT FOR THIS WORK TO BE CONSIDERED INCLUDED IN THE PRICE BID FOR ITEM E-1, ROADWAY EXCAVATION.

PAVEMENT REMOVAL

REMOVAL AND DISPOSAL OF ALL EXISTING PAVEMENT WHERE REQUIRED, EXCEPT THAT SET UP FOR REMOVAL ON THE PLANS AS ITEM E-8 SHALL BE REMOVED AND PAID FOR AS ITEM E-1, ROADWAY EXCAVATION.

CLEARING, GRUBBING AND SCALPING (COMBINED PROJECT)

ALL PROPERTIES OR PORTIONS OF PROPERTIES WITHIN THE RIGHT-OF-WAY FOR THIS PROJECT SHALL BE CLEARED, GRUBBED AND SCALPED IN ACCORDANCE WITH PROVISIONS OF SEC. E-1.03 OF THE CONSTRUCTION AND MATERIAL SPECIFICATIONS.

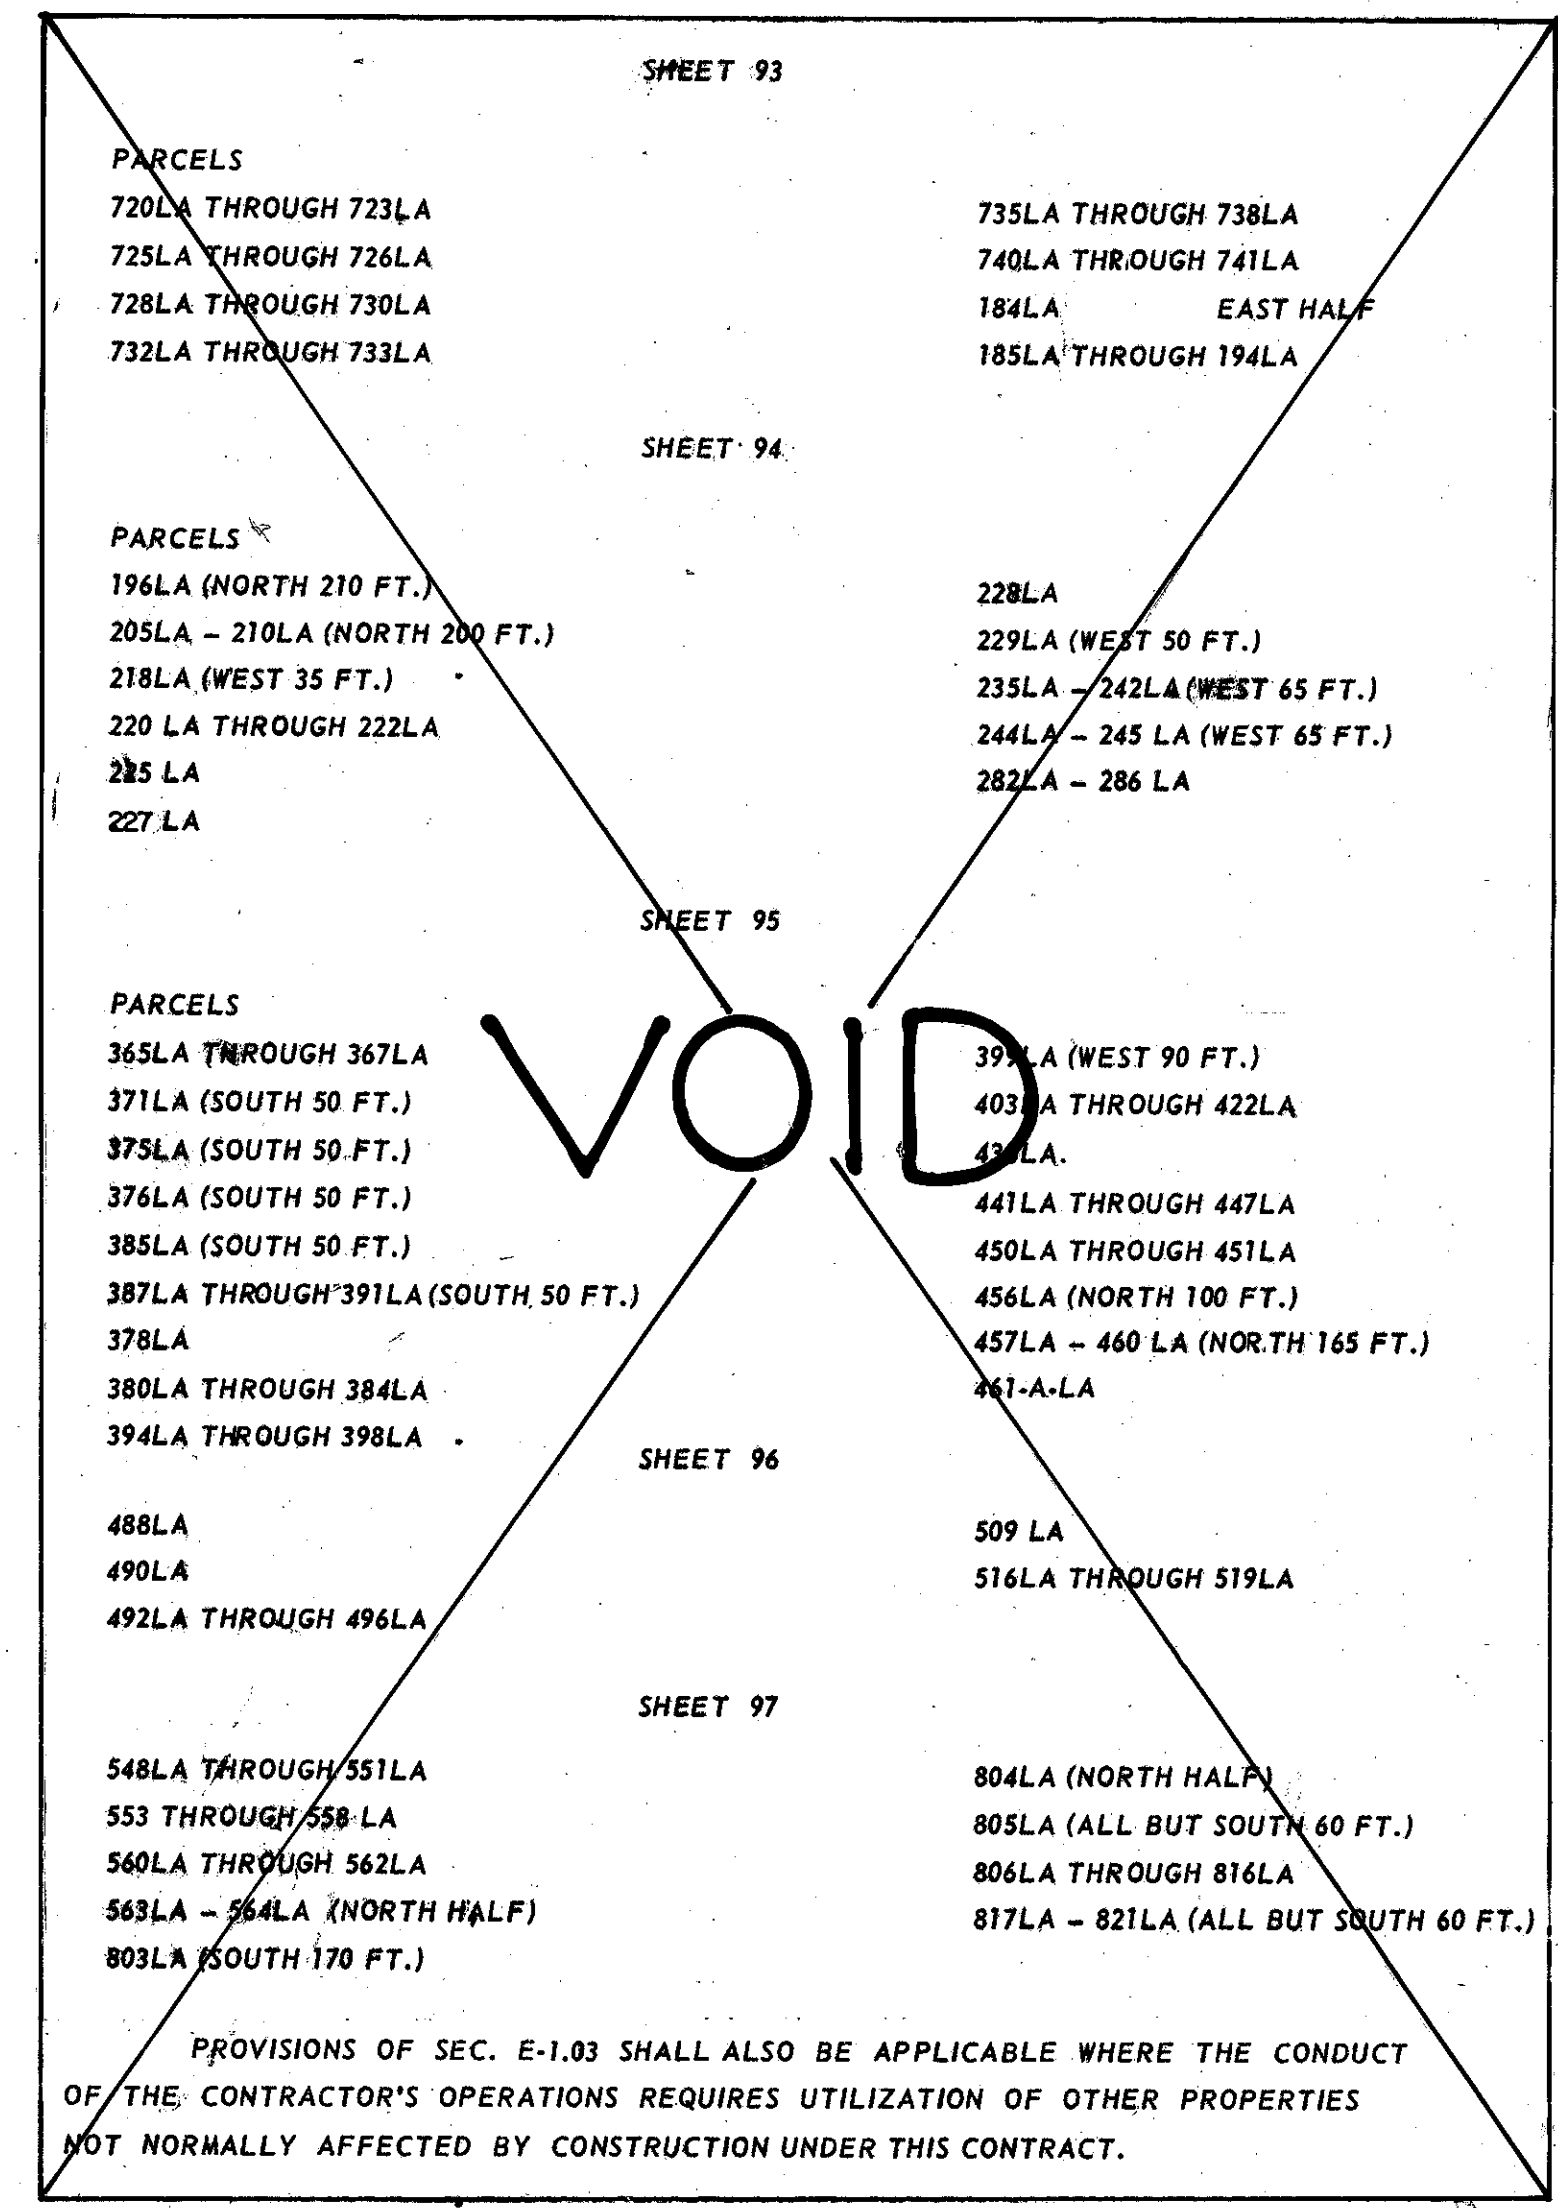

SS-18 FENCING

FOR LOCATION OF FENCING, SEE RIGHT OF WAY SHEETS 92 THROUGH 97, AND SHEETS 55 TO 64 OF PART 7-B

FOR ADDITIONAL NOTES SEE SHEET 10 OF PART 6 AND SHEET 7 OF PART 7-B

ESTIMATED QUANTITIES (COMBINED PROJECT)

SPECIFIC LOCATIONS AND USAGE OF ESTIMATED QUANTITIES SET UP ON THIS PLAN TO BE USED "AS DIRECTED BY THE ENGINEER" SHALL BE MADE A MATTER OF RECORD BY INCORPORATION INTO THE FINAL CHANGE ORDER GOVERNING COMPLETION OF THIS PROJECT.

EARTHWORK

THE TOP 2 FEET OF ALL EMBANKMENT SHALL BE CONSTRUCTED OF SOIL MATERIAL FREE FROM ROCKS, BOULDERS AND OTHER SIMILAR MATERIALS WHICH ARE RESTRICTIVE TO VEGETATIVE GROWTH OR HANDICAP MAINTENANCE OPERATION. DURING THE EXCAVATION AND EMBANKMENT CONSTRUCTION OPERATIONS, THE ROADWAY SECTION SHALL BE MAINTAINED AT ALL TIMES IN SUCH A SHAPE THAT NO CONCENTRATION OF WATER WILL DISCHARGE IN A CONCENTRATED FLOW OVER THE SLOPES.

L-9 SEEDING AND PROTECTING

QUANTITIES FOR SEEDING FOR PART 7-A ARE CALCULATED FOR THE SOIL AREAS BETWEEN THE RIGHT-OF-WAY FENCE LINES, BETWEEN THE RIGHT-OF-WAY LINES IN UNFENCED AREAS, AND WITHIN THE WORK LIMITS FOR AREAS OUTSIDE THE RIGHT-OF-WAY LINES COVERED BY WORK AGREEMENT OR SLOPE EASEMENTS, EXCEPT THOSE AREAS INCLUDED IN PART G.

THE QUANTITY AND LIMITS FOR SEEDING MAY BE REVISED WHERE CONSIDERED NECESSARY BY THE ENGINEER.

THE SEED MIX FOR ALL AREAS IS AS FOLLOWS:

- 30 PER CENT KENTUCKY BLUE GRASS
- 30 PER CENT KENTUCKY, 31 FESCUE
- 20 PER CENT CREEPING RED FESCUE
- 15 PER CENT RED TOP
- 5 PER CENT WHITE DUTCH CLOVER

SEED TO BE APPLIED AT THE RATE OF 3 LBS. PER 1,000 SQ. FT.

L-9 AGRICULTURAL LIMING MATERIALS

AGRICULTURAL LIMING MATERIALS SHALL BE USED IN CONNECTION WITH SEEDING AND SODDING AT THE RATE OF 100 POUNDS PER 1,000 SQ. FT.

ADDITIONAL NOTES

- STRUCTURES SHEETS 98 AND 98A
- DRAINAGE SHEET 40
- LIGHTING SHEET 48

SUGGESTED CONSTRUCTION PROCEDURE FOR COMBINED PROJECT

THE FIRST ORDER OF CONSTRUCTION SHALL COMPRISE "THE SEQUENCE OF CONSTRUCTION" AS OUTLINED ON SHEET NO. 3 IN PART 6 OF THE PLANS AND CONSTRUCTION OF RAMP NO. 8 AS OUTLINED ON SHEET NO. 7 IN PART 7B OF THE PLANS.

THE SCHEDULING OF ALL OTHER WORK, INCLUDING THE CONSTRUCTION OF THE REMAINING PORTIONS OF THE INNER BELT FREEWAY, RAMP AND THE WILLOW FREEWAY, SHALL BE AT THE OPTION OF THE CONTRACTOR, SUBJECT TO APPROVAL BY THE ENGINEER. THIS WORK SHALL BE PERFORMED IN SUCH A MANNER SO AS NOT TO INTERFERE WITH THE CONSTRUCTION OUTLINED IN THE PRECEDING PARAGRAPH.

ALTERNATE CONSTRUCTION PROCEDURE

IN LIEU OF THE SUGGESTED CONSTRUCTION PROCEDURE, THE CONTRACTOR MAY SUBMIT AN ALTERNATE PLAN TO THE DIRECTOR FOR APPROVAL. NO ALTERNATE PLAN SHALL BE PLACED INTO EFFECT UNTIL APPROVAL HAS BEEN GRANTED, IN WRITING, BY THE DIRECTOR.

COMPACTION USING HEAVY PNEUMATIC TIRED ROLLER -

SEE NOTE ON SHEET NO. 10 OF PART 6.

HEAVY EQUIPMENT (COMBINED PROJECT)

THE CONTRACTOR SHALL EXERCISE CARE IN THE USE OF HEAVY EQUIPMENT OVER FINISHED WORK AND WILL BE REQUIRED TO REMOVE AND REPLACE ANY COMPLETED WORK DESTROYED THEREBY. CULVERTS SHALL BE BACKFILLED TO A HEIGHT OF FOUR FEET BEFORE LOADED. EARTH-MOVING EQUIPMENT IS PERMITTED TO CROSS THE TRENCH, ANY ADDITIONAL FILL AND SUBSEQUENT EXCAVATION REQUIRED TO PROVIDE THIS MINIMUM COVER SHALL BE MADE AT NO ADDITIONAL COST TO THE STATE. HEAVY EQUIPMENT SHALL NOT BE OPERATED OVER ANY COMPLETED LAYER OF EMBANKMENT, COMPACTED SUBGRADE, OR SUBBASE IF SUCH OPERATION TENDS TO DESTROY THE SOIL STRUCTURE OR PIPE UNDERDRAINS; HOWEVER, IF SUCH OPERATION CANNOT BE AVOIDED, THE CONTRACTOR WILL BE REQUIRED TO REDUCE THE SIZE OF LOADS TO AN EXTENT THAT DAMAGE DOES NOT OCCUR.

CUYAHOGA COUNTY
CITY OF CLEVELAND
CUY-42-18.42
CUY-21-15.32
QUANTITY CALCULATIONS

T-71 9" REINFORCED P.C.C. PAVEMENT					
ROADWAY	STATION TO STATION		LENGTH	CALCULATION width ft. - 9 sq. yds.	AREA sq. yds.
E-5	2+50.52 8+60.56 9+60.56	8+60.56 9+60.56 11+96.00	610.24 100.00 236.44	16 1/2(19+16) 1/2(16+36) Sub Total	1085 194 683 1962
E-7	1+36.63 2+36.63 3+60.72 3+85.72 4+50.40 4+50.40 6+50.40	2+36.63 3+60.72 3+85.72 4+50.40 6+50.40 7+44.00	100.00 124.09 23.00 64.68 200.00 93.60	24 16 1/2(16+17) 17 1/2(25+15) 1/2(17+10) Sub Total	267 221 46 122 444 140 1240
E-8	0+00 1+47.96 6+17.14 9+94.52	1+47.96 6+17.14 9+94.52 11+74.52	147.96 469.18 377.38 180.00	24 16 18 1/2(27+14) Sub Total	395 834 755 410 2394
E-9	0+00 1+93.60	1+93.60 4+35	193.60 241.40	24 16 Sub Total	516 429 945
E-10	0+00 4+18 4+81.54 5+31.54 7+09.78 9+77 10+33	0+78 4+81.54 5+31.54 7+09.78 10+33 17+96	78.00 63.54 50.00 178.24 85.22 56.00 763.00	1/2(0+4) 24 1/2(24+26) 26 1/2(36+32) 1/2(24+26) 24 Sub Total	17 169 139 515 322 156 2055 3333
E-11	0+00 1+98.46 3+90.04 5+43	1+98.46 3+90.04 5+43 6+55.84	198.46 191.56 152.96 112.84	1/2(0+21) 16 1/2(16+92) 24 Sub Total	232 341 323 301 1197
E-13	0+33 1+03 3+96.25 4+96.25	1+03 3+96.25 4+96.25 6+12.32	70.00 299.25 100.00 116.07	Var. 1/2(24+195) 1/2(22.5+14) Var. Sub Total	356 723 203 69 1351
E-14	0+82 2+72.97 3+22.97 4+72.70 6+16.79 8+76.96 9+79.56	2+72.97 3+22.97 4+72.70 6+16.79 8+76.96 10+79.56	190.97 50.00 149.73 144.09 260.17 102.60 100.00	Var. 1/2(16+18) 18 Var. 24 16 Var. Sub Total	231 94 299 328 694 182 208 2036
Access Road	1+40	3+02.49	162.49	1/2(0+22) Sub Total	199 199
E-15	9+95 12+25.74 14+05.74 17+23	12+25.74 14+05.74 15+01 17+40.32	230.74 180.00 95.26 17.32	Var. 1/2(19+14) 16 1/2(15+14) Sub Total	536 330 169 28 1063
E-16	0+38.25 1+82.29 2+82.29 4+98.38 5+50.46	1+82.29 2+82.29 4+98.38 5+50.46 6+26	144.04 100.00 216.09 52.08 75.54	1/2(28.12+47) 24 16 17 1/2(20+16.5) Sub Total	601 267 384 98 153 1503
E-17	1+60 1+90 2+31.62 6+21.14 7+06.65 8+90.65 9+70.65	1+90 2+31.62 6+21.14 7+06.65 8+90.65 10+70.65	30.00 41.62 389.52 85.51 184.00 80.00 100.00	1/2(38+46) 1/2(20+31) 24 Var. 19 1/2(27+21.5) 1/2(24.5+14) Sub Total	140 118 1039 120 388 216 222 2243
* N-30	* 0+72 * 3+53.61 * 8+50	* 3+53.61 * 8+50 * 9+04.20	281.61 496.39 54.20	Var. 16 1/2(18+14) Sub Total	* 435 * 882 * 96 * 1413
* 30-N	* 0+12 * 1+73.65 * 2+73.65 * 6+16.40 * 7+16.40	* 1+73.65 * 2+73.65 * 6+16.40 * 7+16.40 * 9+87	161.65 100.00 342.75 100.00 270.60	Var. 24 16 1/2(18+14) Var. Sub Total	* 394 * 267 * 609 * 178 * 381 * 1829

T-71 9" REINFORCED P.C.C. PAVEMENT (CONT)					
ROADWAY	STATION TO STATION		LENGTH	CALCULATION width ft. - 9 sq. yds.	AREA sq. yds.
Willow	* 30+41.88 * 30+53.44 * 31+54 * 36+43 44+79 46+37.62	* 30+53.44 * 31+54 * 33+74 * 42+19 46+37.62 49+00	11.56 100.56 220.00 376.00 158.62 262.38	72 82 72 72 72 Var. Sub Total	* 92 * 916 * 1760 * 3008 1269 2038 **9083
Inner Belt	64+68.53 68+46 74+21 74+98.21 70+66.68 78+86.88 79+85.88	64+83 70+64 74+98.21 78+66.68 78+86.88 79+85.88 83+09.31	14.47 218.00 77.21 368.47 20.20 99.00 323.43	72 72 108 1/2(108+96.31) 96.31 1/2(94.31+92) 72 Sub Total	116 1744 926 4183 216 1025 2587 10,797
				CUY 42-18.42	33,590
				CUY 21-15.32	9,018
TOTAL					42,608

* - Project CUY 21-15.32
** - Total includes 5776 sq. yds. under CUY 21-15.32

I-22 SUBBASE								
ROADWAY	LOCATION	STATION TO STATION		LENGTH ft.	WIDTH ft.	AREA sq. yds.	DEPTH in.	VOLUME Cu. Yds.
E-5	Under Pavement " Rt. Shoulder " Lt. "	1+84 2+50.32	12+20 8+60.56	1036.0 610.2	7.00 3.00	1922 806 203	6.00 4.79 6.00	321 107 34 Sub Total 462
E-7	Under Pavement " Rt. Shoulder " Lt. "	2+36.63 1+36.63	4+50.40 7+43	213.8 606.4	8.25 1.75	1240 196 118	6.00 4.95 6.00	207 27 20 Sub Total 254
E-8	Under Pavement " Rt. Shoulder " Lt. " " Lt. " " Lt. "	1+47.96 0-70 0+00 4+50	9+94.52 0+00 4+50 14+10	846.5 70.0 450.0 960.0	7.80 5.00 3.00 1.75	2394 734 39 150 187	6.00 4.79 6.00 6.00 6.00	400 97 7 25 31 Sub Total 560
E-9	Under Pavement " Rt. Shoulder " Lt. "	1+93.60 0+00	4+58 4+38	264.4 438.0	7.00 3.00	945 206 146	6.00 4.79 6.00	158 27 24 Sub Total 209
E-10	Under Pavement " Rt. Shoulder " Lt. " " Lt. " " Lt. "	3+92 9+40 4+18 9+84 17+01.98	7+09.78 18+25 7+98 17+01.98 18+16	317.8 885.0 380.0 718.0 114.0	10.25 10.25 1.75 1.75 3.75	3353 362 1008 74 140 47	6.00 4.87 4.87 6.00 6.00 6.00	560 49 136 12 23 8 Sub Total 788
E-11	Under Pavement " Rt. Shoulder " Rt. " " Lt. "	0+00 4+46.40 4+46.40 1+98.46	4+46.40 5+43 5+65	446.4 96.6 366.5	7.00 1/2(7+138) 3.00	1197 347 45 122	6.00 4.79 6.00 6.00	200 46 8 20 Sub Total 274
E-13	Under Pavement " Rt. Shoulder " Lt. "	1+02 0+50	4+96.25 3+96.25	394.2 346.2	7.00 3.00	1351 307 115	6.00 4.79 6.00	226 41 19 Sub Total 286
E-14	Under Pavement " Rt. Shoulder " Rt. " " Lt. "	2+76.73 8+76.96 2+76.73	4+72.70 10+54.83 9+79.56	196.0 177.9 702.8	7.00 7.00 3.00	2036 152 138 234	6.00 4.79 4.79 6.00	340 20 18 39 Sub Total 417
Access Road	Under Pavement " Rt. Shoulder	0+00	2+02.50	202.5	7.00	199 158	6.00 4.79	33 21 Sub Total 54
E-15	Under Pavement " Rt. Shoulder " Lt. "	10+50 9+54	15+26 12+25.74	476.0 271.7	7.00 3.00	1063 370 91	6.00 4.79 6.00	178 49 15 Sub Total 242
E-16	Under Pavement " Rt. Shoulder " Lt. "	2+82.29 0+38.25	6+50 5+50.46	367.7 512.2	8.25 1.75	1503 337 90	6.00 4.95 6.00	251 46 15 Sub Total 312

CUYAHOGA COUNTY
CITY OF CLEVELAND
CUY-42-18.42
CUY-21-15.32
QUANTITY CALCULATIONS

I-11 SANDSTONE CURB				
ROADWAY	SIDE	STATION TO STATION		LENGTH ft.
E-5	Rt.	1+13.65	2+00	86
	Lt.	1+13.65	9+60.56	847
			Sub Total	933
E-7	Rt.	1+36.63	2+36.63	100
	Rt.	5+50.40	6+50.40	100
	Lt.	1+36.63	7+54	617
			Sub Total	817
E-8	Rt.	0+47.96	1+47.96	100
	Rt.	9+94.52	11+74.52	180
	Lt.	0-70	14+10	1480
			Sub Total	1760
E-9	Rt.	0+93.60	1+93.60	100
	Lt.	0+00	4+54	454
			Sub Total	554
E-10	Rt.	7+09.78	7+95	85
	Lt.	4+05	7+95	390
	Lt.	9+83	18+14	831
			Sub Total	1306
E-11	Lt.	1+98.46	6+55.84	456
			Sub Total	456
E-13	Rt.	0+30	1+20	106
	Lt.	0+30	4+96.25	478
			Sub Total	584
E-14	Rt.	7+76.96	8+76.96	100
	Rt.	10+54	10+79.56	26
	Lt.	2+76.73	10+79.56	803
			Sub Total	929
E-15	Lt.	9+86	14+05.74	420
			Sub Total	420
E-16	Rt.	1+82.29	2+82.29	100
	Lt.	0+38.25	6+30	592
			Sub Total	692
E-17	Rt.	8+90.65	10+70.65	180
	Lt.	2+31.62	6+21.14	389
	Lt.	7+06.65	10+70.65	364
			Sub Total	933
* 30-N	* Rt.	* 1+73.65	* 2+73.65	* 100
	* Lt.	* 0+10	* 7+16.40	* 706
			Sub Total	806
* N-30	* Rt.	* 7+04.20	* 9+04.20	* 200
	* Lt.	* 3+53.61	* 9+04.20	* 551
			Sub Total	751
Willow	* Median	* 30+41.88	* 34+00	* 716
	"	* 36+24	* 42+45	* 1242
	"	* 44+54	* 49+31	* 954
	Rt.	* 46+88.02	* 47+85.02	* 100
	Lt.	* 30+53.44	* 31+53.44	* 100
			Sub Total	**3112
Inner Belt	Median	64+68.53	64+85	33
	"	68+45	70+65	440
	"	74+22	83+09.31	1775
	Rt.	78+86.88	79+86.88	100
	Lt.	79+85.88	80+85.88	100
			Sub Total	2448
		CUY 42-18.42	12,901	
		CUY 21-15.32	3,615	
		TOTAL	16,516	

* - Project CUY 21-15.32
** - Total includes 2058 lin. ft. under CUY 21-15.32

I-21 P.C.C. MEDIAN PAVEMENT (4")					
ROADWAY	STATION TO STATION		LENGTH ft.	WIDTH ft.	AREA sq. yds.
Willow	* 30+41.88	* 34+00	358	5	* 199
	* 36+24	* 42+45	621	5	* 345
	* 44+54	* 49+31	477	5	265
	* 51+07	* 51+86	79	5	44
	* 31+53.44	* Nose	42	1/2(2+10)	* 28
	* 46+85.02	* Nose	46	1/2(2+10)	* 31
				Sub Total	** 912
Inner Belt	64+68	65+10	42	3	14
	68+20	70+90	270	3	90
	73+97	80+09.31	612	3	204
	80+09.31	83+09.31	300	1/2(3+9)	200
	78+86.88	Nose	38	1/2(2+10)	25
	79+85.88	Nose	33	1/2(2+10)	22
				Sub Total	555
E-5	9+60.56	Nose	80	1/2(2+10)	53
	2+50.32	Nose	55	"	37
				Sub Total	90
E-7	1+36.63	Nose	18	1/2(2+10)	12
				Sub Total	12
E-10	8+09.78	Nose	85	1/2(4+10)	66
				Sub Total	66
E-14	10+79.56	Nose	79	1/2(2+10)	53
				Sub Total	53
E-15	14+05.74	Nose	100	1/2(2+10)	67
	17+40.32	Nose	45	1/2(2+6)	20
				Sub Total	87
E-16	0+38.25	Nose	15	1/2(2+10)	10
				Sub Total	10
E-17	2+31.62	Nose	48	1/2(2+10)	32
	7+06.65	Nose	18	"	12
	10+70.65	Nose	28	"	19
				Sub Total	63
* N-30	* 9+04.20	* Nose	78	1/2(2+10)	* 52
				Sub Total	* 52
* 30-N	* 1+73.65	* Nose	60	1/2(2+10)	* 40
				Sub Total	* 40
			CUY 42-18.42	1276	
			CUY 21-15.32	664	
			TOTAL	1940	

* - Project CUY 21-15.32
** - Total includes 572 sq. yds. under CUY 21-15.32

I-12 2A MODIFIED (10") CONCRETE CURB				
ROADWAY	SIDE	STATION TO STATION		LENGTH ft.
E-15	Lt.	16+95	17+40.32	45
			Sub Total	45
Willow	Lt.	48+73.11	49+20	47
			Sub Total	47
		TOTAL		92

L-10 SODDING	
ITEM	AREA Sq. yds.
Sodding	268
Sodding, Including 2" Galvanized Wire Mesh	625

I-7 APPROACH SLABS			
ROADWAY	BRIDGE	LOCATION	AREA sq. yds.
Inner Belt	3	East Approach	216
		West "	217
Inner Belt	4	East Approach	329
		West "	345
E-10	5	South Approach	87
		North "	130
E-15	7	East Approach	85
Willow	8	East Approach	160
		West "	183
E-15	9	East Approach	44
		West "	76
Willow	10	* East Approach	* 200
		West "	204
Willow	11	* East Approach	* 206
		* West "	* 200
		CUY 42-18.42	2076
		CUY 21-15.32	606
		TOTAL	2682

* - Project CUY 21-15.32

CUYAHOGA COUNTY
CITY OF CLEVELAND
CUY-42-18.42
CUY-21-15.32
QUANTITY CALCULATIONS

E-8 REMOVAL & DISPOSAL EXISTING SIDEWALK							
ROADWAY	SIDE	LIMITS	LENGTH	WIDTH	AREA	sq. ft.	
Central	N	19 th St. - 21 st St.	325	12	3900		
	S	" - 20 th St.	230	12	2760		
	S	20 th St. - 21 st St.	170	12	2040		
	N	21 st St. - 22 nd St.	325	13	4225		
	S	" - "	294	12	3528		
Sub Total						16,453	
E. 21 st St.	E	Carnegie - Central	500	5	2500		
	W	" - "	475	6	2850		
Sub Total						5,350	
Charity	N	14 th St. - 20 th St.	320	5	1600		
	S	" - "	320	5	1600		
Sub Total						3,200	
E. 29 th St.	E	Orange - Woodland	250	6	* 1500		
	W	" - "	250	6	* 1500		
Sub Total						* 3,000	
Woodland	N	19 th St. - 20 th St.	152	17	2584		
	S	" - "	258	18.5	4773		
	S	27 th St. - 29 th St.	360	18	* 6480		
	S	29 th St. - 30 th St.	225	18	* 4050		
Sub Total						** 17,887	
E. 19 th St.	E	Woodland - Scovill	752	6	4512		
	W	" - "	740	6	4400		
Sub Total						8,952	
E. 20 th St.	E	Charity - Central	105	5	525		
	W	" - "	105	5	525		
Sub Total						1,050	
						CUY 42-18.42	42,362
						CUY 21-15.32	13,530
TOTAL						55,892	

* - Project CUY 21-15.32
** - Total includes 10,530 sq. ft. under CUY 21-15.32

E-8 REMOVAL & DISPOSAL EXISTING SANDSTONE CURB					
ROADWAY	SIDE	LIMITS	LENGTH	IN.	
E. 19 th St.	E	Woodland - Scovill	782		
	W	" - "	185		
Sub Total			1567		
E. 20 th St.	E	Charity - Central	125		
	W	" - "	125		
Sub Total			250		
E. 21 st St.	E	Charity - Central	70		
	W	" - "	70		
	E	Central - Carnegie	520		
	W	" - "	500		
Sub Total			1160		
* E. 29 th St.	E	* Orange - Woodland	* 280		
	W	* " - "	* 280		
Sub Total			* 560		
Central	N	19 th St. - 22 nd St.	780		
	S	" - "	795		
Sub Total			1575		
Woodland	N	19 th St. - 20 th St.	135		
	S	" - "	265		
	S	* 29 th St. - 30 th St.	* 180		
Sub Total			** 580		
				CUY 42-18.42	4952
				CUY 21-15.32	740
TOTAL				5692	

* - Project CUY 21-15.32
** - Total includes 180 lin. ft. under CUY 21-15.32

E-8 REMOVAL & DISPOSAL EXISTING RIGID PAVEMENT				
ROADWAY	LIMITS	LENGTH	WIDTH	AREA
Central	E. 19 th St. - E. 22 nd St.	695	40	3089
Woodland	E. 19 th St. - E. 20 th St.	217	62	1495
Parcel 184	Market Place			2167
TOTAL				6751

SS-18 FENCING		
PROJECT	SHEET	LENGTH
CUY 42-18.42	Sheet # 92	2255
	" # 93	1587
	" # 94	3218
	" # 95	2380
	" # 96	920
Sub Total		10,360
CUY 21-15.32	Sheet # 97	3900
Sub Total		3900
TOTAL		14,260

I-15 GUARD RAIL		
PROJECT	SHEET	LENGTH
CUY 42-18.42	Sheet # 15	457
	" # 16	660
	" # 18	3583
	" # 19	1167
	" # 20	2175
Sub Total		8,042
CUY 21-15.32	Sheet # 16	560
	" # 17	1870
Sub Total		2430
TOTAL		10,472

I-15 BARRIER RAIL		
PROJECT	SHEET	LENGTH
CUY 42-18.42	Sheet # 16	339
	" # 18	208
	" # 19	48
	" # 20	1162.5
Sub Total		1757.5
CUY 21-15.32	Sheet # 16	286
	" # 17	686.5
Sub Total		972.5
TOTAL		2730

L-9 QUANTITIES			
PROJECT	ITEM	CALCULATION	QUANTITY
CUY 42-18.42	SEEDING & PROTECTION	Planimeter	108,543 Sq. Yds. #
		"	44,500 " "
		Total	153,043 " "
CUY 42-18.42	AGRICULTURAL LIMING MATERIALS	100#/1000 Sq. Ft.	48.84 Tons
		"	20.03 Tons
		Total	68.87 Tons
CUY 42-18.42	COMMERCIAL FERTILIZER	20#/1000 Sq. Ft.	9.77 Tons
		"	4.01 " "
		Total	13.78 Tons

Includes 893 Sq. Yd. Sodding

E-11 WATER		
PROJECT	CALCULATION	M. GAL.
CUY 42-18.42	6.5 gal./cu. yd. embankment x 1.15 = 6.5 x 282,342	1835
CUY 42-18.42	5.0 gal./cu. yd. subbase (See I-22) = 5.0 x 8,085	40
CUY 42-18.42	5.0 gal./cu. yd. Agg. Base (See I-18) = 5.0 x 2,106	11
Sub Total		1886
CUY 21-15.32	6.5 gal./cu. yd. embankment x 1.15 = 6.5 x 124,768	811
CUY 21-15.32	5.0 gal./cu. yd. subbase (See I-22) = 5.0 x 2,589	13
CUY 21-15.32	5.0 gal./cu. yd. Agg. Base (See I-18) = 5.0 x 652	3
Sub Total		827
TOTAL		2713

E-1 COMPACTED SUBGRADE		
PROJECT	ITEM	AREA
CUY 42-18.42	Area of T-71+B-219+I-11+I-7	49,559
CUY 21-15.32	Area of T-71+B-219+I-11+I-7	13,833
TOTAL		63,392

E-9 TREE REMOVAL			
SHEET	SIZE		TOTAL
	12"	18"	
# 92			
# 93	10	3	13
# 94	6	4	10
# 95	38	5	43
# 96			
# 97	4		4
TOTAL	58	12	70

GENERAL SUMMARY ESTIMATED QUANTITIES

FED. ROAD DIV. NO.	STATE	FEDERAL AID PROJECT NO.	TYPE FUNDS
2	OHIO		

CUYAHOGA COUNTY
CITY OF CLEVELAND
CUY-42-18.42
CUY-121-15.32

TYPE CODE 7221

PART 6				PART 7					GRAND TOTAL	UNIT	ITEM NO.	DESCRIPTION	COMBINED TOTALS		I-71-5(8) 248	
SHEET NUMBERS	I-71-5(6) 247		SHEET NO.	I-71-5(8) 248 (PART 7A)		SHEET NO.	I-77-5(1) 162						SHEET NUMBERS	I-71-5(8) 248 (PART 7B)		100% CITY

ROADWAY

13	149337	829	150166		72,796	72,796		3,760	3,760	76,556	10	571,955	571,955	798,677	Cu.Yds.	E-1	Roadway Excavation, Method B, as per plan.	829	197,848	644,751	644,751
13	78010	1,786	7,9796	11	49,388	49,388	11	14,207	14,207	63,595	10	45,255	45,255	188,646	Sq.Yds.	E-1	Compacted Subgrade.	1,786	186,860	94,643	94,643
12	23469		23469	11										23,469	Lin.Ft.	E-8	Removal for Re-use of Existing Sandstone Curb		23,469		
	2000		2000	11	4,952	4,952	11	740	740	5,692	10	283	283	5,975	Lin.Ft.	E-8	Removal and Disposal Existing Sandstone Curb.		5,975	5,235	5,235
13	48722	3,663	52,885	11	1,500	1,500		500	500	2,000	10	79	79	4,000	Cu.Yd.	E-7	Borrow using Granular Material, as per plan		4,000	1,500	1,500
					6,751	6,751				6,751	10			5,921.5	Sq.Yds.	E-8	Removal and Disposal Existing Pavement	3,663	55,552	6,830	6,830
13	175193	17,100	192,293	11	42,362	42,362	11	13,530	13,530	55,892	10	3,193	3,193	251,378	Sq.Ft.	E-8	Removal and Disposal of Existing Sidewalk.	17,100	234,278	45,555	45,555
13	Lump Sum		Lump Sum	11							10	Lump Sum	Lump Sum	Lump Sum	Lump Sum	E-9	Removal of Trees and Stumps.		Lump Sum	Lump Sum	Lump Sum
13	1046		1046	11	1,886	1,886	11	827	827	2,713	10	115	115	3874	M.Gals.	E-11	Water		3874	2,001	2,001
				1178											Lump Sum	Special	Sign Bridge as per plan.		Lump Sum	Lump Sum	Lump Sum
	2		2		2	2		2	2	4	10	3	3	9	Each	I-8	Monument Assemblies Standard.		9	5	5
	2		2		2	2		2	2	4				6	Each	I-8	Monument Boxes Standard.		6	2	2
11	37,157		37,157								10	2,111	2,111	39,268	Sq.Ft.	I-13	4" Concrete Sidewalk, as per plan		39,268	2,111	2,111
12	3742		3,742	11	8,042	8,042	11	2,430	2,430	10,472	10	3,237.5	3,237.5	17,451.5	Lin.Ft.	I-15	Guard Rail, Steel Beam Standard Type (Deep)		17,451.5	11,279.5	11,279.5
12	4375		4,375	11	1,757.5	1,757.5	11	972.5	972.5	2,730.0	10	20,625	20,625	52,300	Lin.Ft.	I-15	Guard Rail, Steel Beam Barrier Type (Deep)		52,300	3,820.0	3,820.0
14	1000		1,000		500	500			500					1500	Lin.Ft.	I-15	Guard Rail, Temporary Steel Beam, as per plan		1500		500
13	120507		1,205,07	11	107,650	107,650	11	44,500	44,500	152,150	10	65,787	65,787	338,444	Sq.Yds.	L-9	Seeding and Protecting, as per plan.		338,444	173,437	173,437
13	1085		1,085	11	9.77	9.77	11	4.01	4.01	13.78	10	5.92	5.92	30.55	Tons	L-9	Commercial Fertilizer (12-12-12)		30.55	15.69	15.69
13	5423		5,423	11	48.84	48.84	11	20.03	20.03	68.87	10	29.60	29.60	152.70	Tons	L-9	Agricultural Liming Materials		152.70	78.44	78.44
13	22		22	10	625	625			625					647	Sq.Yds.	L-10	Sodding, including 2" Galvanized Wire Mesh, as per plan.		647	625	625
13	55		55	10	268	268			268					323	Sq.Yds.	L-10	Sodding		323	268	268
110	10		10		5	5	7		5					15	Tons	M-10	Calcium Chloride Furnished and Applied for Maintaining Traffic		15	5	5
10	500		500		250	250	7		250					750	Cu.Yds.	T-10	Traffic Compacted Surface Course for Maintaining Traffic.		750	250	250
14	2		2	11	10,360	10,360	11	3,900	3,900	14,260	10	20,149	20,149	34,409	Lin.Ft.	33-18	Interstate and Defense Highway Signs Furnished and Erected		34,409	30,509	30,509
											10	21	21	21	Each	33-18	Fence Gates, Type 'C'		21	21	21
10	100		100											100	Cu.Yds.	T-35	Asphaltic Concrete Surface Course or an Approved Bituminous Premixed Surface Course for Maintaining Traffic		100		
10	Lump Sum		Lump Sum		Lump Sum	Lump		Lump Sum	Lump	Lump Sum		Lump Sum	Lump Sum	Lump Sum	Lump	Special	Construction Layout Stakes		Lump Sum	Lump Sum	Lump Sum
10	100		100		75	75		25	25	100				200	Hours	Special	Fill Compaction Using Heavy Pneumatic Tired Roller		200	75	75

LIGHTING (CONTINUED ON SHEET NO 13)

	20	20	56	56	24	24	80	74	52	52	152	Each	S-25	15,000 Lumen Luminaire and Insulating Transformer, as per plan.	152		108	108
	205	205	104	104	13	13	117		38	38	360	Each	S-25	10,000 Lumen Luminaire and Insulating Transformer, as per plan.	360		142	142
									39	39	39	Each	S-25	Lamp Standard, 17 foot Bracket, as per plan		39	39	39
30	51	81		129	129		31	31	2.6	2.6	2.67	Each	S-25	Lamp Standard, 10 foot Bracket, as per plan.		51	216	155
	26	26							11	11	37	Each	S-25	Lamp Standard, Two 10 foot Brackets, as per plan.		26	11	11
31	143	174		129	129		31	31	76	76	410	Each	S-25	Concrete Pole Base, as per plan.		143	207	205
3	22	25		31	31		2	2	92	92	150	Each	S-25	Pull Boxes, Concrete, as per plan.	22	132	128	123
									5	5	5	Each	S-25	Double Pull Box, as per plan.		5	5	5
	20,550	20,550	15,750	15,750	3,600	3,600	13,350		8,330	8,330	48,230	Lin.Ft.	S-25	No. 8 AWG, 5 KV Lighting Cable, as per plan	48,230		24,080	24,080
175		175		575	575				395	395	1,145	Lin.Ft.	S-25	4-Way Duct, 2-2 inch, and 2-4 inch, as per plan		1,145	970	970
32	6943	14,440		10,460	10,460	3,040	3,040	13,500	4,750	4,750	32,690	Lin.Ft.	S-25	1-Way Duct, 2-inch, as per plan	11,230	7,499	15,210	21,460
350	810	4,085		1,165	1,165	160	160	1,325	1,930	1,930	7,340	Lin.Ft.	S-25	2-Way Duct, 2-inch, as per plan	3,735	2,275	3,095	3,095
									1,280	1,280	1,280	Lin.Ft.	S-25	2-Way Duct, 1-2 inch, and 1-4 inch, as per plan		1,280	1,280	1,280
				260	260			260	260	260	260	Lin.Ft.	S-25	3-Way Duct, 2-inch, as per plan.		260	260	260
				140	140			140	140	140	140	Lin.Ft.	S-25	4-Way Duct, 2-inch, as per plan		140	140	140
									85	85	85	Lin.Ft.	S-25	3-Way Duct, 2-2 inch, and 1-4 inch, as per plan		85	85	85
	1,230	1,230		690	690	70	70	760	90	90	2,080	Lin.Ft.	S-25	1-Way Duct, 4-inch, as per plan	1,230	850	780	780
	890	890		70	70			70	450	450	1,410	Lin.Ft.	S-25	2-Way Duct, 4-inch, as per plan	890	520	520	520
	8	8	22	22	2	2	24		28	28	60	Each	S-25	Fluorescent Underdeck Light, as per plan		60		50
	150	150	240	240	80	80	320				470	Lin.Ft.	S-25	Multiple Feeders, No. 6 Conductor, as per plan		470	240	240
									1,175	1,175	1,175	Lin.Ft.	S-25	Multiple Feeders, No. 8 Conductor, as per plan		1,175	1,175	1,175
	750	750	1,800	1,800	250	250	2,050		990	990	3,790	Lin.Ft.	S-25	No. 10 AWG, 600 V. Branch Conductors.	3,790		2,790	2,790
	6	6									7	Each	I-8	Manhole (5'x8'), as per plan		7		1
											1	Each	S-25	Regulator Vault (6'x6'), as per plan		1		1
											2	Each	S-25	Regulator Vault (8'x11'), as per plan		2		2
											2	Each	S-25	Regulator Vault (8'x22'), as per plan		2		
									470	470	470	Lin.Ft.	S-25	3 Way Duct, 1-2 inch and 2-4 inch, as per plan.		470	470	470
											4	Lin.Ft.	I-9	Stone Underdrain No. 2, as per plan.		542	542	542

SCALE: Notes
MADE J.L.C. DATE 11-10-59 HOWARD, NEEDLES, TAMMEN & BERGENDOFF
TRCD. BAS DATE 11-12-59 CONSULTING ENGINEERS
CKD. BMG DATE 11-11-59 KANSAS CITY CLEVELAND NEW YORK
914 SHEET 12

GENERAL SUMMARY ESTIMATED QUANTITIES

TYPE CODE 7221

There are no 100% City Participating Items in Part 7-A or Part 7-B on this sheet.

FED. ROAD DIV. NO.	STATE	FEDERAL AID PROJECT NO.	TYPE FUNDS
2	OHIO		

CUYAHOGA COUNTY
CITY OF CLEVELAND
CUY-42-18.42
CUY-21-18.32

13
181

PART 6				# PART 7					GRAND TOTAL	UNIT	ITEM NO.	DESCRIPTION	COMBINED TOTALS		TOTALS I-71-5(8)248 FED. PARTIC.		
SHEET NUMBERS	I-71-5(8)247 CUY-42-18.29 100% CITY TOTAL			SHEET NUMBERS	I-71-5(8)248 CUY-42-18.42 FED. PARTIC.		I-77-5(1)162 CUY-21-18.32 TOTAL						PART 7-A TOTAL	SHEET NUMBER		I-71-5(8)248 CUY-42-18.42 FED. PARTIC.	
PAVEMENT																	
13	57		57								57	Cu.Yds	B-19	Aggregate Base Course		57	
11	105	13	118								118	Cu.Yds	B-35	Asphaltic Concrete Leveling Course (60-70)	13	105	
12	2462	249	2411								2411	Sq.Yds	B-70	9" Portland Cement Concrete Base Course	249	2,162	
12	262		262	9	1,098	9	339	339	1,437	10	899		B-219	Water Proofed Aggregate Base Course		2,598	1997
11	928		928	10	2,076	10	606	606	2,682		3,610	Sq.Yds	I-7	Reinforced Concrete Approach Slabs (T-13)		3,610	2076
12	7117	1480	8597								8597	Lin.Ft.	I-11	Sandstone Curb reset, as per plan	1480	7117	
12	2644	602	2646	10	12,901	10	3,615	3615	16,516	10	10,121		I-11	6x18" Sandstone Curb, as per plan	602	52,681	23022
13	151		151	10	92				92		243	Lin.Ft.	I-12	Standard Type 2-A Concrete Curb, Modifications "A" & "B" as per plan		243	92
12	405		405	9	2,106	9	652	652	2,758	10	1,721		I-18	Stabilized Crushed Aggregate Shoulders and Approaches		4,884	3827
12	1380		1380	10	1,276	10	664	664	1,940	10	2,803	Sq.Yds	I-21	Portland Cement Concrete Median Pavement, 4" Std. Type I	6123		4079
12	135		135								135	Sq.Yds	I-21	Standard Type 2 Portland Cement Concrete Median Pavement, as per plan		135	
11	13329	257	13586	9	8,085	9	2,589	2589	10,674	10	8559		I-22	Subbase	257	32,562	16644
12	247		247								247	Gals.	T-30	Bituminous Tack Coat, Sec.M-5.5, MS-2 or RS-1 or Sec.M.5.2, RC-1, RC-2, or RC-3, as per Sec.T-30.02		247	
12	1280		1280	9	4,618	9	1,426	1426	6,044	10	4,315		T-30	Bituminous Prime Coat, See M-5.7 RT. 2 or 3		11,639	8933
12	23		23	9	106	9	33	33	139	10	86		T-31	Bituminous Surface Treatment, No. 6 Aggregate		248	192
12	714		714	9	3,303	9	1,018	1018	4,321	10	2,697		T-31	Bituminous Surface Treatment, Bituminous Material, as per plan		7732	6000
11	75	9	84								84	Cu.Yds	T-35	Asphaltic Concrete Surface Course Type "C" (60-70)	11	90	
13	341		341								341	Sq.Yds	T-70	8" Portland Cement Concrete Pavement, as per plan		341	
11	72100	1537	73637	8	33,590	8	9,018	9018	42,608	10	34,467		T-71	9" Reinforced Portland Cement Concrete Pavement, as per plan	1,537	149,175	68057
RETAINING WALLS For Estimated Quantities, see Sheet No. 11, Part 7-B																	
BUILDING REMOVAL For Estimated Quantities, See Sheet No 14-A, 14-B & 14-C of Part No 7-A																	
STRUCTURES OVER 20 FT. SPAN																	
See Sheet N 92-92A (Part 6) For Structure Quantities																	
See Sheet N 99-99A (Part 7-A) For Structure Quantities																	
LIGHTING (CONTINUED FROM SHEET NO. 12)																	
	150	55	205								205	Lin.Ft	S-25	3 Way Duct, 4 inch, as per plan	55	150	
	1	1	1								1	Each	S-25	Removing Wood Pole, as per plan		1	
		65	65								65	Each	S-25	Remove and Reinstall Lighting Unit, as per plan		65	
		2	2								2	Each	S-25	Trolley Pole, 10 foot bracket, as per plan		2	
													S-25	Trolley Pole, 10 foot duplex bracket, as per plan			

SCALE None
MADE JLC DATE 11-10-59 HOWARD, NEEDLES, TAMMEN & BERGENDOFF
TRCD, R.R. DATE 11-10-59 CONSULTING ENGINEERS
CKD, G.M.G. DATE 11-11-59 KANSAS CITY CLEVELAND NEW YORK
914 SHEET 13

GENERAL SUMMARY ESTIMATED QUANTITIES

TYPE CODE 7221

There are no 100% City Participating Items in Part 7-A or Part 7-B on this sheet.

FED. ROAD DIV. NO.	STATE	FEDERAL AID PROJECT NO.	TYPE FUNDS
2	OHIO		

CUYAHOGA COUNTY
CITY OF CLEVELAND
CUY-42-18.42
CUY-21-15.32

14
181

PART 6				PART 7				PART A		PART B		I-71-5(8)248		GRAND TOTAL	UNIT	ITEM NO.	DESCRIPTION	COMBINED TOTALS				
I-71-5(6)247				I-71-5(8)248				I-77-5(1)162		I-71-5(8)248		TOTAL						100% CITY	FED. PART.			
SHEET NUMBERS	CITY-42-18.29			SHEET NUMBERS	CITY-42-18.42			SHEET NUMBERS	CITY-21-15.32		SHEET NUMBERS	CITY-42-18.29		TOTAL								
	FED. PARTIC.	100% CITY	TOTAL		FED. PARTIC.	100% CITY	TOTAL		FED. PARTIC.	TOTAL		FED. PARTIC.	TOTAL									
DRAINAGE (CONTINUED)																						
31-36	1314		1314	140	120		776	116	540	140	140	916	11	573	573	1349	2805	Lin. Ft.	I-2	12" Class B Storm Sewer		2805
31-36	4003	122	4125	114	500		1470	540	430	114	114	1584	11	696	696	2168	6405	Lin. Ft.	I-2	12" Class B Storm Sewer, Under Pavement or Approaches	122	6283
34	226		226															Lin. Ft.	I-2	12" Class B Storm Sewer, Sec. M-6.6 (c)		226
31	33-36	478	478				552	422	130			552				552	1030	Lin. Ft.	I-2	15" Class B Storm Sewer		1030
	31-35	560	98	658			147	147				147	11	623	623	770	1428	Lin. Ft.	I-2	15" Class B Storm Sewer, Under Pavement or Approaches	98	1330
31		74		74												74		Lin. Ft.	I-2	15" Class B Storm Sewer, Sec. M-6.5(b) or M-6.8(b)		74
							500	500				500				500	500	Lin. Ft.	I-2	15" Class B Storm Sewer, Under Pavement or Approaches, Sec. M-6.6(c)		500
	35	146		146			176		176			176				176		Lin. Ft.	I-2	18" Class B Storm Sewer, Sec. M-6.5(b) or M-6.8(b)		322
31,33	35-36	388		388												388		Lin. Ft.	I-2	18" Class B Storm Sewer		388
31	35-36	748		748												748		Lin. Ft.	I-2	18" Class B Storm Sewer, Under Pavement or Approaches		748
	35	204		204			124	124				124				124		Lin. Ft.	I-2	18" Class B Storm Sewer, Under Pavement or Approaches, Sec. M-6.6(c)		328
	33	70		70									11	244	244	244	314	Lin. Ft.	I-2	21" Class B Storm Sewer, Under Pavement or Approaches		314
	33	264		264												264		Lin. Ft.	I-2	21" Class B Storm Sewer		264
	36	106		106			92		92			92				92		Lin. Ft.	I-2	24" Class B Storm Sewer, Under Pavement or Appr's. Sec. M-6.6(b) or M-6.8(b)	106	92
	36	70		70												70		Lin. Ft.	I-2	24" Class B Storm Sewer		70
35	36	264		264									11	290	290	290	290	Lin. Ft.	I-2	24" Class B Storm Sewer, Sec. M-6.6(b) or M-6.8(b)		264
																290		Lin. Ft.	I-2	27" Class B Storm Sewer, Under Pavement or Approaches, Sec. M-6.6(b) or M-6.8(b)		290
	32,36	2		2												2		Each	I-8	Manholes Reconstructed to Grade, as per plan		2
31,33	3436	11		11												11		Each	I-8	Standard No. 3-A Catch Basin		11
	31-36	31		31	1		5	2	3	1		6				5		Each	I-8	Standard No. 2-6" Median Inlet		37
	34	4		4	1	3	8	4	1	1		9				8		Each	I-8	Standard No. 2-6 Paved Shoulder Inlet		13
31-32	34-36	9		9			1	1				1				1		Each	I-8	Standard No. 2-8 Median Inlet		10
	33	3		3			1		1			1				1		Each	I-8	Standard No. 2-10 Median Inlet		4
	31-36	28		28	3	2	19	9	8	3		22	11	24	24	43	74	Each	I-8	Standard No. 2-2-A Catch Basin		74
31-32	34-35	13	2	15			2	1	1			2				2		Each	I-8	Standard No. 3 Catch Basin	2	15
31-33	36	6		6			1		1			1				1		Each	I-8	Standard No. 7 Catch Basin		7
							1		1			1				1		Each	I-8	Standard No. 9-A Catch Basin		1
	31-36	42		42			2		2			2				2		Each	I-8	Manhole Adjusted to Grade		44
31	33	7		7			5		5			5				5		Each	I-8	Inlets Adjusted to Grade		12
	33	1		1												1		Each	I-8	Standard No. 6 Catch Basin		1
31-34	36	33		33			2		7			7				7		Each	I-16	Manholes Abandoned		40
31-34	36	88		88			4		15			15				15		Each	I-16	Inlets Abandoned		103
																5		Each	I-16	Catch Basins Abandoned		5
													11	5	5	5		Each	I-16	Standard Paved Gutter, Type #1 Modified, as per Plan		537
31	34-36	170		170	20	20	250	100	130	20	20	270	11	270	270	520	710	Lin. Ft.	I-14	Special Paved Gutter Aprons, as per plan		710
34	36	210		210			309					309				309		Lin. Ft.	E-12	No. 9 Sewer Removed, as per plan		519
	34	1200		1200												1200		Lin. Ft.	Special	No. 9 Sewer Sand Filled, as per plan		1,200
	31-36	24321	850	25171	3689	3625	9989	2025	3650	3000	3000	12989	11	15046	15046	25035	53208	Lin. Ft.	I-4	6" Underdrain, as per plan	850	52356
31,33	34,36	230	10	240	16	50	120	20	50	16	16	136				120		Lin. Ft.	I-4	8" Pipe Outlet for Underdrain Sec. M-6.4(a)		376
																292		Lin. Ft.	I-4	6" Pipe Outlet for Underdrain Sec. M-6.4(b) Without Perforations		292
																54		Lin. Ft.	I-2	8" Storm Sewer, Sec. M-6.4(c) as per Plan		54
																56		Lin. Ft.	I-2	8" Storm Sewer, Under Pav't or Approaches, Sec. M-6.4(c) as per Plan		56
																122		Lin. Ft.	I-2	12" Class "A" Storm Sewer		122
31	26		26	276	92		276	30	54	176	176	452				478		Lin. Ft.	I-2	12" Class "B" Storm Sewer Sec. M-6.5(b) or M-6.8(b)		478
																1265		Lin. Ft.	I-2	12" Class "A" Storm Sewer, Under Pav't or Approaches, Sec. M-6.5(b) or M-6.8(b)		1,265
																108		Lin. Ft.	I-2	15" Class "A" Storm Sewer Under Pav't or Approaches Sec. M-6.5(b) or M-6.8(b)		108
																76		Lin. Ft.	I-2	30" Class "B" Storm Sewer Under Pavement or Approaches		76
																228		Lin. Ft.	I-2	36" Class "B" Storm Sewer, Under Pavement or Approaches		228
																463		Lin. Ft.	I-2	42" Class "B" Storm Sewer, Under Pavement or Approaches		463
	35	105		105												105		Lin. Ft.	I-2	30" Class "B" Storm Sewers Under Pav't or Approaches, Sec. M-6.6(b) or M-6.8(b)	105	
																926		Lin. Ft.	I-2	36" Storm Sewer, Under Pav't or Approaches, Sec. M-6.6(b) or M-6.8(b)		926
																56		Lin. Ft.	I-2	10" Storm Sewer, Sec. M-6.4(c) as per Plan		56
																16		Lin. Ft.	I-2	10" Storm Sewer, Under Pav't or Approaches, Sec. M-6.4(c) as per Plan		16
31-36	33	2	35	6	13		22	2	7	6	6	28				77		Each	I-5	6" Pipe Special for Underdrain, as per plan		77
																14		Each	I-5	12" Pipe Special for Class "A" Storm Sewer Under Pav't or Appr's. Sec. M-6.5(b) or M-6.8(b)		14
31	110		110													110		Lin. Ft.	I-2	21" Class "B" Storm Sewer Under Pav't or Appr's. Sec. M-6.6(b) or M-6.8(b)		110
																6		Each	I-5	12" Class "B" Pipe Special For Storm Sewer Under Pav't or Approaches		6
																6		Each	I-5	8" Pipe Special For Storm Sewer Sec. M-6.4(c)		6
																3		Each	I-5	10" Pipe Special For Storm Sewer, Sec. M-6.4(c)		3
																1		Each	I-8	Junction Chamber, as per plan		1
31,33	35-36	8		8			3		2			3	11	10	10	13	21	Each	I-8	Standard Manhole, #1 With City Type Frame and Cover, as per Plan		21
	32-36	10		10			1		1			1				4		Each	I-8	Standard Manhole, #2 With City Type Frame and Cover, as per Plan		15
																1		Each	I-8	Standard Catch Basin, #6 Modified, as per Plan		1
																11		Each	I-8	Special Curb Inlets, #1, as per Plan		11
																1		Each	I-8	Special Curb Inlets, #2, as per Plan		1
																1		Each	I-8	Special Catch Basin, #4, as per Plan		1

DRAINAGE (CONTINUED)

SHEET NUMBER	I-71-5(6)247	TOTAL	100% CITY	FED. PART.	SHEET NUMBER	I-71-5(8)248	TOTAL	100% CITY	FED. PART.	SHEET NUMBER	I-77-5(1)162
--------------	--------------	-------	-----------	------------	--------------	--------------	-------	-----------	------------	--------------	--------------






GENERAL SUMMARY

FED. RD. DIVISION	STATE	PROJECT	14-A 181
2	OHIO		

CUYAHOGA COUNTY
CUY-42-18.42; CUY-21-15.32

ITEM N ^o	QUANTITY		UNIT	DESCRIPTION
		CUY 42-18.29 I-71-5(6)247		
				BUILDING REMOVAL
S-24		Lump Sum	Lump	REMOVAL OF 1-STORY BRICK BUILDING, PARCEL N ^o 116 LA
S-24		Lump Sum	Lump	REMOVAL OF 2-STORY BRICK BUILDING AND 1-STORY BRICK BUILDING, PARCEL N ^o 182 LA
S-24		Lump Sum	Lump	REMOVAL OF 3-STORY BRICK, 2-STORY FRAME BUILDING AND 1-STORY BRICK DWELLING, PARCEL N ^o 187 LA
S-24		Lump Sum	Lump	REMOVAL OF 2-STORY BRICK, 1-STORY BRICK BUILDING AND 1-STORY FRAME SHED, PARCEL N ^o 202 LA
S-24		Lump Sum	Lump	REMOVAL OF 2-STORY BRICK BUILDING, 2-STORY BRICK, 1-STORY BRICK BUILDING, AND 2-STORY BRICK, 2-STORY FRAME BUILDING, PARCEL N ^o 205 LA
S-24		Lump Sum	Lump	REMOVAL OF 2-STORY BRICK, 1-STORY BRICK BUILDING, PARCEL N ^o 208 LA
S-24		Lump Sum	Lump	REMOVAL OF 2-STORY FRAME BUILDING, PARCEL N ^o 213 LA
S-24		Lump Sum	Lump	REMOVAL OF 2-STORY BRICK, 1-STORY BRICK BUILDING, PARCEL N ^o 219 LA
S-24		Lump Sum	Lump	REMOVAL OF 2-STORY BRICK BUILDING AND 1-STORY SHEET METAL GARAGE, PARCEL N ^o 227 LA
S-24		Lump Sum	Lump	REMOVAL OF TWO 1-STORY BRICK BUILDINGS AND 1-STORY FRAME, 1-STORY FRAME DWELLING AND 2-STORY FRAME DWELLING, PARCEL N ^o 229 LA
S-24		Lump Sum	Lump	REMOVAL OF 2-STORY BRICK, 1 1/2 STORY FRAME, 1-STORY FRAME DWELLING AND 1-STORY FRAME DWELLING, PARCEL N ^o 232 LA
S-24		Lump Sum	Lump	REMOVAL OF 2-STORY BRICK, 2-STORY FRAME DWELLING AND 2-STORY BRICK AND BLOCK GARAGE, PARCEL N ^o 236 LA
S-24		Lump Sum	Lump	REMOVAL OF 2-STORY FRAME DWELLING AND 1-STORY BRICK AND BLOCK GARAGE, PARCEL N ^o 237 LA
S-24		Lump Sum	Lump	REMOVAL OF 2-STORY FRAME AND BRICK, 1-STORY FRAME DWELLING, PARCEL N ^o 239 LA
S-24		Lump Sum	Lump	REMOVAL OF 2-STORY FRAME DWELLING AND 2-STORY BRICK DWELLING, PARCEL N ^o 240 LA
S-24		Lump Sum	Lump	REMOVAL OF 2-STORY FRAME, 1-STORY FRAME DWELLING AND 2-STORY FRAME DWELLING, PARCEL N ^o 241 LA
S-24		Lump Sum	Lump	REMOVAL OF TWO 2-STORY FRAME DWELLINGS, PARCEL N ^o 242 LA
S-24		Lump Sum	Lump	REMOVAL OF 1-STORY FRAME DWELLING, PARCEL N ^o 248 LA
S-24		Lump Sum	Lump	REMOVAL OF 1-STORY BRICK BUILDING, PARCEL N ^o 257 LA
S-24		Lump Sum	Lump	REMOVAL OF 2-STORY BRICK, 1-STORY FRAME BUILDING, PARCEL N ^o 258 LA
S-24		Lump Sum	Lump	REMOVAL OF THREE 2-STORY FRAME DWELLINGS AND 1-STORY FRAME BUILDING, PARCEL N ^o 260 LA
S-24		Lump Sum	Lump	REMOVAL OF 2-STORY FRAME, 1-STORY FRAME DWELLING, PARCEL N ^o 263 LA
S-24		Lump Sum	Lump	REMOVAL OF 2-STORY BRICK DWELLING AND 1-STORY GARAGE, PARCEL N ^o 265 LA
S-24		Lump Sum	Lump	REMOVAL OF 2-STORY FRAME DWELLING, PARCEL N ^o 268 LA
S-24		Lump Sum	Lump	REMOVAL OF 1 1/2-STORY FRAME DWELLING, 2 1/2-STORY FRAME DWELLING, 2-STORY FRAME DWELLING AND 1-STORY BRICK GARAGE, PARCEL N ^o 269 LA
S-24		Lump Sum	Lump	REMOVAL OF 1-STORY FRAME GARAGE, PARCEL N ^o 272 LA
S-24		Lump Sum	Lump	REMOVAL OF FOUR 1 1/2 STORY FRAME BUILDINGS, PARCEL N ^o 726 LA
S-24		Lump Sum	Lump	REMOVAL OF 2-STORY BRICK, 1-STORY BRICK BUILDING, PARCEL N ^o 728 LA
S-24		Lump Sum	Lump	REMOVAL OF 1-STORY FRAME, 1-STORY FRAME, 2-STORY FRAME BUILDING, AND 1-STORY FRAME BUILDING AND 2-STORY FRAME BUILDING, PARCEL N ^o 733 LA
S-24		Lump Sum	Lump	REMOVAL OF TWO 2-STORY FRAME BUILDINGS AND TWO 1-STORY BRICK BUILDINGS, PARCEL N ^o 736 LA
S-24		Lump Sum	Lump	REMOVAL OF 3-STORY BRICK BUILDING AND 1-STORY BRICK BUILDING, PARCEL N ^o 801 LA
S-24		Lump Sum	Lump	REMOVAL OF 2-STORY BRICK BUILDING, 1-STORY BRICK BUILDING, 1-STORY BRICK GARAGE, PARCEL N ^o 802 LA
S-24		Lump Sum	Lump	REMOVAL OF 3-STORY BRICK BUILDING, 2-STORY FRAME, 2-STORY FRAME AND BRICK BUILDING, AND TWO 2-STORY FRAME BUILDINGS, PARCEL N ^o 803 LA
S-24		Lump Sum	Lump	REMOVAL OF 1-STORY BRICK GARAGE AND 1-STORY SHEET METAL BUILDING, PARCEL N ^o 804 LA
S-24		Lump Sum	Lump	REMOVAL OF 1-STORY SHEET METAL AND FRAME GARAGE WITH HEAVY CONCRETE FLOOR SLAB, 1-STORY CONCRETE BLOCK GARAGE, 3 STORY BRICK BUILDING, 1-STORY FRAME AND BRICK BUILDING WITH HEAVY CONCRETE FLOOR SLAB, PARCEL N ^o 805 LA
S-24		Lump Sum	Lump	REMOVAL OF 1 1/2-STORY FRAME AND BRICK BUILDING AND 2-STORY FRAME DWELLING, PARCEL N ^o 818 LA
S-24		Lump Sum	Lump	REMOVAL OF 1-STORY FRAME GARAGE, PARCEL N ^o 819 LA
(CONTINUED ON SHEET N ^o 14-B)				

CUYAHOGA COUNTY
CITY OF CLEVELAND
CUY-42-18-42
CUY-21-15-32

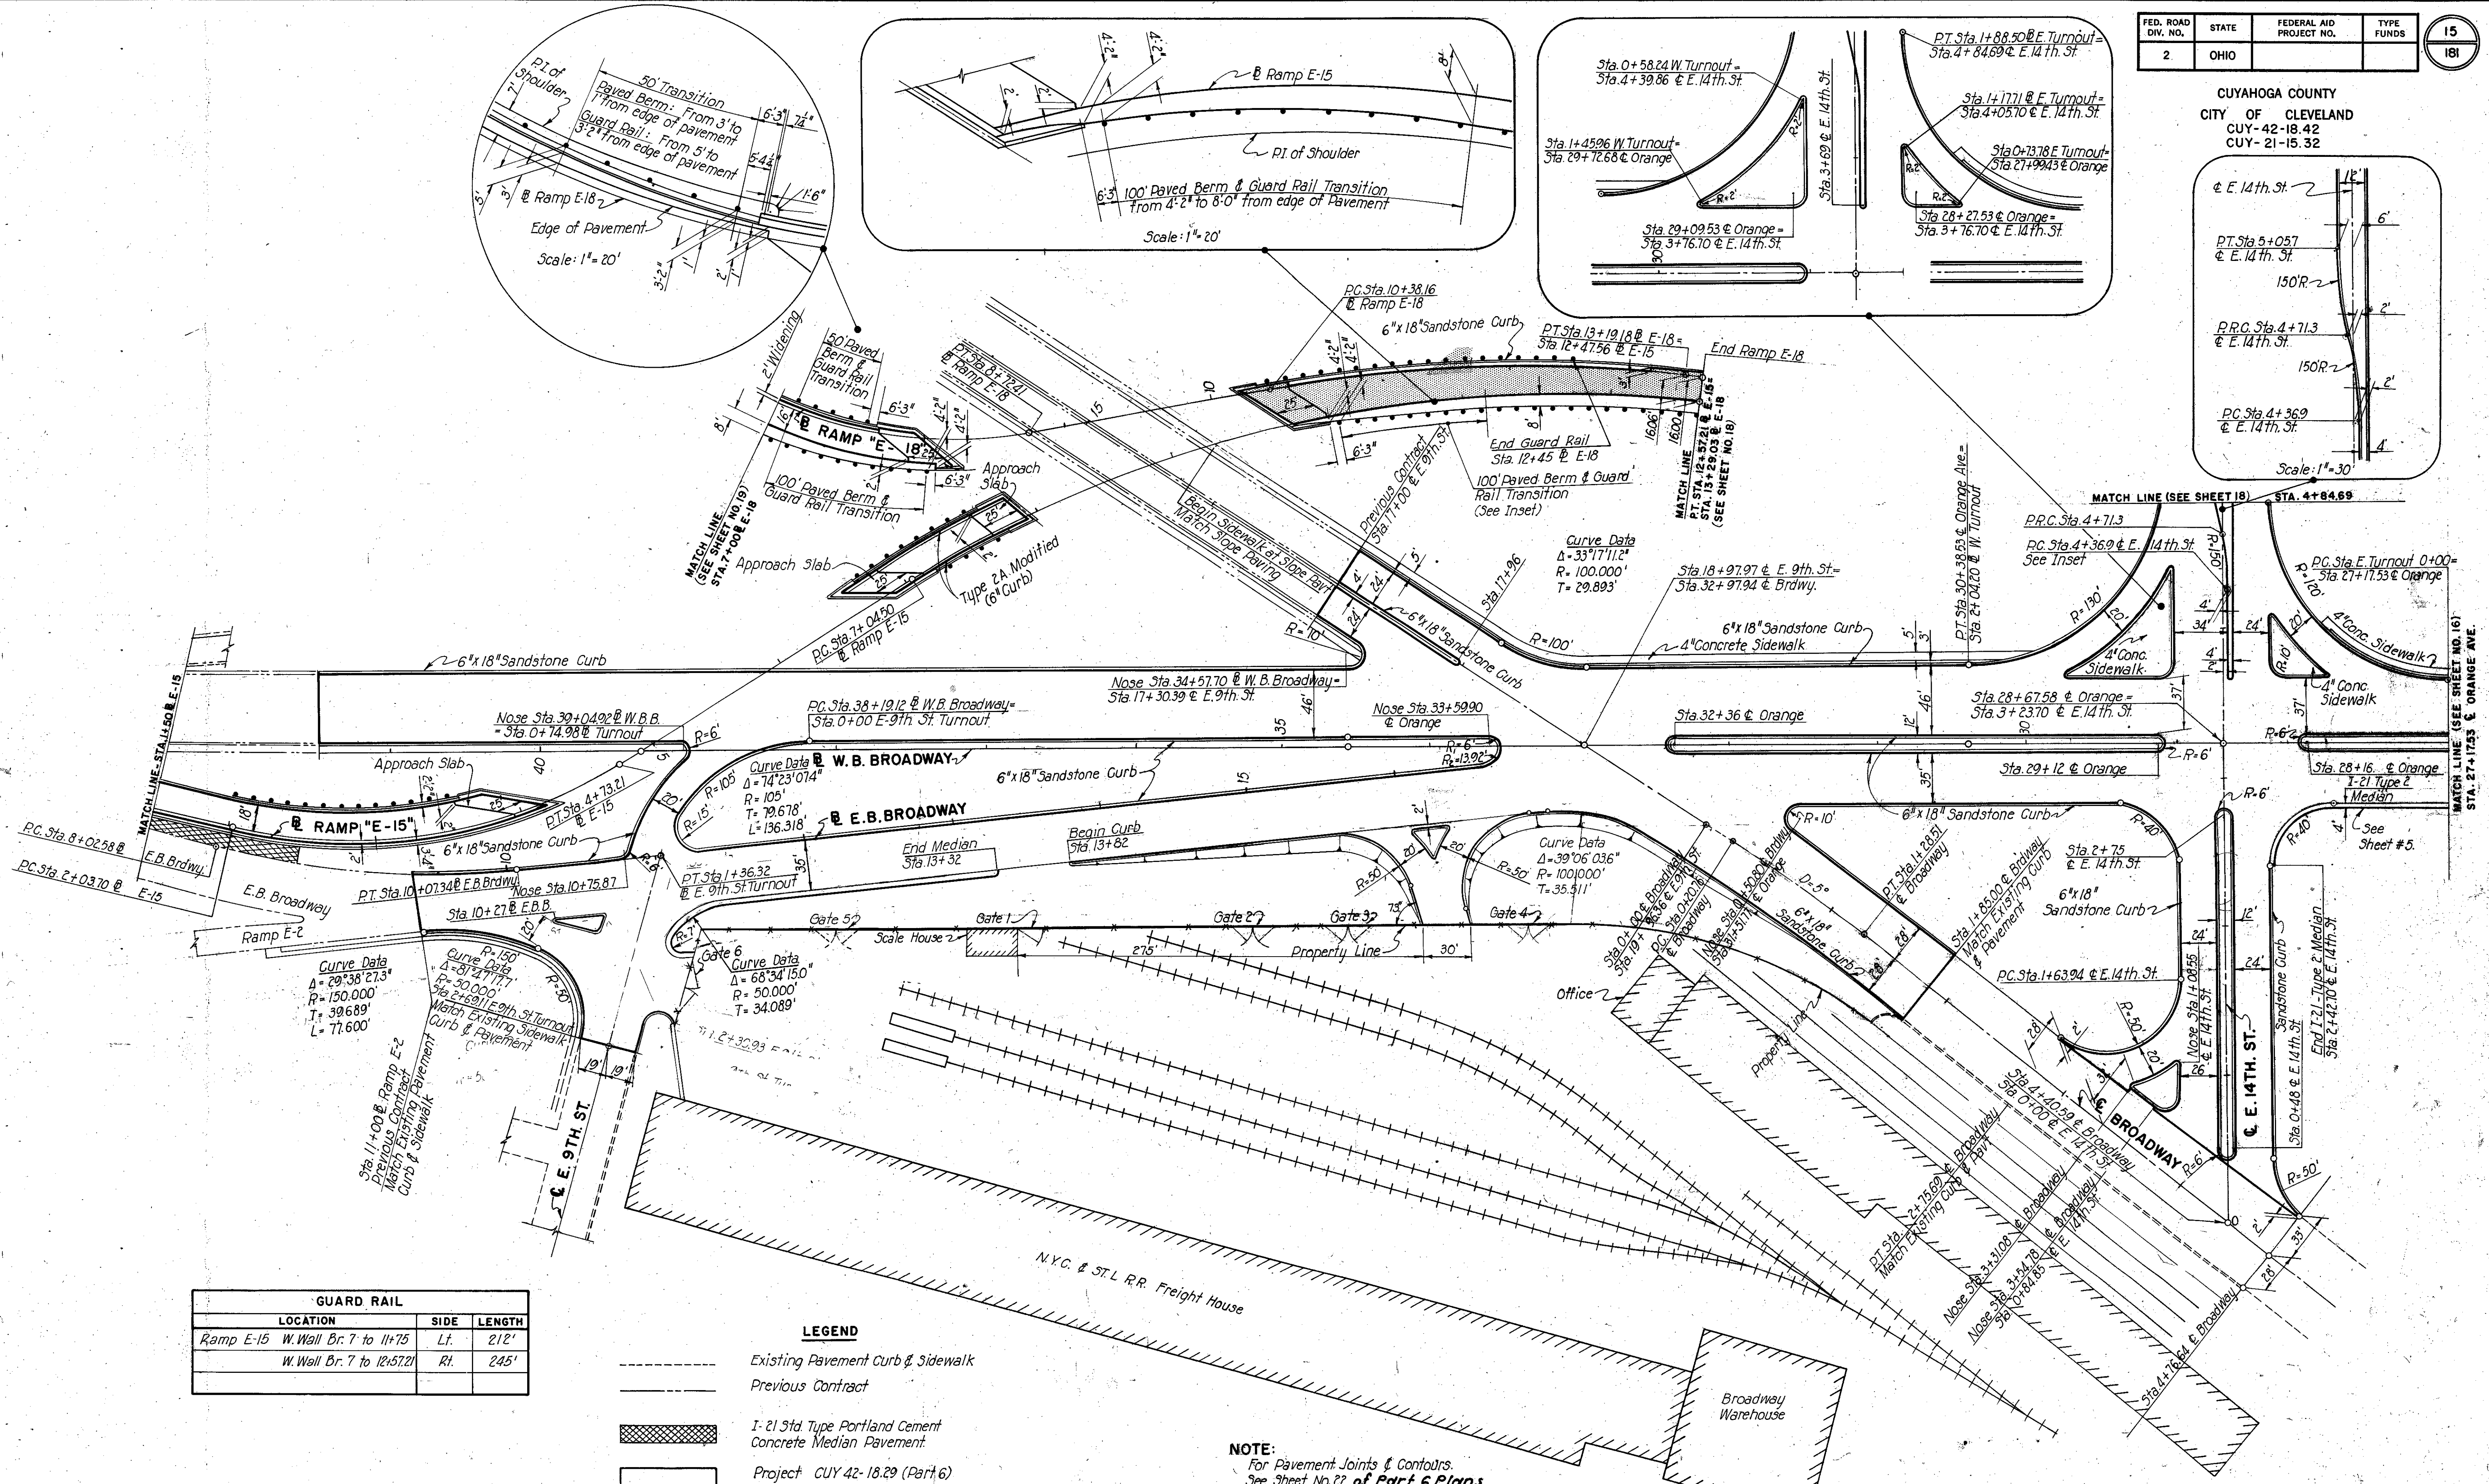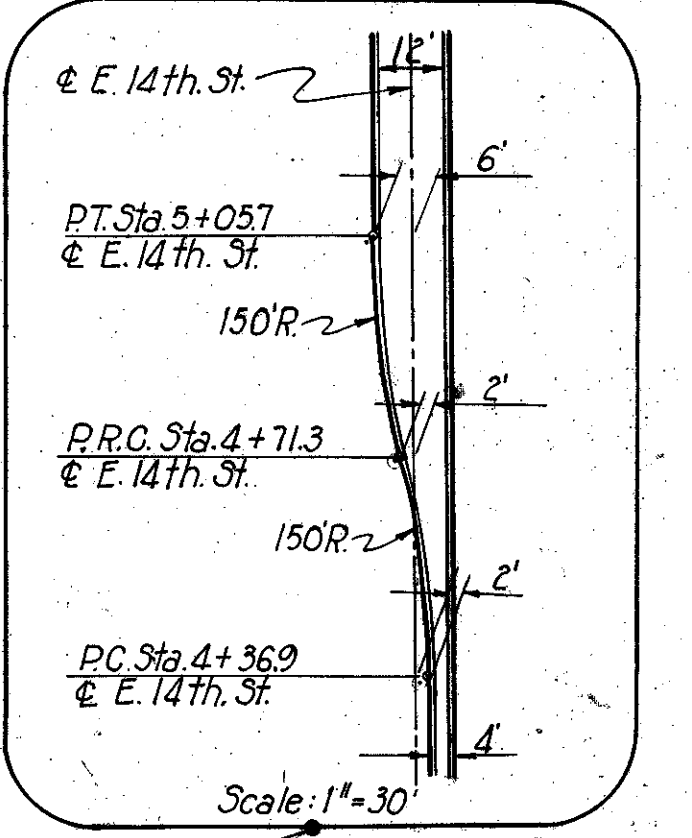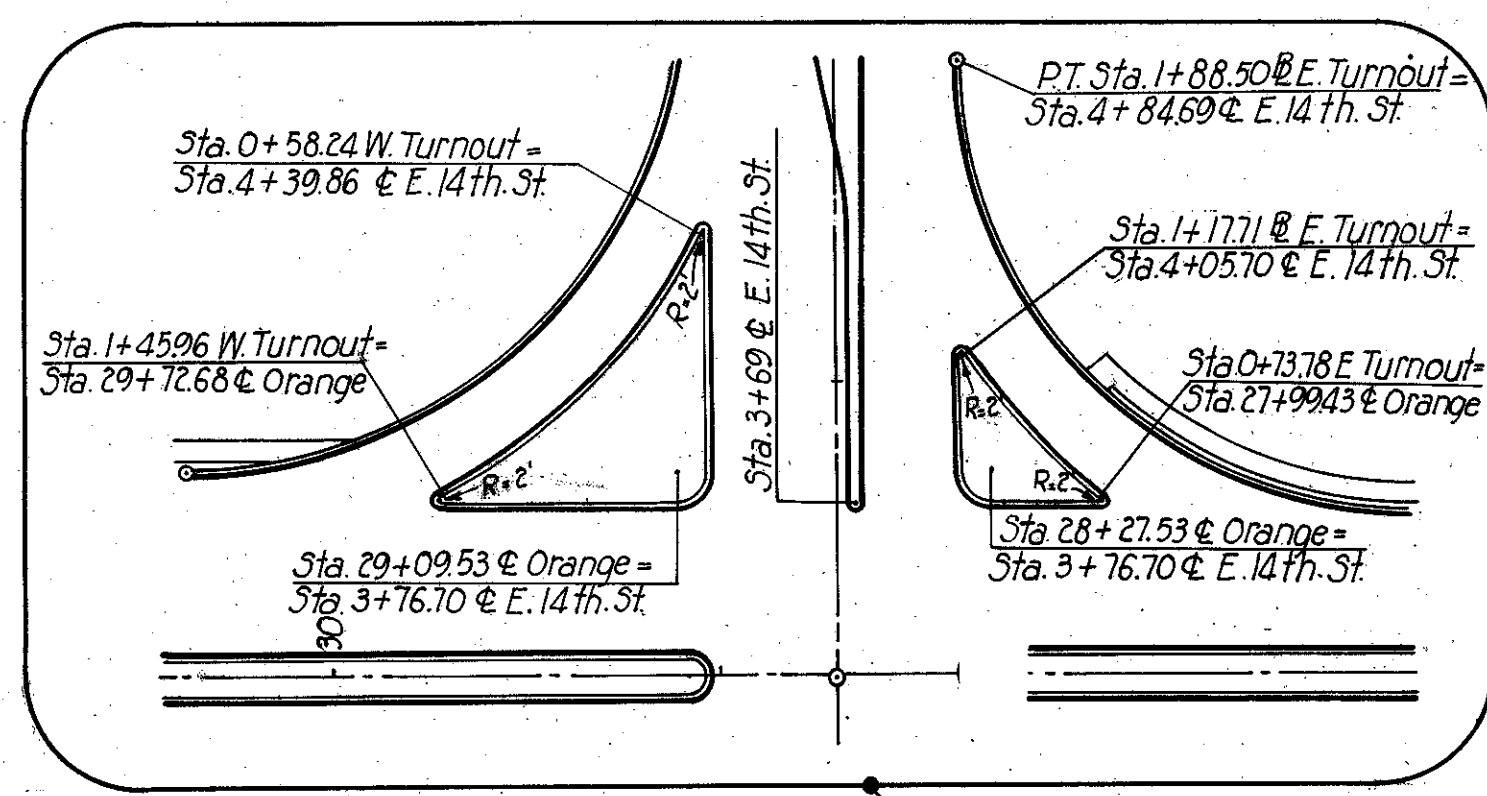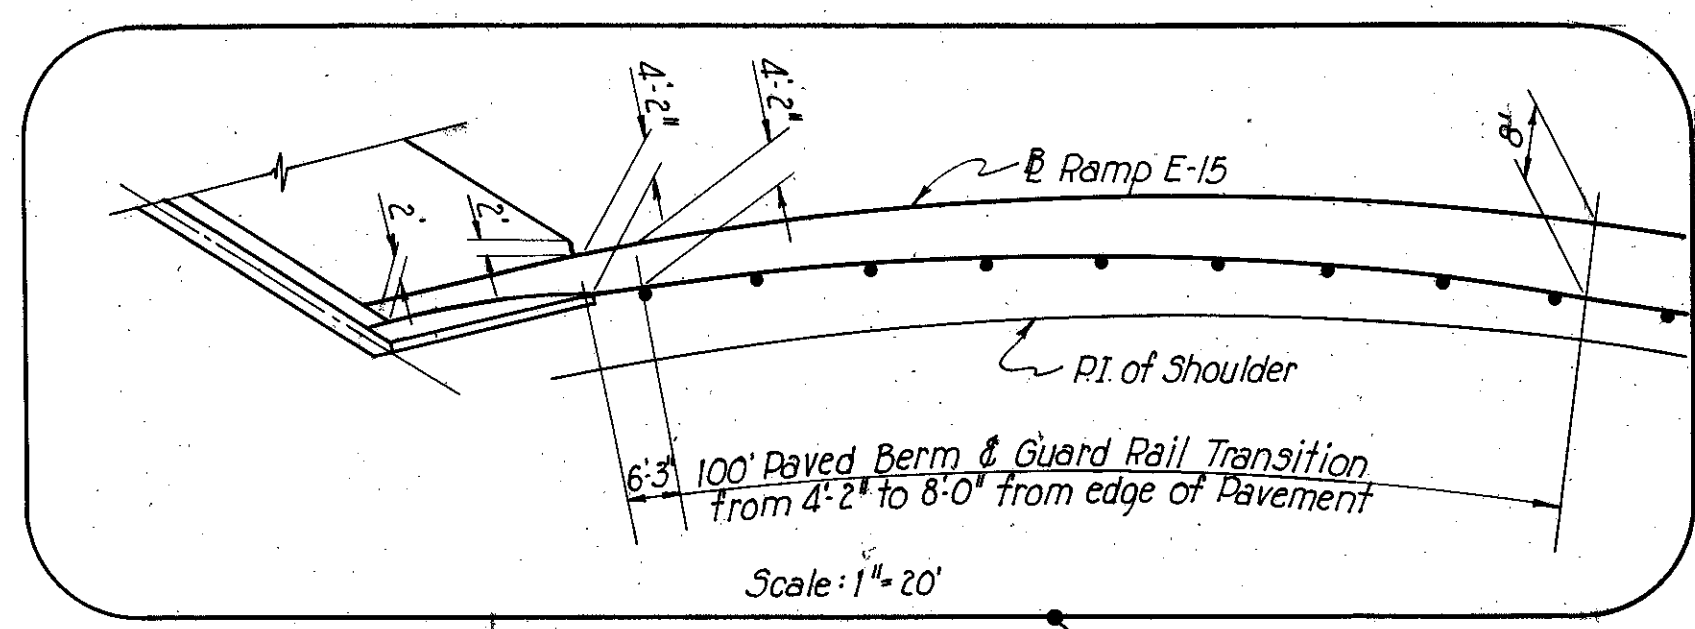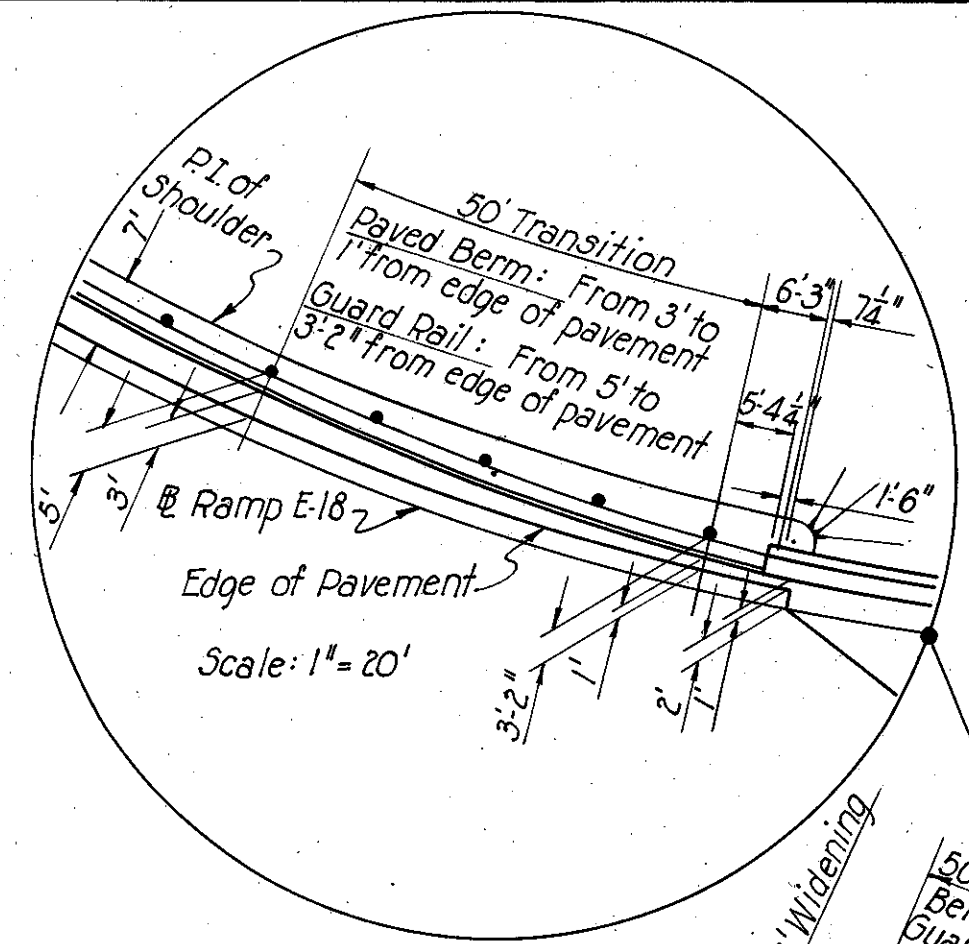



GUARD RAIL		
LOCATION	SIDE	LENGTH
Ramp E-15 W. Wall Br. 7 to 11+75	Lt.	212'
W. Wall Br. 7 to 12+5721	Rt.	245'

- LEGEND**
- Existing Pavement Curb & Sidewalk
 - Previous Contract
 - ▨ I-21 Std Type Portland Cement Concrete Median Pavement
 - ▭ Project CUY 42-18.29 (Part 6)
 - ▭ Project CUY 42-18.42 (Part 7) CUY 21-15.32

NOTE:
For Pavement Joints & Contours. See Sheet No. 22 of Part 6 Plans
For detail of Typical Joint Layout see: Exit Ramps, Sheet 20 of Part 7B, Entrance Ramps, Sheet 21 of Part 7B.


PAVEMENT DETAILS

CUYAHOGA COUNTY
CITY OF CLEVELAND
CUY 42-18.42
CUY 21-15.32

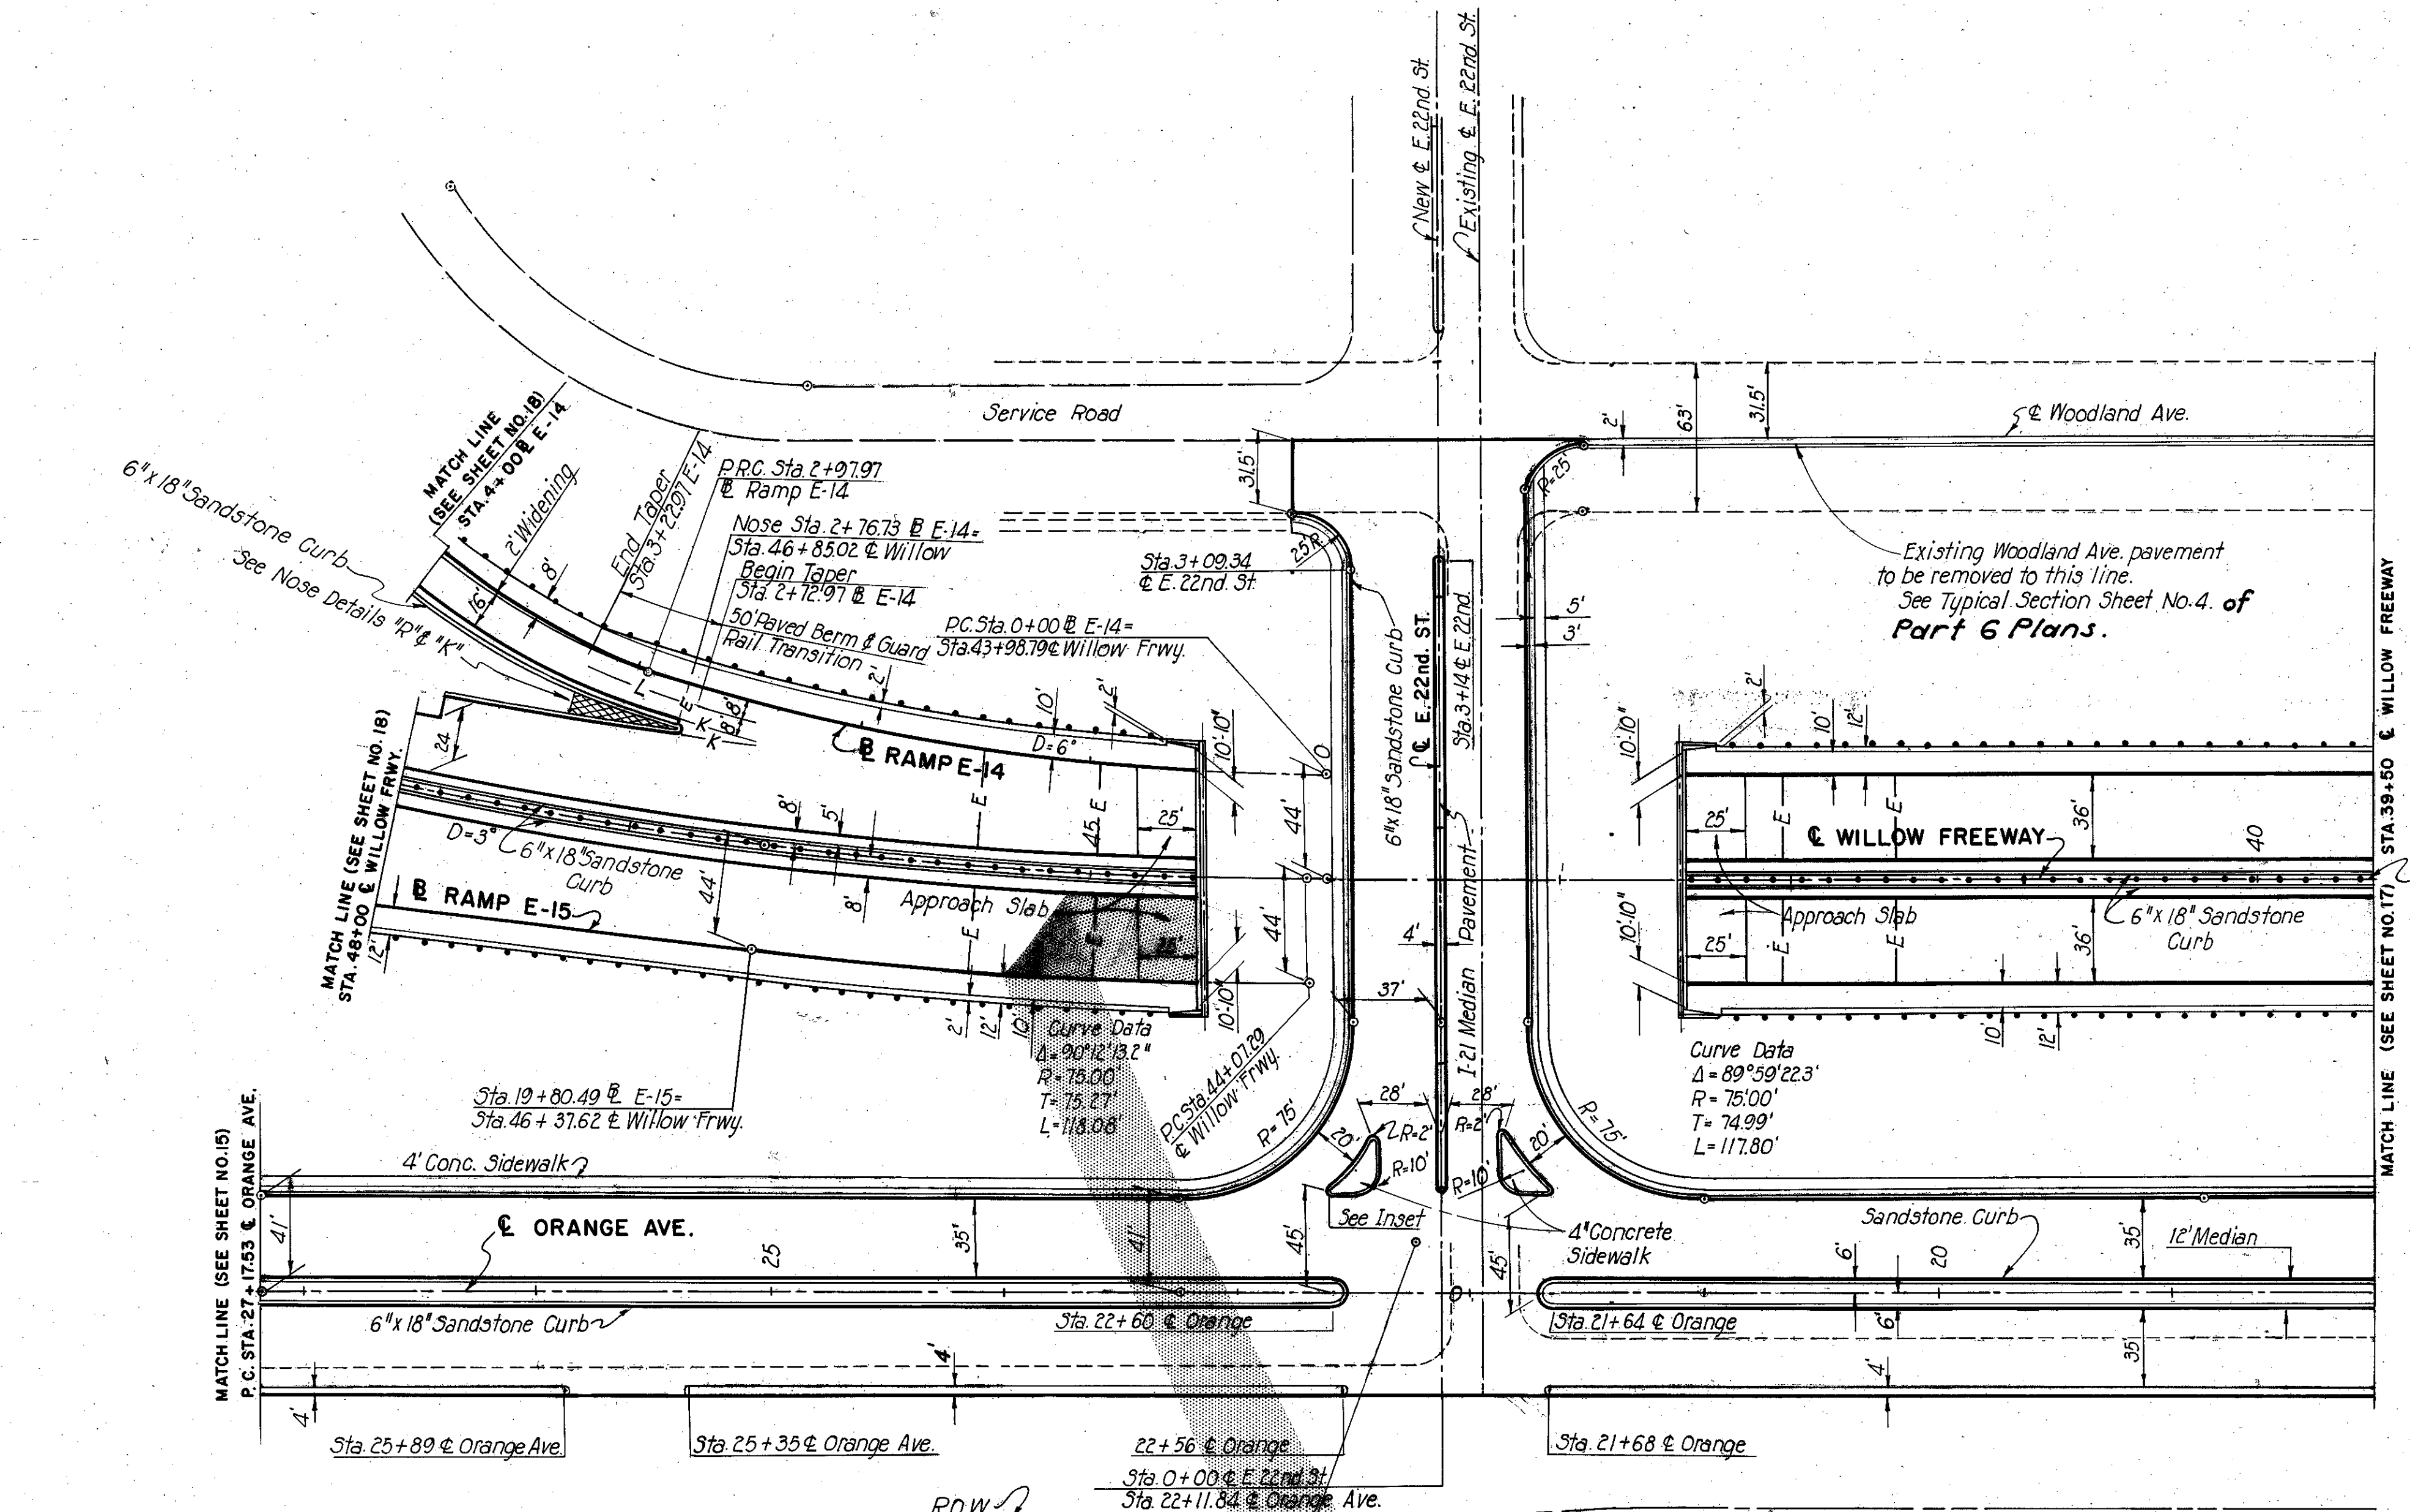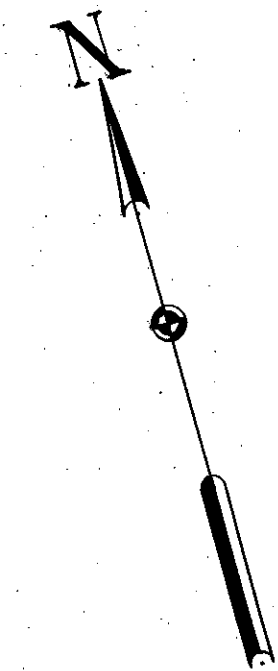

I-15 Guard Rail, Steel Beam Barrier Type (Deep).

GUARD RAIL			
LOCATION	SIDE	LENGTH	
Ramp E-14 W. Wall Br. 10 to 4+00	Rt.	318'	
Ramp E-15 18+17 to 19+80.49	Rt.	162'	
Willow Frwy. W. Wall Br. 10 to 46+37.62	Lt.	180'	
39+50 to W. Wall Br. 10	Lt.	280'	
39+50 to W. Wall Br. 10	Rt.	280'	
BARRIER RAIL			
Willow Frwy. 39+50 to 42+36	Ctr.	286'	
44+61 to 48+00	Ctr.	339'	

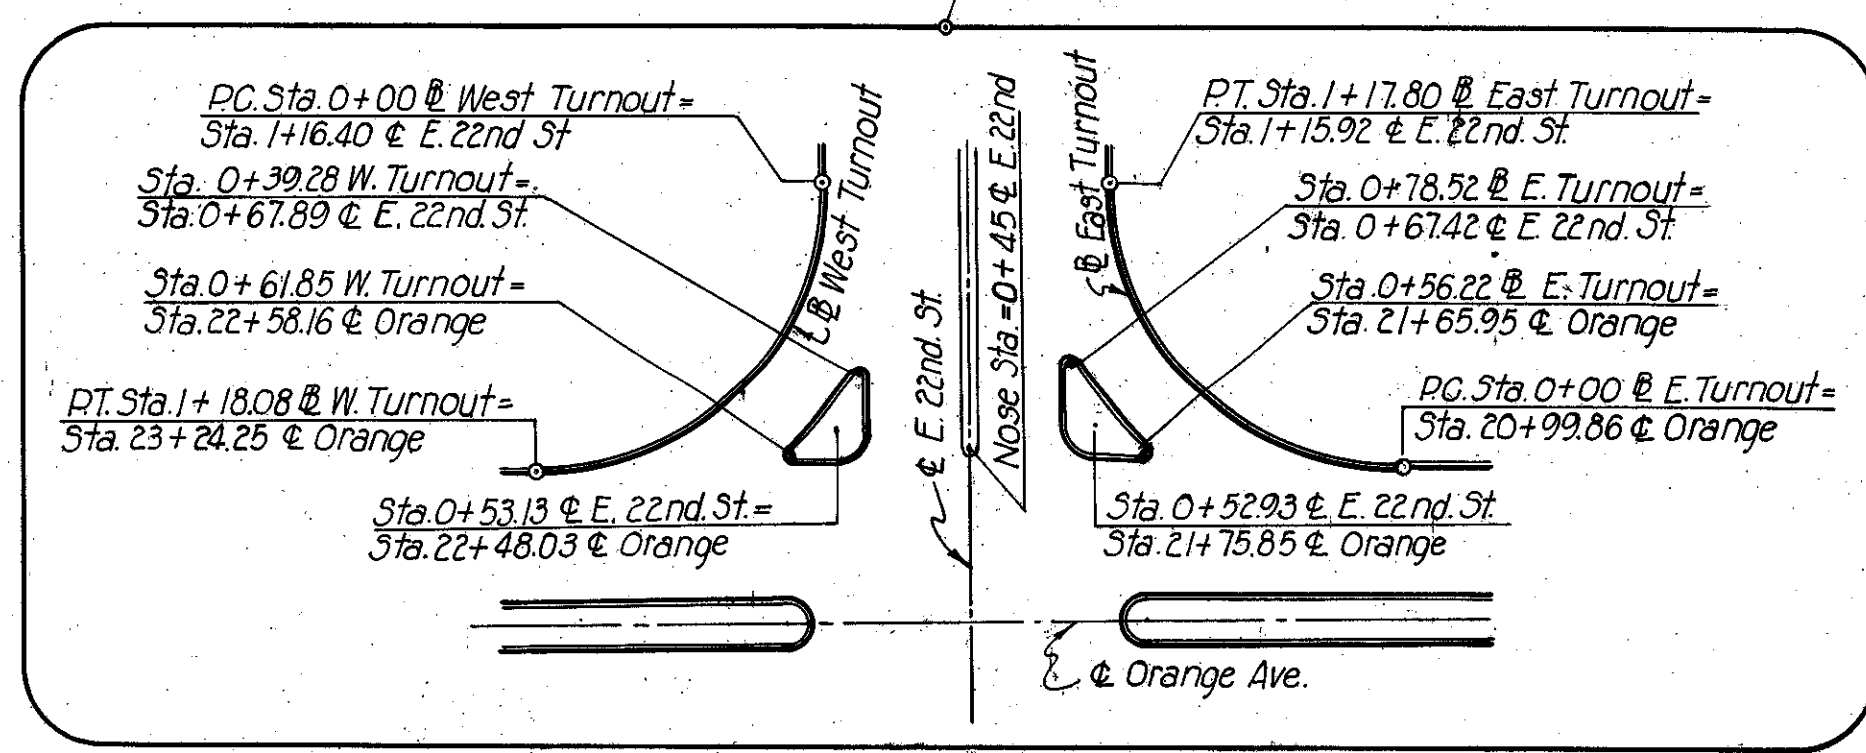

- LEGEND**
- Existing Pavement, Curb & Sidewalk
 - Future Construction
 - ▨ I-21 Std. Type 1 Portland Cement Concrete Median Pavement.
 - ▭ Project: CUY 42-18.29 (Part 6).
 - ▭ Project: CUY 42-18.42 (Part 7). CUY 21-15.32


Note: For Orange Ave. Joint Layout and contours, see Sheet 22 of Part 6 Plans

PAVEMENT DETAILS

CUYAHOGA COUNTY
CITY OF CLEVELAND
CUY 42-18.42
CUY 21-15.32

GUARD RAIL		
LOCATION	SIDE	LENGTH
Ramp 30-N 3+75 to W.Wall Br. II	Rt.	587'
Ramp N-30 W.Wall Br. II to 6+97	Rt.	657'
Willow Frwy. W.Wall Br. II to 39+50	Rt.	399'
W.Wall Br. II to 39+50	Lt.	227'

BARRIER RAIL		
LOCATION	SIDE	LENGTH
Willow Frwy. 30+48.5 to 33+98.5	Ctr.	350'
36+23.5 to 39+50	Ctr.	336.5'

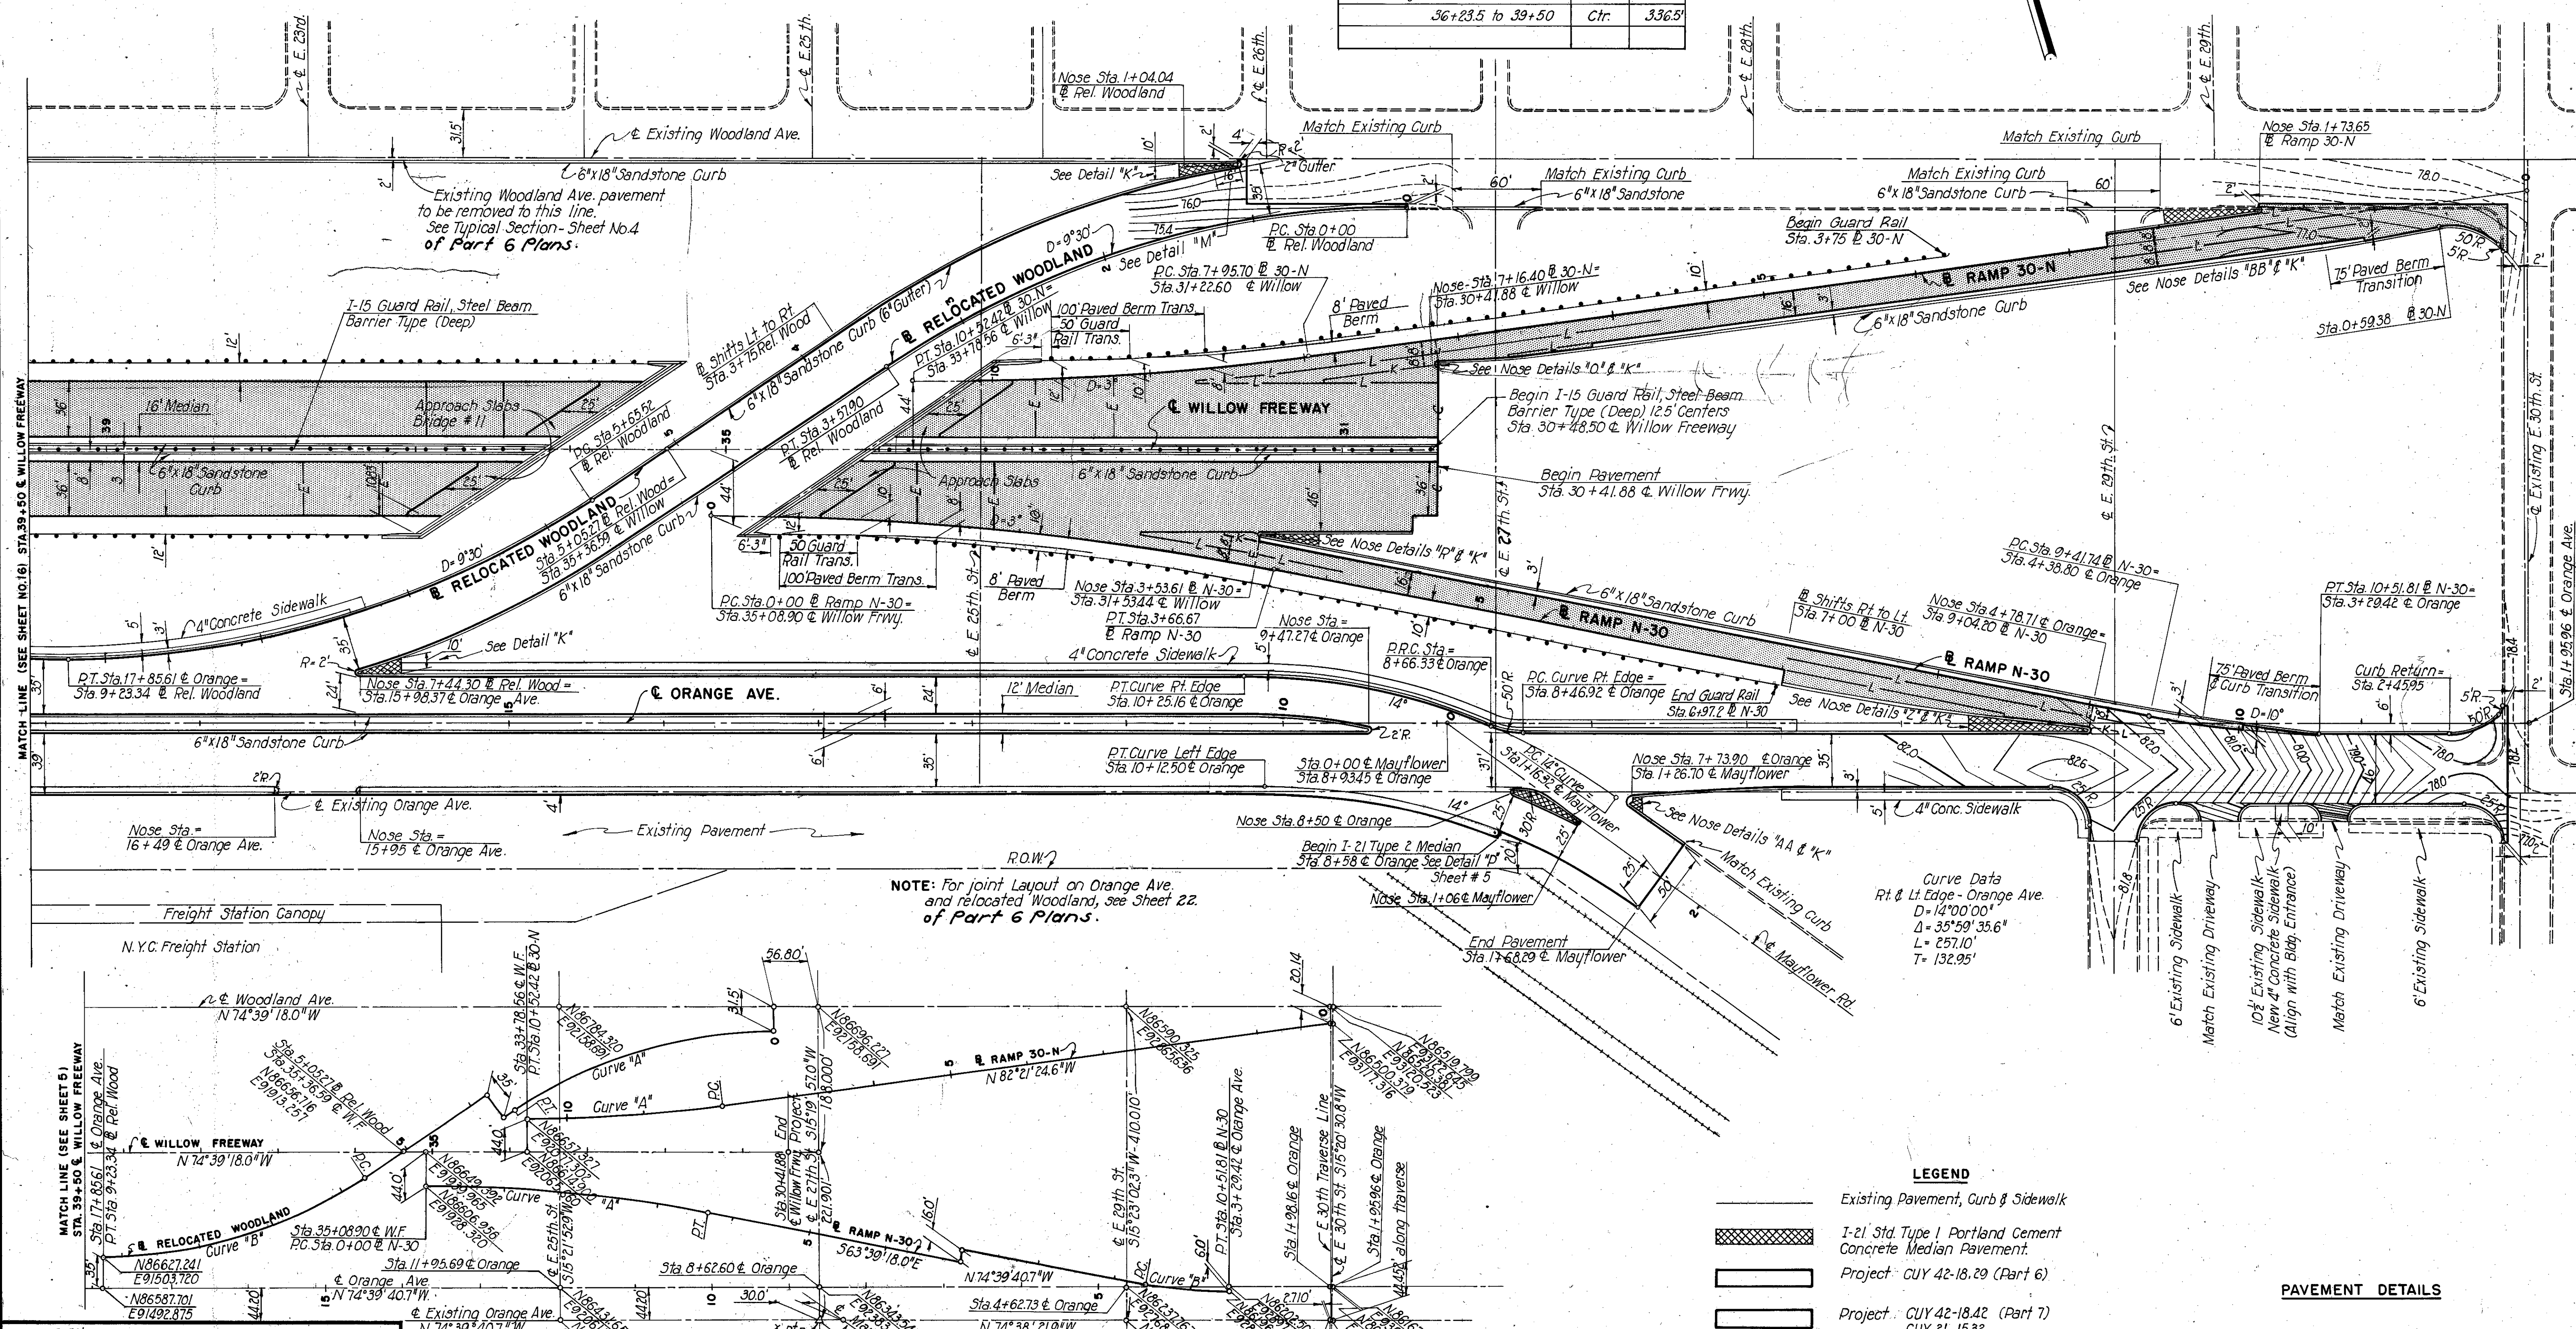

SCALE: 1"=50'
MADE I.E.S. DATE _____
TRCD. R.R. DATE _____
CKD. L.L.C. DATE _____


HOWARD, NEEDLES, TAMMEN & BERGENDOFF
CONSULTING ENGINEERS
KANSAS CITY CLEVELAND NEW YORK
914 SHEET 17

GEOMETRIC LAYOUT
Scale: 1"=100'

Curve Data
Rt & Lt Edge - Orange Ave.
D = 14°00'00"
Δ = 35°59'35.6"
L = 257.10'
T = 132.95'

CUYAHOGA COUNTY
CITY OF CLEVELAND
CUY 42-18.42
CUY 21-15.32

GUARD RAIL				
LOCATION	SIDE	LENGTH		
Ramp E-7	2+00 to W. Wall Br. 9	Lt.	552'	
	2+00 to 4+49	Rt.	251'	
Ramp E-10	13+00 to 14+54	Rt.	147'	
	14+00 to W. Wall Br. 8	Lt.	415'	
Ramp E-15	12+57.21 to W. Wall Br. 8	Rt.	258'	
	W. Wall Br. 8 to 18+17	Rt.	104'	
Ramp E-17	W. Wall Br. 8 to 8+32	Rt.	645'	
	4+27 to 6+21.14	Lt.	204'	
	7+73 to 8+94	Lt.	141'	
Ramp E-9	0+00 to 2+00	Lt.	204'	
	1+67 to 2+00	Rt.	33'	
Ramp E-14	4+00 to 6+00	Rt.	188'	
	4+20 to 7+70	Lt.	361'	
Willow Frwy.	48+45 to W. Wall Br. 8	Rt.	80'	
BARRIER RAIL				
Willow Frwy.	48+00 to Bridge 8	Ctr.	129'	
	Bridge 8 to 51+86	Ctr.	79'	

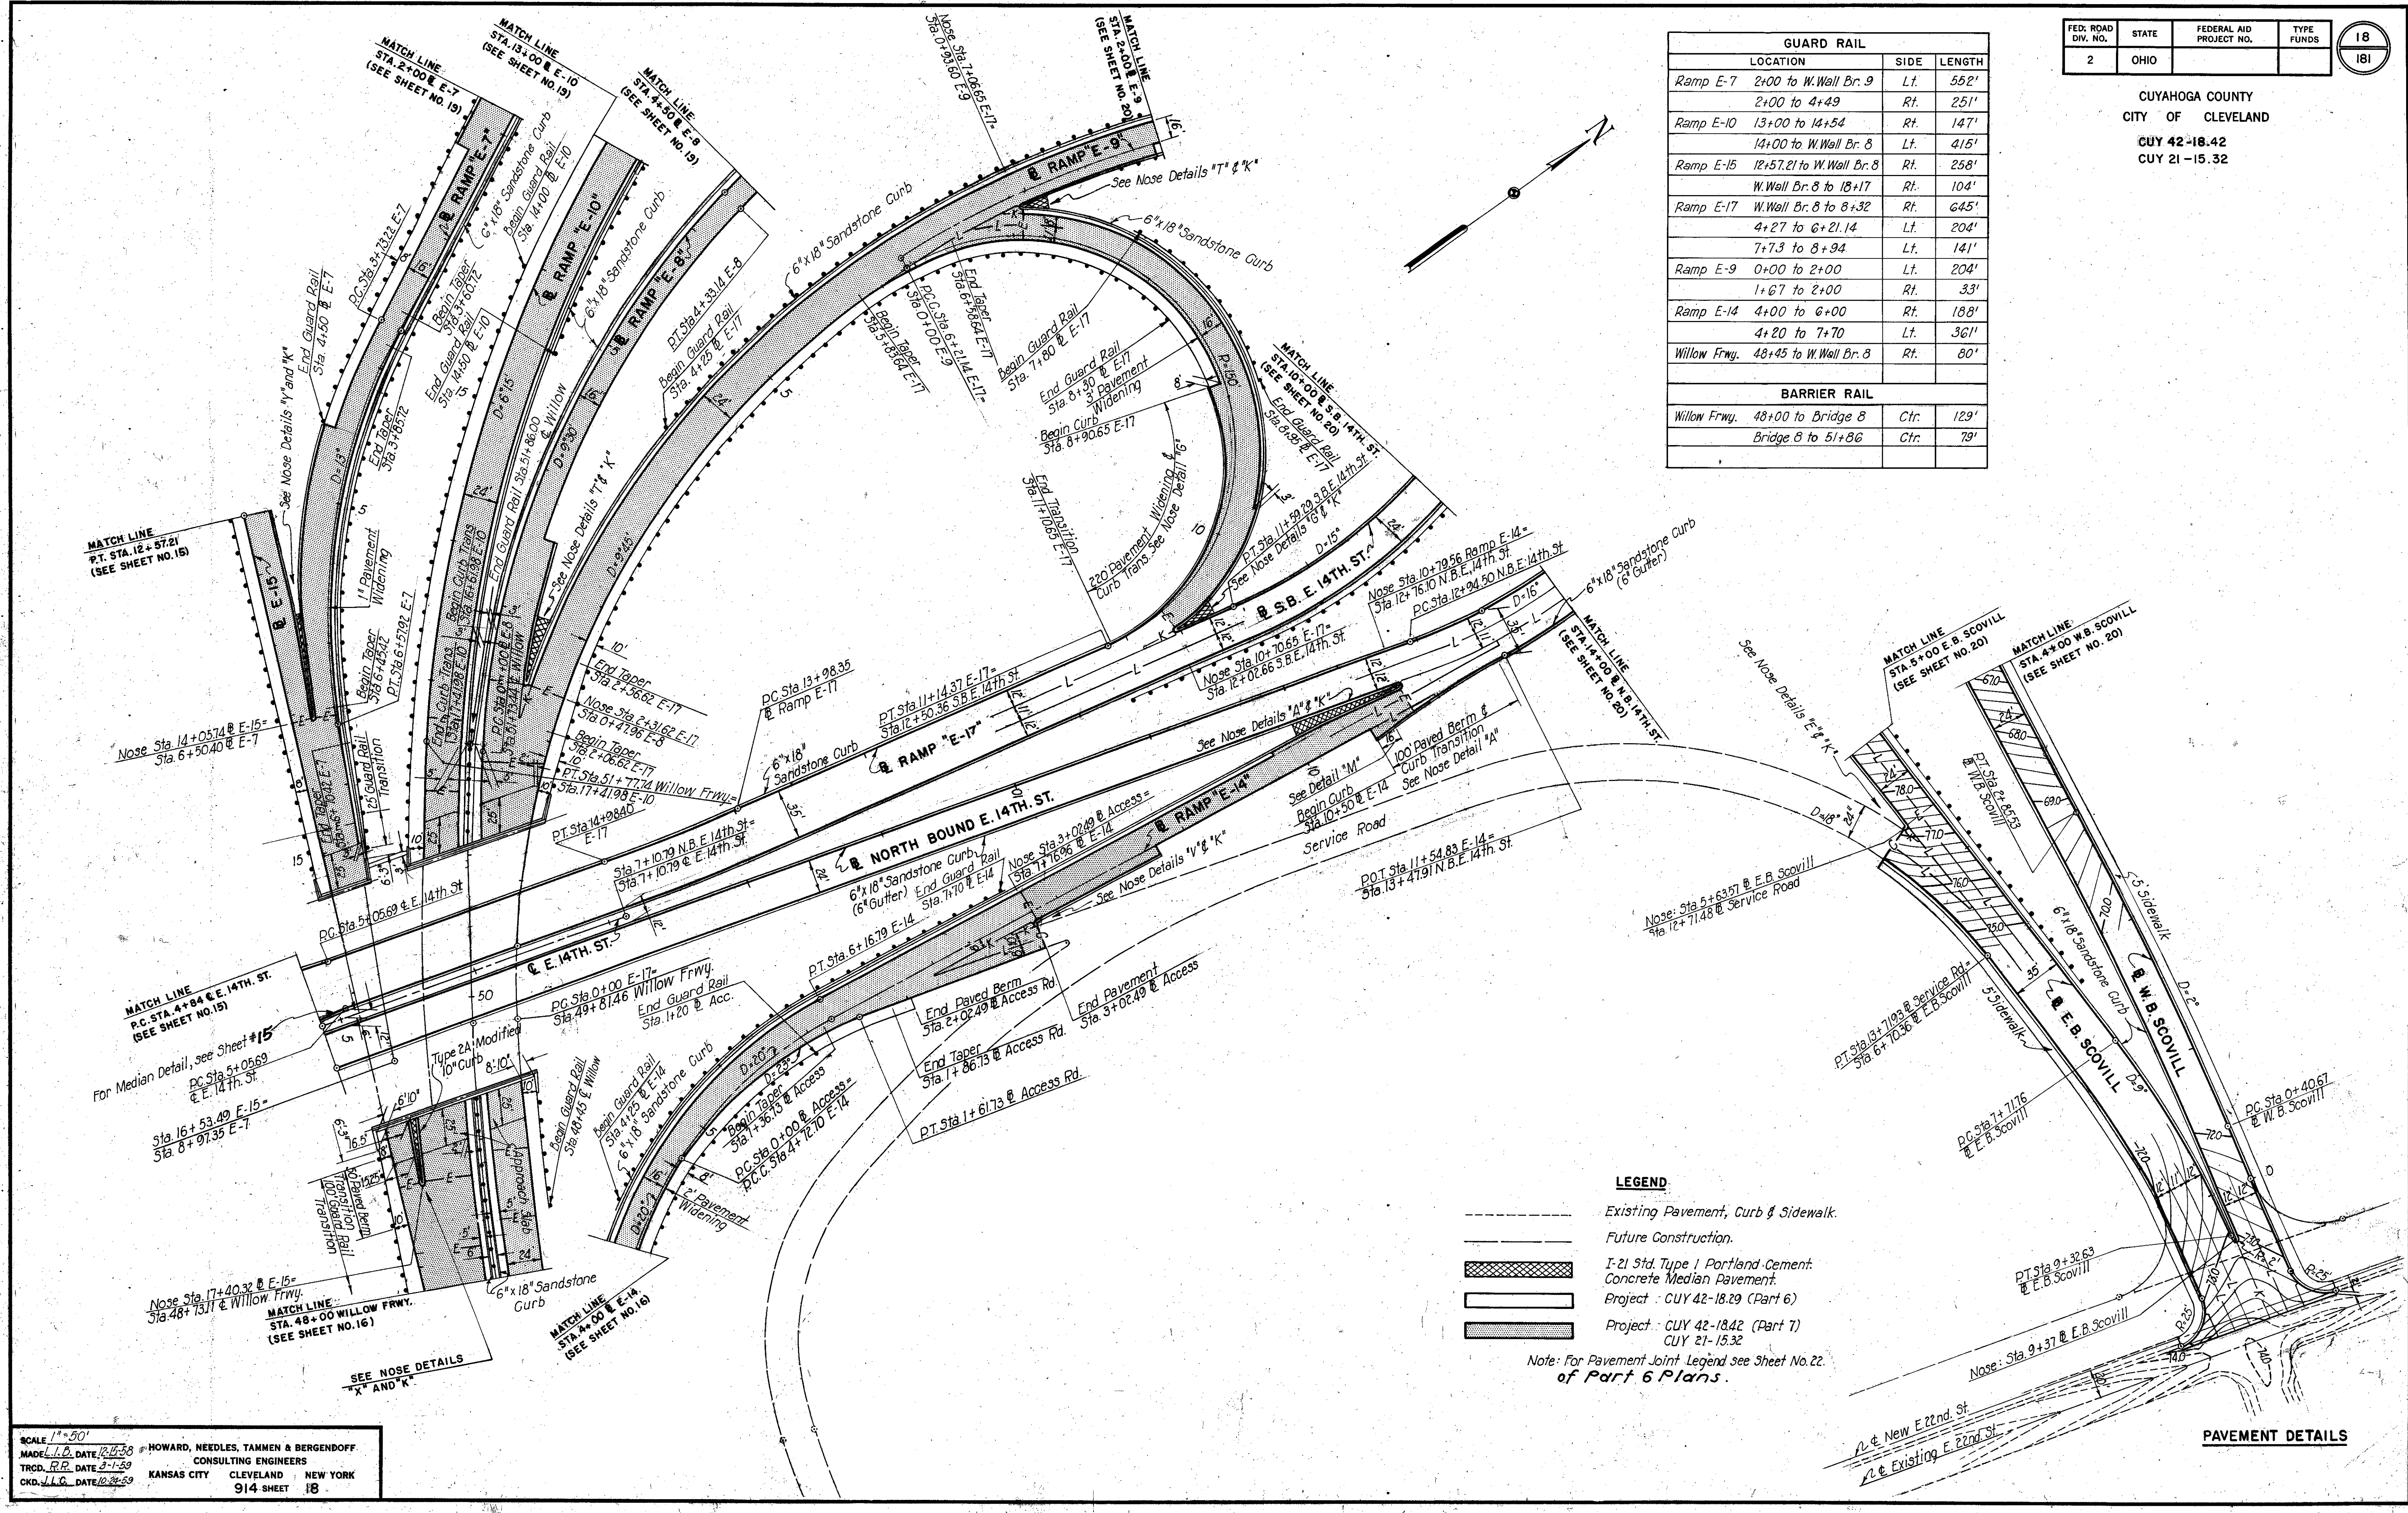

LEGEND


- Existing Pavement, Curb & Sidewalk.
- Future Construction.
- ▨ I-21 Std. Type 1 Portland-Cement Concrete Median Pavement.
- ▨ Project - CUY 42-18.29 (Part 6)
- ▨ Project - CUY 42-18.42 (Part 7)
- ▨ CUY 21-15.32

Note: For Pavement Joint Legend see Sheet No. 22 of Part 6 Plans.

SCALE 1"=50'
MADE L.D. DATE 12-1-58 HOWARD, NEEDLES, TAMMEN & BERGENDOFF
TRCD. R.R. DATE 2-1-59 CONSULTING ENGINEERS
CKD. L.L.C. DATE 12-22-59 KANSAS CITY CLEVELAND NEW YORK
914 SHEET 18

PAVEMENT DETAILS

CUYAHOGA COUNTY
CITY OF CLEVELAND
CUY 42-18-42
CUY 21-15-32

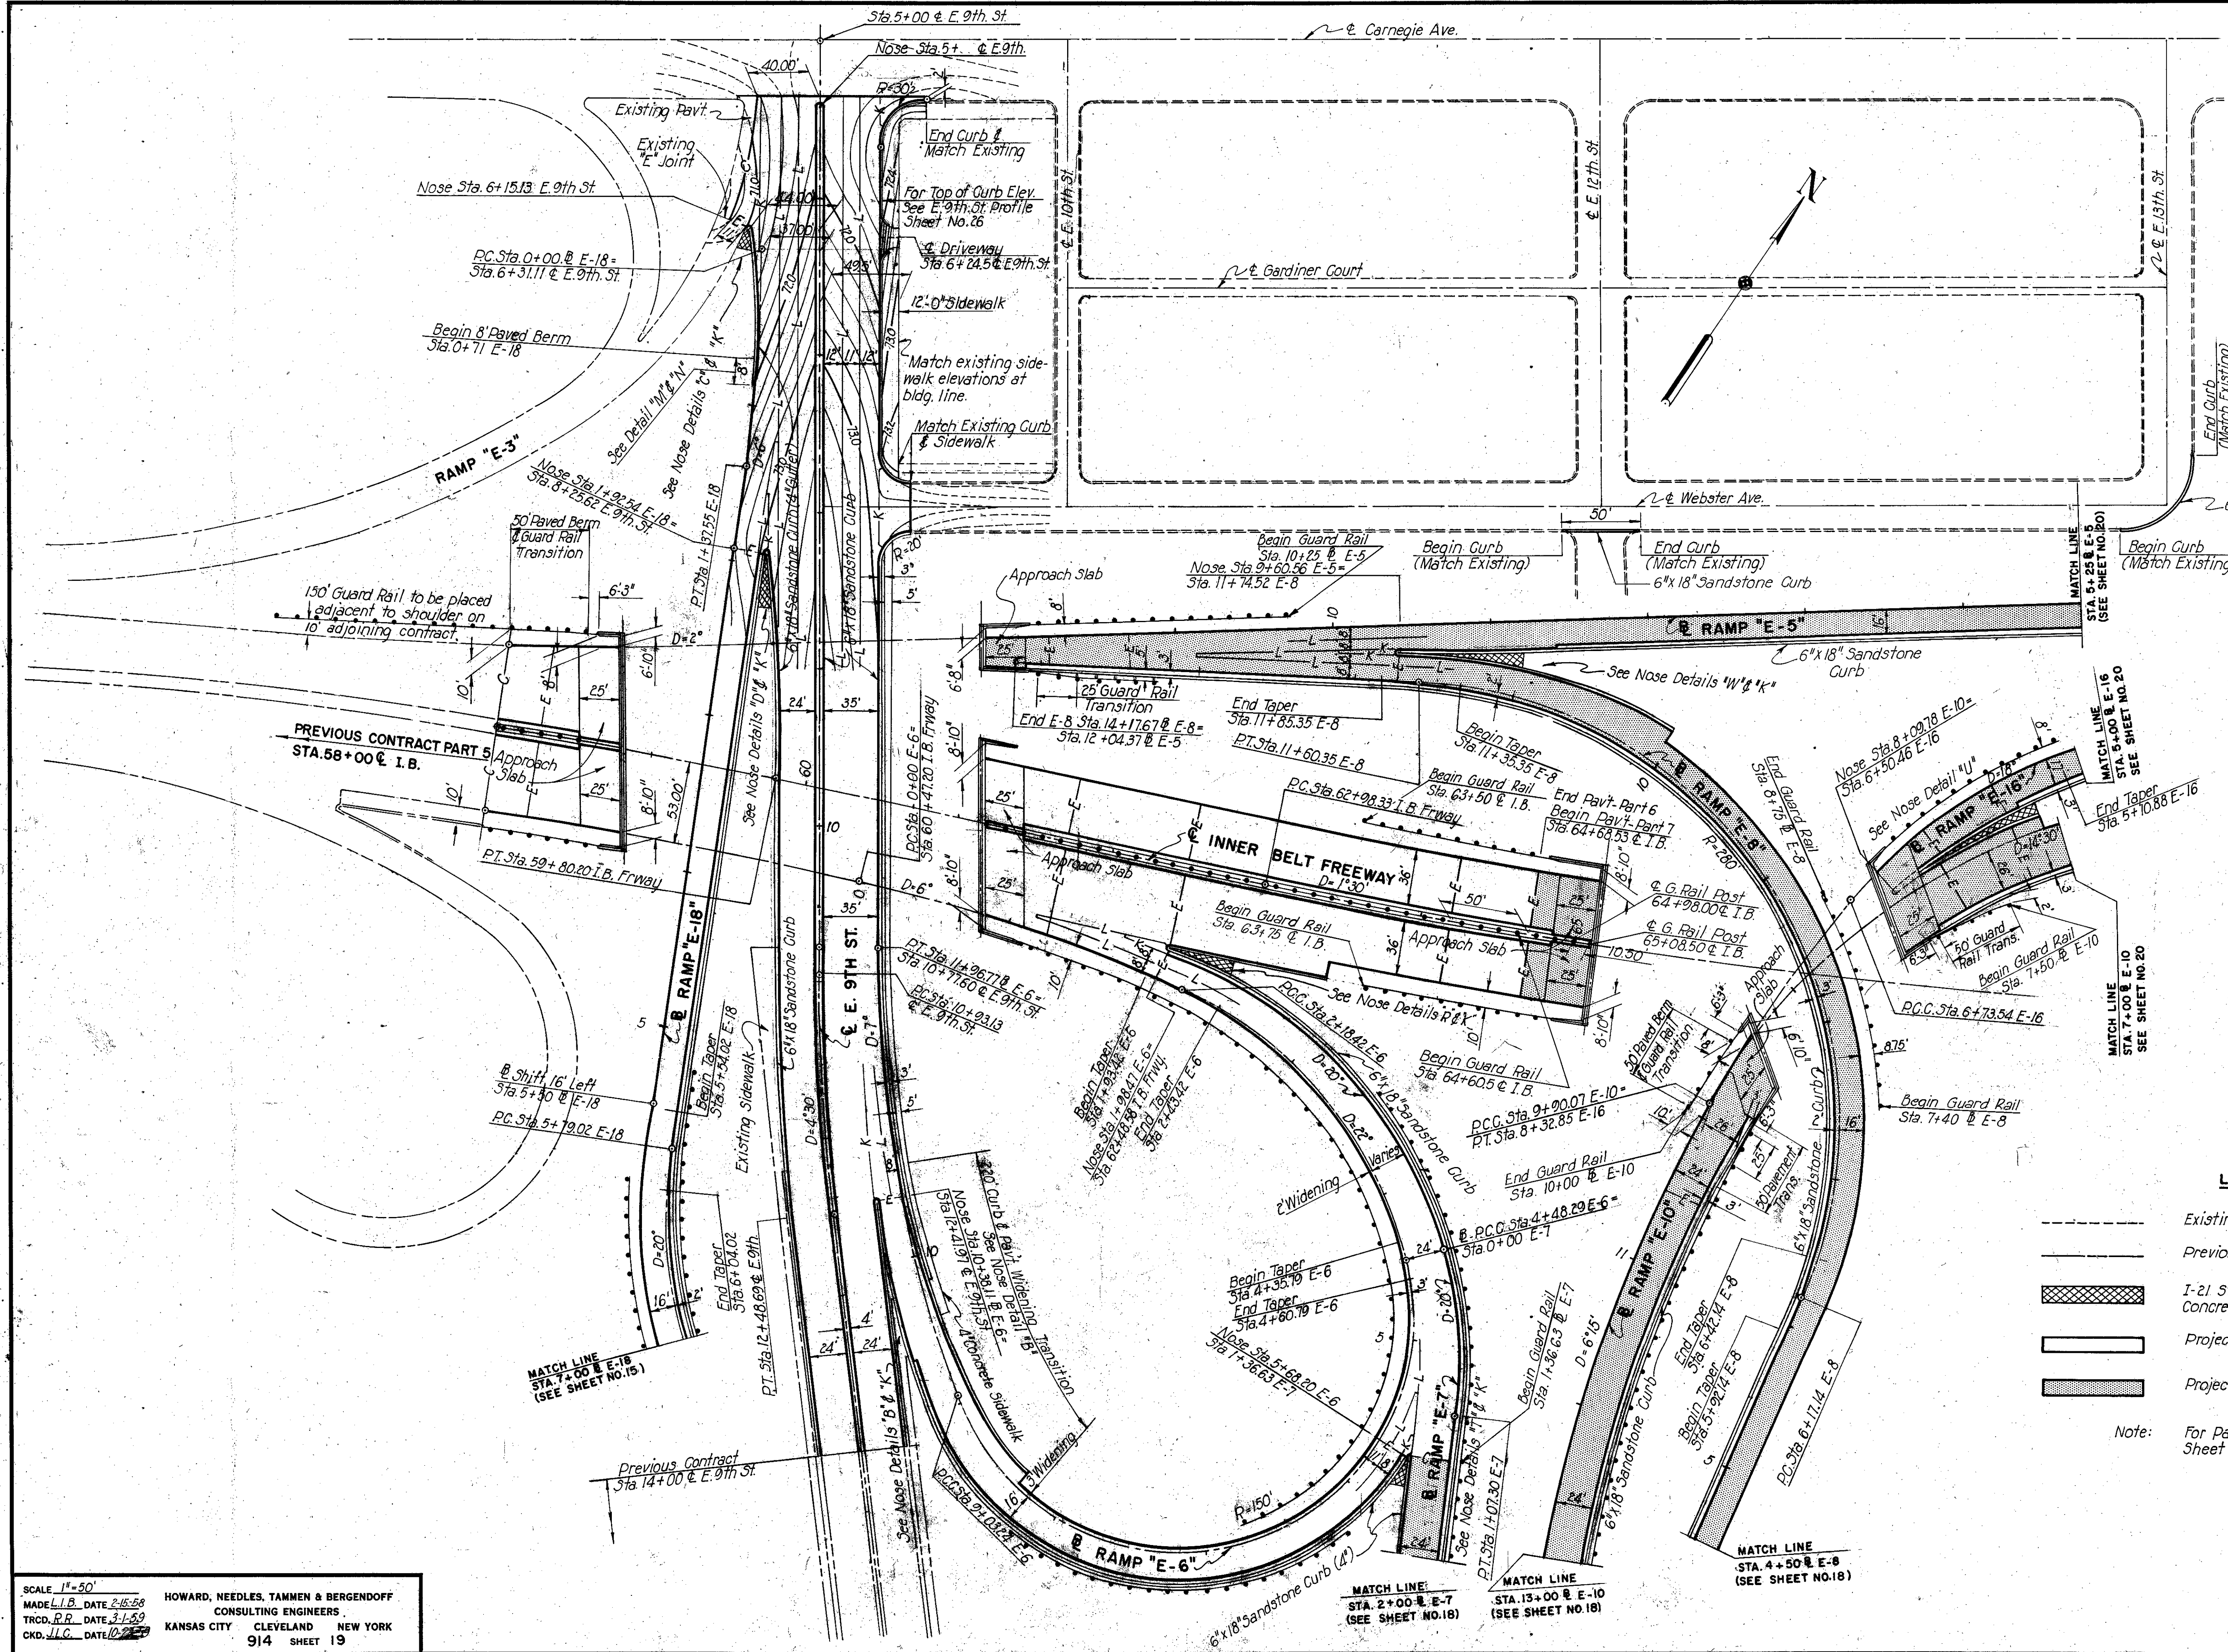

GUARD RAIL			
Location	Side	Length	
Ramp E-5 10+26 to W.Wall Br. 2	Rt.	185'	
Ramp E-8 7+40 to 8+75	Rt.	142'	
Ramp E-10 W.Wall Br. 5 to 13+00	Rt.	303'	
7+48 to W.Wall Br. 5	Lt.	57'	
Ramp E-7 1+36.63 to 2+00	Lt.	63'	
Ramp E-16 5+00 to W.Wall Br. 5	Rt.	137'	
W.Wall Br. 5 to 8+45	Rt.	58'	
Inner Belt G3+50 to W.Wall Br. 3	Lt.	120'	
G3+75 to W.Wall Br. 3	Rt.	122'	

BARRIER RAIL		
Location	Side	Length
Inner Belt G4+60.5 to Bridge 3	Ctr.	48'


LEGEND

- Existing Pavement, Curb & Sidewalk
- Previous Contract
- I-21 Std. Type 1 Portland Cement Concrete Median Pavement
- Project: CUY 42-18-29 (Part 6)
- Project: CUY 42-18-42 (Part 7) CUY 21-15-32

Note: For Pavement Joint Legend, see Sheet No. 22 of Part 6 Plans.

PAVEMENT DETAILS

GUARD RAIL		
LOCATION	SIDE	LENGTH
Ramp E-9 2+00 to W. Wall Br. 4	Rt.	233'
2+00 to W. Wall Br. 4	Lt.	257'
Ramp E-10 W. Wall Br. 4 to 6+25	Rt.	220'
W. Wall Br. 4 to 5+25	Lt.	120'
Ramp E-16 3+50 to 5+00	Rt.	150'
Inner Belt W. Wall Br. 3 to W. Wall Br. 4	Lt.	201'
W. Wall Br. 3 to W. Wall Br. 4	Rt.	260'
W. Wall Br. 4 to 77+75	Lt.	368'
W. Wall Br. 4 to 77+75	Rt.	366'
BARRIER RAIL		
Inner Belt 68+21 to 70+83.5	Ctr.	262.5'
74+05.25 to 83+05.25	Ctr.	900'

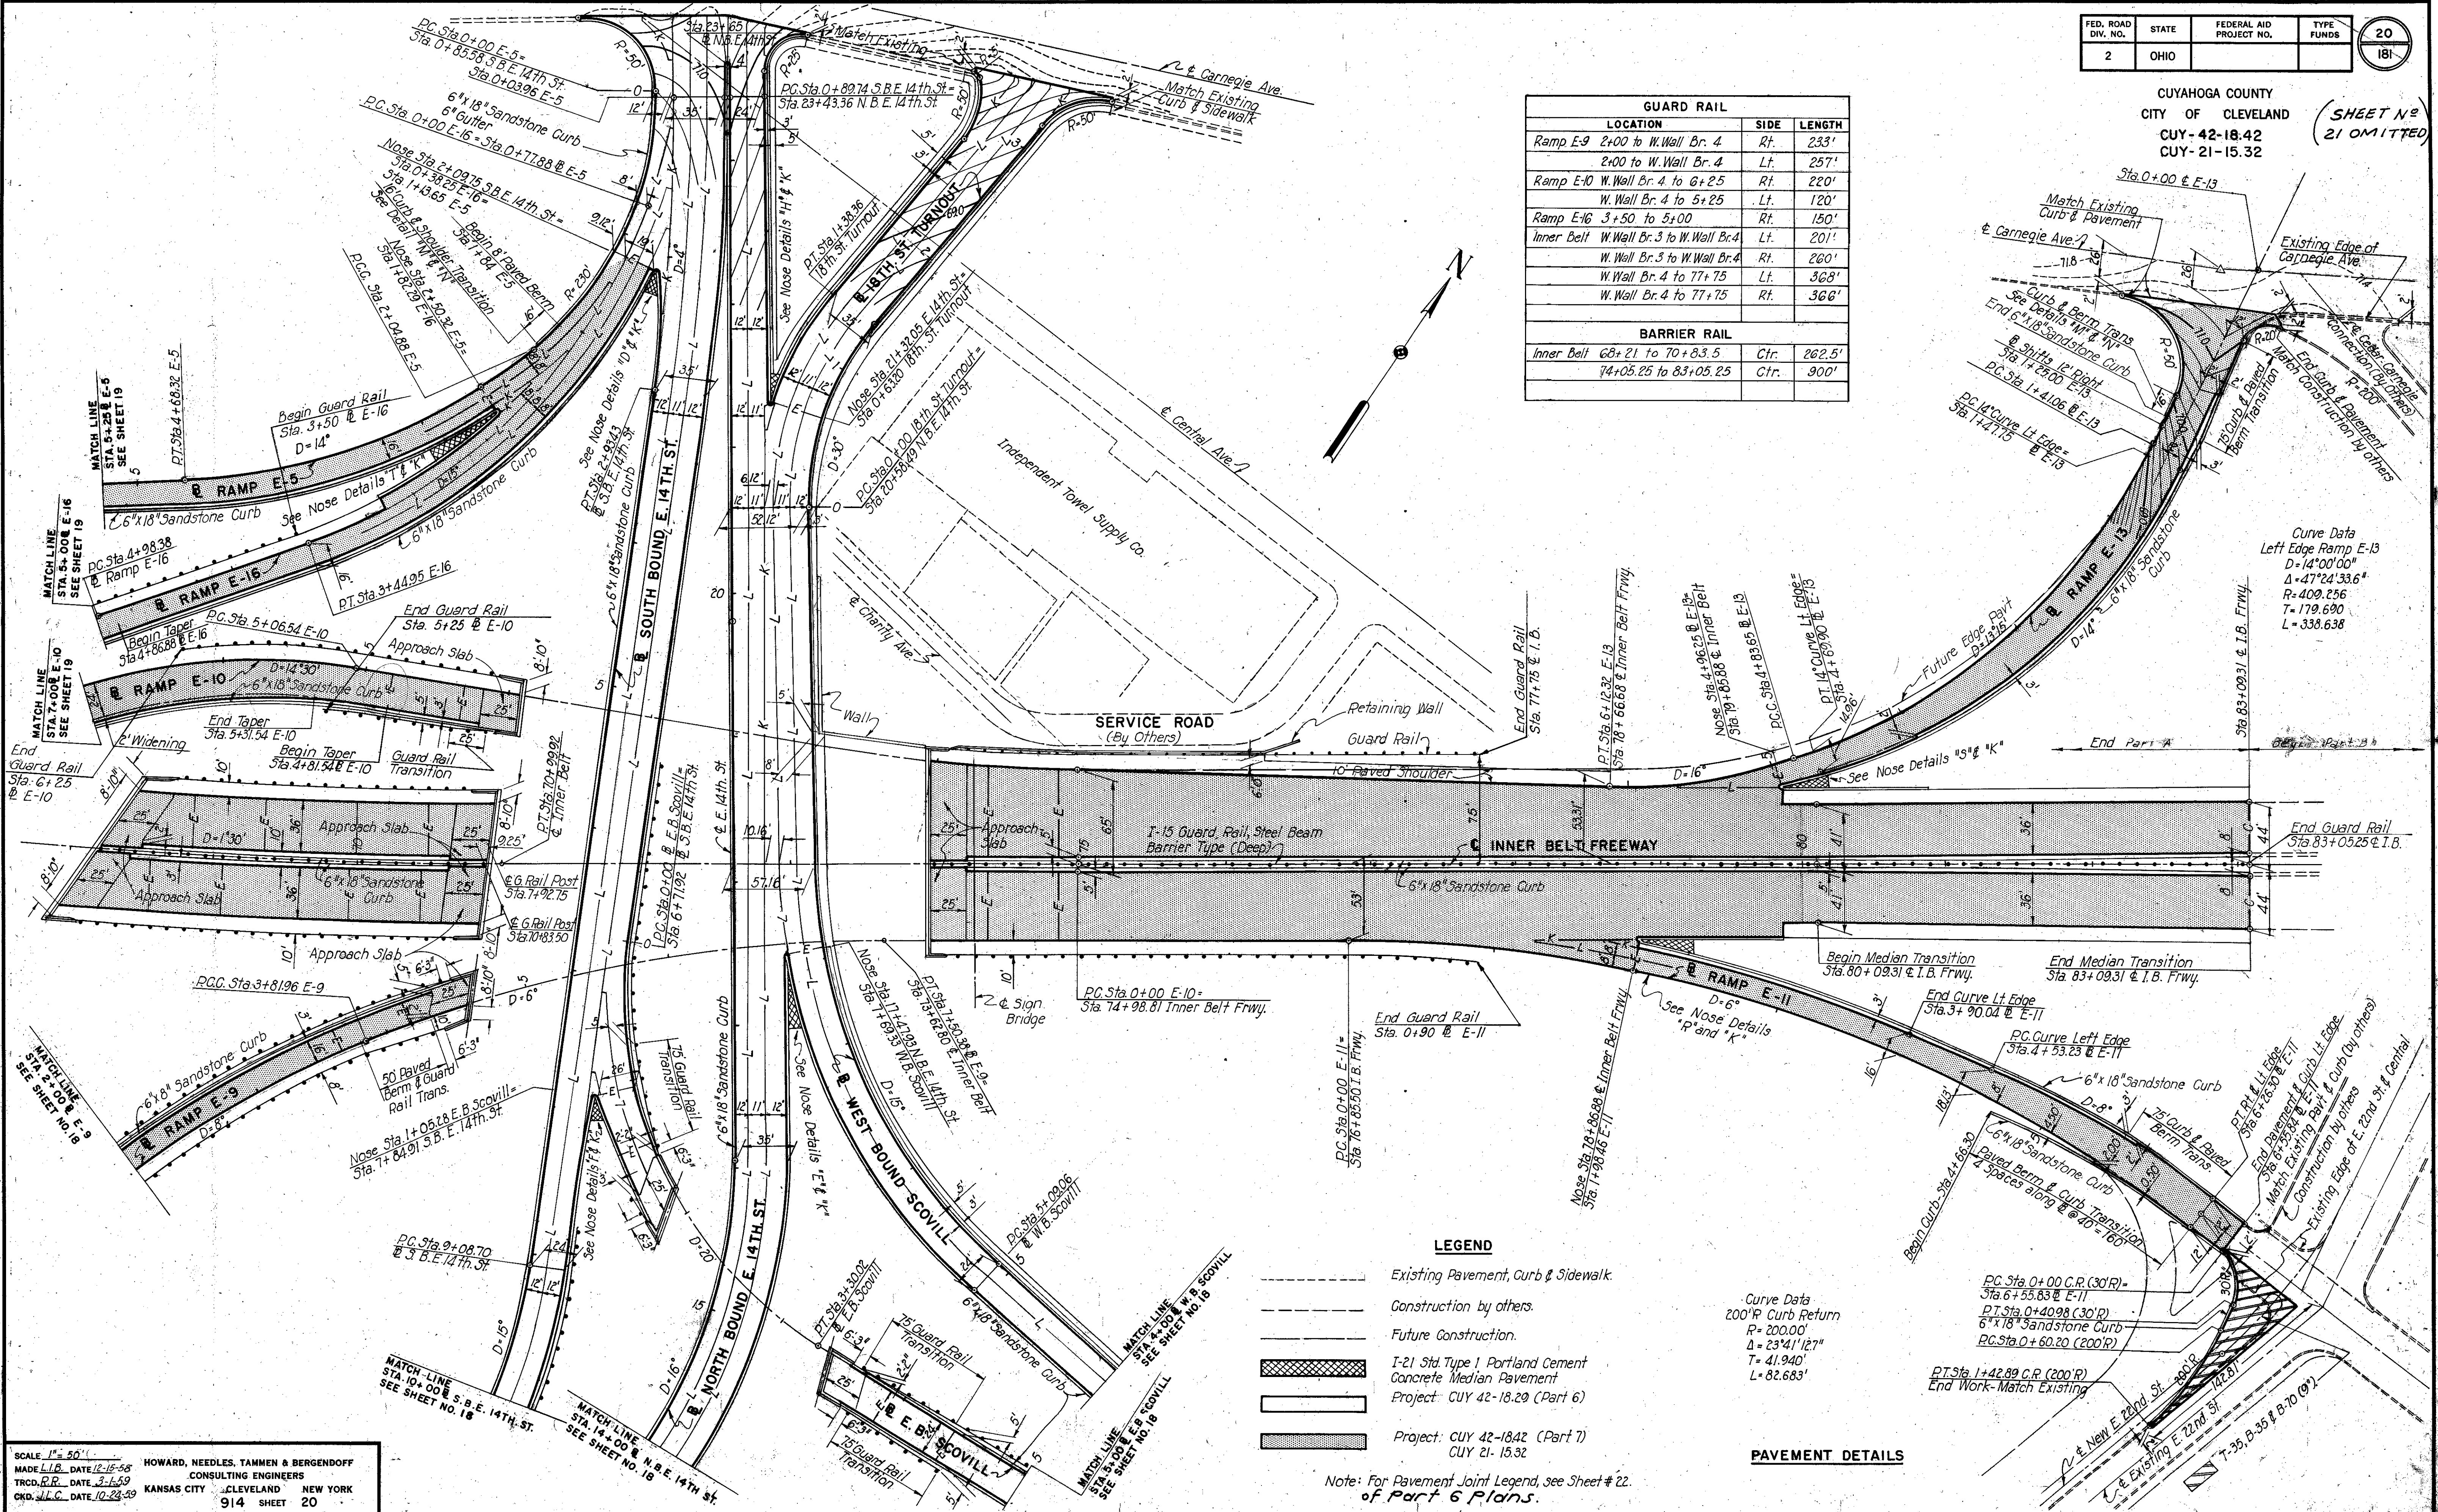

Curve Data
Left Edge Ramp E-13
D=14°00'00"
Δ=47°24'33.6"
R=409.256'
T=179.690'
L=338.638'

Curve Data
200' R Curb Return
R=200.00'
Δ=23°41'12.7"
T=41.940'
L=82.683'

LEGEND





- Existing Pavement, Curb & Sidewalk.
- - - Construction by others.
- Future Construction.
- ▨ I-21 Std. Type 1 Portland Cement Concrete Median Pavement Project: CUY 42-18.29 (Part 6)
- ▨ Project: CUY 42-18.42 (Part 7) CUY 21-15.32

PAVEMENT DETAILS

Note: For Pavement Joint Legend, see Sheet # 22 of Part 6 Plans.






Var Left at Taper	693.22	93.59	93.90	94.20	94.44	94.68	94.92	95.16	95.40	95.64	95.88	96.12	96.36	96.60	96.84	97.08	97.32	97.56	97.80	98.04	98.28	98.52	98.76	99.00	99.24	99.48	99.72	100.00	100.24	100.48	336.16
-------------------	--------	-------	-------	--------	--------	
CUYAHOGA COUNTY
CITY OF CLEVELAND
CUY-42-18-42
INNER BELT FREEWAY - PART
CUY-21-1532
PROFILES

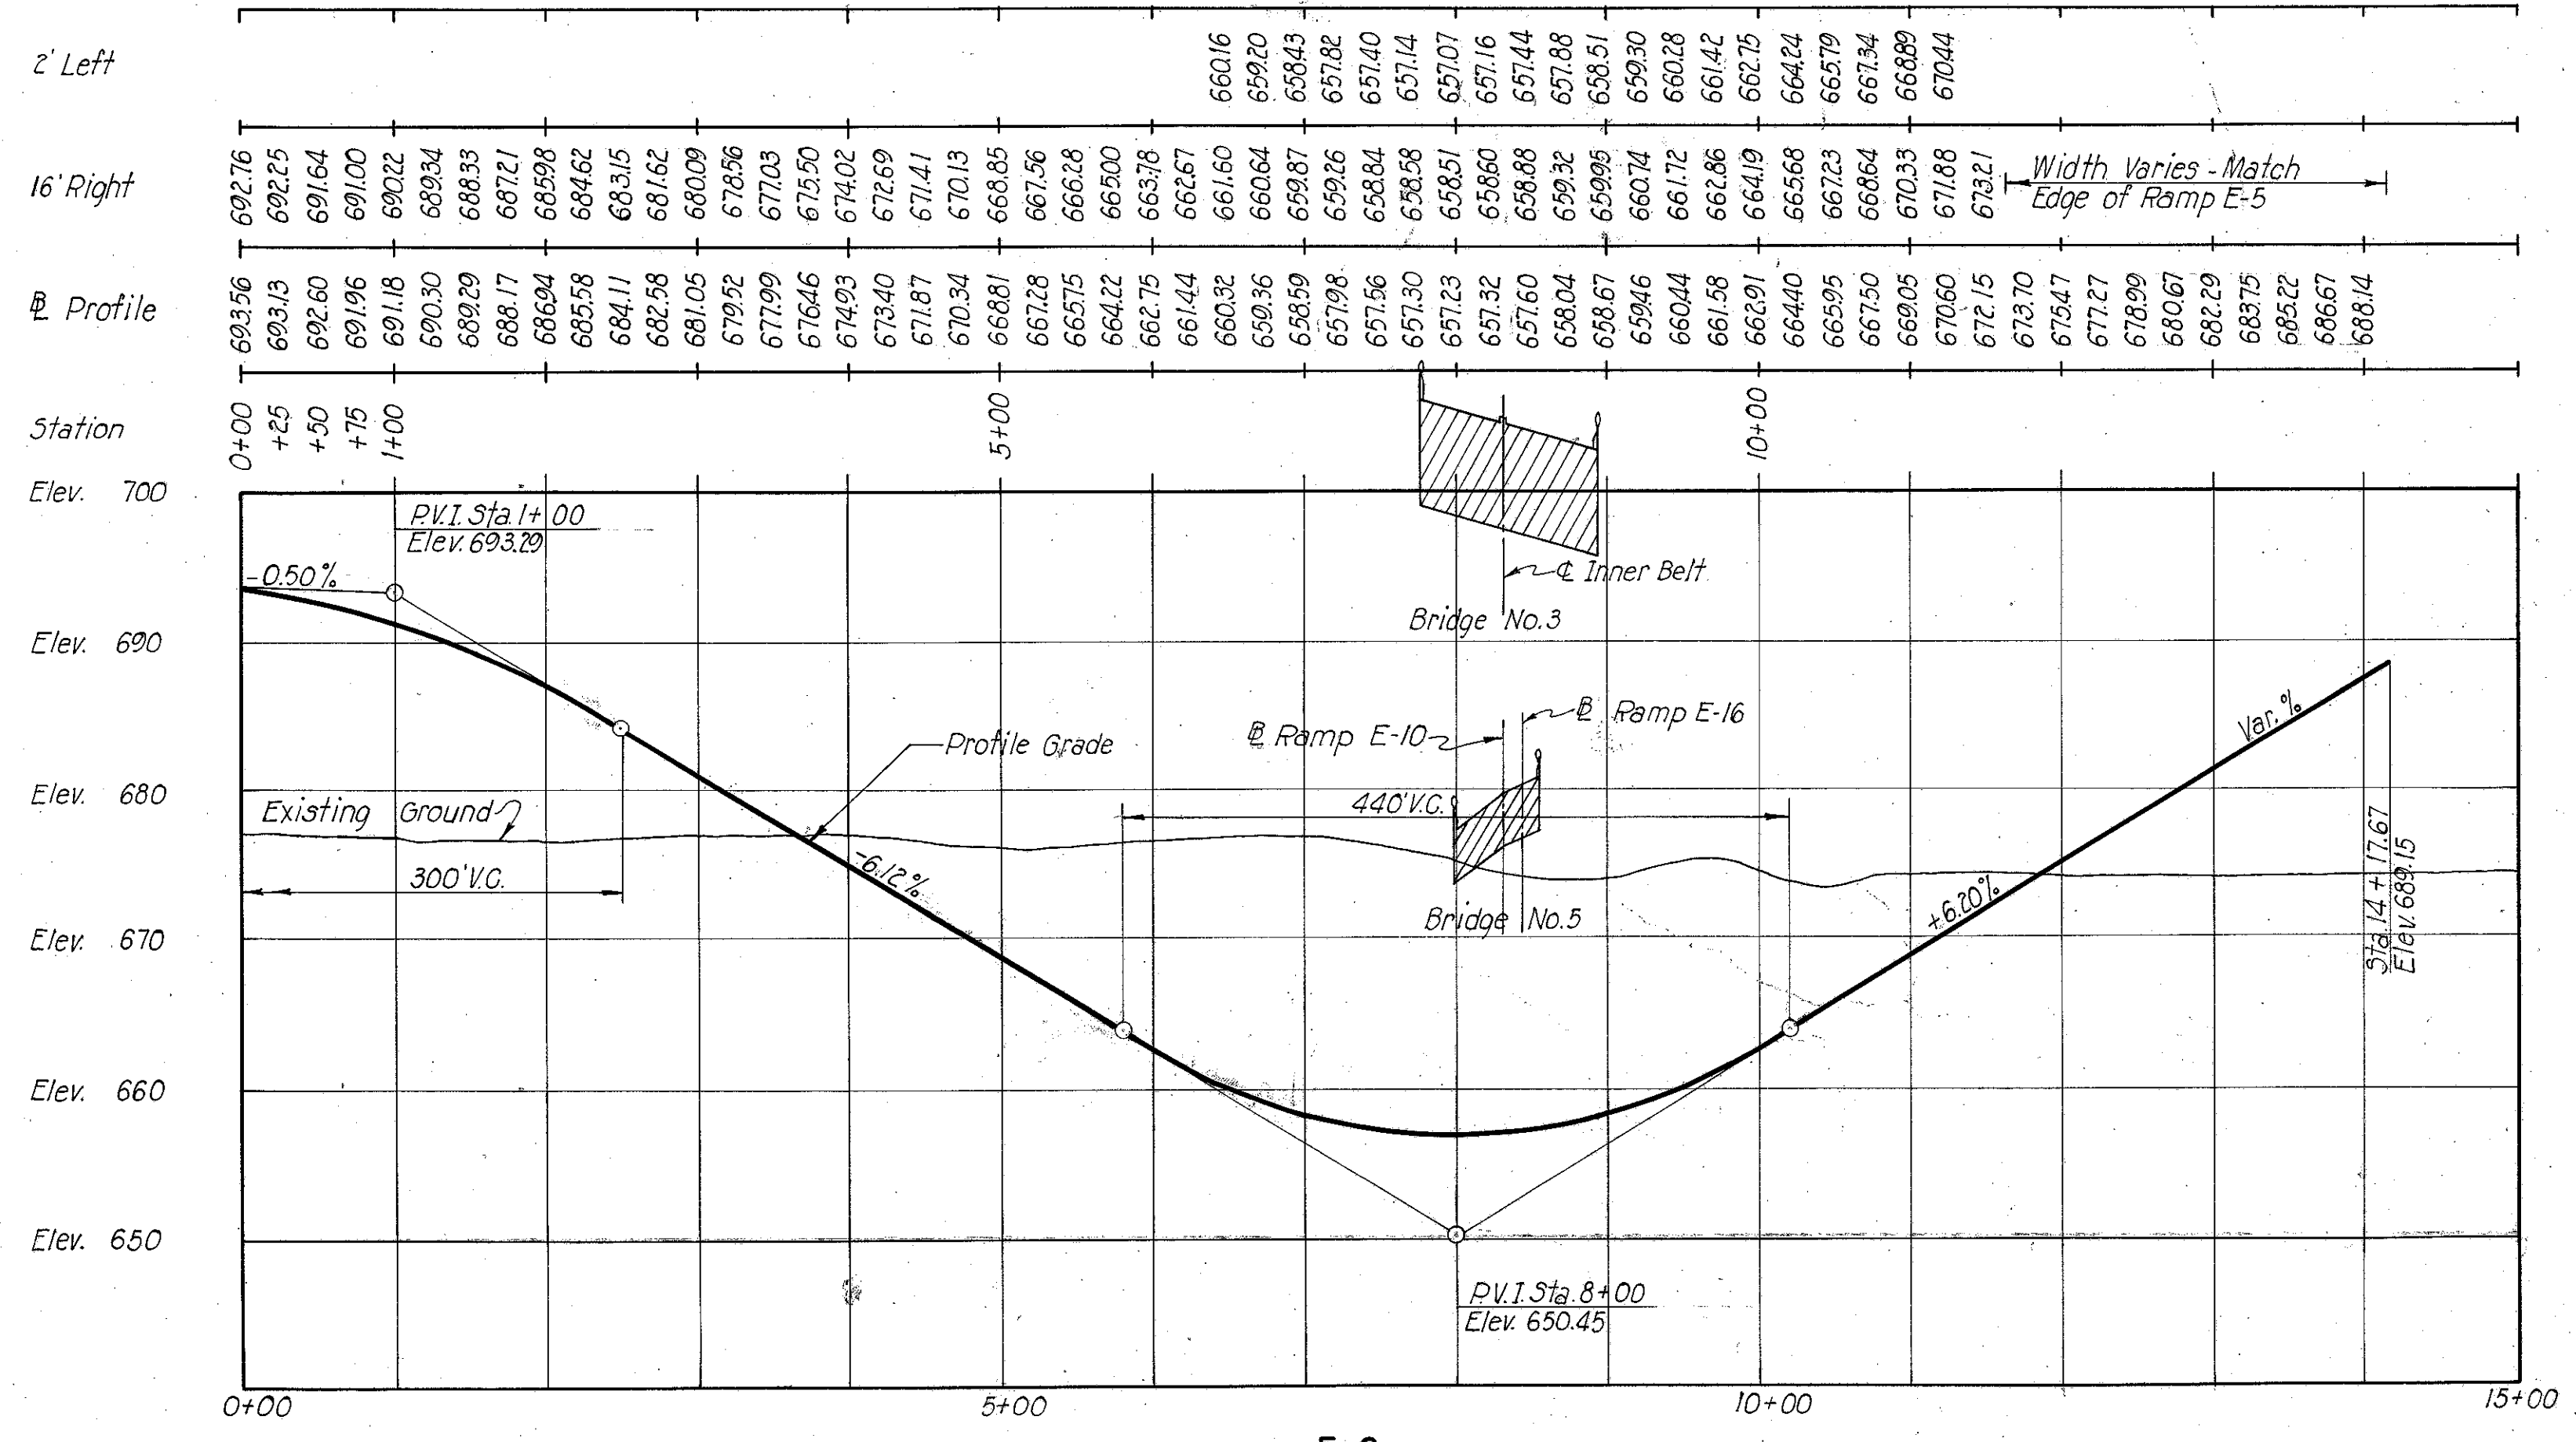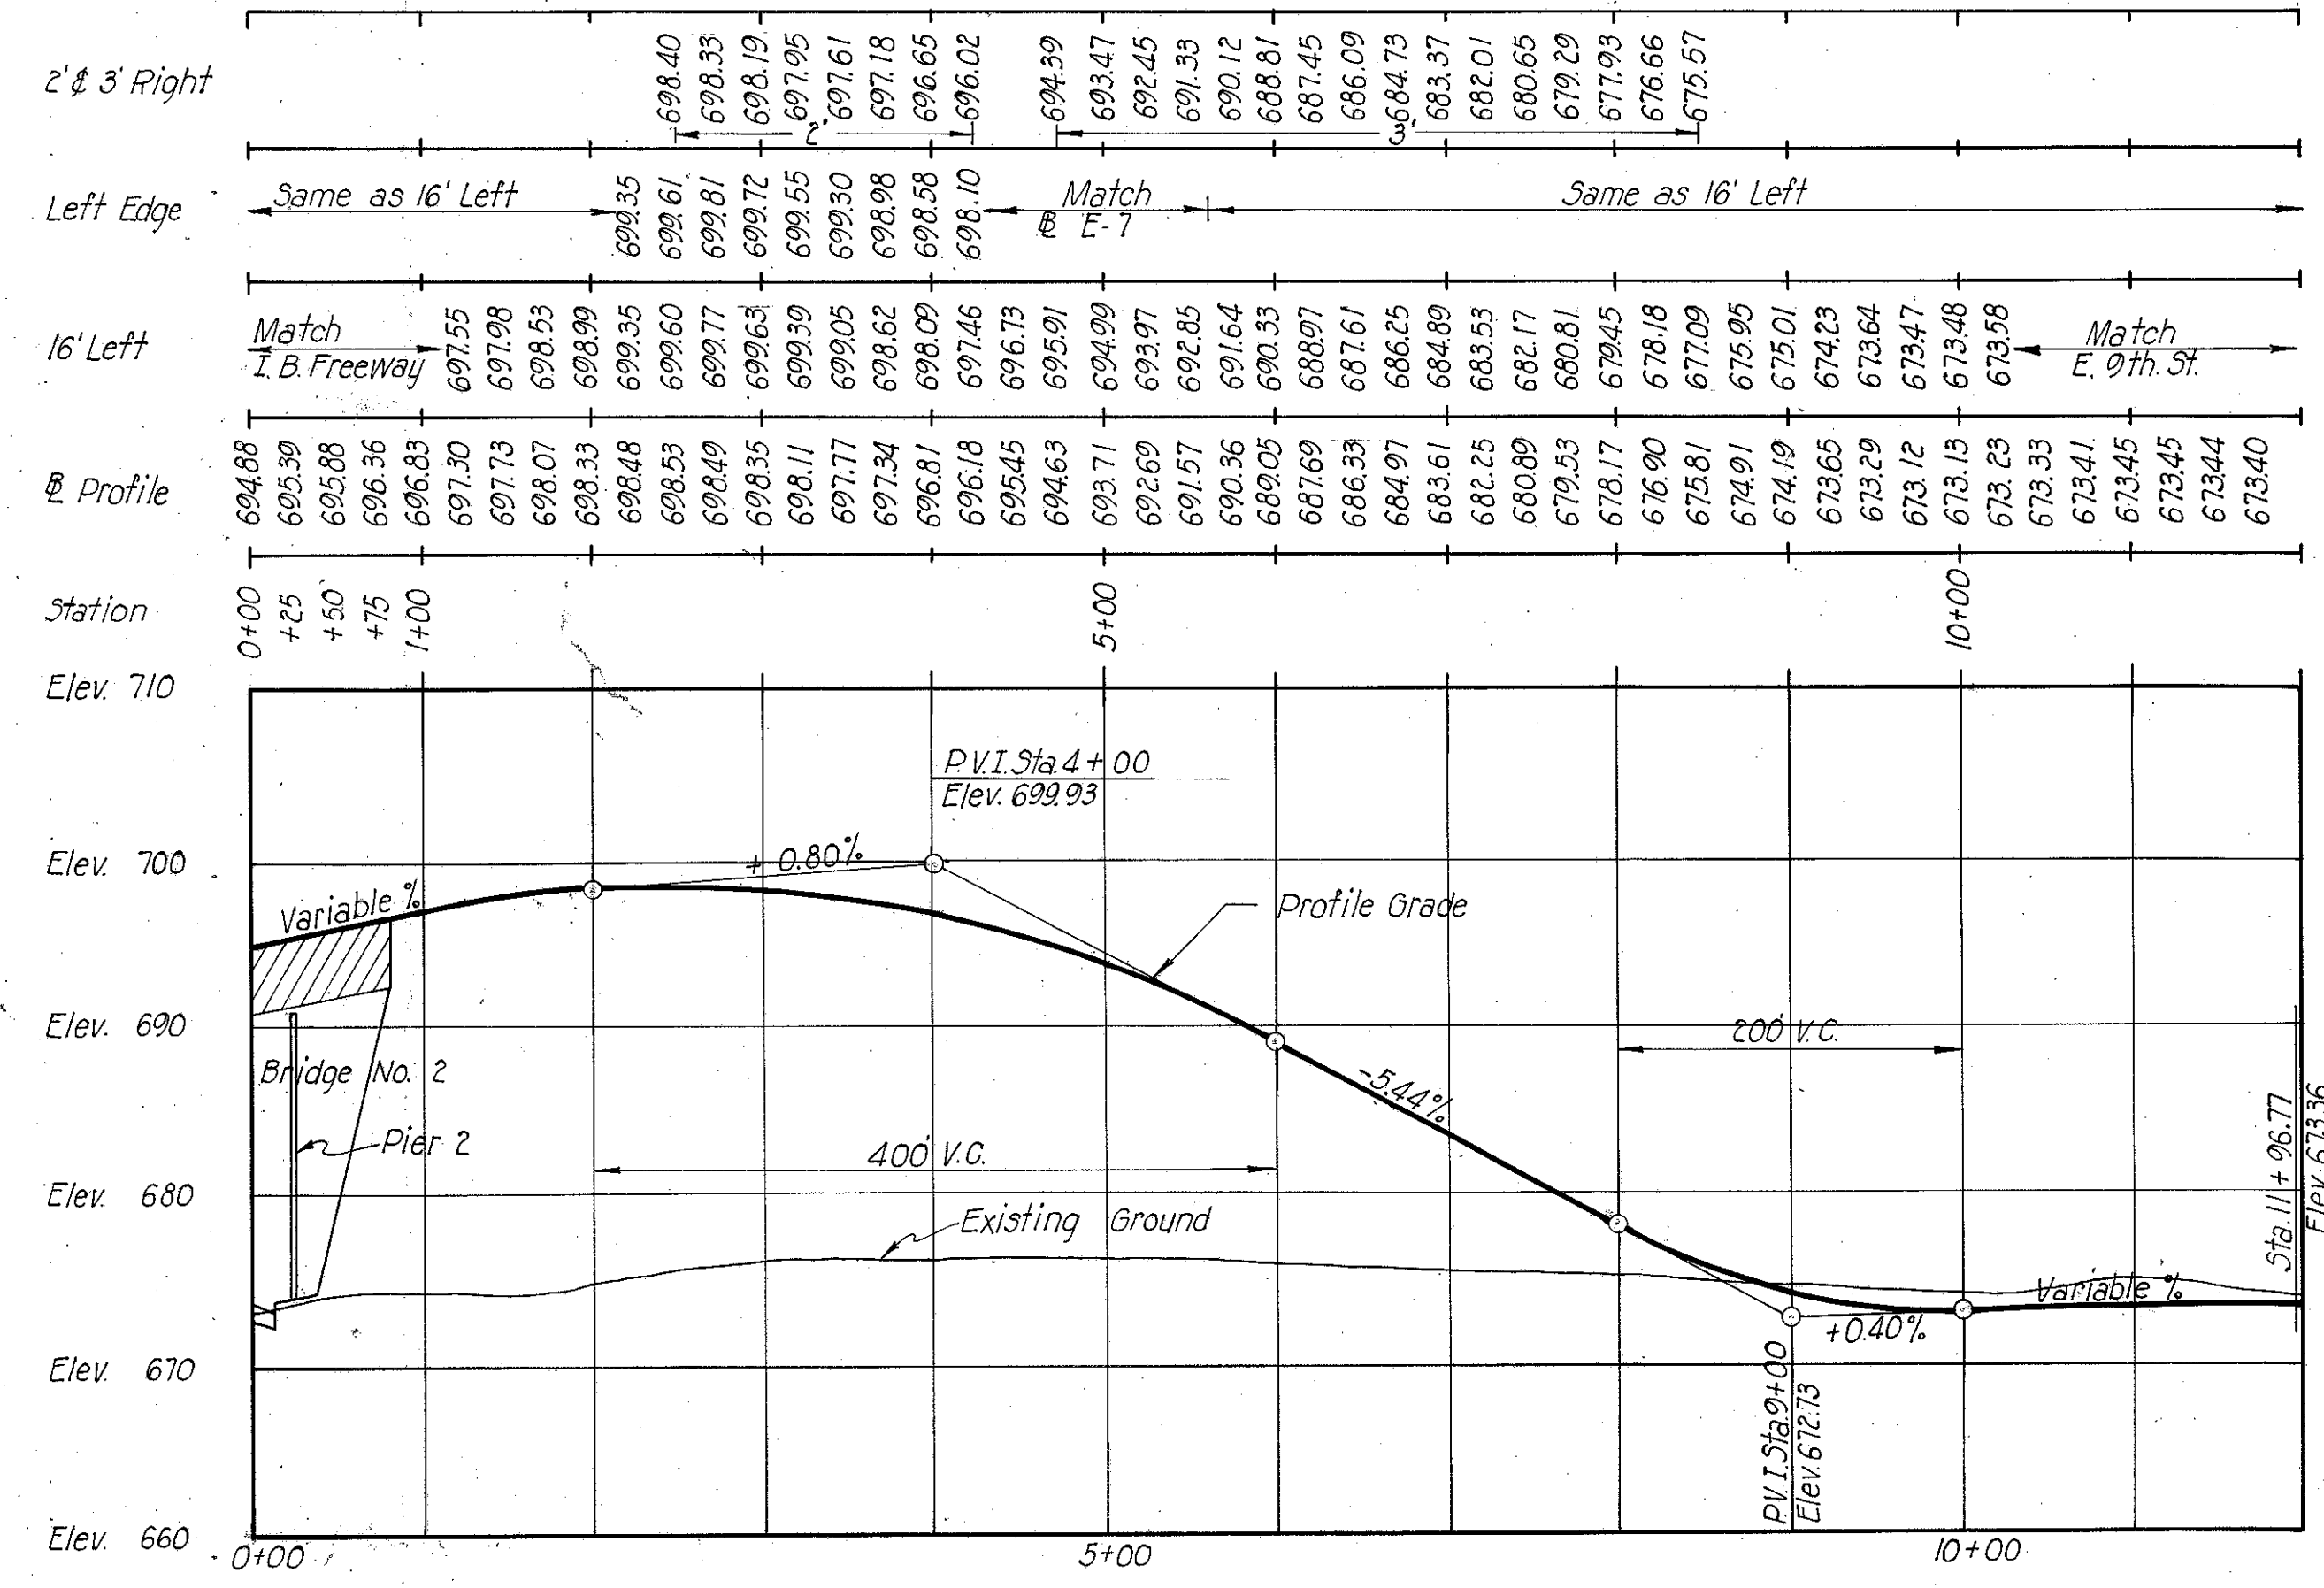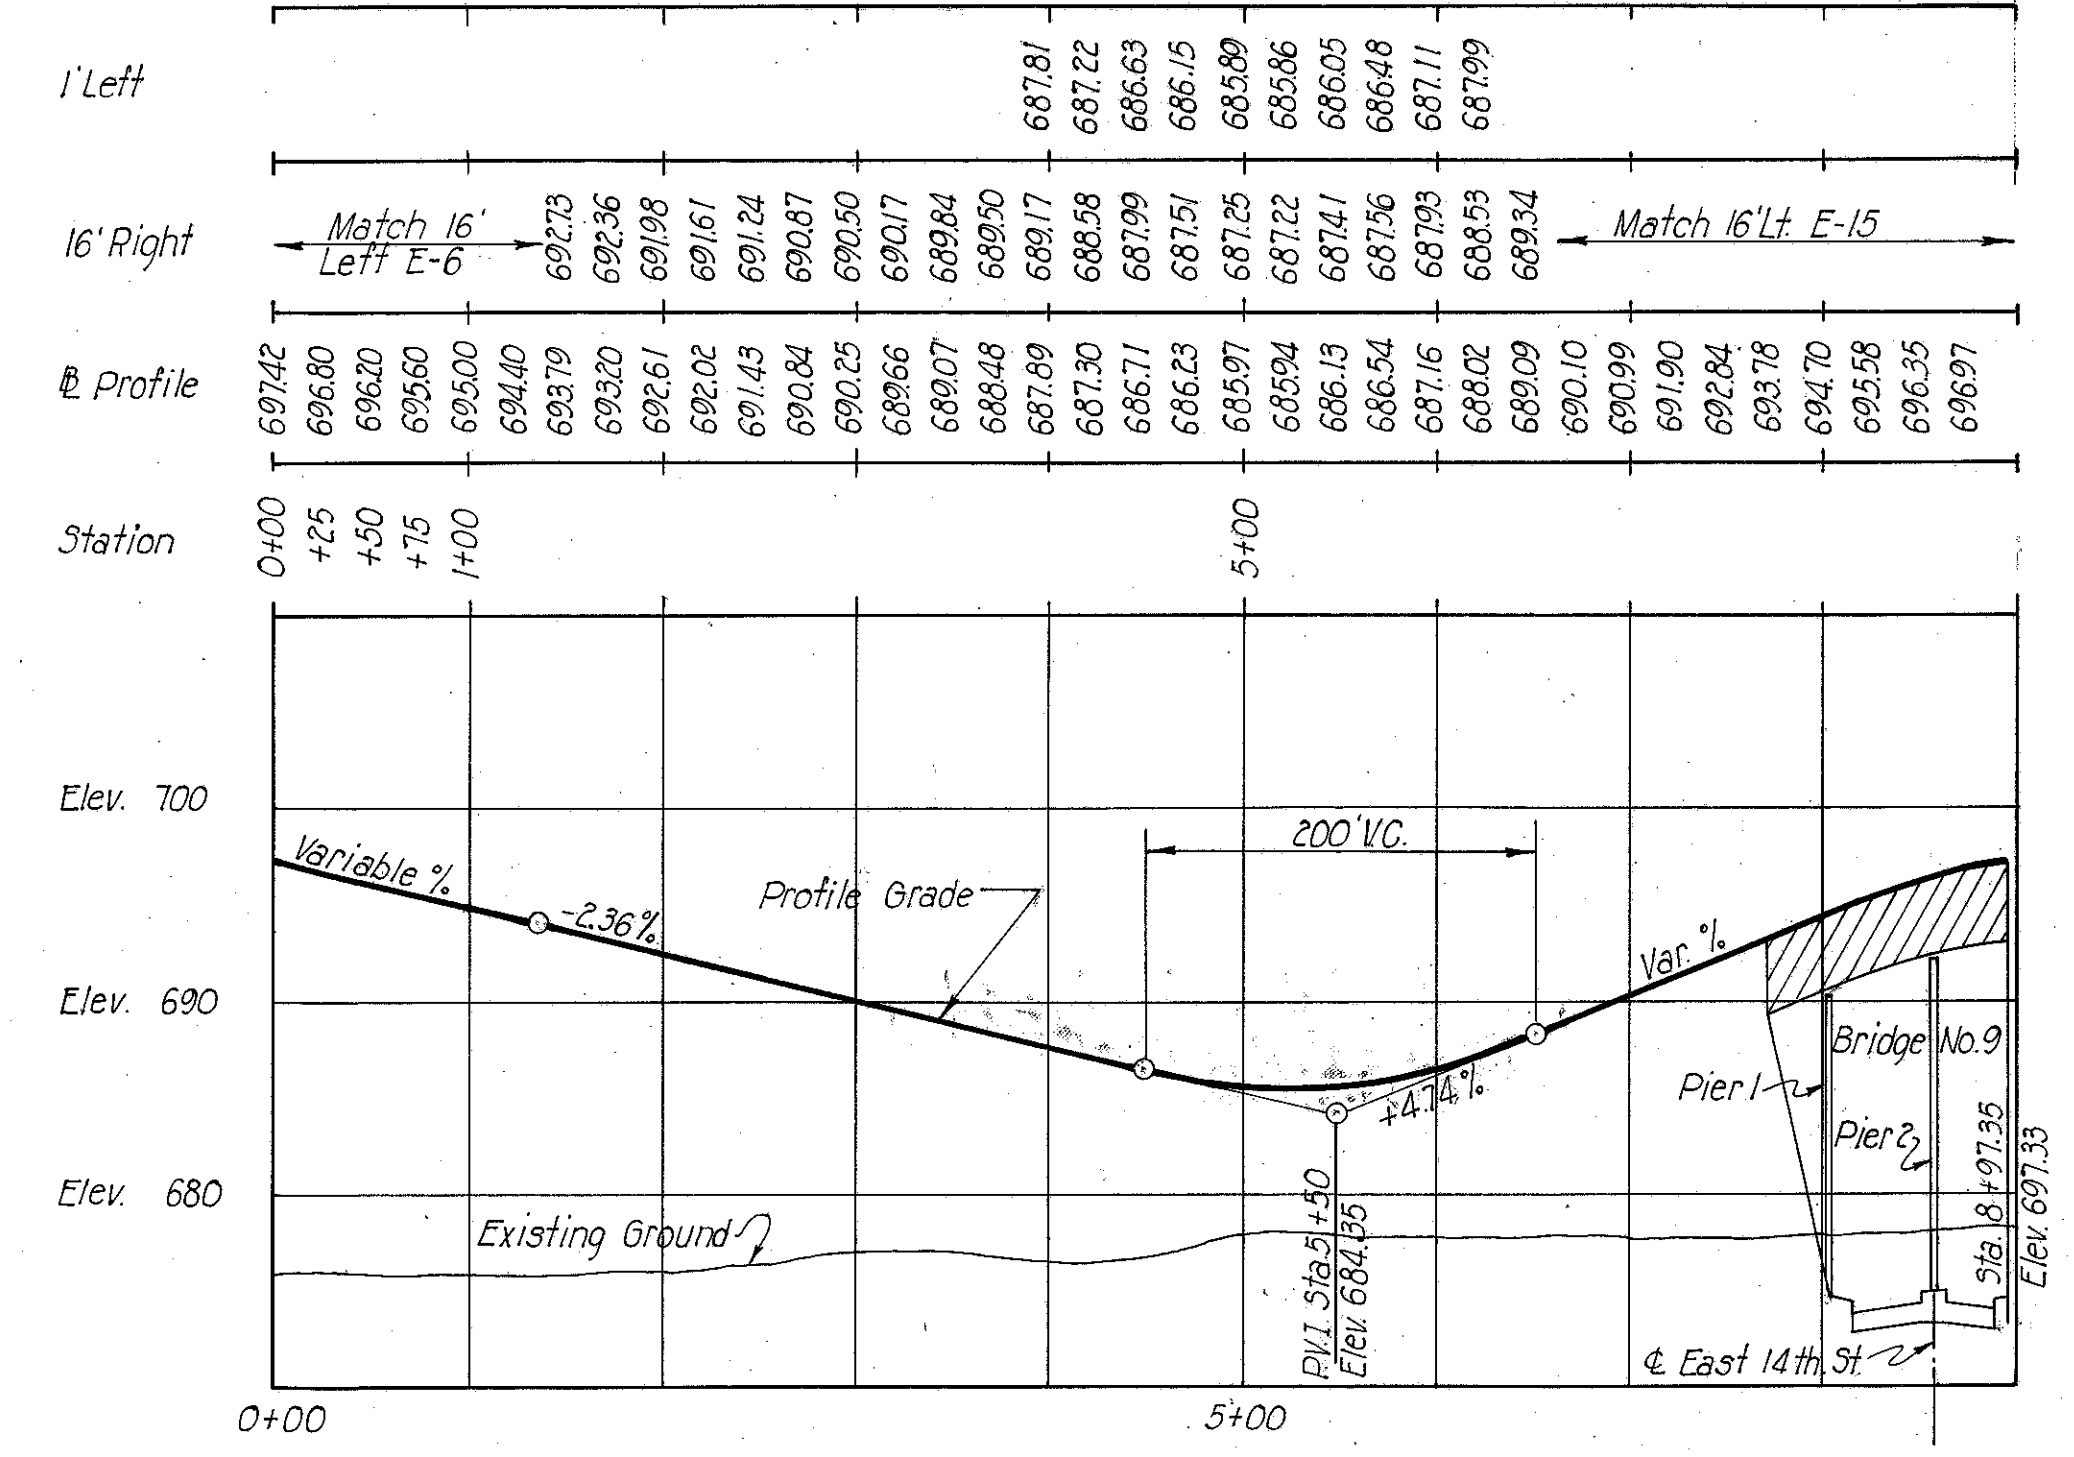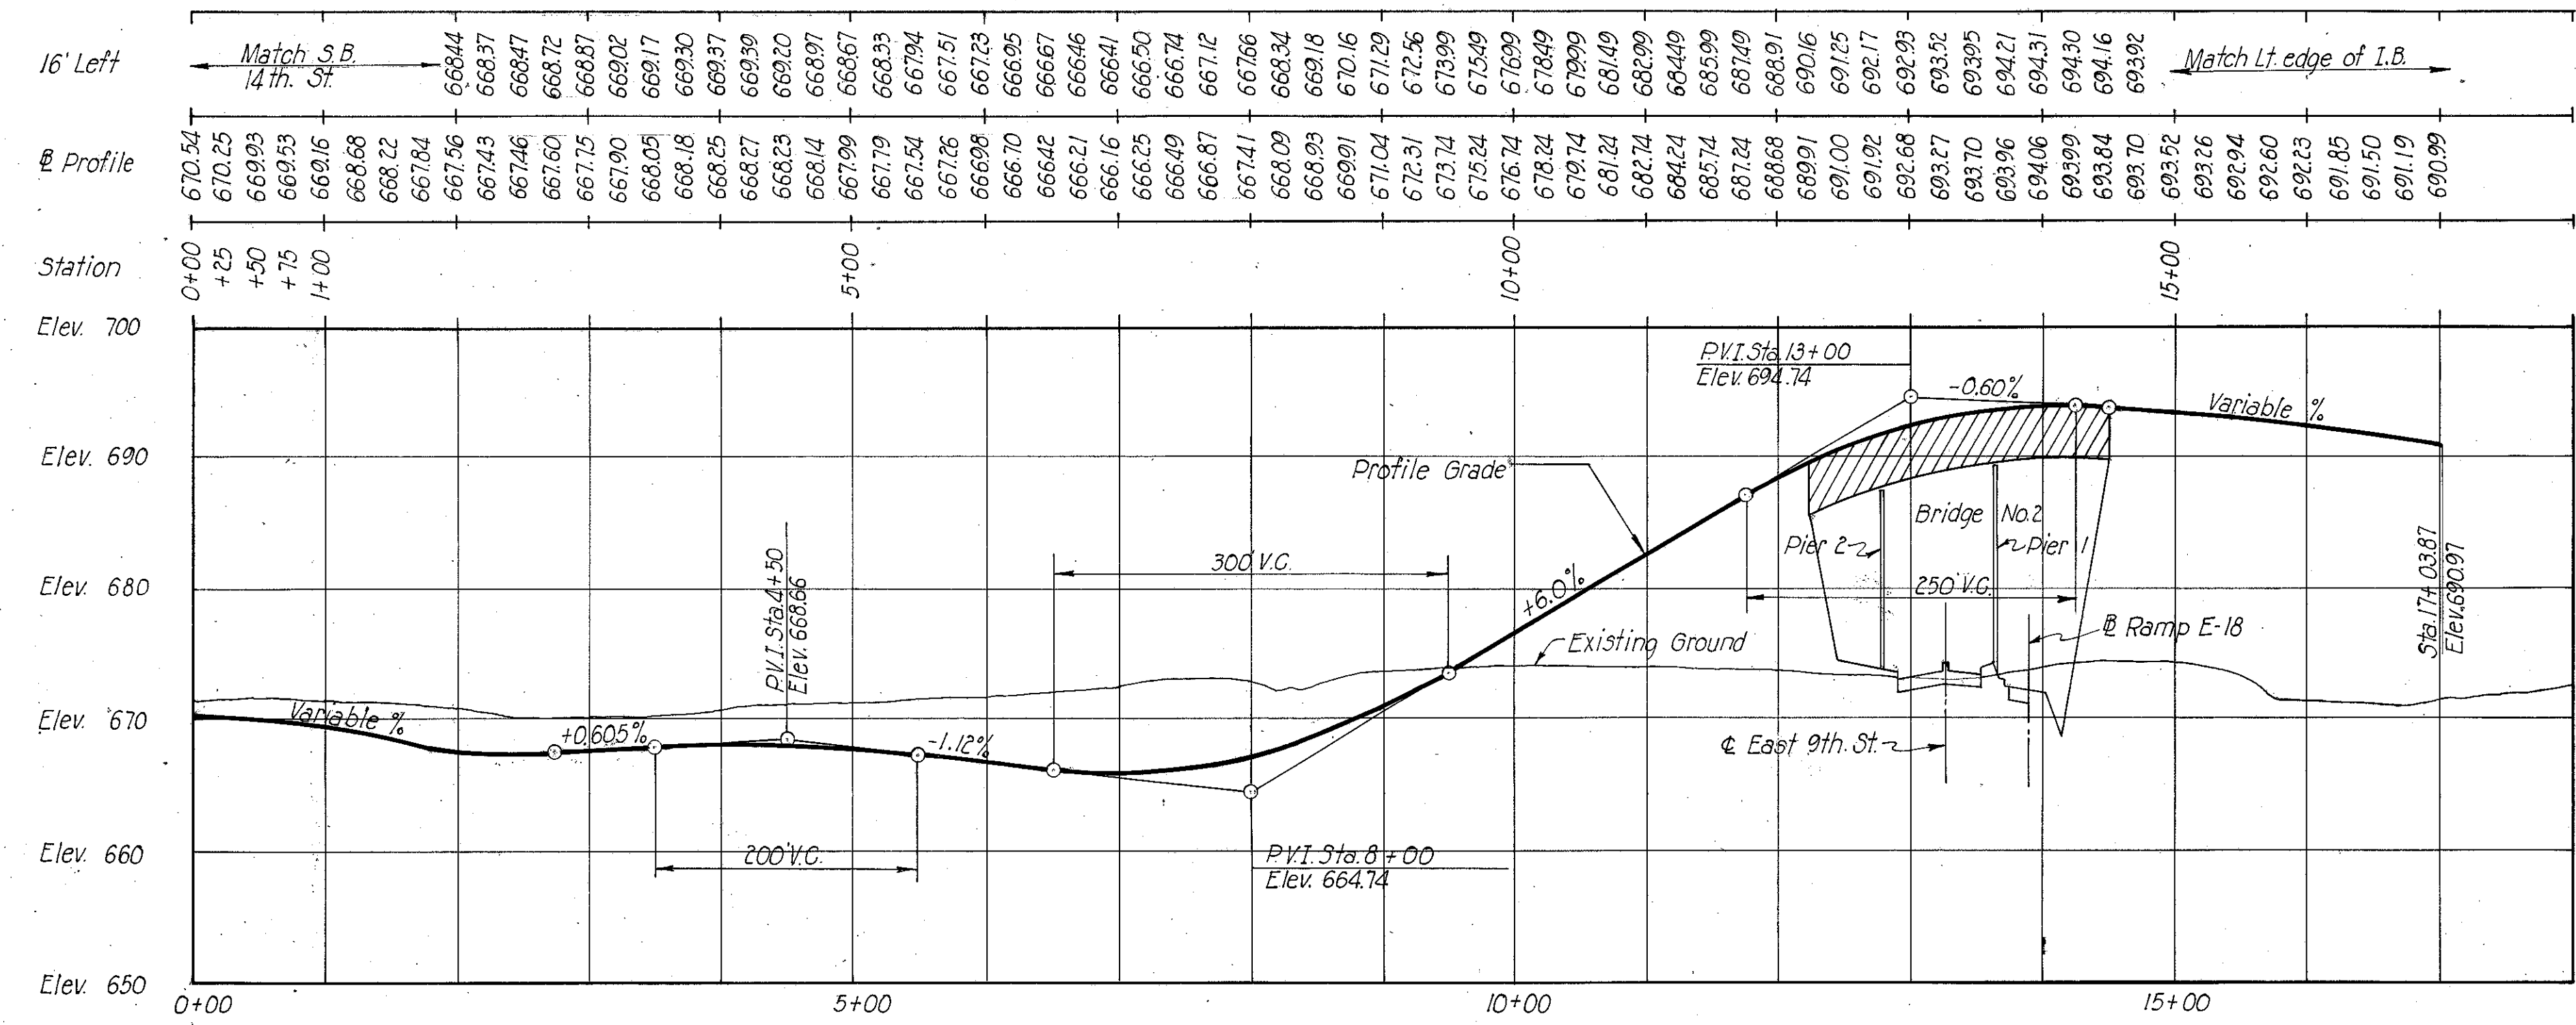




* Not applicable to this contract

CUYAHOGA COUNTY
CITY OF CLEVELAND
INNER CUY-42-18.42
CUY-21-15.32
PROFILES

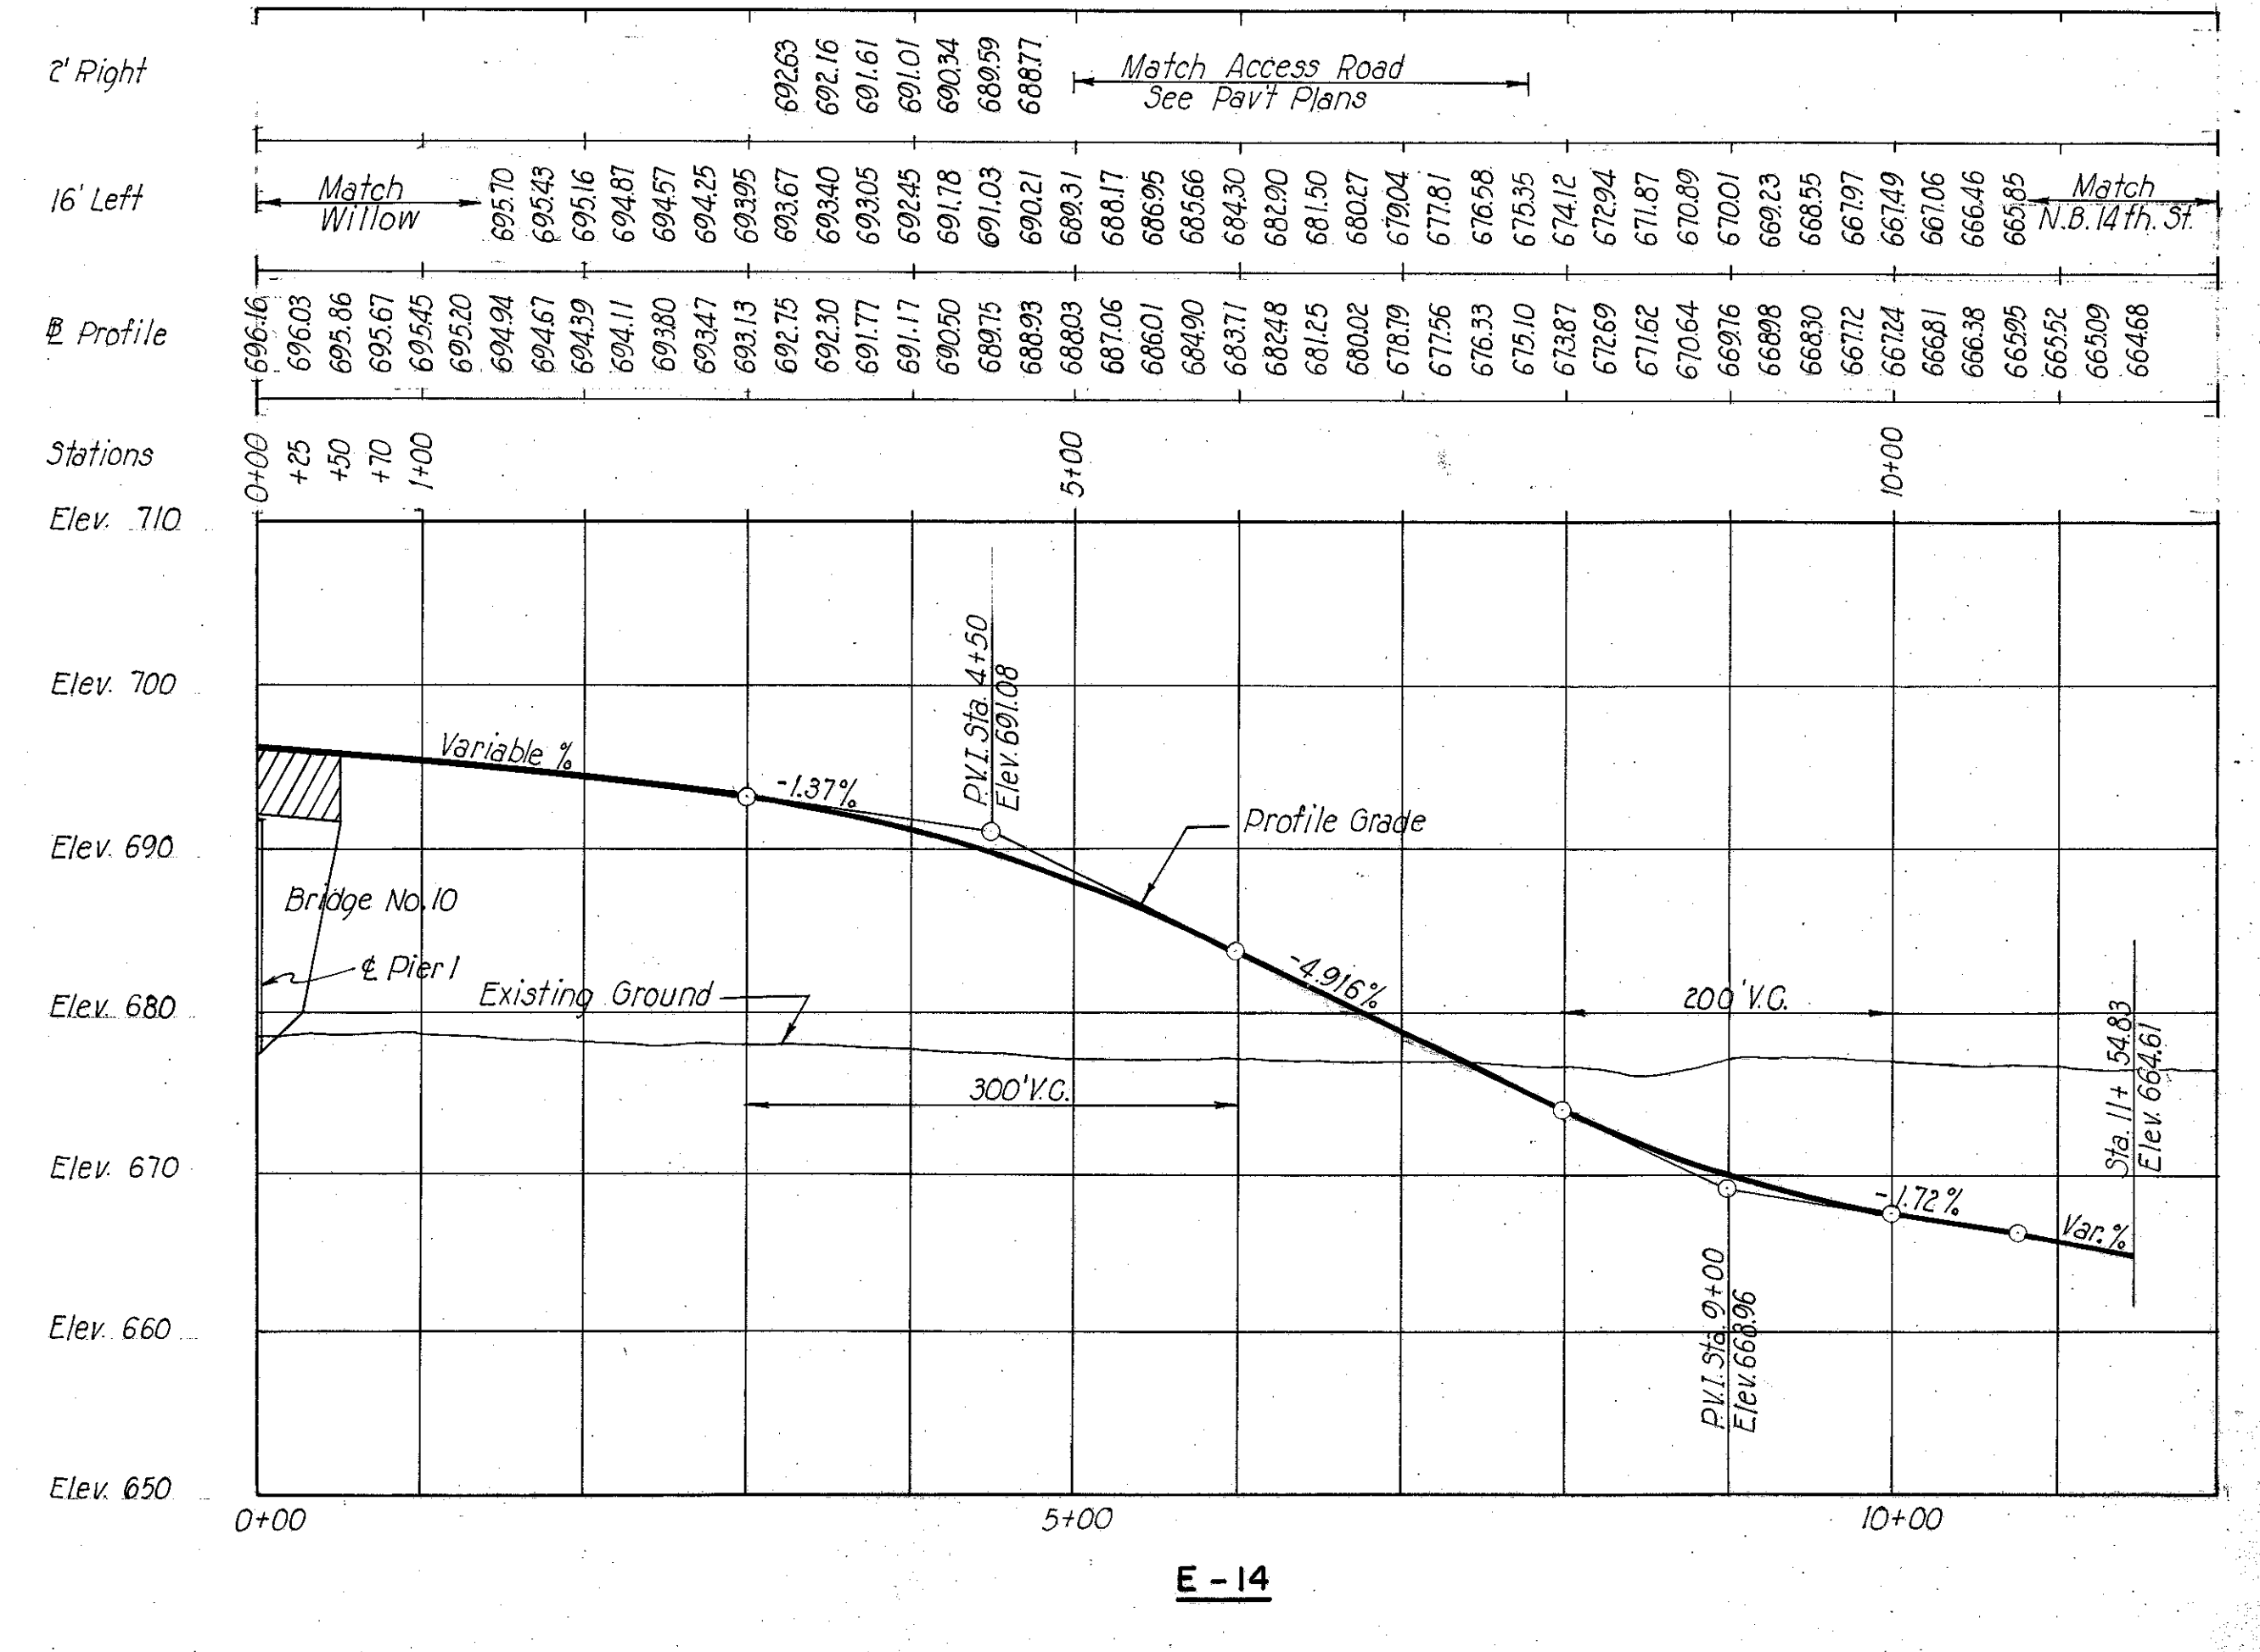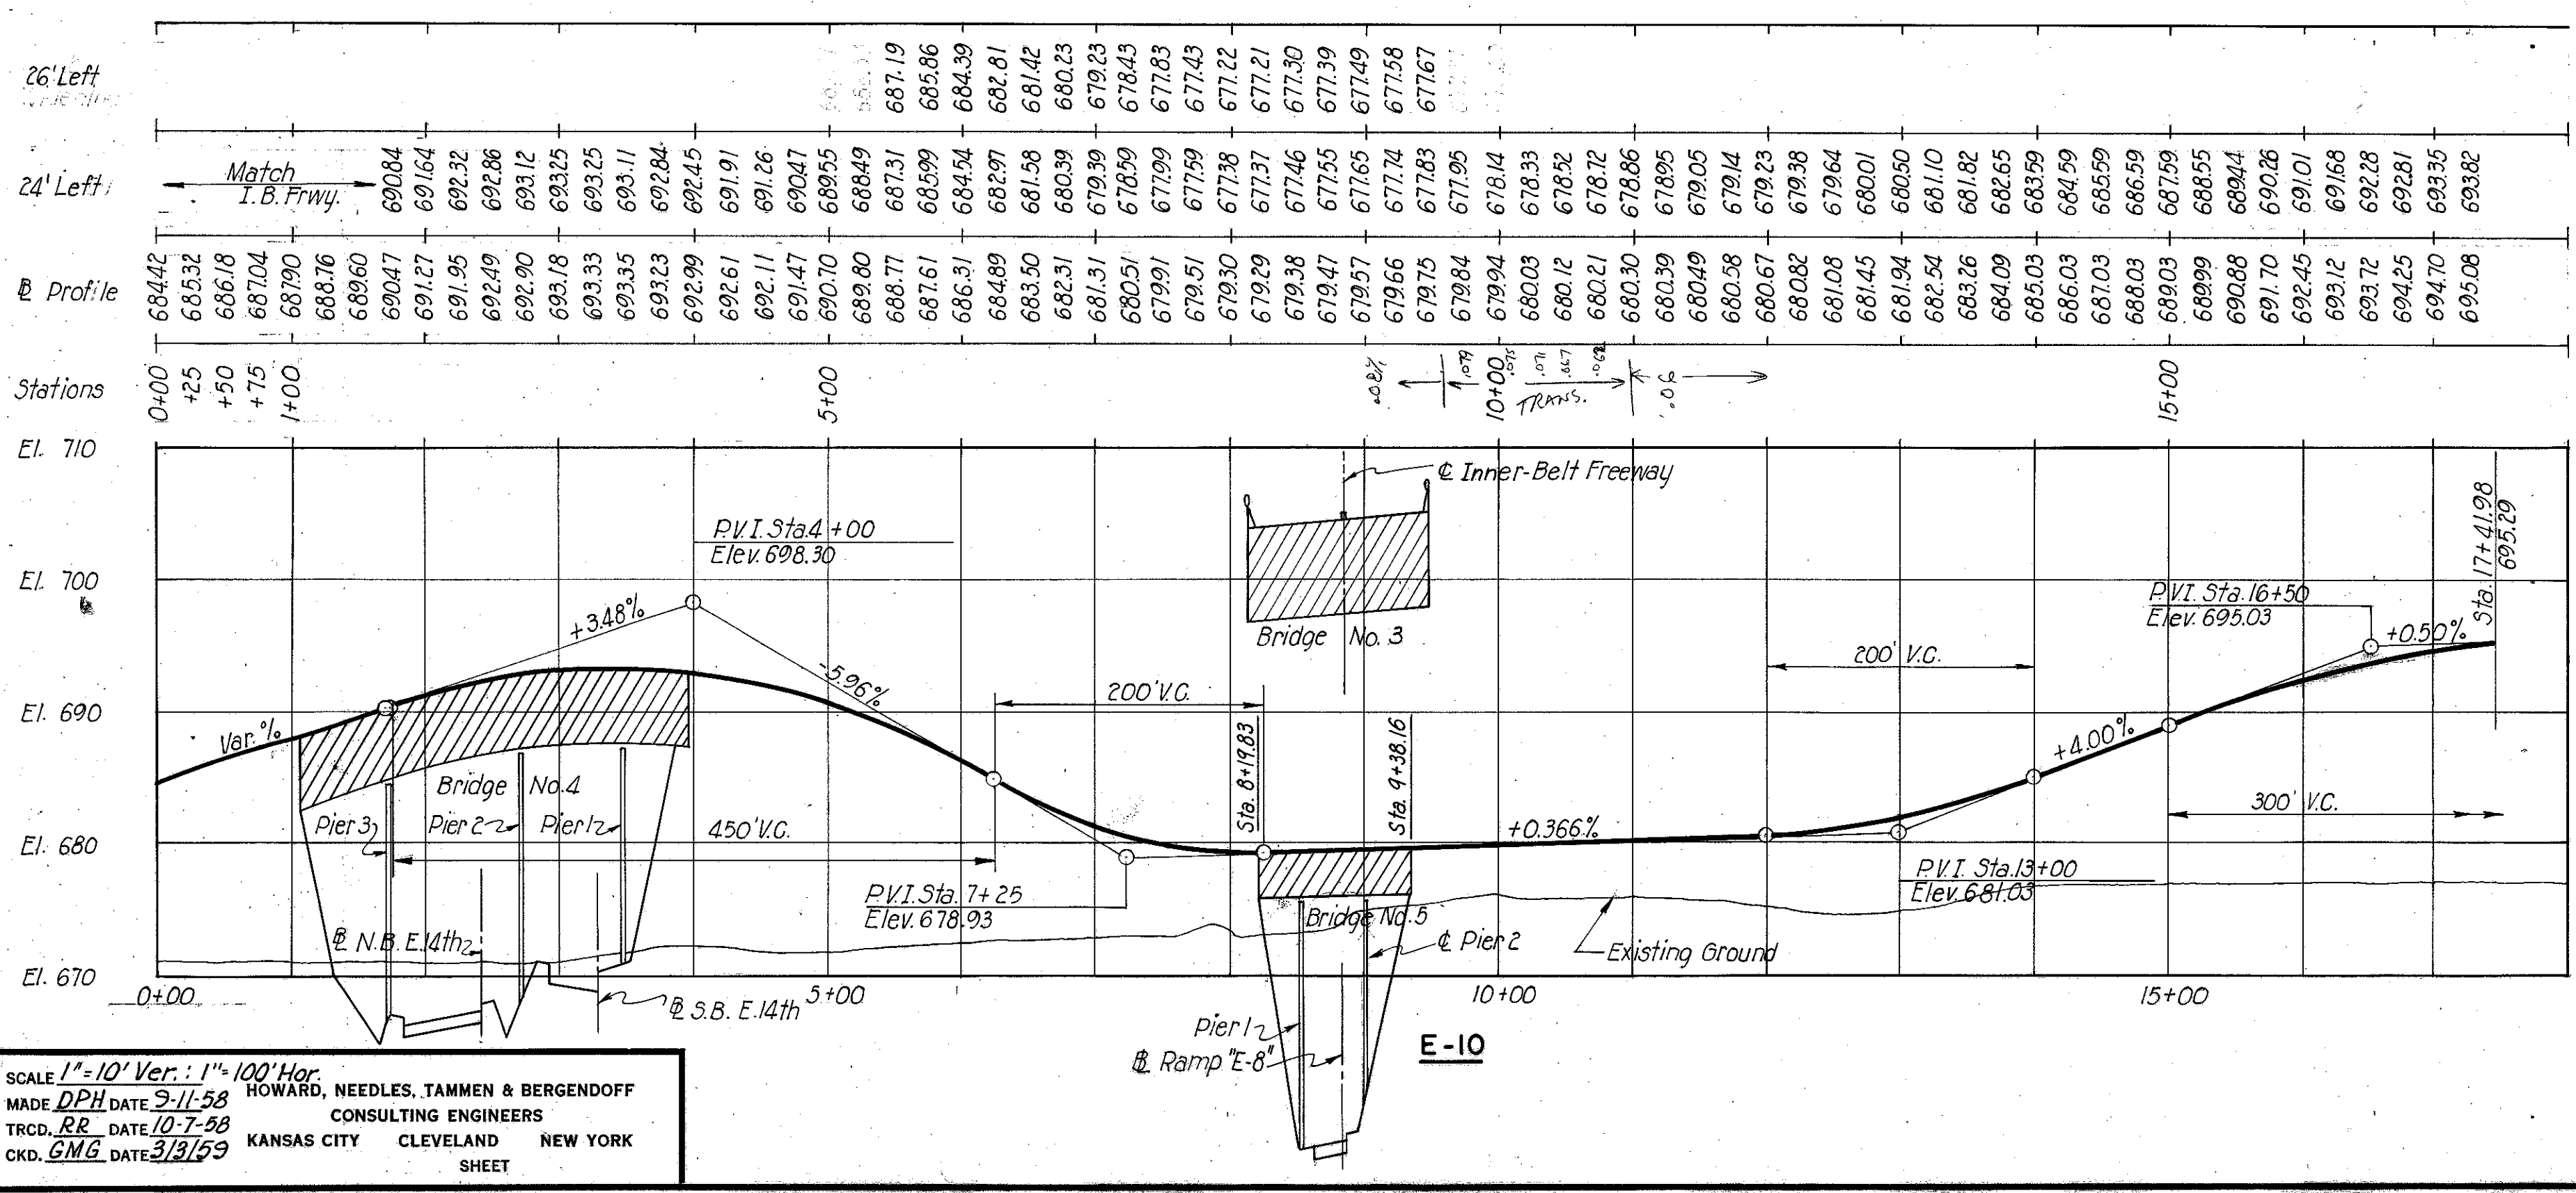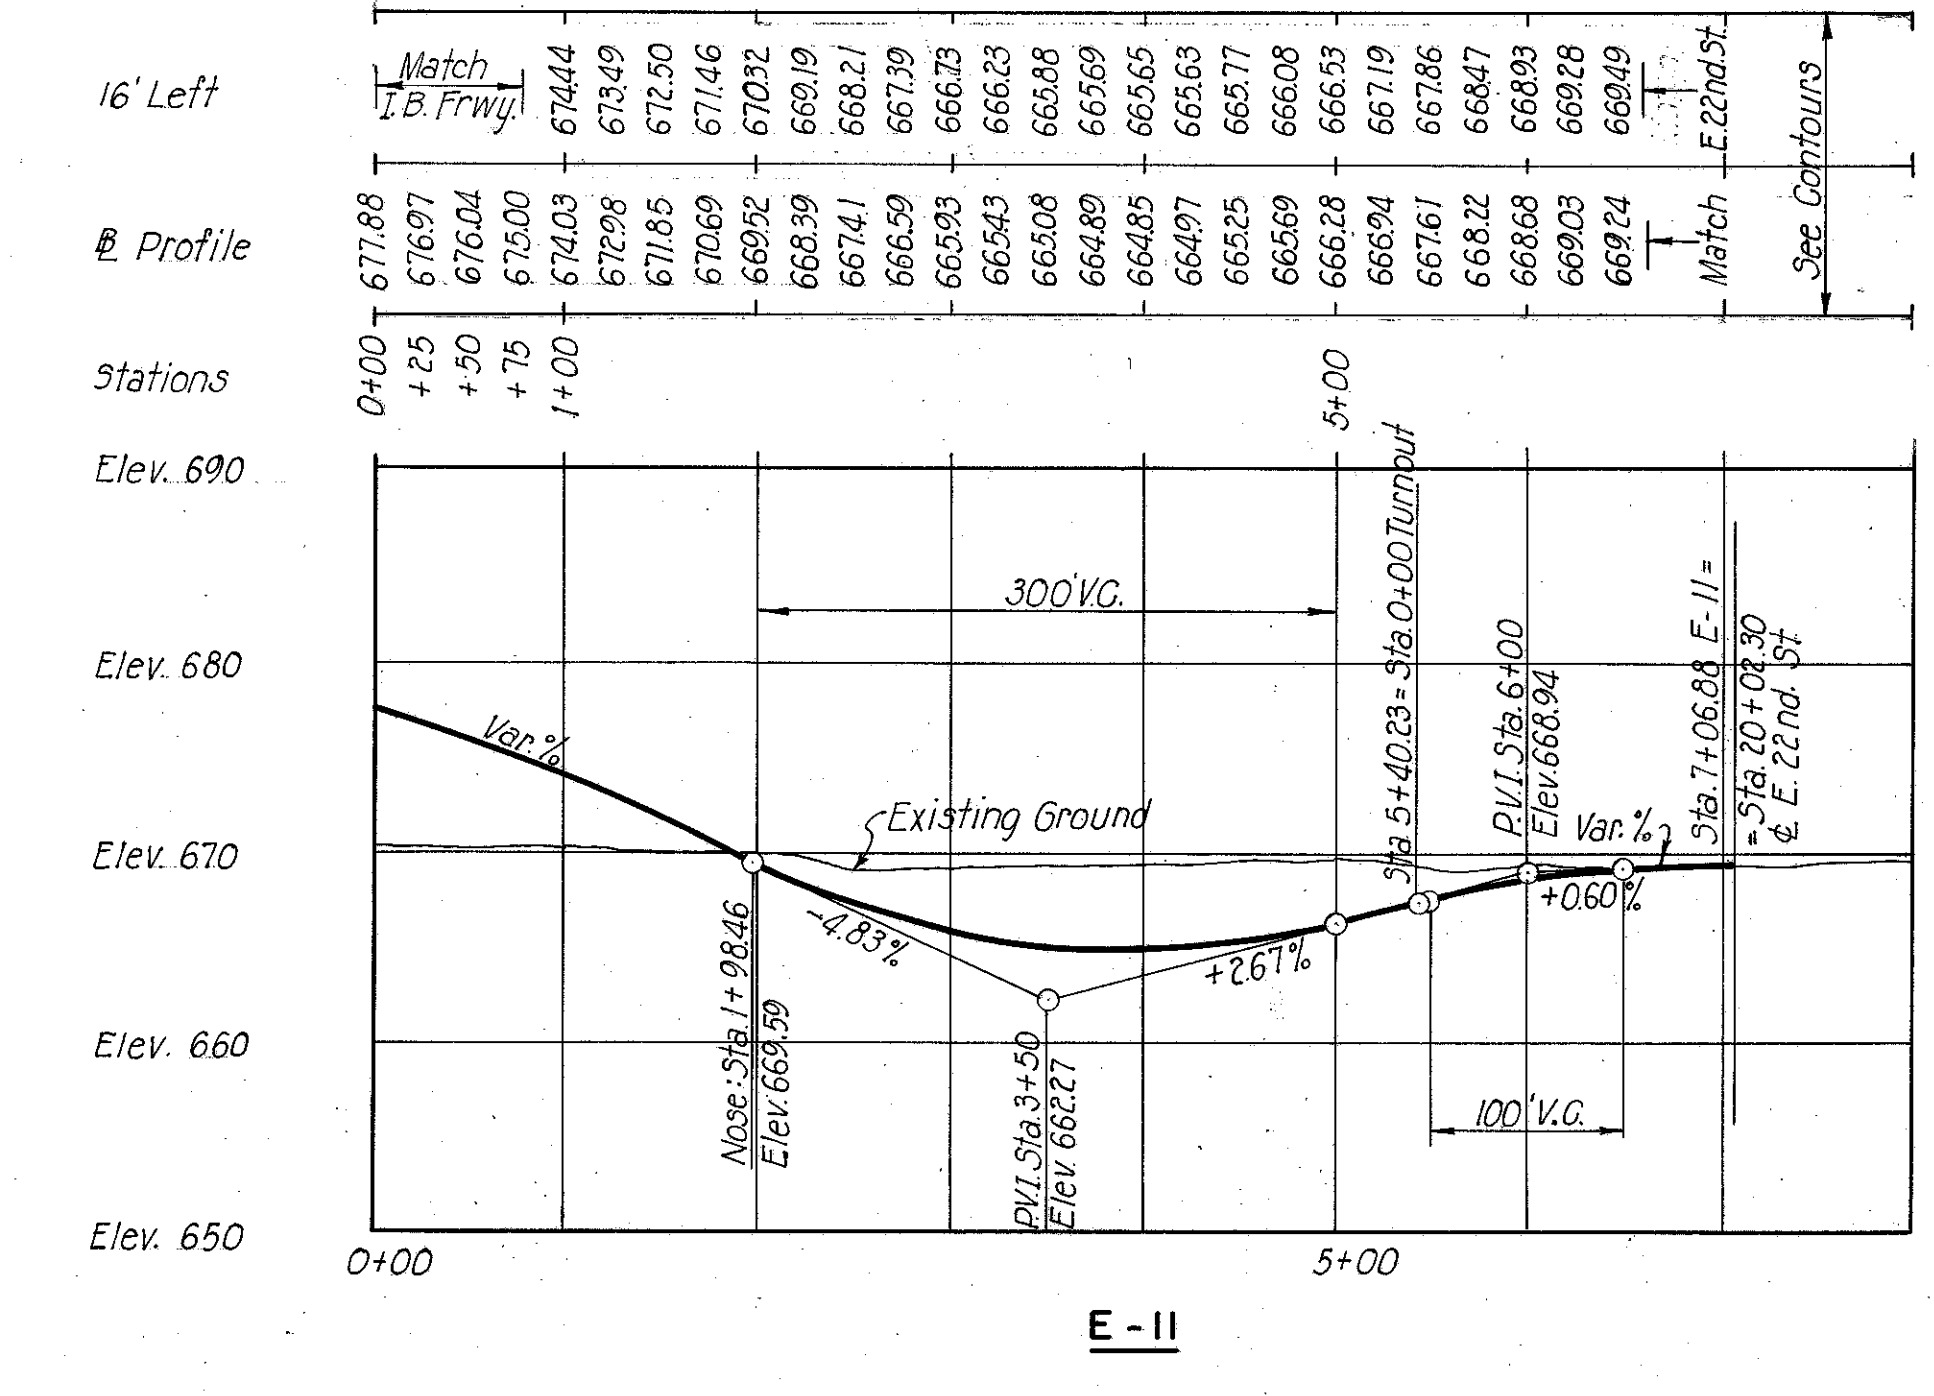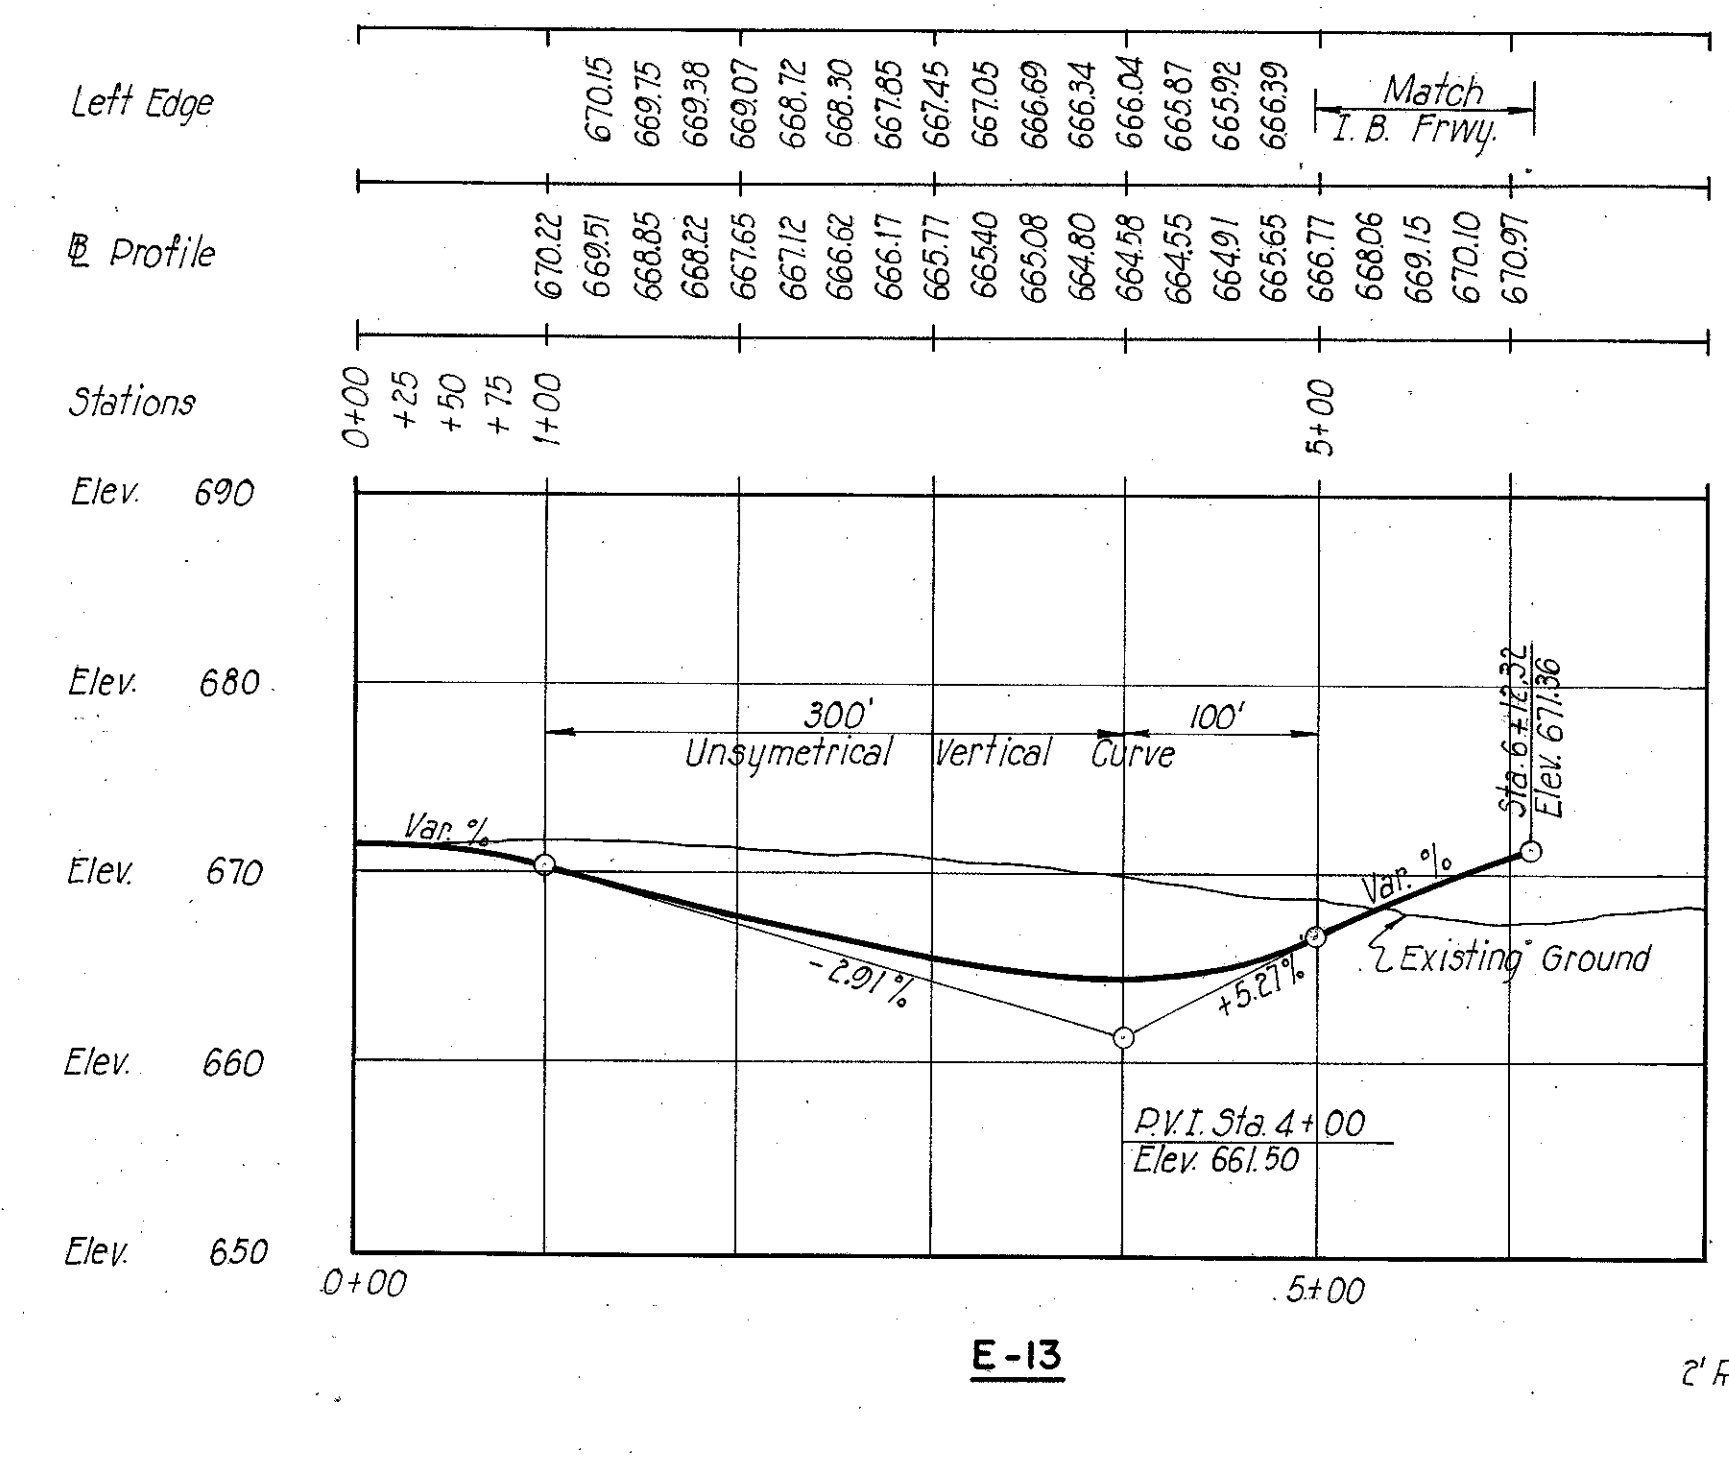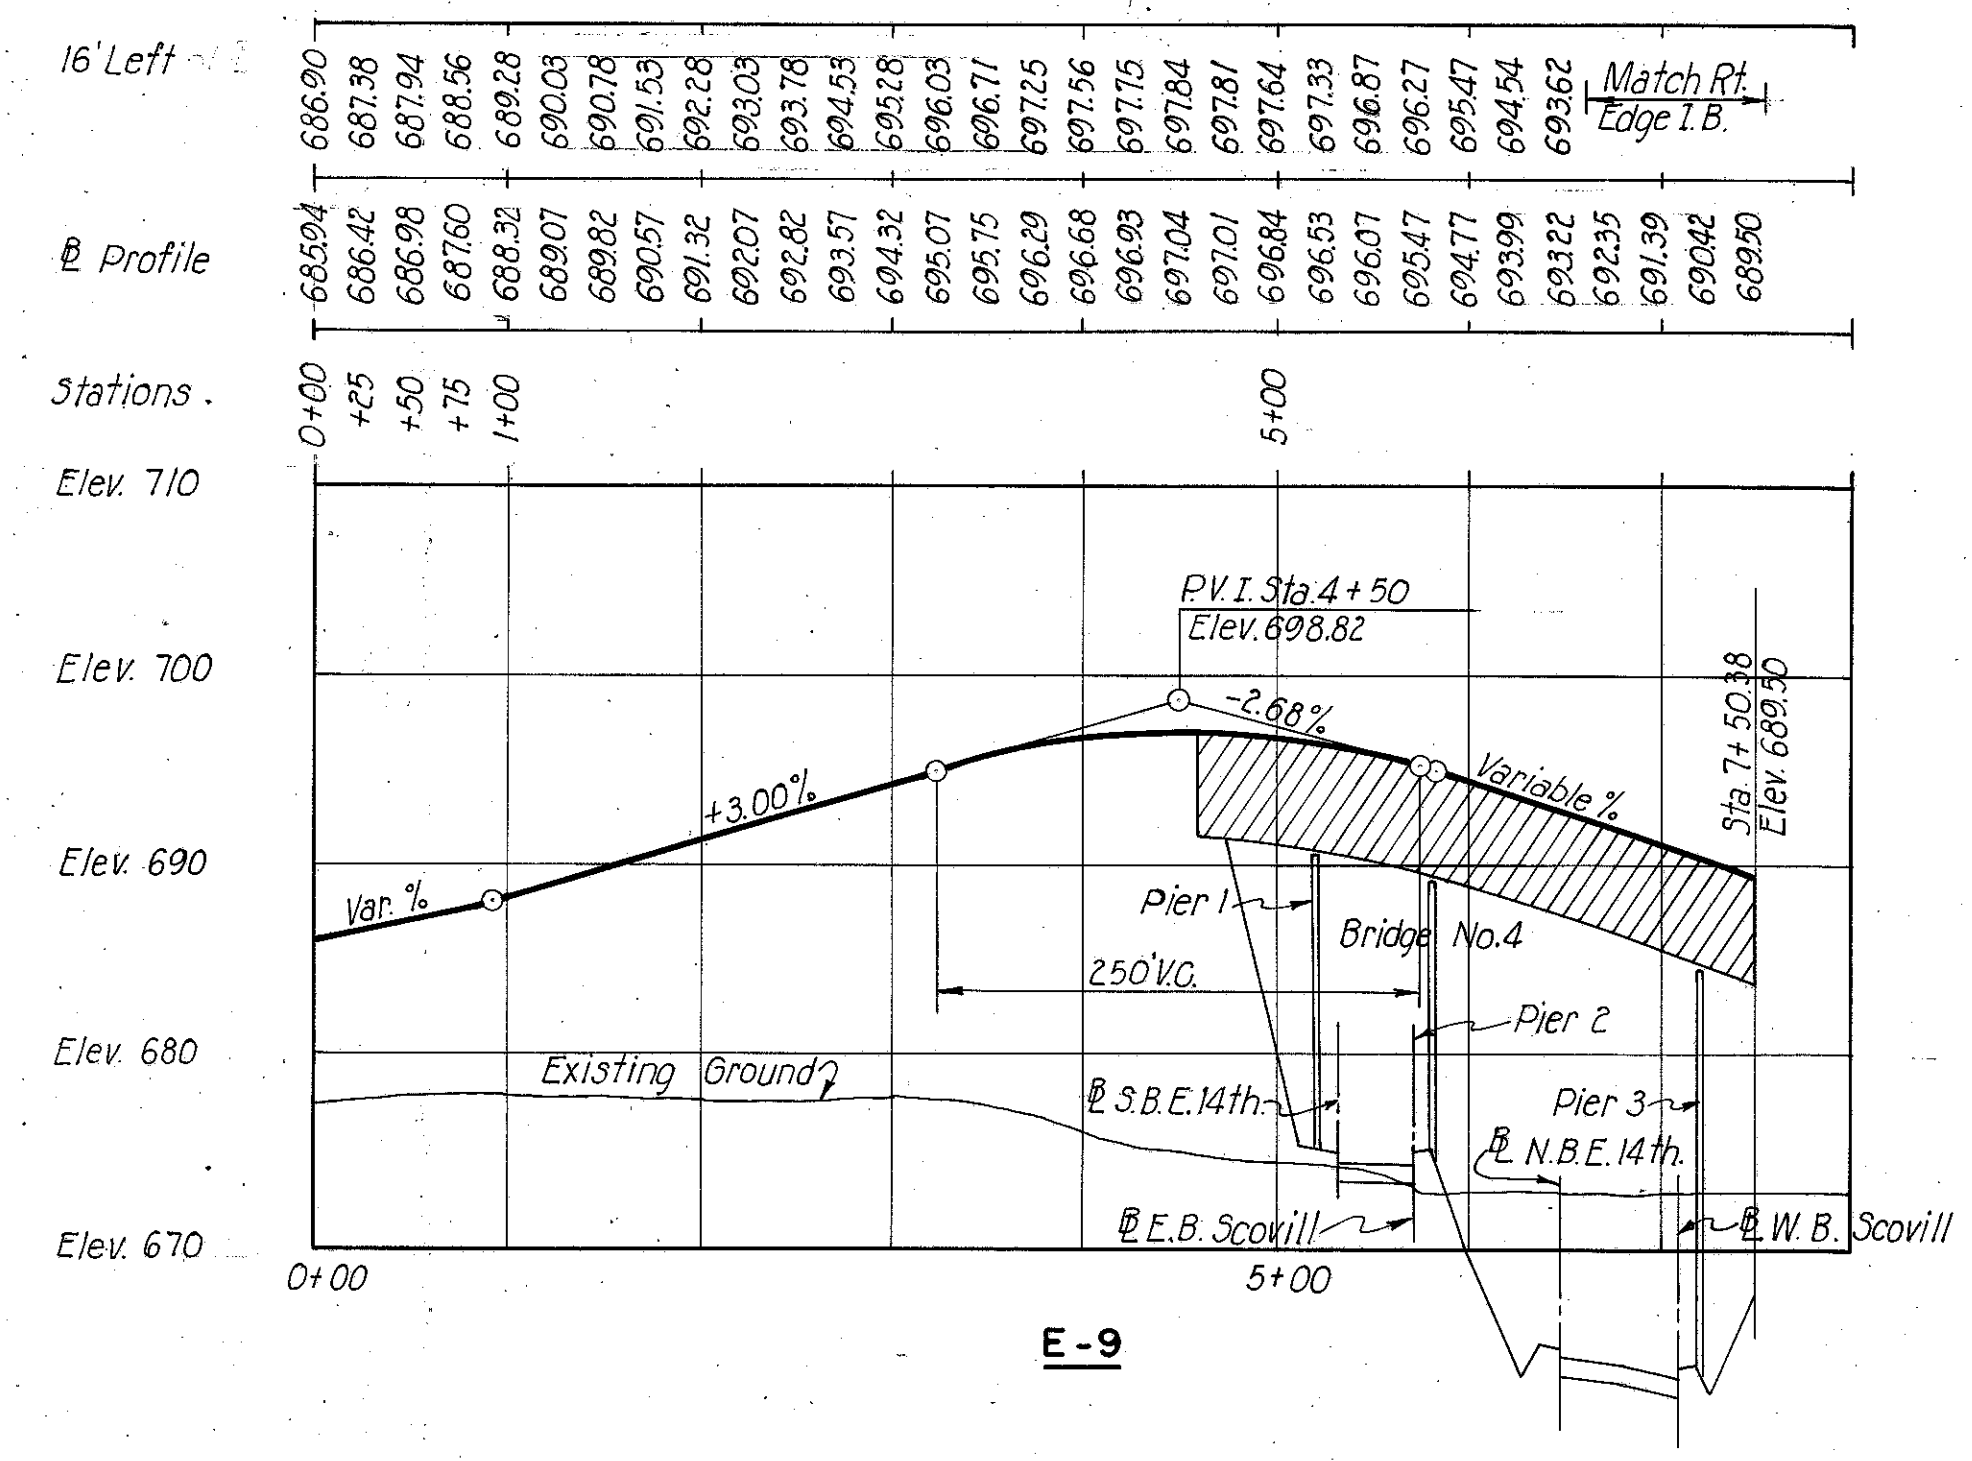


SCALE 1" = 10' Ver. : 1" = 100' Hor.
MADE DPH DATE 5-11-58 HOWARD, NEEDLES, TAMMEN & BERGENDOFF
TRCD. RR DATE 10-7-58 CONSULTING ENGINEERS
CKD. G.M.G. DATE 3/13/59 KANSAS CITY CLEVELAND NEW YORK
SHEET


CUYAHOGA COUNTY
CITY OF CLEVELAND
INNER BELTWAY
CUY-42-18-42
CUY-21-15-32
PROFILES

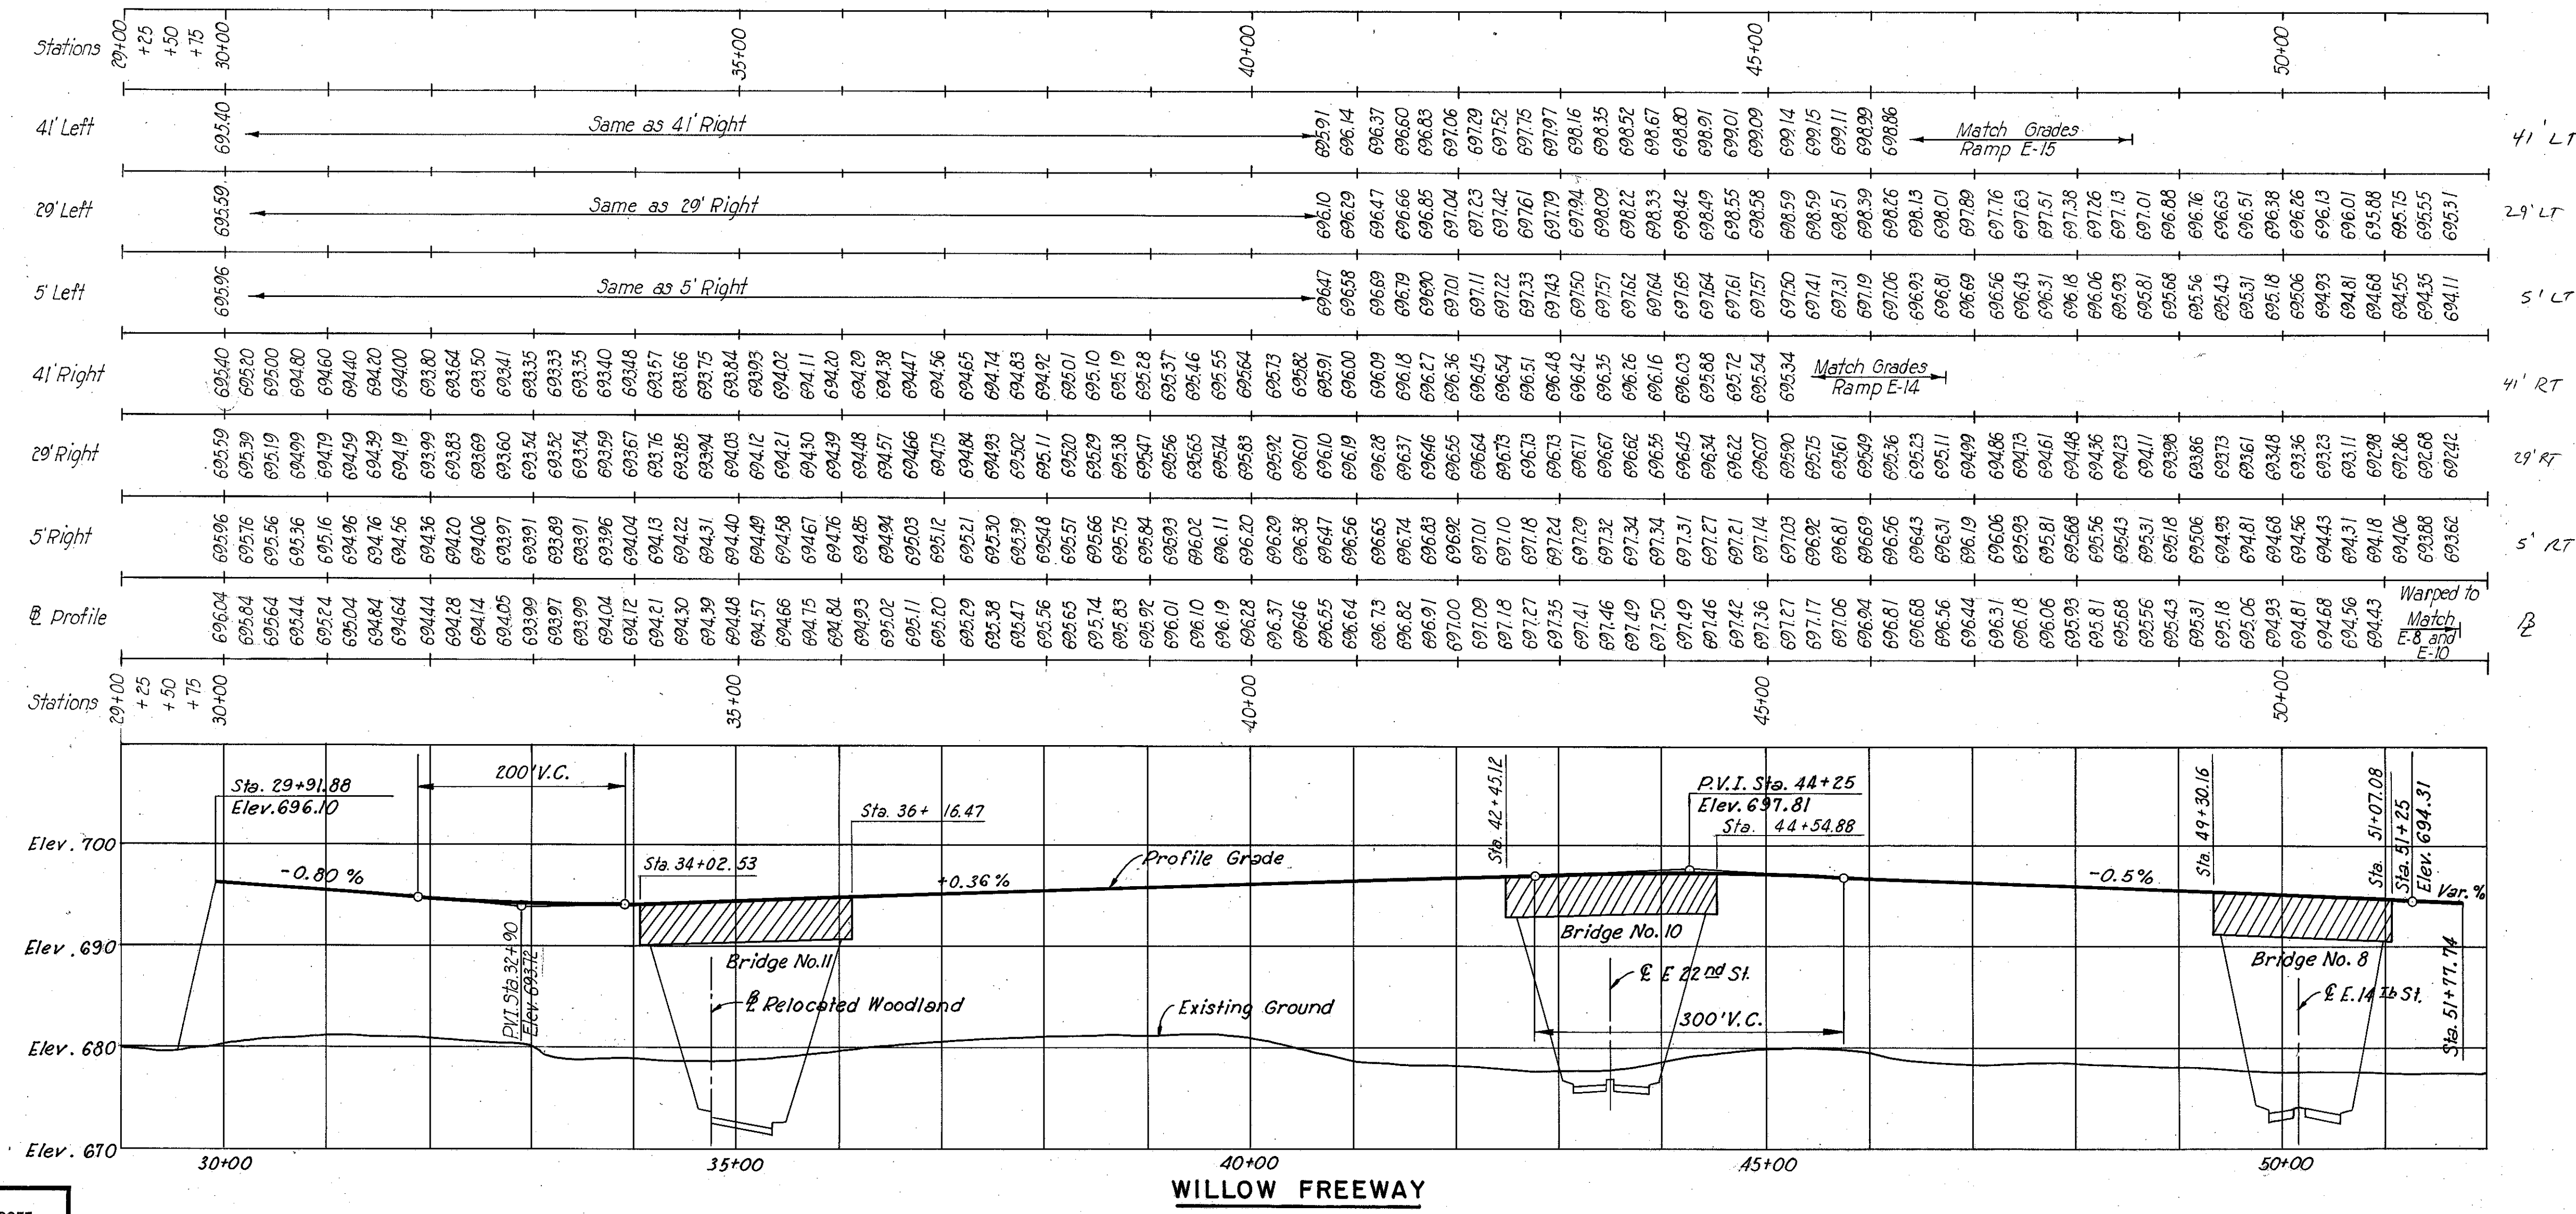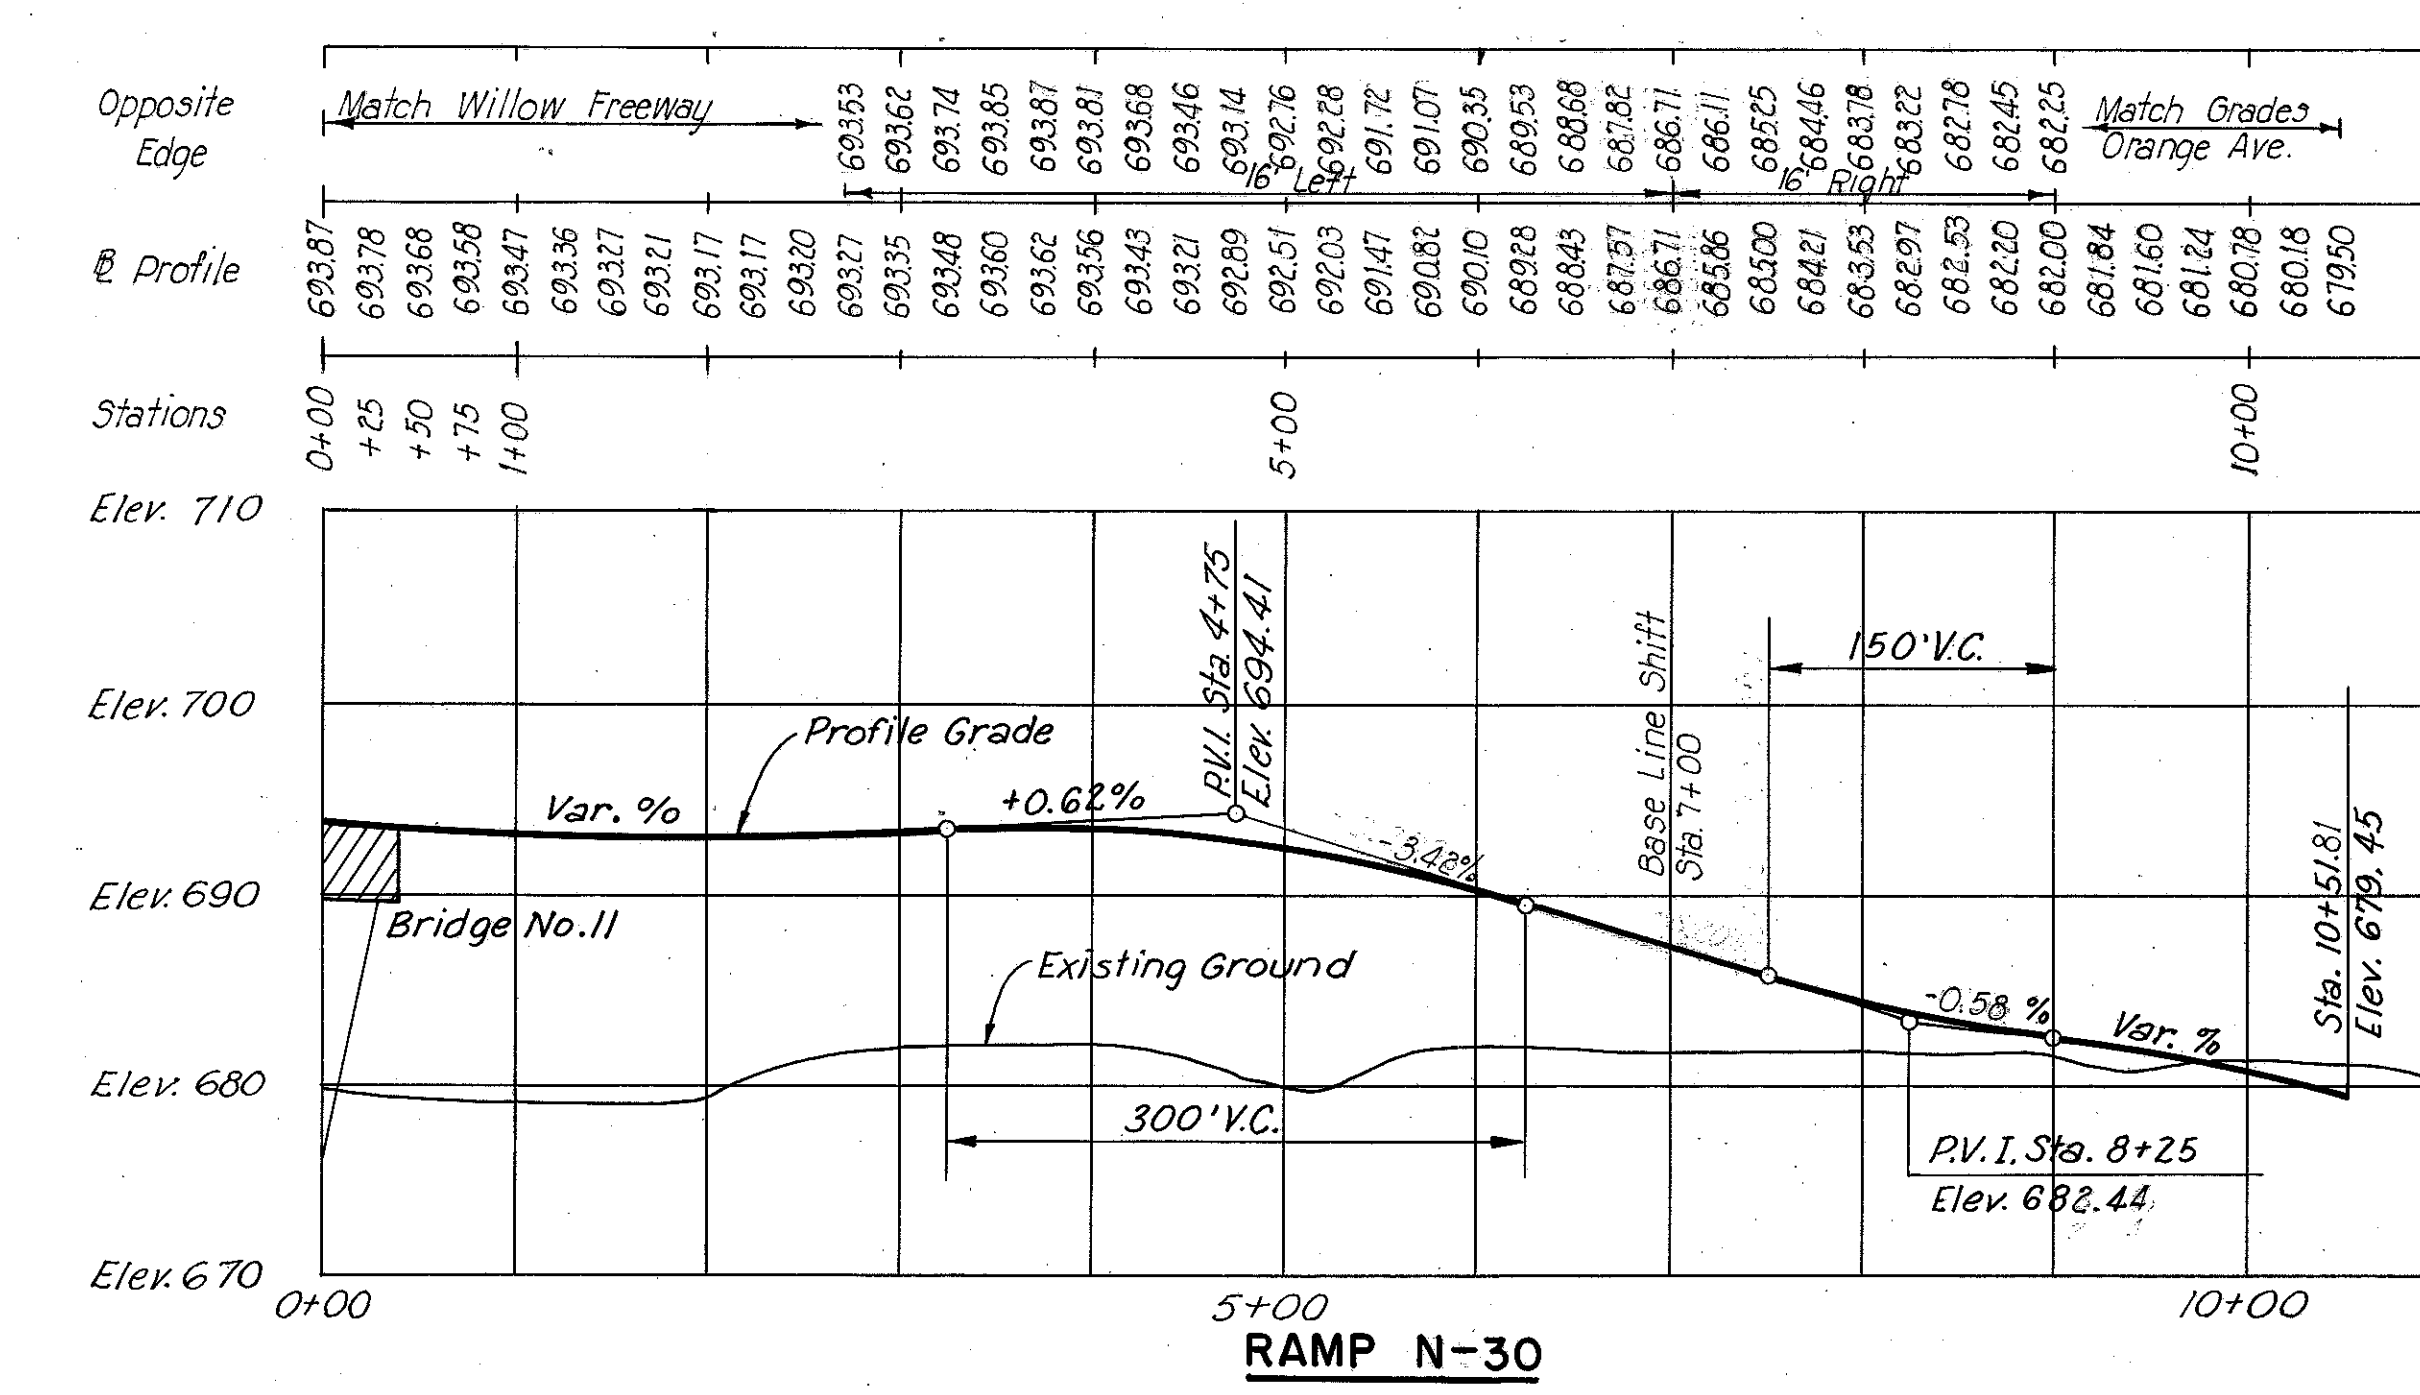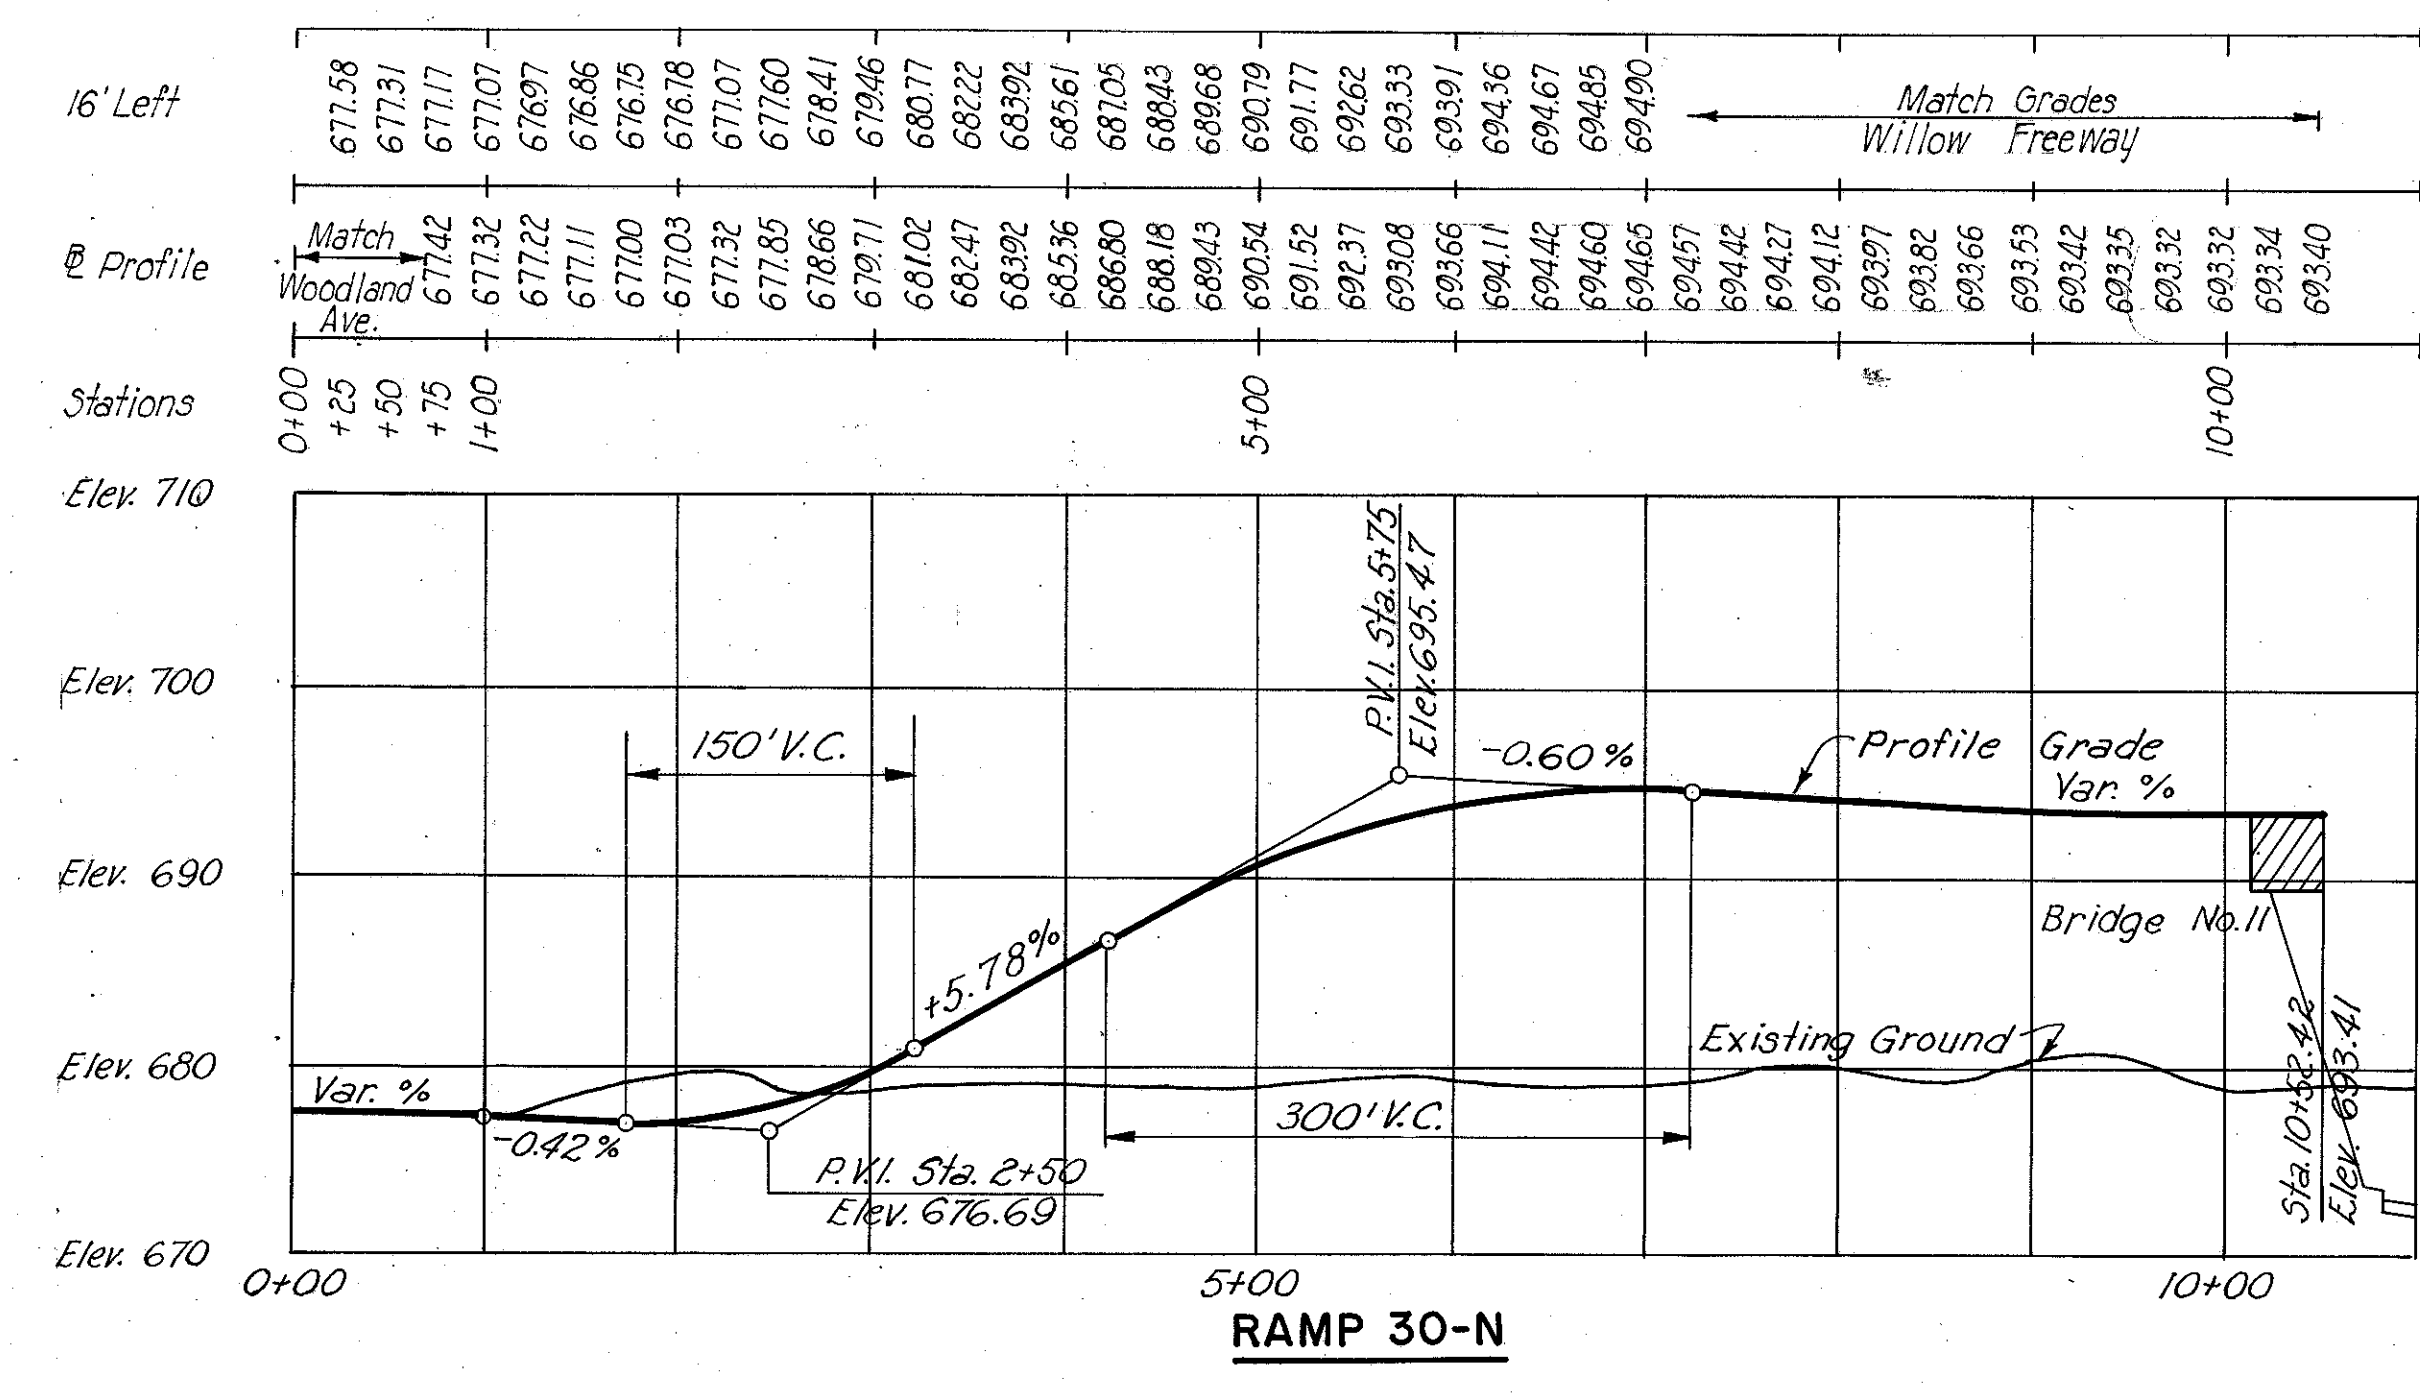


CUYAHOGA COUNTY
CITY OF CLEVELAND
CUY - 42-18.42
CUY - 21-15.32

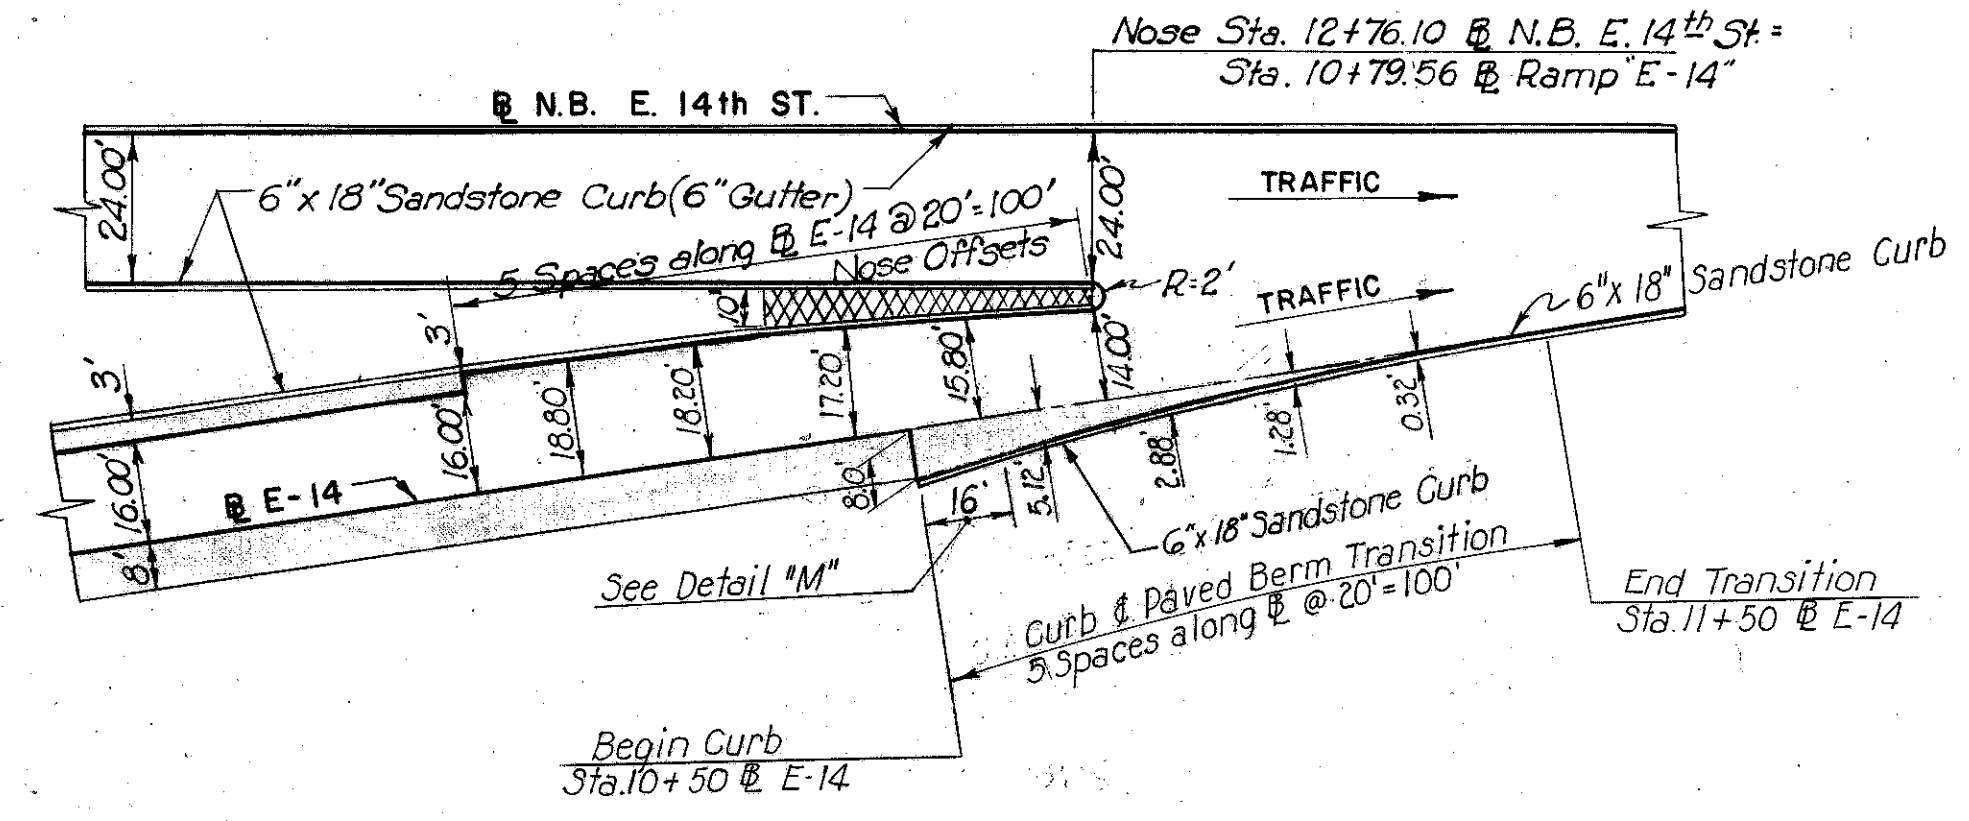


DETAIL "A"

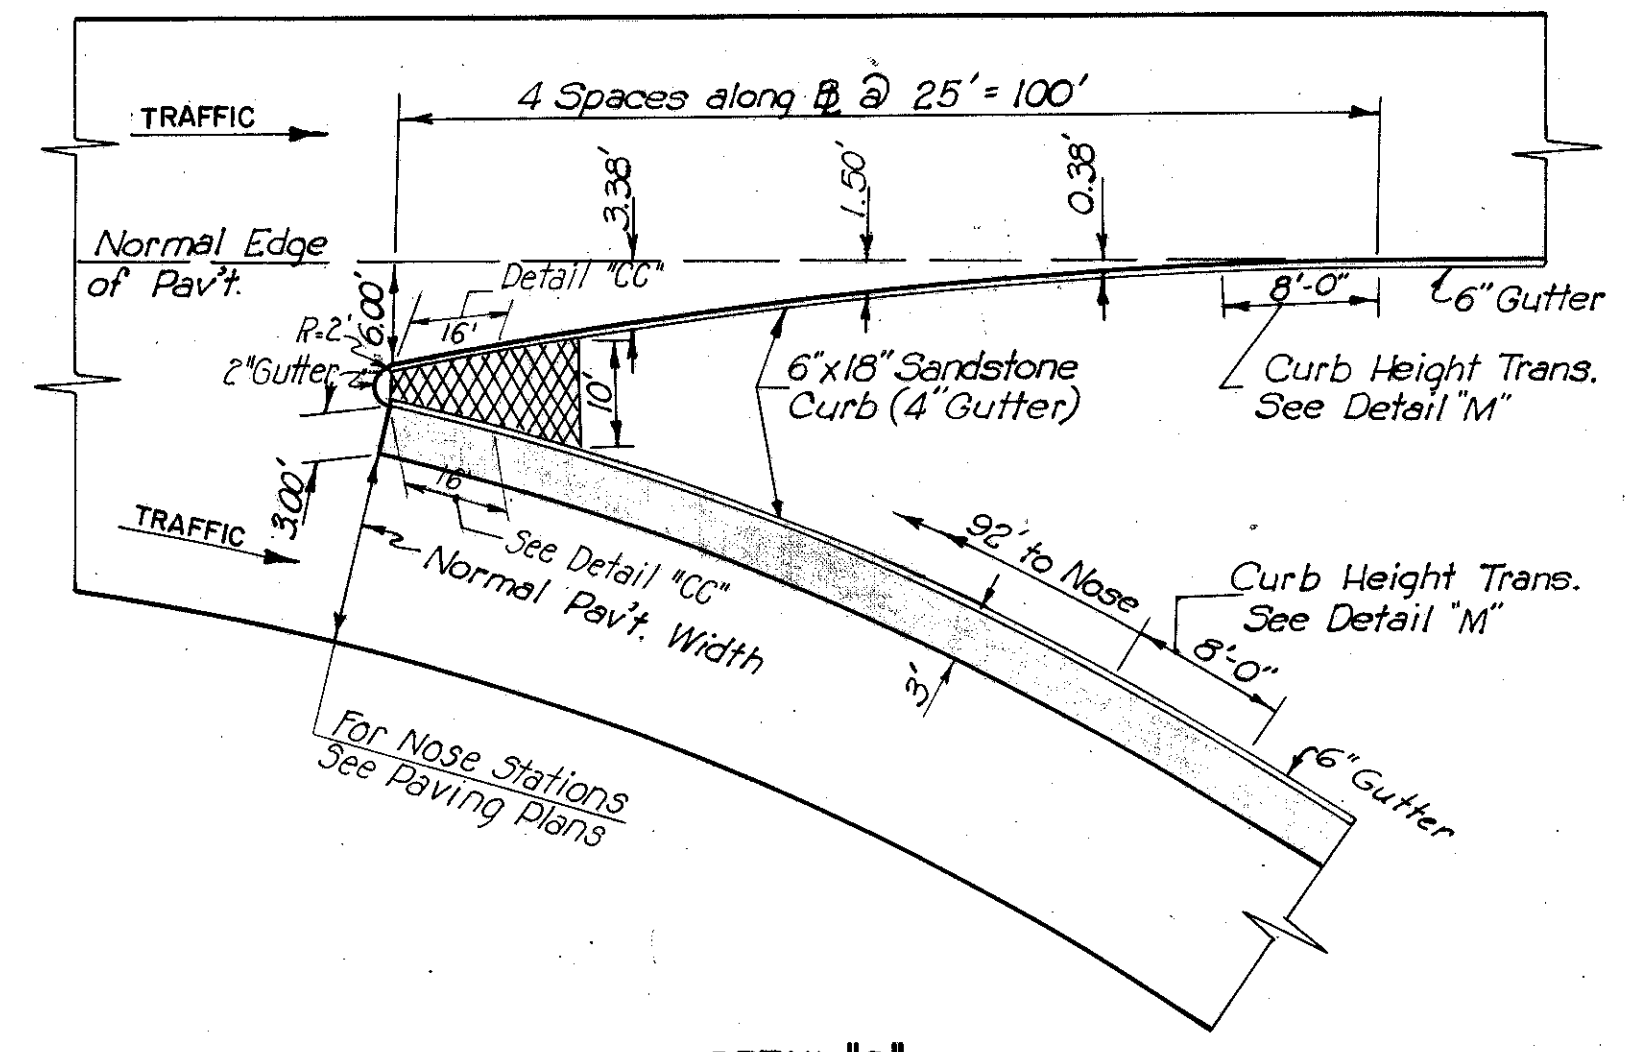


DETAIL "D"

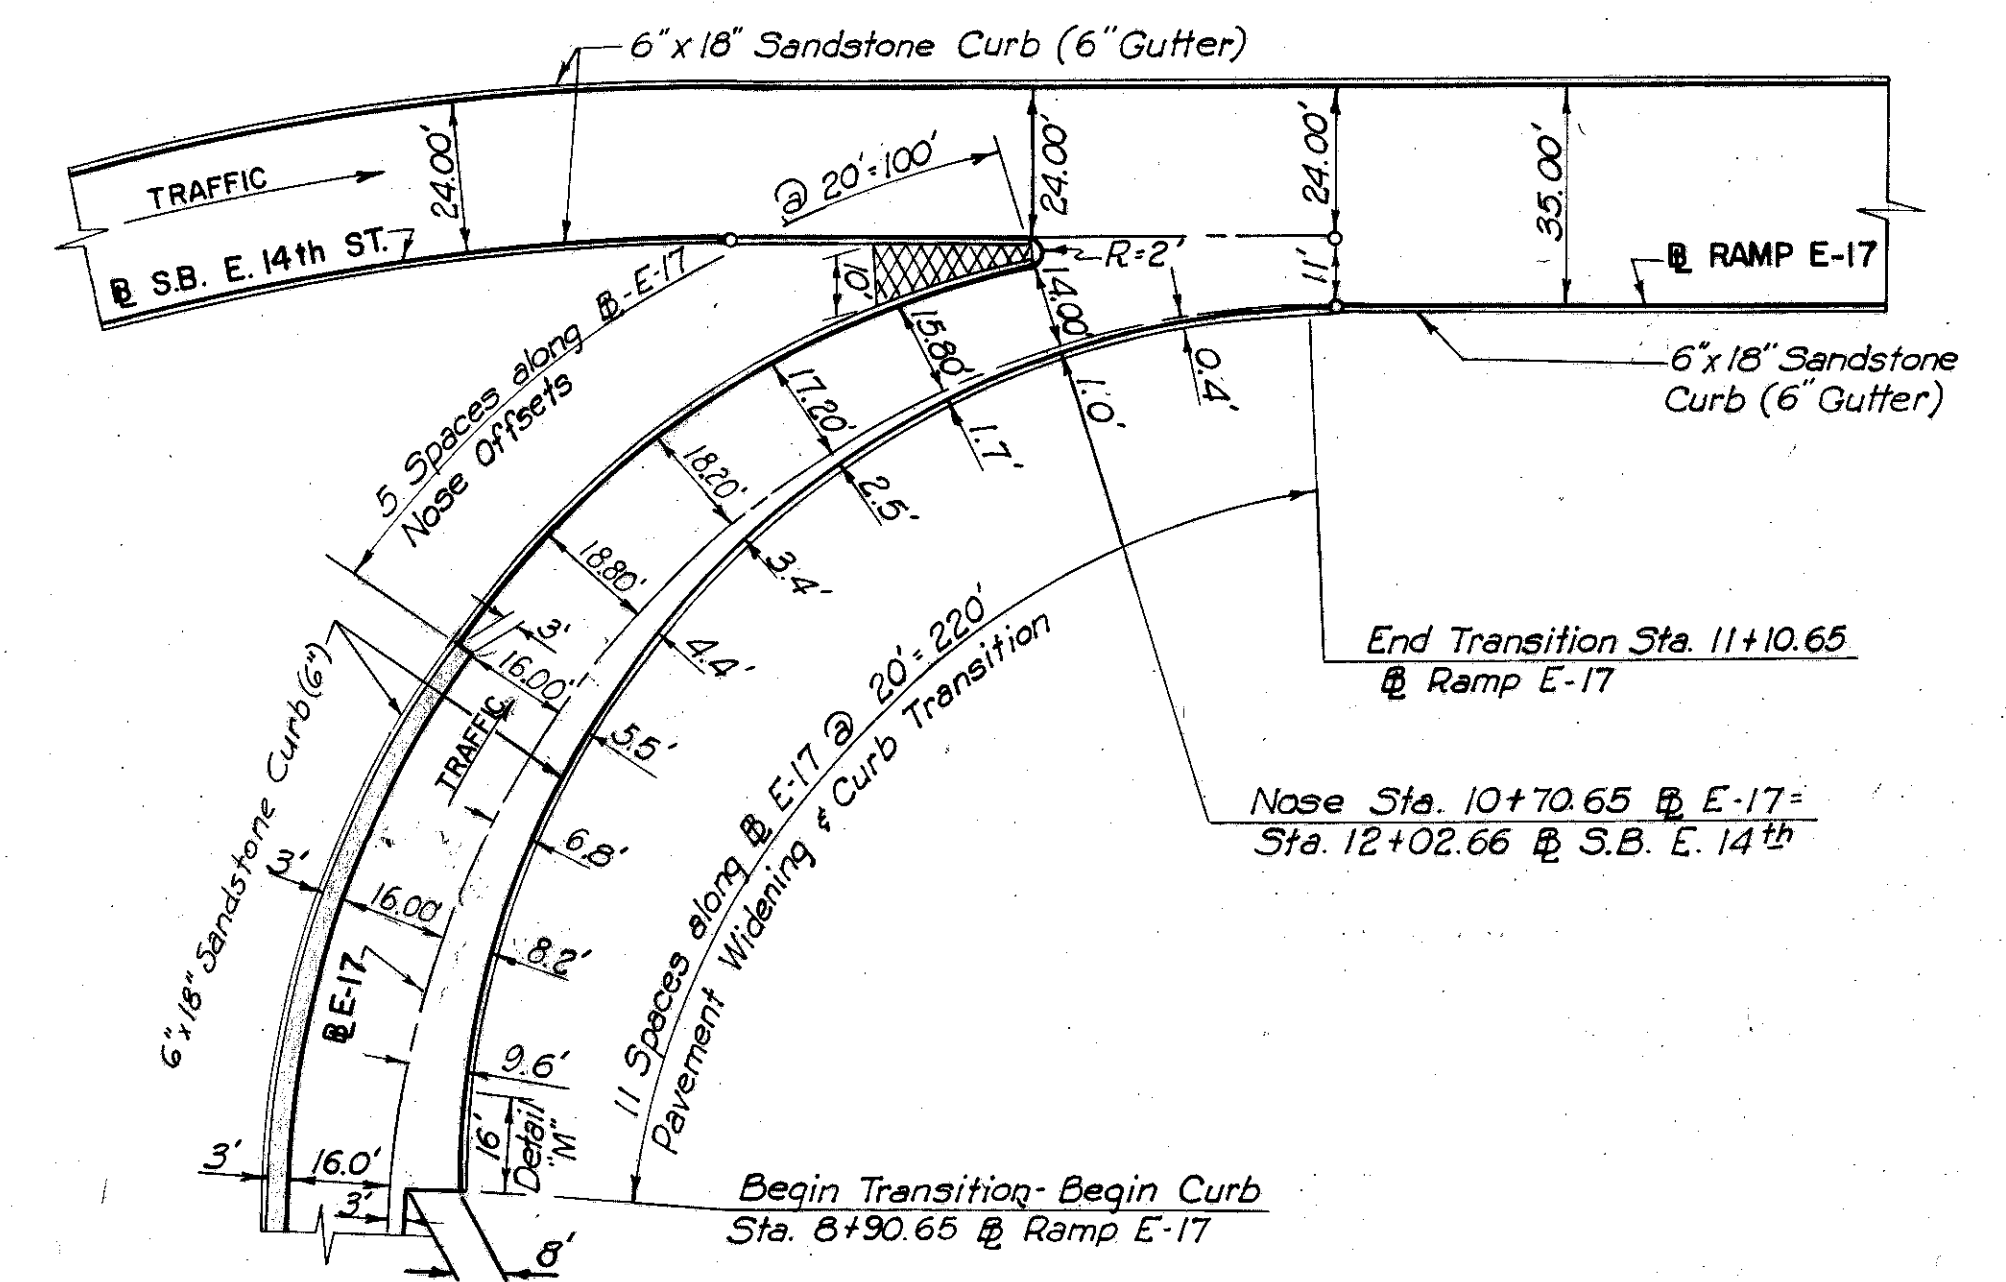


DETAIL "G"

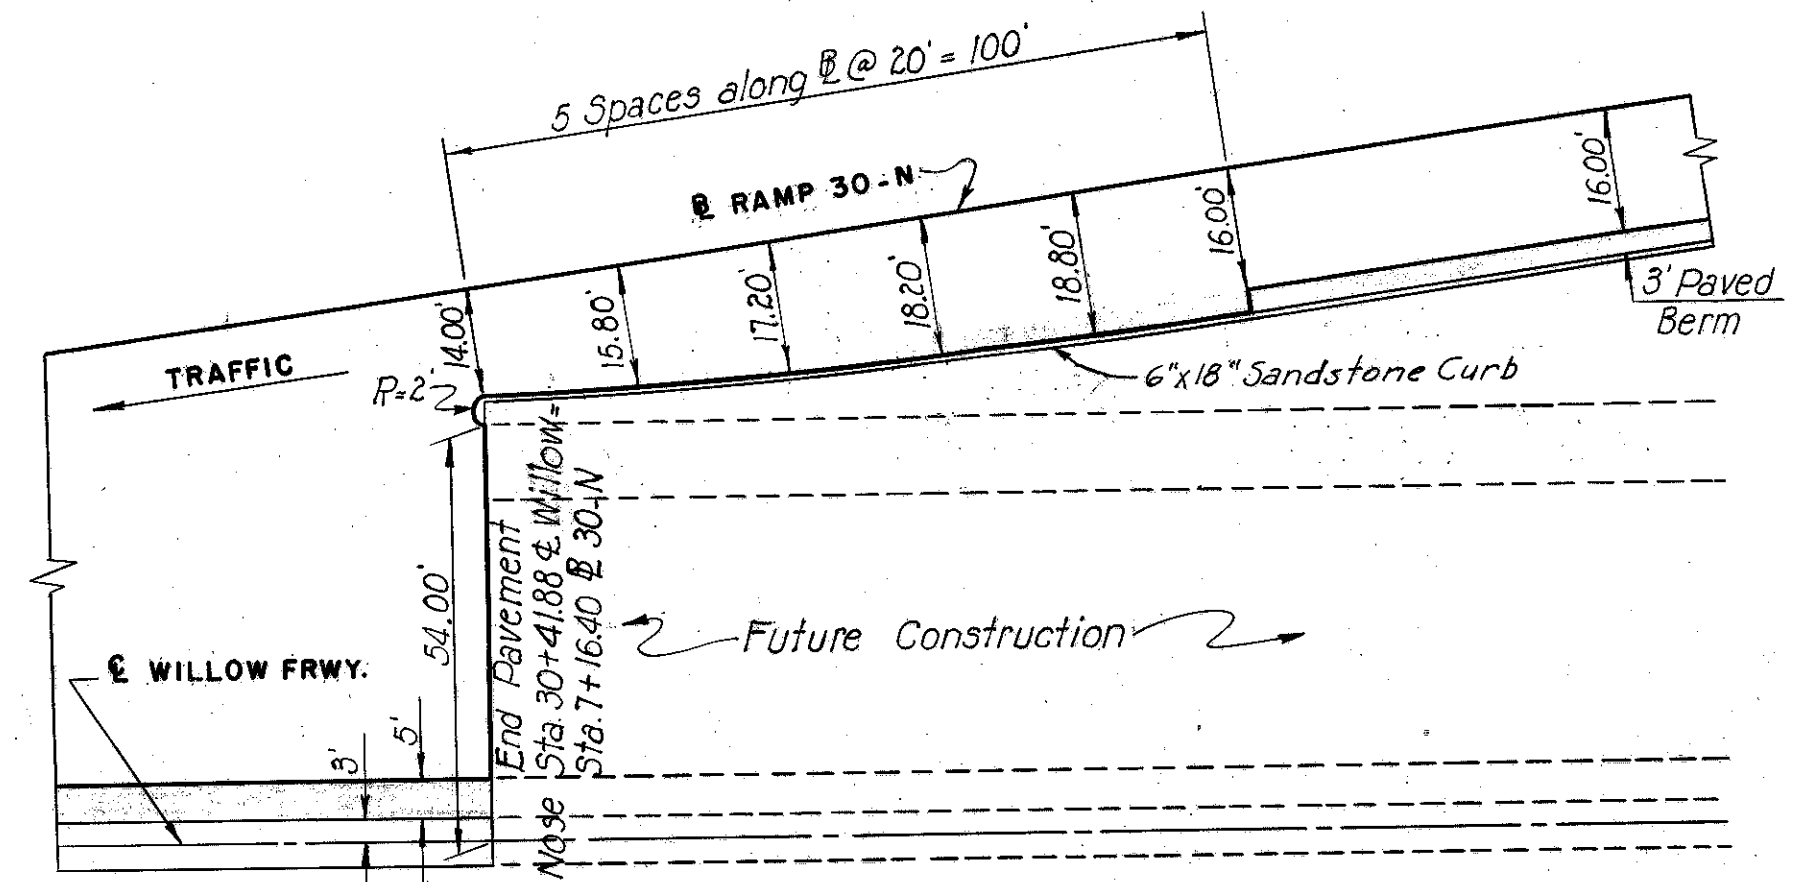


DETAIL "O"

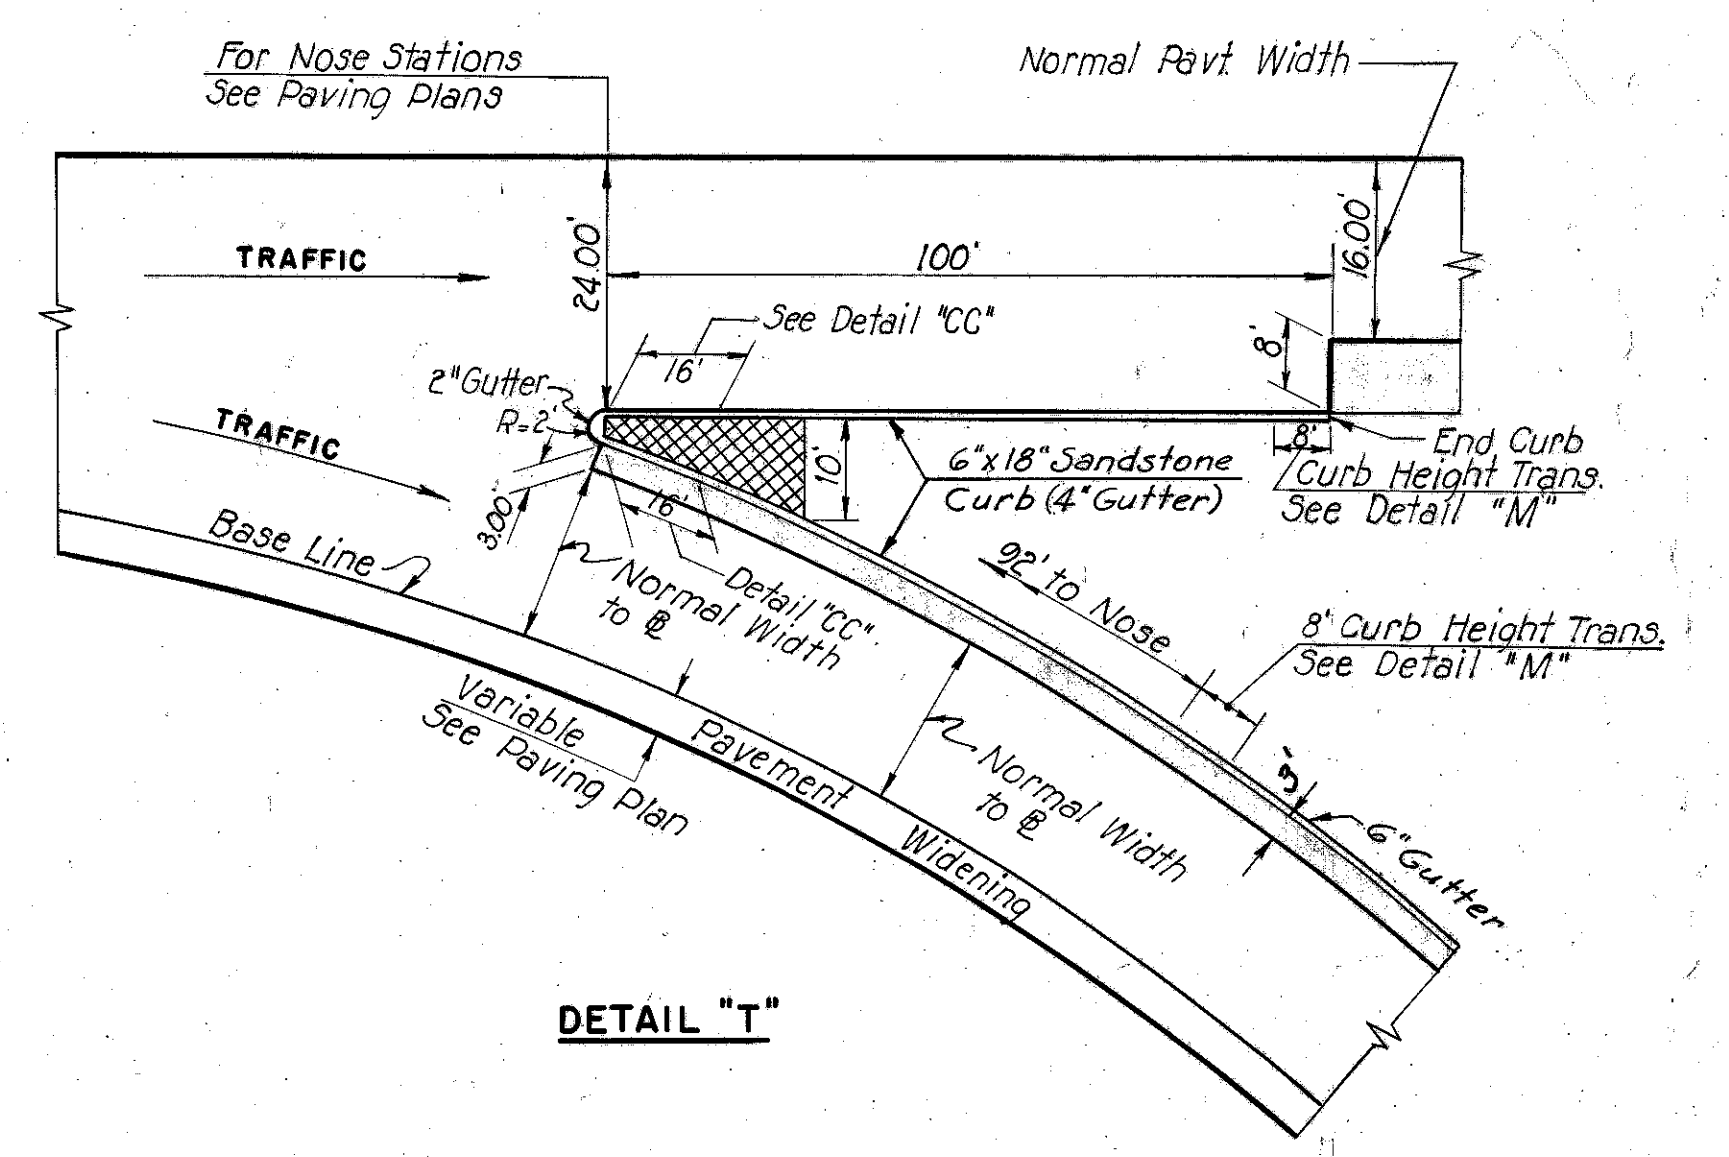

DETAIL "T"

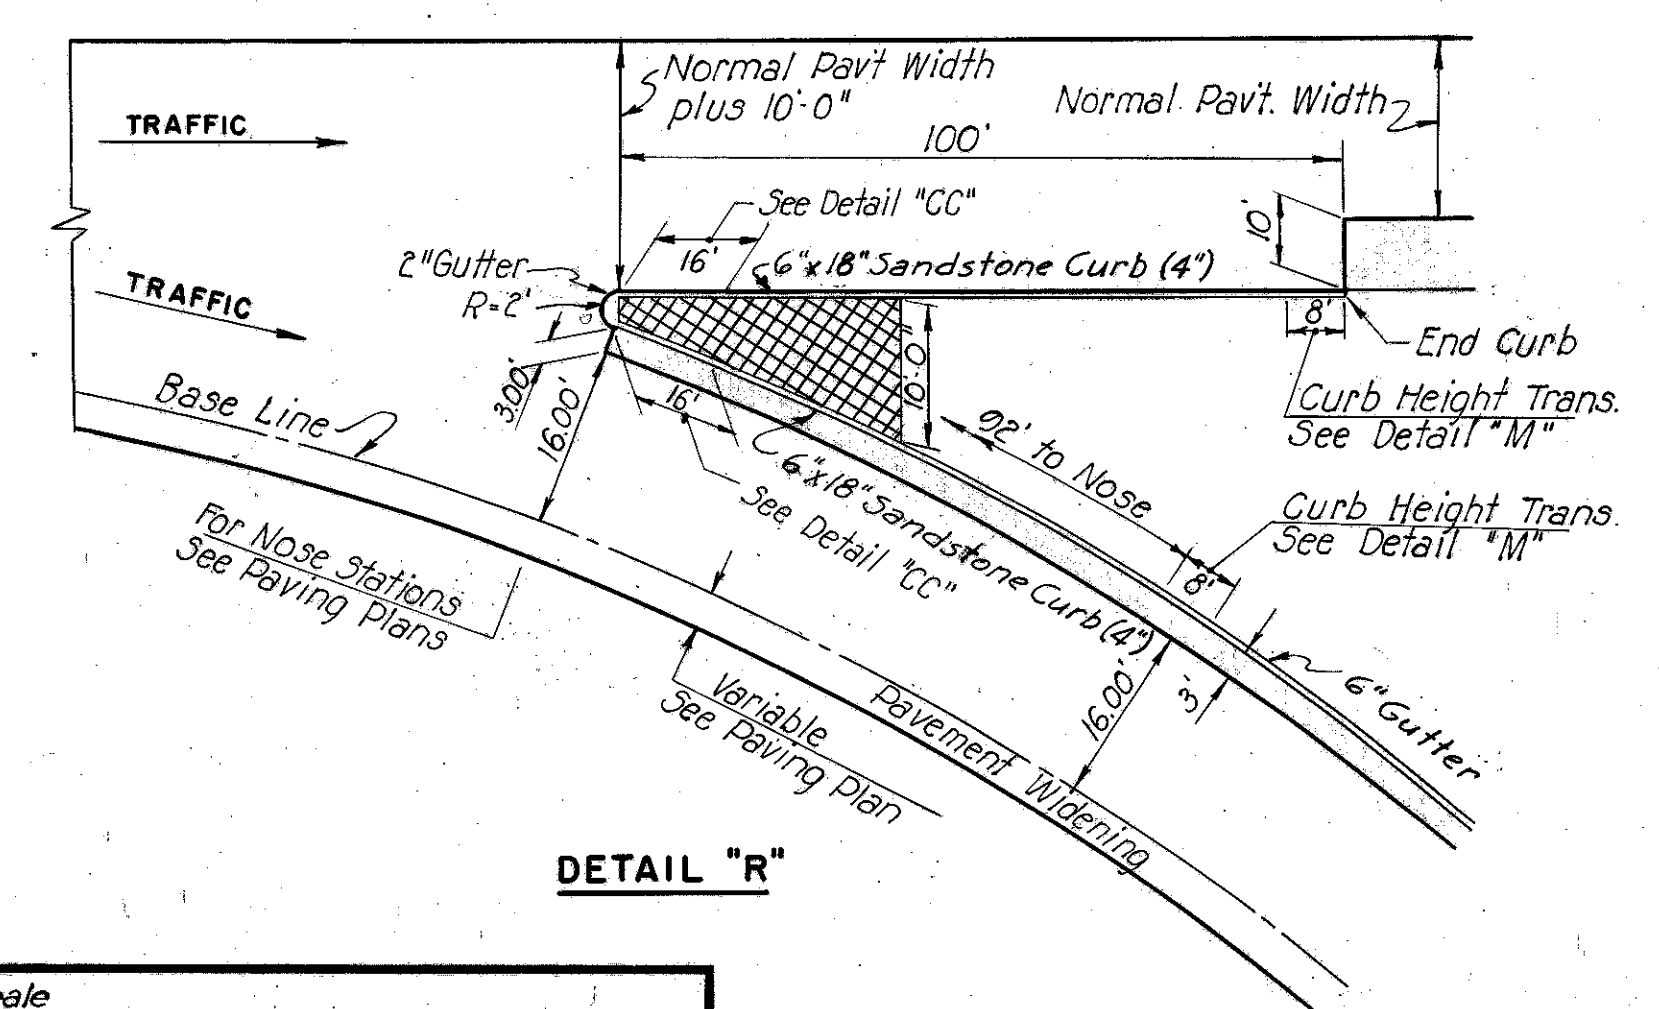

DETAIL "R"

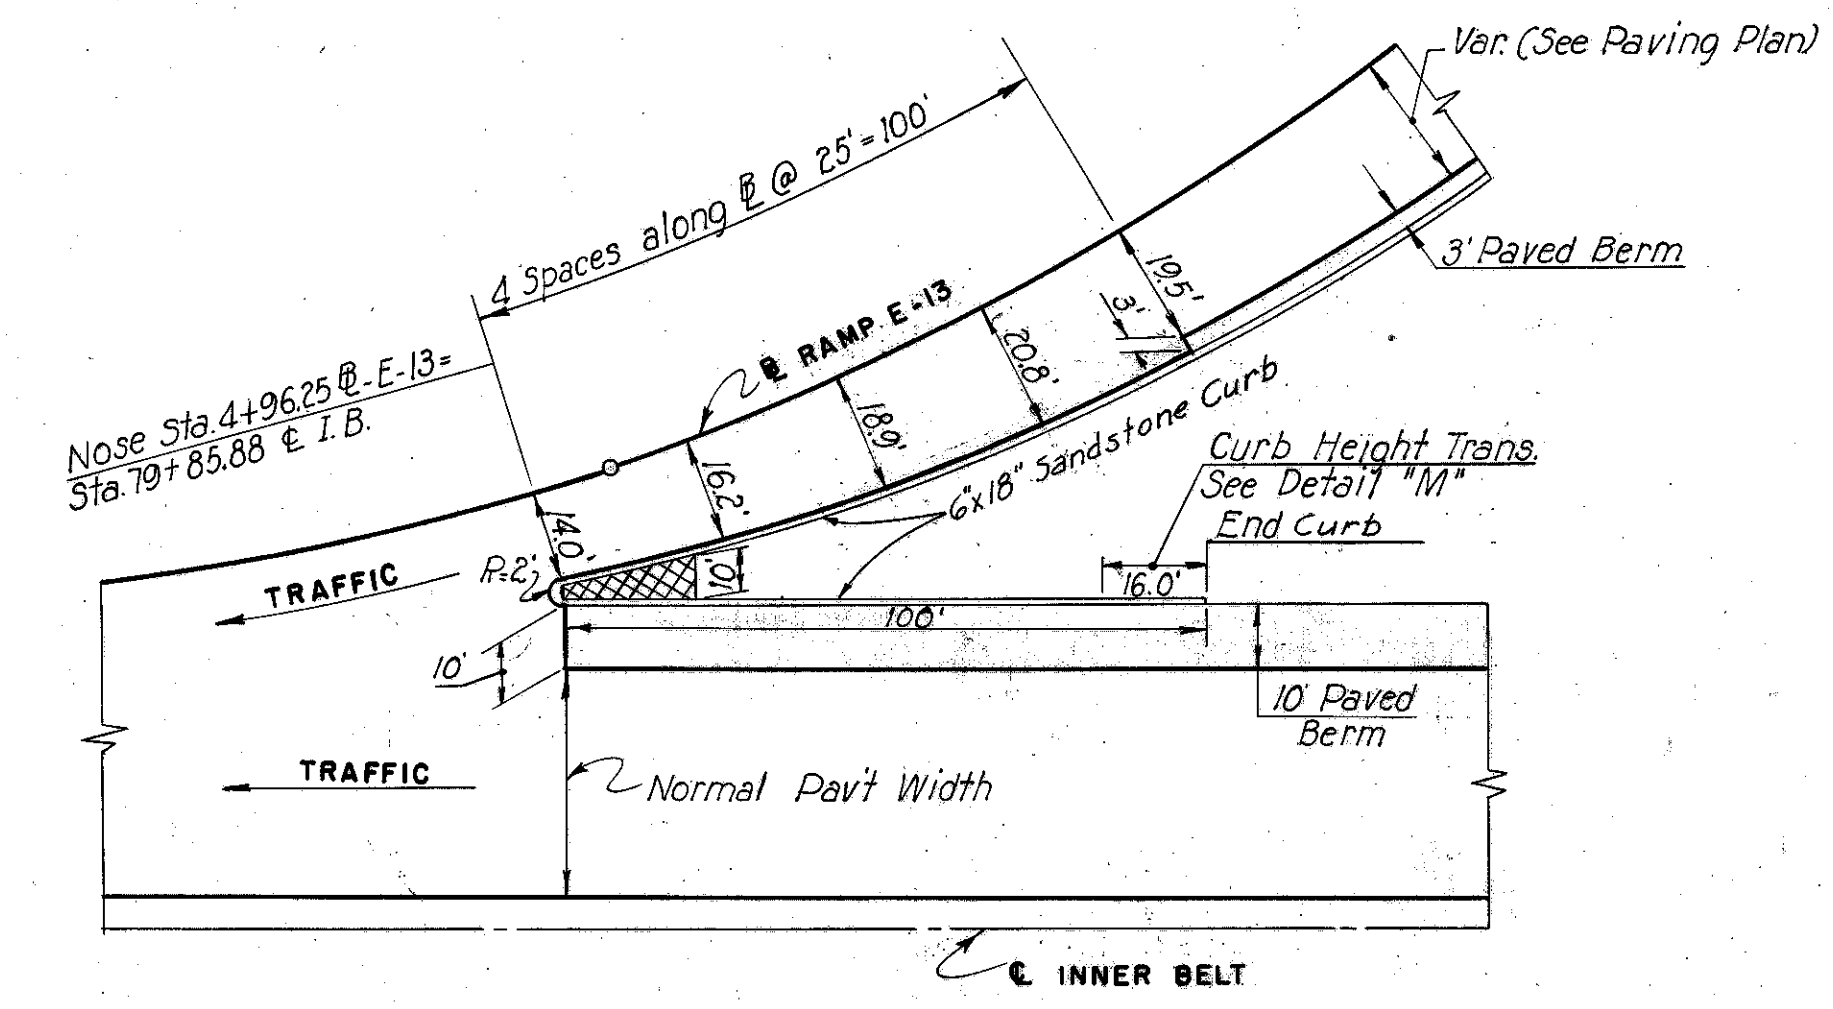

DETAIL "S"


LEGEND

I-21 Standard Type 1 Portland Cement Concrete Median Pavement.

Paved Berm.


NOSE DETAILS
A, D, G, O, R, S & T

CUYAHOGA COUNTY
CITY OF CLEVELAND
INNER CUYAHOGA FREEWAY - PART
CUY-42-18.42
CUY-21-15.32

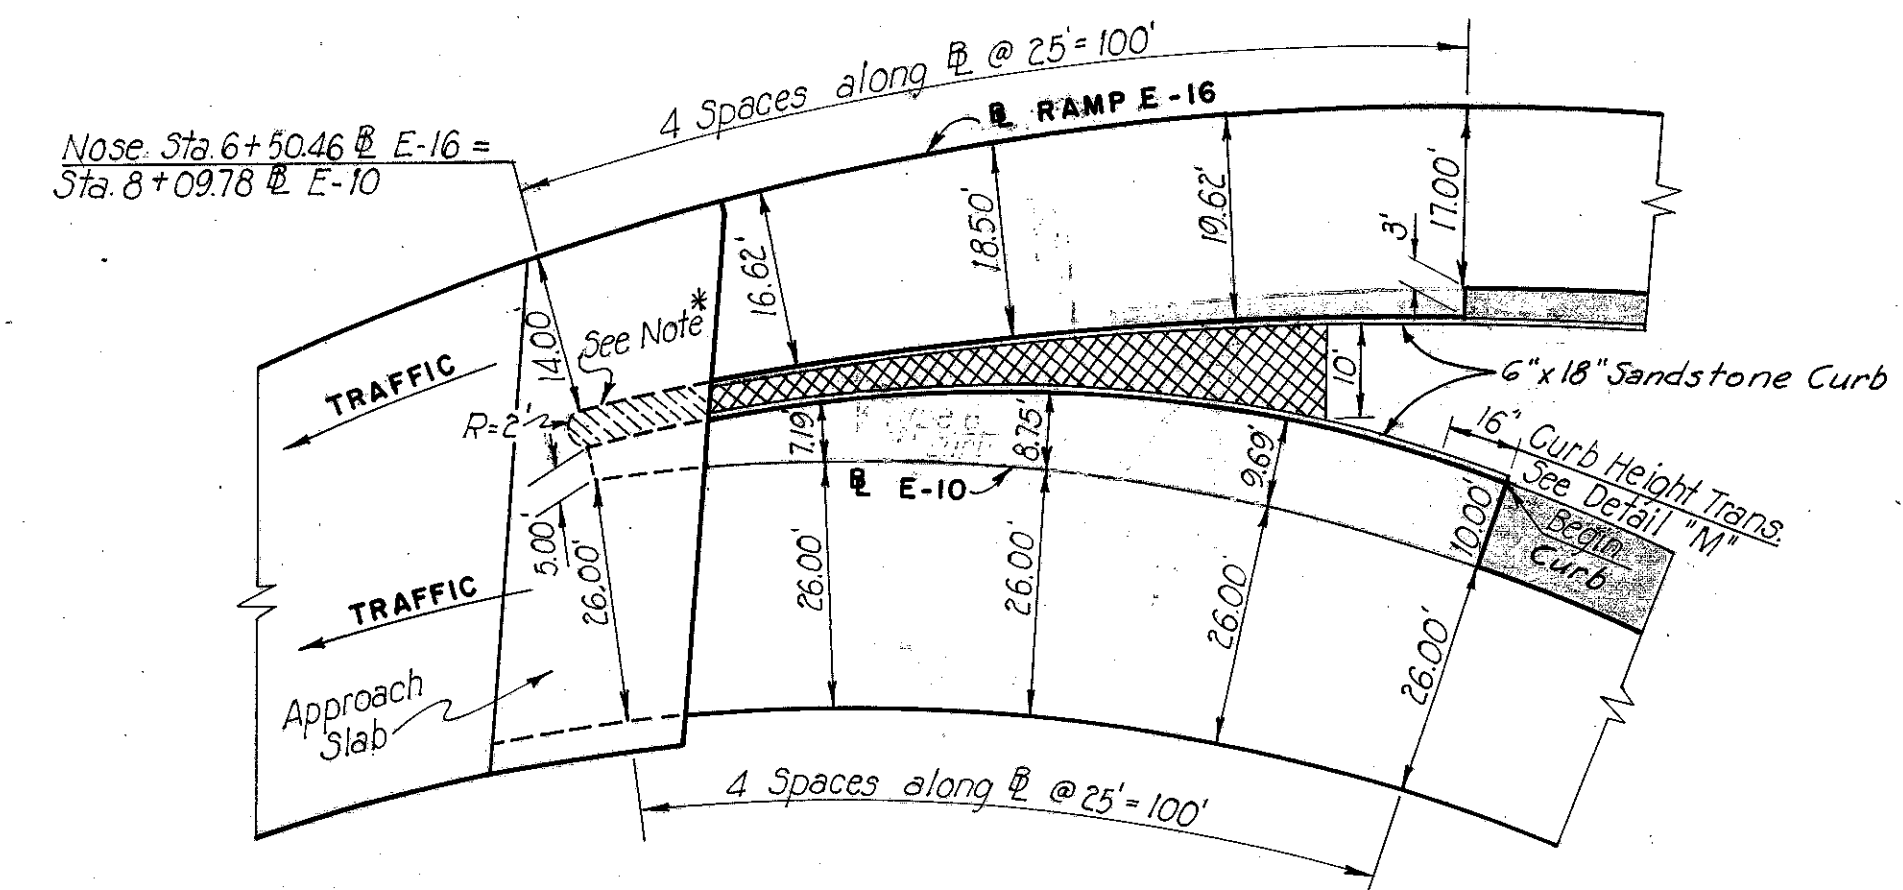


*Note:
6" Concrete median and nose to be placed on top of Approach Slab and anchored with eight (8), #5 round, straight bars, nine (9) inches long, imbedded in Approach Slab to a depth of six (6) inches. Bars to be uniformly spaced throughout median. All the above to be included for payment in the price bid for Item I-7, Approach Slabs.


DETAIL "U"
Not to Scale

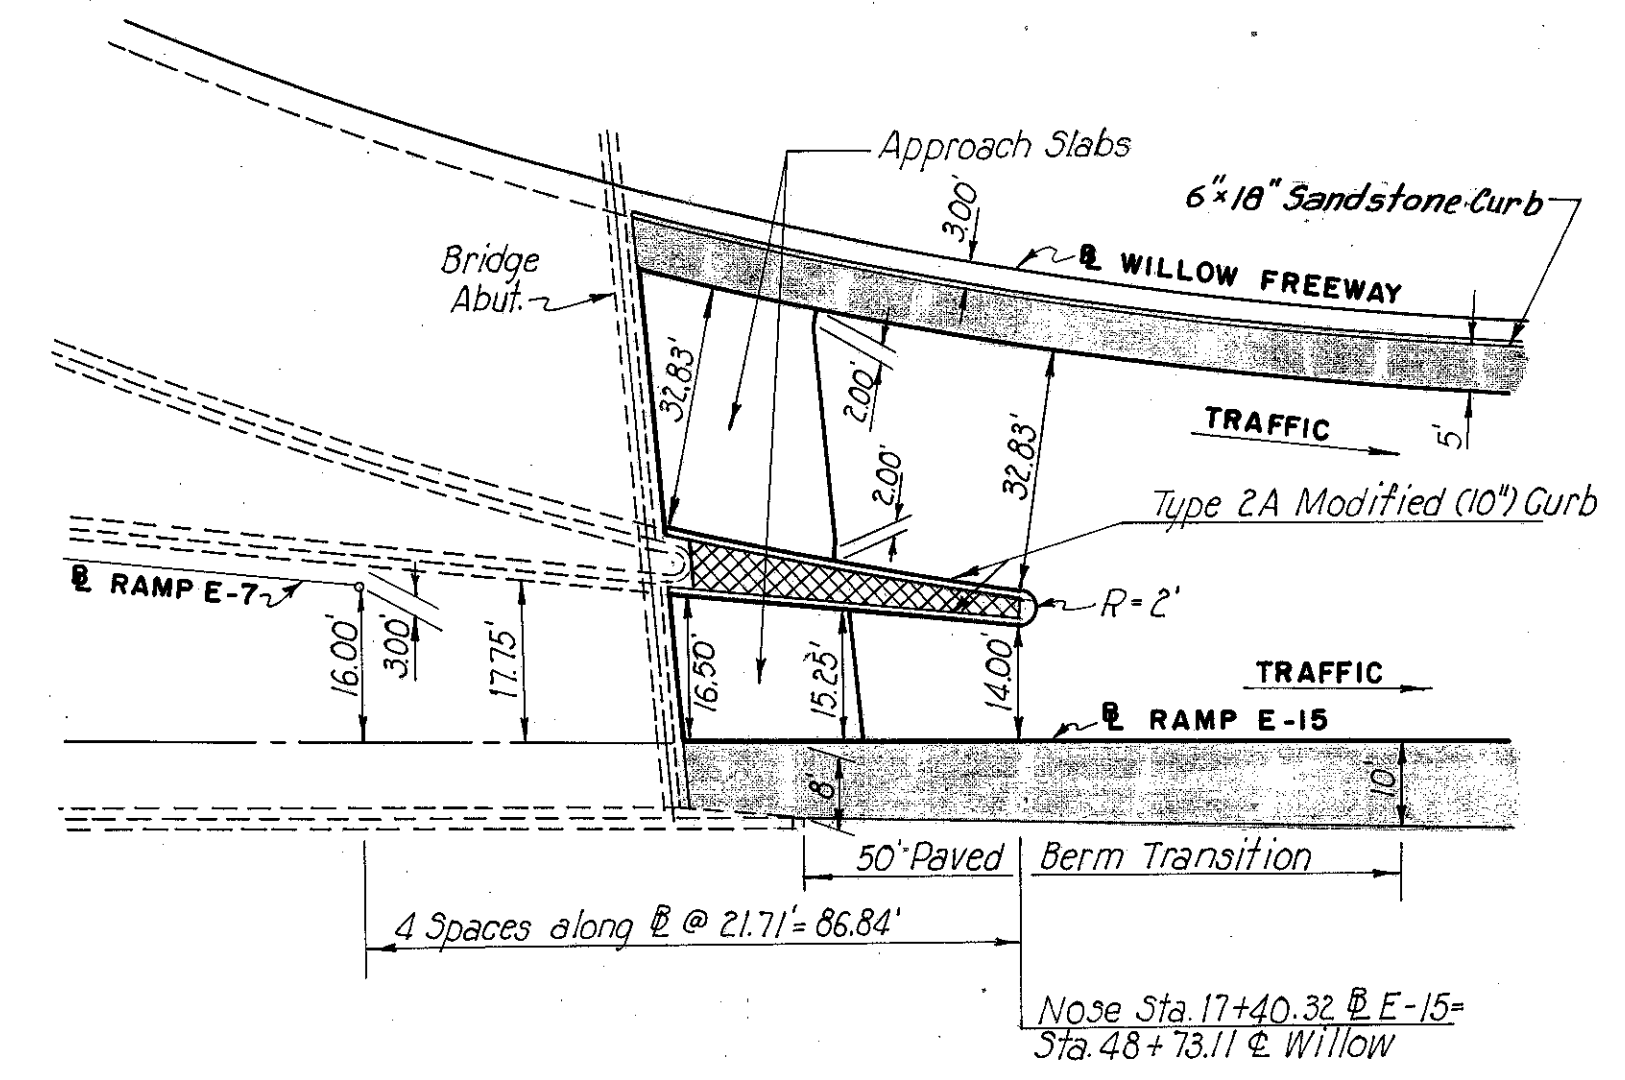


DETAIL "X"
Not to Scale

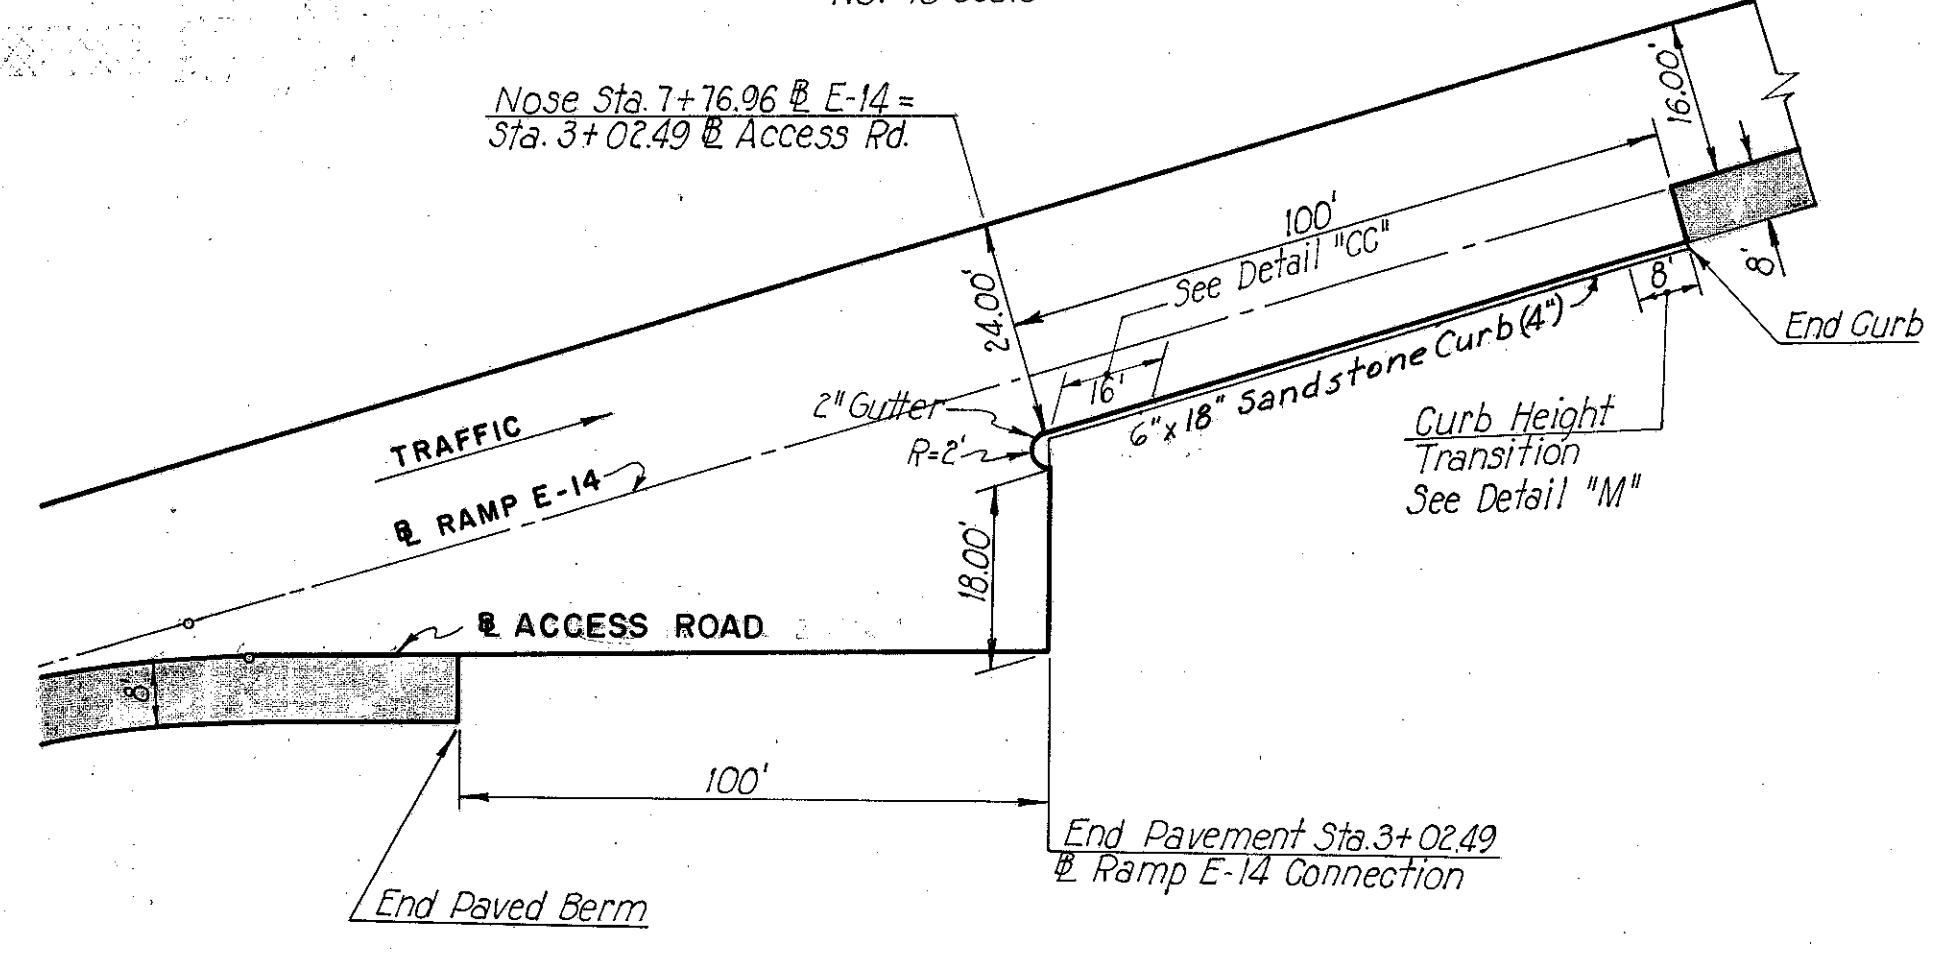


DETAIL "V"
Not to Scale

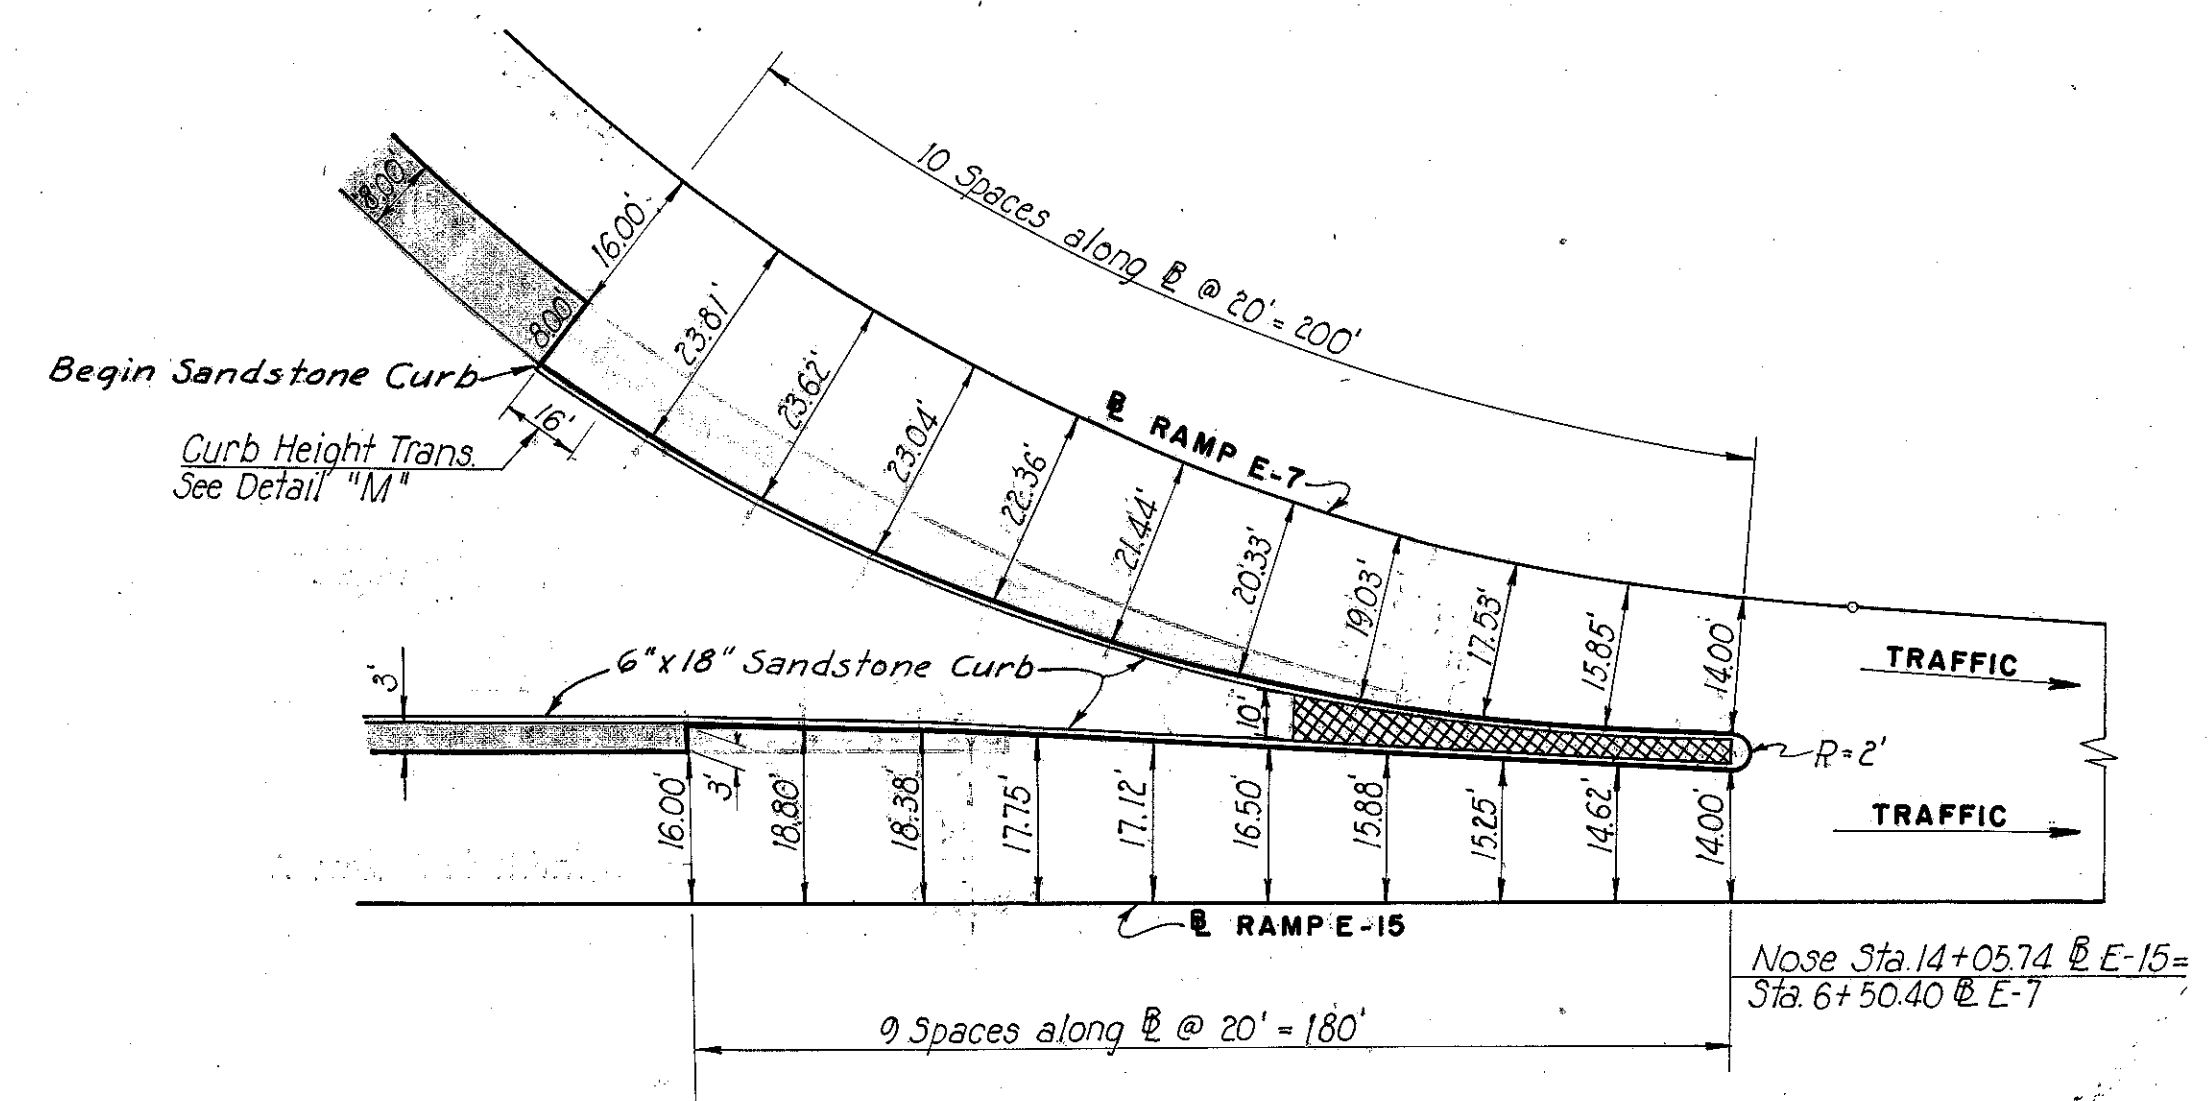


DETAIL "Y"
Not to Scale

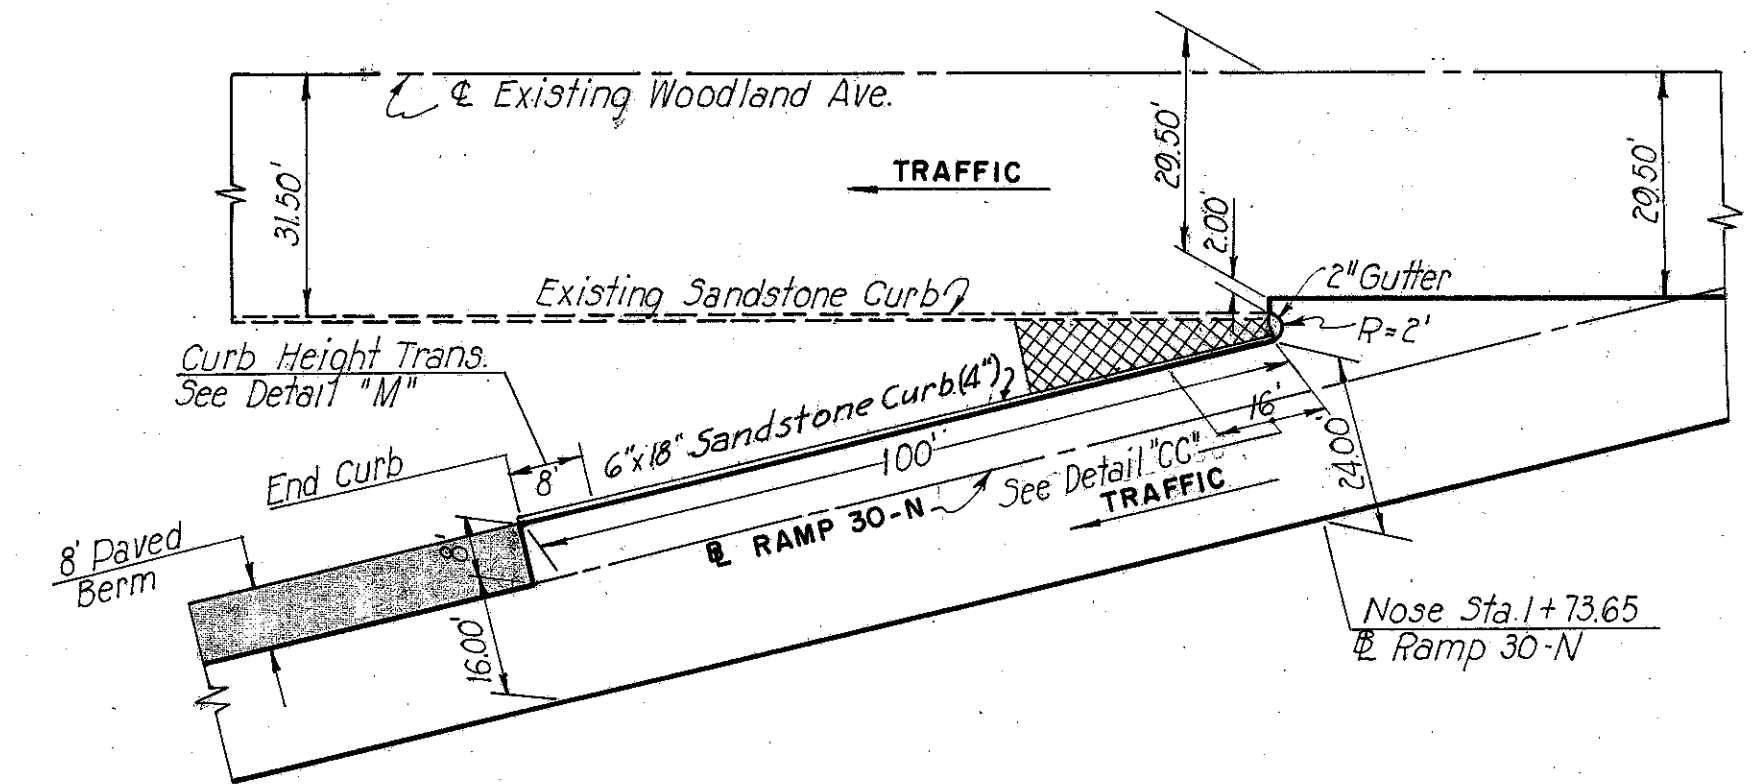

DETAIL "BB"
Not to Scale

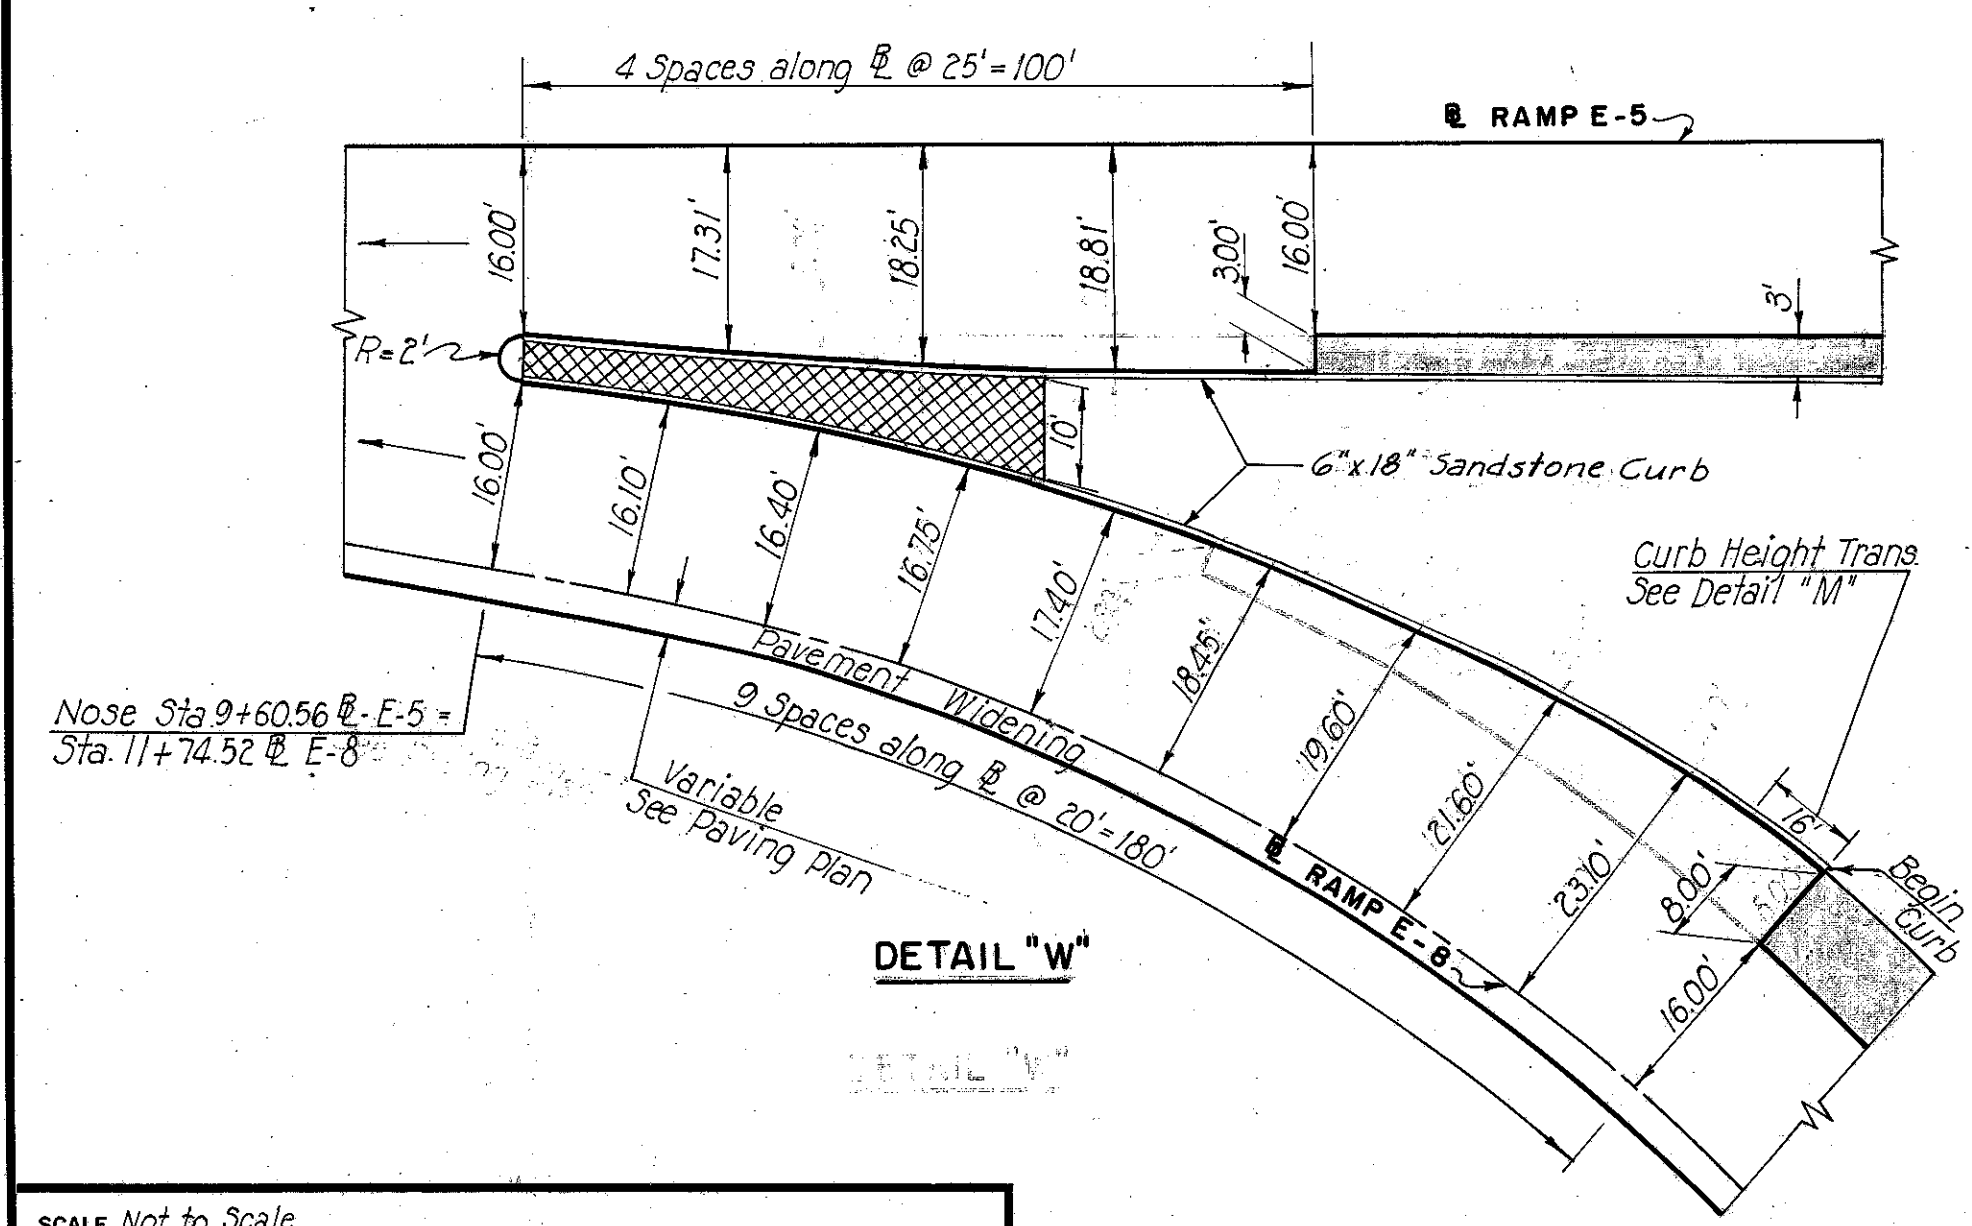

DETAIL "W"
Not to Scale

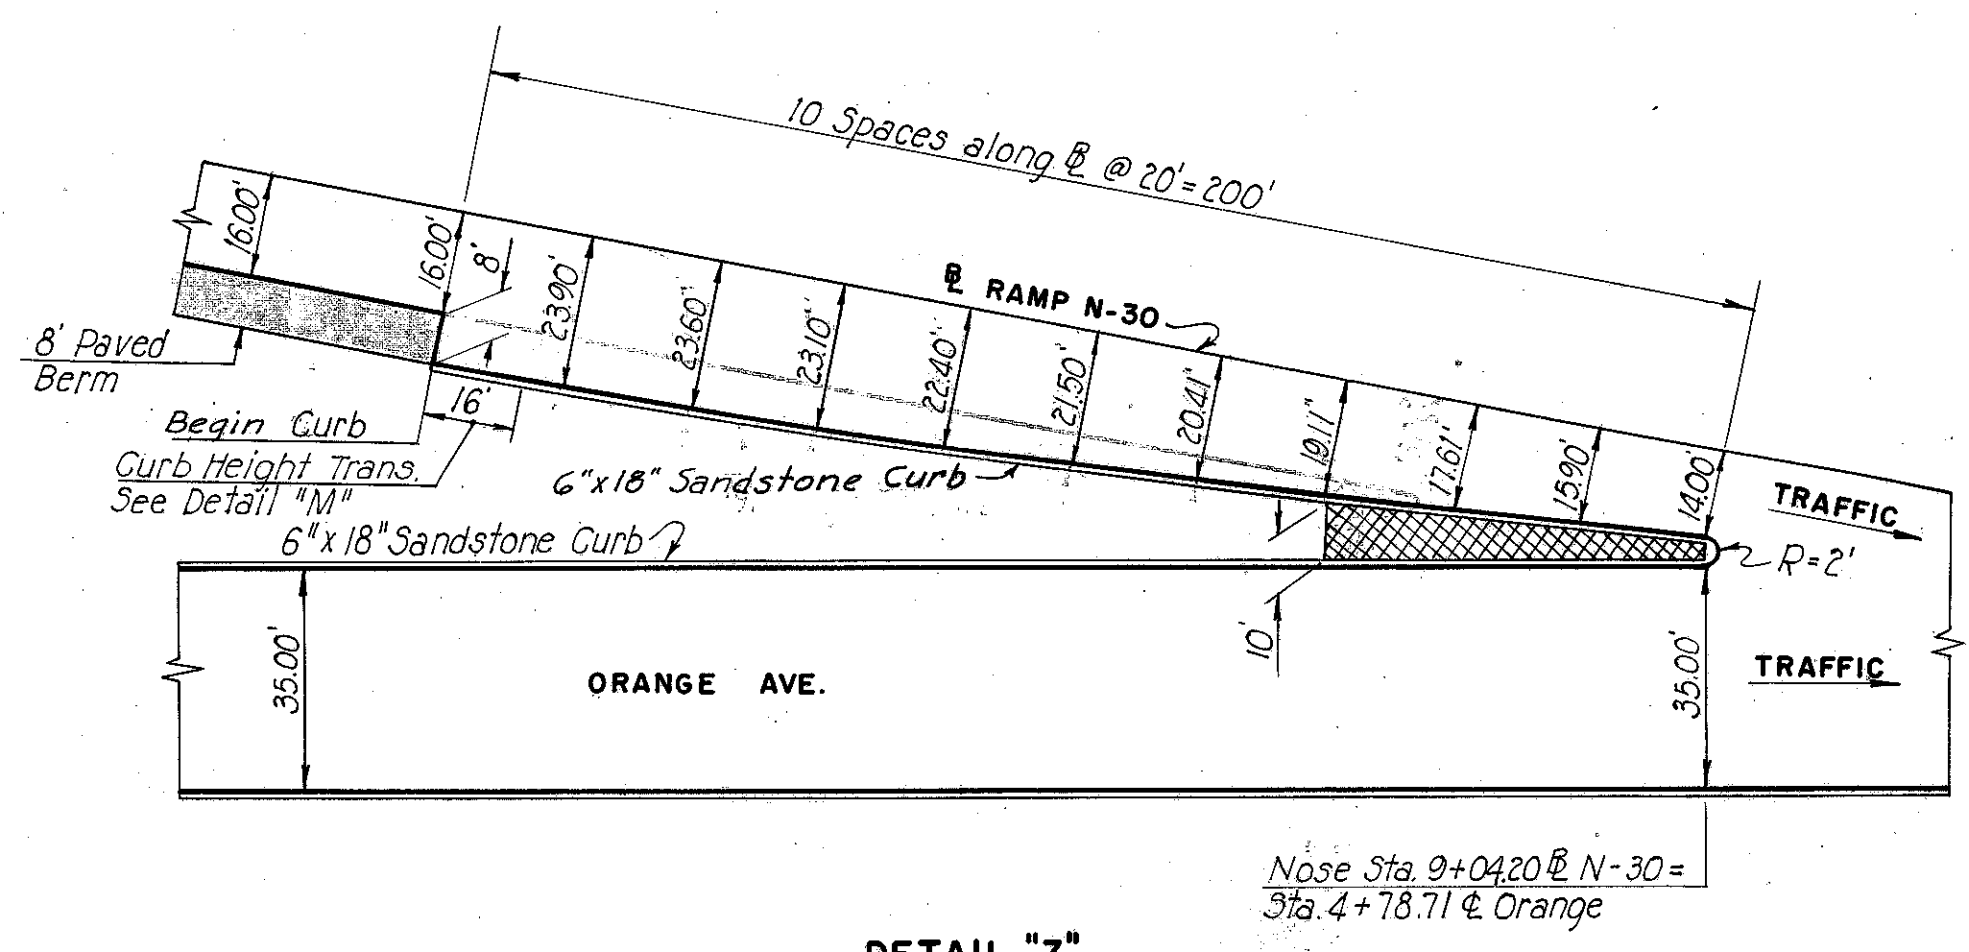


DETAIL "Z"
Not to Scale

LEGEND
 I-21 Standard Type 1 Portland Cement Concrete Median Pavement.
 Paved Berm.

NOSE DETAILS
U, V, W, X, Y, Z & BB

CUYAHOGA COUNTY
CITY OF CLEVELAND
CUY - 42-18.42
CUY - 21-15.32

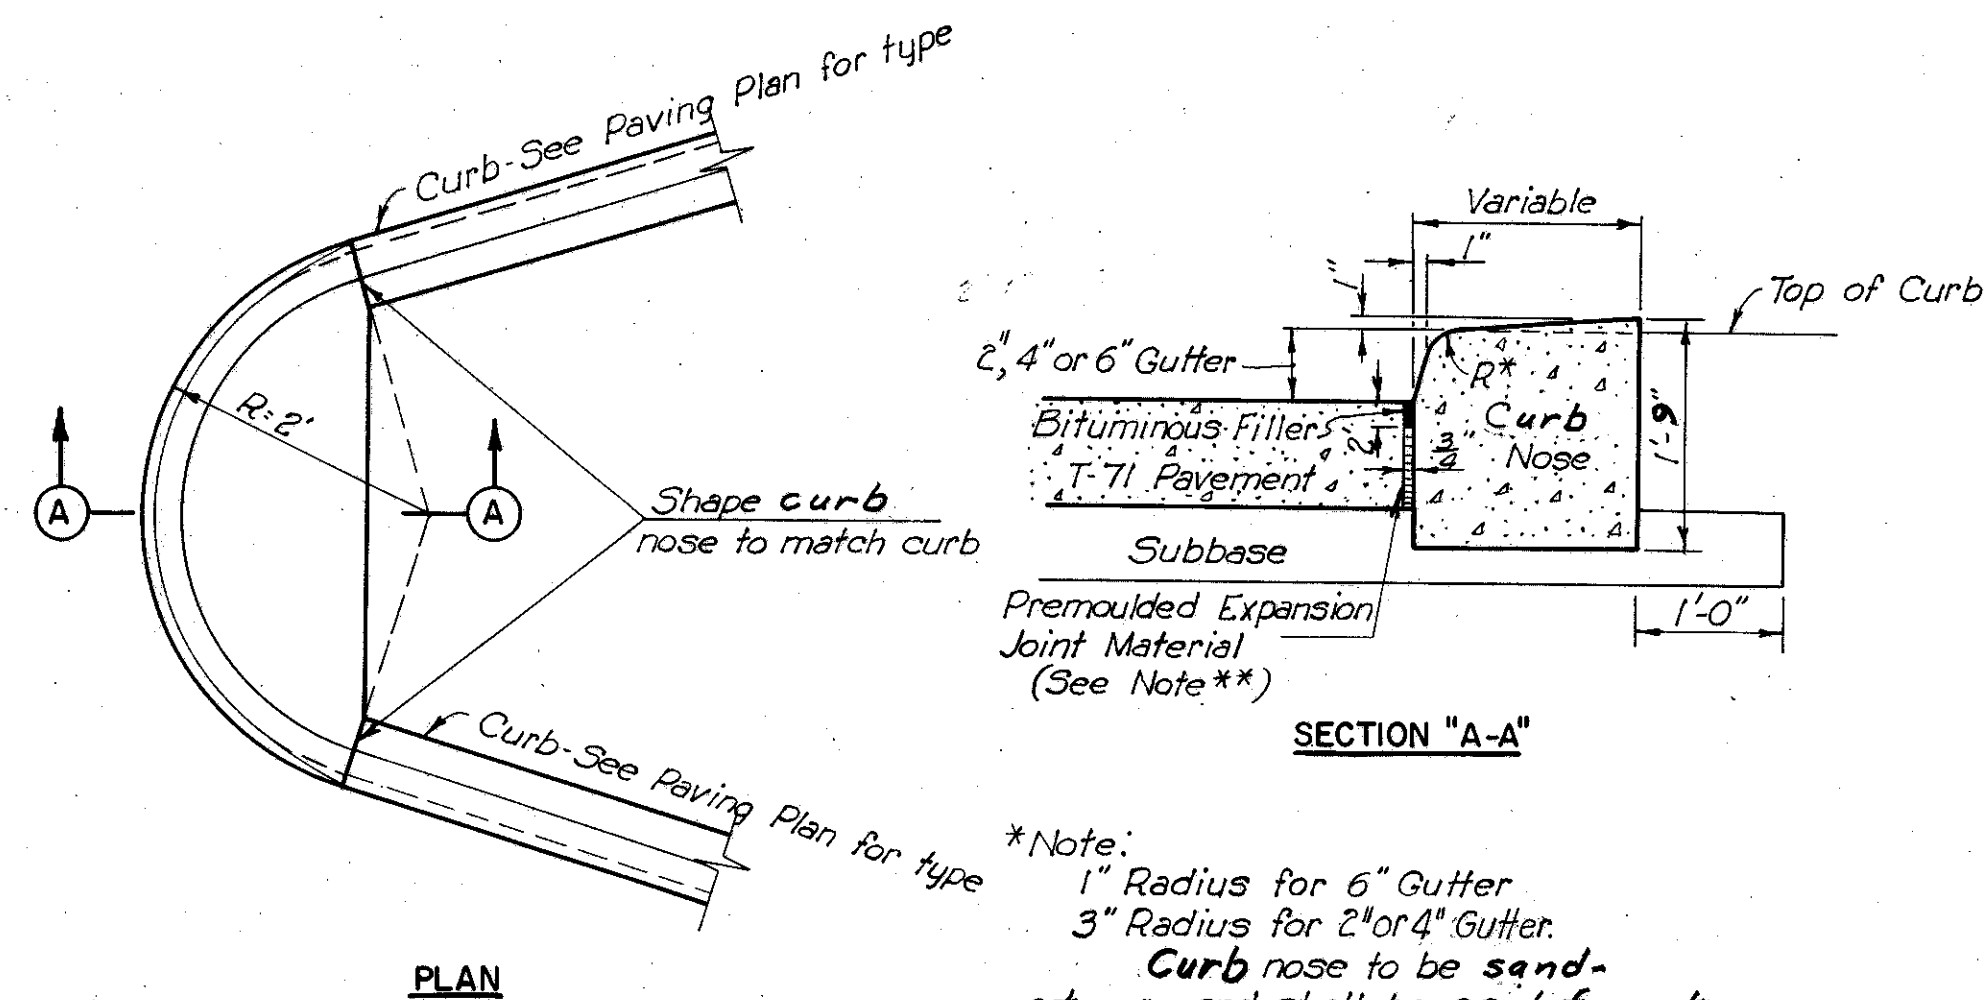


SECTION "A-A"


***Note:**
1" Radius for 6" Gutter
3" Radius for 2" or 4" Gutter.
Curb nose to be sandstone and shall be paid for at price bid per lineal foot of sandstone curb.

**** Note:**
The three quarter (¾) inch Premoulded Joint Material shall meet the requirements of Section M-10.02 of the Standard Specifications. It shall be placed in front of the Bumper Block to within two (2) inches of the surface. The remaining space shall be filled with Bituminous Filler meeting the requirements of Section M-5.6 F2 of the Standard Specifications.
The cost of the joint shall be included in price bid per lineal foot of curb.


DETAIL "K"
CURB TERMINATION AT NOSE AND BUMPER BLOCK
Scale: ¾" = 1'-0"

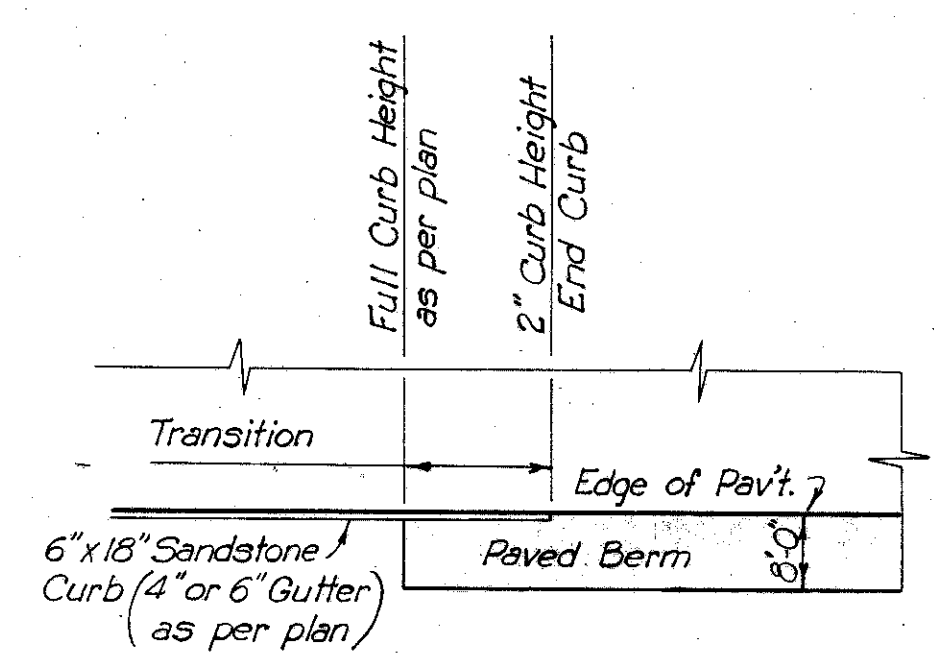


DETAIL "N"
CURB AND SHOULDER TRANSITION
Not to Scale:

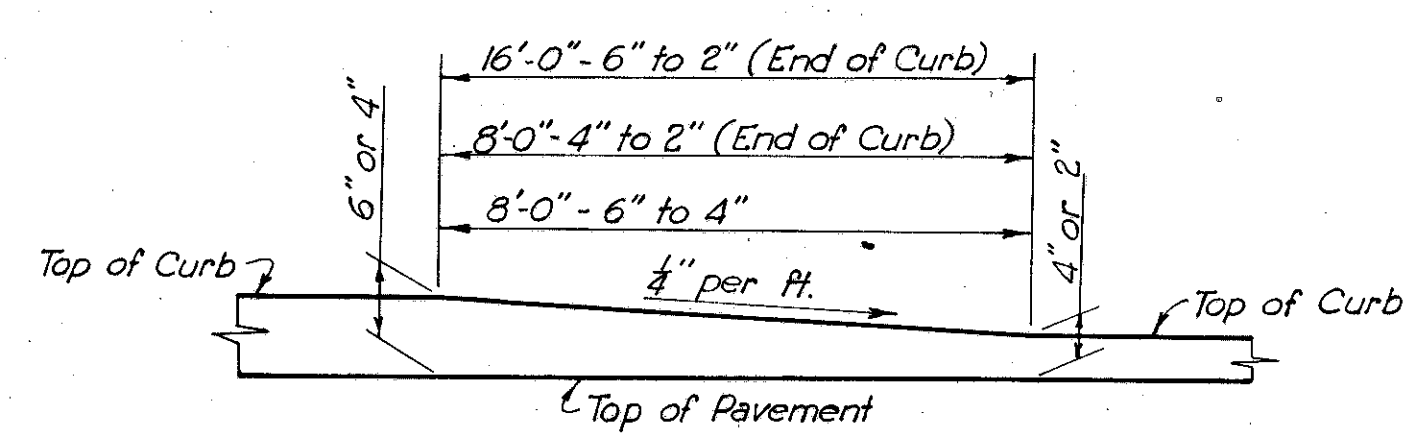

DETAIL "M"
CURB HEIGHT TRANSITION
Not to Scale:

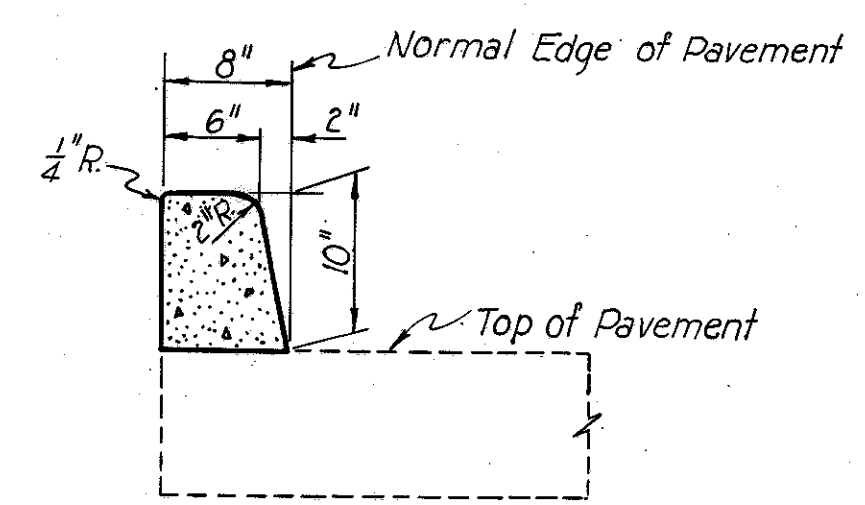


TYPE 2A MODIFIED (10") CURB (MODIFICATION B)
Scale: 1" = 1'-0"

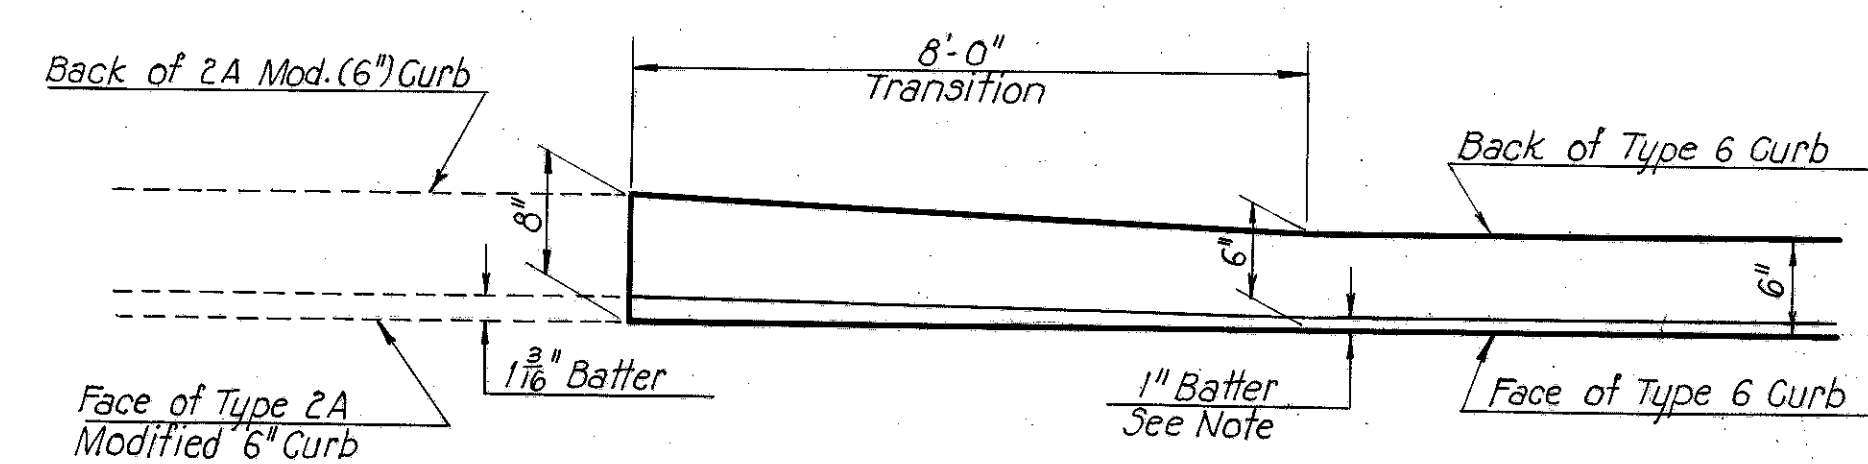


Note:
Type 6 Curb face to be transitioned to match 2A Modified (6") Curb face in the same 8'-0" transition.

DETAIL "Q"
BACK OF CURB TRANSITION
Not to Scale

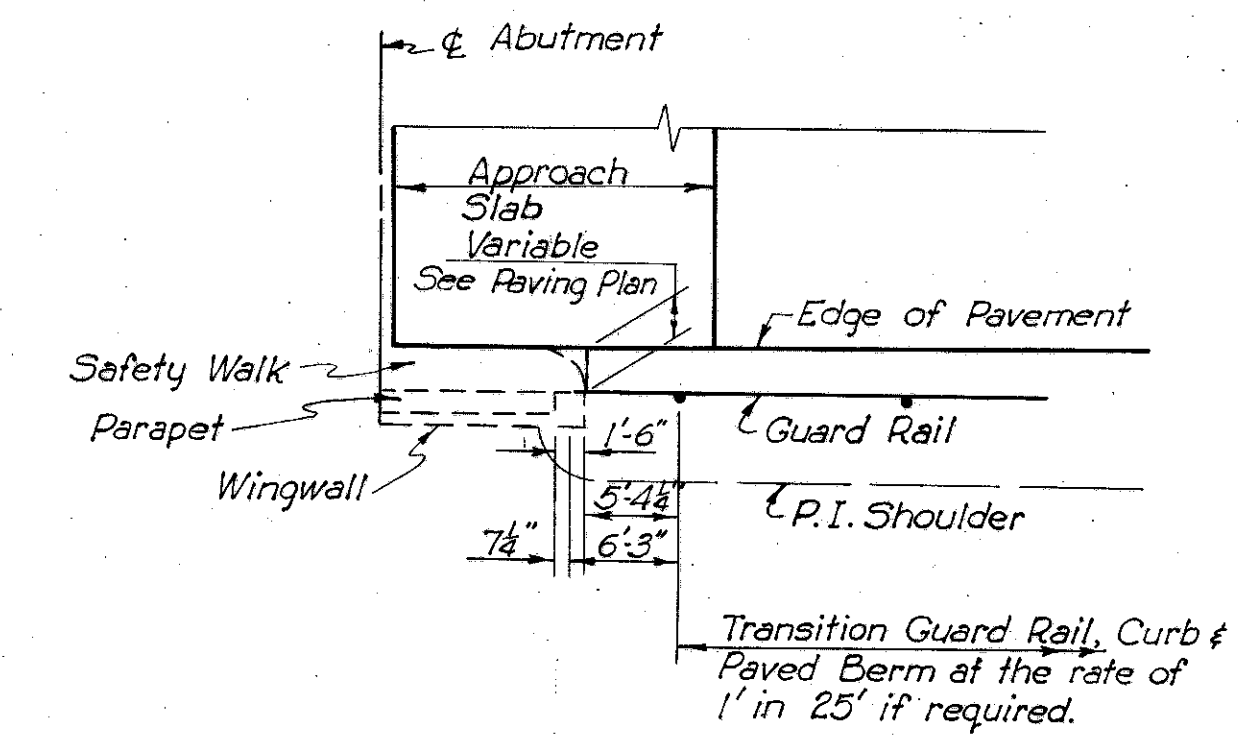


GUARD RAIL TREATMENT AT TERMINAL POST
Not to Scale:

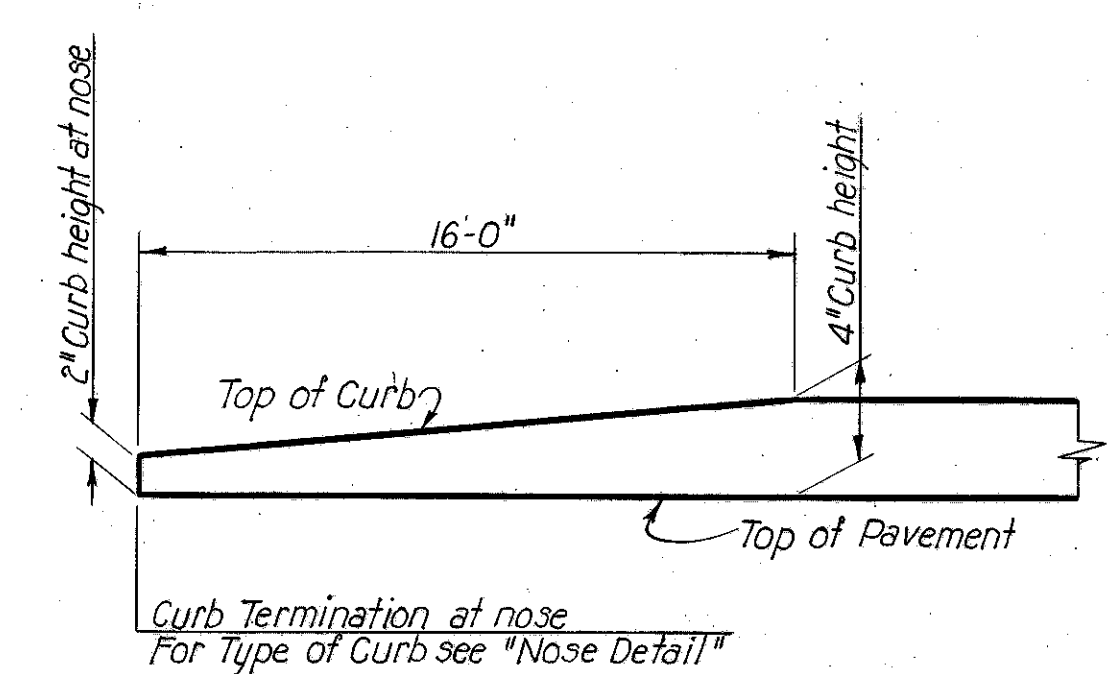


DETAIL "CC"
CURB HEIGHT TRANSITION AT NOSE
FOR
DIVERGING RAMPS & LANES
Not to Scale

MISCELLANEOUS DETAILS


CUYAHOGA COUNTY
CITY OF CLEVELAND
CUY-42-18.42
CUY-21-15.32
APPROACH SLABS

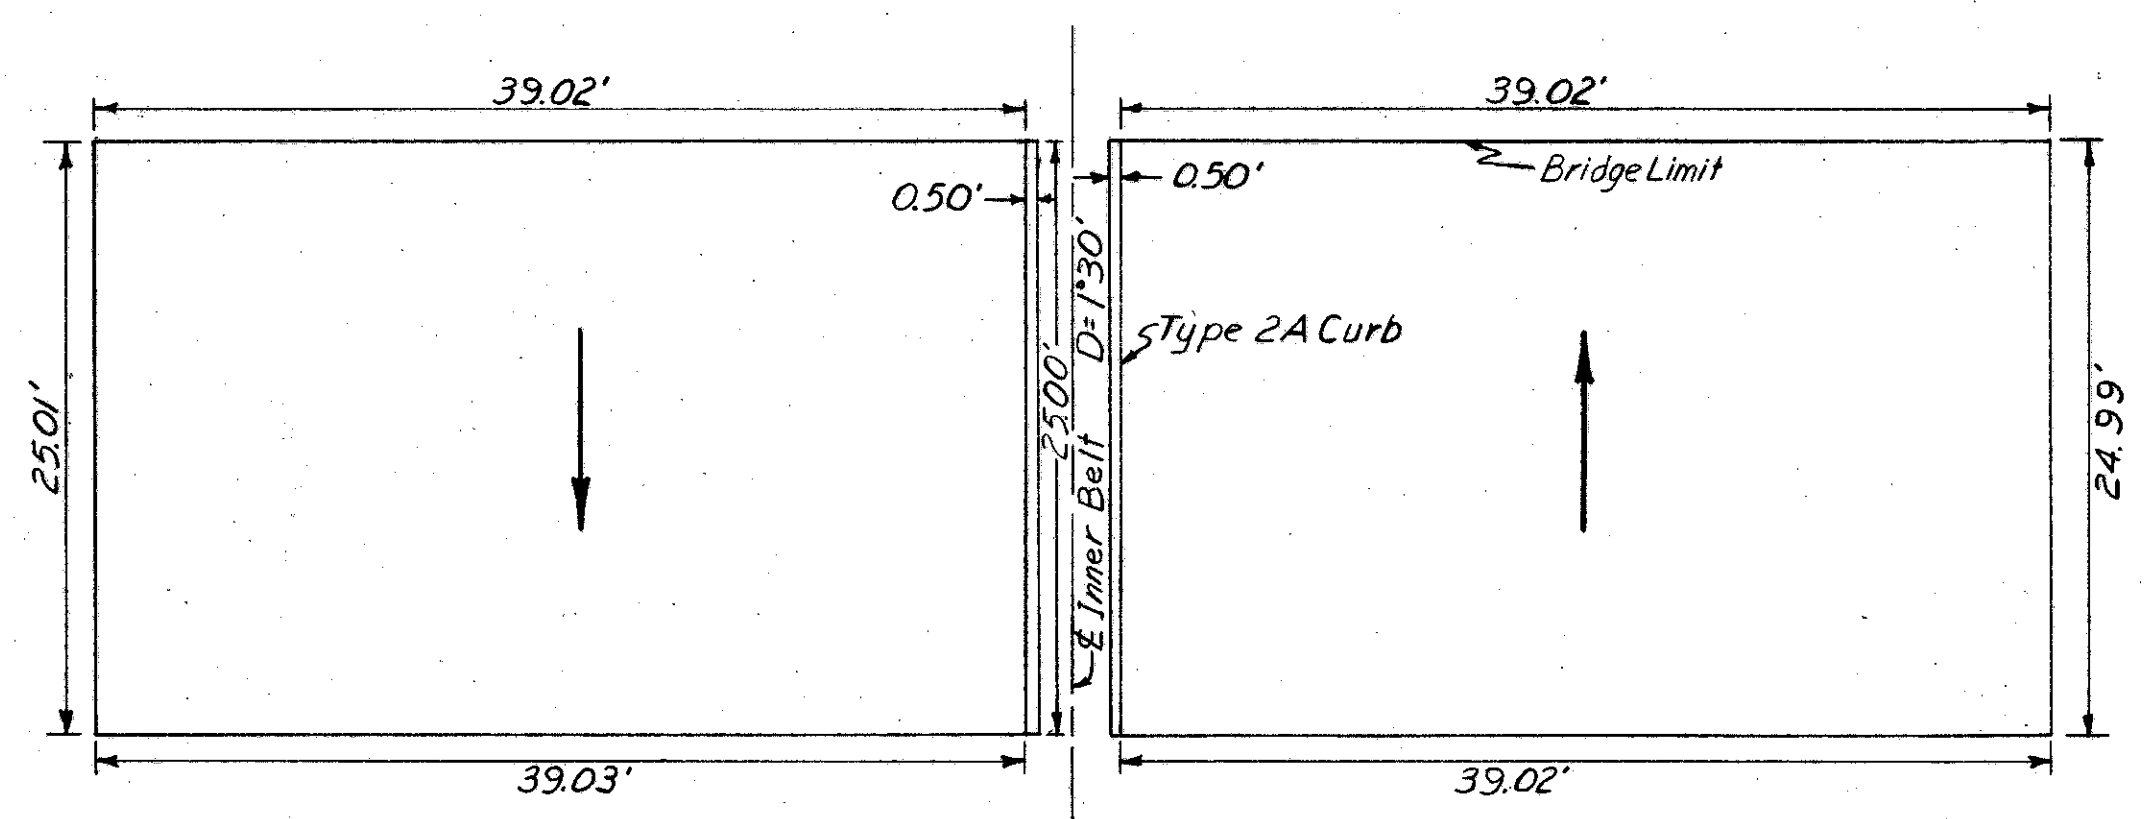


BRIDGE NO. 3
WEST APPROACH SLABS

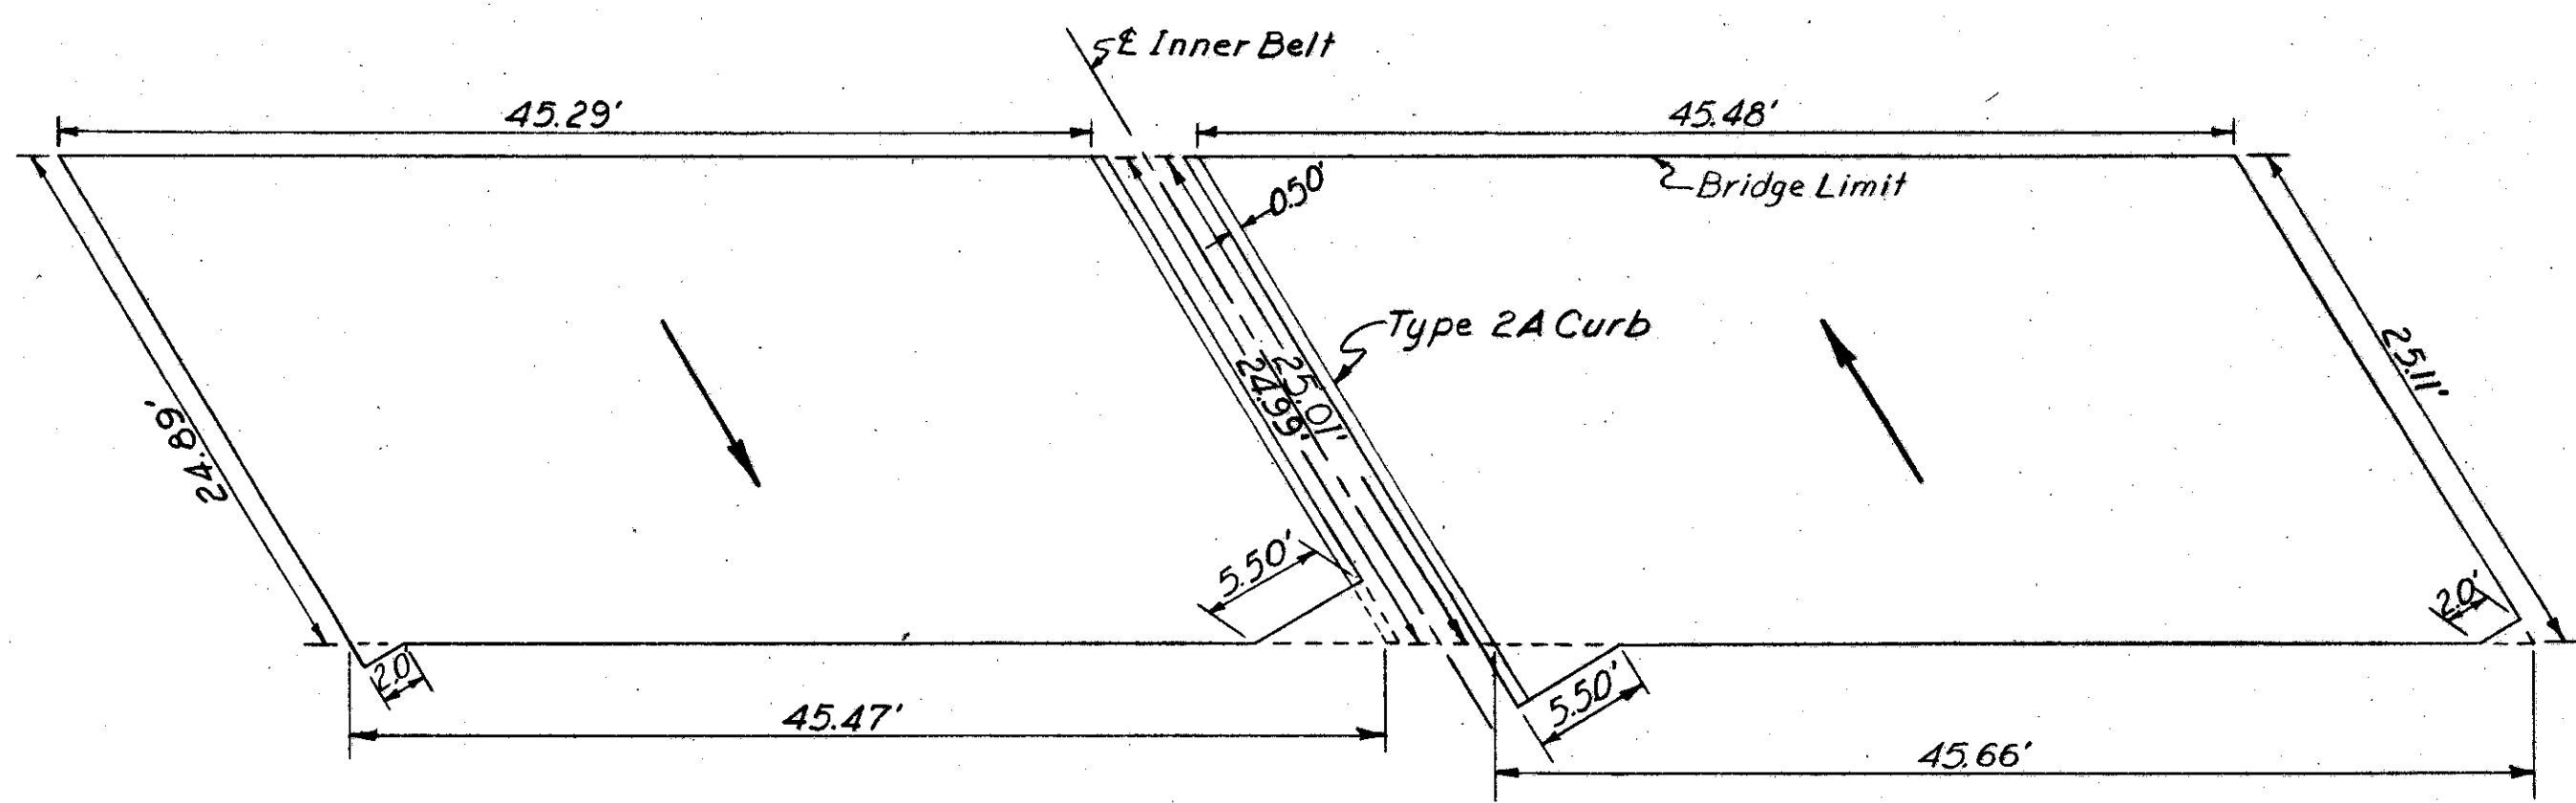


BRIDGE NO. 3
EAST APPROACH SLABS

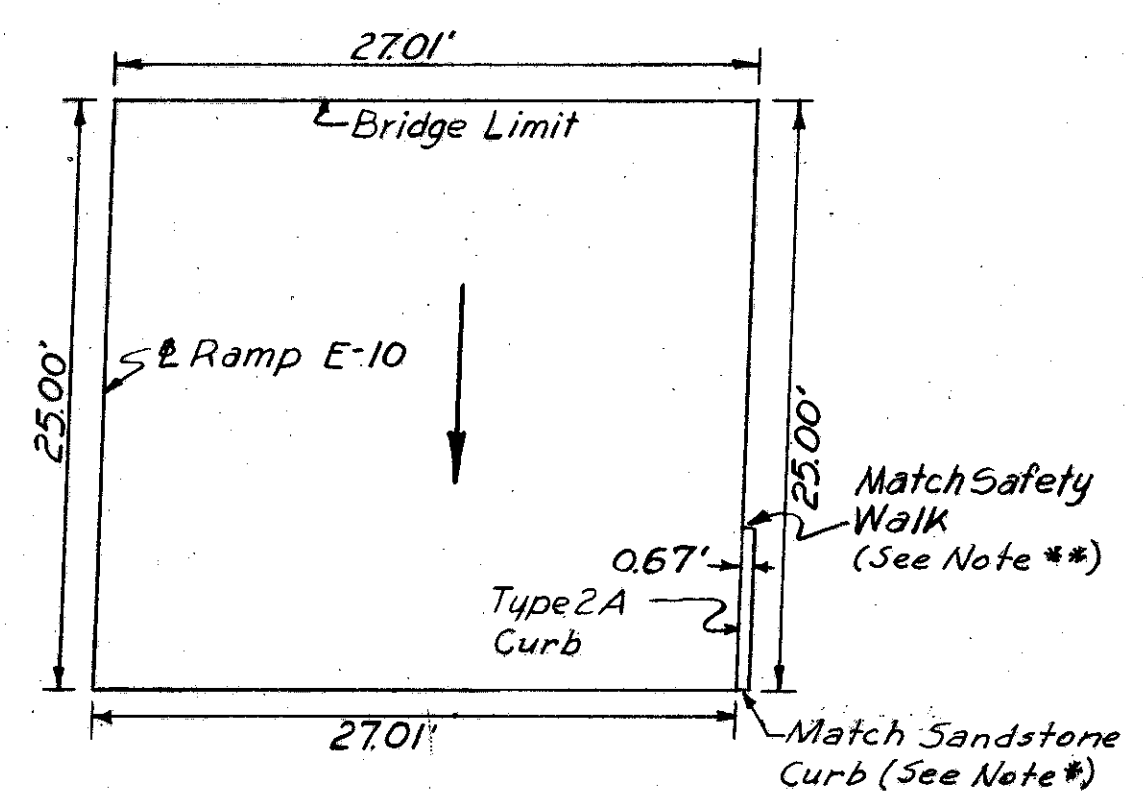


BRIDGE NO. 4
WEST APPROACH SLAB
RAMP E-10

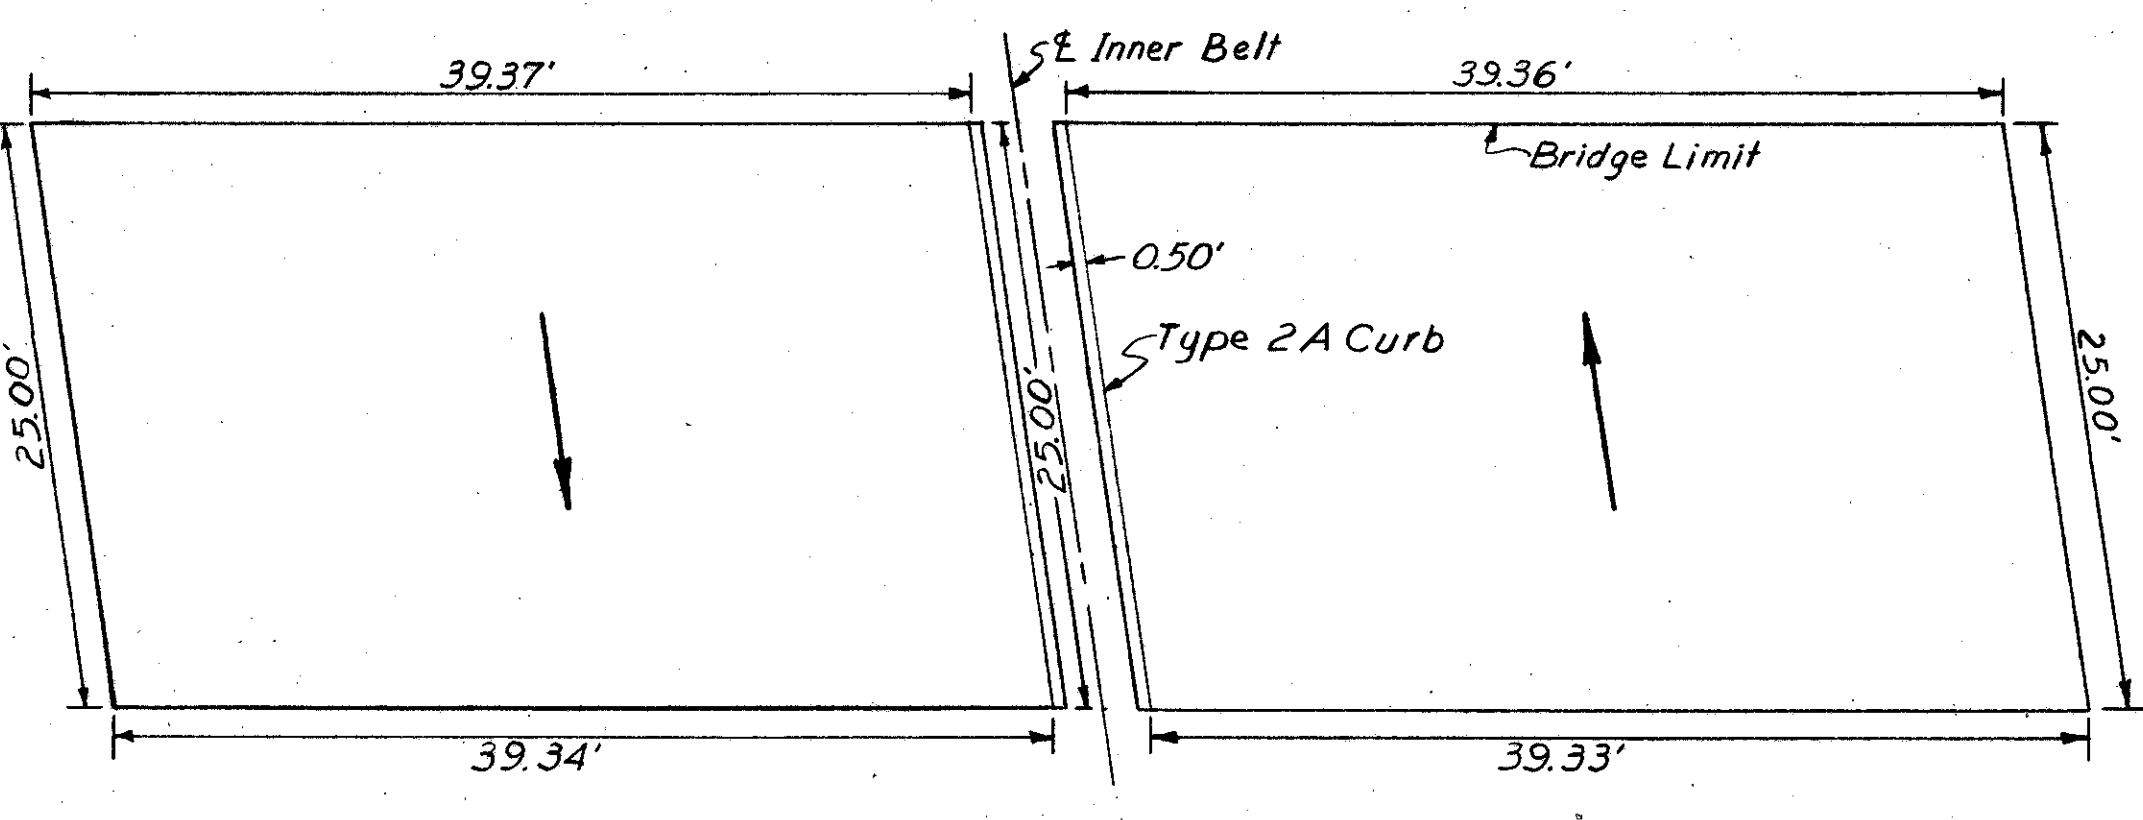


BRIDGE NO. 4
WEST APPROACH SLABS

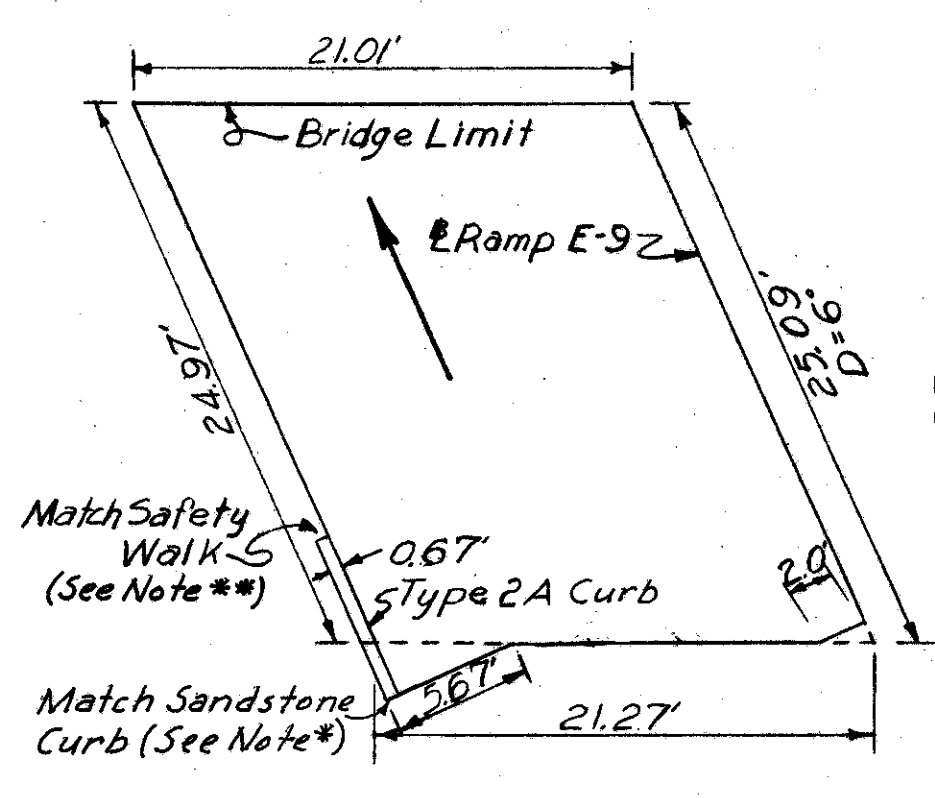


BRIDGE NO. 4
WEST APPROACH SLAB
RAMP E-9

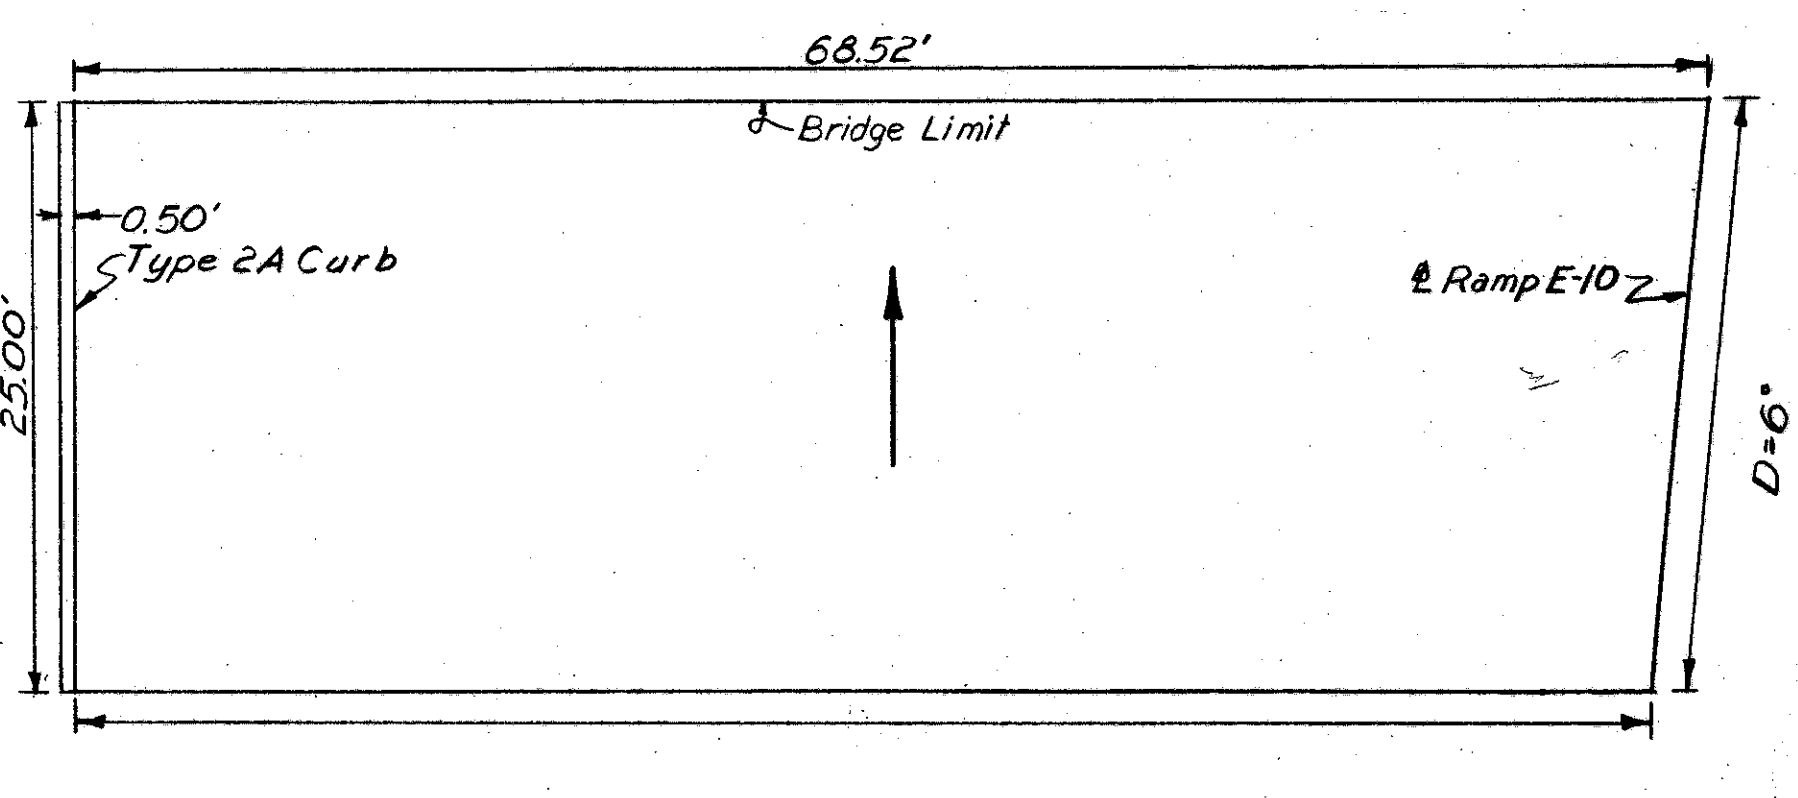


BRIDGE NO. 4
EAST APPROACH SLAB
LEFT LANE

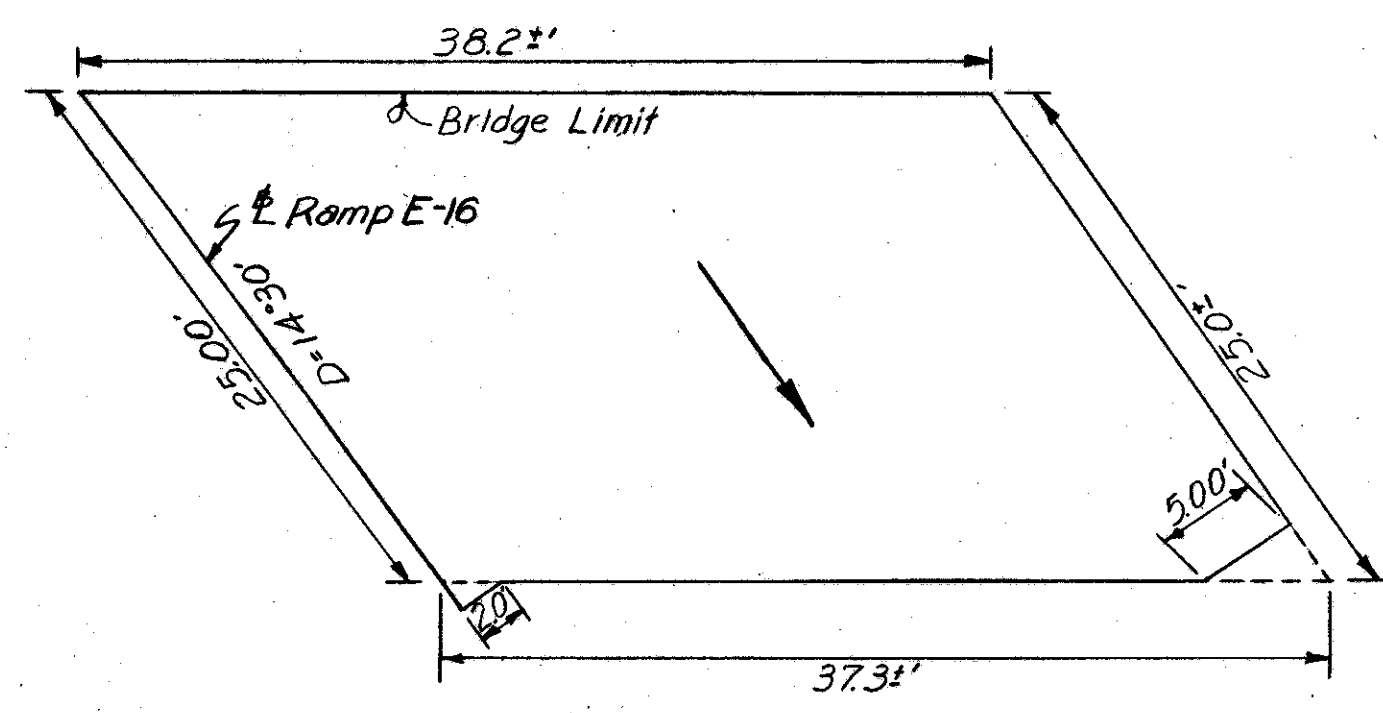


BRIDGE NO. 5
SOUTH APPROACH SLAB

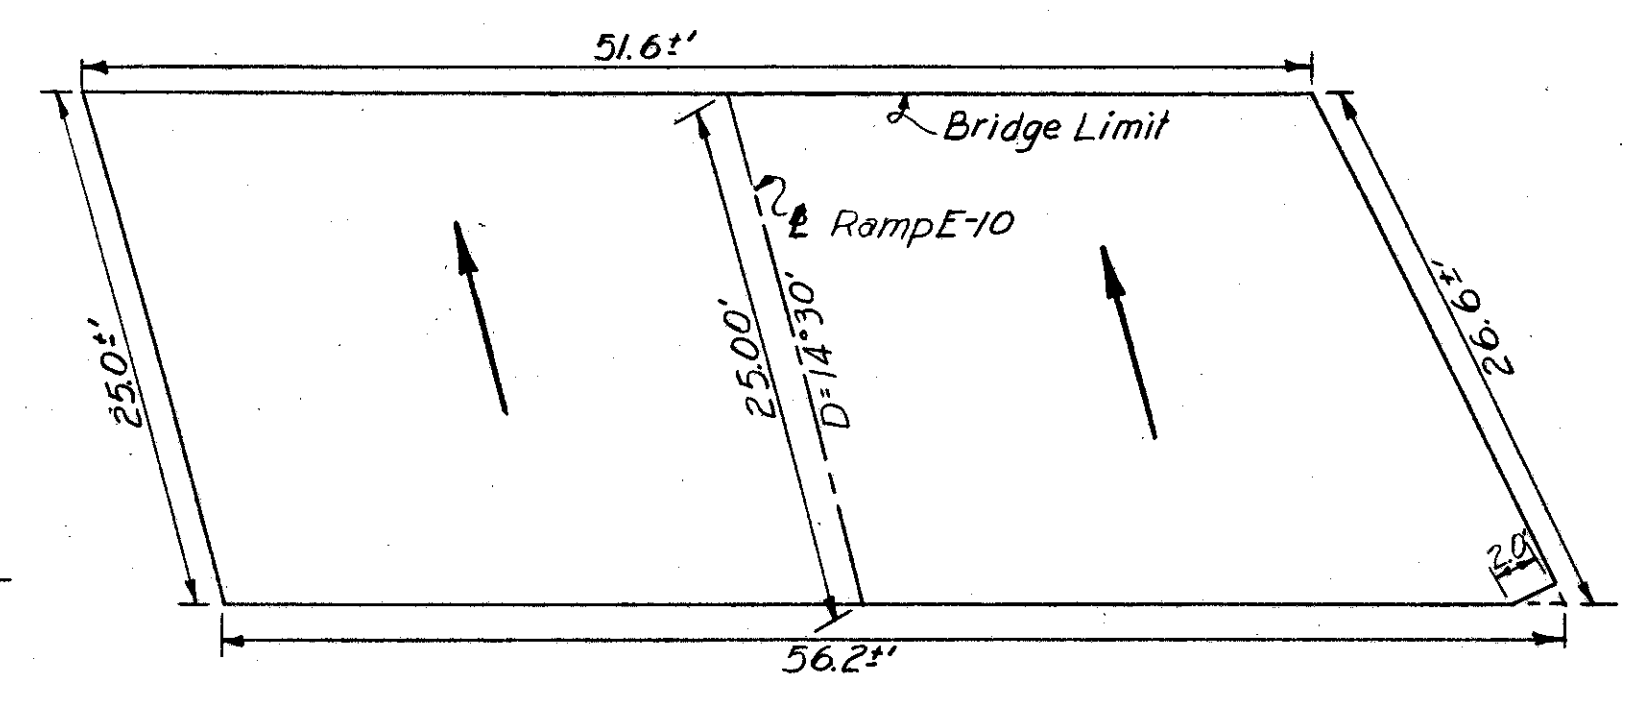


BRIDGE NO. 5
NORTH APPROACH SLAB

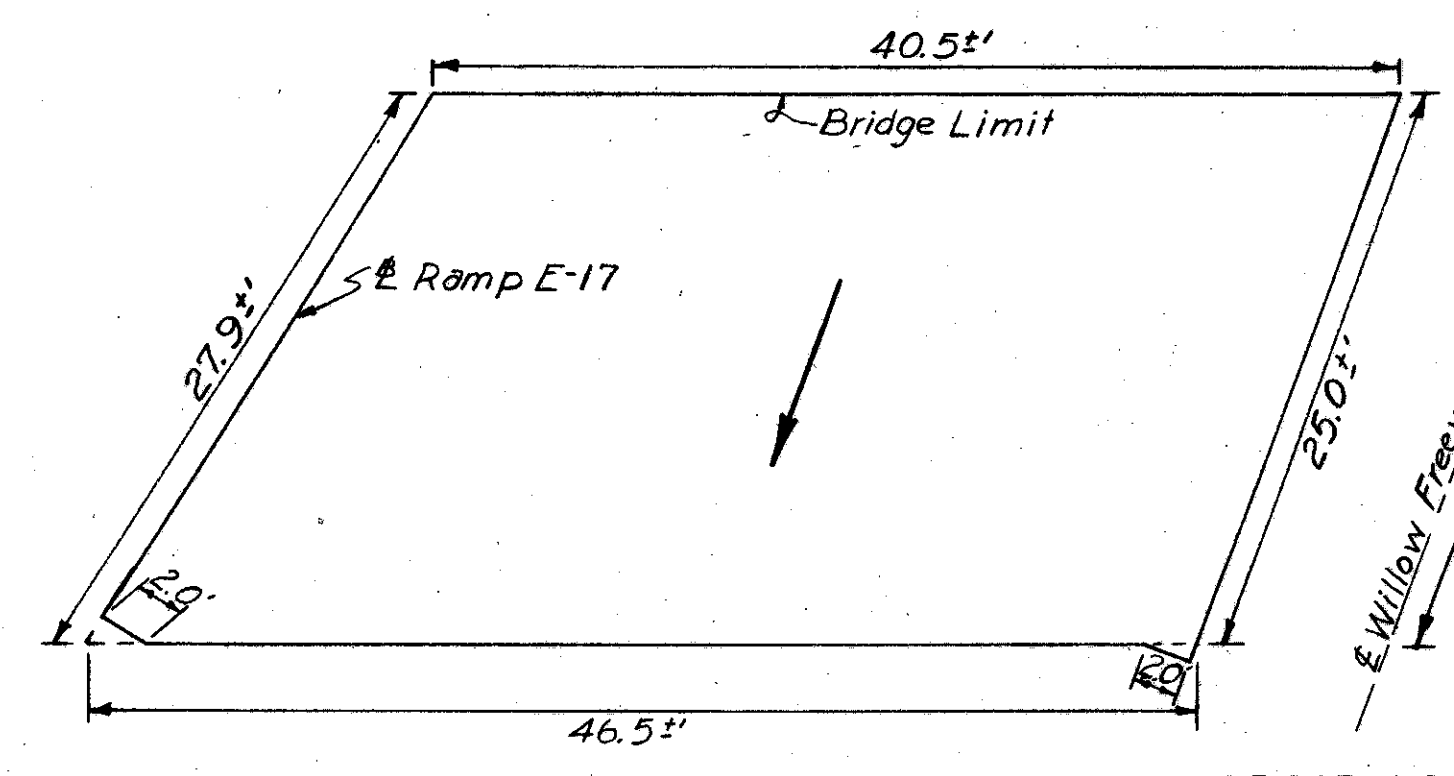


BRIDGE NO. 8
WEST APPROACH SLABS

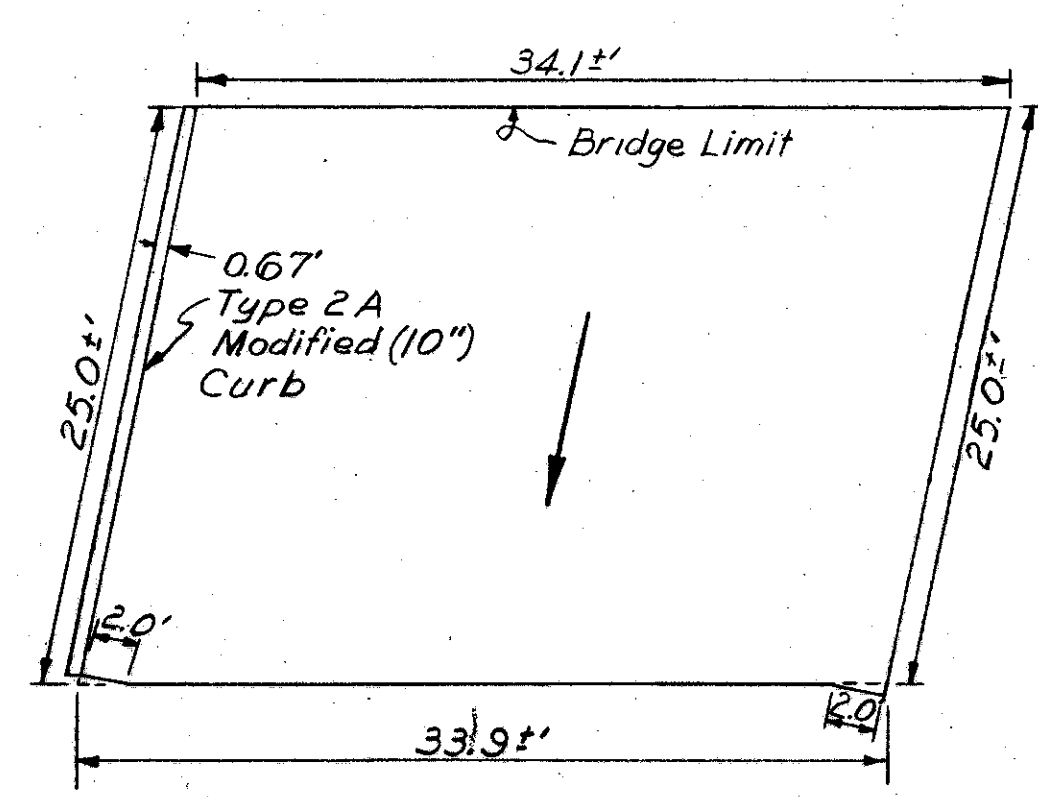

BRIDGE NO. 8
EAST APPROACH SLAB

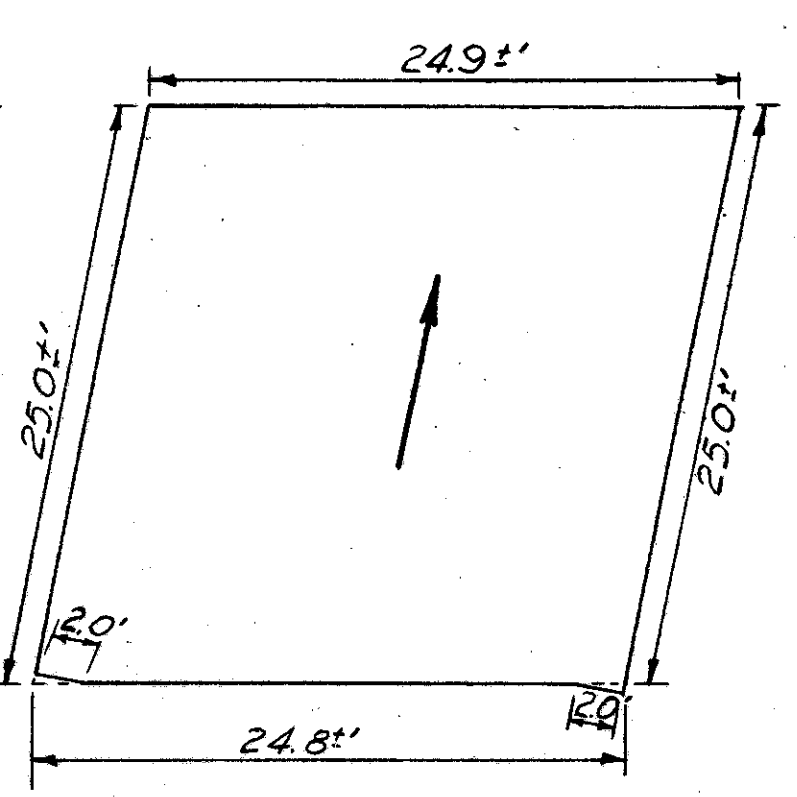

BRIDGE NO. 4
EAST APPROACH SLAB
RIGHT LANE

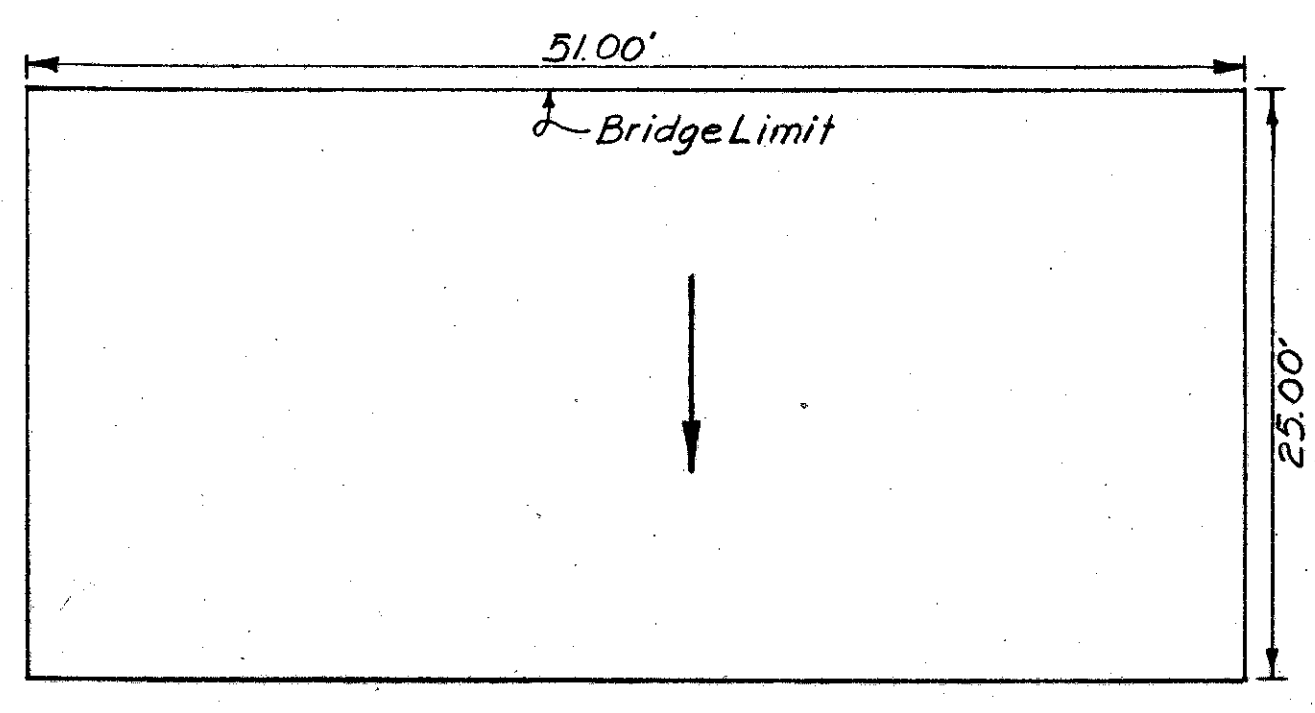

→ Direction of Traffic

* Note:
Type 2A Curb to be transitioned uniformly in eight (8) feet to match 6"x18" Sandstone Curb.


** Note:
The batter on Type 2A Curb to be transitioned uniformly in two (2) feet to match batter on Safety Walk.

Note:
Approach Slabs shall meet construction requirements as shown on State of Ohio Standard Drawing AS-1-54.


Payment for curb sections on approach slabs shall be included in the unit price bid for Item I-7, Approach Slabs.

FED. ROAD DIV. NO.	STATE	FEDERAL AID PROJECT NO.	TYPE FUNDS
2	OHIO		


CUYAHOGA COUNTY
CITY OF CLEVELAND
CUY-42-18-42
CUY-21-15-32
APPROACH SLABS

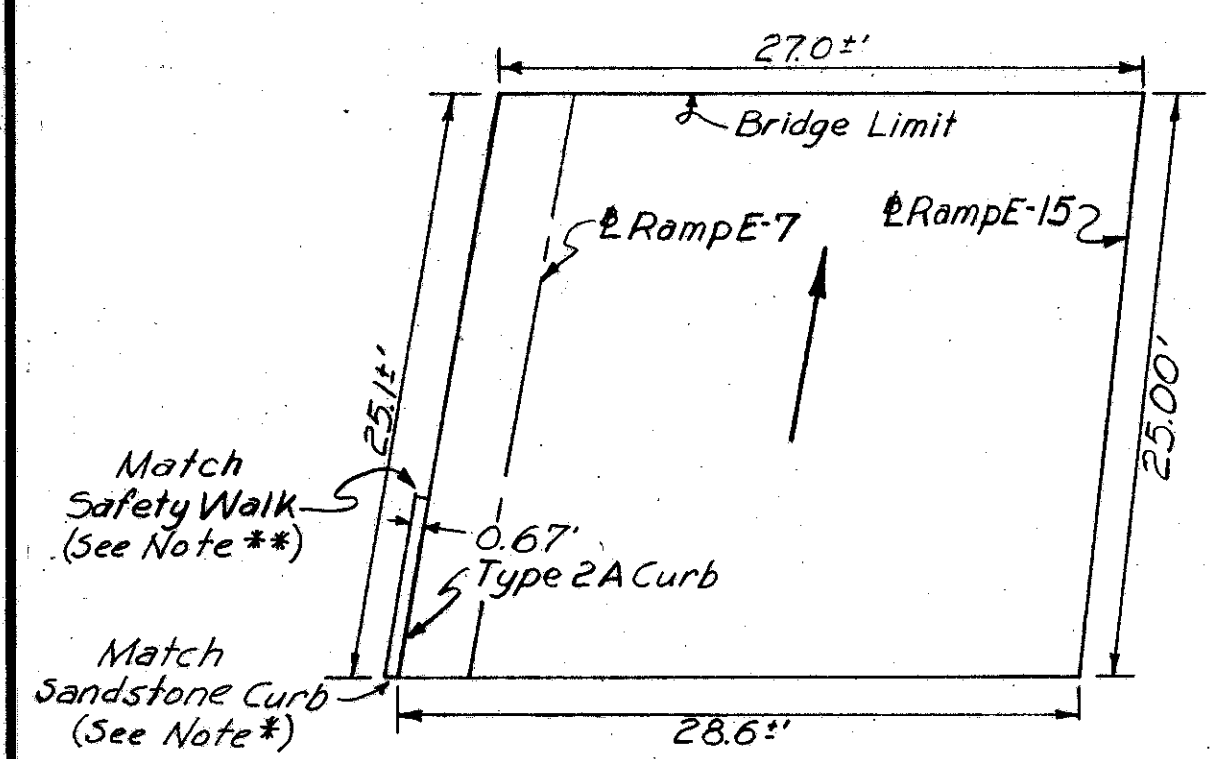




BRIDGE NO. 9
WEST APPROACH SLAB

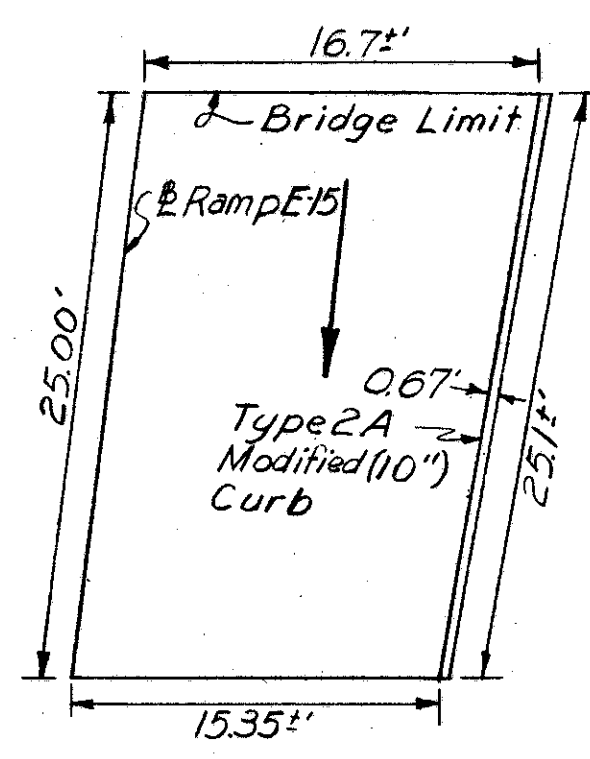


BRIDGE NO. 9
EAST APPROACH SLAB

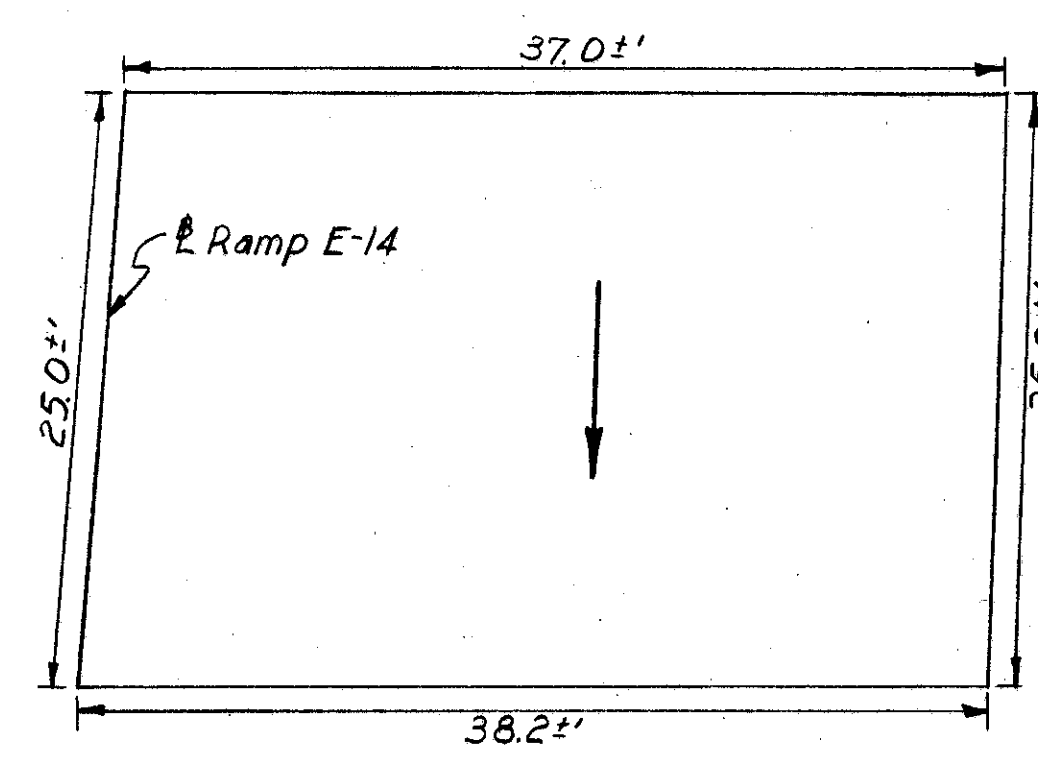


BRIDGE NO. 10
WEST APPROACH SLABS

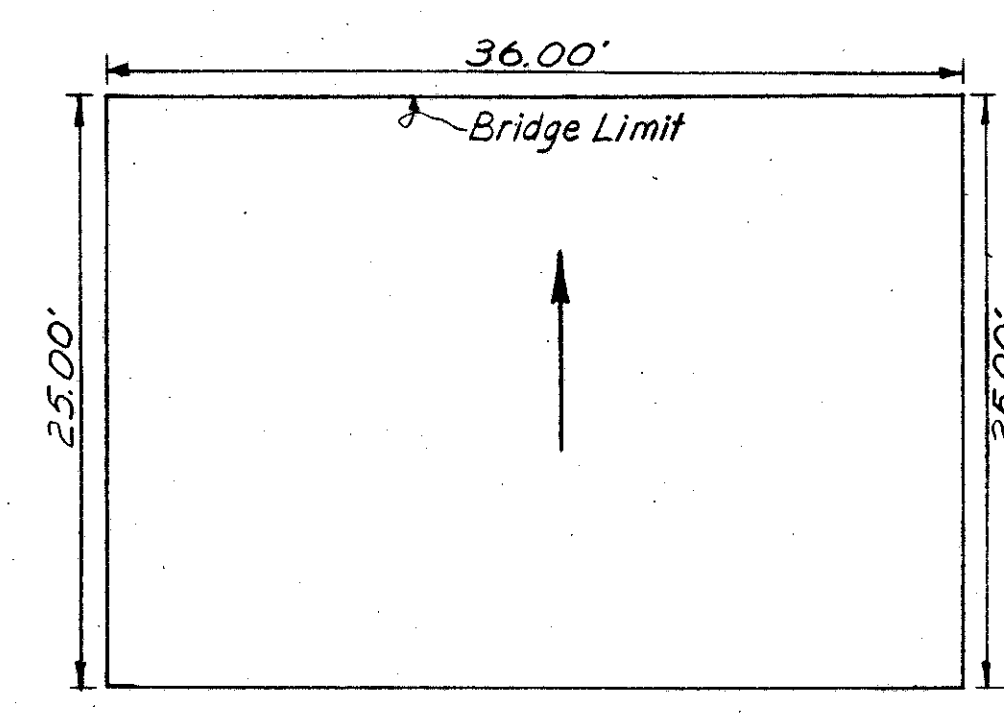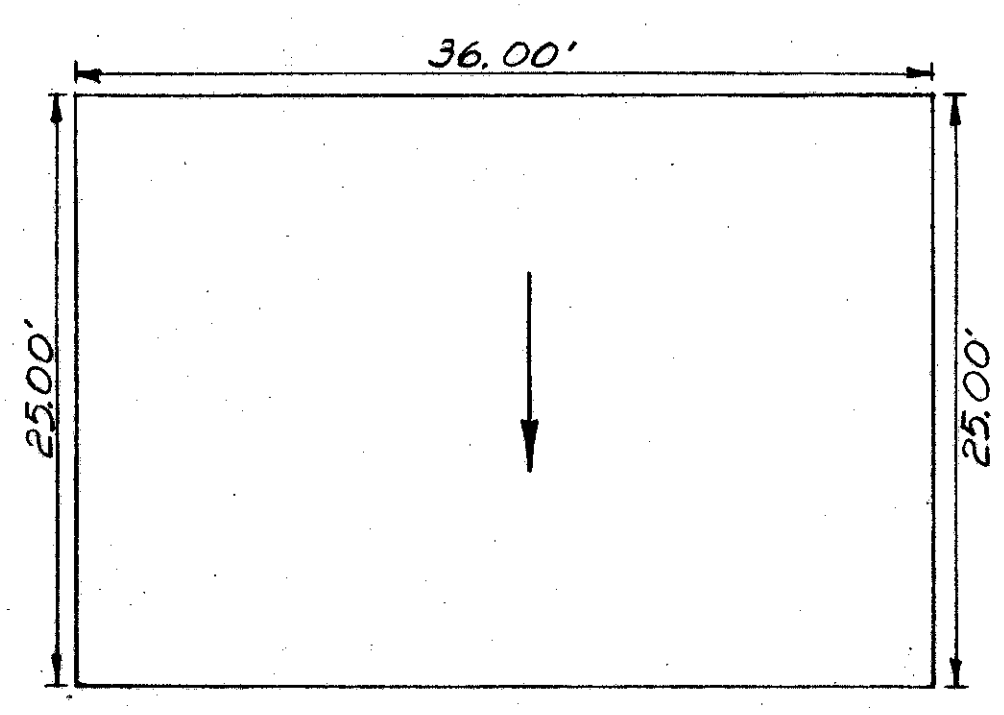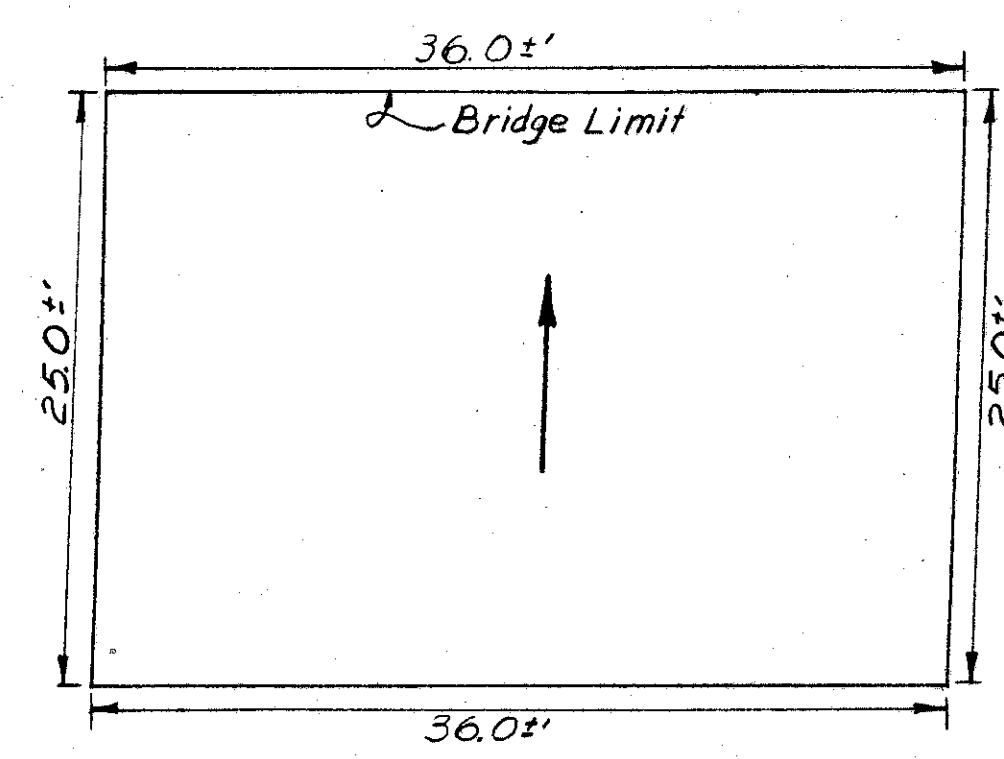


BRIDGE NO. 10
EAST APPROACH SLABS

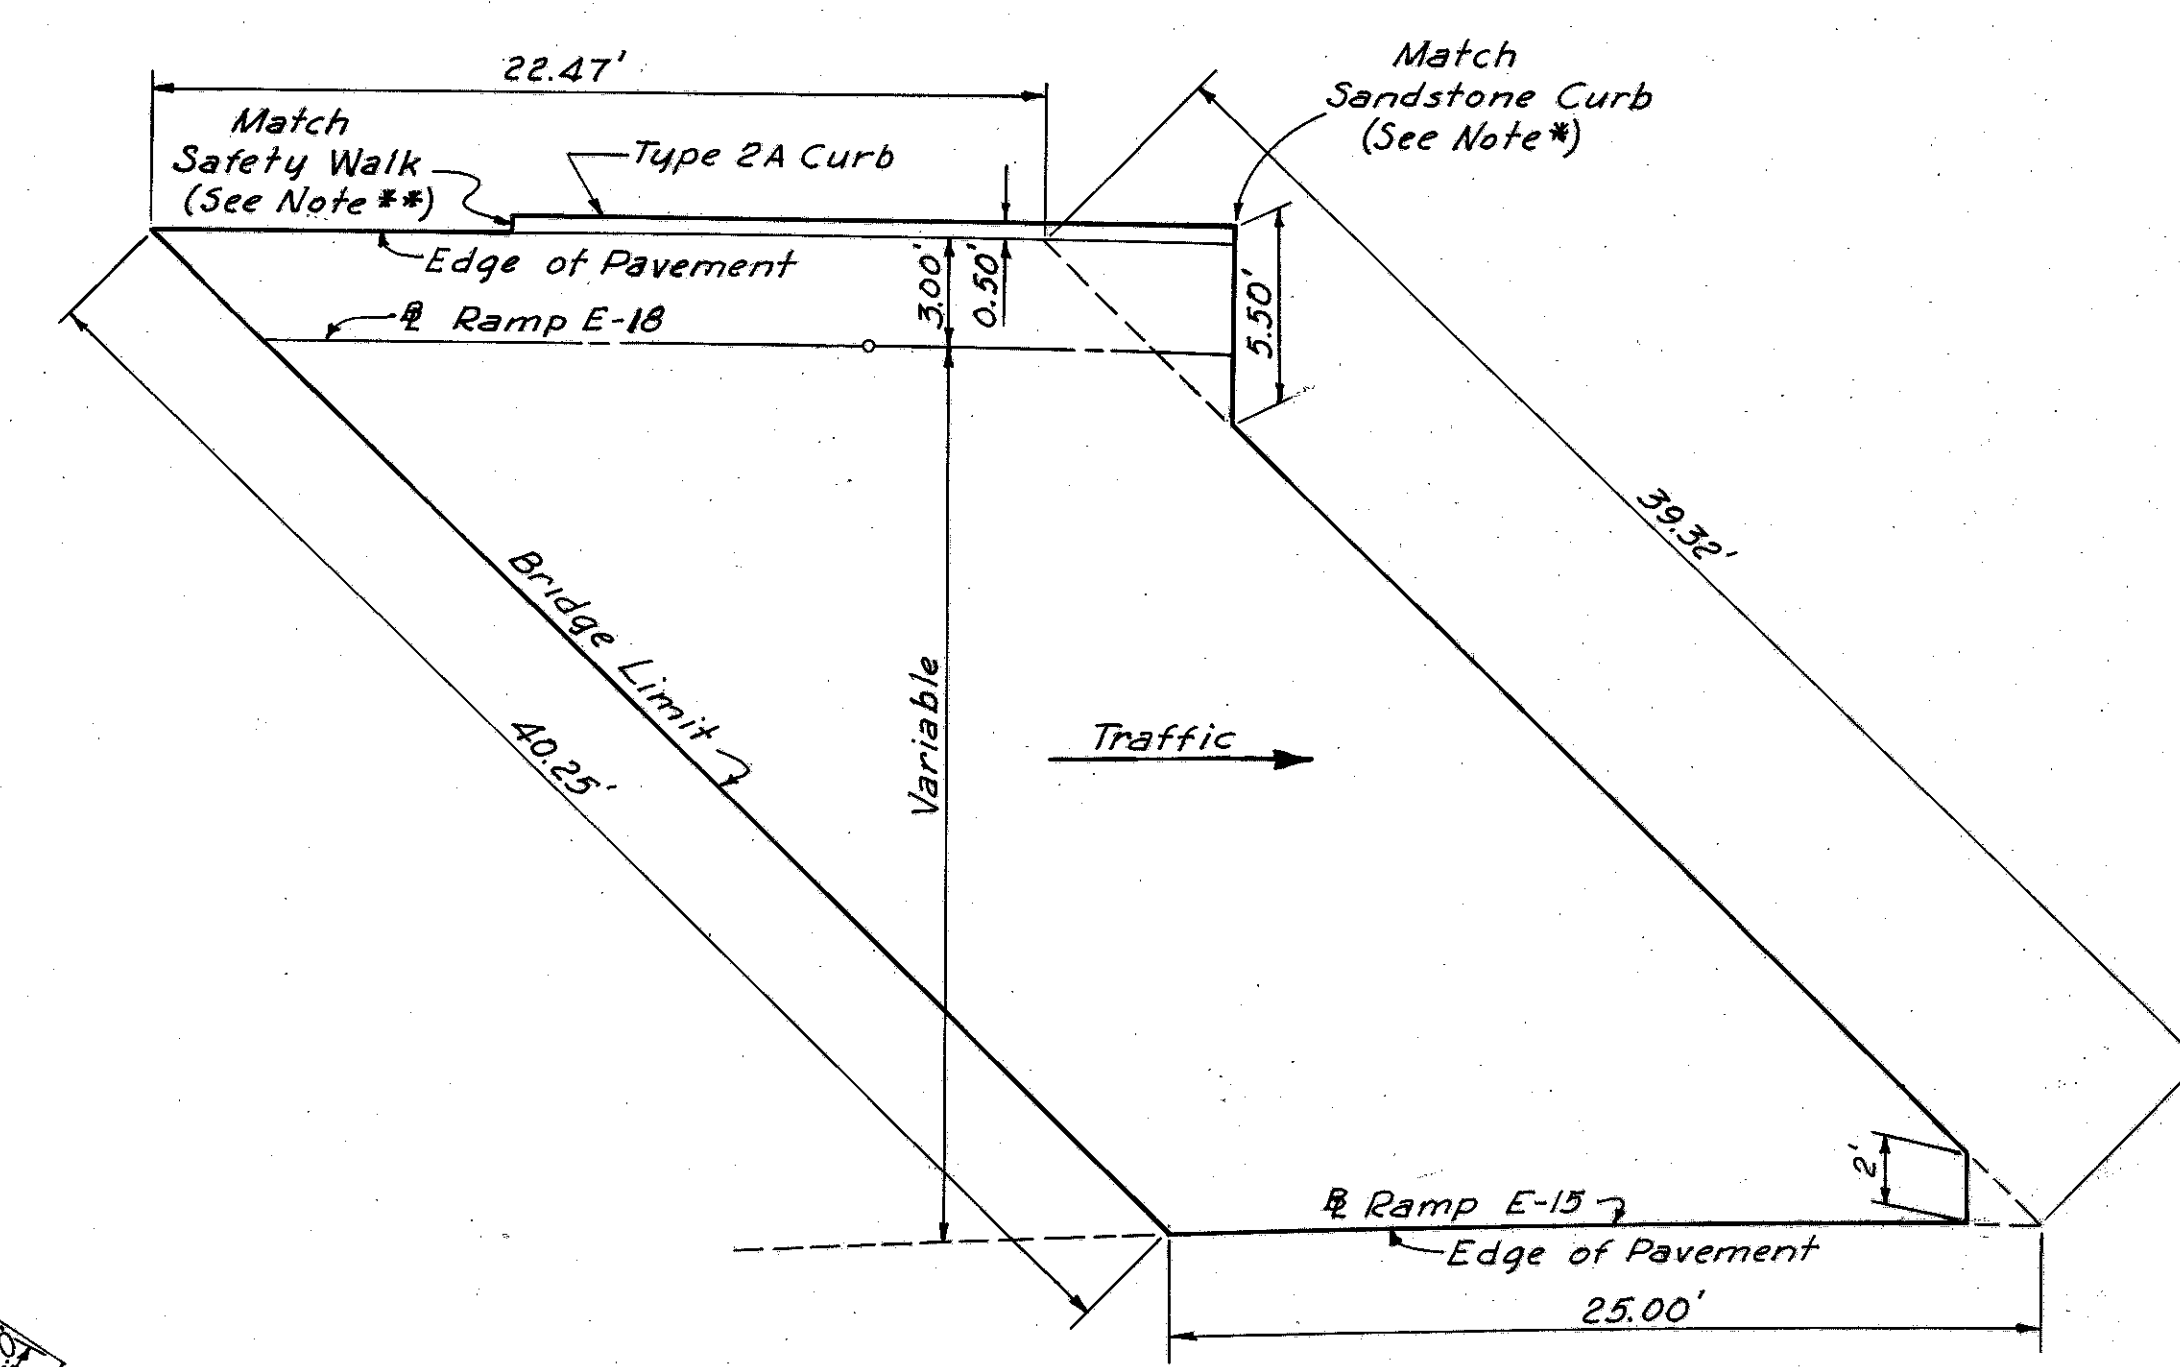



BRIDGE NO. 7
EAST APPROACH SLAB

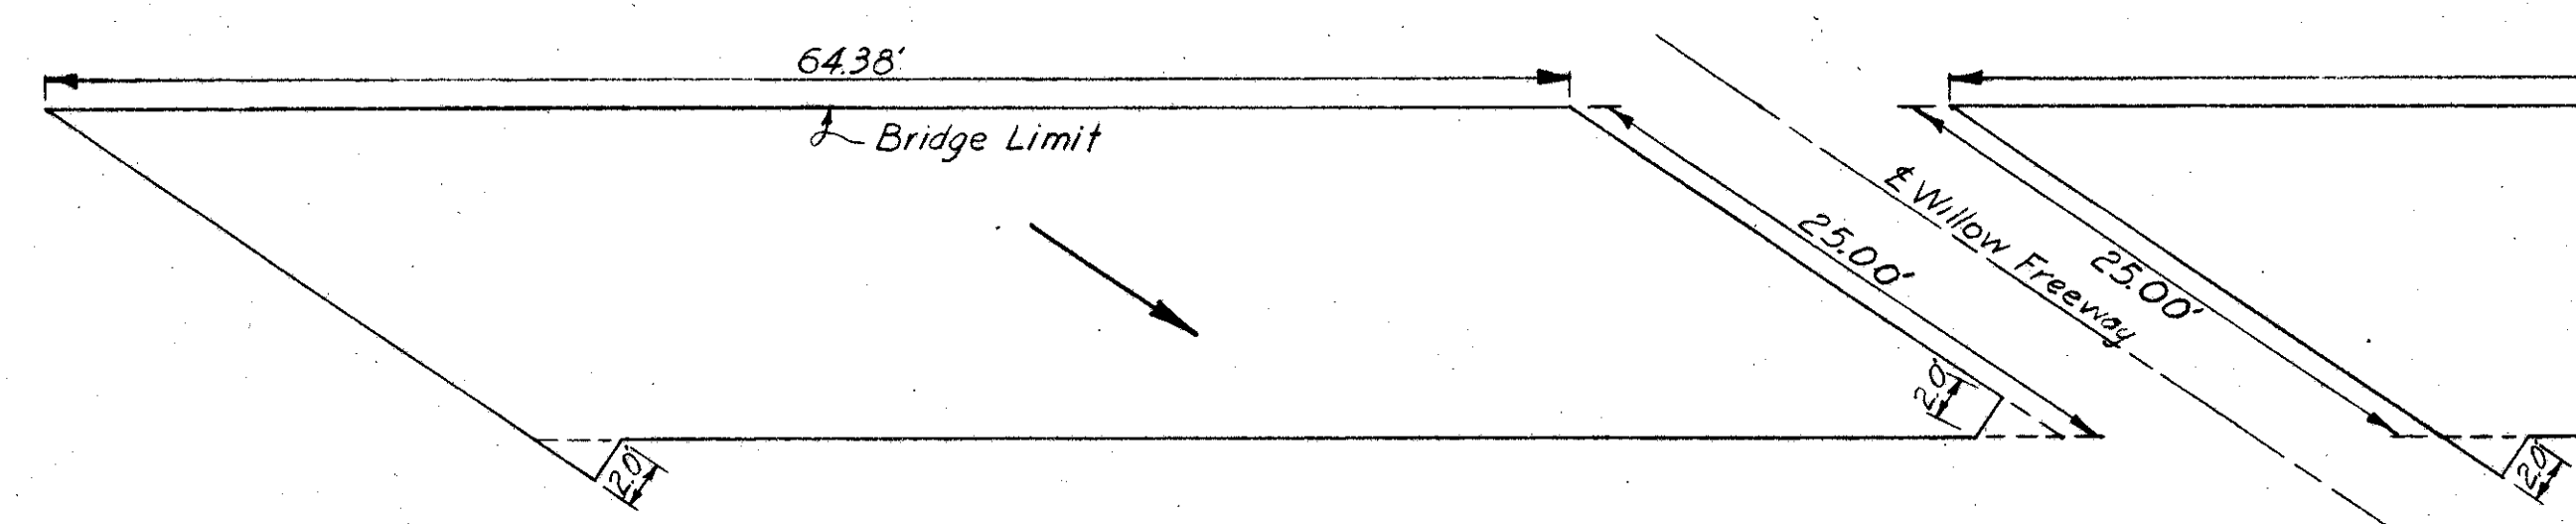

BRIDGE NO. 11
WEST APPROACH SLABS

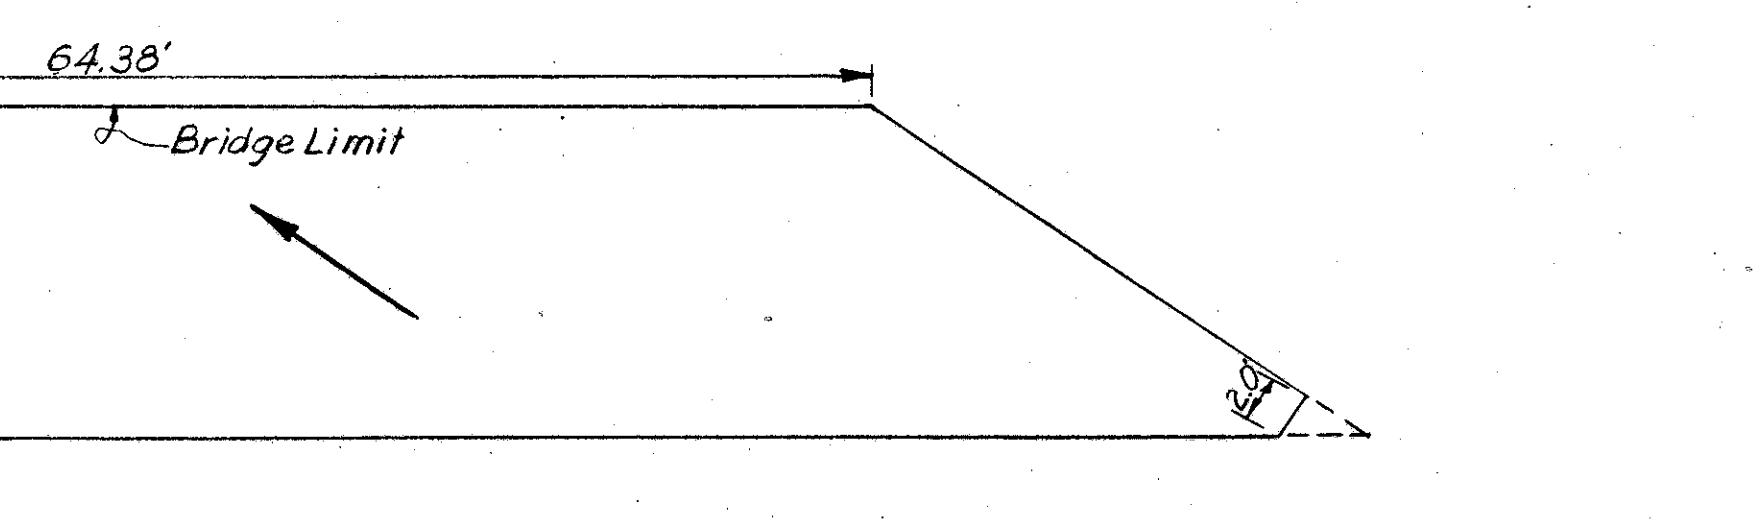

BRIDGE NO. 11
EAST APPROACH SLABS

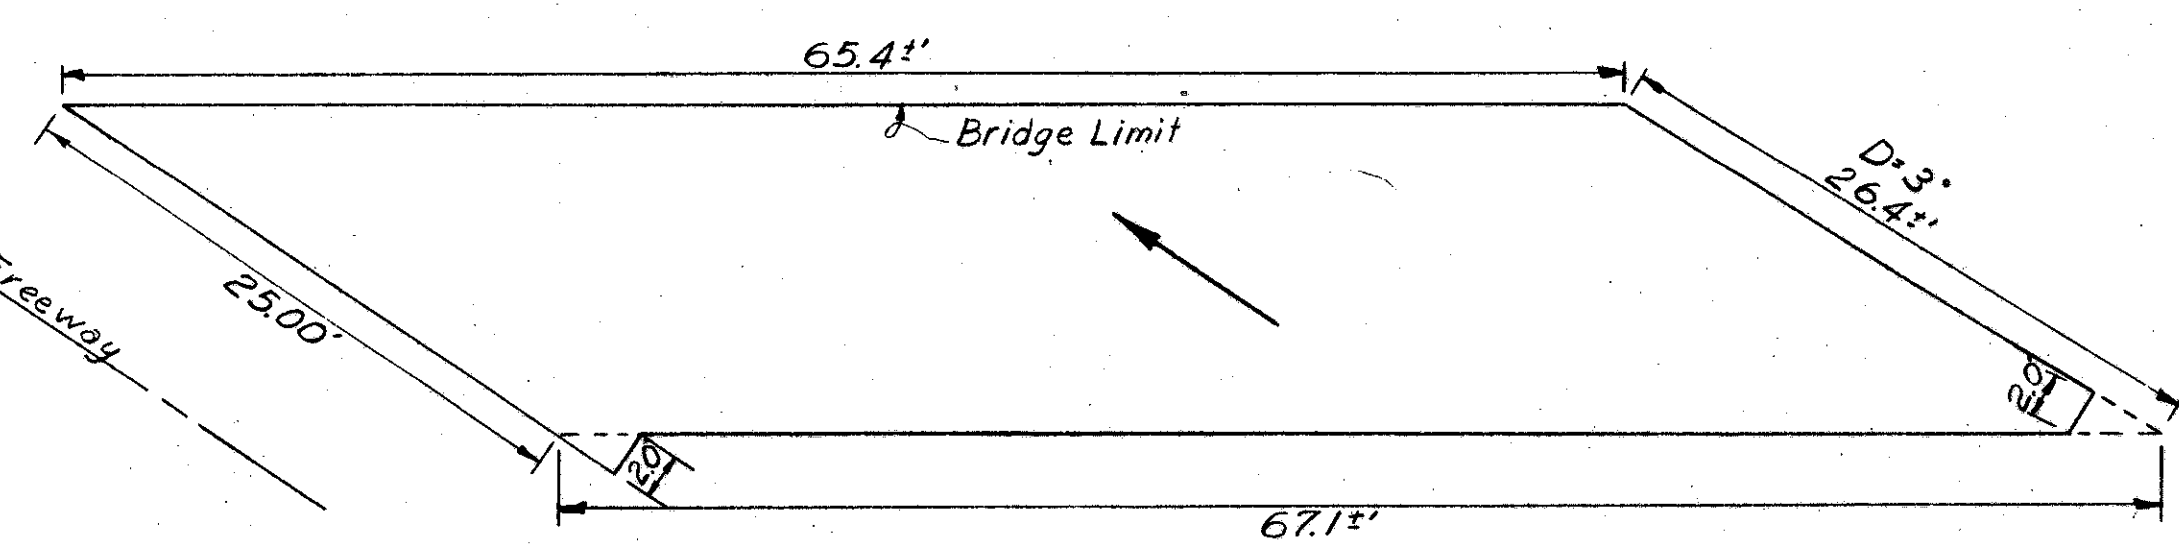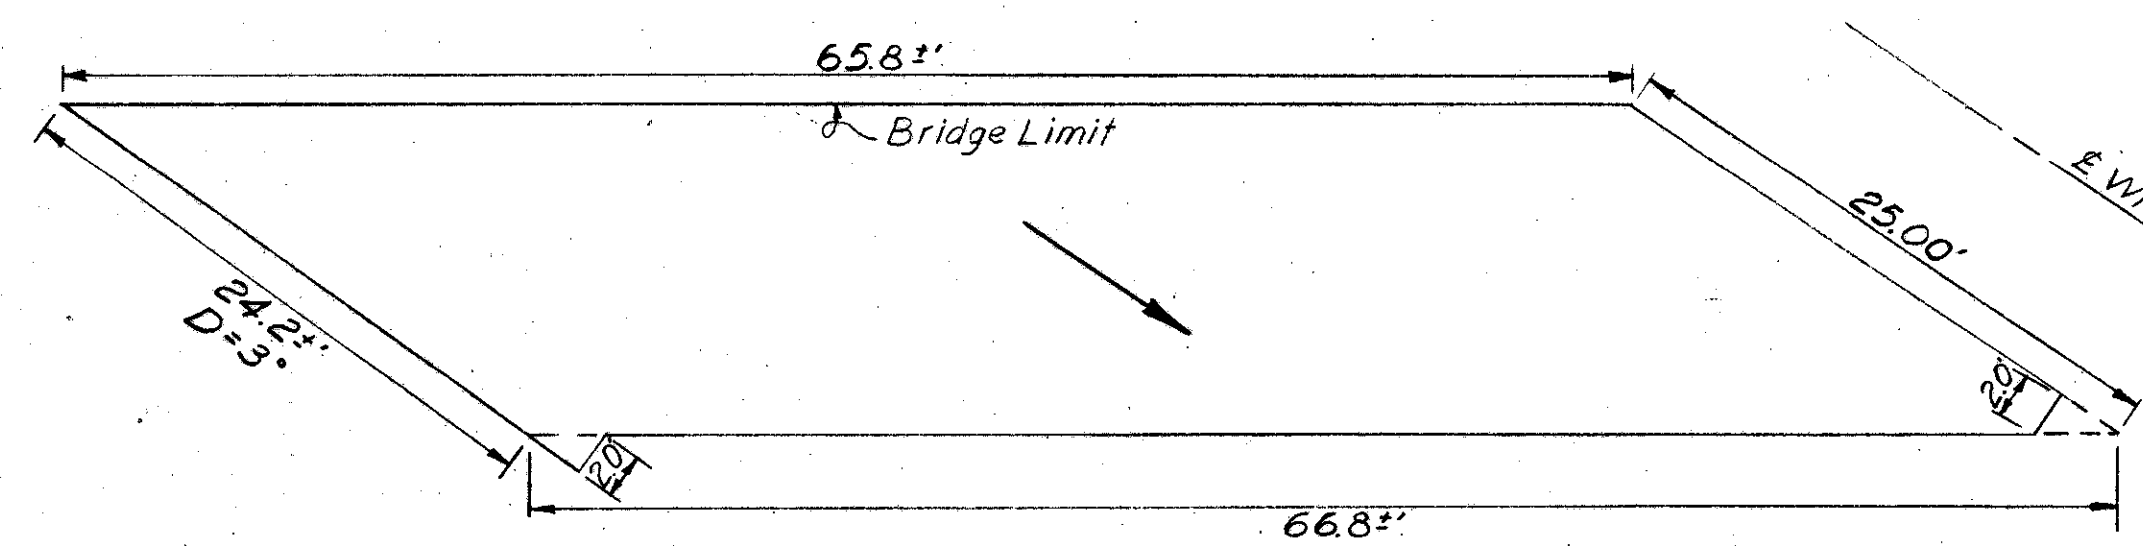


→ Direction of Traffic

*Note:
Type 2A Curb to be transitioned uniformly in eight (8) feet to match 6"x18" Sandstone Curb.

**Note:
The batter on Type 2A Curb to be transitioned uniformly in two (2) feet to match batter on Safety Walk.

Note:
Approach Slabs shall meet construction requirements as shown on State of Ohio Standard Drawing AS-1-54.
Payment for curb sections on approach slabs shall be included in the unit price bid for Item I-7, Approach slabs.

CUYAHOGA COUNTY
CITY OF CLEVELAND
CUY-42-18.42
CUY-21-15.32
DRAINAGE PLAN

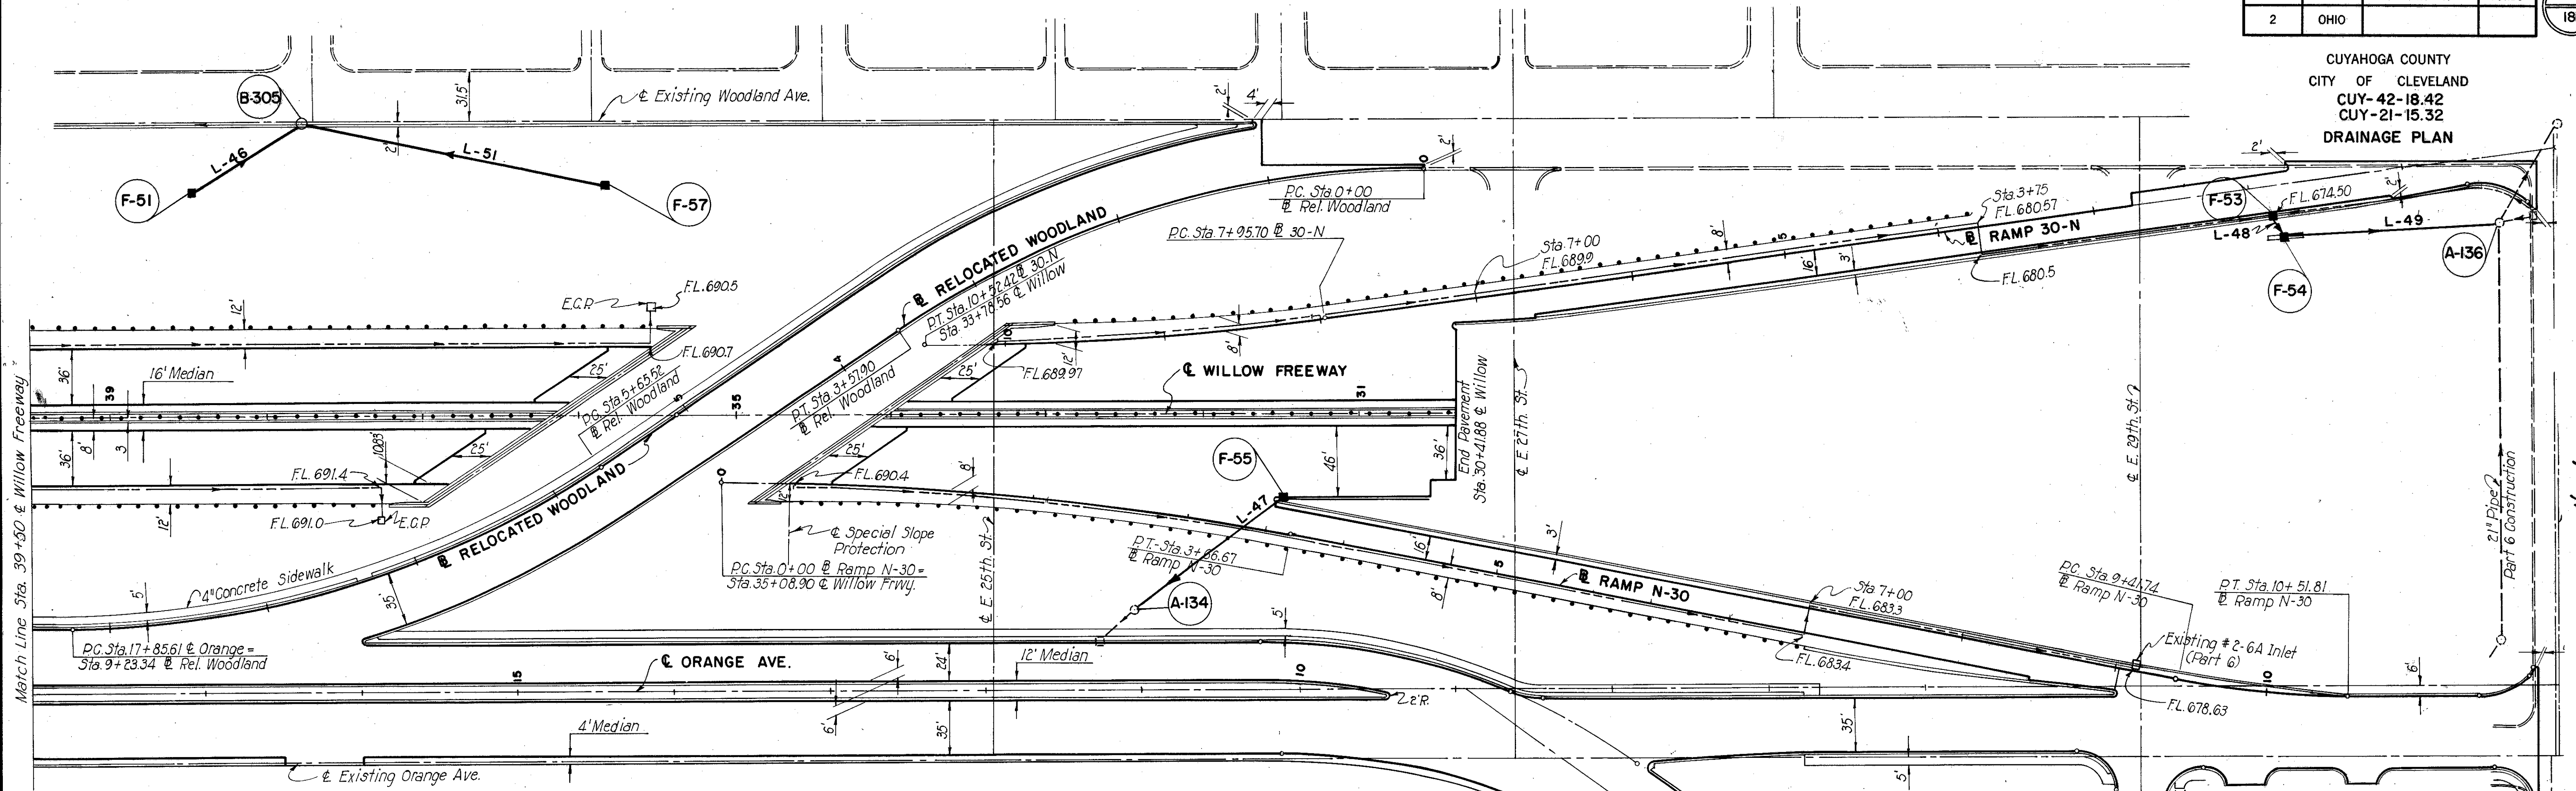

ESTIMATED QUANTITIES-UNDERDRAINS			QUANT.
I-4	6" Pipe for Underdrain	Lin. Ft.	3689
I-4	8" C.M.P. Outlet for Underdrain	Lin. Ft.	16
I-5	6" Pipe Specials	Each	6

CODE	LOCATION	EST. QUANT. C.B. & M.H.S.		
		I-8 Std. 2-6 Inlet Each	I-8 Std. 2-2A C.B. Each	I-14 Paved Apron L.F.
F-51	38+50 Willow 144'lt		1	
* F-53	1+85 30-N 19'lt	1		
F-54	1+79 30N 33'lt		1	20
F-55	31+50 Willow 54'lt	1		
F-57	35+84 Willow 149'lt		1	
Total		2	3	20

* Standard No. 2-6-A Inlet

CODE	ROADWAY	FROM	TO	EST. QUANT.-PIPES		
				I-2 12" C.I. B. L.F.	I-2 12" C.I. B.U.P. L.F.	I-2 12" C.I. B. M-6.5(6) or M-6.8(6) L.F.
L-47	Willow	F-52	A-134		114	
L-48	Ramp 30-N	F-53	F-54	8		
L-49	Ramp 30-N	F-54	A-136		132	
L-46	Woodland	F-51	B-305			78
L-51	Woodland	F-51	B-305			198
Total				140	114	276


SCALE 1"=50'

MADE M.K.M. DATE 3-2-59
TRCD. R.R. DATE 3-5-59
CKD. J.L.C. DATE 3-22-59

HOWARD, NEEDLES, TAMMEN & BERGENOFF
CONSULTING ENGINEERS
KANSAS CITY CLEVELAND NEW YORK

914 SHEET 32

CUYAHOGA COUNTY
CITY OF CLEVELAND
CUY-42-18.42
CUY-21-15.32
DRAINAGE PLAN

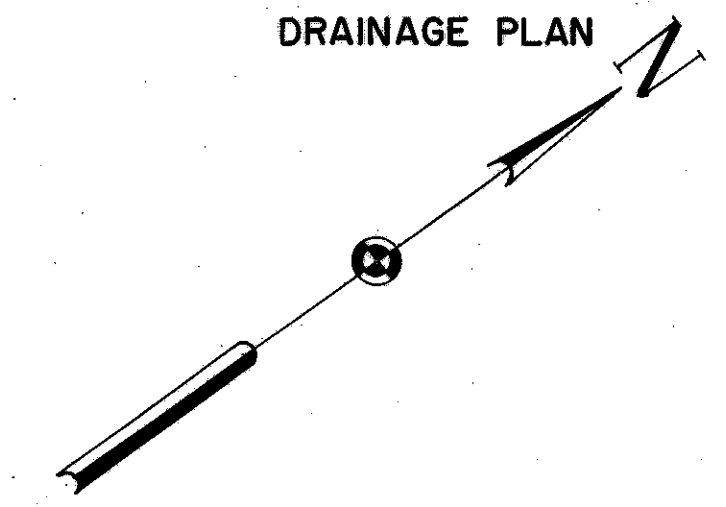

CODE	LOCATION	EST. QUANTITIES	C.B. & M.H.'S		
			I-8 M.H. Adj To Grade Each	I-16 M.H. Abandoned Each	I-16 Inlet Abandoned Each
E-200	2+82 E-7	126 Rt	1		
E-203	3+90 E-14	60 Rt	1		
E-213	2+35 E-7	125 Rt			1
E-220	6+29 E-17	3 Rt		1	
E-222	9+08 E-17	43 Lt			1
E-223	8+64 E-17	28 Lt			1
E-224	2+02 E-9	16 Rt		1	
E-218	13+77 N.B.E. 14th	125 Rt			1
Totals			2	2	4

ESTIMATED QUANTITIES-UNDERDRAINS		
1-4	6" Underdrain Pipe	L.F. 3625
1-4	8" CMP Outlet for Underdrains	L.F. 50
1-5	Pipe Special	Each 13

CODE	LOCATION	EST. QUANTITIES	INLETS AND MANHOLES				
			I-8 Std. 2-6 Inlet Each	I-8 Std #7 C.B. Each	I-8 Std 2-2A C.B. Each	I-8 Std #1 M.H. Each	I-14 Paved Apron L.F.
* F-33	5+16.5 Ramp E-7	4 Lt	1				
F-34	4+50 Ramp E-7	34 Lt			1		20
F-35	3+05 Ramp E-7	140 Rt			1		
* F-46	47+20 Willow	3 Lt	1				
* F-47	49+20 Willow	3 Lt	1				
F-48	49+10 Willow	75 Rt				1	
F-49	4+25 Ramp E-14	60 Rt		1			
TOTAL CUY-42-18.42			3*	1	2	1	20

CODE	ROADWAY	FROM	TO	ESTIMATED QUANTITIES-PIPES			
				I-2 12" Class 'B' L.F.	I-2 12" B-UP L.F.	I-2 12" C.I. B M-6.5(B) L.F.	I-2 12" M-6.8(B) L.F.
L-31	Ramp E-7	F-35	E-200	26			
L-32	Ramp E-7	F-33	F-34	68			
L-33	Ramp E-7	F-34	E-200		226		
L-38	Willow	F-46	F-47		198		
L-39	Willow	F-47	F-48		76		
L-40	Willow	F-48	A-32			92	
L-41	Ramp E-14	F-49	E-203	26			
TOTAL CUY-42-18.42				120	500	92	

- LEGEND**
- No. 3 Existing Sewer
 - Existing Catch Basins & Manholes
 - Proposed Sewer
 - Proposed Manhole
 - Proposed Inlet
 - Proposed Underdrains
 - Existing Sewer to be Abandoned
 - Proposed Drainage Structure
 - Proposed Sewer
 - Proposed Drainage Structure, Part L
 - Existing Drainage Structure, Part B

CUYAHOGA COUNTY
CITY OF CLEVELAND
CUY-42-18.42
CUY-21-15.32
DRAINAGE PLAN

LEGEND

No. 3 Existing Sewers
Existing Catch Basins & Manholes
Proposed Sewers
Proposed Manhole
Proposed Inlet
Proposed Underdrains
Existing Sewer to be Abandoned


FL 680.00
Gardiner Court

ESTIMATED QUANTITIES-UNDERDRAINS

1-4 6" Underdrain Pipe	L.F.	205
1-4 8" C.M.P. Outlet for Underdrains	L.F.	20
1-5 Pipe Special	Each	2

ESTIMATED QUANTITIES, PIPES

CODE	ROADWAY	FROM	TO	ESTIMATED QUANTITIES, PIPES							
				I-2 12" Class 'B' L.F.	I-2 12" B-UP L.F.	I-2 15" Class B L.F.	I-2 15" B-UP L.F.	I-2 15" BUP M-6.6(6) L.F.	I-2 12" C.I. B M-6.6(6) L.F.	I-2 18" B-UP M-6.6(6) L.F.	
L-1	Ramp E-10	F.6	A-142	100							
L-3	Ramp E-8	F.2	F.17	34							
L-4	Ramp E-8	F.17	A-101						204		
L-5	Ramp E-8	F.10	A-101	110							
L-13	Ramp E-10	F.7	F.8	56							
L-14	I-B. Freeway	F.8	F.14			222					
L-15	Ramp E-10	F.24	F.8	116							
L-16	Ramp E-5	F.11	F.12	46							
L-17	Ramp E-5	F.12	A-102						30		
L-18	Ramp E-8	F.16	F.15	58							
L-19	Ramp E-8	F.15	F.1				100				
L-20	Ramp E-8	F.1	A-102						296		
L-22	Ramp E-5	F.19	B-79	46							
L-23	Ramp E-8	F.14	F.30			200					
L-27	Ramp E-8	F.30	F.31				47				
L-28	Ramp E-10	F.31	A-143							124	
L-29	Ramp E-10	F.32	A-143	54							
L-52	Ramp E-16	F.52	F.7	36							
TOTAL CUY-42-18.42				116	540	422	147	500	30	124	

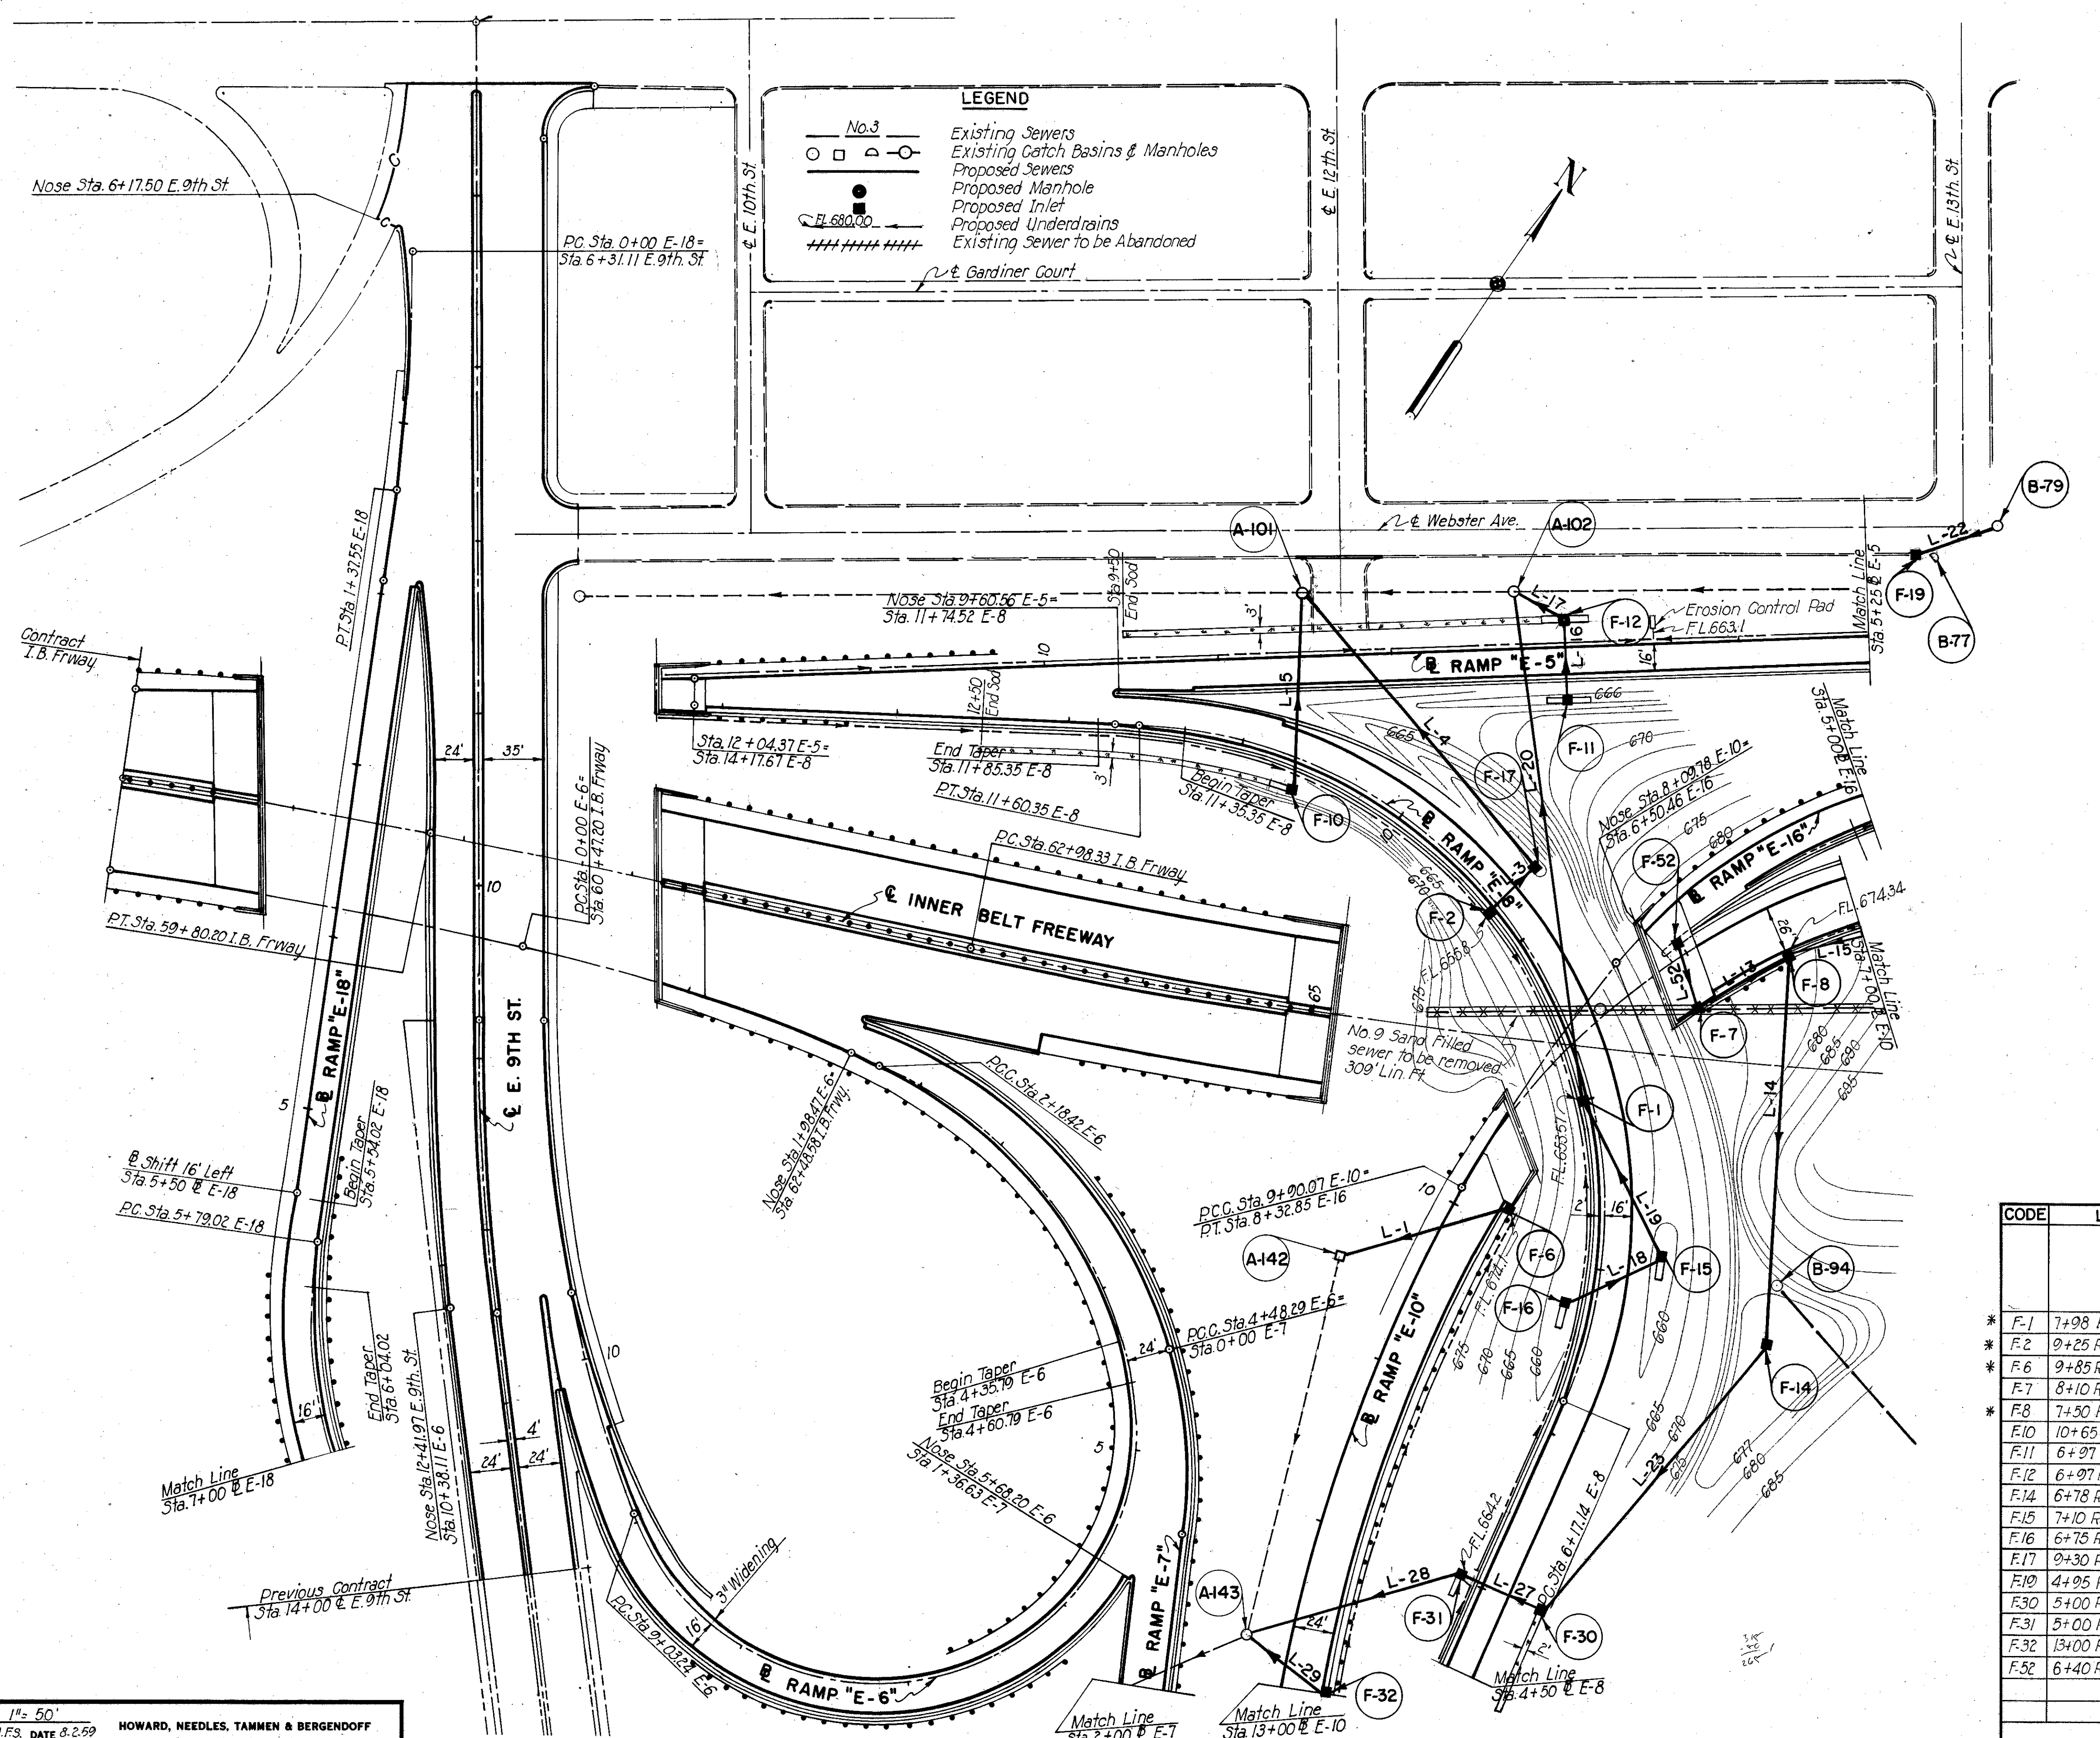

EST. QUANTITIES, CATCH BASINS, INLETS & MHS

CODE	LOCATION	EST. QUANTITIES, CATCH BASINS, INLETS & MHS				
		I-8 Std 2-6 Inlet Each	I-8 Std 2-8 C.B. Each	I-8 Std 2-24 C.B. Each	I-8 Std #3 C.B. Each	I-14 Paved Apron L.F.
* F-1	7+98 Ramp E-8	5	1			
* F-2	9+25 Ramp E-8	5	1			
* F-6	9+85 Ramp E-10	20	1			
F-7	8+10 Ramp E-10	20				
* F-8	7+50 Ramp E-10	20	1			
F-10	10+65 Ramp E-8	18				10
F-11	6+97 Ramp E-5	30				20
F-12	6+97 Ramp E-5	18				20
F-14	6+78 Ramp E-8	100				
F-15	7+10 Ramp E-8	32				10
F-16	6+75 Ramp E-8	18				10
F-17	9+30 Ramp E-8	30				10
F-19	4+95 Ramp E-5	41				1
F-30	5+00 Ramp E-8	37				10
F-31	5+00 Ramp E-8	15				10
F-32	13+00 Ramp E-10	27	1			
F-52	6+40 Ramp E-16	18	1			
TOTAL CUY-42-18.42		6	1	9	1	100

Note: Asterisked inlets are to be Std. 2-4 inlets as per Standard drawing I-8 I & A 4-23-59.


CUYAHOGA COUNTY
CITY OF CLEVELAND
CUY-42-18.42
CUY-21-15.32
DRAINAGE PLAN

CODE	ROADWAY	FROM	TO	EST. QUANTITIES-PIPES							
				I-2 12" C.I. B L.F.	I-2 12" B.U.P L.F.	I-2 12" M-6.5(6) L.F.	I-2 15" C.I. B L.F.	I-2 18" M-6.5(6) L.F.	I-2 24" B.U.P L.F.		
L-10	I.B. Freeway	F-22	F-23		108						
L-11	I.B. Freeway	F-23	F-24		116						
L-12	Ramp E-10	F-25	F-24		70						
L-24	Ramp E-5	F-26	F-27		52						
L-25	Ramp E-5	F-27	F-28					34			
L-26	Ramp E-5	F-29	F-28		34						
L-34	Ramp E-11	F-37	F-38		268						
L-35	Ramp E-11	F-38	F-56					96			
L-36	Ramp E-11	F-39	F-56		16						
L-37	Ramp E-11	F-40	E-202					54			
L-42	I.B. Freeway	F-41	F-42		204						
L-43	Ramp E-13	F-44	F-43		90						
L-44	Ramp E-13	F-43	F-42					176			
L-45	E-22nd St.	F-45	# 5		12						
L-50	Ramp E-11	F-56	E-202						92		
Total CUY-42-1842					540	430	54	130	176	92	

ESTIMATED QUANTITIES-UNDERDRAINS		
I-4, 6" Underdrain Pipe	L.F.	3650
I-4, 8" CMP Outlet for Underdrain	L.F.	50
I-5, 6" Pipe Special	Each	7

CODE	LOCATION	EST. QUANTITIES C.B. & M.H.'S		
		I-8 M.H. Adj. to Grade Each	I-16 M.H. Abandon Each	I-16 Inlet Each
E-202	80+52 Inner Belt	1		
E-225	4+45 E-5	1		
E-226	79+50 Inner Belt			1
E-227	79+59 Inner Belt	1		
E-228	79+69 Inner Belt			1
E-229	79+66 Inner Belt		1	
E-230	6+95 E-11	1		
E-231	7+04 E-11			1
E-232	7+26 E-11	1		
E-233	7+36 E-11			1
E-234	80+80 Inner Belt			1
E-235	8+93 Inner Belt		1	
E-236	81+00 Inner Belt			1
E-237	2+66 E-13		1	
E-238	0+49 E-13			1
B-152	75+11 Inner Belt		1	
B-153	77+33 Inner Belt		1	
E-242	68+41 Inner Belt			1
E-243	68+60 Inner Belt			1
E-244	75+53 Inner Belt			1
E-245	75+68 Inner Belt			1
Total		5	5	11

CODE	LOCATION	ESTIMATED QUANTITIES-INLETS & MANHOLES								
		I-8 Std. 2-6 C.B. Each	I-8 Std. 2-10 C.B. Each	I-8 Std. 2-24 C.B. Each	I-8 Std. 3 C.B. Each	I-8 Std. #1 M.H. Each	I-8 Std. #2 M.H. Each	I-14 Paved Apron L.F.	I-8 Std. #A C.B. Each	
* F-22	70+56 I.B. Frwy.	2								
F-23	69+53 I.B. Frwy.	2								
F-24	6+25 Ramp E-10	37								
* F-25	4+75 Ramp E-16	19						10		
F-26	1+75 Ramp E-5									
F-27	2+31 Ramp E-5	18						20		
F-28	2+73 Ramp E-5	10								
F-29	1+85 Ramp E-16	8								
F-37	76+85 I.B. Frwy.	87						10		
F-38	2+75 Ramp E-11	18						10		
F-39	3+93 Ramp E-11	18						20		
F-40	3+93 Ramp E-11	31						20		
F-41	77+30 I.B. Frwy.	74								1
F-42	78+50 I.B. Frwy.	86								1
E-43	3+14 Ramp E-13	16						20		
F-44	3+38 Ramp E-13	32						20		
F-45	18+65 E-22nd St.	2								
F-56	3+75 Ramp E-11	32								
Total	CUY-42-1842	4	1	8	1	2	1	130	1	

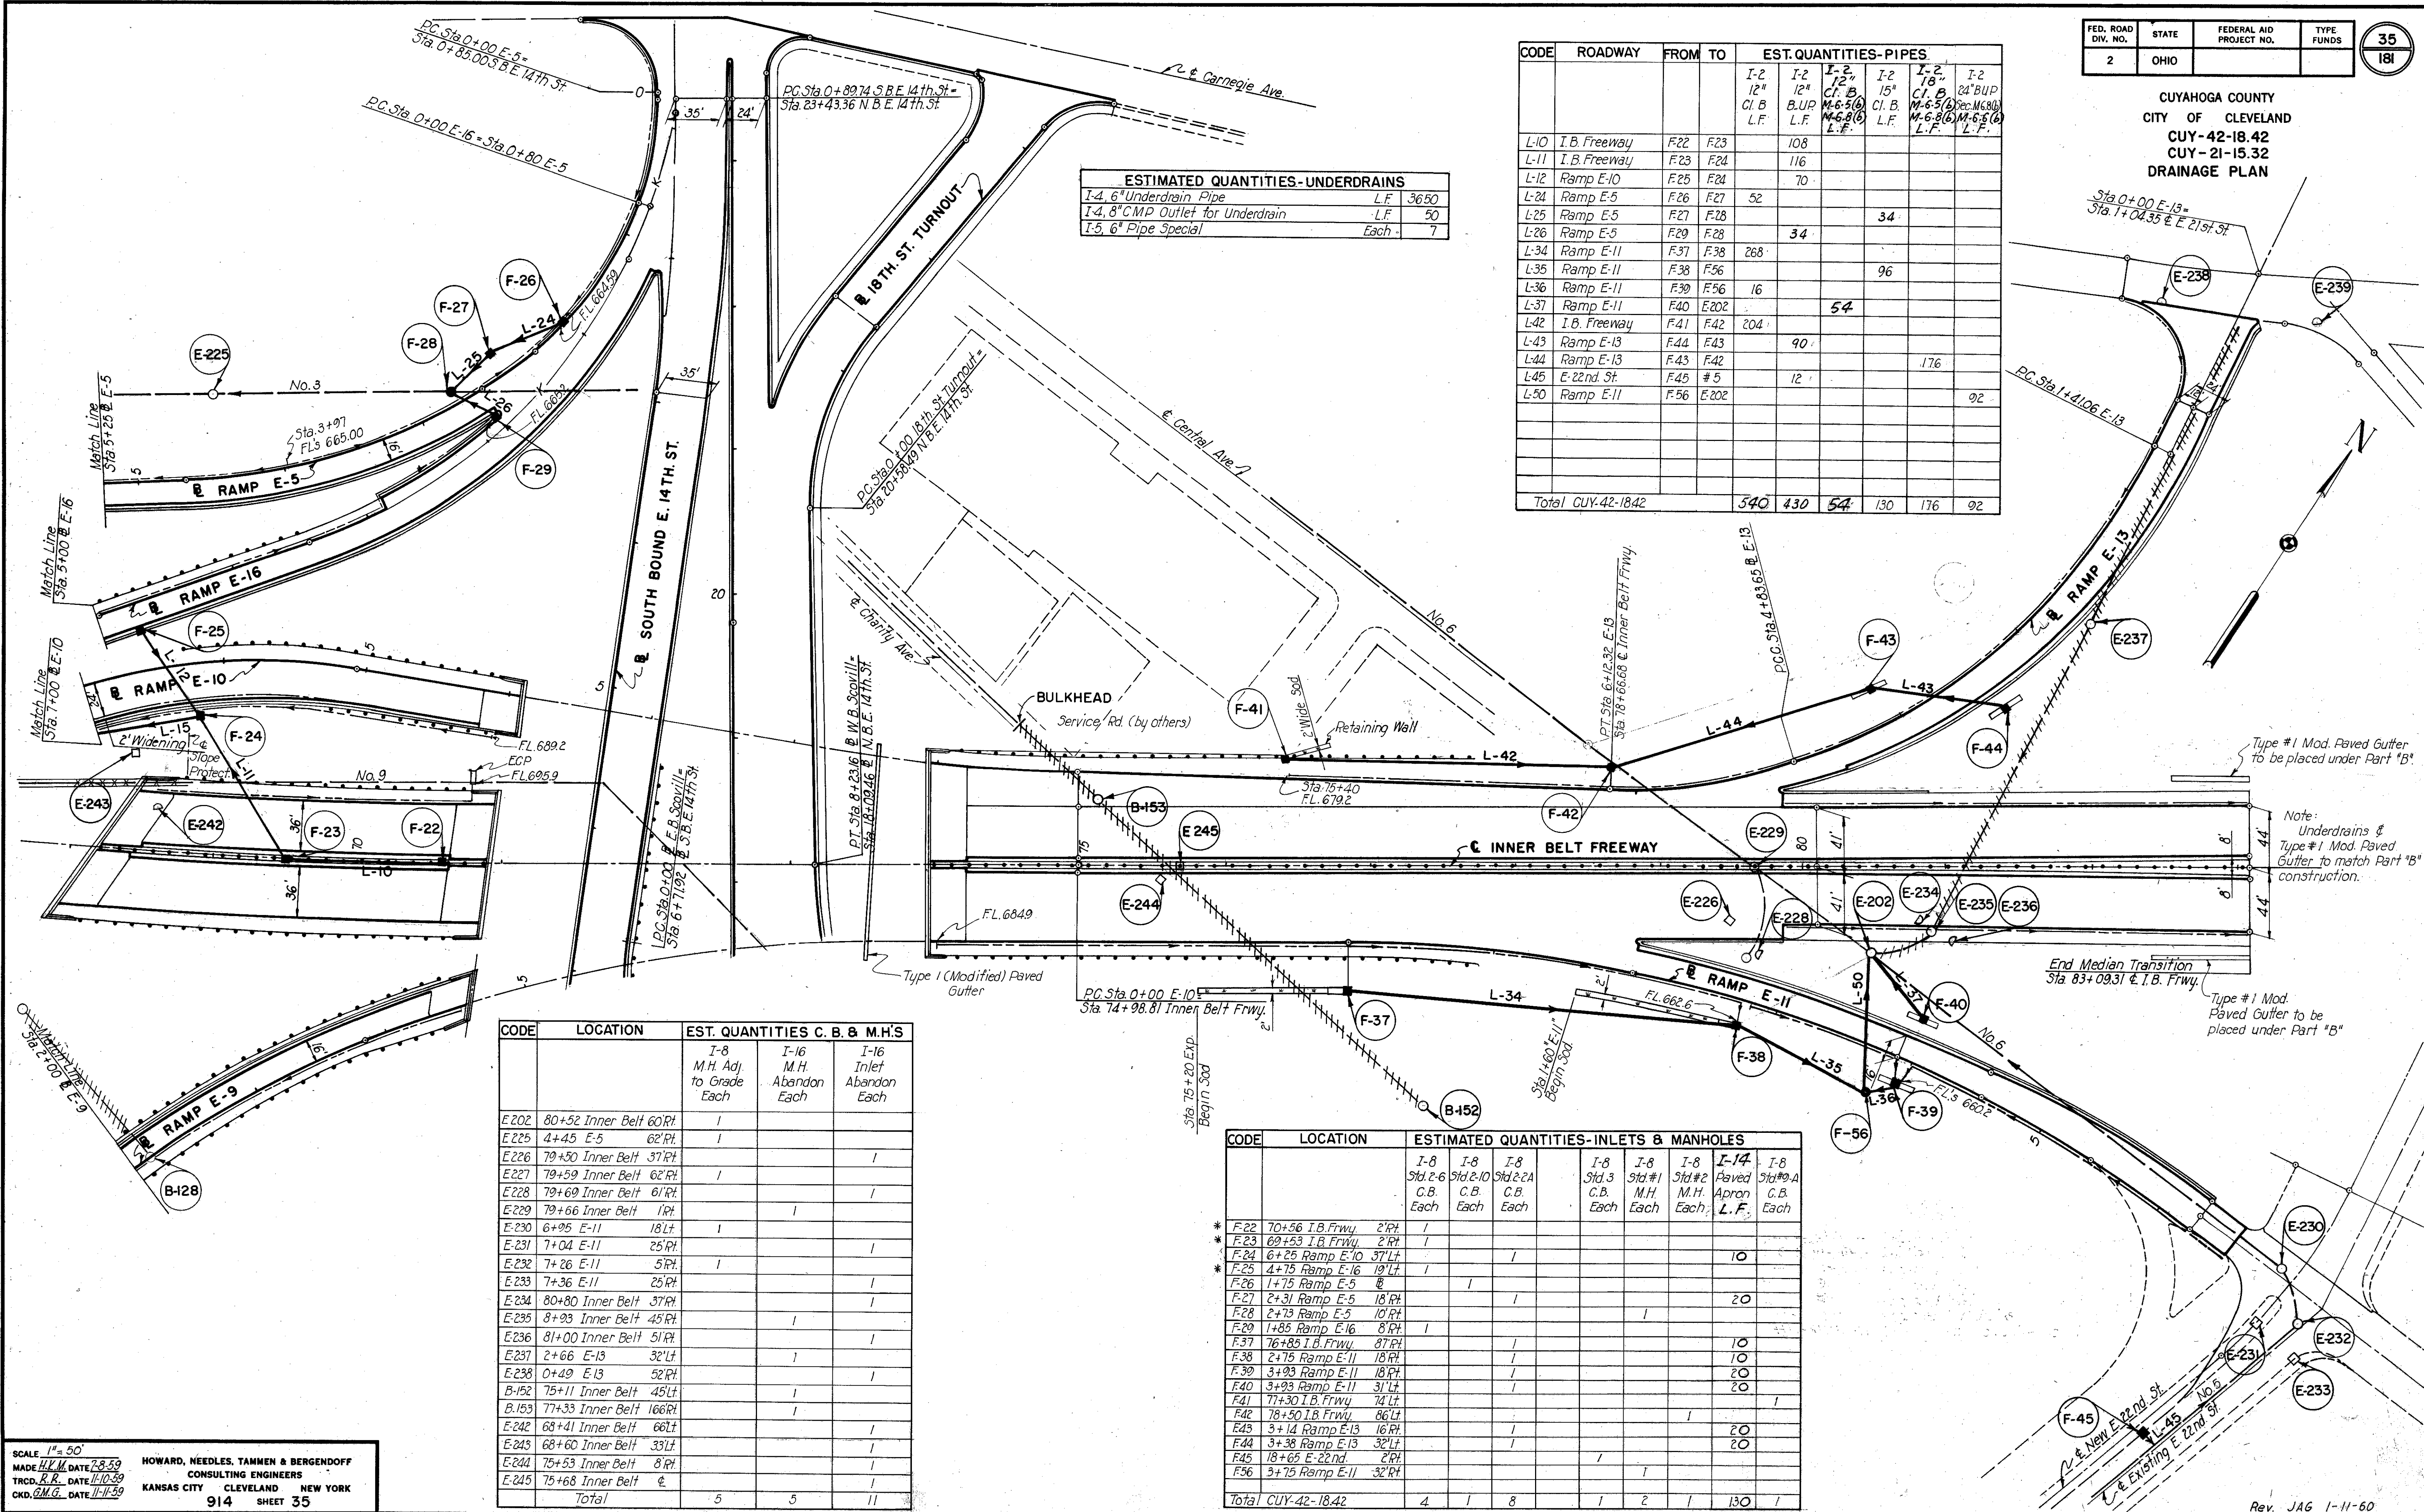

SCALE 1" = 50'
MADE H.K.M. DATE 7-8-59
TRCD. R.R. DATE 11-10-59
CKD. G.M.G. DATE 11-11-59






HOWARD, NEEDLES, TAMMEN & BERGENDOFF
CONSULTING ENGINEERS
KANSAS CITY CLEVELAND NEW YORK

914 SHEET 35

FED. ROAD DIV. NO.	STATE	FEDERAL AID PROJECT NO.	TYPE FUNDS
2	OHIO		

36
181

CUYAHOGA COUNTY
CITY OF CLEVELAND
CUY-42-18.42
CUY-21-15.32
DRAINAGE PROFILES

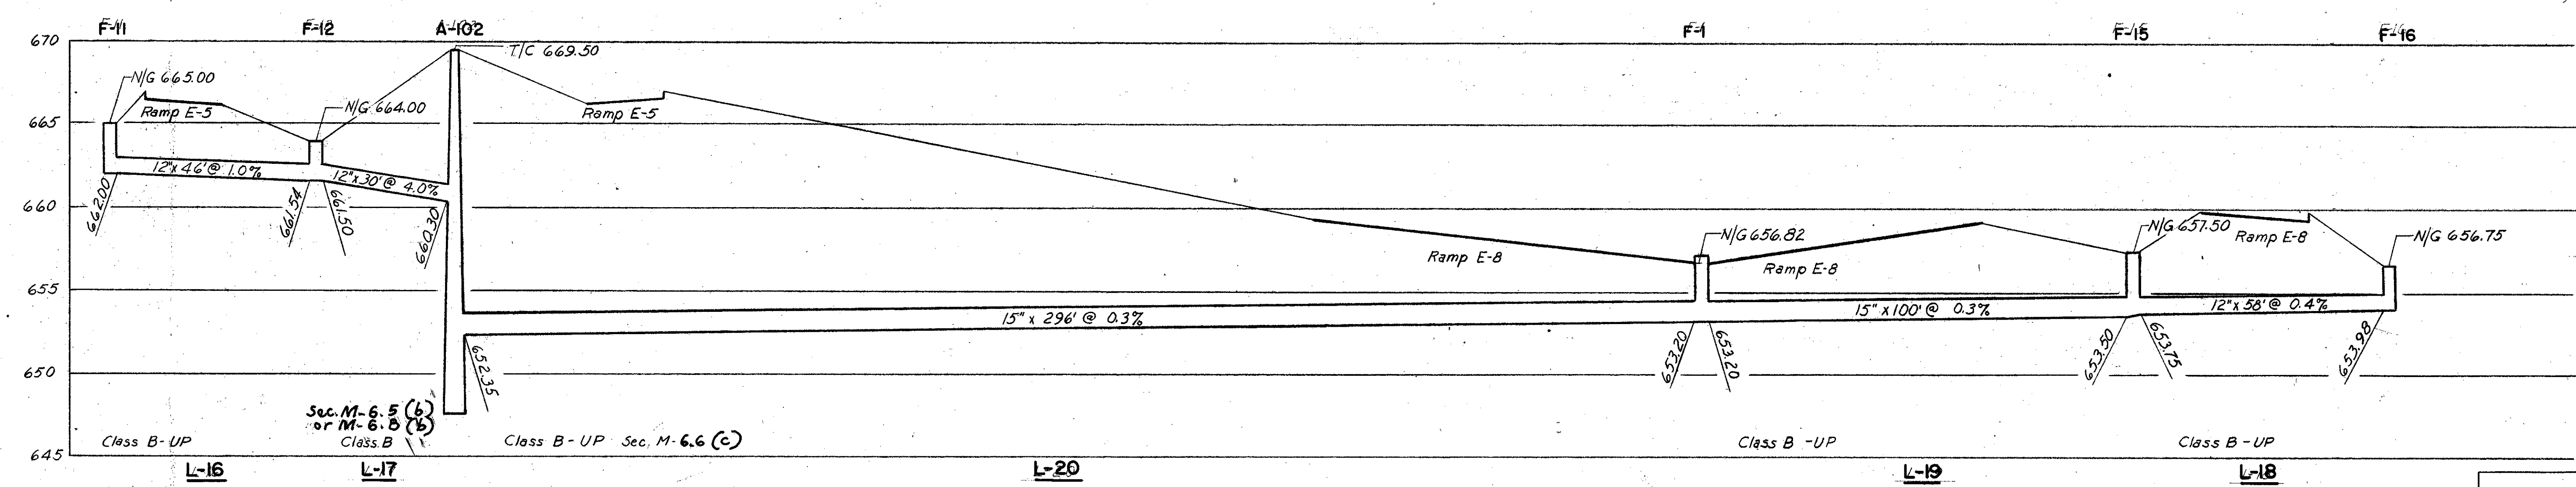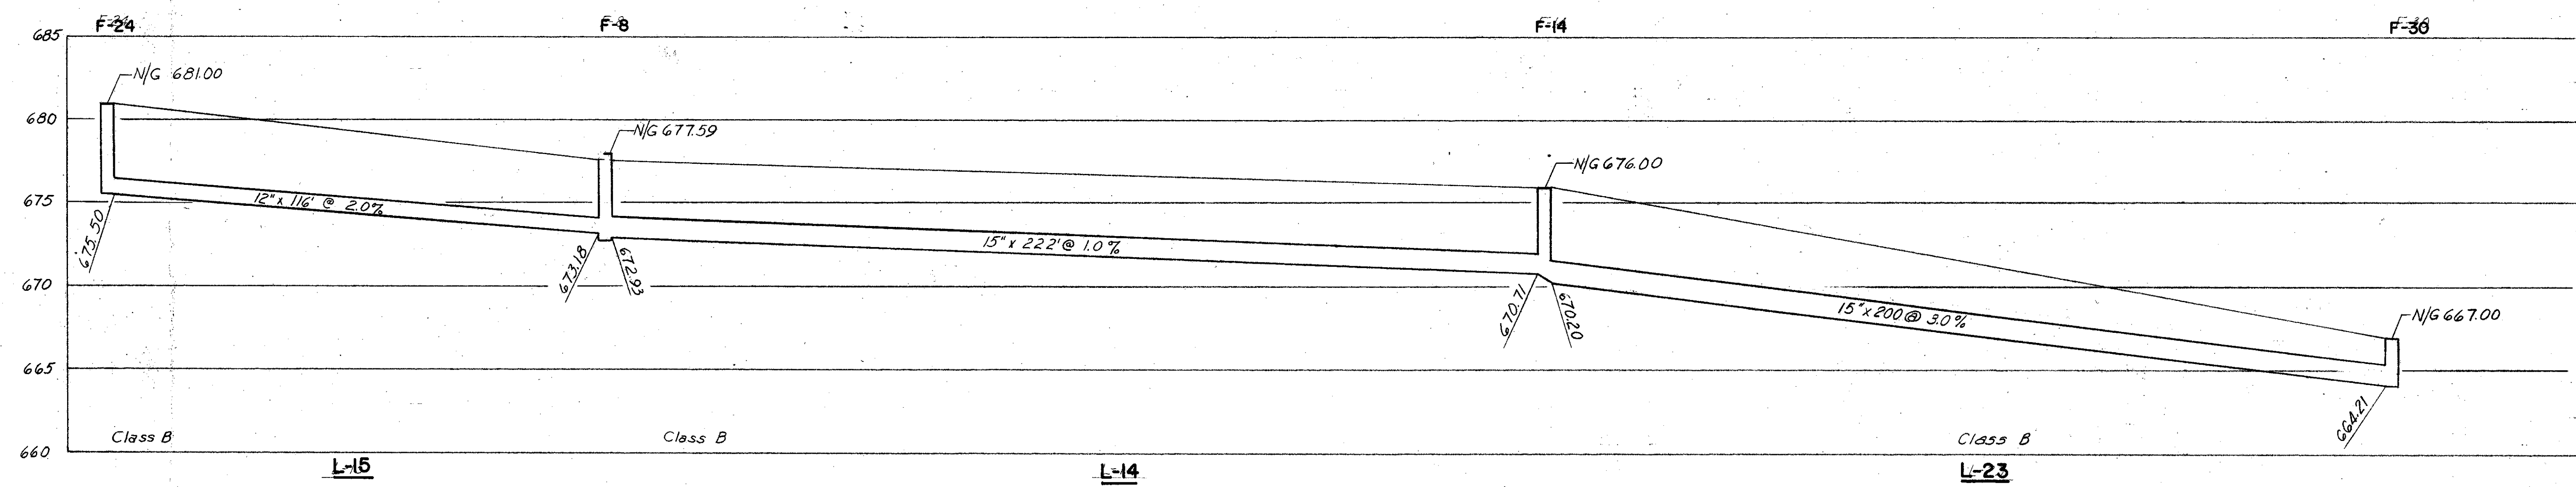
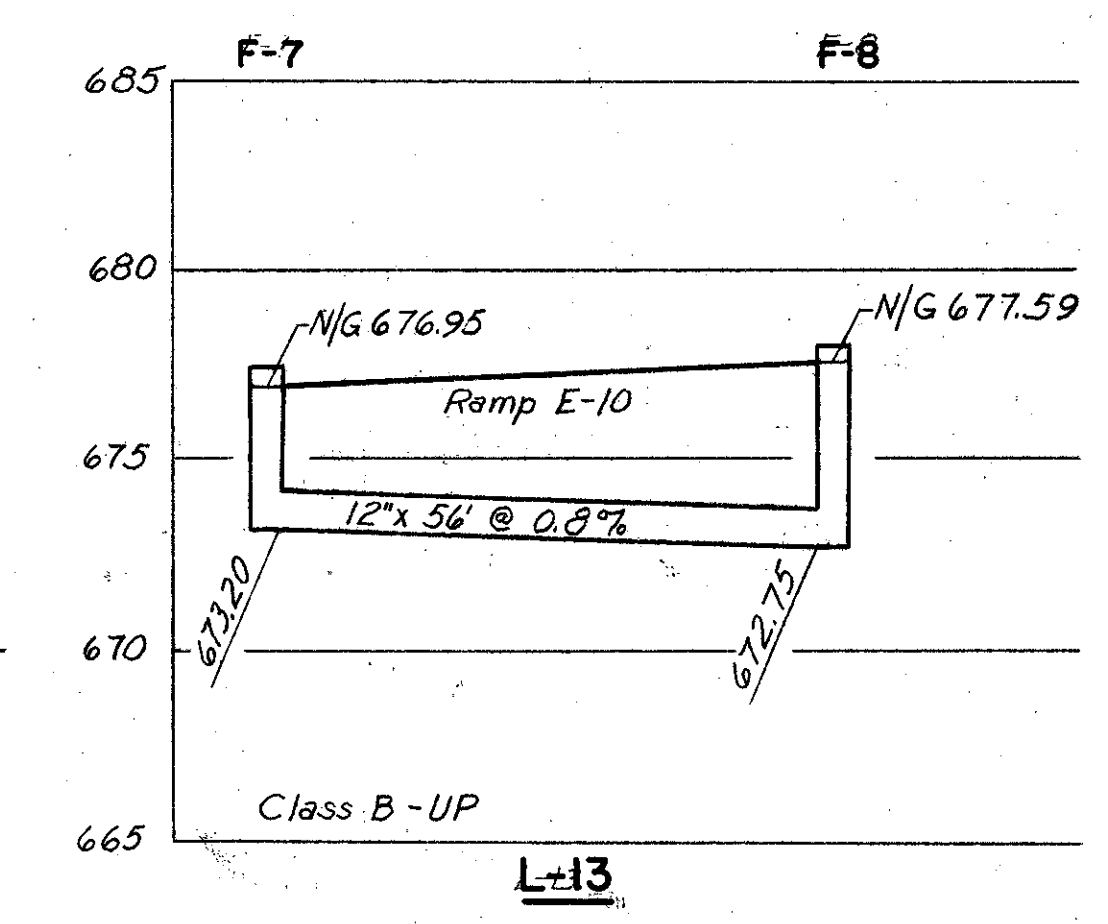
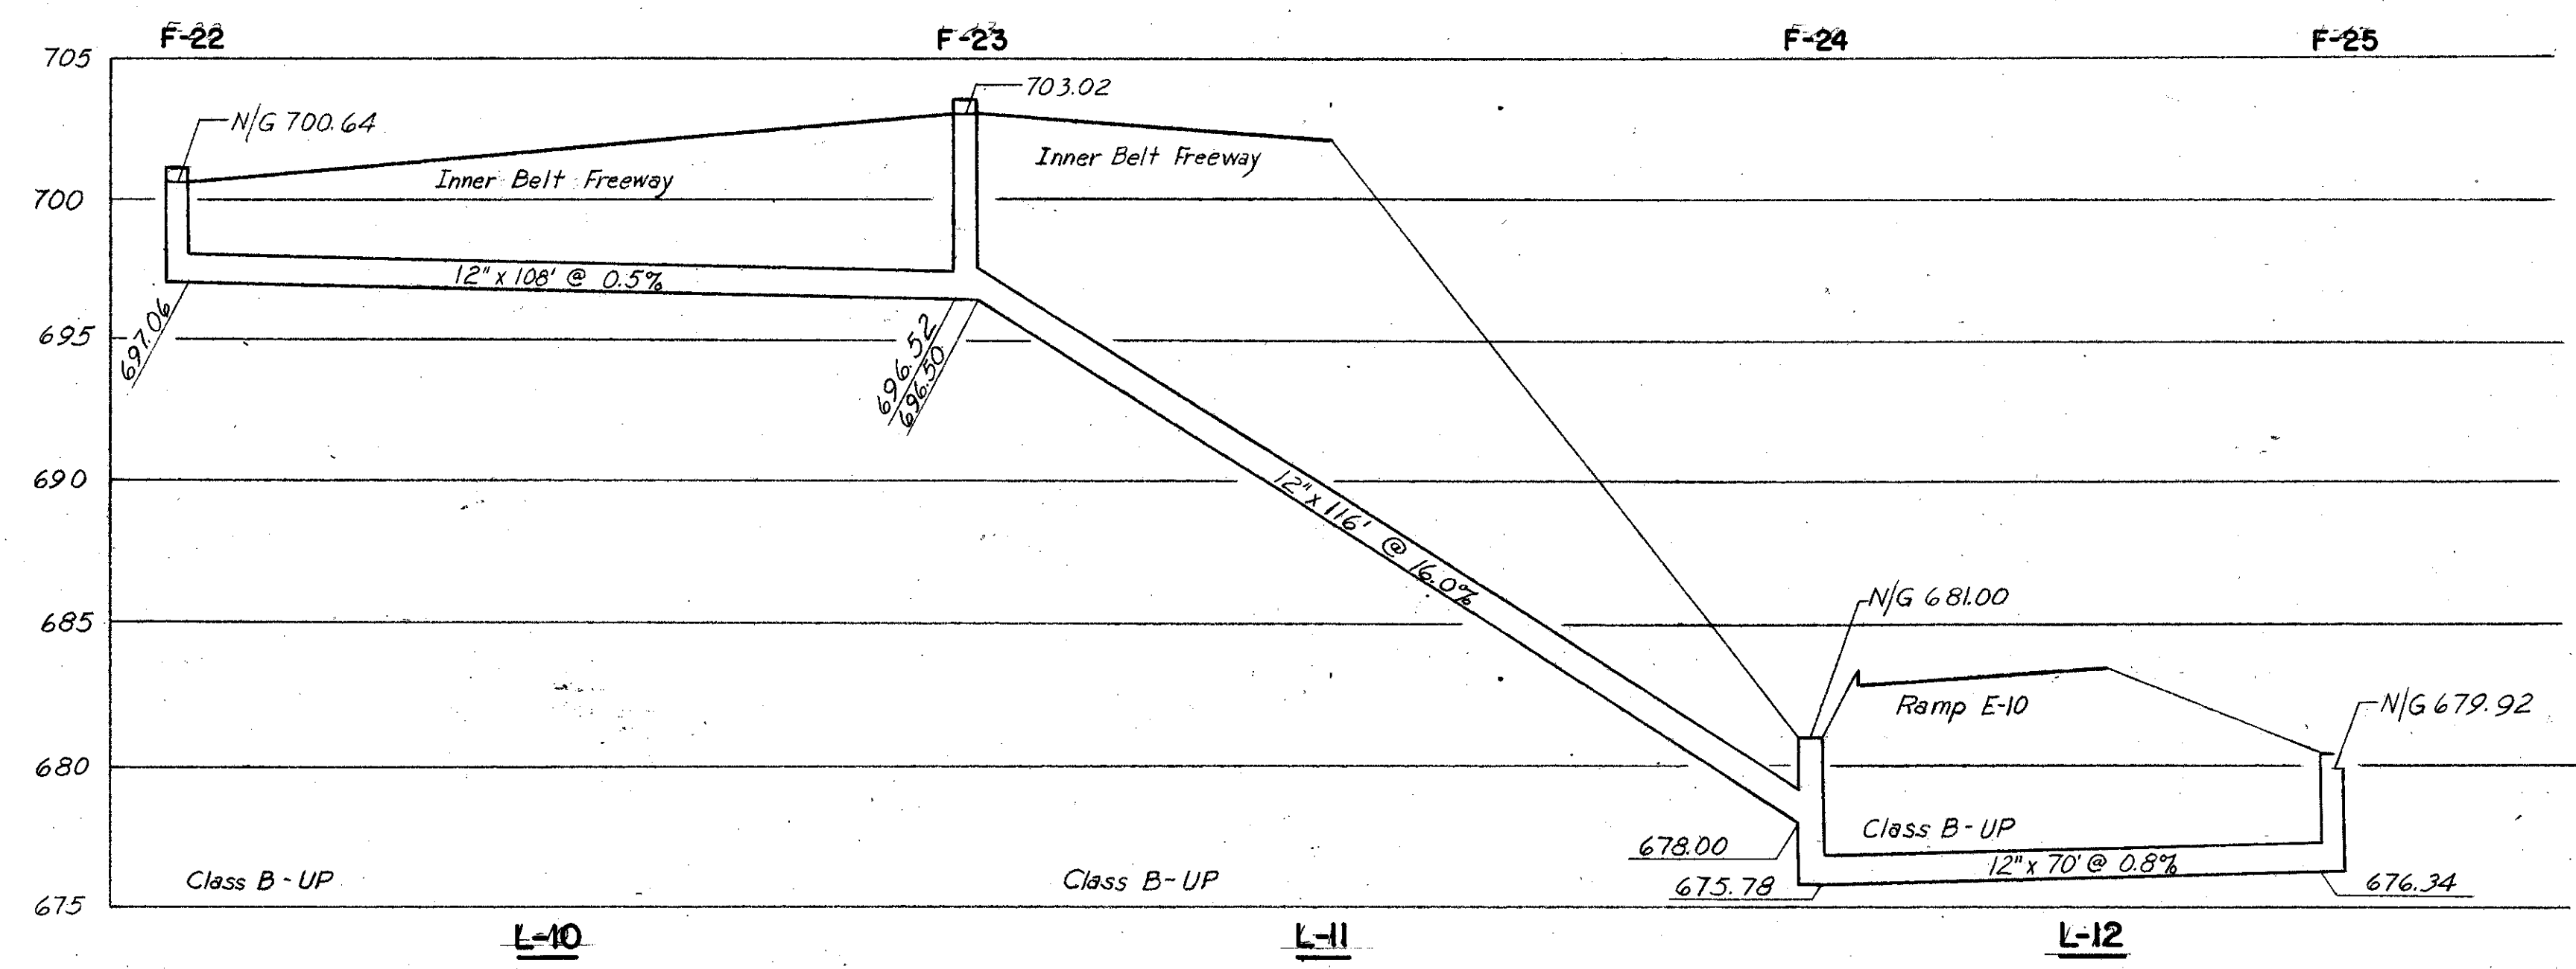
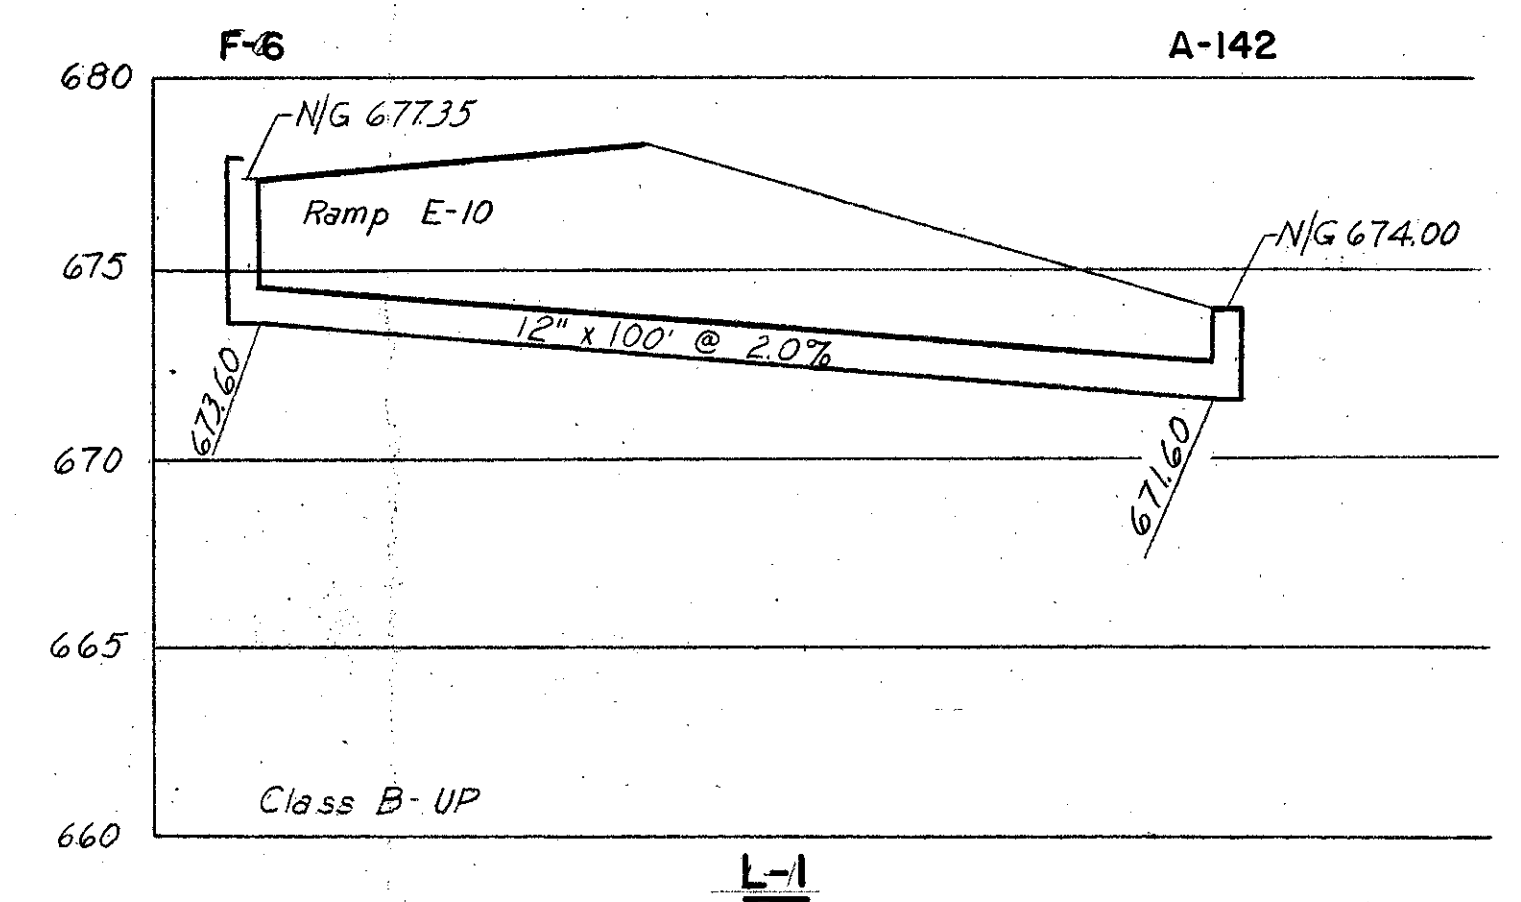


PROFILES
L-1, L-10 TO L-20,
& L-23

FED. ROAD DIV. NO.	STATE	FEDERAL AID PROJECT NO.	TYPE FUNDS
2	OHIO		

37
181

CUYAHOGA COUNTY
CITY OF CLEVELAND
CUY-42-18.42
CUY-21-15.32
DRAINAGE PROFILES

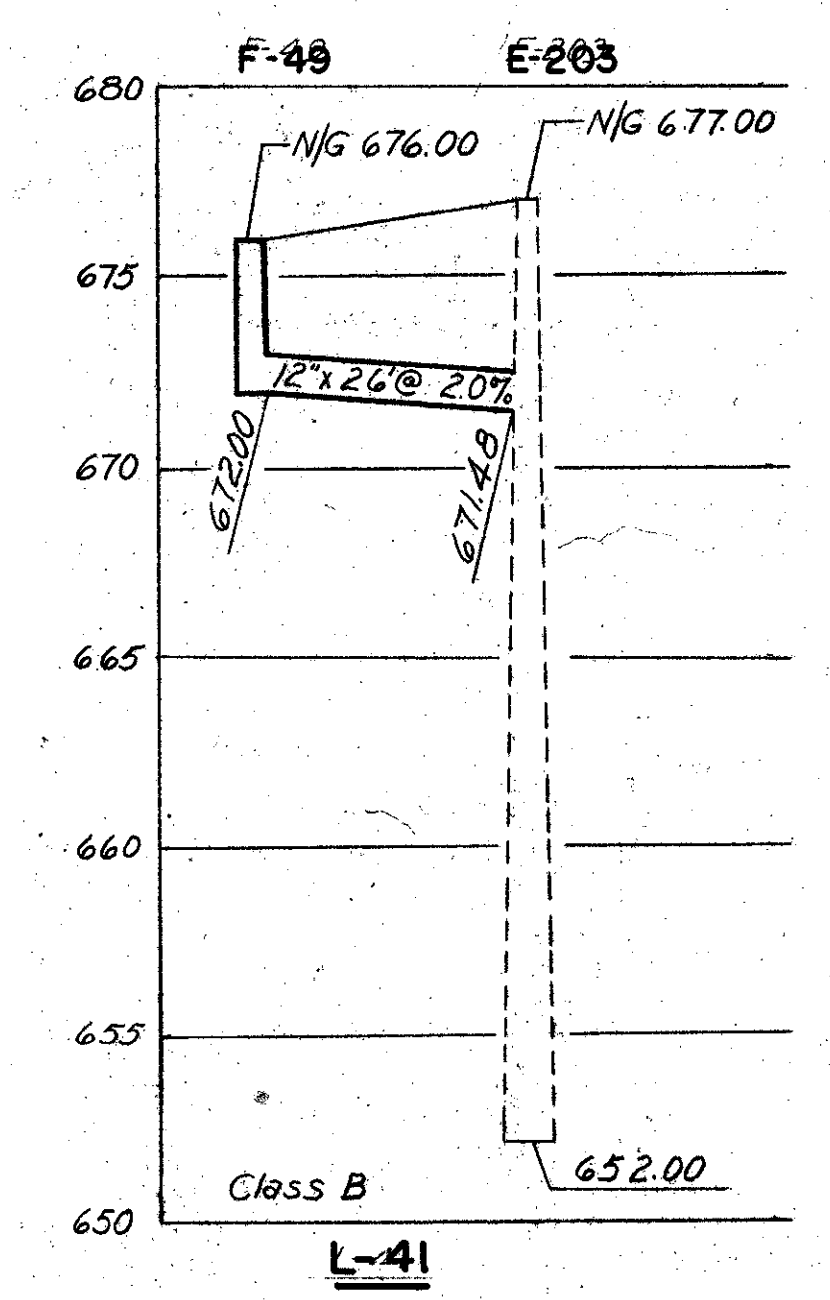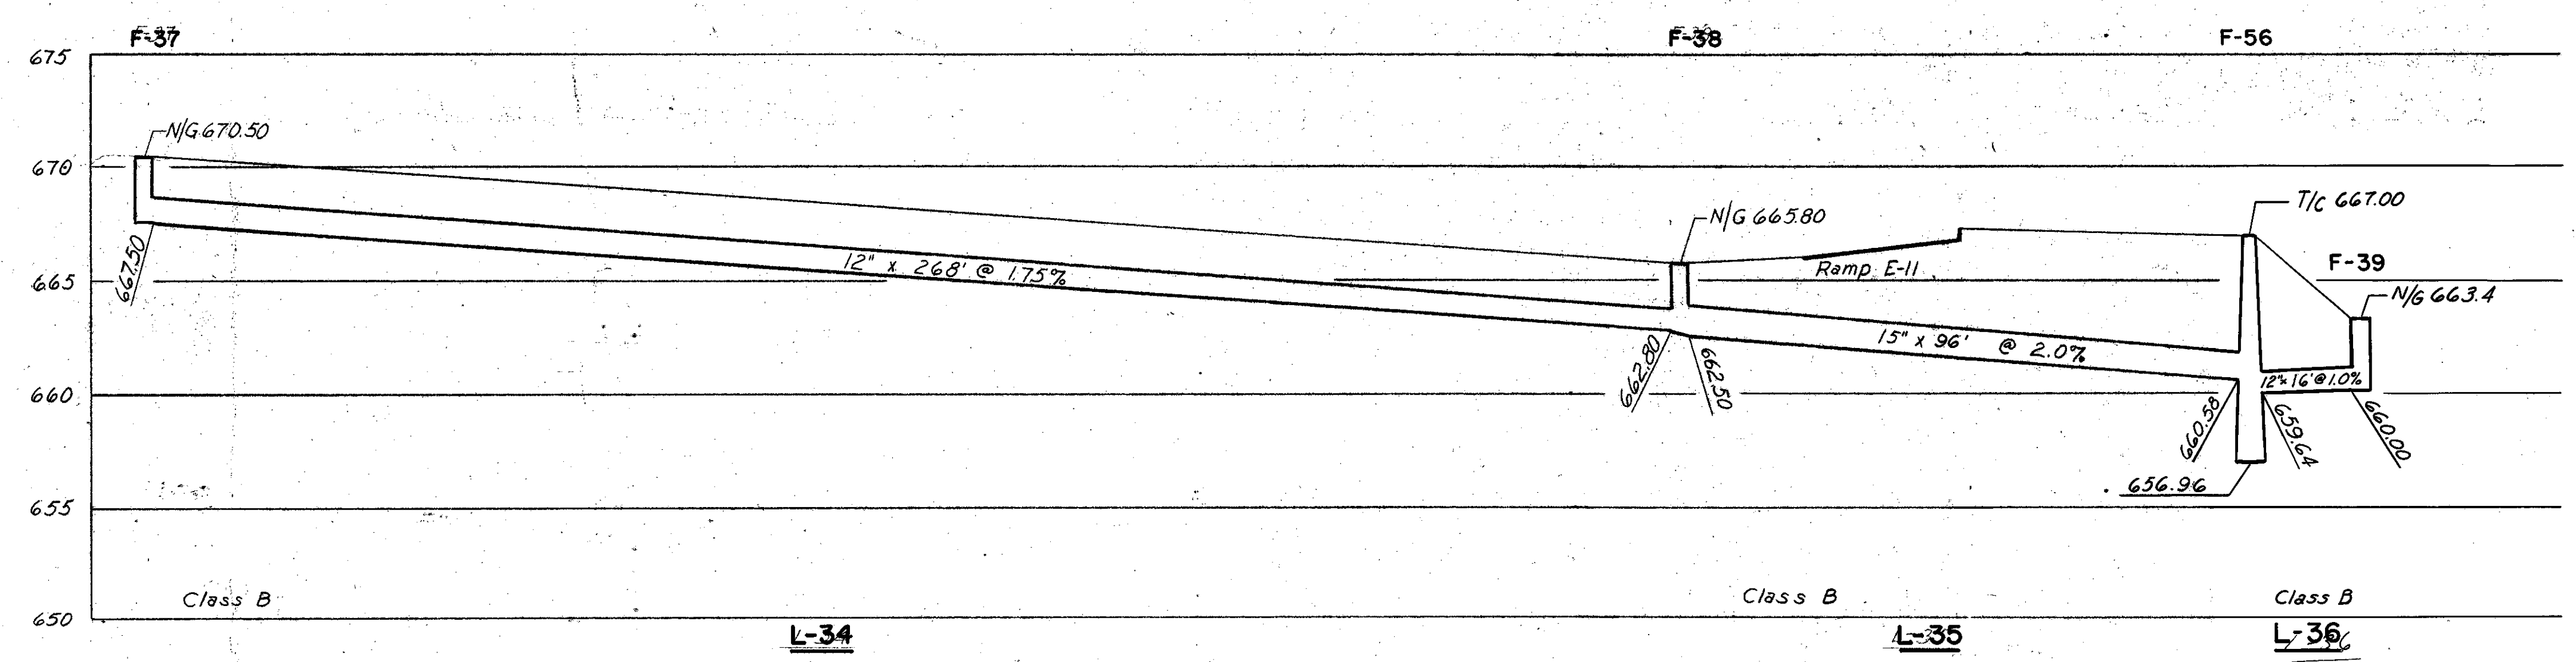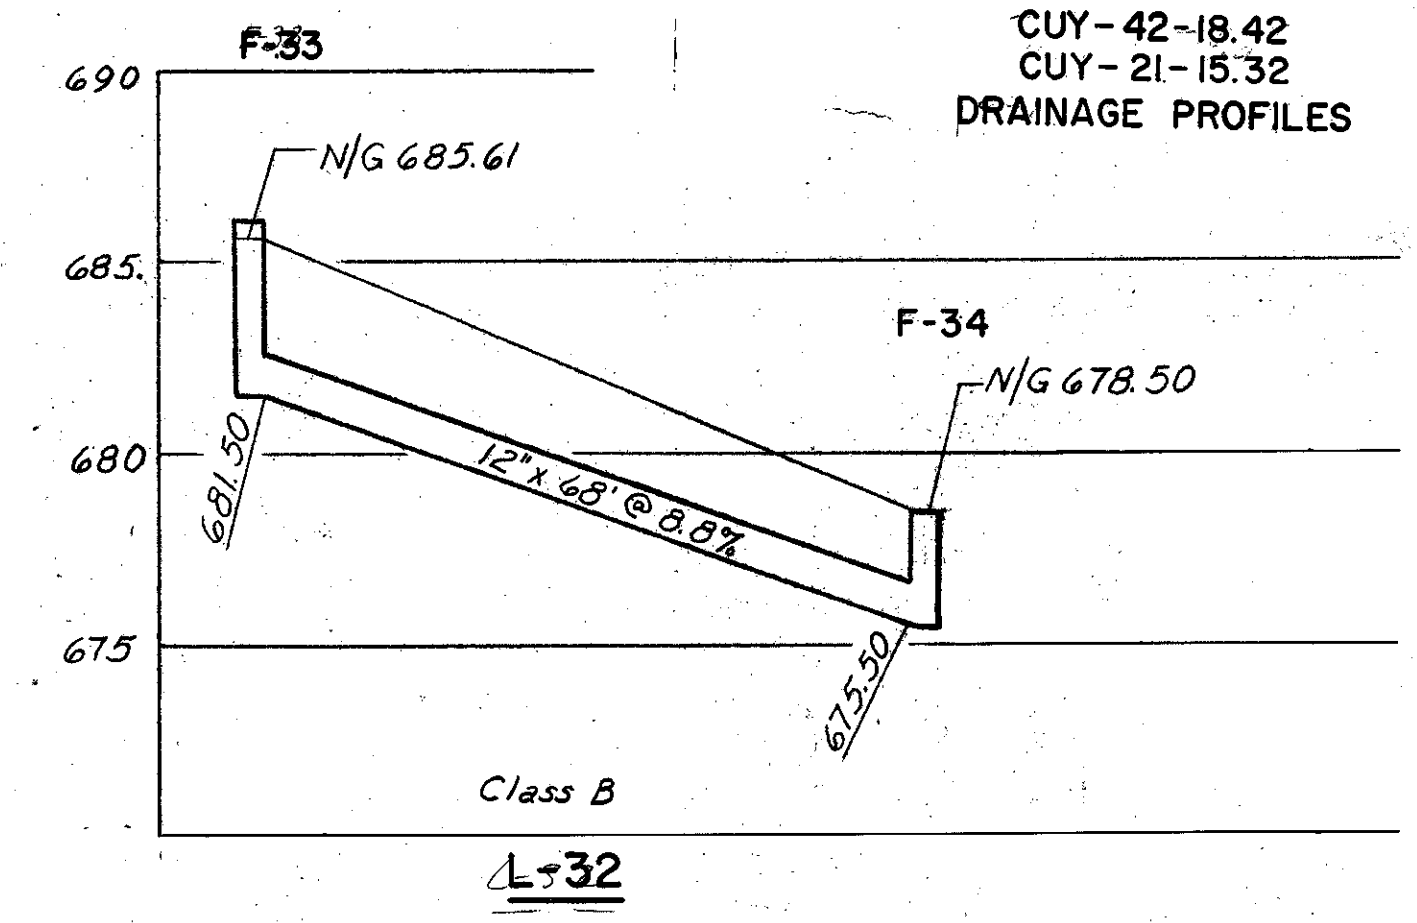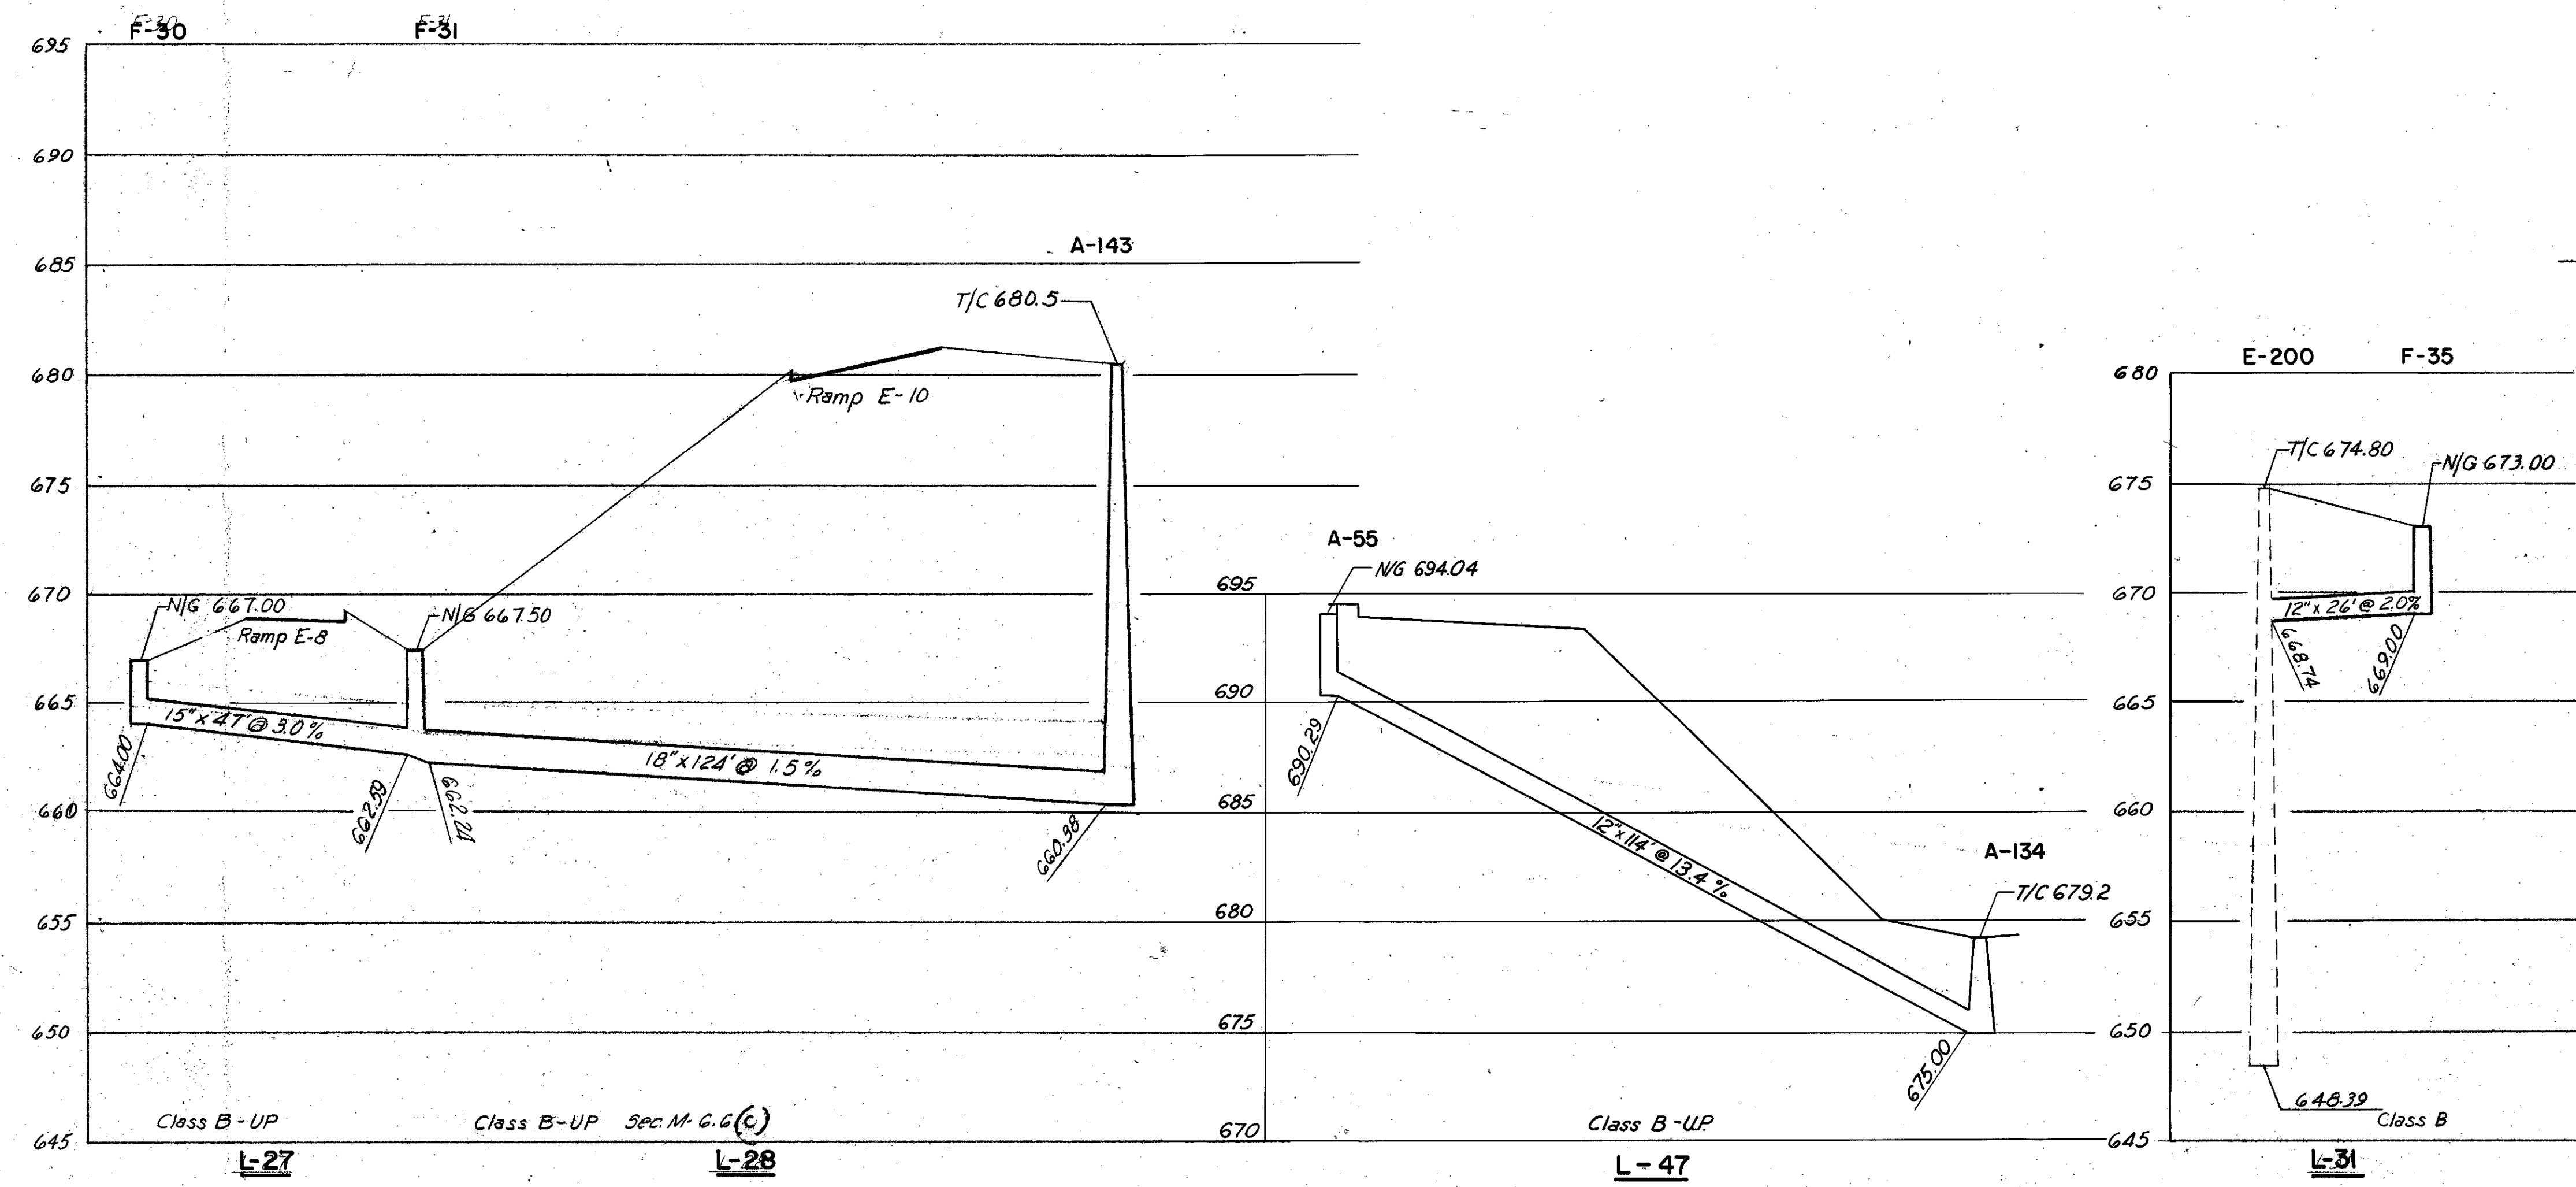

SCALE: 1" = 20'
DATE: 7/10/59
HOWARD, NEEDLES, TAMMEN & BERGENDOFF
CONSULTING ENGINEERS
KANSAS CITY CLEVELAND NEW YORK
914 SHEET 37 37







PROFILES
L-27, L-28, L-31, L-32
L-34, L-35, & L-41
L-36
L-47

Rev. RJK 1-11-60

FED. ROAD DIV. NO.	STATE	FEDERAL AID PROJECT NO.	TYPE FUNDS
2	OHIO		

38
181

CUYAHOGA COUNTY
CITY OF CLEVELAND
CUY - 42-18.42
CUY - 21-15.32
DRAINAGE PROFILES

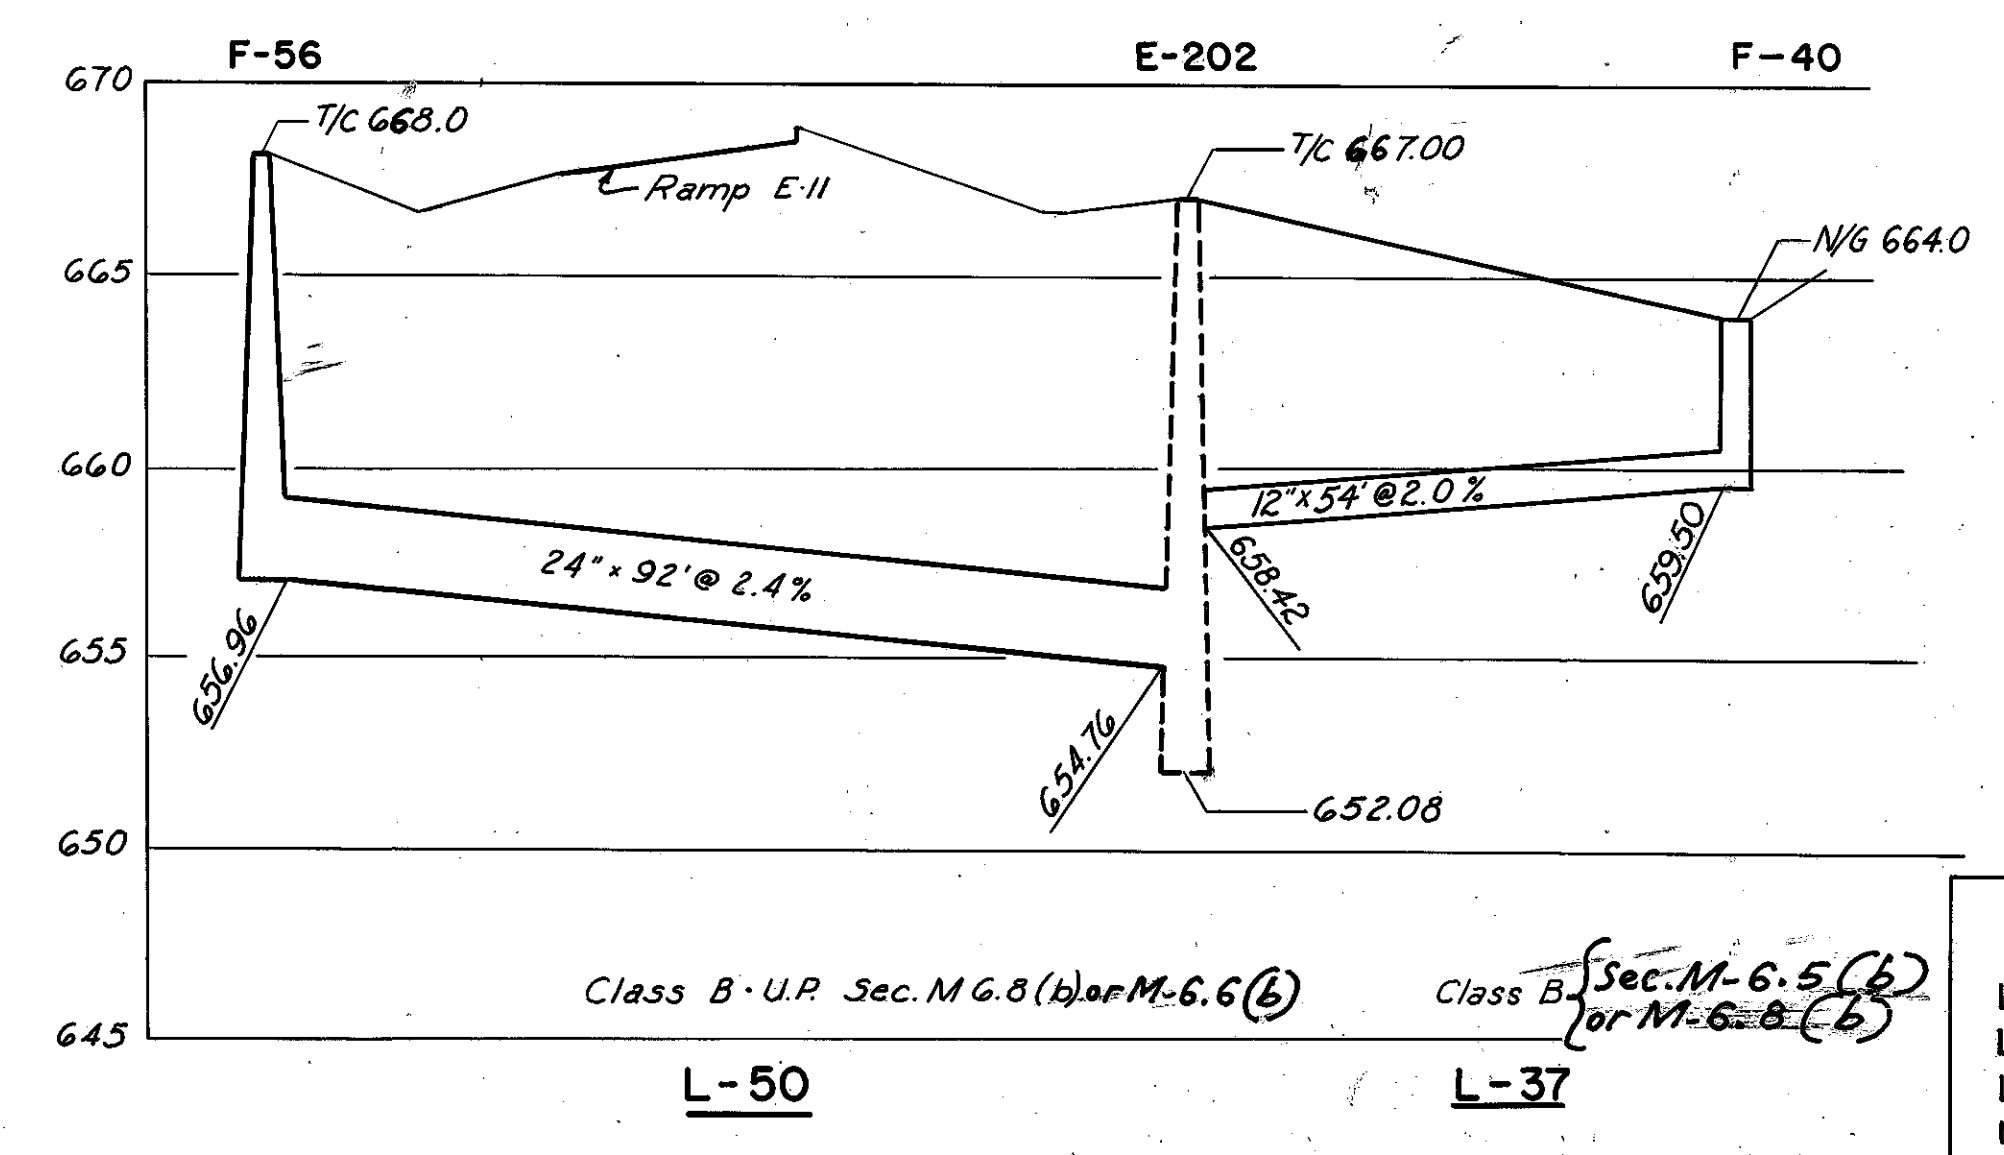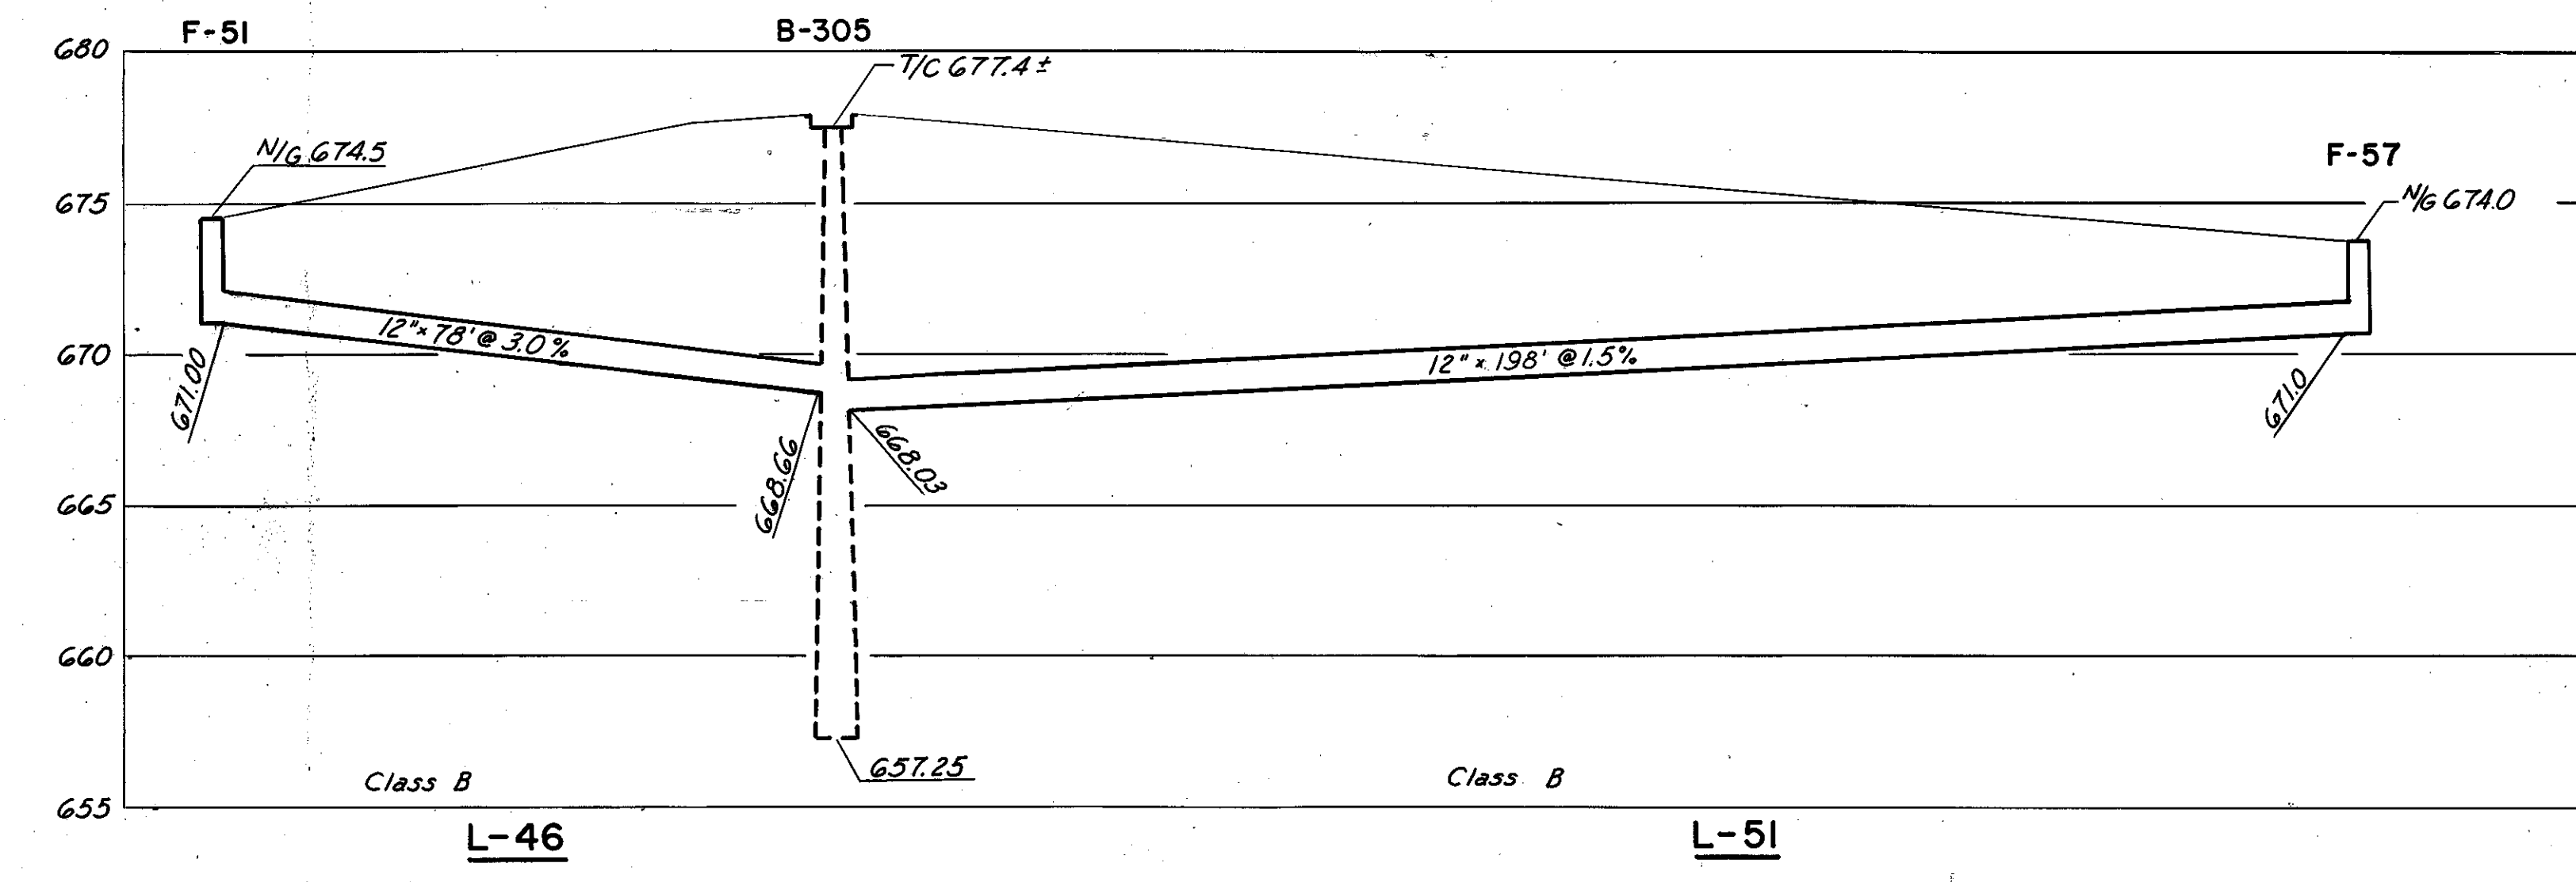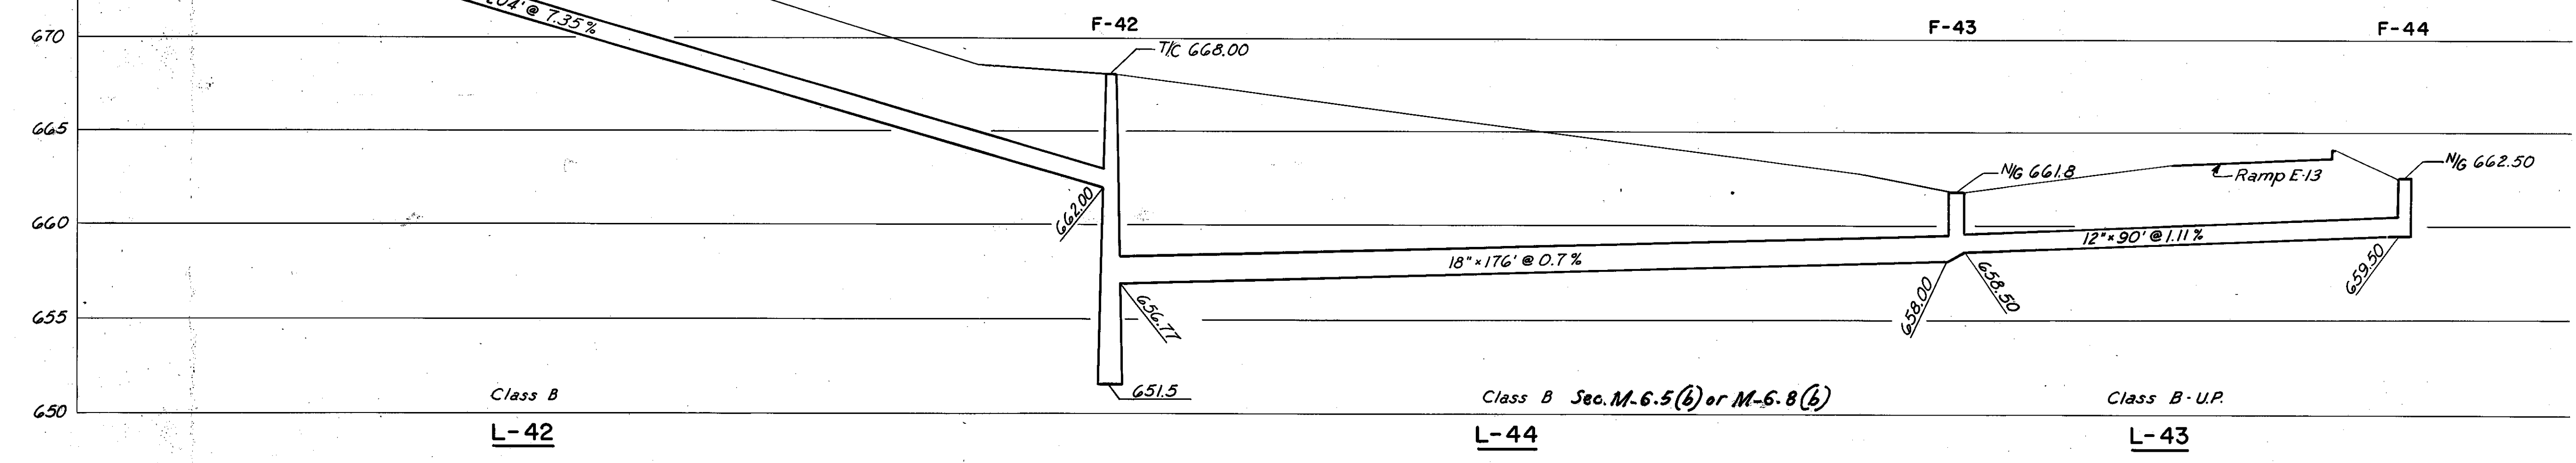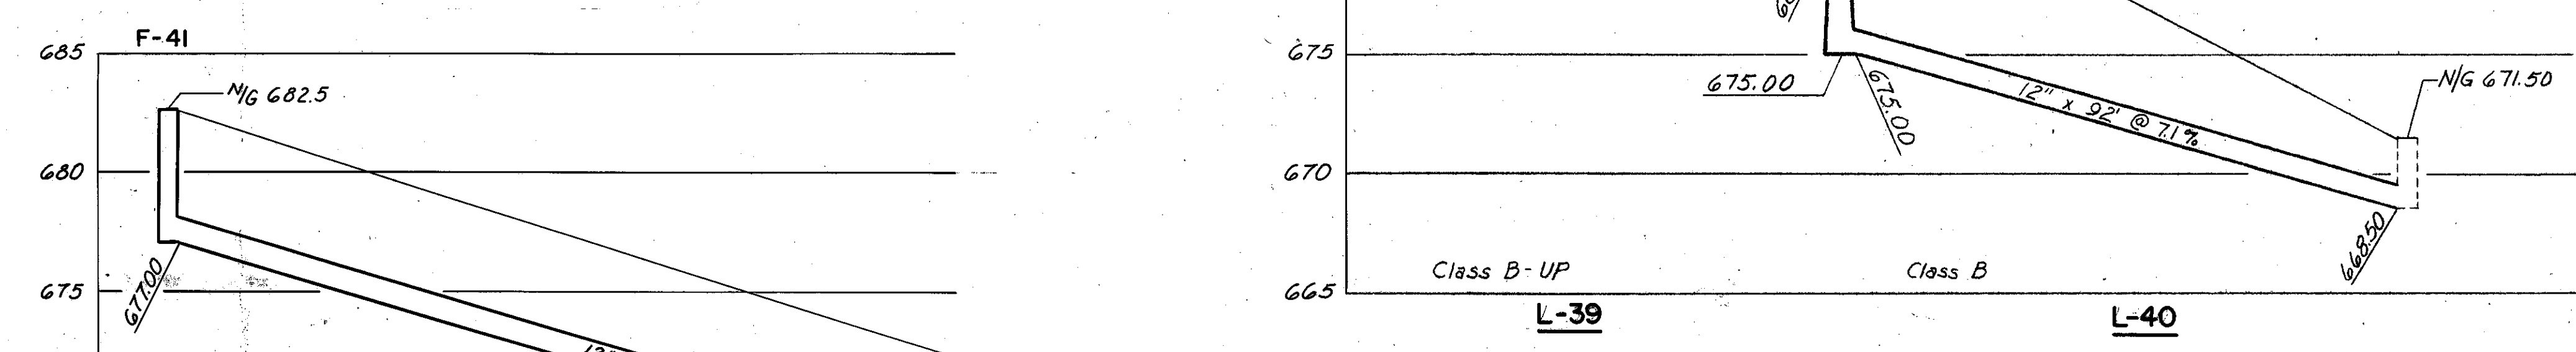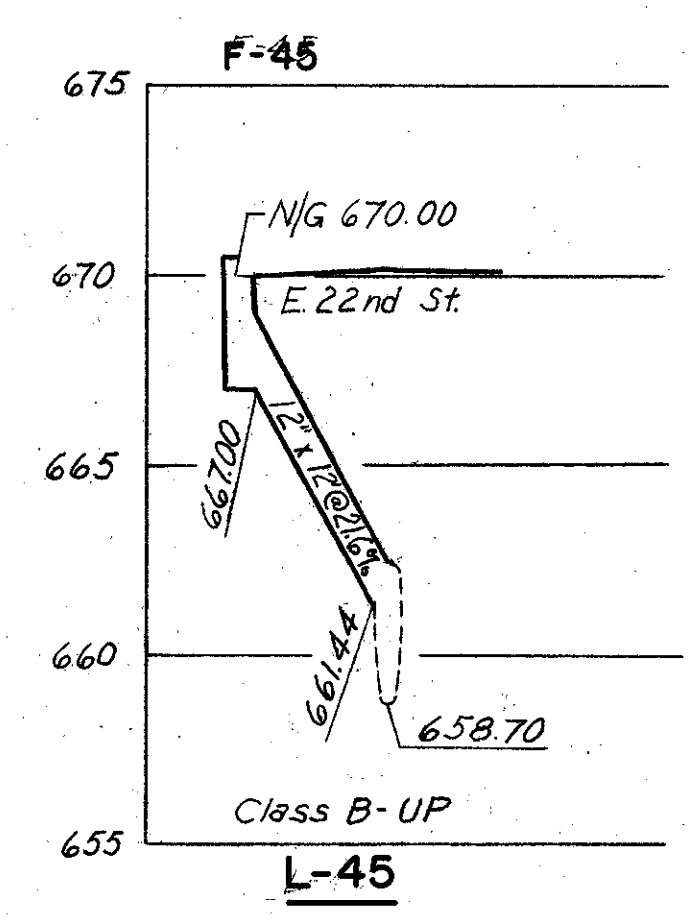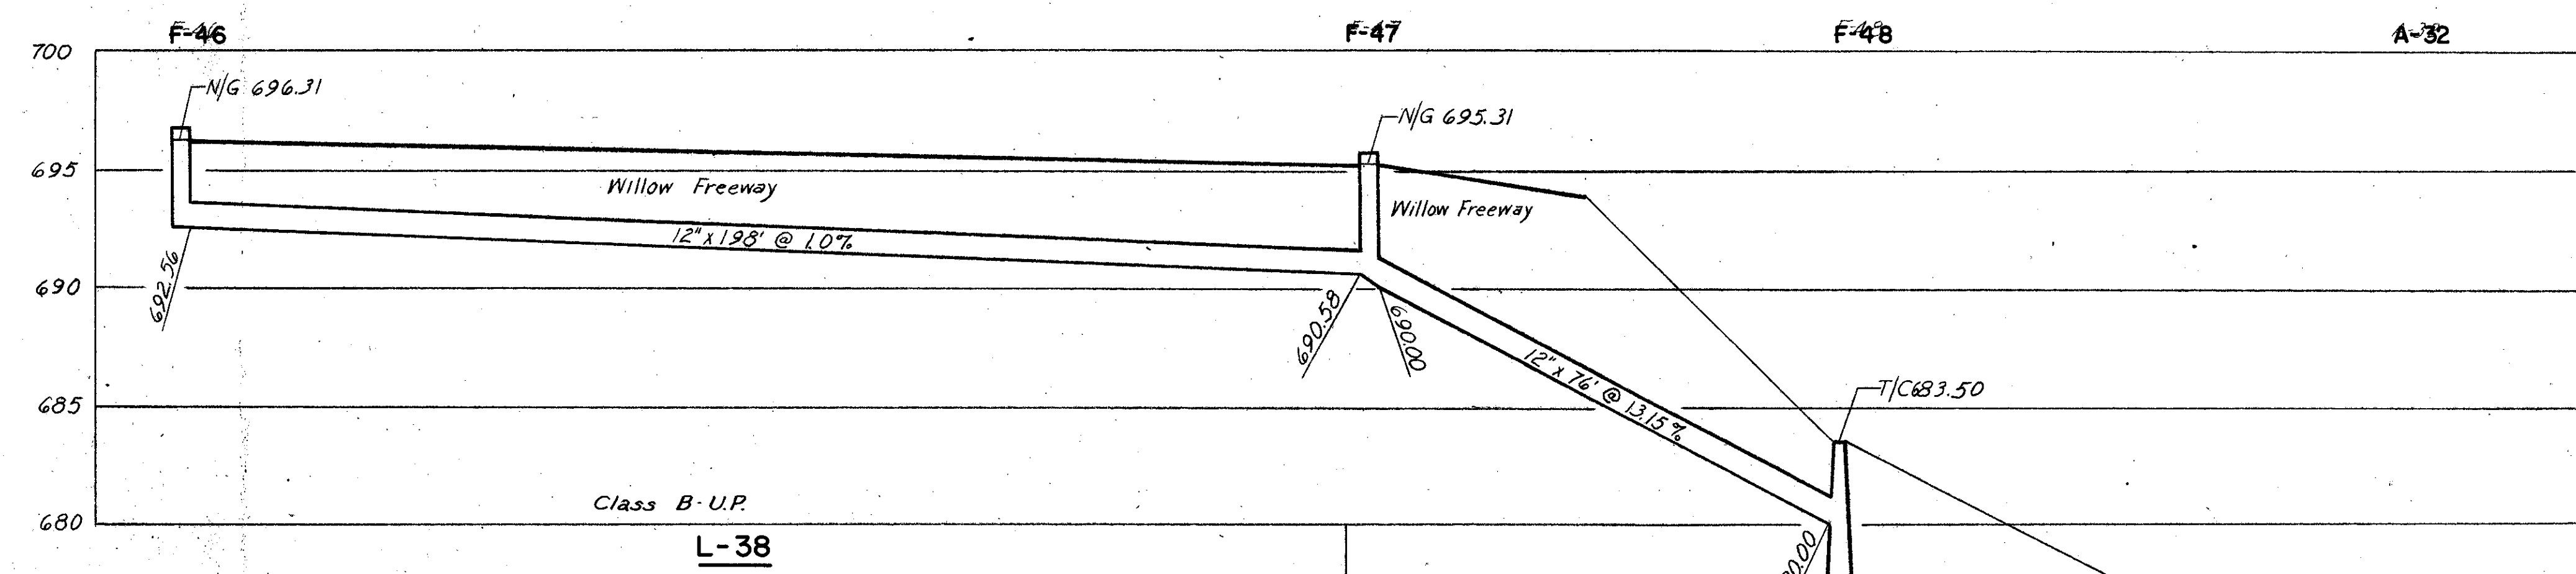

PROFILES

L-38 TO L-40
L-42 TO L-46
L-50 TO L-51
L-37








SCALE: HORIZ. 1" = 20'
VERT. 1" = 5'
DATE: 7-8-59
HOWARD, NEEDLES, TAMMEN & BERGENDOFF
CONSULTING ENGINEERS
KANSAS CITY CLEVELAND NEW YORK
914 SHEET 38

Rev. R.J.K. 1-11-60

FED. ROAD DIV. NO.	STATE	FEDERAL AID PROJECT NO.	TYPE FUNDS
2	OHIO		

39
181

CUYAHOGA COUNTY
CITY OF CLEVELAND
CUY-42-18.42
CUY-21-15.32
DRAINAGE PROFILES

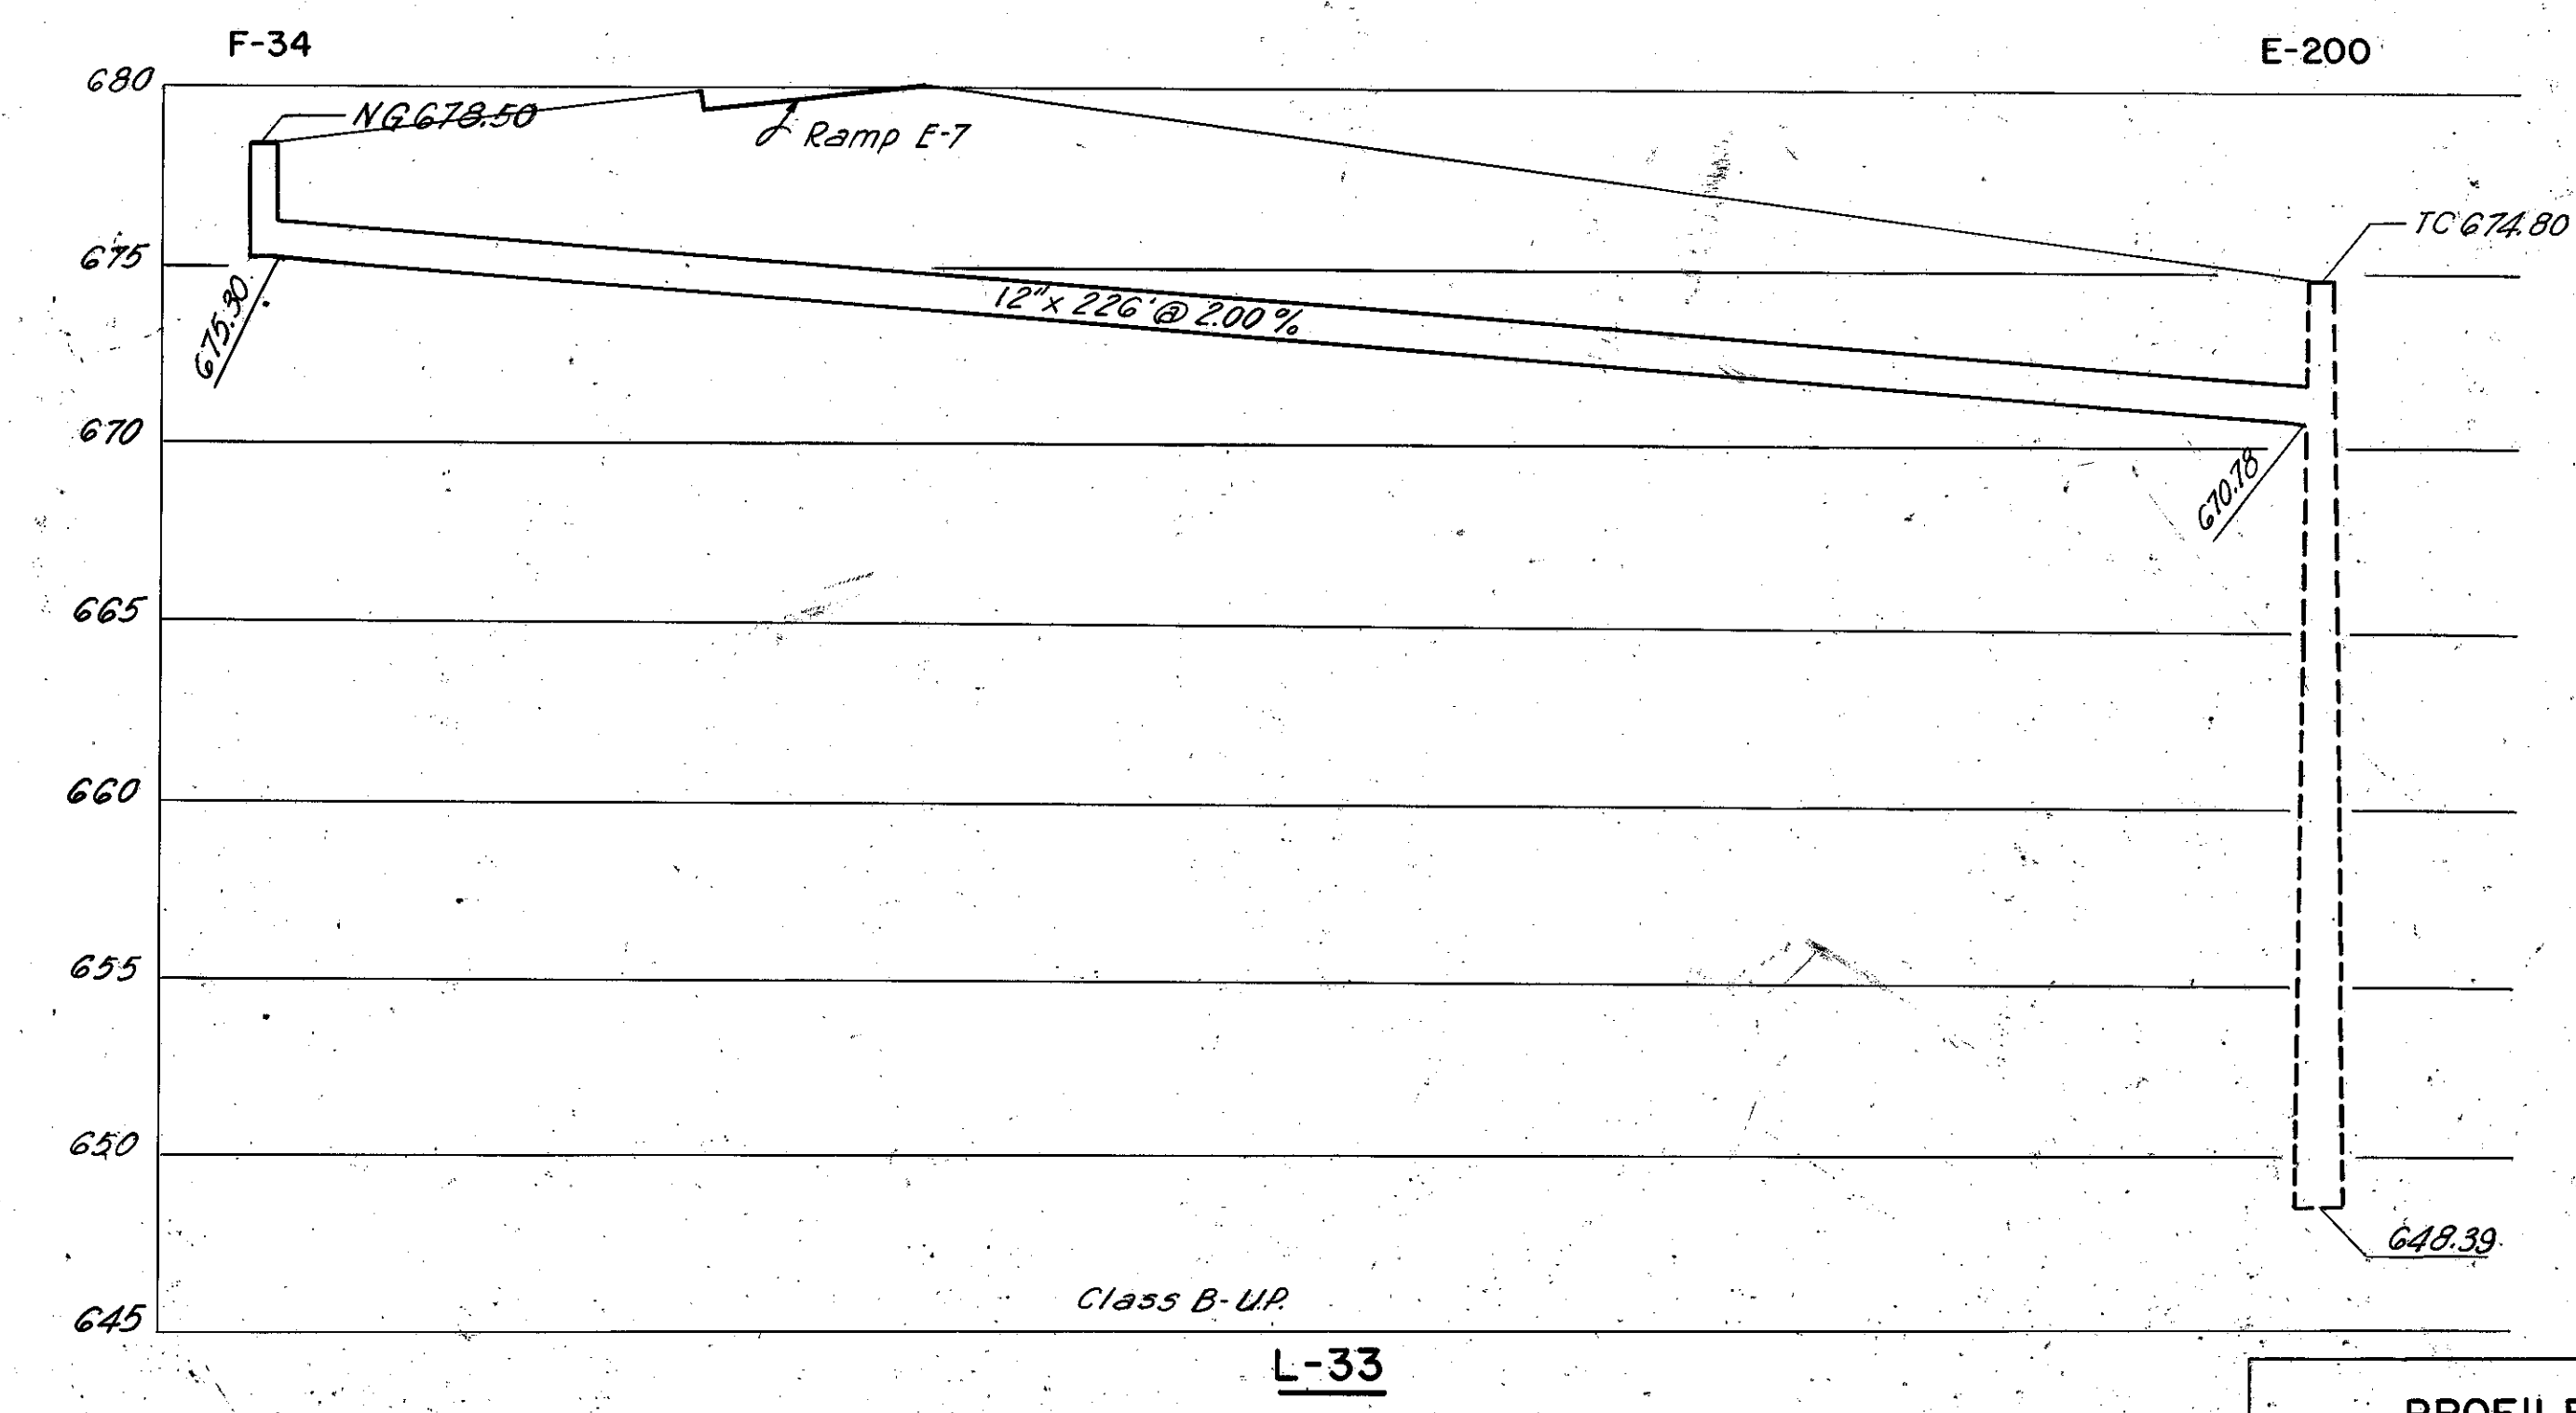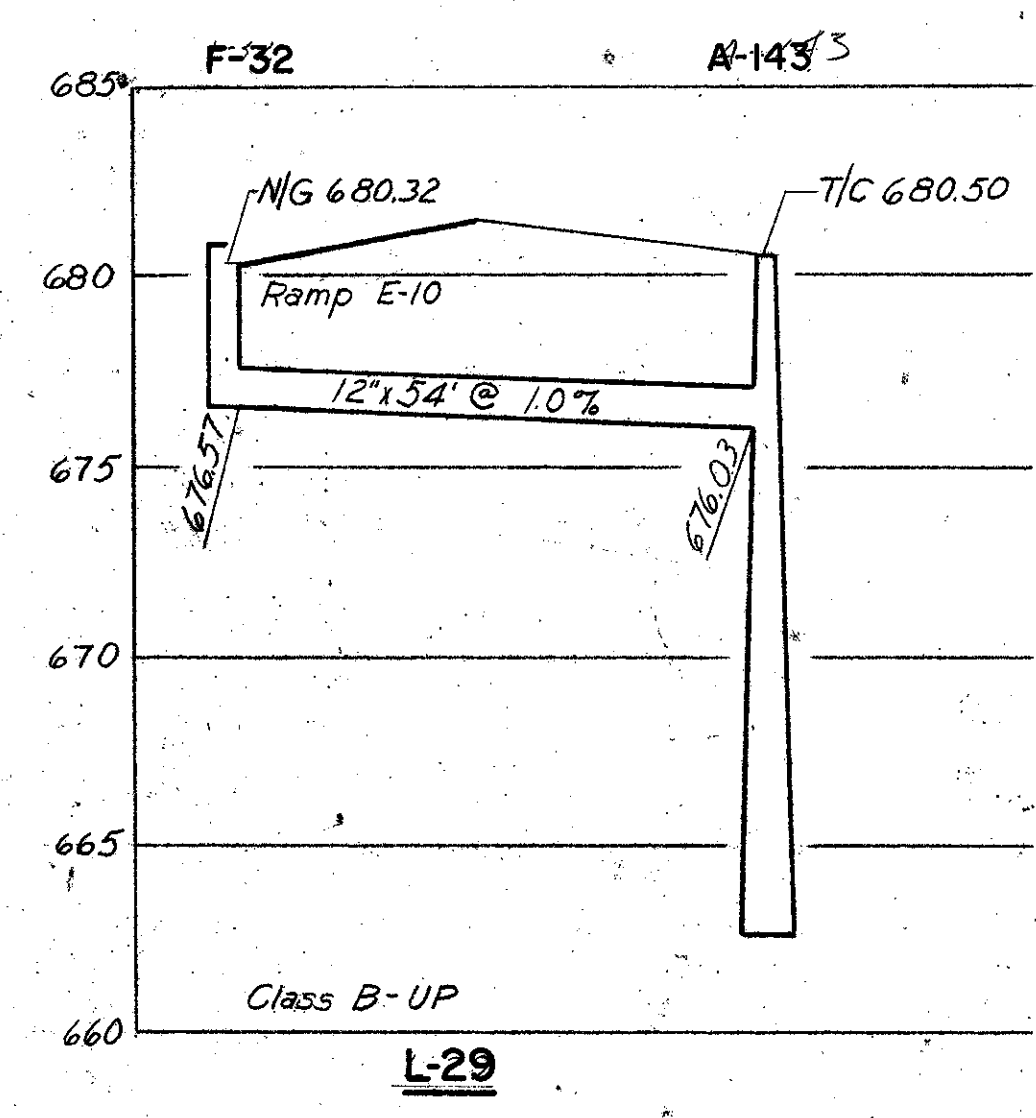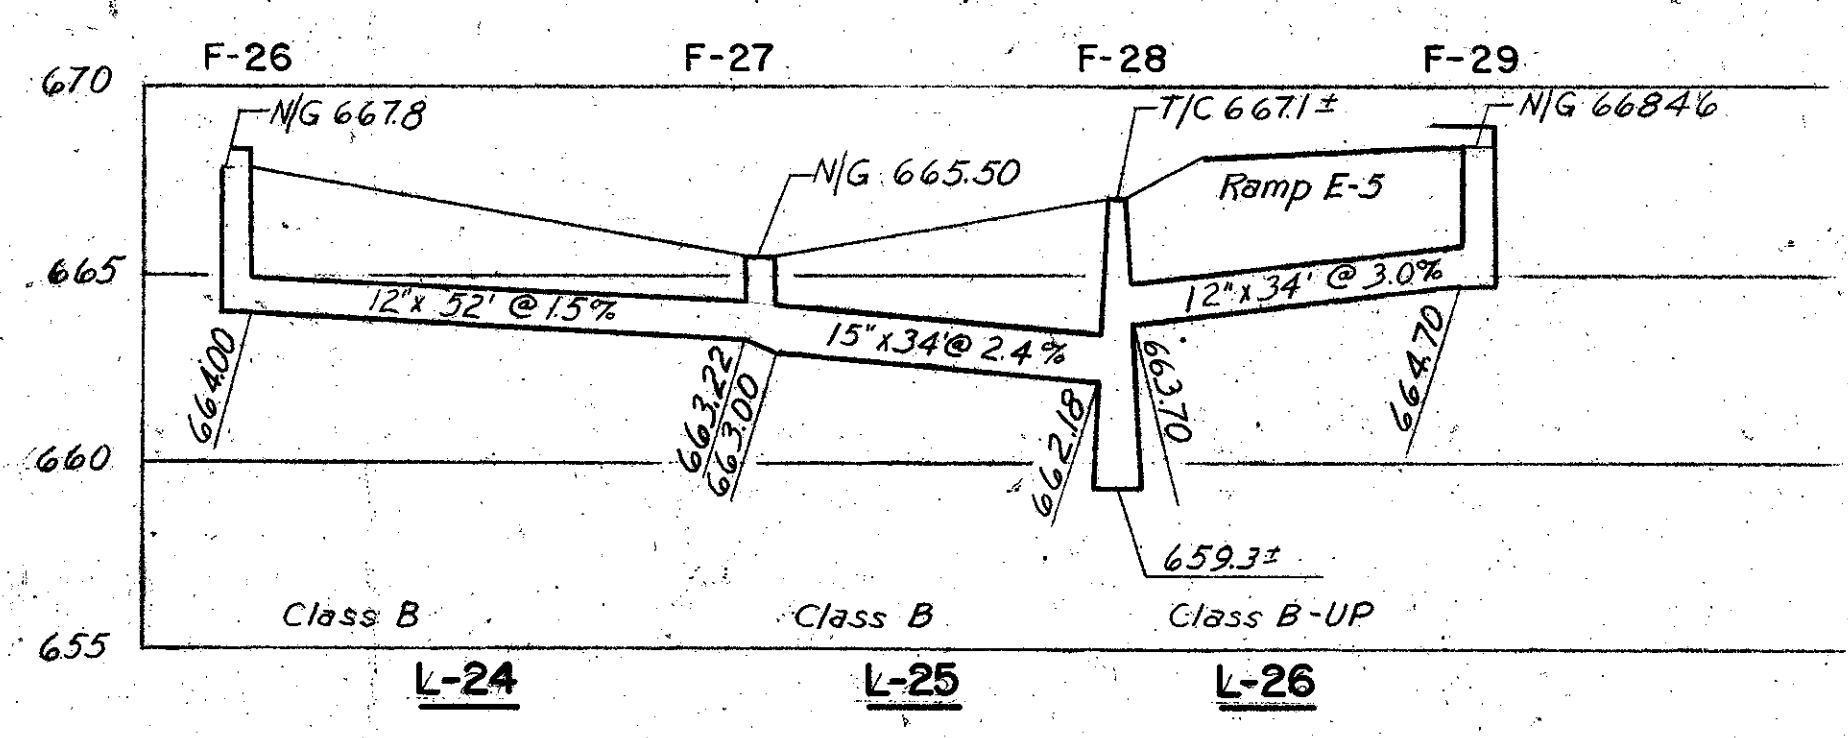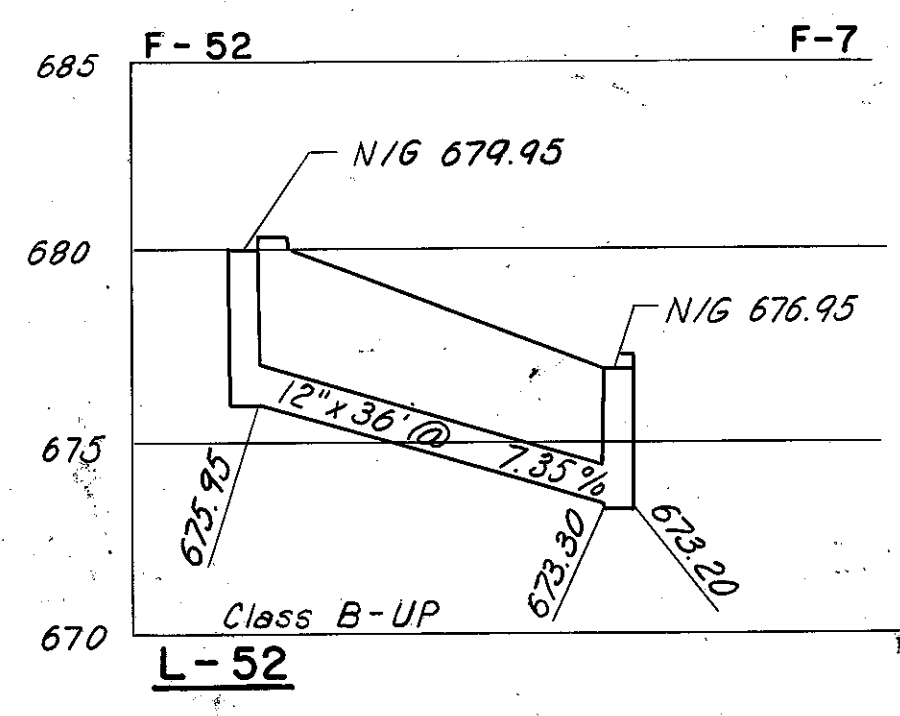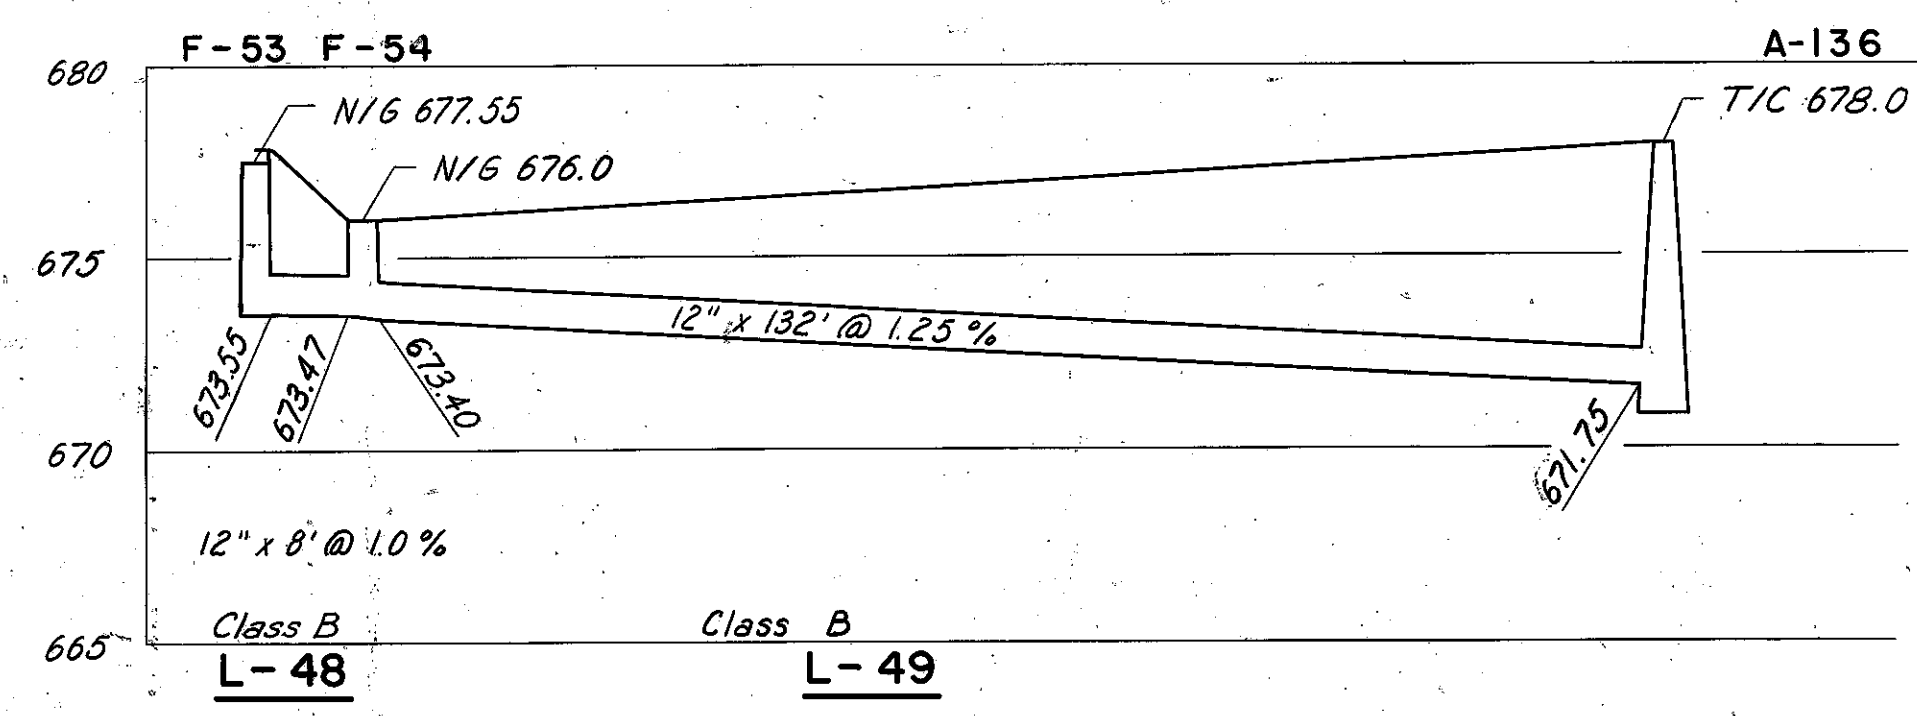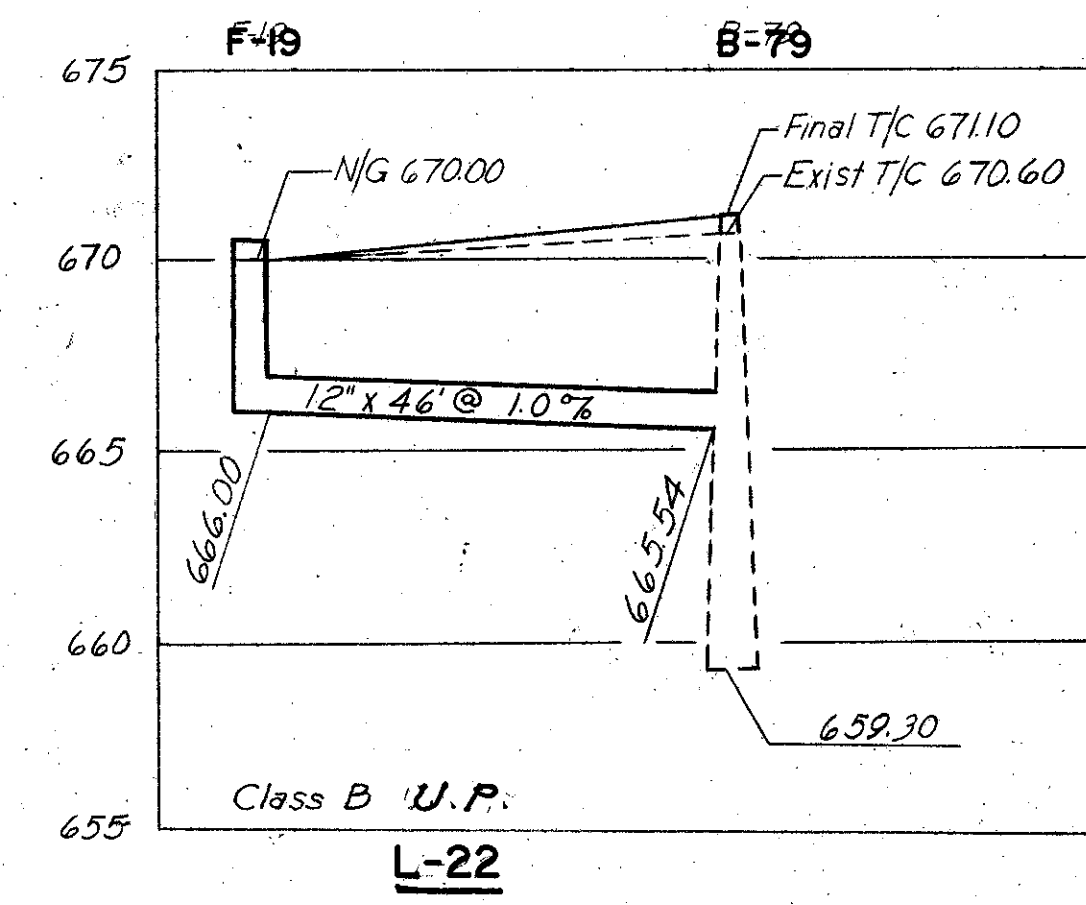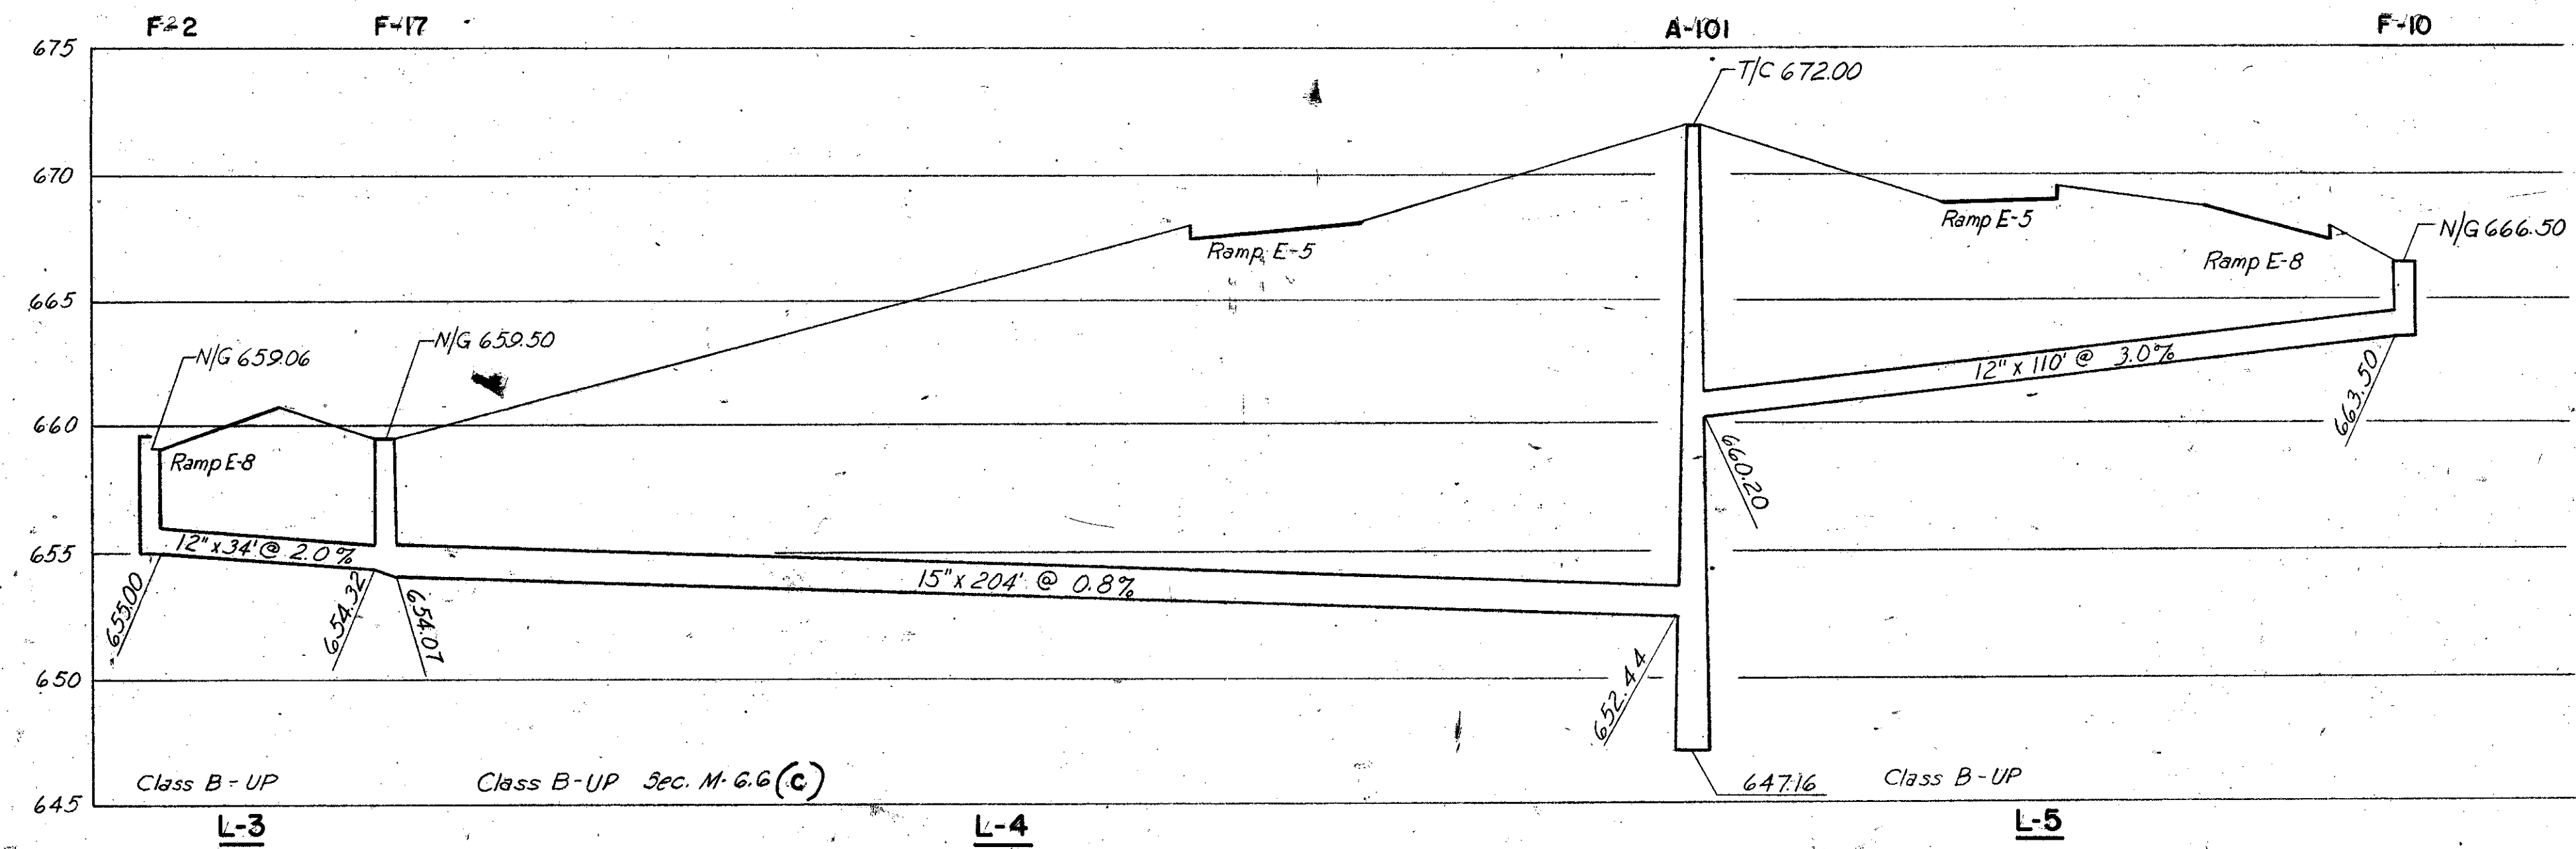


SCALE: HORIZ. 1" = 80'
VERT. 1" = 5'
HOWARD, NEEDLES, TAMMEN & BERGENDOFF
CONSULTING ENGINEERS
KANSAS CITY CLEVELAND NEW YORK
914 SHEET 39

PROFILES
L-3 TO L-5
L-22
L-24 TO L-26
L-29 & L-33
L-48 TO L-49 & L-52

Rev. JAG 1-11-60

FED. ROAD DIV. NO.	STATE	FEDERAL AID PROJECT NO.	TYPE FUNDS	41
				181

CUYAHOGA COUNTY
 CITY OF CLEVELAND
 CUY-42-1842
 CUY-21-1532
 LIGHTING KEY

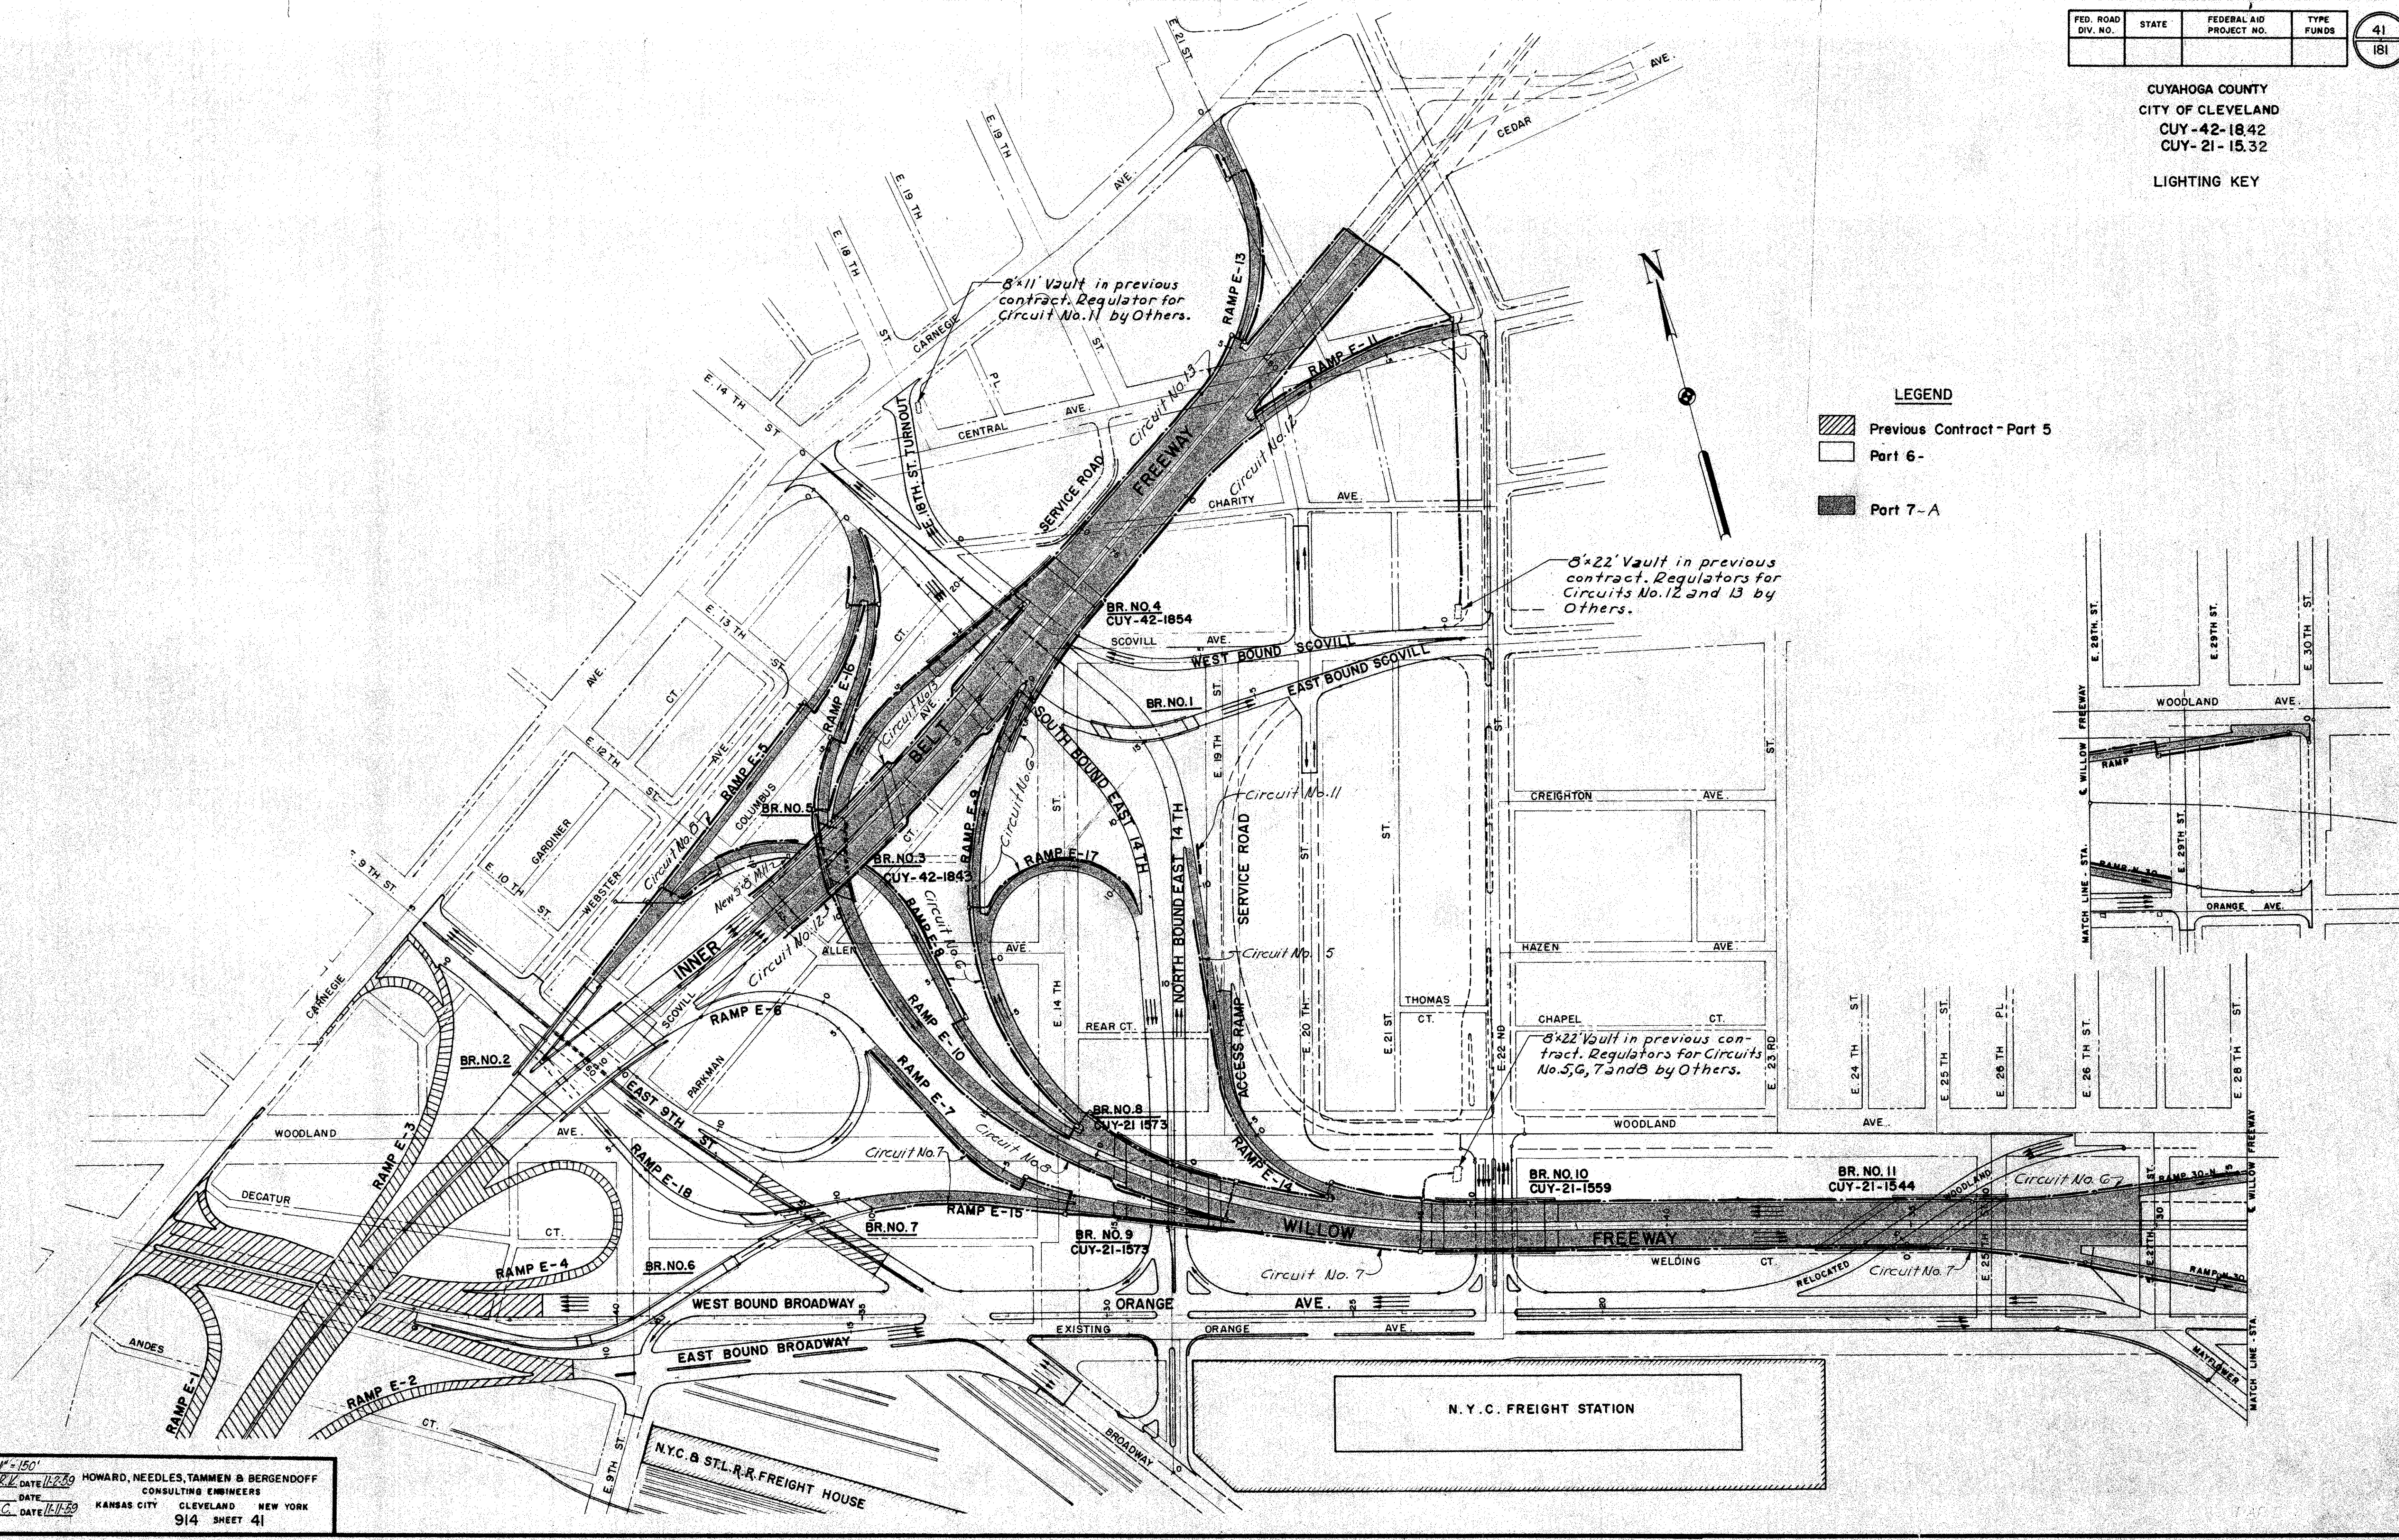


LEGEND

▨ Previous Contract - Part 5

□ Part 6 -

■ Part 7-A

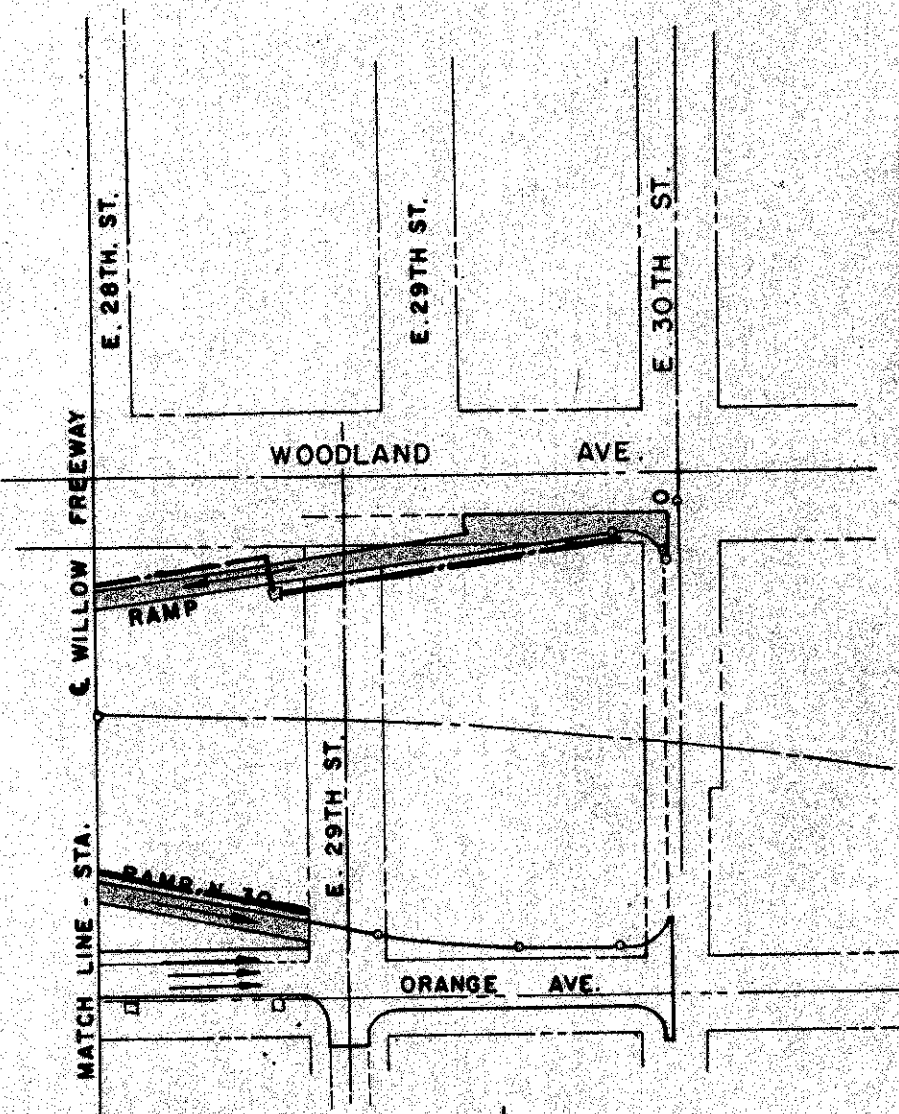


SCALE 1" = 150'
 MADE BY DATE 11-2-59 HOWARD, NEEDLES, TAMMEN & BERGENDOFF
 TRCD. DATE CONSULTING ENGINEERS
 CKD. G.L.C. DATE 11-11-59 KANSAS CITY CLEVELAND NEW YORK
 914 SHEET 41

FED. ROAD DIV. NO.	STATE	FEDERAL AID PROJECT NO.	TYPE FUNDS
2	OHIO		

42
181

CUYAHOGA COUNTY
CITY OF CLEVELAND
CUY-42-18.42
CUY-21-15.32
LIGHTING PLAN

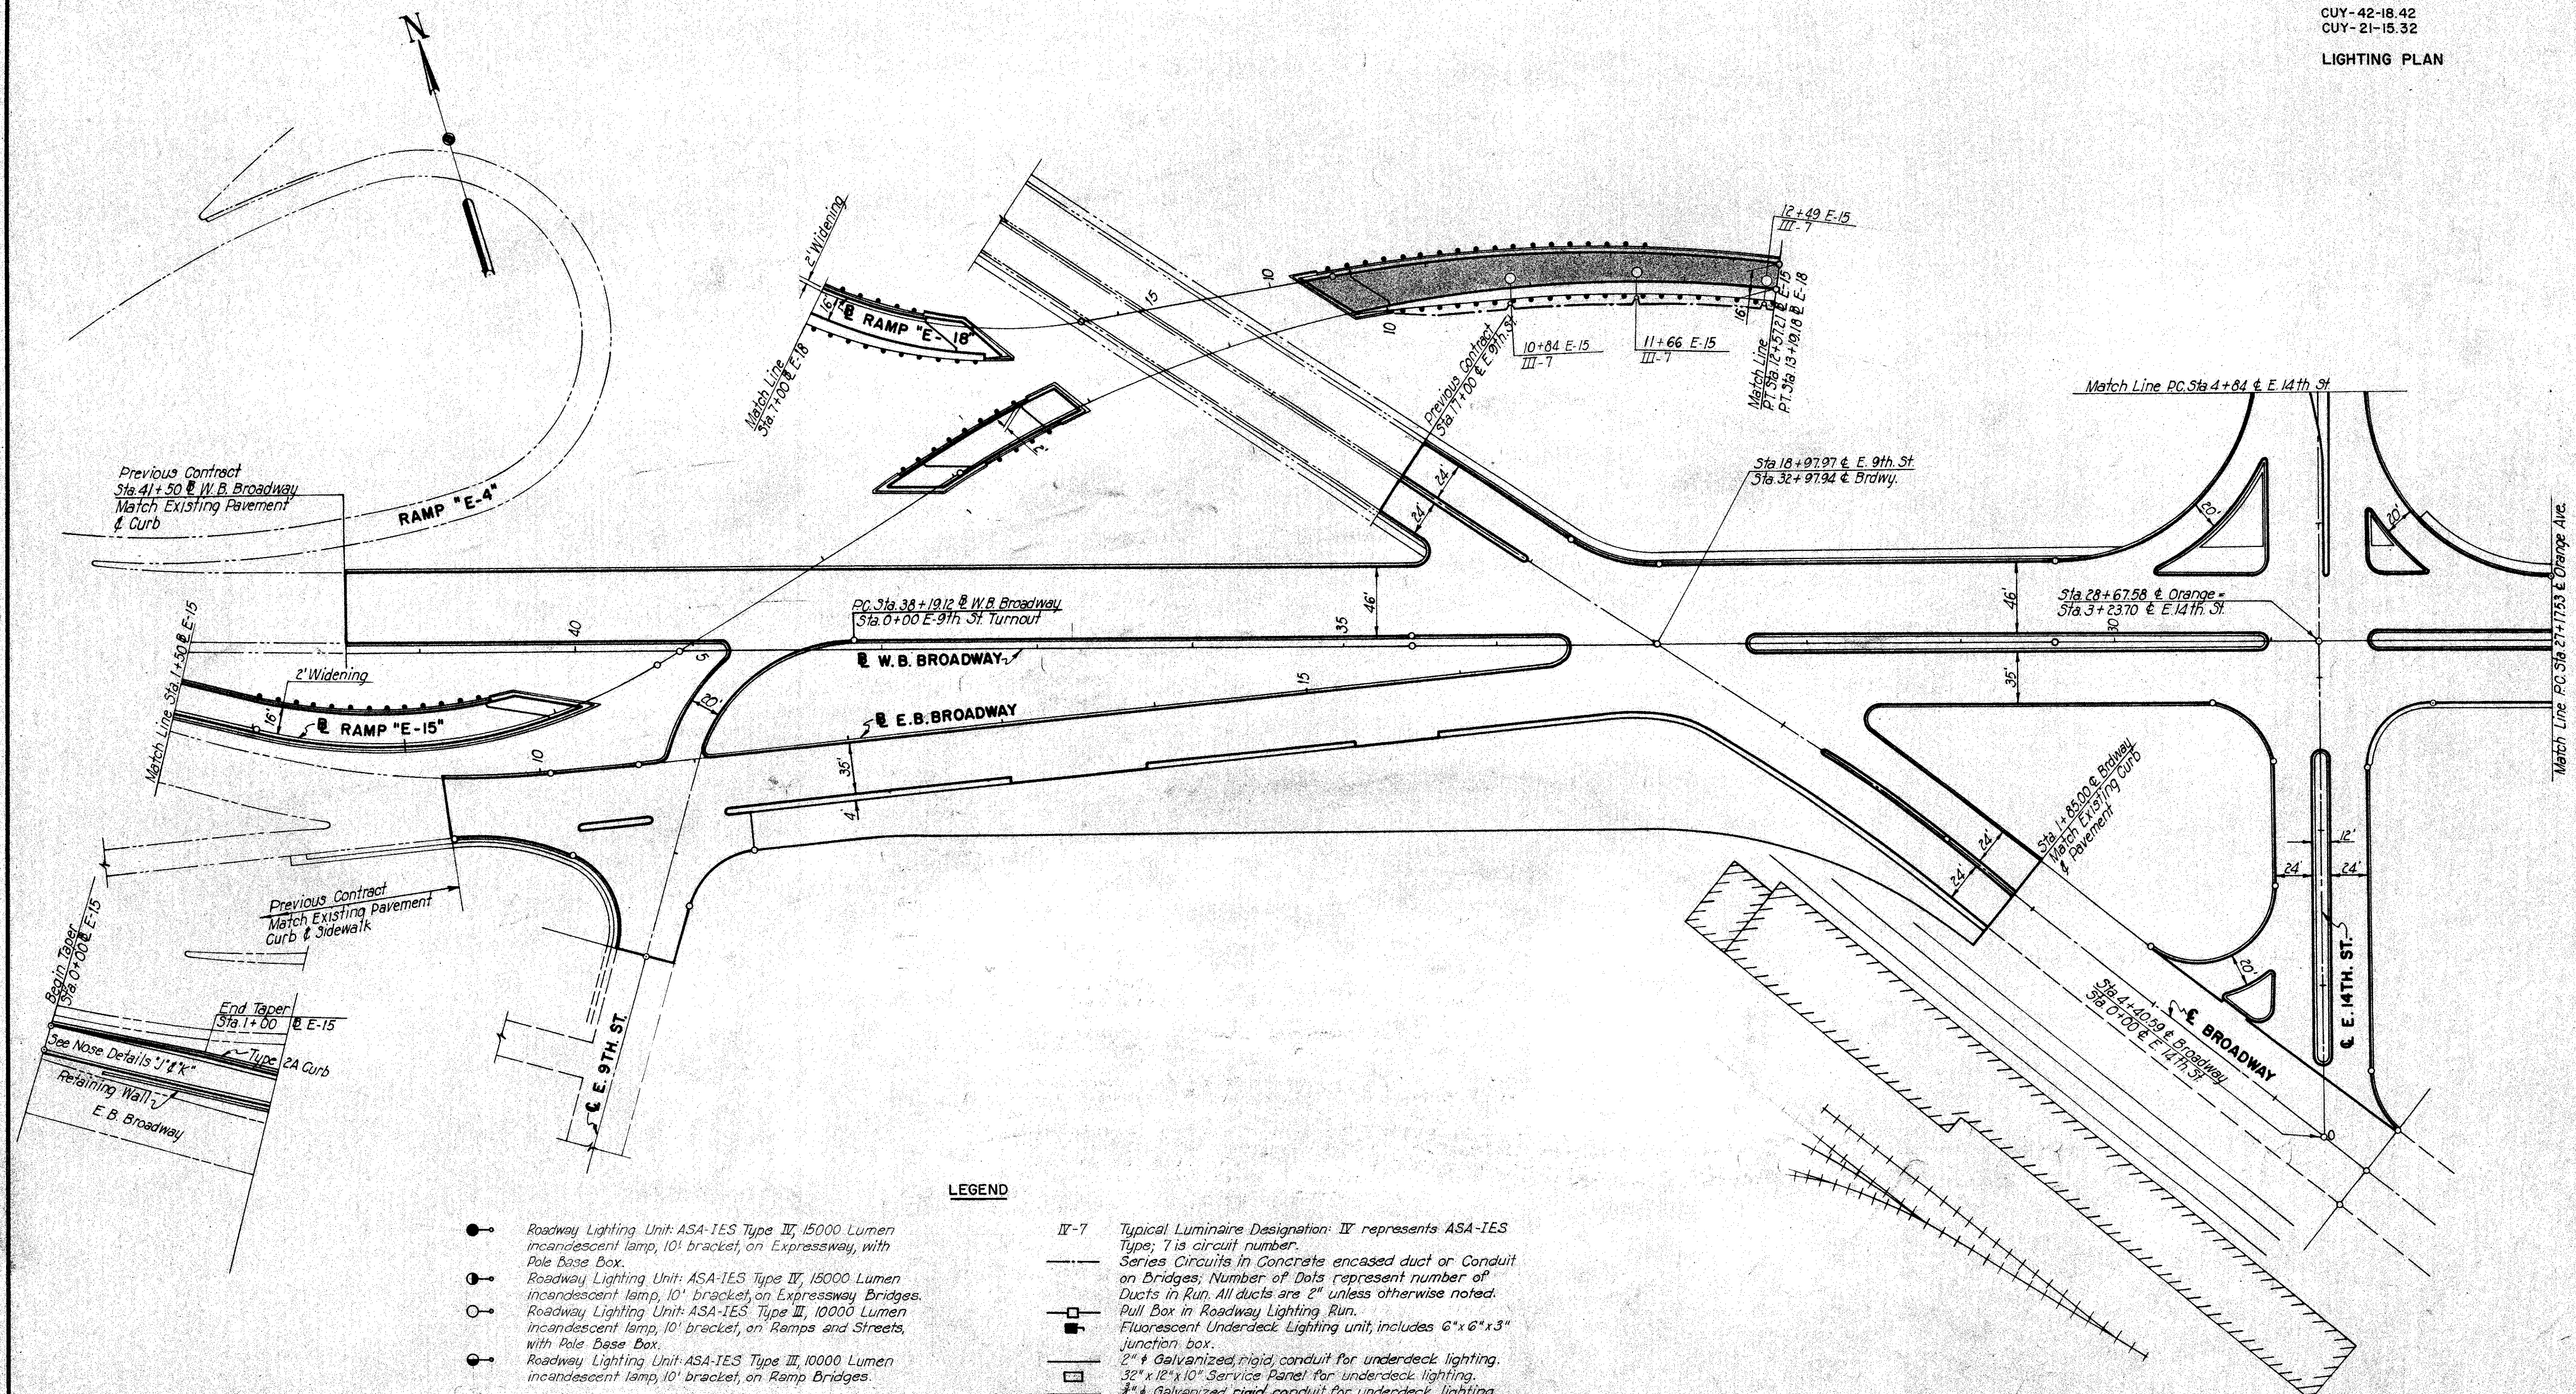

Previous Contract
Sta. 41+50 @ W.B. Broadway
Match Existing Pavement
& Curb

Match Line Sta. 1+50 @ E-15
2' Widening
RAMP "E-15"

Previous Contract
Match Existing Pavement
Curb & Sidewalk

Begin Taper
Sta. 0+00 @ E-15
End Taper
Sta. 1+00 @ E-15
See Nose Details "J" & "K"
Type 2A Curb
Retaining Wall
E.B. Broadway

Match Line
Sta. 7+00 @ E-18
2' Widening
RAMP "E-18"

Previous Contract
Sta. 7+00 @ E-9th St.

Match Line
P.L. Sta. 12+57.2 @ E-15
P.L. Sta. 13+02.18 @ E-18

Sta. 18+97.97 @ E. 9th St
Sta. 32+97.94 @ Brdwy.

Match Line P.C. Sta. 4+84 @ E. 14th St

Sta. 28+67.58 @ Orange
Sta. 3+23.70 @ E. 14th St.

Sta. 1+85.00 @ Rightway
Match Existing
& Pavement

Match Line
Sta. 4+00.00 @ Broadway
Sta. 0+00 @ E. 14th St.

Match Line P.C. Sta. 27+17.53 @ Orange Ave.

LEGEND

- Roadway Lighting Unit: ASA-IES Type IV, 15000 Lumen incandescent lamp, 10' bracket, on Expressway, with Pole Base Box.
 - Roadway Lighting Unit: ASA-IES Type IV, 15000 Lumen incandescent lamp, 10' bracket, on Expressway Bridges.
 - Roadway Lighting Unit: ASA-IES Type III, 10000 Lumen incandescent lamp, 10' bracket, on Ramps and Streets, with Pole Base Box.
 - Roadway Lighting Unit: ASA-IES Type III, 10000 Lumen incandescent lamp, 10' bracket, on Ramp Bridges.
 - IV-7 Typical Luminaire Designation: IV represents ASA-IES Type; 7 is circuit number.
 - Series Circuits In Concrete encased duct or Conduit on Bridges; Number of Dots represent number of Ducts In Run. All ducts are 2" unless otherwise noted.
 - Pull Box in Roadway Lighting Run.
 - Fluorescent Underdeck Lighting unit, includes 6"x6"x3" junction box.
 - 2" Galvanized, rigid, conduit for underdeck lighting.
 - 32"x12"x10" Service Panel for underdeck lighting.
 - 2" Galvanized, rigid, conduit for underdeck lighting.
 - 8"x8"x4" Junction Box for underdeck lighting.
 - Regulator Vault, size called out on sheets.
 - 5'x8' Manhole.
- Note: All ducts under pavement shall be 2-Way Duct, 2-inch, except as otherwise noted.



SCALE 1" = 50'
MADE 1/24 DATE 2-16-59 HOWARD, NEEDLES, TAMMEN & BERGENOFF
TRCD DATE CONSULTING ENGINEERS
KANSAS CITY CLEVELAND NEW YORK
9/4 SHEET 42

FED. ROAD DIV. NO.	STATE	FEDERAL AID PROJECT NO.	TYPE FUNDS
2	OHIO		

43
181

CUYAHOGA COUNTY
CITY OF CLEVELAND
CUY-42-18.42
CUY-21-15.32

LIGHTING PLAN

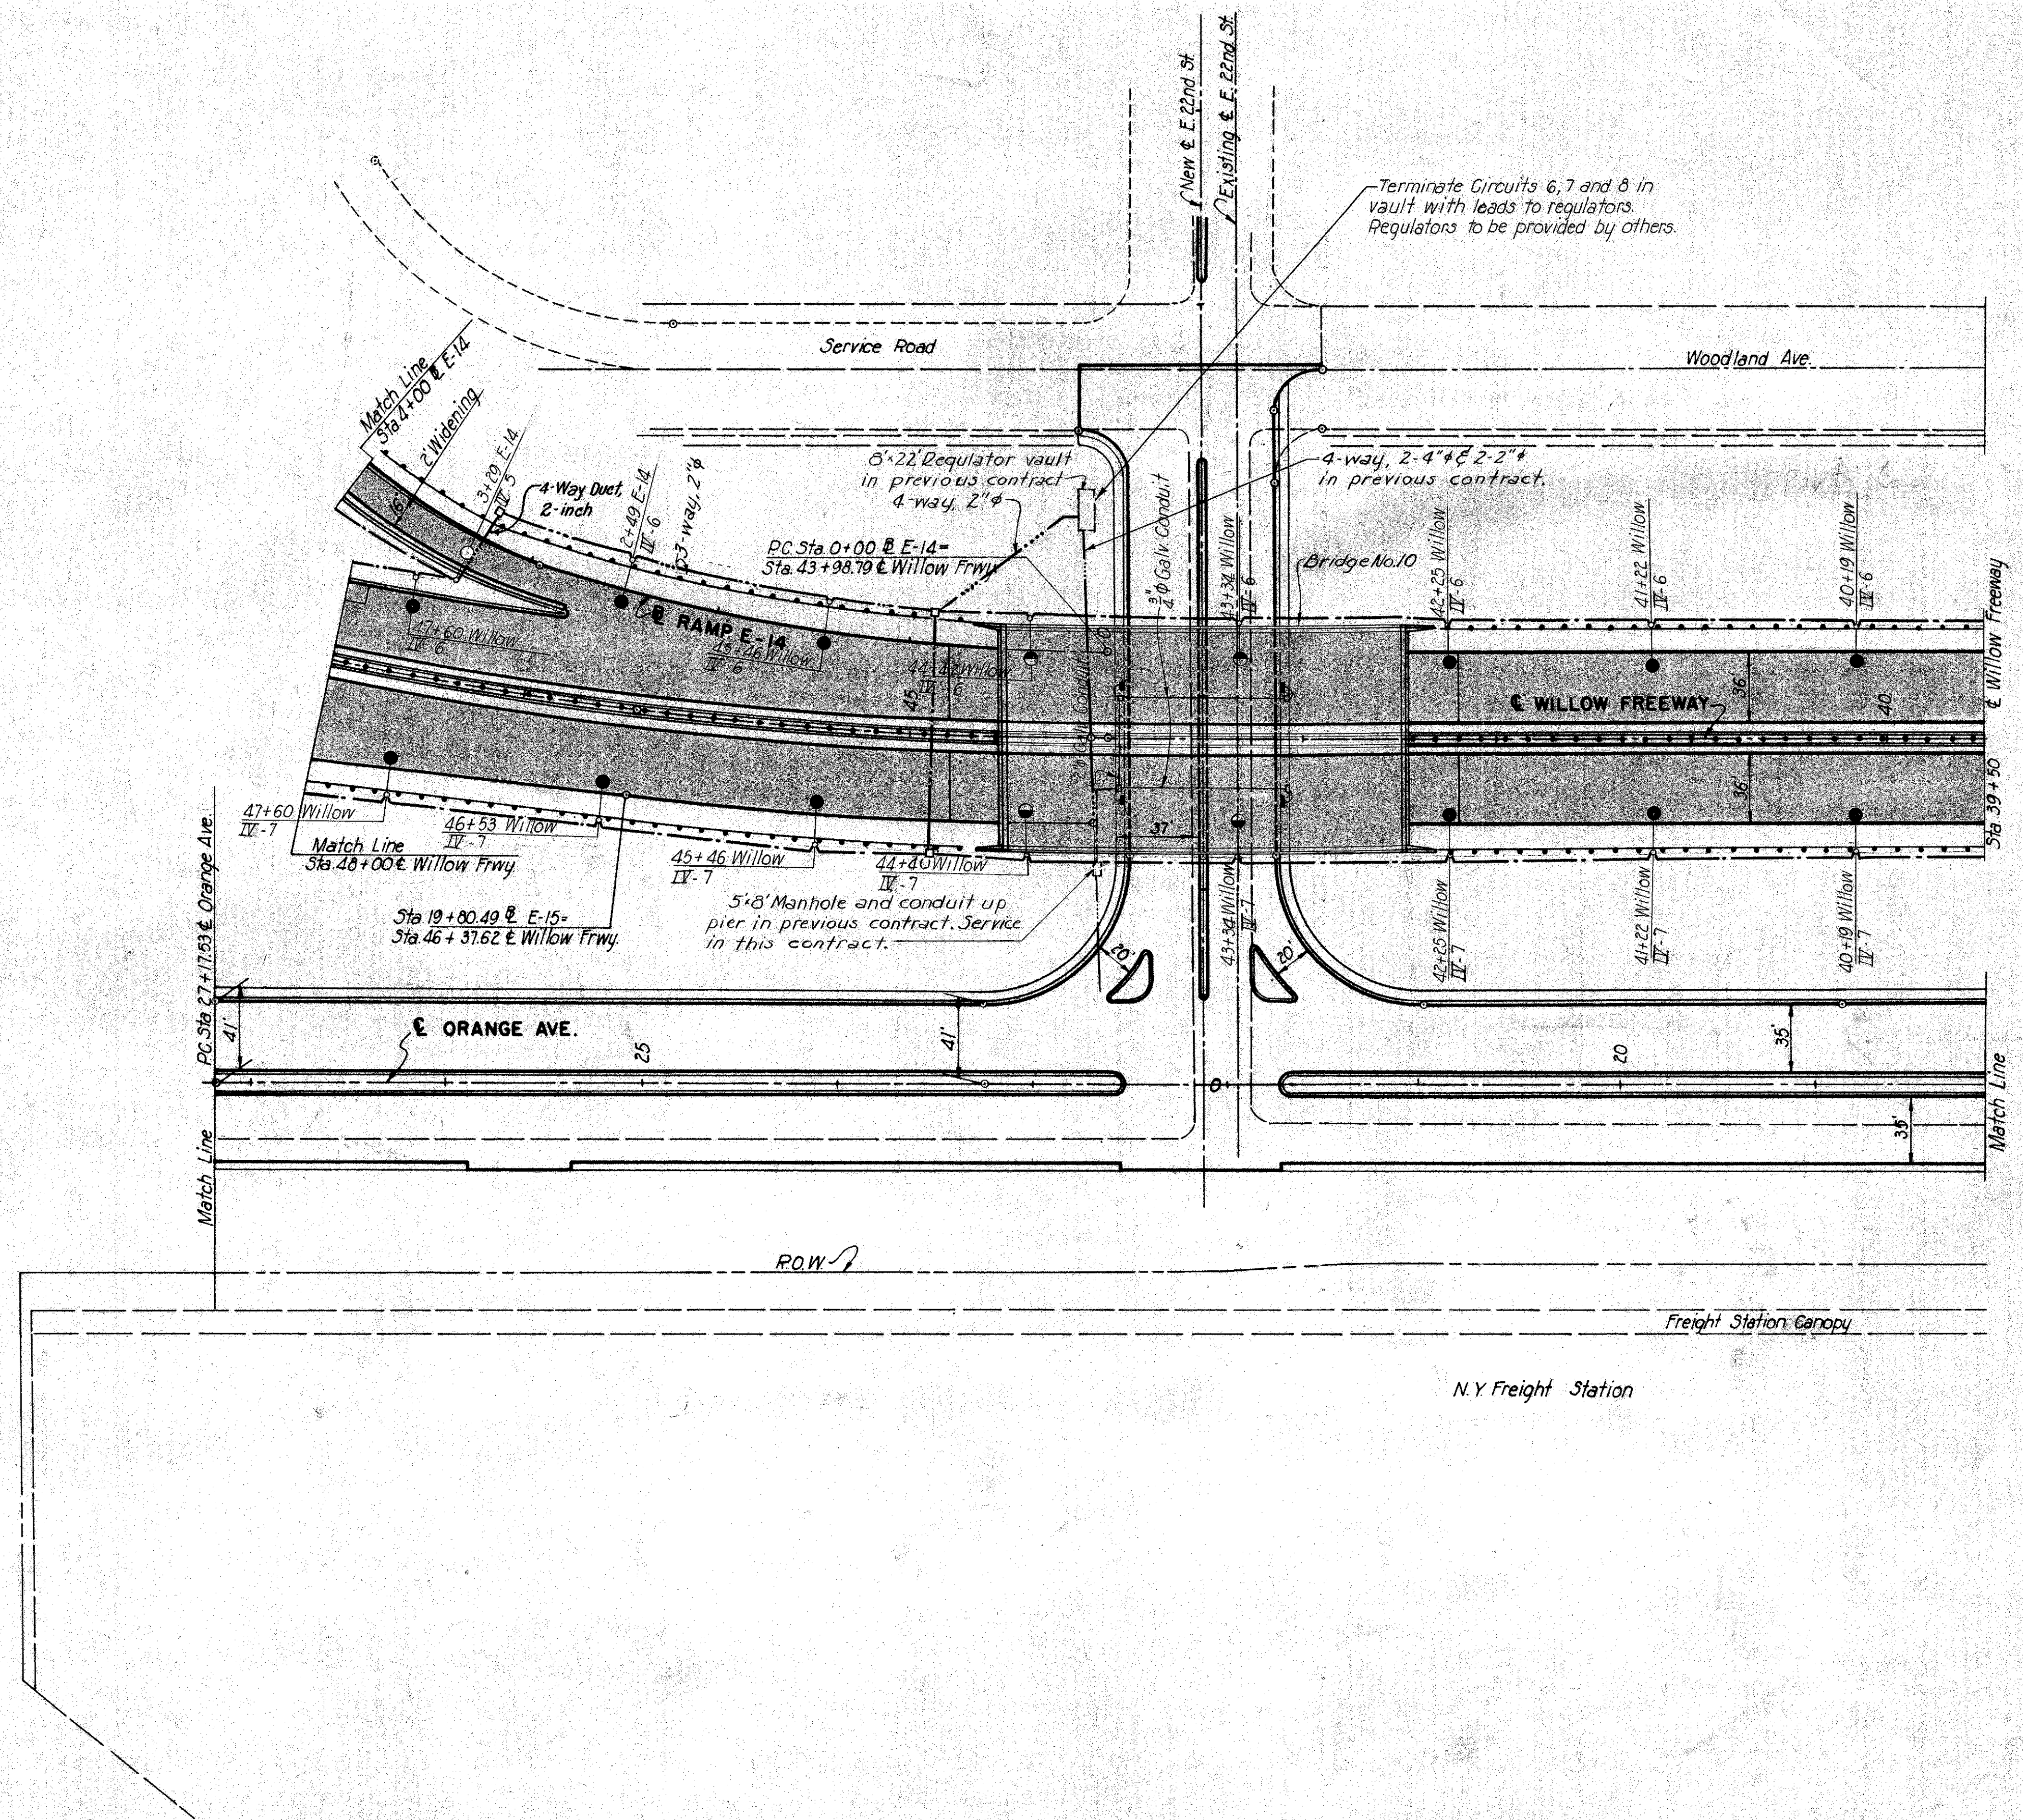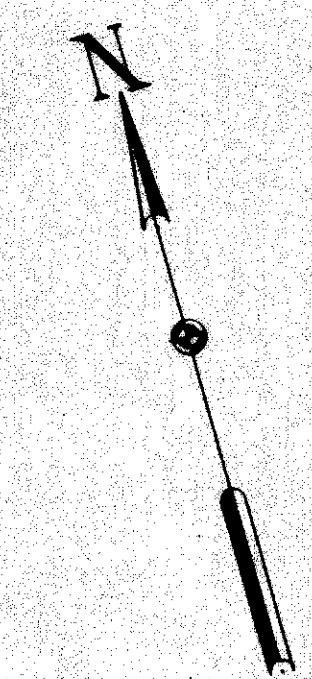


SCALE 1" = 50'
MADE I.P.C. DATE 3-17-59
TRCD. DATE
CKD. DATE 11-12-59
HOWARD, NEEDLES, TAMMEN & BERGENDOFF
CONSULTING ENGINEERS
KANSAS CITY CLEVELAND NEW YORK
914 SHEET 43

FOR LEGEND SEE SHEET 42 Rev F.S.I. 12-16-59

FED. ROAD DIV. NO.	STATE	FEDERAL AID PROJECT NO.	TYPE FUNDS
2	OHIO		

46
181

CUYAHOGA COUNTY
CITY OF CLEVELAND
CUY-42-18.42
CUY-21-15.32
LIGHTING PLAN

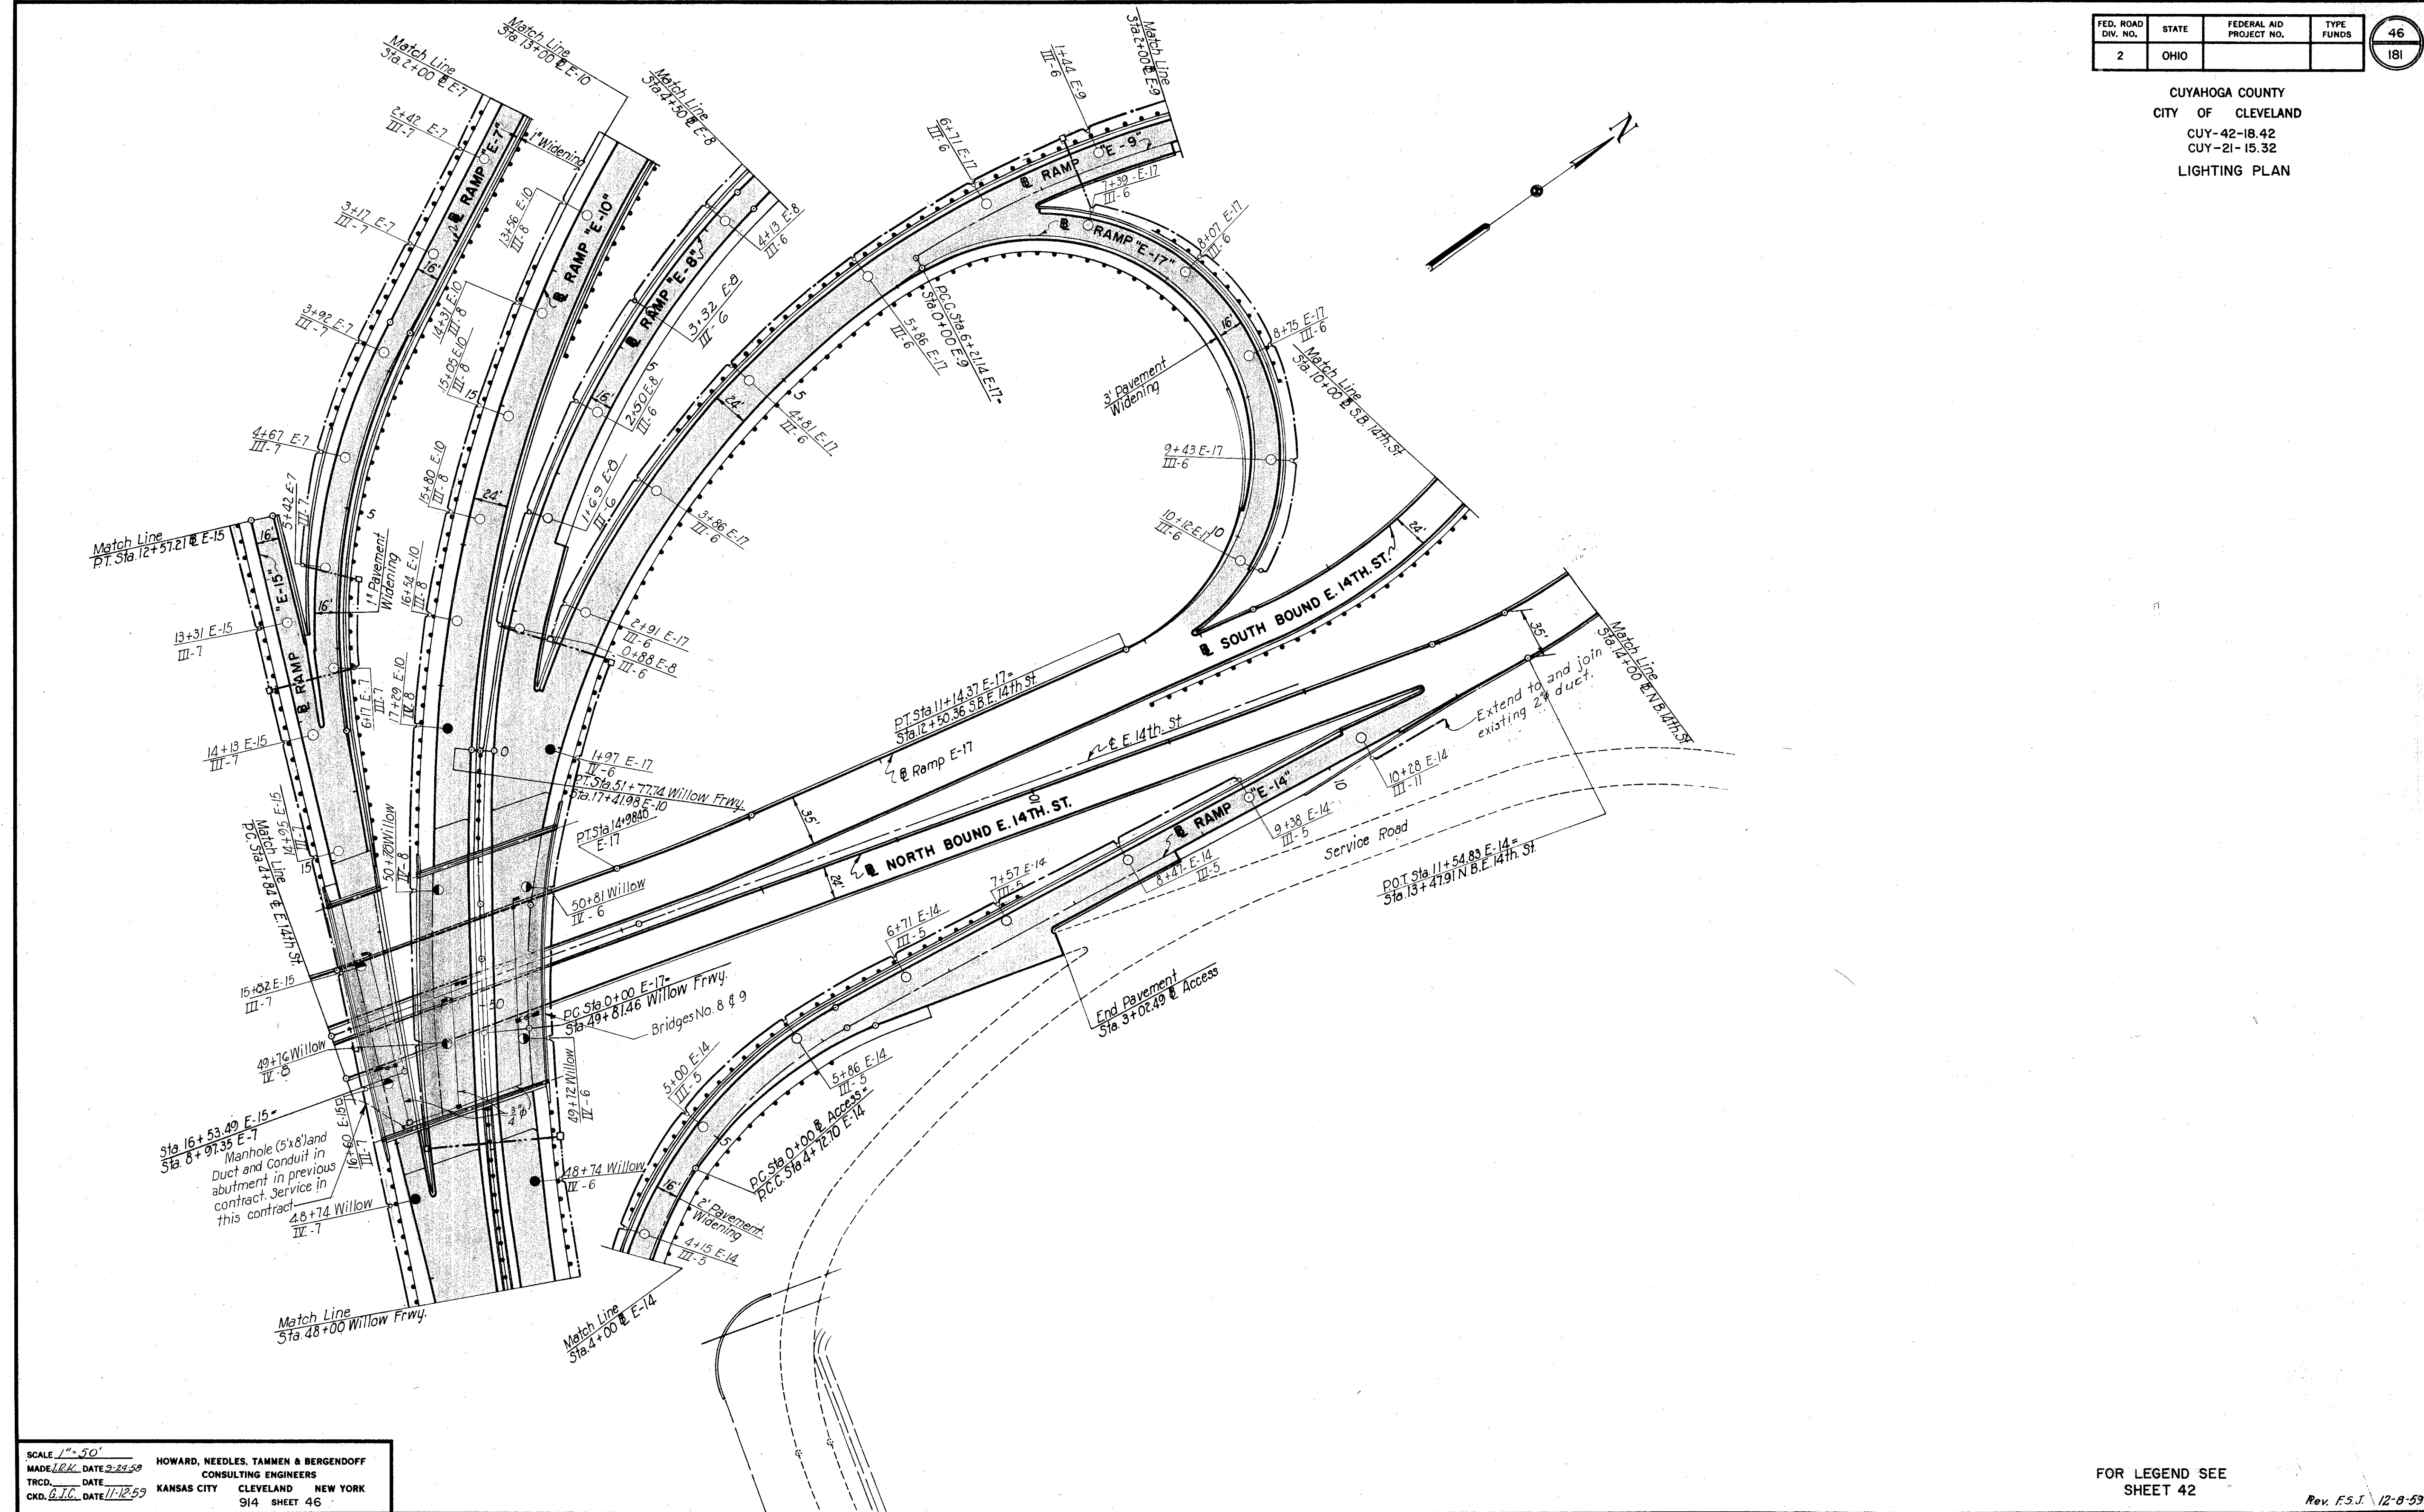

SCALE 1" = 50'
MADE PER DATE 9-24-58
TRCD. DATE
CKD. DATE 11-12-59
HOWARD, NEEDLES, TAMMEN & BERGENDOFF
CONSULTING ENGINEERS
KANSAS CITY CLEVELAND NEW YORK
914 SHEET 46


FOR LEGEND SEE
SHEET 42

Rev. F.5.J. 12-8-59

FED. ROAD DIV. NO.	STATE	FEDERAL AID PROJECT NO.	TYPE FUNDS
2	OHIO		

47
181

CUYAHOGA COUNTY
CITY OF CLEVELAND
CUY-42-18.42
CUY-21-15.32
LIGHTING PLAN

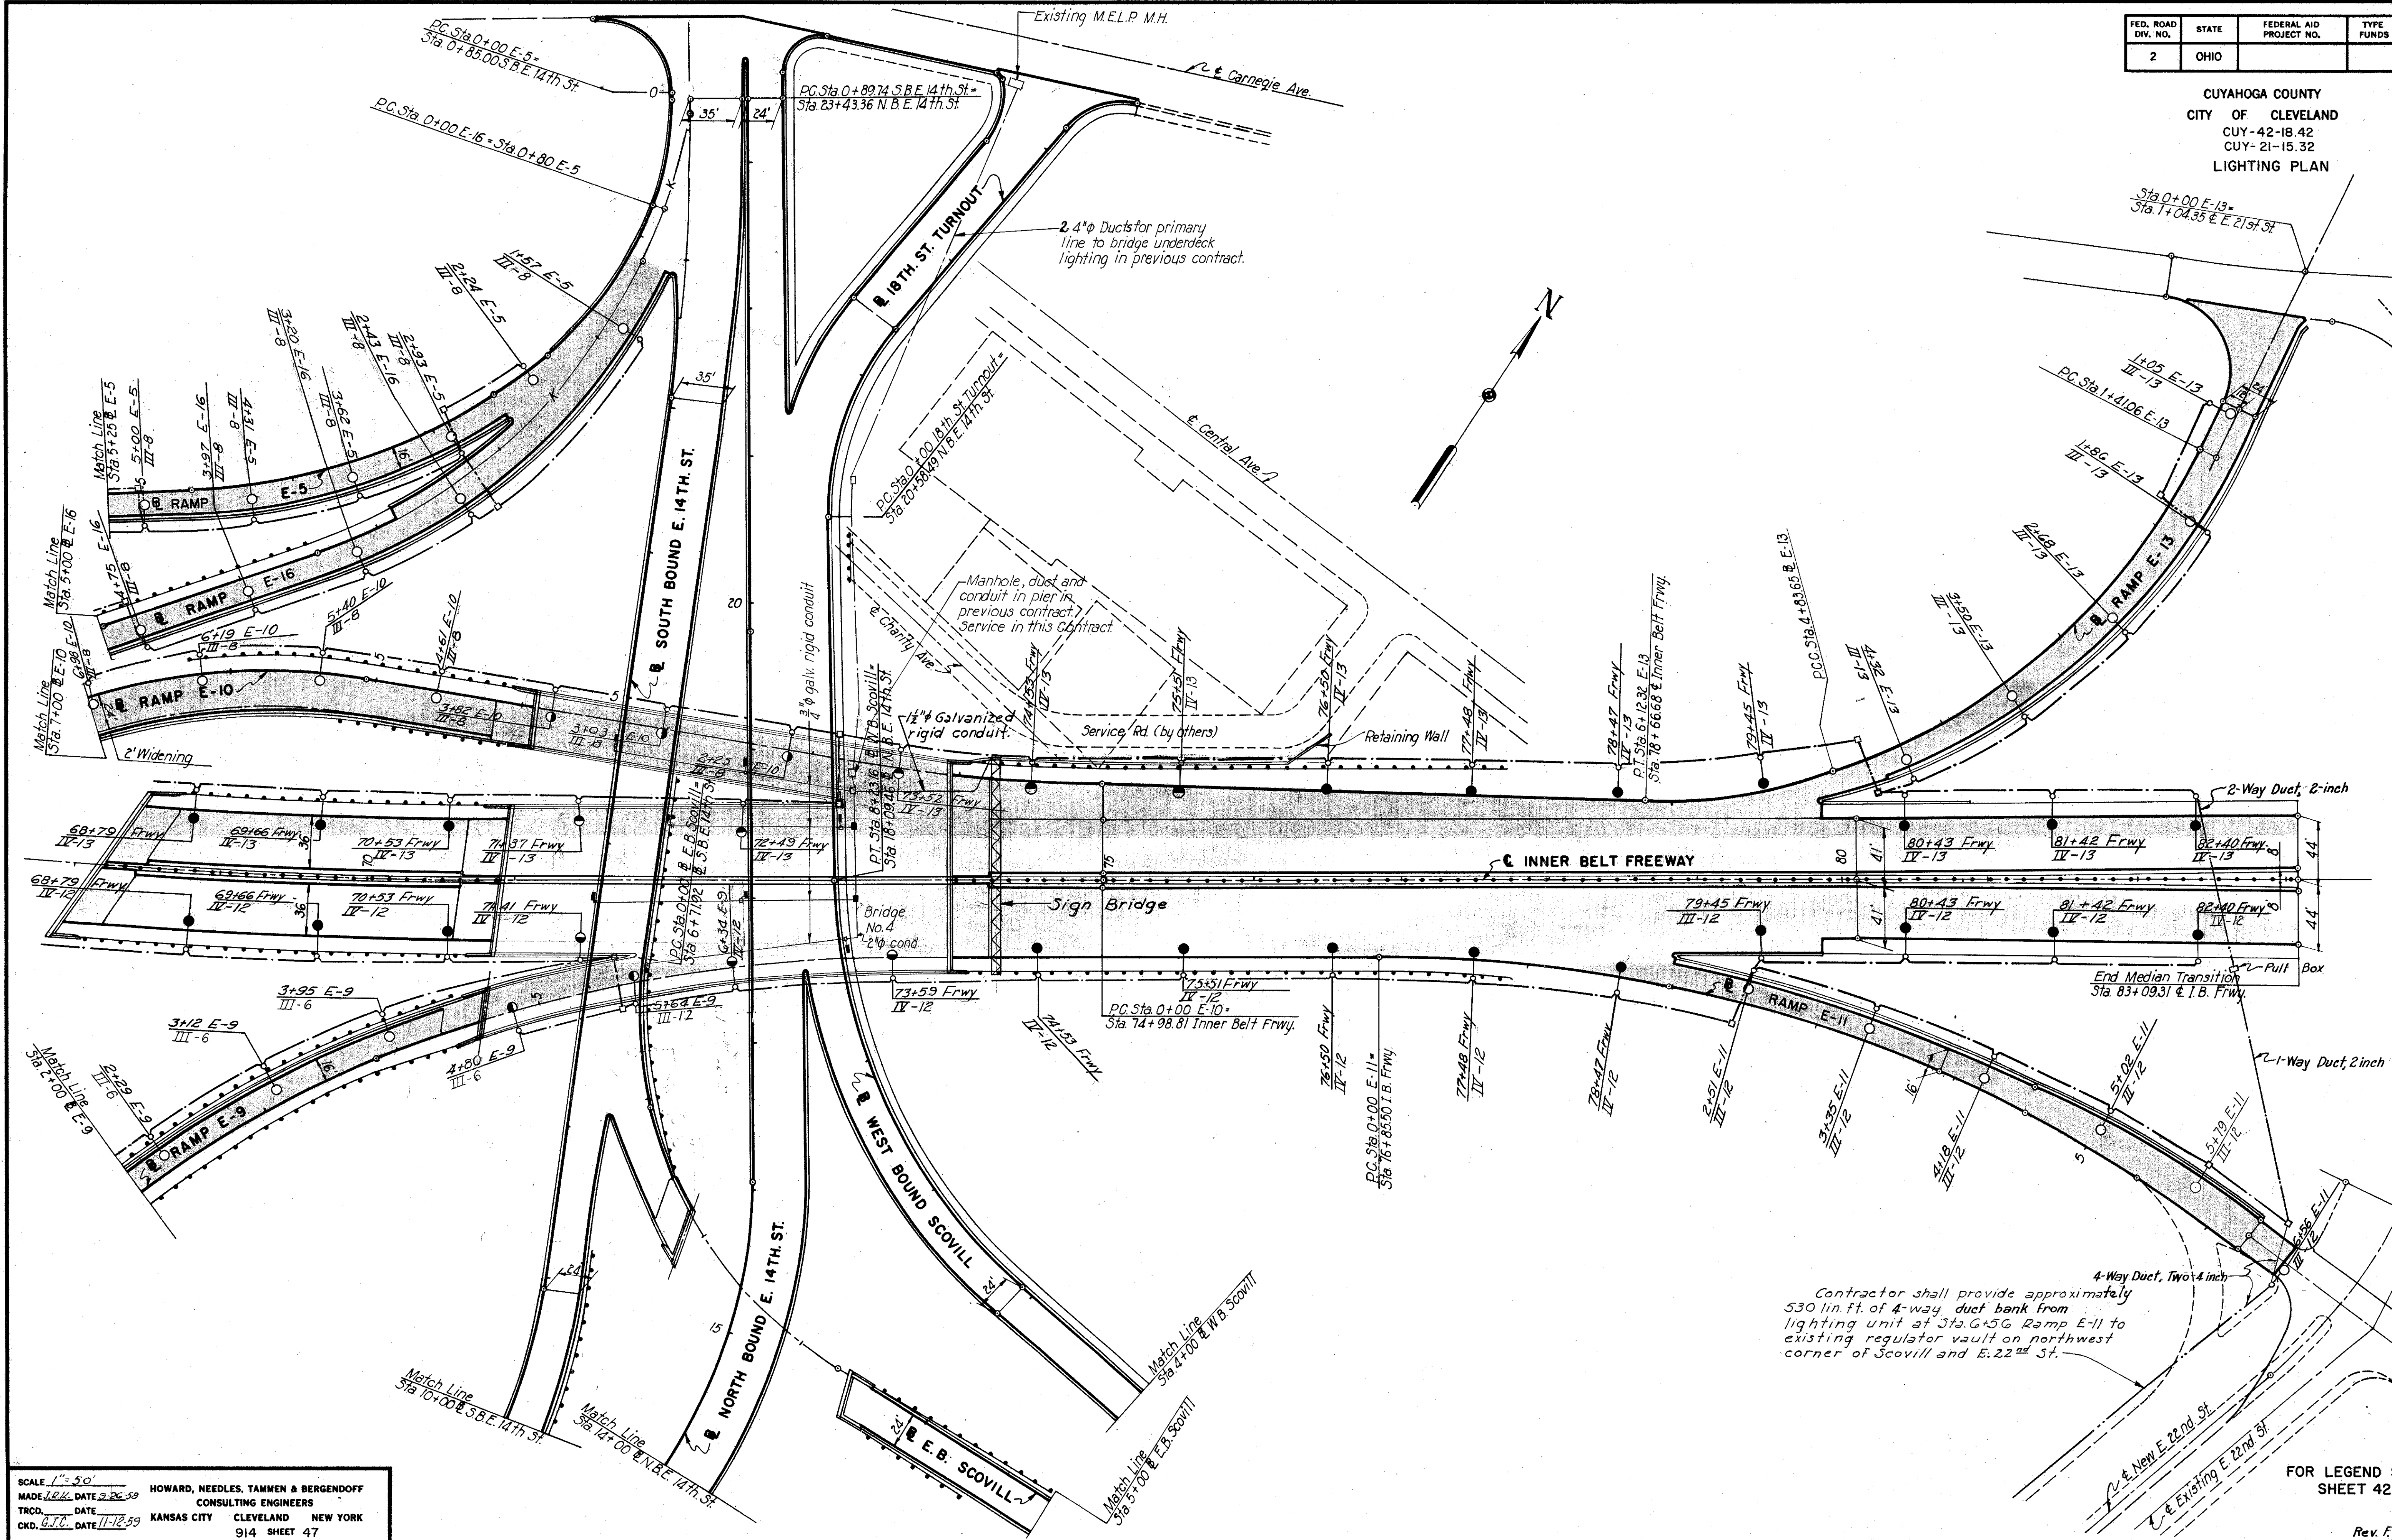

Contractor shall provide approximately 530 lin. ft. of 4-way duct bank from lighting unit at Sta. 6+56 Ramp E-11 to existing regulator vault on northwest corner of Scovill and E. 22nd St.

SCALE 1" = 50'
MADE 12-14-59 DATE 2-26-59
TRCD. DATE
CKD. B.T.C. DATE 11-12-59
HOWARD, NEEDLES, TAMMEN & BERGENDOFF
CONSULTING ENGINEERS
KANSAS CITY CLEVELAND NEW YORK
914 SHEET 47

FOR LEGEND SEE SHEET 42

Rev. F.S. J 12-16-59

LIGHTING NOTES

FED. ROAD DIV. NO.	STATE	FEDERAL AID PROJECT NO.	TYPE FUNDS	48
2	OHIO			181

CUYAHOGA COUNTY
CITY OF CLEVELAND
CUY-42-18.42
CUY-21-15.32
LIGHTING NOTES

1. GENERAL

THIS SPECIFICATION SHALL SUPPLEMENT THE STATE OF OHIO CONSTRUCTION AND MATERIAL SPECIFICATIONS DATED JANUARY 1, 1959, FOR THE MATERIAL USED AND FOR THE INSTALLATION OF COMPLETE SERIES ROADWAY AND MULTIPLE UNDERDECK LIGHTING SYSTEMS FOR THE PART 7 PORTION OF THE INNER BELT-WILLOW INTERCHANGE AND BRIDGES. THE TYPE AND LOCATION OF LIGHTS, THE CIRCUITS AND THE LOCATION OF CABLES AND CONDUITS SHALL BE AS INDICATED ON THE PLANS. THE CABLES FOR ROADWAY LIGHTS SHALL BE IN CONCRETE ENCASED FIBER OR ASBESTOS-CEMENT CONDUIT. FOR THE ROADWAY LIGHTING, 15,000 LUMEN AND 10,000 LUMEN INCANDESCENT LIGHTS ARE TO BE INSTALLED WHERE AND AS INDICATED ON THE PLANS, AND ARE TO BE OPERATED ON 5 PARTIAL AND TWO COMPLETE 6.6 AMP. SERIES CIRCUITS. THE UNDERDECK LIGHTS ARE TO BE 250 WATT. BALLASTS ARE TO BE INSTALLED FOR 230 VOLT OPERATION FROM TRANSFORMER STATIONS AS INDICATED ON SHEETS 41 TO 49 INCLUSIVE, 49A AND 49B.

THE CONTRACTOR SHALL CONSULT AND COOPERATE WITH THE CLEVELAND DIVISION OF LIGHT AND POWER AND THE CLEVELAND ELECTRIC ILLUMINATING COMPANY, BUT HE WILL NOT BE REQUIRED TO FURNISH, INSTALL OR CONNECT CONSTANT CURRENT OR MULTIPLE PRIMARY SERVICES, METERS, METER MOUNTS, METERING EQUIPMENT OR HOUSINGS FOR SAME.

THE CONTRACTOR SHALL FURNISH AND INSTALL ALL LIGHTING EQUIPMENT, INCLUDING MANHOLES, LAMPS, LUMINAIRES, UNDERDECK LIGHTING, FIXTURES, BALLASTS, SERIES CABLES, WIRING, LUMINAIRE BRACKETS AND STANDARDS FOR ROADWAY UNITS OFF STRUCTURES, MULTIPLE FEEDERS, FLEXIBLE CONDUIT CONNECTIONS TO UNDERDECK LIGHTING FIXTURES, JUNCTION BOXES, ADAPTERS, POLE CAP SCREWS, CABLE, CONCRETE POLE BASES, INSULATING TRANSFORMERS, POTHEADS, CONCRETE POLE BASE BOXES, GROUNDS, ALL CONDUITS AND DUCTS FOR PRIMARY AND LIGHTING CIRCUITS WHERE INDICATED, COUPLINGS, FEEDERS AND ALL INCIDENTALS NECESSARY AND INDICATED FOR COMPLETE CIRCUIT INSTALLATIONS, INSTALLED, ACCEPTED AND CONNECTED FOR OPERATION. THE CLOSED TYPE LOOPS OF ALL SERIES LIGHTING CIRCUITS SHALL BE COMPLETE, AND THE CONTRACTOR SHALL FURNISH AND INSTALL ALL EQUIPMENT NECESSARY FOR THE SATISFACTORY OPERATION OF THE CIRCUITS AND FOR THE COMPLETE OPERATION OF THE LIGHTING SYSTEMS, (EXCLUDING PRIMARY SERVICE LEADS, DISTRIBUTION, TRANSFORMERS, PRIMARY ARRESTERS, PRIMARY INSULATORS, CONSTANT CURRENT REGULATORS, SECONDARY ARRESTERS, CONTROLLERS FOR SERIES CIRCUITS, OIL SWITCHES, PRIMARY CONTACTORS, POWER POLES, PRIMARY FUSE CUTOFFS, AND PRIMARY CONNECTIONS TO THE POWER SOURCES) WHETHER SPECIFICALLY MENTIONED OR NOT.

LIGHTING STANDARDS ON BRIDGE AND RETAINING WALL STRUCTURES, COMPLETE WITH BRACKETS, POLE AND BRACKET CABLE, AND GROUNDING; EMPTY JUNCTION BOXES, INSULATING TRANSFORMER BOXES, AND CONDUITS ON STRUCTURES AND IN PIERS AND ABUTMENTS; THE CONTROLLERS FOR UNDERDECK LIGHTING; SERVICE PANELS FOR FLUORESCENT UNDERDECK LIGHTS; AND STRUCTURAL MEMBERS FOR THE MOUNTING OF THE UNDERDECK LIGHTS WILL BE PROVIDED AS A PART OF THE CONSTRUCTION OF THE RESPECTIVE BRIDGES.

THE LIGHTING INSTALLATION, WHEN COMPLETED, SHALL COMPLY WITH THE APPLICABLE PROVISIONS OF THE A.I.E.E. STANDARDS AND PRACTICES, AMERICAN STANDARDS, AND NATIONAL ELECTRIC MANUFACTURERS' ASSOCIATION STANDARDS, AND SHALL CONFORM TO ALL LOCAL AND SPECIAL LAWS AND/OR ORDINANCES GOVERNING SUCH INSTALLATION, AND TO THE SPECIAL REQUIREMENTS HEREIN SET FORTH. SHOULD THE PLANS AND DETAIL SPECIFICATIONS BE IN CONFLICT WITH THESE REQUIREMENTS, THROUGH ERROR OR OMISSION, THE CONTRACTOR SHALL CALL SUCH CONFLICT TO THE ATTENTION OF THE ENGINEER, AND THE CONTRACTOR SHALL MAKE THE NECESSARY CORRECTIONS IN THE INSTALLATION AS MAY BE DIRECTED BY THE ENGINEER.

INsofar AS PRACTICABLE, ALL MAJOR ITEMS OF ELECTRICAL EQUIPMENT SUCH AS LUMINAIRES, CABLE, POLES, INSULATING TRANSFORMERS, ETC., SHALL CONSIST OF PRODUCTS OF THE SAME MANUFACTURER IN ORDER TO SECURE SINGLE RESPONSIBILITY AND MOST SATISFACTORY SERVICE. UNLESS SPECIFICALLY NOTED OTHERWISE, ALL ELECTRICAL EQUIPMENT SHALL BE EQUAL TO THE BEST GRADE OF THAT TYPE OF EQUIPMENT AS MANUFACTURED BY THE GENERAL ELECTRIC COMPANY, THE WESTINGHOUSE ELECTRIC COMPANY, OR THE LINE MATERIAL COMPANY. REFERENCE TO ANY NAME, MAKE OR MANUFACTURER'S NUMBER FOR AN ARTICLE OF EQUIPMENT OR MATERIAL IS INTENDED TO BE DESCRIPTIVE AND SET A STANDARD OF DESIRED QUALITY AND STYLE, BUT IS NOT RESTRICTIVE. IT INDICATES THE MATERIALS THAT WILL BE ACCEPTABLE AND THAT SHOULD BE USED AS THE BASIS OF THE BIDS.

A LAYOUT WIRING DIAGRAM SHOWING IN GENERAL THE ARRANGEMENTS AND LOCATION OF THE EQUIPMENT IS SHOWN ON THE PLANS. THIS SHALL BE CONSIDERED ONLY AS ILLUSTRATIVE AND, SUBJECT TO THE APPROVAL OF THE ENGINEER, THE CONTRACTOR SHALL MODIFY IT AS NECESSARY FOR COMPLETE AND PROPER CONSTRUCTION AND OPERATION. THE LOCATION OF THE TRANSFORMERS, SERVICES, CONDUIT AND LUMINAIRES SHOWN ON THE PLANS ARE DIAGRAMMATIC ONLY, AND MAY BE SUBJECT TO SLIGHT SHIFTING AS THE ENGINEER MAY DIRECT IN ORDER TO CONFORM TO LOCAL CONDITIONS.

BEFORE COMMENCEMENT OF INSTALLATION OF THE ROADWAY AND UNDERDECK LIGHTING SYSTEMS, A COMPLETE SCHEDULE OF MATERIALS AND EQUIPMENT PROPOSED FOR INSTALLATION SHALL BE SUBMITTED FOR THE APPROVAL OF THE ENGINEER. THE SCHEDULE SHALL INCLUDE CATALOGS, CUTS, BROCHURES, DIAGRAMS, DRAWINGS, AND OTHER SUCH DESCRIPTIVE DATA AS MAY BE REQUIRED BY THE ENGINEER. IN THE EVENT ANY ITEMS OF MATERIAL OR EQUIPMENT CONTAINED IN THE SCHEDULE FAIL TO COMPLY WITH SPECIFICATION REQUIREMENTS, SUCH ITEMS WILL BE REJECTED.

2. MATERIALS AND EQUIPMENT

ALL BOLTS, NUTS, STUDS, WASHERS, PINS, TERMINALS, SPRINGS, AND SIMILAR FASTENINGS AND FITTINGS SHALL BE, WHERE PRACTICABLE, OF AN APPROVED CORROSION-RESISTING MATERIAL SUCH AS BRASS OR BRONZE, OR OF A MATERIAL TREATED IN AN APPROVED MANNER TO RENDER IT ADEQUATELY RESISTANT TO CORROSION. HOT-DIP GALVANIZING WILL BE CONSIDERED SUCH APPROVED TREATMENT. ALL MATERIALS FURNISHED SHALL BE NEW, SHALL BE OF THE BEST QUALITY AND WORKMANSHIP, SHALL BE THE BEST STANDARD PRODUCT OF A MANUFACTURER REGULARLY ENGAGED IN THE PRODUCTION OF THIS TYPE OF EQUIPMENT AND SHALL BE OF THE MANUFACTURER'S LATEST APPROVED DESIGN.

EACH ROADWAY LIGHTING UNIT SHALL COMPRISE A POLE WITH A 10 FT. BRACKET AND EITHER A 15,000 LUMEN LUMINAIRE SIMILAR TO GENERAL ELECTRIC FORM 79-AD OR A 10,000 LUMEN LUMINAIRE SIMILAR TO WESTINGHOUSE AK-10 AS INDICATED ON SHEET 49. LUMINAIRES LIGHTING THE ROADWAY ON THE STRUCTURE, RAMPS AND STREETS SHALL MEET THE GENERAL REQUIREMENTS OF I.E.S. TYPE III OR TYPE IV DISTRIBUTION AS INDICATED.

LIGHT STANDARDS SHALL CONFORM AS NEARLY AS POSSIBLE TO THE SPECIFICATIONS HEREIN AND SHALL BE SIMILAR TO UNION METAL DESIGN NO. 70161-Y23 FOR STANDARDS ALONG ROADWAYS AS TO GENERAL DESIGN AND FINISH, HEIGHT, BASE, MAST ARM, DIMENSIONS AND TO METHOD OF FABRICATION. IN GENERAL, EACH STANDARD SHALL CONSIST OF A CAST STEEL ANCHOR BASE TO WHICH SHALL BE WELDED A TAPERED STEEL POLE. TO THE STEEL POLE SHALL BE FASTENED AN ORNAMENTAL POLE TOP TO WHICH SHALL BE WELDED A MAST ARM BRACKET FOR SUPPORTING THE LIGHTING UNIT.

THE TRANSFORMER BOX FOR ALL STANDARDS OFF STRUCTURES SHALL BE A PART OF THE POLE BASE FOUNDATION AS INDICATED ON THE PLANS, WITH CLASS C CONCRETE USING NO. 4 AGGREGATE. GROUND POLES BY A 1" BY 8" COPPER LEAD ROD WITH TOP EXTENDING THROUGH BOTTOM OF BOX. CONNECT TO POLE BY NO. 6 COPPER WIRE.

THE STEEL SHAFT OF THE LIGHTING STANDARDS SHALL BE FABRICATED FROM NOT LESS THAN NO. 11 MANUFACTURER'S STANDARD GAUGE. THE SHAFT SHALL BE FORMED AND WELDED WITH ONLY ONE LONGITUDINAL, AUTOMATICALLY ELECTRICALLY WELDED JOINT AND SHALL HAVE NO HORIZONTAL JOINTS OR WELDS. THE WELD SHALL BE OF FULL PENETRATION. AFTER FORMING AND WELDING, THE TAPERED SHAFT SHALL BE COLD ROLLED OR WORKED UNDER SUFFICIENT PRESSURE TO FLATTEN OUT THE WELD, TO INCREASE THE ELASTIC LIMIT OF THE METAL IN THE COMPLETED SHAFT, AND TO PRODUCE A TRUE TAPERED TUBE WITHOUT FLAT SPOTS AND A CIRCULAR CROSS SECTION THROUGHOUT THE LENGTH OF THE SHAFT. IF THE SHAFT IS FABRICATED BY MEANS OF A BRAKE OR OTHER PROCESS WHICH DOES NOT UTILIZE THE COLD ROLLING PRINCIPLE, IT SHALL BE FABRICATED FROM A STEEL SHEET HAVING A THICKNESS OF NO. 7 MANUFACTURER'S STANDARD GAUGE.

EACH STANDARD SHALL HAVE A MAST OR BRACKET ARM MADE OF STANDARD PIPE OF THE SIZE AND LENGTH AS SHOWN ON THE PLANS. THE INNER END OF THE BRACKET ARM SHALL BE WELDED TO A CAST STEEL HEAD BLOCK SO DESIGNED THAT THE BLOCK CAN BE BOLTED THROUGH A CAST IRON NECK PIECE TO A PLATE WELDED TO THE TOP OF THE POLE TO PERMIT RADIAL ADJUSTMENT OF THE BRACKET ARM. PROVISIONS SHALL BE MADE TO PERMIT PASSAGE OF THE CONCEALED WIRES TO BRACKET ARM. THE ORNAMENTAL CASTING WELDED TO THE OUTER END OF THE BRACKET SHALL BE ARRANGED WITH A LEVELING DEVICE OR "PLUMBER" FOR ADJUSTMENT OF A PENDANT LIGHTING FIXTURE AND SHALL BE TAPPED FOR 1-1/4 INCH PIPE CONNECTION. THE POLE BASE FOUNDATIONS SHALL BE CLASS "C" CONCRETE WITH 1-1/4" x 5" CADMIUM COATED STEEL ANCHOR BOLTS EXTENDED 3-1/16 INCH ABOVE BASE WITH 4 INCH L-BEND AT BOTTOM. EACH ROD SHALL HAVE ONE GALVANIZED AMERICAN STANDARD HEX-NUT. EACH CABLE SHALL ENTER THE STANDARD THROUGH 2-INCH FIBER CONDUIT INSTALLED IN THE CONCRETE FOUNDATION FROM TRANSFORMER POLE BASE BOX. CONDUIT SHALL EXTEND AT LEAST 3 INCHES ABOVE TOP OF FOUNDATION. ALL STANDARDS SHALL HAVE GROUNDING LUGS.

EACH STANDARD SHALL HAVE TWO 9/16 INCH HOLES PROVIDED WHERE SHOWN ON SHEET NO. 49. ALL POLES AND BRACKETS SHALL HAVE A FACTORY APPLIED PRIMER, TOUCHED UP AND THEN SHALL BE PAINTED WITH TWO FIELD COATS OF DARK GREEN WEATHER RESISTING ENAMEL AS USED ON CITY STREETS. FINISH FIELD COATS SHALL BE APPLIED AFTER ERECTION. THE FIRST FIELD COAT SHALL BE TINTED.

EACH LUMINAIRE SHALL CONSIST OF A SUPPORTING HOOD, AND EXTERNAL BODY OR CASING, MAIN REFLECTOR AND A REFLECTOR GLOBE. THE HOOD SHALL BE MADE OF CAST ALUMINUM AND SHALL BE TAPPED FOR 1-1/4 INCH STANDARD PIPE. THE EXTERNAL BODY OR CASING SHALL BE MADE OF CAST ALUMINUM AND SHALL BE FIRMLY ATTACHED TO THE HOOD BY MEANS OF ADEQUATE SCREWS OR BOLTS. THE MAIN REFLECTOR SHALL BE MADE OF HEAVY GAUGE ALUMINUM SHEET, ALZAK FINISHED AND POLISHED. THE ENTIRE REFLECTING ELEMENT SHALL BE RIGIDLY ATTACHED TO THE EXTERNAL BODY BY MEANS OF SCREWS OR BOLTS.

THE GLOBES SHALL BE SUPPLIED WITH A NON-RUSTING METAL SUPPORTING RING OR BAND WITH CLAMPS AROUND THE RIM OR FLANGE OF THE GLOBE. THE SUPPORTING RING SHALL BE SO DESIGNED THAT BROKEN GLOBES CAN BE REPLACED AT THE LAMP LOCATION WITH THE USE OF SIMPLE HAND TOOLS. ALL SCREWS, NUTS, WASHERS, ETC., WHICH MUST BE REMOVED IN ORDER TO REPLACE A BROKEN GLOBE SHALL BE NON-FERROUS AND CORROSION-PROOF. THE GLOBE SUPPORTING RING SHALL BE ATTACHED TO THE REFLECTOR BY MEANS OF A HINGE OR ITS EQUIVALENT ON ONE SIDE AND A LATCH, THUMB SCREW, OR EQUIVALENT ON THE OPPOSITE SIDE. THESE DEVICES SHALL BE SO DESIGNED THAT WITH THE GLOBE IN PLACE, THE LATCH OR THUMB SCREW CAN BE RELEASED BY HAND, THE GLOBE SWUNG DOWN AND THEN LIFTED OFF THE HINGE SO THAT THE GLOBE CAN BE WASHED SEPARATELY FROM THE FIXTURE. THE DESIGN SHALL BE SUCH THAT AFTER WASHING, THE GLOBE CAN BE HOOKED ONTO THE HINGE AND THEN PUSHED UP INTO PLACE AGAINST THE GASKET WITH ONE HAND WHILE THE LATCH OR THUMB SCREW IS TIGHTENED WITH THE OTHER HAND. THE BEST DESIGN SHALL BE THAT WHICH COMBINES SIMPLICITY AND EASE OF OPERATION WITH THE MOST EFFECTIVE SEAL BETWEEN THE GLASS GLOBE AND THE REFLECTOR. FIXTURES HAVING THE REFLECTOR PERMANENTLY ATTACHED OR "SPUN ON" TO THE GLASS GLOBE WILL NOT BE ACCEPTED. A SKELETON TYPE MOGUL MULTIPLE SOCKET SHALL BE MOUNTED IN THE HOOD AND SHALL BE SUITABLE FOR 10,000 OR 15,000 LUMEN, 20 AMPERE LAMPS. THE LUMINAIRES SHALL PRODUCE AN I.E.S. TYPE IV LIGHT DISTRIBUTION CURVE EQUAL TO THE CURVE PRODUCED BY THE GENERAL ELECTRIC FORM 79-AD OR AN I.E.S. TYPE III PRODUCED BY WESTINGHOUSE AK-10, AS REQUIRED.

LAMPS FOR UNDERDECK LUMINAIRES SHALL BE NOMINAL 85 WATT, FLUORESCENT TYPE CW/HO, AND FOR ROADWAY UPRIGHT LUMINAIRES SHALL BE 10,000 LUMEN OR 15,000 LUMEN, 2,000 HOUR LAMPS FOR REGULAR REPLACEMENT, P5-40 BULBS, MOGUL BASE.

EXTERNAL PARTS OF ALL LUMINAIRES SHALL BE FINISHED ALUMINUM. GASKETS USED FOR SEALING THE JOINT BETWEEN GLOBES AND REFLECTORS OR CASINGS SHALL BE PREFORMED CORK OR FELT AND SHALL BE CEMENTED IN PLACE. THE FIXTURES AS SPECIFIED ARE PRECISION OPTICAL DEVICES AND IN ORDER TO DELIVER THE PERFORMANCE REQUIRED THEY MUST HAVE THE LAMP FILAMENT CORRECTLY LOCATED WITH

REFERENCE TO THE REFLECTING OR REFRACTING ELEMENTS. THE SOCKETS SHALL PREFERABLY BE SOLIDLY MOUNTED, WITH THE LAMP FILAMENT AT THE CORRECT OPTICAL CENTER. IF THE MANUFACTURER'S DESIGN PROVIDES FOR VERTICAL ADJUSTMENT OF THE SOCKET, HE SHALL FURNISH A DRAWING SHOWING THE PROPER DIMENSION TO SOME CONVENIENT REFERENCE POINT, SUCH AS THE LOWER EDGE OF THE REFLECTOR OR CASING, SO THAT THE PURCHASER CAN MAKE A GAUGE TO BE USED FOR ACCURATELY SETTING AND LOCKING THE SOCKETS. REFRACTING GLOBES SHALL PREFERABLY BE KEVED TO THE SUPPORTING REFLECTOR SO THAT THEY CANNOT BE PLACED IN ANY OTHER THAN THE CORRECT ANGULAR LOCATION. IN ANY EVENT, THE GLOBES MUST BE PLAINLY MARKED TO INDICATE THE "STREET SIDE" AND THE "HOUSE" OR "SIDEWALK SIDE." ALL LAMPS USED IN THESE FIXTURES WILL BE STANDARD 20 AMPERE, BASE UP MAZDA TYPE WITH MOGUL BASES AND 7 INCH LIGHT CENTERS.

LAMP SOCKETS USED IN ENCLOSED FIXTURES OF THE TYPES SPECIFIED ARE SUBJECTED TO HIGH TEMPERATURES AND THE SOCKETS FURNISHED SHALL BE FOR HEAVY DUTY AND SHALL INCORPORATE ALL THE LATEST DESIGN FEATURES AVAILABLE SUCH AS CENTER SPRING LOADED CONTACTS, PLATED PARTS AND EXTRA HEAVY CAST TERMINALS TO REDUCE THE POSSIBILITY OF CONTACT TROUBLES AND WELDING OF THE LAMP BASE TO THE SOCKET SHELL. EACH FIXTURE SHALL PREFERABLY BE COMPLETELY ASSEMBLED AT THE FACTORY AND SHIPPED IN A SINGLE CONTAINER AS A COMPLETE UNIT.

ALL OF THE SERIES STREET LIGHTING INSULATING TRANSFORMERS WILL BE CONNECTED WITH THEIR PRIMARY WINDINGS IN A 6.6 AMPERE, 60 CYCLE REGULATED CIRCUIT, AND SHALL BE LOCATED EITHER IN CONCRETE POLE BASE BOXES OR IN PARAPET JUNCTION BOXES. TRANSFORMERS FOR LIGHTING UNITS ON RAMPS, ROADWAYS AND LANES SHALL BE LOCATED IN THE POLE BASE BOX OF EACH POLE. THE SECONDARY OF THE 10,000/15,000 LUMEN TRANSFORMERS WILL SUPPLY 20 AMPERES TO ONE LAMP RATED 10,000 OR 15,000 LUMENS. WHEN THE LAMP WATTAGE VARIES BETWEEN 8% ABOVE AND 20% BELOW NORMAL, THE SECONDARY OR LAMP CURRENT SHALL NOT VARY MORE THAN 1% FROM 20 AMPERES WITH 6.6 AMPERES AT 60 CYCLES SUPPLIED TO THE PRIMARY WINDING. EACH TRANSFORMER SHALL BE GIVEN A DIELECTRIC TEST BY THE MANUFACTURER AND SHALL WITHSTAND 22,000 VOLTS BETWEEN PRIMARY WINDING AND ALL OTHER PARTS OF THE TRANSFORMER AND 1,500 VOLTS BETWEEN THE SECONDARY WINDING AND ALL OTHER PARTS OF THE TRANSFORMER. BOTH OF THE ABOVE TESTS SHALL BE APPLIED FOR ONE MINUTE, WITHOUT FAILURE. THE STREET LIGHTING TRANSFORMERS SHALL BE FOR POLE BASE MOUNTING WITH TAPING SLEEVES SIMILAR TO G. E. CAT. NO. 95A62 WHICH WILL BE THE CRITERION IN JUDGING THE ADEQUACY OF THE TYPE PROPOSED BY THE CONTRACTOR. INDIVIDUAL TRANSFORMERS SHALL BE FURNISHED FOR EACH LIGHT.

EACH TRANSFORMER SHALL BE SUPPLIED WITH A NON-CORROSIVE NAME PLATE SHOWING THE FOLLOWING DATA: MAKER'S NAME AND STYLE OR CATALOG NUMBER, RATING IN LUMENS, PRIMARY CURRENT, SECONDARY CURRENT, AND FREQUENCY.

CONDUCTORS FOR ROADWAY LIGHTING SHALL BE TWO SINGLE NO. 8 AWG SOLID SOFT DRAWN COPPER OF NOT LESS THAN 98% CONDUCTIVITY AND SHALL BE COATED WITH LEAD, TIN, OR ANTIMONY ALLOY. INSULATION SHALL CONSIST OF 10/64 INCH OF POLY-VINYL CHLORIDE COMPOUND MADE IN ACCORDANCE WITH A.S.T.M. SPEC. D-734. ALL CONDUCTORS SHALL BE PLACED IN CONDUIT.

CABLE TO BE INSTALLED IN POLES FROM THE SECONDARY TAPS OF THE ISOLATING TRANSFORMERS TO THE BRACKET END AT LUMINAIRE SHALL BE NO. 8 AWG, SINGLE CONDUCTORS, 600 V. CABLE. INSULATION SHALL CONSIST OF 1/4 INCH OF RUBBER OR RUBBER LIKE COMPOUND KNOWN COMMERCIALY AS OZONE RESISTANT INSULATION WITH AN OUTSIDE JACKET OR SHEATH OF NEOPRENE, 1/4 INCH THICK. POLE AND BRACKET ASBESTOS WIRE SHALL BE INSTALLED BETWEEN THE BRACKET END AT LUMINAIRE AND LAMP SOCKET. IT SHALL BE NO. 8 AWG SINGLE CONDUCTOR, SOLID. INSULATION SHALL BE ASBESTOS APPLIED TO THE CONDUCTOR TO FORM A CONTINUOUS TUBE OF ASBESTOS FIBRES AT LEAST 40 MILS THICK TIGHTLY COMPRESSED AND IMPREGNATED WITH A FLAME, HEAT AND MOISTURE-PROOF COMPOUND, AND AN OUTER ASBESTOS BRAID AT LEAST 45 MILS THICK.

UNDERDECK LUMINAIRES SHALL BE EQUAL TO LINE MATERIAL NO. LF1FI WITH TWO 1-AMP. STREET LIGHTING, HIGH OUTPUT FLUORESCENT LAMPS, PRE-HEATED CATHODE, CAT. NO. F7212-CW-HO, COMPLETE WITH 230 VOLT AC MULTIPLE BALLASTS. THE JUNCTION BOX AT EACH UNDERDECK LUMINAIRE SHALL BE CAST IRON, WATERTIGHT, AND EQUAL TO O.Z. TYPE YH CAT. NO. 060403. FOR THE UNDERDECK LIGHTS ON BRIDGE 4, THE CONTRACTOR SHALL PROVIDE ONE 30 AMP. 250 VOLT, DOUBLE POLE CIRCUIT BREAKER IN THE "SERVICE PANEL" PROVIDED WITH BRIDGE 4 CONSTRUCTION.

3. CONSTRUCTION METHODS

THE INSTALLATION AS A WHOLE SHALL BE CARRIED OUT IN CONFORMANCE WITH THE REQUIREMENTS HEREIN STATED AND IMPLIED, AND UPON COMPLETION OF THE WORK SHALL PRESENT A NEAT AND WORKMANLIKE FINISHED APPEARANCE. SAFE CONSTRUCTION AND OPERATING PRACTICES MEETING THE REQUIREMENTS OF THE NATIONAL ELECTRIC SAFETY CODE SHALL BE MAINTAINED.

POLES SHALL BE CAREFULLY SET, THEY SHALL BE RAKED SO THAT THE BACK TAPERED SIDE IS VERTICAL AS SHOWN ON SHEET 53 AND THE LUMINAIRES SHALL BE SUPPORTED WITH BRACKETS ABOUT 28'-0" ABOVE PAVEMENT AS INDICATED. THE CAREFUL ALIGNING AND GRADING OF POLES IS CONSIDERED TO BE AN ESSENTIAL FEATURE OF THE INSTALLATION. THE WORK SHALL BE AS NEARLY PERFECT AS PRACTICABLE, AND NO PERCEPTIBLE TOLERANCES WILL BE PERMITTED. IN ORDER TO ACCOMPLISH THE DESIRED PERFECTION OF ALIGNMENT OF THE LUMINAIRES, THE POLES SHALL BE CAREFULLY ALIGNED IN PLACE, SUPPORTED BY SHIMS AS REQUIRED, AND SECURELY BOLTED.

THE INSTALLATION OF ALL LUMINAIRES AND WIRING SHALL CONFORM TO THE RECOMMENDATIONS OF THE EQUIPMENT MANUFACTURERS AND THE PRACTICE OF THE POWER COMPANY

CABLES SHALL BE INSTALLED IN CONTINUOUS LENGTHS WITHOUT SPLICES, FROM TERMINAL TO TERMINAL. AT THE TERMINALS, CABLE SHALL BE SPLICED TO THE EQUIPMENT LEADS IN STRICT CONFORMITY WITH THE MANUFACTURER'S INSTRUCTIONS AND AS DIRECTED. CARE SHALL BE TAKEN TO INSURE WATERTIGHT JOINTS. SPLICES MAY BE MADE IN CONCRETE PULL BOXES.

SPLICES SHALL NOT BE MADE IN CONDUITS. SPLICES OF CONDUCTORS SHALL BE MADE MECHANICALLY AND ELECTRICALLY SECURE BY USING FOUR SCREW COPPER CONNECTORS AND WRAPPING IN ACCORDANCE WITH THE RECOMMENDATIONS OF THE MANUFACTURER OF THE CABLES SO THAT THE INSULATION AND THE MECHANICAL AND ELECTRICAL QUALITIES OF THE SPLICES SHALL BE EQUAL TO THAT OF THE REMAINDER OF THE CONDUCTOR. TAPE OF THE SAME COMPOSITION AS THE CABLE INSULATION OR SCOTCH BRAND TAPE SHALL BE USED.

FOR LIGHTING NOTES APPLICABLE TO INSTALLATIONS ON STRUCTURES, SEE SHEETS 98A, 176 AND 177.

4. TESTS

THE CONTRACTOR SHALL FURNISH ALL EQUIPMENT AND APPLIANCES NECESSARY TO TEST THE COMPLETED CABLE SYSTEMS. A BURNING TEST WILL BE REQUIRED FOR THE LIGHTS. IN ADDITION, THE CITY OF CLEVELAND WILL MAKE A "MEGGER" TEST OF ALL CIRCUITS. IT SHALL BE THE CONTRACTOR'S RESPONSIBILITY TO DEMONSTRATE TO THE SATISFACTION OF THE DIRECTOR OF HIGHWAYS THAT ALL LIGHTING CIRCUITS ARE CONTINUOUS AND FREE FROM SHORT CIRCUITS AND UNSPECIFIED GROUNDS, THAT ALL CIRCUITS ARE PROPERLY CONNECTED IN ACCORDANCE WITH THE APPLICABLE WIRING DIAGRAMS AND THAT THE RESISTANCE TO GROUND OF NON-GROUNDED SERIES CIRCUITS IS NOT LESS THAN 50,000 OHMS AND PARALLEL UNGROUNDED CIRCUITS IS NOT LESS THAN 100,000 OHMS. THE CONTRACTOR SHALL FURNISH A COMPLETE REPORT OF MEGOHM READINGS ON ALL CIRCUITS INSTALLED.

5. PAYMENT FOR ROADWAY AND UNDERDECK LIGHTING


PAYMENT FOR THE ROADWAY AND UNDERDECK LIGHTING SHALL BE MADE AT THE CONTRACT UNIT PRICE BID FOR ITEMS AS INDICATED IN THE SCHEDULE OF QUANTITIES, WHICH PAYMENT SHALL CONSTITUTE FULL COMPENSATION FOR FURNISHING ALL MATERIALS, LABOR, EQUIPMENT, TOOLS AND INCIDENTALS NECESSARY, WHETHER SPECIFICALLY MENTIONED OR NOT, TO COMPLETE THE ENTIRE WORK, INSTALLED AND IN OPERATING CONDITION FOR FULL ACCEPTANCE, ACCORDING TO THE PLANS AND SPECIFICATIONS. PAYMENT WILL BE MADE AS FOLLOWS:

- "15,000 LUMEN LUMINAIRE AND INSULATING TRANSFORMER," PER EACH AND SHALL INCLUDE LAMP, GLOBE, REFLECTOR, REFLECTOR, LAMP RECEPTACLE, CORROSION RESISTANT FITTINGS, LATCHES, SAFETY CHAIN, GASKETS AND INSULATING TRANSFORMER.
- "10,000 LUMEN LUMINAIRE AND INSULATING TRANSFORMER," PER EACH AND SHALL INCLUDE ALL FEATURES SPECIFIED FOR 15,000 LUMEN LUMINAIRE, ITEM A, EXCEPT USING 10,000 LUMEN LUMINAIRE.
- "STANDARD, 10-FOOT BRACKET," PER EACH AND SHALL INCLUDE POLE FOR 28-FOOT MOUNTING HEIGHT, BRACKET ATTACHMENTS, 10-FOOT STEEL BRACKET, SHIMS, ANCHOR BOLTS, HANDHOLE, ANCHOR BASE, LEAF COVERS, PAINTING, END KNOB WITH PLUMBIZER AND PIPE NIPPLE, SINGLE CONDUCTOR NO. 8 AWG, 600 VOLT POLE AND BRACKET CABLE TO INSULATING TRANSFORMER, ATTACHMENTS TO "J" HOOK, SCREWS, BOLTS, NUTS, WASHERS AND ALL MODIFICATIONS AND INCIDENTALS REQUIRED.
- "CONCRETE POLE BASE," PER EACH AND SHALL INCLUDE CONCRETE POLE BASE BOX, EXCAVATIONS, FORMS, CONCRETE, REINFORCING STEEL, SETTING ANCHOR BOLTS, 2-INCH CONDUIT THRU BASE TO BOX FOR WIRING, GROUNDING POLE, BACKFILLING, TAMPING, REMOVING WASTE, 90-DEGREE BENDS, GALVANIZED COUPLINGS, PIPE NIPPLES, INSULATING BUSHINGS, CONDUIT STUBS THRU POLE BASE BOX WALLS FOR CONTINUOUS RUNS, AND CONDUIT STUBS AND PLUGGING.
- "PULL BOXES, CONCRETE," PER EACH AND SHALL INCLUDE EXCAVATION, FORMS, CONCRETE, REINFORCING STEEL, CONDUIT STUBS THRU WALLS, BACKFILLING, TAMPING AND REMOVING WASTE.
- "NO. 8 AWG, 5 KV LIGHTING CABLE," PER LINEAL FOOT AND SHALL INCLUDE TWO SINGLE CONDUCTOR CABLES IN DUCTS AND JUNCTION BOXES, SPLICING, TERMINALS, CONNECTIONS AND TESTING. MEASUREMENT FOR CABLE SHALL INCLUDE TWO LENGTHS OF SINGLE CABLE RUNS.
- "1-WAY DUCT, 2-INCH," PER LINEAL FOOT AND SHALL INCLUDE FORMS FOR CONCRETE, CONCRETE, END BELLS, PLUGGING DUCTS, CONDITIONING DUCTS, NO. 9 AWG GALVANIZED IRON PULVIN WIRE, AND SEALING AROUND DUCTS WHERE THEY ENTER MANHOLES OR VAULTS.
- "2-WAY DUCT, 2-INCH," PER LINEAL FOOT AND SHALL INCLUDE ALL FEATURES REQUIRED FOR "1-WAY DUCT, 2-INCH", ITEM G, EXCEPT USING TWO DUCT RUNS.
- "3-WAY DUCT, 2-INCH," PER LINEAL FOOT AND SHALL INCLUDE ALL FEATURES REQUIRED FOR "1-WAY DUCT, 2-INCH", ITEM G, EXCEPT USING THREE DUCT RUNS.
- "4-WAY DUCT, 2-INCH," PER LINEAL FOOT AND SHALL INCLUDE ALL FEATURES REQUIRED FOR "1-WAY DUCT, 2-INCH", ITEM G, EXCEPT USING FOUR DUCT RUNS.
- "1-WAY DUCT, 4-INCH," PER LINEAL FOOT AND SHALL INCLUDE ALL FEATURES REQUIRED FOR "1-WAY DUCT, 2-INCH", ITEM G EXCEPT USING 4-INCH DUCT.
- "FLUORESCENT UNDERDECK LIGHT," PER EACH AND SHALL INCLUDE FIXTURE, 2 LAMPS, 230 VOLT DUAL, HIGH POWERFACTOR, LOW STARTING TEMPERATURE BALLAST, BRACKETS, SUPPORT WHERE REQUIRED, GROUNDING FIXTURE, 6" x 6" x 3" JUNCTION BOX, FIXTURE WIRE FROM BALLAST TO FIXTURE, CONNECTION FROM JUNCTION BOX TO FIXTURE, ALL CONNECTIONS TO BALLAST, 3/4 INCH I.D. VINYL-JACKETED, FLEXIBLE CONDUIT, FITTINGS, MOUNTING LUGS AND FASTENINGS.
- "MULTIPLE FEEDERS", PER LINEAL FOOT AND SHALL INCLUDE TWO NO. 6 AWG SINGLE CONDUCTOR CABLES IN CONDUITS, DUCTS, MANHOLES, JUNCTION BOXES, AND SERVICE PANEL, SPLICING, TERMINATIONS, CONNECTIONS AND TESTING. MEASUREMENT FOR CABLE SHALL INCLUDE TWO LENGTHS OF SINGLE CABLE RUNS.
- "MANHOLE", PER EACH AND SHALL INCLUDE REQUIRED EXCAVATION FOR 5 FT. BY 8 FT. MANHOLE, FORMS, REINFORCING STEEL, CONCRETE, MANHOLE FRAMES AND COVERS, BOLTS AND FASTENINGS FOR HOLDING MANHOLE FRAME DOWN, END BELLS FOR DUCTS, PULLING IRONS, CONNECTIONS, TERMINALS, SPLICING, BACKFILLING, TAMPING, COMPACTING, REMOVAL OF WASTE, CAST IRON DRAIN AND GRATING, 6-INCH DIAMETER VITREOUS CLAY PIPE, CONNECTION TO EXISTING SEWER, AND WATERPROOFING, AND CABLE HANGERS.
- "NO. 10 AWG, 600 V. BRANCH CONDUCTORS", PER LINEAL FOOT AND SHALL INCLUDE TWO NO. 10 AWG SINGLE CONDUCTORS FOR FLUORESCENT UNDERDECK LIGHTS IN CONDUITS, JUNCTION BOXES, AND SERVICE PANEL, SPLICING, TERMINATIONS, CONNECTIONS AND TESTING. MEASUREMENT FOR CONDUCTORS SHALL INCLUDE TWO LENGTHS OF SINGLE CONDUCTOR RUNS. THIS PAY ITEM SHALL INCLUDE ONE 30 AMP., DOUBLE POLE UNDERDECK LIGHTS BRANCH CIRCUIT BREAKER TO BE INSTALLED IN THE "SERVICE PANEL" PROVIDED IN BRIDGE NO. 4 CONSTRUCTION.
- "2-WAY DUCT, 4-INCH", PER LINEAL FOOT AND SHALL INCLUDE ALL FEATURES REQUIRED FOR "2-WAY DUCT, 2-INCH", ITEM H, EXCEPT USING 4-INCH DUCT.
- "4-WAY DUCT, TWO 4-INCH", PER LINEAL FOOT AND SHALL INCLUDE ALL FEATURES REQUIRED FOR "2-WAY DUCT, 4-INCH", ITEM H, EXCEPT THE BOTTOM TWO DUCTS SHALL BE 4-INCH AND THE TOP TWO SHALL BE 2-INCH.

SCALE None HOWARD, NEEDLES, TAMMEN & BERGENDOFF
MADE BY DATE 11-2-59 CONSULTING ENGINEERS
TRCD DATE KANSAS CITY CLEVELAND NEW YORK
CKD/RK DATE 11-11-59 914 SHEET 48

CUYAHOGA COUNTY
CITY OF CLEVELAND
CUY 42-18.42
CUY 21-15.32
LIGHTING DETAILS


For manhole frames and covers, see Standard Drawing No. 2371, of The City of Cleveland, Sheet No. 52.

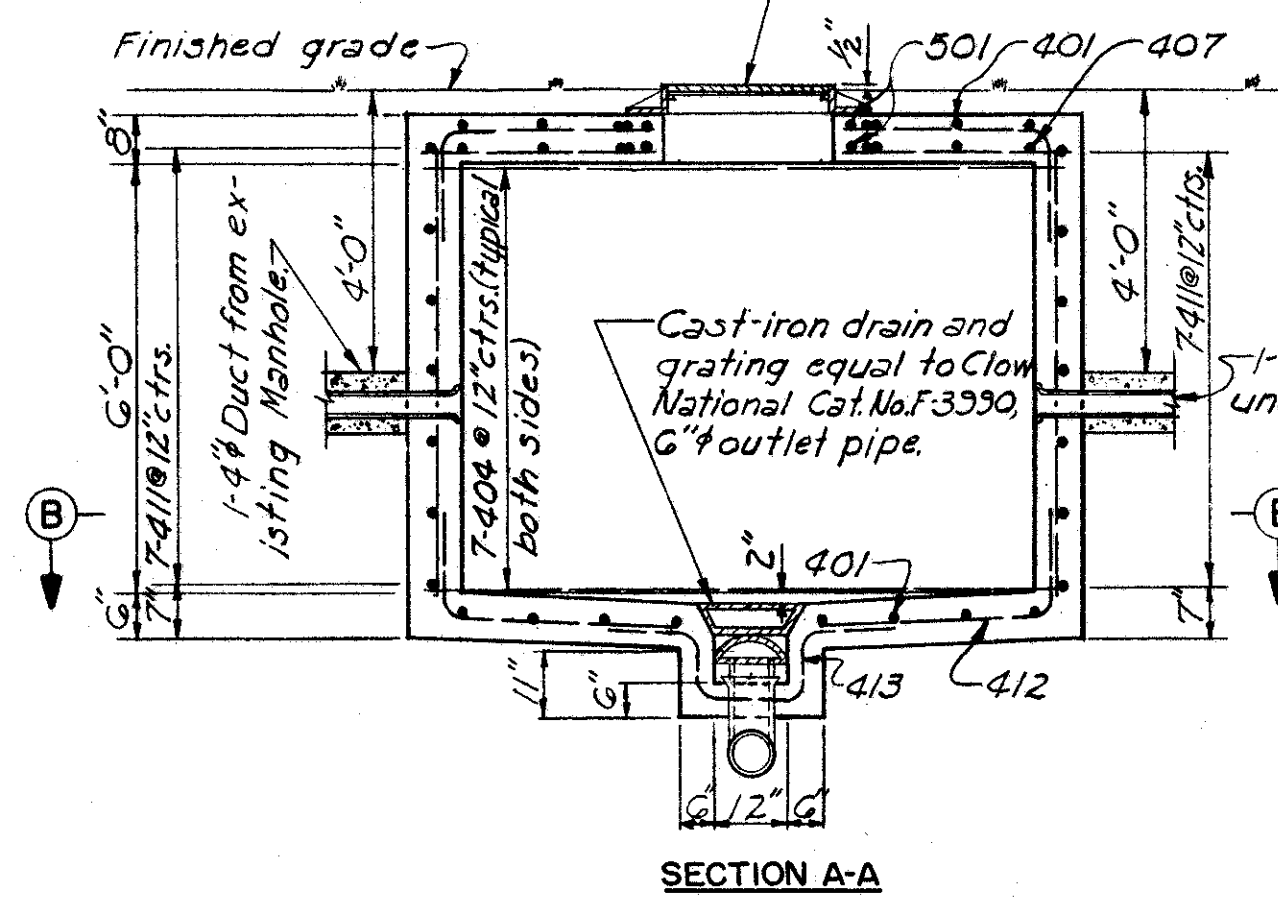

SECTION A-A


Notes:
The top and sides of the manhole shall be provided with "Type B" waterproofing according to Ohio Standard Construction and Materials Specifications. For the floor vapor barrier Plumbizer a 0.004" polyethylene film shall be applied over the sub-grade. The film shall be lapped not less than 6".
A 1" x 10'-0" ground rod shall be placed in one corner of the manhole, with 6" of the rod extending above the floor, for a minimum of 5 ohms to ground.
Install one pulling iron opposite each duct entrance.

For location of drainage manholes and lengths of 6" Vitreous Clay Pipe, see Roadway Lighting Plans.
For number and placement of ducts in and out of Transformer Manhole, see Roadway Lighting Plans.
6" outlet pipe shall be constructed in accordance with Item 1-2 using Sec. M-6.8 (b) pipe.

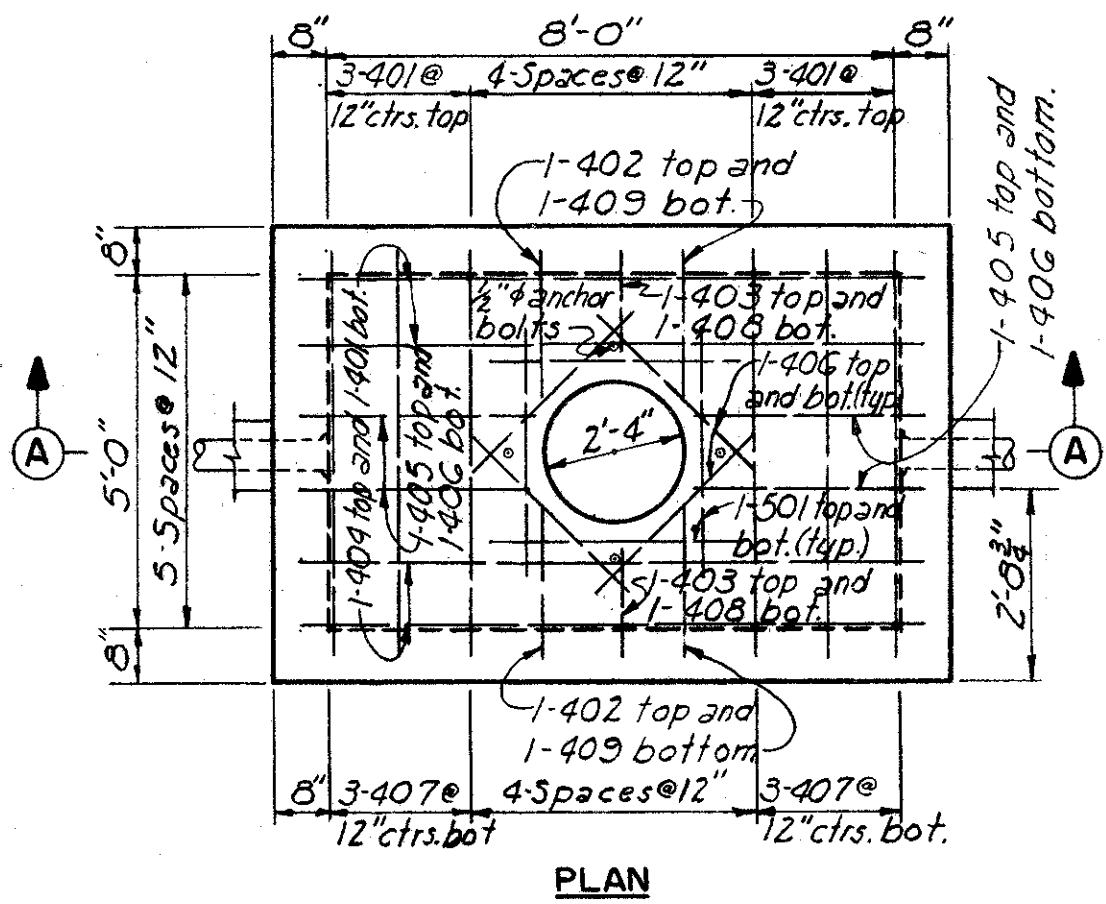


PLAN

TRANSFORMER MANHOLE
Scale: 3/8" = 1'-0"

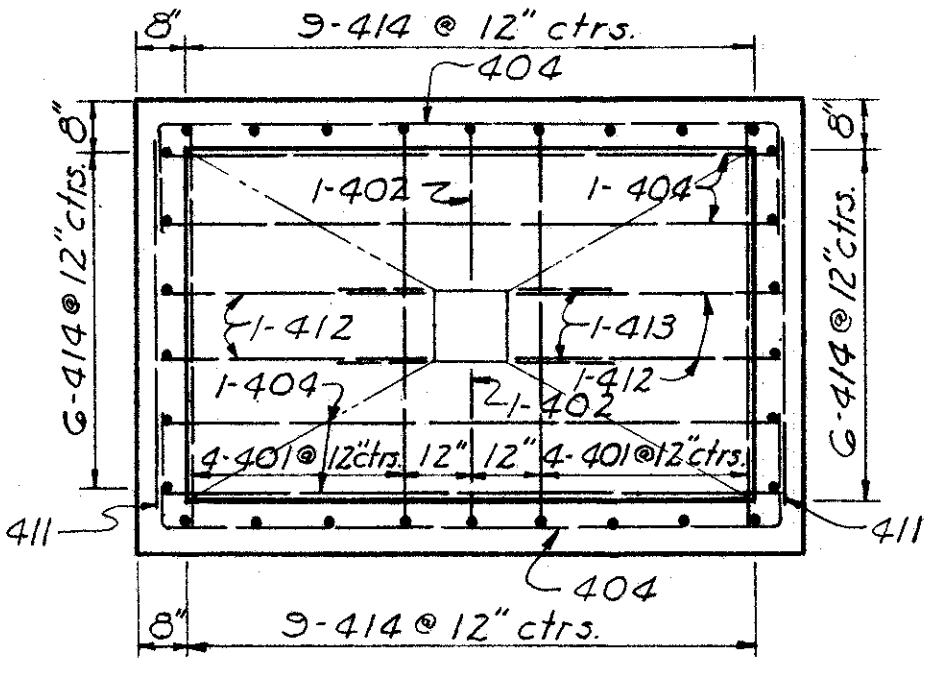


SECTION B-B

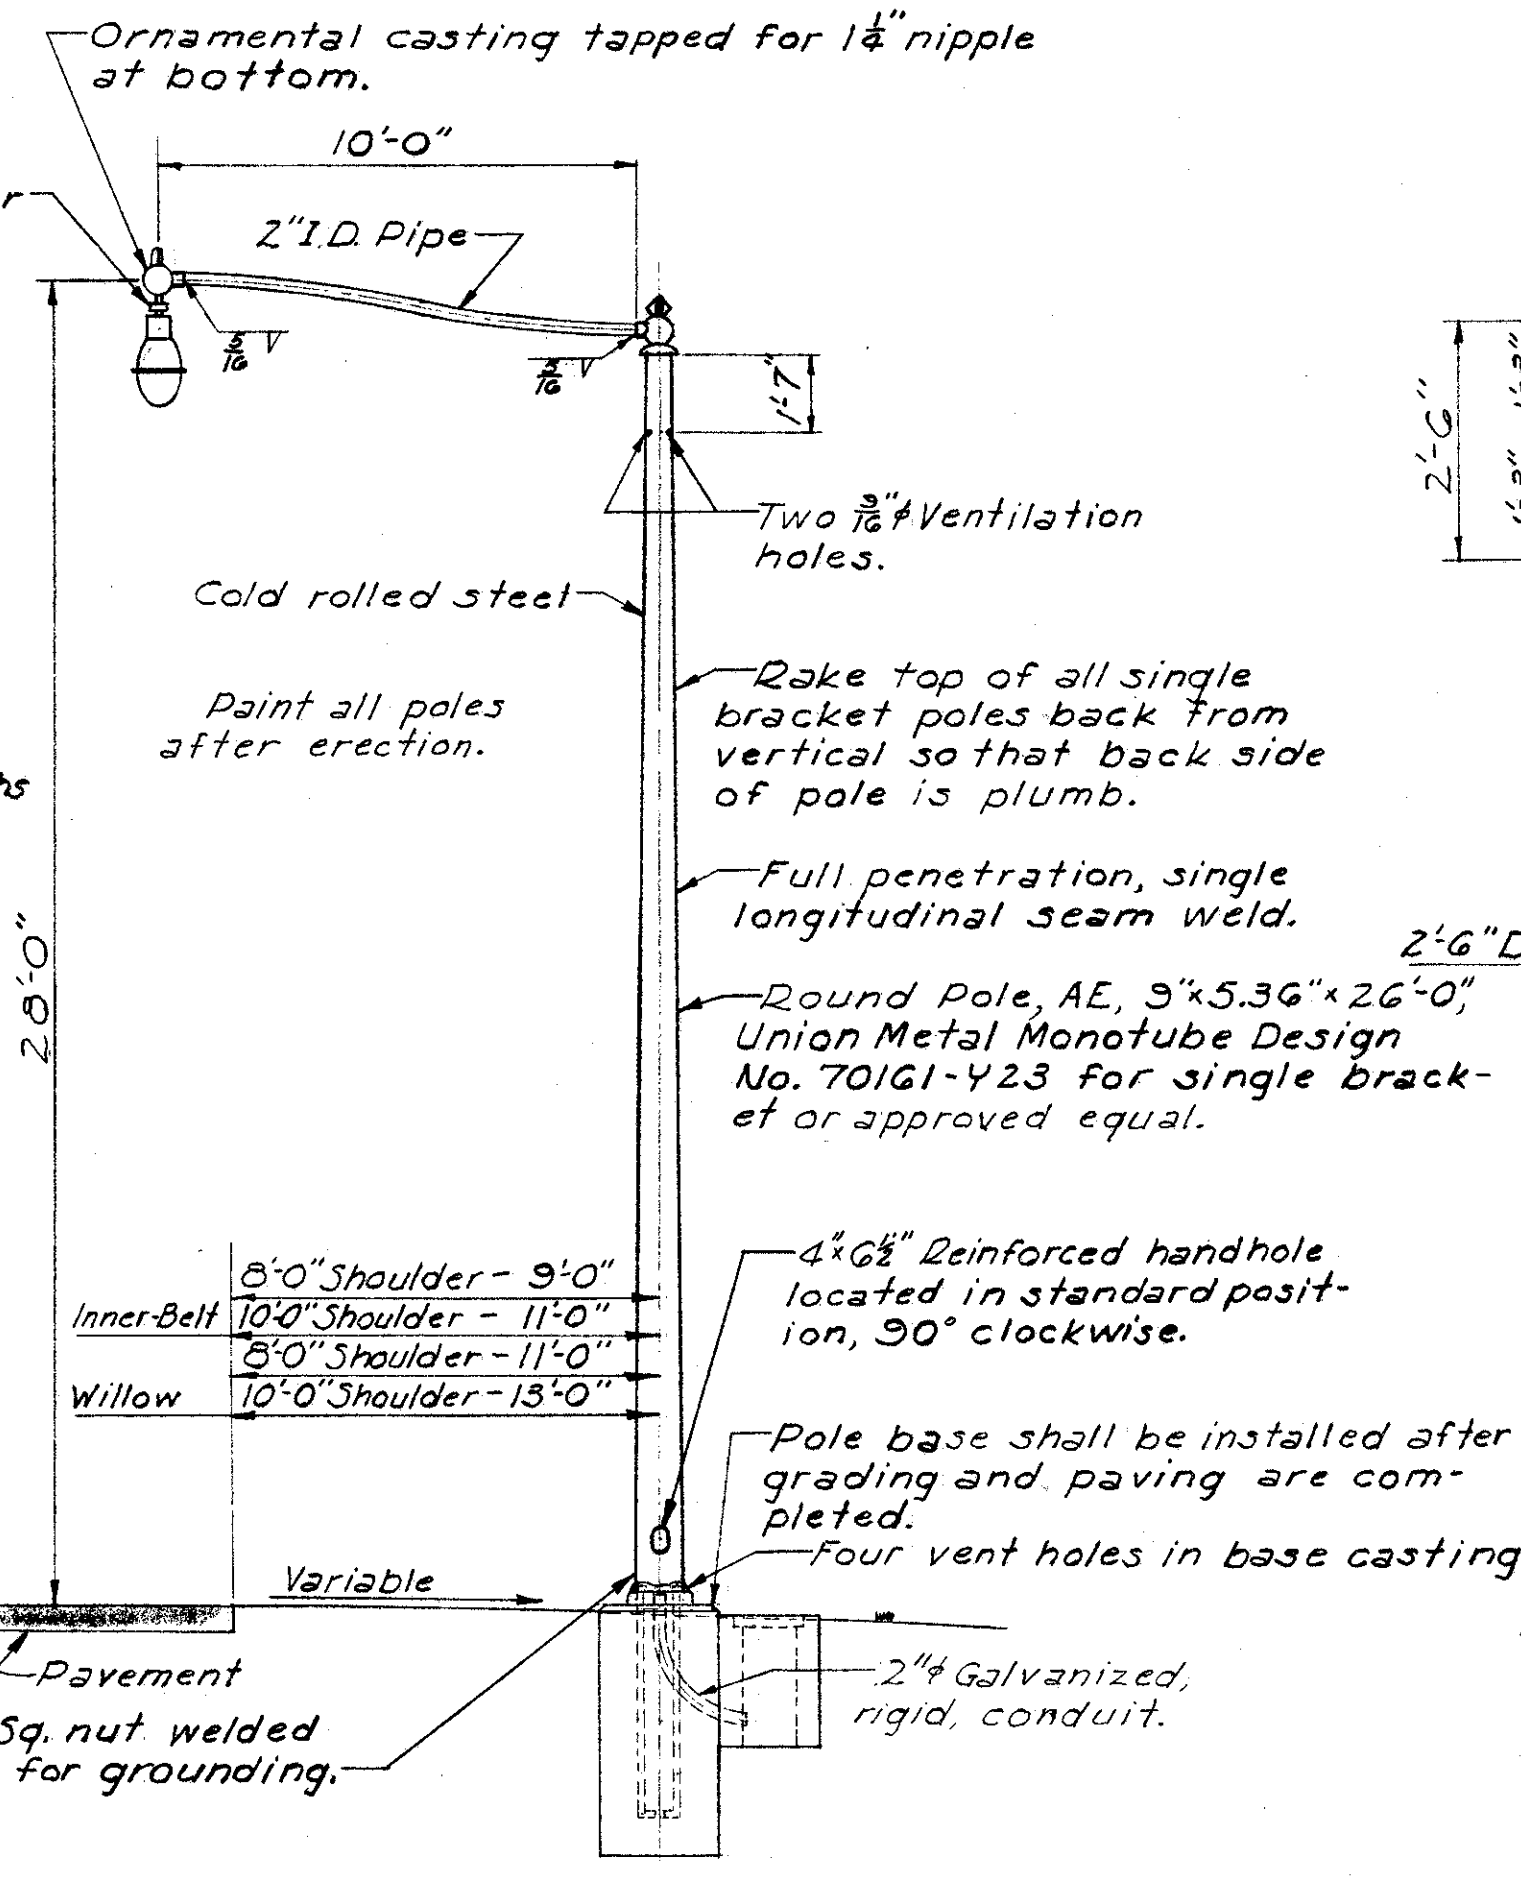


TYPICAL ROADWAY LIGHTING UNIT
No Scale

Note: Allow at least 4 days after pouring before allowing compaction by rollers over duct bank.


REINFORCING BAR SCHEDULE					
MARK	NO.	LENGTH	TYPE	DIMENSIONS	
				A	B
401	14	8'-8"	105	5'-8"	1'-6"
402	6	3'-8"	104	2'-2"	1'-6"
403	2	3'-2"	104	1'-8"	1'-6"
404	22	11'-8"	105	8'-8"	1'-6"
405	4	4'-9"	104	3'-3"	1'-6"
406	12	3'-3"	Str.		
407	6	6'-0"	Str.		
408	2	1'-9"	Str.		
409	4	2'-3"	Str.		
410	4	9'-0"	Str.		
411	14	5'-6"	Str.		
412	4	4'-11"	104	3'-5"	1'-6"
413	2	5'-10"	121	11"	1'-6"
414	30	6'-3"	Str.		
501	8	3'-6"	Str.		

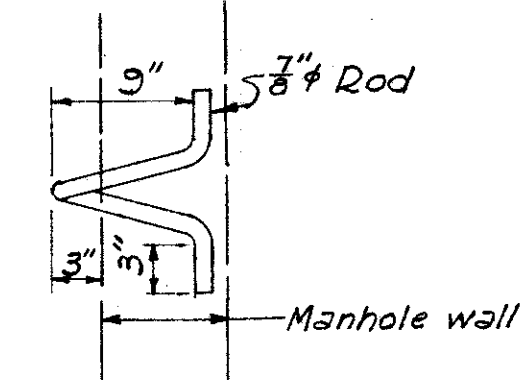


PULLING IRON
No Scale

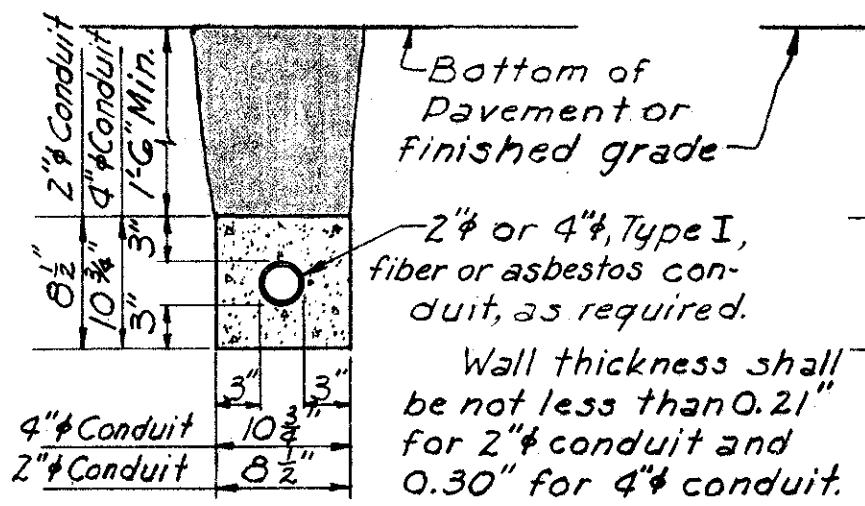


ONE-WAY DUCT BANK
Scale: 1" = 1'-0"

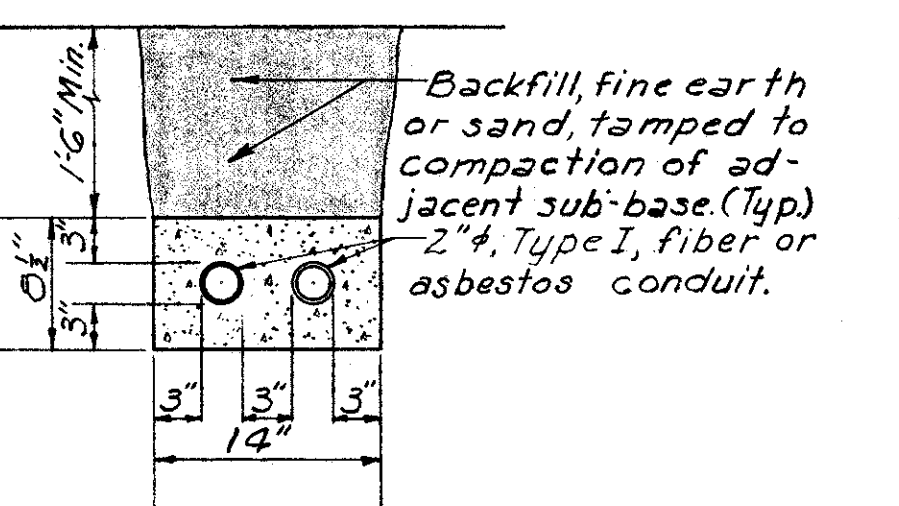


TWO-WAY DUCT BANK
Scale: 1" = 1'-0"

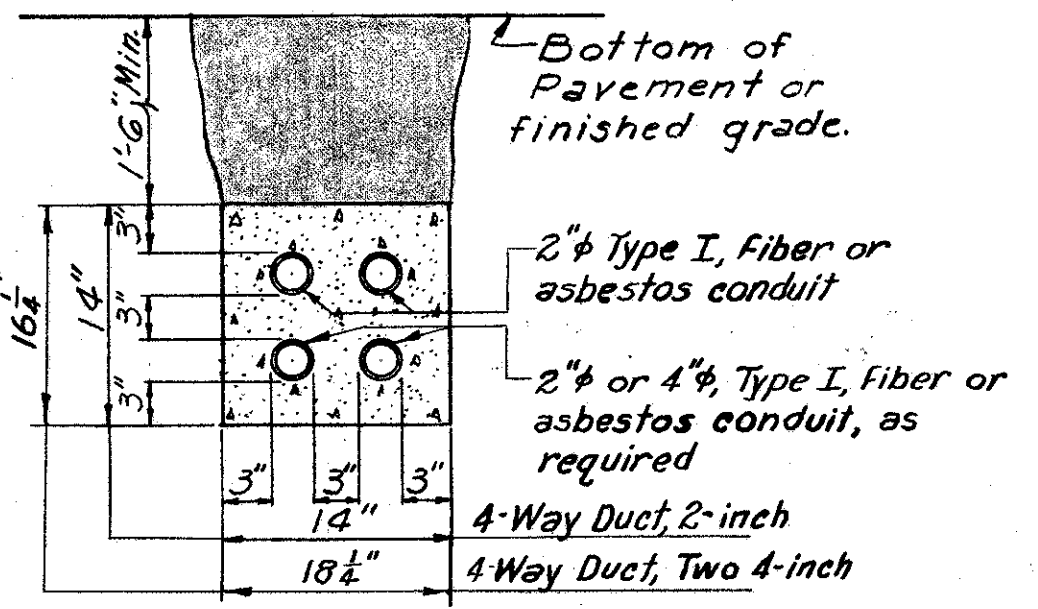

FOUR-WAY DUCT BANK
Scale: 1" = 1'-0"

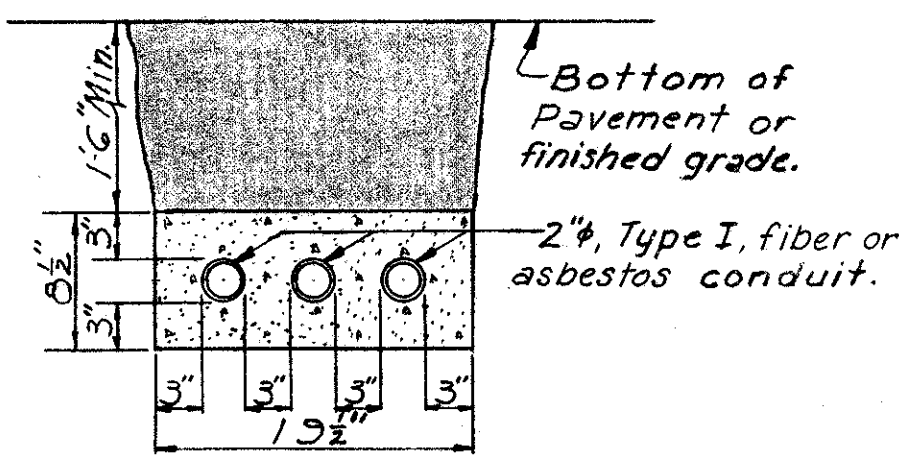


THREE-WAY DUCT BANK
Scale: 1" = 1'-0"

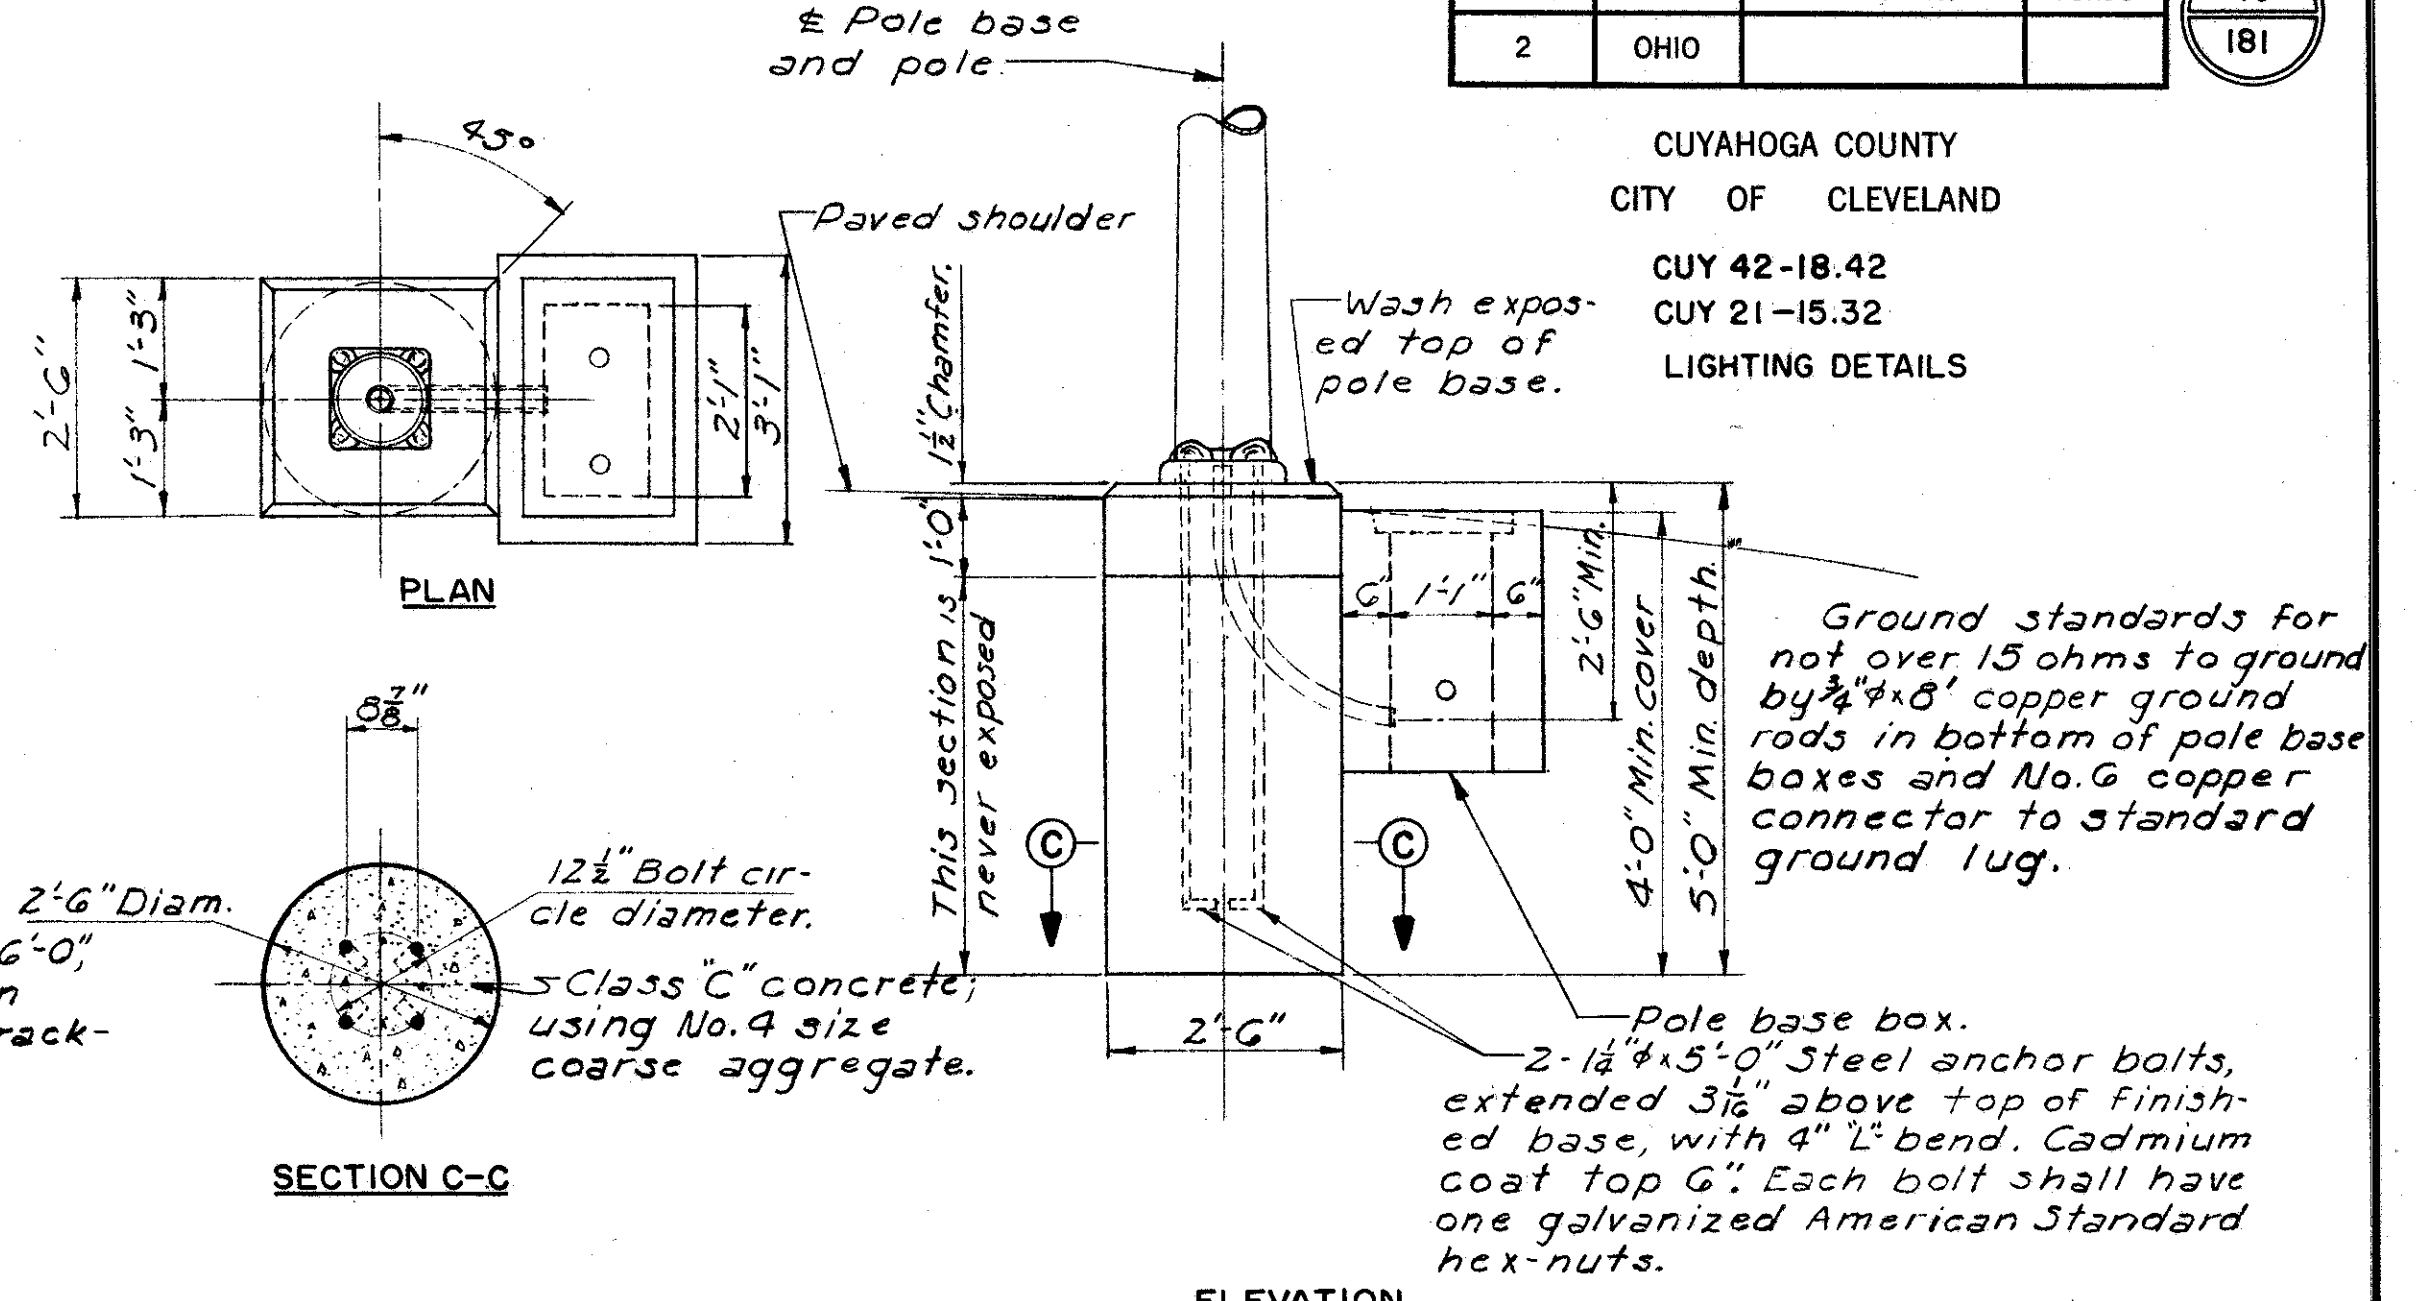


SECTION C-C

ELEVATION


TYPICAL POLE BASE
Scale: 1/2" = 1'-0"

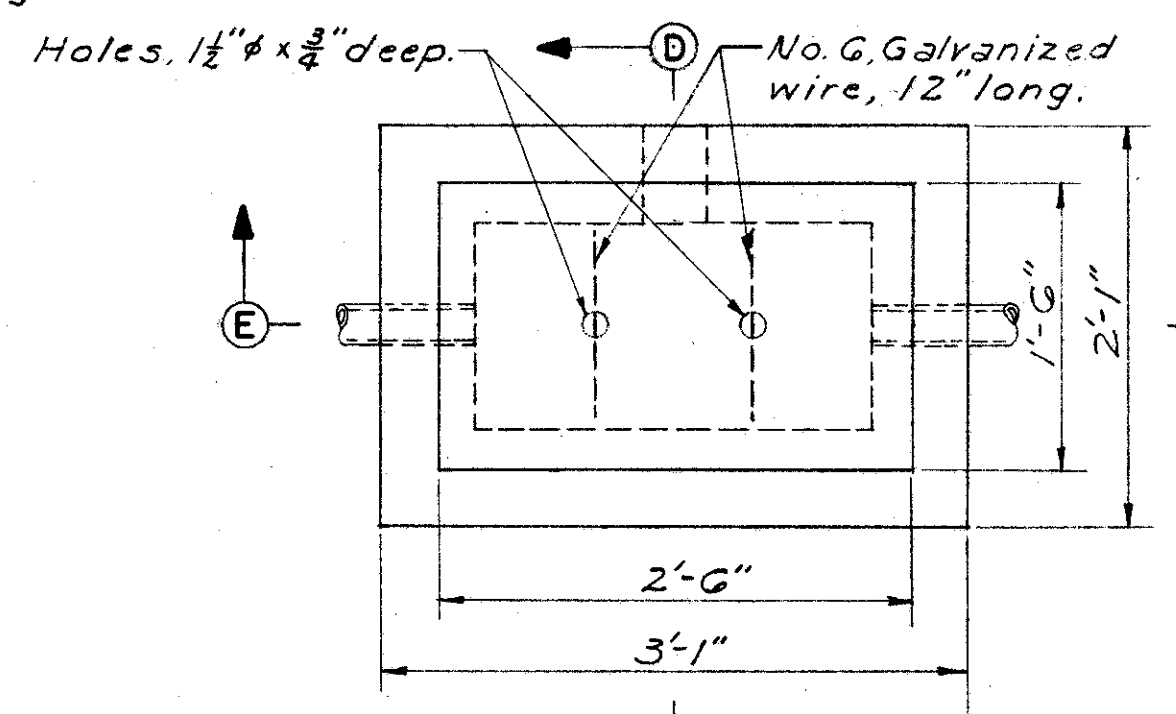

PLAN

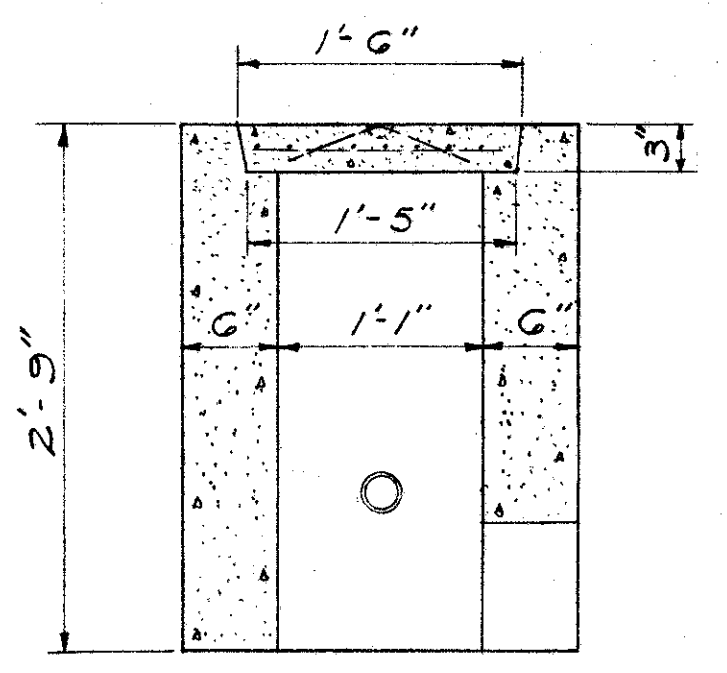

SECTION D-D

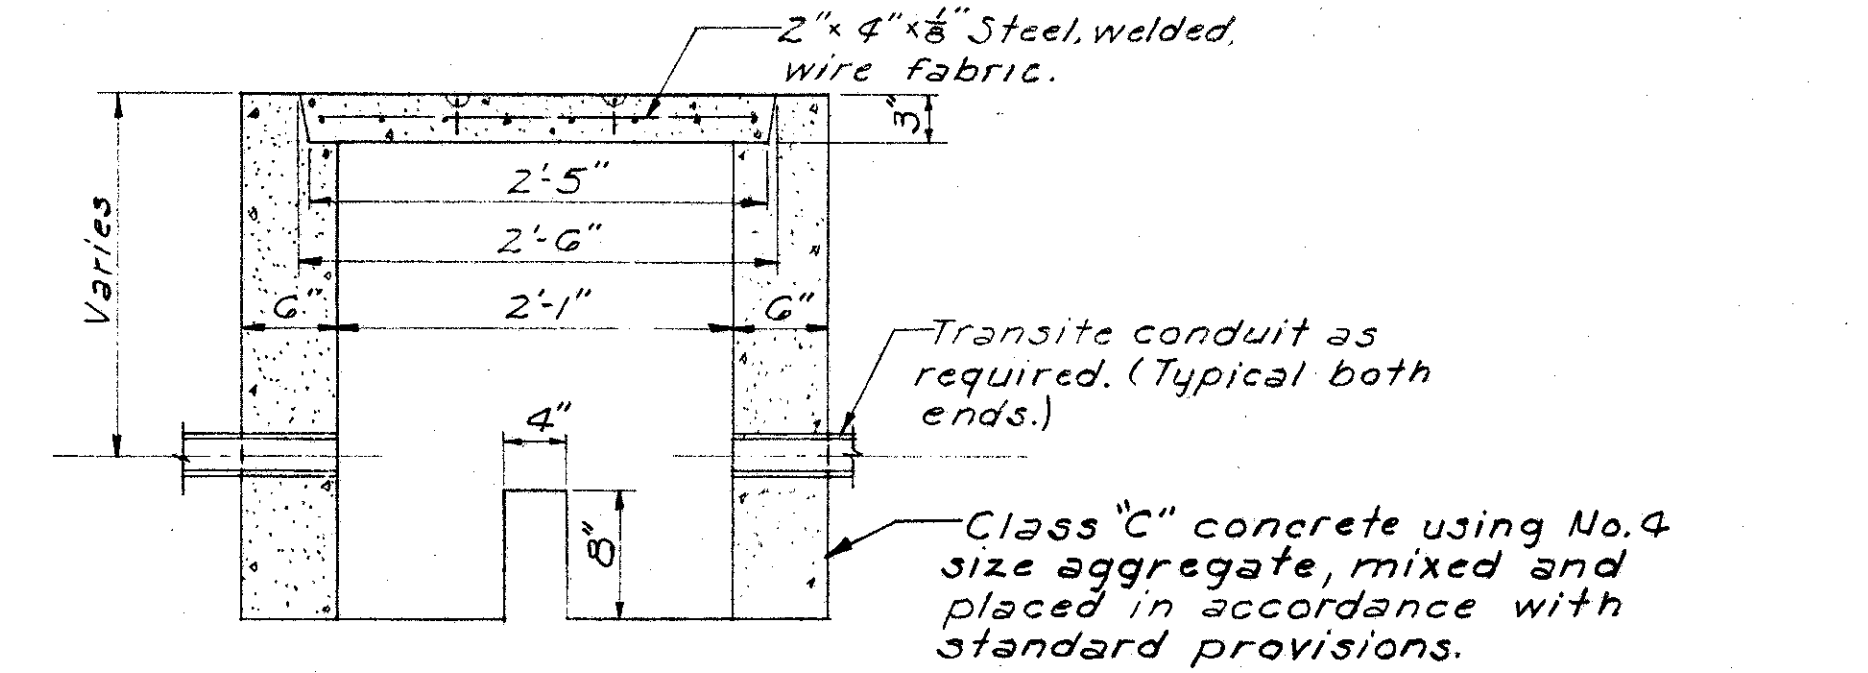

SECTION E-E


CONCRETE PULL BOX
Scale: 1" = 1'-0"

Note: Pitch ducts to drain toward boxes, manholes and vaults a minimum of 1ft. in 100 ft.
Forms for ducts may be omitted if Engineer considers soil sufficiently firm.

FED. ROAD DIV. NO.	STATE	FEDERAL AID PROJECT NO.	TYPE FUNDS
2	OHIO		


50
181

CUYAHOGA COUNTY
CITY OF CLEVELAND
CUY 42-18.42
CUY 21-15.32

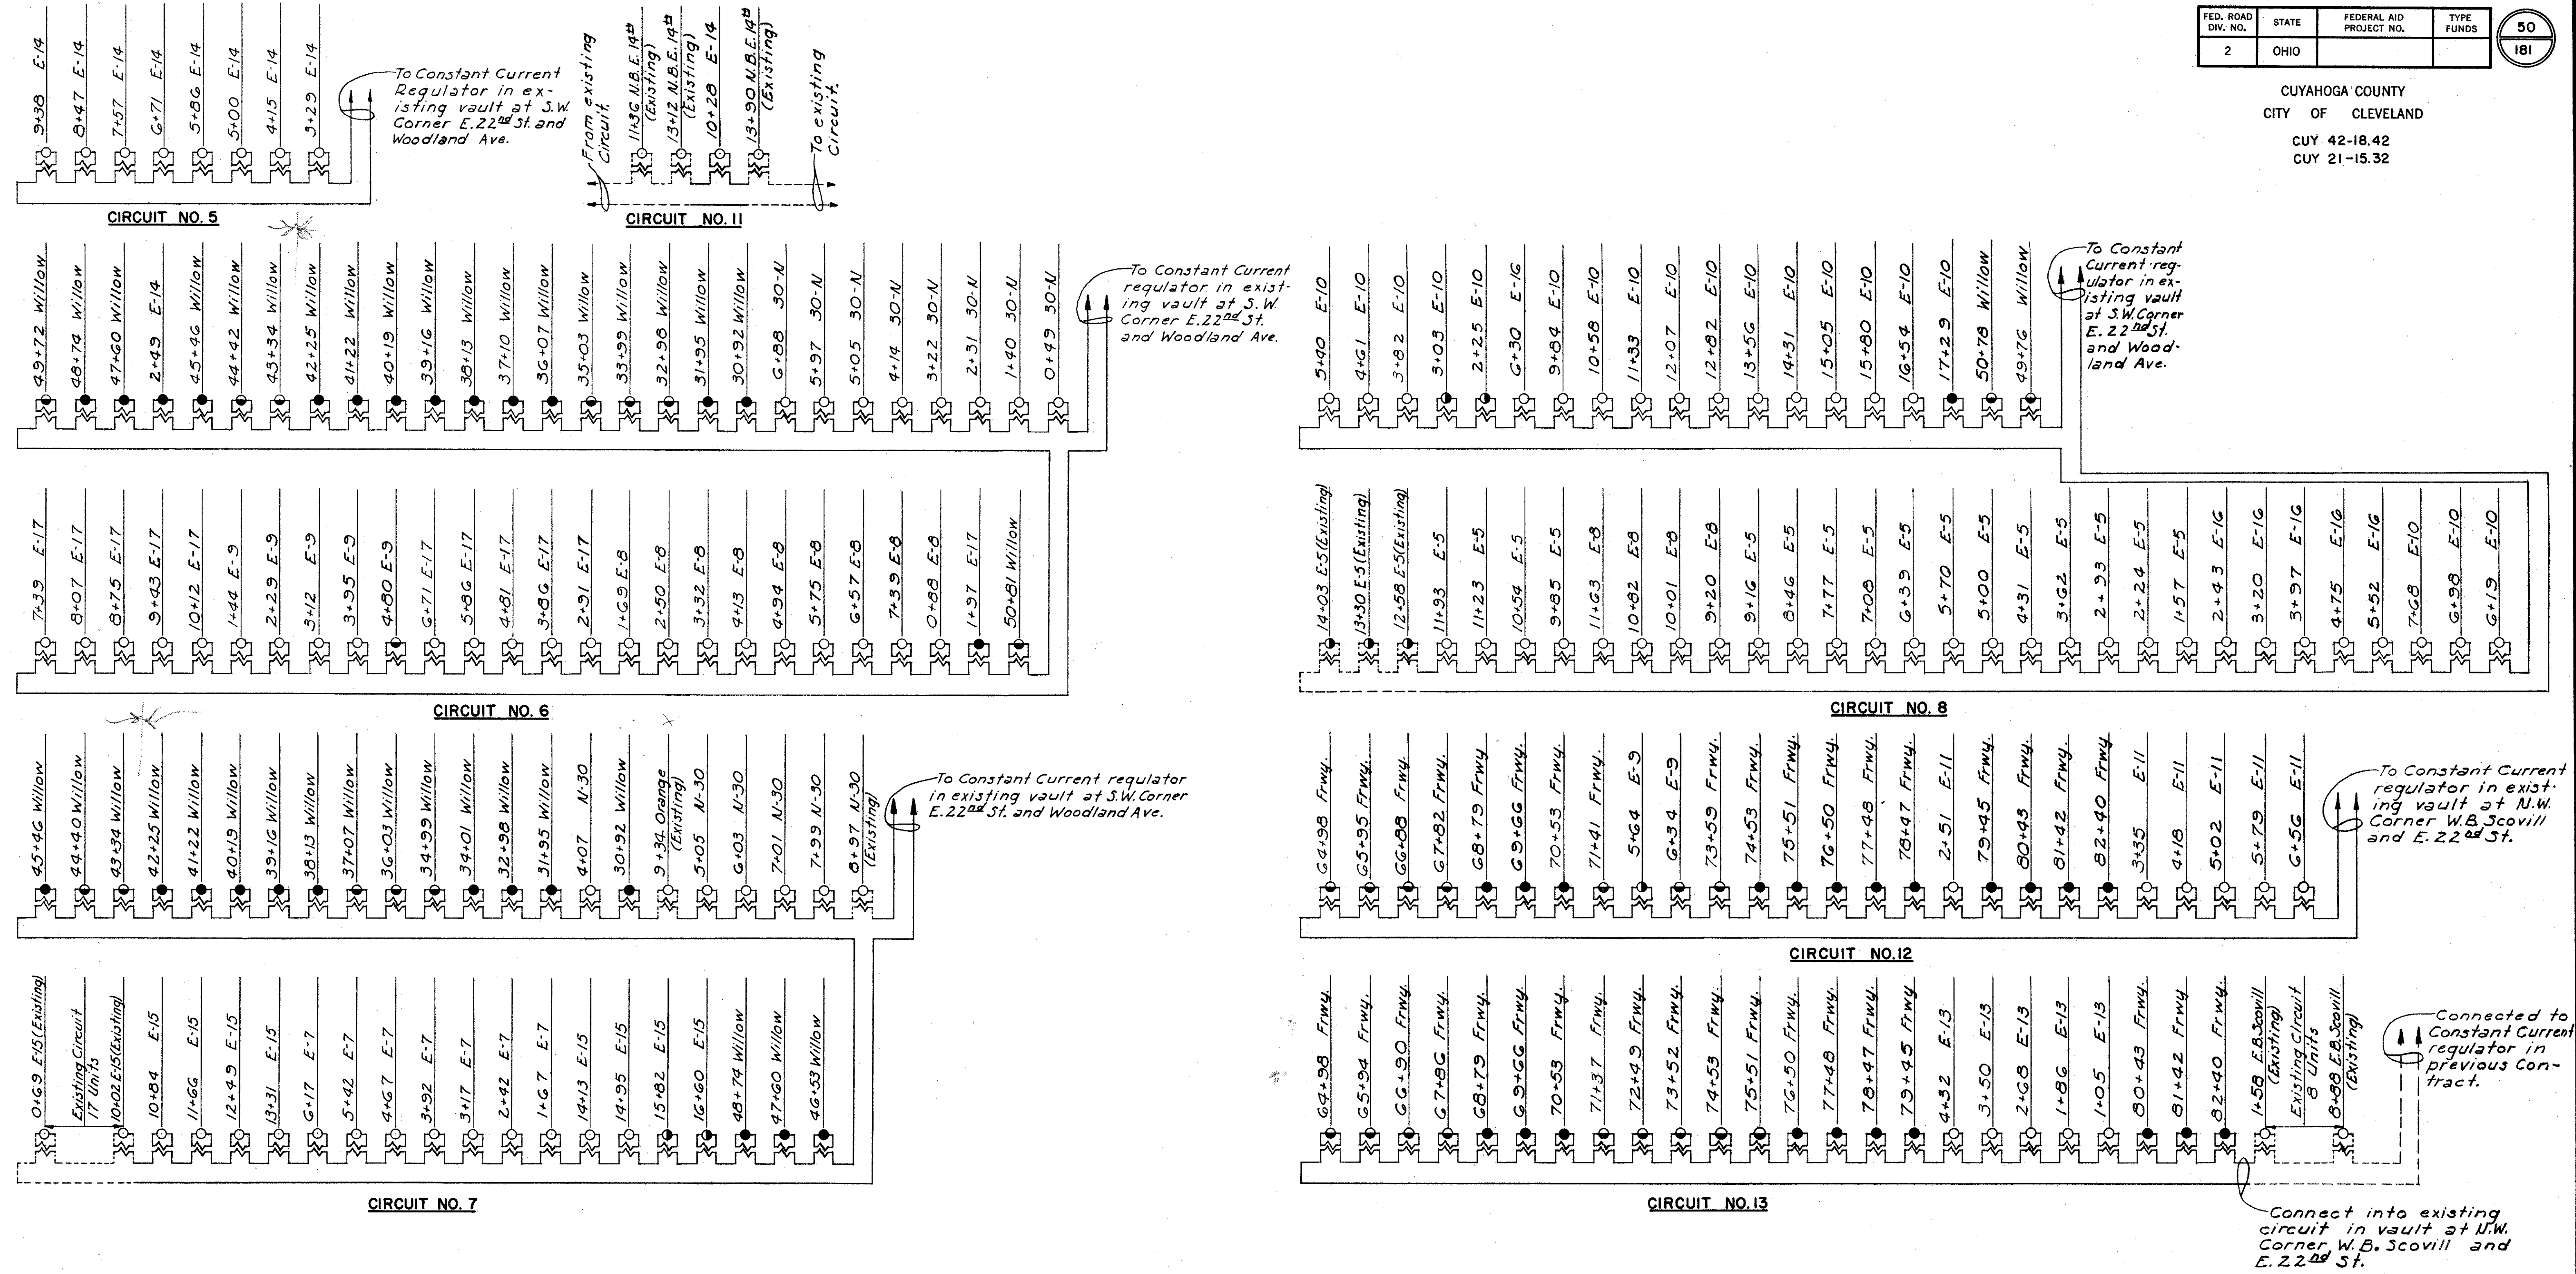


Note: Where Contractor connects with existing ducts, provide coupling and install wiring to next lighting unit.


CUYAHOGA COUNTY
CITY OF CLEVELAND
CUY-42-18.42
CUY-21-15.32
UNDERDECK LIGHTING

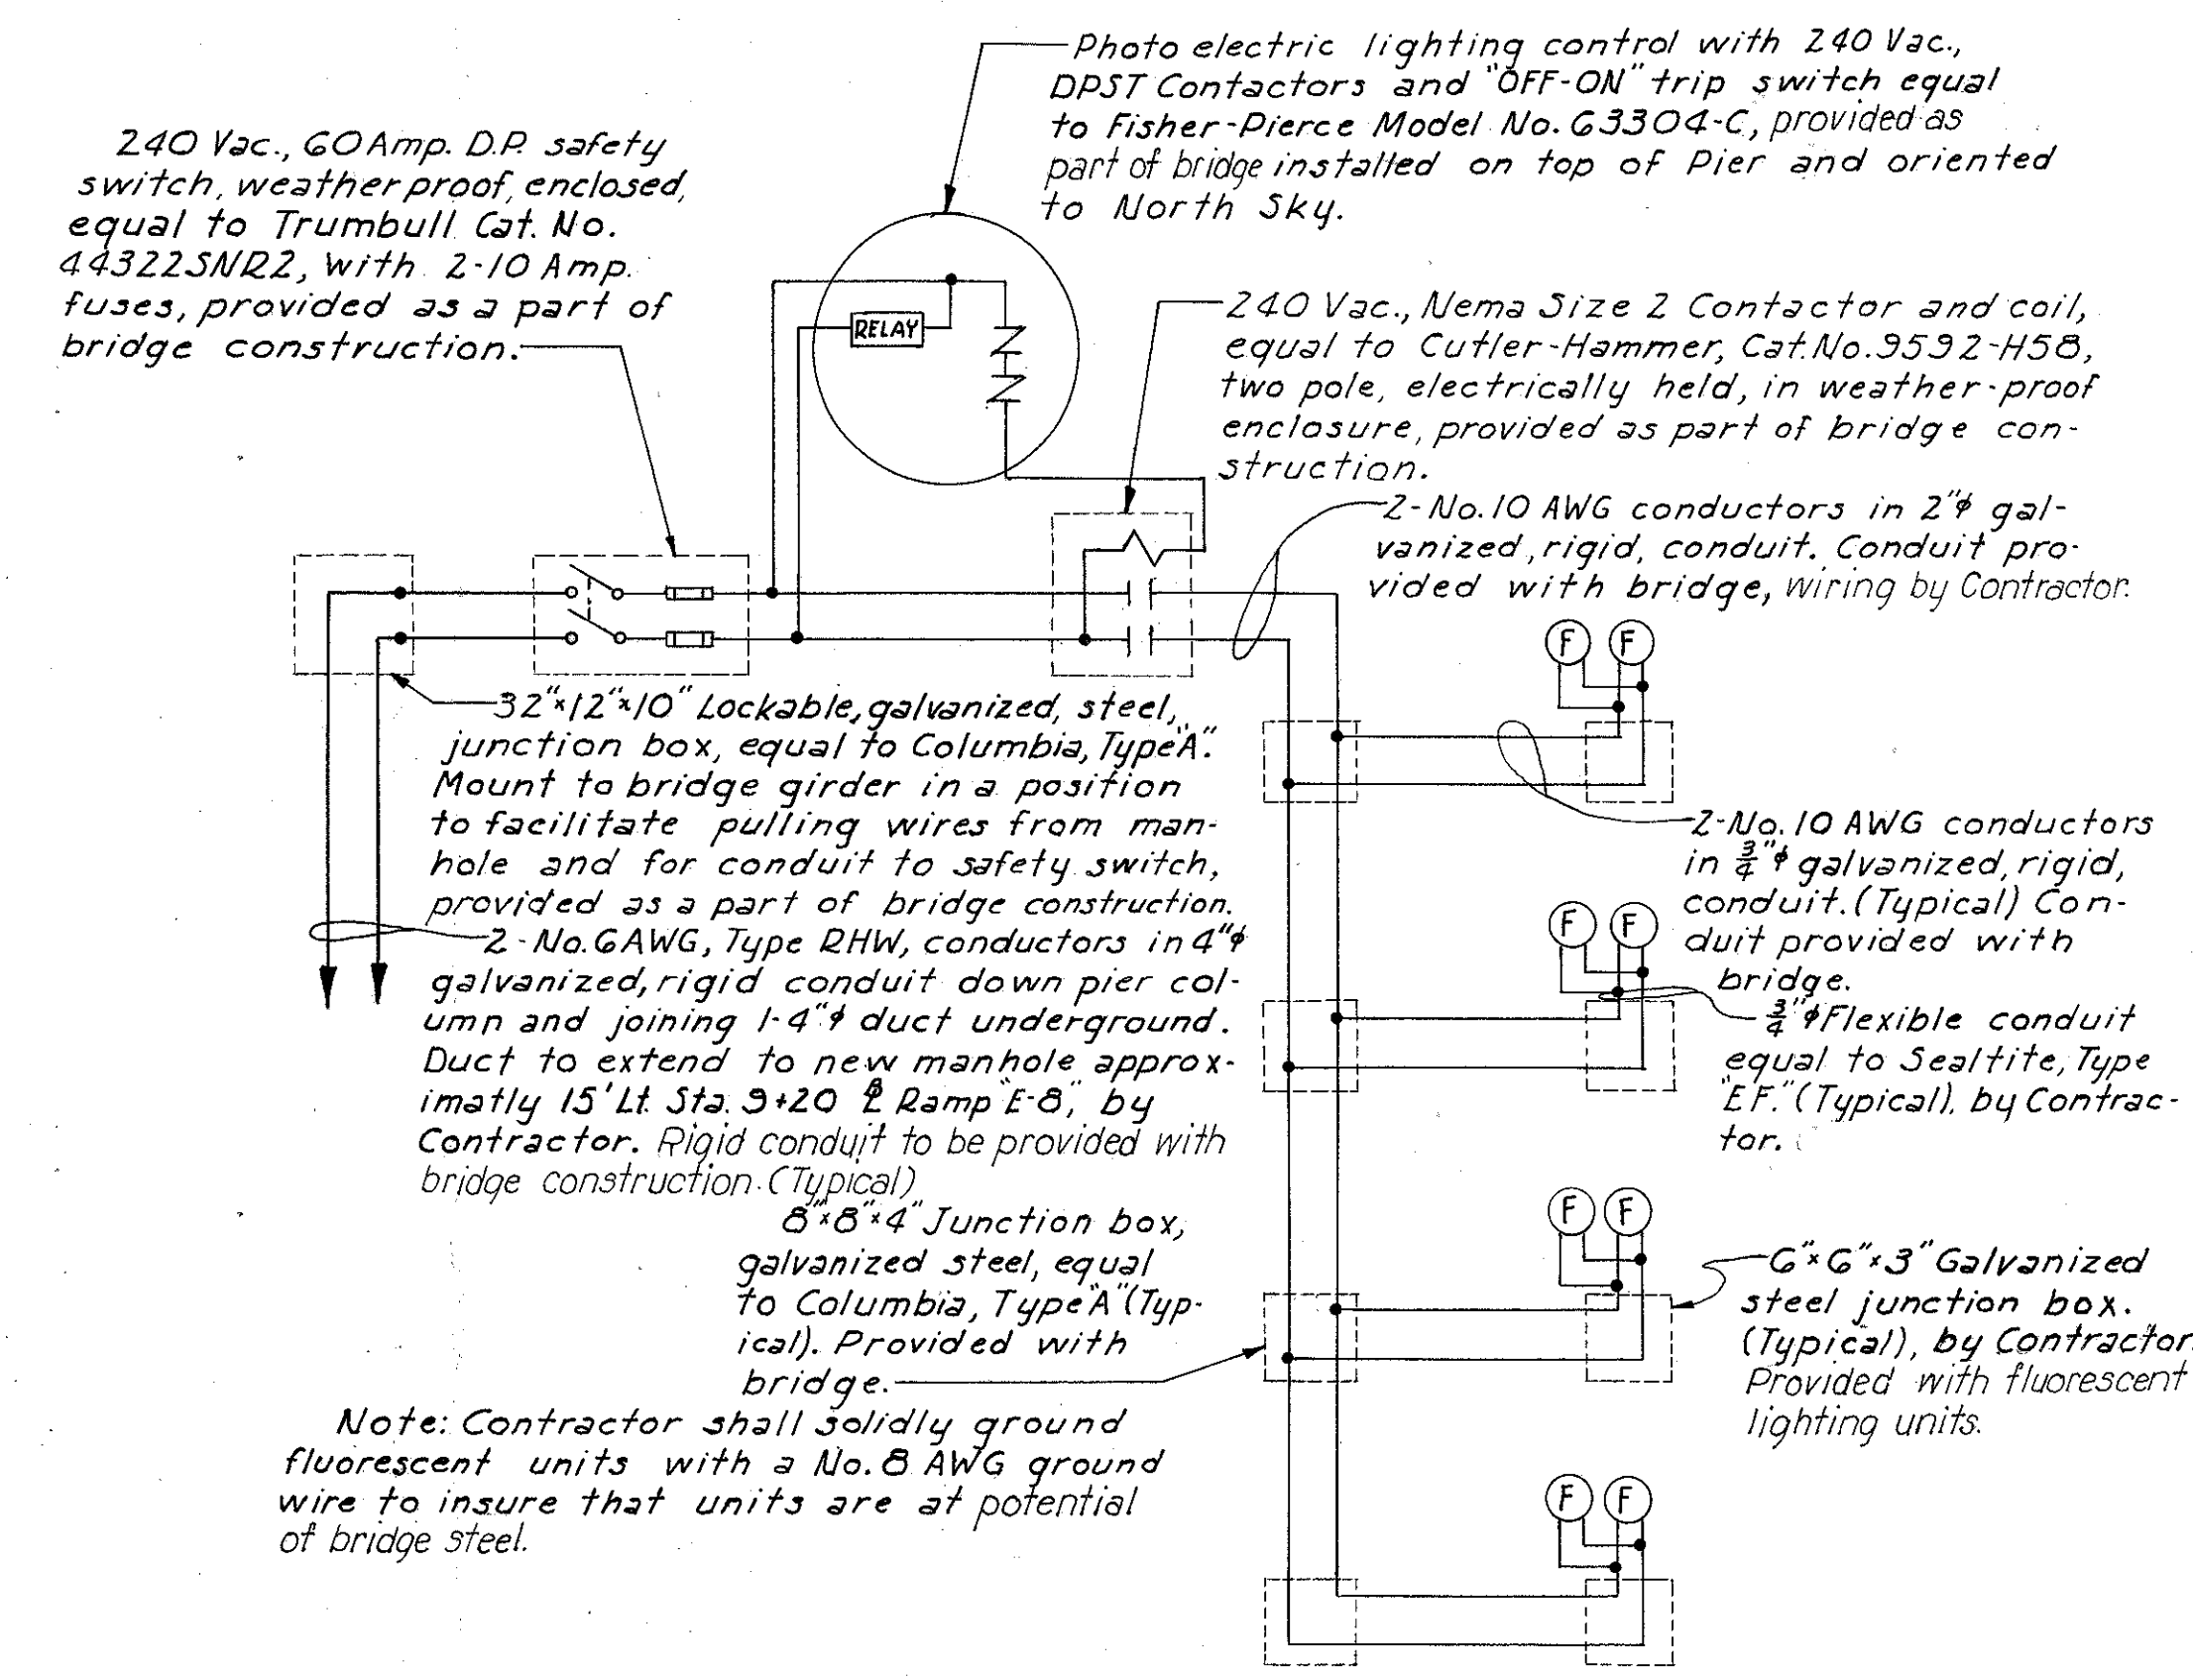


BRIDGE NO. 3 UNDERDECK LIGHTING
WIRING DIAGRAM
No Scale

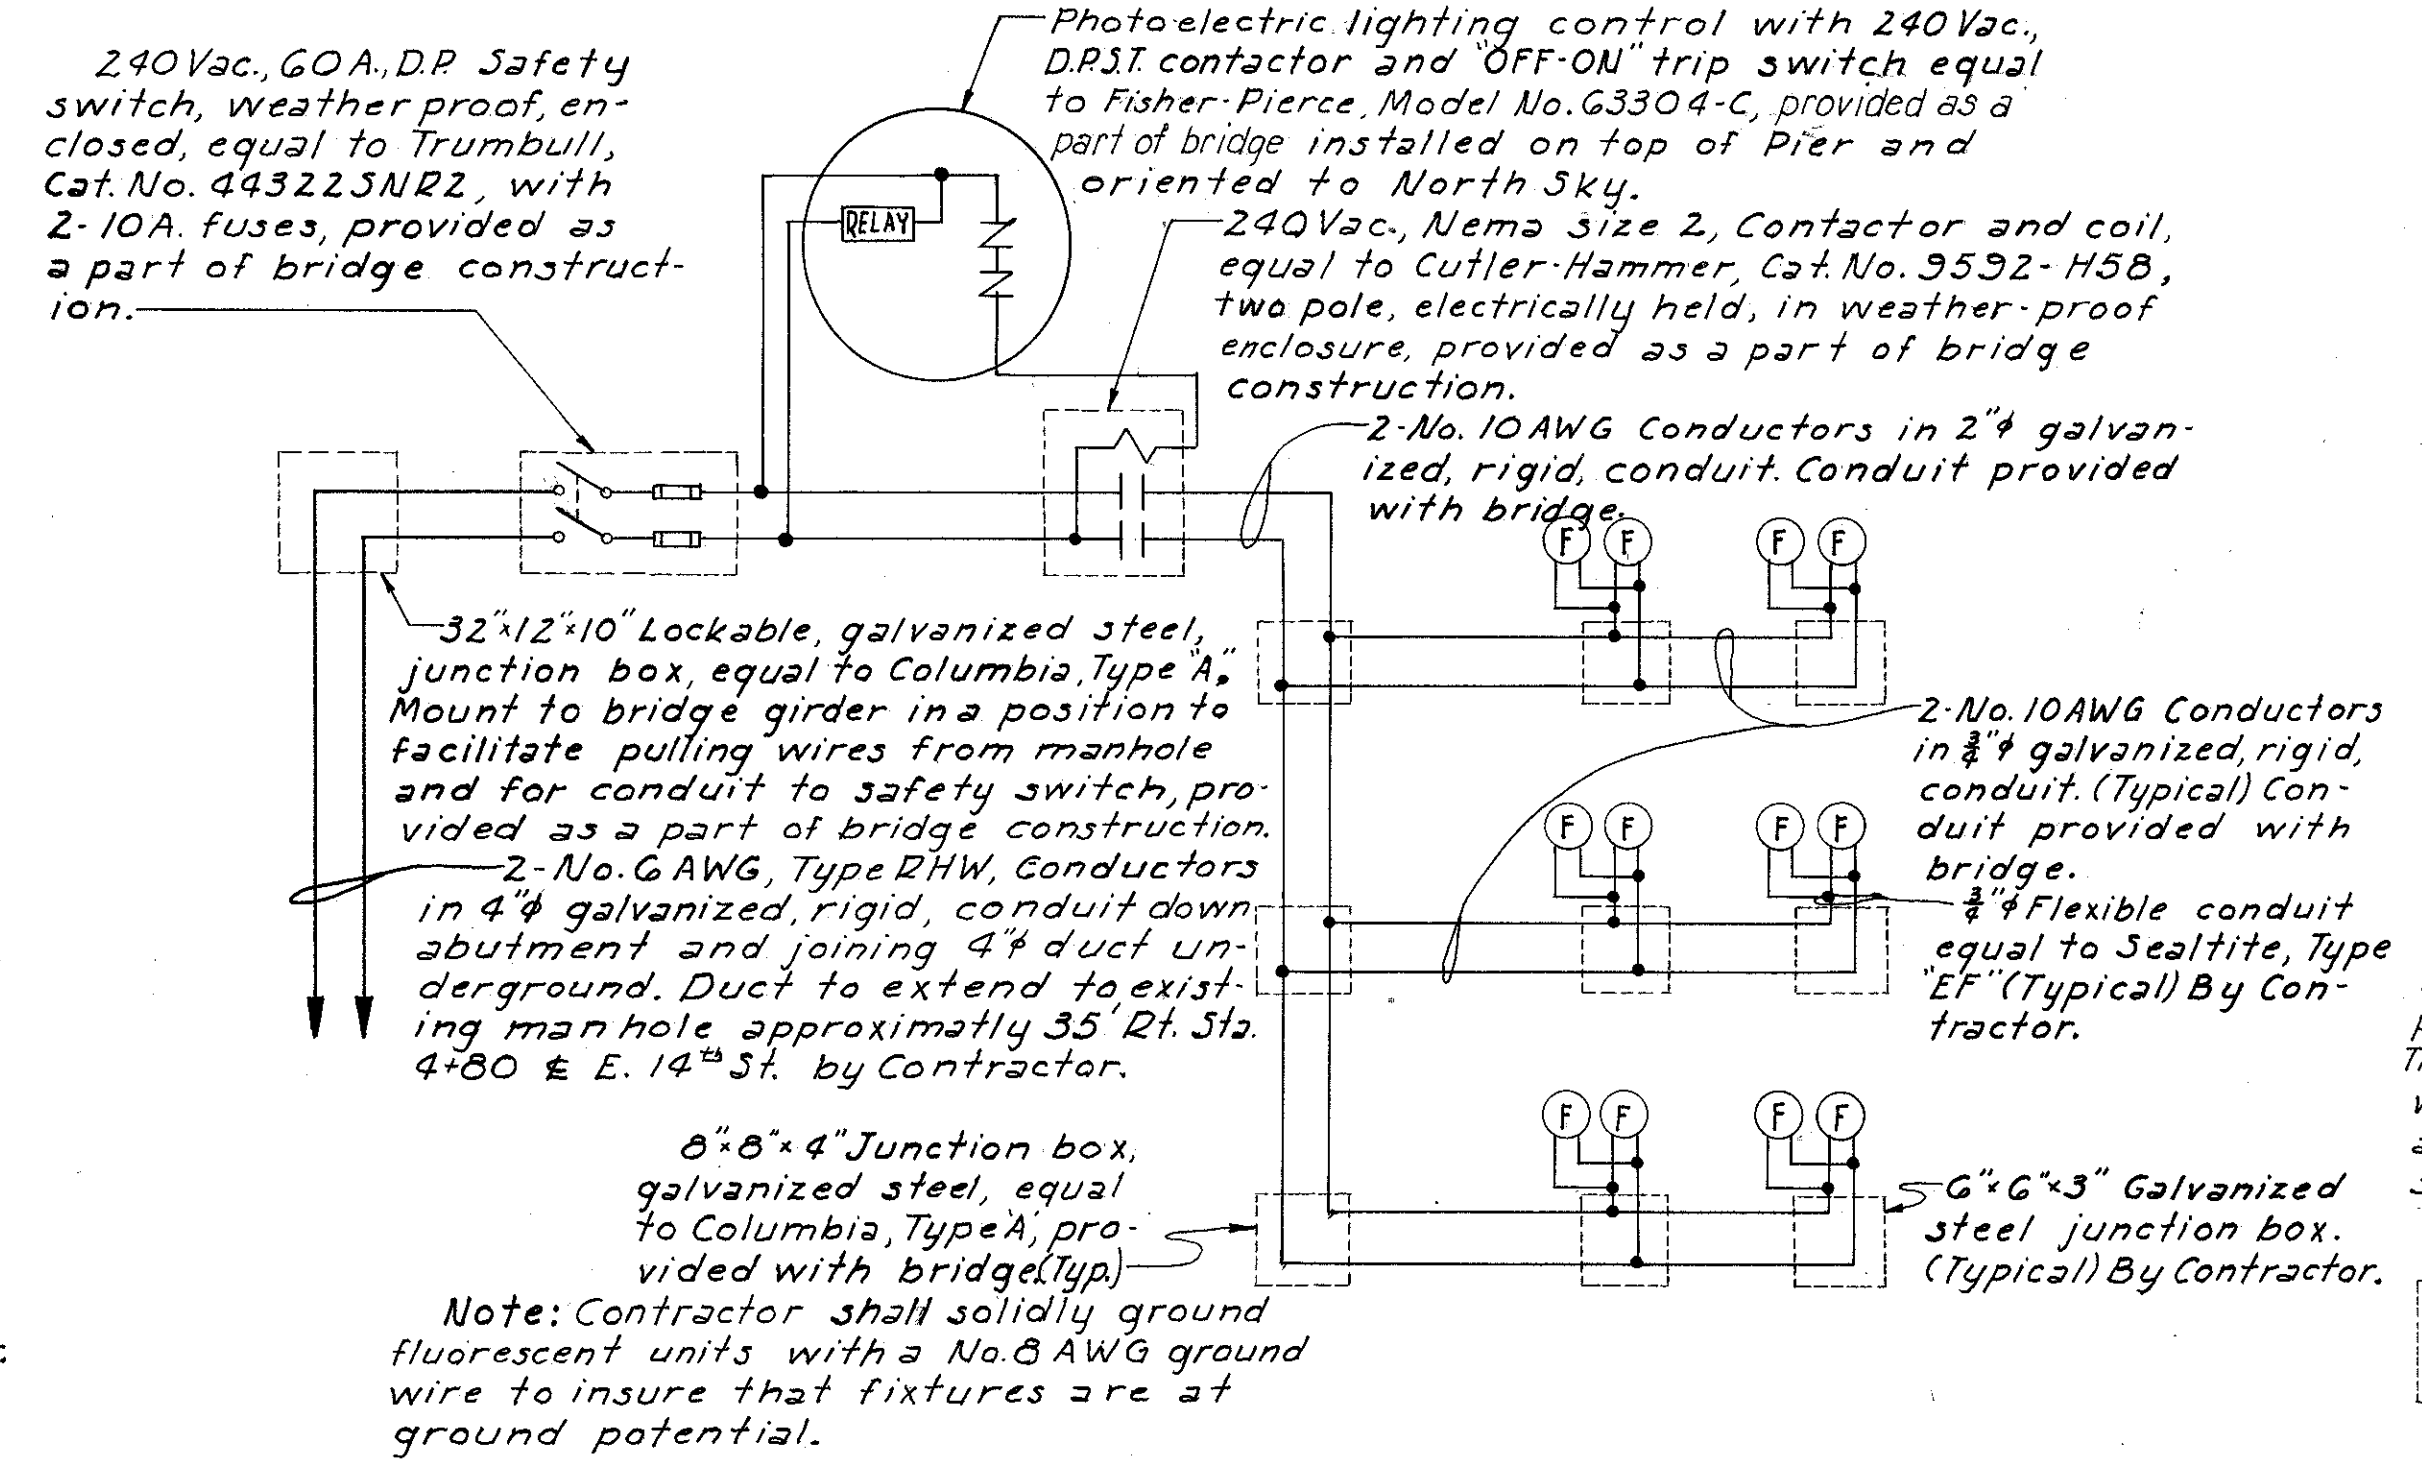


BRIDGE NO. 8&9 UNDERDECK LIGHTING
WIRING DIAGRAM
No Scale

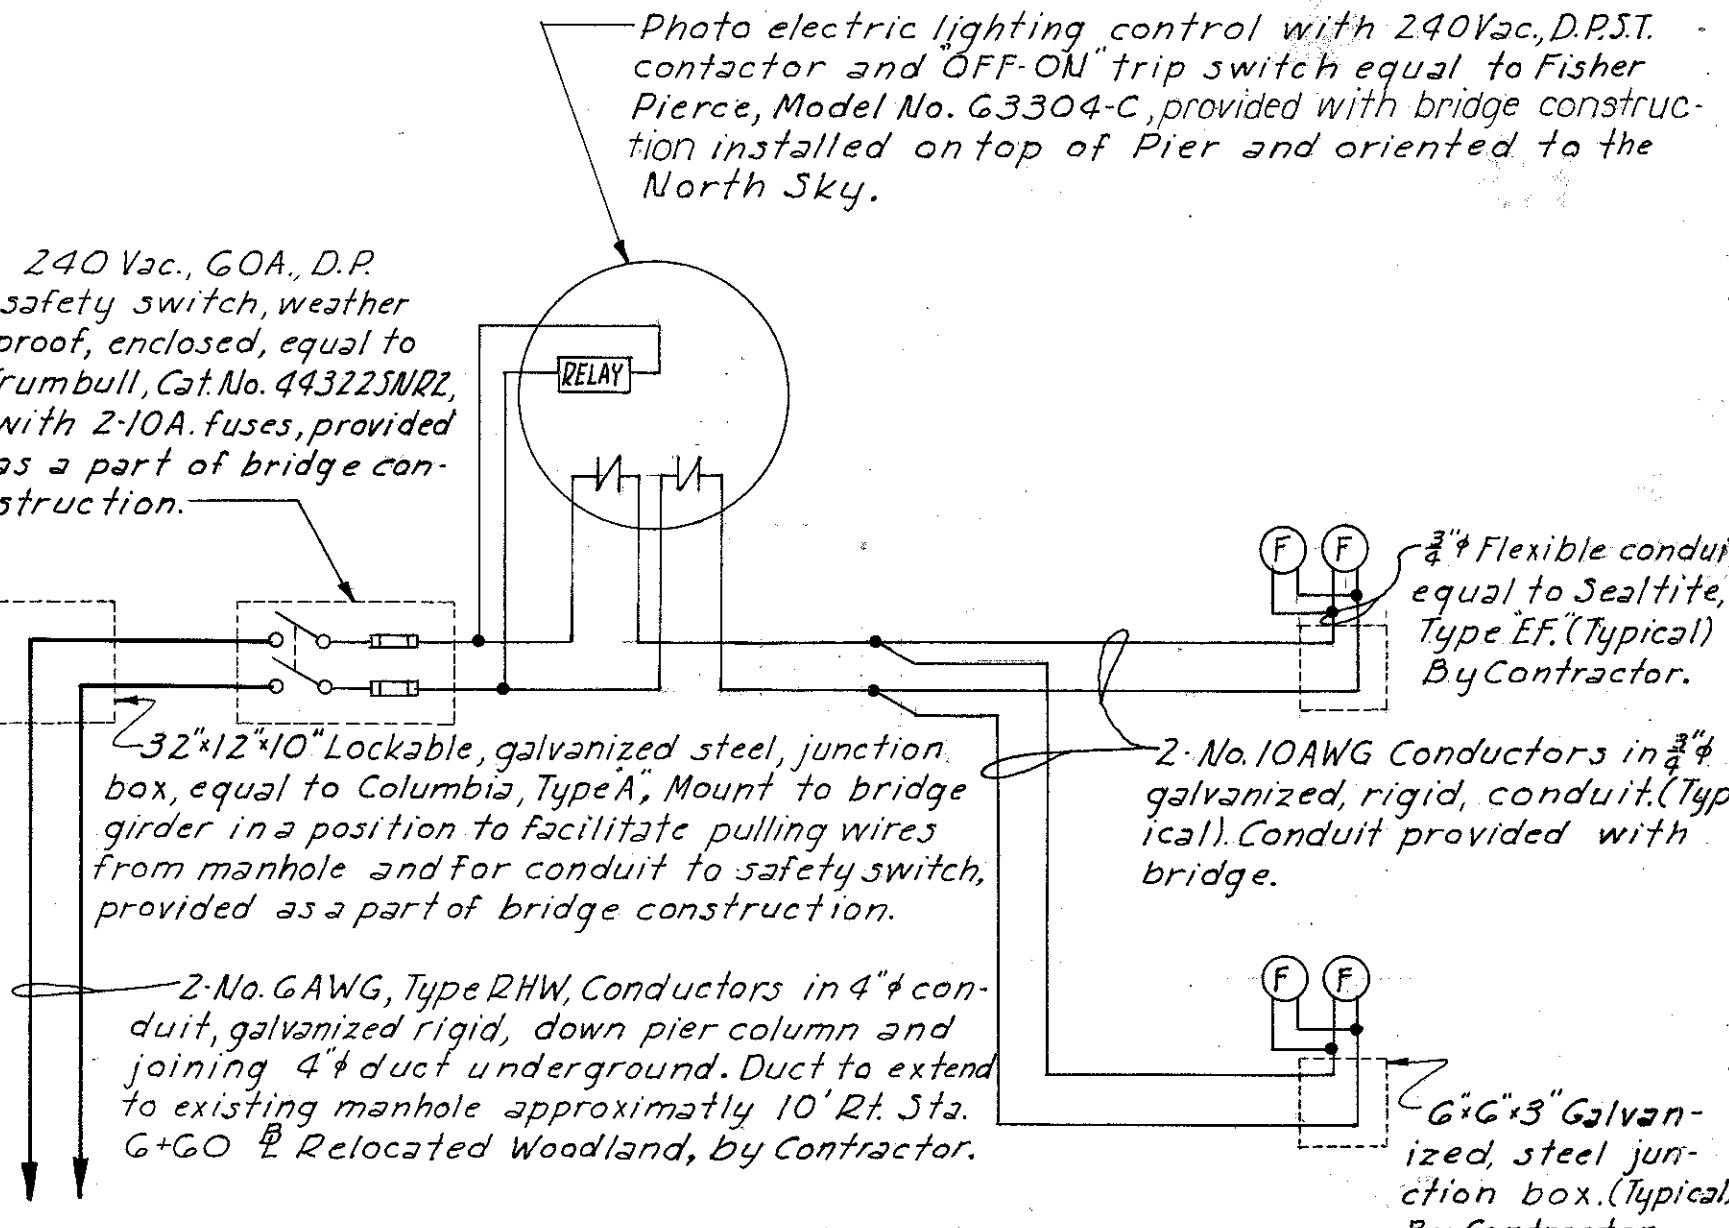

BRIDGE NO. 11 UNDERDECK LIGHTING
WIRING DIAGRAM
No Scale

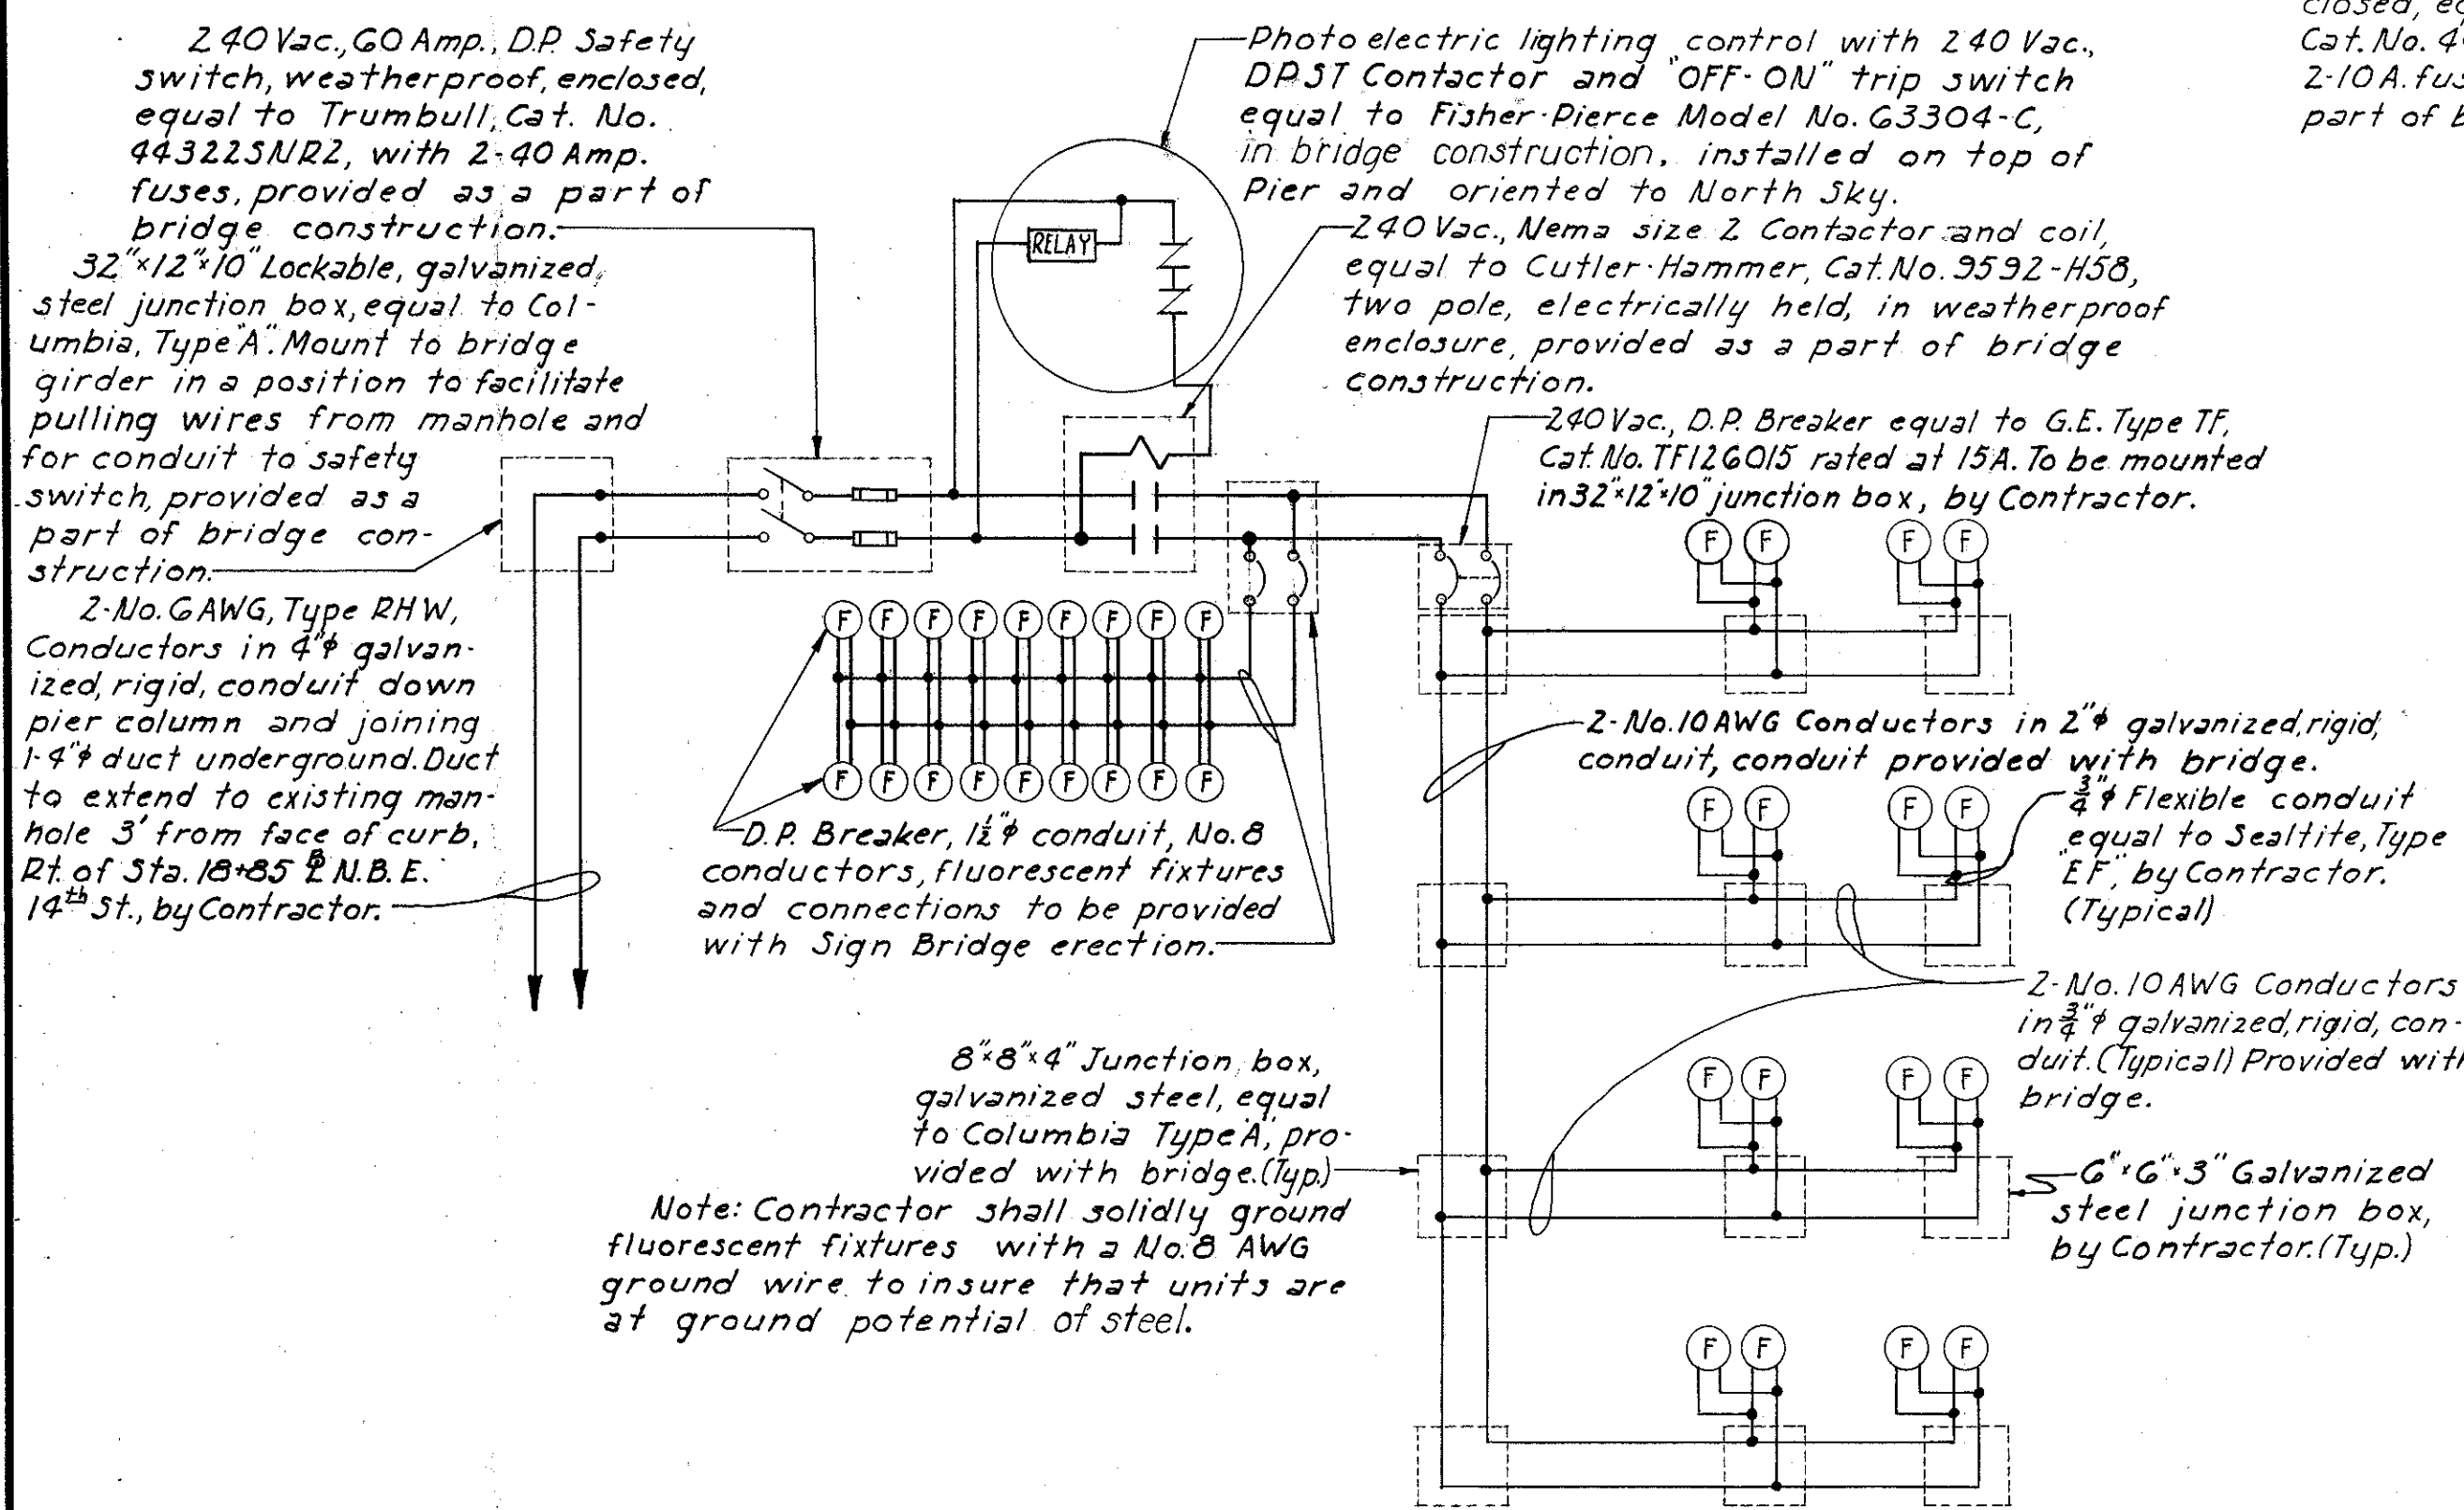








BRIDGE NO. 4 UNDERDECK LIGHTING
WIRING DIAGRAM
No Scale

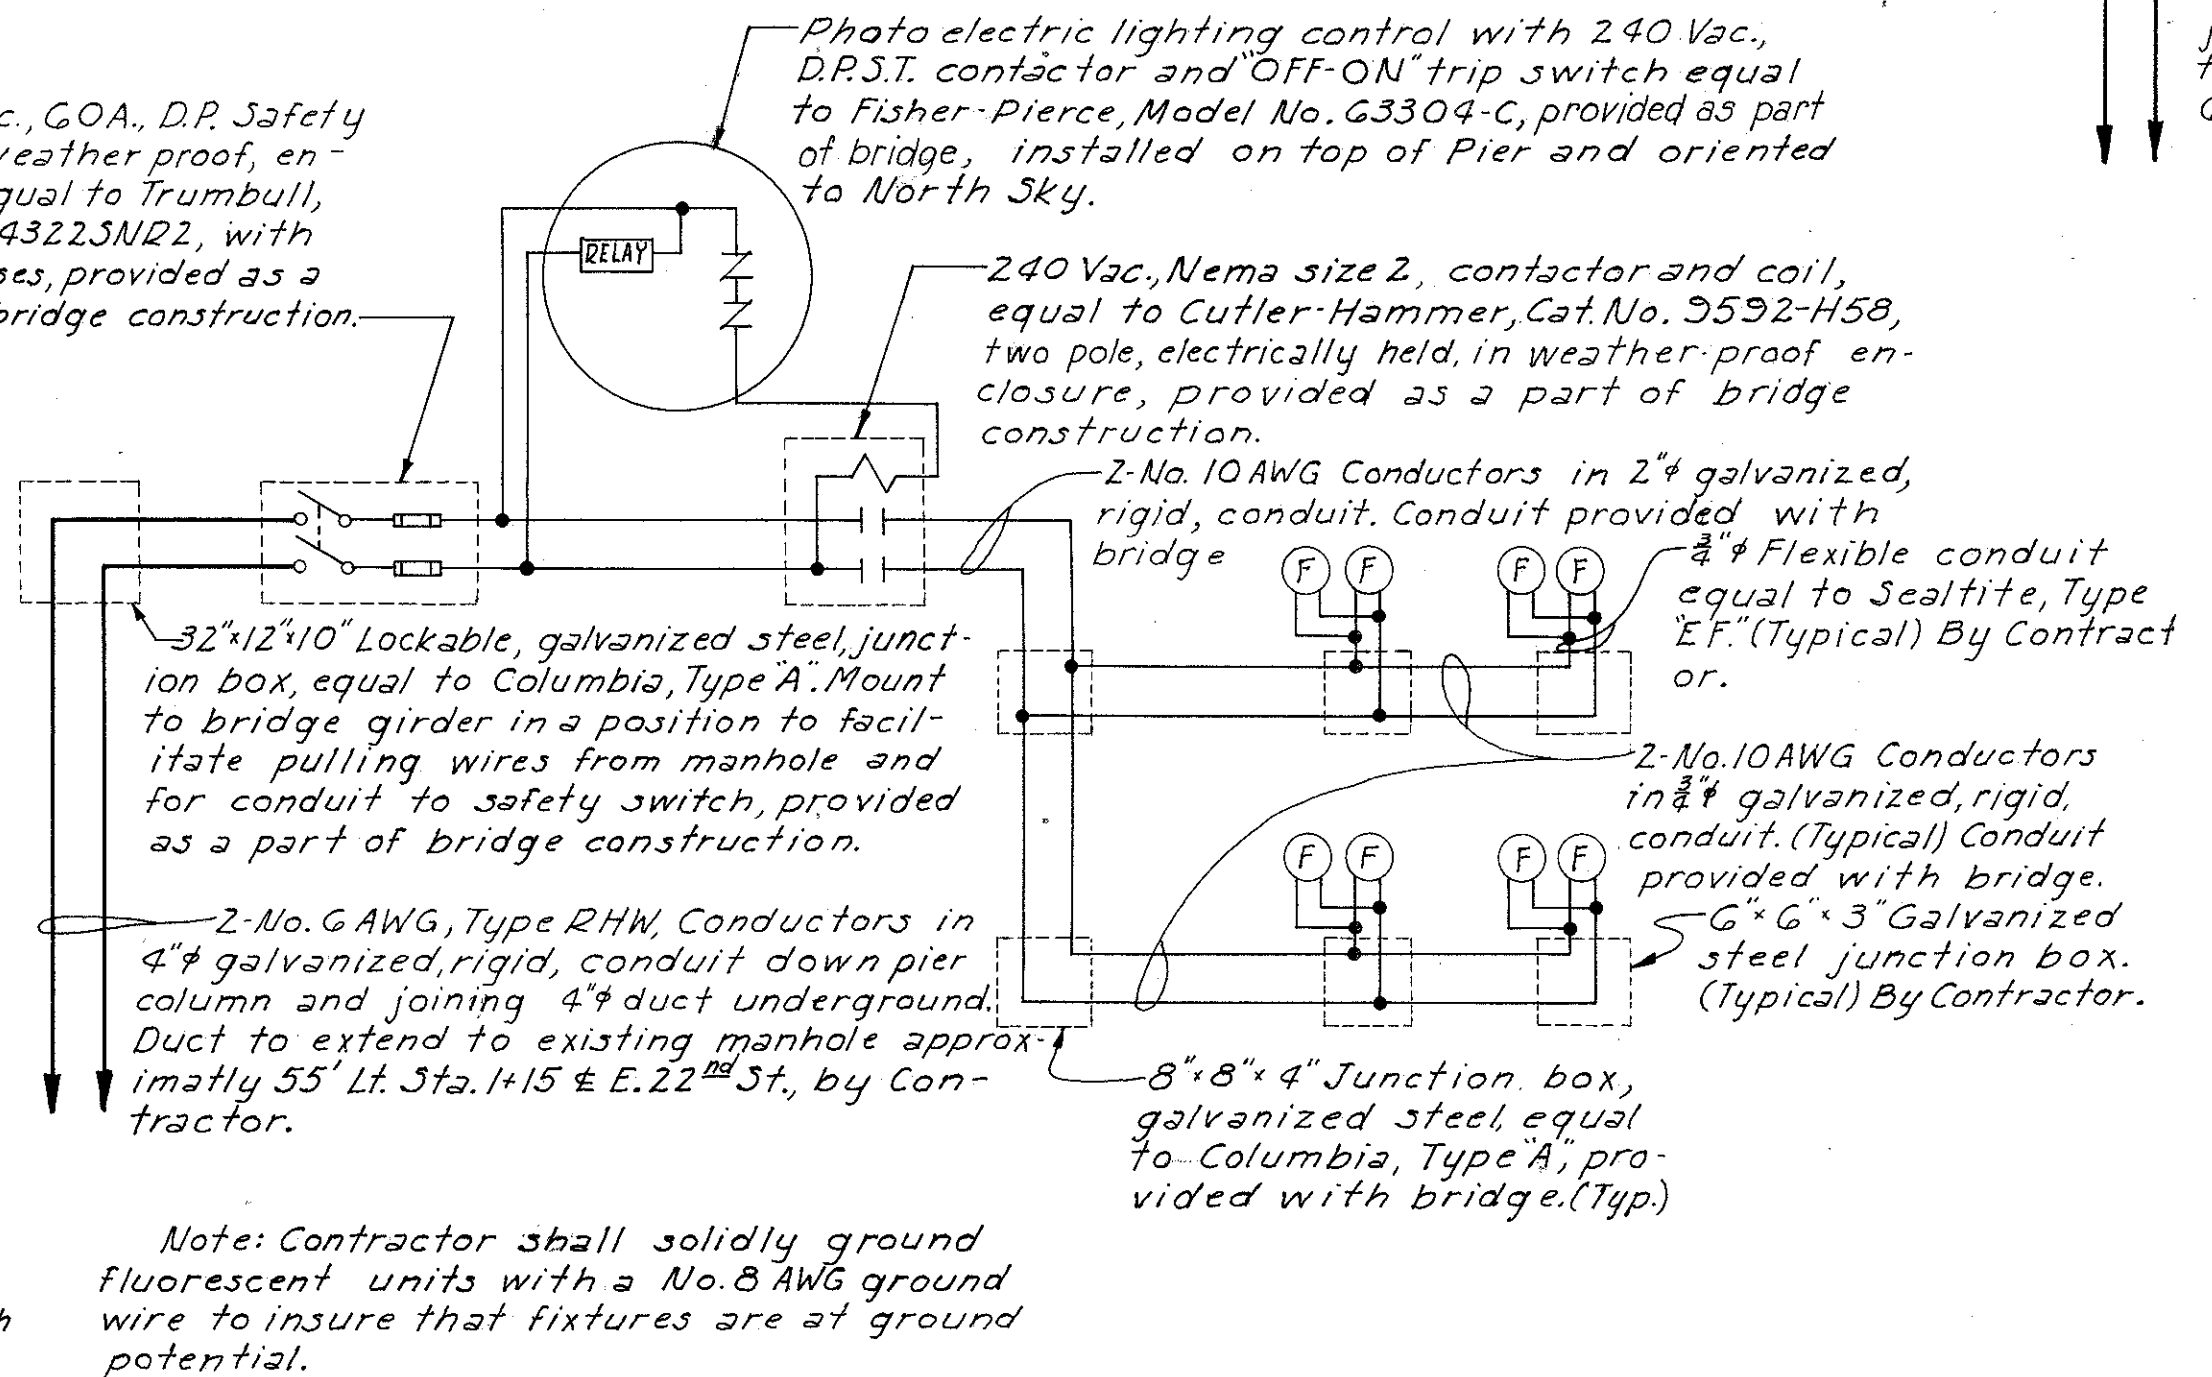


BRIDGE NO. 10 UNDERDECK LIGHTING
WIRING DIAGRAM
No Scale

CUYAHOGA COUNTY
CITY OF CLEVELAND
CUY - 42 - 18.42
CUY - 21 - 15.32

Appropriate handles to be installed in each half cover for lifting. After use handle should slip into holes and be flush with surface of cover.

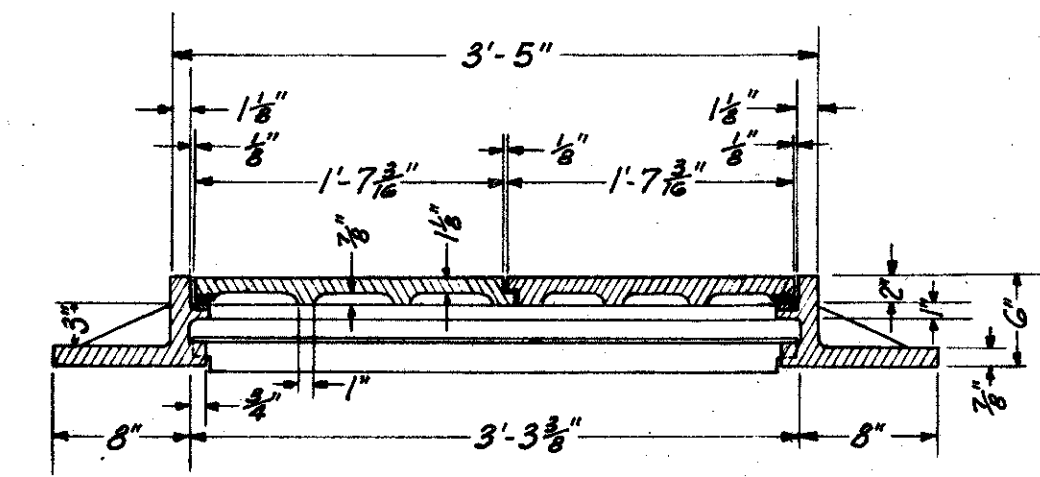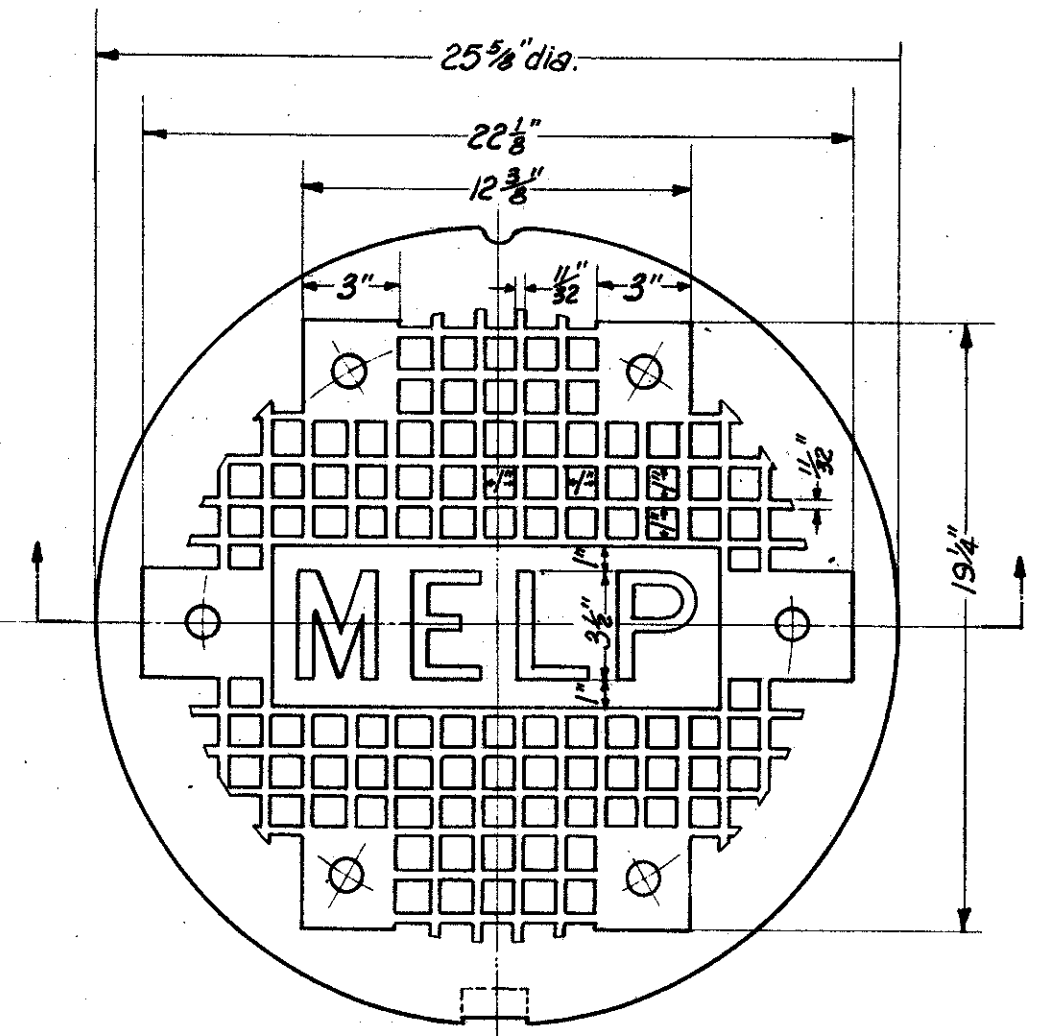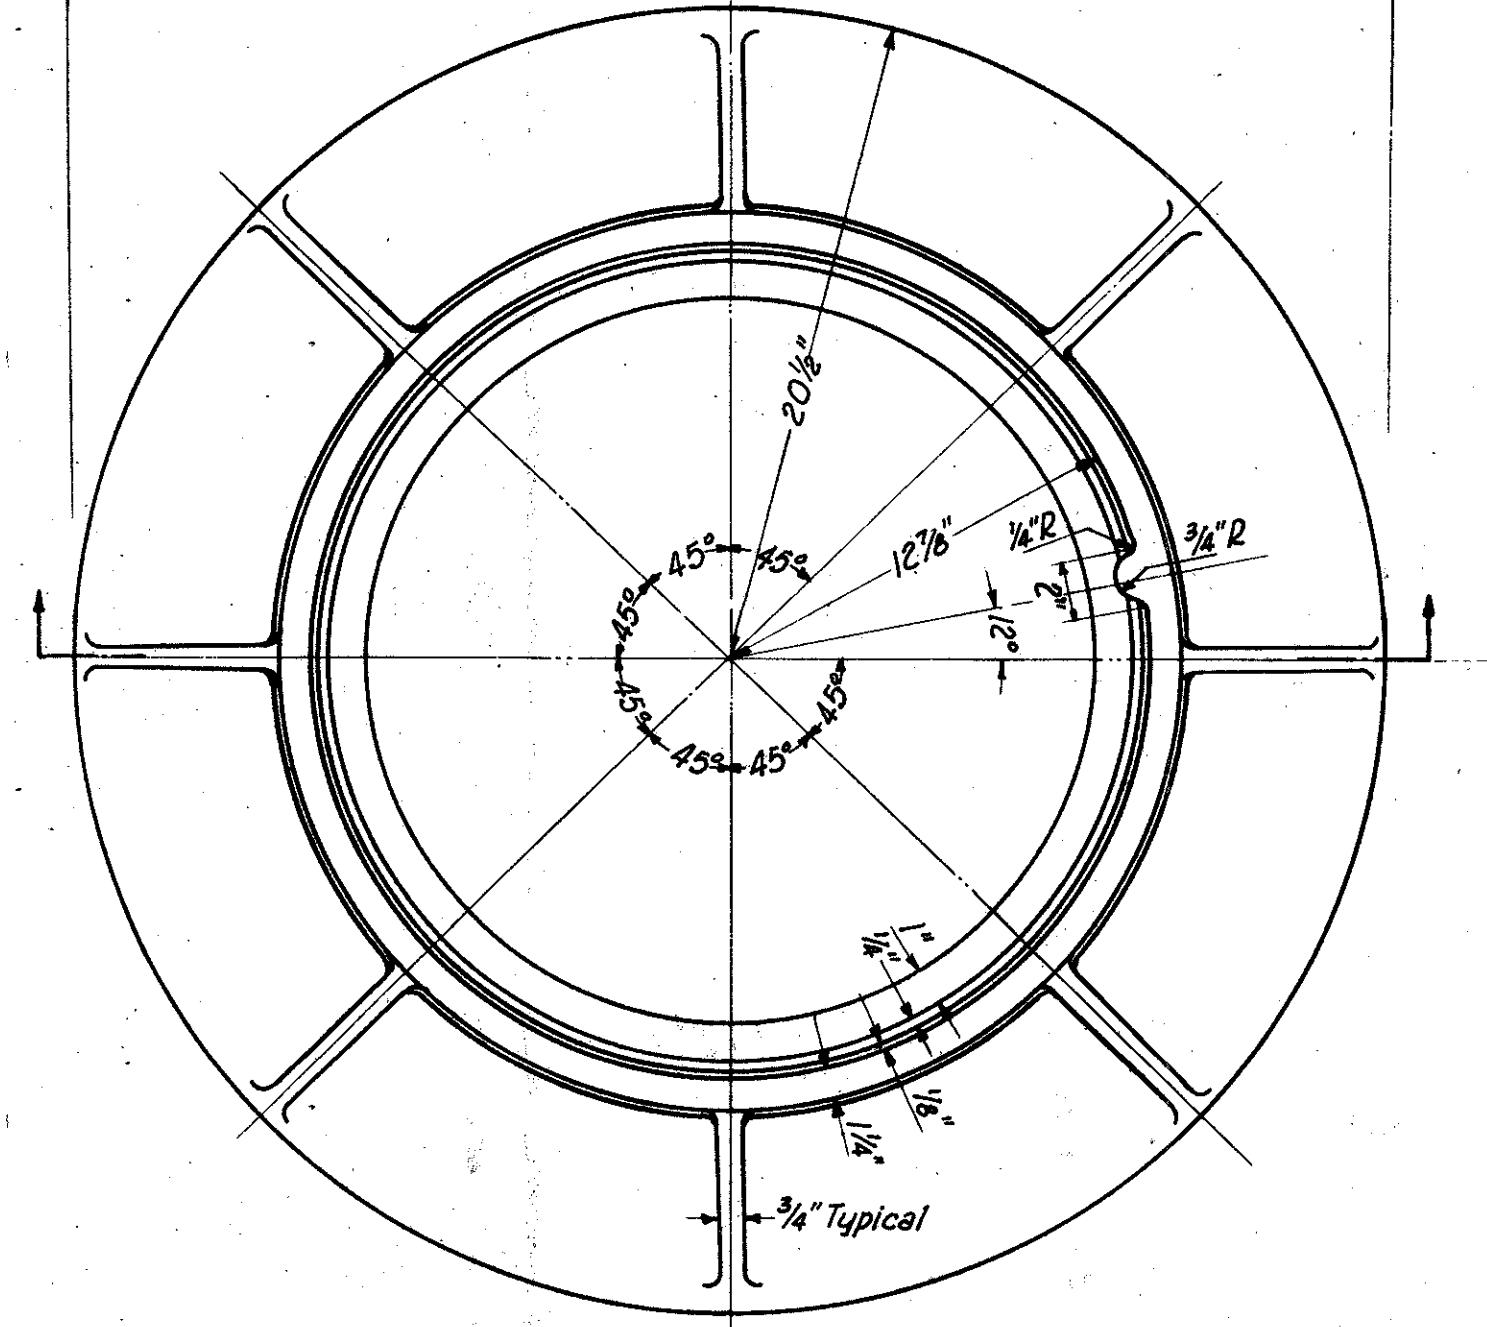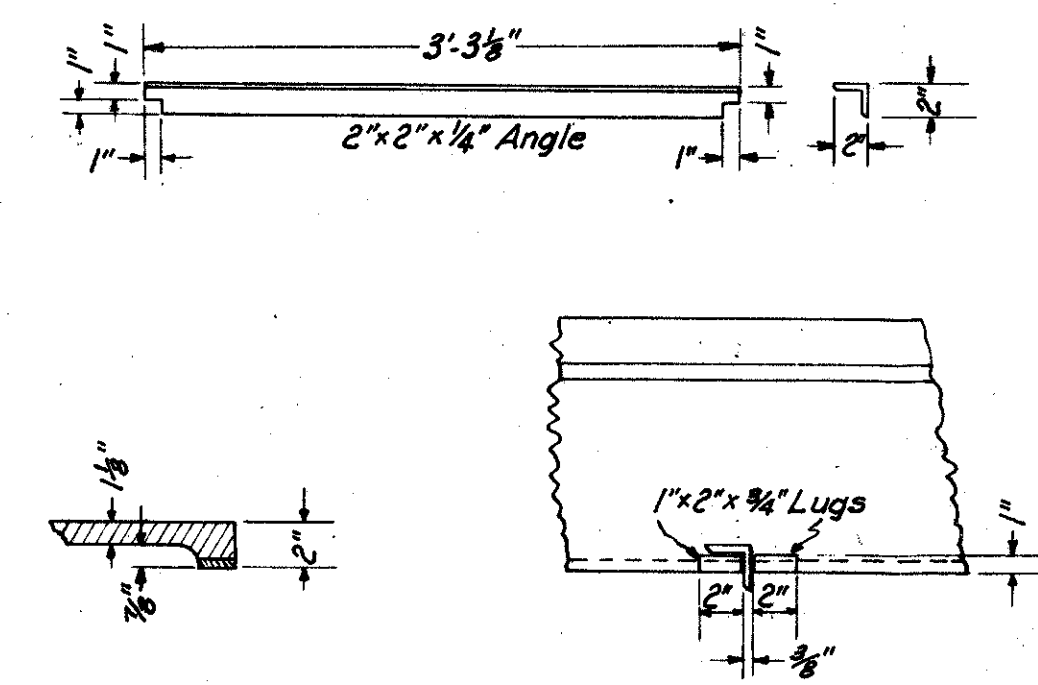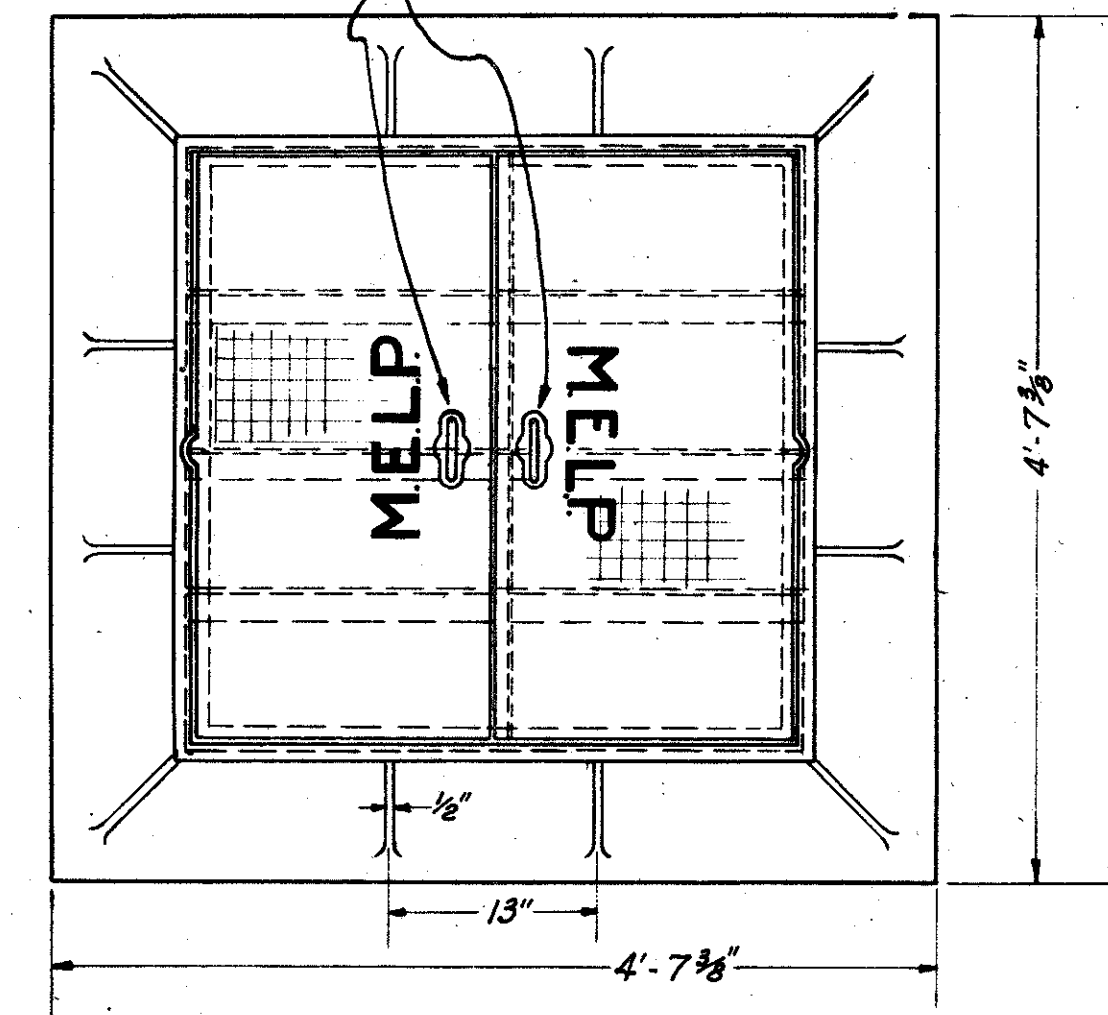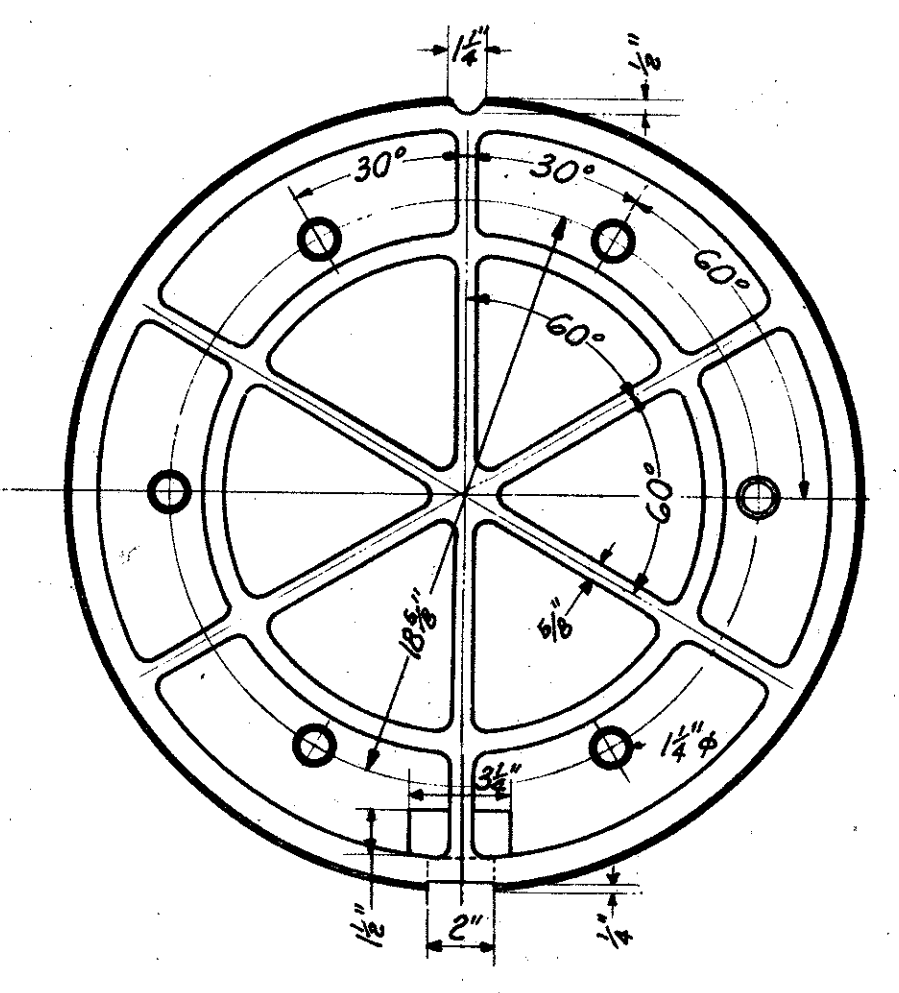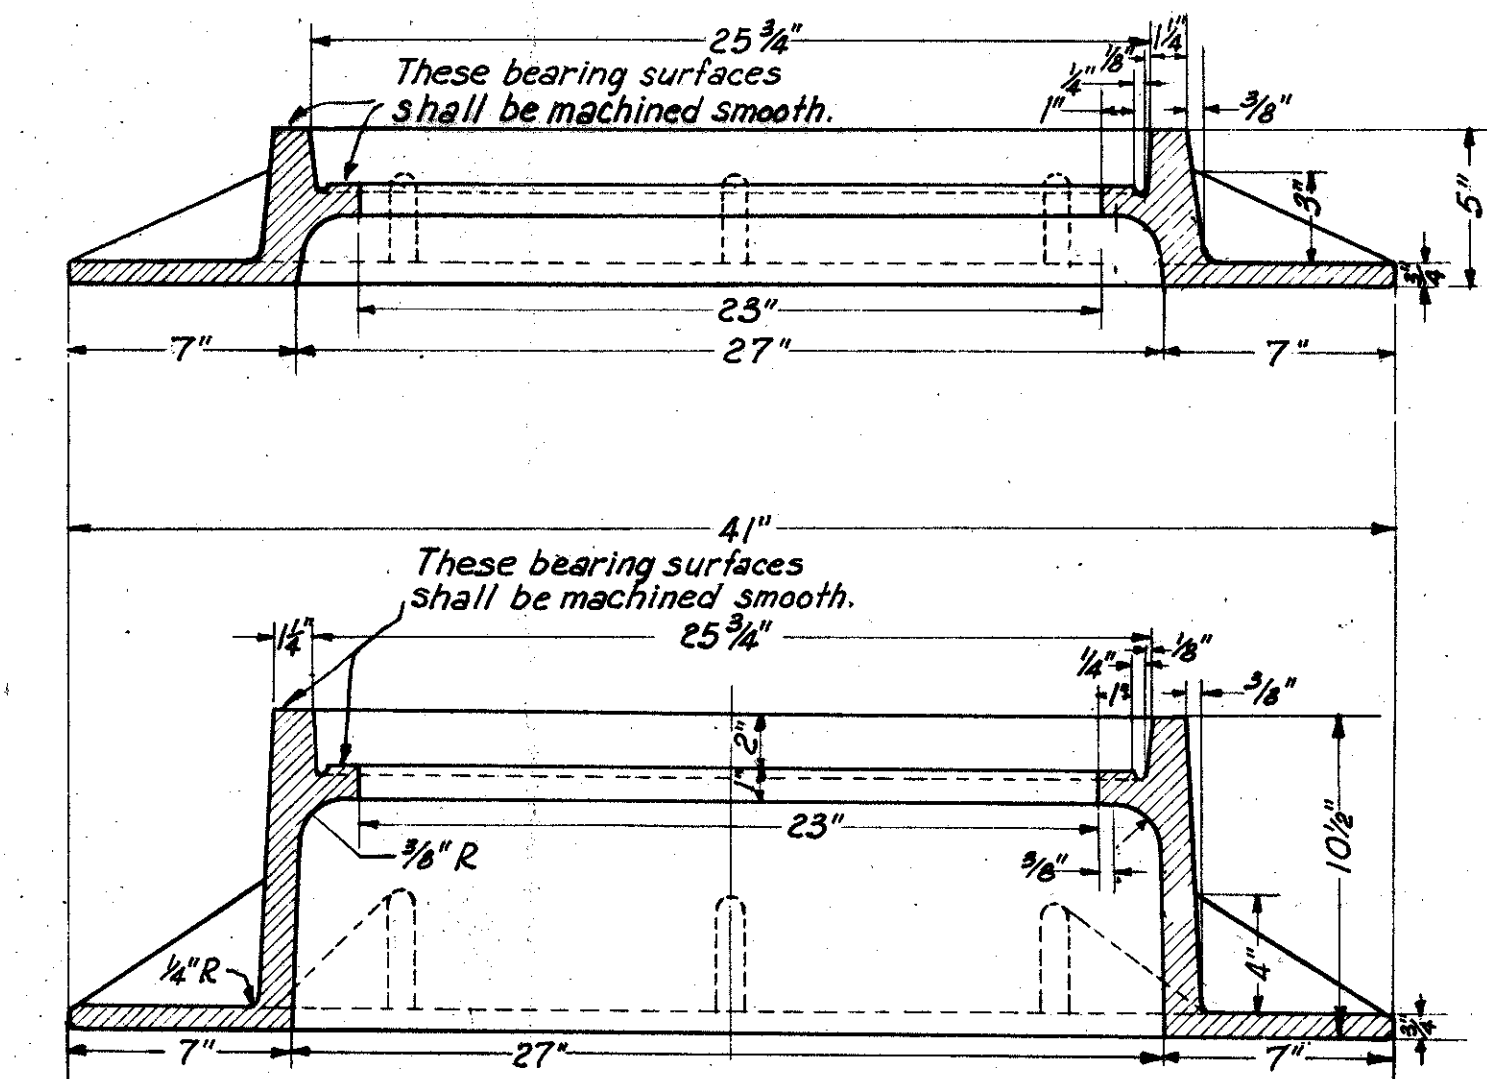


Weight
Street Type Square Manhole Casting Without Cover 700 lbs.
Sidewalk Type Square Manhole Casting Without Cover 450 lbs.
Square Manhole Cover 250 lbs.

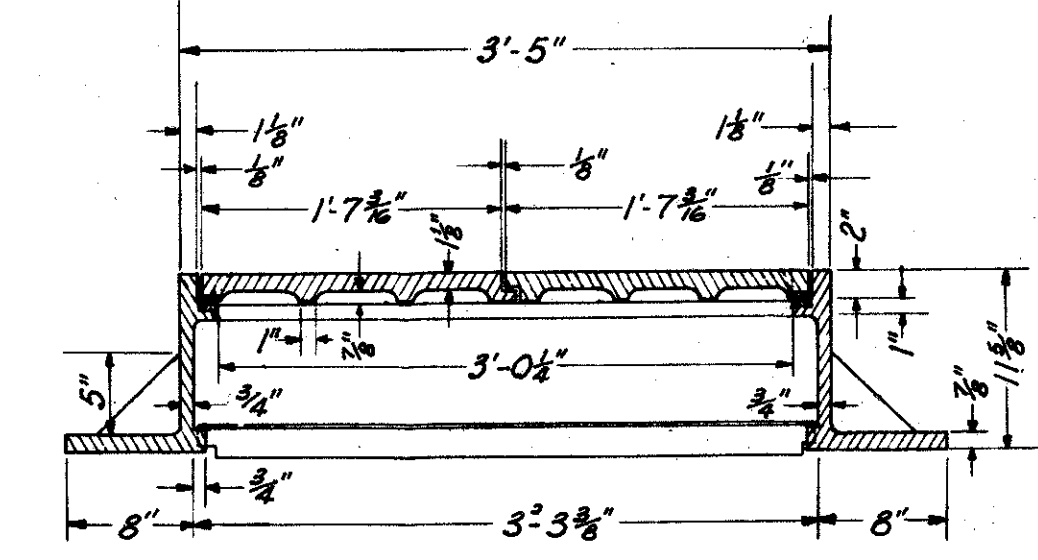

Scale: 1"=1'-0"


Scale: 2"=1'-0"

Weight of Frame 400 lbs min.

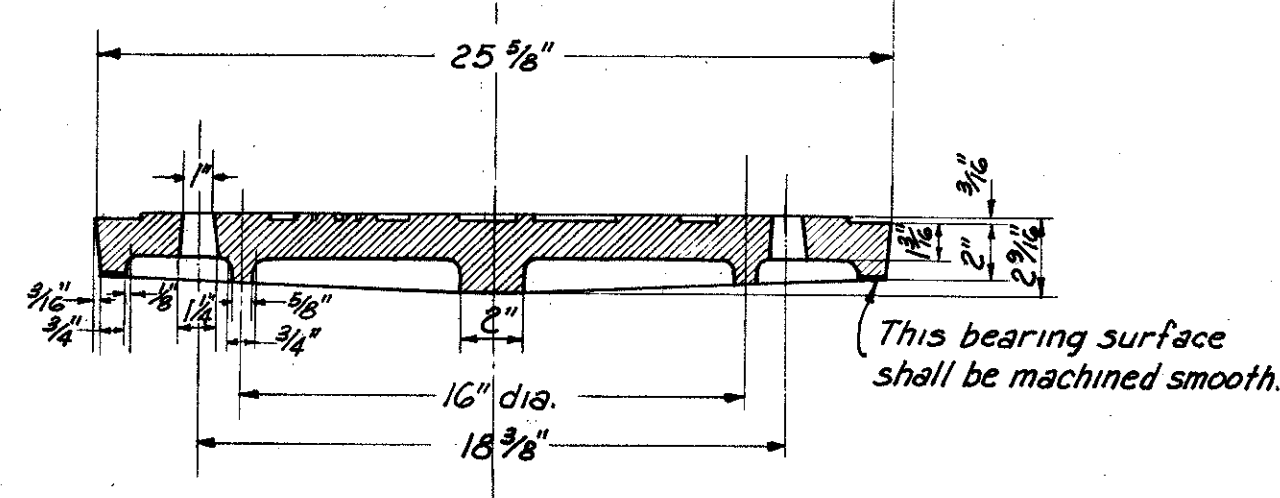


Scale: 2"=1'-0"

This bearing surface shall be machined smooth.

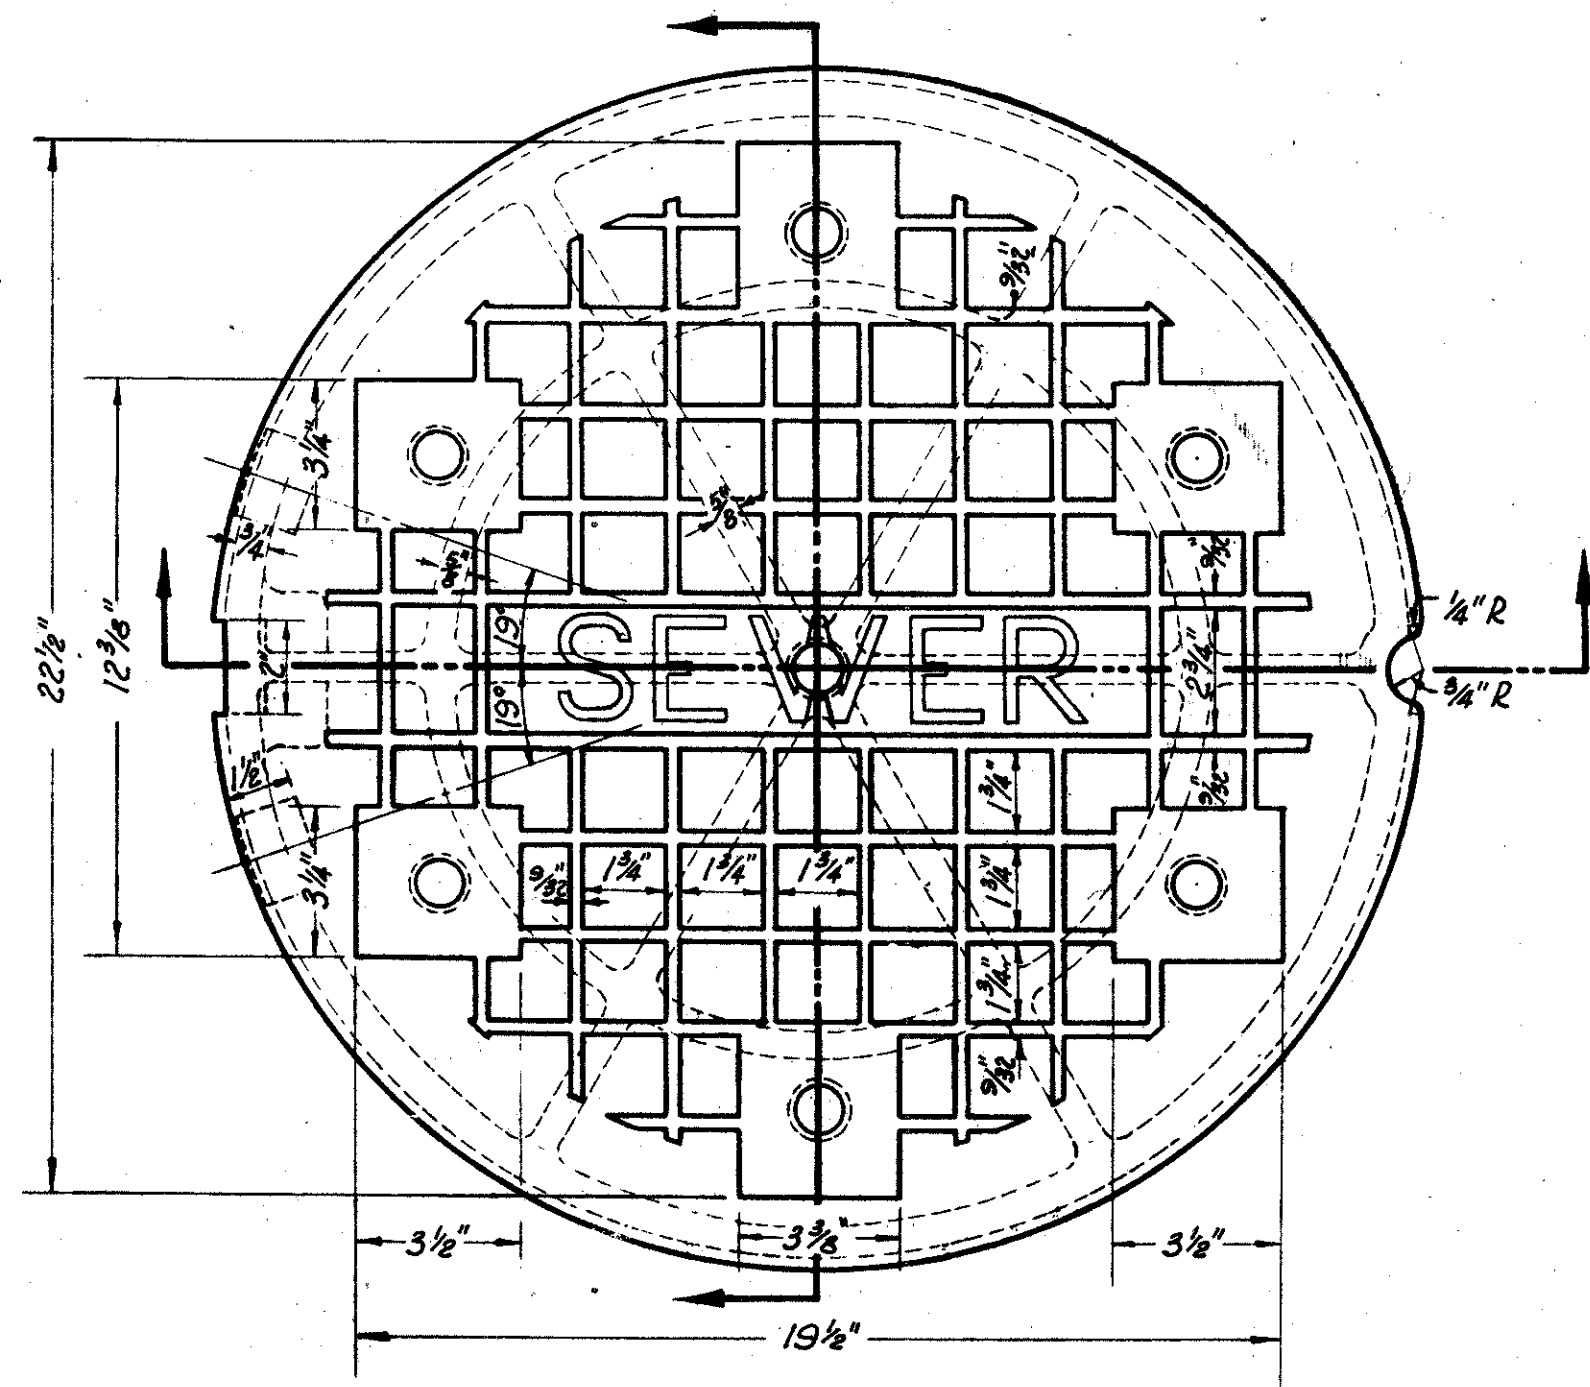

Weight of Cover 195 lbs. min.

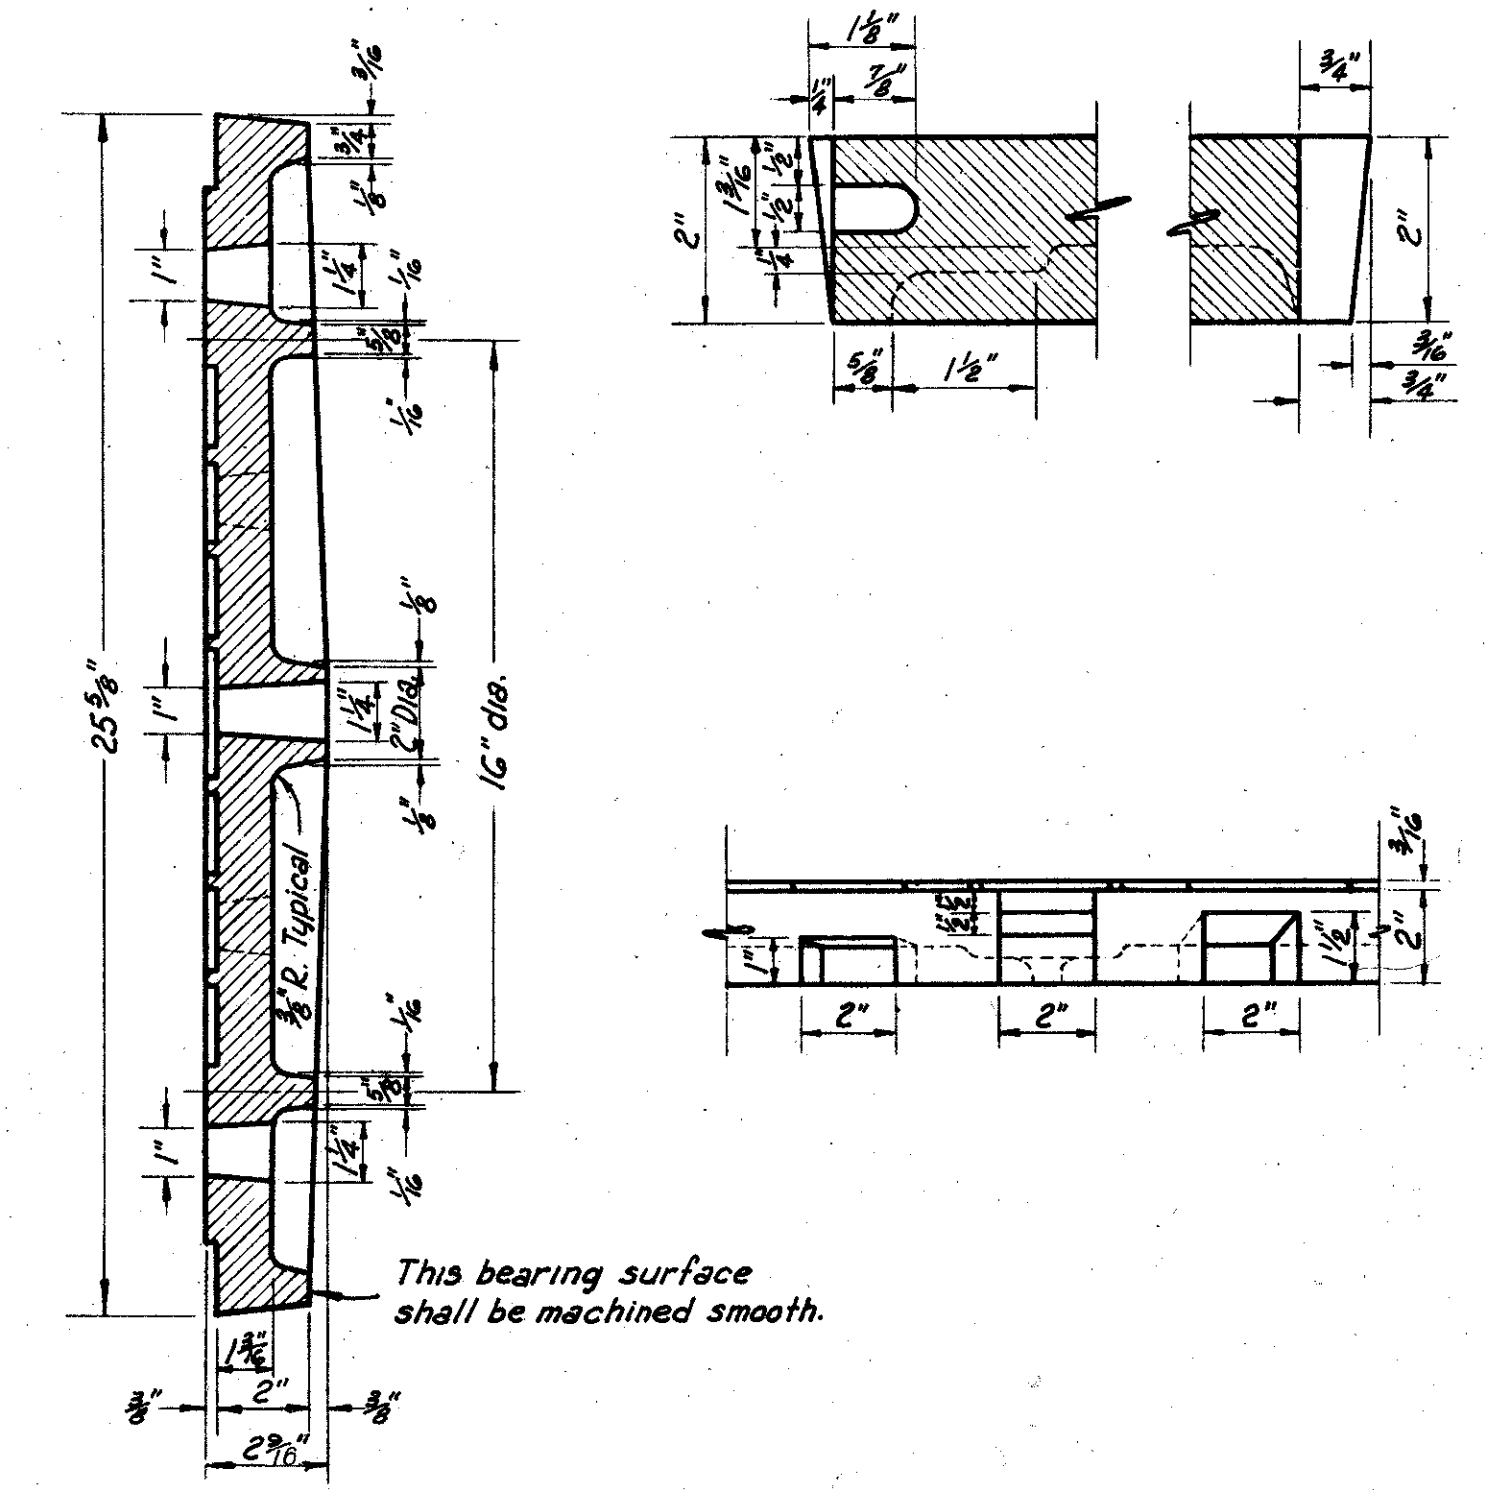


Scale: 3"=1'-0"

This bearing surface shall be machined smooth.

FED. ROAD DIV. NO.	STATE	FED. AID PROJ. NO.	TYPE FUNDS
2	OHIO		


53
181

CUYAHOGA COUNTY
CITY OF CLEVELAND
CUY-42-18.42
CUY-21-15.32

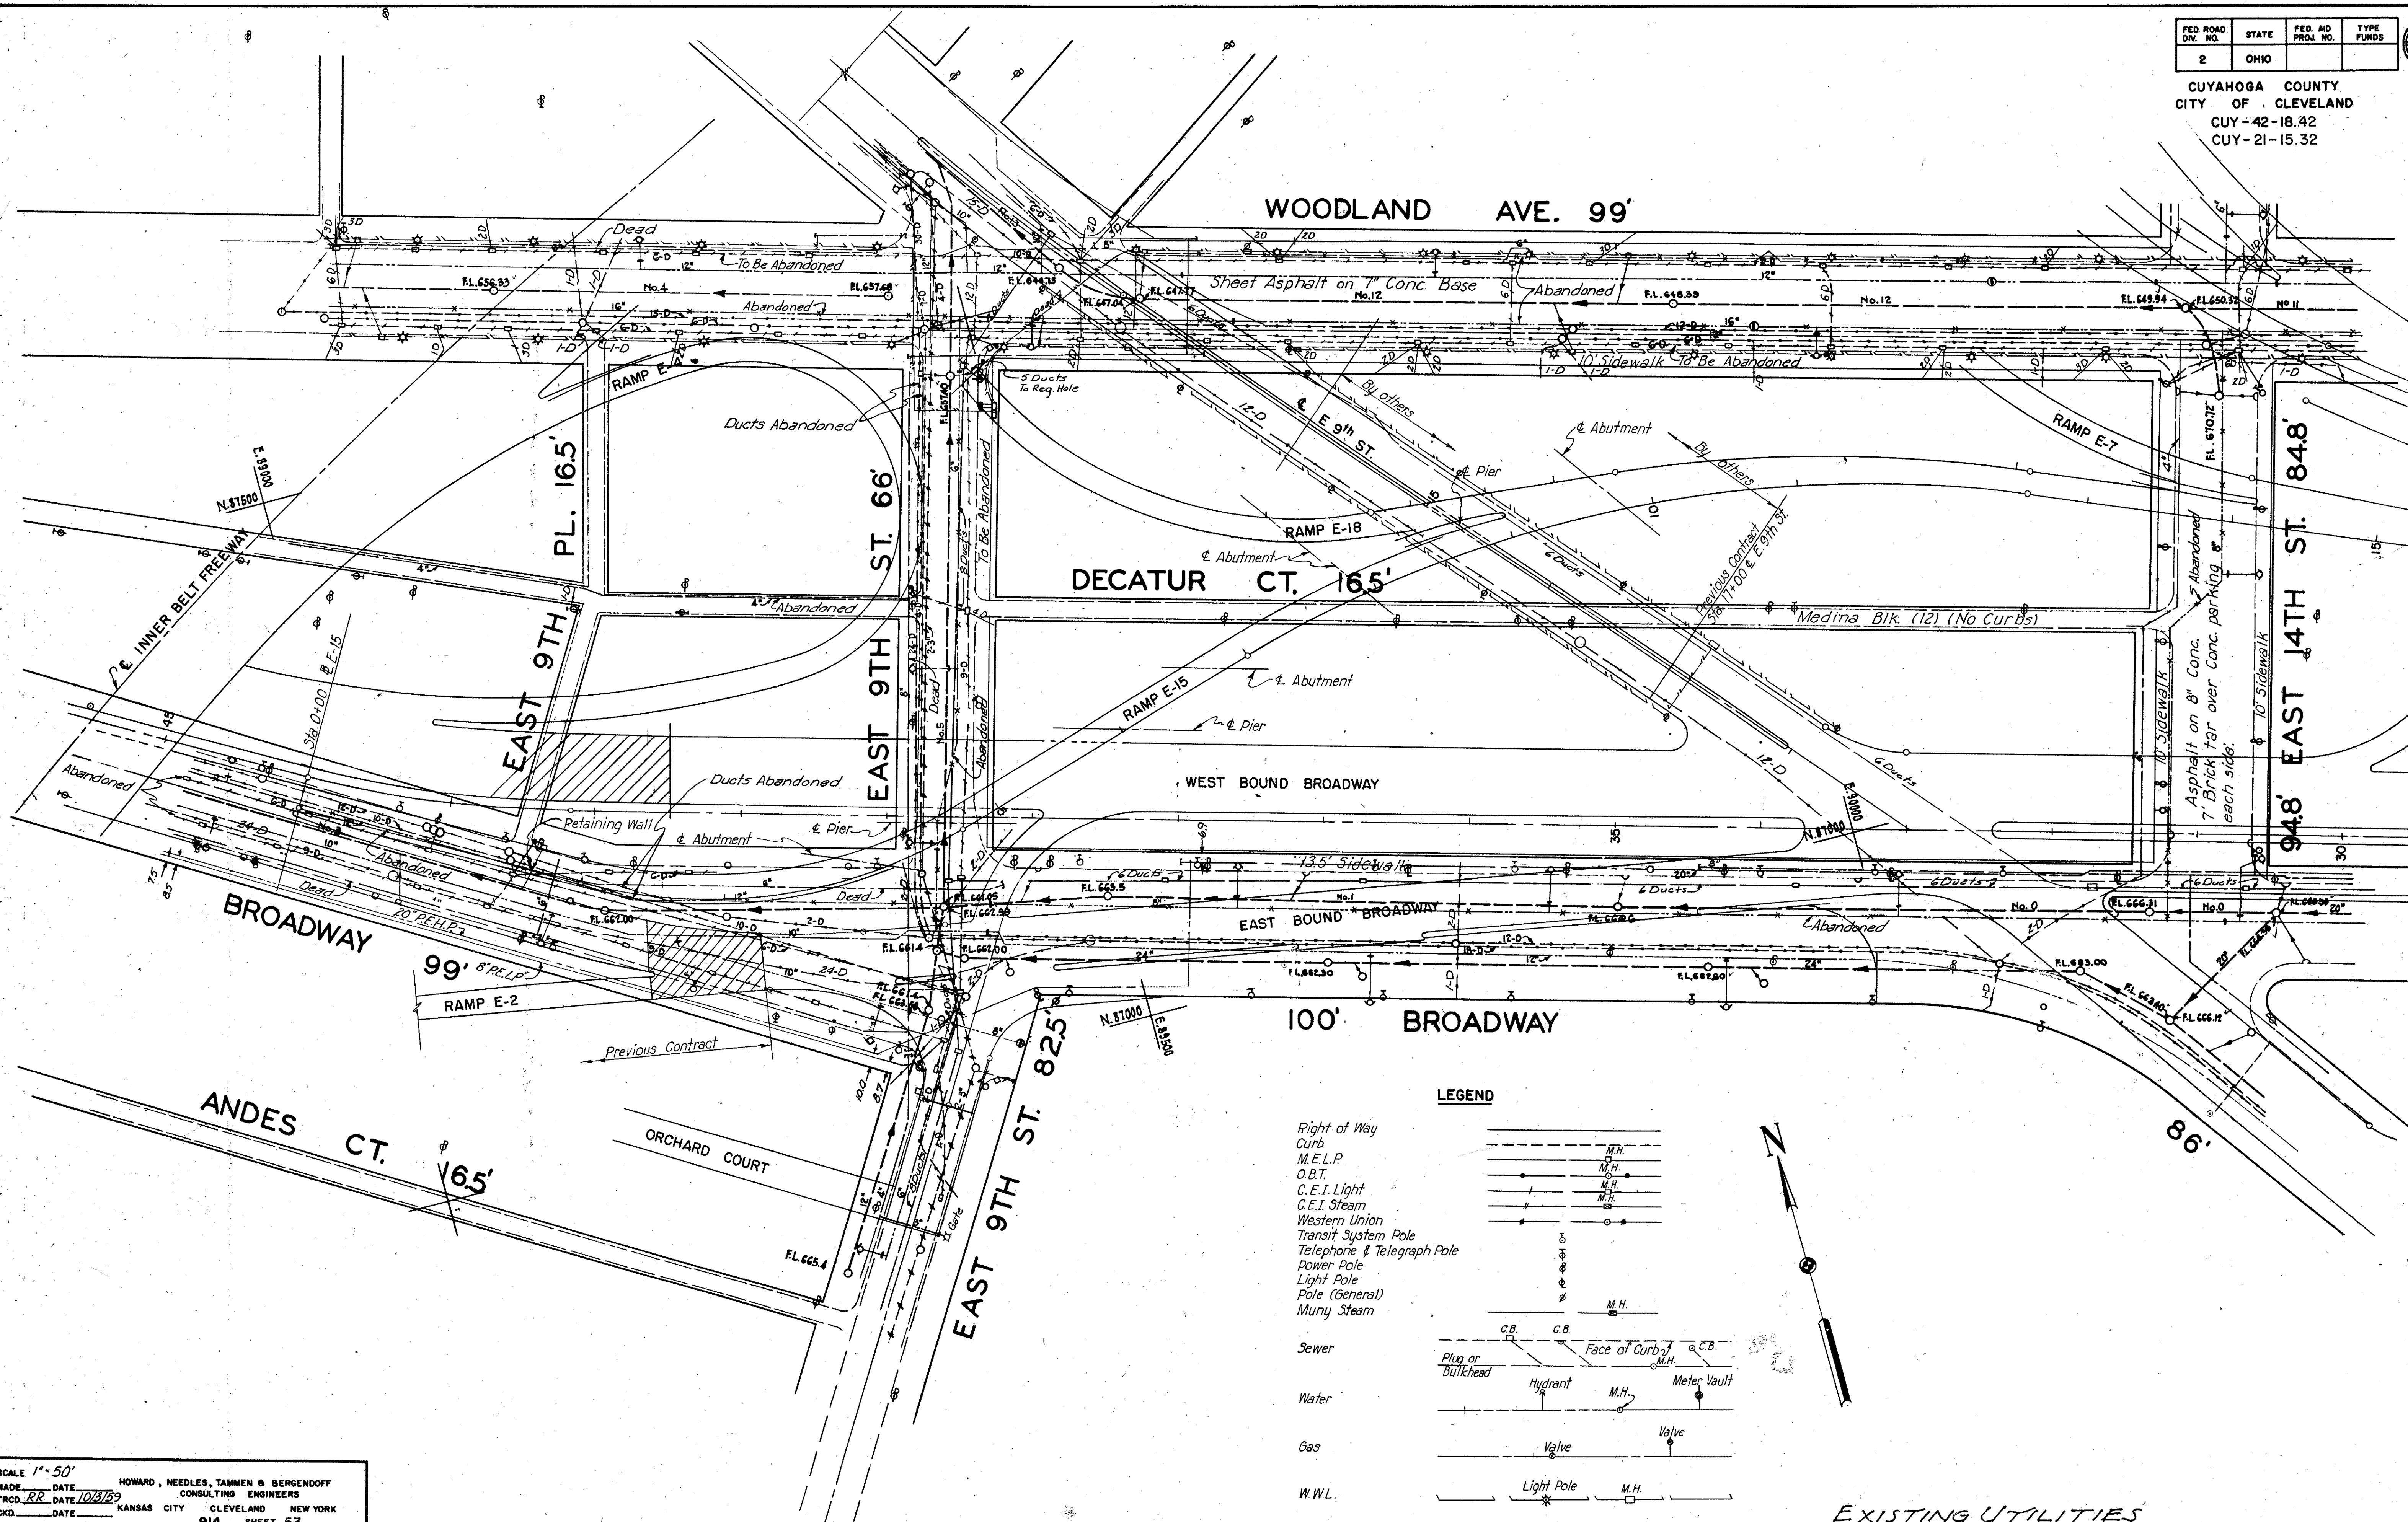

LEGEND

- Right of Way
 - Curb
 - M.E.L.P.
 - O.B.T.
 - C.E.I. Light
 - C.E.I. Steam
 - Western Union
 - Transit System Pole
 - Telephone & Telegraph Pole
 - Power Pole
 - Light Pole
 - Pole (General)
 - Muny Steam
-
- Sewer
 - Water
 - Gas
 - W.W.L.

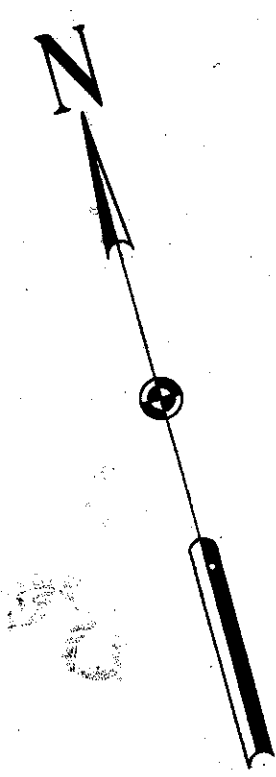


EXISTING UTILITIES

SCALE 1" = 50'
 MADE DATE 10/3/59 HOWARD, NEEDLES, TAMMEN & BERGENOFF
 TRCD. RR DATE 10/3/59 CONSULTING ENGINEERS
 CKD DATE KANSAS CITY CLEVELAND NEW YORK
 914 SHEET 53

FED. ROAD DIV. NO.	STATE	FEDERAL AID PROJECT NO.	TYPE FUNDS
2	OHIO		

54
181

CUYAHOGA COUNTY
CITY OF CLEVELAND
CUY-42-18.42
CUY-21-45.32

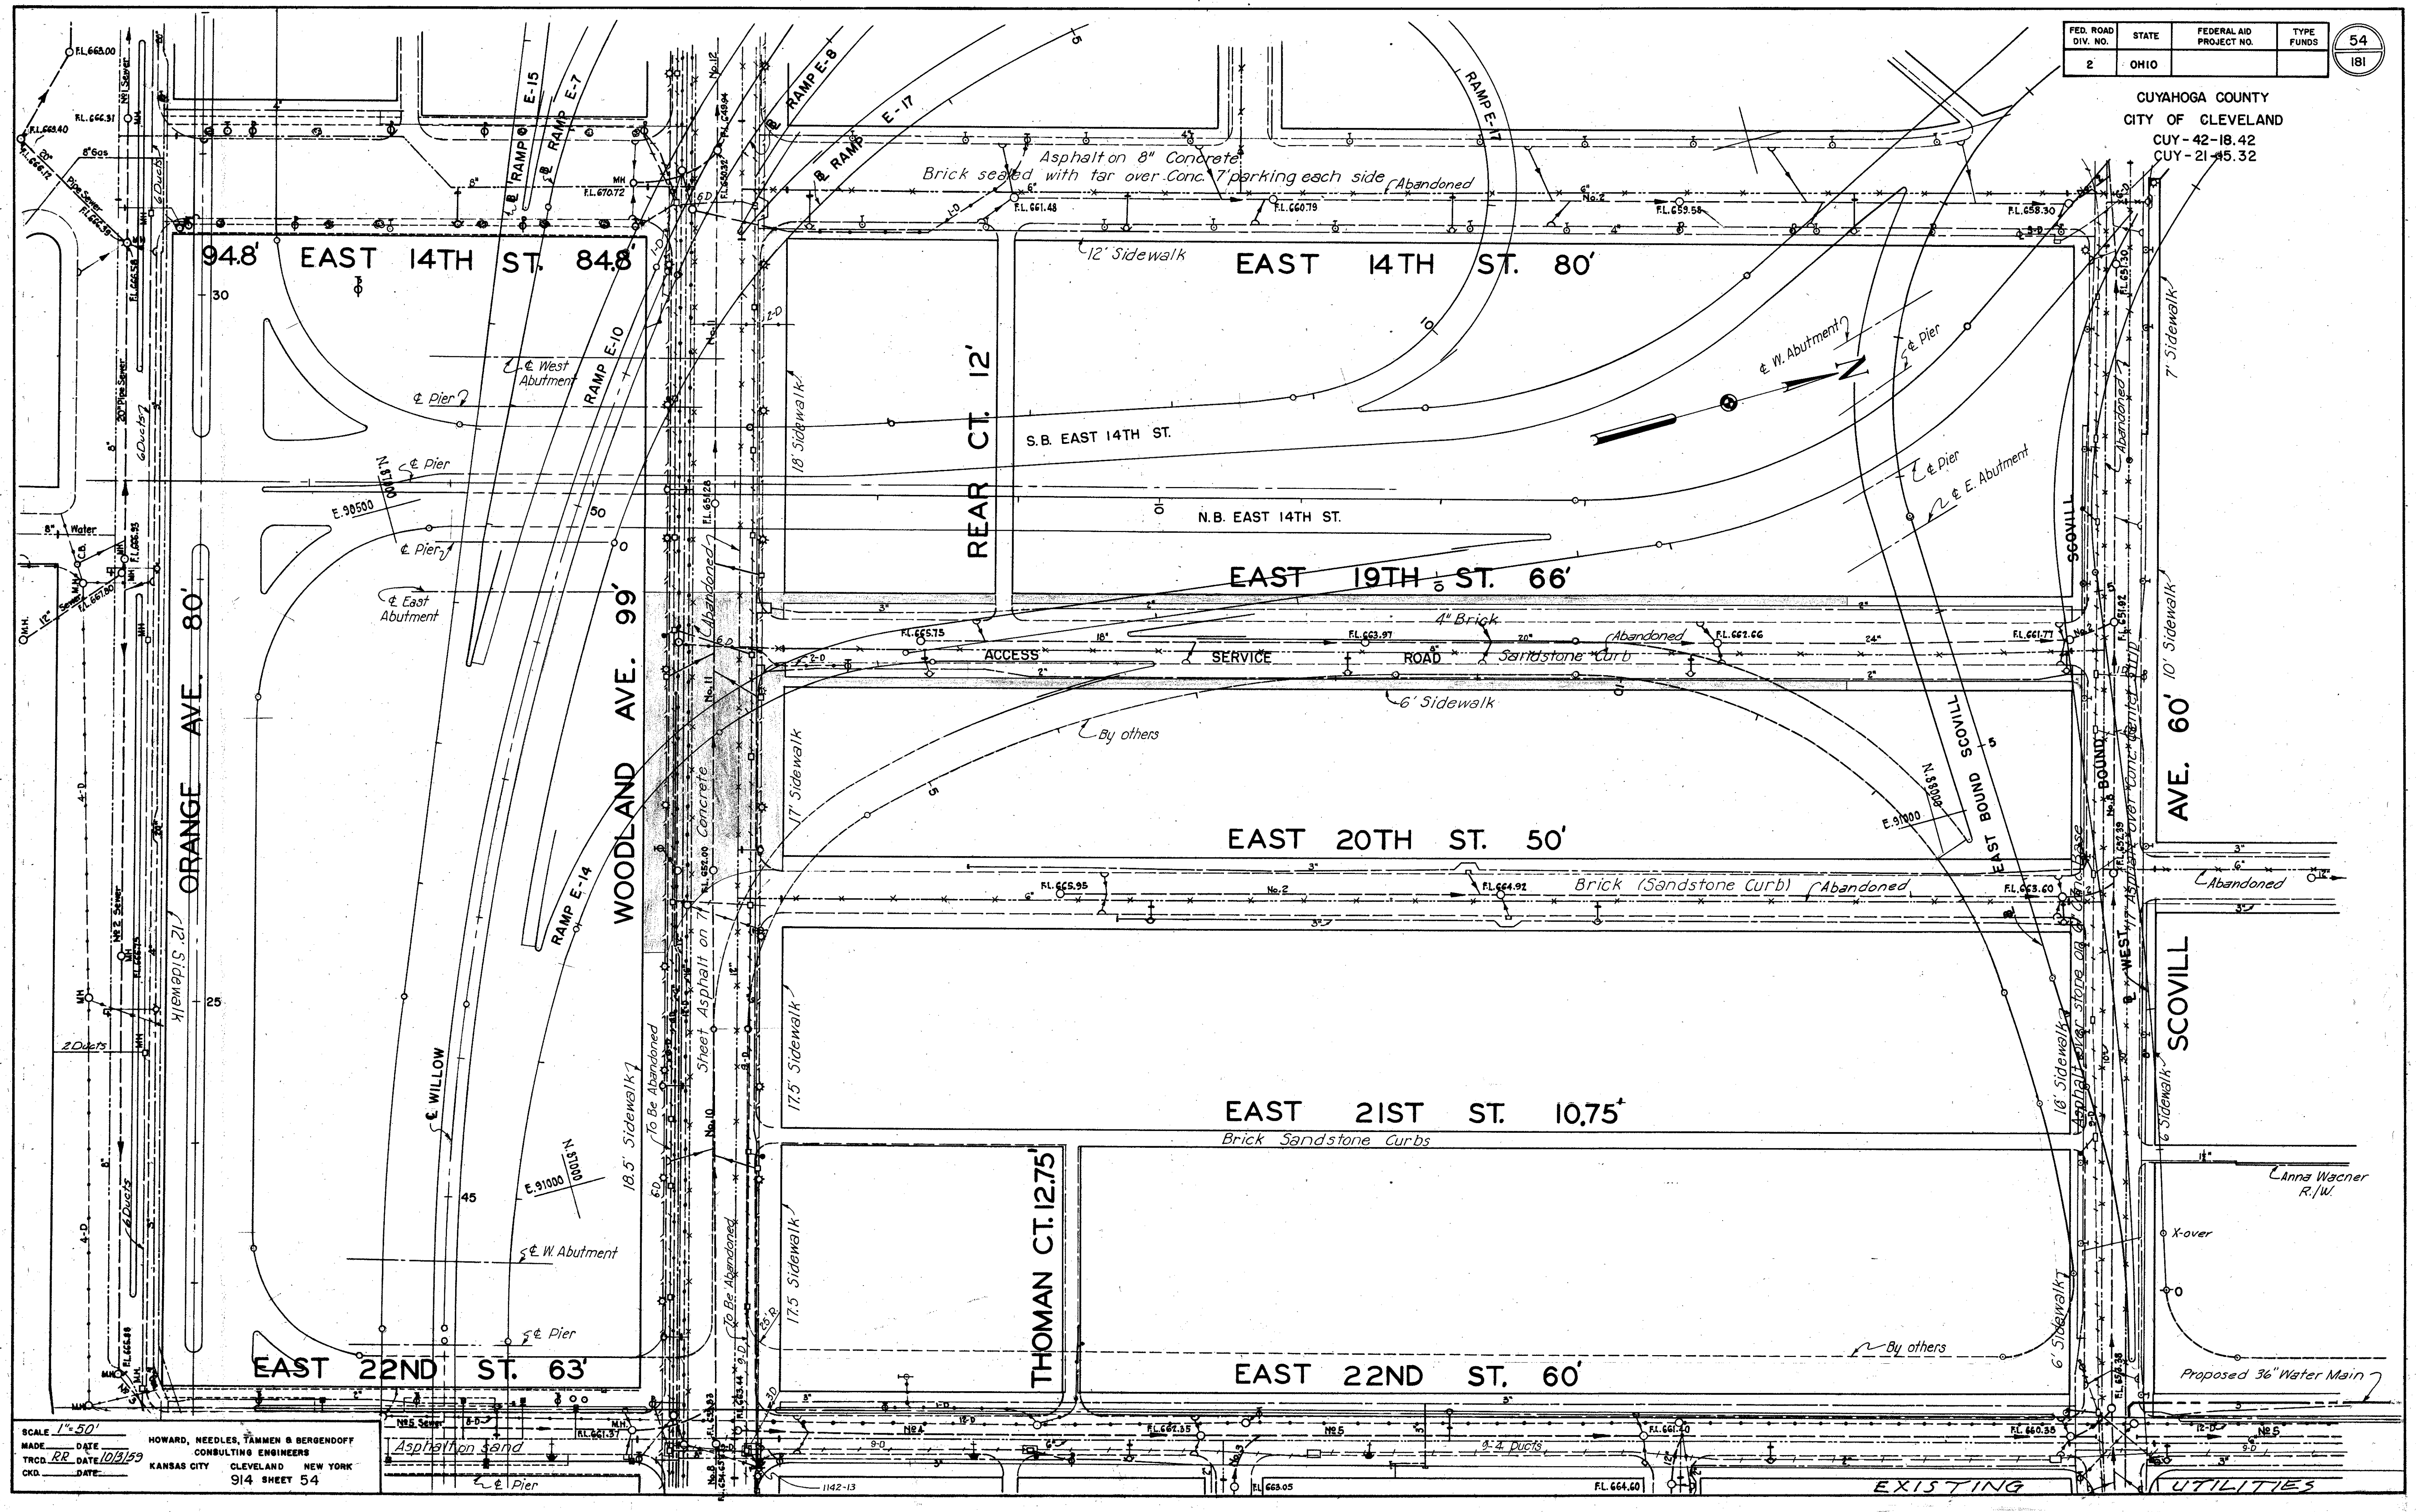



SCALE 1"=50'
 MADE DATE 10/31/59
 TRCD. RR DATE 10/31/59
 CKD. DATE
 HOWARD, NEEDLES, TAMMEN & BERGENDOFF
 CONSULTING ENGINEERS
 KANSAS CITY CLEVELAND NEW YORK
 914 SHEET 54

EXISTING UTILITIES

FED. ROAD DIV. NO.	STATE	FEDERAL AID PROJECT NO.	TYPE FUNDS
2	OHIO		

56
181

CUYAHOGA COUNTY
CITY OF CLEVELAND
CUY-42-18.42
CUY-21-15.32

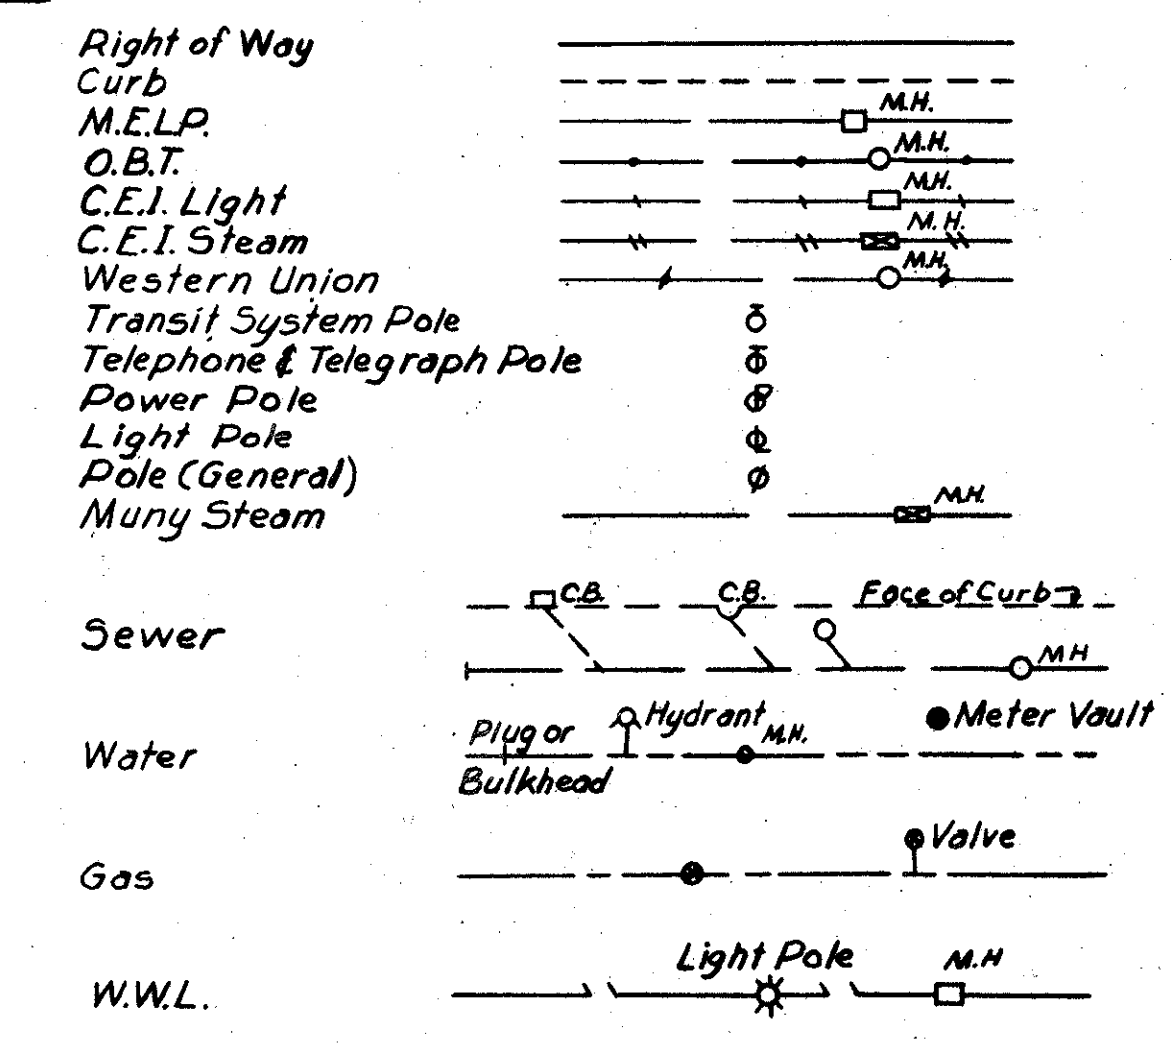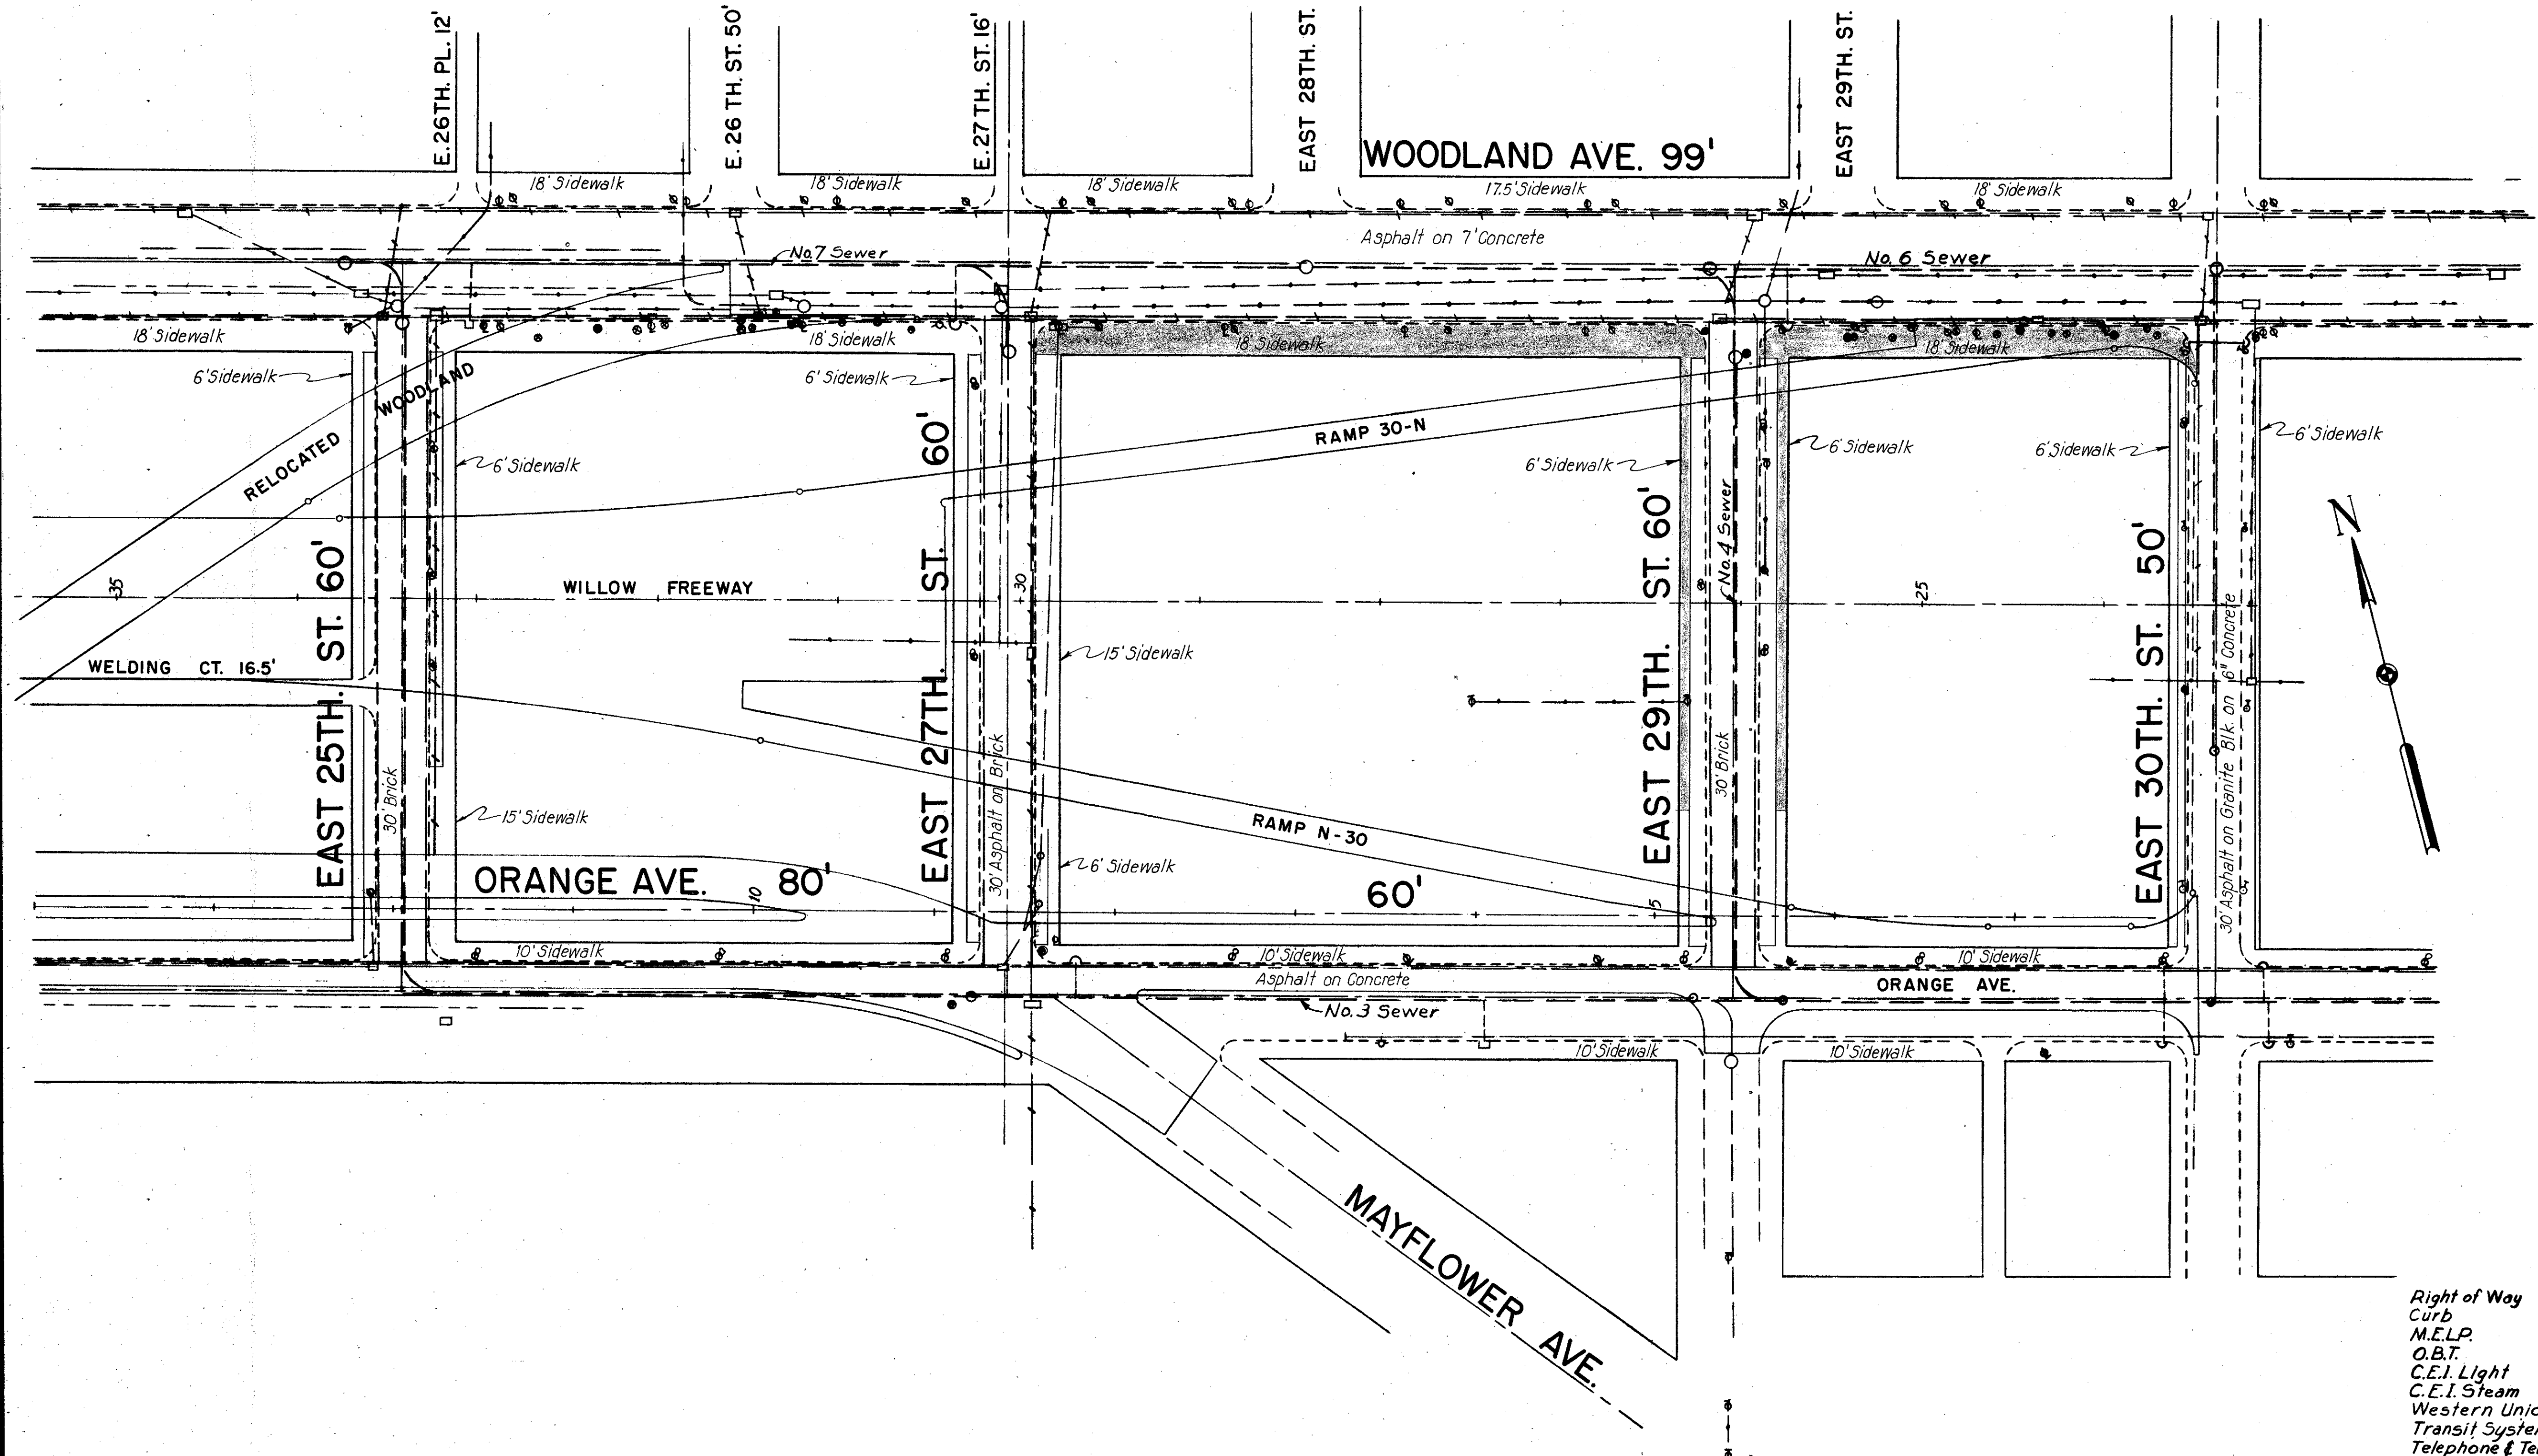


SCALE 1"=30'
MADE B.P.S. DATE 12/1/50
TRCD. R.R. DATE 10/13/50
CKD. DATE

HOWARD, NEEDLES, TAMMEN & BERGENDOFF
CONSULTING ENGINEERS
KANSAS CITY CLEVELAND NEW YORK
914 SHEET 56

FED. ROAD DIV. NO.	STATE	FEDERAL AID PROJECT NO.	TYPE FUNDS
2	OHIO		

58
181

CUYAHOGA COUNTY
CITY OF CLEVELAND
CUY-42-18.42
CUY-21-15.32

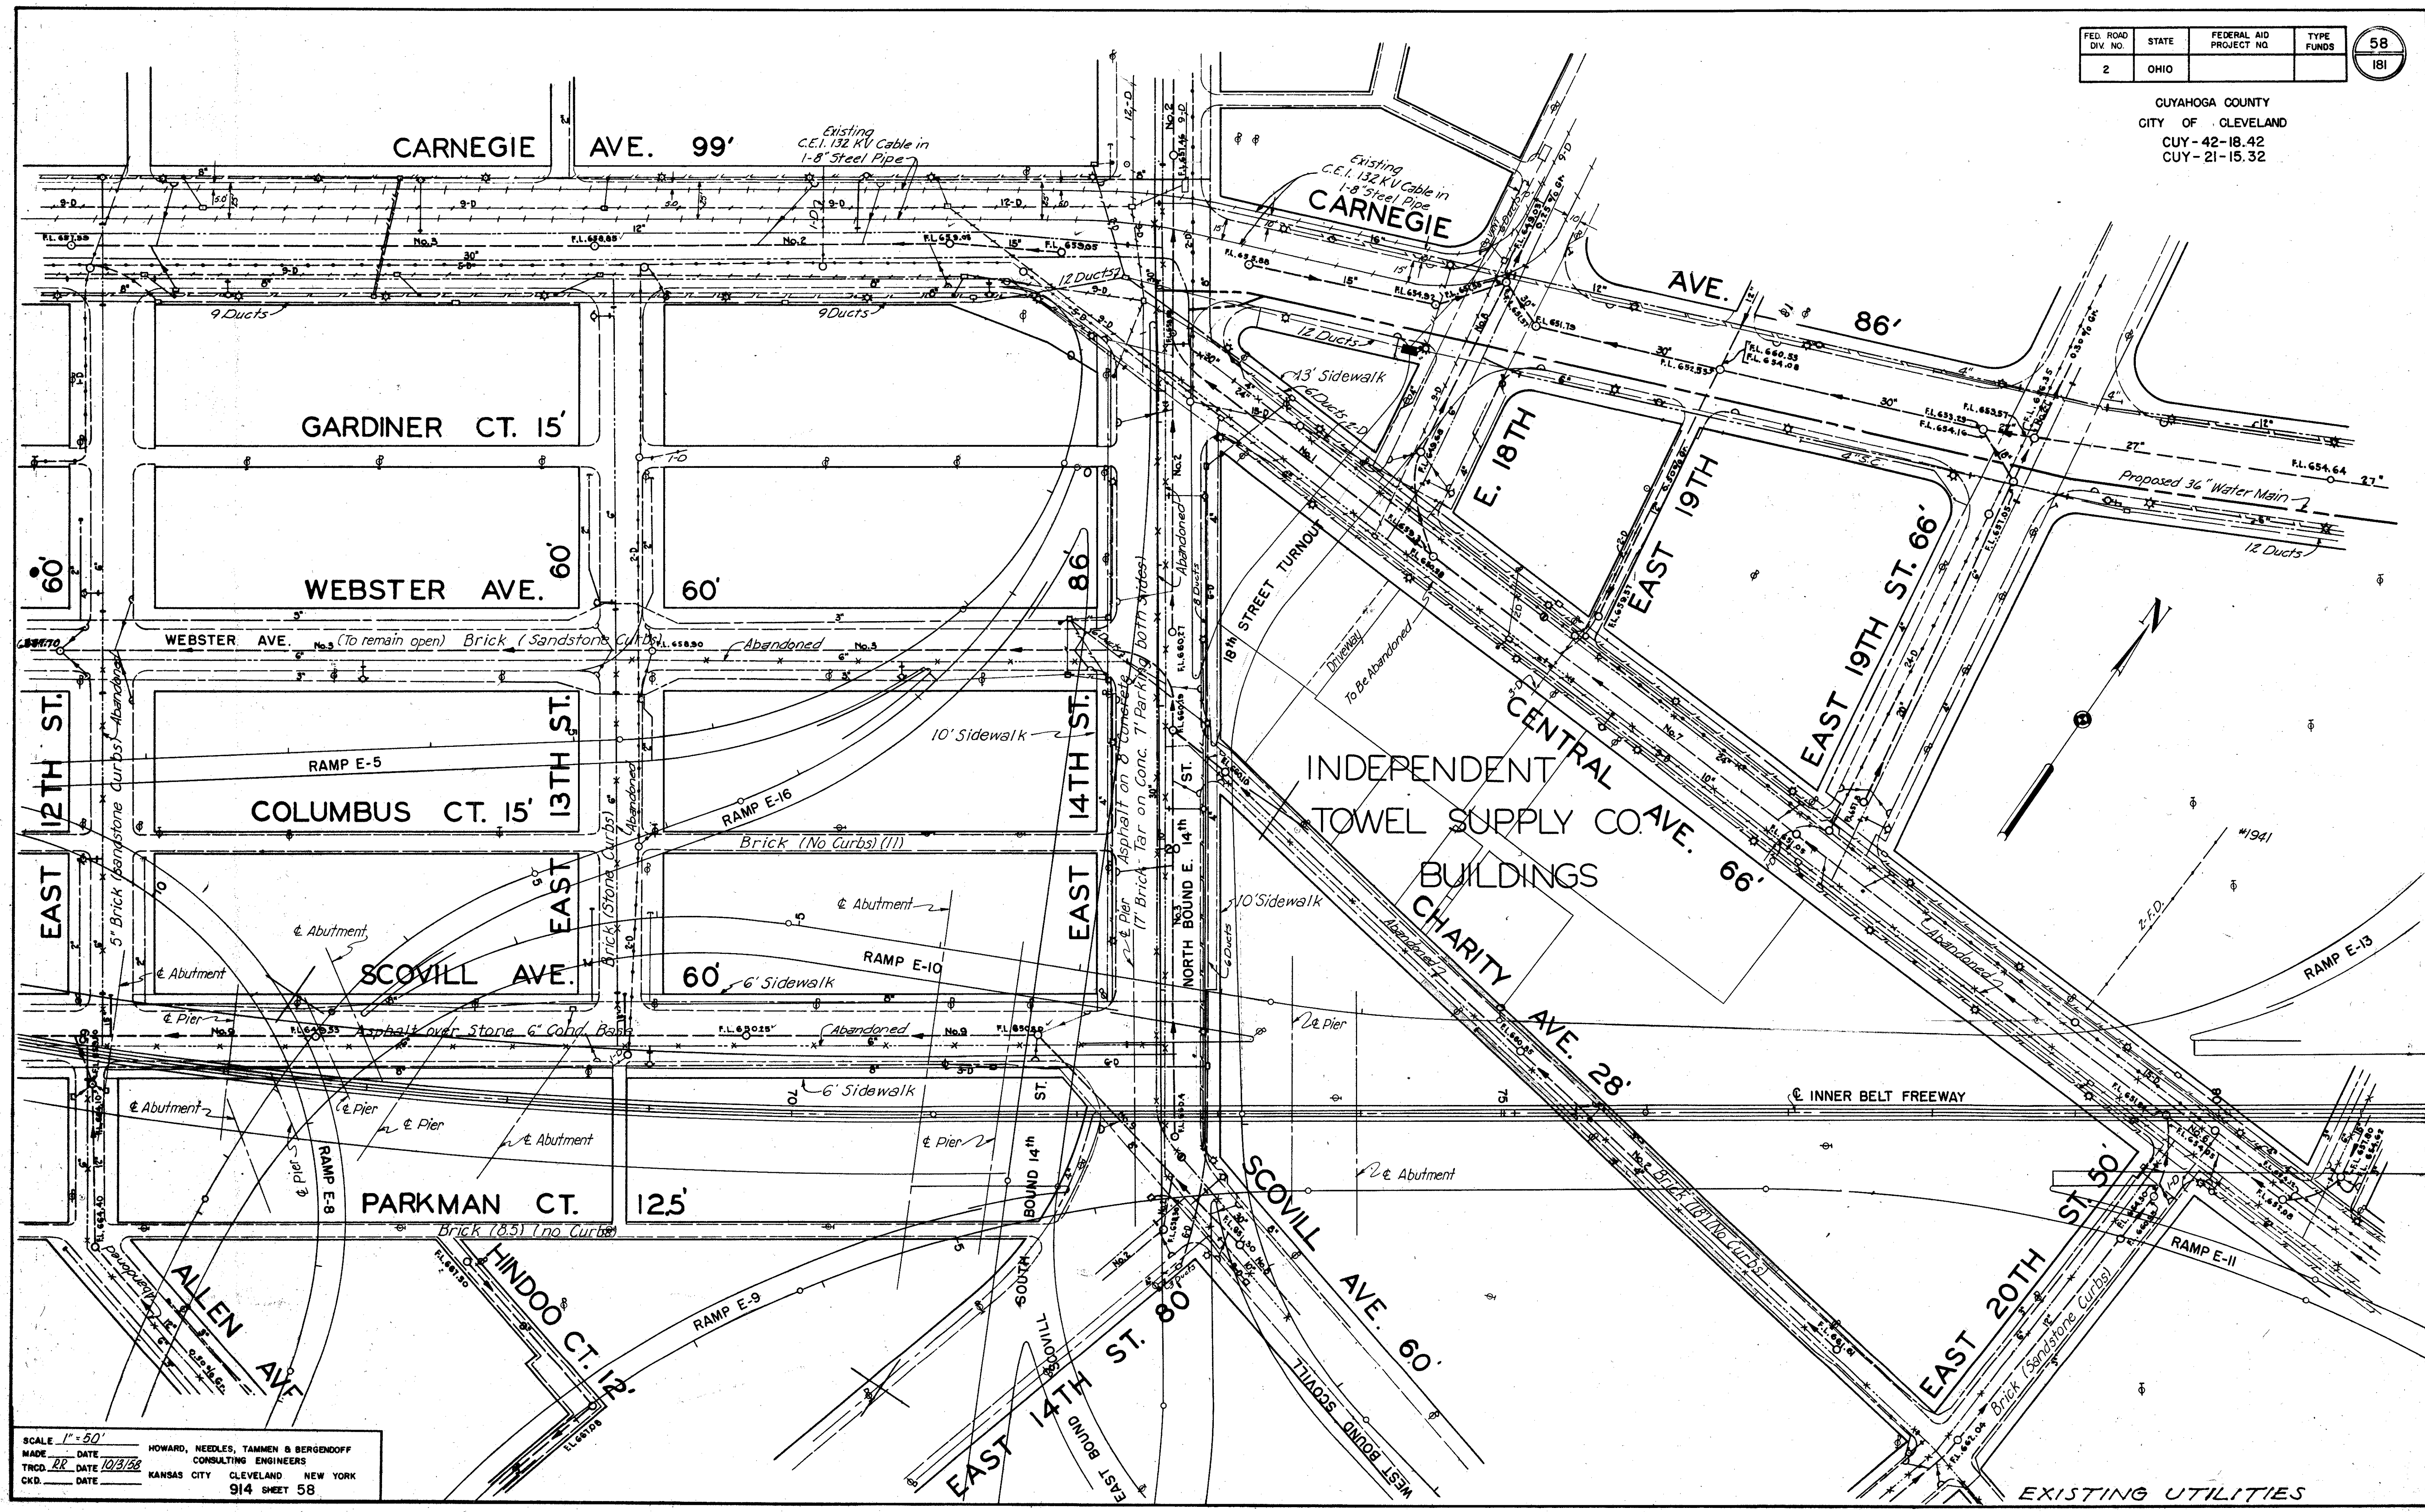


SCALE 1" = 50'
 MADE DATE HOWARD, NEEDLES, TAMMEN & BERGENDOFF
 TRCD. RR DATE CONSULTING ENGINEERS
 CKD. DATE KANSAS CITY CLEVELAND NEW YORK
 914 SHEET 58

EXISTING UTILITIES

FED. ROAD DIV. NO.	STATE	FEDERAL AID PROJECT NO.	TYPE FUNDS
2	OHIO		

57
181

CUYAHOGA COUNTY
CITY OF CLEVELAND
CUY-42-18.42
CUY-21-15.32

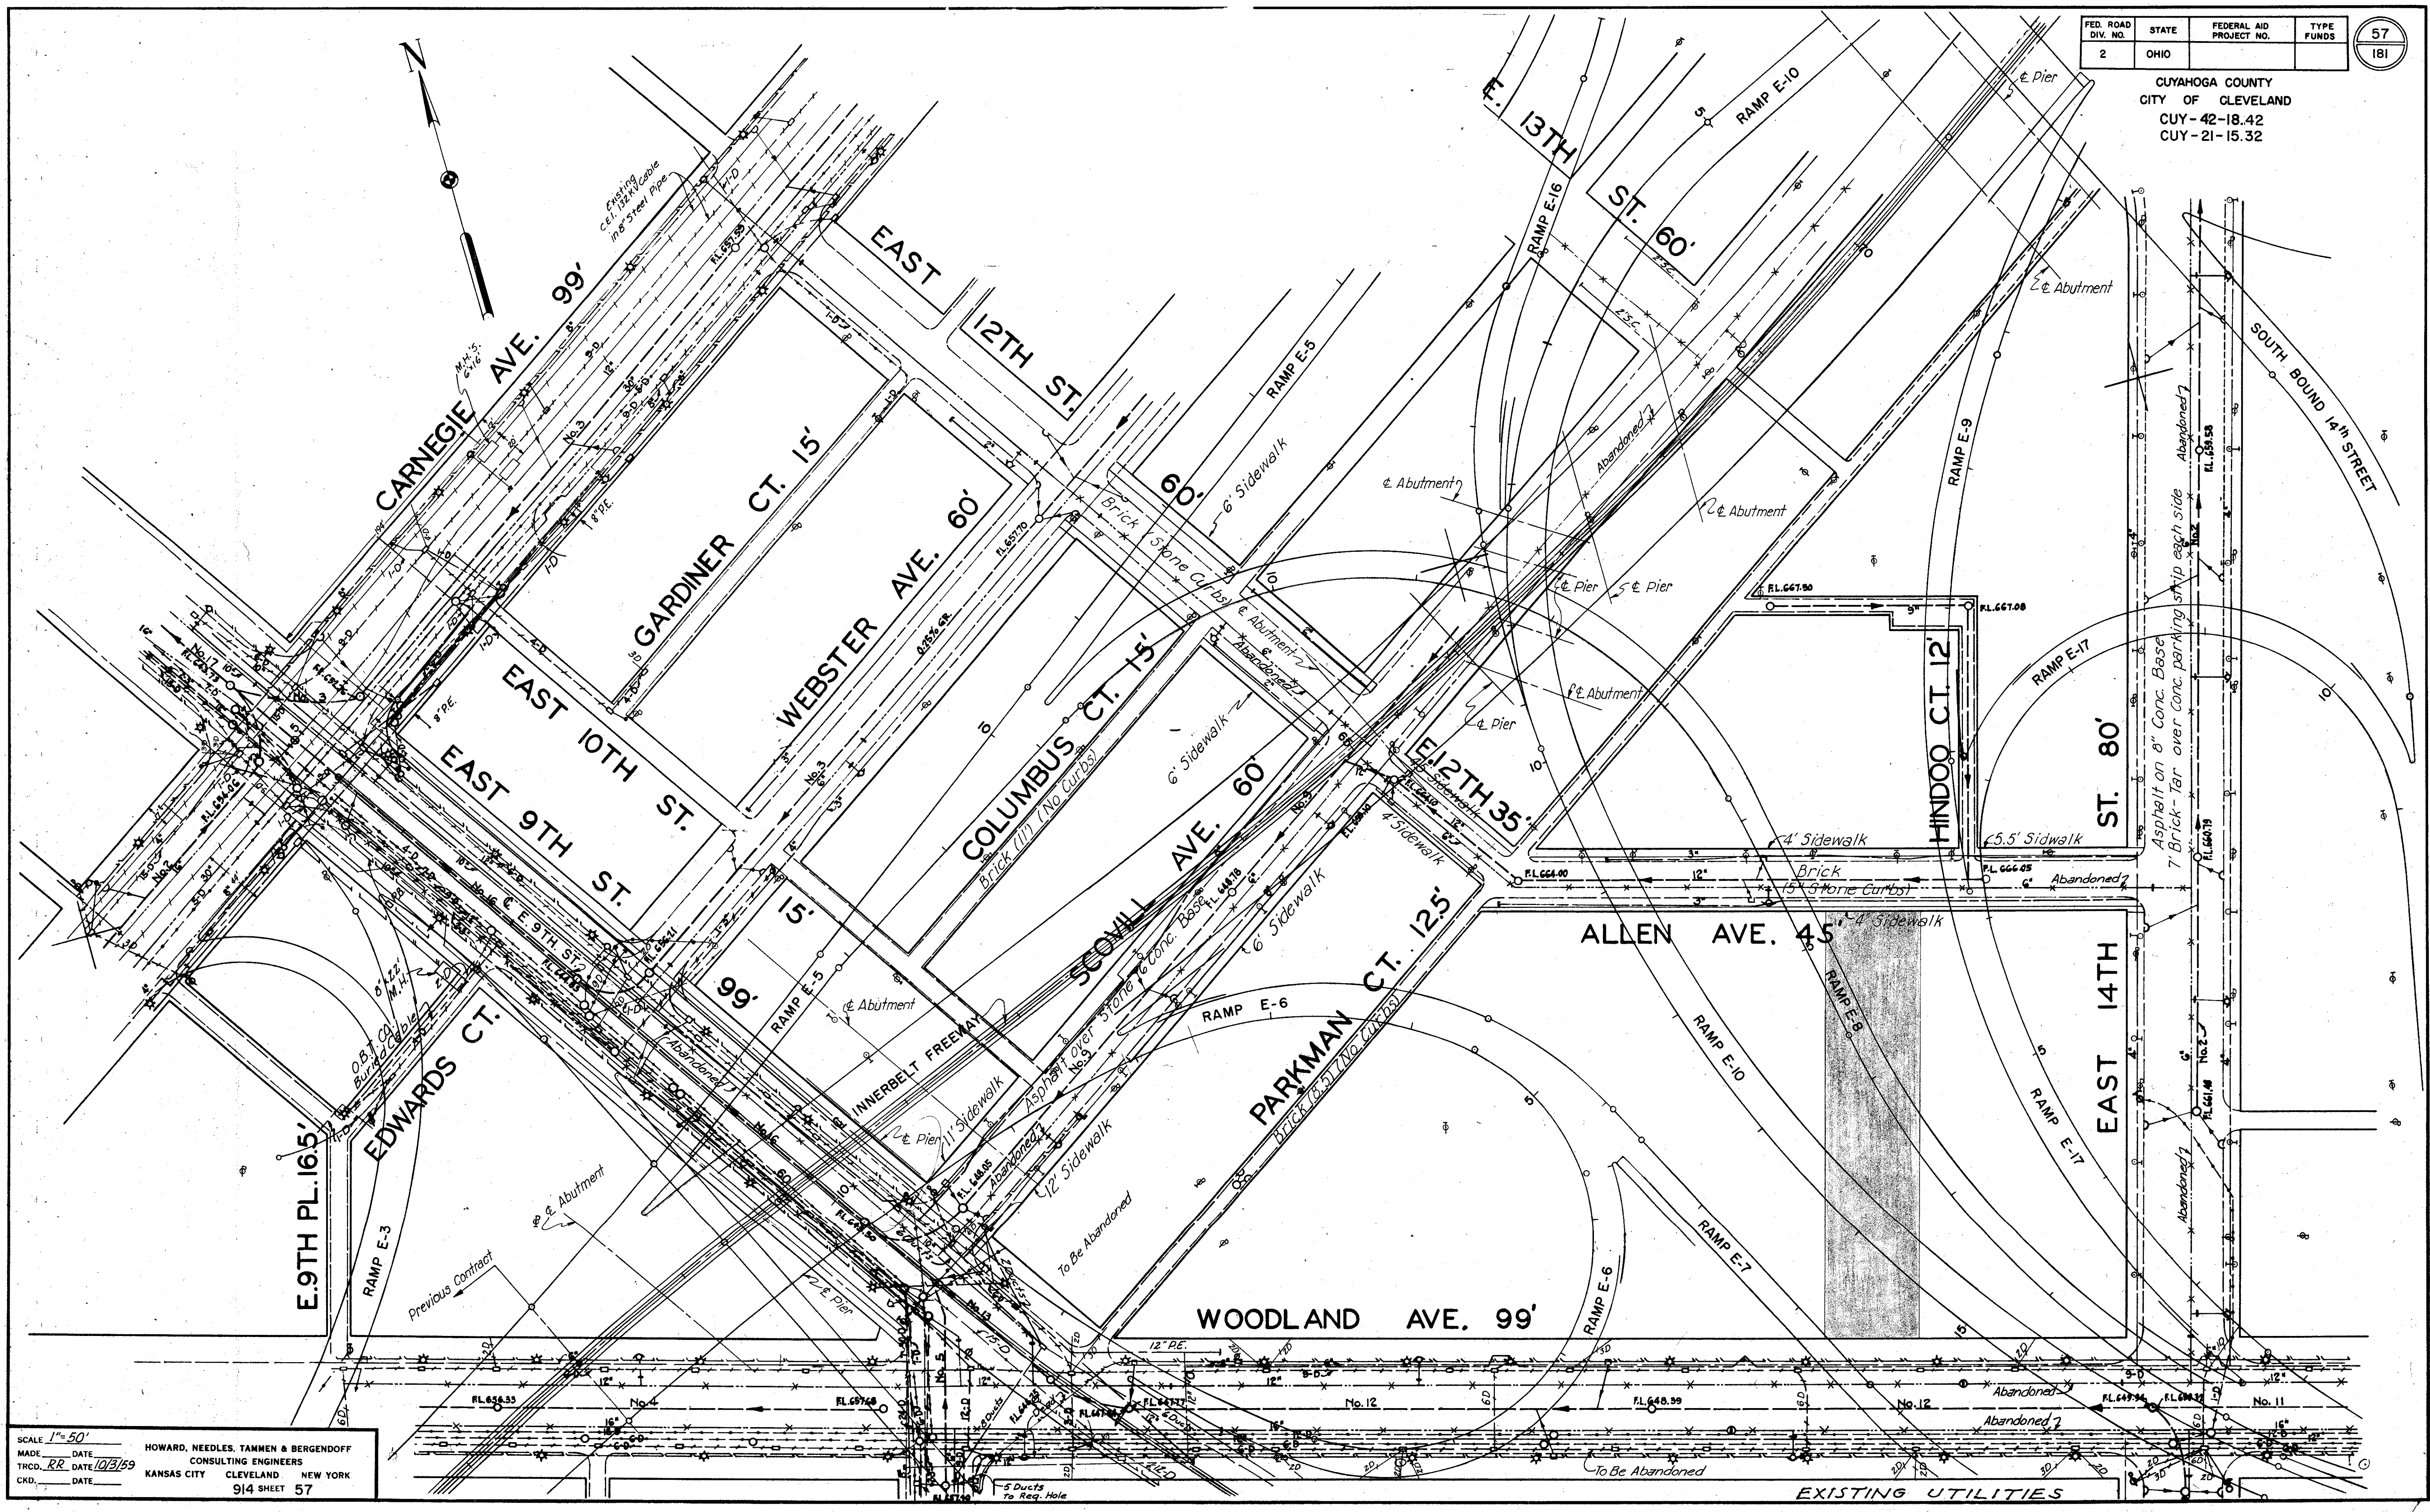


SCALE 1" = 50'
 MADE _____ DATE _____ HOWARD, NEEDLES, TAMMEN & BERGENDOFF
 TRCD. RR. DATE 10/3/59 CONSULTING ENGINEERS
 CKD. _____ DATE _____ KANSAS CITY CLEVELAND NEW YORK
 914 SHEET 57

EXISTING UTILITIES

FED. ROAD DIV. NO.	STATE	FEDERAL AID PROJECT NO.	TYPE FUNDS
2	OHIO		

59
181

CUYAHOGA COUNTY
CITY OF CLEVELAND
CUY-42-18.42
CUY-21-15.32

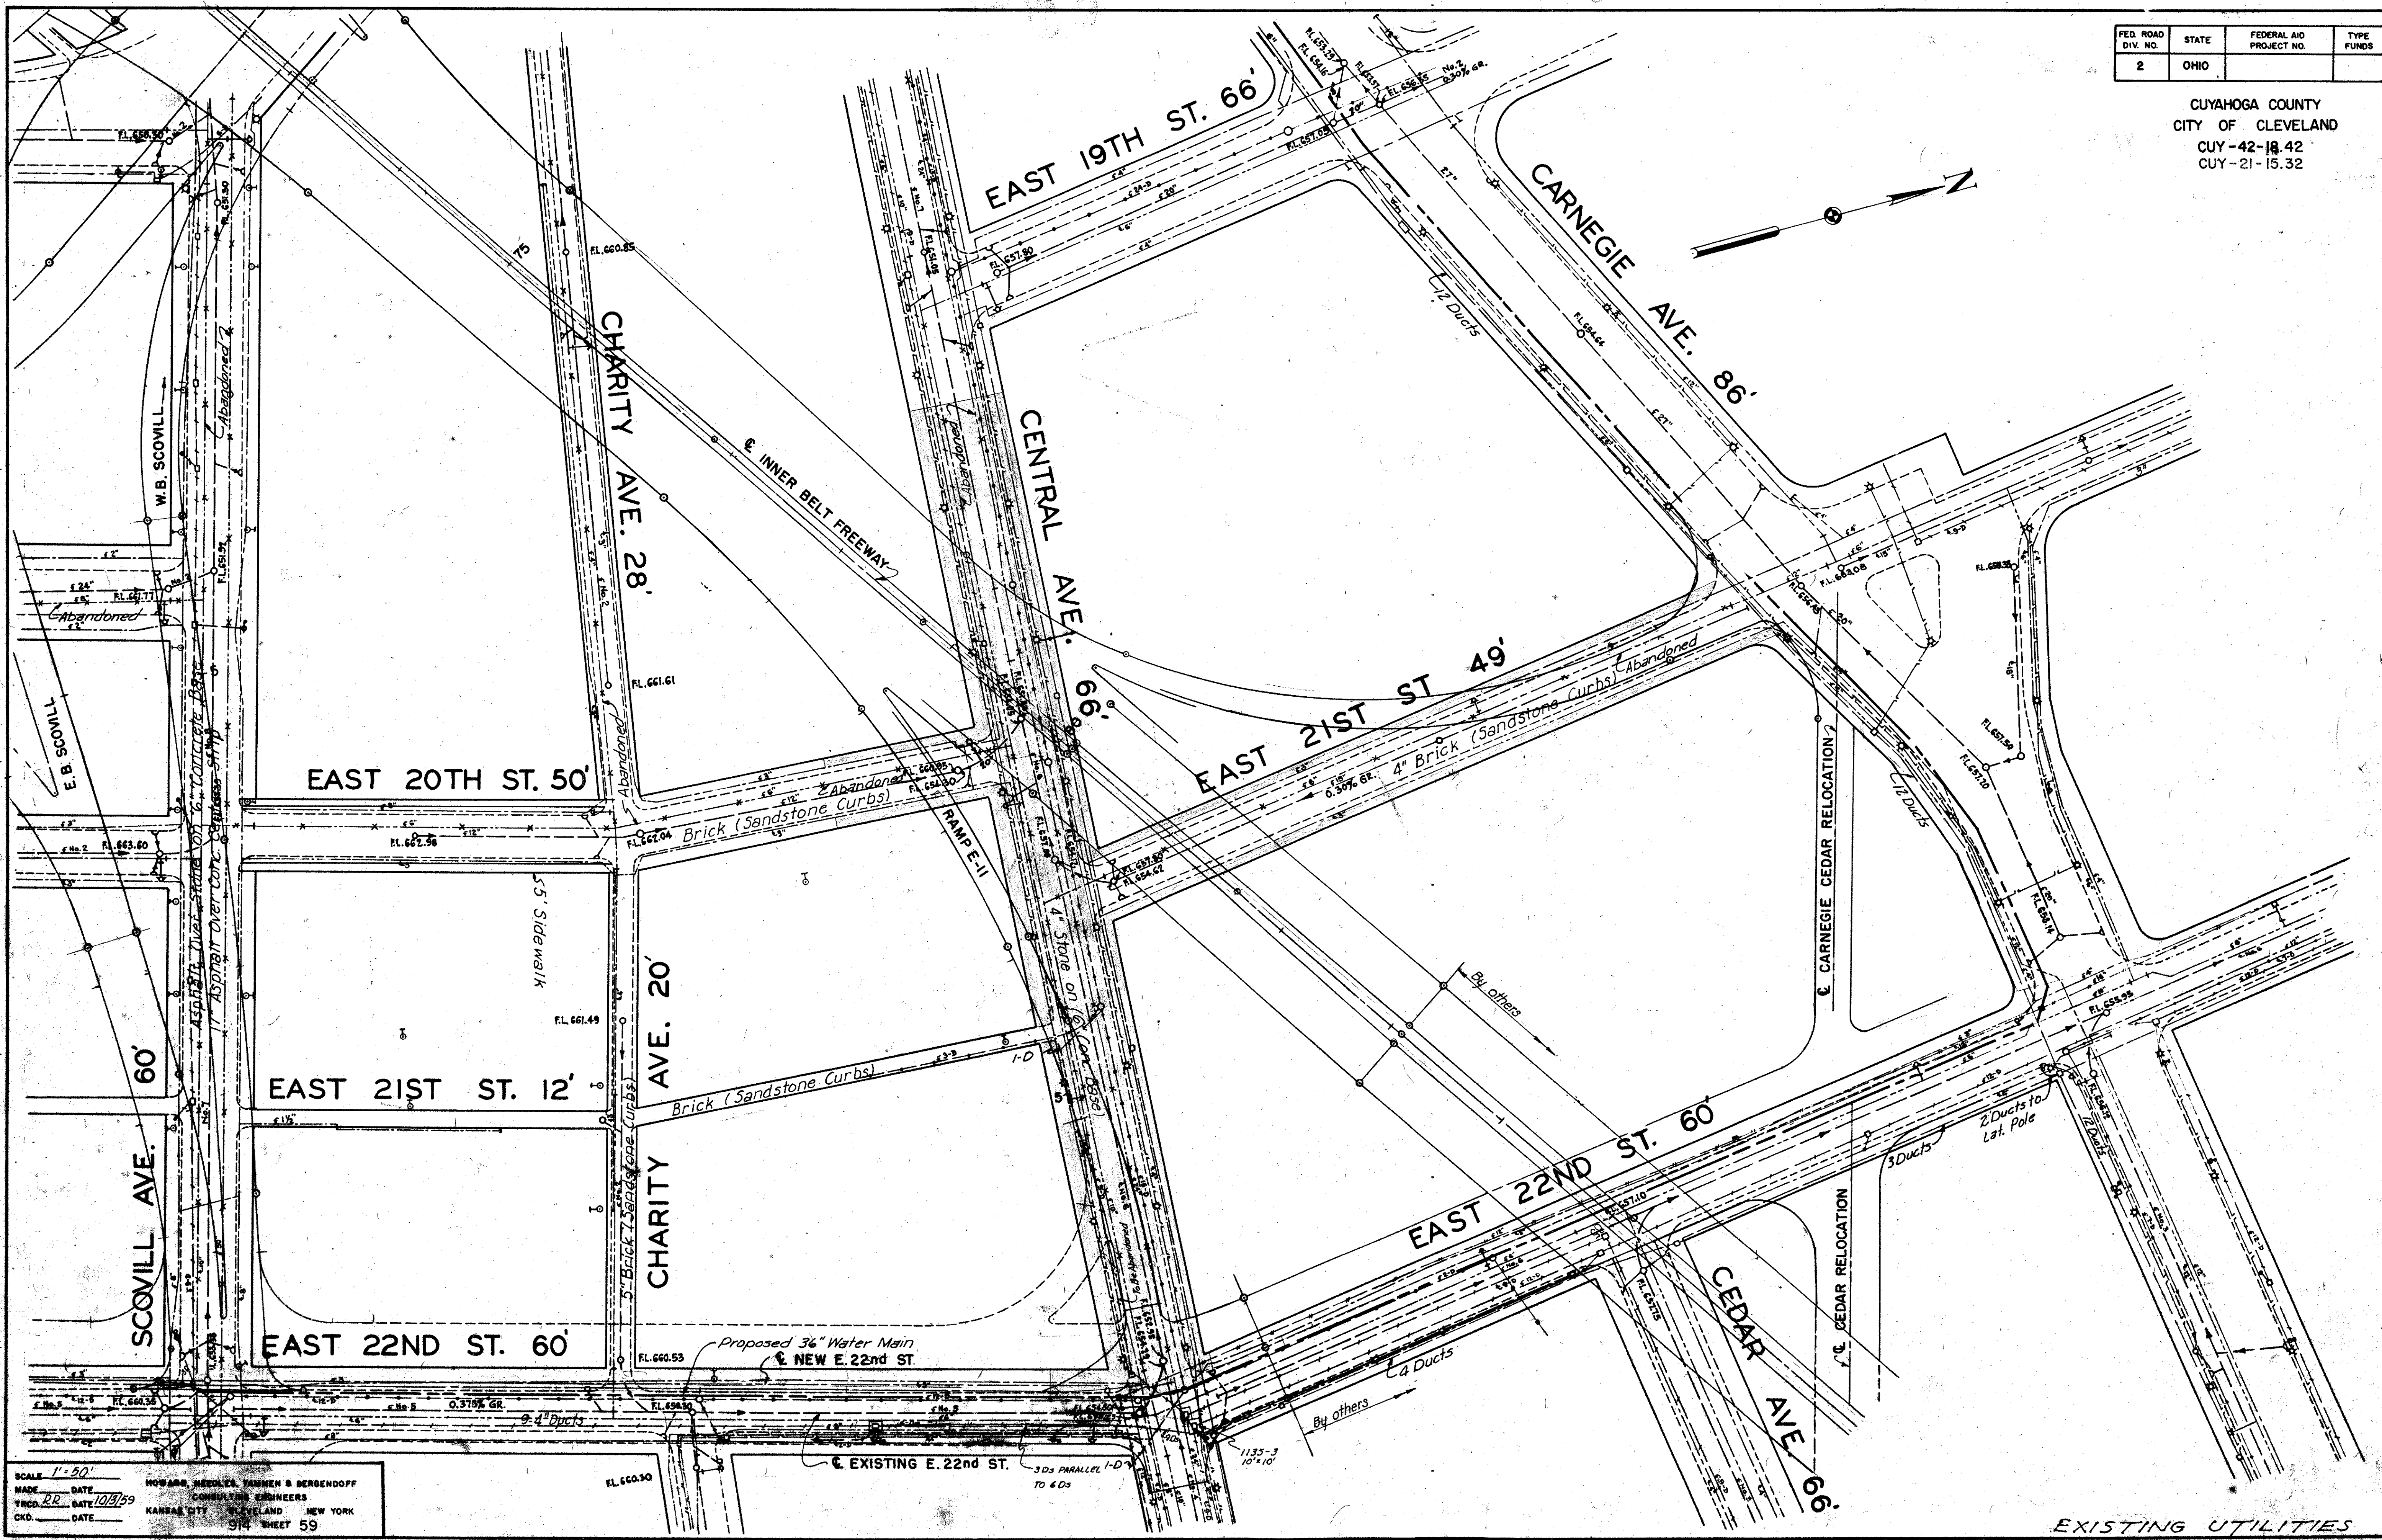

SCALE 1" = 50'
 MADE DATE HOWARD, NEEDLER, FARMAN & BERGENDOFF
 TRCD. RR DATE 10/21/59 CONSULTING ENGINEERS
 CHKD. DATE KANSAS CITY CLEVELAND NEW YORK
 914 SHEET 59

EXISTING UTILITIES

FED. ROAD DIV. NO.	STATE	FEDERAL AID PROJECT NO.	TYPE FUNDS	60 181
2	OHIO			

CUYAHOGA COUNTY
CITY OF CLEVELAND
CUY-42-18.42
CUY-21-15.32
CROSS SECTION LAYOUT




SERIES	SHEETS	STA. TO STA.	CUY 42-18.42		CUY 21-15.32	
			EXCAVA.	EMBANK.	EXCAVA.	EMBANK.
A	61-65	61+50 71+30	19,260	46,640		
B	65-69	74+07 83+09	23,091	23,299		
C	68-69	0+33 81+00	3,635	0		
D	68-69	5+00 81+50	1,301	0		
E	69-70	2+50 7+25	475	4,375		
F	71-73	0+00 9+31	2,487	45,629		
G	74-76	0+00 7+35	17,113	26,239		
H	77-78	0+00 4+80	3	30,840		
I	79-84	4+35 22+33	5,193	10,427		
J	85-87	23+43 35+05			1,806	51,477
K	87-89	35+42 42+77			0	56,710
L	89-90	44+21 49+24	238	58,066		
M	90	0+00 7+15			1,954	27
TOTALS			72,796	245,515	3,760	108,494
* Deficiency				209,546		121,008

Shrinkage Factor 15%


NOTE:
THE B FOR THE INNER BELT CROSS SECTIONS IS THE FORWARD TANGENT AT STA. 70+99.9 PRODUCED BACK. THIS IS ALSO THE REFERENCE LINE FOR SERIES "I" AND "J".

* Obtain from excavation elsewhere on Parts 6 or 7-B.

- LEGEND
- Previous Contract - Part 5
 - Part 6 - Previous Project
 - Part 7 - Present Project
 - Construction Limits

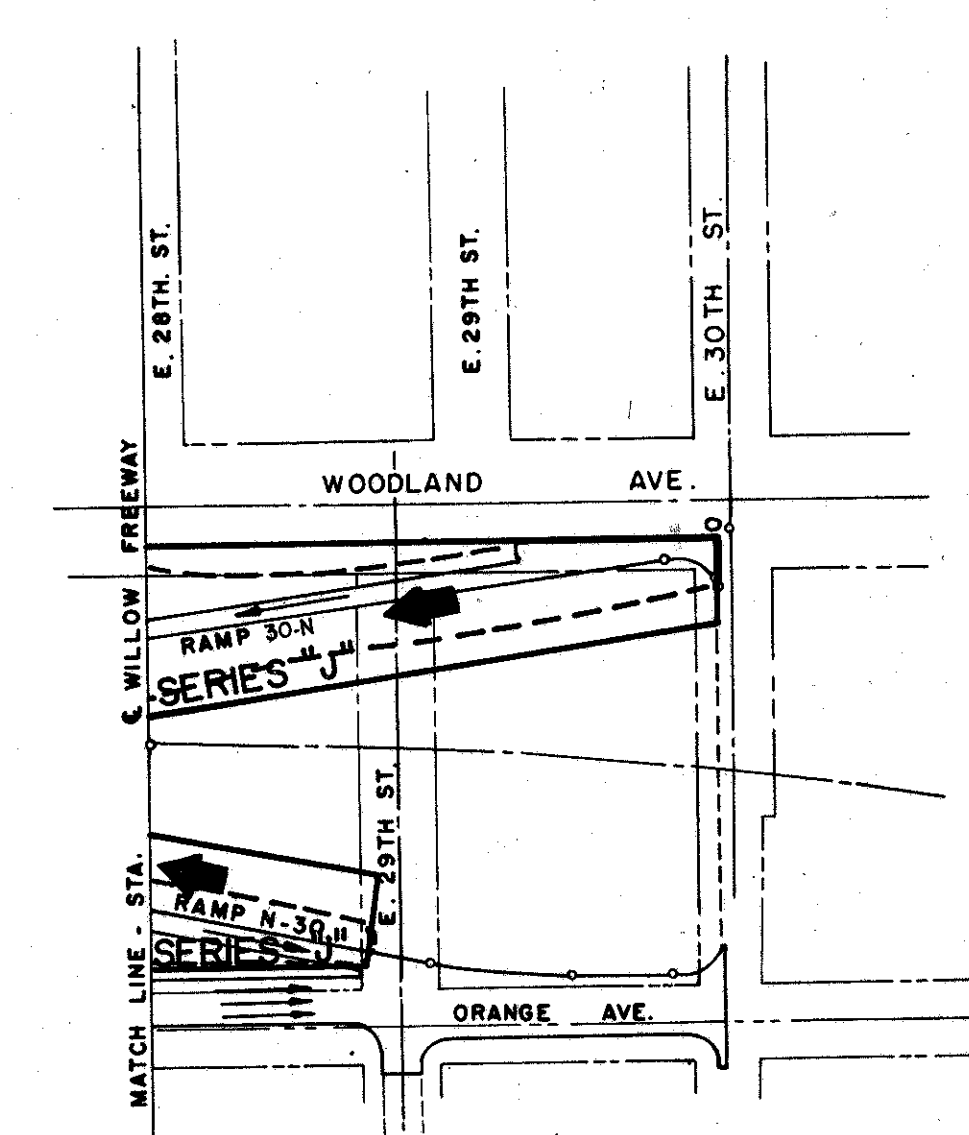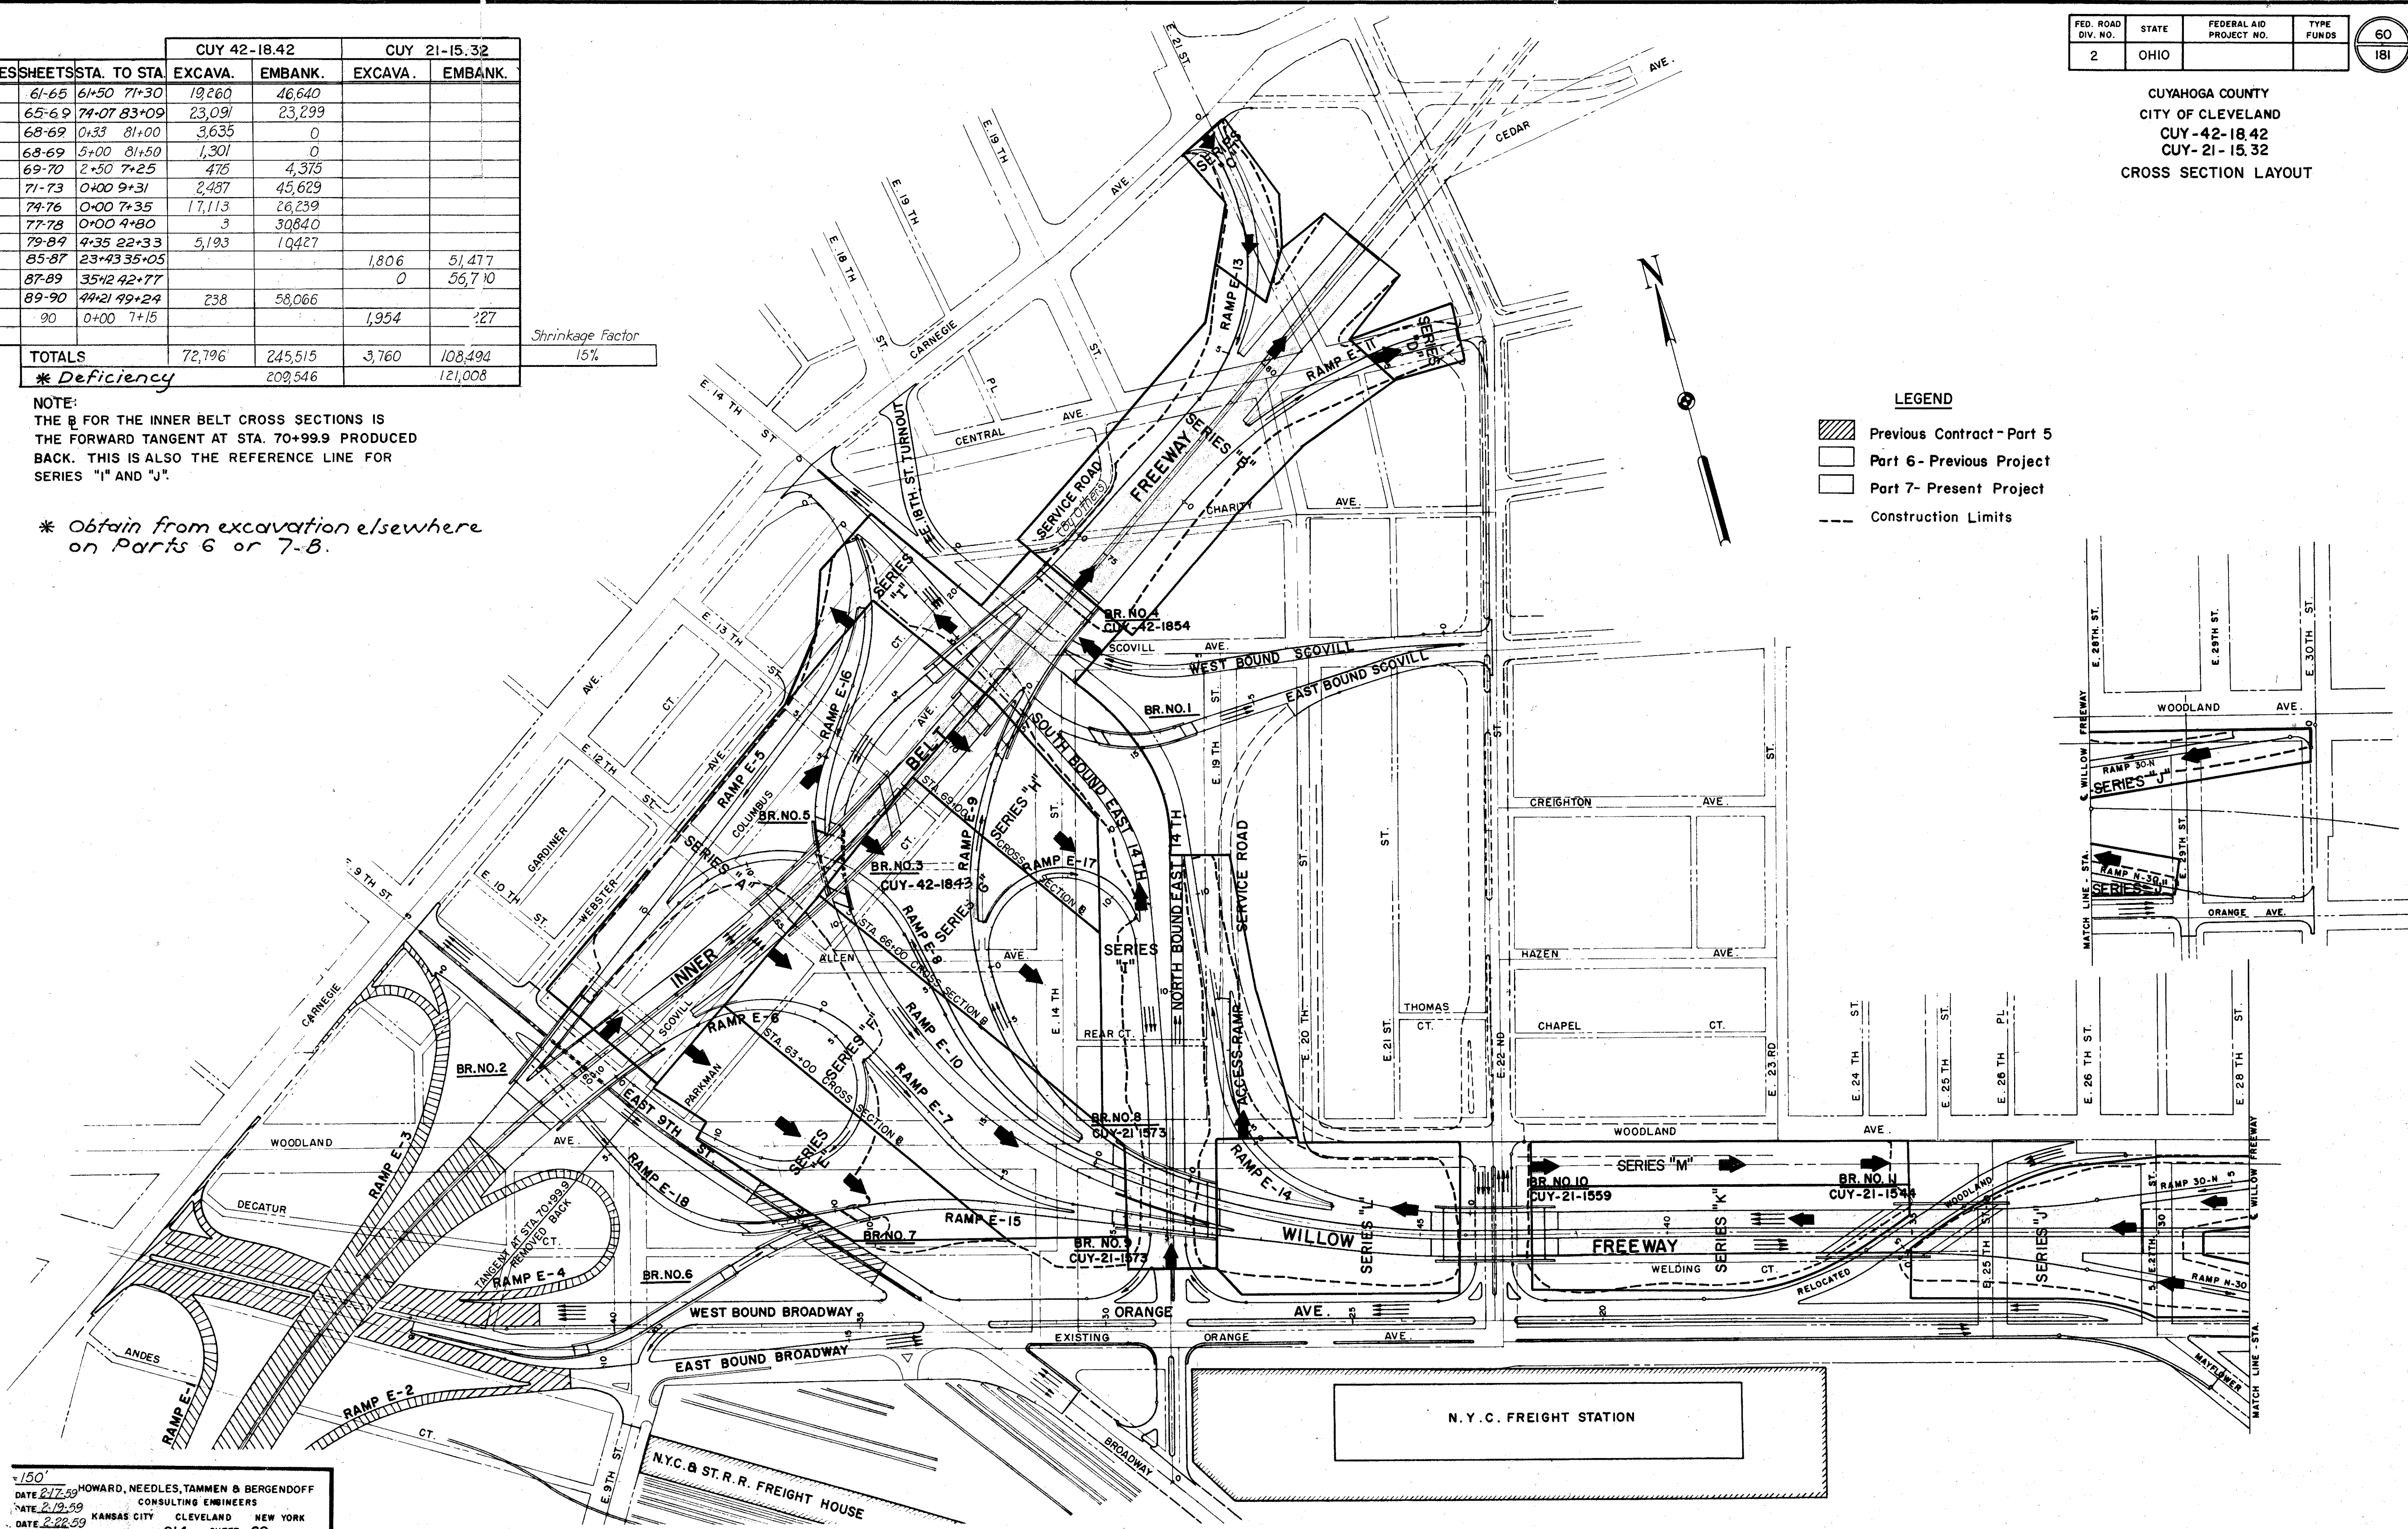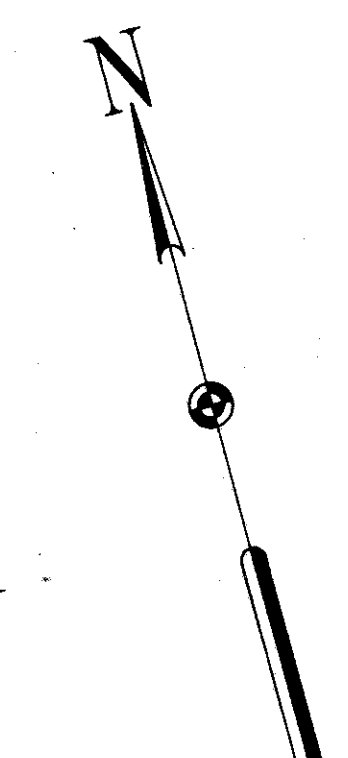

CUYAHOGA COUNTY
CITY OF CLEVELAND
CUY-42-18.42
CUY-21-15.32

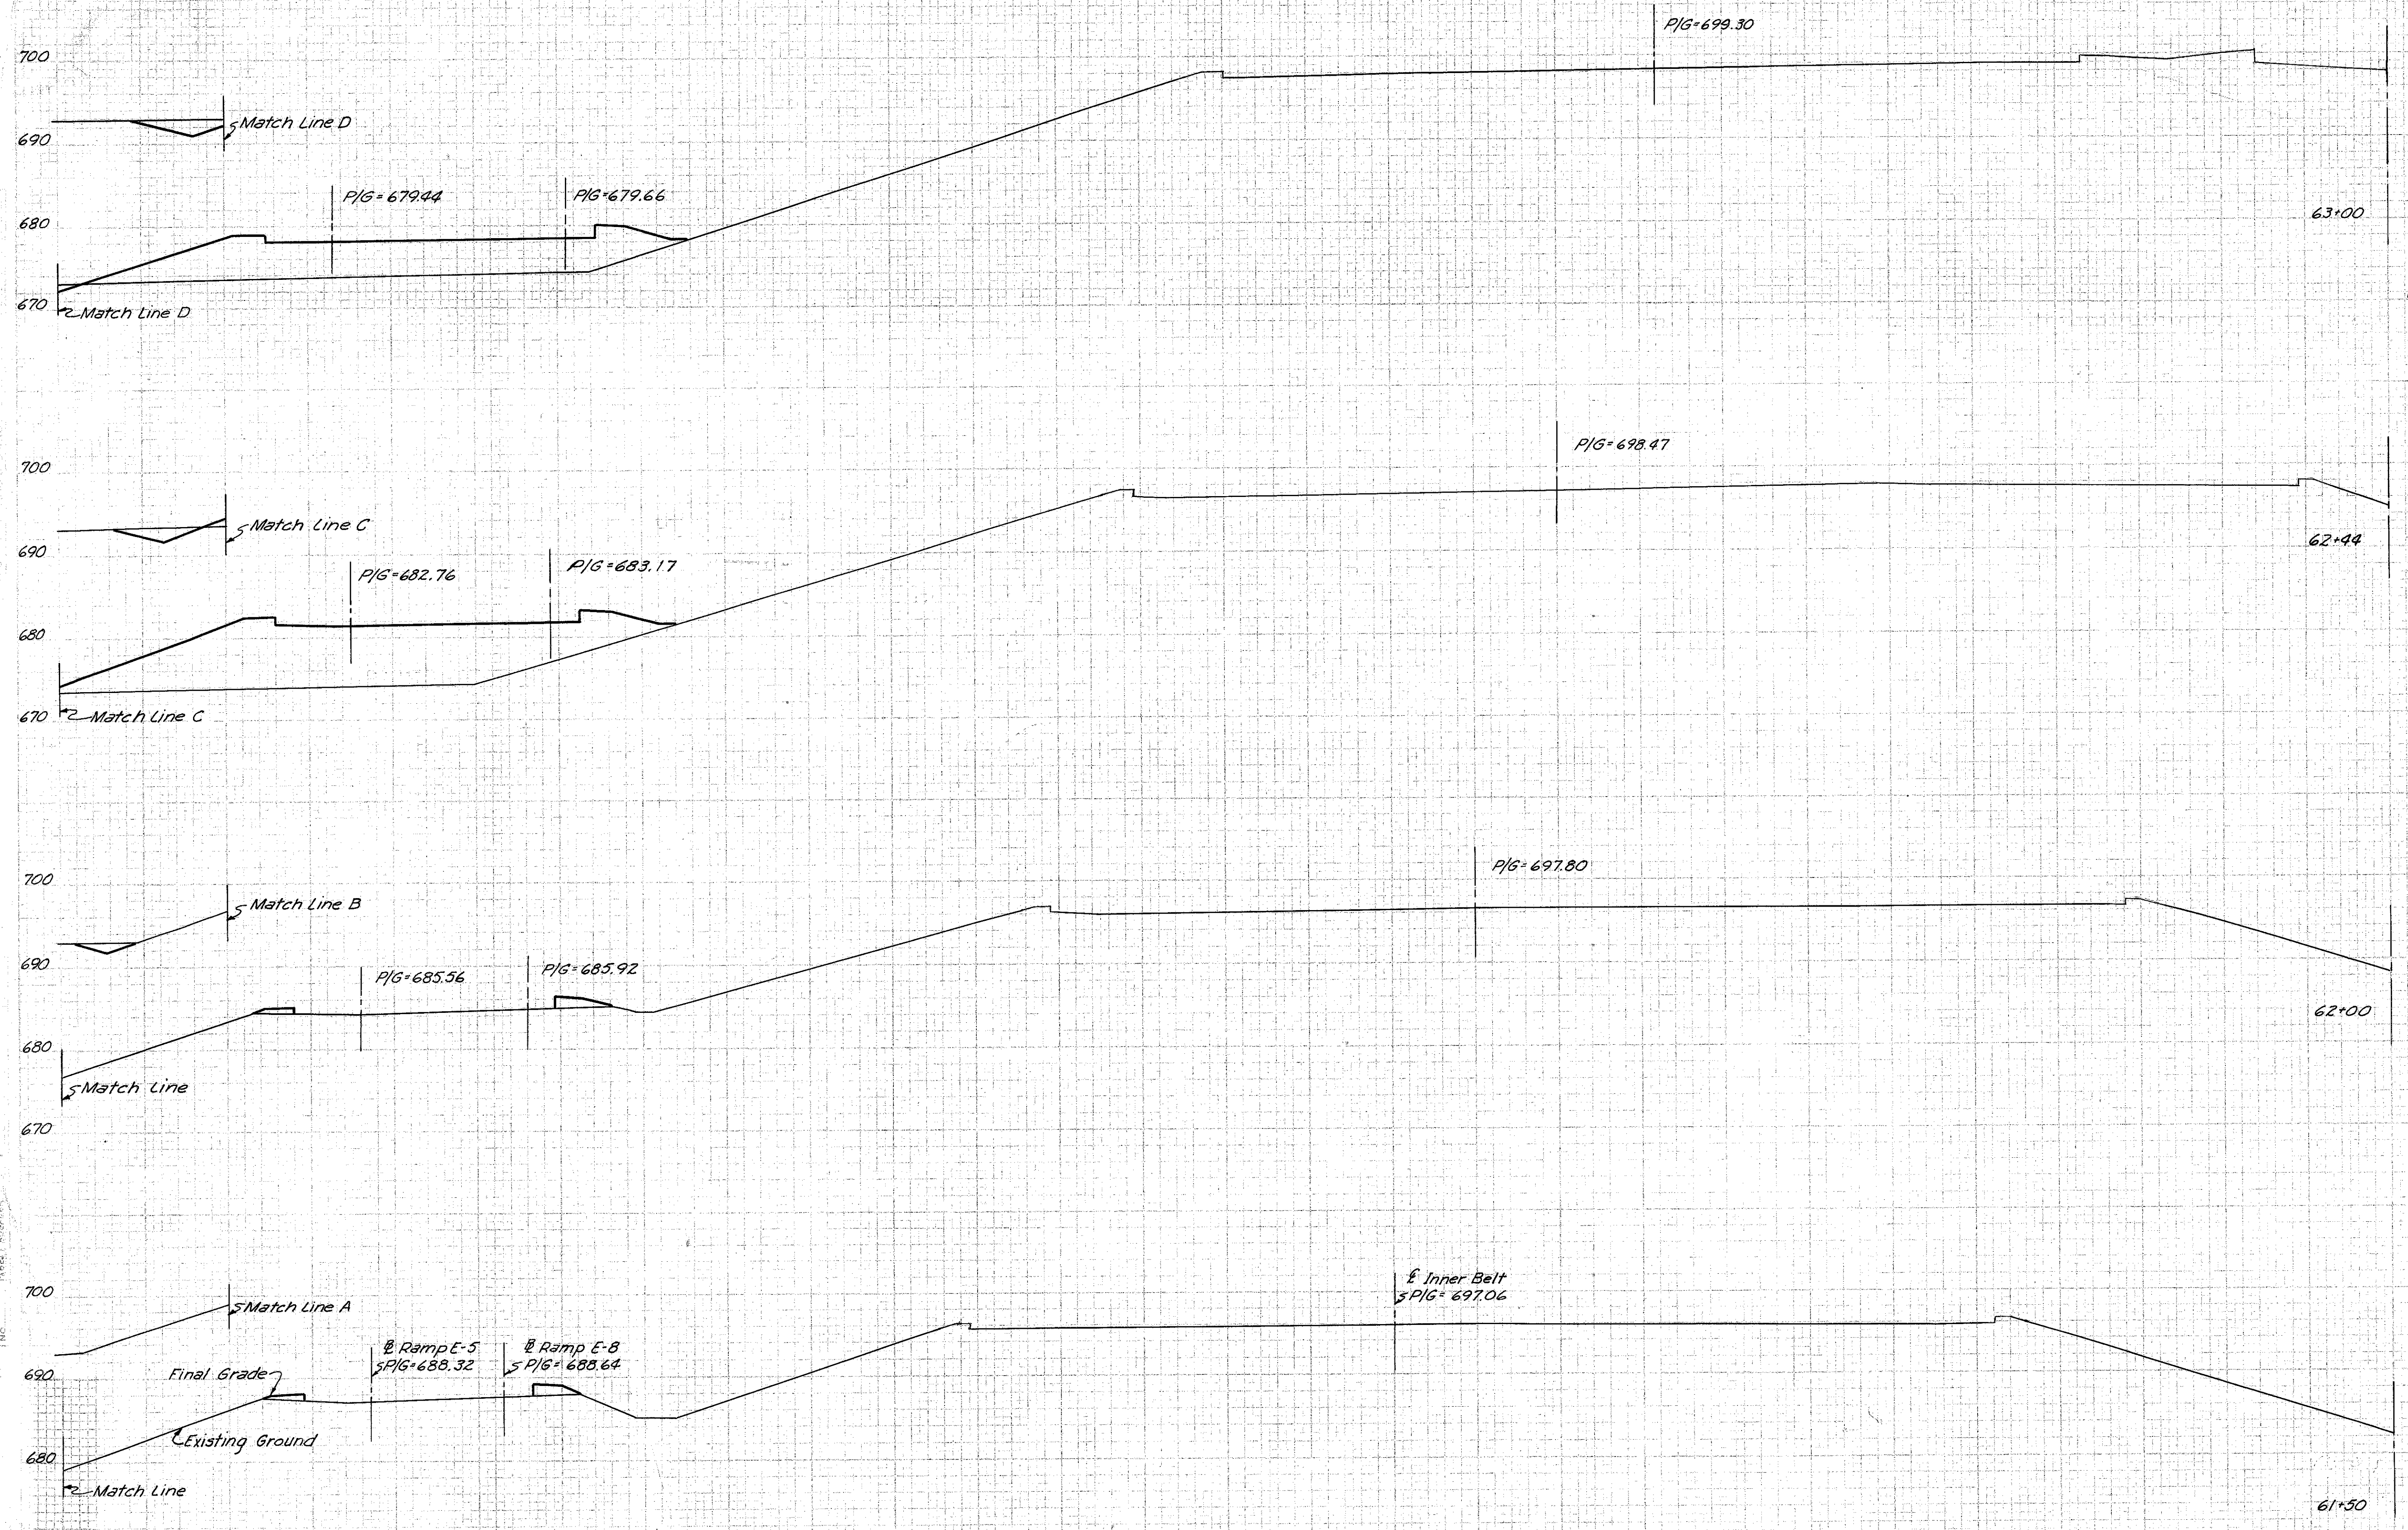

SEEDING		SUBBASE		EARTHWORK			
WIDTH	AREA	AREA	VOL.	END AREA		VOLUME	
L.F.	SQ. YD.	S.F.	C.Y.	EXC.	EMB.	EXC.	EMB.
				14	266		
						24	713
				9	422		
						11	351
				5	9		
						5	16
				0	8		


SERIES A
INNER BELT SECTIONS
STA 61+50 TO STA 63+00

SCALE: 1"=10'
MADE: 1-5-58 DATE: 8-6-58
TPO: 1-13-58 DATE: 1-3-58
CKD: 1-16-58 DATE: 1-23-58

HOWARD, NEEDLES, TAMMEN & BERGENOFF
CONSULTING ENGINEERS
KANSAS CITY CLEVELAND NEW YORK
914 SHEET 61

FED. ROAD DIV. NO.	STATE	FEDERAL AID PROJECT NO.	TYPE FUNDS	62 181
2	OHIO			

CUYAHOGA COUNTY
CITY OF CLEVELAND
CUY-42-18.42
CUY-21-15.32

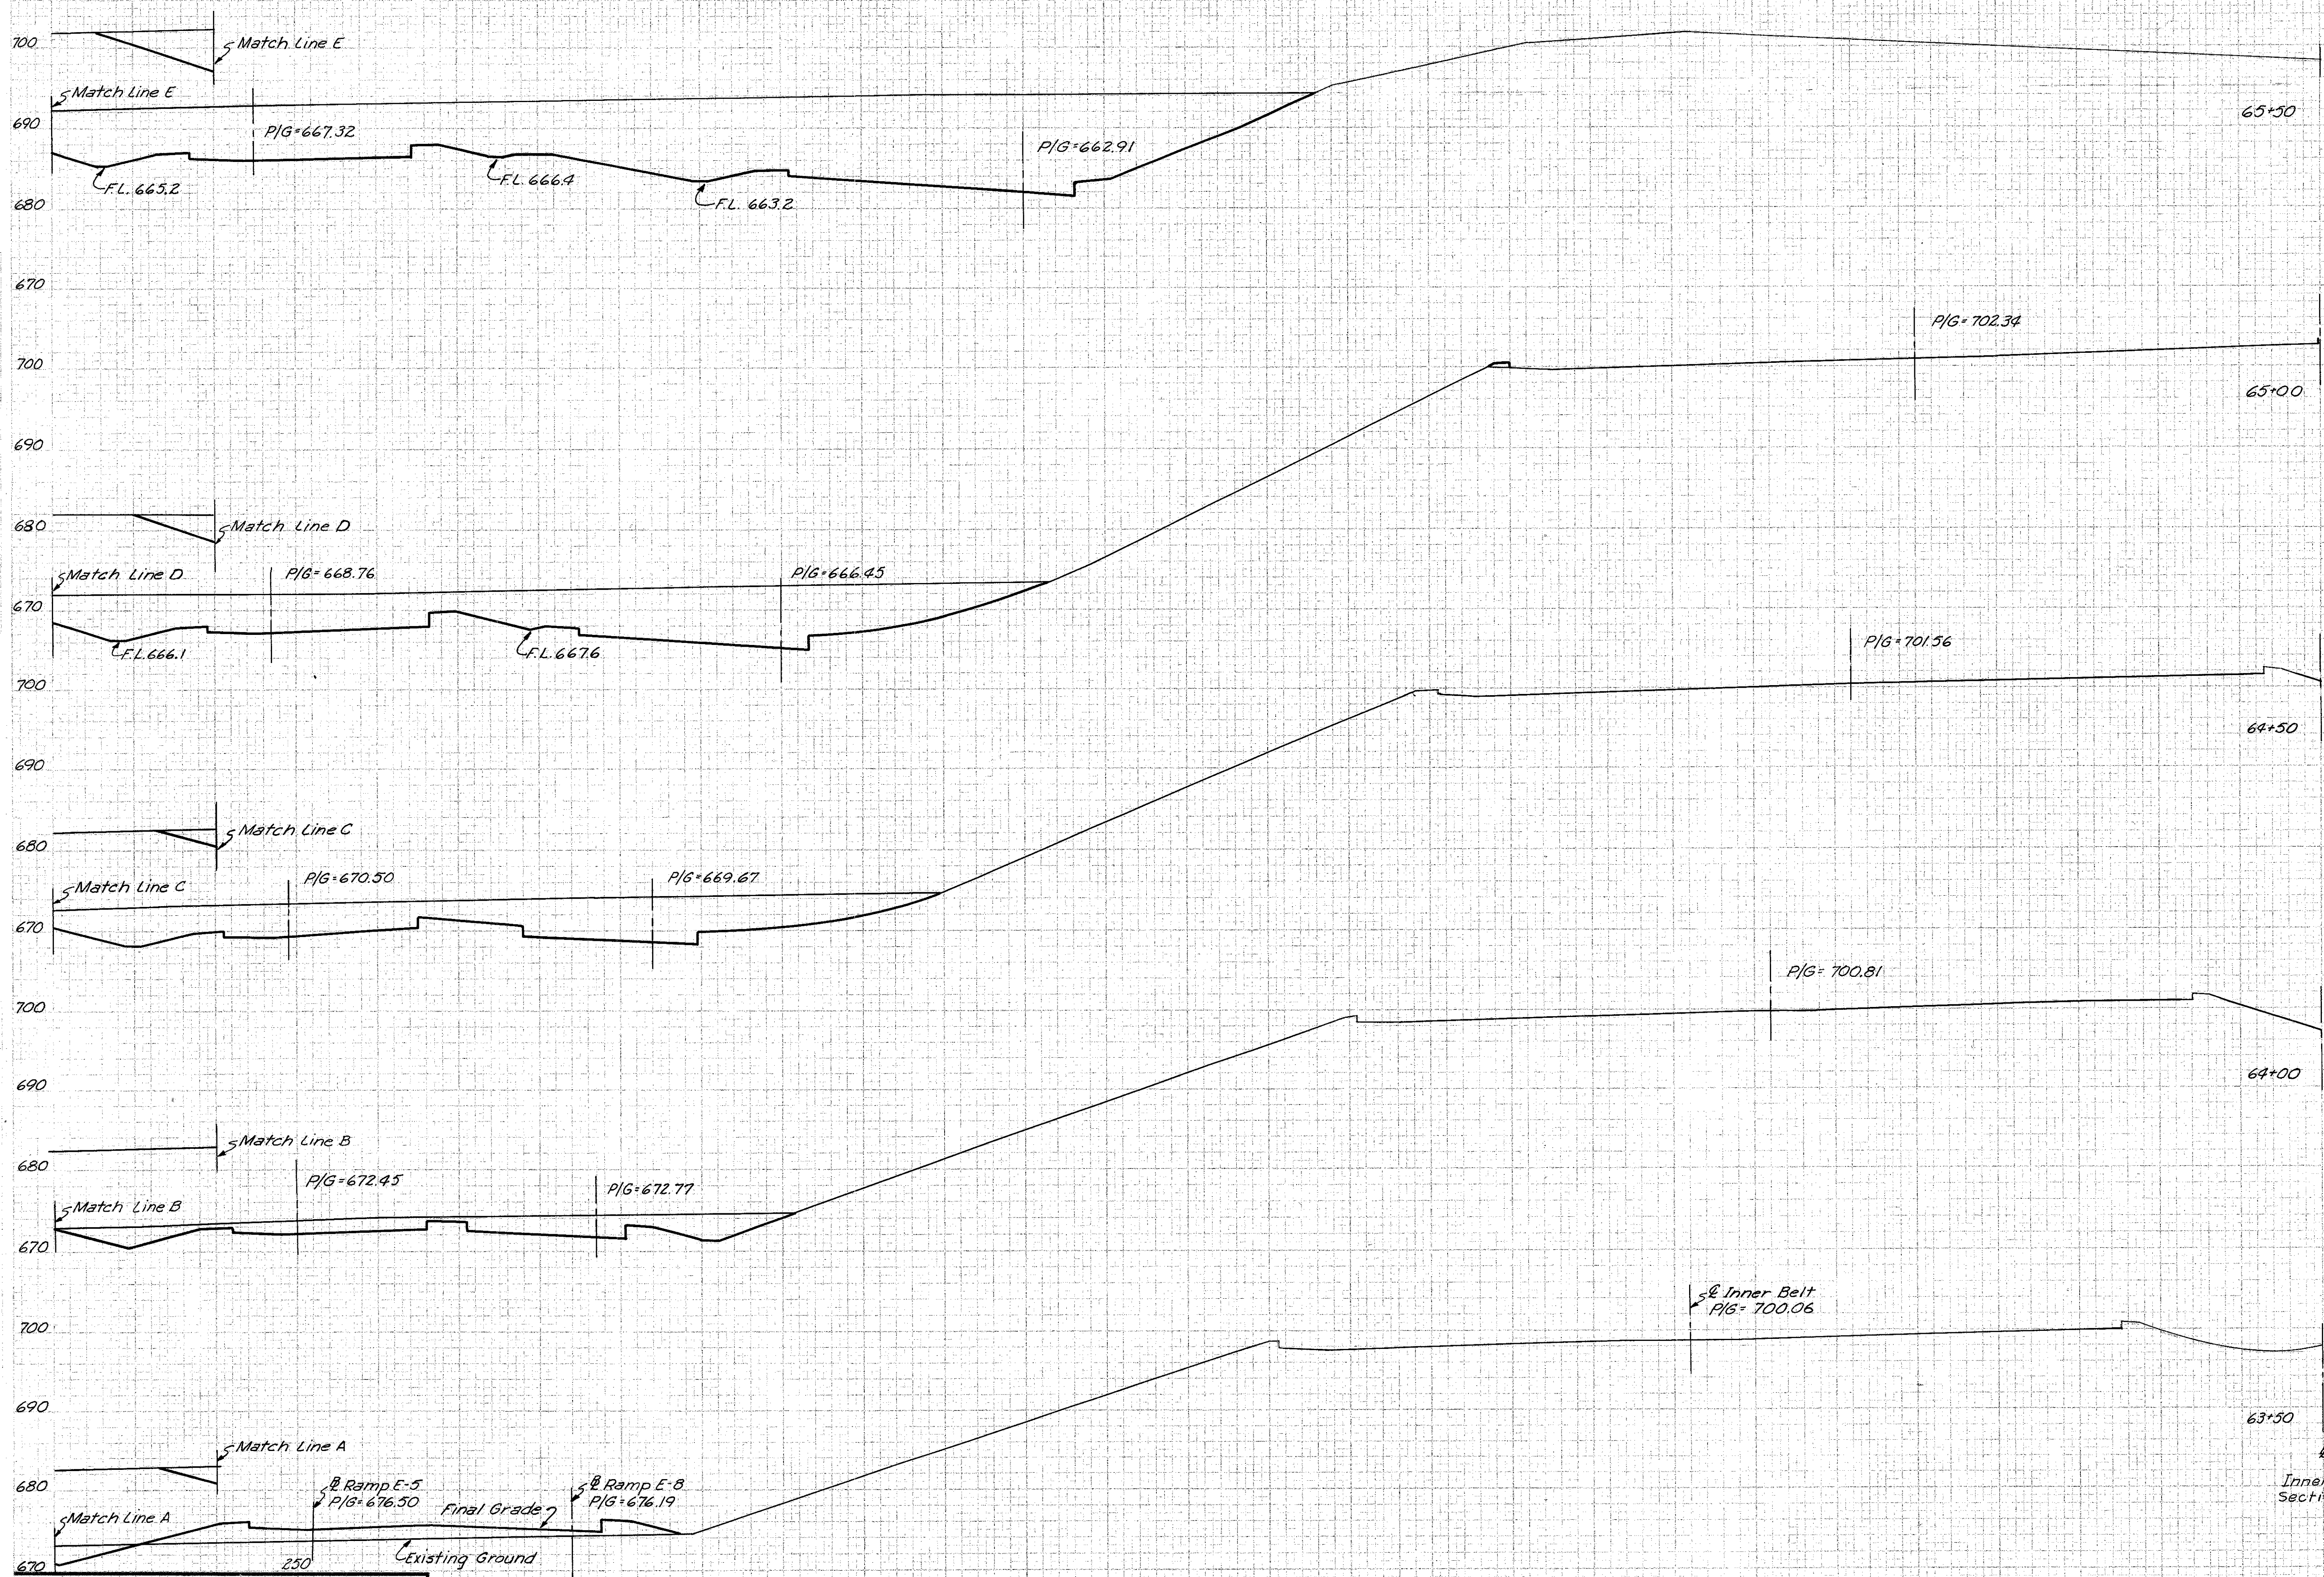

SEEDING		SUBBASE		EARTHWORK			
WIDTH	AREA	AREA	VOL.	END AREA		VOLUME	
L.F.	SQ. YD.	S.F.	C.Y.	EXC.	EMB.	EXC.	EMB.
				1285	0		
65+50						1775	2
65+00				632	2		
65+00						983	2
64+50							
64+50				430	0		
64+00							
64+00				150	0		
64+00						156	96
63+50				18	104		
63+50						26	343
63+00 (See Sheet 61)				14	266		

SERIES A
INNER BELT SECTIONS
STA. 63+50 TO STA. 65+50


SCALE 1"=10'
MADE FL.S. DATE 8-6-58 HOWARD, NEEDLES, TAMMEN & BERGENDOFF
TRCD. M.B. DATE 11-3-58 CONSULTING ENGINEERS
CKD. S.M.G. DATE 12-23-58 KANSAS CITY CLEVELAND NEW YORK
914 SHEET 62

Inner Belt
P/G-704.30

FED. ROAD DIV. NO.	STATE	FEDERAL AID PROJECT NO.	TYPE FUNDS
2	OHIO		

63
181

CUYAHOGA COUNTY
CITY OF CLEVELAND
CUY-42-18.42
CUY-21-15.32

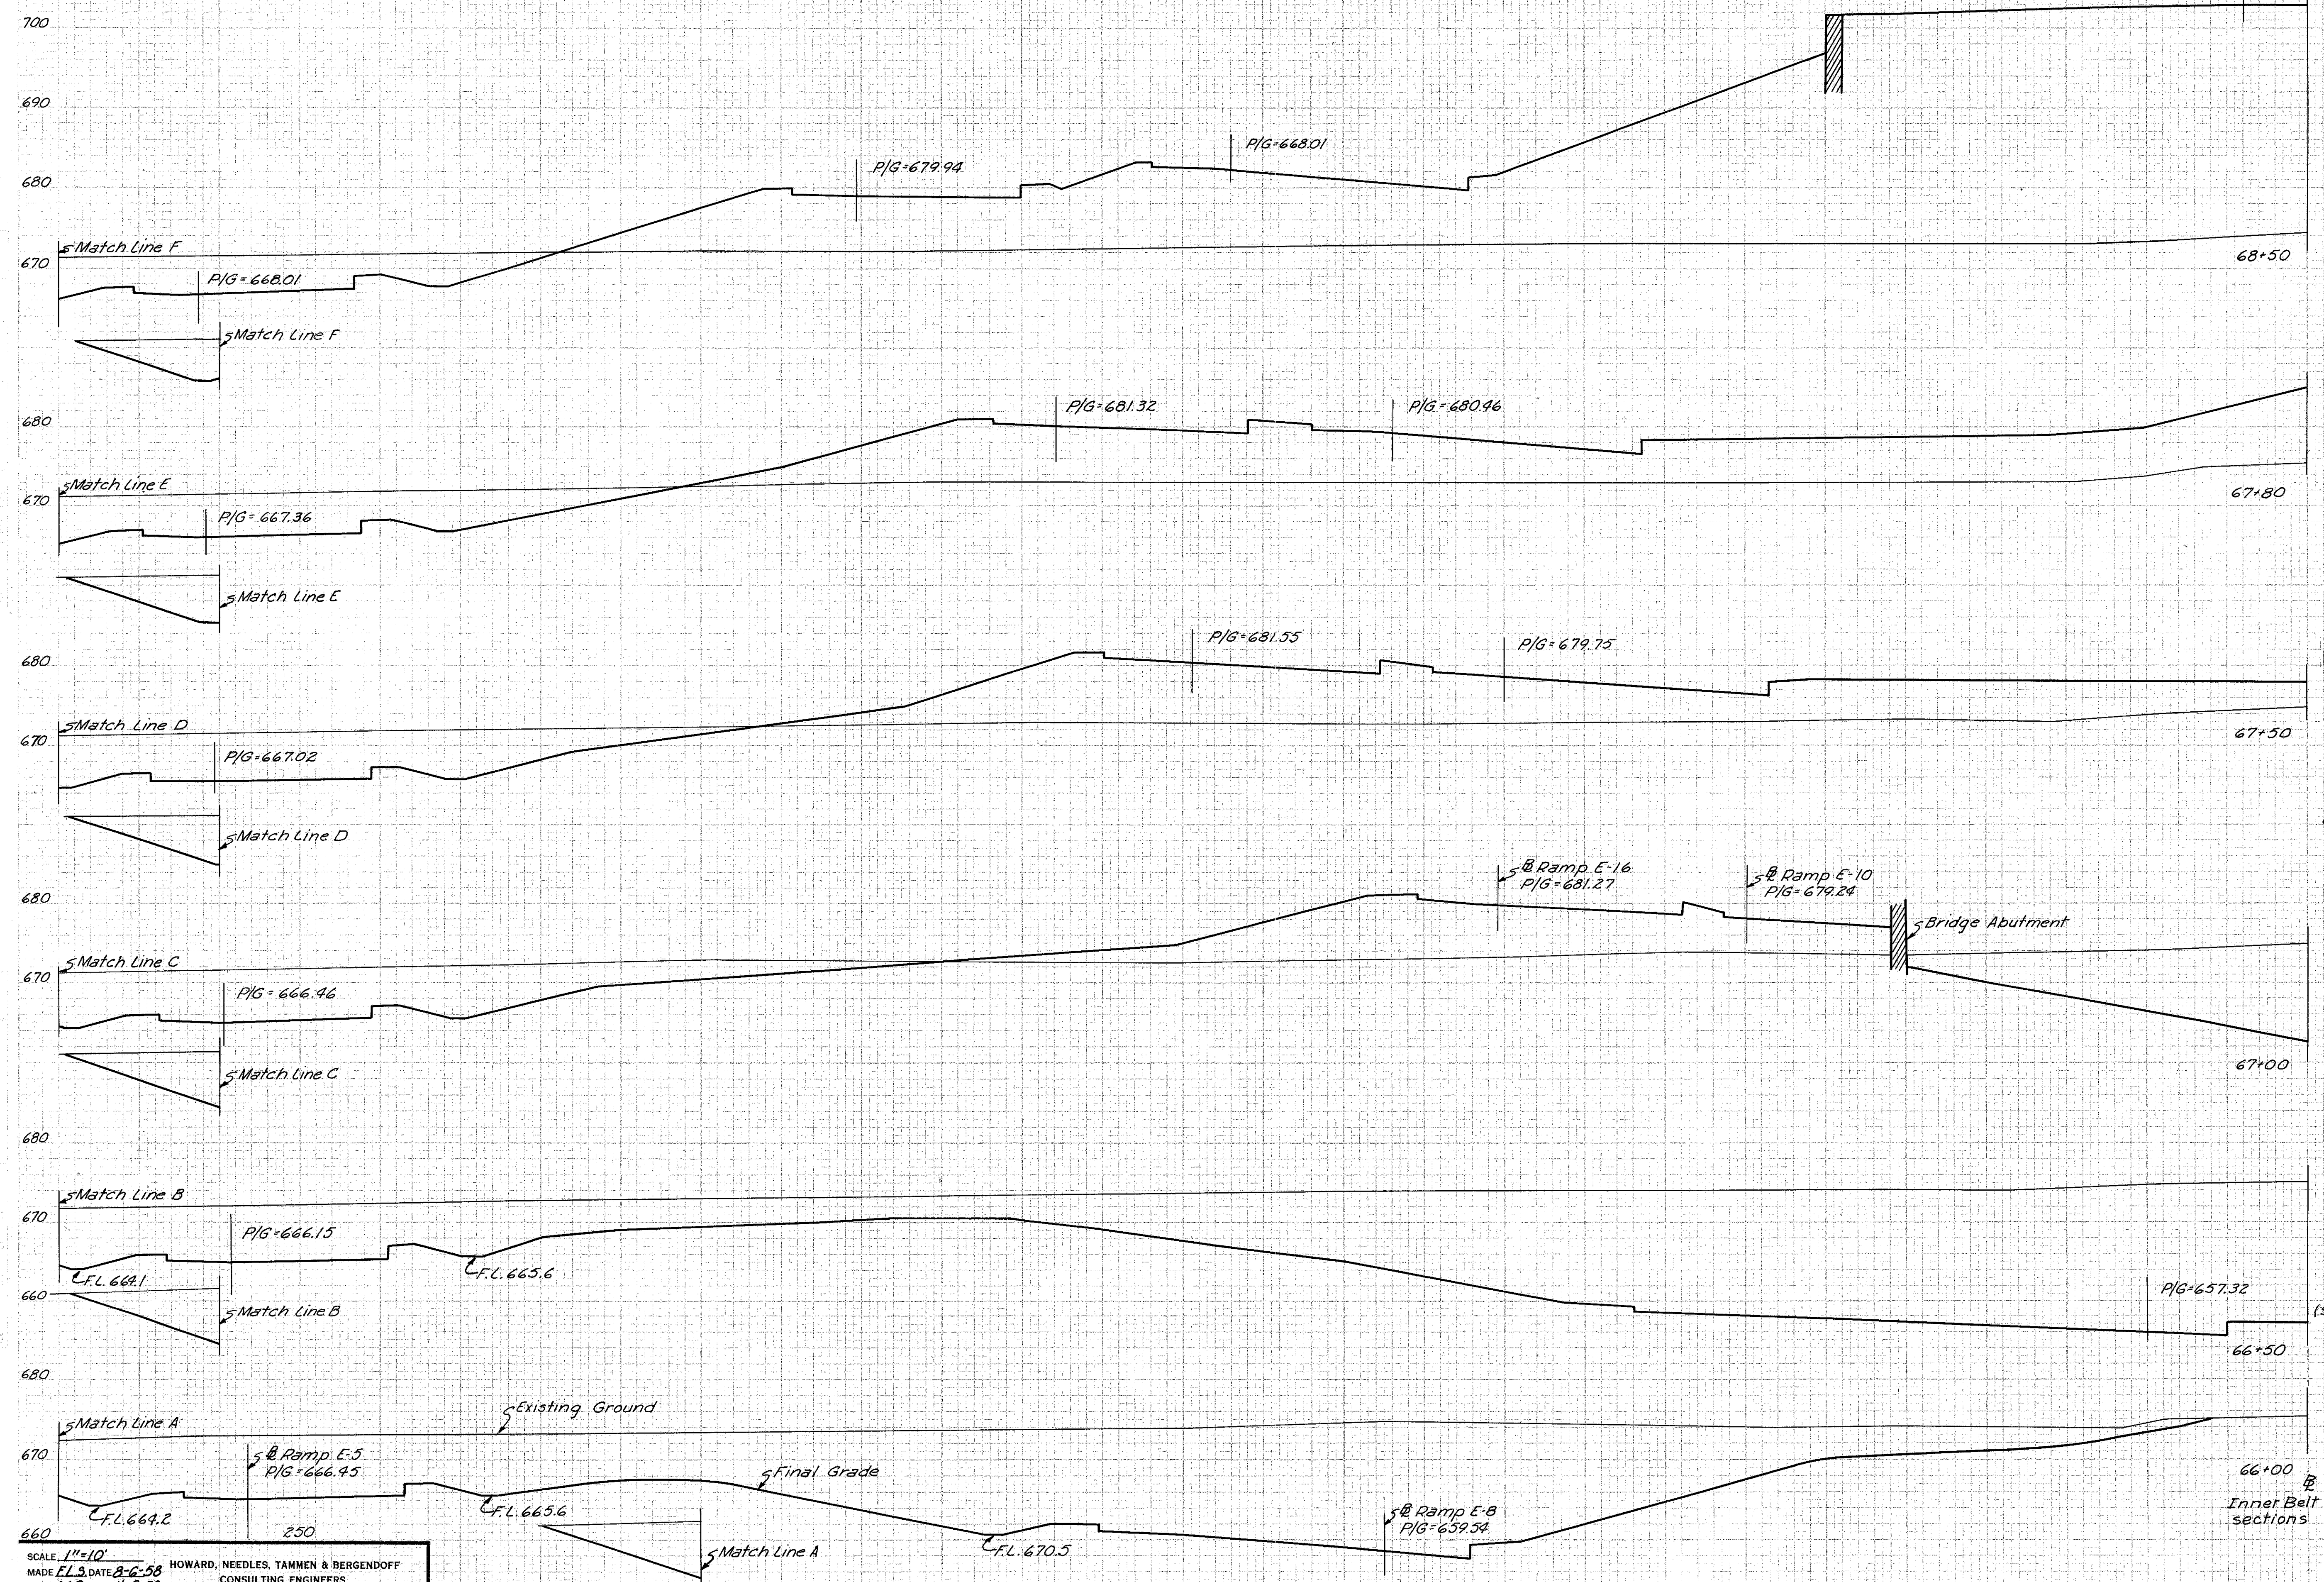

SEEDING		SUBBASE		EARTHWORK			
WIDTH	AREA	AREA	VOL.	END AREA		VOLUME	
L.F.	SQ. YD.	S.F.	C.Y.	EXC.	EMB.	EXC.	EMB.
						290	3250
						861	5734
						374	1173
						454	1196
						444	980
						1224	1404
						878	536
						3427	496
						2823	0
						4849	0
						2414	0
						3425	0
						1285	0


SERIES A
INNER BELT SECTIONS
STA. 66+00 TO STA. 68+50

SCALE 1"=10'
MADE F.L.S. DATE 8-6-58
TRCD. M.B. DATE 11-3-58
CKD. G.M.G. DATE 12-23-58

HOWARD, NEEDLES, TAMMEN & BERGENDOFF
CONSULTING ENGINEERS
KANSAS CITY CLEVELAND NEW YORK
914 SHEET 63

FED. ROAD DIV. NO.	STATE	FEDERAL AID PROJECT NO.	TYPE FUNDS	64 181
2	OHIO			

CUYAHOGA COUNTY
CITY OF CLEVELAND
CUY-42-18.42
CUY-21-15.32

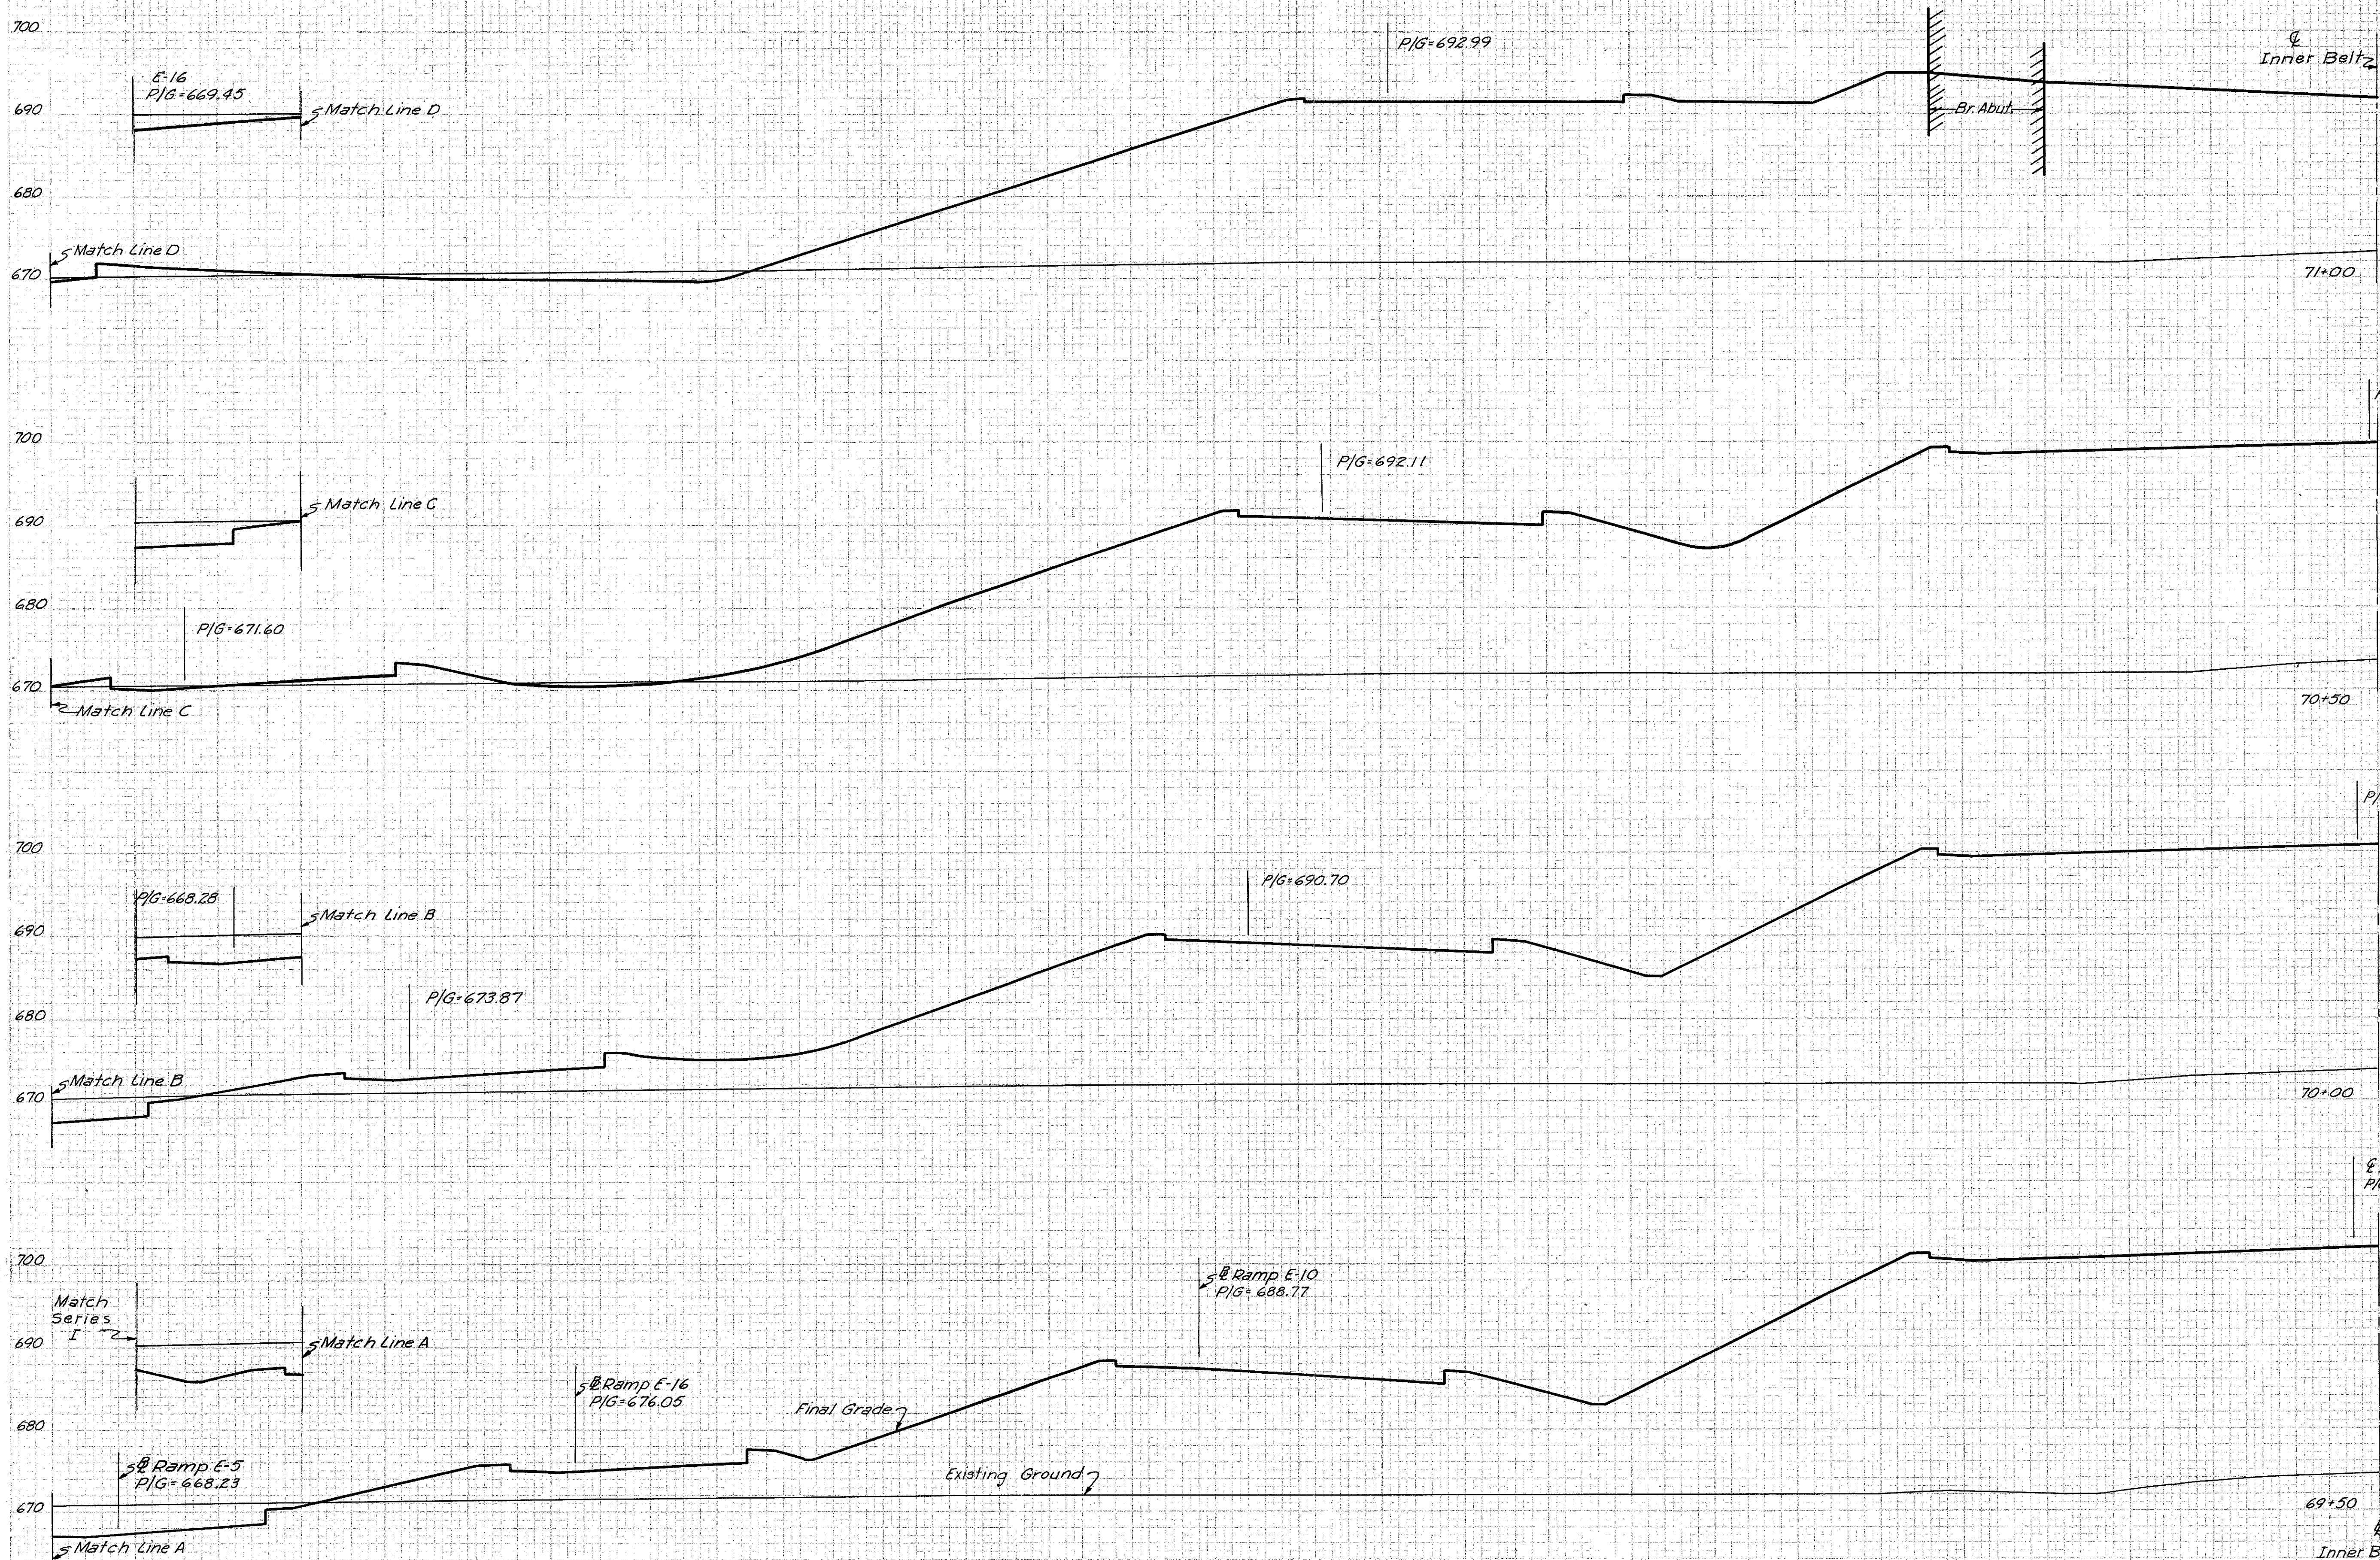

SEEDING		SUBBASE		EARTHWORK			
WIDTH	AREA	AREA	VOL.	END AREA	VOLUME		
L. F.	SQ. YD.	S. F.	C. Y.	EXC.	EMB.	EXC.	EMB.
				72	3352		
						109	6543
				46	3714		
						132	6985
				27	3830		
						268	7032
				192	3765		
						893	12991
				290	3250		


SERIES A
INNER BELT SECTIONS
STA. 69+50 TO STA. 71+00

SCALE 1"=10'
MADE E.L.S. DATE 2-6-58
TRCD. M.B. DATE 11-3-58
CKD. Q.M.G. DATE 12-23-58


HOWARD, NEEDLES, TAMMEN & BERGENDOFF
CONSULTING ENGINEERS
KANSAS CITY CLEVELAND NEW YORK
914 SHEET 64

200 150 100 50 0

FED. ROAD DIV. NO.	STATE	FEDERAL AID PROJECT NO.	TYPE FUNDS
2	OHIO		

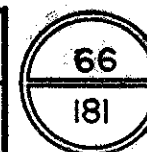

CUYAHOGA COUNTY
CITY OF CLEVELAND
CUY-42-18.42
CUY-21-15.32

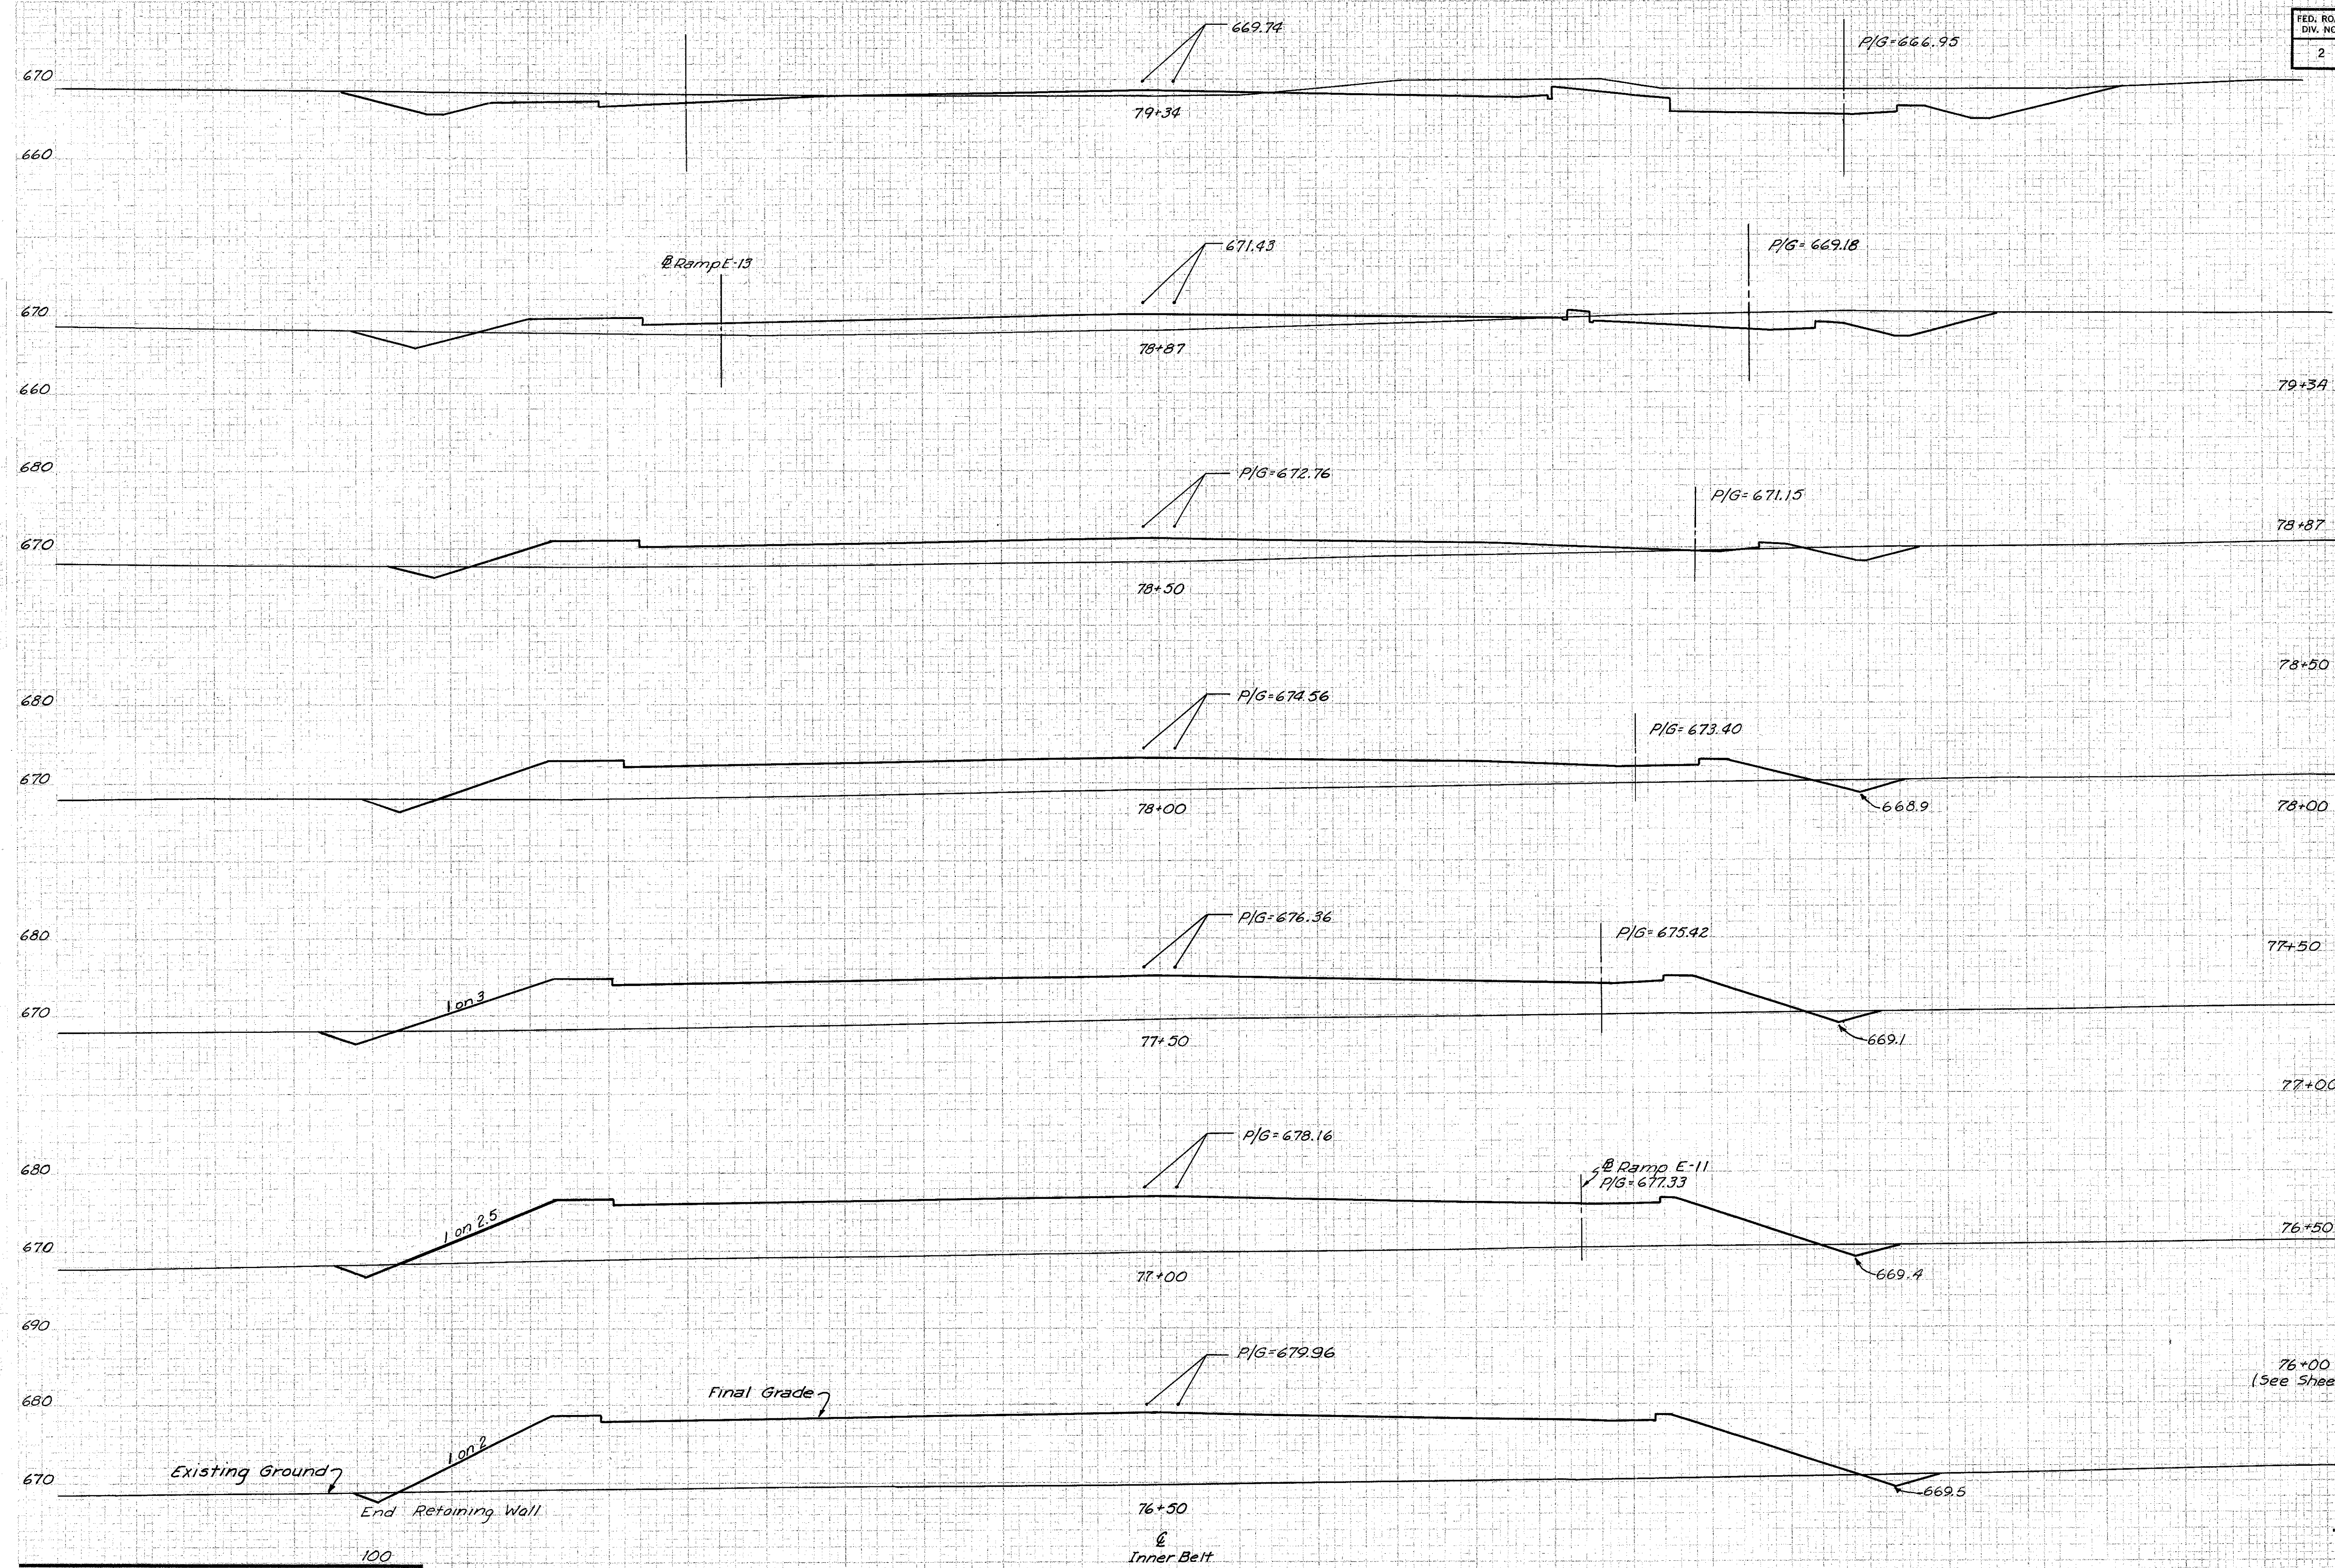

SEEDING		SUBBASE		EARTHWORK			
WIDTH	AREA	AREA	VOL.	END AREA		VOLUME	
L.F.	SQ. YD.	S.F.	C.Y.	EXC.	EMB.	EXC.	EMB.
						324	18
							377 191
				109	202		
						90	378
				23	349		
						31	877
				10	598		
						16	1344
				7	854		
						14	1834
				8	1127		
						15	2320
				8	1379		
						15	2667
				8	1501		

SERIES B
INNER BELT SECTIONS
STA. 76+50 TO STA. 79+34

SCALE 1"=10'
MADE F.L.S. DATE 8-7-58
TRCD. M.B. DATE 11-4-58
CKD. G.M.G. DATE 12-23-58


HOWARD, NEEDLES, TAMMEN & BERGENDOFF
CONSULTING ENGINEERS
KANSAS CITY CLEVELAND NEW YORK

914 SHEET 66

50 0 50 100

FED. ROAD DIV. NO.	STATE	FEDERAL AID PROJECT NO.	TYPE FUNDS	67
2	OHIO			181

CUYAHOGA COUNTY
CITY OF CLEVELAND
CUY-42-18.42
CUY-21-15.32

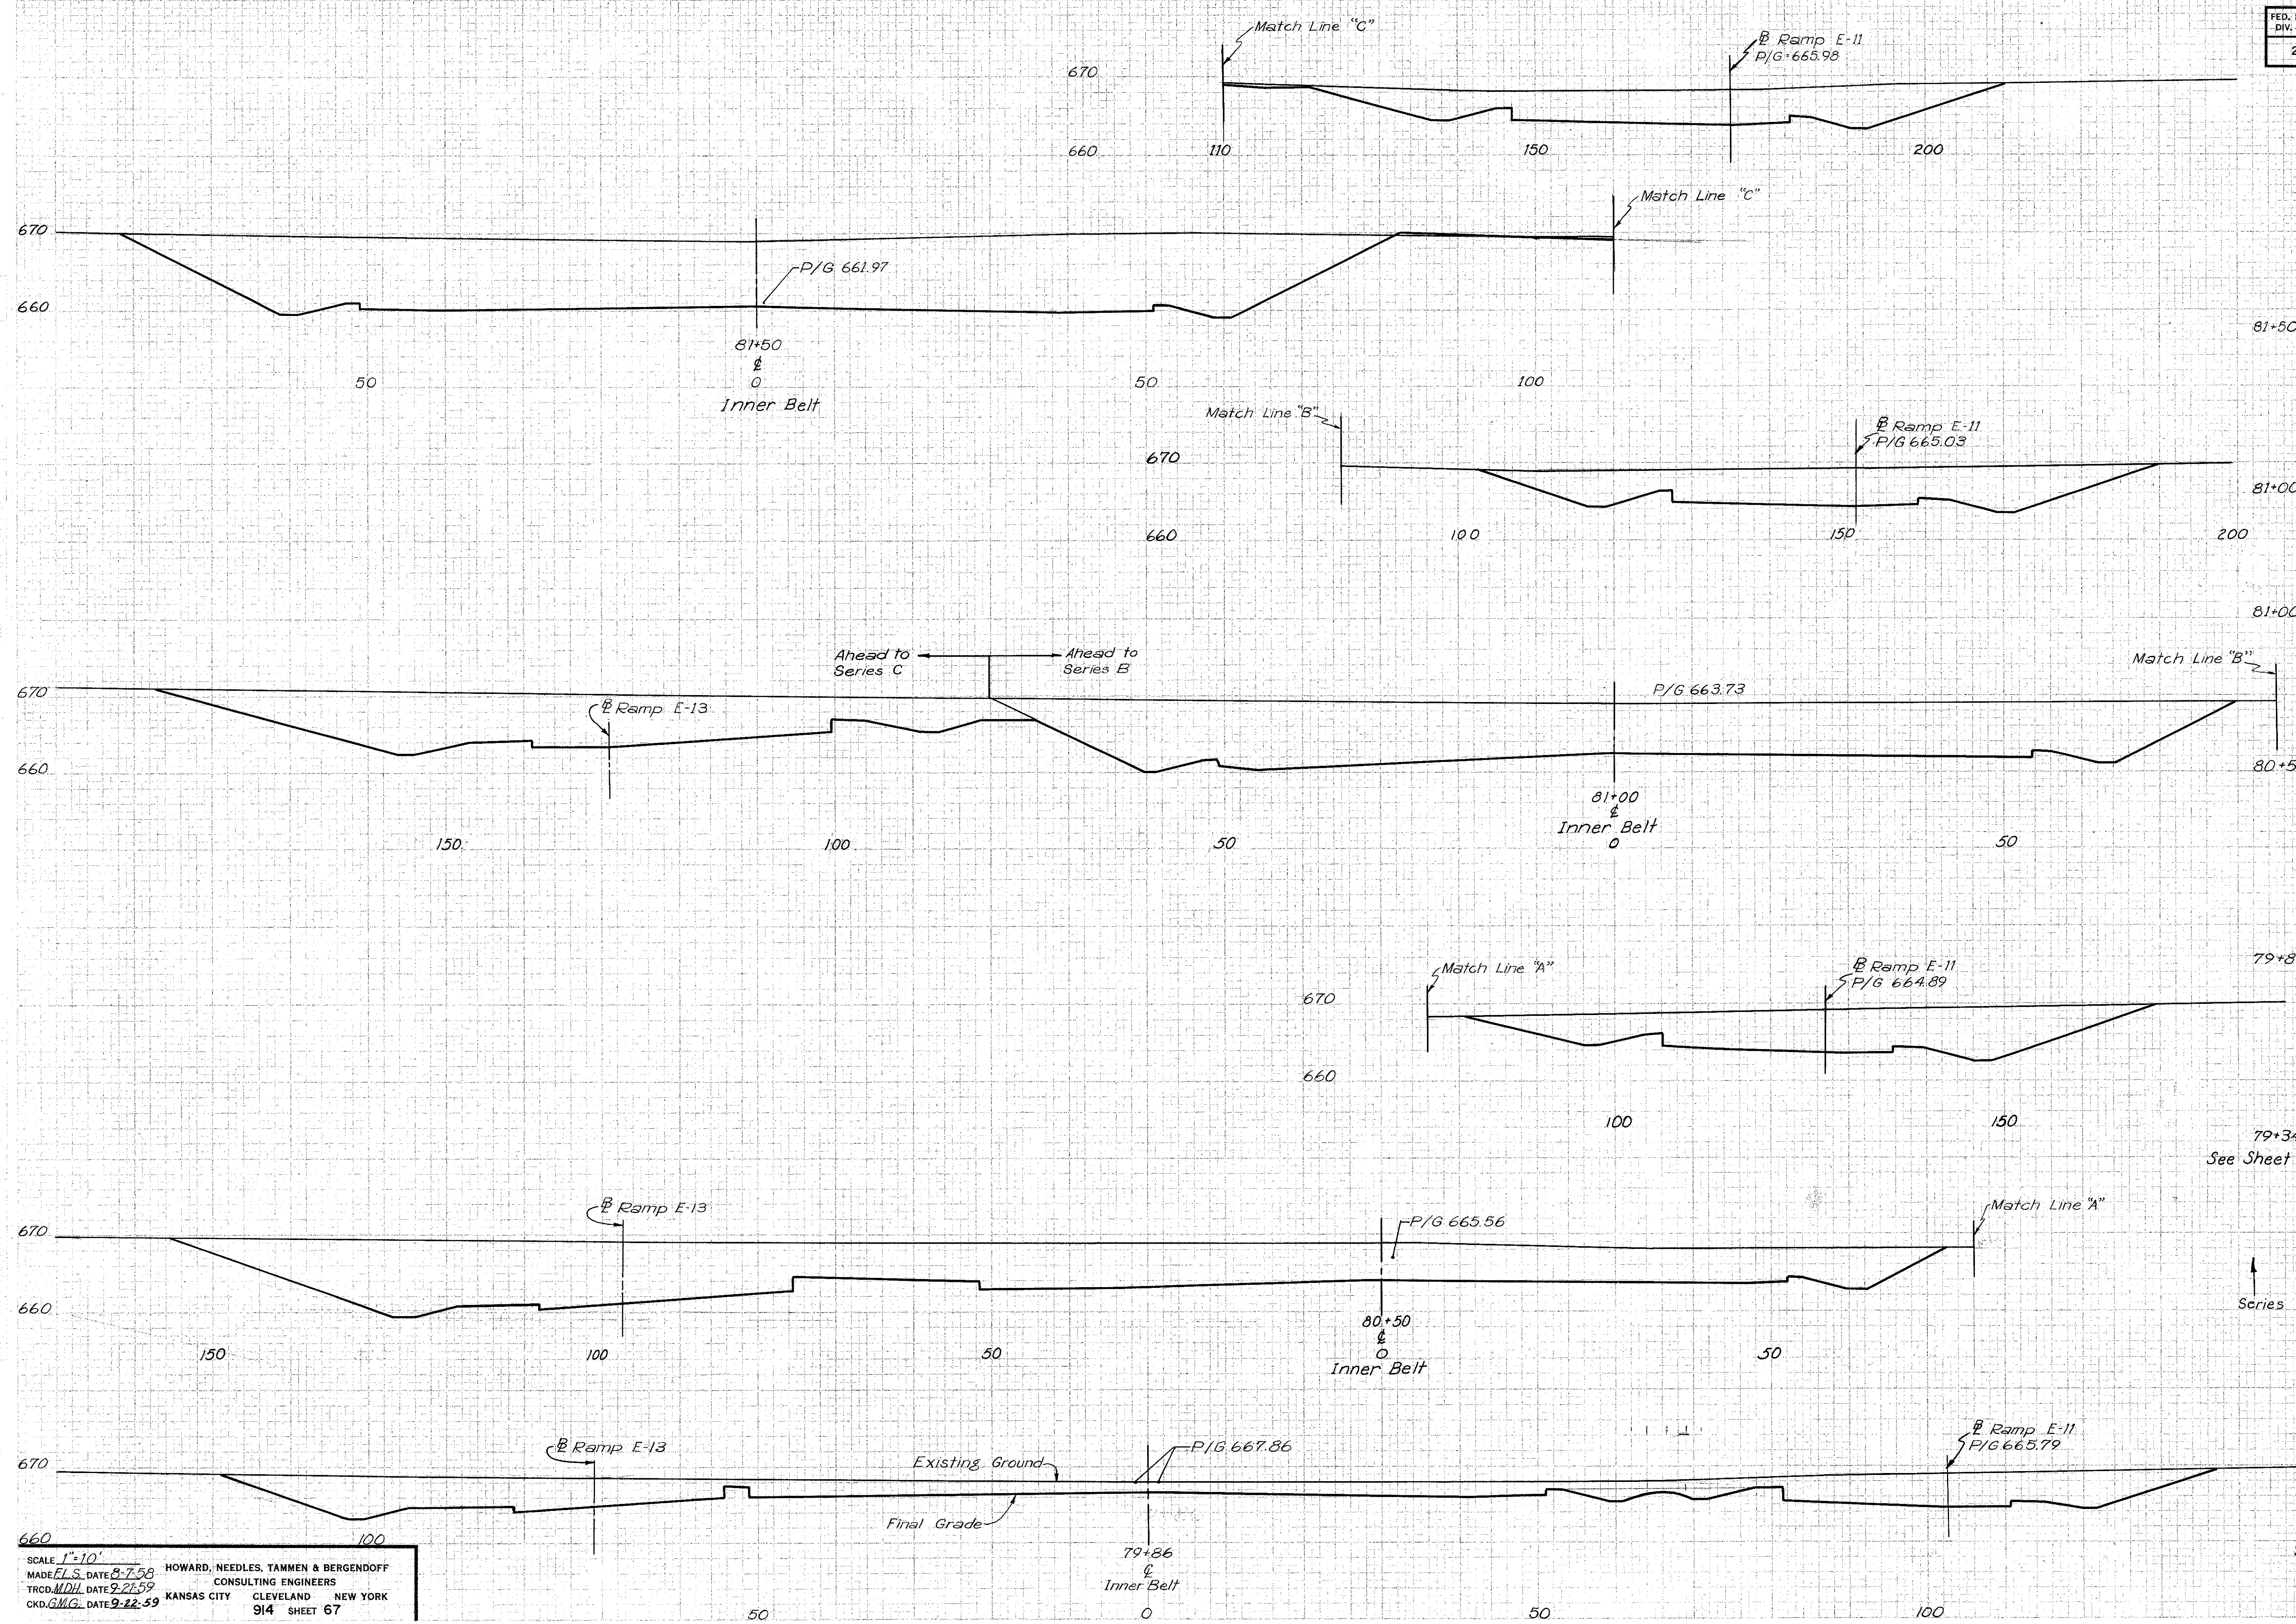

SEEDING	SUBBASE		EARTHWORK					
	WIDTH	AREA	AREA	VOL.	END AREA		VOLUME	
L.F.	SQ. YD.	S.F.	C.Y.	EXC.	EMB.	EXC.	EMB.	
						1720	0	
								2933
						1448	0	
								2010
								3740
						1687	0	
								2874
								738
								1023
						324	18	

SERIES B
INNER BELT SECTIONS
STA. 79+86 TO STA. 81+50


SCALE 1"=10'
MADE F.L.S. DATE 8-7-58
TRCD. M.D.H. DATE 9-21-59
CKD. G.M.G. DATE 9-22-59

HOWARD, NEEDLES, TAMMEN & BERGENDOFF
CONSULTING ENGINEERS
KANSAS CITY CLEVELAND NEW YORK
914 SHEET 67

FED. ROAD DIV. NO.	STATE	FEDERAL AID PROJECT NO.	TYPE FUNDS
2	OHIO		

70
181

CUYAHOGA COUNTY
CITY OF CLEVELAND
CUY-42-18.42
CUY-21-15.32

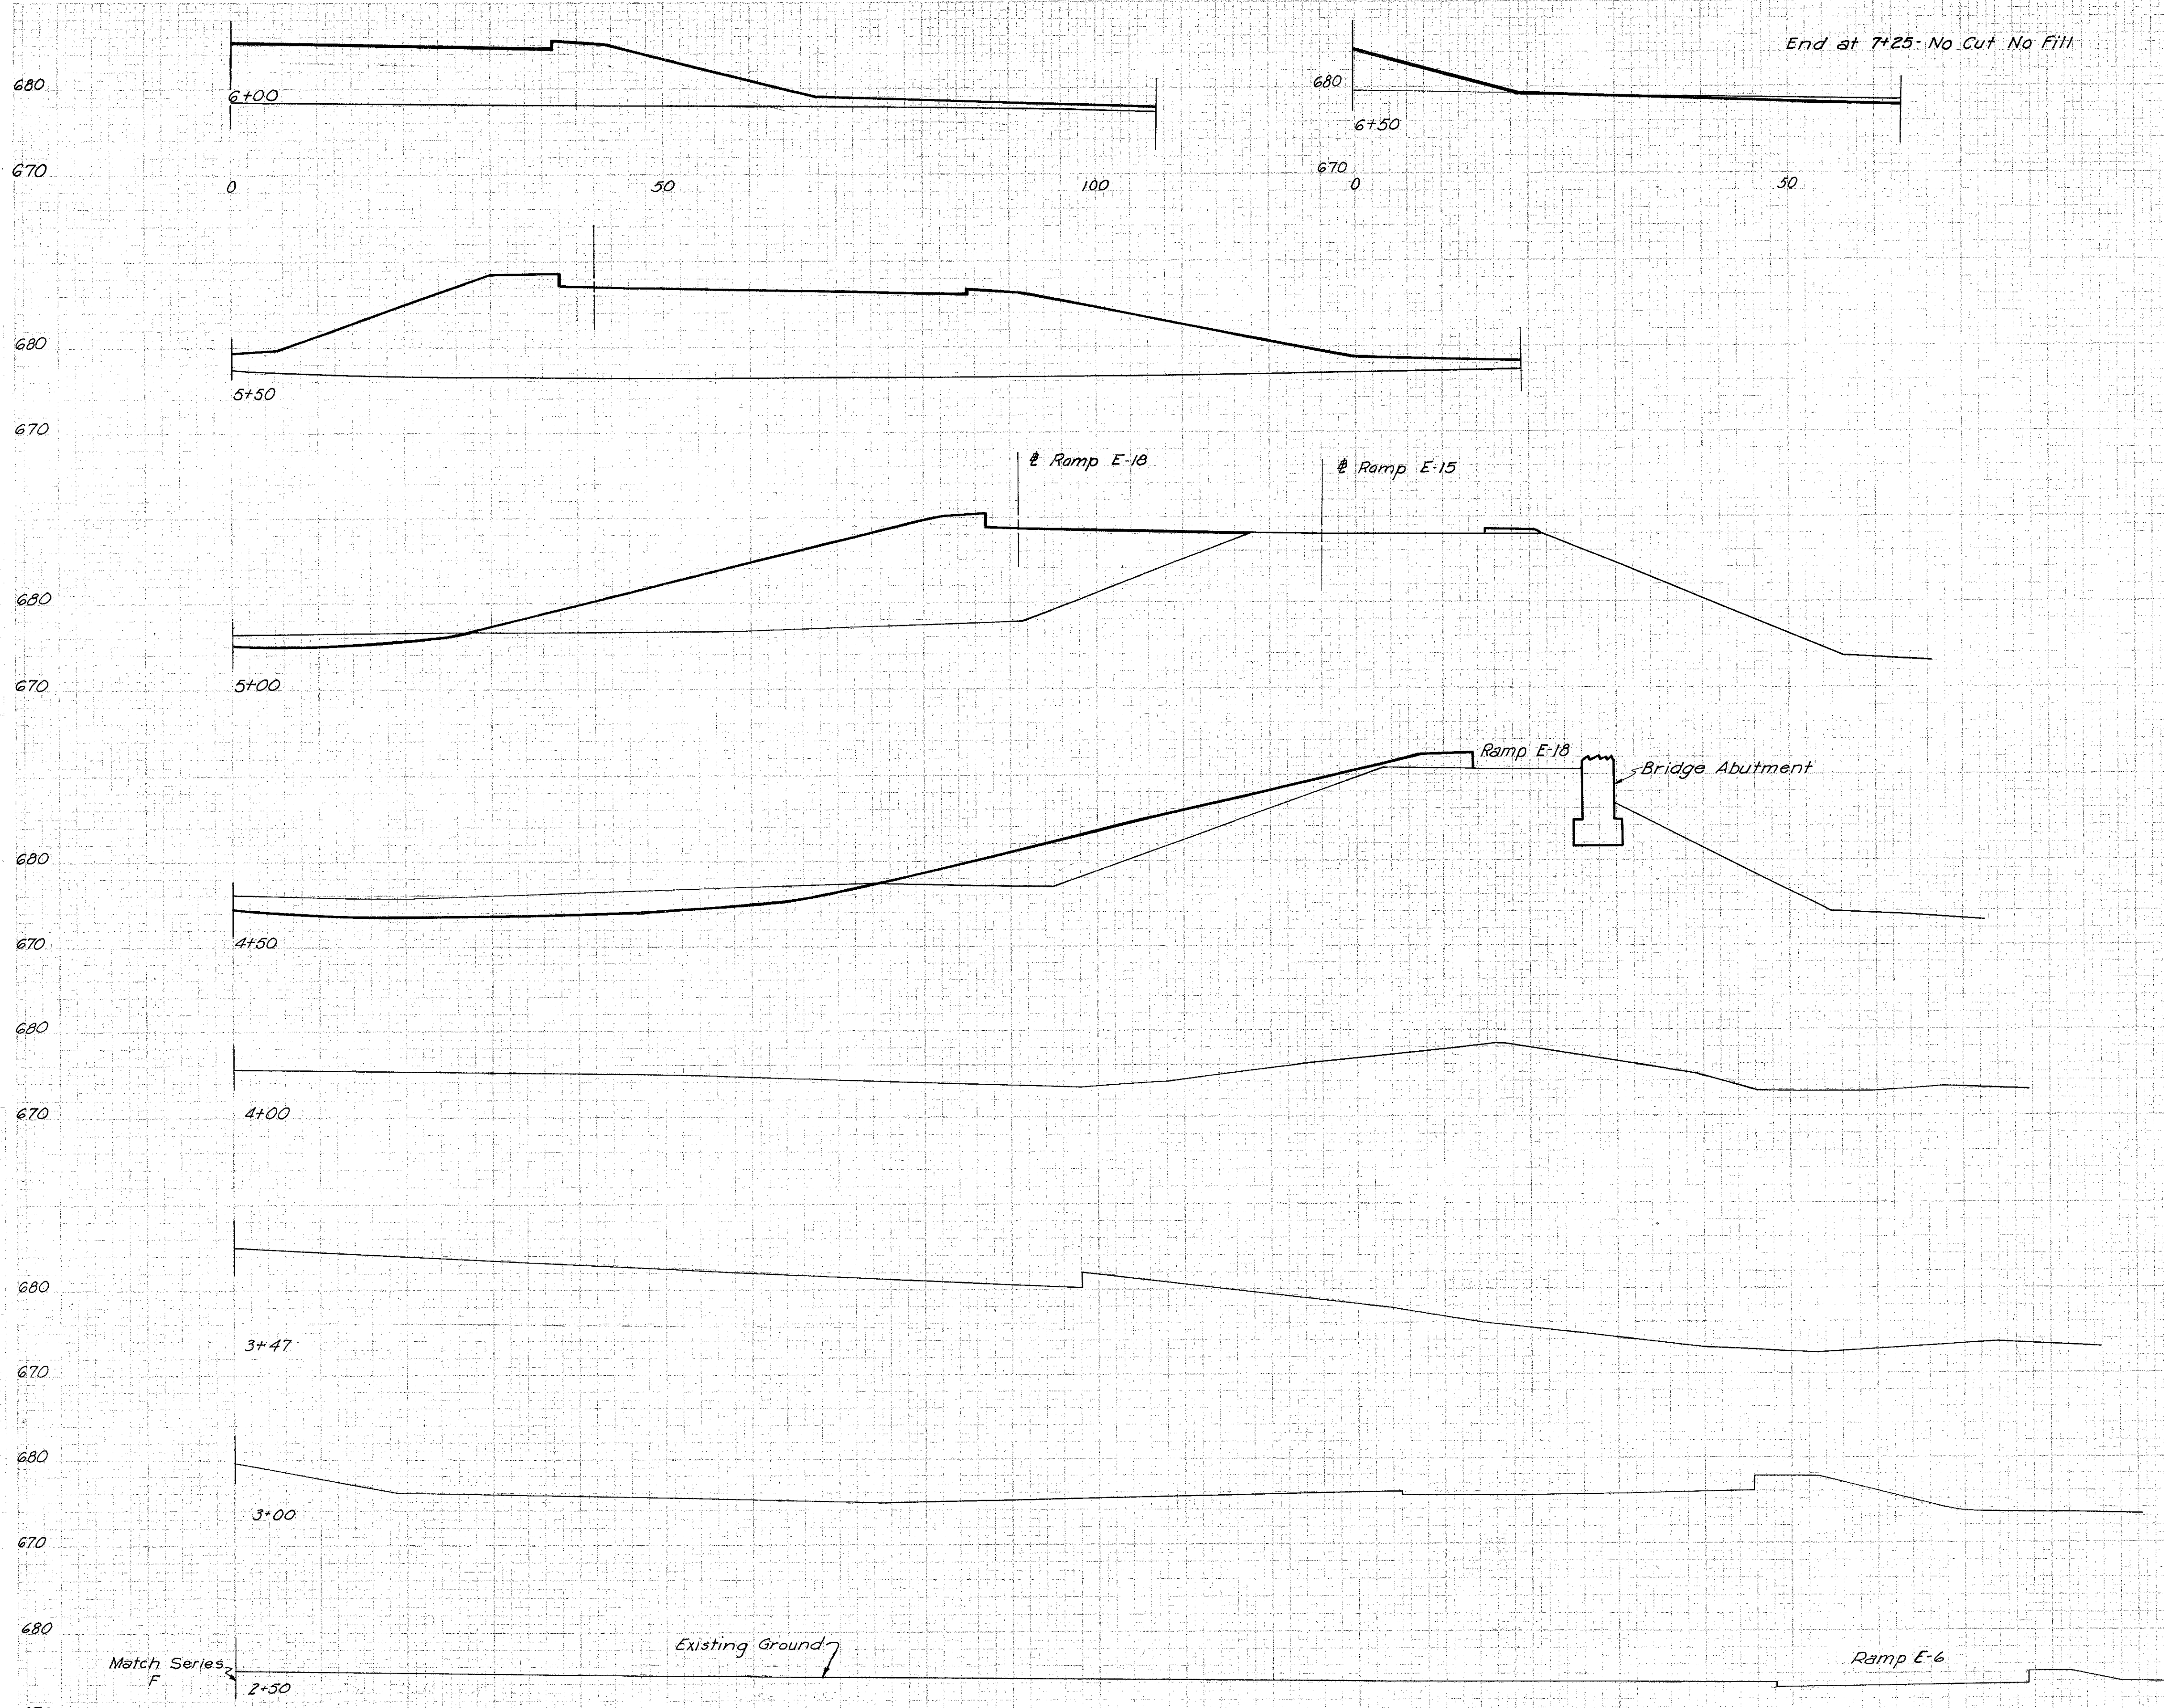

STATION	SEEDING		SUBBASE		EARTHWORK			
	WIDTH L.F.	AREA SQ.YD.	AREA S.F.	VOL. C.Y.	END AREA EXC.	AREA EMB.	VOLUME EXC.	VOLUME EMB.
7+25					0	0		
6+50					13	49	12	68
6+00					0	426		440
5+50					0	1079	0	1394
5+00					32	617	30	1570
4+50					158	179	269	737
4+00					0	0	146	166
3+47					0	0	0	0
3+00					0	0	0	0
2+50					0	0	0	0

SERIES E
SECTIONS RIGHT OF STA. 63+00 B INNER BELT
STA. 2+50 TO STA. 7+25


SCALE: 1" = 10'
MADE C.L.S. DATE 8-6-58
TRCD. M.D. DATE 11-10-58
CKD. R.W.S. DATE 12-10-58

HOWARD, NEEDLES, TAMMEN & BERGENDOFF
CONSULTING ENGINEERS
KANSAS CITY CLEVELAND NEW YORK
914 SHEET 70

0 50 100 150 200

FED. ROAD DIV. NO.	STATE	FEDERAL AID PROJECT NO.	TYPE FUNDS	72
2	OHIO			181

CUYAHOGA COUNTY
CITY OF CLEVELAND
CUY-42-18.42
CUY-21-15.32

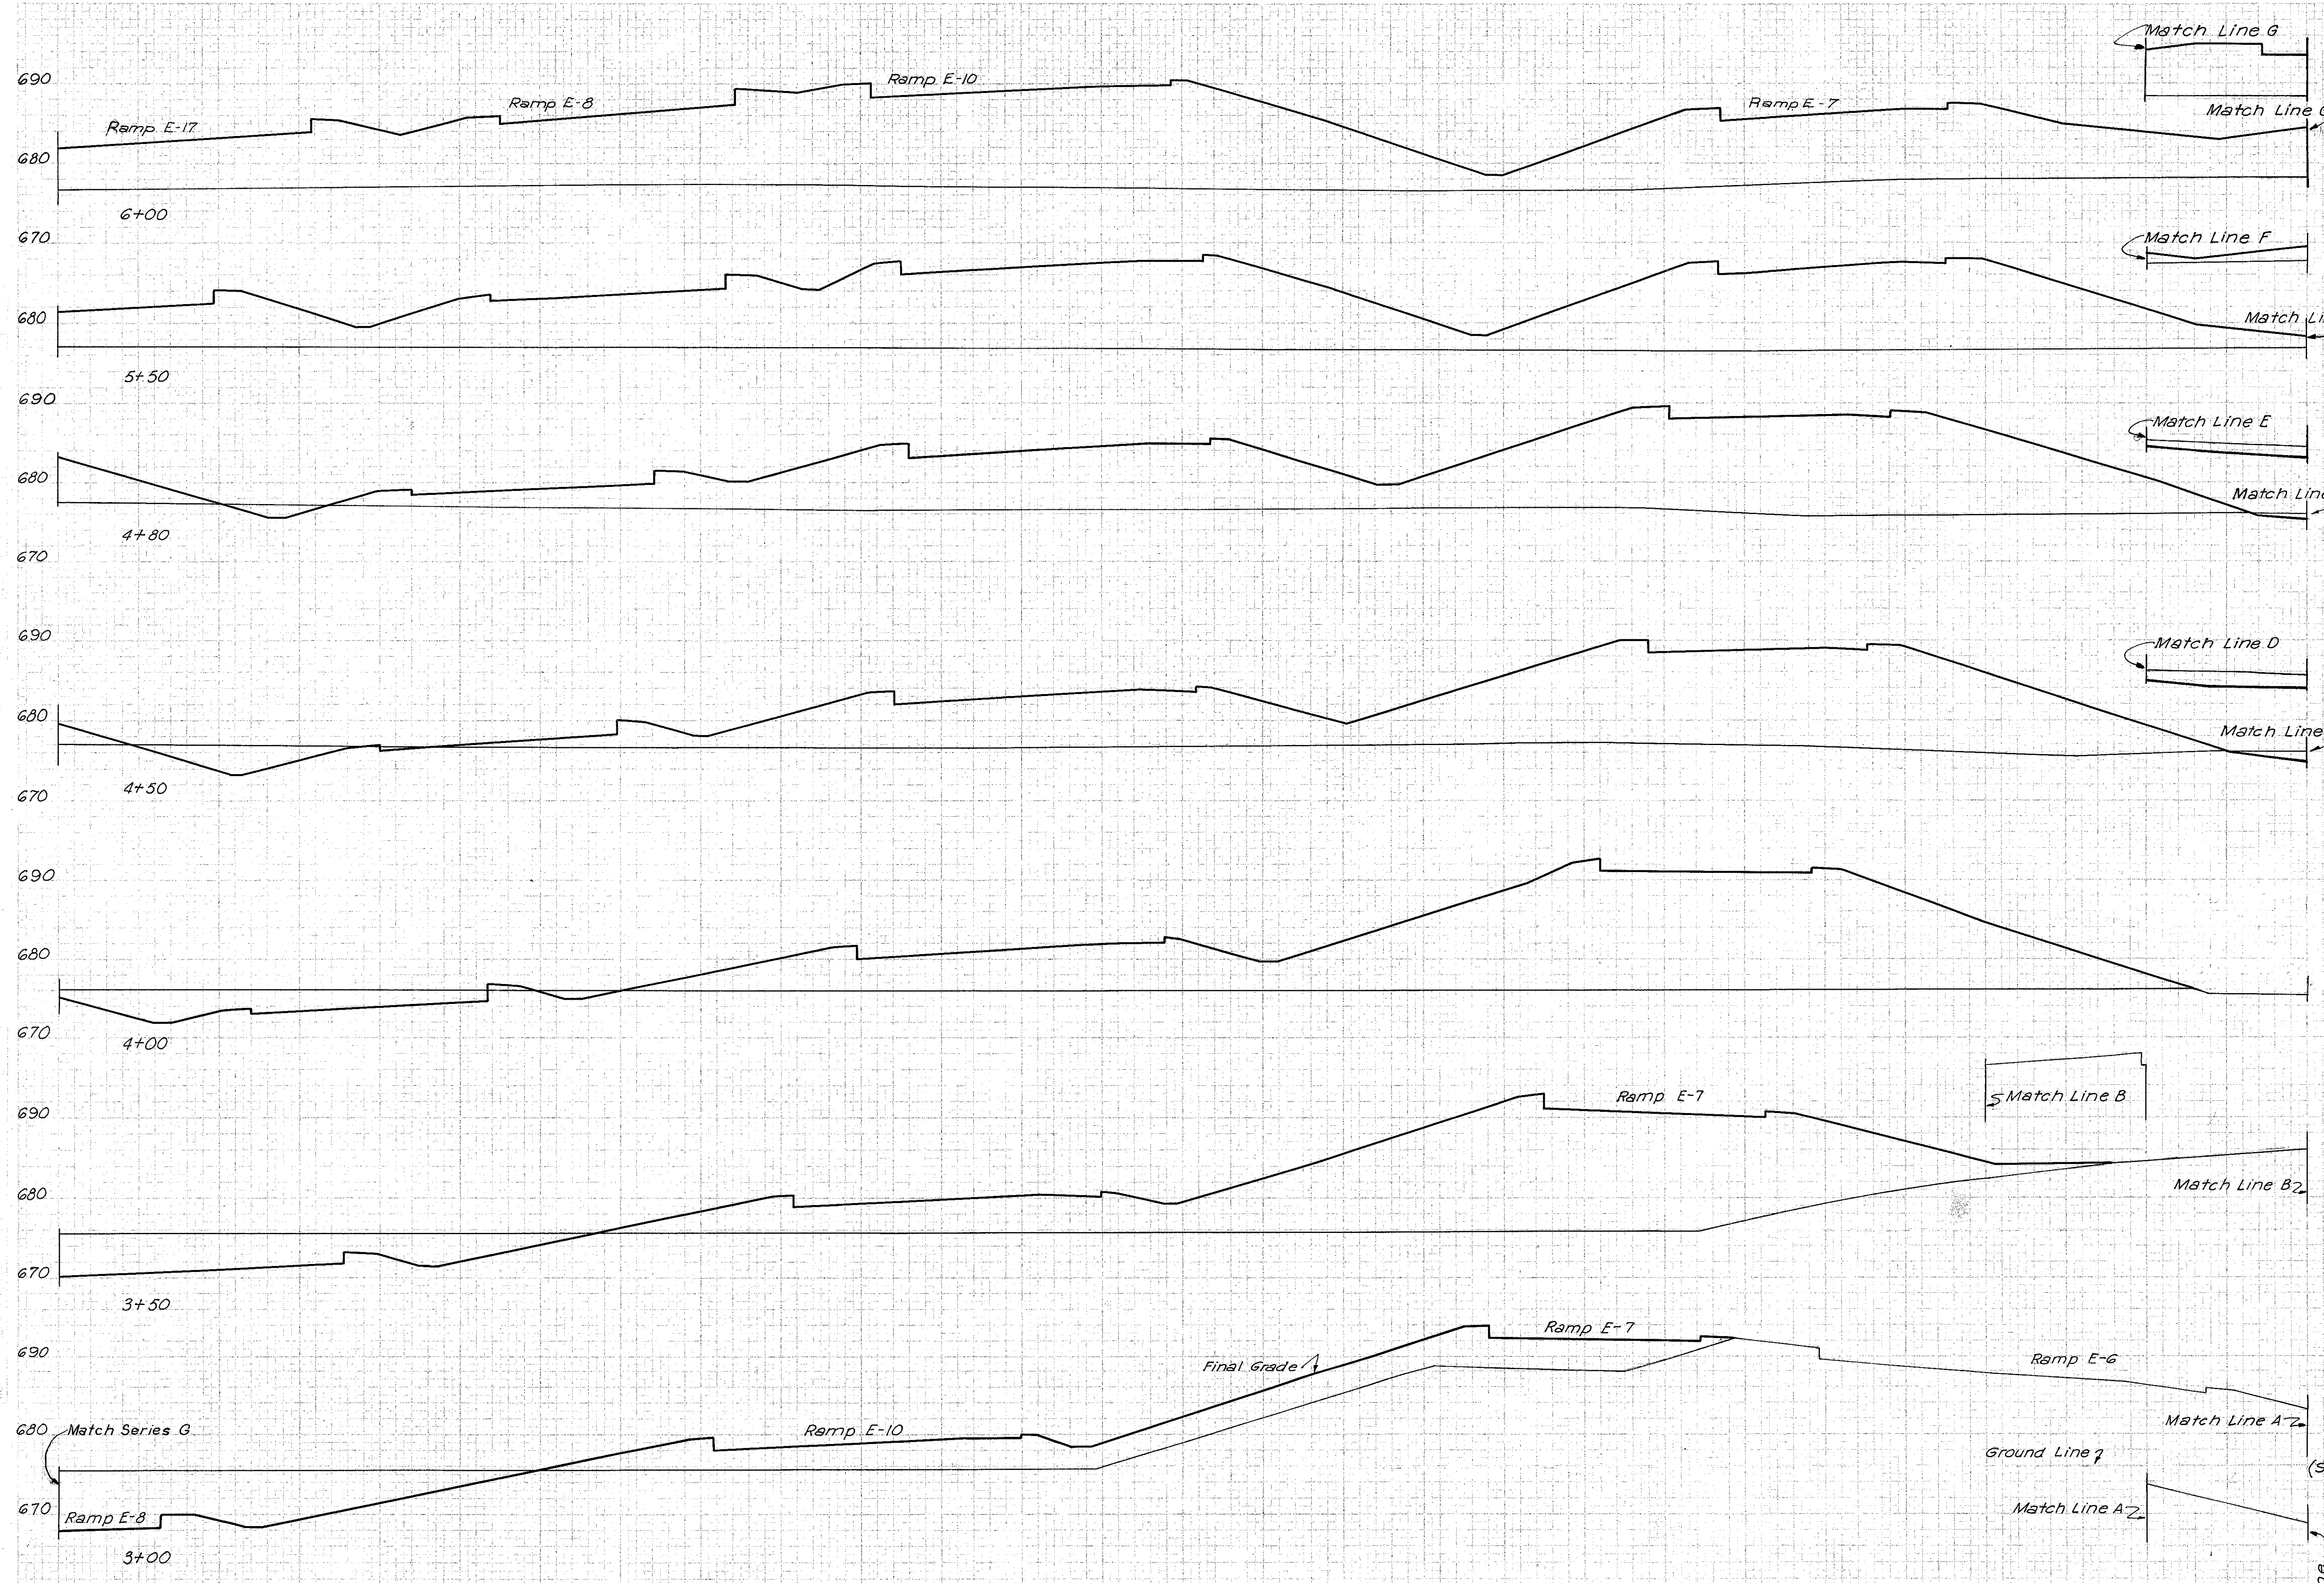

SEEDING		SUBBASE		EARTHWORK			
WIDTH	AREA	AREA	VOL.	END AREA		VOLUME	
L. F.	SQ. YD.	S. F.	C. Y.	EXC.	EMB.	EXC.	EMB.
				0	2402		
						0	4292
				0	2073		
						51	4888
				39	1698		
						75	1762
				96	1473		
						222	2814
				144	1566		
						365	2743
				250	1369		
						509	1737
				300	480		
						557	591
				302	158		

SERIES F
SECTION RIGHT OF STA. 66+00
INNER BELT
STA. 3+00 TO STA. 6+00

SCALE 1" = 10'
MADE E.L.S. DATE 8-8-58
TRCD. S.C. DATE 11-10-58
CKD. B.W.S. DATE 12-10-58


HOWARD, NEEDLES, TAMMEN & BERGENDOFF
CONSULTING ENGINEERS
KANSAS CITY CLEVELAND NEW YORK
914 SHEET 72

0 50 100 150 200 250

FED. ROAD DIV. NO.	STATE	FEDERAL AID PROJECT NO.	TYPE FUNDS
2	OHIO		

73
181

CUYAHOGA COUNTY
CITY OF CLEVELAND
CUY-42-18.42
CUY-21-15.32

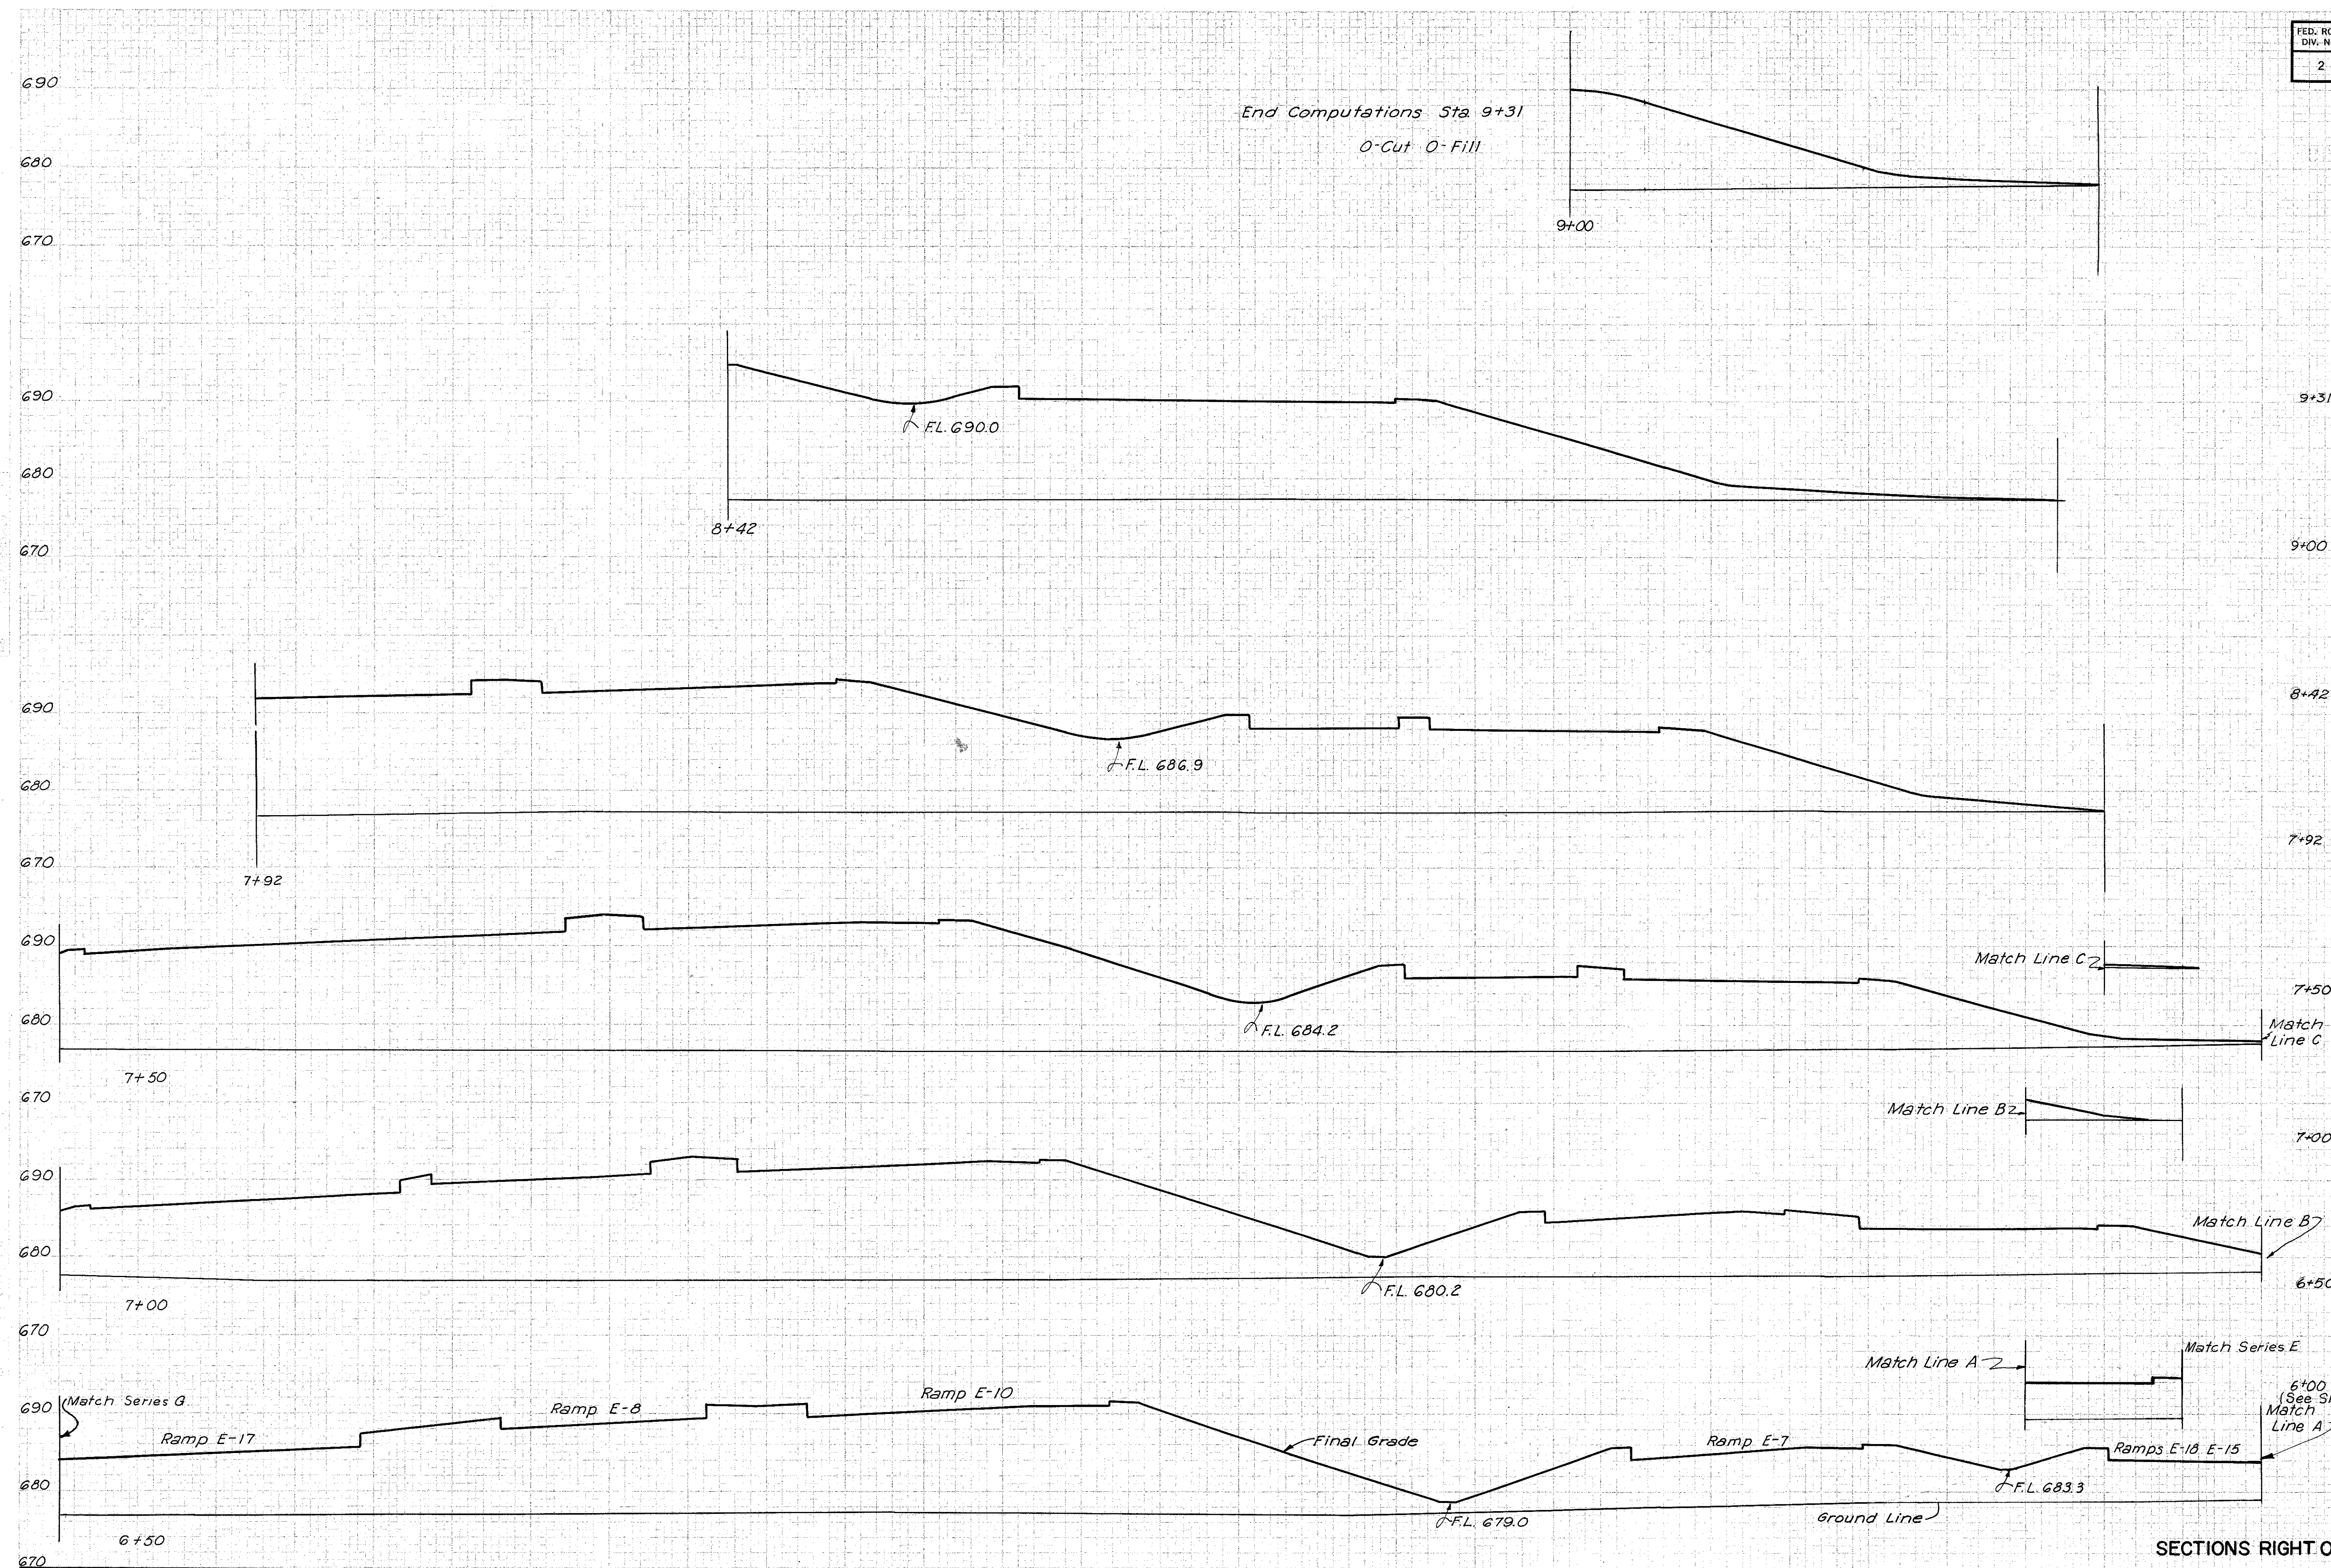

SEEDING		SUBBASE		EARTHWORK			
WIDTH	AREA	AREA	VOL.	END AREA		VOLUME	
L. F.	SQ. YD.	S. F.	C. Y.	EXC.	EMB.	EXC.	EMB.
				0	0		
9+31						0	181
9+00				0	315		
						0	1967
8+42				0	1516		
						0	3886
7+92				0	2681		
						0	4466
7+50				0	3061		
						0	5325
7+00				0	2774		
						0	4956
6+50				0	2300		
						0	4788
				0	2402		


SERIES F
SECTIONS RIGHT OF STA. 66+00 INNER BELT
STA. 6+50 TO STA. 9+31

SCALE 1"=10'
MADE E.L.S. DATE 8-8-58 HOWARD, NEEDLES, TAMMEN & BERGENDOFF
TRCD. S.C. DATE 11-10-58 CONSULTING ENGINEERS
CKD. B.M.S. DATE 12-10-58 KANSAS CITY CLEVELAND NEW YORK
914 SHEET 73

0 50 100 150 200 250

FED. ROAD DIV. NO.	STATE	FEDERAL AID PROJECT NO.	TYPE FUNDS	74 181
2	OHIO			

CUYAHOGA COUNTY
CITY OF CLEVELAND
CUY-42-18.42
CUY-21-15.32

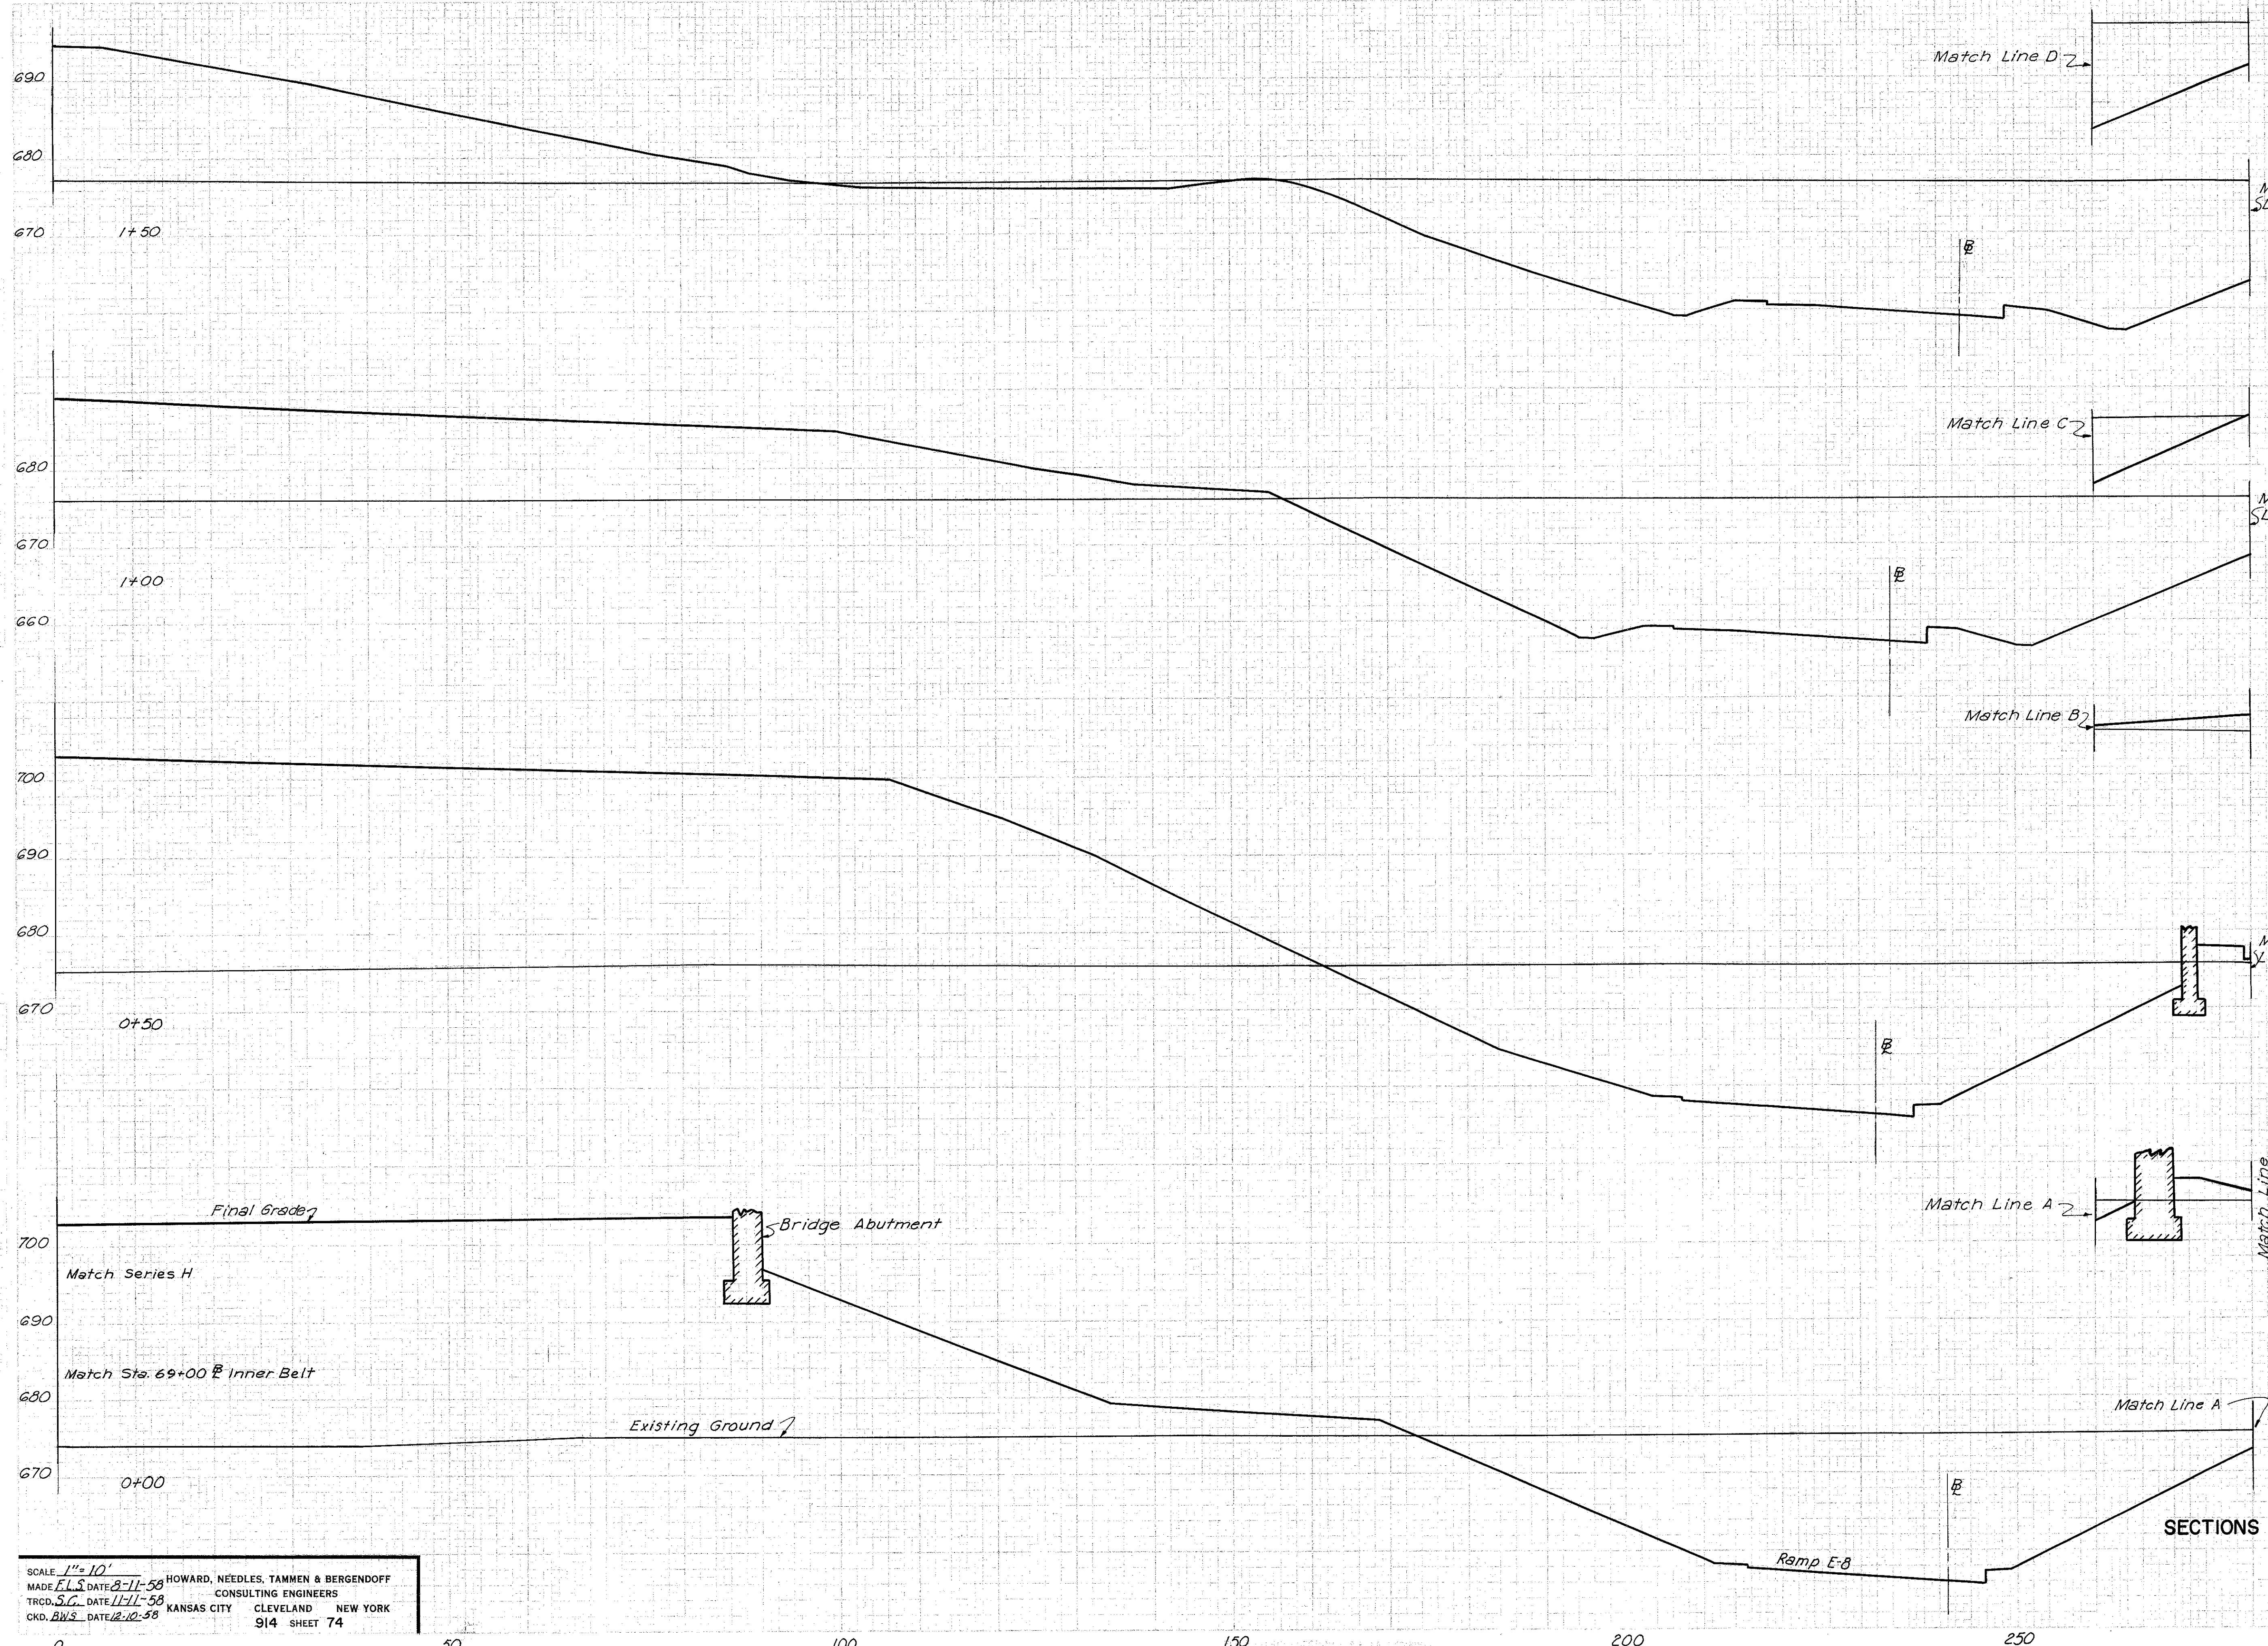

SEEDING		SUBBASE		EARTHWORK			
WIDTH	AREA	AREA	VOL.	END AREA	VOLUME		
L. F.	SQ. YD.	S. F.	C. Y.	EXC.	EMB.	EXC.	EMB.
						1907	889
						3476	2023
						1847	1296
						3044	4398
						1440	3454
						2565	6228
						1330	3272


SERIES G
SECTIONS RIGHT OF STA. 69+00 \bar{E} INNER BELT
STA. 0+00 TO STA. 1+50

SCALE 1" = 10'
MADE E.L.S. DATE 8-11-58 HOWARD, NEEDLES, TAMMEN & BERGENDOFF
TRCD. S.C. DATE 11-11-58 CONSULTING ENGINEERS
CKD. BWS. DATE 12-10-58 KANSAS CITY CLEVELAND NEW YORK
914 SHEET 74

FED. ROAD DIV. NO.	STATE	FEDERAL AID PROJECT NO.	TYPE FUNDS
2	OHIO		

75
181

CUYAHOGA COUNTY
CITY OF CLEVELAND
CUY-42-18.32
CUY-21-15.32

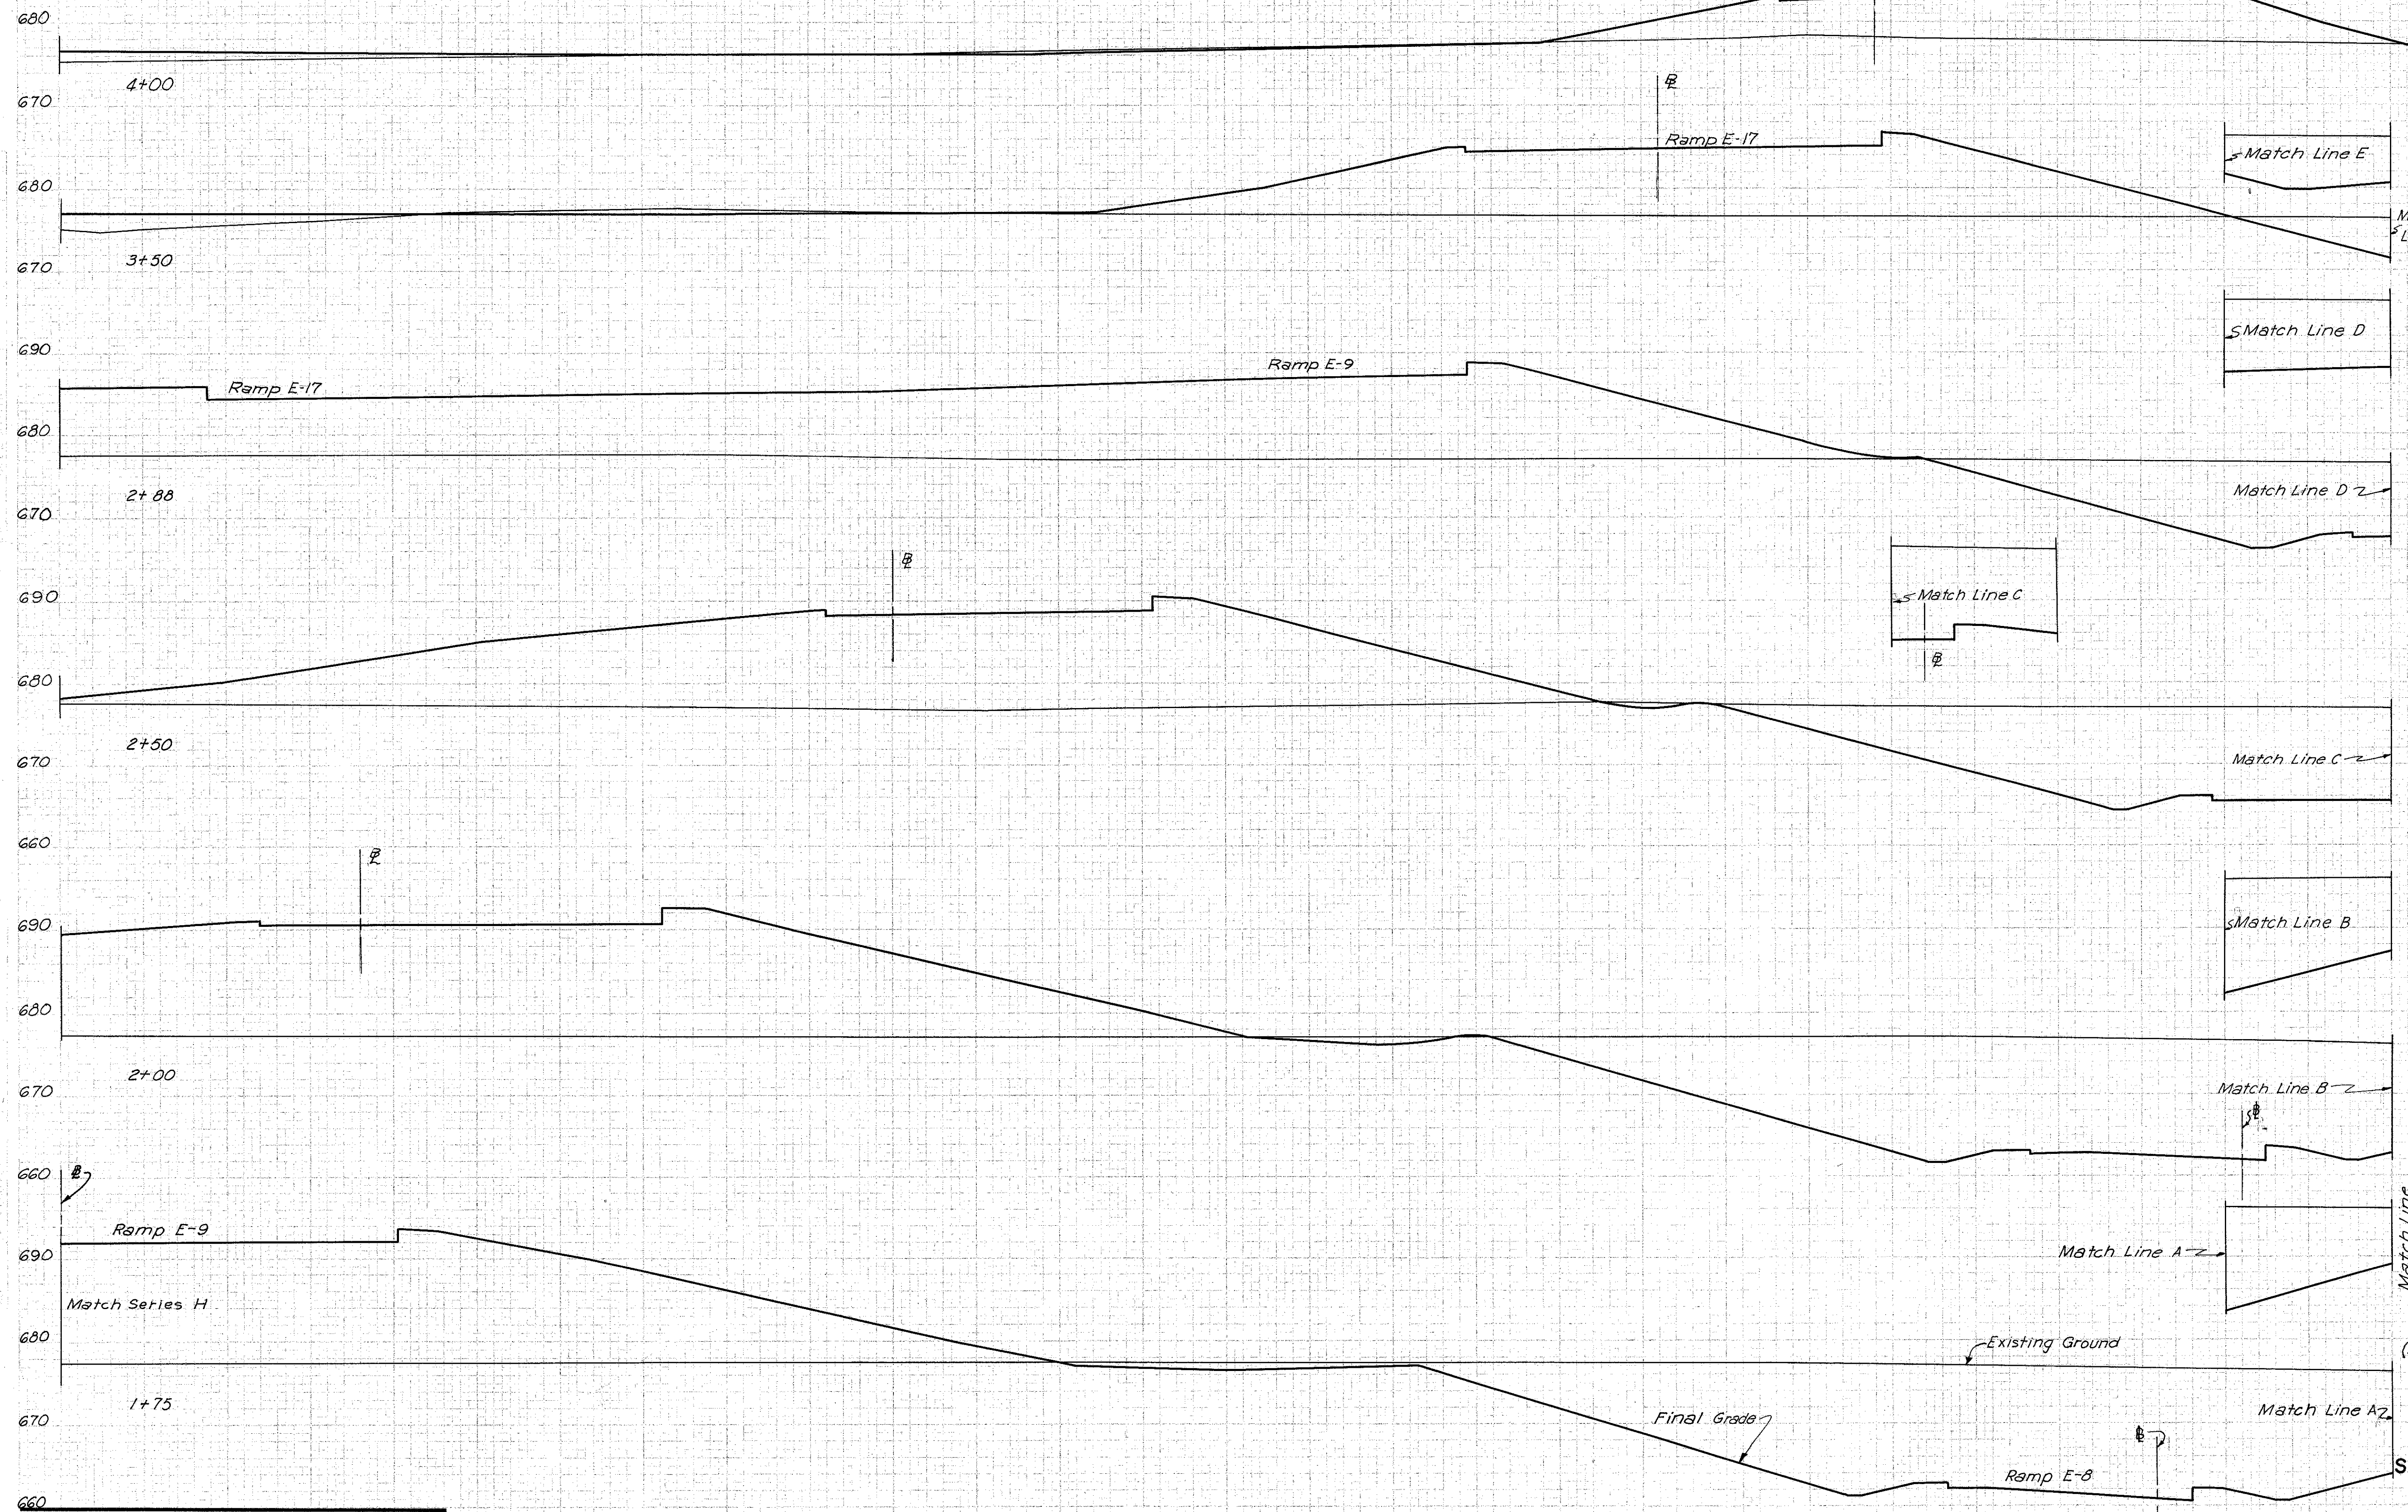

SEEDING		SUBBASE		EARTHWORK			
WIDTH	AREA	AREA	VOL.	END AREA		VOLUME	
L.F.	SQ. YD.	S.F.	C.Y.	EXC.	EMB.	EXC.	EMB.
4+00				33	493		
3+50						199	1273
2+88				182	882		
2+50				532	1721		
2+00						1002	2243
1+75				1441	1535		
1+50						1650	1273
1+50						1697	1001
1+50						1907	889

SERIES G
SECTIONS RIGHT OF STA. 69+00 INNER BELT
STA. 1+75 TO STA. 4+00


SCALE 1"=10'
MADE P.L.S. DATE 8-11-58 HOWARD, NEEDLES, TAMMEN & BERGENDOFF
TRCD. S.C. DATE 11-11-58 CONSULTING ENGINEERS
CKD. B.W.S. DATE 12-11-58 KANSAS CITY CLEVELAND NEW YORK
914 SHEET 75

0 50 100 150 200 250

FED. ROAD DIV. NO.	STATE	FEDERAL AID PROJECT NO.	TYPE FUNDS	76 181
2	OHIO			

CUYAHOGA COUNTY
CITY OF CLEVELAND
CUY-42-18.42
CUY-21-15.32

End Computations
Sta. 7+35 0 Cut 0 Fill

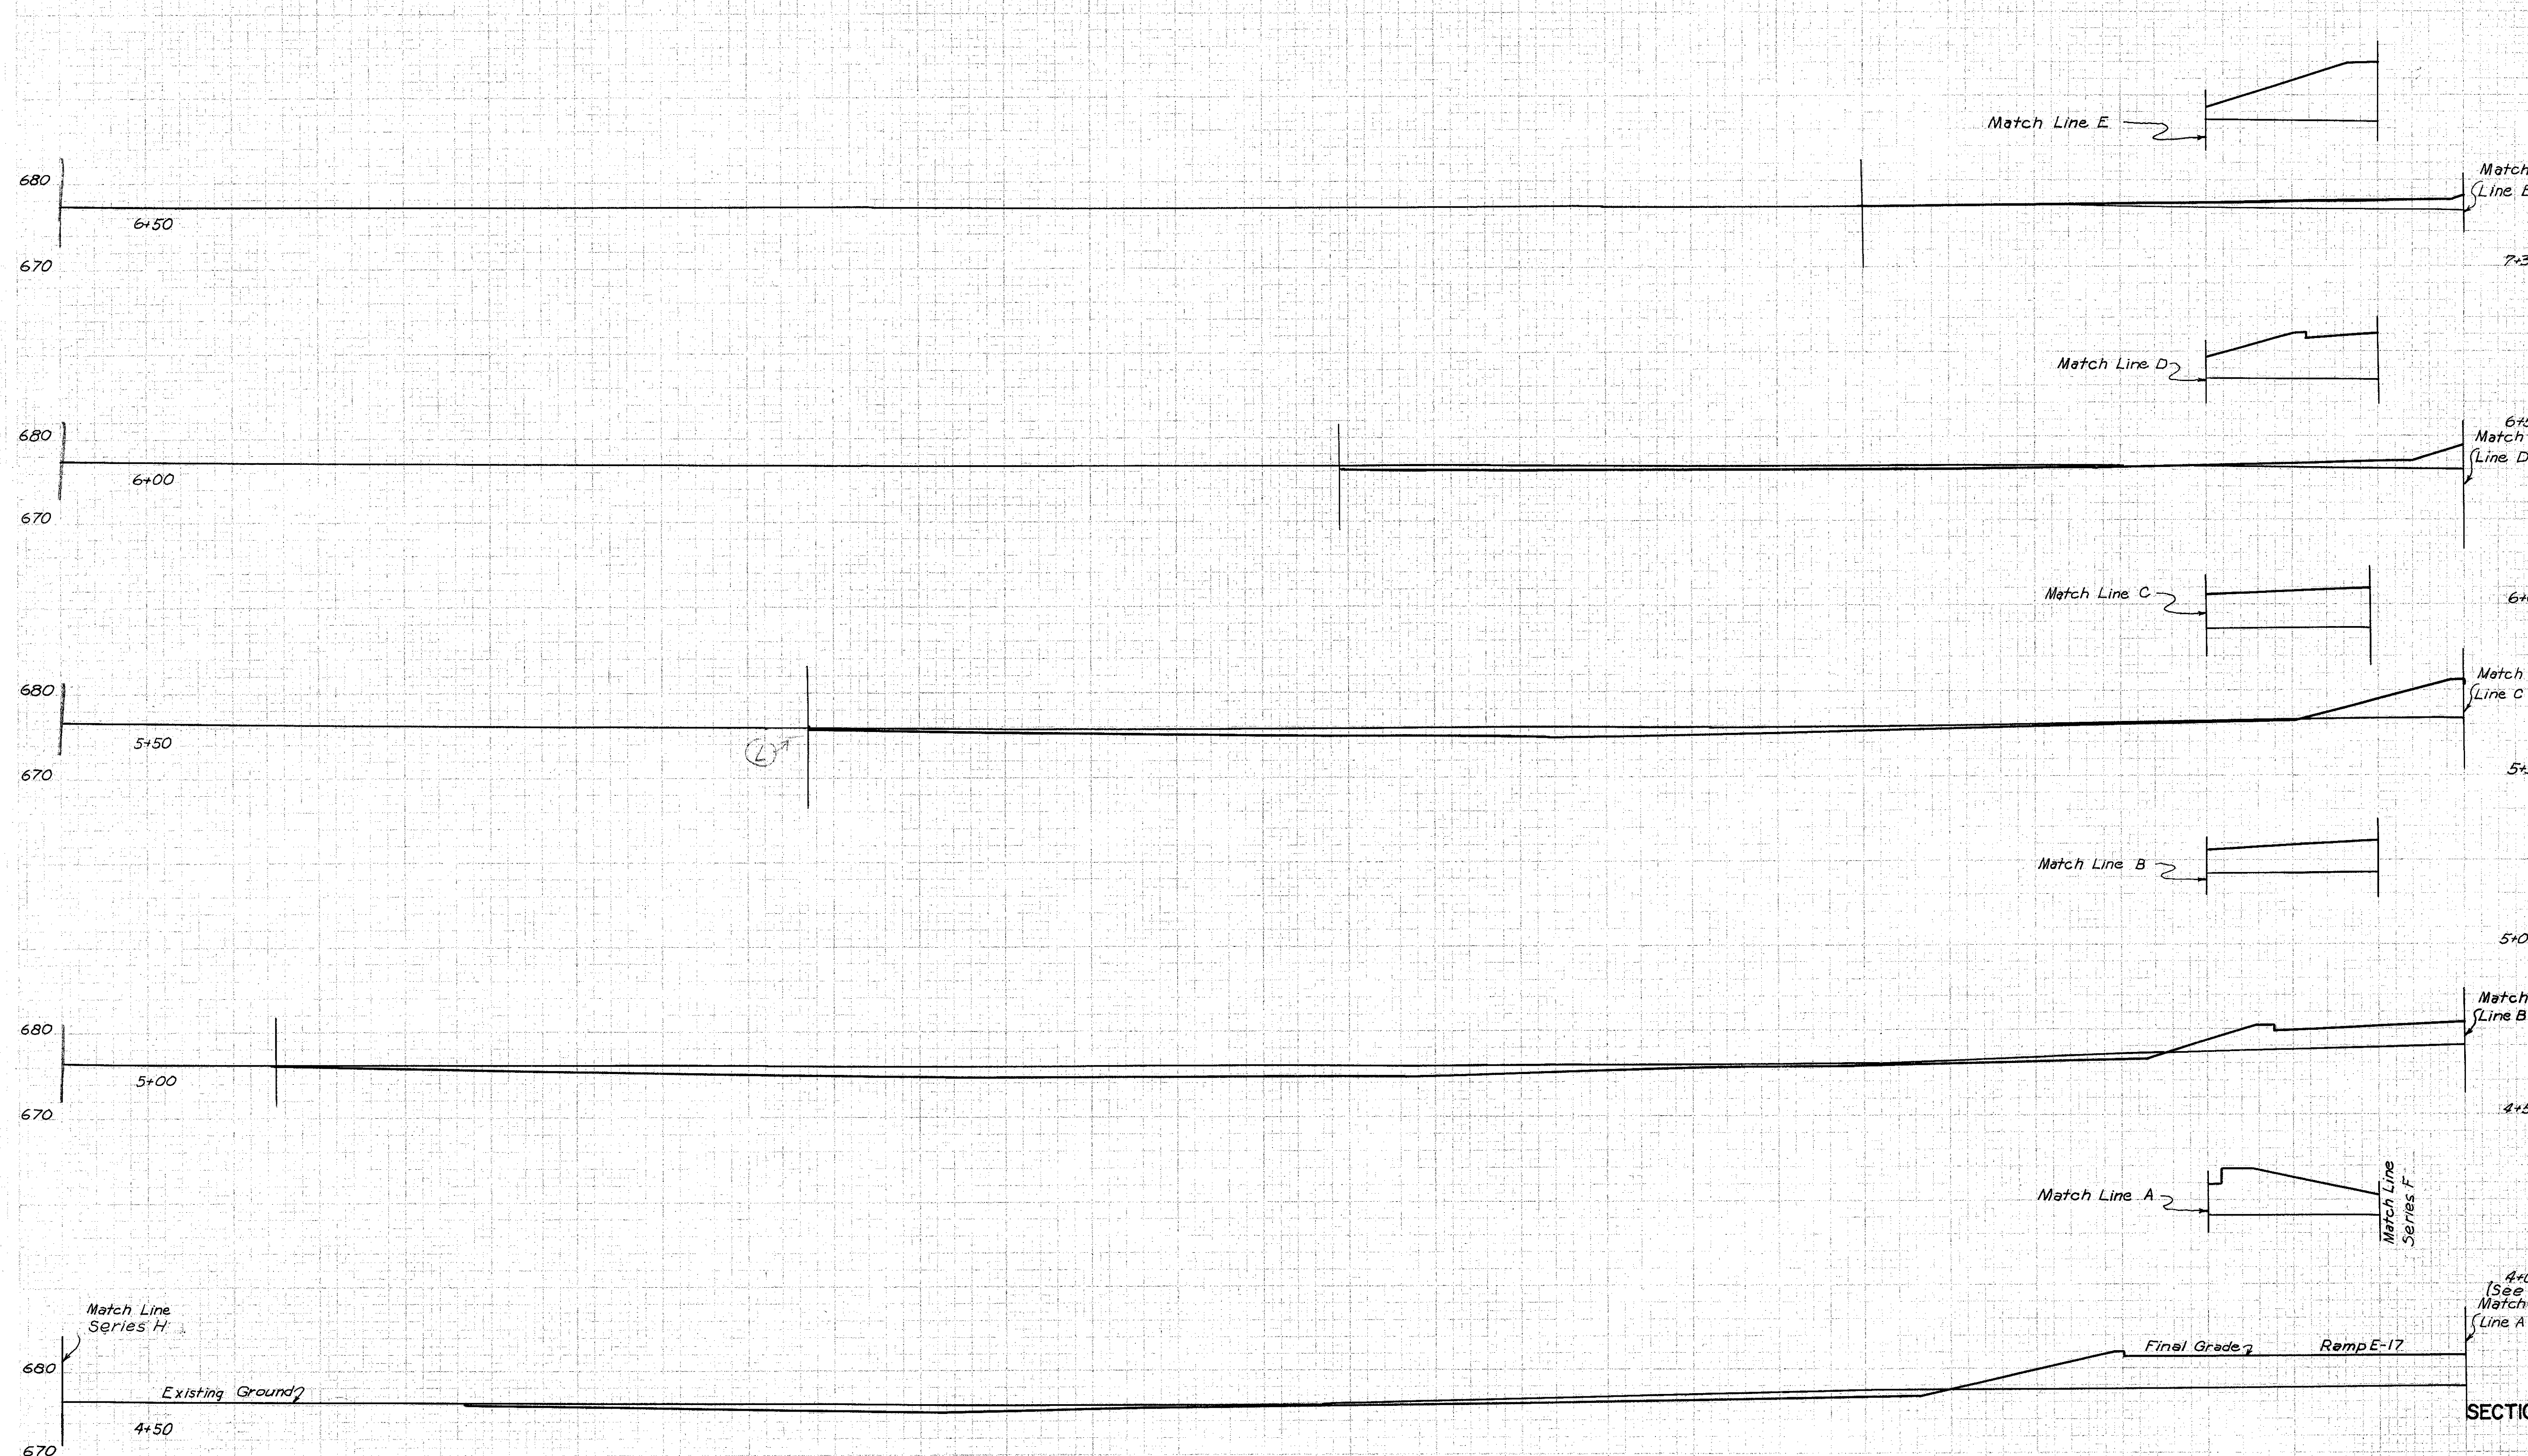

SEEDING		SUBBASE		EARTHWORK			
WIDTH	AREA	AREA	VOL.	END AREA		VOLUME	
L.F.	SQ. YD.	S.F.	C.Y.	EXC.	EMB.	EXC.	EMB.
				0	0		
						0	198
				0	126		
						32	222
				35	119		
							129
				104	131		
							257
				174	148		
							241
				86	273		
							110
				33	493		

SERIES G
SECTIONS RIGHT OF STA. 69+00 & INNER BELT
STA. 4+50 TO STA. 7+35


SCALE: 1"=10'
MADE FLS. DATE 8-11-58
TRCD. M.D.H. DATE 11-12-58
CKD. B.W.S. DATE 12-11-58
HOWARD, NEEDLES, TAMMEN & BERGENDOFF
CONSULTING ENGINEERS
KANSAS CITY CLEVELAND NEW YORK
914 SHEET 76

0 50 100 150 200 250

FED. ROAD DIV. NO.	STATE	FEDERAL AID PROJECT NO.	TYPE FUNDS
2	OHIO		

77
181

CUYAHOGA COUNTY
CITY OF CLEVELAND
CUY - 42 - 18.42
CUY - 21 - 15.32

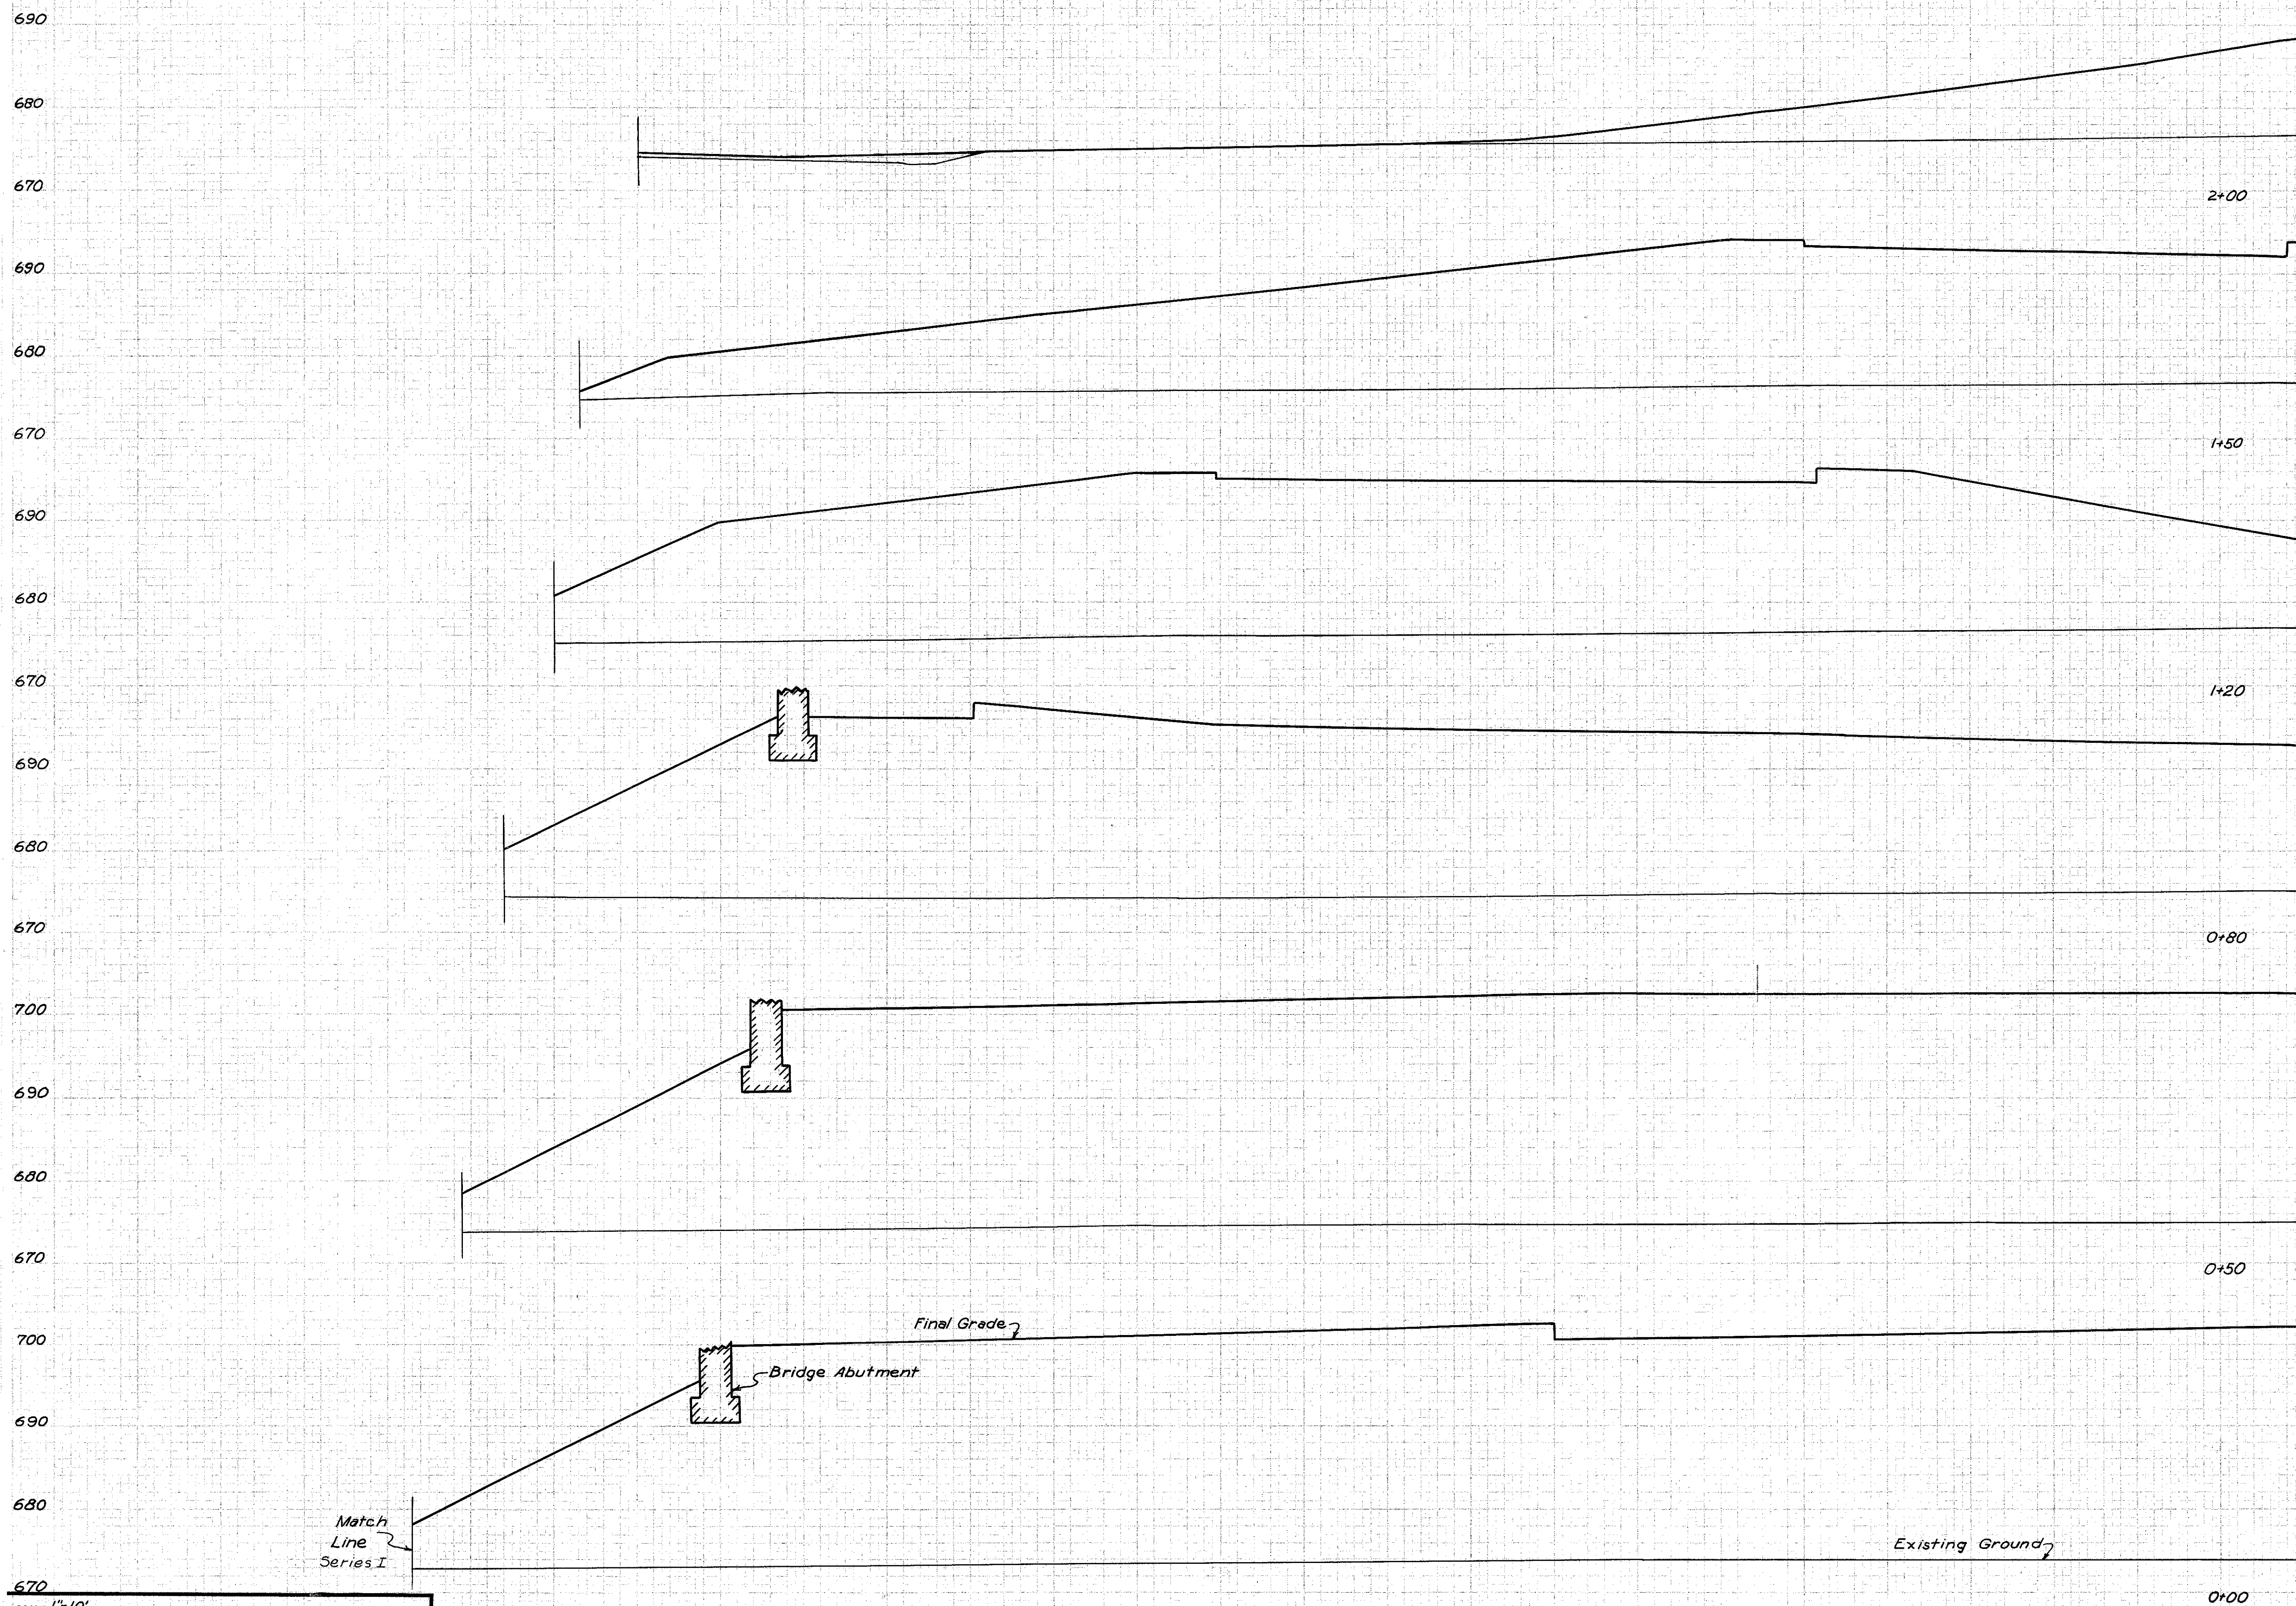

SEEDING		SUBBASE		EARTHWORK			
WIDTH	AREA	AREA	VOL.	END AREA		VOLUME	
L.F.	SQ. YD.	S.F.	C. Y.	EXC.	EMB.	EXC.	EMB.
				0	582		
						0	2926
				0	2578		
						0	3406
				0	3552		
						0	5734
				0	4189		
						0	5420
				0	5367		
						0	10547
				0	5824		

SERIES H
SECTIONS LEFT OF STA. 69+00 IN INNER BELT
STA. 0+00 TO STA. 2+00

SCALE 1"=10'
MADE BY DATE 9/2-58 HOWARD, NEEDLES, TAMMEN & BERGENDOFF
TRCD. M.H. DATE 1/13-58 CONSULTING ENGINEERS
CKD. BKS DATE 12/1-58 KANSAS CITY CLEVELAND NEW YORK
914 SHEET 77

250

200

150

100

50


0

FED. ROAD DIV. NO.	STATE	FEDERAL AID PROJECT NO.	TYPE FUNDS
2	OHIO		



CUYAHOGA COUNTY
CITY OF CLEVELAND
CUY-42-18.42
CUY-21-16.32

End Computations
Sta 4+80 0 Cut 0 Fill

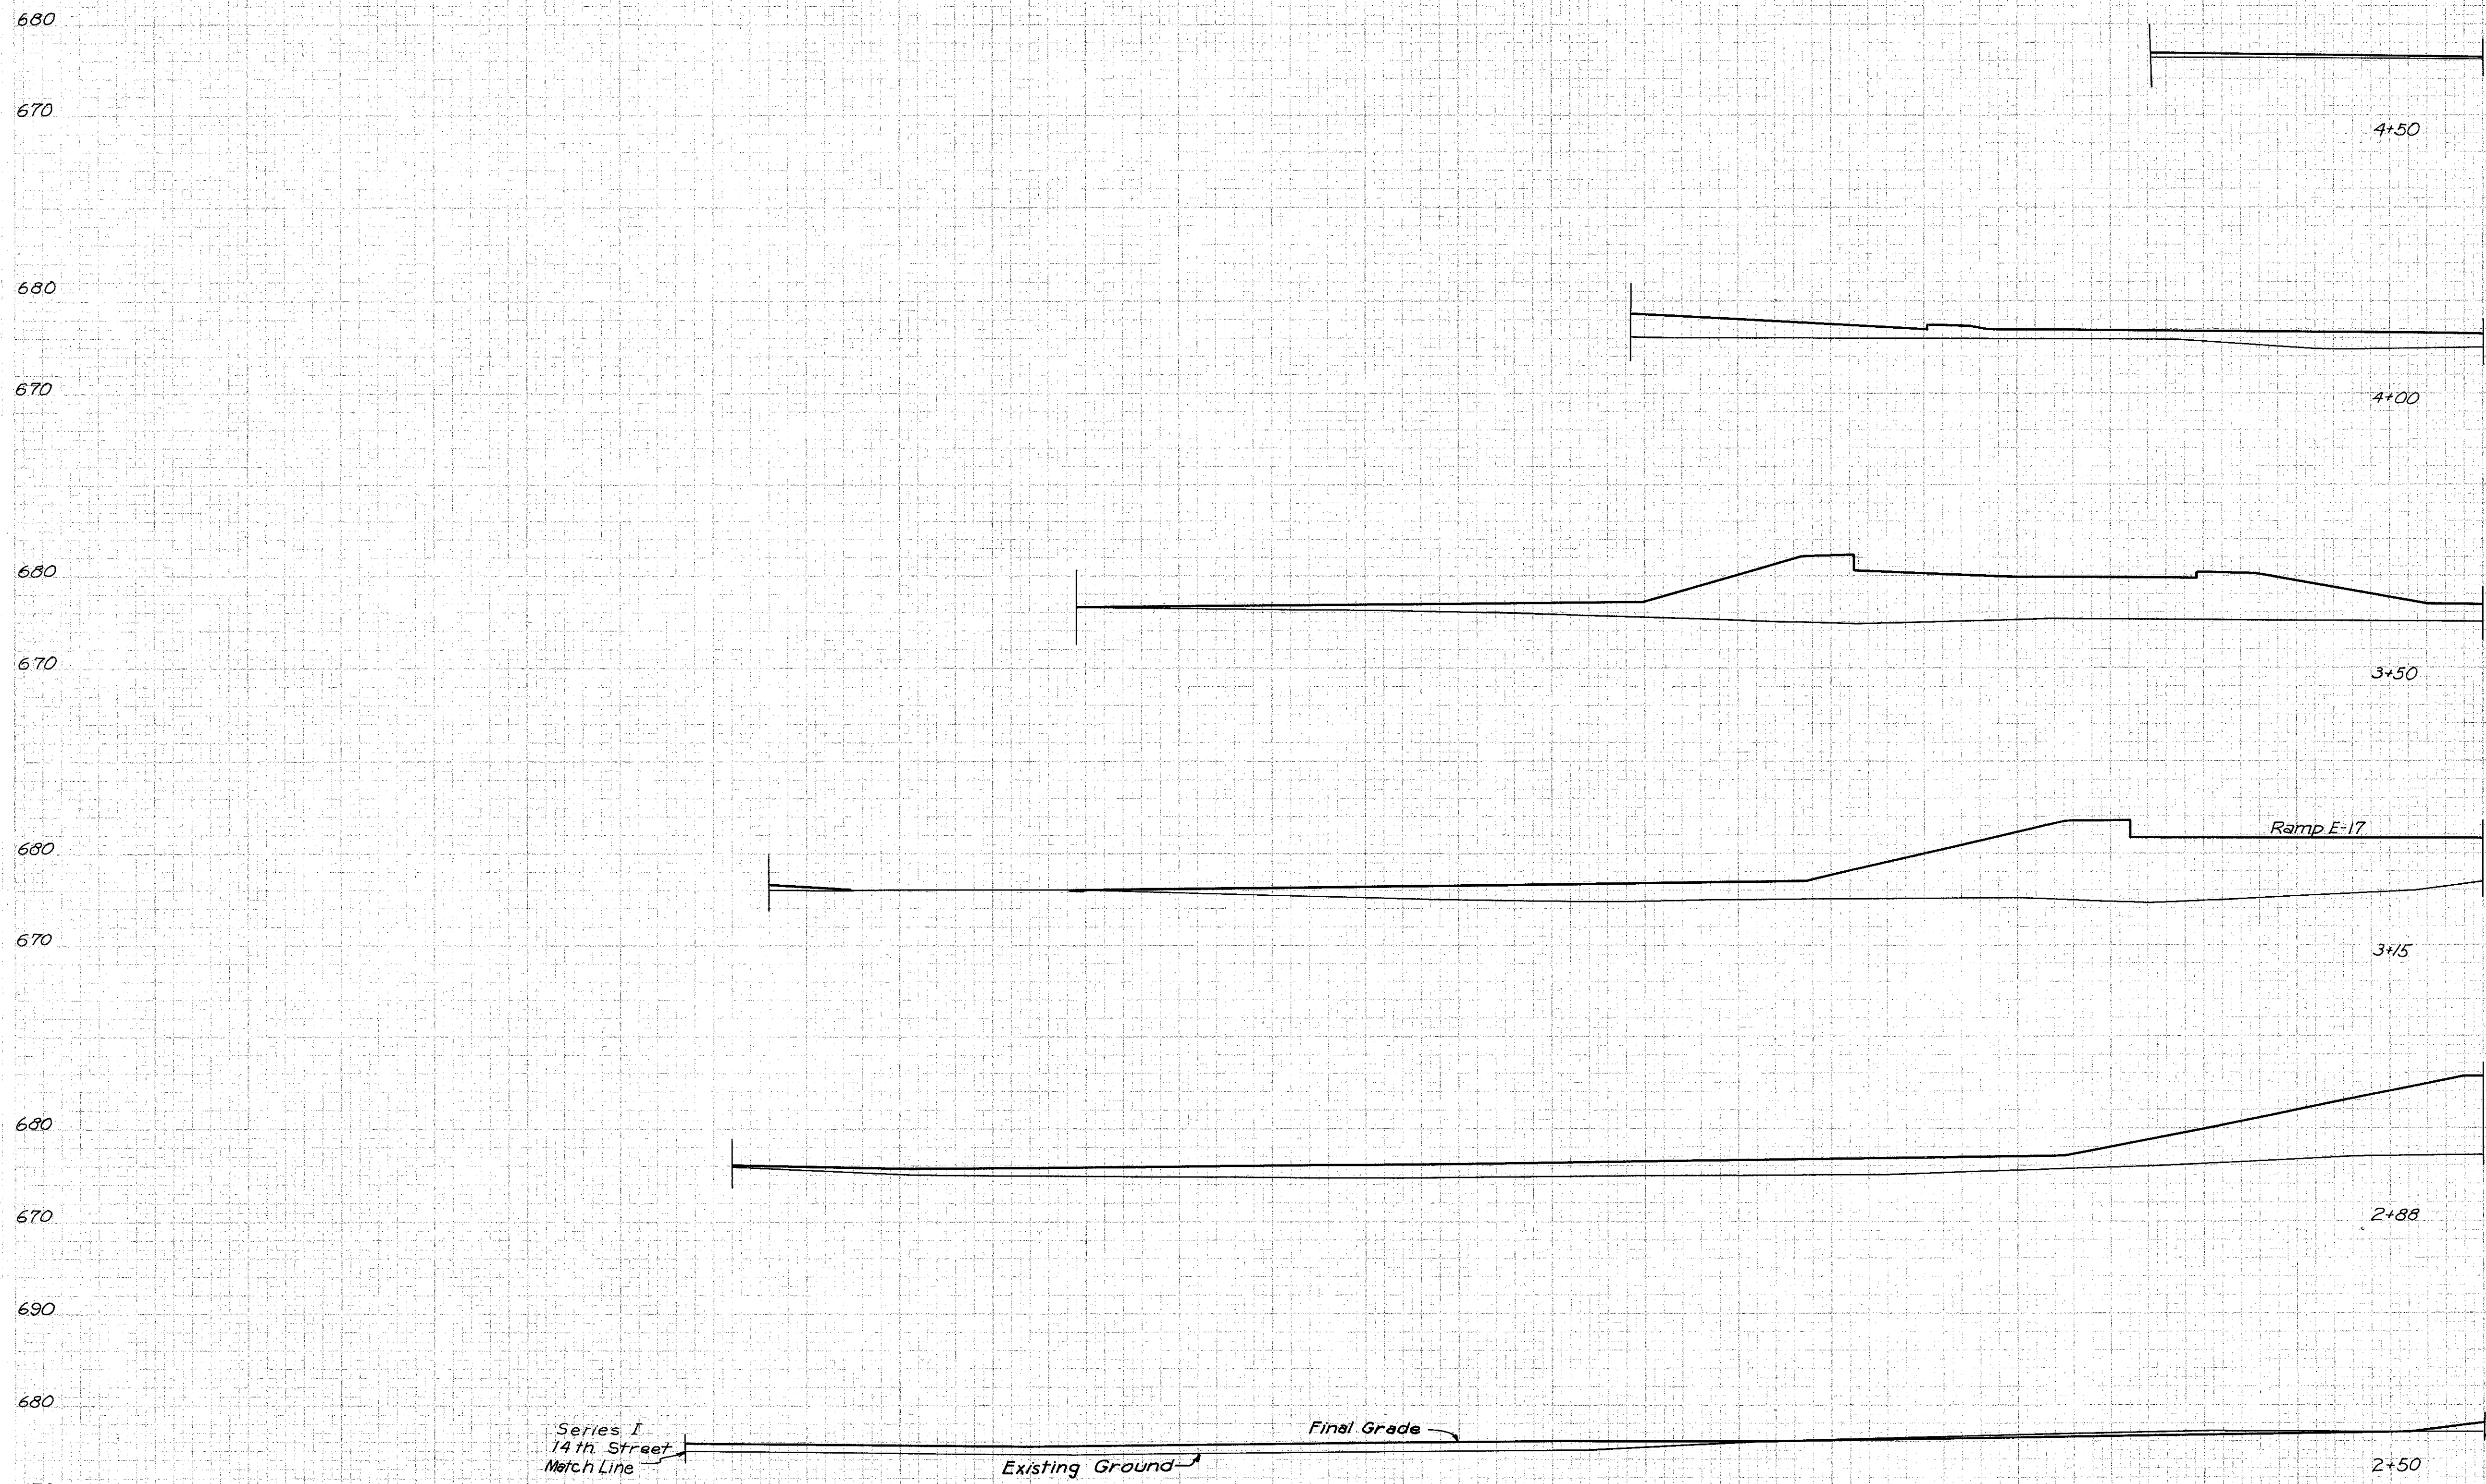

SEEDING	SUBBASE		EARTHWORK					
	WIDTH	AREA	AREA	VOL.	END AREA		VOLUME	
	L.F.	SQ. YD.	S.F.	C.Y.	EXC.	EMB.	EXC.	EMB.
					0	0		
4+80							0	6
4+50					0	11		131
4+00					0	131		533
3+50					0	445		643
3+15					0	547		474
2+88					0	400		367
2+50					2	122		653
2+00 (See Sheet 77)					0	582		

SERIES H
SECTIONS LEFT OF STA. 69 00 **B** INNER BELT
STA. 2+50 TO STA. 4+80

SCALE: 1" = 10'
MADE F.L.S. DATE 8-12-58 HOWARD, NEEDLES, TAMMEN & BERGENDOFF
TRCD. DATE 11-13-58 CONSULTING ENGINEERS
CKD. DATE 12-11-58 KANSAS CITY CLEVELAND NEW YORK
914 SHEET 78

250

200


150

100

50

0

CUYAHOGA COUNTY
CITY OF CLEVELAND
CUY-42-18.42
CUY-21-15.32

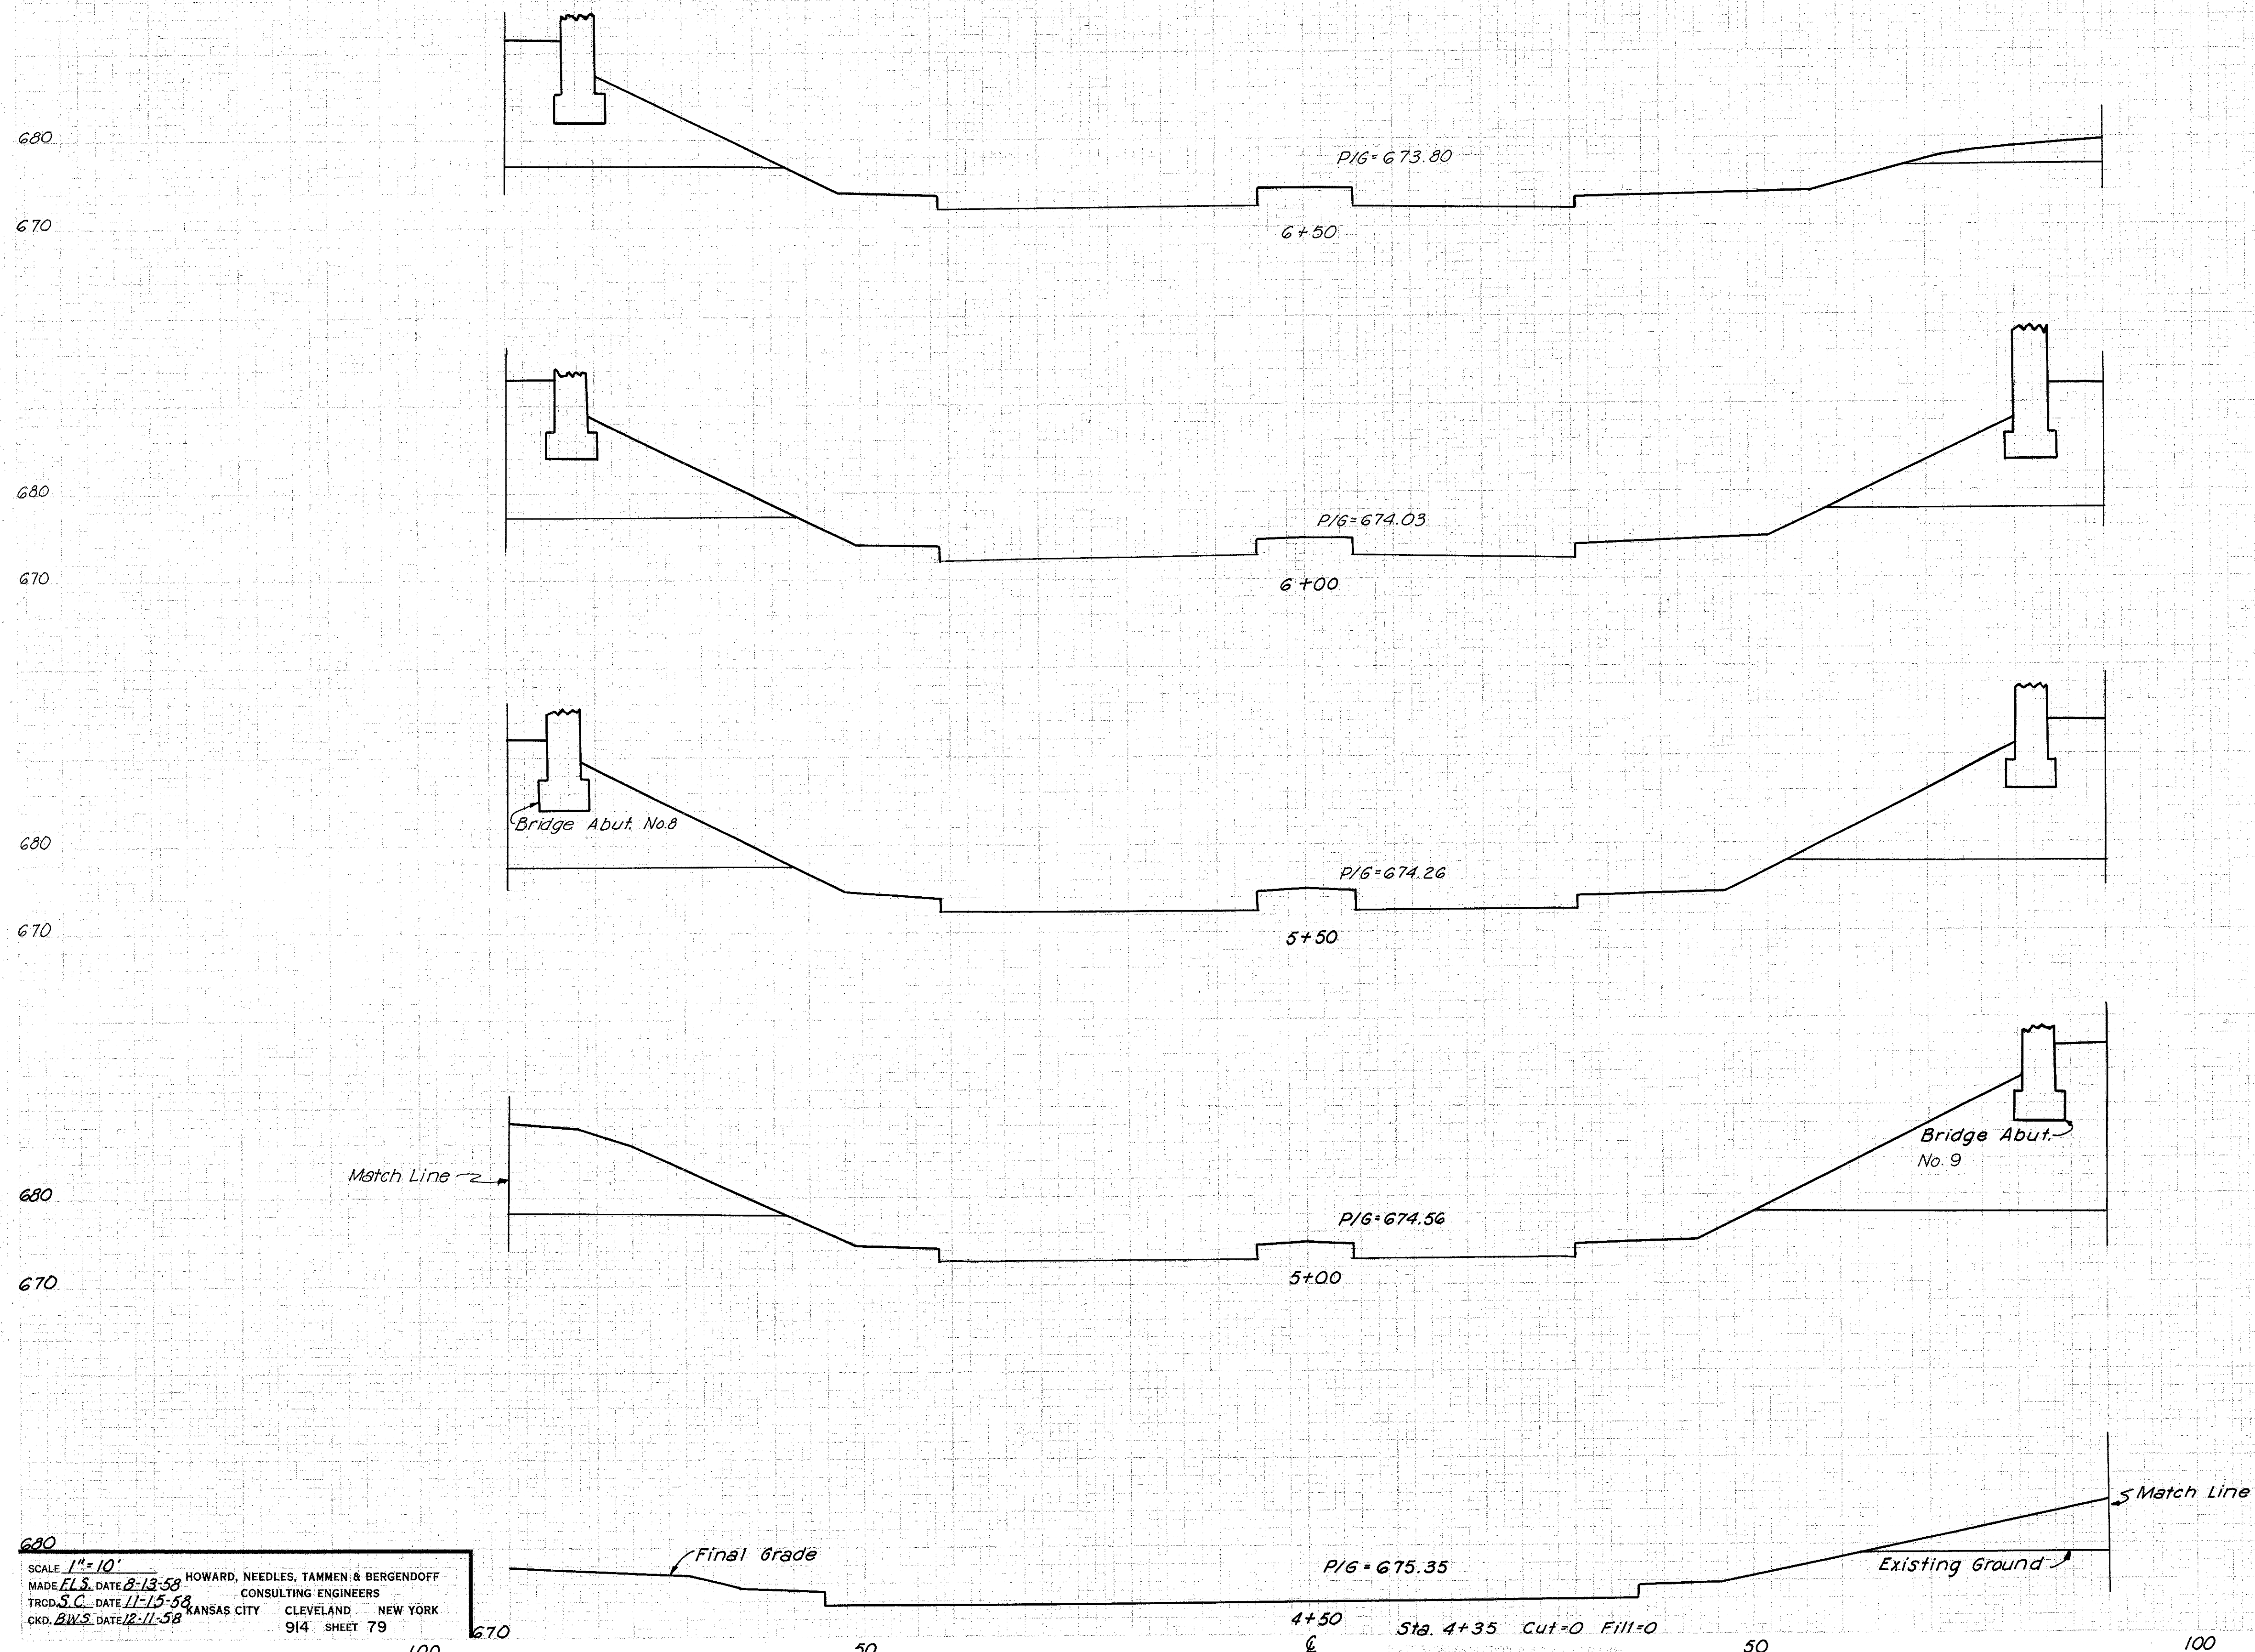


L. F.	SEEDING		SUBBASE		EARTHWORK			
	WIDTH	AREA	AREA	VOL.	END AREA		VOLUME	
	SQ. YD.	S. F.	S. F.	C. Y.	EXC.	EMB.	EXC.	EMB.
6+50					0	262		
							0	665
6+00					0	456		
							0	913
5+50					0	530		
							0	1024
5+00					0	576		
							0	609
4+50					0	82		
							0	23
4+35					0	0		

SERIES I
EAST 14TH ST. SECTIONS
STA. 4+35 TO STA. 6+50

SCALE 1"=10'
MADE F.L.S. DATE 8-13-58 HOWARD, NEEDLES, TAMMEN & BERGENDOFF
TRCD. S.C. DATE 11-15-58 CONSULTING ENGINEERS
CKD. B.W.S. DATE 12-11-58 KANSAS CITY CLEVELAND NEW YORK
914 SHEET 79

FED. ROAD DIV. NO.	STATE	FEDERAL AID PROJECT NO.	TYPE FUNDS	80 181
2	OHIO			

CUYAHOGA COUNTY
CITY OF CLEVELAND
CUY-42-18.42
CUY-21-15.32

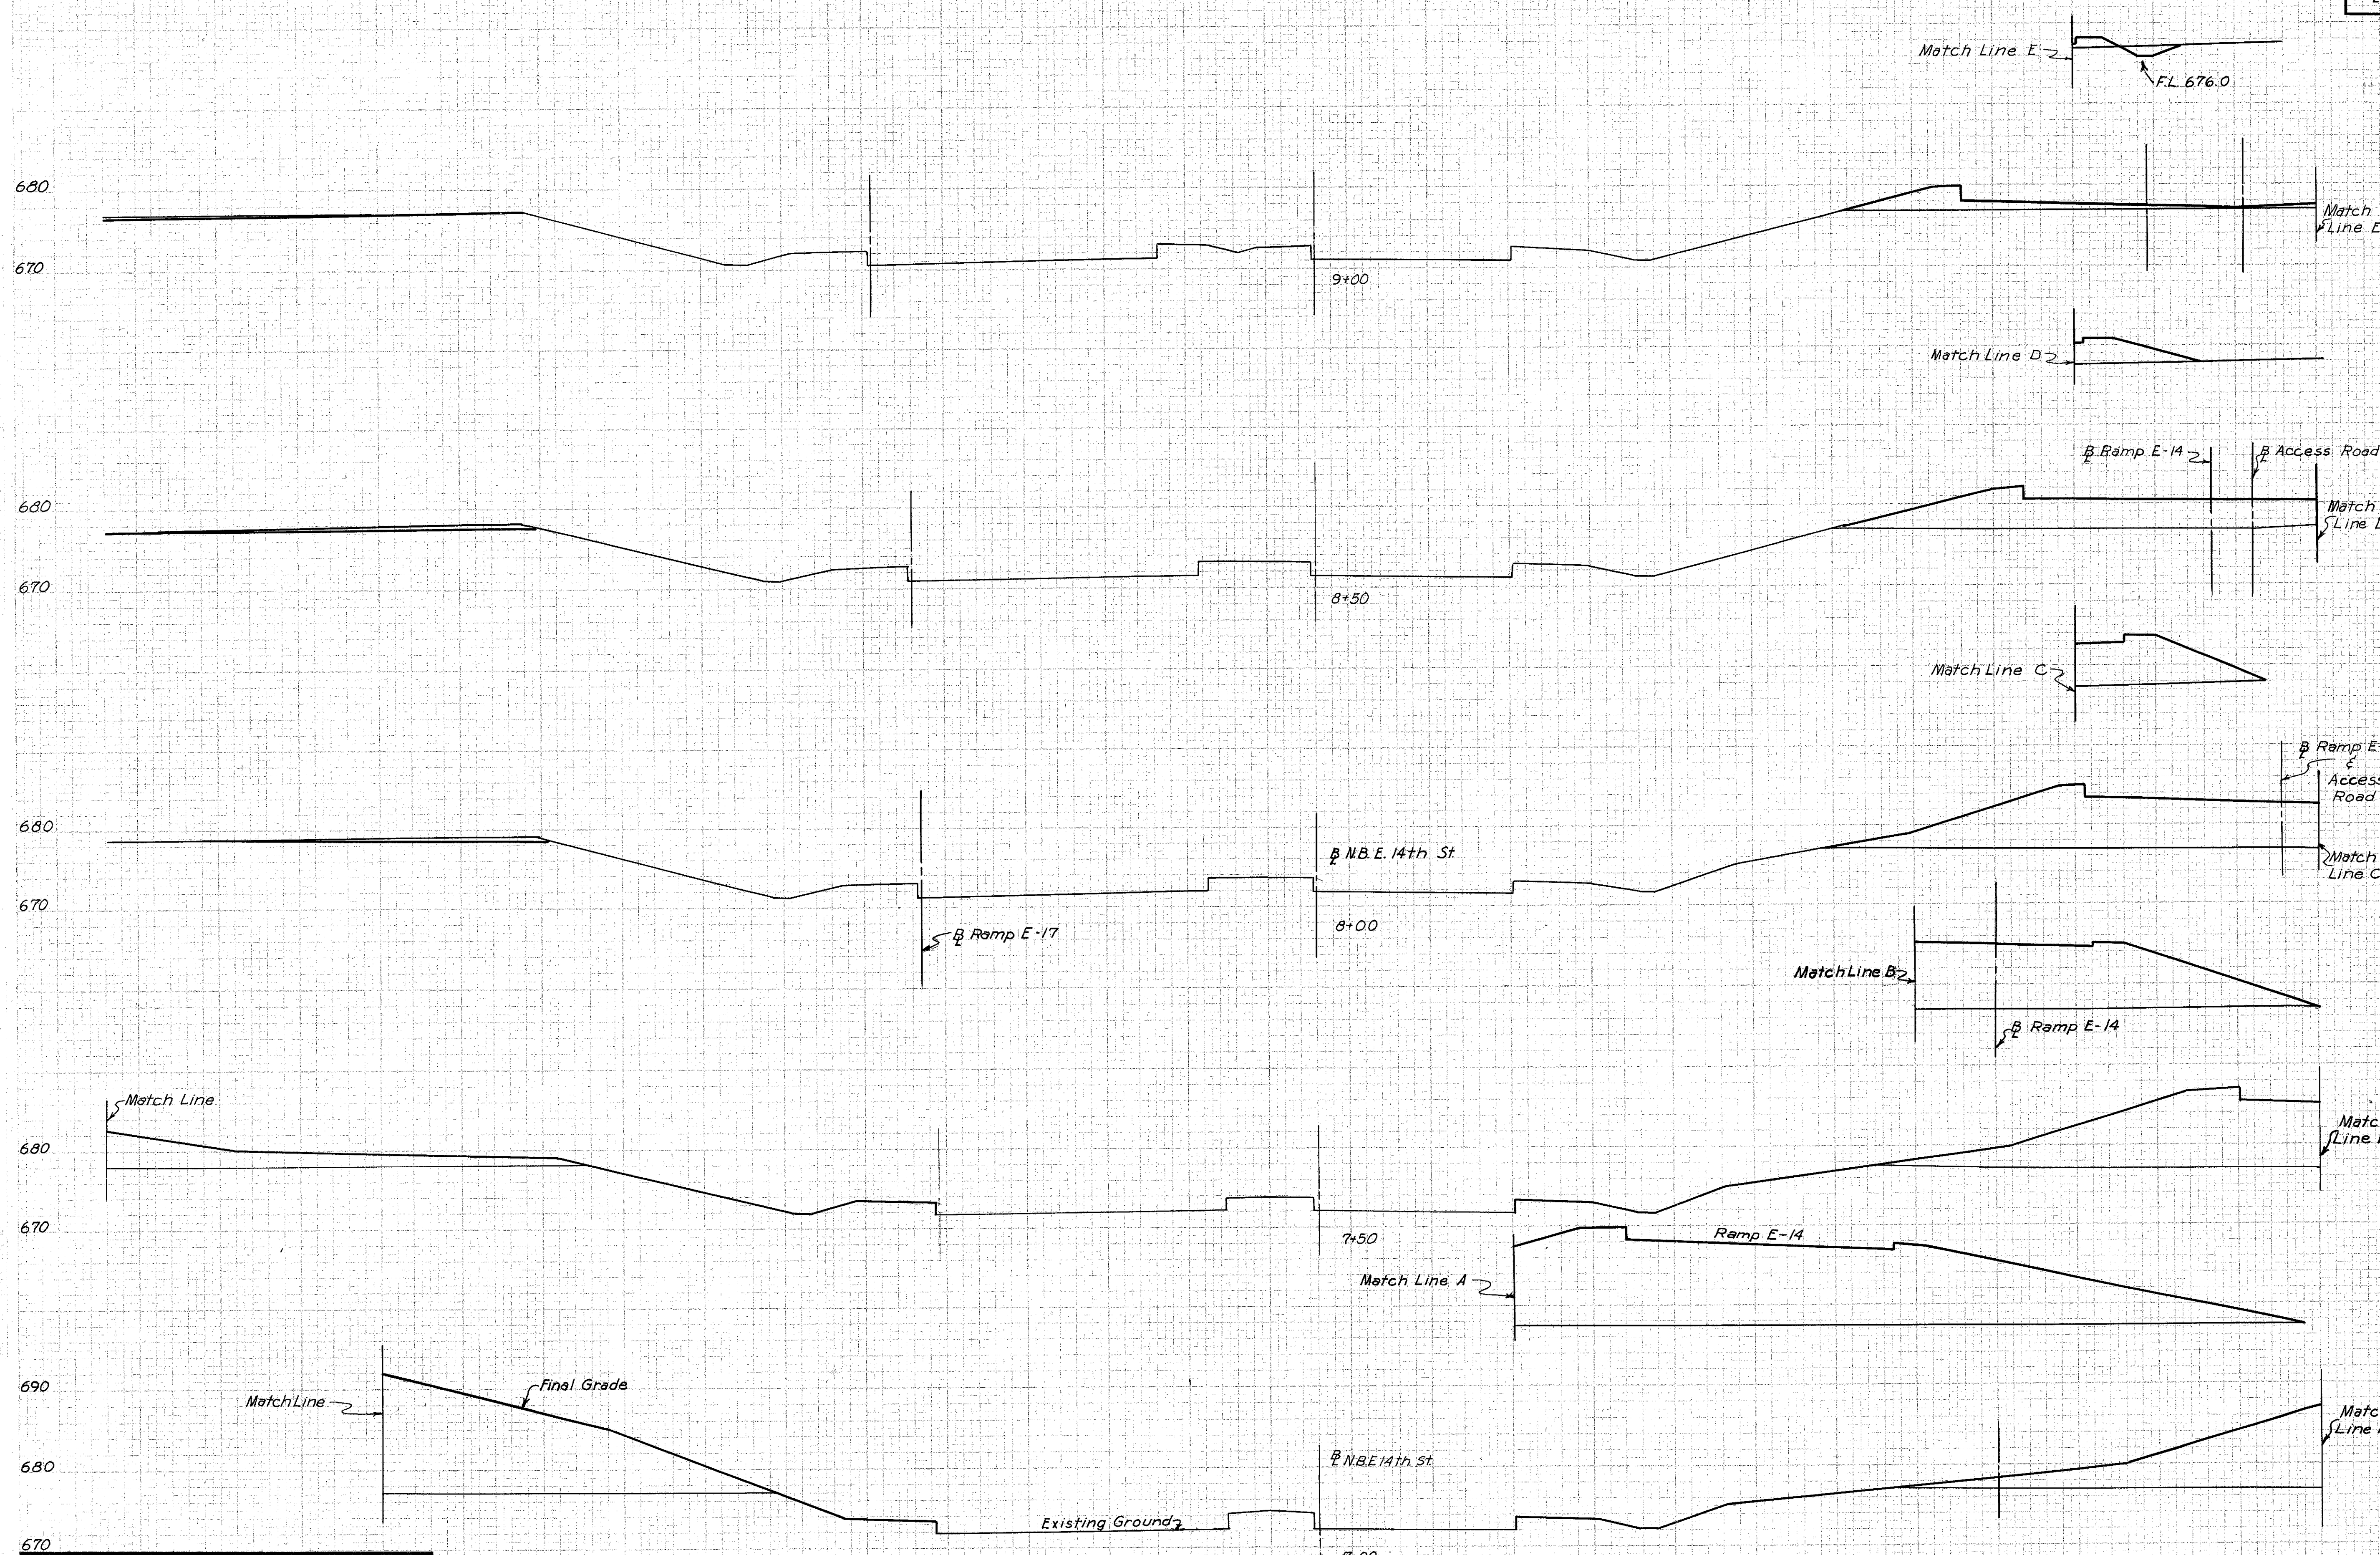

SEEDING		SUBBASE		EARTHWORK			
WIDTH	AREA	AREA	VOL.	END AREA		VOLUME	
L.F.	SQ. YD.	S.F.	C.Y.	EXC.	EMB.	EXC.	EMB.
9+00				13	70		
8+50				26	224		
8+00				18	401		
7+50				0	766		
7+00 (Ahead)				0	1388		
7+00 (Back)				0	407		
6+50 (See Sheet 79)				0	262		
						36	272
						41	579
						17	1081
						0	1994
						0	619

SERIES I
EAST 14TH ST. SECTIONS
STA. 7+00 TO STA. 9+00


SCALE 1"=10'
MADE F.L.S. DATE 8-13-58
TRCD. M.H. DATE 11-15-58
CKD. B.W.S. DATE 12-11-58

HOWARD, NEEDLES, TAMMEN & BERGENDOFF
CONSULTING ENGINEERS
KANSAS CITY CLEVELAND NEW YORK
914 SHEET 80

150 100 50 0 50 100 150

FED. ROAD DIV. NO.	STATE	FEDERAL AID PROJECT NO.	TYPE FUNDS	81
2	OHIO			181

CUYAHOGA COUNTY
 CITY OF CLEVELAND
 CUY-42-18.42
 CUY-21-15.32

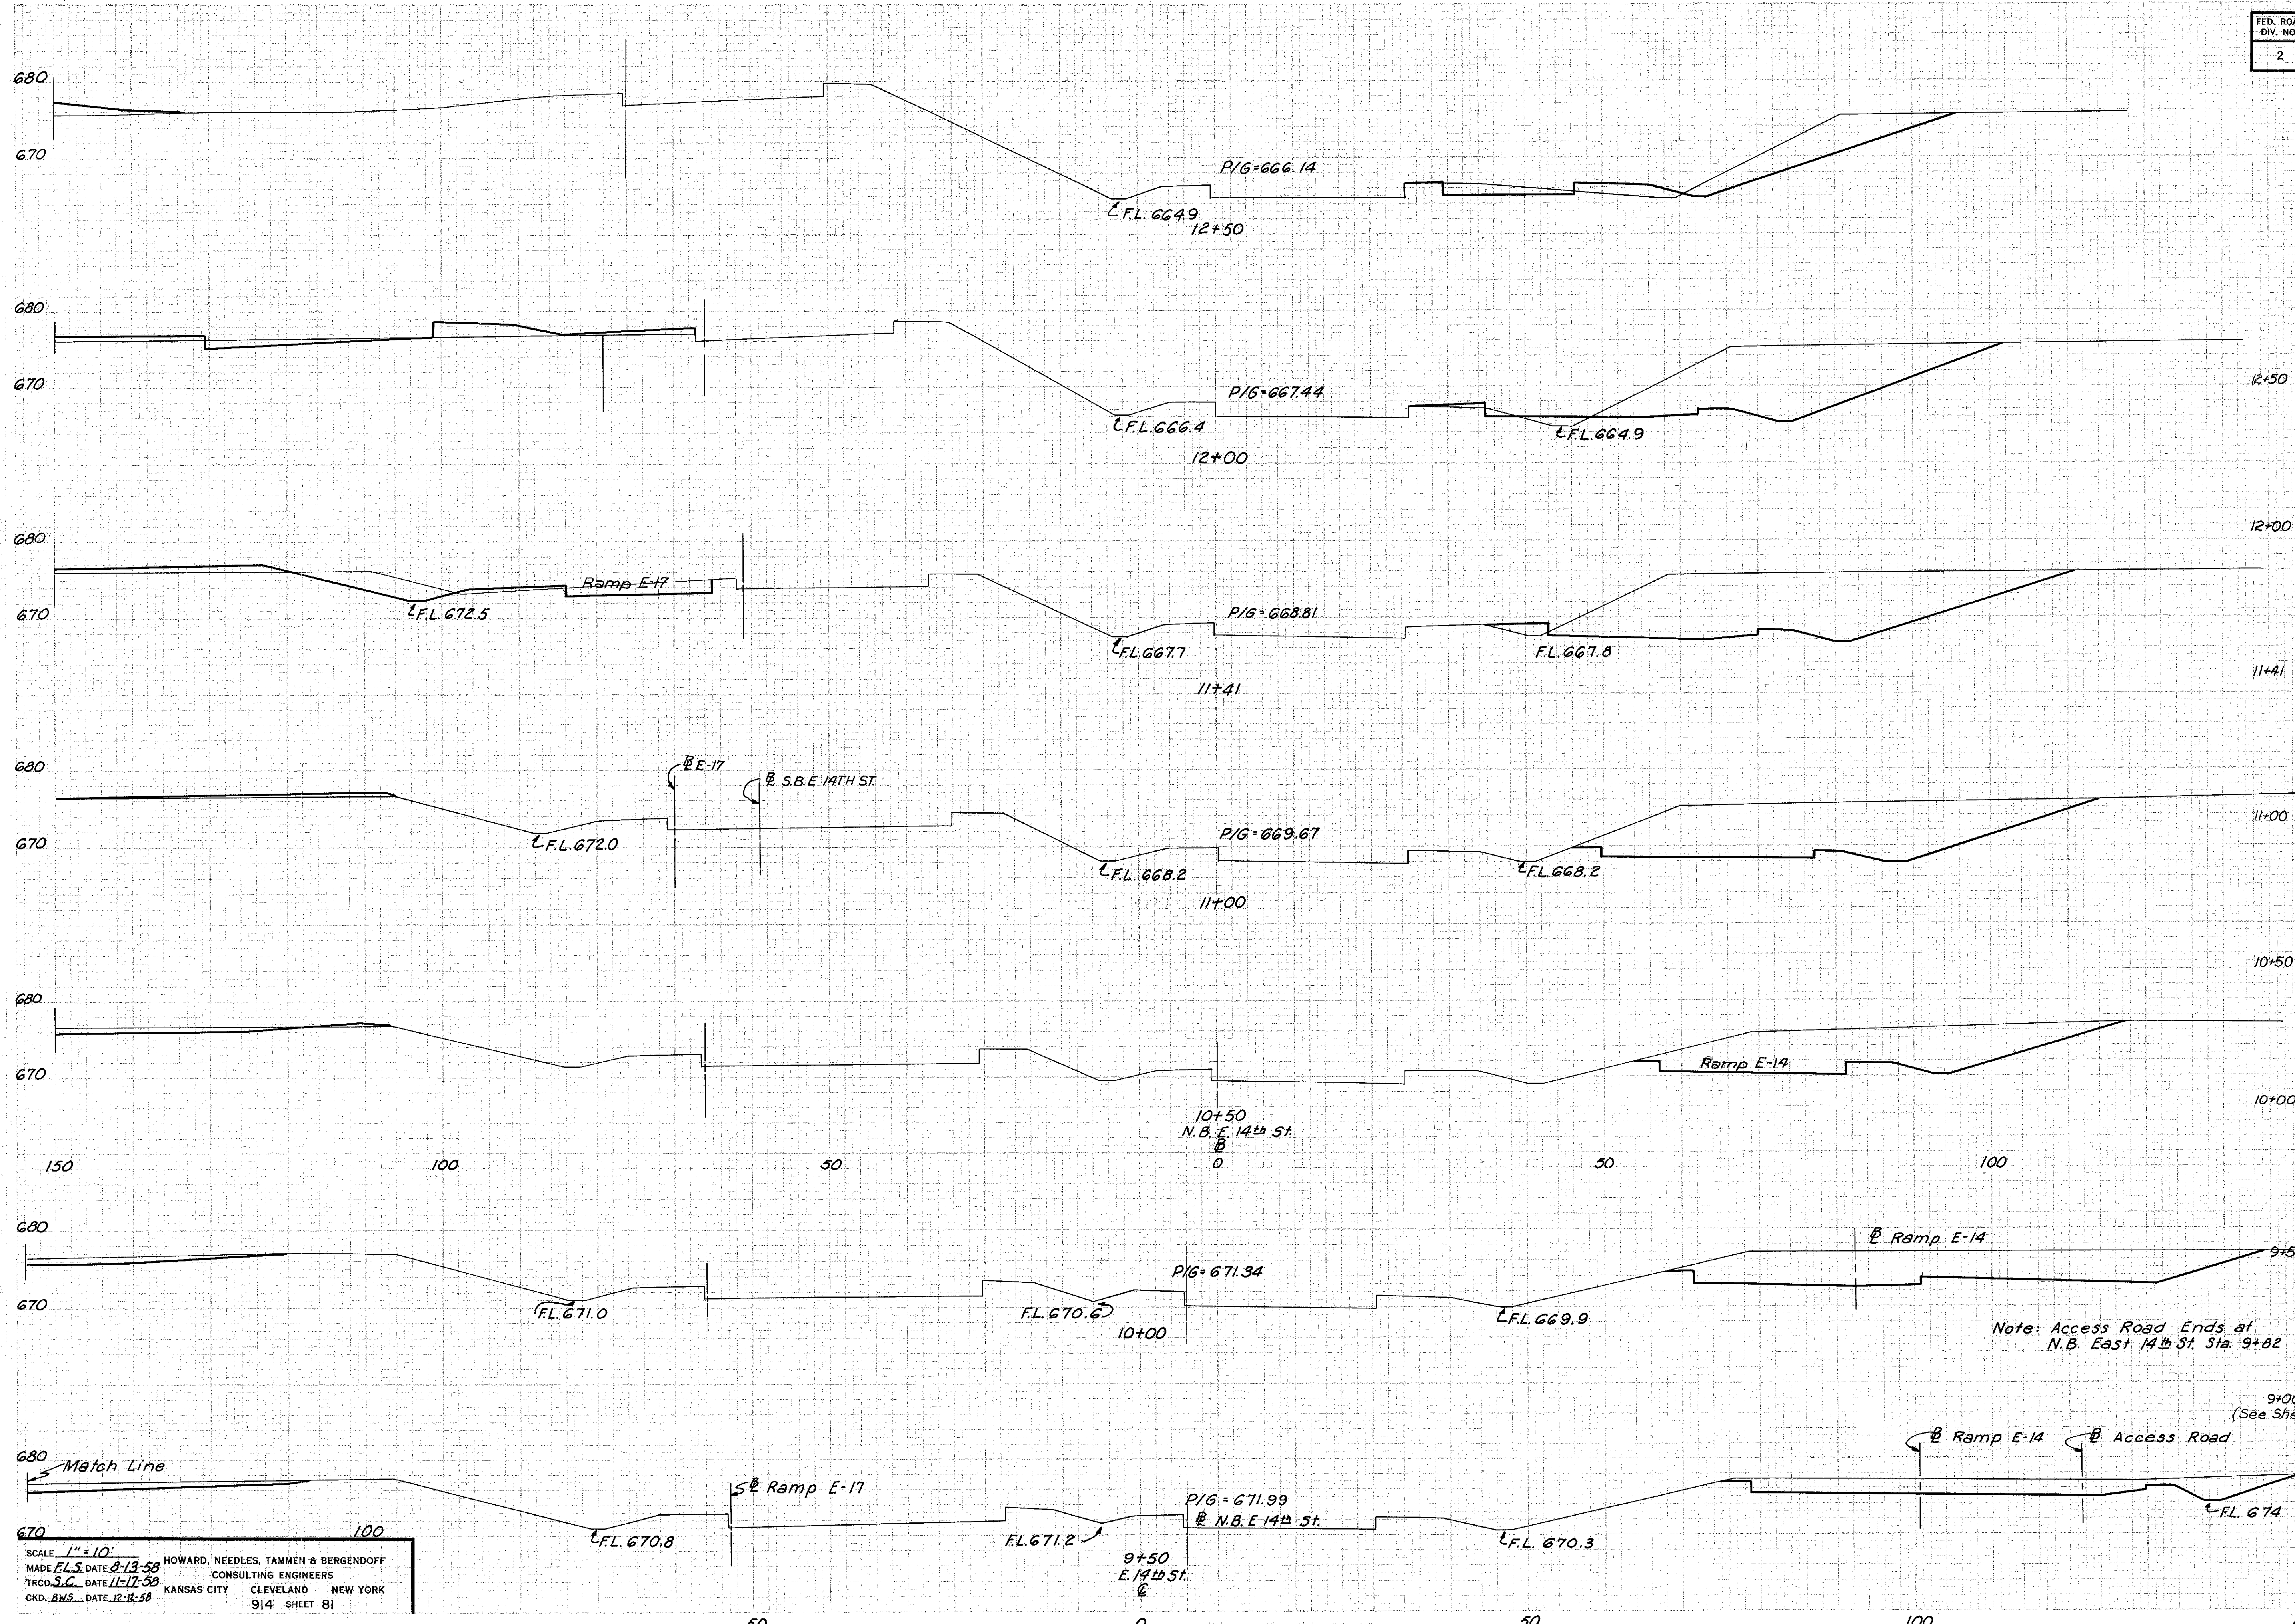

SEEDING		SUBBASE		EARTHWORK			
WIDTH	AREA	AREA	VOL.	END AREA		VOLUME	
L.F.	SQ. YD.	S.F.	C.Y.	EXC.	EMB.	EXC.	EMB.
				114	32		
						381	78
				298	52		
						825	96
				457	36		
						617	36
				355	12		
						572	12
				263	1		
						507	1
				285	0		
						403	0
				150	0		
						151	65
				13	70		


SCALE 1" = 10'
 MADE F.L.S. DATE 8-13-58 HOWARD, NEEDLES, TAMMEN & BERGENDOFF
 TRCD. S.C. DATE 11-17-58 CONSULTING ENGINEERS
 CKD. BWS DATE 12-18-58 KANSAS CITY CLEVELAND NEW YORK
 914 SHEET 81

SERIES I
 EAST 14TH ST SECTIONS
 STA 9+50 TO STA 12+50

FED. ROAD DIV. NO.	STATE	FEDERAL AID PROJECT NO.	TYPE FUNDS
2	OHIO		

82
181

CUYAHOGA COUNTY
CITY OF CLEVELAND
CUY-42-18.42
CUY-42-15.32

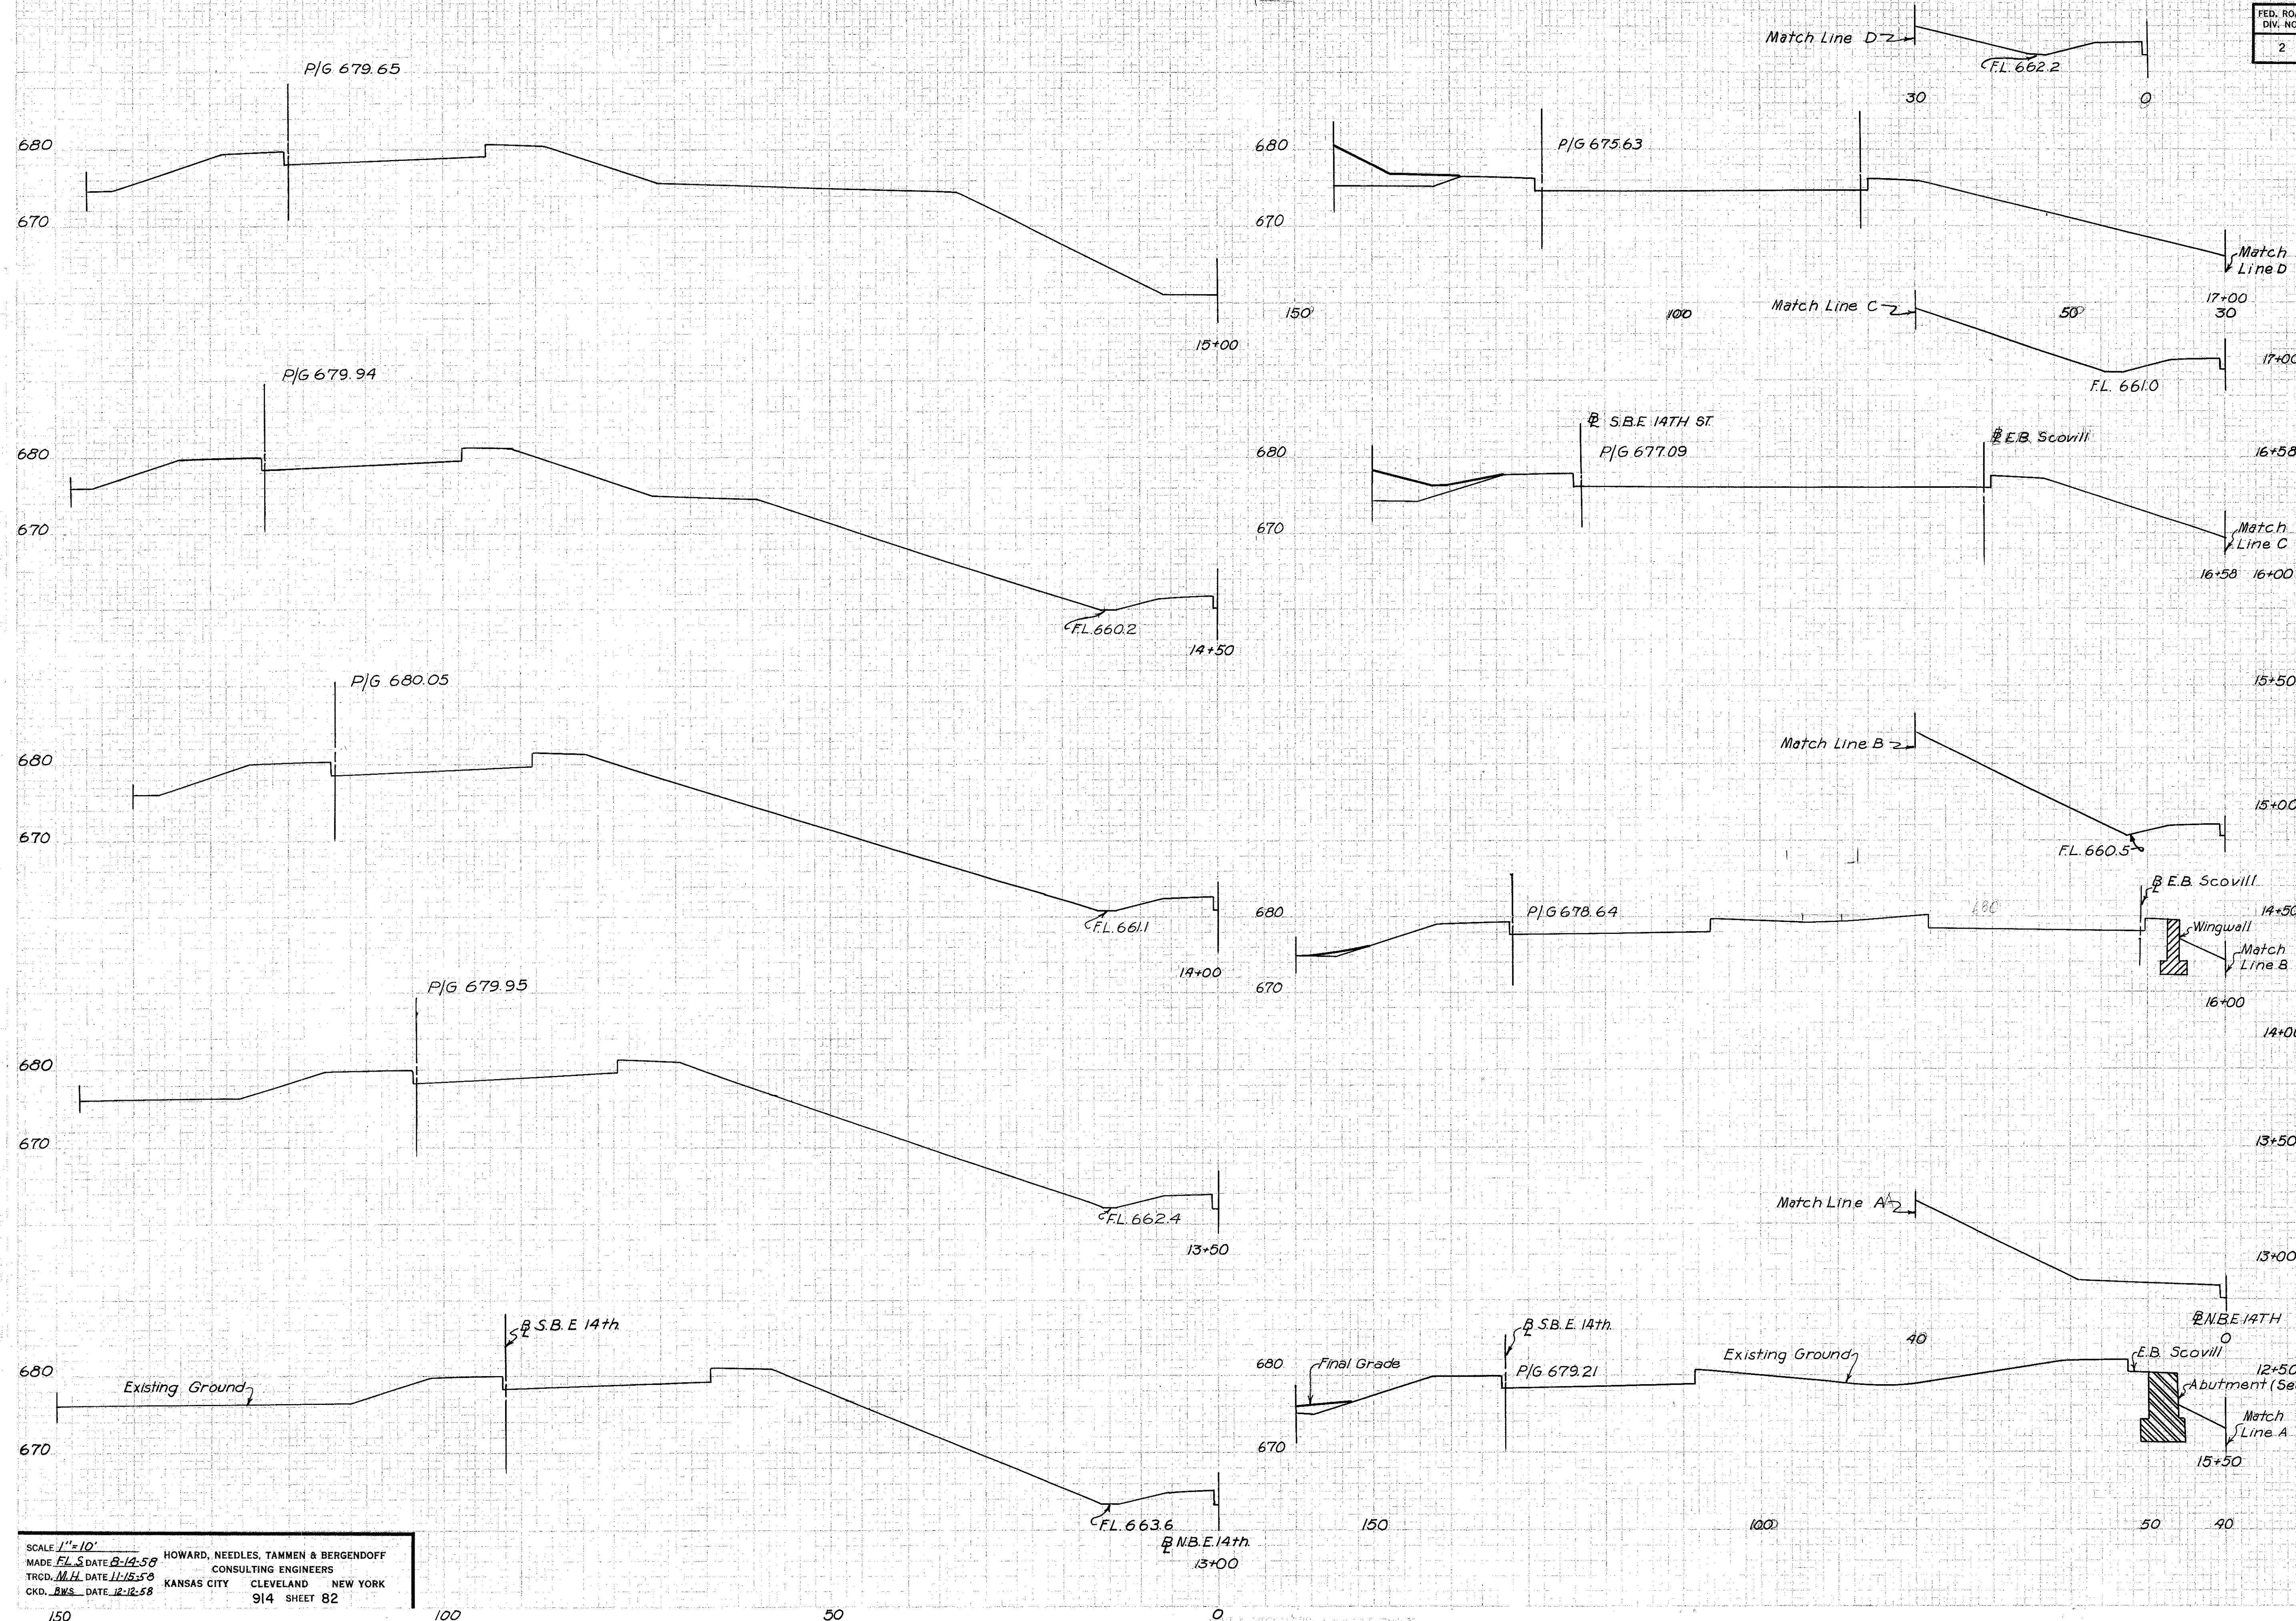

SEEDING		SUBBASE		EARTHWORK			
WIDTH	AREA	AREA	VOL.	END AREA		VOLUME	
L.F.	SQ. YD.	S.F.	C.Y.	EXC.	EMB.	EXC.	EMB.
				0	31		
						0	15
				0	27		
						0	32
				0	3		
						0	8
				0	6		
						0	6
				0	0		
						0	0
						114	32
							106 30


SERIES I
EAST 14TH ST SECTIONS
STA. 13+00 TO STA. 17+00

SCALE 1"=10'
MADE F.L.S. DATE 8-14-58
TRCD. M.H. DATE 11-15-58
CKD. RWS. DATE 12-12-58

HOWARD, NEEDLES, TAMMEN & BERGENDOFF
CONSULTING ENGINEERS
KANSAS CITY CLEVELAND NEW YORK
914 SHEET 82

150 100 50 0

CUYAHOGA COUNTY
 CITY OF CLEVELAND
 CUY-42-18.42
 CUY-21-15.32

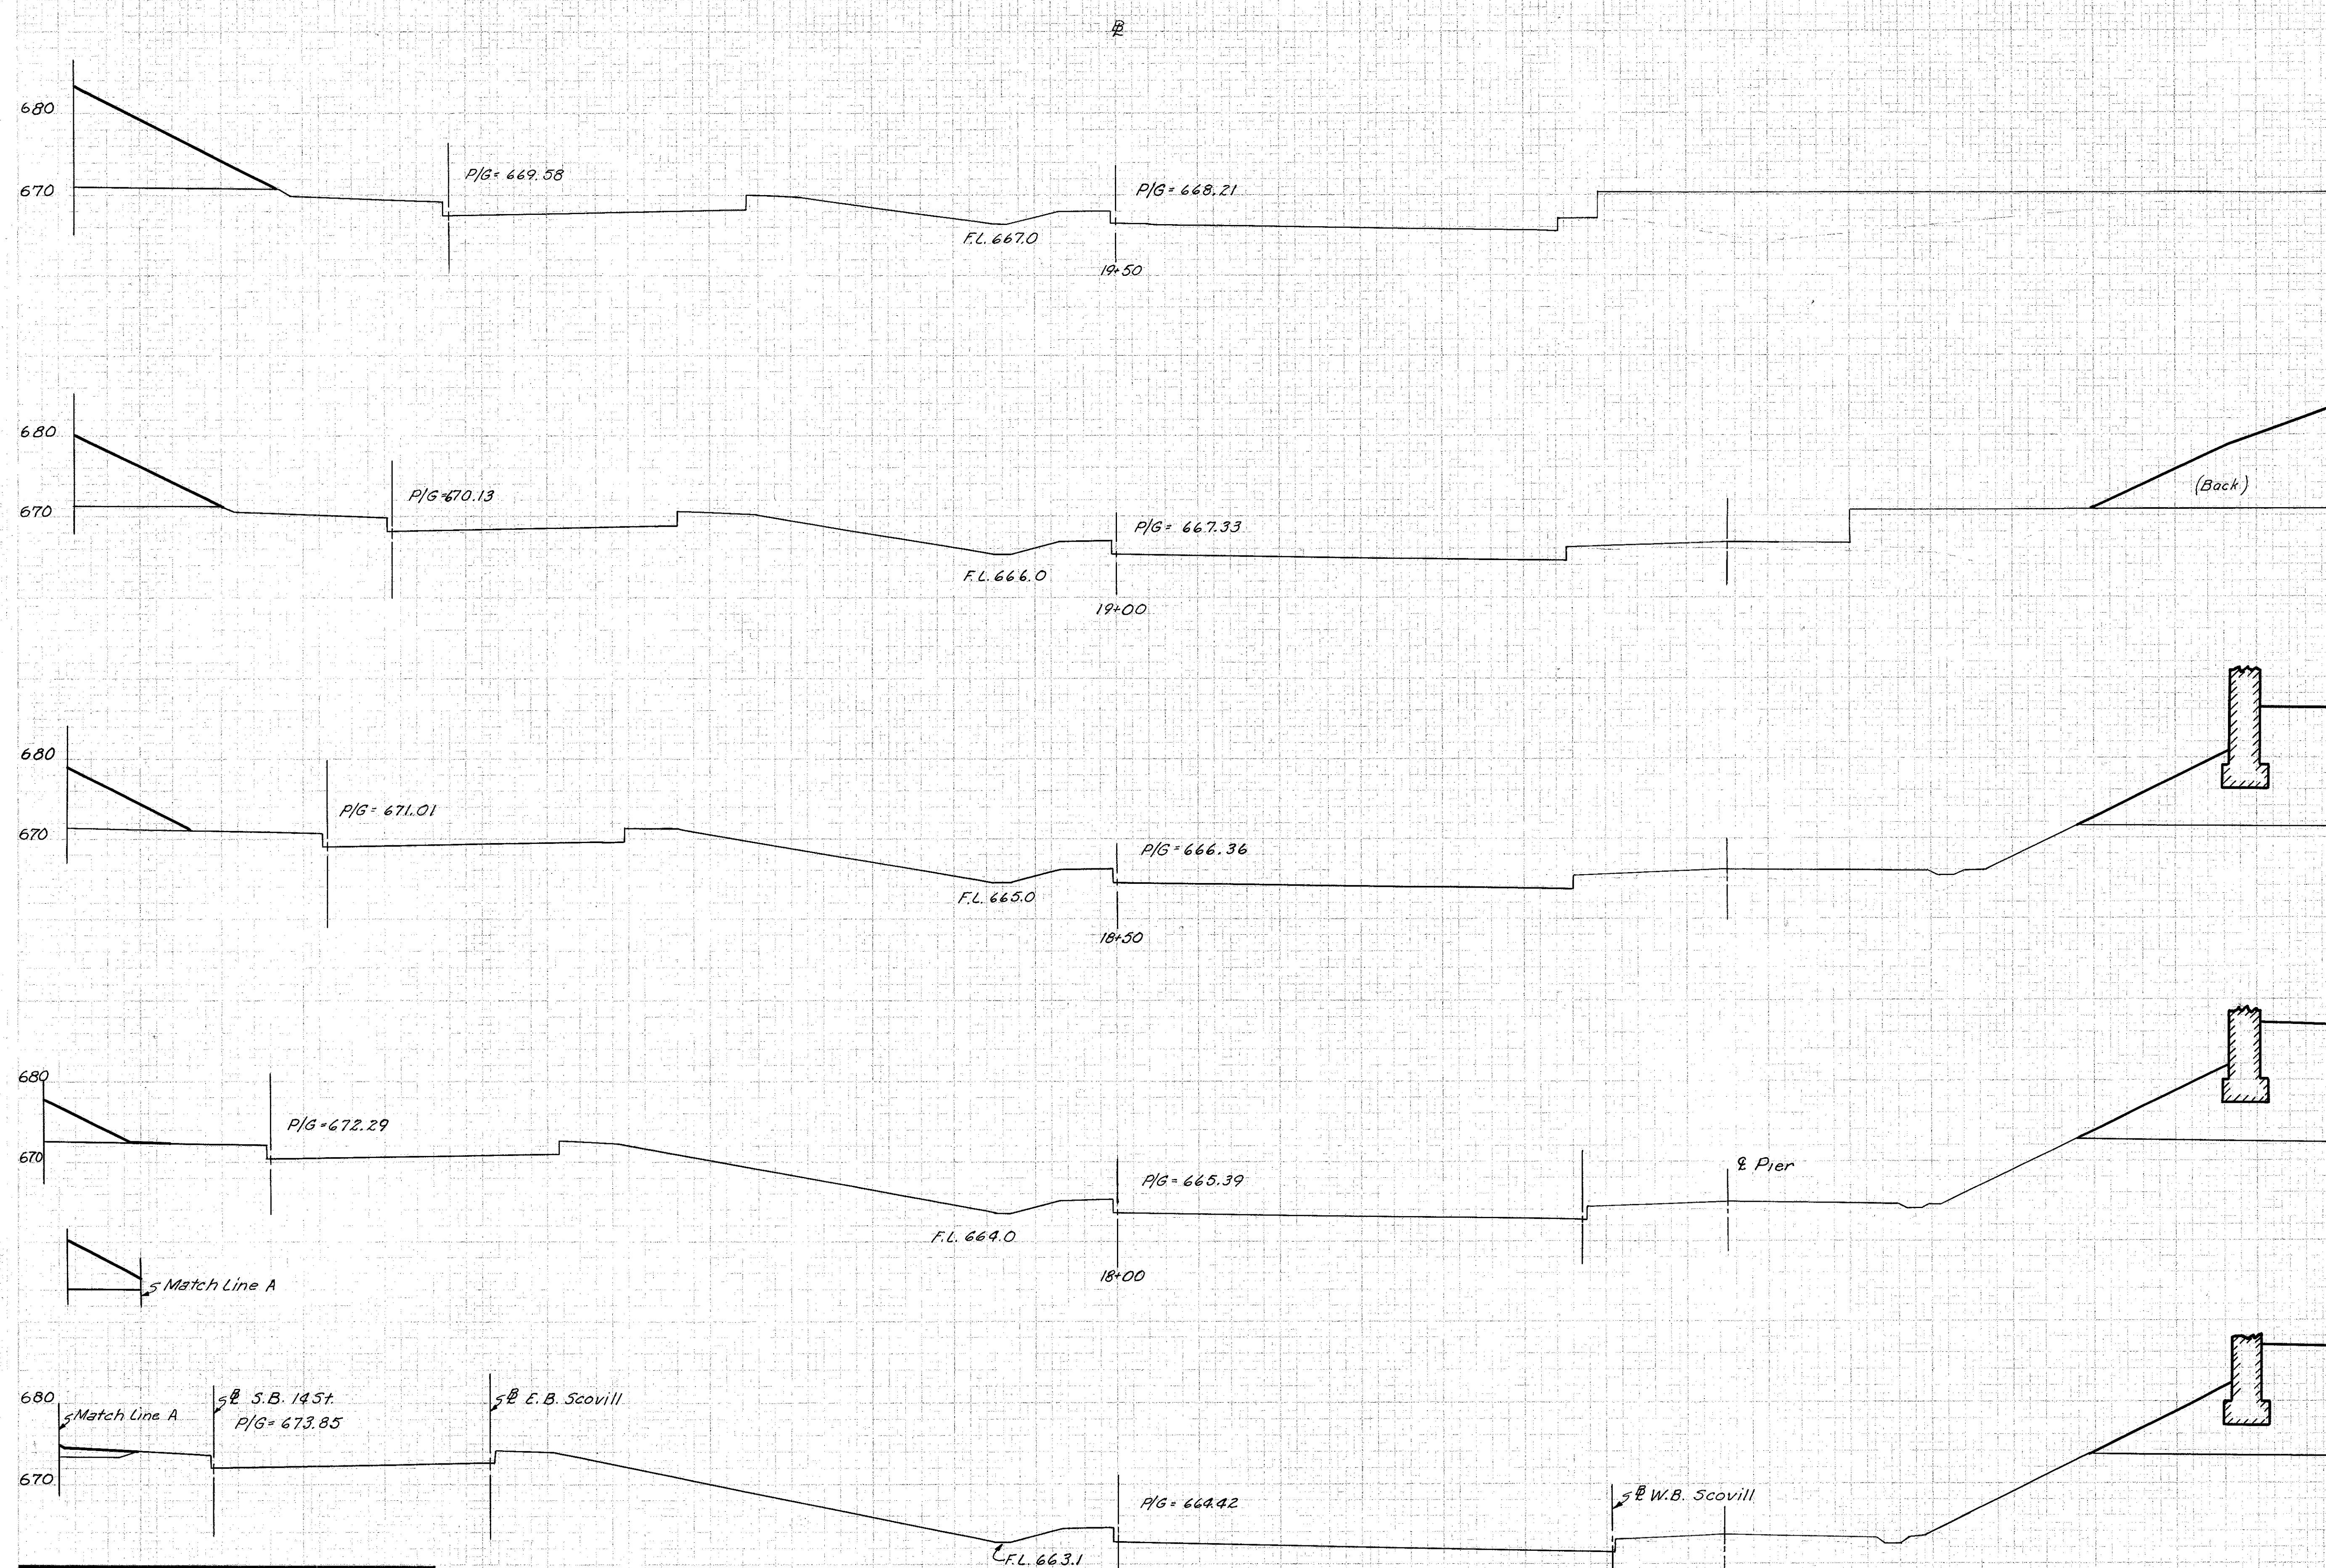

SEEDING		SUBBASE		EARTHWORK			
WIDTH	AREA	AREA	VOL	END AREA		VOLUME	
L.F.	SQ. YD.	S.F.	C.Y.	EXC.	EMB.	EXC.	EMB.
				0	156		
						0	220
				0	81		
				0	276		
						0	542
				0	309		
						0	598
				0	283		
						0	508
				0	266		
						0	275
				0	31		

SERIES I
 EAST 14TH ST. SECTIONS
 STA. 17+50 TO STA. 19+50

SCALE 1"=10'
 MADE F.L.S. DATE 8-14-58 HOWARD, NEEDLES, TAMMEN & BERGENDOFF
 TRCD. M.B. DATE 11-15-58 CONSULTING ENGINEERS
 CKD. B.W.S. DATE 12-12-58 KANSAS CITY CLEVELAND NEW YORK
 914 SHEET 83
 100


50 100 150

FED. ROAD DIV. NO.	STATE	FEDERAL AID PROJECT NO.	TYPE FUNDS
2	OHIO		

84
181

CUYAHOGA COUNTY
CITY OF CLEVELAND
CUY-42-18.42
CUY-21-15.32

STATION	SEEDING		SUBBASE		EARTHWORK			
	WIDTH L.F.	AREA SQ.YD.	AREA S.F.	VOL. C.Y.	END AREA EXC.	END AREA EMB.	VOLUME EXC.	VOLUME EMB.
22+33					0	0		
22+00					297	0		181 0
21+50					377	0		624 0
21+07					523	2		717 2
21+07					0	0		
20+50					8	0		8 0
20+00					0	0		7 0
19+50					0	156		0 144

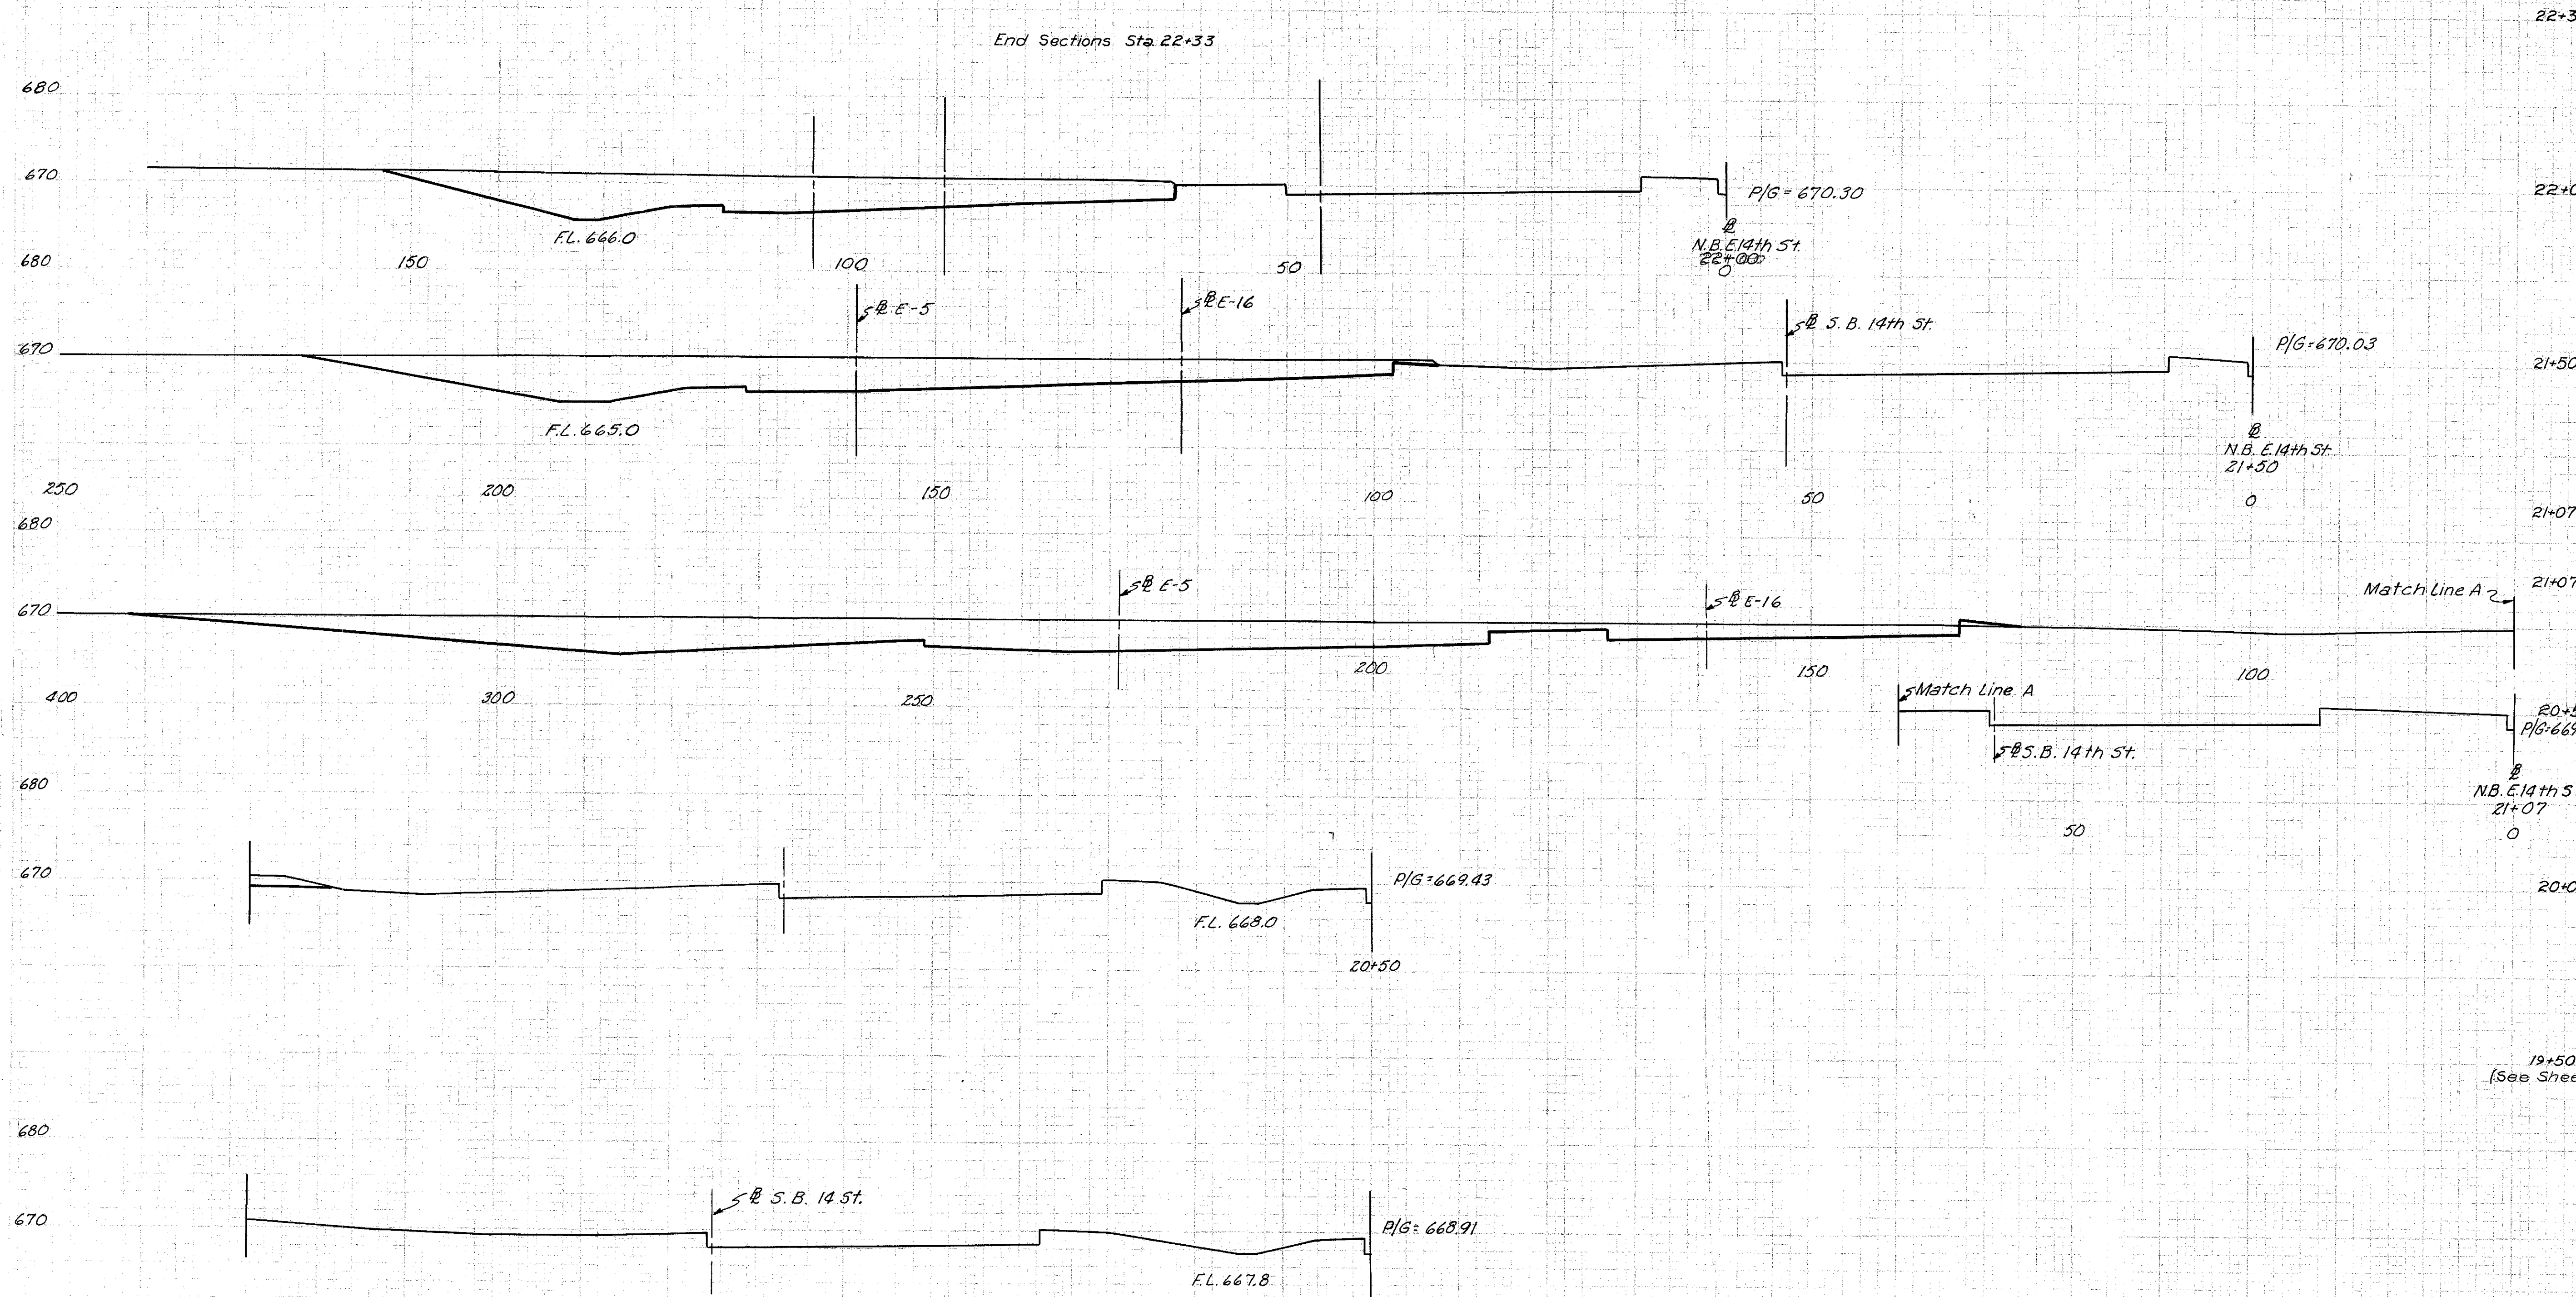


SCALE 1" = 10'
MADE F.L.S. DATE 8-14-58 HOWARD, NEEDLES, TAMMEN & BERGENDOFF CONSULTING ENGINEERS
TRCD. M.B. DATE 11-17-58 KANSAS CITY CLEVELAND NEW YORK
CKD. G.M.G. DATE 12-31-58 914 SHEET 84

SERIES I
EAST 14TH ST. SECTIONS
STA. 20+00 TO STA. 22+33

FED. ROAD DIV. NO.	STATE	FEDERAL AID PROJECT NO.	TYPE FUNDS
2	OHIO		

85
181

CUYAHOGA COUNTY
CITY OF CLEVELAND
CUY-42-18.42
CUY-21-15.32

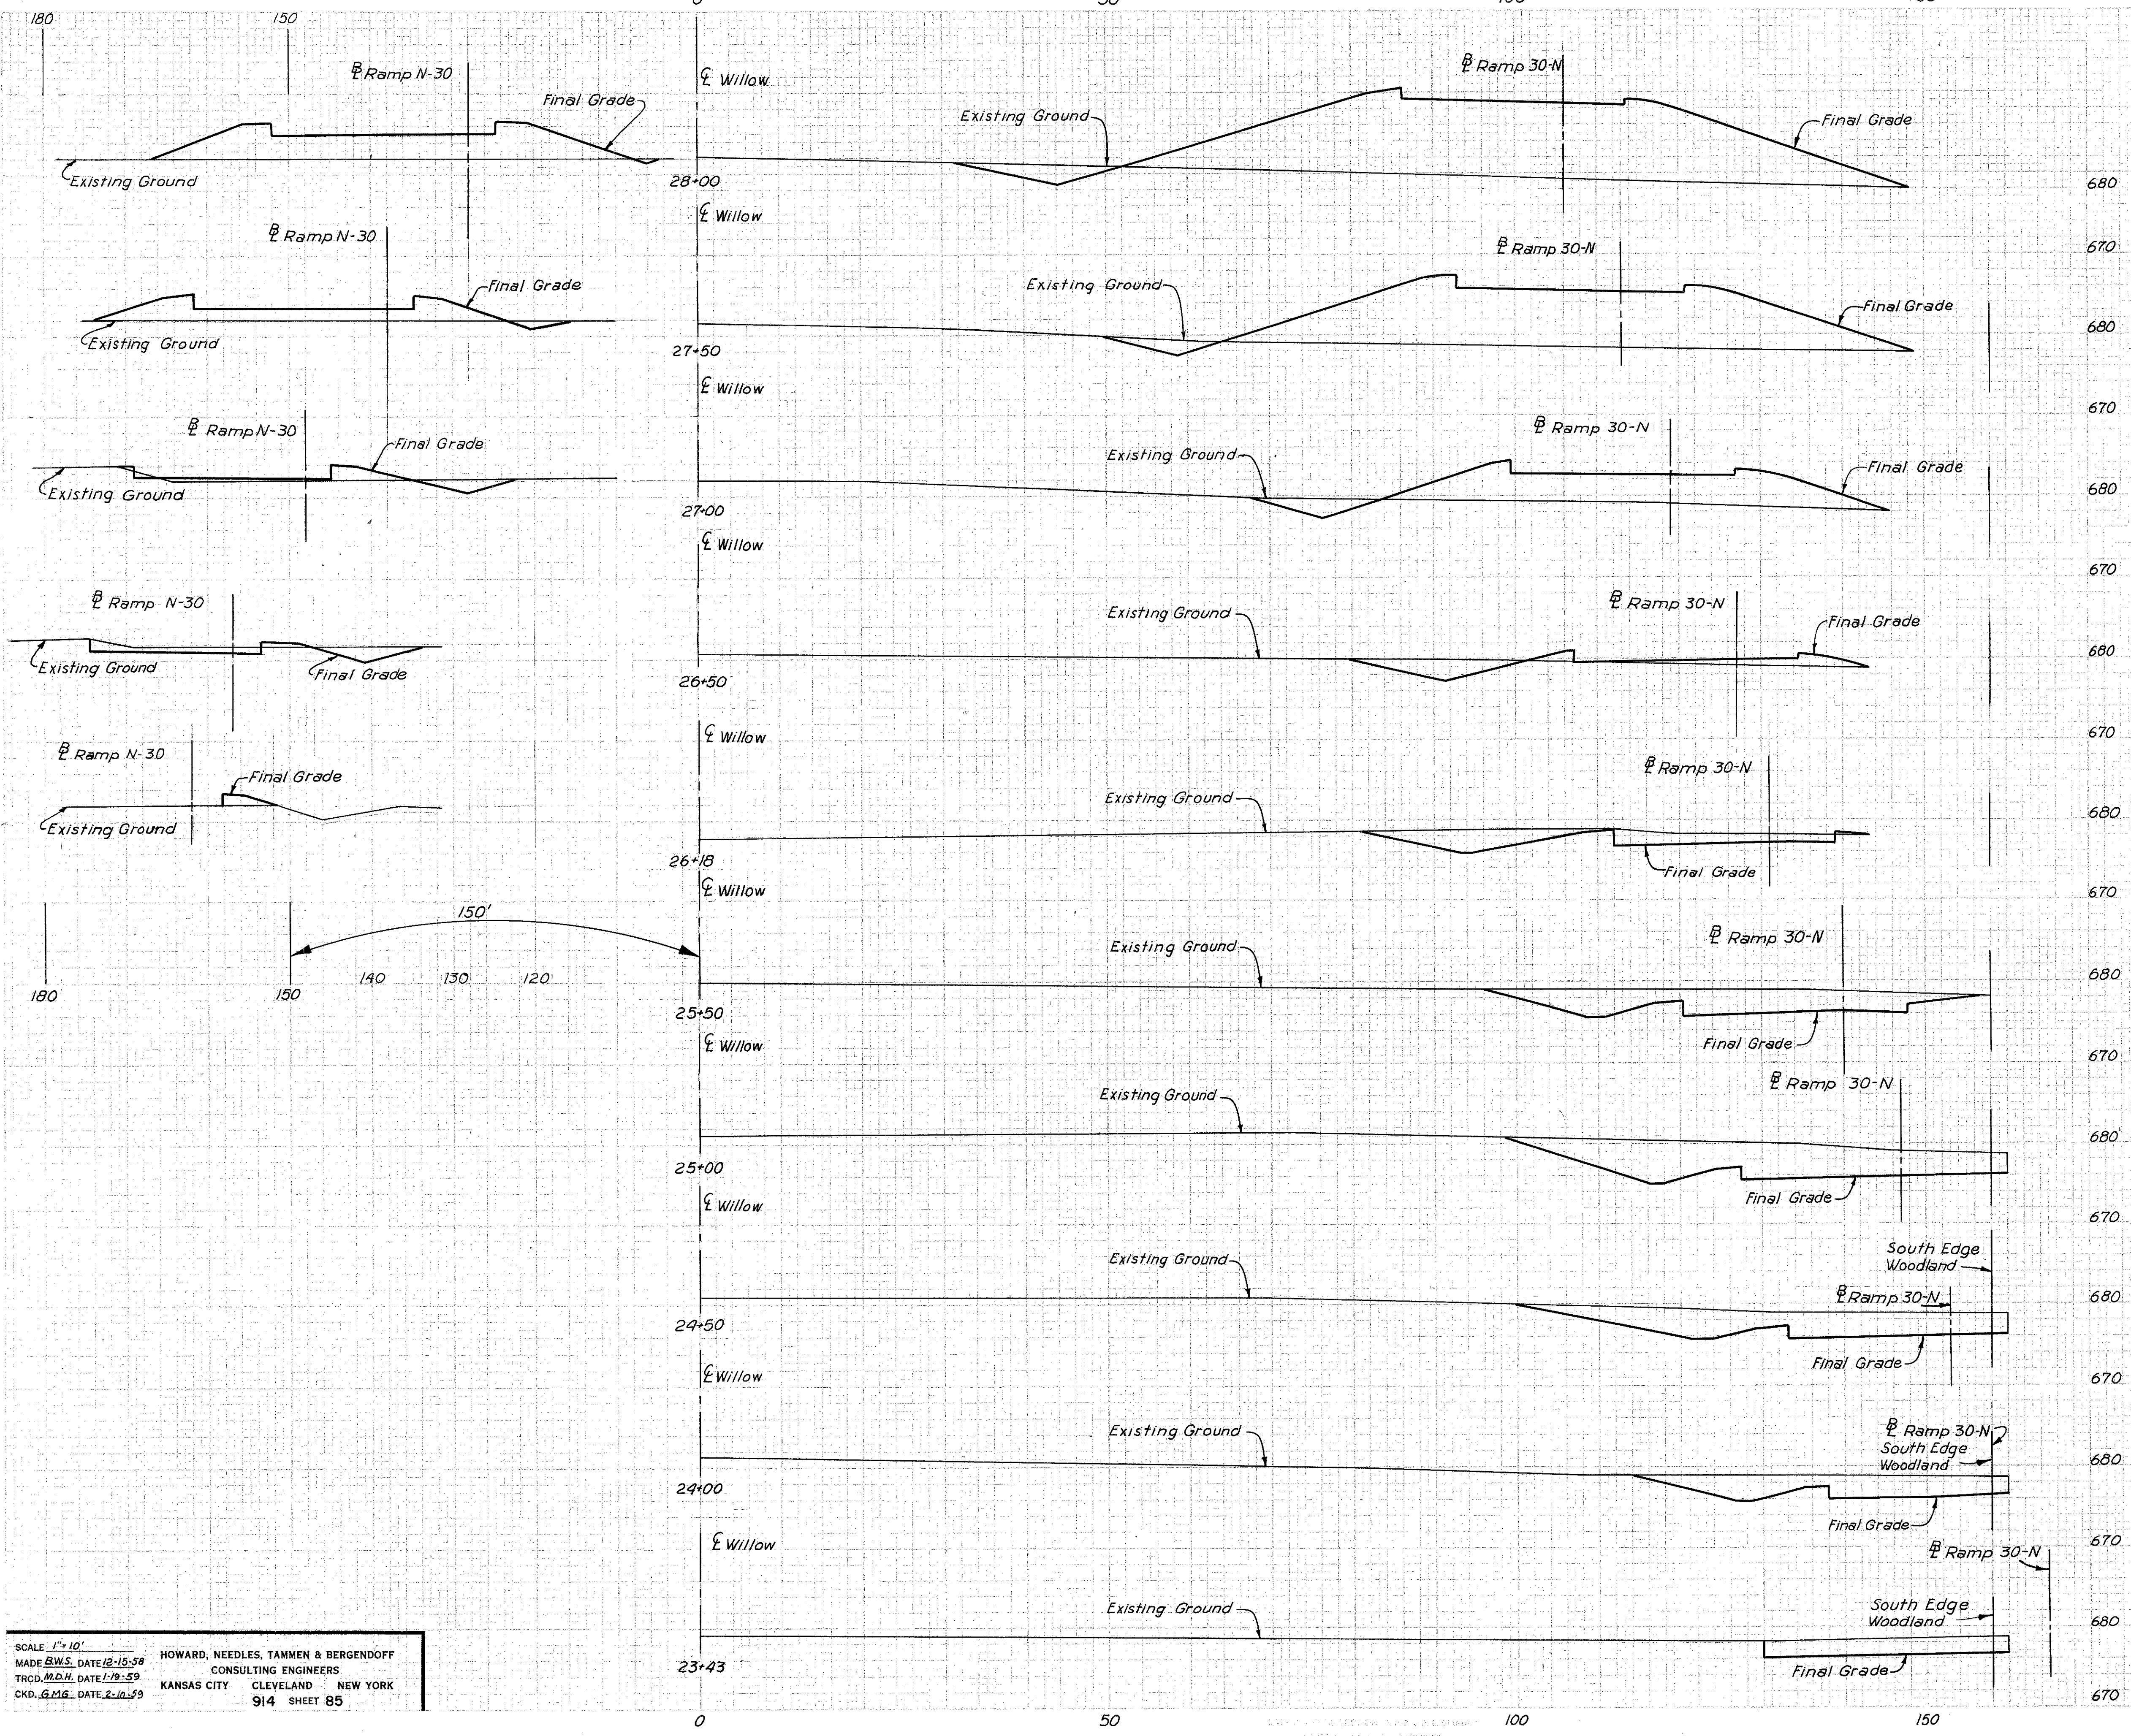

SEEDING	SUBBASE	EARTHWORK					
		WIDTH	AREA	AREA	VOLUME		
L.F.	SQ.YD.	S.F.	C.Y.	EXC.	EMB.	EXC.	EMB.
				26	823		
						43	1258
				20	536		
						48	683
				22	202		
						88	211
				63	26		
						83	20
				77	7		
						277	9
				143	0		
						326	0
				209	0		
						330	0
				147	0		
						232	0
				104	0		
						175	0
				62	0		

SERIES J
WILLOW FREEWAY SECTIONS
STA. 23+43 TO STA. 28+00


SCALE 1"=10'
MADE B.W.S. DATE 12-15-58
TRCD. M.D.H. DATE 1-19-59
CKD. G.M.G. DATE 2-10-59

HOWARD, NEEDLES, TAMMEN & BERGENDOFF
CONSULTING ENGINEERS
KANSAS CITY CLEVELAND NEW YORK
914 SHEET 85

FED. ROAD DIV. NO.	STATE	FEDERAL AID PROJECT NO.	TYPE FUNDS
2	OHIO		



CUYAHOGA COUNTY
CITY OF CLEVELAND
CUY-42-18.42
CUY-21-15.32

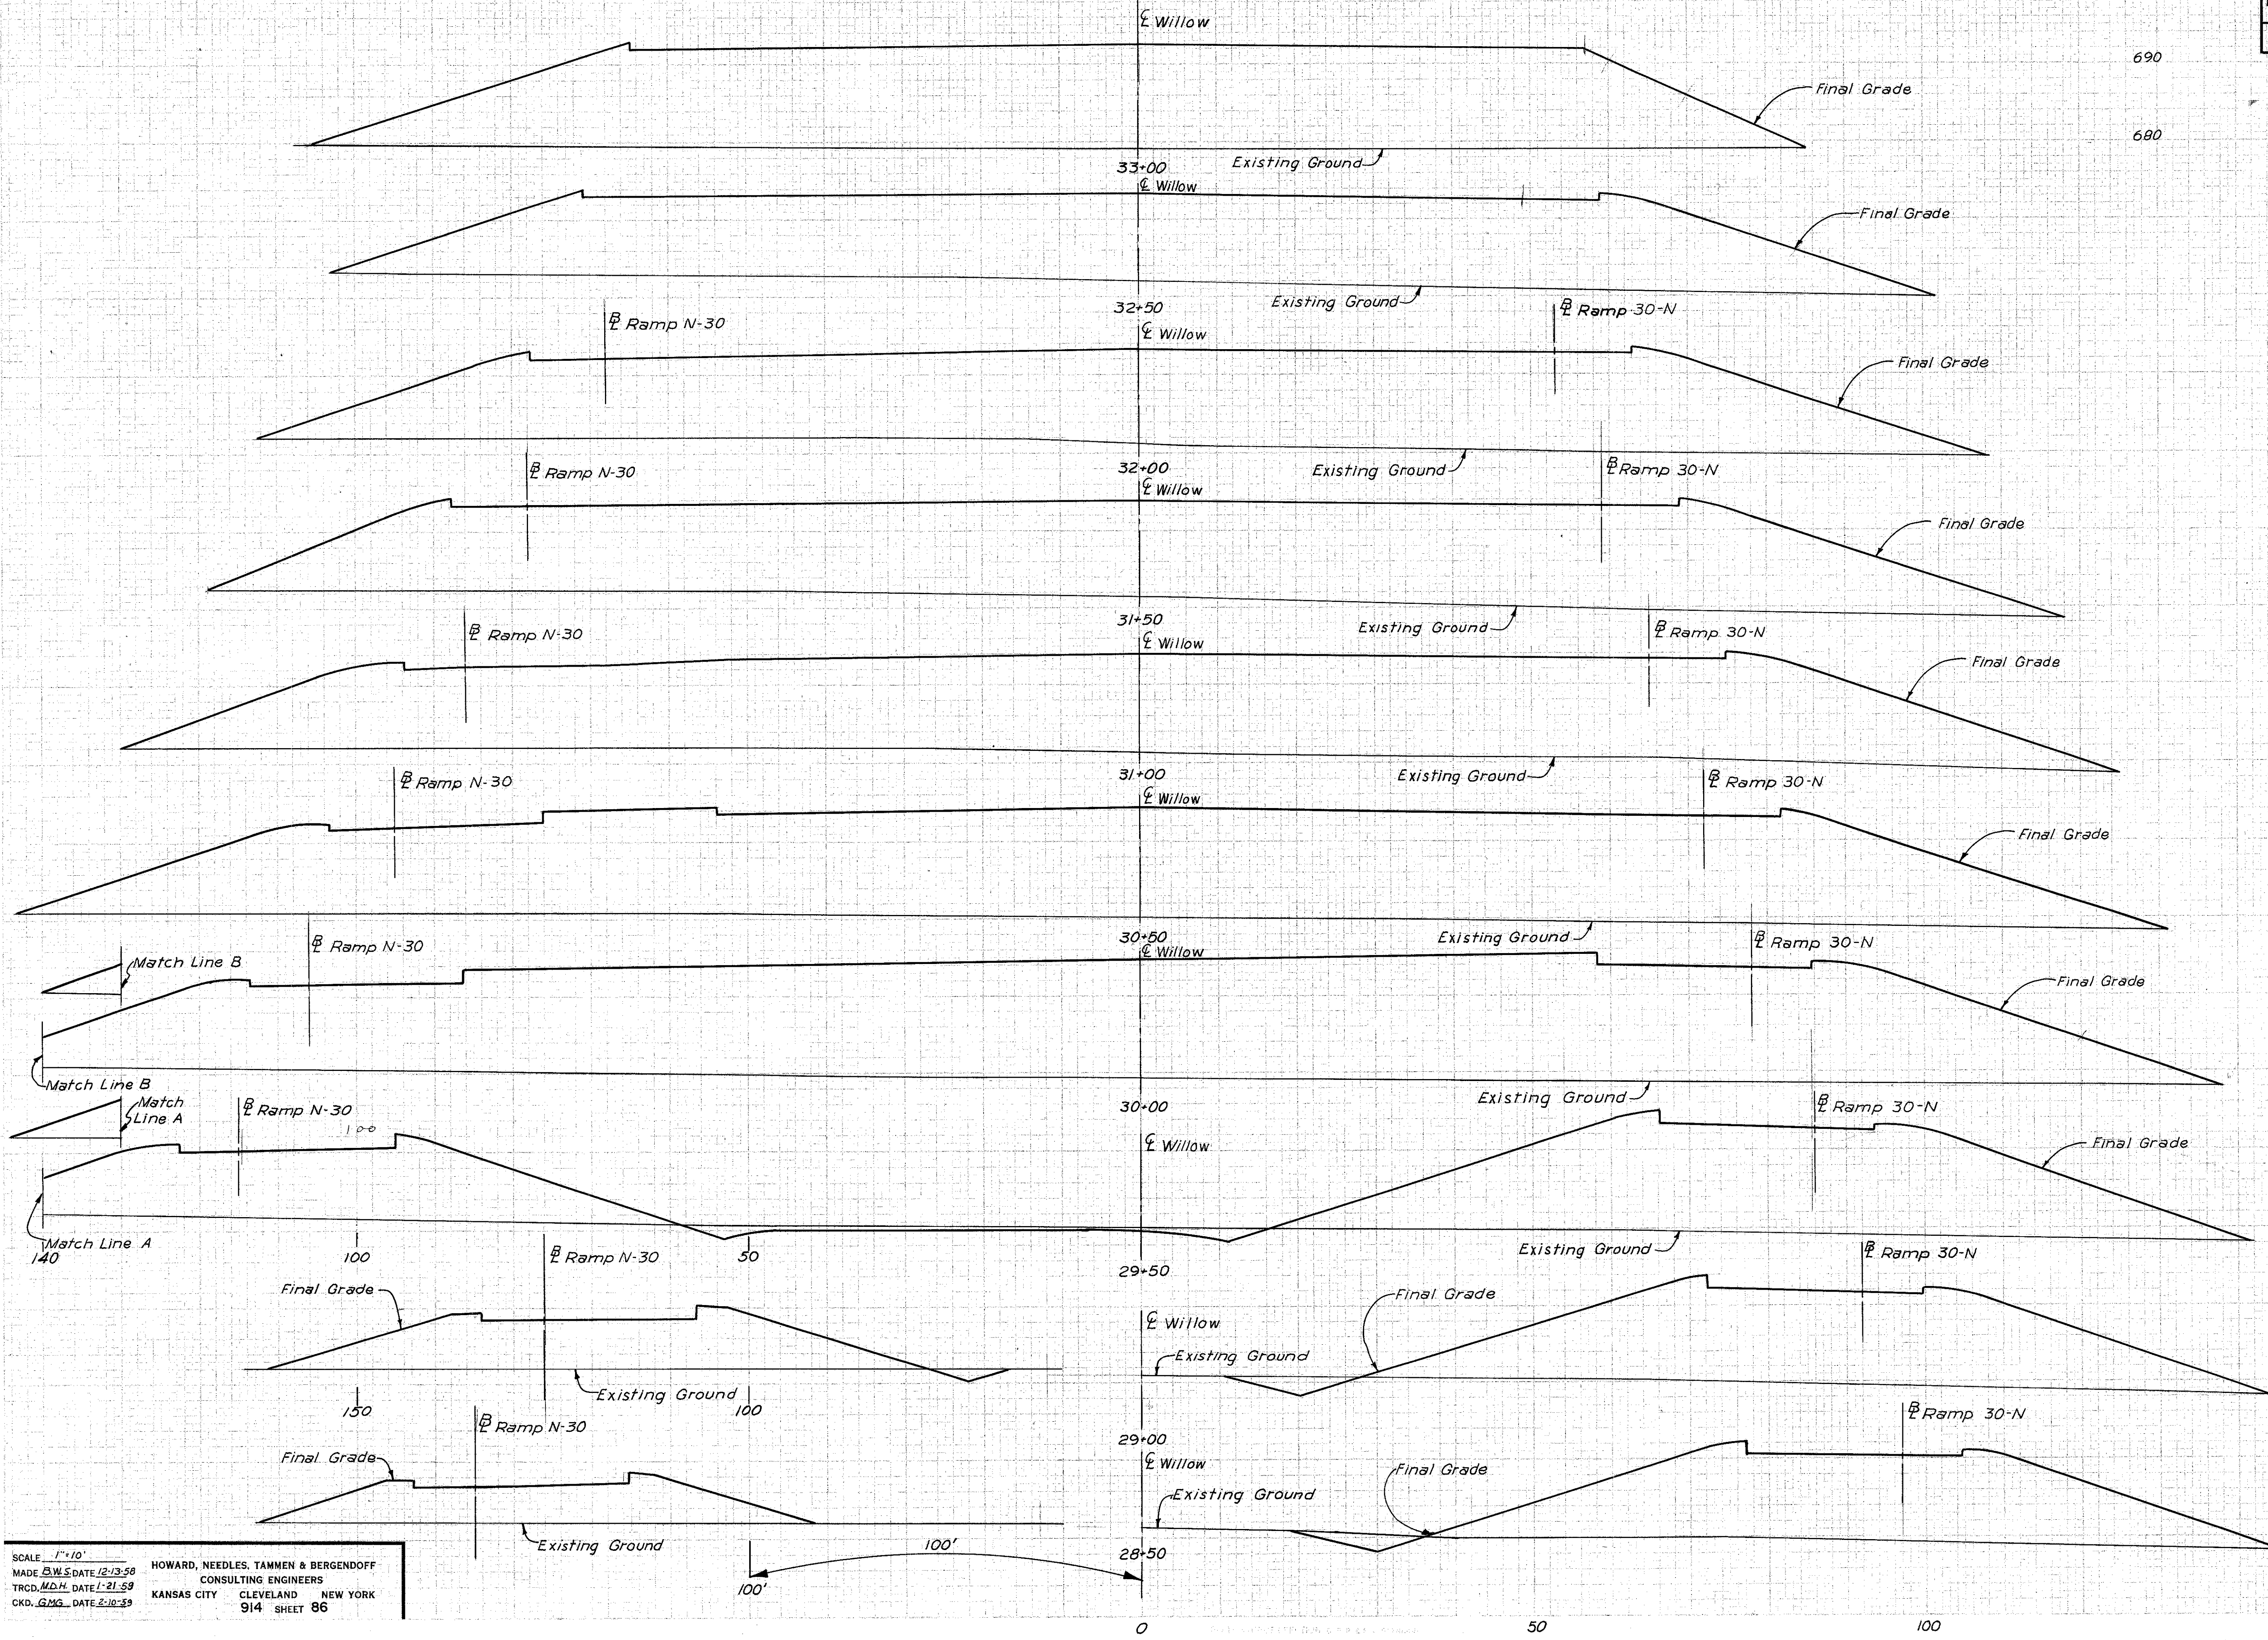

L.F.	SEEDING		SUBBASE		EARTHWORK			
	WIDTH	AREA	AREA	VOL.	END AREA		VOLUME	
	L.F.	SQ. YD.	S.F.	C.Y.	EXC.	EMB.	EXC.	EMB.
670	33+00					2032		
690							0	3644
680	32+50					1903		
670							0	3761
690	32+00					2159		
680							0	4306
670	31+50					2491		
690							0	4765
680	31+00					2655		
670							0	5368
690	30+50					3142		
680							0	6278
670	30+00					0	3638	
690							43	5013
680	29+50				46	1776		
670							71	2994
690	29+00					31	1403	
680							47	2347
670	28+50					20	1132	
690							43	1810
680	28+00 (See Sheet 85)					26	823	

SERIES J
WILLOW FREEWAY SECTIONS
STA. 28+50 TO STA. 33+00


SCALE 1"=10'
MADE BY S.D. DATE 12-13-58
TRCD. M.D.H. DATE 1-21-59
CKD. G.M.G. DATE 2-10-59

HOWARD, NEEDLES, TAMMEN & BERGENOFF
CONSULTING ENGINEERS
KANSAS CITY CLEVELAND NEW YORK
914 SHEET 86

FED. ROAD DIV. NO.	STATE	FEDERAL AID PROJECT NO.	TYPE FUNDS
2	OHIO		

89
181

CUYAHOGA COUNTY
CITY OF CLEVELAND
CUY-42-18.42
CUY-21-15.32

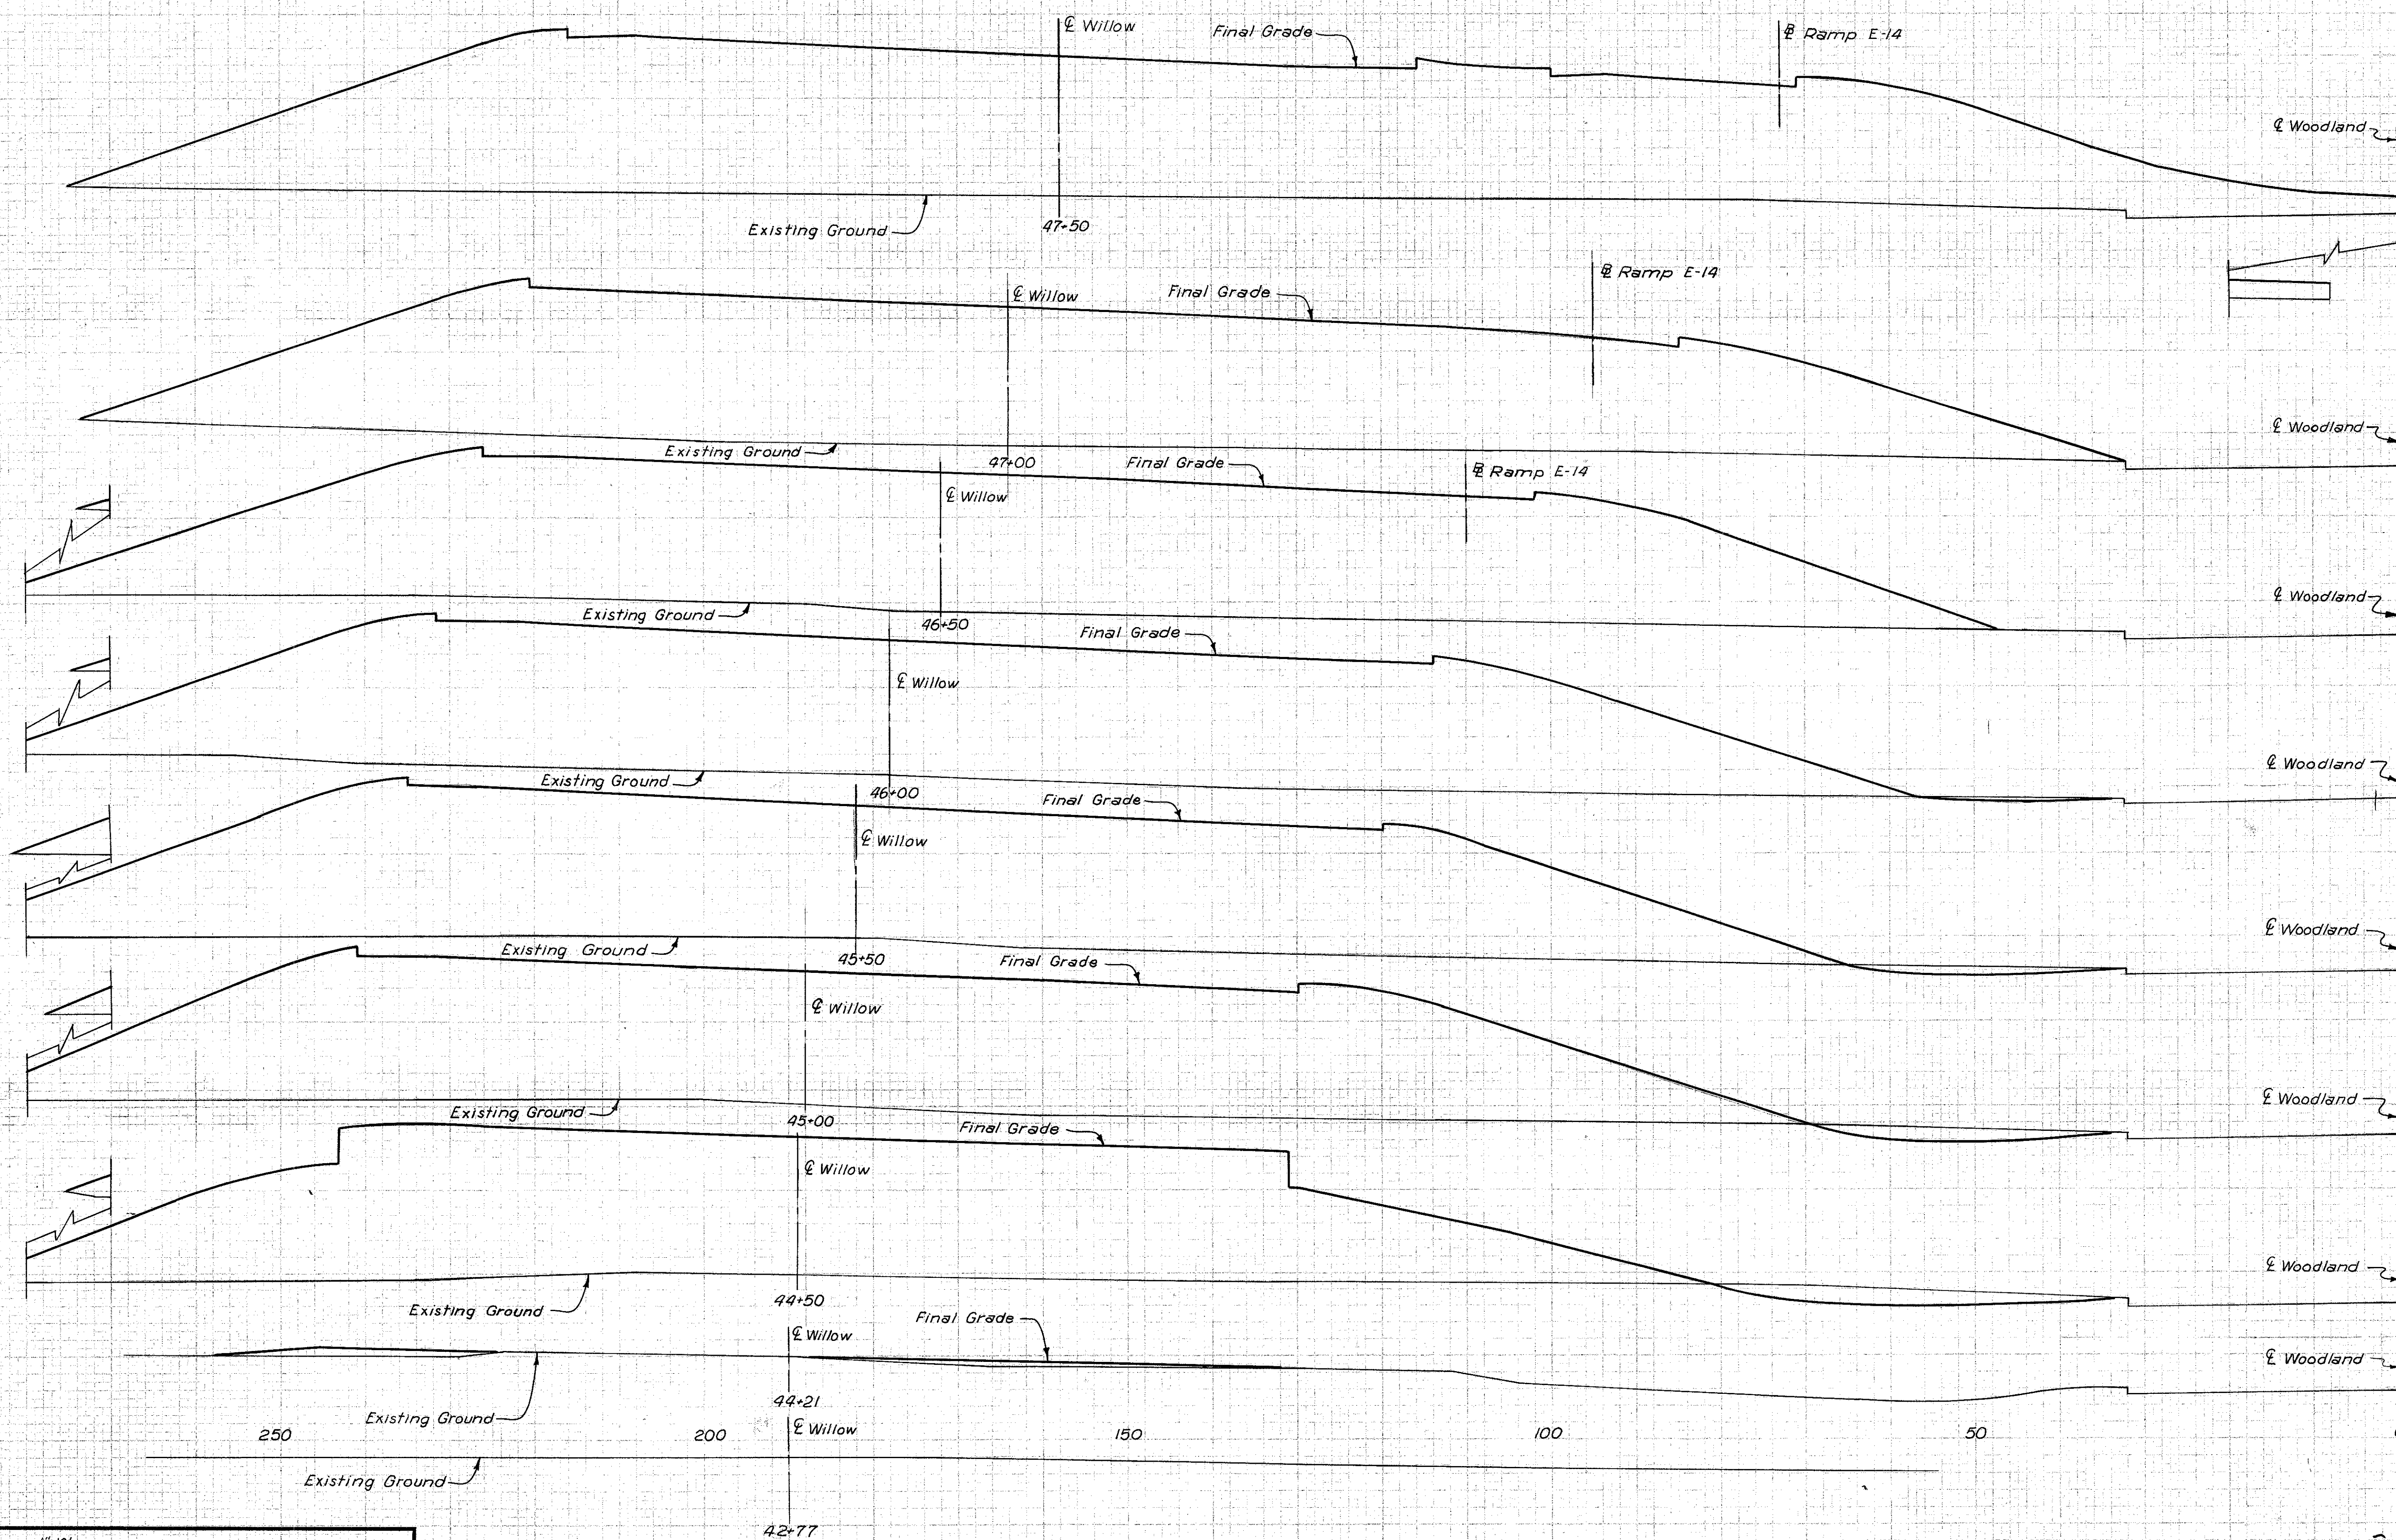

L.F.	WIDTH	AREA	SUBBASE		EARTHWORK				
			AREA	VOL.	END AREA	VOLUME			
	SQ. YD.	S.F.	S.F.	C.Y.	EXC.	EMB.	EXC.	EMB.	
47+50					0	3540		0	6160
47+80					0	3113		0	5673
46+80					0	3014		6	5505
46+60					7	2931		21	5443
46+50					23	2947		63	5323
45+60					45	2802		109	4967
44+50					73	2562		39	1402
44+21					0	48			
42+77					0	0		0	1783
42+45 (See Sheet 88)					0	3008			

SERIES K
WILLOW FREEWAY SECTIONS
STA. 42+77
SERIES L
WILLOW FREEWAY SECTIONS
STA. 44+21 TO STA. 47+50

SCALE 1"=40'
MADE BY S.D. DATE 12-11-58
TRCD. M.D.H. DATE 1-22-59
CKD. G.M.G. DATE 2-10-59

HOWARD, NEEDLES, TAMMEN & BERGENDOFF
CONSULTING ENGINEERS
KANSAS CITY CLEVELAND NEW YORK
914 SHEET 89

250

200

150

100


50

0


90

FED. ROAD DIV. NO.	STATE	FEDERAL AID PROJECT NO.	TYPE FUNDS
2	OHIO		

CUYAHOGA COUNTY
CITY OF CLEVELAND
CUY-42-18.42
CUY-21-15.32

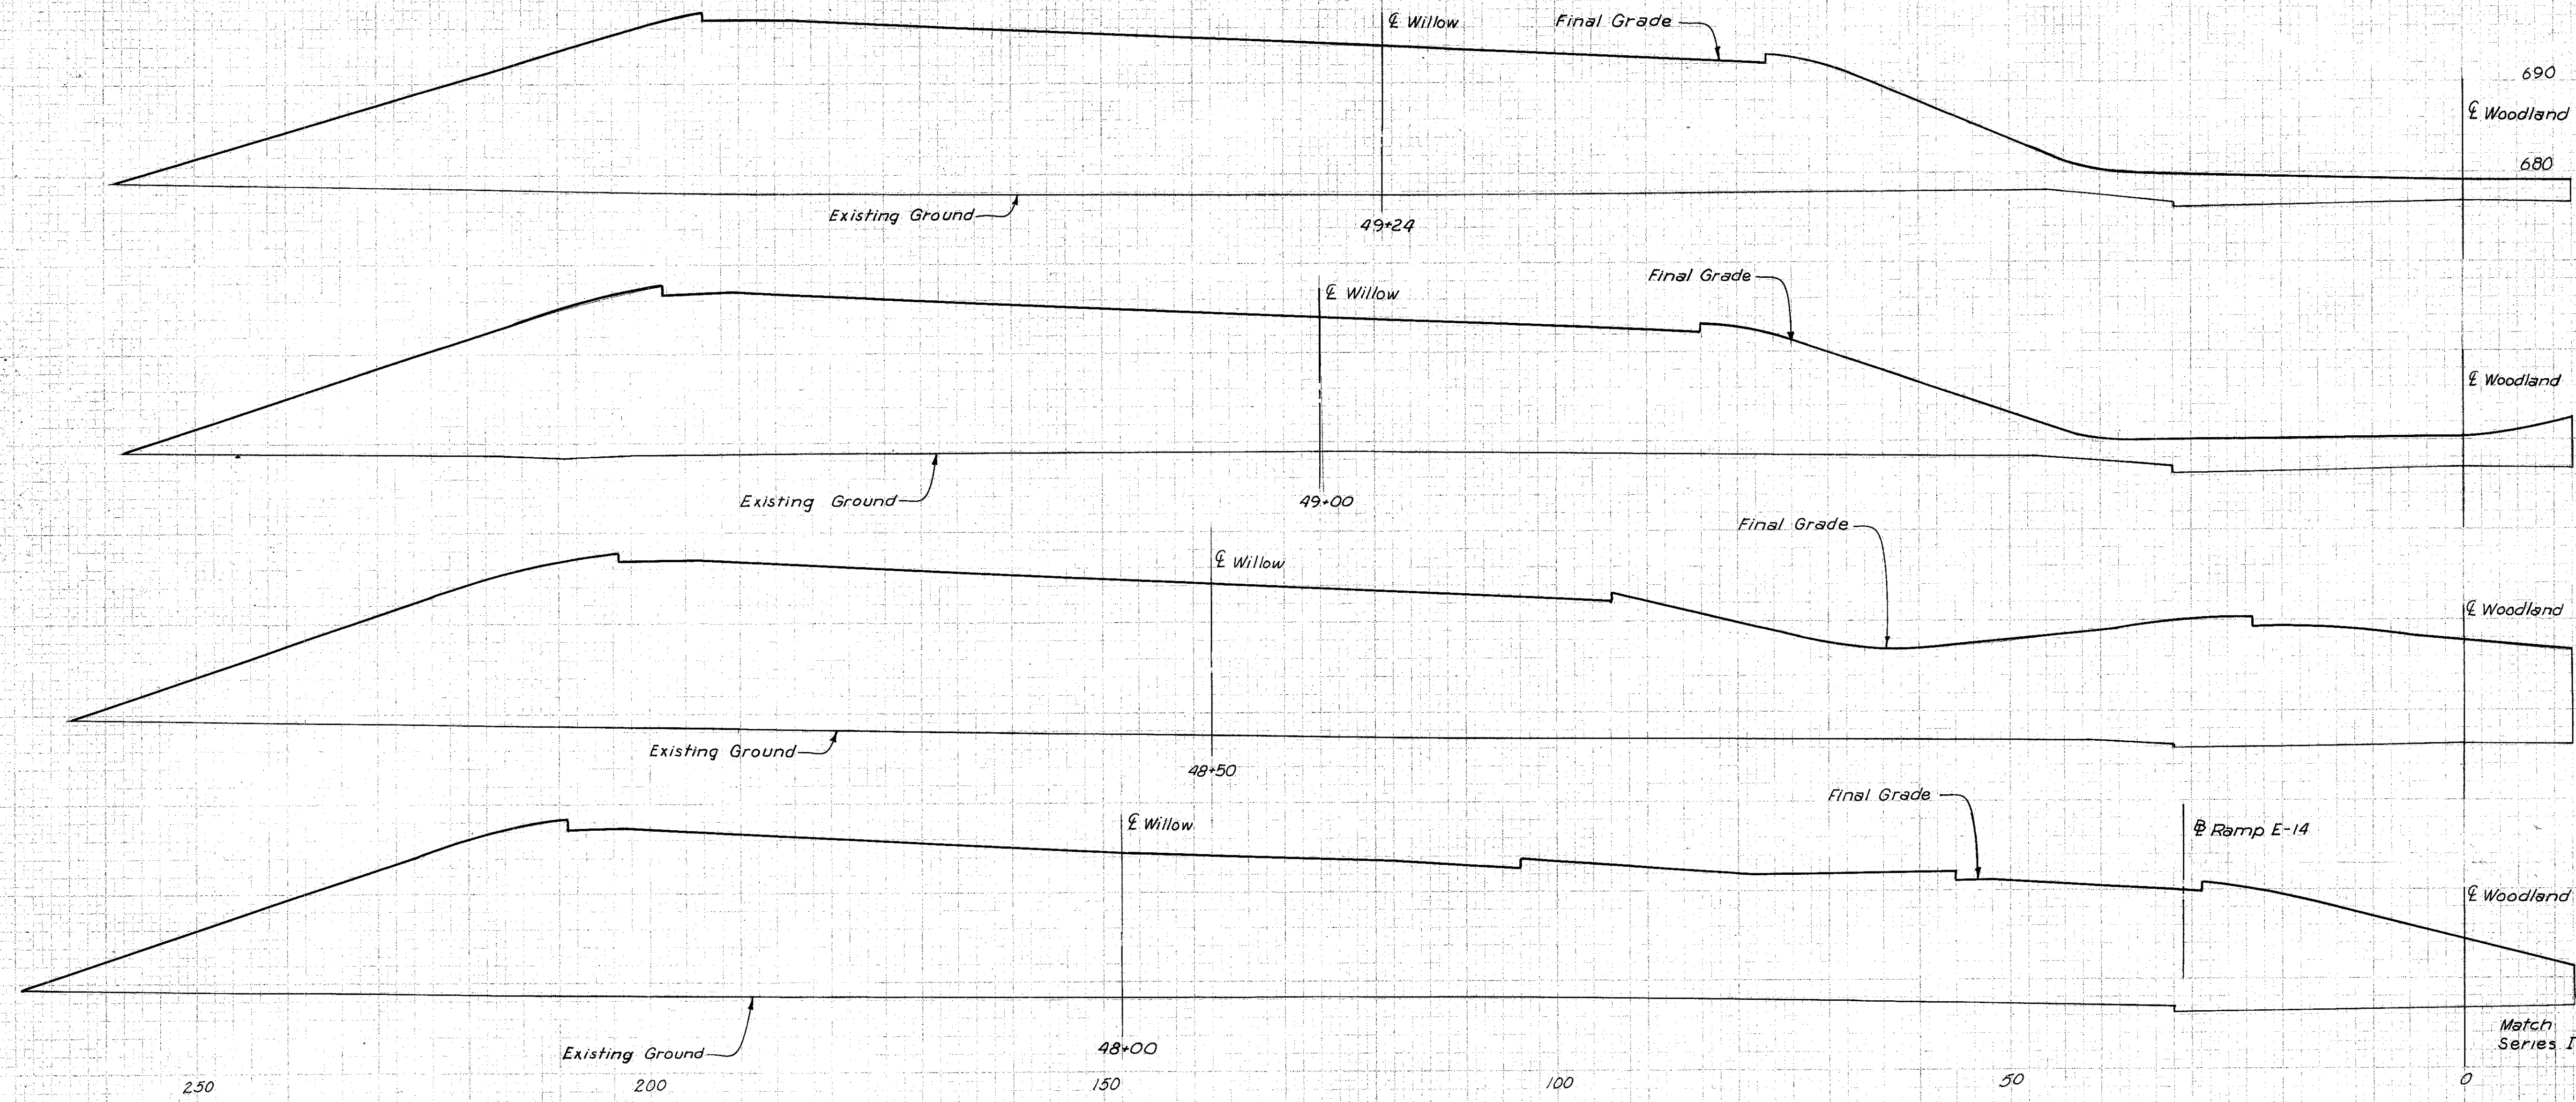

L.F.	SEEDING		SUBBASE		EARTHWORK			
	WIDTH	AREA	AREA	VOL.	END AREA	VOLUME		
	SQ. YD.	S.F.	S.F.	C.Y.	EXC.	EMB.	EXC.	EMB.
49+24					0	3188		
49+00					0	3089		0 2790
48+50					0	4070		0 6629
48+00					0	3849		0 7332
47+50 (See Sheet 89)					0	3540		0 6842
7+15							99	1
7+02					0	0		24 0
6+67					133	2		86 1
4+00					102	6		1162 40
1+35					18	20		589 128
0+00					19	3		93 58

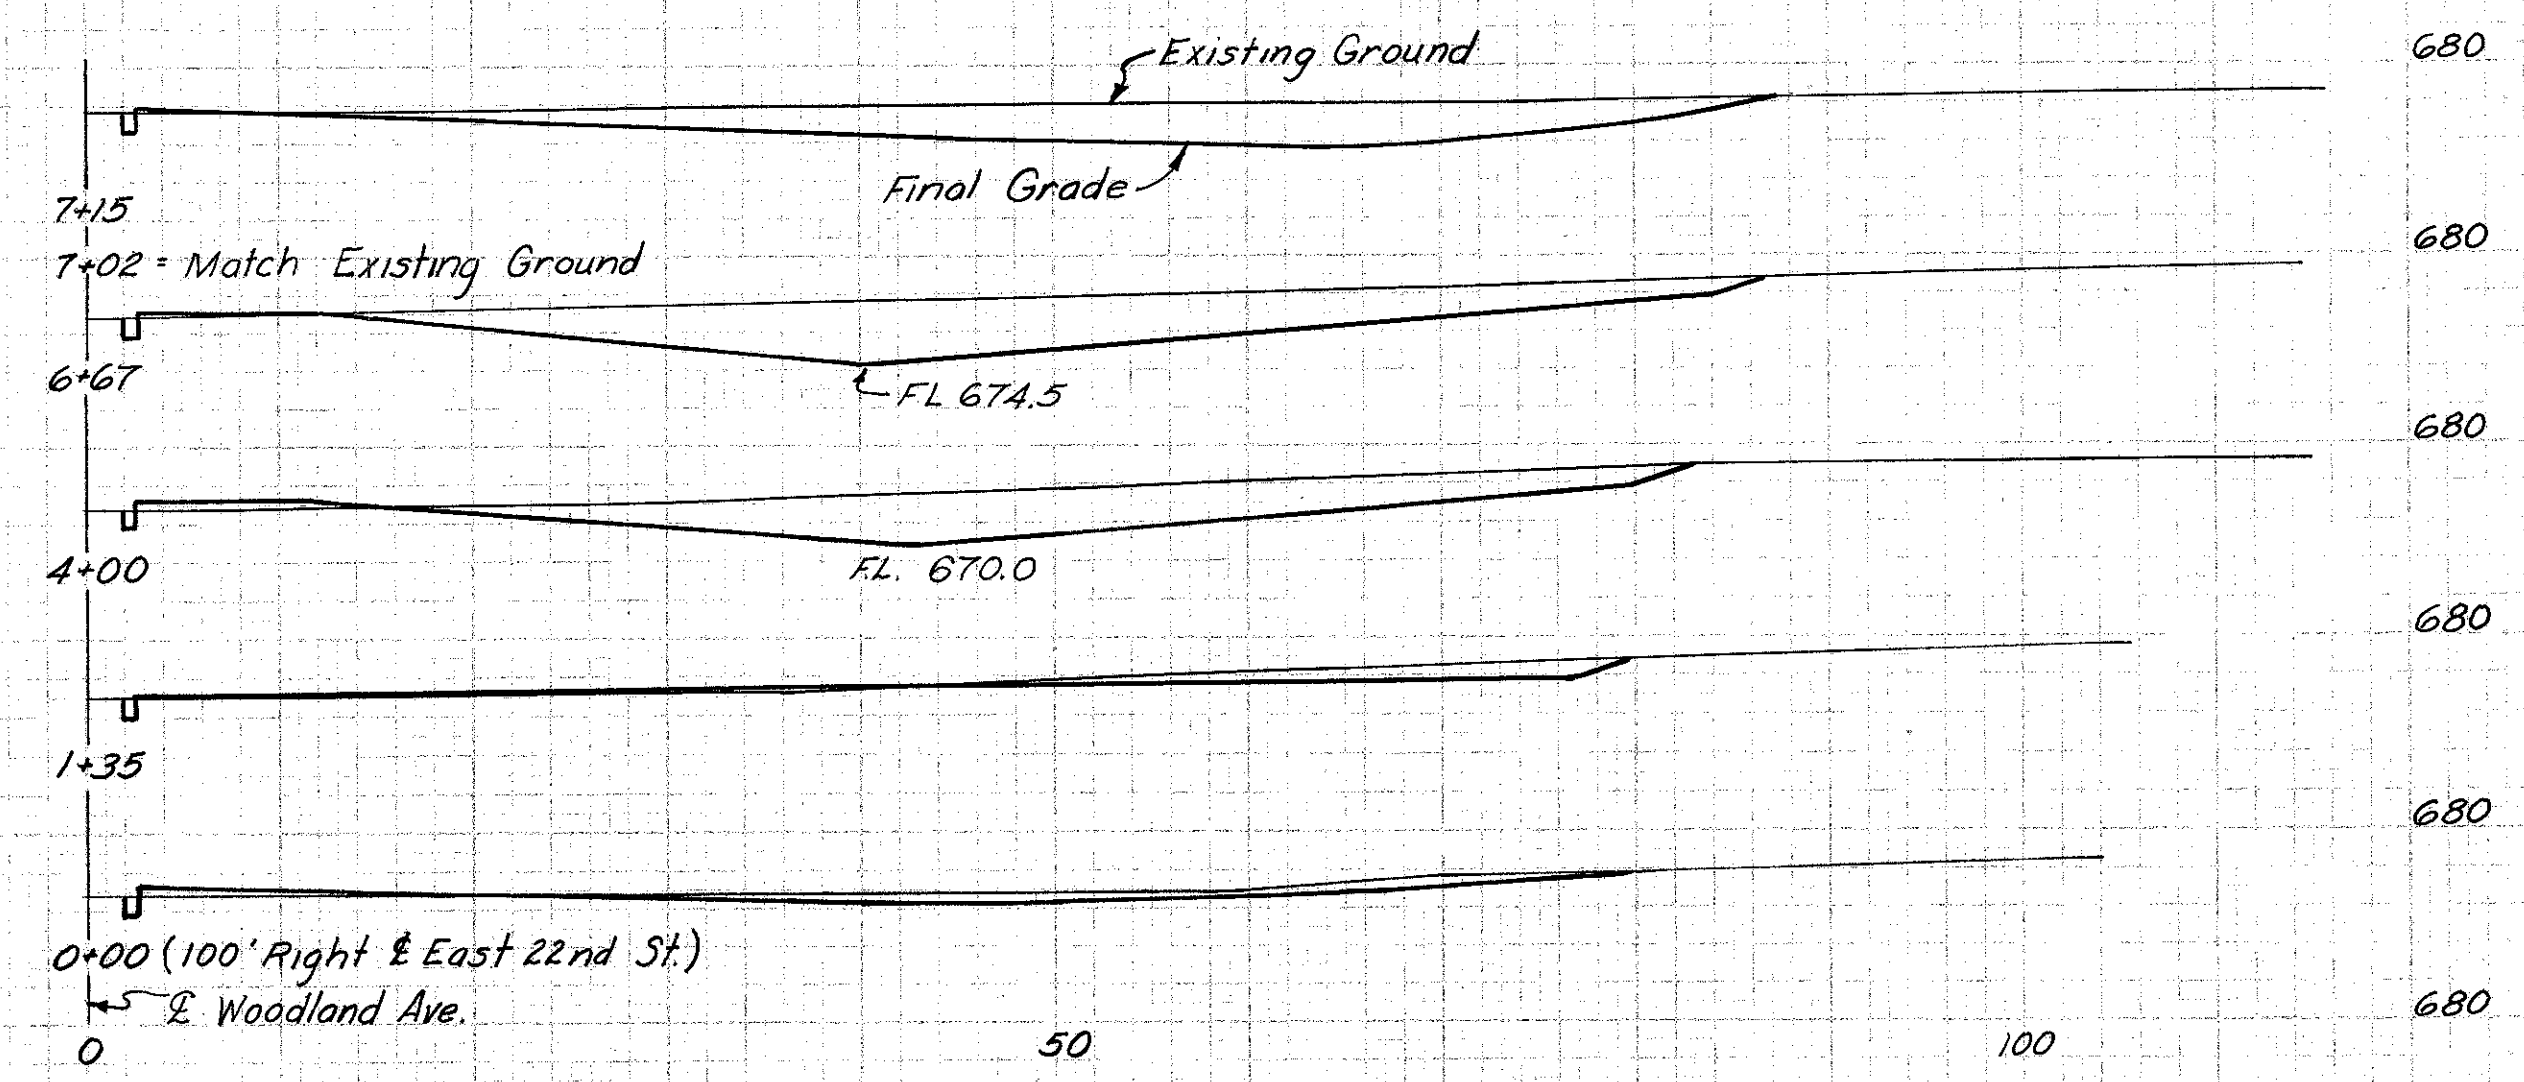

SERIES L
WILLOW FREEWAY SECTIONS
STA. 48+00 TO 49+24
SERIES M
WOODLAND AVE. SECTIONS
STA. 0+00 TO STA. 7+15





EE-9




FED. ROAD DIV. NO.	STATE	FEDERAL AID PROJECT NO.	TYPE FUNDS

91
181

CUYAHOGA COUNTY
 CITY OF CLEVELAND
 CUY-42-18.42
 CUY-21-15.32
 SCHEMATIC PLAN
 OF RIGHT OF WAY

LEGEND


-  Previously Acquired
-  Part 6 R.O.W.
-  Part 7 R.O.W.
-  Acquired for Project CUY-42-18.77

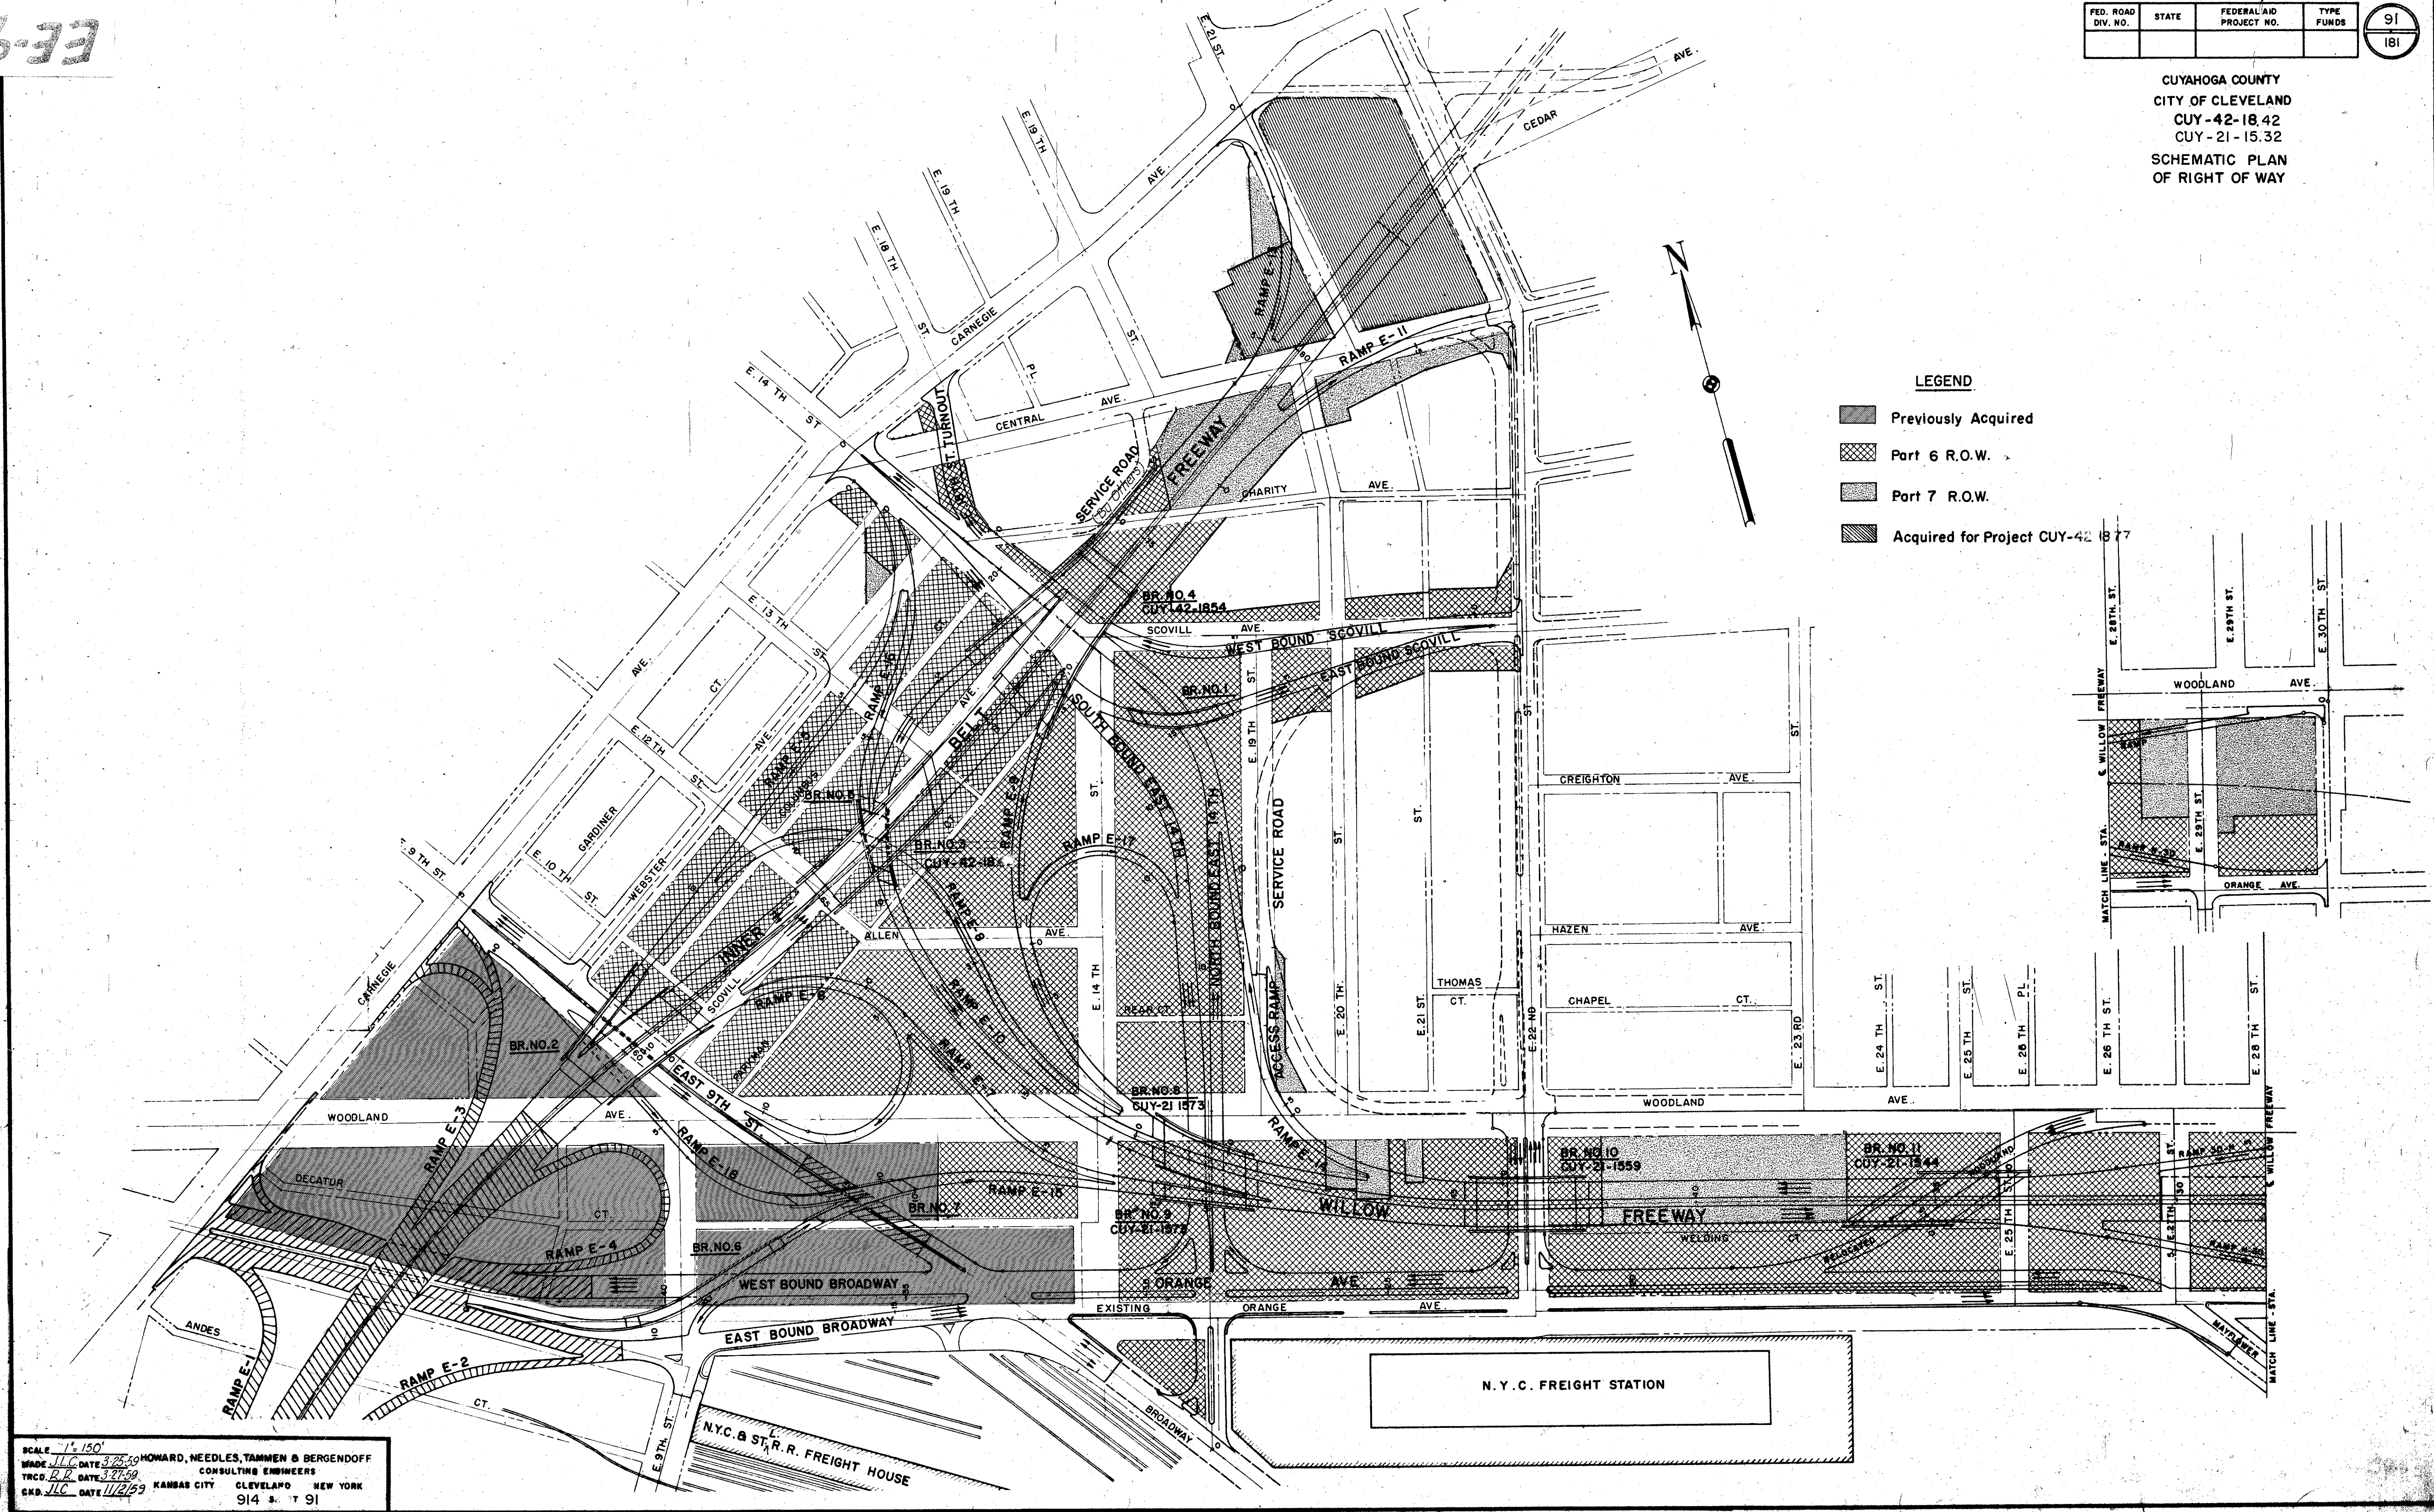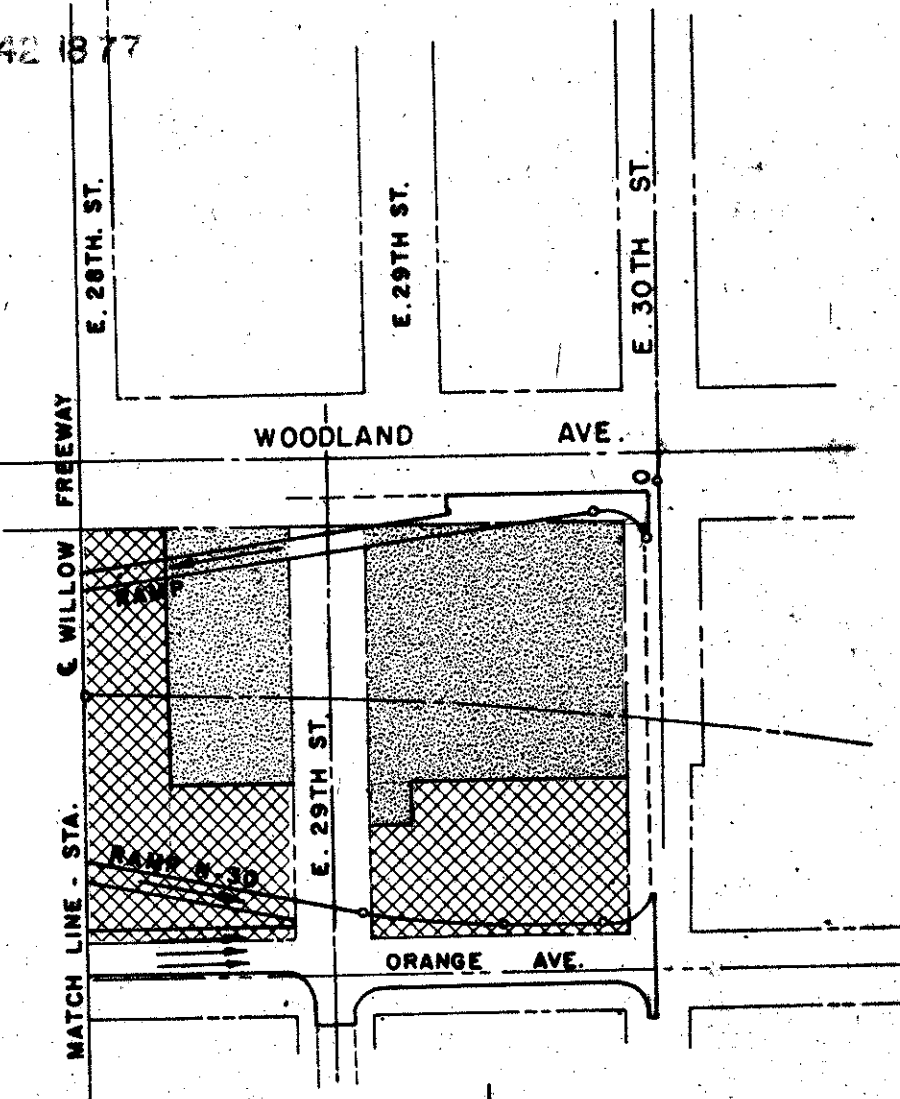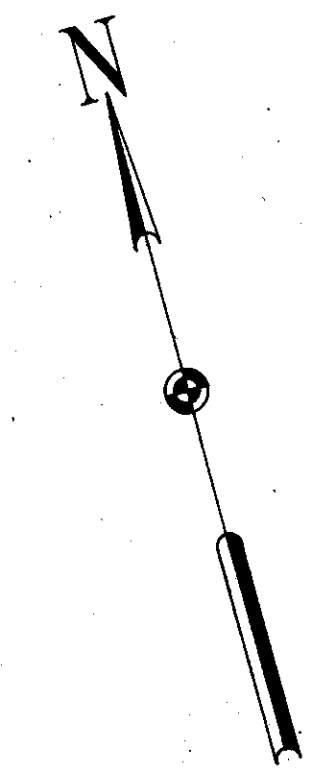

SCALE 1" = 150'
 MADE J.L.C. DATE 3/25/59 HOWARD, NEEDLES, TAMMEN & BERGENOFF
 CONSULTING ENGINEERS
 TRCD. B.L. DATE 3/27/59 KANSAS CITY CLEVELAND NEW YORK
 GKD. J.L.C. DATE 11/2/59 914 S. T 91

Cuy-90-16.37

FED. ROAD DIV. NO.	STATE	FEDERAL AID PROJECT NO.	TYPE FUNDS
2	OHIO		

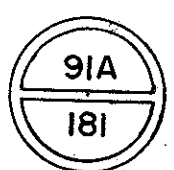


CUYAHOGA COUNTY
 CITY OF CLEVELAND
 CUY-42-18.42
 CUY-21-15.32
 RIGHT OF WAY
 SUMMARY

RIGHT OF WAY SUMMARY					
SHEET NO.	PARCEL NO.	OWNER	AREA	BLDGS	REMARKS
87	216LA	HAROLD SOGLOVITZ, ET AL.	ALL	NO	
87	220LA	MAURICE NECAMKEN	ALL	YES	
"	221LA	MARGHERITA SANSON	ALL	YES	
"	222LA	MACHELENA SANSONE	ALL	YES	
87	225LA	H. & F. REALTY CO.	ALL	YES	
87	282LA	CENTRAL NATIONAL BANK, TRUSTEE (FARMER'S MARKET)	8,054	YES	
"	283LA	GAITANO ZINGALES	960	NO	
"	284LA	FRANK SCAINGOLA	960	YES	
"	285LA	GAITANO & G. ZINGALES	480	YES	
88	365LA	JOHN J. SULLIVAN, SR.	300	YES	
"	366LA	V. GENTILE	998	YES	
"	367LA	J. BURGIO	1,402	YES	
88	441LA	H. J. PATTISON	10,590	NO	
"	442LA	A. JOHNSON	ALL	YES	
"	443LA	WALTER & G. ATTAWAY	ALL	YES	
"	444LA	C. R. & E. HEMMINGWAY	ALL	YES	
"	445LA	CLEVELAND TRUST CO.	8,730	NO	
"	446LA	C. PAUL	3,776	YES	
"	447LA	C. M. BLANK	3,245	NO	
"	450LA	JESSIE MC GHEE	3,751	YES	
"	451LA	J. ROBBINS	810	YES	
89	488LA	EDWIN I. & DIANE R. FERTMAN	1,148	YES	
89	490LA	WELDON REALTY CO.	4,798	YES	
89	492LA	AARON, ET AL.	2,117	NO	
"	493LA	PAULINE MC PHAIL	1,253	YES	
"	494LA	PETER PERILIO	1,132	YES	
"	495LA	TESSIE GALLETI	1,561	YES	
"	496LA	GULF REFINING CO.	1,877	YES	
89	509LA	THE MITTELMAN CO.	646	YES	
"	516	CLEVELAND FED. OF MUSICIANS LOCAL N. 4 AFM	4,991	YES	
"	517LA	COLETTE SCHLEICHER, ET AL.	1,456	YES	
"	518LA	THE TRUNDLE CONSULTANTS INC.	2,275	YES	
"	519LA	THE TRUNDLE CONSULTANTS INC.		NO	
90	548LA	RAYMOND L. WEISFIELD	ALL	YES	
"	549LA	ETHEL B. LUX	ALL	YES	
"	550LA	JAKE M. & FRIEDA BERGER	ALL	YES	
"	551LA	MEYER & JENNIE GREENES	ALL	YES	
90	553LA	FLAVIA NASTASI	ALL	NO	
"	554LA	NETTIE CARCIONE	ALL	YES	
"	555LA	RENA ALSBACHER, ET. AL.	ALL	YES	
"	556LA	NETTIE CARCIONE	ALL	NO	
"	557LA	JOSEPHINE LOMBARDO, ET AL.	ALL	YES	
"	558LA	NETTIE CARCIONE	ALL	YES	
90	560LA	JENNIE CASTELLANA PASSAFIUME	ALL	YES	
90	806LA	THE MITTELMAN CO.	ALL	YES	
"	807LA	CATHERINE E. WENHAM	ALL	NO	
"	808LA	BESSIE KIRSHENBAUM	ALL	YES	
"	809LA	STELLA LA QUATRA	ALL	YES	
"	810LA	JOHN GRECO	ALL	YES	
"	811LA	ANGELINE LA MONTIA	ALL	NO	
"	812LA	H. & F. REALTY CO., INC.	ALL	YES	
"	813LA	SARAH SOBO, TR.	ALL	YES	
"	814LA	GRACE & A. G. PALMERI	ALL	YES	
"	815LA	JOHN GRECO	ALL	YES	
"	816LA	GRACE & A. G. PALMERI	ALL	NO	

FED. ROAD DIV. NO.	STATE	FEDERAL AID PROJECT NO.	TYPE FUNDS
2	OHIO		

92
181

CUYAHOGA COUNTY
CITY OF CLEVELAND
CUY-42-18.42
CUY-21-15.32

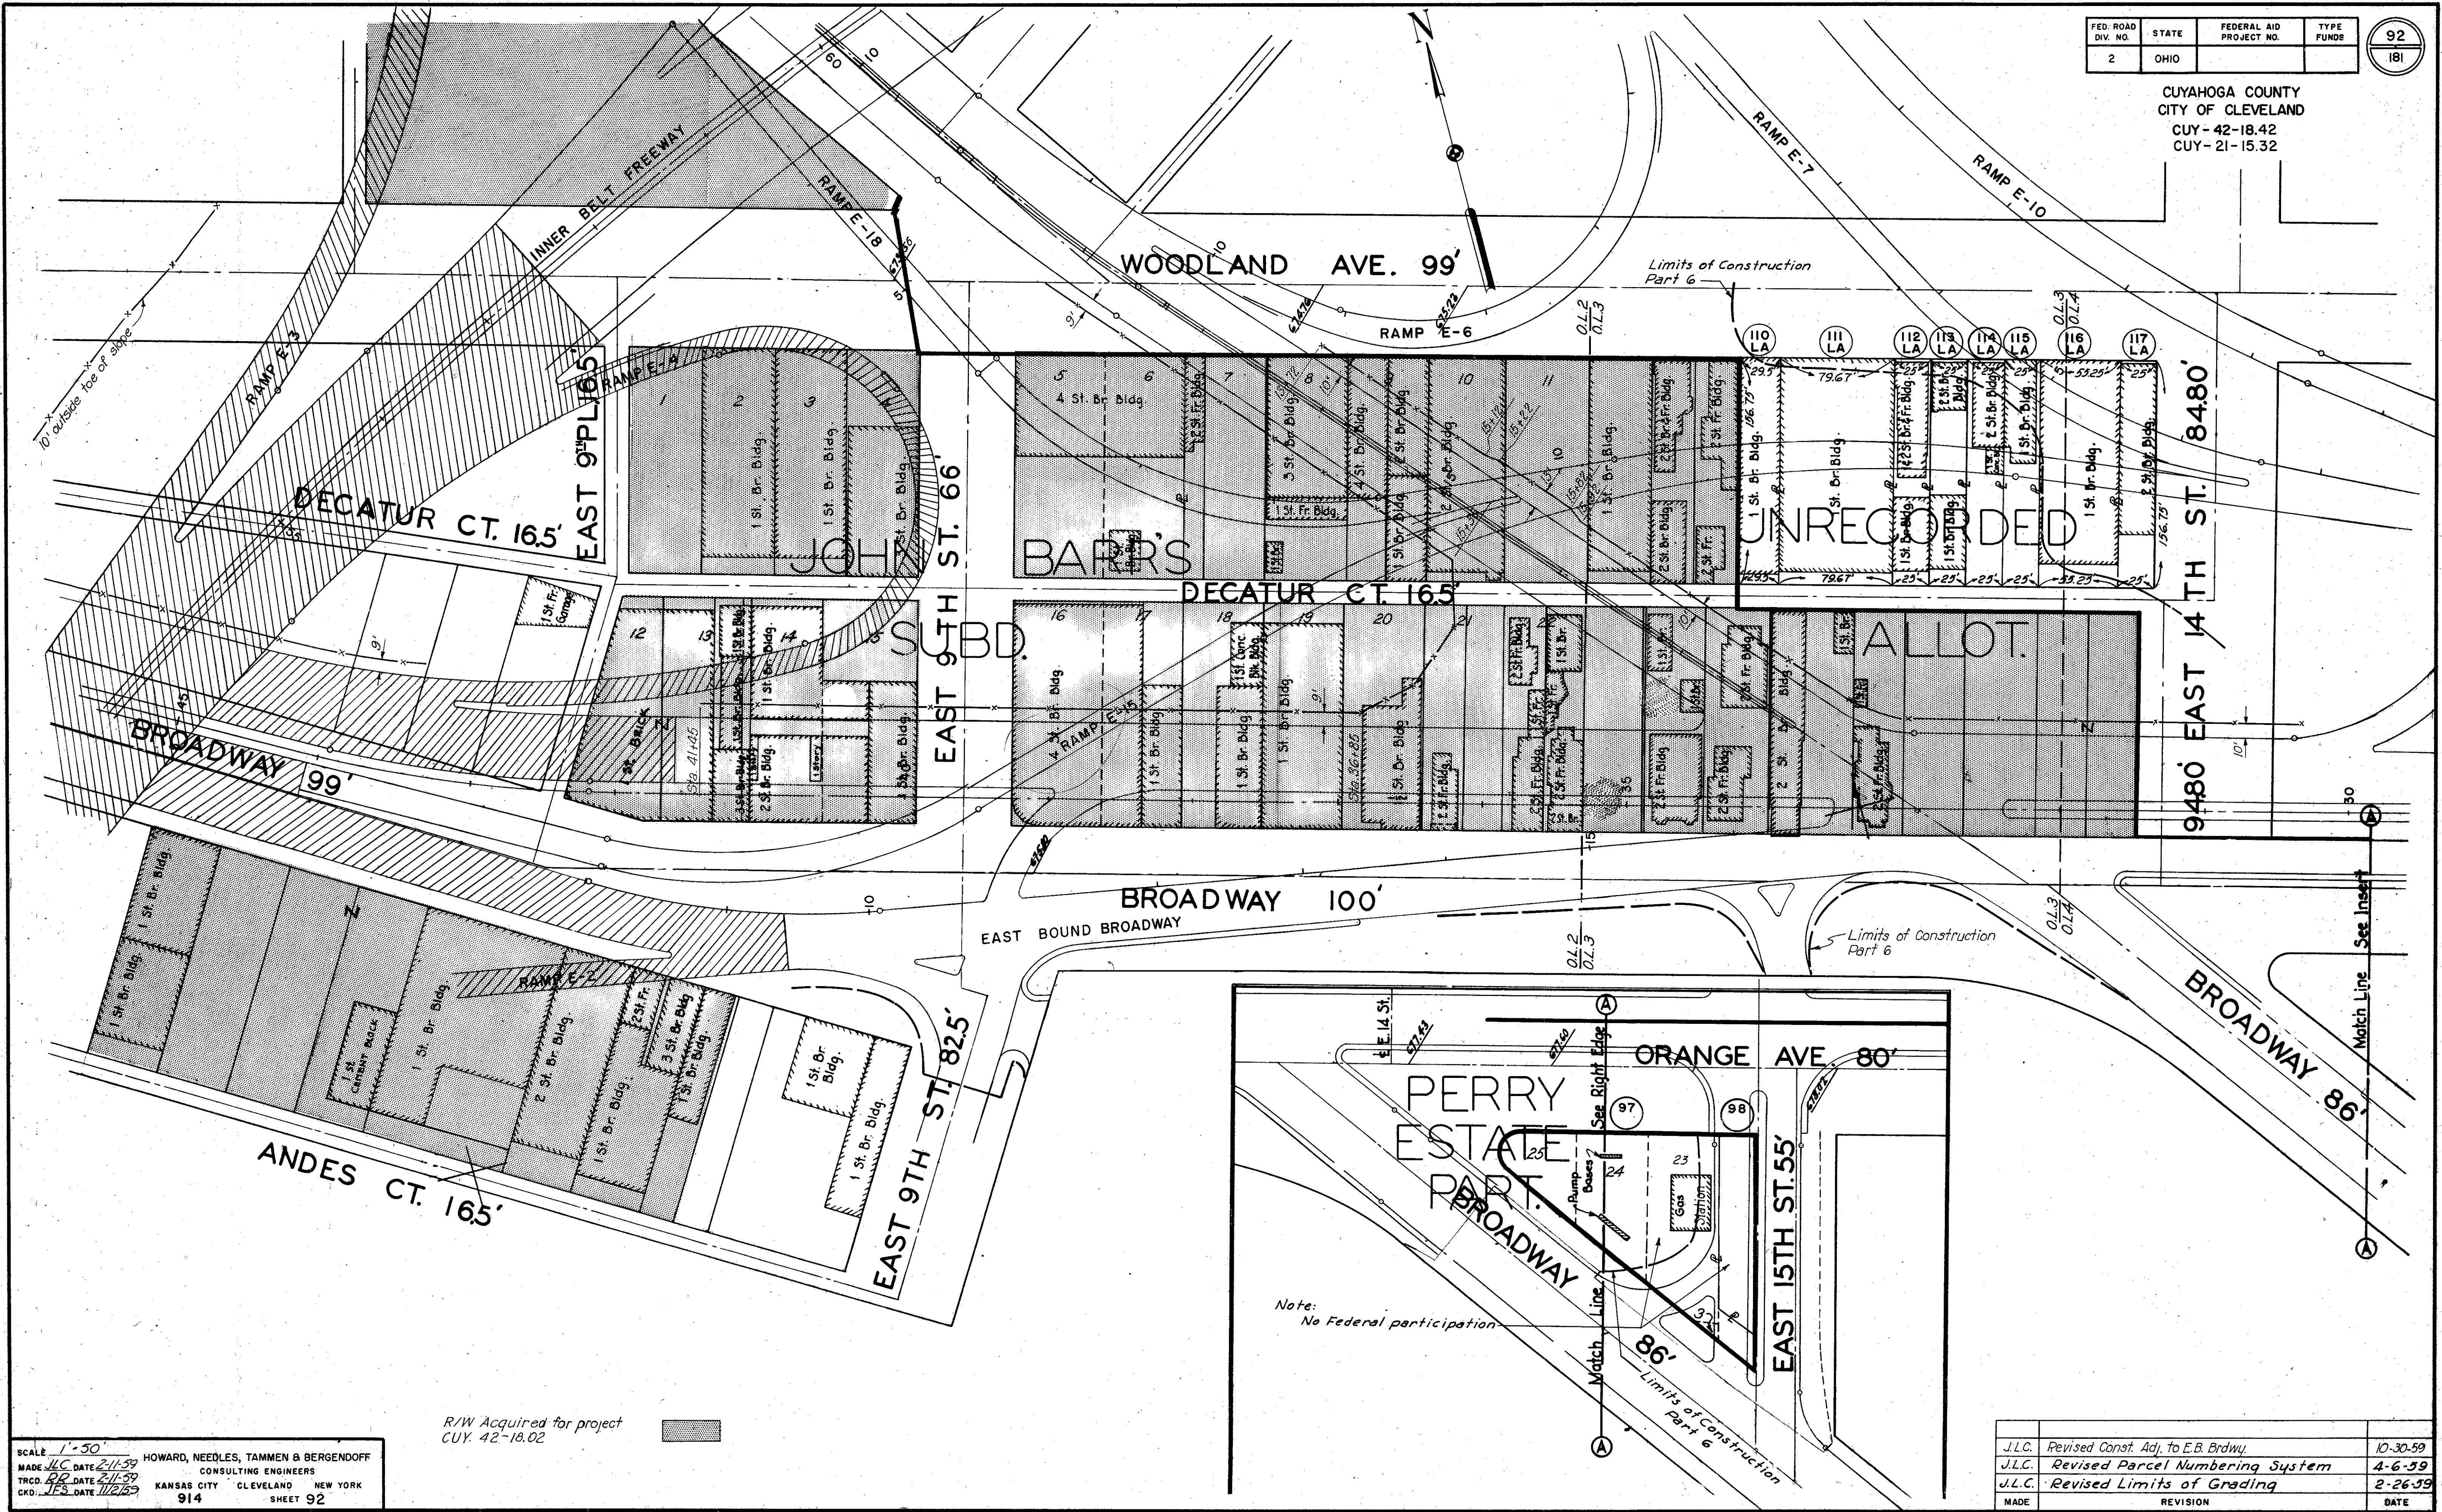

SCALE 1"=50'
MADE J.L.C. DATE 2-11-59
TRCD R.P.C. DATE 2-11-59
CRD J.E.S. DATE 11/2/53

HOWARD, NEEDLES, TAMMEN & BERGENDOFF
CONSULTING ENGINEERS
KANSAS CITY CLEVELAND NEW YORK

914 SHEET 92

R/W Acquired for project
CUY. 42-18.02



MADE	REVISION	DATE
J.L.C.	Revised Const. Adj. to E.B. Bldwy.	10-30-59
J.L.C.	Revised Parcel Numbering System	4-6-59
J.L.C.	Revised Limits of Grading	2-26-59

FED. ROAD DIV. NO.	STATE	FEDERAL AID PROJECT NO.	TYPE FUNDS.
2	OHIO		

93
181

CUYAHOGA COUNTY
CITY OF CLEVELAND
CUY-42-18.42
CUY-21-15.32

R/W Acquired for
Project CUY. 42-18.02

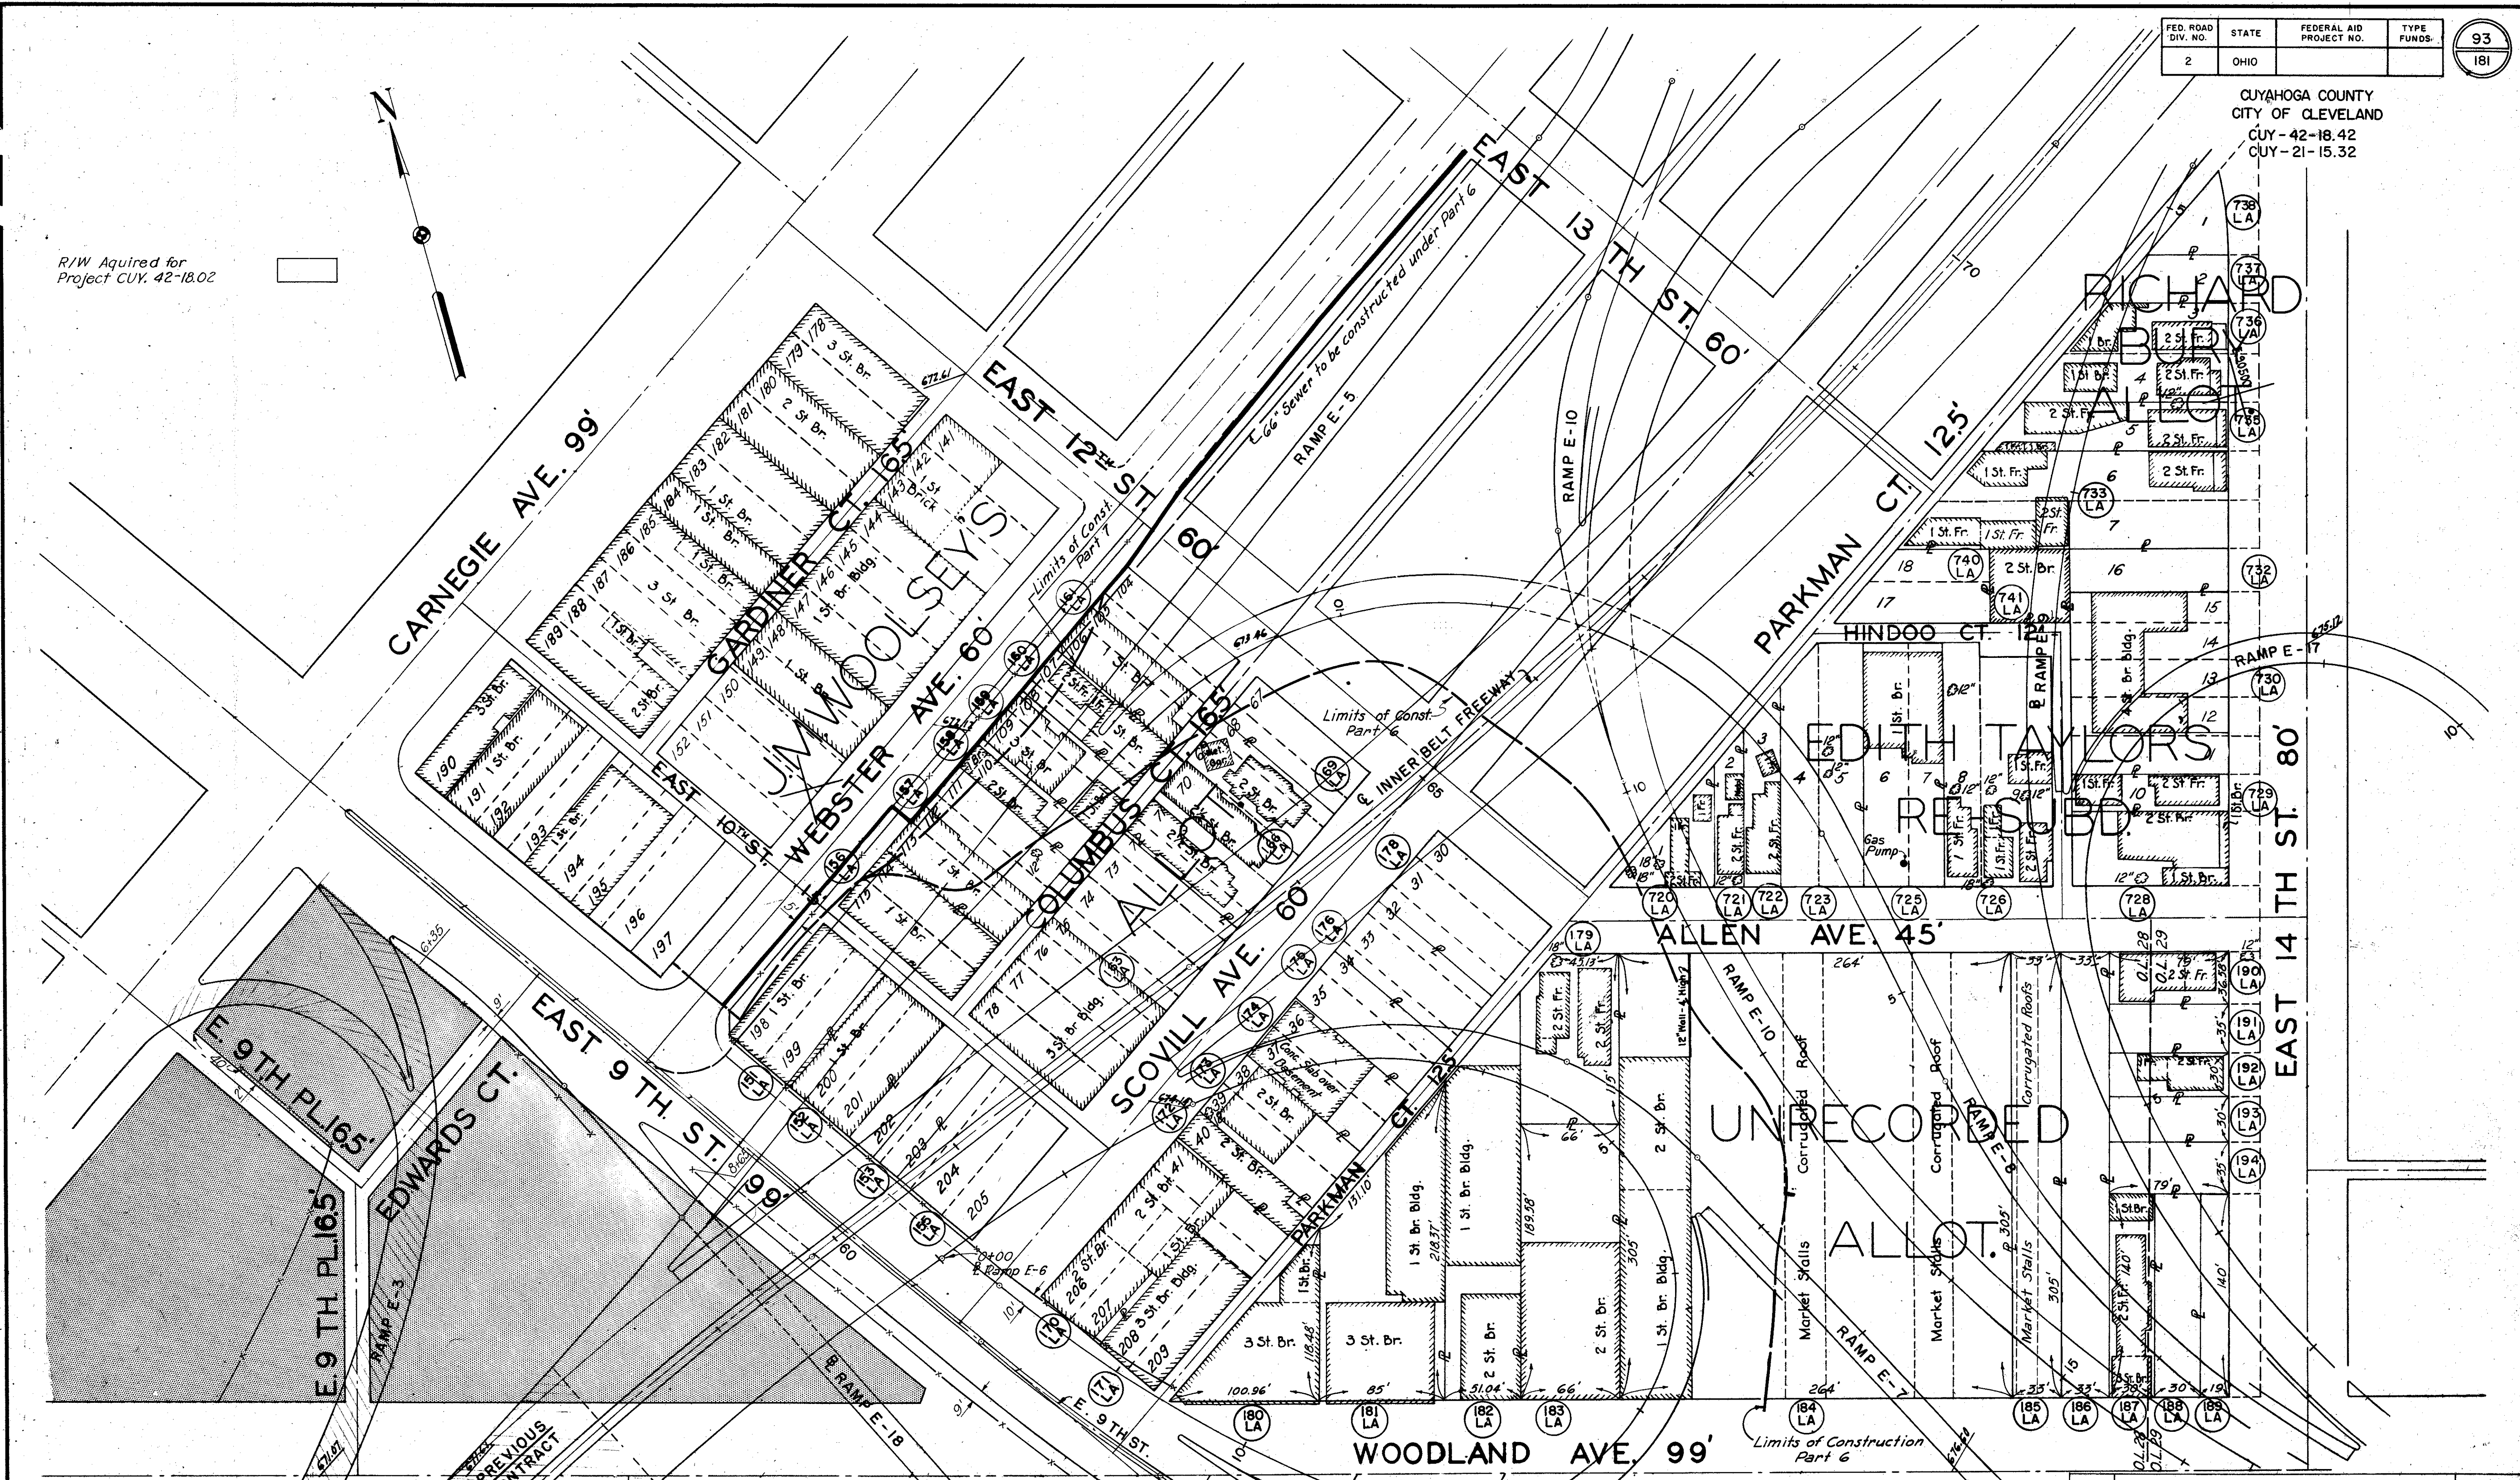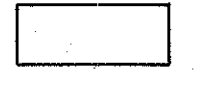


SCALE 1"=50'
MADE J.L.C. DATE 2-11-59
TRCD J.P.S. DATE 2-11-59
CHK J.P.S. DATE 1/12/59

HOWARD, NEEDLES, TAMMEN & BERGENDOFF
CONSULTING ENGINEERS
KANSAS CITY CLEVELAND NEW YORK

914 SHEET 93

J.L.C. Added and removed Bldgs.	11-13-59	
J.L.C. Revised Parcel Numbering System	4-6-59	
J.L.C. Revised Limits of Grading	2-26-59	
MADE	REVISION	DATE

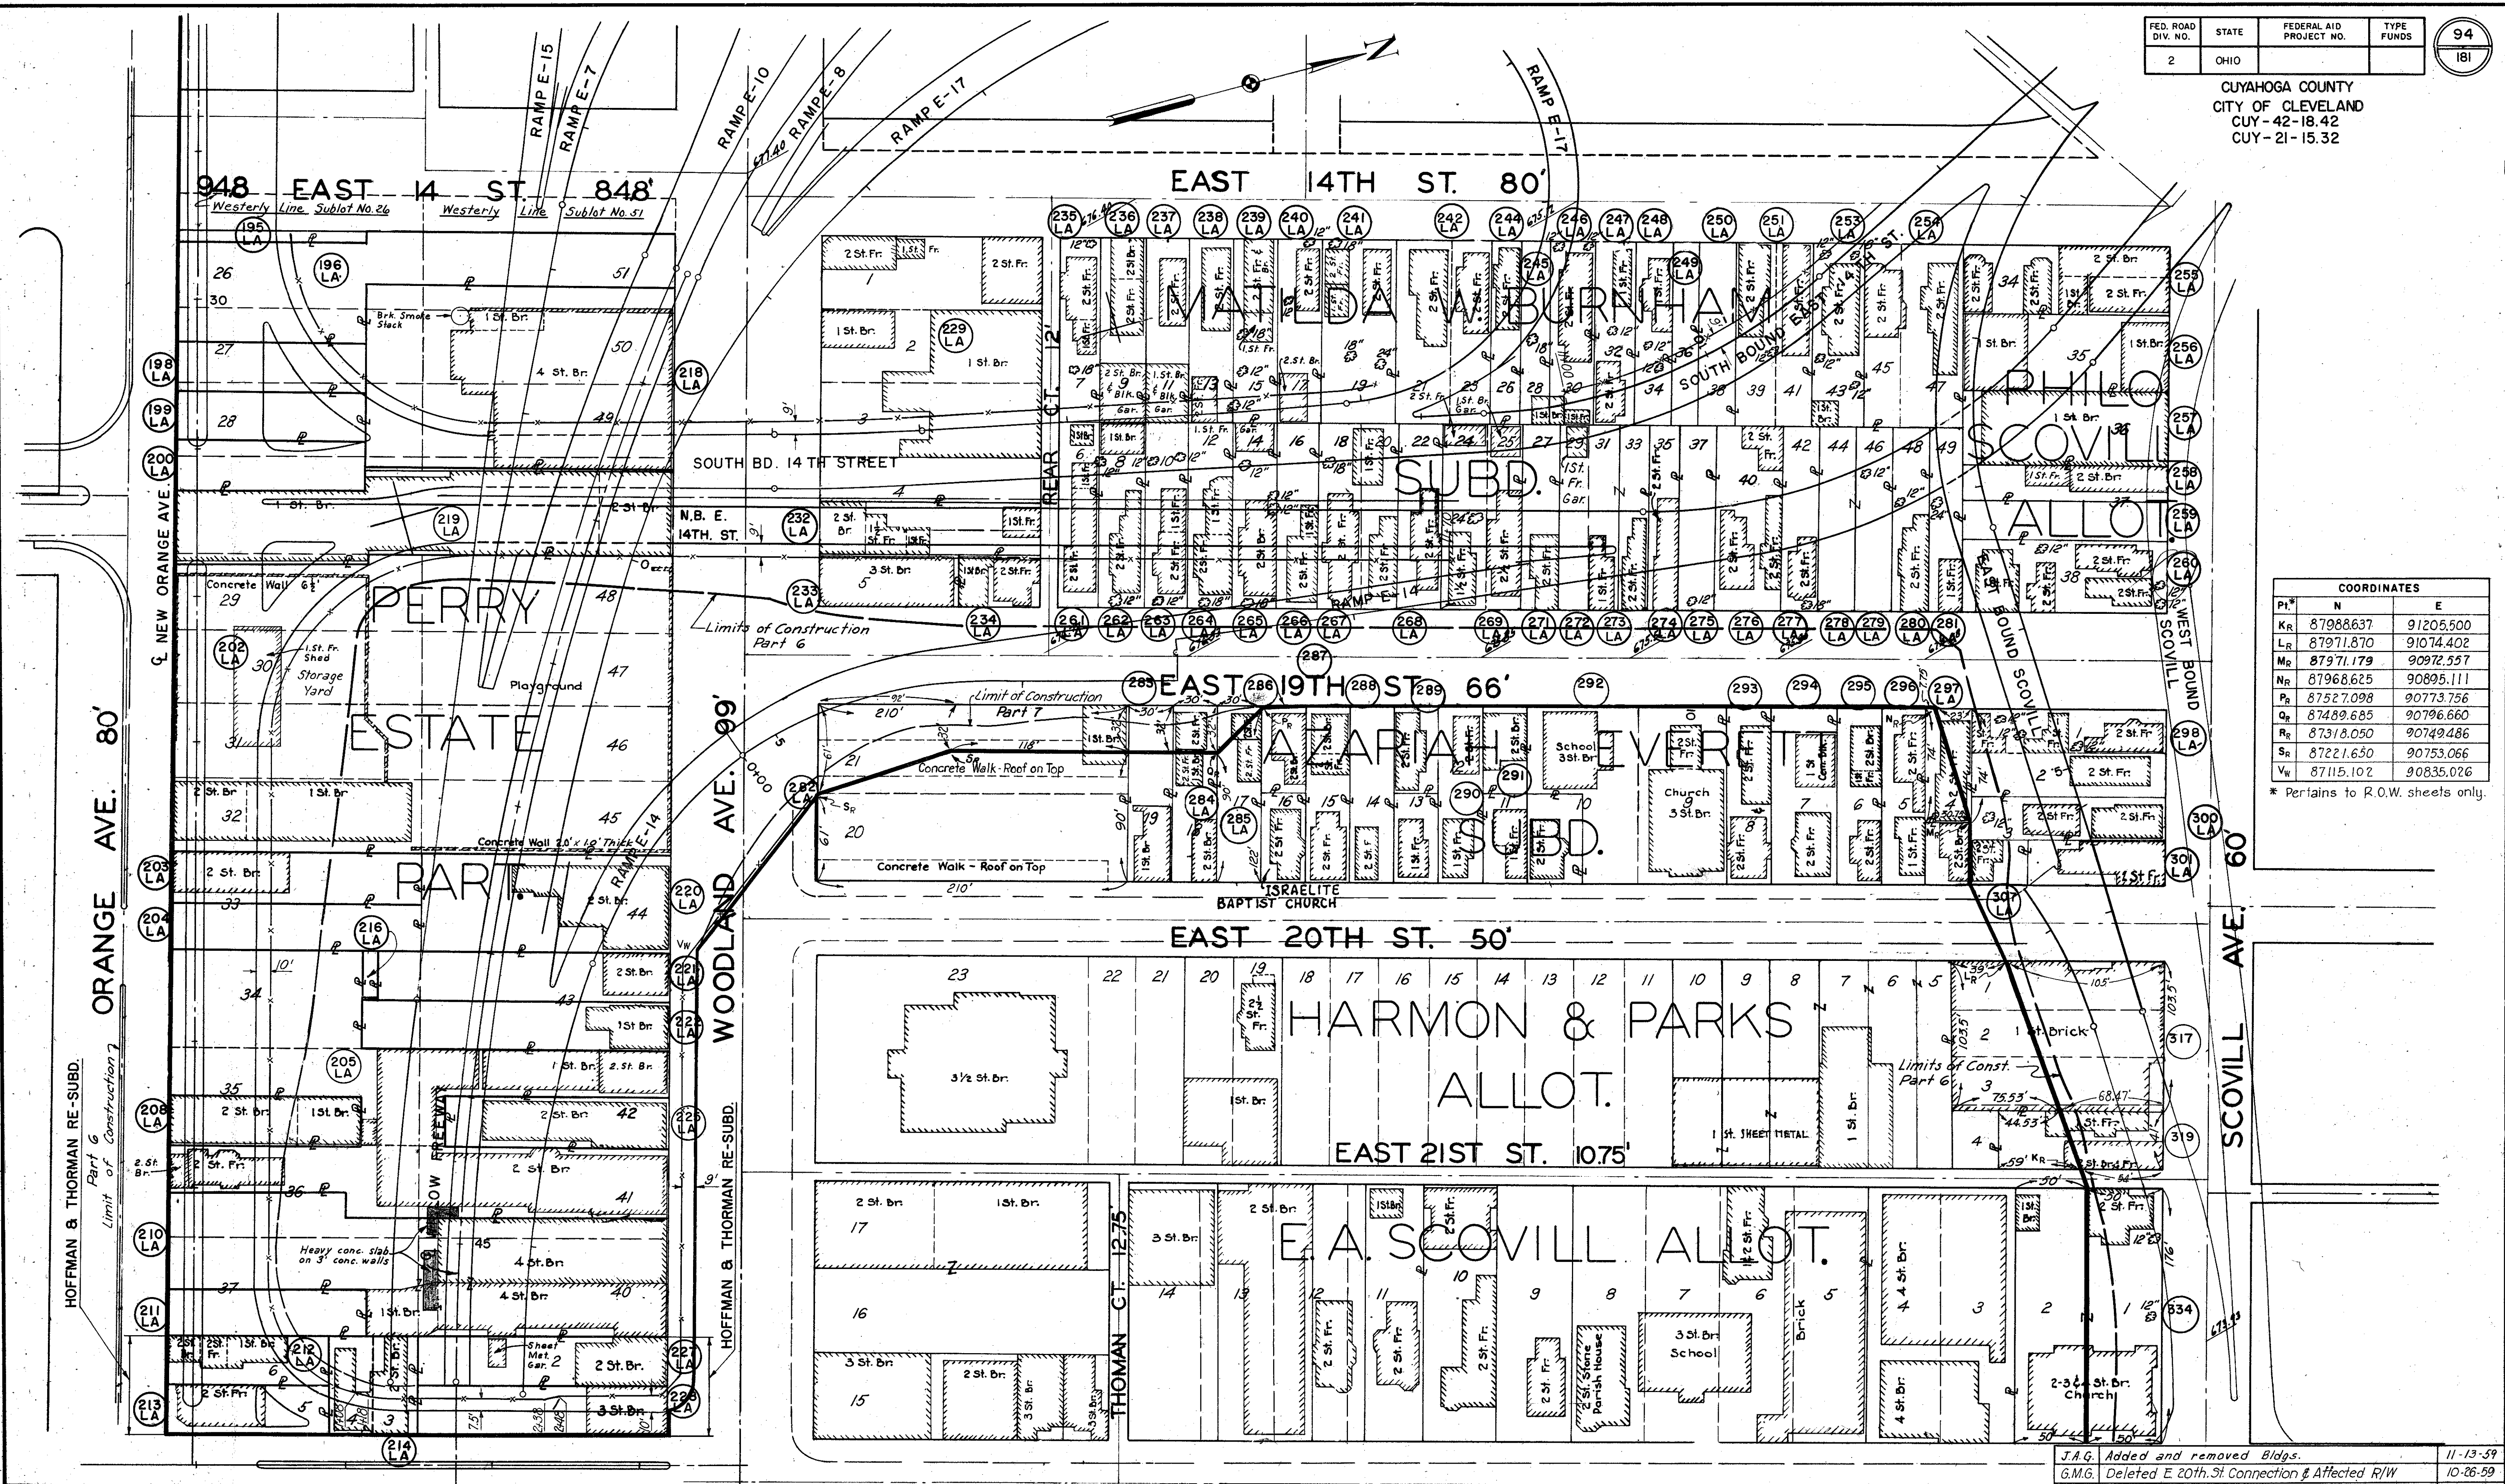

COORDINATES		
Pt.	N	E
Kr	87988.637	91205.500
Lr	87971.870	91074.402
Mr	87971.179	90972.557
Nr	87968.625	90895.111
Pr	87527.098	90773.756
Qr	87489.685	90796.660
Rr	87318.050	90749.486
Sr	87221.650	90753.066
Vr	87115.102	90835.026

* Pertains to R.O.W. sheets only.

SCALE 1"=50'
MADE J.L.C. DATE 2-11-59
TRCD. R.R. DATE 2-11-59
CKD. J.F.S. DATE 11-12-59

HOWARD, NEEDLES, TAMMEN & BERGENDOFF
CONSULTING ENGINEERS
KANSAS CITY CLEVELAND NEW YORK


914 SHEET 94

MADE	REVISION	DATE
J.A.G.	Added and removed Bldgs.	11-13-59
G.M.G.	Deleted E 20th St Connection & Affected R/W	10-26-59
R.J.K.	Removed 1 & 2 Story Frame Bldg. - 283 LA	6-16-59
J.L.C.	Revised Parcel Numbering System	4-6-59
J.L.C.	Revised Limits of Grading	2-26-59

FED. ROAD DIV. NO.	STATE	FEDERAL AID PROJECT NO.	TYPE FUNDS
2	OHIO		

96
181

CUYAHOGA COUNTY
CITY OF CLEVELAND
CUY-42-18.42
CUY-21-15.32

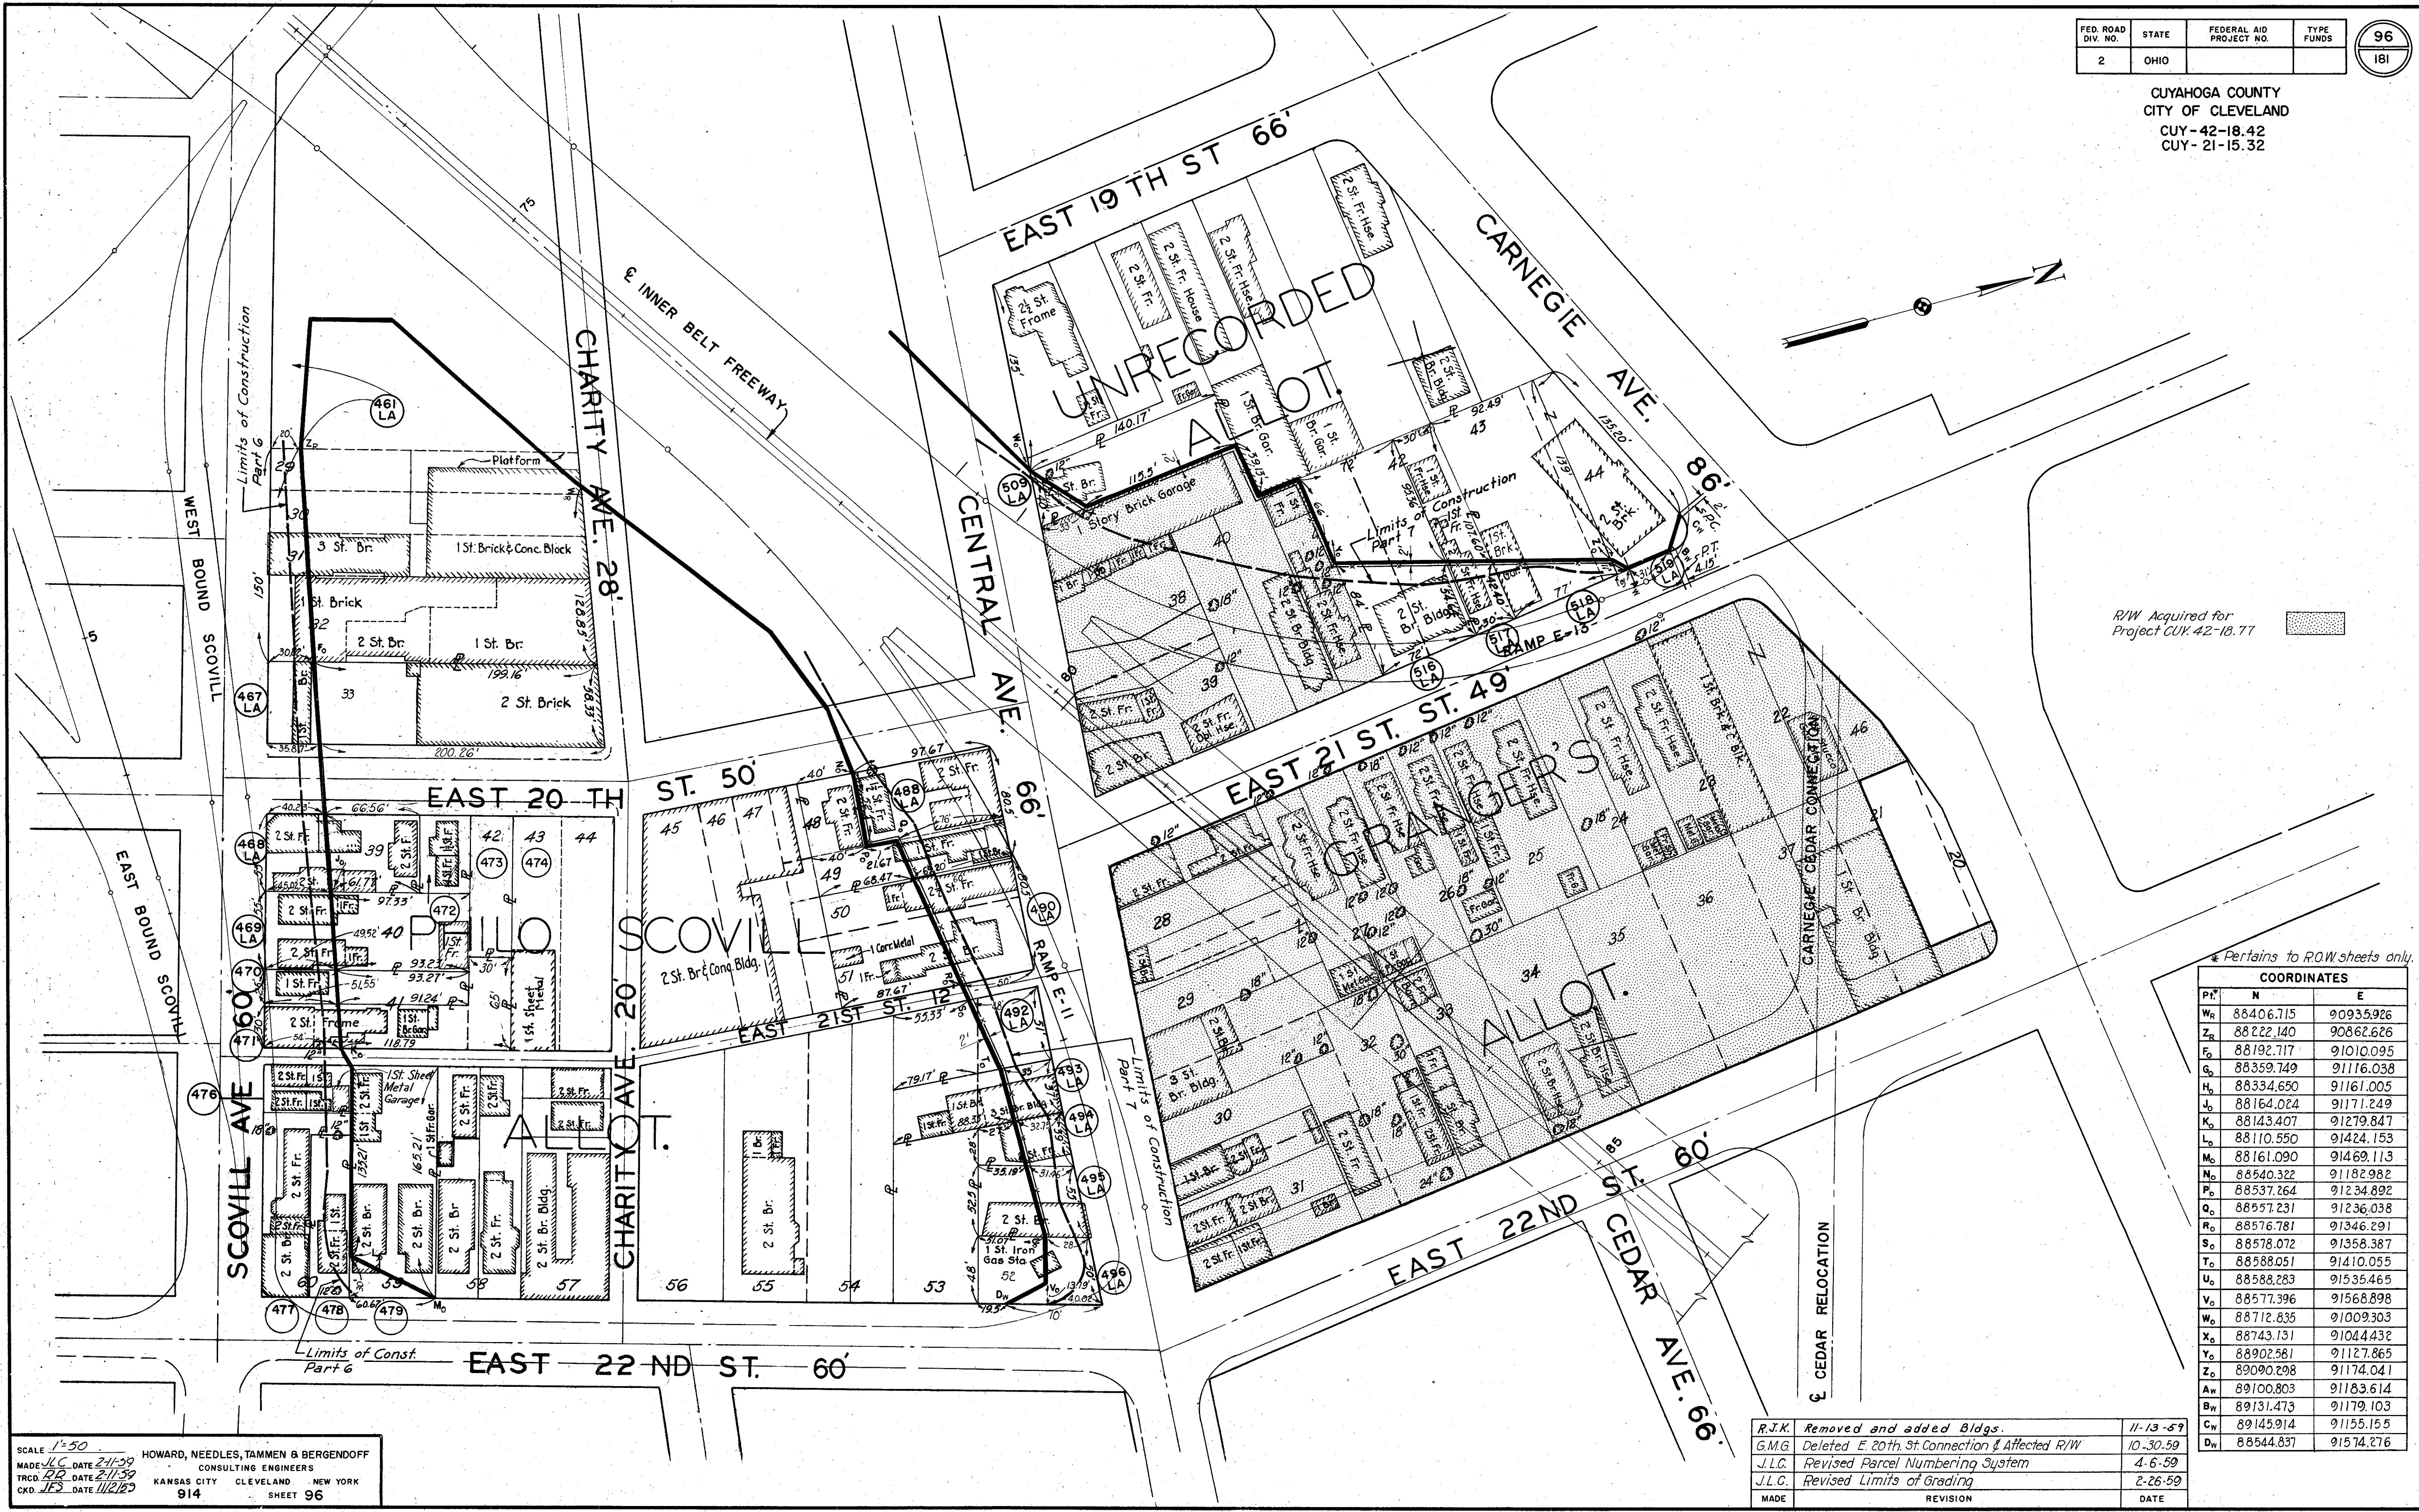

R/W Acquired for Project CUY-42-18.77

* Pertains to R/W sheets only.





COORDINATES		
PT.	N	E
W _r	88406.715	90935.926
Z _r	88222.140	90862.626
F _o	88192.717	91010.095
G _o	88359.749	91116.038
H _o	88334.650	91161.005
J _o	88164.024	91171.249
K _o	88143.407	91279.847
L _o	88110.550	91424.153
M _o	88161.090	91469.113
N _o	88540.322	91182.982
P _o	88537.264	91234.892
Q _o	88557.231	91236.038
R _o	88576.781	91346.291
S _o	88578.072	91358.387
T _o	88588.051	91410.055
U _o	88588.283	91535.465
V _o	88577.396	91568.898
W _o	88712.835	91009.303
X _o	88743.131	91044.432
Y _o	88902.561	91127.865
Z _o	89090.298	91174.041
A _w	89100.803	91183.614
B _w	89131.473	91179.103
C _w	89145.914	91155.155
D _w	88544.837	91574.276

R.J.K.	Removed and added Bldgs.	11-13-59
G.M.G.	Deleted E. 20th St Connection & Affected R/W	10-30-59
J.L.C.	Revised Parcel Numbering System	4-6-59
J.L.C.	Revised Limits of Grading	2-26-59
MADE	REVISION	DATE

SCALE 1"=50'
 MADE J.L.C. DATE 2/1/59
 TRCD. R.R. DATE 2/1/59
 CKD. J.F.S. DATE 11/2/59
 HOWARD, NEEDLES, TAMMEN & BERGENDOFF
 CONSULTING ENGINEERS
 KANSAS CITY CLEVELAND NEW YORK
 914 SHEET 96

FED. ROAD DIV. NO.	STATE	FEDERAL AID PROJECT NO.	FUNDS
2	OHIO		97 181

CUYAHOGA COUNTY
CITY OF CLEVELAND
CUY-42-18.42
CUY-21-15.32

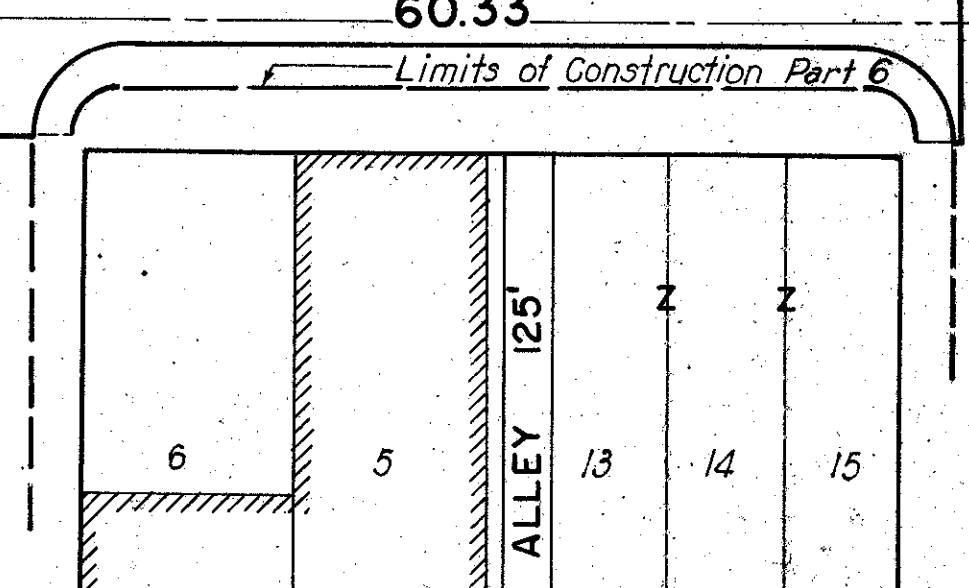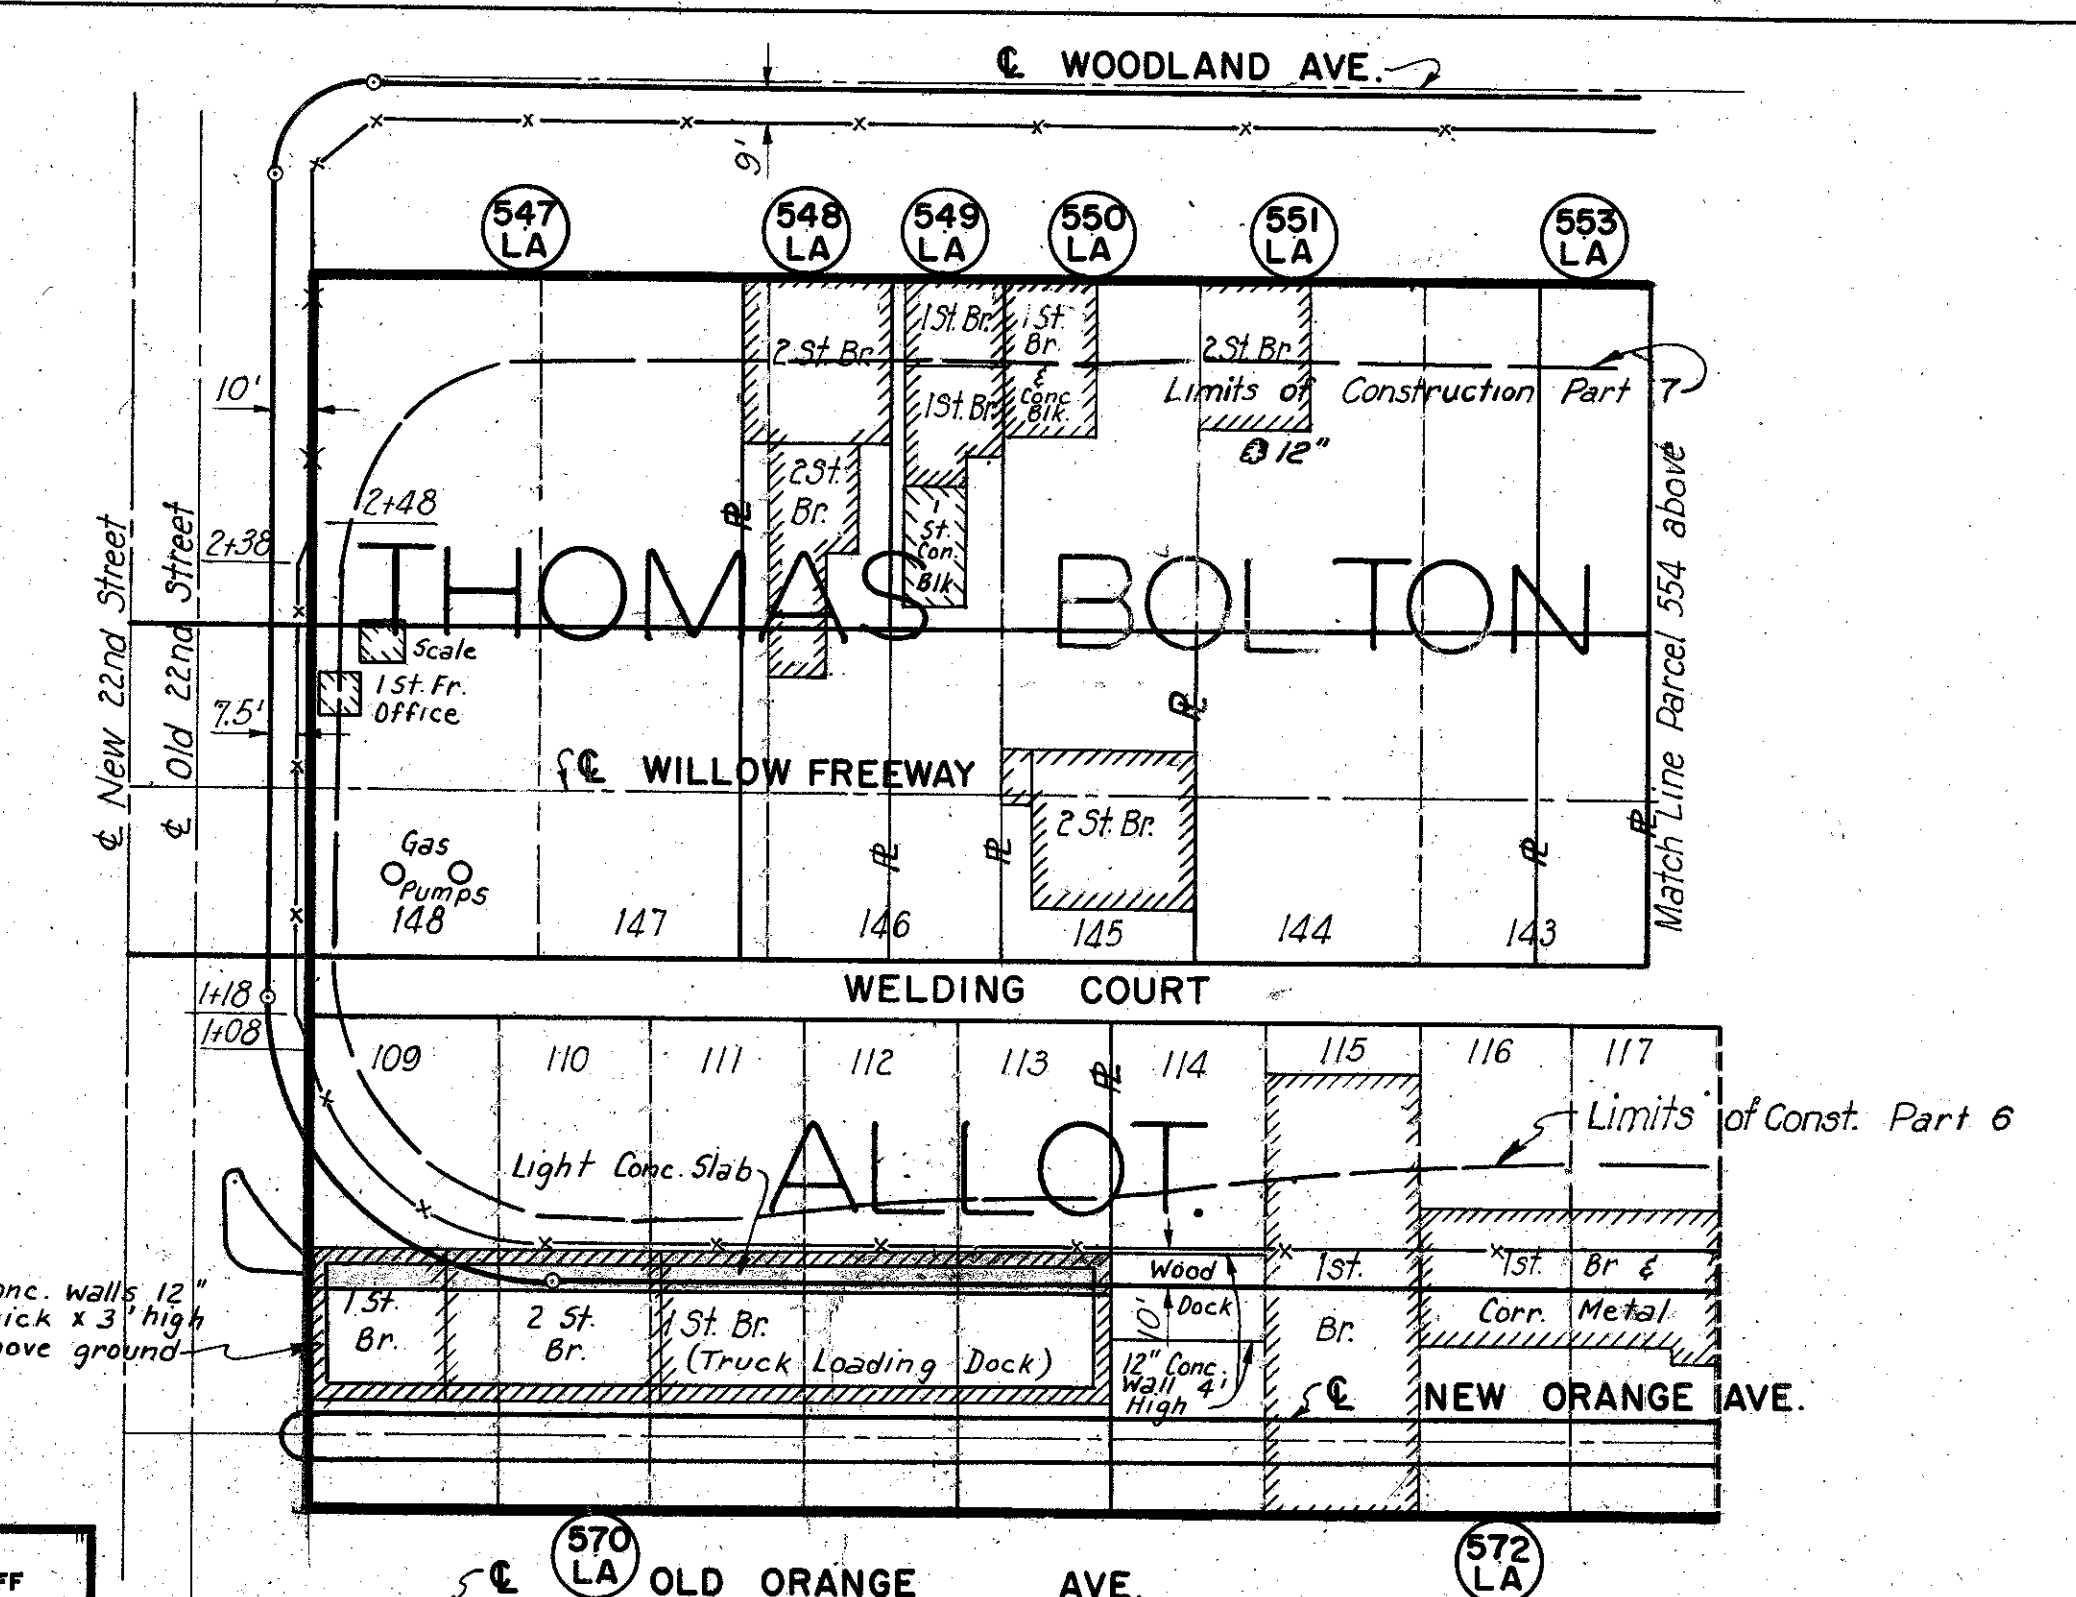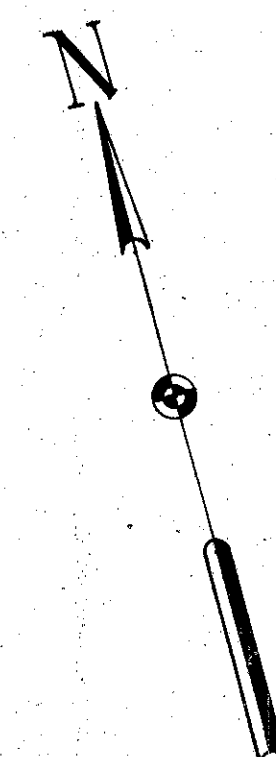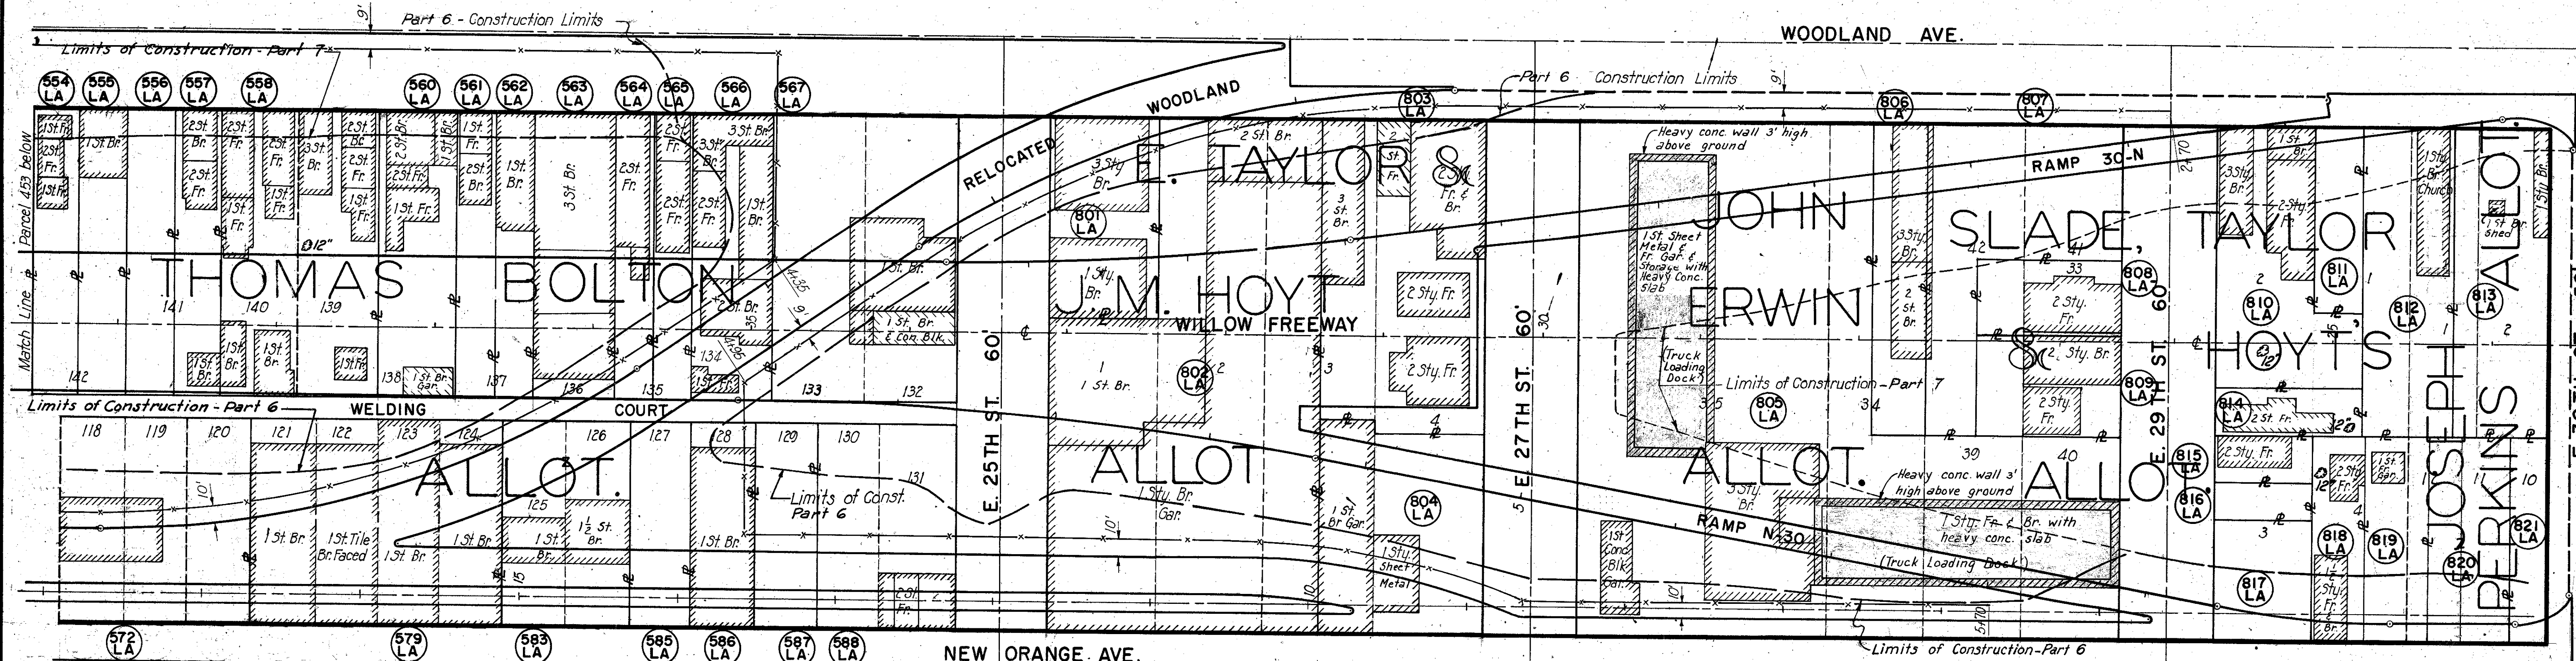

SCALE 1"=50'
MADE J.L.C. DATE 2-11-39
TRCD. B.R. DATE 2-11-39
CHK. J.F.S. DATE 11/2/59
HOWARD, NEEDLES, TAMMEN & BERGENDOFF
CONSULTING ENGINEERS
KANSAS CITY CLEVELAND NEW YORK
914 SHEET 97

MADE	REVISION	DATE
A.E.K.	Added and removed Bldgs.	11-13-59
J.L.C.	Revised Parcel Numbering System	4-6-59
J.L.C.	Revised Limits of Grading	2-26-59

DESIGN SPECIFICATIONS

DESIGN SPECIFICATIONS FOR HIGHWAY STRUCTURES OF THE STATE OF OHIO, DEPARTMENT OF HIGHWAYS, DATED SEPTEMBER 1, 1957, AND REVISED FEBRUARY 21, 1958.

SUPPLEMENTAL SPECIFICATIONS

REFERENCE SHALL BE MADE TO SUPPLEMENTAL SPECIFICATIONS NO. S-207, HIGH STRENGTH STEEL BOLTS, DATED APRIL 28, 1955, AND NO. M-206, 14 ASBESTOS CEMENT CONDUIT DATED JULY 15, 1949, AND 3-101 DATED 12-2-59

REFERENCE DRAWINGS

REFERENCE SHALL BE MADE TO STANDARD DRAWING NUMBERS RB-1-55 REVISED 2/2/59, AR-1-57 REVISED 2/2/59, AND TO AS-1-54 REVISED 12/1/54.

DIMENSIONS

DIMENSIONS GIVEN ARE MEASURED HORIZONTALLY AND AT 60°F. UNLESS OTHERWISE NOTED.

UTILITIES

ANY EXISTING UTILITY FACILITIES ENCOUNTERED AT THE SITE OF THE WORK WHICH WILL INTERFERE WITH PORTIONS OF THE FINISHED ROADWAYS OR STRUCTURES WILL BE REMOVED OR RELOCATED BY OTHERS UNLESS OTHERWISE SHOWN. THE CONTRACTOR SHALL COORDINATE HIS OPERATIONS WITH THE WORK OF THE UTILITY OWNERS OR OTHERS WHO MAY BE MAKING THE RELOCATIONS, AND SHALL NOTIFY THE OWNERS OF THE UTILITIES OF HIS SCHEDULE SUFFICIENTLY IN ADVANCE TO PERMIT THEM TO MAKE THE NECESSARY ALTERATIONS.

EXISTING SEWERS WILL BE RELOCATED OR REMOVED BY THE CONTRACTOR AS SHOWN ON THE ROADWAY PLANS.

EXCAVATION

AT THE PIERS THE EXCAVATION QUANTITY FOR PAYMENT WILL BE COMPUTED FROM THE COMPLETED CONSTRUCTION CROSS SECTIONS AND GRADE LINES OF THE LOWER ROADWAY.

FOR THE ABUTMENTS THE EXCAVATION QUANTITY FOR PAYMENT WILL BE COMPUTED FROM THE COMPLETED CROSS SECTION OF THE LOWER ROADWAY AND/OR THE SURFACE OF THE PROPOSED EMBANKMENT.

THE EMBANKMENT SHALL BE PLACED AND COMPACTED UP TO THE FINISHED SPILL-THRU SLOPE AND TO THE LEVEL OF THE SUBGRADE, AFTER WHICH THE EXCAVATION SHALL BE MADE. BACKFILL BEHIND THE ABUTMENTS SHALL BE MADE WITH MATERIAL MEETING THE REQUIREMENTS OF SEC. 1-22 AND SHALL BE COMPACTED IN ACCORDANCE WITH THE REQUIREMENTS FOR EMBANKMENT COMPACTION. THE PAYMENT FOR THIS 1-22 BACKFILL SHALL BE CONSIDERED AS INCLUDED IN THE PAYMENT FOR E-2. UNCLASSIFIED EXCAVATION.

BORINGS

BORING INFORMATION, LOGS AND SAMPLES OF MATERIALS ENCOUNTERED MAY BE EXAMINED AT THE DIVISION OFFICE IN GARFIELD HEIGHTS, OHIO AND AT THE BRIDGE BUREAU OFFICE IN COLUMBUS, OHIO, BUT THE STATE DOES NOT GUARANTEE THESE BORINGS TO PRESENT A COMPLETE PICTURE OF SUBSURFACE CONDITIONS TO BE ENCOUNTERED. FOUNDATION DESIGN AND FOUNDATION QUANTITIES ARE BASED ON A STUDY OF THE BORINGS.

PILING

PILES SHALL BE DRIVEN TO A MINIMUM BEARING CAPACITY OF 35 TONS FOR THE ABUTMENTS AND 45 TONS FOR THE PIERS.

CONCRETE

a. THE CONCRETE ROADWAY SLABS SHALL BE SO CONSTRUCTED THAT, AFTER COMPLETION AND AFTER REMOVAL OF FORMS AND ANY FALSEWORK, AND AFTER THE STEELWORK HAS DEFLECTED UNDER THE WEIGHT OF THE CONCRETE, THE TOP SURFACE OF THE ROADWAY SHALL CONFORM AS NEARLY AS PRACTICABLE TO THE ELEVATIONS AND CONTOUR LINES SHOWN ON THE PLANS.

b. THE TOTAL DEPTH OF THE BRIDGE SLAB AND HAUNCH OVER EACH BEAM (TOP OF CONCRETE TO TOP OF FLANGE) OR GIRDER (TOP OF CONCRETE TO TOP OF WEB) AT THE SUPPORTS IS GIVEN ON THE PLANS. THE STEEL BEAMS AND GIRDERS SHALL BE FABRICATED WITH THE CAMBER, AS SPECIFIED ON THE PLANS, TO COMPENSATE FOR THE DEFLECTIONS DUE TO WEIGHT OF CONCRETE AND STEEL.

THE THEORETICAL DEFLECTIONS ARE TABULATED ON THE PLANS. TO COMPENSATE FOR DEFLECTIONS DUE TO THE DEAD LOAD OF THE CONCRETE THE SCREEDS USED TO STRIKE OFF THE SURFACE OF THE CONCRETE SLAB SHALL BE SET UP WITH CAMBER ABOVE THE FINAL DESIRED GRADE LINE BY AMOUNTS EQUAL TO DEFLECTIONS SHOWN FOR THIS DEAD LOAD. SCREEDS MAY REQUIRE FURTHER ADJUSTMENT DUE TO IRREGULARITIES IN THE FABRICATED STEEL. THE CONCRETE SLAB SHALL BE OF UNIFORM THICKNESS BETWEEN BEAMS WITH CAMBER SETTING OBTAINED BY VARYING THE THICKNESS OF THE HAUNCHES OVER THE BEAMS.

REINFORCING STEEL

BARs SHALL, UNLESS OTHERWISE SHOWN, BE 3 INCHES CLEAR FROM THE FACE OF CONCRETE IN FOOTINGS AND 2 INCHES CLEAR ELSEWHERE, EXCEPT IN SLABS WHERE BARS SHALL BE 1 INCH CLEAR ON THE BOTTOM AND 1 INCH PLUS THE THICKNESS OF THE MONOLITHIC WEARING SURFACE ON THE TOP.

ALL BARS ARE DESIGNATED ON THE PLANS BY BAR NUMBERS. THE BAR SIZE IS INDICATED BY THE FIRST DIGIT OF THREE-DIGIT NUMBERS AND BY THE FIRST TWO DIGITS OF FOUR-DIGIT NUMBERS.

IF REINFORCING BARS ARE FABRICATED FROM STOCK WHICH HAS PREVIOUSLY BEEN TESTED AND APPROVED BY THE OHIO HIGHWAY TESTING LABORATORY, TEST SAMPLES AS PROVIDED IN SEC. S-4.02 NEED NOT BE FURNISHED, AND REPLACEMENT BARS WILL NOT BE REQUIRED.

WATERPROOFING

ALL CONTRACTION AND EXPANSION JOINTS IN BACK FACE OF SUB-STRUCTURE AGAINST WHICH EARTH IS TO BE PLACED SHALL BE WATERPROOFED WITH A PRE-MOLDED SEALING STRIP OR TYPE "B" WATERPROOFING AS SHOWN IN THE PLANS.

WELDING

ALL WELDING SHALL BE CLASS "A" EXCEPT AS NOTED IN THE TAIL OF THE WELDING SYMBOL.

RADIOGRAPHIC EXAMINATION OF WELDS

THIS WORK SHALL CONSIST OF THE PERFORMANCE AND INTERPRETATION OF A RADIOGRAPHIC EXAMINATION OF BUTT WELDS AS REQUIRED BY THESE SPECIFICATIONS. IT SHALL INCLUDE THE PREPARATION AND POSITIONING OF WELDS FOR EXAMINATION, THE RADIOGRAPHING OF WELDS, THE PROCESSING AND EXAMINATION OF RADIOGRAPHS, THE INTERPRETATION OF RADIOGRAPHS FOR COMPLIANCE WITH THESE SPECIFICATIONS, AND THE PERFORMANCE AND INTERPRETATION OF ANY RETAKES OF RADIOGRAPHS REQUIRED FOR WELDS MADE TO REPLACE UNSATISFACTORY WELDS.

a. APPROVAL OF DIRECTOR

THE CONTRACTOR SHALL FURNISH EVIDENCE, ACCEPTABLE TO THE DIRECTOR, OF THE ADEQUACY OF THE EQUIPMENT TO BE USED AND THE COMPETENCE OF THE PERSONNEL.

THE INTERPRETATION OF RADIOGRAPHS AND THE CORRECTION OF DEFECTIVE WELDS SHALL BE SUBJECT TO THE APPROVAL OF THE DIRECTOR.

b. SCOPE OF EXAMINATION

BY MEANS OF RADIOGRAPHIC EXAMINATION, THE CONTRACTOR SHALL FURNISH EVIDENCE OF THE ACCEPTABLE QUALITY OF THE BUTT WELDS OF ALL GIRDERS. THE PARTS OF THESE MEMBERS TO BE RADIOGRAPHED ARE AS FOLLOWS:

(1) THE COMPLETE BUTT WELDS IN THE FLANGES OF EACH GIRDER EXCEPT THE BOTTOM FLANGE OVER THE BEARING DEVICES.

(2) ONE FOOT AT EACH END OF EACH OF THE WEB SPLICE WELDS.

THE SHOP EXAMINATION OF THE BUTT WELDS OF THE FLANGE PLATES AND OF THE WEB PLATES SHALL BE DETERMINED TO BE ACCEPTABLE BEFORE THESE FLANGE AND WEB PLATES ARE ASSEMBLED AND WELDED TO FORM THE GIRDERS. THE EXAMINATION OF FIELD WELDS SHALL BE MADE AS SOON AS PRACTICABLE AFTER WELDING AT EACH FIELD SPLICE IS COMPLETED.

RADIOGRAPHIC INSPECTION OF WELDS OF ROLLED BEAMS WILL NOT BE REQUIRED.

c. WELD CONDITION

ALL WELDED JOINTS WHICH ARE TO BE RADIOGRAPHED SHALL BE FREE OF PAINT, SCALE AND GREASE AND SHALL BE FOUND FREE OF ALL WELD RIPPLES AND SURFACE IRREGULARITIES ON BOTH SIDES. THE DIRECTION OF GRINDING SHALL BE PERPENDICULAR TO THE LENGTH OF THE WELD. THE WELDS SHALL BE GROUND TO SUCH A DEGREE THAT THE RESULTING RADIOGRAPHIC CONTRAST, DUE TO REMAINING IRREGULARITIES, CANNOT MASK OR BE CONFUSED WITH THAT OF ANY OBJECTIONABLE DEFECT AND THAT THE WELD SURFACE WILL MERGE SMOOTHLY INTO THE PLATE SURFACE. UNLESS SPECIFIED TO BE GROUND FLUSH, THE FINISHED SURFACE OF THE REINFORCEMENT MAY HAVE A CROWN EQUAL TO ONE-EIGHTH THE THICKNESS OF THE METAL BUT NOT MORE THAN ONE-EIGHTH INCH.

d. RADIOGRAPHIC TECHNIQUE

THE WELD SHALL BE RADIOGRAPHED WITH A TECHNIQUE WHICH WILL DETERMINE QUANTITATIVELY THE SIZE OF DEFECTS WITH THICKNESSES EQUAL TO OR GREATER THAN 2 PER CENT OF THE THICKNESS OF THE BASE METAL. IN THE CASE OF A WELD JOINING PLATES OF UNEQUAL THICKNESS, BOTH PLATES MUST BE RADIOGRAPHED AT 2 PER CENT SENSITIVITY TOGETHER OR SINGLY, WITH THE WELD JUNCTION EVIDENT IN BOTH VIEWS.

TO DETERMINE WHETHER THE RADIOGRAPHIC TECHNIQUE EMPLOYED IS DETECTING DEFECTS OF A THICKNESS EQUAL TO OR GREATER THAN 2 PER CENT OF THE THICKNESS OF THE BASE MATERIAL, THICKNESS GAGES OR PENETRATORS OF THE TYPE HEREINAFTER SPECIFIED SHALL BE PLACED ON THE SIDE OF THE WELDED PLATE NEAREST THE SOURCE OF RADIATION AT AN EXTREME EDGE OF THE RADIOGRAPHIC PLATE OR FILM.

THE MATERIAL OF THE PENETRATOR SHALL BE SUBSTANTIALLY THE SAME AS THAT OF THE WELDED PLATE.

THE THICKNESS OF THE PENETRATOR SHALL BE NOT MORE THAN 2 PER CENT OF THE THICKNESS OF THE PLATE EXCLUSIVE OF ANY WELD REINFORCEMENT. PENETRATORS DESIGNED FOR INCREMENTS OF 1/8" OF PLATE THICKNESS ARE ACCEPTABLE.

IN EACH PENETRATOR THERE SHALL BE THREE HOLES WITH DIAMETERS EQUAL RESPECTIVELY TO TWO, THREE, AND FOUR TIMES THE PENETRATOR THICKNESS, BUT IN NO CASE SHALL LESS THAN 1/16" DIAMETER BE USED.

EACH PENETRATOR SHALL CARRY AN IDENTIFYING NUMBER REPRESENTING IN TWO SIGNIFICANT FIGURES THE MINIMUM THICKNESS IN INCHES OF THE PLATE FOR WHICH IT MAY BE USED. PENETRATORS MAY BE ESTABLISHED FOR DIFFERENCES IN THICKNESS NOT TO EXCEED 1/8" SO THAT A SET OF PENETRATORS VARYING FOR INCREMENTS OF PLATE THICKNESS OF 1/8" WILL BE ADEQUATE TO SERVE PLATES HAVING THICKNESSES BETWEEN THESE 1/8" DIMENSIONS.

THE IMAGES OF IDENTIFYING NUMBERS AND THE HOLES OF EACH PENETRATOR MUST APPEAR CLEARLY ON THE RADIOGRAPH TO ESTABLISH THE 2 PER CENT SENSITIVITY.

FOR PLATES UP TO AND INCLUDING 2-1/2" IN THICKNESS, EACH PENETRATOR SHALL BE 1-1/2" LONG AND 1/2" WIDE. FOR PLATES THICKER THAN 2-1/2", EACH PENETRATOR SHALL BE 2-1/4" LONG AND 1" WIDE.

THE FILM DURING EXPOSURE SHALL BE AS CLOSE TO THE WELD AS PRACTICABLE. IF POSSIBLE, THIS DISTANCE SHALL BE NOT GREATER THAN 1 INCH. IN ANY EVENT, THE RATIO

$$\frac{\text{DISTANCE FROM SOURCE OF RADIATION TO WELD SURFACE TO WARD RADIATION}}{\text{DISTANCE FROM WELD SURFACE TOWARD RADIATION TO FILM}}$$

SHALL BE AT LEAST 7 TO 1.

ALL RADIOGRAPHS SHALL BE FREE FROM EXCESSIVE MECHANICAL PROCESSING DEFECTS WHICH WOULD INTERFERE WITH PROPER INTERPRETATION OF THE RADIOGRAPH.

IDENTIFICATION MARKERS, THE IMAGES OF WHICH WILL APPEAR ON THE FILM, SHALL BE PLACED ADJACENT TO THE WELD, AND THEIR LOCATIONS SHALL BE ACCURATELY AND PERMANENTLY MARKED ON THE OUTSIDE SURFACE NEAR THE WELD SO THAT A DEFECT APPEARING ON THE RADIOGRAPH MAY BE ACCURATELY LOCATED.

THE SIZE OF FILM TO BE USED SHALL BE ^{at least} 3" WIDE x 15" LONG UNLESS PERMISSION TO USE A DIFFERENT SIZE IS OBTAINED IN WRITING FROM THE DIRECTOR

e. STANDARDS OF ACCEPTABILITY

THE ACCEPTABILITY OF THE WELDS EXAMINED BY RADIOGRAPHY SHALL BE JUDGED BY THE FOLLOWING STANDARDS.

(1) CRACKS:

DEFINITION - A DISCONTINUITY RESULTING FROM A VERY NARROW SEPARATION OF METAL.

STANDARD - NO WELD CONTAINING CRACKS, REGARDLESS OF LENGTH, SIZE OR LOCATION, SHALL BE CONSIDERED ACCEPTABLE.

(2) GAS POROSITY:

DEFINITION - GAS POCKETS OR VOIDS IN METAL.

STANDARD - THE MAXIMUM DIMENSION OF ANY INDIVIDUAL GAS POCKET SHALL NOT EXCEED 1/8 INCH. THE MAXIMUM ACCUMULATION OF GAS POCKETS SHALL NOT EXCEED THAT SHOWN IN THE "POROSITY STANDARDS" OF THE AMERICAN SOCIETY OF MECHANICAL ENGINEERS.

(3) SLAG INCLUSIONS:

DEFINITION - NONMETALLIC, SOLID MATERIAL ENTRAPPED IN WELD METAL OR BETWEEN WELD METAL AND BASE METAL.

STANDARD-A - ELONGATED SLAG INCLUSIONS: NO ELONGATED SLAG INCLUSION SHALL EXCEED TWO-THIRDS OF THE THICKNESS OF THE THINNER PLATE OF THE JOINT IN LENGTH AND 1/16" IN WIDTH, EXCEPT THAT REGARDLESS OF THE PLATE THICKNESS, NO SUCH INCLUSION SHALL BE LONGER THAN 3/4" AND EXCEPT THAT NO SUCH INCLUSION WHICH IS SHORTER THAN 1/4" SHALL BE CAUSE FOR REJECTION.

B - ISOLATED SLAG INCLUSIONS: IN ANY 12 INCH LENGTH OF WELD, THE MAXIMUM WIDTH OF ANY ISOLATED SLAG INCLUSION SHALL NOT EXCEED 1/8 INCH, THE SUMMATION OF LENGTHS OF ISOLATED SLAG INCLUSIONS SHALL NOT EXCEED 1 INCH, AND THERE SHALL BE NO MORE THAN FOUR ISOLATED SLAG INCLUSIONS OF THE MAXIMUM WIDTH OF 1/8 INCH. ANY TWO SUCH INCLUSIONS SHALL BE SEPARATED BY AT LEAST 2 INCHES OF SOUND WELD METAL.

FED. ROADS DIV. NO.	STATE	FED. AID PROJ. NO.
2	OHIO	

98
181

CUYAHOGA COUNTY
CITY OF CLEVELAND
CUY - 21-15.32
CUY - 42-18.42

(4) INCOMPLETE FUSION:

DEFINITION - FAILURE OF THE WELD METAL TO FUSE COMPLETELY WITH THE BASE METAL OR PRECEDING BEADS.

STANDARD - NO INDIVIDUAL LACK OF FUSION SHALL EXCEED 1/2 INCH IN LENGTH. IN ANY 12 INCH LENGTH OF WELD, THE SUMMATION OF LENGTHS OF LACK OF FUSION SHALL NOT EXCEED 3/4 INCH AND INDIVIDUAL DEFECTS SHALL BE SEPARATED BY AT LEAST 6 INCHES OF SOUND METAL.

(5) INCOMPLETE PENETRATION:

DEFINITION - ROOT PENETRATION WHICH IS LESS THAN COMPLETE OR FAILURE OF A ROOT PASS AND A BACKING PASS TO FUSE WITH EACH OTHER.

STANDARD - NO INDIVIDUAL LACK OF PENETRATION SHALL EXCEED 1/2 INCH IN LENGTH. IN ANY 12 INCH LENGTH OF WELD, THE SUMMATION OF LENGTHS OF LACK OF PENETRATION SHALL NOT EXCEED 3/4 INCH AND INDIVIDUAL DEFECTS SHALL BE SEPARATED BY AT LEAST 6 INCHES OF SOUND METAL.

f. REPAIR OF DEFECTIVE WELDS

DEFECTIVE WELDS SHALL BE REPAIRED BY CHIPPING OR MELTING OUT SUCH DEFECTS FROM ONE OR BOTH SIDES OF THE JOINT AS REQUIRED, REMOVING ONLY SUFFICIENT WELD METAL TO CORRECT THE DEFECT. THE JOINT SHALL THEN BE REWELDED AND AGAIN RADIOGRAPHED.

g. ADDITIONAL RADIOGRAPHS

WHEREVER AN UNACCEPTABLE WELD OCCURS, A RADIOGRAPH SHALL BE MADE OF THE ADJOINING 12-INCH LENGTHS OF WELD TO DETERMINE IF THE FLAWS EXTEND BEYOND THE LIMITS OF THE ORIGINAL RADIOGRAPH. IF UNACCEPTABLE FLAWS OCCUR IN THESE ADJOINING LENGTHS OF WELD, THESE DEFECTIVE WELDS SHALL BE REPAIRED, AND THIS ENTIRE PROCEDURE REPEATED FOR THE NEXT ADJOINING 12-INCH LENGTH OF WELD.

h. CUSTODY OF RADIOGRAPHS

AS SOON AS THE RADIOGRAPHING OF THE WELDMENTS ON THE FULL LENGTH OF EACH FLANGE OR WEB PLATE BETWEEN FIELD SPLICES HAS BEEN COMPLETED, THE CONTRACTOR SHALL SEND TO THE STATE THE PROCESSED CONTACT FILM (THAT FILM CLOSEST TO THE SOURCE OF RADIATION) OF ALL ORIGINAL AND RETAKE RADIOGRAPHS. THESE RADIOGRAPHS SHALL BE ACCOMPANIED BY A CERTIFICATION FROM THE CONTRACTOR THAT THE RADIOGRAPHIC EXAMINATION WAS PERFORMED IN CONFORMANCE WITH THESE SPECIFICATIONS. THE RADIOGRAPHS SHALL BECOME THE PROPERTY OF THE STATE. EACH RADIOGRAPH SHALL BE CLEARLY IDENTIFIED TO SHOW THE LOCATION ON THE STRUCTURE AT WHICH IT WAS TAKEN. UNACCEPTABLE DEFECTS SHALL BE IDENTIFIED IN EACH RADIOGRAPH IN WHICH THEY OCCUR, AND THE REPAIR OR REPLACEMENT OF EACH UNACCEPTABLE WELD DEFECT SHALL BE NOTED AND IDENTIFIED.

i. REPORT OF COST

AFTER THE COMPLETION OF THE RADIOGRAPHIC INSPECTION OF WELDS, THE CONTRACTOR SHALL FURNISH THE STATE A COMPLETE REPORT OF THE COST OF PERFORMING THIS WORK, SEPARATED INTO THE ITEMS MENTIONED IN THE FOLLOWING PARAGRAPH.

j. BASIS OF PAYMENT

PAYMENT FOR THIS WORK, INCLUDING ALL LABOR, EQUIPMENT, MATERIALS, AND INCIDENTALS, SHALL BE INCLUDED IN THE UNIT PRICE BID FOR S-7, "STRUCTURAL STEEL."

MICROFILMED

JUL 3 1985

PART 7-A

HOWARD, NEEDLES, TAMMEN & BERGENDOFF
CONSULTING ENGINEERS
KANSAS CITY CLEVELAND NEW YORK

GENERAL NOTES

WILLOW - INNER BELT FREEWAY
CLEVELAND CUYAHOGA COUNTY OHIO

DRAWN	TRACED	CHECKED	REVIEWED	REVISED
H.A.H.	C.G.	C.G.	C.P.	
DATE 10-4-57	DATE	DATE 11-10-57	DATE 11-10-57	SHEET 98

MICROFILMED
JUL 3 1985

CUYAHOGA COUNTY
CITY OF CLEVELAND
CUY-21-15.32
CUY-42-18.42

PAINTING

PAINTING OF SUPERSTRUCTURE METALWORK SHALL BE ACCORDING TO ITEM S-8 OF THE CONSTRUCTION AND MATERIAL SPECIFICATIONS EXCEPT AS MODIFIED HEREIN.

- A. COATS OF PAINT. THE PAINT SHALL BE APPLIED BY BRUSHING IN FOUR COATS AS FOLLOWS:
- A FIRST COAT OF RED LEAD PAINT APPLIED IN THE SHOP ON CLEAN METAL SURFACES PREPARED FOR PAINTING AS SPECIFIED IN SEC. S-8.03.
 - A SECOND COAT OF RED LEAD PAINT APPLIED IN THE FIELD AFTER ERECTION. FOR SURFACES THAT WILL BE INACCESSIBLE AFTER ERECTION, THIS SECOND COAT MAY BE APPLIED EITHER IN THE SHOP OR IN THE FIELD.
 - A THIRD AND A FOURTH COAT CONSISTING OF WHITE LEAD PAINT. THE FOURTH COAT SHALL BE TINTED A MEDIUM SHADE OF GRAY THAT MEETS THE APPROVAL OF THE DIRECTOR OF HIGHWAYS AND THE CITY OF CLEVELAND.
 - LIGHT STANDARDS SHALL BE PAINTED WITH TWO FIELD COATS OF DARK GREEN WEATHER RESISTING ENAMEL AFTER ERECTION. THE FIRST FIELD COAT SHALL BE TINTED.

- B. MATERIALS
- THE PAINT TO BE USED FOR THE FIRST AND SECOND RED LEAD COATS SHALL BE OF THE FOLLOWING COMPOSITION AND PROPERTIES:

PIGMENT

RED LEAD (97% GRADE)-----	99.6% (MINIMUM)
ALUMINUM STEARATE-----	0.3-0.4%

VEHICLE

RAW LINSEED OIL-----	35% to 50%
*PALE HEAT BODIED LINSEED OIL (Z ₂)-----	15% to 30%
VOLATILE MINERAL SPIRITS AND DRIER-----	35% (MAXIMUM)
*THE ACID NUMBER OF THIS OIL SHALL NOT BE OVER 11, THE COLOR NOT DARKER THAN 7 (GARDINER 1933) AND SHALL HAVE A WIJS IODINE VALUE OF 110-125.	

PAINT	FIRST COAT	SECOND COAT
PIGMENT	73% (MINIMUM)-----	77% (MIN.)-----
VEHICLE	27% (MAXIMUM)-----	23% (MAX.)-----
WEIGHT PER GALLON	21.0 LBS. (MINIMUM)-----	24.0 LBS. (MIN.)-----
CONSISTENCY	175 GRAMS TO 250 GRAMS D562-42-T OR FEDERAL SPECIFICATION TT-P-141a, METHOD 428.1)	(ASTM METHOD)

FINENESS OF GRIND 5 (MINIMUM)
DRYING TIME:

SET TO TOUCH----6 HOURS (MAXIMUM)
DRY THROUGH----36 HOURS (MAXIMUM)
THE PAINT SHALL BE WELL GROUND, SHALL NOT SETTLE EXCESSIVELY OR CAKE IN THE CONTAINER, SHALL BE READILY BROKEN UP WITH A PADDLE TO A SMOOTH UNIFORM PAINT HAVING GOOD BRUSHING PROPERTIES. THE PAINT WHEN BRUSHED ON A CLEAN, SMOOTH STEEL PANEL MAINTAINED IN A VERTICAL POSITION, SHALL DRY TO A SMOOTH UNIFORM FINISH FREE FROM ROUGHNESS, GRIT, UNEVENNESS, STREAKING, SEPARATION, RUNNING, CURTAINING AND SAGGING.

FOR CONTRAST BETWEEN THE FIRST AND SECOND COATS, THE SECOND COAT SHALL BE TINTED WITH LAMPBLACK-IN-OIL TO CHANGE ITS COLOR TO A CHOCOLATE BROWN.

- THE WHITE LEAD THIRD AND FOURTH COATS OF PAINT SHALL CONFORM TO THE FOLLOWING:
- TYPE. THIS SPECIFICATION COVERS A GRADE OF READY-MIXED LINSEED OIL WHITE OR TINTED PAINT MADE ON A WHITE LEAD (BASIC LEAD CARBONATE) BASE SUITABLE FOR USE AS FINISH COATS ON EITHER WOOD OR METAL AND AFTER THINNING (SEC. M-9.7 (b) AS A PRIME COAT FOR WOOD.

COMPOSITION AND PROPERTIES

2. PIGMENT. THE PIGMENT SHALL BE BASIC CARBONATE WHITE LEAD CORRESPONDING APPROXIMATELY TO THE FORMULA 2 PbCO₃ · Pb(OH)₂. IT SHALL MEET THE FOLLOWING COMPOSITION REQUIREMENTS:

	MAXIMUM PER CENT	MINIMUM PER CENT
BASIC CARBONATE WHITE LEAD		
LEAD CARBONATE (PbCO ₃)-----	75	65
LEAD HYDROXIDE (Pb(OH) ₂)-----	35	25
OTHER PIGMENTS*-----	0.0	--

*TINTING COLORS NOT TO EXCEED 5 PER CENT OF THE TOTAL PIGMENT MAY BE ADDED WHEN A TINTED PAINT IS REQUIRED.

3. LIQUID. THE LIQUID SHALL CONTAIN NOT LESS THAN 85 PER CENT RAW OR BOILED LINSEED OIL (SEC. M-9.1 OR M-9.2), THE BALANCE COMBINED DRIER (SEC. M-9.5) AND THINNER. THE THINNER SHALL BE TURPENTINE (SEC. M-9.3), MINERAL SPIRITS (SEC. M-9.4) OR A MIXTURE THEREOF.

4. FINISHED PAINT. THE PAINT SHALL BE WELL GROUND, SHALL NOT SETTLE TO THE EXTENT THAT THE PIGMENT CANNOT BE READILY AND UNIFORMLY DISPERSED THROUGHOUT THE VEHICLE OR CAKE IN THE CONTAINER AND SHALL BE READILY BROKEN UP BY STIRRING AND BOXING TO A SMOOTH, UNIFORM PAINT OF GOOD BRUSHING CONSISTENCY. WHEN BRUSHED ON A SMOOTH VERTICAL TIN PANEL IT SHALL DRY WITHIN 18 HOURS WITHOUT STREAKING, RUNNING OR SAGGING. THE COLOR AND HIDING POWER, WHEN SPECIFIED, SHALL BE EQUAL TO THOSE OF A SAMPLE MUTUALLY AGREED UPON BY THE LABORATORY AND THE SELLER. THE PAINT SHALL ALSO MEET THE FOLLOWING REQUIREMENTS:

	MAXIMUM	MINIMUM
PIGMENT -----	75%	71%
LIQUID (CONTAINING AT LEAST 85 PER CENT LINSEED OIL)-----	29%	25%
PIGMENT BY VOLUME (BASED ON TOTAL NON-VOLATILE PORTION OF PAINT)-----	32%	28%
WATER-----	0.2%	---
COARSE PARTICLES AND "SKINS" (TOTAL RESIDUE RETAINED ON NO. 325 SIEVE; BASED ON PIGMENT)-----	2.0%	---
WEIGHT PER GALLON-----	---	19.5 Lbs.
DRYING TIME-----	18 Hrs.	---

c. THE TWO COATS OF DARK GREEN WEATHER RESISTING ENAMEL SHALL CONFORM TO THE SPECIFICATIONS OF THE CITY OF CLEVELAND, DIVISION OF LIGHT AND POWER.

LIGHTING SYSTEM

GENERAL

THIS SPECIFICATION SUPPLEMENTS THE STATE OF OHIO CONSTRUCTION AND MATERIAL SPECIFICATIONS DATED JANUARY 1, 1959, FOR THE MATERIALS USED AND FOR THE INSTALLATION OF ROADWAY AND UNDERDECK LIGHTING UNITS FOR THE WILLOW-INNER BELT FREEWAY STRUCTURES. THE TYPE AND LOCATION OF LIGHTS AND CONDUITS ON THE BRIDGES AND RETAINING WALLS SHALL BE AS INDICATED ON THE PLANS.

THE CONTRACTOR SHALL CONSULT AND COOPERATE WITH THE CLEVELAND DIVISION OF LIGHT AND POWER AND THE CLEVELAND ELECTRIC ILLUMINATING COMPANY.

THE CONTRACTOR SHALL FURNISH AND INSTALL LIGHTING EQUIPMENT AS SHOWN ON THE PLANS AND AS FURTHER DESCRIBED HEREIN AND ON SHEET 48.

INSO FAR AS PRACTICABLE, ALL MAJOR ITEMS OF ELECTRICAL EQUIPMENT SHALL CONSIST OF PRODUCTS OF THE SAME MANUFACTURER, IN ORDER TO SECURE SINGLE RESPONSIBILITY AND MOST SATISFACTORY SERVICE. REFERENCE TO ANY NAME, MAKE OR MANUFACTURER'S NUMBER FOR AN ARTICLE OF EQUIPMENT OR MATERIAL IS INTENDED TO BE DESCRIPTIVE, BUT NOT RESTRICTIVE AND IS INTENDED TO INDICATE THE MATERIALS THAT WILL BE ACCEPTABLE.

BEFORE COMMENCEMENT OF INSTALLATION, A COMPLETE SCHEDULE OF MATERIALS AND EQUIPMENT PROPOSED FOR INSTALLATION SHALL BE SUBMITTED FOR THE APPROVAL OF THE ENGINEER. THE SCHEDULE SHALL INCLUDE CATALOG CUTS, DIAGRAMS, AND OTHER SUCH DESCRIPTIVE DATA AS MAY BE REQUIRED BY THE ENGINEER. IN THE EVENT ANY ITEMS OF MATERIAL OR EQUIPMENT CONTAINED IN THE SCHEDULE FAIL TO COMPLY WITH THE SPECIFICATION REQUIREMENTS, SUCH ITEMS WILL BE REJECTED.

MATERIALS AND EQUIPMENT

ALL BOLTS, NUTS, STUDS, WASHERS, PINS, TERMINALS, SPRINGS, AND SIMILAR FASTENINGS AND FITTINGS SHALL BE, WHERE PRACTICABLE, OF AN APPROVED CORROSION-RESISTING MATERIAL SUCH AS BRASS OR BRONZE, OR OF A MATERIAL TREATED IN AN APPROVED MANNER TO RENDER IT ADEQUATELY RESISTANT TO CORROSION; HOT-DIP GALVANIZING WILL BE CONSIDERED SUCH APPROVED TREATMENT. ALL MATERIALS FURNISHED SHALL BE NEW, SHALL BE OF THE BEST QUALITY AND WORKMANSHIP, SHALL BE THE BEST STANDARD PRODUCT OF A MANUFACTURER REGULARLY ENGAGED IN THE PRODUCTION OF THIS TYPE OF EQUIPMENT AND SHALL BE OF THE MANUFACTURER'S LATEST APPROVED DESIGN.

LIGHT STANDARDS SHALL CONFORM AS NEARLY AS POSSIBLE TO THIS SPECIFICATION AS TO GENERAL DESIGN AND FINISH, HEIGHT, BASE, BRACKET, DIMENSIONS AND TO METHOD OF FABRICATION, AND SHALL BE SIMILAR TO UNION METAL COMPANY DESIGN NO. 70161-23.

IN GENERAL, EACH STANDARD SHALL CONSIST OF A CAST STEEL ANCHOR BASE TO WHICH SHALL BE WELDED A TAPERED STEEL POLE. TO THE STEEL POLE SHALL BE FASTENED AN ORNAMENTAL POLE TOP TO WHICH SHALL BE WELDED A BRACKET FOR SUPPORTING THE LIGHTING UNIT.

THE STEEL SHAFT OF THE LIGHTING STANDARDS SHALL BE FABRICATED FROM NOT LESS THAN NO. 11 MANUFACTURER'S STANDARD GAUGE. THE SHAFT SHALL BE FORMED AND WELDED WITH ONLY ONE LONGITUDINAL, AUTOMATICALLY, ELECTRICALLY WELDED JOINT AND SHALL HAVE NO HORIZONTAL JOINTS OR WELDS. THE WELD SHALL BE OF FULL PENETRATION.

AFTER FORMING AND WELDING, THE TAPERED SHAFT SHALL BE COLD ROLLED OR WORKED UNDER SUFFICIENT PRESSURE TO FLATTEN OUT THE WELD, TO INCREASE THE ELASTIC LIMIT OF THE METAL IN THE COMPLETE SHAFT, AND TO PRODUCE A TRUE TAPERED TUBE WITHOUT FLAT SPOTS AND A CIRCULAR CROSS-SECTION THROUGHOUT THE LENGTH OF THE SHAFT. IF THE SHAFT IS FABRICATED BY MEANS OF A BRAKE OR OTHER PROCESS WHICH DOES NOT UTILIZE THE COLD ROLLING PRINCIPLE, IT SHALL BE FABRICATED FROM A STEEL SHEET HAVING A THICKNESS OF NO. 7 MANUFACTURER'S STANDARD GAUGE.

EACH STANDARD SHALL HAVE A BRACKET MADE OF STANDARD PIPE OF THE SIZE AND LENGTH AS SHOWN ON THE PLANS. THE INNER END OF THE BRACKET ARM SHALL BE WELDED TO A CAST STEEL HEAD BLOCK SO DESIGNED THAT THE BLOCK CAN BE BOLTED THROUGH A CAST IRON NECK PIECE TO A PLATE WELDED TO THE TOP OF THE POLE TO PERMIT RADIAL ADJUSTMENT OF THE BRACKET. PROVISIONS SHALL BE MADE TO PERMIT PASSAGE OF THE CONCEALED WIRES TO BRACKET. THE ORNAMENTAL CASTING WELDED TO THE OUTER END OF THE BRACKET SHALL BE ARRANGED WITH A LEVELING DEVICE OR "PLUMBIZER" FOR ADJUSTMENT OF A PENDANT LIGHTING FIXTURE AND SHALL BE TAPPED FOR 1-1/4 INCH PIPE CONNECTIONS. THE ANCHOR BOLTS SHALL BE OF THE SIZE AND MATERIALS AS SHOWN ON SHEETS 122 AND 176. EACH POLE BASE SHALL HAVE A 2-INCH, SHOP BENT, RIGID GALVANIZED ELBOW, FROM JUNCTION BOX AND EXTENDED AT LEAST 3 INCHES ABOVE TOP OF CONCRETE.

EACH POLE SHALL HAVE TWO 9/16 INCH HOLES PROVIDED, WHERE SHOWN ON SHEET 176 ALL POLES AND BRACKETS SHALL HAVE ONE FACTORY APPLIED PRIMER COAT, TOUCHED UP, AND THEN SHALL HAVE TWO FIELD COATS APPLIED OF DARK GREEN WEATHER-RESISTING ENAMEL, CONFORMING TO THE SPECIFICATIONS OF THE CITY OF CLEVELAND, DIVISION OF LIGHT AND POWER. FINISH FIELD COATS SHALL BE APPLIED AFTER ERECTION. THE FIRST FIELD COAT SHALL BE TINTED.

CONDUIT IN PARAPETS OF BRIDGES AND IN RETAINING WALLS SHALL BE OF ASBESTOS CEMENT CONFORMING TO SUPPLEMENTAL SPECIFICATION NO. M-206.14 OR FIBER EQUIVALENT TO ORANGEBURG NOCRETE. THE CONDUITS SHALL BE 2-INCH INSIDE DIAMETER AND SHALL BE PLACED AS SHOWN ON BRIDGE DECK AND RETAINING WALL PLANS AND DETAILS.

THE JUNCTION BOX AT EACH ROADWAY LIGHTING UNIT ON BRIDGES AND RETAINING WALLS FOR BRANCHES TO LIGHTS FROM THE 2-INCH LONGITUDINAL CONDUIT RUNS SHALL BE WATER-TIGHT AND MOUNTED IN PARAPETS, CURBS AND WALLS WHERE INDICATED. SEE SHEETS 176 AND 177 FOR METHODS OF MOUNTING. BOXES SHALL BE GALVANIZED WELDED PLATE OR CAST IRON AND SIMILAR TO O. Z. TYPE YU, CAT. NO. 241010.

RIGID METAL CONDUIT FOR UNDERDECK LIGHTS SHALL BE 3/4-INCH, 2-INCH OR 4-INCH AS INDICATED, AND NATIONAL "SHERARDUCT" OR AN APPROVED EQUAL.

JUNCTION BOXES FOR UNDERDECK LIGHTING BRANCH CIRCUITS AND FOR EACH UNDERDECK LIGHTING UNIT SHALL BE CAST IRON, WATER-TIGHT AND EQUAL TO O. Z. TYPE YH, CAT. NO. 080804. AND 060603, RESPECTIVELY.

ALL LUMINAIRES, TRANSFORMERS, CIRCUIT CONDUCTORS, AND POLE AND BRACKET CONDUCTORS SHALL CONFORM TO THE SPECIFICATIONS SHOWN ON SHEET 48 OF THE PLANS.

CONSTRUCTION METHODS

THE INSTALLATION AS A WHOLE SHALL BE CARRIED OUT IN CONFORMANCE WITH THE REQUIREMENTS HEREIN STATED AND IMPLIED, AND UPON COMPLETION OF THE WORK SHALL PRESENT A NEAT AND WORKMANLIKE FINISHED APPEARANCE. SAFE CONSTRUCTION AND OPERATING PRACTICES MEETING THE REQUIREMENTS OF THE NATIONAL ELECTRIC SAFETY CODE SHALL BE MAINTAINED.

POLES SHALL BE CAREFULLY SET. THEY SHALL BE RAKED AS SHOWN ON SHEET 176 THE CAREFUL ALIGNING AND GRADING OF POLES IS CONSIDERED TO BE AN ESSENTIAL FEATURE OF THE INSTALLATION. THE WORK SHALL BE AS NEARLY PERFECT AS PRACTICABLE AND NO PERCEPTIBLE TOLERANCES WILL BE PERMITTED. IN ORDER TO ACCOMPLISH THE DESIRED PERFECTION OF ALIGNMENT OF THE LUMINAIRES THE POLES SHALL BE CAREFULLY ALIGNED BY THE USE OF SHIMS AS REQUIRED.

CONDUITS SHALL BE FIRMLY CLAMPED TO THE STRUCTURES TO PREVENT RATTLING, SHALL BE RUN IN LINES PARALLEL AND PERPENDICULAR TO LINES OF STRUCTURE AND SHALL BE SO PLACED THAT DIRT WILL NOT ACCUMULATE AROUND THEM. SUPPORTS SHALL BE AT NOT MORE THAN 6-FOOT CENTERS. THERE SHALL BE AT LEAST ONE INCH CLEARANCE BETWEEN CONDUITS. IF ON A HORIZONTAL SURFACE FOR OVER ONE FOOT, THEY SHALL CLEAR THE SURFACE BY AT LEAST THREE INCHES. ADEQUATE APPROVED PROVISION FOR THE MOVEMENT OF CONDUITS SHALL BE MADE WHEREVER CONDUITS CROSS EXPANSION OR FIXED JOINTS IN THE SUPPORTING STRUCTURES. FOR CONDUIT IN PARAPETS OF BRIDGES AND IN RETAINING WALLS, ONE FACTORY EXPANSION COUPLING WITH RUBBER RING SHALL BE USED AT ALL EXPANSION JOINTS, INCLUDING PARAPET JOINTS. RIGID CONDUIT ACROSS EXPANSION JOINTS, WHERE USED, SHALL HAVE AN EXPANSION COUPLING SIMILAR TO O. Z. TYPE "EX" OR "AX" AS REQUIRED, COMPLETE WITH BONDING JUMPER, OR BE IN FLEXIBLE COUPLINGS EQUAL TO GROUSE-HINDS TYPE "EC".

ELECTRICAL GROUNDS

FOR BRIDGES NOS. 3, 4, 8, 9, 10 AND 11 ALL PARTS OF THE SUPERSTRUCTURE STEELWORK AND THE CONDUIT AND EQUIPMENT FOR THE LIGHTING SYSTEM SHALL BE THOROUGHLY GROUNDED AT TWO PIER COLUMNS.

FOR BRIDGE NO. 3 A SOLID NO. 0 BARE COPPER WIRE ELECTRICAL GROUND SHALL BE EMBEDDED IN AN OUTSIDE COLUMN OF THE FIXED PIERS, AS NOTED ON SHEETS 101 AND 102. THE LOWER ENDS OF THE WIRES SHALL BE BRAZED TO THE STEEL SHELL OF ONE OF THE C.I.P. REINFORCED CONCRETE PILES AND THE UPPER ENDS SHALL EXTEND SUFFICIENTLY ABOVE THE TOP OF CONCRETE TO PROVIDE FOR A SUITABLE SPLICE AND EXTENSION FOR CONNECTION TO THE SUPERSTRUCTURE. FOR BRIDGE NOS. 4, 8, 9, 10 AND 11, SEE NOTE ON SHEET NO. 91A-6.

SEE SHEET 171 FOR LOCATIONS. THE GIRDERS OR BEAMS SHALL BE GROUNDED BY A NO. 6 COPPER WIRE BOLTED OR BRAZED TO THE BOTTOM FLANGE AND TO THE BOTTOM PORTION OF THE SHOE AND CARRIED TO CONNECTION WITH THE GROUND WIRE EXTENDING TO THE FOUNDATION PILE. CONDUIT AND EQUIPMENT SECURELY ATTACHED TO THE SUPERSTRUCTURE STEELWORK REQUIRES NO FURTHER GROUNDING.

FOR OTHER DESCRIPTIVE NOTES OF THE LIGHTING SYSTEM SEE SHEETS 48 AND 176.

PAYMENT FOR ROADWAY AND UNDERDECK LIGHTING

PAYMENT FOR ITEMS OF ROADWAY AND UNDERDECK LIGHTING ON STRUCTURES SHALL BE MADE AT THE CONTRACT UNIT PRICE BID FOR THE FOLLOWING ITEMS. PAYMENT SHALL CONSTITUTE FULL COMPENSATION FOR FURNISHING ALL MATERIALS, LABOR, EQUIPMENT, TOOLS AND INCIDENTALS NECESSARY, WHETHER SPECIFICALLY MENTIONED OR NOT, TO COMPLETE THE ENTIRE WORK, INSTALLED, ACCEPTED, AND IN OPERATING CONDITION, ACCORDING TO THE PLANS AND SPECIFICATIONS. PAYMENT WILL BE MADE AS FOLLOWS:

A. "LIGHT STANDARD ON STRUCTURE, 10-FOOT BRACKET", PER EACH, AS PER PLAN, AND SHALL INCLUDE POLE FOR 28-FOOT MOUNTING HEIGHT, BRACKET ATTACHMENTS, 10-FOOT STEEL BRACKET, SHIM, ANCHOR BOLTS, HANDHOLE, ANCHOR BASE, LEAF COVERS, PAINTING, END KNOB WITH PLUMBIZER AND PIPE NIPPLE, SINGLE CONDUCTOR NO. 8 AWG, 600 VOLT POLE AND BRACKET CABLE, ALL CONNECTIONS AND SPLICING, 2-INCH RIGID GALVANIZED ELBOW, SCREWS, BOLTS, NUTS, WASHERS, AND ALL MODIFICATIONS AND INCIDENTALS REQUIRED.

B. "SERVICE PANEL," PER EACH AND SHALL INCLUDE 32-INCH BY 12-INCH BY 10-INCH STEEL JUNCTION BOX, SAFETY SWITCH, CONTACTOR, PHOTO-CELL CONTROL UNIT, MOUNTINGS, ALL INTERCONNECTING CONDUITS, ALL EXTRA WIRING AND CABLE NOT SPECIFICALLY CALLED FOR, ALL CONNECTIONS, TERMINALS, SPLICES, FLEXIBLE CONDUITS, CONDUIT ADAPTERS, LOCKNUTS, INSULATING BUSHINGS, MOUNTING BOLTS, NUTS, WASHERS AND SPACERS.

C. "PARAPET JUNCTION BOX", PER EACH AND SHALL INCLUDE 24-INCH BY 10-INCH BY 10-INCH GALVANIZED WELDED PLATE OR CAST IRON JUNCTION BOX, COVER, GASKET, MODIFICATIONS, THREADED BOSSES, DRAIN HOLE, DRAIN PIPE, CONDUIT CONNECTIONS, LOCKNUTS, BUSHINGS AND GROUT.

D. "JUNCTION BOX", PER EACH AND SHALL INCLUDE 8-INCH BY 8-INCH BY 4-INCH JUNCTION BOX, COVER, GASKET, ATTACHMENTS, FITTINGS, FASTENINGS, CONDUIT CONNECTIONS, AND A SEPARATELY ENCLOSED CIRCUIT BREAKER.

E. "TWO-INCH CONDUIT," PER LINEAL FOOT AND SHALL INCLUDE HANGERS, COUPLINGS, EXPANSION FITTINGS, ATTACHMENTS, BUSHINGS, ADAPTERS, LOCKNUTS, CONDITIONING DUCTS, NO. 9 AWG GALVANIZED IRON PULL-IN WIRE, AND FASTENINGS.

F. "FOUR-INCH RIGID GALVANIZED CONDUIT," PER LINEAL FOOT AND SHALL INCLUDE REAMING, THREADING, COUPLINGS, FITTINGS, FASTENINGS, ATTACHMENTS, LOCKNUTS, BUSHINGS, EXPANSION COUPLINGS, CONDULETS, RIGID TO NON-METALLIC ADAPTERS, AND JUMPERS.

G. "TWO-INCH RIGID, GALVANIZED CONDUIT," PER LINEAL FOOT AND SHALL INCLUDE COUPLINGS, FITTINGS, FASTENINGS, ATTACHMENTS, LOCKNUTS, INSULATING BUSHINGS, AND ALL FEATURES REQUIRED FOR "4-INCH RIGID GALVANIZED CONDUIT," ITEM F.

H. "THREE-QUARTER-INCH RIGID GALVANIZED CONDUIT," PER LINEAL FOOT AND SHALL INCLUDE ALL FEATURES AND ITEMS SPECIFIED FOR "TWO-INCH RIGID GALVANIZED CONDUIT," ITEM H, EXCEPT FOR 3/4-INCH CONDUIT IN LIEU OF 2-INCH, AND SHALL INCLUDE ALL NO. 12 AWG BRANCH CIRCUIT WIRING.

I. "ONE-WAY DUCT, FOUR-INCH," PER LINEAL FOOT AND SHALL INCLUDE FORMS FOR CONCRETE, CONCRETE, END BELLS, PLUGGING DUCTS, CONDITIONING DUCTS, JOINT FILLER, NO. 9 AWG GALVANIZED IRON PULL-IN WIRE, AND SEALING AROUND DUCTS WHERE THEY ENTER MANHOLES OR VAULTS.

J. "ELECTRICAL GROUNDS," PER EACH AND SHALL INCLUDE NO. 0 BARE GROUND IN PIER BRAZED TO PILE AT LOWER END, NO. 6 GROUND TO GIRDER OR BEAM, AND CONNECTIONS, AS REQUIRED.

ALL LUMINAIRES, FLUORESCENT UNDERDECK LIGHTS AND LIGHTING CABLE ARE INCLUDED FOR PAYMENT WITH LIGHTING UNDER ROADWAY PLANS. SEE SHEET 48.

Cross References are to sheets in Part 7-A

*CONSTRUCTION UNDER OTHER CONTRACTS:
Reference to work under other contracts (previous or future) shall be considered void.*

PART 7-A

HOWARD, NEEDLES, TAMMEN & BERGENDOFF CONSULTING ENGINEERS KANSAS CITY CLEVELAND NEW YORK		
GENERAL NOTES		
WILLOW-INNER BELT FREEWAY		
CLEVELAND	CUYAHOGA COUNTY	OHIO
DRAWN H.A.M.	TRACED	CHECKED
DATE 10-8-59	DATE	DATE 11-10-59
REVIEWED	DATE 11-10-59	REVISION
		SHEET 98A

MICROFILMED
JUL 9 1985

CUYAHOGA COUNTY
CITY OF CLEVELAND
CUY-21-15.32
CUY-42-18.42

ITEM	DESCRIPTION	UNIT	ESTIMATED QUANTITIES																							
			BRIDGE NO. 3 I-71-5(8)248						BRIDGE NO. 4 I-71-5(8)248						BRIDGE NO. 5 I-71-5(8)248						BRIDGE NO. 8 I-71-5(8)248					
			ABUT- MENTS	PIERS	SUPER- STRUCTURE	GENERAL	TOTAL	ABUT- MENTS	RETAINING WALL	SUPER- STRUCTURE	GENERAL	TOTAL	AS BUILT	ABUT- MENTS	PIERS	SUPER- STRUCTURE	GENERAL	TOTAL	AS BUILT	ABUT- MENTS	SUPER- STRUCTURE	GENERAL	TOTAL	AS BUILT		
E-2	Cofferdams, Cribbs & Sheeting	Lump Sum					Lump Sum	Lump Sum																		
E-2	Excavation for Structures (Unclassified)	Cu. Yd.	620	680				1300																		
S-1	Class "C" Concrete, Superstructure	Cu. Yd.			965			965			1605				1605	CO-21 -1570	39			195						
S-1	Class "C" Concrete, Pier Columns & Cap	Cu. Yd.		225				225											75							
S-1	Class "C" Concrete, Walls	Cu. Yd.									210				210											
S-1	Class "C" Concrete, Abutments & Walls	Cu. Yd.	15					15			70				70											
S-1	Class "E" Concrete, Stub Abutments (above footings)	Cu. Yd.	300					300			310				310				110						185	
S-1	Class "E" Concrete, Footings	Cu. Yd.	182	223				405			255	235			490				90	80					170	
S-3	Waterproofing, Premolded Sealing Strip	Lin. Ft.	80					80			63	92			155	CO-15 -11	144			15					10	
S-4	Reinforcing Steel	Lbs.	33,425	93,475	272,500			399,400			44,984	37,476	454,440			536,900				14,293	20,463	52,444		87,400		
S-7	Structural Steel	Lbs.			1,174,000			1,174,000					1,454,000			1,454,000						147,000		147,000		
S-8	Field Painting of Structural Steel (3 Coats)	Lbs.			1,174,000			1,174,000					1,454,000			1,454,000						147,000		147,000		
S-9	1" Gray Rubber Preformed Expansion Joint Filler	Sq. Ft.	95					95			95	70			165										75	
S-14	Aluminum Railing (Including Parapet)	Lin. Ft.	92		612			704			133		1136			1269				59		241		300		
S-14	Guard Rail, Steel Beam Barrier Type (Deep)	Lin. Ft.			305			305					303			303										
S-16	First Test Pile (12" or 14" C.I.P.)	Lump Sum						Lump Sum								Lump Sum										
S-17	First Pile Test Load	Lump Sum						Lump Sum								Lump Sum										
S-17	Subsequent Pile Test Load	Ea.						1								1										
S-18	12" C.I.P. Reinforced Concrete Piles	Lin. Ft.	3890					3890			4230	2460			6690	CO-15 -339	7029			1190					2740	
S-18	14" C.I.P. Reinforced Concrete Piles	Lin. Ft.		5400				5400												2210					2135	
S-25	Electrical Grounds	Ea.					2	2																		
S-25	Light Standard on Structure, 10-Foot Bracket	Ea.			6			6			2	11			13										4	
S-25	Parapet Junction Box (24" x 10" x 10")	Ea.			6			6			2	15			17										4	
S-25	2" Conduit	Lin. Ft.	103		612			715			110	215	1025			1350				27		128		155		
S-25	10,000 Lumen Luminaire & Insulating Transformer	Ea.											5		5											
S-25	15,000 Lumen Luminaire & Insulating Transformer	Ea.											8		8										4	
S-25	Fluorescent Underdeck Light	Ea.											8		8										4	
S-25	Service Panel	Ea.			1			1					1		1											
S-25	Junction Box (8" x 4" x 4")	Ea.			2			2					3		3										1	
S-25	3/4" Rigid Galvanized Conduit	Lin. Ft.			175			175					695		695										270	
S-25	2" Rigid Galvanized Conduit	Lin. Ft.			65			65					165	+80	165										45	
S-25	4" Rigid Galvanized Conduit	Lin. Ft.		45				45																	45	
S-25	1-Way Duct, 4 inch	Lin. Ft.					20	20																		
S-29	Porous Backfill	Cu. Yd.	140					140			170	205			375										40	
S-29	6" W.I. or Galvan. Steel Pipe, incl. Fastenings & Specials	Lin. Ft.		60				60							37										40	
S-29	8" W.I. or Galvan. Steel Pipe, incl. Fastenings & Specials	Lin. Ft.													100										75	
I-10	Crushed Aggregate Slope Protection Sec. I-10.04	Sq. Yd.					3180	3180																	775	
I-10	Crushed Aggregate Slope Protection (No. 4 or 4 1/2 Stone or Slag)	Sq. Yd.																							775	
I-10	Concrete Slope Protection Sec. I-10.05	Sq. Yd.											1645		1645										450	
I-10	Concrete Slope Protection (4")	Sq. Yd.											1670		1670										450	
I-14	Type I - Modified Paved Gutter	Lin. Ft.											155		155											

- NOTES:
- Pile Test Loads shall be performed only if required by the Engineer.
 - ① North Wingwall, West Abutment.
 - ② North Wingwall and adjoining section of abutment as per plan, East Abutment.
 - ③ Includes Bridge No. 5
 - ④ Includes entire East Abutment common to Bridges No. 8 & 9.
 - ⑤ At Pier 2, Bridge No. 4.
 - ⑥ At Piers 2 & 3, Bridge No. 4.
 - ⑦ Included in the 165' total.

- + 100% City Participation
- ≠ 100% City Participation. Included with quantities under Roadway Plans. See sheet 12-7A
- ⑧ FIRST TEST PILE: Payment will be made for only one first test pile. It may be driven for either H.N.T.B. Bridge No. 3 or H.N.T.B. Bridge No. 5.
- ⑨ For additional quantities see sheet 92A-Part 6

H.N.T.B. BR. NO.	STATE BR. NO.
3	CUY-42-1843
4	CUY-42-1854
5	Ramp E-10 over Ramp E-8
8	CUY-21-1573 A

PART 7A

HOWARD, NEEDLES, TAMMEN & BERGENDOFF
CONSULTING ENGINEERS
KANSAS CITY CLEVELAND NEW YORK

ESTIMATED QUANTITIES
BR. NOS. 3, 4, 5 & 8

WILLOW-INNER BELT FREEWAY
CLEVELAND CUYAHOGA COUNTY OHIO

DRAWN DATE 1/14/59	TRACED DATE 11-6-59	CHECKED DATE 11-9-59	REVIEWED DATE 11-13-59	REVISION
D.R.K.	A.E.K.	J.C.T.		

SHEET 99

MICROFILMED
JUL 3 1965

CUYAHOGA COUNTY
CITY OF CLEVELAND
CUY-21-15.32
CUY-42-18.42

ESTIMATED QUANTITIES																			
ITEM	DESCRIPTION	UNIT	BRIDGE NO. 9 I-71-5(0)248					BRIDGE NO. 10 I-71-5(0)248					BRIDGE NO. 11 I-71-5(1)162					SIGN BRIDGE AT STA. 74+25	
			ABUT- MENTS	SUPER- STRUCTURE	GEN- ERAL	TOTAL	AS BUILT	ABUT- MENTS	SUPER- STRUCTURE	GEN- ERAL	TOTAL	AS BUILT	ABUT- MENTS	SUPER- STRUCTURE	GEN- ERAL	TOTAL	AS BUILT	TOTAL	
Special	Sign Bridge, as per Plan	Lump Sum																Lump Sum	
E-2	Excavation for Structures (Unclassified)	Cu. Yd.	110			110				480			480				850		850
S-1	Class "C" Concrete, Superstructure	Cu. Yd.		190		190	⁰⁰¹⁴ ₋₁₈₇	3			735			735			755	⁰⁰¹⁴ ₋₁₅₄	1
S-1	Class "C" Concrete, Abutments and Walls	Cu. Yd.														20 ⁰	755	⁰⁰¹⁴ ₋₁₅	15
S-1	Class "E" Concrete, Stub Abutments (above Footings)	Cu. Yd.	45			45				190			190	⁰⁰¹⁵ ₊₁₁	201	365		365	
S-1	Class "E" Concrete, Footings	Cu. Yd.	35			35				160			160			300		300	
S-3	Waterproofing, Premolded Sealing Strip	Lin. Ft.								50			50	⁰⁰¹⁵ ₊₆	50	90		90	
S-4	Reinforcing Steel	Lbs.	4,981	4,819		54,800				25,000	200,400		225,400			41,070	194,830	235,900	
S-7	Structural Steel	Lbs.		133,500		133,500					839,000		839,000				855,000	⁰⁰⁸ _{+24,621}	879,621
S-8	Field Painting of Structural Steel (3 Coats)	Lbs.		133,500		133,500					839,000		839,000				855,000	⁰⁰⁸ _{+24,621}	879,621
S-9	1" Gray Rubber Preformed Expansion Joint Filler	Sq. Ft.								80			80			95		95	
S-14	Aluminum Railing (Including Parapet)	Lin. Ft.	26	334		360				54	413		467			65	419	484	
S-14	Guard Rail, Steel Beam Barrier Type (Deep)	Lin. Ft.									207		207				208		208
S-16	12" C.I.P. Reinforced Concrete Piles	Lin. Ft.	490			490	⁰⁰¹⁴ ₋₈₁	409		2920			2920			6050		⁰⁰¹¹ ₋₁₈₁	5869
S-25	Light Standard on Structure, 10-foot Bracket	Ea.		2		2					4		4			1	4	5	
S-25	Parapet Junction Box (24" x 10" x 10")	Ea.		2		2					4		4			1	4	5	
S-25	2" Conduit	Lin. Ft.	15	170		185				60	415		475			70	415	485	
S-25	10,000 Lumen Luminaire & Insulating Transformer	Ea.			2	2													
S-25	15,000 Lumen Luminaire & Insulating Transformer	Ea.									4		4				5		
S-25	Fluorescent Underdeck Light	Ea.			2	2					4		4				2		
S-25	Service Panel	Ea.		1		1					1		1				1		
S-25	3/4" Rigid Galvanized Conduit	Lin. Ft.		125		125					235		235				220	⁰⁰¹⁴ ₋₇	113
S-25	1-Way Duct, 4 inch	Lin. Ft.			50	50	⁰⁰³⁰ ₊₁₇	69											
S-29	Porous Backfill	Cu. Yd.	12			12				80			80	⁰⁰¹⁴ ₊₁₁	91	180		180	
S-29	6" W.I. or Galvanized Steel Pipe incl. Fastenings & Specials	Lin. Ft.									16 ⁰		16						
I-10	Crushed Aggregate Slope Protection, Sec. I-10.04	Sq. Yd.			345	345	⁰⁰¹⁴ ₋₃₉	306									1375		1375
I-10	Crushed Aggregate Slope Protection (No. 4 or 4 1/2 Stone or Slag)	Sq. Yd.			145	145	⁰⁰¹⁴ ₋₂₇	118									580		580
I-10	Concrete Slope Protection, Sec. I-10.05	Sq. Yd.									910		910	⁰⁰¹⁵ ₊₂₄	994				
I-10	Concrete Slope Protection (4")	Sq. Yd.									855		855						

NOTES:
 Pile Test Loads shall be performed only if required by the Engineer.
 ① Southwest and Northeast Wingwalls.
 ② West Abutment only.
 ③ At Pier 2, Bridge No. 10.
 ④ For additional quantities see sheet 92A-Part 6

+ 100% City Participation
 ≠ 100% City Participation. Included with quantities under Roadway Plans.
 See sheet 12-7A

H.N.T.B. BR. NO. STATE BR. NO.
 9 CUY-21-1573 B
 10 CUY-21-1559
 11 CUY-21-1544

PART 7A

HOWARD, NEEDLES, TAMMEN & BERGENDOFF
 CONSULTING ENGINEERS
 KANSAS CITY CLEVELAND NEW YORK

ESTIMATED QUANTITIES

BR. NOS. 9, 10 & 11
 AND SIGN BRIDGE AT STA. 74+25
WILLOW-INNER BELT FREEWAY
 CLEVELAND CUYAHOGA COUNTY OHIO

DRAWN DATE 1-14-59	TRACED DATE 11-4-59	CHECKED DATE 11-9-59	REVIEWED DATE 11-13-59
-----------------------	------------------------	-------------------------	---------------------------

SHEET 99A

21-0



Q-16

CUY-90-16.37 CUY-77-15.62

FED. ROADS DIV. NO.	STATE	FED. AID PROJ. NO.	100 181
2	OHIO		


MICROFILMED
JUL 3 1985

CUYAHOGA COUNTY
CITY OF CLEVELAND
CUY-21-15.32
CUY-42-18.42

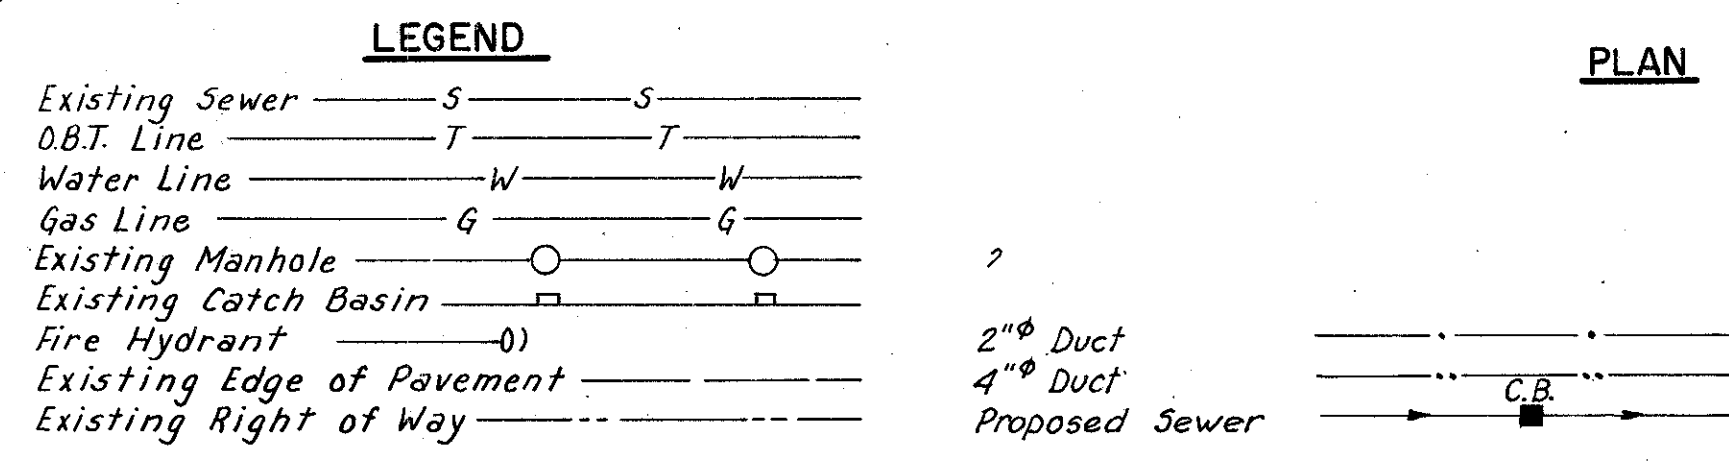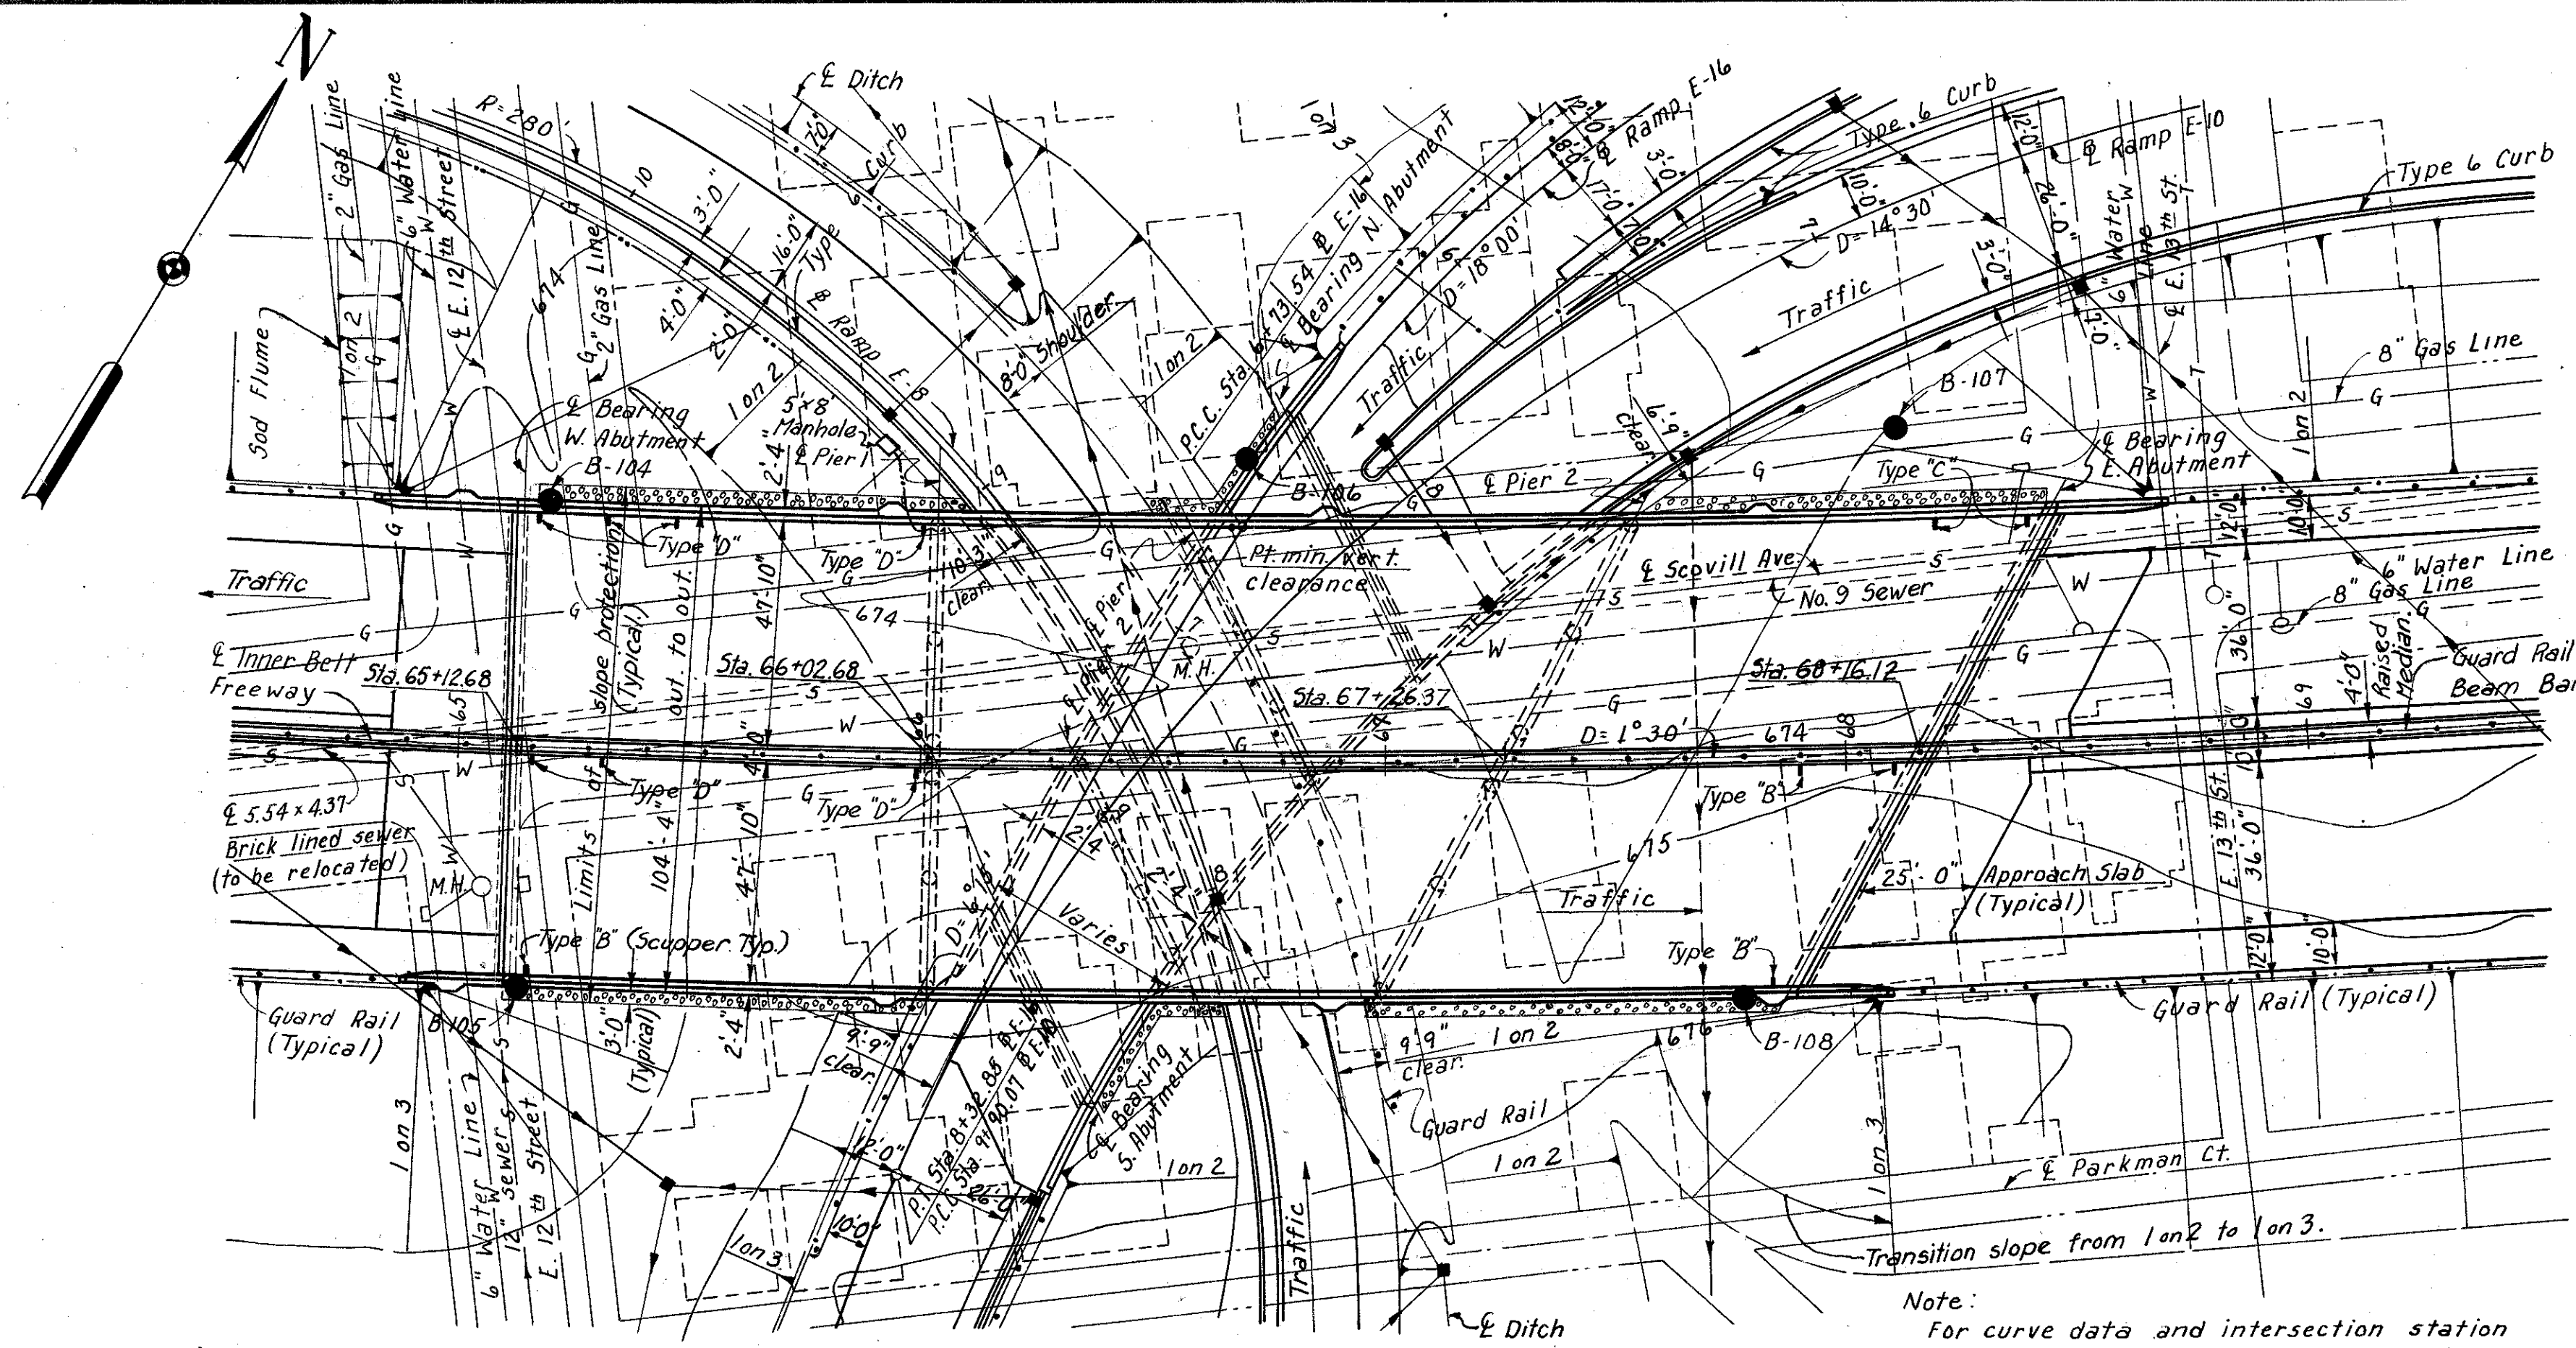

PLAN

Note:
For curve data and intersection station equations of Inner Belt Freeway and Ramps see Site Plan Bridge #5 sheet 137-7A

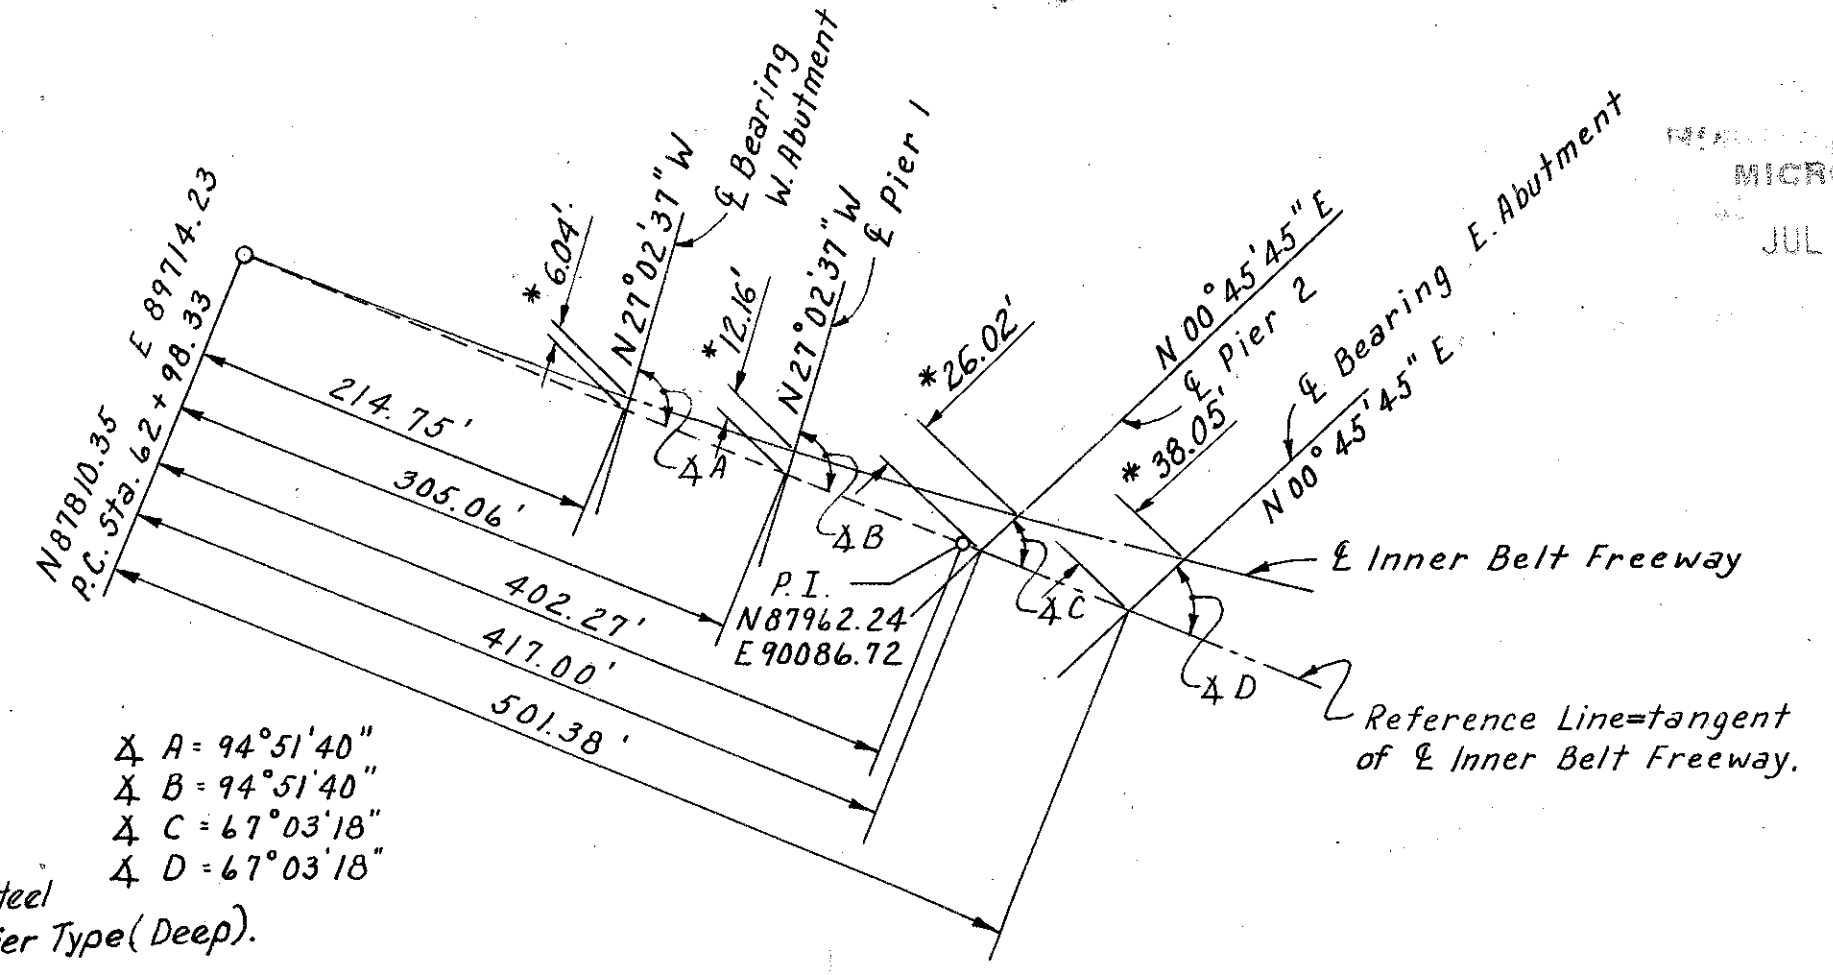

BRIDGE LAYOUT DIAGRAM
No Scale

* Offsets measured from reference line to E Inner Belt Freeway along E bearings.

Elev.	Soil Description
674.8	
13	
11	
32	Brown Silty Gravelly Sand
36	Brown Silty Sand
60	Brown Sand
38	
36	Brown Silty Sand
45	
58	
68	Gray Sandy Silt
28	
38	
38	
52	
15	
31	
68	Gray Silt
589.8	
584.8	Gray Sand

BORING B-106


Vertical Scale 1" = 20'
Sta. 66+70 65' Lt.

Note:
The figures to the left indicates the number of hammer blows required to drive the sample spoon 1 ft. They are given at 5' intervals starting at Elev. 674.8

NOTES:
Rod soundings only were taken at location B-104, B-105, B-107 and B-108. The core drilling made at B-106 is plotted.
For details of slope protection see sheet 174-7A
The following items are not included in the Bridge Plans. (See Roadway Plans for details.)
Removal of existing pavements, etc.
Relocation or removal of existing utilities.
Approach grading, pavement and slab.
Roadway guard rail.


PILE INFORMATION			
Location	Diameter	Number	Estimated ave. length
W. Abutment	12"	48	39'
E. Abutment	12"	51	40'
Pier 1	14"	56	27'
Pier 2	14"	60	65'

Pile lengths are based on boring data and are approximate only. The Contractor shall assume full responsibility for length of piling selected for driving.

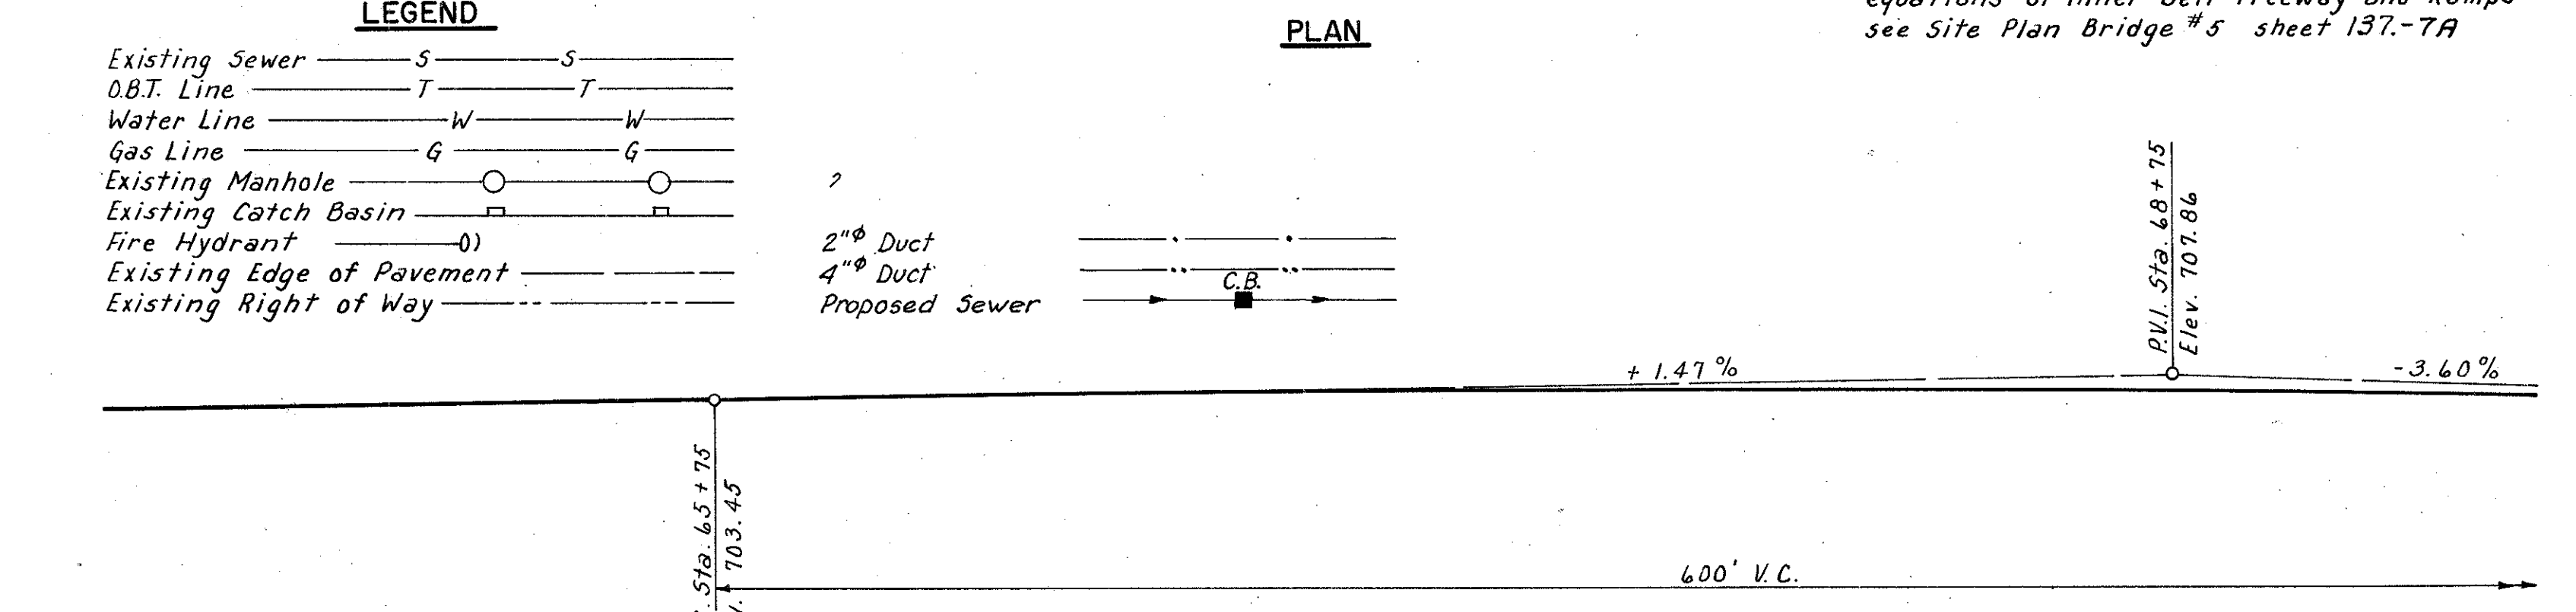

PROFILE

PROPOSED STRUCTURE
Type: Continuous welded steel girder with reinforced concrete deck and substructure
Spans: 90'-0", 123'-8 1/2" & 89'-9" (along E Inner Belt Fr'wy.)
Roadway: 102'-0" f/f parapets
Loading: CF 2000 - Adequate for A.A.S.H.O. alternate loading
Skew: Varies
Surface Course: 1" Monolithic Concrete.
Alignment: 1° 30' curve left.
Approach Slabs: AS-1-54 (25' Long)
Superelevation: .03' per ft.

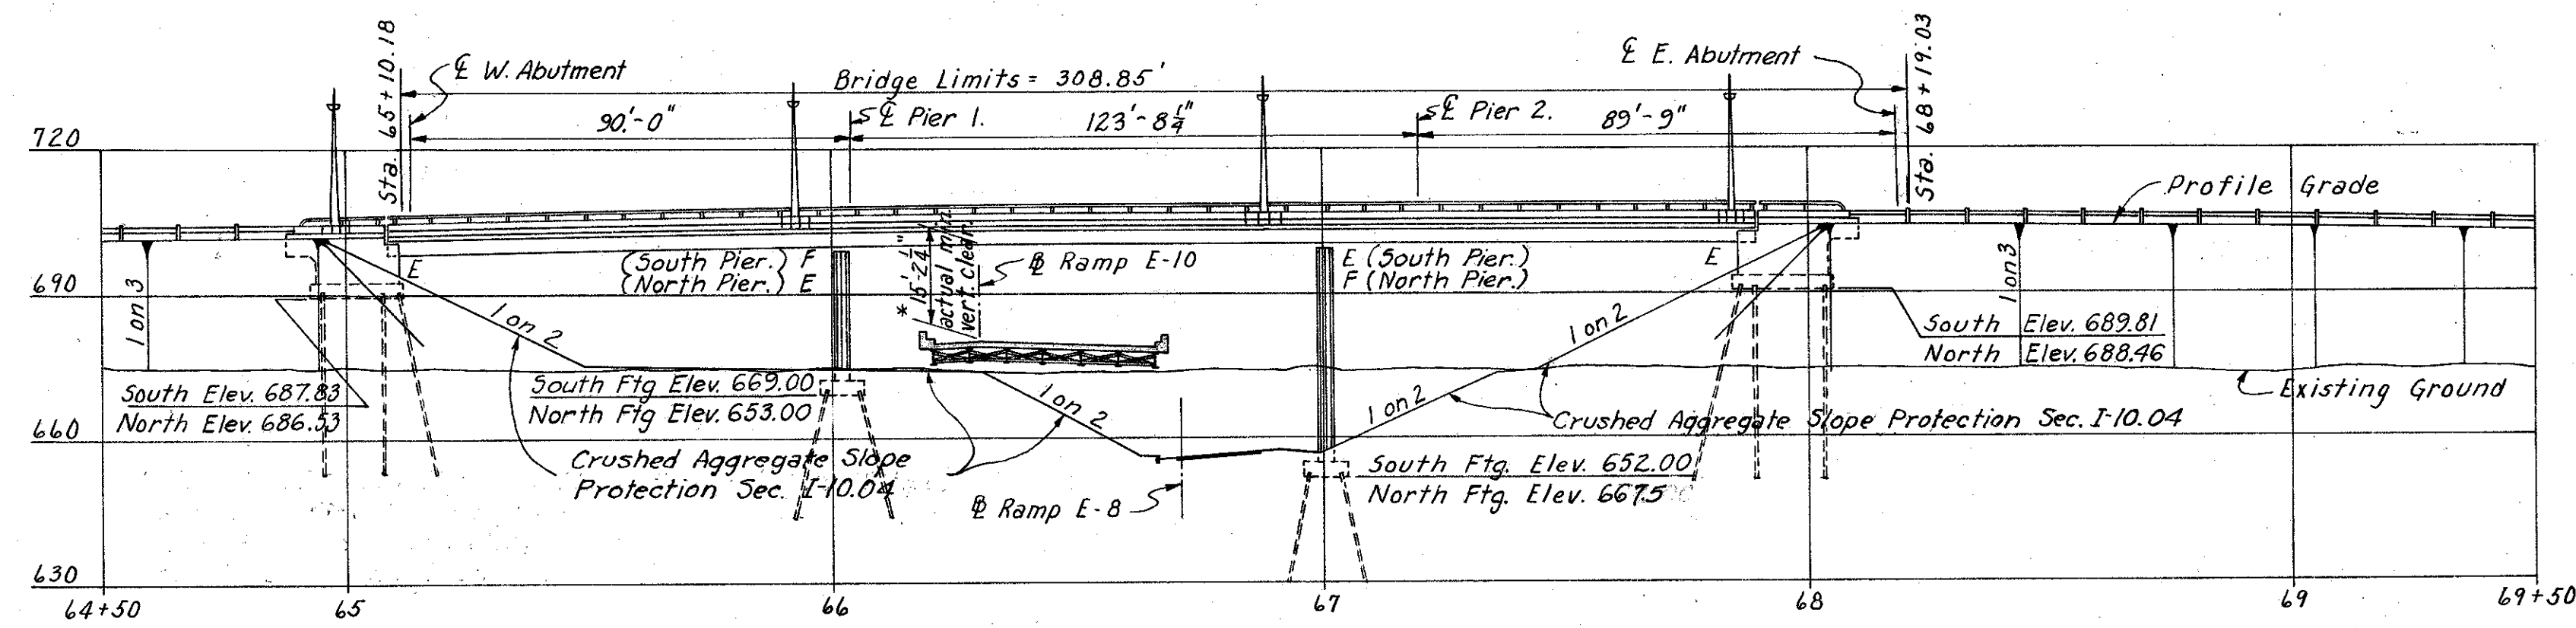

ELEVATION

Note: Elevations for pier footings are shown for exterior footing only. For other elevations see sheets 101-7A & 102-7A

* 15'-0" Required minimum vertical clearance.
Point of actual minimum vertical clearance occurs at North exterior girder and 2'-6" Rt. E Ramp E-16.

H.N.T.B. BR. NO. 3 PART 7A

HOWARD, NEEDLES, TAMMEN & BERGENDOFF
CONSULTING ENGINEERS
KANSAS CITY CLEVELAND NEW YORK

SITE PLAN
INNER BELT FREEWAY OVER
RAMPS E-8, E-10 AND E-16
BR. NO. CUY-42-1843 STA. 65+10.18
Scale: 1" = 30' STA. 68+19.03

WILLOW-INNER BELT FREEWAY
CLEVELAND CUYAHOGA COUNTY OHIO




DRAWN A.J.S. | TRACED A.E.K. | CHECKED D.M. | REVIEWED J.C.T. | REVISED
DATE 7-2-58 | DATE 8-20-58 | DATE 8-4-58 | DATE 11-13-57 | SHEET 100

Note: Special care shall be taken when placing reinforcing steel so as not to interfere with anchor bolt or anchor bar setting.

Holes for anchor bars noted as thus \odot are to be drilled before placing bottom angle of the cross frame.

JUL 3 1965

CUYAHOGA COUNTY
CITY OF CLEVELAND
CUY-21-15.32
CUY-42-18.42

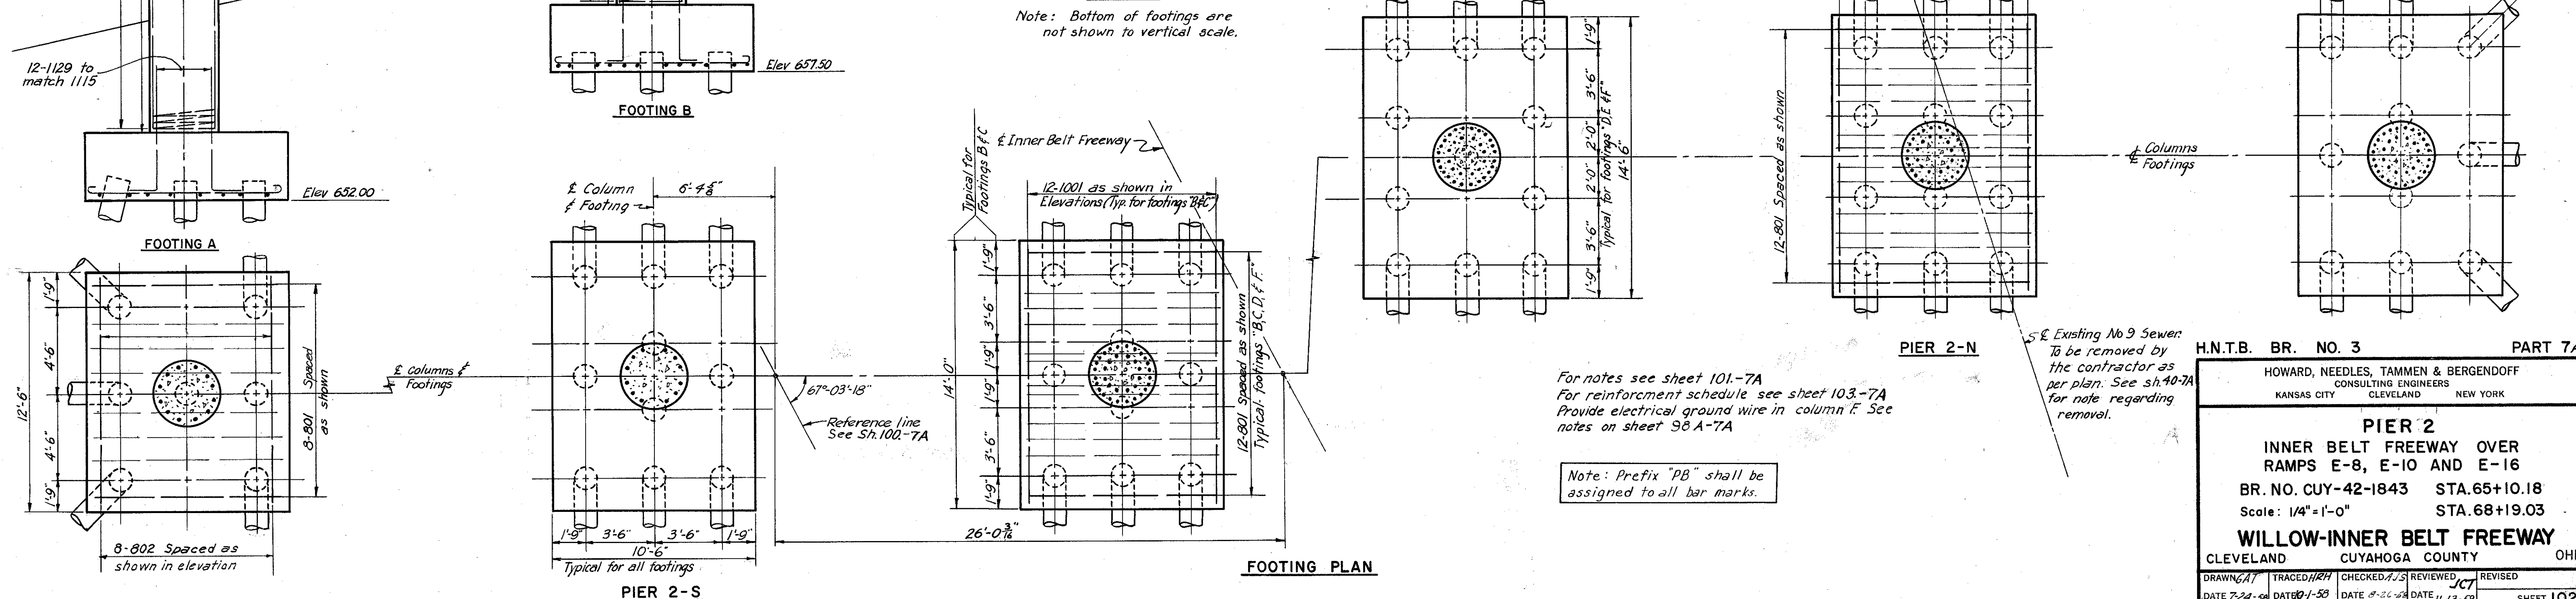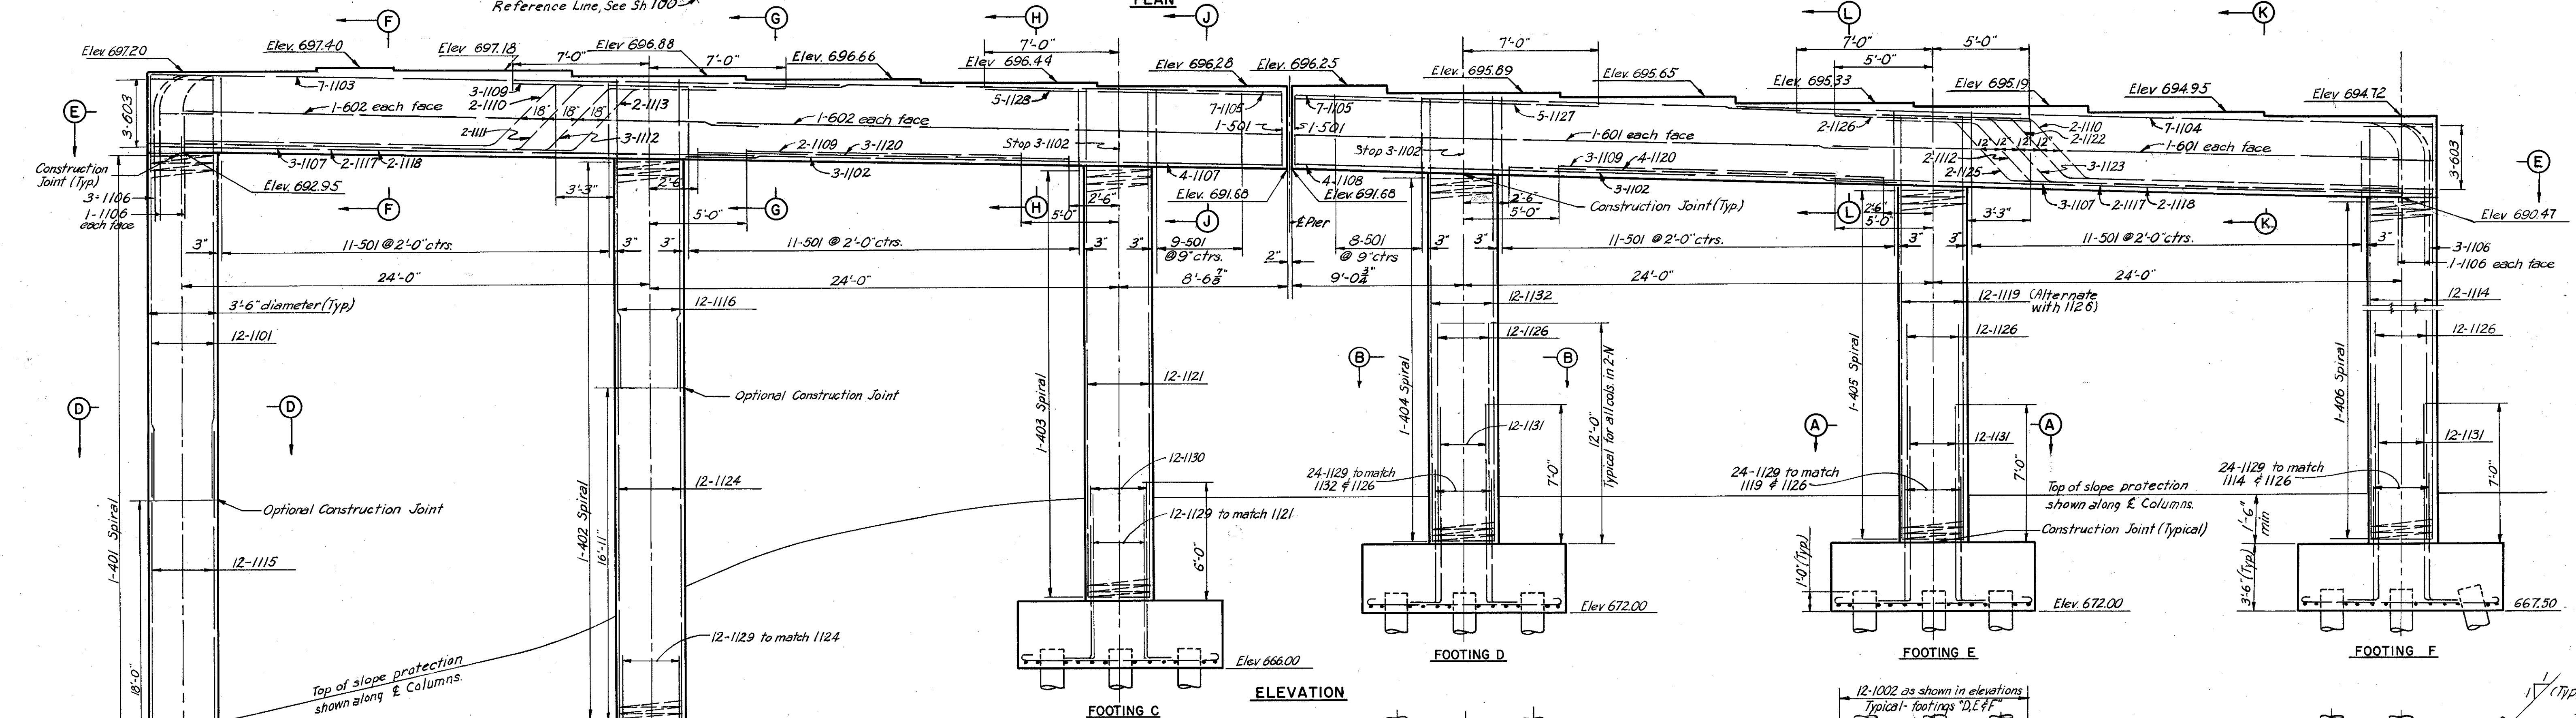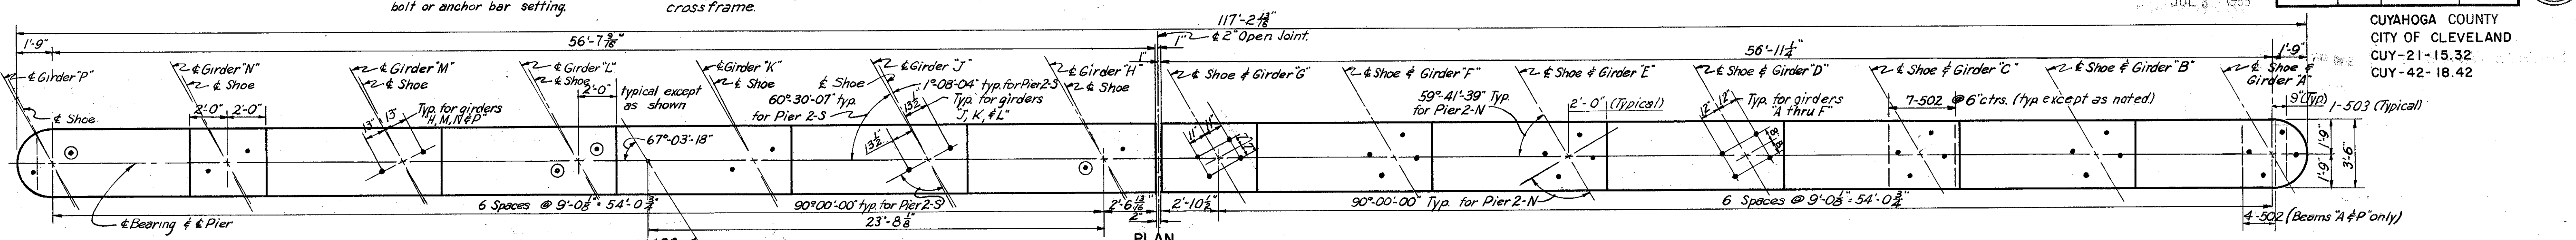

For notes see sheet 101-7A
For reinforcement schedule see sheet 103-7A
Provide electrical ground wire in column F. See notes on sheet 98A-7A.

Note: Prefix "PB" shall be assigned to all bar marks.

Existing No. 9 Sewer to be removed by the contractor as per plan. See sheet 40-7A for note regarding removal.

H.N.T.B. BR. NO. 3 PART 7A

HOWARD, NEEDLES, TAMMEN & BERGENDOFF
CONSULTING ENGINEERS
KANSAS CITY CLEVELAND NEW YORK

PIER 2
INNER BELT FREEWAY OVER
RAMPS E-8, E-10 AND E-16
BR. NO. CUY-42-1843 STA. 65+10.18
Scale: 1/4" = 1'-0" STA. 68+19.03

WILLOW-INNER BELT FREEWAY
CLEVELAND CUYAHOGA COUNTY OHIO

DRAWN BY TRACED BY CHECKED BY REVIEWED BY REVISIONS
DATE 7-24-65 DATE 8-26-65 DATE 11-13-59 SHEET 102

REINFORCEMENT SCHEDULES FOR PIER 1									
MARK	NO.	LENGTH	TYPE	DIMENSIONS				SERIES INCREMENT	WEIGHT (POUNDS)
				A	B	C	D		
501	92	5'-11"	105	3'-2"	1'-6"				568
502	50	13'-10"	109	3'-2"	3'-6"				721
503	2	5'-9"	105	3'-0"	1'-6"				12
601	8	25'-9"	5tr.						309
602	6	8'-10"	144	1'-11"	5'-0"				80
801	72	12'-10"	100	10'-2"					2467
802	10	14'-10"	100	12'-2"					396
1001	36	17'-10"	100	14'-2"					2763
1002	12	16'-4"	100	13'-8"					843
1101	14	17'-6"	5tr.						1302
1102	36	12'-0"	5tr.						2295
1103	14	14'-6"	123	5'-10"	5'-10"				1079
1104	14	37'-0"	5tr.						2752
1105	10	14'-0"	5tr.						744
1106	8	14'-6"	5tr.						616
1107	12	26'-6"	5tr.						1690
1108	6	19'-0"	5tr.						606
1109	4	17'-6"	5tr.						372
1110	4	27'-9"	5tr.						590
1111	6	28'-0"	5tr.						893
1112	2	29'-2"	118	11'-0"	14'-0"	3'-1"	3'-1"		310
1113	2	23'-2"	118	3'-6"	15'-6"	3'-1"	3'-1"		244
1114	3	24'-8"	118	3'-6"	17'-0"	3'-1"	3'-1"		393
1115	2	29'-2"	118	11'-6"	13'-8"	2'-10"	2'-10"		310
1116	2	29'-2"	118	10'-6"	14'-8"	2'-10"	2'-10"		310
1117	3	23'-2"	118	3'-6"	15'-8"	2'-10"	2'-10"		369
1118	12	23'-3"	5tr.						1729
1119	12	23'-0"	5tr.						1466
1120	12	25'-6"	5tr.						1626
1121	12	28'-6"	5tr.						1817
1122	12	16'-6"	5tr.						1052
1123	36	20'-3"	5tr.						3873
1124	36	11'-5"	104	10'-3"	1'-6"				2184
1125	108	7'-11"	104	6'-9"	1'-6"				4543
1126	2	19'-3"	5tr.						205
1127	2	24'-2"	118	3'-6"	16'-8"	2'-10"	2'-10"		257
								Total	41,788



SPIRAL REINFORCEMENT SCHEDULE						
MARK	NO.	CORE DIA. % SPIRAL	LENGTH	PITCH	NO. OF TURNS	WEIGHT (POUNDS)
401	1	3'-2"	19'-10"	4"	62	461
402	1	3'-2"	19'-4"	4"	61	454
403	1	3'-2"	21'-3"	4"	67	498
404	1	3'-2"	24'-10"	4"	78	580
405	1	3'-2"	29'-10"	4"	92	685
406	1	3'-2"	33'-3"	4"	103	767
					Total	3,445

NOTE:
All bar dimensions are given out to out.


REINFORCEMENT SCHEDULES FOR PIER 2									
MARK	NO.	LENGTH	TYPE	DIMENSIONS				SERIES INCREMENT	WEIGHT (POUNDS)
				A	B	C	D		
501	63	14'-7"	109	3'-2"	3'-11"				958
502	92	5'-11"	105	3'-2"	1'-6"				568
503	2	5'-9"	105	3'-0"	1'-6"				12
601	4	29'-6"	5tr.						177
602	4	29'-3"	5tr.						176
603	6	8'-10"	144	1'-11"	5'-0"				80
801	68	12'-2"	100	10'-0"					2209
802	8	14'-2"	100	12'-0"					303
1001	24	16'-4"	100	13'-6"					1487
1002	36	16'-10"	100	14'-0"					2608
1101	12	23'-6"	5tr.						1498
1102	6	22'-3"	5tr.						709
1103	7	35'-6"	5tr.						1320
1104	7	36'-0"	5tr.						1339
1105	14	26'-0"	5tr.						1934
1106	14	14'-6"	123	5'-10"	5'-10"				1079
1107	10	30'-9"	5tr.						1634
1108	4	31'-3"	5tr.						664
1109	8	14'-0"	5tr.						595
1110	4	32'-0"	118	12'-0"	15'-11"	3'-1"	3'-1"		680
1111	2	32'-5"	118	10'-6"	17'-7"	3'-4"	3'-4"		344
1112	5	26'-6"	118	3'-6"	18'-11"	3'-1"	3'-1"		704
1113	2	28'-0"	118	3'-6"	20'-5"	3'-1"	3'-1"		298
1114	12	23'-3"	5tr.						1482
1115	12	21'-3"	5tr.						1355
1116	12	18'-9"	5tr.						1195
1117	4	30'-3"	5tr.						643
1118	4	29'-0"	5tr.						616
1119	12	19'-3"	5tr.						1227
1120	7	19'-0"	5tr.						707
1121	12	26'-6"	5tr.						1690
1122	2	32'-0"	118	11'-0"	16'-11"	3'-1"	3'-1"		340
1123	3	32'-5"	118	10'-0"	17'-11"	3'-4"	3'-4"		517
1124	12	20'-3"	5tr.						1291
1125	2	27'-6"	118	3'-6"	19'-11"	3'-1"	3'-1"		292
1126	38	12'-0"	5tr.						2423
1127	5	16'-0"	5tr.						425
1128	5	15'-6"	5tr.						412
1129	108	8'-0"	104	6'-9"	1'-6"				4590
1130	12	10'-6"	104	9'-3"	1'-6"				669
1131	36	11'-6"	104	10'-3"	1'-6"				2200
1132	12	20'-0"	5tr.						1275
								Total	44,925

SPIRAL REINFORCEMENT SCHEDULE						
MARK	NO.	CORE DIA. % SPIRAL	LENGTH	PITCH	NO. OF TURNS	WEIGHT (POUNDS)
401	1	3'-2"	37'-5"	4"	115	859
402	1	3'-2"	31'-5"	4"	97	724
403	1	3'-2"	22'-5"	4"	70	522
404	1	3'-2"	16'-0"	4"	61	380
405	1	3'-2"	15'-6"	4"	49	365
406	1	3'-2"	19'-5"	4"	61	455
					Total	3,305

Note: Prefixes shall be assigned to bar marks as follows:
Pier 1 "PA"
Pier 2 "PB"

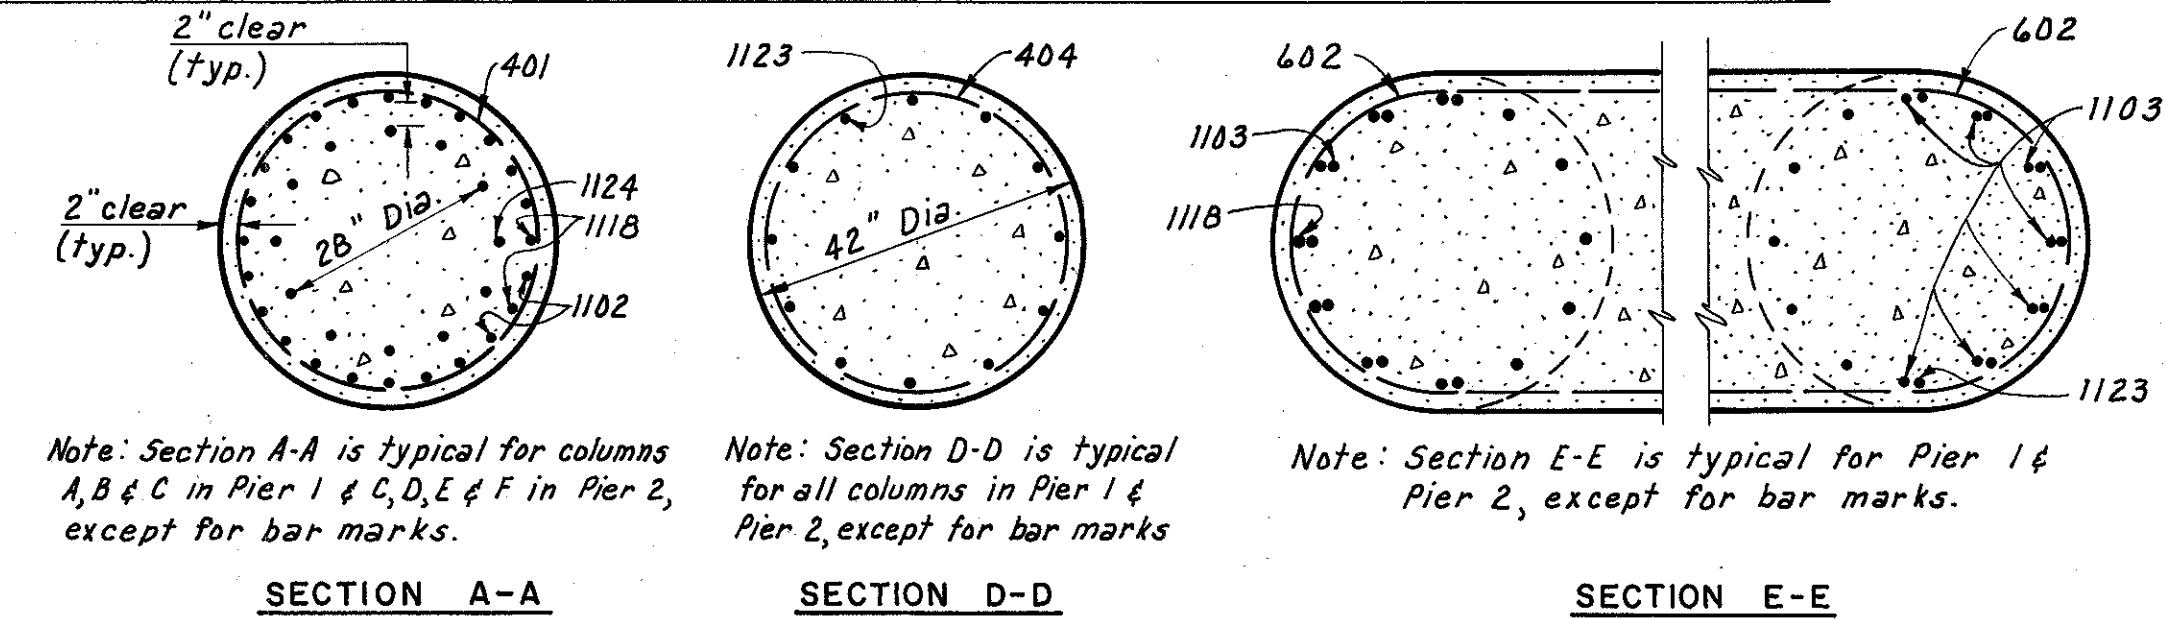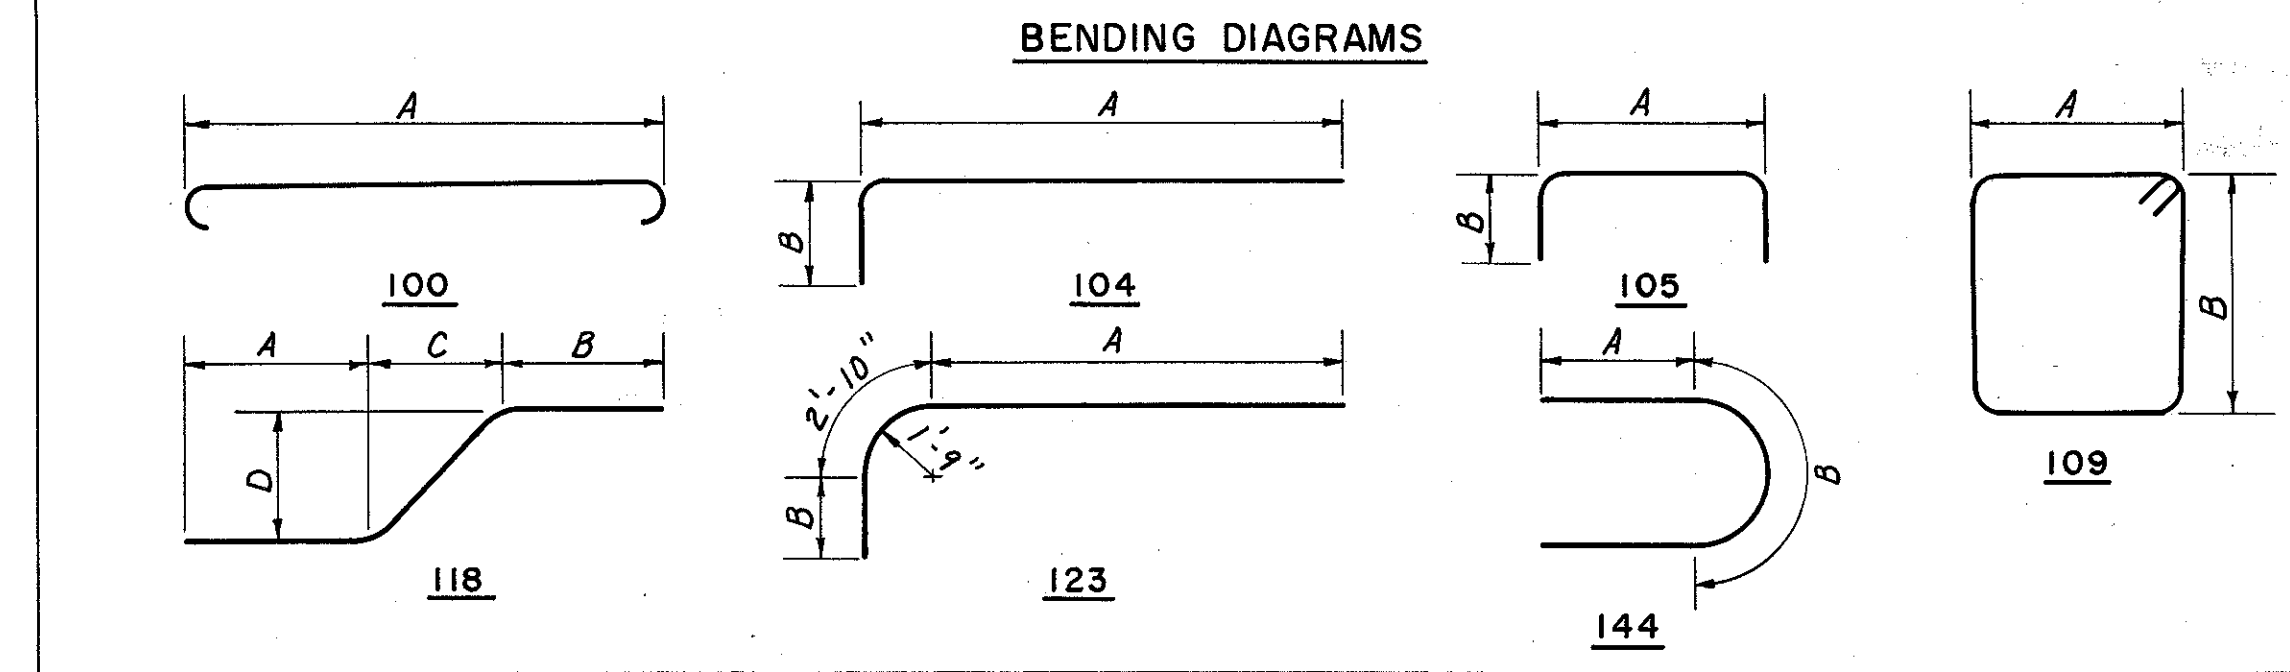

Note: Section A-A is typical for columns A, B & C in Pier 1 & C, D, E & F in Pier 2, except for bar marks.
Note: Section D-D is typical for all columns in Pier 1 & Pier 2, except for bar marks.
Note: Section E-E is typical for Pier 1 & Pier 2, except for bar marks.

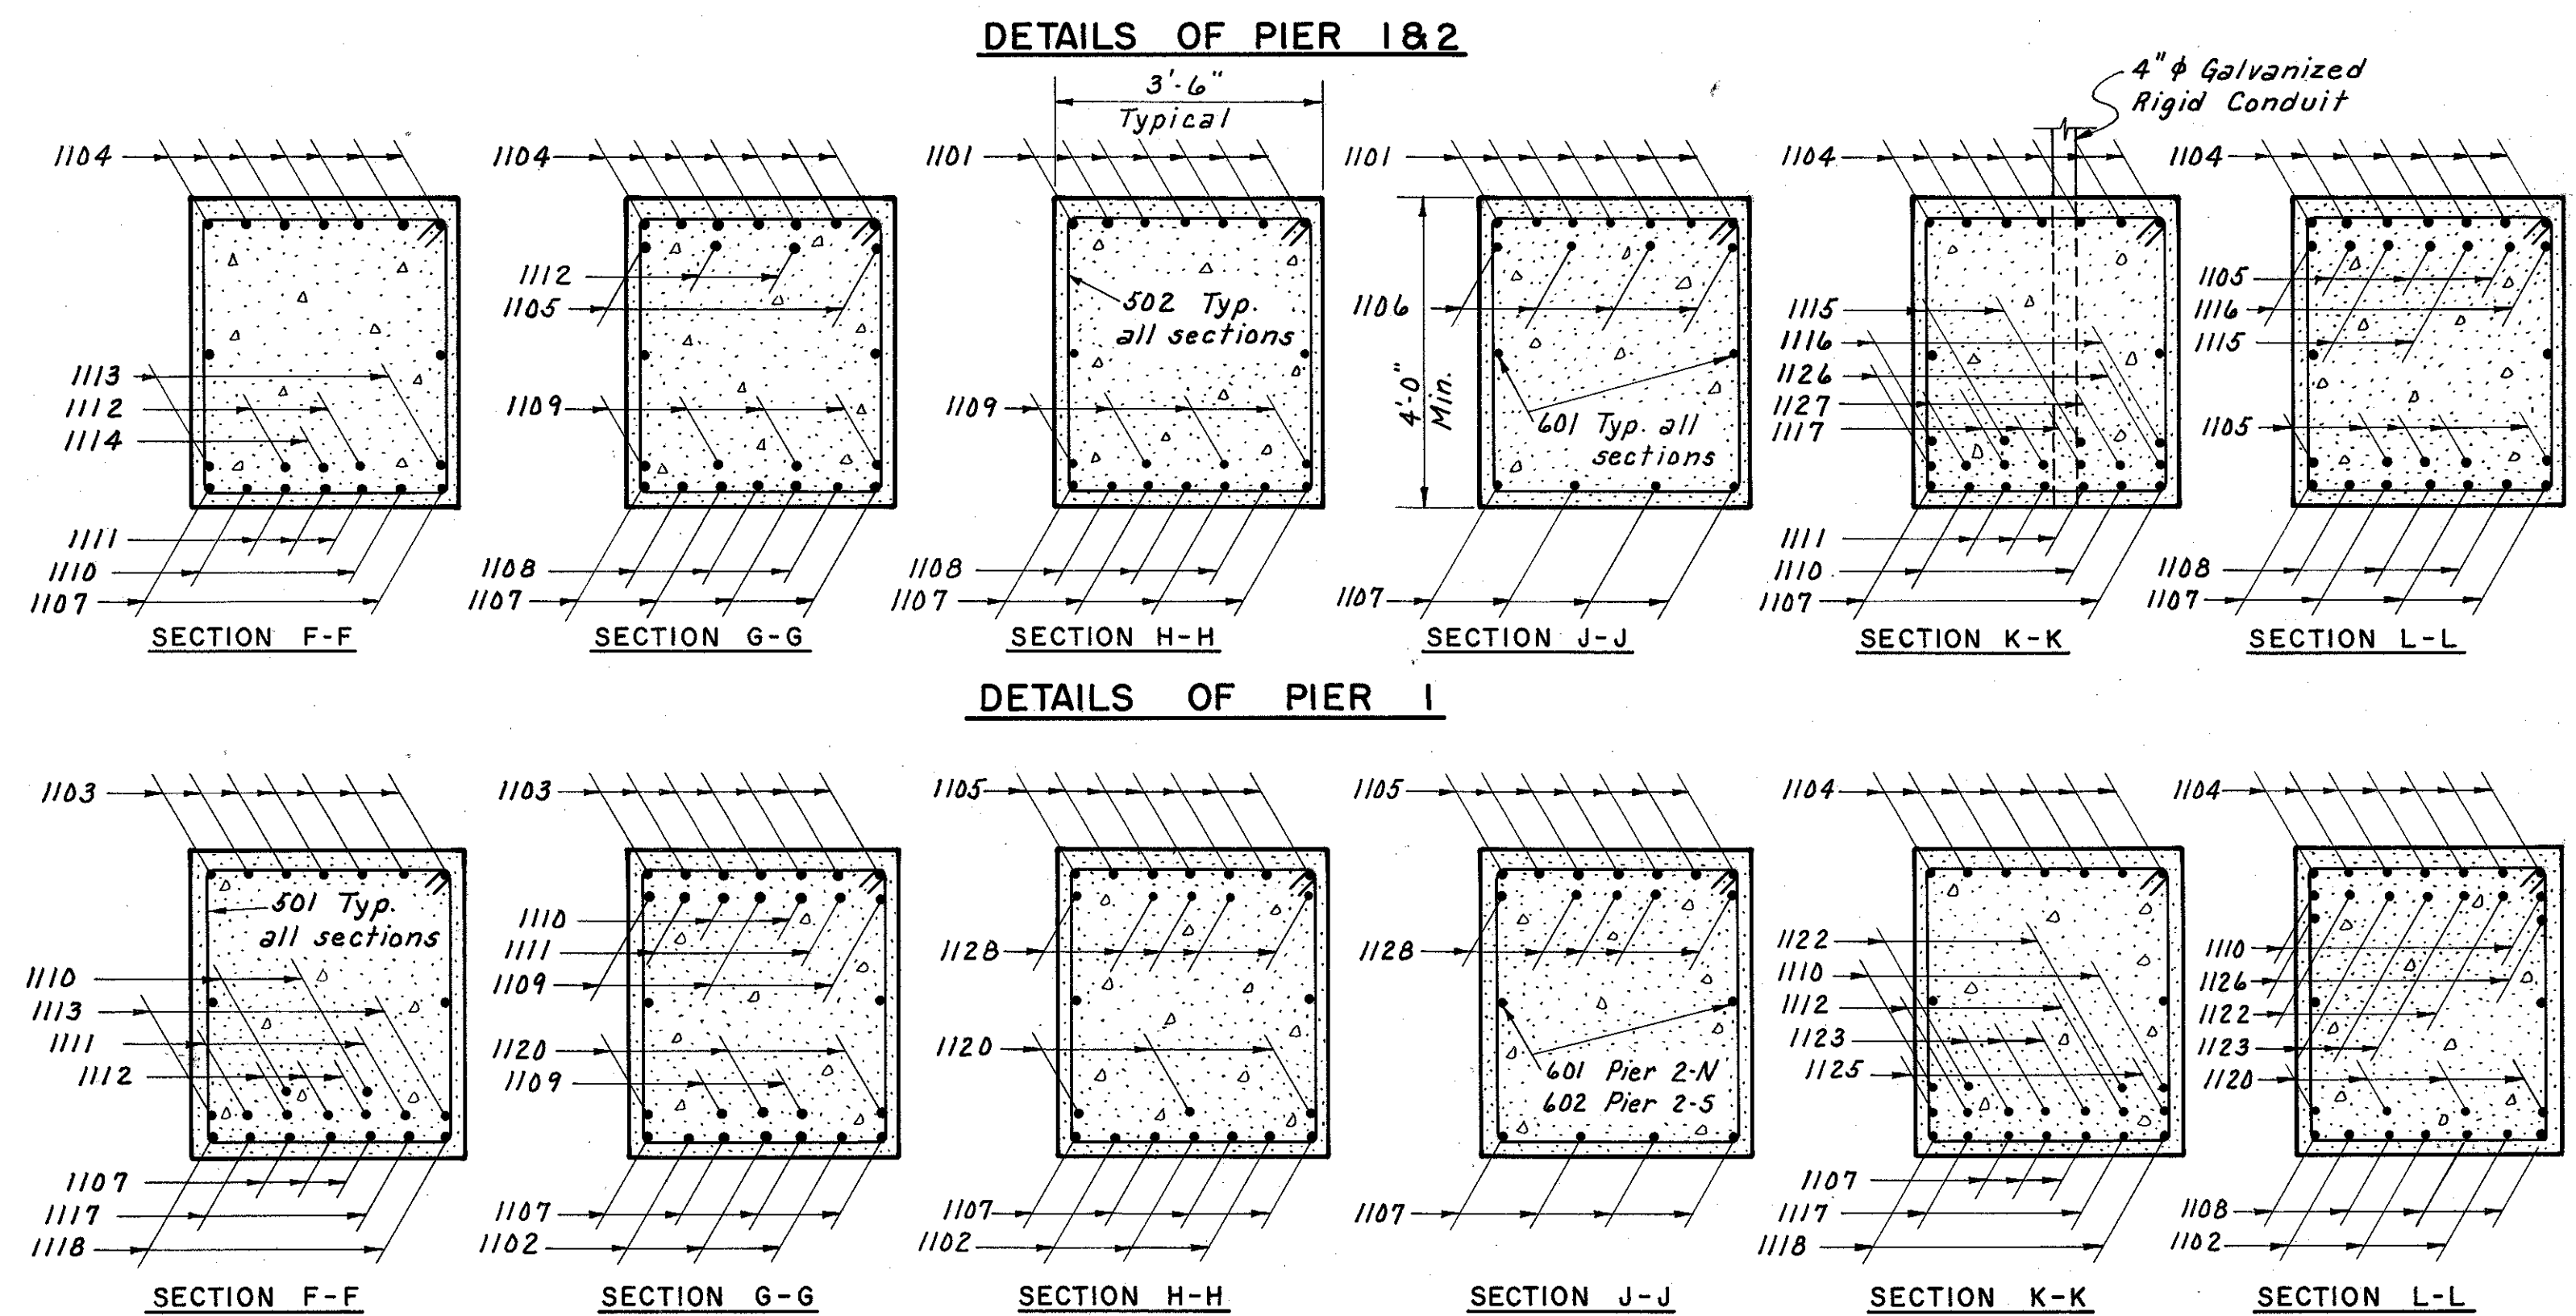

SPIRAL REINFORCING BARS:

The "length" shown in the reinforcement schedule for the spiral bars is the distance from the top of the footing to the bottom of the pier cap.

The "No. of Turns" shown is the "length" divided by the pitch, plus 3 turns (total number of closed coils), expressed as the nearest whole number.

Spiral reinforcing bars shall not have deformations, but shall in other respects conform to Item S-4. 1/2 closed coils shall be provided at the ends of each spiral unit.

Four steel channel, tee or angle spacers, weighing approximately 0.68 lb. per lin. ft. of spacer, shall be provided for each spiral unit. They shall be equally spaced along the periphery of the coil. The number of pounds of these spacers, based on 0.68 lb. per lin. ft., will be paid for as reinforcing steel and is included in the tabulated quantity of spiral bars.

REPLACEMENT REINFORCEMENT SCHEDULE			
SIZE	NO.	LENGTH	TYPE
4	2	5'-3"	5tr.
5	24	5'-9"	5tr.
6	51	6'-0"	5tr.
7	4	6'-3"	5tr.
8	1	6'-6"	5tr.
9	1	7'-0"	5tr.
10	1	7'-3"	5tr.
11	4	7'-6"	5tr.

Replacement bars are listed for the entire contract.

CUYAHOGA COUNTY
CITY OF CLEVELAND
CUY-21-15.32
MICROFILMED CUY-42-18.42
JUL 9 1985

H.N.T.B. BR. NO. 3 PART 7A

HOWARD, NEEDLES, TAMMEN & BERGENOFF
CONSULTING ENGINEERS
CLEVELAND NEW YORK




PIER DETAILS
INNER BELT FREEWAY OVER
RAMPS E-8, E-10 AND E-16
BR. NO. CUY-42-1843 STA. 65+10.18
Scale: 1/2"=1'-0" STA. 68+19.03

WILLOW-INNER BELT FREEWAY
CLEVELAND CUYAHOGA COUNTY OHIO

MICROFILMED
JUL 8 1985

CUYAHOGA COUNTY
CITY OF CLEVELAND
CUY-21-15.32
CUY-42-18.42

Note: Prefix "AA" shall be assigned to all bar marks.

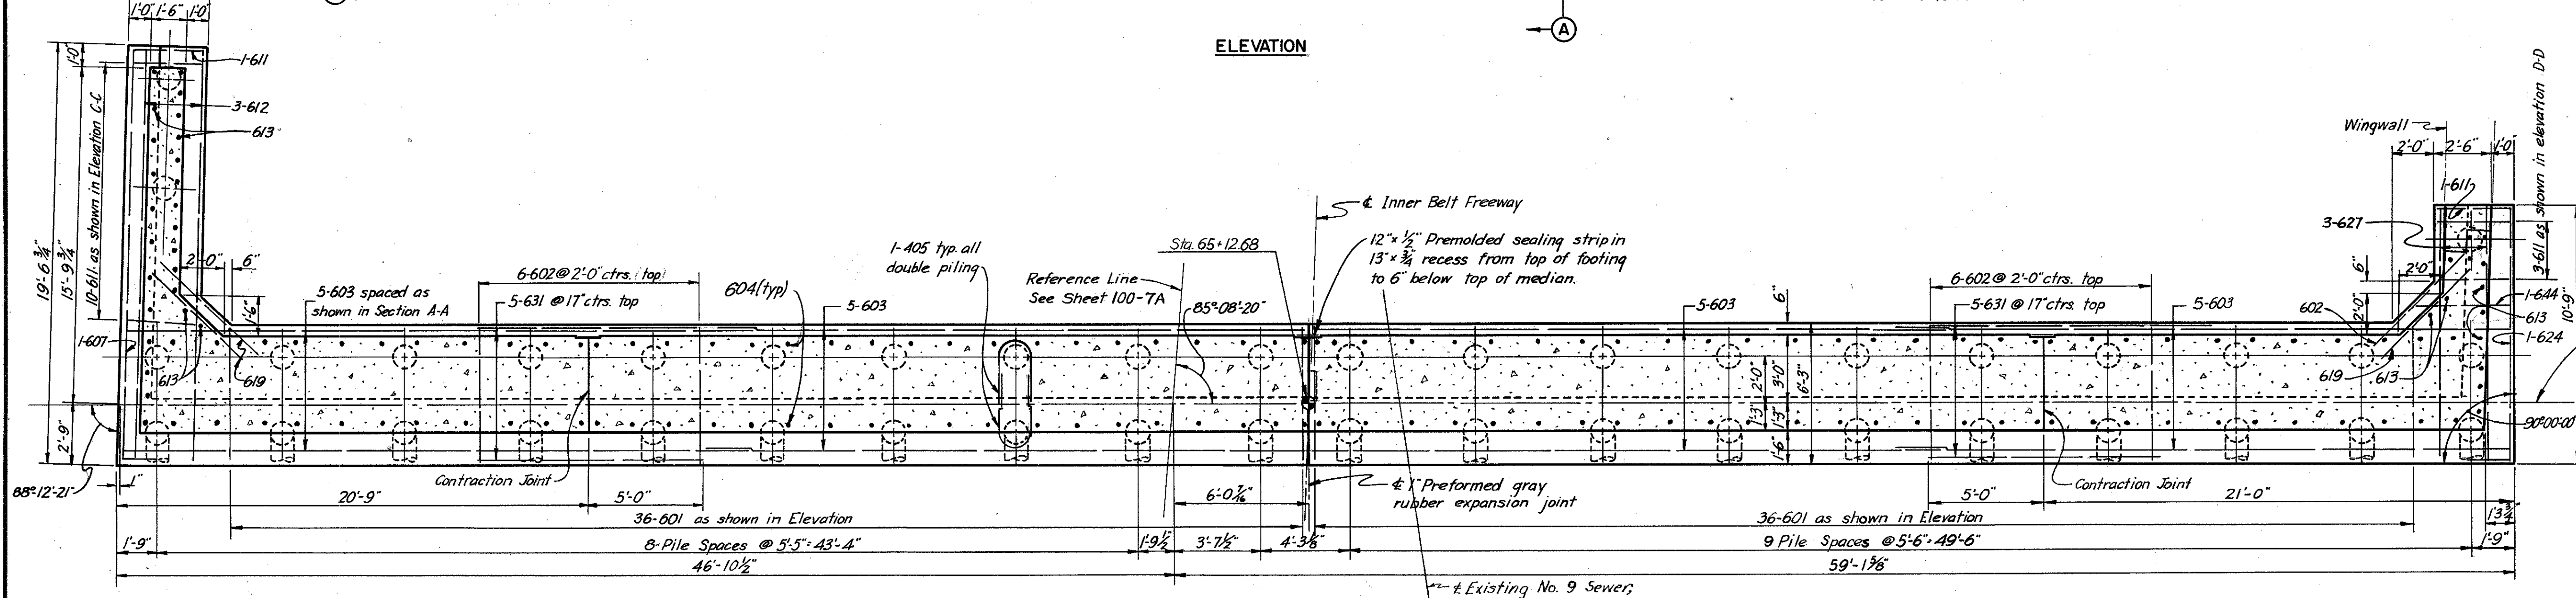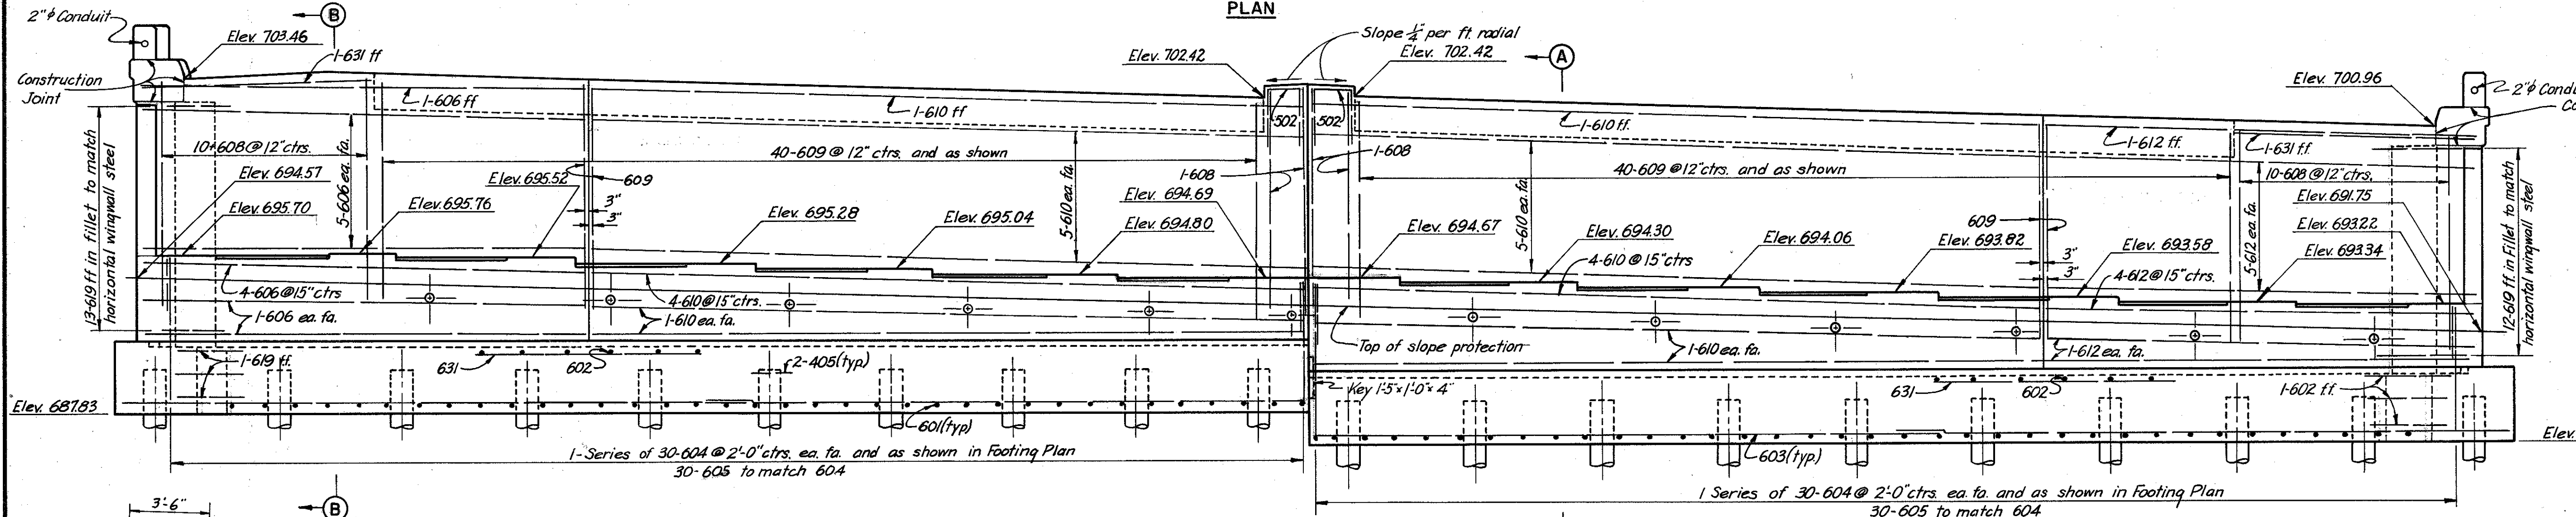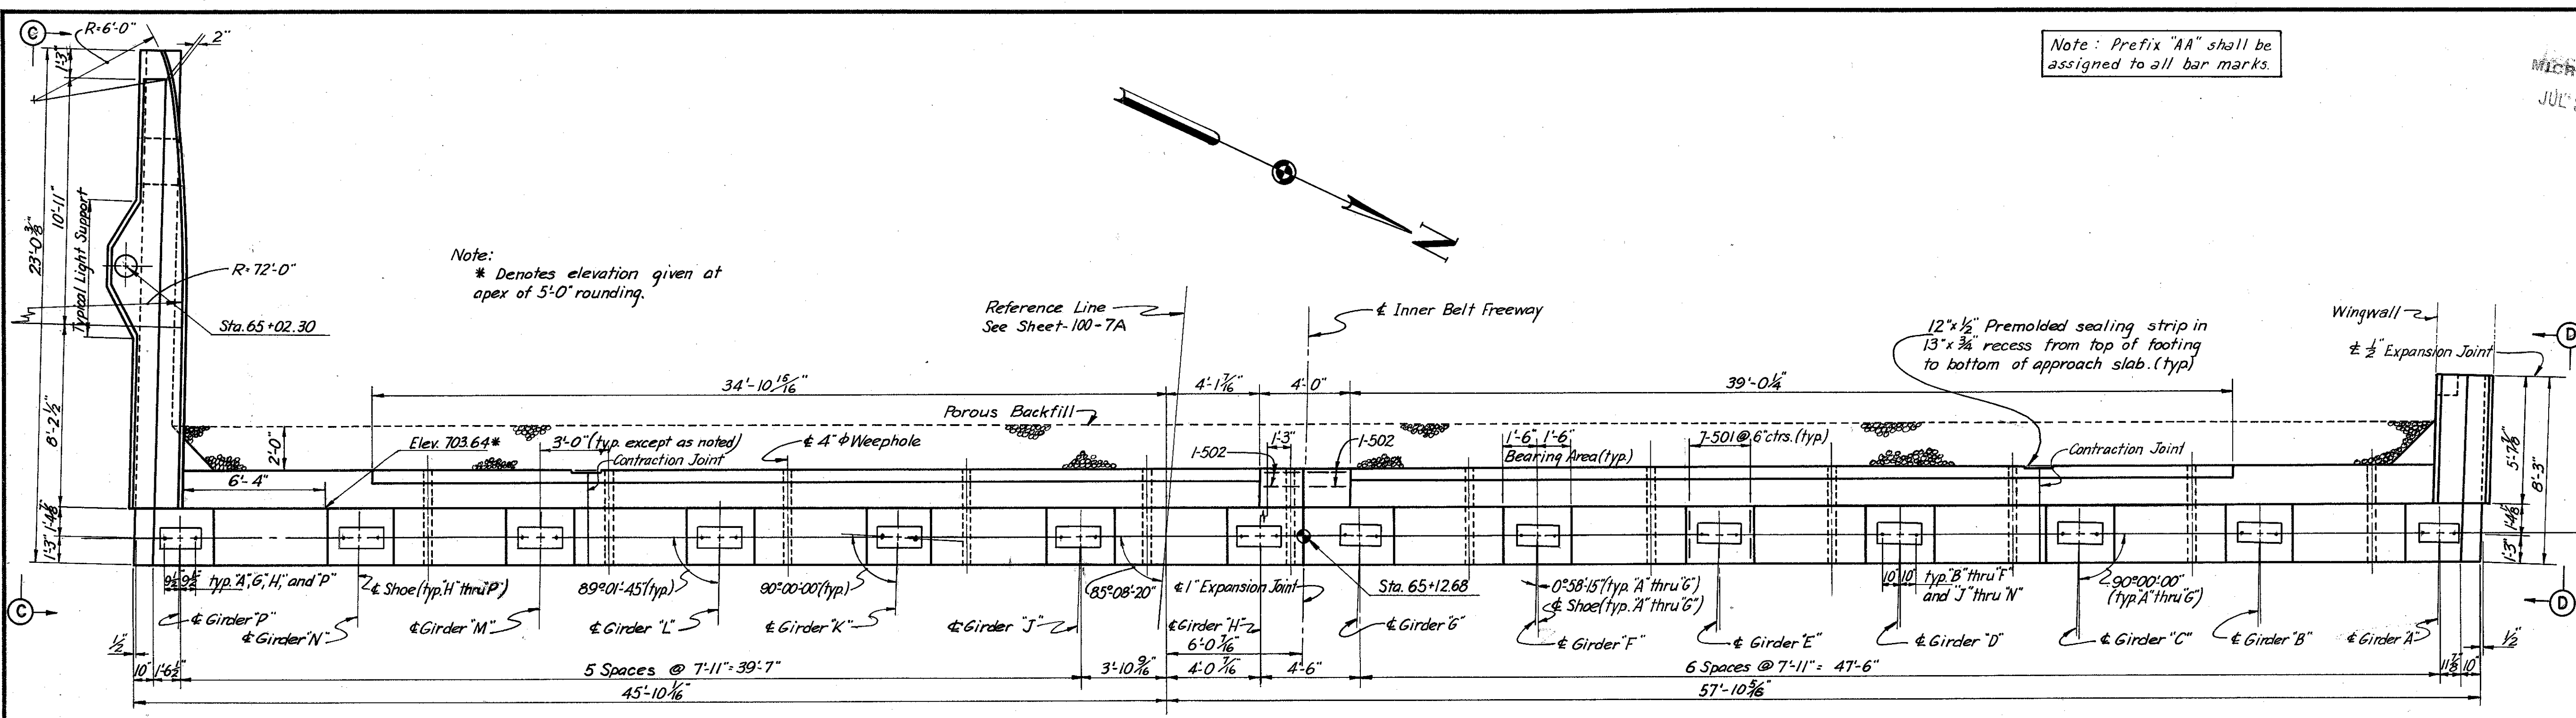

Note: Type "A" railing not shown.

Note: Elevations along backwall are given to back of 6x4x1/2 angle.

Note: For sections and additional notes, See Sheet 105-7A








H.N.T.B. BR. NO. 3 PART 7A
HOWARD, NEEDLES, TAMMEN & BERGENDOFF
CONSULTING ENGINEERS
KANSAS CITY CLEVELAND NEW YORK

WEST ABUTMENT
INNERBELT FREEWAY OVER
RAMPS E-8, E-10 AND E-16
BR. NO. CUY-42-1843 STA. 65+10.18
Scale: 1/4"=1'-0" STA. 68+19.03
WILLOW-INNER BELT FREEWAY
CLEVELAND CUYAHOGA COUNTY OHIO

DRAWN A.U.	TRACED H.R.	CHECKED F.S.	REVIEWED J.C.T.	REVISED
DATE 7-26-58	DATE 3-16-59	DATE 2-20-59	DATE 11-13-59	



SHEET 104

REINFORCEMENT SCHEDULE									
MARK	NO.	LENGTH	TYPE	DIMENSIONS				SERIES INCREMENT	WEIGHT (LBS.)
				A	B	C	D		
401	32	6'-7"	154	1'-4"	1'-10"	1'-4"	1'-8"		141
402	2Series 6	6'-1" to 6'-7"	154	1'-4"	1'-10"	1'-4"	1'-8"	1'-8"	51
403	2Series 6	4'-7" to 5'-11"	154	1'-4"	1'-10"	1'-4"	1'-8"	3'-2"	42
404	41	5'-7"	105	8"	2'-7"				153
405	42	6'-4"	144	2'-3"	1'-10"				178
*451	4	8'-11"	131	2'-6"	1'-2"				24
*452	4	9'-11"	131	3'-0"	1'-8"				26
*453	6	9'-5"	131	3'-2"	1'-0"				38
*454	4	5'-7"	155	2'-2"					14
*455	4	6'-1"	155	2'-8"					16
*456	6	6'-3"	155	2'-10"					26
501	98	5'-1"	105	2'-2"	1'-7"				520
502	4	5'-5"	105	1'-8"	2'-0"				23
601	72	7'-3"	100	5'-11"					784
602	15	5'-9"	Str.						130
603	20	2'-6"	Str.						826
604	4Series 30	6'-3" to 7'-8"	104	5'-7" to 7'-0"	10"			8"	1254
605	60	7'-5"	105	3'-11"	1'-11"			8"	668
606	19	19'-3"	Str.						549
607	1	20'-9"	104	19'-0"	1'-11"				31
608	24	22'-6"	154	9'-6"	1'-5"	9'-6"	1'-4"		811
609	80	23'-8"	112	10"	1'-5"	8'-2"	9'-6"		2844
610	38	3'-9"	Str.						1812
611	15	4'-6"	100	3'-2"					101
612	25	19'-0"	Str.						713
613	37	5'-6"	104	4'-10"	10"				306
614	5	18'-5"	104	16'-8"	1'-11"				138
615	3	22'-6"	Str.						101
616	5	16'-6"	Str.						124
617	3	20'-0"	Str.						90
618	31	12'-9"	Str.						594
619	30	6'-9"	Str.						304
620	6	11'-3"	Str.						101
621	14	3'-9"	Str.						79
622	20	4'-3"	Str.						128
623	3	20'-0"	133	12'-0"	8'-0"				90
624	1	12'-0"	104	10'-3"	1'-11"				18
*625	6	25'-6"	Str.						—
626	4	7'-0"	100	5'-8"					42
627	3	10'-3"	Str.						46
628	4	12'-11"	127	7'-11"	8"	1'-11"	2'-11"		78
629	8	11'-2"	126	7'-11"	8"	2'-11"			134
630	6	5'-3"	Str.						47
631	20	10'-0"	Str.						300
632	13	11'-9"	Str.						229
633	3	26'-10"	133	12'-0"	14'-10"				121
634	4	3'-8"	105	8"	1'-8"				22
635	21	4'-3"	104	2'-9"	1'-8"				134
636	9	7'-7"	149	2'-9"	7"	1'-8"	3'-0"		103
637	4	4'-0"	100	2'-8"					24
638	9	26'-9"	Str.						362
639	2Series 5	6'-0" to 18'-9"	Str.					3'-2"	186
640	2Series 10	5'-6" to 10'-0"	Str.					6"	233
*641	6	18'-9"	Str.						—
642	6	8'-11"	104	8'-3"	10"				80
*643	6	5'-3"	Str.						—
644	1	5'-6"	100	4'-2"					8
*651	4	9'-5"	141	2'-11"	1'-10"				56
*652	6	14'-6"	141	5'-3"	3'-0"				130
*653	2	5'-0"	Str.						16
801	2	25'-0"	Str.						134
Total									16,933

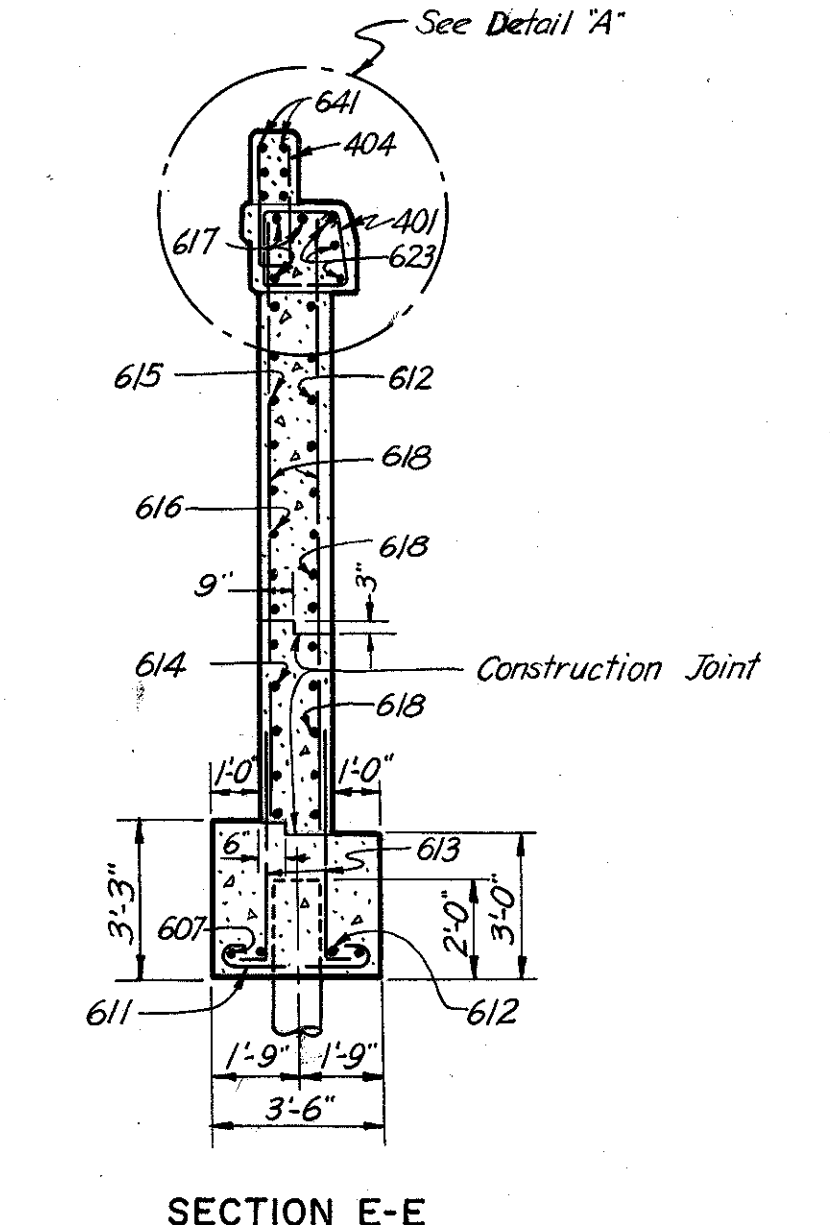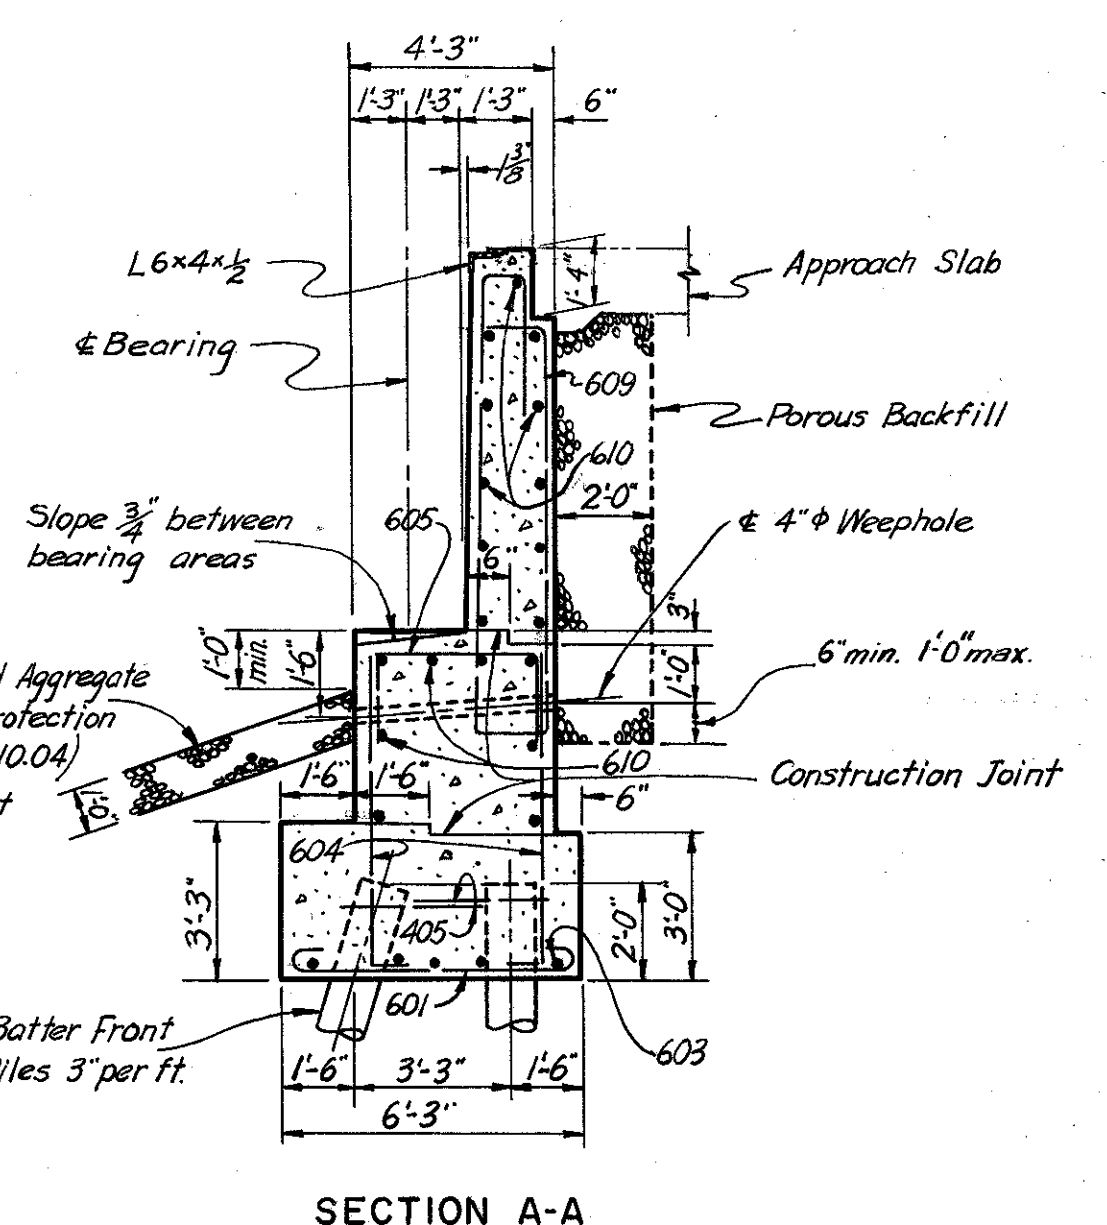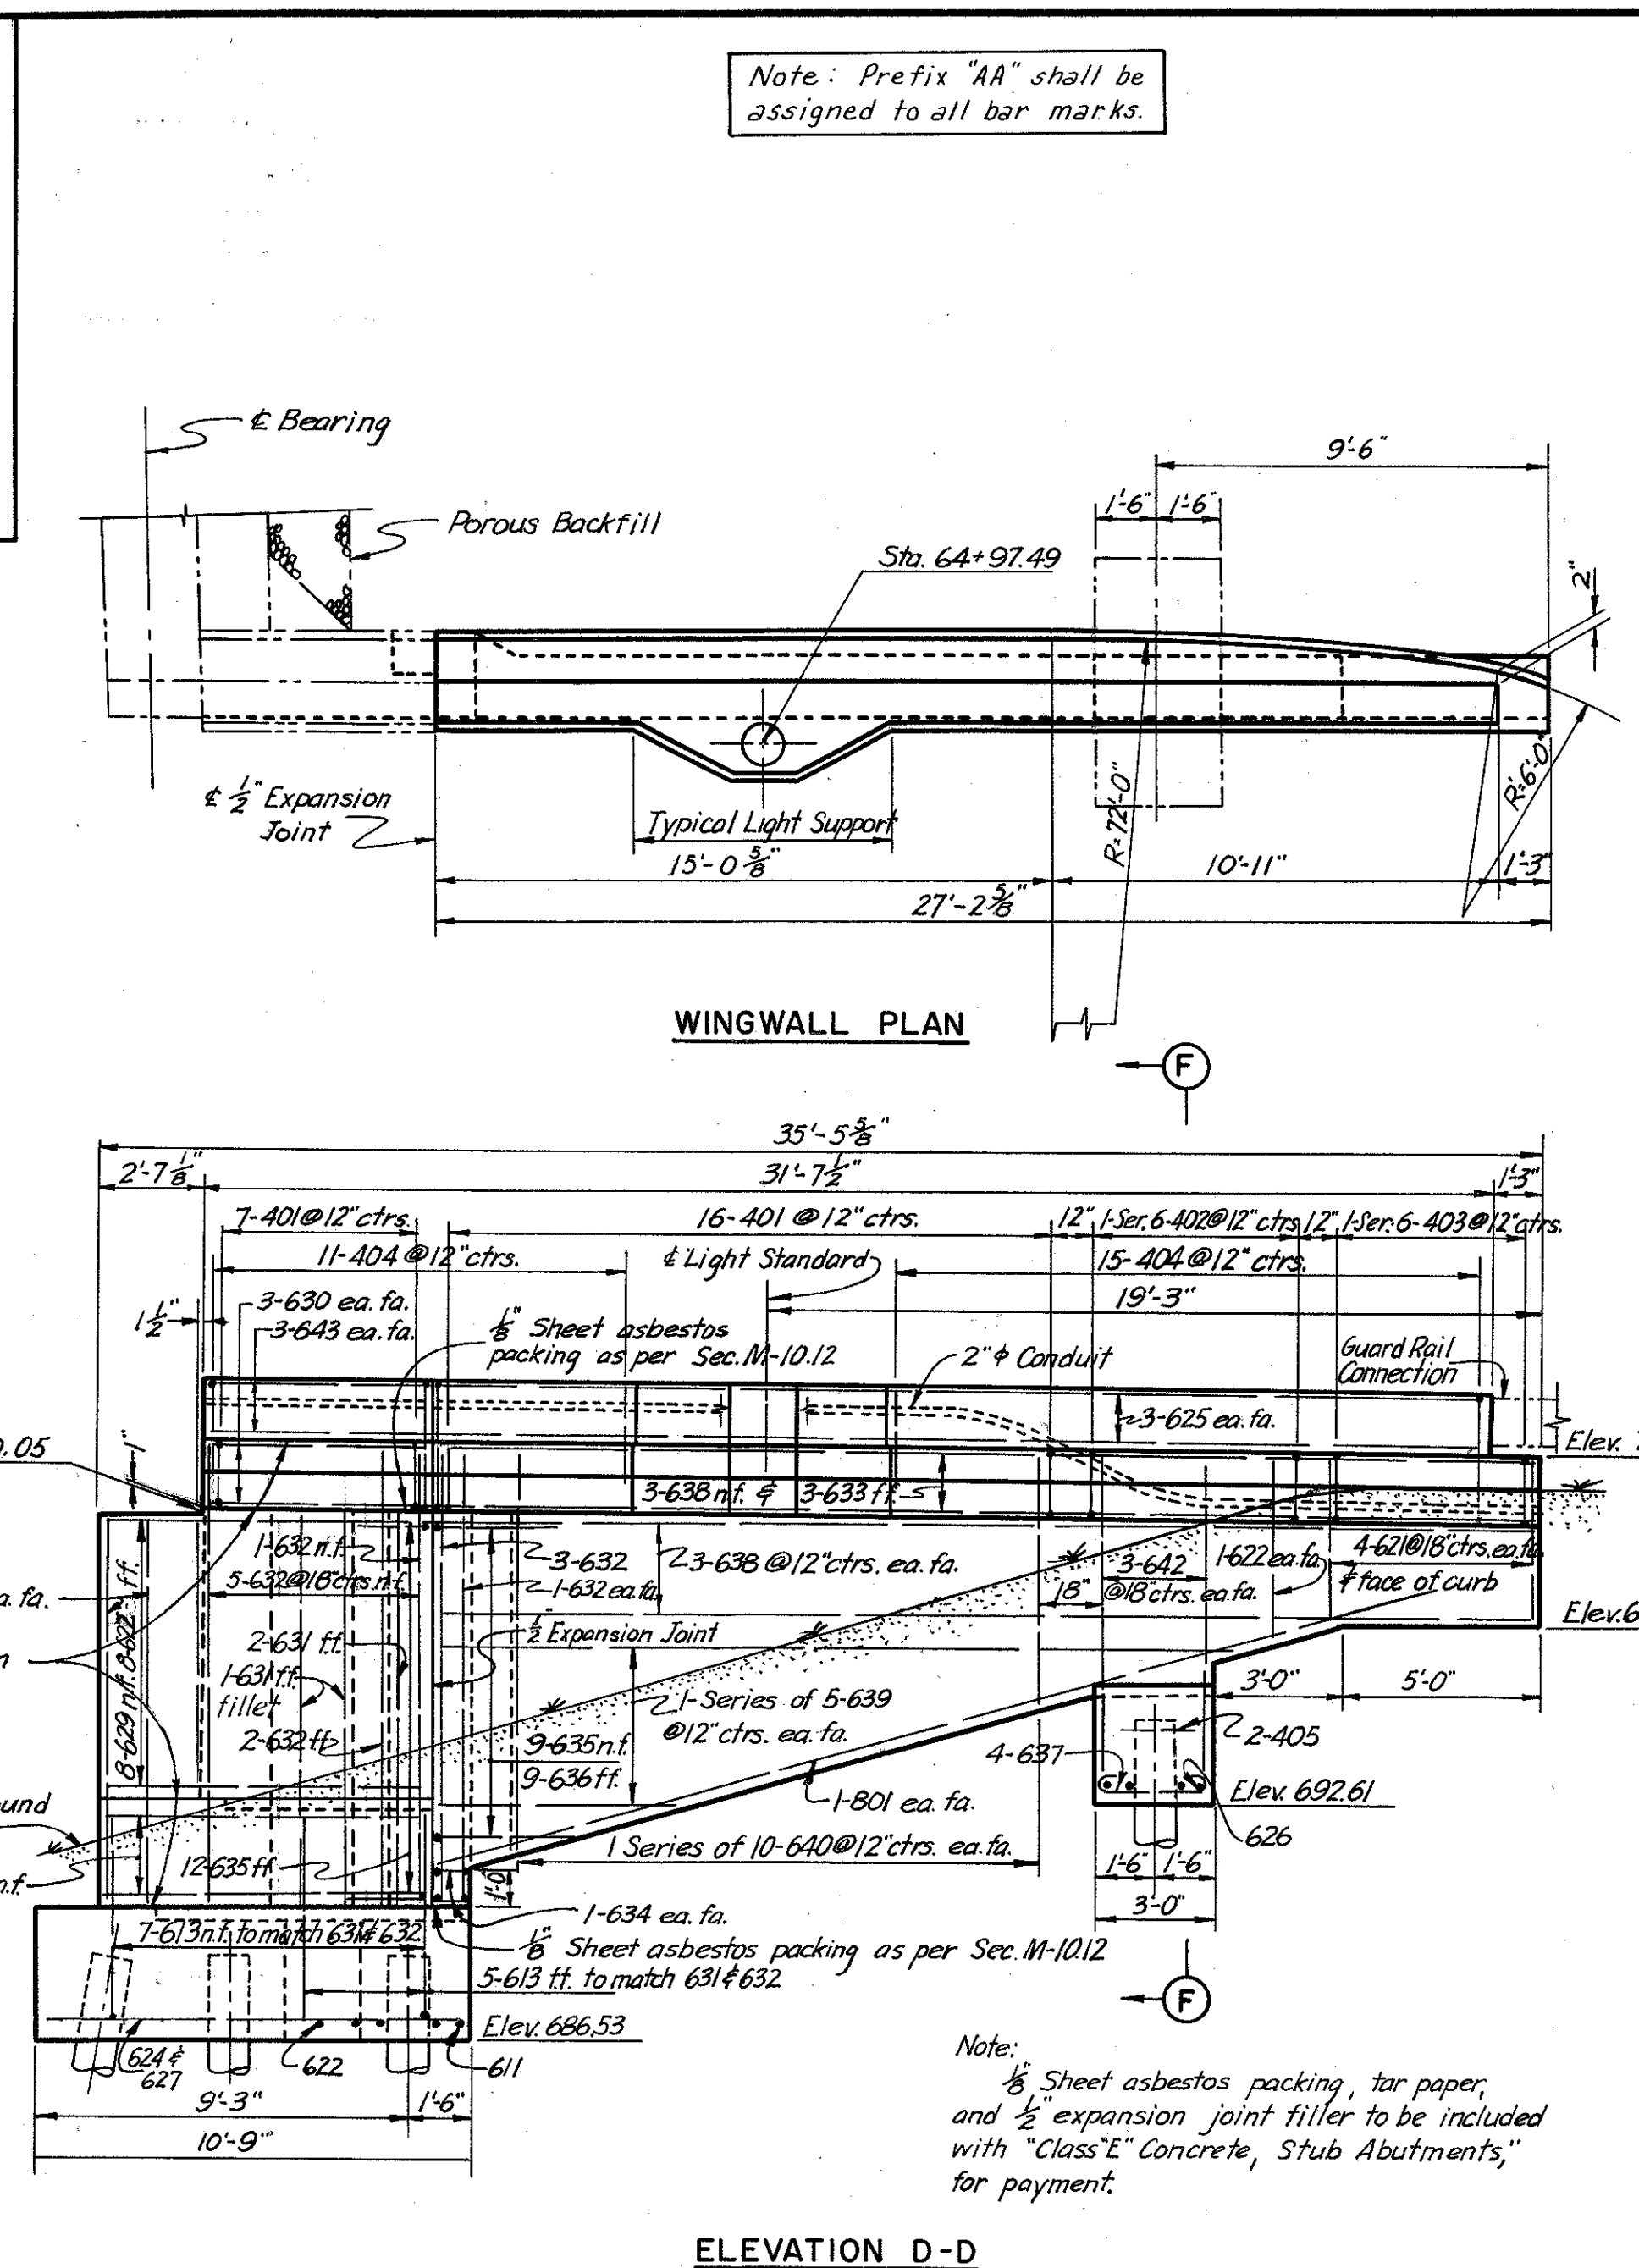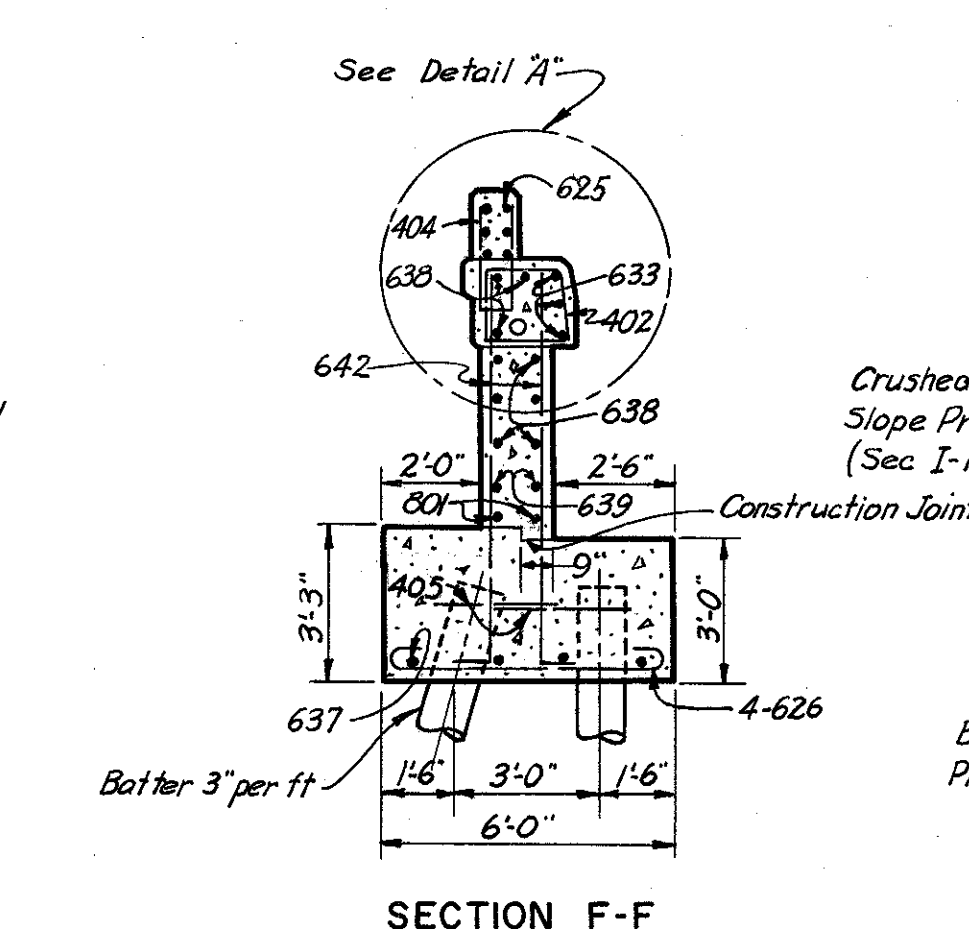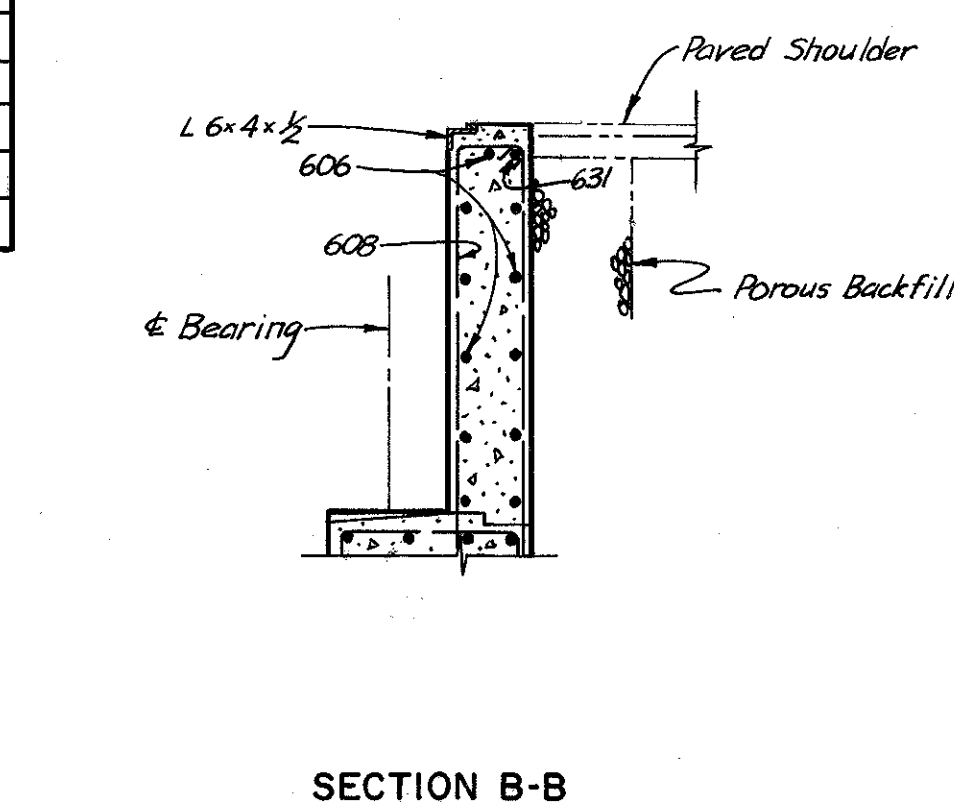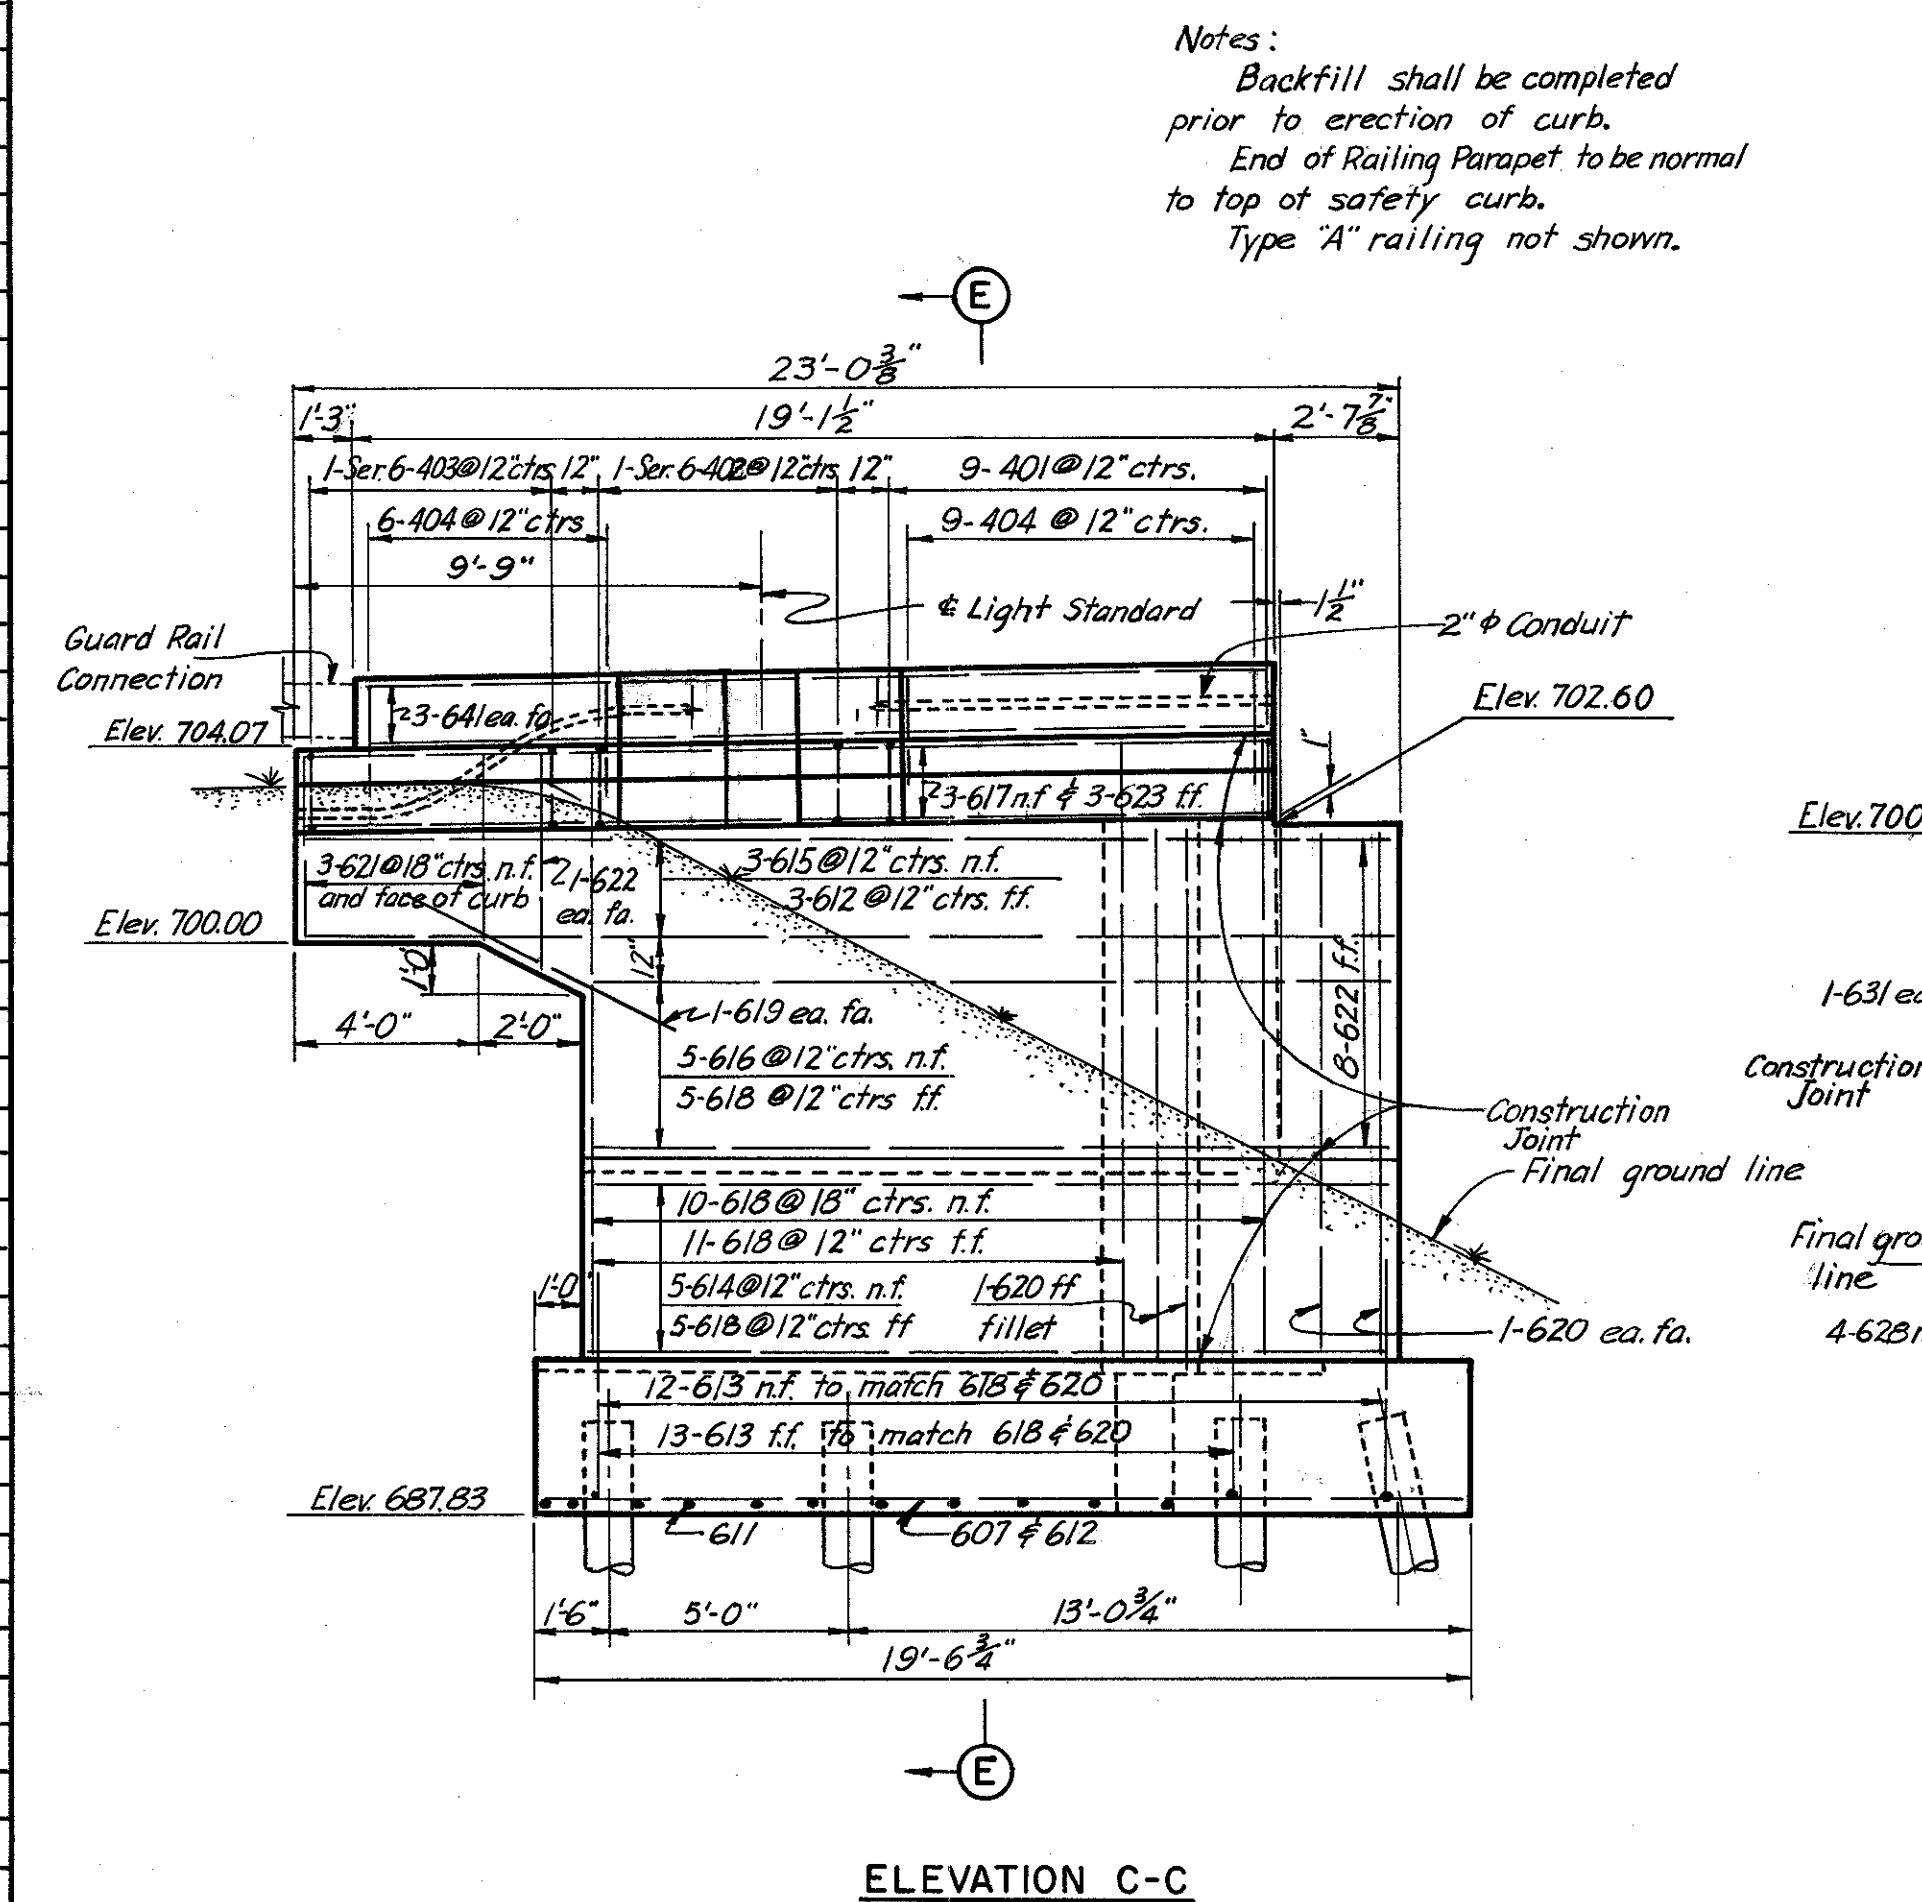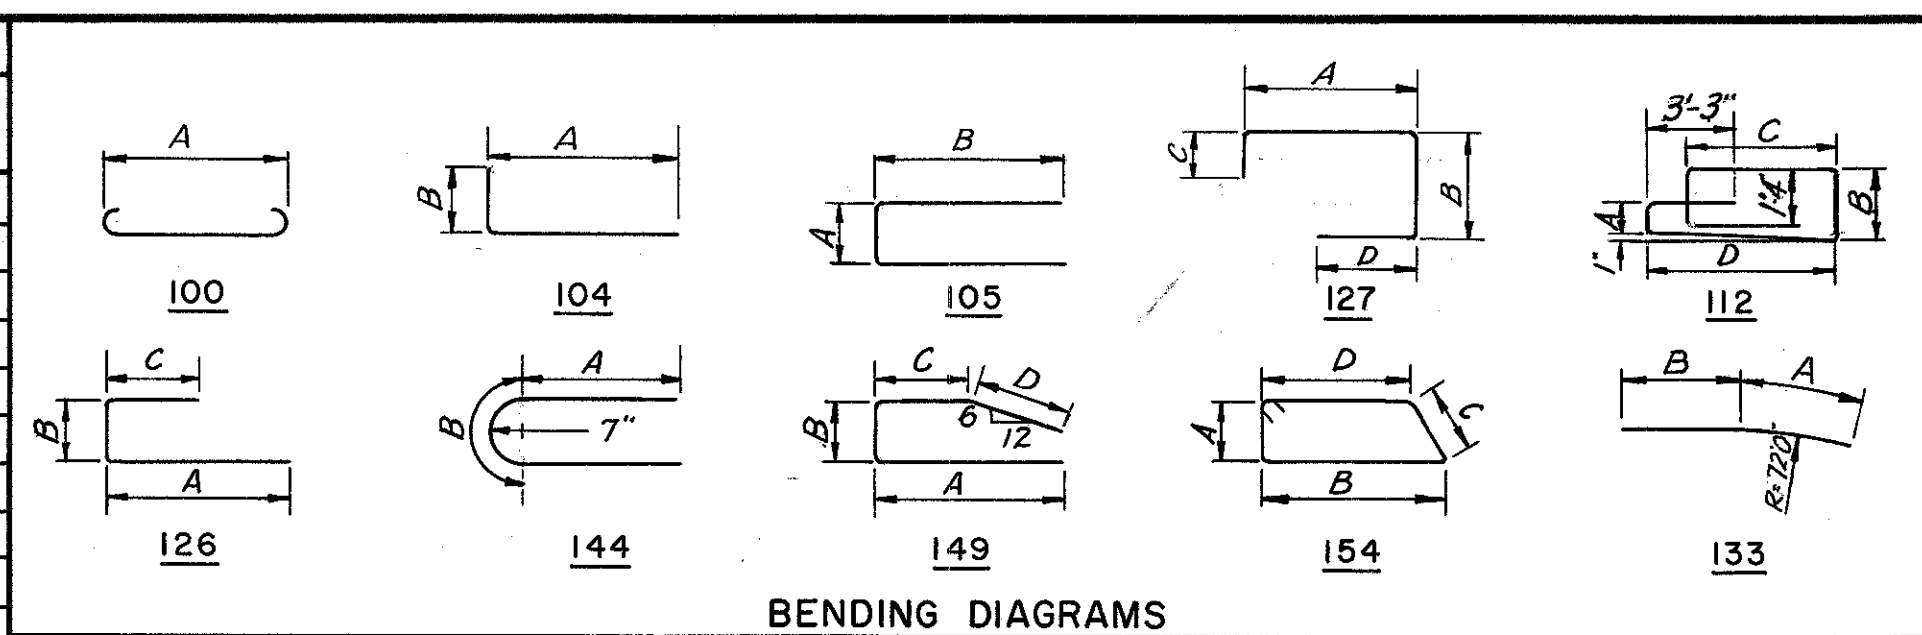

FED. ROADS DIV. NO. 2 STATE OHIO FED. AID PROJ. NO. CUYAHOGA COUNTY CITY OF CLEVELAND CUY-21-15.32 CUY-42-18.42

JUL 3 1965

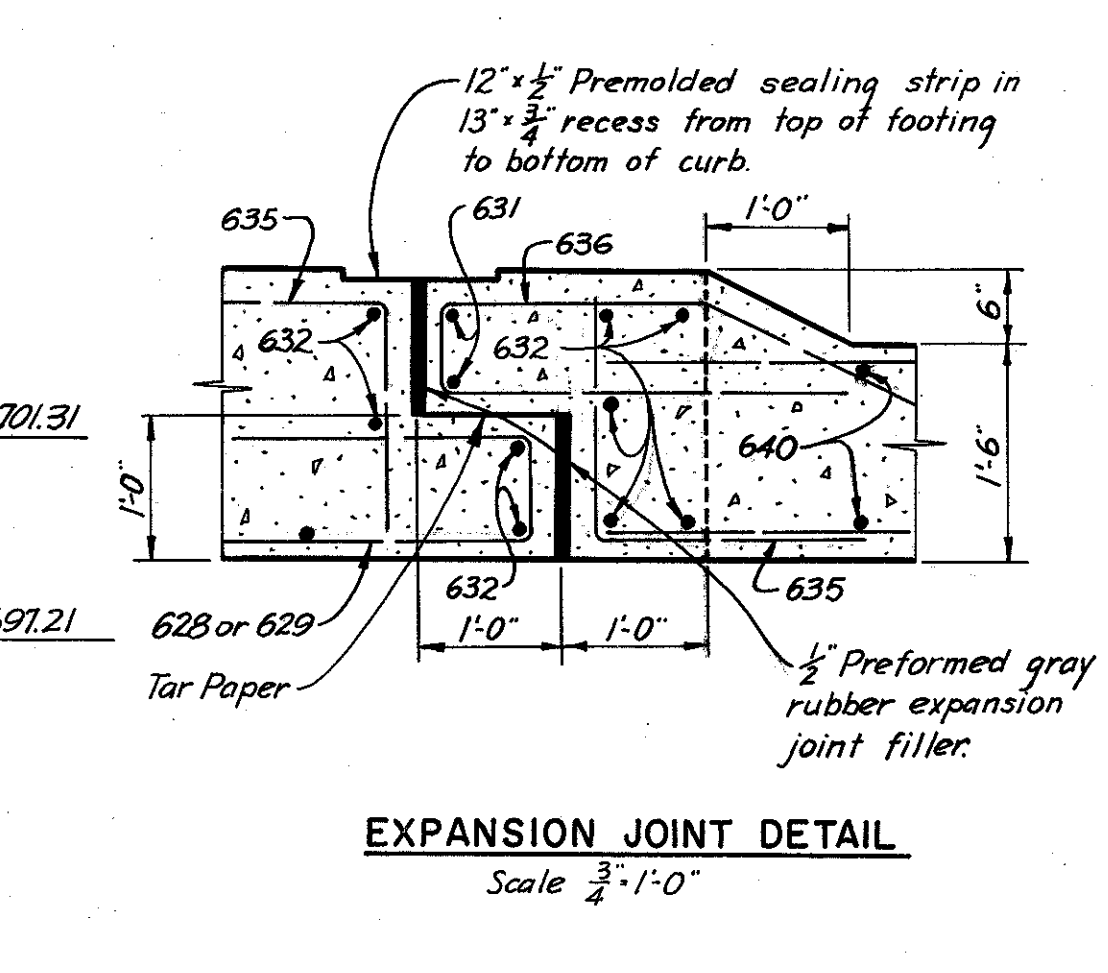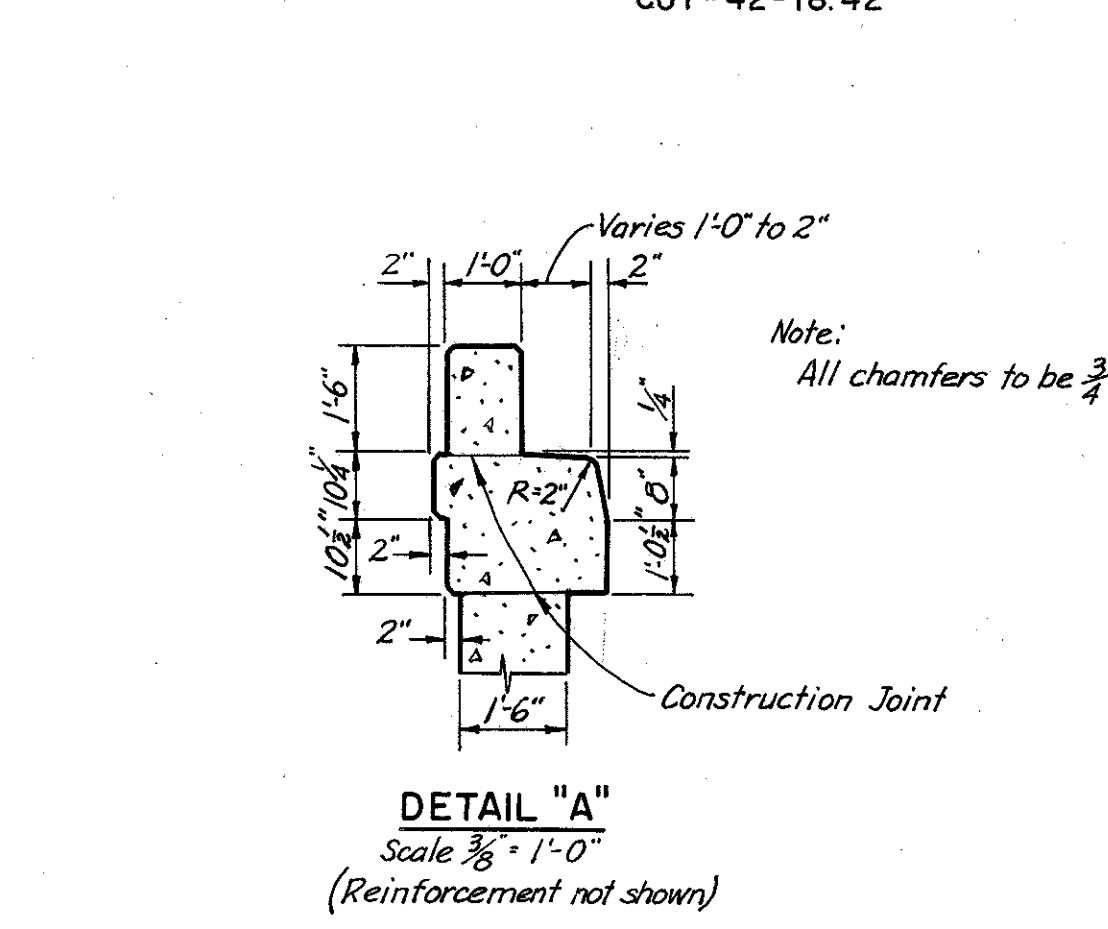

NOTES:
All piles shall be 12" cast-in-place reinforced concrete piles. All battered piles shall be battered 3in/2 in direction shown. Pile spacings given along bottom of footing. For details of end dam, see sheet 173-7A. For masonry plate details, see sheet 173-7A. For Railing Post spacing, details of Railing and Guard Rail Connection, see sheet 175-7A. Reinforcement bars shall be 3 inches clear from bottom of footings and 2 inches elsewhere. n.f. = near face; f.f. = far face; ea.fa. = each face. # Bars 625, 641, and 643 are included for payment with Item 5-14, Railing. For Slope Protection details, see sheet 174-7A. Bar dimensions are given out to out. Bars of a series shall vary in length by a constant increment. For Replacement Schedule, see sheet 103-7A. For reinforcement details of Light Standard Support, see sheet 176-7A. * Designates Light Standard Support Reinforcement steel. For details of Light Standard Support, see sheet 176-7A.

H.N.T.B. BR. NO. 3 PART 7A


HOWARD, NEEDLES, TAMMEN & BERGENOFF CONSULTING ENGINEERS KANSAS CITY CLEVELAND NEW YORK

WEST ABUTMENT DETAILS INNER BELT FREEWAY OVER RAMPS E-8, E-10 AND E-16 BR. NO. CUY-42-1843 STA. 65+10.18 Scale: 1/4"=1'-0" Except STA. 68+19.03 as noted WILLOW-INNER BELT FREEWAY CLEVELAND CUYAHOGA COUNTY OHIO

DATE 7-24-58 TRACED 11/11/59 CHECKED 11/13/59 REVISIONS DATE 2-23-59 DATE 11-13-59 SHEET 105

MARK	NO.	LENGTH	TYPE	DIMENSIONS				SERIES INCREMENT	WEIGHT
				A	B	C	D		
401	21	6'-9"	154	1'-5"	1'-10"	1'-5"	1'-8"	95	
402	2 Ser. of 6	6'-3 7/8 to 6'-9"	154	1'-5"	1'-7 to 1'-10"	1'-5"	1'-5 to 1'-8"	52	
403	2 Ser. of 6	4'-9" to 6'-1"	154	1'-5"	1'-0 to 1'-6"	1'-5"	8" to 1'-4"	43	
404	43	5'-5"	105	8"	2'-6"			156	
405	44	6'-3"	144	2'-3"	1'-9"			184	
501	98	5'-1"	105	2'-2"	1'-7"			520	
502	1	5'-5"	105	2'-6"	1'-7"			6	
503	1	5'-9"	105	2'-10"	1'-7"			6	
504	1	3'-10"	105	11"	1'-7"			4	
505	1	4'-5"	105	1'-6"	1'-7"			5	
601	86	7'-3"	100	5'-11"				936	
602	40	5'-9"	Str.					345	
603	10	40'-0"	Str.					601	
604	38	32'-3"	Str.					1841	
605	4 Ser. of 34	6'-2" to 7'-8"	104	5'-6 to 7'-0"	1'-0"			1413	
606	68	7'-5"	105	3'-11"	1'-11"			758	
607	2	27'-9"	Str.					83	
608	26	22'-7"	109	1'-5"	9'-6"			882	
609	92	22'-6"	112	11"	1'-5"	8'-2"	9'-6"	3109	
610	32	4'-6"	100	3'-2"				216	
611	59	5'-6"	104	4'-10"	1'-0"			481	
612	4	21'-7"	108	19'-9"	1'-11"	20"		130	
613	9	25'-9"	Str.					348	
614	8	15'-0"	Str.					180	
615	8	23'-3"	Str.					279	
616	35	11'-3"	Str.					591	
617	22	9'-9"	Str.					322	
618	12	3'-9"	Str.					68	
619	12	4'-3"	Str.					77	
620	4	19'-9"	Str.					119	
621	1	6'-6"	124	2'-9"	2'-0"	2'-0"	8	10	
622	3	23'-9"	133	12'-0"	11'-9"			107	
623	5	19'-2"	124	17'-0"	6"	1'-11"	8	144	
624	5	17'-0"	Str.					128	
625	3	23'-0"	Str.					104	
626	10	12'-0"	Str.					180	
627	3	20'-0"	Str.					90	
628	22	13'-0"	Str.					430	
629	13	27'-3"	Str.					532	
630	3	19'-6"	133	12'-0"	7'-6"			88	
*631	6	8'-9"	Str.						
632	1	7'-8"	104	7'-0"	1'-0"			12	
*633	6	22'-0"	Str.						
634	1	23'-9"	108	21'-11"	1'-11"	20"		36	
635	10	10'-0"	Str.					150	
636	3	22'-3"	Str.					100	
637	7	18'-9"	Str.					197	
638	8	21'-0"	Str.					252	
639	13	26'-0"	Str.					308	
640	1 Ser. of 4	26'-0" to 27'-9"	Str.					161	
								Total 17,085	

BENDING DIAGRAMS

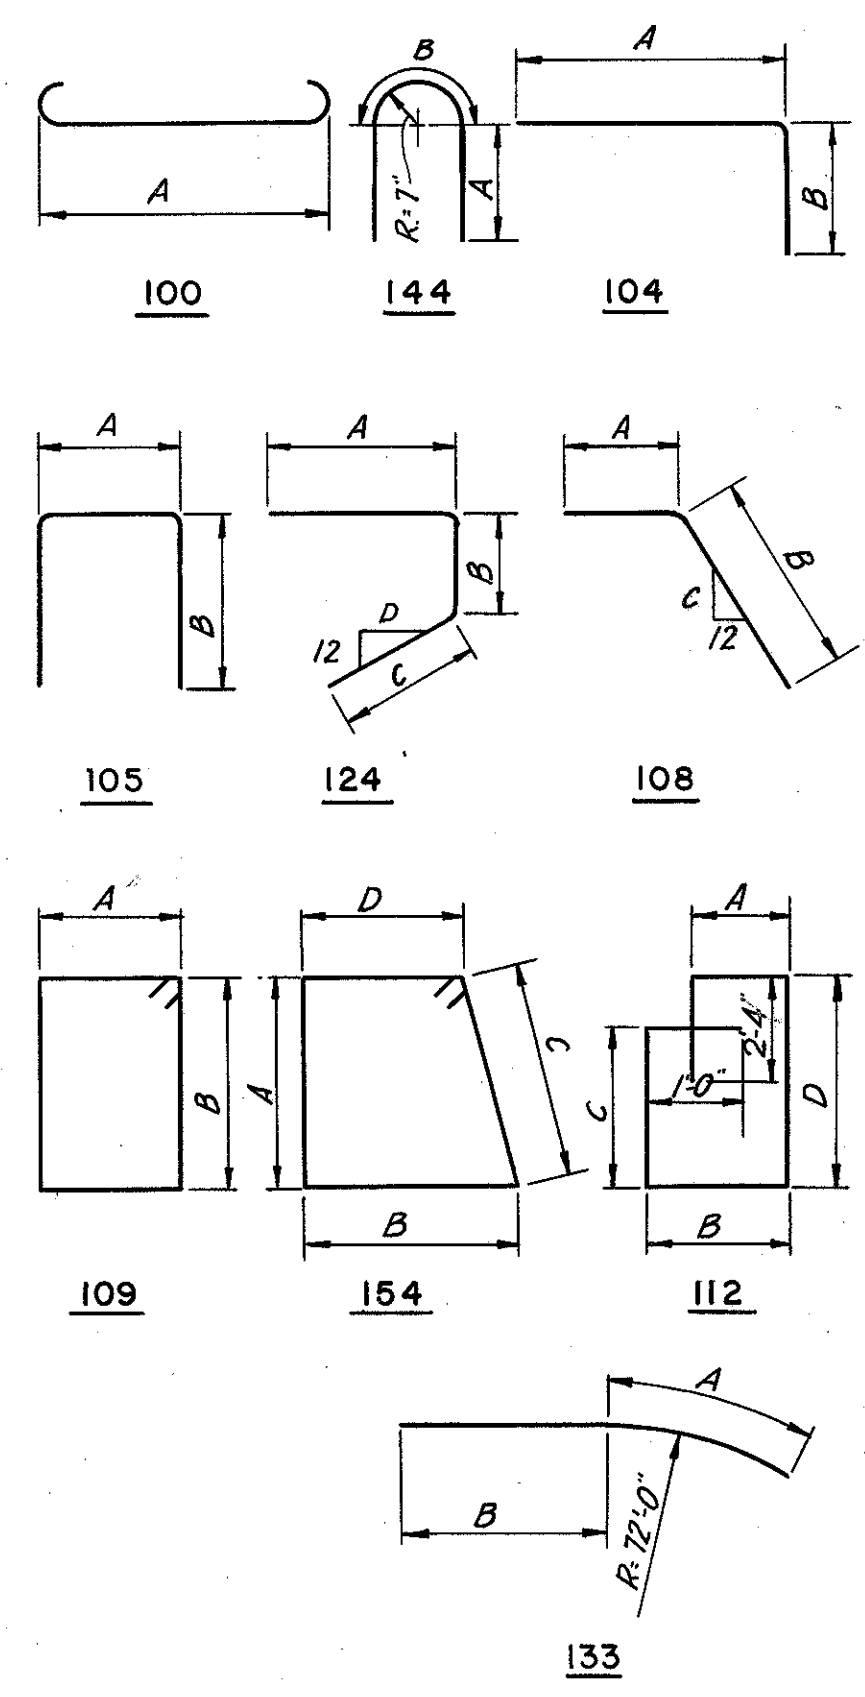

NOTES:
 All piles shall be 12" cast-in-place reinforced concrete piles.
 All battered piles shall be battered 3 in 12 in direction shown.
 Pile spacings are given along bottom of footing.
 Reinforcement bars shall be 3 inches clear from bottom of footing and 2 inches elsewhere.
 For Replacement Schedule see sheet 103-7A
 Bars of a series shall vary in length by a constant increment.
 * Bars 631 & 633 are included for payment with Item 5-14, Railing.
 Bar dimensions are given out to out.
 n.f. - near face; f.f. - far face; ea. fa. - each face.
 For masonry plate details see sheet 173-7A
 For details of end dam see sheet 173-7A
 For Slope Protection details see sheet 174-7A
 For location of lighting conduit see sheet 176-7A
 For Railing Post spacing, details of Railing, and Guard Rail connection see sheet 175-7A
 For additional sections see sheet 106-7A


Note: Prefix AB shall be assigned to all bar marks

Note: Special care shall be taken when placing reinforcing steel so as not to interfere with anchor bar setting.


Note: # Denotes Elevation given at P.V.I. of 5'-0" rounding

Note: Elevation along backwall are given to back of 6"x4"x 1/2" angle.
 Note: Type "A" Railing not shown.


Note: End of Railing Parapet to be normal to top of safety curb.
 Backfill shall be completed prior to construction of safety curb.

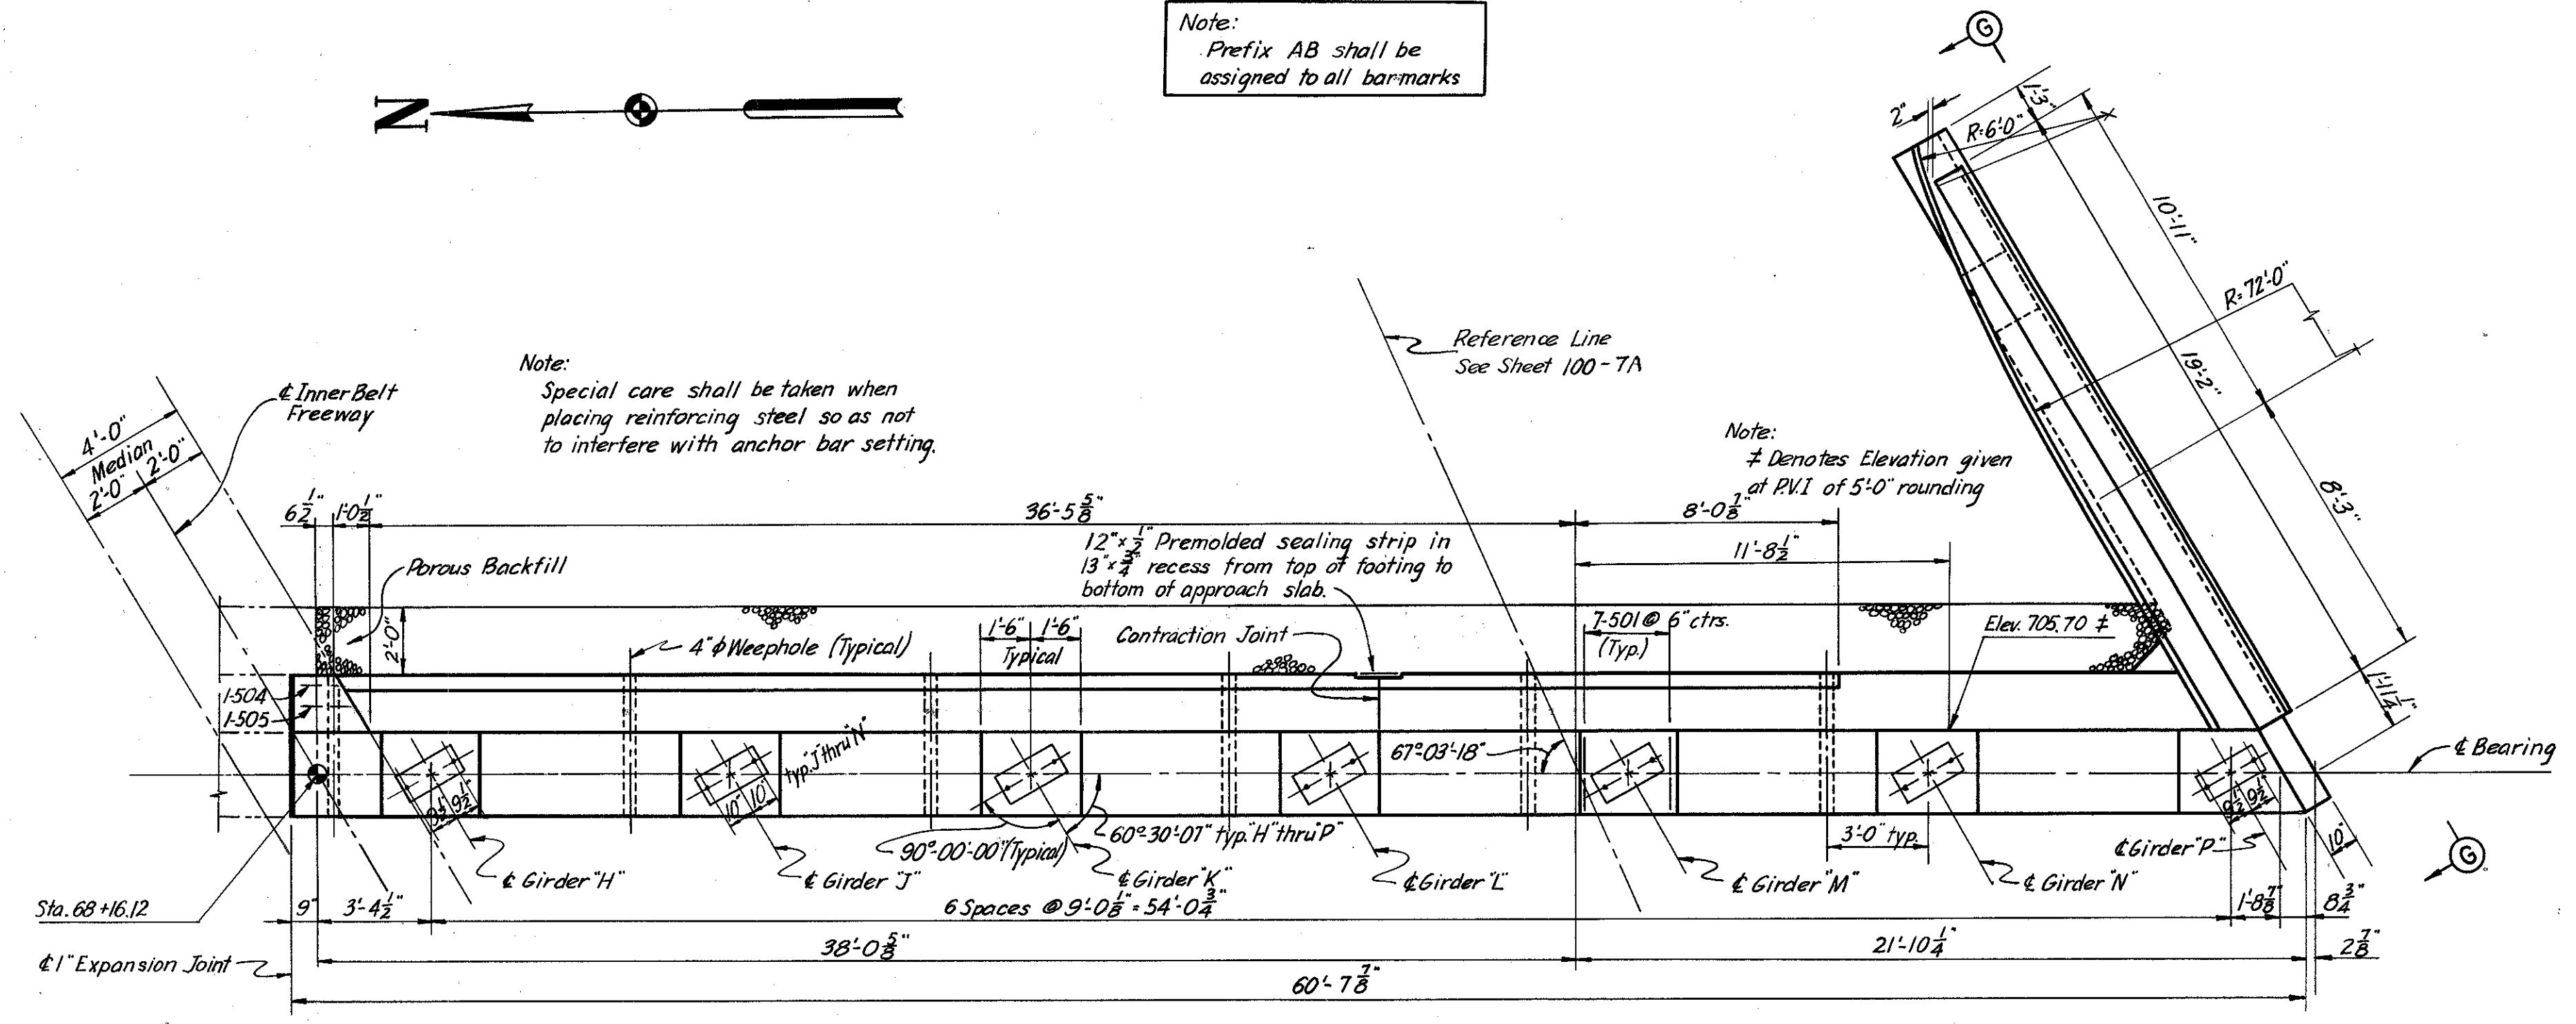


PLAN

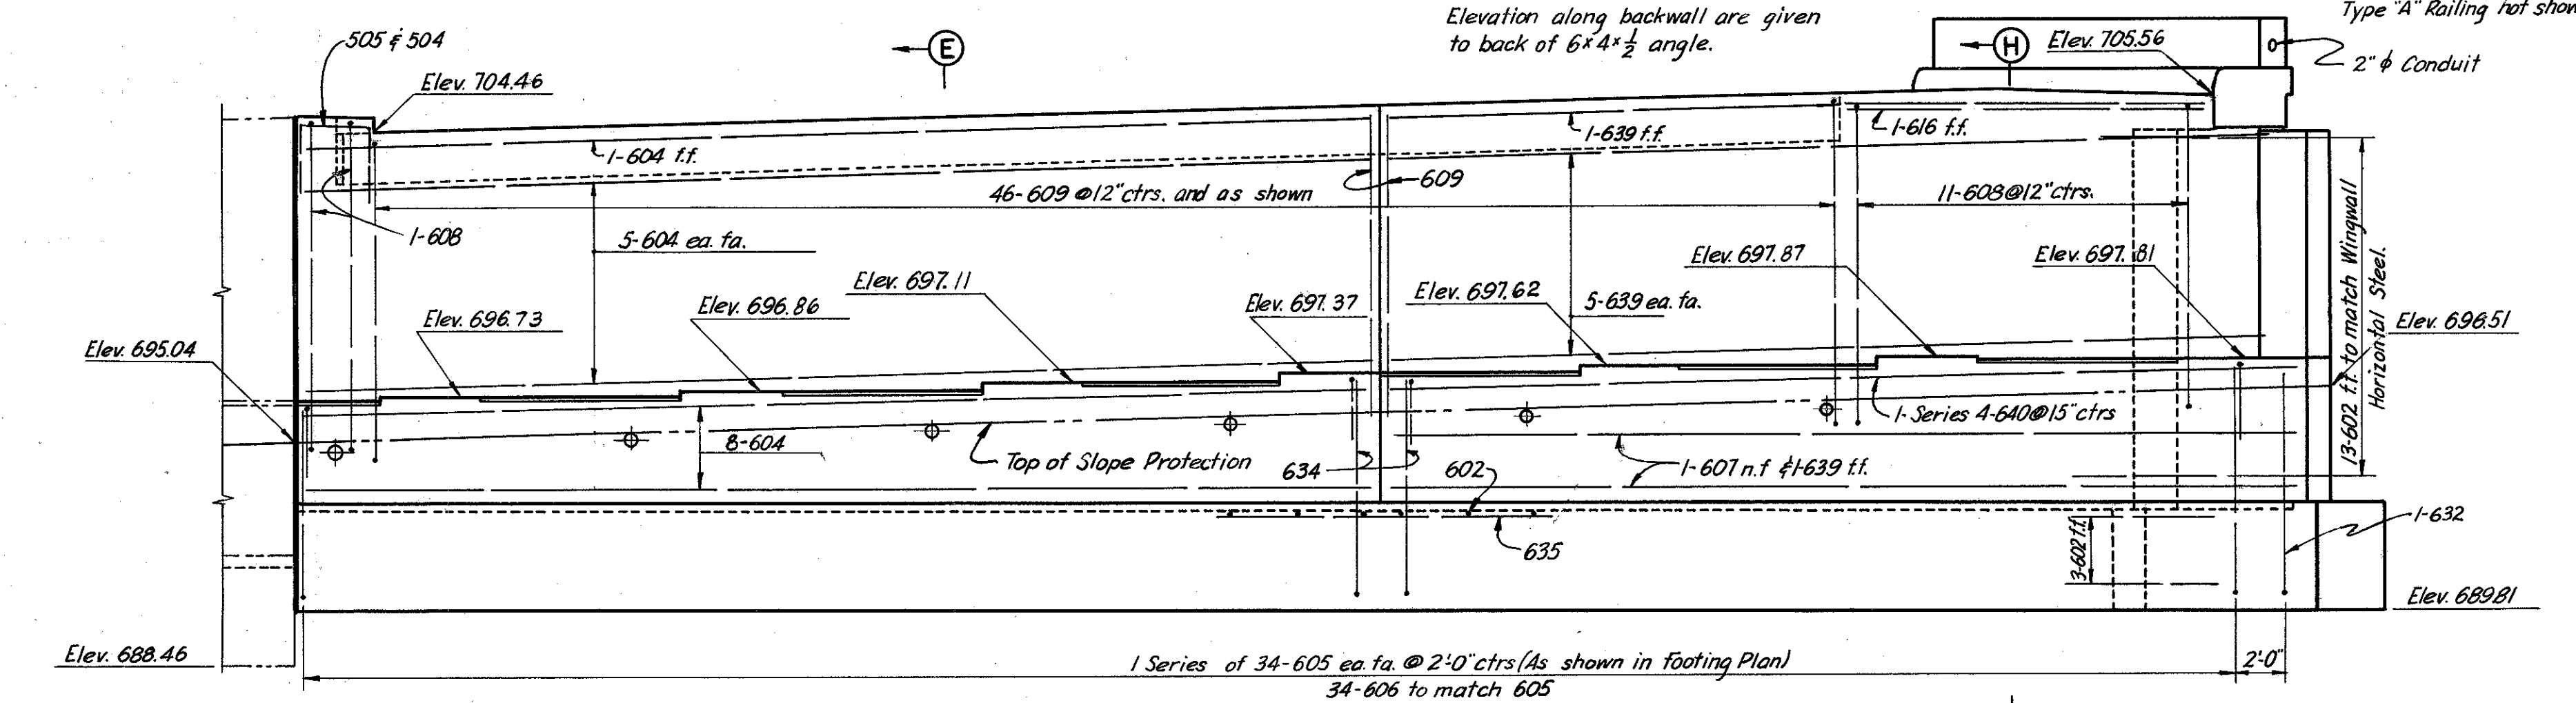

ELEVATION

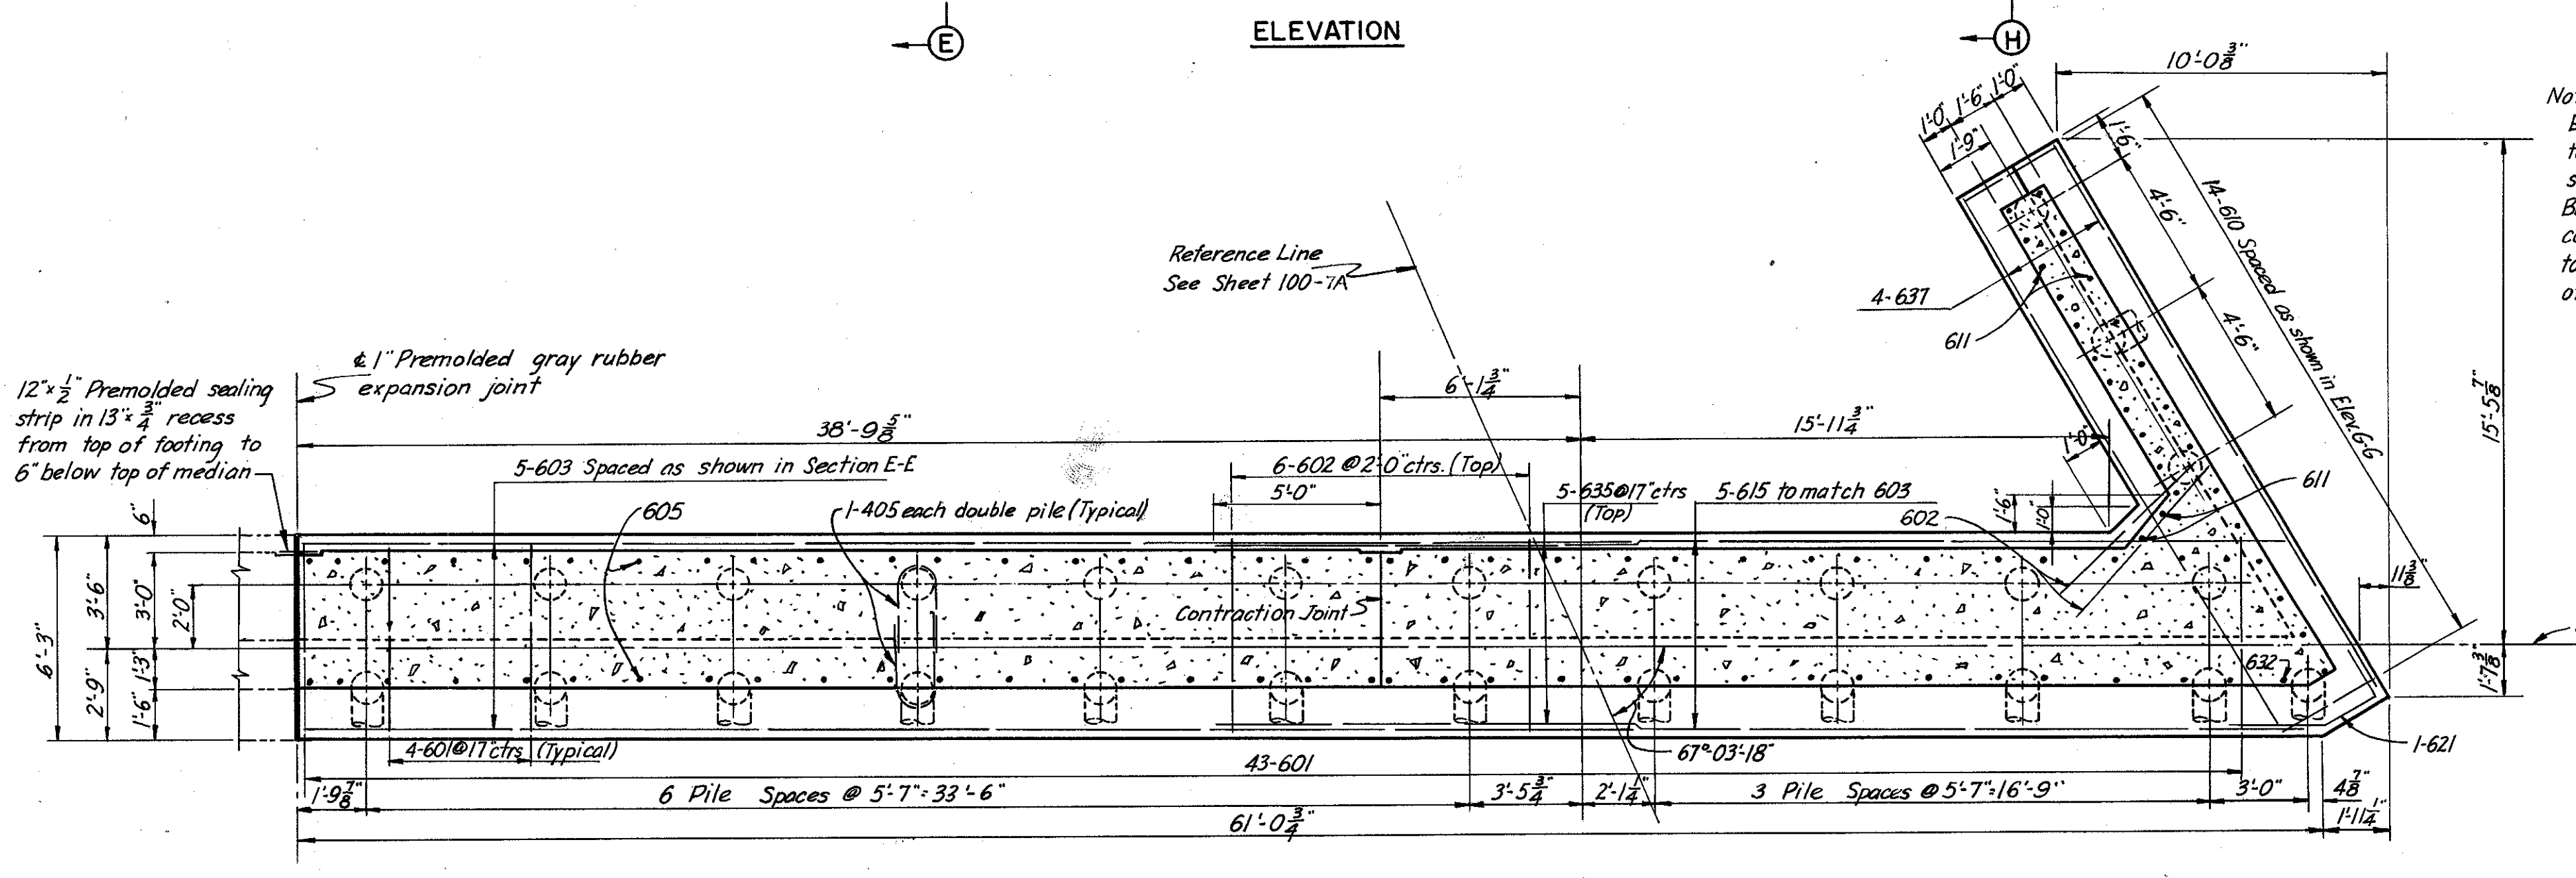


FOOTING PLAN

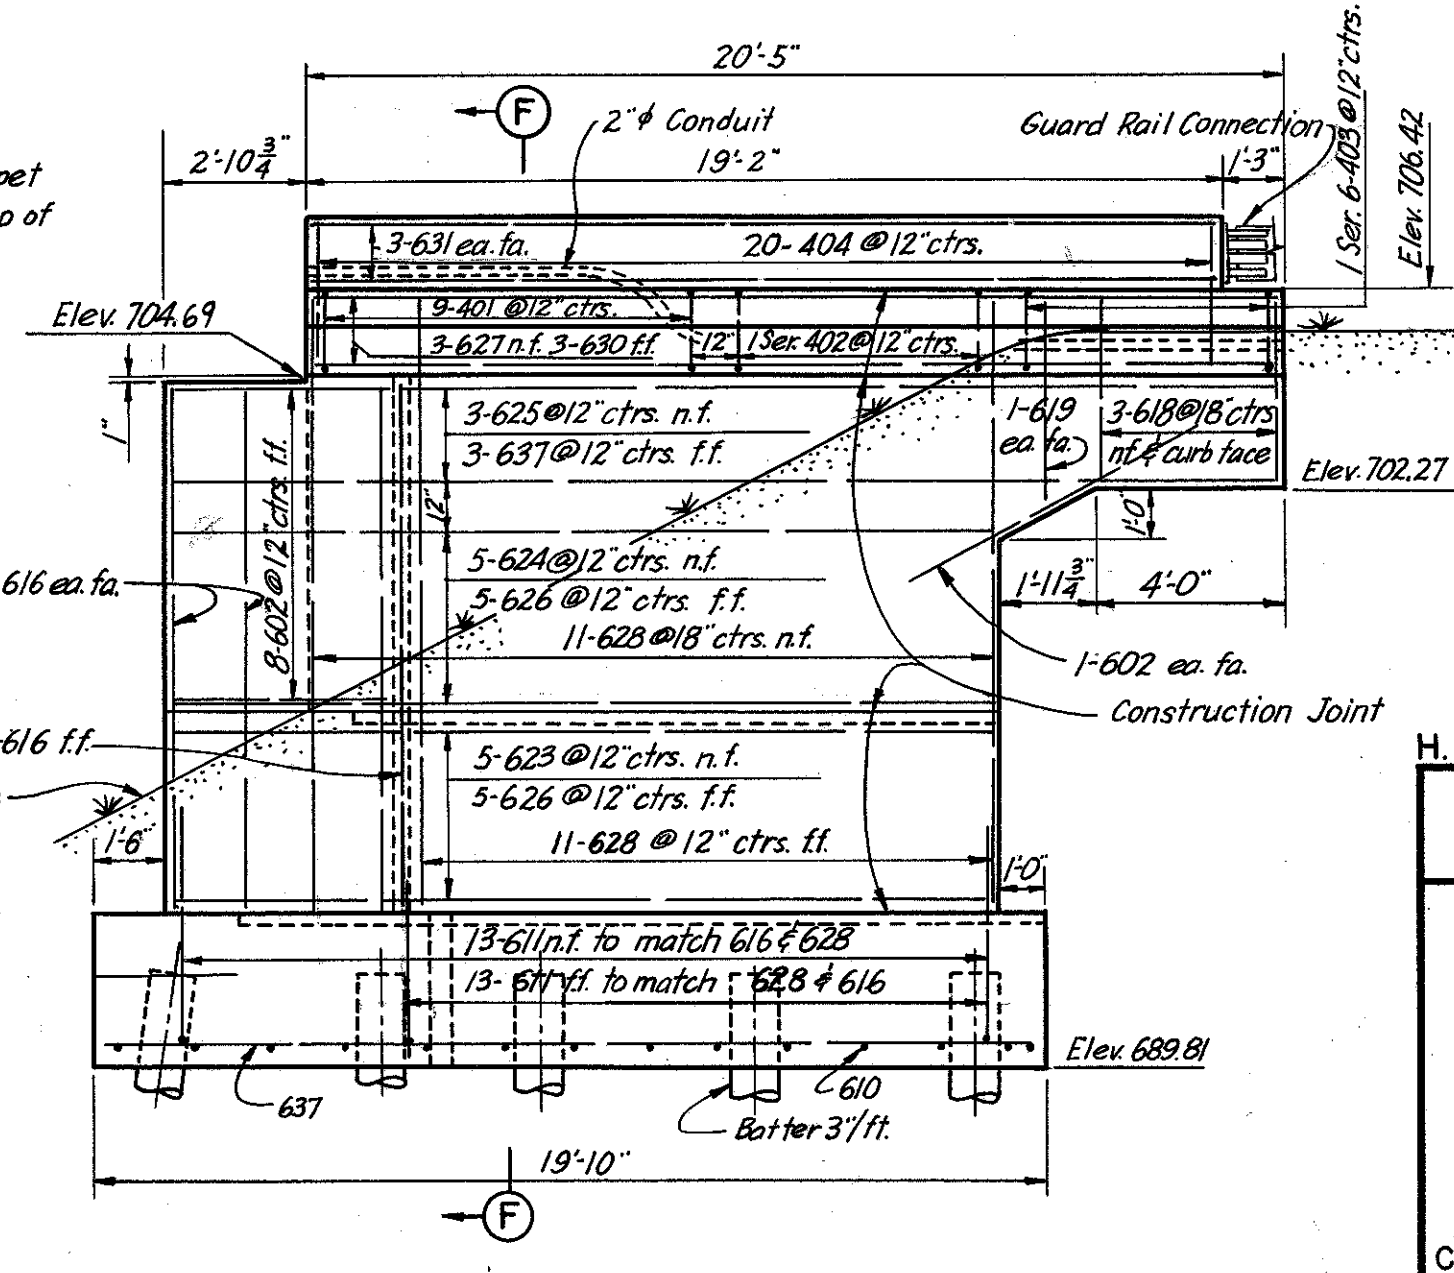

ELEVATION G-G

H.N.T.B. BR. NO. 3 PART 7A
 HOWARD, NEEDLES, TAMMEN & BERGENDOFF
 CONSULTING ENGINEERS
 KANSAS CITY CLEVELAND NEW YORK
EAST ABUTMENT-SOUTH HALF
 INNER BELT FREEWAY OVER
 RAMPS E-8, E-10 AND E-16
 BR. NO. CUY-42-1843 STA. 65+10.18
 Scale: 1/4" = 1'-0" STA. 68+19.03
WILLOW-INNER BELT FREEWAY
 CLEVELAND CUYAHOGA COUNTY OHIO
 DRAWN N/V TRACED H/W CHECKED J.P.P. REVIEWED J.C.T. REVISIONS
 DATE 7/2/59 DATE 3/16/59 DATE 2-21-59 DATE 1-13-59 SHEET 107

CUYAHOGA COUNTY
CITY OF CLEVELAND
CUY-21-15.32
CUY-42-18.42

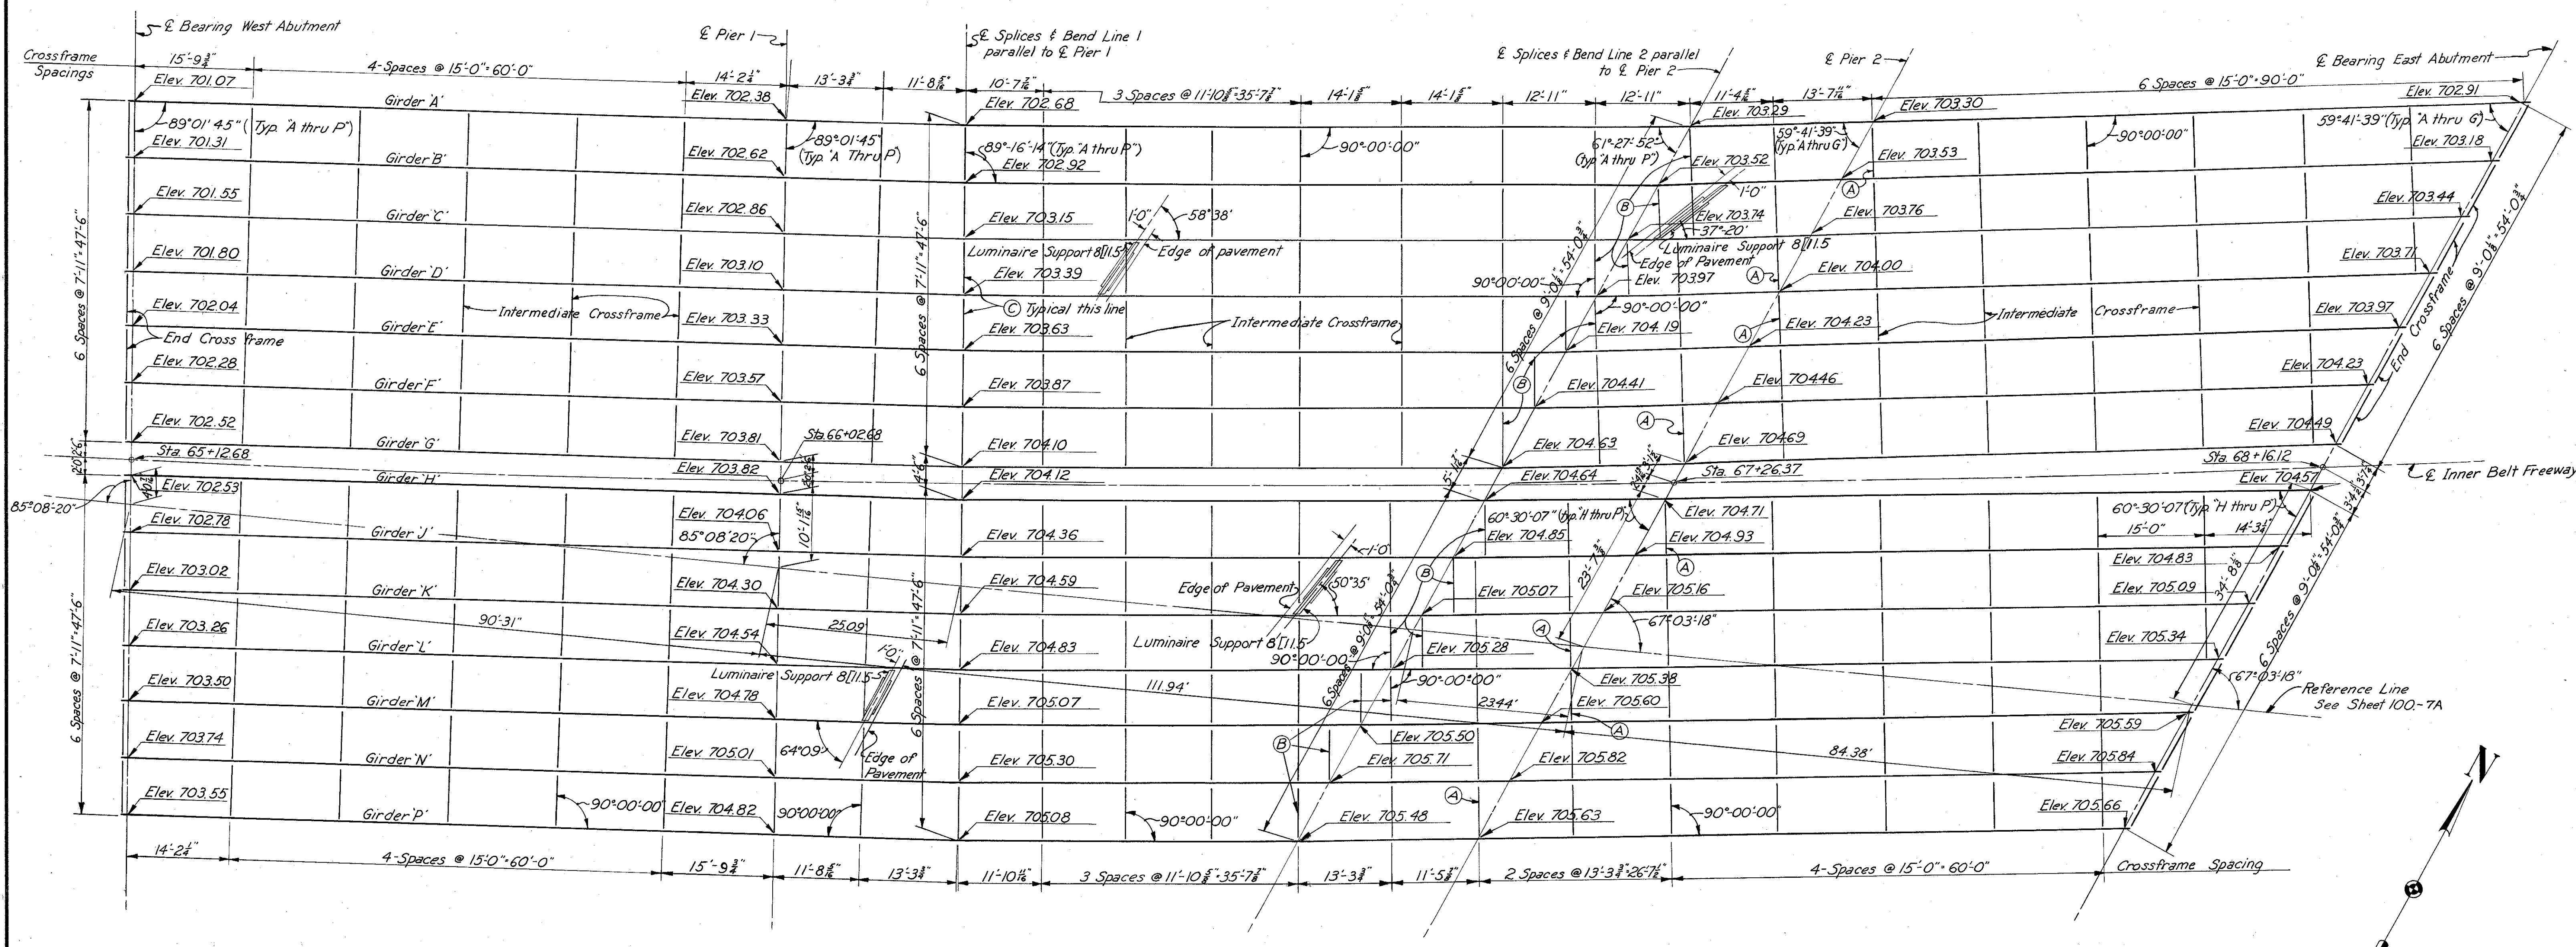

FRAMING PLAN

NOTES:
Elevations shown are to the top of pavement
For superstructure details, other than girder elevations, see sheet 112-7A
For girder notes see sheet 109-7A
A, B, C indicate special crossframes, see sheet 112-7A for their details.

H.N.T.B. BR. NO. 3 PART 7A

HOWARD, NEEDLES, TAMMEN & BERGENDOFF CONSULTING ENGINEERS KANSAS CITY CLEVELAND NEW YORK			
FRAMING PLAN			
INNER BELT FREEWAY OVER RAMPS E-8, E-10 AND E-16			
BR. NO. CUY-42-1843		STA. 65+10.18	
Scale: 3/32" = 1'-0"		STA. 68+19.03	
WILLOW-INNER BELT FREEWAY			
CLEVELAND		CUYAHOGA COUNTY OHIO	
DRAWN A.B.	TRACED R.C.	CHECKED C.A.B.	REVIEWED J.C.T.
DATE 4-18-58	DATE 5-7-59	DATE 8-25-58	DATE 11-13-57

JUL 3 1955

CUYAHOGA COUNTY
CITY OF CLEVELAND
CUY-21-15.32
CUY-42-18.42

NOTES:

Top of finished pavement elevations along girders are given at tenth points between bearings and are shown on sheet 111-7A. The girders shall be fabricated to lines parallel to profiles formed by these elevations, plus the camber required to compensate for dead load deflections.

Top and bottom flange plates are to be the same and shall be spliced at the points shown in the girder elevations, and as otherwise required. The web plate may be spliced as required by available plate lengths.

Intermediate stiffeners shall be as shown in Table 'A' below and shall be placed in pairs on all interior girders. These stiffeners shall not be welded to the flanges, but fitted to close enough contact that the shop coat, when applied, shall fill and close the openings.

Intermediate stiffeners shall be used on the inside only of exterior girders and shall be welded to top or bottom flanges within the limits shown on the girder elevations with a 5/16" fillet weld on both sides of the joint for a distance of 2" from the outside edge of the stiffener. The other end shall have a tight fit with the flange.

Bearing stiffeners shall be 5 x 7/8 Rs. at the abutments and 8 x 1 Rs. at the piers and shall be placed in pairs on all girders. They shall be grooved and fully butt welded to the lower flange and fitted to close contact, without welding, at the upper flange.

Angles shall be used as shown in Table 'A' at all field splices. All girder field splices shall be made with 7/8" high strength bolts conforming to Supplemental Spec. S-207. The bolts shall be placed with the heads on the outside face of exterior girders and on bottom of girder flanges.

At bend points, the girders change direction at the center line of the field splice. Specially cut splice plates will be required at these locations.

Welding shown for girder "A" is typical for all girders.

Welding shall be done in accordance with Sec. S-7.22 of the Specifications.

Longitudinal dimensions of the girders are measured horizontally along E of web plate.

For top of pavement elevations and deflections see sheet 111-7A.

For splice details and other superstructure details see sheet 112-7A.

For details of rocker masonry plates see sheet 123-7A.


For other rocker details and details of bolsters see Ohio Standards, Dwg. RB-1-35.

For details of end dams see sheet 123-7A.

Intermediate stiffeners shall be spaced equally as shown between crossframes.

For Shop Drawing and Assembly Notes see sheet 128-7A.

GIRDER FLANGE WIDTH	INTERMEDIATE STIFFENER	SPLICE ANGLE
12"	R 5X 5/8	5X 3 1/2 X 5/8
14" - 16"	R 6X 3/4	6X 3 1/2 X 5/8
18" & Up	R 8X 1	8X 4 X 5/8

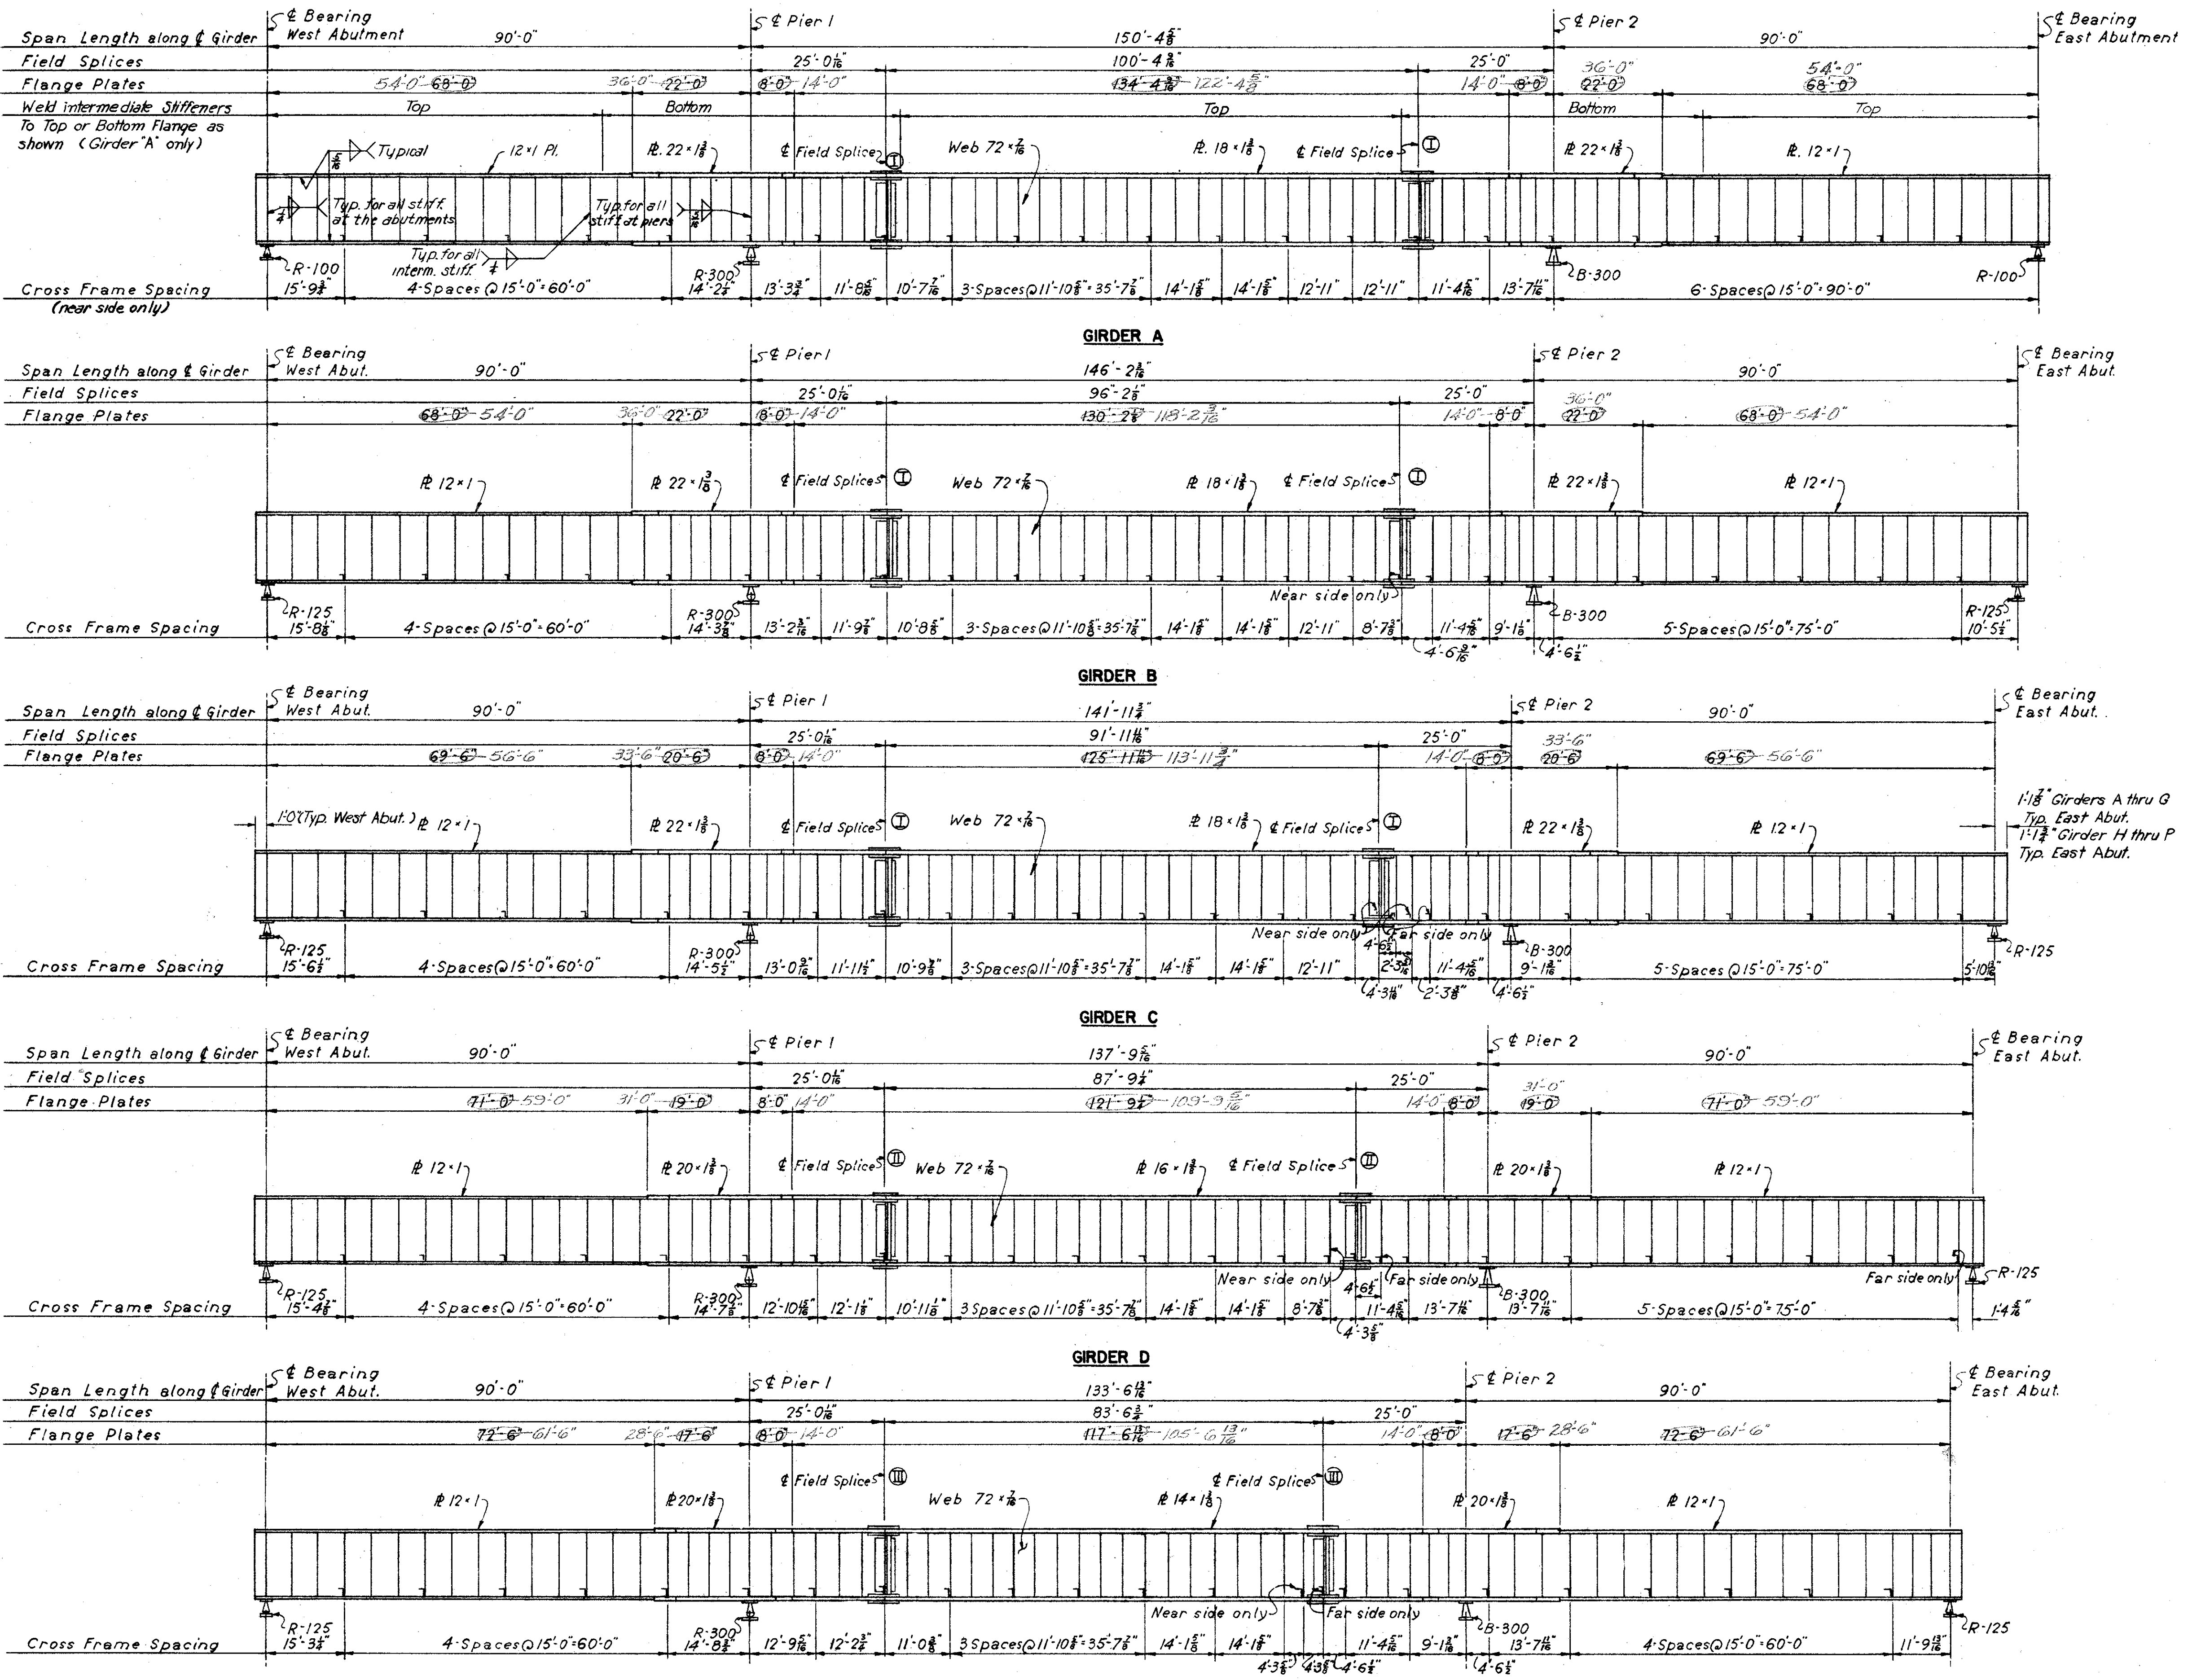

GIRDER E
Horizontal Scale 1/8" = 1'-0"
No Vertical Scale

H.N.T.B. BR. NO. 3 PART 7A

HOWARD, NEEDLES, TAMMEN & BERGENDOFF
CONSULTING ENGINEERS
KANSAS CITY CLEVELAND NEW YORK







GIRDER ELEVATIONS
INNER BELT FREEWAY OVER
RAMPS E-8, E-10 AND E-16
BR. NO. CUY-42-1843 STA. 65+10.18
Scale: As noted STA. 68+19.03

WILLOW-INNER BELT FREEWAY
CLEVELAND CUYAHOGA COUNTY OHIO

DRAWN A.B.	TRACED	CHECKED L.C.	REVIEWED JCT	REVISED 5-20-60
DATE 5-19-55	DATE	DATE 7-2-55	DATE 11-13-57	SHEET 109

JUL 3 1965

CUYAHOGA COUNTY
CITY OF CLEVELAND
CUY-21-15.32
CUY-42-18.42

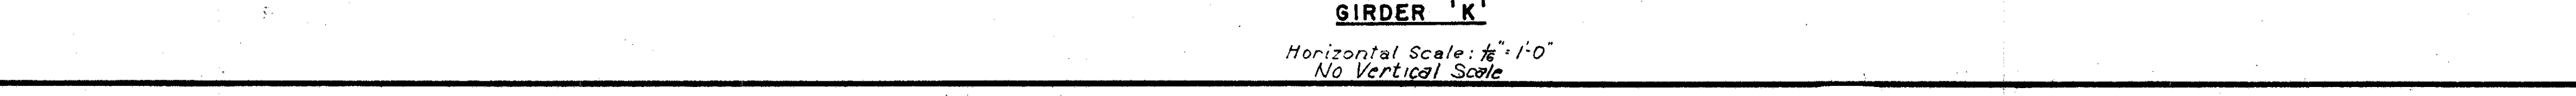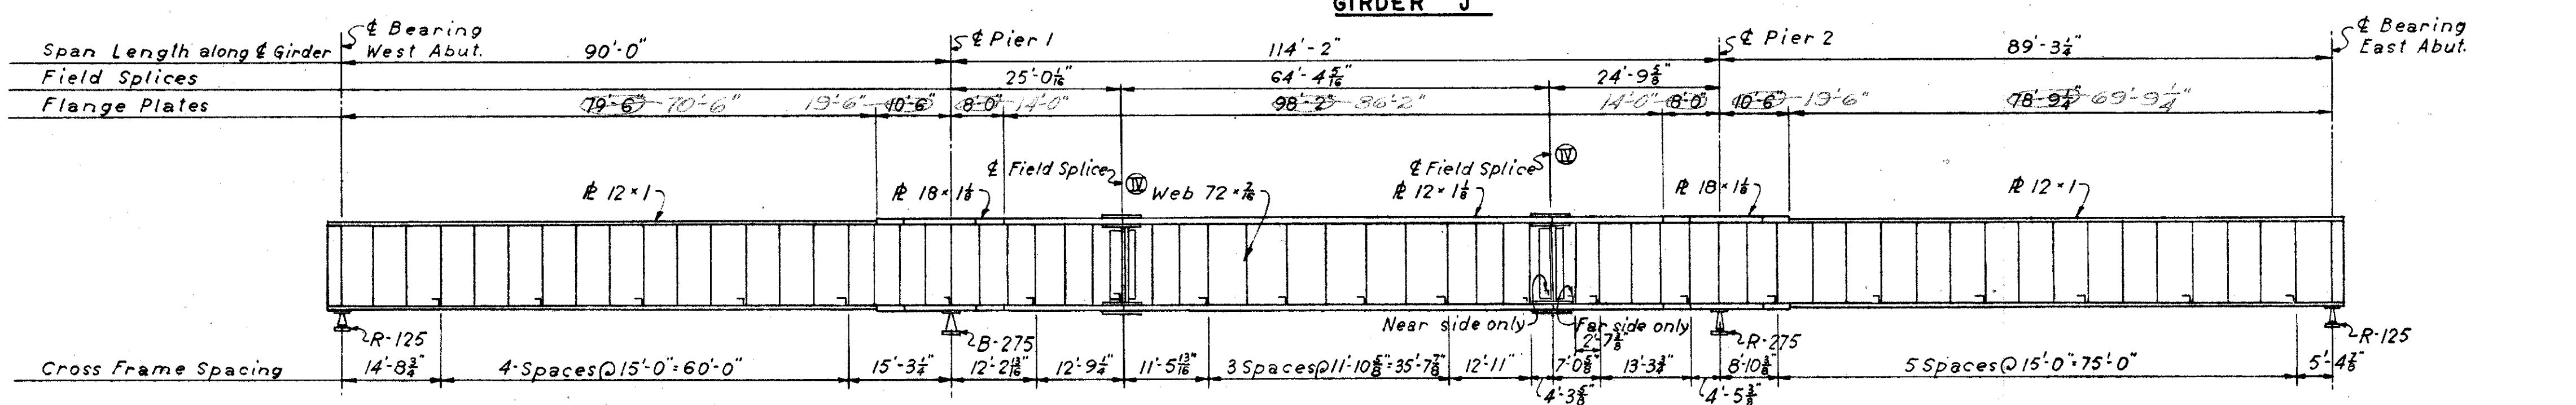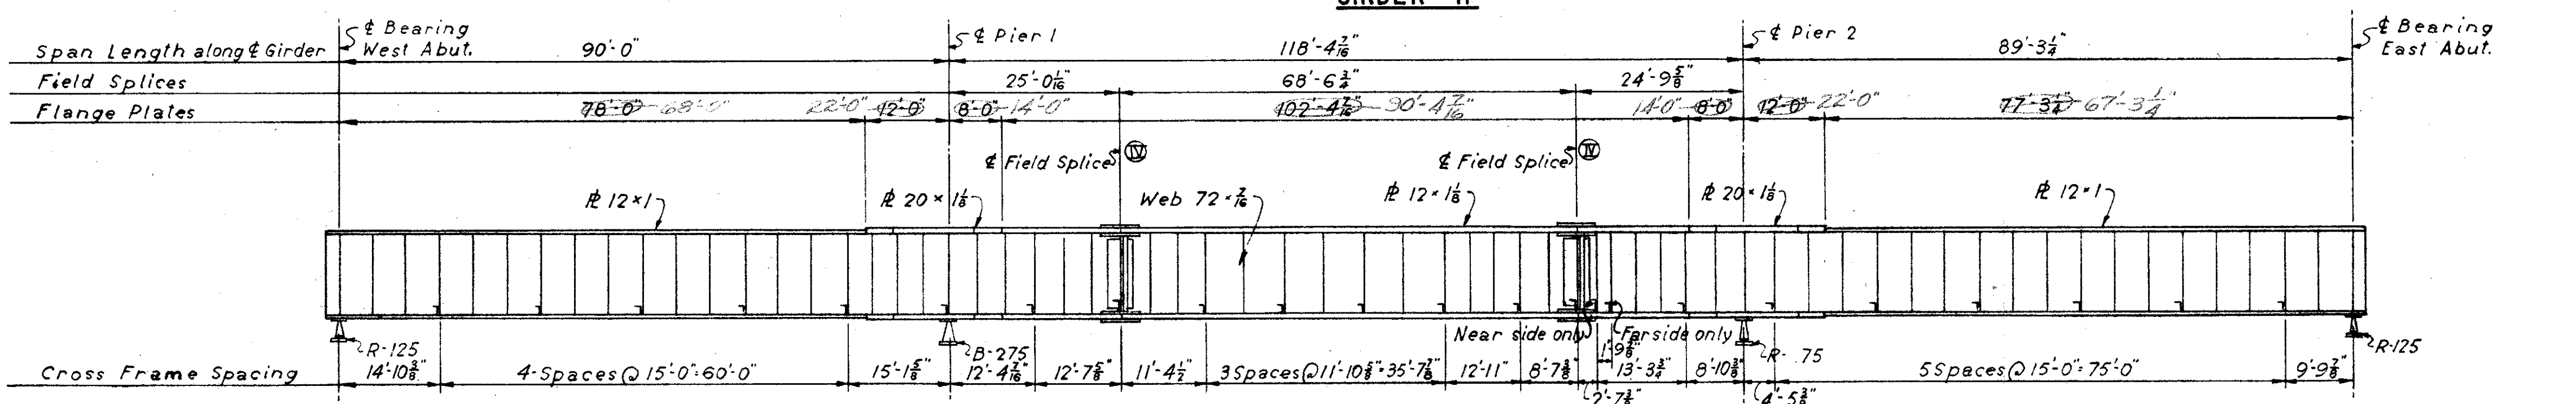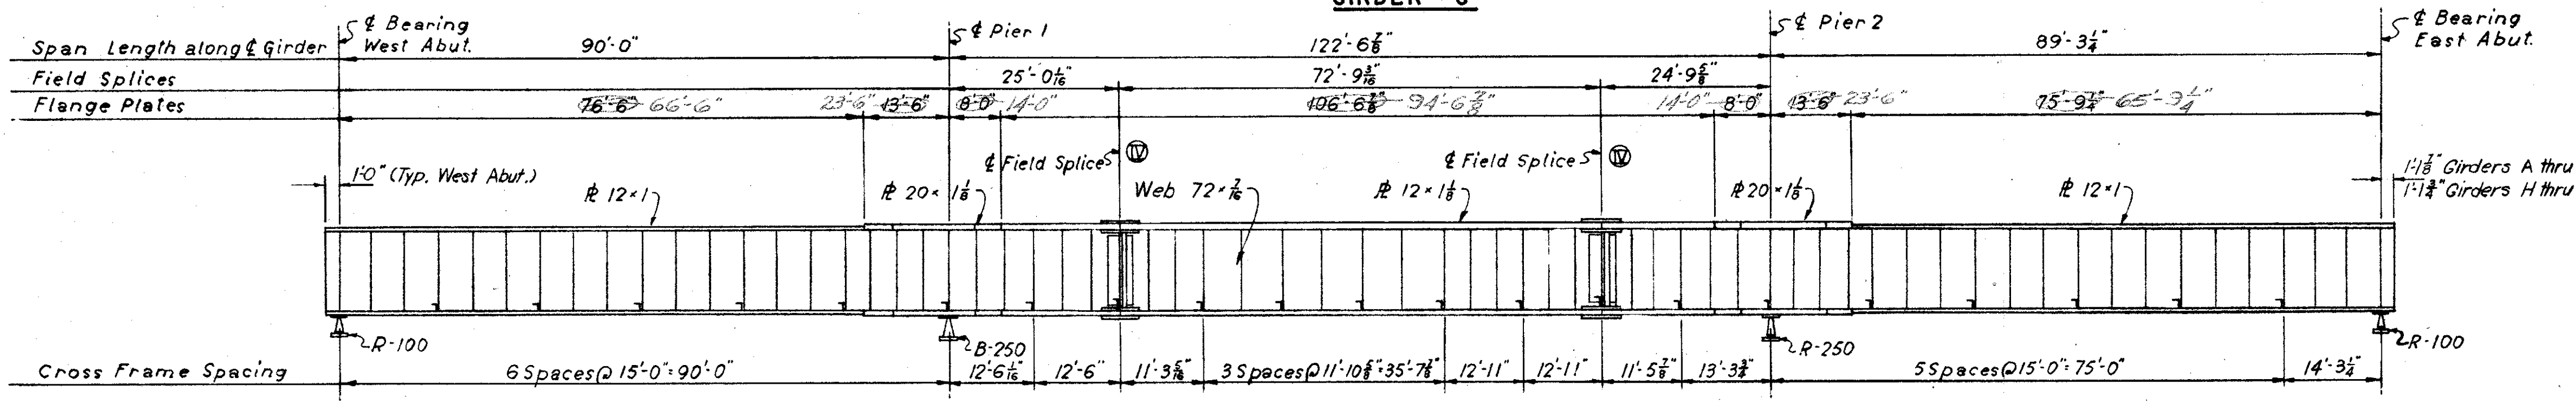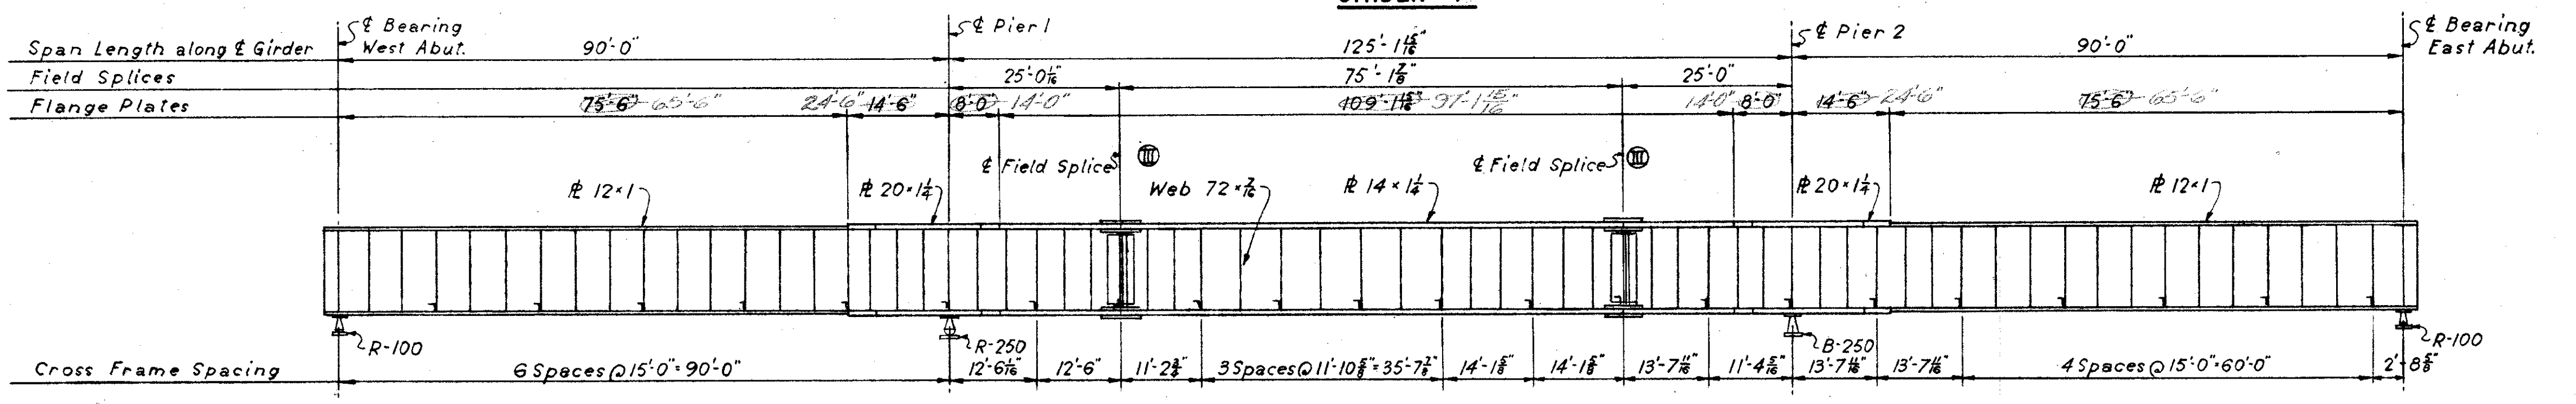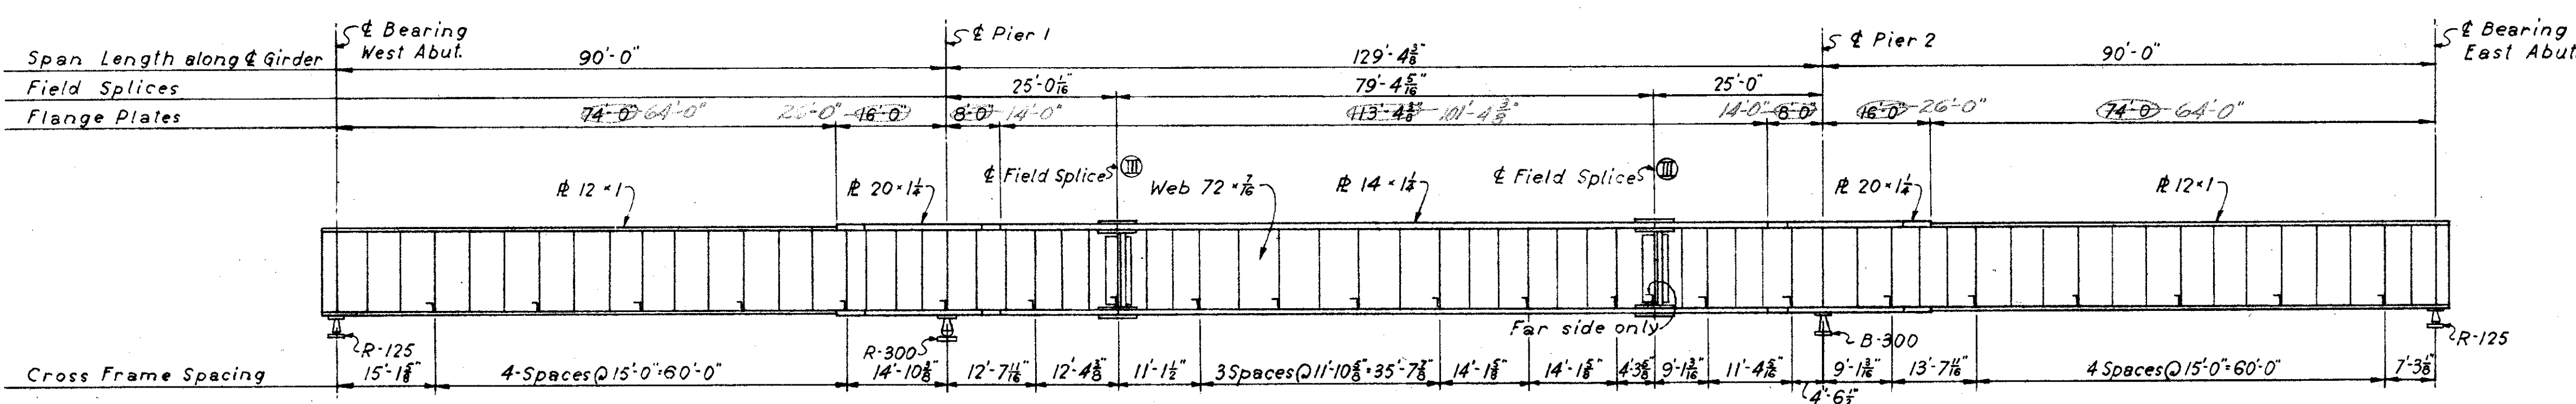

Horizontal Scale: 1/4" = 1'-0"
No Vertical Scale

NOTE: For girder notes see sheet 109-7A.


H.N.T.B. BR. NO. 3 PART 7A

HOWARD, NEEDLES, TAMMEN & BERGENDOFF
CONSULTING ENGINEERS
KANSAS CITY CLEVELAND NEW YORK

GIRDER ELEVATIONS
INNER BELT FREEWAY OVER
RAMPS E-8, E-10 AND E-16
BR. NO. CUY-42-1843 STA. 65+10.18
Scale: As noted STA. 68+19.03

WILLOW-INNER BELT FREEWAY
CLEVELAND CUYAHOGA COUNTY OHIO


DRAWN A.B.	TRACED	CHECKED J.L.C.	REVIEWED J.C.T.	REVISED 6-20-60
DATE 5-23-59	DATE	DATE 7-3-59	DATE 11-13-59	SHEET 110

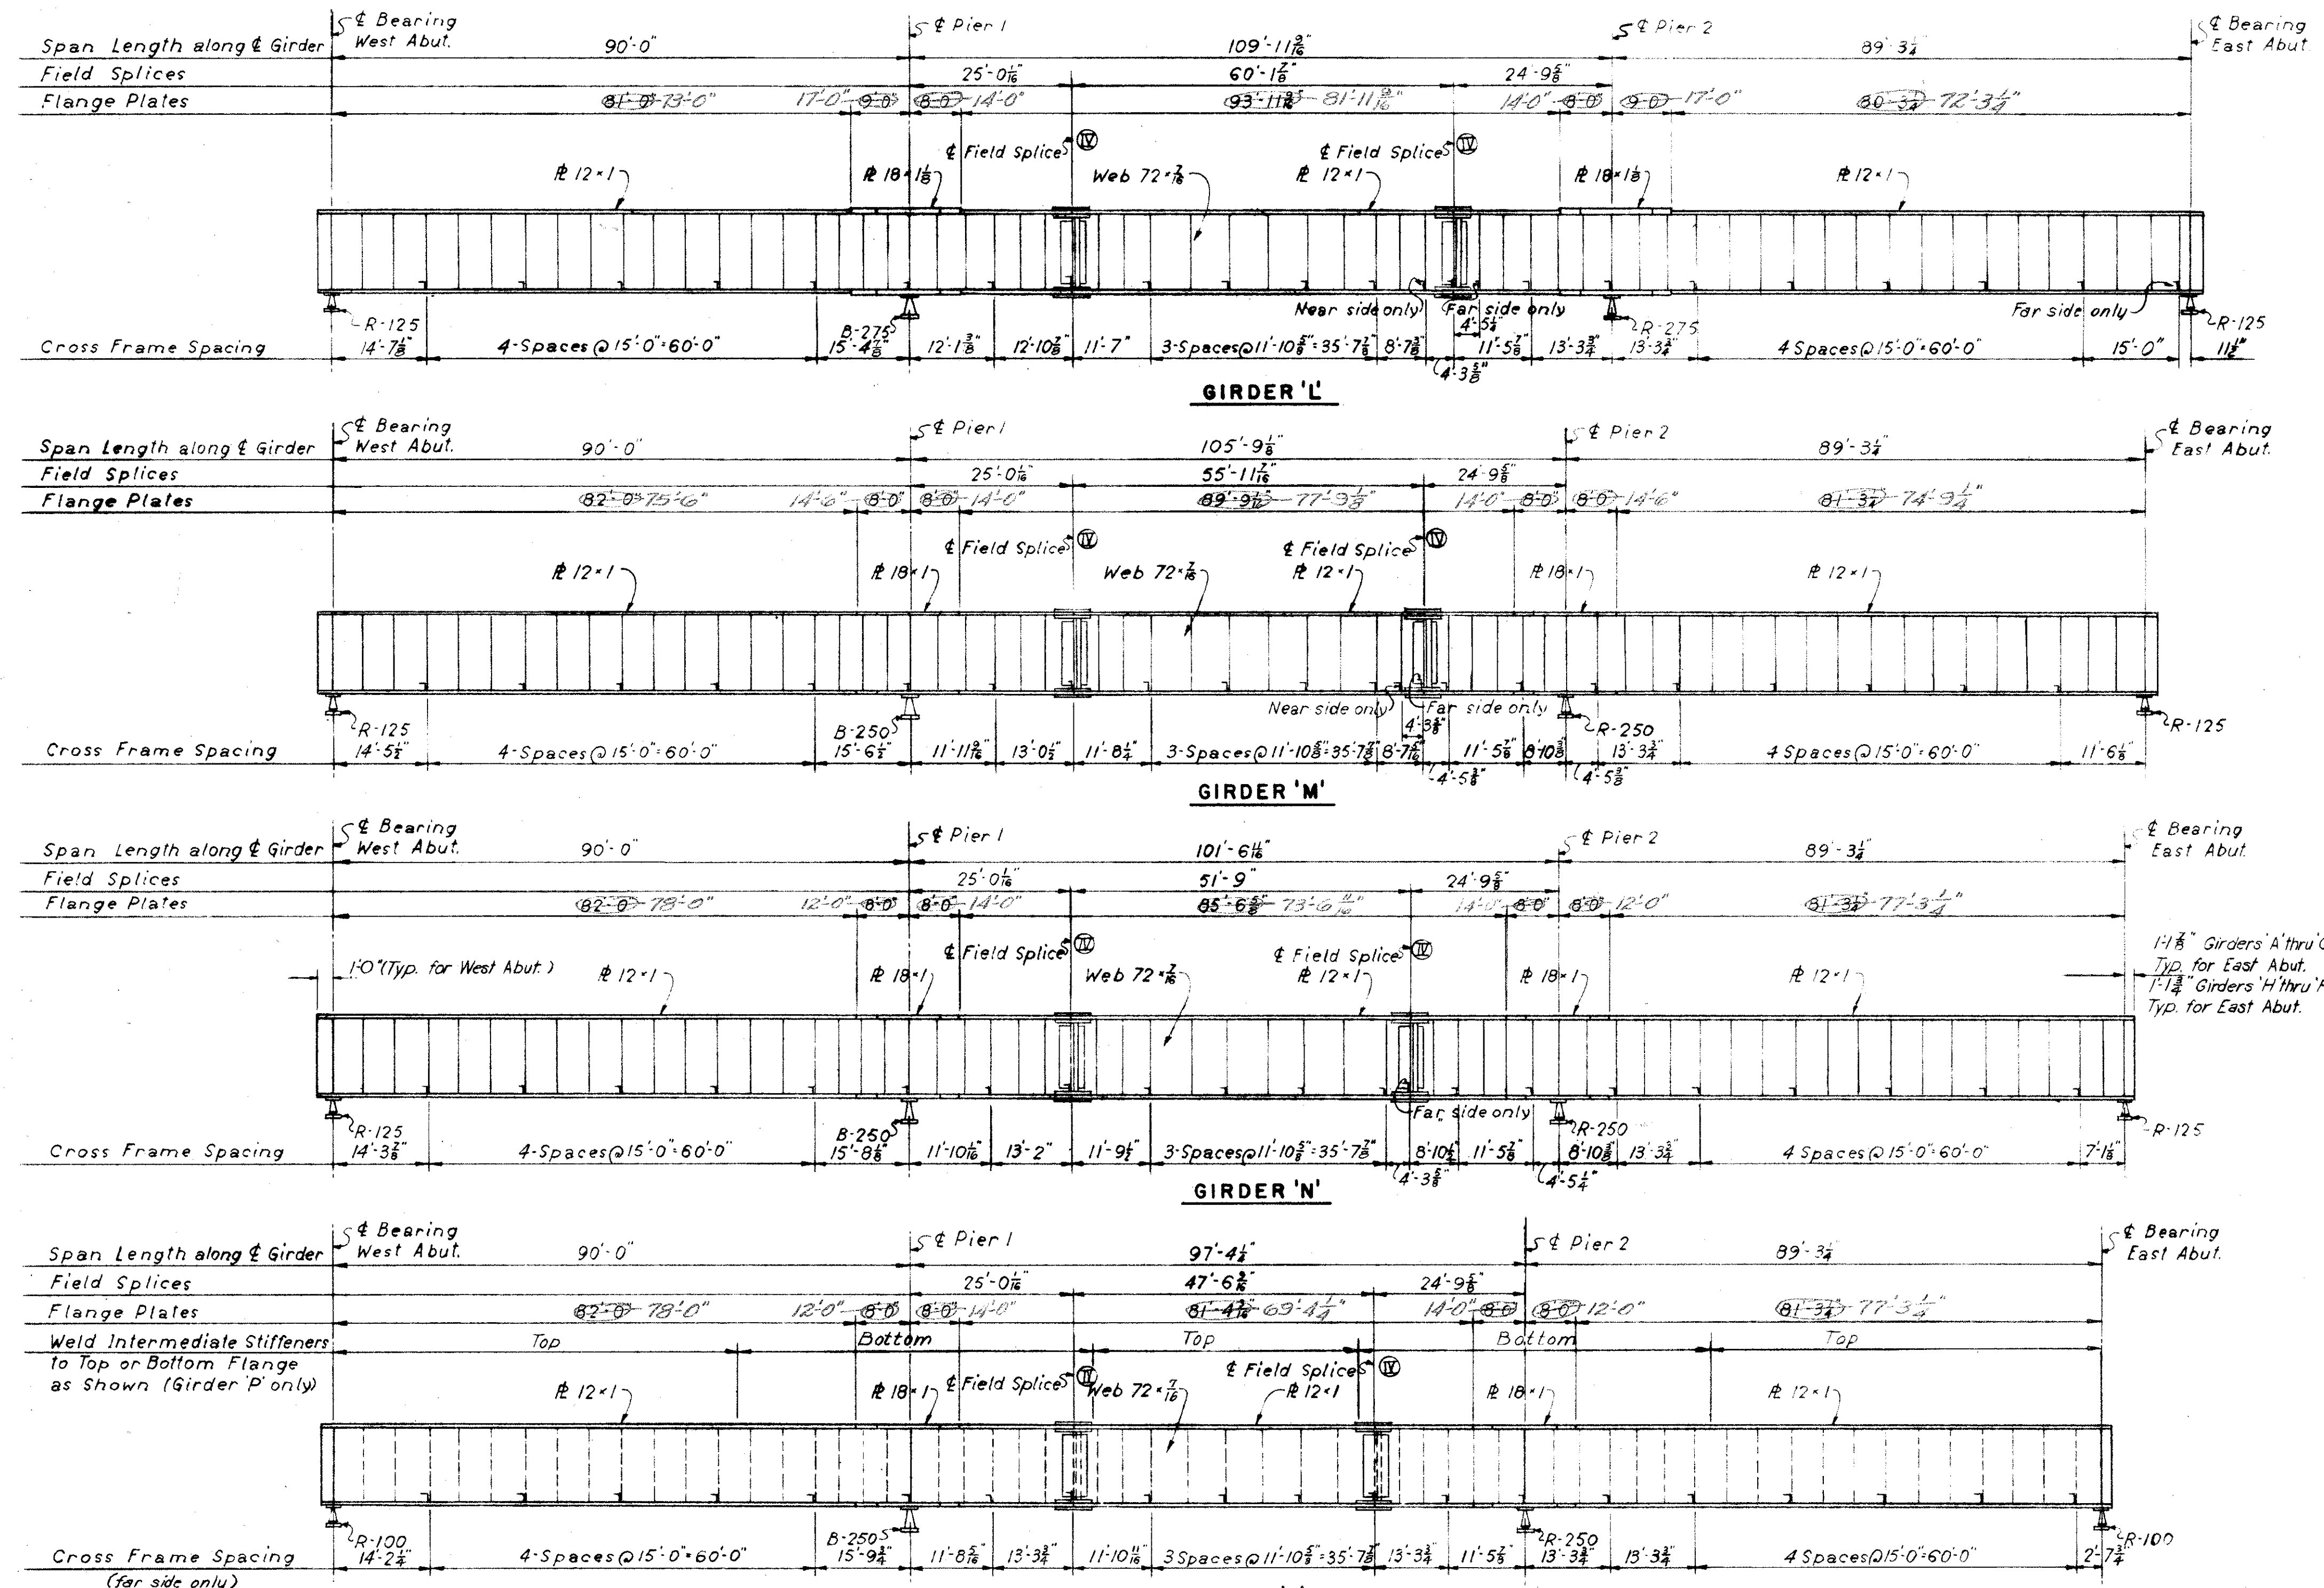

TOP OF PAVEMENT ELEVATIONS AND DEAD LOAD DEFLECTIONS

GIRDERS

	A	B	C	D	E	F	G	H	J	K	L	M	N	P
1	701.20	701.44	701.68	701.92	702.17	702.41	702.65	702.89	703.13	703.37	703.61	703.85	704.09	704.33
2	701.34	701.58	701.82	702.06	702.30	702.54	702.78	703.02	703.26	703.50	703.74	703.98	704.22	704.46
3	701.47	701.71	701.95	702.19	702.43	702.67	702.91	703.15	703.39	703.63	703.87	704.11	704.35	704.59
4	701.60	701.84	702.08	702.32	702.56	702.80	703.04	703.28	703.52	703.76	704.00	704.24	704.48	704.72
5	701.74	701.97	702.21	702.45	702.69	702.93	703.17	703.41	703.65	703.89	704.13	704.37	704.61	704.85
6	701.87	702.11	702.35	702.59	702.83	703.07	703.31	703.55	703.79	704.03	704.27	704.51	704.75	704.99
7	702.00	702.24	702.48	702.72	702.96	703.20	703.44	703.68	703.92	704.16	704.40	704.64	704.88	705.12
8	702.14	702.37	702.61	702.85	703.09	703.33	703.57	703.81	704.05	704.29	704.53	704.77	705.01	705.25
9	702.26	702.50	702.74	702.98	703.22	703.46	703.70	703.94	704.18	704.42	704.66	704.90	705.14	705.38
10	702.39	702.63	702.87	703.11	703.35	703.59	703.83	704.07	704.31	704.55	704.79	705.03	705.27	705.51
11	702.52	702.76	703.00	703.24	703.48	703.72	703.96	704.20	704.44	704.68	704.92	705.16	705.40	705.64
12	702.65	702.89	703.13	703.37	703.61	703.85	704.09	704.33	704.57	704.81	705.05	705.29	705.53	705.77
13	702.78	703.02	703.26	703.50	703.74	703.98	704.22	704.46	704.70	704.94	705.18	705.42	705.66	705.90
14	702.91	703.15	703.39	703.63	703.87	704.11	704.35	704.59	704.83	705.07	705.31	705.55	705.79	706.03
15	703.04	703.28	703.52	703.76	704.00	704.24	704.48	704.72	704.96	705.20	705.44	705.68	705.92	706.16
16	703.17	703.41	703.65	703.89	704.13	704.37	704.61	704.85	705.09	705.33	705.57	705.81	706.05	706.29
17	703.30	703.54	703.78	704.02	704.26	704.50	704.74	704.98	705.22	705.46	705.70	705.94	706.18	706.42
18	703.43	703.67	703.91	704.15	704.39	704.63	704.87	705.11	705.35	705.59	705.83	706.07	706.31	706.55
19	703.56	703.80	704.04	704.28	704.52	704.76	705.00	705.24	705.48	705.72	705.96	706.20	706.44	706.68
20	703.69	703.93	704.17	704.41	704.65	704.89	705.13	705.37	705.61	705.85	706.09	706.33	706.57	706.81
21	703.82	704.06	704.30	704.54	704.78	705.02	705.26	705.50	705.74	705.98	706.22	706.46	706.70	706.94
22	703.95	704.19	704.43	704.67	704.91	705.15	705.39	705.63	705.87	706.11	706.35	706.59	706.83	707.07
23	704.08	704.32	704.56	704.80	705.04	705.28	705.52	705.76	706.00	706.24	706.48	706.72	706.96	707.20
24	704.21	704.45	704.69	704.93	705.17	705.41	705.65	705.89	706.13	706.37	706.61	706.85	707.09	707.33
25	704.34	704.58	704.82	705.06	705.30	705.54	705.78	706.02	706.26	706.50	706.74	706.98	707.22	707.46
26	704.47	704.71	704.95	705.19	705.43	705.67	705.91	706.15	706.39	706.63	706.87	707.11	707.35	707.59
27	704.60	704.84	705.08	705.32	705.56	705.80	706.04	706.28	706.52	706.76	707.00	707.24	707.48	707.72

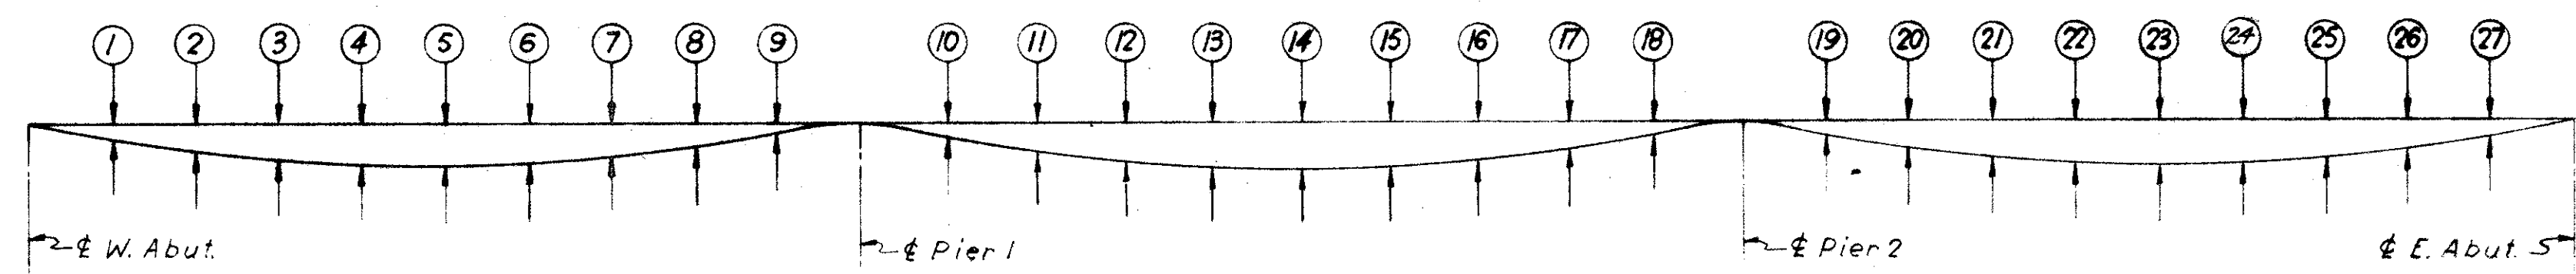

DEAD LOAD DEFLECTION DIAGRAM
 This diagram locates points only and does not necessarily show the correct direction of deflections

NOTES:
 Figures in the left columns are the total deflections due to the dead load of concrete and steel. Figures in the right columns are dead load deflections due to concrete only.

Negative sign indicates upward deflection. Deflections are given to the nearest 1/16 inch.

Note: For girder notes see sheet 109-7A

H.N.T.B. BR. NO. 3 PART 7A

HOWARD, NEEDLES, TAMMEN & BERGENDOFF
 CONSULTING ENGINEERS
 KANSAS CITY CLEVELAND NEW YORK


GIRDER ELEVATIONS
 INNER BELT FREEWAY OVER
 RAMPS E-8, E-10 AND E-16
 BR. NO. CUY-42-1843 STA. 65+10.18
 Scale: As noted STA. 68+19.03

WILLOW-INNER BELT FREEWAY
 CLEVELAND CUYAHOGA COUNTY OHIO

DRAWN A.B. TRACED DATE 5-29-58 CHECKED F.C. DATE 7-7-58 REVIEWED J.C. DATE 11-13-59 REVISIONS 6-20-60 SHEET 111












Note: Prefix "S" shall be assigned to all bar marks

CUYAHOGA COUNTY
CITY OF CLEVELAND
CUY-21-15.32
CUY-42-18.42

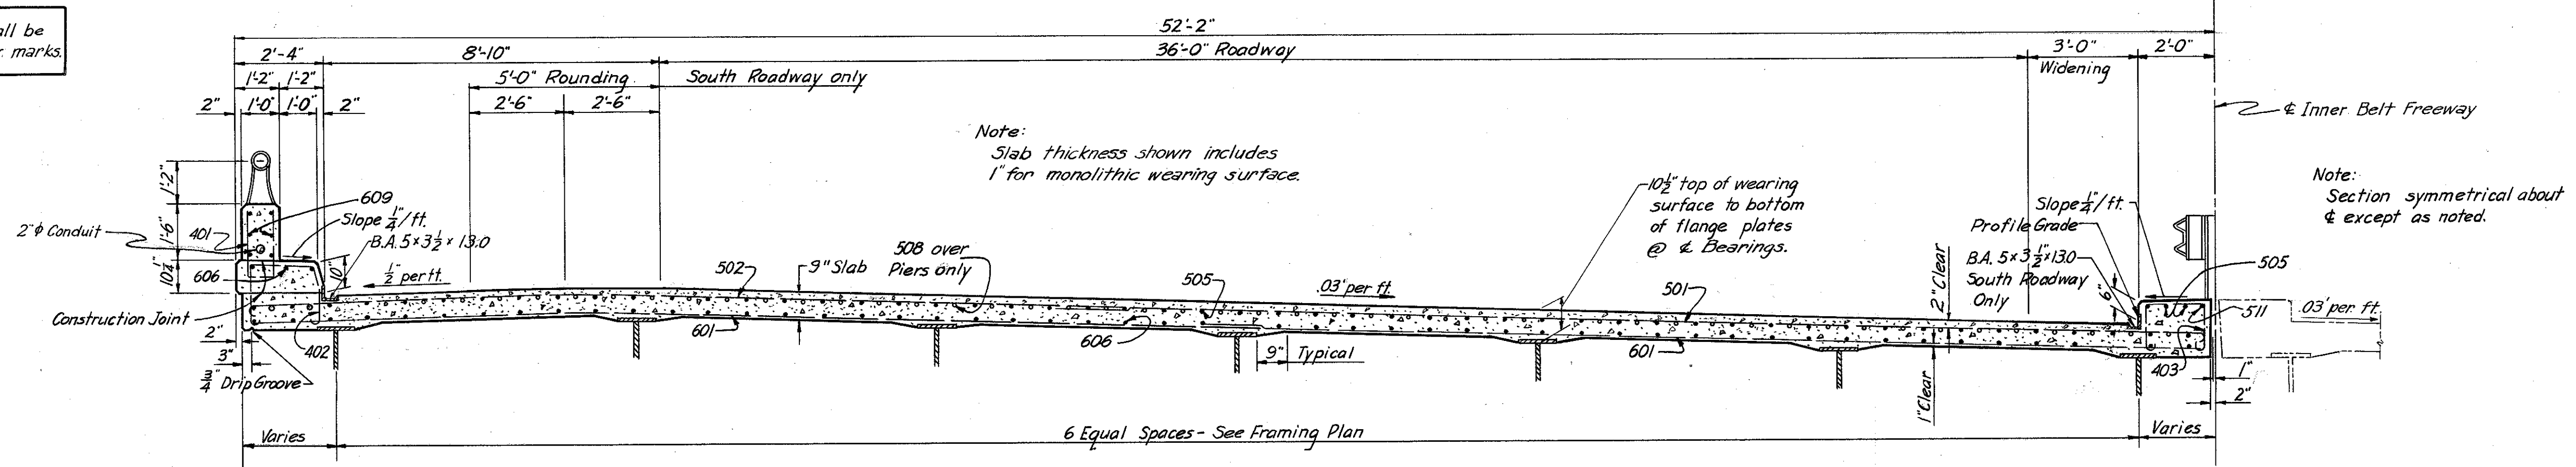


Note: Slab thickness shown includes 1" for monolithic wearing surface.

Note: Section symmetrical about centerline except as noted.

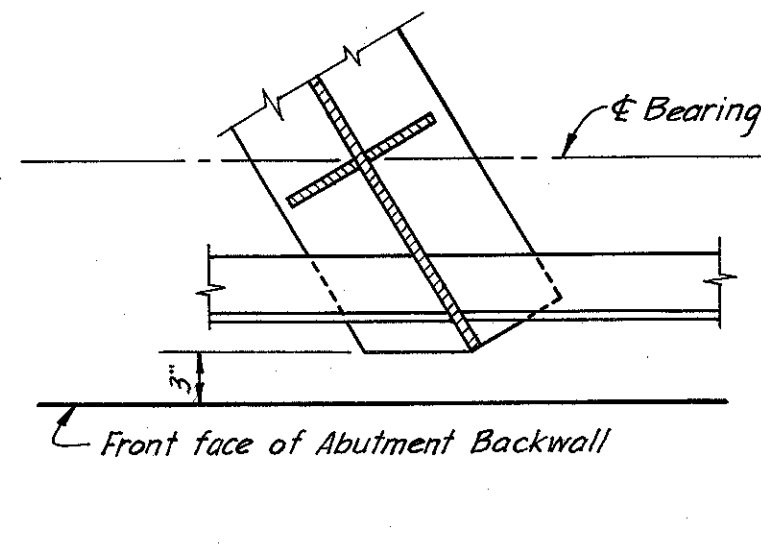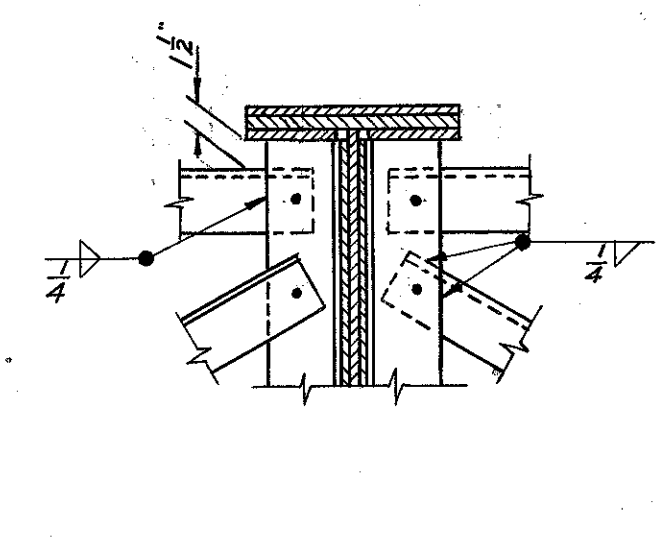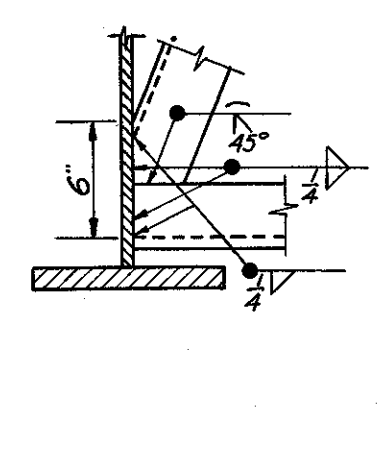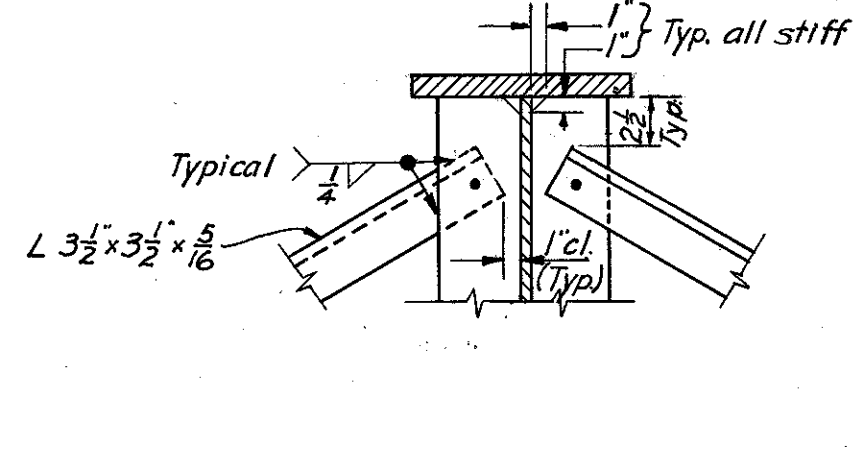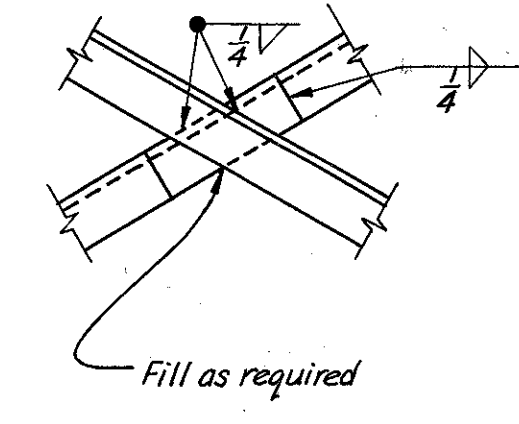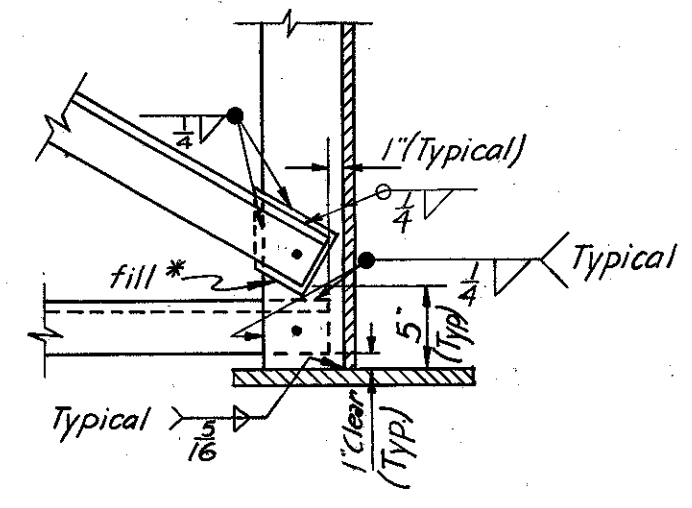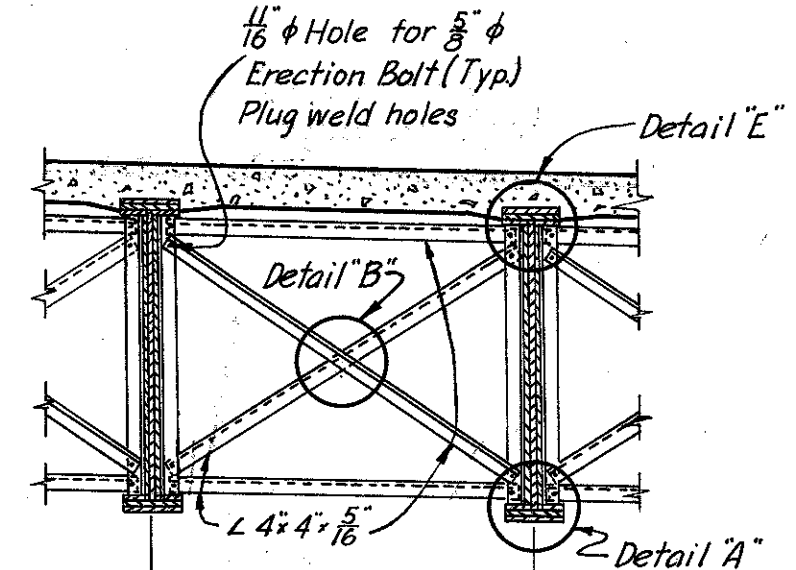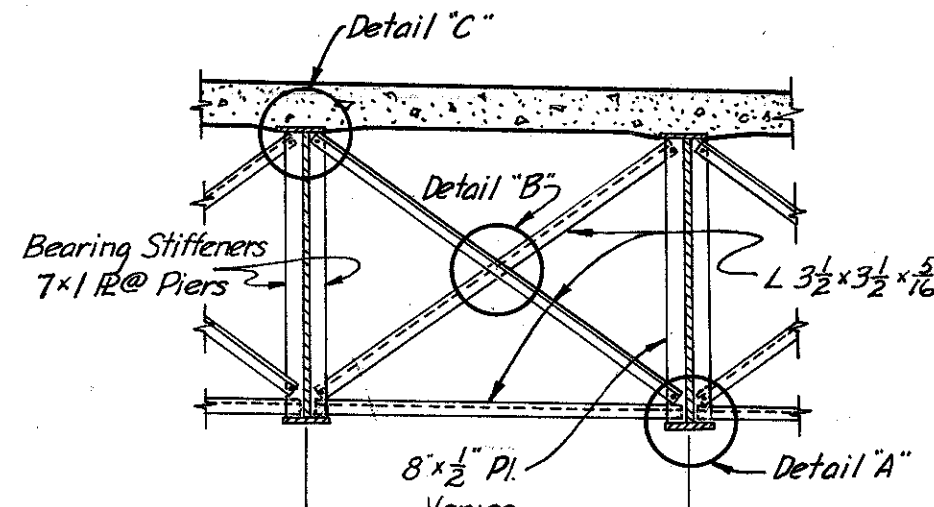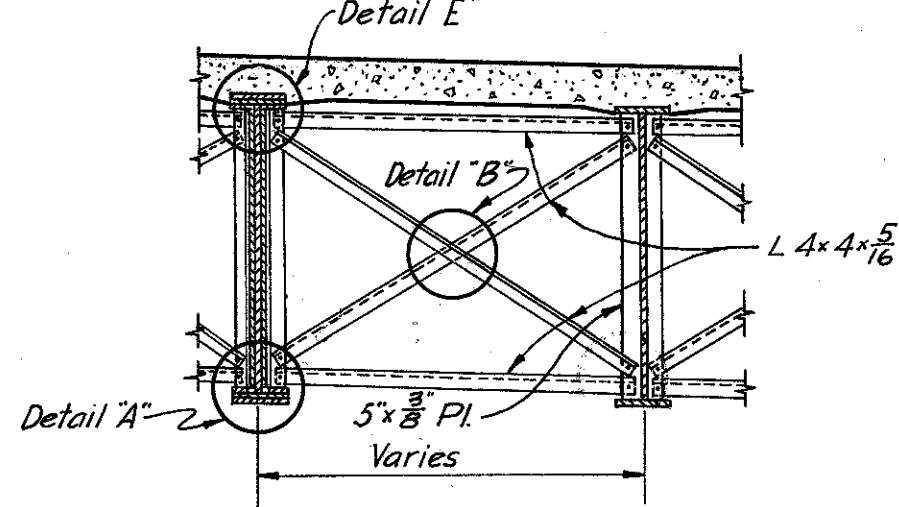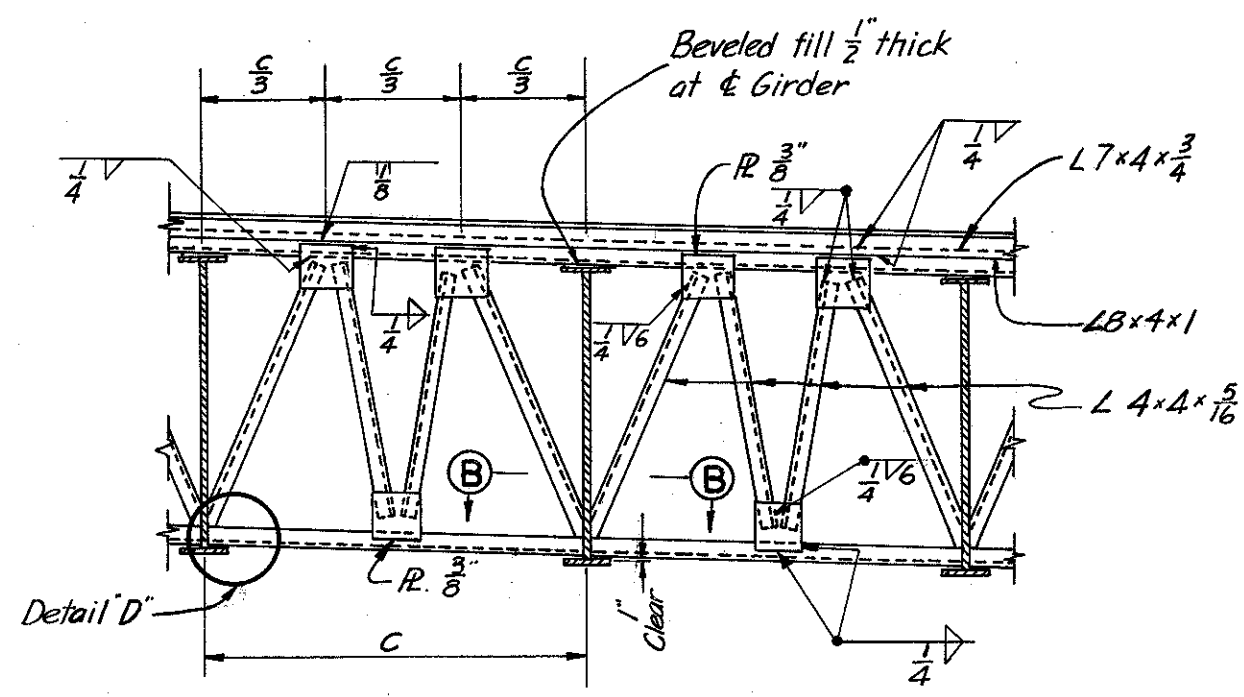
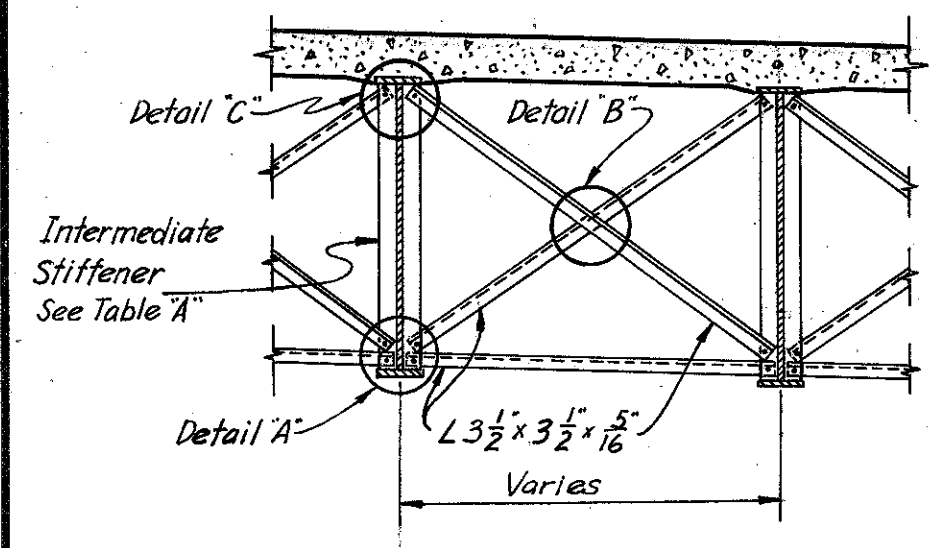


FLANGE WIDTH	INTERMEDIATE STIFFENER
12"	R 5" x 3/8"
14" to 16"	R 6" x 3/8"
18" and Up	R 8" x 1/2"

NOTES:
For Deck Plan and location of Section A-A see sheet 113-7A
For additional notes see sheet 109-7A

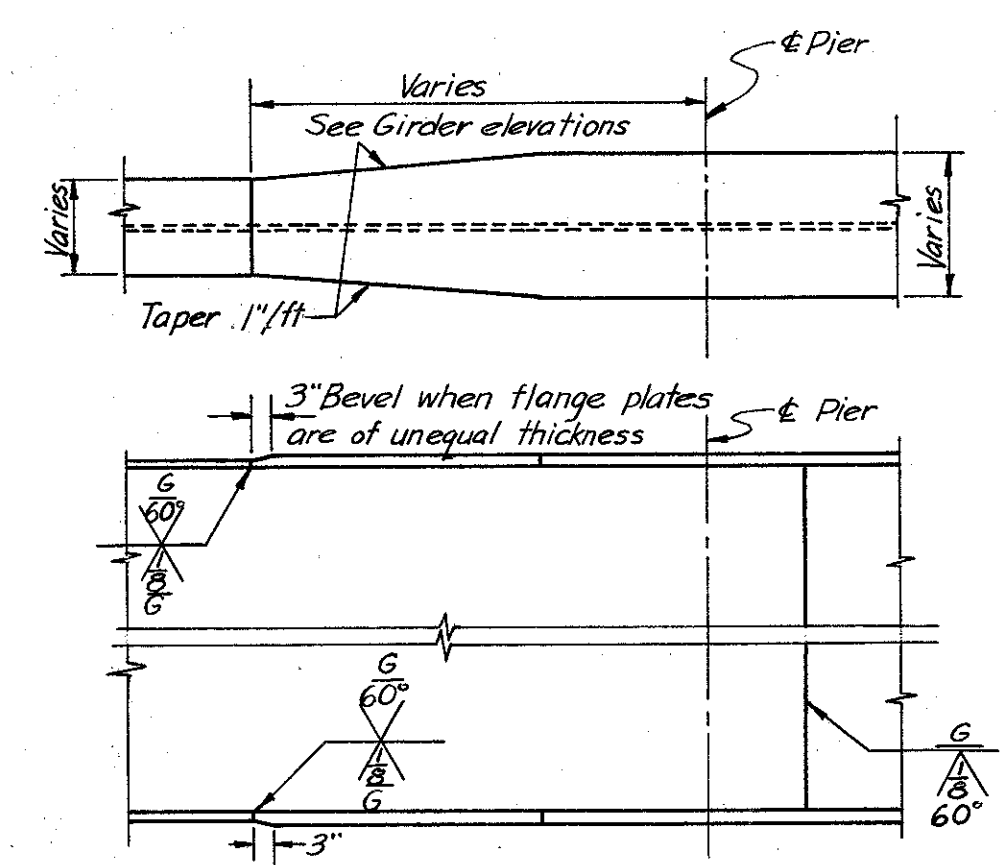

Note: Shop Splices may be located as required by available plate lengths. Web and flange splices shall not coincide.

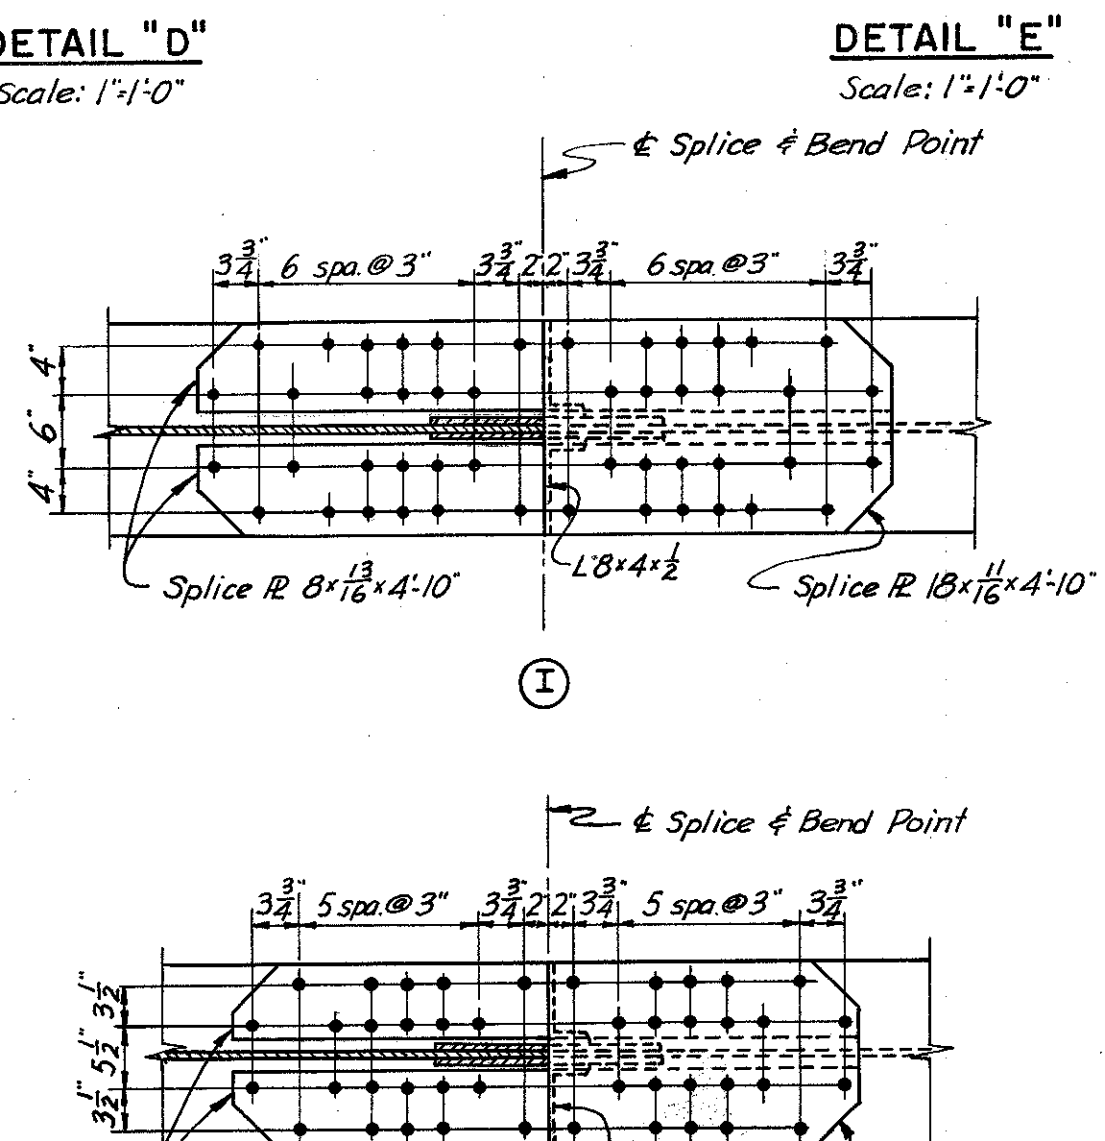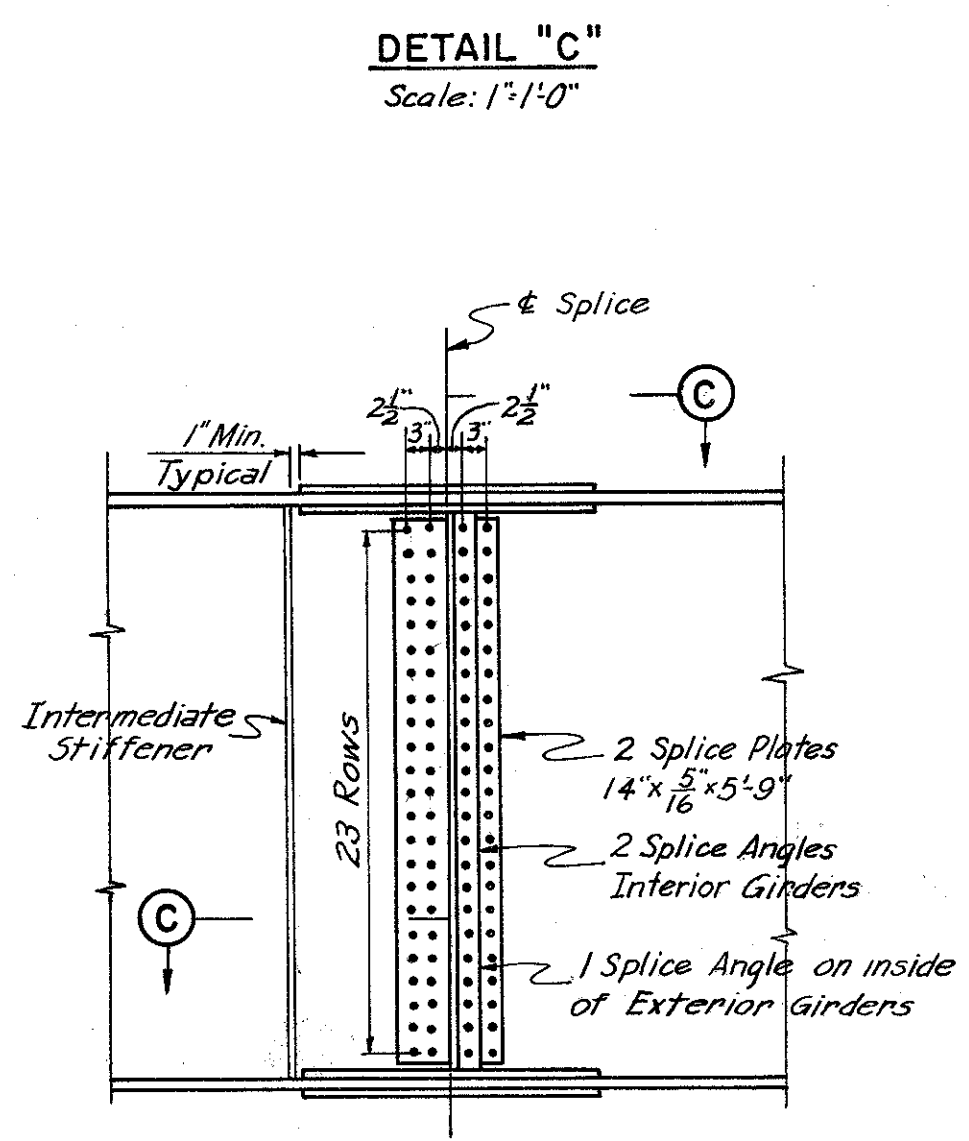

GIRDER FIELD SPLICE DETAILS

H.N.T.B. BR. NO. 3 PART 7A

HOWARD, NEEDLES, TAMMEN & BERGENDOFF
CONSULTING ENGINEERS
KANSAS CITY CLEVELAND NEW YORK

SUPERSTRUCTURE DETAILS
INNER BELT FREEWAY OVER
RAMPS E-8, E-10 AND E-18
BR. NO. CUY-42-1843 STA. 65+10.18
Scale: As noted STA. 68+19.03

WILLOW-INNER BELT FREEWAY
CLEVELAND CUYAHOGA COUNTY OHIO


DRAWN/RL	TRACED/1/14	CHECKED/2/1	REVIEWED
DATE 6-20-38	DATE 9/11/39	DATE 7-21-58	DATE 1-13-59

SHEET 112

NOTE:
In order to facilitate water curing of the concrete of the deck slab, the placing of concrete shall progress upgrade. The slab may be placed in sections, between transverse construction joints which are parallel to the transverse bars in the slab and are located near the center of any span.


NOTES:
For details of railing parapet joints and guard rail see sheet 175-7A
(1) For details of Light Standard Support and other lighting details see sheet 176-7A
For cross section thru deck and other superstructure details see sheet 112-7A
For Drainage details see sheet 174-7A
For End Dam details see sheet 173-7A
For Section A-A see sheet 112-7A

Note: Prefix "S" shall be assigned to all bar marks.

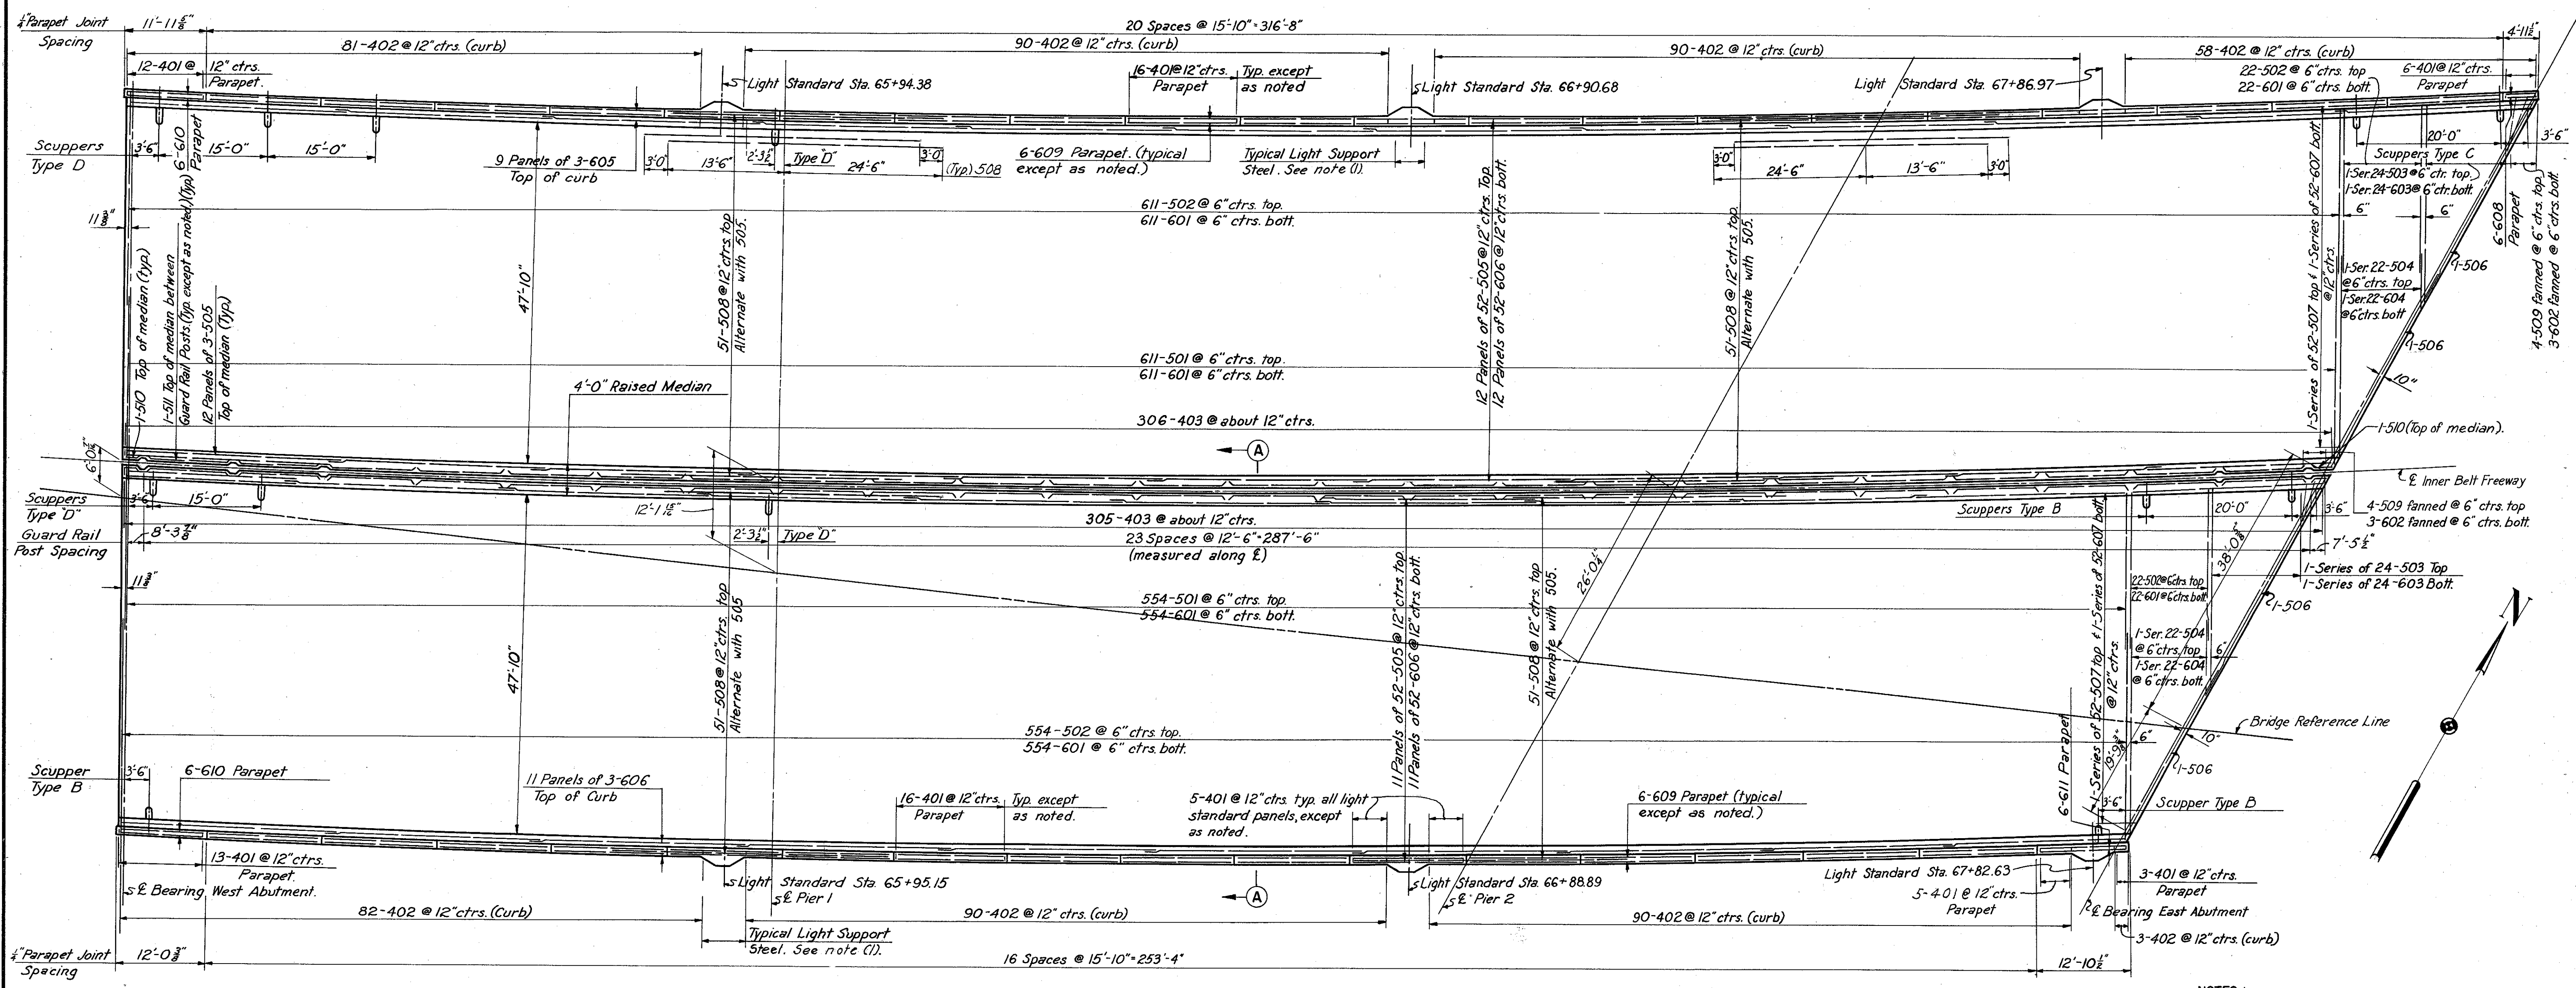

PLAN

REINFORCEMENT SCHEDULE																														
MARK	NO.	LENGTH	TYPE	DIMENSIONS				SERIES INC.	WEIGHT (LBS)	MARK	NO.	LENGTH	TYPE	DIMENSIONS				SERIES INC.	WEIGHT (LBS)	MARK	NO.	LENGTH	TYPE	DIMENSIONS				SERIES INC.	WEIGHT (LBS)	
				A	B	C	D							A	B	C	D							A	B	C	D			
401	585	4'-5"	105	8"	2'-0"				1726	511	48	13'-0"	159	11'-2"	0'-6"	0'-10"			651	12	8'-11"	131	2'-6"	1'-2"						72
402	584	5'-1"	122	1'-8"	1'-4"				1983										452	12	9'-11"	131	3'-0"	1'-8"					78	
403	611	4'-3"	122	1'-6"	1'-0"				1735										453	18	9'-5"	131	3'-2"	1'-0"					114	
501	1165	30'-7"	101	30'-0"					37162	601	2374	26'-9"	Str.						95384	454	12	5'-7"	155	2'-2"					42	
502	1209	23'-7"	101	23'-0"					29738	602	6	7'-6"	Str.						68	455	12	6'-1"	155	2'-8"					48	
503	2 Series of 24	7'-7" to 29'-7"	101	7'-0" to 29'-0"				11 1/2"	930	603	2 Series of 24	7'-0" to 29'-0"	Str.						11 1/2"	1298	456	18	6'-3"	155	2'-10"				78	
504	2 Series of 24	8'-6" to 28'-0"	Str.					11 1/2"	838	604	2 Series of 24	5'-6" to 24'-6"	Str.						10 3/8"	991										
505	1268	26'-9"	Str.						35378	605	27	38'-9"	Str.						1571	651	12	9'-5"	141	2'-11"	1'-10"				168	
506	4	30'-3"	Str.						126	606	1229	27'-0"	Str.						49841	652	18	14'-6"	141	5'-3"	3'-0"				390	
507	2 Series of 24	3'-0" to 29'-0"	Str.					6 3/8"	1376	607	2 Series of 24	3'-0" to 29'-0"	Str.						6 3/8"	2499	653	6	5'-0"	Str.					48	
508	204	38'-0"	Str.						8085	*609	216	15'-6"	Str.																Total	272,493
509	8	7'-6"	Str.						63	*610	12	11'-6"	Str.																	
510	4	2'-11"	108	2'-0"	0'-6"	0'-10"			12	*611	6	12'-6"	Str.																	

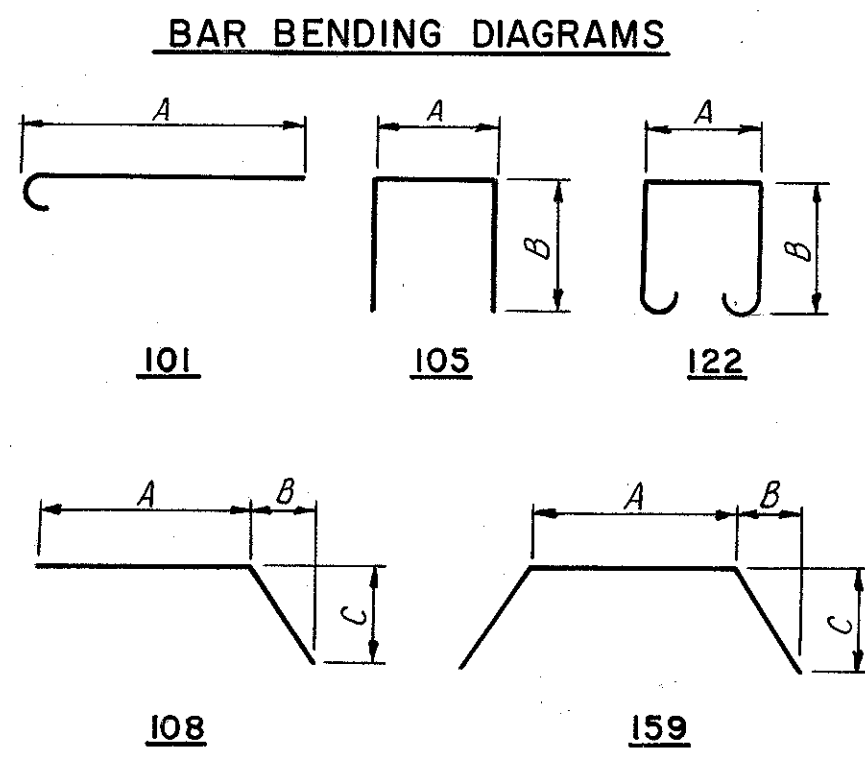



NOTES:
* Bars are for the Light Standard Supports. For their bending diagrams and placement see sheet 176-7A
* Bars are included with Item 3-14, Railing for payment. For Replacement Schedule See Sheet 103-7A
All bar dimensions are given out to out. Bars of a series shall vary in length by a constant increment.

H.N.T.B. BR. NO. 3 PART 7A
HOWARD, NEEDLES, TAMMEN & BERGENDOFF
CONSULTING ENGINEERS
KANSAS CITY CLEVELAND NEW YORK

DECK PLAN
INNER BELT FREEWAY OVER
RAMPS E-8, E-10 AND E-16
BR. NO. CUY-42-1843 STA. 65+10.18
Scale: 3/32" = 1'-0" STA. 68+19.03



WILLOW-INNER BELT FREEWAY
CLEVELAND CUYAHOGA COUNTY OHIO

DRAWN A.B. TRACED R.K. CHECKED A.L. REVIEWED J.C.T. REVISIONS
DATE 4-25-58 DATE 3-4-59 DATE 6-30-59 DATE 11-13-59 SHEET 113

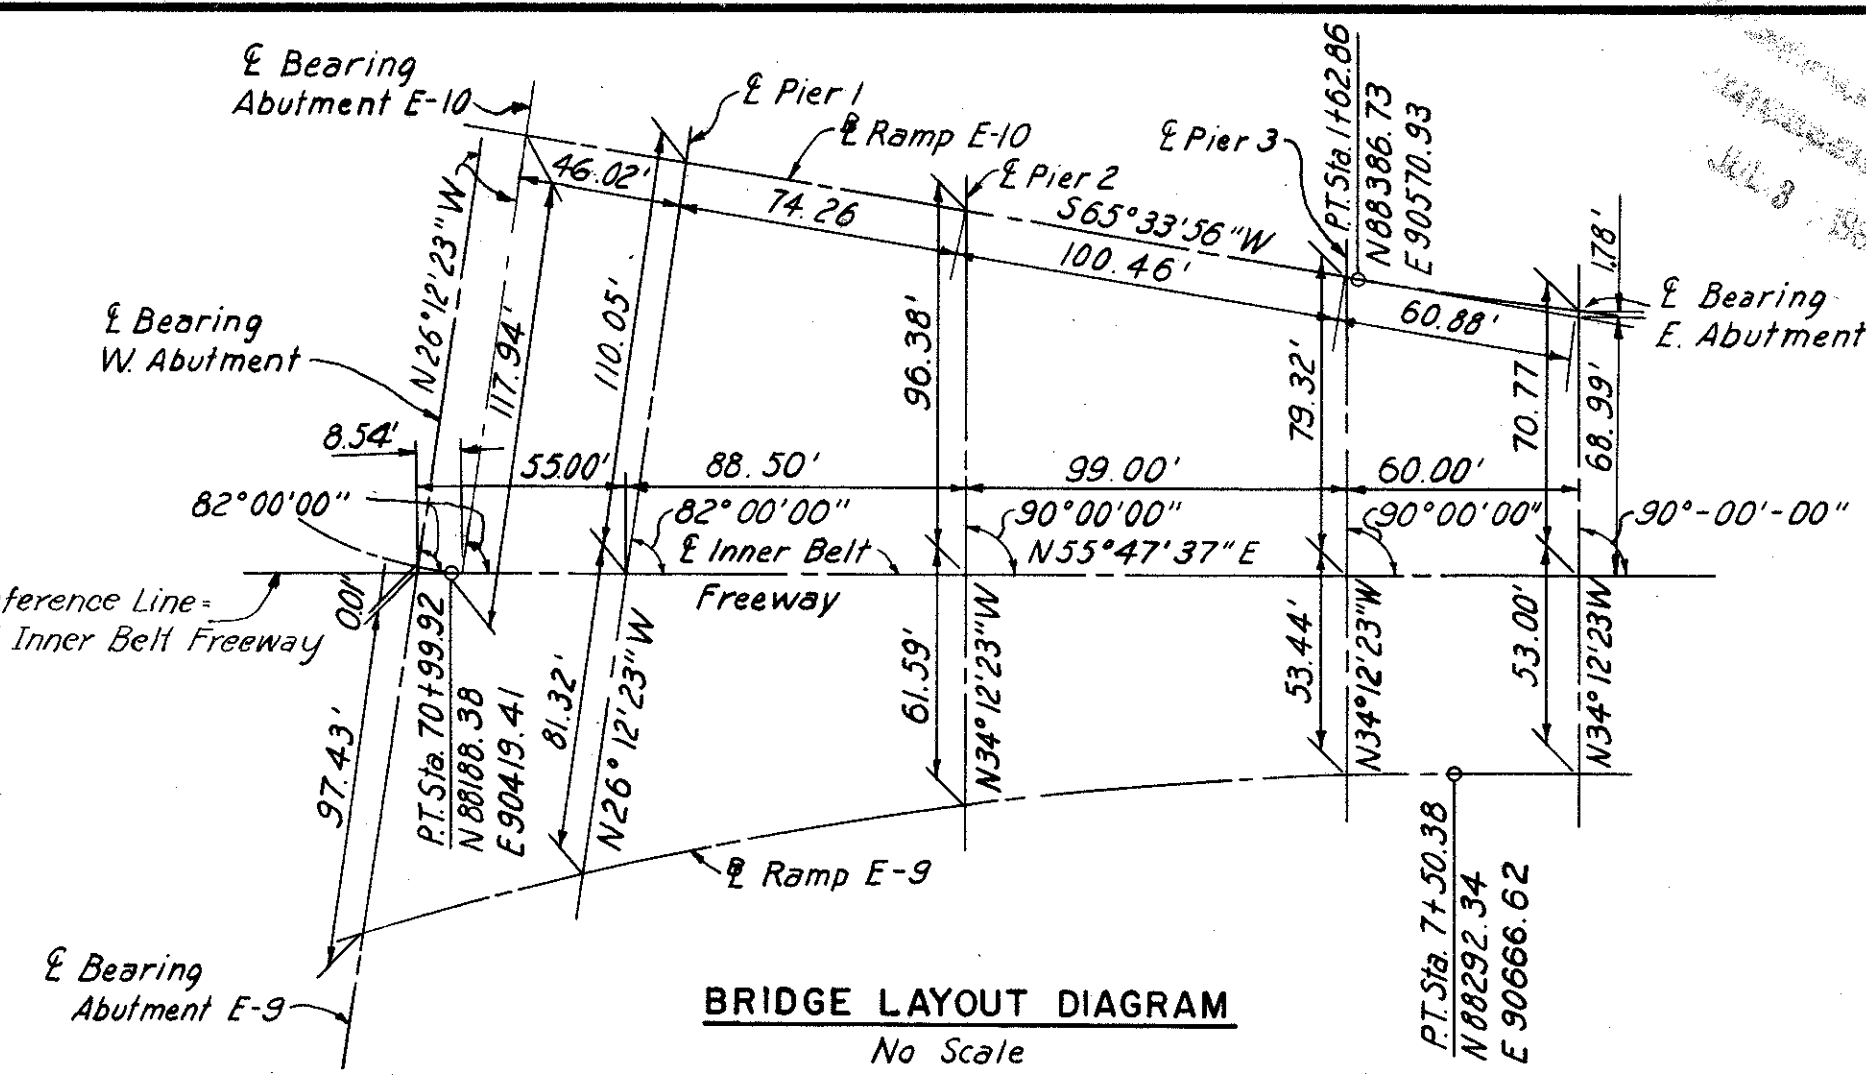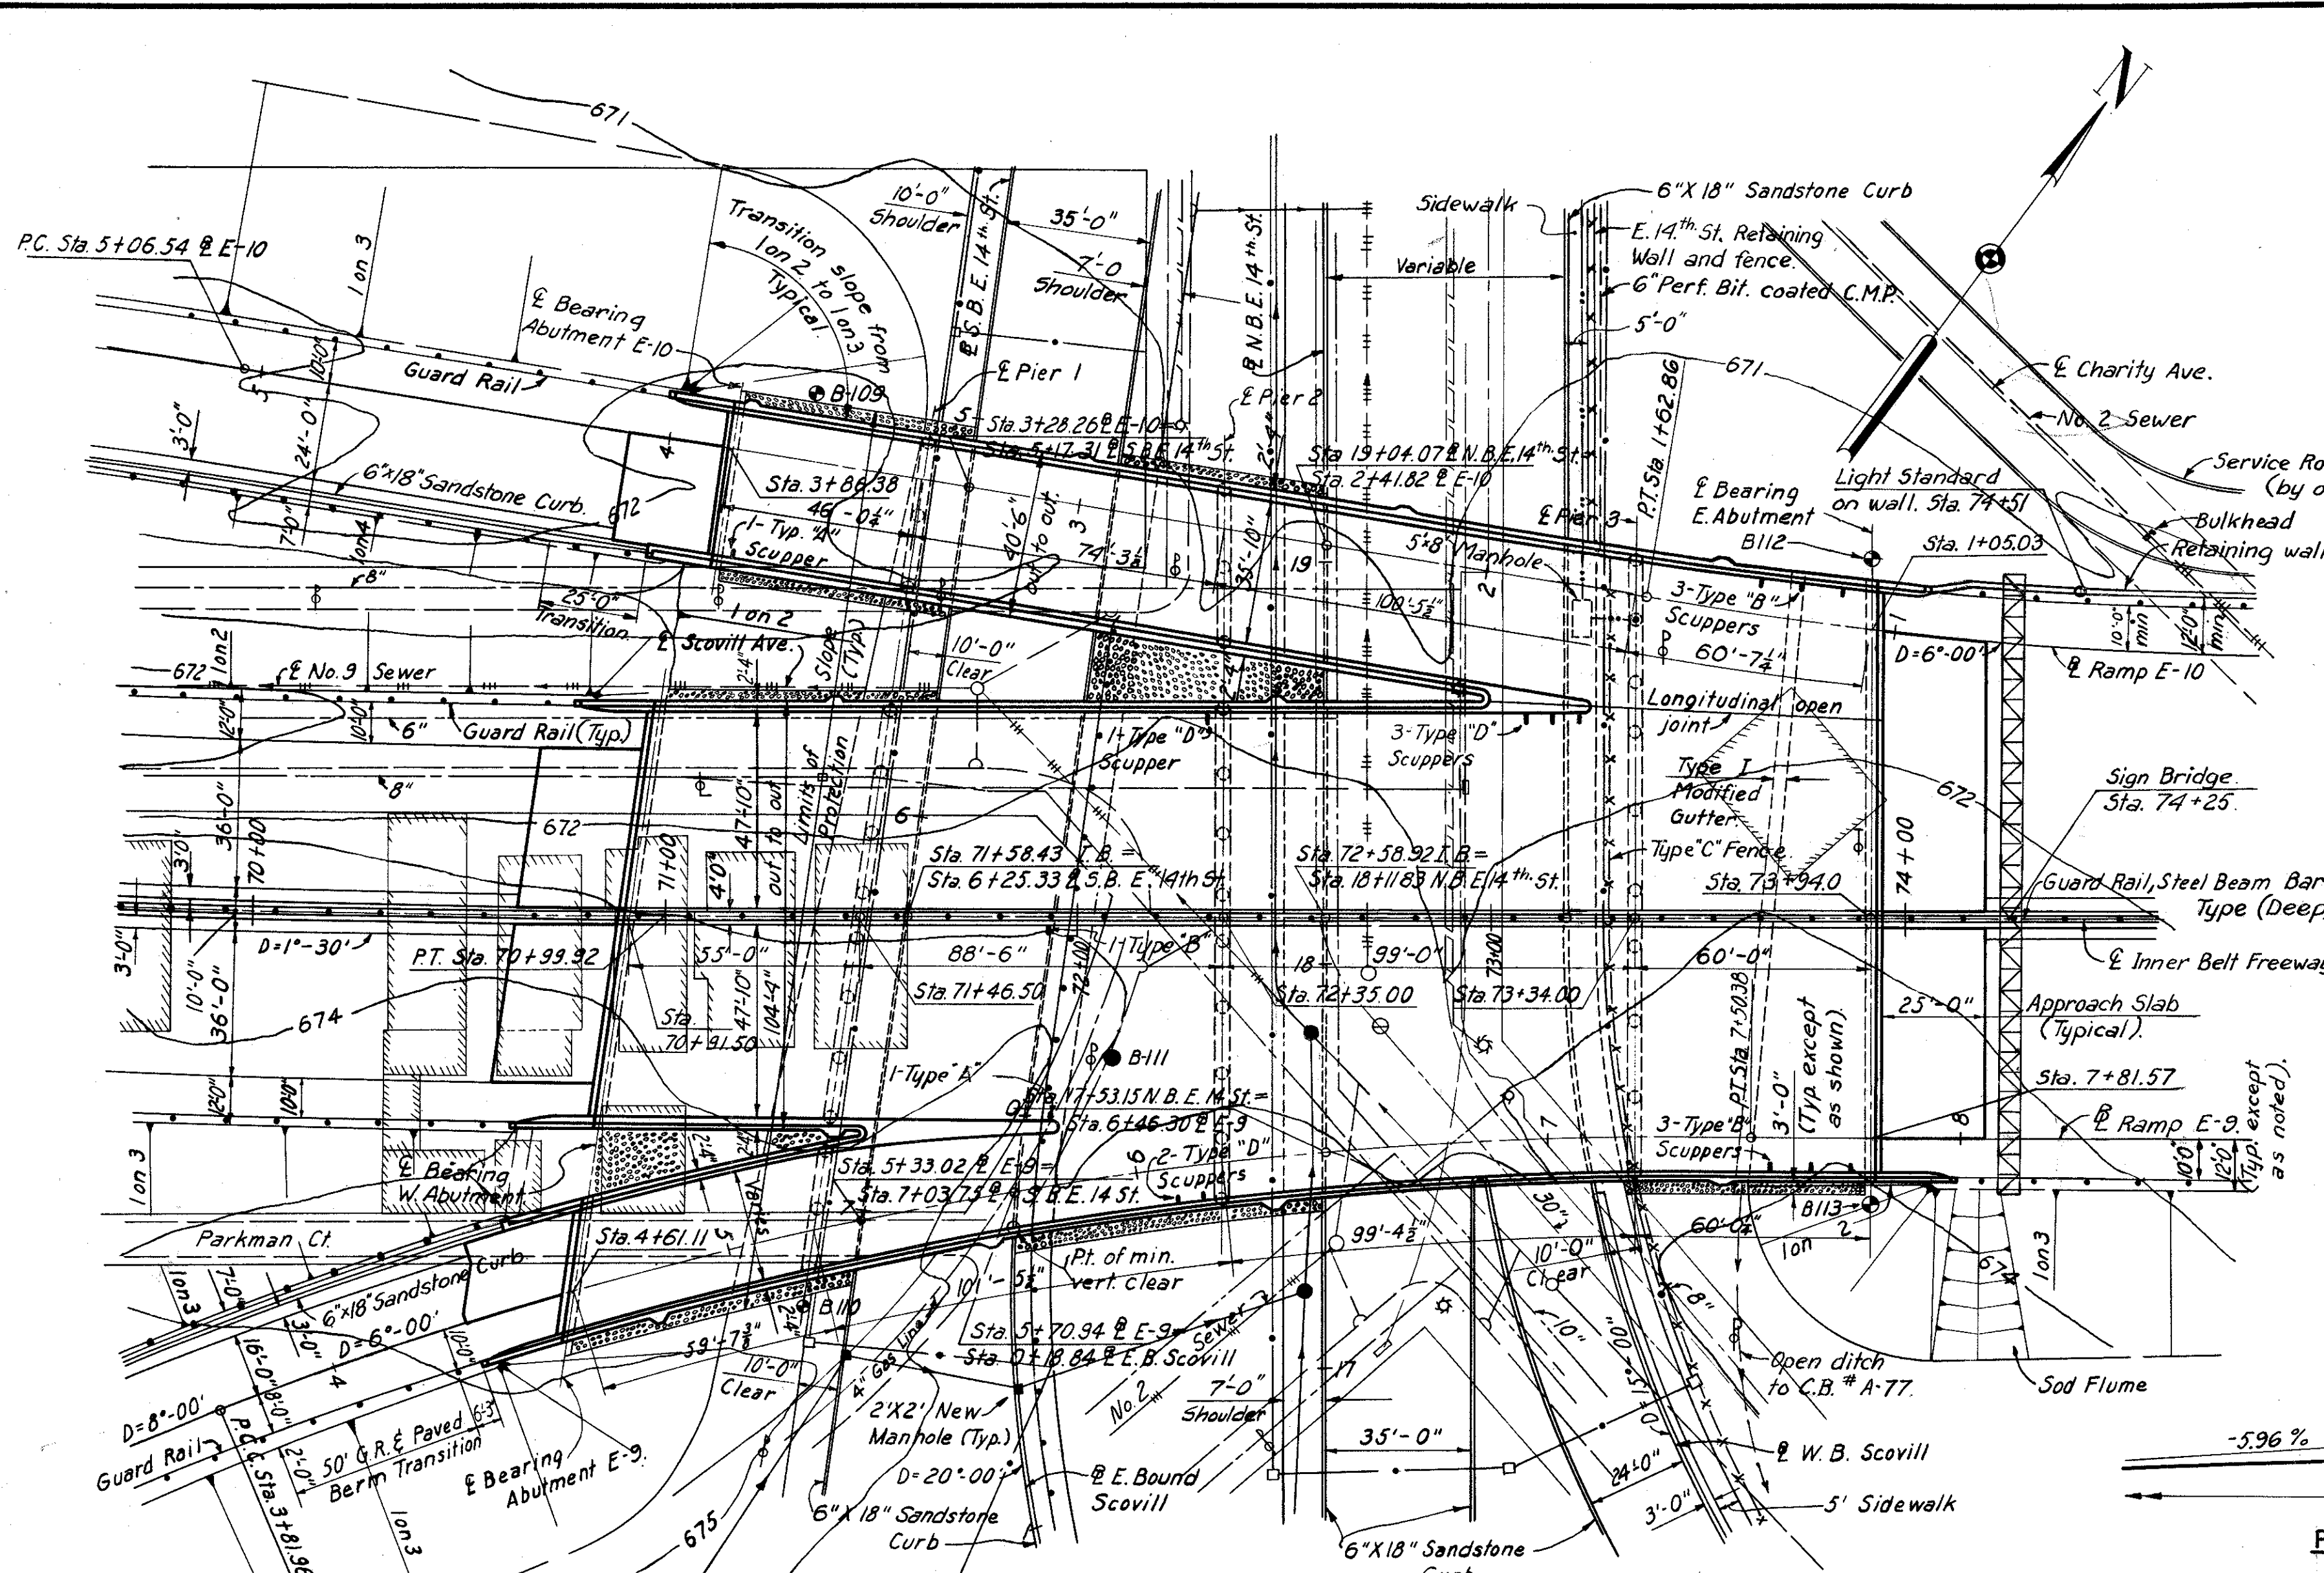

Elev. 673.0	Brick & Cinder
19 668.0	Brown Silty Sand
24 663.0	Brown Silty Gravelly Sand
41	
18	
21	
40	
93 638.0	Brown Silty Sand
36 633.0	Gray Sandy Silt
34	
21	
39	
20	
26	
34	
27	
45 592.0	Gray Silt

CURVE DATA I. B. FREEWAY	CURVE DATA RAMP E-9	CURVE DATA RAMP E-10
$\Delta = 12^\circ 01' 26''$	$\Delta = 22^\circ 06' 19''$	$\Delta = 9^\circ 46' 18''$
$D = 1^\circ 30'$	$D = 6^\circ 00'$	$D = 6^\circ 00'$
$R = 3819.72'$	$R = 954.93'$	$R = 954.93'$
$T = 402.27'$	$T = 186.53'$	$T = 81.63'$
$L = 801.59'$	$L = 368.42'$	$L = 162.86'$

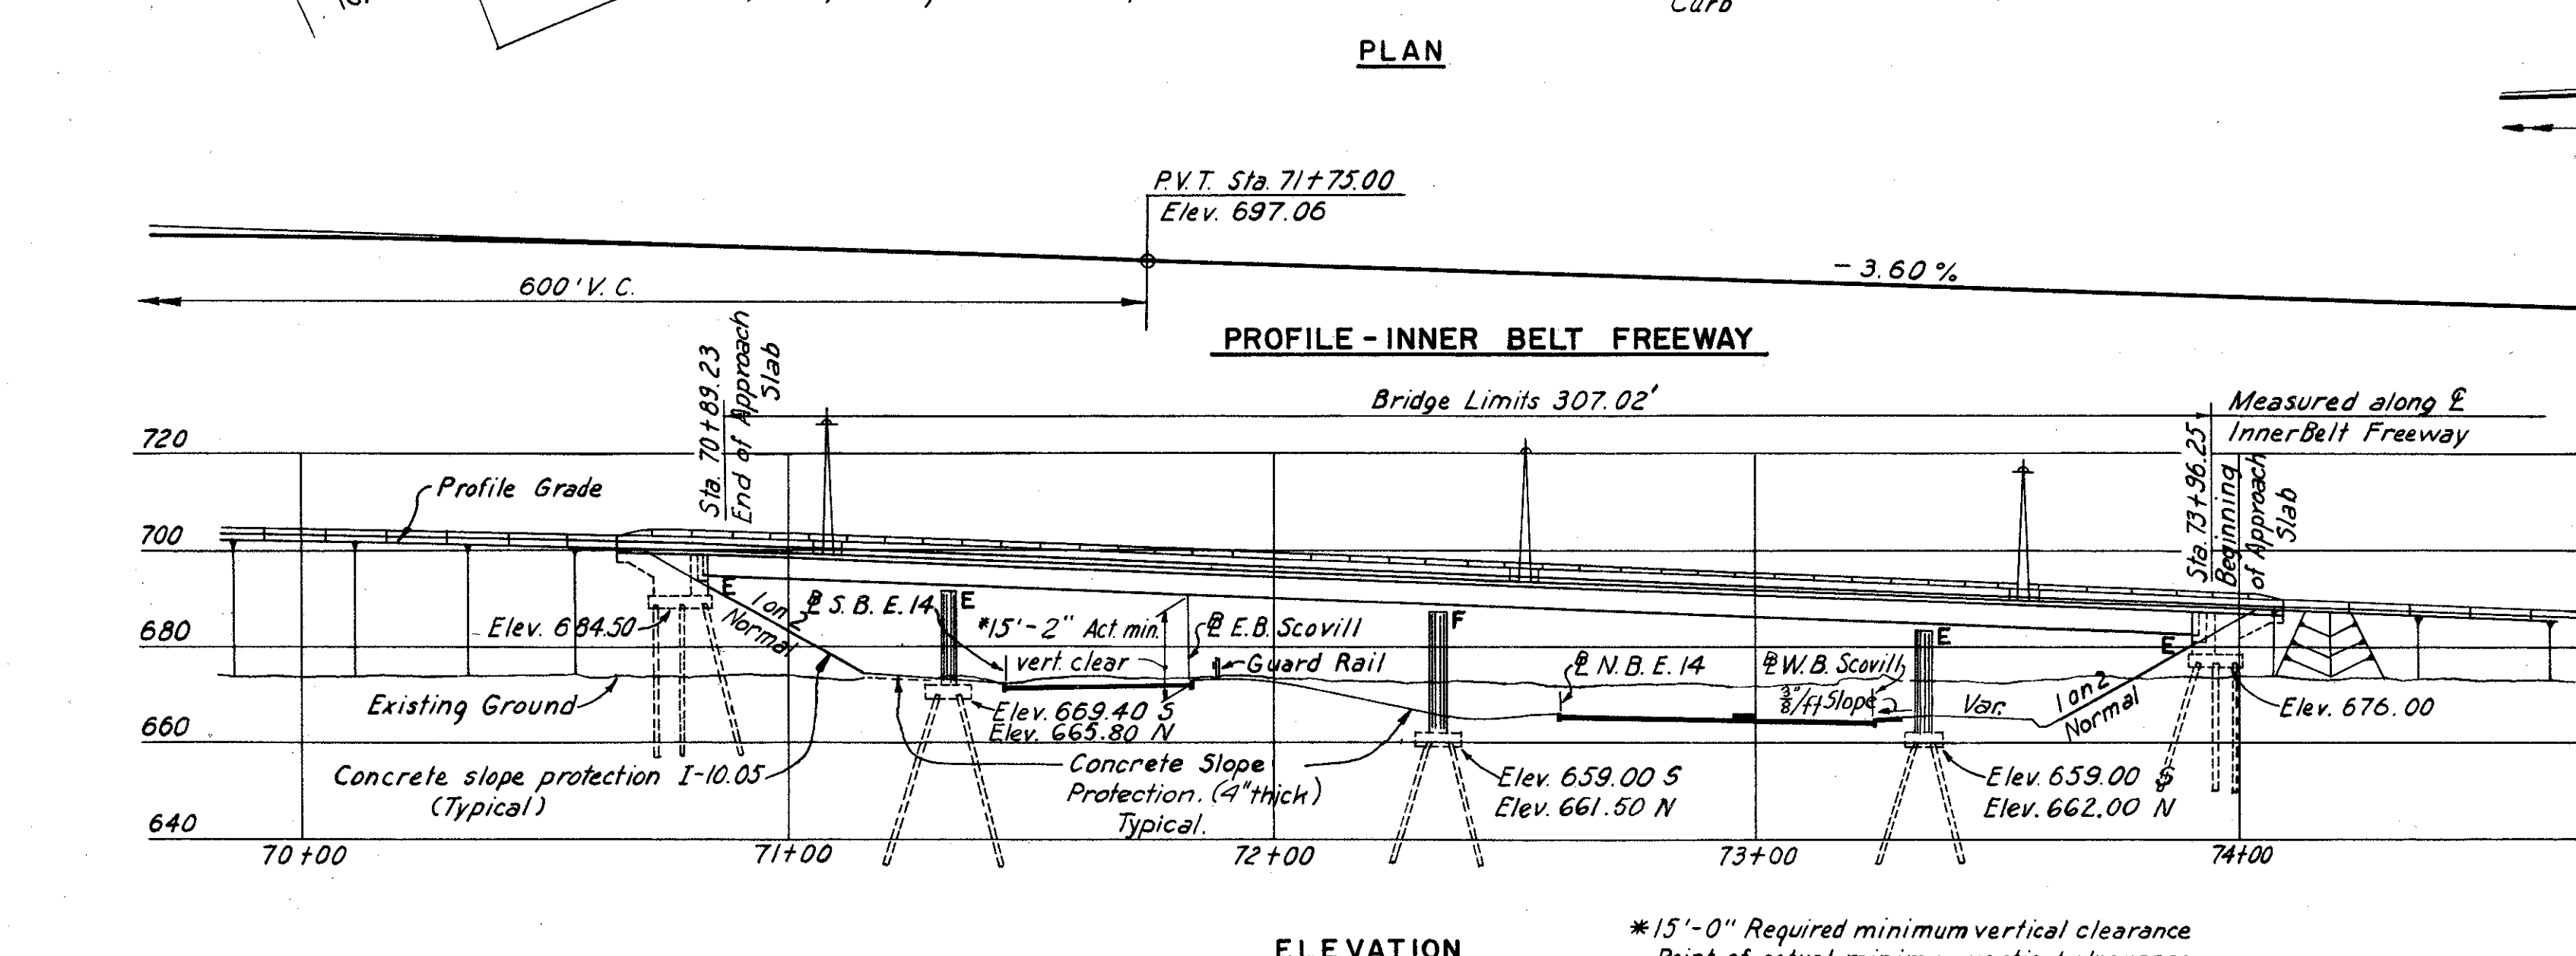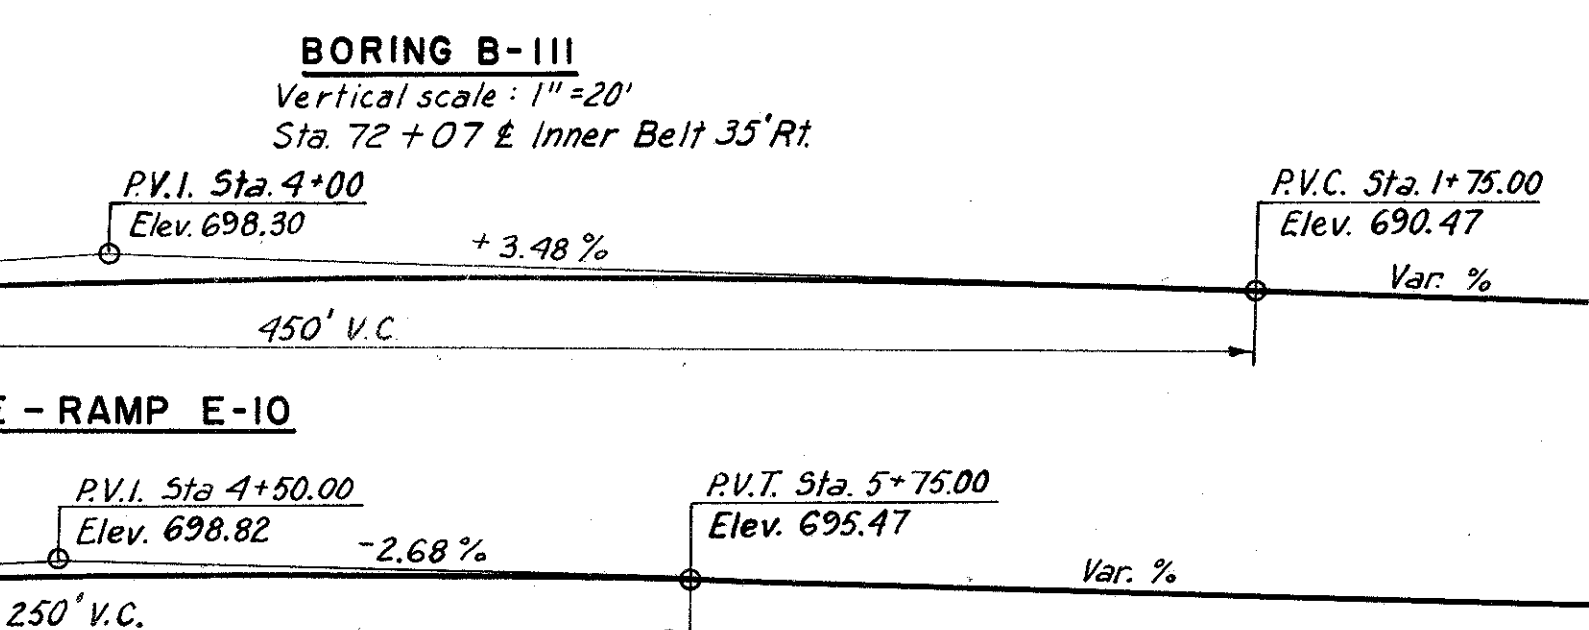

PILE INFORMATION			
Location	Diameter	Number	Estimated ave. length
Abutment E-9	12"	17	23'
Abutment E-10	12"	20	23'
W. Abutment	12"	42	28'
E. Abutment	12"	74	28'
Retaining wall	12"	92	27'
Pier 1	14"	48	28'
Pier 2	14"	80	26'
Pier 3	14"	56	27'
E. 14th St. Retain. wall	12"	39	29'

All piles to be C.I.P. Reinforced Concrete.
 Note: Piers for Br. No. 4 and E. 14th St. Retaining Walls, are included in Part 6.

PROPOSED STRUCTURE
 TYPE: Continuous welded steel girder with reinforced concrete deck and substructure.
 SPANS: 55'-0", 88'-6", 99'-0", & 60'-0" along E. I. B. ROADWAY: Varies
 LOADING: C.F. - 2000 - Adequate for A.A.S.H.O. alternate loading.
 SKEW: Varies
 SURFACE COURSE: 1" Monolithic Concrete
 ALIGNMENT: 1° 30' Lt. Tangent
 APPROACH SLABS: AS-1-54 (25' long)
 SUPERELEVATION: Varies

NOTES:
 The following items are not included in the Bridge Plans: (See Roadway Plans for Details) Approach grading, pavement and slabs, Roadway Guard Rail, Sod Flumes.
 For details of pier plans & drain pipe locations at piers see sheets 135-7A, 172-7A & 174-7A
 For details of slope protection, see Sh. 174-7A
 Rod sounding only were taken at location B-109, B-110, B-112, & B-113. The core drilling made at B-111 is plotted.

Pile lengths are based on boring data and are approximate only. The Contractor shall assume full responsibility for length of piling selected for driving.

For details of slope protection behind Pier 3, see sheet 120-7A
 For details of Sign Bridge, see sheets 177A-7A, 178-7A




H.N.T.B. BR. NO. 4 PART 7A
 HOWARD, NEEDLES, TAMMEN & BERGENOFF CONSULTING ENGINEERS
 KANSAS CITY CLEVELAND NEW YORK

SITE PLAN
 INNER BELT FREEWAY OVER EAST 14th ST.
 BR. NO. CUY-42-1854 STA. 70+89.23
 - Scale: 1" = 30' STA. 73+96.25

WILLOW-INNER BELT FREEWAY
 CLEVELAND CUYAHOGA COUNTY OHIO


CUYAHOGA COUNTY
CITY OF CLEVELAND
CUY-21-15.32
CUY-42-18.42

Note: Prefix "AB" shall be assigned to all bar marks.

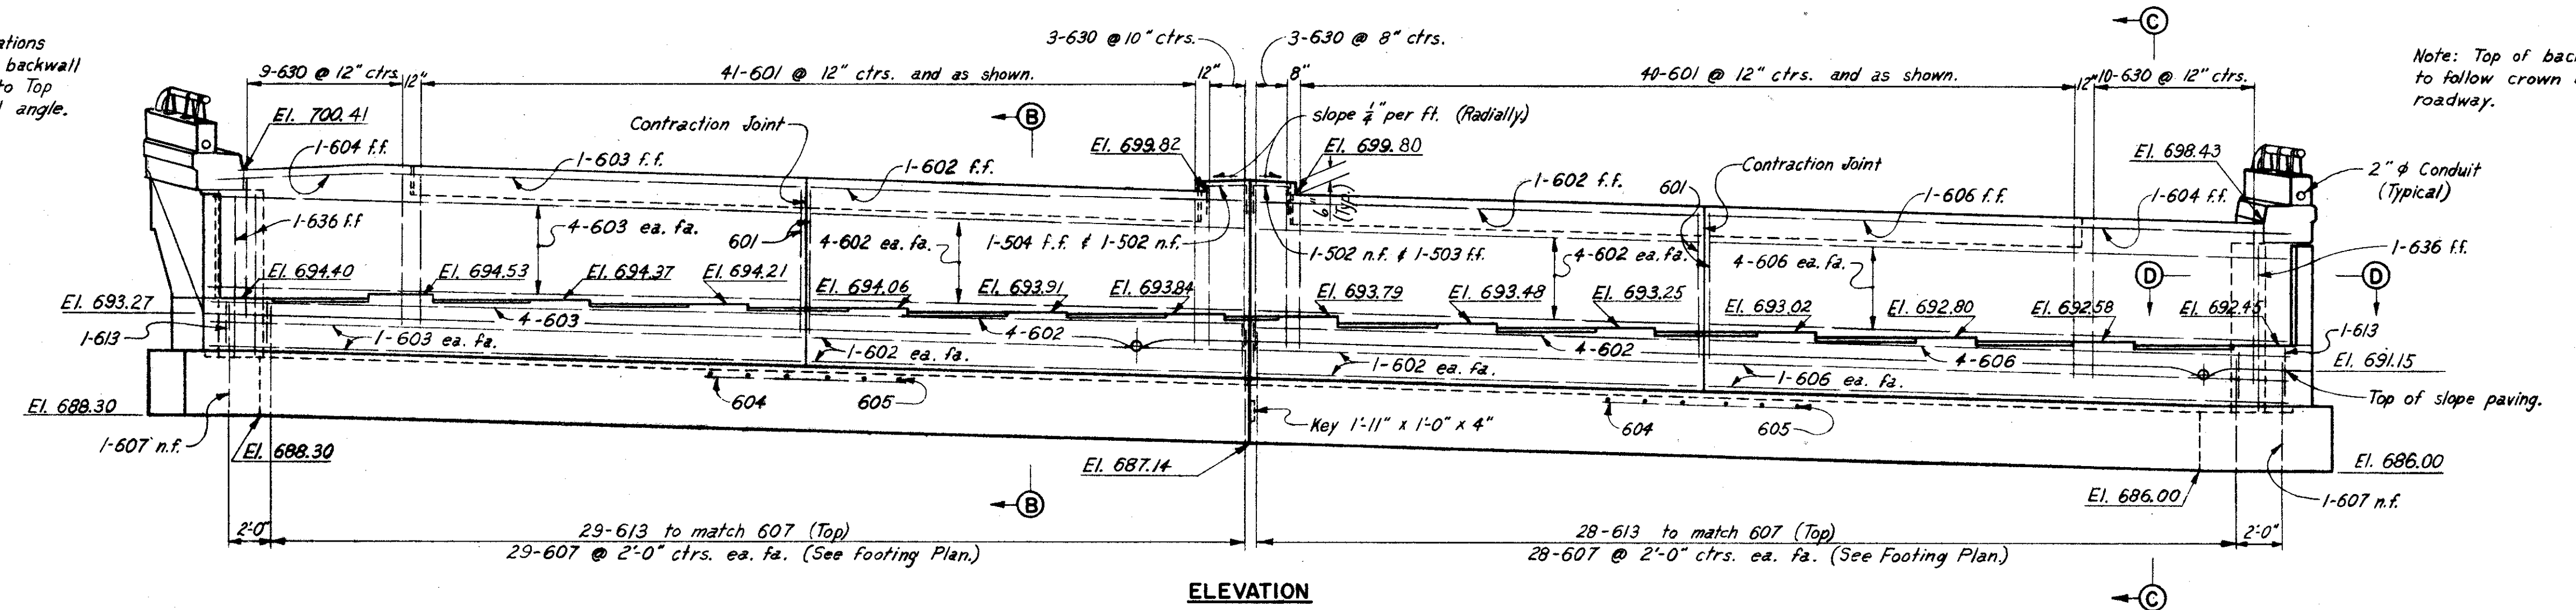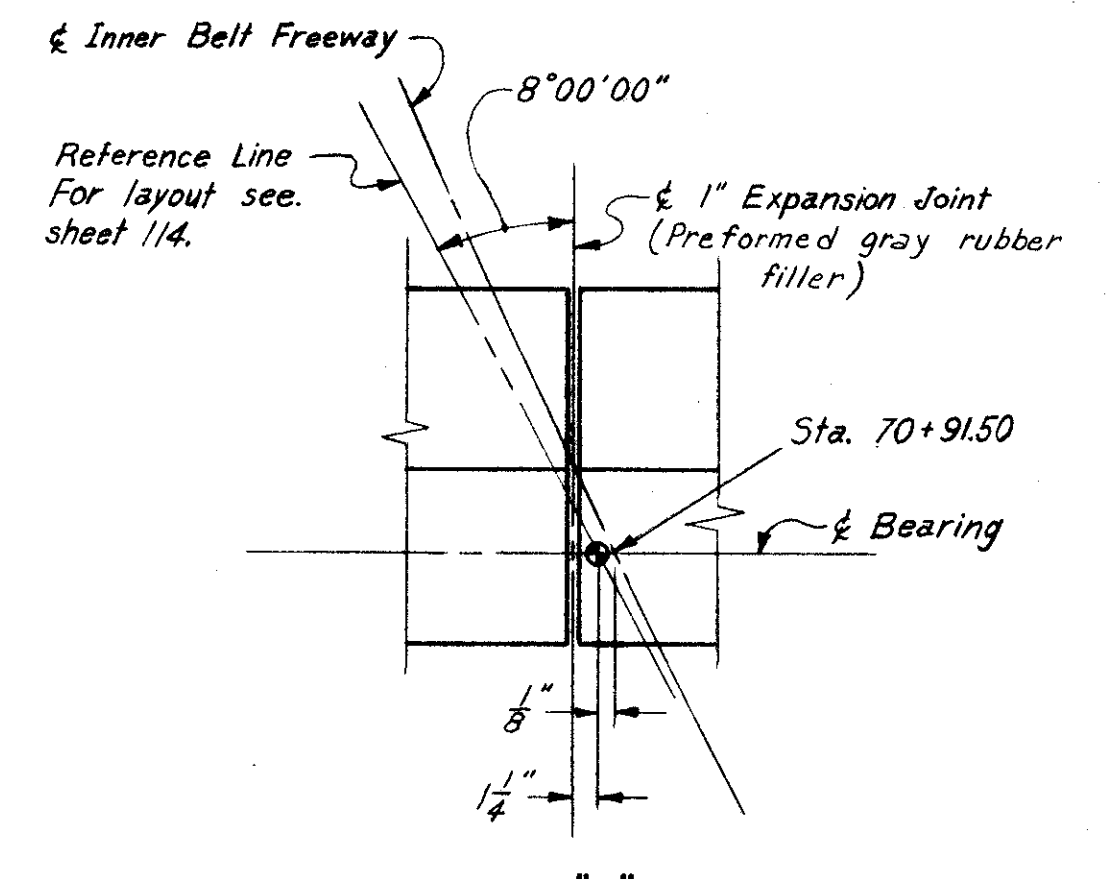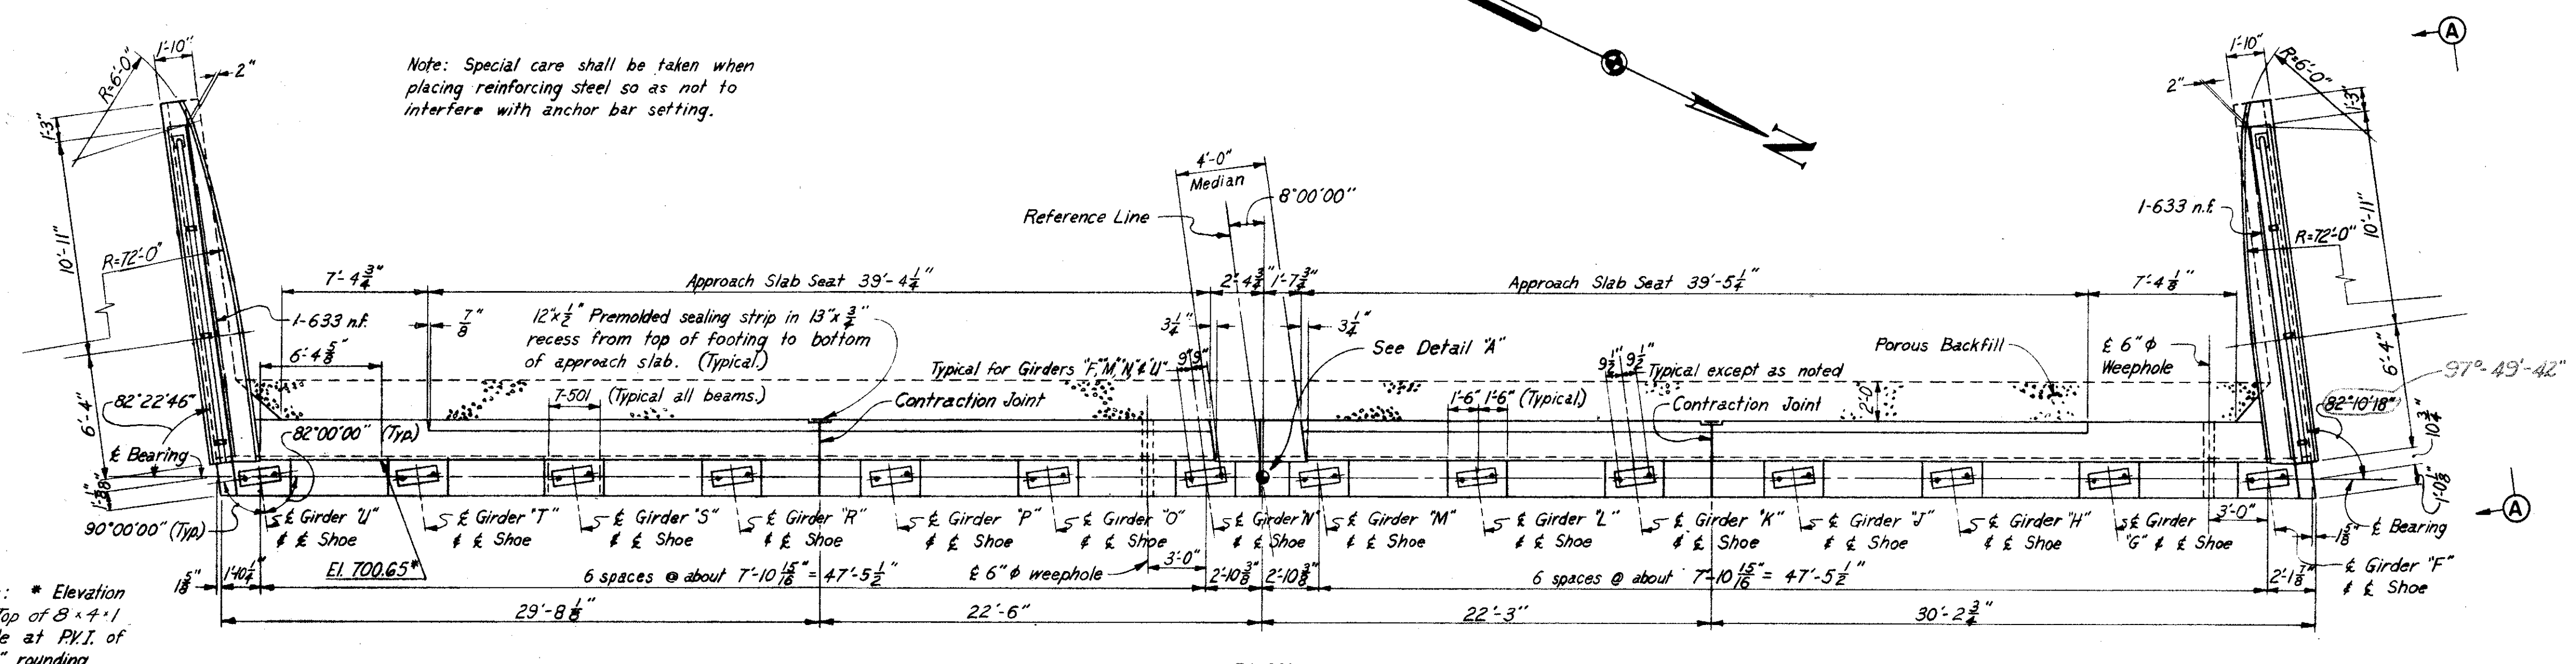

NOTES:

- All piles shall be 12" ϕ Cast-in-Place reinforced Concrete.
- All battered piles shall be battered 3 in 12 in direction shown.
- Pile spacings are given along bottom of footing.
- For details of end dam, see Sheet 173-7A
- For masonry plate details, see Sheet 174-7A
- Reinforcement bars shall be 3 inches clear from bottom of footing and 2 inches elsewhere.
- For Reinforcement Schedule, see Sheet 117-7A
- For Slope Protection details, see Sheet 174-7A
- For location of lighting conduit, see Sheet 176-7A
- For Railing details and Guard Rail connection details, see Sheet 175-7A
- For sections, see Sheet 117-7A
- n.f. = near face; f.f. = far face; ea. fa. = each face.

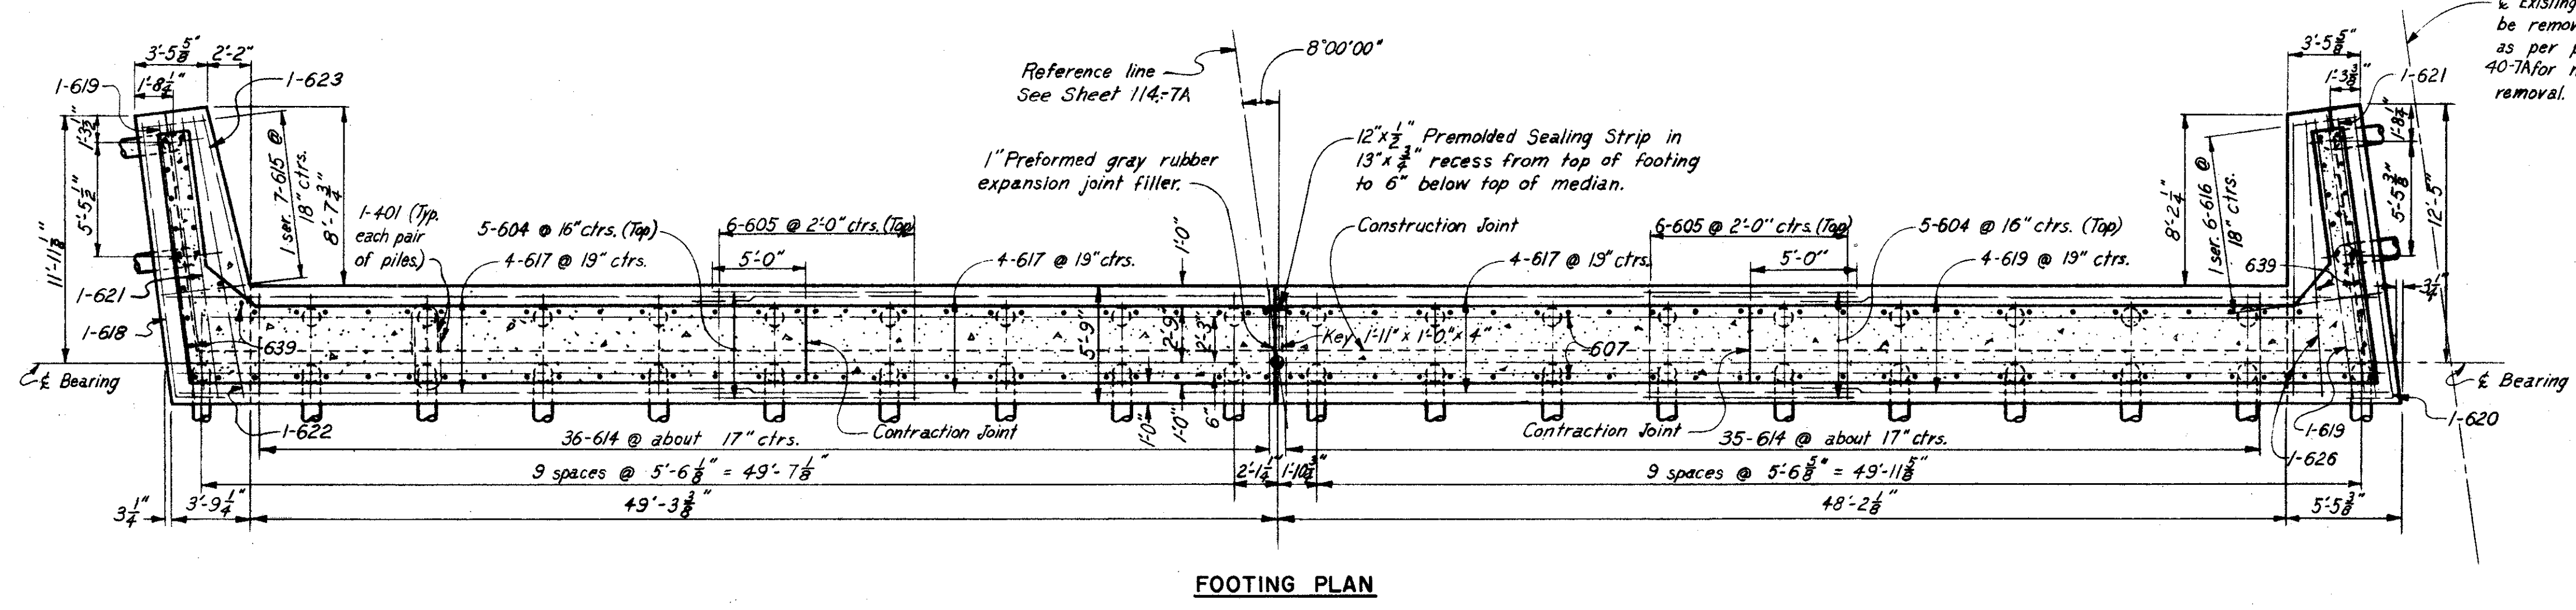

H.N.T.B. BR. NO. 4 PART 7A

HOWARD, NEEDLES, TAMMEN & BERGENOFF
CONSULTING ENGINEERS
KANSAS CITY CLEVELAND NEW YORK

WEST ABUTMENT

INNER BELT FREEWAY OVER EAST 14th ST.
BR. NO. CUY - 42-1854 STA. 70 + 89.23
Scale: 3/16" = 1'-0" STA. 73 + 96.25
Except as noted


WILLOW-INNER BELT FREEWAY
CLEVELAND CUYAHOGA COUNTY OHIO

DRAWN C.M.	TRACED	CHECKED H.R.L.	REVIEWED J.C.T.	REVISED 6-17-60
DATE 1-14-59	DATE	DATE 1-22-59	DATE 1-13-59	SHEET 116

CUYAHOGA COUNTY
CITY OF CLEVELAND
CUY-21-15.32
CUY-42-1842


Note: Prefix "AB" shall be assigned to all bar marks.

Note: End of railing parapet to be normal to top of safety curb.

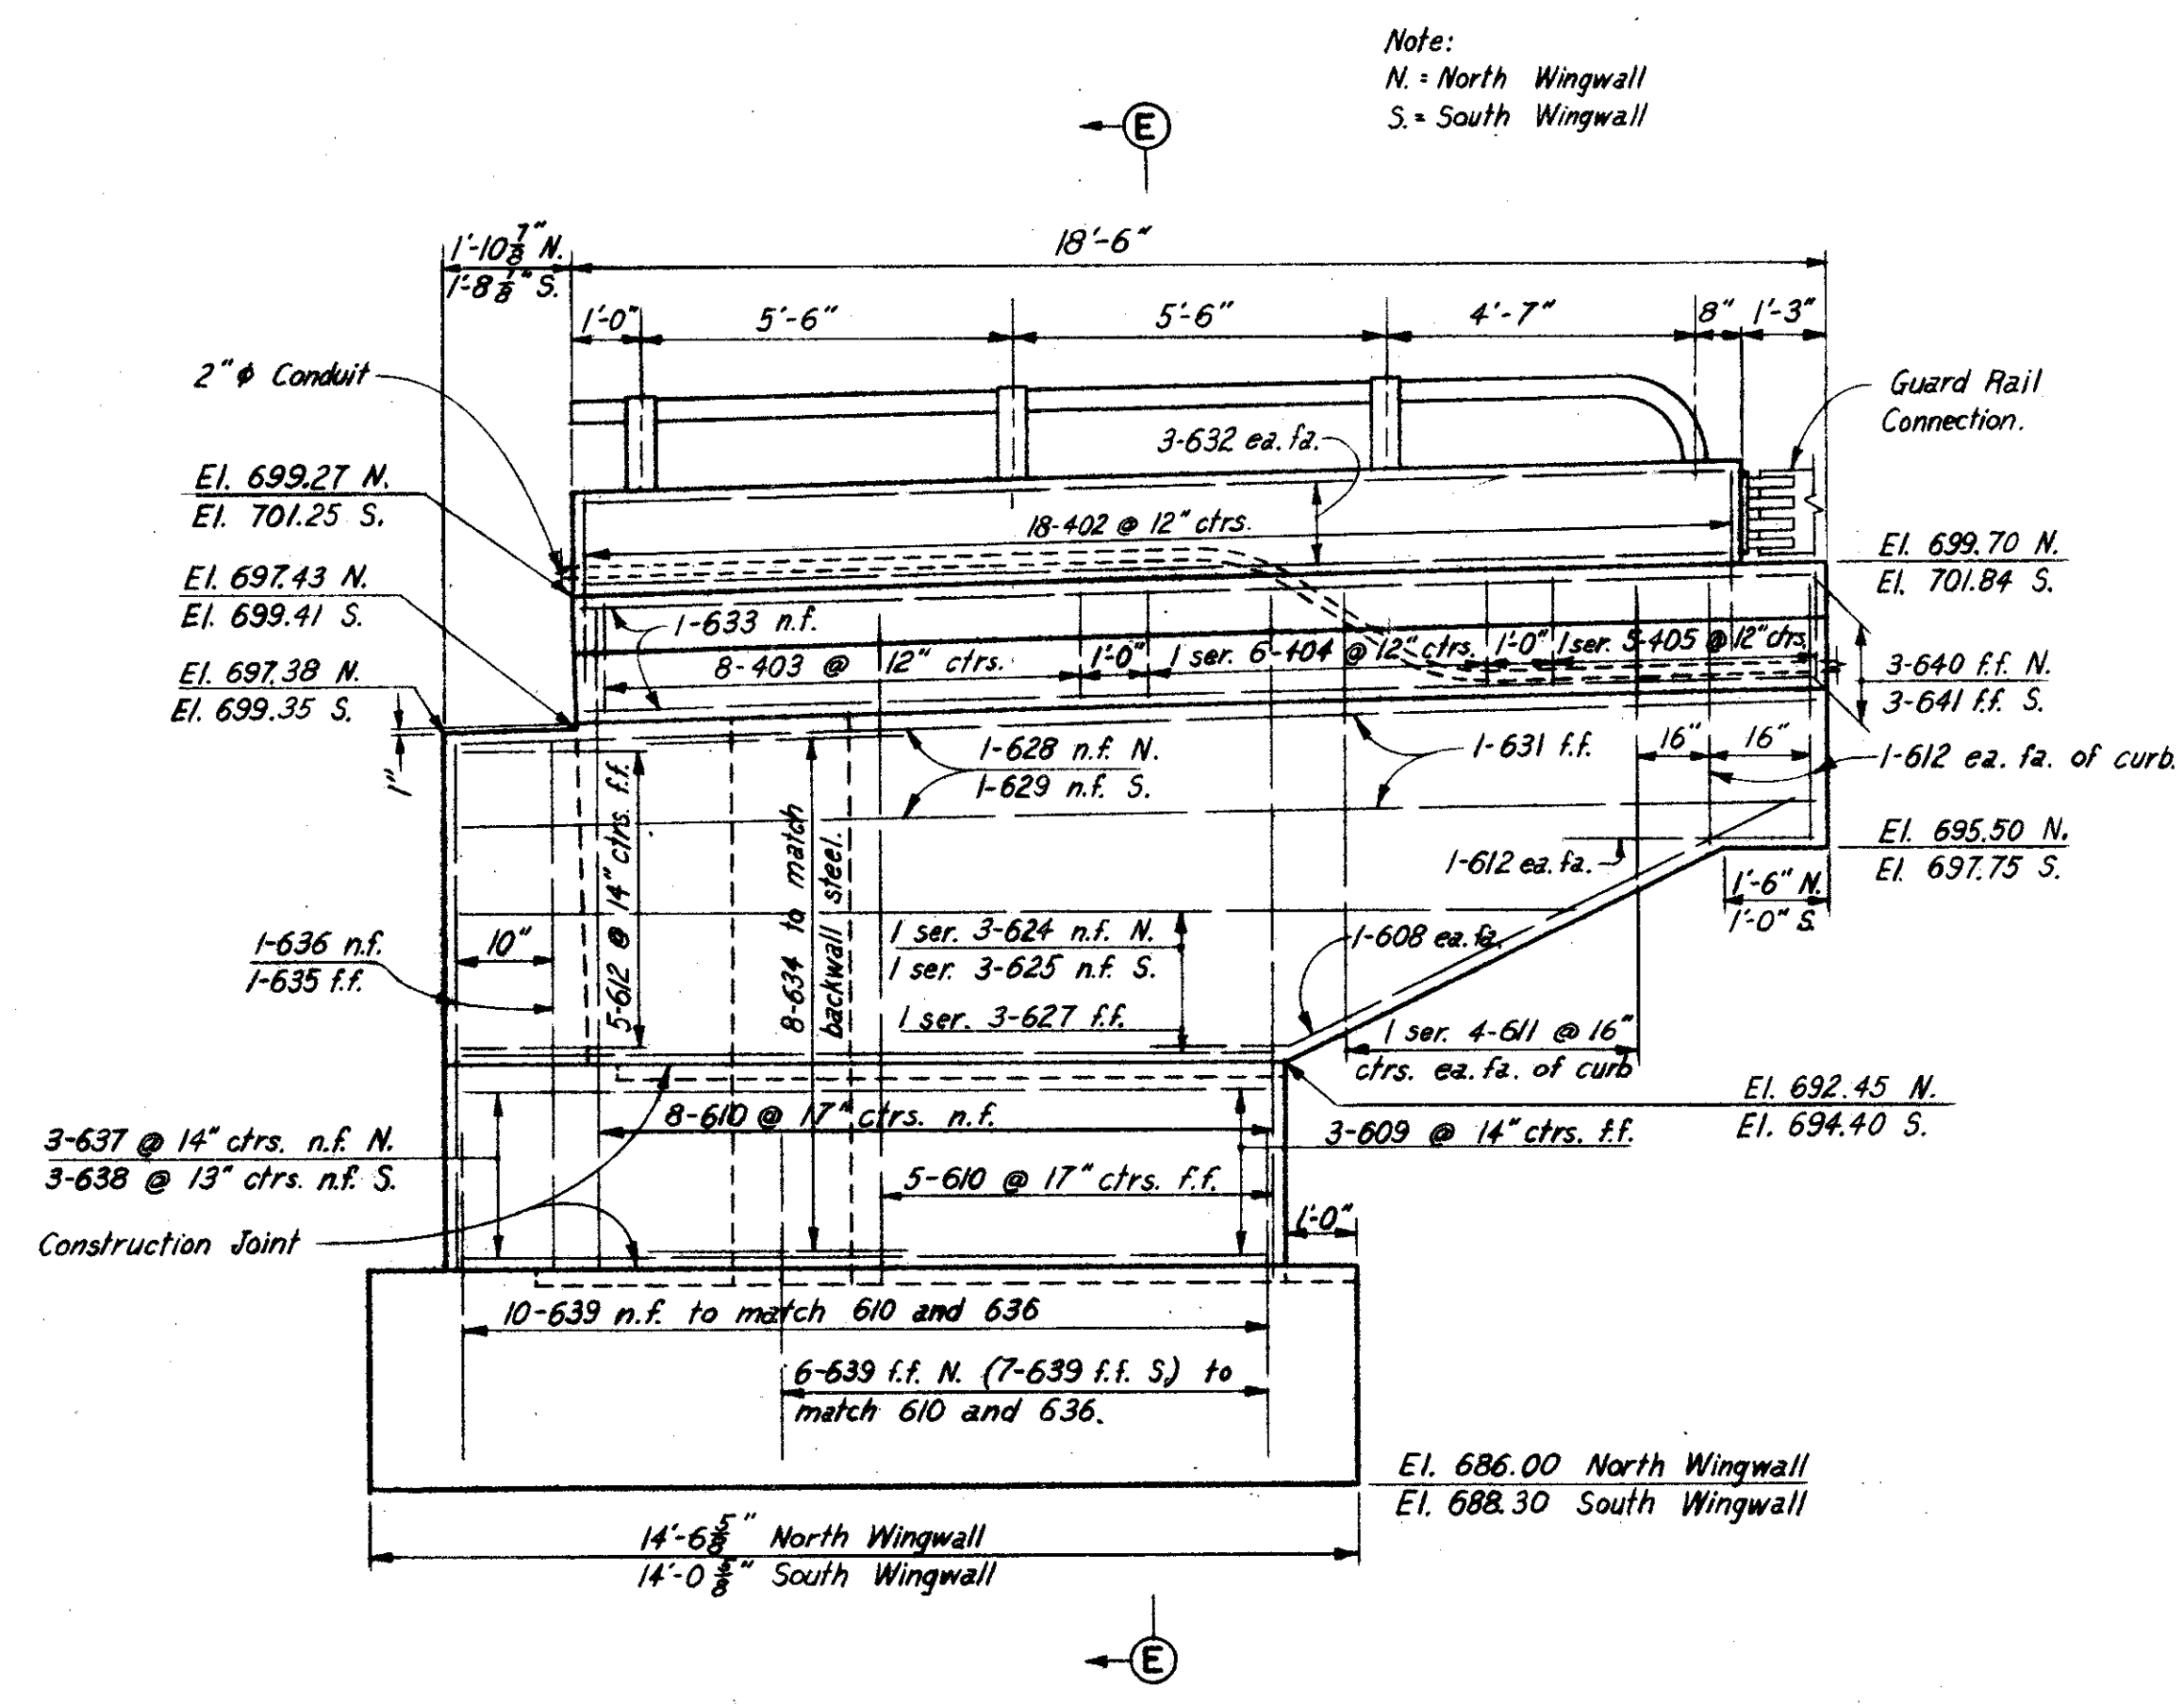


ELEVATION A-A


Elevation South Wingwall similar except as noted.

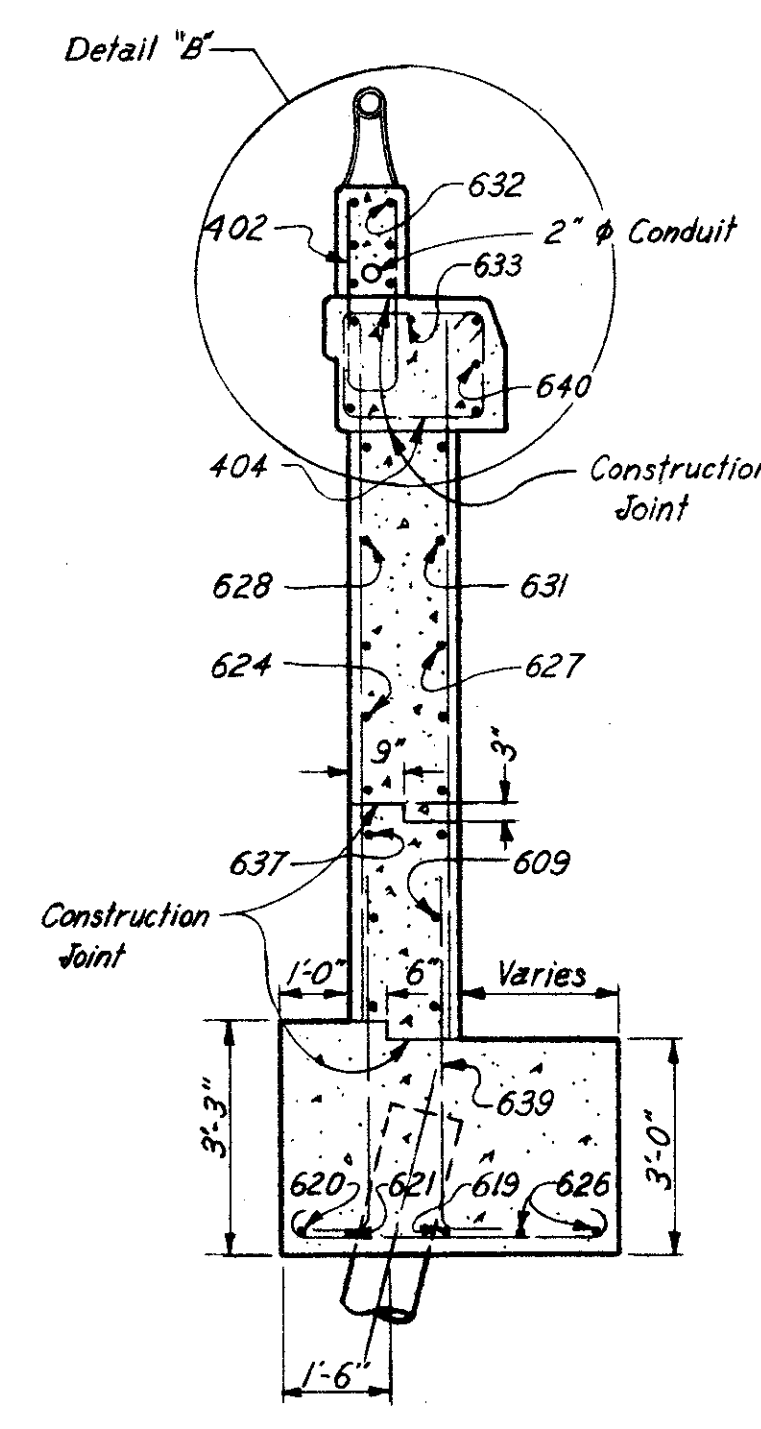


SECTION E-E

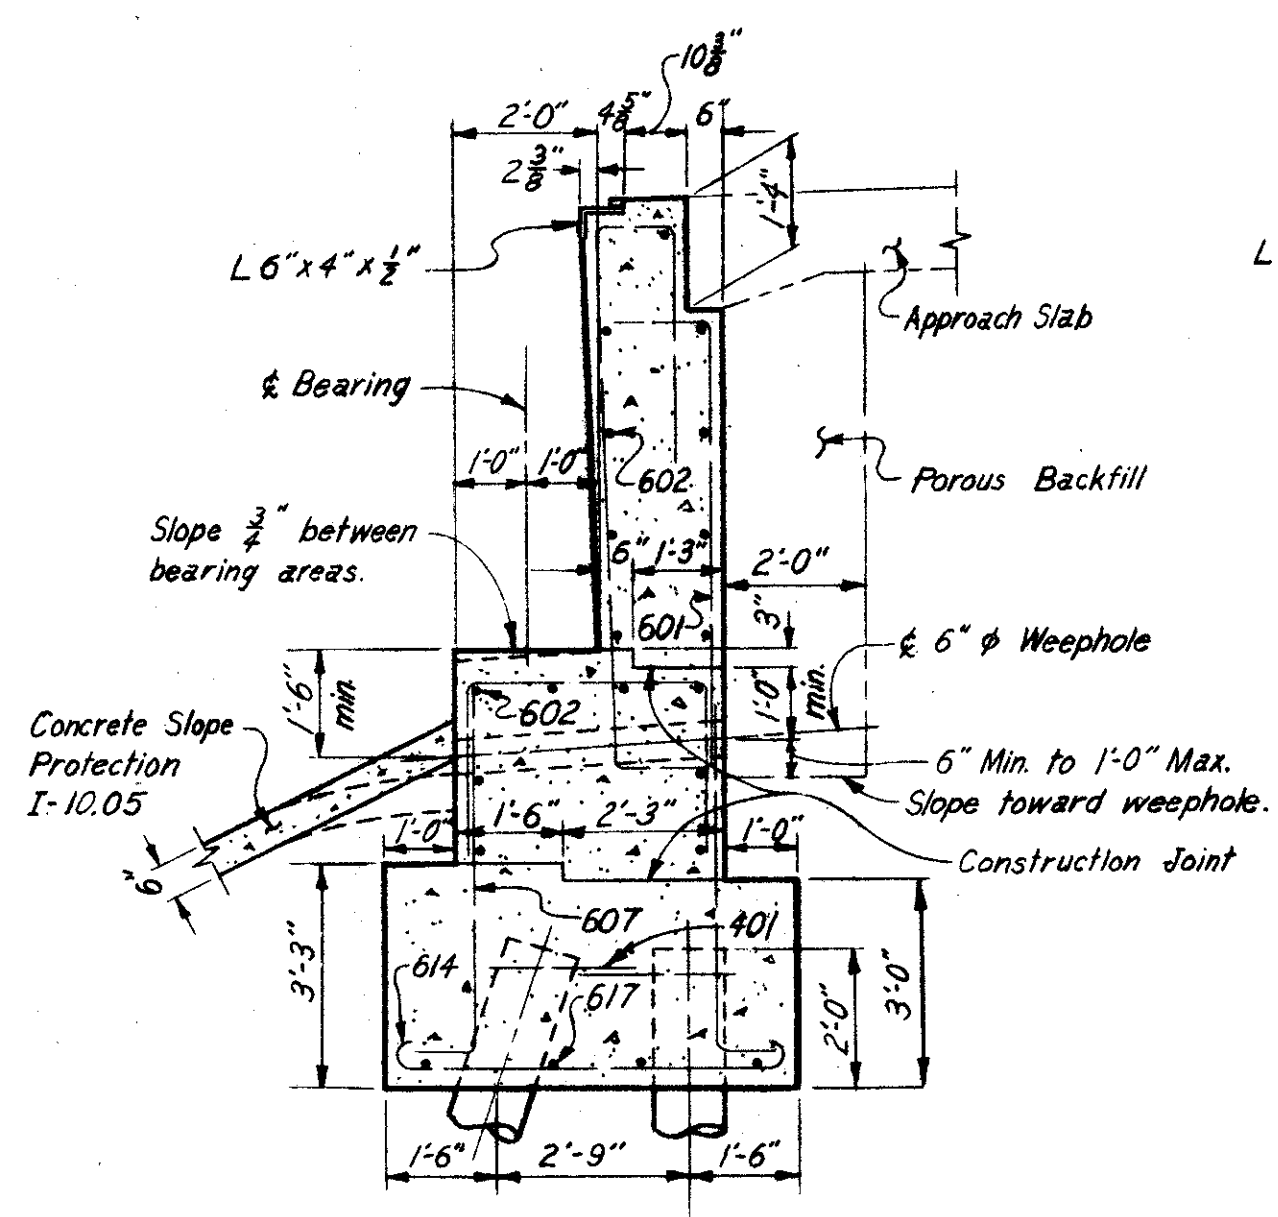


SECTION B-B

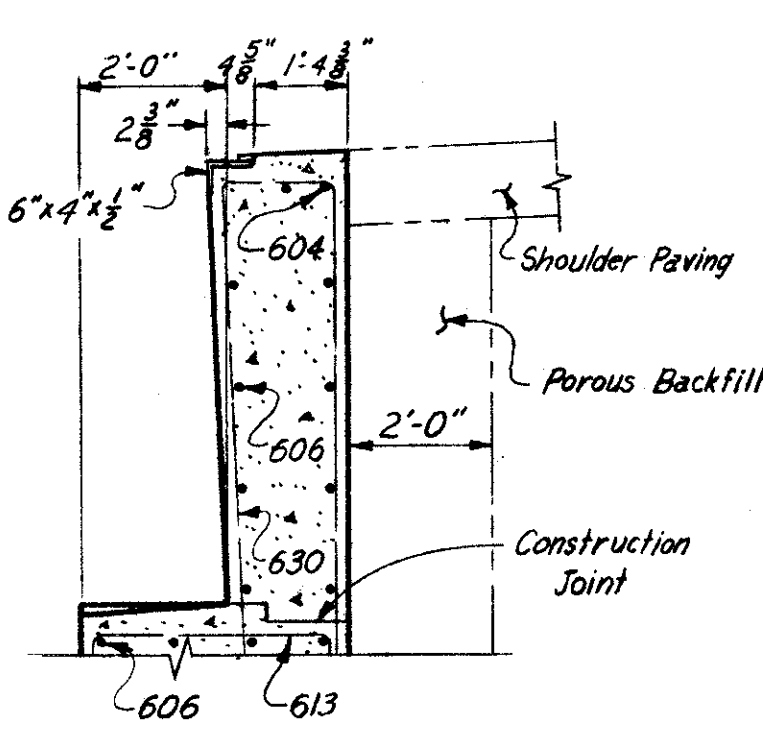

PART SECTION C-C

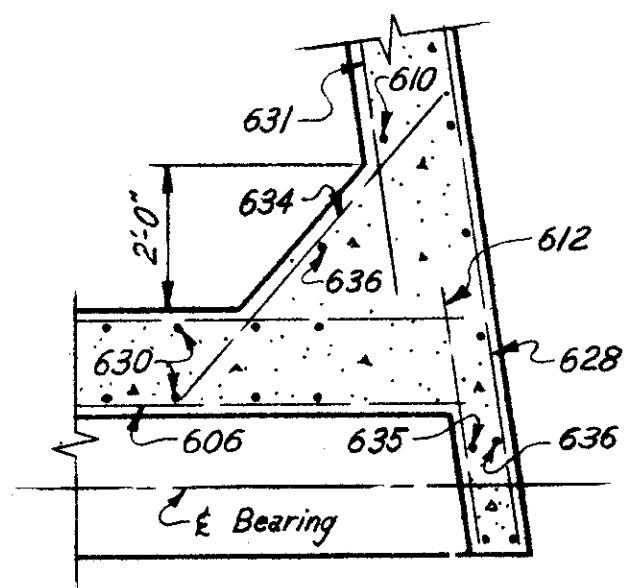

SECTION D-D

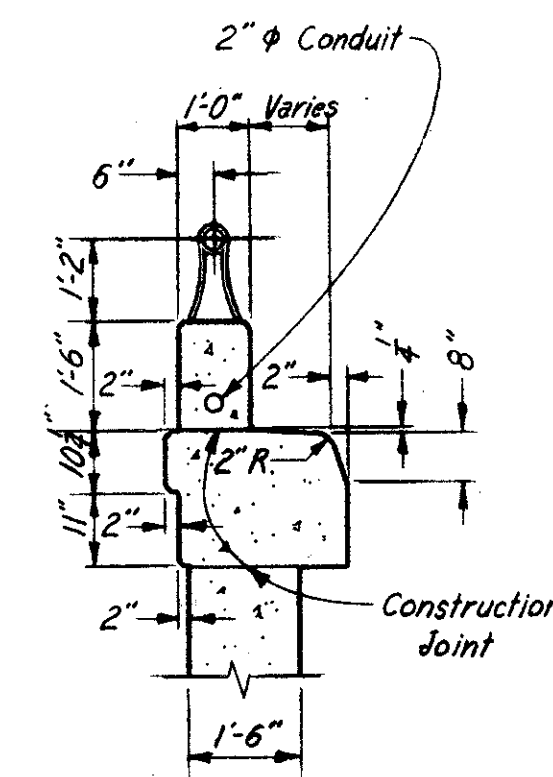


DETAIL "B"

All chamfers to be 3/4"

MARK	NO.	LENGTH	TYPE	DIMENSIONS				SERIES INCREMENT	WEIGHT (LBS)
				A	B	C	D		
401	36	5'-10"	144	2'-0"	1'-10"	7"		140	
402	36	5'-9"	105	8"	2'-8"			138	
403	16	6'-7"	109	1'-8"	1'-5"			70	
404	2-series-6	6'-1" to 6'-7"	109	1'-5" to 1'-8"	1'-5"		1/8"	51	
405	2-series-5	4'-3" to 5'-11"	109	0'-6" to 1'-4"	1'-5"		5"	34	
501	98	4'-5"	105	1'-8"	1'-6"			452	
502	2	4'-7"	105	1'-8"	1'-7"			10	
503	1	4'-4"	105	1'-5"	1'-7"			5	
504	1	4'-10"	105	1'-11"	1'-7"			5	
601	81	19'-10"	112	1'-1"	7'-6"	6'-2"	2"	2413	
602	34	22'-0"	str.					1123	
603	17	29'-6"	str.					753	
604	12	10'-0"	str.					180	
605	12	5'-3"	str.					95	
606	17	29'-3"	str.					747	
607	116	6'-2"	104	5'-6"	10"			1074	
608	4	10'-8"	108	8'-9"	1'-9 1/2"	10 3/4"		64	
609	6	8'-3"	str.					74	
610	26	9'-6"	str.					371	
611	4-series-4	4'-3" to 6'-3"	str.				8"	126	
612	22	3'-9"	str.					124	
613	59	7'-1"	105	3'-5"	2'-0"			627	
614	71	6'-9"	100	5'-5"				720	
615	1-series-7	4'-6" to 5'-6"	100	3'-2" to 4'-2"			2"	53	
616	1-series-6	4'-6" to 5'-6"	100	3'-2" to 4'-2"			2 3/8"	45	
617	16	27'-9"	str.					667	
618	1	15'-8"	108	13'-9"	3 1/2"	1'-11"		23	
619	2	13'-9"	str.					41	
620	1	15'-9"	148	14'-2"	1'-11"	3 1/2"		24	
621	2	14'-0"	str.					42	
622	1	14'-3"	str.					21	
623	1	10'-6"	str.					16	
624	1-series-3	12'-0" to 16'-9"	str.				2'-4 1/2"	65	
625	1-series-3	11'-9" to 16'-6"	str.				2'-4 1/2"	64	
626	2	13'-6"	str.					41	
627	2-series-3	8'-3" to 13'-0"	str.				2'-4 1/2"	96	
628	2	20'-0"	str.					60	
629	2	19'-9"	str.					59	
630	25	18'-6"	154	1'-4"	1'-7"	7'-6"	7'-6"	695	
631	4	16'-0"	str.					96	
*632	12	16'-9"	str.						
633	6	18'-0"	str.					162	
634	16	5'-9"	str.					138	
635	4	6'-9"	str.					41	
636	7	7'-6"	str.					79	
637	3	13'-10"	148	12'-0"	2'-0"	3"		62	
638	3	13'-6"	108	11'-8"	3"	2'-0"		61	
639	33	5'-8"	104	5'-0"	10"			281	
640	3	18'-0"	133	6'-0"	12'-0"	71'-10"		81	
641	3	18'-4"	133	6'-4"	12'-0"	71'-10"		83	
Total								12,492	

NOTES:

*Bars included for payment with "Item 5-14, Railing."
Bar dimensions are given out to out.
Bars of a series shall vary in length by a constant increment.
For replacement schedule, see Sheet 103-7A.
For additional notes, see Sheet 116-7A.

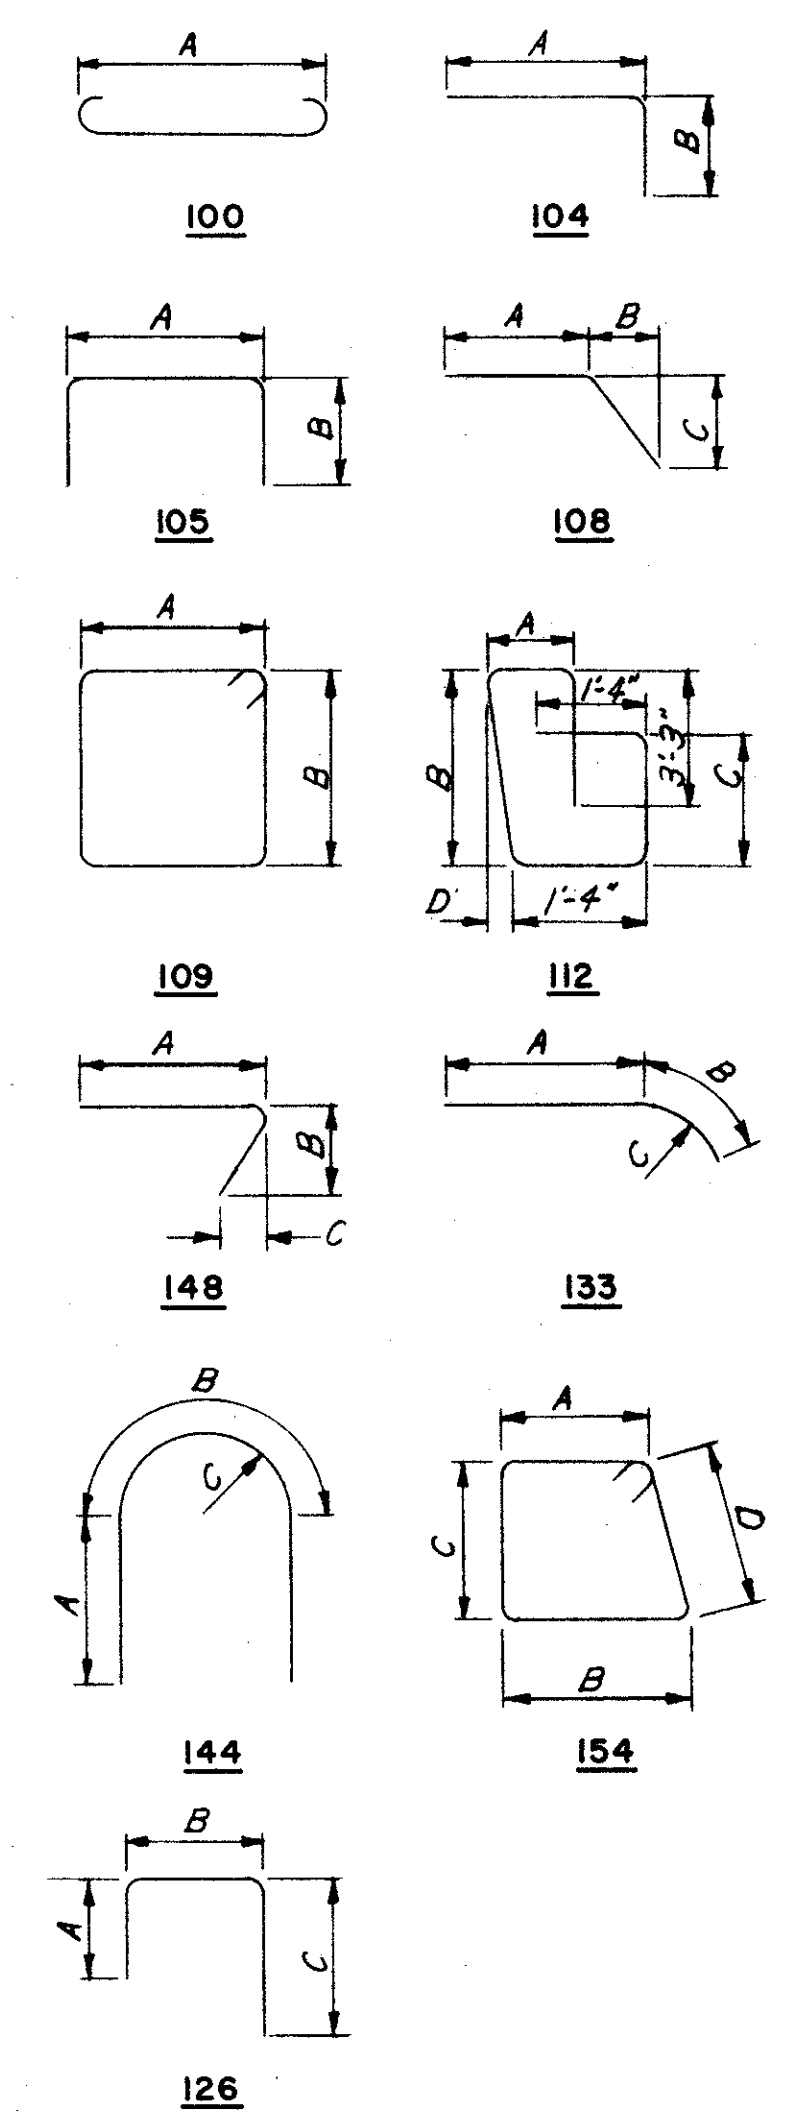

BENDING DIAGRAMS

H.N.T.B. BR. NO. 4 PART 7A

HOWARD, NEEDLES, TAMMEN & BERGENDOFF
CONSULTING ENGINEERS
KANSAS CITY CLEVELAND NEW YORK

WEST ABUTMENT-SECTIONS

INNER BELT FREEWAY OVER EAST 14th ST.
BR. NO. CUY - 42-1854 STA. 70+89.23
Scale: 3/8" = 1'-0" STA. 73+96.25









WILLOW-INNER BELT FREEWAY
CLEVELAND CUYAHOGA COUNTY OHIO

DRAWN C.M.	TRACED	CHECKED H.P.L.	REVIEWED J.C.T.	REVISED
DATE 1-14-59	DATE	DATE 1-22-59	DATE 1-13-59	SHEET 117


Note:
Sections are typical except for bar marks.

JUL 3 1985

Note: Prefix "AC" shall be assigned to all bar marks.

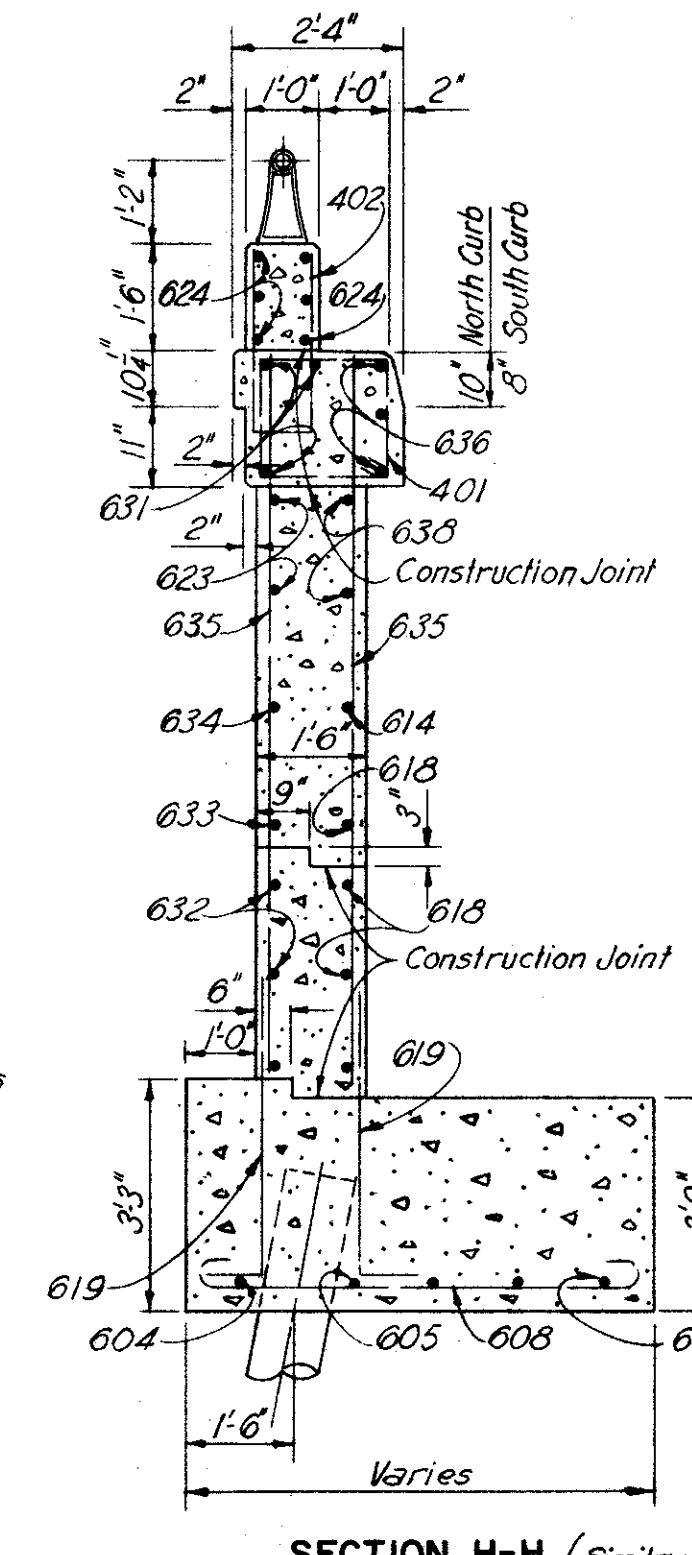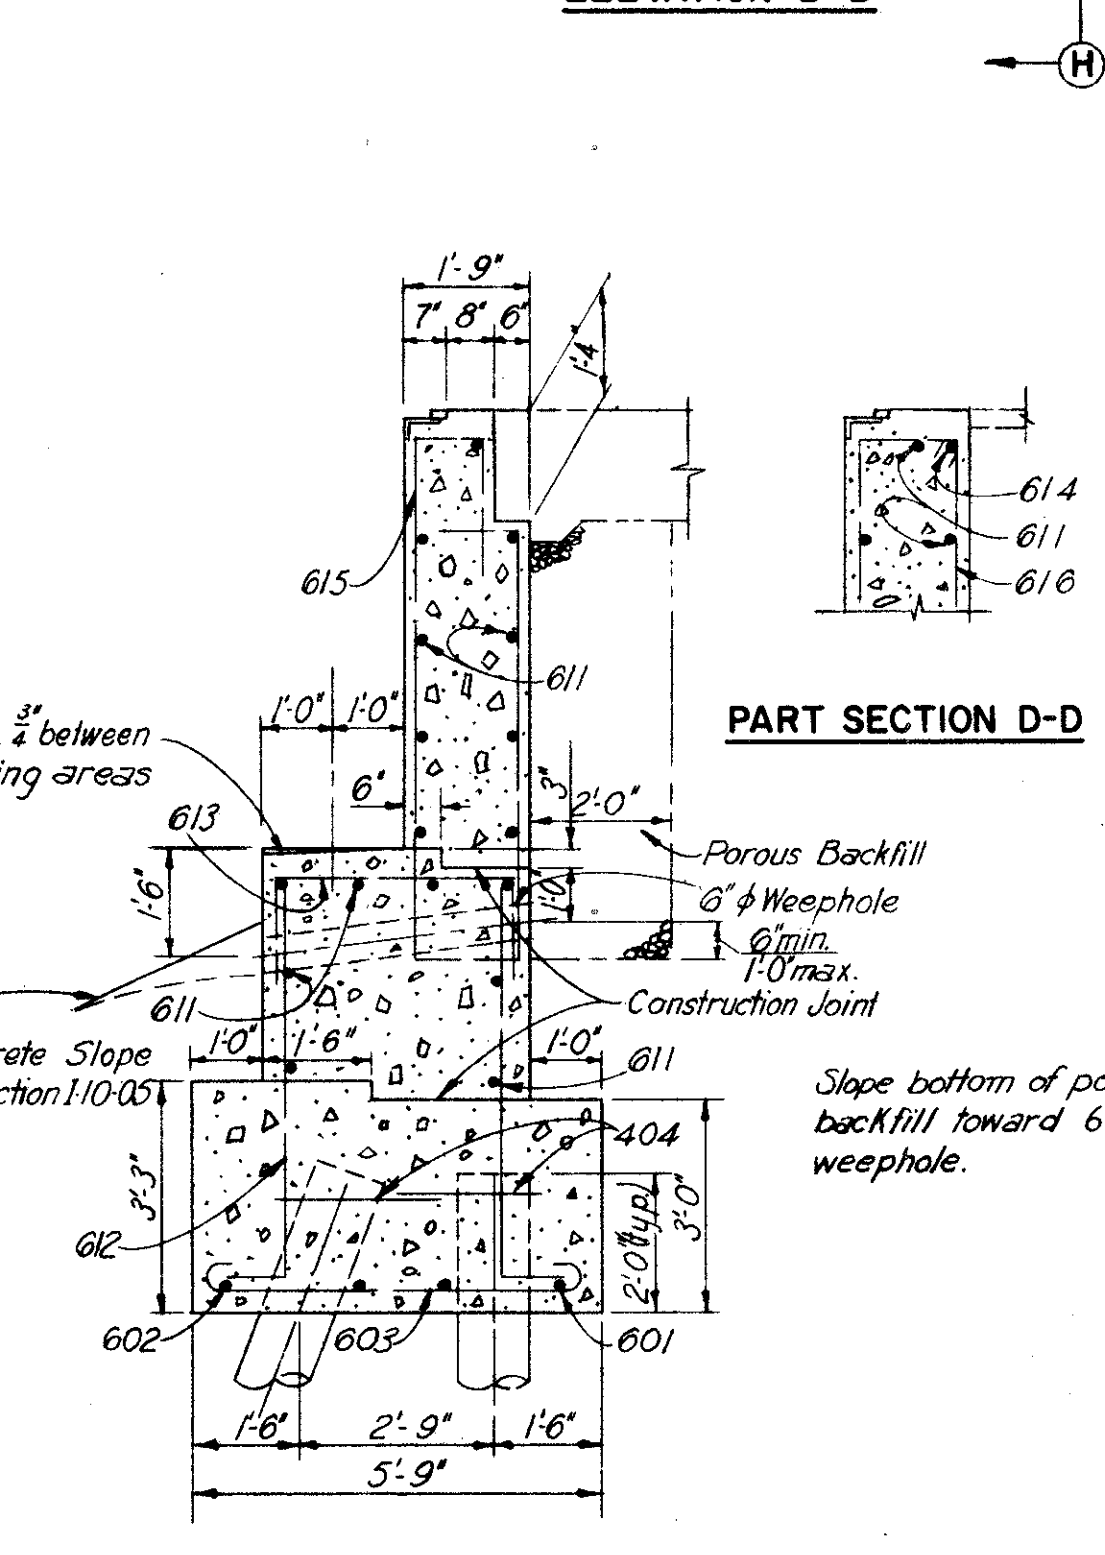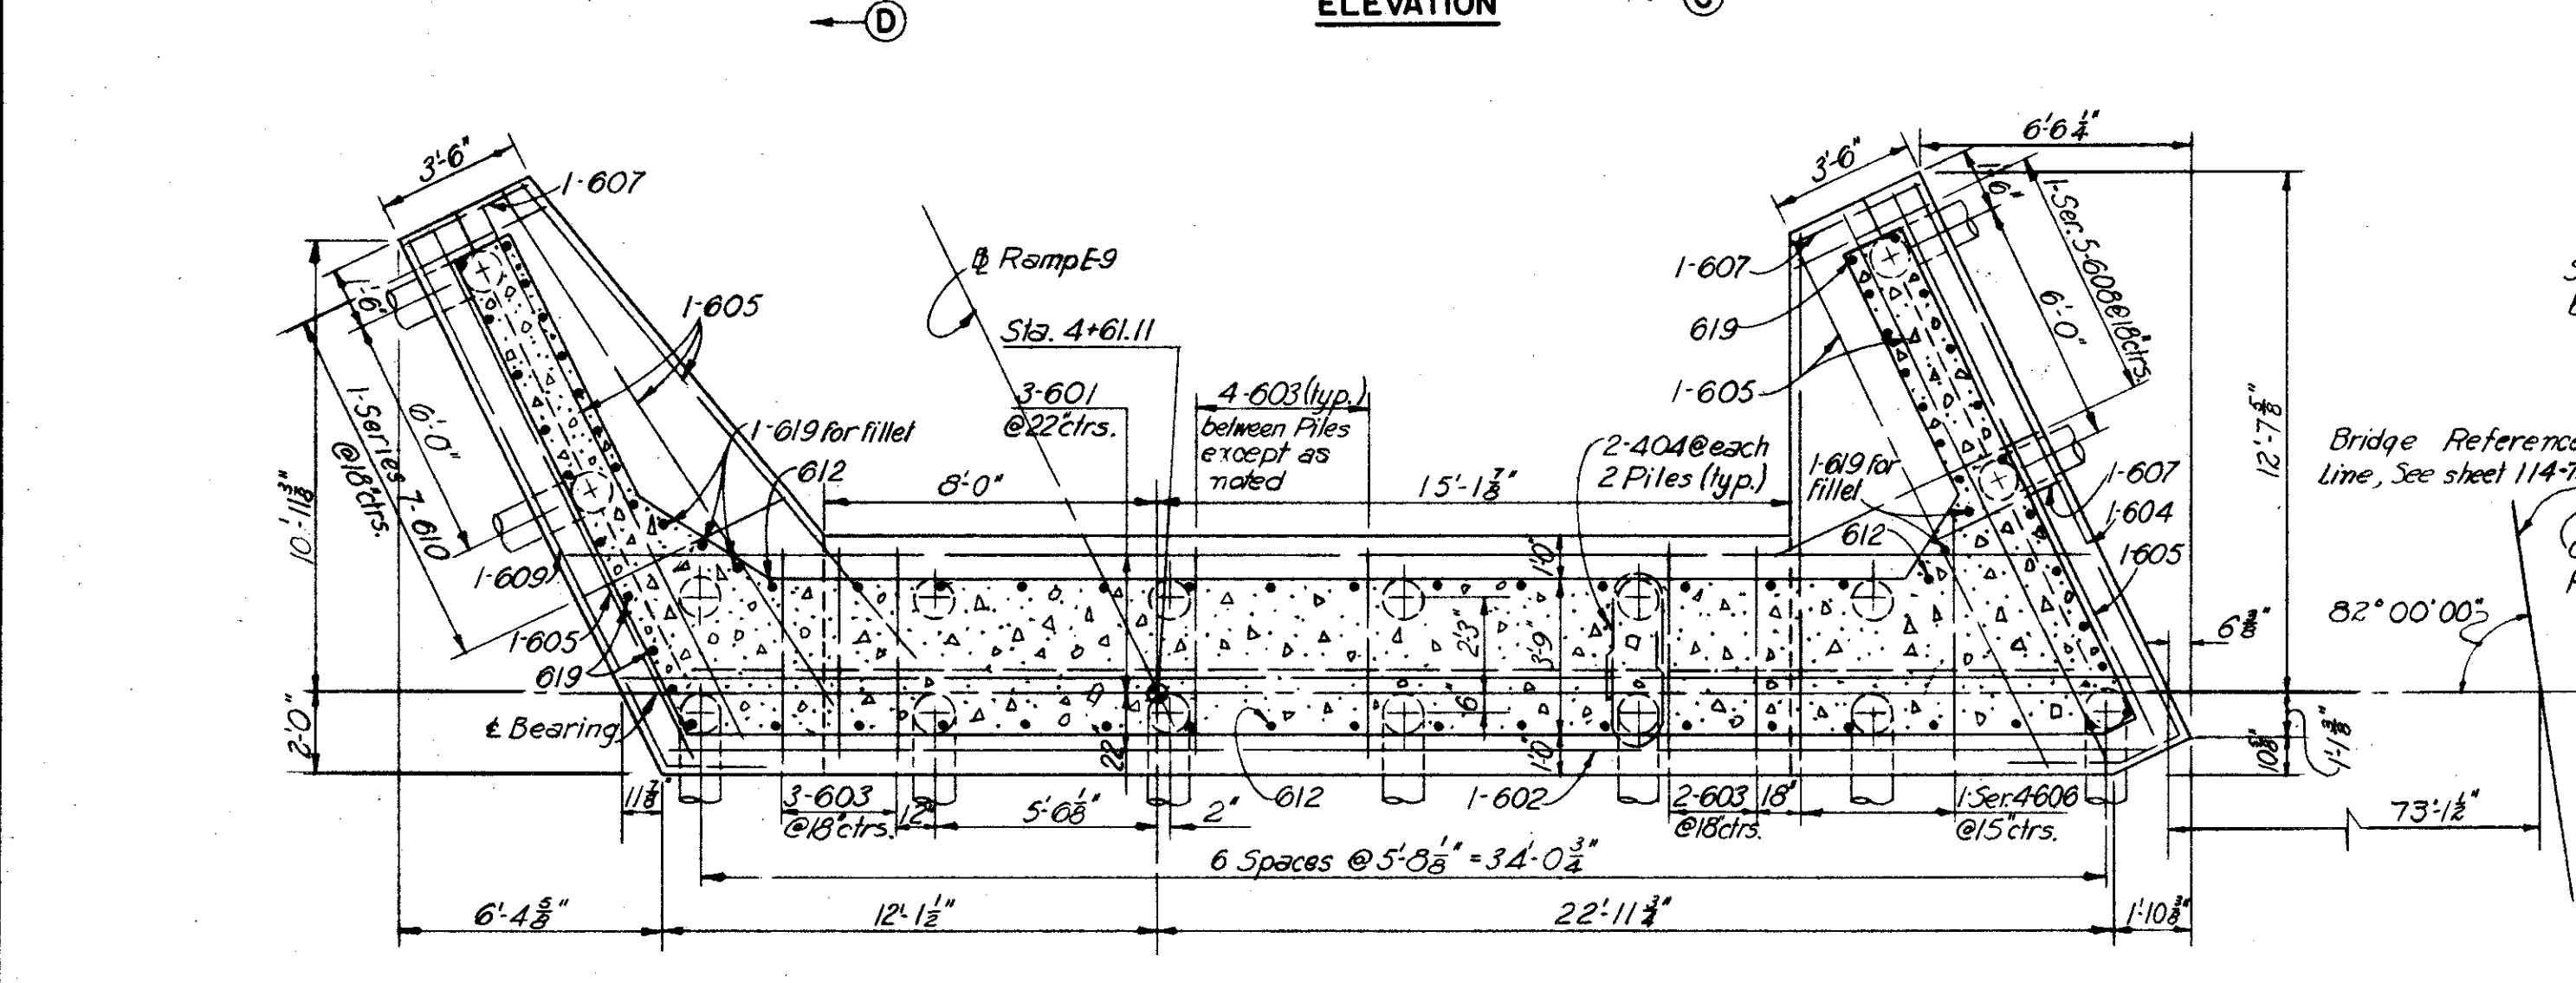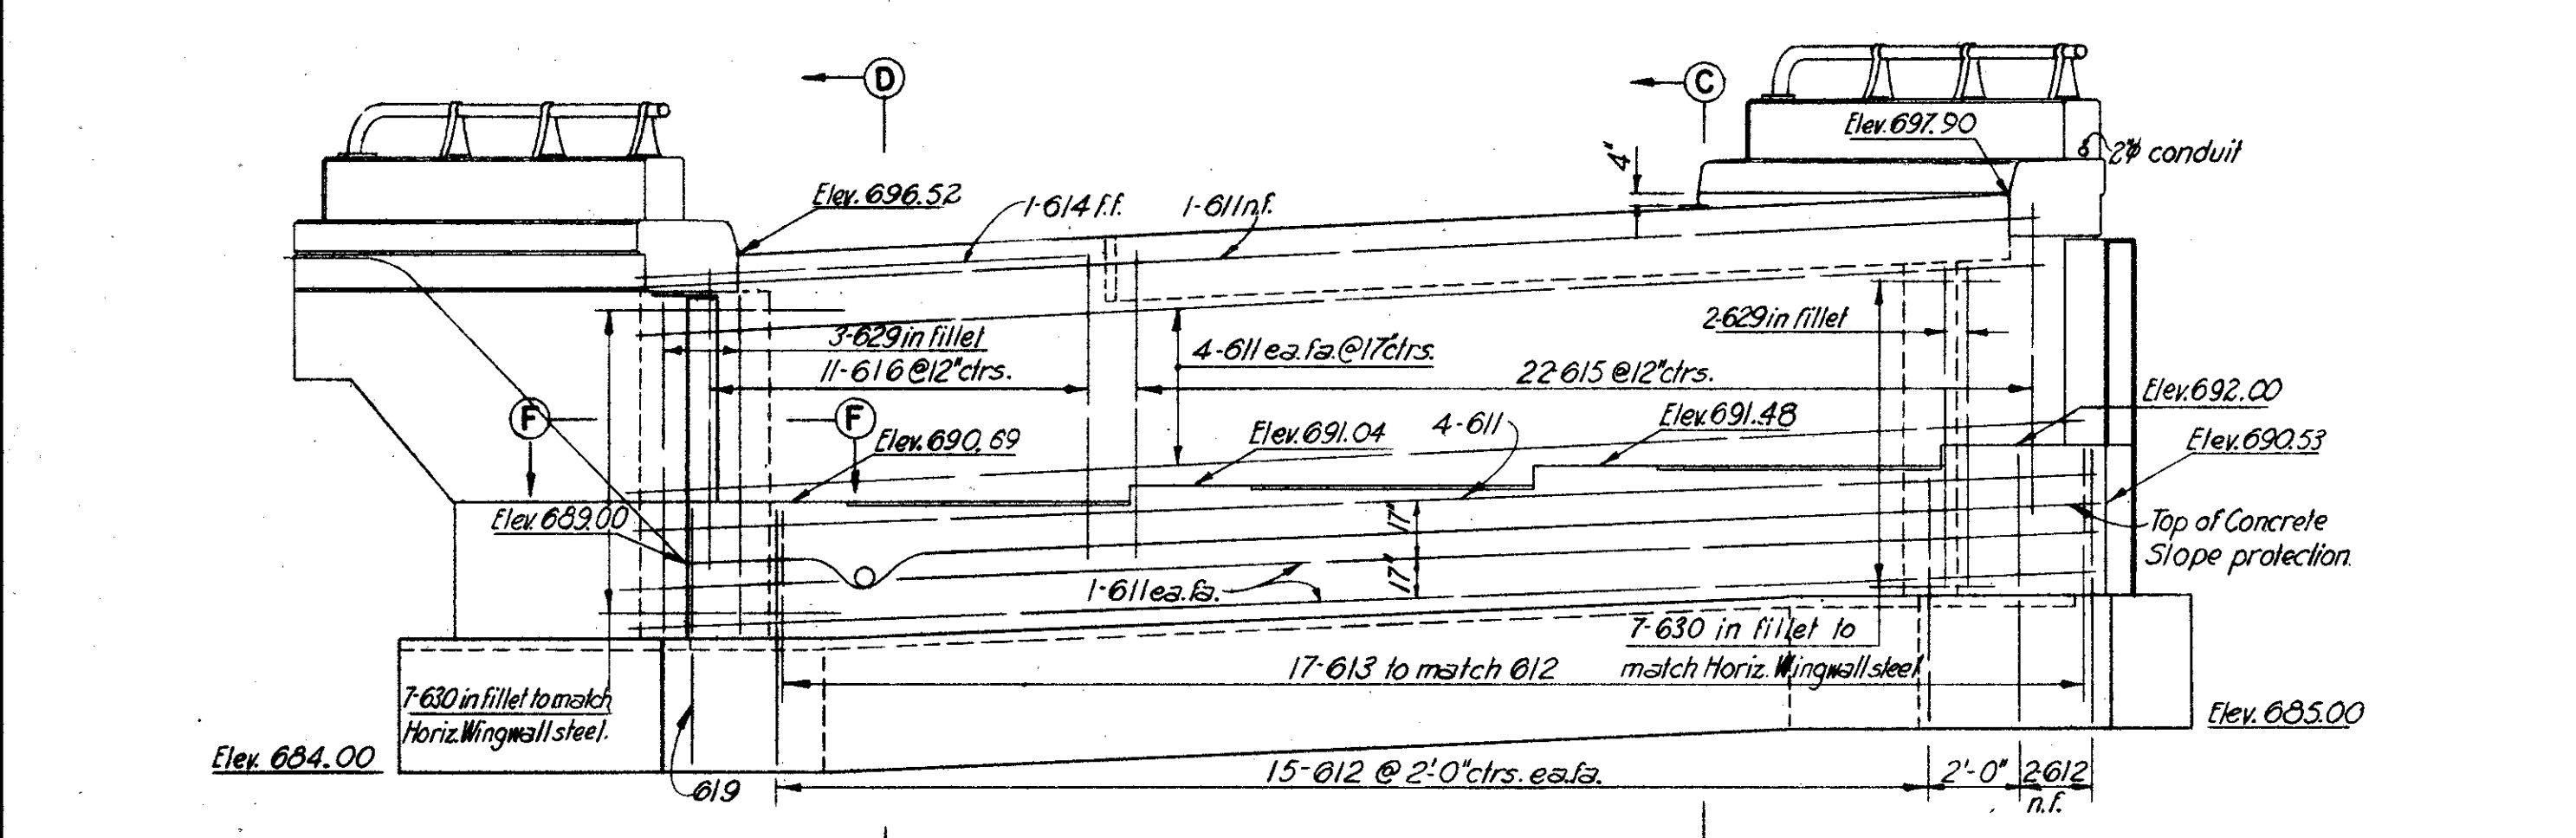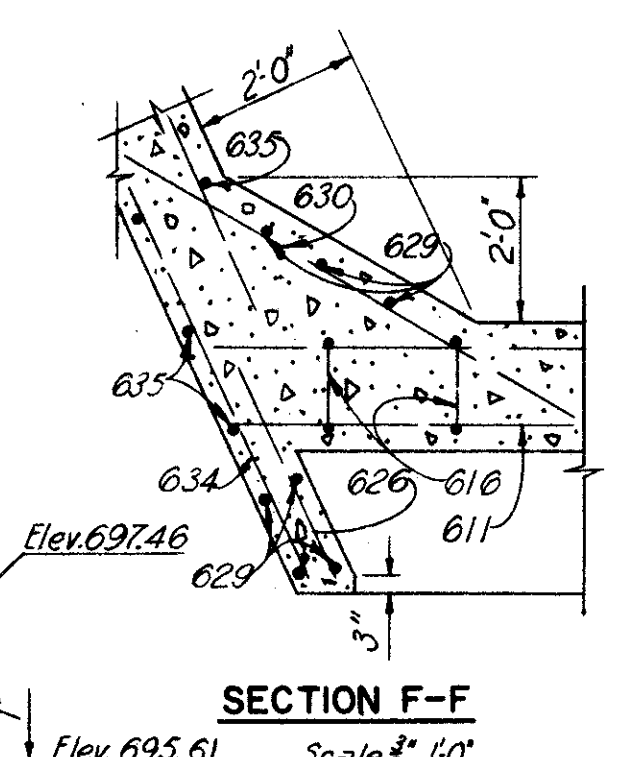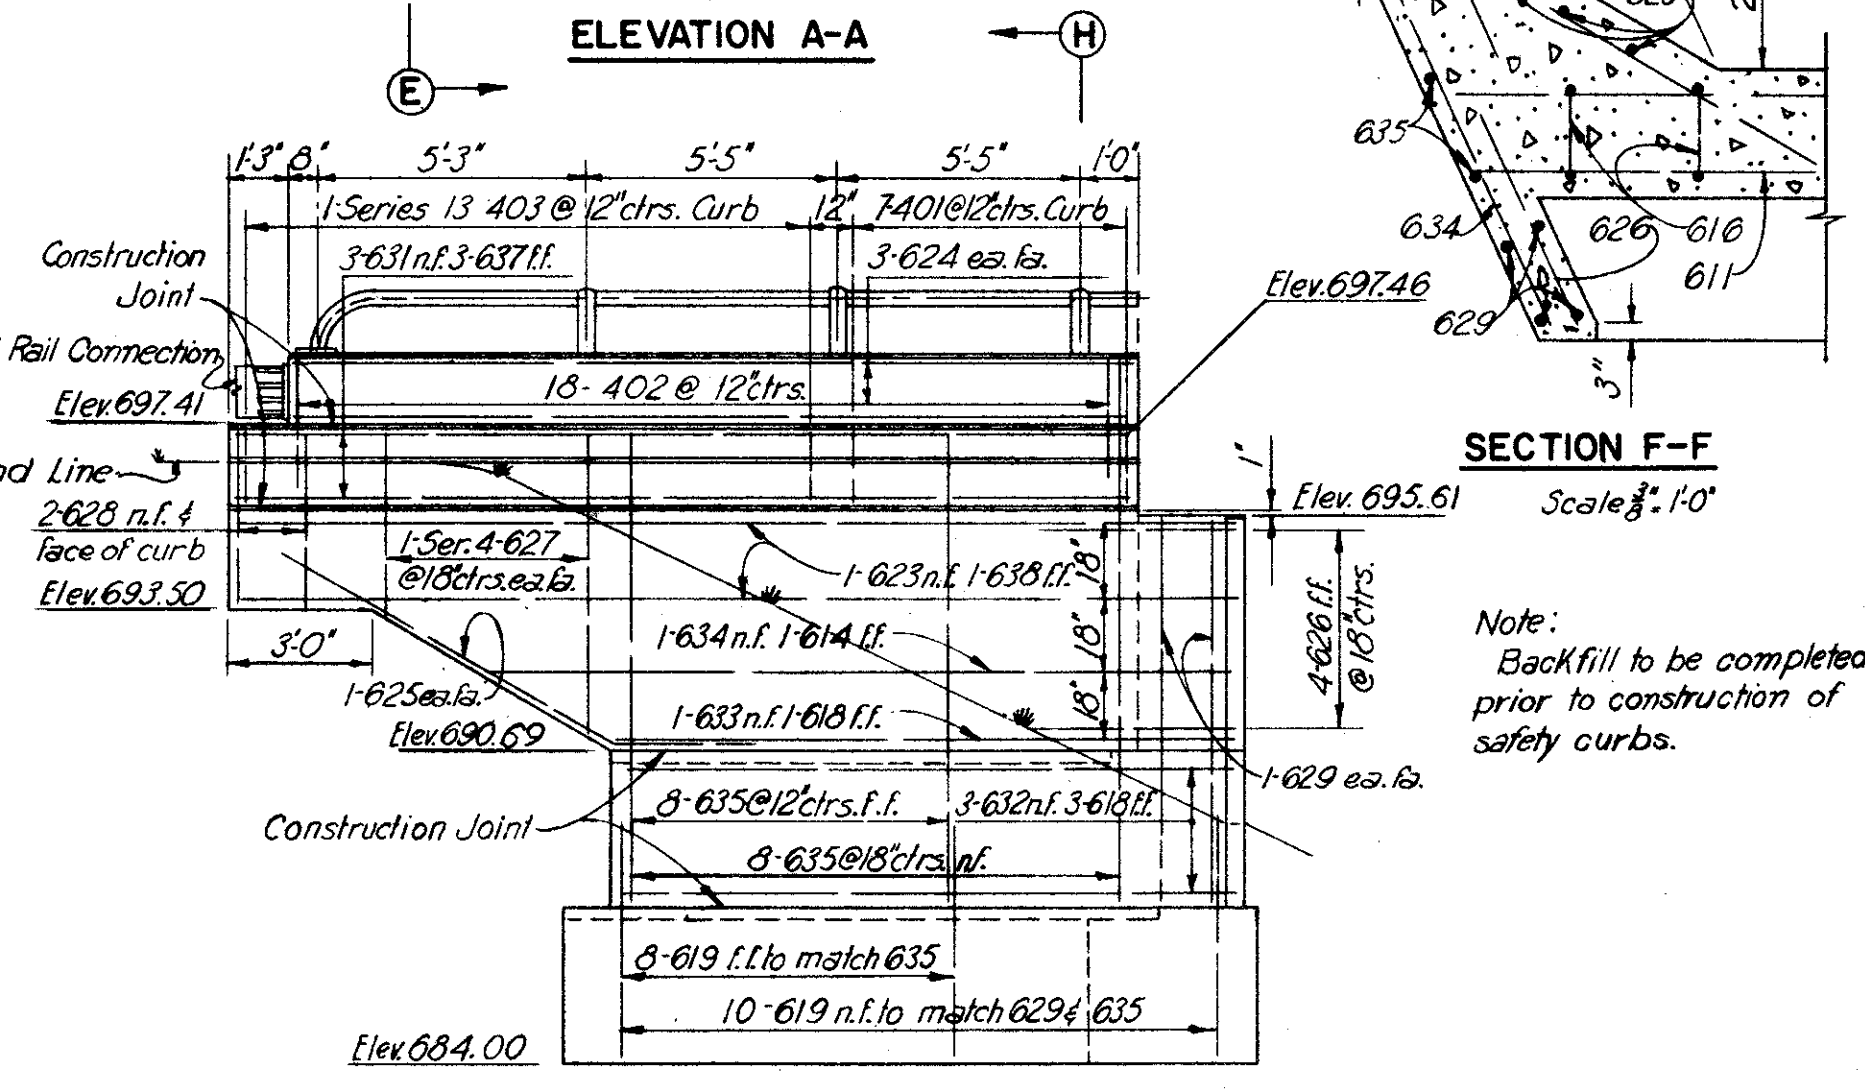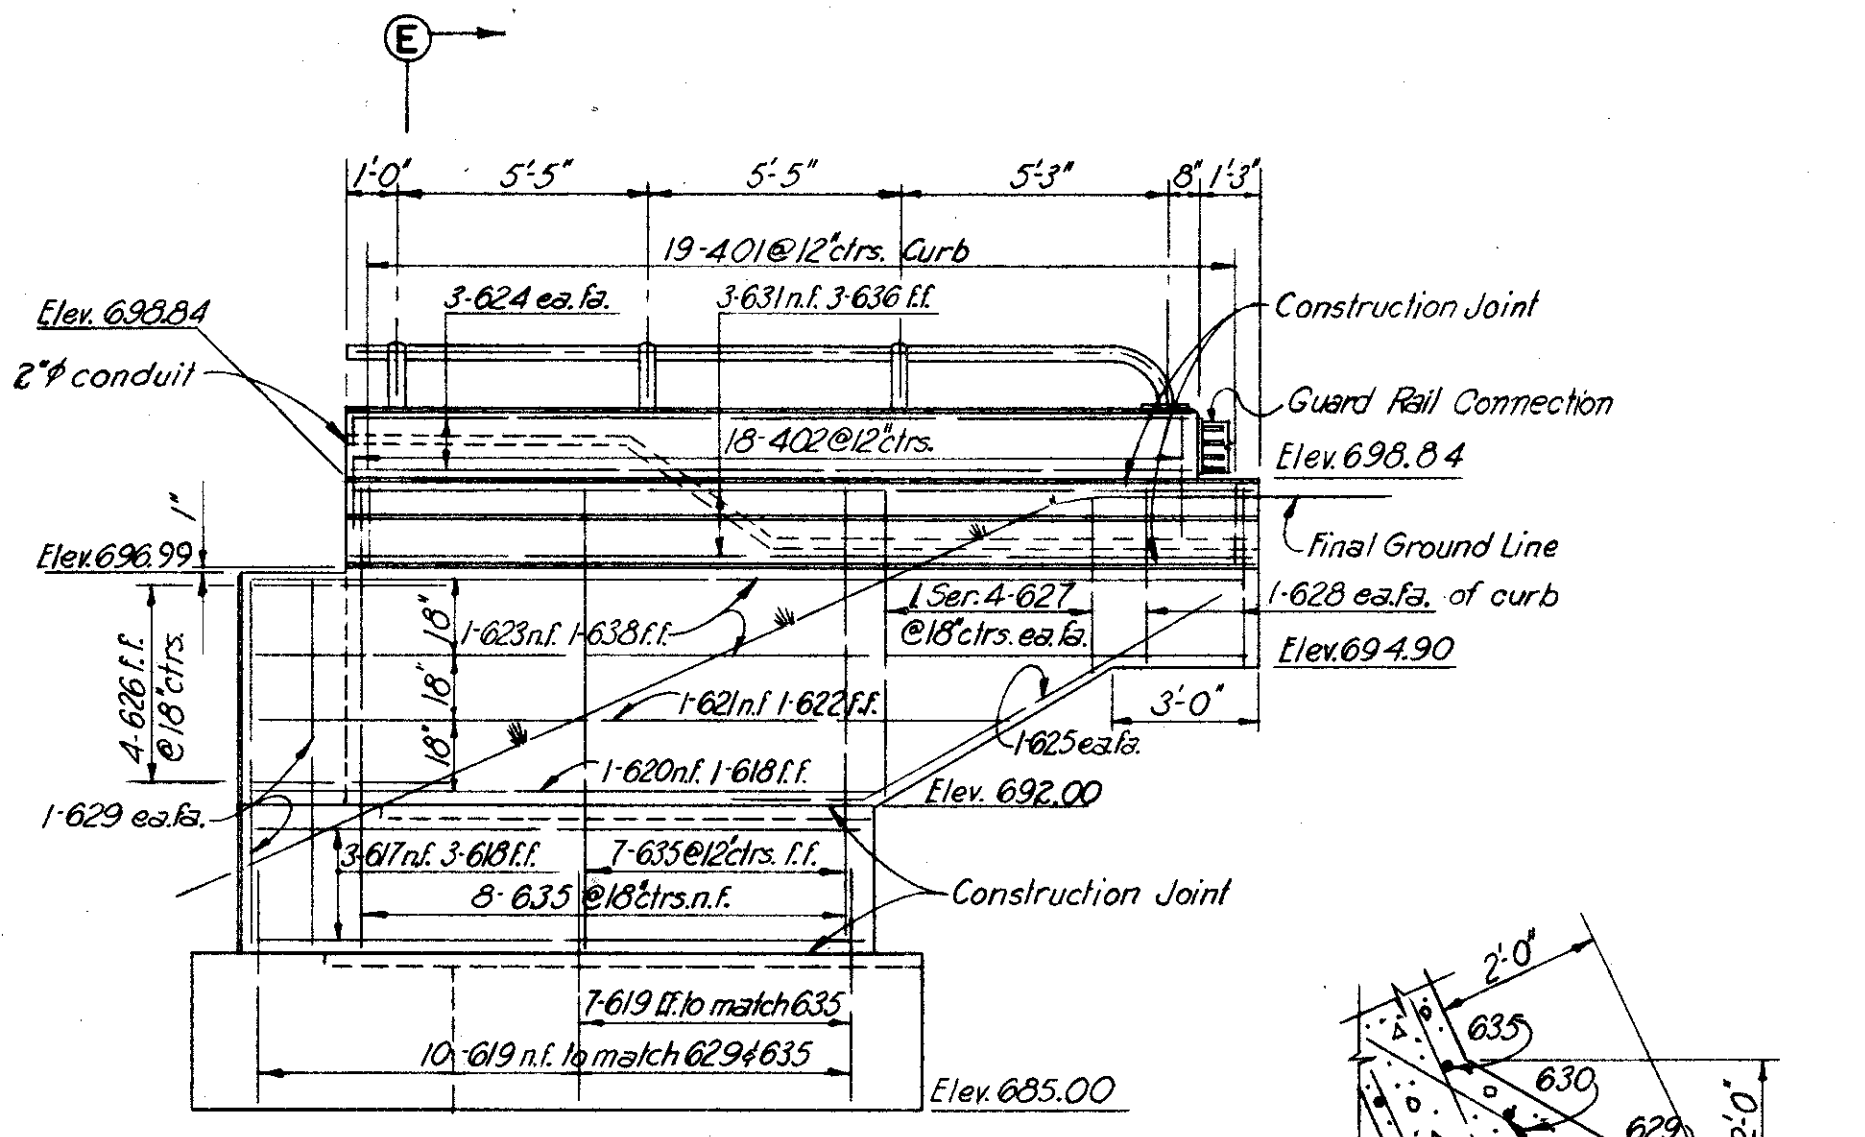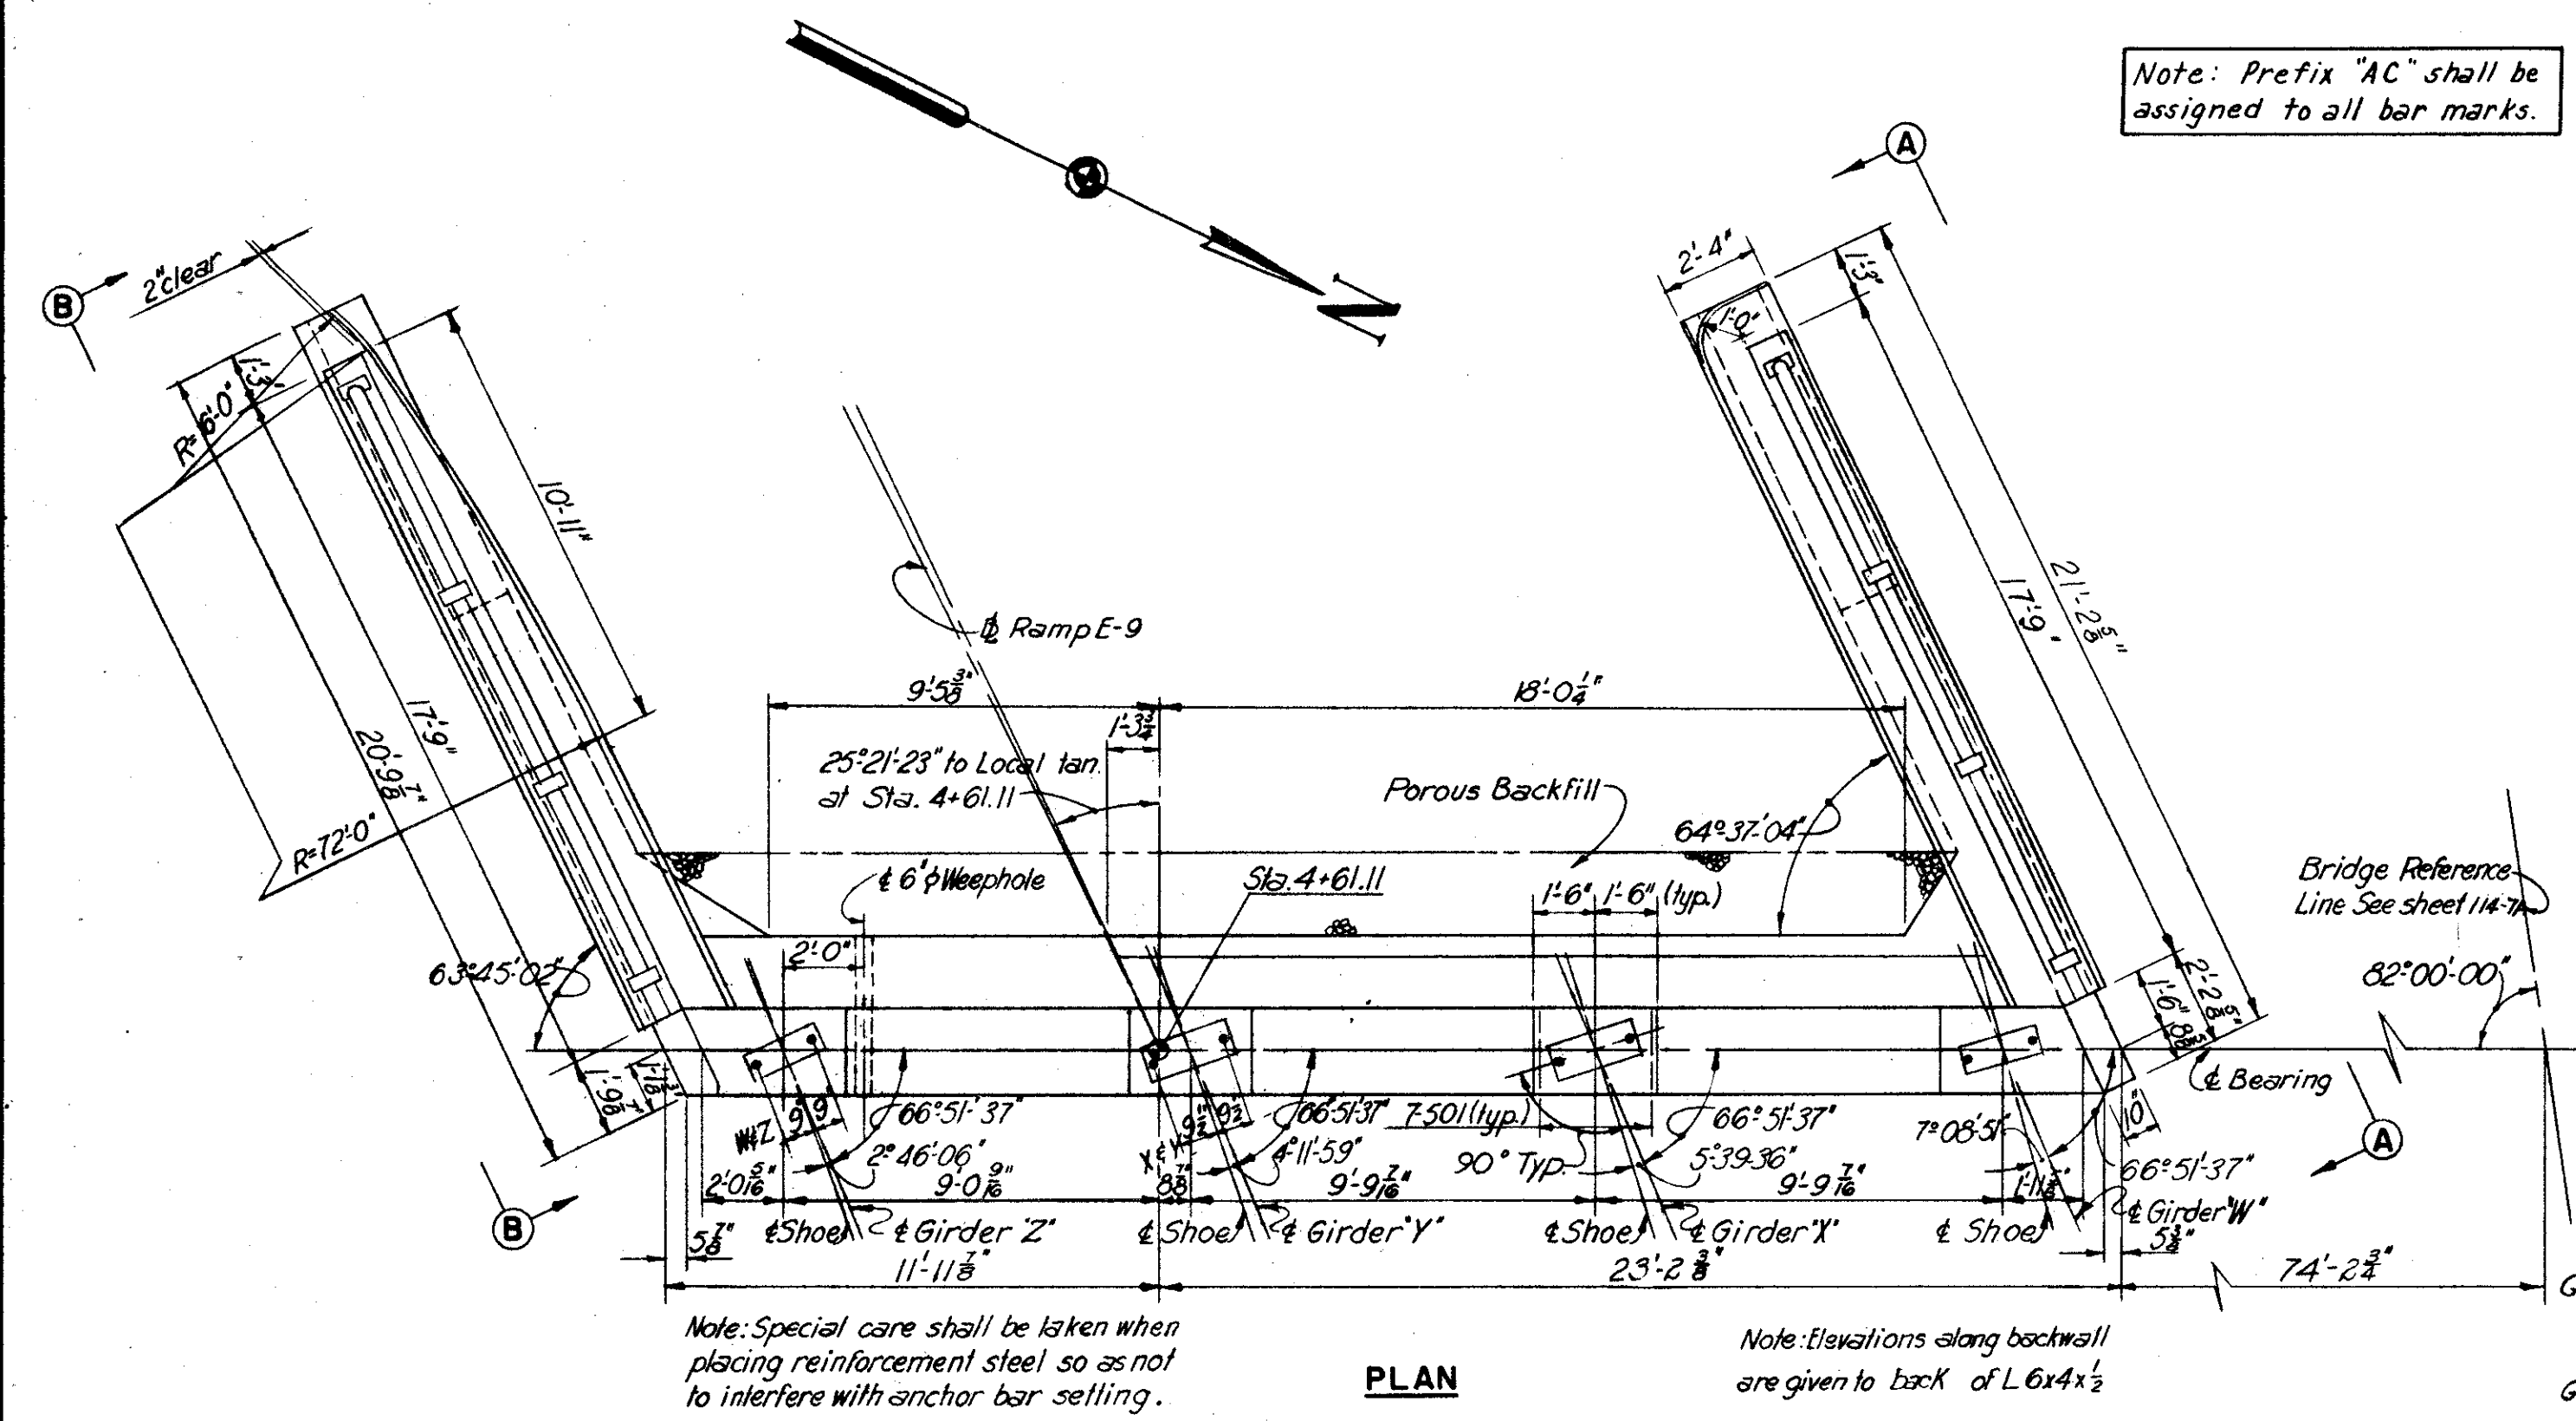

REINFORCEMENT SCHEDULE										
MARK	NO.	LENGTH	TYPE	DIMENSIONS				SERIES INCR.	WEIGHT	
				A	B	C	D			
401	26	6'-5"	109	1'-8"	1'-5"				113	
402	36	5'-5"	105	8"	2'-6"				130	
403	13	4'-8" to 6'-6"	109	8 1/2"	1'-5"			2'	48	
404	12	6'-10"	144	6"	1'-10"				55	
501	28	4'-7"	103	1'-8"	1'-7"				134	
601	3	3'-0"	Str.						167	
602	1	3'-0"	Str.						54	
603	17	6'-8"	100	5'-4"					170	
604	1	18'-1"	124	14'-9"	1'-7"	2'-0"			27	
605	7	14'-9"	Str.						155	
606	1 Ser. 4	7'-5" to 13'-3"	101	6 3/4"			2'-0"		63	
607	3	4'-6"	100	3'-2"					20	
608	1 Ser. 5	4'-10" to 8'-4"	100	3 1/2"			10 1/2"		49	
609	1	16'-0"	108	14'-0"	2'-0"				24	
610	1 Ser. 7	4'-7" to 6'-7"	100	8 3/4"			4'		59	
611	17	34'-3"	Str.						875	
612	32	8'-5"	104	10'	5'-9"				308	
613	17	7'-5"	105	3'-5"	2'-2"				189	
614	2	11'-0"	Str.						33	
615	22	20'-6"	112	11'	8'-6"	1'-5"	7'-2"		677	
616	11	20'-4"	109	1'-5"	8'-6"				336	
617	3	15'-0"	124	12'-9"	8"	2'-0"			68	
618	8	9'-0"	Str.						108	
619	40	5'-8"	104	10'	5'-0"				340	
620	1	13'-3"	Str.						20	
621	1	16'-0"	Str.						24	
622	1	12'-3"	Str.						18	
623	4	20'-9"	Str.						125	
624	12	17'-3"	Str.							
625	4	10'-6"	108	8'-6"	2'-0"				63	
626	8	4'-0"	Str.						48	
627	4 Ser. 8	3'-6" to 6'-3"	Str.				11'		117	
628	8	3'-6"	Str.						42	
629	13	8'-3"	Str.						161	
630	14	6'-0"	Str.						126	
631	6	18'-6"	Str.						167	
632	3	14'-6"	108	12'-8"	2'-0"				63	
633	1	12'-6"	Str.						19	
634	1	15'-0"	Str.						22	
635	31	10'-0"	Str.						466	
636	3	18'-0"	Str.						81	
637	3	19'-0"	Str.						86	
638	4	17'-3"	Str.						104	
									Total	5,956

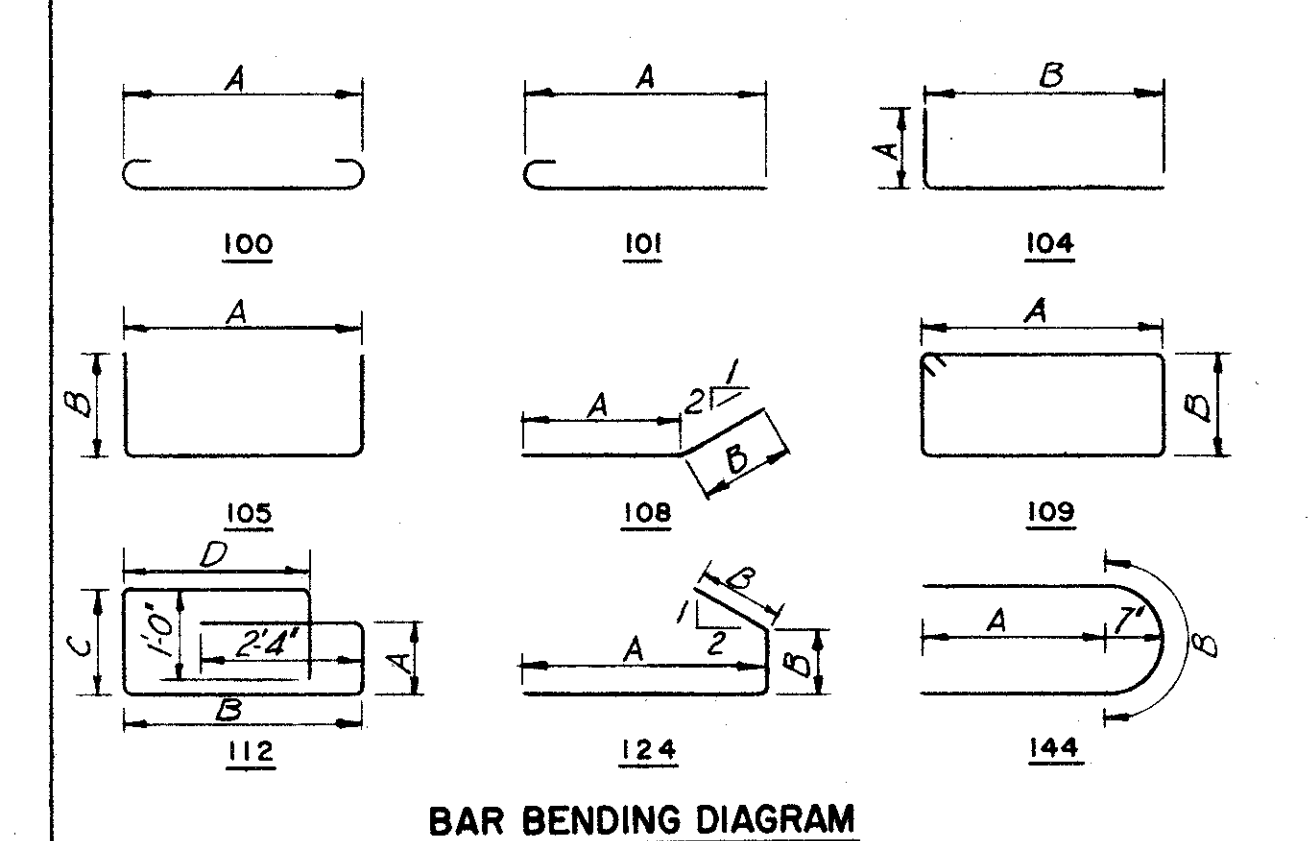

NOTES:
 * bars are included for payment with Item 'S14' Railing
 For additional notes see sheet 115-7A

H.N.T.B. BR. NO. 4 PART 7A

HOWARD, NEEDLES, TAMMEN & BERGENDOFF
 CONSULTING ENGINEERS
 KANSAS CITY CLEVELAND NEW YORK

ABUTMENT E-9


INNER BELT FREEWAY OVER EAST 14th ST.
 BR. NO. CUY-42-1854 STA. 70+89.23
 Scale: 1/4" = 1'-0" STA. 73+96.25
 Except as noted

WILLOW-INNER BELT FREEWAY
 CLEVELAND CUYAHOGA COUNTY OHIO

DRAWN BY: M. TRACED CHECKED: C. H. E. REVIEWED: JCT REVISIONS:
 DATE: 1-20-59 DATE: 1-22-59 DATE: 11-13-59


SHEET 118

CUYAHOGA COUNTY
 CITY OF CLEVELAND
 CUY-21-15.32
 CUY-42-18.42

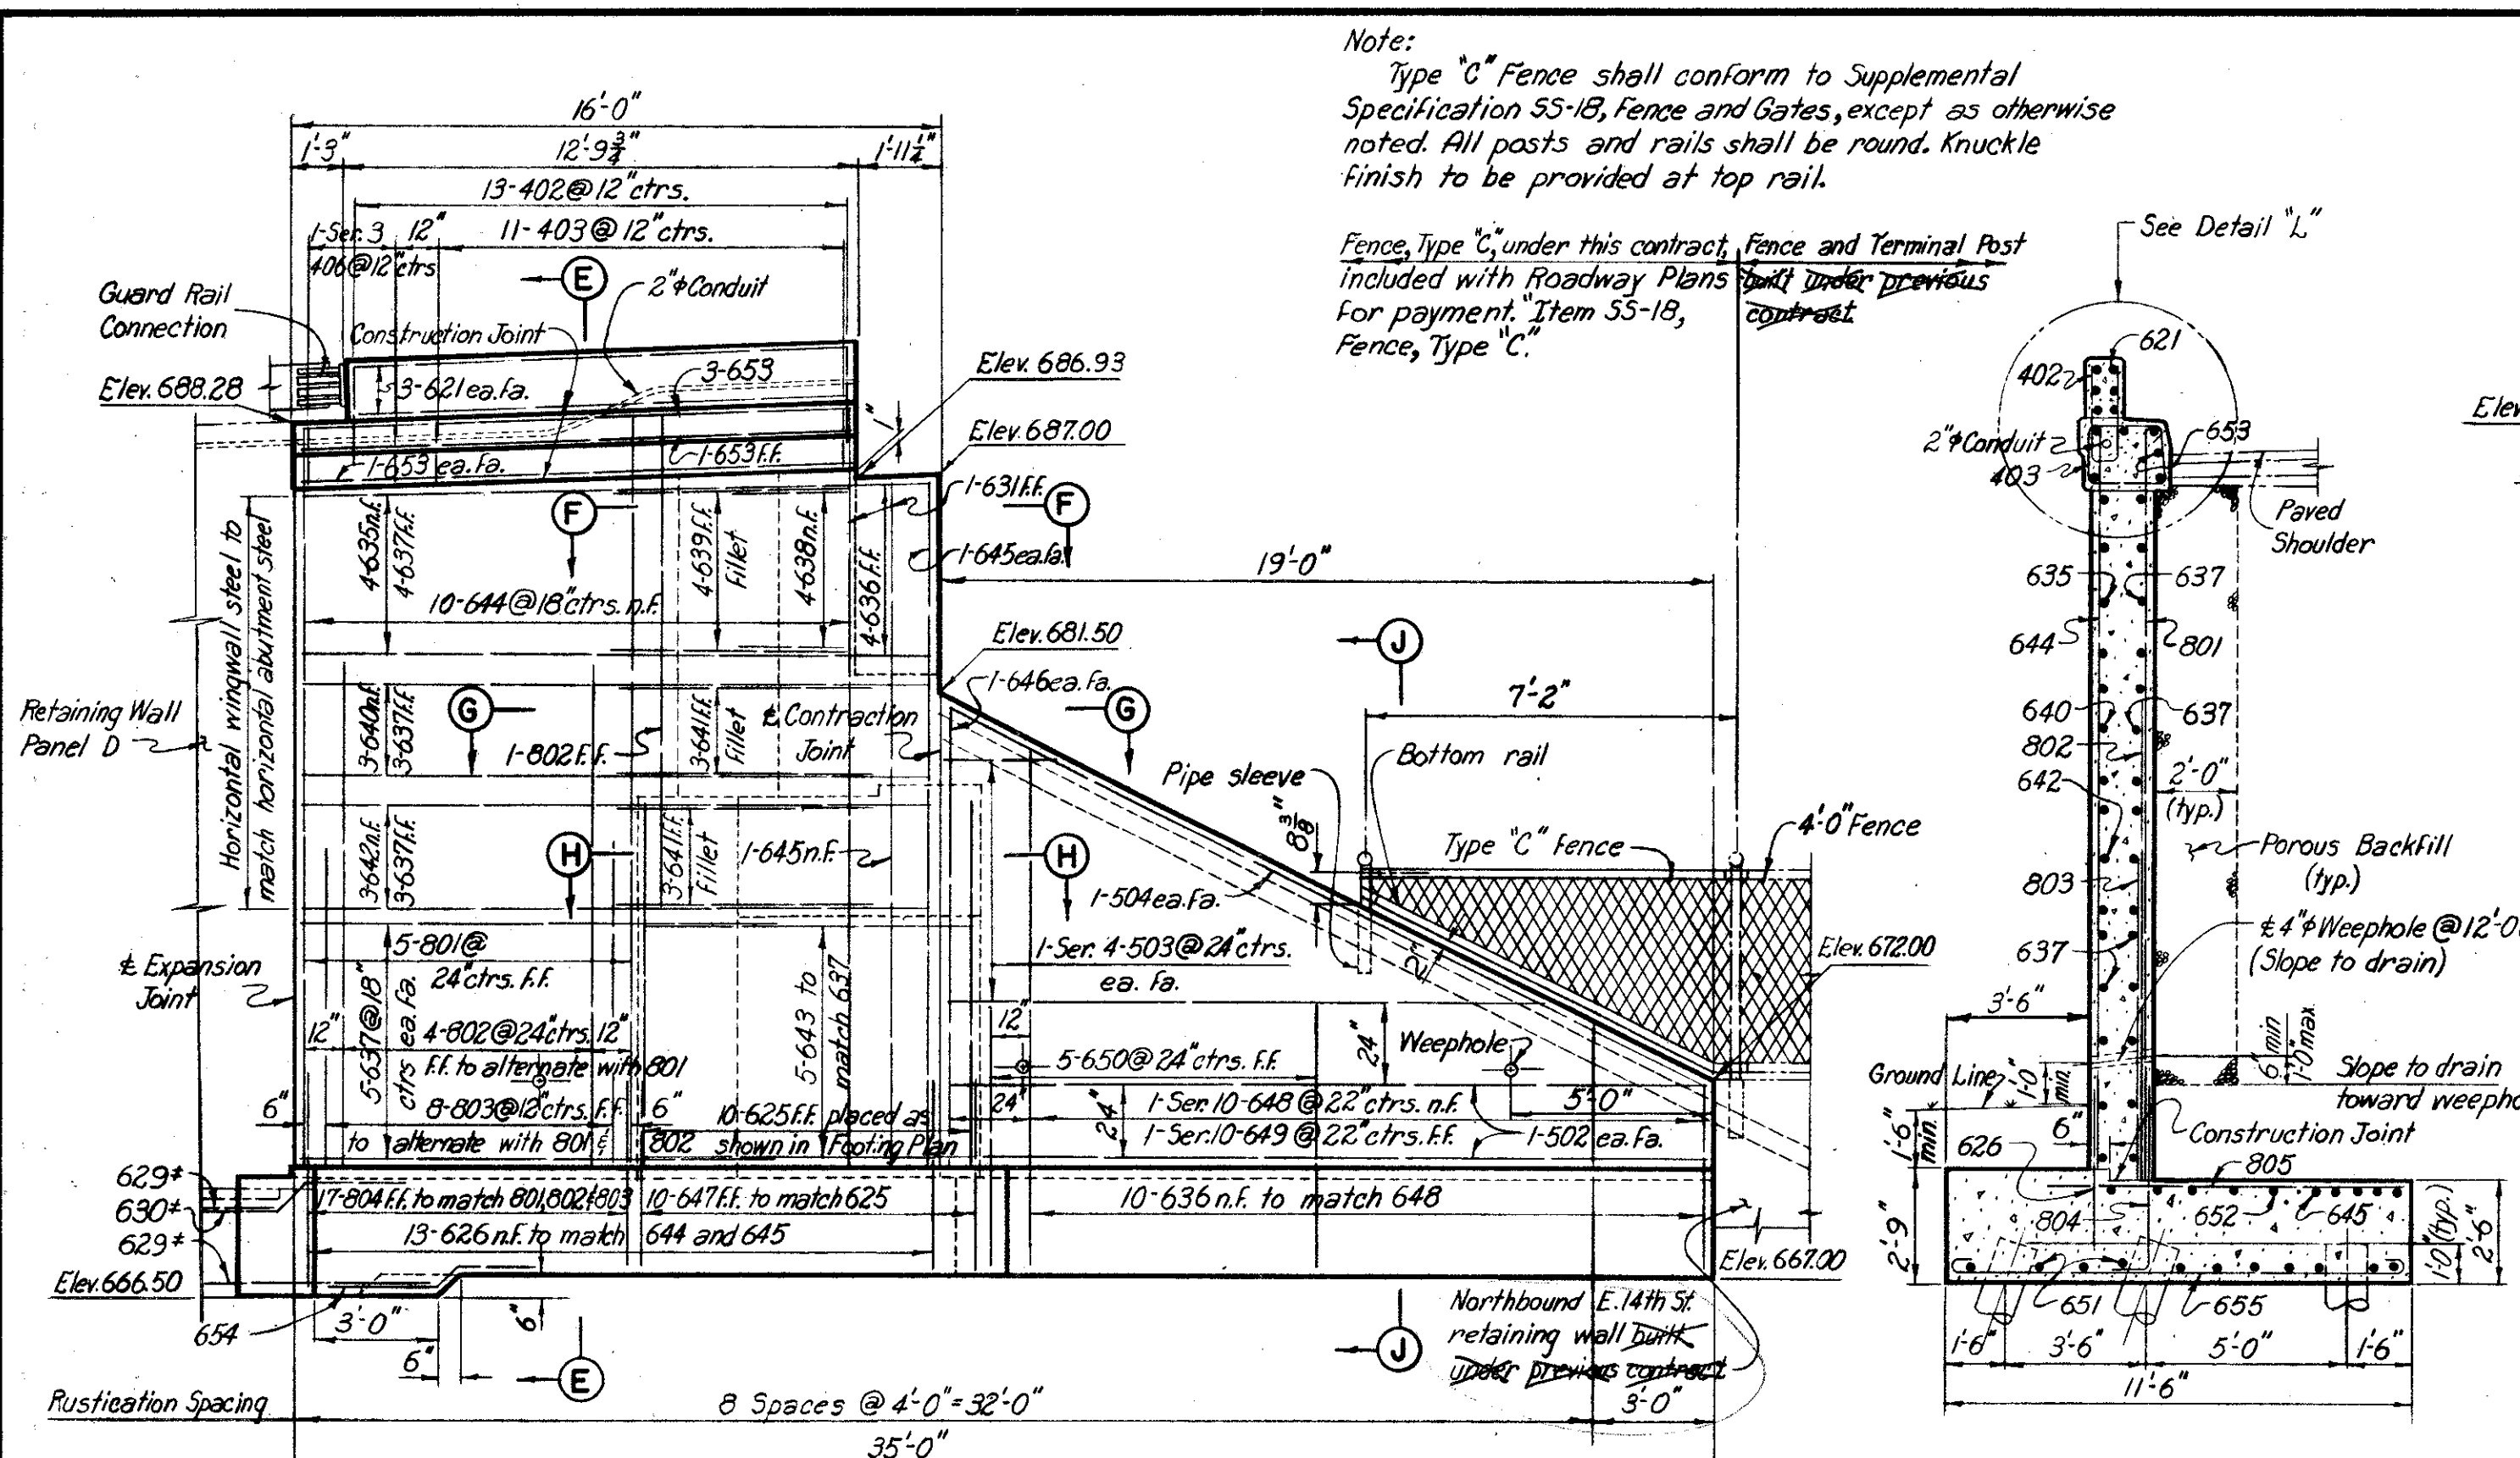


ELEVATION A-A
 (Piles not shown)

Note:
 † designates Retaining Wall Panel D footing reinforcement. See Sheets 121-7A and 122-7A.

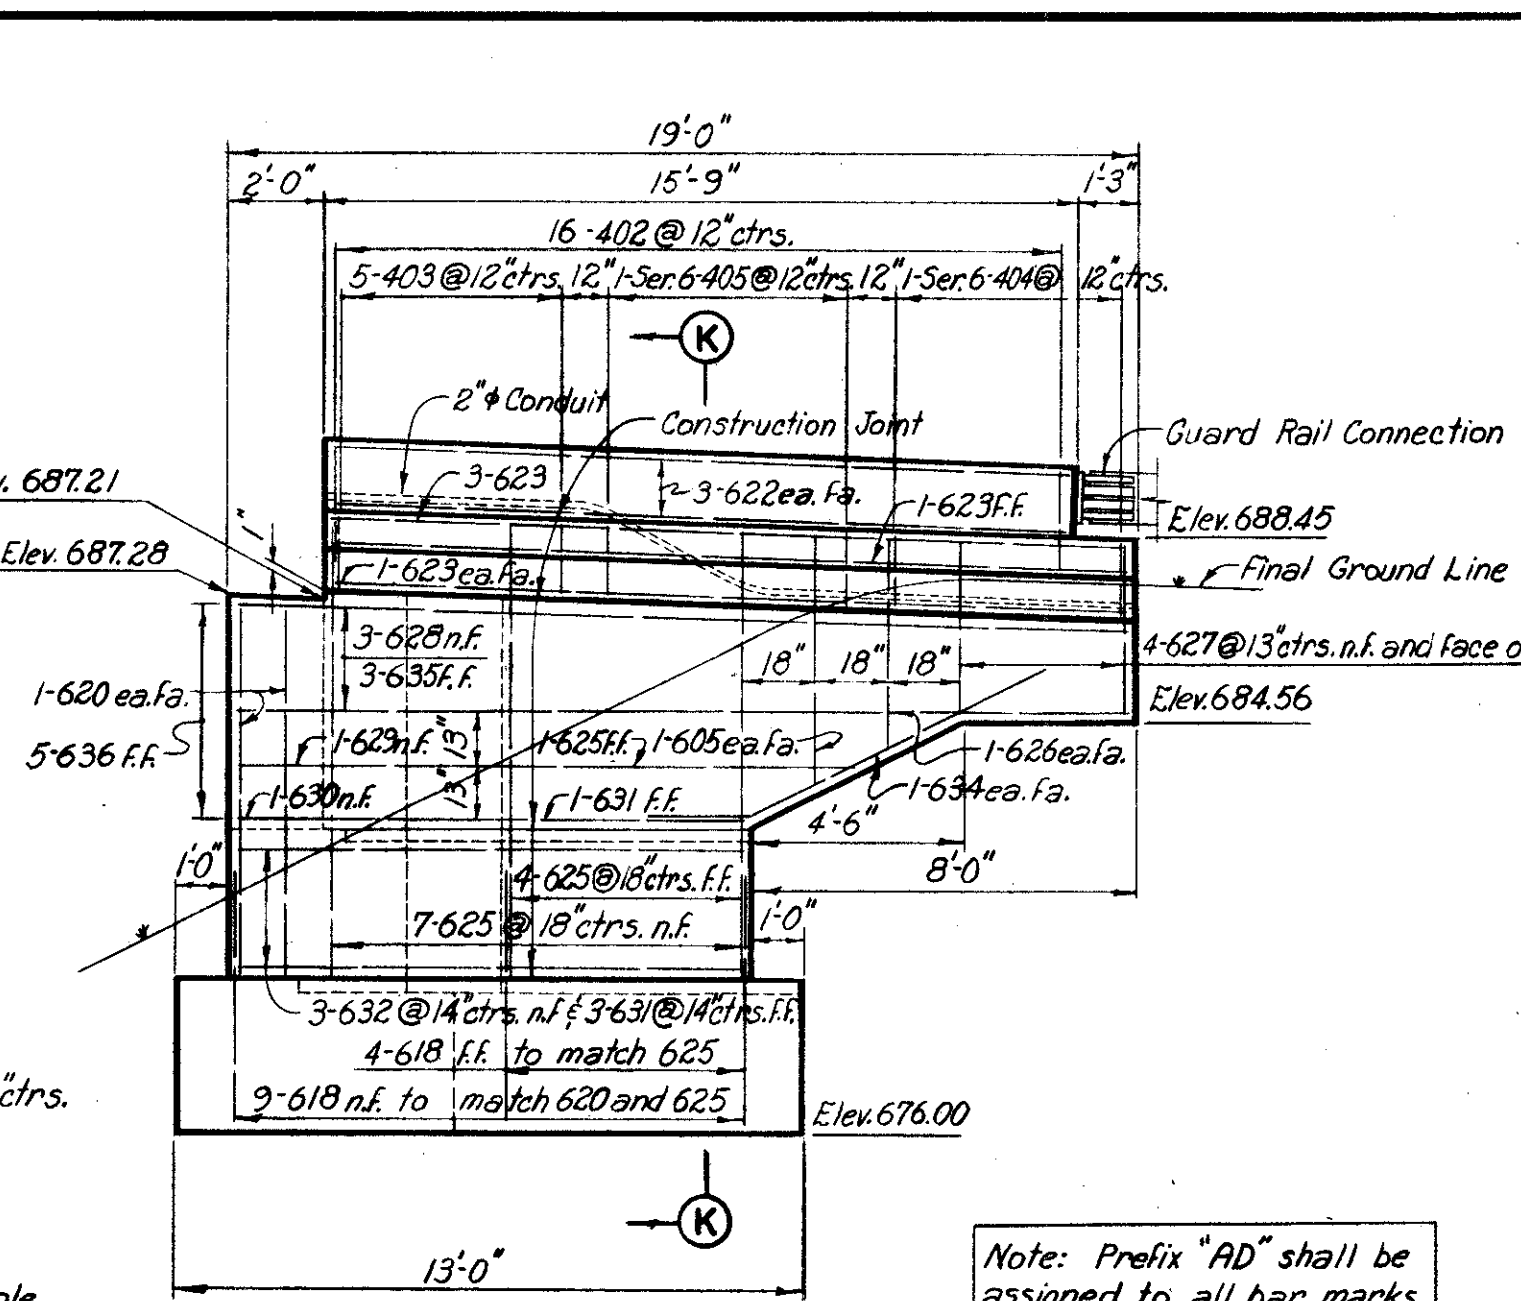


ELEVATION B-B
 (Piles not shown)

Note: Prefix "AD" shall be assigned to all bar marks.

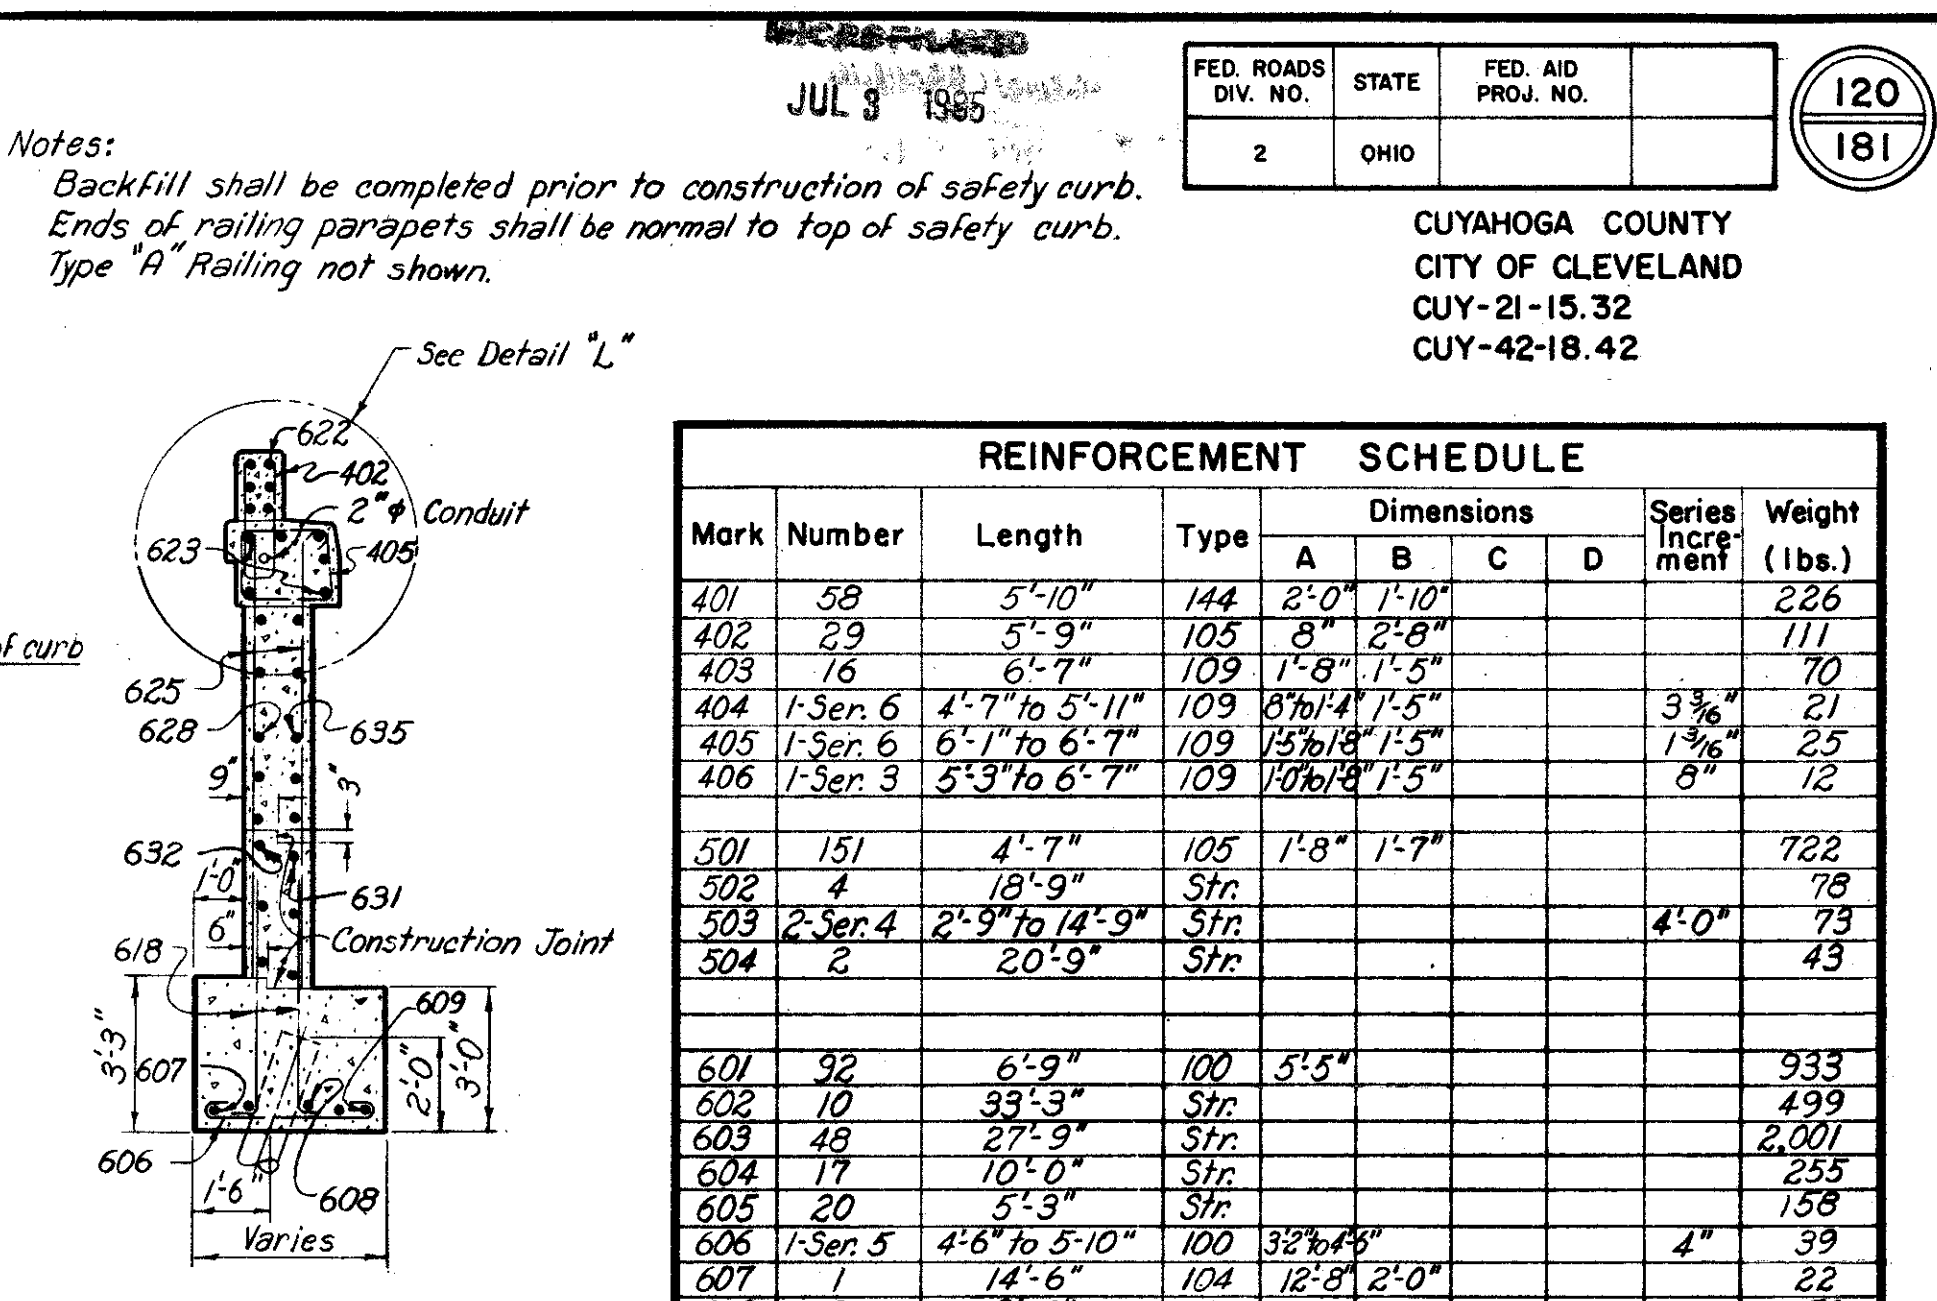


SECTION K-K


Note: All chamfers to be 3/8".
 Scale: 3/8"=1'-0"
 (Reinforcement not shown)

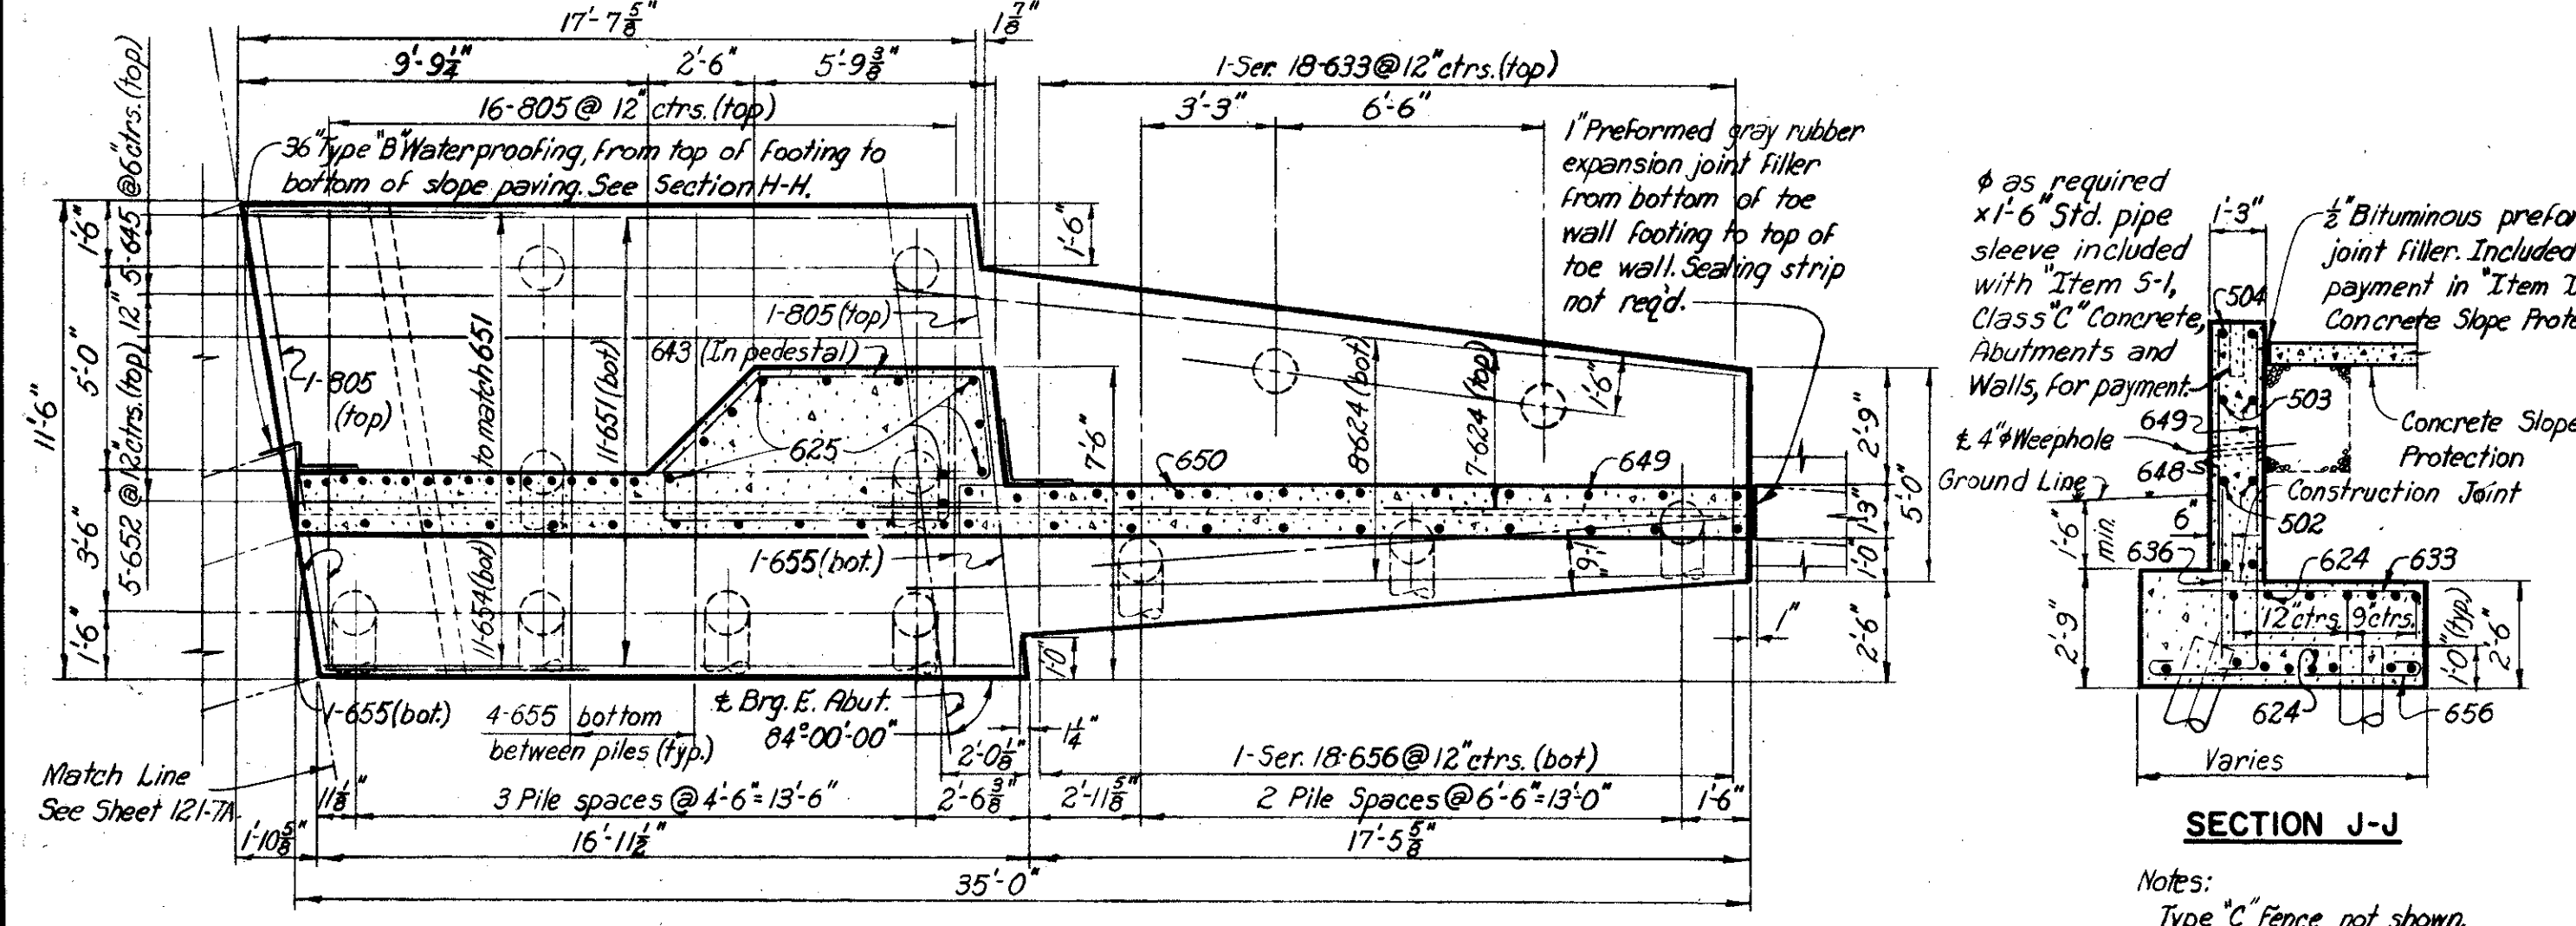

FOOTING PLAN

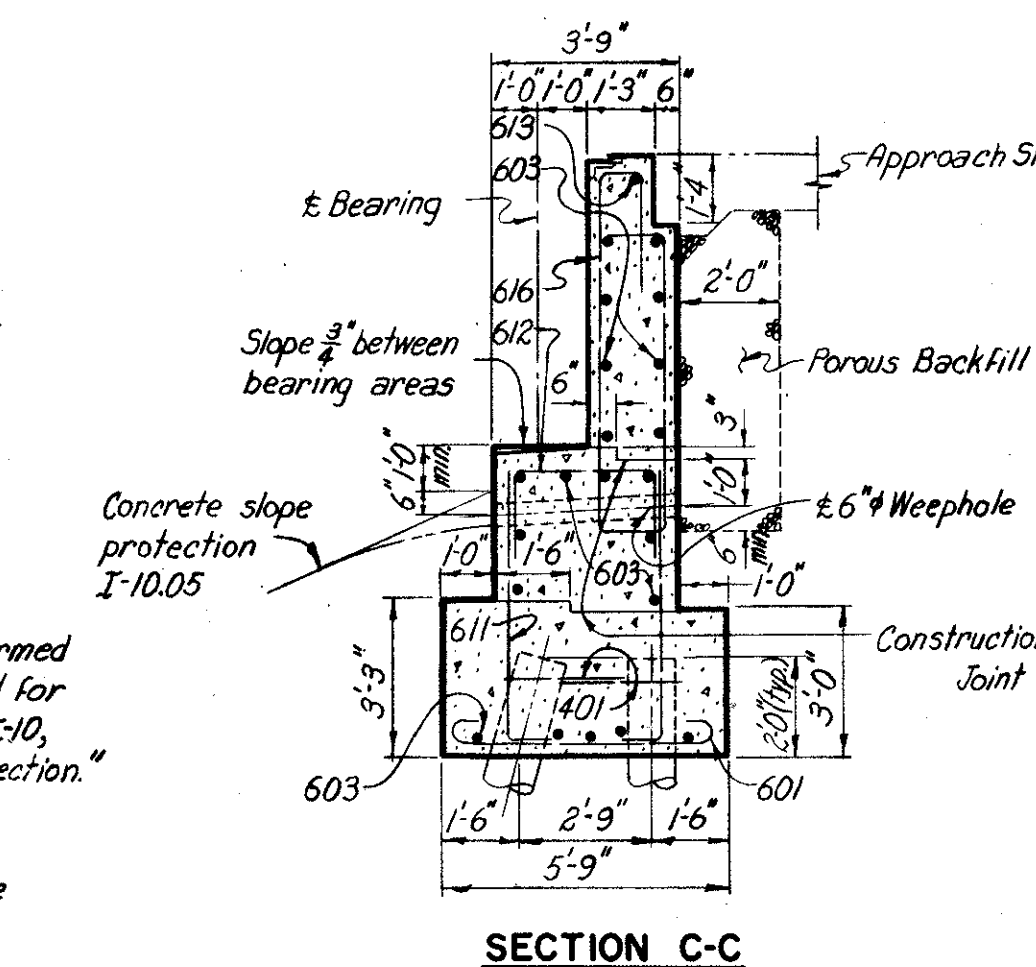

SECTION E-E

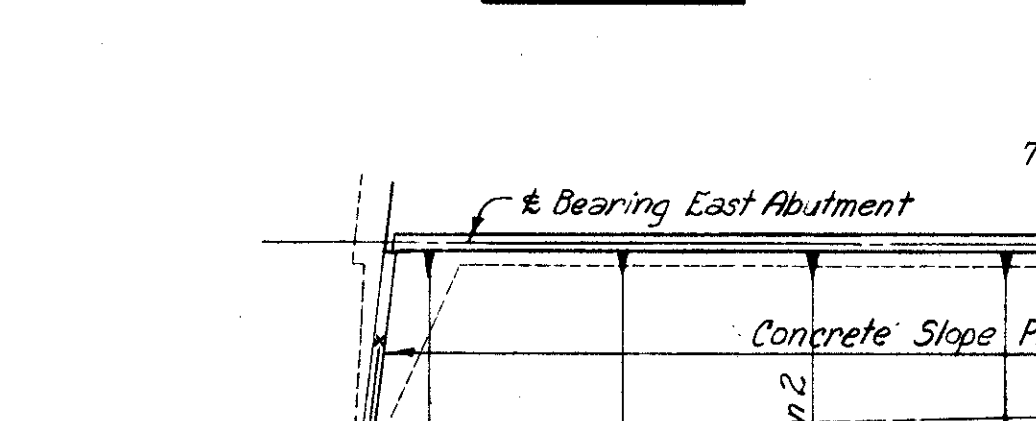

SECTION C-C

Notes:
 Type C' Fence not shown. For typical weephole placement, see Section E-E.


PART SECTION D-D

DETAIL L-L
 Scale: 3/8"=1'-0"
 (Reinforcement not shown)

NOTES:
 For Expansion joint detail, see Sheet 122-7A.
 * Bars are included with Item 5-14, Railing for payment.
 Bars of a series shall vary in length by a constant increment.
 For Bending Diagrams, see Sheet 122-7A.
 For Replacement Schedule, see Sheet 103-7A.
 For additional notes, see Sheet 119-7A.
 For rustication details, see Sheet 122-7A.


Mark	Number	Length	Type	Dimensions	Series	Weight (lbs.)
401	58	5'-10"	144	2'-0" 1'-10"		226
402	29	5'-9"	105	8" 2'-8"		111
403	16	6'-7"	109	1'-8" 1'-5"		70
404	1-Ser. 6	4'-7" to 5'-11"	109	8 1/2" 1'-5"	3 3/4"	21
405	1-Ser. 6	6'-1" to 6'-7"	109	15 1/2" 1'-5"	1 7/8"	25
406	1-Ser. 3	5'-3" to 6'-7"	109	10 1/2" 1'-5"	8"	12
501	151	4'-7"	105	1'-8" 1'-7"		722
502	4	18'-9"	Str.			78
503	2-Ser. 4	2'-9" to 14'-9"	Str.		4'-0"	73
504	2	20'-9"	Str.			43
601	92	6'-9"	100	5'-5"		933
602	10	33'-3"	Str.			499
603	48	27'-9"	Str.			2,001
604	17	10'-0"	Str.			255
605	20	5'-3"	Str.			158
606	1-Ser. 5	4'-6" to 5'-10"	100	3 3/4" 4'-8"	4"	39
607	1	14'-6"	104	12'-8" 2'-0"		22
608	3	12'-6"	Str.			56
609	1	9'-6"	Str.			14
610	8	7'-5"	108	6'-8" 10"	12	89
611	158	6'-2"	104	5'-8" 10"		1,463
612	80	8'-1"	105	3'-5" 2'-6"		971
613	18	28'-9"	Str.			777
614	17	34'-6"	Str.			881
615	17	23'-3"	Str.			594
616	120	19'-9"	112	11" 7'-6" 6'-2" 1'-5"		3,560
617	24	18'-7"	109	7'-6" 1'-5"		670
618	16	5'-8"	104	5'-0" 10"		136
619	3	5'-4"	103	3'-0" 2'-6"	1	24
620	7	7'-5"	Str.			81
621	6	12'-6"	Str.			—
622	6	15'-6"	Str.			151
623	0	16'-9"	Str.			467
624	15	20'-9"	Str.			306
625	22	3'-3"	Str.			101
626	15	4'-6"	Str.			42
627	8	3'-6"	Str.			84
628	3	18'-9"	Str.			19
629	7	12'-9"	Str.			76
630	1	10'-9"	Str.			63
631	5	7'-0"	104	1'-11" 10'-9"		56
632	3	12'-6"	Str.			135
633	1-Ser. 18	4'-9" to 6'-9"	Str.		1 7/8"	27
634	2	8'-10"	108	1'-11" 7'-0"	6	166
635	7	15'-9"	Str.			114
636	19	4'-0"	Str.			353
637	20	11'-9"	Str.			35
638	4	5'-9"	148	4'-0" 1'-11"	1	48
639	4	8'-0"	141	6'-6" 10"		88
640	3	13'-6"	148	15'-8" 4'-0"	1	74
641	6	8'-2"	108	7'-8" 10"	12	84
642	3	18'-7"	104	15'-8" 3'-11"		135
643	5	24'-7"	135	7'-0" 3'-0" 2'-9" 1'-4"		274
644	10	18'-3"	Str.			204
645	8	17'-0"	Str.			35
646	2	11'-6"	Str.			78
647	10	5'-2"	104	4'-6" 10"		94
648	1-Ser. 10	2'-0" to 10'-6"	Str.		1 1/2"	141
649	1-Ser. 10	5'-2" to 13'-8"	104	4 1/2" 13'-8"	10"	54
650	5	7'-2"	104	6'-6" 10"		231
651	11	14'-0"	Str.			126
652	5	18'-9"	Str.			171
653	6	13'-9"	Str.			89
654	11	5'-8"	118	2'-10" 6" 6"		300
655	16	12'-8"	100	11'-2"		435
656	1-Ser. 18	6'-0" to 9'-8"	100	4 1/2" 9'-8"	2 3/8"	212
801	5	18'-6"	Str.			160
802	3	12'-0"	Str.			171
803	8	8'-0"	Str.			257
804	17	5'-8"	104	4'-9" 1'-1"		435
805	18	9'-0"	Str.			20,168

H.N.T.B. BR. NO. 4 PART 7A

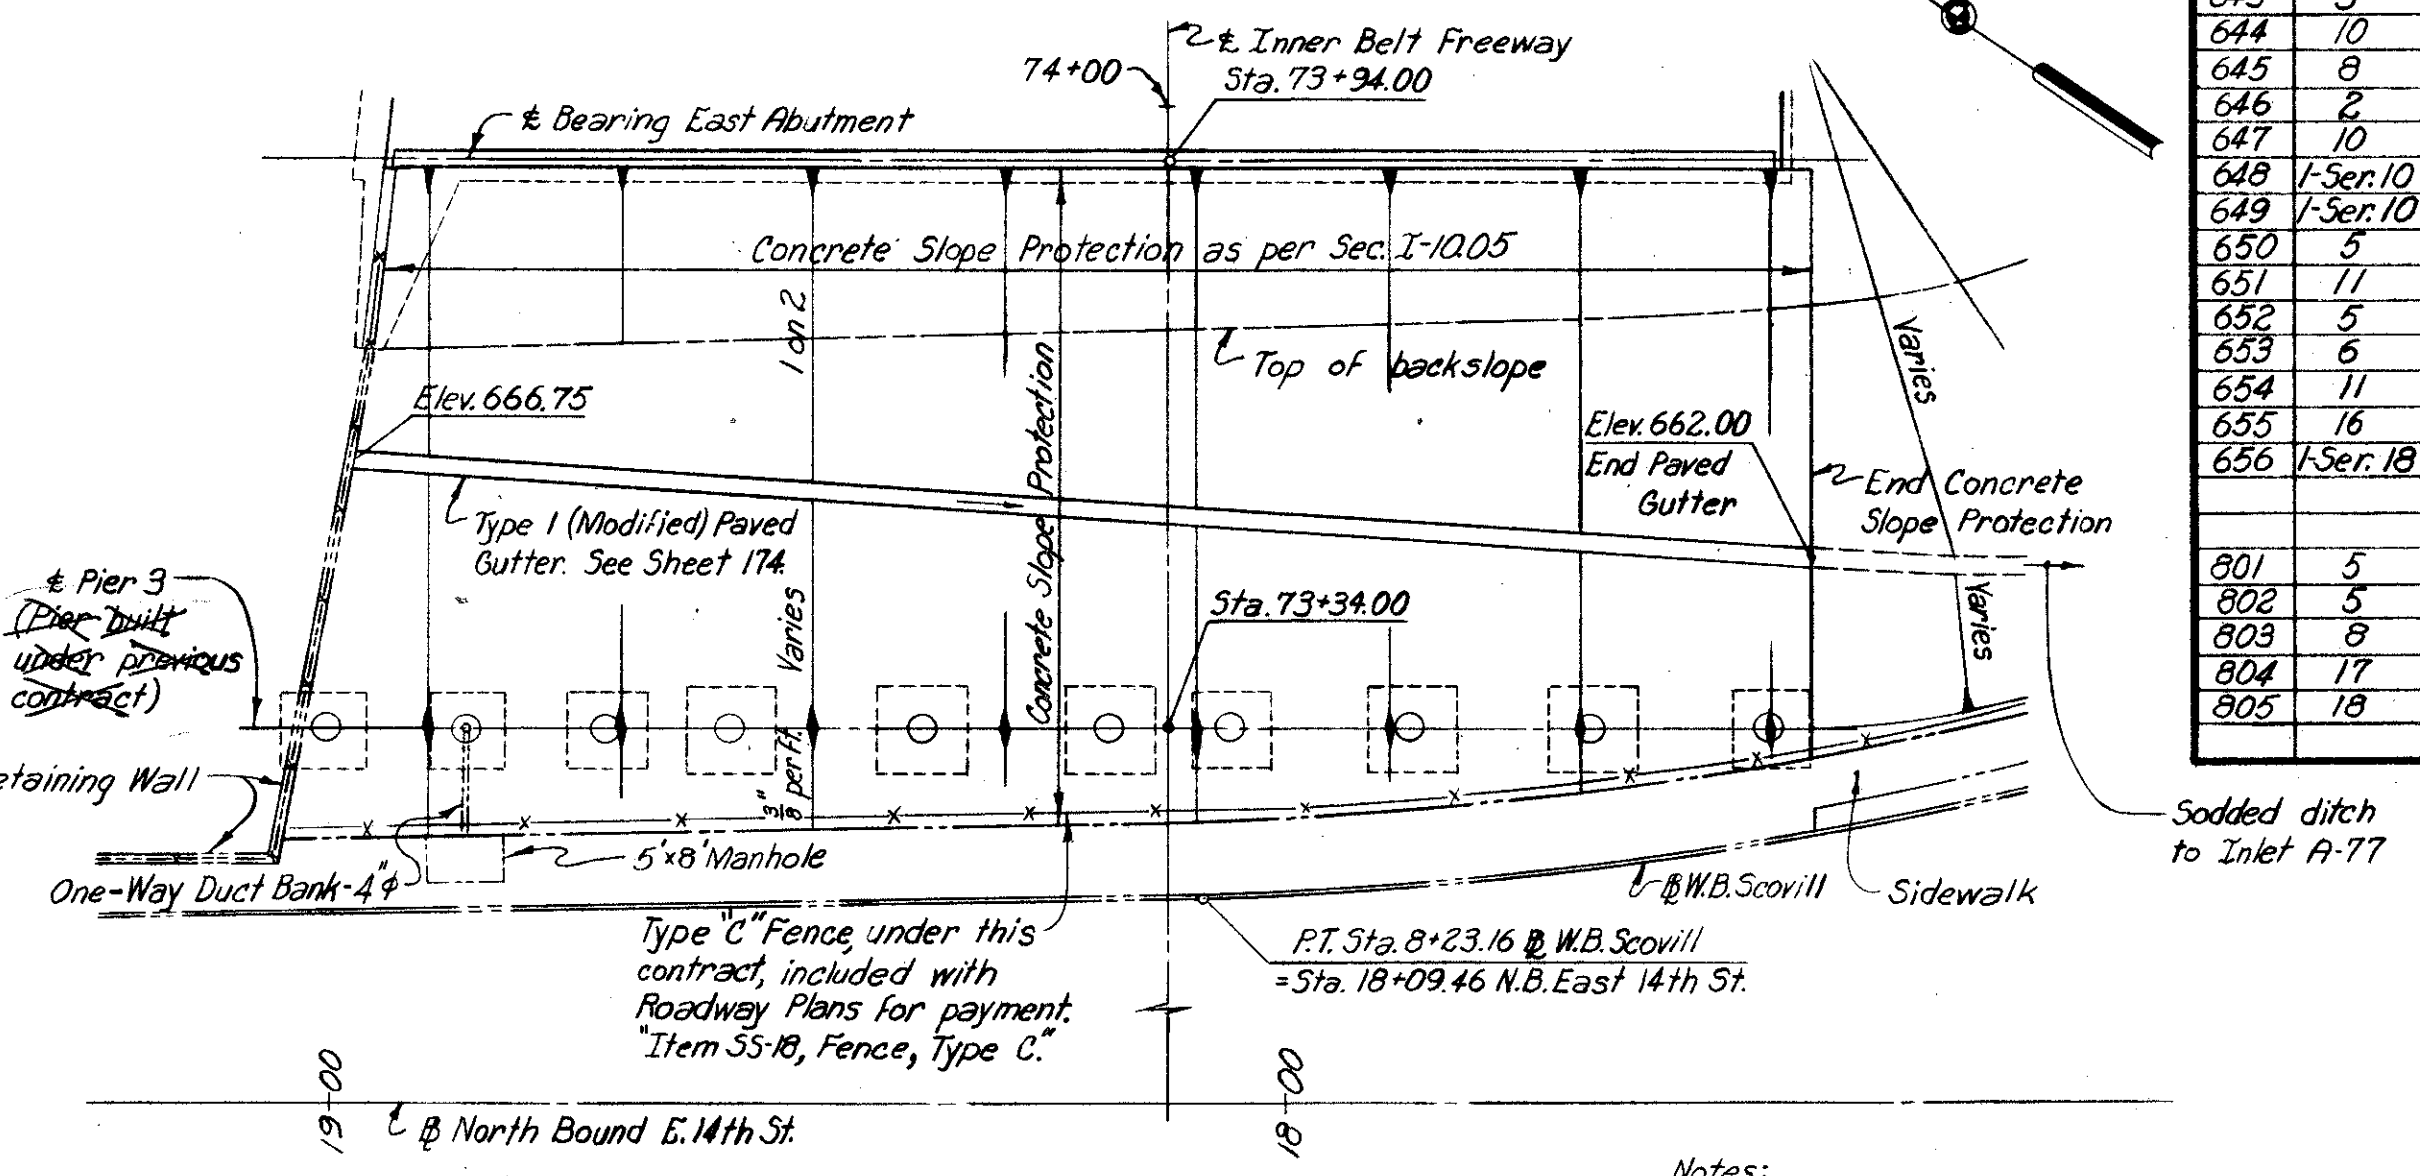

EAST ABUTMENT SLOPE PROTECTION DETAILS
 Scale: 1"=20'

Notes:
 For details of slope protection not shown, see Sheet 174-7A.
 Indicates construction under previous contract.

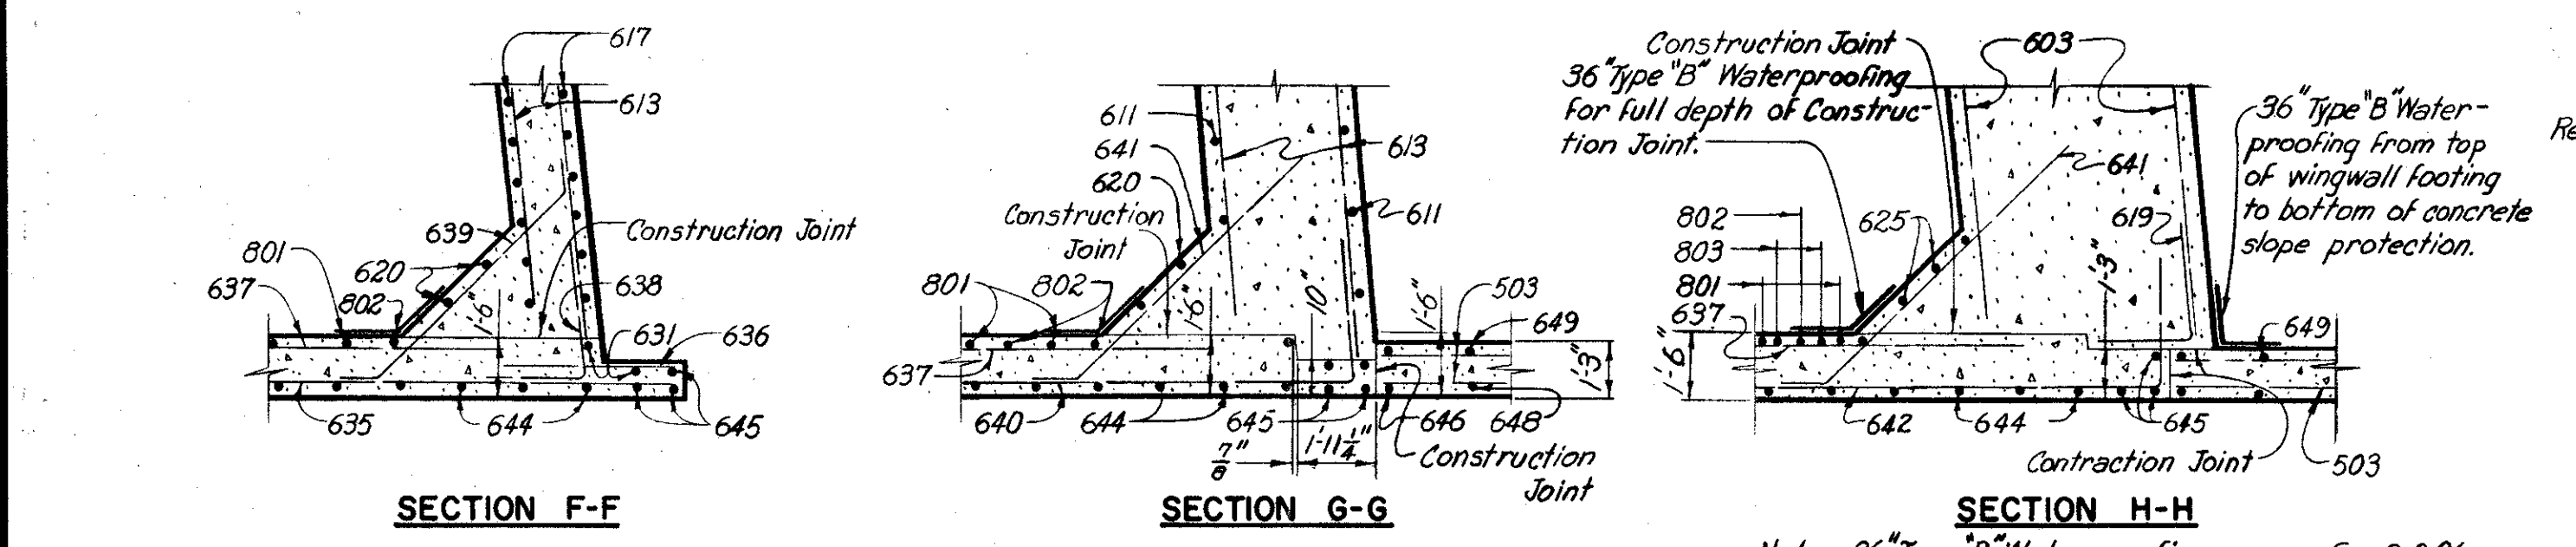

SECTION F-F

SECTION G-G

SECTION H-H

Note: 36" Type B Waterproofing as per Sec. S-3.06, included with Item 5-1, Class C Concrete, Abutments and Walls, for payment.




EAST ABUTMENT DETAILS
 INNER BELT FREEWAY OVER EAST 14th ST.
 BR. NO. CUY - 42-1854 STA. 70+89.23
 Scale: 1/4"=1'-0" Except as noted STA. 73+96.25
WILLOW-INNER BELT FREEWAY
 CLEVELAND CUYAHOGA COUNTY OHIO
 DRAWN: F.S.J. TRACED CHECKED: K.B. DATE: 10-29-59 REVIEWED: J.T. DATE: 11-13-59 REVISED: F.S.J. 11-24-59 SHEET 120

JUL 3 1985

FED. ROADS DIV. NO.	STATE	FED. AID PROJ. NO.	121 181
2	OHIO		

CUYAHOGA COUNTY
CITY OF CLEVELAND
CUY-21-15.32
CUY-42-18.42

Location	Offset (X)	Station (Y)
1	80.08'	74+09.07
2	81.82'	74+16.88
3	80.04'	74+40.81
4	78.61'	74+72.78
5	78.25'	75+04.78
6	78.25'	75+36.78
7	78.25'	75+68.78
8	78.25'	75+96.78
9	78.25'	76+24.78
10	93.29'	76+49.39

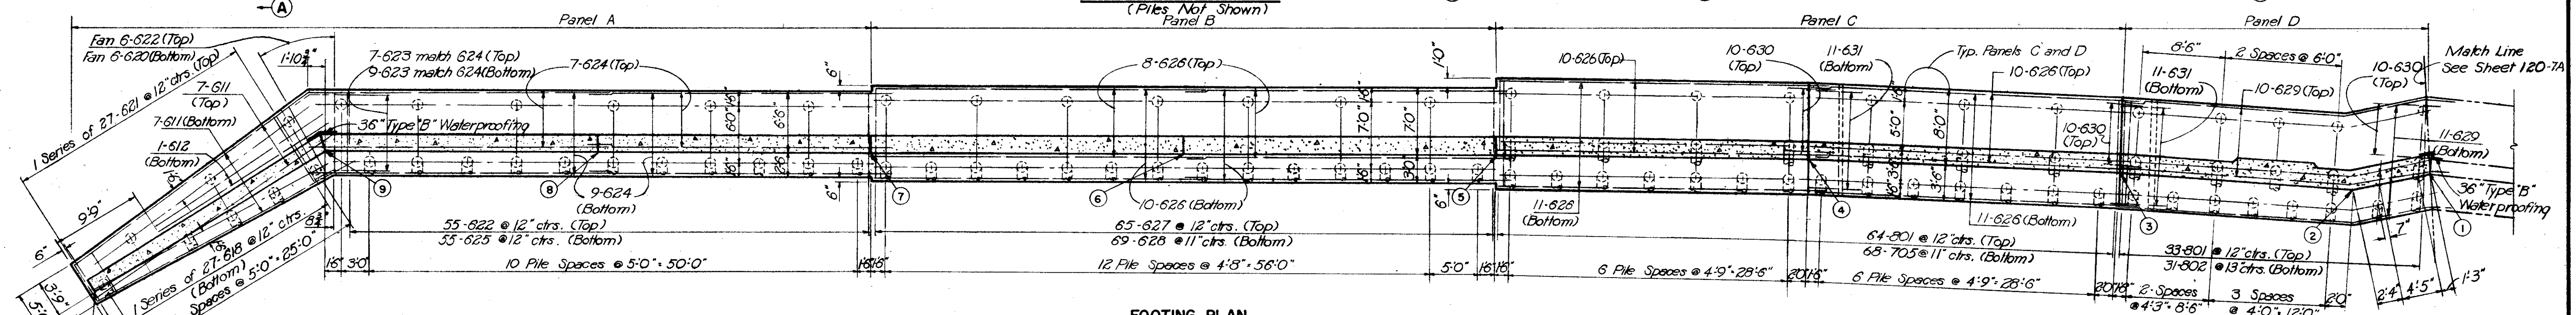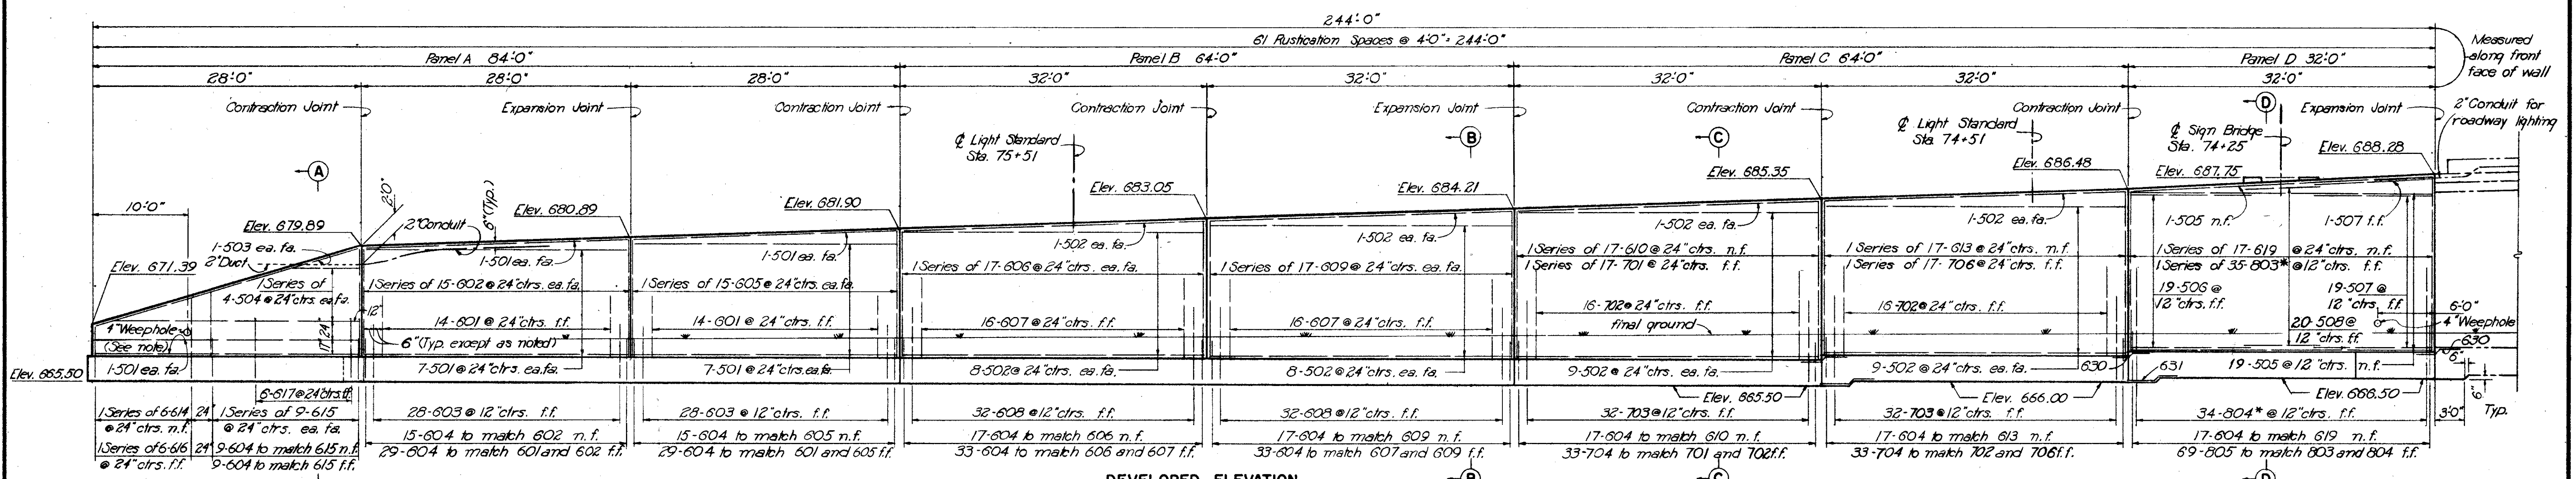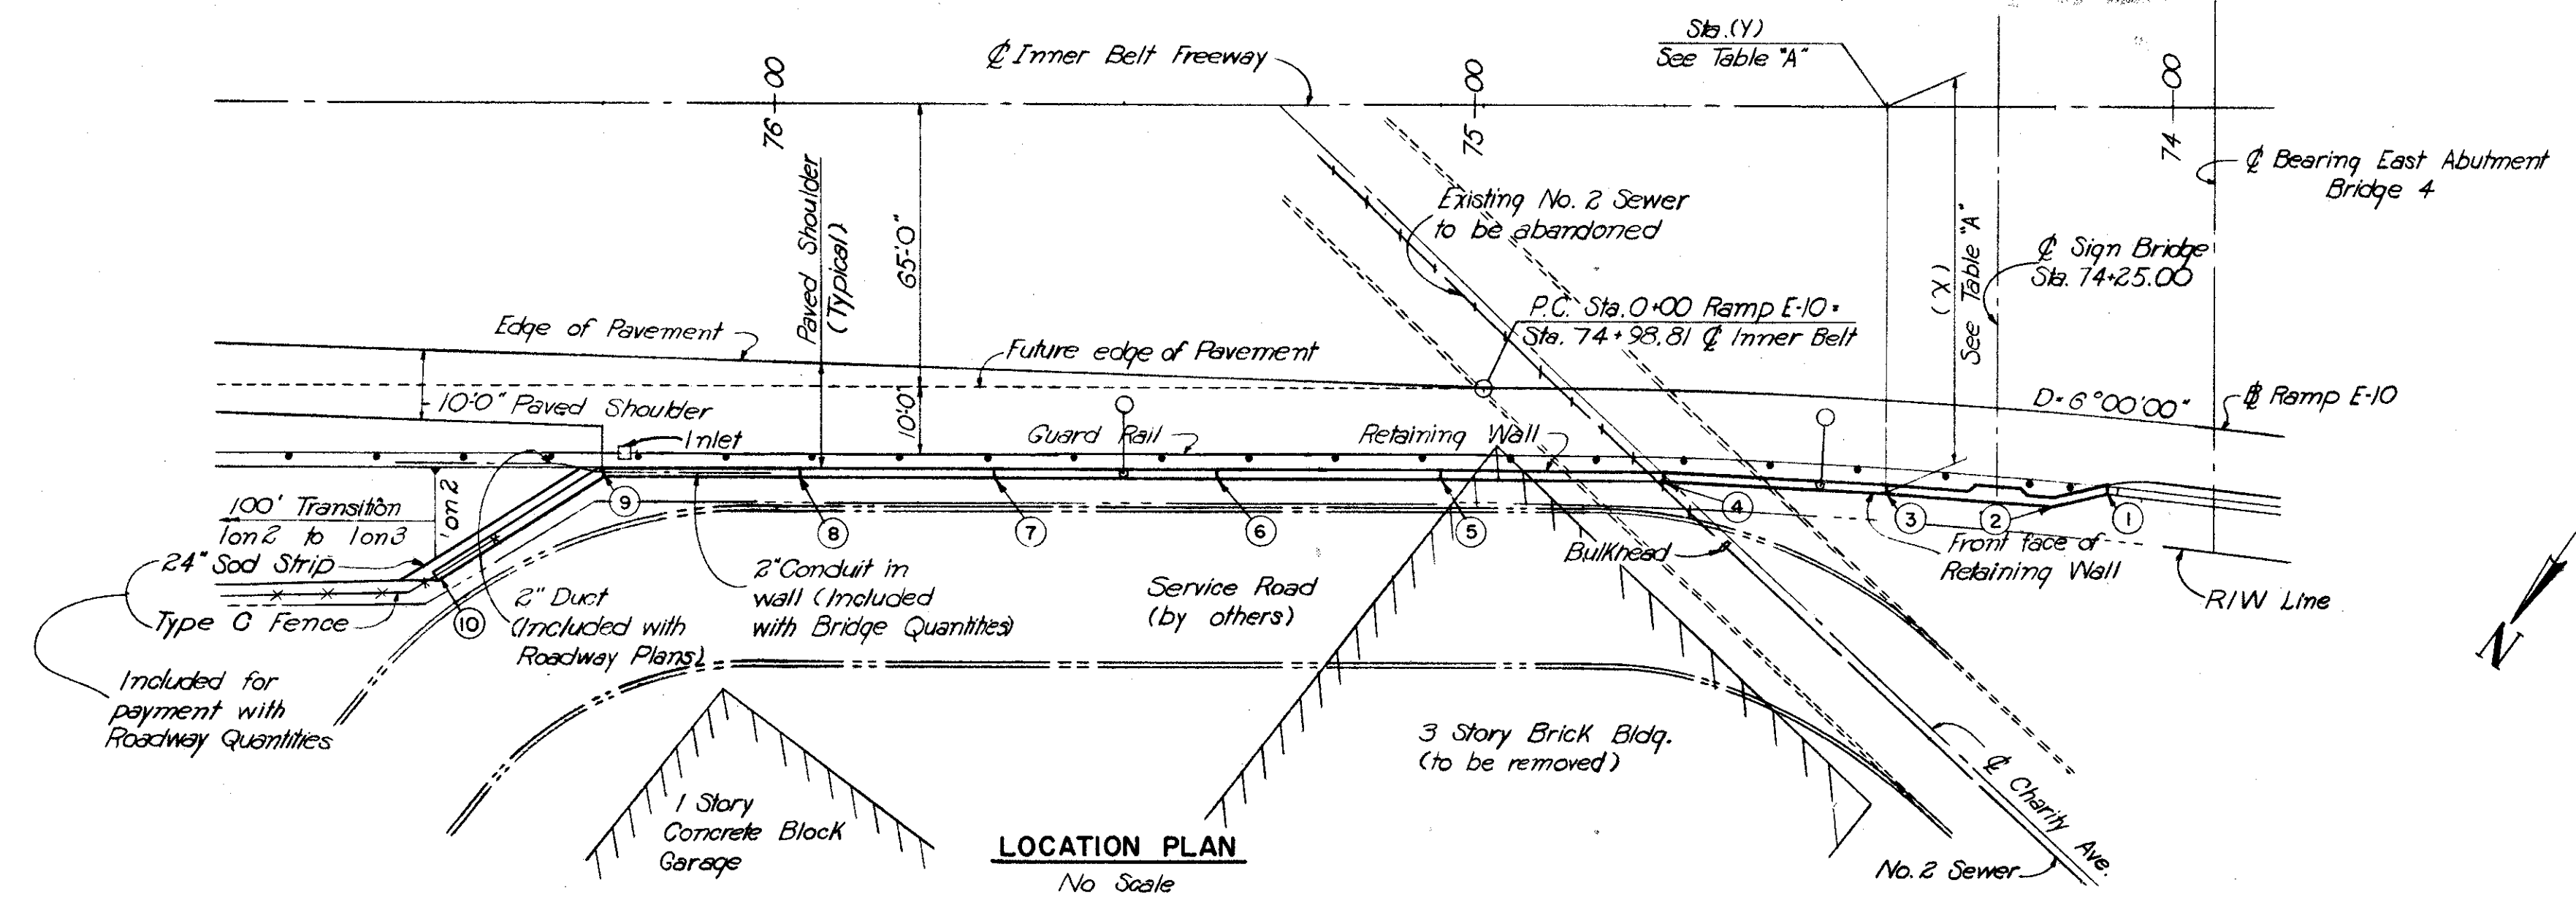

Note: Prefix "W" shall be assigned to all bar marks.

NOTES:
For details of light standard support see sheet 122-7A.
For lighting details see sheet 176-7A.
All piles shall be 12" cast-in-place reinforced concrete.
Front and center row piles shall be battered 3 in 12 in the direction shown.
Pile spacings are given along front face of retaining wall.
Reinforcing bars shall be 3-inches clear from bottom of footing and 2-inches elsewhere.
Spacing of longitudinal footing reinforcement in a panel is similar to that shown in the section for that panel.

For reinforcement schedule and bar bending diagrams; expansion and contraction joint details; sections; rustication details; sign bridge support details see sheet 122-7A.
The two extreme weepholes shown in the "Developed Elevation" shall be set 1'0" above final ground. Intermediate weepholes, not shown, shall be placed at 12'-0" ctrs. measured along the front face of the wall, and set on a straight line grade between the two extreme weepholes.
* For placement of these bars see sign bridge details, sheet 122-7A.
n.f. - near face; f.f. - far face; ea. fa. - each face.

Optional transverse construction joints in footing may be located beneath any wall joint.

HOWARD, NEEDLES, TAMMEN & BERGENOFF
CONSULTING ENGINEERS
KANSAS CITY CLEVELAND NEW YORK

RETAINING WALL

INNER BELT FREEWAY OVER EAST 14th ST.
BR. NO. CUY - 42-1854 STA. 70+89.23
Scale: 1/8" = 1'-0" STA. 73+96.25
Except as noted

WILLOW-INNER BELT FREEWAY
CLEVELAND CUYAHOGA COUNTY OHIO


H.N.T.B. BR. NO. 4
PART 7A

DRAWN	TRACED	CHECKED	REVIEWED	REVISED
DATE 11-3-85	DATE 11-13-85	DATE 11-13-85	DATE 11-13-85	DATE 11-13-85


SHEET 121

CUYAHOGA COUNTY
CITY OF CLEVELAND
CUY-21-15.32
CUY-42-18.42


Note: Prefix "W" shall be assigned to all bar marks.

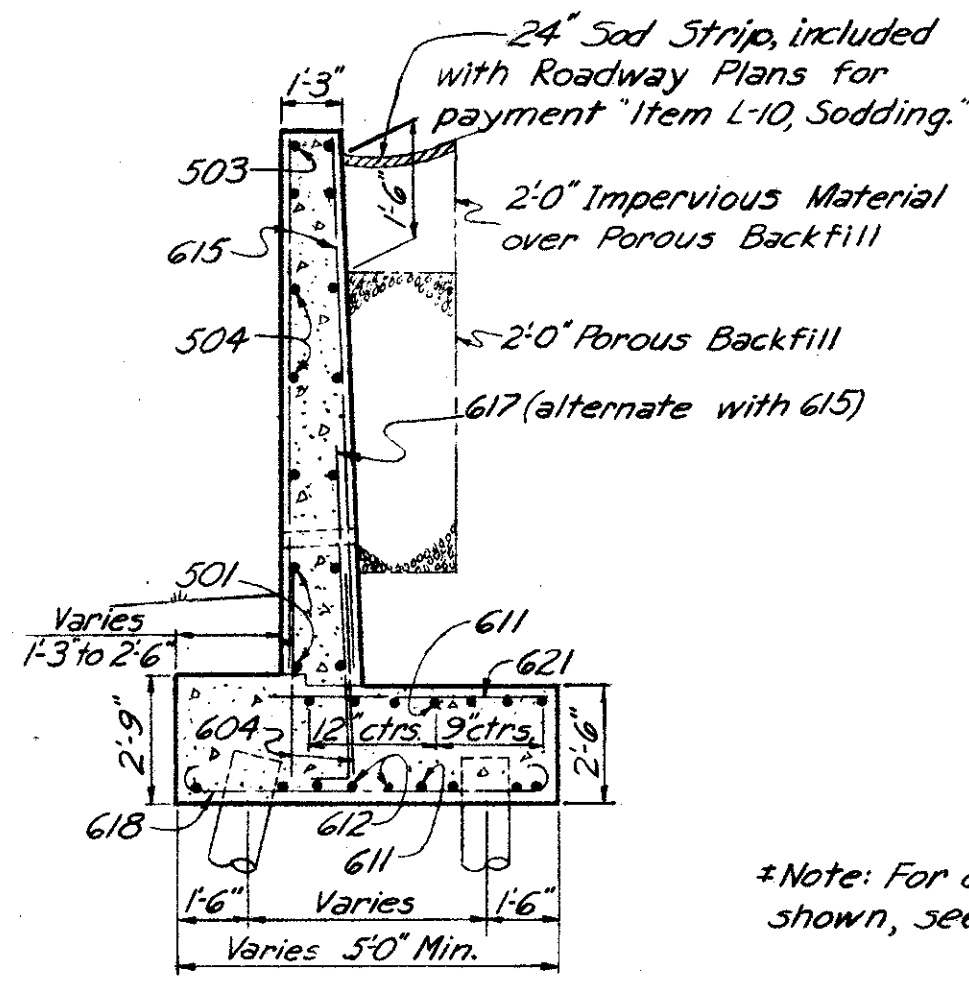


SECTION A-A #
Typical Panel A
except for Sod Strip

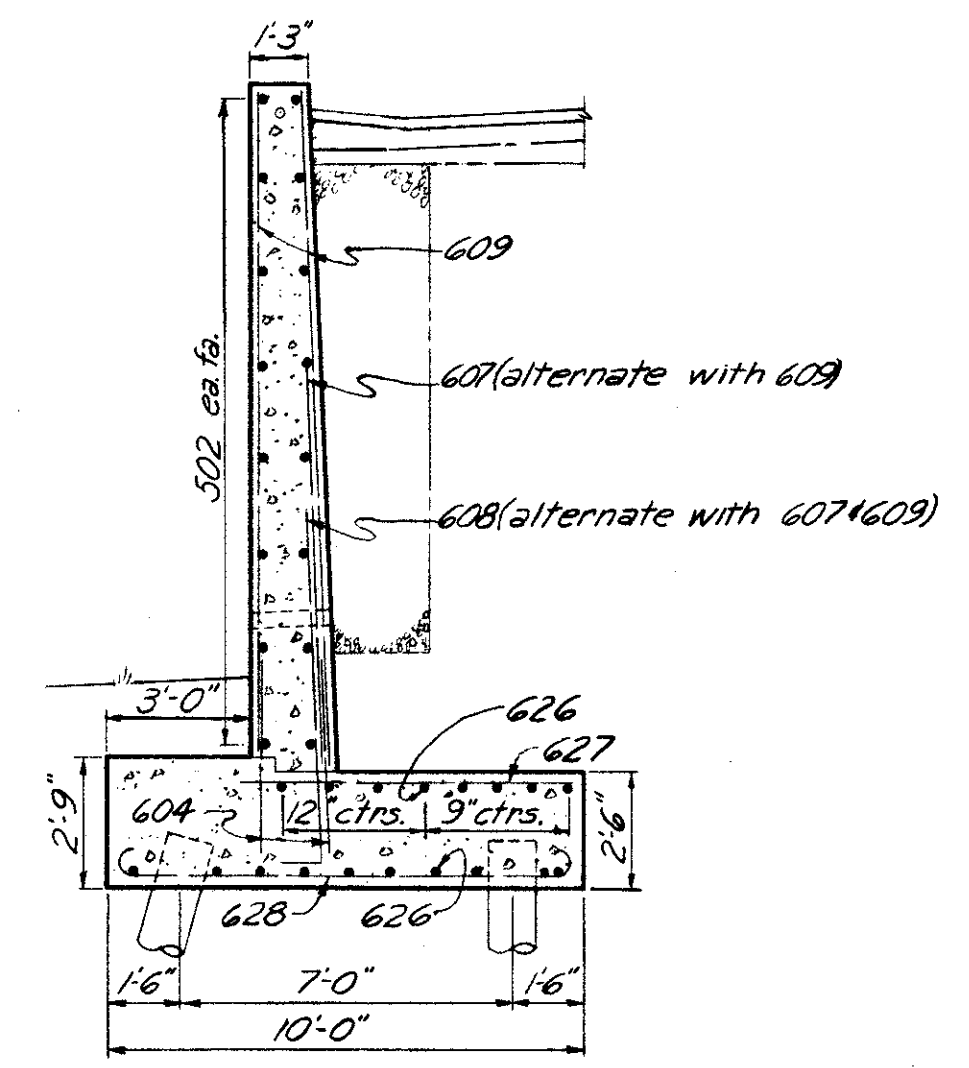


SECTION B-B #
Typical Panel B

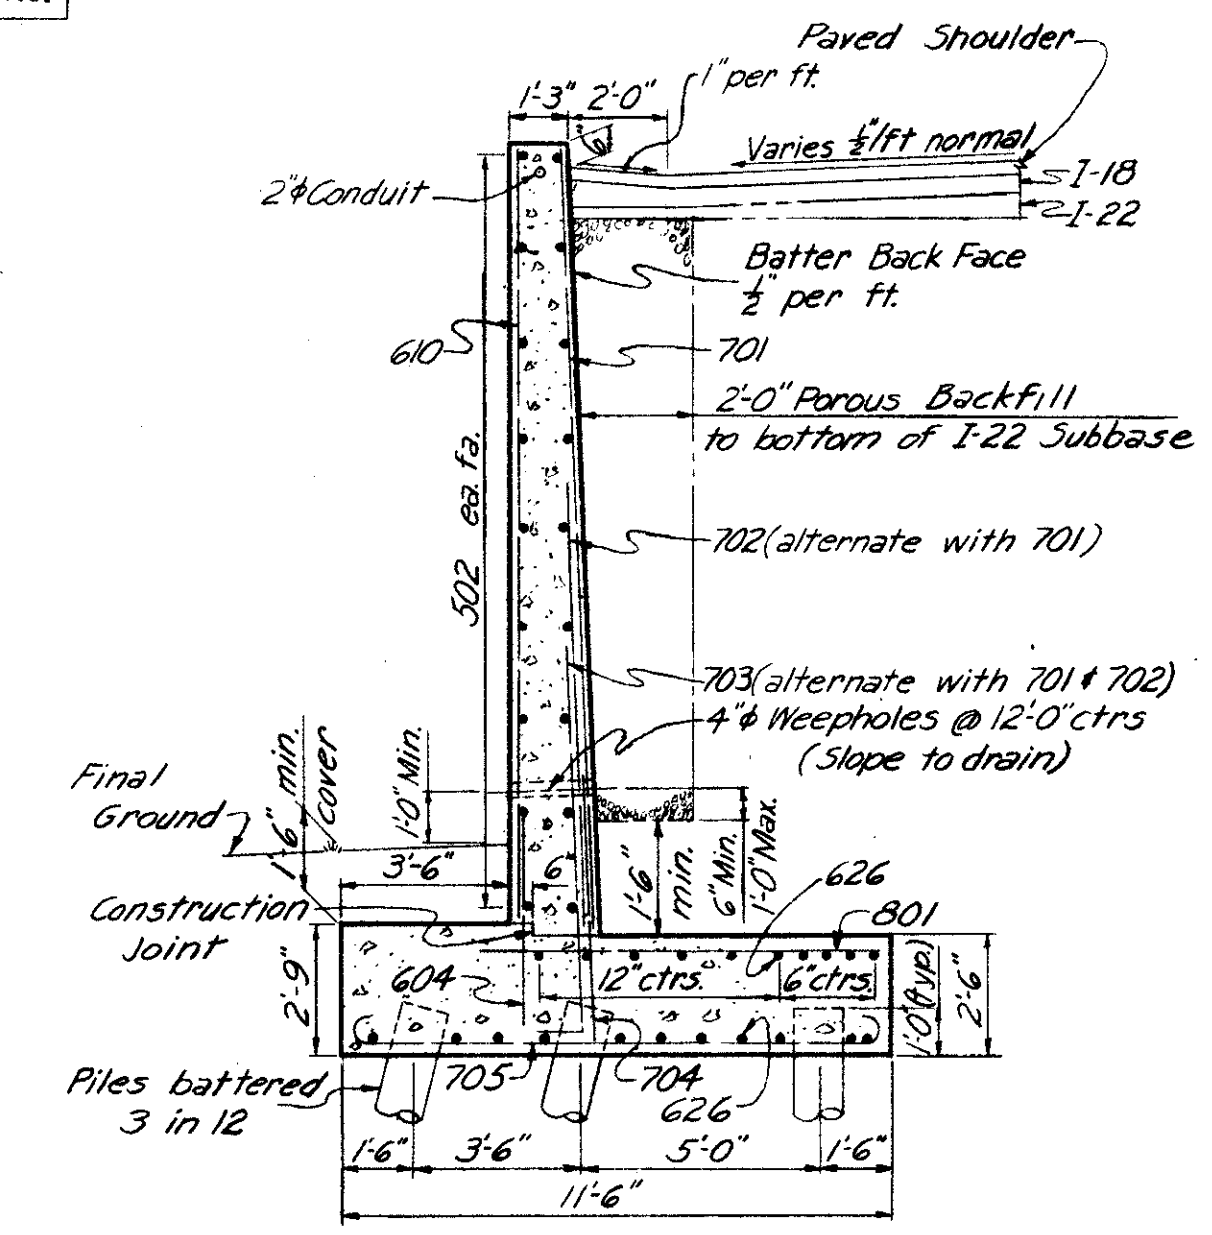

SECTION C-C #
Typical Panel C

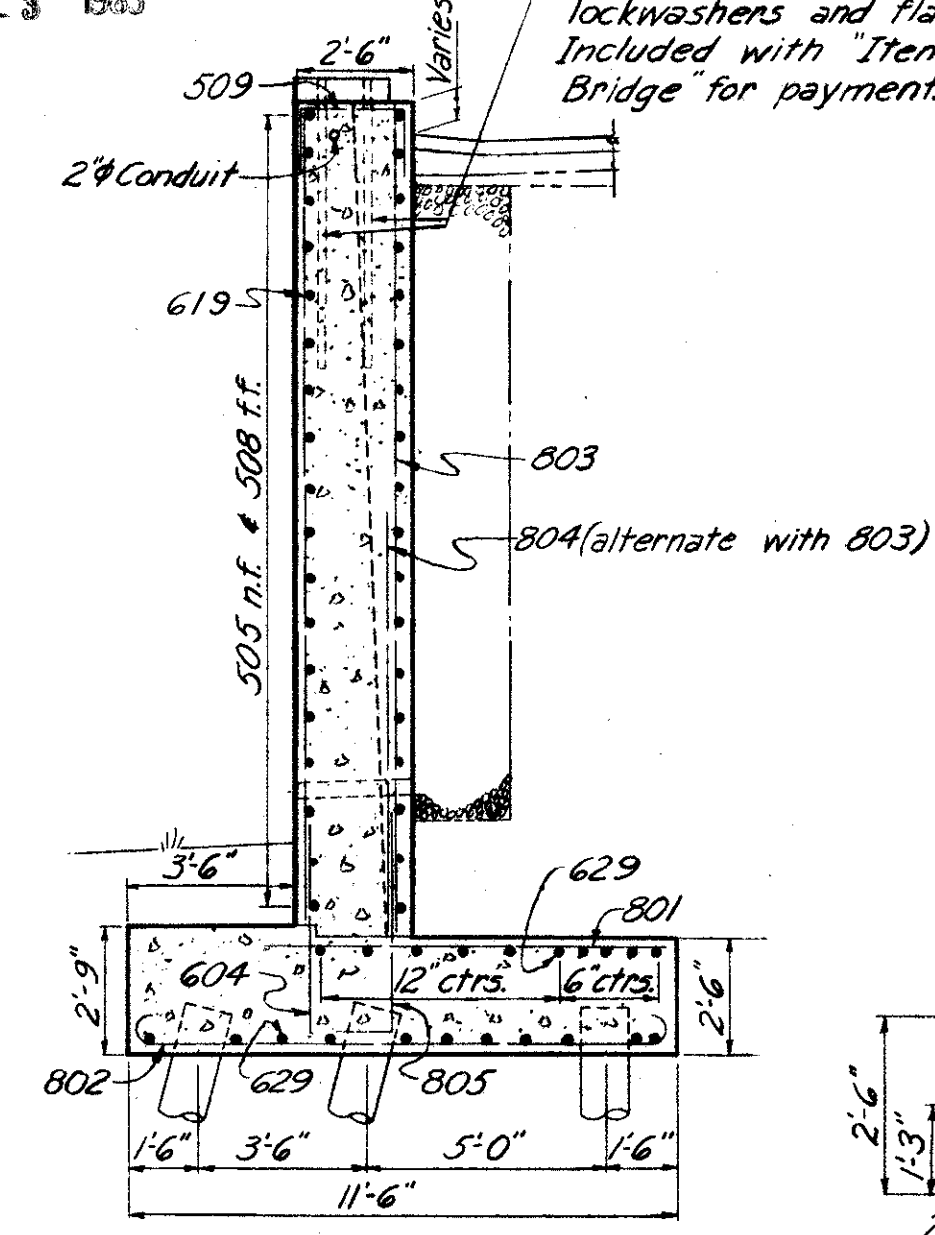


SECTION D-D #
Typical Panel D
except for wall width

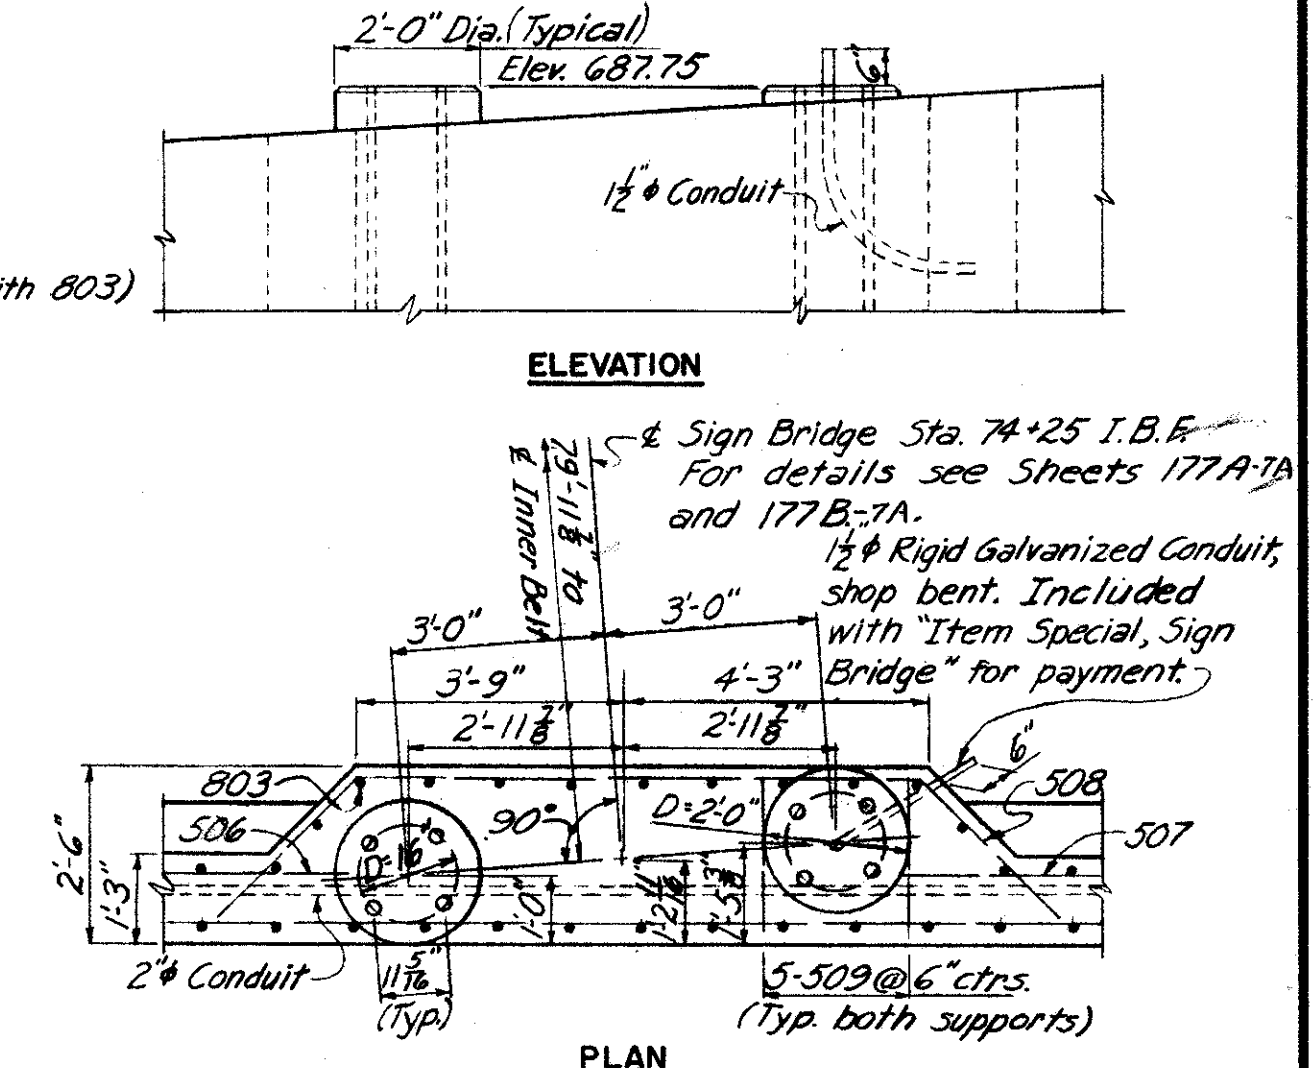


SIGN BRIDGE SUPPORT DETAILS


Scale: 3/8" = 1'-0"
Note: Sign Bridge support pads to be poured monolithic with retaining wall. For general notes and details not shown, see Sheet 177B-7A.

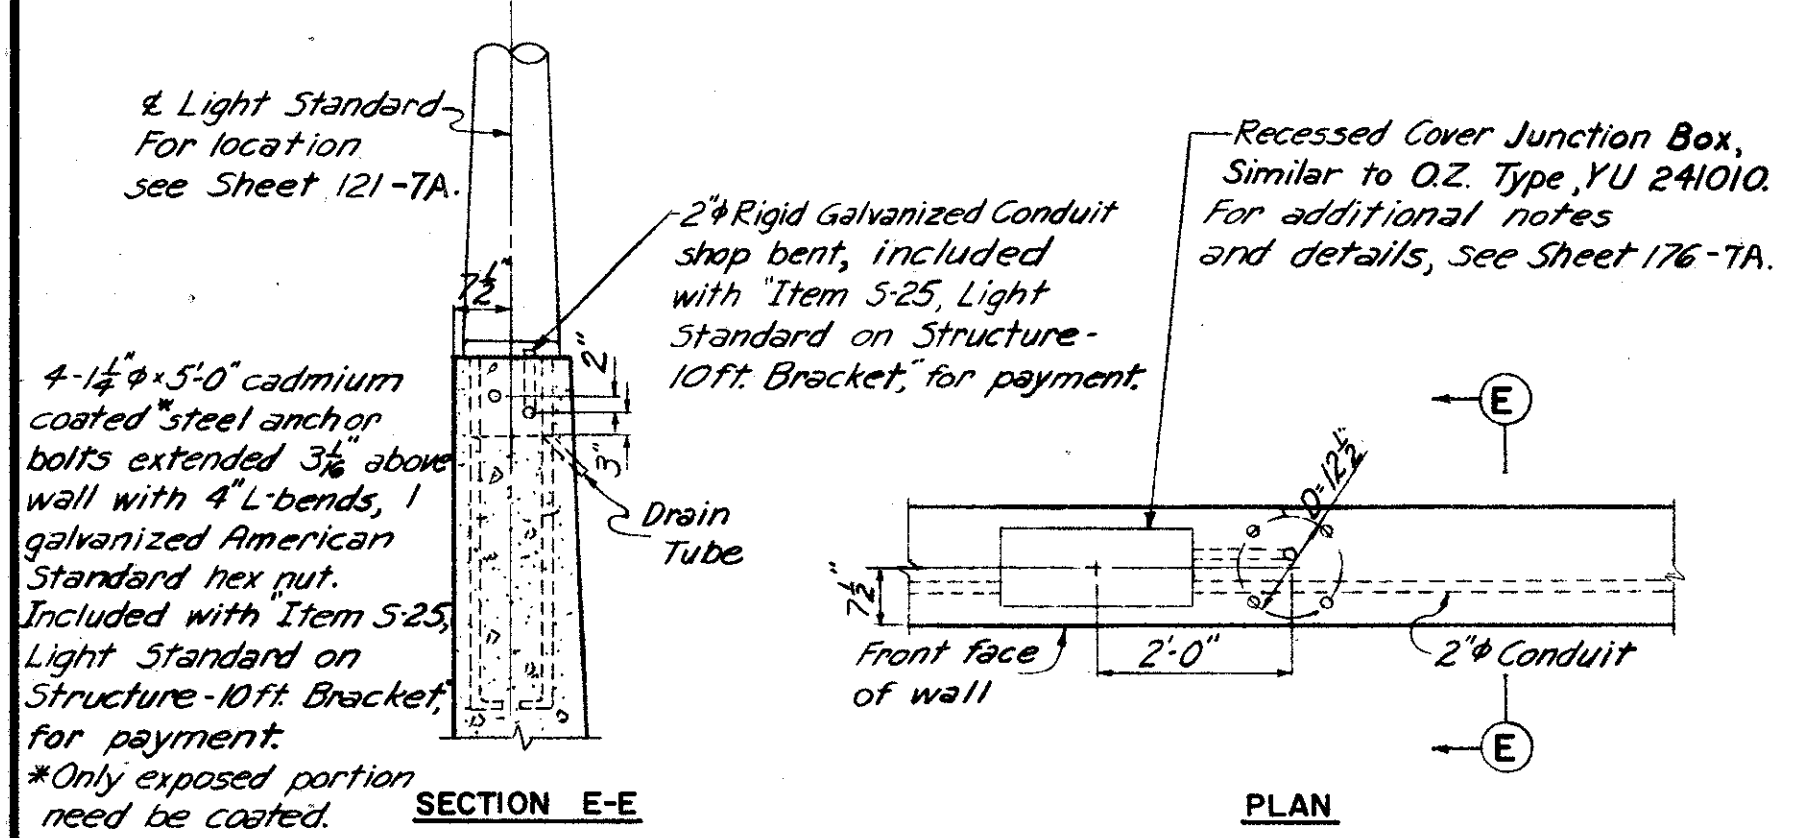


DETAILS AT LIGHT STANDARDS
Scale: 3/8" = 1'-0"

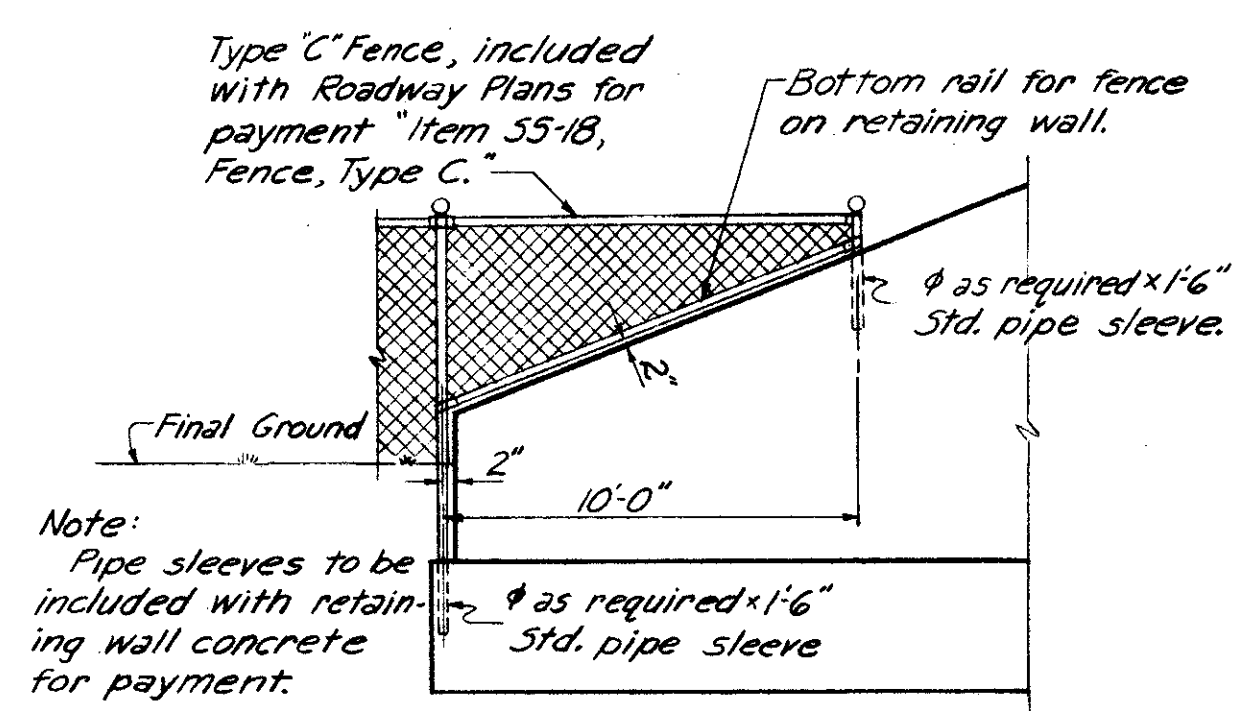

FENCE DETAIL

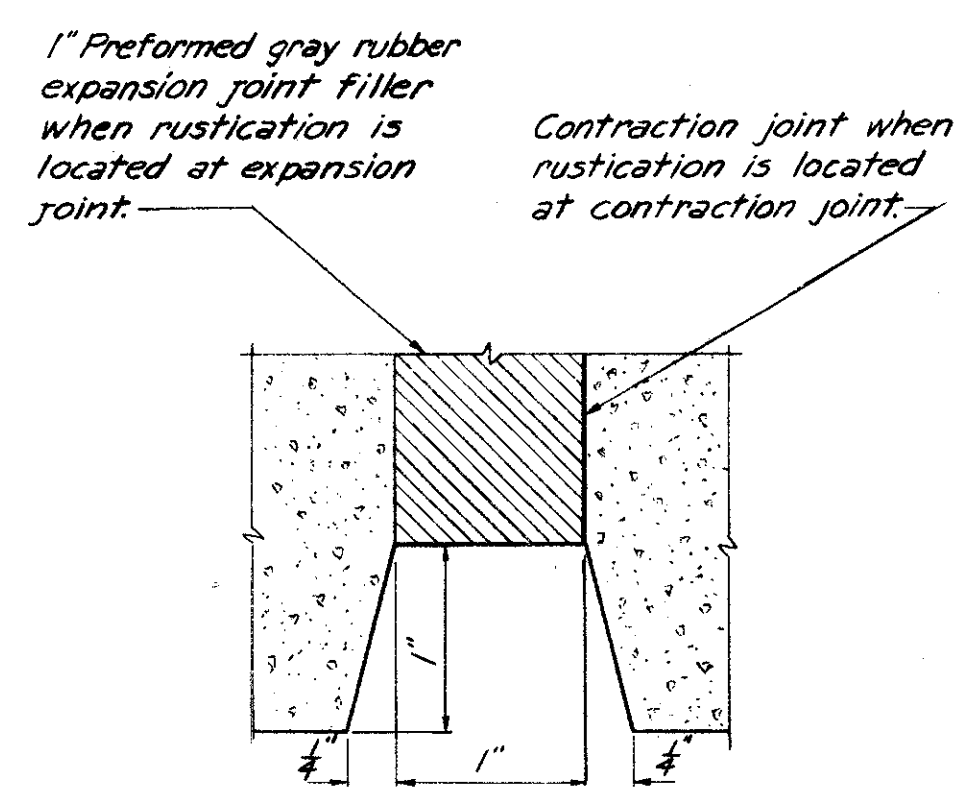


RUSTICATION DETAIL
Scale: Full Size

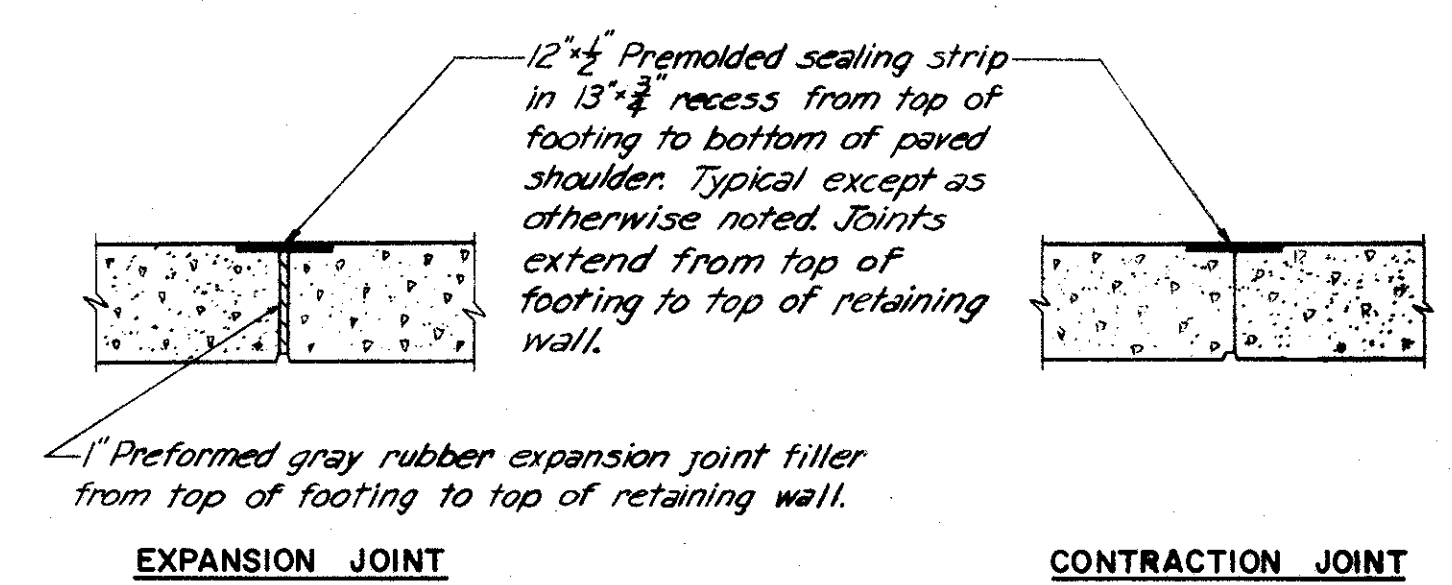

JOINT DETAILS
Scale: 3/8" = 1'-0"

REINFORCEMENT SCHEDULE																										
MARK	NO.	LENGTH	TYPE	DIMENSIONS			SERIES INCREMENT	WEIGHT (LBS)	MARK	NO.	LENGTH	TYPE	DIMENSIONS			SERIES INCREMENT	WEIGHT (LBS)	MARK	NO.	LENGTH	TYPE	DIMENSIONS			SERIES INCREMENT	WEIGHT (LBS)
				A	B	C							A	B	C							A	B	C		
501	36	27'-6"	Str.				1033	609	2 Series of 17	14'-6" to 15'-9"	Str.	1/2"	772	627	65	7'-0"	Str.									683
502	76	31'-6"	Str.				2497	610	1 Series of 17	15'-9" to 16'-9"	Str.	3/8"	415	628	69	11'-0"	100	9'-8"							1140	
503	2	28'-9"	Str.				60	611	14	30'-0"	Str.		631	629	21	34'-0"	118	24'-0"	2'-4"	7'-8"					1072	
504	2 Series of 17	6'-6" to 26'-6"	Str.				138	612	2	20'-3"	Str.		61	630	30	4'-7"	118	2'-0"	6"	6"					207	
505	20	31'-8"	108	23'-10"	7'-10"	3 1/2	661	613	1 Series of 17	16'-3" to 17'-6"	Str.	1/2"	431	631	22	5'-7"	118	3'-0"	6"	6"					184	
506	19	12'-6"	Str.				248	614	1 Series of 6	5'-6" to 8'-6"	Str.	7/8"	63													
507	20	12'-3"	108	4'-5"	7'-10"	3 1/2	256	615	2 Series of 9	6'-6" to 11'-3"	Str.	7/8"	240	701	1 Series of 12	15'-9" to 16'-9"	Str.								565	
508	20	13'-2"	141	7'-8"	2'-10"		275	616	1 Series of 6	6'-2" to 9'-2"	148	5/8" to 10"	7/8"	69	702	32	9'-6"	Str.							621	
509	10	3'-3"	105	2'-2"	8"		34	617	6	6'-11"	148	6'-3" to 10"	1/2"	62	703	64	9'-1"	148	8'-3"	1'-0"	1/2				1188	
								618	1 Series of 17	6'-0" to 9'-6"	100	4'-8" to 8'-2"	1/2"	314	704	66	4'-9"	Str.							641	
								619	1 Series of 17	17'-0" to 18'-9"	Str.	1/2"	456	705	68	12'-10"	100	11'-2"							1784	
601	28	6'-6"	Str.				273	620	6	9'-4"	101	8'-8"		84	706	1 Series of 17	16'-3" to 17'-6"	Str.							586	
602	2 Series of 17	11'-6" to 12'-6"	Str.				541	621	6	9'-4"	101	8'-8"		84												
603	56	6'-5"	148	5'-9"	10"	1/2	540	621	1 Series of 27	4'-6" to 6'-3"	Str.		218													
604	257	4'-6"	Str.				1737	622	61	6'-9"	Str.		619	801	97	8'-6"	Str.								2201	
605	2 Series of 17	12'-6" to 13'-6"	Str.				586	623	16	3'-11"	108	2'-0"	94	802	31	13'-4"	100	11'-2"							1104	
606	2 Series of 17	13'-6" to 14'-6"	Str.				715	624	32	31'-0"	Str.		1490	803	1 Series of 35	17'-0" to 18'-9"	Str.								1670	
607	32	8'-6"	Str.				409	625	55	10'-0"	100	8'-8"	826	804	34	12'-0"	Str.								1089	
608	64	8'-5"	148	7'-9"	10"	1/2	809	626	78	34'-0"	Str.		3983	805	69	5'-11"	148	5'-0"	1'-1"	1/2					1090	

Total Weight = 37,465

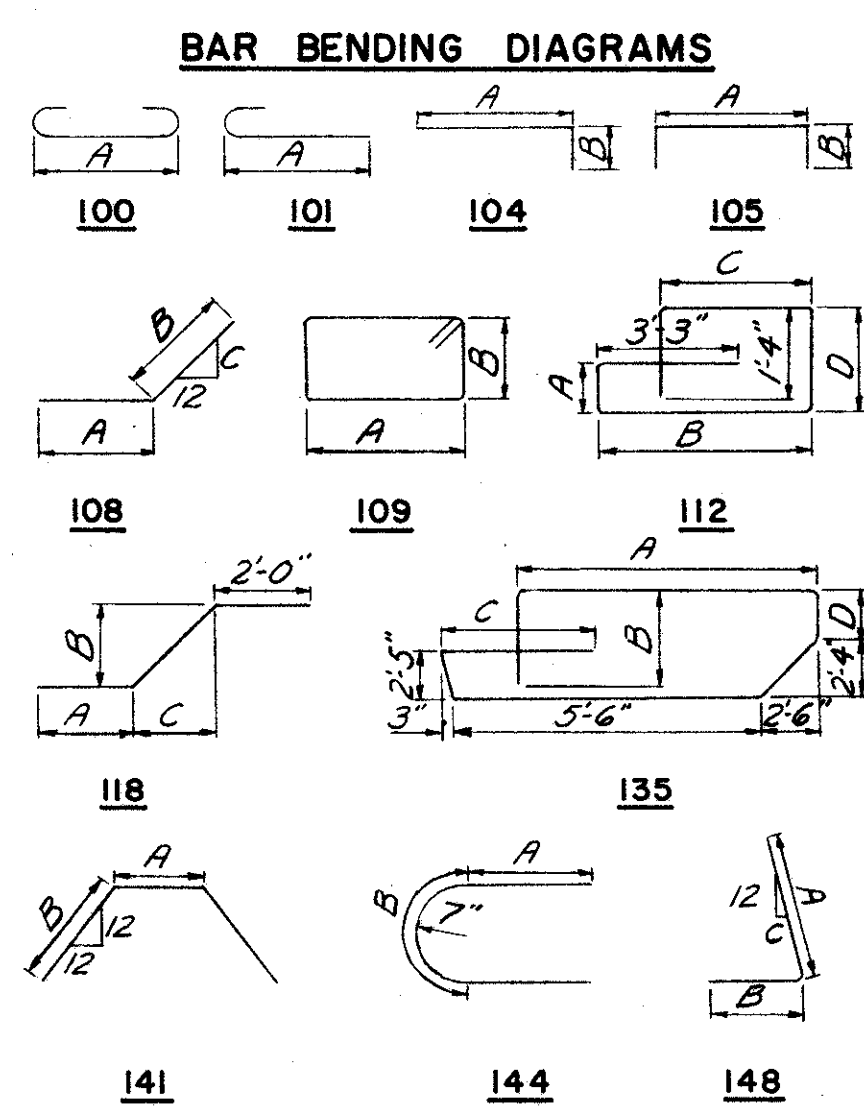


NOTES:
For Location Plan, Developed Elevation and Footing Plan see Sheet 121-7A.
For Replacement Schedule see Sheet 103-7A.
All bar dimensions are given out to out. Bars of a series shall vary in length by a constant increment.

H.N.T.B. BR. NO. 4 PART 7A
HOWARD, NEEDLES, TAMMEN & BERGENDOFF
CONSULTING ENGINEERS
CLEVELAND NEW YORK
KANSAS CITY CLEVELAND NEW YORK

RETAINING WALL DETAILS
INNER BELT FREEWAY OVER EAST 14th ST.
BR. NO. CUY-42-1854 STA. 70+89.23
Scale: 1/4" = 1'-0" STA. 73+96.25
Except as noted
WILLOW-INNER BELT FREEWAY
CLEVELAND CUYAHOGA COUNTY OHIO


DRAWN: ARZ	TRACED	CHECKED: G.A.B.	REVIEWED: J.C.T.	REVISED
DATE: 11/6/55	DATE:	DATE: 11/13/59	DATE: 11/13/59	SHEET 122

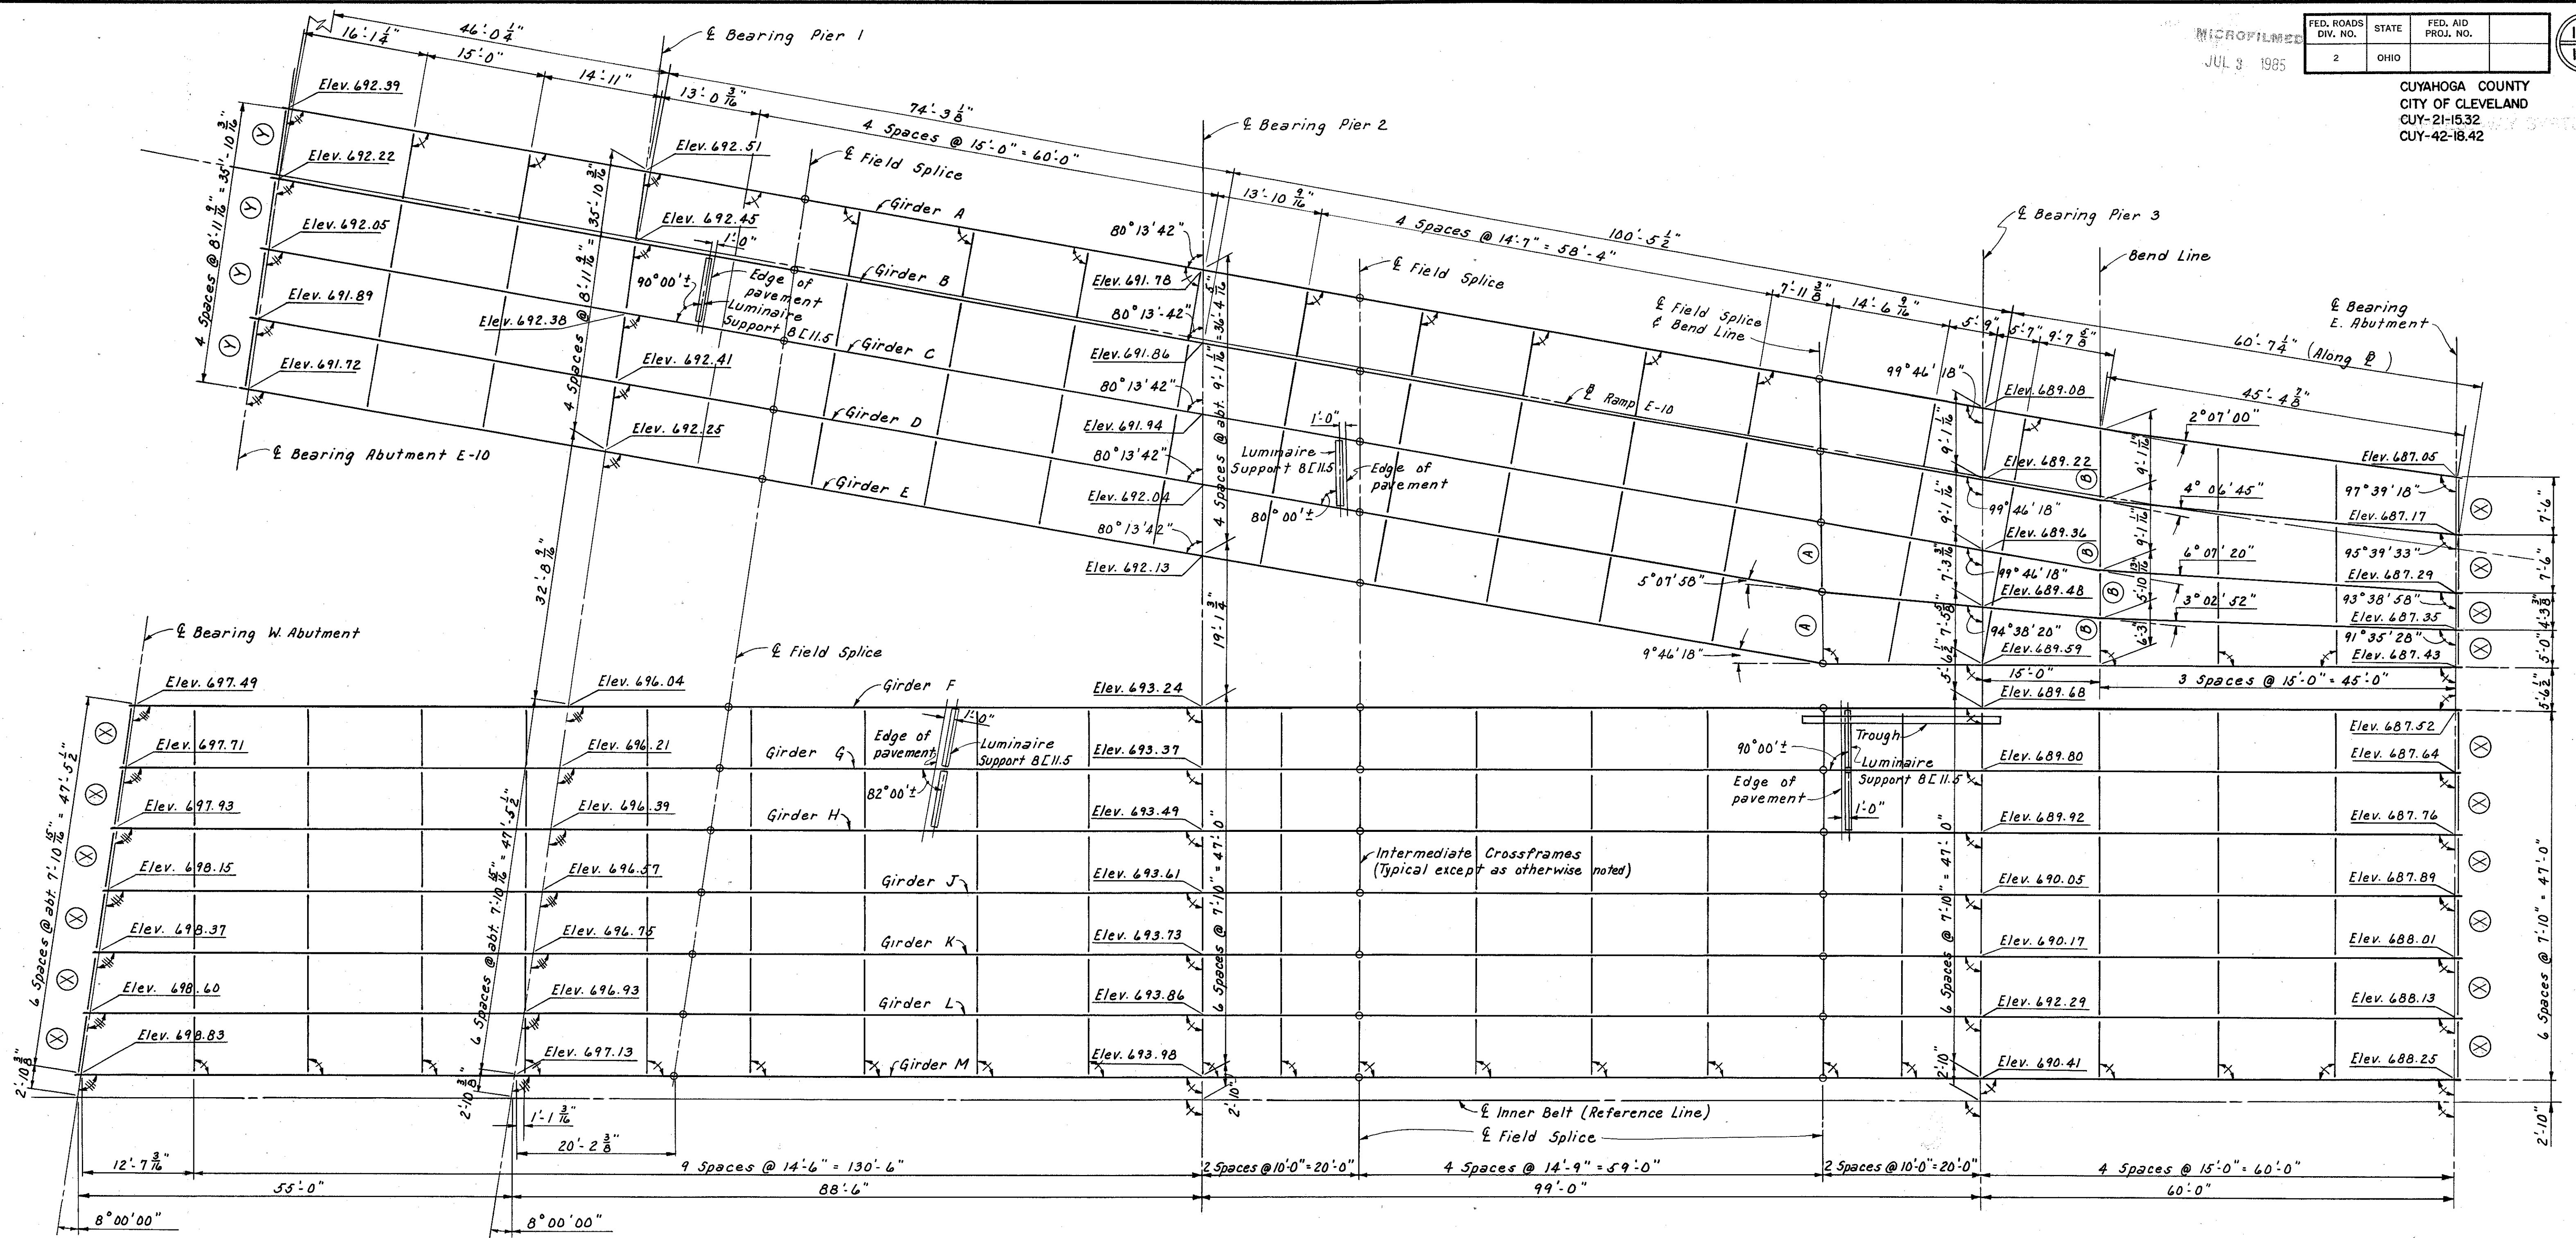

FRAMING PLAN

LEGEND

- Indicates 90° angles
- Indicates 88° 13' 42" angle
- Indicates 98° 00' 00" angle
- (A), (B), (X) or (Y) indicates type of crossframe, see sheet 130 for details.

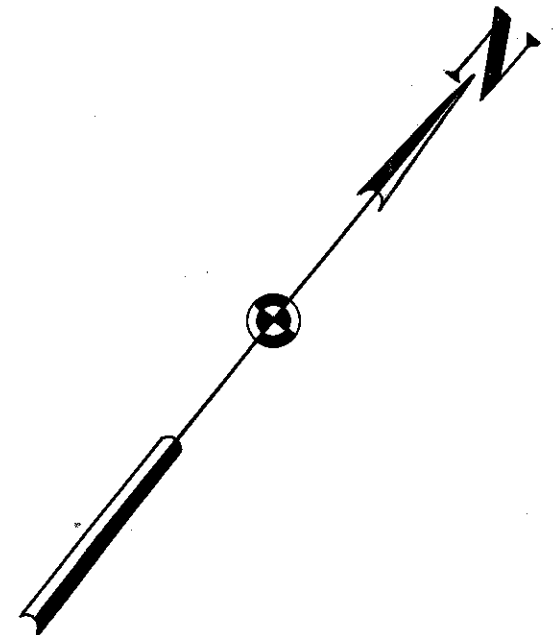

NOTES:

For end dam details see sheet 173-7A
For trough details see sheet 174-7A
For details of underdeck lighting see sheets 176-7A and 177-7A
For details of shoes see Ohio State Standard, Drawing RB-1-55.
Elevations shown are to the top of web over the supports.

H.N.T.B. BR. NO. 4 PART 7A


HOWARD, NEEDLES, TAMMEN & BERGENDOFF
CONSULTING ENGINEERS
KANSAS CITY CLEVELAND NEW YORK

FRAMING PLAN-NORTH HALF
INNER BELT FREEWAY OVER EAST 14th ST.
BR. NO. CUY-42-1854 STA. 70+89.23
Scale: 1" = 10'-0" STA. 73+96.25
WILLOW-INNER BELT FREEWAY
CLEVELAND CUYAHOGA COUNTY OHIO

DRAWN BY	TRACED BY	CHECKED BY	REVIEWED BY	DATE
LB	AK	AK	CT	7-10-59

JUL 2 1985

CUYAHOGA COUNTY
 CITY OF CLEVELAND
 CUY-21-15.32
 CUY-42-18.42

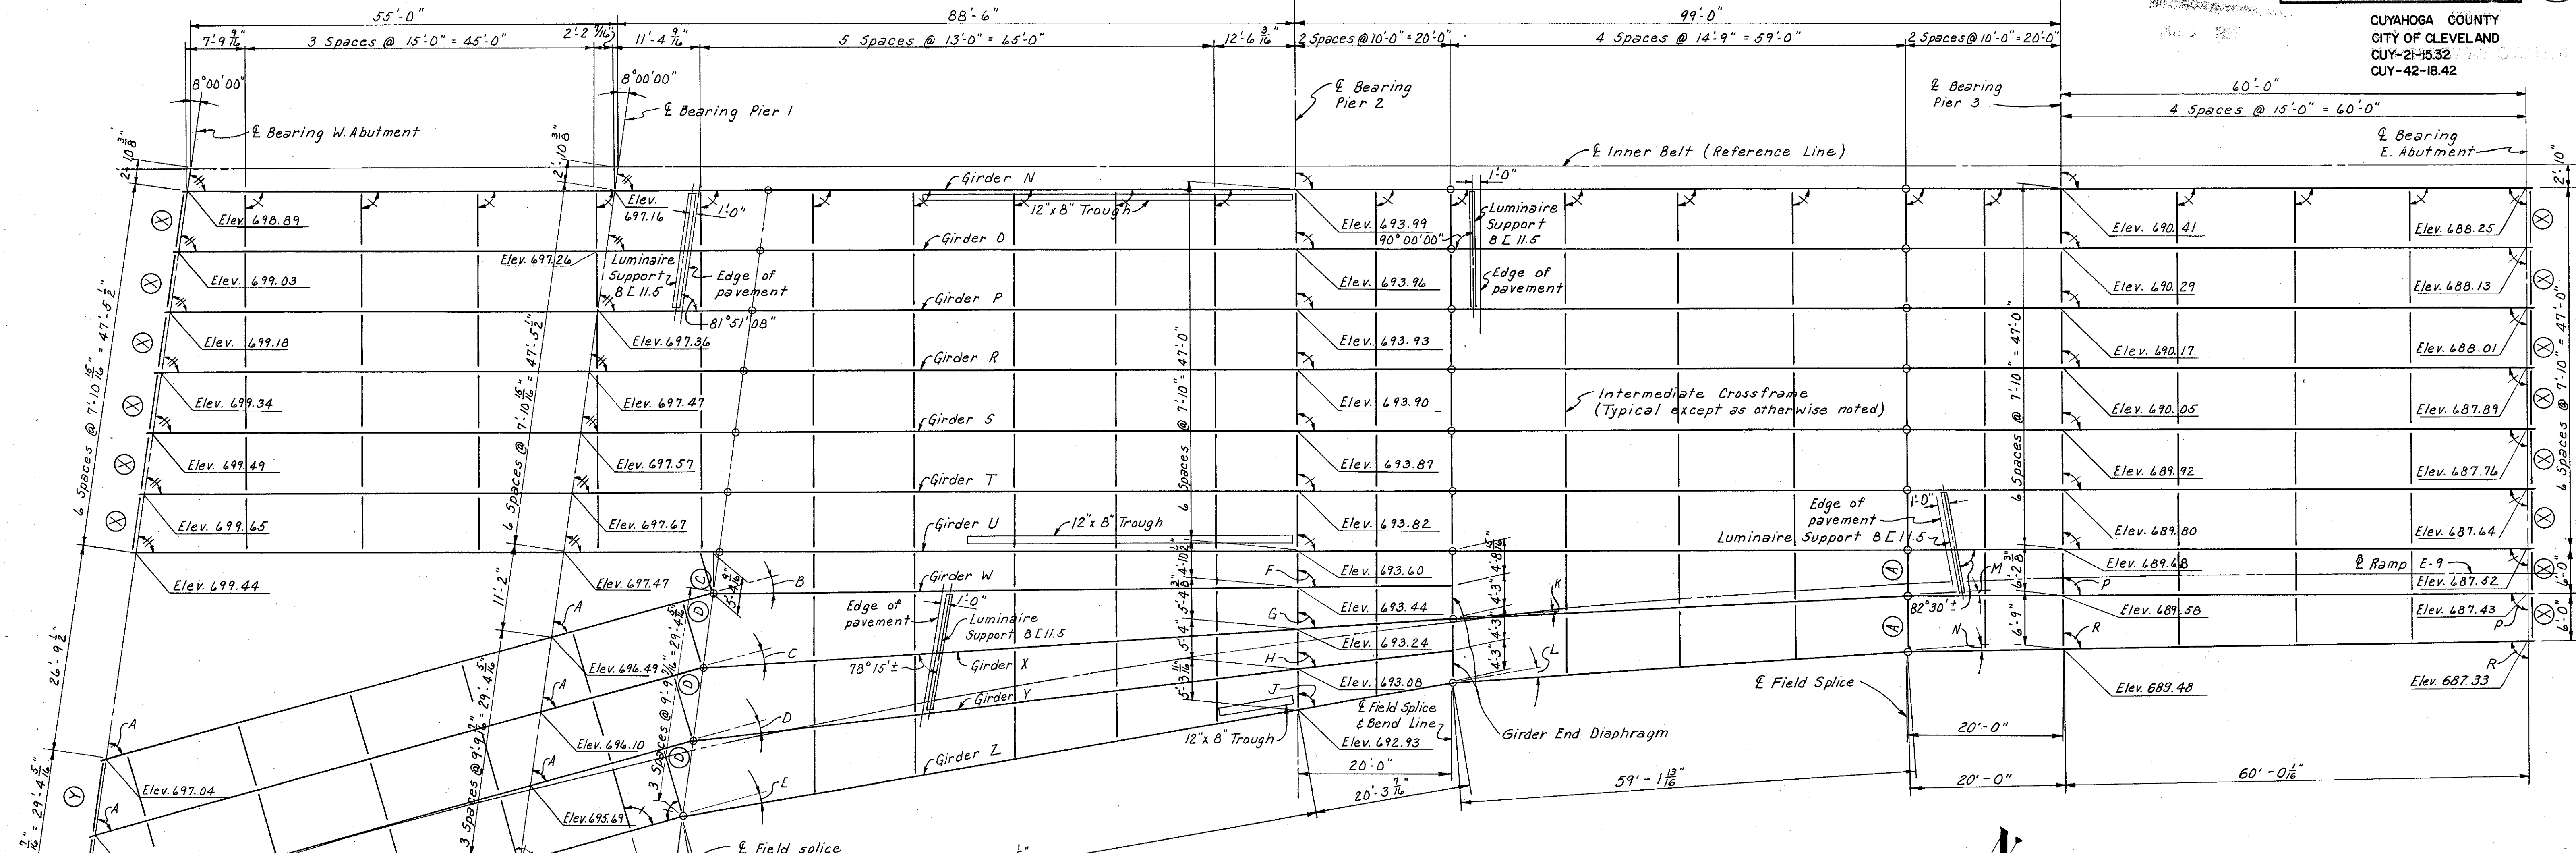


FRAMING PLAN


TABLE OF ANGLES			
A	66° 51' 37"	H	83° 20' 51"
B	14° 45' 33"	J	80° 23' 11"
C	11° 34' 08"	K	00° 55' 10"
D	8° 29' 14"	L	5° 30' 38"
E	5° 31' 34"	M	2° 27' 56"
F	89° 37' 10"	N	3° 12' 03"
G	86° 25' 45"	P	89° 48' 50"
		R	89° 05' 52"

LEGEND


- ☒ Indicates 90° angle
- ☒ Indicates 82° angle
- (A) (C) (D) (X) or (Y) indicates type of cross frame, see sheet 130 for details

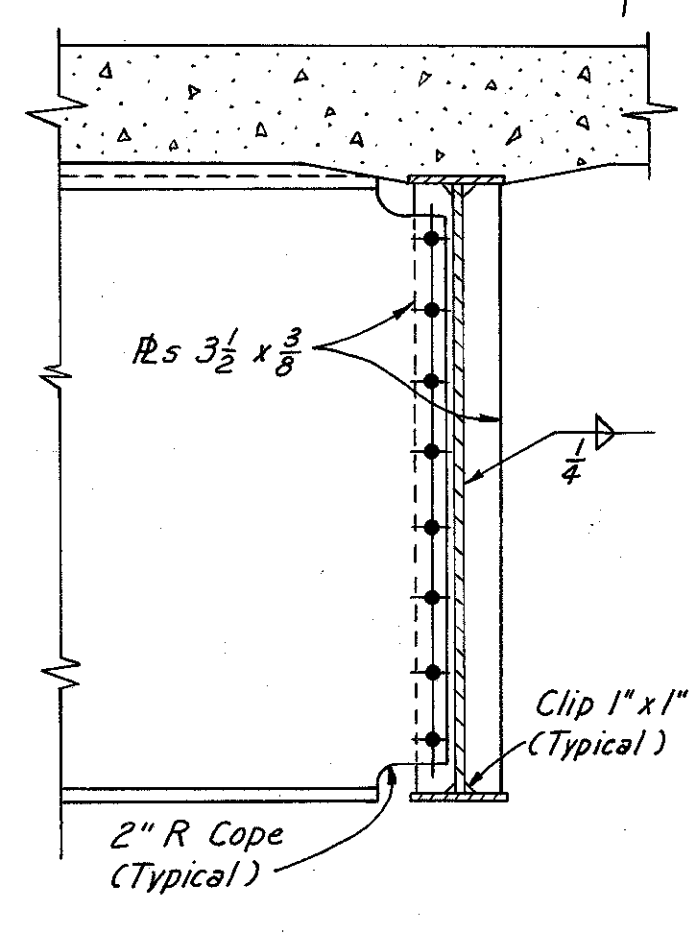

SECTION A-A
Scale: 3/4" = 1'-0"

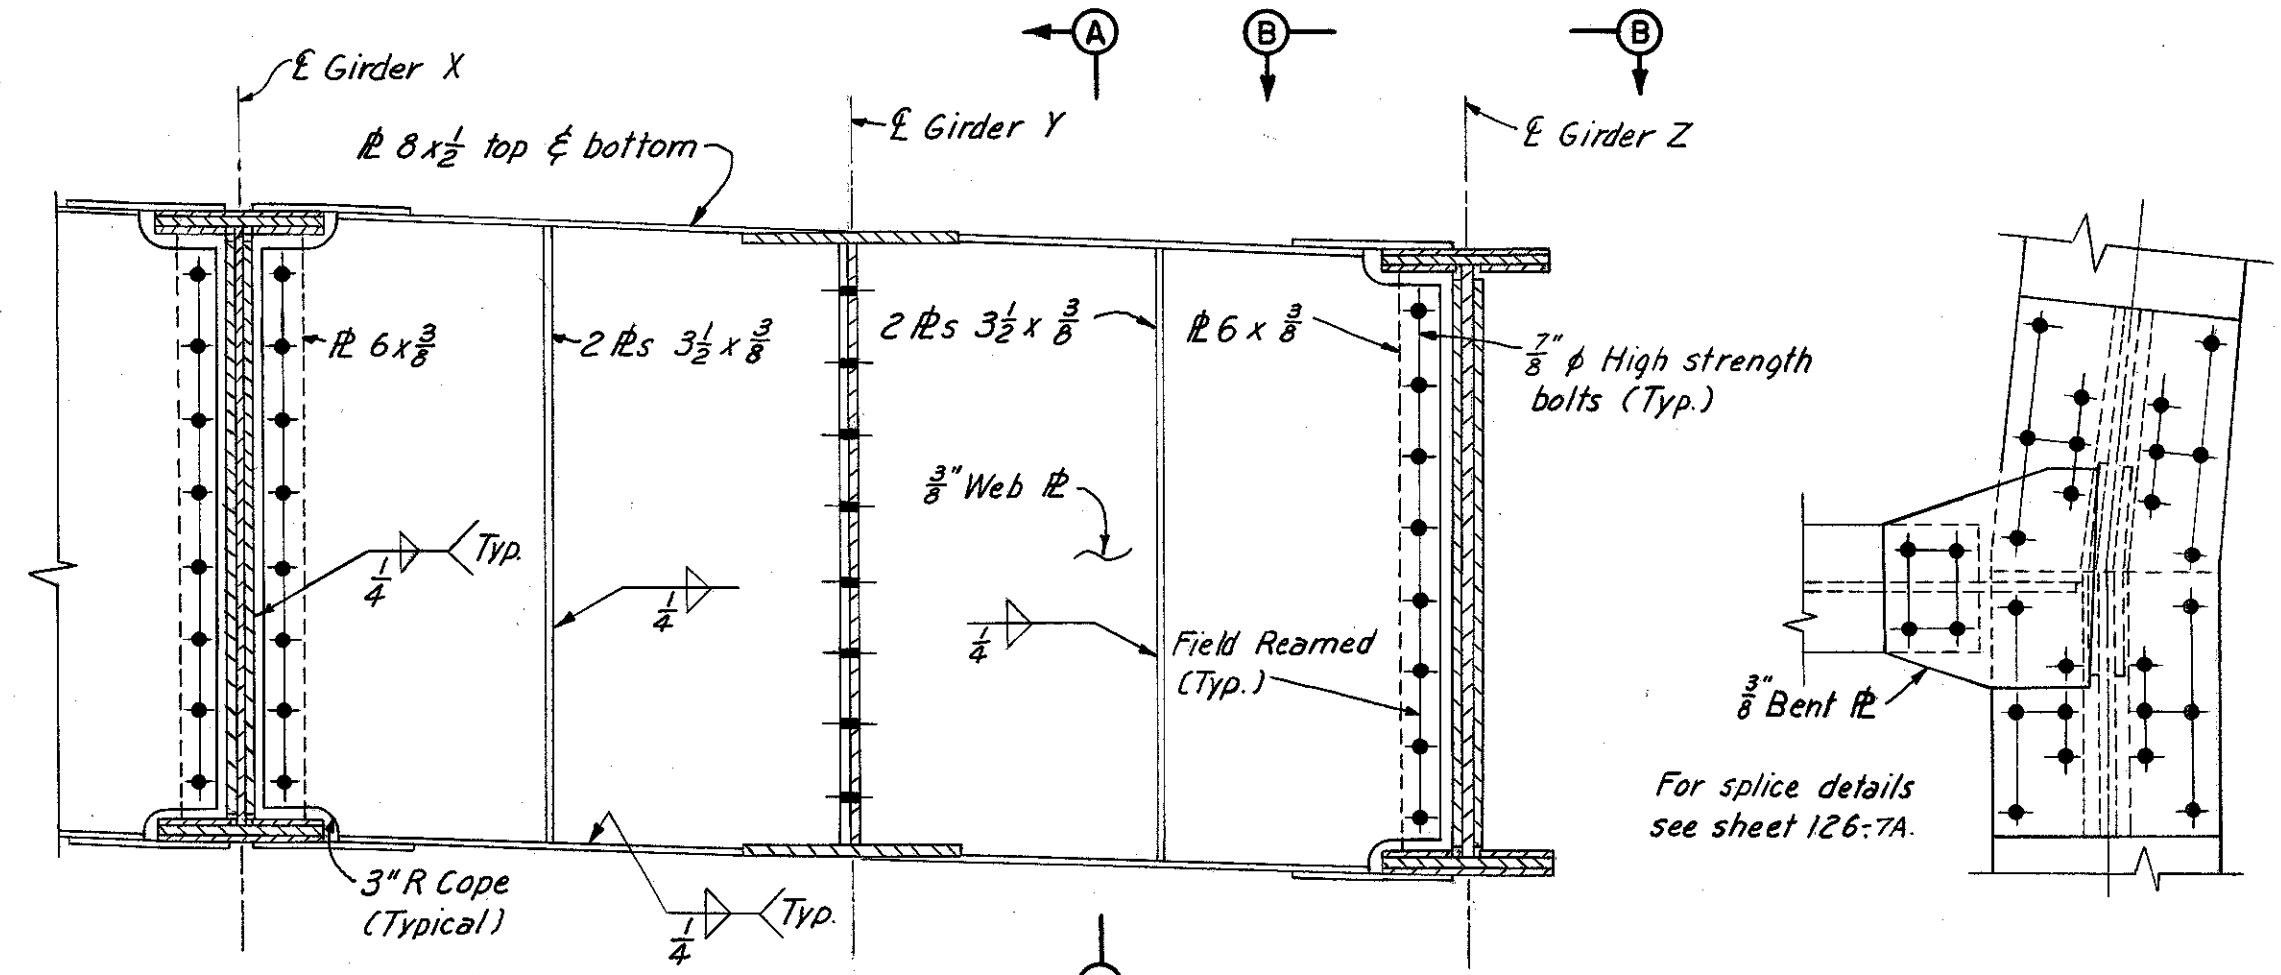

ELEVATION
GIRDER END DIAPHRAGM
Scale: 3/4" = 1'-0"

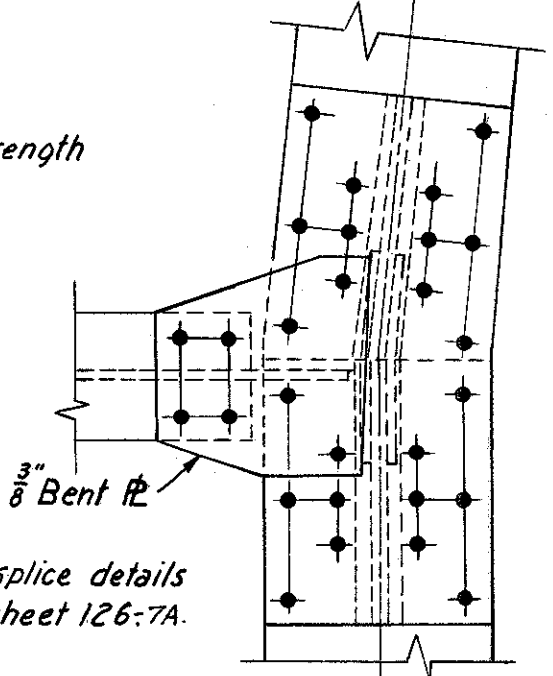

VIEW B-B
Scale: 1" = 1'-0"

NOTES:
 For end dam details see sheet 173-7A
 For trough details see sheet 174-7A
 For details of underdeck lighting see sheets 176-7A & 177-7A
 For details of shoes see Ohio State Standard, Drawing RB-1-55.
 Elevations shown are to the top of web over the supports.

H.N.T.B. BR. NO. 4 PART 7A

HOWARD, NEEDLES, TAMMEN & BERGENDOFF
 CONSULTING ENGINEERS
 KANSAS CITY CLEVELAND NEW YORK




FRAMING PLAN-SOUTH HALF

INNER BELT FREEWAY OVER EAST 14th ST.
 BR. NO. CUY-42-1854 STA. 70+89.23
 Scale: As shown STA. 73+96.25

WILLOW-INNER BELT FREEWAY
 CLEVELAND CUYAHOGA COUNTY OHIO

DRAWN LDF	TRACED R.C.	CHECKED RSG	REVIEWED JCT
DATE 5-10-88	DATE 4-23-89	DATE 7-8-89	DATE 11-13-89

SHEET 124

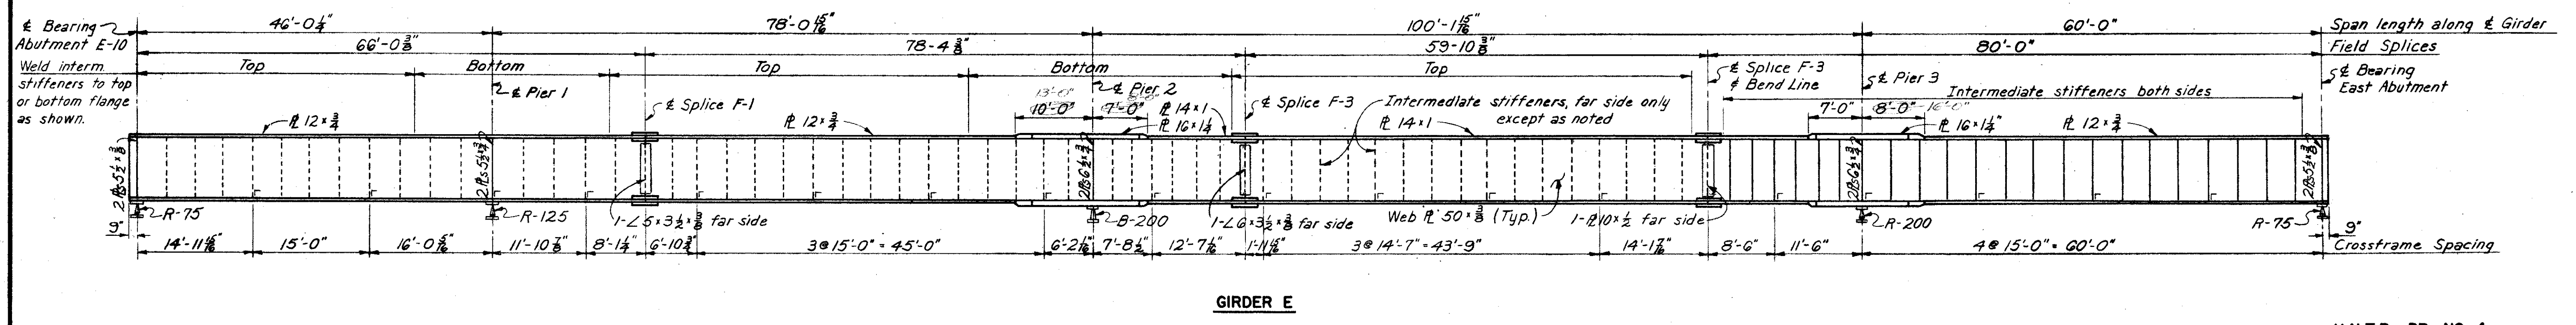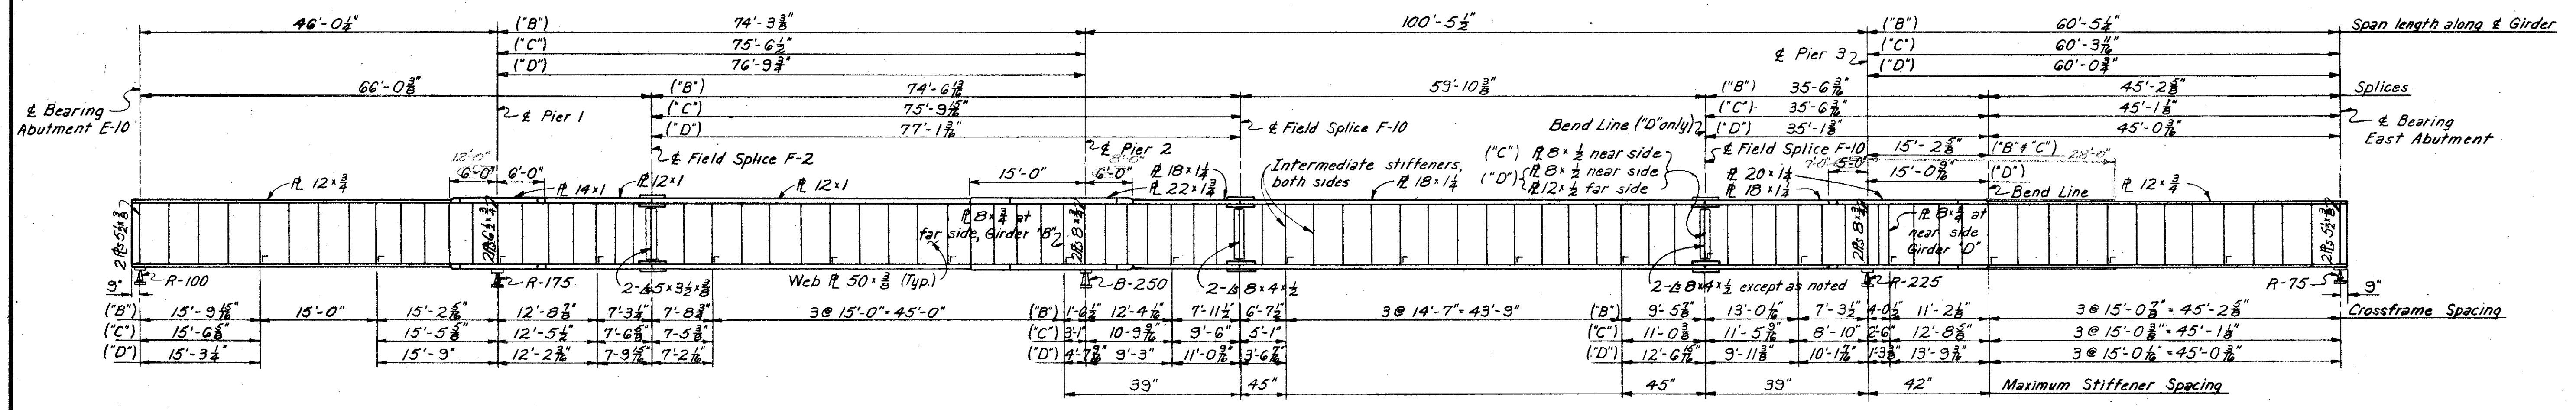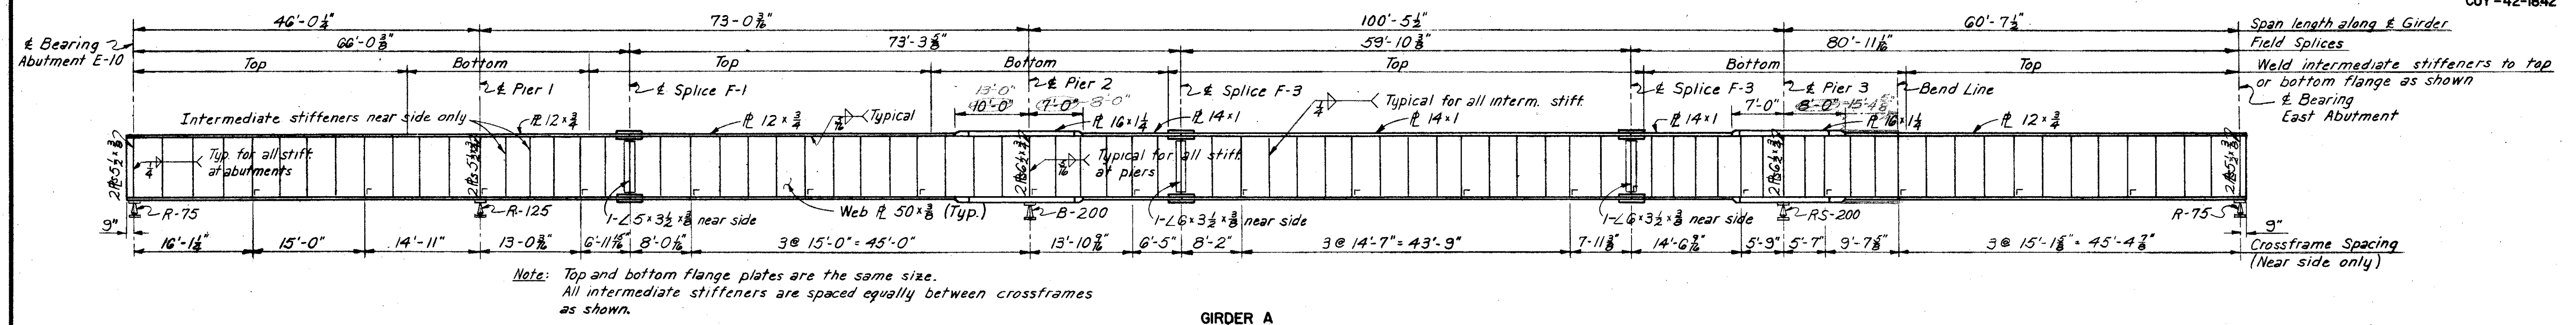

For notes see sheet 127-7A

H.N.T.B. BR. NO. 4 PART 7A

HOWARD, NEEDLES, TAMMEN & BERGENDOFF
CONSULTING ENGINEERS
KANSAS CITY CLEVELAND NEW YORK

GIRDER ELEVATIONS


INNER BELT FREEWAY OVER EAST 14th ST.
BR. NO. CUY-42-1854 STA. 70+89.23
Scale: None STA. 73+96.25

WILLOW-INNER BELT FREEWAY
CLEVELAND CUYAHOGA COUNTY OHIO

DRAWN	TRACED	CHECKED	REVIEWED	REVISED
CKB			CT	6-20-60
DATE 1-3-59	DATE	DATE 1-15-59	DATE 11-13-59	SHEET 125


CUYAHOGA COUNTY
CITY OF CLEVELAND
CUY-21-15.32
CUY-42-18.42

JUL 3 1965

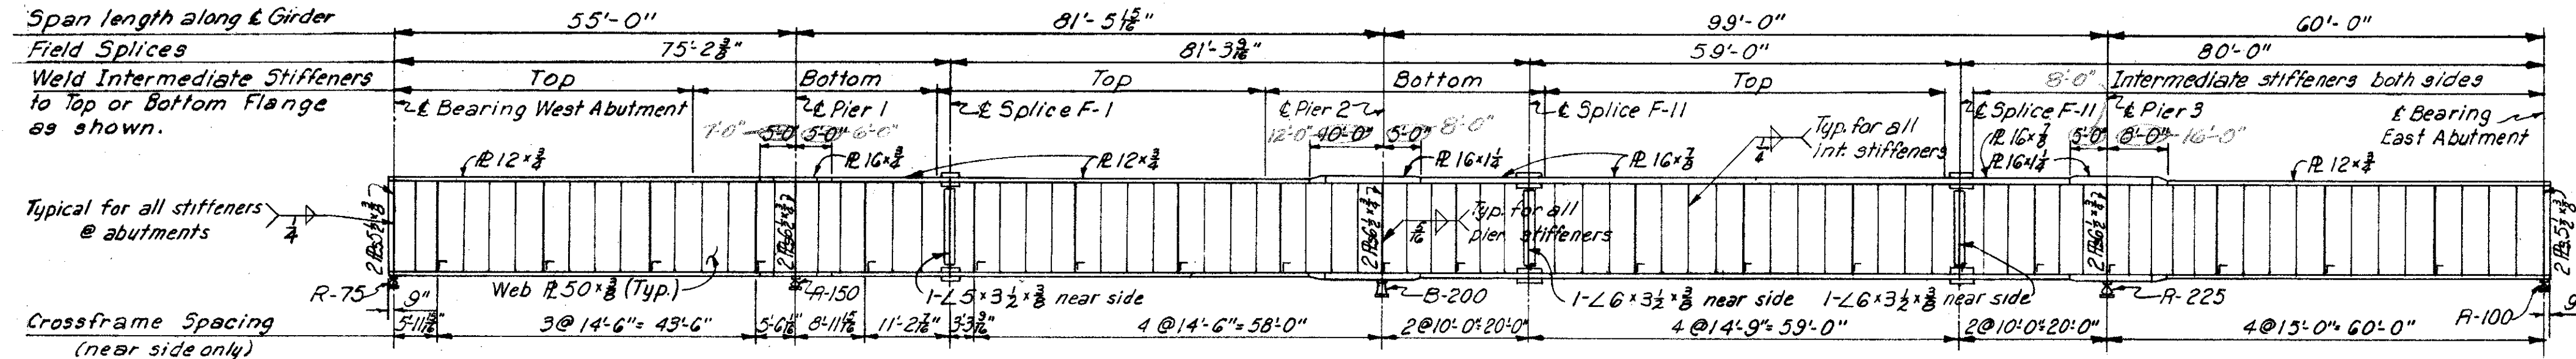


GIRDER F

Note: Intermediate stiffeners near side only except as noted.

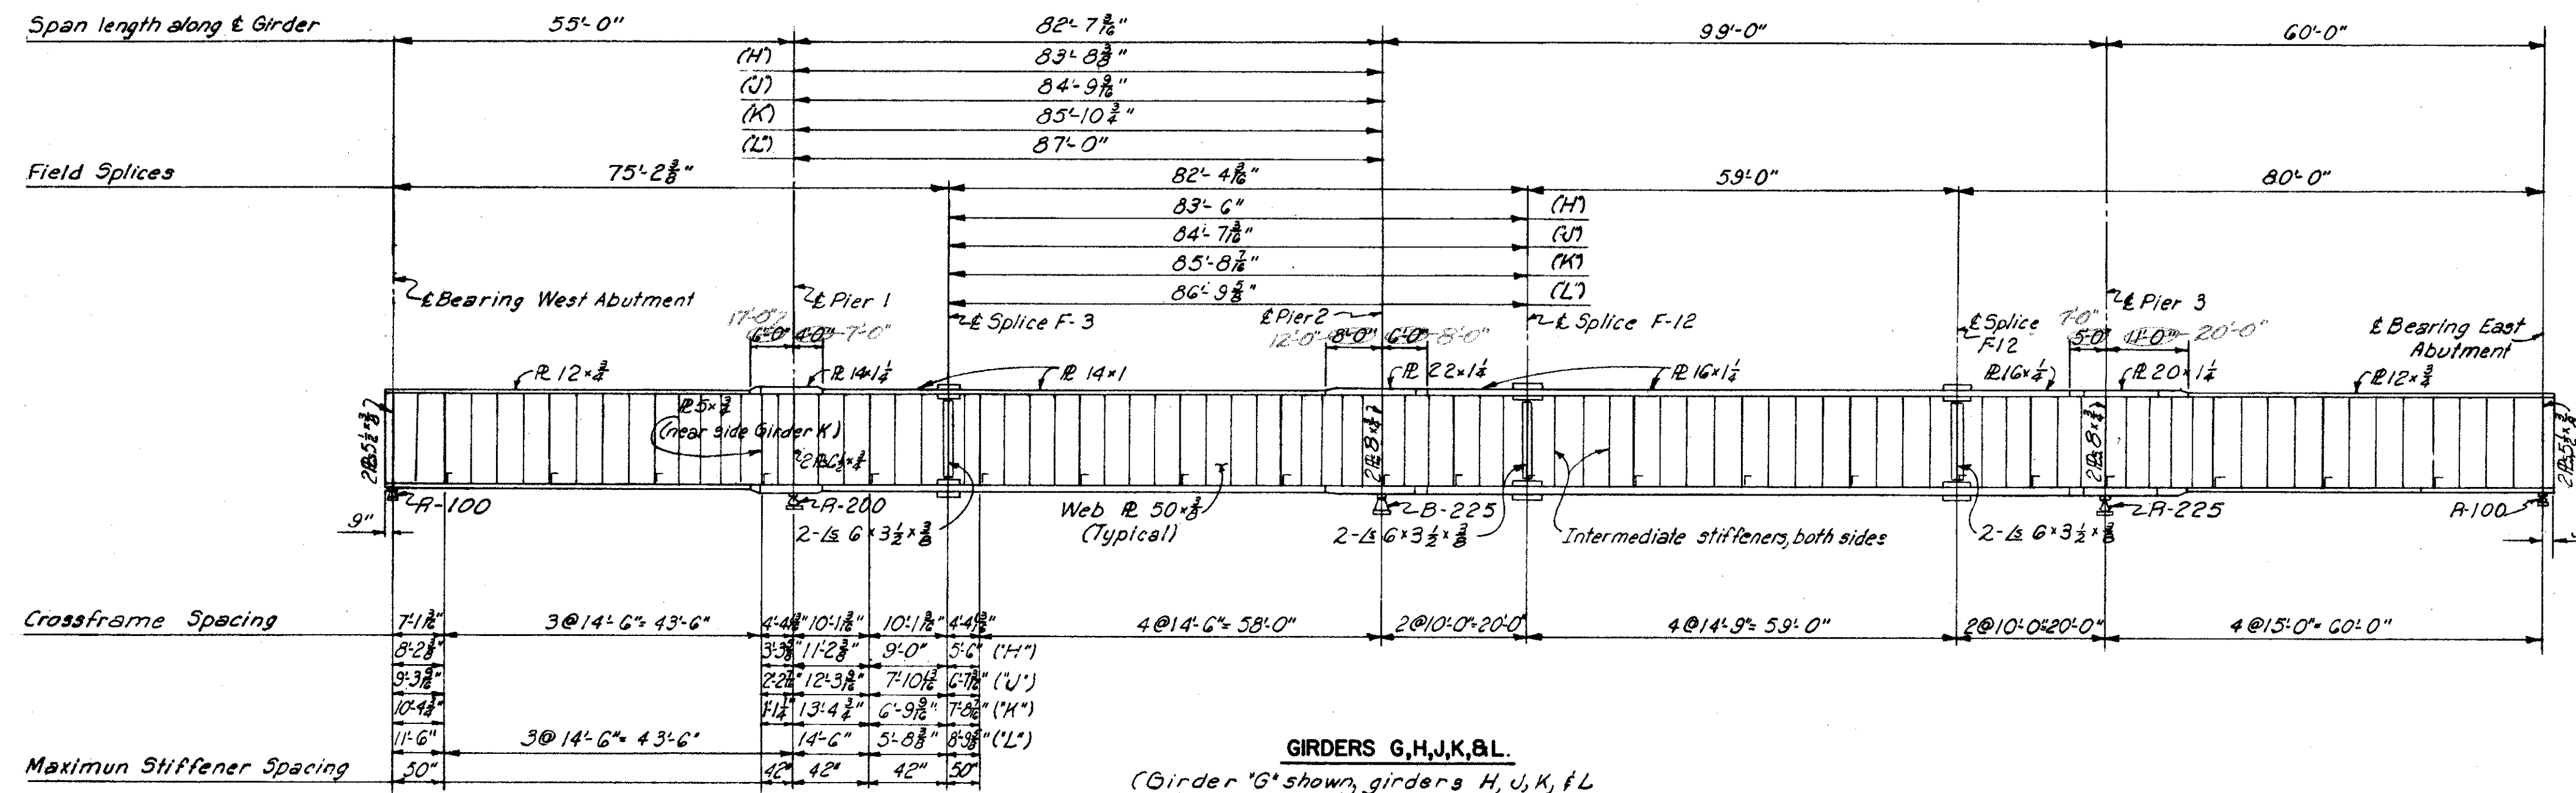



GIRDERS G, H, J, K, & L

(Girder 'G' shown, girders H, J, K, & L similar except as noted)

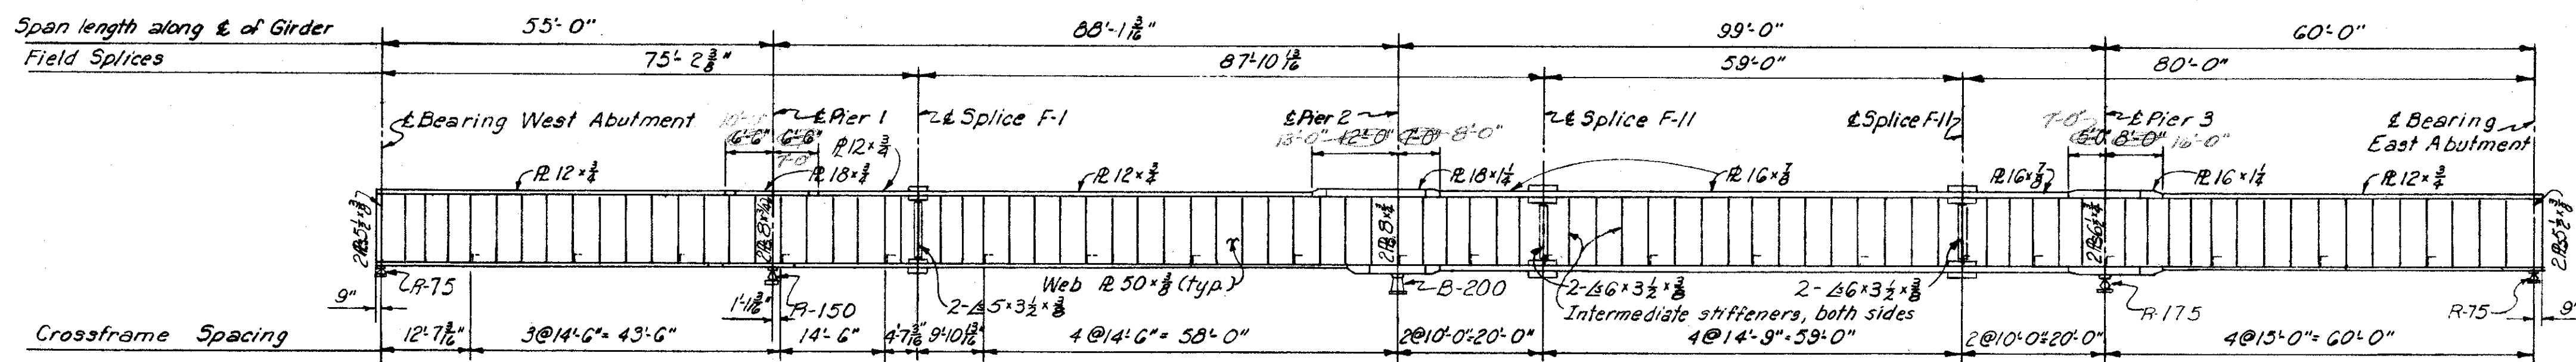

GIRDER M

NOTES:
For modification of splices at crossframes Types A, C & D see Detail "A" sheet 130-7A
For girder notes see sheet 127-7A

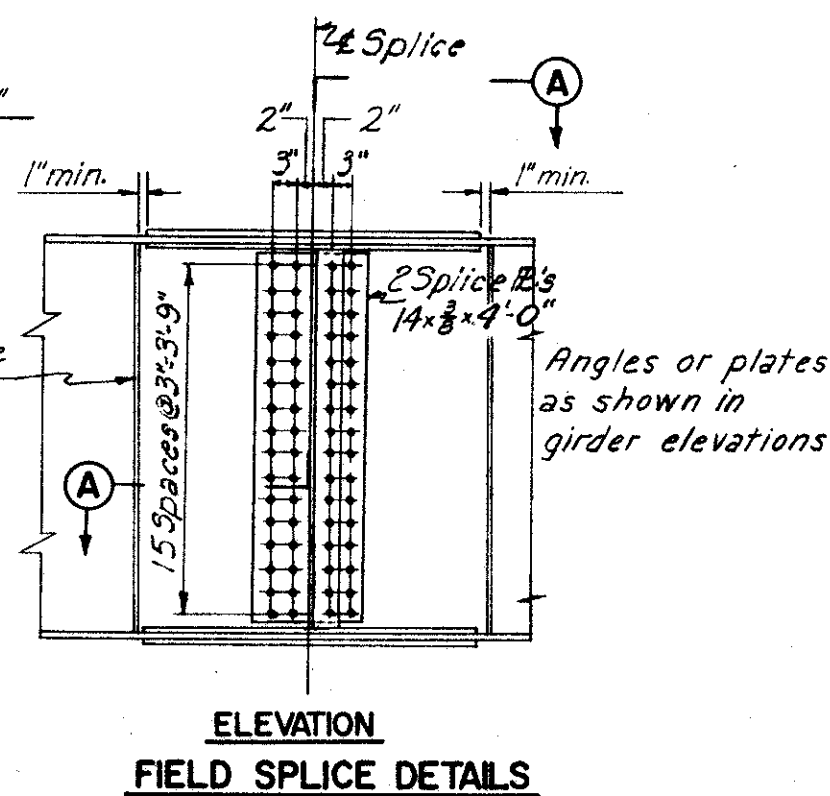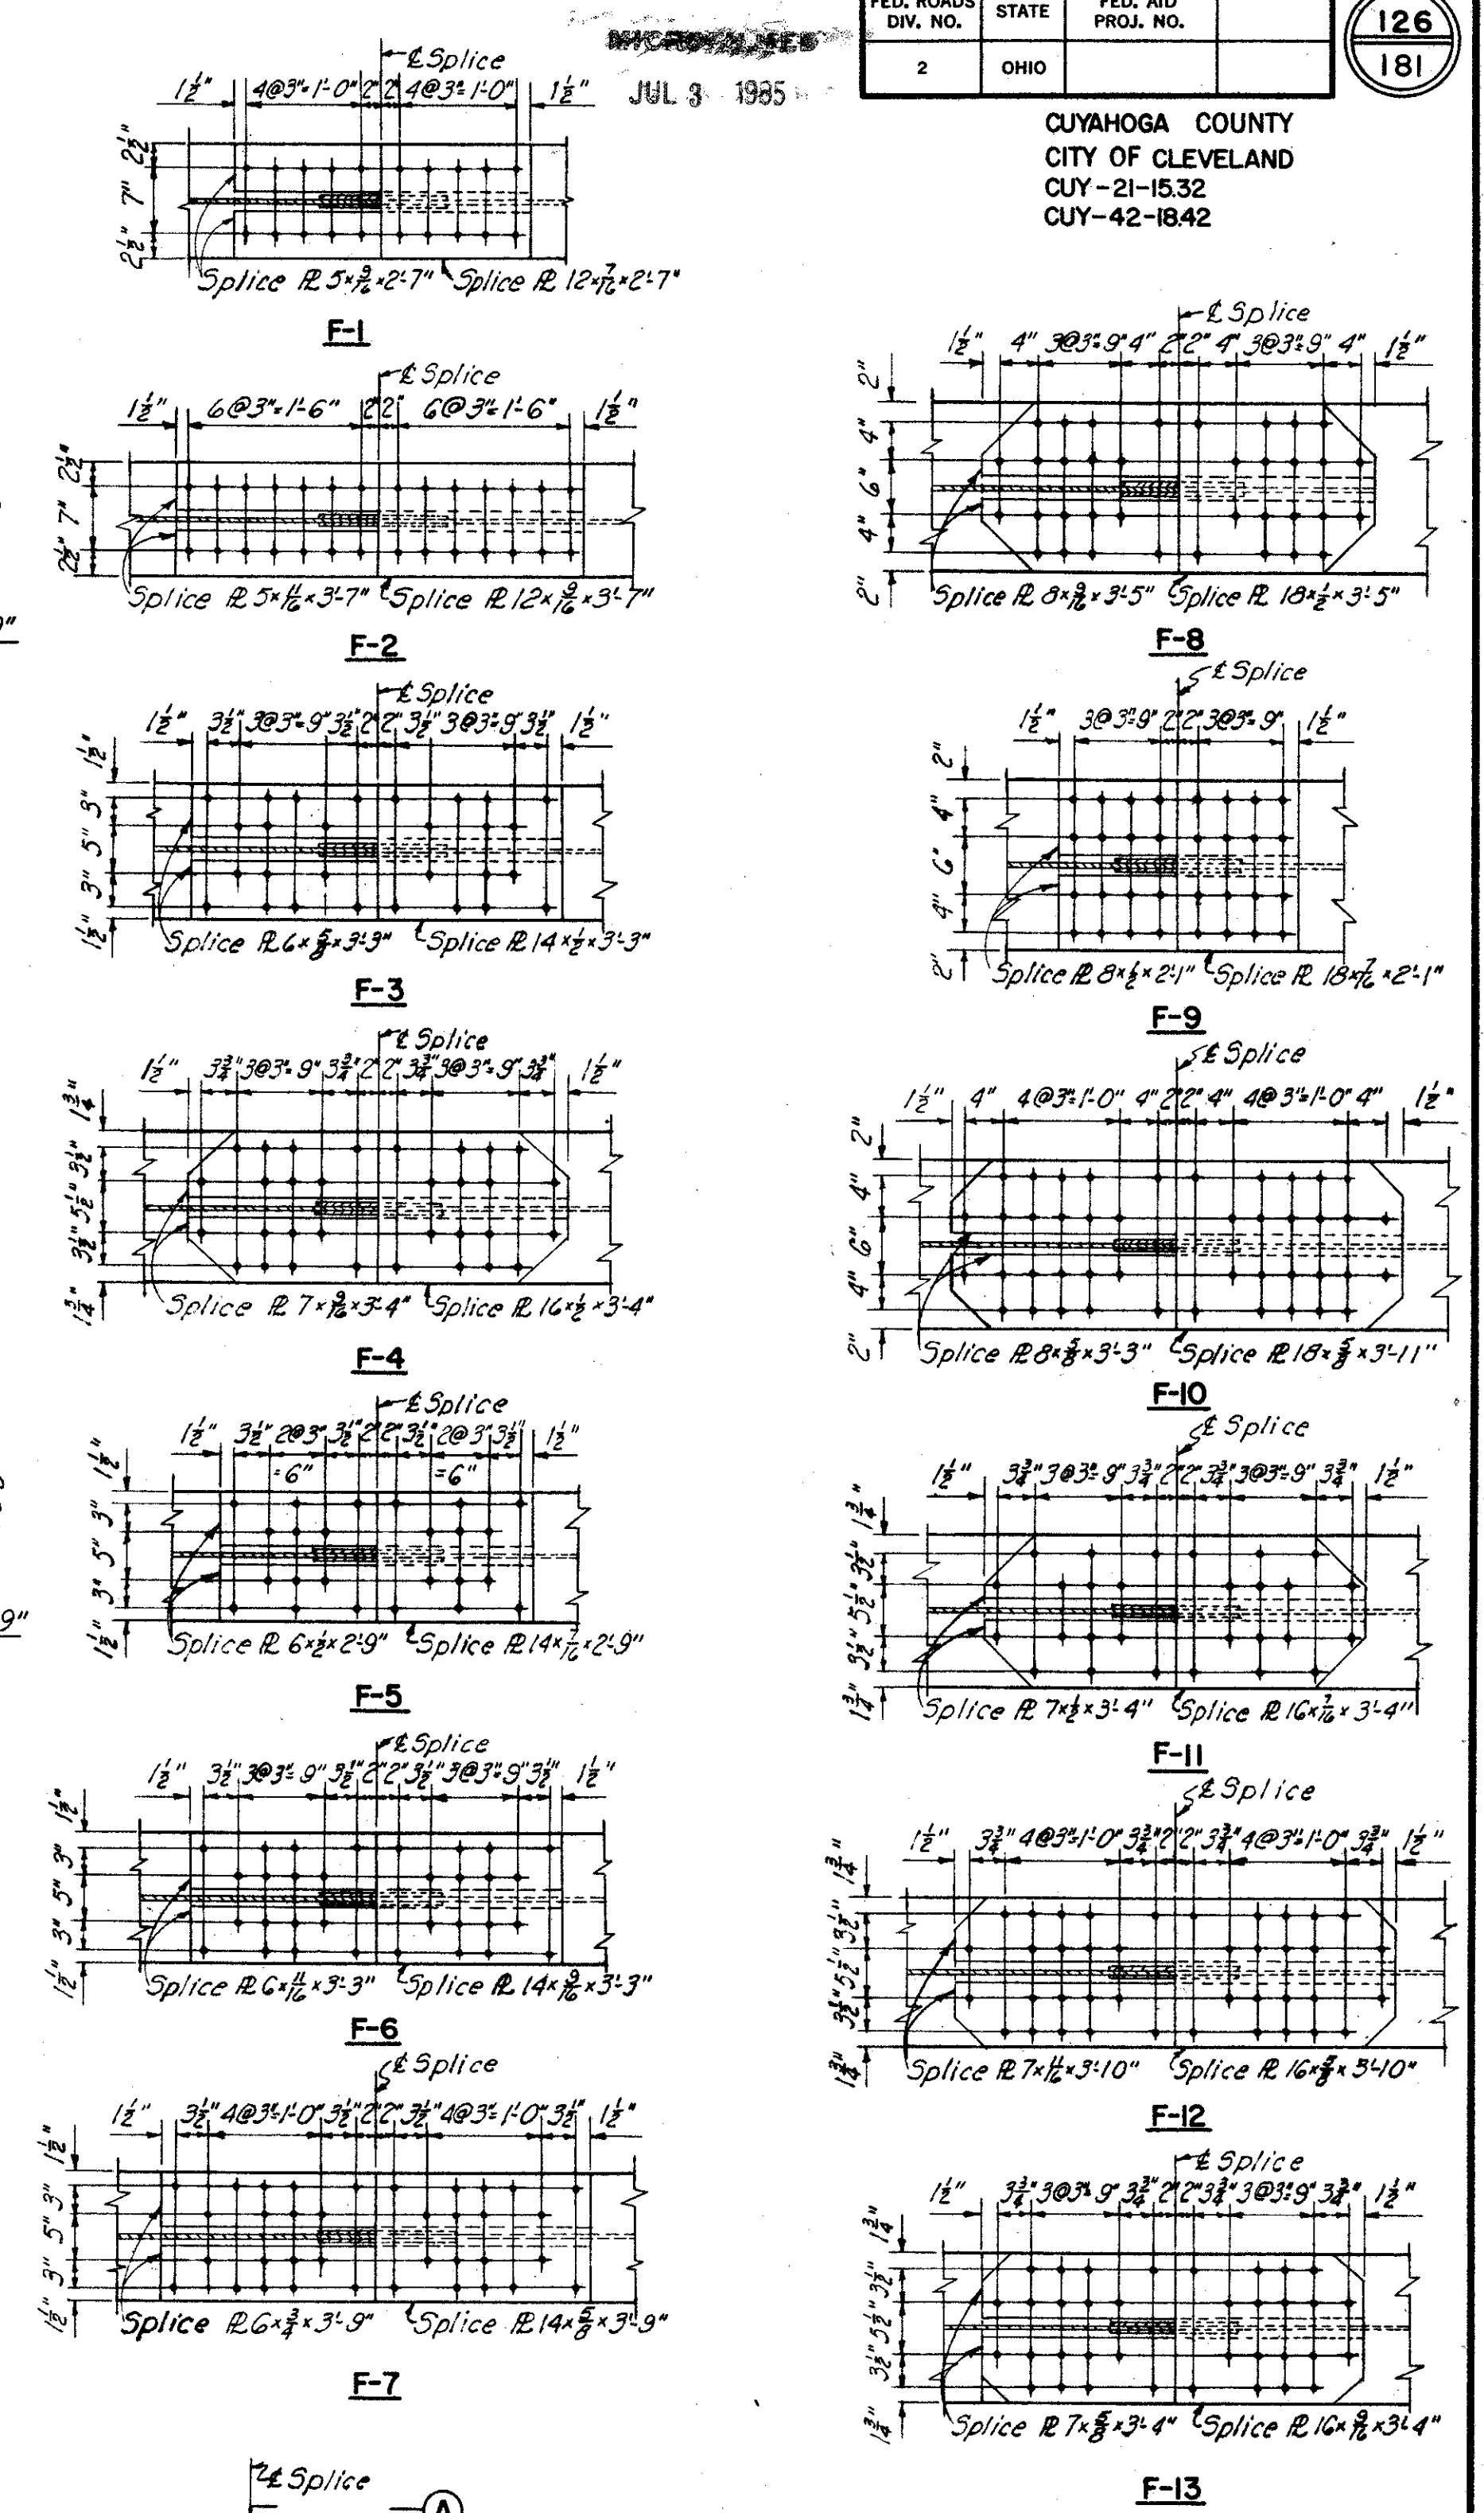

H.N.T.B. BR. NO. 4 PART 7A

HOWARD, NEEDLES, TAMMEN & BERGENOFF
CONSULTING ENGINEERS
KANSAS CITY CLEVELAND NEW YORK

GIRDER ELEVATIONS

INNER BELT FREEWAY OVER EAST 14th ST.
BR. NO. CUY-42-1854 STA. 70+89.23
Scale: None STA. 73+96.25

WILLOW-INNER BELT FREEWAY

CLEVELAND CUYAHOGA COUNTY OHIO

DRAWN RA	TRACED	CHECKED CAN	REVIEWED JCT	REVISED
DATE 1-7-57	DATE	DATE 1-23-59	DATE 11-13-59	6-20-60





SHEET 126

JUL 3 1955

FED. ROADS DIV. NO.	STATE	FED. AID PROJ. NO.
2-55	OHIO	

127
181

CUYAHOGA COUNTY
CITY OF CLEVELAND
CUY-21-1532
CUY-42-1842

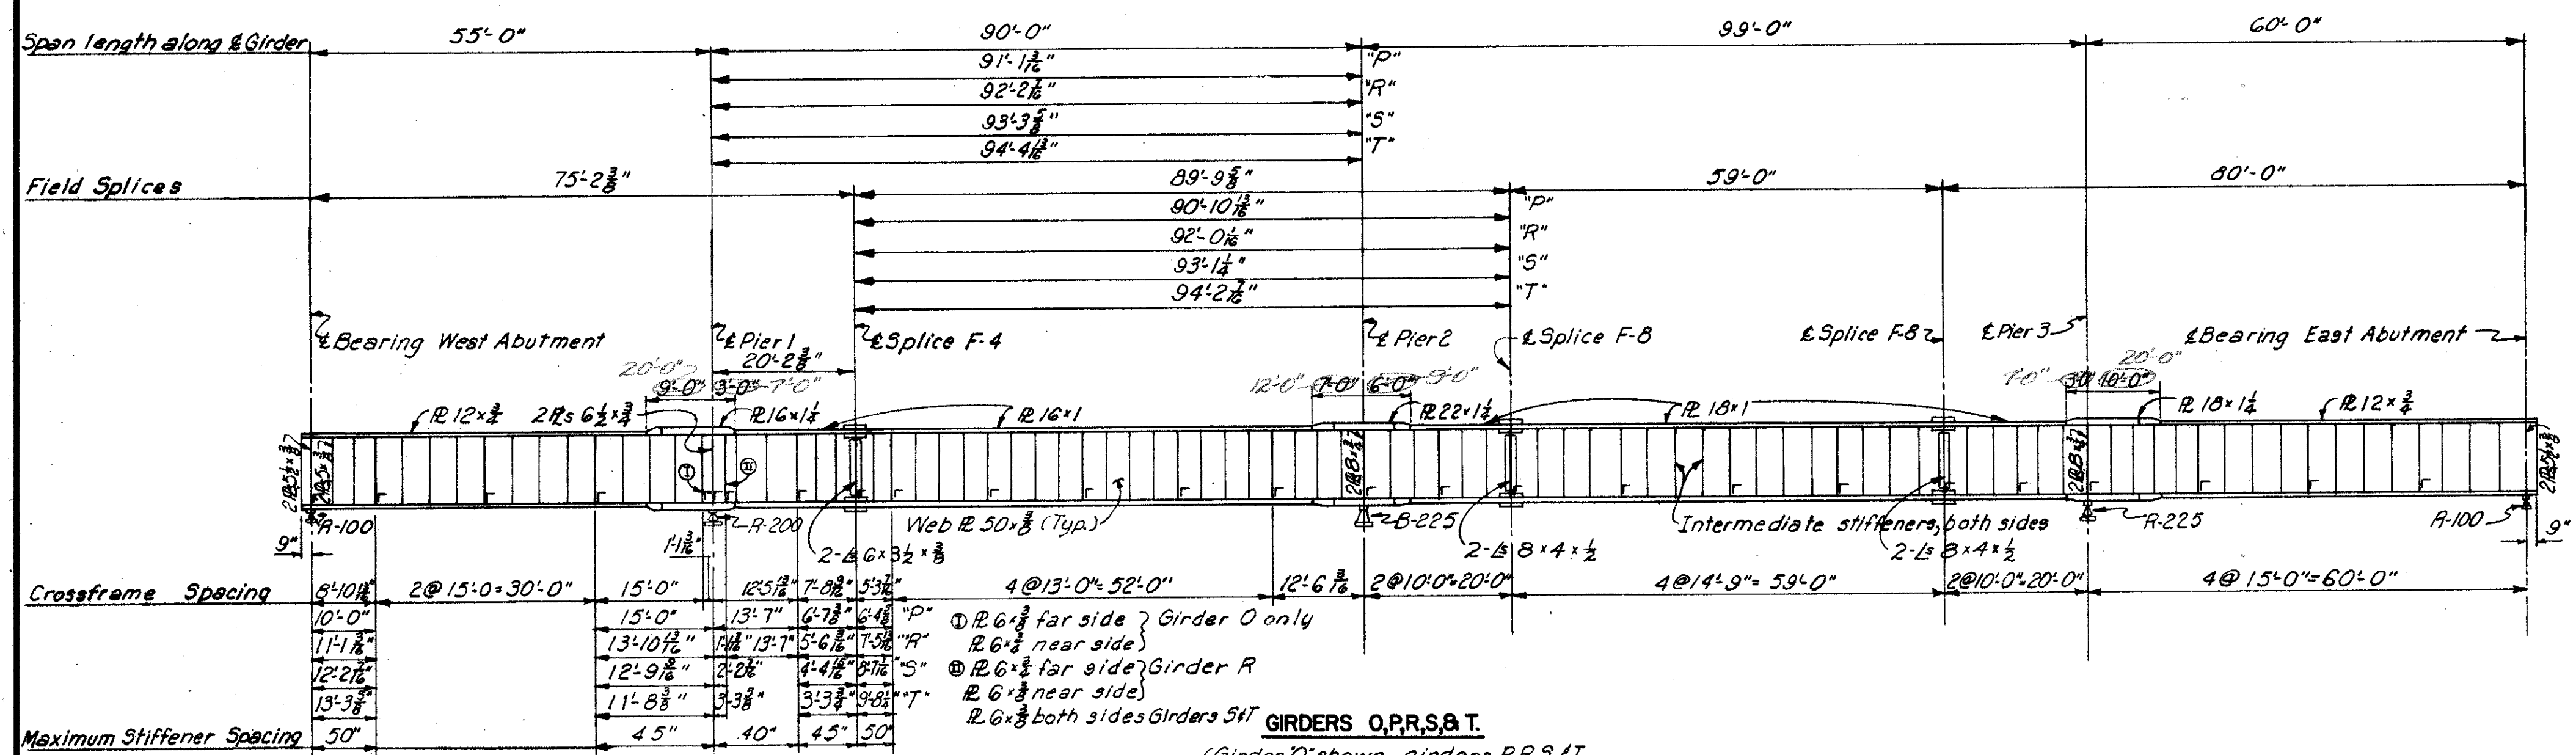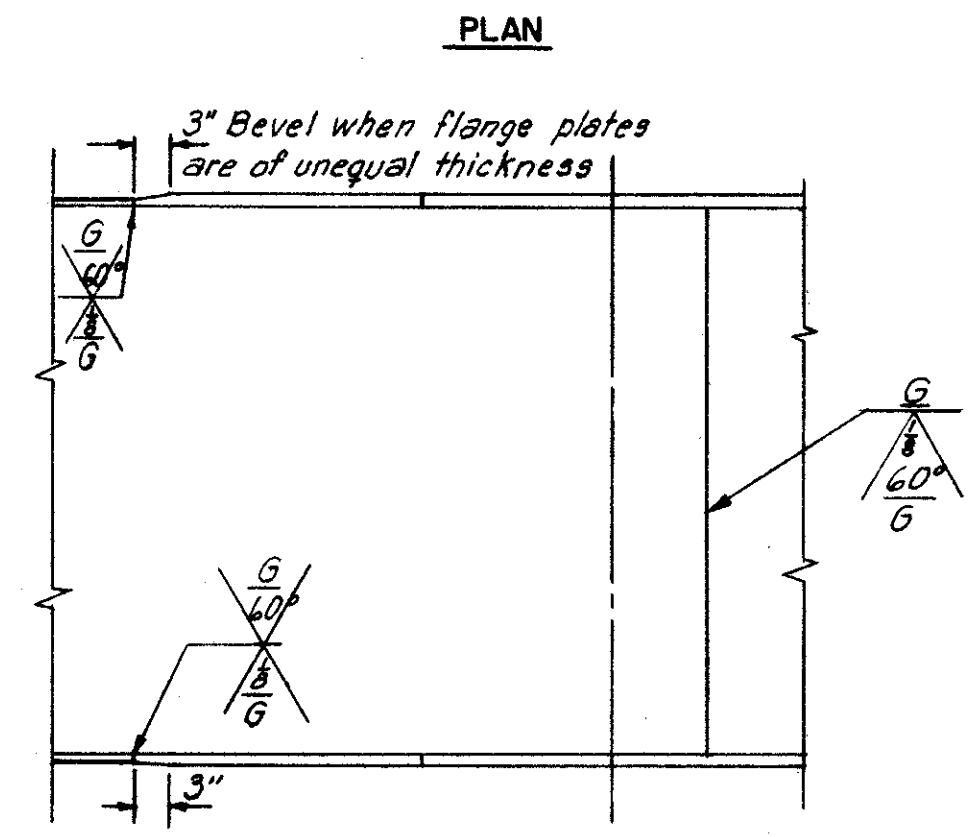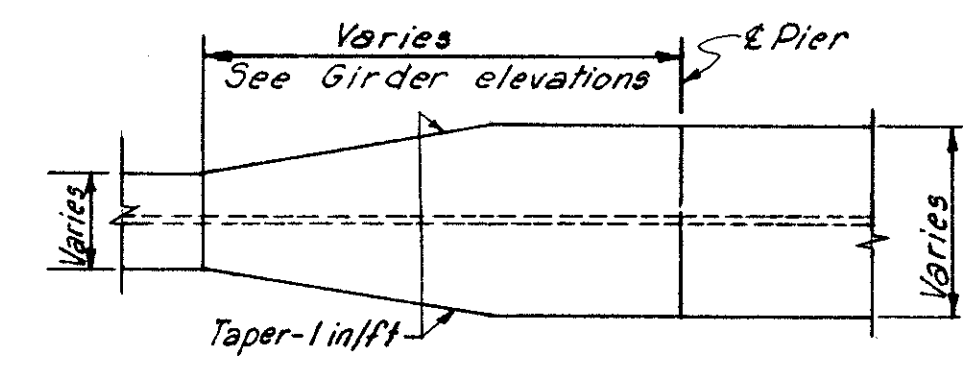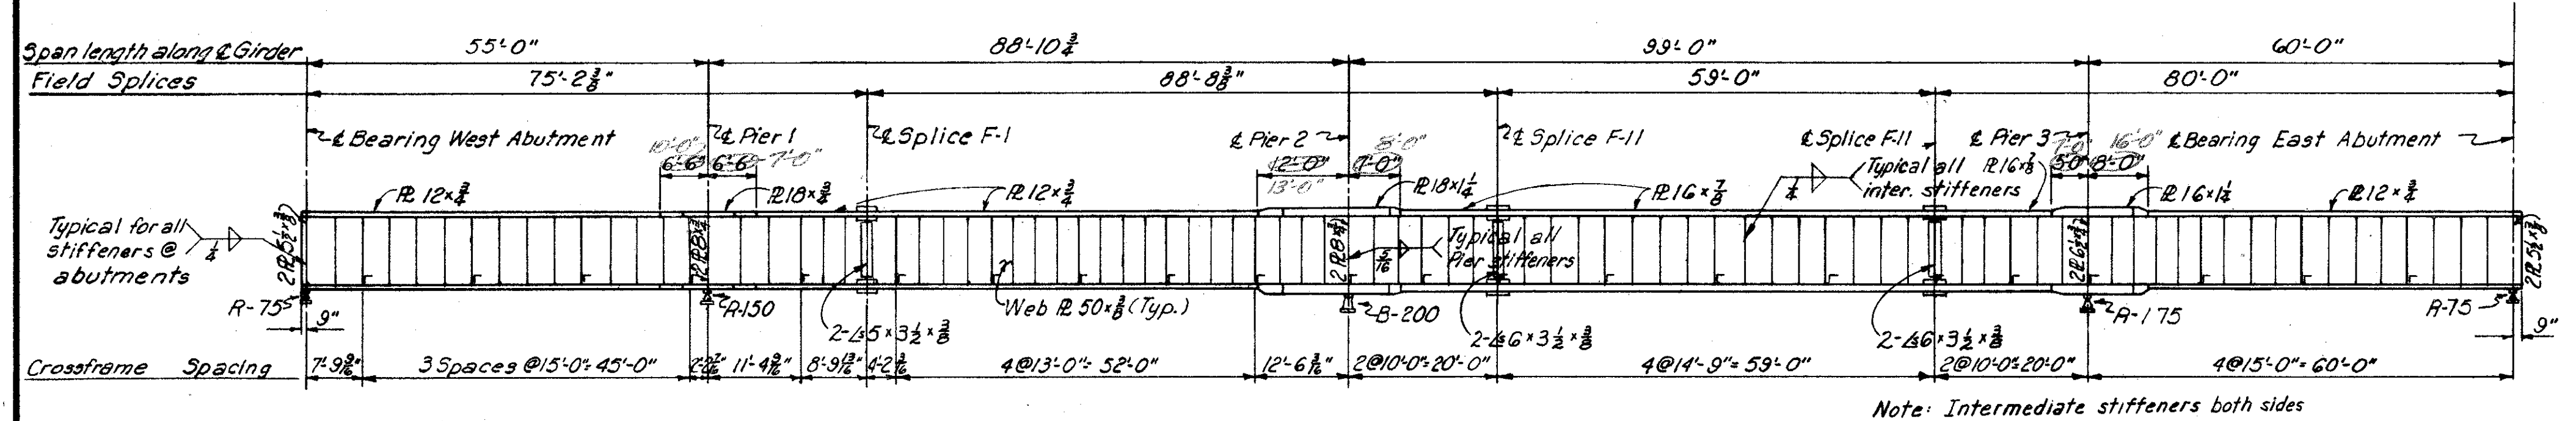

GIRDER NOTES

The girders shall be fabricated to lines parallel to profiles formed by top of pavement elevations directly over the girders, plus the camber required to compensate for dead load deflections.

Top and bottom flange plates are to be the same and shall be spliced at the points shown in girder elevations, and as otherwise required.

The web plate may be spliced as required by available plate lengths.

Intermediate stiffeners shall be as shown in Table "A", except as otherwise noted at special crossframes. These stiffeners shall be placed singly or in pairs as shown on the girder elevations. Stiffeners placed in pairs shall not be welded to the flanges, but shall be fitted to close enough contact that the shop coat, when applied, will fill and close the openings. Stiffeners placed singly shall be welded to top or bottom flanges within the limits shown on the girder elevations with a 3/8" fillet weld on both sides of the joint for a distance of 2" from the outside edge of the stiffener. The other end shall have a tight fit with the flange.

Angles or plates as noted on the girder elevations shall be used at all field splices.

Bearing stiffeners at abutments and piers shall be as shown on the girder elevations and shall be placed in pairs on all girders. They shall be grooved and fully butt welded to the lower flange and fitted to close contact, without welding, at the upper flange.

All field connections and girder field splices shall be made with 3/4" high strength bolts conforming to Supplemental Spec. 5-207. The bolts shall be placed with their heads on the outside face of exterior girders and on the bottom of girder flanges.

At bend points, the girders change direction at the center line of the field splice. Specialty cut splice plates will be required at these locations.

Welding shall be done in accordance with Sec. 5-7.22 of the Specifications.

Longitudinal dimensions of the girders are measured horizontally along center line of web plate.

For top of pavement elevations see sheets 134-7A & 135-7A.

For deflections see sheet 129-7A.


For cross section through deck and other superstructure details see sheet 130-7A.

For details of rocker masonry plates see sheet 173-7A.

For other rocker details and details of bolsters see Ohio Standards, DWG. RB-1-55.

For details of end dams see sheet 173-7A.

For Shop Drawing and Assembly Notes see sheet 128-7A.

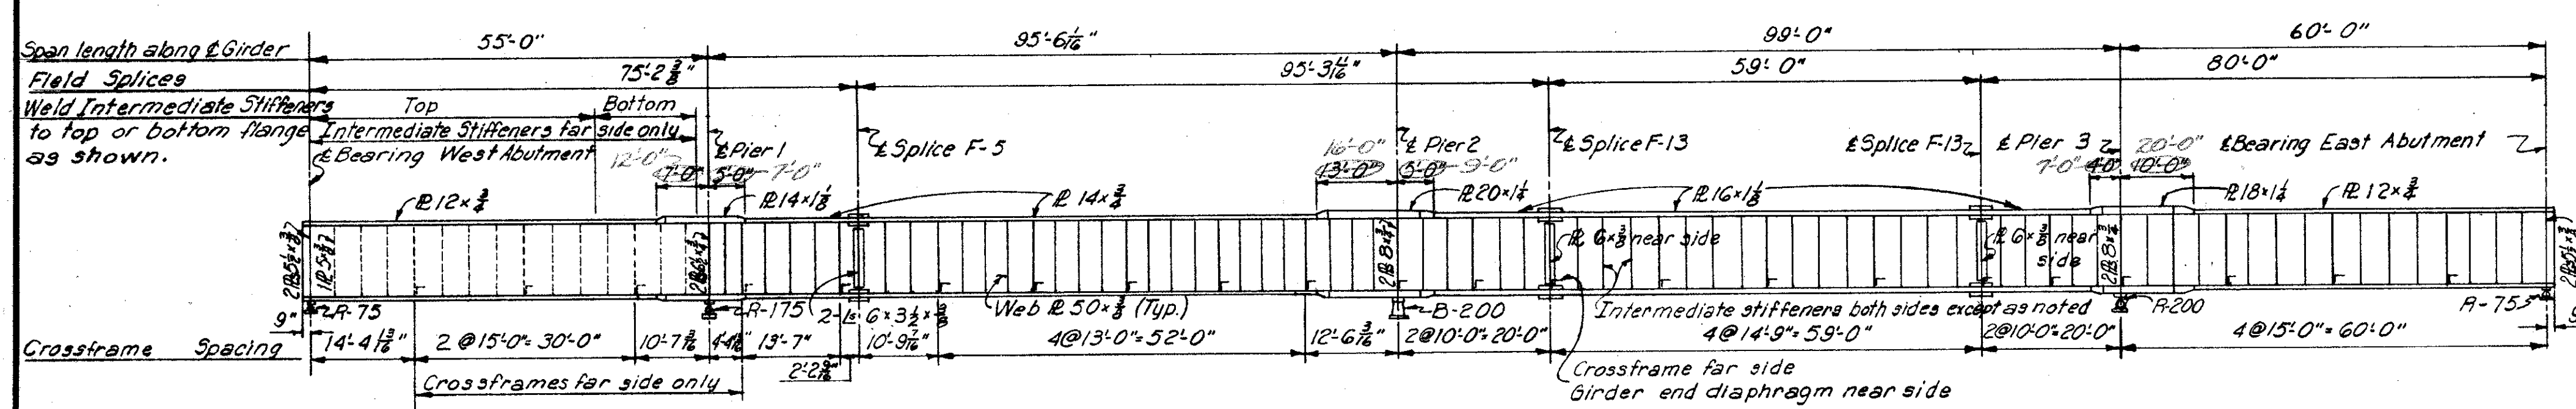

GIRDER FLANGE WIDTH	INTERMEDIATE STIFFENER
12"	R 5 x 3
14" to 16"	R 6 x 3
18" and up	R 8 x 1/2

H.N.T.B. BR. NO. 4 PART 7A

HOWARD, NEEDLES, TAMMEN & BERGENDOFF
CONSULTING ENGINEERS
KANSAS CITY CLEVELAND NEW YORK

GIRDER ELEVATIONS

INNER BELT FREEWAY OVER EAST 14th ST.
BR. NO. CUY-42-1854 STA. 70+89.23
Scale: None STA. 73+96.25

WILLOW-INNER BELT FREEWAY
CLEVELAND CUYAHOGA COUNTY OHIO

DRAWN	TRACED	CHECKED	REVIEWED	REVISED
R. A.		P. H.	J. C.	6-20-60
DATE 1-7-59	DATE	DATE 1-11-59	DATE 11-13-59	SHEET 127

Note: Prefix "SB" shall be assigned to all bar marks.


MICROFILMED
JUL 8 1985

FED. ROADS DIV. NO.	STATE	FED. AID PROJ. NO.
2	OHIO	

130
181


CUYAHOGA COUNTY
CITY OF CLEVELAND
CUY-21-1532
CUY-42-1842

Note:
Details shown in section A-A are typical throughout superstructure except for bar marks, direction of roadway slope, and roadway width.
For location of Section A-A see sh. 132-7A.
For location of 2" Conduit see sh. 134-7A & 135-7A.

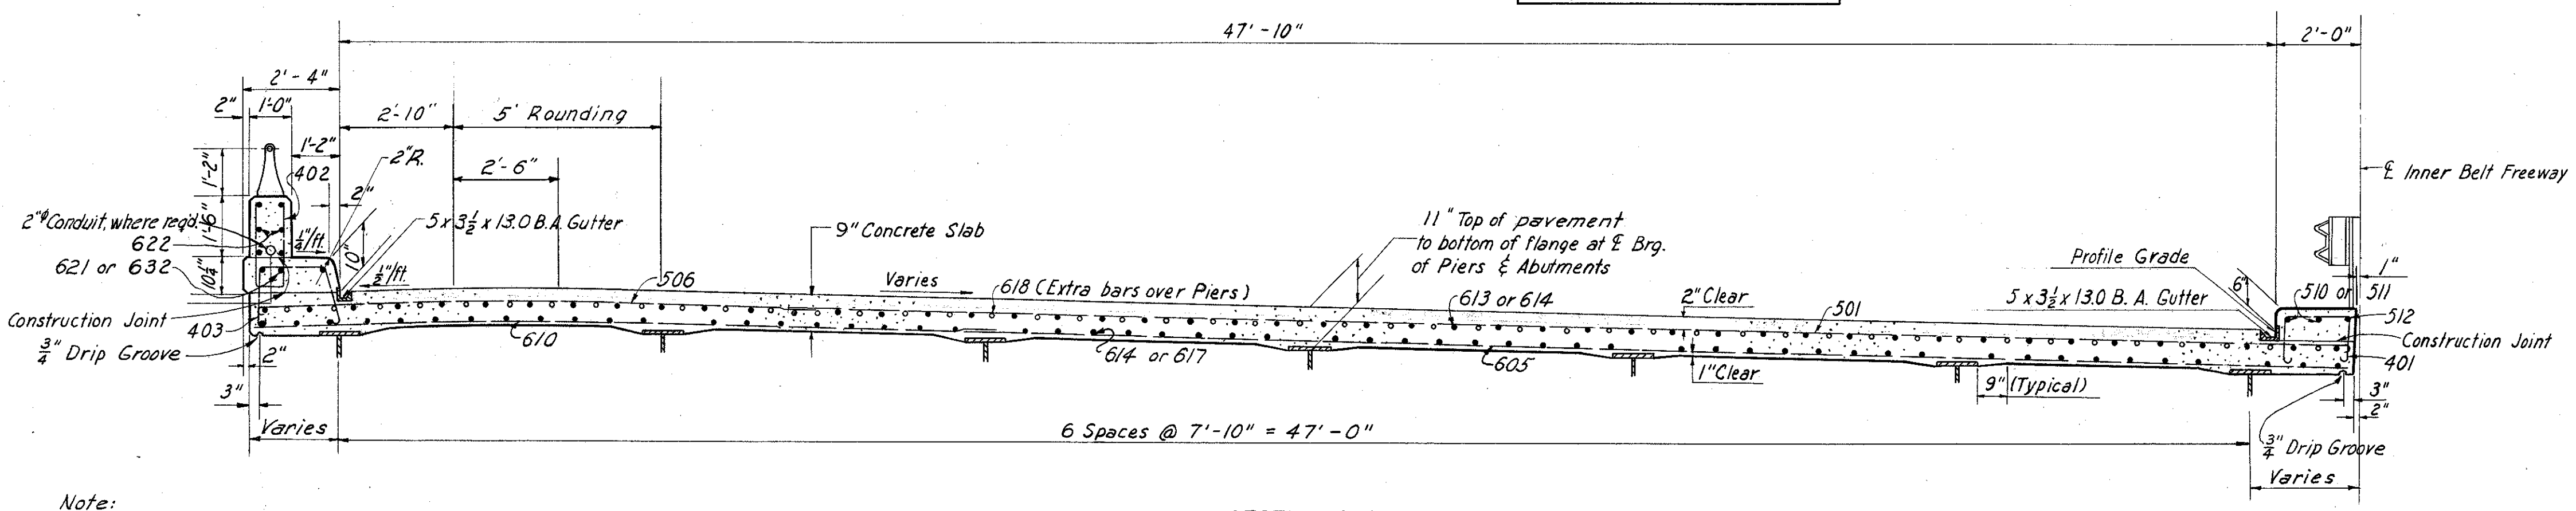


Note:
Slab thickness shown includes 1" for monolithic wearing surface.


SECTION A-A
Scale: 3/8" = 1'-0"

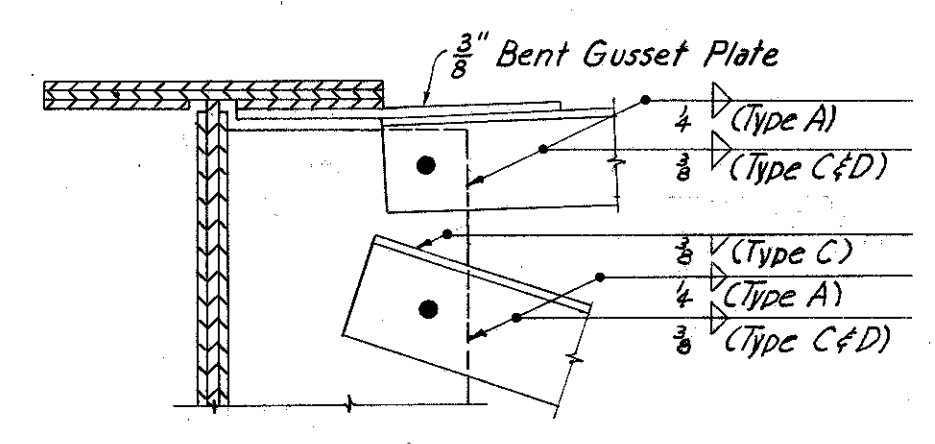


DETAIL "A"
Scale: 1/2" = 1'-0"

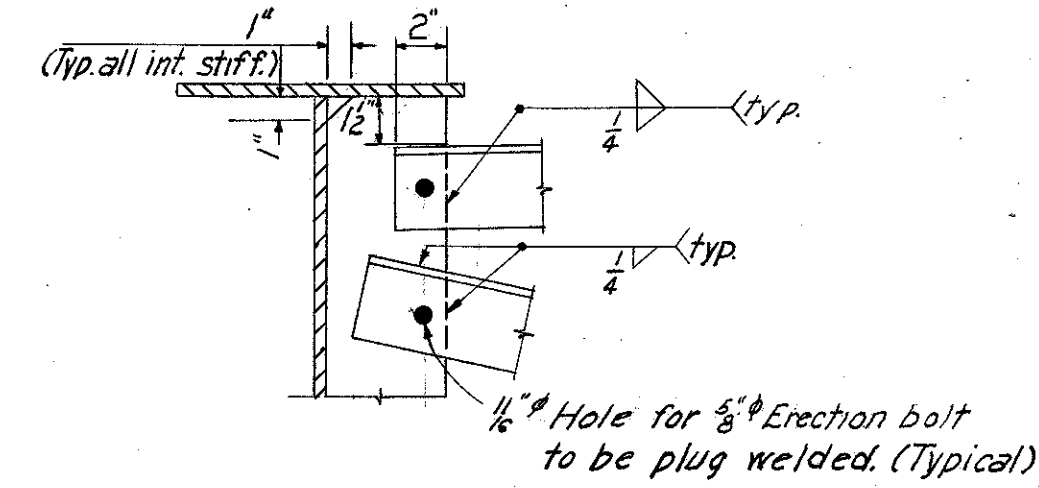


DETAIL "B"
Scale: 1/2" = 1'-0"

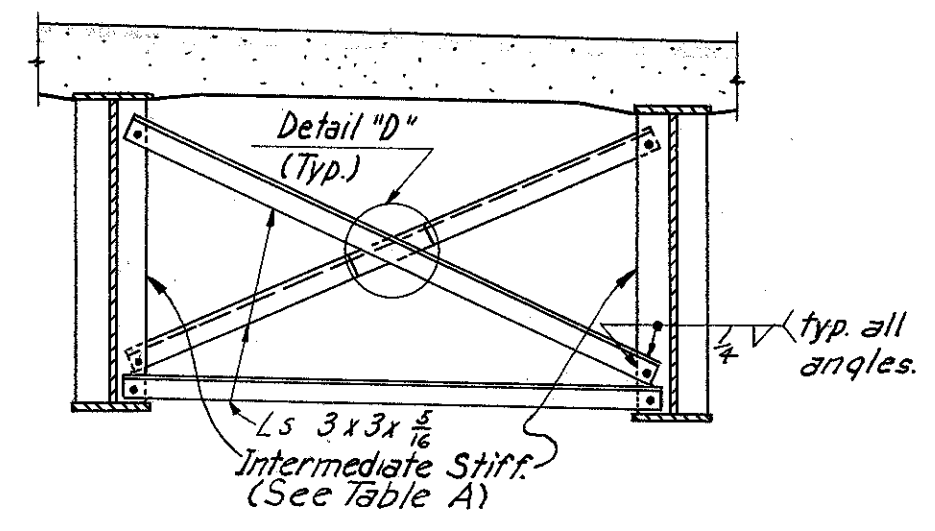


TYPICAL INTERMEDIATE CROSSFRAME

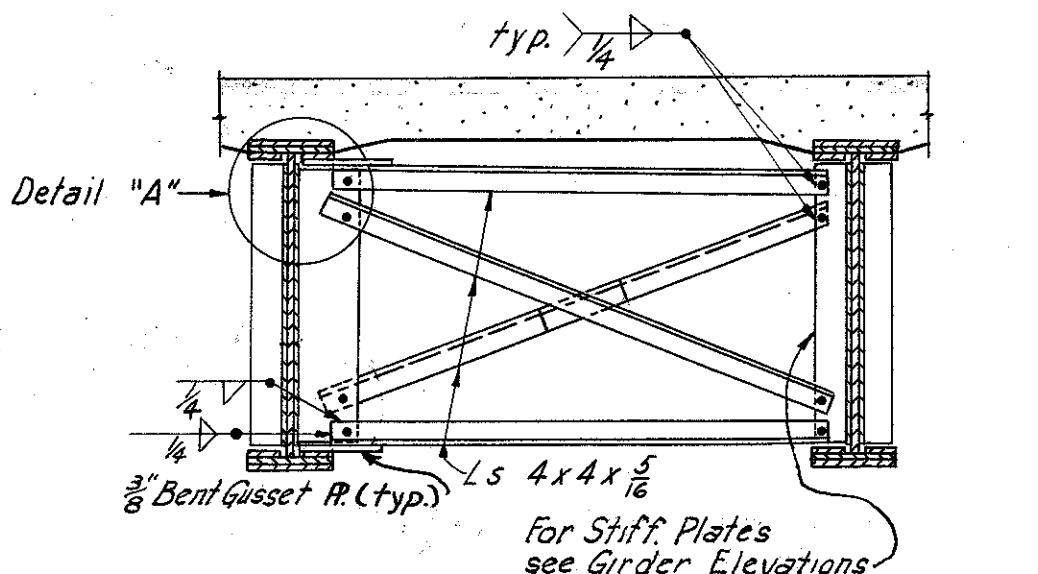


BEND LINE CROSSFRAME AT FIELD SPLICE
TYPE (A)

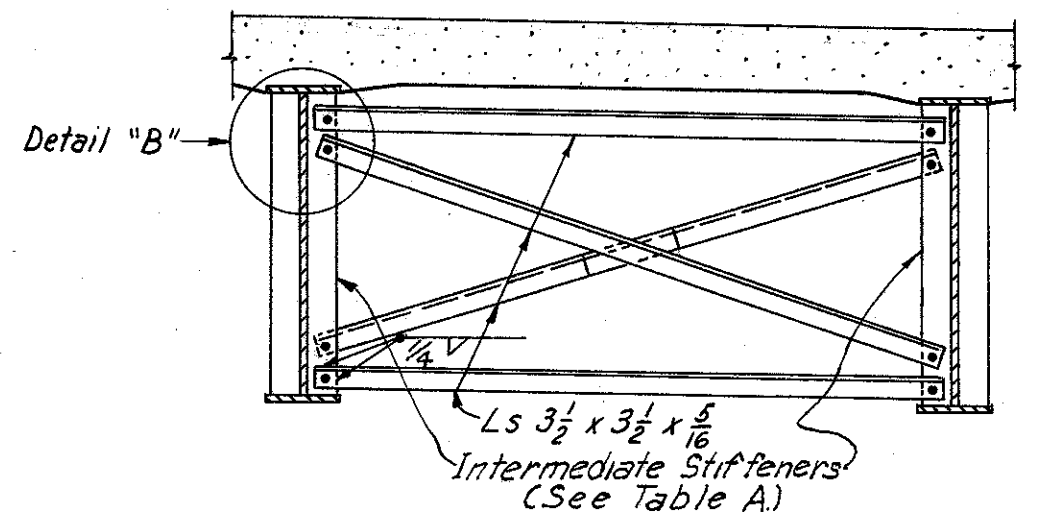


BEND LINE CROSSFRAME
TYPE (B)

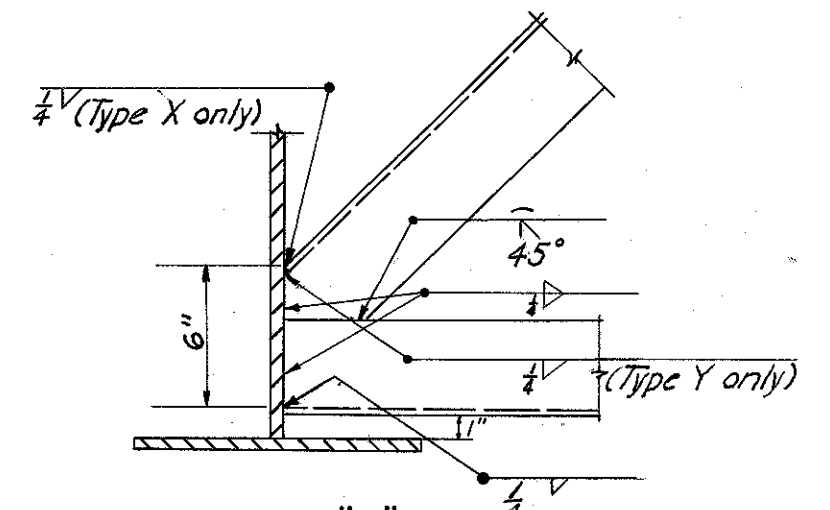


DETAIL "C"
Scale: 1/2" = 1'-0"

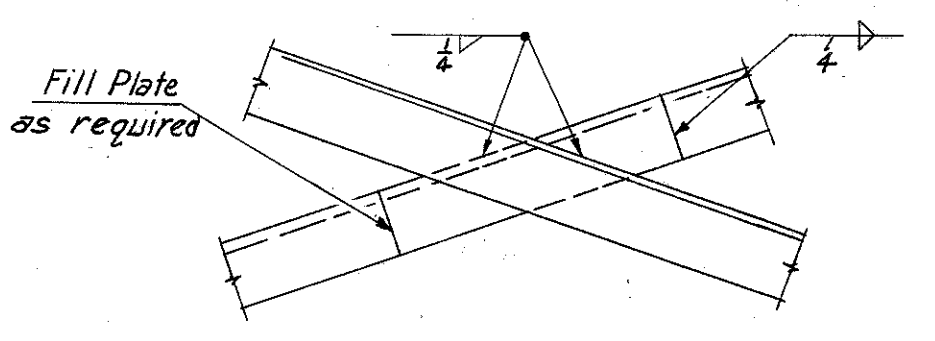


DETAIL "D"
Scale: 1/2" = 1'-0"

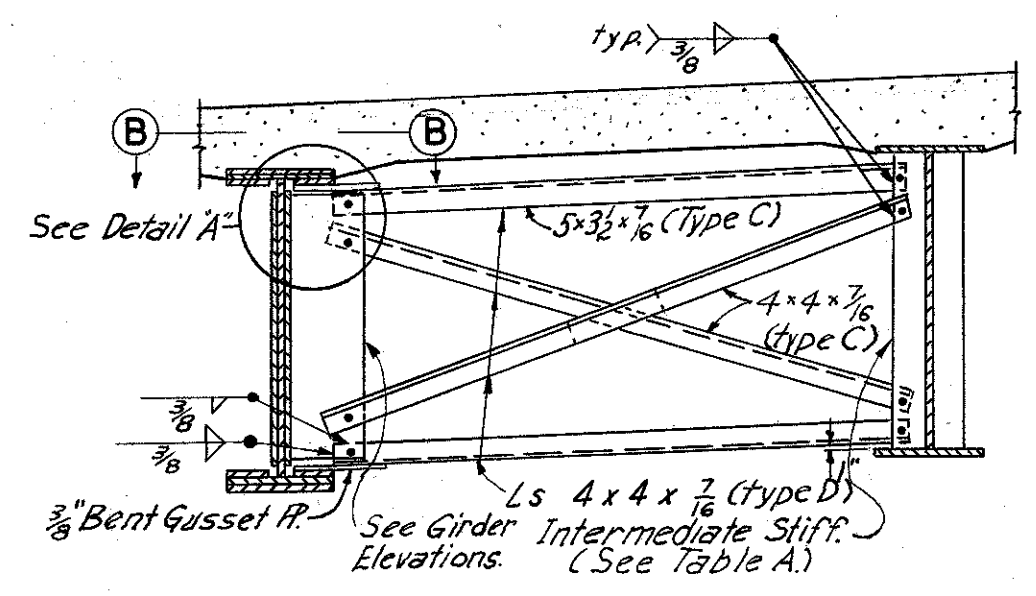


BEND LINE CROSSFRAME AT FIELD SPLICE
TYPE (C&D)

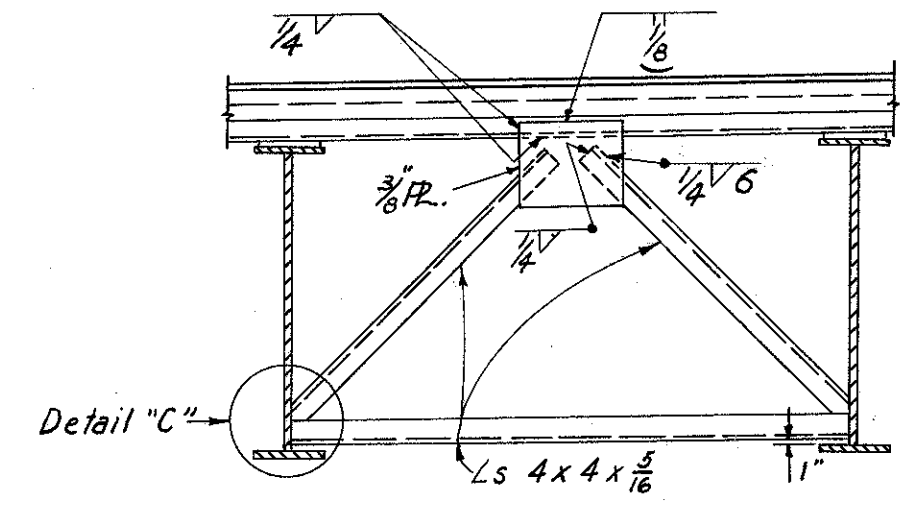

END CROSSFRAME
TYPE (X)

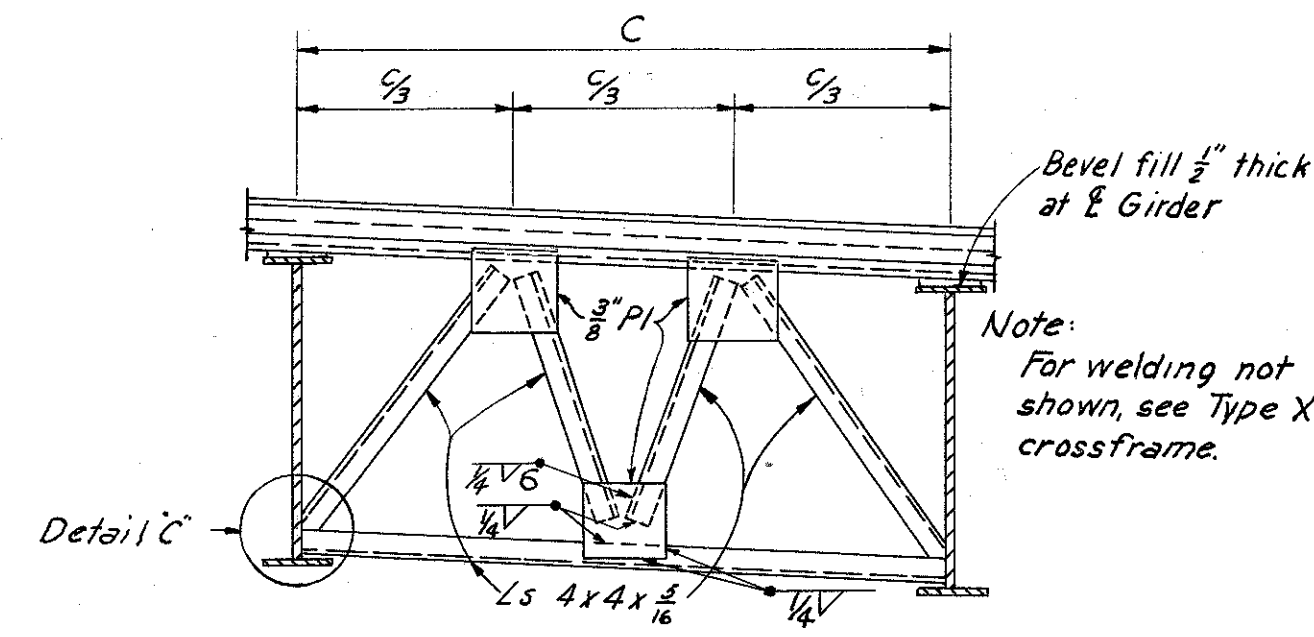

END CROSSFRAME
TYPE (Y)

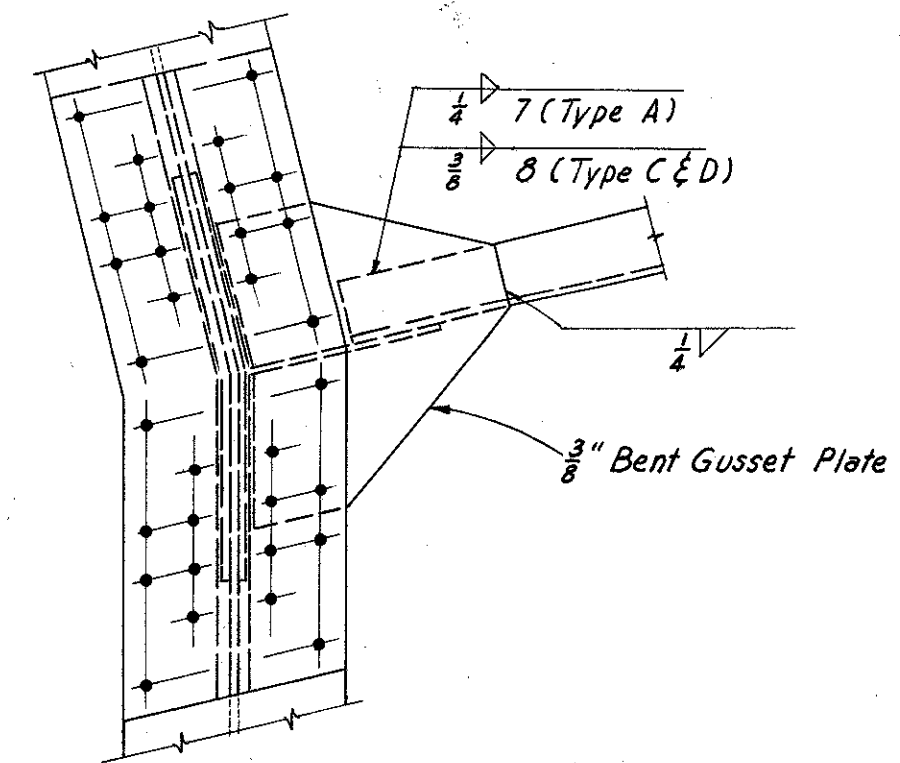

SECTION B-B
Scale: 1" = 1'-0"
(Connection typical for top and bottom flanges, crossframes types A, C & D.)

FLANGE WIDTH	INTERMEDIATE STIFFENER
12"	5" x 3/8"
14"-16"	6" x 3/8"
18"-22"	8" x 1/2"

Note:
For End Dam Details see sh. 173-7A
For Drainage Details see sh. 174-7A


H.N.T.B. BR. NO. 4 PART 7A
HOWARD, NEEDLES, TAMMEN & BERGENDOFF
CONSULTING ENGINEERS
KANSAS CITY CLEVELAND NEW YORK

TYPICAL SECTIONS
INNER BELT FREEWAY OVER EAST 14th ST.
BR. NO. CUY-42-1854 STA. 70+89.23
Scale: 3/8" = 1'-0" Except as noted STA. 73+96.25
WILLOW-INNER BELT FREEWAY
CLEVELAND CUYAHOGA COUNTY OHIO
DRAWN GAT TRACED G.A.T. CHECKED A.F. REVIEWED J.C.T. REVISION
DATE 2-27-59 DATE 2-27-59 DATE 11-4-59 DATE 11-13-59 SHEET 130

CUYAHOGA COUNTY
CITY OF CLEVELAND
CUY-21-1532
CUY-42-1842

Note: Prefix "SB" shall be assigned to all bar marks.

MICROFILMED
NOV 8 1985

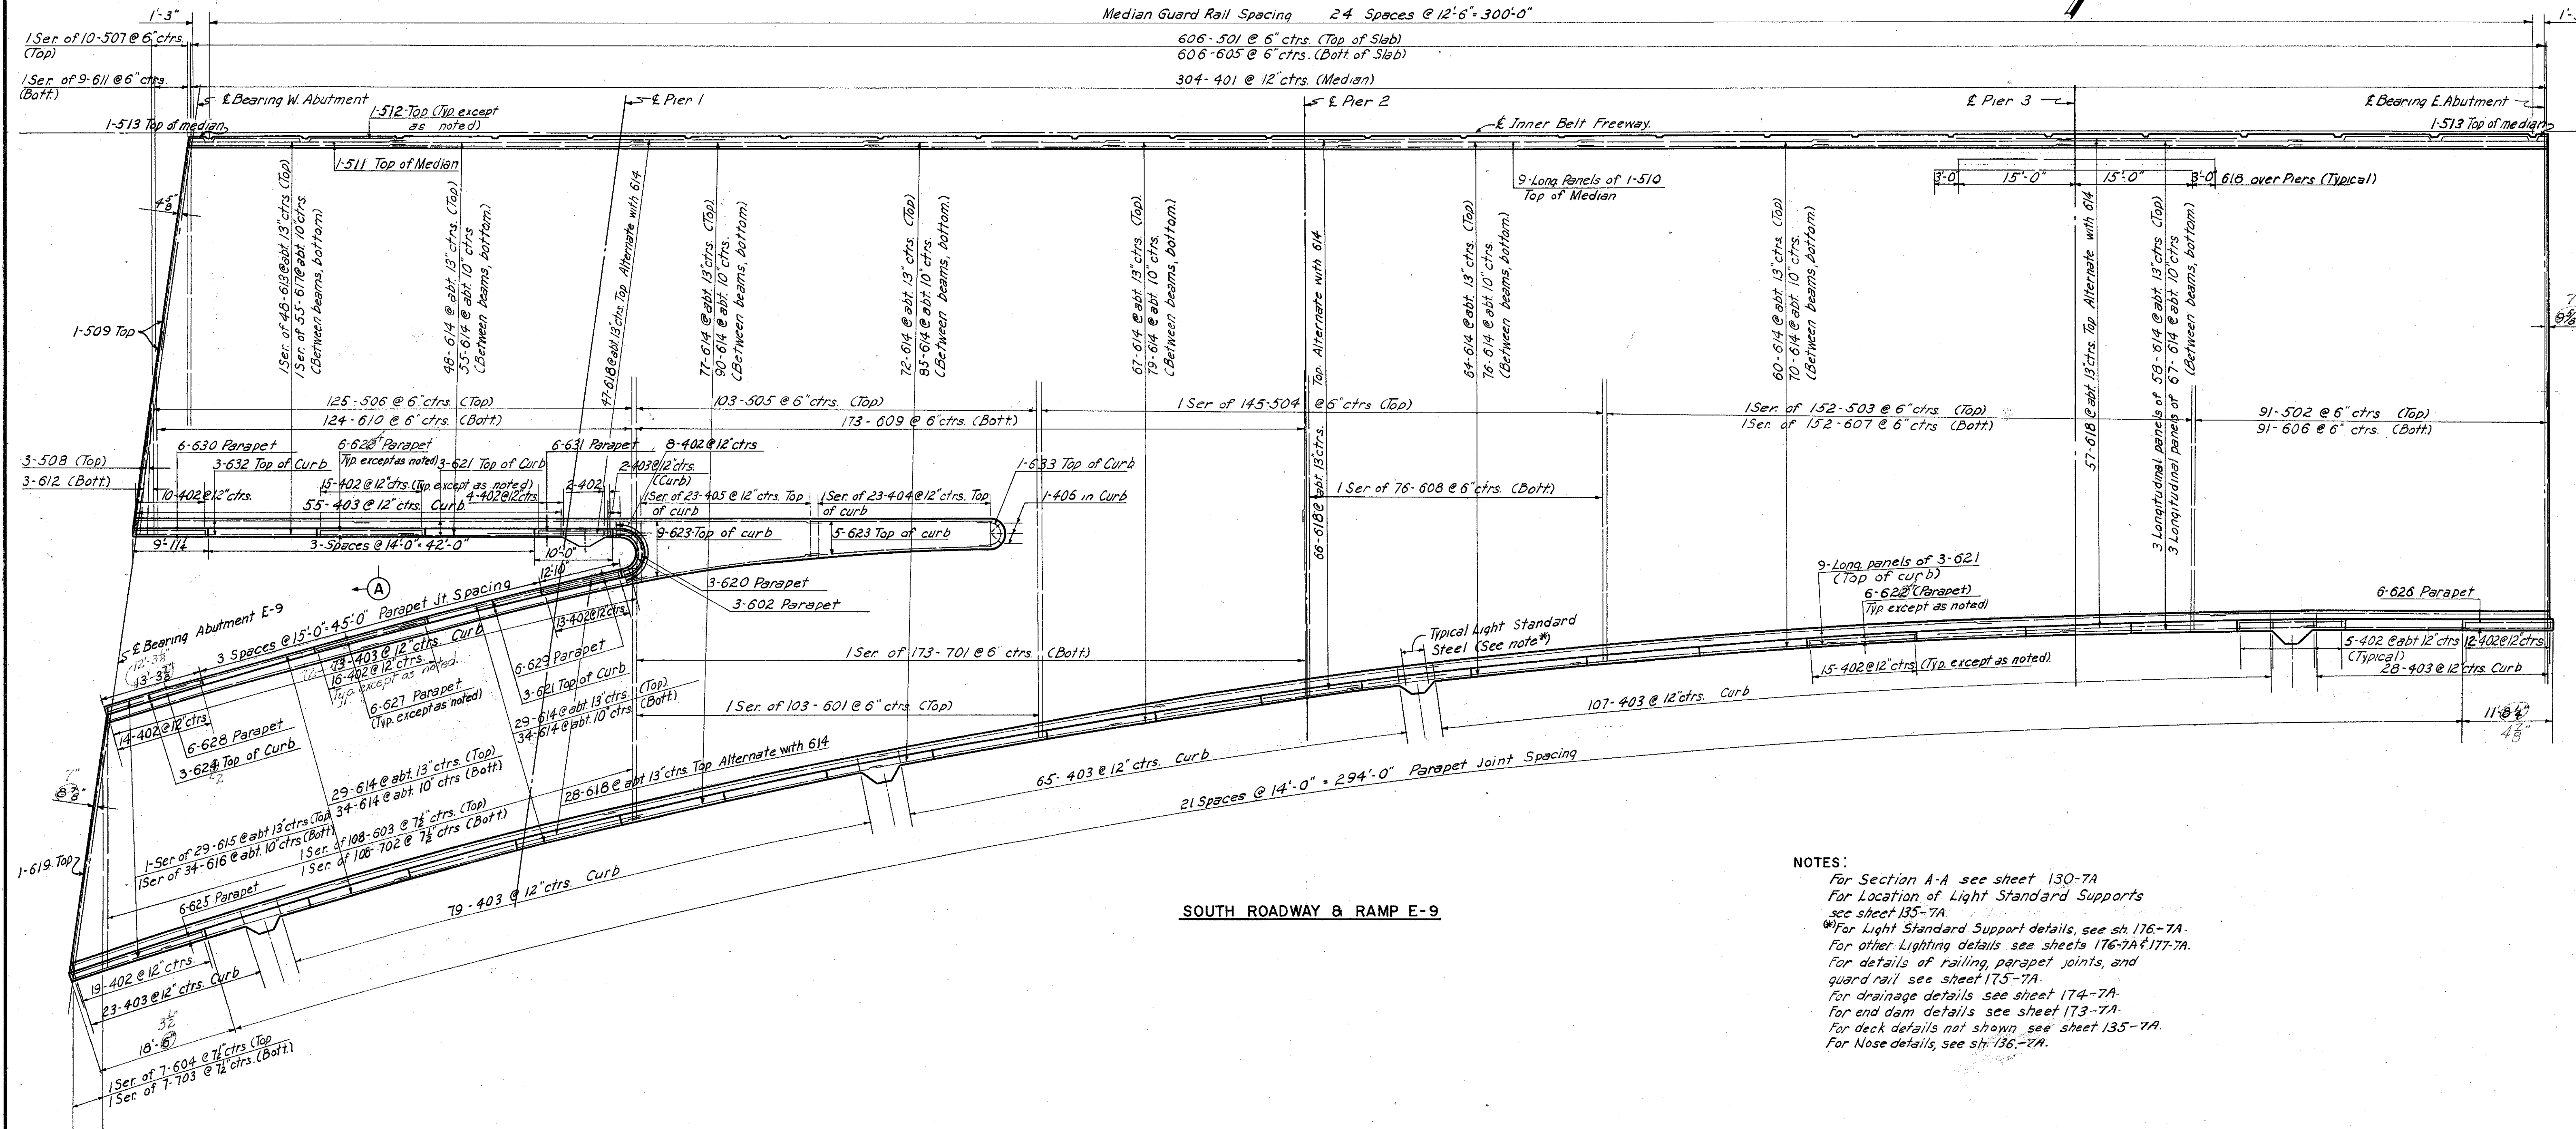


SOUTH ROADWAY & RAMP E-9


- NOTES:**
- For Section A-A see sheet 130-7A
 - For Location of Light Standard Supports see sheet 135-7A
 - For Light Standard Support details, see sh. 176-7A
 - For other Lighting details see sheets 176-7A & 177-7A
 - For details of railing, parapet joints, and guard rail see sheet 175-7A
 - For drainage details see sheet 174-7A
 - For end dam details see sheet 173-7A
 - For deck details not shown see sheet 135-7A
 - For Nose details, see sh. 136-7A

H.N.T.B. BR. NO. 4 PART 7A


HOWARD, NEEDLES, TAMMEN & BERGENDOFF CONSULTING ENGINEERS KANSAS CITY CLEVELAND NEW YORK			
DECK PLAN- SOUTH HALF			
INNER BELT FREEWAY OVER EAST 14th ST.			
BR. NO. CUY- 42-1854		STA. 70+8923	
Scale: 1" = 10'-0"		STA. 73+96.25	
WILLOW-INNER BELT FREEWAY			
CLEVELAND	CUYAHOGA COUNTY	OHIO	
DRAWN <i>AM</i>	TRACED <i>AM</i>	CHECKED <i>AL</i>	REVIEWED <i>AM</i>
DATE 2-12-59	DATE 2-13-59	DATE 2-24-59	DATE 11-13-59
			SHEET 132

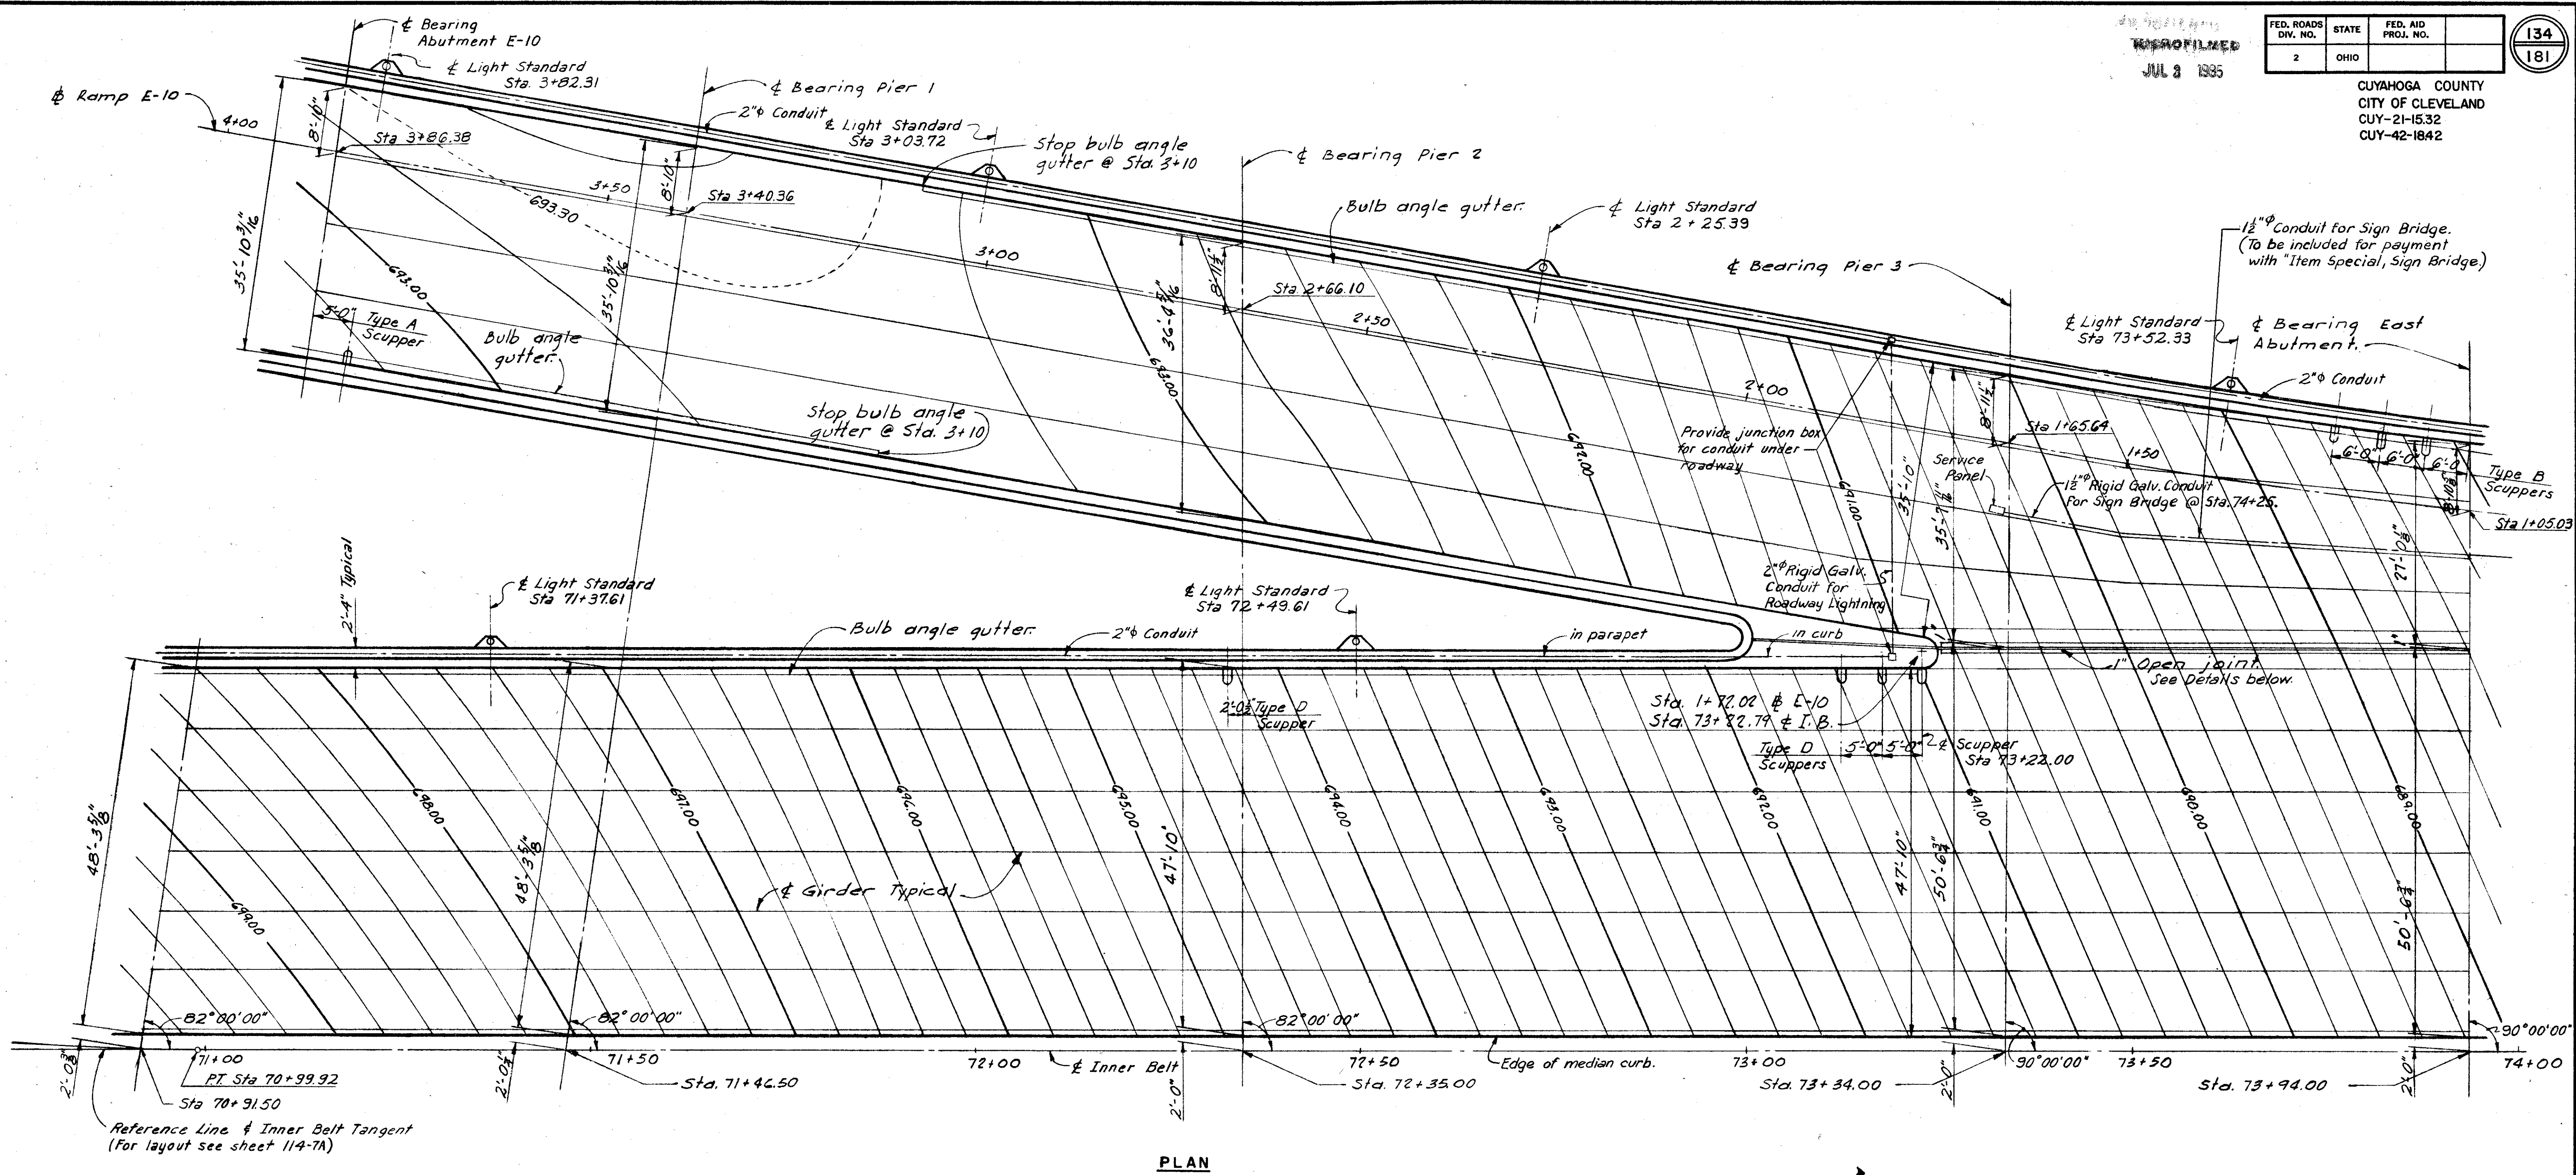


PLAN

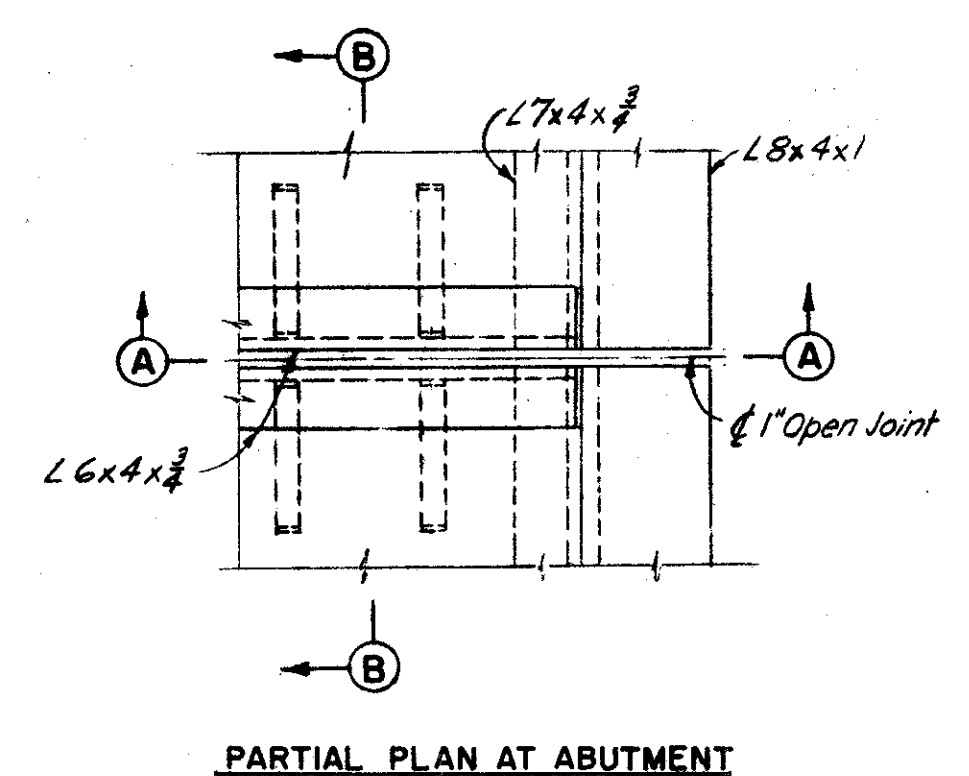

PARTIAL PLAN AT ABUTMENT

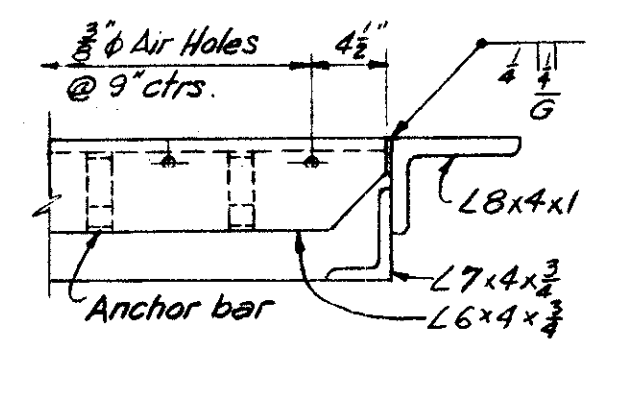


SECTION A-A

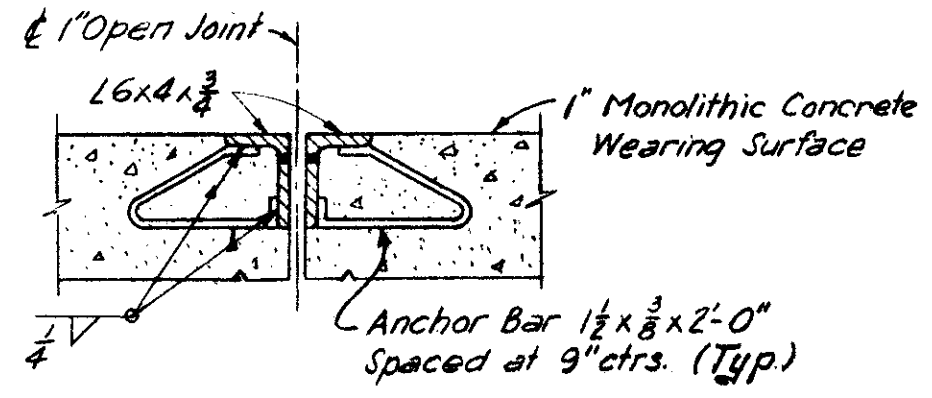

SECTION B-B

**DETAILS OF 1\"/>
 Scale 1"=1'-0"**

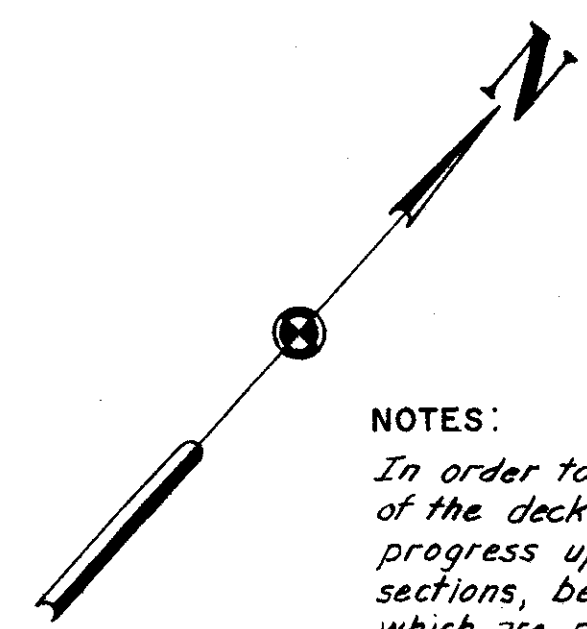

NOTES:
 In order to facilitate water curing of the concrete of the deck slab, the placing of concrete shall progress upgrade. The slab may be placed in sections, between transverse construction joints which are parallel to transverse reinforcing steel and are located near the center of any span. For Light Standard support and other lighting details see sheets 176-7A & 177-7A. For Railing details see sheet 175-7A. For Guard Rail details see sheet 175-7A. For Drainage details see sheet 135-7A & 174-7A. Conduit shown crossing ramps shall be placed below girders. For details see sheets 176-7A & 177-7A. For Nosa details see sheet 136-7A.

H.N.T.B. BR. NO. 4 PART 7A

HOWARD, NEEDLES, TAMMEN & BERGENDOFF
 CONSULTING ENGINEERS
 KANSAS CITY CLEVELAND NEW YORK


DECK DETAILS-NORTH HALF

INNER BELT FREEWAY OVER EAST 14th ST
 BR. NO. CUY-42-1854 STA. 70+89.23
 Scale: 1"=10'-0" Except STA. 73+96.25
 as noted
WILLOW-INNER BELT FREEWAY
 CLEVELAND CUYAHOGA COUNTY OHIO

DRAWN L.D.F.	TRACED	CHECKED T.M.	REVIEWED J.C.T.	REVISED
DATE 5-13-56	DATE 6-6-58	DATE 11-13-57	DATE	DATE
				SHEET 134


JUL 8 1965

CUYAHOGA COUNTY
CITY OF CLEVELAND
CUY-21-15.32
CUY-42-18.42

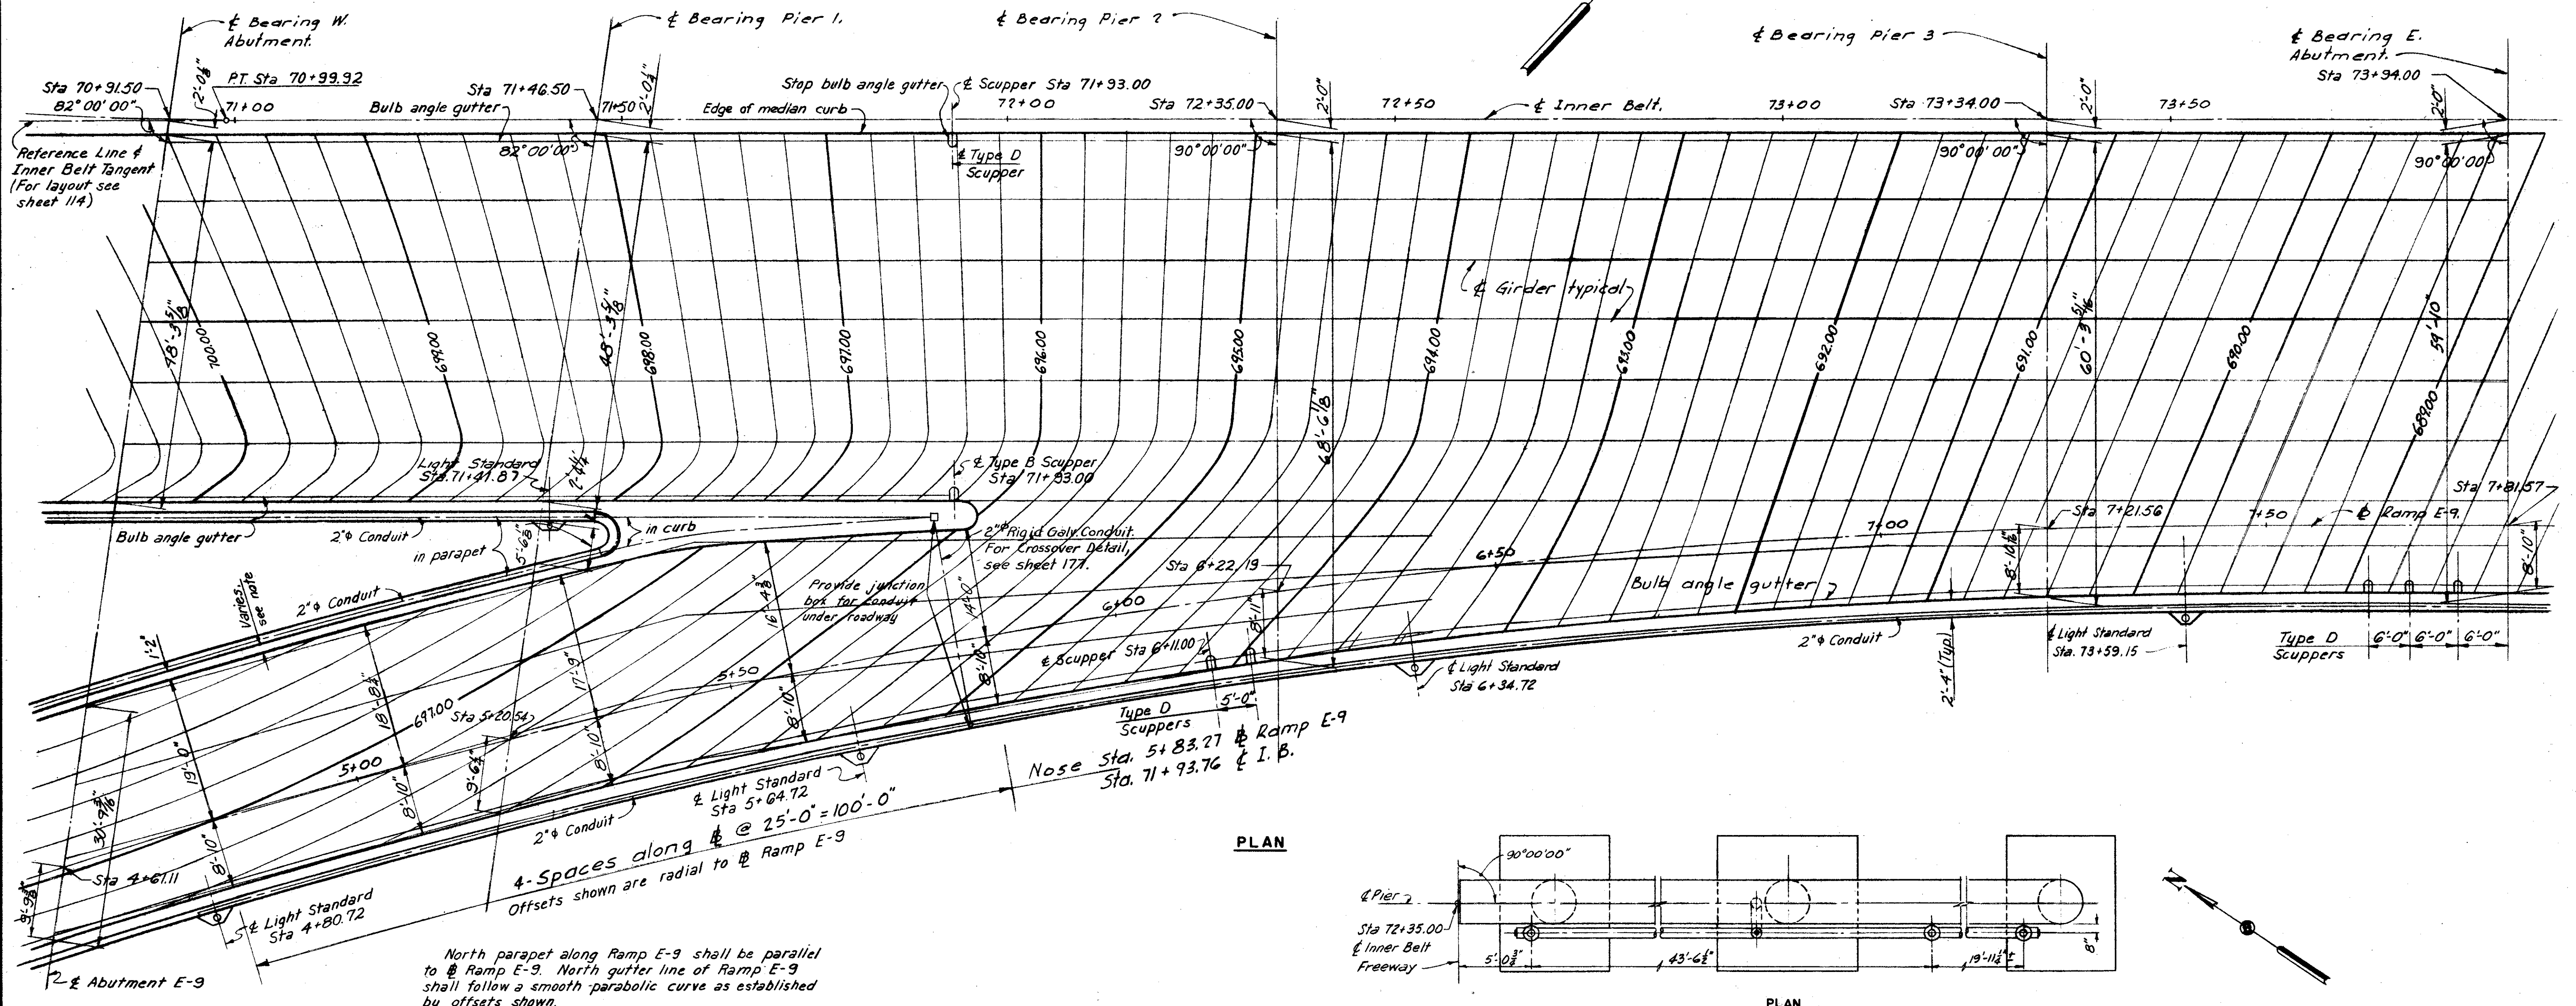


For notes see sheet 134-7A

PLAN

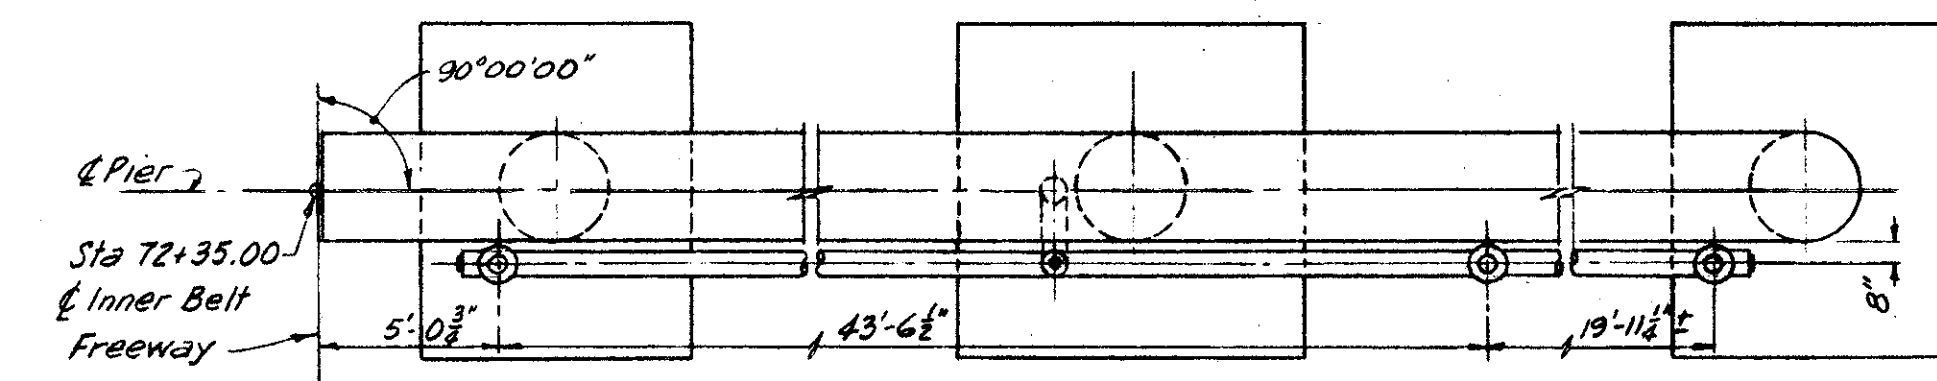

PLAN

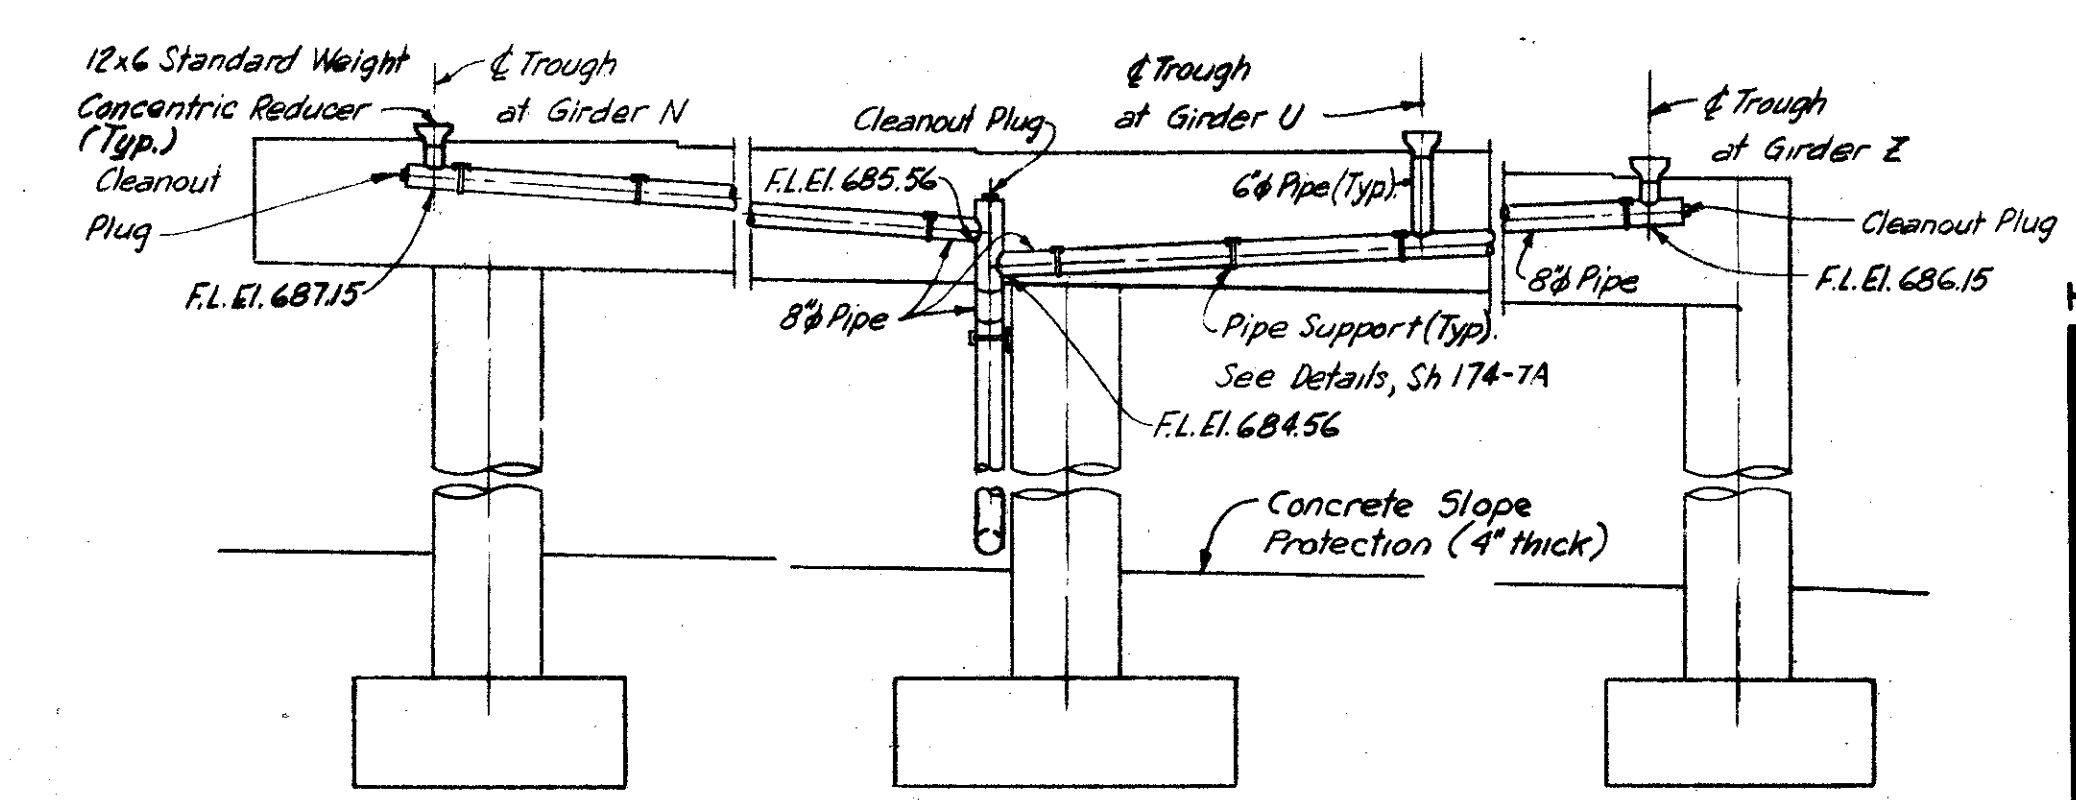

DRAINAGE PROVISION AT PIER 2-S
Scale 1/2" = 1'-0"

H.N.T.B. BR. NO. 4 PART 7A

HOWARD, NEEDLES, TAMMEN & BERGENDOFF
CONSULTING ENGINEERS
KANSAS CITY CLEVELAND NEW YORK

DECK DETAILS - SOUTH HALF
INNER BELT FREEWAY OVER EAST 14th ST.
BR. NO. CUY-42-1854 STA. 70+89.23
Scale: 1" = 10'-0" Except STA. 73+96.25
as noted
WILLOW-INNER BELT FREEWAY
CLEVELAND CUYAHOGA COUNTY OHIO

DRAWN	TRACED	CHECKED	REVIEWED
DATE 5-20-58	DATE	DATE 6-5-58	DATE 11-13-57


SHEET 135

MICROFILMED
JUL 3 1985


FED. ROADS DIV. NO.	STATE	FED. AID PROJ. NO.
2	OHIO	

136
181

CUYAHOGA COUNTY
CITY OF CLEVELAND
CUY-21-15.32
CUY-42-18.42

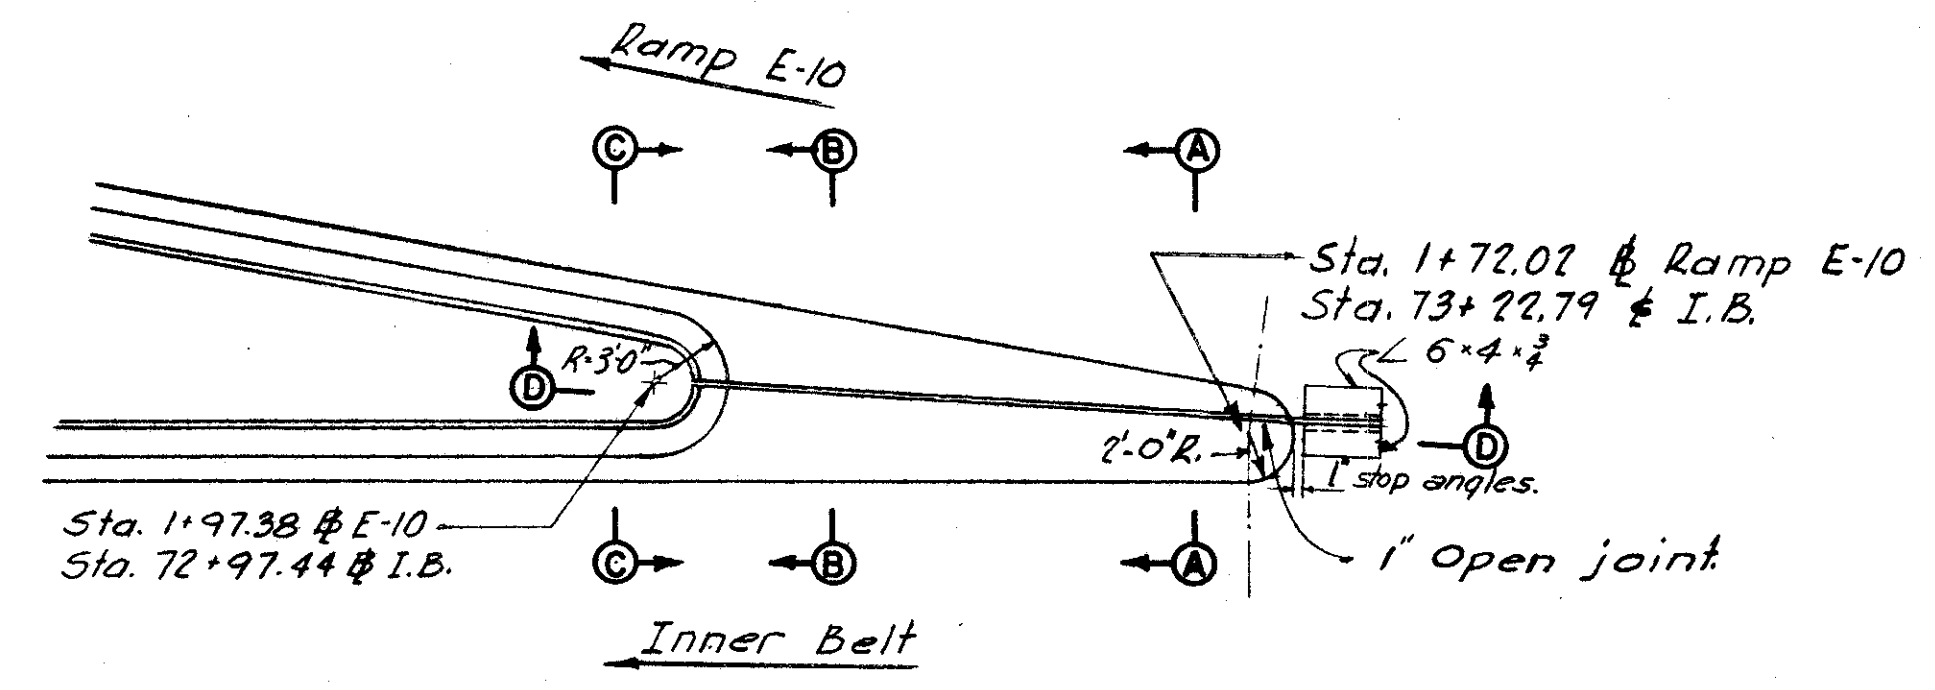


NOSE PLAN - WEST BOUND

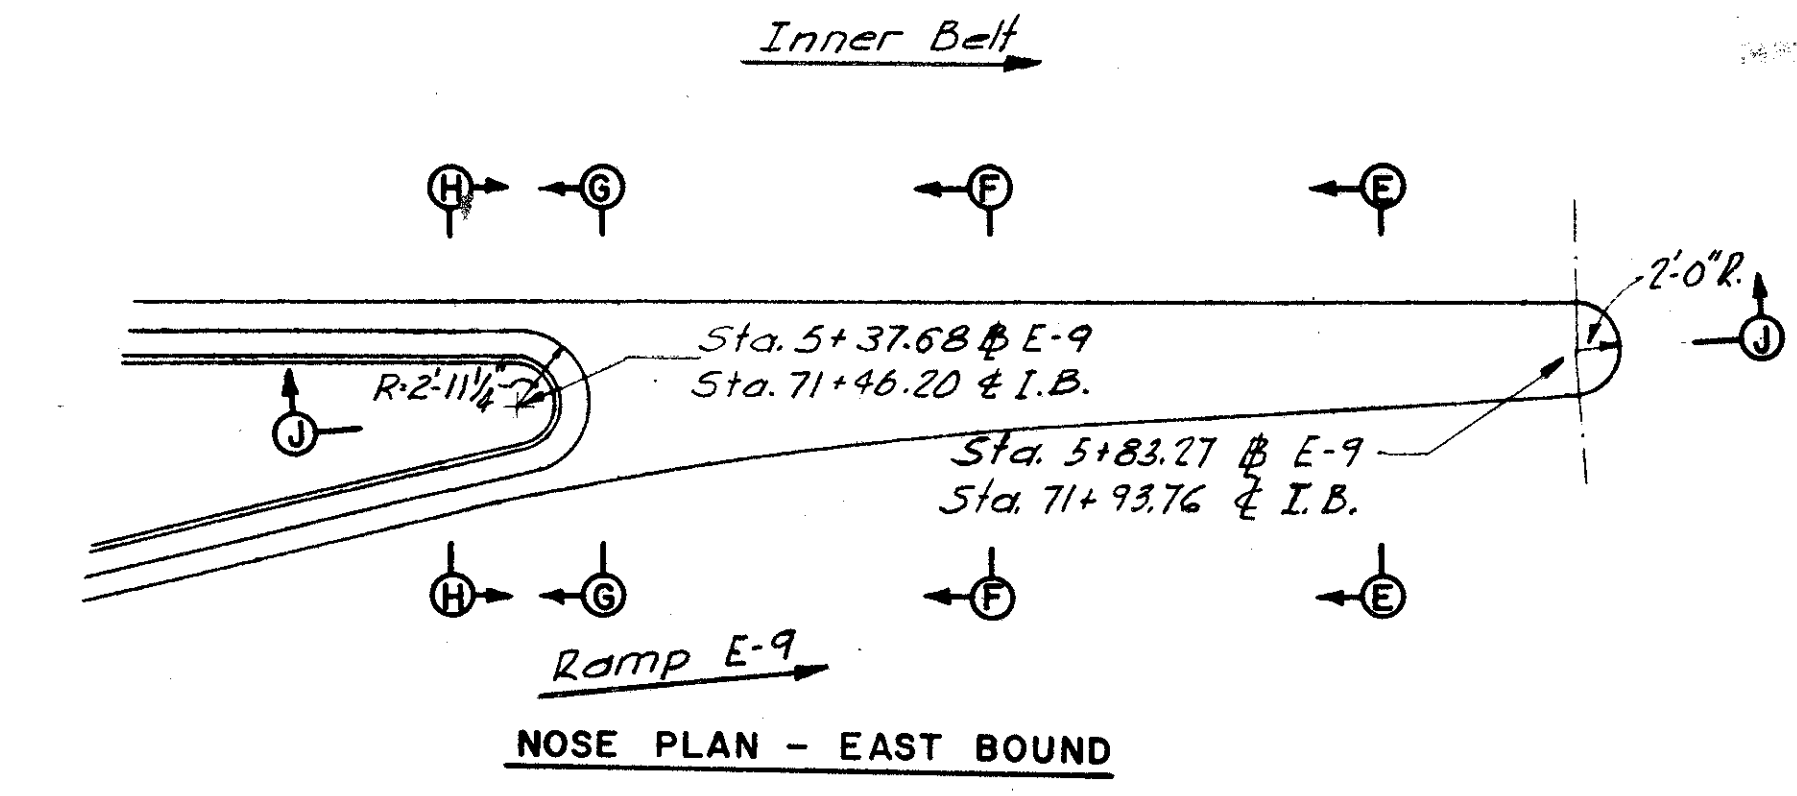


NOSE PLAN - EAST BOUND


Note: Prefix "SA" shall be assigned to all bar marks.

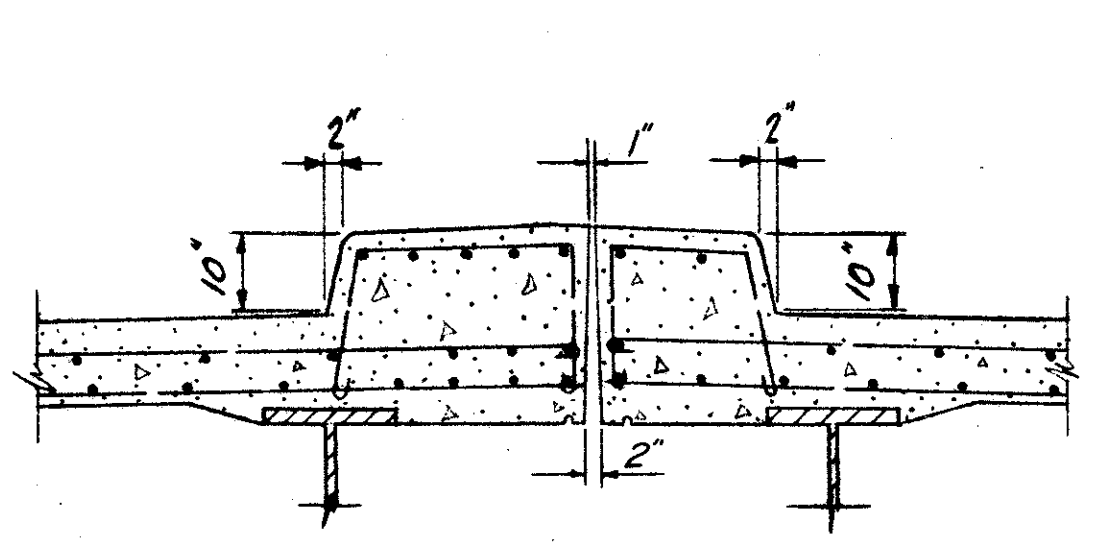


SECTION A-A

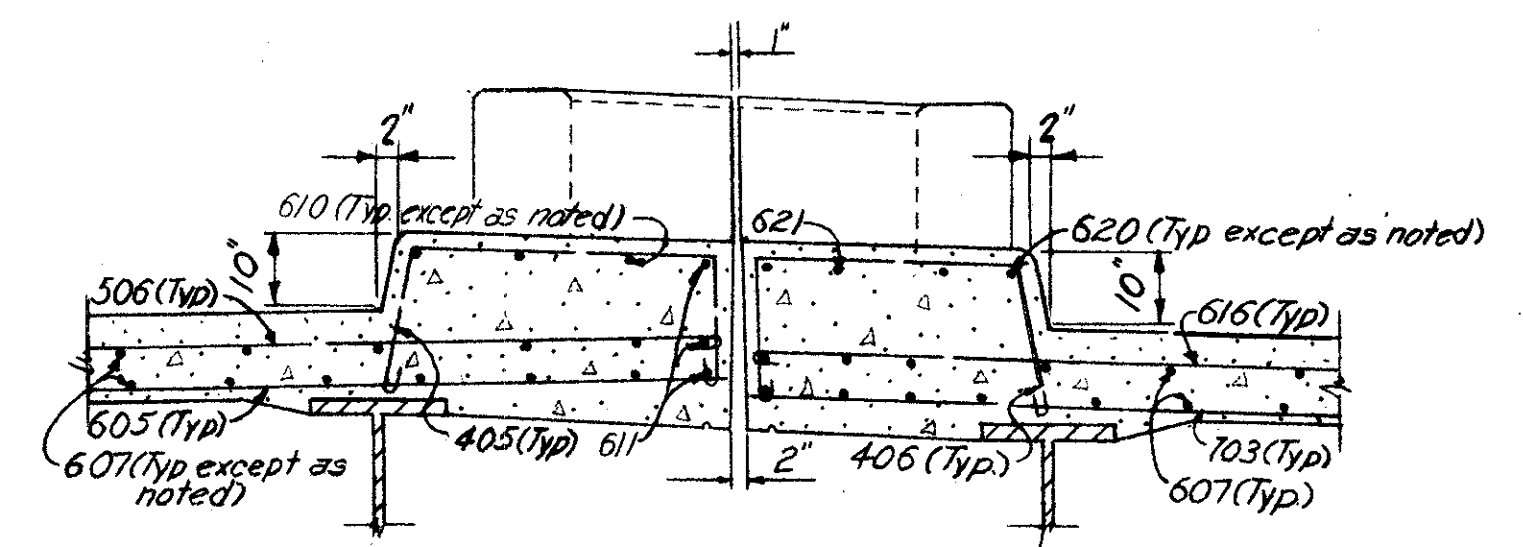

SECTION B-B

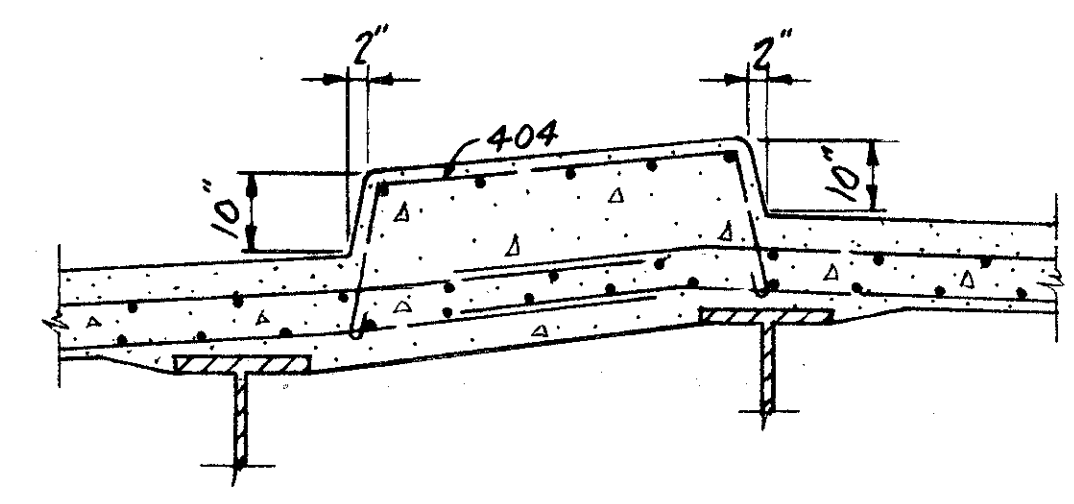


SECTION E-E

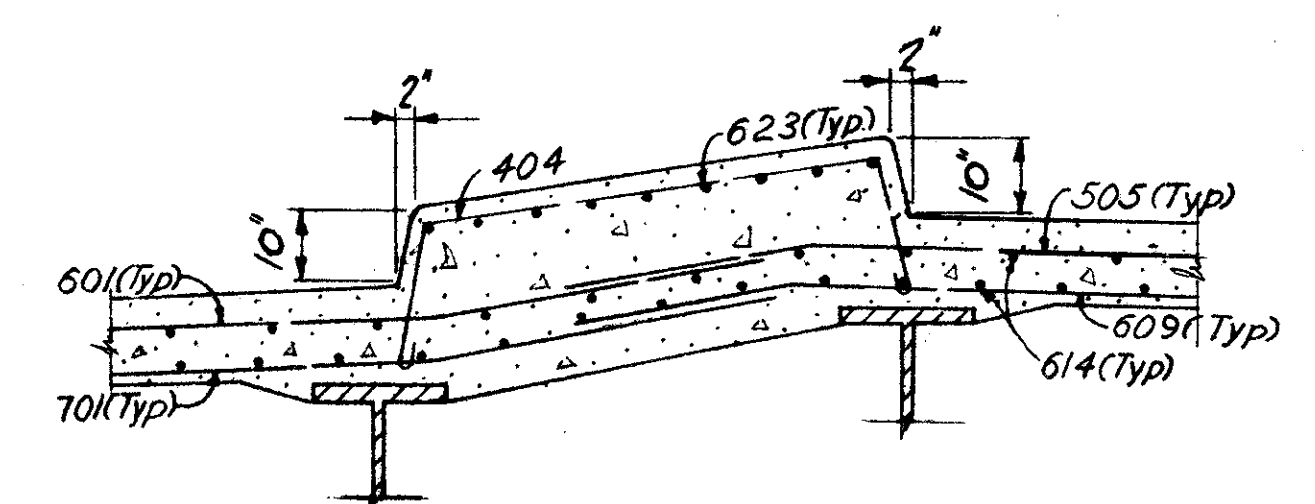


SECTION F-F


Note: Prefix "SB" shall be assigned to all bar marks.

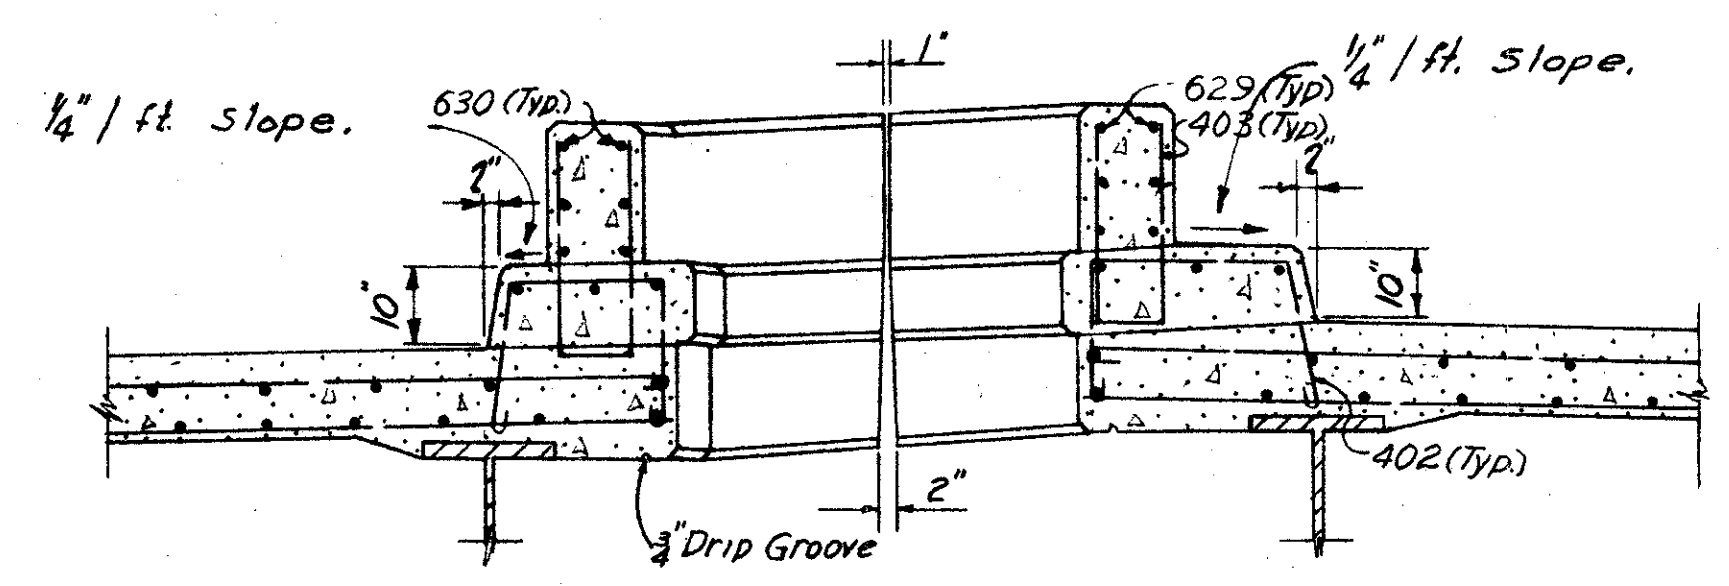


SECTION C-C

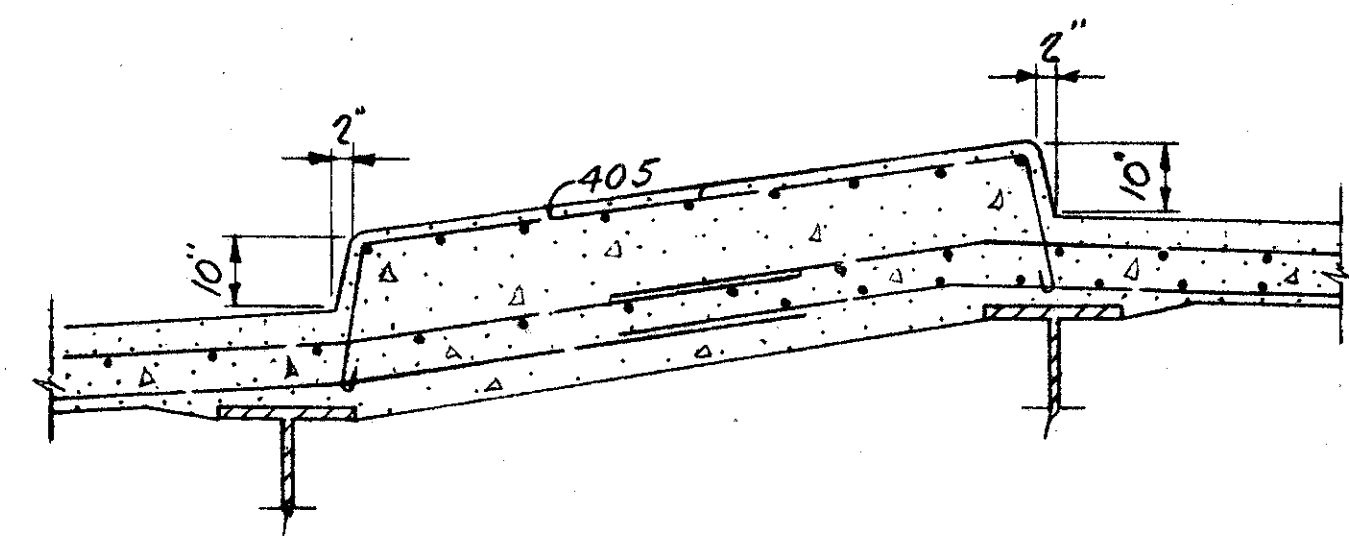


SECTION G-G

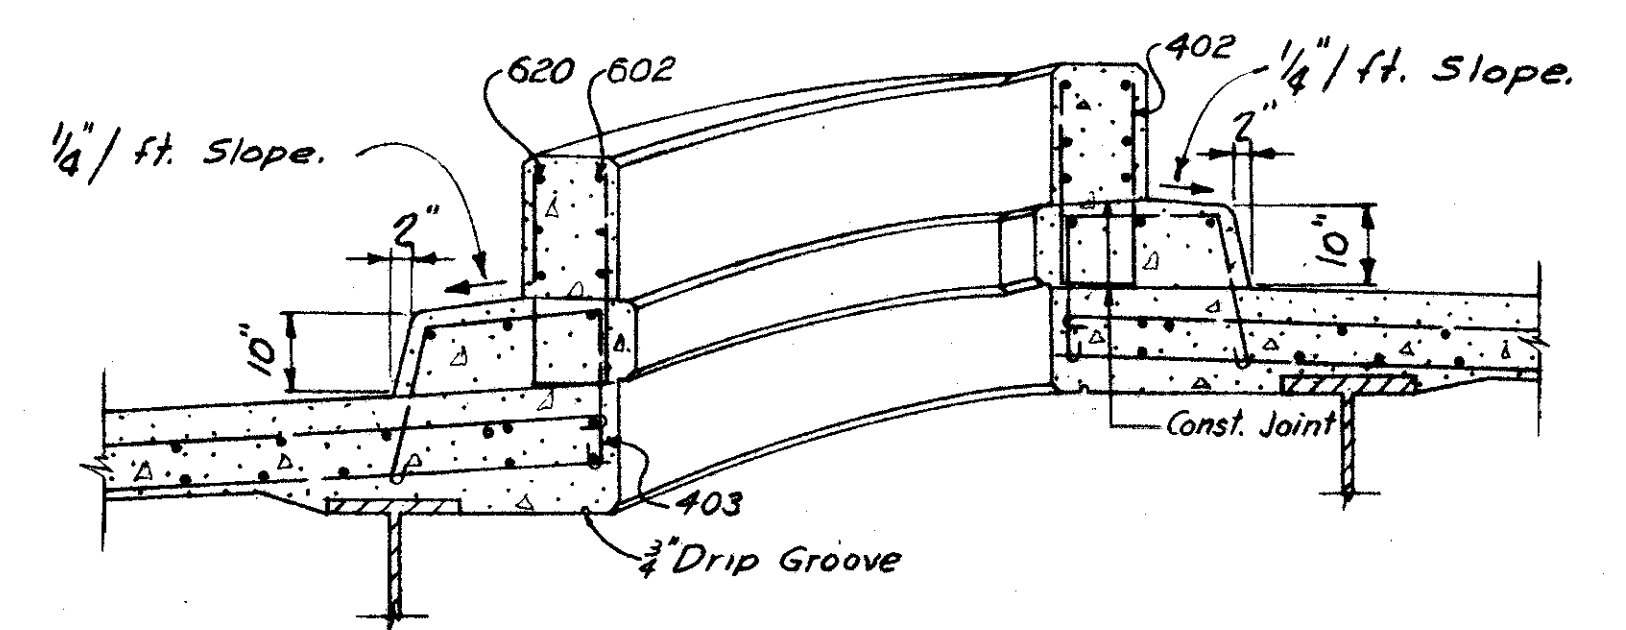

SECTION H-H

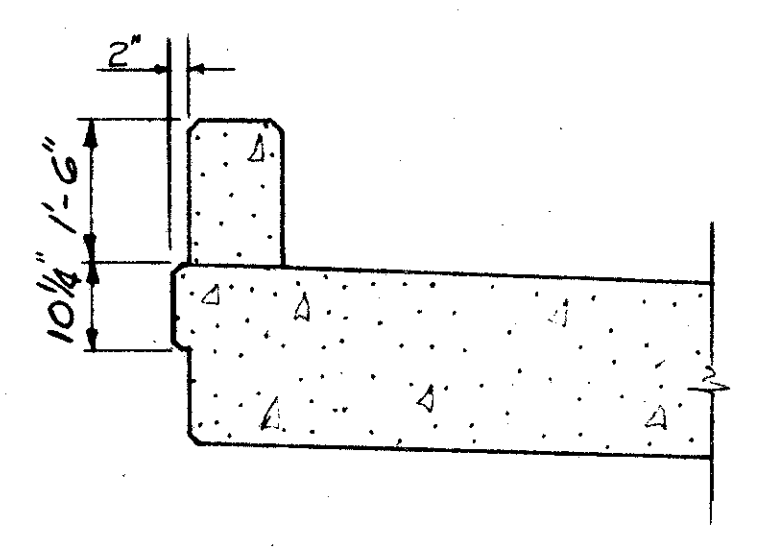

SECTION D-D

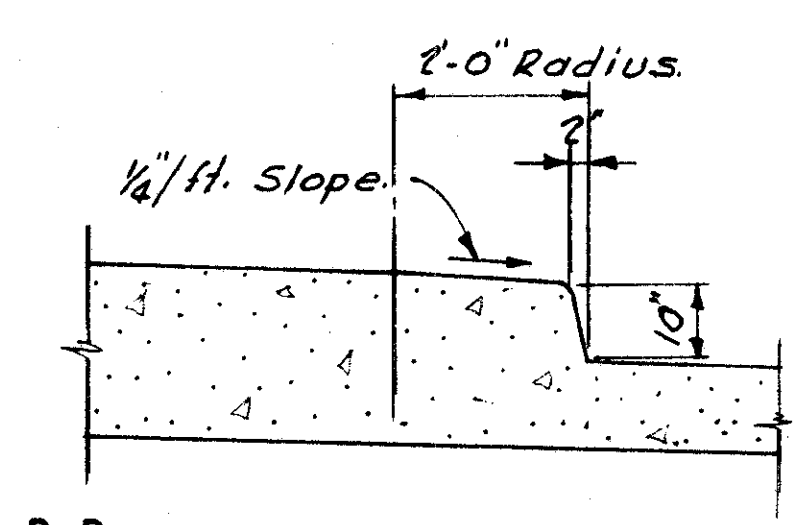

SECTION J-J

H.N.T.B. BR. NO. 4 PART 7A

HOWARD, NEEDLES, TAMMEN & BERGENDOFF
CONSULTING ENGINEERS
KANSAS CITY CLEVELAND NEW YORK

NOSE DETAILS

INNER BELT FREEWAY OVER EAST 14th ST.
BR. NO. CUY-42-1854 STA. 70+89.23
Scale: 1/2" = 1'-0" STA. 73+96.25


WILLOW-INNER BELT FREEWAY
CLEVELAND CUYAHOGA COUNTY OHIO

DRAWN L.D.F.	TRACED	CHECKED T.C.H.	REVIEWED J.C.T.	REVISED
DATE 6-3-80	DATE	DATE 7-5-80	DATE 11-13-81	SHEET 136


MICROFILMED
JUL 3 1985

FED. ROADS DIV. NO.	STATE	FED. AID PROJ. NO.	137 181
2	OHIO		

CUYAHOGA COUNTY
CITY OF CLEVELAND
CUY-21-15.32
CUY-42-18.42

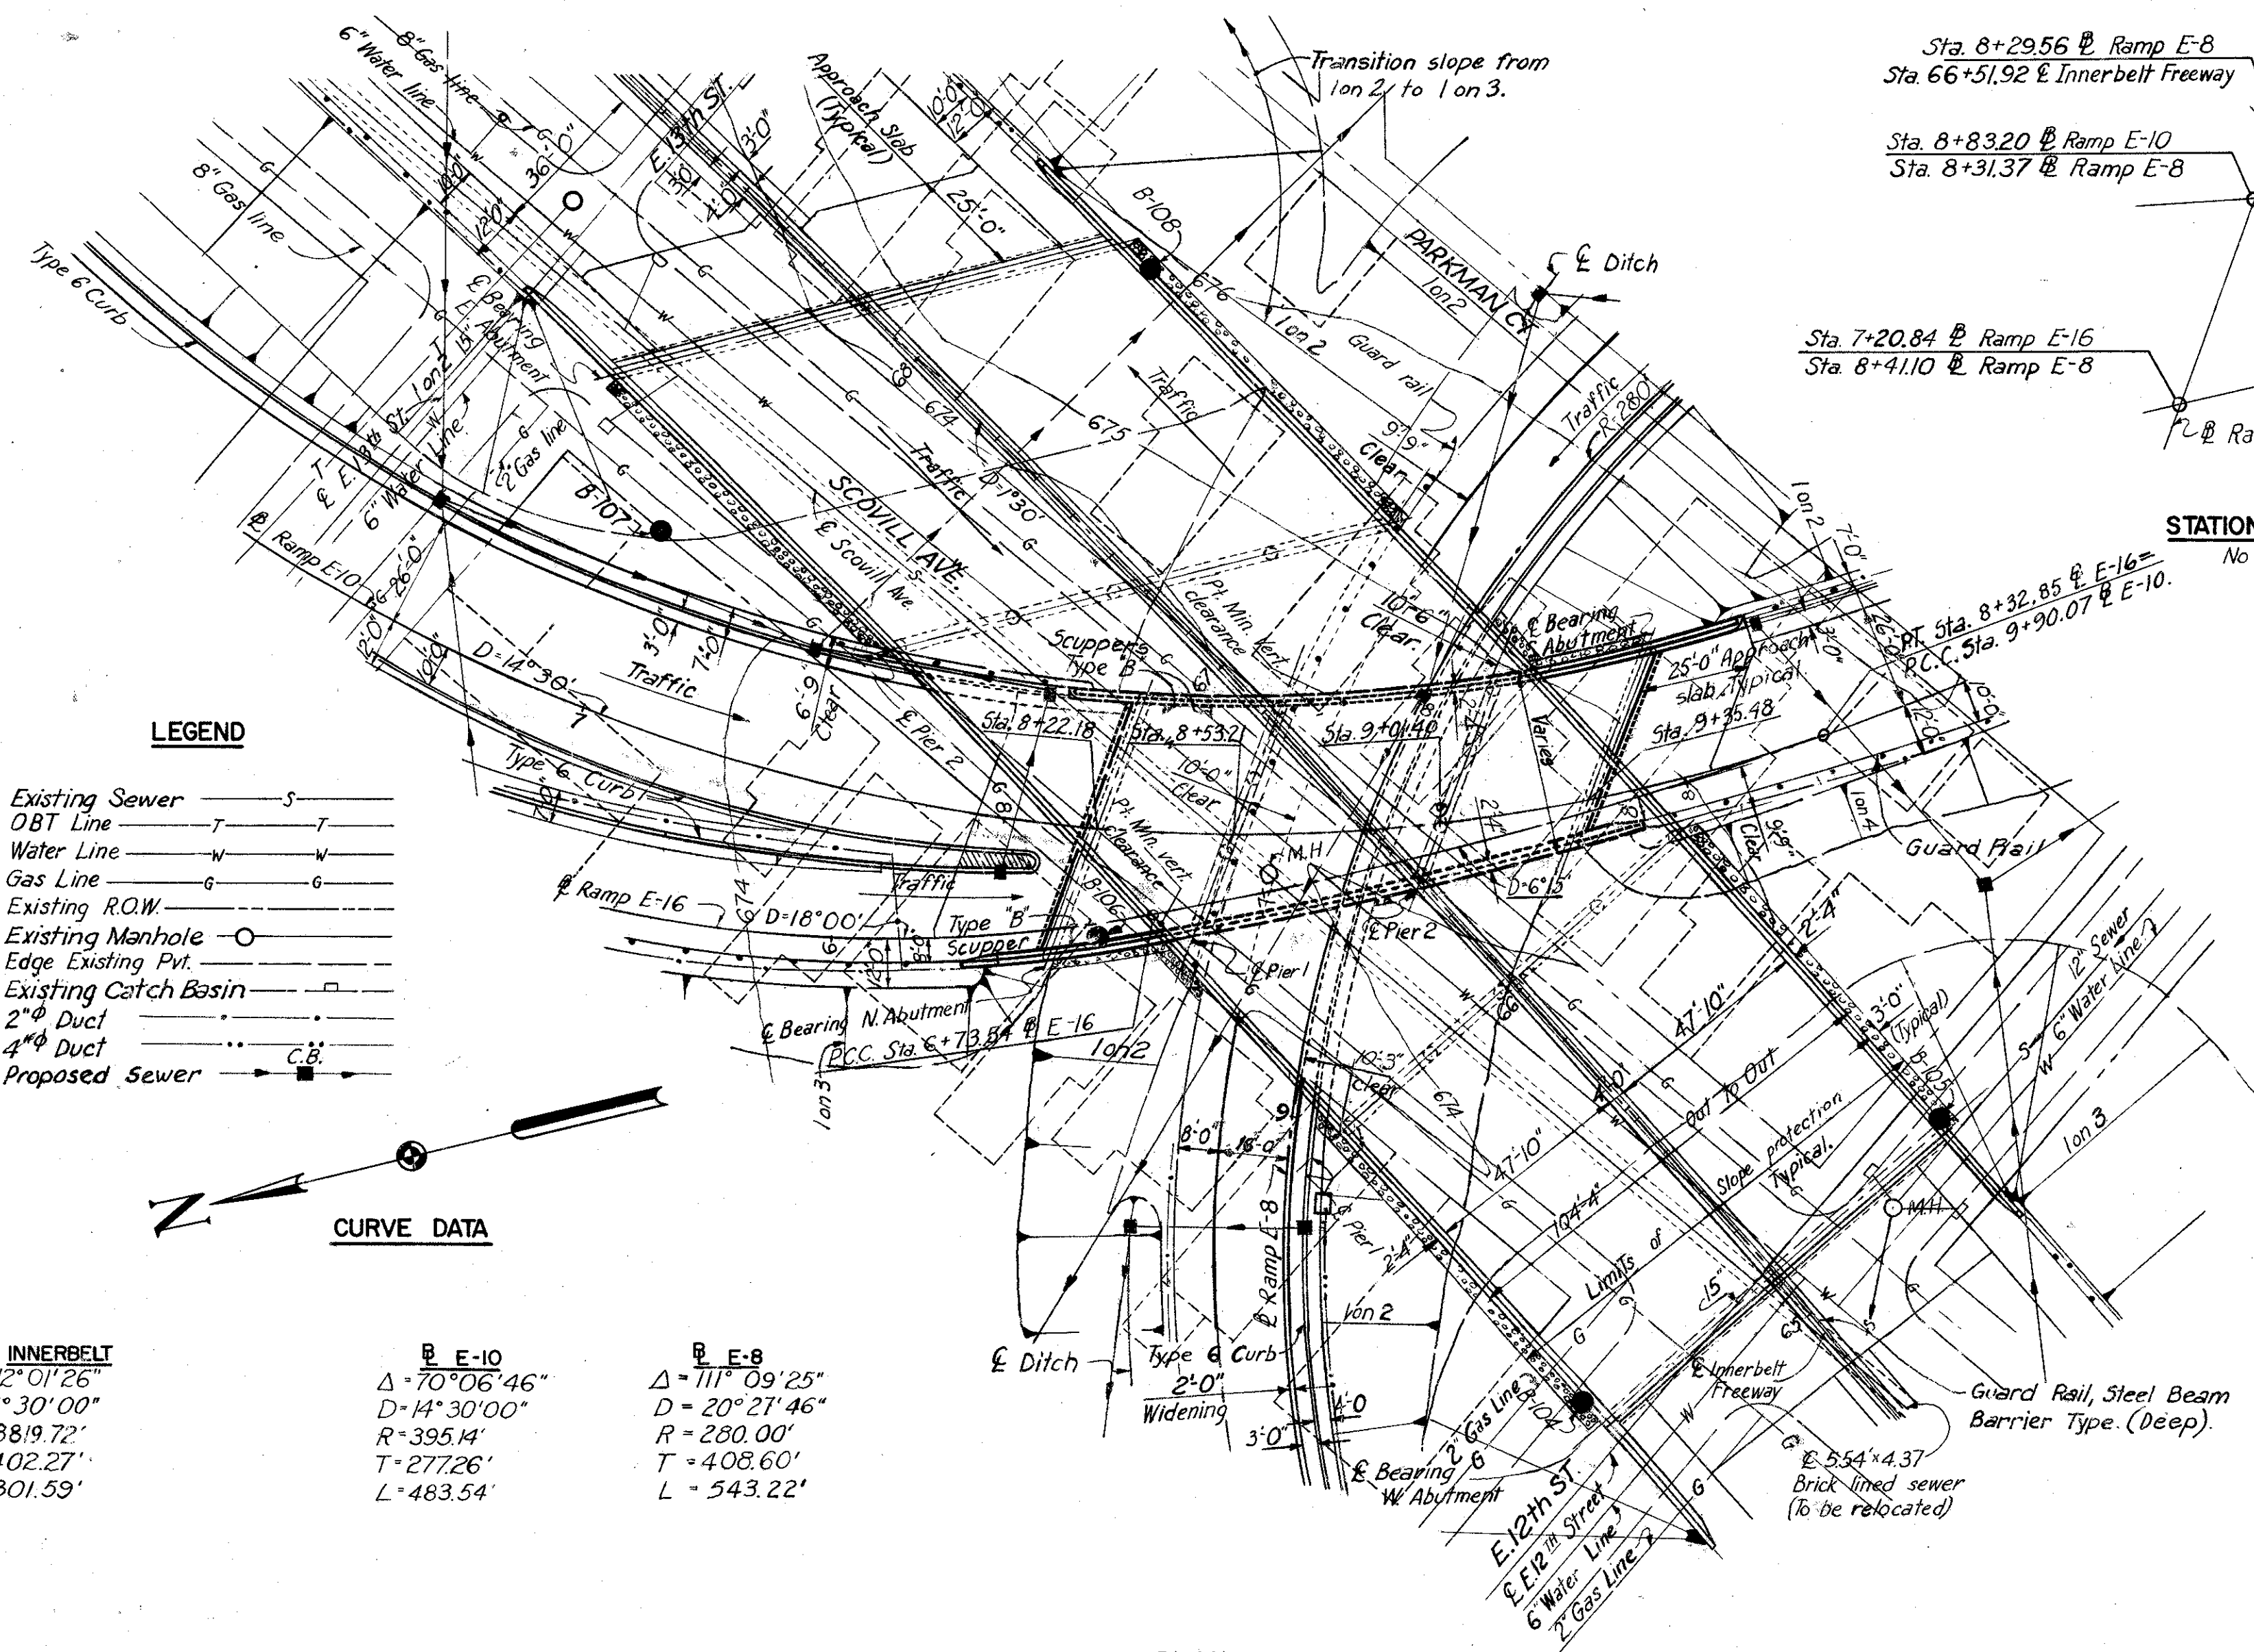


STATION EQUATIONS
No Scale

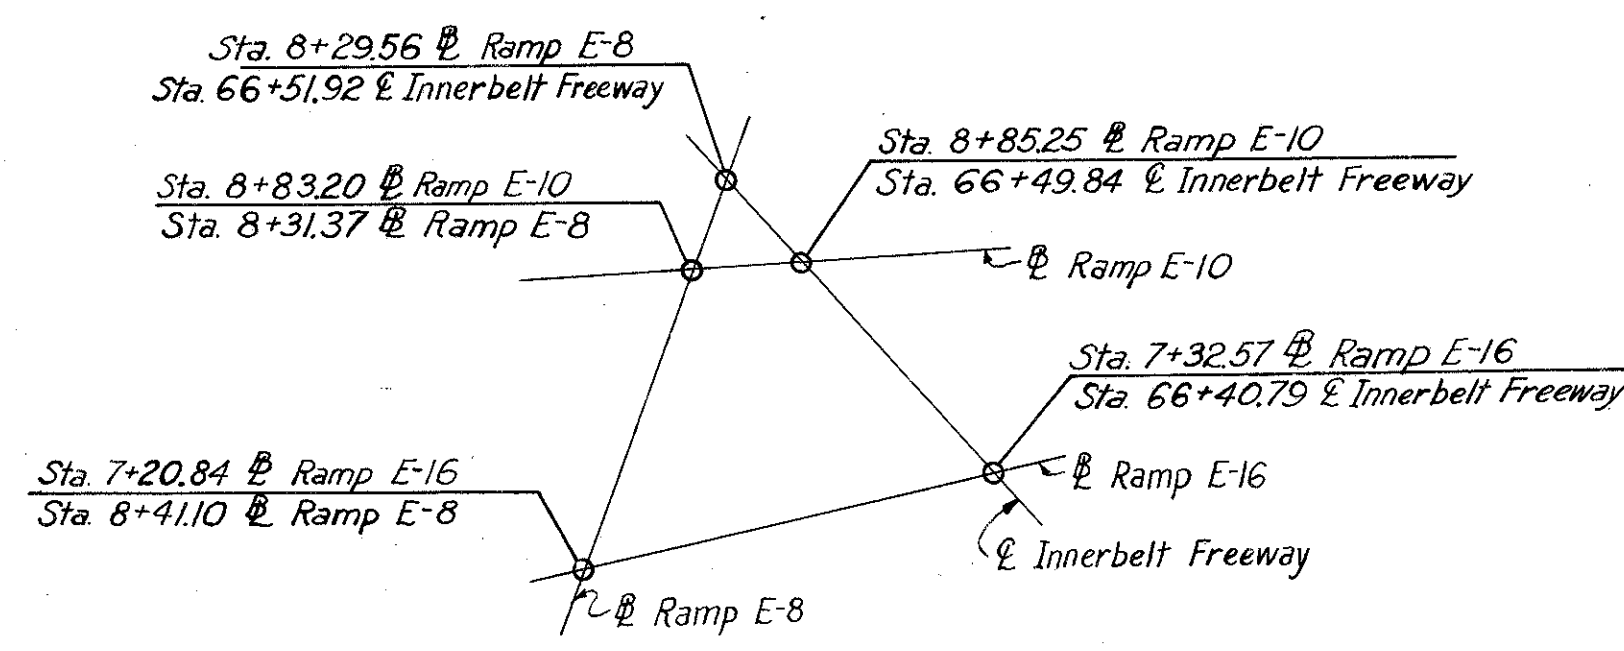

LEGEND

Existing Sewer	S
OBT Line	T
Water Line	W
Gas Line	G
Existing R.O.W.	G
Existing Manhole	○
Edge Existing Pvt.	—
Existing Catch Basin	□
2" Duct	—
4" Duct	—
Proposed Sewer	—

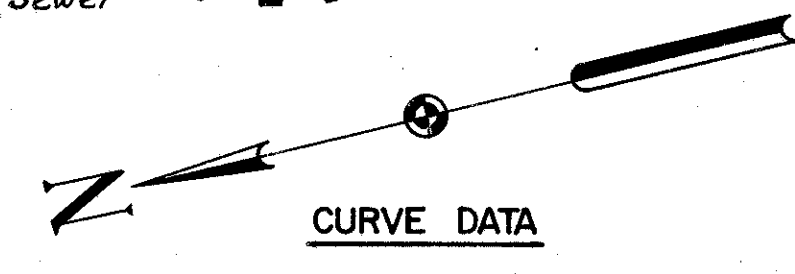

INNERBELT

$\Delta = 12^{\circ}01'26''$	$\Delta = 70^{\circ}06'46''$	$\Delta = 111^{\circ}09'25''$
$D = 18^{\circ}30'00''$	$D = 14^{\circ}30'00''$	$D = 20^{\circ}27'46''$
$R = 389.72'$	$R = 395.14'$	$R = 280.00'$
$T = 402.27'$	$T = 277.26'$	$T = 408.60'$
$L = 801.59'$	$L = 483.54'$	$L = 543.22'$

E-10

$\Delta = 70^{\circ}06'46''$	$\Delta = 70^{\circ}06'46''$
$D = 14^{\circ}30'00''$	$D = 14^{\circ}30'00''$
$R = 395.14'$	$R = 395.14'$
$T = 277.26'$	$T = 277.26'$
$L = 483.54'$	$L = 483.54'$

E-8

$\Delta = 111^{\circ}09'25''$	$\Delta = 111^{\circ}09'25''$
$D = 20^{\circ}27'46''$	$D = 20^{\circ}27'46''$
$R = 280.00'$	$R = 280.00'$
$T = 408.60'$	$T = 408.60'$
$L = 543.22'$	$L = 543.22'$

E-16

$\Delta = 31^{\circ}31'44''$	$\Delta = 9^{\circ}57'26''$
$D = 18^{\circ}00'00''$	$D = 6^{\circ}15'00''$
$R = 318.31'$	$R = 916.73'$
$T = 89.86'$	$T = 79.86'$
$L = 175.16'$	$L = 159.32'$

PROPOSED STRUCTURE BR. NO. 5

Type: Continuous steel beam with reinforced concrete deck and substructure

Spans: 31'-0" 48'-2" 34'-1" along E-10

Roadway: Varies

Loading: CF-2000 Adequate for A.A.S.H.O. alternate loading

Skew: Varies

Surface Course: 1" Monolithic Concrete

Alignment: 14'30" curve left

Approach Slabs: AS-1-54 (25' long)

Superelevation: .08 ft. per ft.

NOTES:

The following items are not included in the Bridge Plans: (See Roadway Plans for Details).
 Removal of existing pavements, etc.
 Relocation or removal of existing utilities.
 Approach grading, pavement and slabs.
 Roadway Guard Rail.


Rod soundings were taken at location B-104, B-105, B-107 and B-108. The core drilling made at B-106 is plotted on site plan for Bridge No. 3. For details of slope protection see sheet 17A.

PILE INFORMATION

Location	Diameter	Number	Estimated ave. length
N. Abutment	12"	22	29'
S. Abutment	12"	19	29'
Pier 1	14"	18	65'
Pier 2	14"	16	65'


All piling to be C.I.P. Reinforced Concrete.

Pile lengths are based on boring data and are approximate only. The Contractor shall assume full responsibility for length of piling selected for driving.

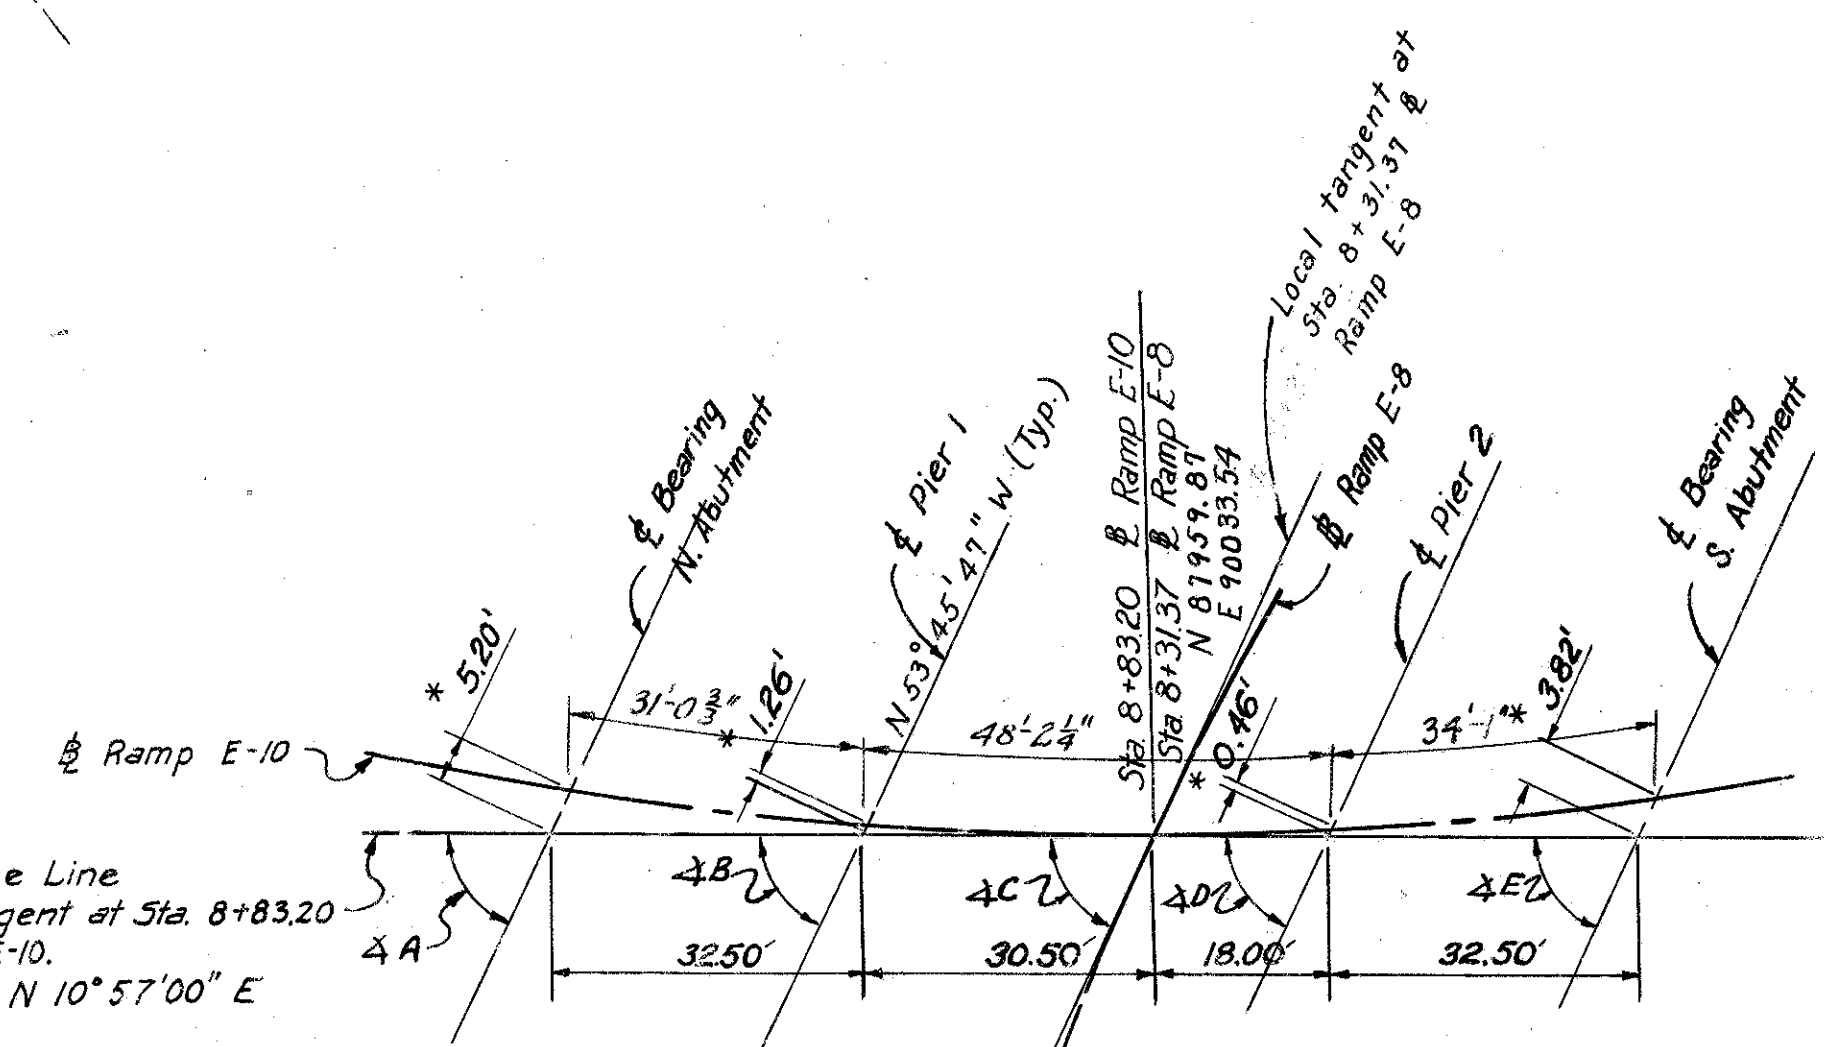

BRIDGE LAYOUT DIAGRAM
No Scale

- $\Delta A = 64^{\circ}-42'-47''$
 - $\Delta B = 64^{\circ}-42'-47''$
 - $\Delta C = 65^{\circ}-12'-47''$
 - $\Delta D = 64^{\circ}-42'-47''$
 - $\Delta E = 64^{\circ}-42'-47''$
- *Offsets measured from reference line to Ramp E-10 along bearings.

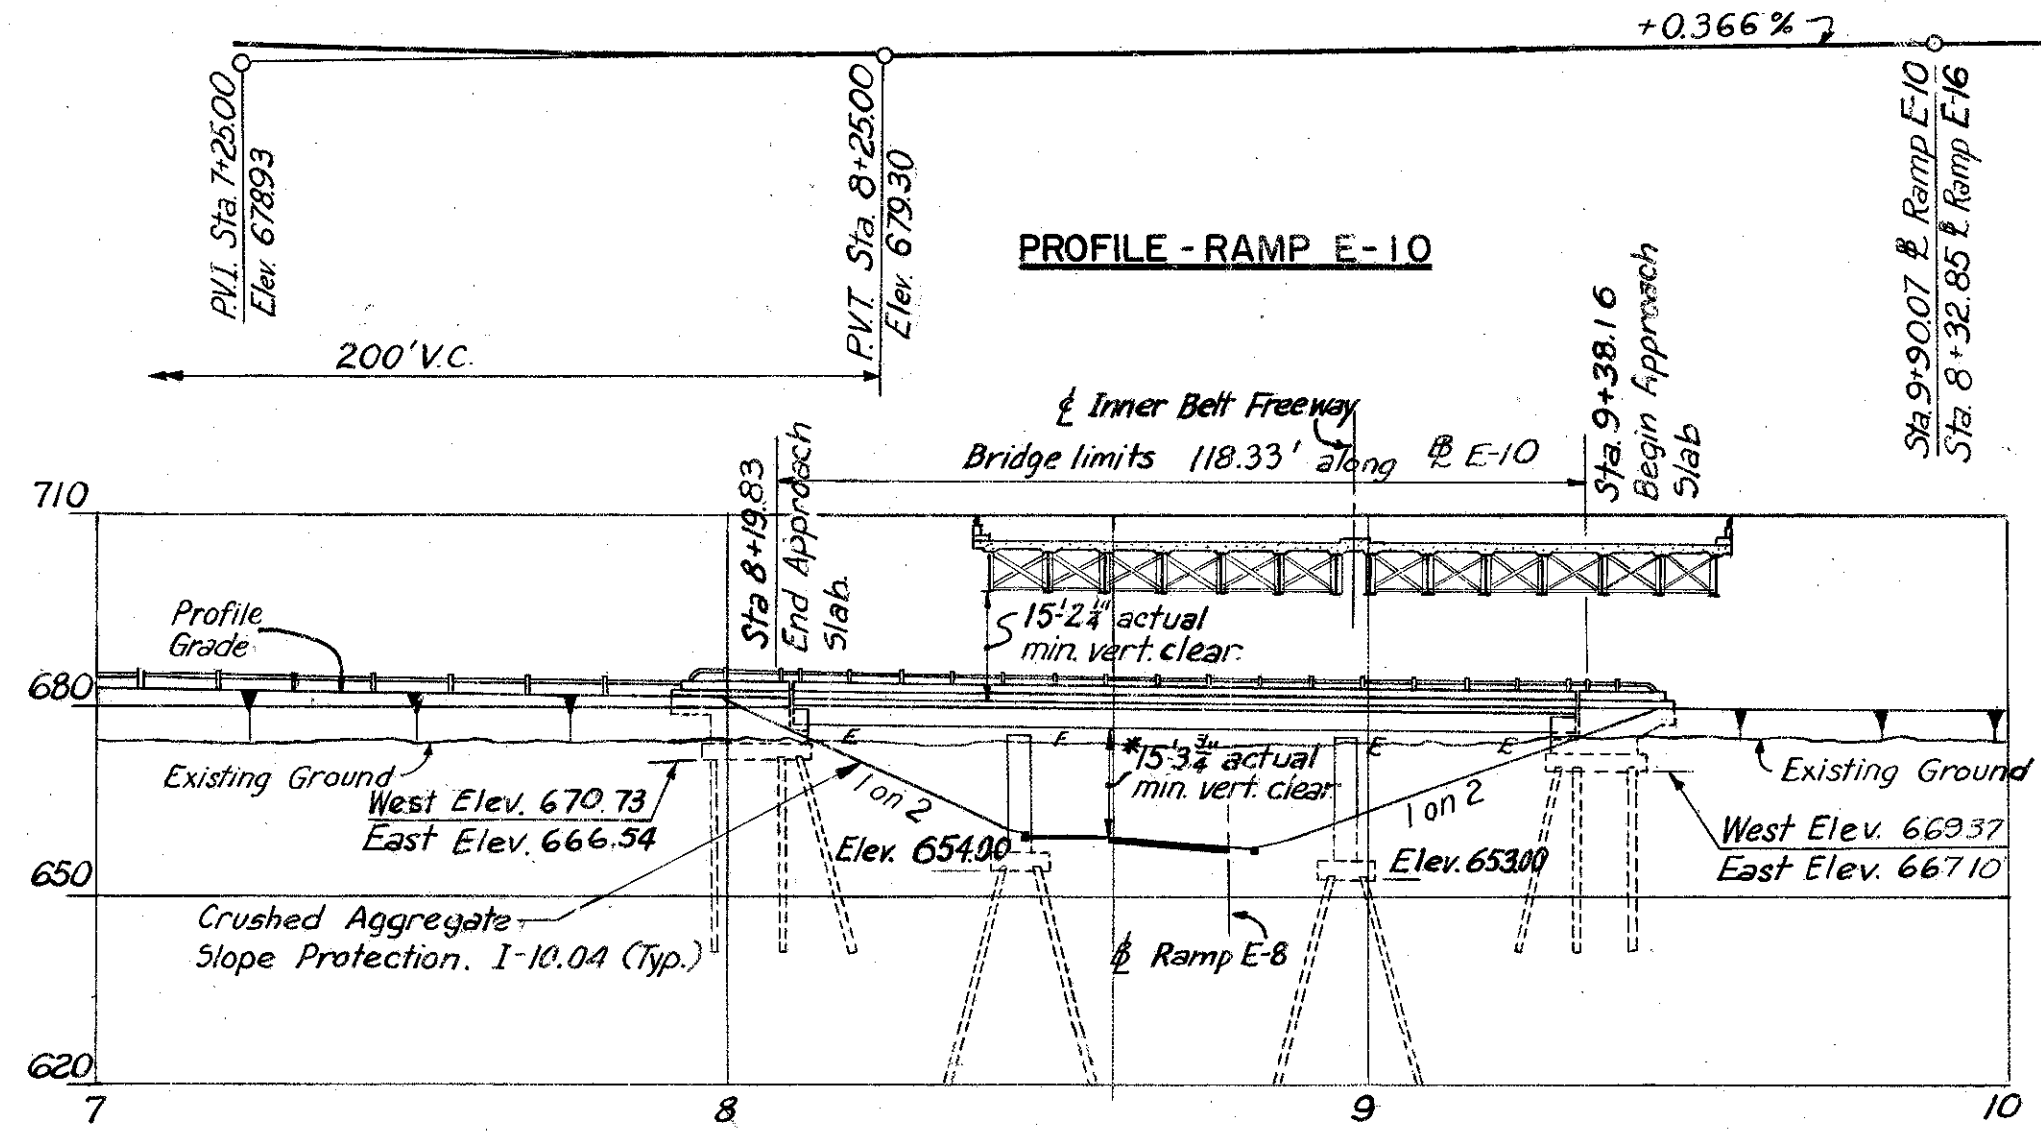


PROFILE - RAMP E-10

*15'-0" Required minimum vertical clearance. Point of actual minimum vertical clearance occurs at East exterior beam and North edge of Ramp E-8.

ELEVATION BRIDGE NO. 5

Note: Slopes shown in Elevation are normal to Ramp E-8.

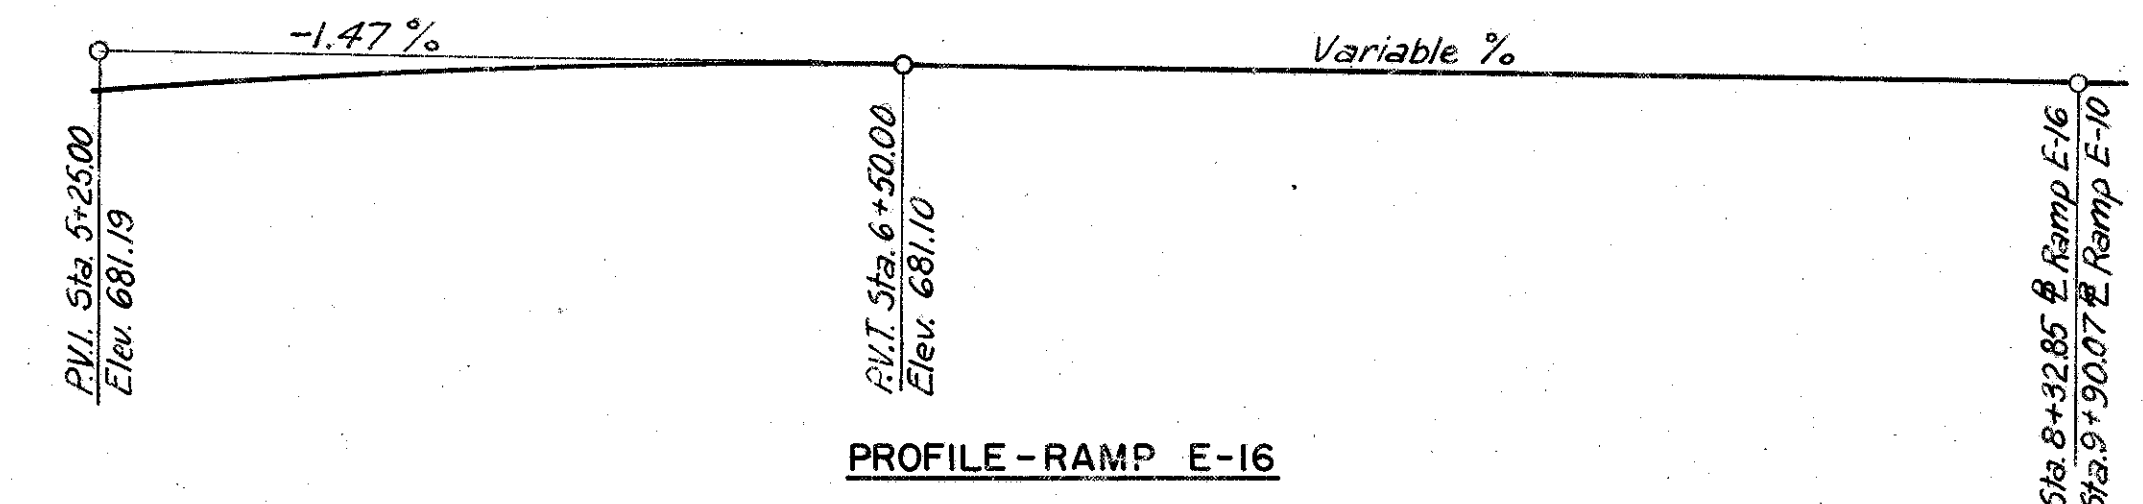

PROFILE - RAMP E-16

H.N.T.B. BR. NO. 5 PART 7A

HOWARD, NEEDLES, TAMMEN & BERGENDOFF
CONSULTING ENGINEERS
KANSAS CITY CLEVELAND NEW YORK

SITE PLAN

RAMP E-10 OVER RAMP E-8

Scale: 1" = 30'

STA 8+19.83
STA 9+38.16


WILLOW-INNER BELT FREEWAY

CLEVELAND CUYAHOGA COUNTY OHIO


DRAWN J.J.S.	TRACED	CHECKED D.M.	REVIEWED J.C.T.	REVISED
DATE 6-19-53	DATE	DATE 7-28-53	DATE 11-13-53	

SHEET 137

Note: Prefix "PA" shall be assigned to all bar marks.

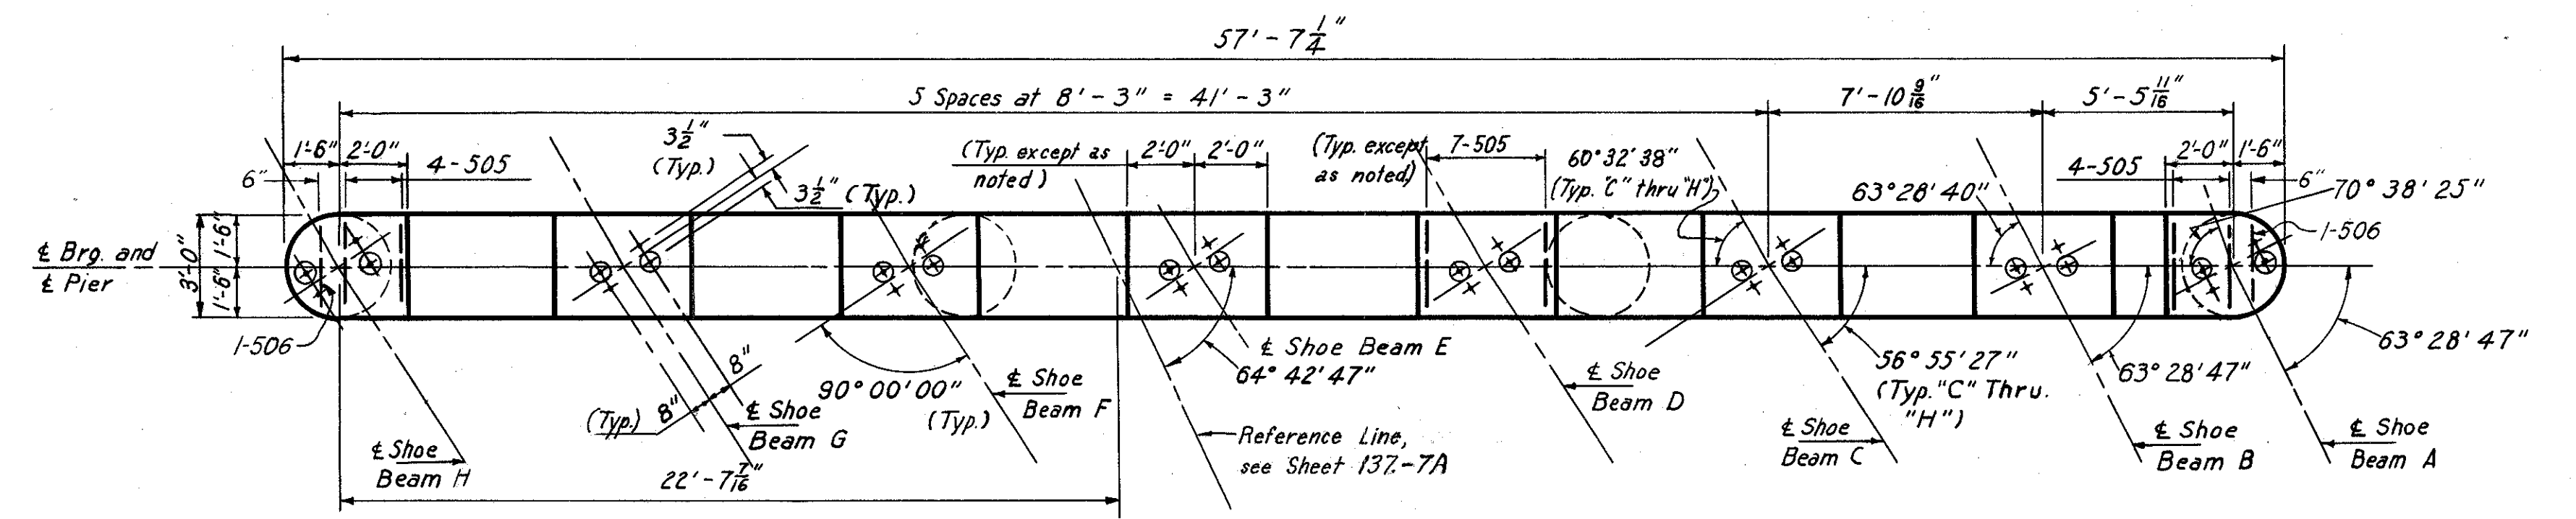


NOTE:
Special care to be taken when placing reinforcing steel so as not to interfere with anchor bolt setting.
Holes for anchor bolts, noted as such, are to be drilled before placing of diaphragm.

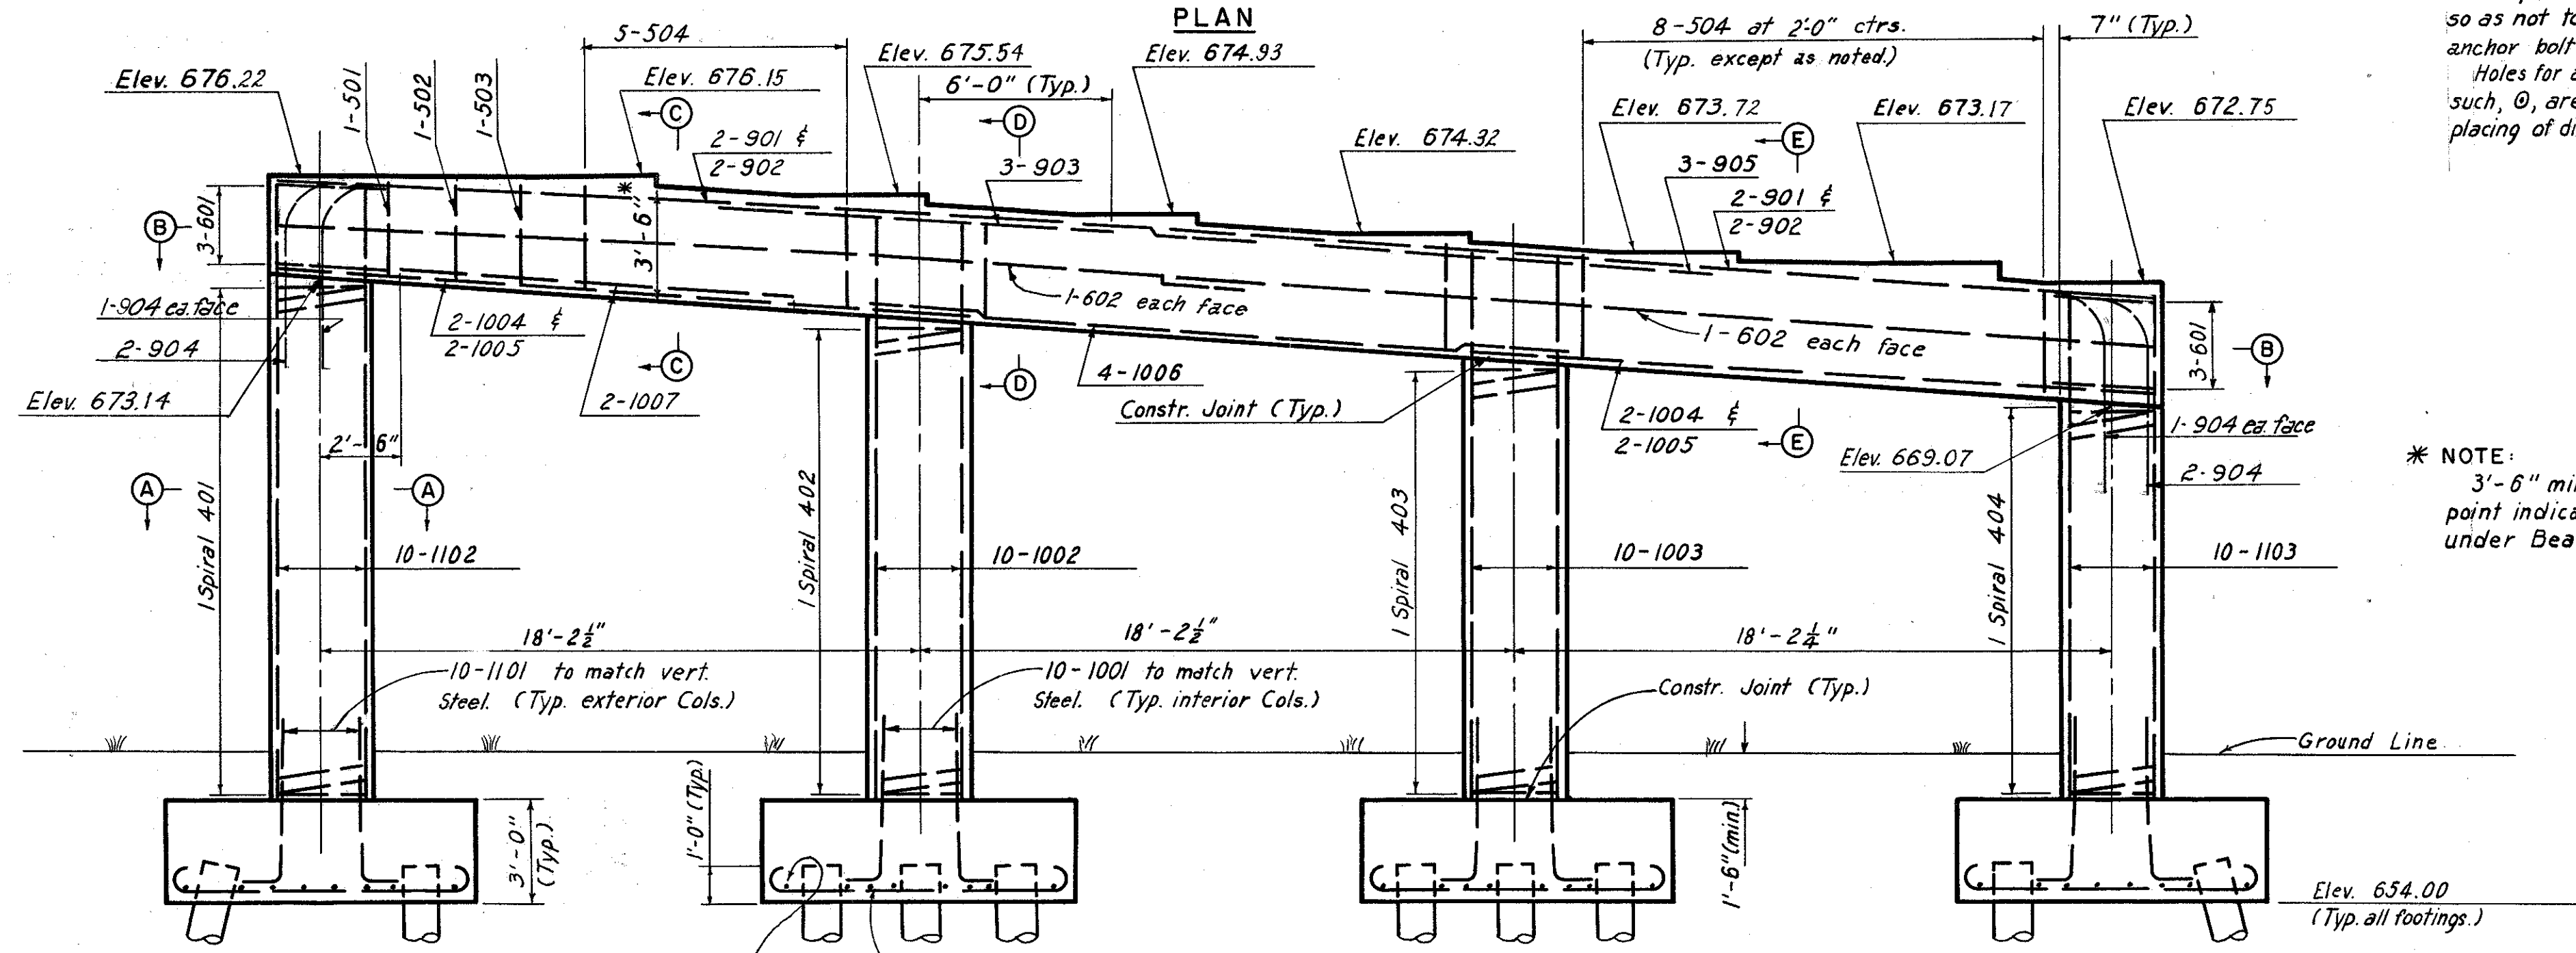

* NOTE:
3'-6" min. to be held from point indicated through section under Beam "A".

MARK	NO.	LENGTH	TYPE	DIMENSIONS				SERIES INCR. MENT	WEIGHT (POUNDS)
				A	B	C	D		
501	1	11'-6"	109	2'-8"	2'-10"			12	
502	1	11'-10"	109	2'-8"	3'-0"			12	
503	1	12'-0"	109	2'-8"	3'-1"			12	
504	21	12'-2"	109	2'-8"	3'-2"			266	
505	50	5'-5"	105	2'-8"	1'-6"			283	
506	2	5'-3"	105	2'-6"	1'-6"			11	
601	6	7'-11"	144	1'-11"	4'-1"			71	
602	4	28'-3"	str.					170	
701	64	10'-10"	100	9'-2"				1417	
901	4	28'-9"	Str.					391	
902	4	30'-0"	Str.					408	
903	6	12'-0"	str.					245	
904	8	11'-6"	123	4'-4"	4'-4"			313	
1001	20	6'-11"	104	5'-10"	1'-4"			595	
1002	10	17'-9"	str.					764	
1003	10	16'-6"	str.					710	
1004	4	19'-9"	str.					340	
1005	4	21'-0"	str.					361	
1006	4	21'-6"	str.					370	
1007	2	12'-0"	str.					103	
1101	20	7'-0"	104					744	
1102	10	18'-9"	str.					996	
1103	10	15'-3"	str.					810	
Total =								9,404	

MARK	NO.	CORE DIA. % SPIRAL	LENGTH	PITCH	NO. OF TURNS	WEIGHT (POUNDS)
402	1	2'-8"	14'-8"	4 1/2"	42	379
403	1	2'-8"	13'-4"	4 1/2"	38	342
404	1	2'-8"	11'-11"	4 1/2"	35	305
Total =						1442

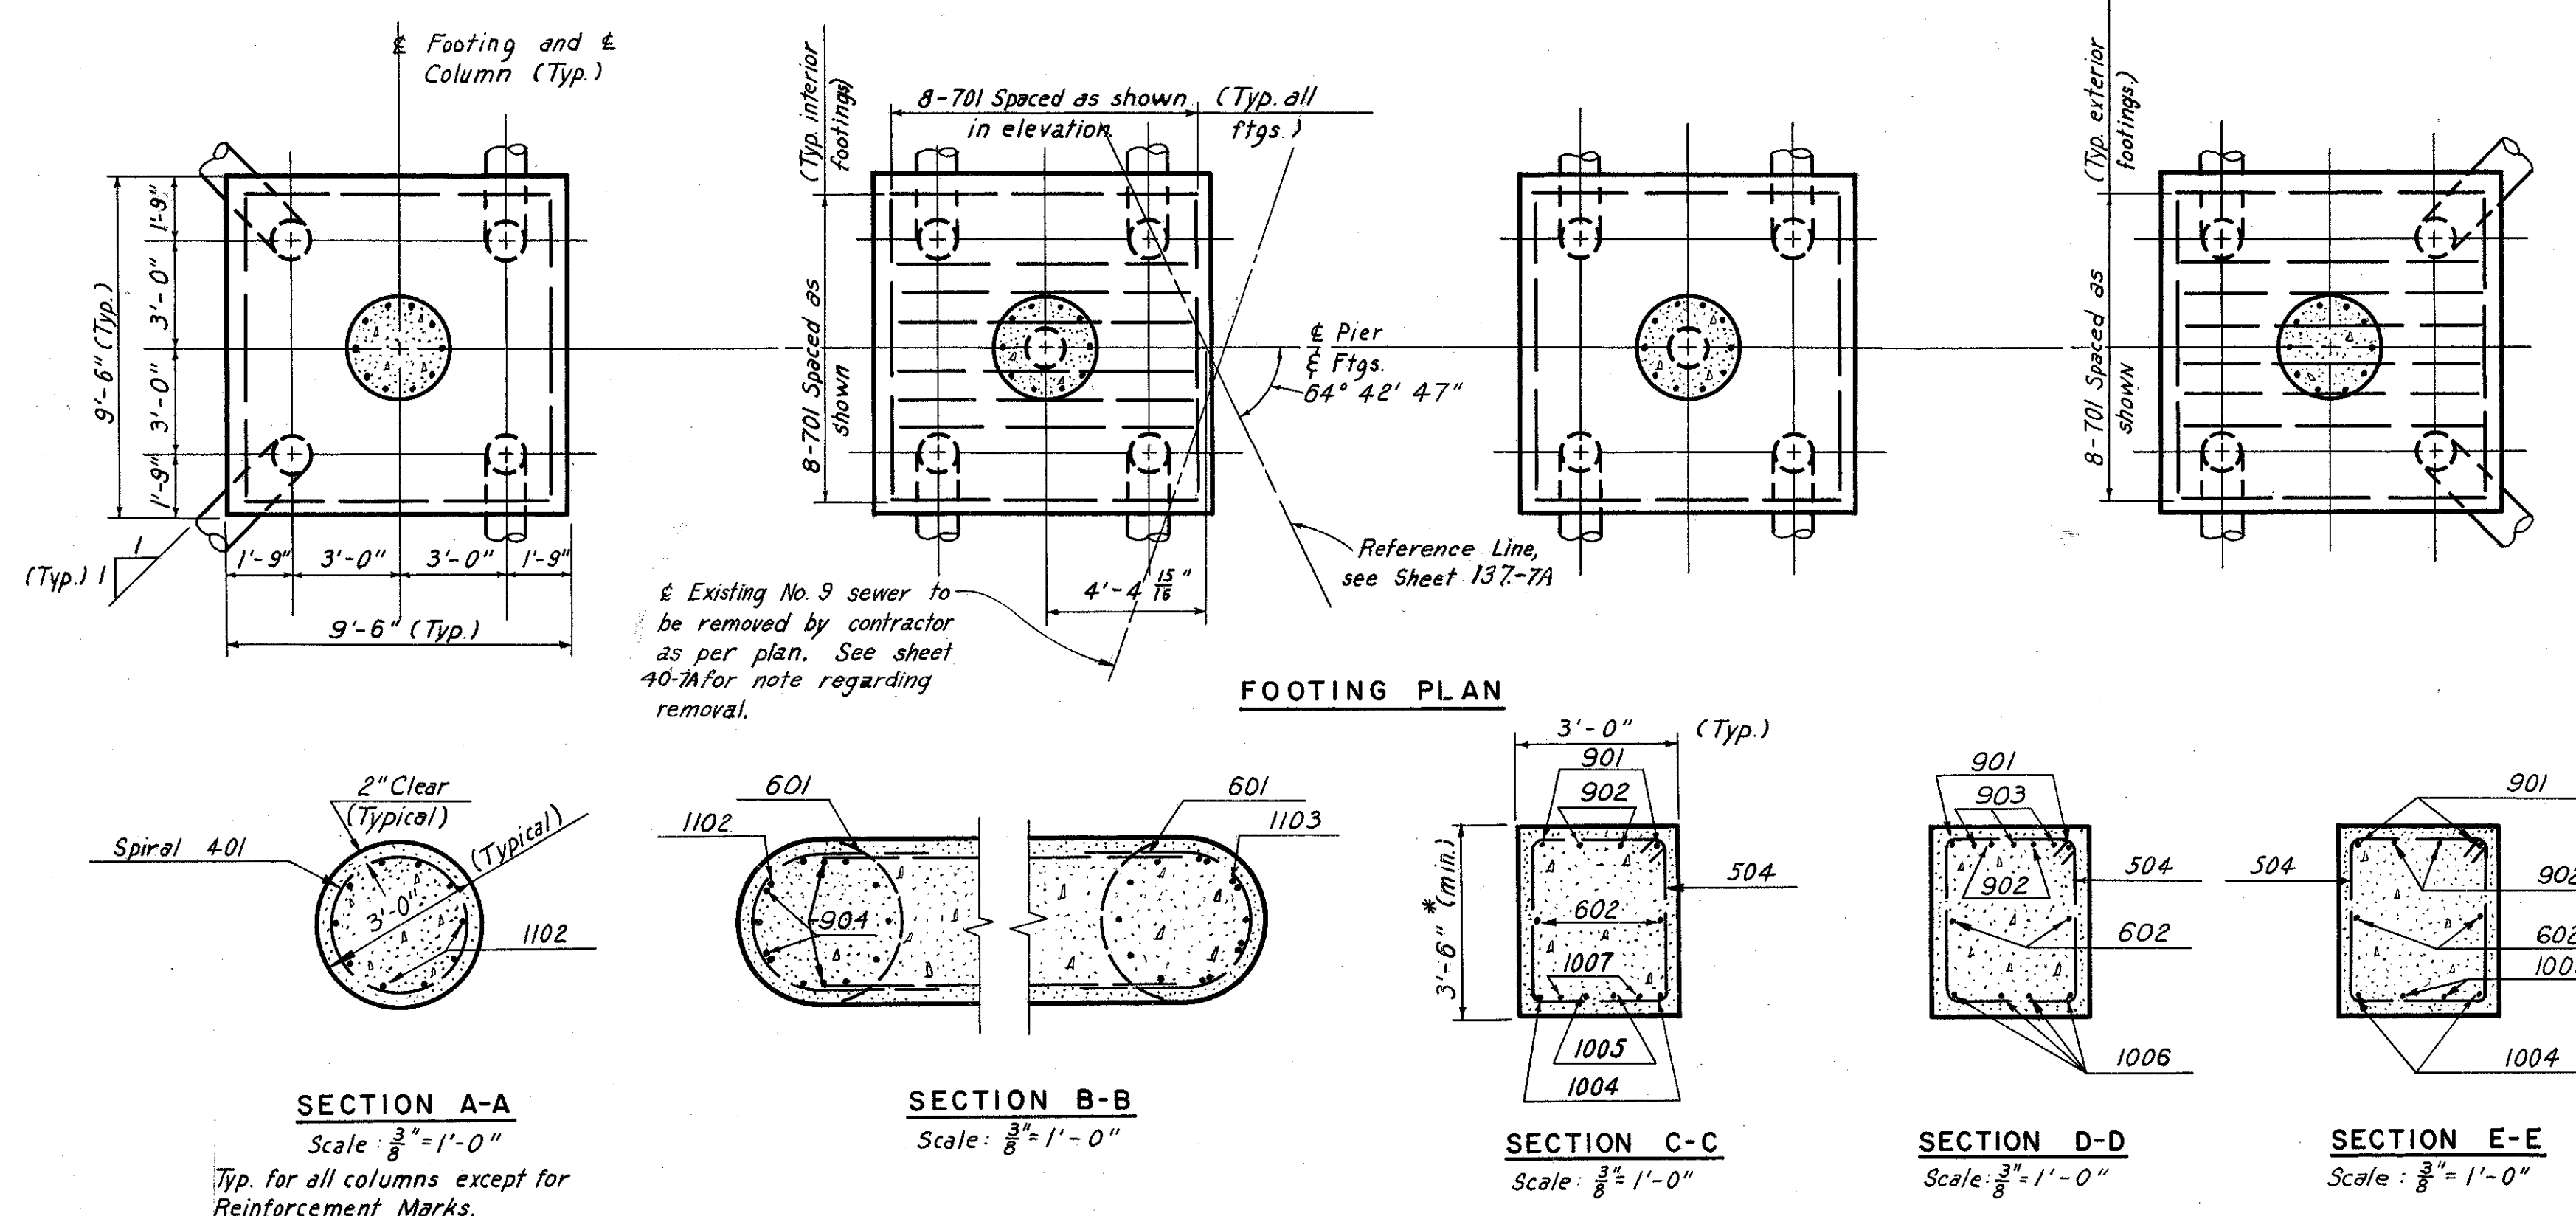

NOTES:
All Battered Piles shall be battered 3 in 12 in direction shown.
All Piles shall be 14" # C.I.P. Reinforced Concrete.
For bar bending diagram, see sheet 103-7A.
For masonry plate details, see Ohio Standards, Drawing RB-1-55.
For replacement steel schedule, see sheet 103-7A.
For spiral reinforcement notes, see sheet 103-7A.
Pile spacings are given along bottom of footing.
Reinforcement bars shall be 3 inches clear from face of concrete in footings and 2 inches elsewhere.
All bar dimensions are given out to out.

H.N.T.B. BR. NO. 5 PART 7A
HOWARD, NEEDLES, TAMMEN & BERGENOFF
CONSULTING ENGINEERS
KANSAS CITY CLEVELAND NEW YORK

PIER I
RAMP E-10 OVER RAMP E-8
Scale: 1/4" = 1'-0"
Except as noted
STA. 8+19.83
STA. 9+38.16

WILLOW-INNER BELT FREEWAY
CLEVELAND CUYAHOGA COUNTY OHIO


DRAWN: M. TRACED: J.A.G. CHECKED: J. REVIEWED: J.C.T. REVISIONS:
DATE: 7-11-58 DATE: 8-22-58 DATE: 7-25-58 DATE: 11-13-59

SHEET 138

Note: Prefix "PB" shall be assigned to all bar marks.


REINFORCEMENT SCHEDULE									
MARK	NO.	LENGTH	TYPE	DIMENSIONS				SERIES INCREMENT	WEIGHT (POUNDS)
				A	B	C	D		
1001	4	17'-9"	Str.						306
1002	10	16'-6"	Str.						710
1003	10	17'-6"	Str.						753
1004	10	18'-9"	Str.						807
1005	10	19'-3"	Str.						828
1006	4	18'-9"	Str.						323
1007	40	6'-10"	104	5'-9"	16 1/2"				1176
1008	4	19'-3"	Str.						331
901	4	26'-6"	Str.						361
902	4	25'-3"	Str.						343
903	2	12'-0"	Str.						82
904	8	11'-6"	123	4'-4"	4'-4"				313
701	64	10'-10"	100						1417
601	6	7'-11"	144	1'-11"	4'-0"				71
602	4	24'-6"	Str.						147
501	21	12'-1"	109	2'-8"	3'-2"				265
502	43	3'-8"	105	2'-8"	1'-6"				247
503	2	3'-6"	105	2'-6"	1'-6"				11
Total									8,491

SPIRAL REINFORCEMENT SCHEDULE						
MARK	NO.	CORE DIA. % SPIRAL	LENGTH	PITCH	NO. OF TURNS	WEIGHT (POUNDS)
401	1	2'-8"	13'-2"	4 1/2"	39	254
402	1	2'-8"	14'-4"	4 1/2"	41	267
403	1	2'-8"	15'-5"	4 1/2"	44	287
404	1	2'-8"	16'-6"	4 1/2"	47	307
Total						1115

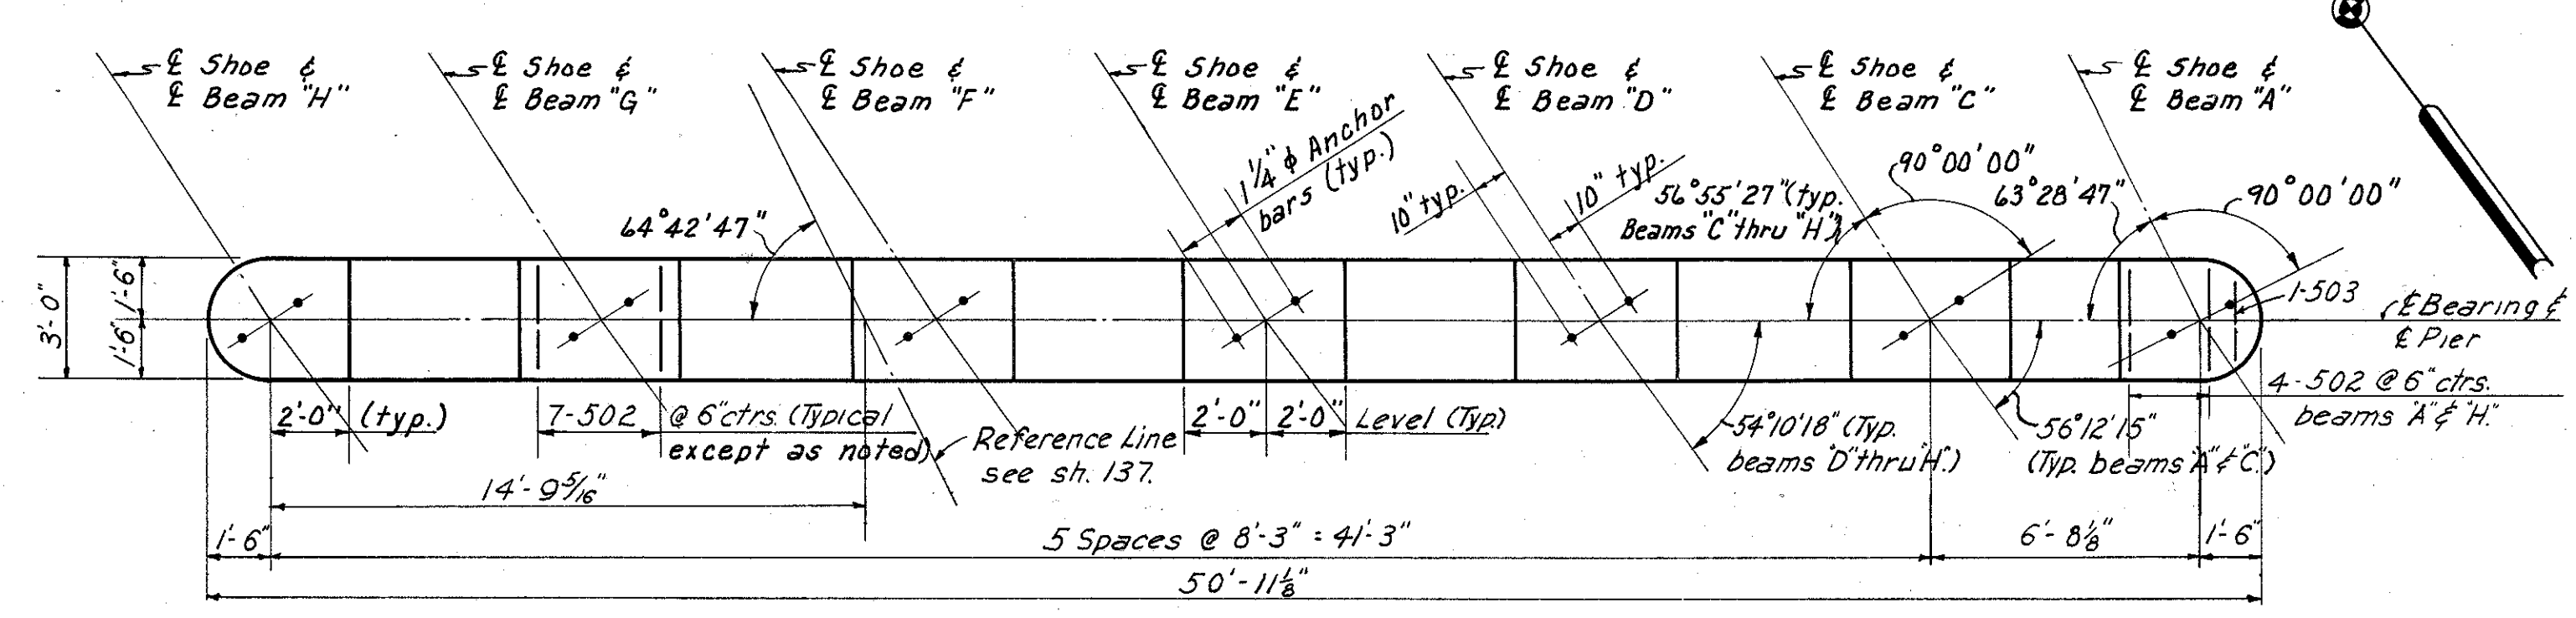


PLAN


Note: Special care shall be taken when placing reinforcing steel so as not to interfere with anchor bar setting.

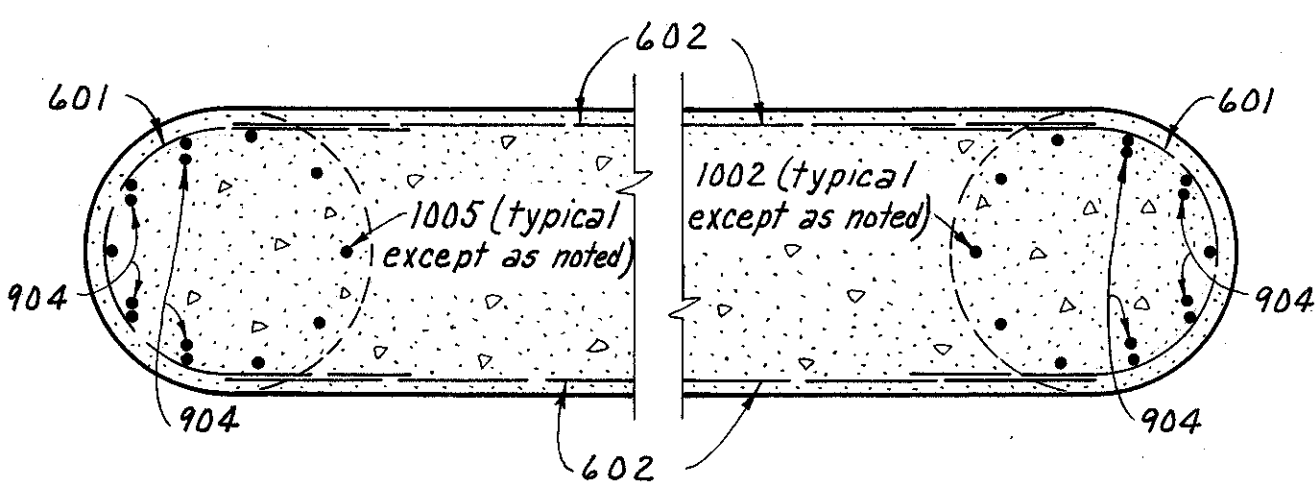


SECTION A-A

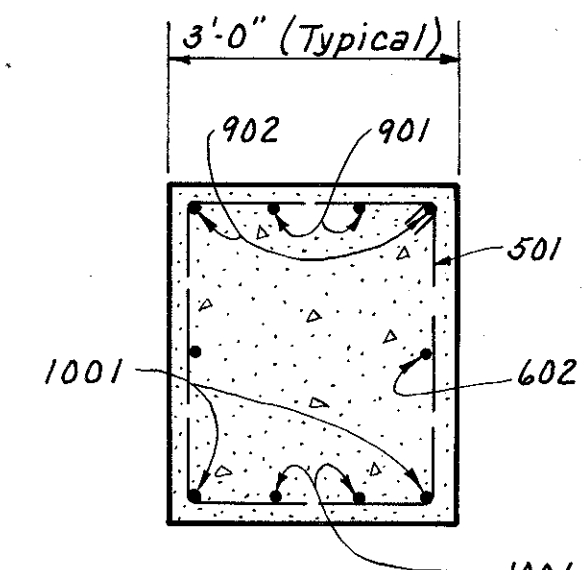

SECTION B-B

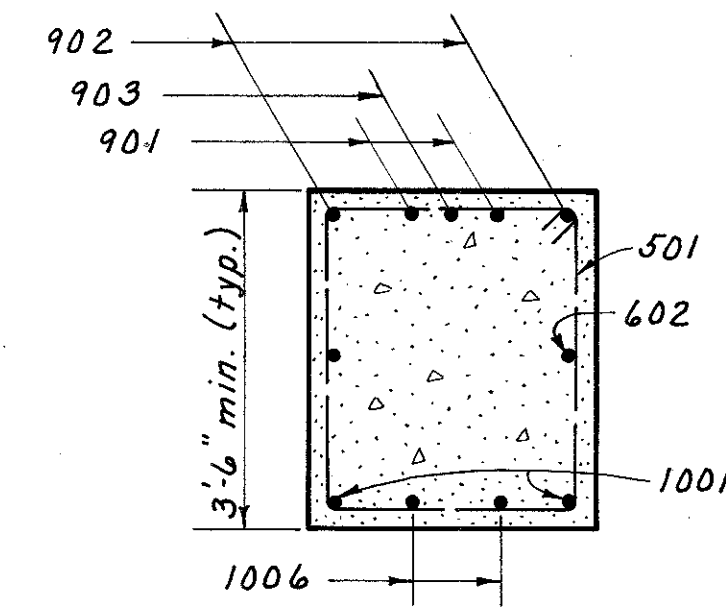


SECTION C-C

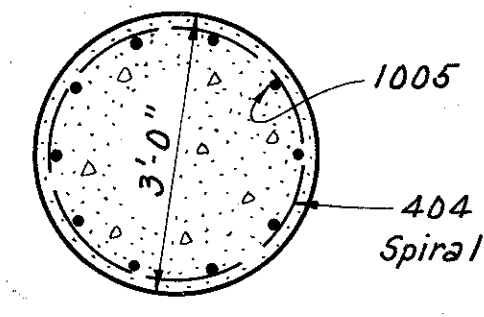


SECTION D-D

Scale: 1/2" = 1'-0"
 Typical for all columns except for bar marks

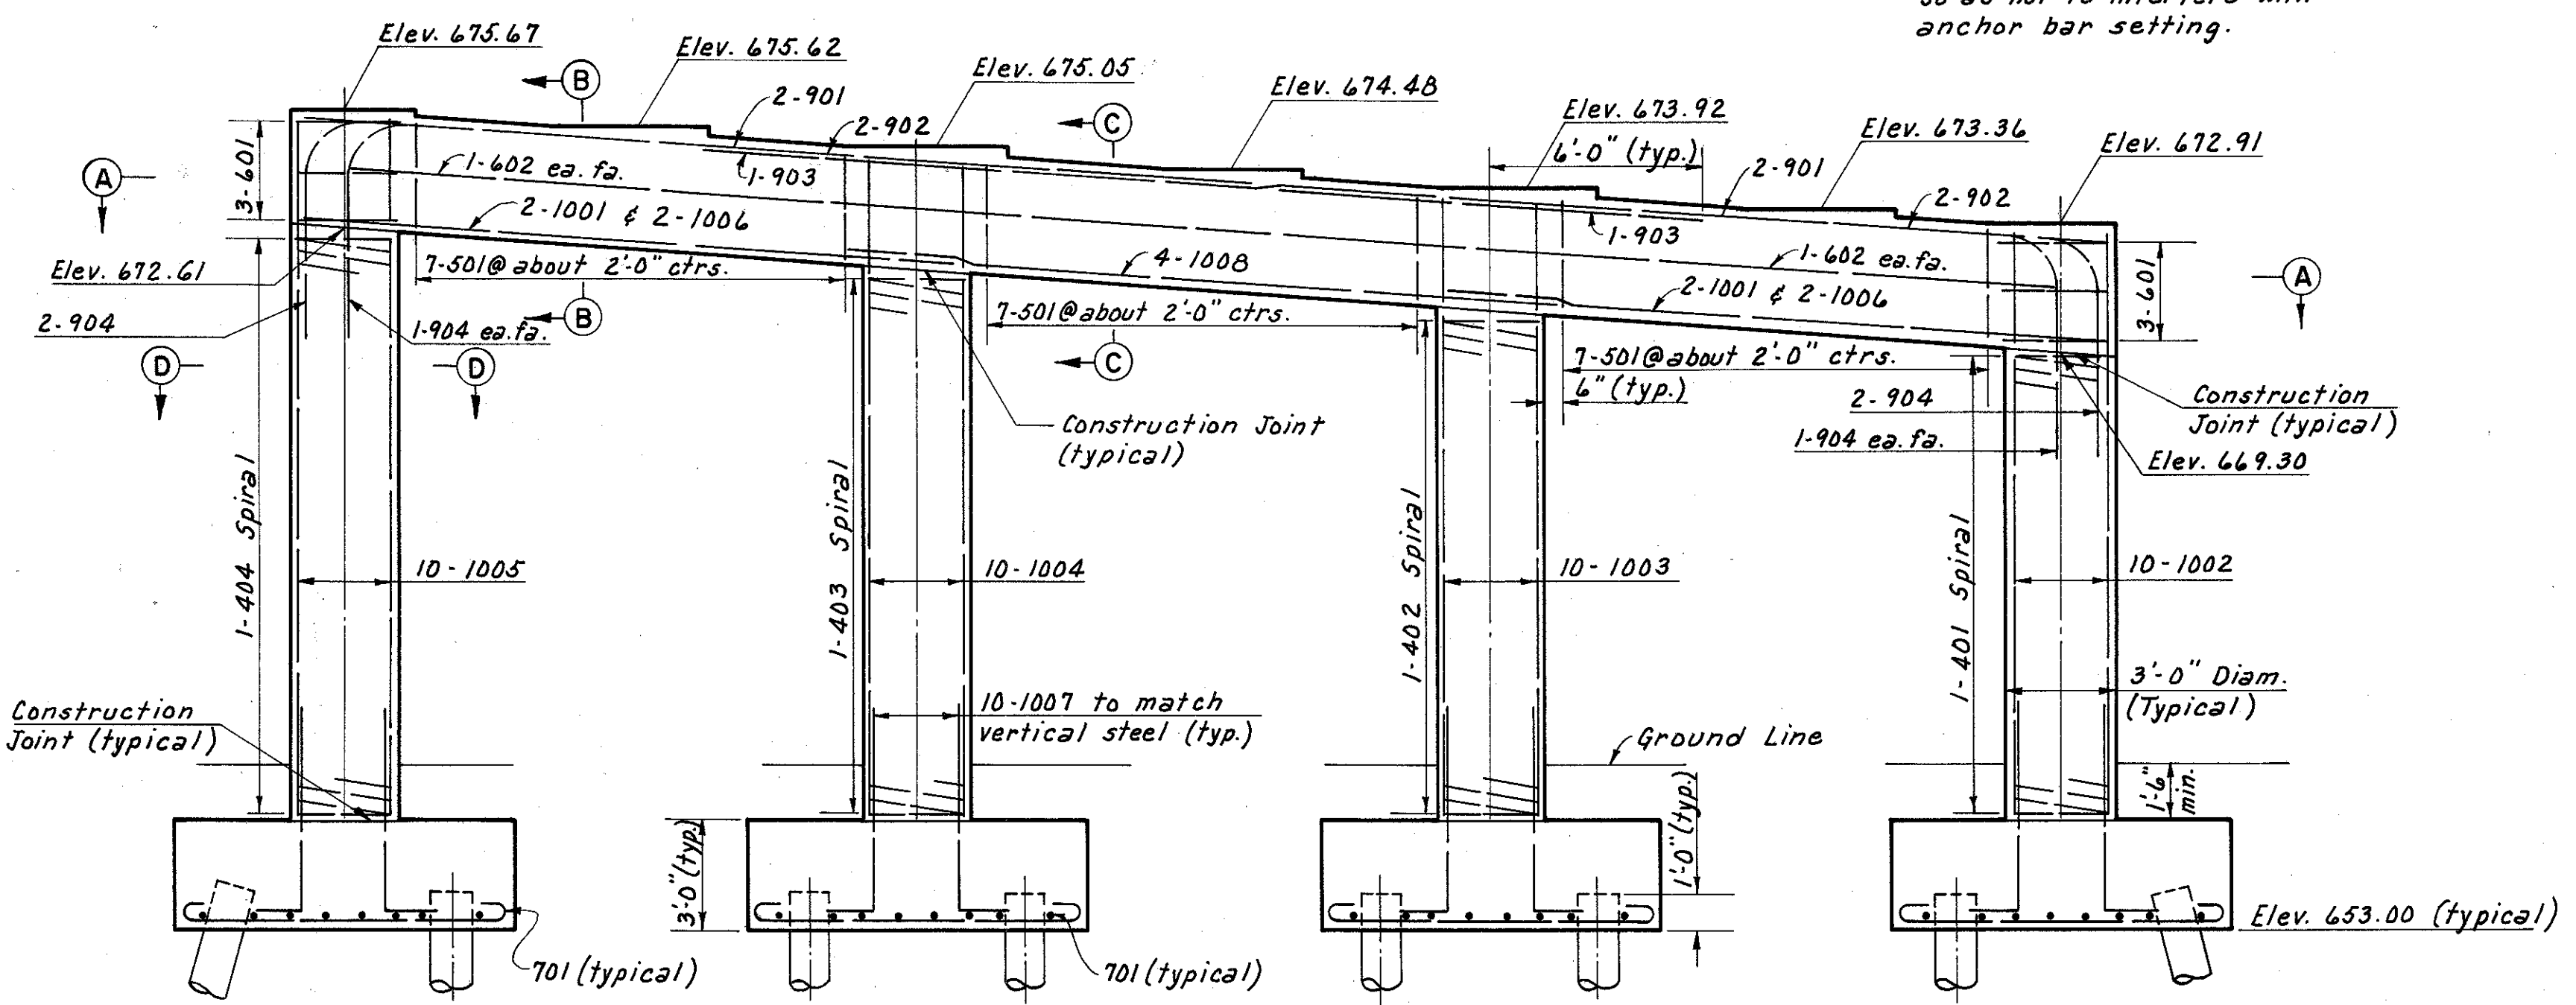

ELEVATION

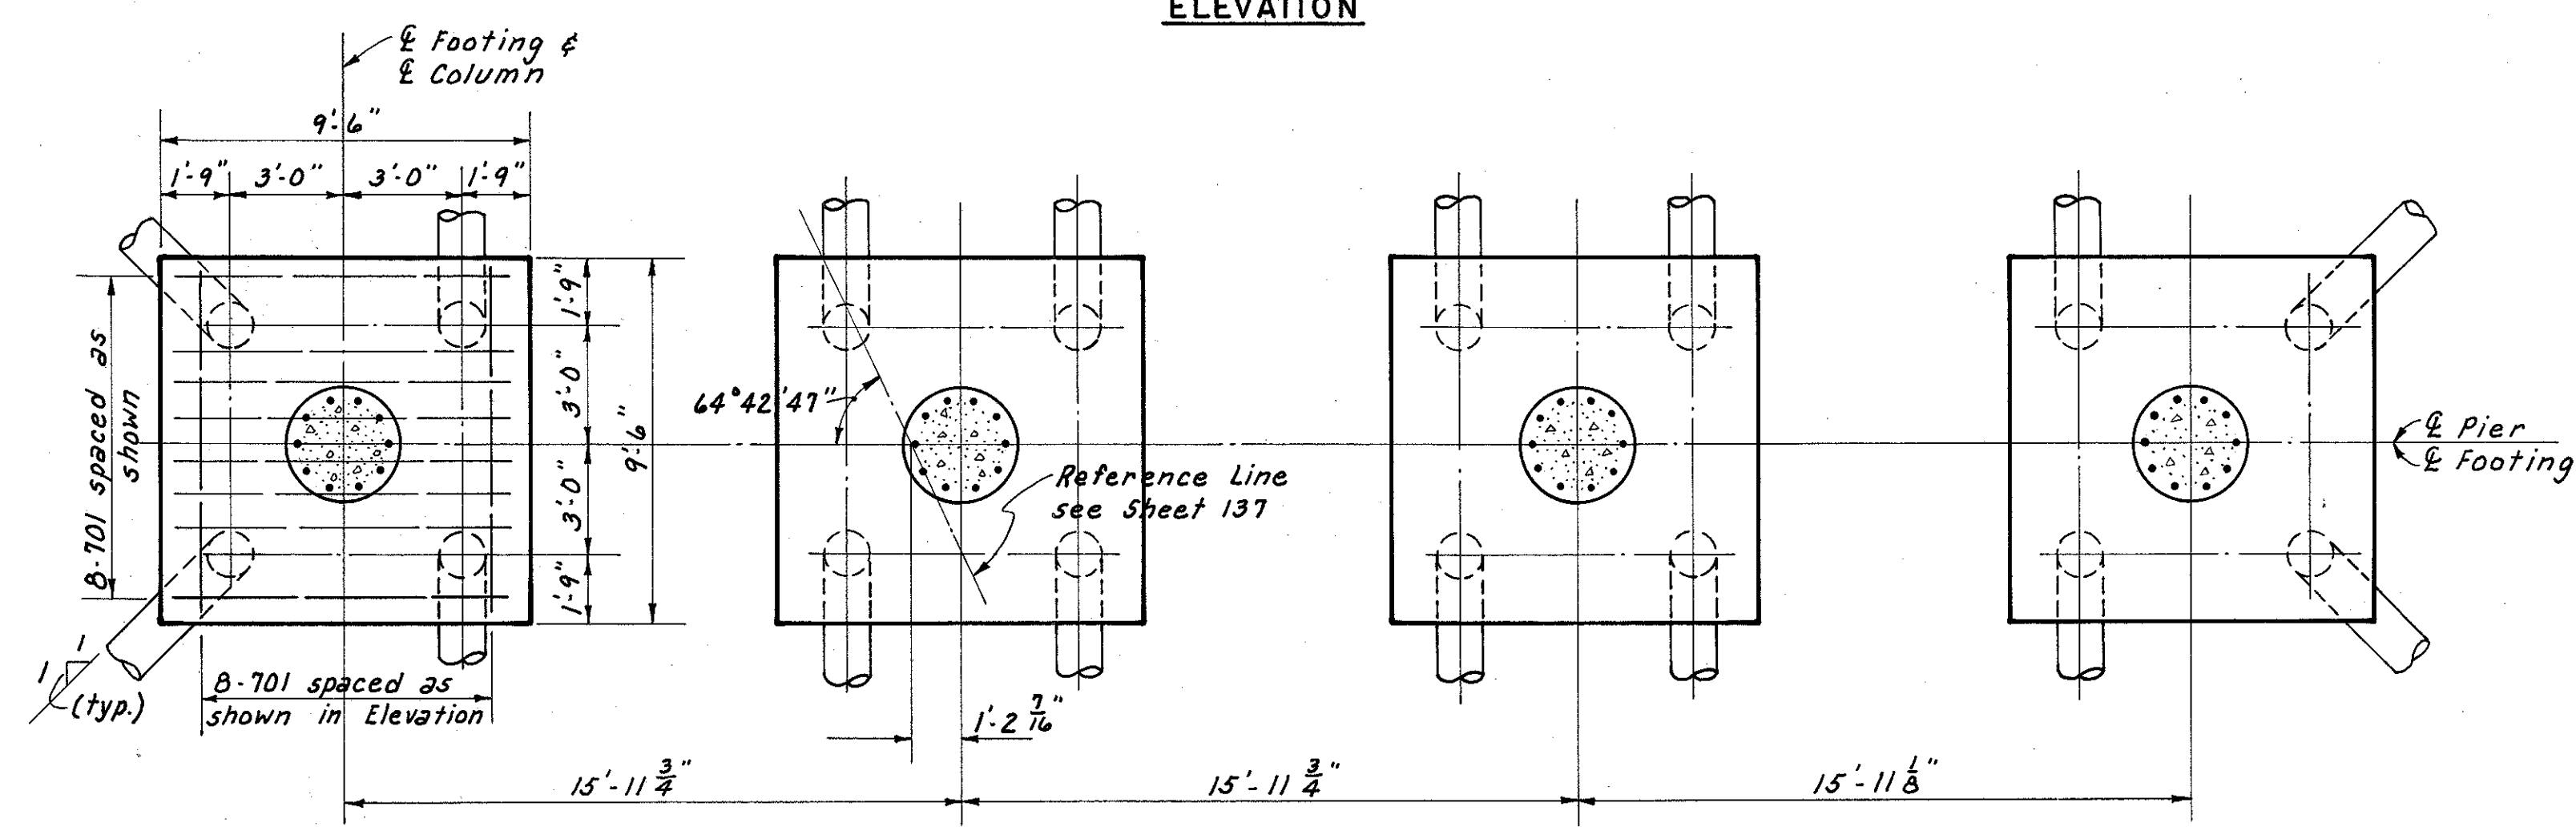

FOOTING PLAN

Note: Footing reinforcement and dimensions are typical for all footings.

NOTES:
 All battered piles shall be battered 3 in 12 in direction shown.
 For details of masonry plate, see sheet 173-7A.
 Reinforcement bars shall be 3 inches clear from face of concrete in footings and 2 inches elsewhere.
 Bar dimensions are given out to out.
 For bar bending diagram, see sheet 103-7A.
 For Spiral Reinforcement Note, see sheet 103-7A.
 For Replacement Schedule, see sheet 103-7A.

H.N.T.B. BR. NO. 5 PART 7A

HOWARD, NEEDLES, TAMMEN & BERGENDOFF
 CONSULTING ENGINEERS
 KANSAS CITY CLEVELAND NEW YORK

PIER 2
 RAMP E-10 OVER RAMP E-8
 Scale: 1/4" = 1'-0" STA. 8+19.83
 Except as noted STA. 9+38.16

WILLOW-INNER BELT FREEWAY
 CLEVELAND CUYAHOGA COUNTY OHIO

DATE 9-3-80 TRACED R.E.M. CHECKED J.C.T. REVISIONS
 DATE 5-13-81 DATE 4-16-83 DATE 11-13-89


MICROFILMED
JUL 9 1985

CUYAHOGA COUNTY
CITY OF CLEVELAND
CUY-21-15.32
CUY-42-18.42

REINFORCEMENT SCHEDULE FOR NORTH ABUTMENT									
MARK	NO.	LENGTH	TYPE	DIMENSIONS				SERIES INCREMENT	WEIGHT (LBS)
				A	B	C	D		
401	28	5'-7"	105	8"	2'-7"				105
402	17	6'-7"	154	1'-10"	1'-4"				75
403	1 Ser. of 6	6'-1" to 6'-7"	154	1'-7" to 1'-10"	1'-4"			1 1/8"	25
404	1 Ser. of 6	4'-7" to 5'-11"	154	10" to 1'-6"	1'-4"			3 3/8"	21
405	1	6'-3"	109	1'-10"	1'-1"				4
406	20	6'-4"	144	2'-3"	1'-10"				85
501	54	4'-7"	105	1'-8"	1'-7"				258
601	10	34'-9"	Str.						522
602	6	12'-3"	Str.						110
603	1	5'-9"	124	2'-4"	1'-8"	1'-11"	4		9
604	8	10'-0"	Str.						120
605	47	6'-9"	100	5'-5"					477
606	14	4'-6"	100	3'-2"					95
607	1	13'-4"	108	11'-6"	1'-11"	24			20
608	6	5'-3"	Str.						47
609	4	31'-9"	Str.						191
610	2	33'-0"	Str.						99
611	1 Ser. of 4	31'-9" to 33'-0"	Str.					5"	195
612	7	32'-6"	Str.						342
613	1	9'-0"	Str.						14
614	9	31'-0"	Str.						419
615	1 Ser. of 4	31'-0" to 31'-9"	Str.					3"	189
616	72	6'-1"	104	5'-5"	10				658
617	35	7'-7"	105	3'-5"	2'-3"				399
618	55	15'-11"	112	1'-5"	5'-9"				1,315
619	8	15'-1"	109	1'-5"	5'-9"				181
620	6	12'-9"	Str.						-
621	7	14'-0"	Str.						147
622	6	14'-6"	Str.						131
623	2	15'-9"	Str.						47
624	4	6'-10"	108	1'-11"	5'-0"	6			41
625	1	9'-9"	Str.						15
626	3	11'-9"	108	9'-11"	1'-11"	24			53
627	4	8'-6"	Str.						51
628	8	4'-0"	Str.						48
629	6	3'-6"	Str.						32
630	2	4'-9"	Str.						14
631	27	7'-9"	Str.						314
632	20	6'-0"	Str.						180
633	6	13'-3"	Str.						-
634	1	15'-3"	123	13'-2"	1'-3"	10"			23
635	2	16'-6"	Str.						50
636	3	12'-10"	124	10'-8"	6"	1'-11"	4		58
637	4	6'-3"	Str.						38
638	6	3'-0"	Str.						27
639	1	10'-6"	Str.						16
640	34	5'-6"	104	4'-10"	10"				281
									Total 7,541



REINFORCEMENT SCHEDULE FOR SOUTH ABUTMENT									
MARK	NO.	LENGTH	TYPE	DIMENSIONS				SERIES INCREMENT	WEIGHT (LBS)
				A	B	C	D		
401	34	5'-7"	105	8"	2'-7"				127
402	22	6'-7"	154	1'-10"	1'-4"				97
403	1 Ser. of 6	4'-3" to 5'-9"	154	8" to 1'-5"	1'-4"			3 3/8"	20
404	1	6'-3"	109	1'-10"	1'-1"				4
405	14	6'-4"	144	2'-3"	1'-10"				59
406	1 Ser. of 6	5'-11" to 6'-7"	154	1'-6" to 1'-10"	1'-4"			1 1/8"	25
501	40	4'-5"	105	1'-8"	1'-6"				184
601	10	28'-0"	Str.						421
602	2	6'-6"	104	5'-10"	10"				20
603	6	3'-0"	Str.						27
604	3	29'-9"	Str.						134
605	33	6'-9"	100	5'-5"					335
606	19	4'-6"	100	3'-2"					128
607	1	21'-0"	108	19'-1"	2'-0"	16			32
608	2	19'-6"	Str.						59
609	1	17'-6"	108	15'-0"	2'-7"	12			26
610	8	10'-0"	Str.						120
611	1	4'-0"	Str.						6
612	6	5'-3"	Str.						47
613	2	22'-3"	Str.						69
614	54	6'-1"	104	5'-5"	10"				493
615	39	5'-8"	104	5'-0"	10"				332
616	34	7'-9"	Str.						396
617	5	6'-3"	Str.						47
618	11	3'-6"	Str.						58
619	2	23'-6"	Str.						71
620	5	21'-9"	Str.						163
621	4	19'-7"	108	17'-8"	2'-0"	16			118
622	5	15'-9"	Str.						118
623	3	14'-0"	Str.						63
624	3	9'-3"	Str.						42
625	4	10'-4"	124	8'-2"	6"	1'-11"	9		62
626	1	8'-0"	Str.						12
627	6	20'-6"	Str.						-
628	1	4'-1"	123	2'-0"	1'-3"	10"			6
629	3	20'-3"	Str.						91
630	4	6'-10"	108	1'-11"	5'-0"	6			41
631	6	10'-3"	Str.						-
632	3	11'-9"	Str.						53
633	27	7'-1"	105	3'-5"	2'-0"				287
634	38	15'-11"	112	1'-5"	5'-9"				908
635	10	15'-1"	109	1'-5"	5'-9"				227
636	6	28'-6"	Str.						257
637	7	21'-3"	Str.						223
638	2	19'-0"	Str.						57
639	2	30'-6"	Str.						92
640	3	11'-0"	Str.						50
641	1 Ser. of 4	28'-6" to 30'-6"	Str.					8"	177
642	1 Ser. of 4	19'-0" to 21'-3"	Str.					9"	121
643	1	17'-6"	Str.						26
644	8	5'-6"	Str.						66
645	8	4'-3"	Str.						51
646	3	3'-9"	Str.						17
647	4	6'-0"	Str.						36
648	3	5'-0"	Str.						23
649	1	13'-7"	124	10'-0"	1'-10"	2'-0"	9		20
									Total 6,744

Note:
All chamfers to be 3/4"

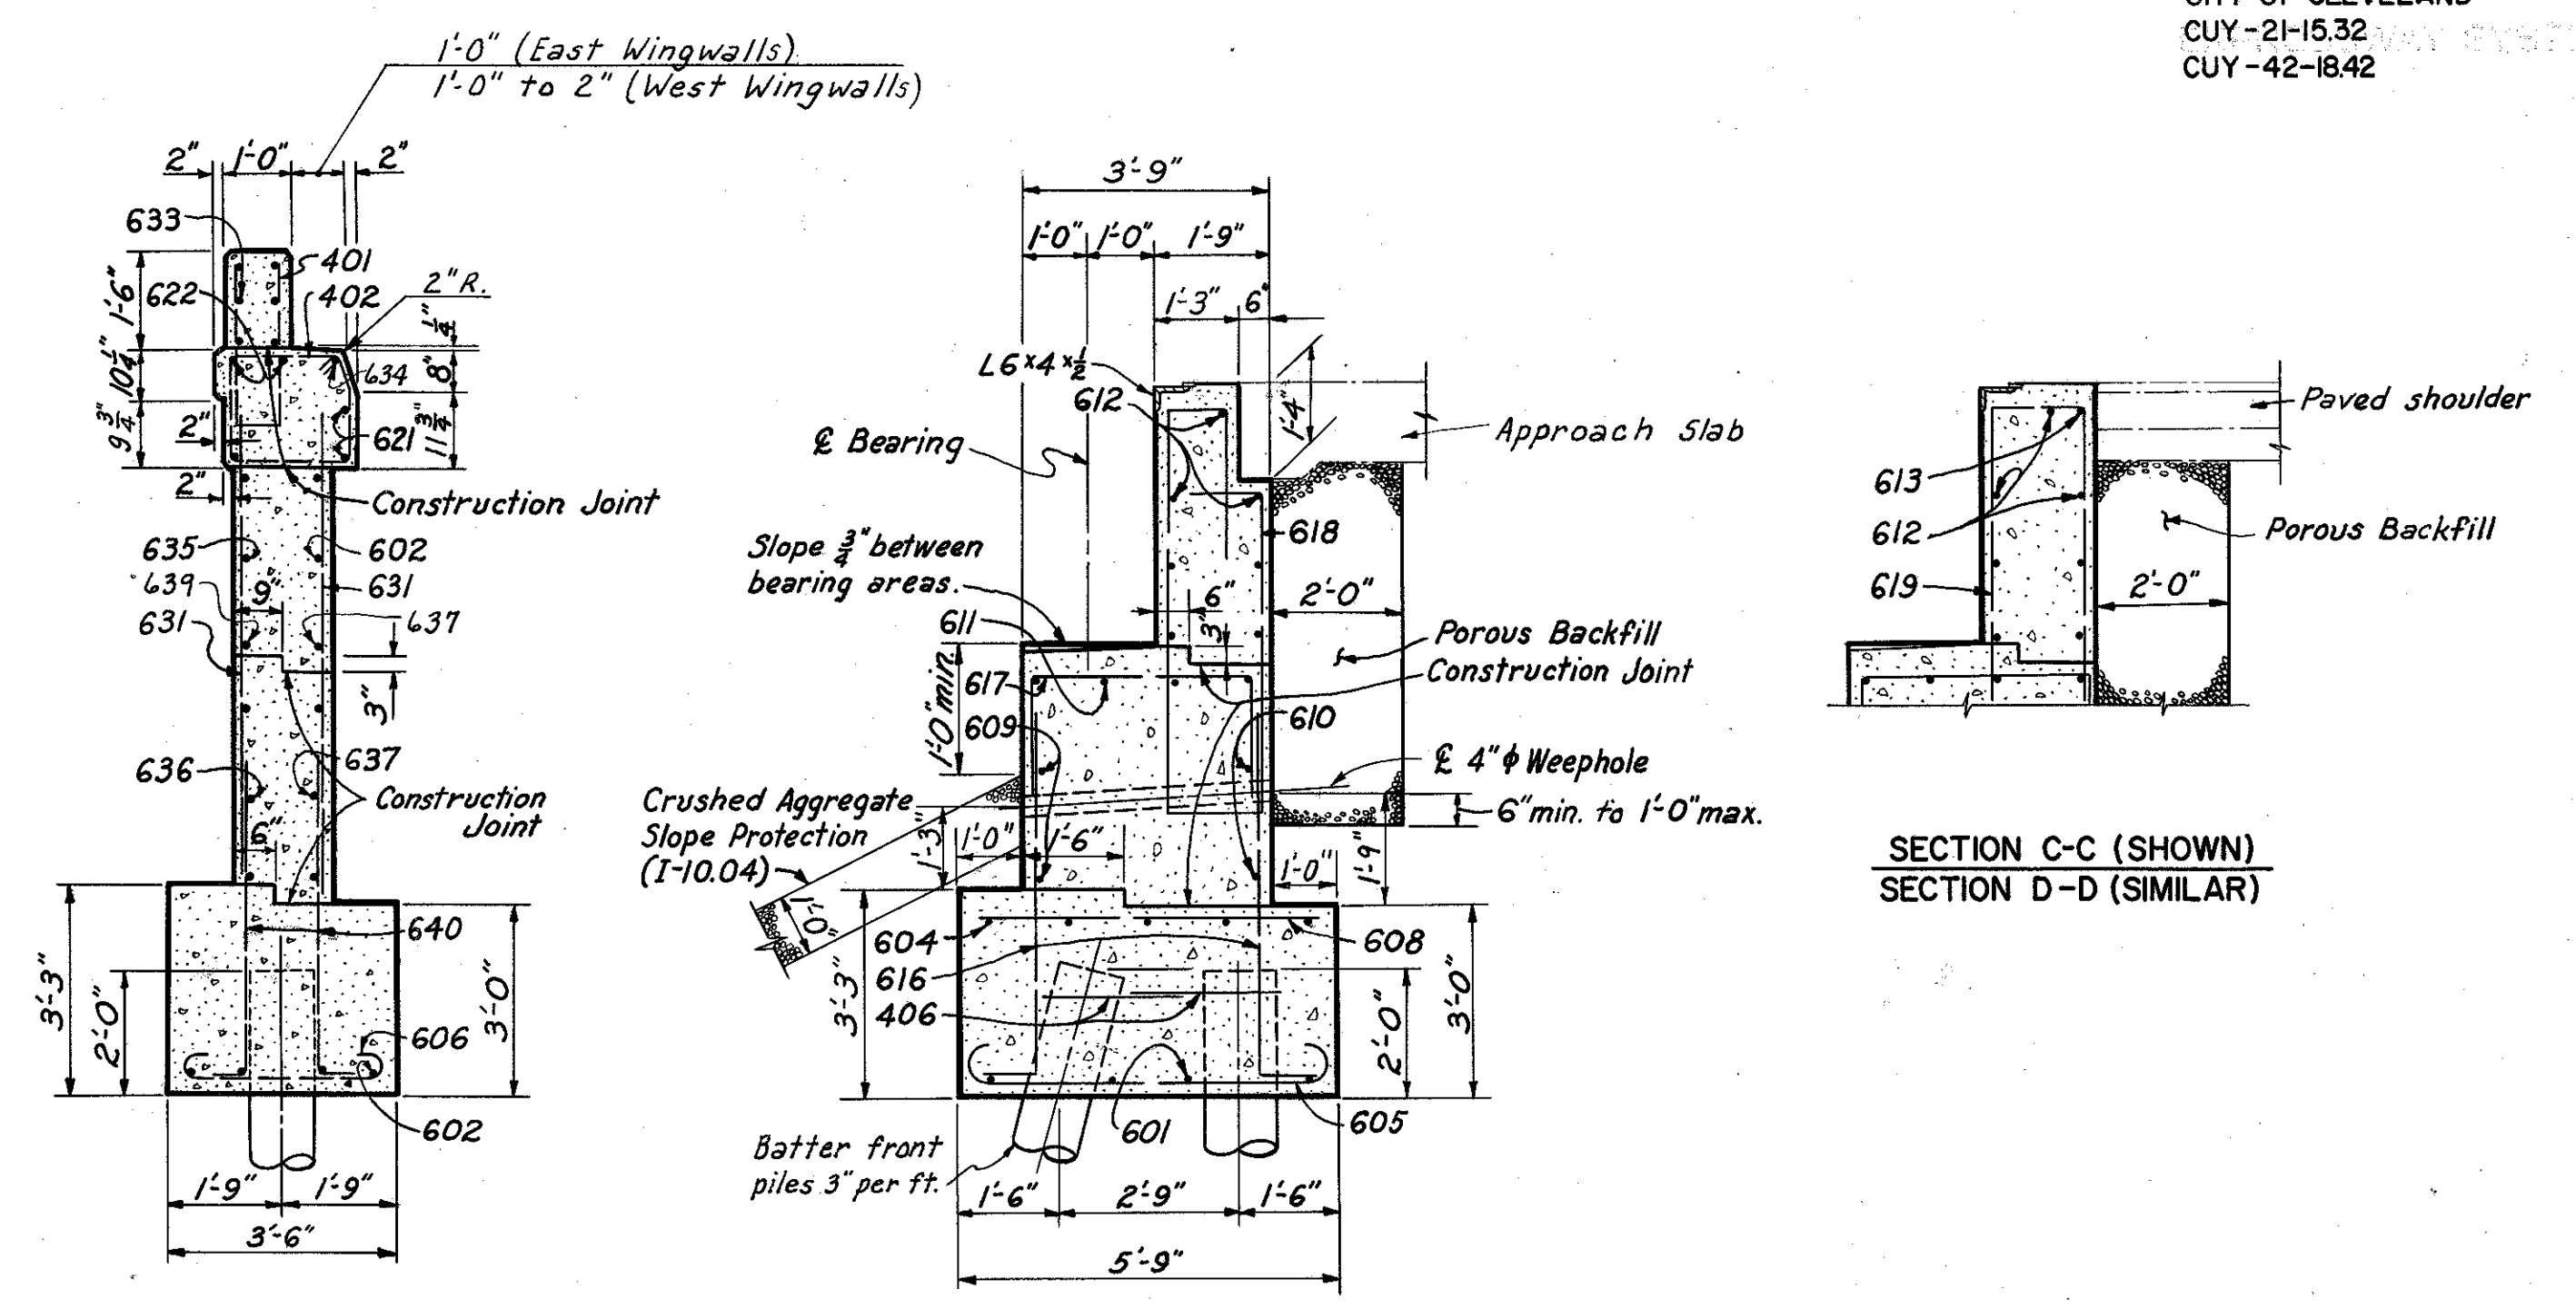

SECTION G-G (SHOWN)
SECTION F-F (SIMILAR)


SECTION H-H (SHOWN)
SECTION E-E (SIMILAR)

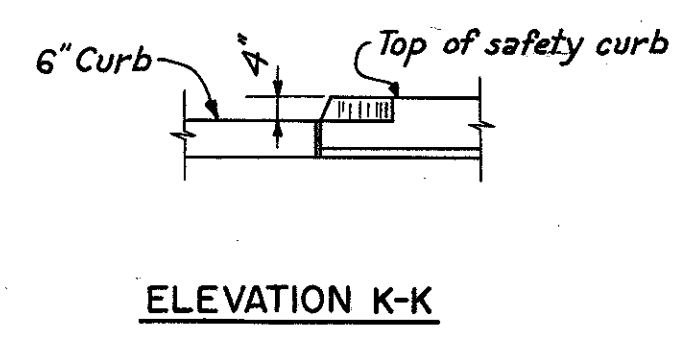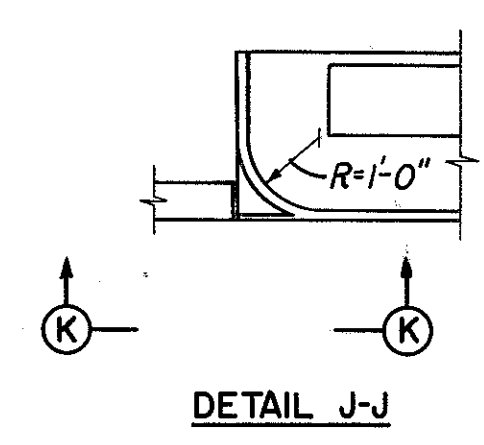

NOTES:
* Bars are included with "Item S-14, Railing" for payment.
Bar dimensions are given out to out.
Bars of a series shall vary in length by a constant increment.
For replacement schedule see sheet 103-7A
For additional notes, see sheet 141-7A

Note: Prefixes shall be assigned to bar marks as follows:
North Abutment: "AA"
South Abutment: "AB"

BENDING DIAGRAMS

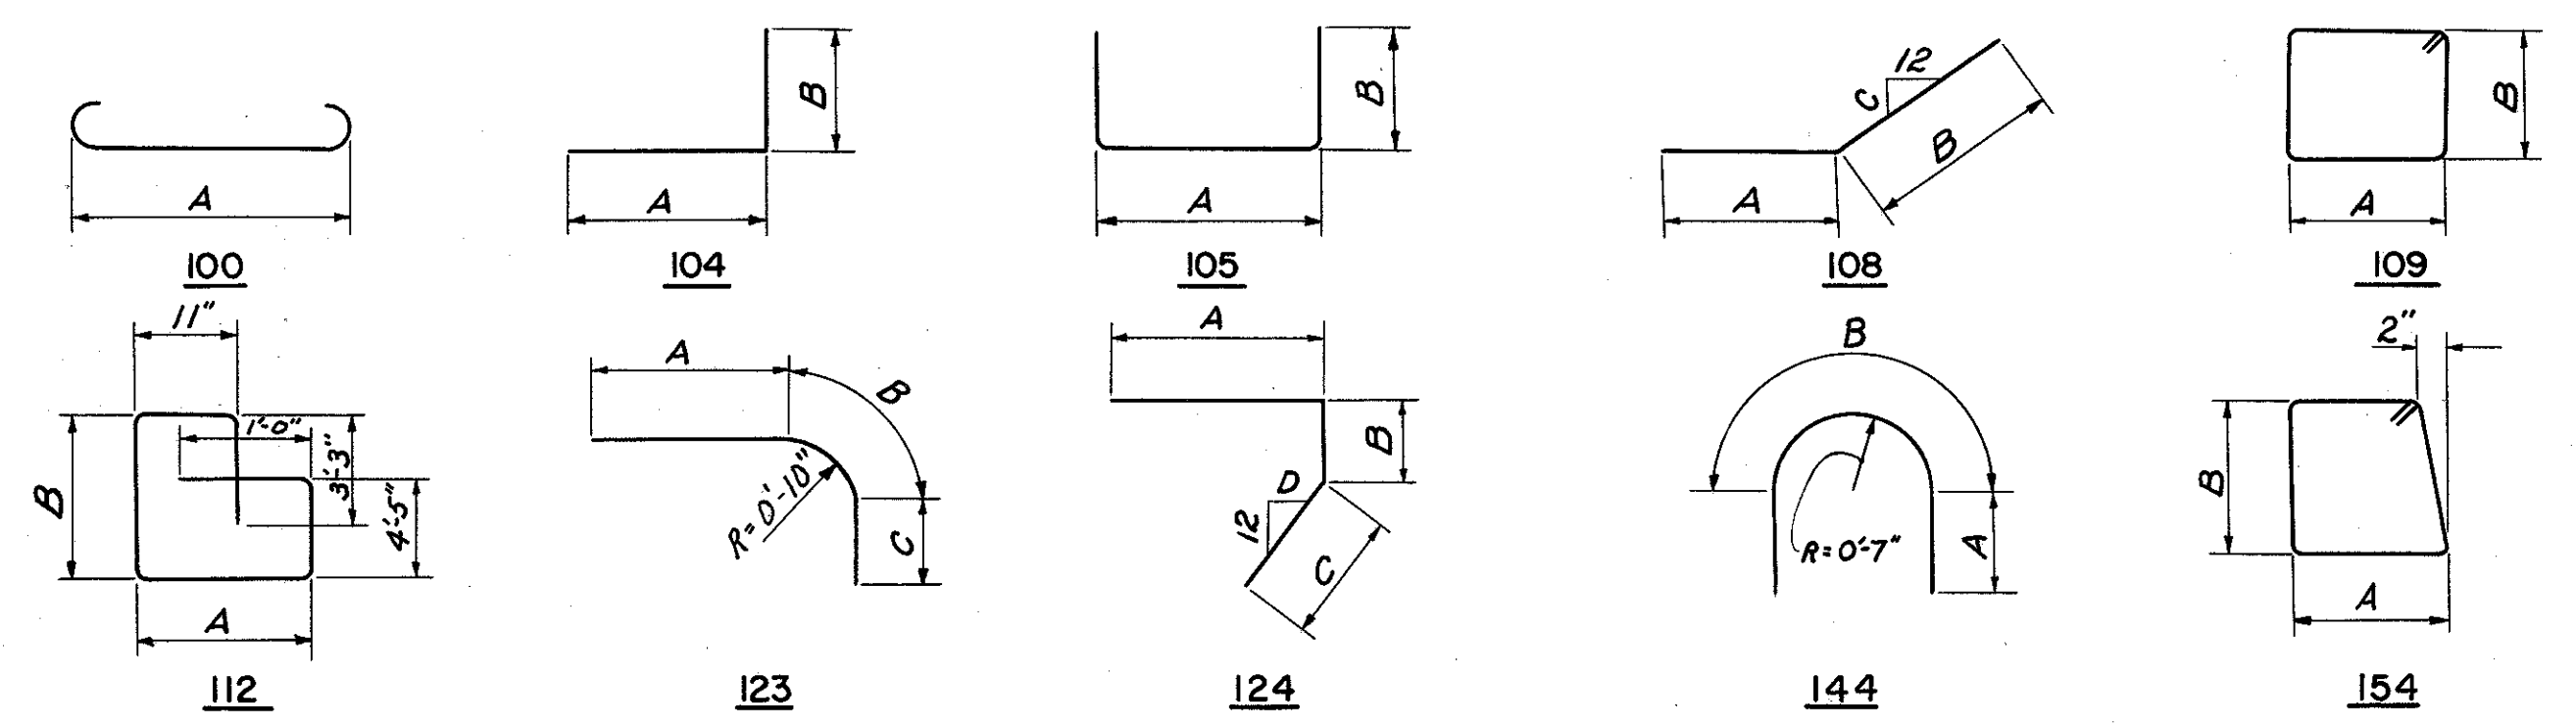

H.N.T.B. BR. NO. 5 PART 7/A

HOWARD, NEEDLES, TAMMEN & BERGENDOFF
CONSULTING ENGINEERS
KANSAS CITY CLEVELAND NEW YORK

ABUTMENT DETAILS
RAMP E-10 OVER RAMP E-8

Scale: 3/8" = 1'-0" STA. 8+19.83
STA. 9+38.16


WILLOW-INNER BELT FREEWAY
CLEVELAND CUYAHOGA COUNTY OHIO

DRAWN A.B. TRACED A.M. CHECKED R.C. REVIEWED J.C.T. REVISED
DATE 6-28-58 DATE 3-7-59 DATE 7-31-58 DATE 11-13-59

SHEET 142


JUL 8 1955

CUYAHOGA COUNTY
CITY OF CLEVELAND
CUY-21-15.32
CUY-42-18.42

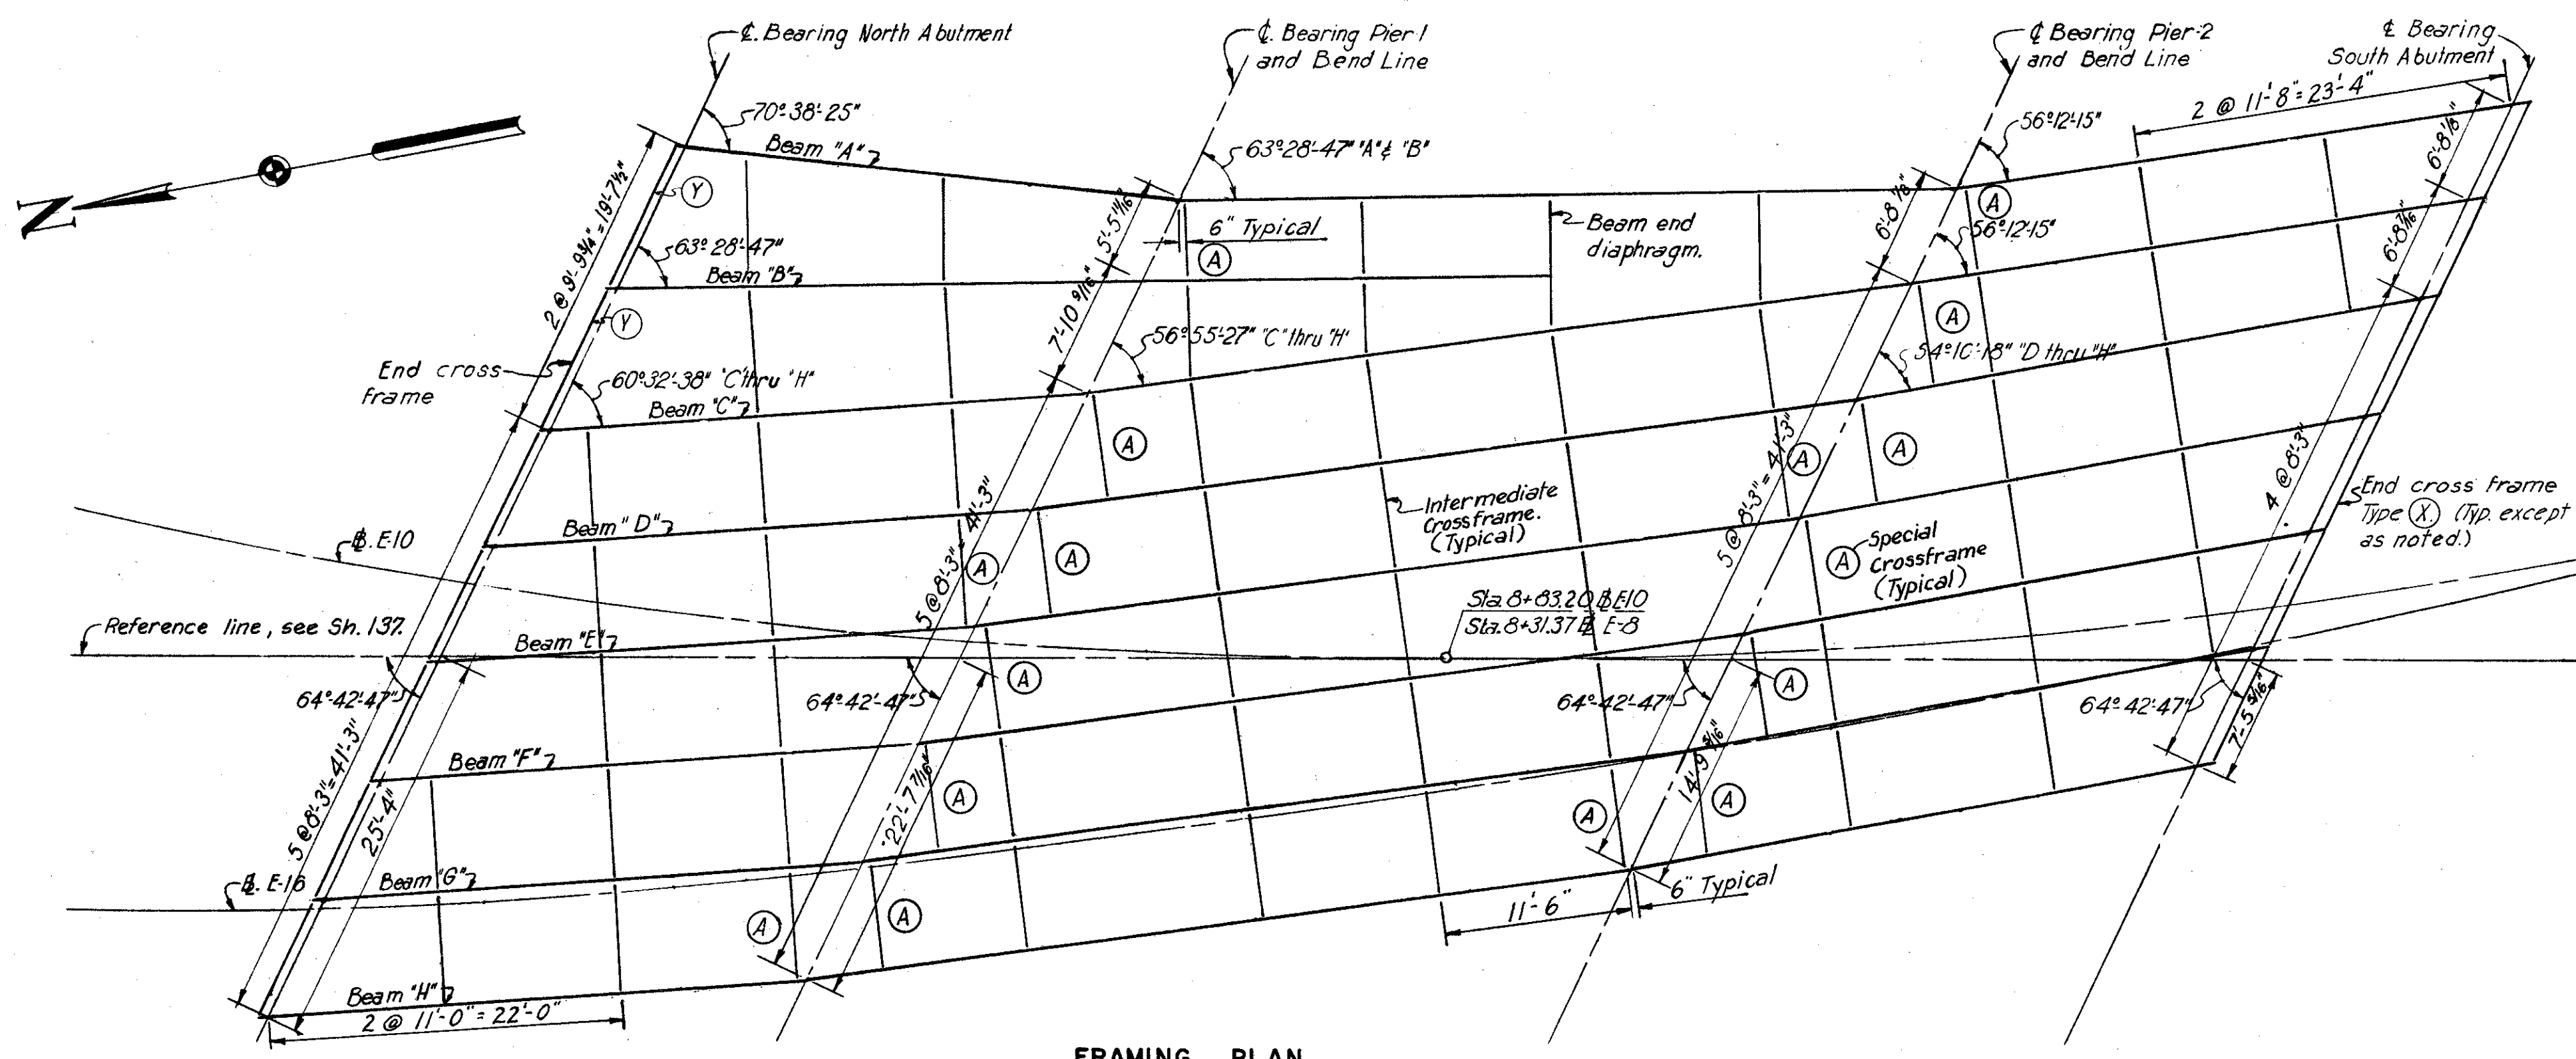




BEAM SPLICE WELDING PROCEDURE

- 1- With the beams in their final position, butt-weld the beam flanges and web at the piers, using the following sequence; make two passes on each flange, then two on the web; repeat, using one pass at each location, until welds are completed.
- 2- Weld bottom and top cover plates.
- 3- Weld Type 'A' cross frames into position.

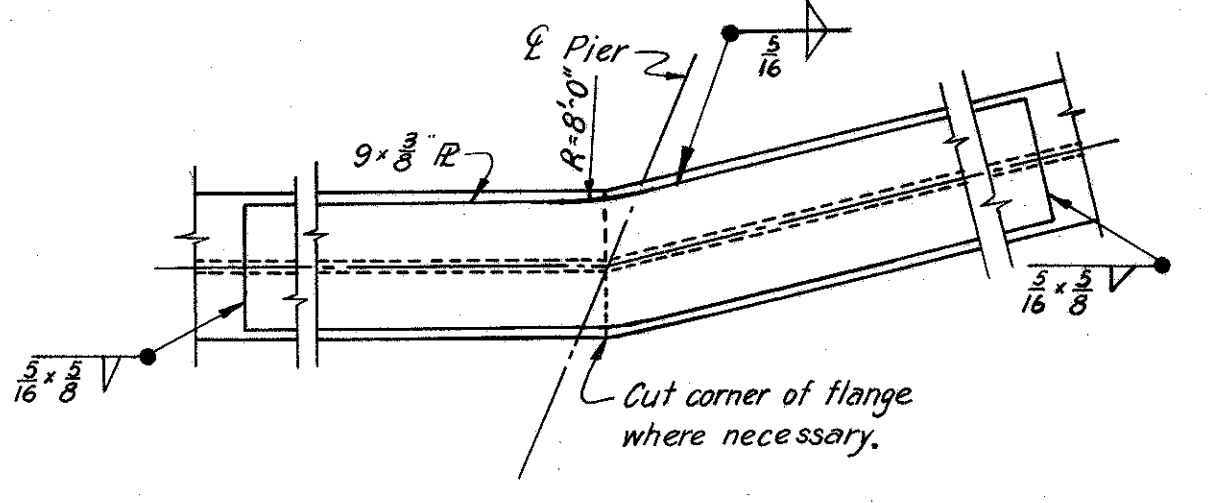

NOTES:

Cover Plates may be fabricated from a single wide plate or from two plates butt welded for full strength and ground smooth in the shop. The splice shall be a minimum of 2'-0" from the bend point.
"G" indicates a smooth grind in the direction of the stress.

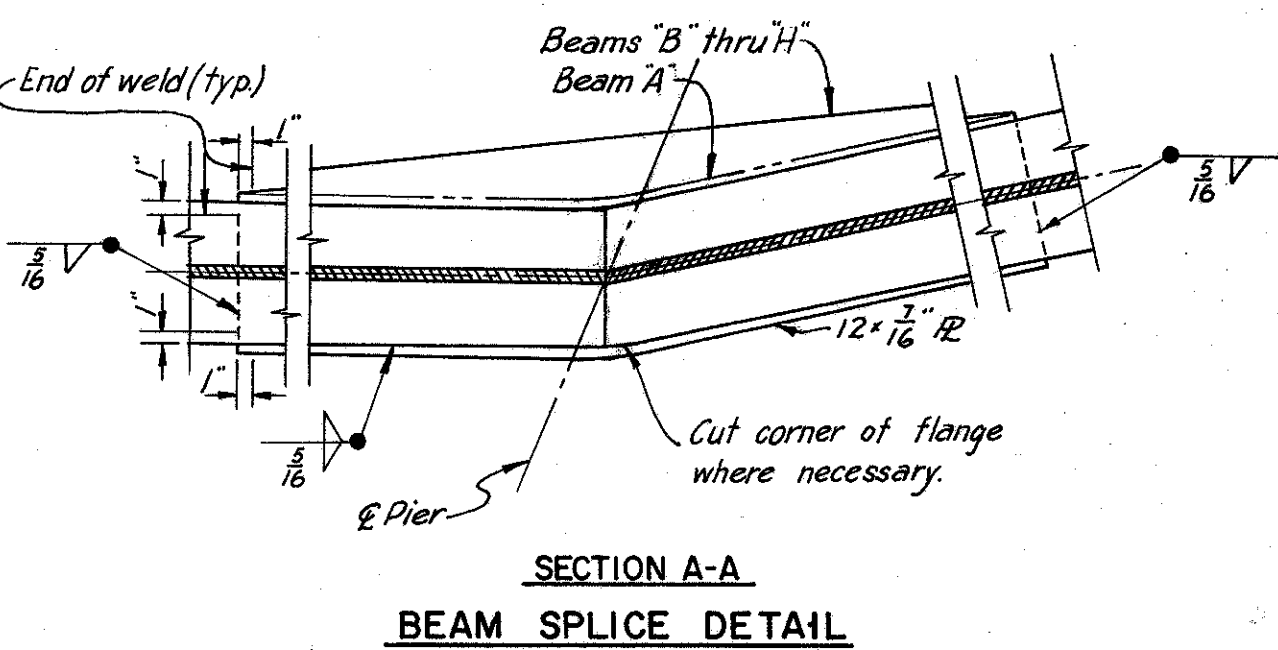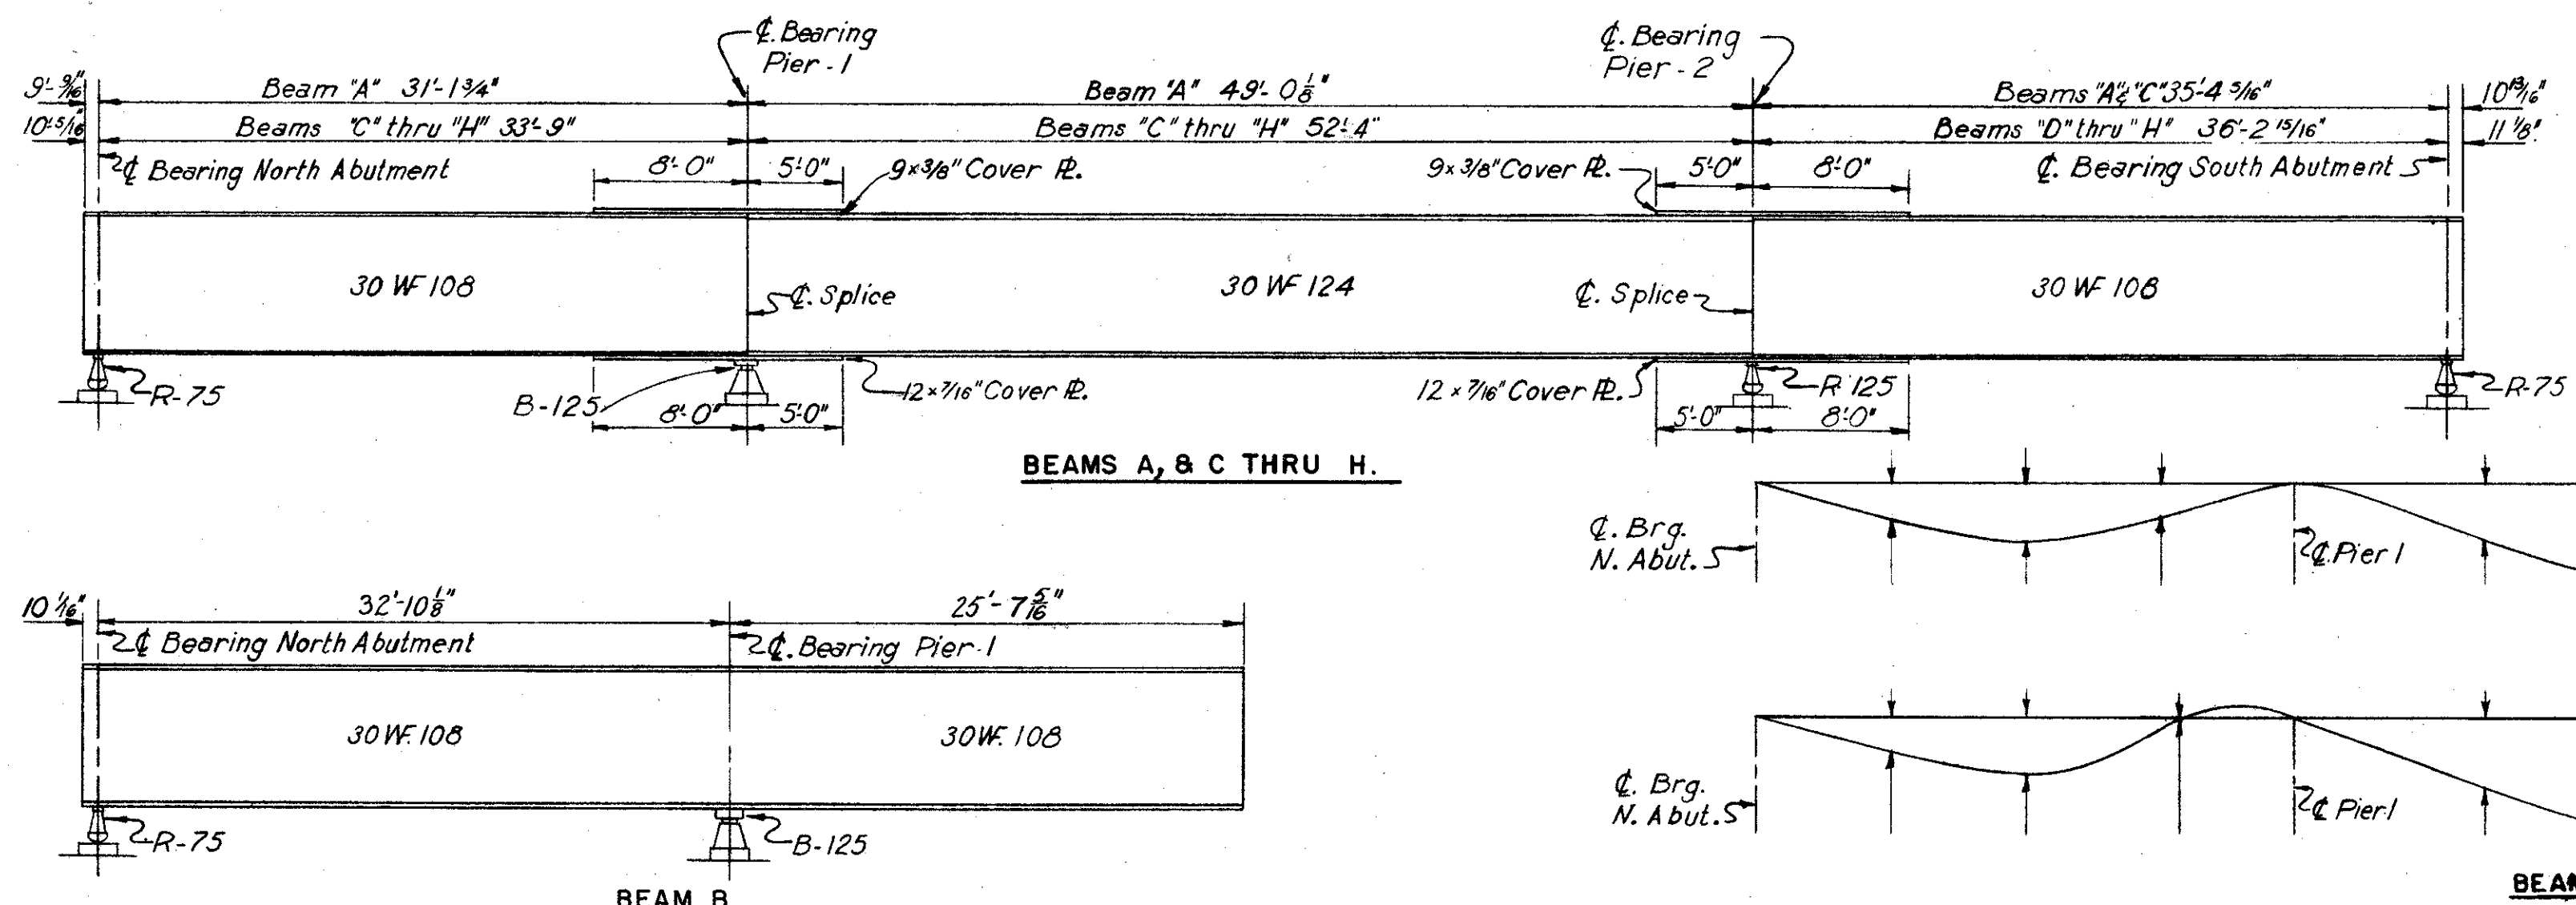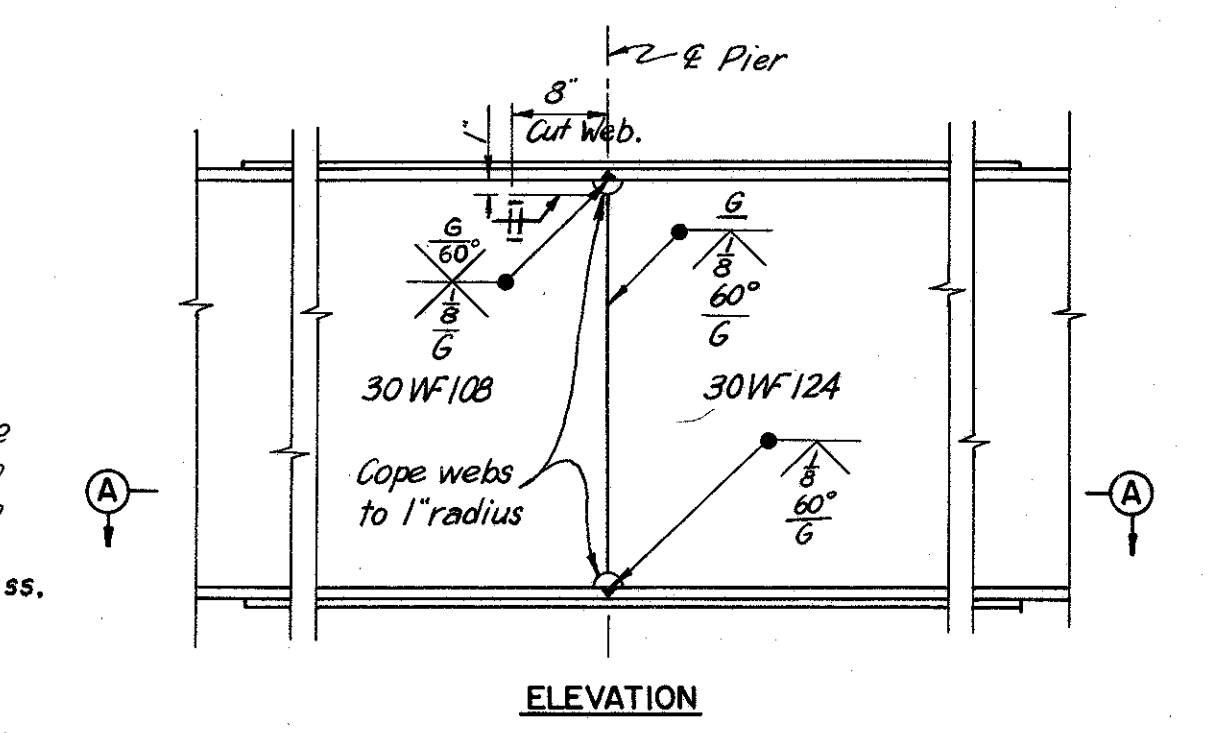

NOTES:

For details of end dams, see Sh. 173-7A
For cross frame details, see Sh. 144-7A
For details of rocker masonry plates, see Sh. 173-7A
For other rocker details and details of bolsters, see Ohio Standards Sh. RB-1-55.

No cambering of the beams is required, but they shall be so fabricated and erected that any curved beam shall be placed with the convex flange up.

Elevations shown in table are located at intersection of E bearings & E beams

Deflections are given at the quarter points and are measured to the nearest 1/16 inch.

(D.L. Defl.) - denotes dead load deflections.
(Tot.) - refers to the total deflection from dead load of steel and concrete.
(Con.) - denotes deflections for concrete.
(PVMT) - denotes pavement.

BEAM	DEFLECTION & ELEVATION TABLE																															
	NORTH ABUTMENT						SPAN 1						PIER 1		SPAN 2						PIER 2		SPAN 3						SOUTH ABUTMENT			
	TOP OF BEAM ELEV.	TOP OF PVMT. ELEV.	TOP OF PVMT. ELEV.	DL DEF. CON.	DL DEF. TOT.	PVMT. ELEV.	DL DEF. CON.	DL DEF. TOT.	PVMT. ELEV.	DL DEF. CON.	DL DEF. TOT.	PVMT. ELEV.	DL DEF. CON.	DL DEF. TOT.	PVMT. ELEV.	DL DEF. CON.	DL DEF. TOT.	PVMT. ELEV.	DL DEF. CON.	DL DEF. TOT.	PVMT. ELEV.	DL DEF. CON.	DL DEF. TOT.	PVMT. ELEV.	DL DEF. CON.	DL DEF. TOT.	PVMT. ELEV.	DL DEF. CON.	DL DEF. TOT.	PVMT. ELEV.		
A	676.25	677.00	677.02	0	0	677.05	0	0	677.10	0	0	676.29	677.16	677.19	0	0	677.25	0	0	676.48	677.35	677.35	0	0	677.37	0	0	677.40	0	0	676.71	677.46
B	676.99	677.74	677.67	1/16	1/16	677.62	1/16	1/16	677.58	0	0	676.69	677.56	677.19	1/16	1/16	677.25	1/16	1/16	676.48	677.35	677.35	0	0	677.37	1/16	1/16	677.40	1/16	1/16	676.71	677.46
C	677.73	678.48	678.37	1/16	1/16	678.27	1/16	1/16	678.19	0	0	677.26	678.13	677.99	1/16	1/16	677.89	1/16	1/16	676.93	677.80	677.79	0	0	677.80	1/16	1/16	677.83	1/16	1/16	677.13	677.83
D	678.35	679.10	678.99	1/16	1/16	678.89	1/16	1/16	678.80	0	0	677.86	678.73	678.58	1/16	1/16	678.47	1/16	1/16	678.40	678.36	678.32	0	0	678.29	1/16	1/16	678.29	1/16	1/16	677.55	678.30
E	678.98	679.73	679.60	1/16	1/16	679.50	1/16	1/16	679.41	0	0	678.47	679.34	679.18	1/16	1/16	679.06	1/16	1/16	678.97	678.92	678.87	0	0	678.84	1/16	1/16	678.83	1/16	1/16	678.08	678.83
F	679.61	680.36	680.23	1/16	1/16	680.12	1/16	1/16	680.02	0	0	679.07	679.94	679.78	1/16	1/16	679.65	1/16	1/16	679.55	679.49	679.43	0	0	679.39	1/16	1/16	679.37	1/16	1/16	678.61	679.36
G	680.24	680.99	680.85	1/16	1/16	680.74	1/16	1/16	680.64	0	0	679.68	680.55	680.38	1/16	1/16	680.24	1/16	1/16	680.13	680.06	679.99	0	0	679.95	1/16	1/16	679.91	1/16	1/16	679.15	679.90
H	680.34	681.09	680.99	0	0	680.88	0	0	680.76	0	0	679.77	680.64	680.49	0	0	680.35	0	0	679.24	680.11	680.11	0	0	680.00	0	0	679.95	0	0	679.16	679.91

H.N.T.B. BR. NO. 5 PART 7A

HOWARD, NEEDLES, TAMMEN & BERGENDOFF
CONSULTING ENGINEERS
KANSAS CITY CLEVELAND NEW YORK



FRAMING PLAN
RAMP E-10 OVER RAMP E-8

Scale: 1/8" = 1'-0"
Except as noted

STA. 8 + 19.83
STA. 9 + 38.16









WILLOW-INNER BELT FREEWAY
CLEVELAND CUYAHOGA COUNTY OHIO

DRAWN N.N. TRACED H.L. CHECKED J.C.T. REVISIONS
DATE 4/17/58 DATE 4/29/58 DATE 11-13-59 SHEET 143

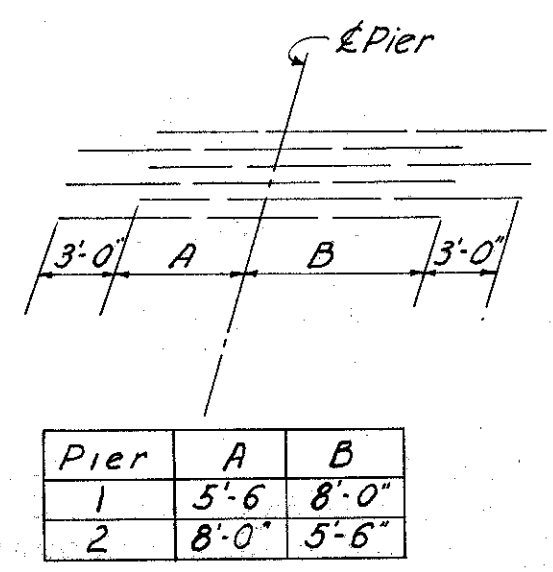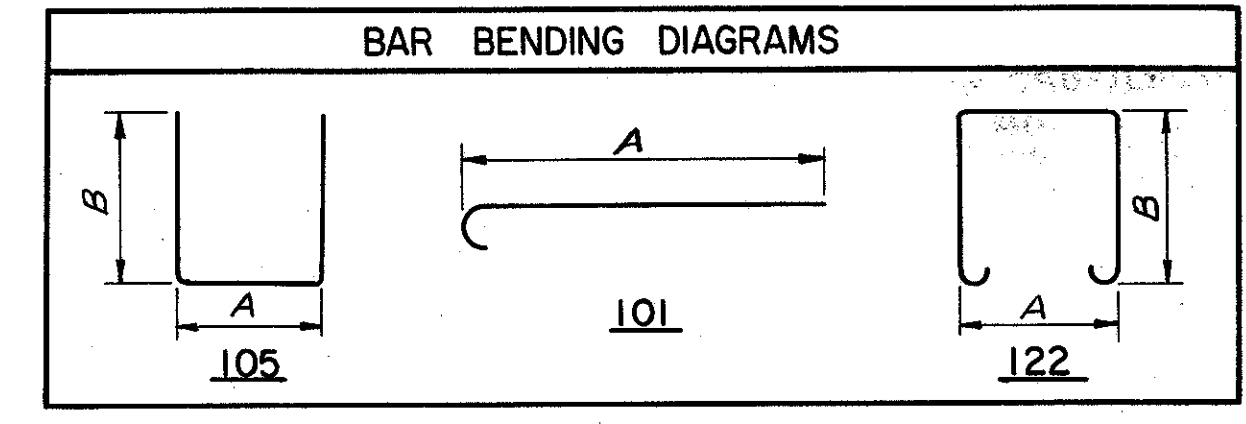

REINFORCEMENT SCHEDULE

MARK	NO.	LENGTH	TYPE	DIMENSIONS		SERIES INCREMENT	WEIGHT	
				A	B			
401	250	4'-5"	105	8"	2'-0"		738	
402	243	5'-1"	122	1'-8"	1'-4"		825	
501	94	16'-6"	Str.				1617	
502	2	32'-9"	Str.				68	
503	202	28'-1"	101	27'-6"			5917	
504	1	12'-0"	Str.				12	
505	6	30'-6"	Str.				191	
506	184	32'-3"	Str.				6189	
507	1 Ser. of 5	5'-9" to 26'-9"	Str.			5'-3"	85	
508	1 Ser. of 4	6'-9" to 26'-9"	Str.			6'-8"	70	
509	1 Ser. of 3	8'-9" to 26'-9"	Str.			9'-0"	56	
510	10	6'-7"	101	6'-0"			69	
511	1 Ser. of 40	7'-7" to 40'-7"	101	7'-0" to 40'-0"		10 3/8"	1005	
512	3	26'-0"	Str.				81	
513	1 Ser. of 21	15'-1" to 30'-7"	101	14'-6" to 30'-0"		9 3/8"	500	
514	1 Ser. of 91	22'-4" to 31'-7"	101	22'-3" to 31'-0"		1 1/8"	2583	
515	1 Ser. of 91	17'-4" to 22'-10"	101	16'-9" to 22'-3"		3/4"	1906	
516	1 Ser. of 51	7'-4" to 40'-7"	101	6'-9" to 40'-0"		8"	1214	
601	72	16'-0"	Str.					
602	6	4'-9"	Str.					
603	6	13'-0"	Str.					
604	12	12'-3"	Str.					
605	220	30'-9"	Str.				10161	
606	196	32'-6"	Str.				9568	
607	1 Ser. of 5	5'-9" to 26'-9"	Str.			5'-3"	122	
608	1 Ser. of 4	7'-0" to 27'-0"	Str.			6'-8"	102	
609	1 Ser. of 3	9'-0" to 27'-0"	Str.			9'-0"	81	
610	10	6'-0"	Str.				90	
611	1 Ser. of 40	7'-0" to 40'-0"	Str.			10 1/8"	1412	
612	1	29'-6"	Str.				44	
613	1 Ser. of 21	11'-9" to 26'-9"	Str.			9"	607	
614	1 Ser. of 91	19'-3" to 27'-9"	Str.			1 1/8"	3212	
615	1 Ser. of 91	13'-9" to 19'-3"	Str.			3/4"	2256	
616	1 Ser. of 51	6'-9" to 40'-0"	Str.			8"	1791	
							Total	52632

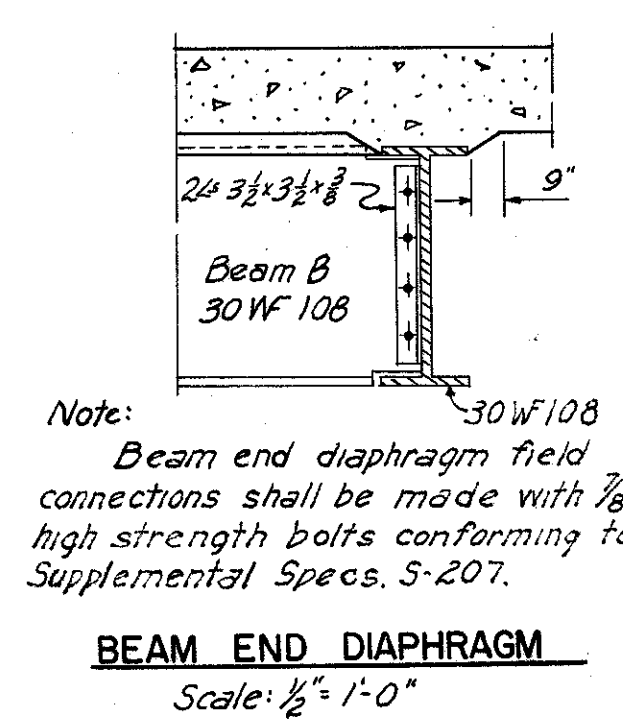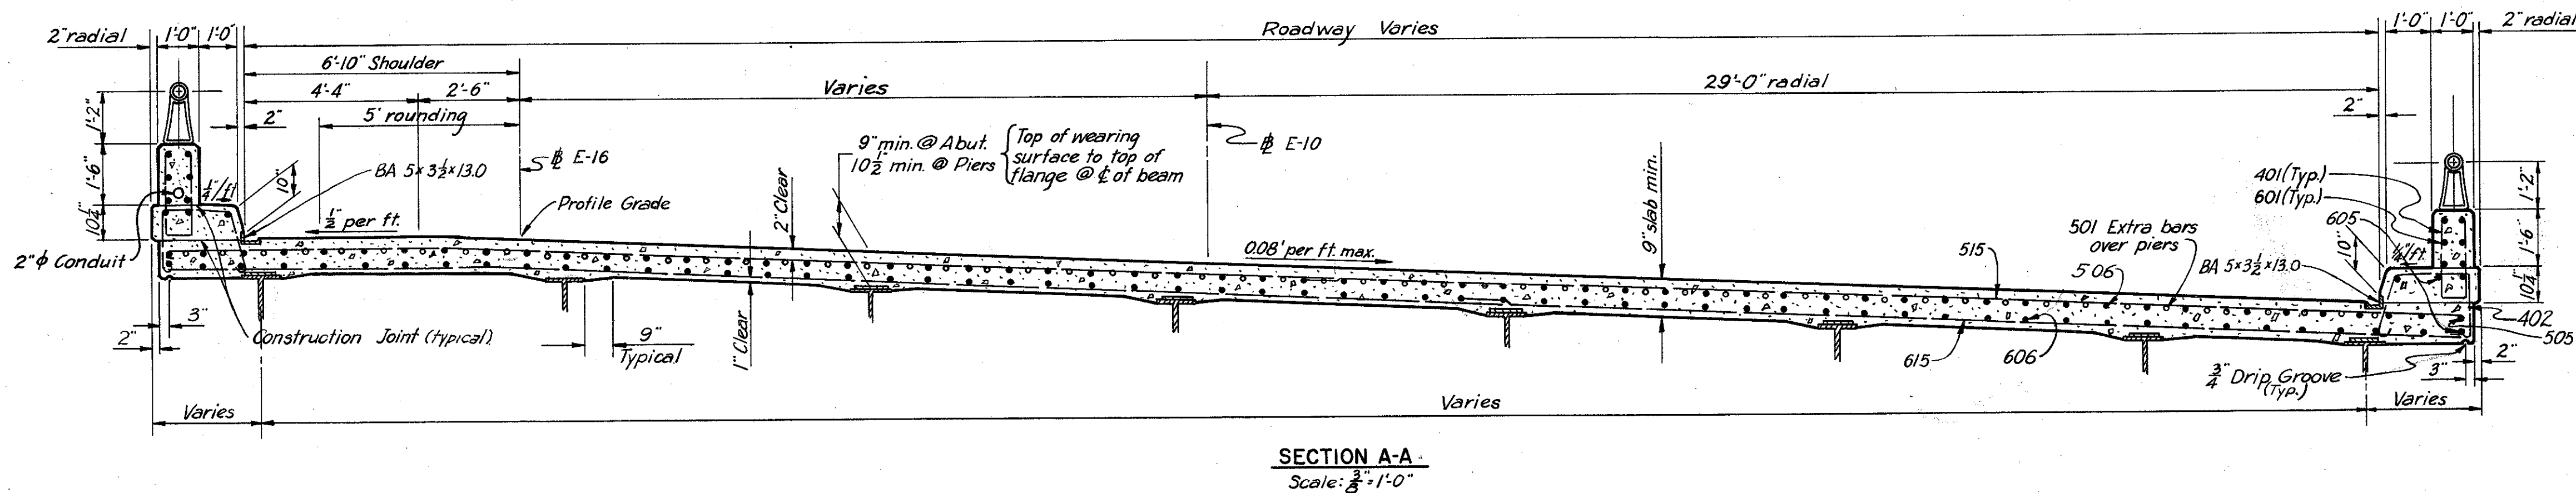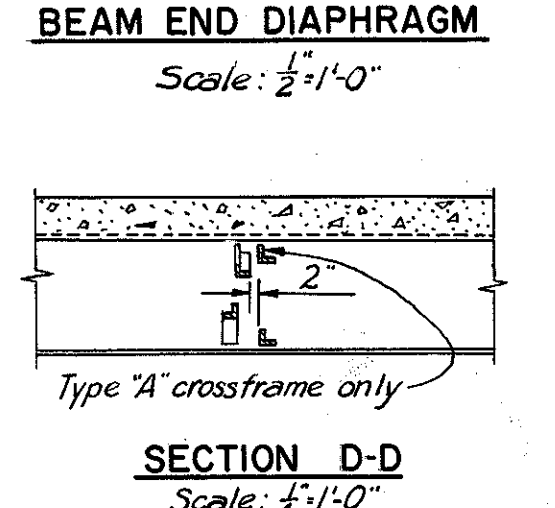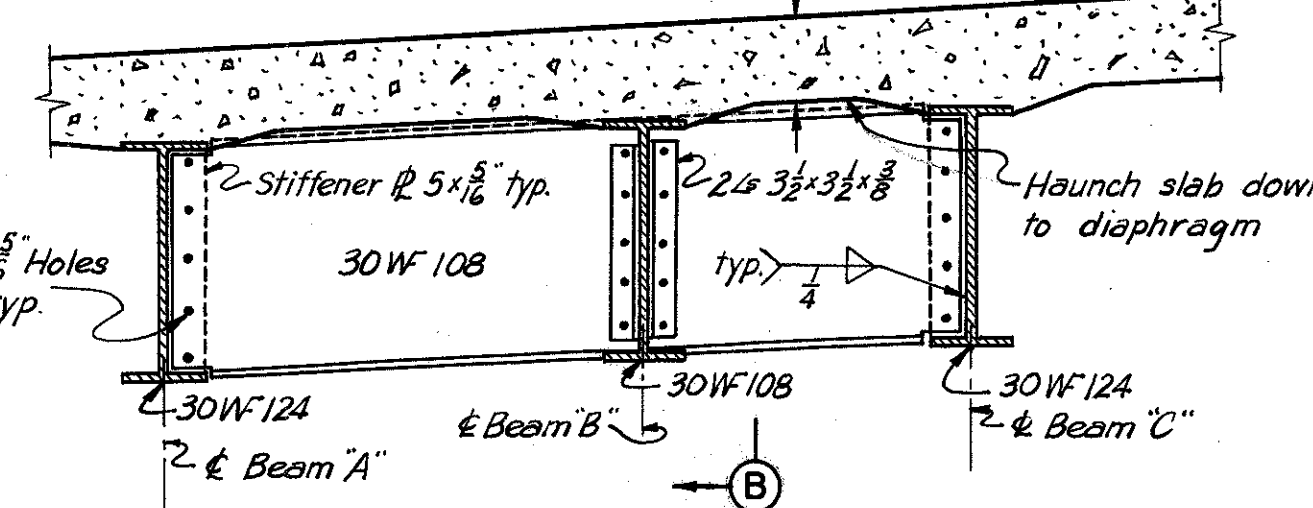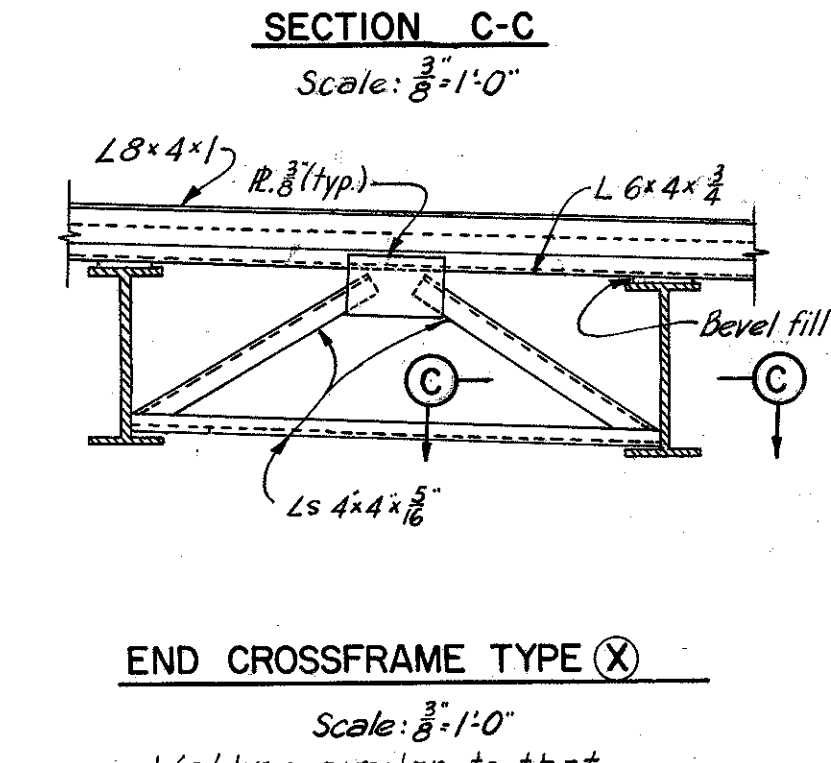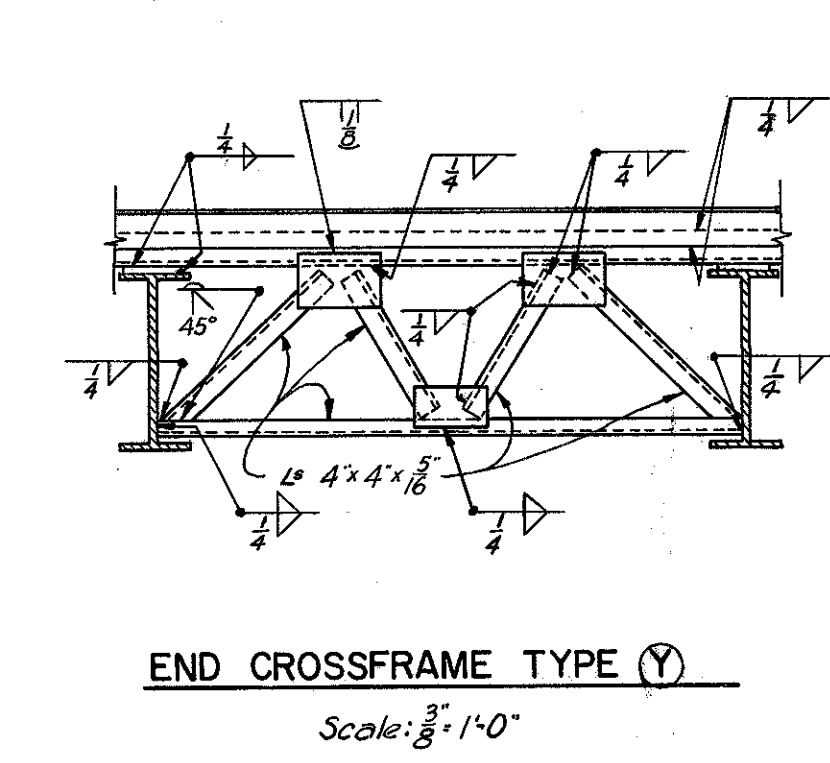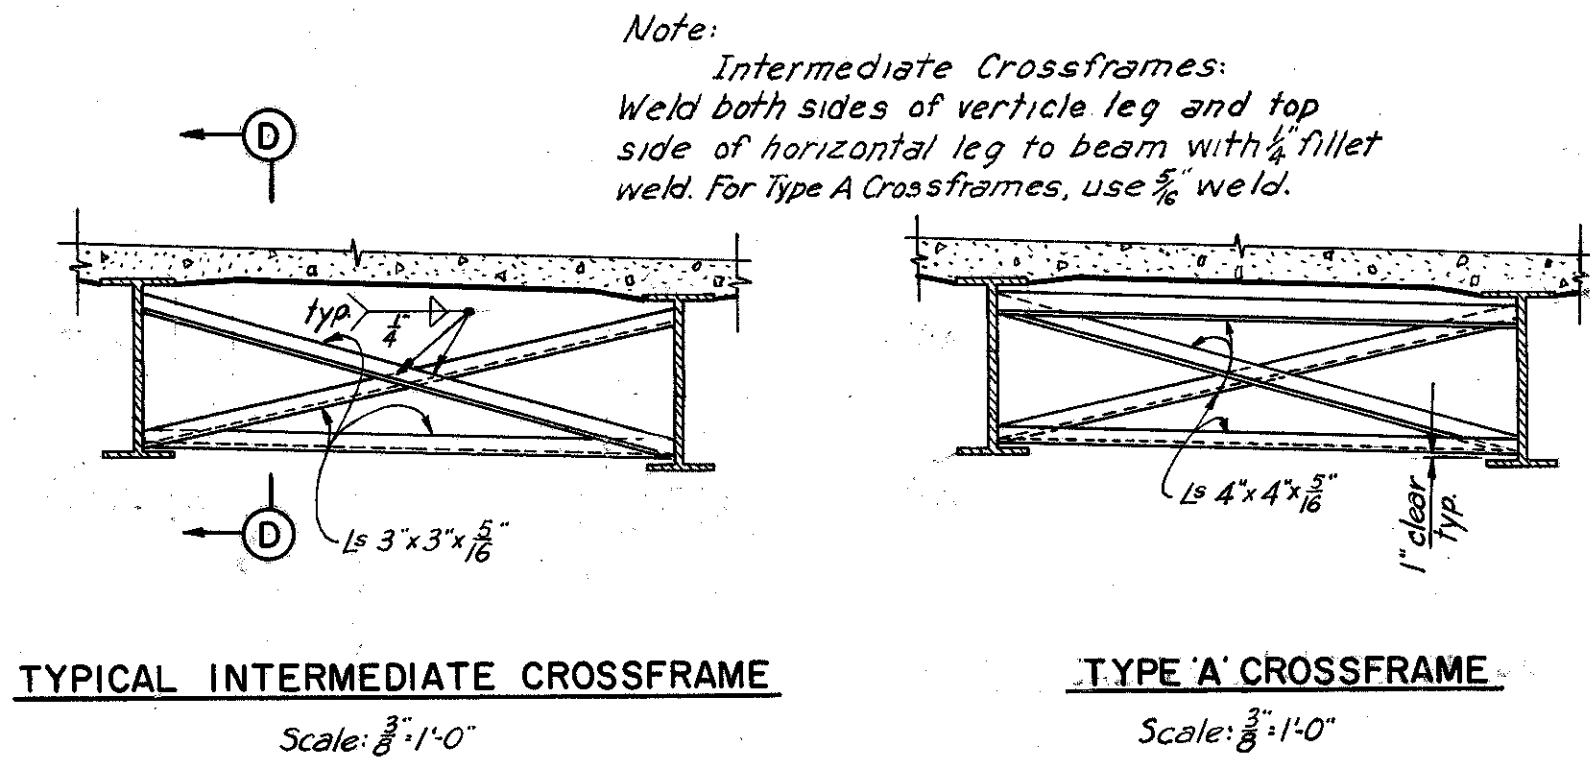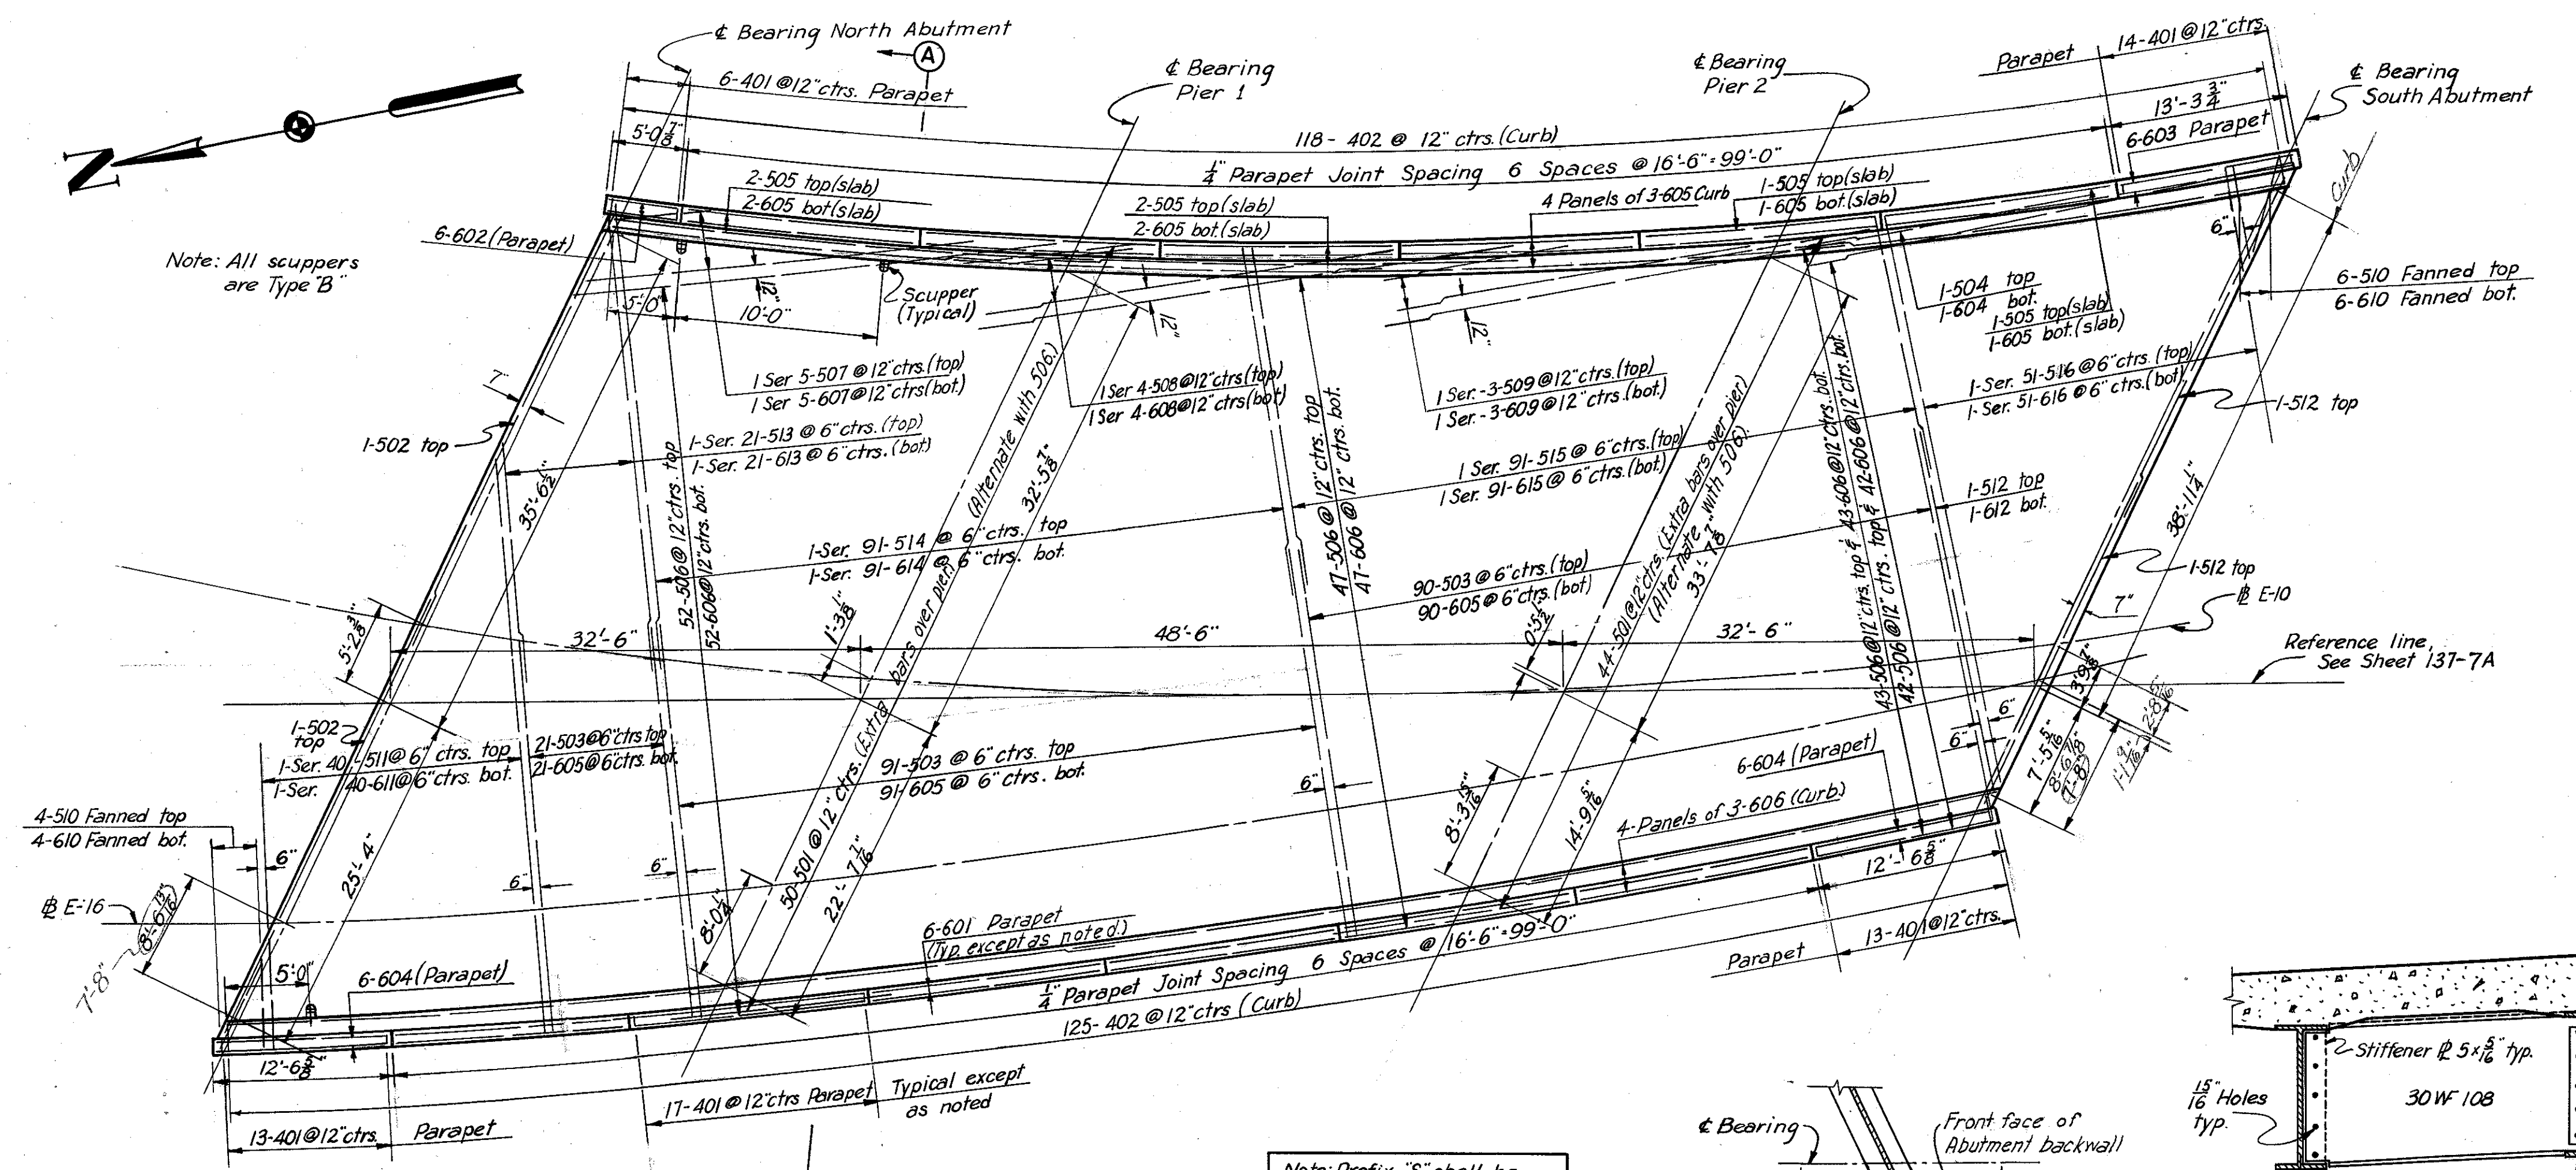

NOTES:

- Bars of a series shall vary in length by a constant increment. For replacement schedule, see Sheet 103-7A.
- All bar dimensions are given out to out.
- † Bars are included with "Item S-14, Railing" for payment.
- For drainage details, see Sheet 174-7A.
- For Railing and Parapet Joint details, see Sheet 175-7A.
- In order to facilitate water curing of the concrete of the deck slab, the placing of concrete shall progress upgrade. The slab may be placed in sections, between transverse construction joints which are parallel to transverse bars in the slab, and are located near the center of any span.
- For Lighting details, see Sheet 176-7A.
- For End Finish details not shown see Sheet 156-7A.

H.N.T.B. BR. NO. 5 PART 7A
 HOWARD, NEEDLES, TAMMEN & BERGENOFF
 CONSULTING ENGINEERS
 KANSAS CITY CLEVELAND NEW YORK

DECK PLAN
RAMP E-10 OVER RAMP E-8
 Scale: 1/8" = 1'-0" STA. 8+19.83
 Except as noted STA. 9+38.16

WILLOW-INNER BELT FREEWAY
 CLEVELAND CUYAHOGA COUNTY OHIO

DRAWN N.N. TRACED H.R.H. CHECKED G.T. REVIEWED J.C.T. REVISION 1-12-61
 DATE 9-25-58 DATE 5-7-59 DATE 3-11-59 DATE 11-13-59 SHEET 144

210

MICROFILMED
JUL 2 1985

FED. ROADS DIV. NO.	STATE	FED. AID PROJ. NO.
2	OHIO	

145
181


CUYAHOGA COUNTY
CITY OF CLEVELAND
CUY-21-15.32
CUY-42-18.42

LEGEND

- Existing R/W
- Existing Edge of Pavement
- Existing Sewer
- OBT Line
- Water Line
- Gas Line
- Street Lights
- CEI Line
- Existing Manhole
- Existing Catch Basin
- *Sewers
- *Inlets
- *Manholes
- *2" Duct
- *4" Duct
- * Built under previous contract.

CURVE DATA


- Willow Freeway
Δ = 23°06'48"
D = 3°00'00"
R = 1909.86'
T = 390.54'
L = 770.50'
- Ramp E-17
Δ = 60°33'40"
D = 9°45'00"
R = 587.65'
T = 343.13'
L = 621.14'

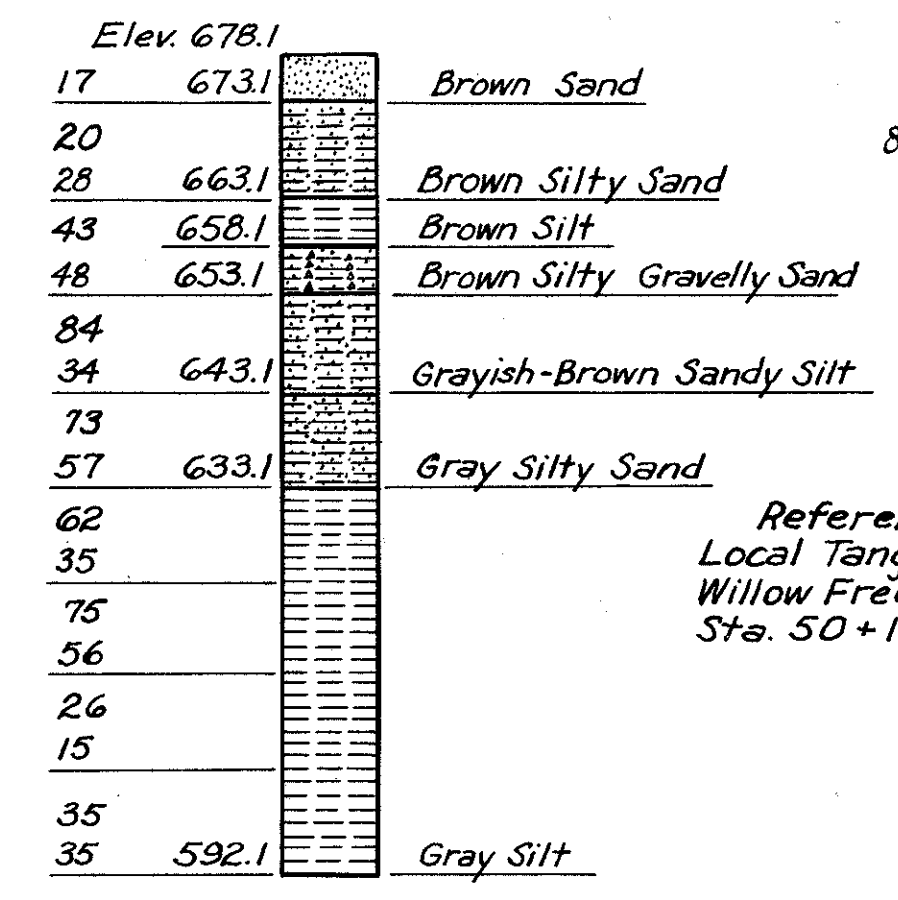

BORING 121

Vertical Scale: 1"=20'
Sta. 14+63.1 Ramp E-15 33' Rt.

Note: The figures to the left indicate the number of hammer blows required to drive the sampling spoon 1 ft. They are given at 5' intervals starting at elev. 678.1.

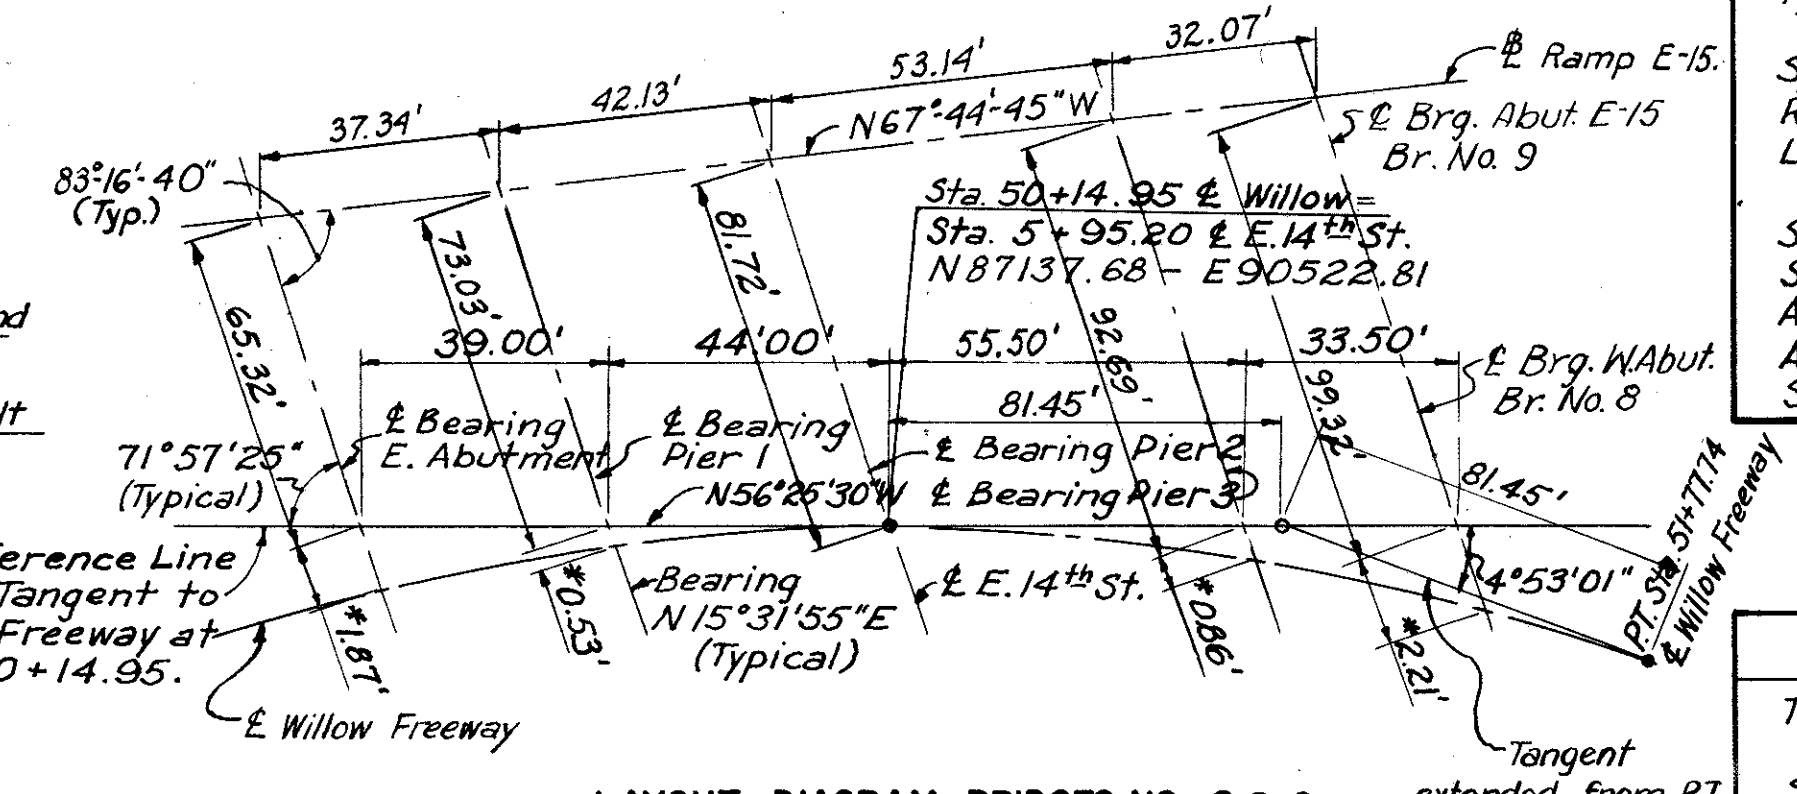

LAYOUT DIAGRAM BRIDGES NO. 8 & 9


No Scale
*Offsets measured from reference line to Willow Freeway along bearings.

PROPOSED STRUCTURE BR. NO. 8

Type: Continuous steel beam with reinforced concrete deck and substructure.
Spans: 38'-7 1/2", 43'-10", 55'-9 1/2", 33'-11 1/2" along Willow Freeway.
Roadway: 84'-0" (nominal) face to face parapets.
Loading: CF-2000-Adequate for A.A.H.S.O. alternate loading.
Skew: Varies
Surface Course: 1" Monolithic Concrete.
Alignment: 3°00'00" Rt.
Approach Slabs: AS-1-54 (25' Long)
Superelevation: .05 ft/ft.

PROPOSED STRUCTURE BR. NO. 9


Type: Continuous steel beam with reinforced concrete deck and substructure.
Spans: 37'-4 1/2", 42'-1 1/2", 53'-1 1/2", 32'-0 3/8" along E-15.
Roadway: Varies
Loading: CF-2000-Adequate for A.A.H.S.O. alternate loading.
Skew: 6°43'20"
Surface Course: 1" Monolithic Concrete.
Alignment: Tangent.
Approach Slabs: AS-1-54 (25' Long)
Superelevation: Varies.

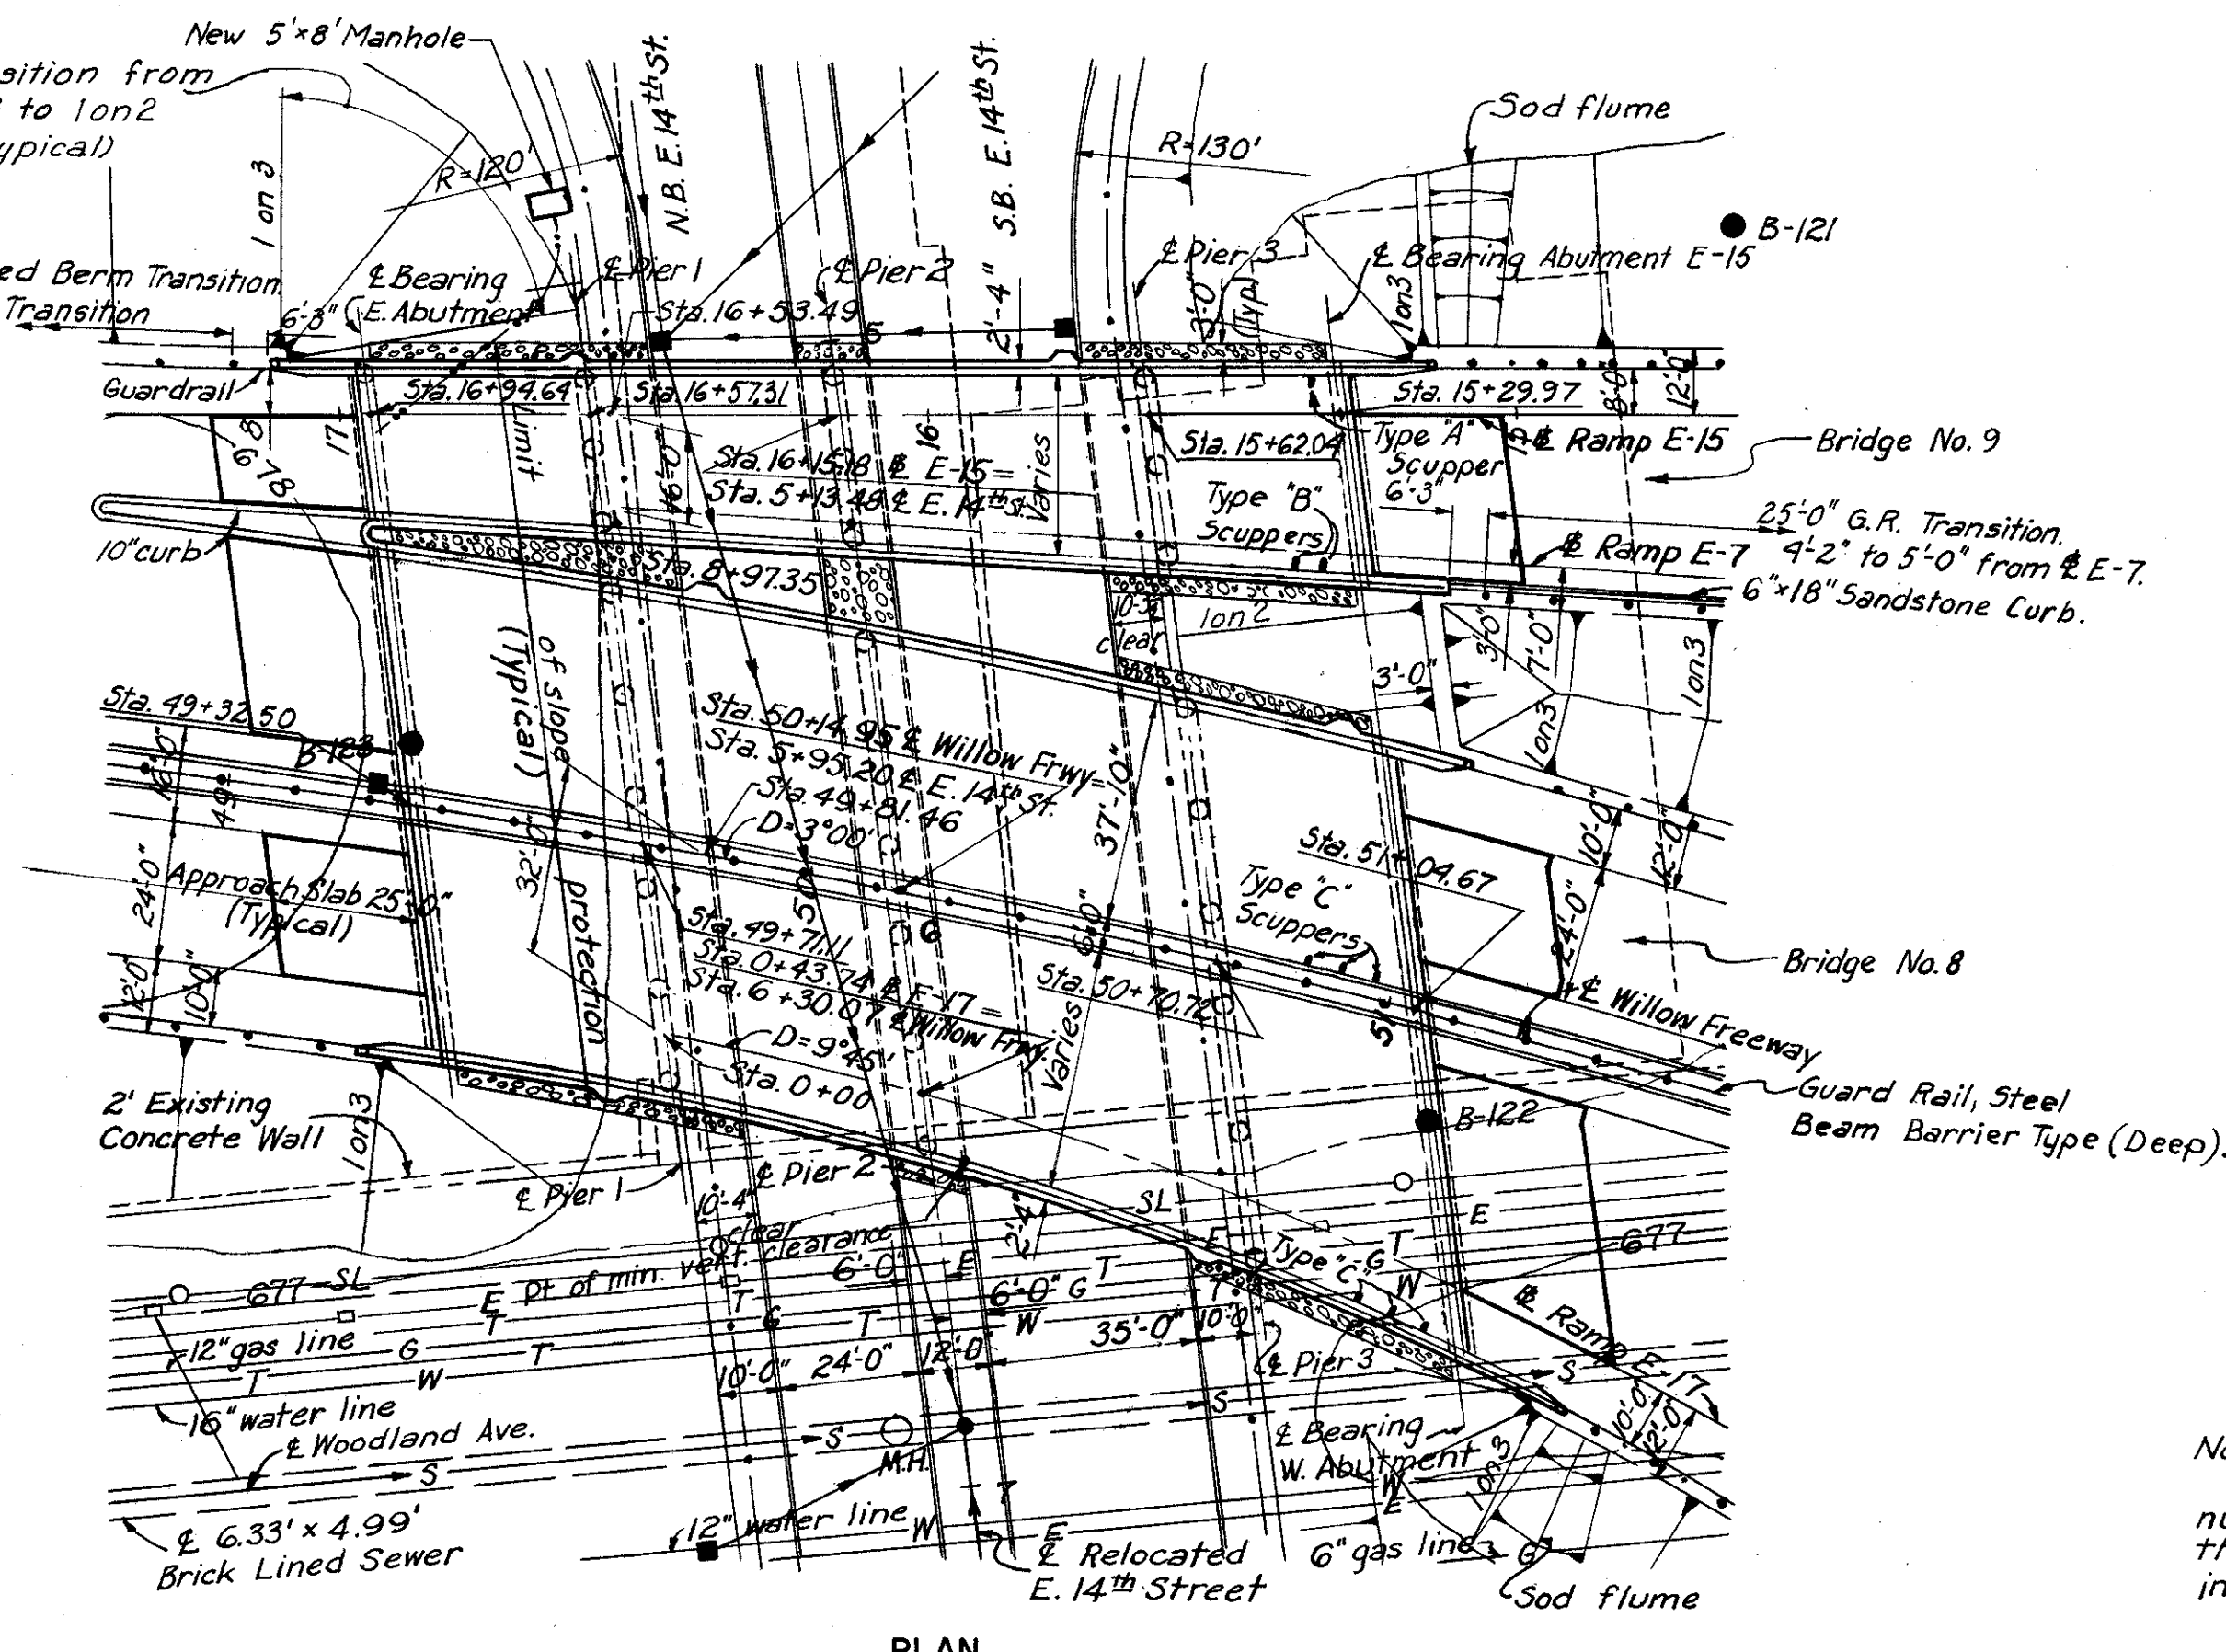


PLAN



PROFILE BRIDGE NO. 8

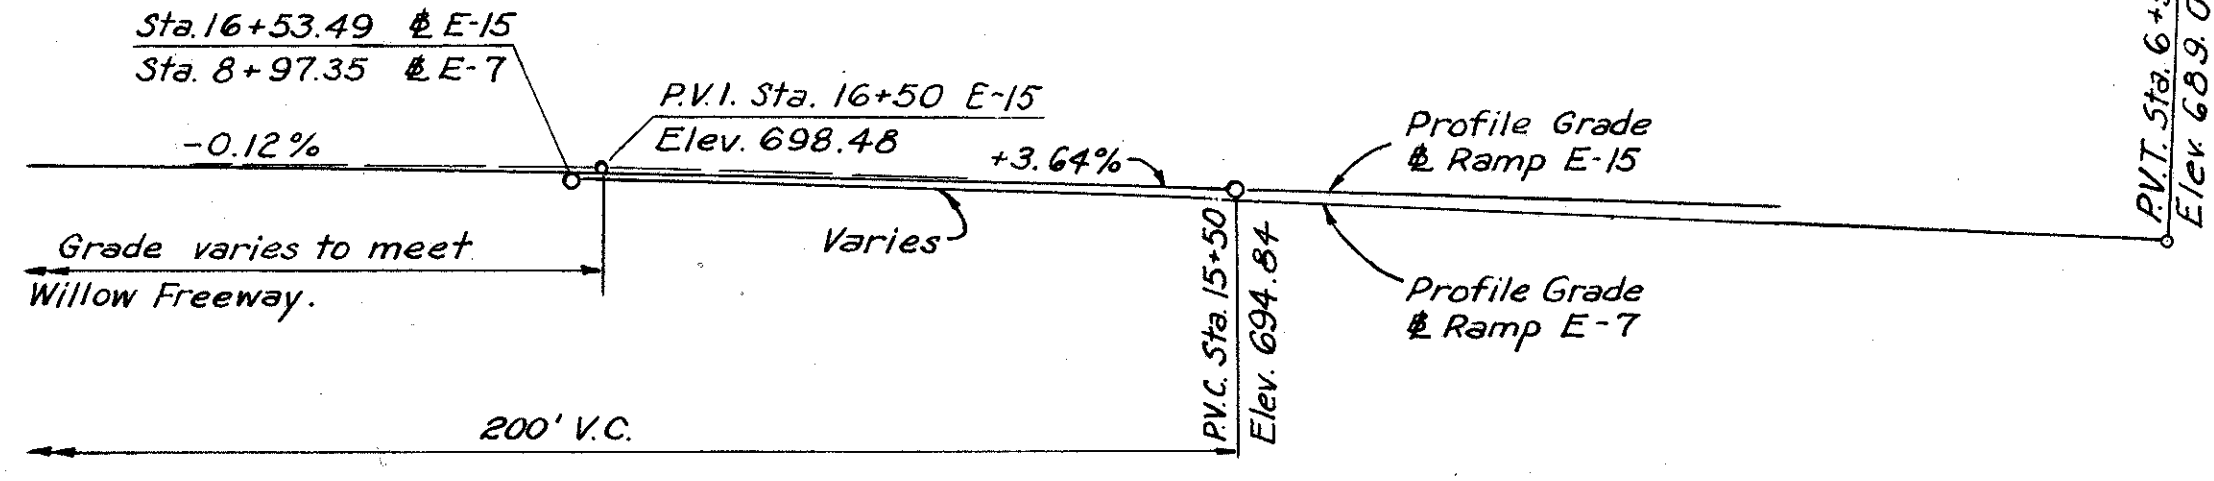


PROFILE BRIDGE NO. 9

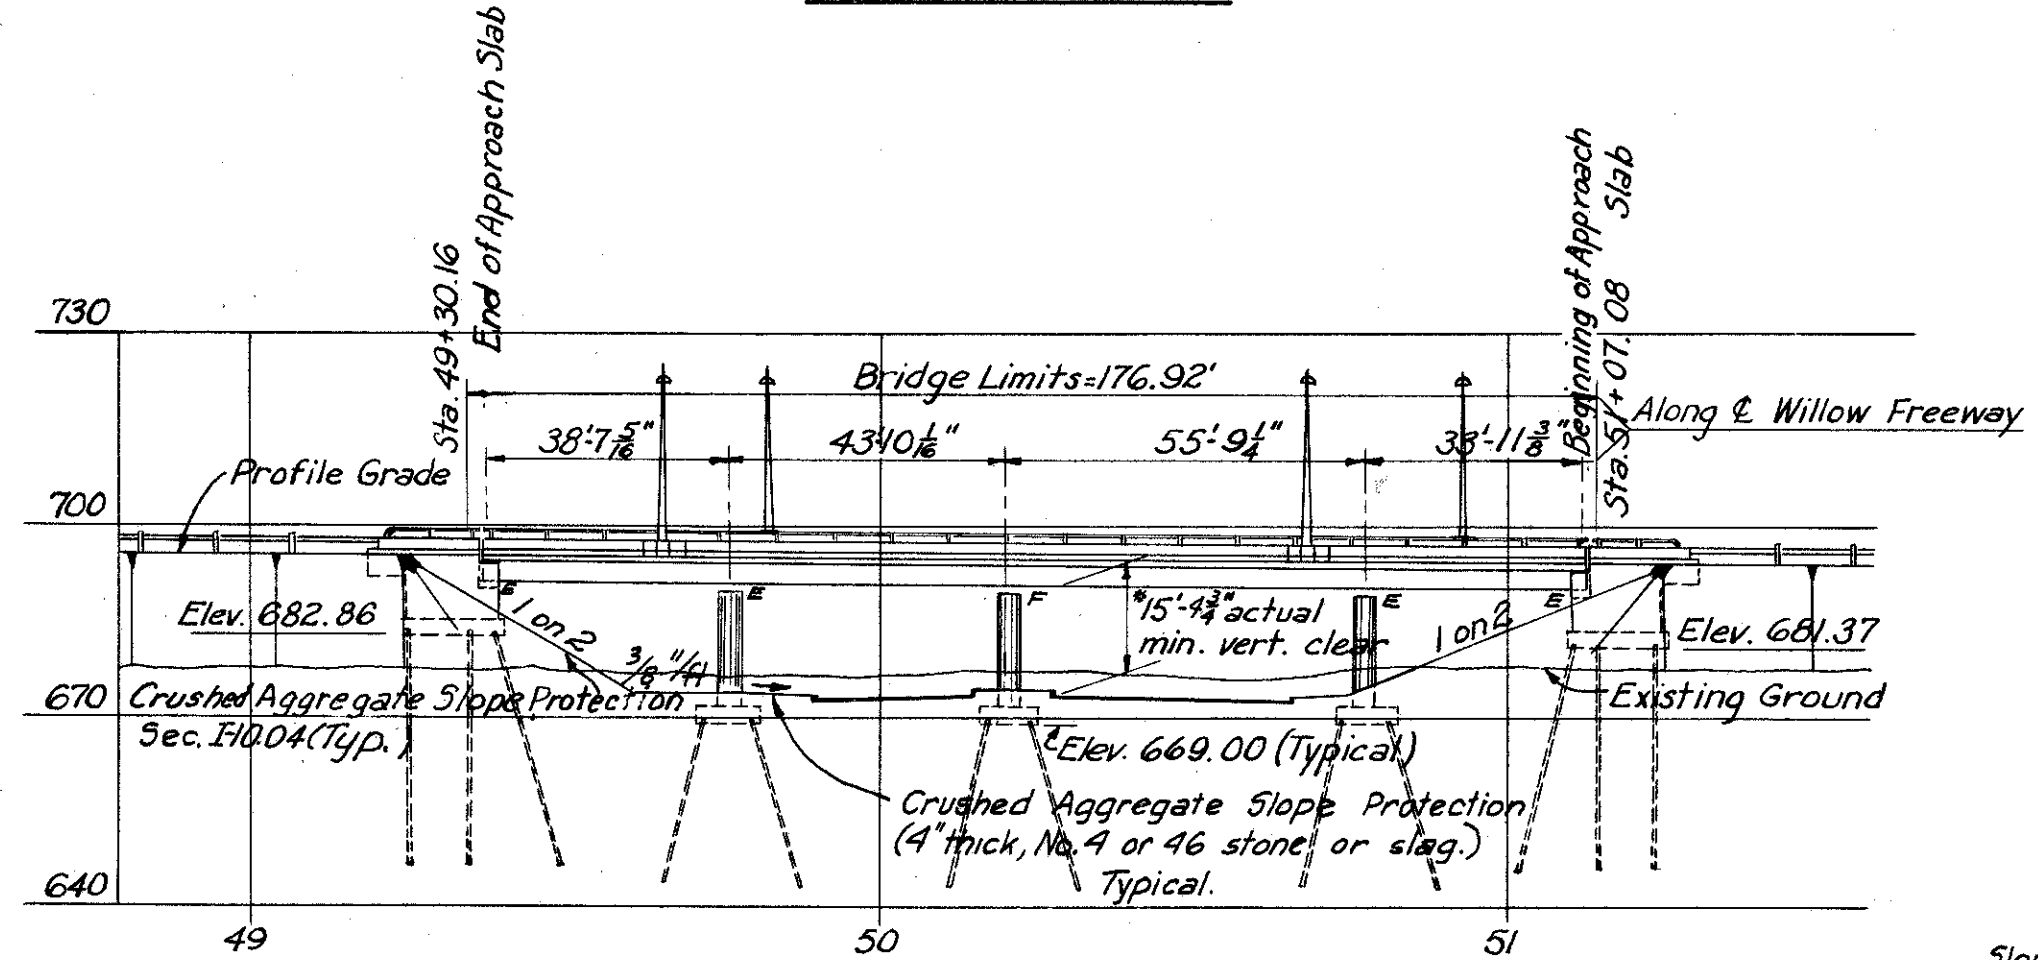

ELEVATION BRIDGE NO. 8

*15'-0" required minimum vertical clearance. Point of actual minimum vertical clearance occurs at the median curb of Southbound E. 14th St. and the north exterior beam.

Slopes shown in Elevation are normal to E. 14th St.

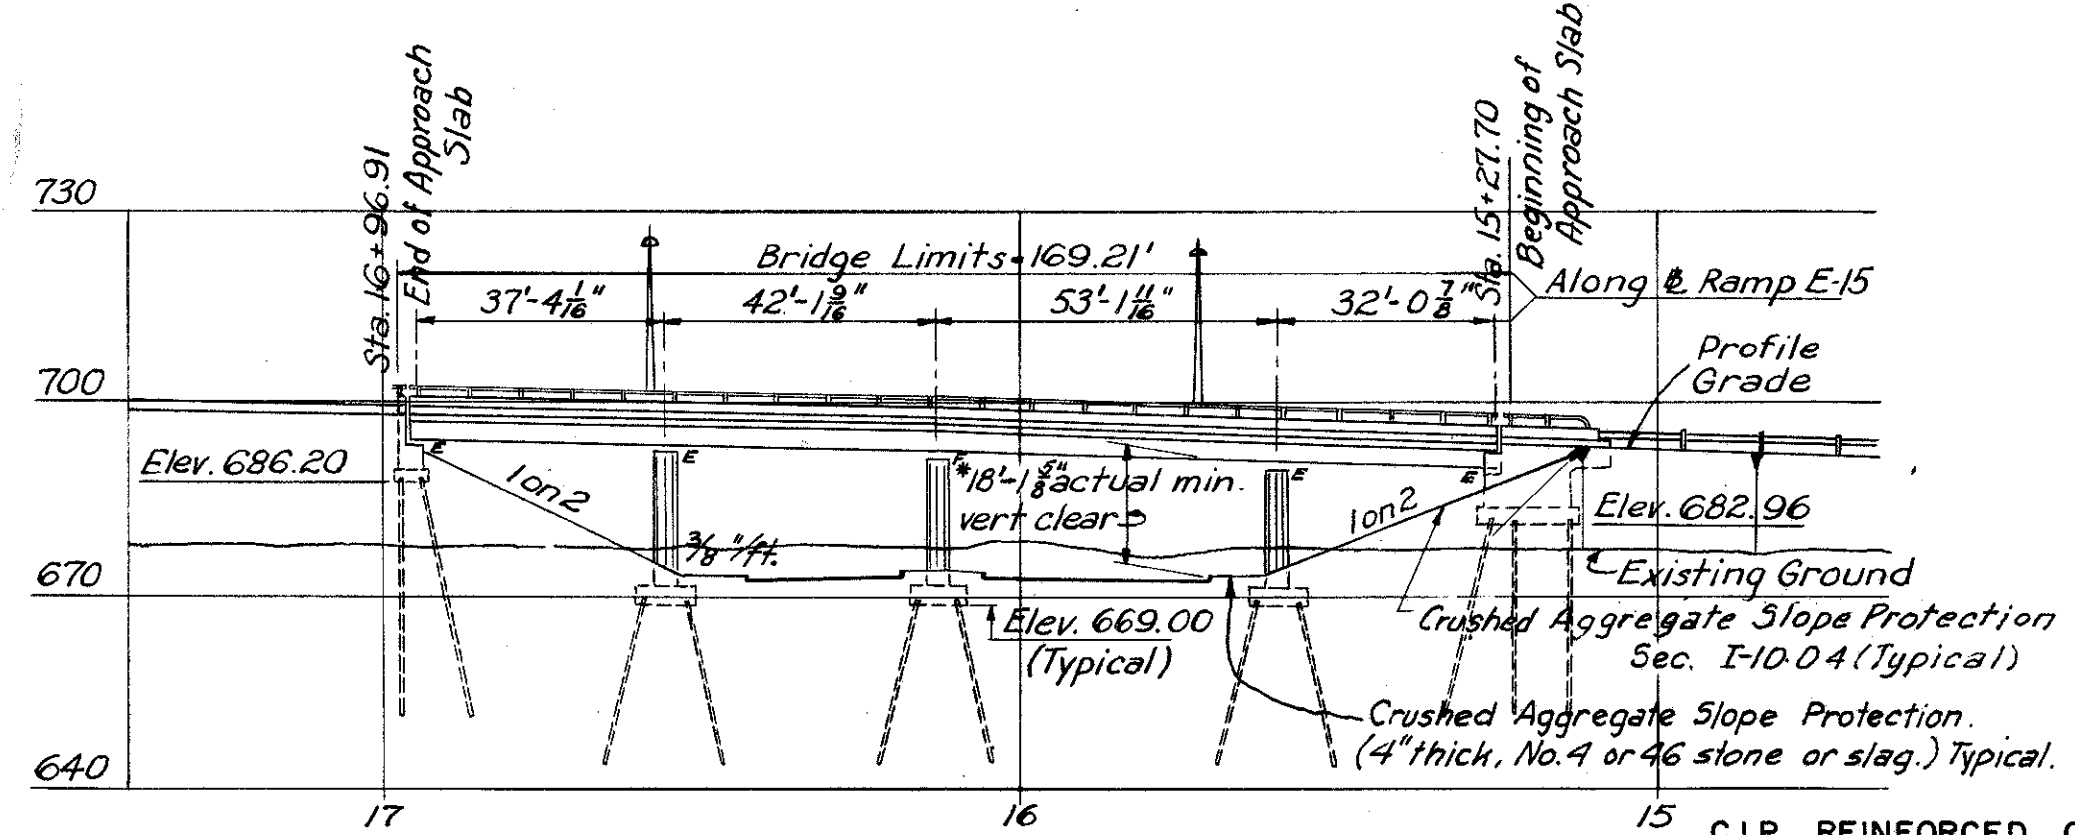

ELEVATION BRIDGE NO. 9

*15'-0" required minimum vertical clearance. Point of actual minimum vertical clearance occurs at the west curb of Southbound E. 14th St. and the north exterior beam.

RAMP E-15 OVER EAST 14th ST.

C.I.P. REINFORCED CONCRETE PILES.			
PILE INFORMATION			
Location	Diameter	Number	Estimated ave. length
Bridge 8			
West Abutment	12"	36	35 ft
Piers 1, 2, & 3	14"	75	27 ft
Bridge No. 9			
Abutment E-15	12"	14	35 ft
Piers 1, 2, & 3	14"	36	27 ft
Bridge No. 8 & No. 9			
East Abutment	12"	40	37 ft

NOTES:
Rod soundings only were taken at location B-122 and B-123. The core drilling made at B-121 is plotted.
Pile lengths are based on boring data and are approximate only. The Contractor shall assume full responsibility for length of piling selected for driving.
The following items are not included in the bridge plans: (See Roadway Plans for details).
Approach grading, pavements, and slabs.
Roadway Guard Rail, Sod Flumes.
For details of slope protection see Sh. 174-7A.
For details of pier plans & drain pipe locations at piers see Sh. 171-7A & 174-7A.

Note: Piers for Bridges 8 & 9 are included in Part 6.

H.N.T.B. BRS. NO. 8 AND 9 PART 7A

HOWARD, NEEDLES, TAMMEN & BERGENDOFF
CONSULTING ENGINEERS
KANSAS CITY CLEVELAND NEW YORK

SITE PLAN
WILLOW FREEWAY & RAMP E-15 OVER E. 14TH STREET
STA. 49+30.16 STA. 51+07.08 (WILLOW FREEWAY)
STA. 15+27.70 STA. 16+96.91 (RAMP E-15)
BR. NO. CUY-21-1573 A & B Scale: 1" = 30'
WILLOW-INNER BELT FREEWAY
CLEVELAND CUYAHOGA COUNTY OHIO




DATE: 6-26-58 TRACED: DLV CHECKED: DRX REVIEWED: JCT
DATE: 7-29-58 DATE: 7-14-58 DATE: 11-13-57

MICROFILMED
JUL 3 1965





FED. ROADS DIV. NO.	STATE	FED. AID PROJ. NO.	147
2	OHIO		181

CUYAHOGA COUNTY
CITY OF CLEVELAND
CUY-21-15.32
CUY-42-18.42





Note:
Special care shall be taken when placing reinforcing steel so as not to interfere with anchor bar setting.

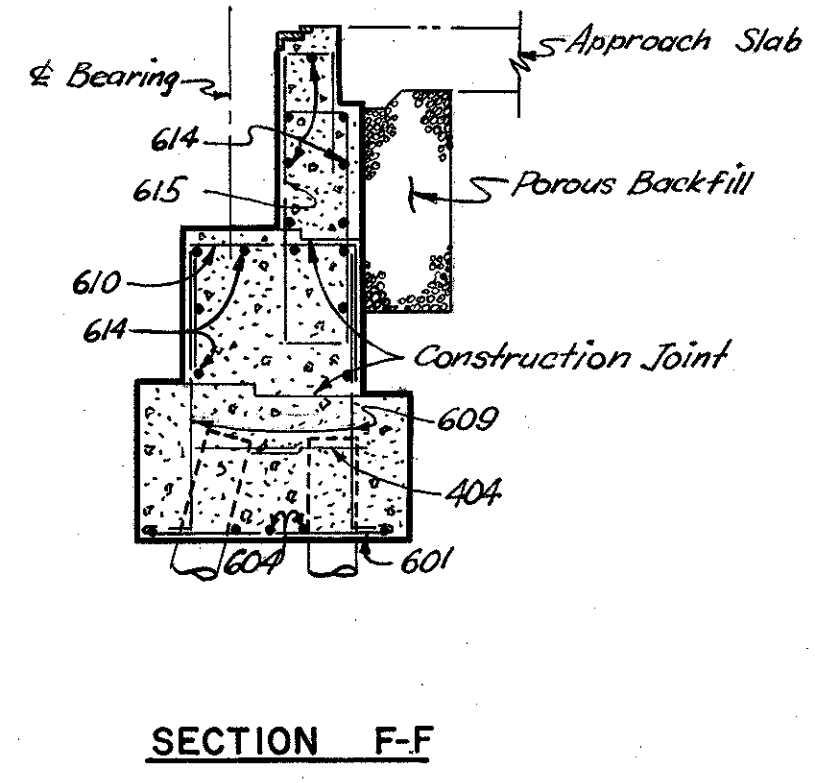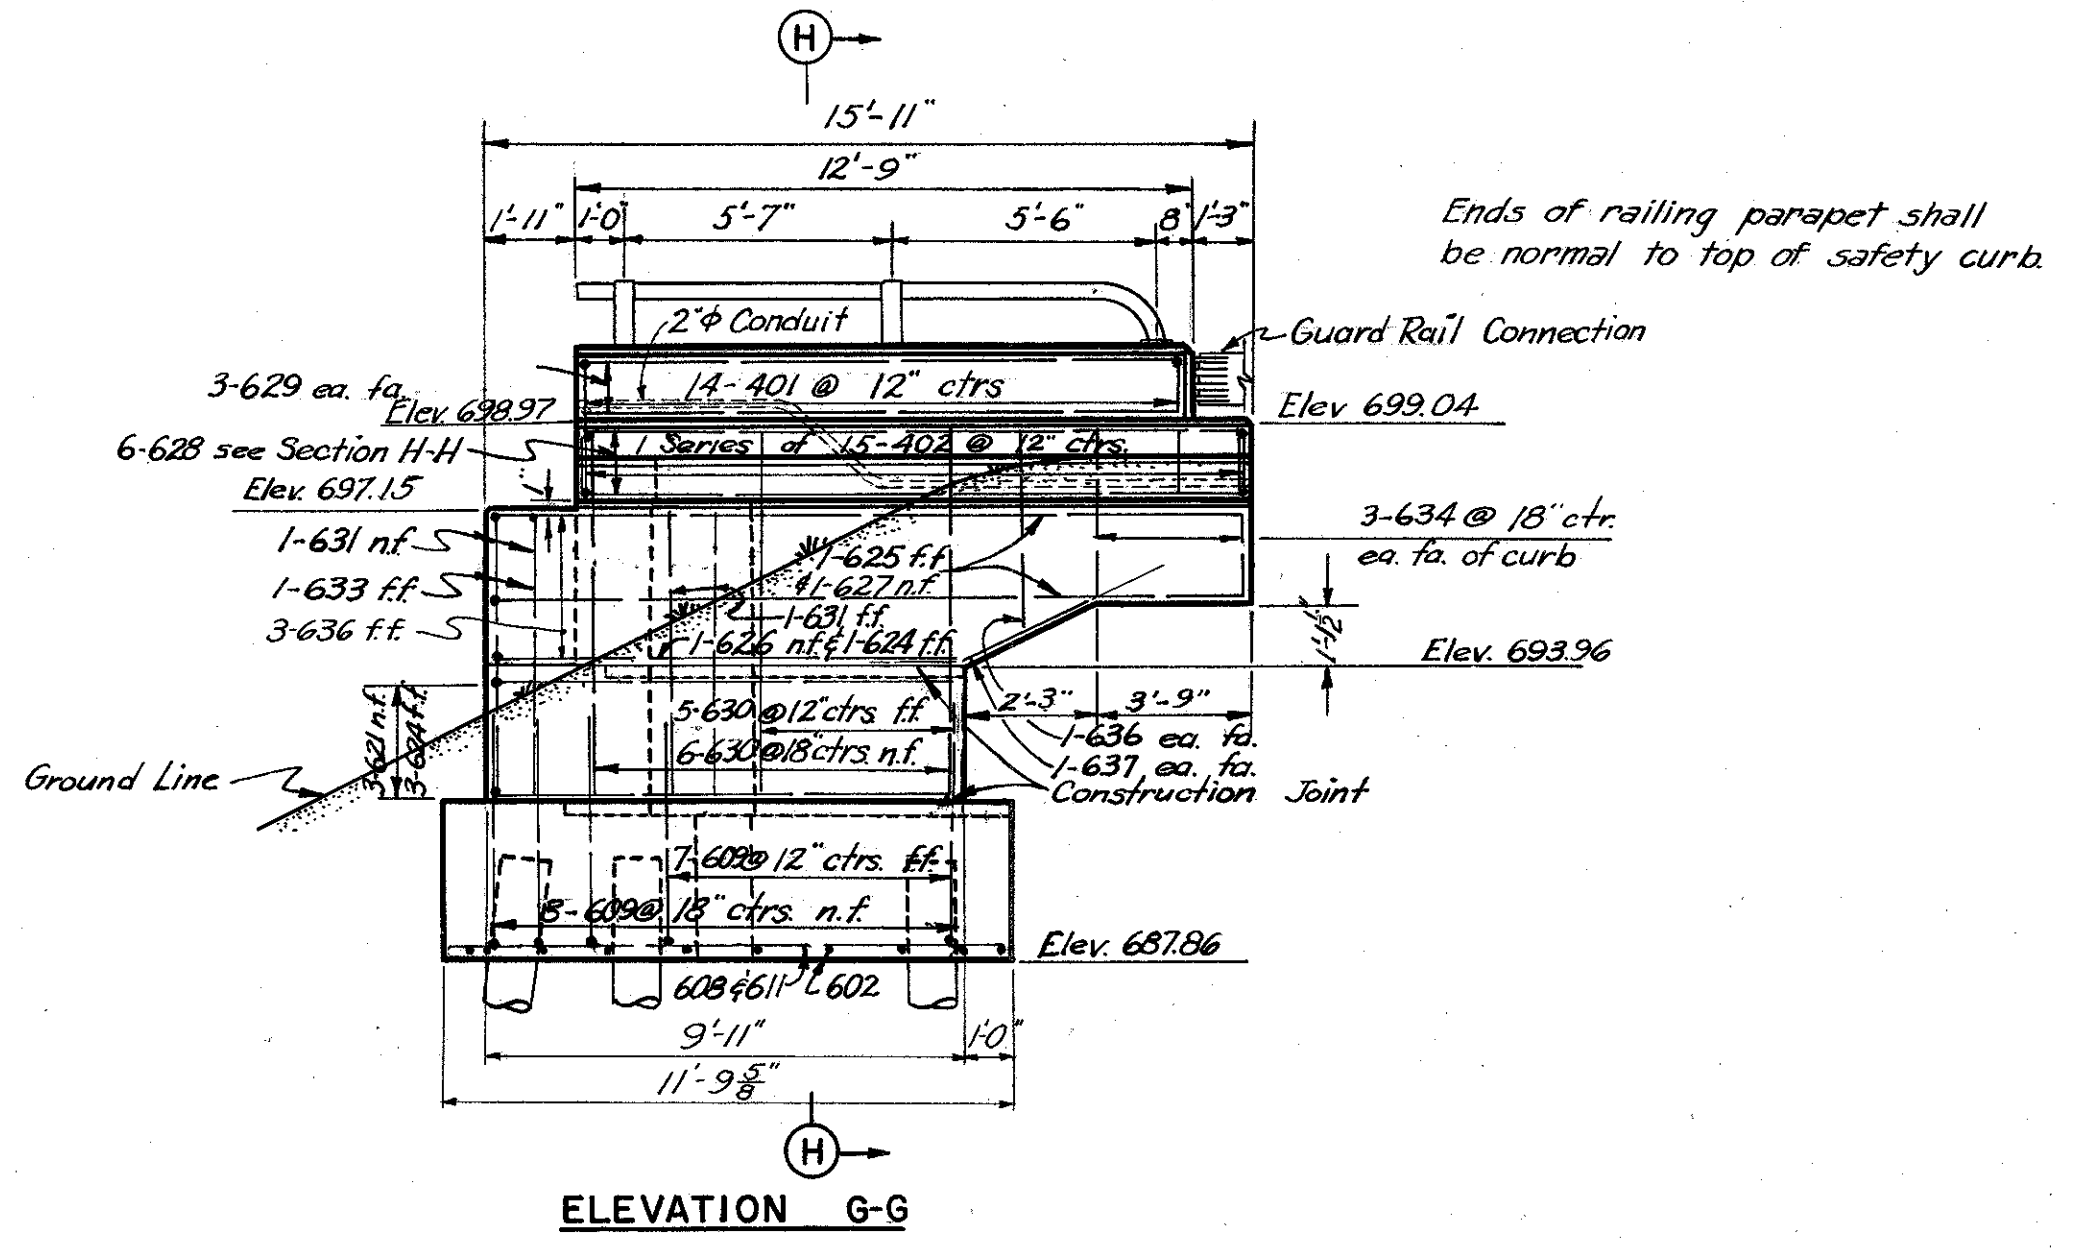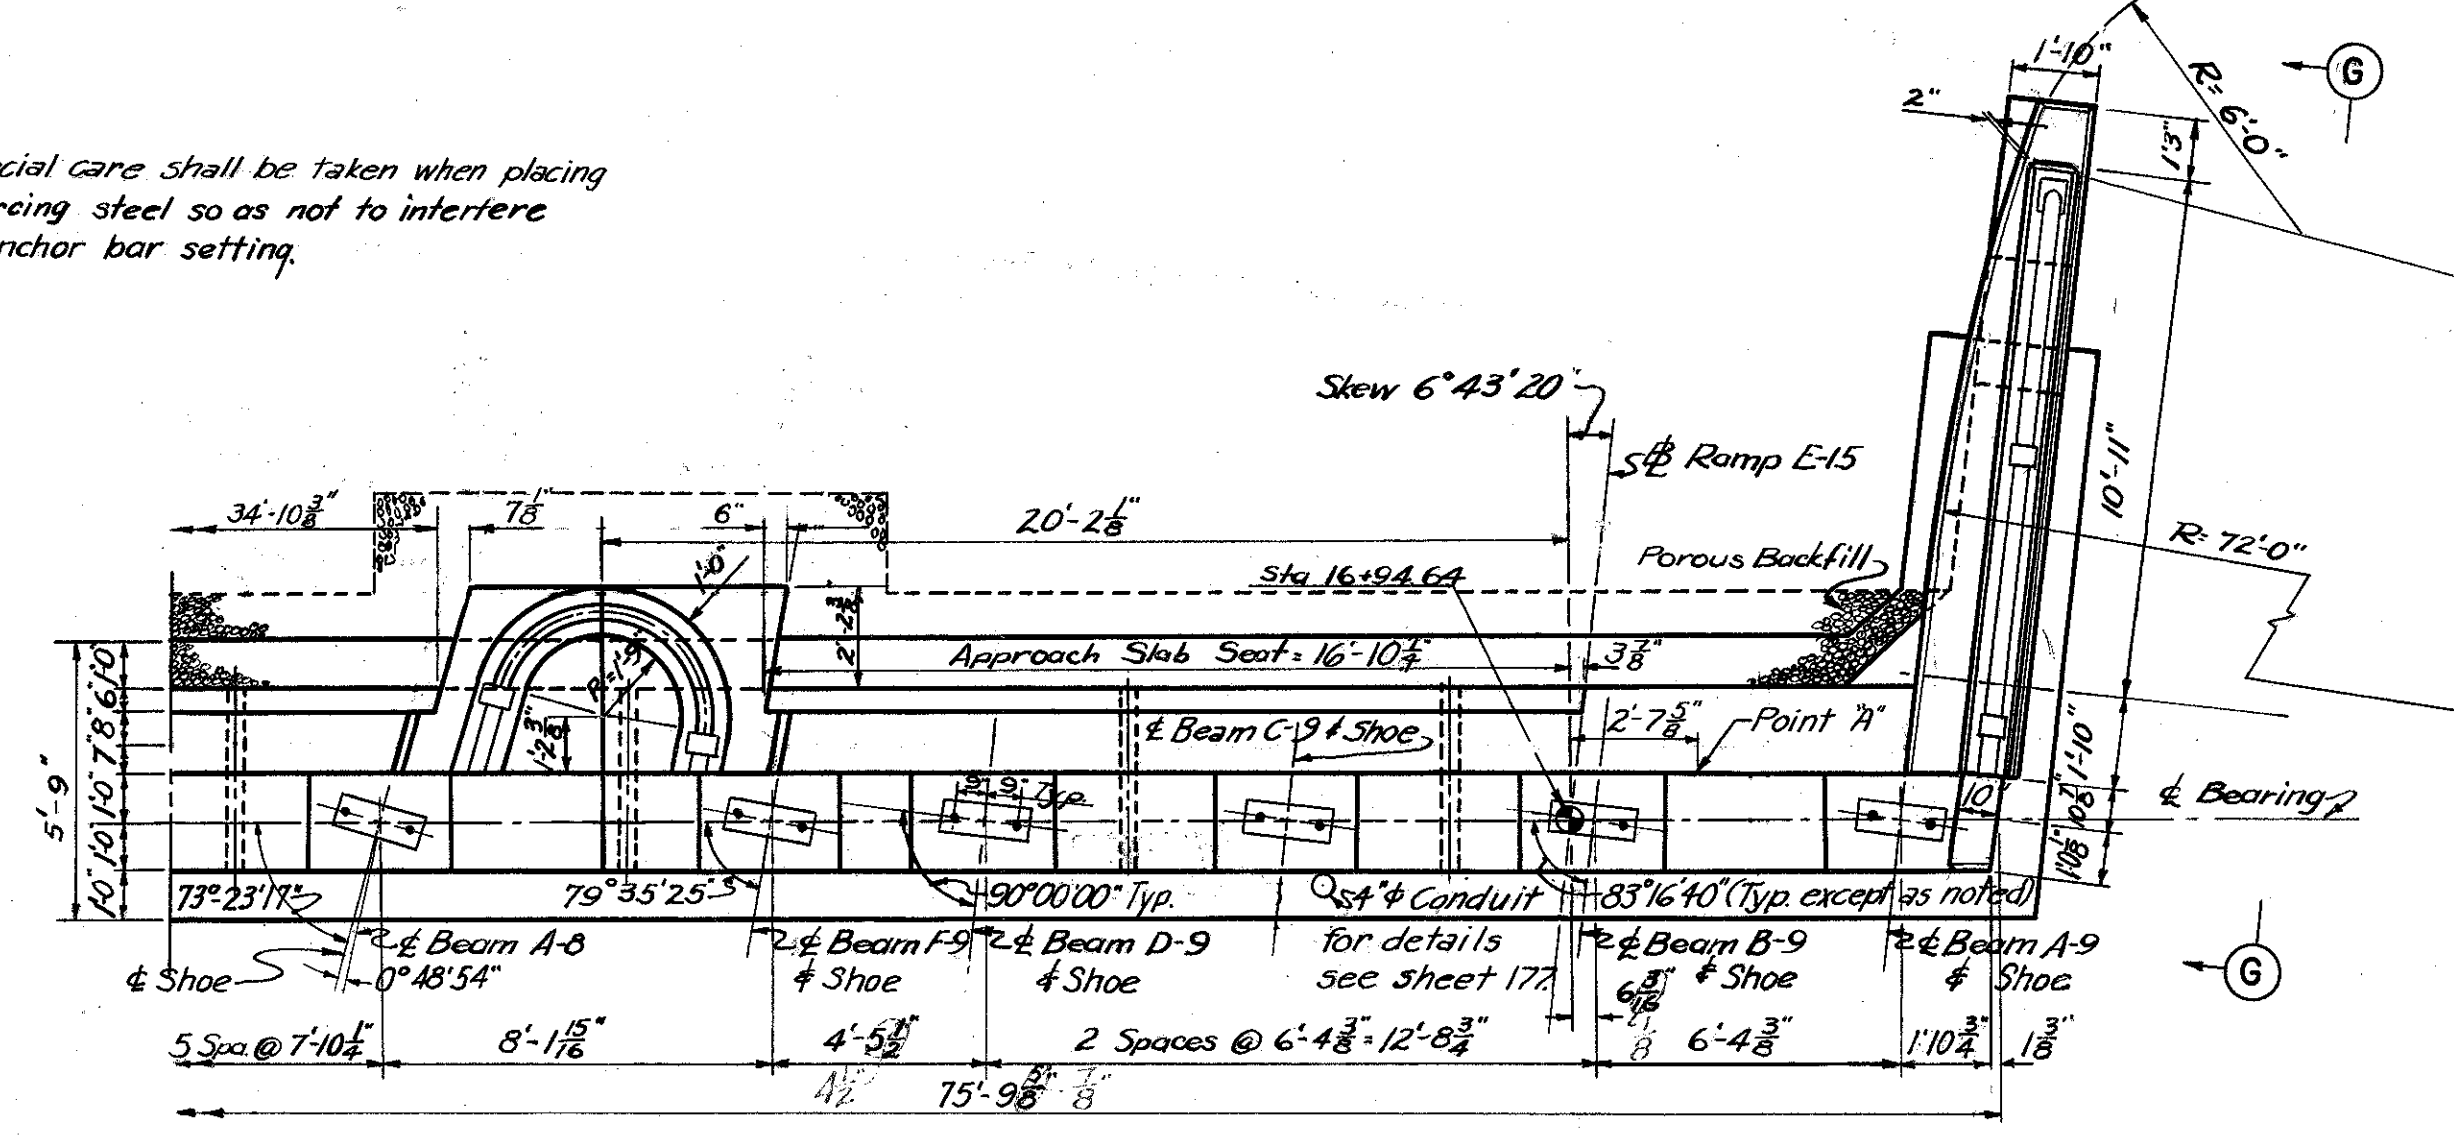

Note:
Elevations along backwall are given to back of 6x4x1/2 angle.

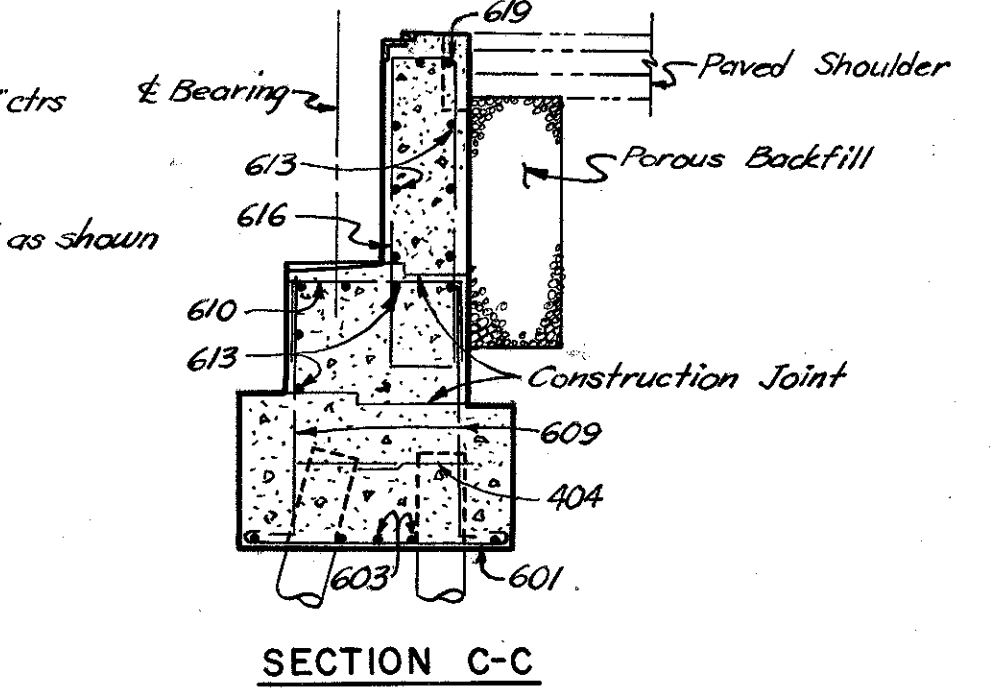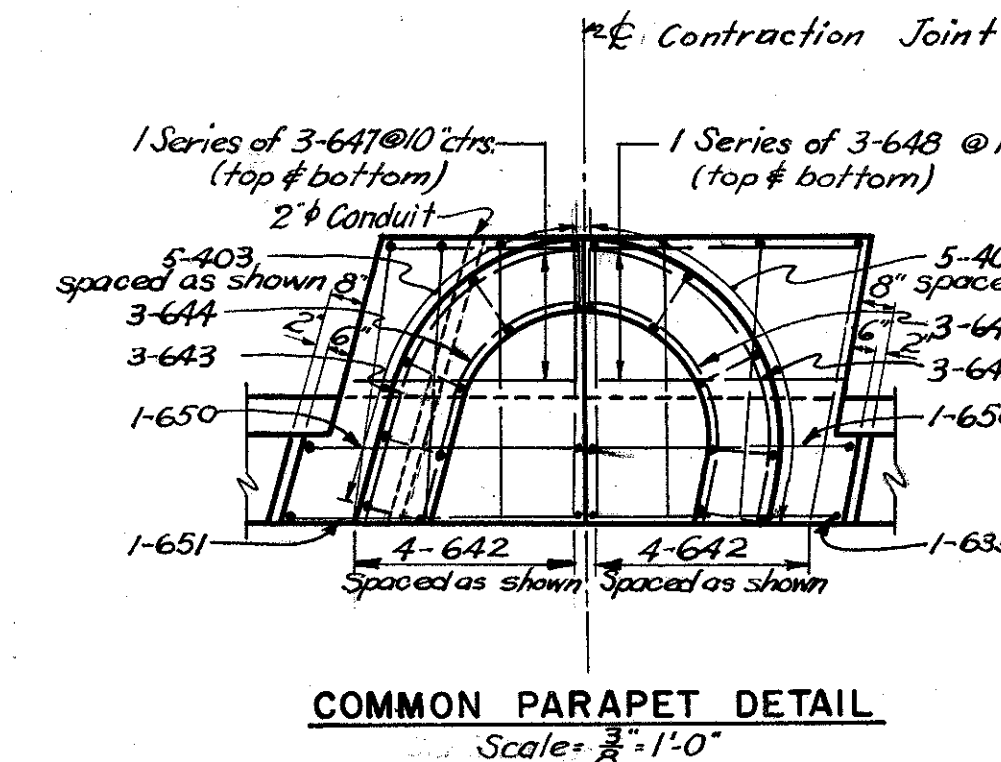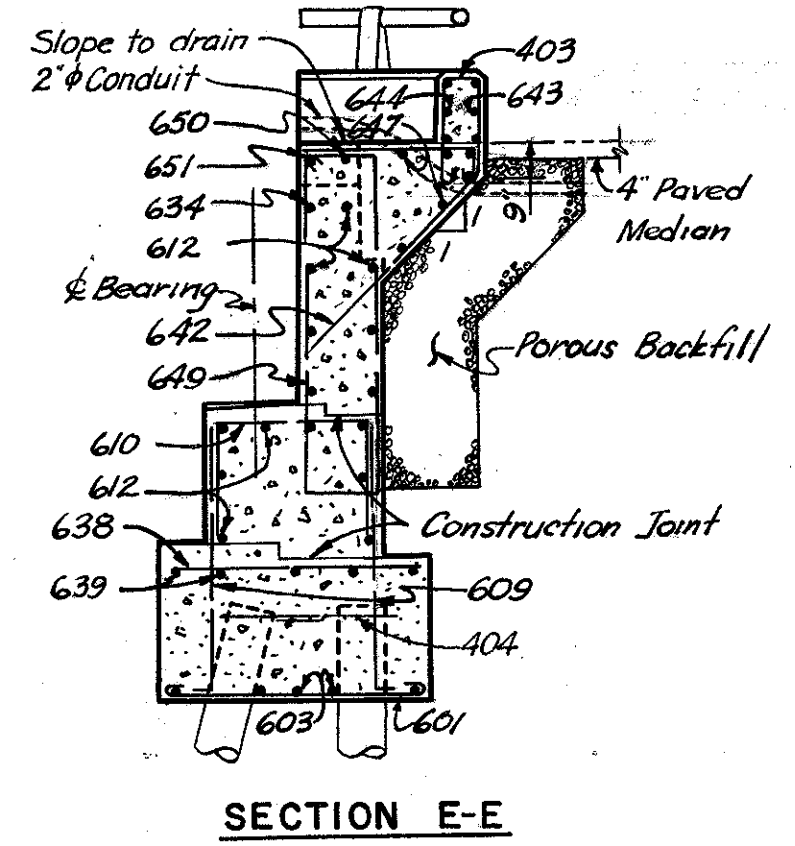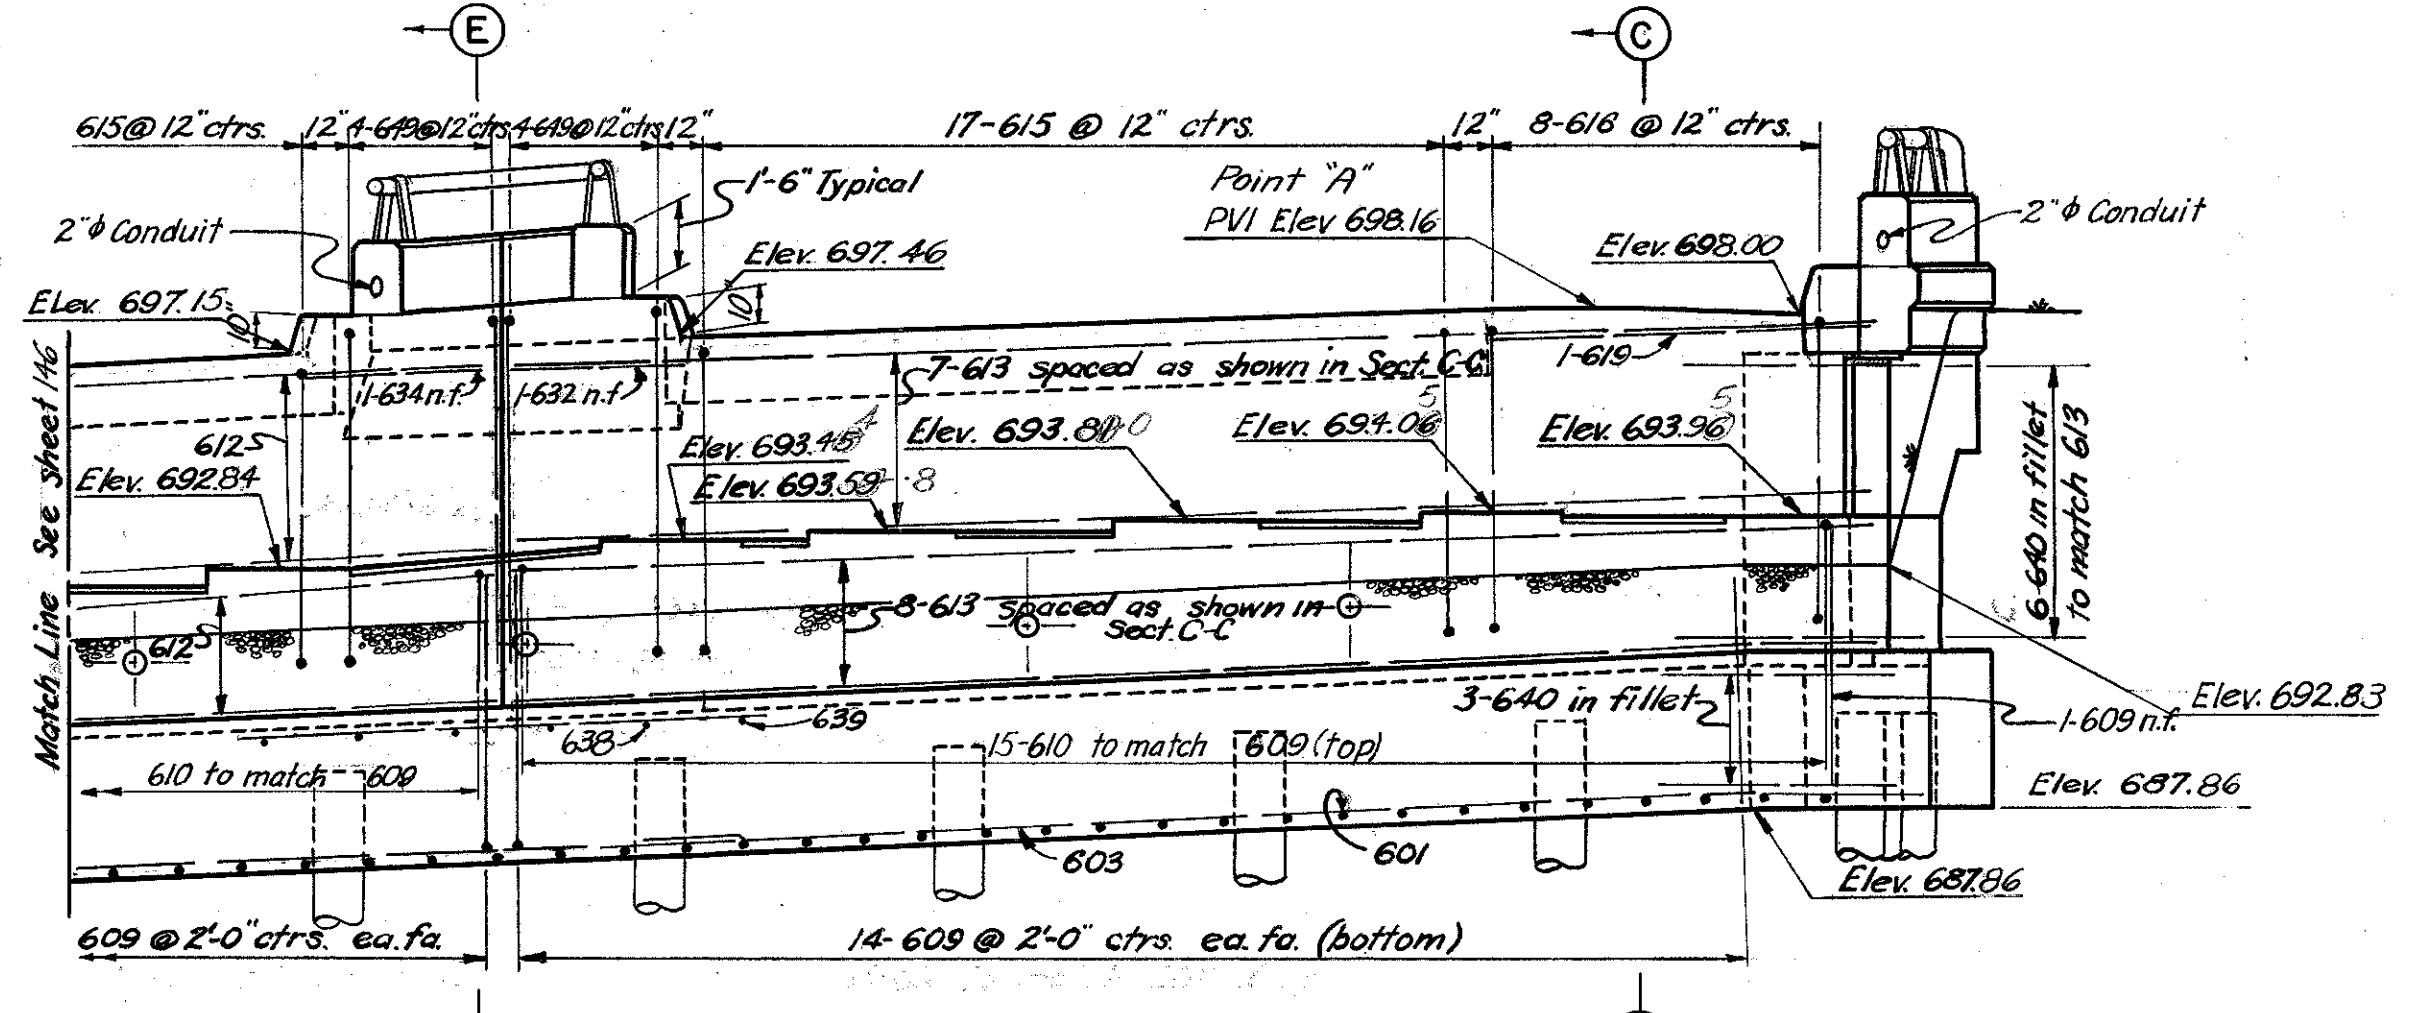

Note: Prefix "AA" shall be assigned to all bar marks.

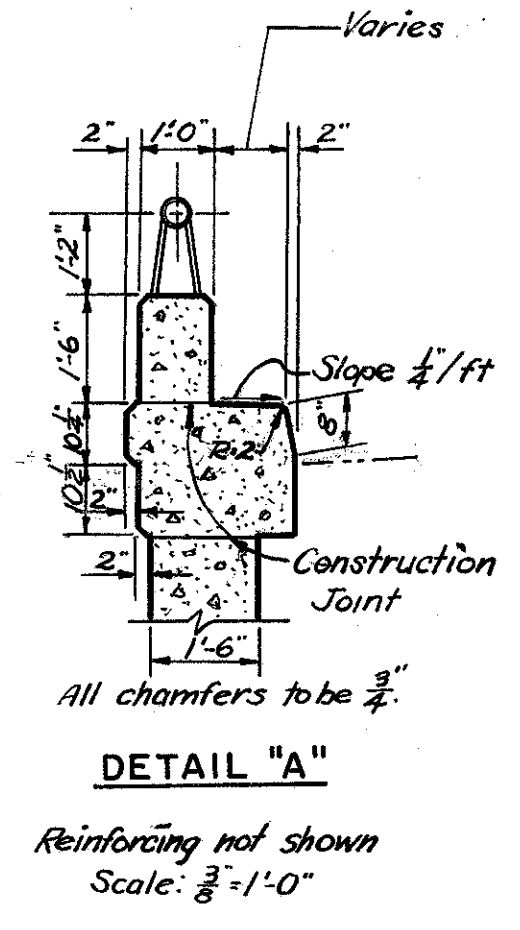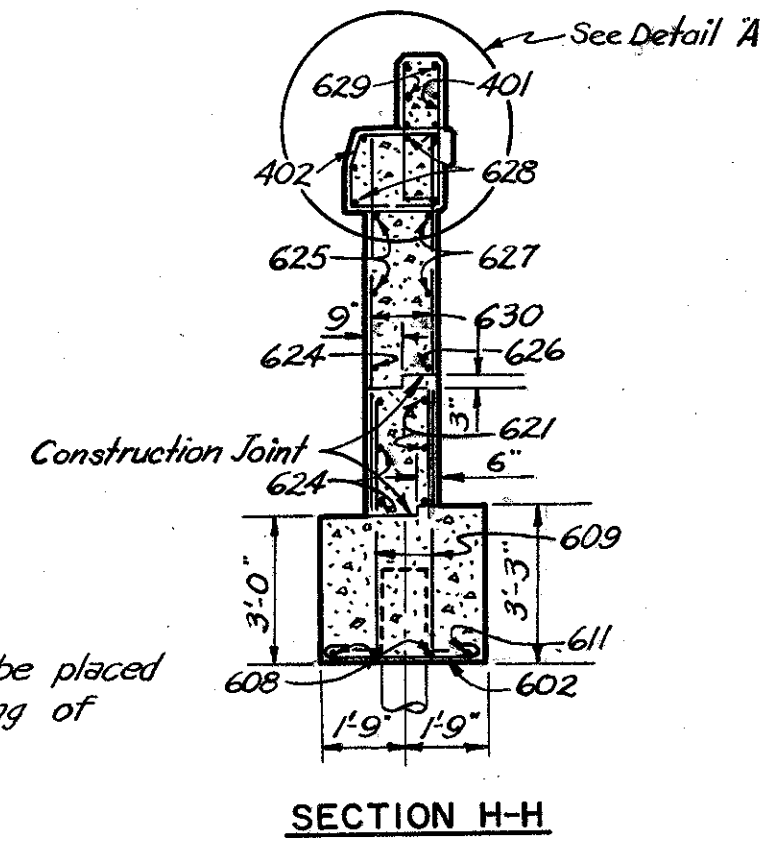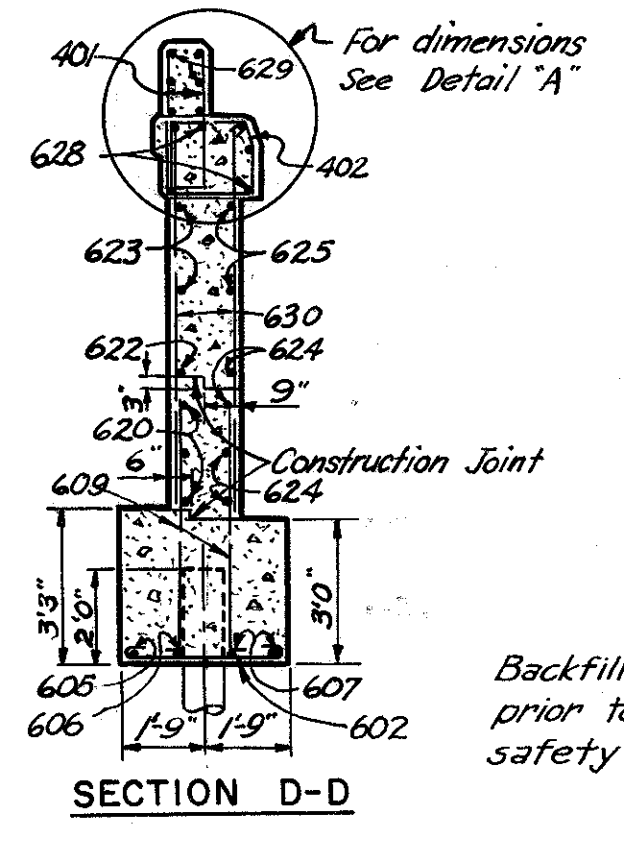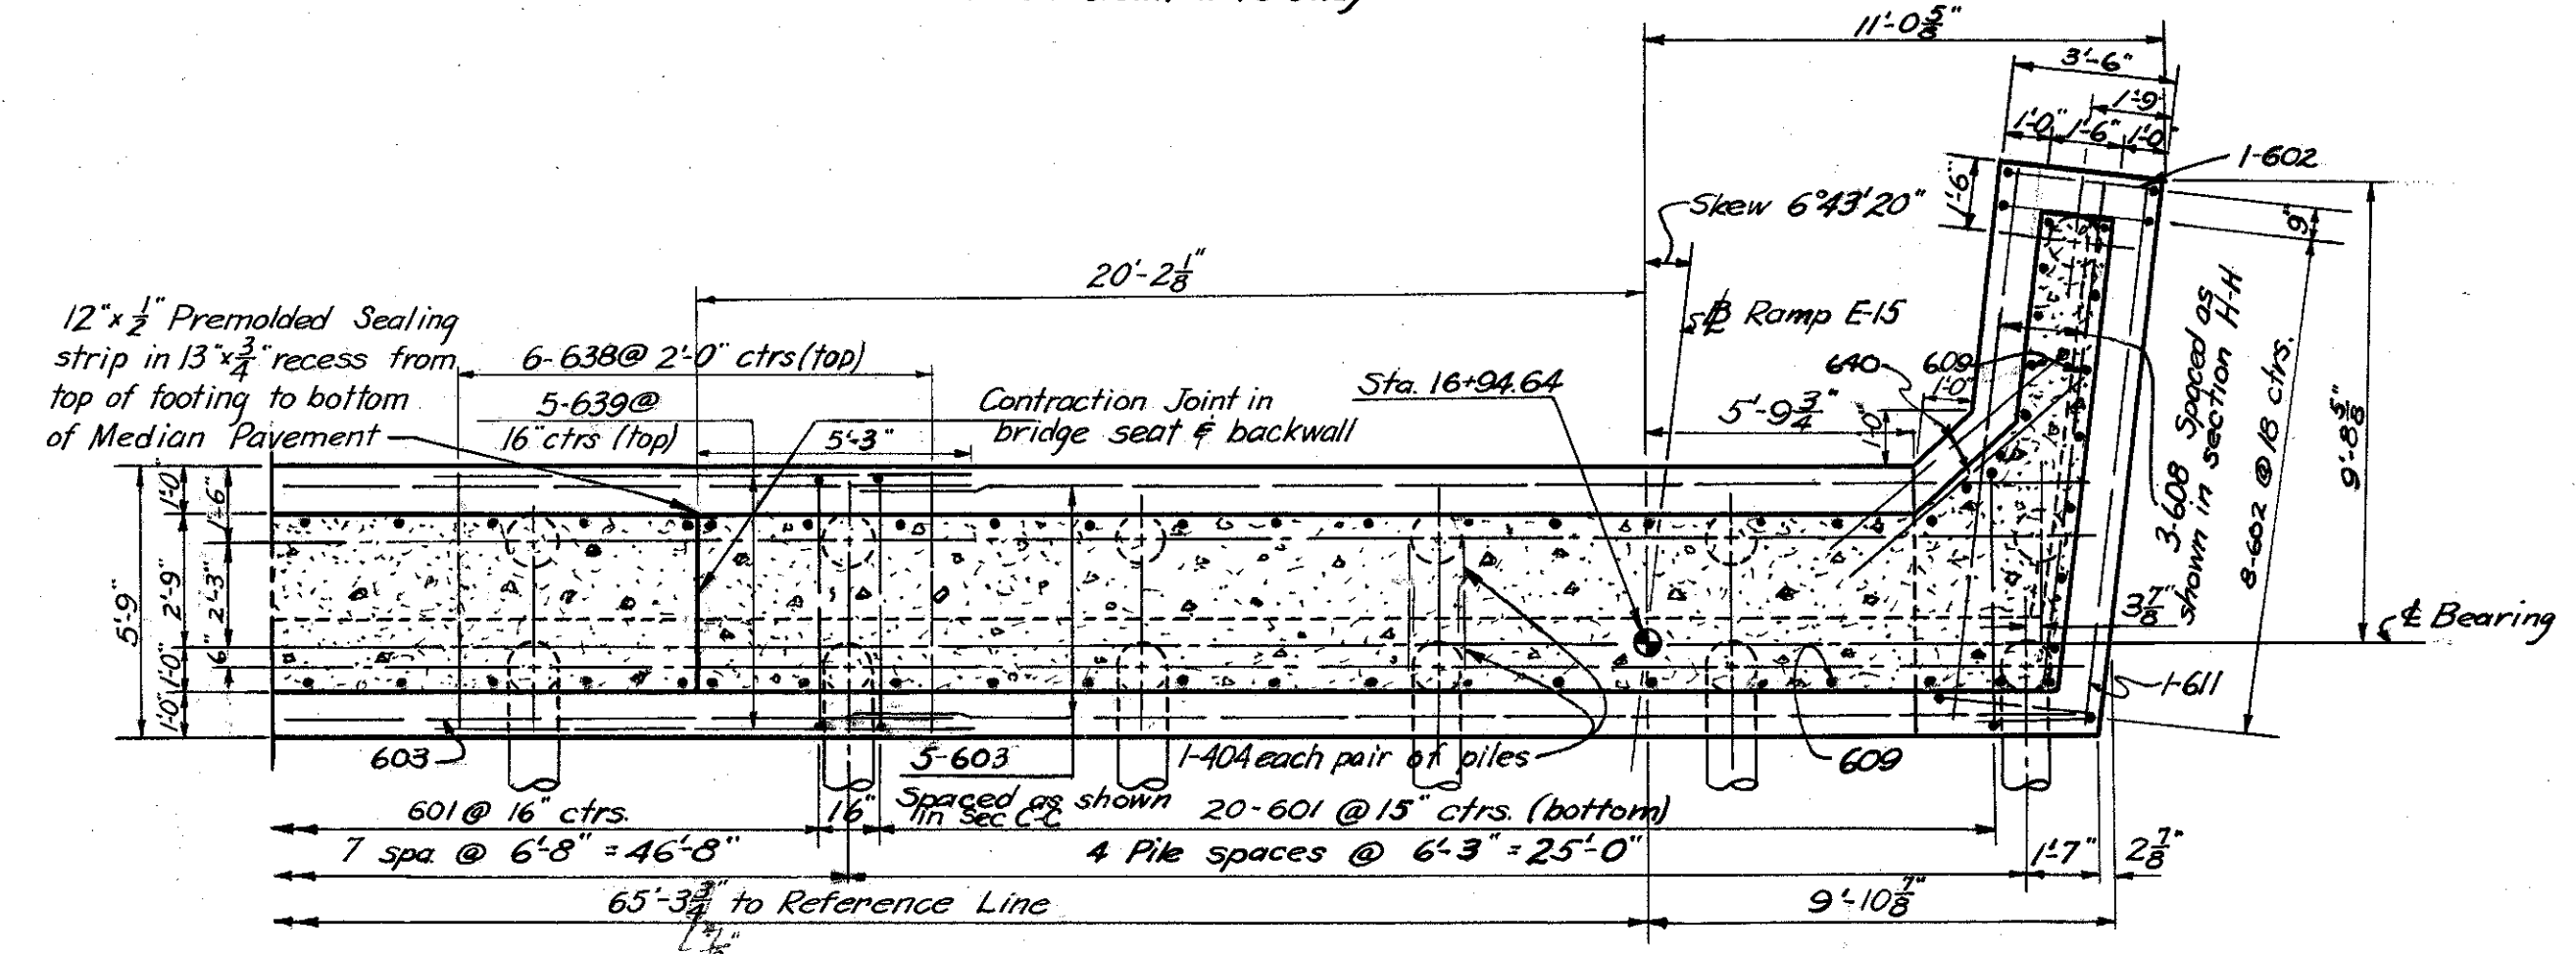

NOTES:
For dimensions and details not shown in section views see Section B-B sheet 146-7A.
Top of parapet and safety curb construction joints are to be parallel with roadway grade.
n.f. = near face; f.f. = far face; ea. fa. = each face
For reinforcement schedule see sheet 151-7A
For additional notes see sheet 146-7A

H.N.T.B. BRS. NO. 8 AND 9 PART 7A

HOWARD, NEEDLES, TAMMEN & BERGENDOFF
CONSULTING ENGINEERS
KANSAS CITY CLEVELAND NEW YORK

EAST ABUTMENT-SOUTH HALF
WILLOW FREEWAY OVER EAST 14th ST.
STA. 49+30.16 STA. 51+07.08 (WILLOW FREEWAY)
STA. 15+27.70 STA. 16+96.91 (RAMP E-15)
BR. NO. CUY-21-1573A¹⁸ Scale: 1/4" = 1'-0" Except as noted



WILLOW-INNER BELT FREEWAY
CLEVELAND CUYAHOGA COUNTY OHIO

DRAWN	TRACED	CHECKED	REVIEWED	REVISED
DATE 7/25/60	DATE 8/18/60	DATE 7/31/60	DATE 11-13-59	


Revised 9-21-60

CUYAHOGA COUNTY
CITY OF CLEVELAND
CUY-21-15.32
CUY-42-18.42


Note:
Ends of railing parapet shall be normal to top of safety curb.

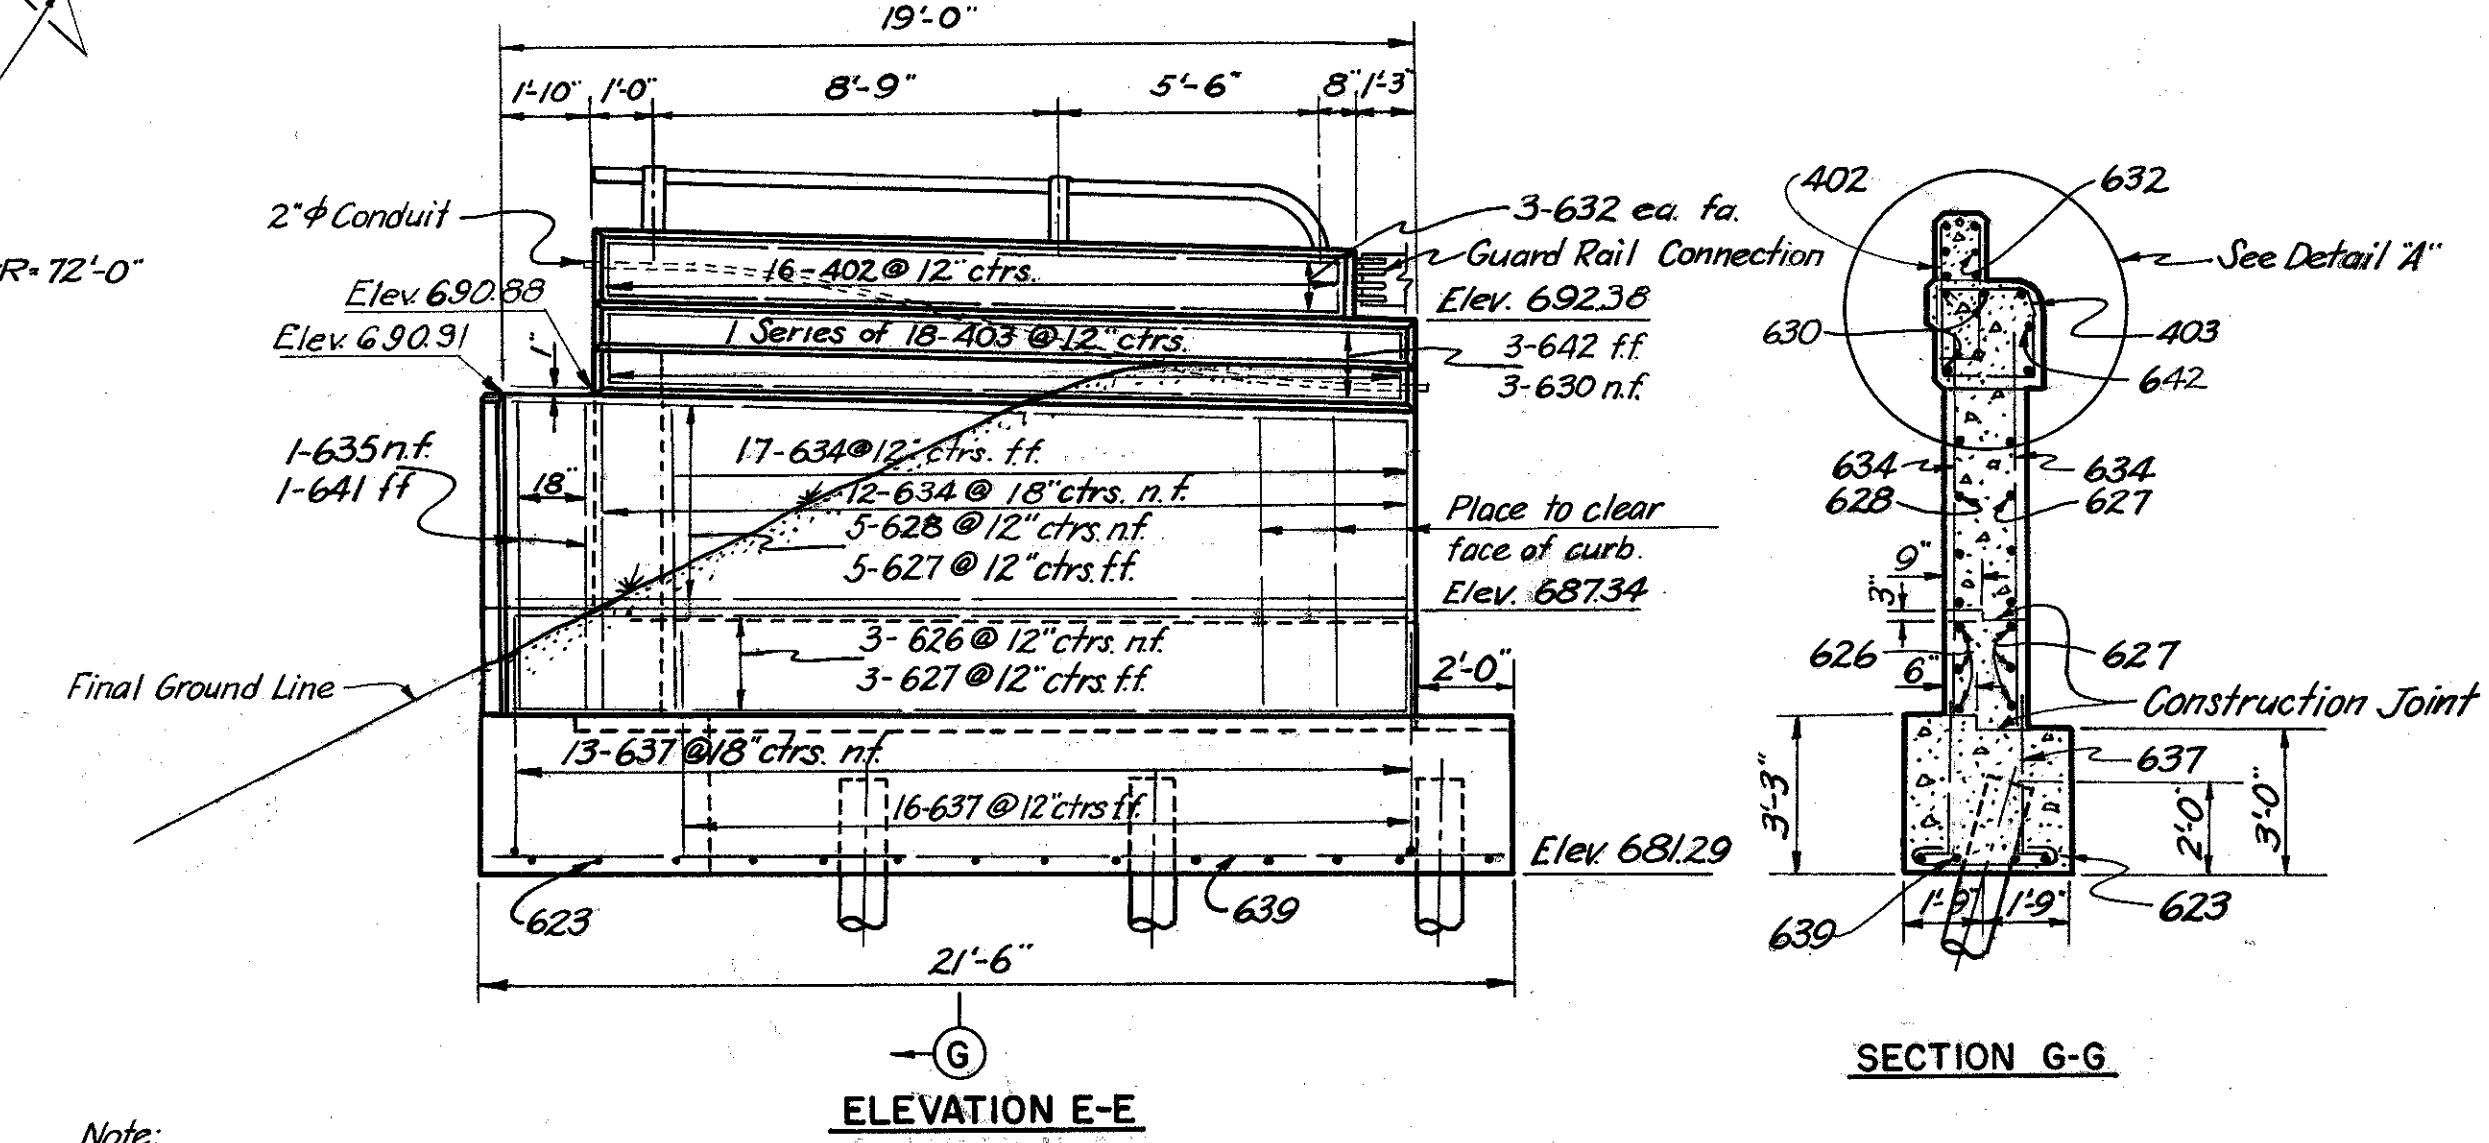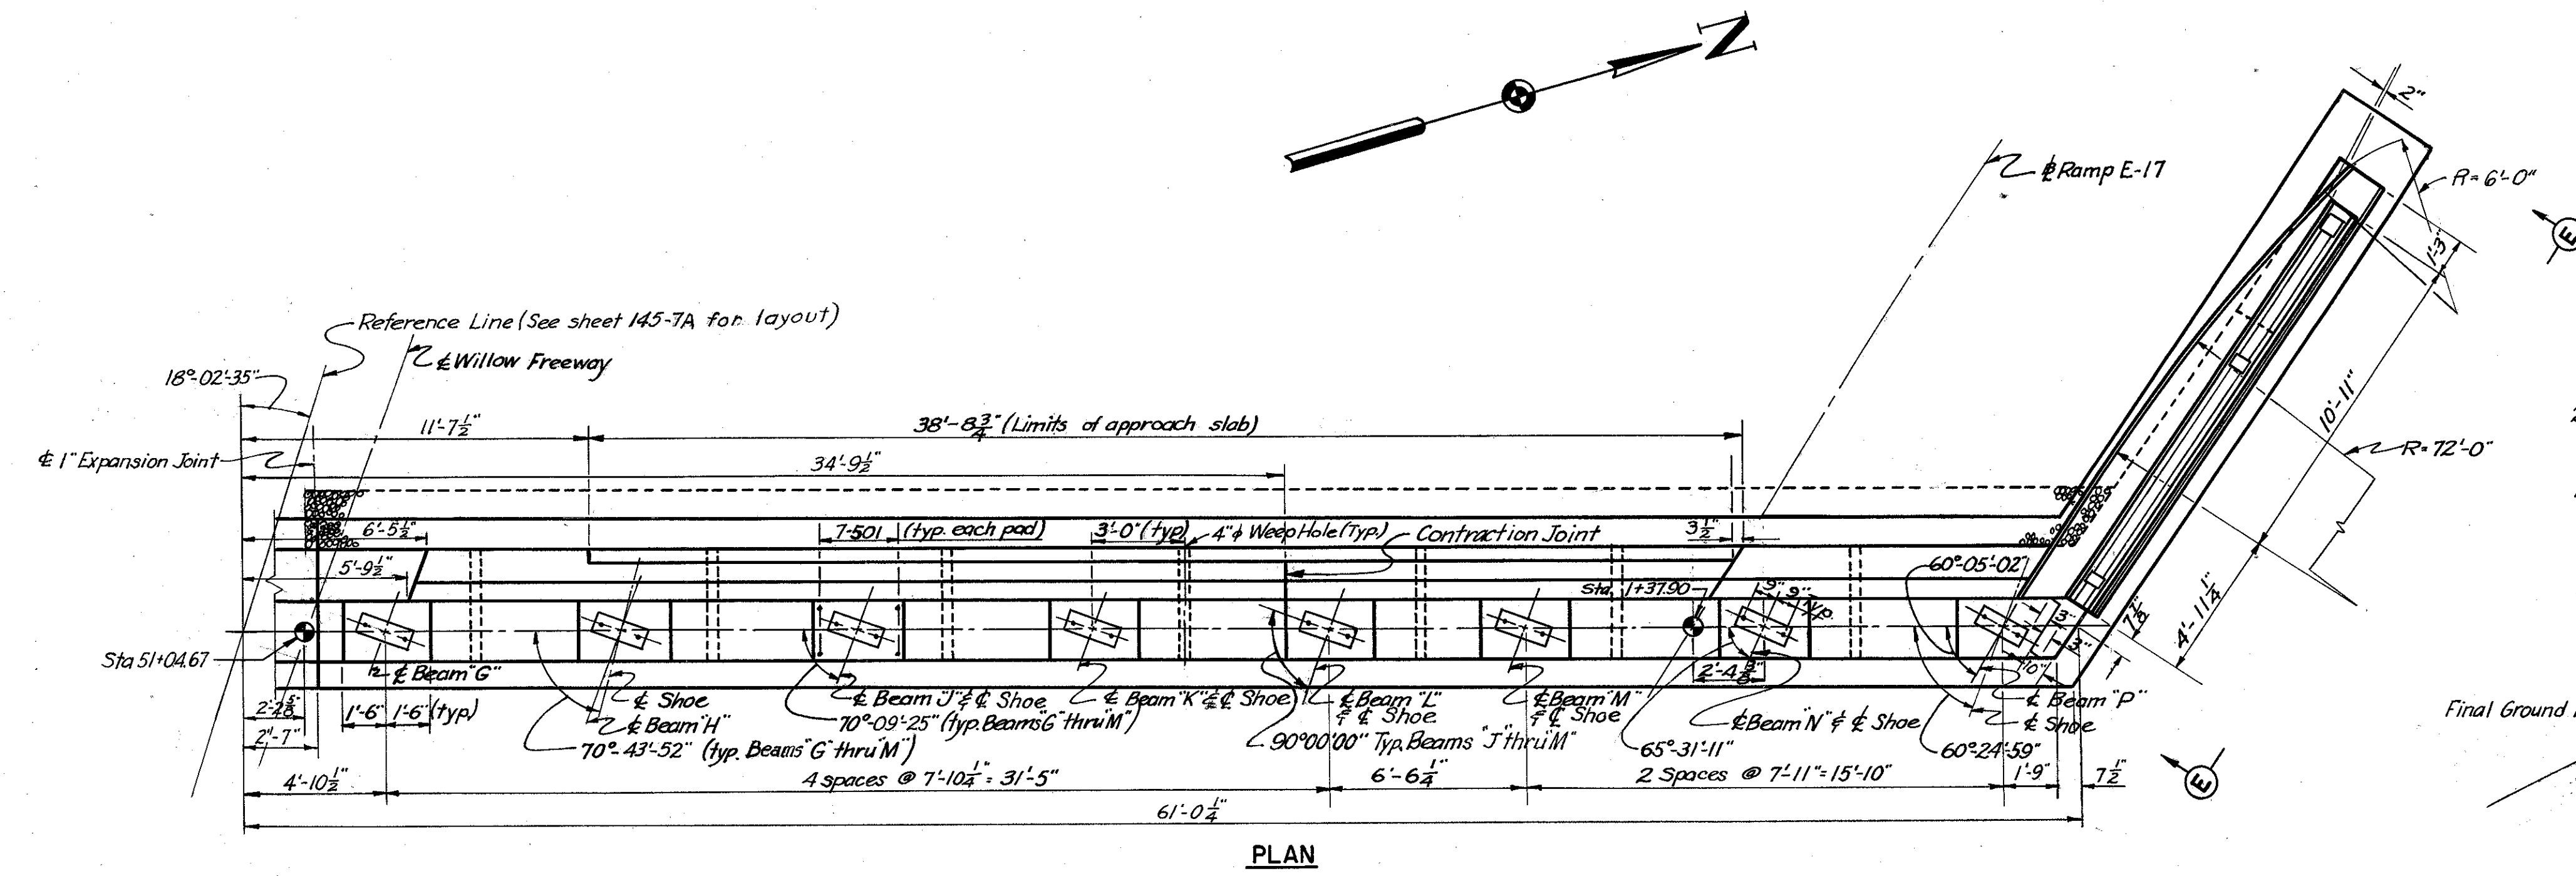

Note:
Elevations along backwall are given to back of 6" x 4" angle.

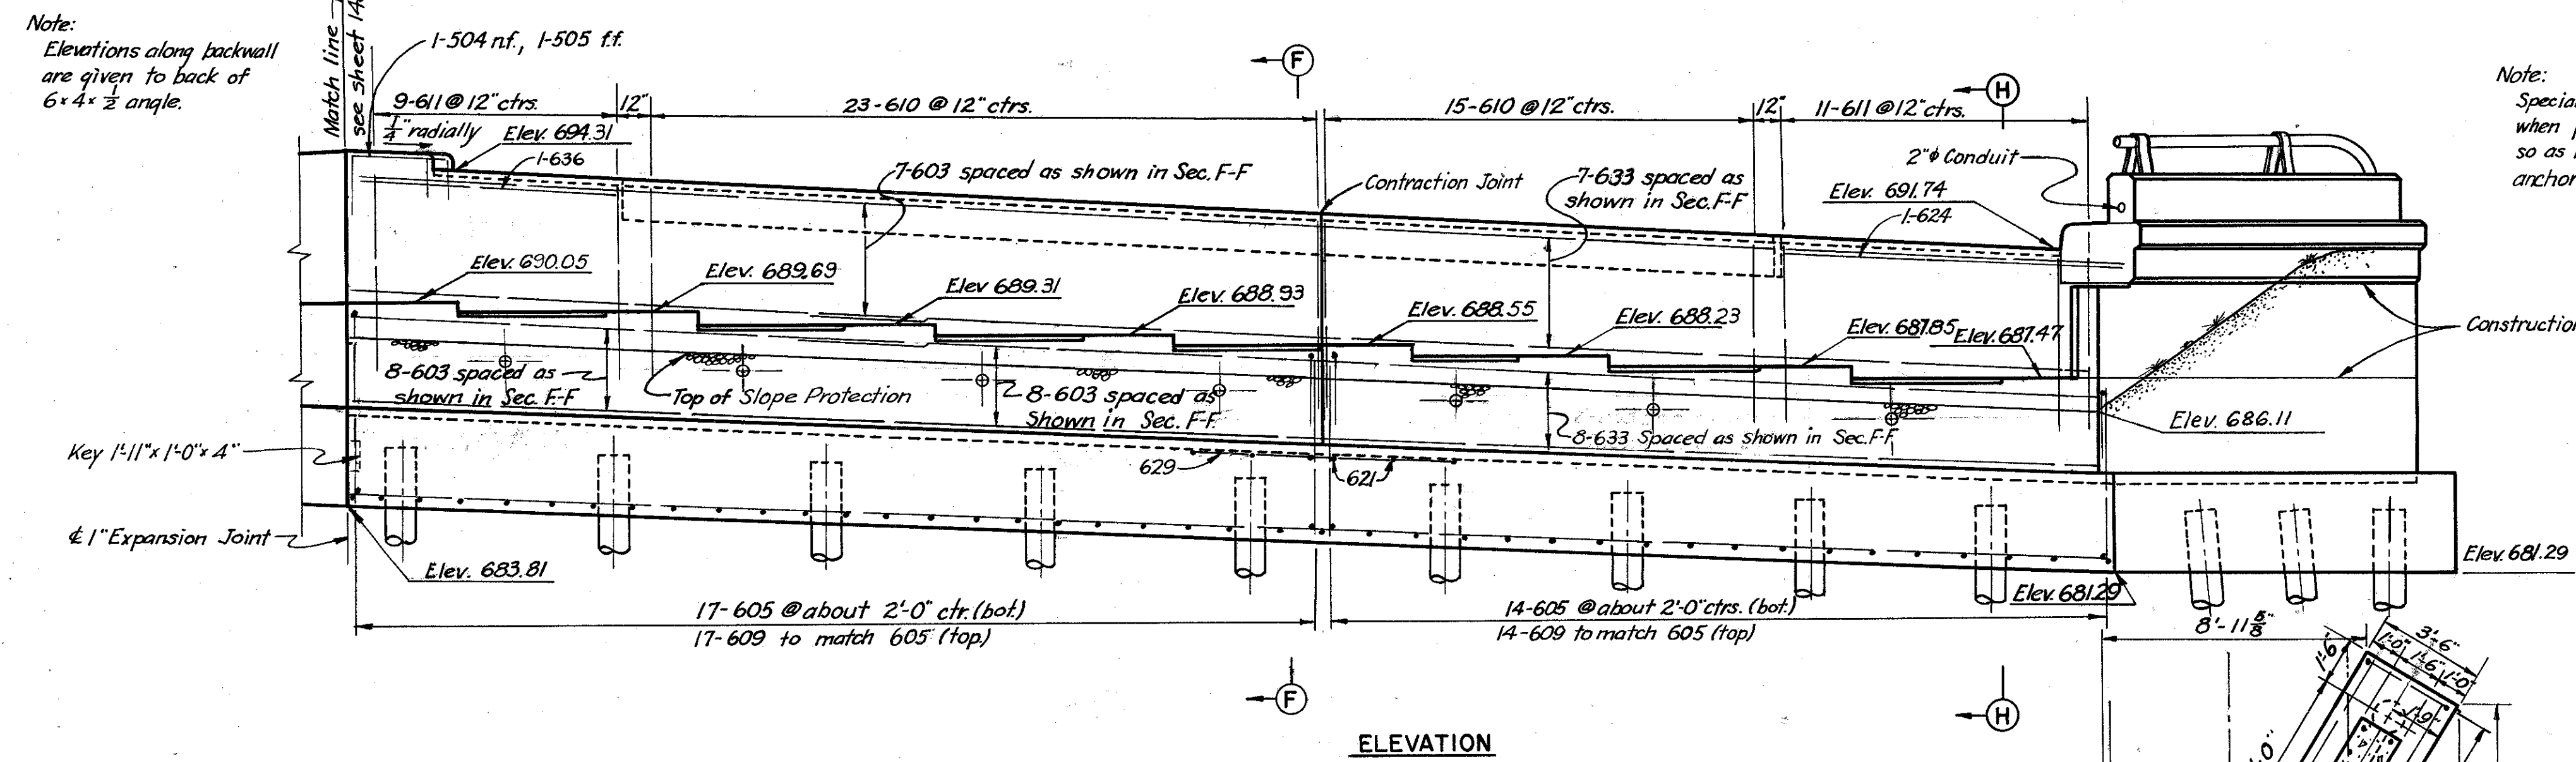


Note:
Special care shall be taken when placing reinforcing steel so as not to interfere with anchor bar setting.

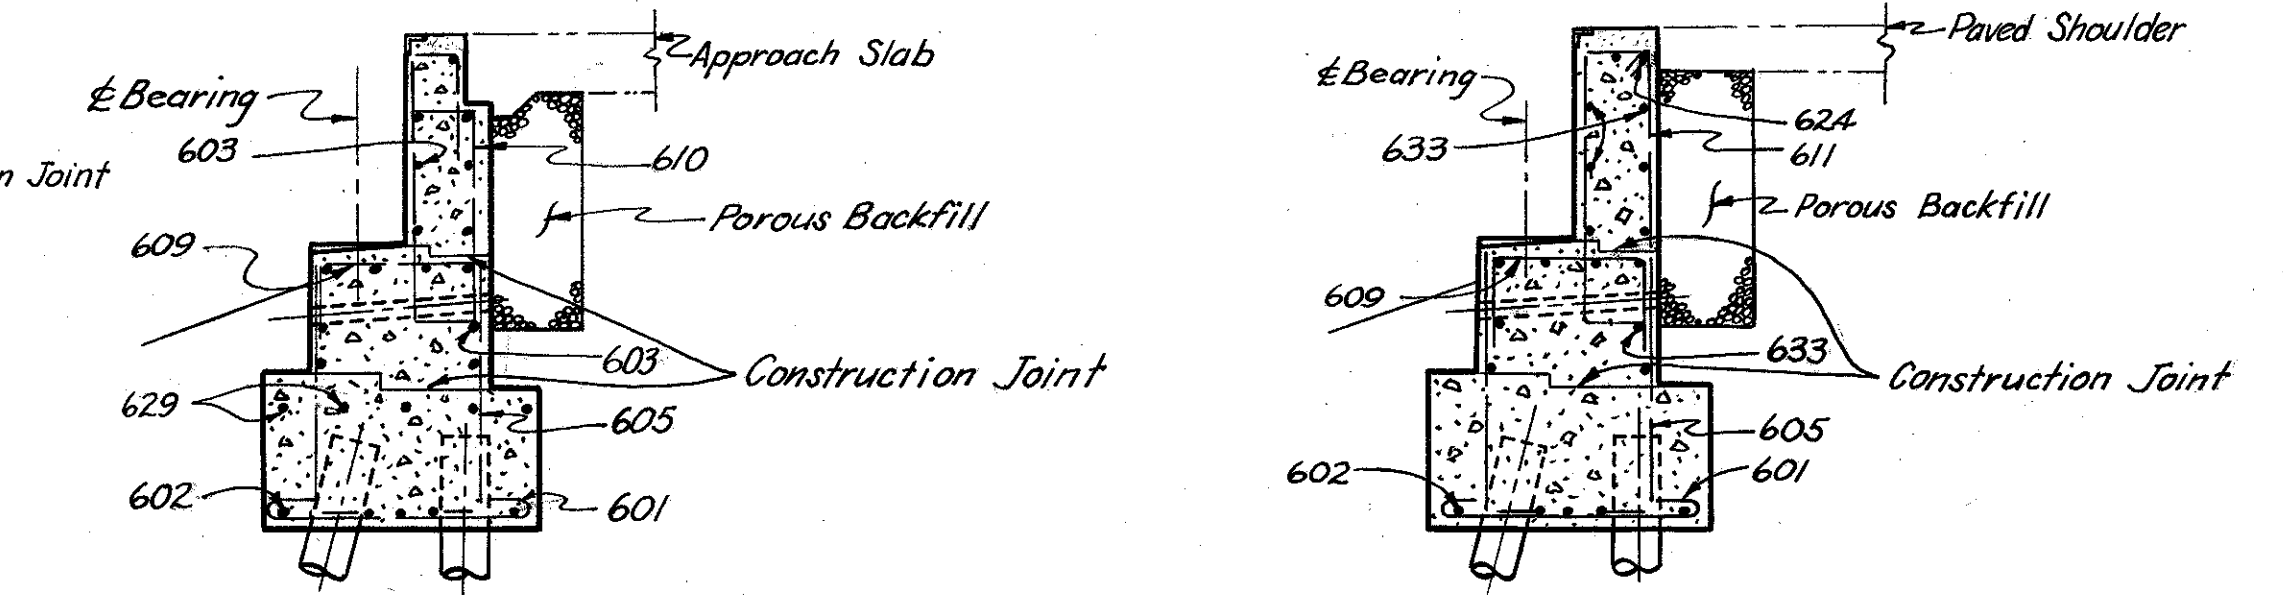

For dimensions and details not shown in view, see section B-B sheet

SECTION H-H

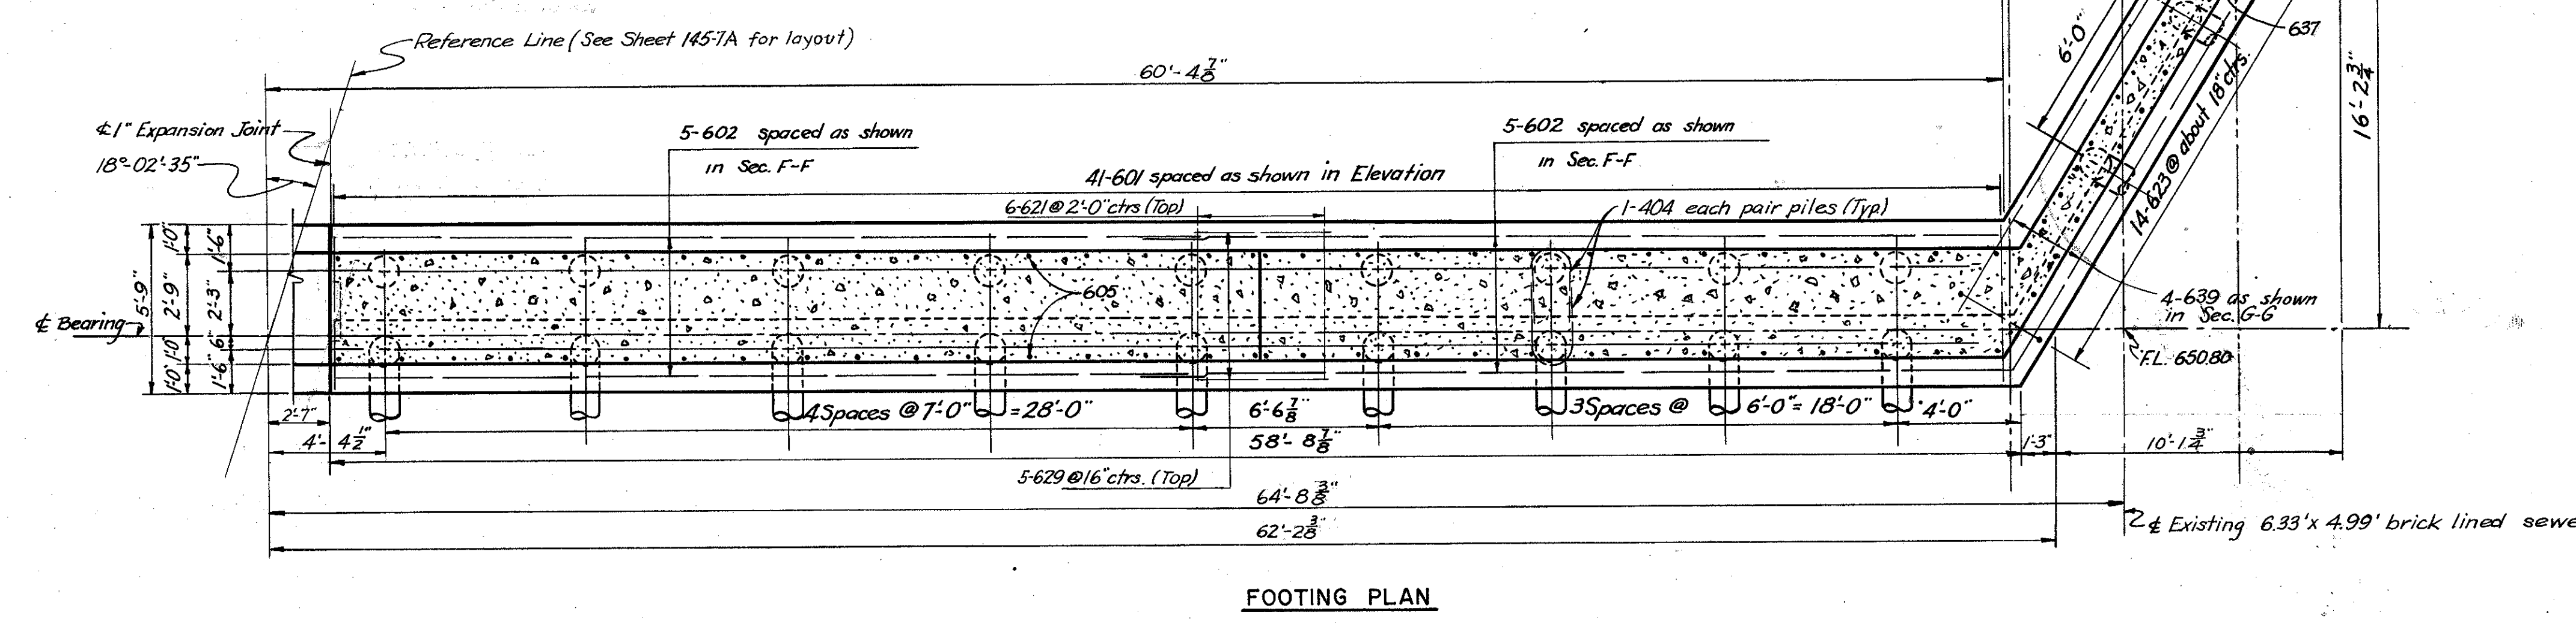

Note: Prefix "AB" shall be assigned to all bar marks.

For additional notes see sheet 146-7A

H.N.T.B. BR. NO. 8 PART 7A

HOWARD, NEEDLES, TAMMEN & BERGENDOFF
CONSULTING ENGINEERS
KANSAS CITY CLEVELAND NEW YORK

WEST ABUTMENT-NORTH HALF

WILLOW FREEWAY OVER EAST 14th ST.
BR. NO. CUY-21-1573A STA. 49+30.16
Scale: 1/4" = 1'-0" STA. 51+07.08

WILLOW-INNER BELT FREEWAY
CLEVELAND CUYAHOGA COUNTY OHIO

DRAWN BY	TRACED BY	CHECKED	REVIEWED	REVISED
DATE 7-31-59	DATE 8-20-59	DATE 8-7-59	DATE 11-13-59	







SHEET 149

MICROFILMED
JUL 8 1985

FED. ROADS DIV. NO.	STATE	FED. AID PROJ. NO.
2	OHIO	

150
181

CUYAHOGA COUNTY
CITY OF CLEVELAND
CUY-21-15.32
CUY-42-18.42

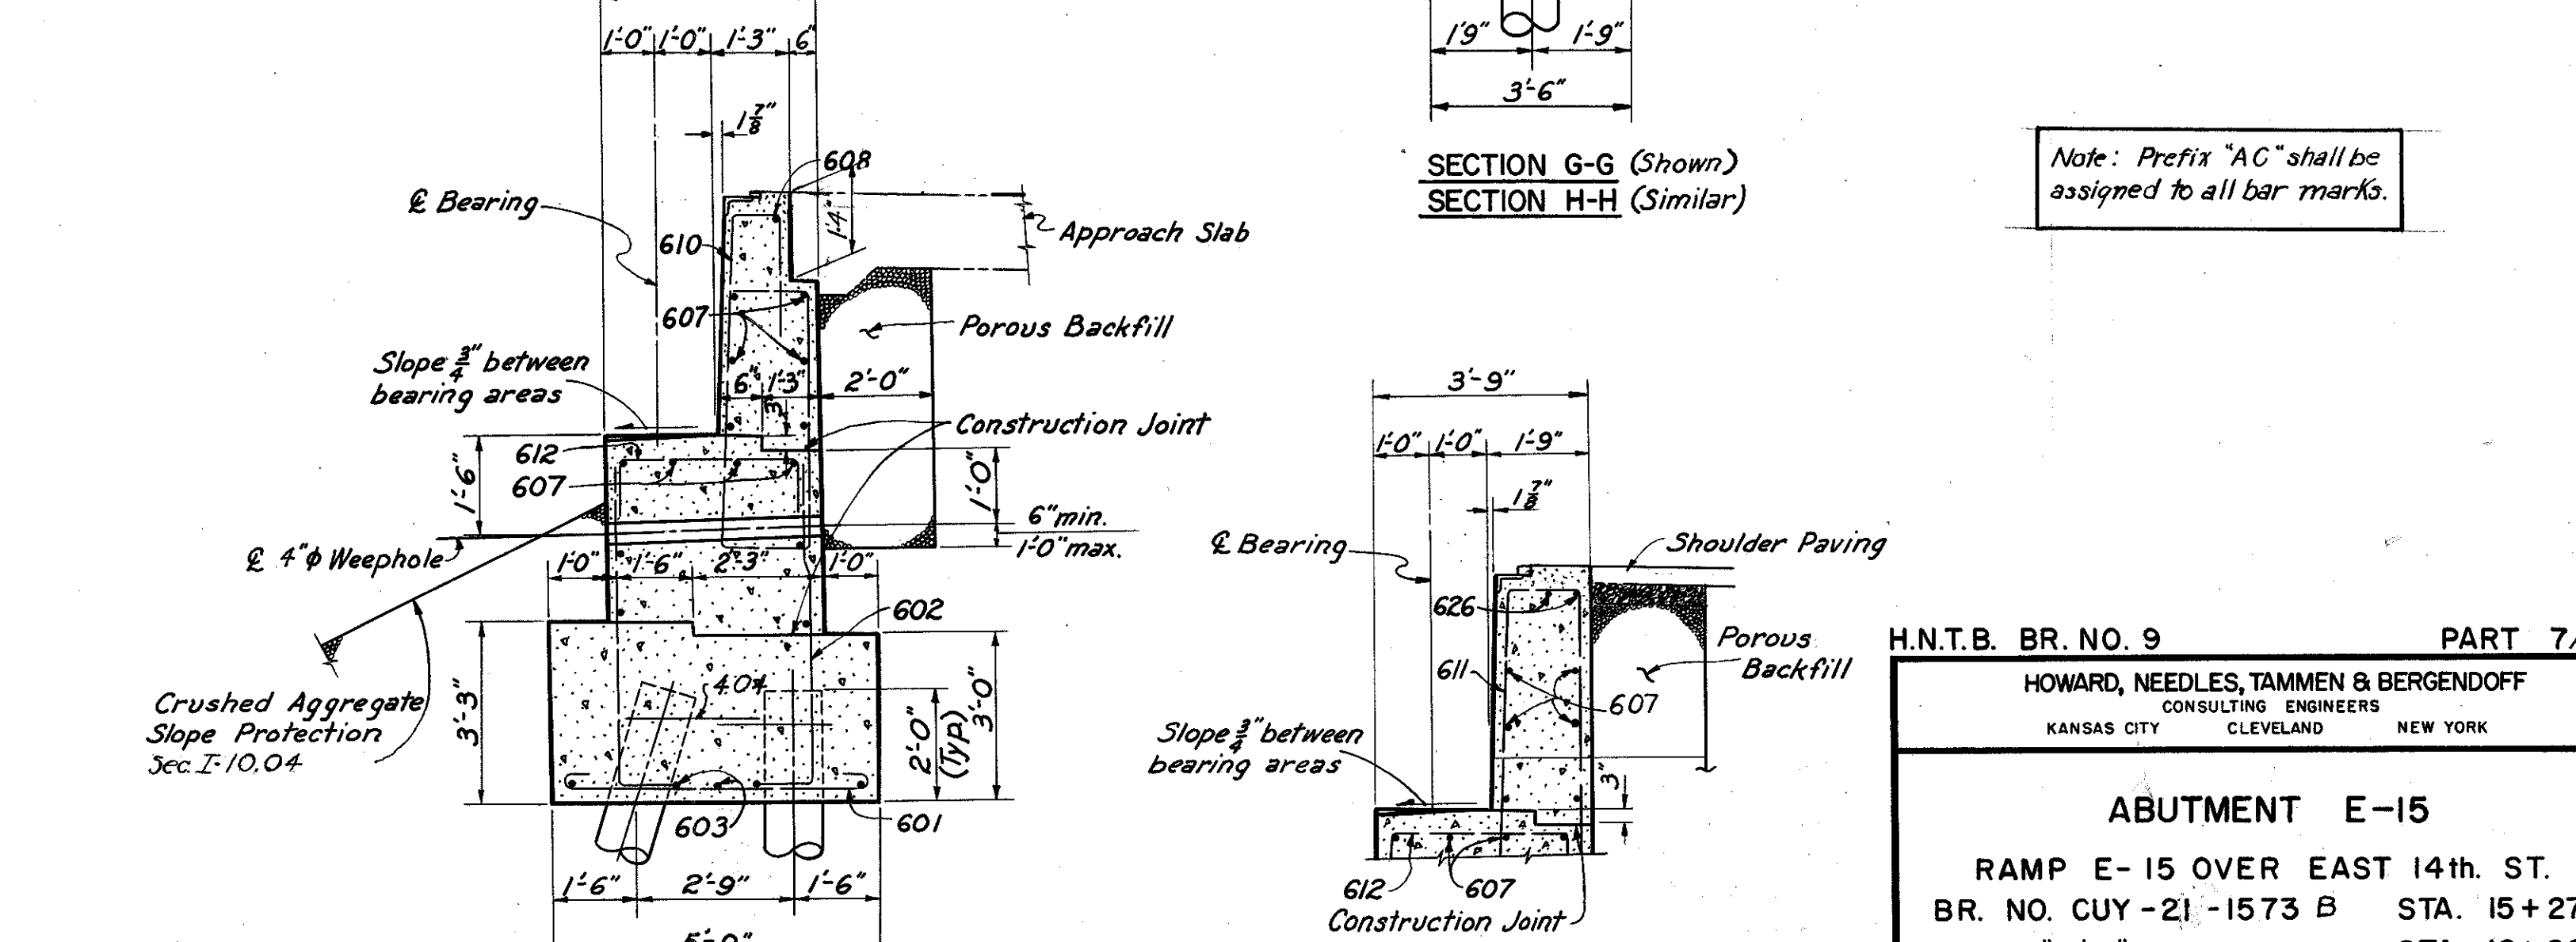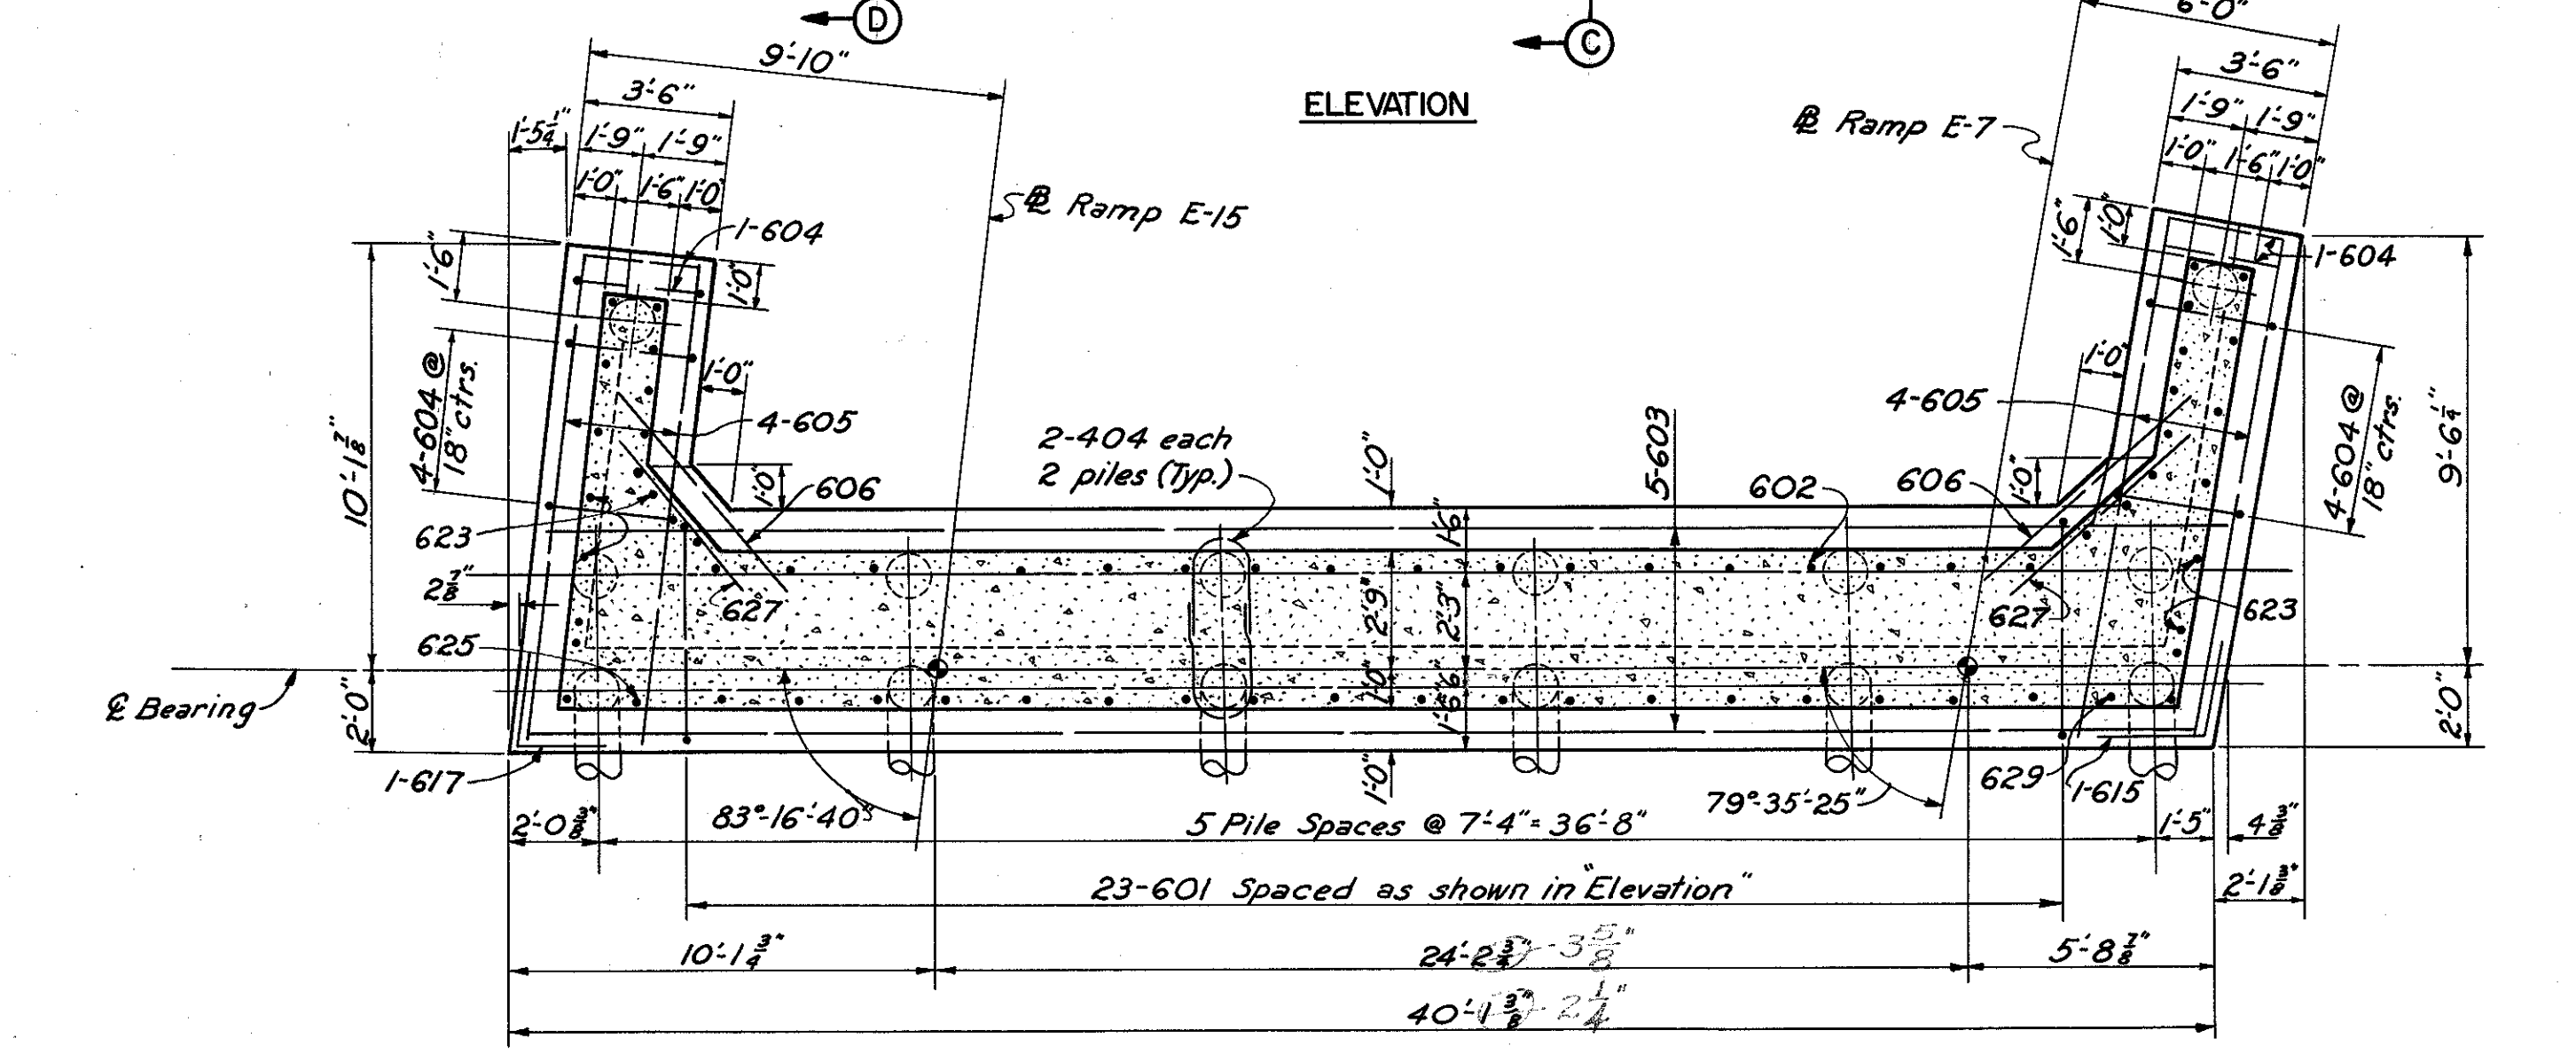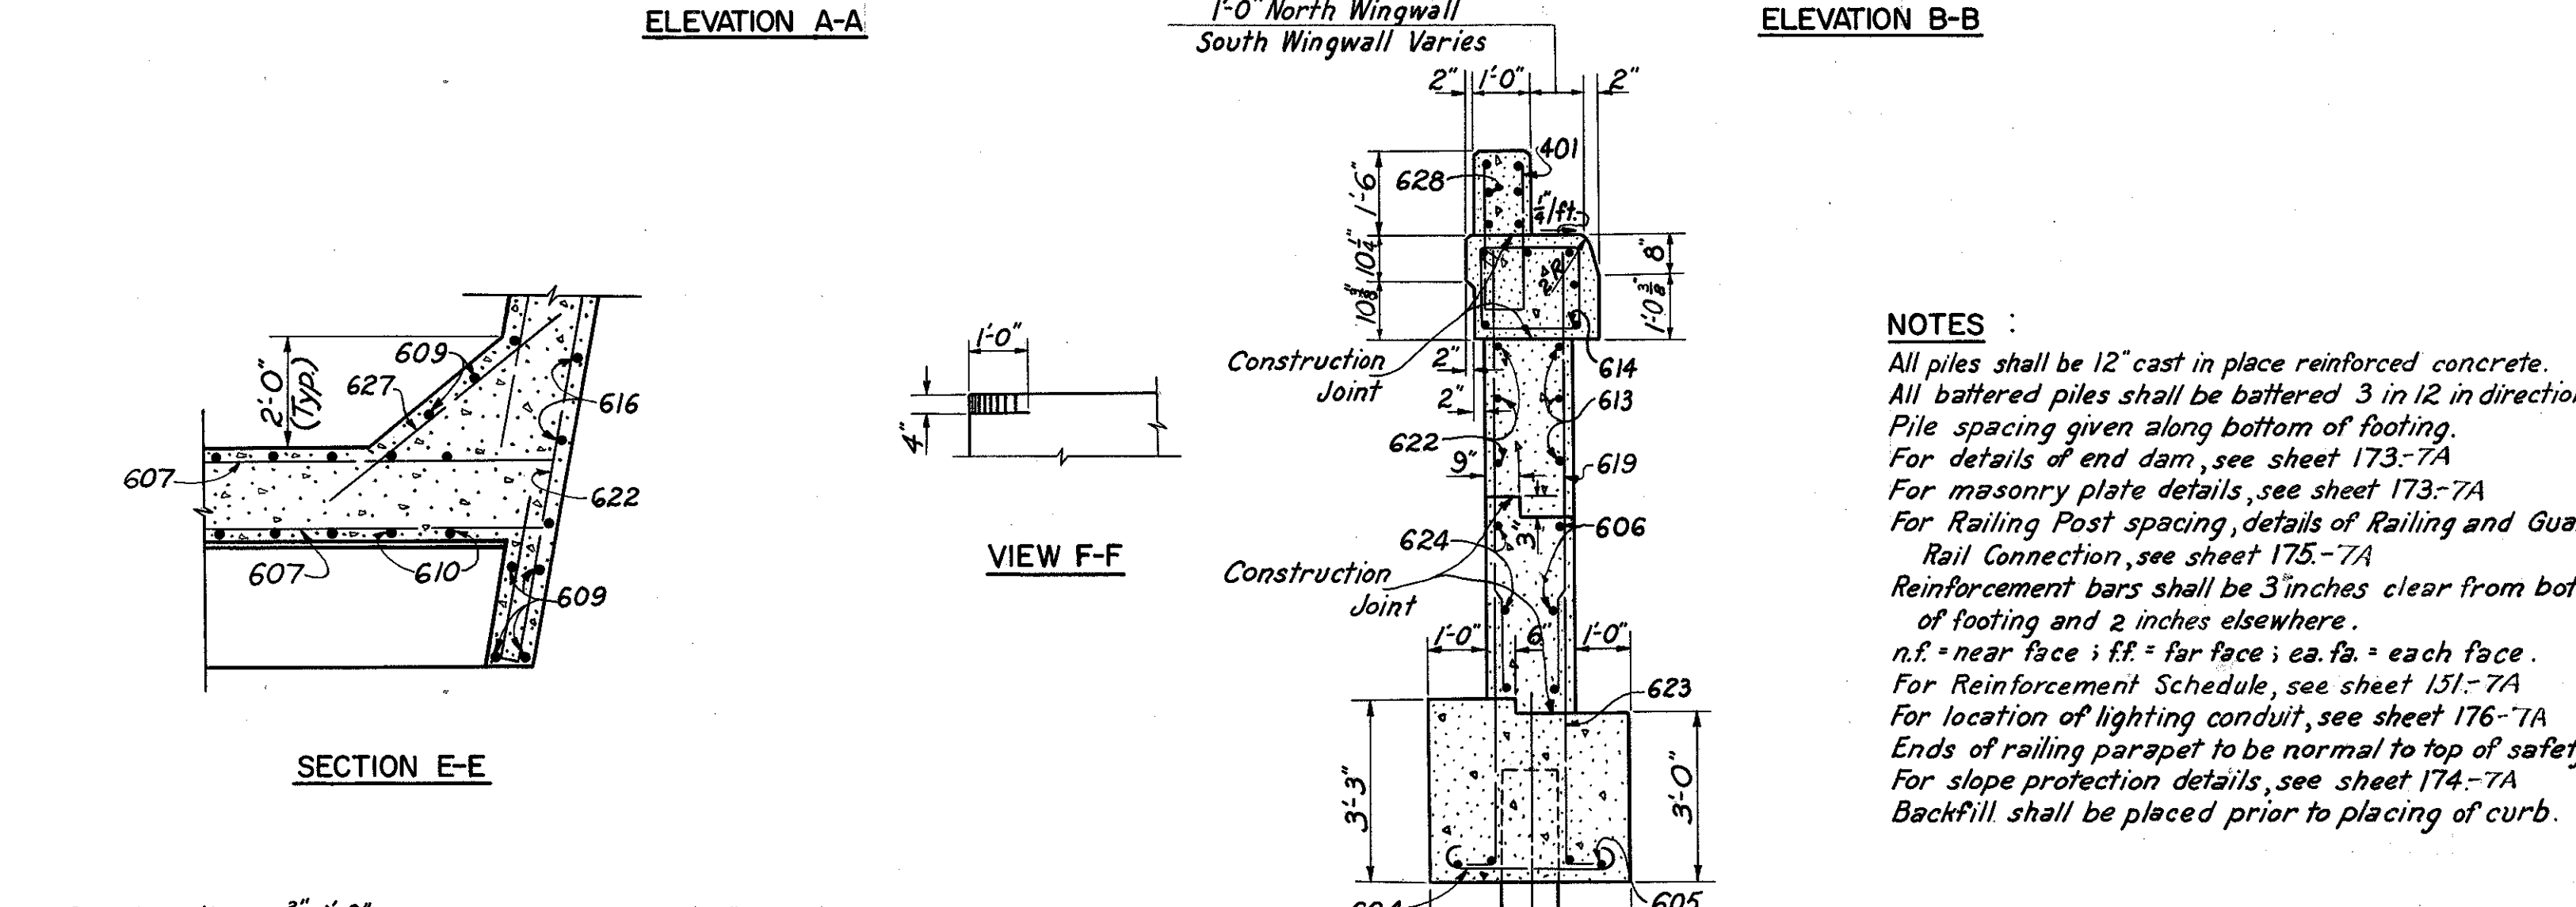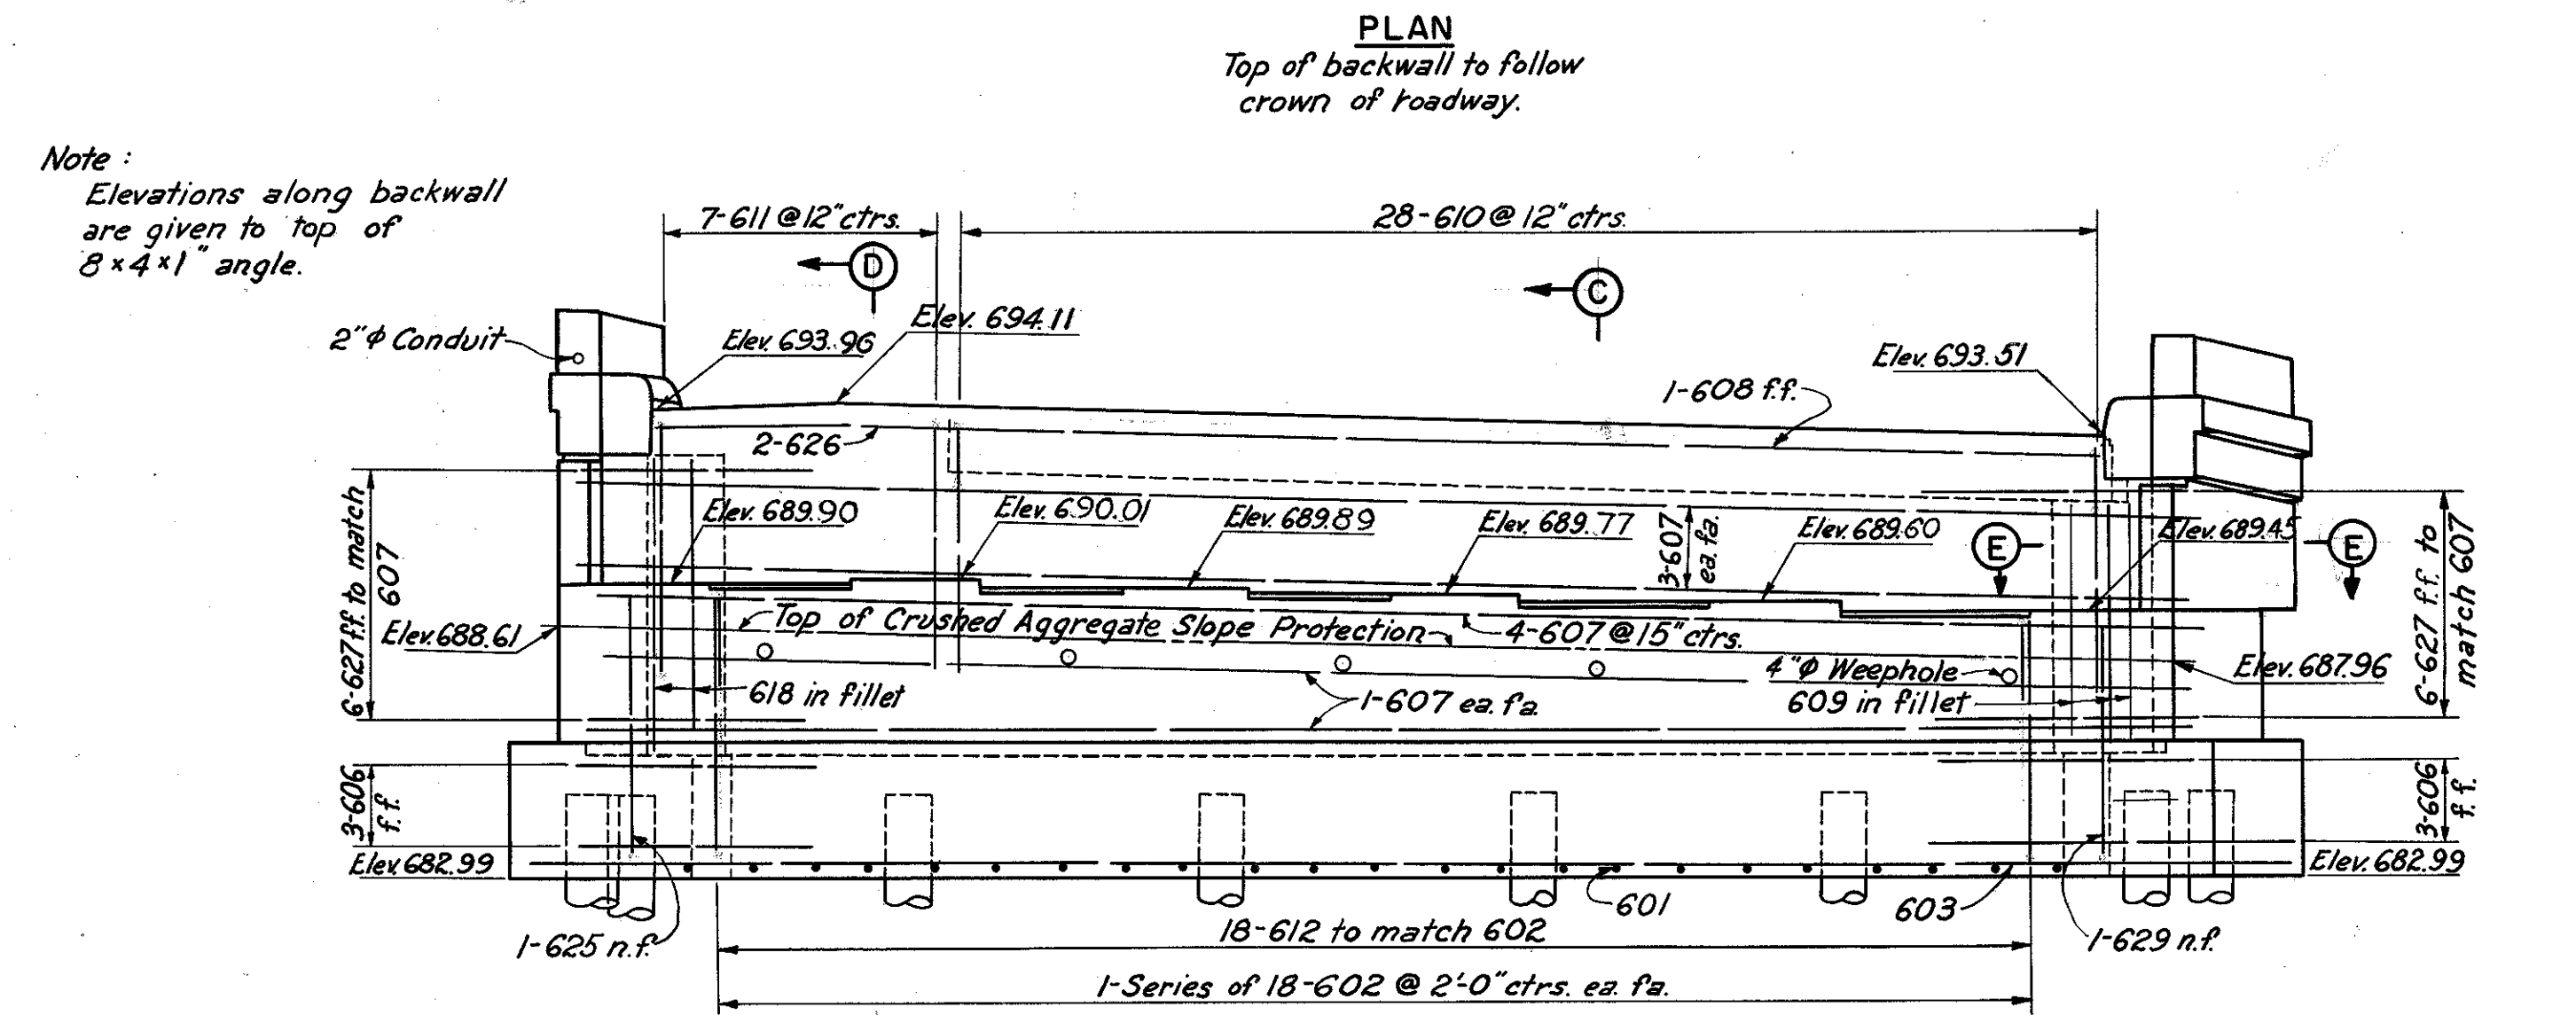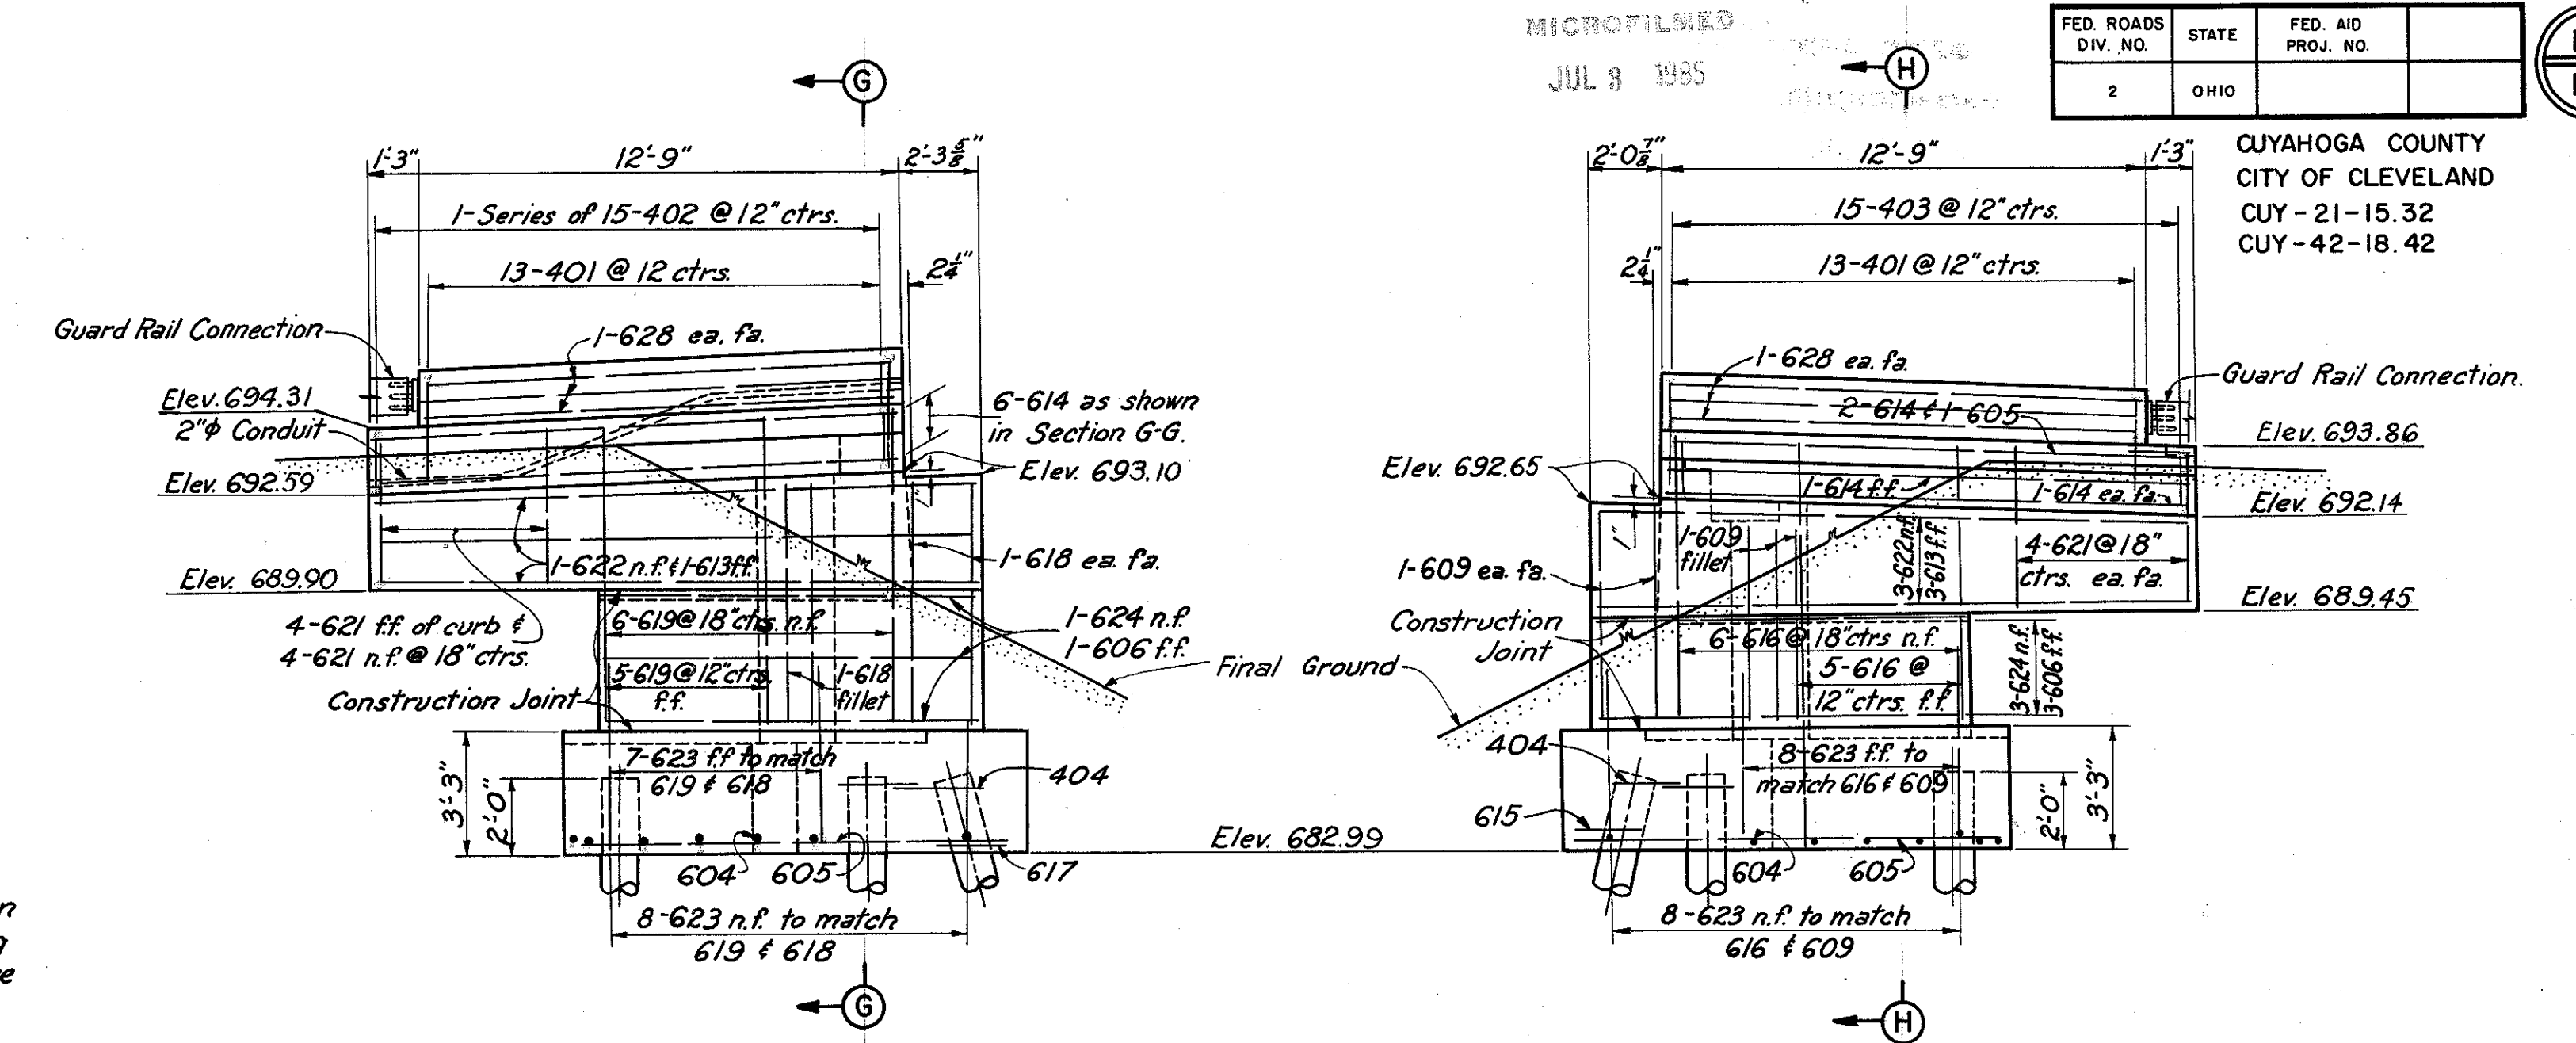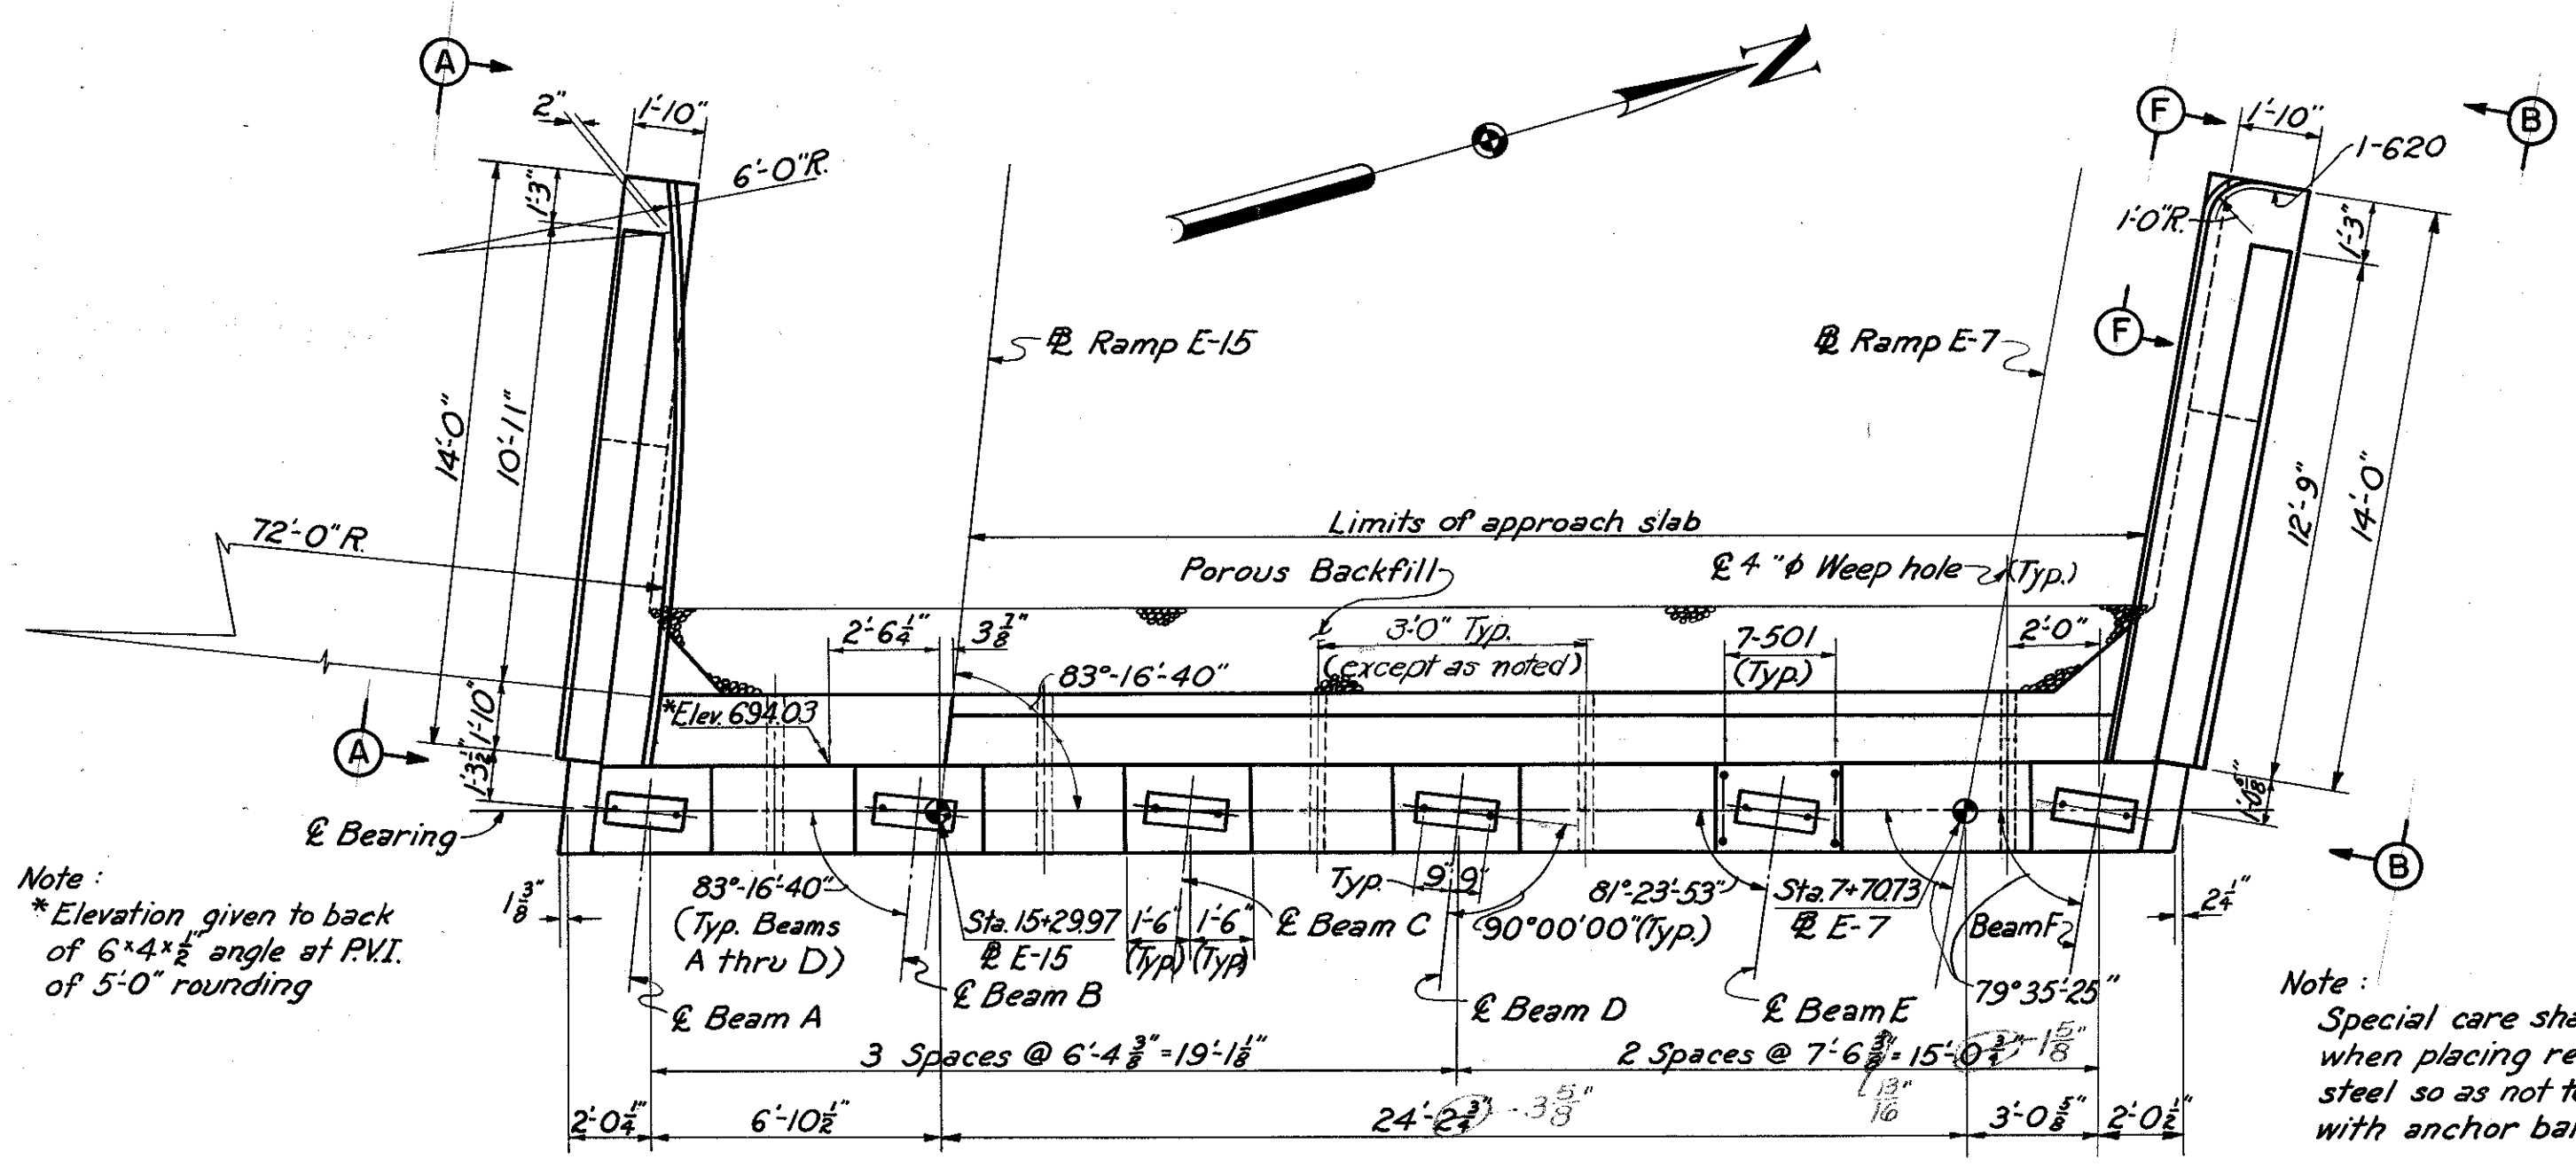

Note:
*Elevation given to back of 6'4"x1/2" angle at P.V.I. of 5'0" rounding

Note:
Special care shall be taken when placing reinforcing steel so as not to interfere with anchor bar setting.

Note:
Elevations along backwall are given to top of 8'x4'x1" angle.

NOTES:
All piles shall be 12" cast in place reinforced concrete.
All battered piles shall be battered 3 in 12 in direction shown.
Pile spacing given along bottom of footing.
For details of end dam, see sheet 173-7A
For masonry plate details, see sheet 173-7A
For Railing Post spacing, details of Railing and Guard Rail Connection, see sheet 175-7A
Reinforcement bars shall be 3 inches clear from bottom of footing and 2 inches elsewhere.
n.f. = near face; ff. = far face; ea. fa. = each face.
For Reinforcement Schedule, see sheet 151-7A
For location of lighting conduit, see sheet 176-7A
Ends of railing parapet to be normal to top of safety curb.
For slope protection details, see sheet 174-7A
Backfill shall be placed prior to placing of curb.

Note: Prefix "AC" shall be assigned to all bar marks.

H.N.T.B. BR. NO. 9 PART 7A
HOWARD, NEEDLES, TAMMEN & BERGENDOFF
CONSULTING ENGINEERS
KANSAS CITY CLEVELAND NEW YORK

ABUTMENT E-15
RAMP E-15 OVER EAST 14th. ST.
BR. NO. CUY-21-1573 B STA. 15+27.70
Scale: 1/4" = 1'-0" Except as noted. STA. 16+96.91

WILLOW-INNER BELT FREEWAY
CLEVELAND CUYAHOGA COUNTY OHIO

DRAWN C.C.D.	TRACED R.M.K.	CHECKED C.A.B.	REVIEWED J.C.T.
DATE 3-20-59	DATE 3-25-59	DATE 3-25-59	DATE 4-13-59

REVISED 9-21-60
SHEET 150

RECORDED JUL 9 1965


CUYAHOGA COUNTY CITY OF CLEVELAND CUY-21-15.32 CUY-42-18.42

EAST ABUTMENT									
MARK	NO.	LENGTH	TYPE	DIMENSIONS				SERIES INCREMENT	WEIGHT (LBS)
				A	B	C	D		
601	91	6'-9"	100	5'-5"					923
602	18	4'-6"	100	3'-2"					122
603	20	2'-9"	Str.						804
604	5	19'-8"	108	4'-6"	15'-2"	1/2	12		148
605	1	15'-3"	124	11'-9"	1'-9"	2'-0"	3		23
606	1	11'-9"	Str.						18
607	2	9'-6"	Str.						29
608	3	11'-6"	Str.						52
609	151	5'-7"	104	4'-11"	10"				1266
610	62	8'-3"	105	3'-5"	2'-7"				768
611	1	13'-4"	108	11'-6"	2'-0"	12	1		20
612	45	24'-3"	Str.						1439
613	15	28'-6"	Str.						642
614	15	22'-9"	Str.						513
615	75	15'-8"	112	1'-5"	6'-0"	4'-8"	11"		1765
616	37	15'-7"	109	1'-5"	6'-0"				866
617	2	8'-0"	Str.						24
618	1	11'-0"	Str.						17
619	1	8'-6"	Str.						13
620	3	12'-2"	124	9'-9"	8"	1'-11"	3		55
621	3	11'-4"	108	9'-7"	1'-11"	12	1		51
622	1	10'-0"	Str.						15
623	2	15'-9"	Str.						47
624	8	6'-0"	Str.						72
625	4	12'-0"	Str.						72
626	1	9'-9"	Str.						15
627	2	15'-6"	Str.						47
628	12	13'-6"	Str.						243
629	12	12'-3"	Str.						
630	22	7'-6"	Str.						248
631	8	5'-9"	Str.						69
632	1	3'-3"	Str.						5
633	2	5'-0"	Str.						15
634	13	3'-9"	Str.						73
635	1	7'-10"	155	3'-3"	1'-11"				12
636	10	4'-3"	Str.						64
637	4	5'-4"	108	3'-6"	1'-11"	6	12		32
638	8	5'-3"	Str.						63
639	5	10'-6"	Str.						79
640	9	7'-0"	Str.						95
641	9	5'-6"	Str.						74
642	8	8'-10"	124	3'-7"	6"	5'-0"	12		106
643	3	4'-10"	133	3'-1"	1'-9"	2'-6"			22
644	3	4'-1"	133	2'-5"	1'-8"	2'-0"			18
645	3	4'-9"	133	4'-2"	7"	2'-6"			21
646	3	4'-0"	133	3'-4"	8"	2'-0"			18
647	2 series of 3	2'-8"	Str.					3"	25
648	2 series of 3	3'-0"	Str.					3"	29
649	8	17'-3"	109	1'-5"	6'-10"				207
650	2	8'-1"	155	3'-6"	1'-11"				24
651	1	8'-5"	155	3'-10"	1'-11"				13
501	119	4'-7"	105	1'-8"	1'-7"				569
502	2	6'-6"	105	2'-9"	2'-0"				14
503	1	6'-0"	105	2'-3"	2'-0"				6
504	1	7'-0"	105	3'-3"	2'-0"				7
401	28	5'-7"	105	8"	2'-7"				105
402	10	5'-3"	122	8"	1'-11"				35
403	36	5'-10"	144	2'-0"	1'-10"				140
Total									12,562

WEST ABUTMENT (BRIDGE NO. 8)									
MARK	NO.	LENGTH	TYPE	DIMENSIONS				SERIES INCREMENT	WEIGHT (LBS)
				A	B	C	D		
601	73	6'-9"	100	5'-5"					740
602	30	30'-0"	Str.						1352
603	30	17'-0"	Str.						766
604	5	17'-6"	Str.						131
605	108	6'-0"	104	5'-4"	10"				973
606	1	11'-6"	Str.						17
607	2	9'-3"	Str.						28
608	15	17'-0"	Str.						383
609	54	7'-7"	105	3'-5"	2'-3"				615
610	65	16'-0"	112	1'-5"	6'-0"	4'-8"	11"		1562
611	40	13'-3"	109	1'-5"	6'-0"				916
612	3	11'-7"	124	9'-3"	0'-8"	1'-11"	4		52
613	4	5'-0"	Str.						30
614	1	13'-5"	126	9'-3"	0'-6"	4'-0"			20
615	2	19'-8"	126	15'-6"	0'-6"	4'-0"			59
616	2	12'-6"	Str.						38
617	6	3'-6"	Str.						32
618	2	4'-9"	Str.						14
619	14	8'-3"	Str.						173
620	6	13'-6"	Str.						122
621	6	5'-3"	Str.						47
622	6	12'-3"	Str.						
623	22	4'-6"	100	3'-2"					149
624	1	11'-0"	Str.						17
625	1	10'-6"	Str.						16
626	3	20'-4"	108	18'-6"	1'-11"	12	5		92
627	8	16'-0"	Str.						192
628	5	28'-8"	126	18'-6"	0'-6"	4'-0"			170
629	5	8'-6"	Str.						64
630	6	16'-9"	Str.						151
631	9	6'-6"	Str.						88
632	6	15'-6"	Str.						
633	15	26'-0"	Str.						586
634	29	7'-6"	Str.						326
635	4	6'-0"	Str.						18
636	1	8'-6"	Str.						13
637	46	5'-7"	104	4'-11"	0'-10"				386
638	1	7'-9"	Str.						12
639	4	21'-3"	Str.						128
640	4	3'-0"	Str.						18
641	2	5'-4"	108	3'-6"	1'-11"	6	12		16
642	3	17'-6"	Str.						79
643	3	13'-3"	Str.						60
644	1	15'-0"	124	11'-6"	1'-9"	2'-0"	4		23
501	98	3'-1"	105	1'-8"	10"				315
502	1	7'-4"	105	2'-7"	2'-6"				8
503	1	6'-11"	105	2'-2"	2'-6"				7
504	1	7'-6"	105	2'-9"	2'-6"				8
505	1	7'-11"	105	3'-2"	2'-6"				8
401	2 series of 3	4'-1" to 6'-5"	109	0'-6" to 1'-8"	1'-4"			2"	53
402	29	5'-7"	105	0'-8"	2'-7"				121
403	13 series of 18	4'-1" to 6'-5"	109	0'-6" to 1'-8"	1'-4"			1 5/8"	63
404	28	5'-10"	144	2'-0"	1'-10"				109
Total									11,361

ABUTMENT E-15 (BRIDGE NO. 9)									
MARK	NO.	LENGTH	TYPE	DIMENSIONS				SERIES INCREMENT	WEIGHT (LBS)
				A	B	C	D		
401	28	5'-5"	105	8"	2'-6"				94
402	1 series of 15	4'-1" to 6'-5"	109	6" to 1'-6"	1'-4"			2"	53
403	15	6'-5"	109	1'-8"	1'-4"				64
404	12	5'-10"	144	2'-0"	1'-10"				47
501	42	4'-5"	105	1'-8"	1'-6"				193
601	23	6'-9"	100	5'-5"					233
602	2 series of 18	6'-9" to 7'-2"	104	5'-11" to 6'-4"	1'-0"			5/16"	376
603	5	39'-9"	Str.						299
604	12	4'-6"	100	3'-2"					81
605	9	11'-3"	Str.						152
606	12	6'-6"	Str.						117
607	14	37'-9"	Str.						794
608	1	30'-0"	Str.						45
609	7	5'-9"	Str.						61
610	28	14'-4"	112	1'-5"	5'-6"	4'-2"	7"		603
611	7	14'-2"	109	5'-6"	1'-4"				149
612	18	6'-1"	105	3'-5"	1'-6"				164
613	6	12'-3"	Str.						110
614	11	13'-6"	Str.						223
615	1	3'-10"	108	2'-0"	2'-0"	12"	2"		6
616	11	7'-6"	Str.						124
617	1	3'-10"	148	2'-0"	2'-0"				6
618	6	6'-3"	Str.						59
619	11	7'-9"	Str.						128
620	1	4'-0"	123	2'-0"	1'-4"	8"			6
621	16	4'-0"	Str.						96
622	6	19'-5"	126	15'-6"	9"	3'-9"			175
623	31	5'-10"	104	5'-0"	1'-0"				272
624	6	11'-3"	104	9'-6"	1'-11"				101
625	1	7'-2"	104	6'-4"	1'-0"				11
626	2	8'-6"	Str.						25
627	12	5'-0"	Str.						90
628	12	12'-3"	Str.						-
629	1	6'-9"	104	5'-11"	1'-0"				10
Total									4967

BENDING DIAGRAMS

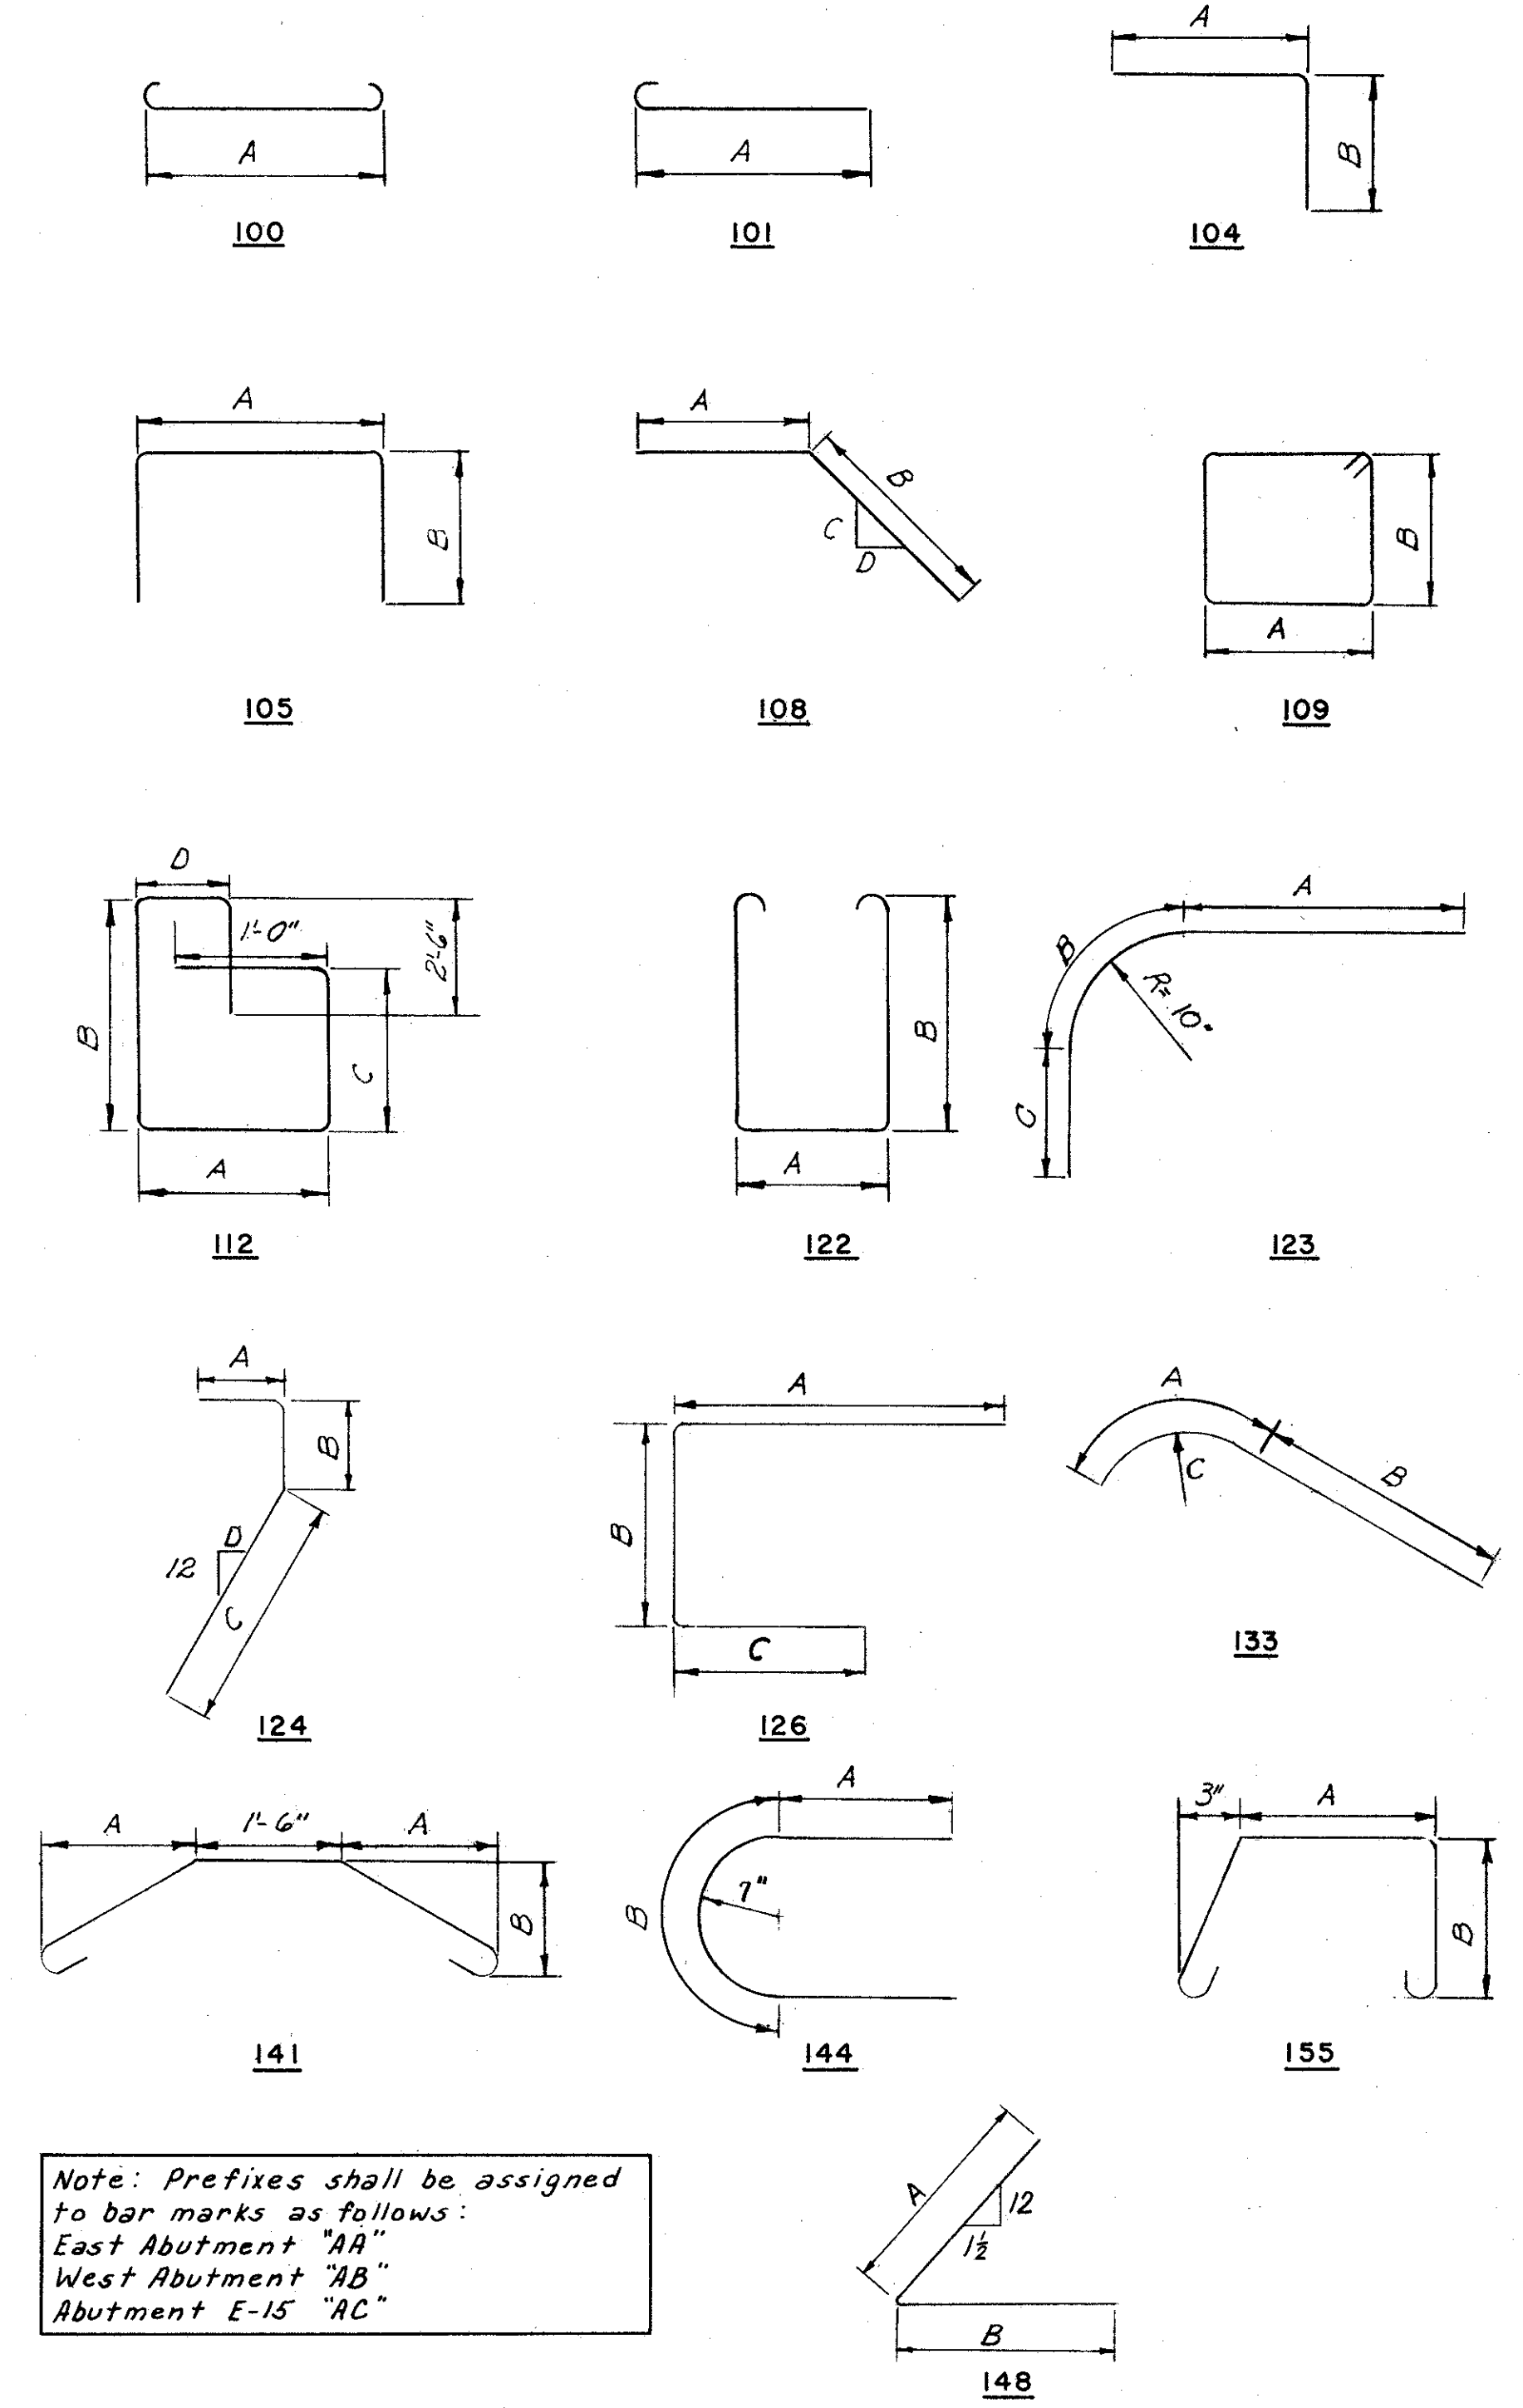

Note: Prefixes shall be assigned to bar marks as follows:
 East Abutment "AA"
 West Abutment "AB"
 Abutment E-15 "AC"

NOTES:
 All bar dimensions are given out to cut.
 Bars of a series shall vary in length by a constant increment.
 For Replacement Schedule see Sheet 103-7A
 * Denotes bars to be included with Item 5-14, Railing for payment.

H.N.T.B. BRS. NO. 8 AND 9 PART 7A


HOWARD, NEEDLES, TAMMEN & BERGENDOFF CONSULTING ENGINEERS KANSAS CITY CLEVELAND NEW YORK

REINFORCEMENT SCHEDULE-ABUTMENTS
 WILLOW FREEWAY & RAMP E-15 OVER E. 14th STREET
 STA. 49+30.16 STA. 51+07.08 (WILLOW FREEWAY)
 STA. 15+27.70 STA. 16+96.91 (RAMP E-15)
 BR. NO. CUY-21-1573A#B Scale: None
 WILLOW-INNER BELT FREEWAY
 CLEVELAND CUYAHOGA COUNTY OHIO


DRAWN: ARZ TRACED: [] CHECKED: [] REVIEWED: [] REVISION: []
 DATE: 8-28-58 DATE: [] DATE: [] DATE: [] SHEET 151

JUL 3 1935


CUYAHOGA COUNTY
CITY OF CLEVELAND
CUY-21-15.32
CUY-42-18.42

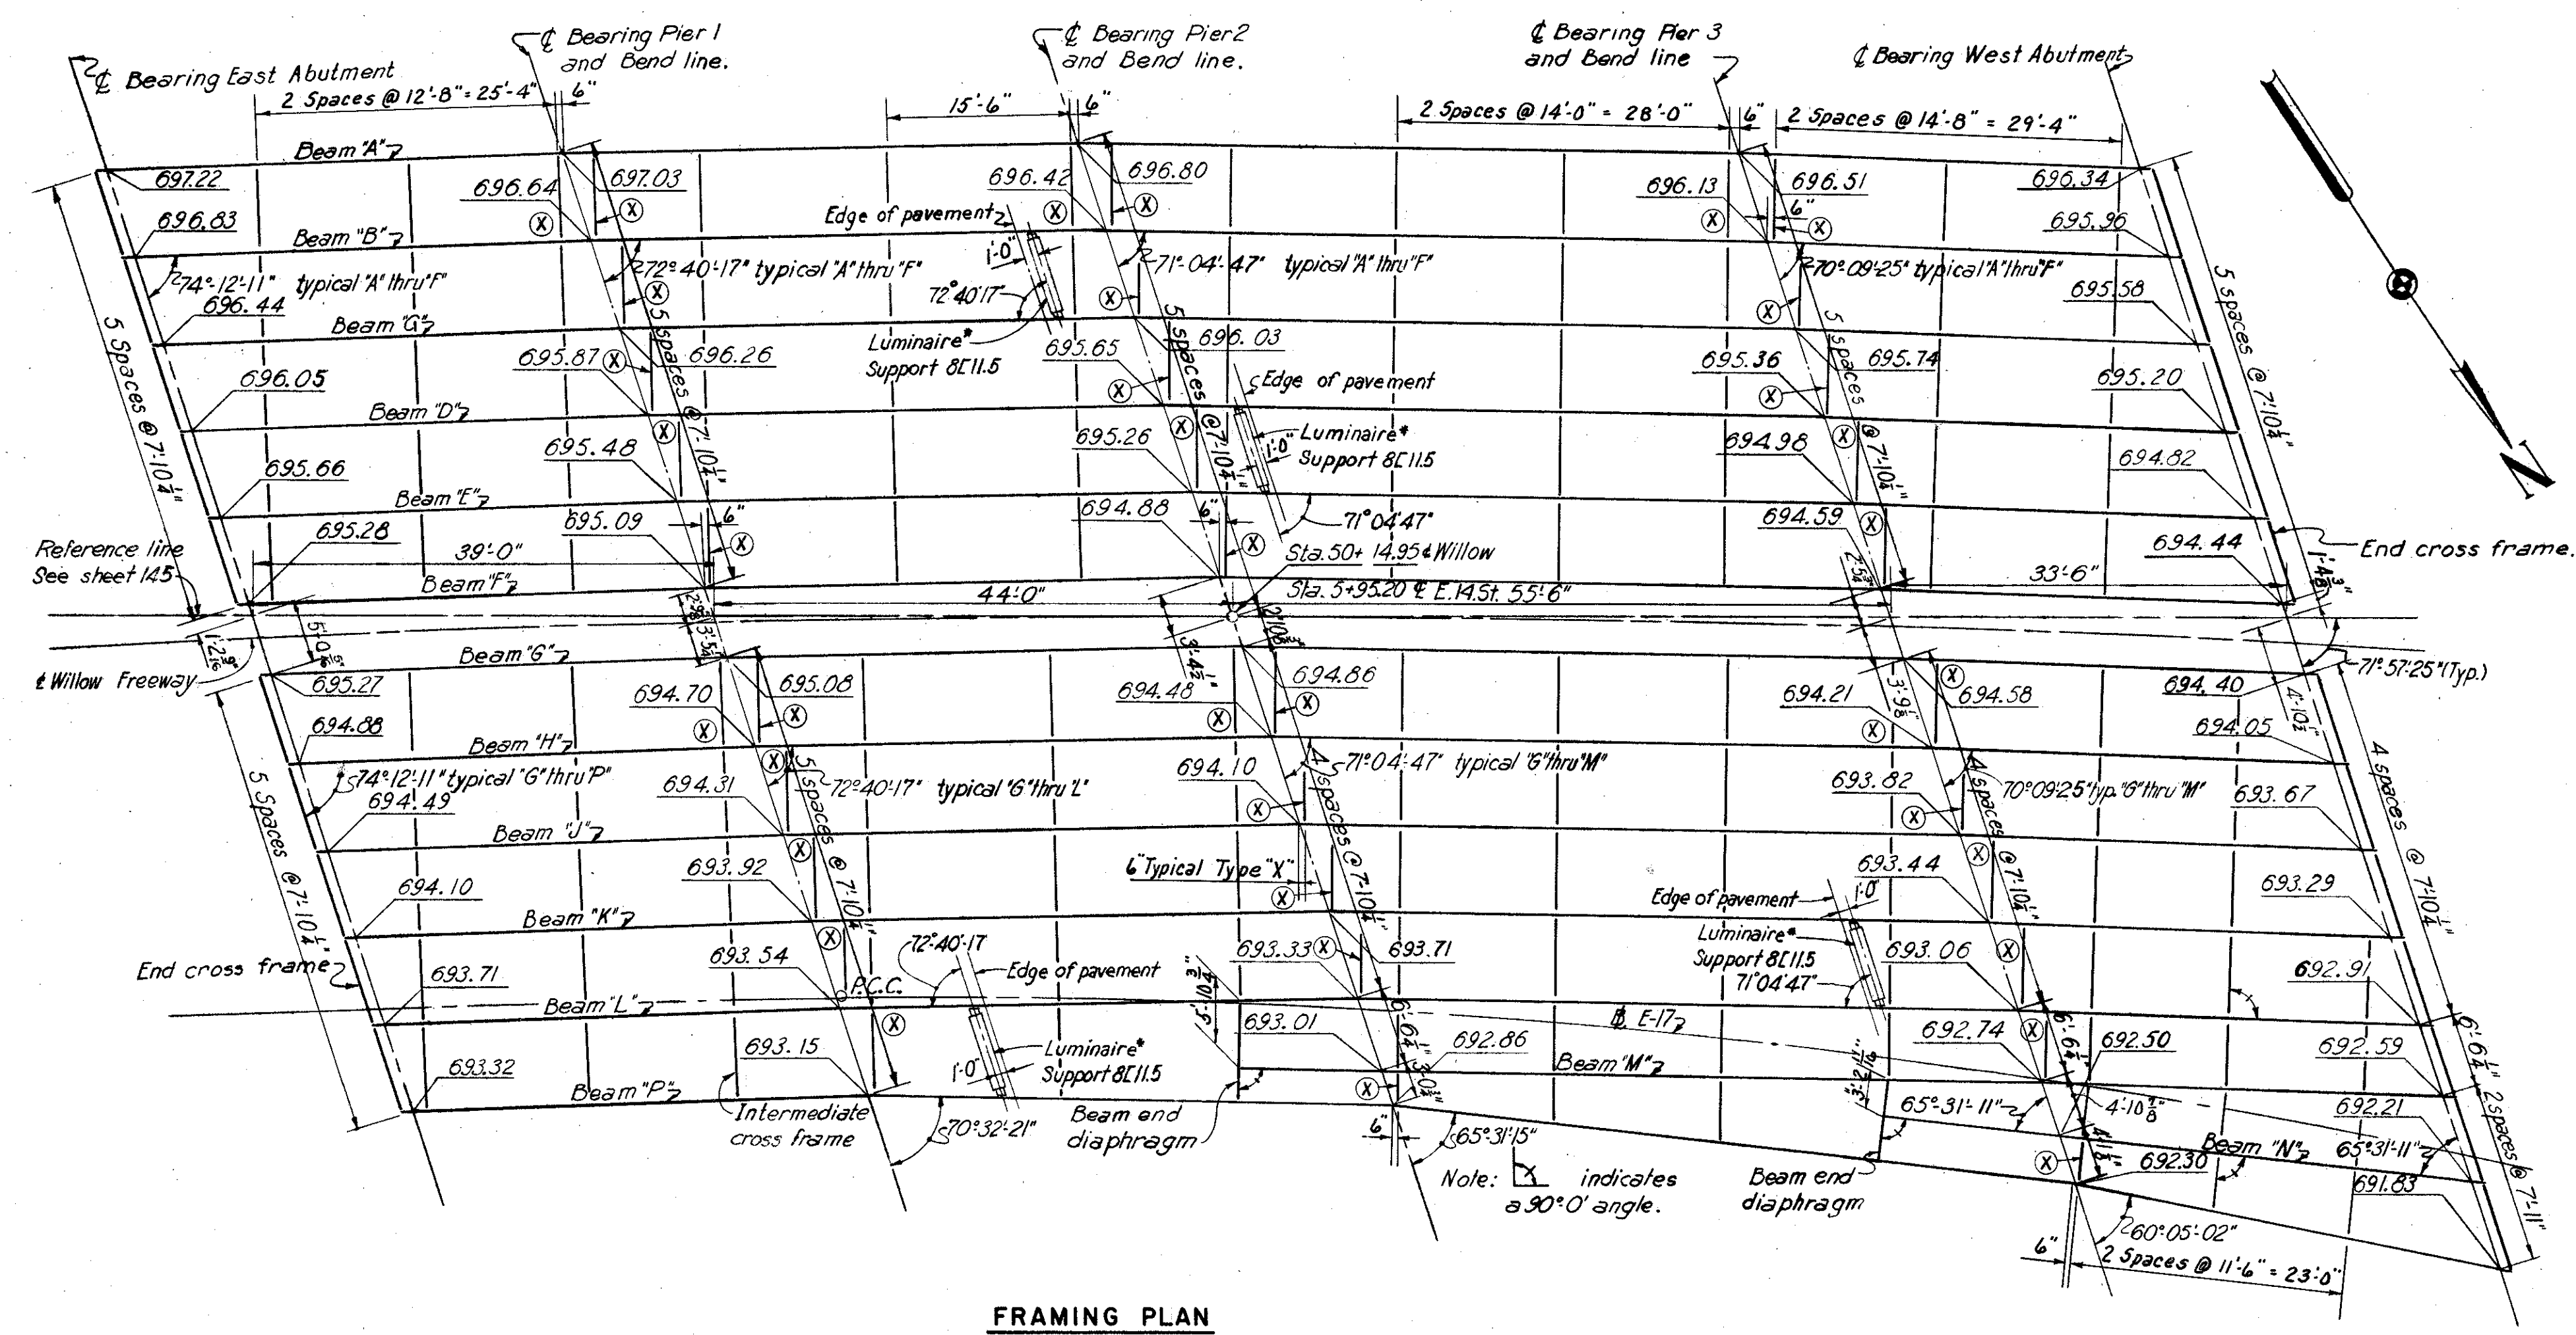

FRAMING PLAN
Scale: 3/8" = 1'-0"

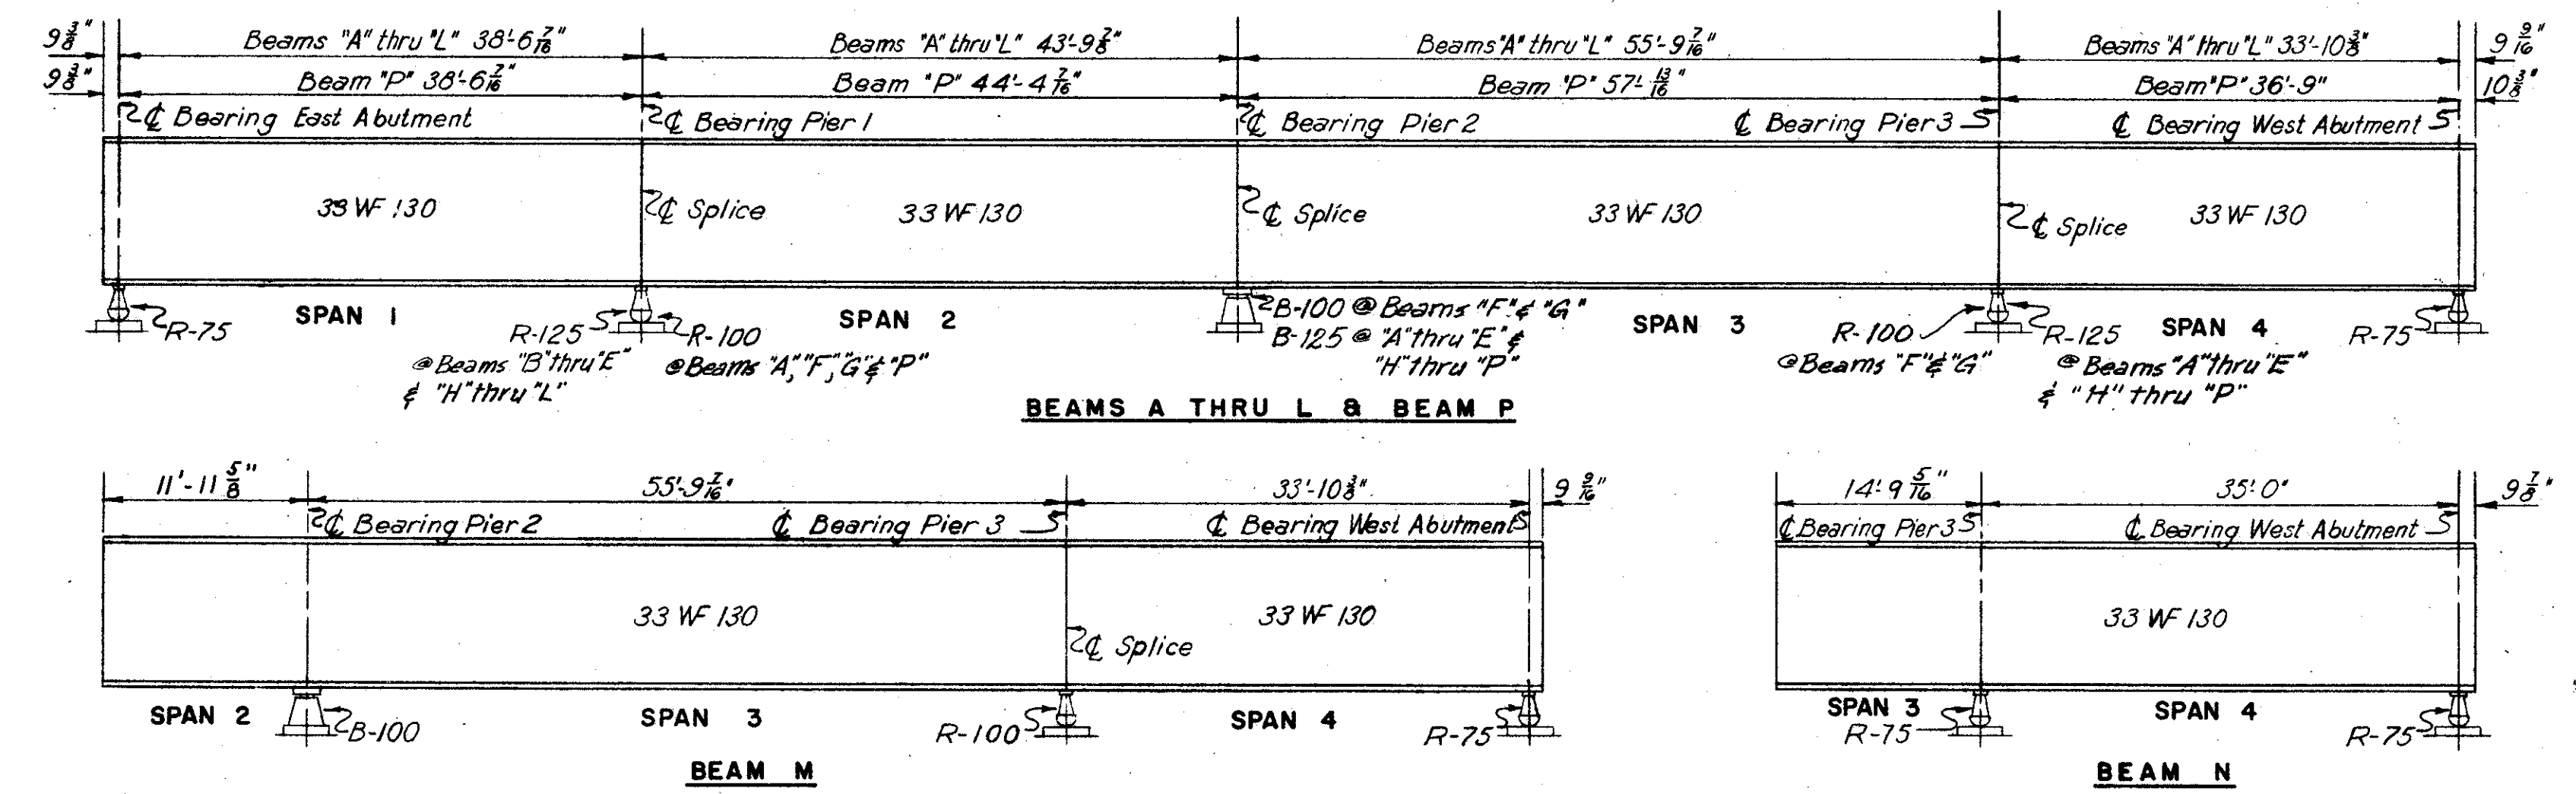

BEAM ELEVATIONS
Scale: 3/8" = 1'-0"

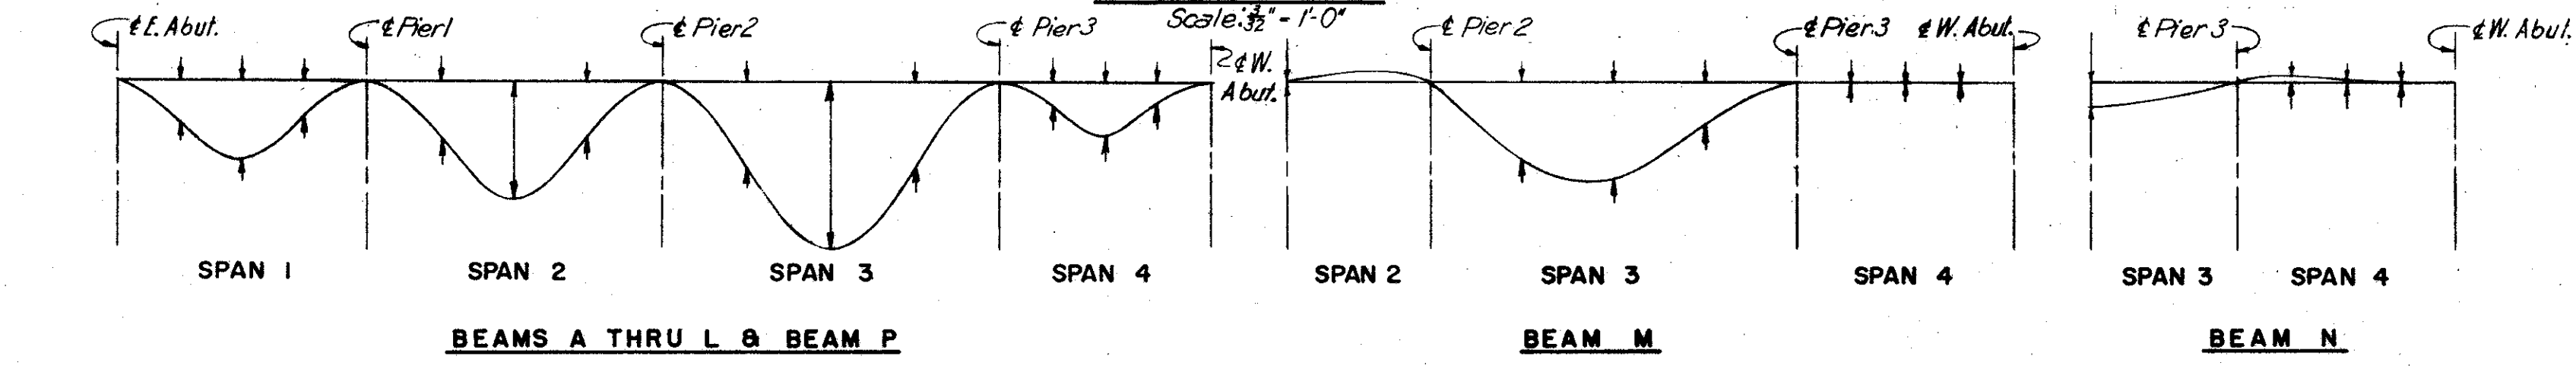


BEAM DEFLECTION DIAGRAMS
No Scale

These diagrams locate points only and do not necessarily show the correct direction of deflections.

BEAM SPLICE WELDING PROCEDURE

1. Raise beams "A" thru "L" 1/2" & beam "P" 3/8" at Pier 1
2. Butt-weld the beam flanges and web at Pier 2, using the following sequence: make two passes on each flange, then two on the web; repeat, using one pass at each location, until welds are completed.
3. Weld Type "X" crossframes into position.
4. Lower the beam ends to final position.
5. Repeat step 2 at Piers 1 and 3 for all beams. No raising of beams at abutments required.

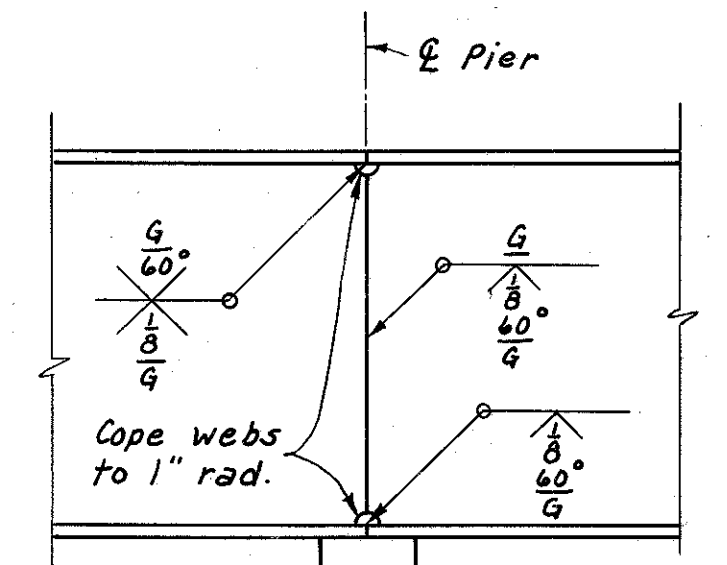

BEAM SPLICE DETAIL
Scale: 3/4" = 1'-0"

BEAM	TOP OF PAVEMENT ELEVATIONS											
	SPAN 1			SPAN 2			SPAN 3			SPAN 4		
	1/4	C	3/4	1/4	C	3/4	1/4	C	3/4	1/4	C	3/4
A	697.17	697.12	697.07	696.97	696.91	696.86	696.72	696.65	696.58	696.46	696.42	696.38
B	696.78	696.73	696.69	696.58	696.52	696.47	696.34	696.26	696.19	696.08	696.04	696.00
C	696.39	696.34	696.30	696.20	696.14	696.08	695.95	695.88	695.81	695.70	695.66	695.62
D	696.00	695.96	695.91	695.81	695.75	695.70	695.57	695.49	695.42	695.32	695.28	695.24
E	695.61	695.57	695.52	695.42	695.36	695.31	695.18	695.11	695.04	694.93	694.89	694.85
F	695.23	695.18	695.14	695.03	694.98	694.92	694.80	694.73	694.66	694.55	694.51	694.47
G	695.22	695.17	695.12	695.02	694.96	694.91	694.79	694.72	694.65	694.53	694.49	694.4
H	694.83	694.78	694.74	694.61	694.56	694.54	694.41	694.34	694.27	694.16	694.12	694.09
J	694.44	694.40	694.35	694.25	694.20	694.15	694.02	693.95	693.88	693.78	693.74	693.70
K	694.05	694.00	693.96	693.87	693.81	693.76	693.64	693.57	693.50	693.40	693.36	693.32
L	693.66	693.62	693.58	693.48	693.42	693.38	693.25	693.18	693.12	693.02	692.98	692.94
M							*693.09	692.93	692.86	692.80	692.70	692.66
N									*692.64	692.43	692.35	692.28
P	693.28	693.23	693.19	693.07	693.00	692.92	692.71	692.57	692.43	692.18	692.06	691.94

* Denotes end of beam

BEAM	DEAD LOAD DEFLECTION TABLE											
	SPAN 1			SPAN 2			SPAN 3			SPAN 4		
	1/4	C	3/4	1/4	C	3/4	1/4	C	3/4	1/4	C	3/4
A	1/16	3/16	5/16	1/16	3/16	5/16	0	0	0	0	0	0
B	1/16	3/16	5/16	1/16	3/16	5/16	0	0	0	0	0	0
C	1/16	3/16	5/16	1/16	3/16	5/16	0	0	0	0	0	0
D	1/16	3/16	5/16	1/16	3/16	5/16	0	0	0	0	0	0
E	1/16	3/16	5/16	1/16	3/16	5/16	0	0	0	0	0	0
F	1/16	3/16	5/16	1/16	3/16	5/16	0	0	0	0	0	0
G	1/16	3/16	5/16	1/16	3/16	5/16	0	0	0	0	0	0
H	1/16	3/16	5/16	1/16	3/16	5/16	0	0	0	0	0	0
J	1/16	3/16	5/16	1/16	3/16	5/16	0	0	0	0	0	0
K	1/16	3/16	5/16	1/16	3/16	5/16	0	0	0	0	0	0
L	1/16	3/16	5/16	1/16	3/16	5/16	0	0	0	0	0	0
M							*0	0	1/16	3/16	5/16	0
N									1/16	3/16	5/16	0
P	1/16	3/16	5/16	1/16	3/16	5/16	0	0	0	0	0	0

NOTES:
In Dead Load Deflection Table, CON = Dead load deflection due to concrete.
TOT = Total dead load deflection
On Framing Plan, Elevations shown are to top of pavement, 0.81' above top of beams.
Deflections are given at the quarter points and are measured to the nearest tenth for details of rocker masonry plates see sheet 173-7A.
For other rocker details and details of bolsters see Ohio Standards, Sheet RB-1-55.
For details of end dams see sheet 173-7A
* For under deck lighting details see sheet 176-7A & 177-7A
The WF beams shall not be cambered but shall be fabricated so that any curved beam will be placed with the convex flange up.
For cross frame details see sheet 154-7A

H.N.T.B. BR. NO. 8 PART 7A

HOWARD, NEEDLES, TAMMEN & BERGENOFF
CONSULTING ENGINEERS
KANSAS CITY CLEVELAND NEW YORK

FRAMING PLAN

WILLOW FREEWAY OVER EAST 14th ST.
BR. NO. CUY-21-1573 A STA. 49+30.16
Scale: As noted STA. 51+07.08




WILLOW-INNER BELT FREEWAY
CLEVELAND CUYAHOGA COUNTY OHIO

DRAWN N/N TRACED CHECKED J.A. REWISD J.C.T.
DATE 7-1-35 DATE 7-28-35 DATE 11-13-35

SHEET 152




JUL 3 1935

CUYAHOGA COUNTY
CITY OF CLEVELAND
CUY-21-15.32
CUY-42-18.42

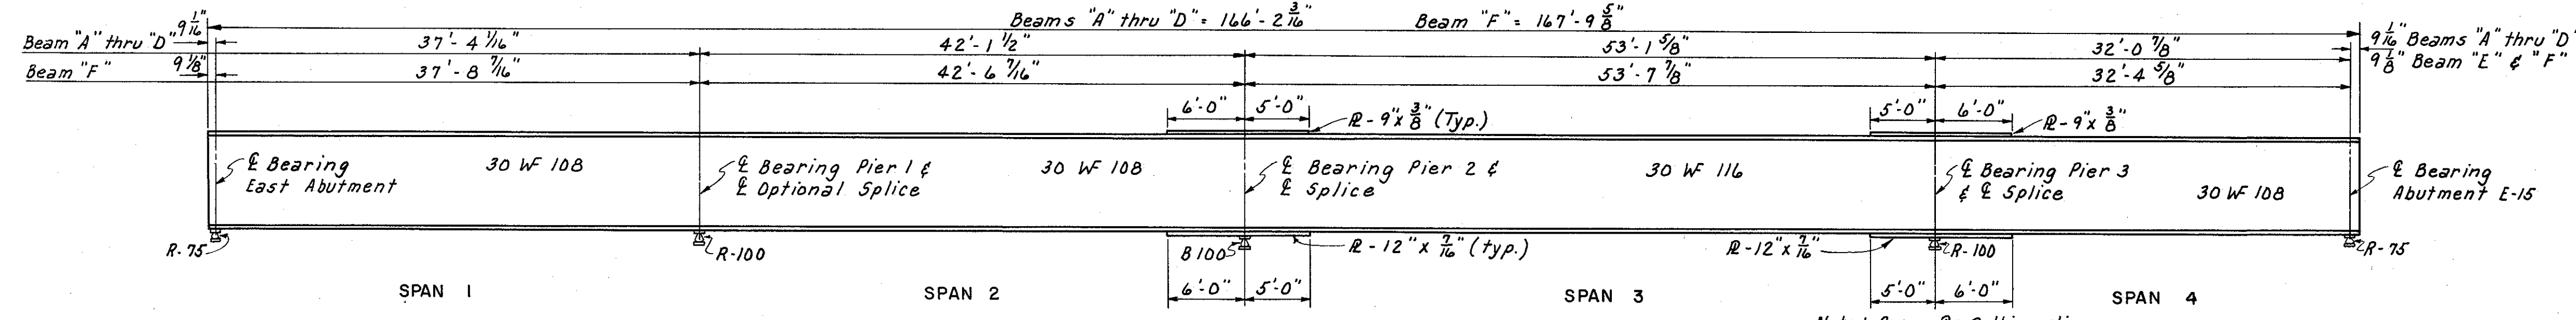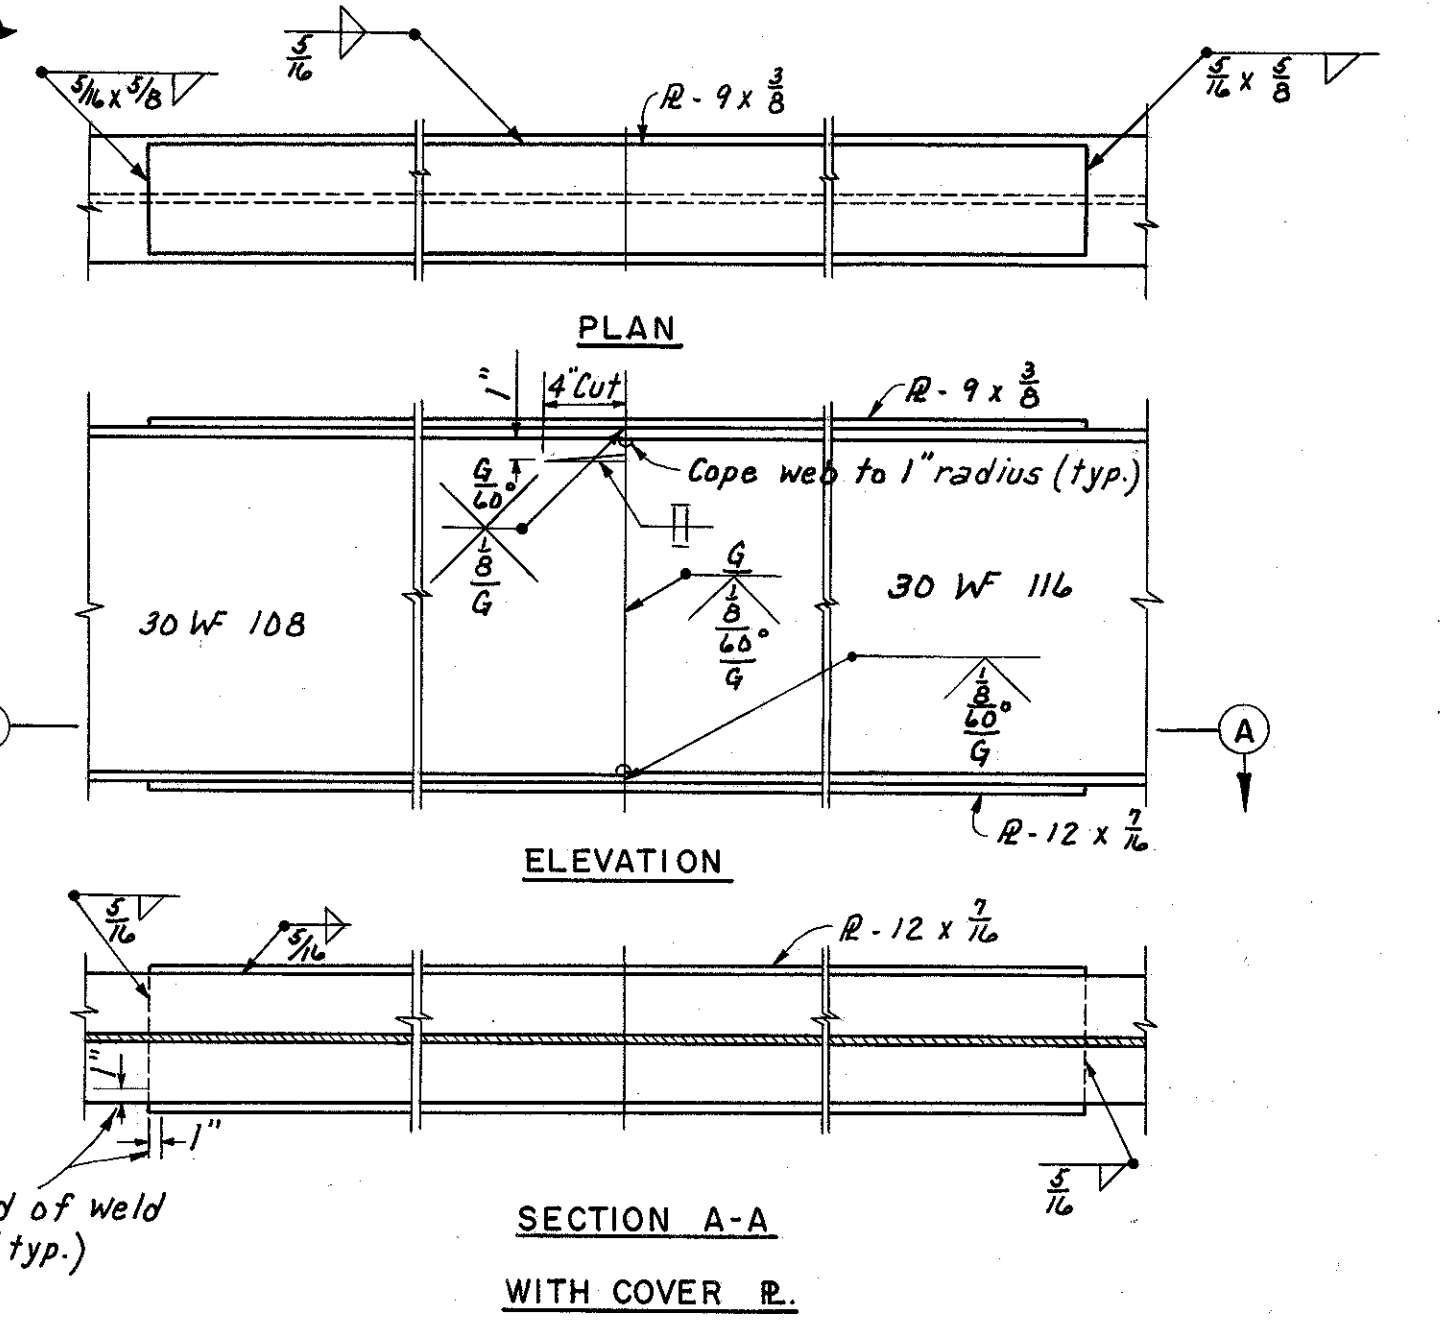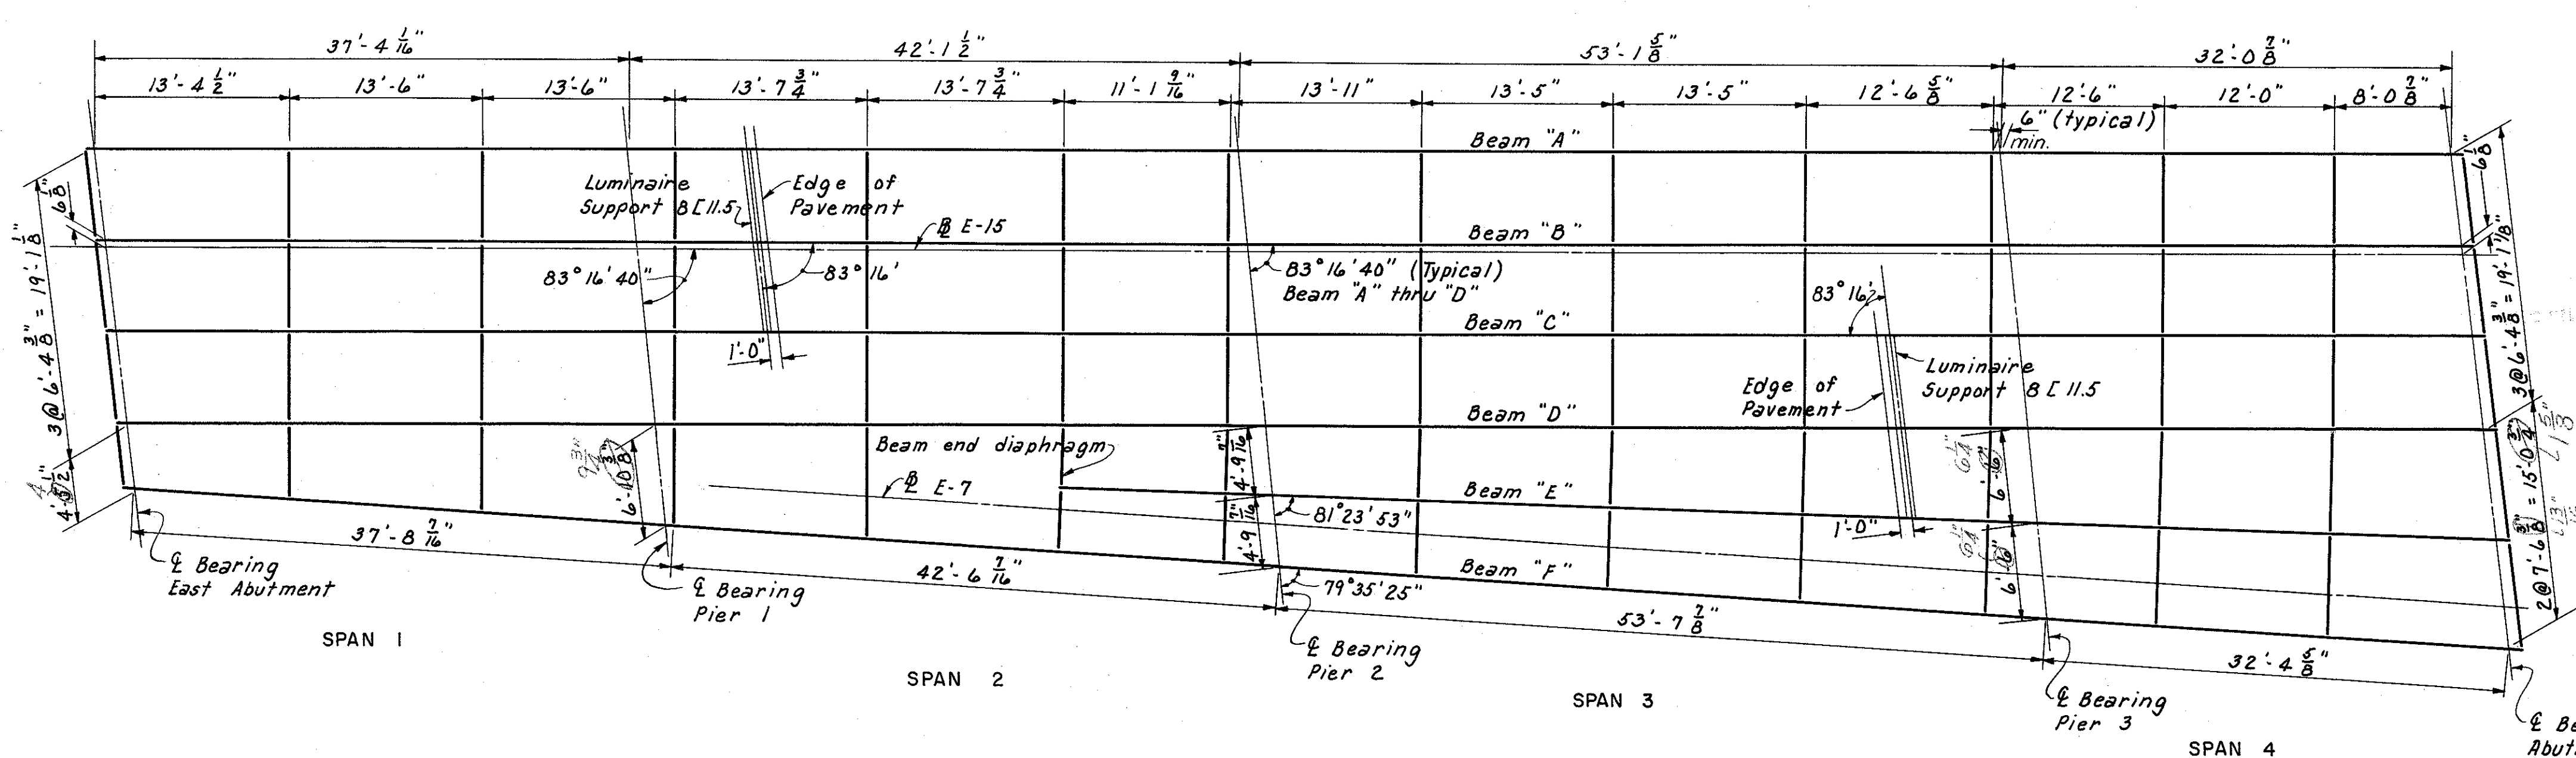

BEAM E

Beam "A"	697.94	697.83	697.70	697.36	697.15	696.93	696.36	695.98	695.60	694.88	694.59	694.29
Beam "B"	698.05	697.93	697.80	697.48	697.27	697.06	696.47	696.08	695.70	694.97	694.68	694.40
Beam "C"	697.84	697.77	697.67	697.37	697.16	696.94	696.34	695.97	695.58	694.85	694.56	694.28
Beam "D"	697.64	697.59	697.50	697.26	697.05	696.83	696.22	695.85	695.47	694.72	694.44	694.16
Beam "F"	697.50	697.43	697.37	697.13	696.91	696.67	696.03	695.66	695.25	694.48	694.18	693.87

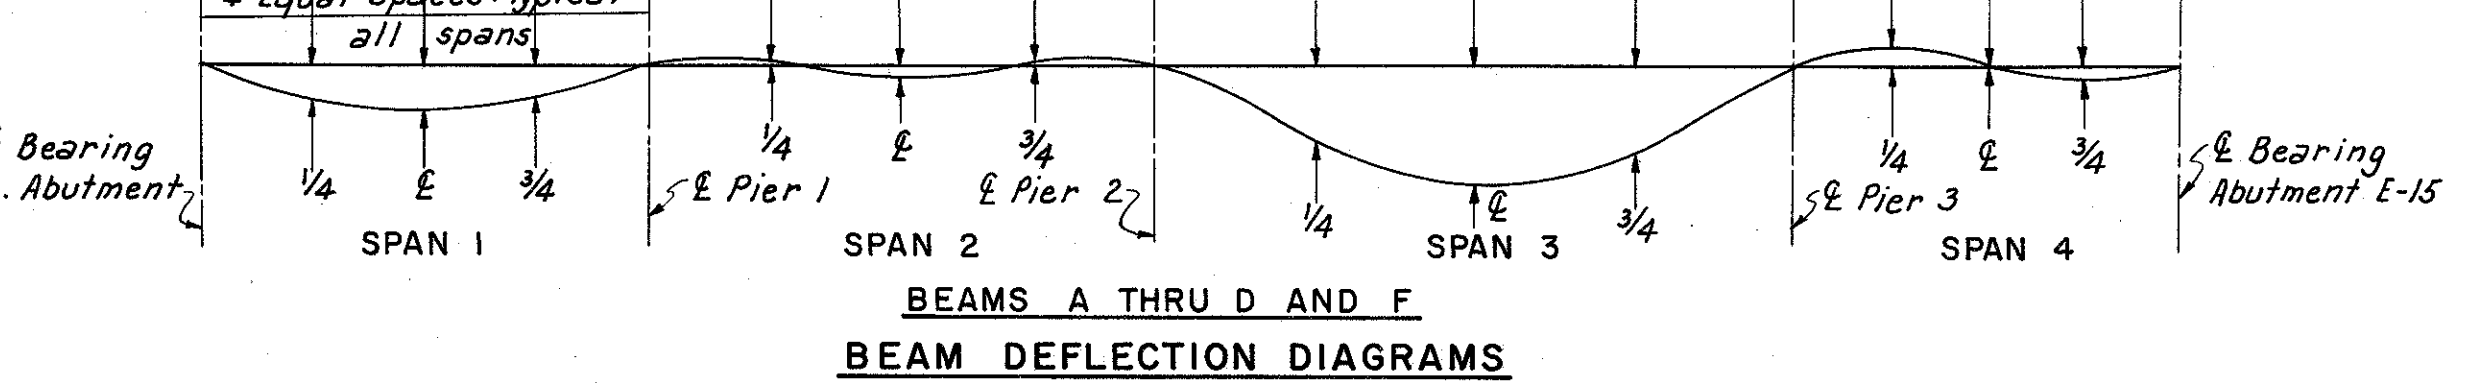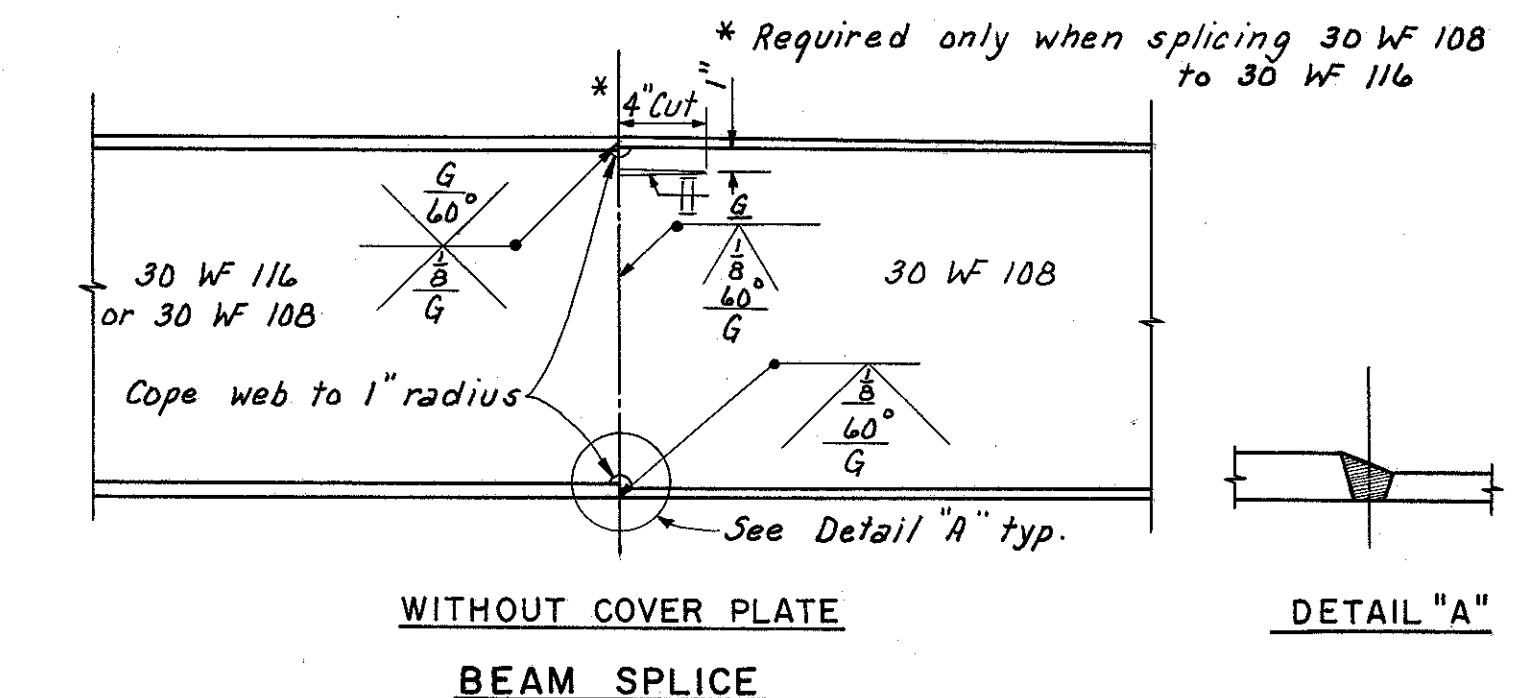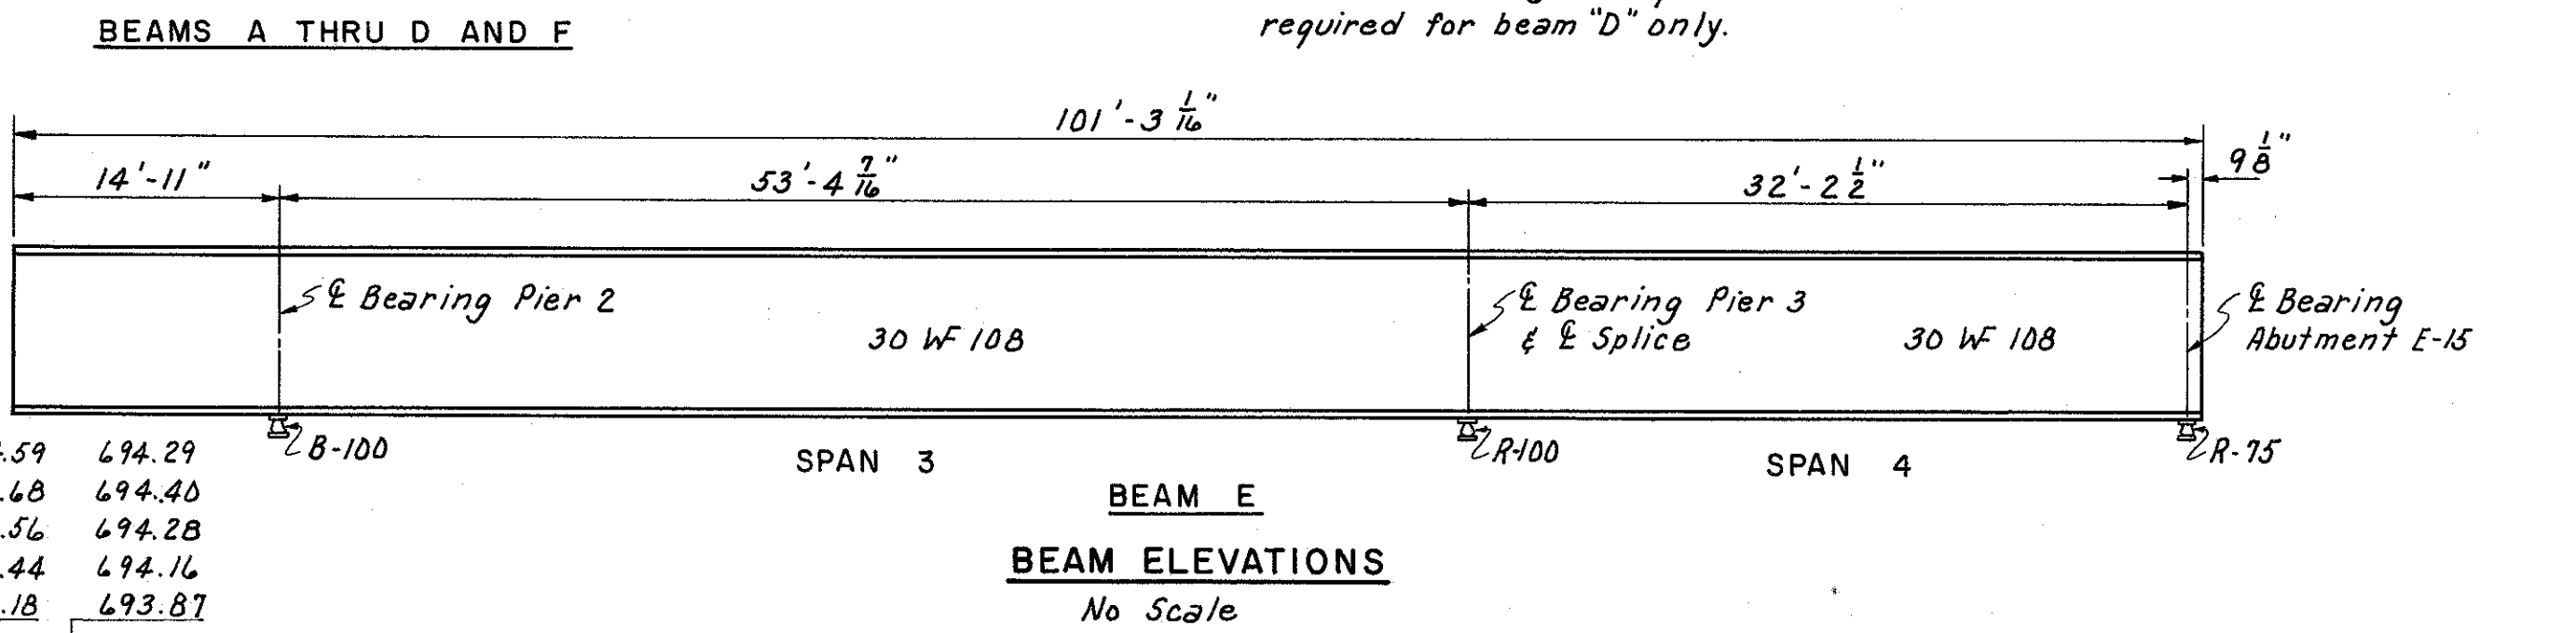

NOTES:
Top of beam elevations are exclusive of cover plates.
For details of end dams, see sheet 173-7A
For crossframe details, see sheet 155-7A
For Drainage Details, see sheet 174-7A
For details of rocker masonry plates, see sheet 173-7A
For other rocker and bolster details, see Ohio Standard Drawing RB-1-55.
Elevations shown in table are located at intersections of bearing and beams.

BEAM SPLICE WELDING PROCEDURE

1. Raise ends of beams "A" thru "D" and "F" 3/8" at Pier 3.
2. Butt-weld the beam flanges and web at Pier 2 using the following sequence: make two passes on each flange then two on the web; repeat, using one pass at each location, until welds are completed.
3. Weld the top and bottom cover plates.
4. Lower the beam ends at Pier 3 to final position.
5. Repeat step 2 and, in the case of beam "D", also step 3 at Pier 3. No raising of beam ends @ Abutment E-15 required. (The above procedure assumes that no splice is made at Pier 1. If the beams are spliced at Pier 1, only step 2 is required.)

ELEVATIONS AND DEFLECTIONS

BEAM	EAST ABUTMENT		SPAN 1			PIER NO. 1			SPAN 2			PIER NO. 2			SPAN 3			PIER NO. 3			SPAN 4			ABUTMENT E-15												
	TOP OF BEAM	TOP OF PVMT.	D.L. DEF.	D.L. DEF.	D.L. DEF.	TOP OF BEAM	TOP OF PVMT.	D.L. DEF.	D.L. DEF.	D.L. DEF.	TOP OF BEAM	TOP OF PVMT.	D.L. DEF.	D.L. DEF.	D.L. DEF.	TOP OF BEAM	TOP OF PVMT.	D.L. DEF.	D.L. DEF.	D.L. DEF.	TOP OF BEAM	TOP OF PVMT.	D.L. DEF.	D.L. DEF.												
	ELEVATION	ELEVATION	CON	TOT	CON	TOT	ELEVATION	ELEVATION	CON	TOT	CON	TOT	ELEVATION	ELEVATION	CON	TOT	CON	TOT	CON	TOT	ELEVATION	ELEVATION	CON	TOT	CON	TOT										
A	697.25	698.05	3/8	3/8	1/4	1/4	1/8	1/8	0	0	1/16	1/16	0	0	695.90	696.70	3/8	3/8	1/2	1/2	9/16	9/16	1/4	1/4	3/8	3/8	694.30	695.16	-1/16	-1/16	0	0	0	0	693.20	694.00
B	697.34	698.15	1/8	1/8	3/16	3/16	1/16	1/16	0	0	0	0	0	0	696.02	696.82	1/4	1/4	1/2	1/2	5/16	5/16	3/8	3/8	1/4	1/4	694.43	695.25	0	0	0	0	0	0	693.32	694.11
C	697.10	697.90	1/8	1/8	3/16	3/16	1/16	1/16	0	0	0	0	0	0	695.90	696.70	1/4	1/4	3/8	3/8	5/16	5/16	3/8	3/8	1/4	1/4	694.34	695.14	0	0	0	0	0	0	693.20	693.99
D	696.88	697.68	1/8	1/8	1/8	1/8	1/16	1/16	0	0	0	0	0	0	695.77	696.57	1/4	1/4	1/2	1/2	3/16	3/16	3/4	3/4	1/4	1/4	694.22	695.02	0	0	0	0	0	0	693.00	693.87
E	697.50	697.50	1/4	1/4	1/4	1/4	1/16	1/16	End of beam	-1/16	-1/16	0	0	0	695.68	696.48	1/4	1/4	1/2	1/2	5/16	5/16	3/8	3/8	1/4	1/4	694.08	694.88	0	0	0	0	1/16	1/16	692.90	693.70
F	696.74	697.54	1/4	1/4	5/16	5/16	3/16	3/16	0	0	0	0	-1/16	-1/16	695.61	696.41	3/8	3/8	3/8	3/8	9/16	9/16	1	1	3/8	3/8	693.93	694.76	-1/16	-1/16	0	0	0	0	692.75	693.55

NOTES:
The beams in Span 3 shall be cambered as follows:
Where the sum of the deflections and convexity is 3/4" to 1" the required camber will be 1", and if greater than 1", the required camber will be the same as the sum.
Beams in Span 1, 2 & 4 do not require camber, but shall be fabricated so that any curved beam will be placed with the convex flange up.
Deflections are given at the quarter points and are measured to the nearest 1/16 inch.
In Elevation and Deflection Table, the following abbreviations are used:
(D.L. Defl.) denotes dead load deflections. (Tot.) refers to total deflections from dead load of steel, and concrete.
(Con.) denotes deflections for concrete.
Convexity denotes corrections required for vertical curvature of the roadway gradient.
(P.V.M.T.) - denotes pavement.

H.N.T.B. BR. NO. 9 PART 7A

HOWARD, NEEDLES, TAMMEN & BERGENOFF
CONSULTING ENGINEERS
KANSAS CITY CLEVELAND NEW YORK

FRAMING PLAN

RAMP E-15 OVER EAST 14th ST.
BR. NO. CUY - 21-1573 B STA. 15+27.70
Scale: As noted STA. 16+96.91


WILLOW - INNER BELT FREEWAY
CLEVELAND CUYAHOGA COUNTY OHIO

DRAWN R.B. TRACED R.J.K. CHECKED A.L. REVIEWED C.T. REVISION 7-22-60
DATE 8-8-58 DATE 3-18-59 DATE 8-15-58 DATE 11-13-59 SHEET 153

NOTES:
Bars of a series shall vary in length by a constant increment.
For replacement schedule, see Sh. 103-7A
All bar dimensions are given out to out.
(* Bars 451 thru 456 and 651 thru 653 are for light standard support. For their placement and bending diagram, see Sh. 176-7A
† Bars 601 thru 605 are to be included with "Item 5-14, Railing", for payment.


Note: Transverse bars to extend to vertical leg of end dam angle.

MICROFILMED
JUL 3 1985

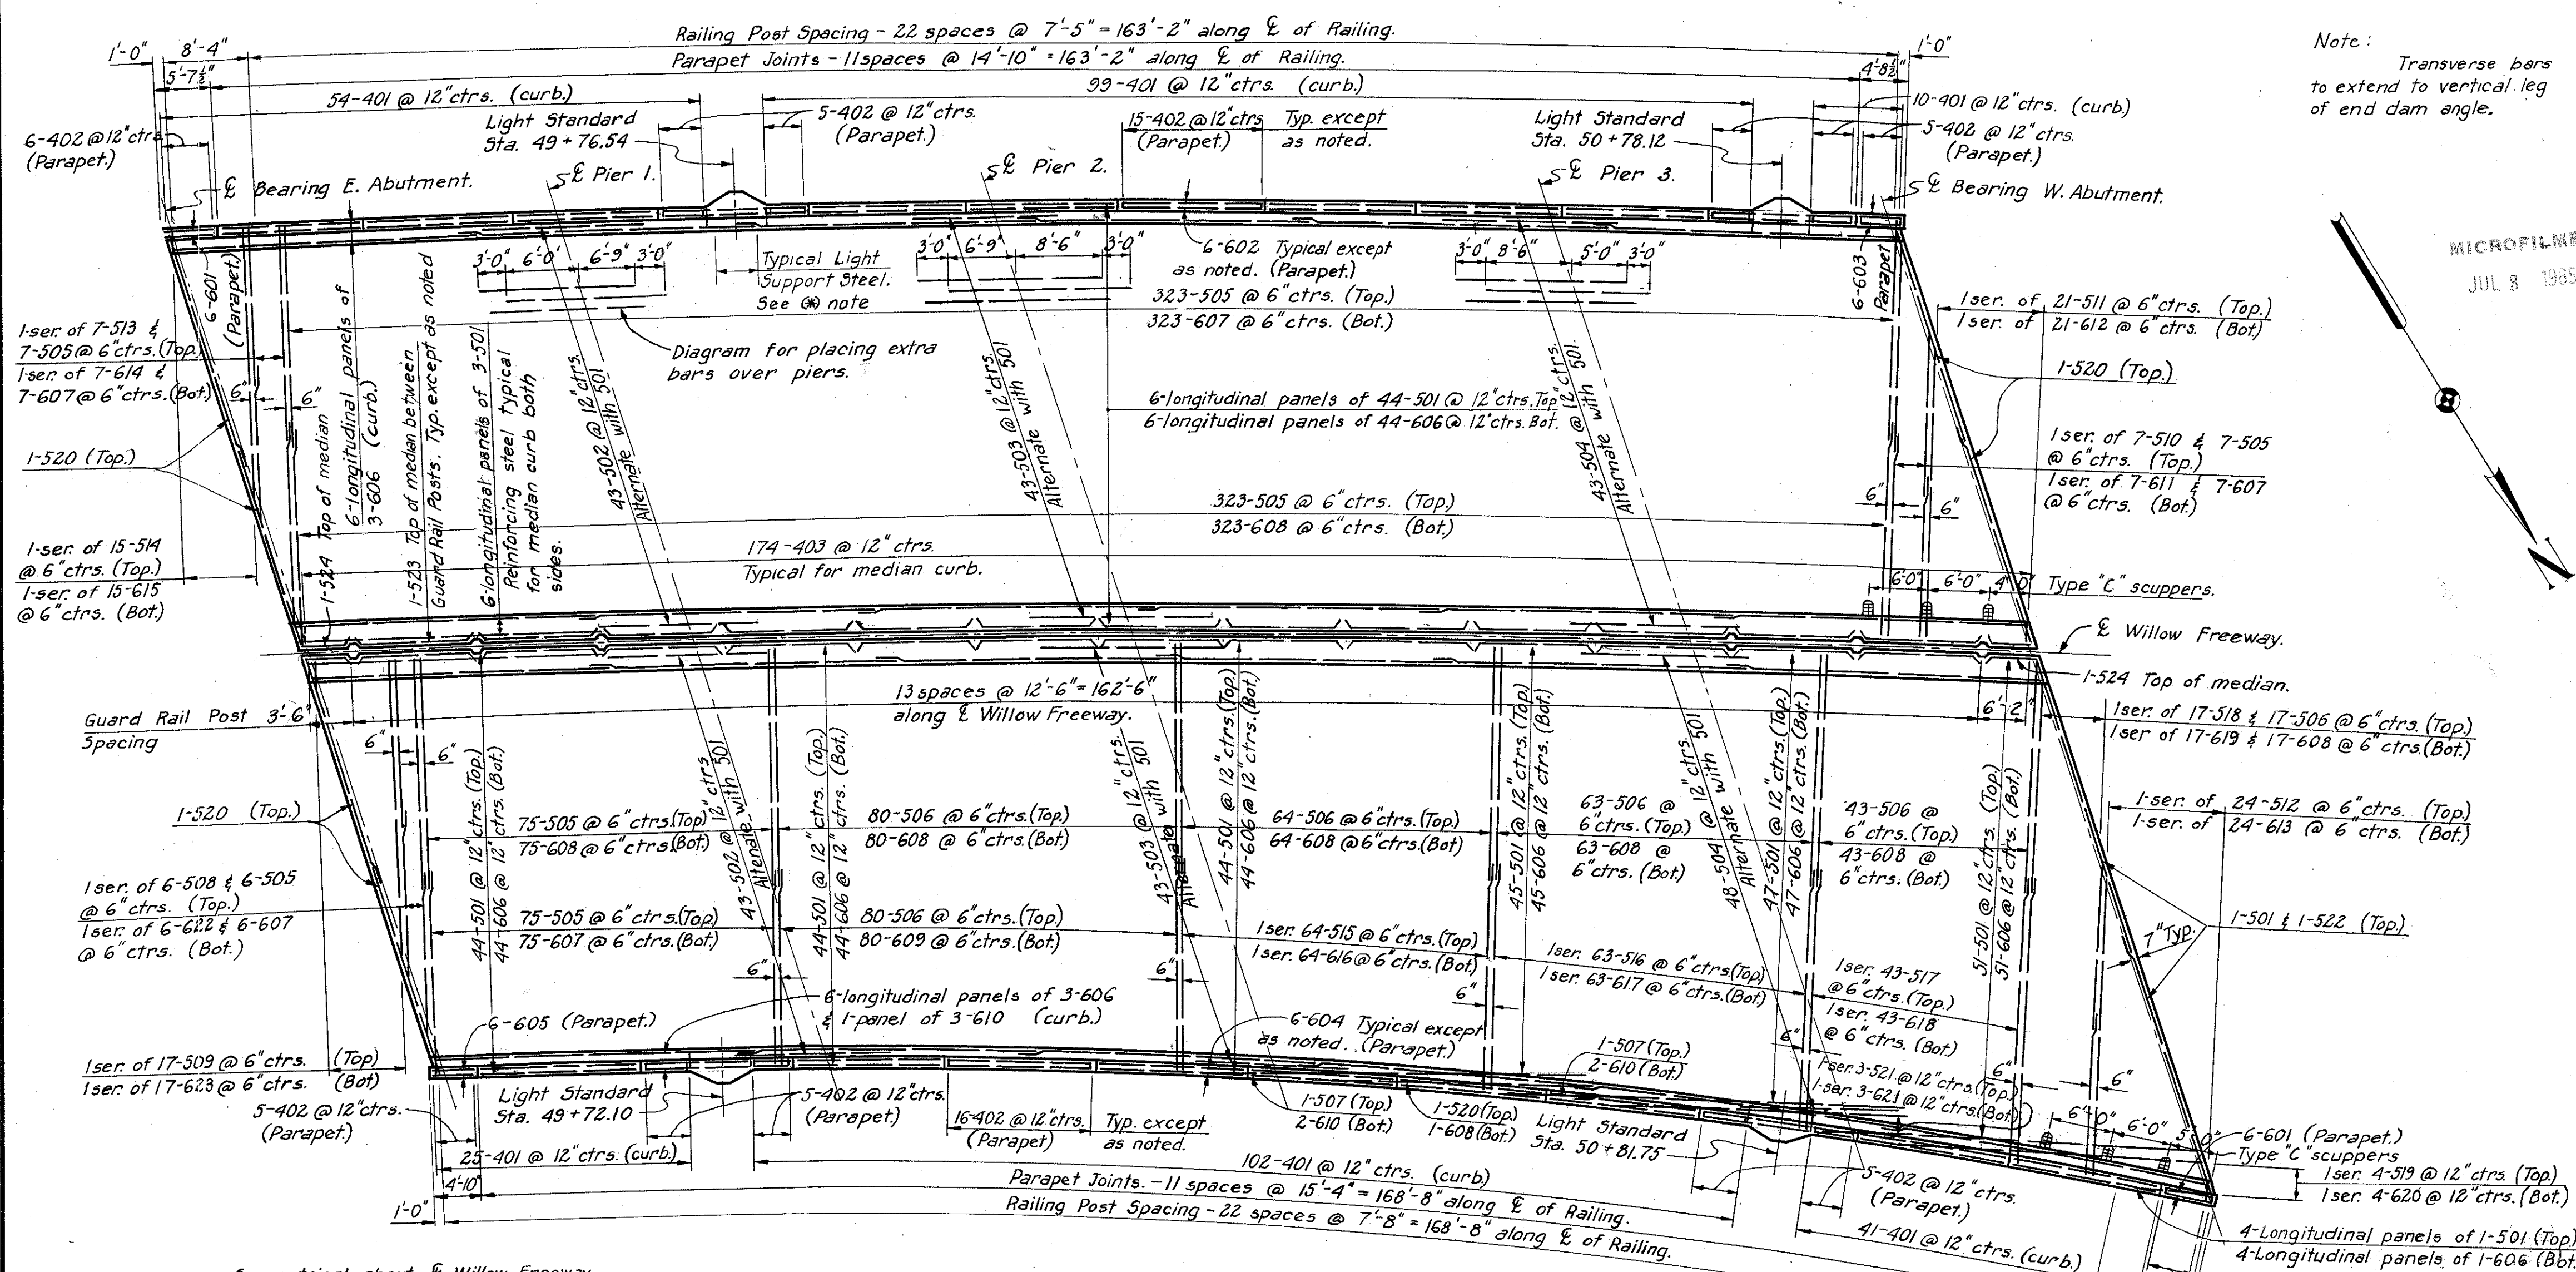


DECK PLAN
Scale: 3/8" = 1'-0"

Note: Prefix "SA" shall be assigned to all bar marks.

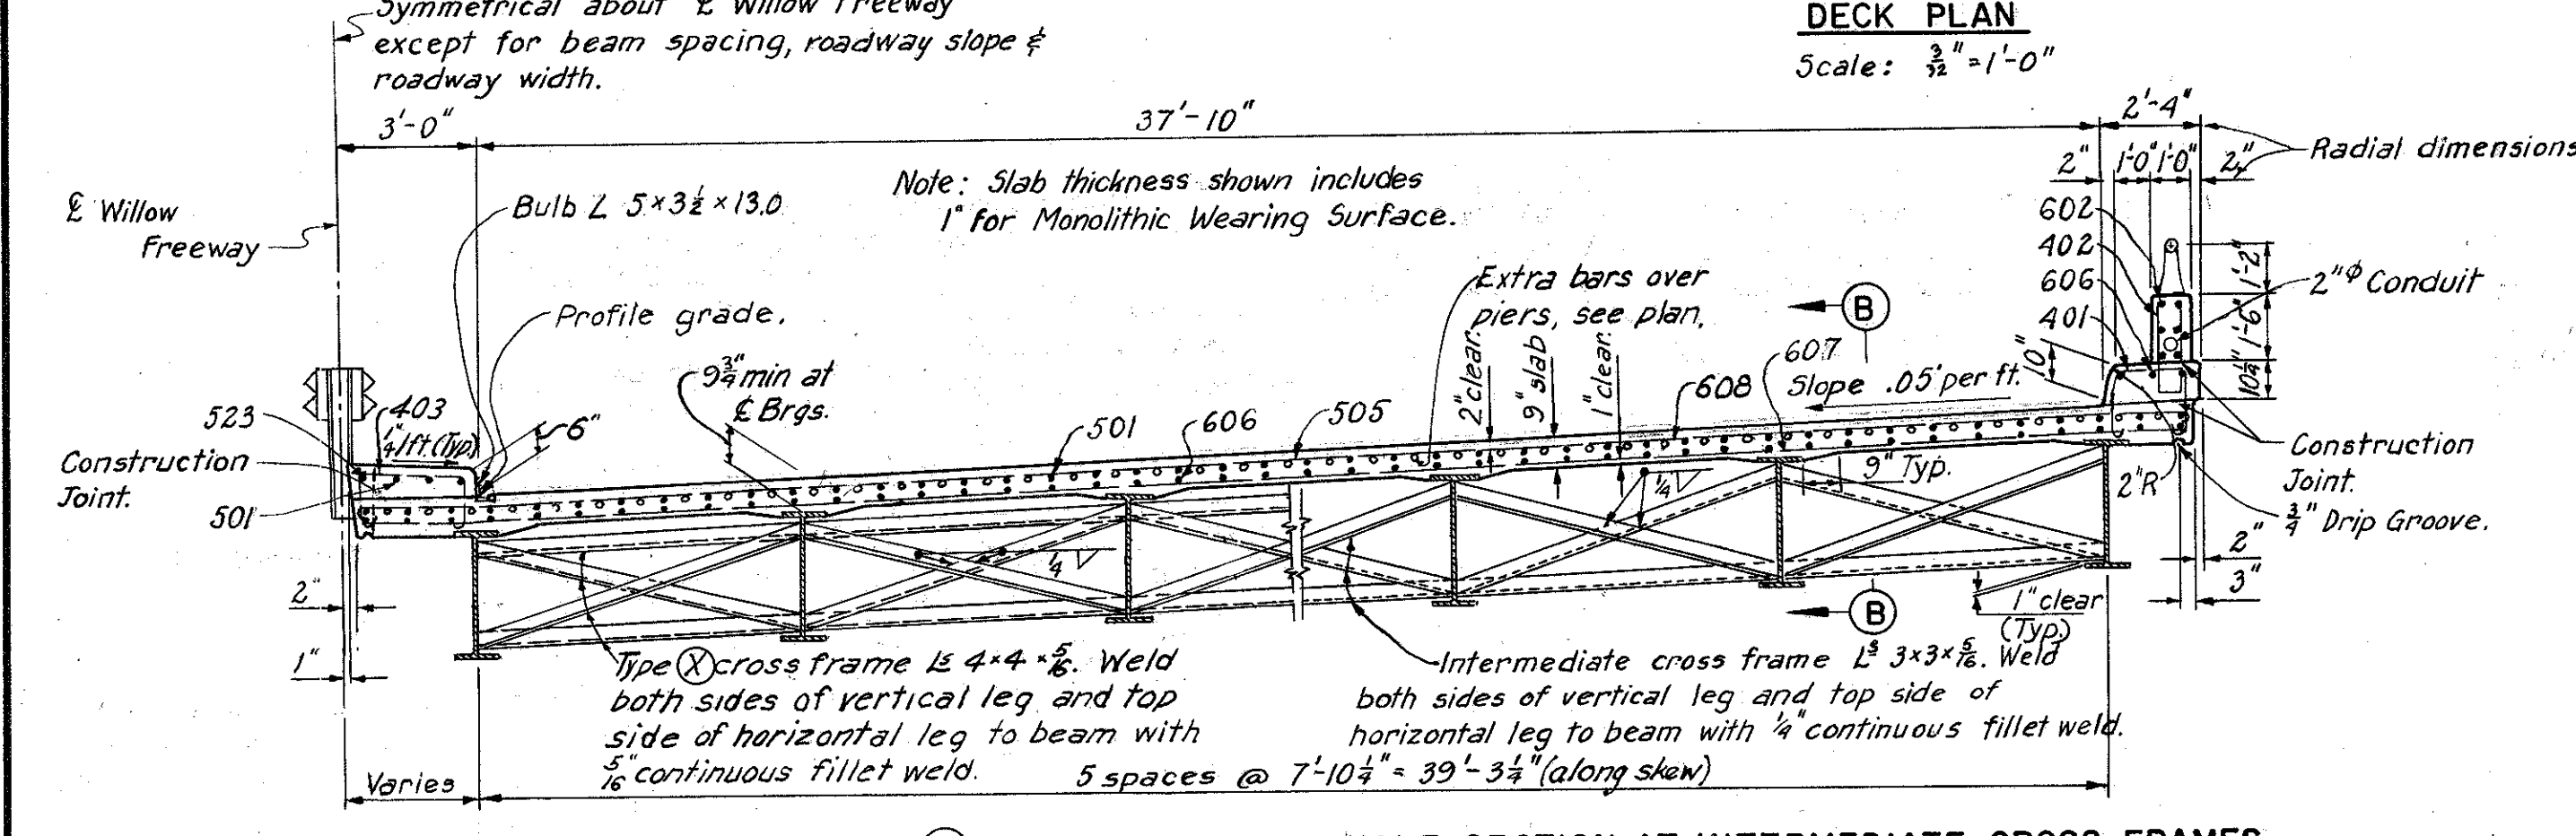

HALF SECTION AT TYPE (X) CROSSFRAMES
Scale: 1/4" = 1'-0"


HALF SECTION AT INTERMEDIATE CROSS FRAMES
Scale: 1/4" = 1'-0"

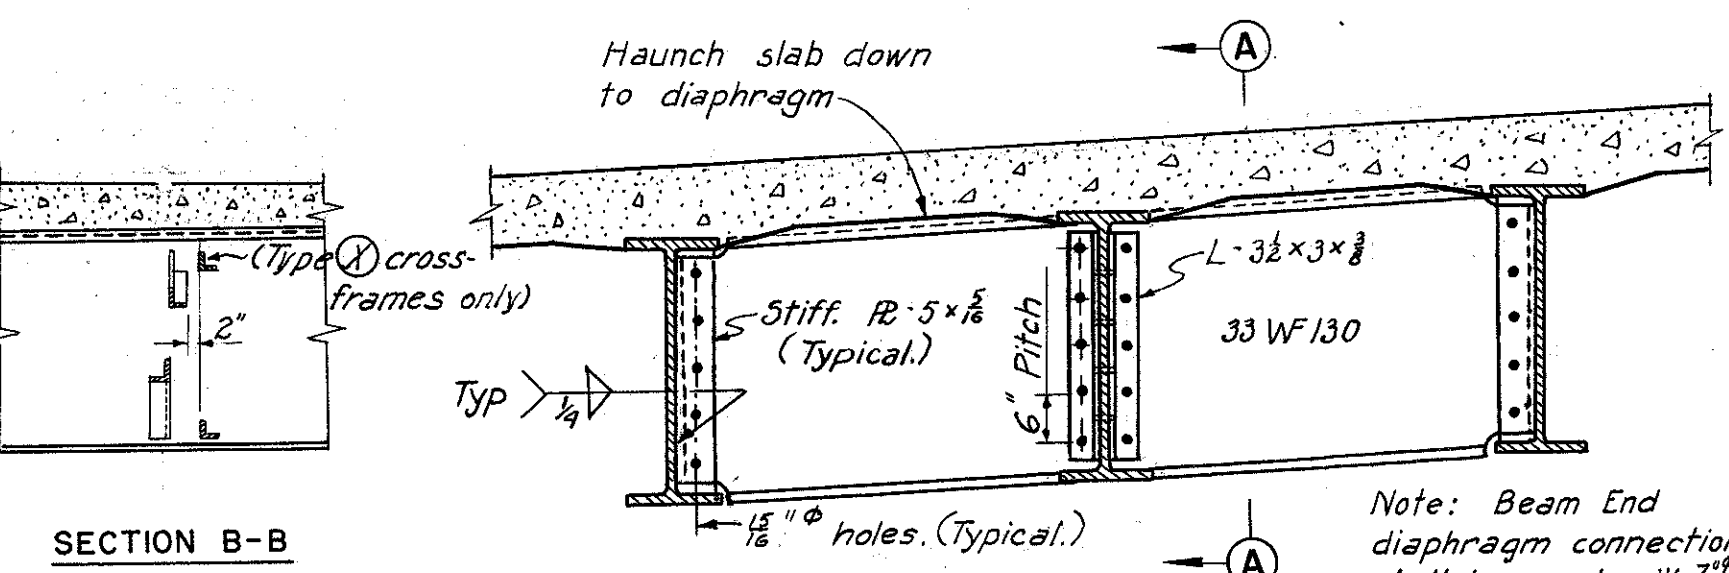

SECTION B-B

BEAM END DIAPHRAGM
Scale: 1/2" = 1'-0"

Note: Beam end diaphragm connections shall be made with high-strength bolts conforming to Supplemental Spec. 5-207.

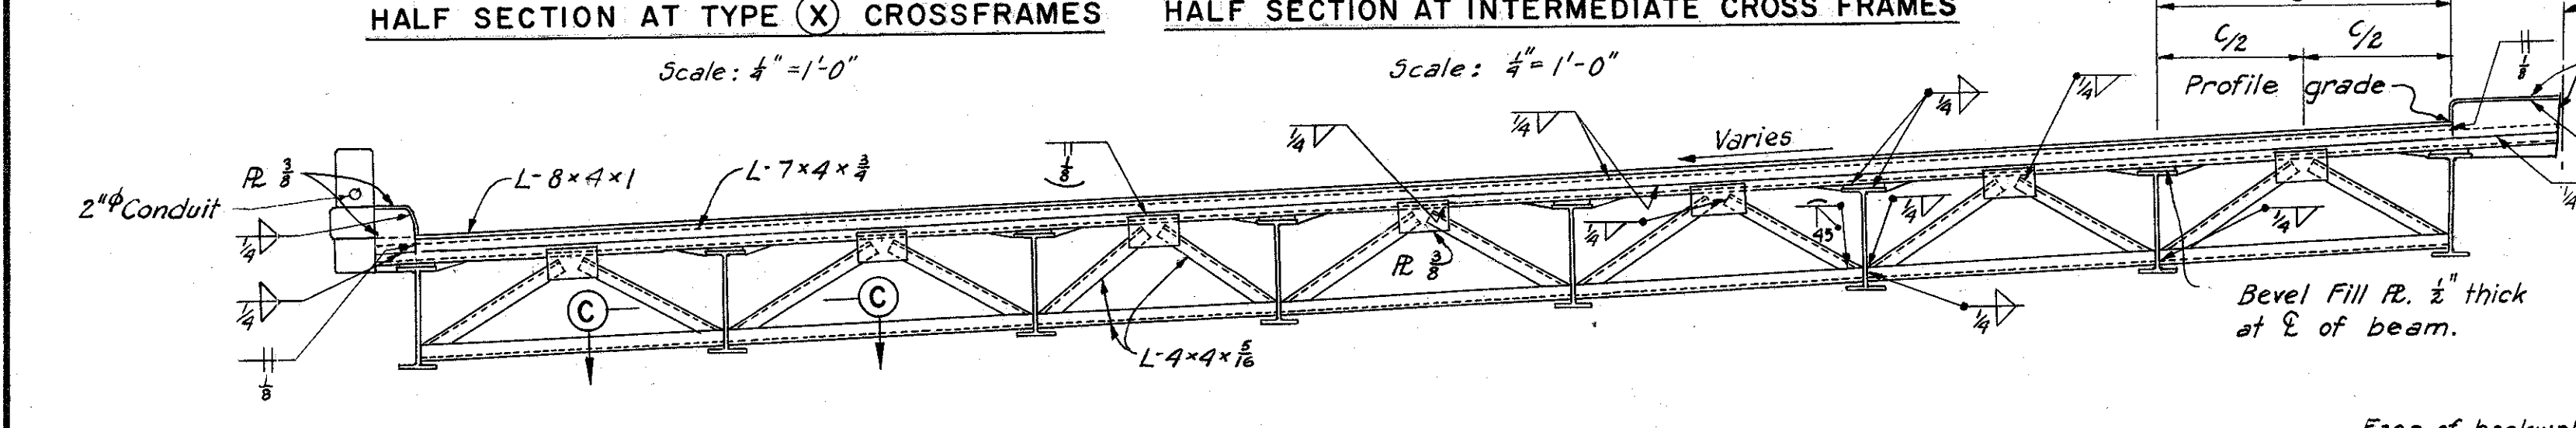

HALF SECTION AT ABUTMENTS
Scale: 1/4" = 1'-0"

SECTION C-C
Scale: 1/2" = 1'-0"

NOTES:
For drainage details, see Sh. 174-7A
For light standard support and other lighting details, see Sh. 176-7A & 177-7A
For Railing, Guard Rail, and Parapet Joint details, see Sh. 175-7A
In order to facilitate water curing of the concrete of the deck slab, the placing of concrete shall progress upgrade. The slab may be placed in sections, between transverse construction joints, which are parallel to the transverse bars in the slab, and are located near the center of any span. For bar bending diagrams, see Sh. 170-7A

H.N.T.B. BR. NO. 8
PART 7A


HOWARD, NEEDLES, TAMMEN & BERGENDOFF
CONSULTING ENGINEERS
KANSAS CITY CLEVELAND NEW YORK

DECK PLAN
WILLOW FREEWAY OVER EAST 14th ST.
BR. NO. CUY-21-1573 A STA. 49+30.16
Scale: As noted STA. 51+07.08
WILLOW-INNER BELT FREEWAY
CLEVELAND CUYAHOGA COUNTY OHIO


MARK	NO.	LENGTH	TYPE	DIMENSIONS				SERIES INCREMENT	WEIGHT (POUNDS)
				A	B	C	D		
401	321	5'-1"	122	1'-8"	1'-4"				1090
402	341	4'-3"	105	0'-8"	2'-0"				1310
403	348	5'-2"	122	2'-5"	1'-0"				1201
451 *	8	9'-3"	131	2'-6"	3'-0"	1'-2"			49
452 *	8	10'-3"	131	3'-0"	3'-0"	1'-8"			55
453 *	12	9'-9"	131	3'-2"	3'-0"	1'-0"			78
454 *	8	5'-9"	155	2'-2"	1'-6"				31
455 *	8	6'-5"	155	2'-8"	1'-6"				34
456 *	12	6'-7"	155	2'-10"	1'-6"				53
501	580	30'-9"	5tr						18602
502	86	15'-9"	5tr						1413
503	86	18'-3"	5tr						1637
504	91	16'-6"	5tr						1566
505	816	22'-8"	101	22'-1"					19291
506	347	23'-1"	101	22'-6"					8354
507	2	12'-0"	5tr						25
508	1-ser of 6	11'-6" to 19'-6"	5tr					1'-7 1/2"	97
509	1-ser of 17	2'-10" to 30'-7"	101	2'-3" to 30'-0"				1'-8 1/2"	296
510	1-ser of 7	11'-6" to 19'-6"	5tr					1'-4"	113
511	1-ser of 21	2'-10" to 30'-7"	101	2'-3" to 30'-0"				1'-4 1/2"	366
512	1-ser of 24	2'-10" to 30'-7"	101	2'-3" to 30'-0"				1'-2 1/2"	418
513	1-ser of 7	11'-6" to 21'-6"	5tr					1'-8"	120
514	1-ser of 15	2'-10" to 30'-7"	101	2'-3" to 30'-0"				1'-11 1/2"	261
515	1-ser of 64	23'-2" to 25'-2"	101	22'-5" to 24'-7"				3/8"	1613
516	1-ser of 63	25'-2" to 28'-2"	101	24'-7" to 27'-7"				3/8"	1752
517	1-ser of 43	28'-2" to 31'-2"	101	27'-7" to 30'-7"				3/8"	1331
518	1-ser of 17	10'-3" to 29'-9"	5tr					1'-2 3/8"	355
519	1-ser of 4	7'-0" to 25'-0"	5tr					6'-0"	67
520	7	24'-0"	5tr						175
521	1-ser of 3	10'-0" to 26'-0"	5tr					8'-0"	56
522	1	27'-9"	5tr						29
523	26	13'-0"	141	1'-0"	11'-2"				353
524	4	4'-1"	108	3'-2"	1'-0"				17
601 †	12	5'-3"	5tr						
602 †	66	14'-6"	5tr						
603 †	6	4'-3"	5tr						
604 †	66	15'-0"	5tr						
605 †	6	4'-6"	5tr						
606	579	30'-9"	5tr						26742
607	418	18'-0"	5tr						11301
608	666	26'-6"	5tr						24509
609	80	19'-0"	5tr						2283
610	5	7'-0"	5tr						53
611	1-ser of 7	16'-0" to 24'-0"	5tr					1'-4"	210
612	1-ser of 21	2'-6" to 30'-0"	5tr					1'-4 1/2"	513
613	1-ser of 24	2'-6" to 30'-0"	5tr					1'-2 3/8"	586
614	1-ser of 7	16'-0" to 26'-0"	5tr					1'-8"	221
615	1-ser of 15	2'-6" to 30'-0"	5tr					1'-11 1/2"	366
616	1-ser of 64	19'-0" to 21'-0"	5tr					3/8"	1923
617	1-ser of 63	21'-0" to 24'-0"	5tr					3/8"	2129
618	1-ser of 43	24'-0" to 27'-0"	5tr					3/8"	1647
619	1-ser of 17	6'-6" to 26'-3"	5tr					1'-2 3/8"	418
620	1-ser of 4	7'-0" to 25'-0"	5tr					6'-0"	96
621	1-ser of 3	10'-0" to 26'-0"	5tr					8'-0"	81
622	1-ser of 6	16'-0" to 25'-0"	5tr					1'-9 3/8"	185
623	1-ser of 17	2'-6" to 30'-0"	5tr					1'-8 3/8"	415
651 *	8	9'-5"	141	2'-11"	1'-10"				113
652 *	12	14'-6"	141	5'-3"	3'-0"				261
653 *	4	5'-0"	5tr						30
Total									138,290

Note: Prefix "SB" shall be assigned to all bar marks.


JUL 9 1985

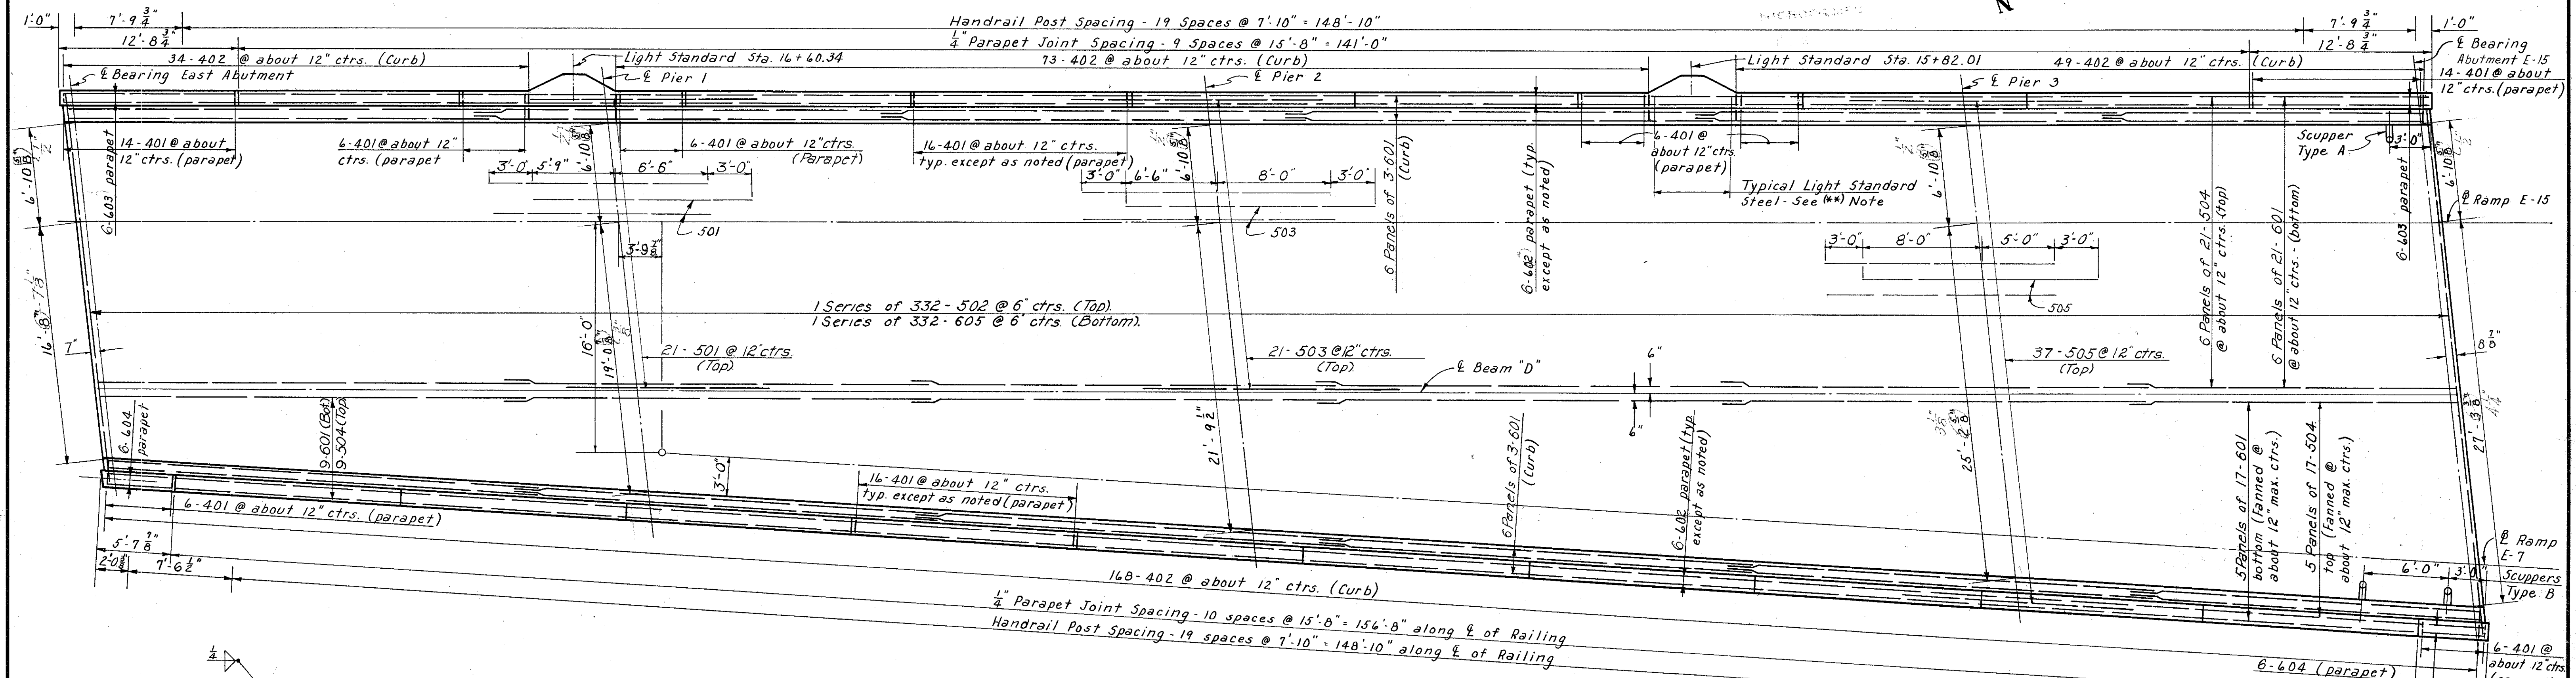


DECK PLAN
Scale: 1/8" = 1'-0"

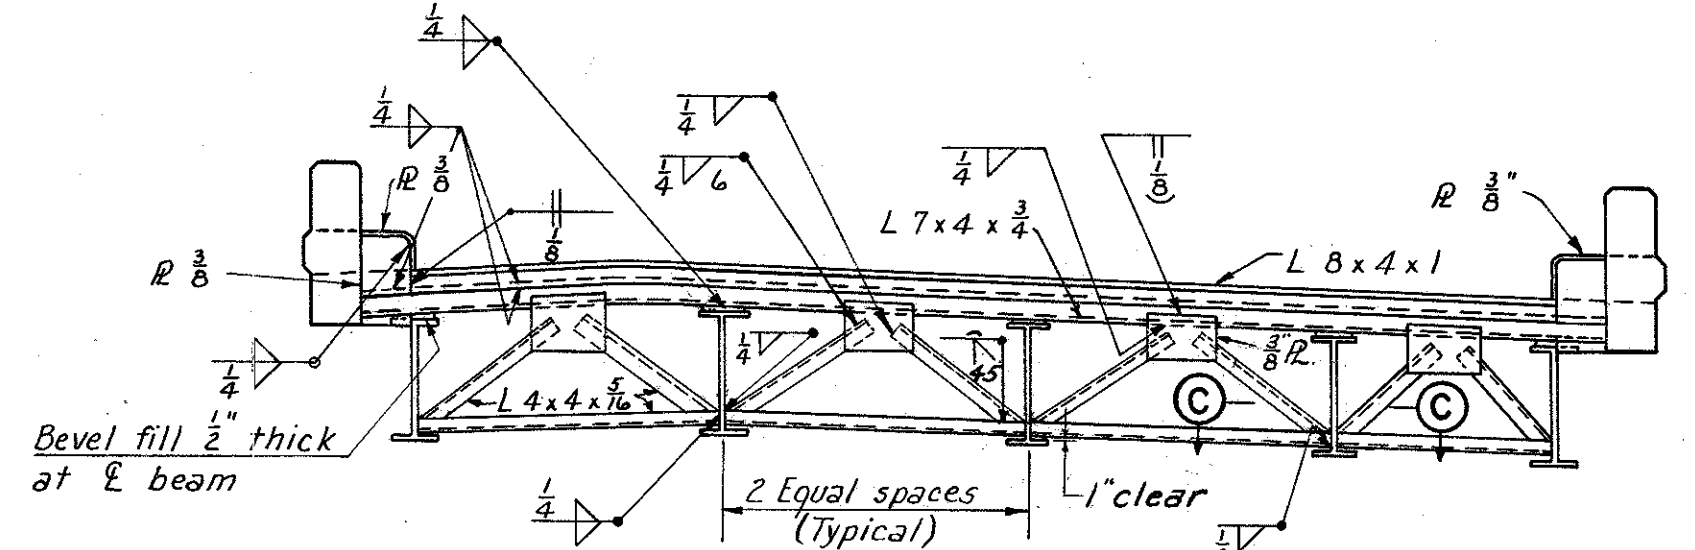


SECTION AT END FINISH
East End Shows, West End similar except for the number of panels.
Scale: 1/4" = 1'-0"

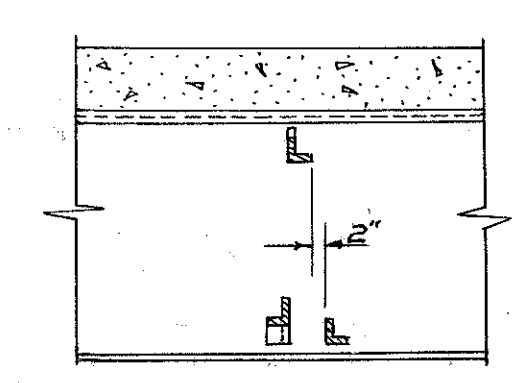

SECTION B-B
Scale: 1/2" = 1'-0"

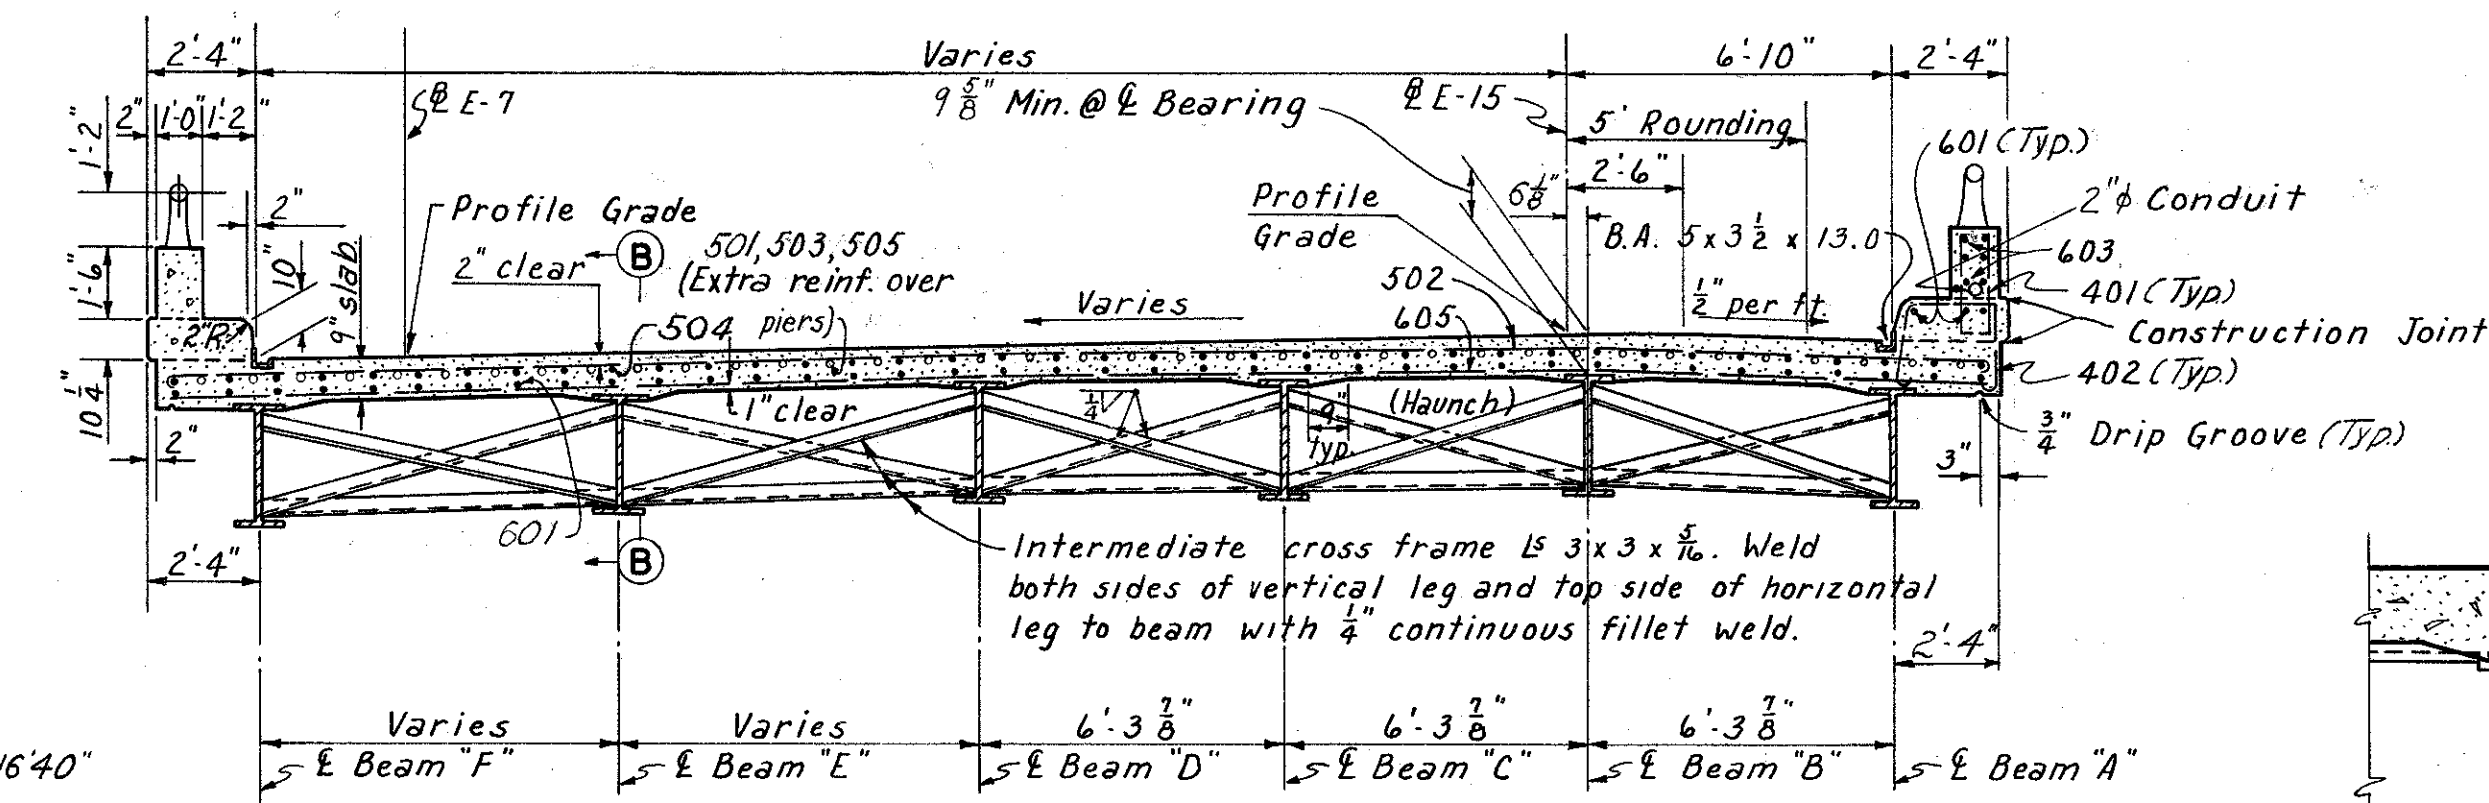


TYPICAL SECTION AT INTERMEDIATE CROSS FRAMES
Scale: 1/4" = 1'-0"

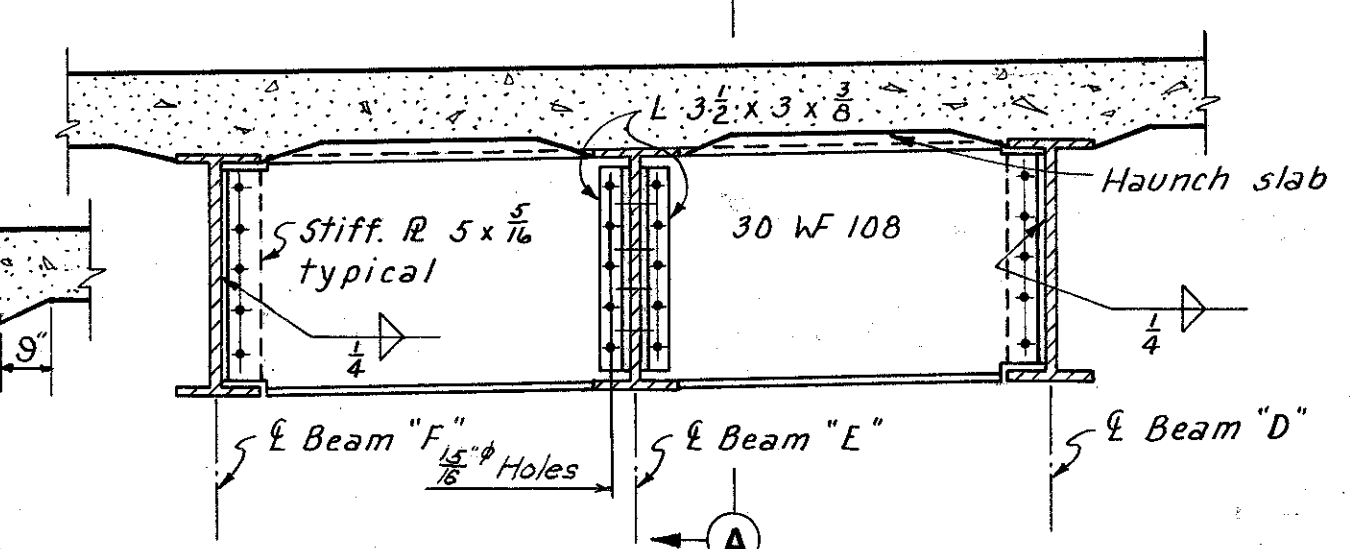

BEAM END DIAPHRAGM
Scale: 1/2" = 1'-0"

REINFORCEMENT SCHEDULE		DIMENSIONS		SERIES INCREMENT	WEIGHT (POUNDS)	
MARK	NO.	LENGTH	TYPE			A
401	336	4'-5"	105	0'-8"	2'-0"	991
402	324	5'-11"	122	1'-8"	1'-4"	1100
*451	4	9'-3"	131	2'-6"	1'-2"	24
*452	4	10'-3"	131	3'-0"	1'-8"	28
*453	6	9'-9"	131	3'-2"	1'-0"	40
*454	4	5'-11"	155	2'-2"		16
*455	4	6'-5"	155	2'-8"		18
*456	6	6'-7"	155	2'-10"		26
501	21	15'-3"	Str.			334
502	1 Ser. of 332	28'-5" to 39'-2"	100	27'-3" to 38'-0"		1101
503	21	17'-6"	Str.			383
504	220	29'-3"	Str.			6712
505	37	16'-0"	Str.			617
601	256	29'-6"	Str.			11343

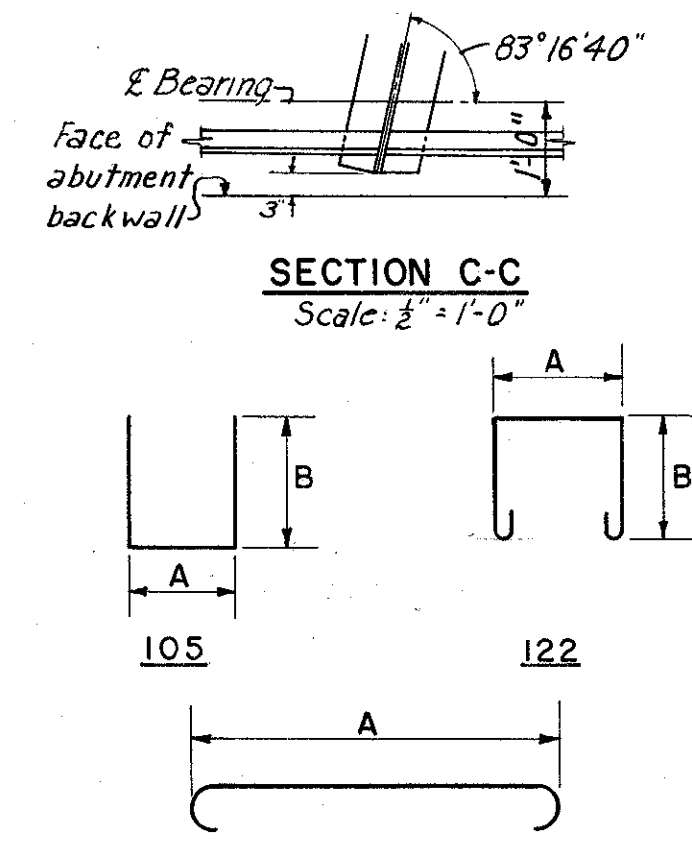

BAR BENDING DIAGRAMS

REINFORCEMENT SCHEDULE		DIMENSIONS		SERIES INCREMENT	WEIGHT (POUNDS)	
MARK	NO.	LENGTH	TYPE			A
#602	114	15'-3"	Str.			
#603	12	12'-3"	Str.			
#604	12	5'-0"	Str.			
605	1 Ser. of 332	27'-3" to 38'-0"	Str.			16269
*651	4	9'-5"	141	2'-11"	1'-10"	57
*652	6	14'-6"	141	5'-3"	3'-0"	131
*653	2	5'-0"	Str.			15
Total						49,805

NOTES:

In order to facilitate water curing of the concrete of the deck slab, the placing of the concrete shall progress up grade. The slab may be placed in sections between transverse construction joints which are parallel to the transverse reinforcing steel and are located near the center of any span.
For Railing details see sheet 175-7A
** for Light Standard Support and other lighting details see sheet 176-7A & 177-7A
For drainage details see sheet 174-7A
For end dam details see sheet 173-7A
* Bars are for the Light Standard Support. For their placement and bending diagram see sheet 176-7A
Bars included for payment with "Item 5-14, Railing"
For replacement bars see sheet 103-7A

Note: Beam end diaphragm connections shall be made with 7/8" high strength bolts conforming to Supplemental Specs. S-201.

H.N.T.B. BR. NO. 9 PART 7A

HOWARD, NEEDLES, TAMMEN & BERGENDOFF
CONSULTING ENGINEERS
KANSAS CITY CLEVELAND NEW YORK

DECK PLAN

RAMP E-15 OVER EAST 14th ST.
BR. NO. CUY-21-1573 B STA. 15+27.70


Scale: As noted STA. 16+96.91

WILLOW-INNER BELT FREEWAY
CLEVELAND CUYAHOGA COUNTY OHIO

JUL 3 1955
 CUYAHOGA COUNTY
 CITY OF CLEVELAND
 CUY-21-15.32
 CUY-42-18.42

- LEGEND**
- Existing Right of Way
 - Existing Edge of Pavement
 - Existing Sewer Line
 - O.B.T. Line
 - Water Line
 - Gas Line
 - Existing Manhole
 - Existing Catch Basin
 - * Inlet
 - * Manhole
 - * Sewer
 - * 2" Duct
 - * 4" Duct


* Built under previous contract.

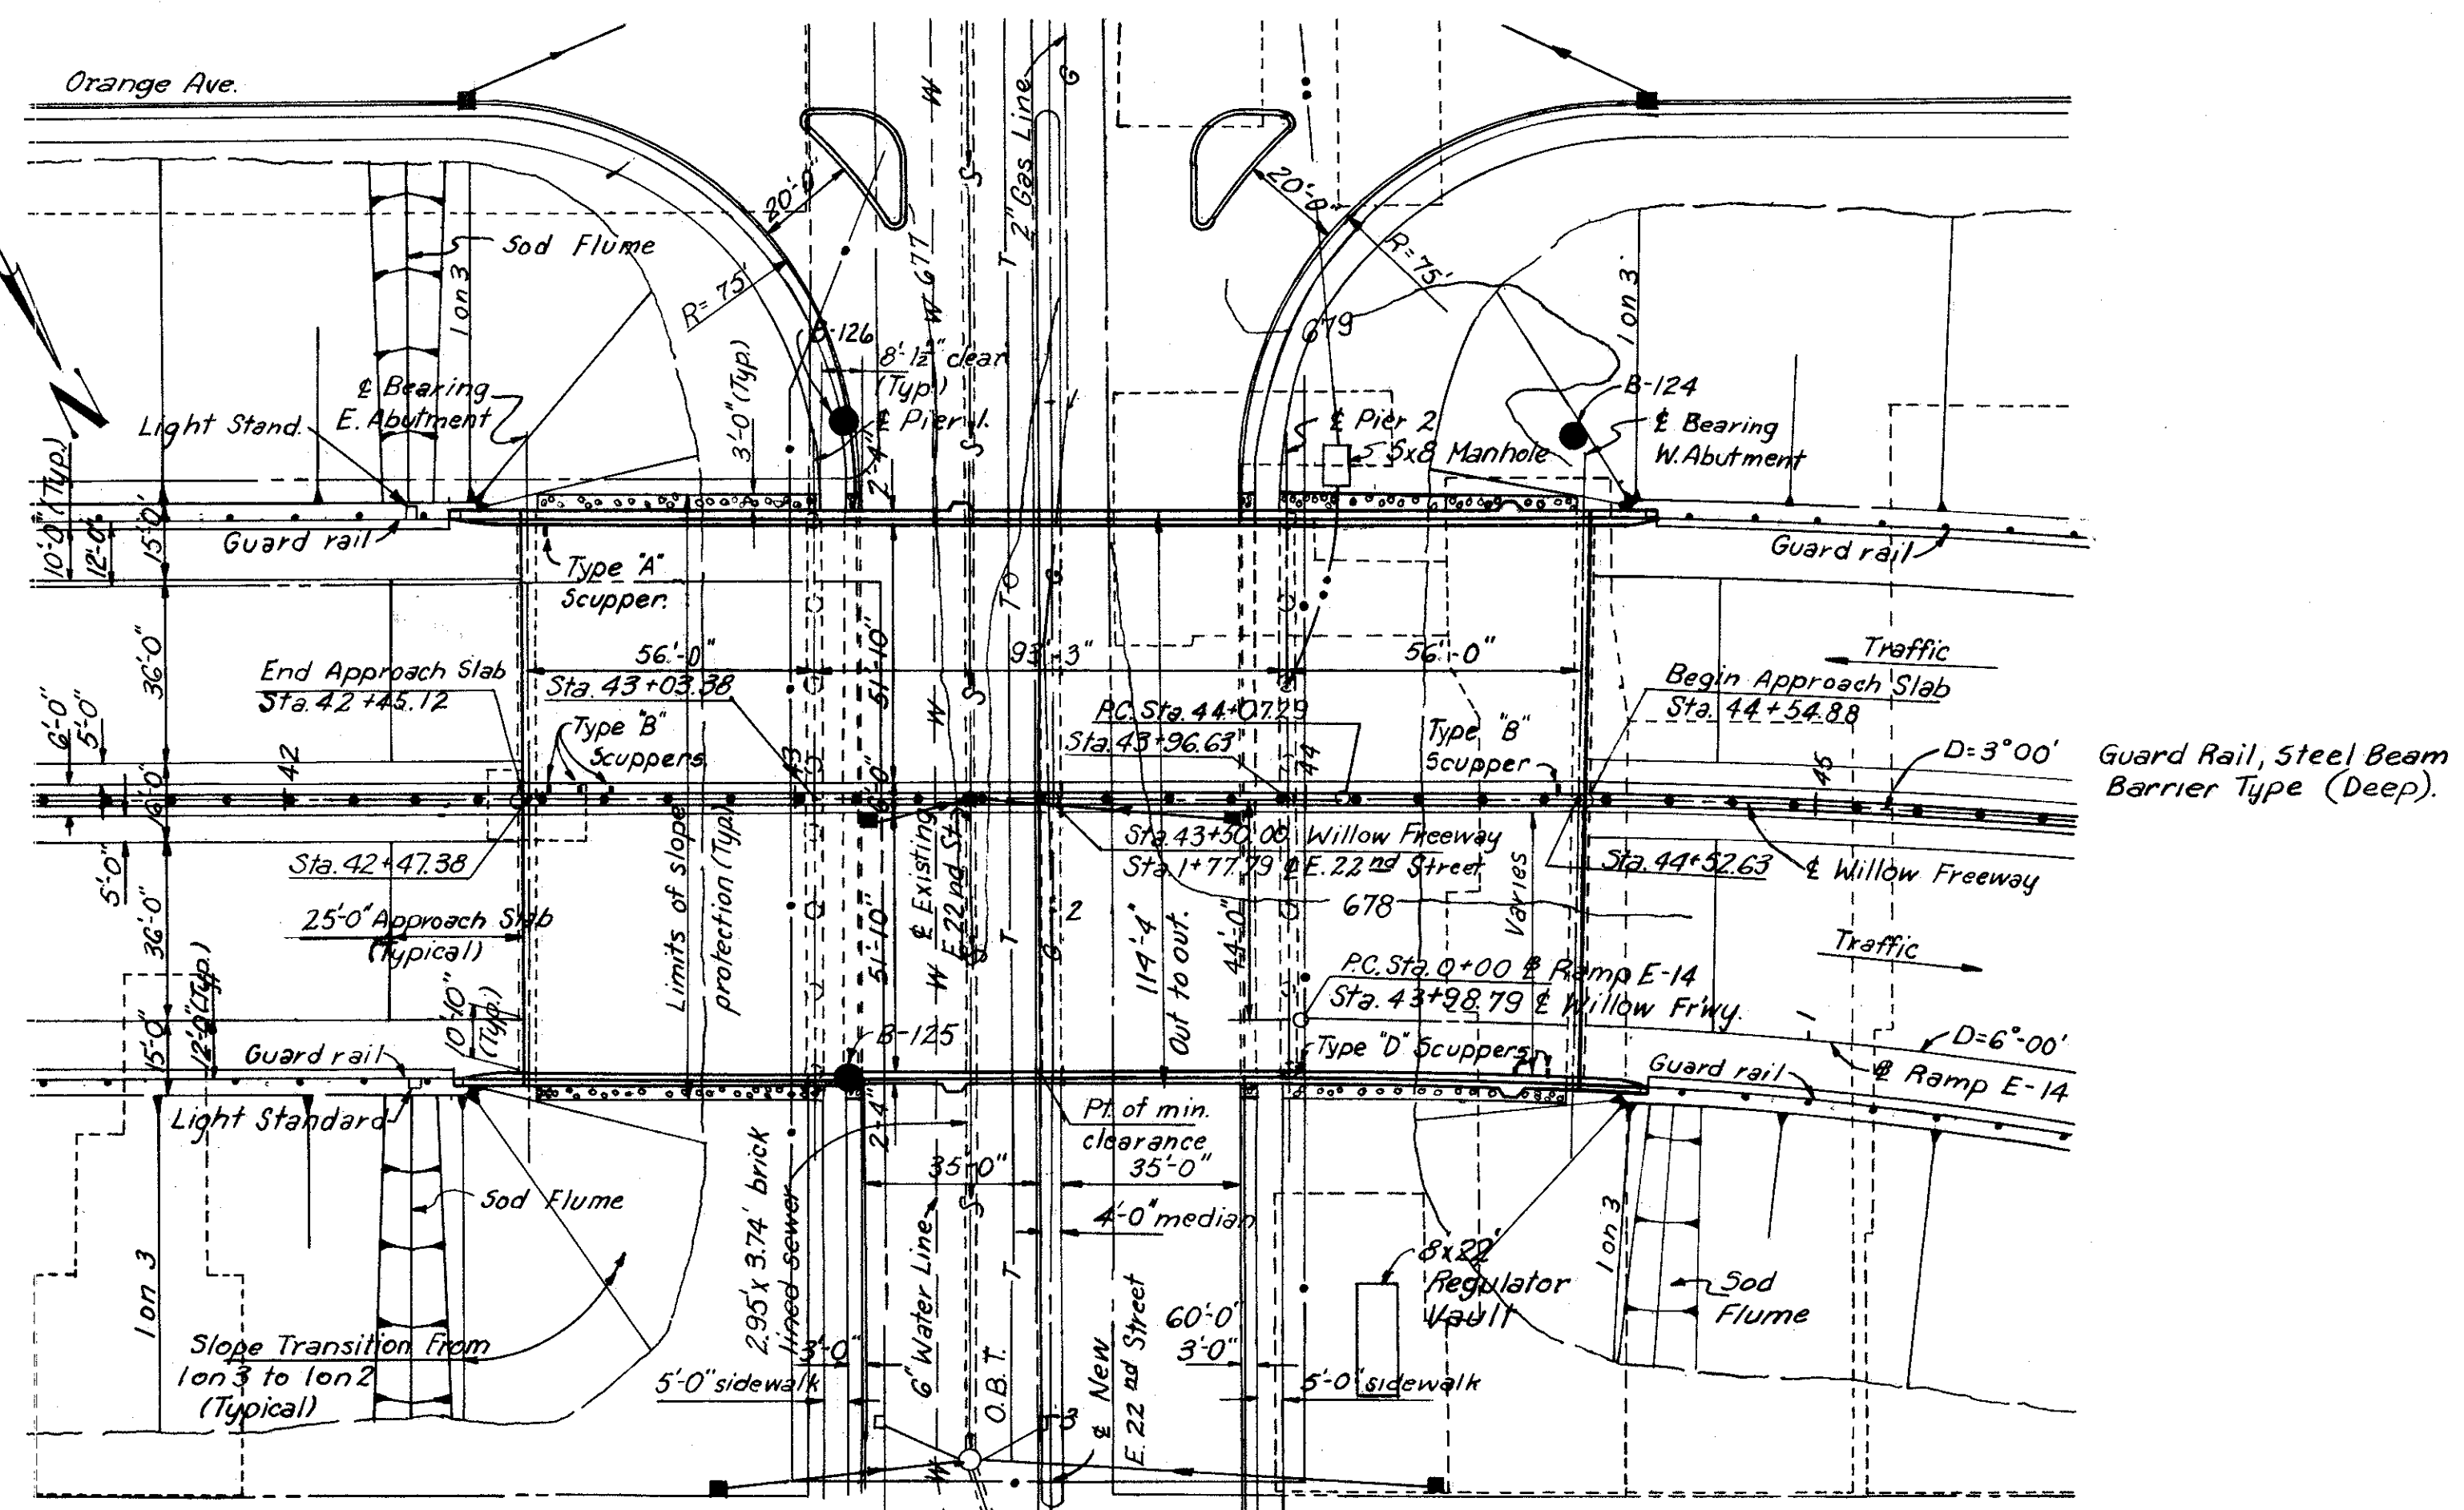

Guard Rail, Steel Beam Barrier Type (Deep).

CURVE DATA

WILLOW	RAMP E-14
$\Delta = 23^{\circ} 06' 48''$	$\Delta = 17^{\circ} 52' 41''$
$D = 3^{\circ} 00' 00''$	$D = 6^{\circ} 00' 00''$
$R = 1909.86'$	$R = 954.93'$
$L = 770.50'$	$L = 297.97'$
$T = 390.54'$	$T = 150.20'$

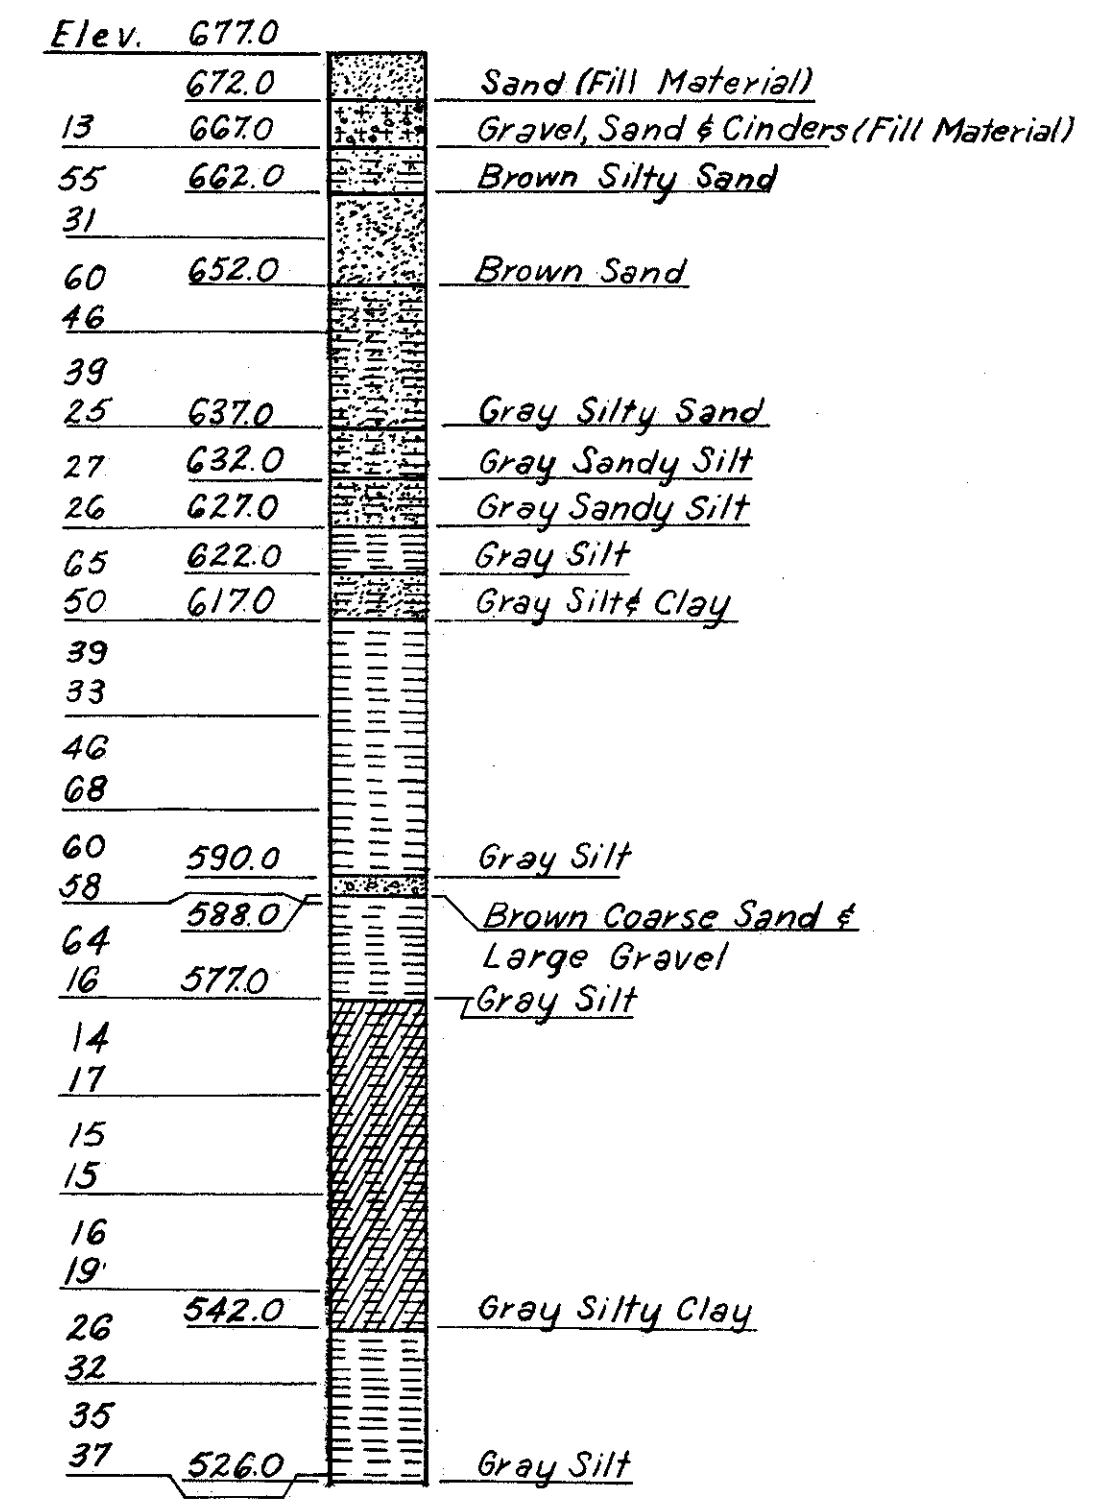


BORING B-125
 Sta. 43+10 60' Rt
 Vertical Scale: 1" = 20'

Note:
 The figures to the left indicates the number of hammer blows required to drive the sample spoon 1 ft. They are given at 5' intervals starting at elevation 667.0.

PROPOSED STRUCTURE

Type: Continuous steel beam with reinforced concrete deck and substructure.
 Spans: 56'-0", 93'-3", 56'-0" along Willow Frwy.
 Roadway: 112'-0" (nominal) flt parapets.
 Loading: CF 2000-Adequate for A.A.S.H.O. alternate loading.
 Surface Course: 1" Monolithic Concrete.
 Alignment: Tangent to 3°00' Rt.
 Approach Slabs: AS-1-54 (25' Long).
 Superelevation: Varies.
 Skew: 0° 00'.

Note:
 Piers for Bridge No. 10 are included in Part 6.

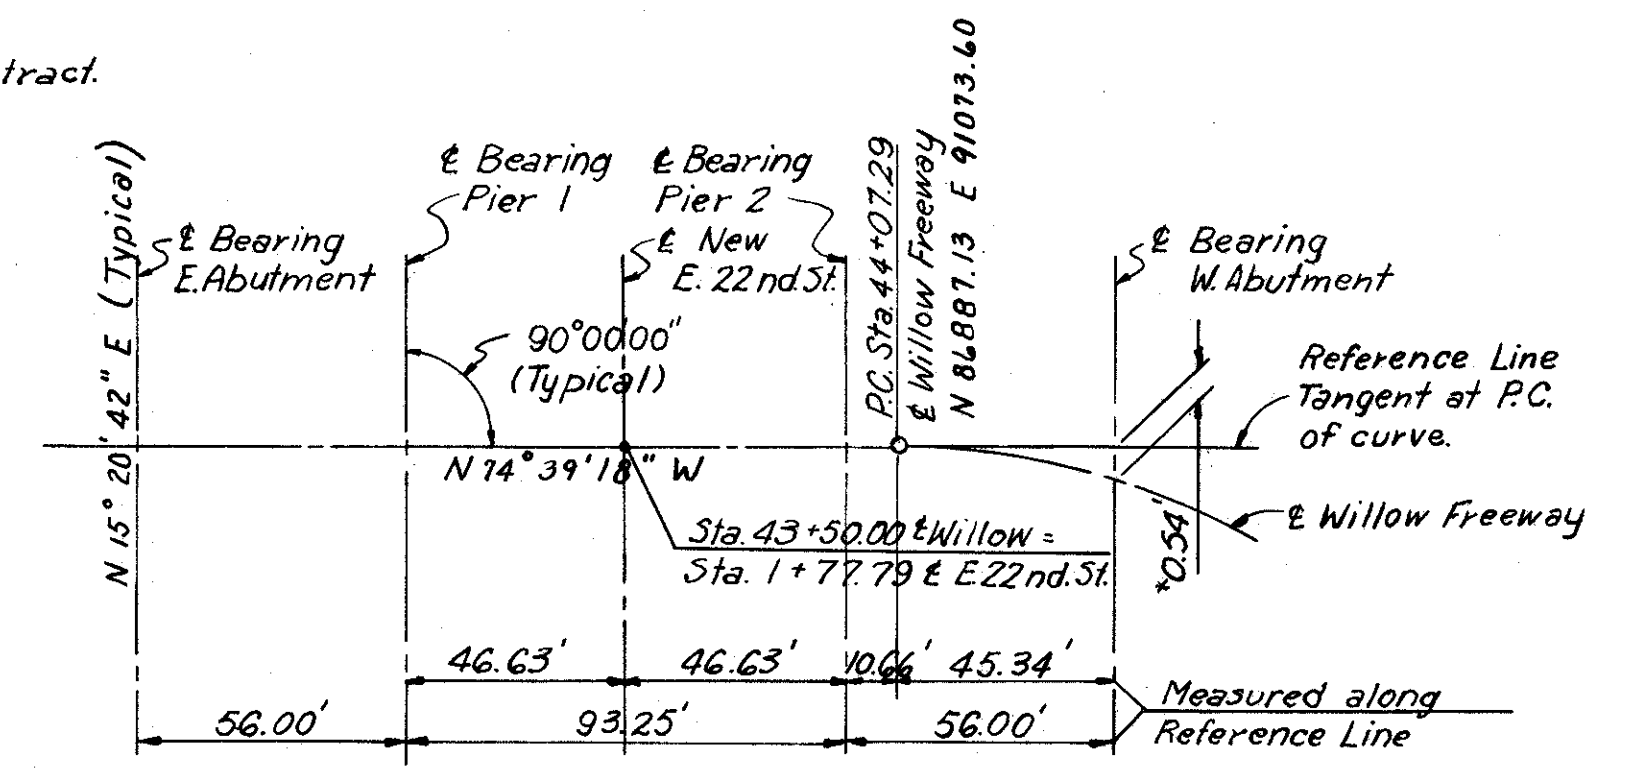

BRIDGE LAYOUT DIAGRAM
 No Scale

* Offset measured from reference line to Willow Freeway along Bearings


PILE INFORMATION

Location	Diameter	Number	Estimated ave. length
E. Abutment	12"	42	34'
W. Abutment	12"	42	35'
Pier 1	14"	50	26'
Pier 2	14"	50	26'

All piling to be C.I.P. Reinforced Concrete.

NOTES:

Rod soundings only were taken at location B-124 & B-126. The core drilling made at B-125 is plotted. Detail for slope protection see sheet 174-7A. Pile lengths are based on boring data and are approximate only. The Contractor shall assume full responsibility for length of piling selected for driving. The following items are not included in the bridge plans. See Roadway Plans for details. Approach grading, pavements and slabs. Roadway Guard Rail. Sod Flumes. For details of pier plans & drain pipe locations at piers see sheets 172-7A & 174-7A.

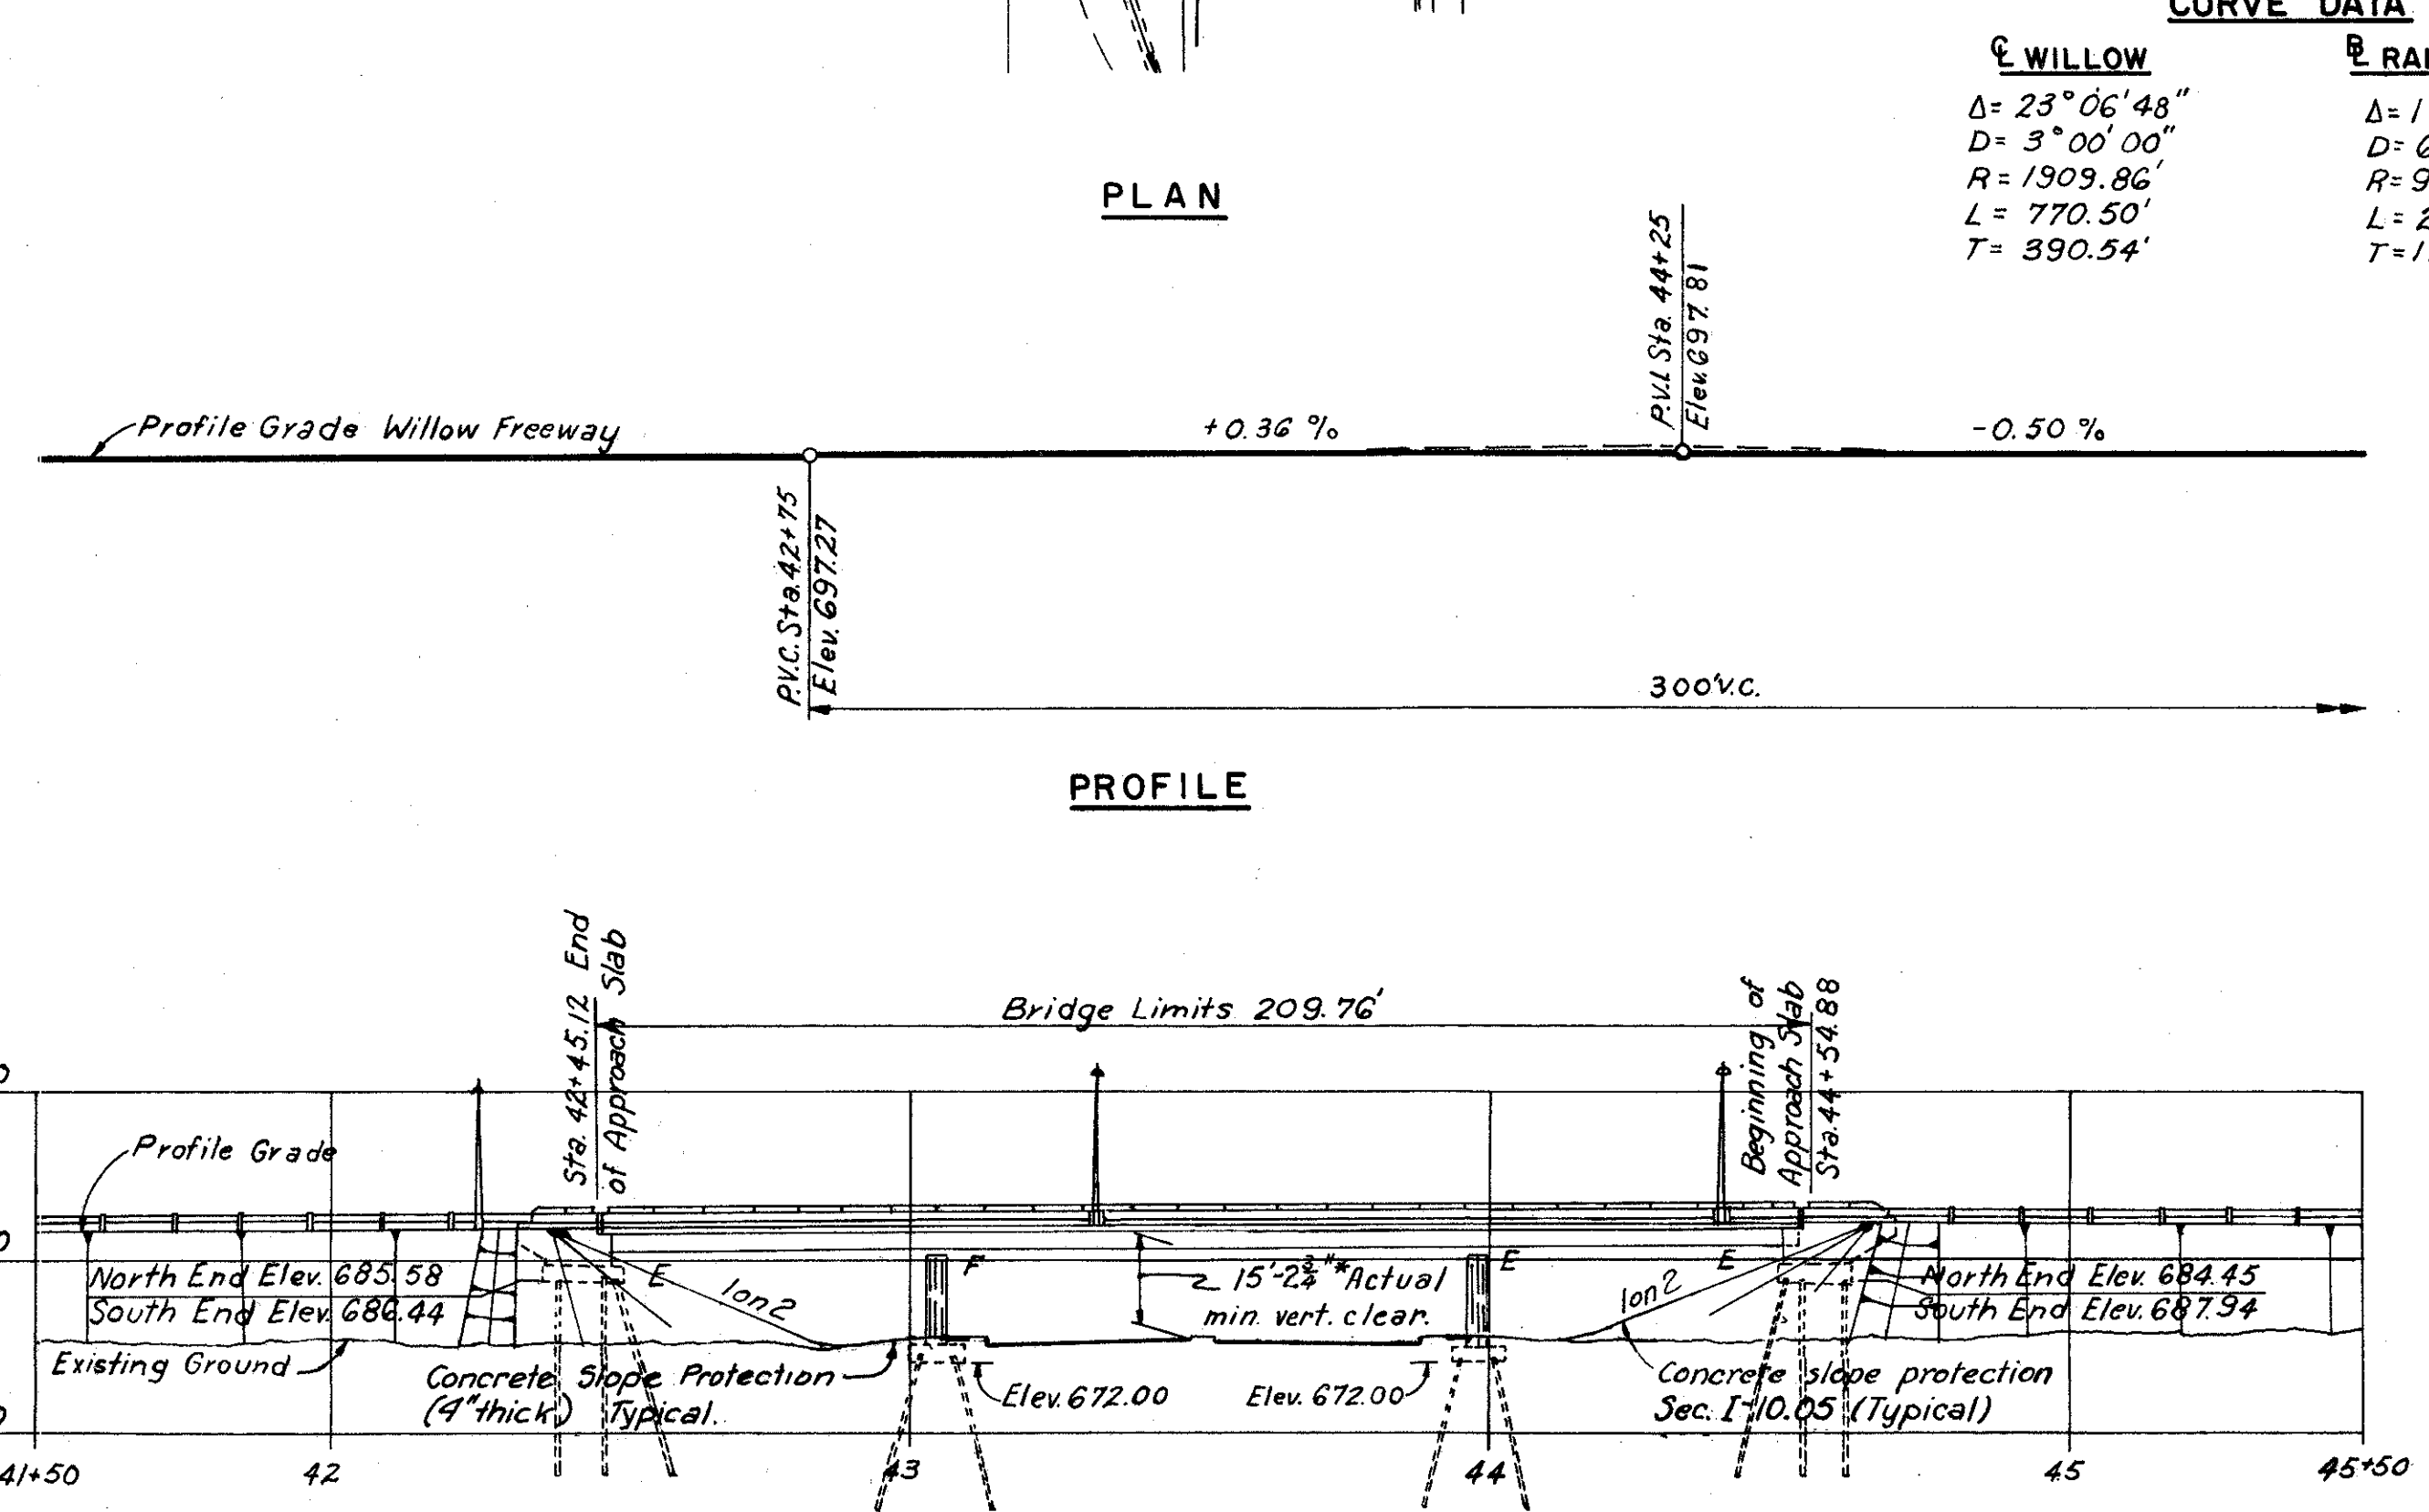

ELEVATION

* 15'-0" Required minimum vertical clearance. Point of actual minimum vertical clearance occurs at East edge of median and the North exterior beam.

H.N.T.B. BR. NO. 10 PART 7A
 HOWARD, NEEDLES, TAMMEN & BERGENDOFF
 CONSULTING ENGINEERS
 KANSAS CITY CLEVELAND NEW YORK






SITE PLAN

WILLOW FREEWAY OVER EAST 22nd. ST.
 BR. NO. CUY-21-1559 STA. 42+45.12
 Scale: 1" = 30' STA. 44+54.88

WILLOW-INNER BELT FREEWAY
 CLEVELAND CUYAHOGA COUNTY OHIO

DRAWN BY J.S. TRACED BY M.E.S. CHECKED BY P.M. REVIEWED BY J.C.T. REVISIONS
 DATE 4/14/50 DATE 7-23-50 DATE 11-13-51 SHEET 156

CUYAHOGA COUNTY
CITY OF CLEVELAND
CUY - 21-15.32
CUY - 42-18.42

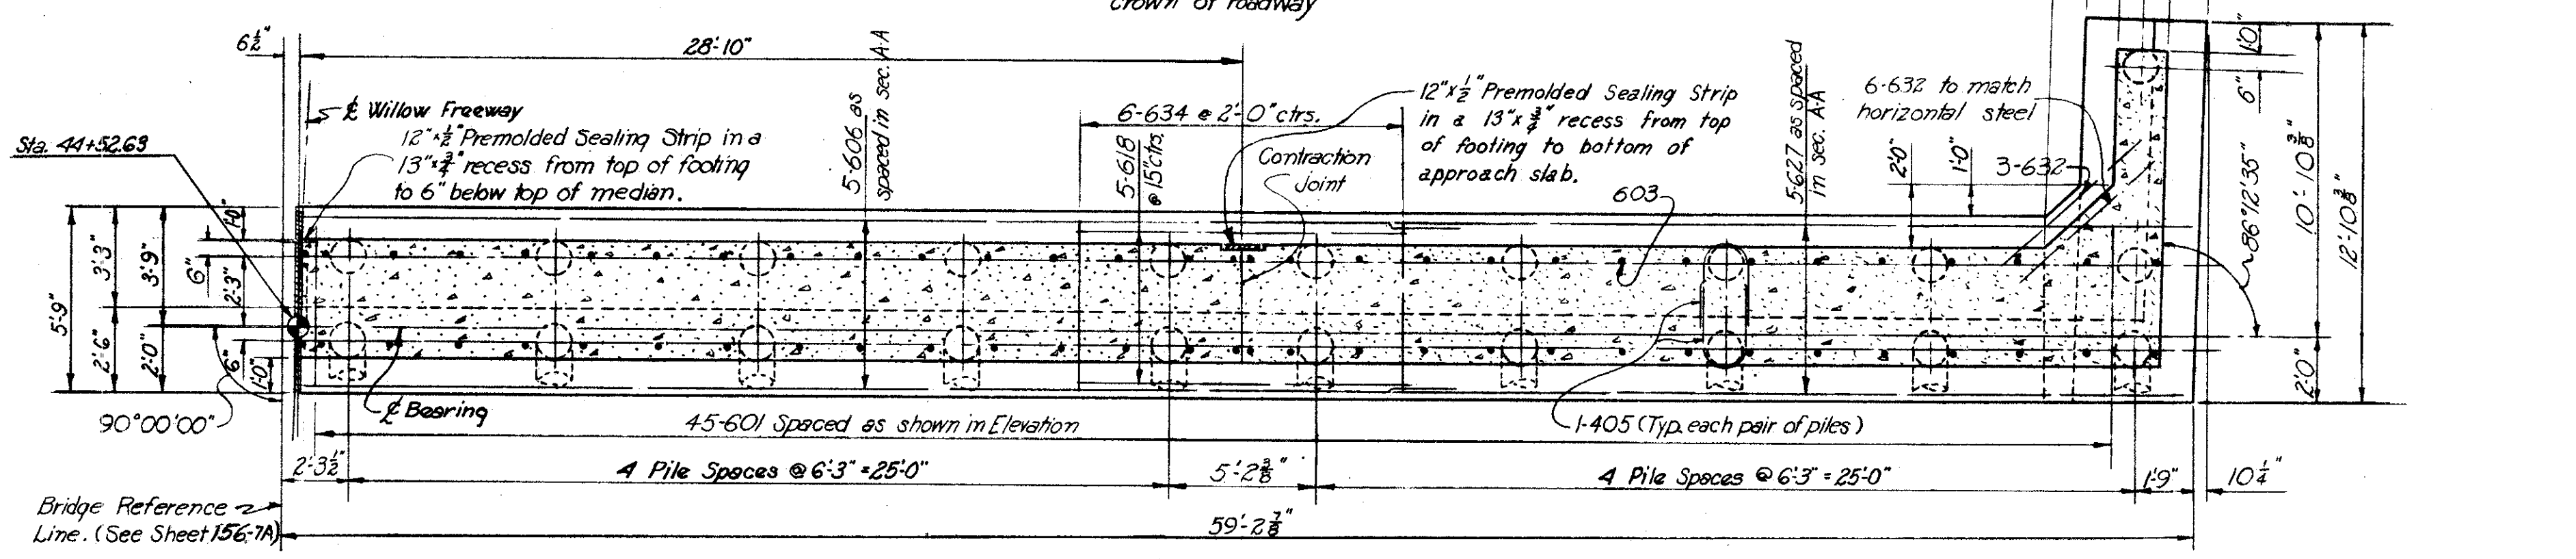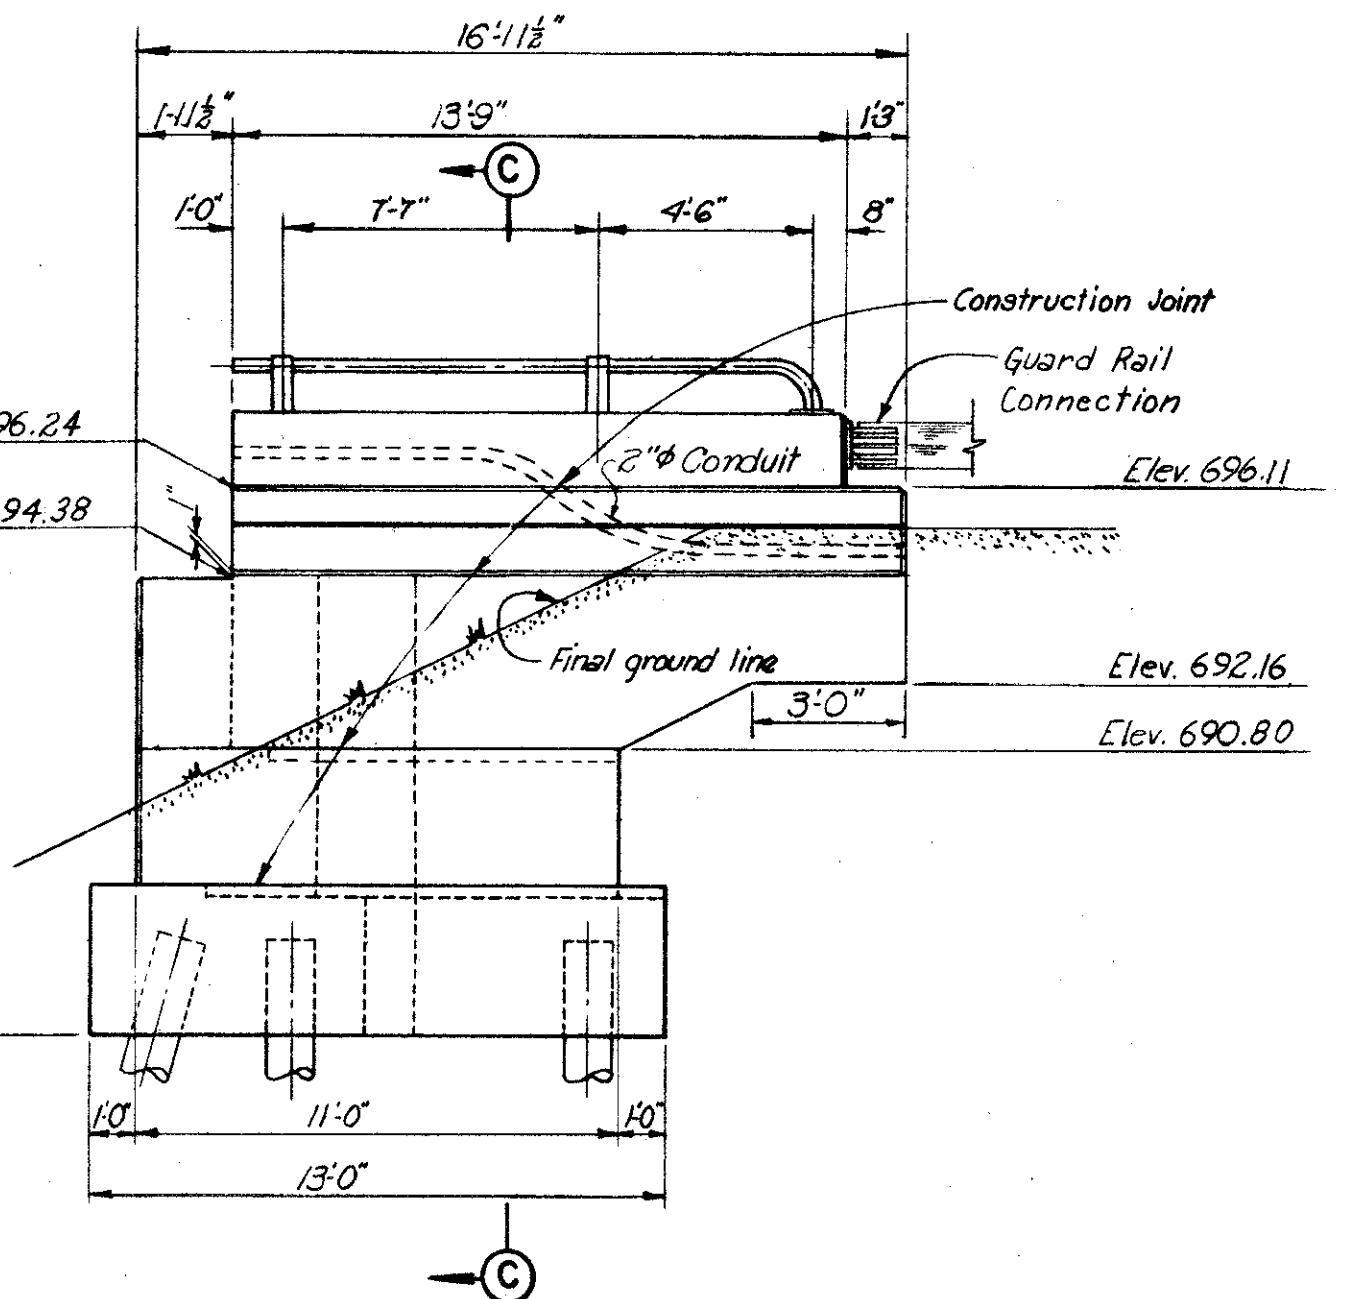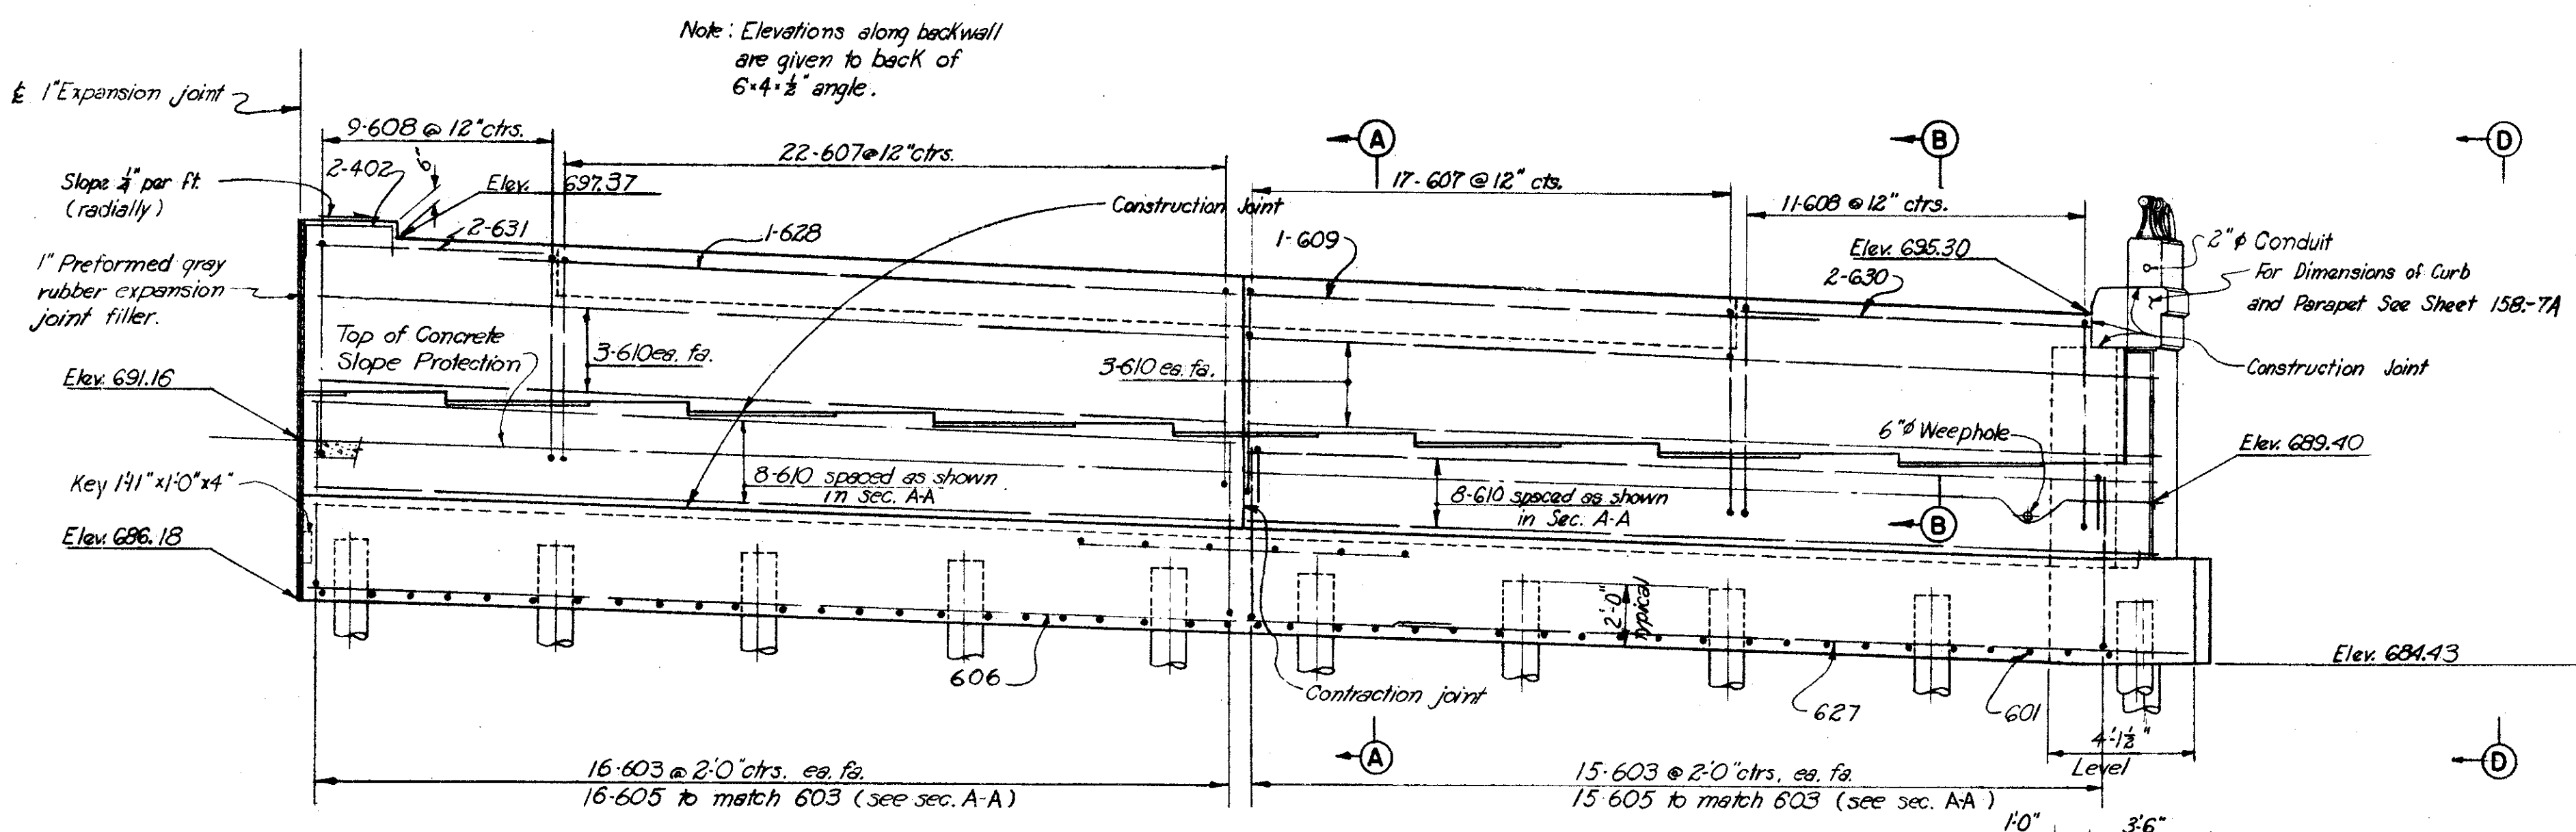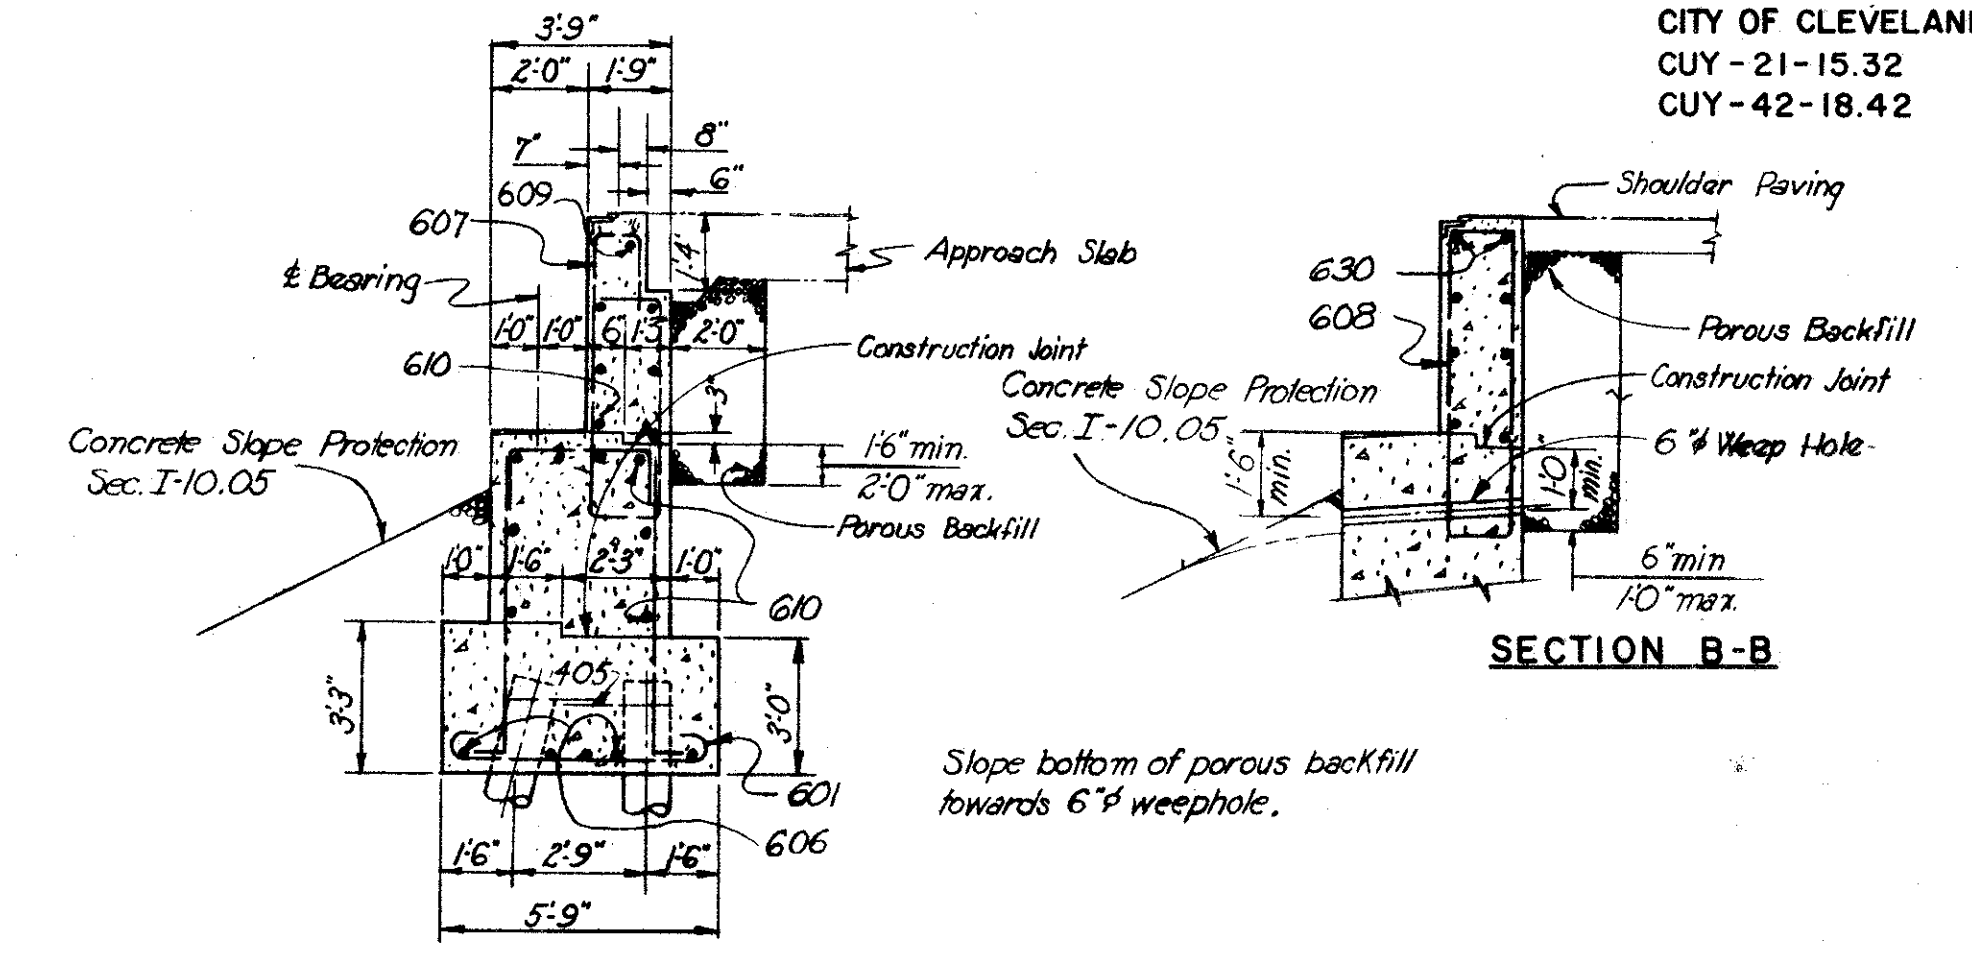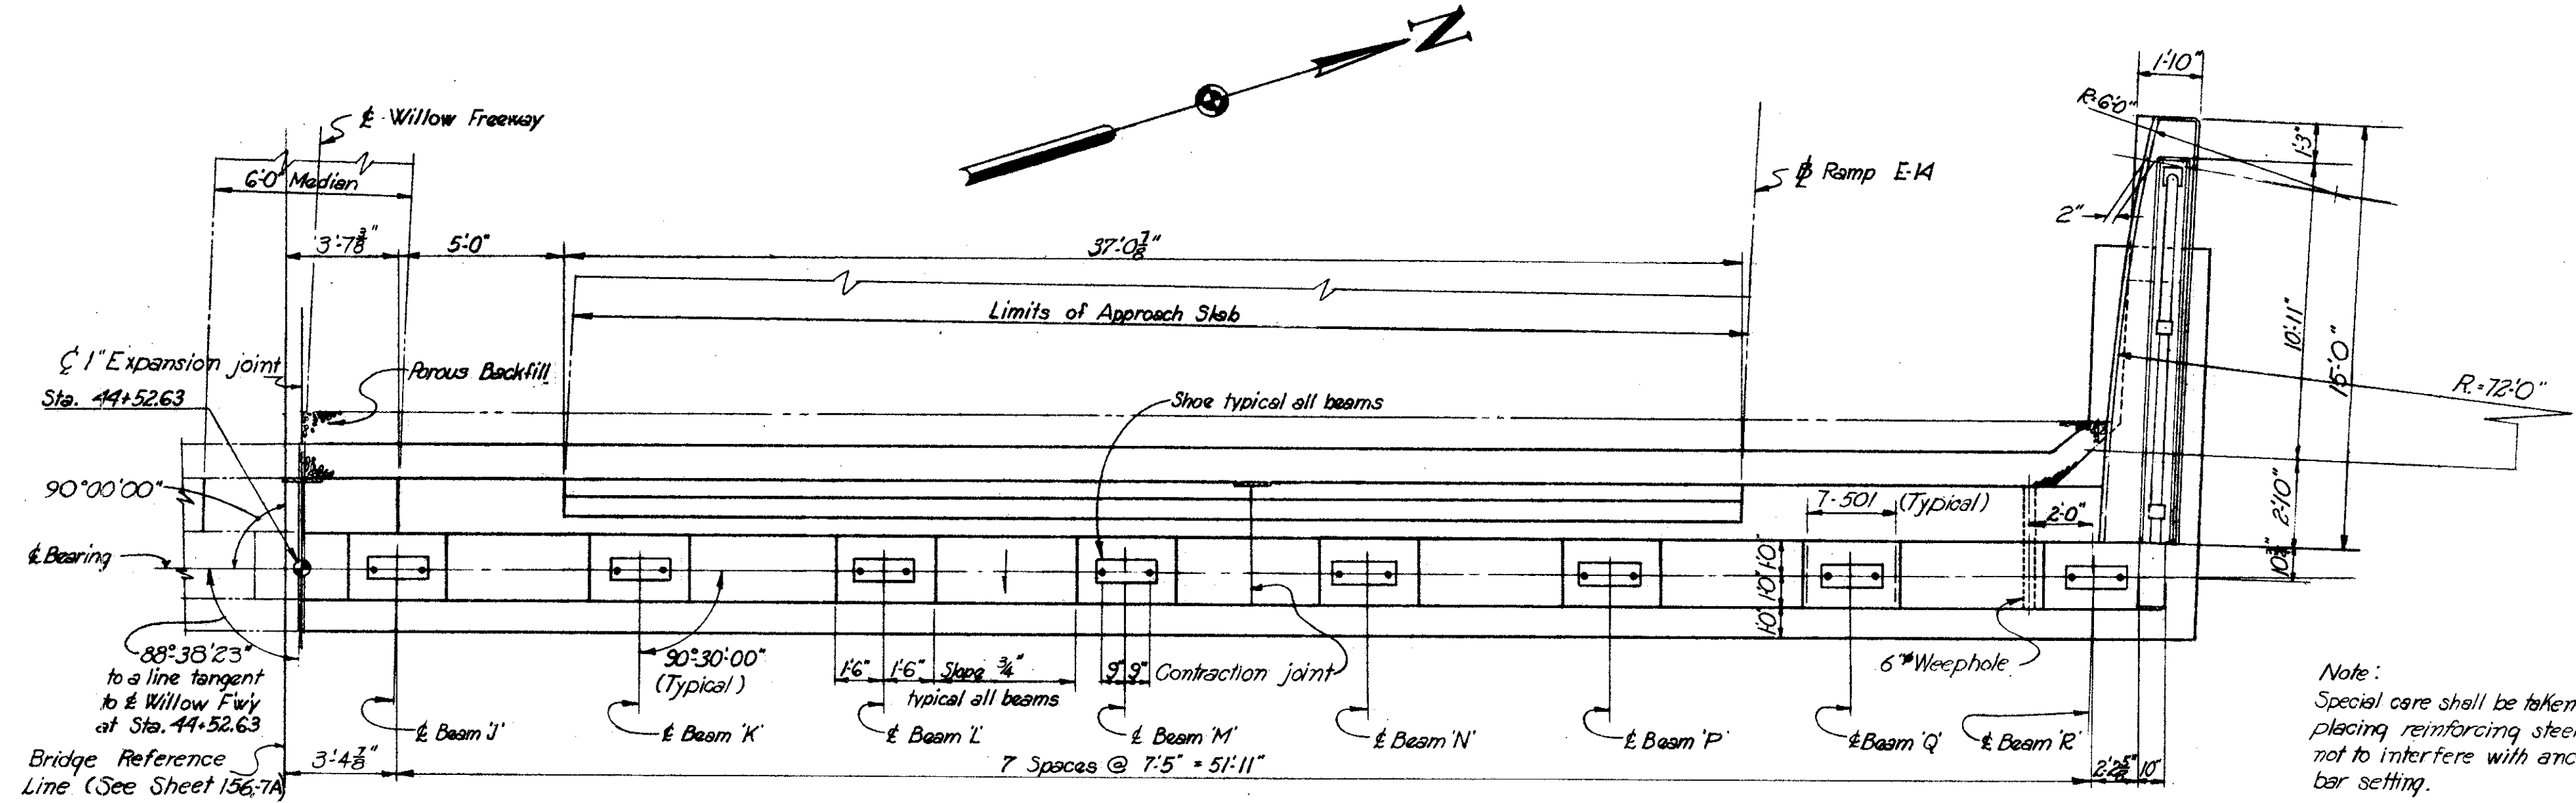

Beam	Elevation
J	692.82
K	692.53
L	692.25
M	691.96
N	691.67
P	691.38
Q	691.09
R	690.80

For notes see sheet 159-7A.

H.N.T.B. BR. NO. 10 PART 7A


HOWARD, NEEDLES, TAMMEN & BERGENDOFF
CONSULTING ENGINEERS
KANSAS CITY CLEVELAND NEW YORK

WEST ABUTMENT-NORTH HALF

WILLOW FREEWAY OVER EAST 22nd ST
BR. NO. CUY - 21-1559 STA. 42+45.12
Scale: 1/4" = 1'-0" STA. 44+54.88


WILLOW-INNER BELT FREEWAY
CLEVELAND CUYAHOGA COUNTY OHIO

DRAWN C.D.D.	TRACED	CHECKED C.M.	REVIEWED J.C.T.	REVISED
DATE 5-20-58	DATE	DATE 2-27-59	DATE 11-13-59	SHEET 160

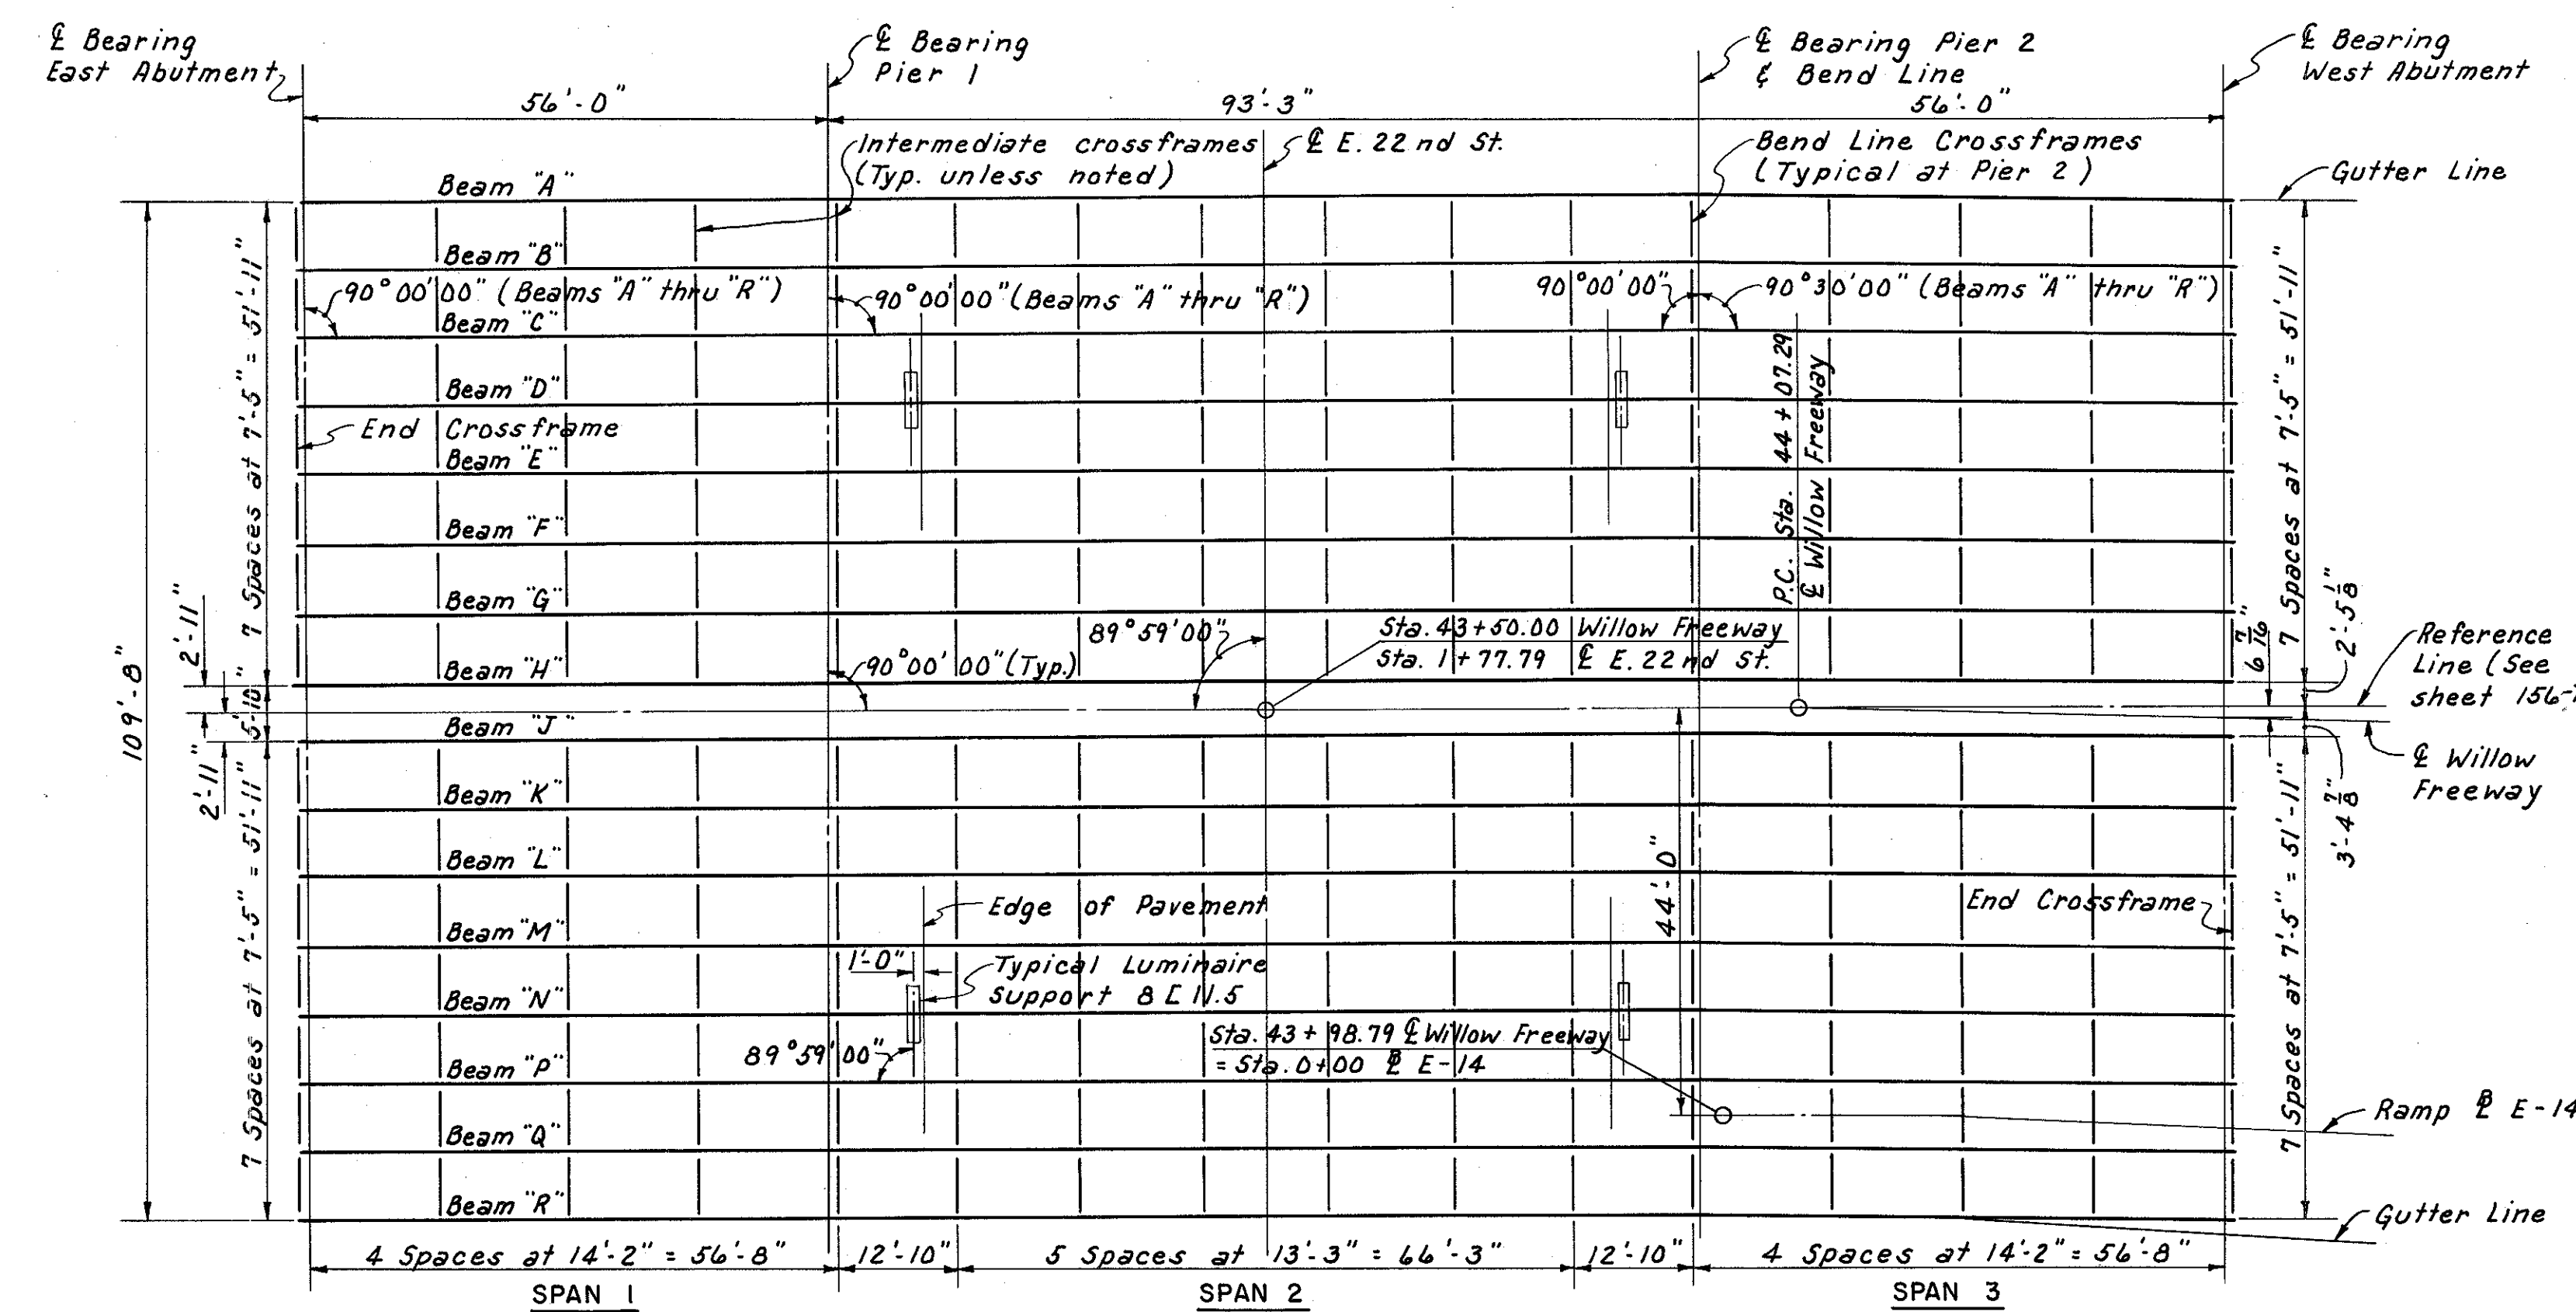


ELEVATION AND DEFLECTION TABLE

BEAM	EAST ABUTMENT		SPAN 1			PIER 1		SPAN 2					PIER 2		SPAN 3			WEST ABUTMENT										
	TOP OF BEAM ELEV.	TOP OF PAVEMENT ELEV.	D.L. DEFL.		D.L. DEFL.	TOP OF BEAM ELEV.	TOP OF PAVEMENT ELEV.	D.L. DEFL.		D.L. DEFL.		D.L. DEFL.		TOP OF BEAM ELEV.	TOP OF PAVEMENT ELEV.	D.L. DEFL.		TOP OF BEAM ELEV.	TOP OF PAVEMENT ELEV.									
			CON	TOT				CON	TOT	CON	TOT	CON	TOT			CON	TOT			CON	TOT							
"A"	696.32	697.16	1/16	1/8	0	0	-1/4	-1/4	696.85	697.69	1/16	1/8	1/16	1/8	1/16	1/8	1/16	1/8	697.53	698.37	-1/4	-1/4	0	0	1/16	1/8	697.82	698.66
"B"	696.62	697.46	1/16	1/8	0	0	-3/16	-3/16	697.14	697.98	1/16	1/8	1/16	1/8	1/16	1/8	1/16	1/8	697.82	698.66	-3/16	-3/16	0	0	1/16	1/8	698.11	698.95
"C"	696.62	697.46	1/16	1/8	0	0	-3/16	-3/16	697.09	697.93	1/16	1/8	1/16	1/8	1/16	1/8	1/16	1/8	697.75	698.59	-3/16	-3/16	0	0	1/16	1/8	697.94	698.78
"D"	696.56	697.40	1/16	1/8	0	0	-3/16	-3/16	696.98	697.82	1/16	1/8	1/16	1/8	1/16	1/8	1/16	1/8	697.49	698.33	-3/16	-3/16	0	0	1/16	1/8	697.68	698.52
"E"	696.51	697.34	1/16	1/8	0	0	-3/16	-3/16	696.87	697.70	1/16	1/8	1/16	1/8	1/16	1/8	1/16	1/8	697.28	698.12	-3/16	-3/16	0	0	1/16	1/8	697.41	698.25
"F"	696.45	697.29	1/16	1/8	0	0	-3/16	-3/16	696.75	697.59	1/16	1/8	1/16	1/8	1/16	1/8	1/16	1/8	697.07	697.91	-3/16	-3/16	0	0	1/16	1/8	697.15	697.99
"G"	696.39	697.23	1/16	1/8	0	0	-3/16	-3/16	696.64	697.47	1/16	1/8	1/16	1/8	1/16	1/8	1/16	1/8	696.86	697.70	-3/16	-3/16	0	0	1/16	1/8	696.88	697.72
"H"	696.33	697.17	1/16	1/8	0	0	-3/16	-3/16	696.52	697.36	1/16	1/8	1/16	1/8	1/16	1/8	1/16	1/8	696.66	697.50	-3/16	-3/16	0	0	1/16	1/8	696.62	697.46
"J"	696.33	697.17	1/16	1/8	0	0	-3/16	-3/16	696.52	697.36	1/16	1/8	1/16	1/8	1/16	1/8	1/16	1/8	696.66	697.50	-3/16	-3/16	0	0	1/16	1/8	696.62	697.46
"K"	696.22	697.06	1/16	1/8	0	0	-3/16	-3/16	696.36	697.20	1/16	1/8	1/16	1/8	1/16	1/8	1/16	1/8	696.42	697.26	-3/16	-3/16	0	0	1/16	1/8	696.34	697.17
"L"	696.10	696.94	1/16	1/8	0	0	-3/16	-3/16	696.20	697.04	1/16	1/8	1/16	1/8	1/16	1/8	1/16	1/8	696.18	697.02	-3/16	-3/16	0	0	1/16	1/8	696.05	696.89
"M"	695.99	696.82	1/16	1/8	0	0	-3/16	-3/16	696.04	696.88	1/16	1/8	1/16	1/8	1/16	1/8	1/16	1/8	695.94	696.78	-3/16	-3/16	0	0	1/16	1/8	695.76	696.60
"N"	695.87	696.71	1/16	1/8	0	0	-3/16	-3/16	695.88	696.72	1/16	1/8	1/16	1/8	1/16	1/8	1/16	1/8	695.70	696.54	-3/16	-3/16	0	0	1/16	1/8	695.47	696.31
"P"	695.75	696.59	1/16	1/8	0	0	-3/16	-3/16	695.72	696.56	1/16	1/8	1/16	1/8	1/16	1/8	1/16	1/8	695.46	696.30	-3/16	-3/16	0	0	1/16	1/8	695.18	696.02
"Q"	695.64	696.48	1/16	1/8	0	0	-3/16	-3/16	695.56	696.40	1/16	1/8	1/16	1/8	1/16	1/8	1/16	1/8	695.22	696.06	-3/16	-3/16	0	0	1/16	1/8	694.89	695.73
"R"	695.52	696.36	1/16	1/8	0	0	-3/16	-3/16	695.40	696.24	1/16	1/8	1/16	1/8	1/16	1/8	1/16	1/8	694.98	695.82	-3/16	-3/16	0	0	1/16	1/8	694.60	695.44

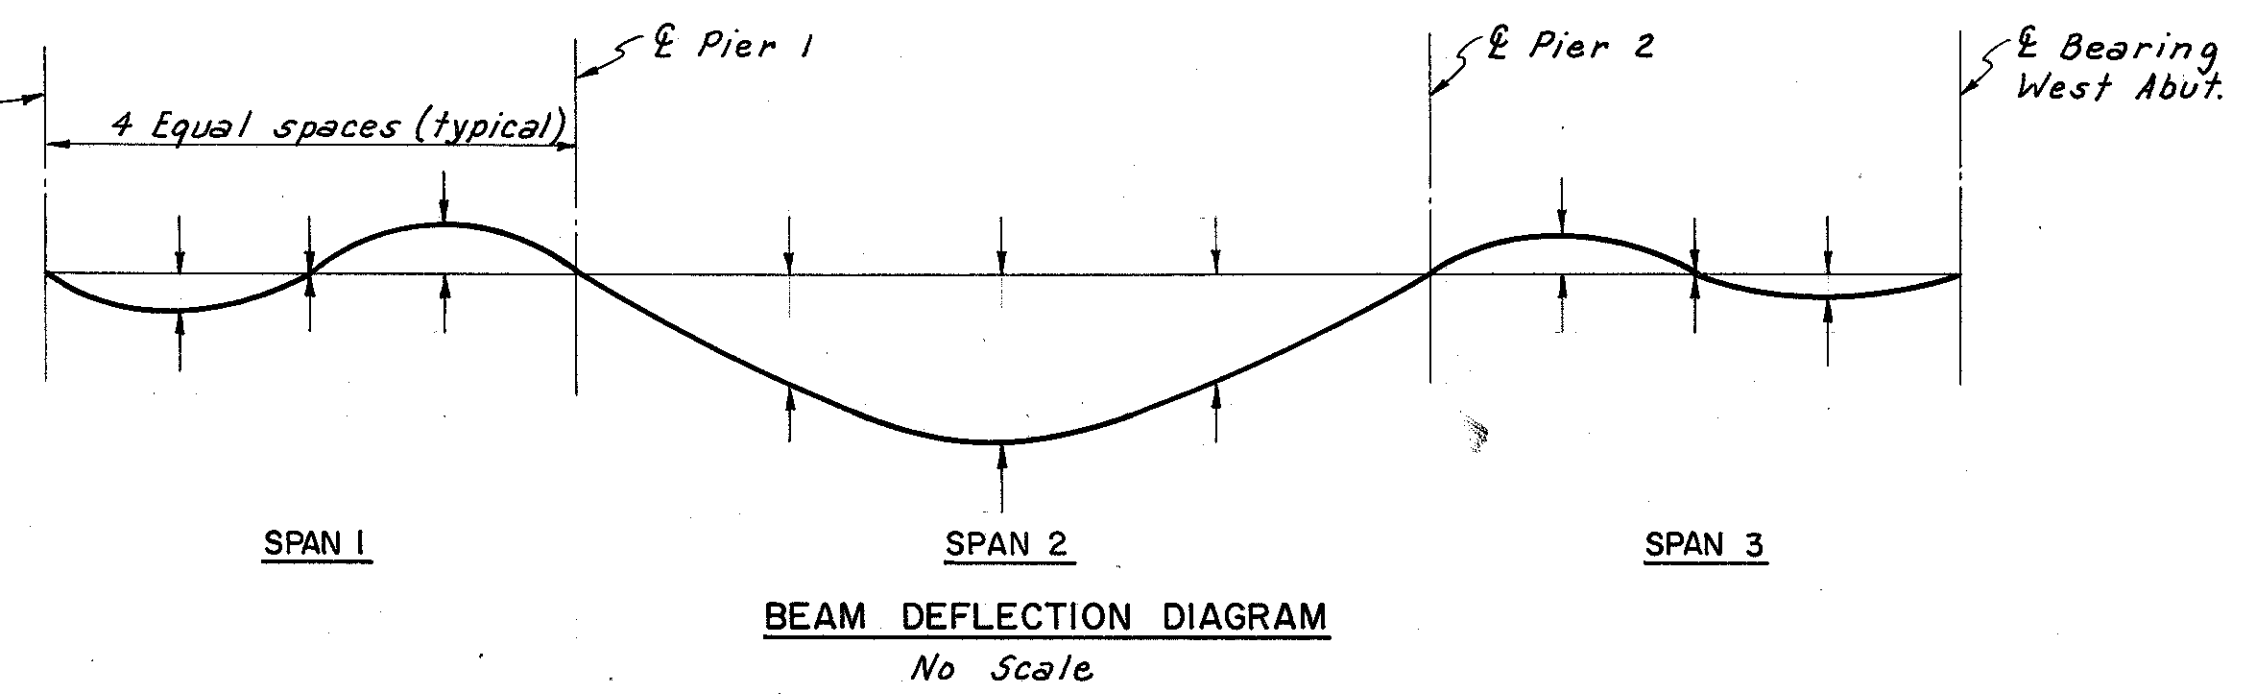


TOP OF PAVEMENT ELEVATIONS

BEAMS	SPAN 1		SPAN 2		SPAN 3				
	1/4	3/4	1/4	3/4	1/4	3/4			
"A"	697.29	697.42	697.55	697.88	698.07	698.23	698.45	698.52	698.59
"B"	697.58	697.71	697.84	698.17	698.36	698.52	698.75	698.82	698.89
"C"	697.58	697.70	697.81	698.11	698.27	698.41	698.59	698.65	698.71
"D"	697.51	697.61	697.71	697.97	698.11	698.23	698.42	698.46	698.46
"E"	697.44	697.53	697.61	697.83	697.95	698.04	698.15	698.18	698.22
"F"	697.36	697.44	697.52	697.69	697.78	697.86	697.93	697.95	697.97
"G"	697.29	697.36	697.42	697.55	697.62	697.67	697.71	697.71	697.72
"H"	697.22	697.27	697.32	697.42	697.46	697.49	697.49	697.49	697.48
"J"	697.22	697.27	697.32	697.42	697.46	697.49	697.49	697.49	697.48
"K"	697.10	697.14	697.17	697.24	697.26	697.27	697.24	697.22	697.20
"L"	696.97	697.00	697.02	697.06	697.06	696.05	696.99	696.96	696.92
"M"	696.85	696.86	696.87	696.88	696.86	696.83	696.74	696.69	696.64
"N"	696.72	696.72	696.72	696.70	696.66	696.61	696.48	696.43	696.37
"P"	696.55	696.59	696.58	696.52	696.46	696.39	696.23	696.16	696.09
"Q"	696.47	696.45	696.43	696.33	696.26	696.17	695.98	695.90	695.81
"R"	696.35	696.31	696.28	696.15	696.06	695.95	695.73	695.63	695.54

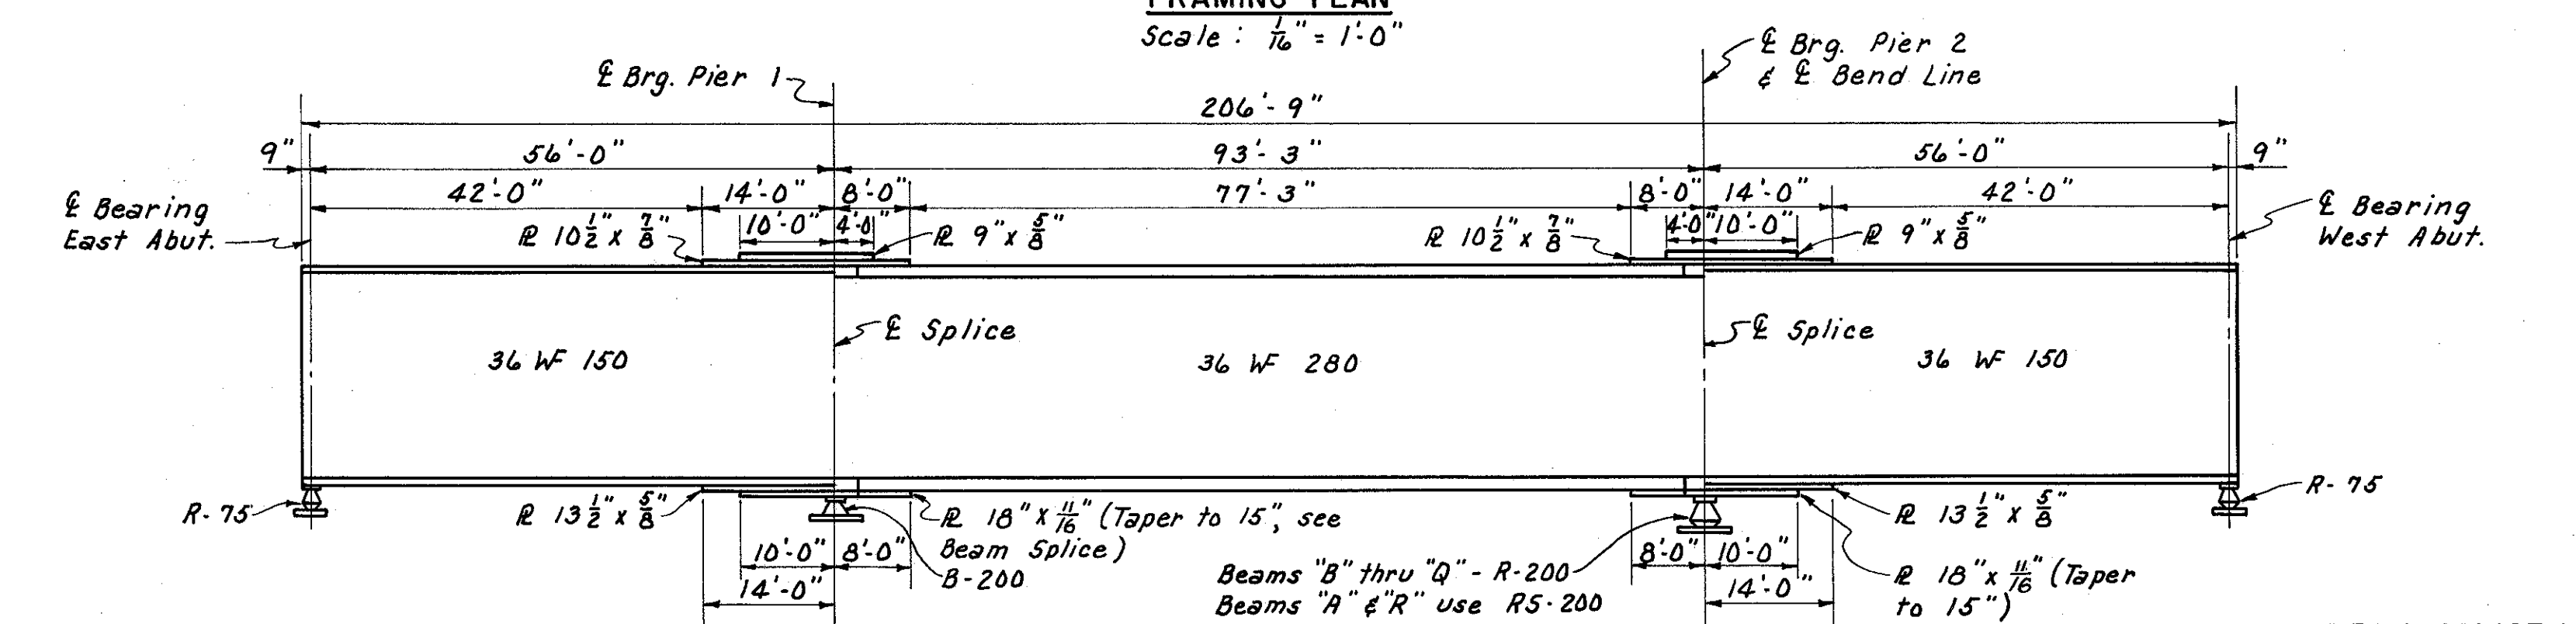

- BEAM SPLICE WELDING PROCEDURE**
1. Raise the abutment ends of the beams 1/2".
 2. Butt-weld the beam flanges and web, using the following sequences: make two passes on each flange, then two on the web; repeat using one pass at each location, until welds are completed.
 3. Weld the top and bottom cover plates.
 4. Lower the beam ends to final position.

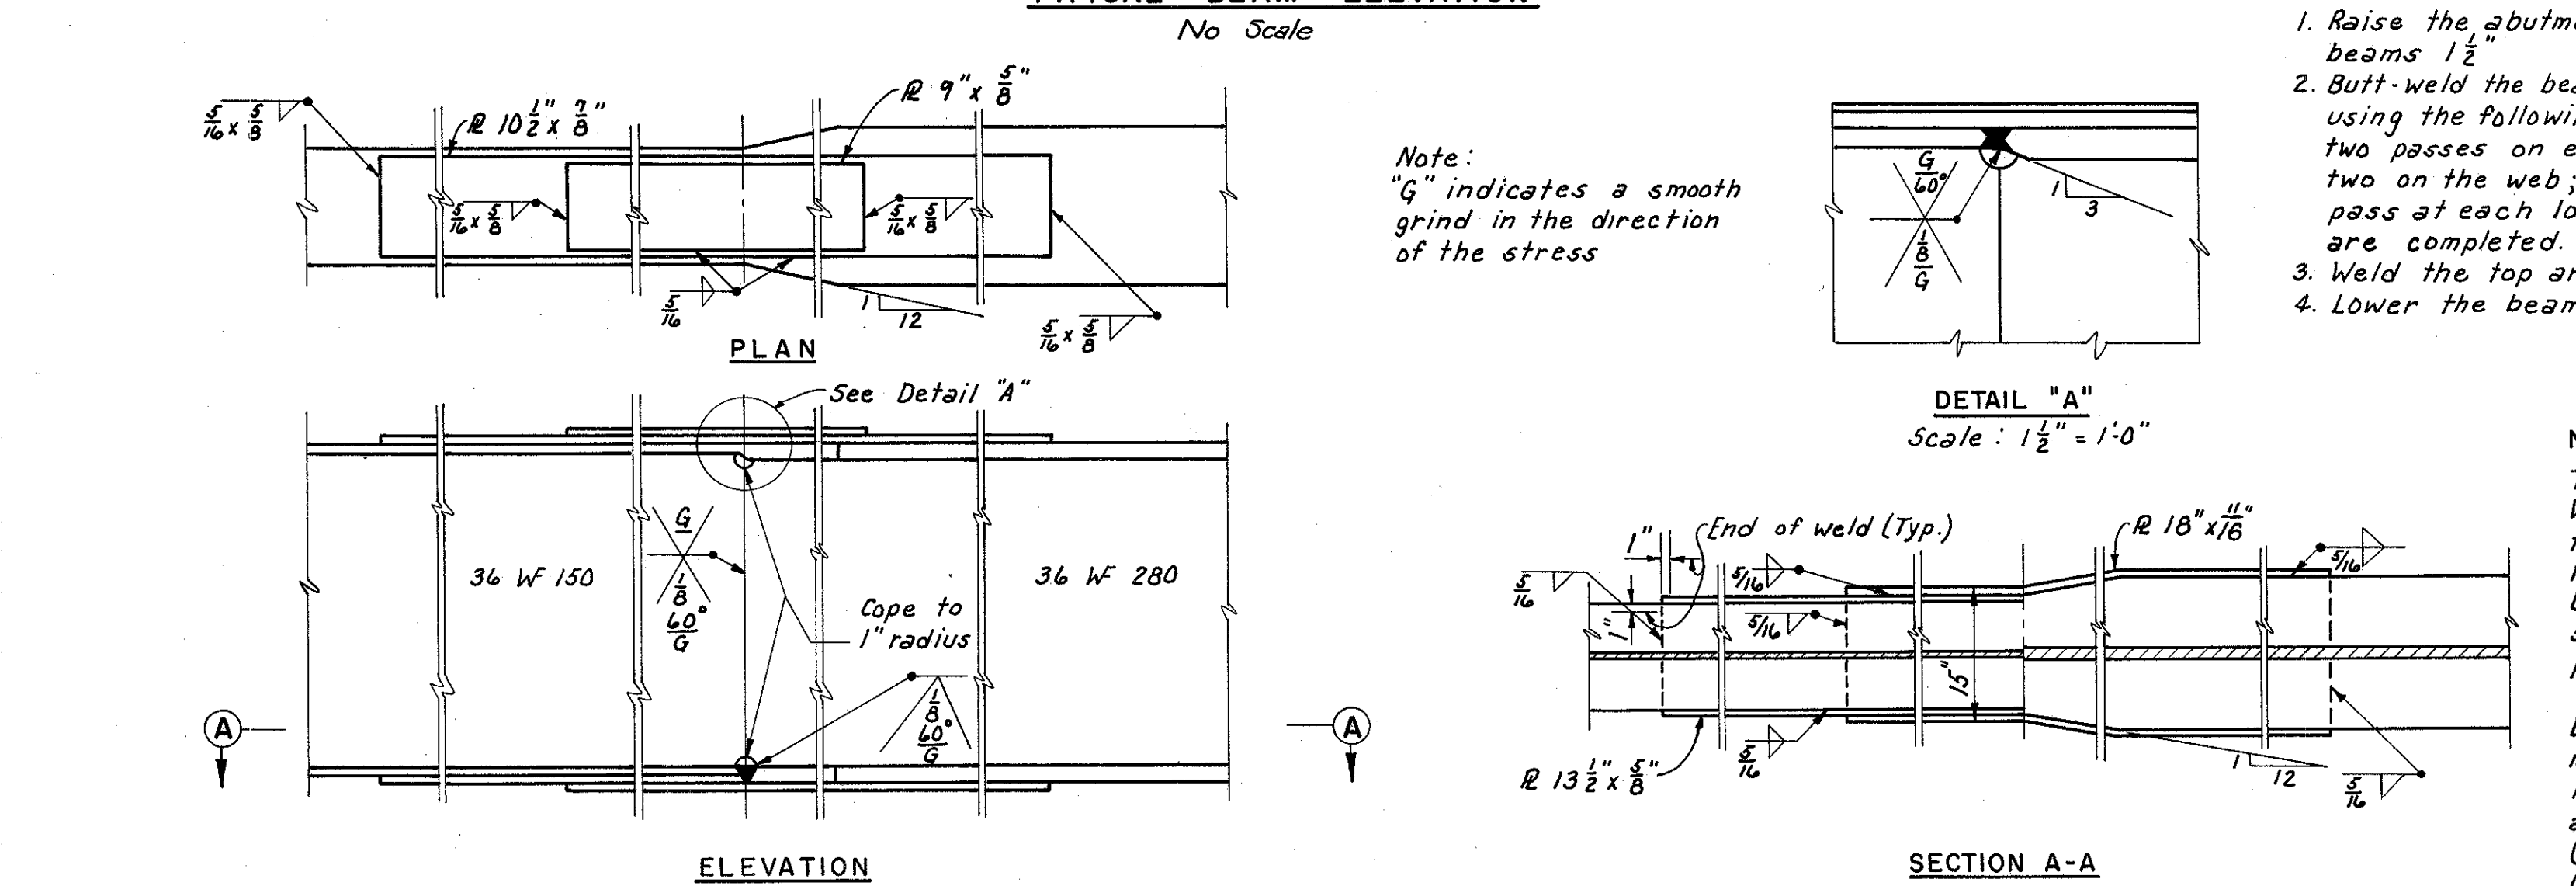


NOTES:
 The beams in Span 2 shall be cambered as follows: Where the sum of the deflections and convexity is 3/8" to 1" the required camber will be 1", and if greater than 1" the required camber will be the same as the sum. Beams in Spans 1 and 3 do not require camber, but shall be fabricated so that any curved beam will be placed with the convex flange up.
 Deflections are given at the quarter points and are measured to the nearest 1/16 inch.
 In Elevation and Deflection Table, the following abbreviations are used:
 (D.L. Defl.) denotes dead load deflections.
 (Tot.) refers to total deflections from dead load of steel and concrete.
 (Con.) denotes deflections due to concrete.

Elevations shown in the "Elevation and Deflection Table" are given at intersection of bearings and beams. Top of beam elevations are exclusive of cover plates.
 Notes:
 For details of end dams see sheet 173-7A
 For cross-frame details see sheet 163-7A
 For drainage details see sheet 174-7A
 For details of rocker masonry plates see sheet 173-7A
 For other rocker and bolster details see Ohio Standard Drawing RB 1-55.
 For details of Underdeck Lighting see sheet 177-7A




H.N.T.B. BR. NO. 10 PART 7A
 HOWARD, NEEDLES, TAMMEN & BERGENOFF
 CONSULTING ENGINEERS
 KANSAS CITY CLEVELAND NEW YORK
FRAMING PLAN
 WILLOW FREEWAY OVER EAST 22nd ST.
 BR. NO. CUY - 21-1559 STA. 42+45.12
 Scale: As noted STA. 44+54.88
WILLOW-INNER BELT FREEWAY
 CLEVELAND CUYAHOGA COUNTY OHIO
 DRAWN P.A. TRACED J.E.K. CHECKED D.R.K. REVIEWED J.C.T. REVISION 12-6-60
 DATE 4-15-59 DATE 10-2-59 DATE 6-25-59 DATE 11-13-59 SHEET 162

JUL 3 1959

Note: Prefix 'S' shall be assigned to all bar marks.

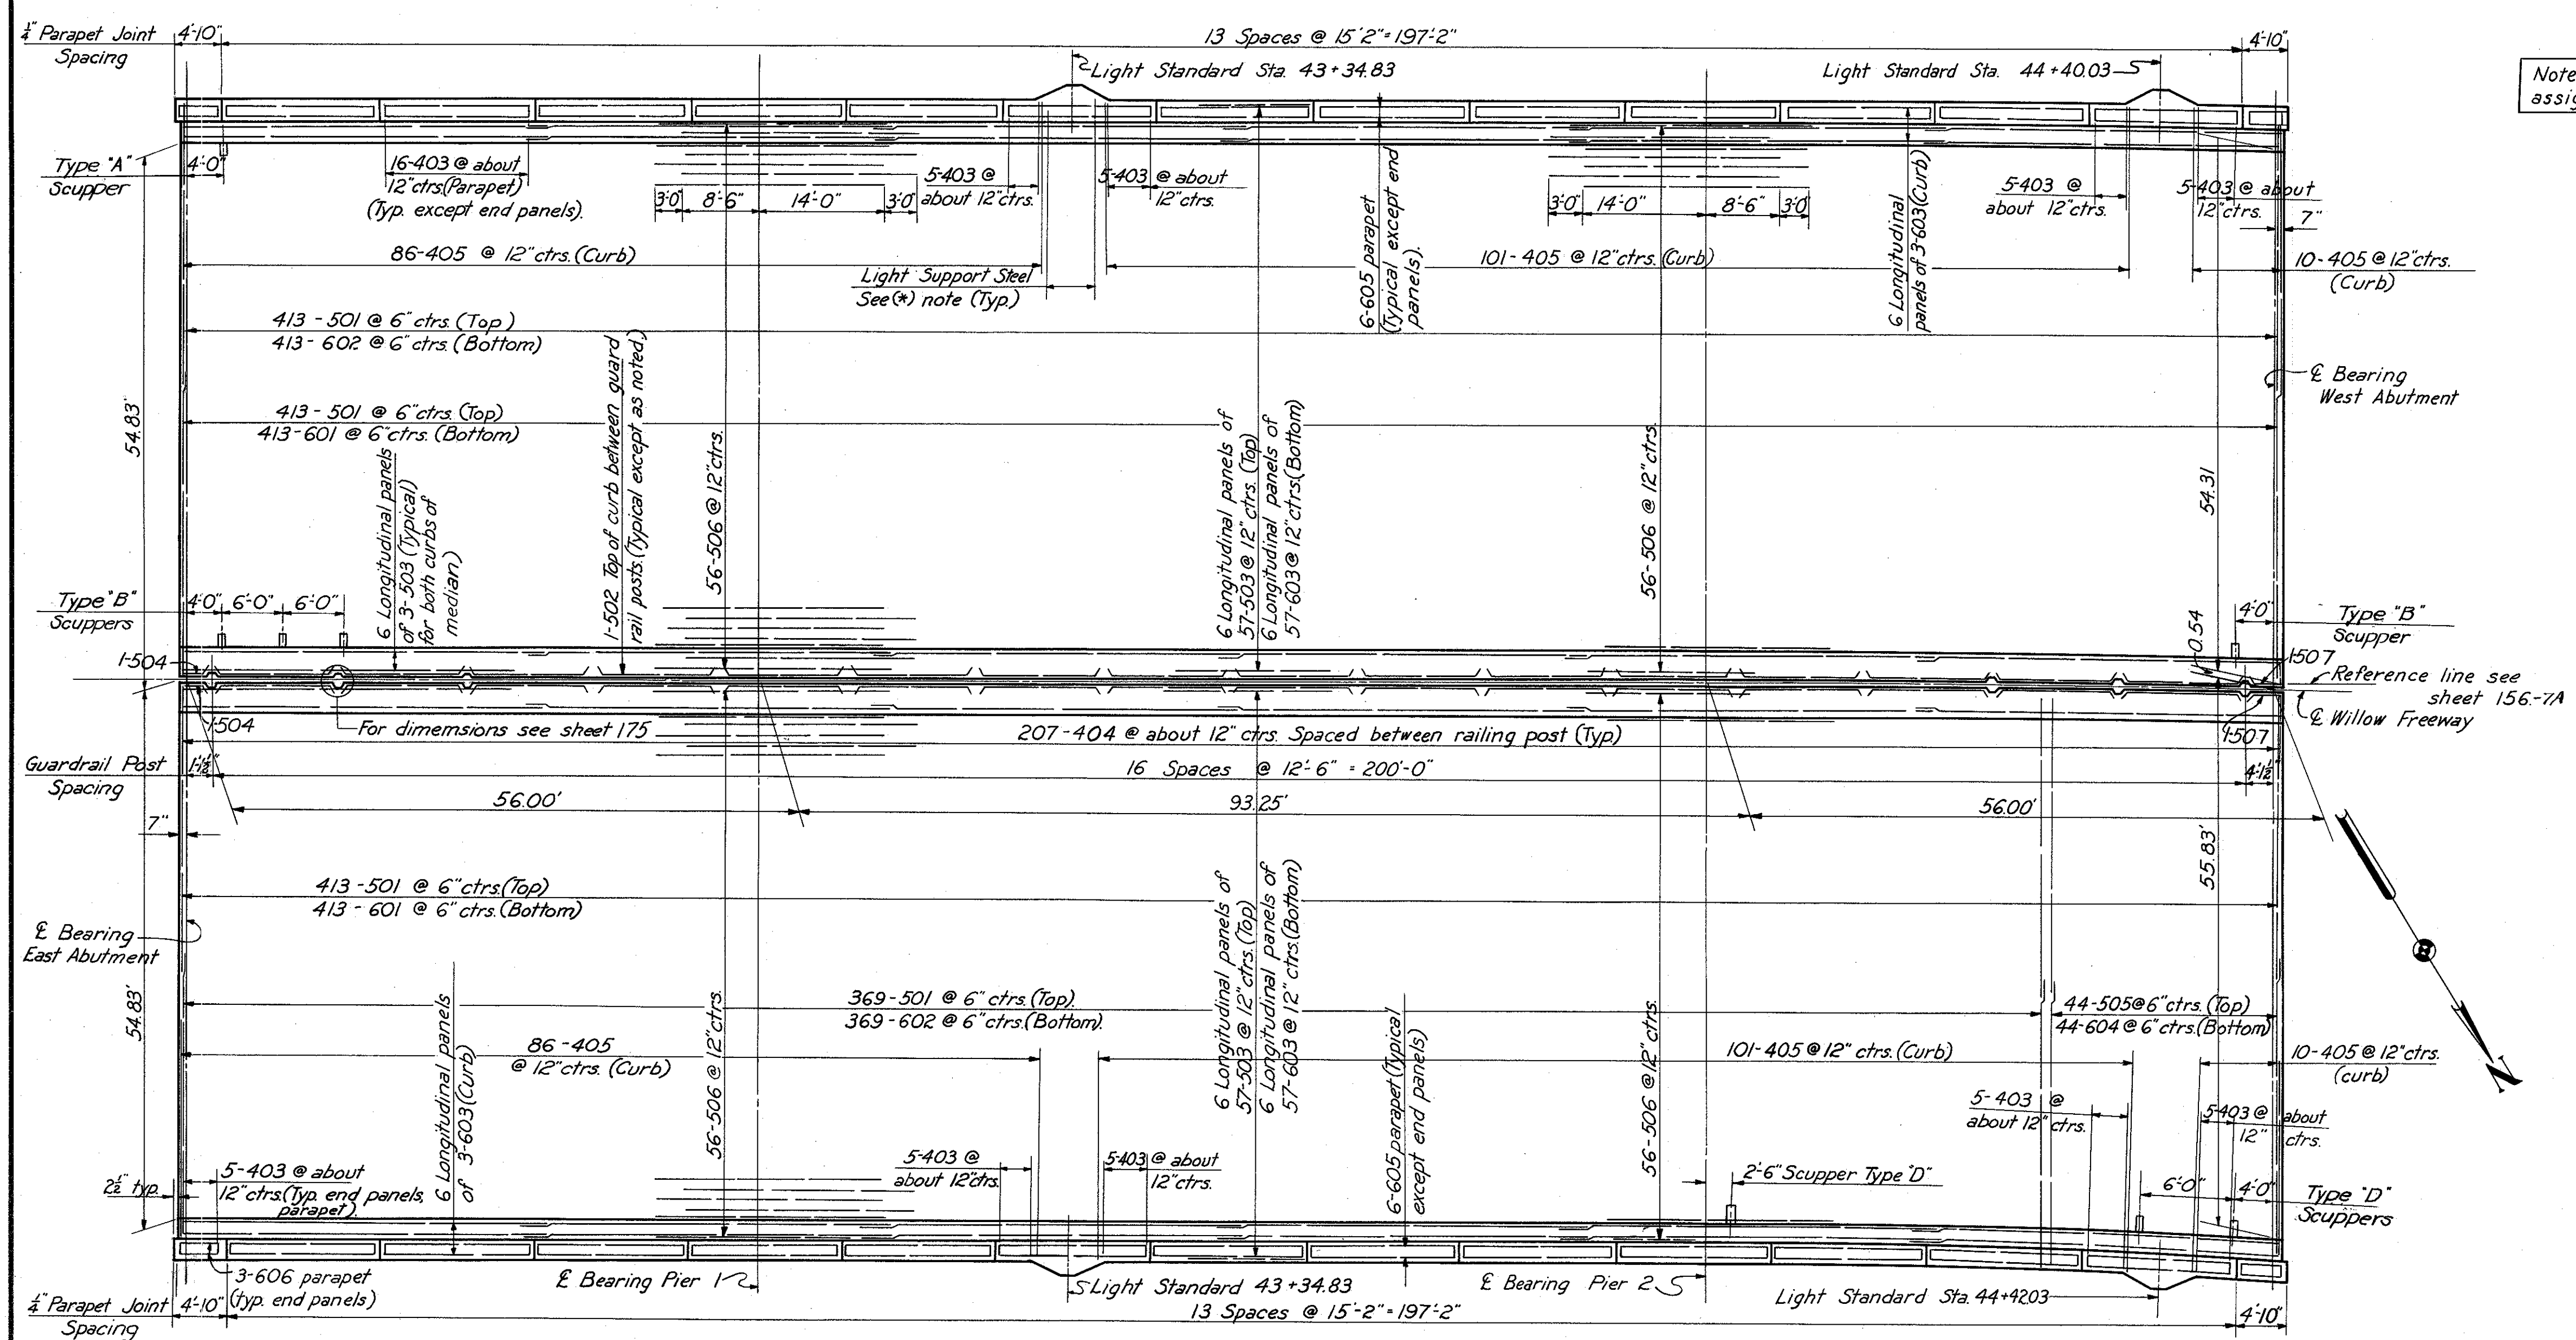


MARK	NUMBER	LENGTH	TYPE	DIMENSIONS				SERIES INCREMENT	WEIGHT (LBS.)
				A	B	C	D		
403	412	4'-5"	105	0'-8"	2'-0"				1,217
404	414	5'-3"	122	2'-6"	1'-0"				1,454
405	394	5'-1"	122	1'-8"	1'-4"				1,340
451*	8	9'-3"	131	2'-6"	3'-0"	1'-2"			48
452*	8	10'-3"	131	3'-0"	3'-0"	1'-8"			56
453*	12	9'-9"	131	3'-2"	3'-0"	1'-0"			80
454*	8	5'-9"	155	2'-2"	1'-6"				32
455*	8	6'-5"	155	2'-8"	1'-6"				36
456*	12	6'-7"	155	2'-10"	1'-6"				52
501	1608	29'-7"	101	29'-0"					49,615
502	32	13'-0"	159	11'-2"	0'-6"	0'-10"			434
503	720	35'-9"	Str.						26,847
504	2	1'-9"	108	0'-10"	0'-6"	0'-10"			4
505	44	30'-10"	101	30'-3"					1,415
506	224	25'-6"	Str.						5,958
507	2	4'-8"	108	3'-8"	0'-6"	0'-10"			10
601	826	27'-9"	Str.						34,428
602	782	30'-9"	Str.						36,118
603	720	36'-0"	Str.						38,932
604	44	32'-0"	Str.						2,115
605*	156	14'-9"	Str.						
606*	24	4'-6"	Str.						
651*	8	9'-5"	141	2'-11"	1'-10"				112
652*	12	14'-6"	141	5'-3"	3'-0"				260
653*	4	5'-0"	Str.						32
Total									200,595

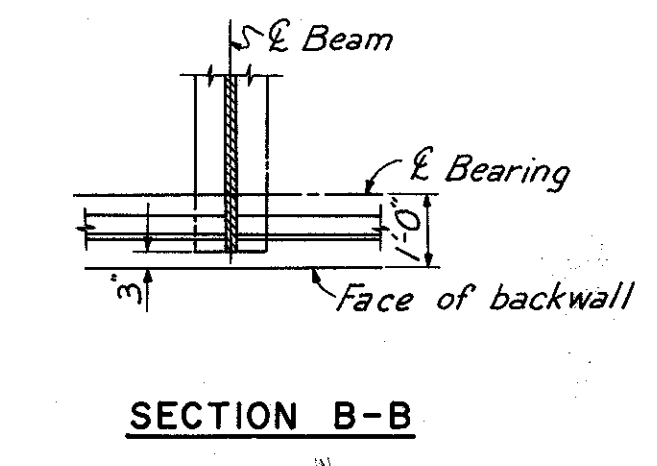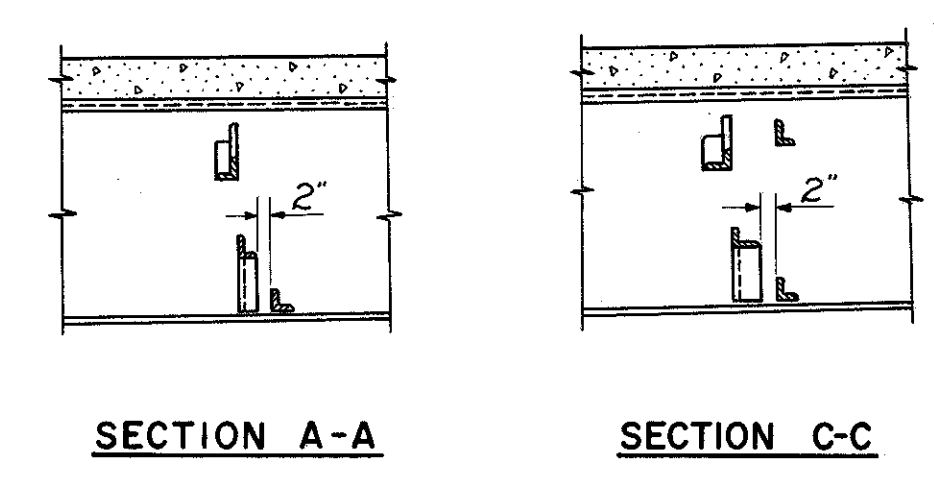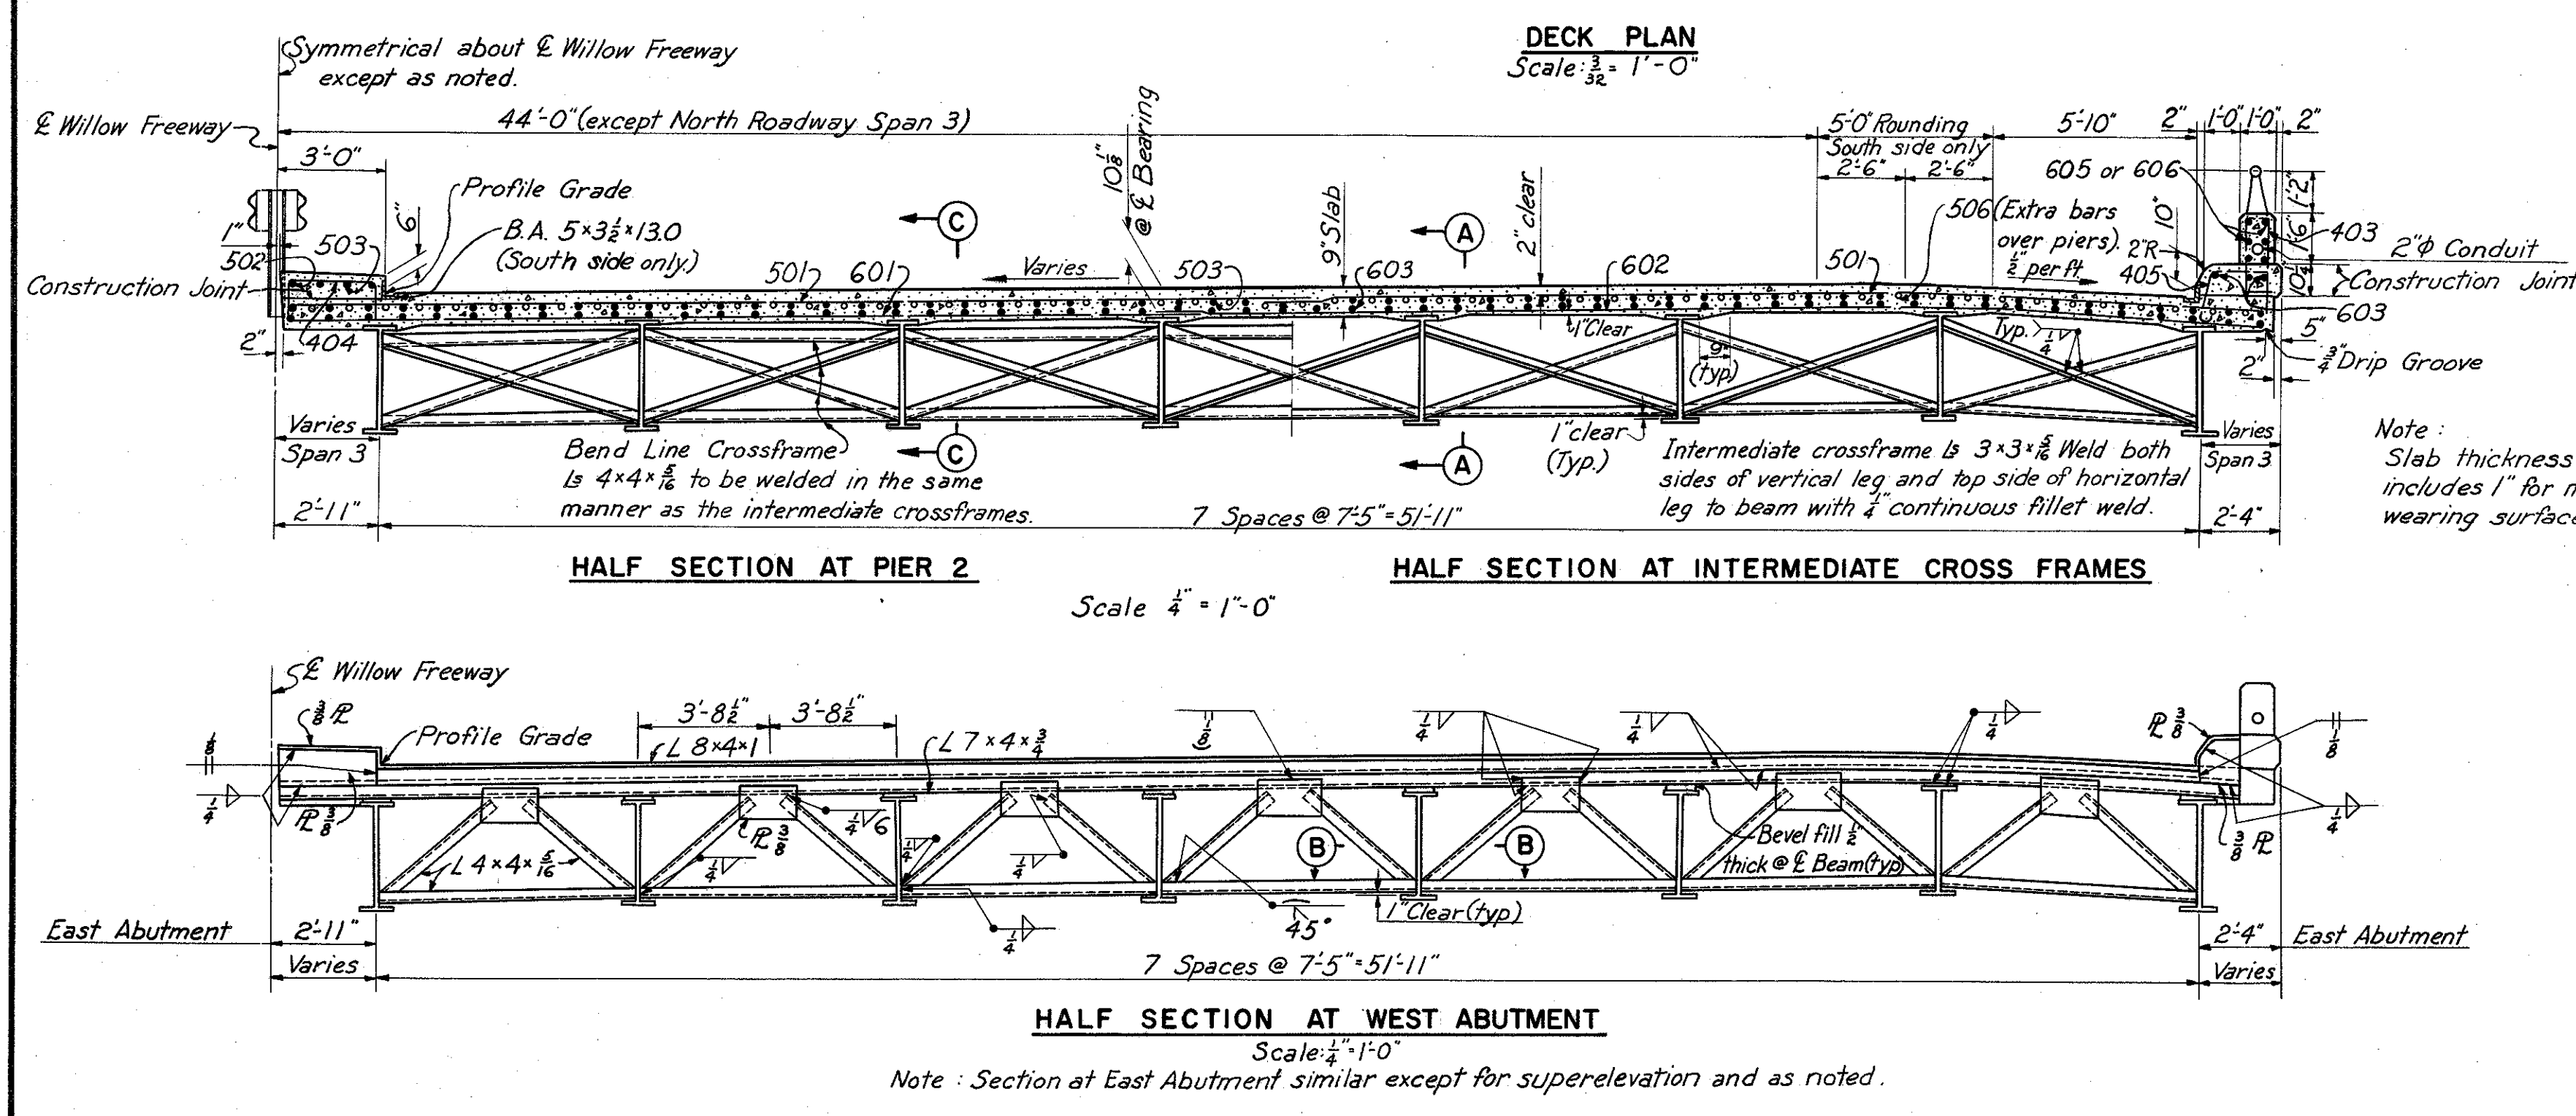

NOTES:
 *Bars 451 thru 456 and 651 thru 653 are for the light standard supports. For their bar bending diagrams and placement see sheet 176-7A
 *Bars 605 and 606 are included for payment with "Item S-14, Railing".
 All bar dimensions are given out to out. For replacement schedule see sheet 103-7A for light standard and other lighting details see sheets 176-7A & 177-7A
 For railing details see sheet 175-7A
 For expansion dam details see sheet 173-7A
 For parapet joint details see sheet 175-7A
 For drainage details see sheet 174-7A
 In order to facilitate water curing of the concrete of the deck slab, the placing of concrete shall progress up-grade. The slab may be placed in sections, between transverse construction joints which are parallel to the transverse bars in the slab and are located near the center of any span.
 For bar bending diagram, see sheet 170-7A

H.N.T.B. BR. NO. 10 PART 7A
 HOWARD, NEEDLES, TAMMEN & BERGENDOFF CONSULTING ENGINEERS KANSAS CITY CLEVELAND NEW YORK
DECK PLAN
 WILLOW FREEWAY OVER EAST 22nd ST.
 BR. NO. CUY-21-1559 STA. 42+45.12
 Scale: As noted STA. 44+54.88
WILLOW-INNER BELT FREEWAY
 CLEVELAND CUYAHOGA COUNTY OHIO
 DRAWN R.A. TRACED R/R CHECKED C.A.B. REVIEWED J.C.T. REVISIONS
 DATE 6/17/59 DATE 5/6/59 DATE 6-28-59 DATE 11-13-59
 SHEET 163

CUYAHOGA COUNTY
CITY OF CLEVELAND
CUY-21-15.32
CUY-42-18.42

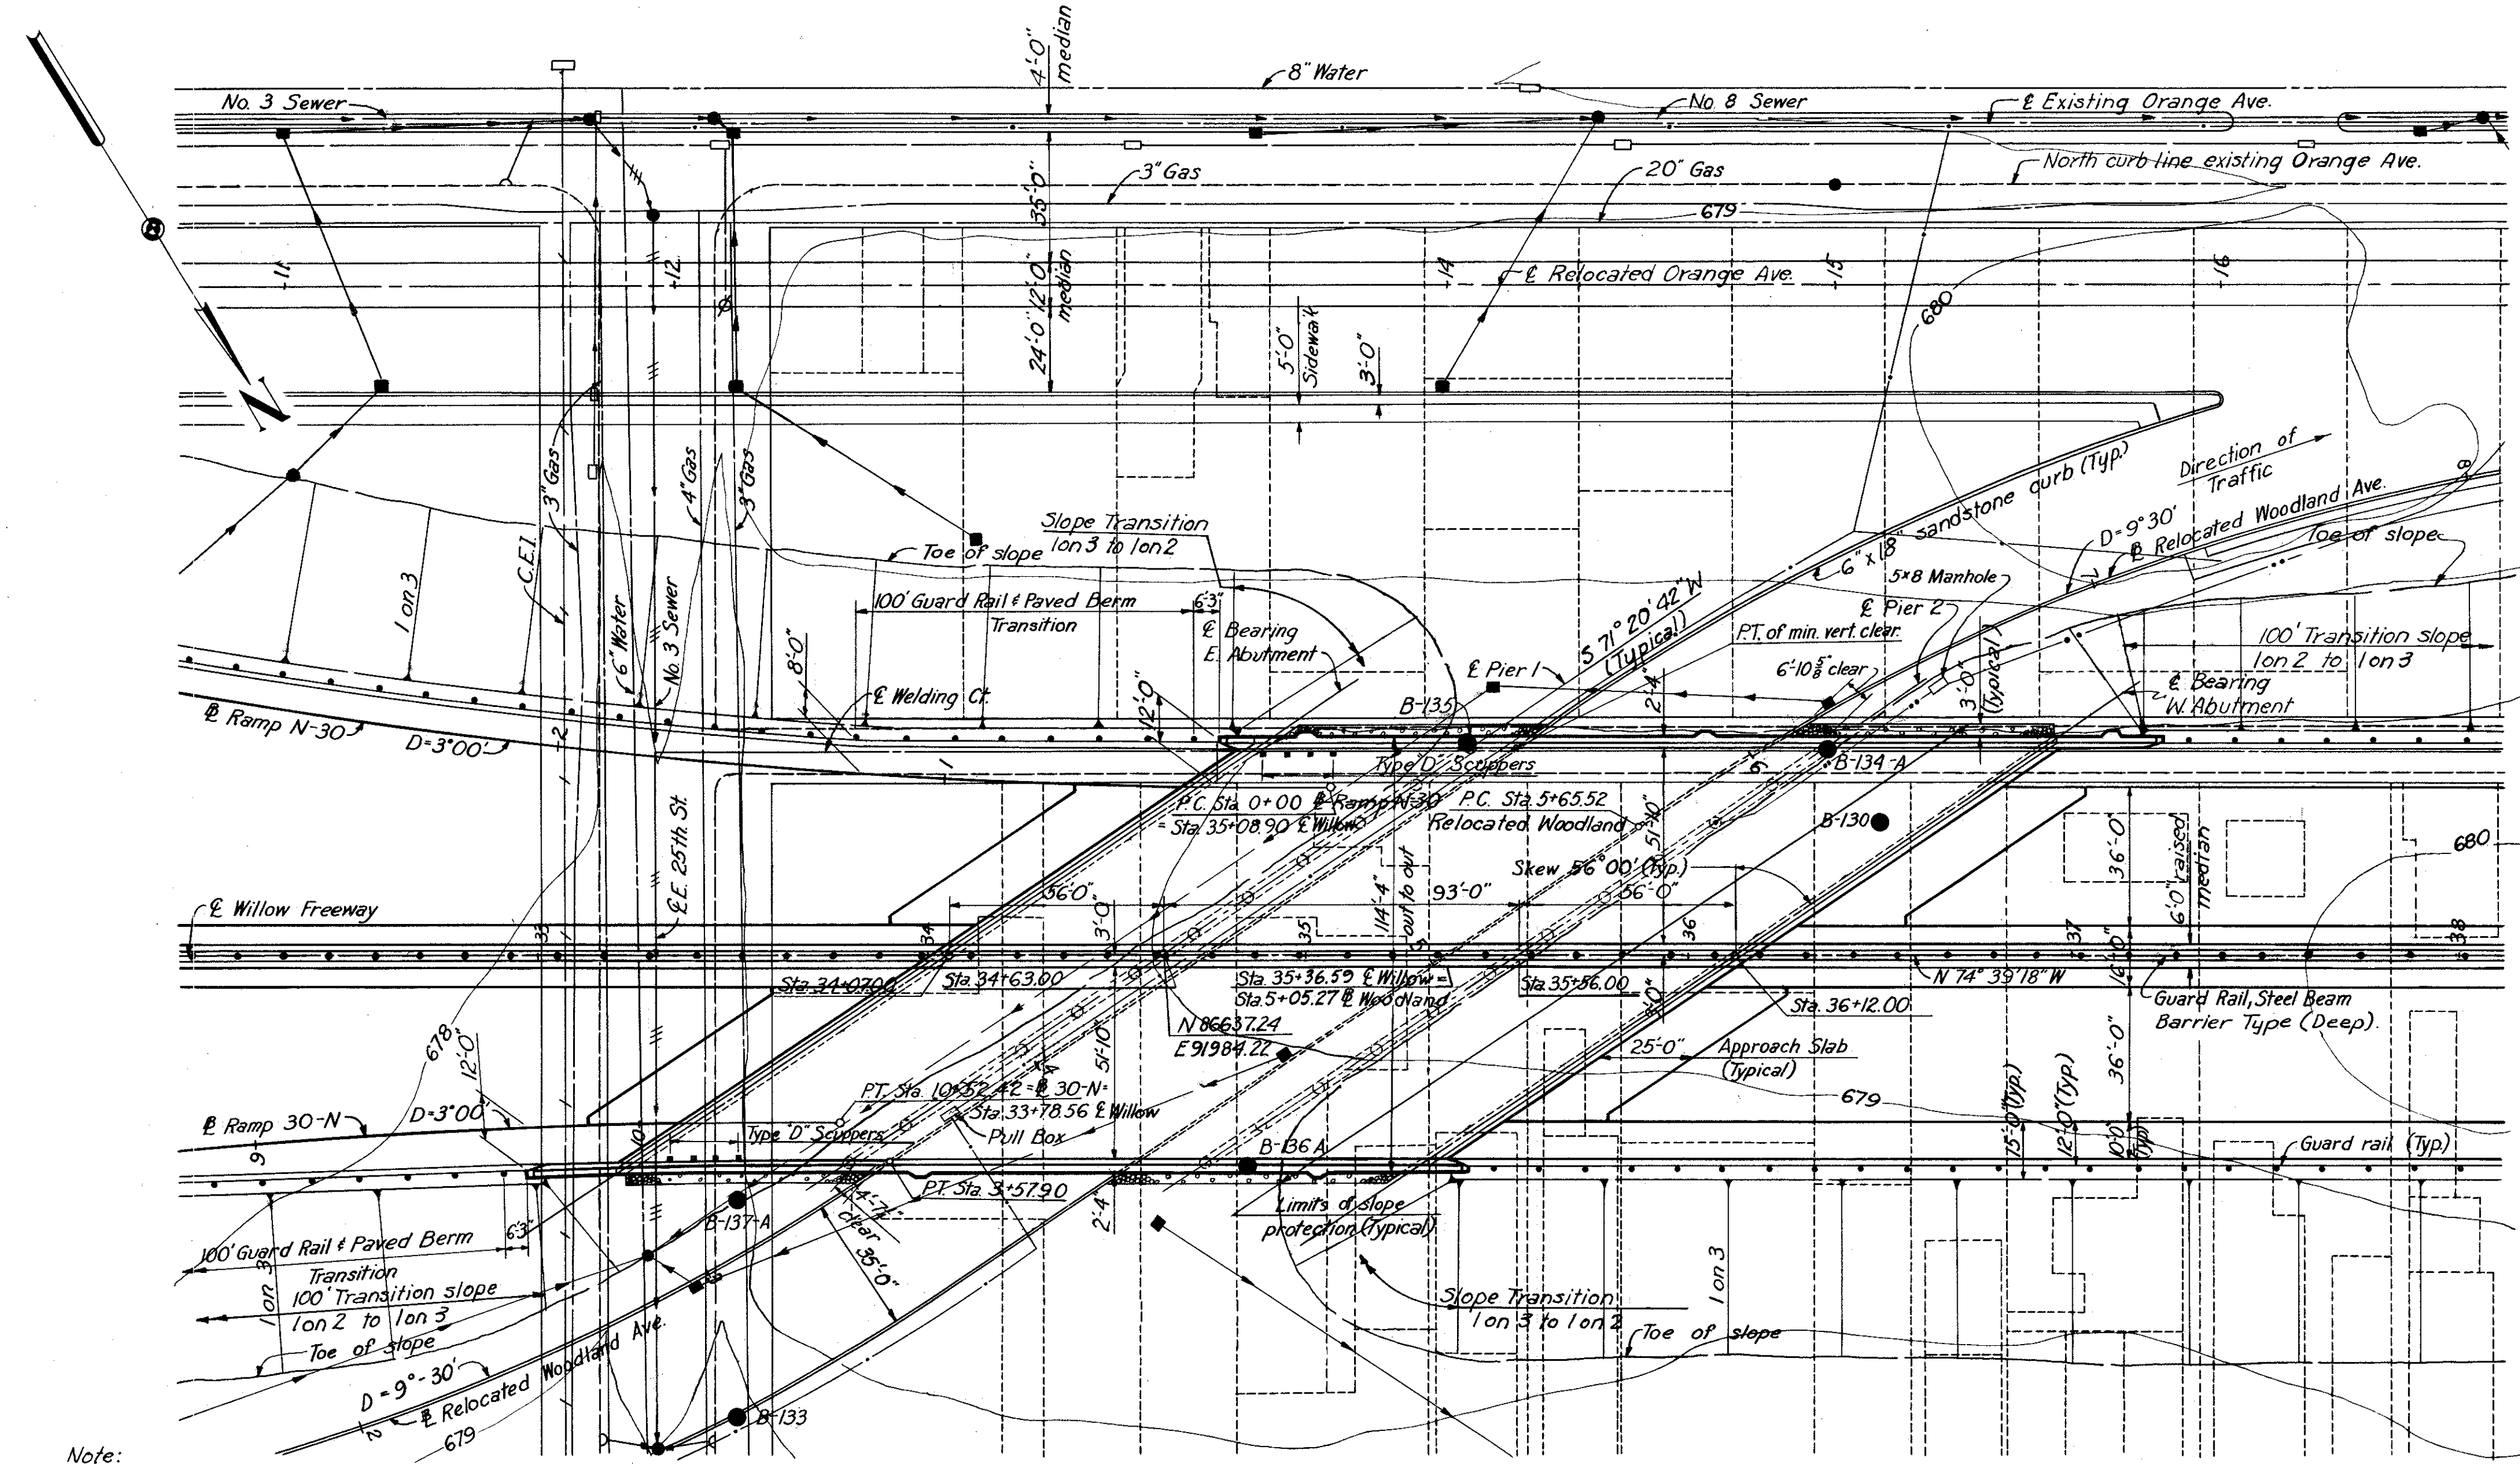

Elev 678.3

19	673.3	Brown Silty Gravelly Sand
10		
11	663.3	Brown Gravelly Sand
12	658.3	Brown Sand
15	653.3	Brown Silty Sand
36	648.3	Gray Silty Sand
11		
15	638.3	Gray Silt
32	633.3	Gray Gravelly Sand
51	628.3	Gray Sandy Silt
48		
47		
9		
20		
60		
26	598.3	Gray Silt

BORING B-134 A
Vertical Scale: 1"=20'
Sta. 36+36 55Lt.

Elev 676.5

5	671.5	Brown Sand
8	666.5	Brown Silty Gravelly Sand
11		
17	656.5	Brown Silty Sand
16		
14		
18	641.5	Gray Silt
36	636.5	Brown Gravelly Sandy Silt
57	631.5	Gray Sandy Gravelly Silt
67		
19		
40		
14		
70		
601.5		Gray Silt

BORING B-137 A
Vertical Scale: 1"=20'
Sta. 33+52 65Rt.

Note:
The figures to the left indicates the number of hammer blows required to drive the sample spoon 1ft. They are given at 5' intervals starting at Elev. 678.3 and Elev. 676.5.

CURVE DATA

RAMP N-30	RAMP 30-N	REL. WOODLAND AVE.	REL. WOODLAND AVE.
$\Delta=11^{\circ}00'00''$	$\Delta=7^{\circ}42'07''$	$\Delta=34^{\circ}00'00''$	$\Delta=33^{\circ}59'37''$
$D=3^{\circ}00'$	$D=3^{\circ}00'$	$D=9^{\circ}30'$	$D=9^{\circ}30'$
$R=1909.86'$	$R=1909.86'$	$R=603.11'$	$R=603.11'$
$T=183.90'$	$T=184.35'$	$T=184.39'$	$T=184.35'$
$L=366.67'$	$L=256.73'$	$L=357.90'$	$L=357.83'$


PROPOSED STRUCTURE

Type: Continuous steel beam with reinforced concrete deck and substructure.
Spans: 56'-0", 93'-0" & 56'-0"
Roadway: 112'-0" (normal) 1/1' parapets.
Loading: CF 2000 - Adequate for A.A.S.H.O. alternate loading.
Surface Course: 1" Monolithic Concrete.
Alignment: Tangent.
Approach Slabs: AS-1-54. (25' long).
Superelevation: None.
Skew: 56° 00'.

NOTES:

Rod soundings only were taken at location B-130, B-133, B-135 A & B-136 A. The core drillings made at B-134 A & B-137 A are plotted.
For details of slope protection see sheet 174-7A.
Foundation design and foundation quantities are based on a study of these borings.
The following items are not included in the Bridge Plans. See Roadway Plans for details.
Approach grading, pavement and slabs.
Roadway guard rail.
For details of pier plans & drain pipe locations at piers see sheets 172-7A & 174-7A.


LEGEND

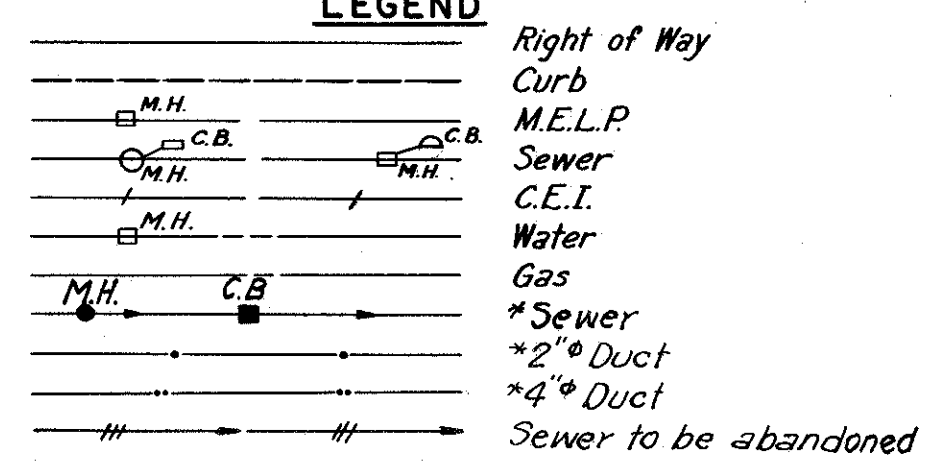


* Drill under previous contract.

PLAN

PROFILE

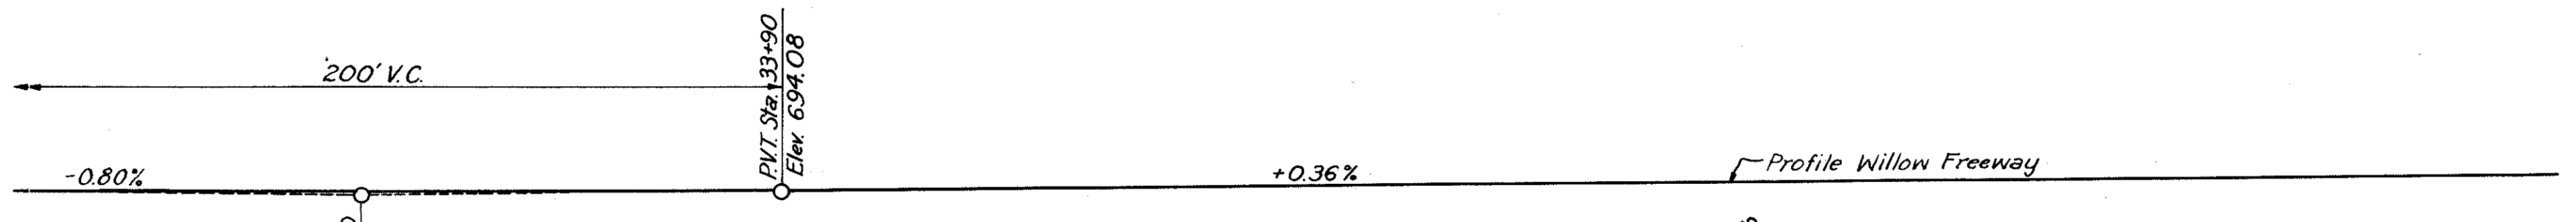

ELEVATION

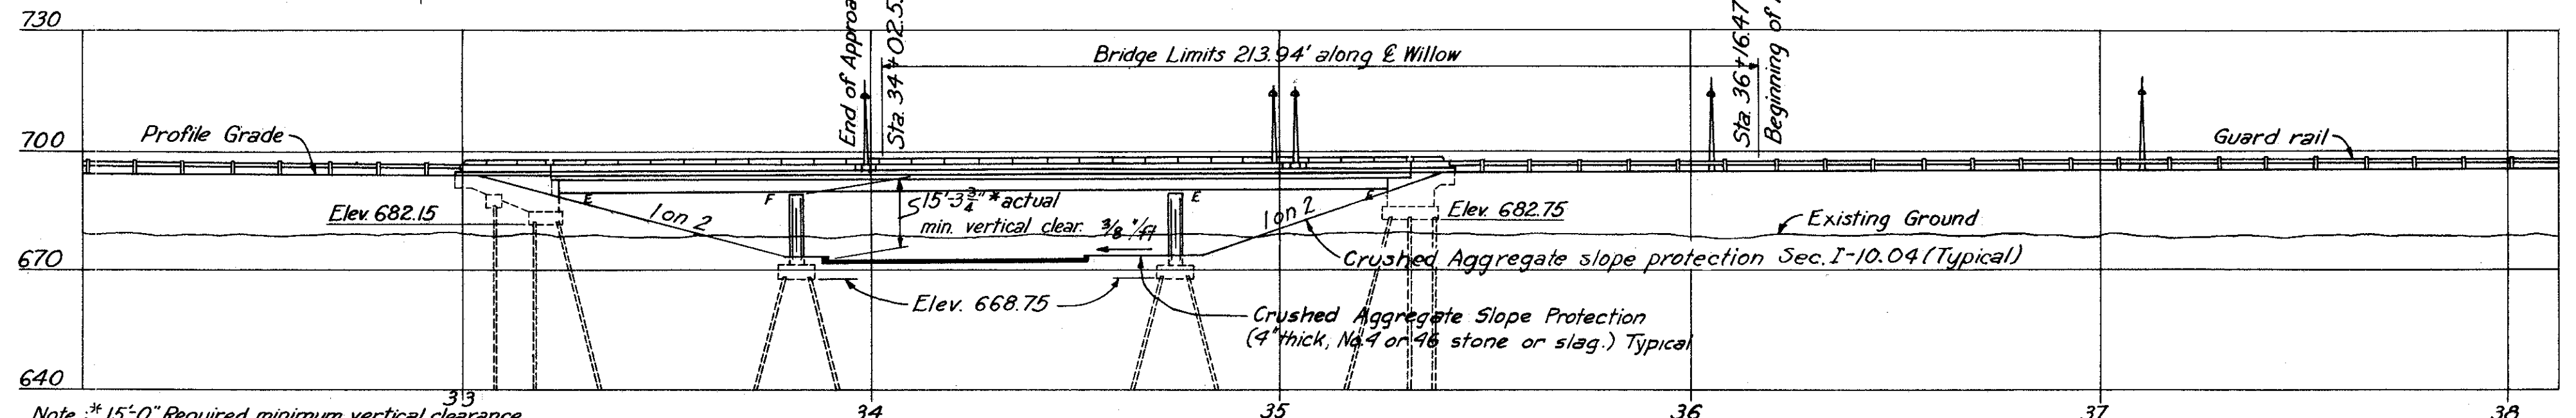

Note:
Relocated Woodland Ave. shifts from left to right at Sta. 3+75.

Note: *15'-0" Required minimum vertical clearance. Point of actual minimum vertical clearance occurs at the South exterior beam and the East curb line of Relocated Woodland Ave.

Note:
Piers for Bridge No. 11 are included in Part 6.

H.N.T.B. BR. NO. 11 PART 7A

HOWARD, NEEDLES, TAMMEN & BERGENDOFF
CONSULTING ENGINEERS
KANSAS CITY CLEVELAND NEW YORK

SITE PLAN

WILLOW FREEWAY OVER REL. WOODLAND AVE.
BR. NO. CUY-21-1544 STA. 34+02.53
Scale: 1"=30' STA. 36+16.47

WILLOW-INNER BELT FREEWAY

CLEVELAND CUYAHOGA COUNTY OHIO



DRAWN A.J.S. TRACED R.W.K. CHECKED J.C.T. REVISIONS
DATE 11-24-58 DATE 12-30-58 DATE 12-11-58 DATE 11-13-59

SHEET 164




REVISIONS
JUL 3 1955

CUYAHOGA COUNTY
CITY OF CLEVELAND
CUY-21-15.32
CUY-42-18.42

Note: Prefix "A" shall be assigned to all bar marks.

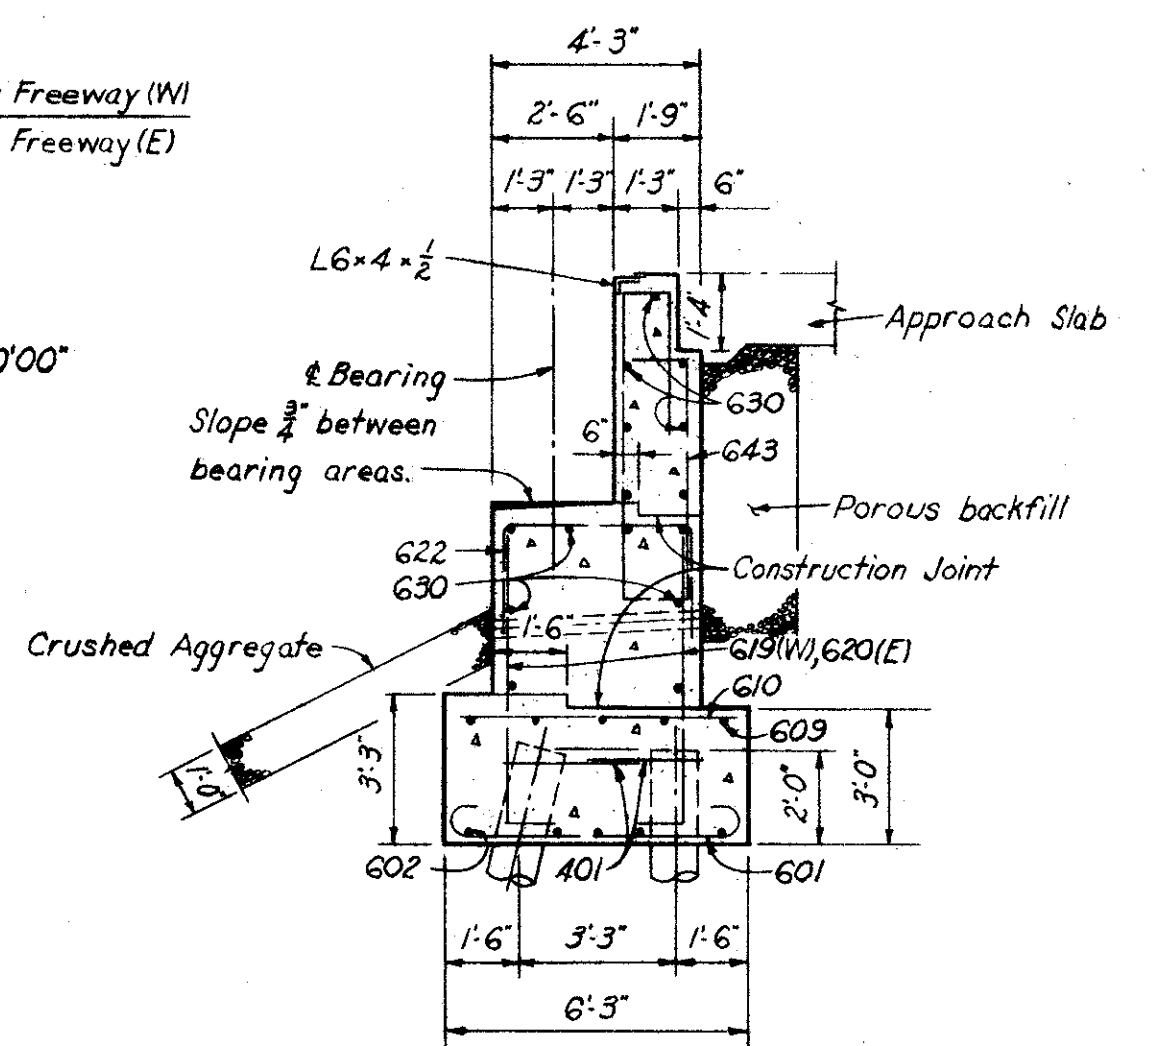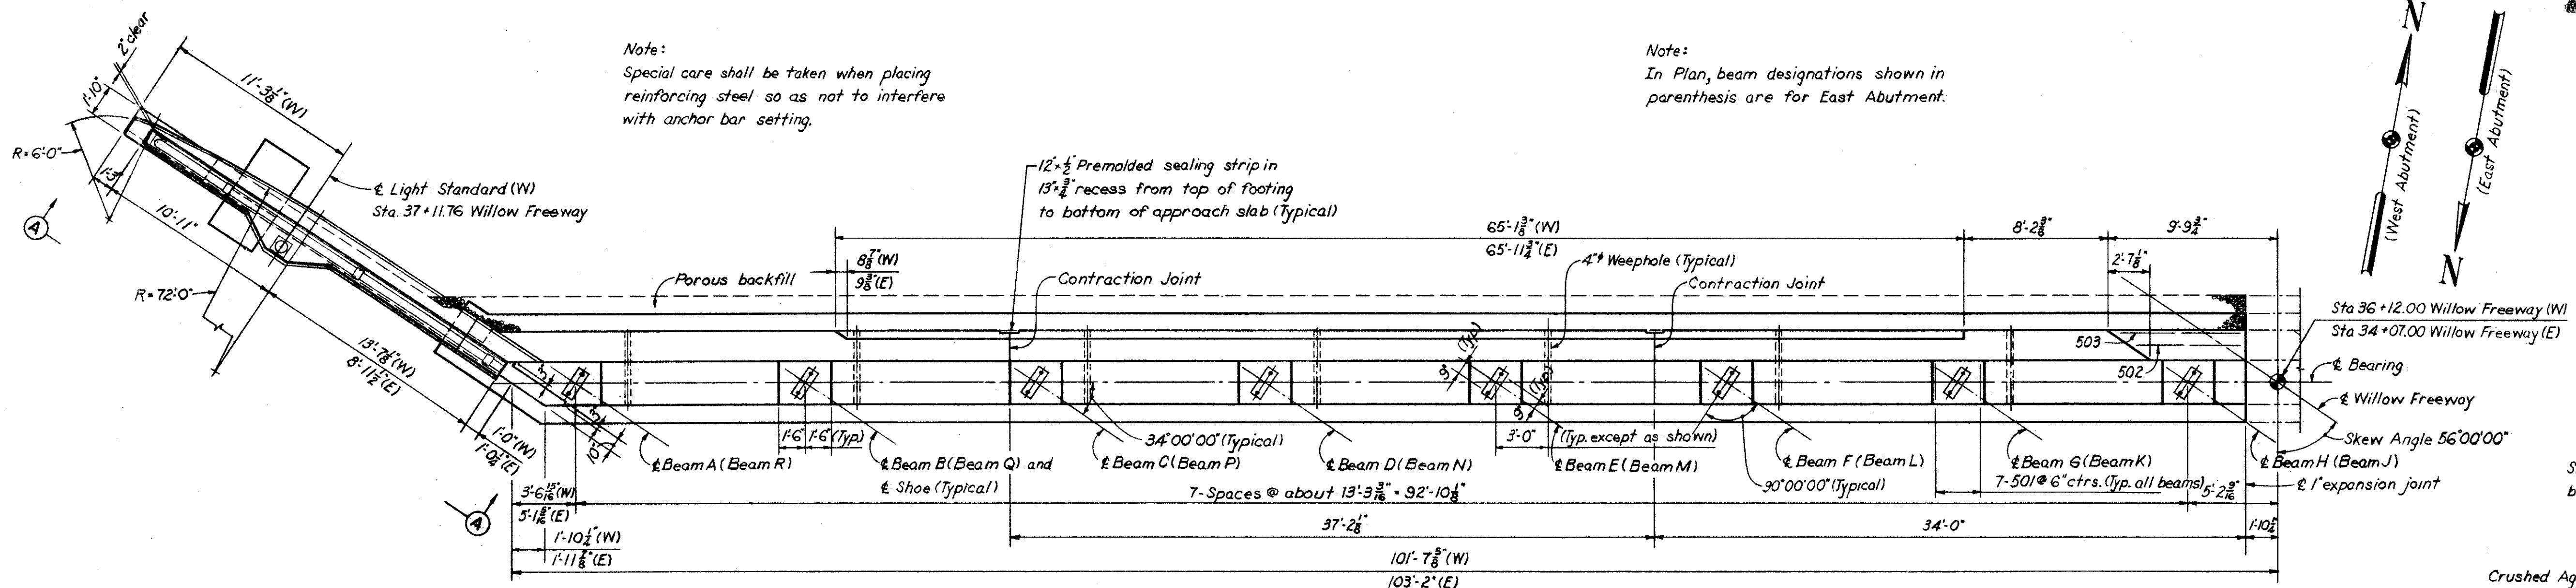

Note: Elevations along backwall are given to back of 6x4 1/2 angle.

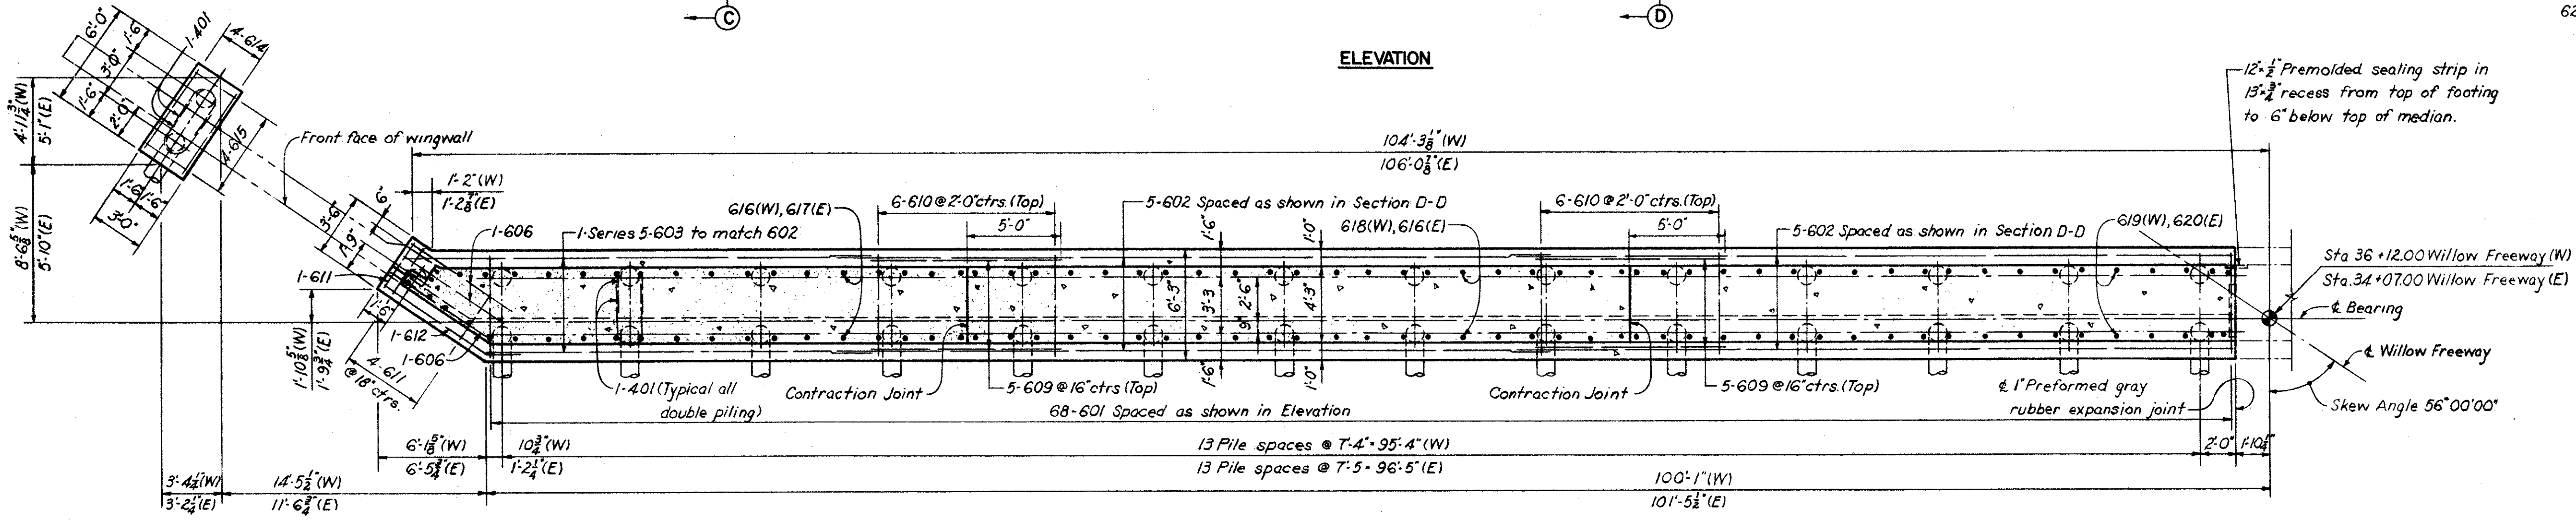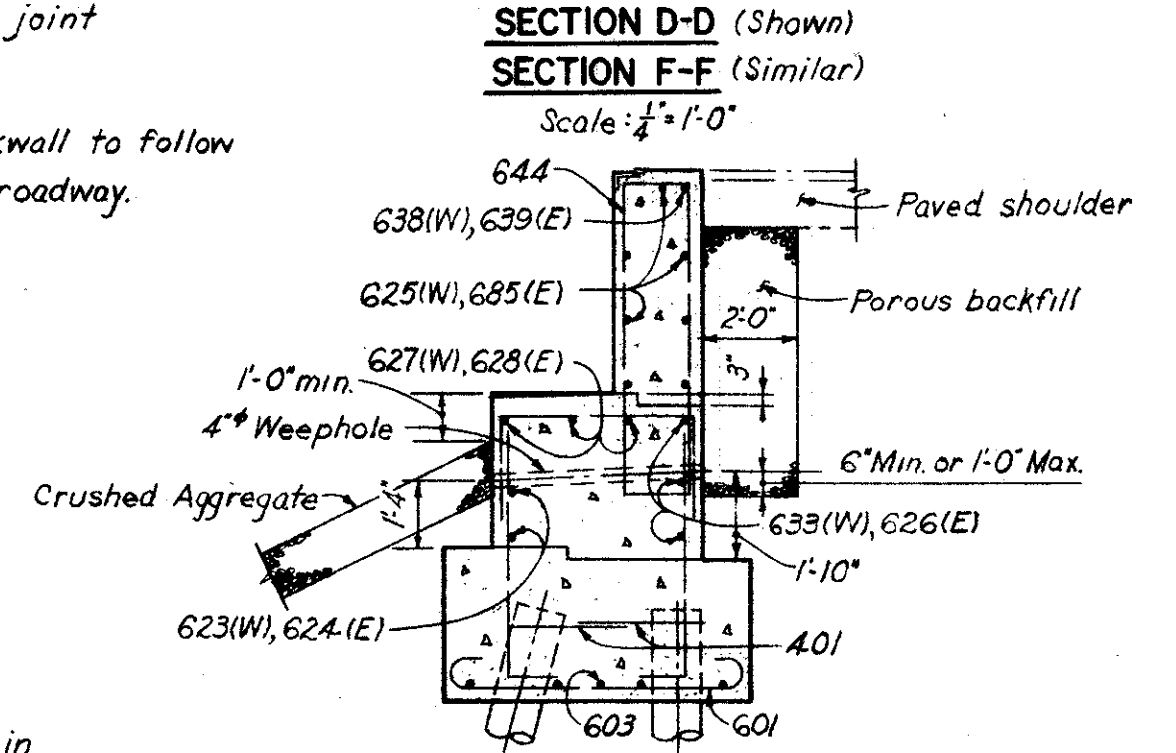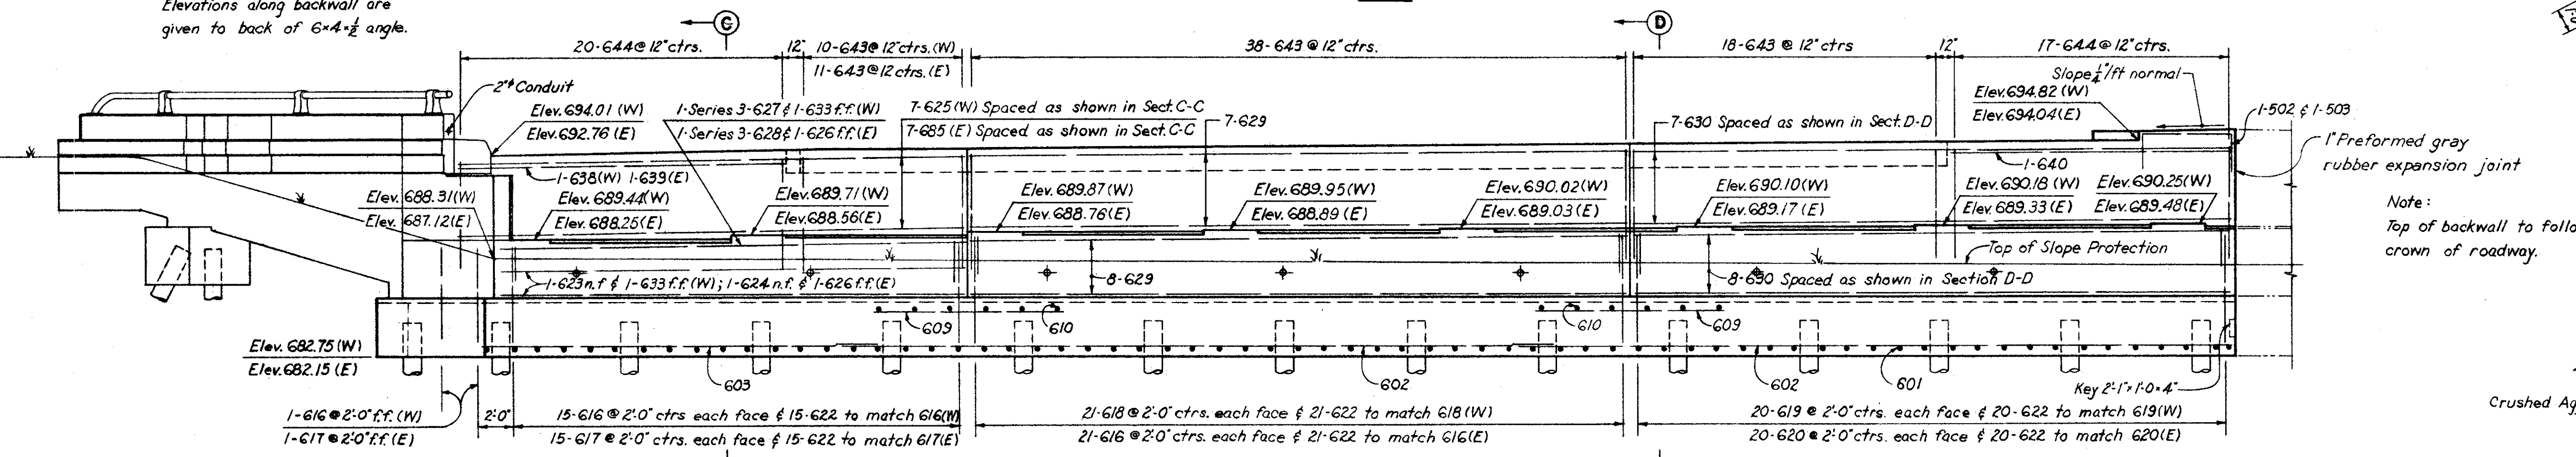

NOTES:

- All piles shall be 12" C.I.P. Reinforced Concrete.
- All battered piles shall be battered 3 in 12 in direction shown.
- For details of end dam see sheet 173-7A
- For details of masonry plates see sh. 173-7A
- For Reinforcement schedule see sheet 168-7A
- For Railing details and Guard Rail connection details see sheet 175-7A
- Reinforcement bars shall be 3 inches clear from bottom of footing and 2 inches elsewhere.
- Top of parapet and safety curb construction joints are to be parallel to roadway grade.
- Pile spacings given along bottom of footing.
- For additional notes and sections see sheet 167-7A

Note: Dimensions and reinforcement are the same for both abutments except where noted as follows:
(W) denotes West Abutment
(E) denotes East Abutment

H.N.T.B. BR. NO. 11 PART 7A

HOWARD, NEEDLES, TAMMEN & BERGENDOFF
CONSULTING ENGINEERS
KANSAS CITY CLEVELAND NEW YORK

ABUTMENTS

WILLOW FREEWAY OVER REL. WOODLAND AVE.
BR. NO. CUY-21-1544 STA. 34+02.53
Scale: 3/16" = 1'-0" Except as noted
STA. 36+16.47

WILLOW-INNER BELT FREEWAY
CLEVELAND CUYAHOGA COUNTY OHIO

DRAWN T/P	TRACED	CHECKED S/J	REVIEWED C/T
DATE 12/29/54	DATE	DATE 1-10-55	DATE 1-13-55

SHEET 165

NOT RECORDED
JUL 3 1965

FED. ROADS DIV. NO.	STATE	FED. AID PROJ. NO.
2	OHIO	


166
181

CUYAHOGA COUNTY
CITY OF CLEVELAND
CUY-21-15.32
CUY-42-18.42

Note:
Special care shall be taken when placing reinforcing steel so as not to interfere with anchor bar setting.


12" x 1/2" Premolded sealing strip in 13" x 3/4" recess from top of footing to bottom of approach slab. (Typical)

Note:
In Plan, beam designations shown in parenthesis are for East Abutment.

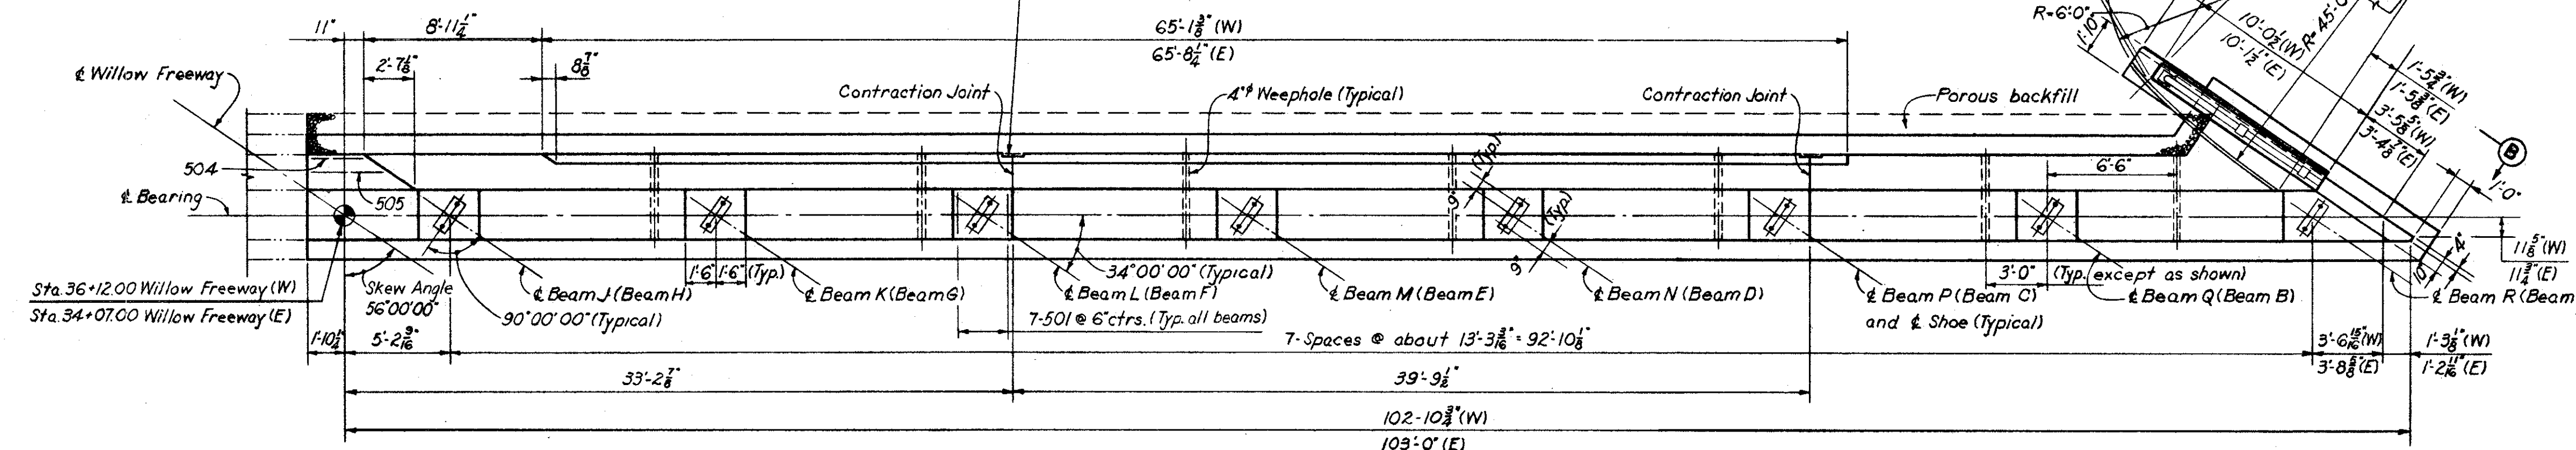

PLAN


Note:
Elevations along backwall are given to back of 6'-4-1/2" angle.

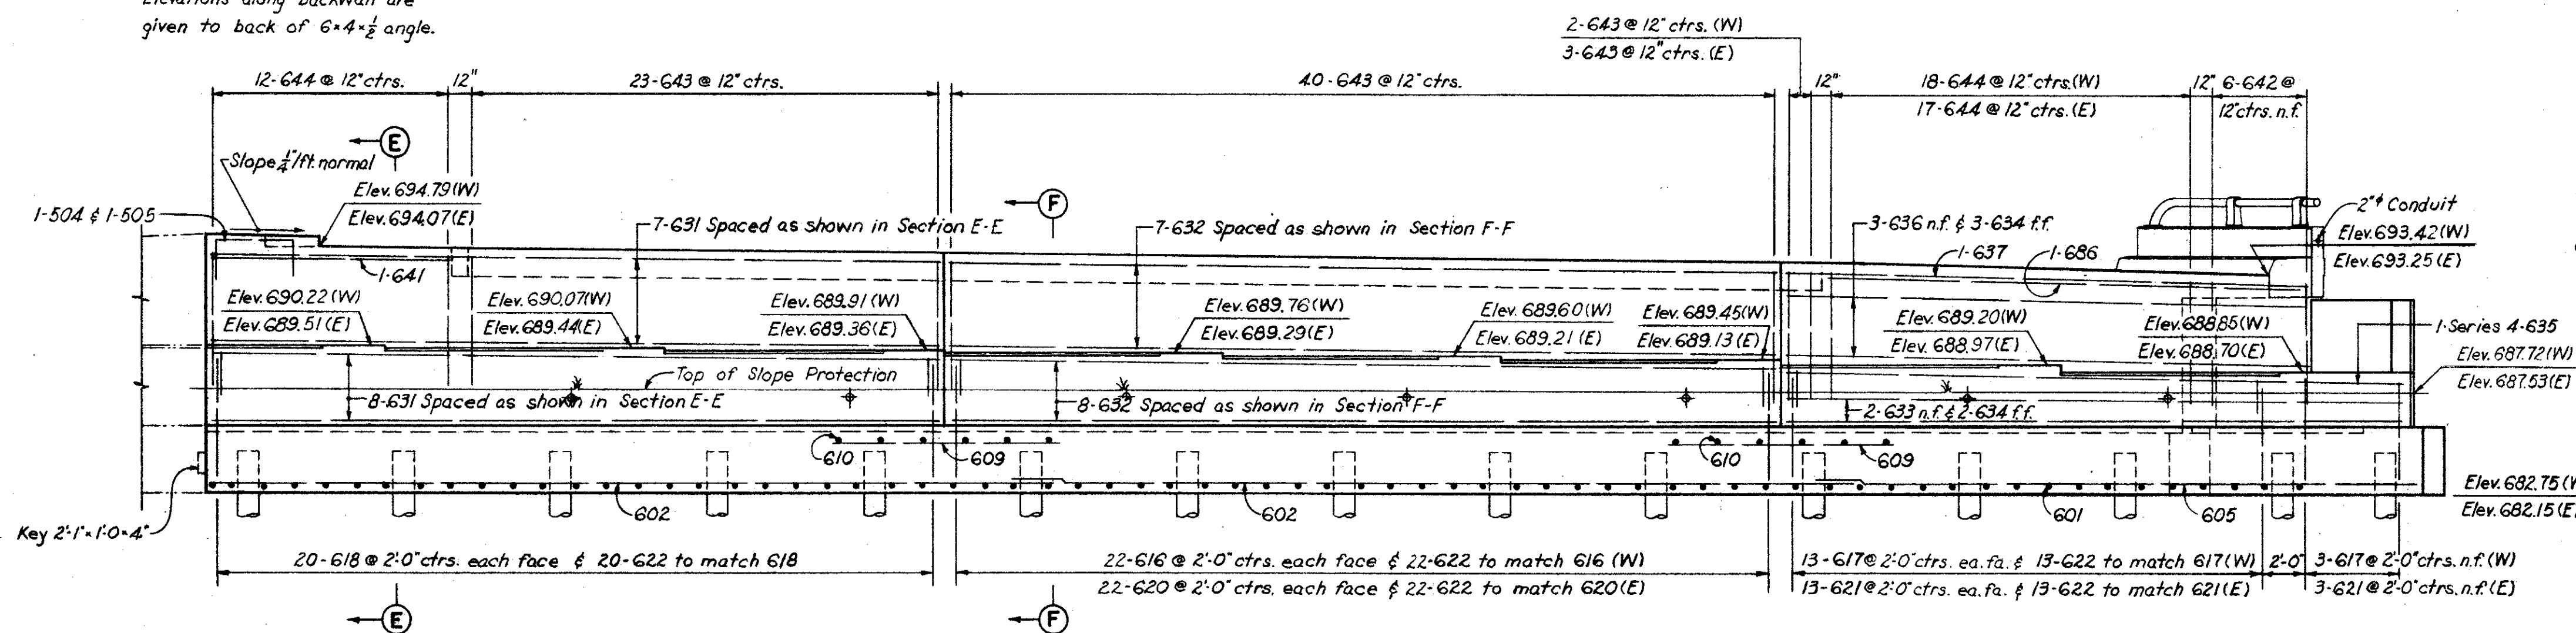

ELEVATION

Note:
Top of backwall to follow crown of roadway.

Note: Prefix "A" shall be assigned to all bar marks.

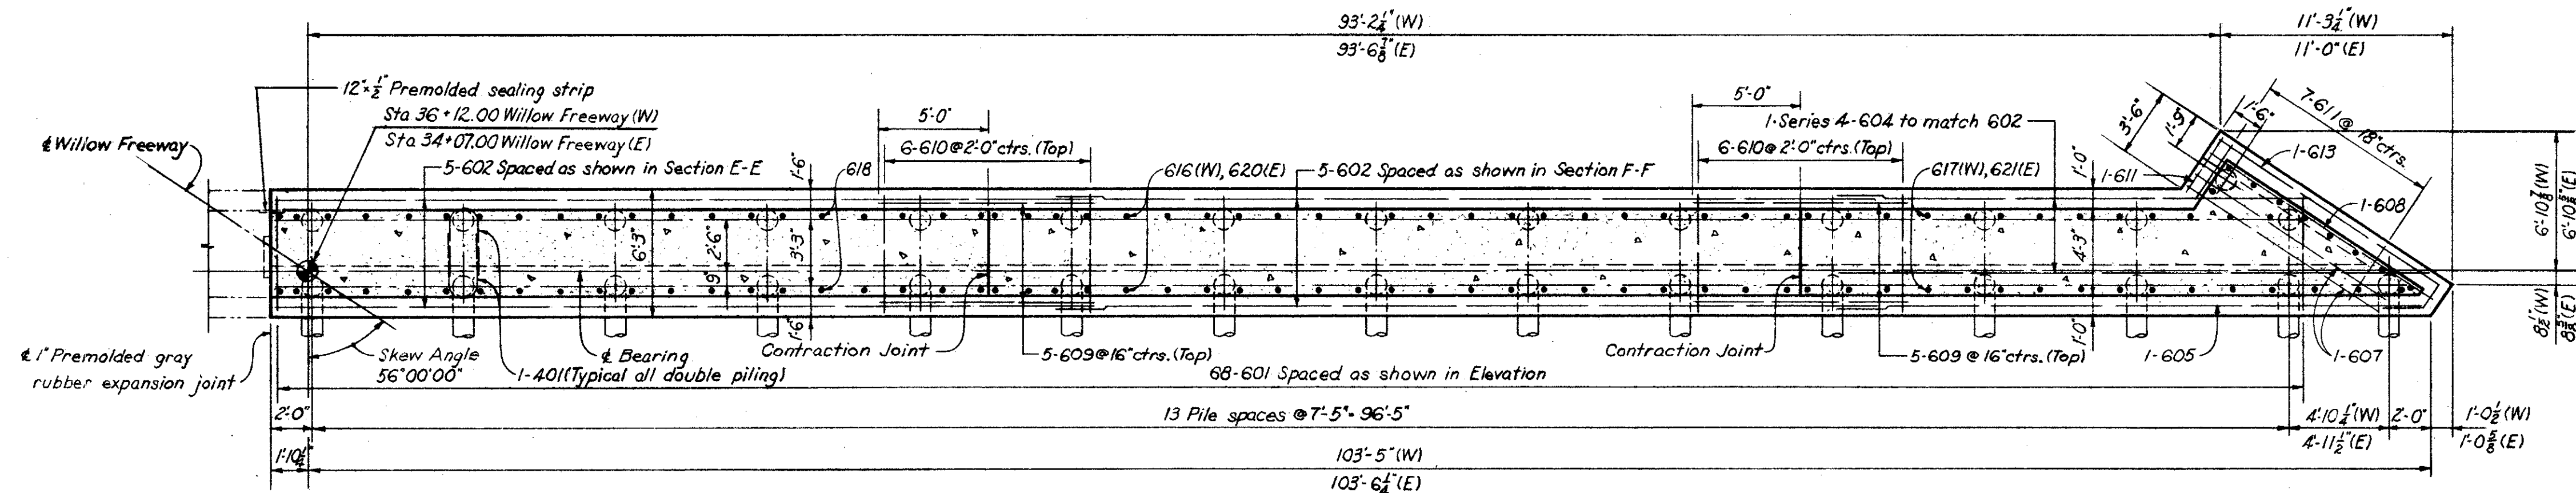

FOOTING PLAN

Note:
Dimensions and reinforcement are the same for both abutments except where noted as follows:
(W) denotes West Abutment
(E) denotes East Abutment


NOTES:
n.f. - near face; f.f. - far face; ea. fa. - each face
For additional notes and sections see sheets 165-7A & 147-7A

H.N.T.B. BR. NO. 11 PART 7A

HOWARD, NEEDLES, TAMMEN & BERGENDOFF
CONSULTING ENGINEERS
KANSAS CITY CLEVELAND NEW YORK

ABUTMENTS
WILLOW FREEWAY OVER REL. WOODLAND AVE.
BR. NO. CUY-21-1544 STA. 34+02.53
Scale: 3/16" = 1'-0" STA. 36+16.47
WILLOW-INNER BELT FREEWAY
CLEVELAND CUYAHOGA COUNTY OHIO


DRAWN T.J.P.	TRACED	CHECKED F.S.J.	REVIEWED C.T.	REVISED
DATE 12/30/59	DATE	DATE 1/15/59	DATE 11/13/59	SHEET 166

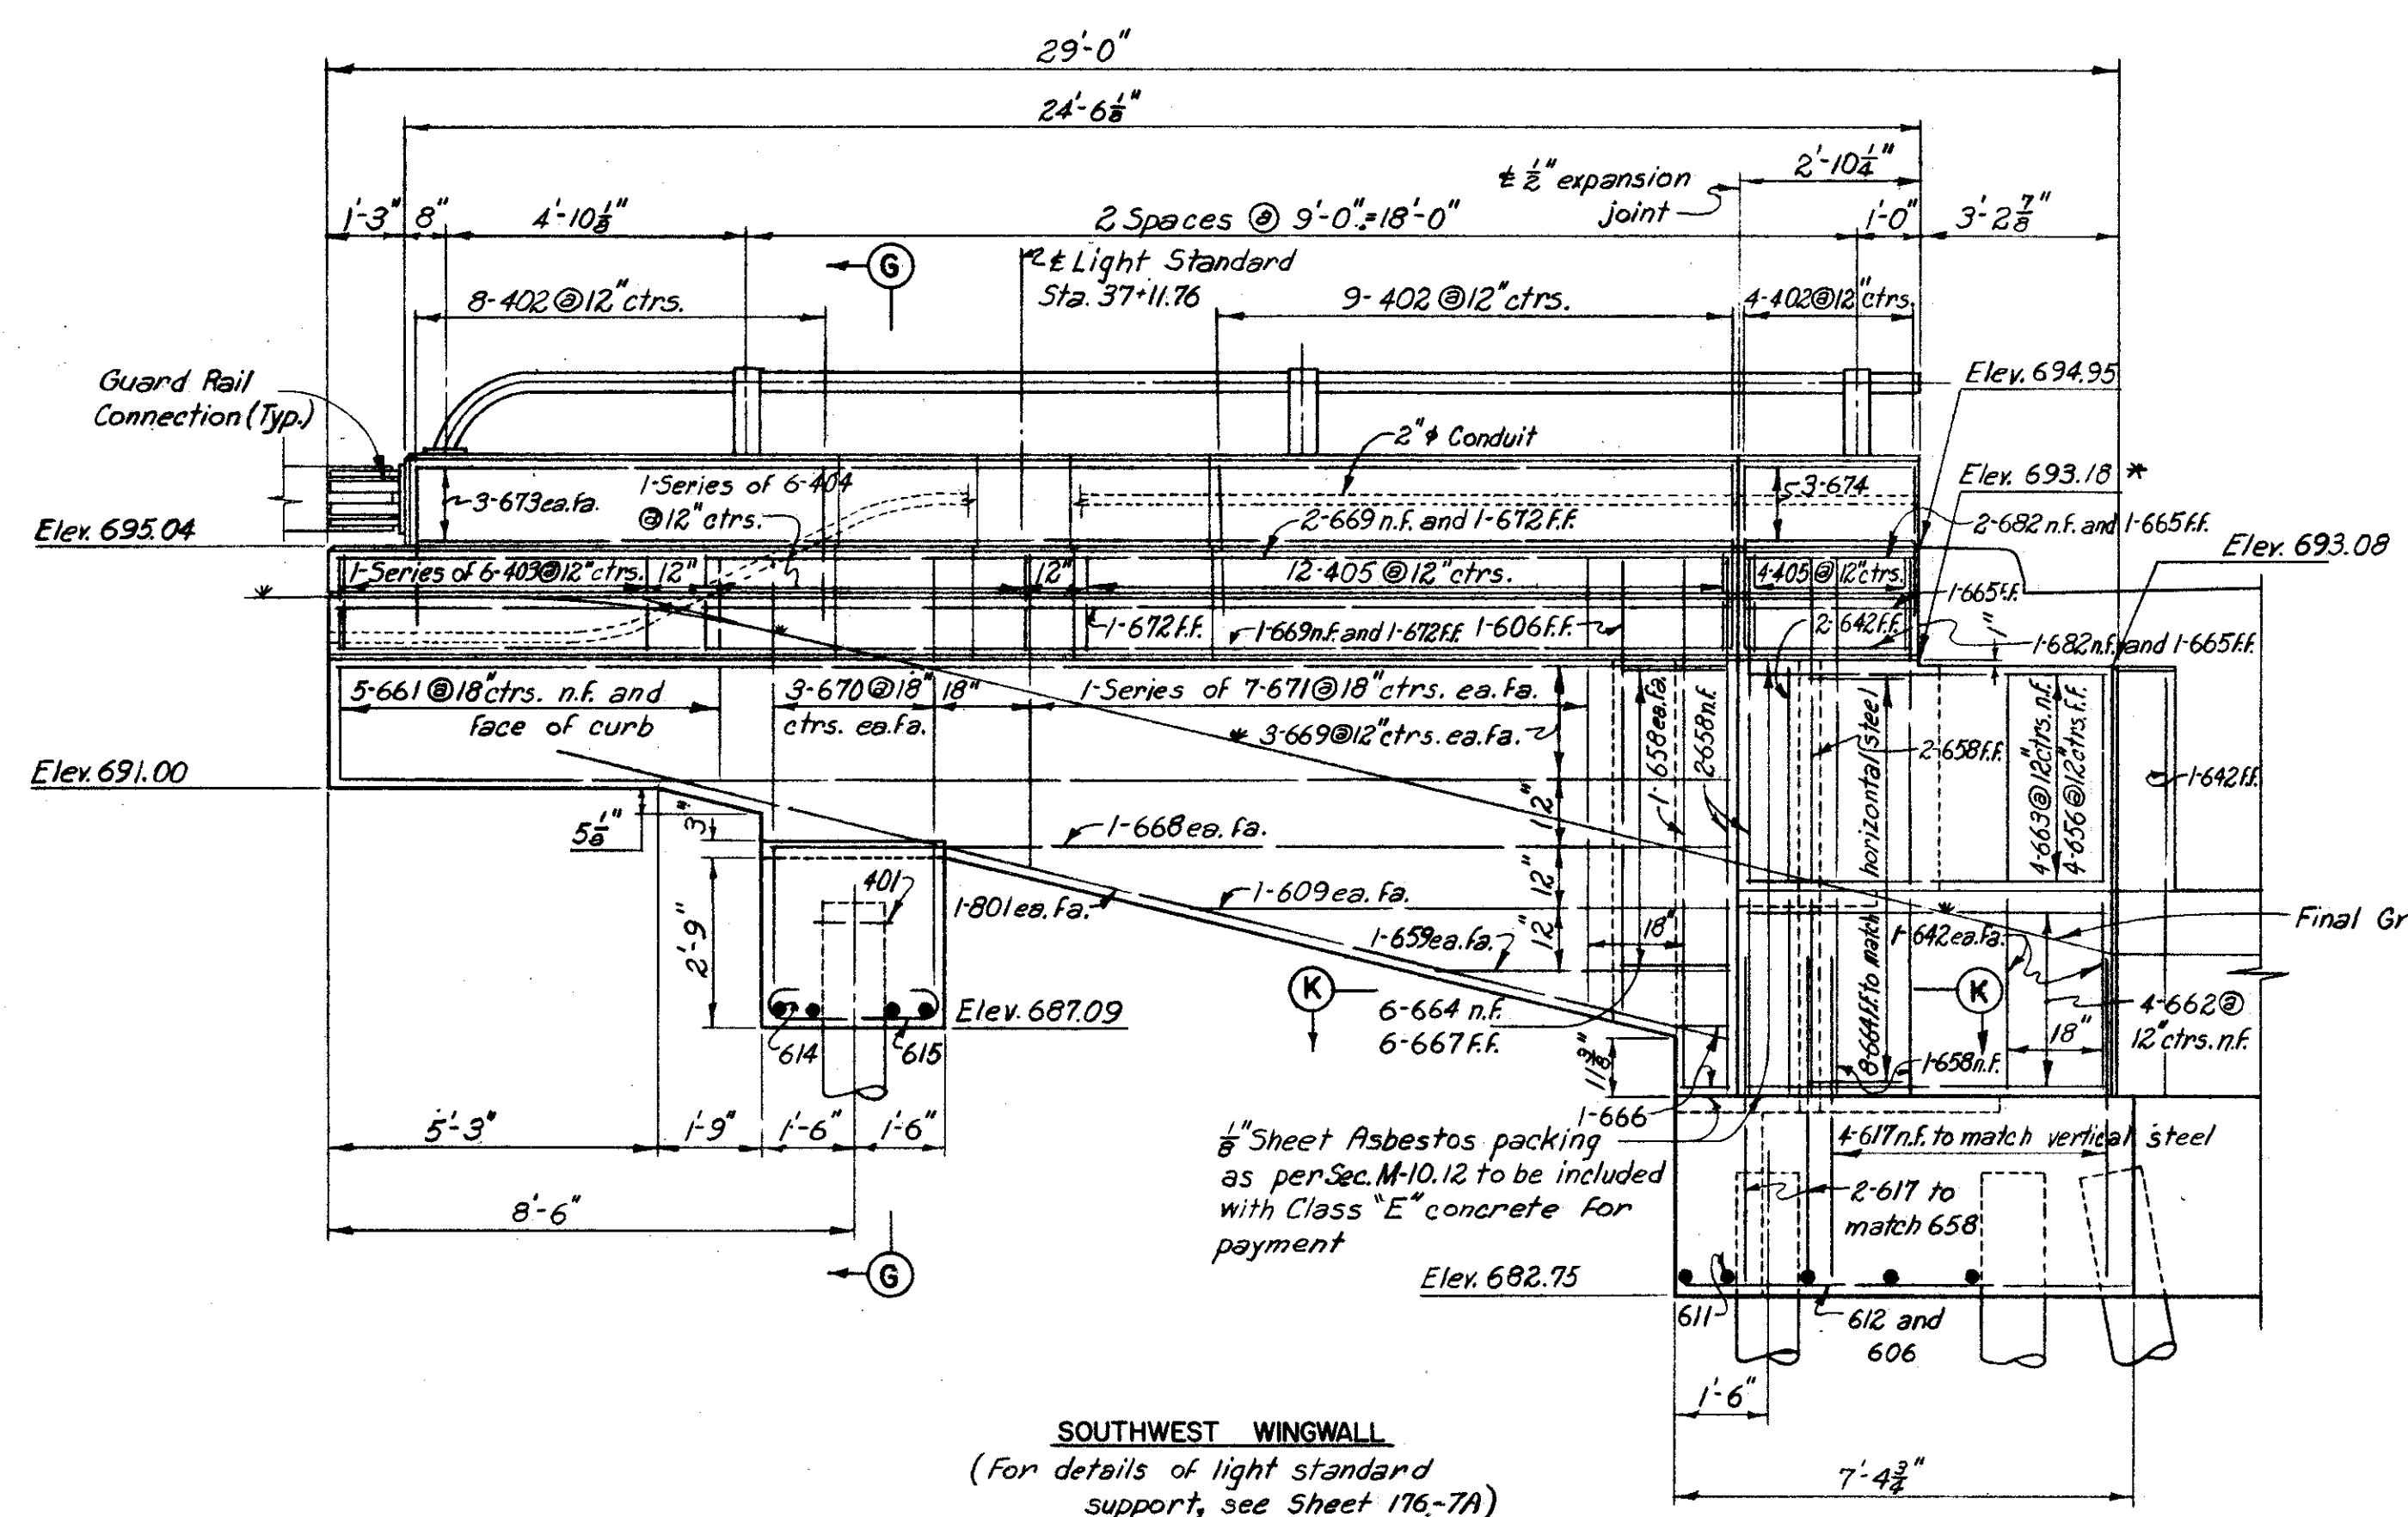


SOUTHWEST WINGWALL
(For details of light standard support, see Sheet 176-7A)

Notes.
Backfill shall be completed prior to construction of curb.
Ends of railing parapet shall be normal to top of safety curb.
*denotes elevation given at construction joint.


Note: Prefix "A" shall be assigned to all bar marks.

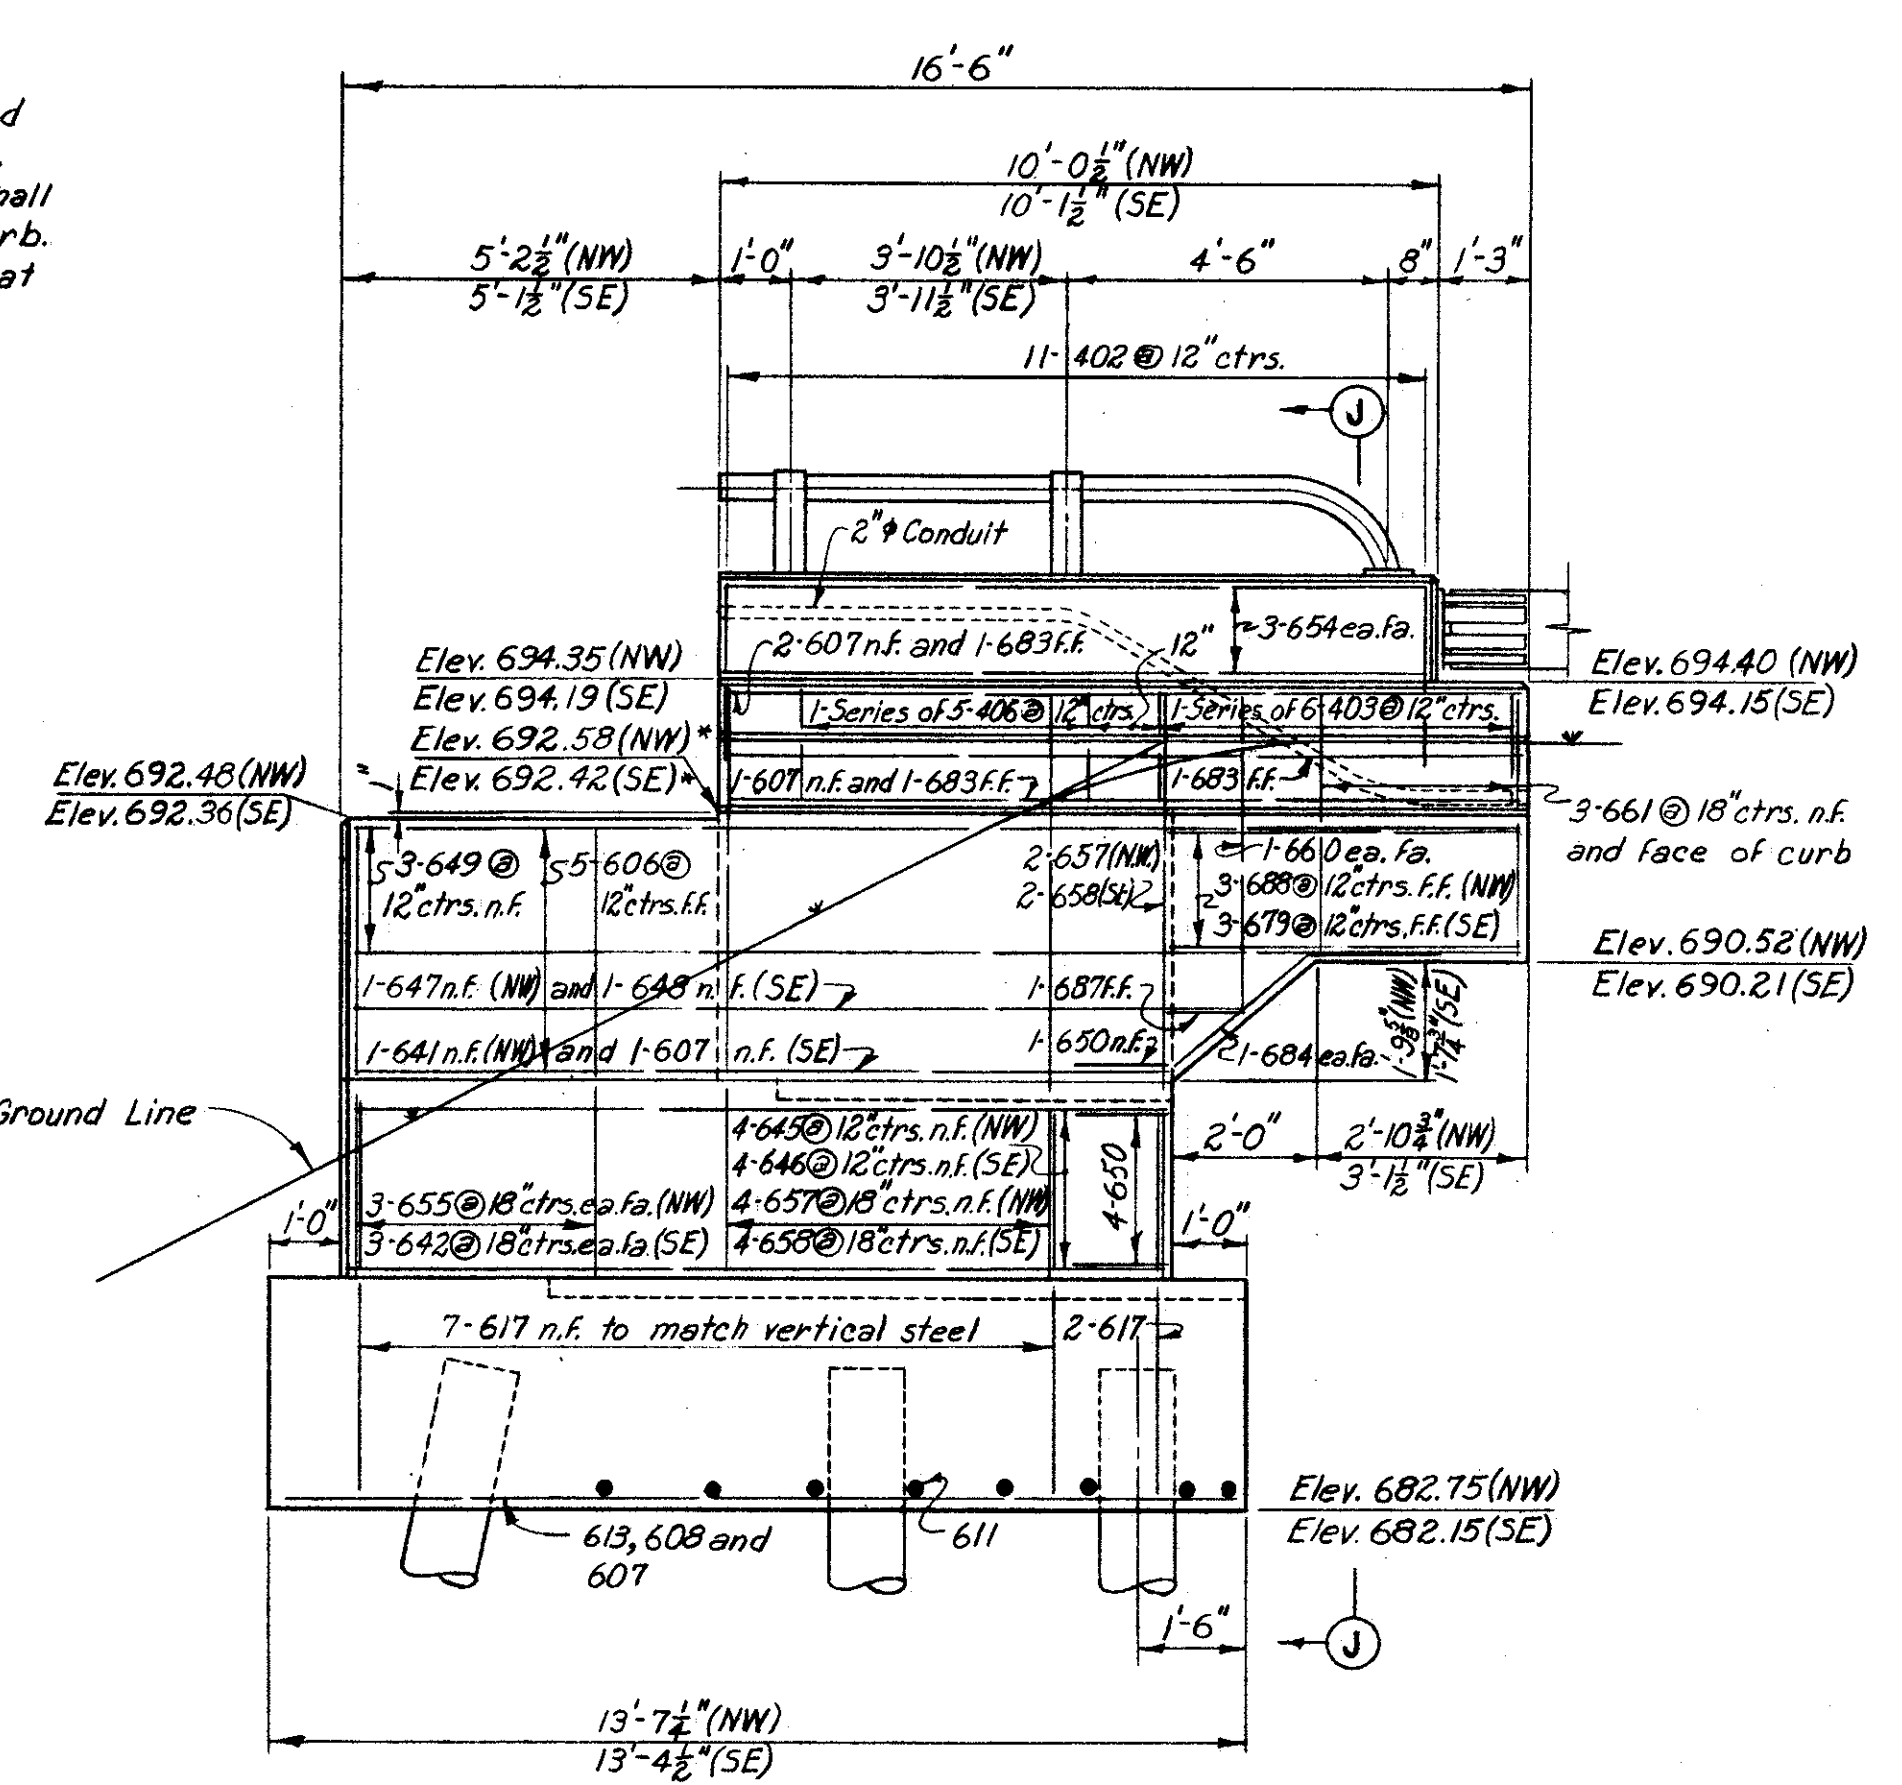


ELEVATION B-B
(Northwest wingwall shown)
(Southeast wingwall similar except as noted)

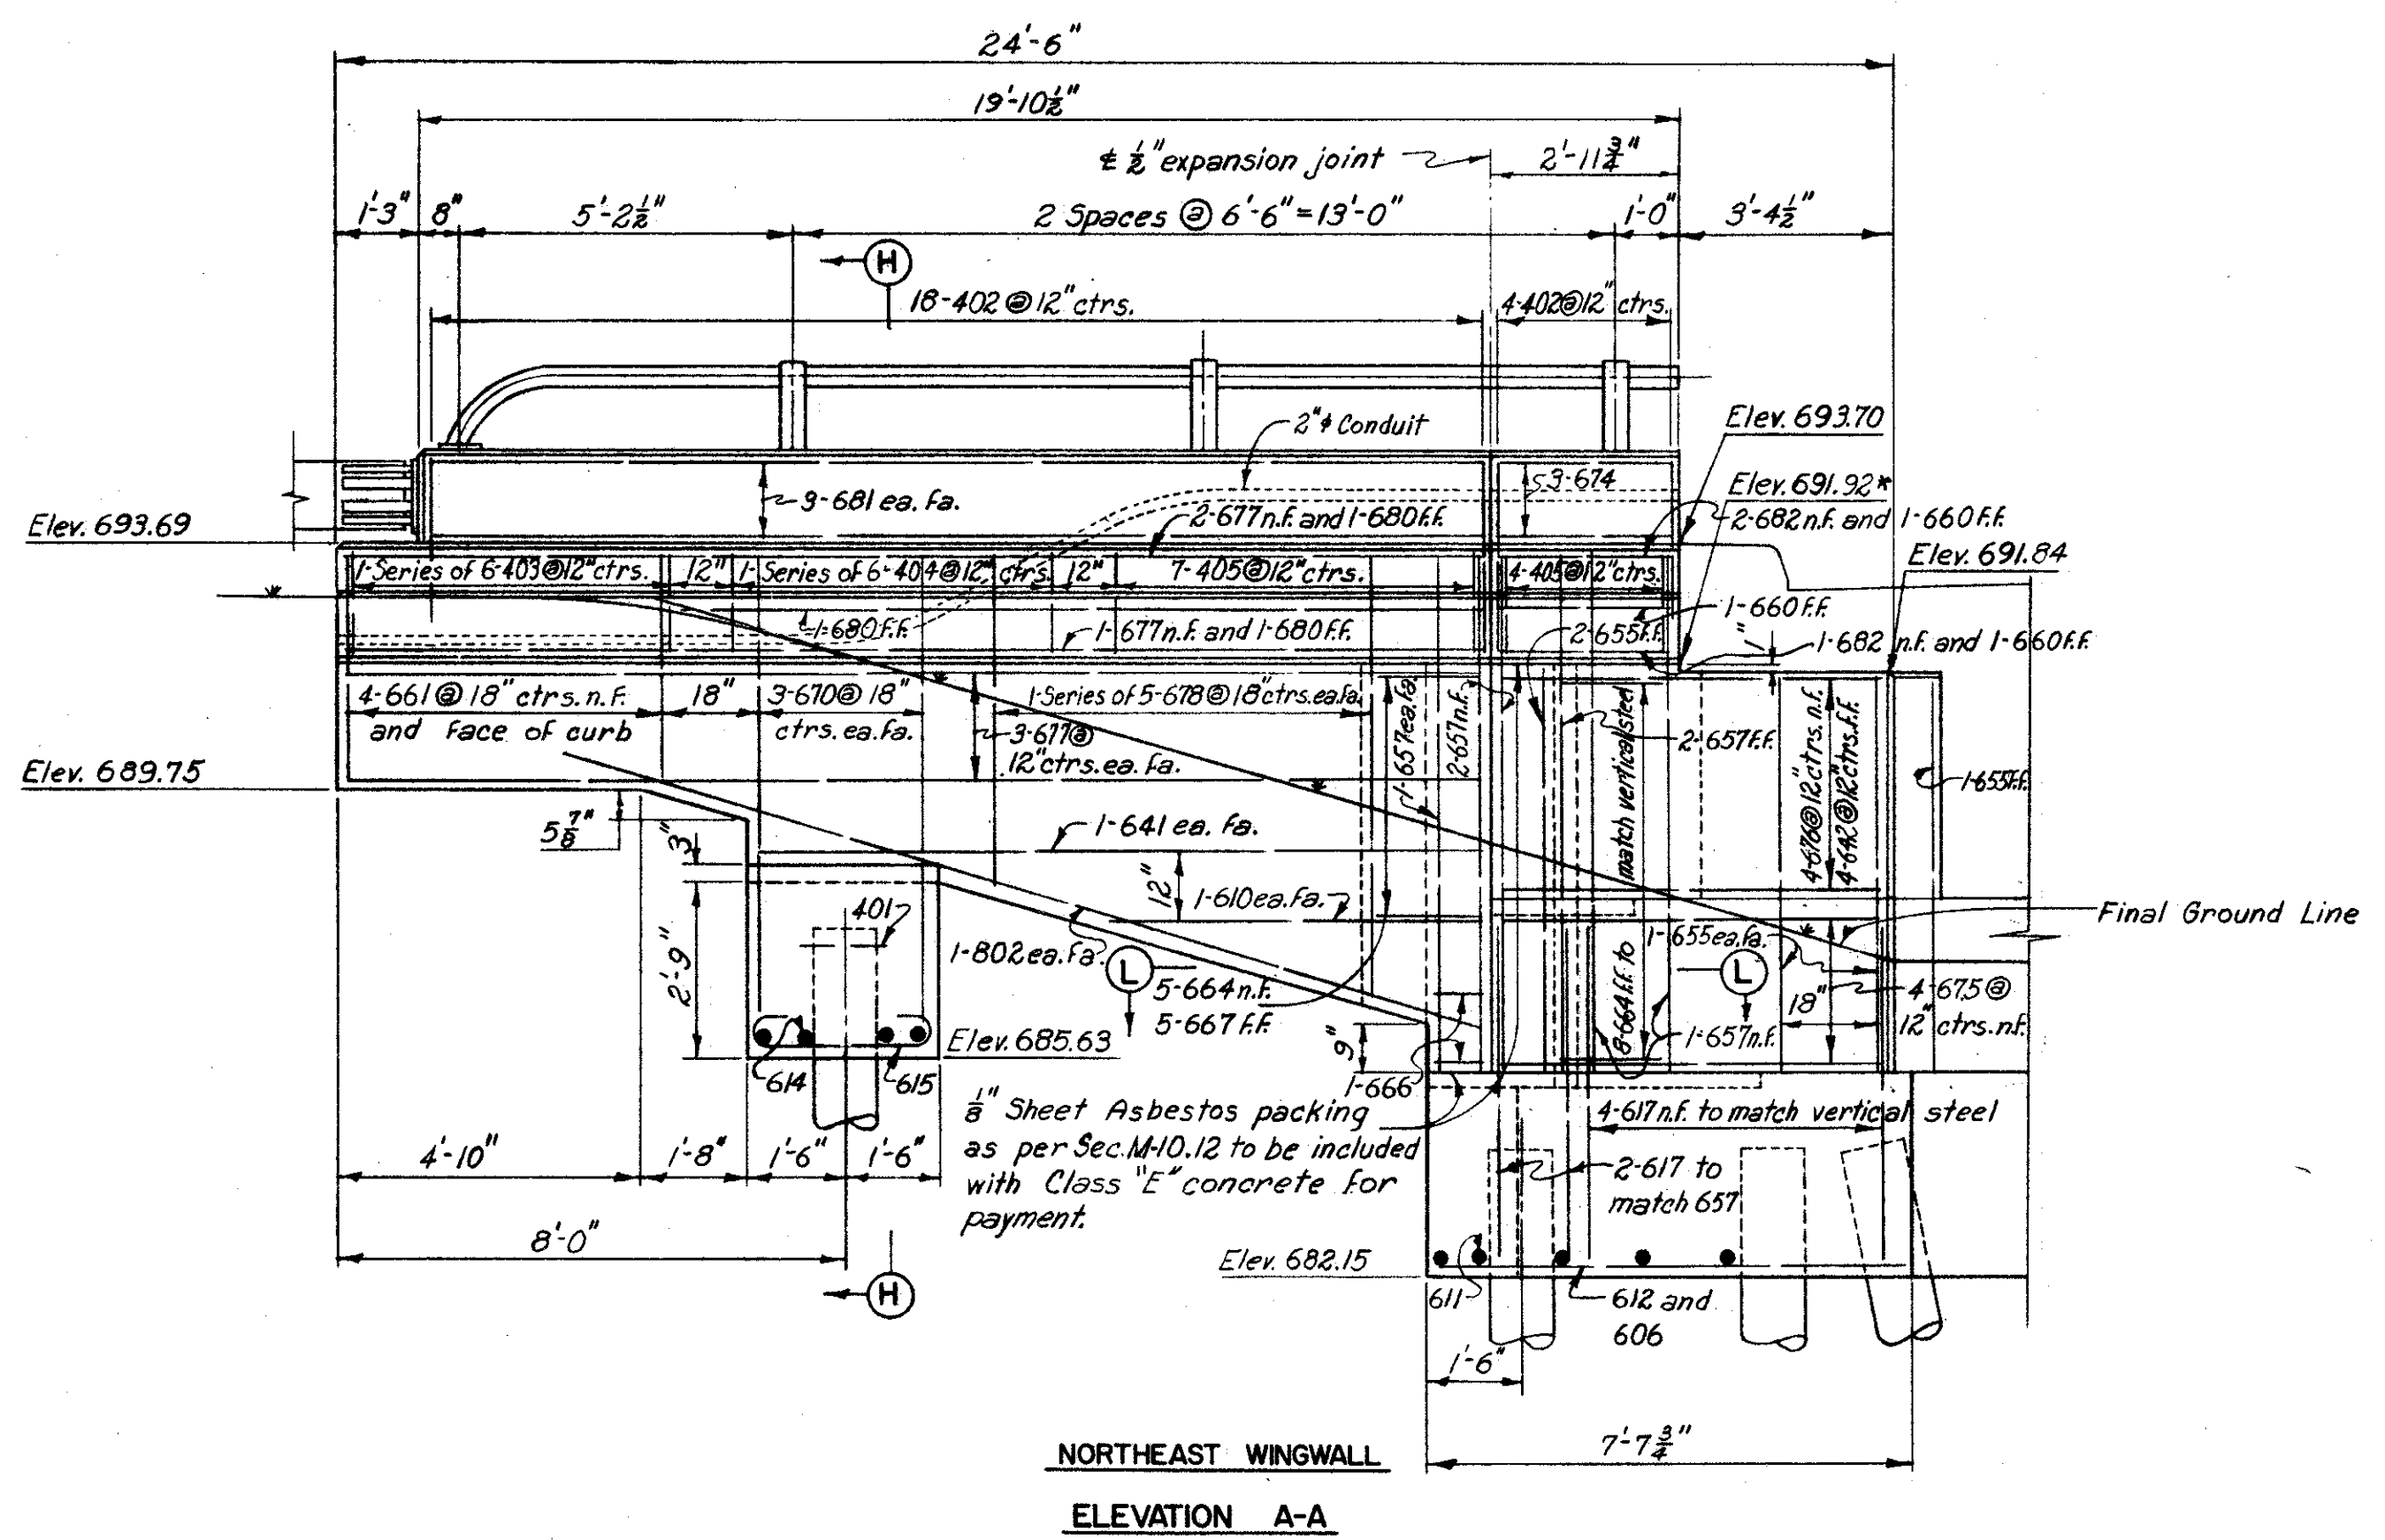


NORTHEAST WINGWALL
ELEVATION A-A

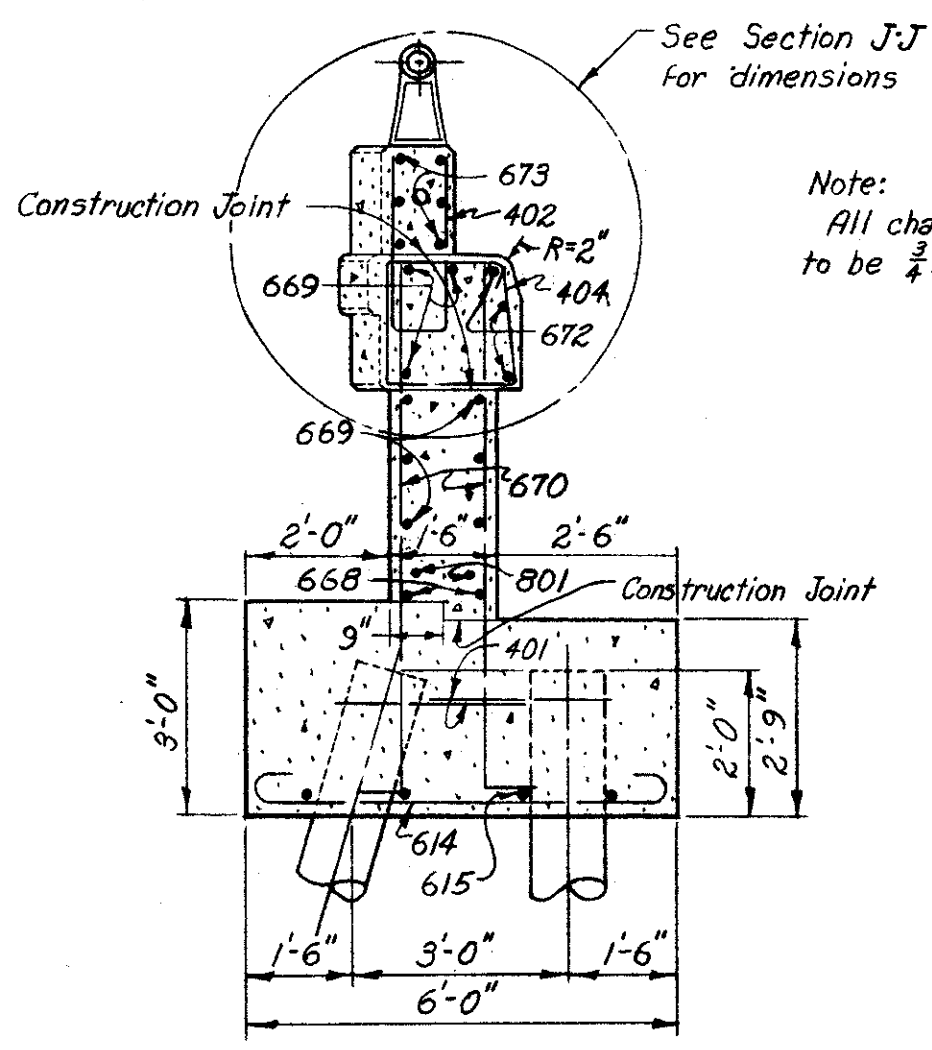


SECTION G-G (Shown)

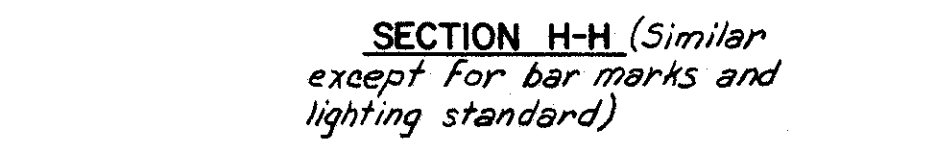

SECTION H-H (Similar except for bar marks and lighting standard)

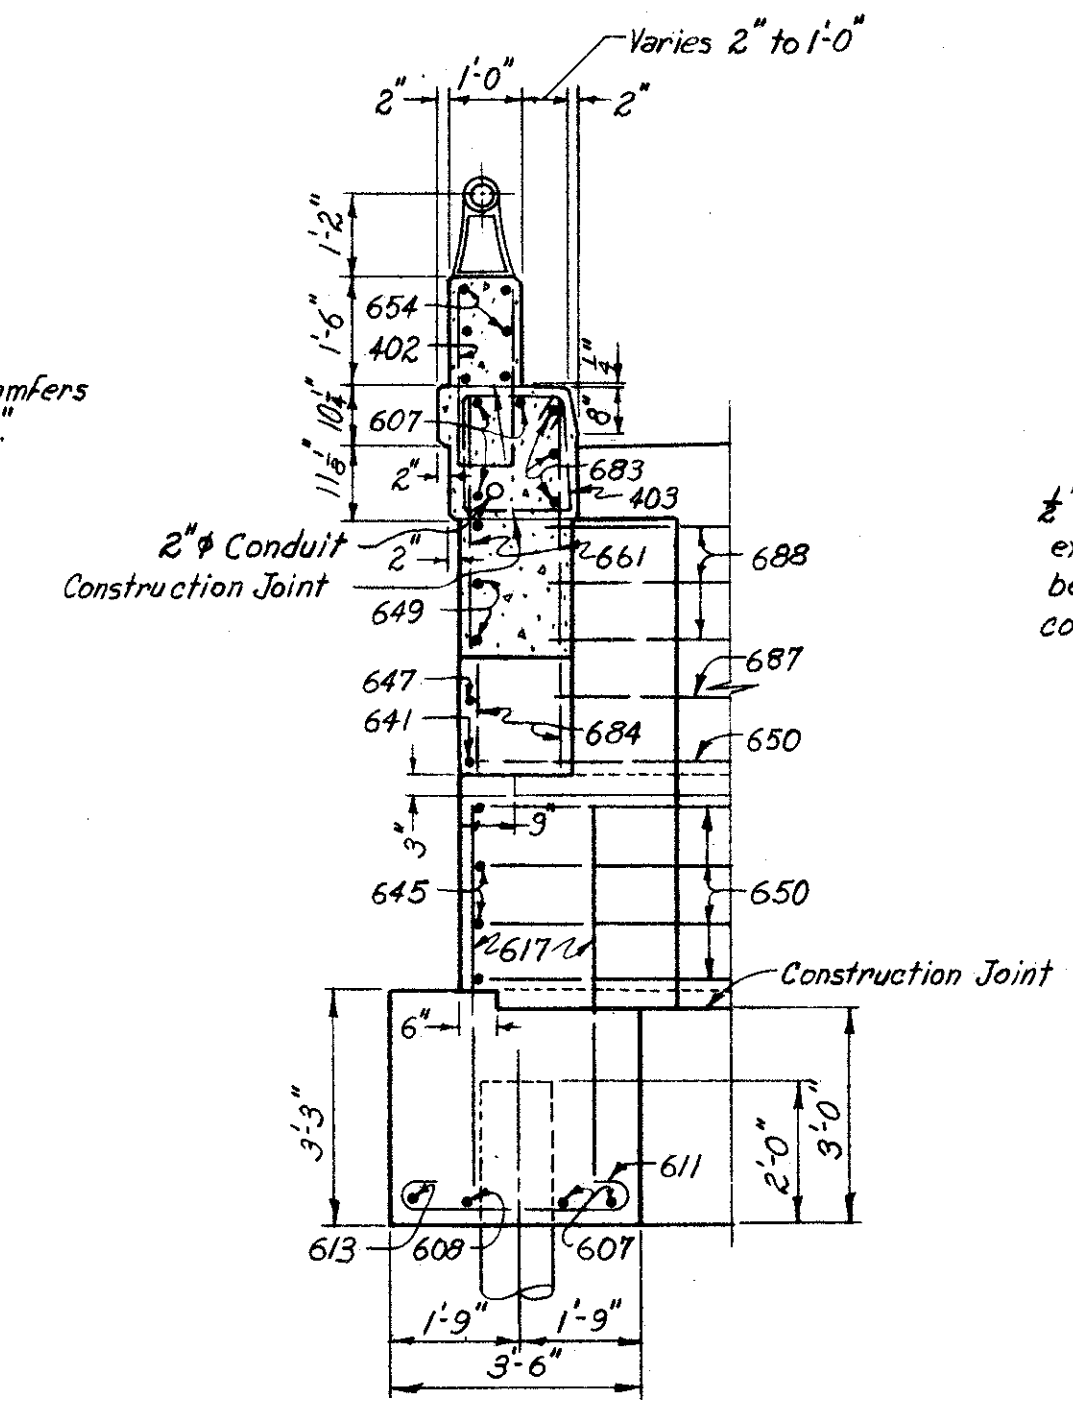

SECTION J-J
(Northwest wingwall shown)
(Southeast wingwall similar)

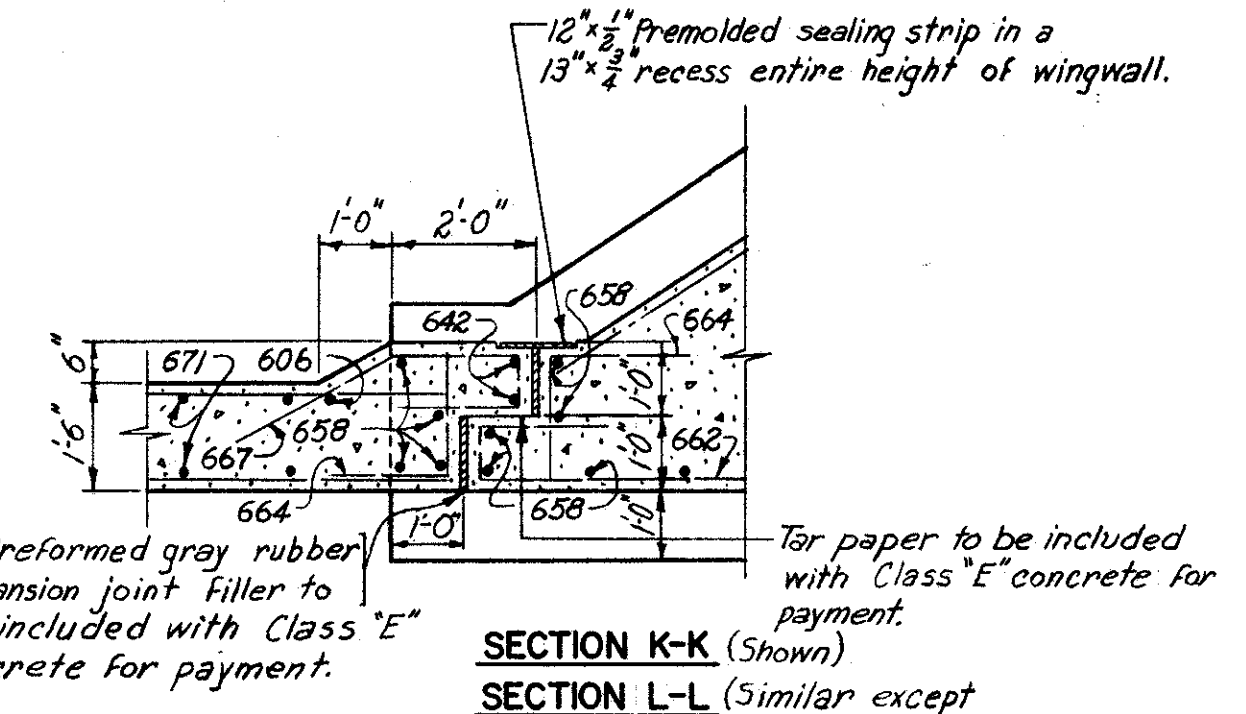

NOTES:
For location of lighting conduit, see Sheet 176-7A
For railing details and Guard Rail connection details, see Sheet 175-7A
Following abbreviations are used: (NW) = Northwest; (SE) = Southeast; n.f. = near face; f.f. = far face and ea. fa. = ea. face.
For additional notes, see Sheet 165-7A

H.N.T.B. BR. NO. 11 PART 7A

HOWARD, NEEDLES, TAMMEN & BERGENDOFF
CONSULTING ENGINEERS
KANSAS CITY CLEVELAND NEW YORK

ABUTMENT DETAILS

WILLOW FREeway OVER REL. WOODLAND AVE.
BR. NO. CUY-21-1544 STA. 34+02.53
Scale: 3/8" = 1'-0" STA. 36+16.47


WILLOW-INNER BELT FREEWAY

CLEVELAND CUYAHOGA COUNTY OHIO


DATE 1/3-59 TRACED CHECKED 7/4/59 REVIEWED 1/13-59
DATE 1-15-59 DATE 1/13-59 SHEET 167

CUYAHOGA COUNTY
 CITY OF CLEVELAND
 CUY-21-15.32
 CUY-42-18.42


Note: Elevations shown are to the top of WF beams. (Exclusive of cover plates)
 Top elevations are for the south half.
 Bottom elevations are for the north half.
 To obtain top of pavement elevations at supports add 0.84' to top of WF beam elevations shown.

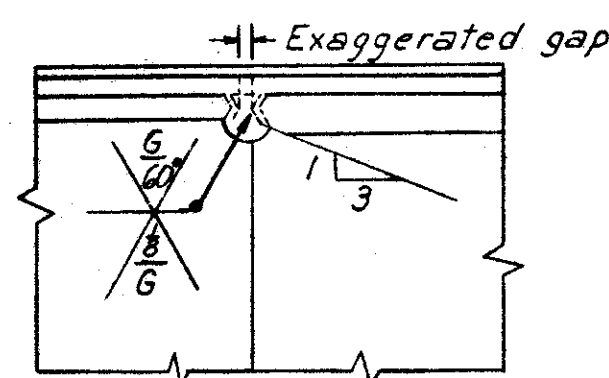


DETAIL "A"
 No Scale

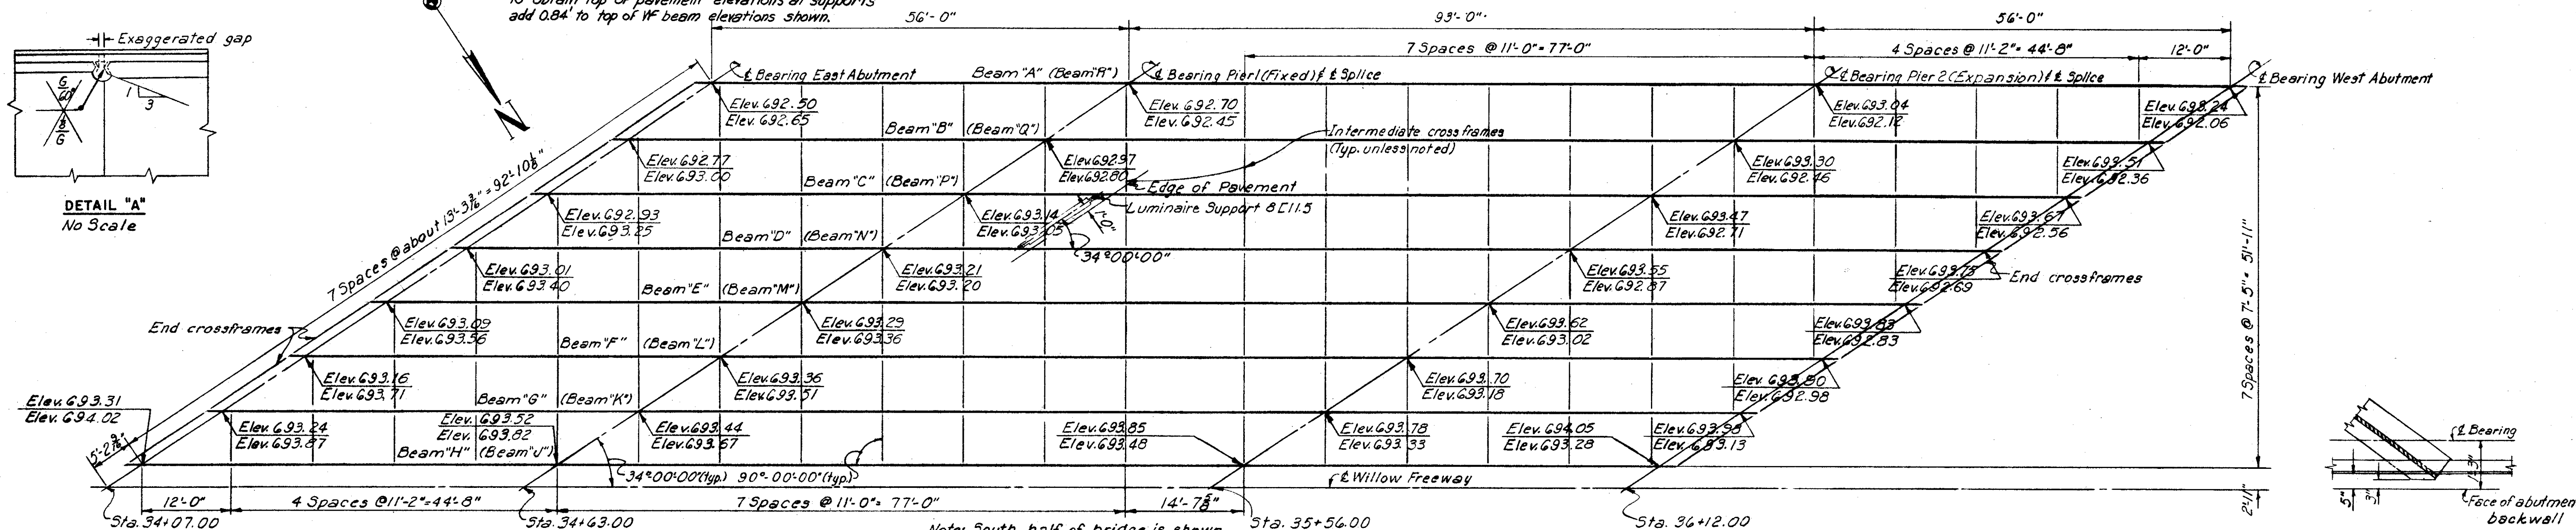


FRAMING PLAN
 Scale 1/4" = 1'-0"

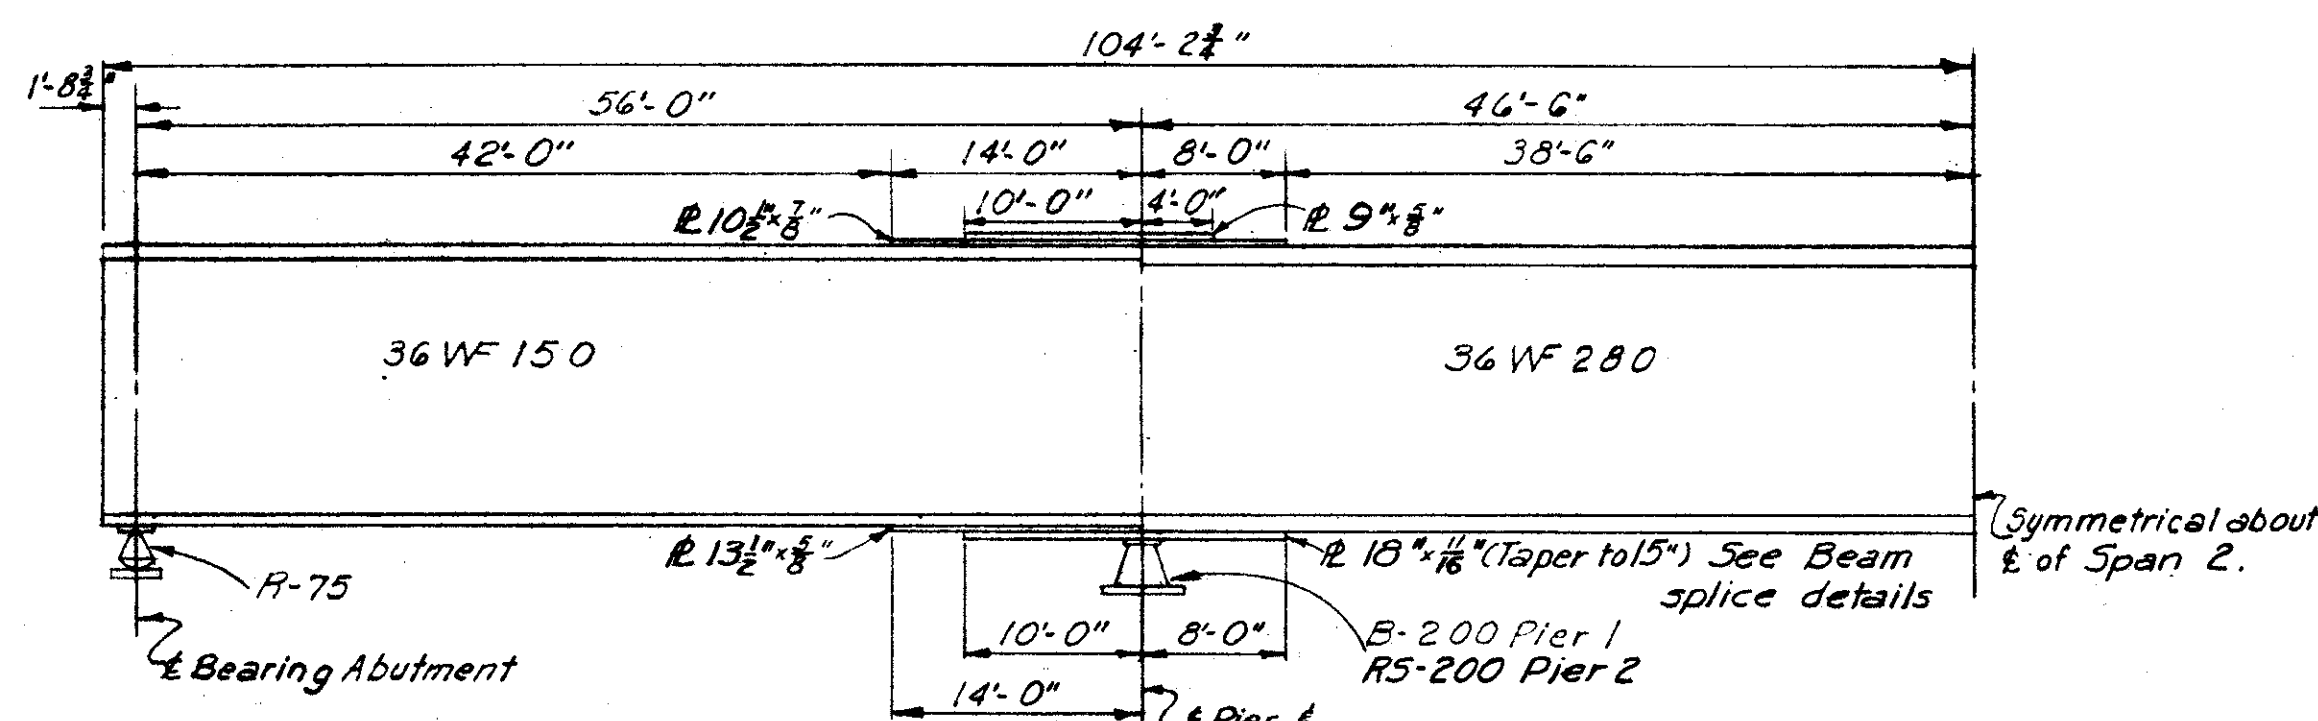

TYPICAL BEAM ELEVATION
 No Scale

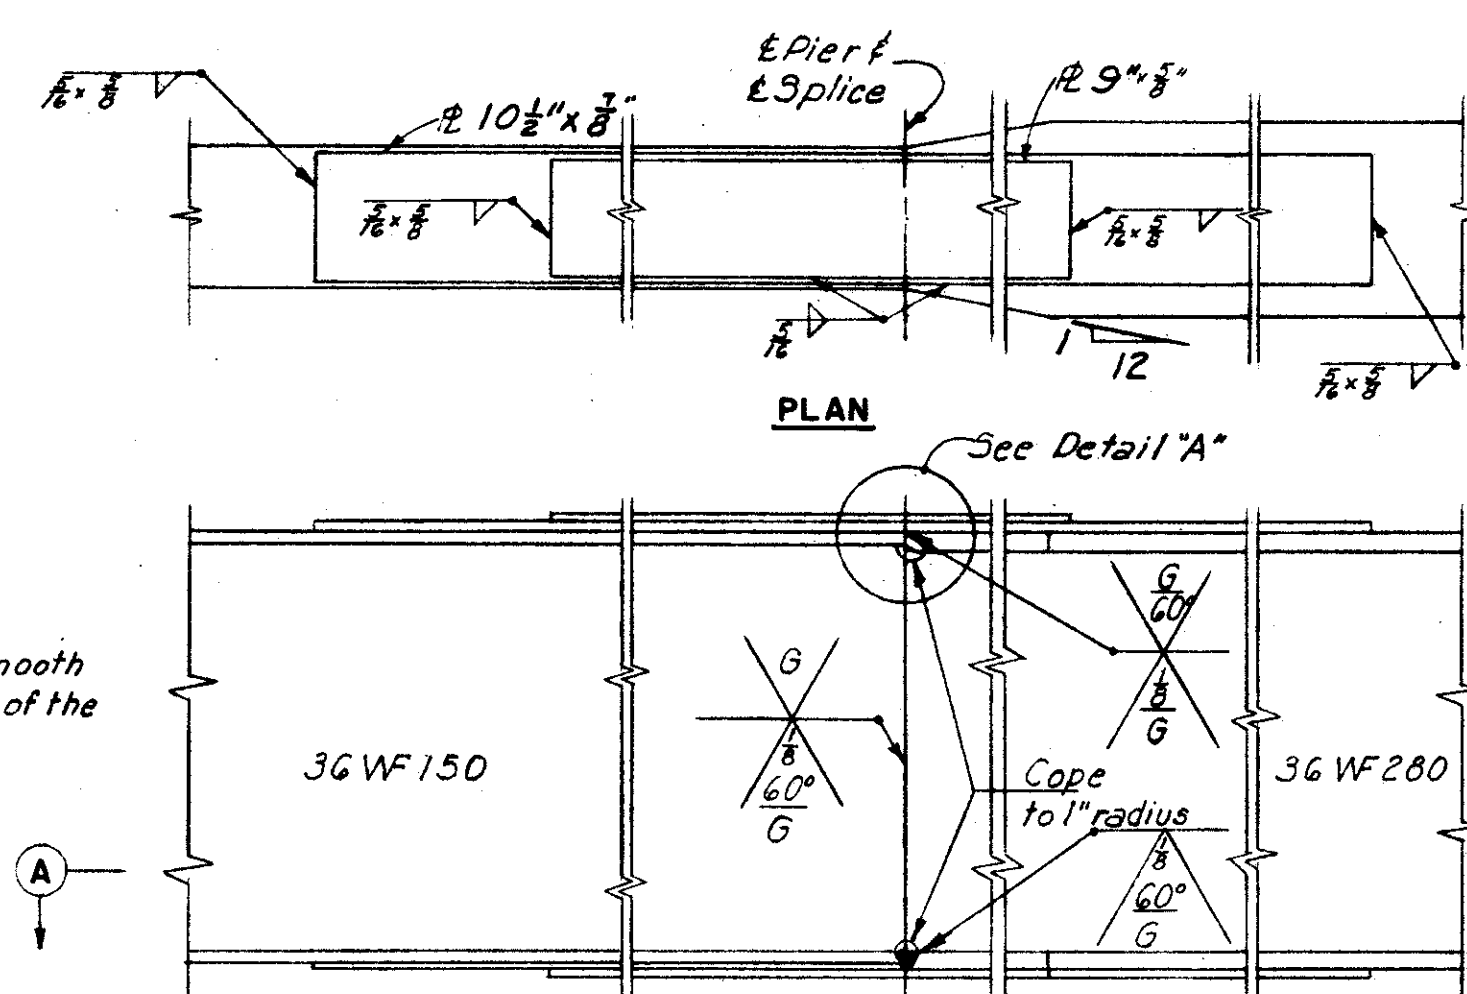


SECTION A-A
BEAM SPlice
 No Scale

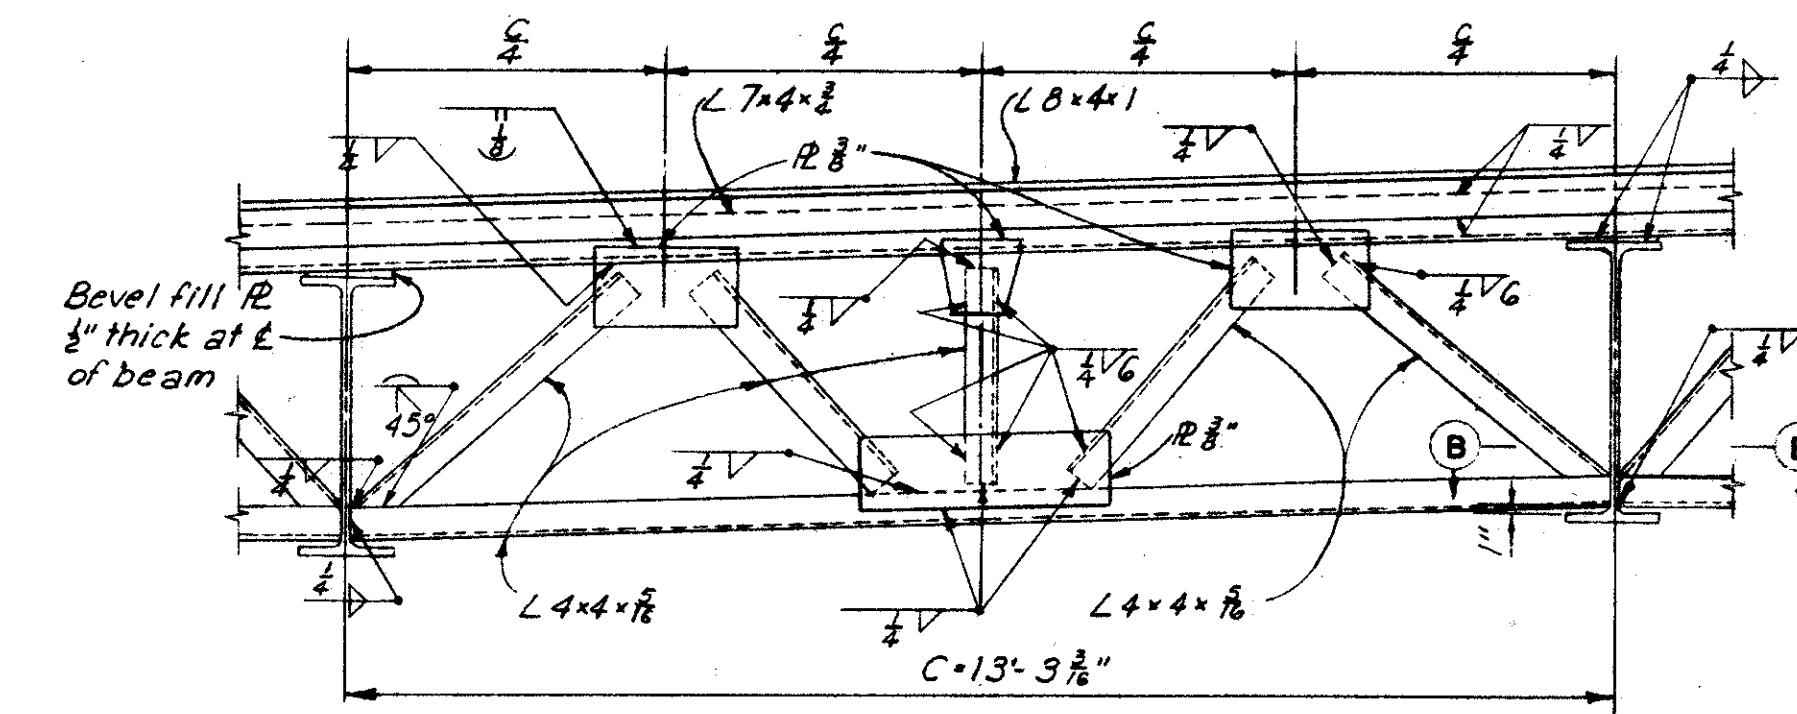

END CROSSFRAME
 Scale 1/4" = 1'-0"

NOTES:
 The beams in Span 2 shall be cambered as follows. Where the total deflection is 1/4" to 1", the required camber will be 1", and if greater than 1", the required camber will be the same as this amount.
 Beams in Spans 1 & 3 do not require camber, but shall be fabricated so that any curved beam will be placed with the convex flange down.
 For drainage details, see Sh. 174-7A
 For intermediate cross-frame details, see Sh. 163-7A
 For typical cross-section through deck, see Sh. 170-7A
 For details of end dams, see Sh. 173-7A
 For details of underdeck lighting see Sh. 176-7A & 177-7A
 For details of rocker base plates, see Sh. 173-7A
 For other rocker details, and details of bolsters, see Ohio Standard Drawing RB-1-55.

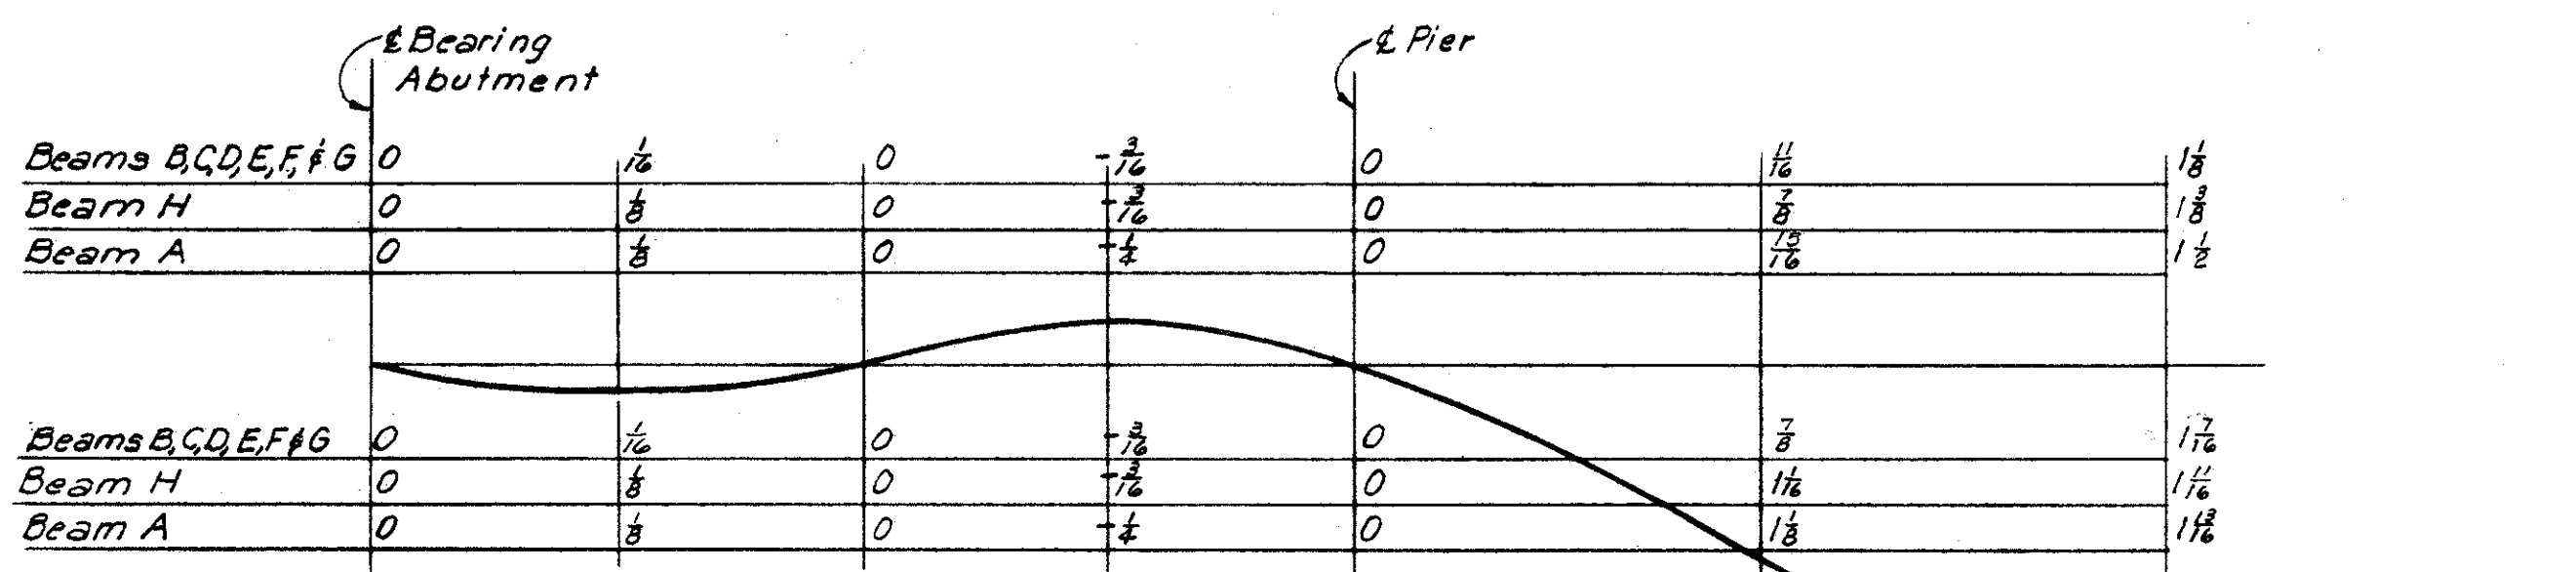

BEAM DEFLECTION DIAGRAM
 No Scale

Deflections are given at the quarter points.
 Deflections shown above base line are deflections due to concrete.
 Deflections shown below base line are total dead load deflections.
 Deflections are measured to the nearest 1/8 inch.
 Negative deflections are upward.

BEAM SPlice WELDING PROCEDURE
 1.-Raise the abutment ends of the beams 1/8".
 2.-Butt-Weld the beam flanges and web using the following sequence: make two passes on each flange, then two on the web; repeat, using one pass at each location, until welds are completed.
 3.-Weld the bottom and top cover plates.
 4.-Lower the beam ends to final position.

H.N.T.B. BR. NO. 11 PART 7A
 HOWARD, NEEDLES, TAMMEN & BERGENDOFF
 CONSULTING ENGINEERS
 KANSAS CITY CLEVELAND NEW YORK

FRAMING PLAN
 WILLOW FREEWAY OVER REL. WOODLAND AVE.
 BR. NO. CUY-21-1544 STA. 34+02.53
 Scale: As noted STA. 36+16.47
WILLOW INNER BELT FREEWAY
 CLEVELAND CUYAHOGA COUNTY OHIO

DRAWN: A.	TRACED	CHECKED: AR.K.	REVIEWED: J.C.T.	REVISED
DATE: 11-15-57	DATE:	DATE: 12-2-58	DATE: 11-13-59	SHEET 169

CUYAHOGA COUNTY
CITY OF CLEVELAND
CUY-21-15.32
CUY-42-18.42


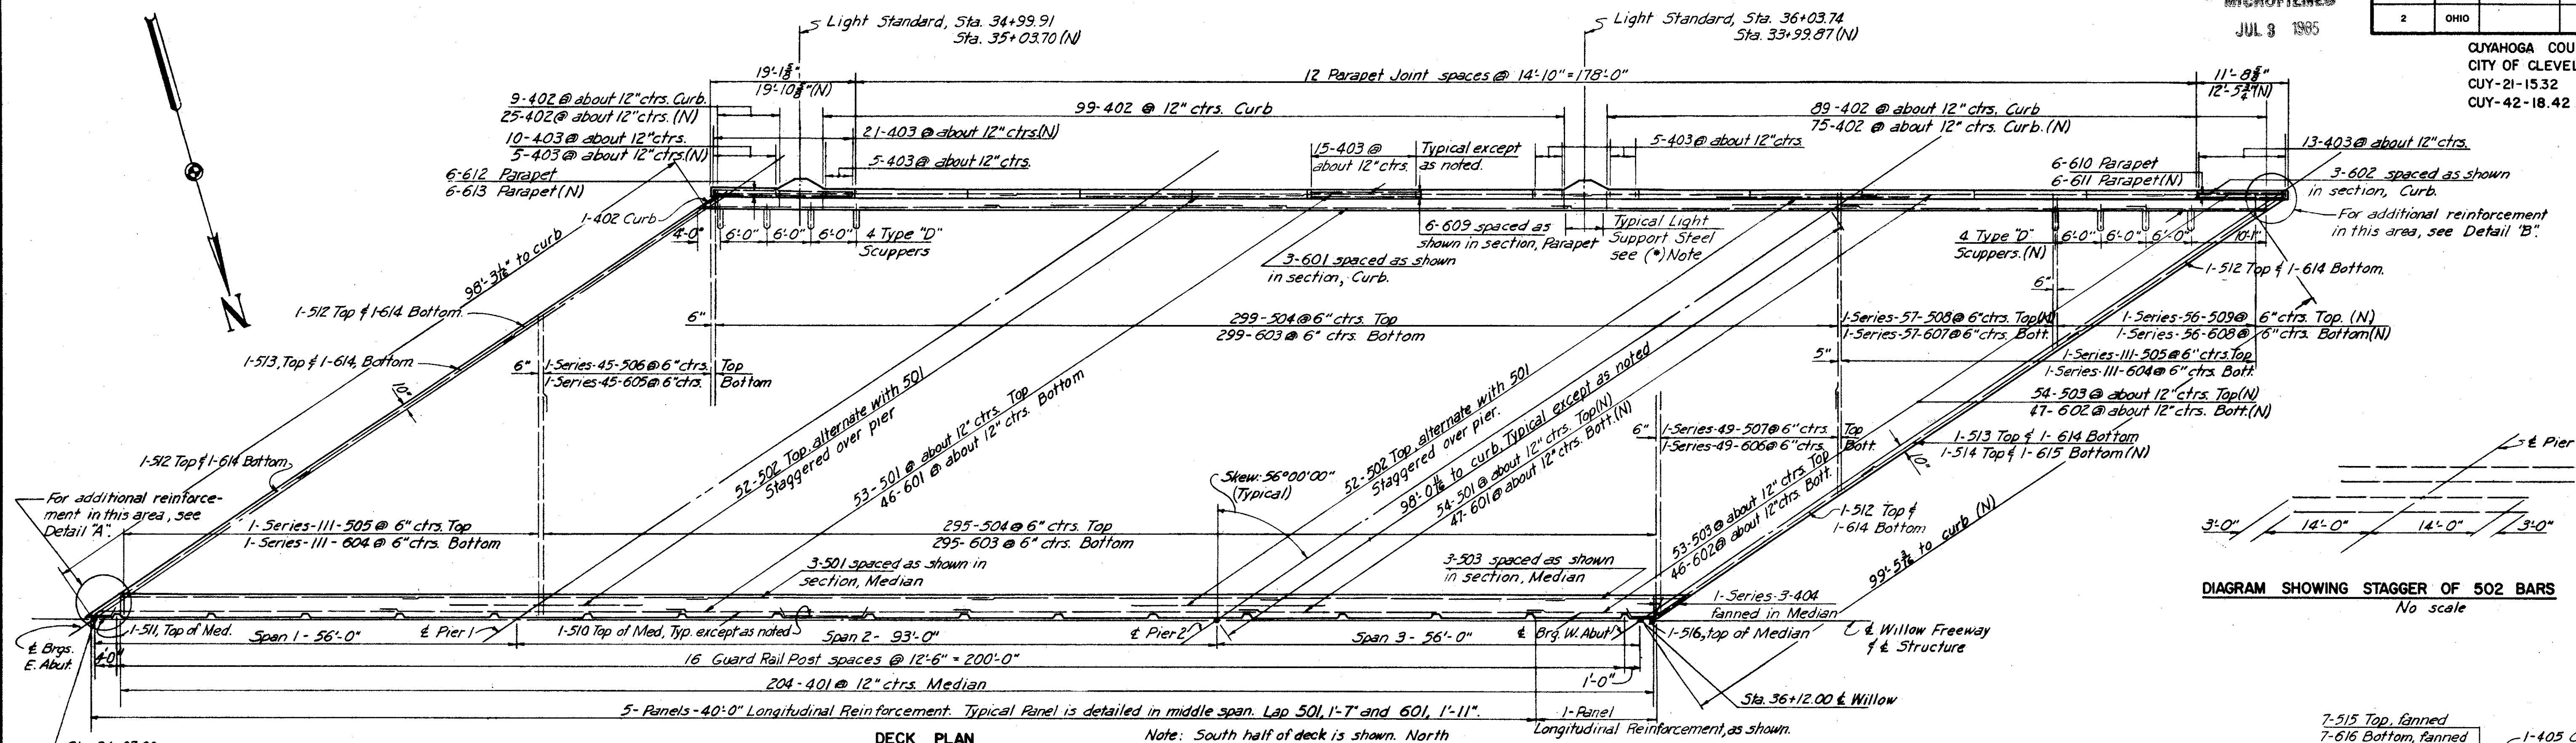


DIAGRAM SHOWING STAGGER OF 502 BARS
No scale

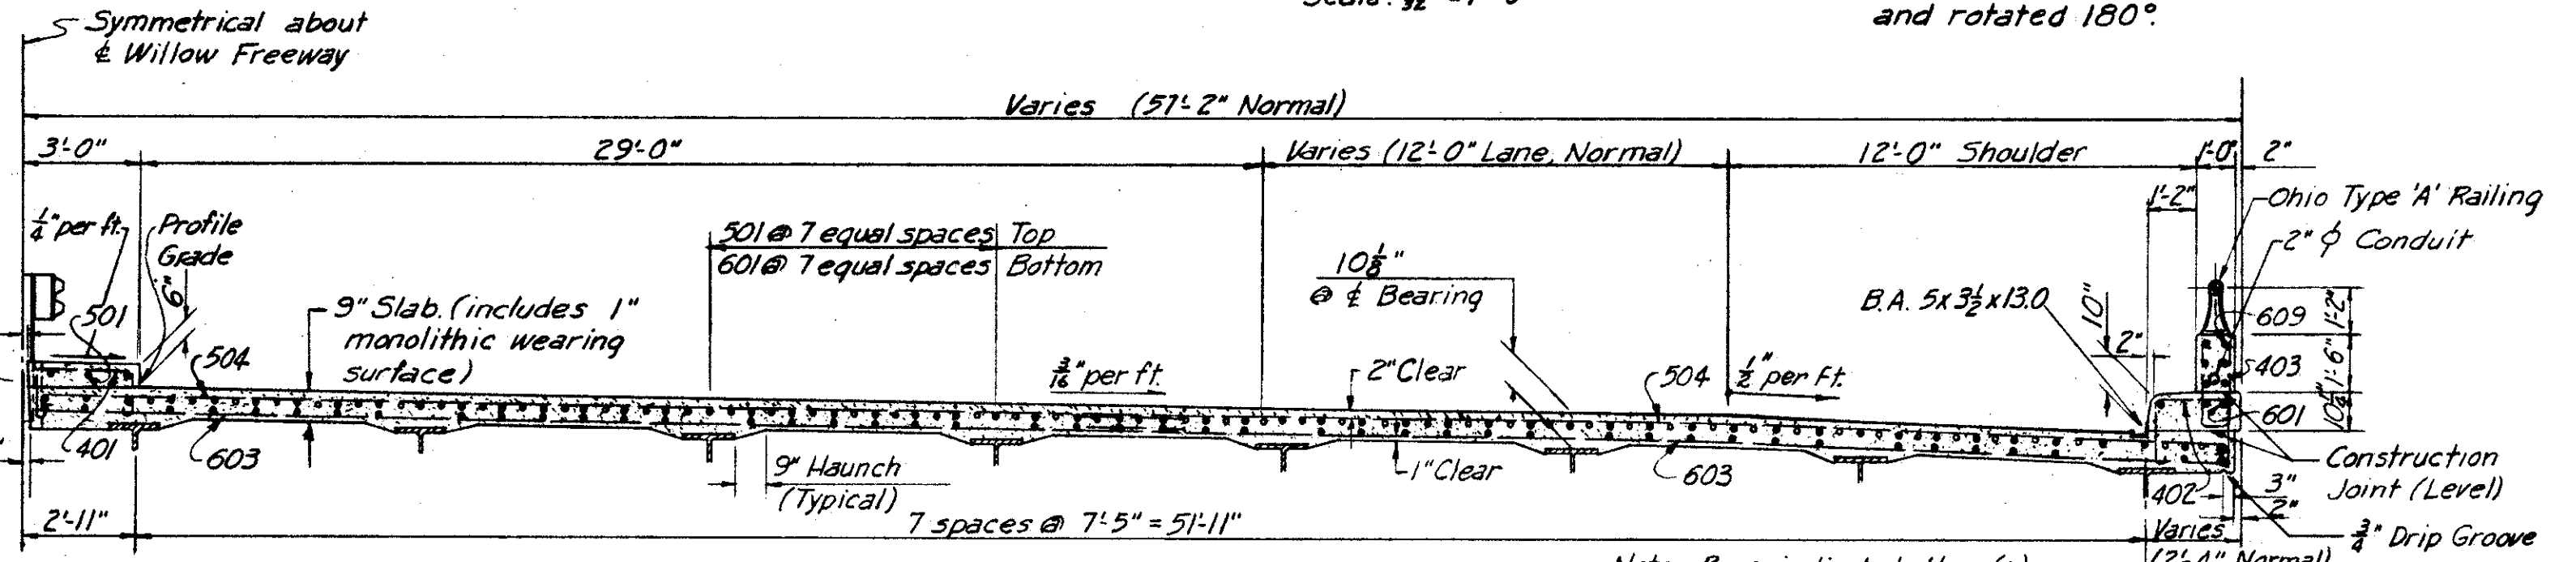

TYPICAL SECTION
Scale: 1/4" = 1'-0"


Note: Prefix 'S' shall be assigned to all bar marks.

DETAIL A
Scale: 3/8" = 1'-0"

DETAIL B
Scale: 3/8" = 1'-0"

NOTES:
In order to facilitate water curing of the concrete of the deck slab, the placing of concrete shall progress upgrade. The slab may be placed in sections, between transverse construction joints which are parallel to the transverse bars in the slab and are located near the center of any span.
For intermediate cross frame details see sheet 163-7A
For end cross frame details, see sheet 169-7A
For light standard support and other lighting details, see sheet 176-7A
For Railing, Guard Rail and Parapet Joint details, see sheet 175-7A
For Drainage details, see sheet 174-7A
For End Dam details, see sheet 173-7A
Bars of a series shall vary in length by a constant increment.

REINFORCEMENT SCHEDULE																										
MARK	NUMBER	LENGTH	TYPE	DIMENSIONS			SERIES INCREMENT	WEIGHT POUNDS	MARK	NUMBER	LENGTH	TYPE	DIMENSIONS			SERIES INCREMENT	WEIGHT POUNDS	MARK	NUMBER	LENGTH	TYPE	DIMENSIONS			SERIES INCREMENT	WEIGHT POUNDS
				A	B	C							A	B	C							A	B	C		
401	408	5'-3"	122	2'-6"	1'-0"		1431	505	3 Series of 11	3'-6" to 40'-7"	101	2'-11" to 40'-0"	4 1/2"	7655	606	2 Series of 49	13'-4" to 29'-6"	Str.	4 1/2"	3152						
402	398	5'-1"	122	1'-8"	1'-4"		1351	506	2 Series of 49	12'-10" to 27'-8"	Str.		4 1/2"	1901	607	1 Series of 31	21'-3" to 40'-0"	Str.	4"	2622						
403	422	4'-5"	105	8"	2'-"		1201	507	2 Series of 49	13'-1" to 29'-3"	Str.		4 1/2"	2164	608	1 Series of 31	3'-0" to 21'-0"	Str.	3 1/2"	1009						
404	4 Series of 3	5'-3" to 6'-11"	122	2'-6" to 4'-2"	1'-0"	10"	49	508	1 Series of 57	21'-10" to 40'-7"	101	2'-3" to 40'-0"	4"	1855	609	1 Series of 36	14'-6"	Str.								
405	2	5'-3"	122	1'-10"	1'-4"		7	509	1 Series of 36	3'-7" to 21'-7"	101	3'-0" to 2'-0"	3 1/2"	735	610	6	11'-3"	Str.								
406	2	6'-1"	122	2'-8"	1'-4"		8	510	32	13'-0"	159	11'-2"	0'-6"	0'-10"	434	611	6	12'-0"	Str.							
451	8	8'-11"	131	2'-6"	1'-2"	2'-10"	48	511	2	6'-0"	108	5'-1"	0'-6"	0'-10"	13	612	6	18'-9"	Str.							
452	8	9'-11"	131	3'-0"	1'-8"	2'-10"	52	512	8	35'-1"	101	34'-6"		293	613	6	19'-6"	Str.								
453	12	9'-5"	131	3'-2"	1'-0"	2'-10"	76	513	3	34'-6"	Str.			108	614	11	34'-9"	Str.								
454	8	5'-7"	155	2'-2"	1'-4"		28	514	1	36'-0"	Str.			38	615	1	36'-0"	Str.								
455	8	6'-4"	155	2'-8"	1'-4"		32	515	28	3'-7"	101	3'-0"		105	616	28	3'-0"	Str.								
456	12	6'-3"	155	2'-10"	1'-4"		52	516	2	3'-2"	108	2'-3"	0'-6"	0'-10"	7	651	8	9'-5"	141	2'-11"	1'-10"					
501	561	40'-0"	Str.				23405	602	491	40'-0"	Str.			29499	652	12	14'-6"	141	5'-3"	3'-0"						
502	208	31'-0"	Str.				6725	603	99	17'-9"	Str.			2639	653	4	5'-0"	Str.								
503	113	16'-0"	Str.				1886	604	1188	29'-6"	Str.			52639												
504	1188	29'-10"	101	29'-3"			36966	605	3 Series of 11	2'-11" to 40'-0"	Str.			4 1/2"	10733											
									2 Series of 45	12'-11" to 27'-9"	Str.			4 1/2"	2749											

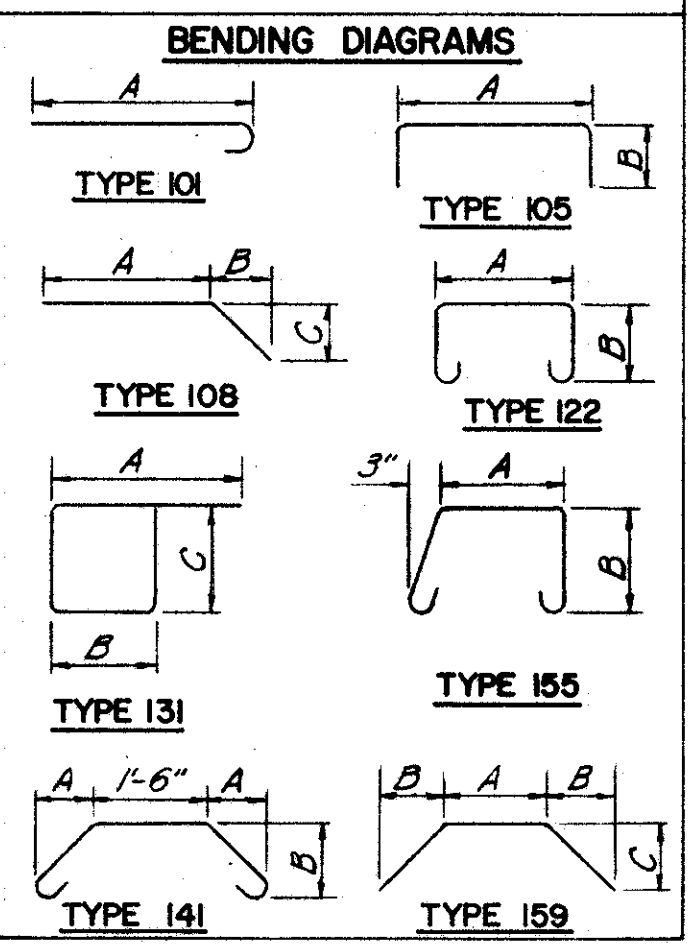

* Bars 451 through 456 and 651 through 653 are for the light supports. For their placement, see sheet 176
† Bars 609, 610, 611, 612 & 613 are included for payment with "Item 5-14, Railing"

Note: All bar dimensions are given out to out.
For Replacement Schedule, see sheet 103-7A


H.N.T.B. BR. NO. 11 PART 7A

HOWARD, NEEDLES, TAMMEN & BERGENDOFF
CONSULTING ENGINEERS
KANSAS CITY CLEVELAND NEW YORK


DECK PLAN
WILLOW FREEWAY OVER REL. WOODLAND AVE.
BR. NO. CUY-21-1544 STA. 34+02.53
Scale: As noted STA. 36+16.47
WILLOW-INNER BELT FREEWAY
CLEVELAND CUYAHOGA COUNTY OHIO

DRAWN: DRA DATE: 11-23-59
TRACED: DATE: 12-3-59
CHECKED: G.A.T. DATE: 11-13-59
REVIEWED: J.C.T. DATE: 11-13-59
SHEET 170


CUYAHOGA COUNTY
CITY OF CLEVELAND
CUY-21-15.32
CUY-42-18.42

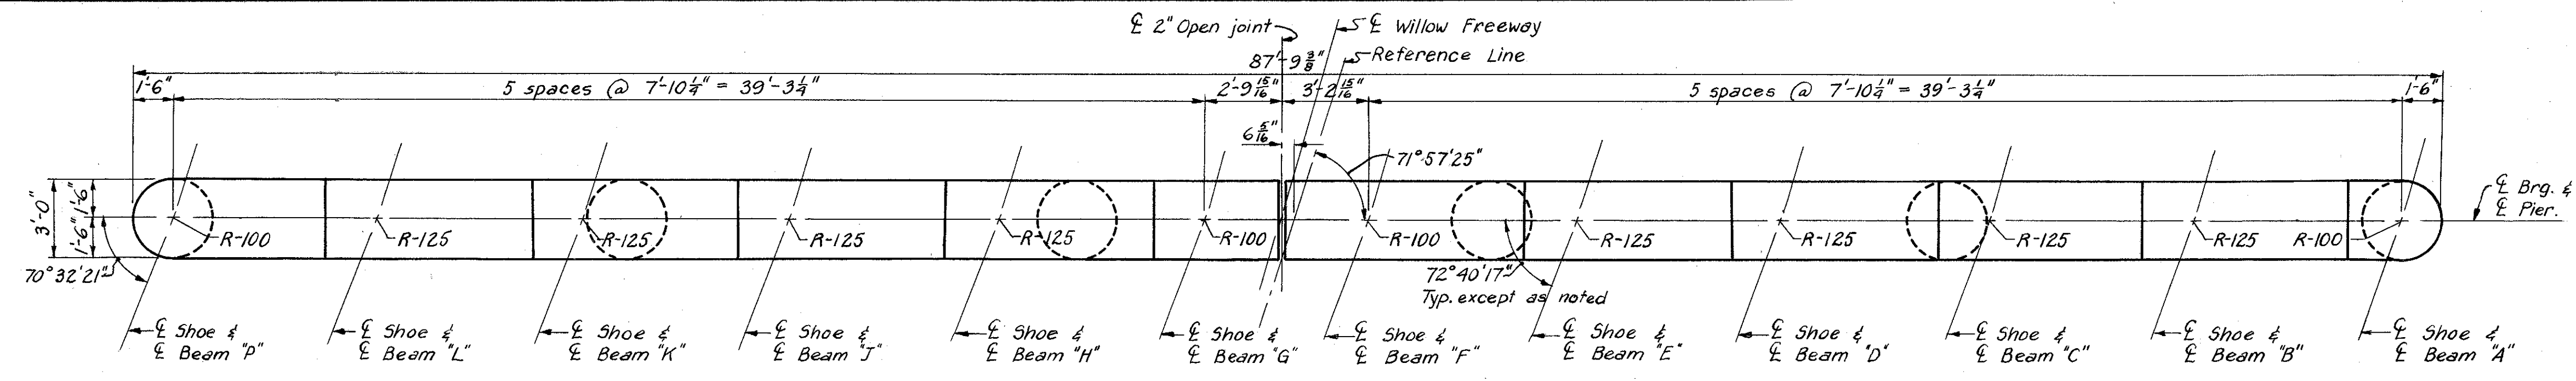


BRIDGE NO. 8 - PIER 1

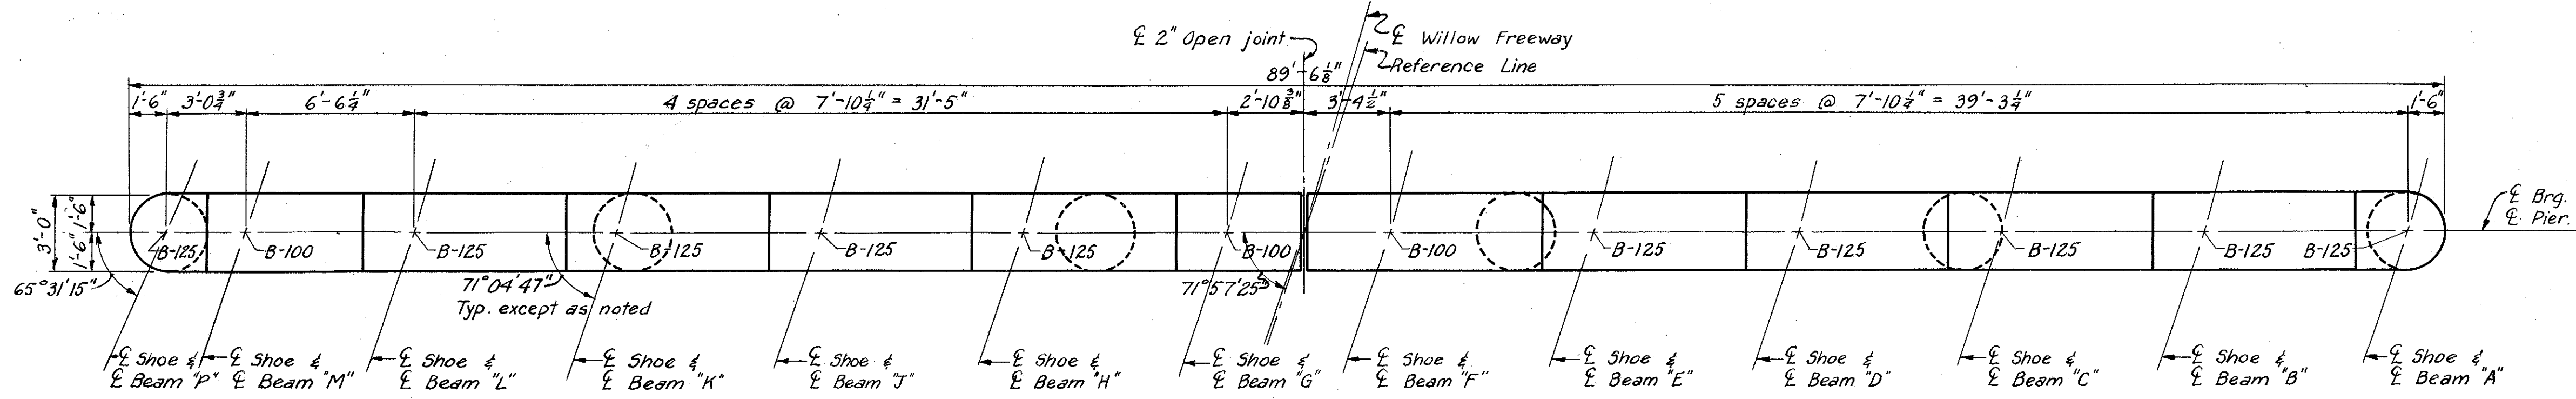


BRIDGE NO. 8 - PIER 2

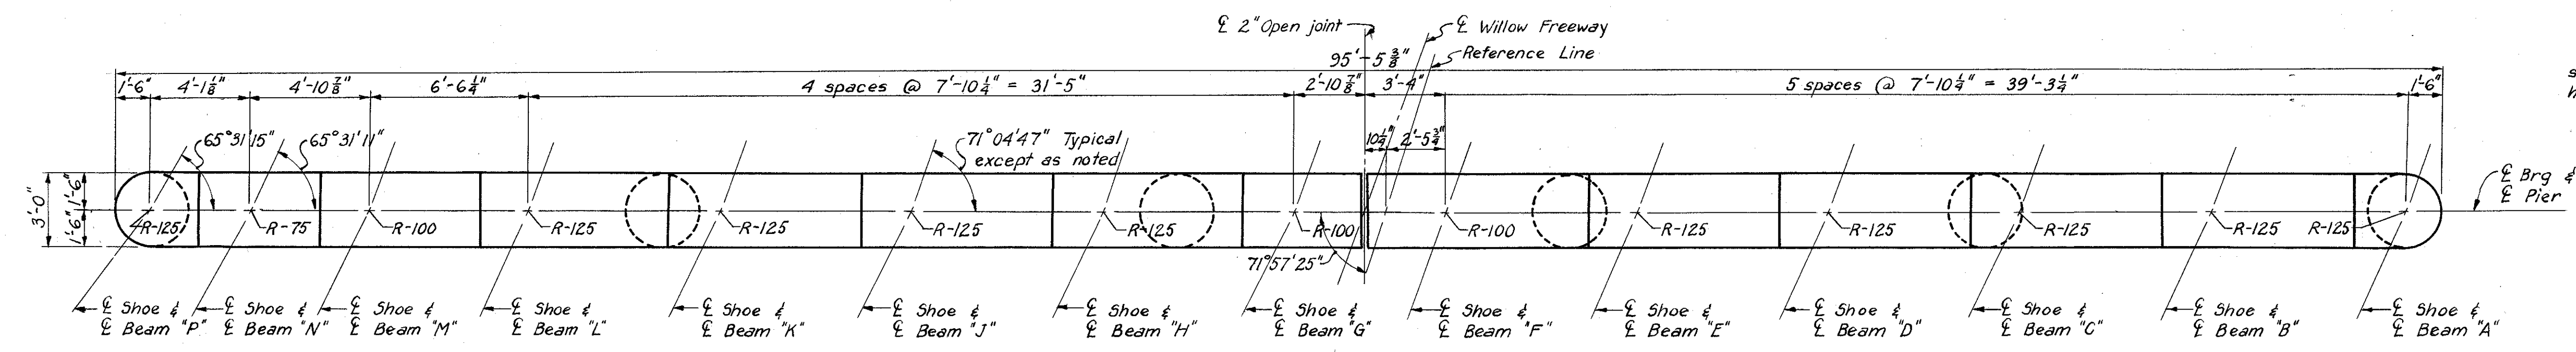


BRIDGE NO. 8 - PIER 3

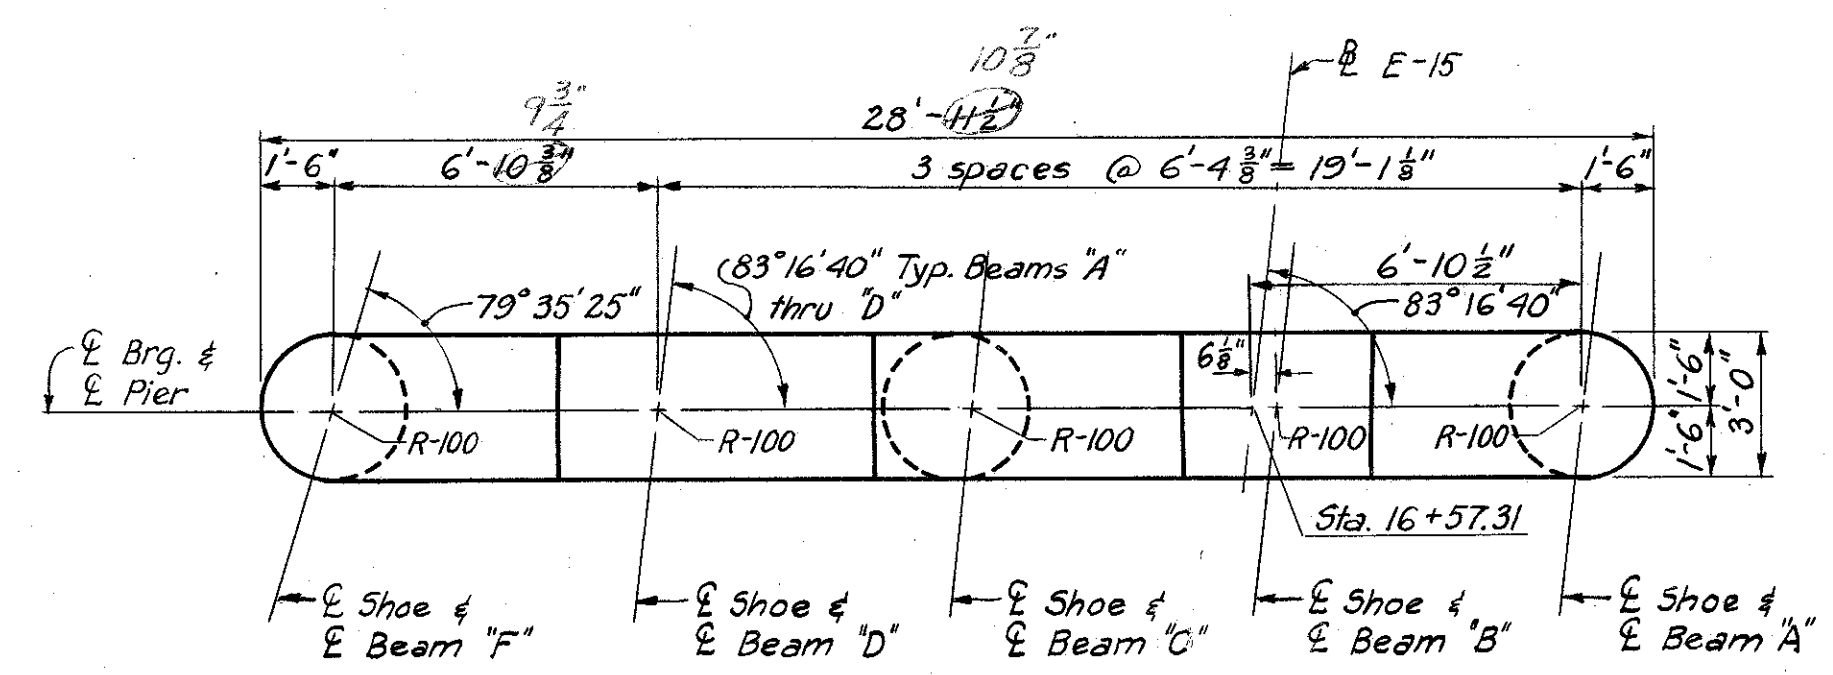


BRIDGE NO. 9 - PIER 1

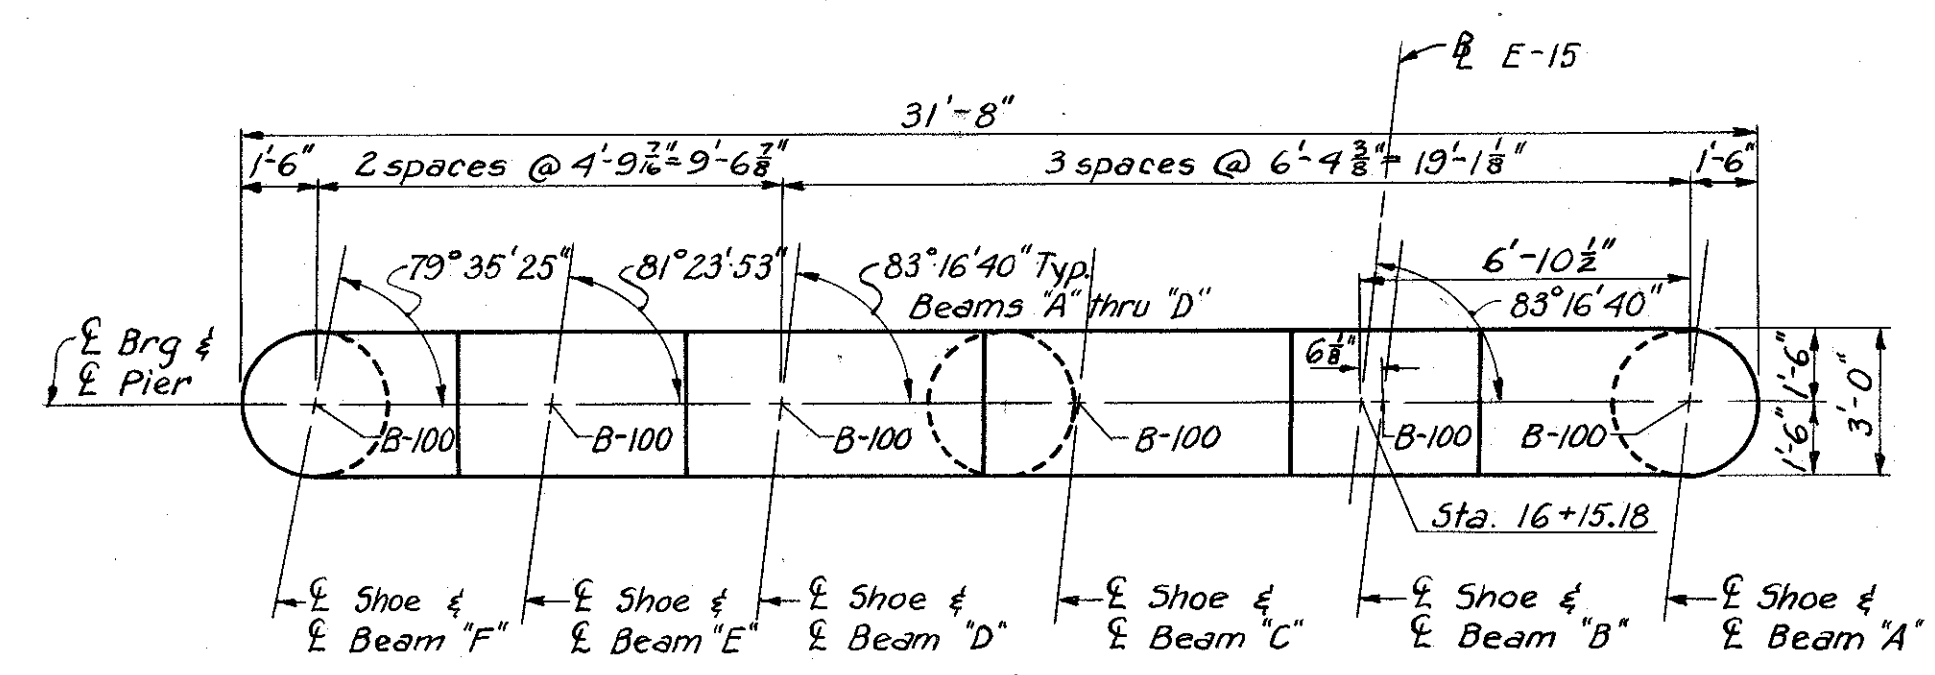

BRIDGE NO. 9 - PIER 2

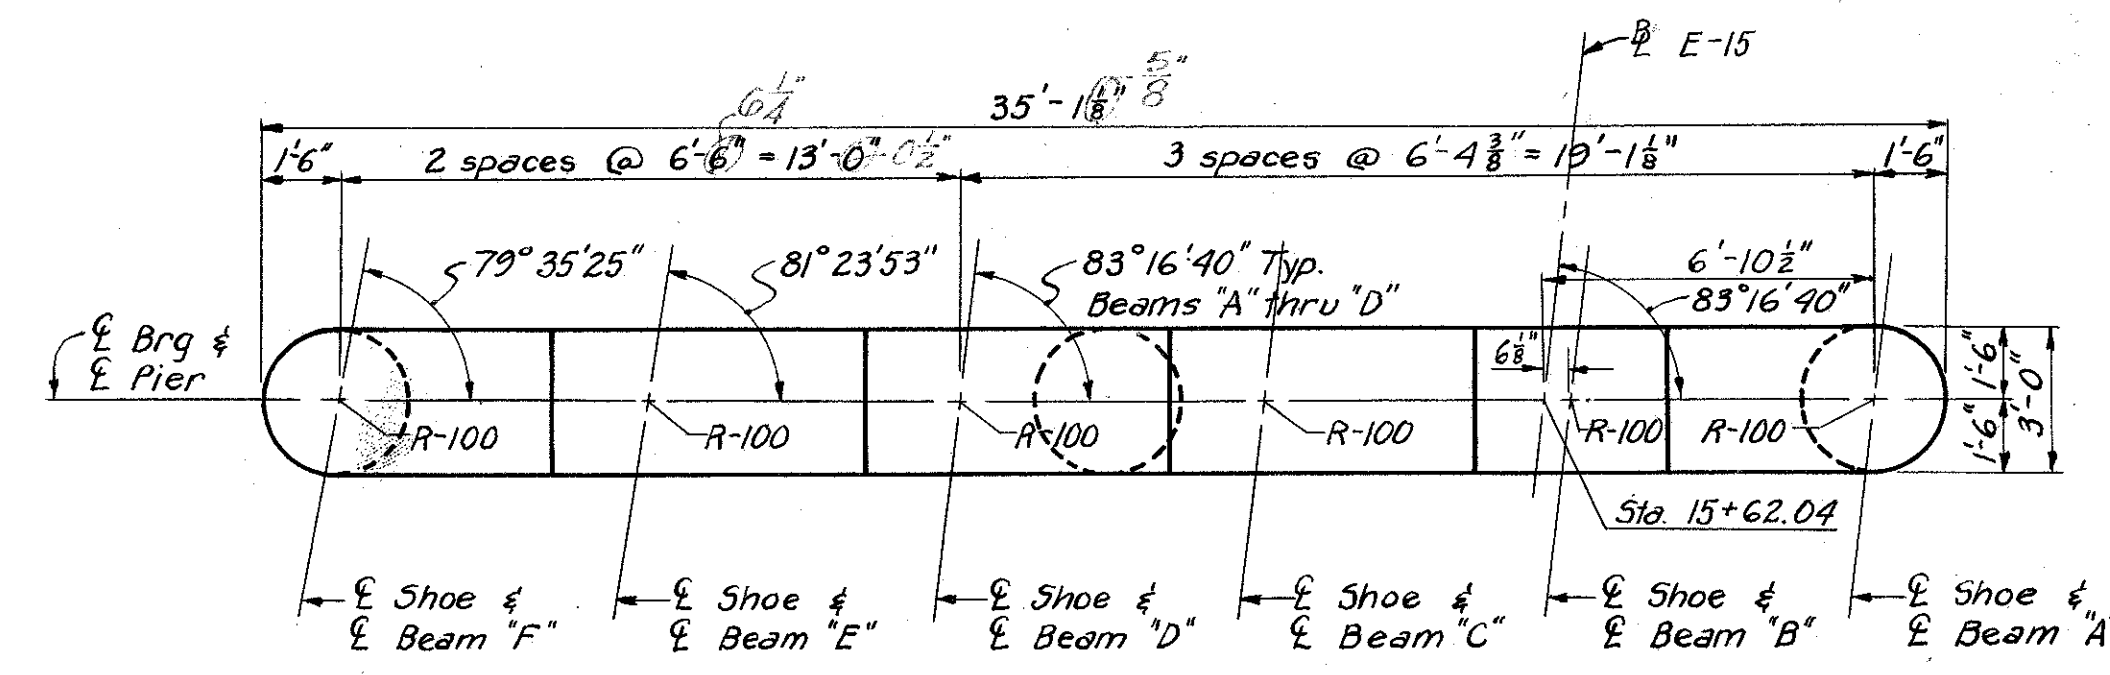

BRIDGE NO. 9 - PIER 3

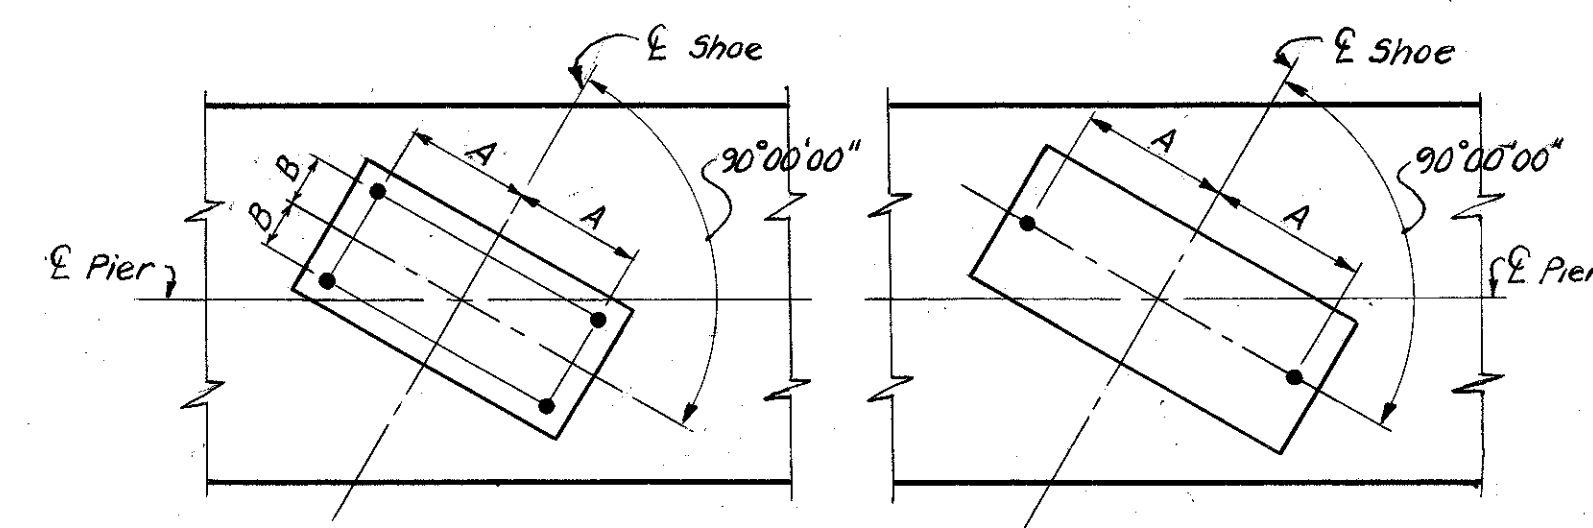

ANCHOR BOLTS ANCHOR BARS

LAYOUT DIAGRAMS

No scale

NOTES:
The anchor bolts and anchor bars and all drainage provisions shall be furnished and set under this contract.
The 4" rigid galvanized conduits were placed and capped 1'-0" above tops of masonry under a previous contract. Connections to service panels shall be included in this contract.
Electrical grounds which extend above top of masonry were placed under a previous contract. These grounds shall be spliced and connected to the superstructure with a No. 6 copper wire bolted to the bottom flange and to the bottom portion of the shoe. Grounds are located in the outside columns as follows:
Bridge No. 4 Pier 2-N45.
Bridge No. 8 Pier 2. Bridge No. 10 Pier 1.
Bridge No. 9 Pier 2. Bridge No. 11 Pier 1.
For drainage details, see Sh. 174-7A
For additional drainage details at Pier 2, Bridge 4, see Sh. 135-7A
For details of 4" rigid galvanized conduit, see Sh. 177-7A
Crossframes or beam/girder flanges will interfere with the setting of anchor bars or anchor bolts at all piers, therefore the holes shall be drilled prior to erection of the interfering member.

TYPE OF SHOE	DIMENSIONS	
	A	B
R-75	9"	
R-100	9 1/2"	
R-125	10"	
B-100	7 1/2"	3"
B-125	8"	3 1/2"

TOP OF MASONRY ELEVATIONS											
BRIDGE NO. 8							BRIDGE NO. 9				
BEAM	PIER 1	PIER 2	PIER 3	BEAM	PIER 1	PIER 2	PIER 3	BEAM	PIER 1	PIER 2	PIER 3
A	692.57	692.21	691.92	H	690.11	689.89	689.62	A	693.35	692.447	690.906
B	692.06	691.83	691.54	J	689.72	689.57	689.24	B	693.49	692.569	690.909
C	691.67	691.44	691.15	K	689.34	689.12	688.85	C	693.37	692.447	690.889
D	691.28	691.06	690.77	L	688.95	688.74	688.47	D	693.24	692.304	690.769
E	690.89	690.67	690.39	M		688.54	688.28	E		692.30	690.70
F	690.63	690.29	690.13	N			688.12	F	693.11	692.1573	690.5016
G	690.61	690.27	689.11	P	688.69	688.27	687.71				

HOWARD, NEEDLES, TAMMEN & BERGENDOFF
CONSULTING ENGINEERS
KANSAS CITY CLEVELAND NEW YORK

PIER CAP PLANS
BRIDGE NOS. 8 & 9


Scale: 1/4"=1'-0"

WILLOW-INNER BELT FREEWAY
CLEVELAND CUYAHOGA COUNTY OHIO

DRAWN A.L. TRACED A.L. CHECKED C.A.B. REVIEWED J.C.T. REVISION 1-23-60
DATE 1-26-59 DATE 1-26-59 DATE 1-29-59 DATE 1-13-59 SHEET 171

JUL 9 1965


CUYAHOGA COUNTY
CITY OF CLEVELAND
CUY-21-15.32
CUY-42-18.42

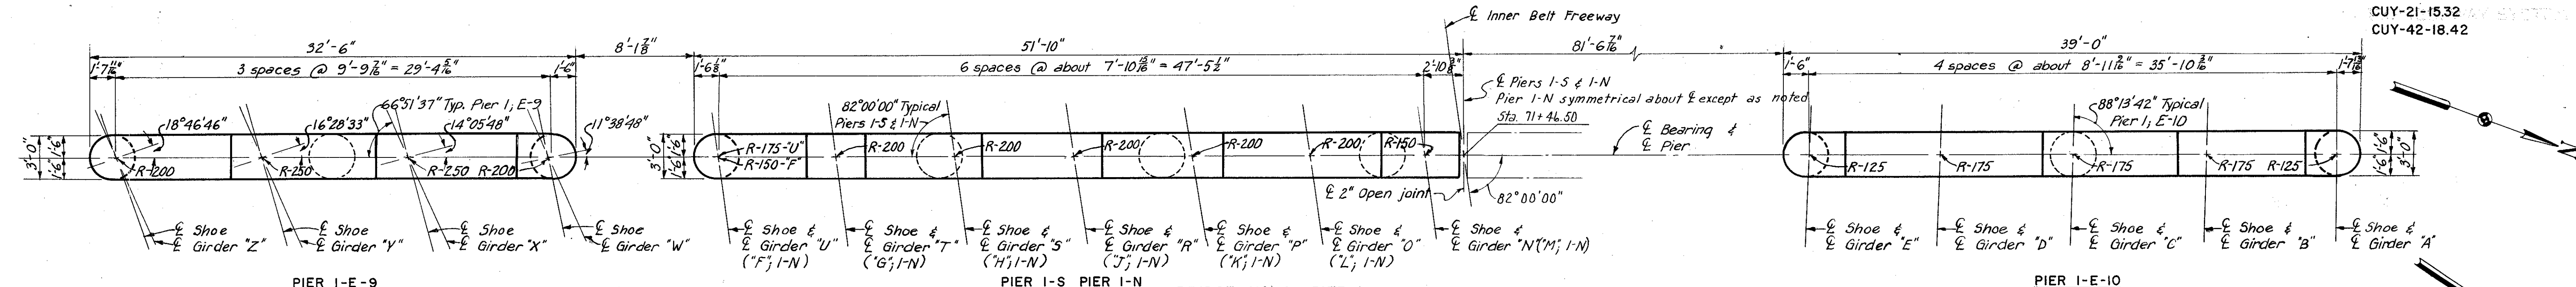

PIER 1-E-9

BRIDGE NO. 4 - PIER 1

PIER 1-E-10

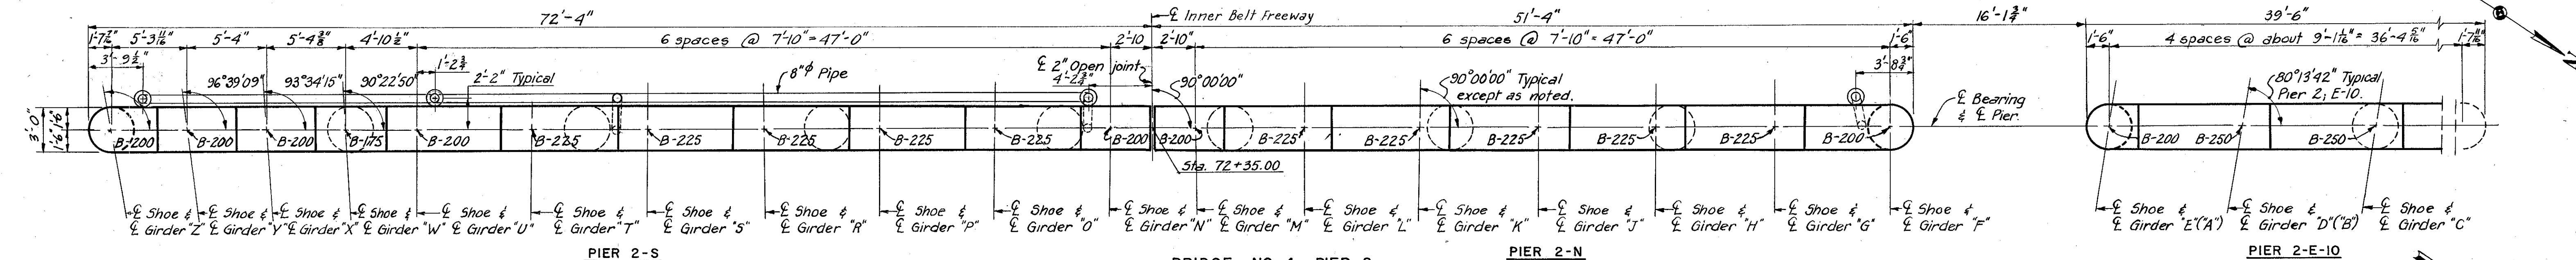


PIER 2-S

BRIDGE NO. 4 - PIER 2

PIER 2-N

PIER 2-E-10

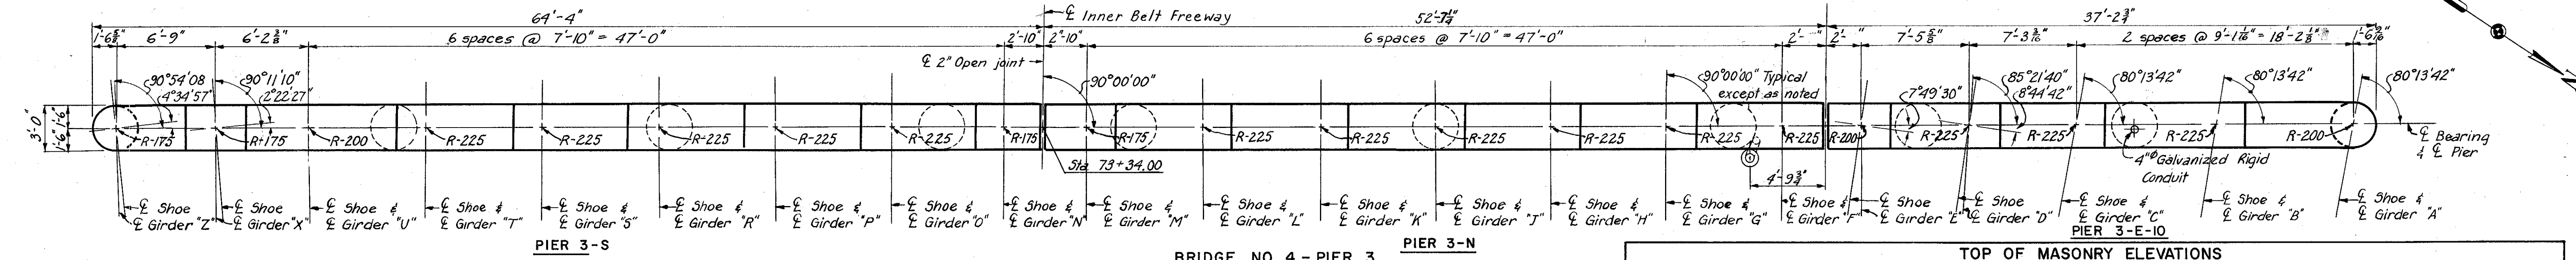


PIER 3-S

BRIDGE NO. 4 - PIER 3

PIER 3-N

PIER 3-E-10

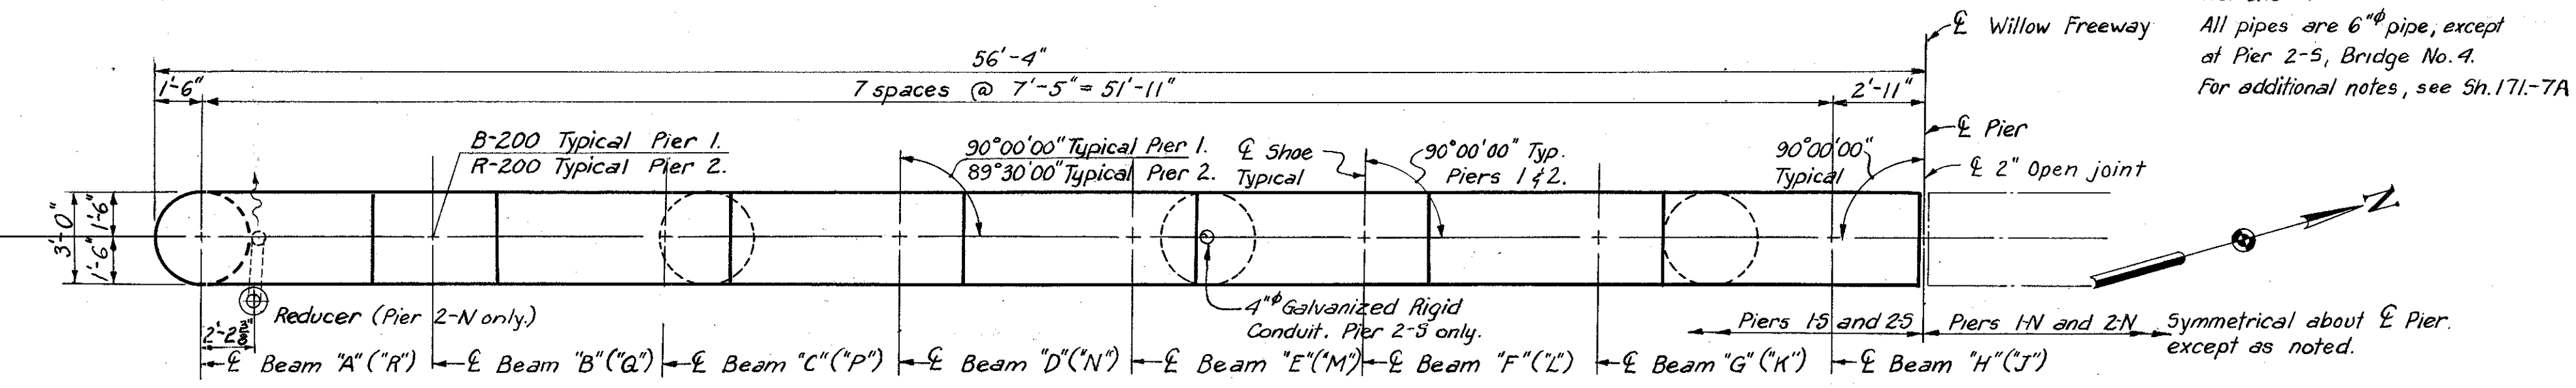

BRIDGE NO. 10 - PIERS 1 & 2
Scale: 1/4" = 1'-0"

⊙ - Indicates 6x12" reducer
(-) - Indicates similar girder not shown.
All pipes are 6" pipe, except at Pier 2-S, Bridge No. 4.
For additional notes, see Sh. 171-7A

TOP OF MASONRY ELEVATIONS											
BRIDGE NO. 4											
GIRDER	PIER 1	PIER 2	PIER 3	GIRDER	PIER 1	PIER 2	PIER 3	GIRDER	PIER 1	PIER 2	PIER 3
A	687.26	686.13	683.43	J	690.92	687.92	684.36	S	691.92	688.18	684.23
B	686.93	686.07	683.53	K	691.10	688.04	684.48	T	692.02	688.13	684.11
C	686.86	686.15	683.67	L	691.28	688.17	684.60	U	691.94	688.25	684.03
D	686.79	686.25	683.79	M	691.78	688.33	684.87	W	690.86	687.91	
E	687.00	686.47	683.94	N	691.81	688.34	684.87	X	690.35	687.59	684.04
F	690.69	687.59	683.99	O	691.61	688.27	684.60	Y	689.94	687.46	
G	690.56	687.68	684.11	P	691.71	688.24	684.48	Z	689.66	687.28	683.94
H	690.74	687.80	684.23	R	691.82	688.21	684.36				

BRIDGE NO. 10				BRIDGE NO. 11				
BEAM	PIER 1	PIER 2	BEAM	PIER 1	PIER 2	BEAM	PIER 1	PIER 2
A	692.38	693.06	J	692.05	692.19	A	688.23	688.57
B	692.67	693.35	K	691.89	691.95	B	688.50	688.84
C	692.63	693.28	L	691.73	691.71	C	688.67	689.00
D	692.51	693.02	M	691.57	691.47	D	688.74	689.08
E	692.40	692.81	N	691.41	691.23	E	688.82	689.15
F	692.28	692.60	P	691.25	690.99	F	688.90	689.23
G	692.17	692.39	Q	691.09	690.75	G	688.97	689.31
H	692.05	692.19	R	690.93	690.51	H	689.05	689.38

For layout diagrams, see Sh. 171-7A

TYPE OF SHOE	DIMENSIONS	
	A	B
R-125	10"	
R-150	11"	
R-175	11 1/2"	
R-200	12"	
R-225	12 1/2"	
R-250	13"	
B-175	9 1/2"	5"
B-200	10"	6"
B-225	10 1/2"	6 1/2"
B-250	11"	7"

HOWARD, NEEDLES, TAMMEN & BERGENOFF
CONSULTING ENGINEERS
KANSAS CITY CLEVELAND NEW YORK

PIER CAP PLANS
BRIDGE NOS. 4, 10 & 11



Scale: 3/16" = 1'-0" Except as noted

WILLOW - INNER BELT FREEWAY
CLEVELAND CUYAHOGA COUNTY OHIO

DRAWN A.L. TRACED A.L. CHECKED C.H.B. REVIEWED J.C.T. REVISIONS
DATE 1-29-59 DATE 1-29-59 DATE 1-30-59 DATE 1-13-59





PART 7A
SHEET 172

Note: Roadway and curb joints shall be shop assembled, corrected to provide uniform close contact between the two mating parts of each joint, match-marked and erected to required lines and grades. Omit shop coat on all portions of end dams. Portions in contact with steel or concrete shall not be painted. All other portions shall be cleaned and given the shop coat in the field as well as the two field coats. All sliding contact surfaces of the expansion joint materials shall not be painted and shall be lubricated with flake graphite prior to placing of backwall concrete.



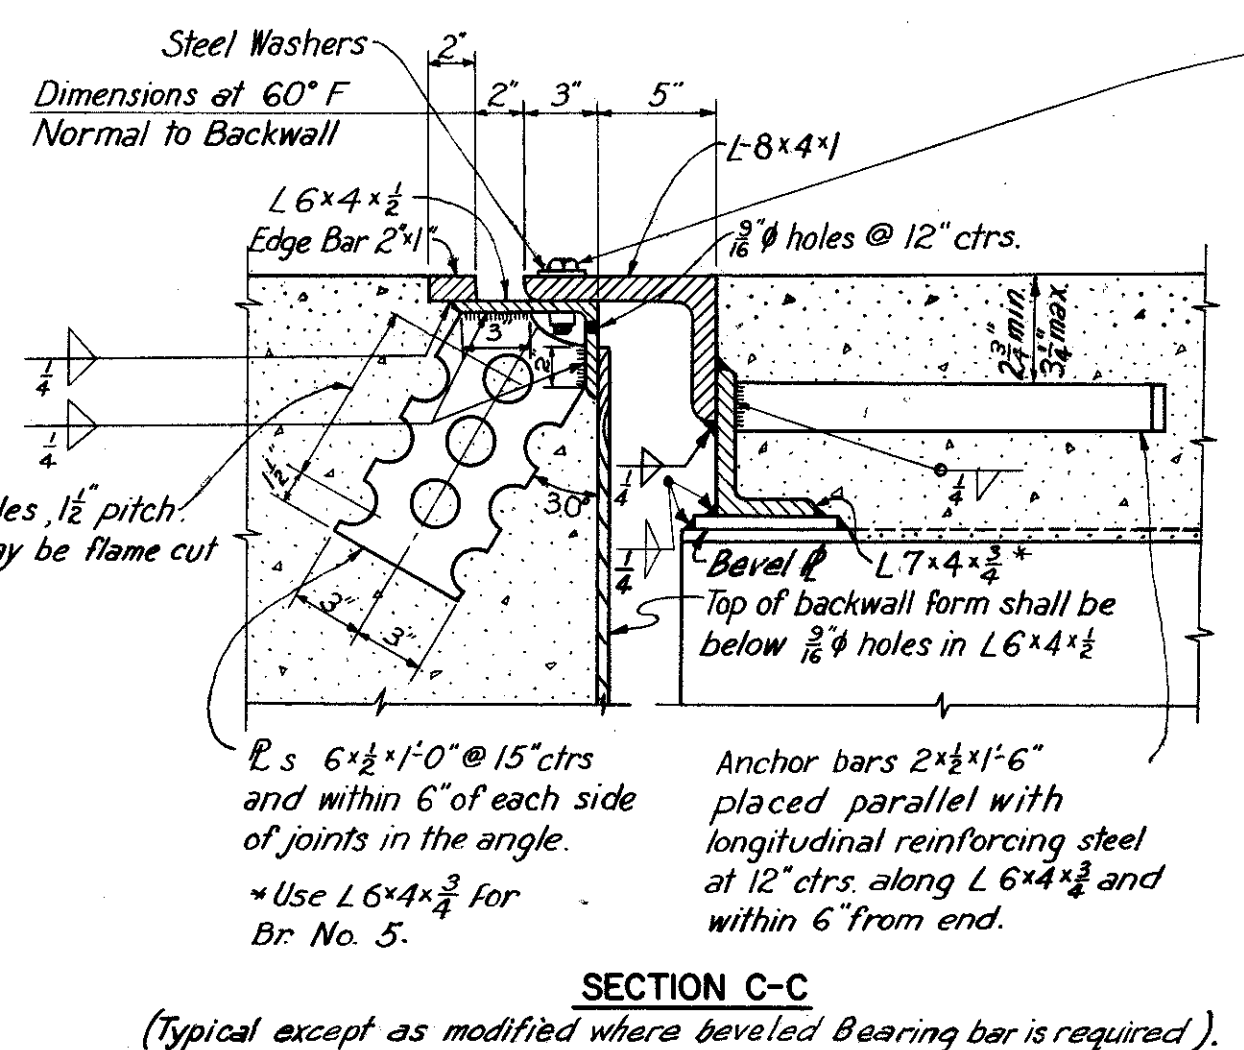
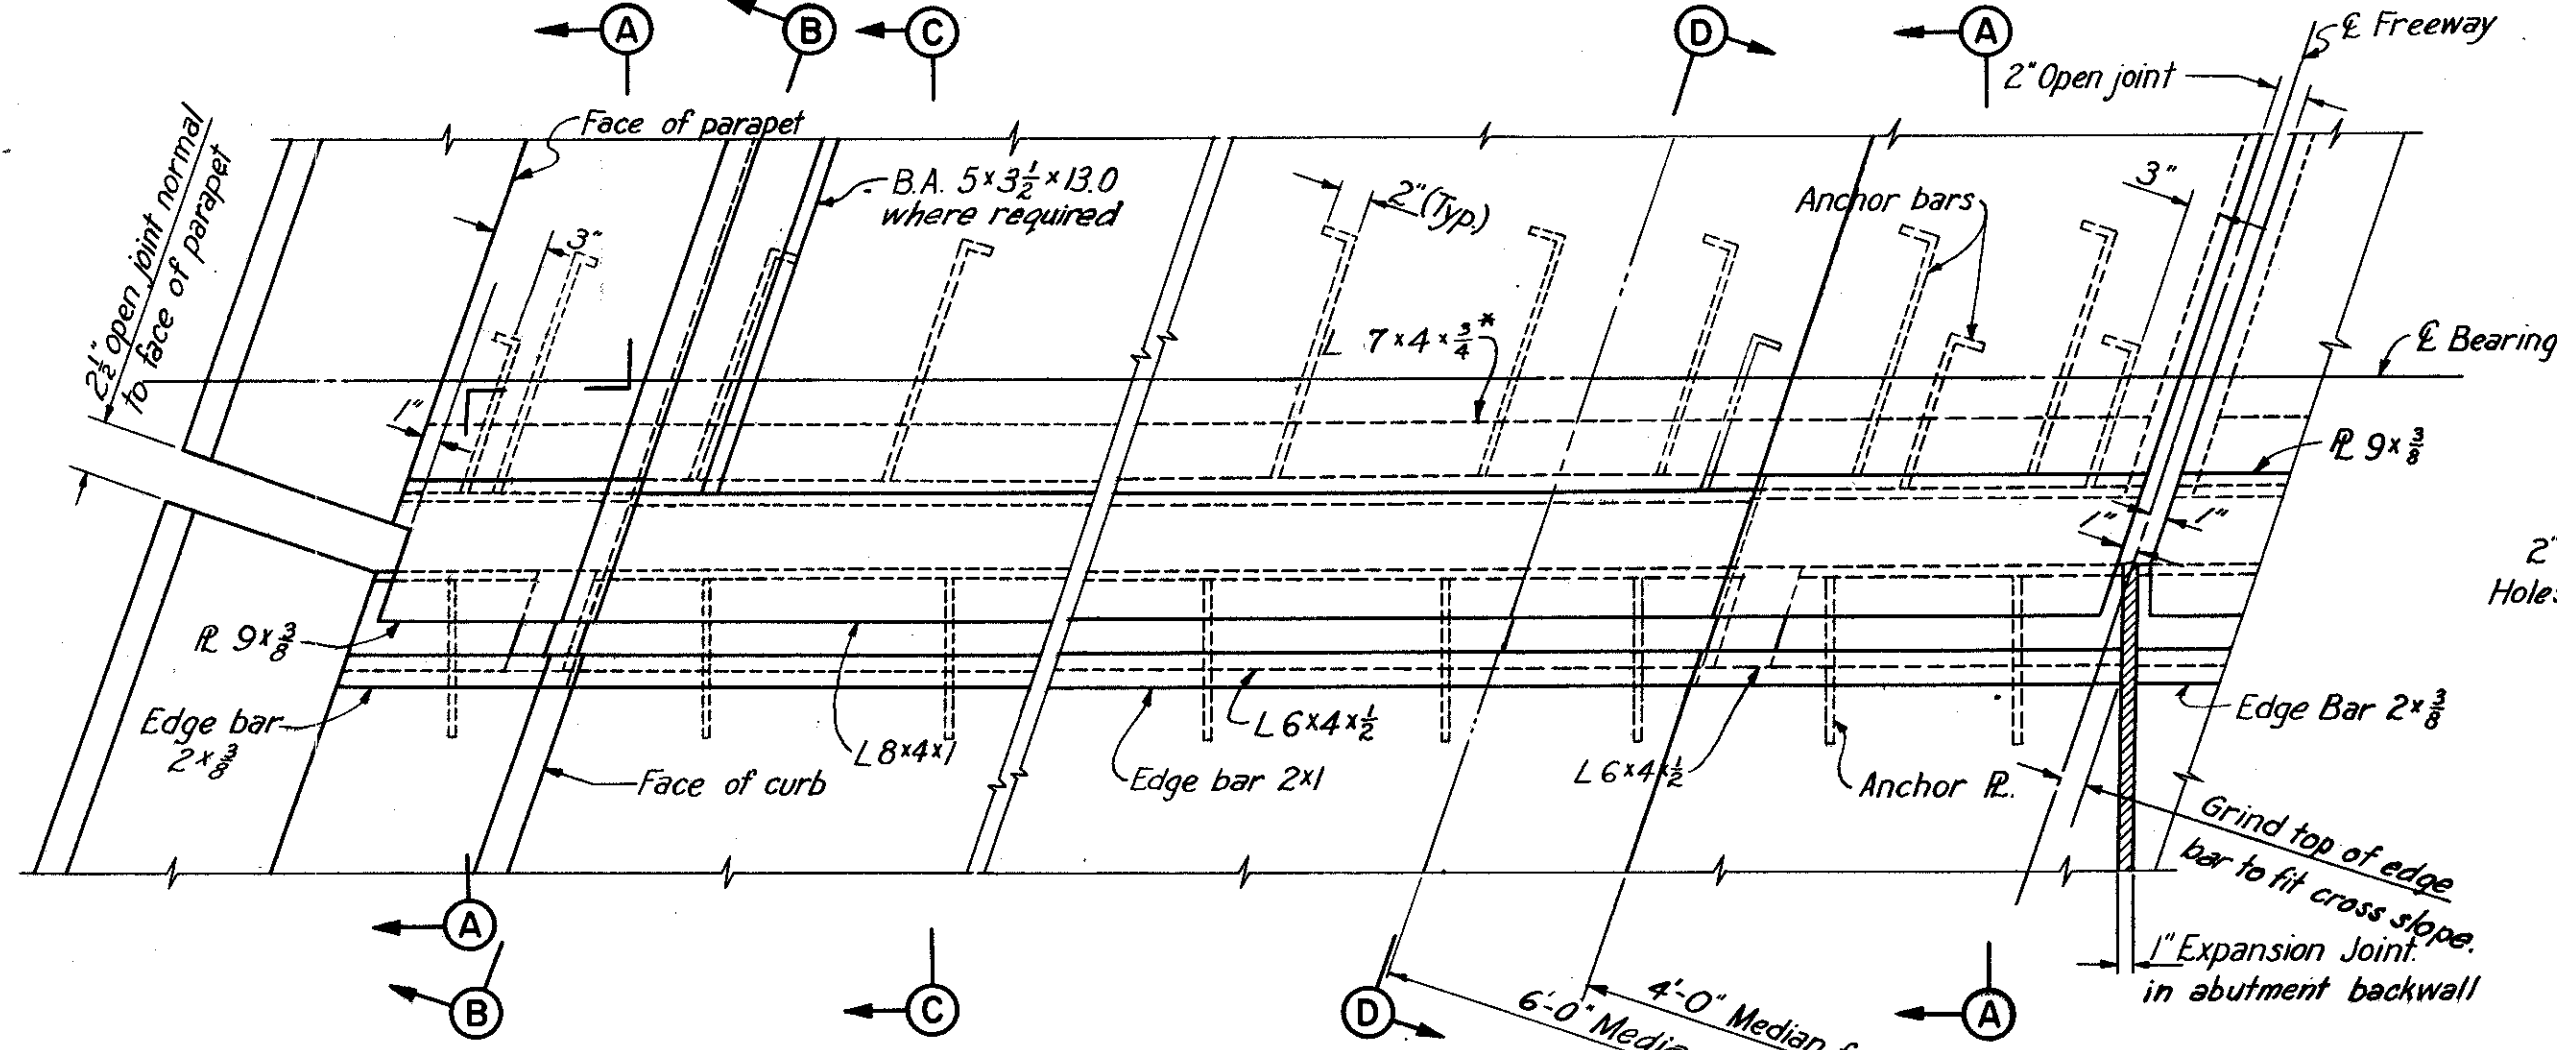


$\frac{5}{8}$ " x 2" bolts at not more than 2'-0" ctrs with nuts tack-welded to under side of lower angle. Holes to be $\frac{1}{8}$ " in upper angle. Center $\frac{5}{8}$ " bolts in $\frac{1}{8}$ " holes. Apply flake graphite between washers and angles. Turn bolts tight and release one-half turn. Remove bolts as soon as concrete has reasonably set preferably within 2 hours after placing. Fill holes with bituminous material.

Note: A welded butt joint shall be provided at the apex of the 5'-0" rounding for that portion of the end dam attached to the superstructure of Bridges No. 3, 4, 5, 9, 10 & 11. (See detail of Welded Butt Joint). The portion attached to the backwall shall be placed in segments not less than 6'-0" in length with a joint at the apex of the 5'-0" rounding and at all abutment contraction joints. These shall be closely butted but shall not be welded. Beveled bearing bars shall be used for end dams at the following locations only:
1. Bridge No. 4, East and West Abutments
2. Bridge No. 9, Abutment E-15
See detail of Beveled Bearing Bar.

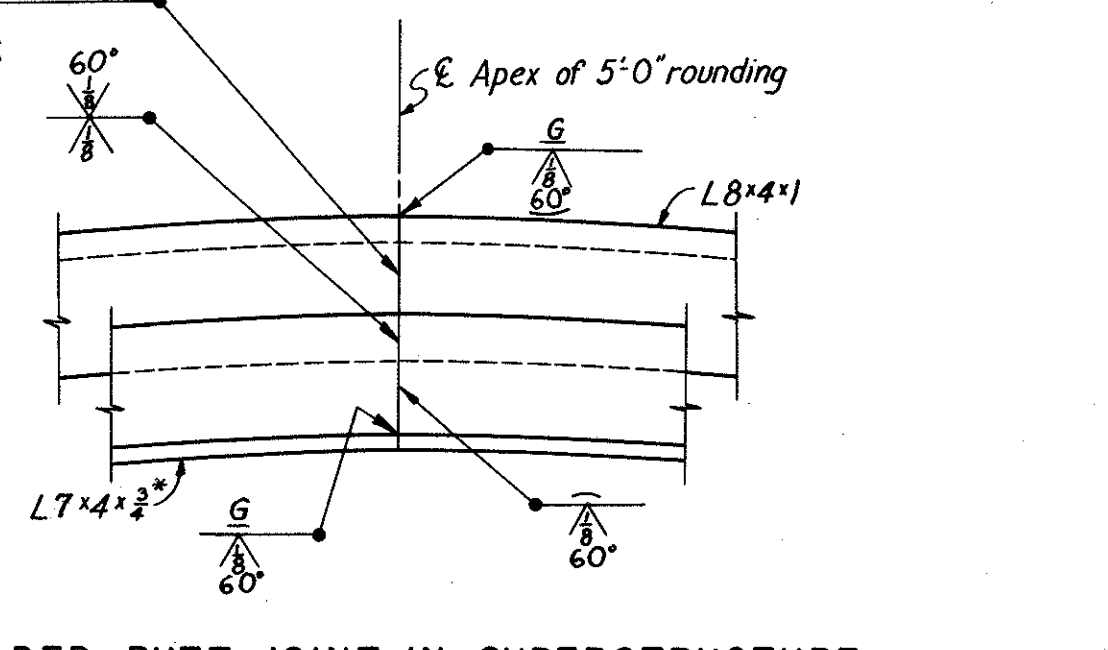
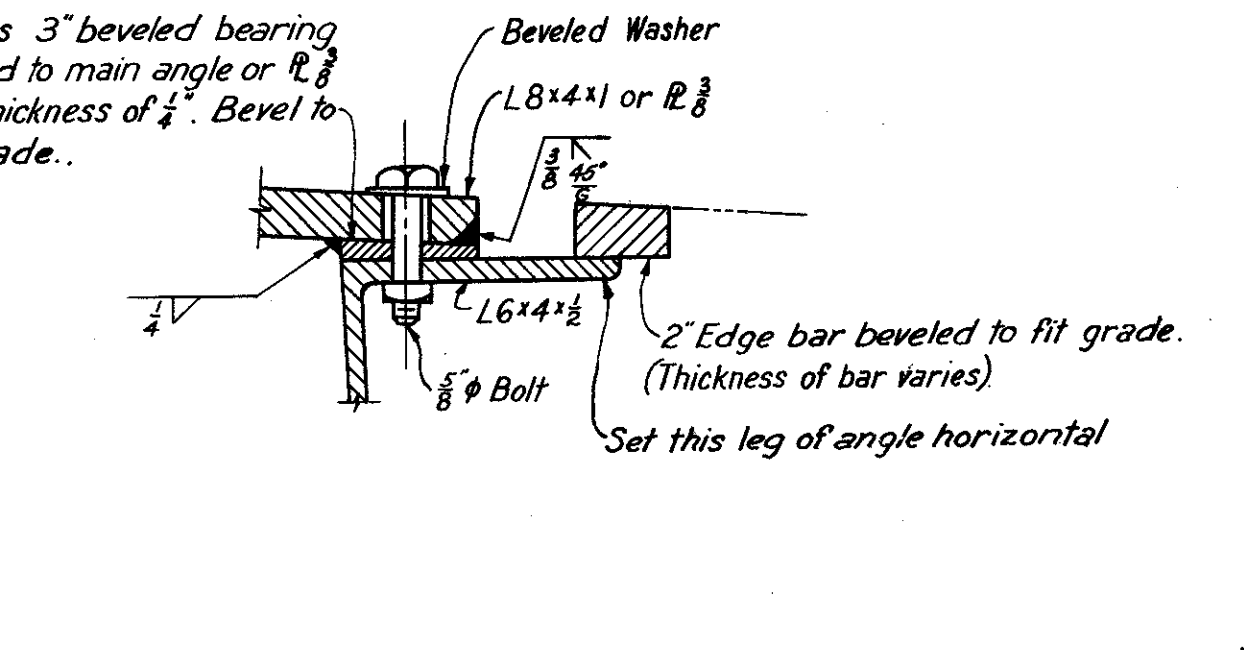
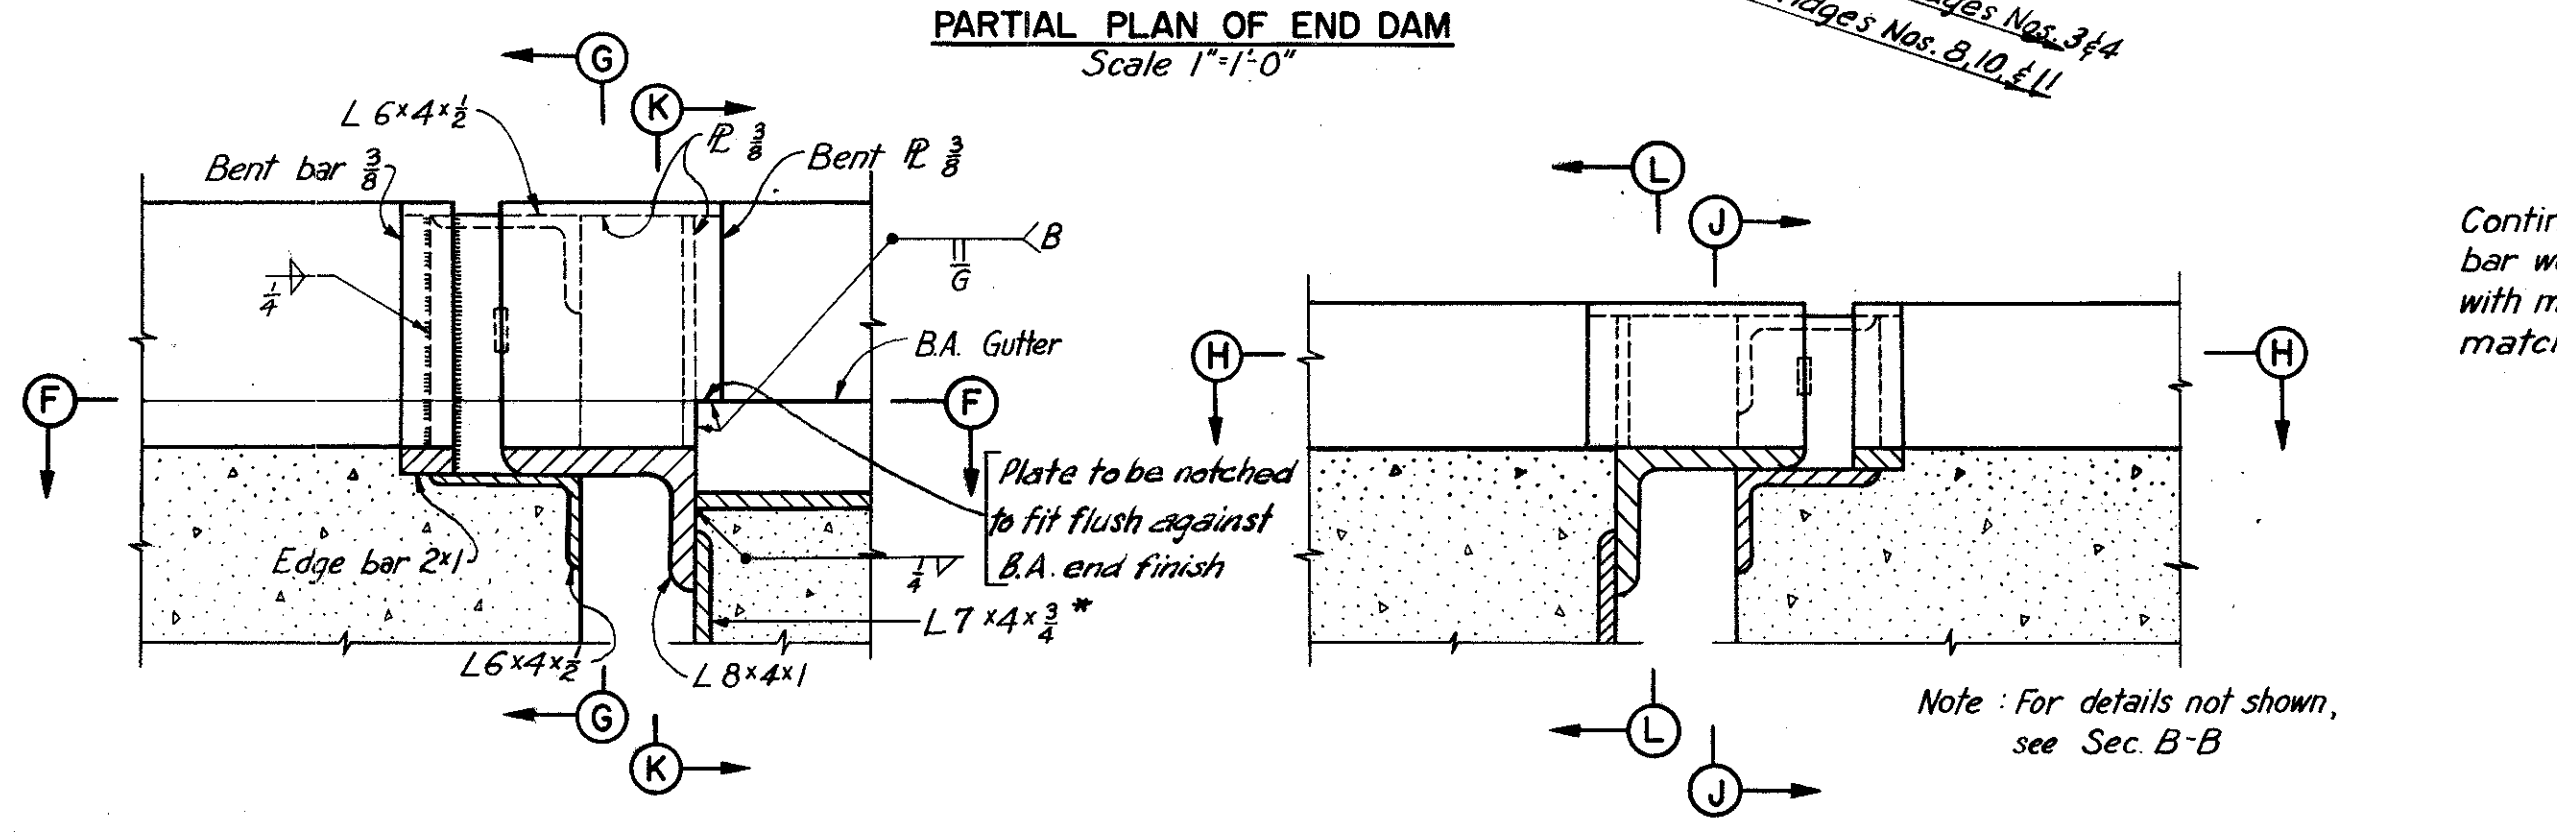
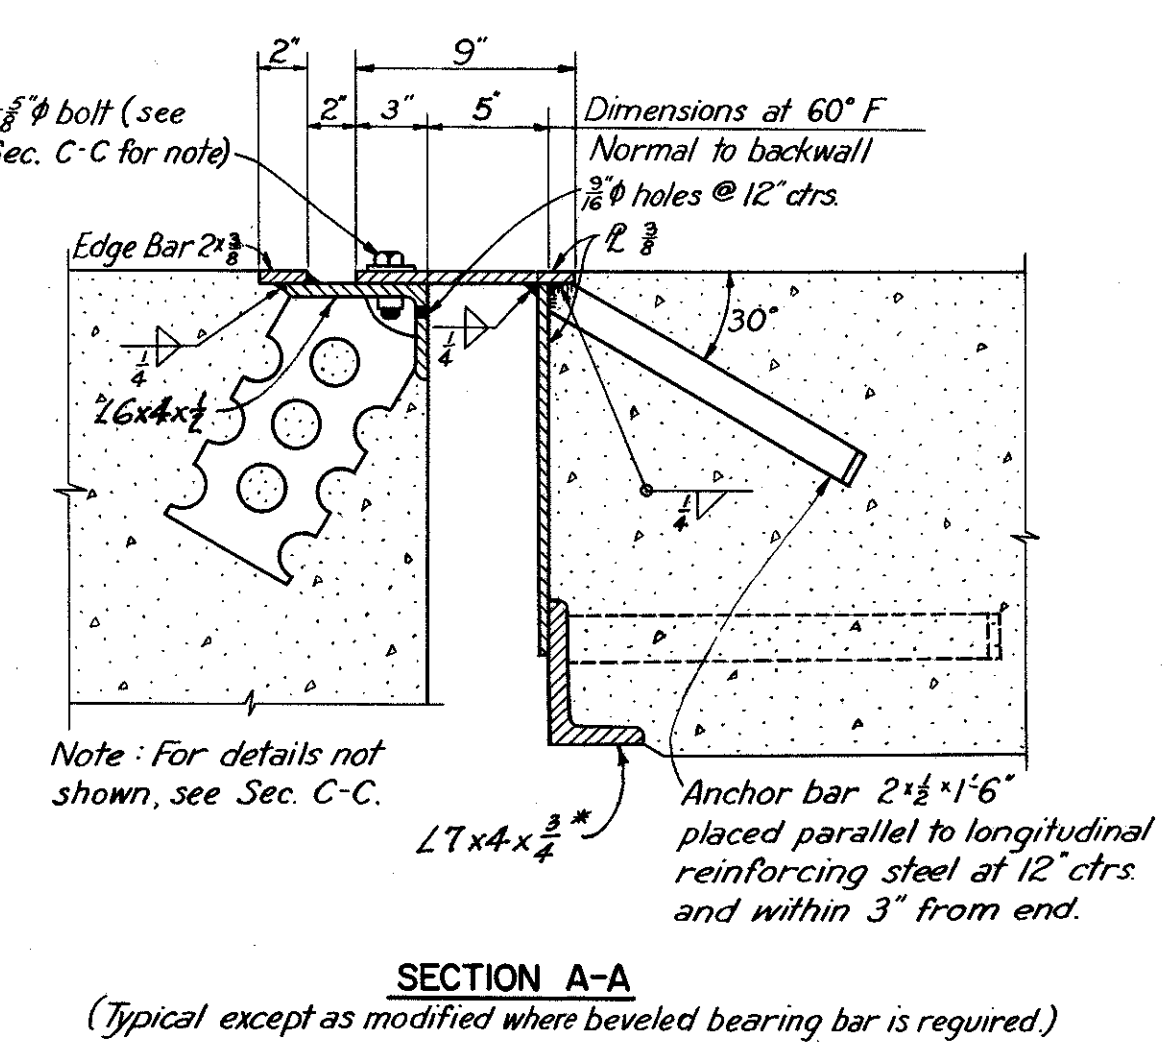


Note: All end dam steel shall be included with Item 5-7, Structural Steel for payment.

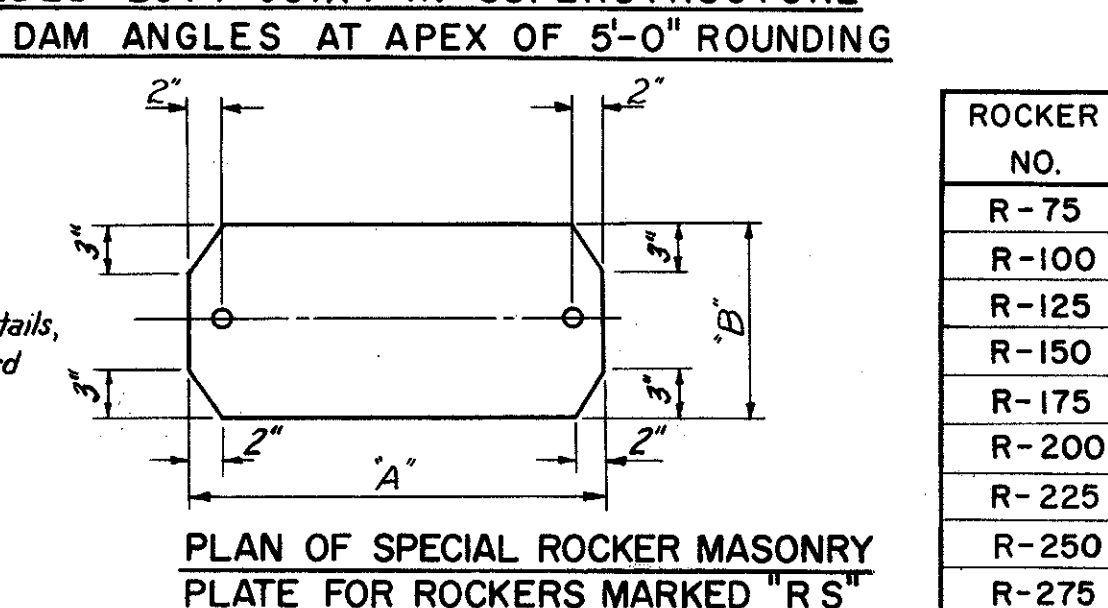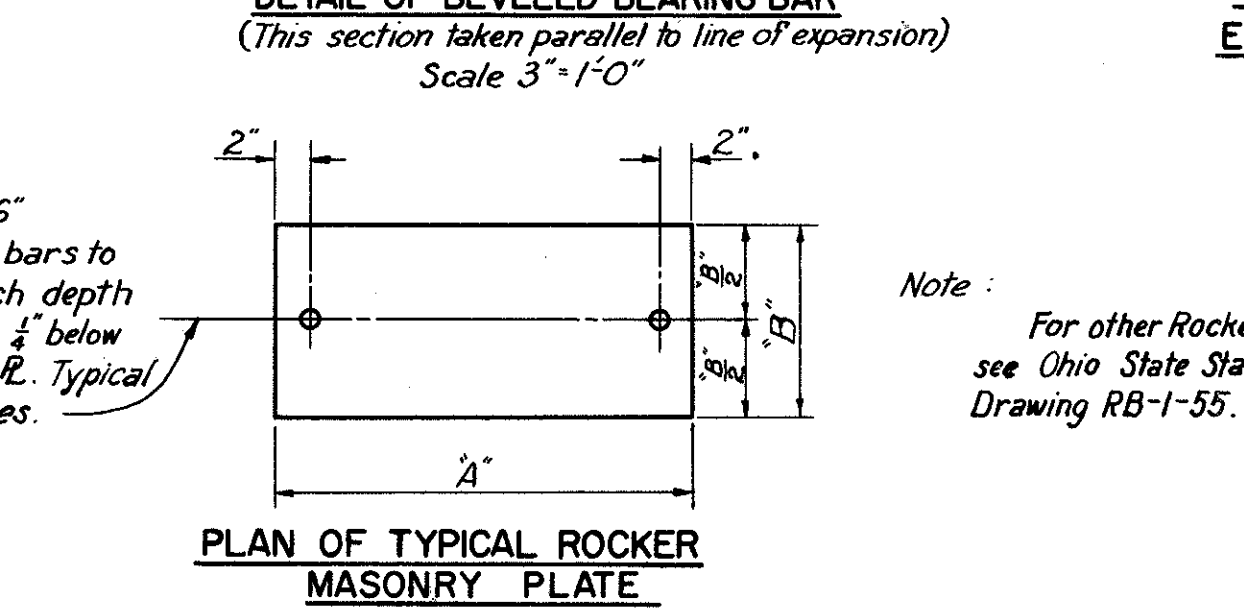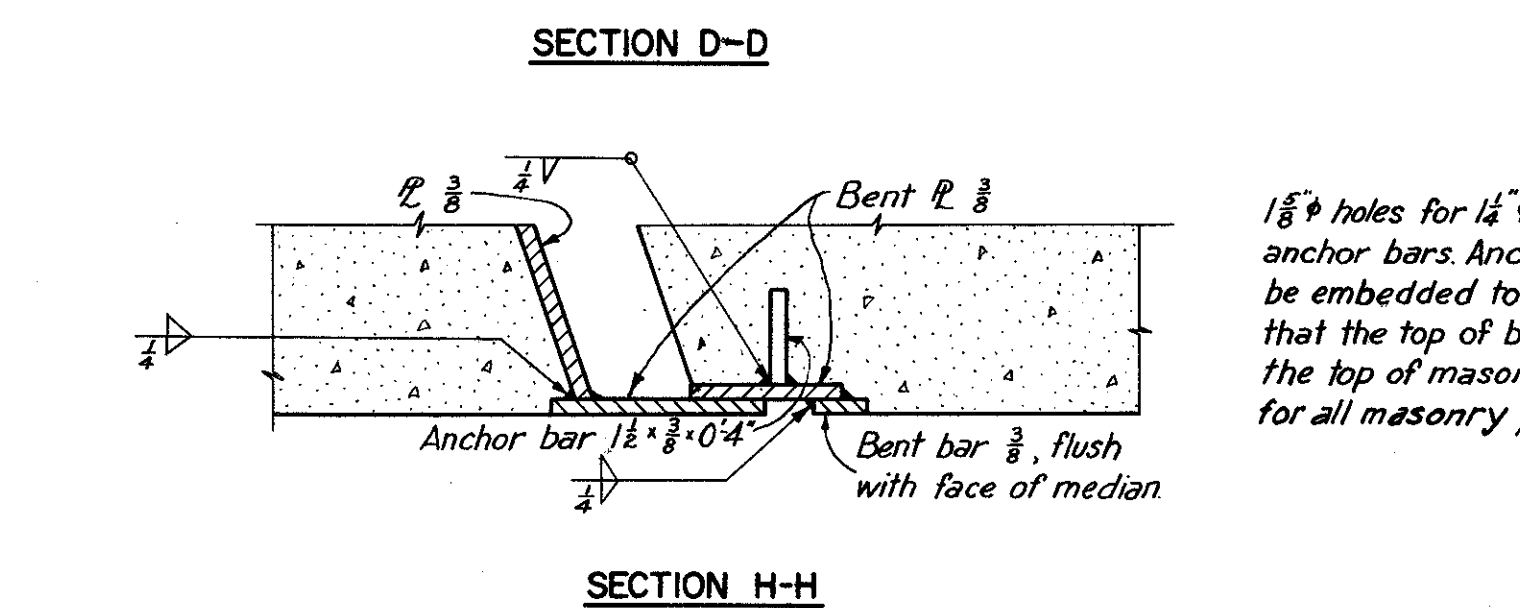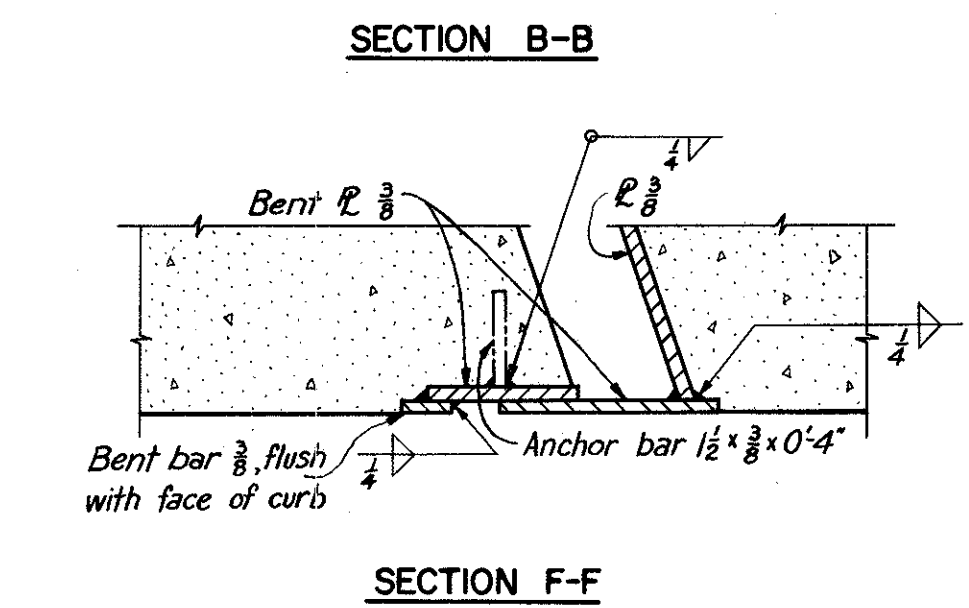

ROCKER NO.	DIMENSIONS	
	A (in.)	B (in.)
R-75	22	8
R-100	23	10
R-125	24	11
R-150	26	12
R-175	27	14
R-200	28	16
R-225	29	17
R-250	30	18
R-275	31	19
R-300	32	20

Note: Details for Rockers marked 'RS' are the same as for Rockers marked 'R'.

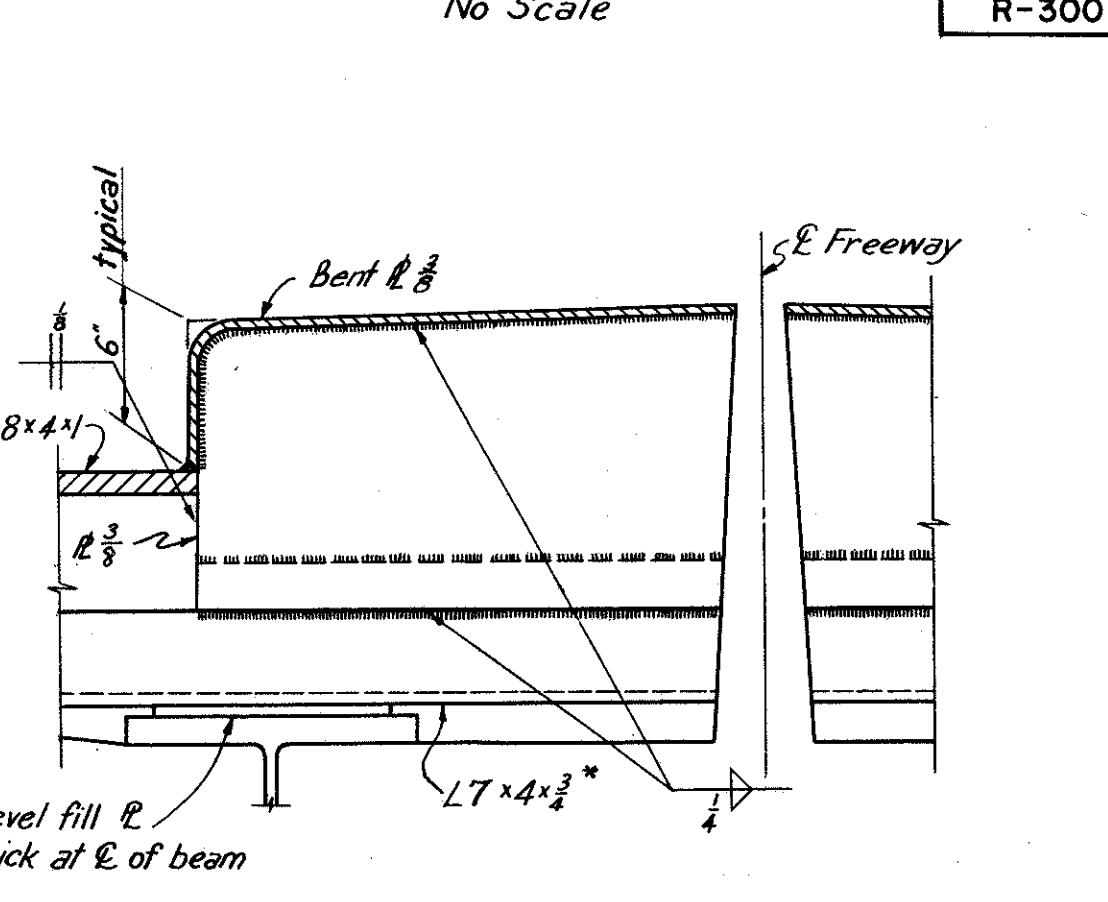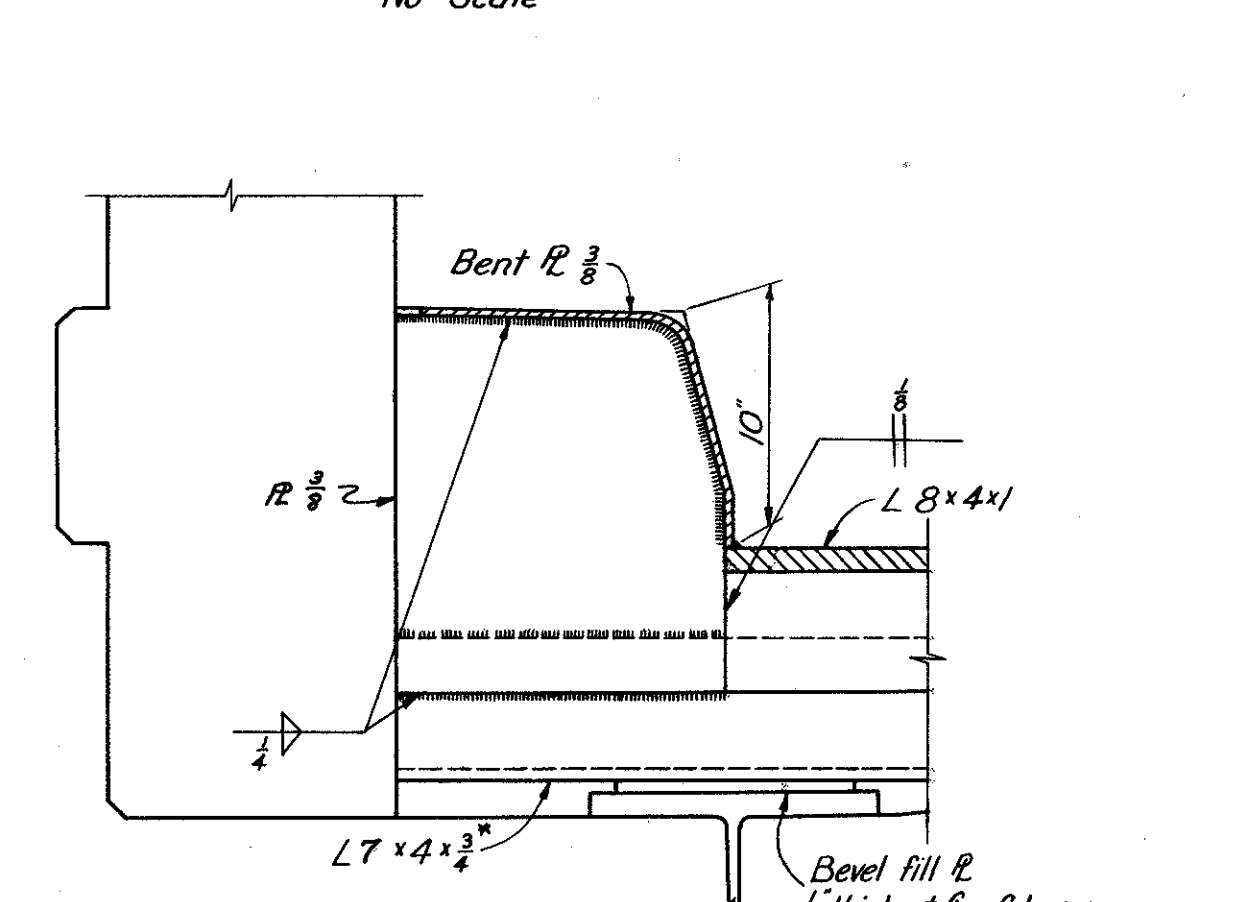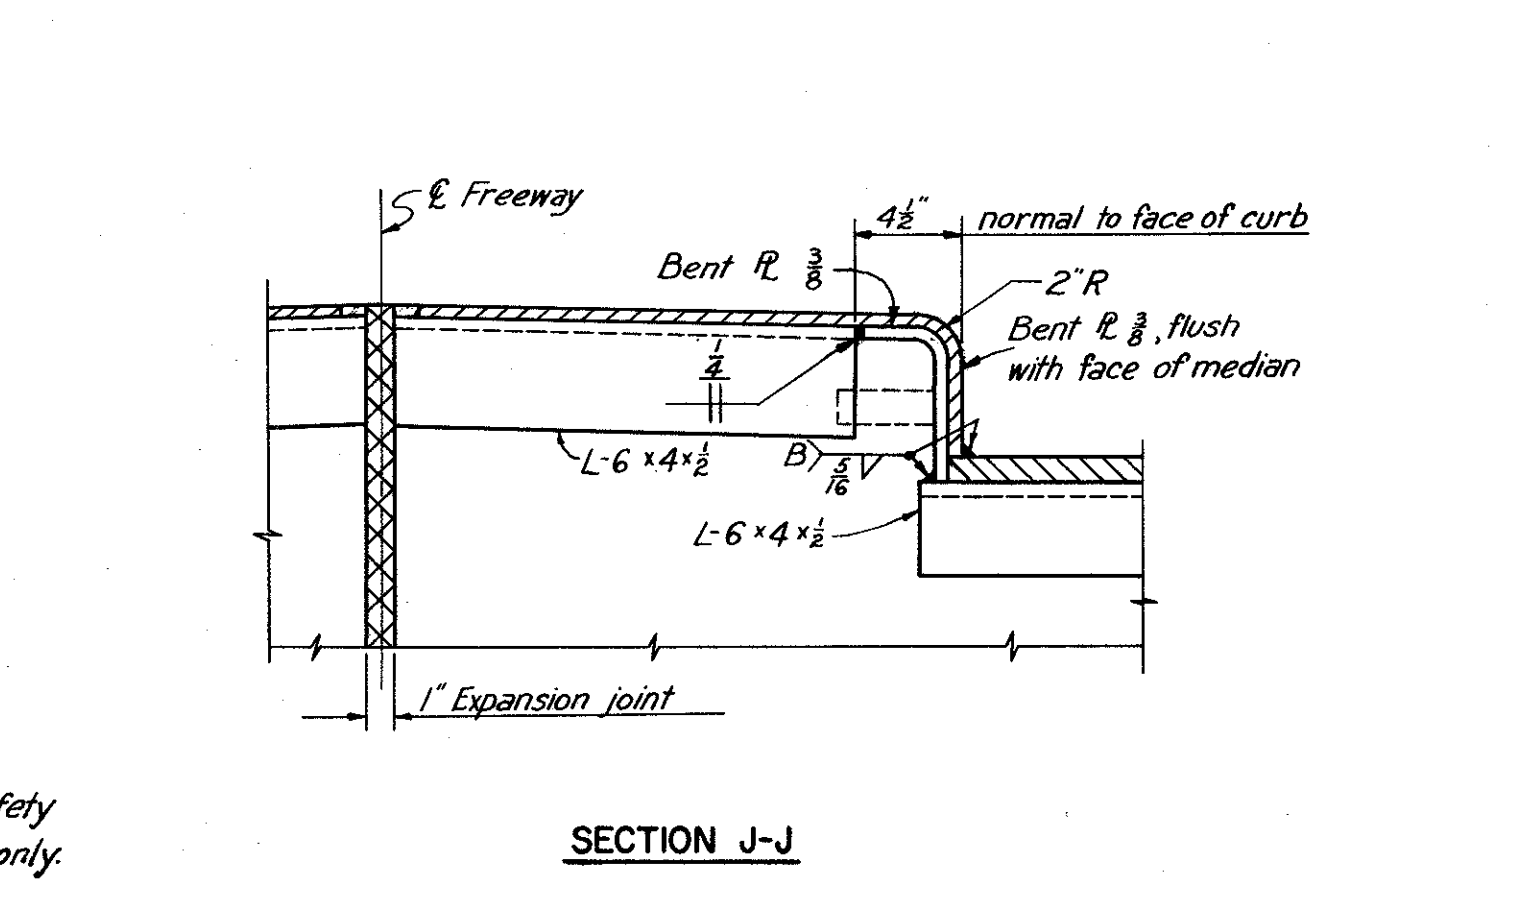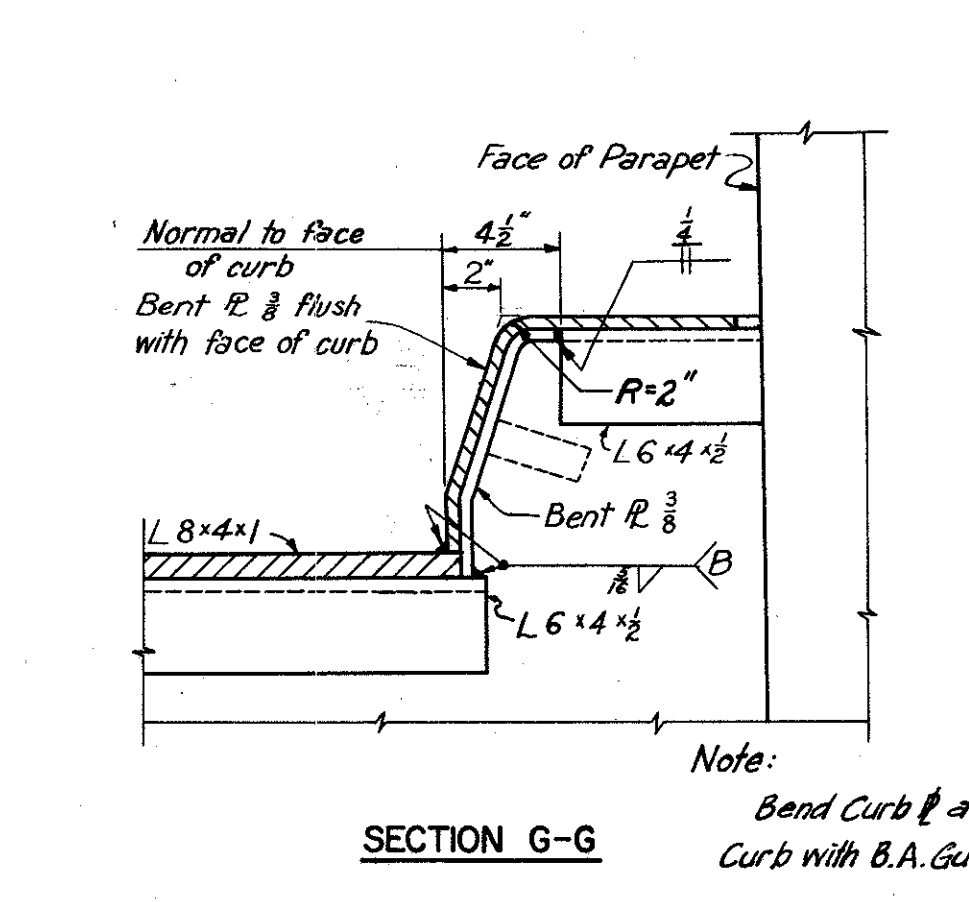

PART 7A

HOWARD, NEEDLES, TAMMEN & BERGENOFF
CONSULTING ENGINEERS
KANSAS CITY CLEVELAND NEW YORK

END DAM DETAILS






Scale: 1 1/2" = 1'-0" Except as noted

WILLOW-INNER BELT FREEWAY


CLEVELAND CUYAHOGA COUNTY OHIO

DRAWN FLC TRACED RJK CHECKED J.J. REVIEWED JCT REVISIONS
DATE 11-24-58 DATE 11-26-58 DATE 12-5-58 DATE 11-13-59 SHEET 173


CUYAHOGA COUNTY
CITY OF CLEVELAND
CUY-21-15.32
CUY-42-18.42

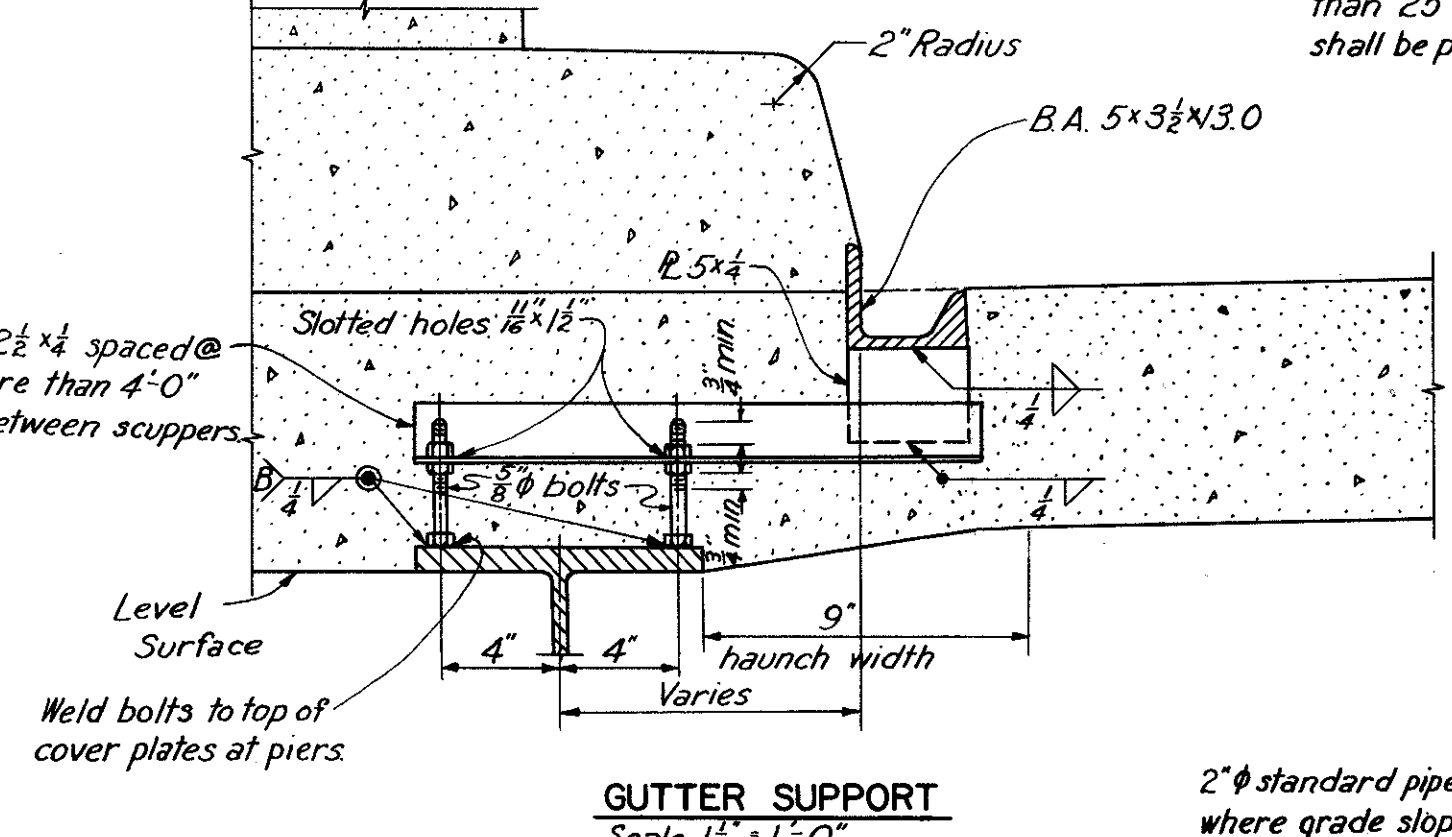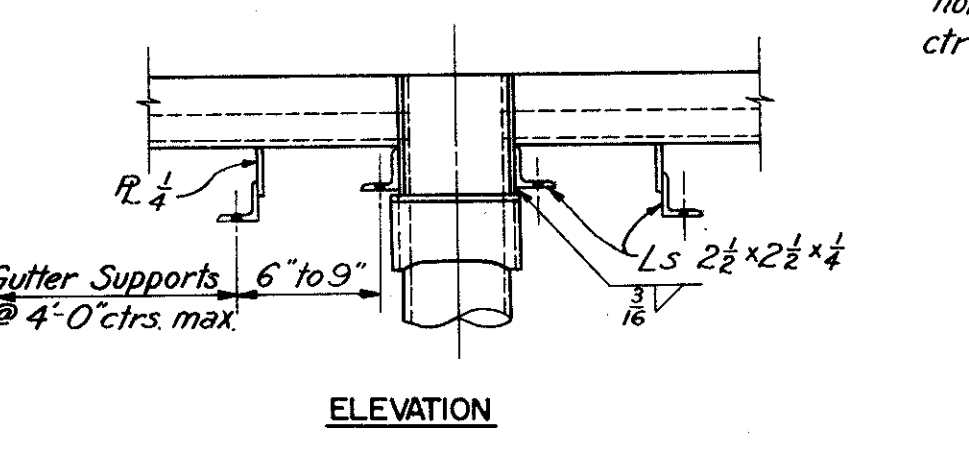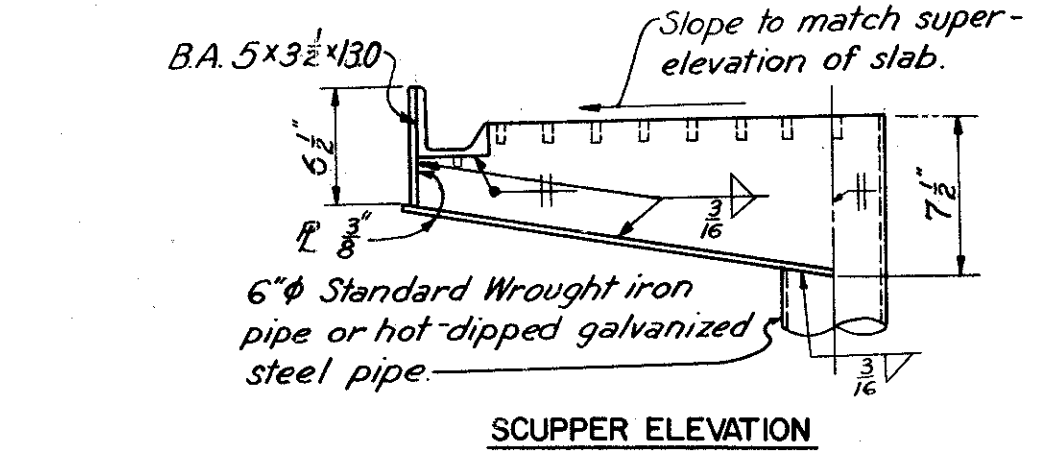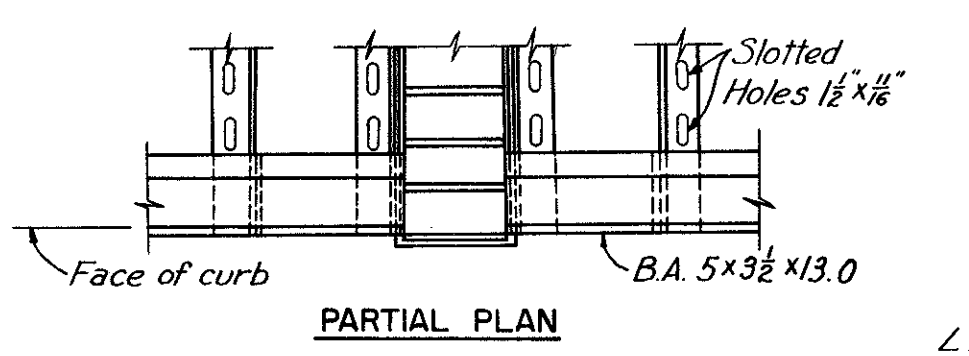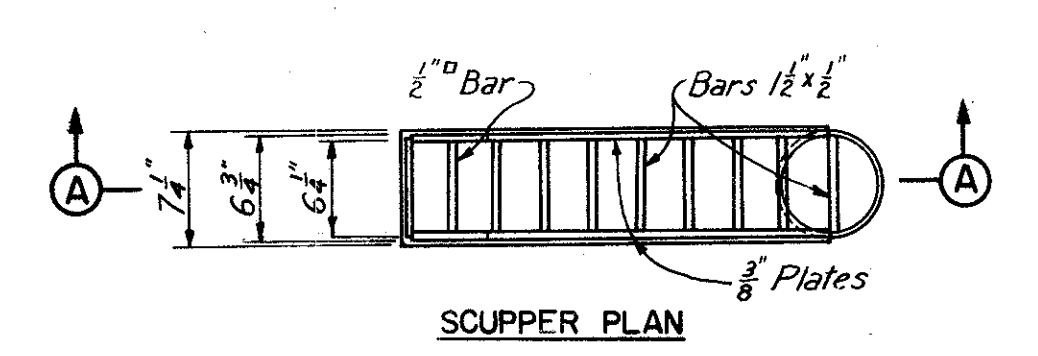

GUTTER SUPPORT
Scale 1/2" = 1'-0"

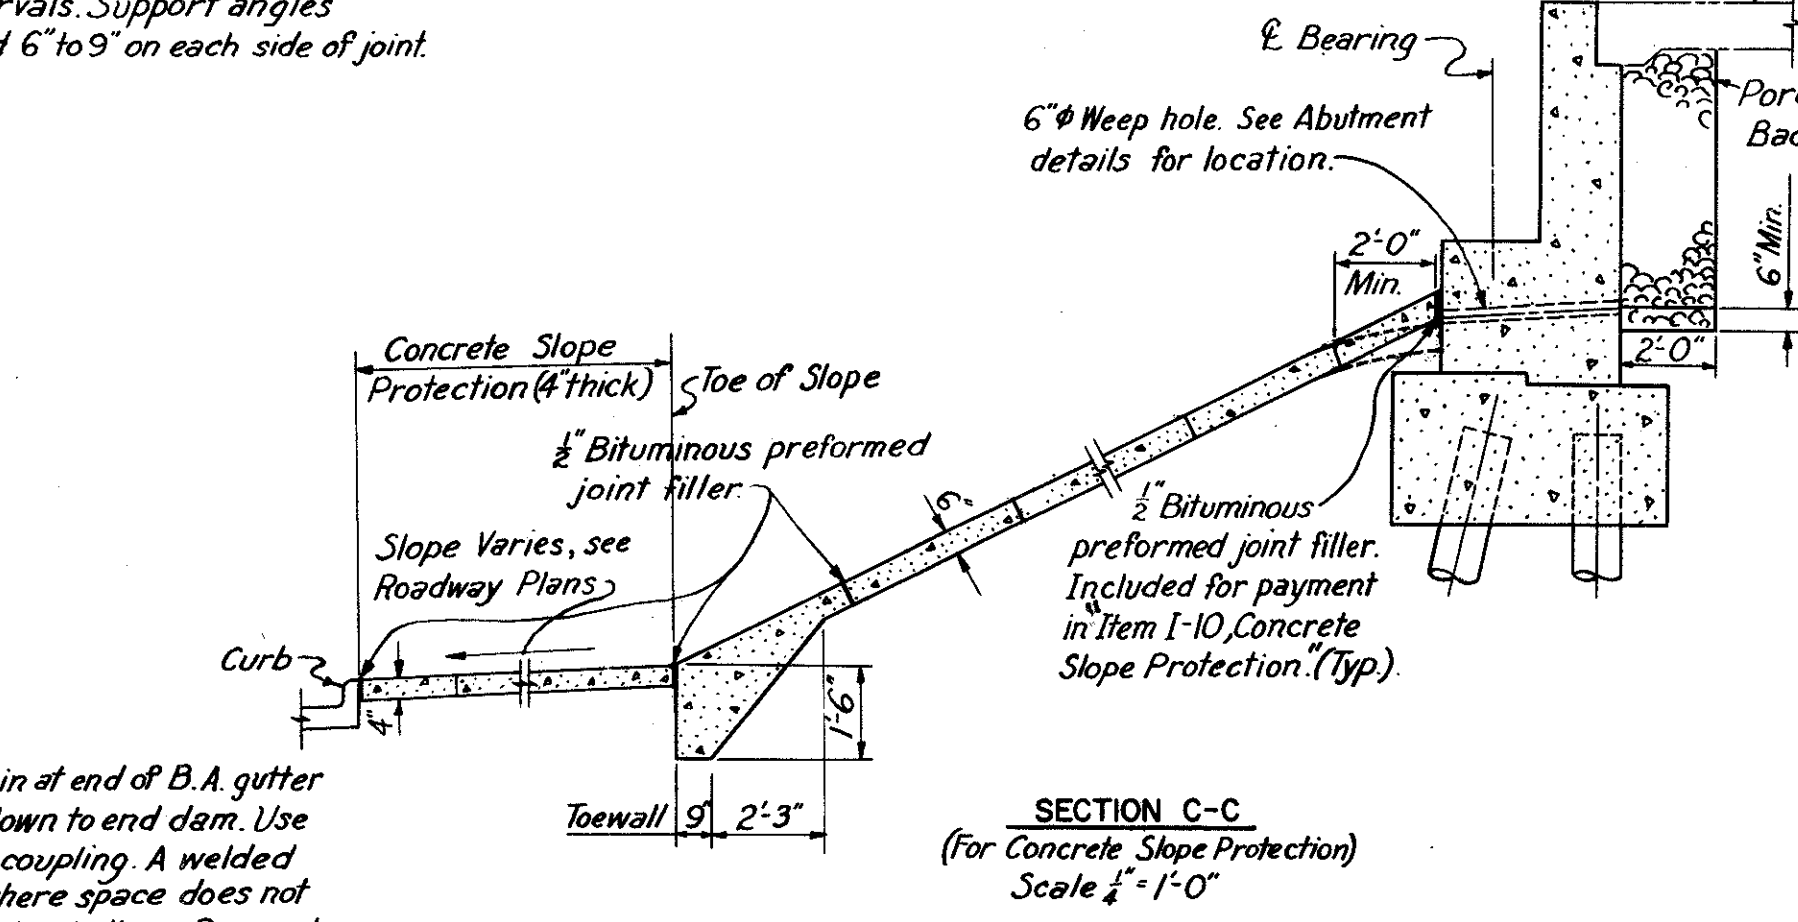


SECTION C-C
(For Concrete Slope Protection)
Scale 1/4" = 1'-0"

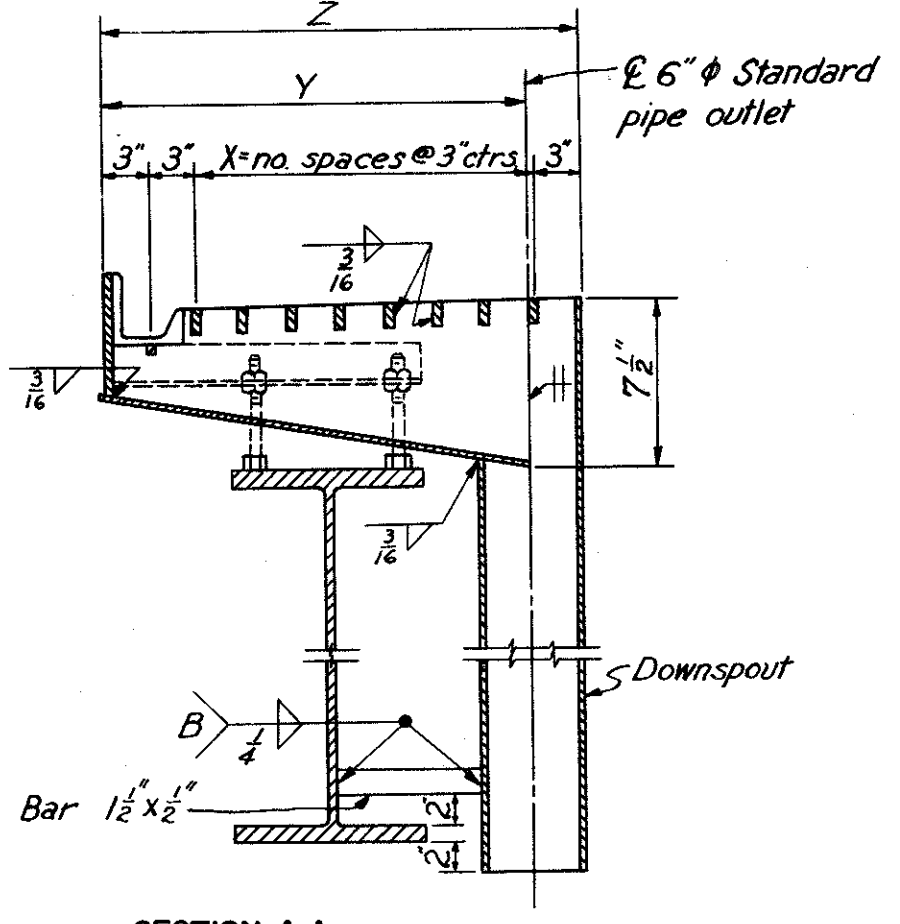


SECTION A-A
(Typical except where scupper empties into trough or 12x6 Standard Concentric reducer)
SCUPPER DETAILS
Scale 1" = 1'-0"

SCUPPER TYPE	X	Y	Z
A	2	11 3/4	1'-3"
B	3	1'-2 3/4	1'-6"
C	5	1'-8 3/4	2'-0"
D	7	2'-2 3/4	2'-6"

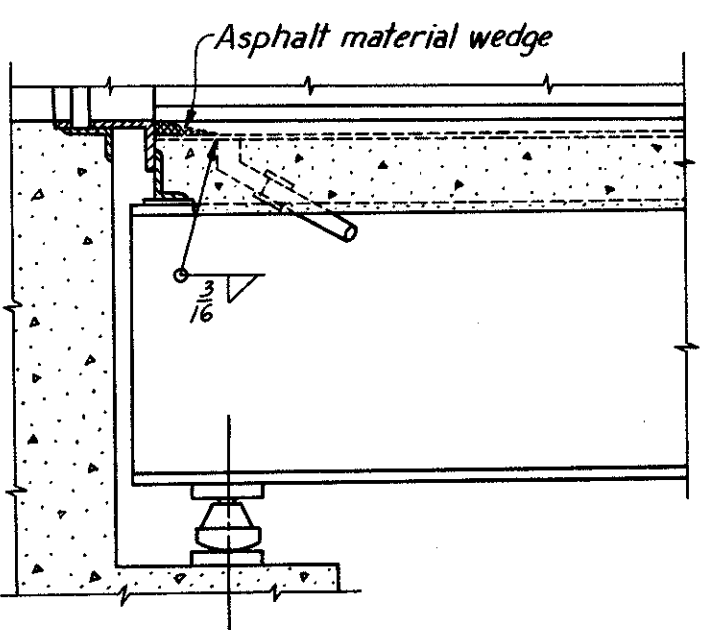


SECTION B-B

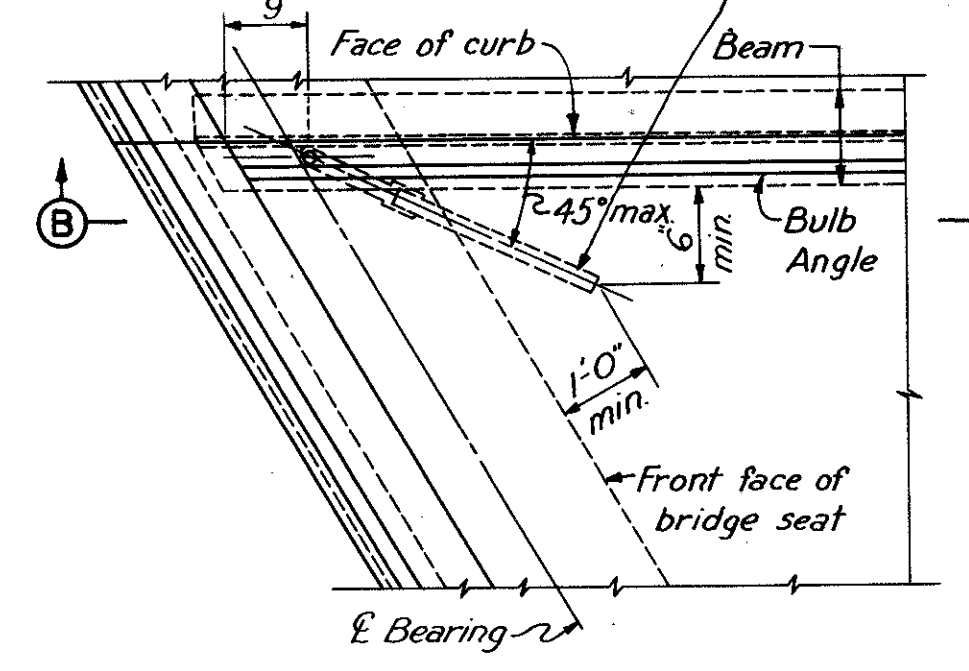

PARTIAL PLAN AT ABUTMENT


DETAIL OF DRAIN AT LOW END OF GUTTER
Scale 1/2" = 1'-0"

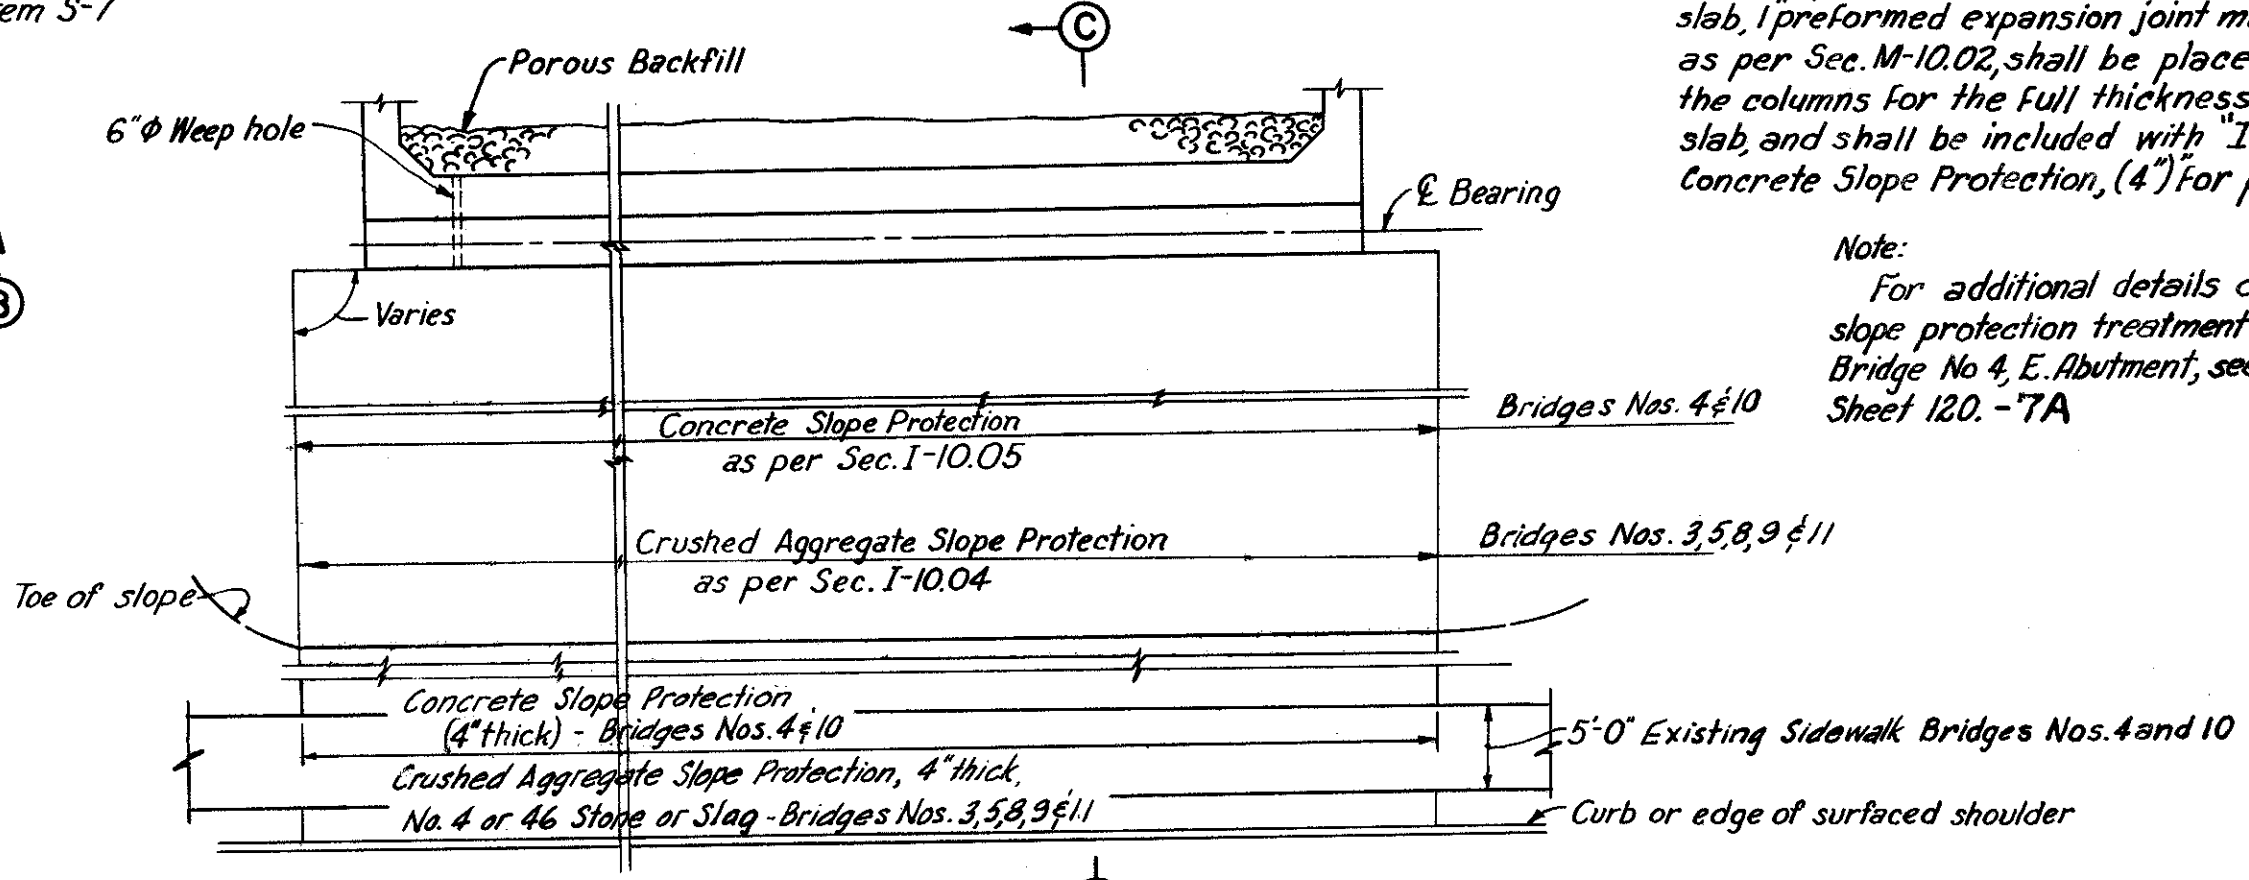


PLAN
Not to scale

Note:
Concrete or Crushed Aggregate Slope Protection material, as required, shall be placed within the limits shown on the Site Plans.
Slope Protection material required on all roadway areas beyond the toe of slopes shall be as follows:
Concrete shall conform to Sec. I-10.05 except that it shall be 4" thick.
Crushed aggregate shall be 4" thick and shall consist of No. 4 or 46 stone or slag placed flush with the adjacent finished ground.
Where pier columns extend through the slab, 1 preformed expansion joint material, as per Sec. M-10.02, shall be placed around the columns for the full thickness of the slab and shall be included with Item I-10, Concrete Slope Protection, (4") for payment.


Note:
For additional details of slope protection treatment at Bridge No. 4, E. Abutment, see Sheet 120.-7A

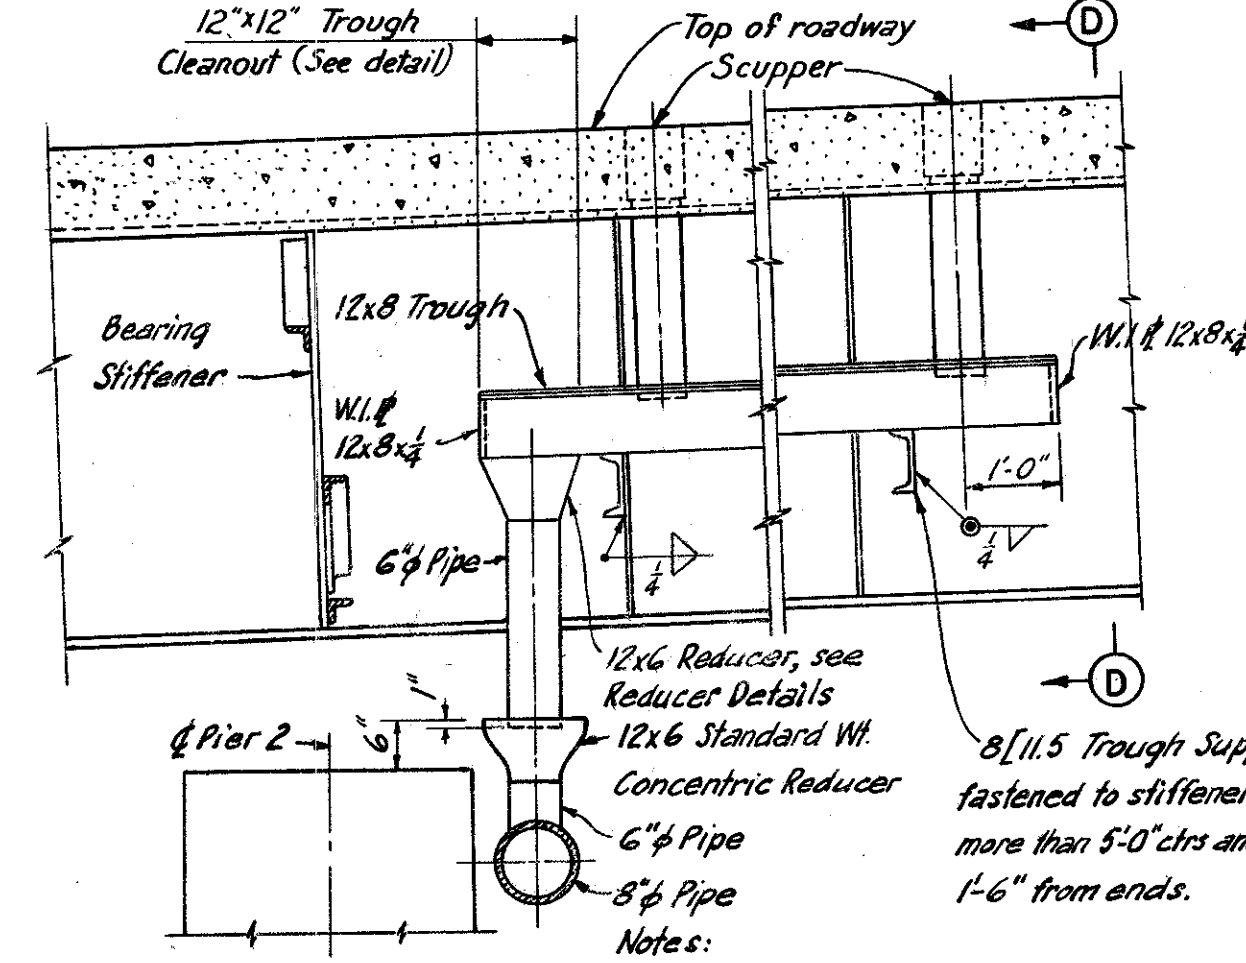


TROUGH ELEVATION
(Elevation of trough attached to Girder Z, Bridge No. 4, shown. Other troughs similar.)
Scale 1/2" = 1'-0"

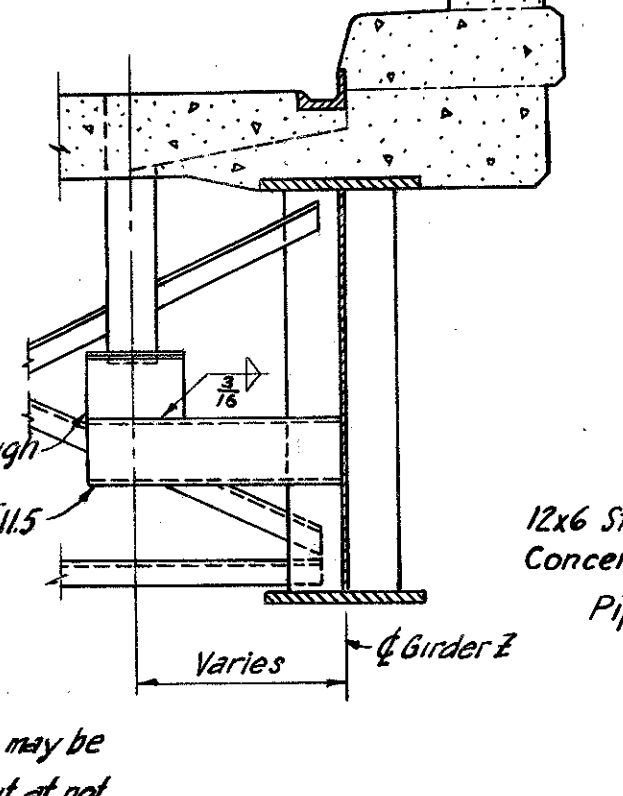


SECTION D-D
Scale 1/2" = 1'-0"

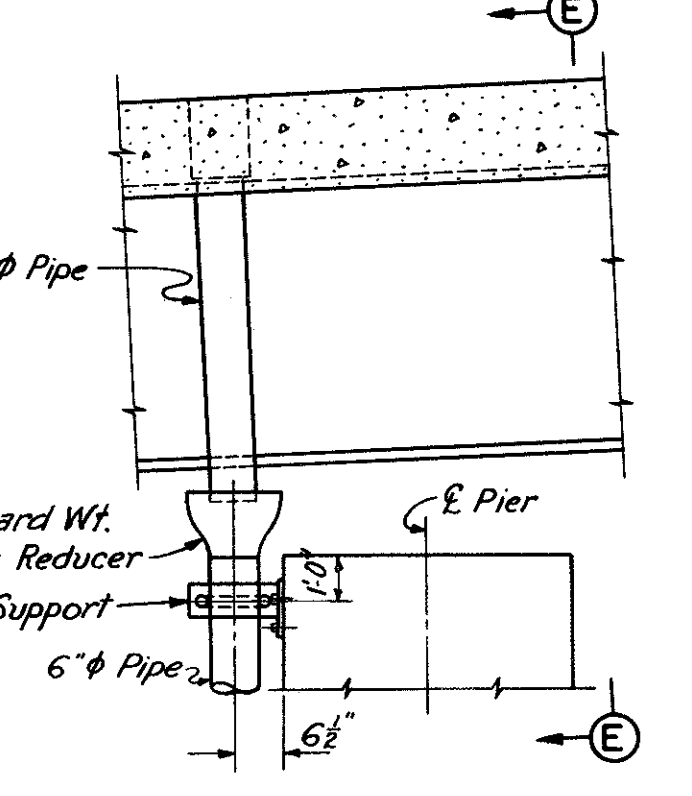


TYPICAL SCUPPER ELEVATION AT PIERS
Scale 1/2" = 1'-0"

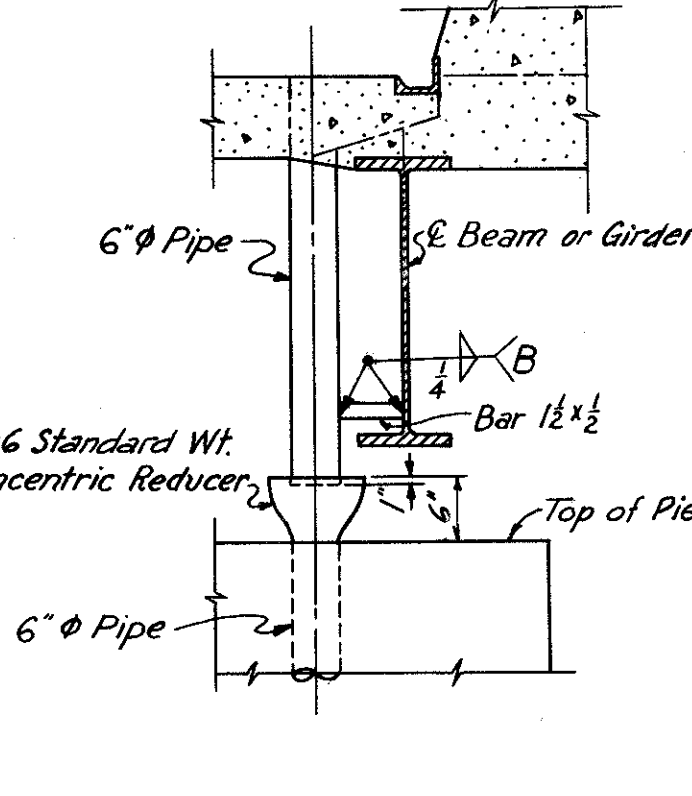

SECTION E-E
Scale 1/2" = 1'-0"

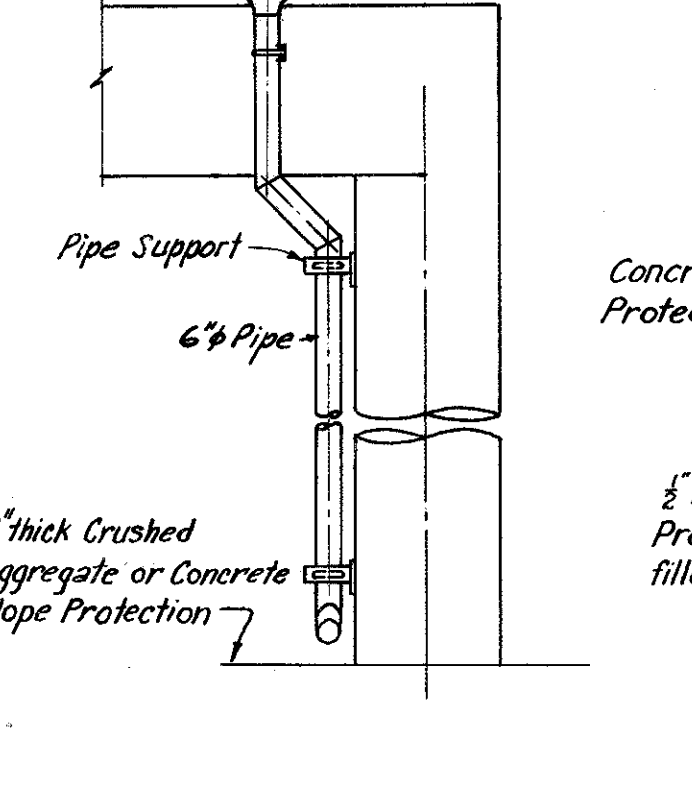


DRAINAGE PROVISIONS AT PIERS
Scale 1/4" = 1'-0"

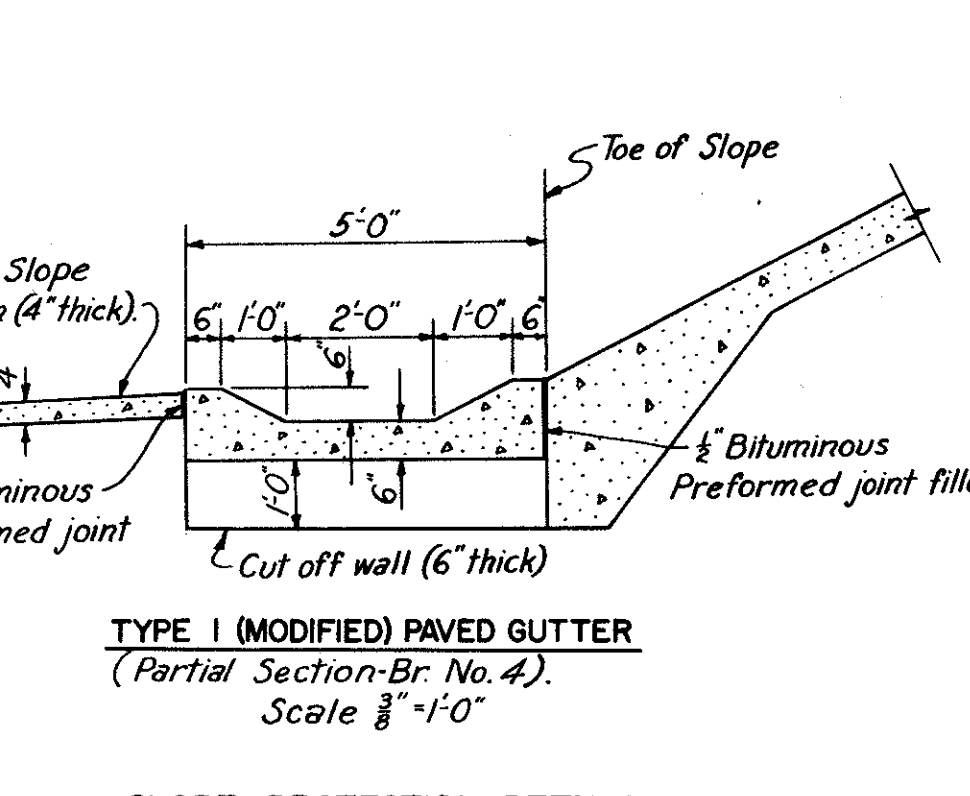


SLOPE PROTECTION DETAILS
Scale 1/4" = 1'-0"


NOTES:
All 6" x 8" pipe shall be standard weight wrought iron or hot dipped galvanized steel pipe with extra strong weld type seamless steel fittings or galvanized Victaulic couplings or approved equal.
Welded joints of all pipes and fittings to be single bevel butt welds - full penetration with 1/8" root opening and 45" included angle.
Where W.I. plates are called for, Mayari R or Cor-Ten steel may be used.
All welds on drainage fittings shall be 1/8" fillet welds except as shown.
Steel pipe, all steel fittings, all pipe supports, trough supports, nuts, bolts and washers shall be hot dipped galvanized after fabrication.
Field welds shall be field galvanized by an approved method.
Cut 7" holes in 10 Ga. E of trough for 6" pipes.
For scupper locations, see Deck Plans.
For trough locations, see Framing Plans Bridge No. 4.
All pipes attached to the substructure including fittings, supports and accessories shall be included in Item S-29, 6" W.I. or Galvanized Steel Pipe including Fastenings & Specials for payment.
All other metalwork of the drainage system shall be included in Item S-7.

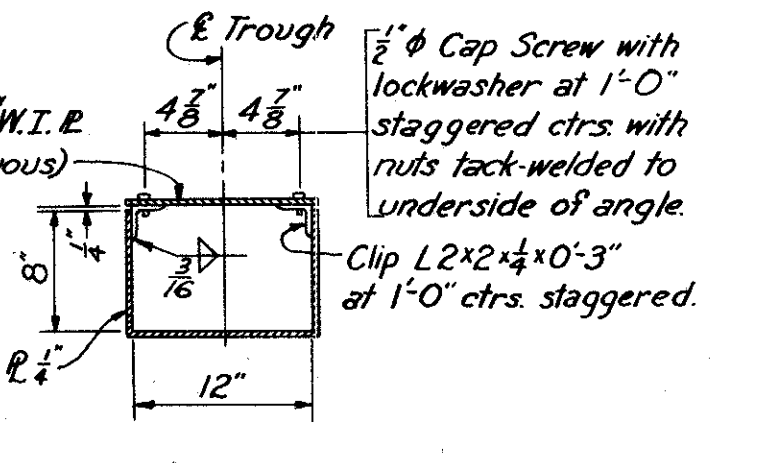


TYPICAL TROUGH SECTION
Scale 1" = 1'-0"

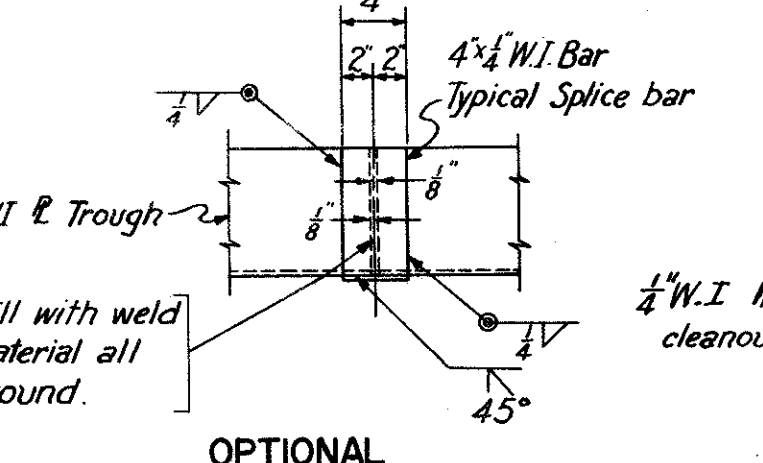


OPTIONAL TROUGH FIELD SPICE
Scale 1" = 1'-0"

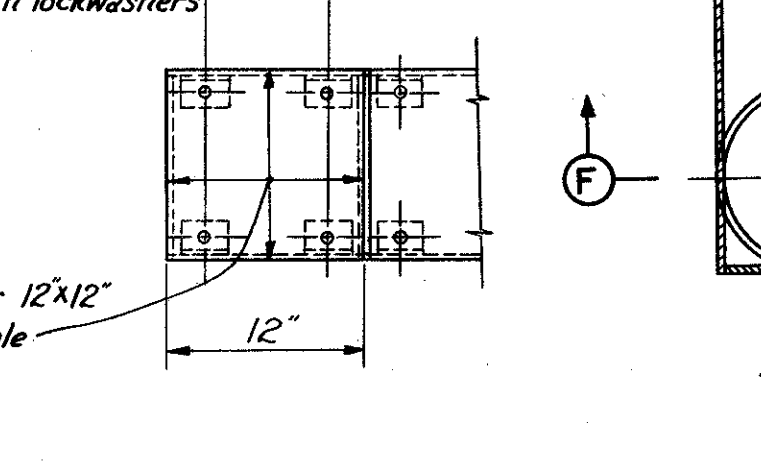


PLAN OF TROUGH CLEANOUT
Scale 1" = 1'-0"

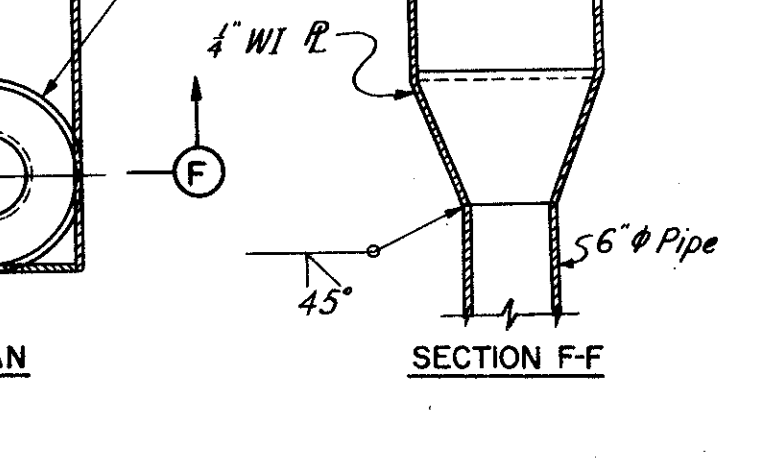

REDUCER DETAILS
Scale 1" = 1'-0"

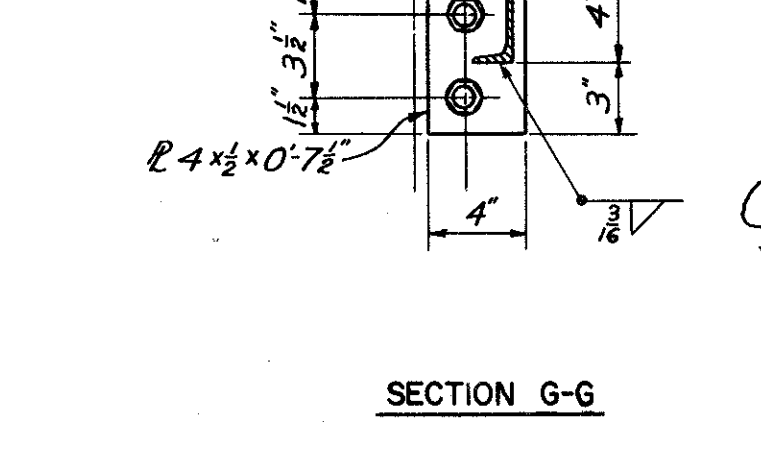

PIPE SUPPORT DETAILS
Scale 1/2" = 1'-0"

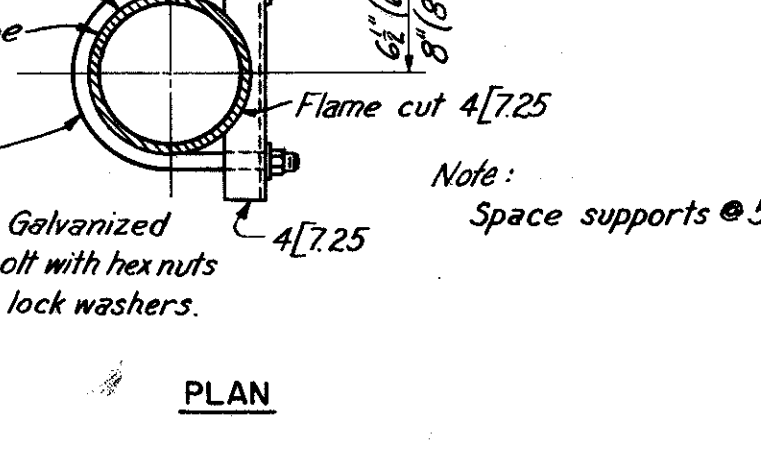

PLAN

HOWARD, NEEDLES, TAMMEN & BERGENDOFF
CONSULTING ENGINEERS
KANSAS CITY CLEVELAND NEW YORK

DRAINAGE DETAILS

Scale: As shown

WILLOW-INNER BELT FREEWAY


CLEVELAND CUYAHOGA COUNTY OHIO

DATE 11-4-58 TRACED RJK CHECKED 7/5/71 REVIEWED JCT
DATE 11-24-58 DATE 12-22-58 DATE 11-13-59


SHEET 174

Bridge No.	Railing.	West Abutment North Abutment		East Abutment South Abutment
3	North	4'-8 1/2" 3 spa. @ 8'-5"	7'-1 1/2"	41 spa. @ 7'-11" = 324'-7"
	South	4'-7 1/2" 2 spa. @ 6'-5"	7'-2 3/4"	34 spa. @ 7'-11" = 269'-2"
4	North (Ramp E-10)	4'-7" 2 spa. @ 5'-3"	8'-4 1/2"	34 spa. @ 7'-10" = 266'-4"
	South (Ramp E-10)	4'-7" 2 spa. @ 5'-3"	7'-2 3/4"	23 spa. @ 7'-6" = 172'-6"
	North (I.B.F.)	4'-7" 2 spa. @ 5'-6"	5'-5 1/2"	27 spa. @ 7'-0" = 189'-0"
	South (I.B.F.)	4'-7" 2 spa. @ 5'-6"	5'-5 1/2"	8 spa. @ 7'-0" = 56'-0"
	North (Ramp E-9)	5'-3" 2 spa. @ 5'-5"	6'-9 3/4"	7 spa. @ 7'-6" = 52'-6"
	South (Ramp E-9)	5'-3" 2 spa. @ 5'-5"	6'-9 3/4"	45 spa. @ 7'-0" = 315'-0"
5	East	4'-6" 1 spa. @ 7'-4 1/2"	8'-2 3/4"	12 spa. @ 8'-3" = 99'-0"
8	West	4'-6" 1 spa. @ 7'-0 1/2"	7'-5 1/2"	13 spa. @ 8'-3" = 107'-3"
	North	5'-6" 1 spa. @ 8'-9"	8'-7 1/2"	22 spa. @ 7'-8" = 168'-8"
	South	4'-6" 1 spa. @ 6'-6"	8'-4"	22 spa. @ 7'-5" = 163'-2"
9	North	4'-6" 1 spa. @ 6'-7"	7'-9 3/4"	19 spa. @ 7'-10" = 148'-10"
	South	4'-6" 1 spa. @ 6'-7"	7'-9 3/4"	19 spa. @ 7'-10" = 148'-10"
10	North	4'-6" 1 spa. @ 7'-7"	7'-7 1/2"	25 spa. @ 7'-7" = 189'-7"
	South	4'-6" 1 spa. @ 7'-7"	7'-7 1/2"	25 spa. @ 7'-7" = 189'-7"
11	North	4'-6" 1 spa. @ 3'-10 1/2"	7'-9 1/2"	26 spa. @ 7'-5" = 192'-10"
	South	4'-10 1/2" 2 spa. @ 9'-0"	7'-0 1/2"	26 spa. @ 7'-5" = 192'-10"


* See Nose detail for distance from E. Post to end of parapet.

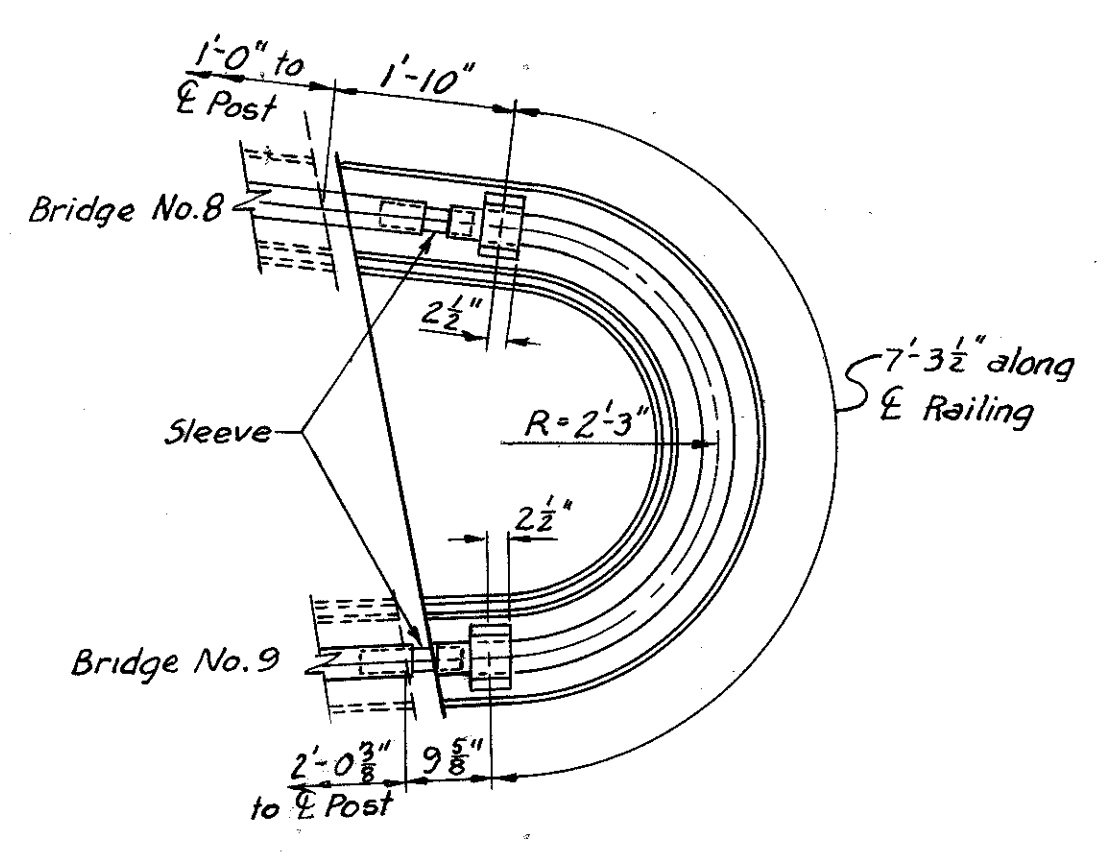

NOSE DETAIL FOR
BRIDGE NO. 8 & 9
Scale: 1/2" = 1'-0"

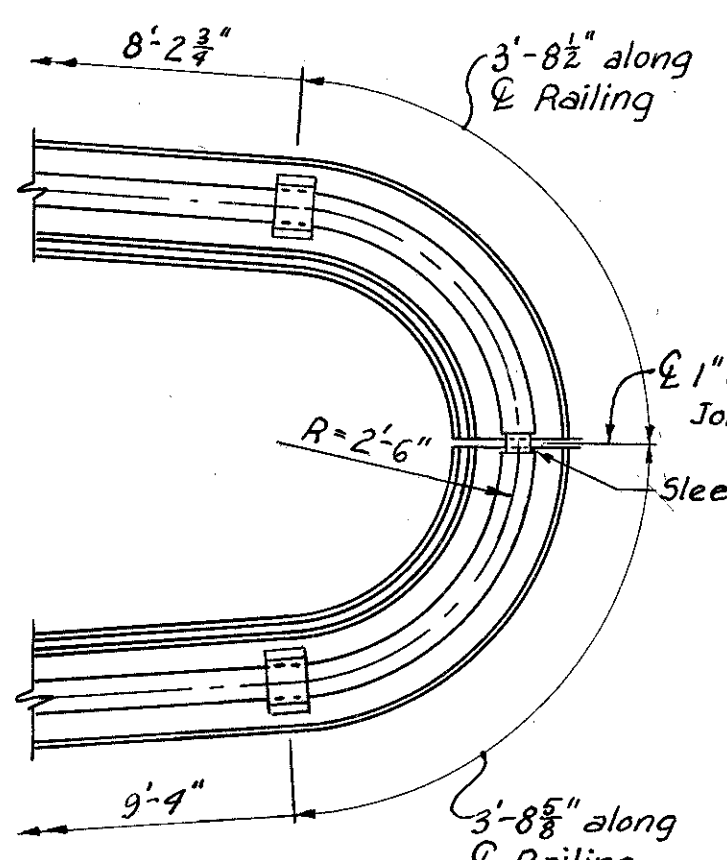


NOSE DETAIL FOR
INNER BELT & RAMP E-10
Scale: 1/2" = 1'-0"

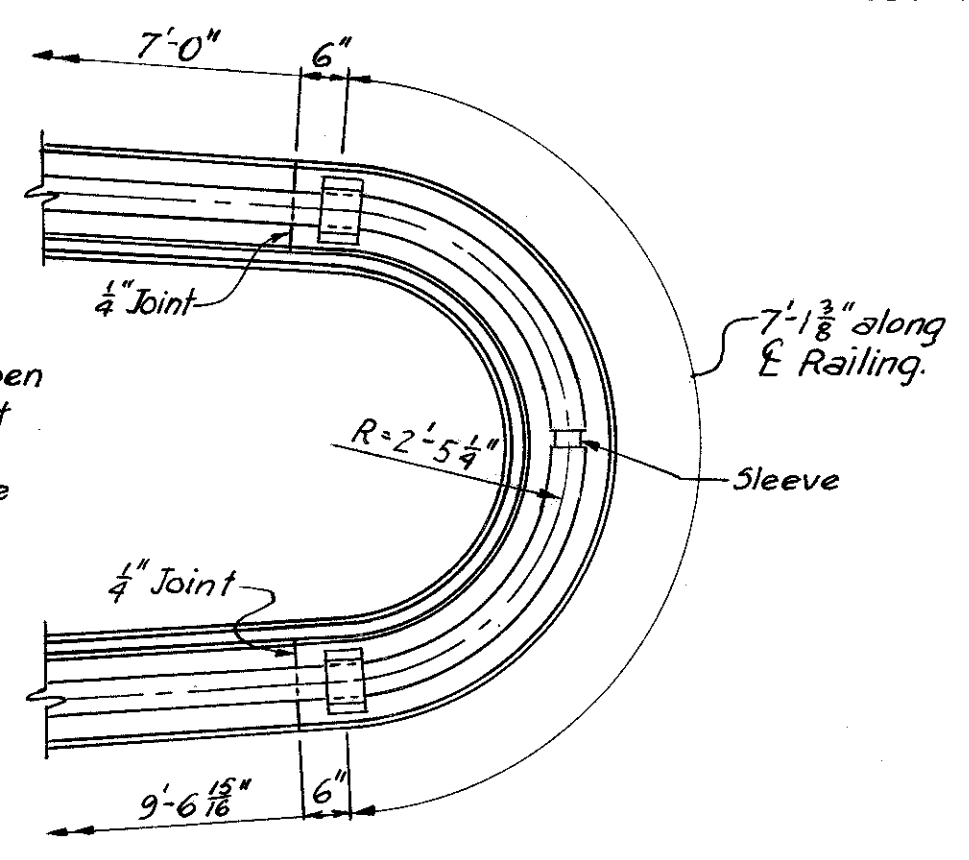


NOSE DETAIL FOR
INNER BELT & RAMP E-9
Scale: 1/2" = 1'-0"


RAILING POST SPACING
No Scale

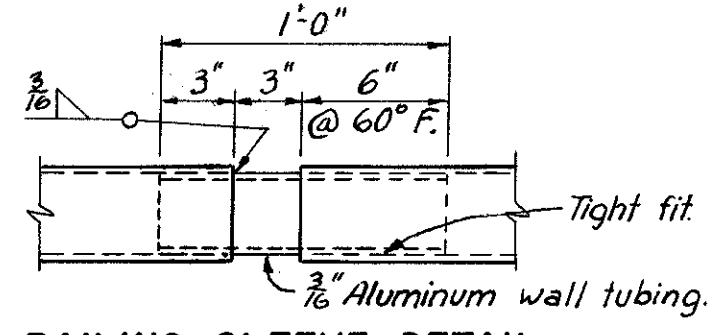


RAILING SLEEVE DETAIL
Scale: 1 1/2" = 1'-0"

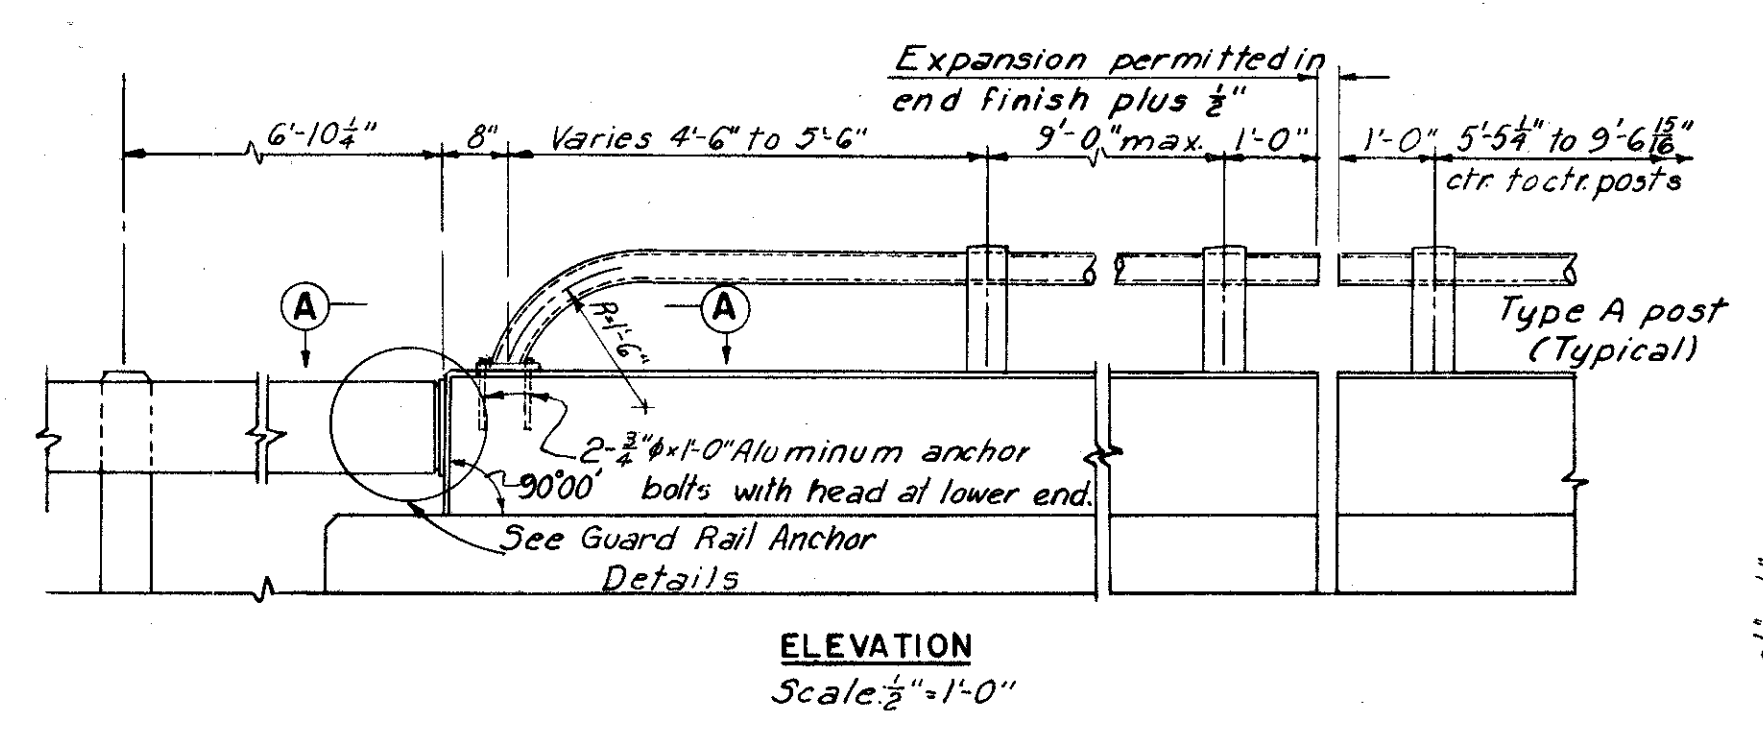


DETAILS AT END OF RAILING

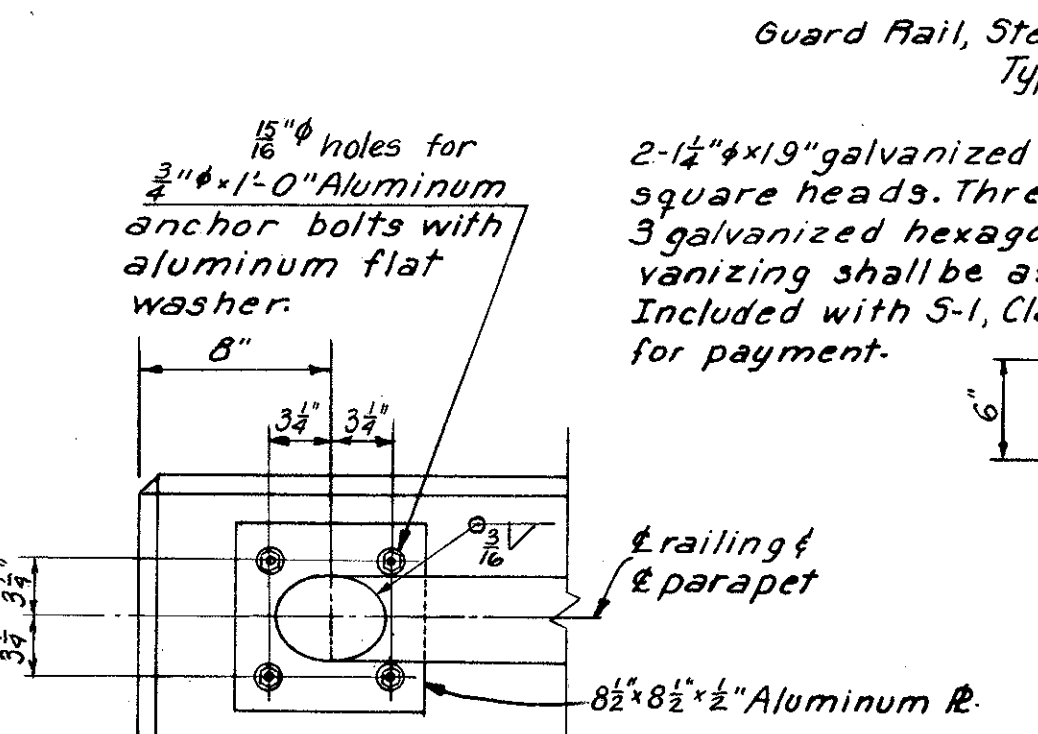


SECTION A-A
Scale: 1 1/2" = 1'-0"

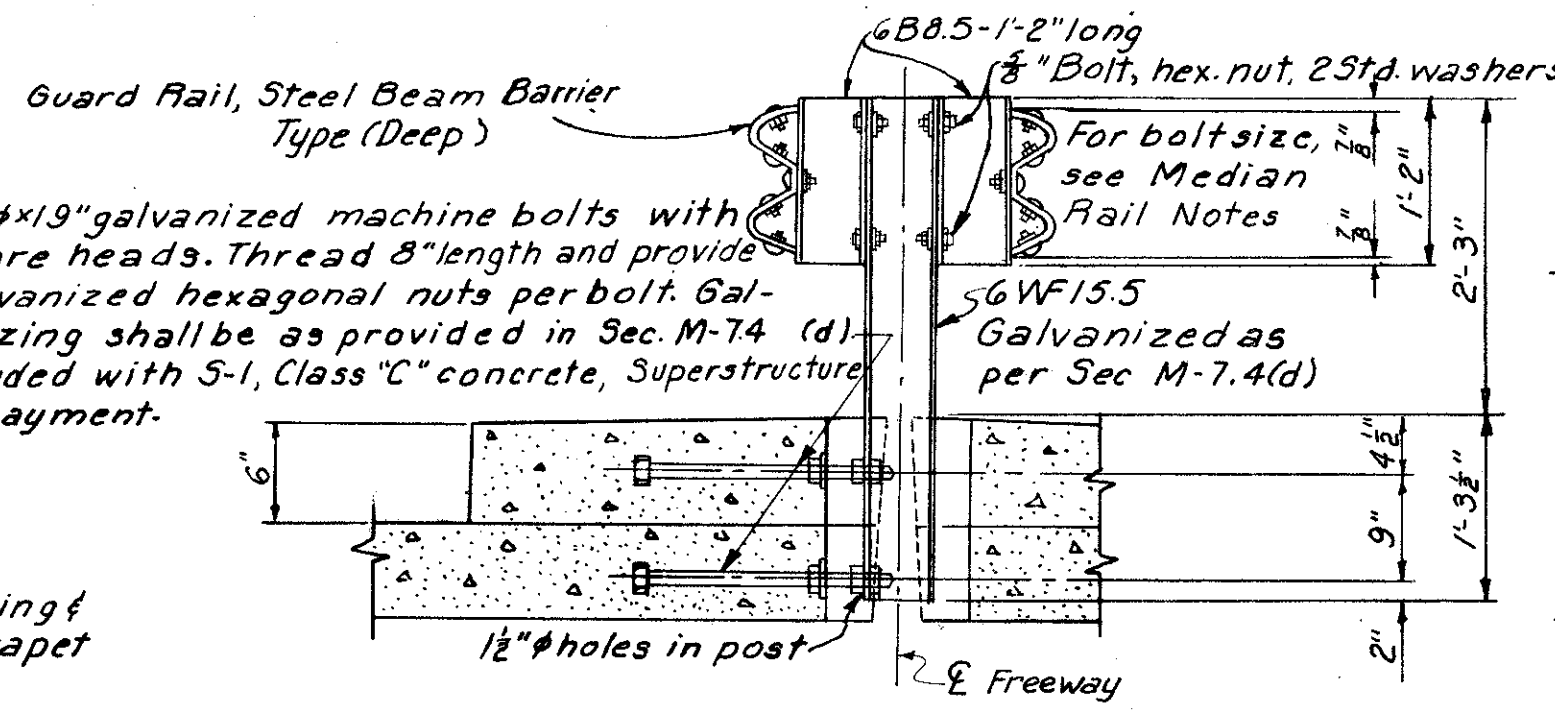


MEDIAN GUARD RAIL
Scale: 3/4" = 1'-0"

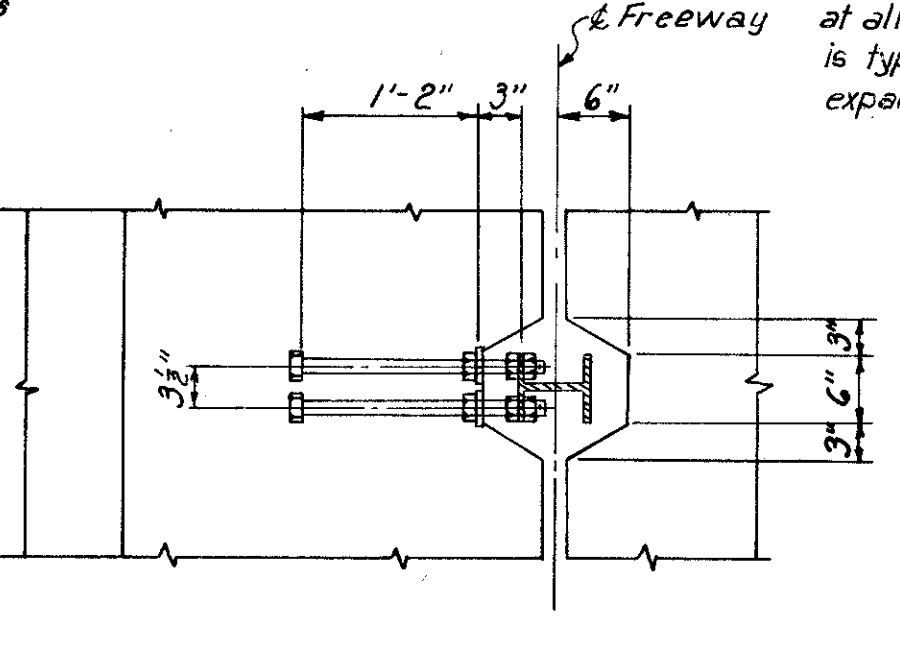

POST ANCHOR DETAIL
Scale: 3/4" = 1'-0"

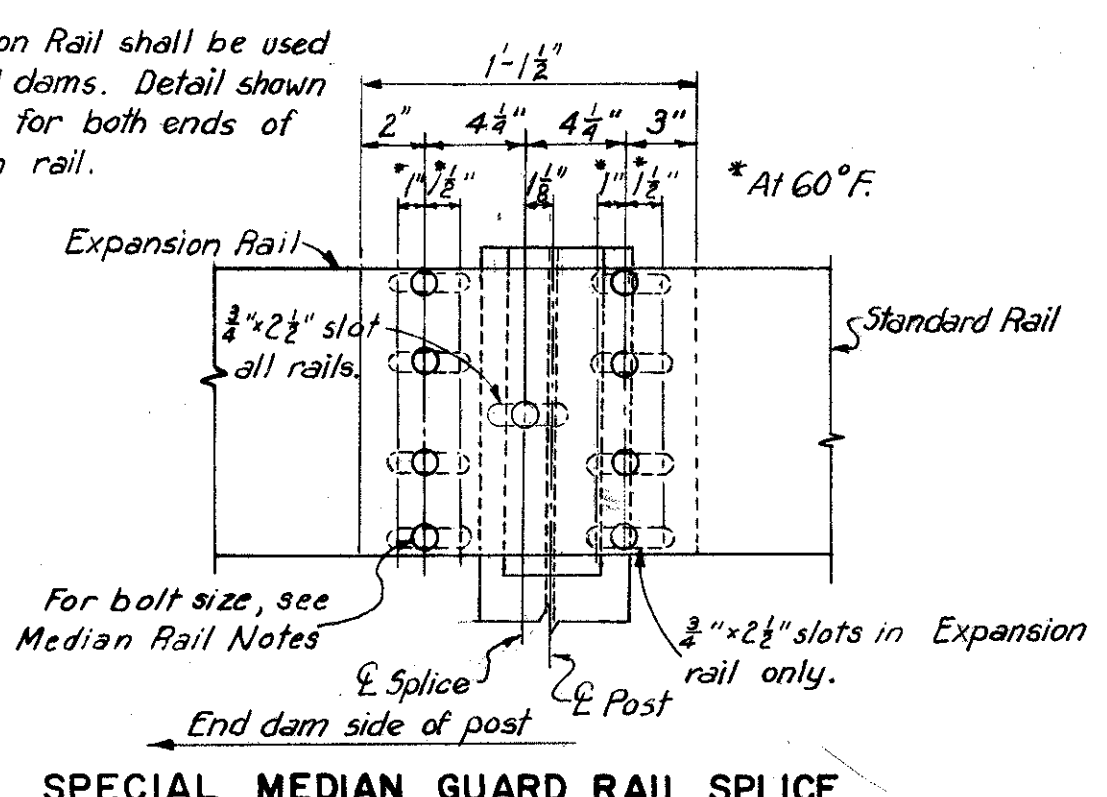

SPECIAL MEDIAN GUARD RAIL SPLICE
Scale: 1 1/2" = 1'-0"

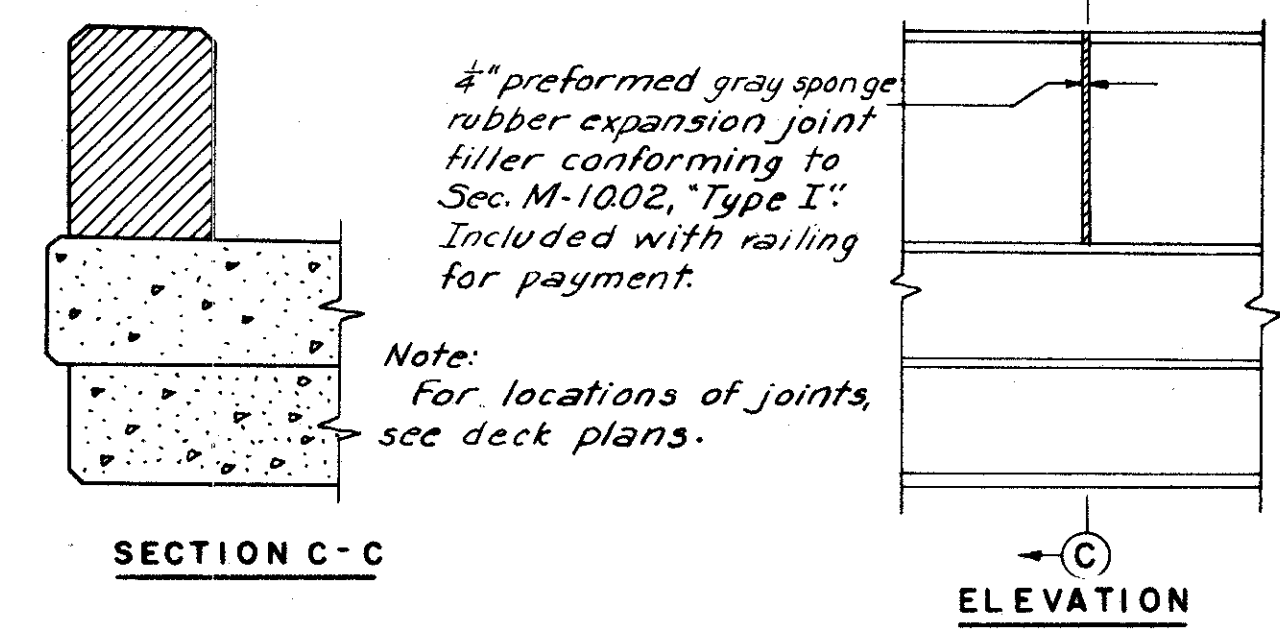


PARAPET JOINT
Scale: 3/4" = 1'-0"

Railing shall be fabricated in lengths not less than three panels each and furnished railing shall be free of burrs, sharp corners and rough surfaces. Shims if required for adjustment to line or grade, shall be of aluminum alloy, 2 3/8" x 1/2" x 8", and shall be slotted to permit insertion after posts are in place. Anchor bolts shall be aluminum with a head or nut at lower end. They shall be 1'-0" long and shall have a minimum diameter of 0.62" at the root of the thread. Bolts and nuts shall be anodized. Railing posts shall be normal to grade and the final adjustment of the railing shall be such that the top rail shall not depart more than 3/8" from correct line or grade.


For additional details and notes regarding railing see Ohio Standard Drawing AR-1-57.

Payment for Railing shall be made at the contract unit price bid for Item S-14, Aluminum Railing (including parapet). Pay length shall be the overall length of the parapets and shall include cost of anchor bolts, set screws, nuts, shims and etc. necessary to complete the installation of railing.

Concrete and longitudinal reinforcing steel in the parapet shall be included in Item S-14, Railing, (including parapet) for payment. All other reinforcing steel in parapet shall be included in Item S-4 for payment.

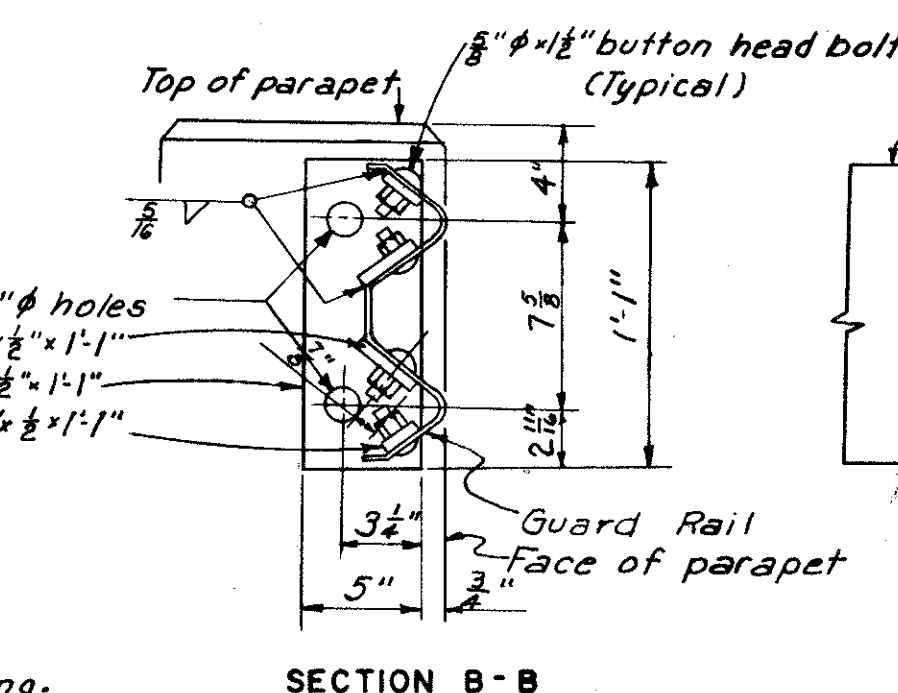

SECTION B-B

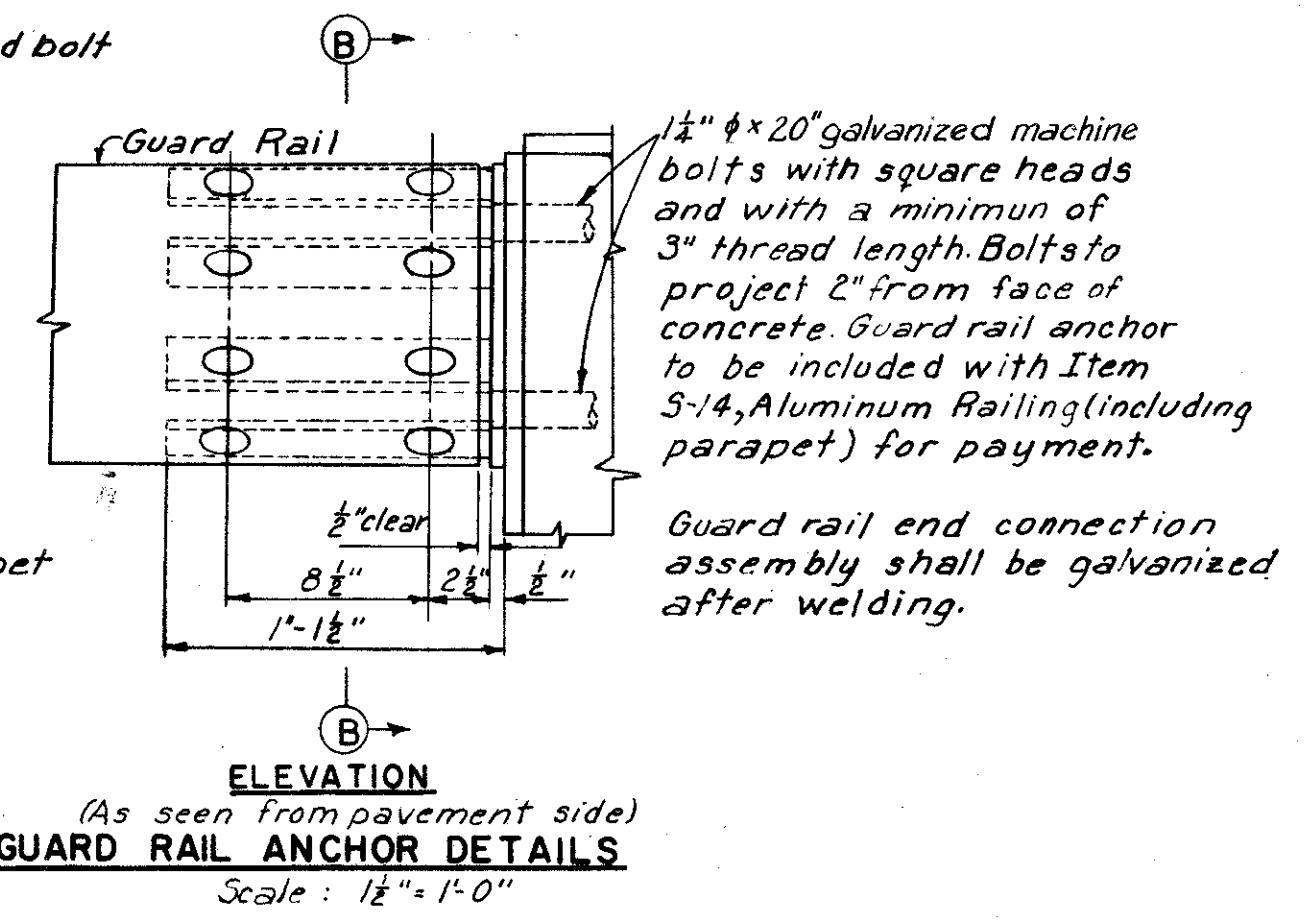

RAILING ANCHOR DETAILS
Scale: 1 1/2" = 1'-0"

Median Rail Notes.
Bolts for rail splice and for fastening rail to posts shall be 5/8" diameter with button head, washer and hexagonal nuts.
For median guard rail spacing See Deck plans.

PART 7A

HOWARD, NEEDLES, TAMMEN & BERGENDOFF
CONSULTING ENGINEERS
KANSAS CITY CLEVELAND NEW YORK

**RAILING AND
GUARD RAIL DETAILS**


Scale: As noted

WILLOW-INNER BELT FREEWAY


CLEVELAND CUYAHOGA COUNTY OHIO

DRAWN A.L.	TRACED A.L.	CHECKED DRK	DATE 3-20-59	REVIEWED JCT	DATE 11-13-59	REVISED 6-17-60
2-26-59	2-26-59	2-26-59				


SHEET 175

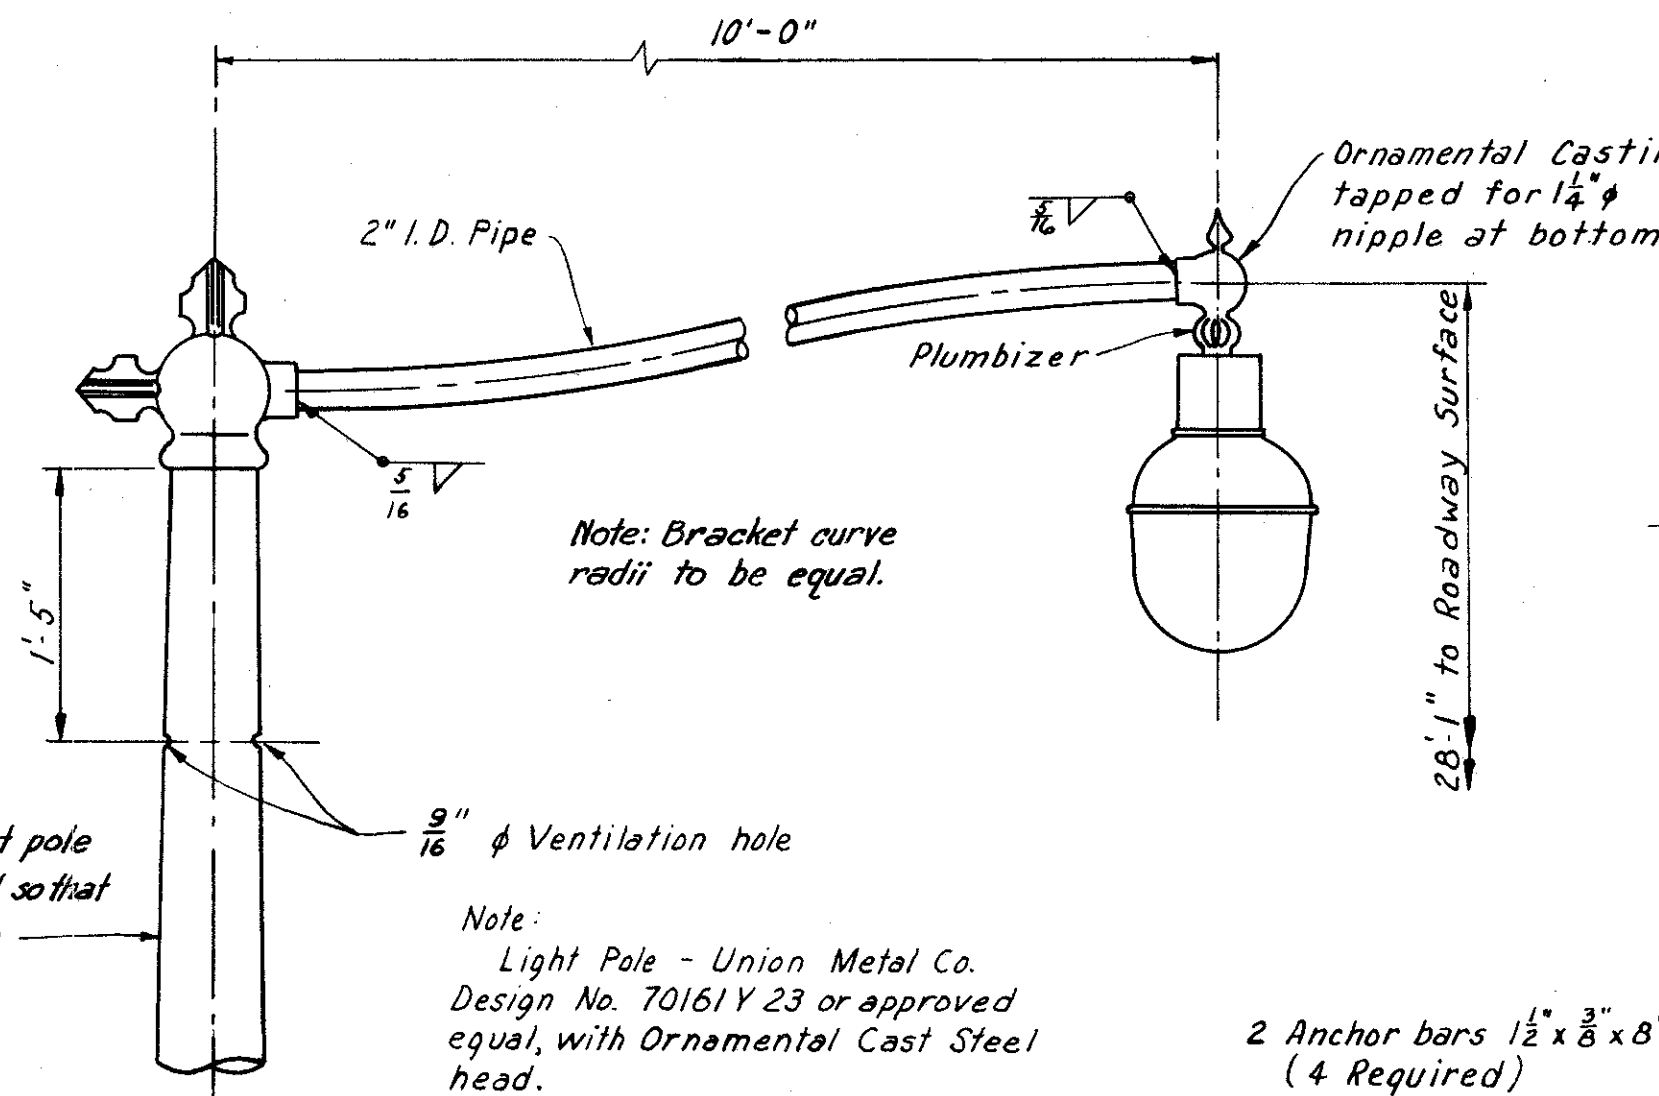


Note: Light Pole - Union Metal Co. Design No. 70161Y 23 or approved equal, with Ornamental Cast Steel head.

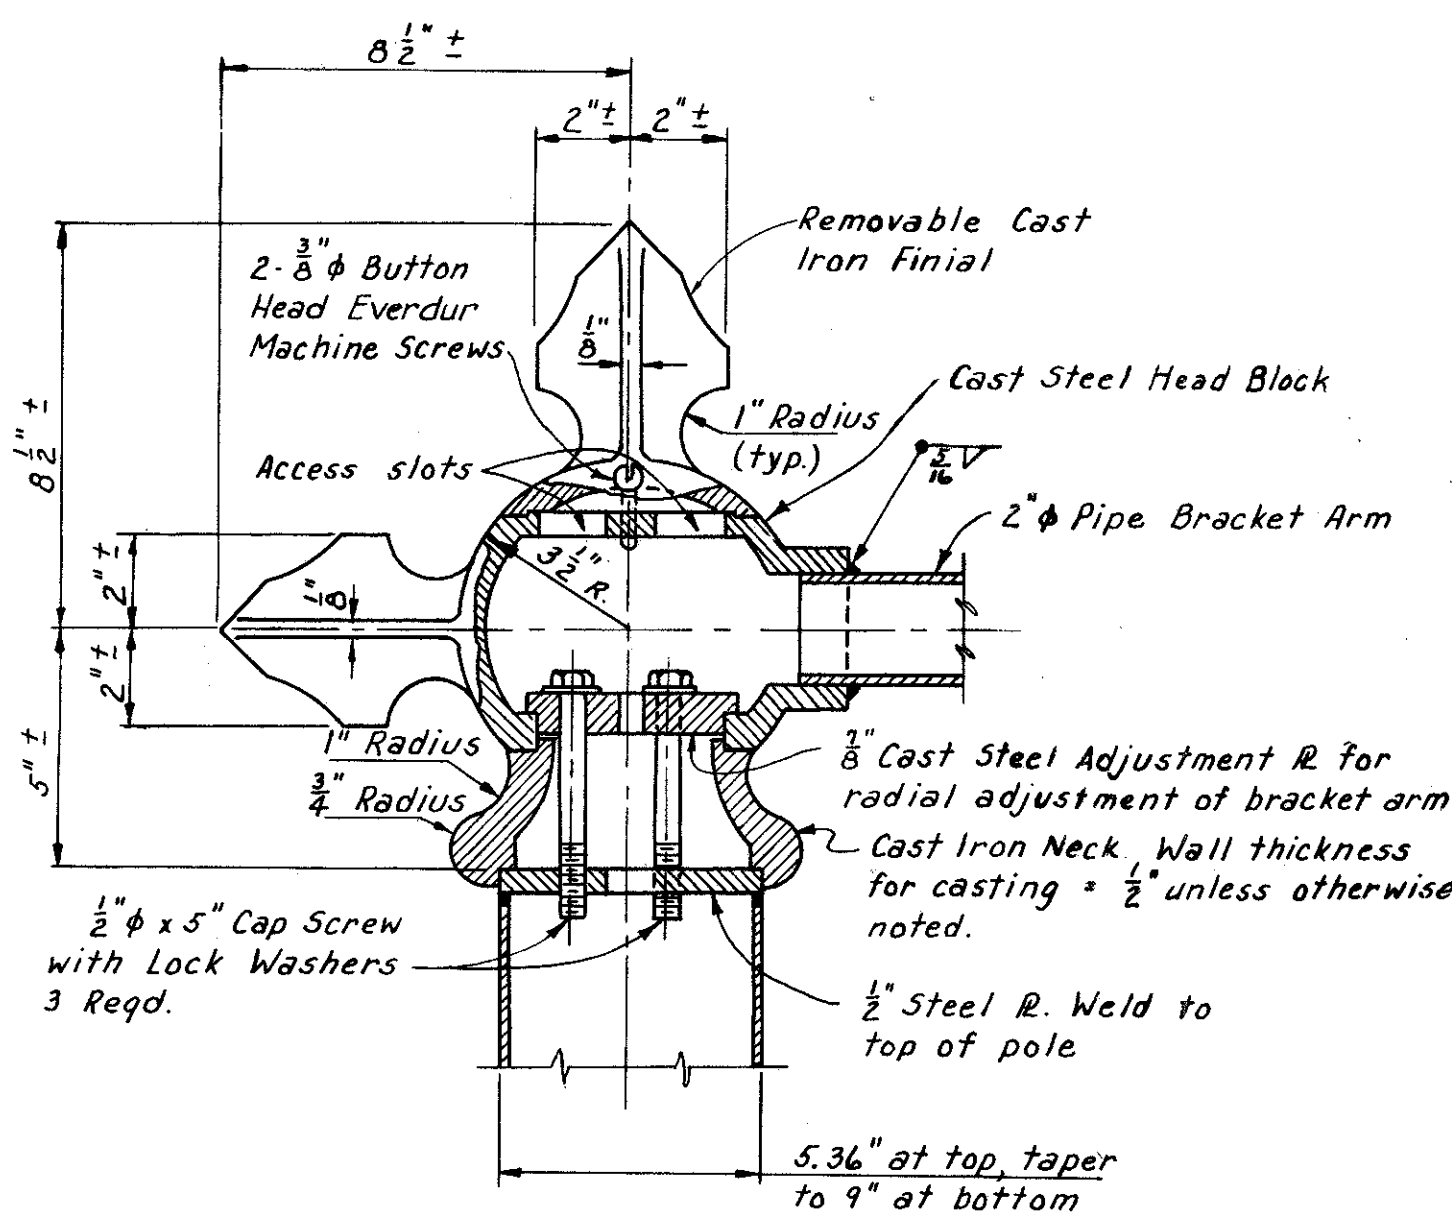

ORNAMENTAL LIGHT POLE HEAD
Scale: 3" = 1'-0"

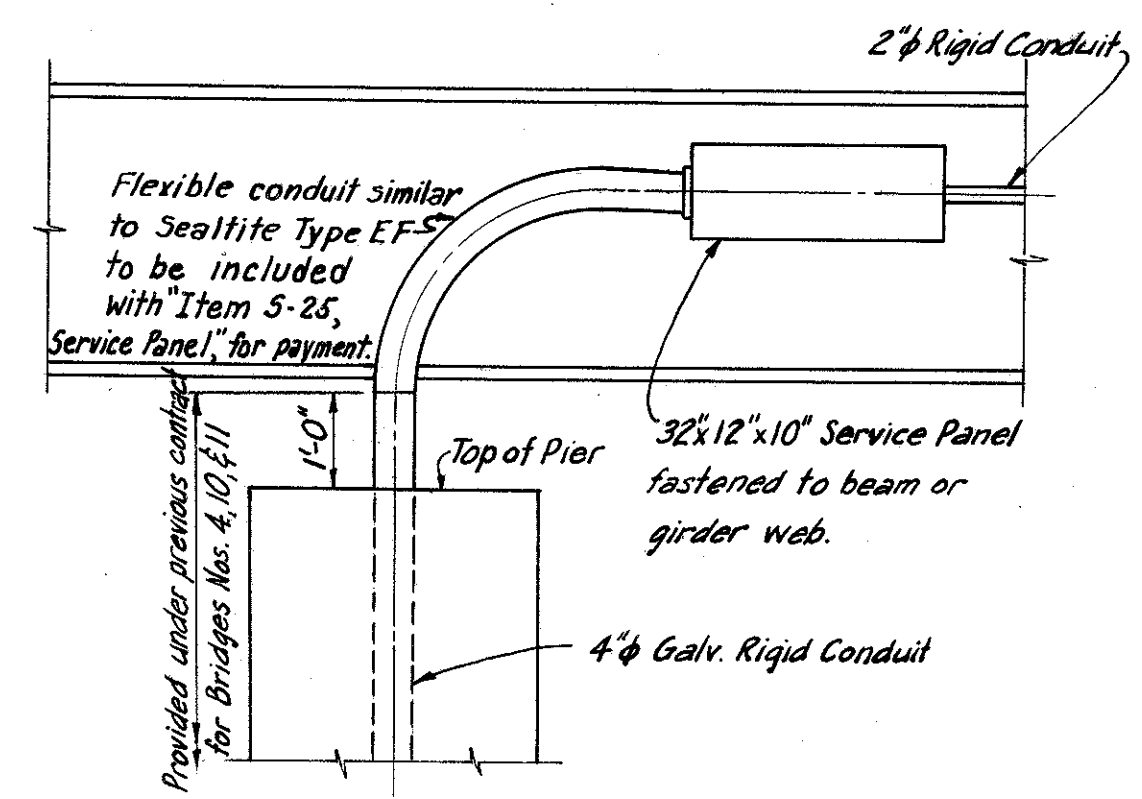


DETAIL C
For Pier 1 of Bridge No. 3; Pier 3 of Bridge No. 4; Pier 2 of Bridge No. 10; Pier 2 of Bridge No. 11. See Pier Sheets for location.
Scale: 1/2" = 1'-0"

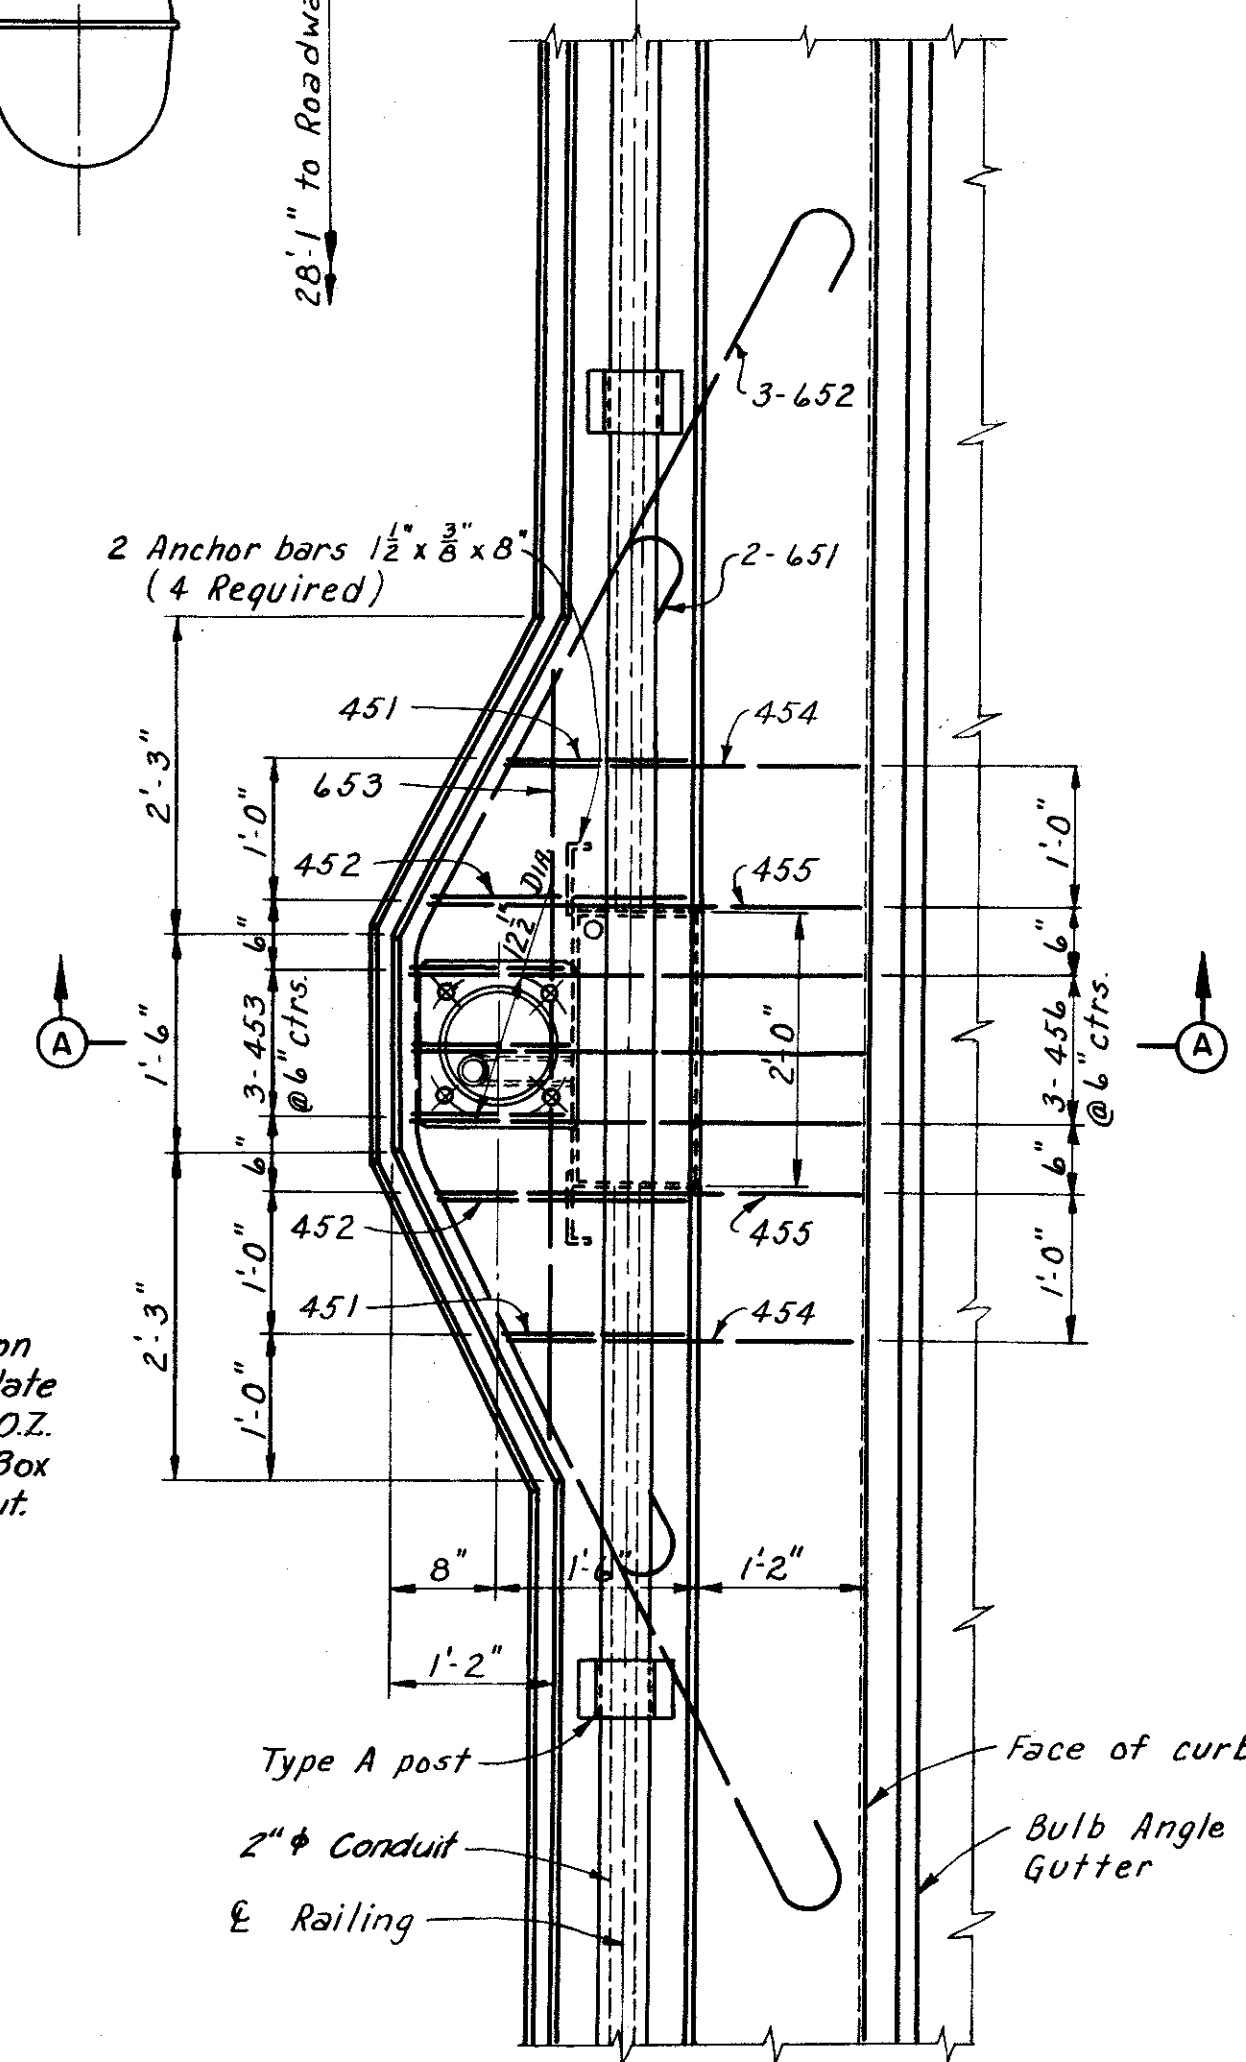


PARTIAL PLAN OF LIGHT STANDARD SUPPORT
Scale: 3/8" = 1'-0"

Note: Only additional reinforcement for light support shown.

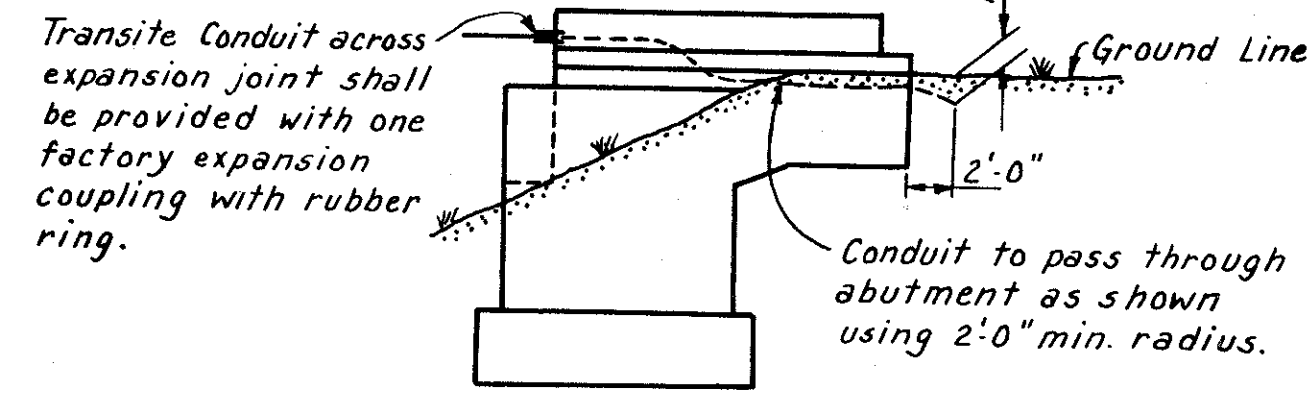

TYPICAL DETAIL FOR CONDUIT AT ABUTMENT
No Scale


Note: Expansion Coupling in Conduit shall be provided at expansion joints between abutment and wingwalls and at all parapet joints.

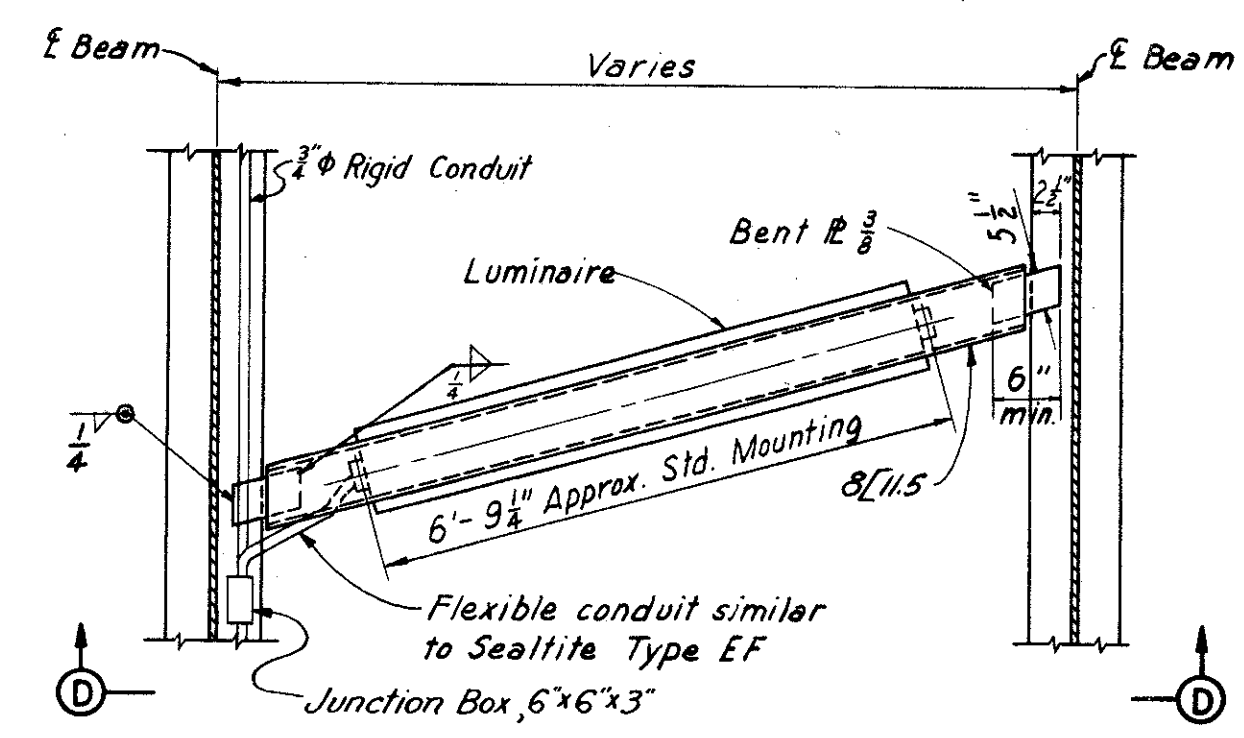

PARTIAL PLAN

Note: Junction box 6"x6"x3" to be included with Item 5-25, Fluorescent Underdeck Light for payment. The 8" I.I.S. supports and connections to beams are to be included with Item 5-7, Structural Steel for payment. Underdeck luminaires shall be equal to Line Material No. LF1F1. For size of safety switch, contactor and photo cell control unit in Service Panel, see Sheet 48-7 of Roadway Plans.

NOTES:
For location of light standards and conduit, see Deck Plans.
For location of Underdeck Luminaires see sheet 171-7A
For additional lighting notes, see Sheet 171-7A

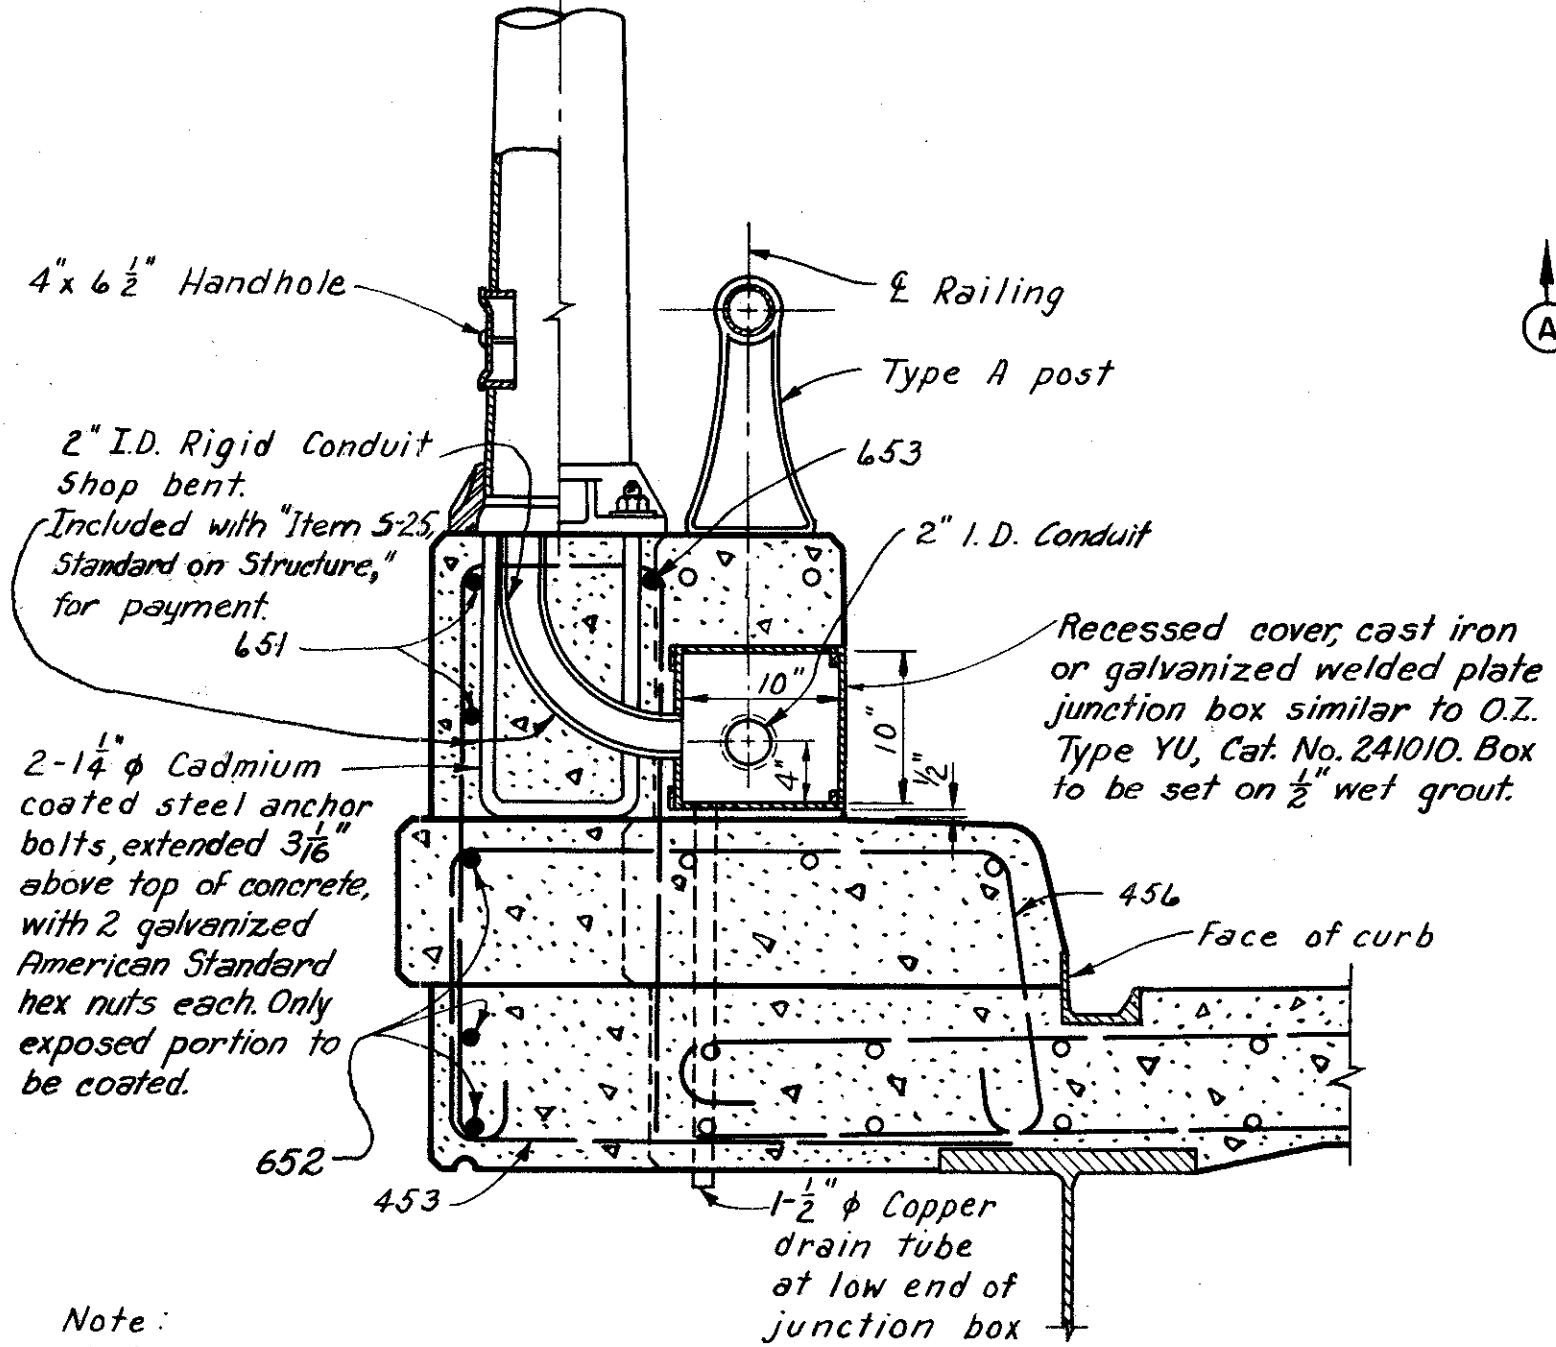


SECTION A-A
Scale: 1" = 1'-0"


Note: Normal longitudinal reinforcement shown as a circle. Additional longitudinal light support reinforcement is shown blackened.

REINFORCEMENT SCHEDULE FOR LIGHT STANDARD SUPPORT						
MARK	NO.	LENGTH	TYPE	DIMENSIONS		WEIGHT
				A	B	
4.51	2	8'-11"	131	2'-6"	1'-2"	12
4.52	2	9'-11"	131	3'-0"	1'-8"	13
4.53	3	9'-5"	131	3'-2"	1'-0"	19
4.54	2	5'-7"	155	2'-2"		7
4.55	2	6'-1"	155	2'-8"		8
4.56	3	6'-3"	155	2'-10"		13
6.51	2	9'-5"	141	2'-11"	1'-10"	28
6.52	3	14'-6"	141	5'-3"	3'-0"	65
6.53	1	5'-0"	Str.			8
				Total		173


Notes: Bar list is for one light standard support. Total No. Required: 34. Bar dimensions are given out to out.

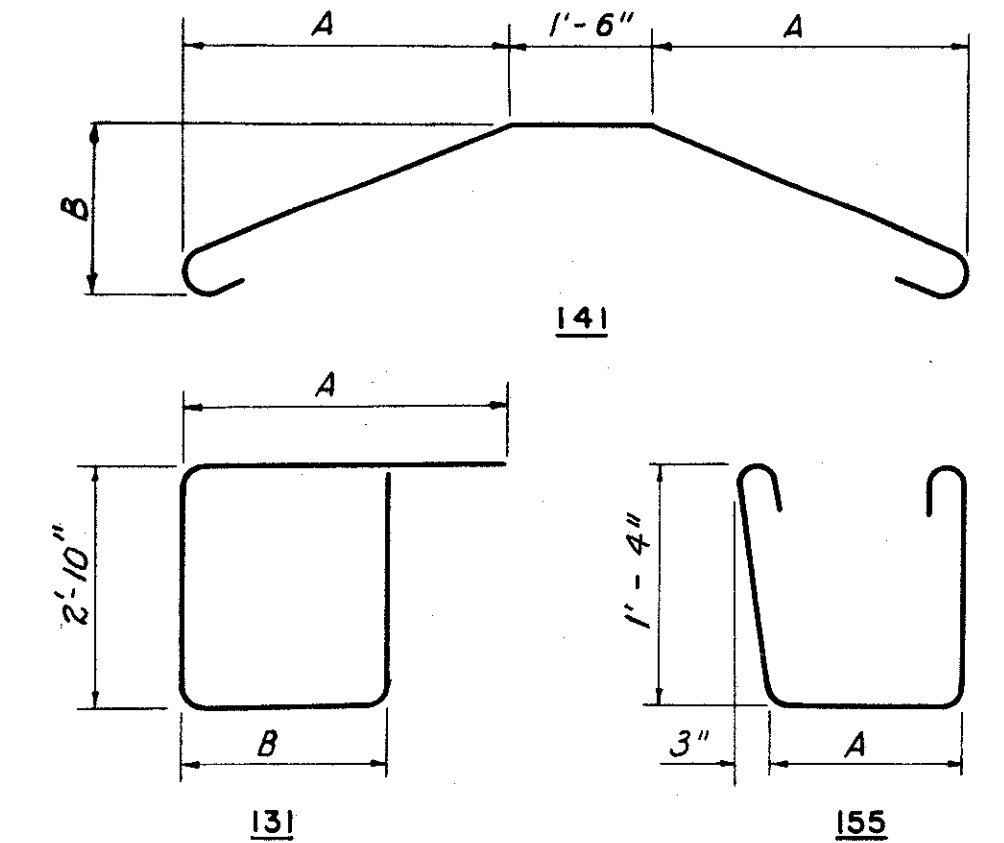

BENDING DIAGRAMS

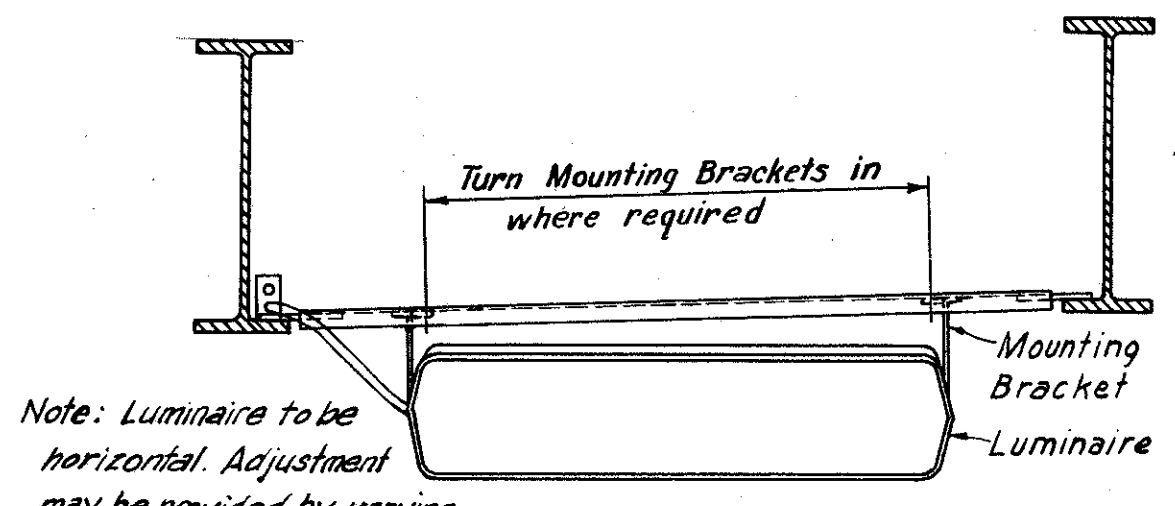

TYPE A LUMINAIRE MOUNTING
Scale: 1/2" = 1'-0"

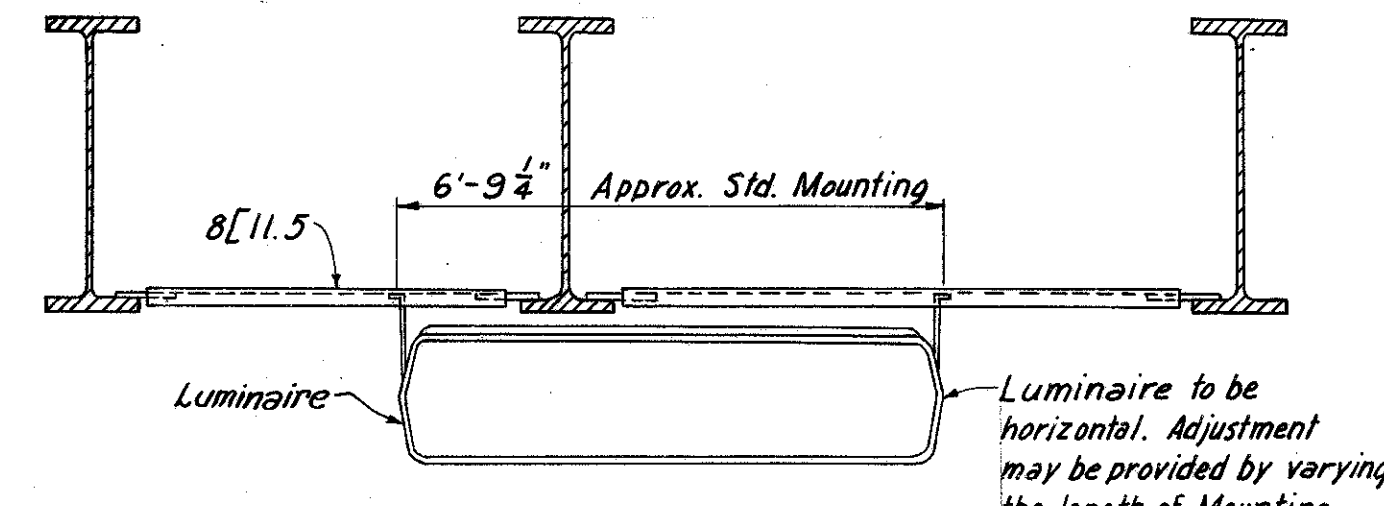

TYPE B LUMINAIRE MOUNTING
Scale: 1/2" = 1'-0"

PART 7A

HOWARD, NEEDLES, TAMMEN & BERGENDOFF
CONSULTING ENGINEERS
KANSAS CITY CLEVELAND NEW YORK

LIGHTING DETAILS






Scale as noted

WILLOW-INNER BELT FREEWAY


CLEVELAND CUYAHOGA COUNTY OHIO

DRAWN P.L.G. TRACED J.A.G. CHECKED S.J. REVIEWED J.C.T. REVISION
DATE 9-24-58 DATE 11-26-58 DATE 12-18-58 DATE 11-13-59


CUYAHOGA COUNTY
CITY OF CLEVELAND
CUY - 21-15.32
CUY - 42-18.42

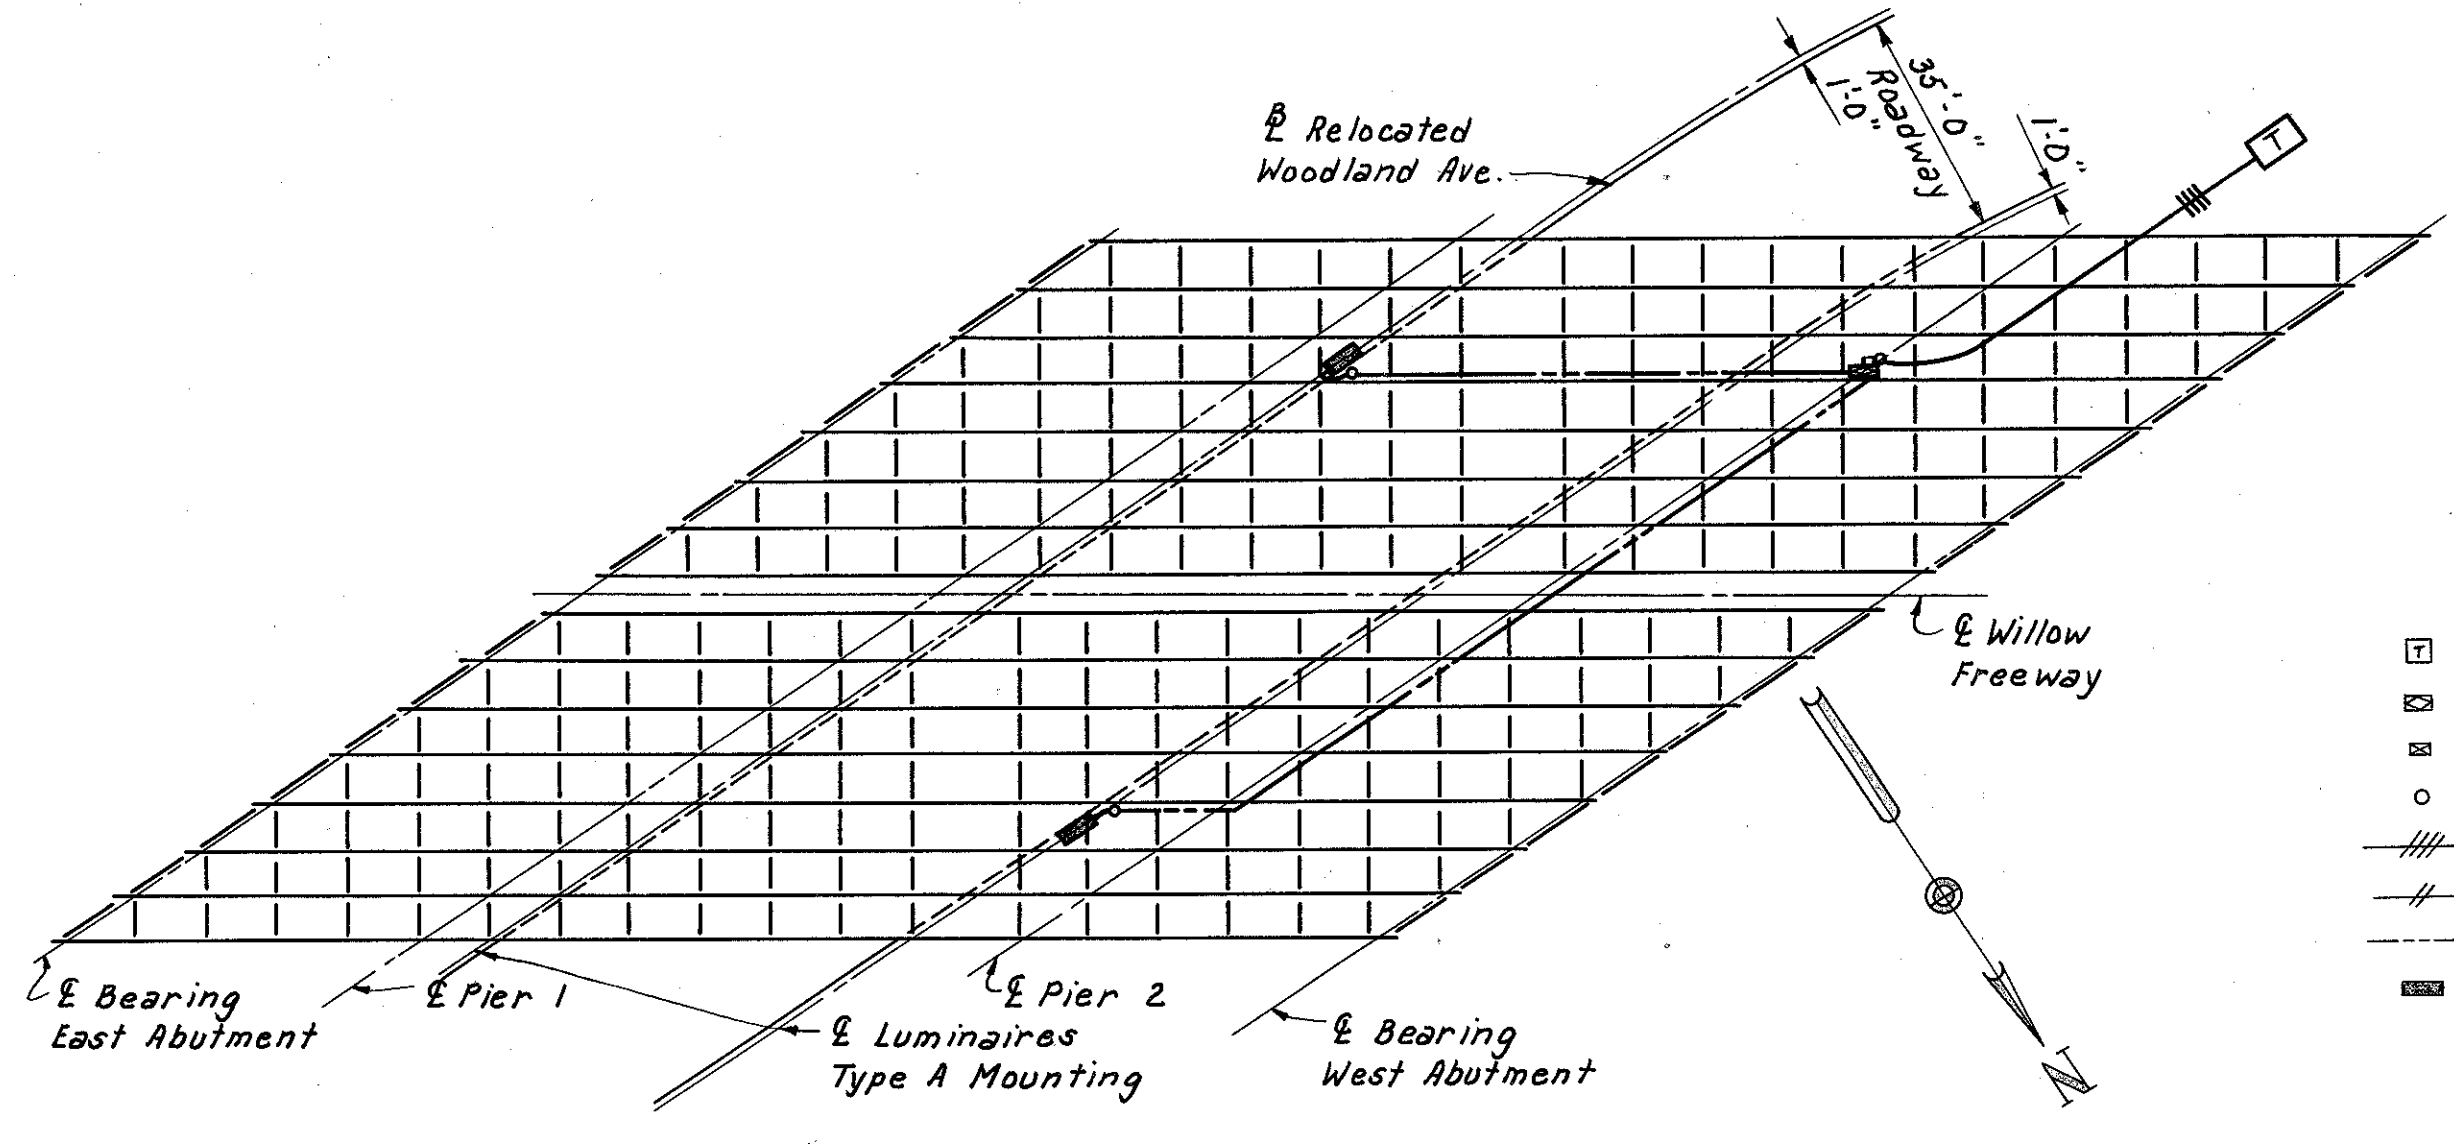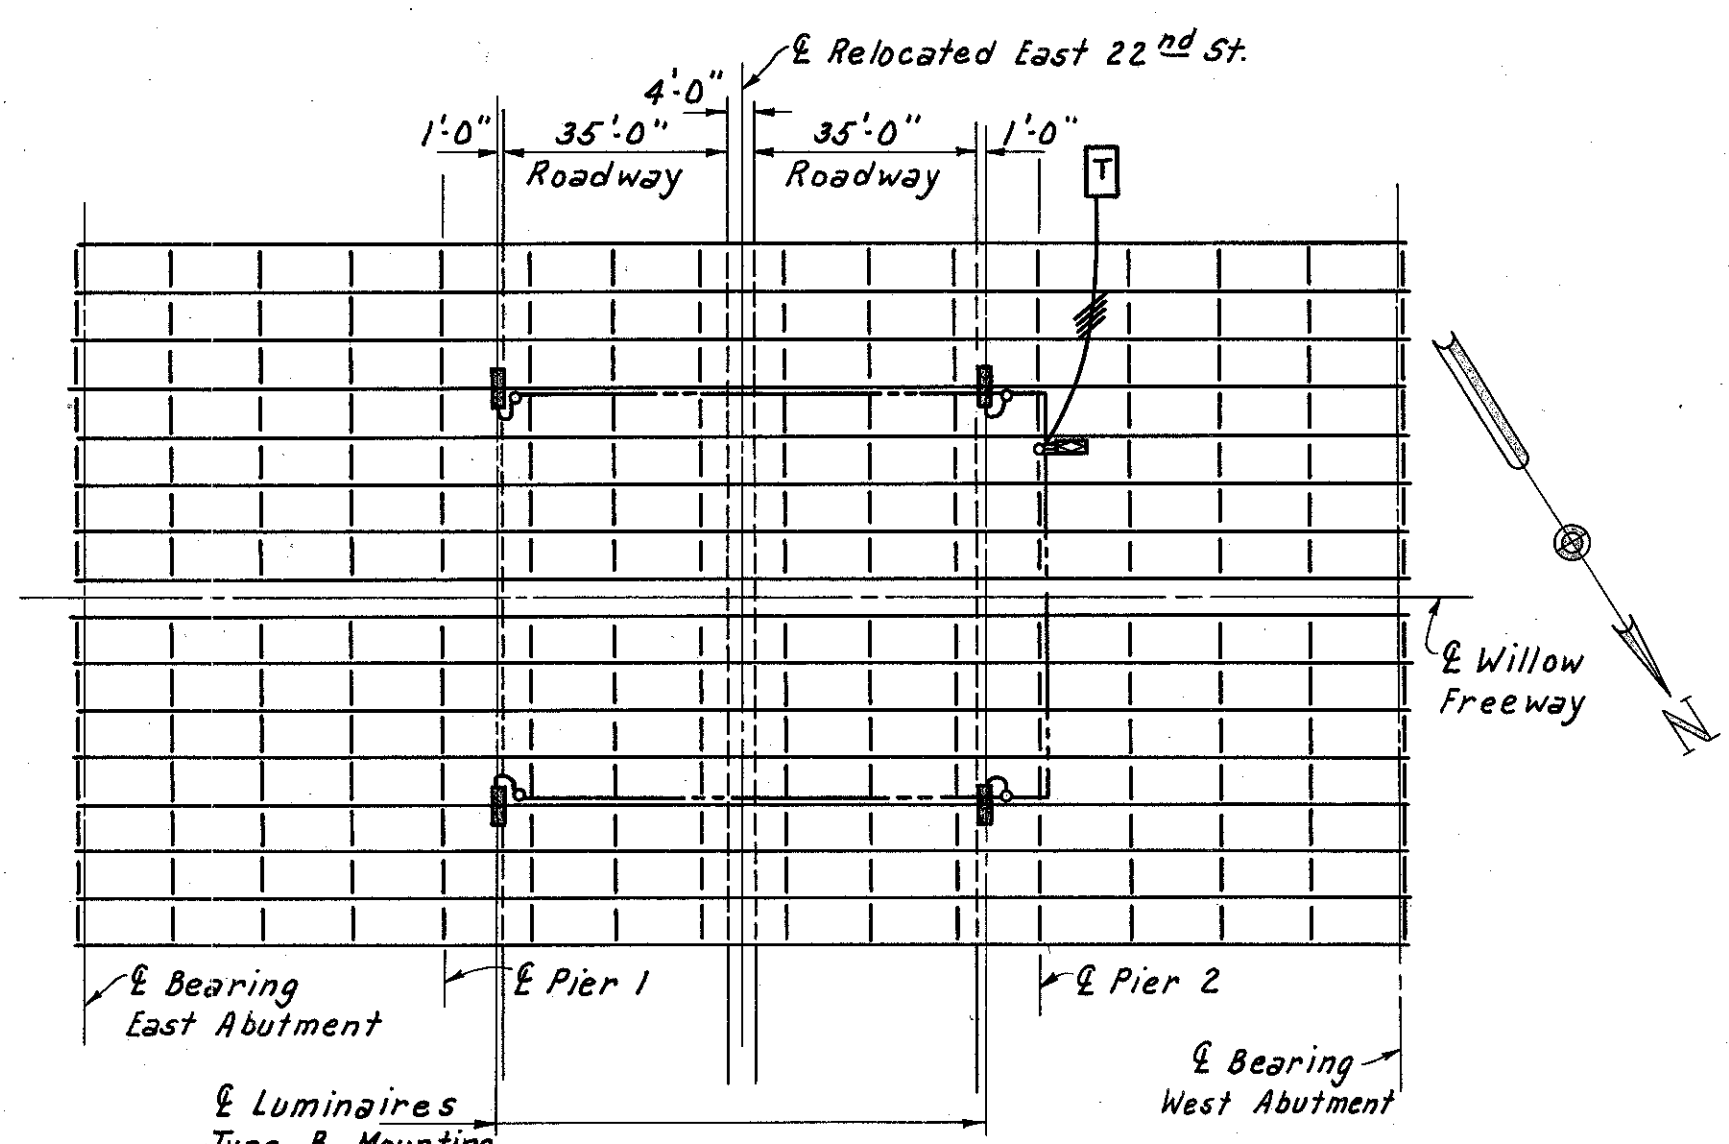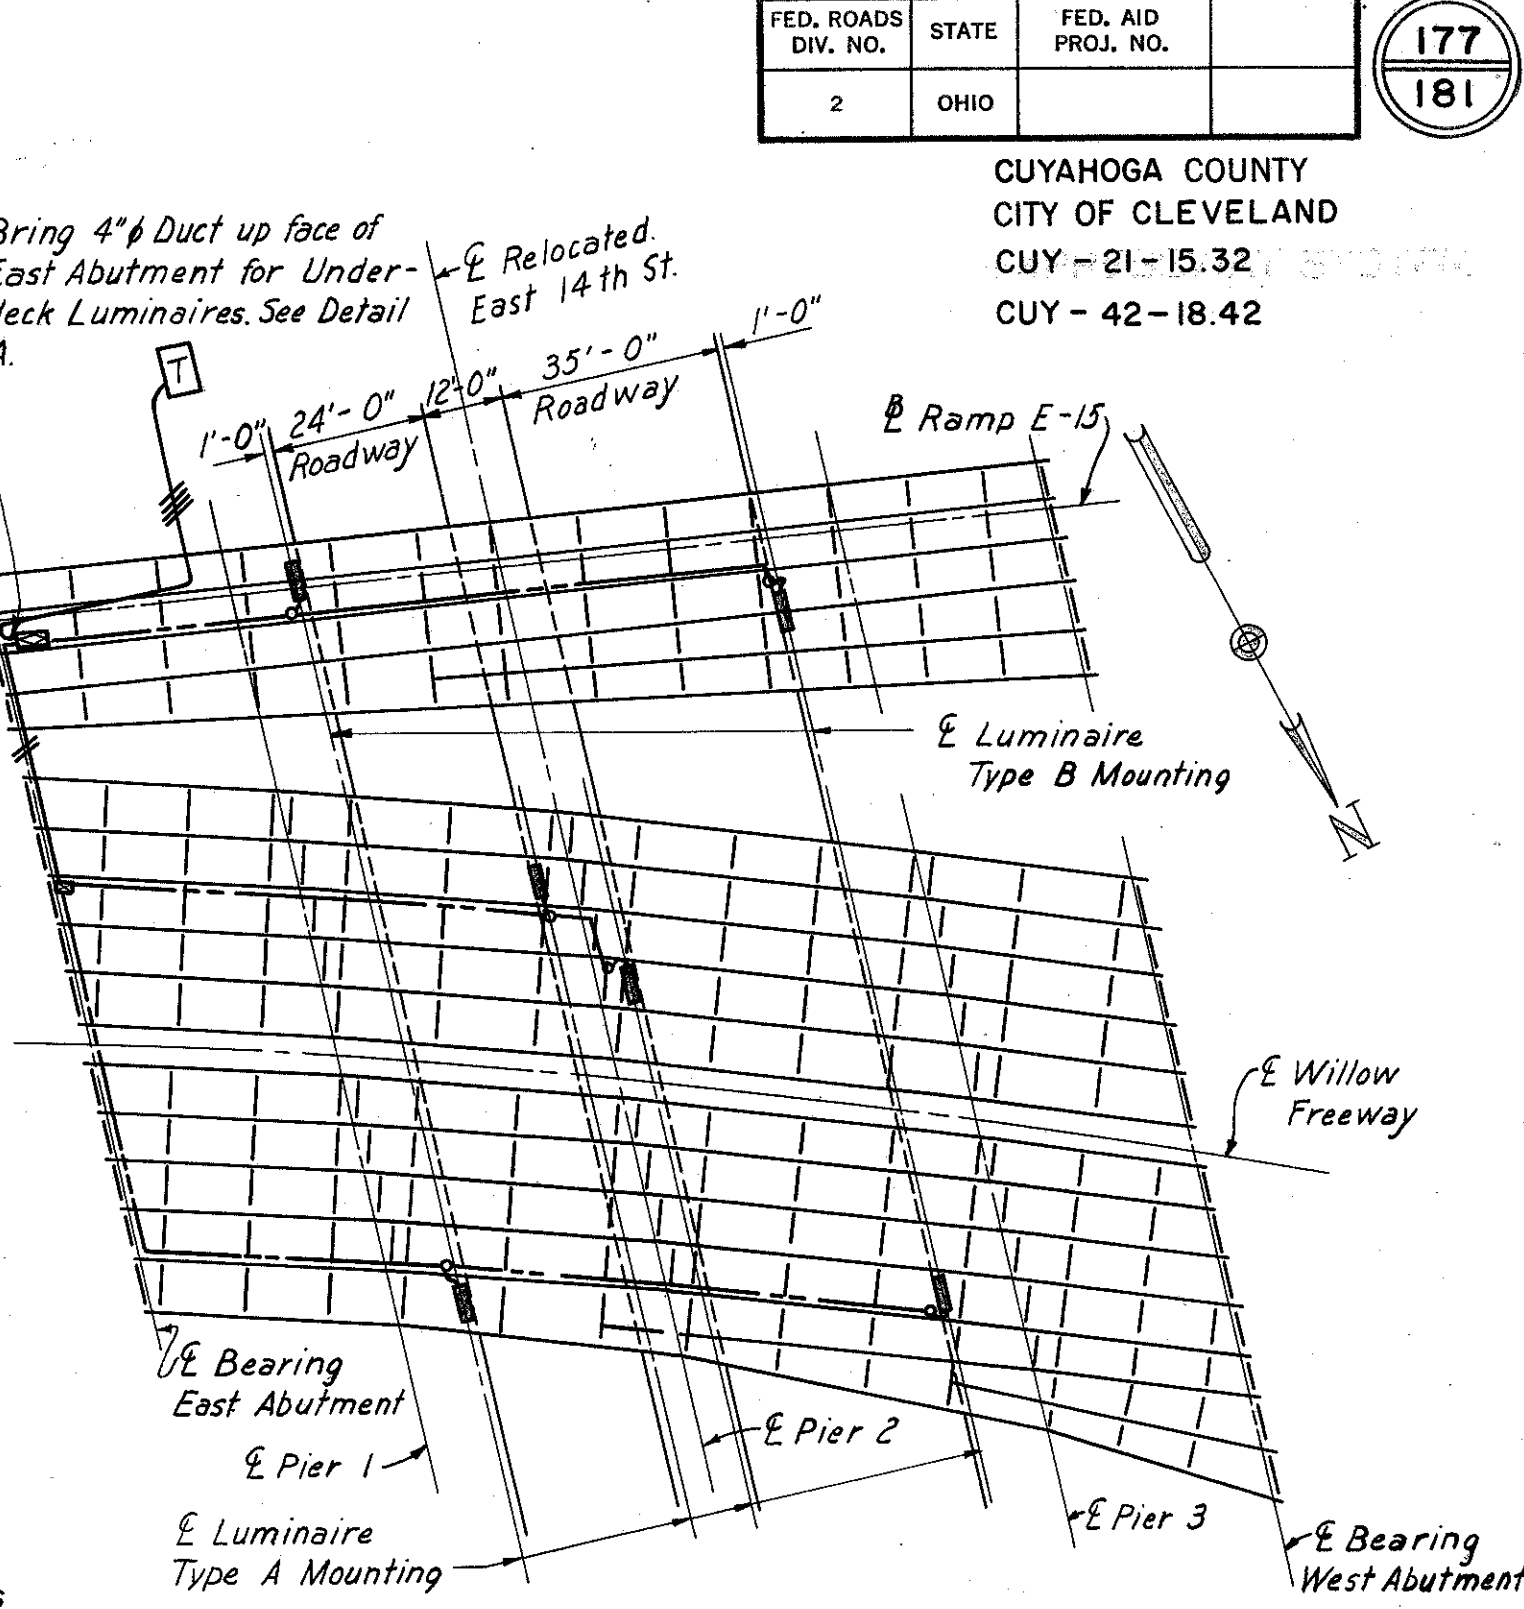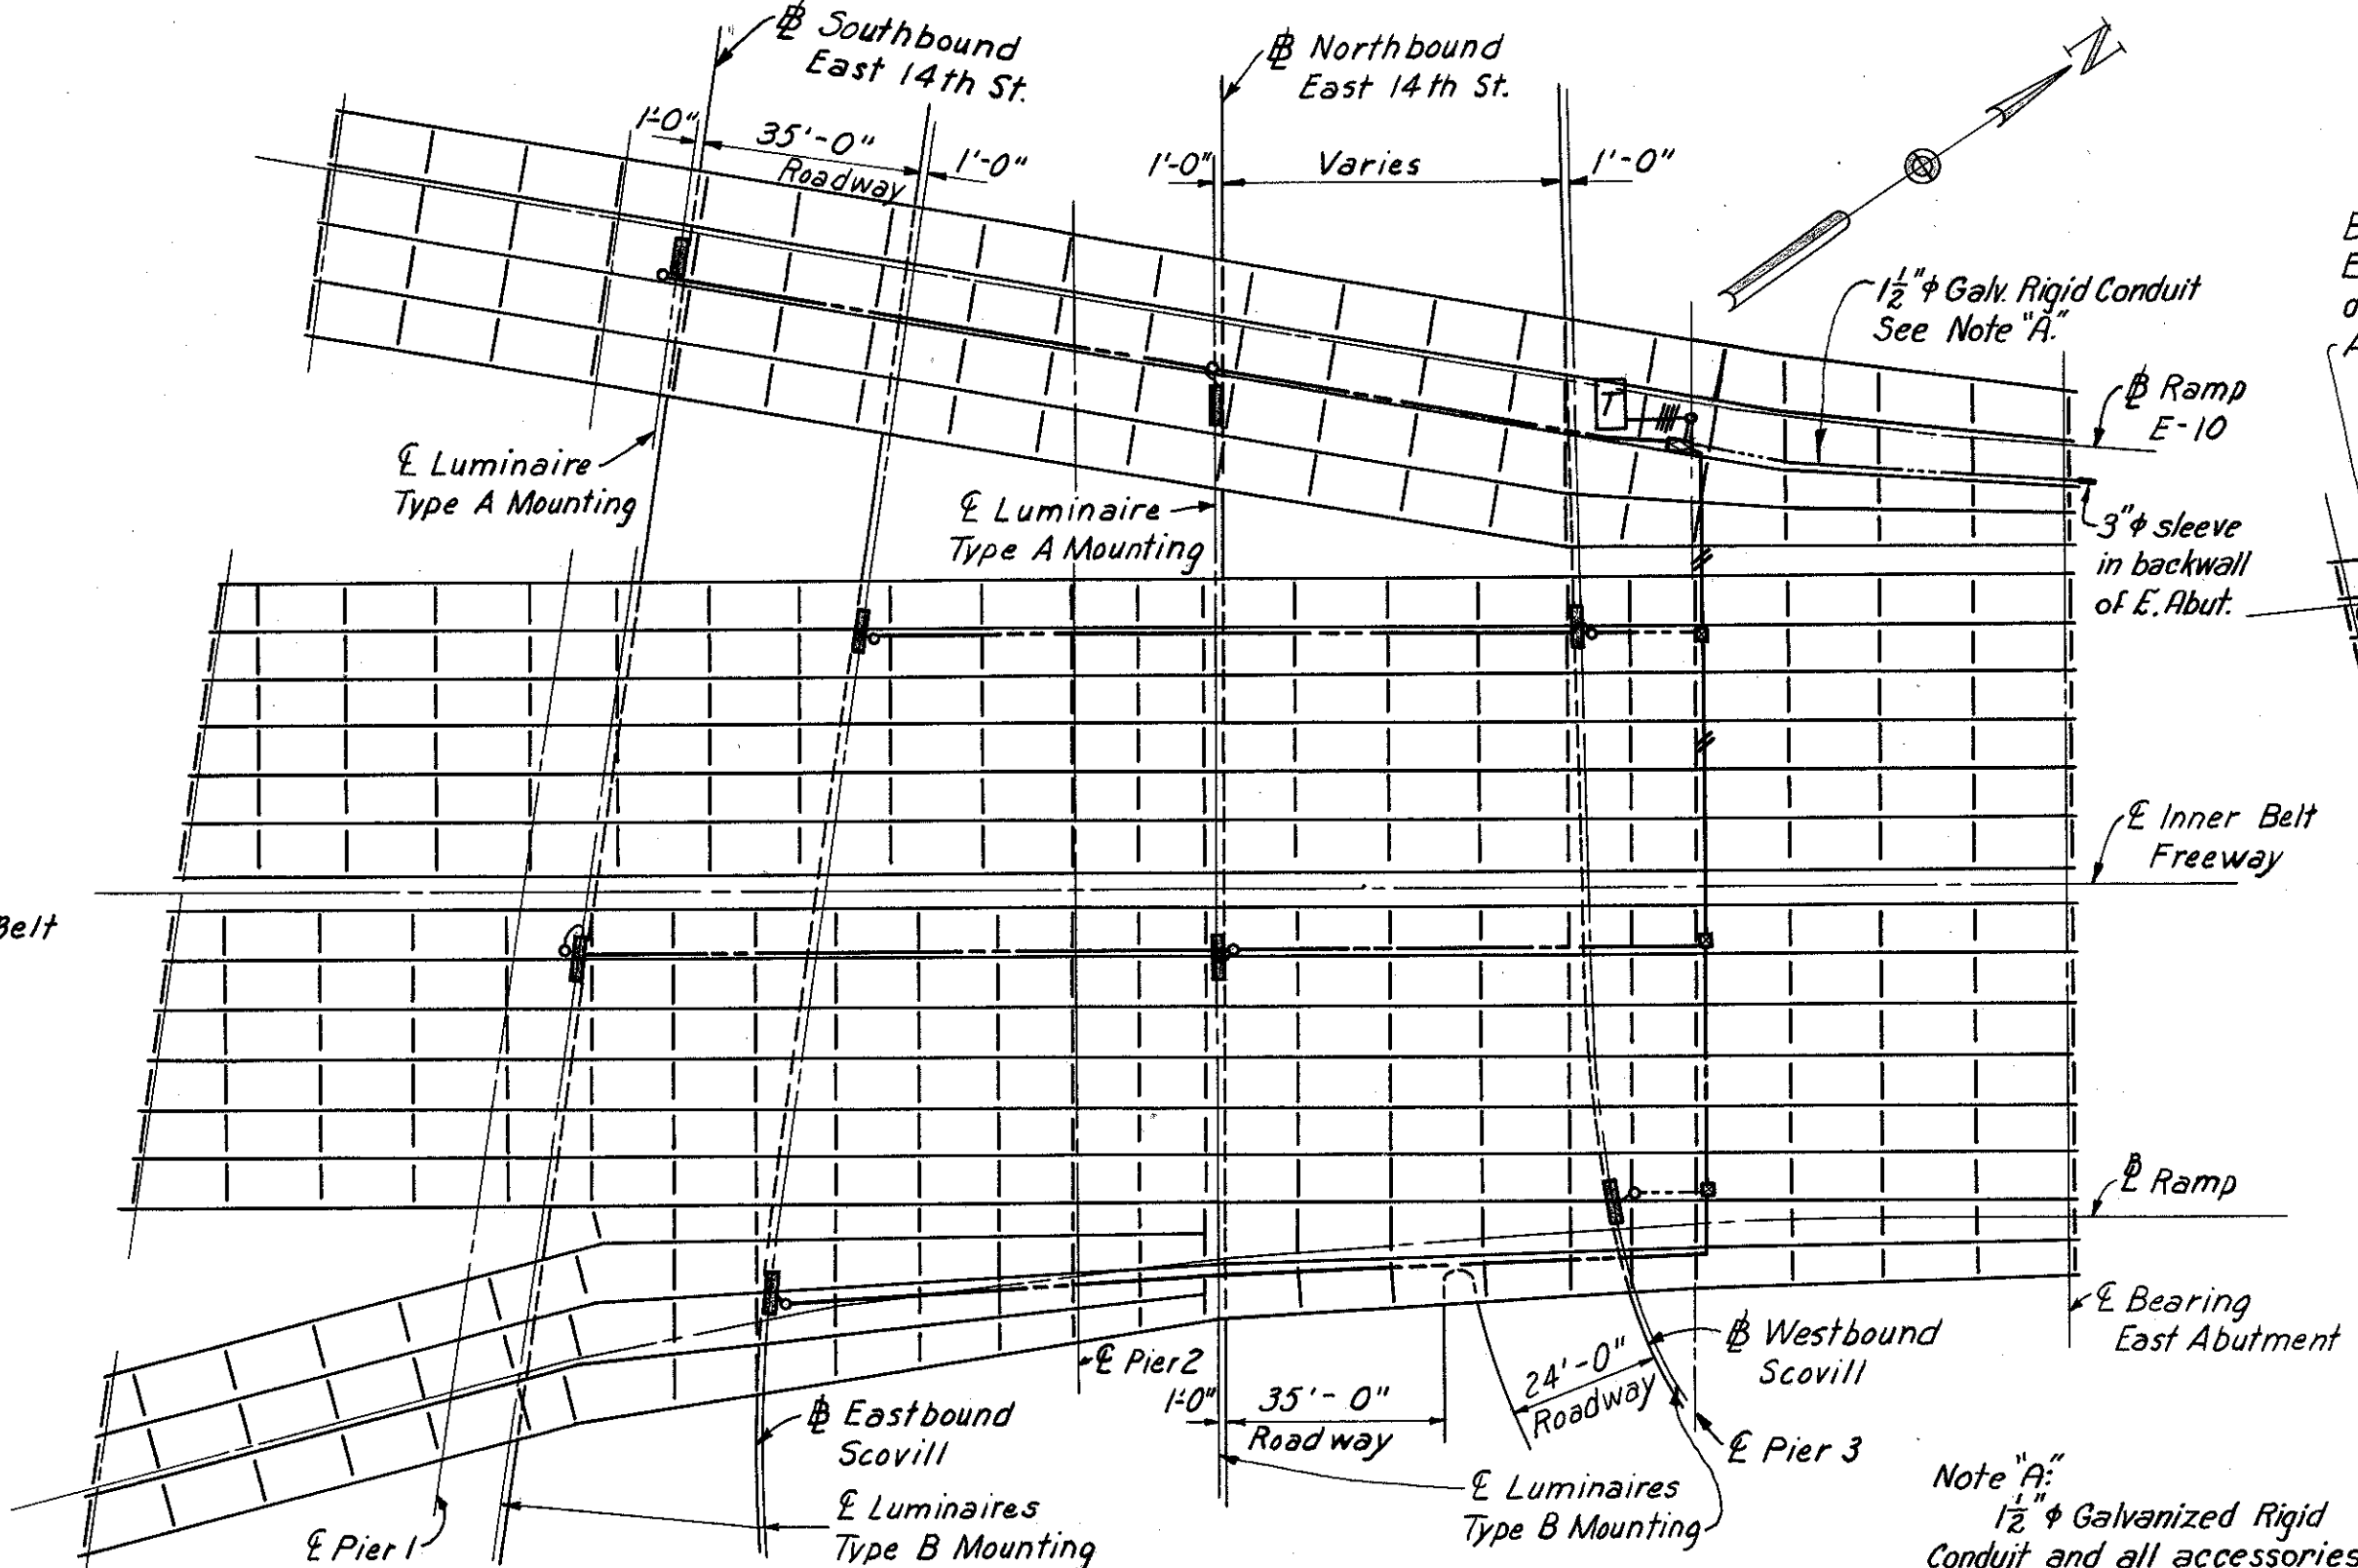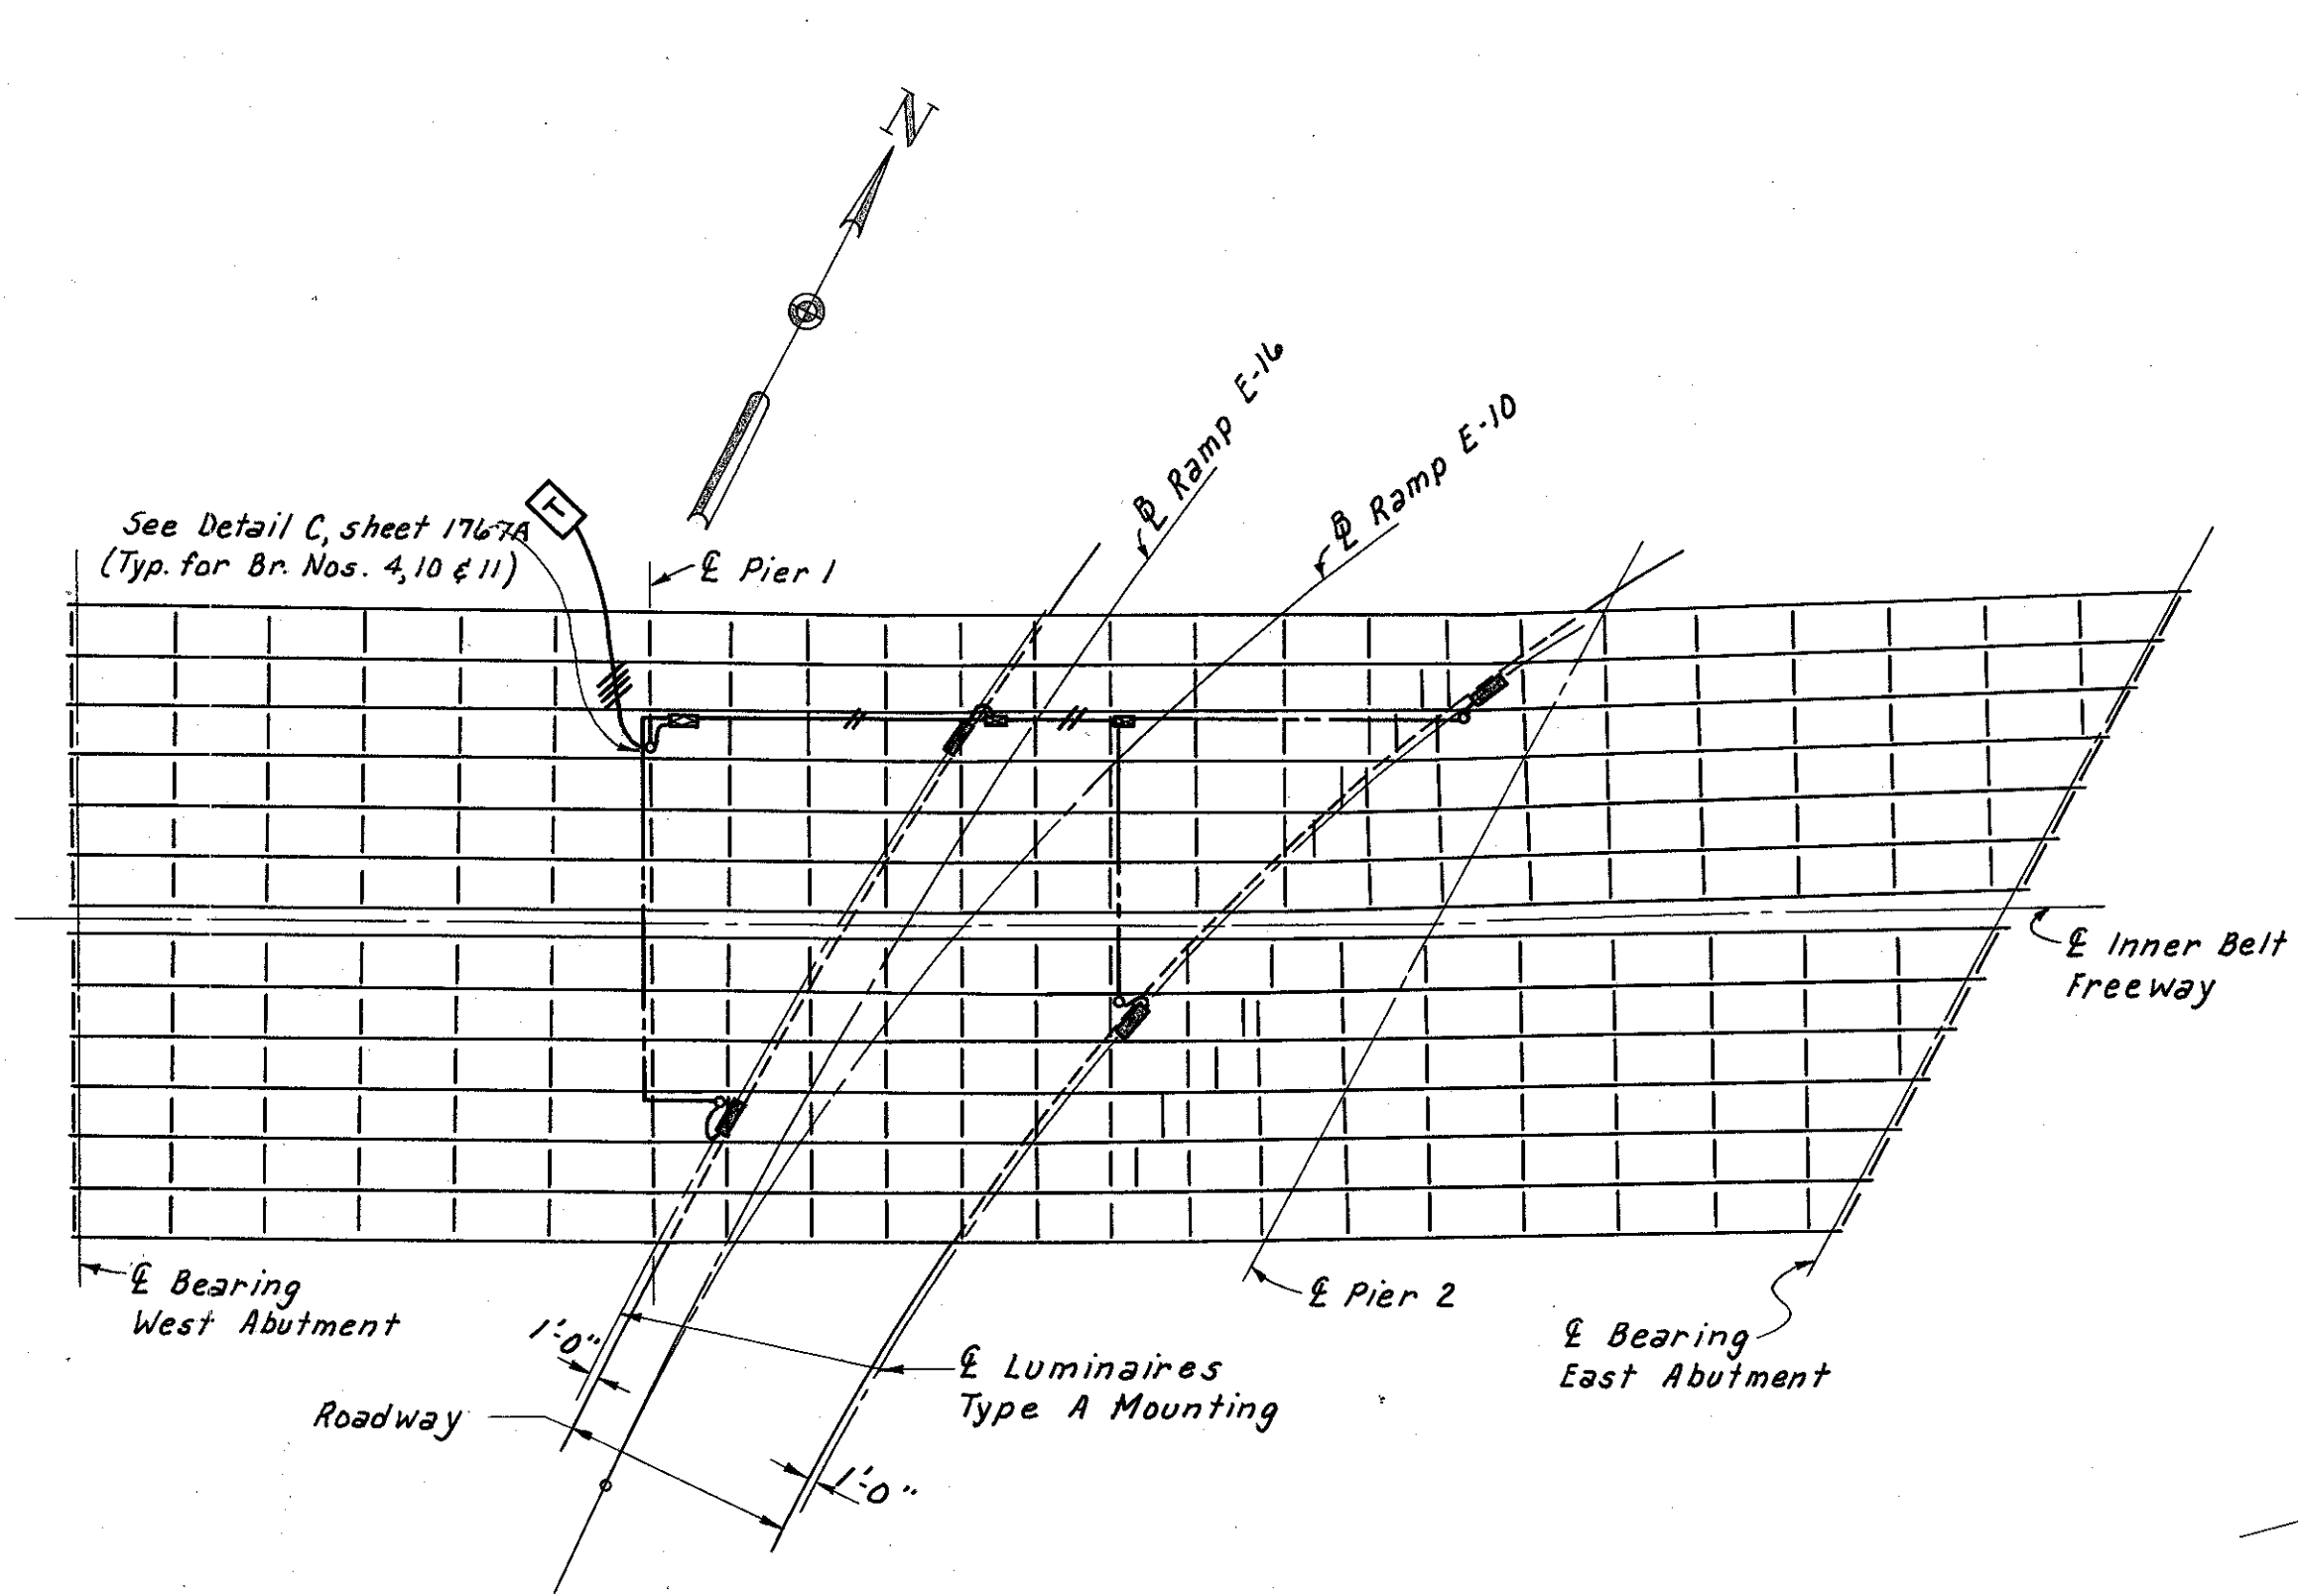

- LEGEND**
- Manhole for transformer
 - ▣ Service Panel, 32"x12"x10"
 - Junction Box, 8"x8"x4"
 - Junction Box, 6"x6"x3"
 - 4" Duct
 - 2" Galvanized Rigid Conduit
 - 3/4" Galvanized Rigid Conduit
 - ▣ Underdeck Luminaire

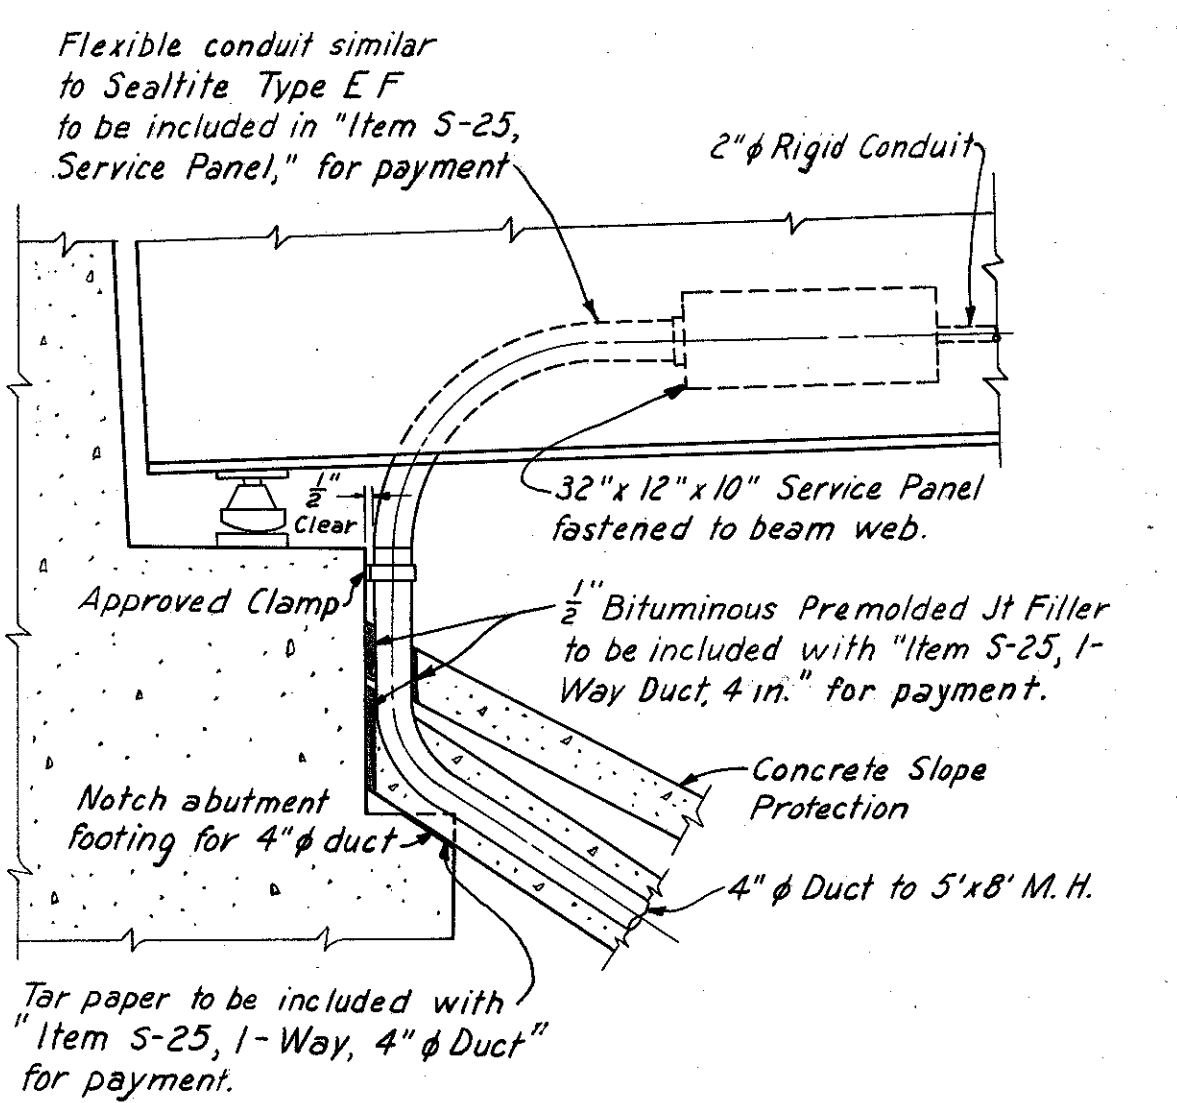


Note:
Conduit running parallel to the beams shall be fastened to the beam web just above the intersection of the diagonal and bottom chord cross-frame angles with approved clamps at not more than 4'-0" ctrs.*
Conduit running transversely to beams and girders shall be fastened to the beam or girder flanges and shall be located in-line with the crossframe angles, except as shown in the plans.

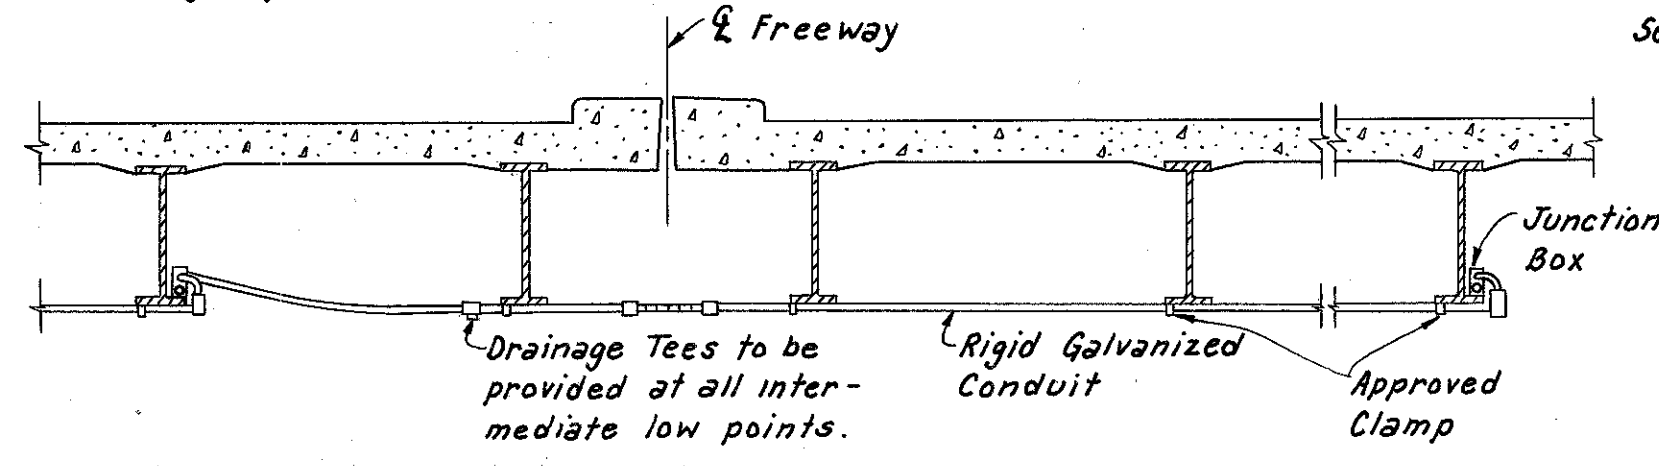


* Note: For girder bridges, conduit shall be fastened to alternate stiffeners just above the intersection of the diagonal and bottom chord crossframe angles.

UNDERDECK LIGHTING - CONDUIT DETAILS
Scale: 1/4" = 1'-0"


LOCATION OF UNDERDECK LUMINAIRES
Scale: 1" = 30'-0"

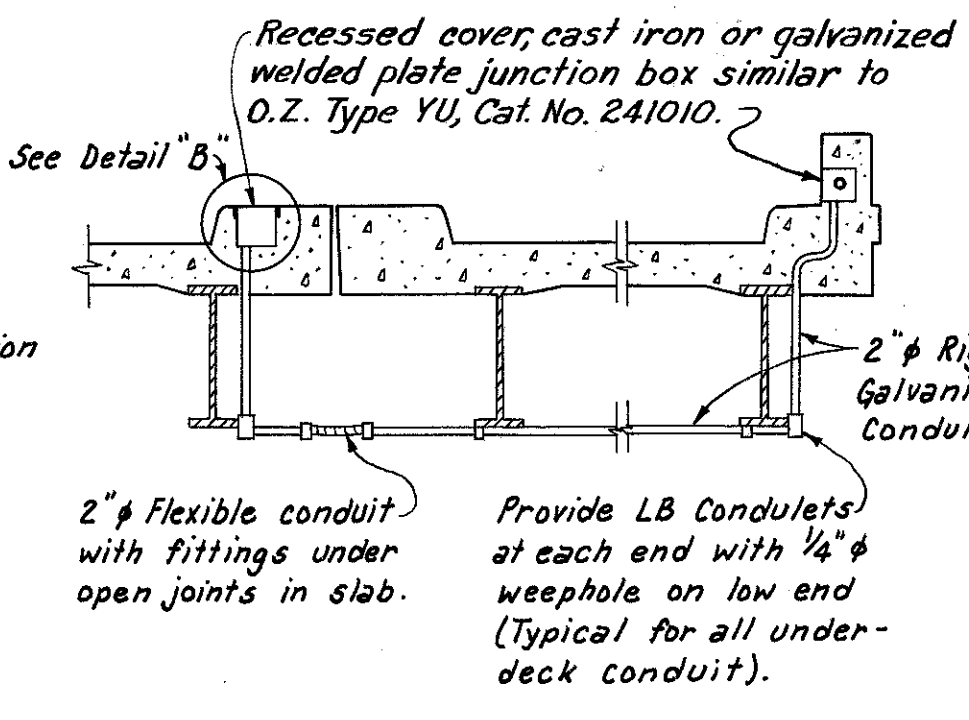

CONDUIT CROSSOVER DETAIL
Scale: 1/4" = 1'-0"

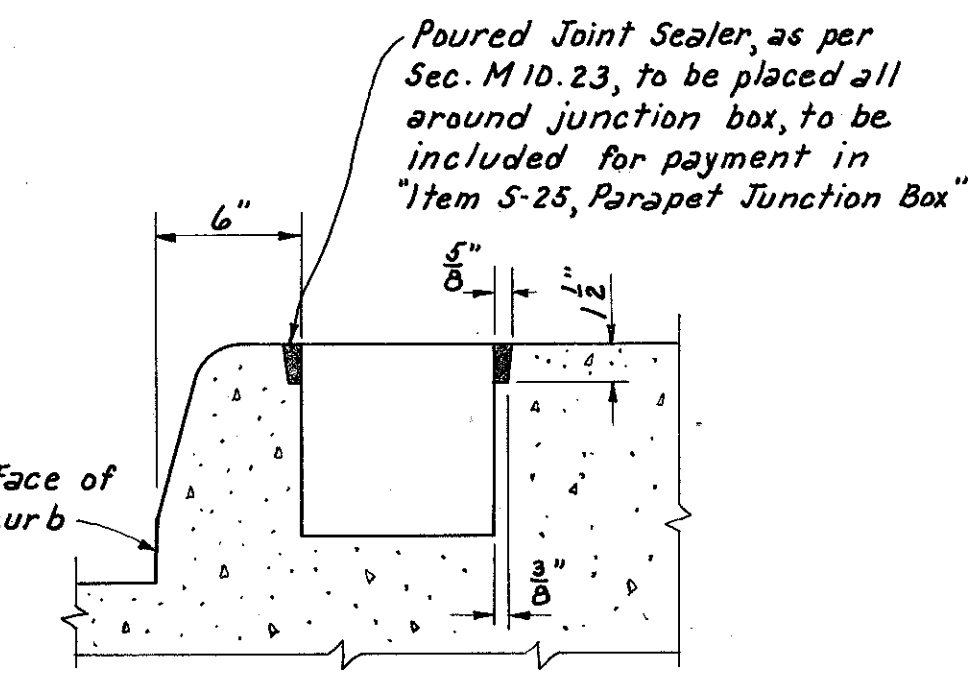

DETAIL B
Scale: 1/2" = 1'-0"

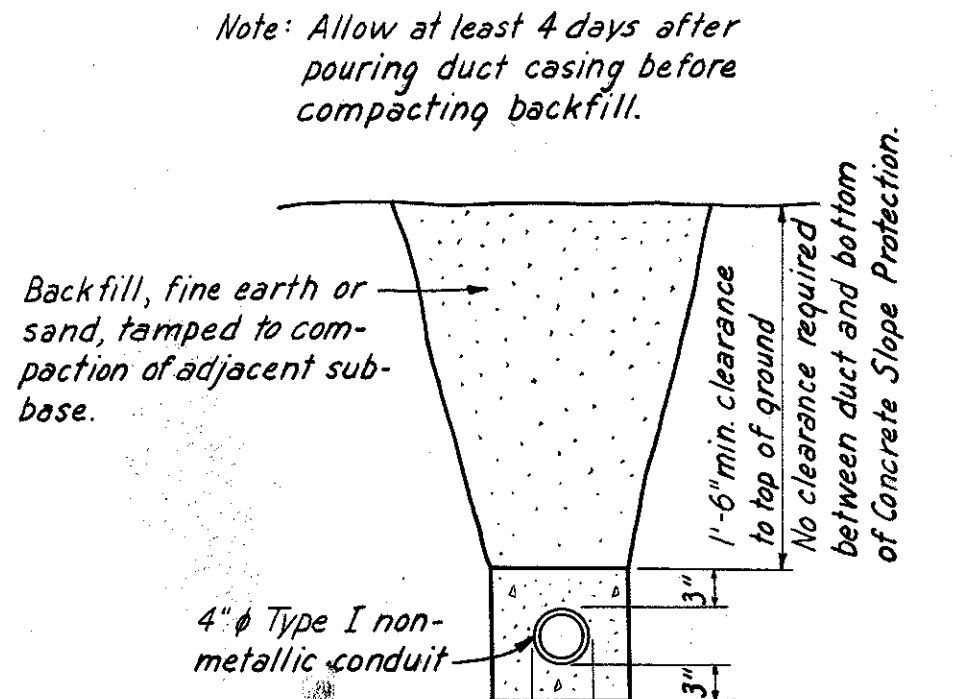

ONE-WAY DUCT BANK
Scale: 3/4" = 1'-0"

PART 7A

HOWARD, NEEDLES, TAMMEN & BERGENDOFF
CONSULTING ENGINEERS
KANSAS CITY CLEVELAND NEW YORK


LIGHTING DETAILS

Scale as noted


WILLOW-INNER BELT FREEWAY
CLEVELAND CUYAHOGA COUNTY OHIO

DRAWN P.L.C.	TRACED J.H.G.	CHECKED E.S.J.	REVIEWED J.C.T.	REVISED
DATE 12-12-58	DATE 8-22-59	DATE 1-20-59	DATE 11-13-57	

SHEET 177

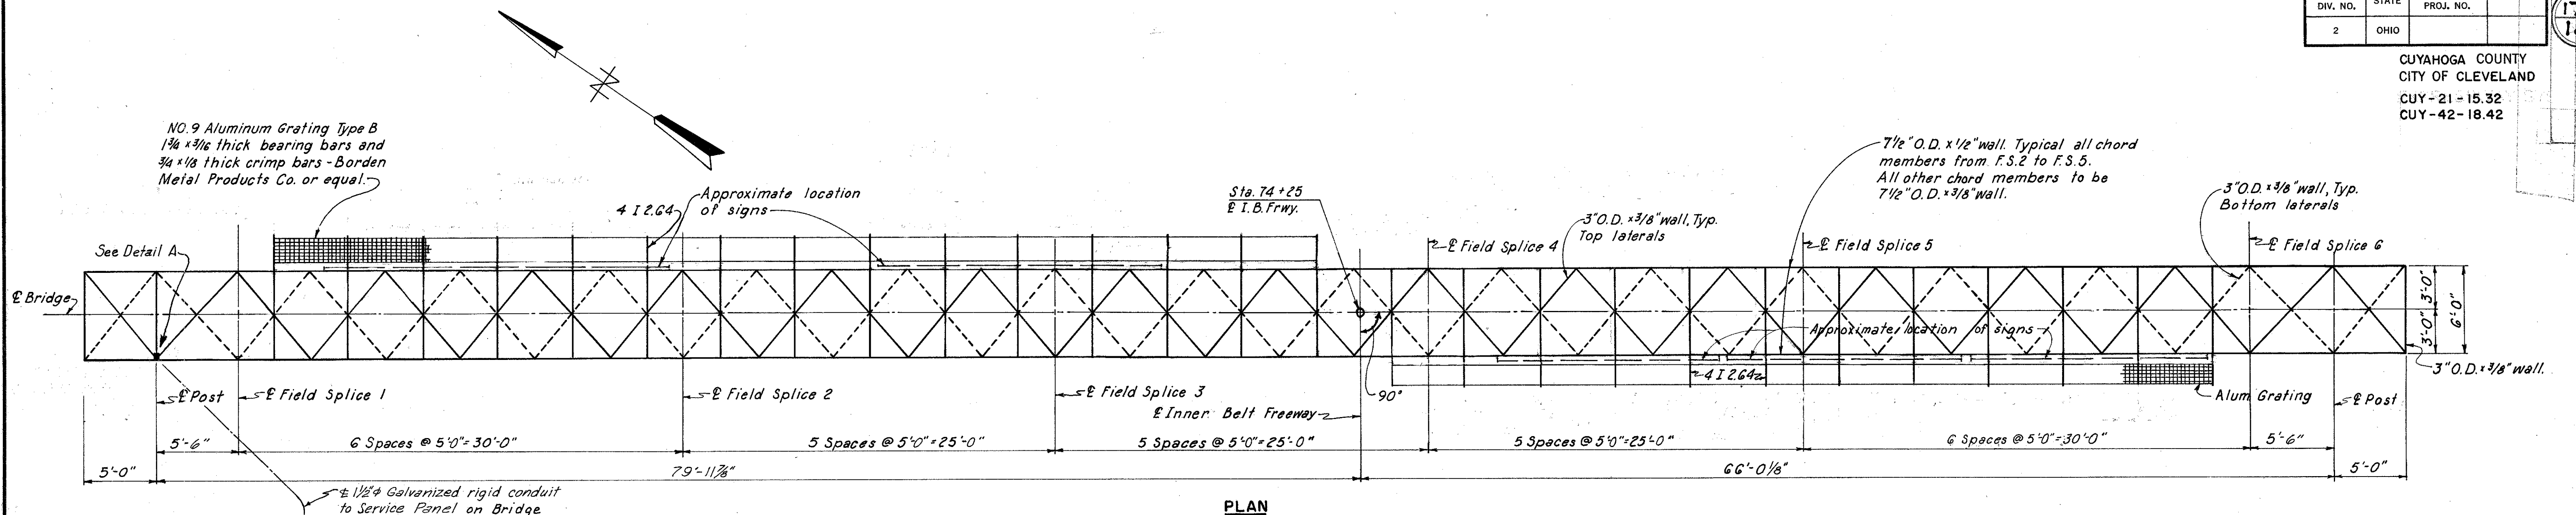


PLAN

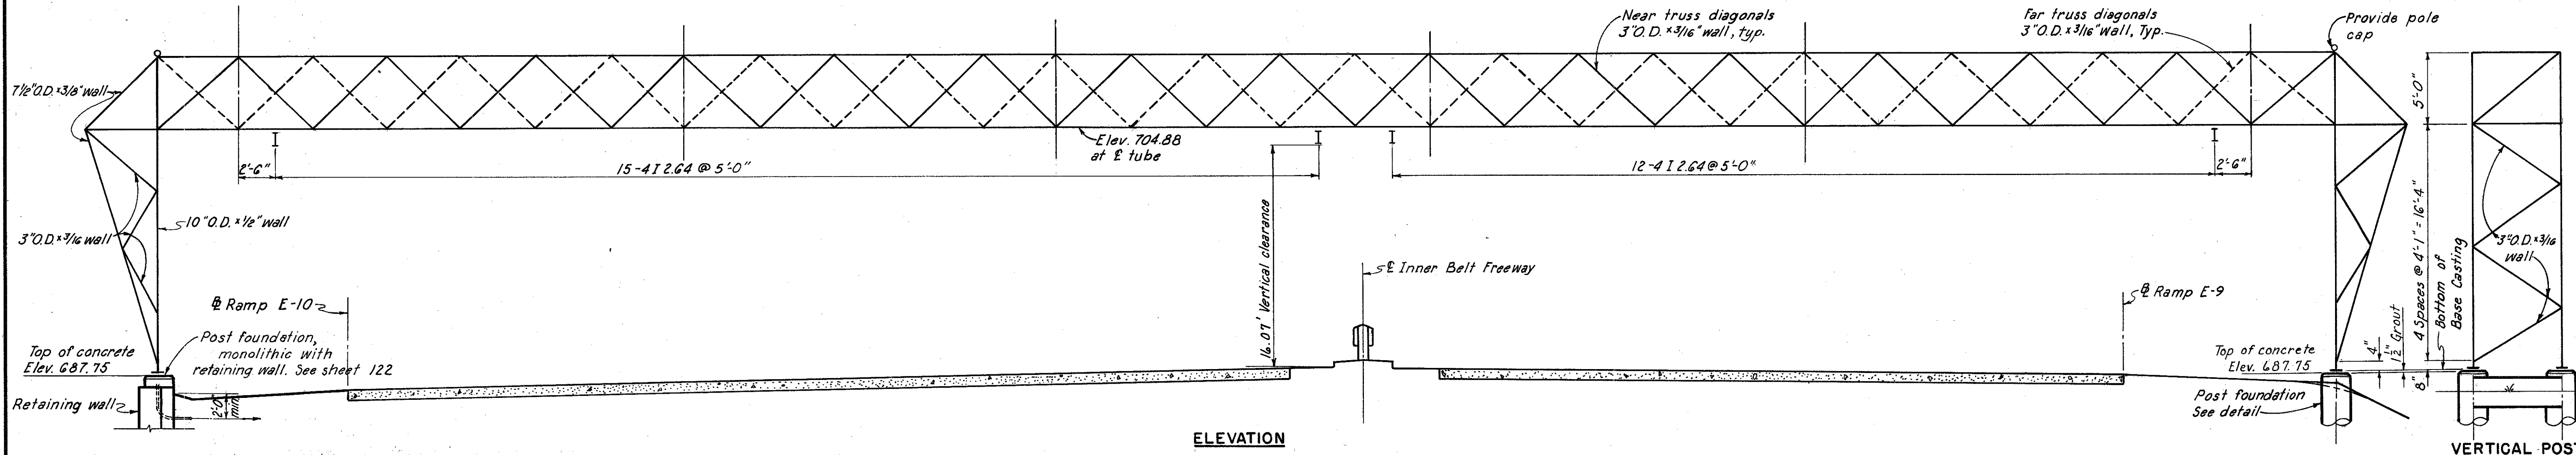


ELEVATION

VERTICAL POST
END ELEVATION

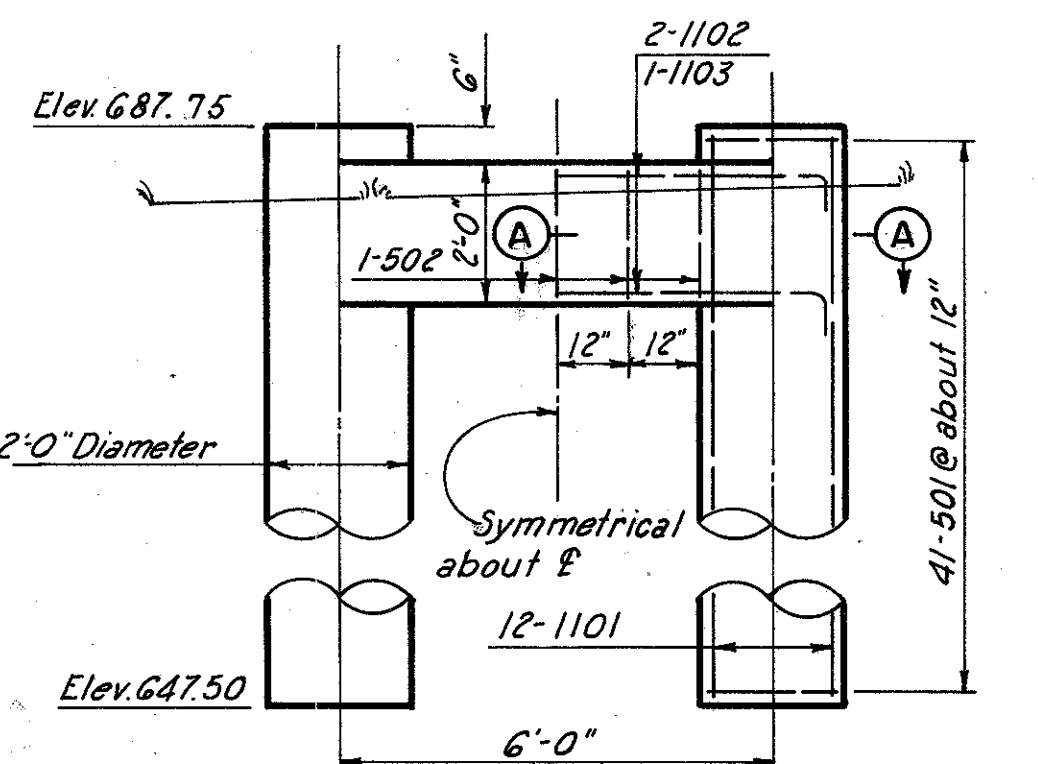

CONCRETE FOUNDATION FOR SOUTH POST
Scale: 3/8" = 1'-0"

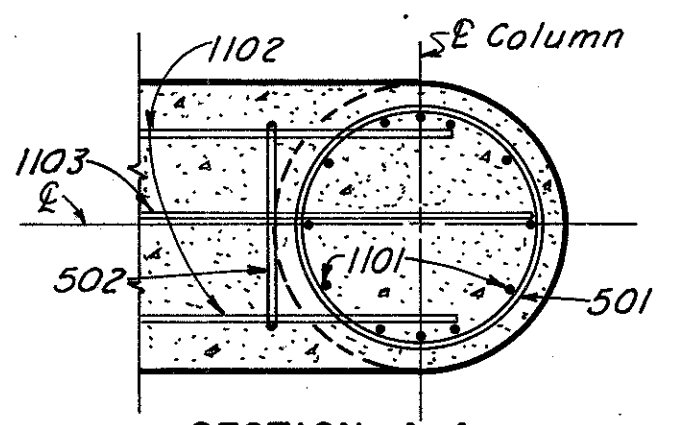


SECTION A-A
Scale: 3/4" = 1'-0"

REINFORCEMENT SCHEDULE				
MARK	NO.	LENGTH	TYPE	DIM. "A"
501	82	6'-4"	119	
502	5	7'-2"	109	
1101	24	39'-9"	Str.	
1102	4	7'-9"	105	6'-4"
1103	2	8'-9"	105	7'-4"

A	105	1'-0"
	108	1'-8"
	109	1'-8"
	119	1'-6"

BENDING DIAGRAMS

Note: Prefix "SB" shall be assigned all bar marks.

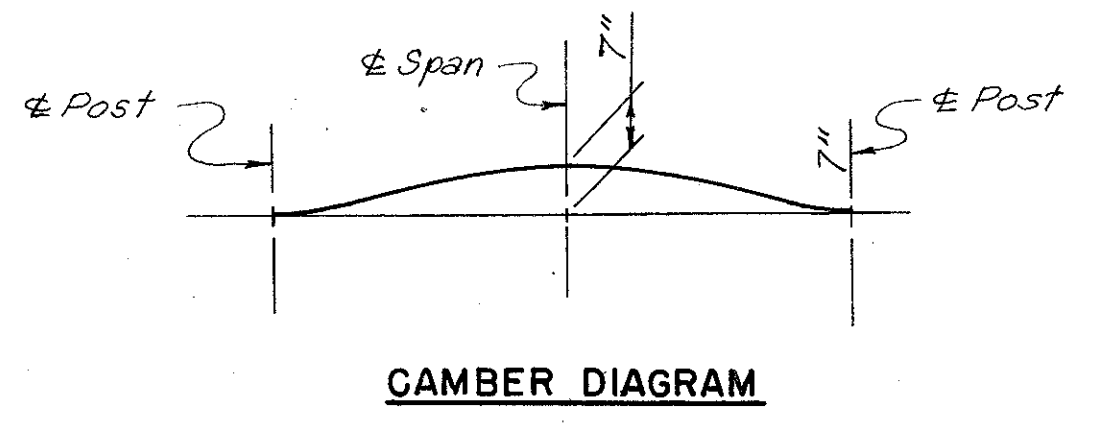

CAMBER DIAGRAM

Notes:

Sway braces not shown in plan and elevation views.
Bracing shown in post End Elevation is in the vertical plane only.

Note: Reinforcing included for payment under "Item Special, Sign Bridge, as per plan."

Rev. 3-16-60 R.E.C.

PART 7

HOWARD, NEEDLES, TAMMEN & BERGENDOFF
CONSULTING ENGINEERS
KANSAS CITY CLEVELAND NEW YORK

SIGN BRIDGE AT STA. 74 + 25
GENERAL PLAN AND ELEVATION

Scale: 3/16" = 1'-0" Except as noted

WILLOW-INNER BELT FREEWAY
CLEVELAND CUYAHOGA COUNTY OHIO

DRAWN W.Z.D.	TRACED C.R.J.	CHECKED B.L.C.	REVIEWED J.C.T.	REVISED
DATE 8-6-59	DATE 10-14-59	DATE 8-13-59	DATE 11-13-59	

SHEET 177A

A. FOUNDATIONS
One foundation shall be monolithic with the retaining wall as shown on the plans. The other foundation shall be constructed as specified in Section S-25.11 of the Specifications except that concrete shall be Class E. Posts shall be adjusted by leveling nuts as shown on the plans. Anchor rods shall be accurately held in place until the concrete has set. Grout shall consist of one (1) part Portland Cement, one (1) part Embecco or equal, one (1) part sand. The 24" diameter shafts for the post foundations shall not be placed until all pile driving in the area is completed.

B. STRUCTURAL MATERIALS
All metalwork shall conform to the following applicable A.S.T.M. Designations -B-209-58T, B-210-58T, B-211-58T, B-221-58T, B-235-58T and B-241-58T for GS11A-T6 aluminum alloy unless otherwise specified herein or shown on the plans. Stainless steel U-bolts and bolts for field splices shall conform to A.S.T.M. Designation A 320-58T Grade B8 annealed. Nuts shall conform to A.S.T.M. Designation A 194-58T, and washers shall be of the same material as the bolts. Castings shall conform to the requirements of A.S.T.M. Designation B-26-58T for SG70A-T6 aluminum alloy. Ornamental pole cap shall be aluminum alloy of a standard design.

Grating shall be constructed of GS11A-T6 aluminum alloy except crimp bars may be of GS10A-T5 aluminum alloy.

C. FABRICATION AND ERECTION
The sign bridge structure shall be shop fabricated in sections suitable for shipment. All shop connections shall be welded. The sections shall be assembled in the field with bolts. Fabrication and erection shall conform to the requirements of Item S-7 except as hereinafter modified. Aluminum tubing shall be sawed or cut with a router. Other material may be sheared, sawed or cut with a router. Cut edges shall be true and smooth and free from excessive burrs or ragged breaks. Center punching and scribing shall be used where such marks will remain on completed members. Hole centers may be punch marked by punching or scribing. All fabrication marks and irregularities shall be removed. Parts shall be welded with an arc or resistance welding process. No welding process that requires the use of a welding flux shall be used. The filler metal shall be aluminum alloy 4043 (ASTM Designation SSB), 5154 (ASTM Designation GR40A) or approved equal. Preheating for welding is permissible provided the temperature does not exceed 400° F. for a total time of 30 minutes. In preparation for welding, dirt, grease, forming or machining lubricants or any organic materials shall be removed from the areas to be welded by cleaning with a suitable solvent or by vapor degreasing. Additional operations to remove the oxide coating just prior to welding are required when the inert gas tungsten arc welding method is used. This may be done by etching or by scratch brushing. The oxide coating may not need to be removed if the welding is done with the automatic or semiautomatic inert gas shielded metal arc. Suitable edge preparation to ensure 100 per cent penetration in butt welds shall be used. Flame cutting shall not be used. Sawing, chipping or machining may be used. Holes in castings shall be cored or drilled. Drain holes shall be provided for hollow members. Conduit inlet holes and handholes shall be provided in the structural columns to provide access for installation of electrical cables. The bottom surface of the post base castings shall be coated with one (1) heavy coat of alkali-resistant bituminous paint equal to Bitumastic Super-Service Black as manufactured by Koppers Company, Inc.

D. ELECTRICAL WORK
a. General
The sign bridge item shall include furnishing and installing electrical components as noted below and structure grounding in accordance with Item S-25. This work shall include:
Underground conduit from "Service Panel" under deck of Bridge No. 4, including conduit on bridge and through approaches.
Grounding of the sign bridge.
Conduit through sign bridge foundation, and all mounting holes and fittings.

The photo cell control unit for feeder on Bridge No. 4 is not included in the sign bridge item.
Where materials, equipment, or other products are specified by manufacturer, brand name type, or catalog number, such designation is to establish standards of desired quality and style and shall be the basis of the bid; however, materials and equipment approved equal by the Director will be allowed.
Where such substitutions alter design or space requirements, the Contractor shall include all items of cost for the revised design and construction including cost of all trades involved.

All electrical materials, construction and installations shall meet the requirements of the Cleveland Division of Light and Power and the Cleveland Electric Illuminating Company in addition to the requirements of the Standard Specifications.

The electrical work shall be laid out and installed in conjunction with the construction of the Bridge 4 abutment and slab and shall include furnishing and installing all necessary hangers to support the conduit on Bridge 4.

b. Service
Power for the sign fixtures will be available from the load side of photo-cell-controlled contactors in the service panel below the deck of Bridge No. 4 over 14th Street. This service will be 230 volts.
This item shall include furnishing and installing a weatherproof, double-pole, 250-volt safety switch and all wiring connections to the load side of the contactors. Terminals, conduit, fittings, lugs, etc., as necessary to make a complete connection shall be provided. The safety switch shall be mounted on or immediately adjacent to the service panel.

c. Grounding
The sign bridge structure shall be grounded by an equipment ground for not over 25 ohms resistance to ground. Grounding shall be accomplished by means of at least one copper-clad ground rod, 1-inch diameter, and ten feet long with an approved type grounding clamp at the top and a No. 6 AWG bare stranded copper conductor to the sign bridge grounding lug.
The top of the ground rod shall be at least one foot below finished grade. The grounding conductor shall be so installed through the sign bridge base so as to permit the shortest and most direct path from support to ground rod. The ground conductor shall be installed in a 1" concealed galvanized rigid metal conduit sleeve with conductor and conduit bonded at each end.
The resistance between ground and absolute earth shall be measured by the Contractor in the presence of the Engineer.

d. Conduits
Conduit on Bridge No. 4 and in the underground portion shall be 1-1/2" galvanized steel.
Insulated bushings shall be used at terminations of the 1-1/2" conduits. Insulated bushings shall be equal to O. Z. Type A.
Exposed conduits under Bridge No. 4 shall be securely fastened in place at not more than 5-foot centers, and hangers, supports or fastenings shall be provided at each elbow. Conduit runs on Bridge No. 4 may be supported by hangers, two-hole malleable straps or beam clamps. Hangers shall be made of durable materials suitable for the application and shall be galvanized. The use of perforated iron for supporting conduits will not be permitted.
An expansion coupling similar to O.Z. Type AX shall be provided at the abutment, complete with bonding jumper, and a malleable "T" 1-1/2" x 1-1/2" x 1-1/2" drain at the low point in the run, complete with one-half cubic yard gravel pocket.


e. Cables
All conductors shall be insulated for 600 volts. The conductors for the branch circuit between the service panel on Bridge No. 4 and the handhole at the sign bridge shall be stranded, Type RHW. The pole and bracket cable for circuits on the sign bridge above the handhole to the ballast primaries shall be _____ type for 600-volt ratings, _____ stranded, _____ polyvinylchloride insulation.
Conductors shall be thoroughly tinned, soft drawn copper. Wire size, insulation type and manufacturer's name shall be permanently marked on the conductor jackets at regular intervals. Wires shall be color coded and the coding used consistently throughout the installation.
Wire and cable shall be as manufactured by Okonite, Phelps-Dodge, Ansco, General Electric, General Cable, Kaiser, or approved equal.

f. Wireway
A wireway shall be provided along each walkway, complete with necessary fittings, to house ballasts, the transverse branch circuit, and the transverse wiring between ballast secondaries and lamps. The cross-sectional dimensions of the wireways shall be 6 inch by 6 inch.
Wireways shall be of high strength, corrosion-resistant aluminum alloy extrusions, and shall conform with the Joint Industry Conference Standards. Metal shall be aluminum alloy 6061-T6, not less than .071" thick in body and .125" thick flanges.
Wireways shall be sectionalized generally in not less than ten-foot sections. The top cover shall have a sponge-rubber Neoprene gasket. Closure plates and telescoping fittings shall have solid Neoprene gaskets. Double 1/8 inch drain holes shall be placed in bottom at not over 12 inch centers. Attach wireway by not less than 3/8 inch stainless steel bolts at each support, complete with stainless steel nuts and lock washers. Covers shall be lift-off hinges with two chains per cover. External clamps shall be at not over 4 foot centers. Use telescoping fittings to move flanges off supports. Nuts and bolts for joining sections of wireway shall be aluminum or stainless steel. Attach ballasts to wireway with some type bolts and nuts. Knockouts shall be provided at the proper locations for attaching conduits by "Screw-It" connectors with Neoprene gaskets. The wireway with complete complement of fittings shall be a tight sectionalized type as manufactured by the Hoffman Engineering Corporation of Anoka, Minnesota or approved equal.


g. Fixtures
The sign lighting fixtures shall consist of aluminum housings with baked enamel reflecting surfaces, cast aluminum and fittings suitable for standard 3/4 inch conduit connections, spring loaded telescopic lamp holders, and clear door covers of impact-resistant plastic material. The units shall be for 4 foot power groove lamps, and shall have all external surfaces protected by weather and corrosion-resistant enamel, with stainless steel hardware.
Fixtures shall be adjusted for optimum sign illumination and uniformity, and shall be adjustable so as to permit positive locking in any desired position.
Fixtures shall be wired with not smaller than No. 14 Type AF asbestos covered wire. No splice or tap shall be located within an arm. Wire shall be continuous from lamp sockets to ballast terminals.
The units shall be listed by Underwriters' Laboratories. Units shall be General Electric Type L 104 Fluorofloods or as approved by the Director.

h. Ballasts
Ballasts shall be of the high power factor type and their construction shall conform to the Certified Ballast Manufacturers' Standards.
Ballasts shall provide completely reliable starting to 20° F., shall be for 230-volt operation, shall fit in the 6 x 6 wireways, and shall be designed for power groove or super-high output lamps.
The ballasts for each set of 2 lamps shall be No. 6G2519 outdoor type with one No. 2T51Y6432 (240-120) 500 Va transformer as manufactured by the General Electric Company, or approved equal.


i. Lamps
Fixtures shall be provided with cool white double dimpled power groove or super-high output lamps equal to General Electric F48PG17/CW.
E. METHOD OF MEASUREMENT AND BASIS OF PAYMENT
Except as noted below, no measurement will be made of the component parts comprising the Sign Bridge Installation and payment will be made of the contract lump sum price for "Item Special, Sign Bridge as per plan" in place completed and accepted, which price and payment shall constitute full compensation for all excavation, backfill, concrete, reinforcing steel, anchor bolts, aluminum alloy, stainless steel, welding, preparing and erecting all materials including electrical work consisting of grounds, conduits, and connections, and all other items specified herein and that may be required to construct the Sign Bridge, complete, and for all labor, materials, equipment, tools, and incidentals necessary to complete this item. Payment for the foundation that is monolithic with the retaining wall will be measured for payment as concrete and reinforcing steel in the retaining wall. The signs will be furnished and mounted on the bridge by others.

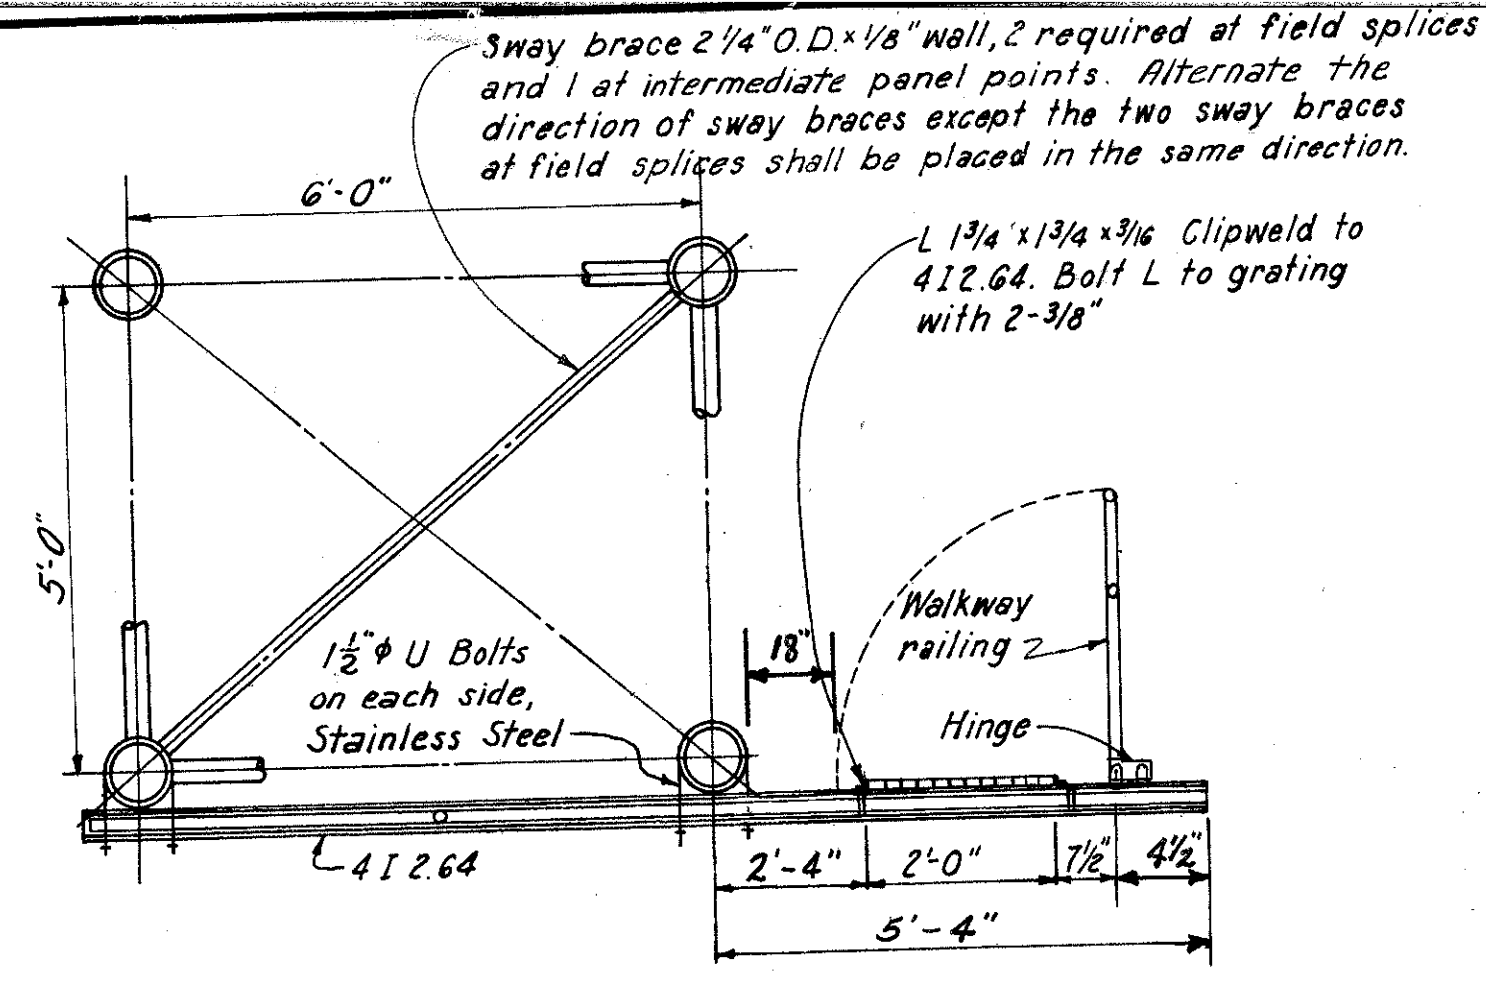

TYPICAL SECTION
Scale: 1/2" = 1'-0"

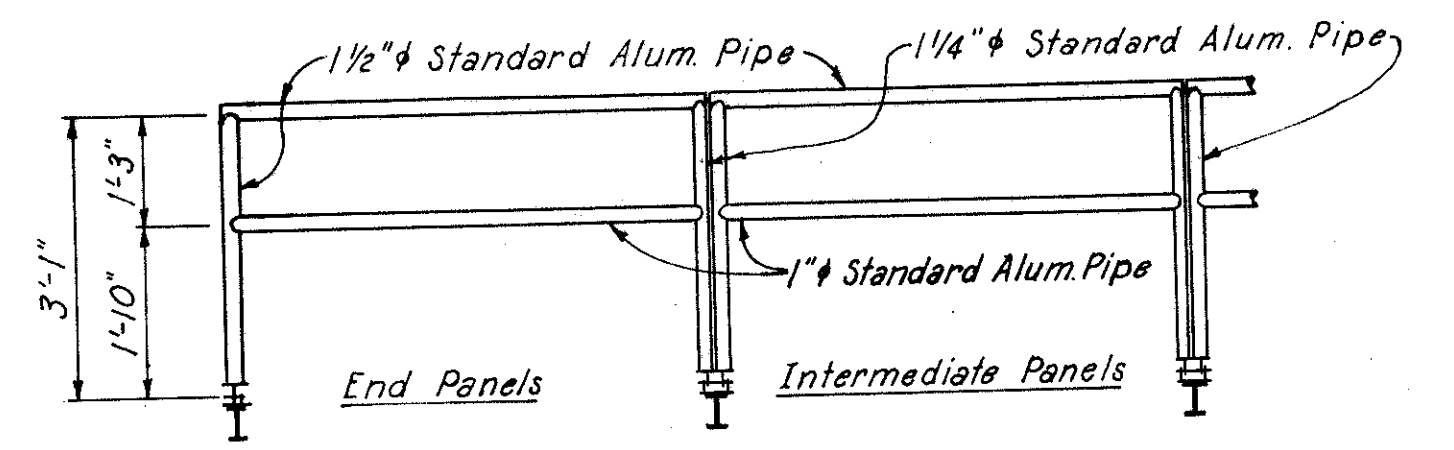


WALKWAY RAILING DETAIL
Scale: 1/2" = 1'-0"

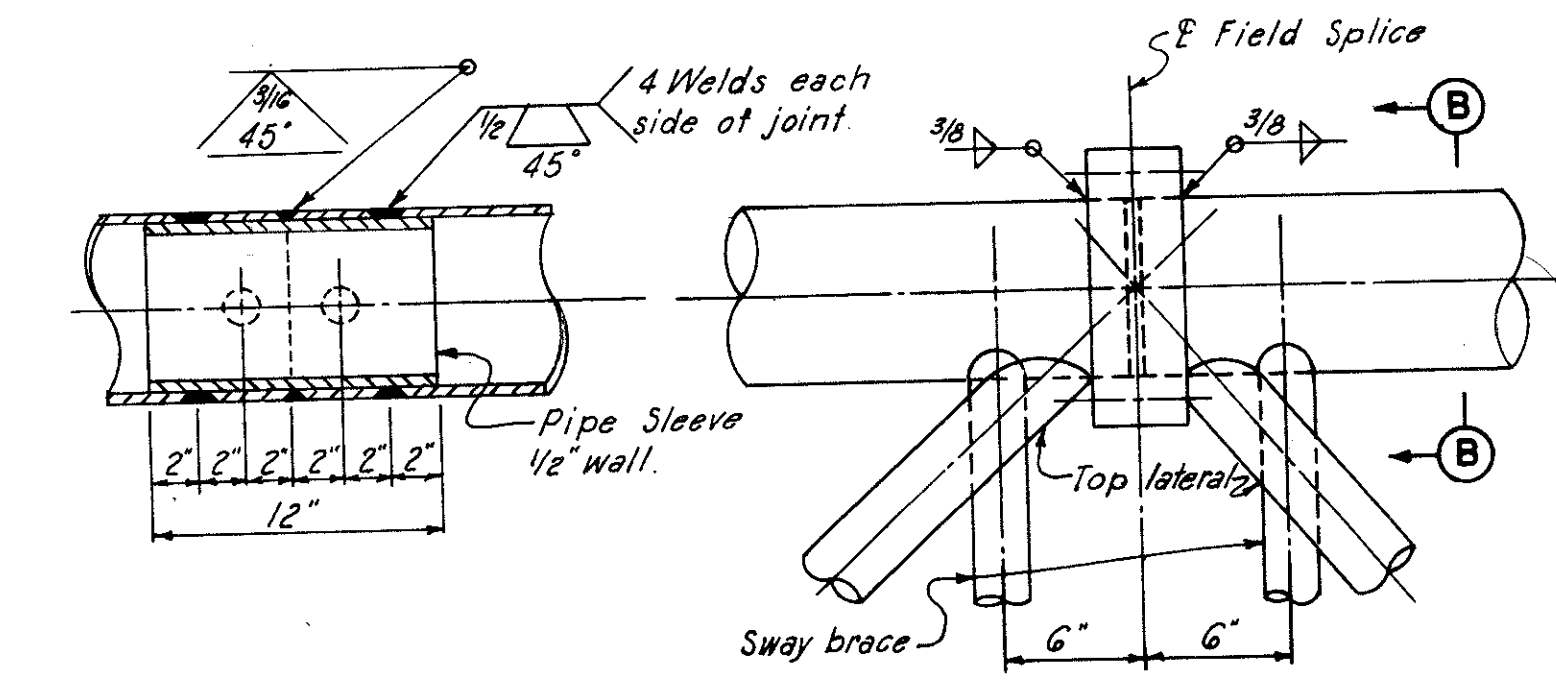


SHOP CHORD SPLICE
Scale: 1/2" = 1'-0"


FIELD CHORD SPLICE
Scale: 1 1/2" = 1'-0"

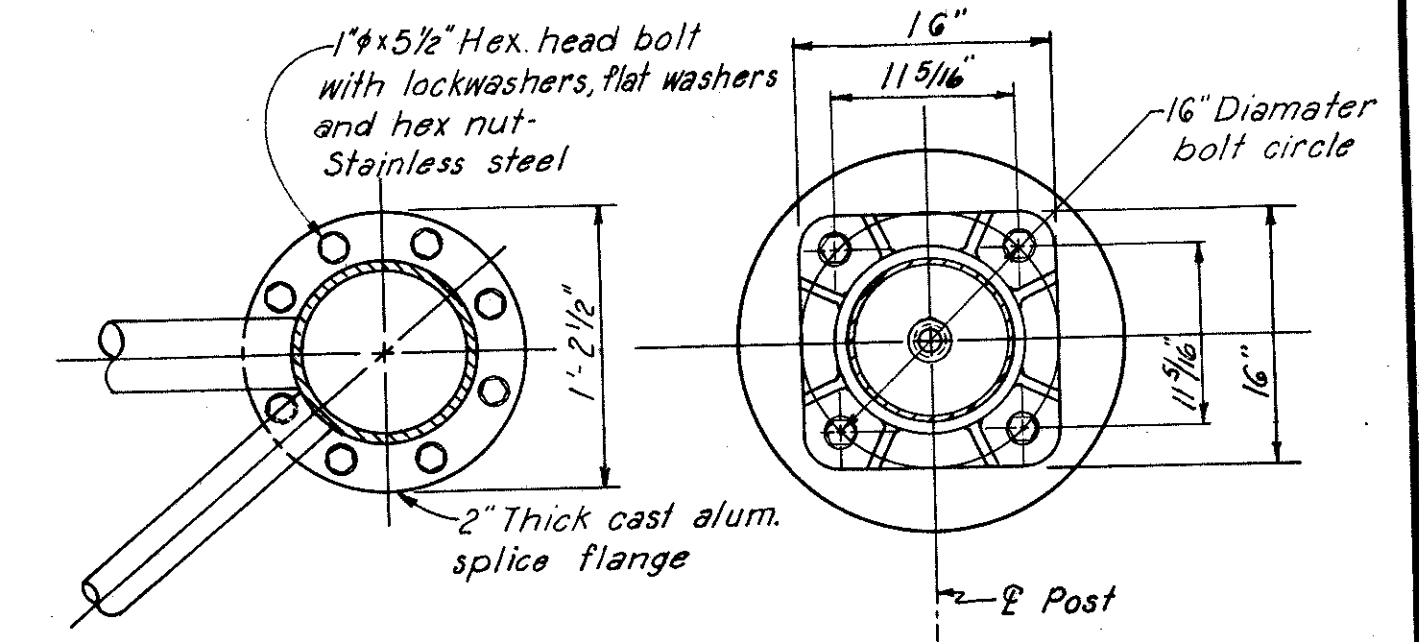


SECTION B-B
Scale: 1 1/2" = 1'-0"

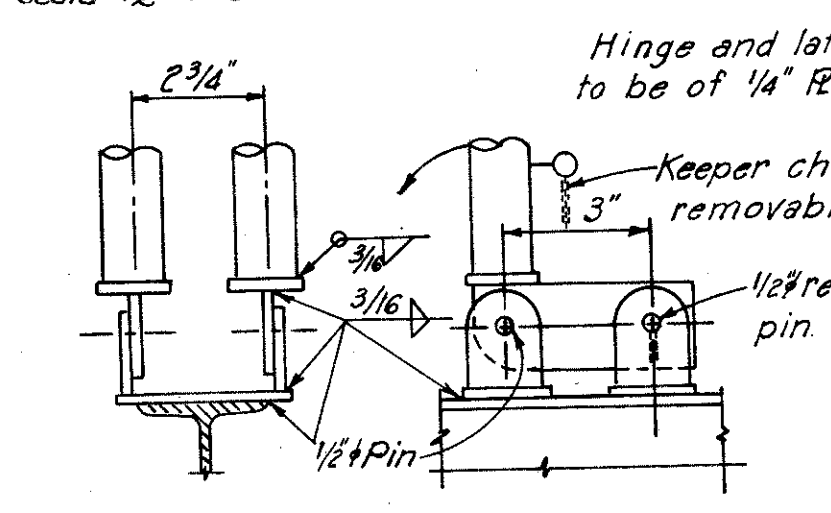


WALKWAY RAILING HINGE DETAIL
Scale: 3" = 1'-0"

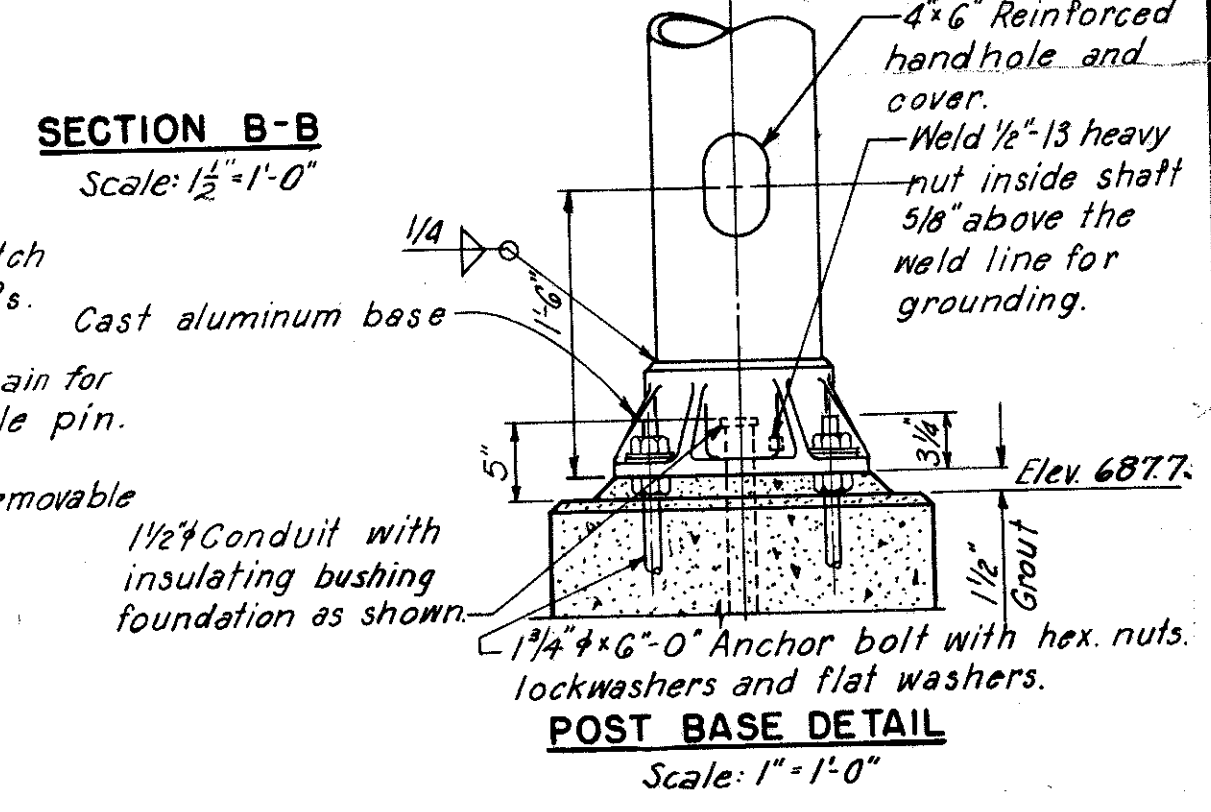

POST BASE DETAIL
Scale: 1" = 1'-0"

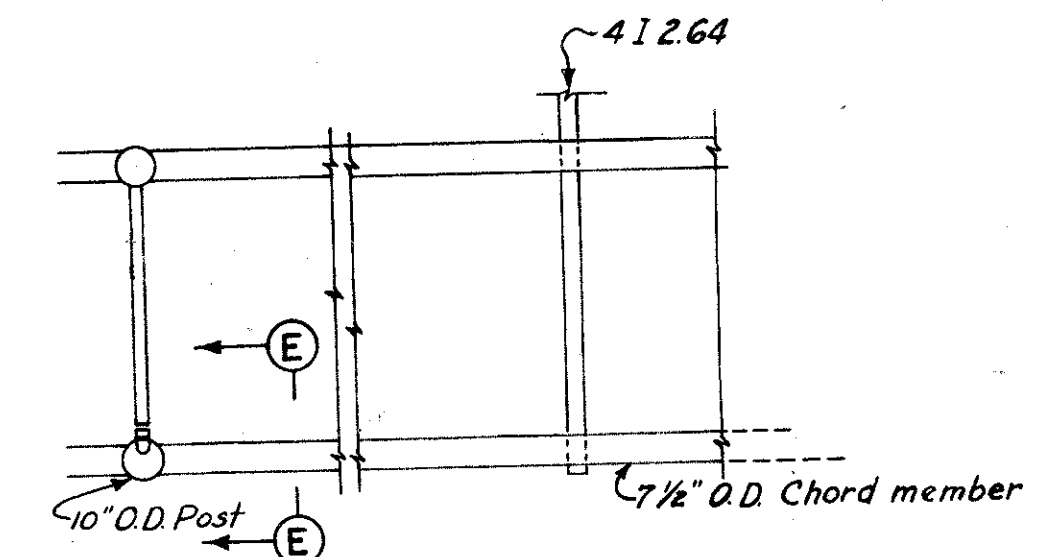

DETAIL "A"
Scale: 1/4" = 1'-0"

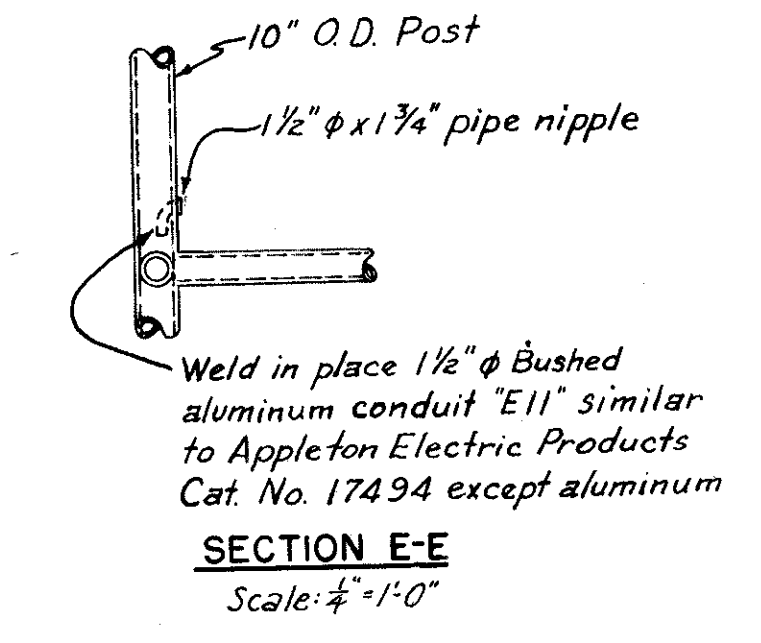

SECTION E-E
Scale: 1/2" = 1'-0"

Weld in place 1 1/2" x 1 3/4" Bushed aluminum conduit "E11" similar to Appleton Electric Products Cat. No. 17494 except aluminum

HOWARD, NEEDLES, TAMMEN & BERGENDOFF
CONSULTING ENGINEERS
KANSAS CITY CLEVELAND NEW YORK

SIGN BRIDGE AT STA. 74 + 25
GENERAL NOTES AND DETAILS

Scale: As noted

WILLOW-INNER BELT FREEWAY
CLEVELAND CUYAHOGA COUNTY OHIO

DRAWN: J.D. TRACED: R.J. CHECKED: J.L. REVIEWED: J.C.T.
DATE: 8-6-59 DATE: 10-16-59 DATE: 8-13-59 DATE: 11-13-59

R.W. 3-16-60 R.E.C. SHEET 177B