

O.D.O.T. DISTRICT 2 SURVEY OFFICE (USE ONLY)

PERSONNEL

REFERENCE NO.

9 B

SHEET 14 OF 38

NOTES LEU

DATE 4/13/17

ROUTE US 20

H.C. HOMAN

WEATHER OVERCAST

COUNTY FULTON

R.C. LEU

TEMP. 48°F

TOWNSHIP GORHAM

SECTION 19

T 9 S R 1 E

TYPE MONUMENT 5/8" IPIN


~~ON SURFACE~~ - BELOW 6"

~~LEFT~~ - ℄ PAV'T - RIGHT 0.3', 1.9' W OF ℄ S


14.9 TO LT EDGE PAVEMENT

S.L.M. 199+53

Grid: Northing: 736412.126 Easting: 1467759.787

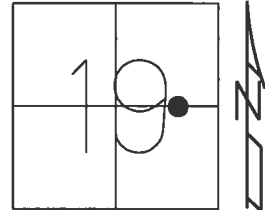

RECORD:
P.K. NAIL
5-17-02, MB
SET P.K./WASHER
6-6-02, MB
FD 5/8" I.PIN
LEANING NW
REFB9
4-13-2017, DCH
SET MAG/WASHER
08-14-2017, DCH

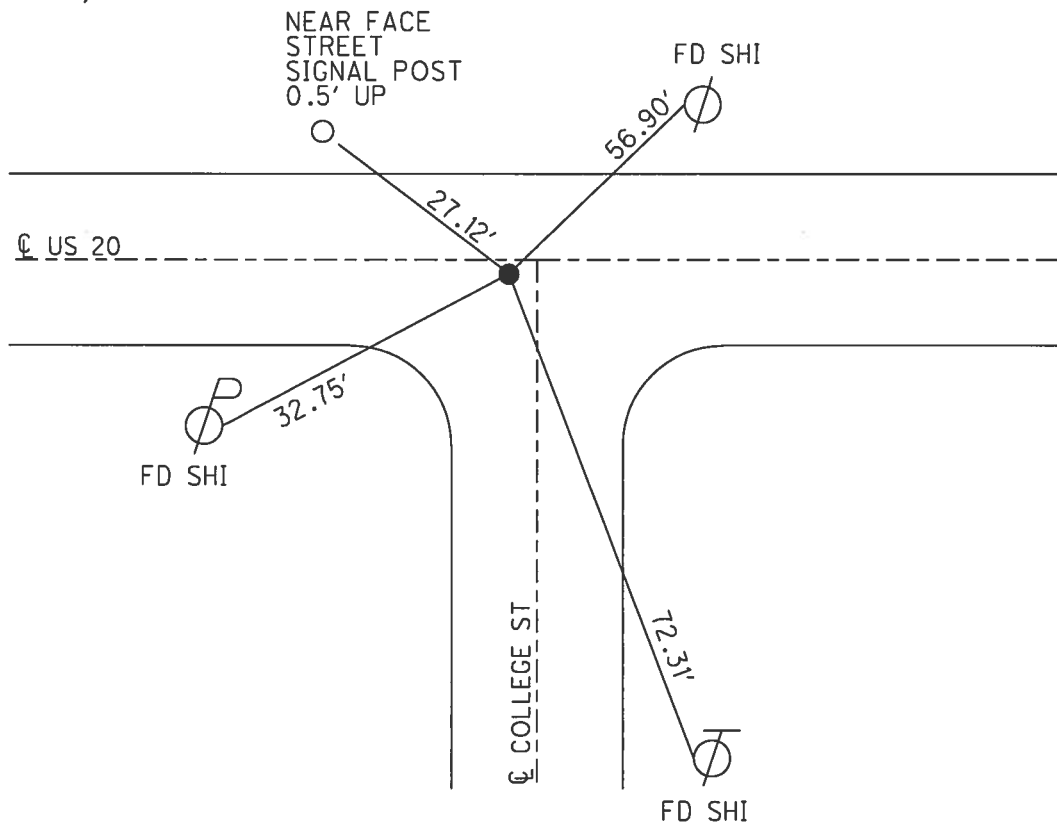

O.D.O.T. DISTRICT 2 SURVEY OFFICE

PERSONNEL

REFERENCE NO. 9-B

SHEET 9 OF 13

NOTES M. Canterbury

H.C. M. Barnard

R.C. K. Mosea

DATE 5-17-02

WEATHER overcast

TEMP. 52°

ROUTE US 20

COUNTY Fulton

TOWNSHIP Gorham

SECTION 19

T 9 S R 1 E


TYPE MONUMENT P.K. Nail

ON SURFACE - BELOW yes


LEFT - 0 PAV'T. - RIGHT 0.3'

14.9 TO LT EDGE PAVEMENT (CURB) 1.9' west of to South

S.L.M. 199+53

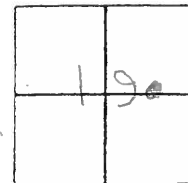

Reset P.K. w/ washer
6-6-02 MB

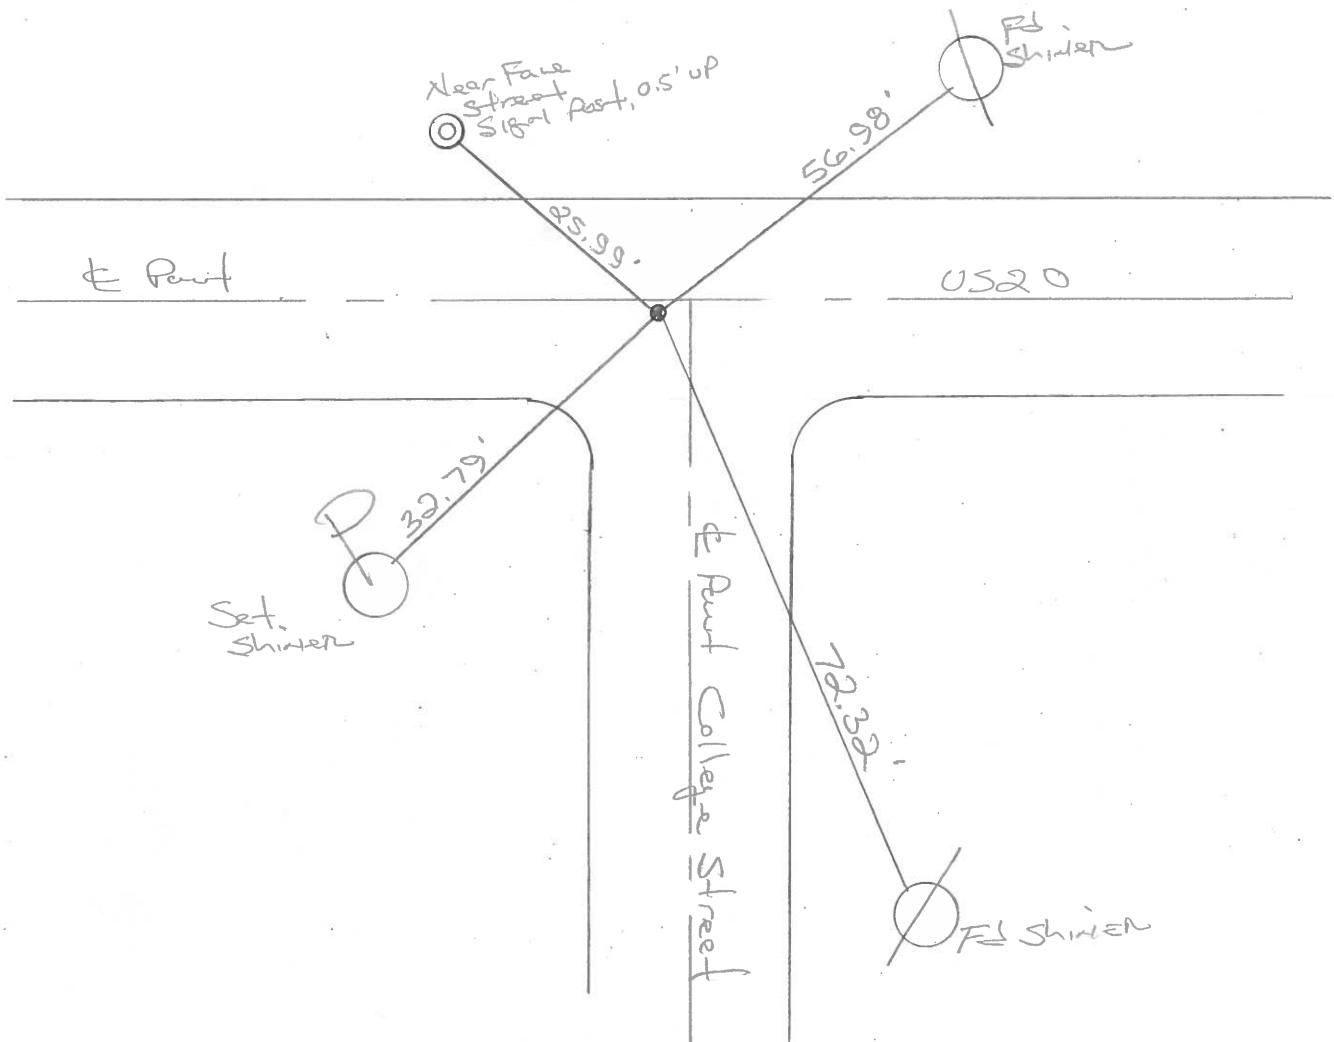

O.D.O.T. DISTRICT 2 SURVEY OFFICE

PERSONNEL

REFERENCE NO. 9-15

SHEET 9 OF

NOTES 1.5 tone

H.C. D. Curtis

R.C. C. Lochrke

DATE 24 July 91

WEATHER Windy

TEMP. 830

ROUTE US # 20

COUNTY Fulton

TOWNSHIP Gorham

SECTION 19

T_____R_____



TYPE MONUMENT PK Nail Set P.K./WASHER

ON SURFACE - BELOW Surface

LEFT - & PAN'T. - RIGHT

_____ TO _____ EDGE PAVEMENT

S.L.M. 205784

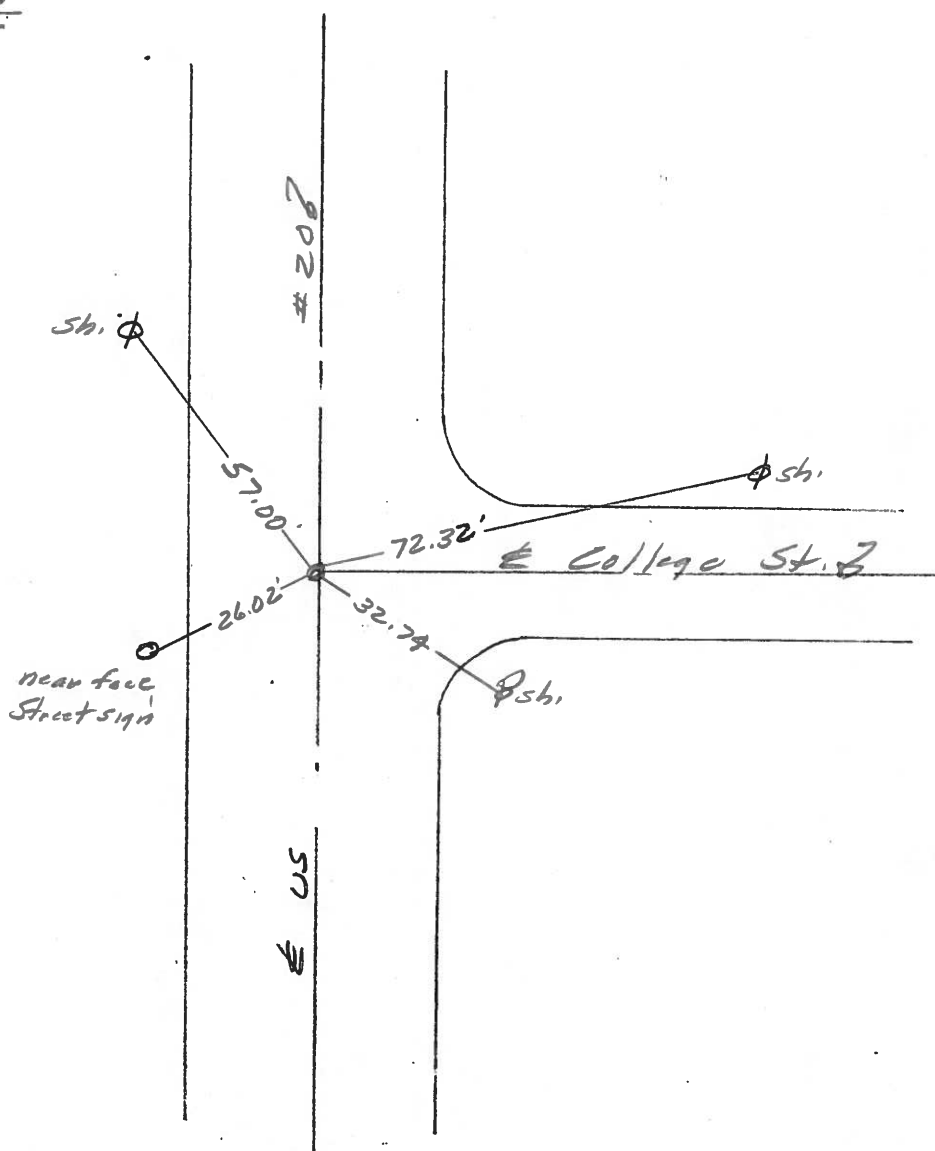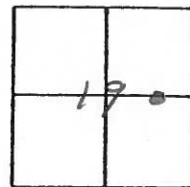

County Fulton S.R. US#20

Township Gorcham

Section 19

T, N, R E

Personnel I. Stone

P. Newson


R. Michalak

D. Curtis


Date 18 May 82

Weather Warm

Temp. 79°

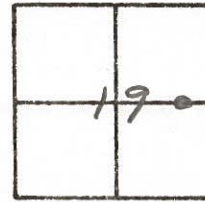

REF. NO. 98

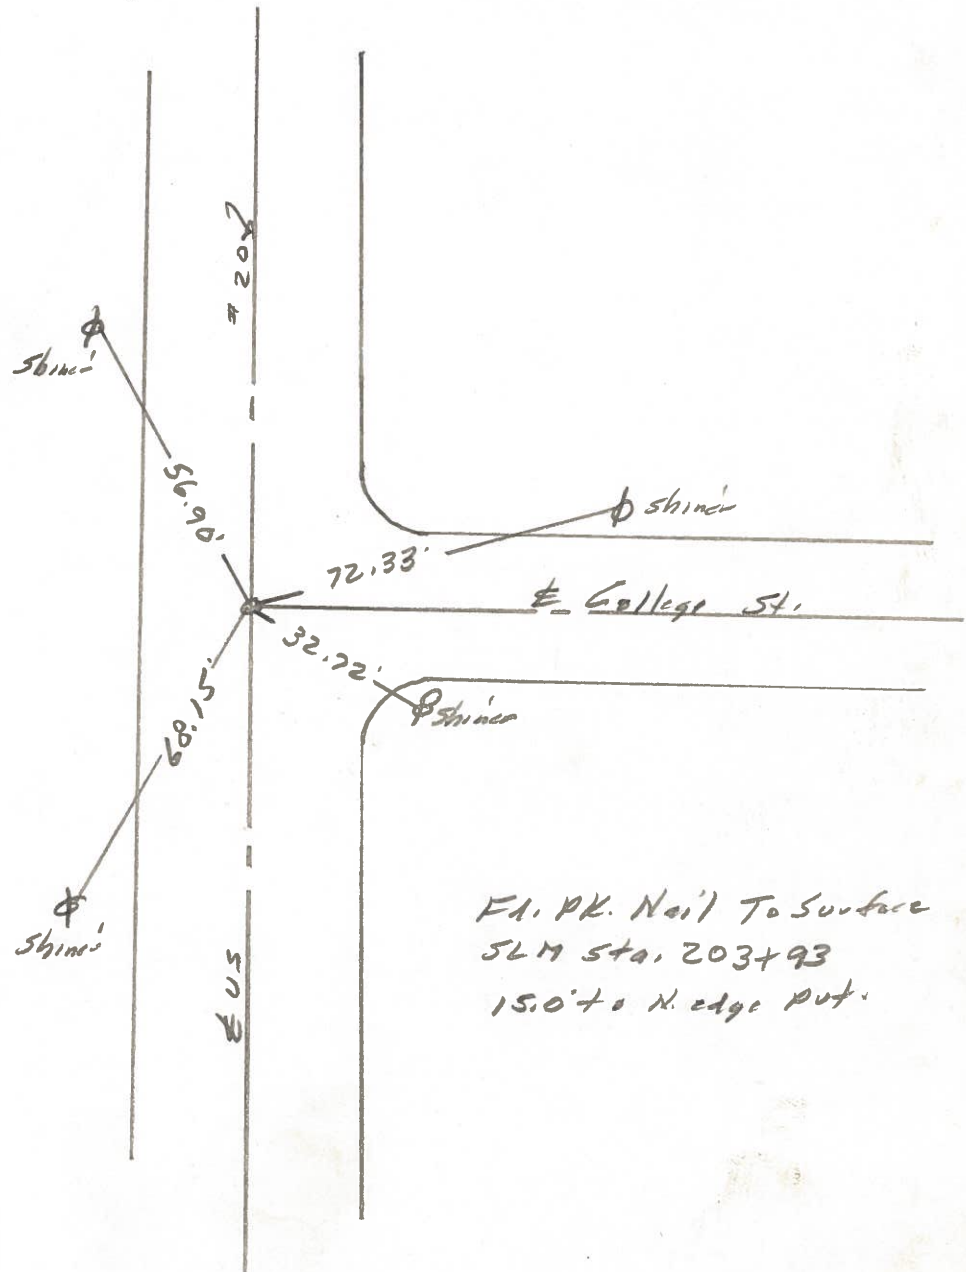

FL. PK. Nail To Surface
SLM Sta. 203+93
15.0' to N edge put.

PERSONNEL	TITLE	PERSONNEL	TITLE	COUNTY	DATE
Tomsic				Fulton	JUNE 1 1973
Neuser				S. R. U.S. 20	WEATHER
Granata				SEC. FAYETTE O.	TEMP.

DESCRIPTION	LEFT	CENTER LINE	RIGHT	JOB NO.
-------------	------	-------------	-------	---------

