


O.D.O.T. DISTRICT 2 SURVEY OFFICE (USE ONLY)


PERSONNEL _____ REFERENCE NO. 10 SHEET 15 OF 38
NOTES LEU DATE 4/13/17 ROUTE US 20
H.C. HOMAN WEATHER OVERCAST COUNTY FULTON
R.C. LEU TEMP. 48°F TOWNSHIP GORHAM
SECTION 19
T 9 S R 1 E

TYPE MONUMENT P.K./WASHER
ON SURFACE - ~~BELOW~~ ON
LEFT - CL PAV'T - RIGHT ON
15.3 TO RT EDGE PAVEMENT
S.L.M. 201+46

Grid: Northing: 736409.652 Easting: 1467953.901

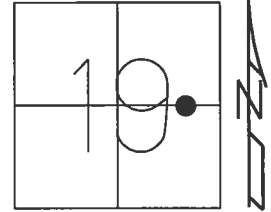

RECORD:
1/2" IPIPE
1 1/2" DOWN
7-24-91
FD 1/2" IPIPE
5-17-02, MB
SET P.K./WASHER
6-6-02, MB
FD P.K./WASHER
REF10
4-13-2017
SET MAG/WASHER
08-14-2017, DCH

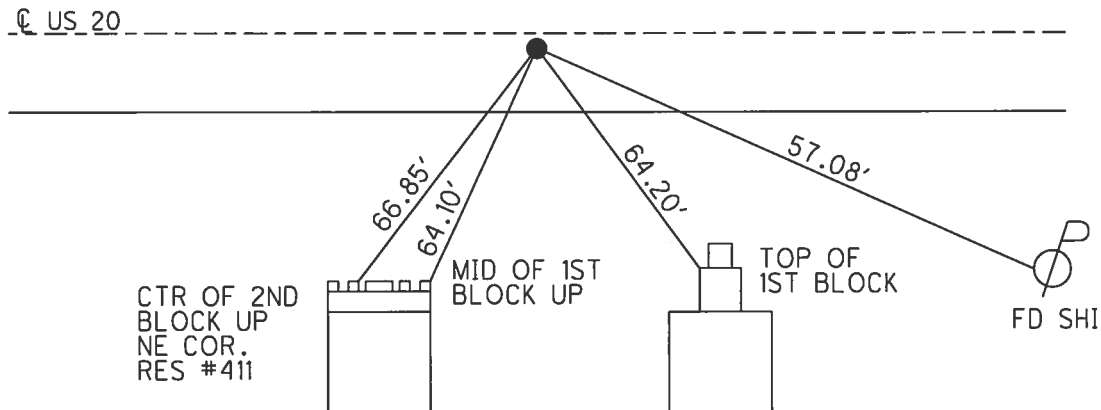

O.D.O.T. DISTRICT 2 SURVEY OFFICE

PERSONNEL

REFERENCE NO. 10

SHEET 10 OF 13

NOTES M. Canterbury

H.C. M. Barak 1551

R.C. K. moza

DATE 5-17-02

WEATHER OVERCAST

TEMP. 52°

ROUTE US 20

COUNTY FULTON

TOWNSHIP GorhamSECTION 19

T9SR1E


TYPE MONUMENT 1/2" I.P.D.E

ON SURFACE - BELOW 4 1/2"

LEFT - & PAW'T. - RIGHT 0.3'

15.3 TO RT EDGE PAVEMENT (CURB)

S.L.M. 201+46

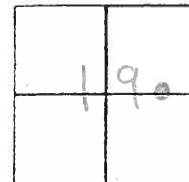

Recuerda!


1/2" PIPE

1 1/2" down

1/16 CORAL Sec 19

7-24-91

Reset PR. w/washer
6-6-02 MB

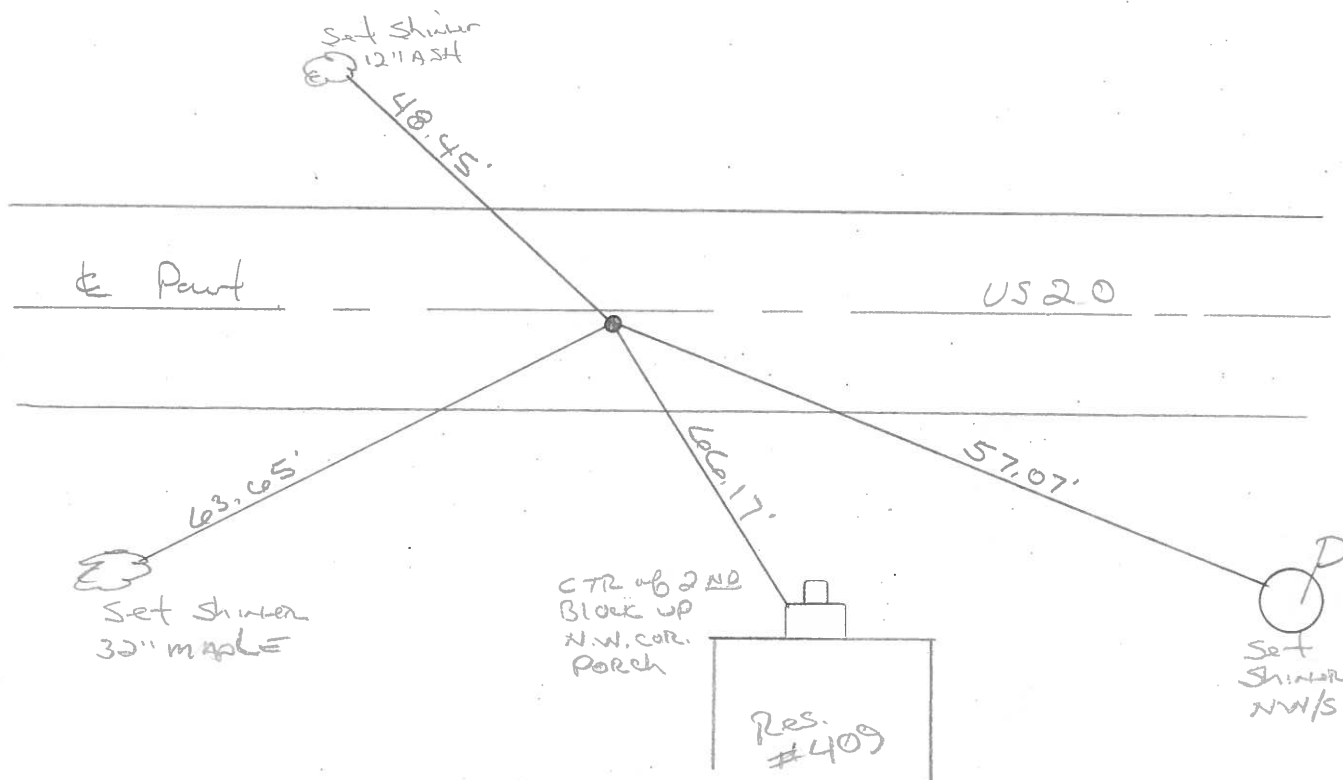

O.D.O.T. DISTRICT 2 SURVEY OFFICE

PERSONNEL

REFERENCE NO. 10

SHEET 10 OF

NOTES 1. Stone

H.C. D. Curtis

R.C. C. Lochrke

DATE 24 July 91

WEATHER Warm

TEMP. 82°

ROUTE US #20

COUNTY Ft. Holy

TOWNSHIP Gorham

SECTION 19

T R


TYPE MONUMENT 1/2" I. pipe Set, P.K./WASHER

ON SURFACE - BELOW 1 1/2" deep


LEFT- & PAW'T. - RIGHT chr. put.

TO EDGE PAVEMENT

S.L.M. 207+77

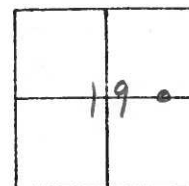

RECORD: 1/16 COR SEC 19

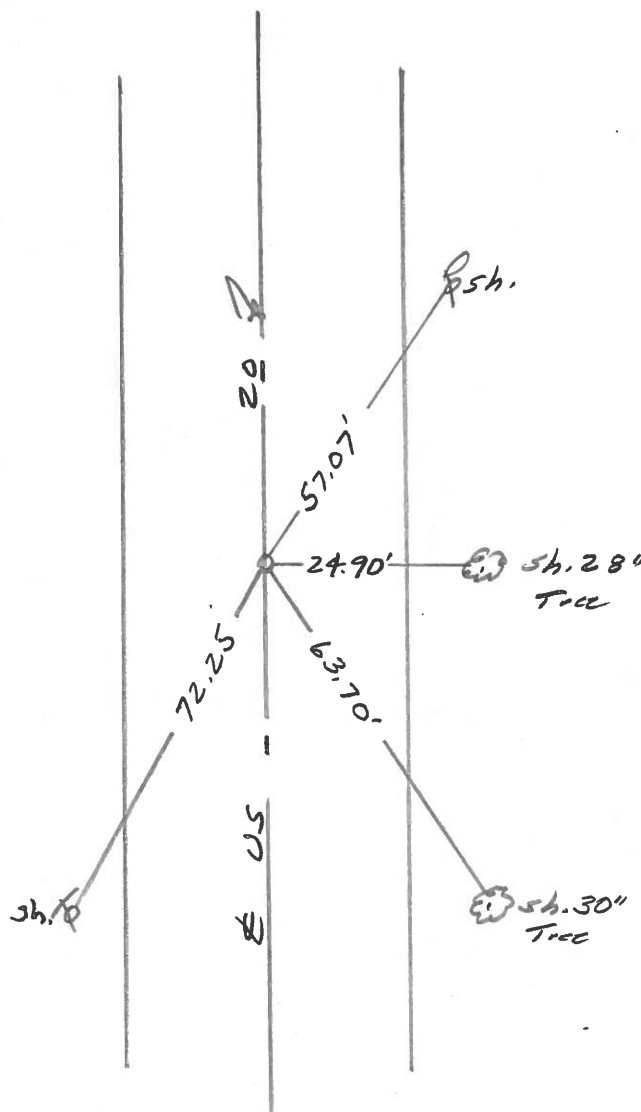

Date 18 May 82

Weather Warm

Temp. 79°

190	



24

P. Neuser

R. Michalak

D. Curtis

REF. No. 10

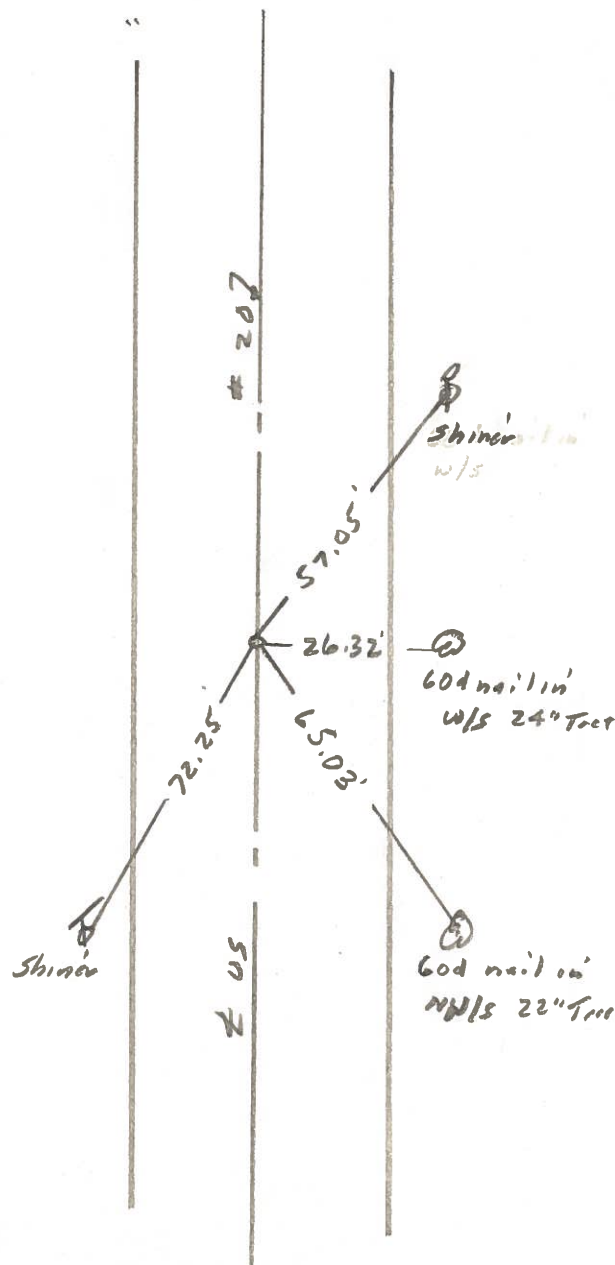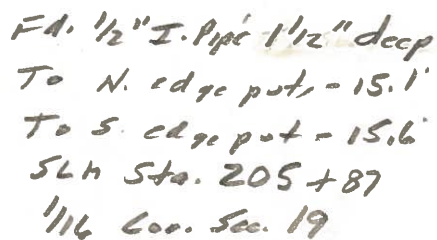

PERSONNEL	TITLE	PERSONNEL	TITLE
1	2	3	4
5	6	7	8
9	10	11	12
13	14	15	16
17	18	19	20
21	22	23	24
25	26	27	28
29	30	31	32
33	34	35	36
37	38	39	40
41	42	43	44
45	46	47	48
49	50	51	52
53	54	55	56
57	58	59	60
61	62	63	64
65	66	67	68
69	70	71	72
73	74	75	76
77	78	79	80
81	82	83	84
85	86	87	88
89	90	91	92
93	94	95	96
97	98	99	100

COUNTY Fulton

DATE June 74

Red Beach

W. Knappe

D. Boyle

J. Bagdonas

S. R. US 20

WEATHER


SEC. Fayette, Gorham Twp

TEMP

DESCRIPTION	CONTROL POINTS
1. The first control point is the starting point of the route, located at the intersection of the main road and the side road.	
2. The second control point is the intersection of the main road and the side road, located at the intersection of the main road and the side road.	
3. The third control point is the intersection of the main road and the side road, located at the intersection of the main road and the side road.	
4. The fourth control point is the intersection of the main road and the side road, located at the intersection of the main road and the side road.	
5. The fifth control point is the intersection of the main road and the side road, located at the intersection of the main road and the side road.	
6. The sixth control point is the intersection of the main road and the side road, located at the intersection of the main road and the side road.	
7. The seventh control point is the intersection of the main road and the side road, located at the intersection of the main road and the side road.	
8. The eighth control point is the intersection of the main road and the side road, located at the intersection of the main road and the side road.	
9. The ninth control point is the intersection of the main road and the side road, located at the intersection of the main road and the side road.	
10. The tenth control point is the intersection of the main road and the side road, located at the intersection of the main road and the side road.	

JOB NO

⑨

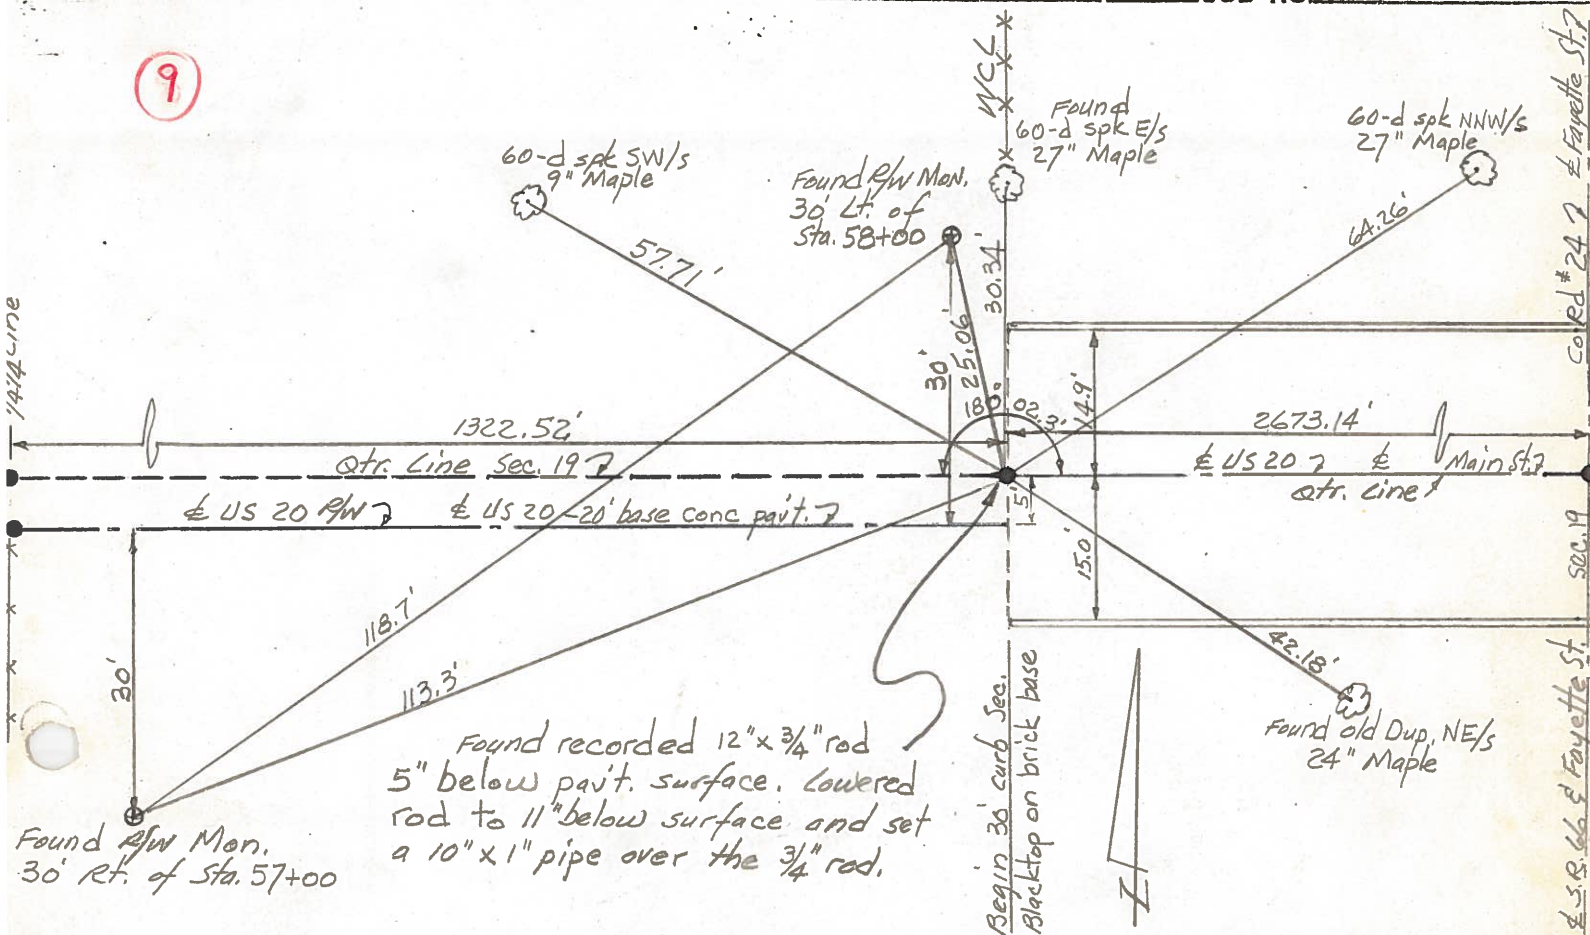

10

