

O.D.O.T. DISTRICT 2 SURVEY OFFICE (USE ONLY)

PERSONNEL _____ REFERENCE NO. 10 B SHEET 17 OF 38
NOTES LEU DATE 4/13/17 ROUTE US 20
H.C. HOMAN WEATHER OVERCAST COUNTY FULTON
R.C. LEU TEMP. 48°F TOWNSHIP GORHAM
SECTION 19
T 9 S R 1 E

TYPE MONUMENT P.K.SHANK


~~ON SURFACE~~ - BELOW 1"

LEFT - ℄ PAV'T - ~~RIGHT~~ 0.3


- TO - EDGE PAVEMENT

S.L.M. 208+39

Grid: Northing: 736401.000 Easting: 1468644.388

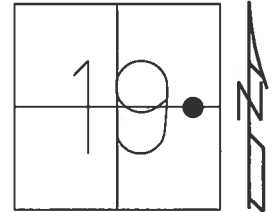

RECORD:
FD P.K. NAIL
5-17-02, MB
SET P.K./WASHER
6-6-02, MB
FD P.K.SHANK
REFBIO
4-13-2017, DCH
SET MAG/WASHER
08-14-2017, DCH

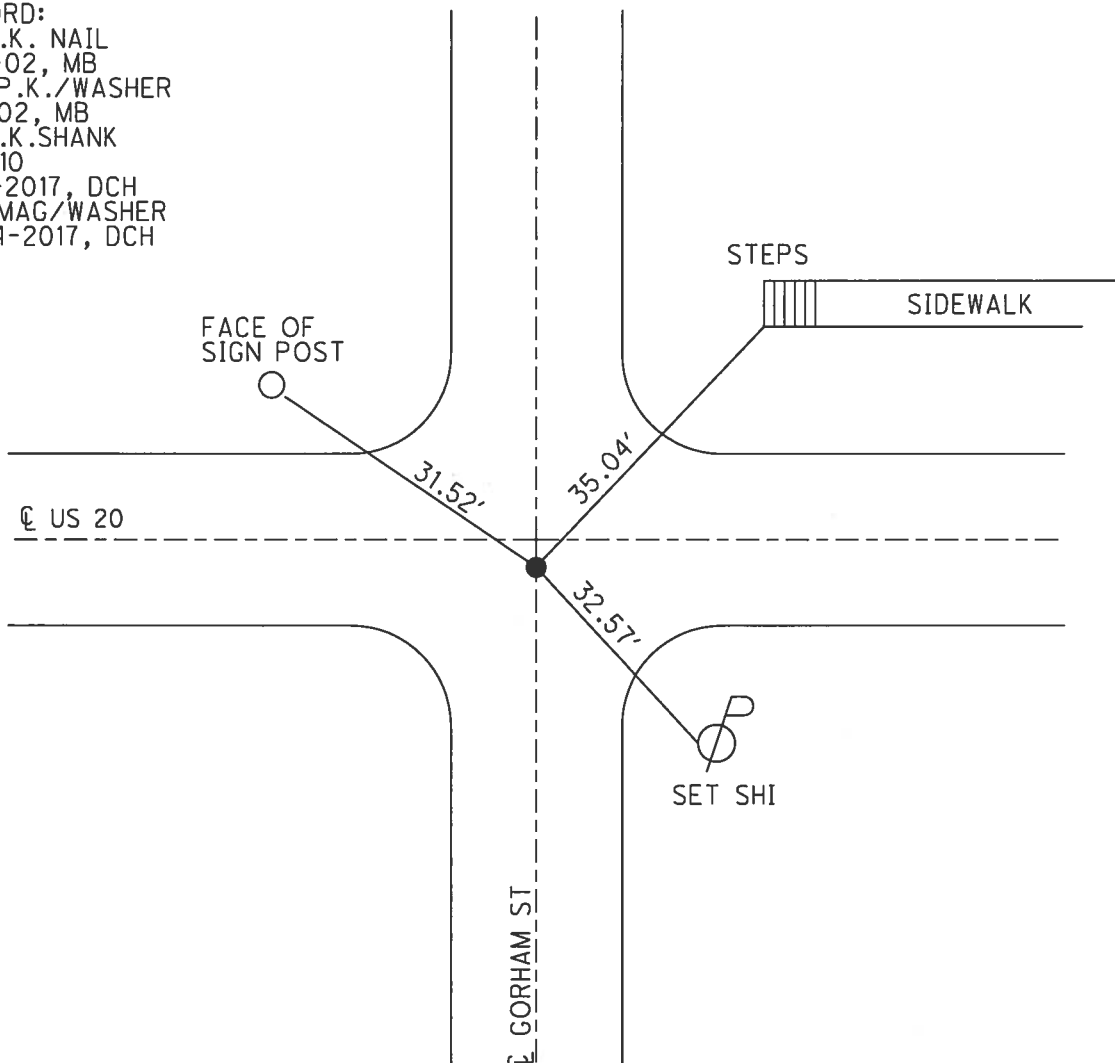

O.D.O.T. DISTRICT 2 SURVEY OFFICE

PERSONNEL

REFERENCE NO. 10-B

SHEET 12 OF 13

NOTES M. C. H. G. W. W. W.

H.C. M. B. W. W. W.

R.C. K. M. W. W. W.

DATE 5-17-02

WEATHER overcast

TEMP. 50°

ROUTE US 20

COUNTY Fulton

TOWNSHIP Cowardin

SECTION 19

T. 9 S. R. 1 E


TYPE MONUMENT P.K. nail

ON SURFACE - BELOW 1 1/2"


LEFT - & PAW'T. - RIGHT 03

TO — EDGE PAVEMENT

S.L.M. 208 + 39

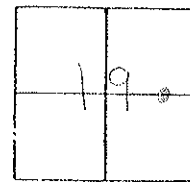

Re-survey PR w/ section
6.6.02 MB

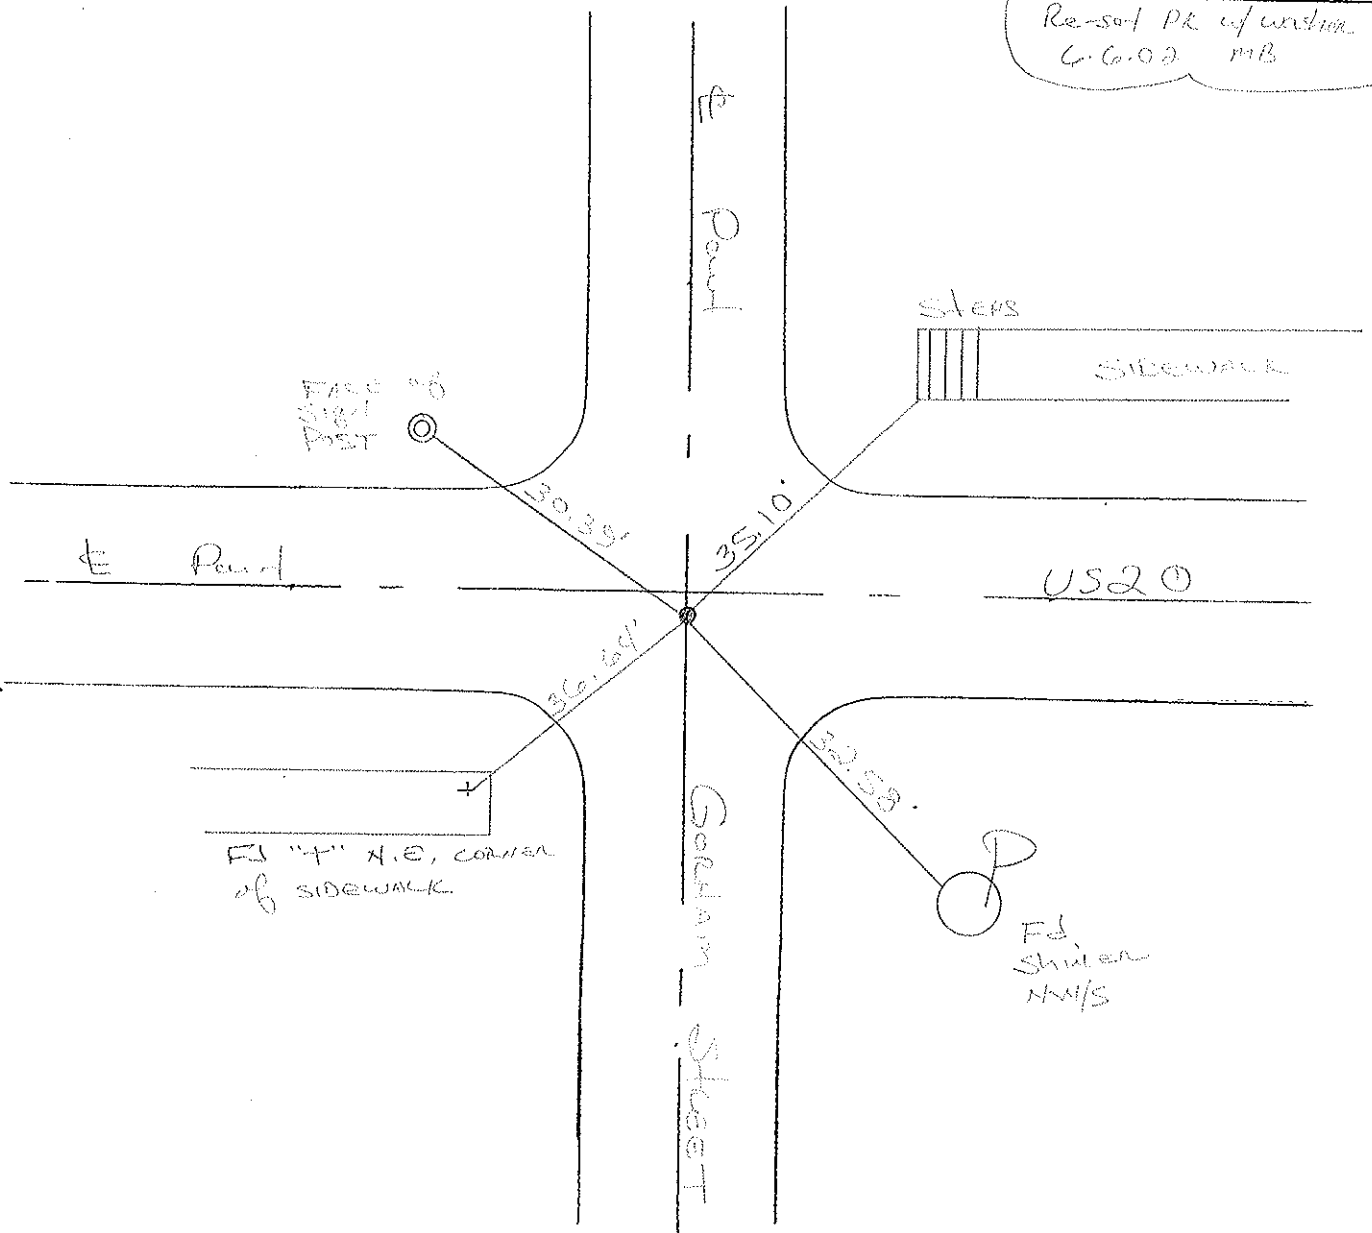

O.D.O.T. DISTRICT 2 SURVEY OFFICE

PERSONNEL

REFERENCE NO. 10-13

SHEET 1 OF 2

NOTES

Huss

H.C.

VanRusen

R.C.

B. Lordes

DATE

5-7-98

WEATHER

Pt. Cldy-Fair

TEMP.

+64°F

ROUTE

US-20

COUNTY

Fulton

TOWNSHIP

Gorham

SECTION

19

T. R.


TYPE MONUMENT PK/WASHER

ON SURFACE - ~~BELOW~~ YES

~~LEFT~~ - RIGHT YES


14.2 TO ht EDGE PAVEMENT

S.L.M. 212+61

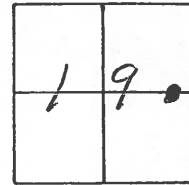

SET PK/WASHER
 11-13-98
 J.A.H.

Fayette

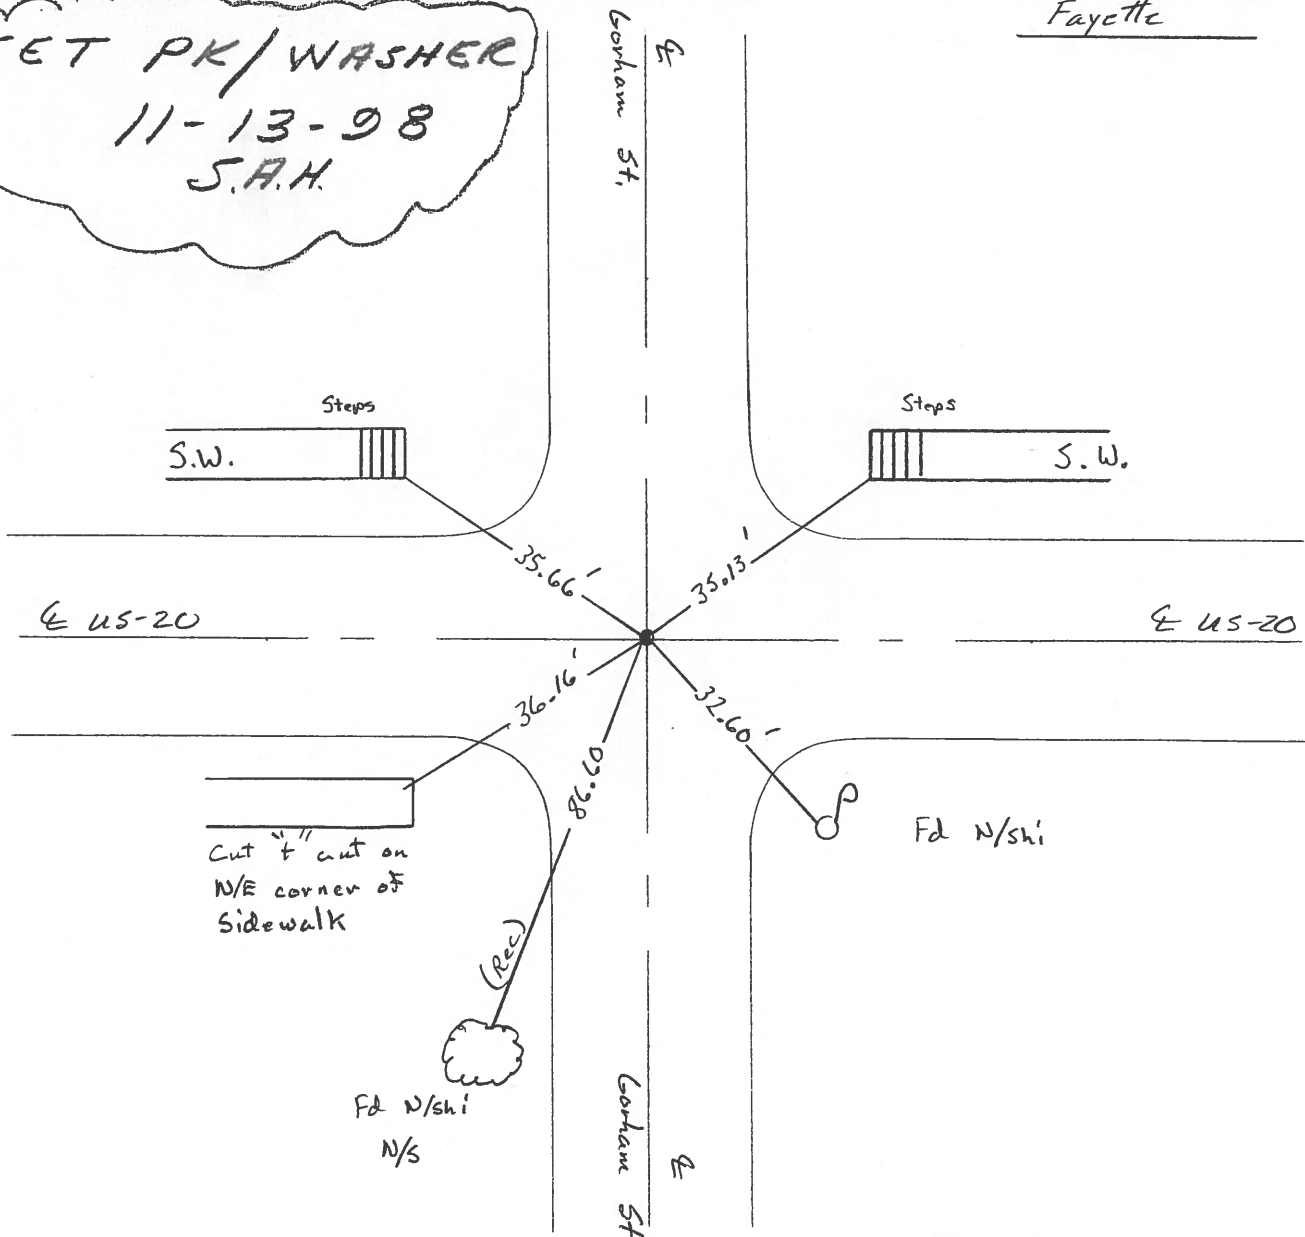

Resurveyed 1998

O.D.O.T. DISTRICT 2 SURVEY OFFICE

PERSONNEL

REFERENCE NO. 10-B

SHEET 12 OF

NOTES 1. Stone

H.C. D. Curtis

R.C. C. Lochter

DATE 16 Aug. 91

WEATHER Fair

TEMP. 26°

ROUTE US#20

COUNTY Fulton

TOWNSHIP Gorham

SECTION 19

T R



TYPE MONUMENT PK Nail Set. P.K. / WASHER

ON SURFACE - BELOW Surface 3-27-92

LEFT- & PAW'T. - RIGHT

TO EDGE PAVEMENT

S.L.M. 217+68

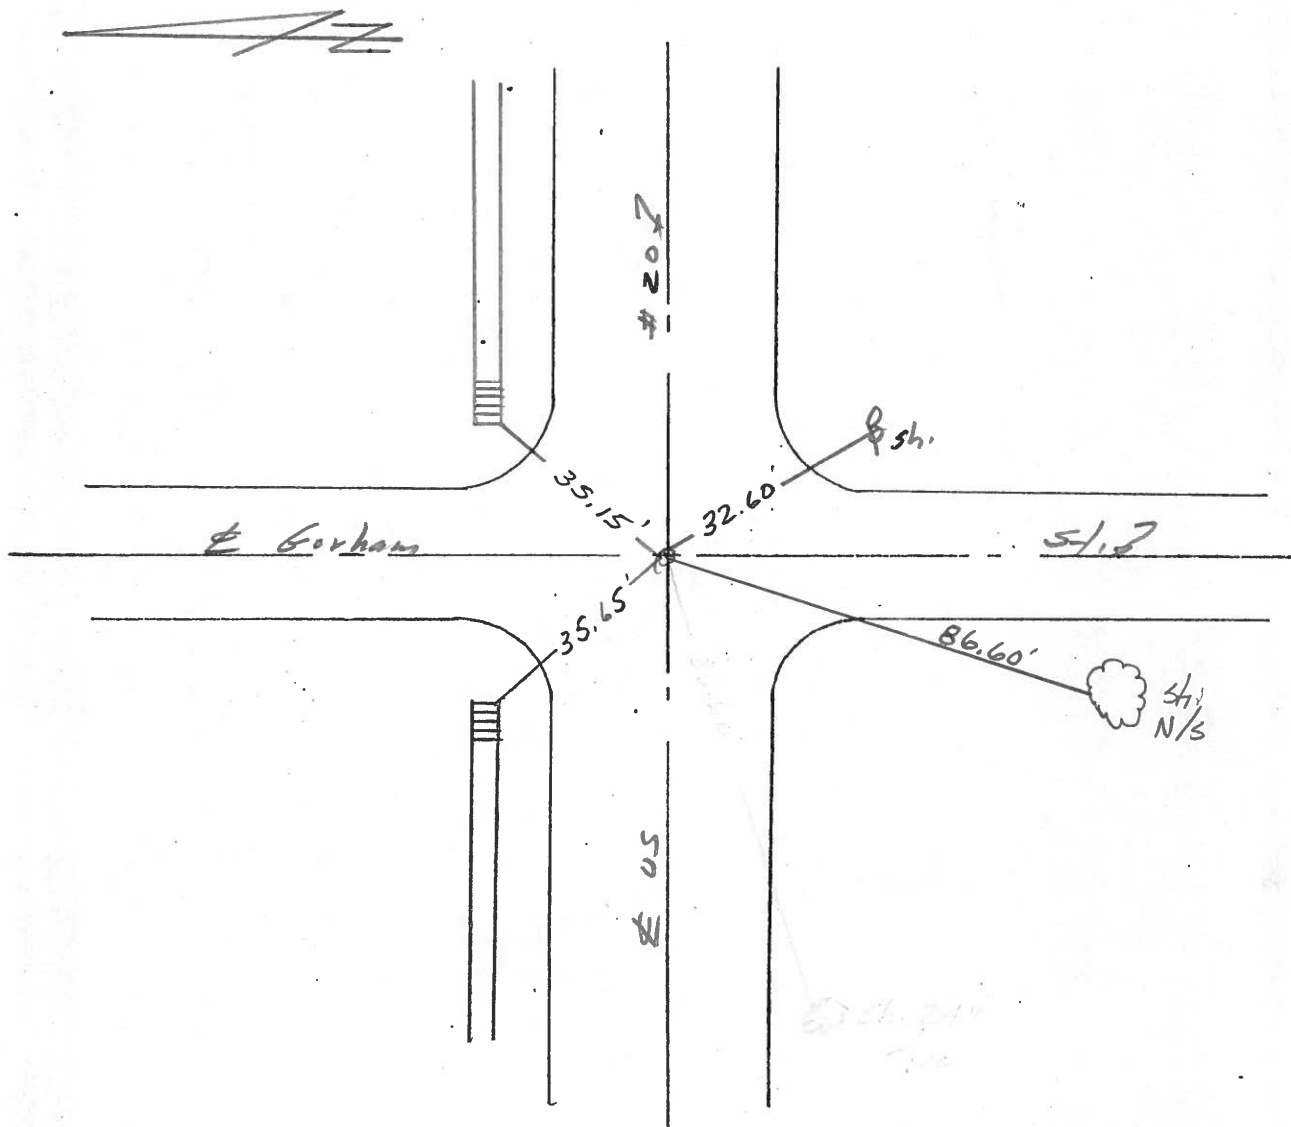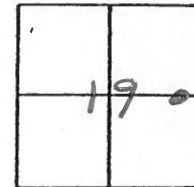

County Fulton S.R. US #20

Date 18 May 82

Township Gorham


Weather Warm

Section 19

Temp. 80°

T N R E

Personnel I. Stone

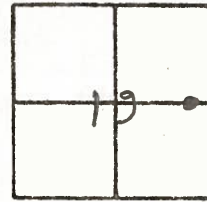

P. Neuse

R. Michalek

D. Curtis

REF. NO. 108

