


O.D.O.T. DISTRICT 2 SURVEY OFFICE (USE ONLY)


PERSONNEL _____ REFERENCE NO. 11 SHEET 19 OF 38
 NOTES LEU DATE 4/17/17 ROUTE US 20
 H.C. HOMAN WEATHER SUNNY COUNTY FULTON
 R.C. LEU TEMP. 65°F TOWNSHIP GORHAM
 SECTION 20
 T 9 S R 1 E

TYPE MONUMENT SM.R.R.SPIKE
~~ON SURFACE~~ - BELOW 3"
 LEFT - ℄ PAV'T - RIGHT ON
- TO - EDGE PAVEMENT
 S.L.M. 234+53

Grid: Northing: 736408.264 Easting: 1470629.132

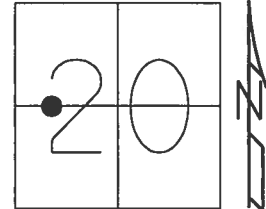

RECORD:
 FD R.R. SPIKE
 2" DOWN
 SET P.K./WASHER
 8-16-91, IRS
 FD SM.R.R.SPIKE
 REF11
 4-17-2017, DCH
 SET MAG/WASHER
 08-14-2017, DCH

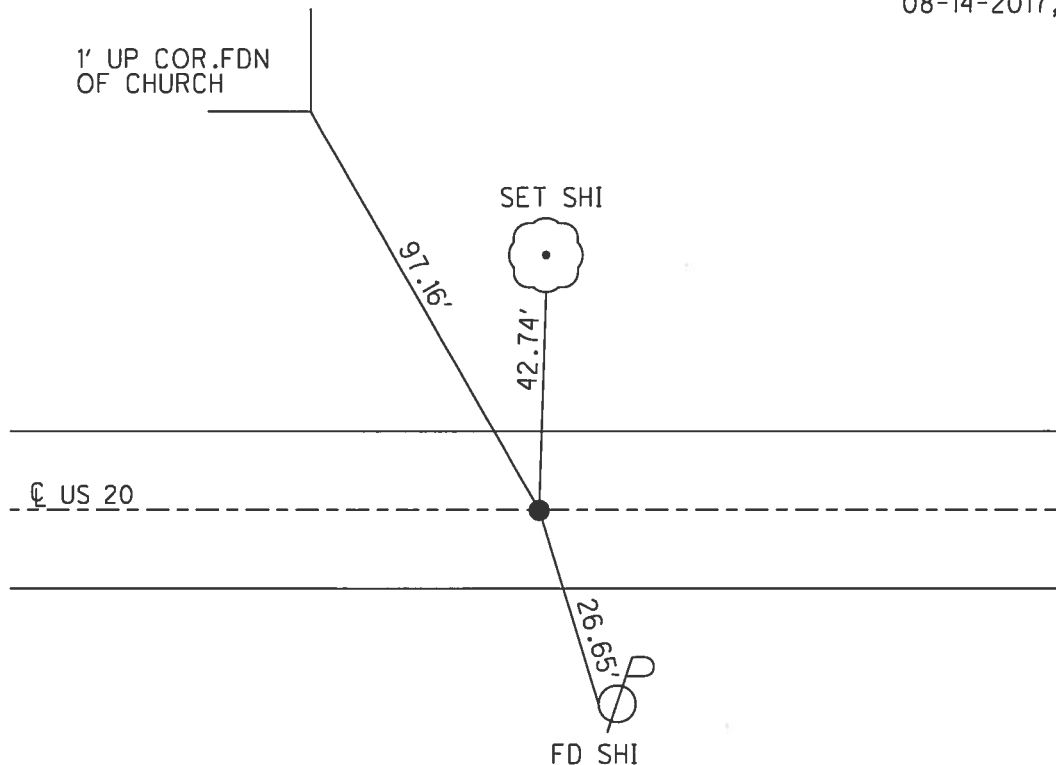

O.D.O.T. DISTRICT 2 SURVEY OFFICE

PERSONNEL

REFERENCE NO. 11

SHEET 14 OF

NOTES 1. Stone

H.C. D. Curtis

R.C. C. Lockbe

DATE 16 Aug. 91

WEATHER Warm

TEMP. 78°

ROUTE US # 20

COUNTY Fulton

TOWNSHIP 6th

SECTION 20

T. R.


TYPE MONUMENT Ed. PK Nail Set. P.K. / WASHER

ON SURFACE - BELOW Surface 3-27-92


LEFT - & PAW'T. - RIGHT


TO EDGE PAVEMENT

S.L.M. 234453

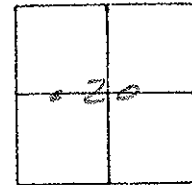


Record: Fd R.R. Spk
2" deep
1/16 cor. Sec. 20

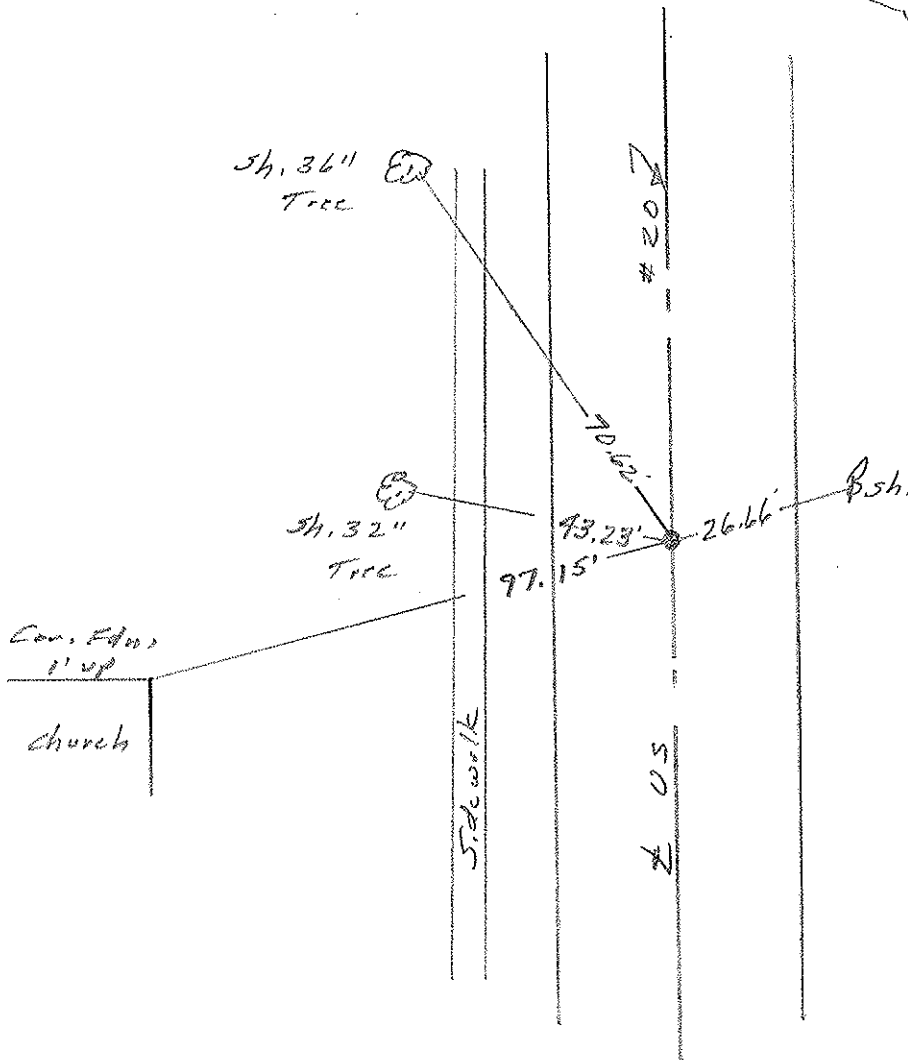

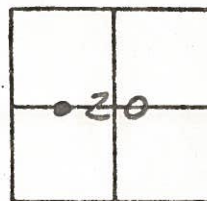County Fulton S.R. US #20Date 18 May 82Township GorhamWeather WarmSection 20Temp. 80°T N, R EPersonnel I. StoneP. NeuserD. CurtisR. Michalak

REF. NO. 11

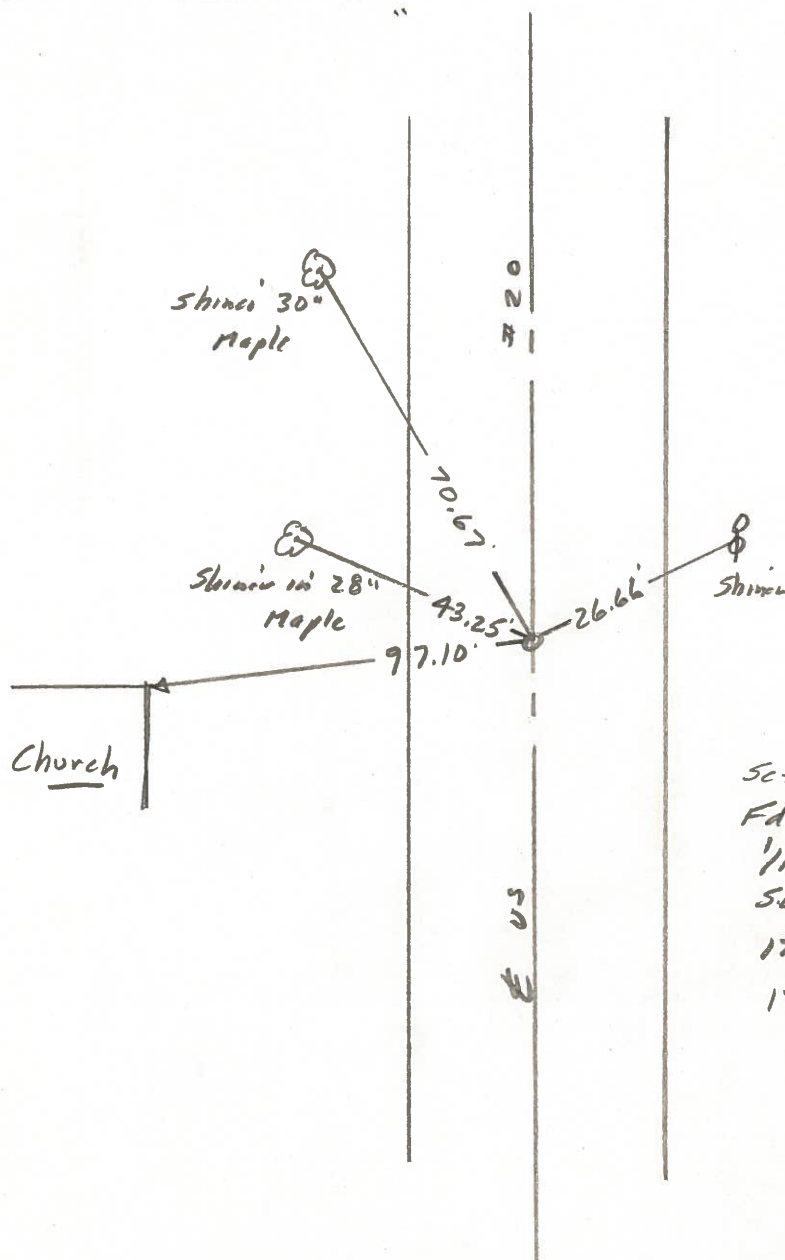

Set RR Spt. 7/13/82
Fd. RR Spt. 2" deep
1/16 cor. Sec. 20
S.L.M. 232 + 62
17.1' to N. edge put.
17.3' to S. edge put.

PERSONNEL	TITLE	PERSONNEL	TITLE
Tomsic			
Neuser			
Granata			

COUNTY Fulton

DATE June-11-1973

Checked - Jan-75

S. R. V. S. 20

WEATHER

SEC. FAYETTE O.

TEMP.

DESCRIPTION.

LEFT

CENTER LINE

RIGHT

JOB NO.

