


O.D.O.T. DISTRICT 2 SURVEY OFFICE (USE ONLY)


PERSONNEL	REFERENCE NO. <u>16</u>	SHEET <u>26</u> OF <u>38</u>
NOTES <u>LEU</u>	DATE <u>4/17/17</u>	ROUTE <u>US 20</u>
H.C. <u>HOMAN</u>	WEATHER <u>SUNNY</u>	COUNTY <u>FULTON</u>
R.C. <u>LEU</u>	TEMP. <u>70°F</u>	TOWNSHIP <u>GORHAM</u>
		SECTION <u>22</u>
		T <u>9</u> S R <u>1</u> E

TYPE MONUMENT 1" IPIPE
~~ON SURFACE~~ - BELOW 5 1/2"
~~LEFT~~ - ℄ PAV'T - RIGHT 12.8'
1.7' TO RT EDGE PAVEMENT
 S.L.M. 379+21

Grid: Northing: 736322.455 Easting: 1485208.971

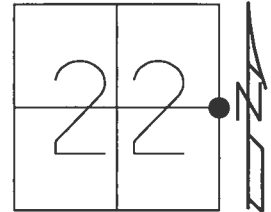

RECORD: P.I.
 FD 1" IPIPE
 3" DOWN
 SET SM.R.R.SPIKE
 11-05-84
 FD SM.R.R.SPIKE
 5-7-98, HUSS
 SET P.K./WASHER
 11-13-98, SAH
 FD 1" IPIPE
 REF16
 4-17-2017, DCH
 SET MAG/WASHER
 8-14-2017, DCH

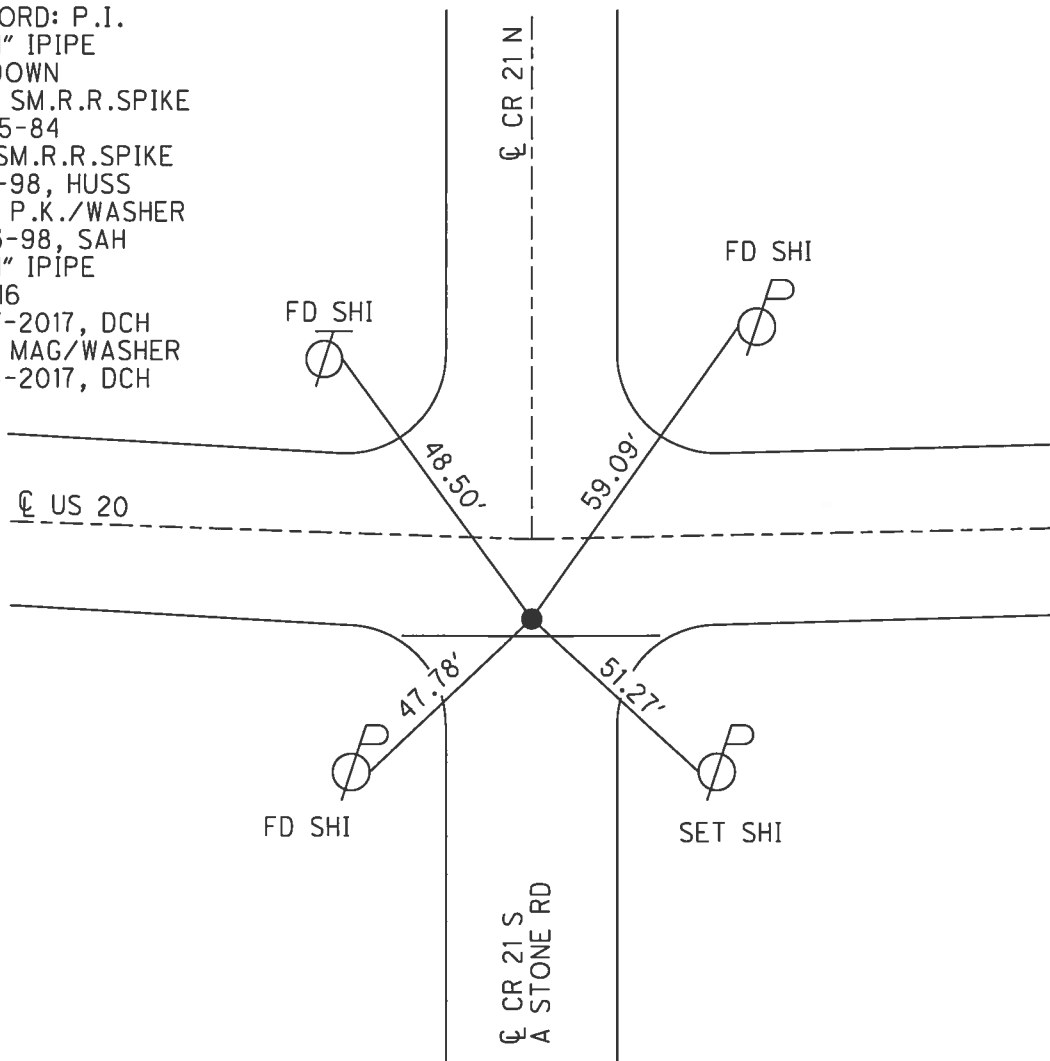

O.D.O.T. DISTRICT 2 SURVEY OFFICE

PERSONNEL

REFERENCE NO. 16

SHEET 1 OF 11

NOTES - Huss

H.C. Van Dusen

R.C. Cordes

Huss

DATE 5-7-78

WEATHER Pt Cldy-Fair

TEMP. +62°F

ROUTE US-20

COUNTY Fulton

TOWNSHIP Gorham

SECTION 22

T 9 S R 1 E


TYPE MONUMENT SMALL R.R. SPK.

ON SURFACE - ~~BELOW~~ YES

LEFT ~~PAV'T~~ - RIGHT 13.2' Rt


1.7 Rt. TO Rt EDGE PAVEMENT

S.L.M. 379+21

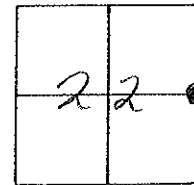

Record: Fd 1" I Pipe
3" deep - PI to Curve -
Set Sm. Spk. 11-05-84

{ Set PK/W SAM
11-13-78

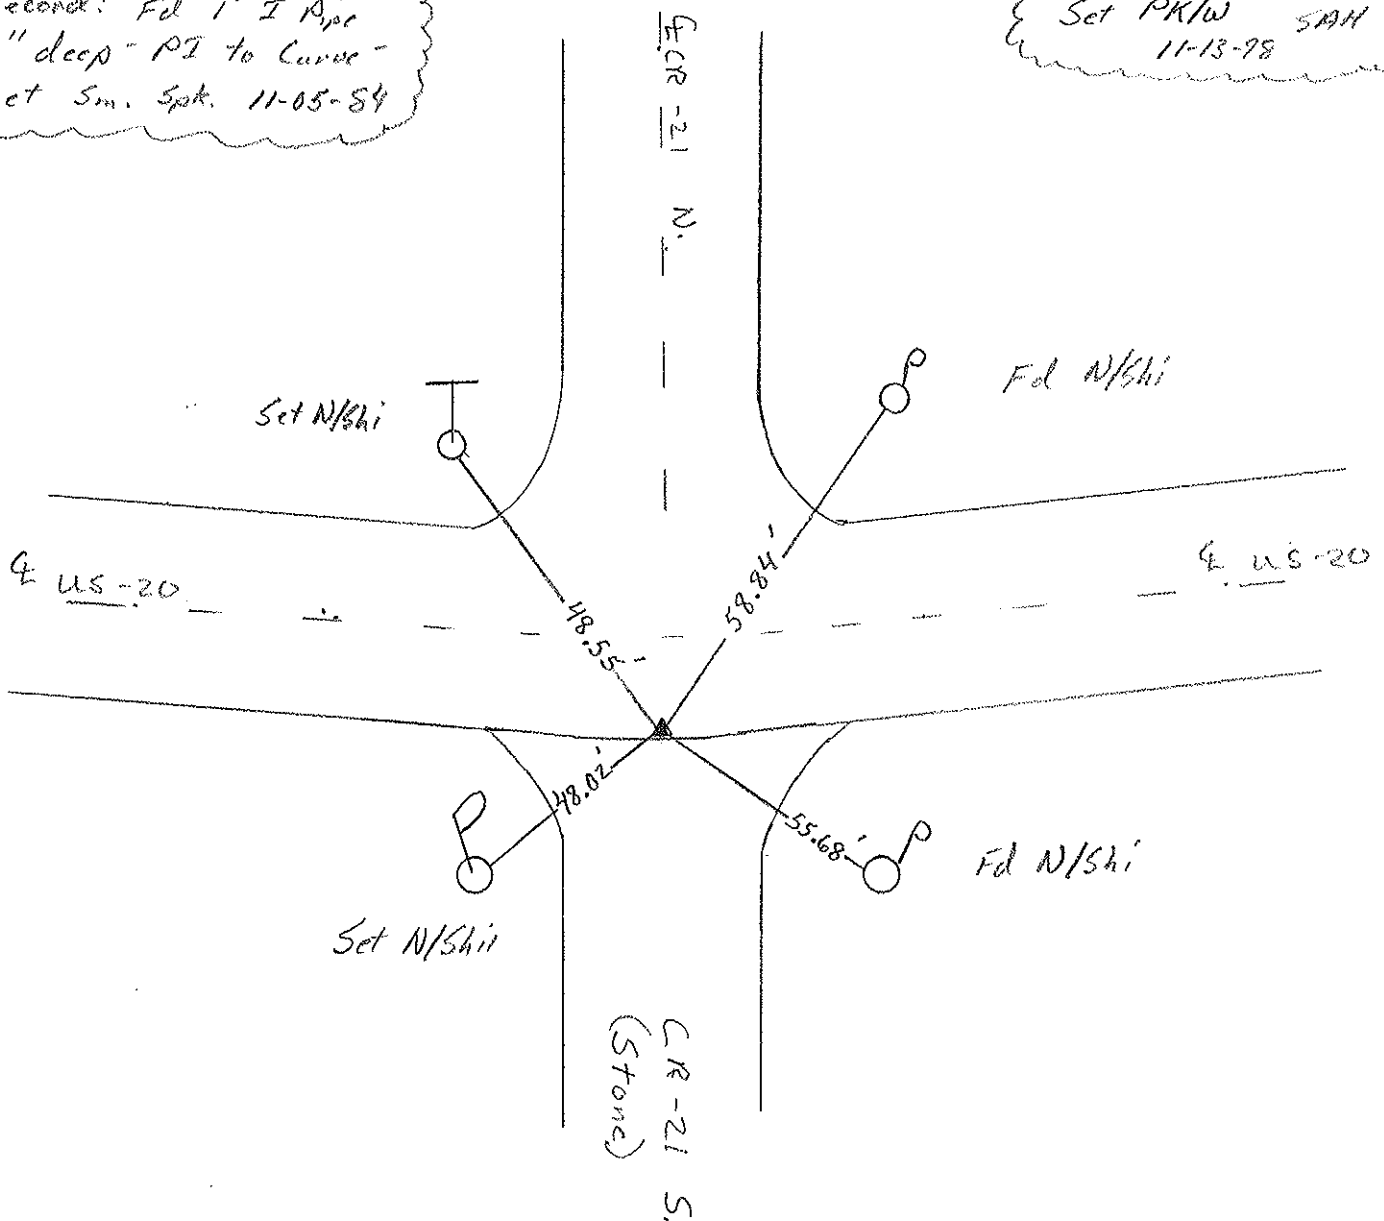


SMT-1

Resurfaced 1998


O.D.O.T. DISTRICT 2 SURVEY OFFICE

SHEET 4 OF

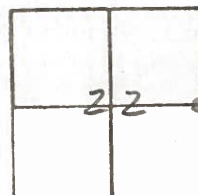County Fulton S.R. 05#20Township GorhamSection 22T N, R EPersonnel L. StoneP. NeuserR. MichalekDate 27 July 84Weather cloudyTemp. 70°

SLM STA. 379+21

REF. No. 16

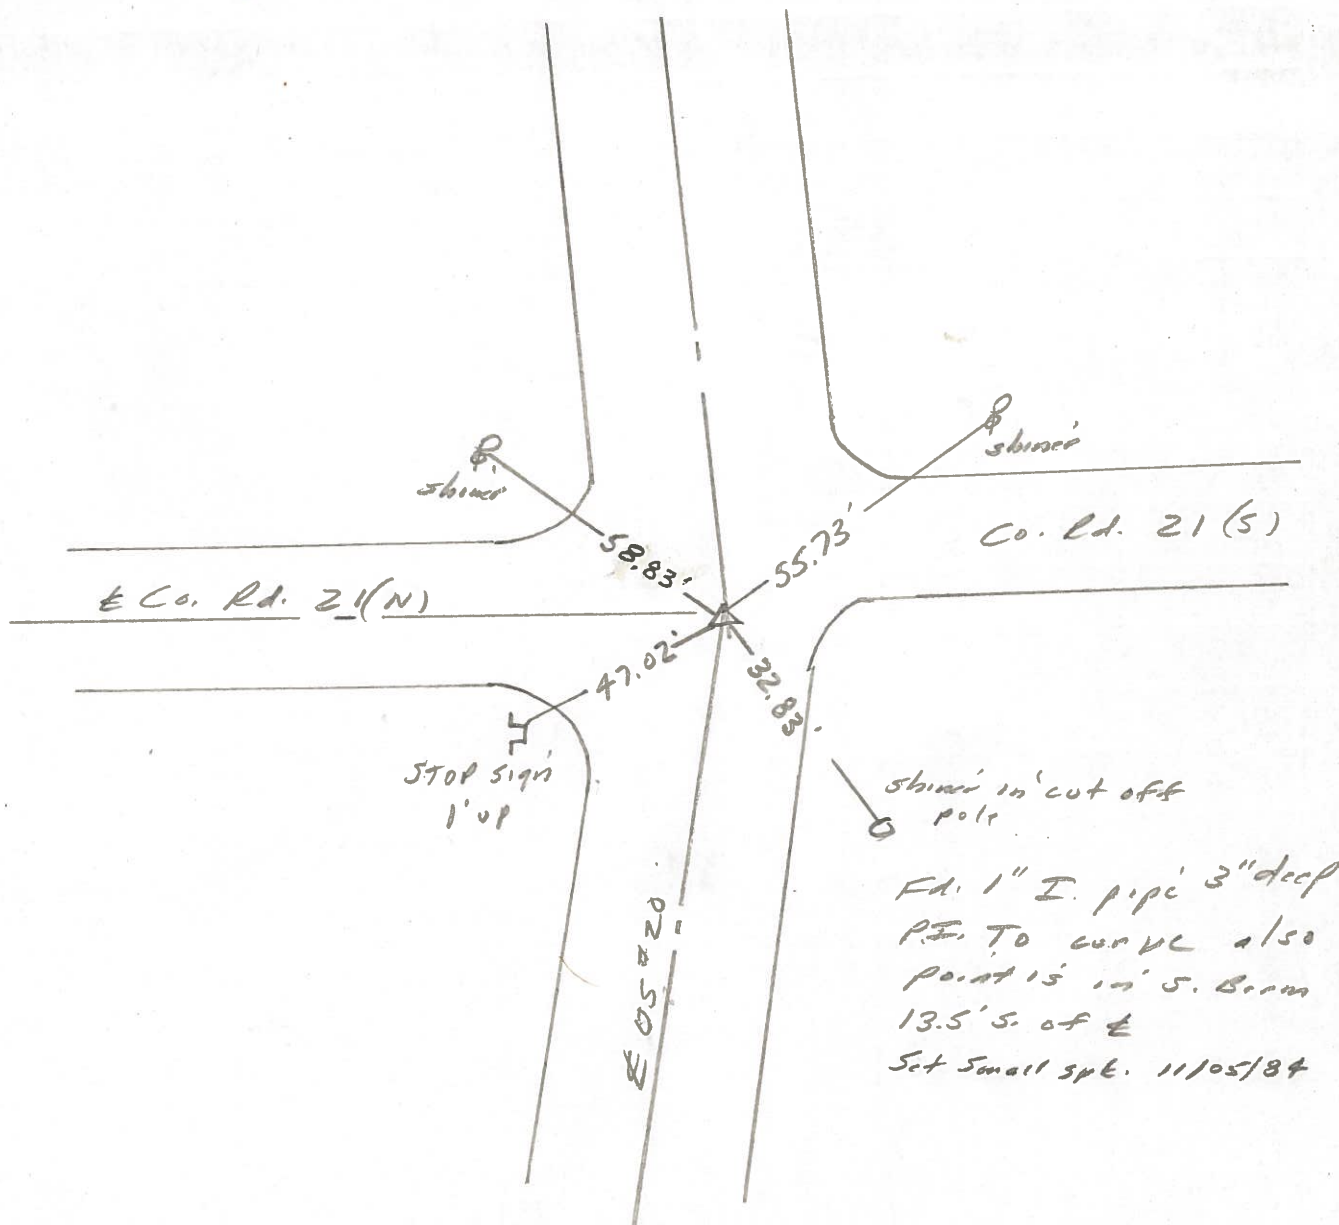

PERSONNEL	TITLE	PERSONNEL	TITLE	COUNTY	DATE	WEATHER	TEMP
Tomsic				Fulton	JUNE 5, 1973		
Neuser				S. R. U.S. 20			
Granata				SEC. Gorham TWP			

DESCRIPTION	LEFT	CENTER LINE	RIGHT	JOB NO.
-------------	------	-------------	-------	---------

