

O.D.O.T. DISTRICT 2 SURVEY OFFICE (USE ONLY)

PERSONNEL

REFERENCE NO. 21 A

SHEET 35 OF 38

NOTES AUBLE

DATE 12/21/23

ROUTE SR 20

H.C. NIESE

WEATHER CLOUDY

COUNTY FULTON

R.C. ASTON

TEMP. 45°

TOWNSHIP CHESTERFIELD

DWG BY RHOADES

PID PAVING TRAIN

SECTION 30

T 9 N R 2 E

TYPE MONUMENT MAG/WASHER

ON SURFACE - ~~BELOW~~ ON

OFFSET Q PAVEMENT 1.1' LT : ~~RT~~

9.5' TO LT EDGE PAVEMENT


STATION: 533+77

HORIZ.DATUM: NAD83 2011

GEOID: NAVD88 2018


GRID: NORTHING: 733678.479

EASTING: 1497227.061

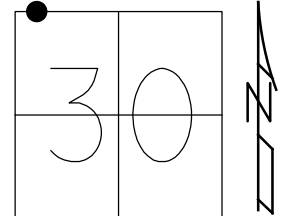

RECORD:
FD 1/2" IPIPE
4" DOWN
10-17-84
FD 1/2" IPIPE
11-16-98, SAH
SET P.K./WASHER
11/16/98, SAH
FD 1/2" IPIPE
REFA21
4-18-17, DCH
SET MAG/WASHER
8/16/17, DCH
FD MAG/WASHER
FUL20REF21A
6/9/23, JAM
12/21/23, DSA

FULTON LPD:
N: 389176.135
E: 143563.107

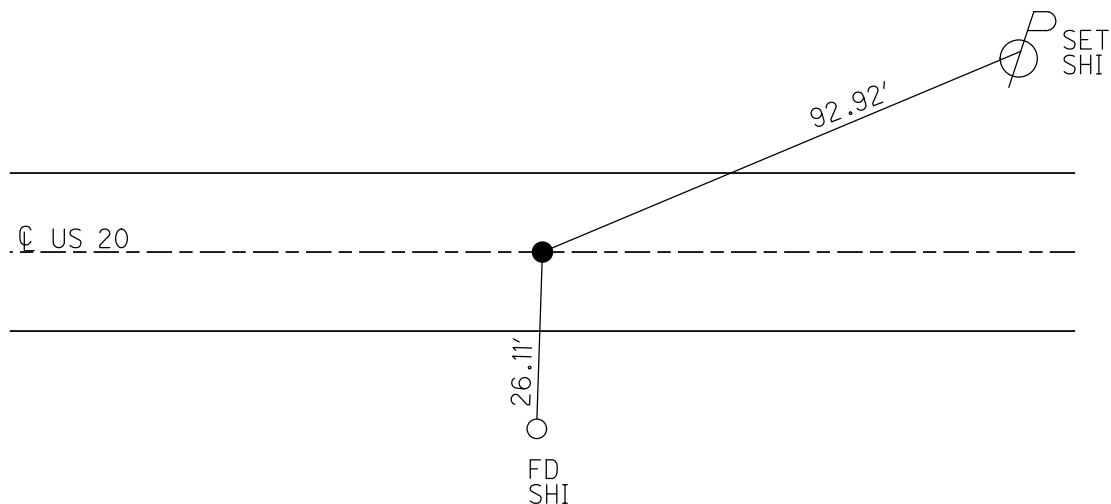


O.D.O.T. DISTRICT 2 SURVEY OFFICE (USE ONLY)


PERSONNEL _____ REFERENCE NO. 21 A SHEET 35 OF 38
NOTES LEU DATE 4/18/17 ROUTE US 20
H.C. HOMAN WEATHER SUNNY COUNTY FULTON
R.C. LEU TEMP. 75°F TOWNSHIP CHESTERFIELD
SECTION 30
T 9 S R 2 E

TYPE MONUMENT 1/2" IPIPE
~~ON SURFACE~~ - BELOW 3"
LEFT - CL PAV'T - ~~RIGHT~~ 1.1'
9.5 TO LT EDGE PAVEMENT
S.L.M. 533+77

Grid: Northing: 733678.475 Easting: 1497227.087

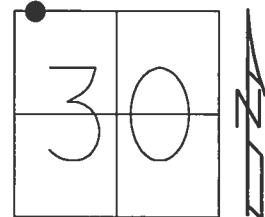

RECORD:
FD 1/2" IPIPE
4" Down
10-17-84
FD 1/2" IPIPE
11-16-98, SAH
SET P.K./WASHER
11/16/98, SAH
FD 1/2" IPIPE
REFA21
4-18-17, DCH
SET MAG/WASHER
08-16-2017, DCH

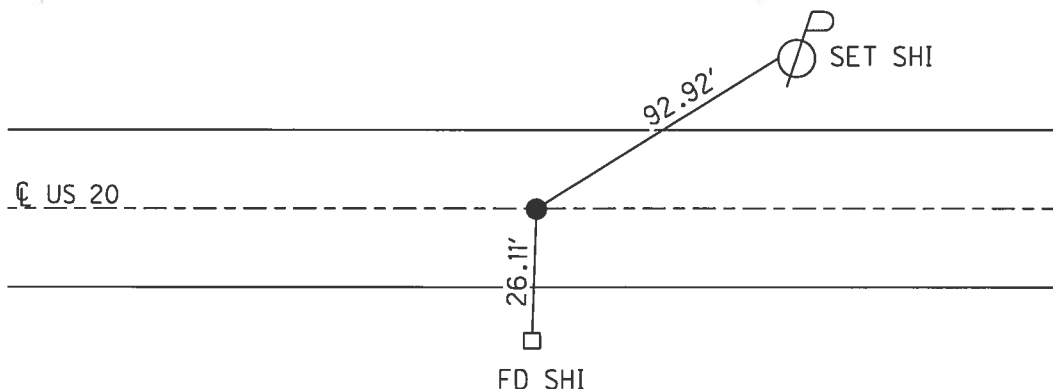

O.D.O.T. DISTRICT 2 SURVEY OFFICE

PERSONNEL

REFERENCE NO. 21-A

SHEET 9 OF 11

NOTES Huss

H.C. Moser

R.C. VanNusen

DATE 11-16-98

WEATHER Pt Cldy - Fair

TEMP +39°F

ROUTE US-20

COUNTY Fulton

TOWNSHIP Chesterfield

SECTION 30

T9 S R 2 E


TYPE MONUMENT 1/2" I Pipe

~~ON-SURFACE~~ BELOW 4" Deep

LEFT ~~UNPAVED~~ RIGHT 10.1' ht of G

9.5 TO Lt. EDGE PAVEMENT

S.L.M. 16+269.3 SLK / 533+77 SLM

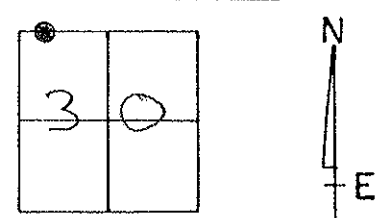

Record.

Set 1/2" I. Pipe 4" deep


10.0' to S. EOP, 9.6'


to N. EOP, 1/4 Corn.

Sec 30

10-17-84


Set PK/W
11-16-98
SAH

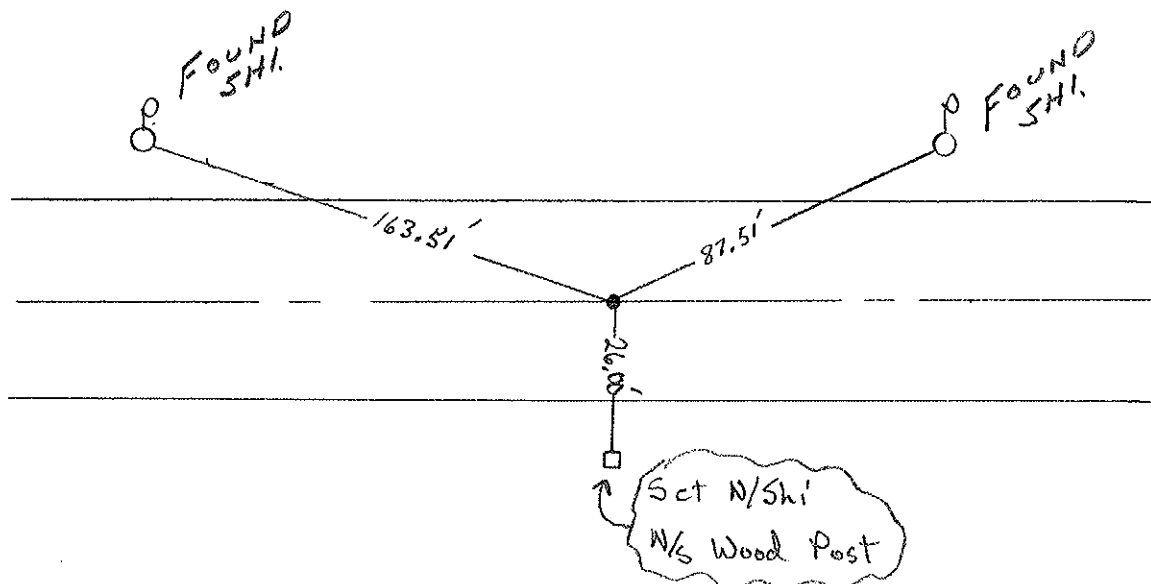

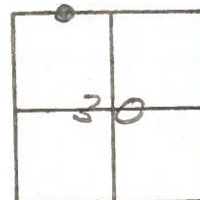County Fulton S.R. US#20Township Cheston fieldSection 30T N, R EPersonnel I. StoneP. NeuseR. MichalakD. CurtisDate 27 July 84Weather CloudyTemp. 70°

SLM STA, 533+39

REF. NO. 21-4

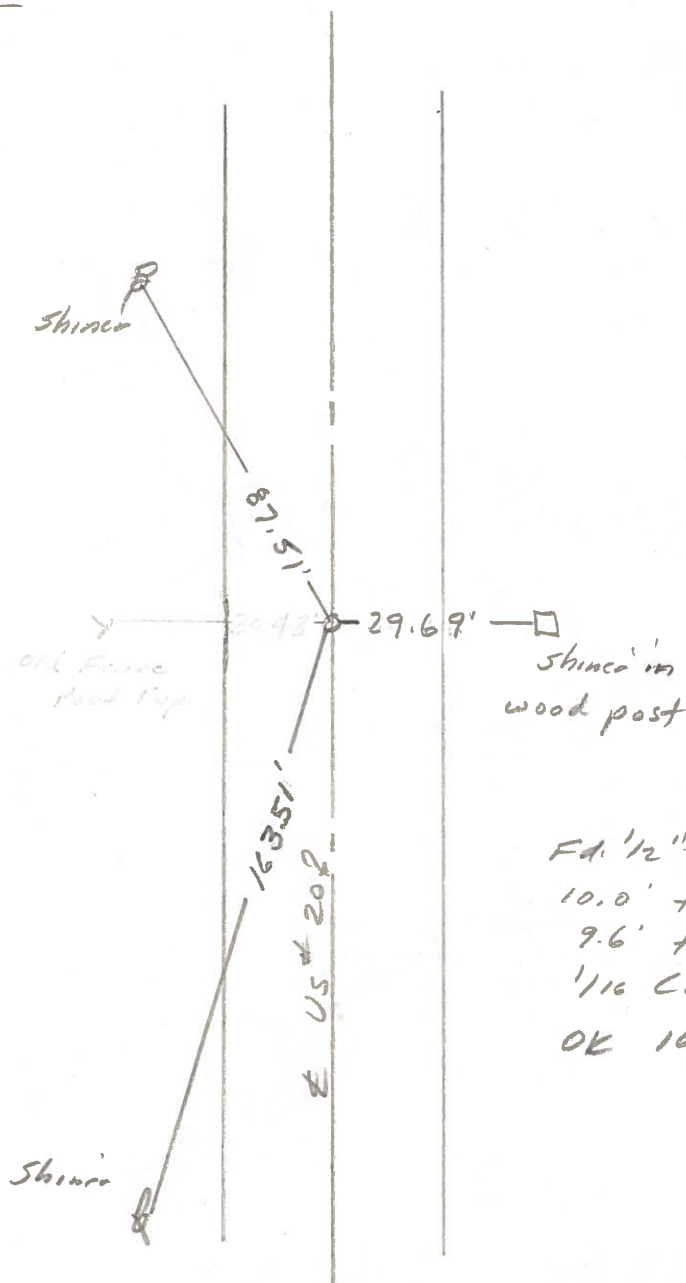

Ed. 1/2" I. Pipe 4" drop
 10.0' to S. edge put,
 9.6' to N. edge put
 1/16 Con. Sec. 30
 OK 10/17/84

PERSONNEL TITLE PERSONNEL TITLE

Red Beach
W. KnopeCOUNTY FultonDATE Aug-Sept. 1975S. R. US 20



WEATHER

SEC. 19/30 Chesterfield Twp. TEMP.

DESCRIPTION

CONTROL POINTS

JOB NO.

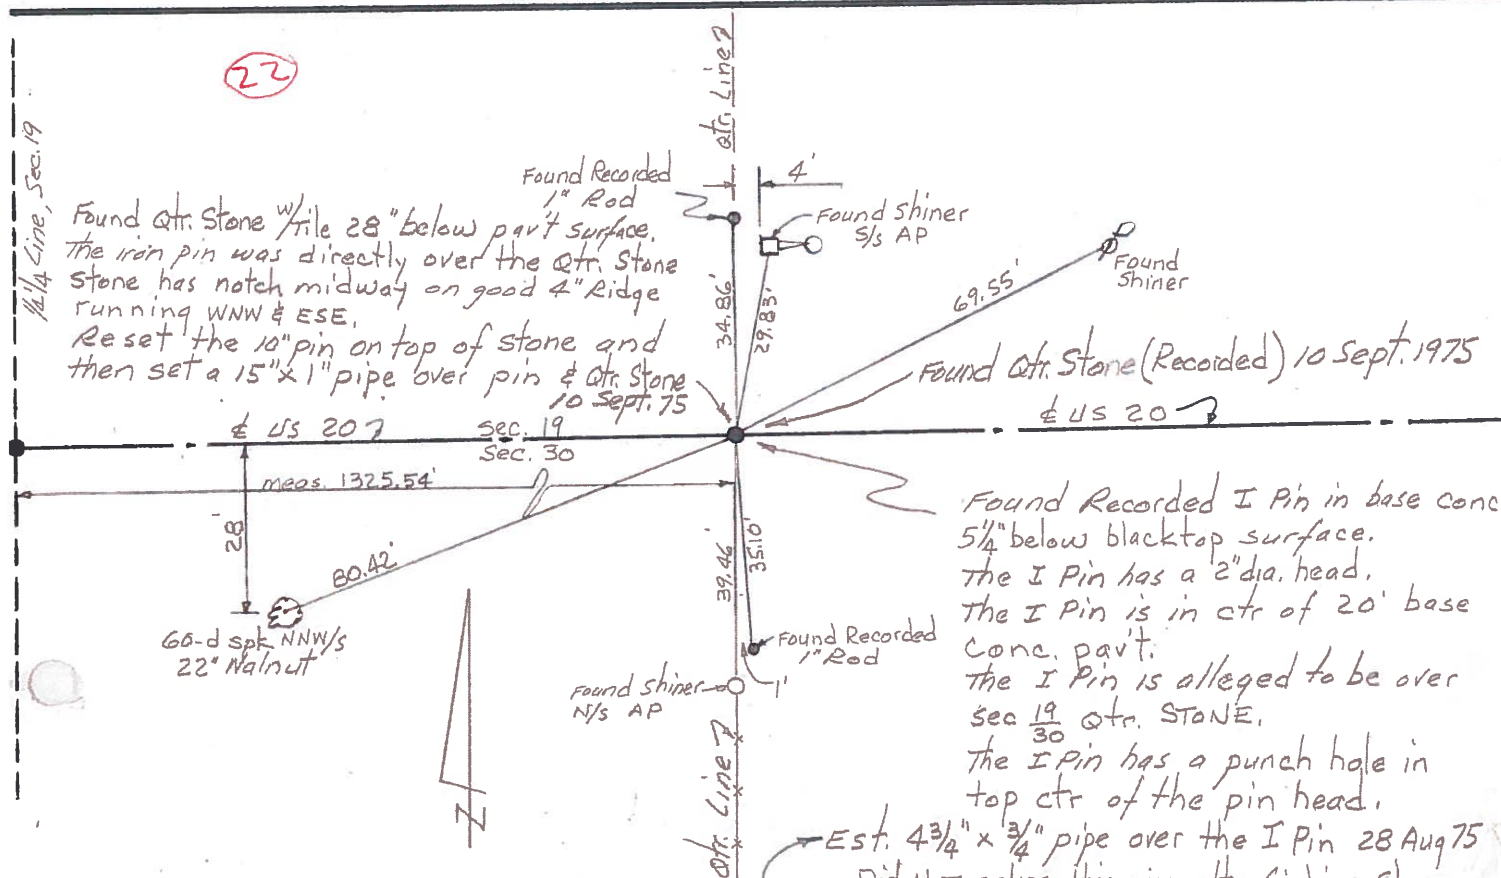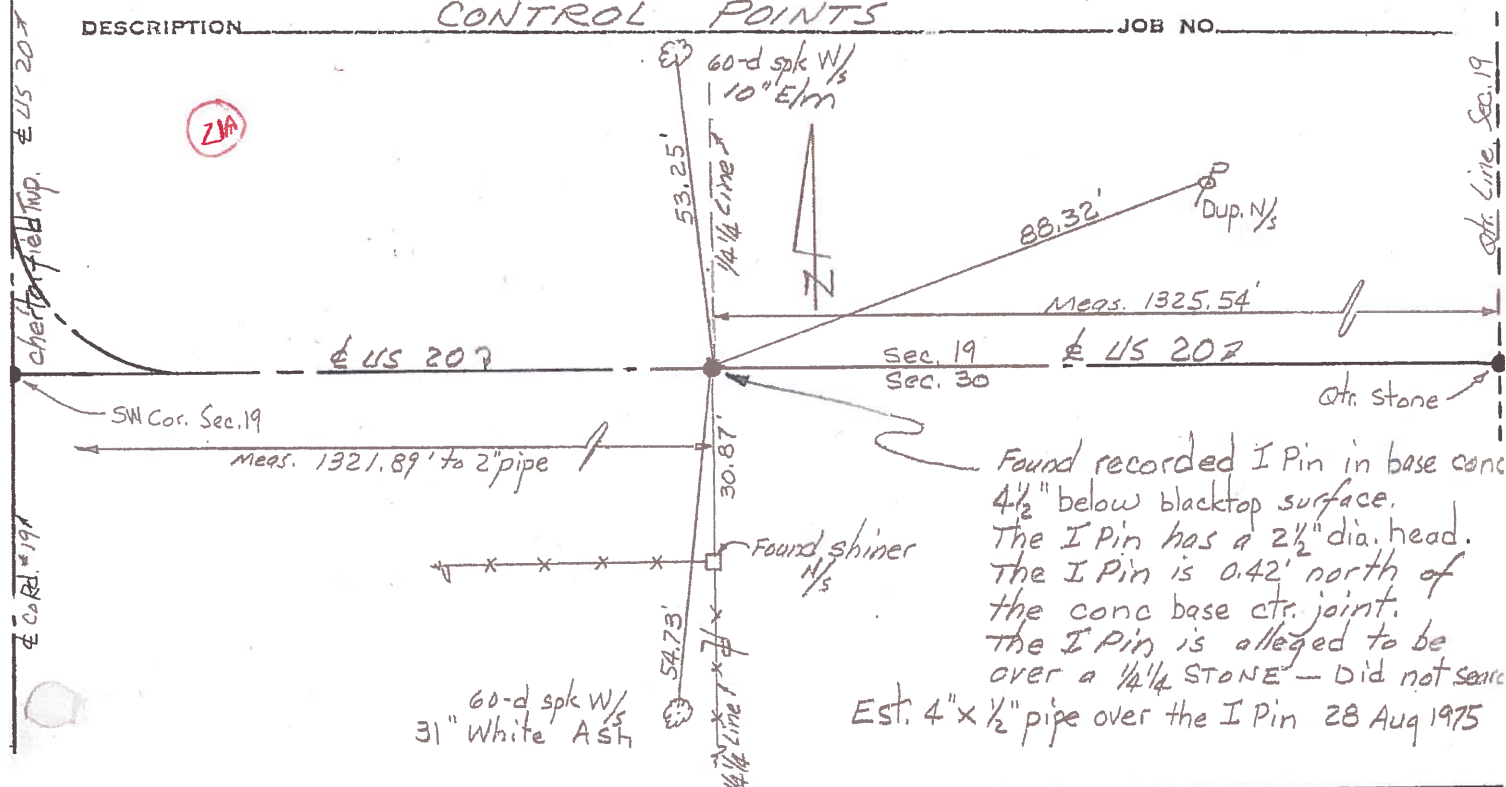

PERSONNEL	TITLE	PERSONNEL	TITLE	COUNTY	DATE	WEATHER	TEMP
Tamsic		Boyle			June 11, 1973		
Dawser				S. R.			
Granata				SEC.			
Vanyo							

DESCRIPTION _____ LEFT _____ CENTER LINE _____ RIGHT _____ JOB NO. _____

