

O.D.O.T. DISTRICT 2 SURVEY OFFICE (USE ONLY)

PERSONNEL

REFERENCE NO. 41

SHEET 1 OF 28


NOTES RHOADES
H.C. O'DONNELL
R.C. HELDMAN

DATE 4/11/17
WEATHER CLOUDY
TEMP. 56°


ROUTE US 20
COUNTY FULTON
TOWNSHIP ROYALTON
SECTION 23
T 9 S R 3 E

TYPE MONUMENT _____ MAG NAIL
ON SURFACE - ~~BELOW~~ _____ ON
~~LEFT -~~ ℄ PAV'T - ~~RIGHT~~ _____ ON
_____ TO _____ EDGE PAVEMENT
S.L.M. 1071+46.20

GRID: NORTHING: 733891.188 EASTING: 1551554.517

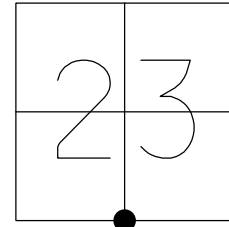

RECORD:
S 1/4 COR. SEC. 23
SET P.K./WASHER
6-21-01, BVD
FD HOLE WHERE PK/WASHER WERE
TIES GOOD. RESET AFTER PRPJECT
9-24-15, JFO
SET MAG/WASHER
REF41
11-4-15, JFO
SET MAG/WASHER
6-29-18, JFO

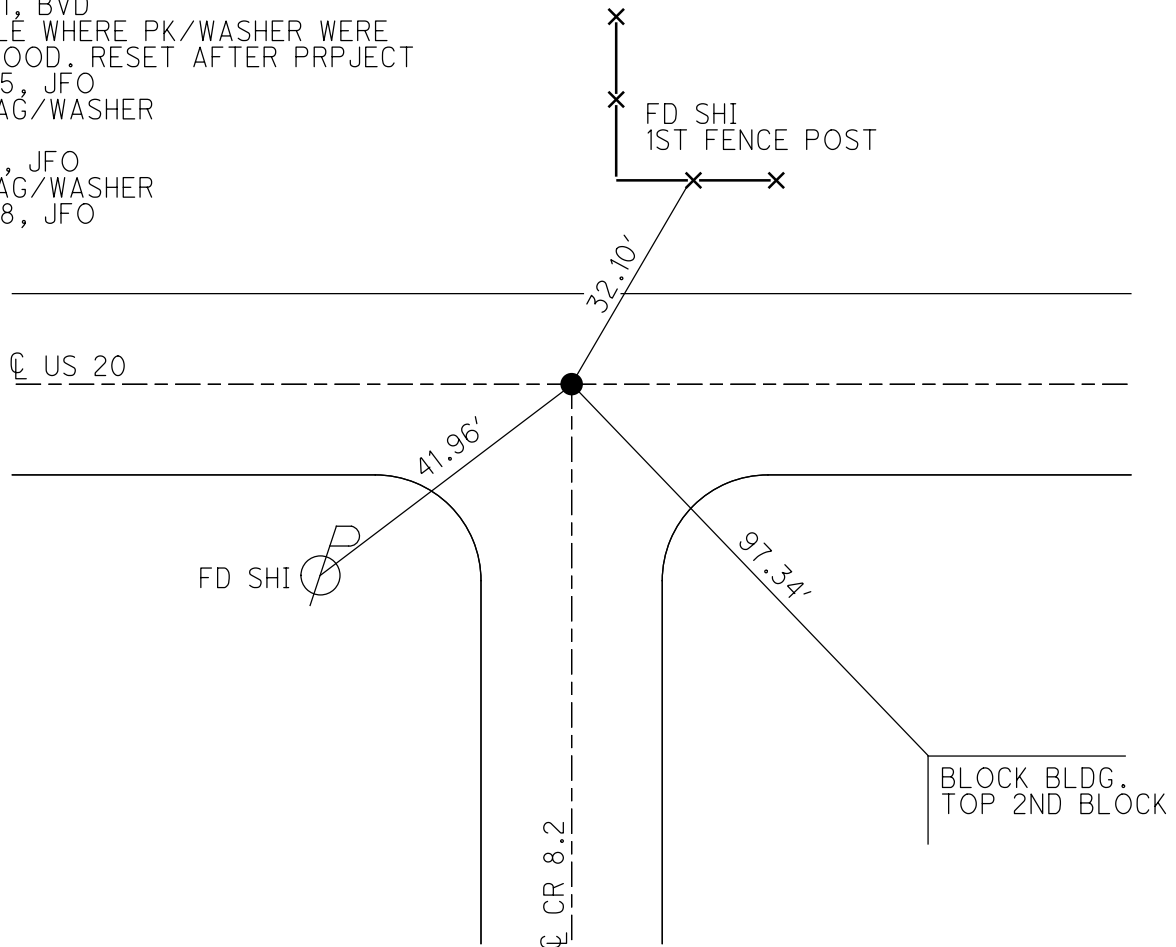

O.D.O.T. DISTRICT 2 SURVEY OFFICE

PERSONNEL

REFERENCE NO. 41

SHEET 1 OF 27

NOTES HUSS

H.C. CORDES

R.C. KARGER

DATE 7/19/00

WEATHER PT. CLOUDY, FAIR

TEMP. 72°

ROUTE US 20

COUNTY FULTON

TOWNSHIP ROYALTON

SECTION 23

T 9 S R 3 E

TYPE MONUMENT SM.R.R.SPIKE


ON SURFACE - ~~BELOW~~ ON

LEFT - C PAV'T - RIGHT ON

11.8' TO LT. EDGE PAVEMENT


S.L.M. 1078+48

Grid: Northing: _____ Easting: _____

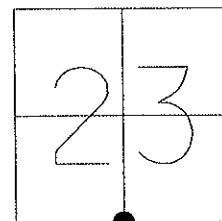

RECORD:
S $\frac{1}{4}$ CORNER SEC 23

SET P.K./WASHER
6/21/01, BVD

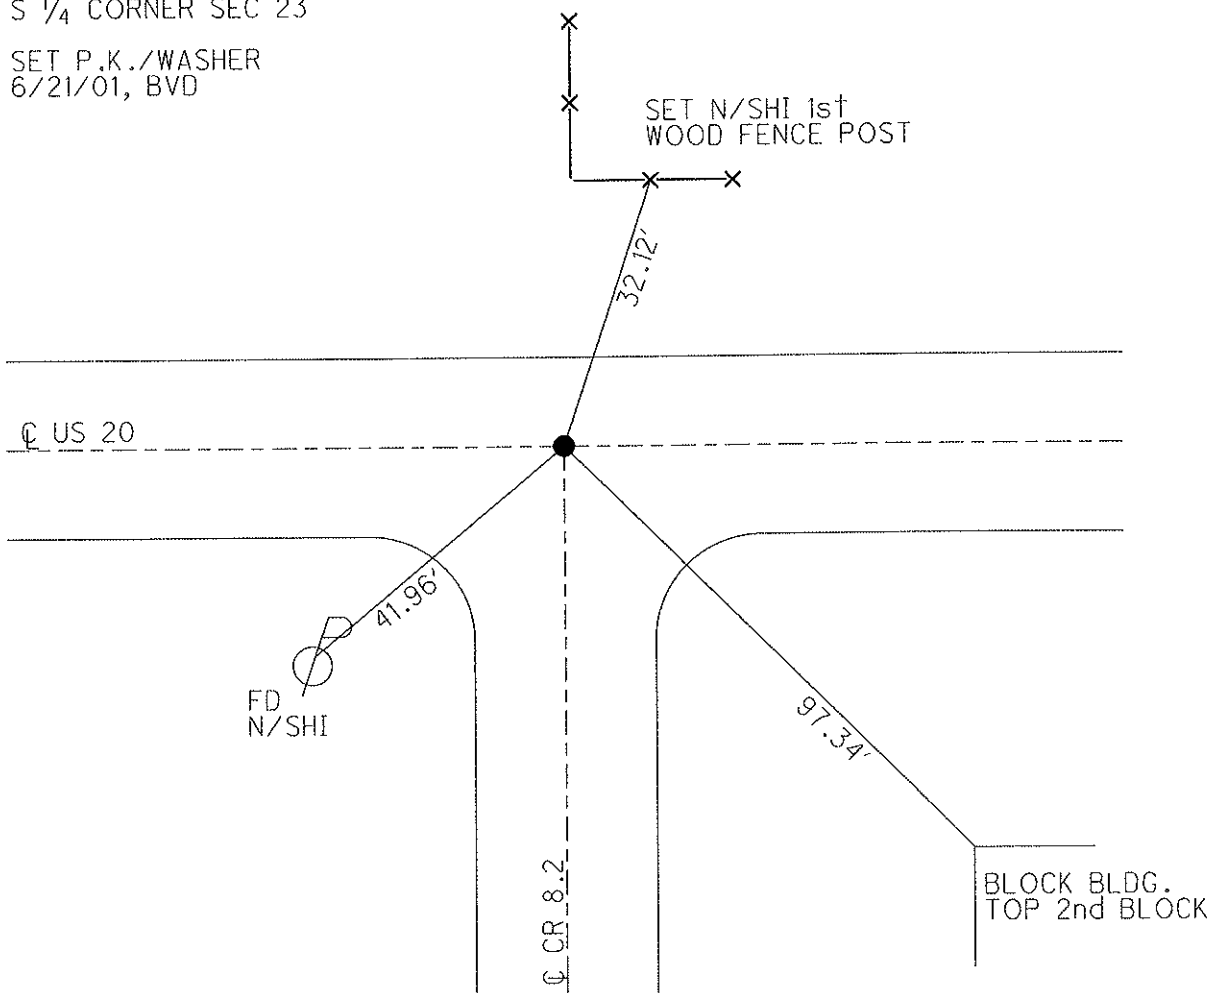

O.D.O.T. DISTRICT 2 SURVEY OFFICE

PERSONNEL

REFERENCE NO. 41

SHEET 2 OF 24

NOTES Huss

H.C. Condes

R.C. Kanger

DATE 7-19-00

WEATHER Pr Cldy Fair

TEMP. 72°F

ROUTE US-20

COUNTY Fulton

TOWNSHIP Royalton

SECTION 23

T 9 S R 3 E


TYPE MONUMENT Small RR Spk.

ON SURFACE ~~BELOW~~ surface

~~LEFT~~ ← PAV'T. ~~RIGHT~~ ← Pavt.

11.8' TO RT. EDGE PAVEMENT


S.L.M. 1078+48

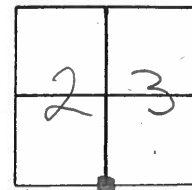

Record
S 1/4 Corner Sec 23

SET PK & WASHER
6-21-01
BYD

Set N/S/hi
1st Wood Fenc. Post

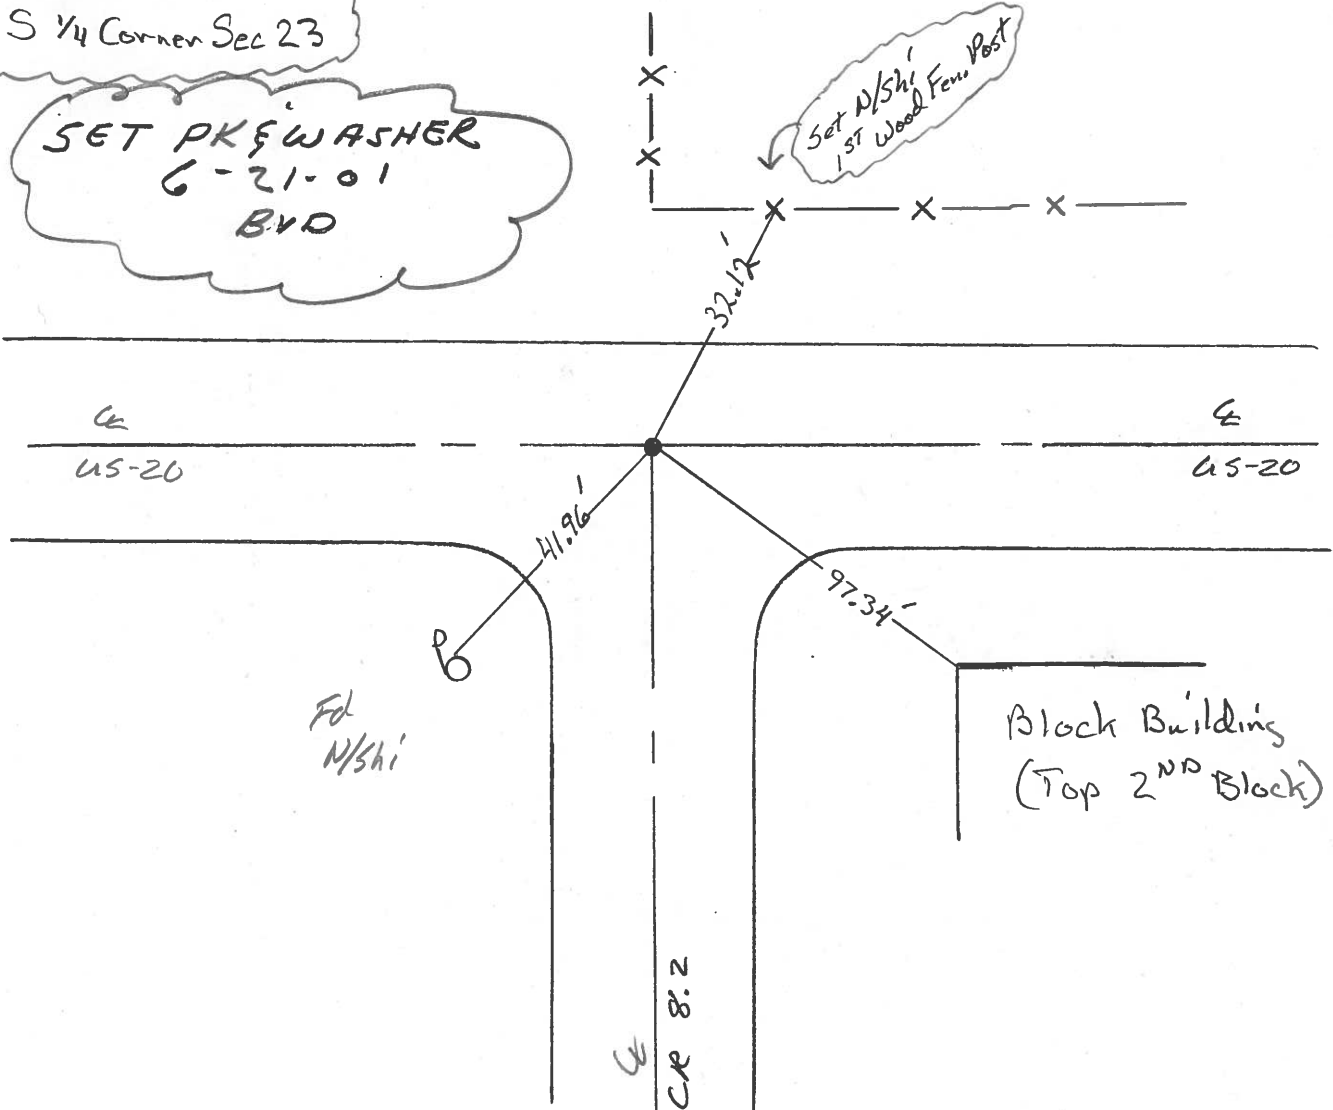

O.D.O.T. DISTRICT 2 SURVEY OFFICE

PERSONNEL

REFERENCE NO. 41

SHEET 1 OF

NOTES D. CURTIS

H.C. J. HOUSEHOLDER

R.C. R. MICHALAK

DATE 4-24-86

WEATHER MILD

TEMP. 45°

ROUTE U.S. #20

COUNTY FULTON

TOWNSHIP ROYALTON

SECTION 23

T R


TYPE MONUMENT SM. R.E. SPK.

ON SURFACE - BELOW ON SURFACE

LEFT- & PAV'T. - RIGHT & PAV'T

TO EDGE PAVEMENT


S.L.M.

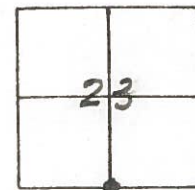

REF. No. 41

S. 1/4 COR. SEC. 23

Set Small Spk. 8/27/86

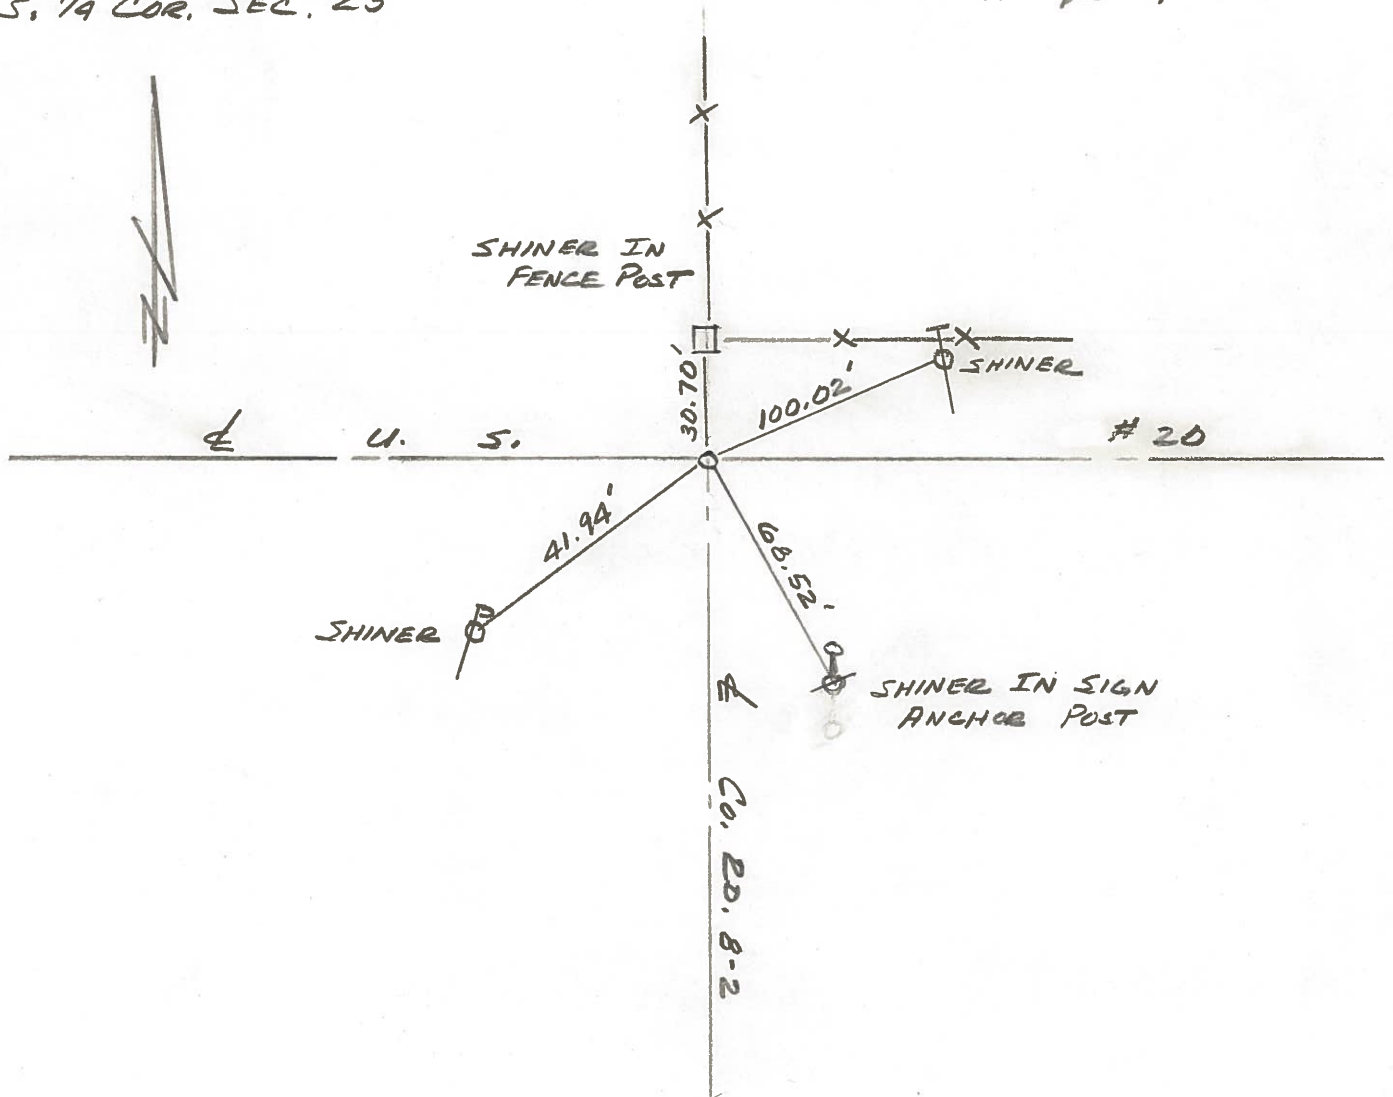

Q.D.O.T. DISTRICT 2 SURVEY OFFICE

Sht. 2 of

County FULTON S.R. US-20

Township ROYALTON

Section 23

T N, R E

Personnel I. STONE

E. MICHALAK

P. NEUSER


D. CURTIS

D. GRANATH

Date 9 MAY 1979

Weather WARM

Temp. 78°

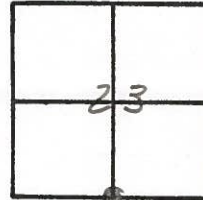

REF. NO. 41

S. 1/4 COR. SEC. 23

