

O.D.O.T. DISTRICT 2 SURVEY OFFICE (USE ONLY)

PERSONNEL

REFERENCE NO. 25

SHEET 7 OF 35

NOTES RHOADES
H.C. O'DONNELL
R.C. RHOADES

DATE 4/23/21
WEATHER CLOUDY
TEMP. 46°

ROUTE SR 109
COUNTY FULTON
TOWNSHIP PIKE
SECTION 2
T 7 N R 7 E

DWG BY NIESE PID PAVE TRAIN

TYPE MONUMENT MONBOX W/ 1" IPIN



ON SURFACE - ~~BELOW~~ ON

OFFSET $\varnothing$ PAVEMENT ON LT : RT
- TO - EDGE PAVEMENT

STATION: 510+24.71

HORZ.DATUM: NAD83(2011) GEOID: 2018

GRID: NORTHING: 706596.506 EASTING: 1547953.257

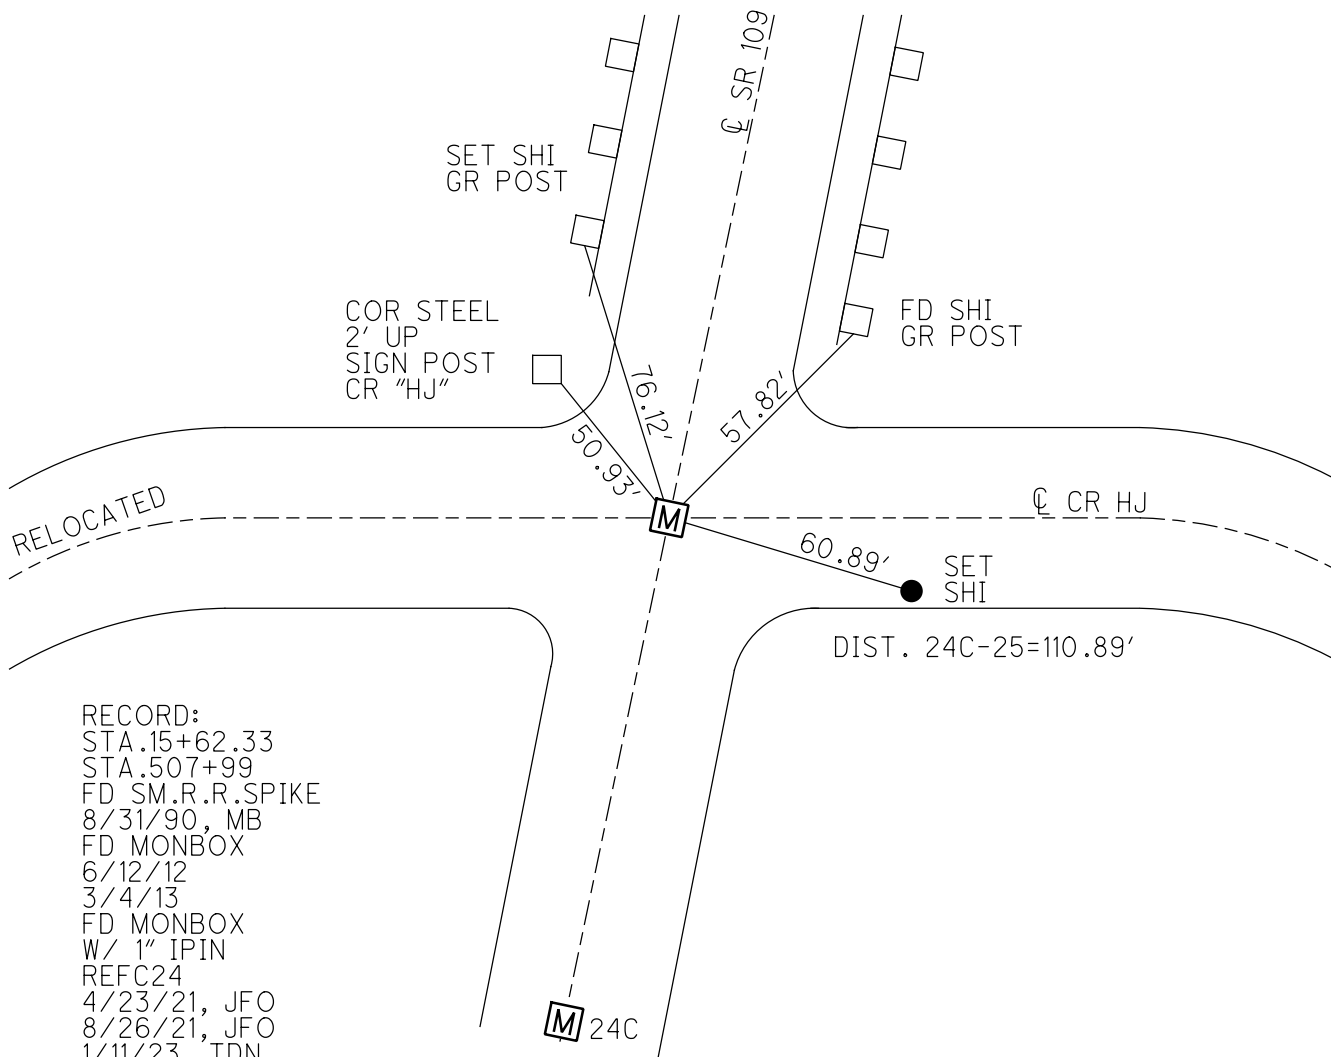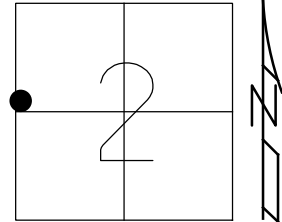

O.D.O.T. DISTRICT 2 SURVEY OFFICE (USE ONLY)

PERSONNEL

REFERENCE NO. 25

SHEET 7 OF 35

NOTES RHOADES

DATE 4/23/21

ROUTE SR 109

H.C. O'DONNELL

WEATHER CLOUDY

COUNTY FULTON

R.C. RHOADES

TEMP. 46°

TOWNSHIP PIKE

DWG BY NIESE

PID PAVE TRAIN

SECTION 2

T 7 N R 7 E

TYPE MONUMENT MONBOX W/ 1" IPIN

ON SURFACE - ~~BELOW~~ ON

OFFSET Q PAVEMENT ON LT : RT

- TO - EDGE PAVEMENT



STATION: 510+24.71

HORZ.DATUM: NAD83(2011)

GEOID: 2018

GRID: NORTHING: 706596.506

EASTING: 1547953.257

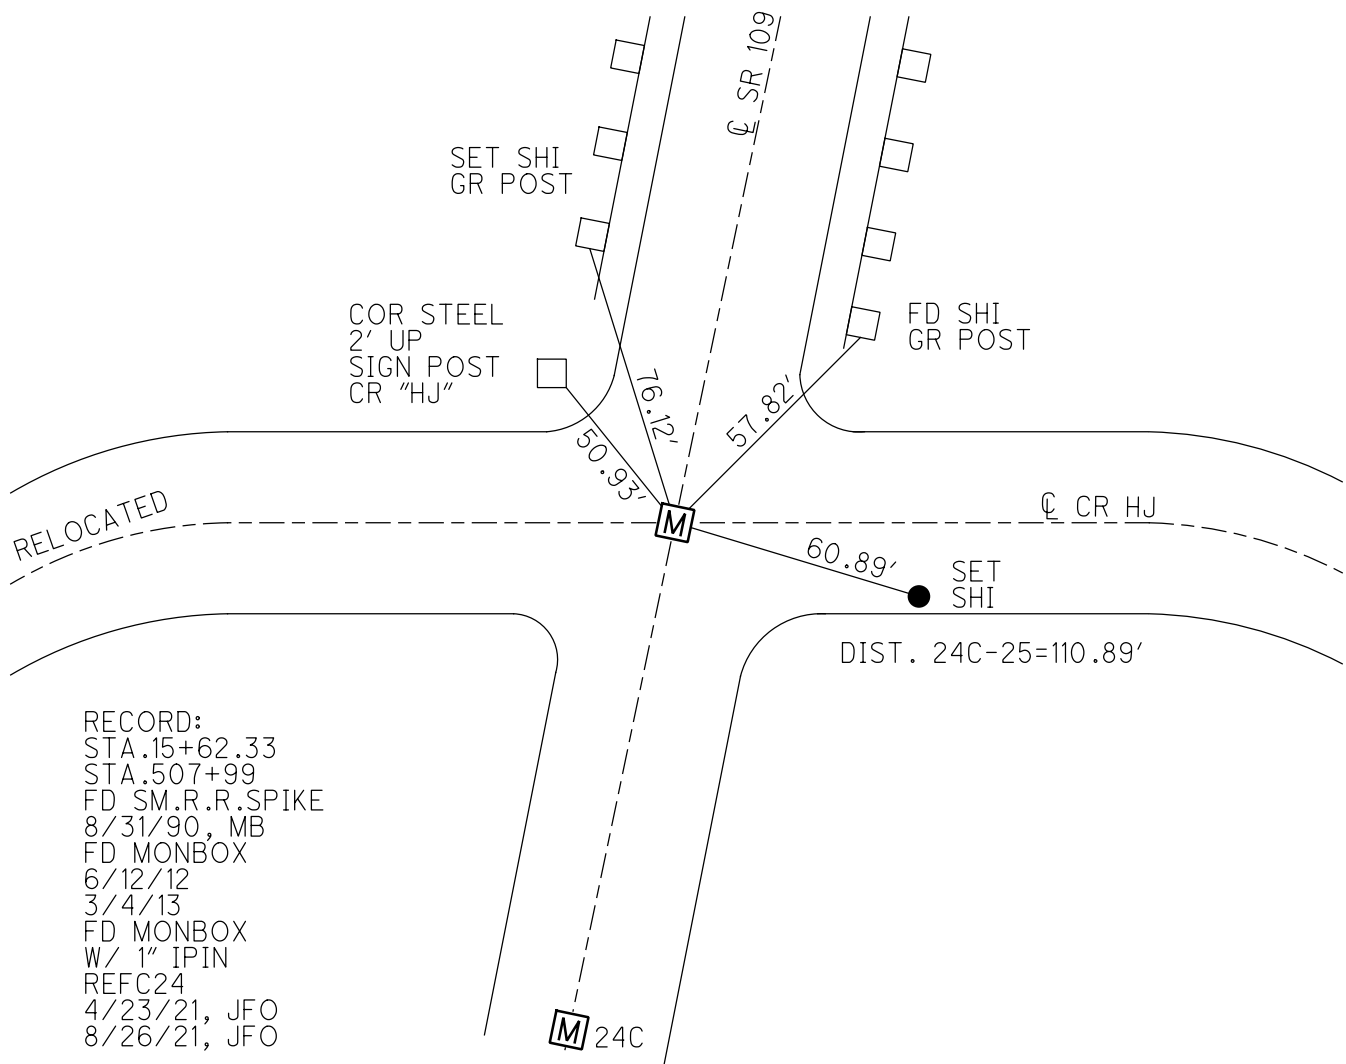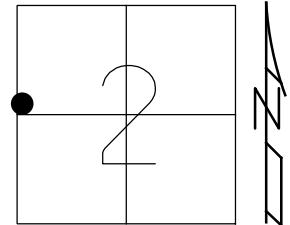

RECORD:
STA.15+62.33
STA.507+99
FD SM.R.R.SPIKE
8/31/90, MB
FD MONBOX
6/12/12
3/4/13
FD MONBOX
W/ 1" IPIN
REFC24
4/23/21, JFO
8/26/21, JFO

O.D.O.T. DISTRICT 2 SURVEY OFFICE (USE ONLY)

PERSONNEL

REFERENCE NO. 25-AA

SHEET 8 OF 35

NOTES HUSS

DATE 06-12-12

ROUTE SR 109

H.C. HUSS

WEATHER CLEAR

COUNTY FULTON

R.C. CANTERBURY

TEMP. 76°

TOWNSHIP PIKE

COUTCHER

SECTION 2

T 7 N R 7 E

TYPE MONUMENT MON BOX


ON SURFACE - BELOW ON

LEFT - Q PAV'T - RIGHT ON


- TO - EDGE PAVEMENT

S.L.M. 511+43

Grid: Northing: 706596.494 Easting: 1547953.204

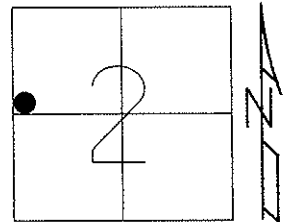

06-12-12 GPS REF A25, SAH
03-04-13 GPS FIN A25, MC

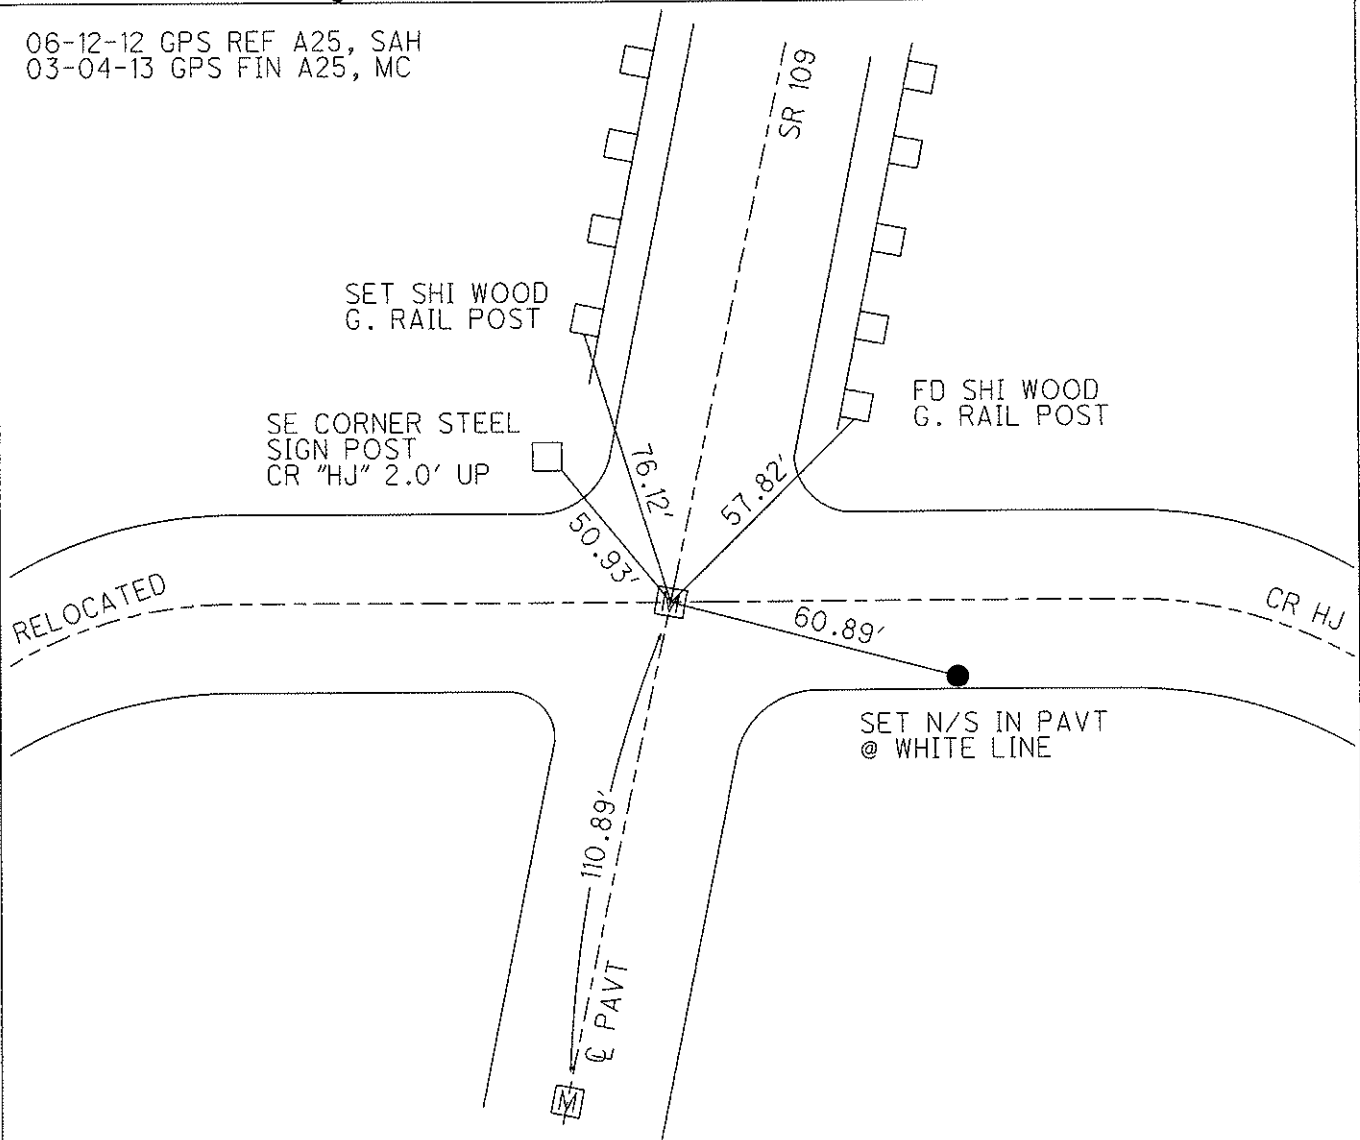

O.D.O.T. DISTRICT 2 SURVEY OFFICE (USE ONLY)

PERSONNEL

REFERENCE NO. 25

SHEET 6 OF 35


NOTES BARNHISEL
H.C. BARNHISEL
R.C. HOFFMAN

DATE 08-31-90
WEATHER CLEAR
TEMP. 72°

ROUTE SR 109
COUNTY FULTON
TOWNSHIP PIKE
SECTION 3
T 7 N R 7 E


TYPE MONUMENT SM RR SPK
ON SURFACE - BELOW ON
LEFT - Q PAV'T - RIGHT 3.5'
- TO - EDGE PAVEMENT
S.L.M. 507+99

Grid: Northing: _____ Easting: _____

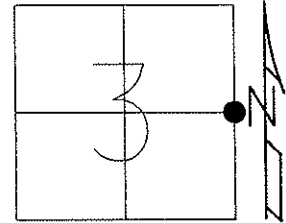

NOTE:
ROAD HJ WAS
RELOCATED BY
THE TURNPIKE
INTERCHANGE
PROJECT; 1996

SEE NEXT SHEET

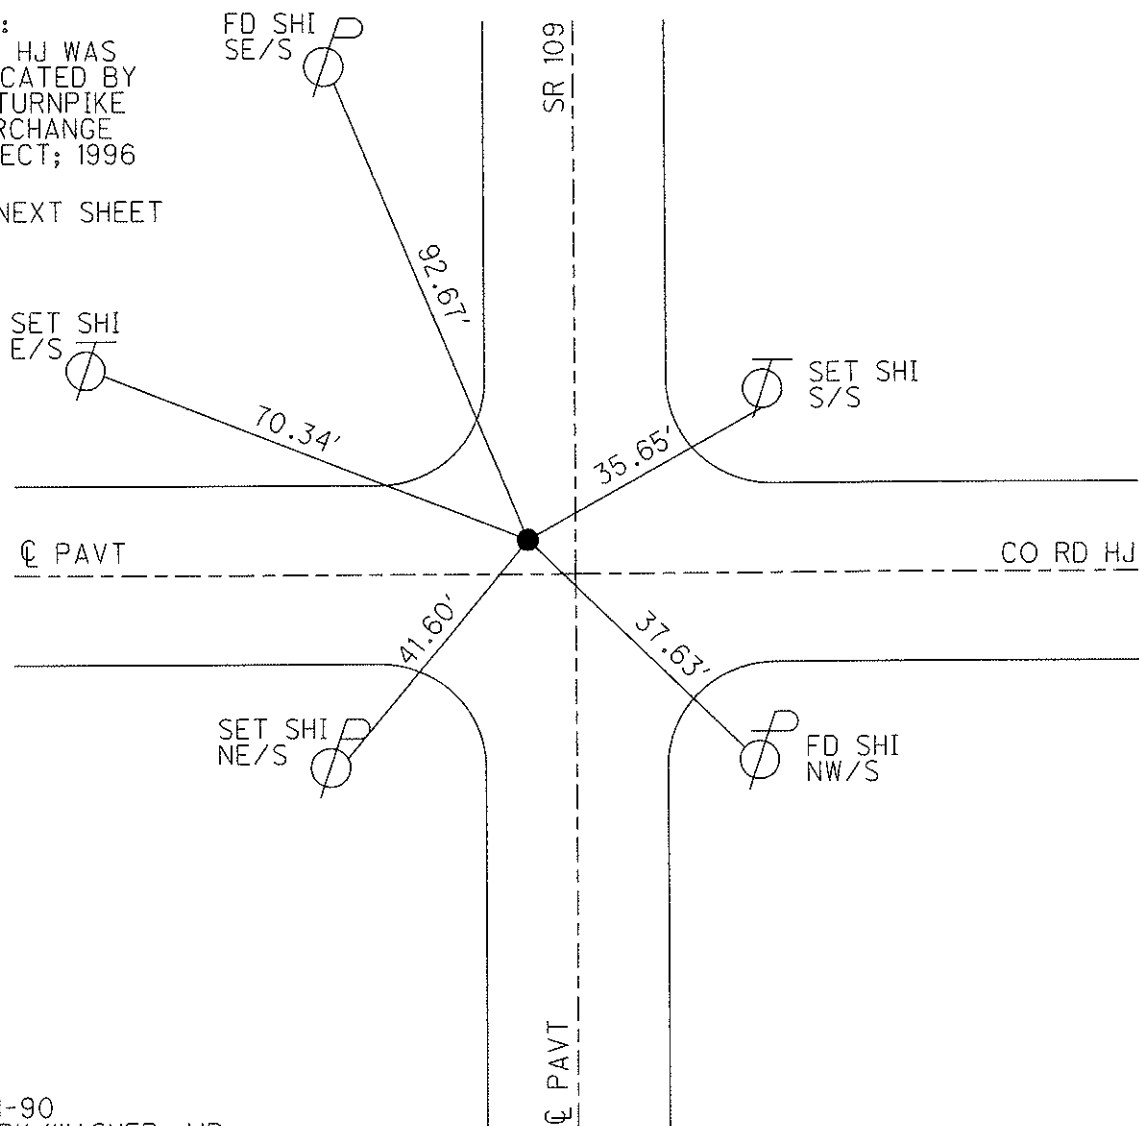

10-01-90
SET PK/WASHER, MB

O.D.O.T. DISTRICT 2 SURVEY OFFICE

PERSONNEL

REFERENCE NO. 25

SHEET 5 OF 28

NOTES BARNHISEL

H.C. " "

R.C. HOFFMAN

DATE 8-31-90

WEATHER clear

TEMP. +72°

ROUTE 109

COUNTY Fulton

TOWNSHIP PIKE

SECTION 3

T 7 N R 7 E

TYPE MONUMENT Sm RR Spk


ON SURFACE - BELOW yes

LEFT-E PAV'T. - RIGHT 3.5

— TO — EDGE PAVEMENT


S.L.M. 507+99

2.5 N. OF E. W.

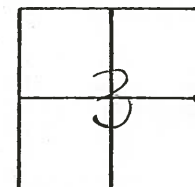

NOTE:
Road HJ was
Relocated by the
Turnpike Interchange
Project; 1996

Set P.K. & Washer
10-1-90
MB

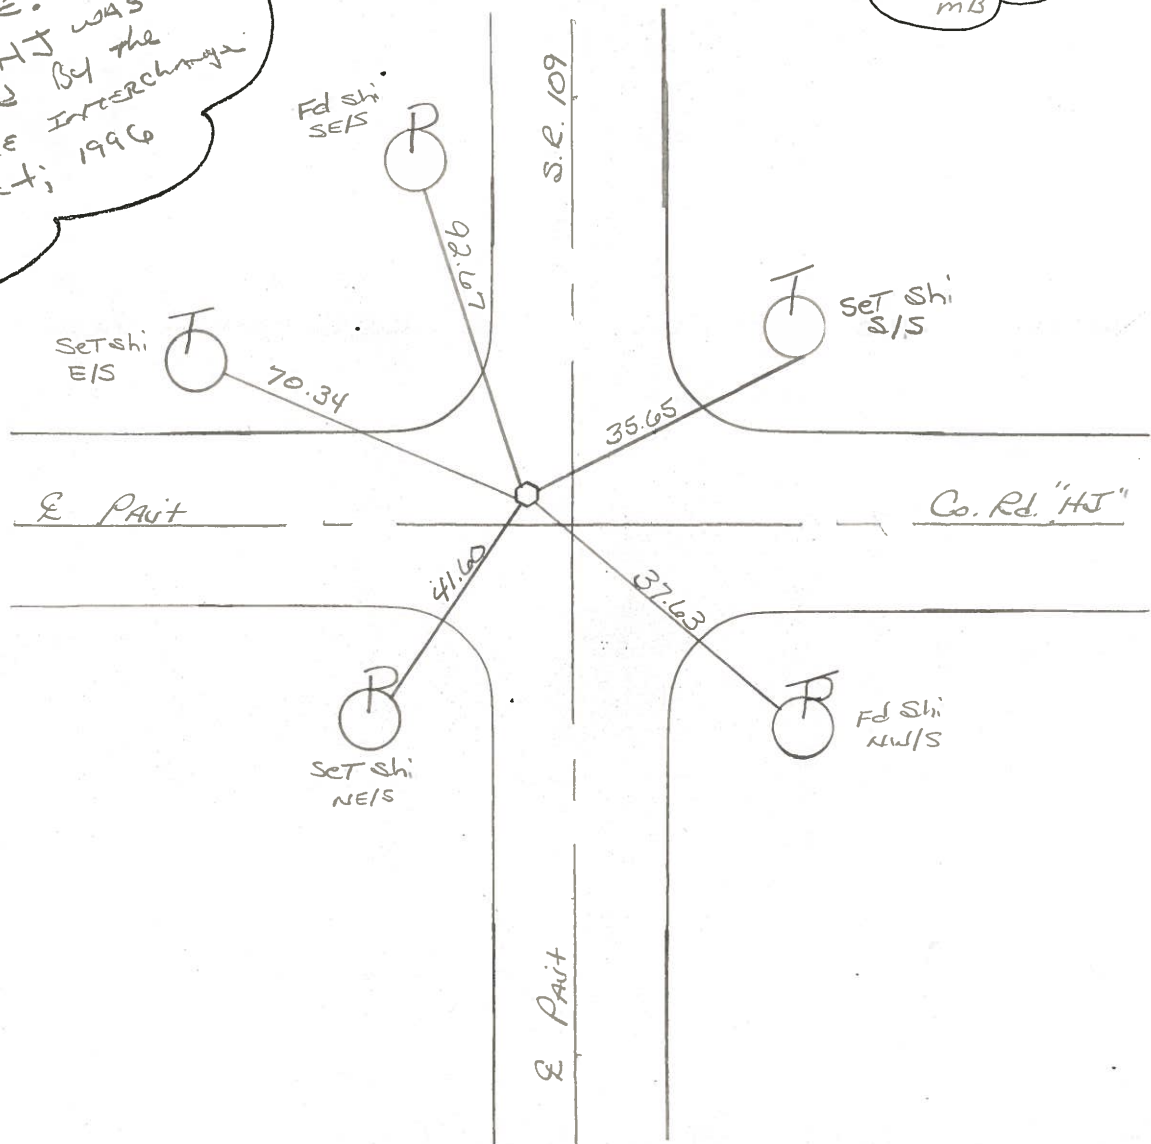

Q.D.O.T. DISTRICT 2 SURVEY OFFICE

SHEET 3 OF

County Fulton S.R. 109

Township RIKE

Section 2-3

T N, R E

Personnel I. Stone

P. Nease


R. Michalek

D. Curtis


Date 11 April 84



Weather Fair

Temp. 480

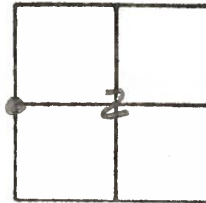

REF. NO. 25

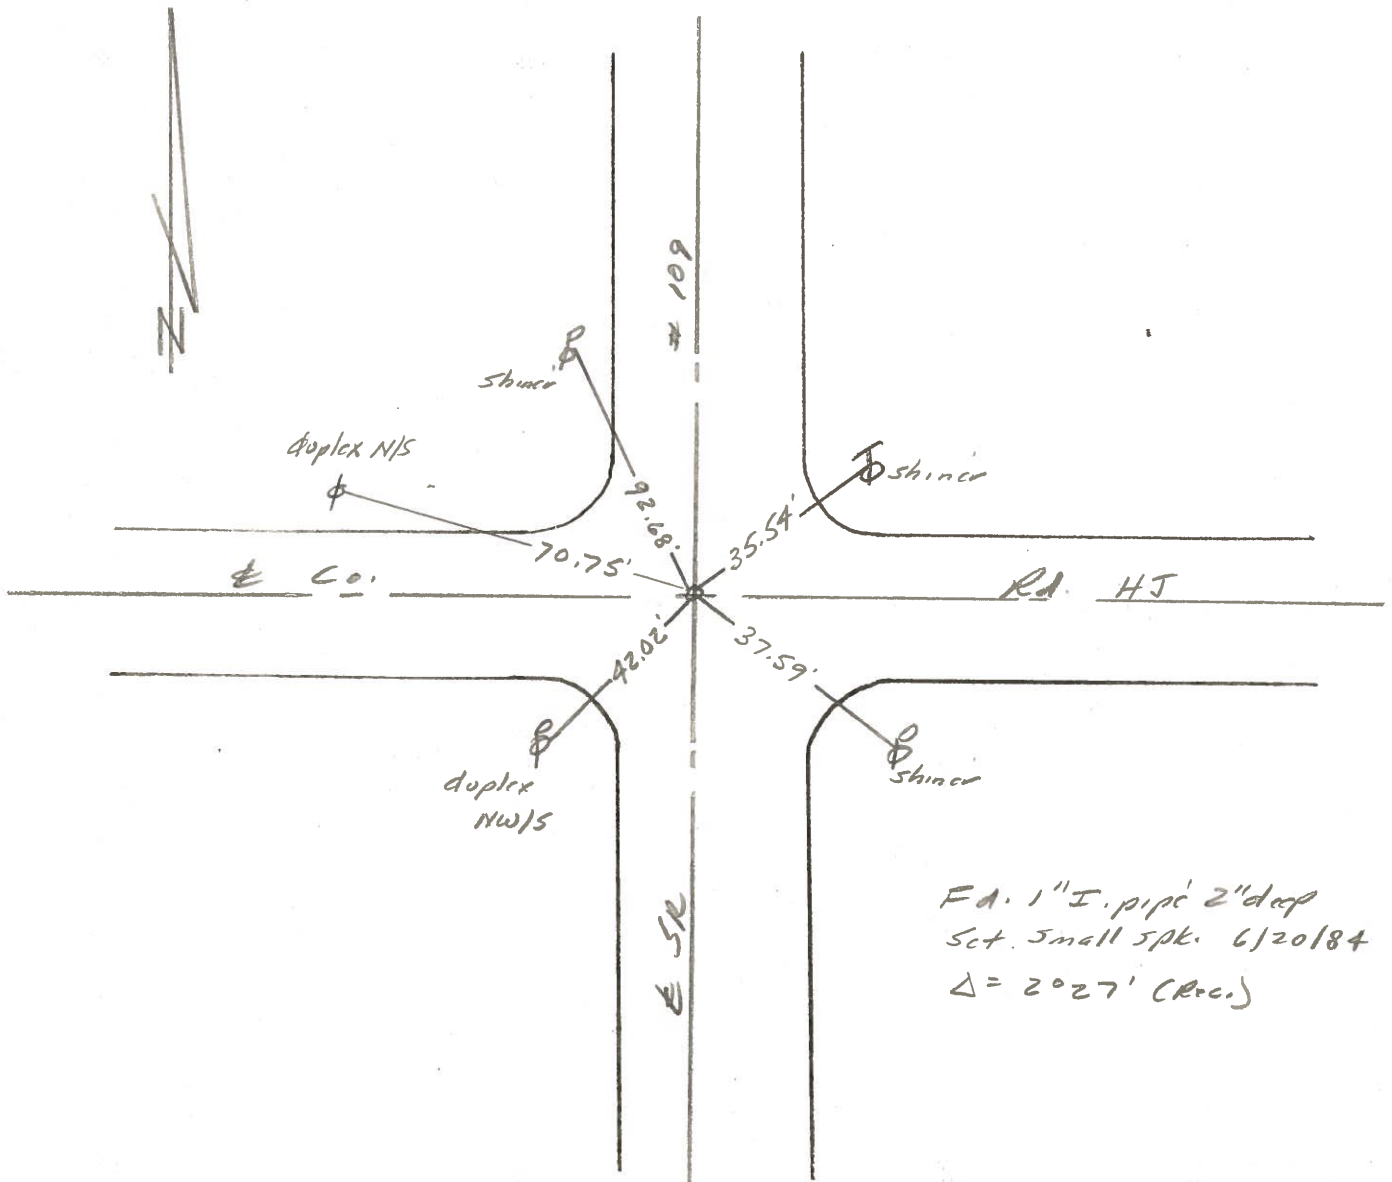

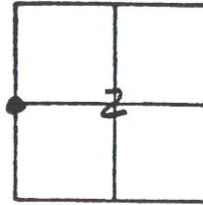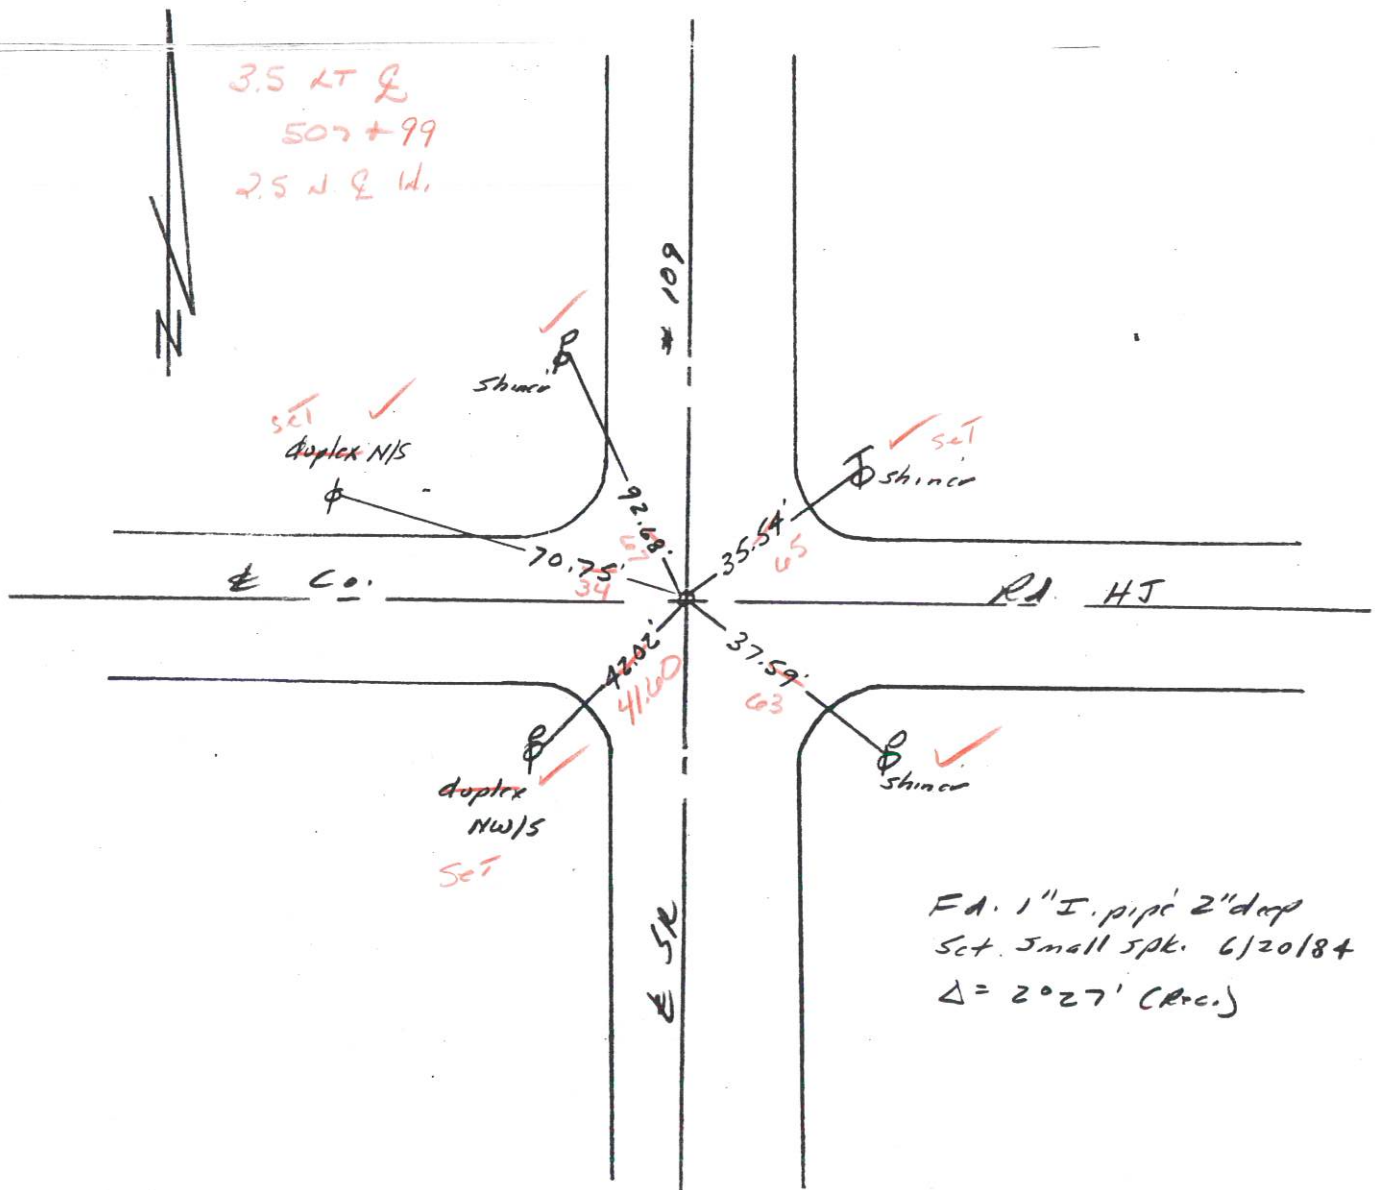County Fulton S.R. 109Date 11 April 84Township PIKEWeather FairSection 2-3Temp. 480T N, R EPersonnel I. StoneP. NeaseR. MichaelD. CurtisREF. NO. 25

ODOT. DISTRICT 2 SURVEY OFFICE

SHEET 1 OF 3

County Fulton S.R. 109

Township PIKE

Section 2-3

T N, R E

Personnel I. Stone

P. Noosce

R. Mikaluk

D. Curtis

Date 6 Jan. 82


Weather cloudy

Temp. 35°

34	35
3	2



REF NO. 25

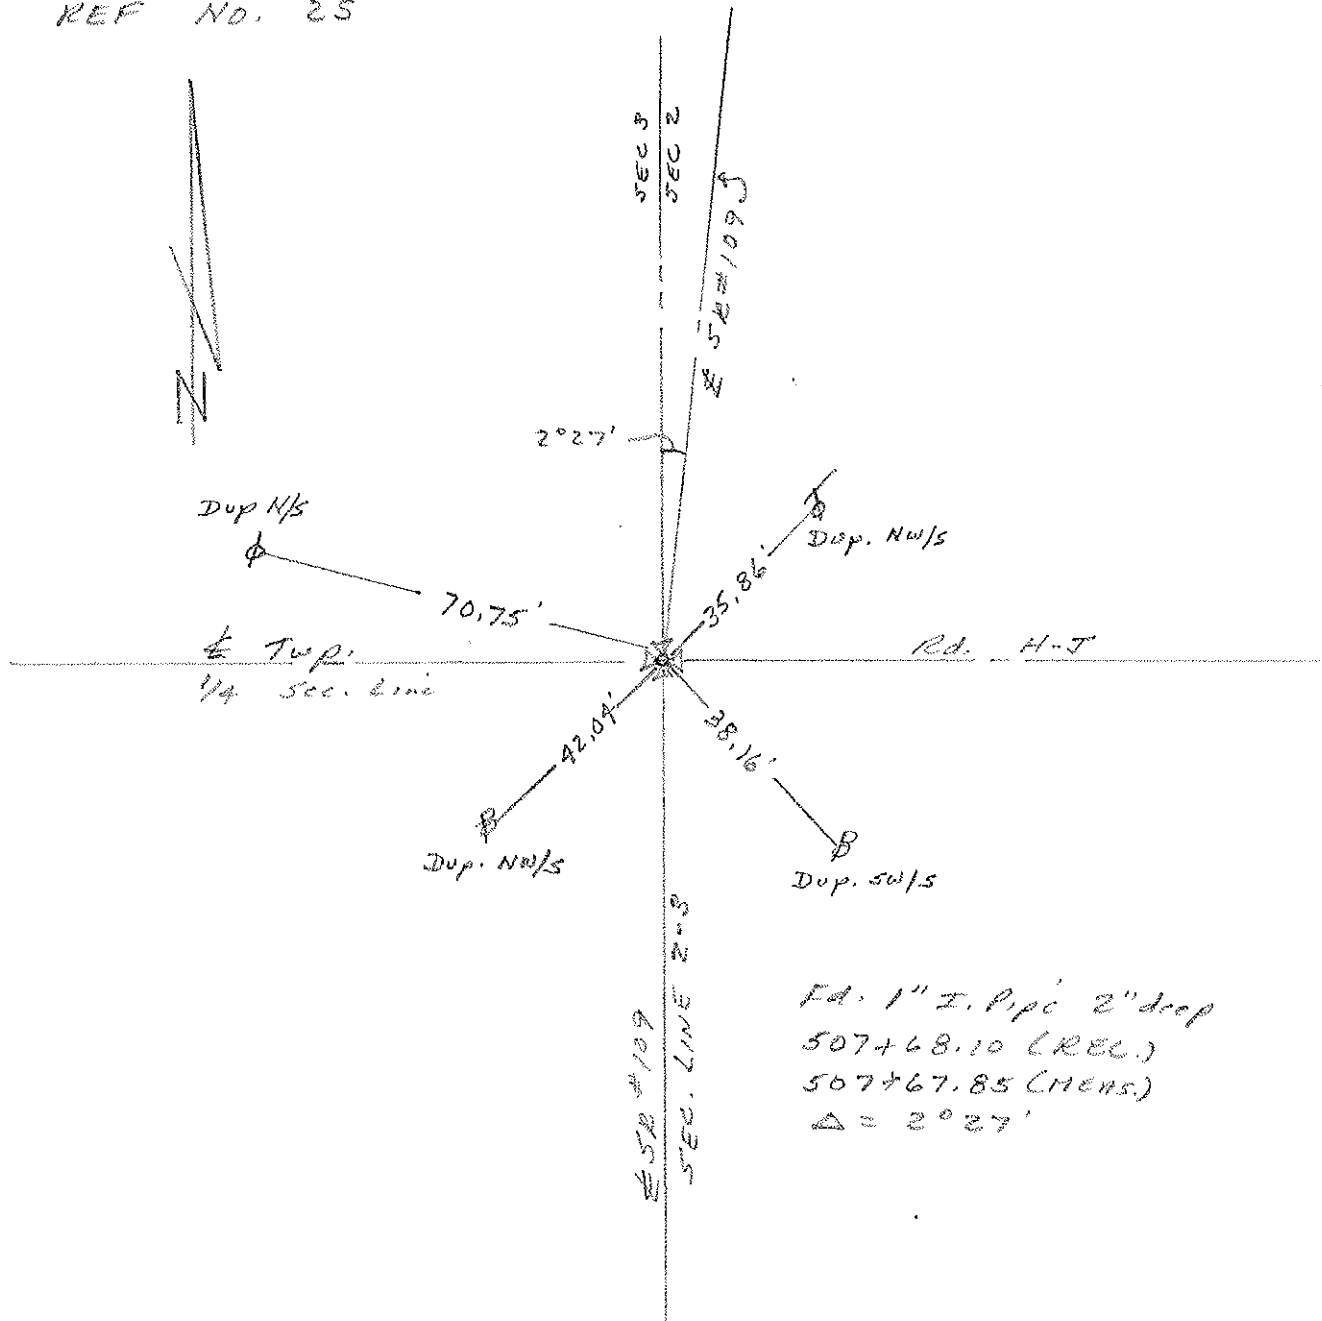

PERSONNEL	TITLE	PERSONNEL	TITLE
1	2	3	4
5	6	7	8
9	10	11	12
13	14	15	16
17	18	19	20
21	22	23	24
25	26	27	28
29	30	31	32
33	34	35	36
37	38	39	40
41	42	43	44
45	46	47	48
49	50	51	52
53	54	55	56
57	58	59	60
61	62	63	64
65	66	67	68
69	70	71	72
73	74	75	76
77	78	79	80
81	82	83	84
85	86	87	88
89	90	91	92
93	94	95	96
97	98	99	100

Red Beach

W. Knabe

COUNTY Fulton

DATE 15 Feb '77



S. R. 109

WEATHER

SEC. PIKE TWP.

TEMP.


DESCRIPTION CONTROL POINTS

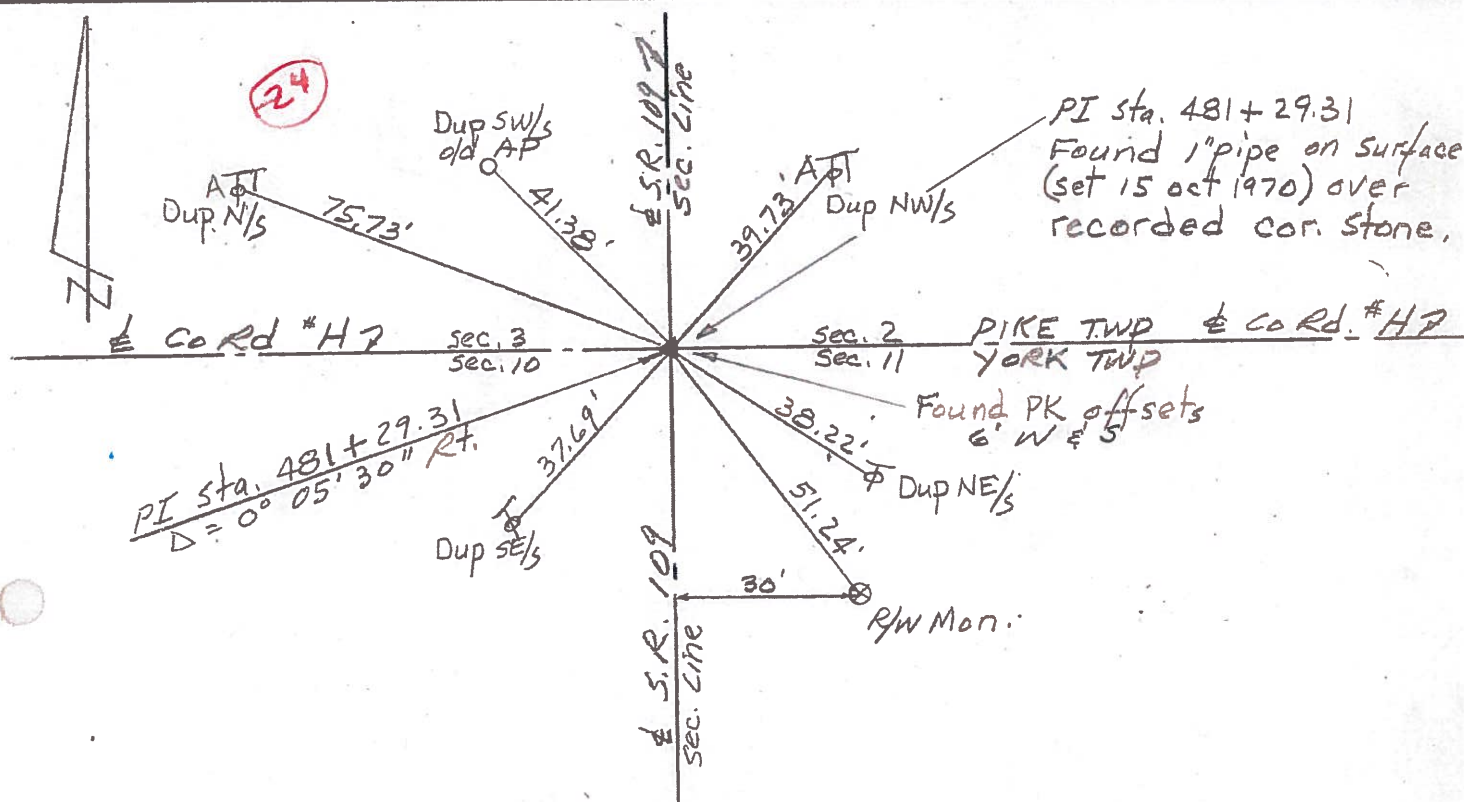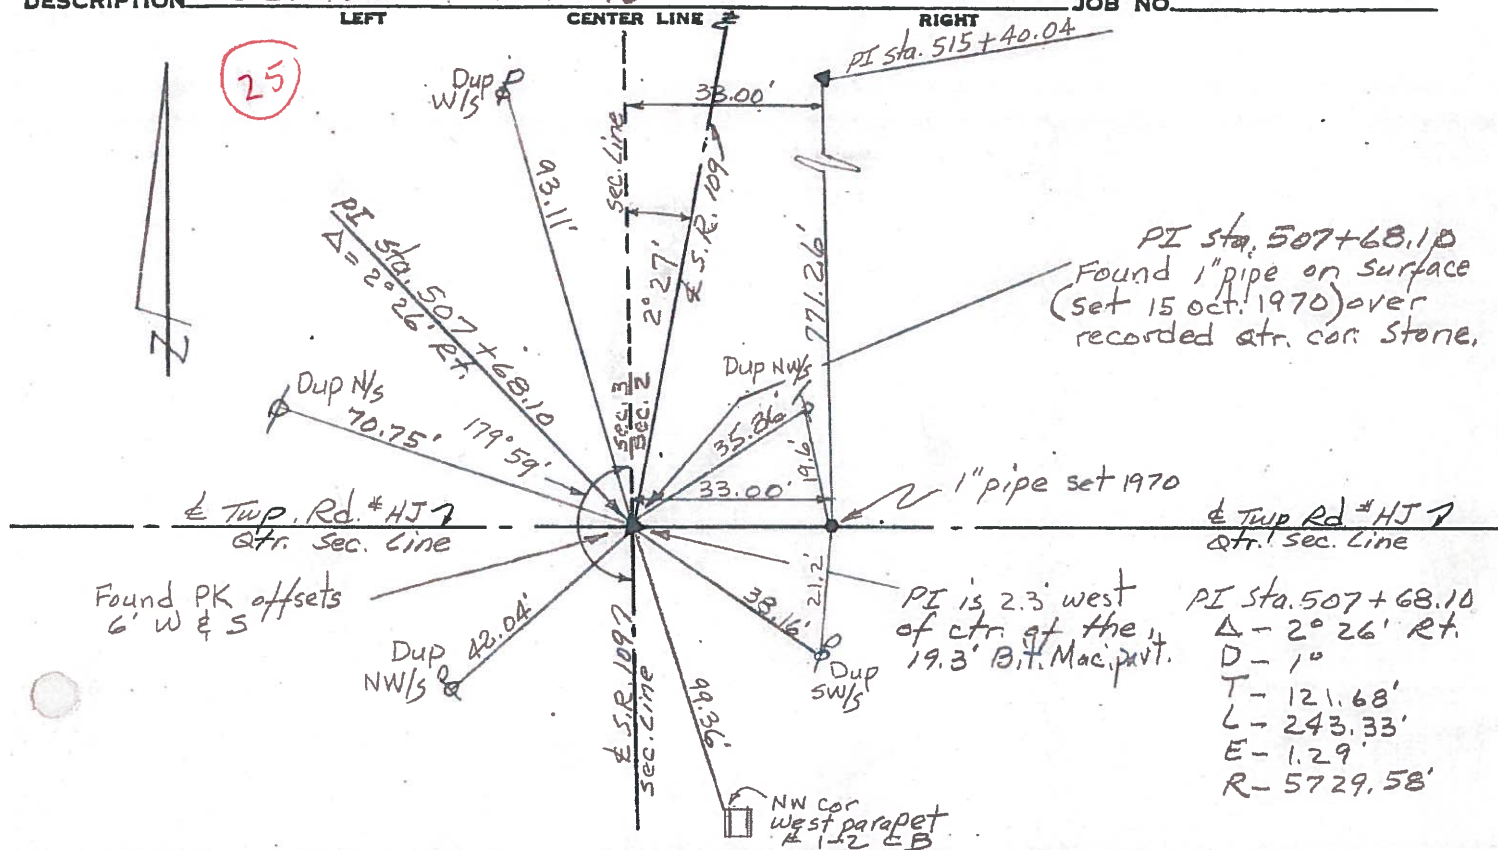JOB NO.

SHEET NO. 12

PERSONNEL	TITLE	PERSONNEL	TITLE	COUNTY	DATE	WEATHER	TEMP.
Tomsic		Granata		Fulton	July-18-73	80°	
Neuser				S. R. 109			
Vanjo				SEC.			
Boyle							clear

DESCRIPTION MON LEFT CENTER LINE RIGHT JOB NO. 02 4610

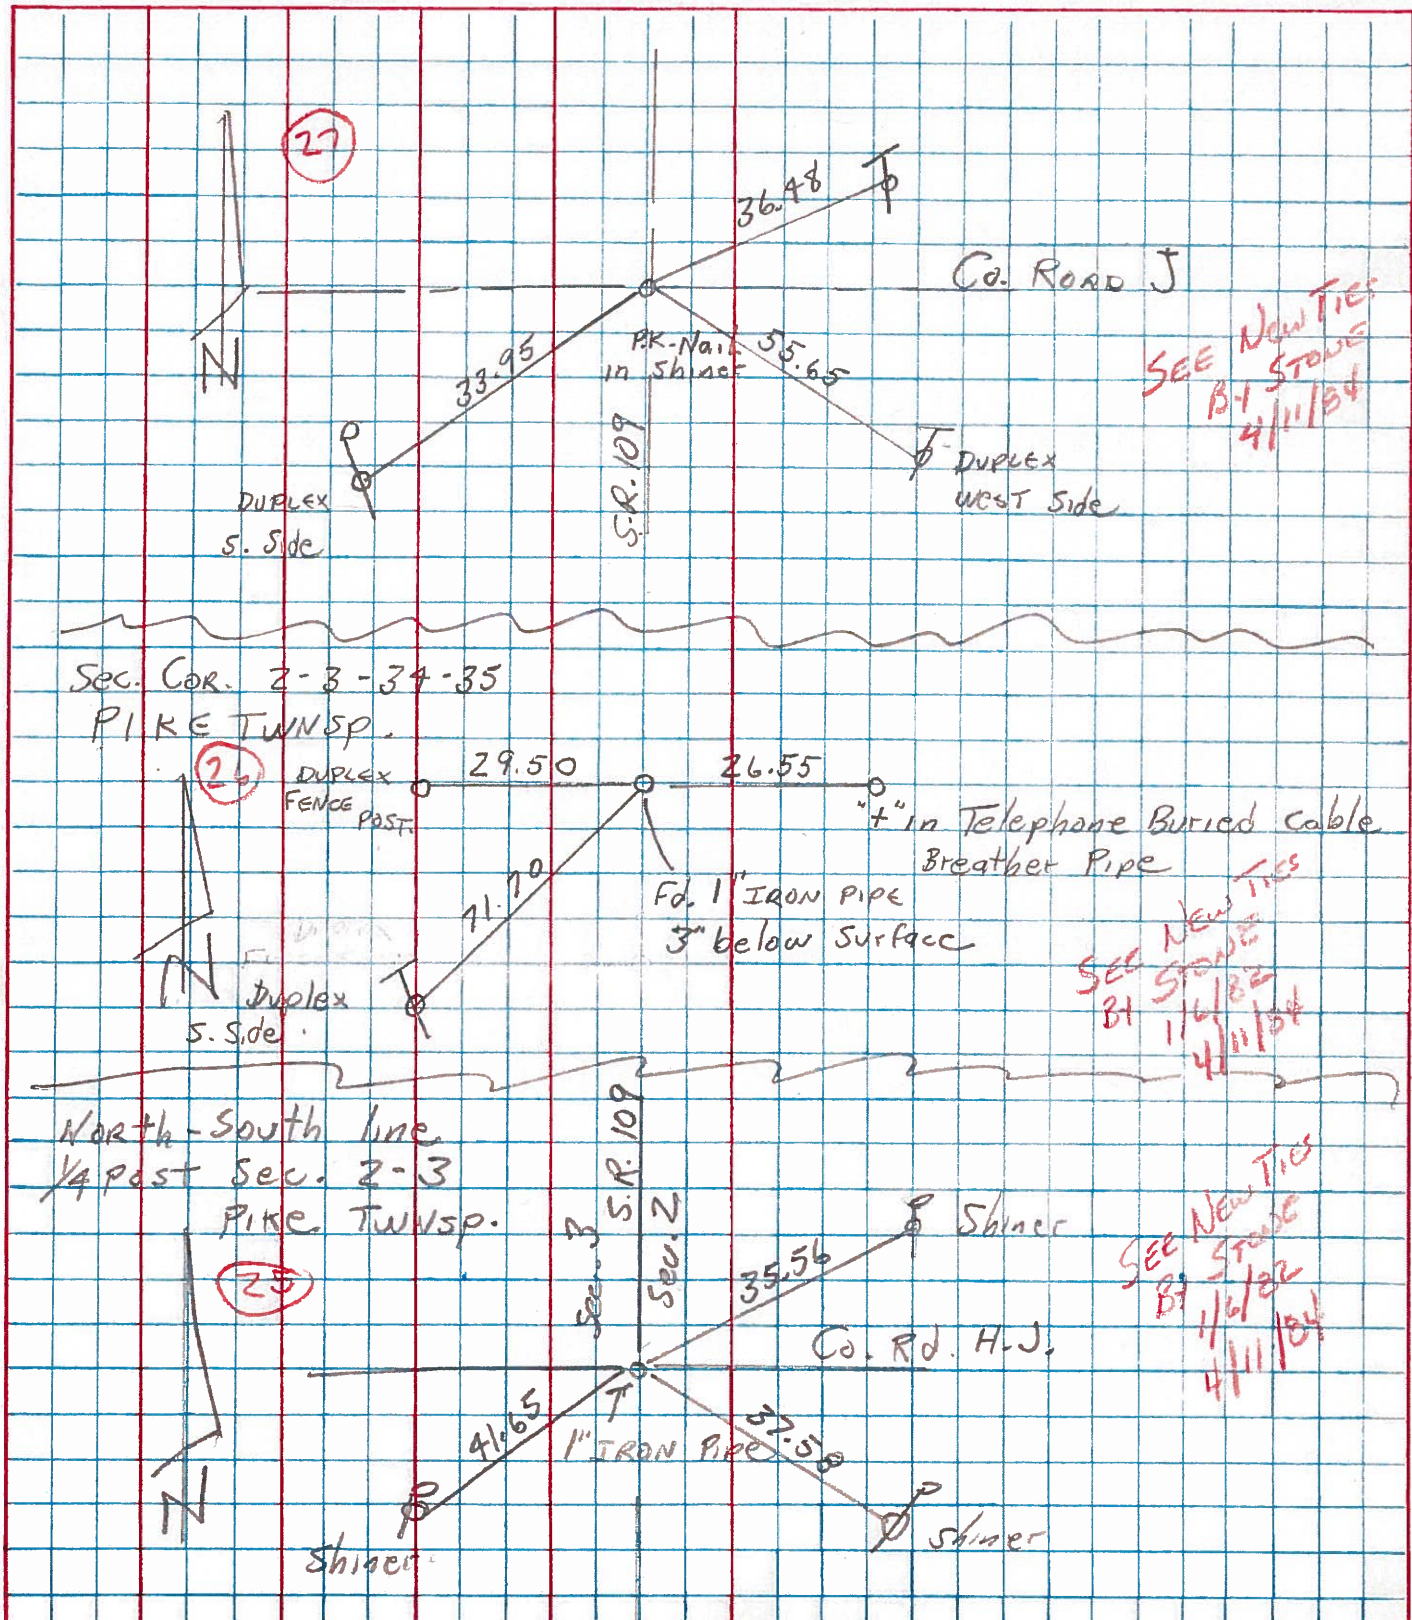

PERSONNEL	TITLE	PERSONNEL	TITLE
Red Beach			
Newcomb			
Knappe			
Wise			

COUNTY Fulton DATE Oct. 1970
S. R. 109 WEATHER _____
SEC. Pike Twp TEMP _____

DESCRIPTION	CONTROL POINTS	JOB NO

ctr. Post Stone, Sec. 3, Pike Trwp T-7-N

Found stone w/brick
9" below road surface,
chiseled "+" top of stone
lowered stone to 2.7"
below surface and est.
24"x1" pipe over stone
20 Oct, 1970

Near side 4" steel
Panhandle East.
pipeline marker

32.52'

TWP. 12S., R. 9E.

Near Side 4" steel
Panhandle East.
pipeline marker

Stone is 2' east of ctr. of 14" stone Rd # 9-2.
Stone is in ctr. of 14" Stone Rd # 11.
Road metal is 5" of stone & gravel on
sandy subgrade.

ctr. Post, Sec. 2, Pike Twp. T-7-N

W $\frac{1}{4}$ Post Stone, Sec. 2, Pike Twp. T-7-N
E $\frac{1}{4}$ Post Stone, Sec. 3, Pike Twp. T-7-N

PI sta. $515 + 40.04$

*See New Twp
21 Spacing
1/4 Sec*

N

DUP NW/4

P.I. Sta. 507+68.10
 $\Delta = 2^\circ 26' \text{ Rt.}$

70.85'

E. Twp Rd. "HJ"

Found Stone w/ brick
22" below part. surf.

Found 10" pin 3" below
surface and approx.
over stone. Removed
Pin. Good stone
with N-S ridge,
Est. 16"x1" pipe over stone

93.13'

Sec. 20

33'

2° 27'

771.97.0

DUP NNW/4

35.80'

Est. 12"x1" pipe

P.I. Sta. 507+68.10
 $\Delta = 2^\circ 26' \text{ Rt.}$
D-1°
T-121.68'
L-243.33'
E-1.29'
R-5729.58'
P.C. sta. 506+46.42
P.T. sta. 508+89.75

99.34'

NW cor.
west parapet
1-2 CB

[illegible]

PERSONNEL	TITLE	PERSONNEL	TITLE
1	2	3	4
5	6	7	8
9	10	11	12
13	14	15	16
17	18	19	20
21	22	23	24
25	26	27	28
29	30	31	32
33	34	35	36
37	38	39	40
41	42	43	44
45	46	47	48
49	50	51	52
53	54	55	56
57	58	59	60
61	62	63	64
65	66	67	68
69	70	71	72
73	74	75	76
77	78	79	80
81	82	83	84
85	86	87	88
89	90	91	92
93	94	95	96
97	98	99	100

Red Beach

Newcomb

Кнаре

Wise

COUNTY FULTON

DATE Oct. 1970

S. R. 109

WEATHER


SEC PIKE TWP

TEMP.


DESCRIPTION

ALIGNMENT & CONTROLS

JOB NO

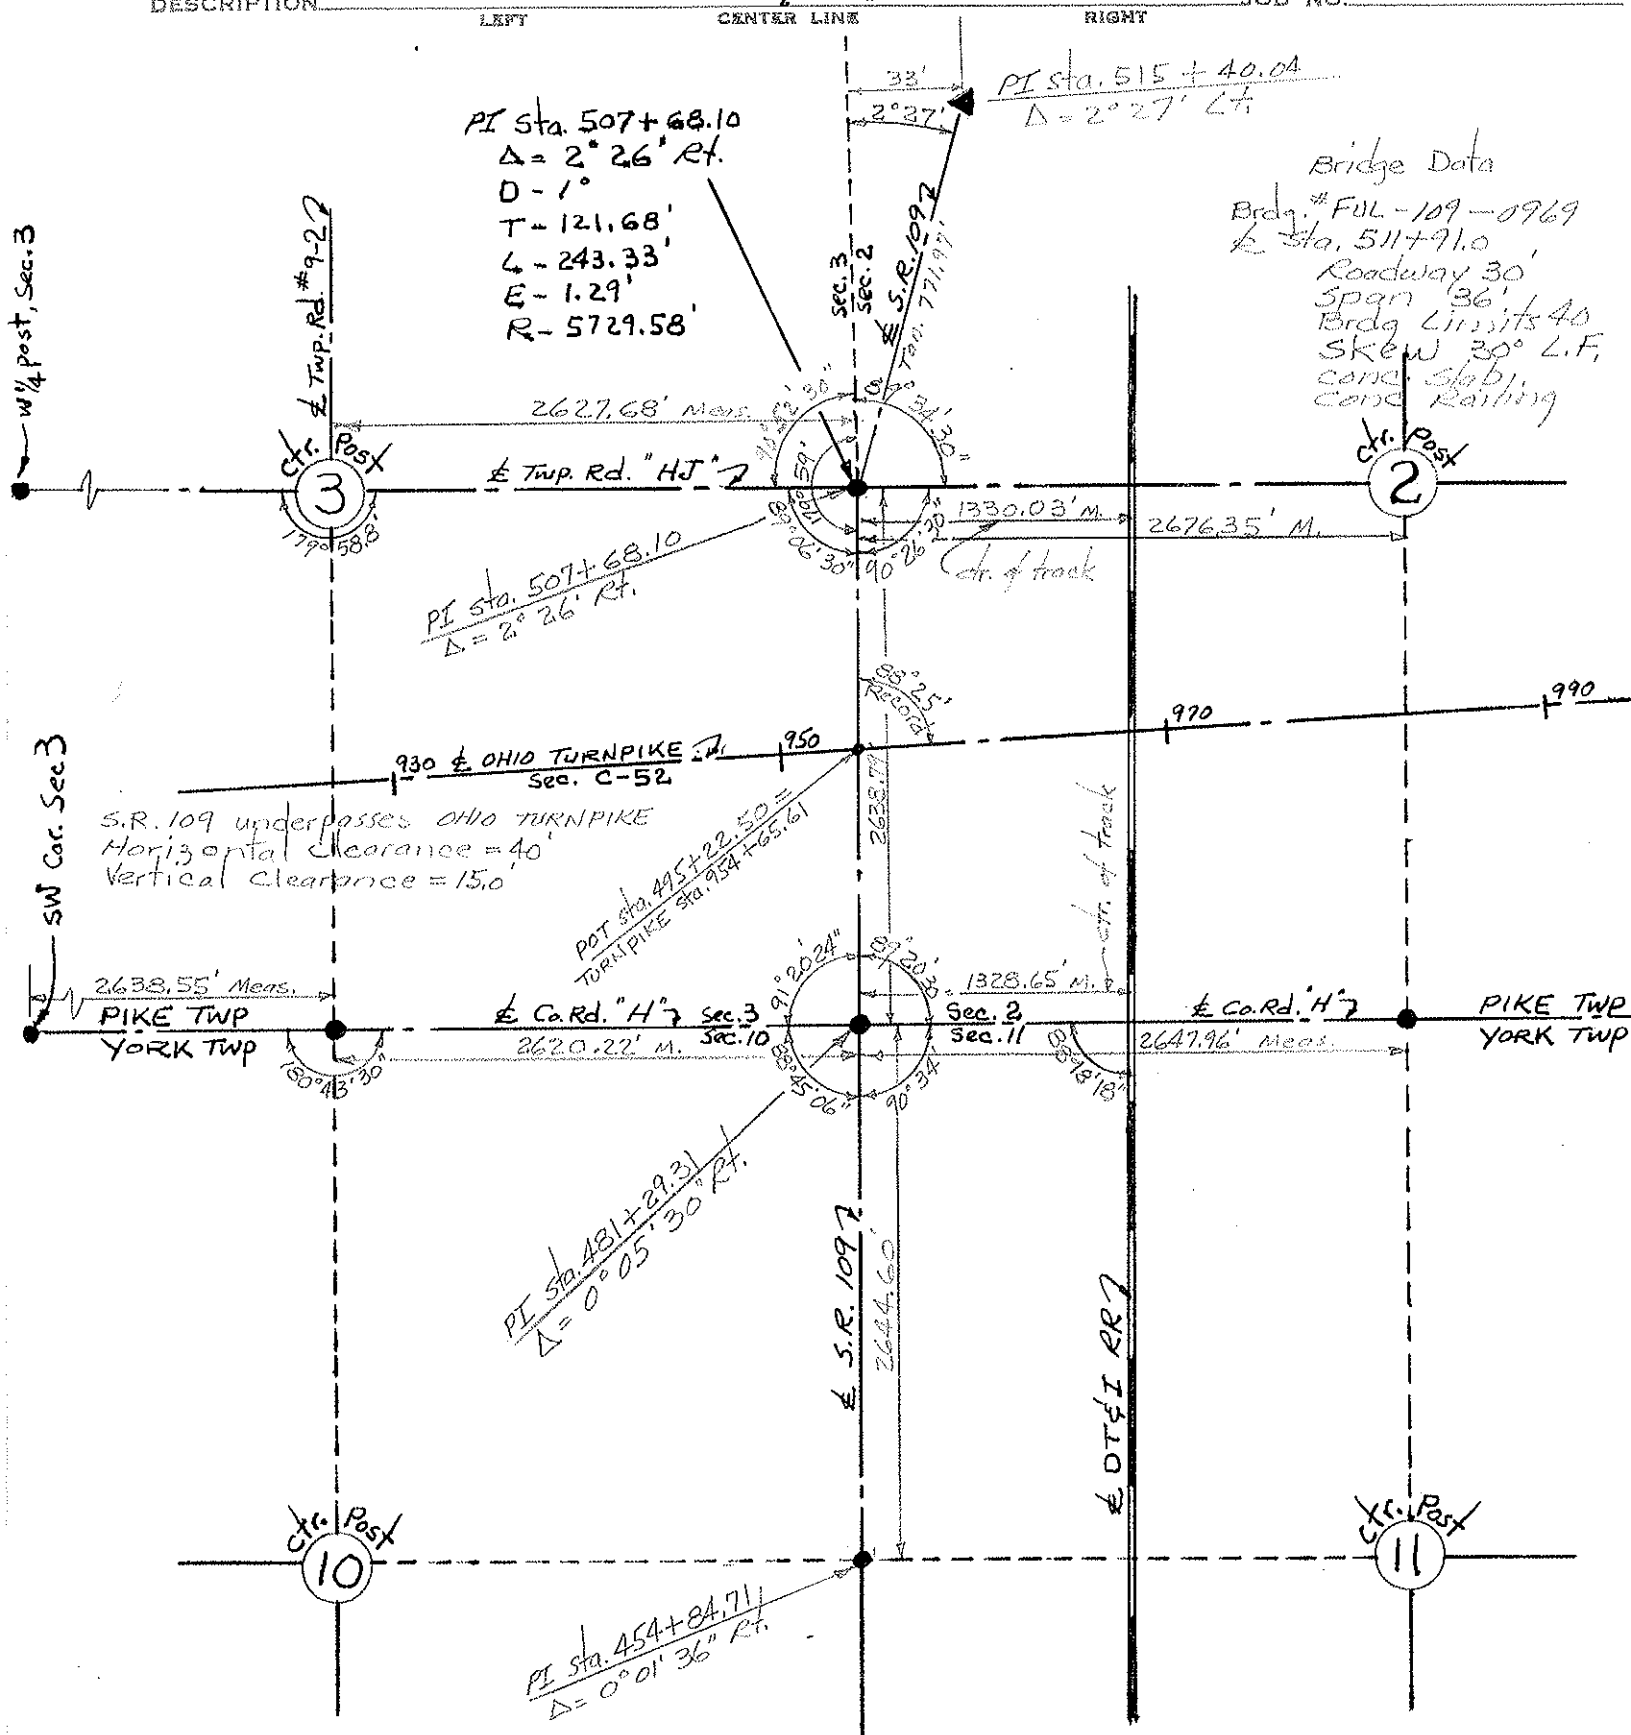

PERSONNEL	TITLE	PERSONNEL	TITLE	COUNTY	DATE
Red Beach				FULTON	OCT-NOV. '70
Newcomb				S. R. 109	WEATHER
Knappe				SEC. PIKE TWP	TEMP.
Wise					
ALIGNMENT & CONTROLS				JOB NO.	

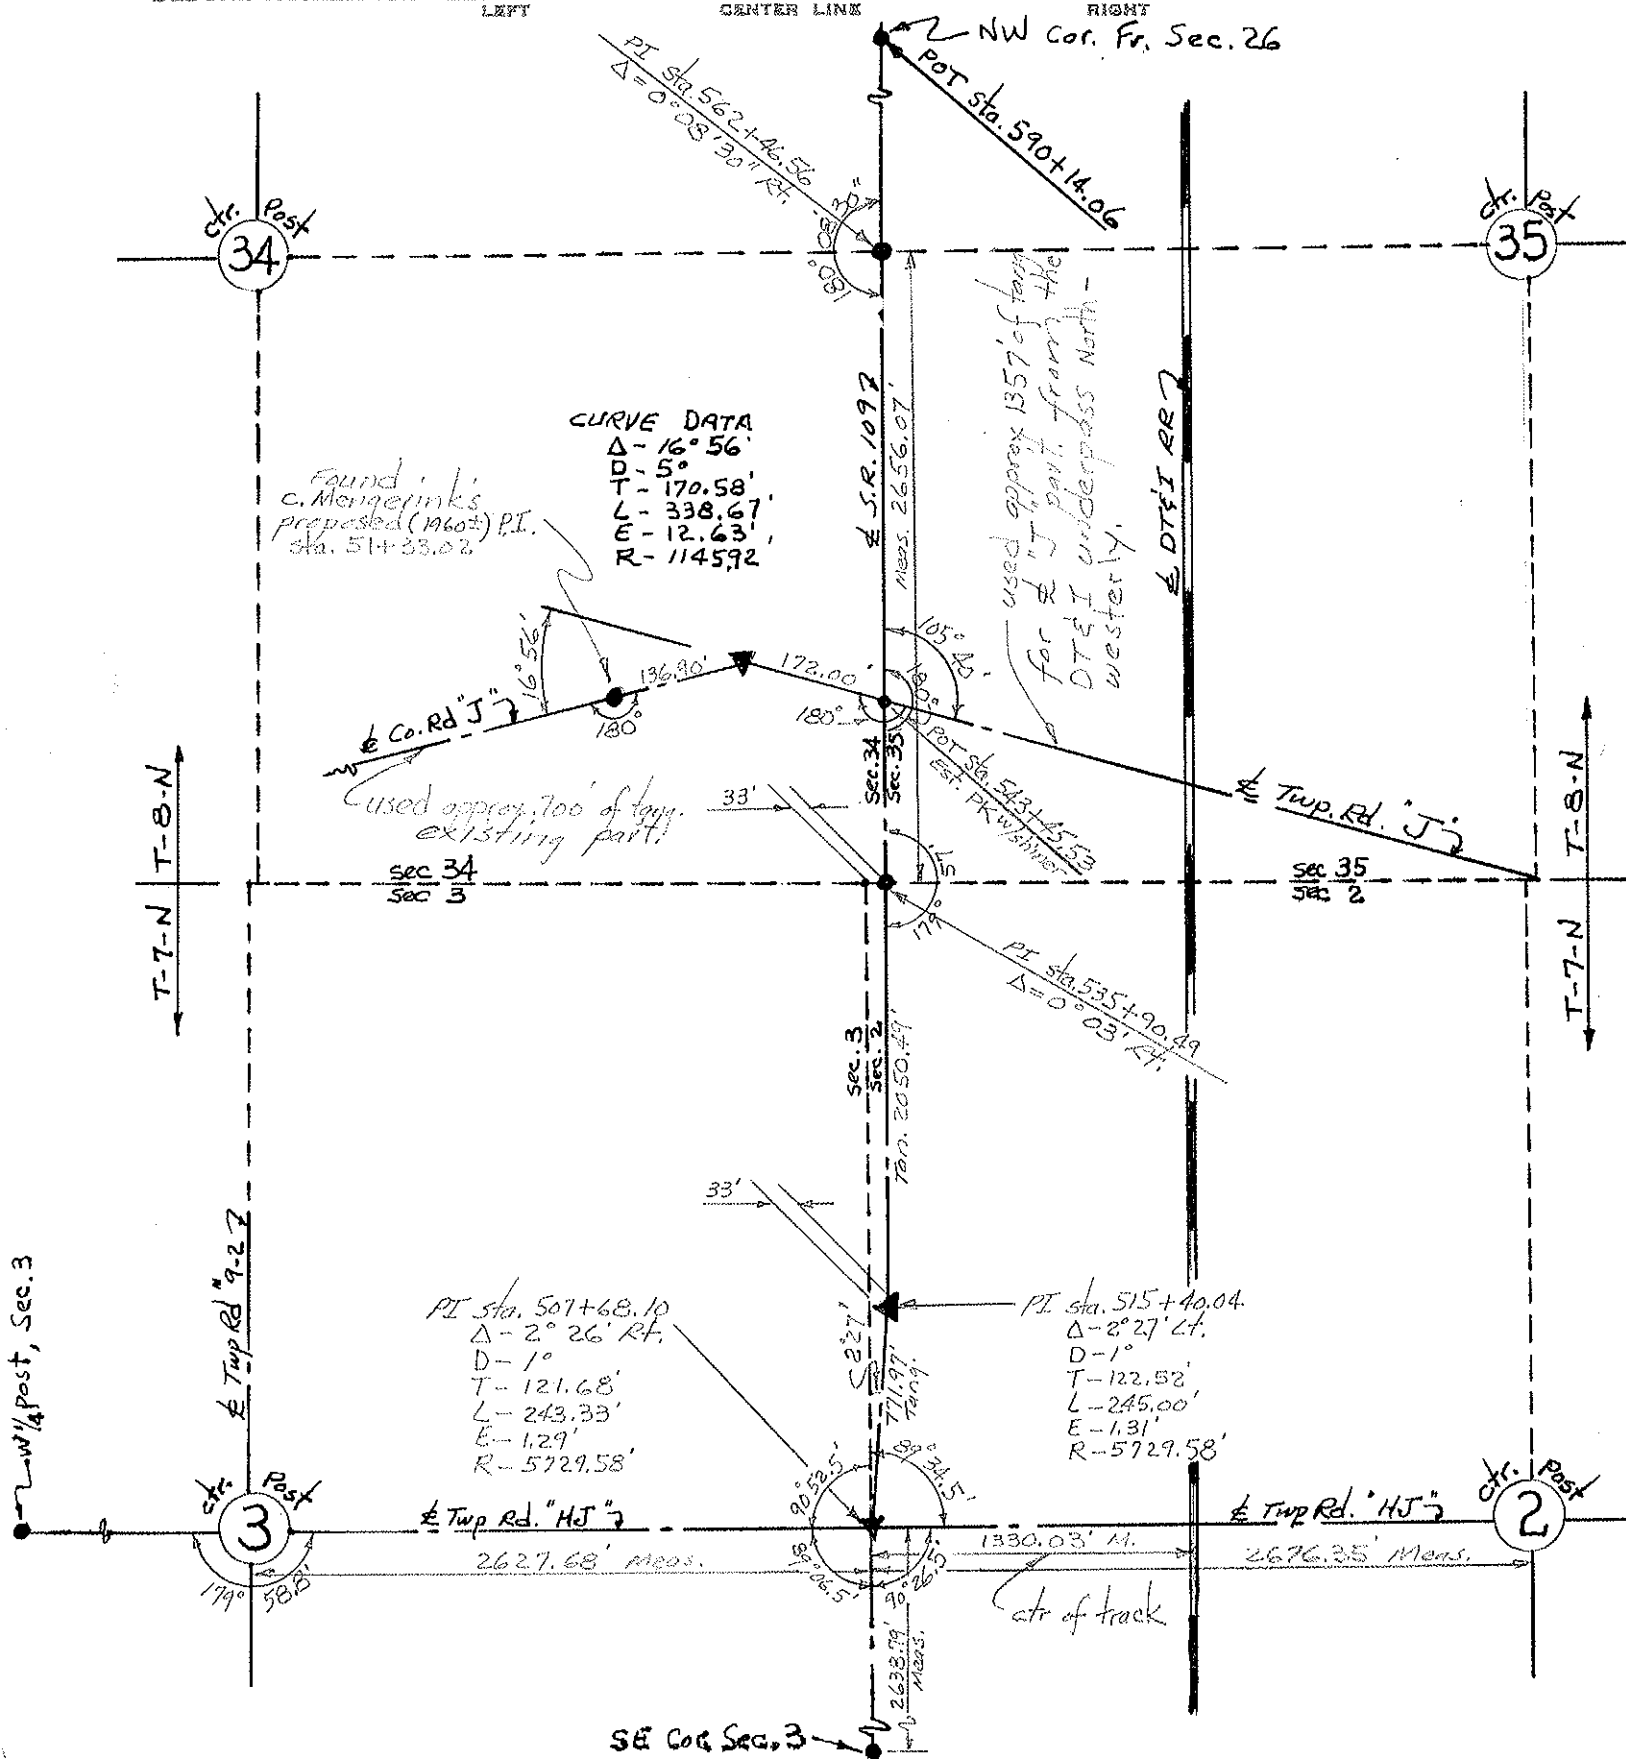

PERSONNEL	TITLE	PERSONNEL	TITLE	COUNTY	DATE	WEATHER	TEMP.
Red Beach				FULTON	OCT. 1970		
Newcomb				S. R. 109			
Knape				SEC. US-20-A North			
Wise							

DESCRIPTION **ALIGNMENT & CONTROLS** JOB NO.

LEFT CENTER LINE RIGHT

