

O.D.O.T. DISTRICT 2 SURVEY OFFICE (USE ONLY)

PERSONNEL

REFERENCE NO. 26

SHEET 9 OF 35

NOTES RHOADES

DATE 4/23/21

ROUTE SR 109

H.C. O'DONNELL

WEATHER CLOUDY

COUNTY FULTON

R.C. RHOADES

TEMP. 46°

TOWNSHIP PIKE

SECTION 35

DWG BY NIESE PID PAVE TRAIN

T 8 N R 7 E

TYPE MONUMENT MAG/WASHER

ON SURFACE - ~~BELOW~~ ON

OFFSET Q PAVEMENT ON LT : RT

10.7' TO RT EDGE PAVEMENT


STATION: 536+14.86

HORIZ.DATUM: NAD83(2011)


GEOID: 2018

GRID: NORTHING: 709185.333

EASTING: 1548022.859

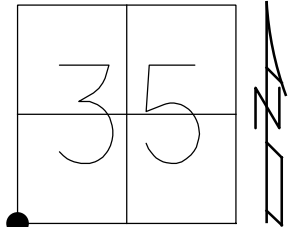

RECORD: P.I.
STA 535+90.49
 $\Delta = 00^\circ 03' 03''$ RT
SET P.K./WASHER
11/20/96, MRC
FD SM. SPIKE
0.1' DOWN
6/12/12, SAH
3/5/15, MC
SET MAG/WASHER
3/15/13, MC
FD MAG/WASHER
REF26
4/23/21, JFO
8/26/21, JFO

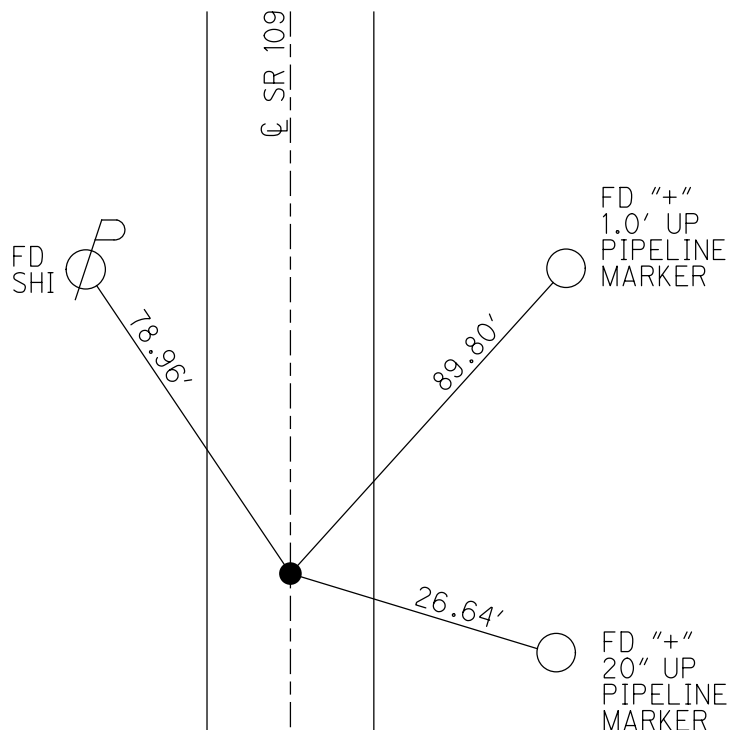

FULTON COUNTY LAND CORNER REFERENCE SHEET

OFFICE OF THE FULTON COUNTY ENGINEER

Section: 2 & 3 Town: 7 North Range: 7 East Corner Code: I-01

Point # 142 Weather: Drizzle 70°F Road: ±33' Off   SR 109 (HJ – J)

Township: Pike Corner: Section Corner (NOT COMMON)

I, Justin L. Leu, PS, in a field survey on **October 5, 2023**
do hereby state that the survey monument mentioned has been located and identified. The old witnesses, if available, were checked and if necessary a new monument was brought to the surface. New witnesses have been set where necessary using a 1-½" brass tag stamped "Fulton County", unless indicated otherwise. All information has been researched to the best of my knowledge.

	A	B	C	D	E	F	G	H	I	J	K	L	M
1													
2	6		5		4		3			2		1	
3													
4	7		8		9		10			11		12	
5													
6	18		17		16		15			14		13	
7													
8	19		20		21		22			23		24	
9													
10	30		29		28		27			26		25	
11													
12	31		32		33		34			35		36	
13													

A. Description of original monument and accessories and/or subsequent restoration:

1821 N. Beasley, General Land Office.

[1] E 50 Links (33') Section Corner, Sections 34 & 35, T8N, R7E

???? O. Griffin, Office of the Fulton County Engineer. **Stone In Line With Fence To West**

[2] N 16.5' Spike in Anchor Post

[3] W 21.1' Spike in Anchor Post

[4] W 24.2' 1" Gas Pipe

1929 ???? , State of Ohio Department of Highways. **Stone In Line With Fence To West**
- 1929 Highway Plan

[5] N 31.9' Spike in Anchor Post

[1] E 33' Stone, Section Corner, Sections 34 & 35, T8N, R7E

[3] W 21.1' Spike in Anchor Post

[4] W 24.2' 1" Gas Pipe North Side of Fence Line

1970 R. Beach, State of Ohio Department of Highways. **See Note Below**


2010 J. Fenicle, PS, Office of the Fulton County Engineer. **Large Iron Pipe (0.2' North of Town Line)**
- Page 5 of 7 on Survey Volume R, Page 228A

[1] E 33.07' PK Nail & Washer, Section Corner, Sections 34 & 35, T8N, R7E

2020 R. Lumbrezer, Private Surveyor. **Found Iron Pipe**
- Survey Volume S, Page 82C

2020 D. Kaiser, Private Surveyor. **Found Iron Pipe**
- Survey Volume S, Page 87

Continued on Page 2 of 2...

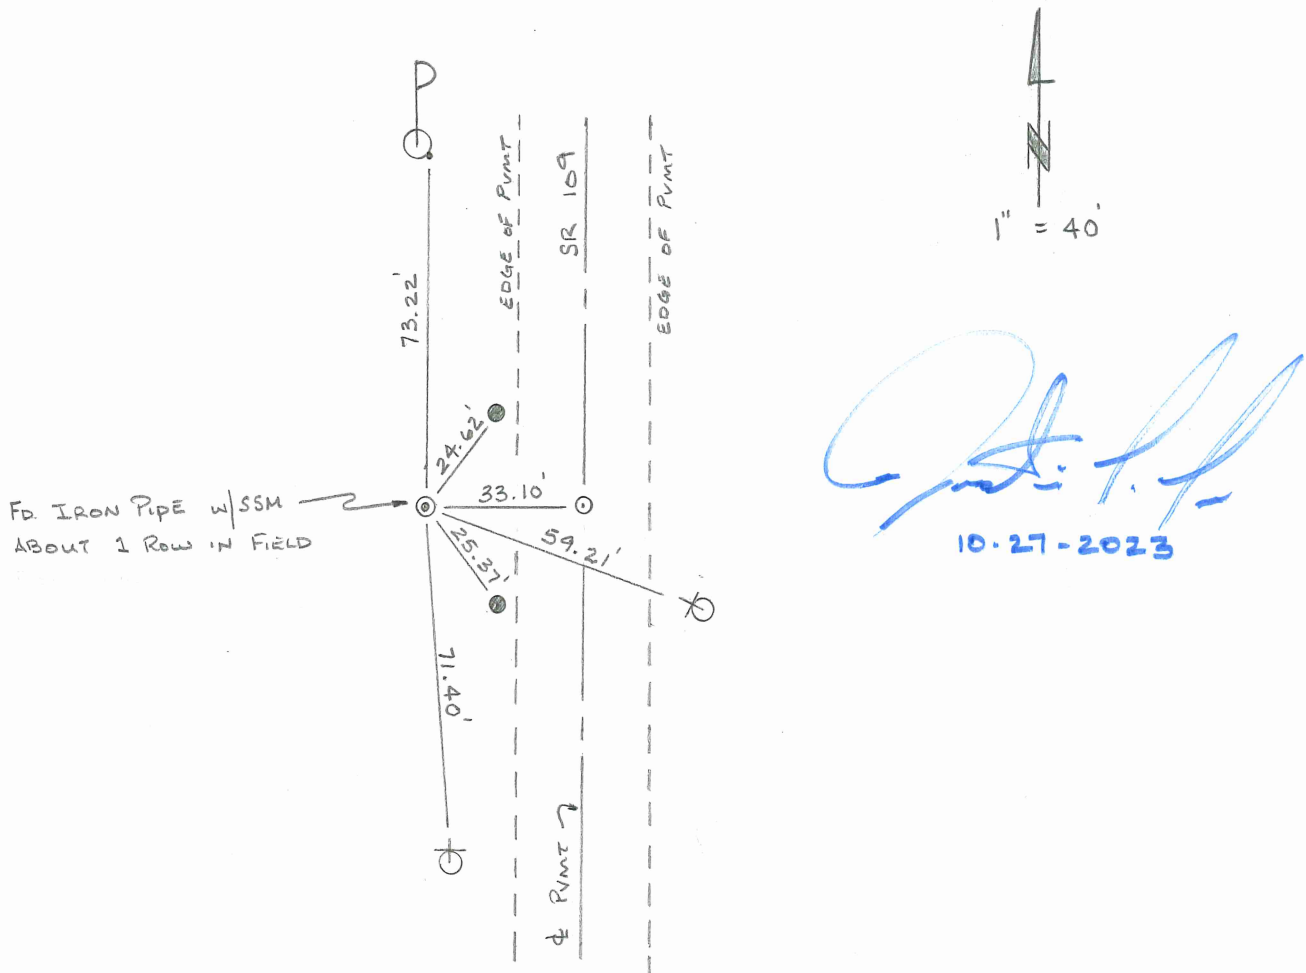

2023 J. Leu, PS, Office of the Fulton County Engineer. Found Iron Pipe w/ Steel Survey Marker Inside

[6]	N	73.22'	Found Nail & Shiner in South-Southeast Face of Power Pole #9194 007 (PLUMB)
[7]	NE	24.62'	Set #5 x 24" Long Rebar with Fulton County Cap - 4' West of Edge of Pavement (PLUMB)
[1]	E	33.10'	Found MAG Nail & Washer, Section Corner, Sections 34 & 35, T8N, R7E (PLUMB)
[8]	SE	59.21'	Found & Refreshed "X" on near face of Metal Gas Pipe Line Marker - 20" up (PLUMB)
[9]	SE	25.37'	Set #5 x 24" Long Rebar with Fulton County Cap - 4' West of Edge of Pavement (PLUMB)
[10]	S	71.40'	Set "X" in North Face of Metal Gas Line Marker - ± 2' up (Above Arm) (PLUMB)

B. State Plane Coordinates ODOT VRS (NAD1983[2011] 2010.0 Epoch), Ohio North Zone (3401), U.S. Survey Feet.

North 709185.9 East 1547989.807

C. Notes

10.05.2023 Corner Referenced and Shot w/ GPS.

In October 1970 Red Beach on page 11 of 19 of his field notes he states for this corner... "Found four smaller than normal sized stones 1' to 2' below sod in fence line and the recorded 33'± west of the corner stone for section 34 & 35. Unable to resolve the section corner for the section 2 & 3 - dug the hole shut, henceforth."

On October 5, 2023 Justin L. Leu, PS and A. Dolph found a 1" I.D. iron pipe with collar near the edge of the field line with a steel survey marker inside. We proceeded to dig and found 3 stones around the iron pipe (East side, Southwest side & Northwest side). Due to the iron pipe being found at ground level in the field. We drove the iron pipe ±10" below grade to approximately the same depth of the stone found on the East side of the iron pipe.

ORIGINAL DOCUMENT IS ON FILE WITH THE OFFICE OF THE FULTON COUNTY ENGINEER
9120 COUNTY ROAD 14, WAUSEON, OH 43567-9669
JUSTIN L. LEU, PS

O.D.O.T. DISTRICT 2 SURVEY OFFICE (USE ONLY)

PERSONNEL

REFERENCE NO. 26

SHEET 10 OF 35

NOTES HUSS

DATE 06-12-12

ROUTE SR 109

H.C. HUSS

WEATHER FAIR

COUNTY FULTON

R.C. CANTERBURY

TEMP. 76°

TOWNSHIP PIKE

COUTCHER

SECTION 35

T 7 N R 7 E

TYPE MONUMENT SM SPK


ON SURFACE - BELOW 0.1'

LEFT - Q PAV'T - RIGHT ON

10.7' TO RT EDGE PAVEMENT

S.L.M. 536+21

Grid: Northing: 709185.325 Easting: 1548022.845

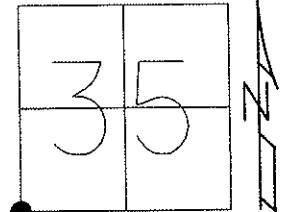

RECORD: P.I. STA 535+90.49

$\Delta = 00^{\circ}03'03''$ RT


11-20-96 SET PK/WASHER
IN LEVELING COURSE, MRC

03-15-13 RESET

MAG/WASHER, MC

06-12-12 GPS REF 26

03-05-13 GPS FIN 26, MC

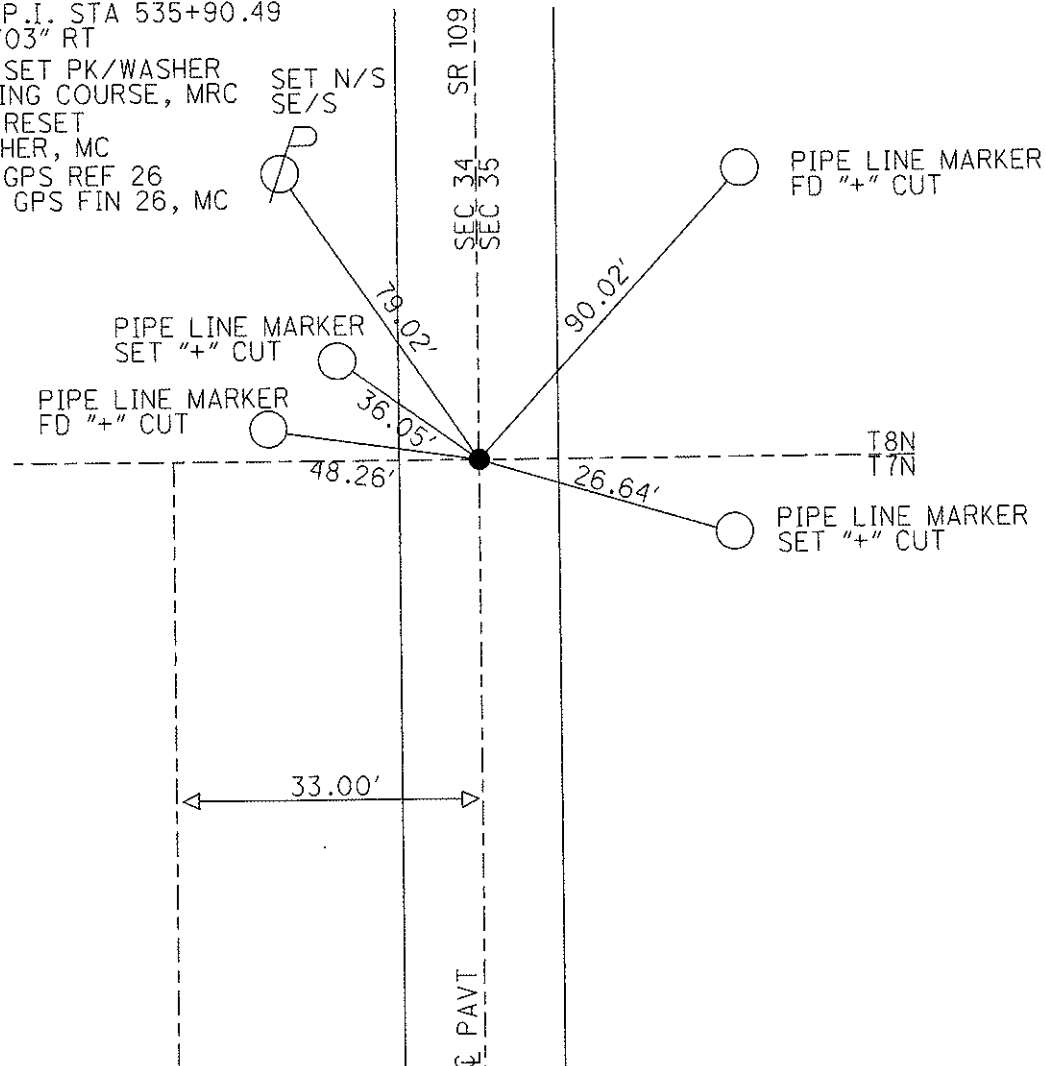

O.D.O.T. DISTRICT 2 SURVEY OFFICE

PERSONNEL

REFERENCE NO. 26

SHEET 8 OF 28

NOTES CANTERBURY

H.C. ROUSOS

R.C. LOEHRKE

DATE 8-20-96

WEATHER FAIR

TEMP. +85°

ROUTE S.R. 109

COUNTY FULTON

TOWNSHIP PIKE

SECTION SW COR. 35

T 7 N R 7 E

Reset
10-6-97
C.L.


TYPE MONUMENT PK & WASHER

ON SURFACE - ~~BELOW~~ YES

~~LEFT - & PAV'T. - RIGHT~~ ON &

~~Z.82 TO RT~~ EDGE PAVEMENT


S.L.M. E6 +347.2 (536 +21)

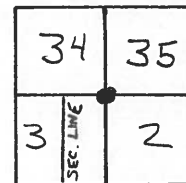

RECORD: P.I. STA: 535 + 90.49

$\Delta = 0^\circ - 03' - 03''$ RT

SET P.K./WASHER IN LEVELING COURSE
11/20/96 MRC.

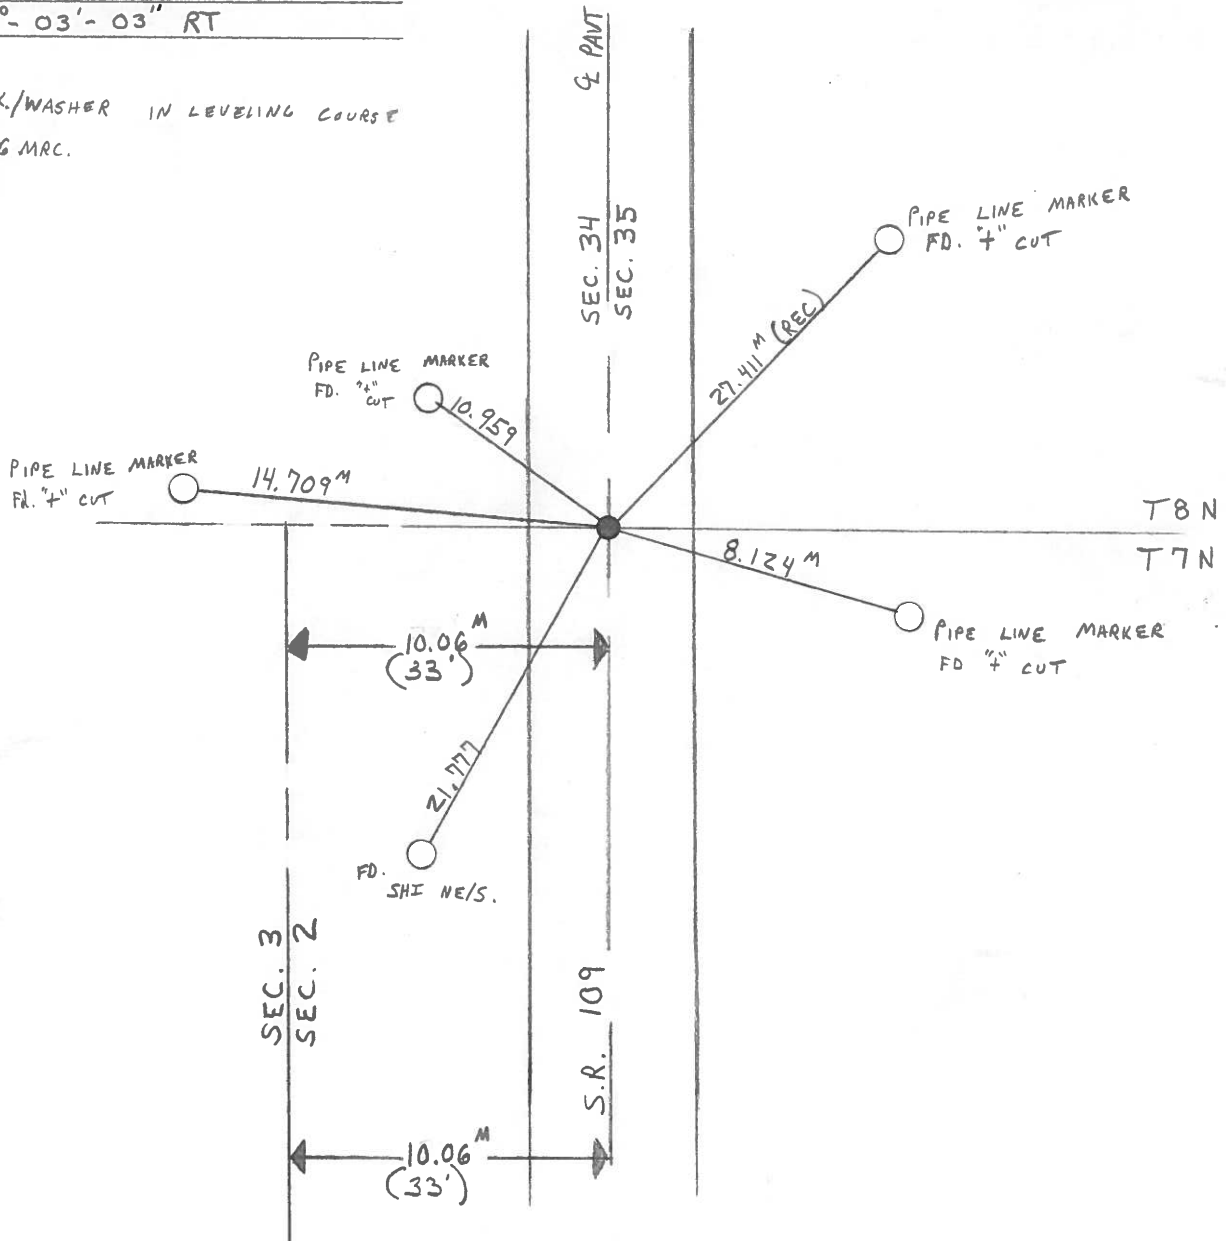

O.D.O.T. DISTRICT 2 SURVEY OFFICE

PERSONNEL

REFERENCE NO. 26

SHEET _____ OF _____

NOTES BARNHISEL

H.C. 11 11

R.C. HOFFMAN

DATE 8-31-90

WEATHER Clear

TEMP. +72°

ROUTE 109

COUNTY *Fulton*

TOWNSHIP PIKE

SECTION SW Cor. 35

T 7 N R 7 E

TYPE MONUMENT P.K. NAIK

ON SURFACE - ~~BELOW~~ yes

LEFT - & PAW'T. - RIGHT 0.5

9.7 TO RT EDGE PAVEMENT


SI. M. 536+21



Set P.K. & Washer
10-1-90
mB

RECORDED

P.I. STA: 535+90.49
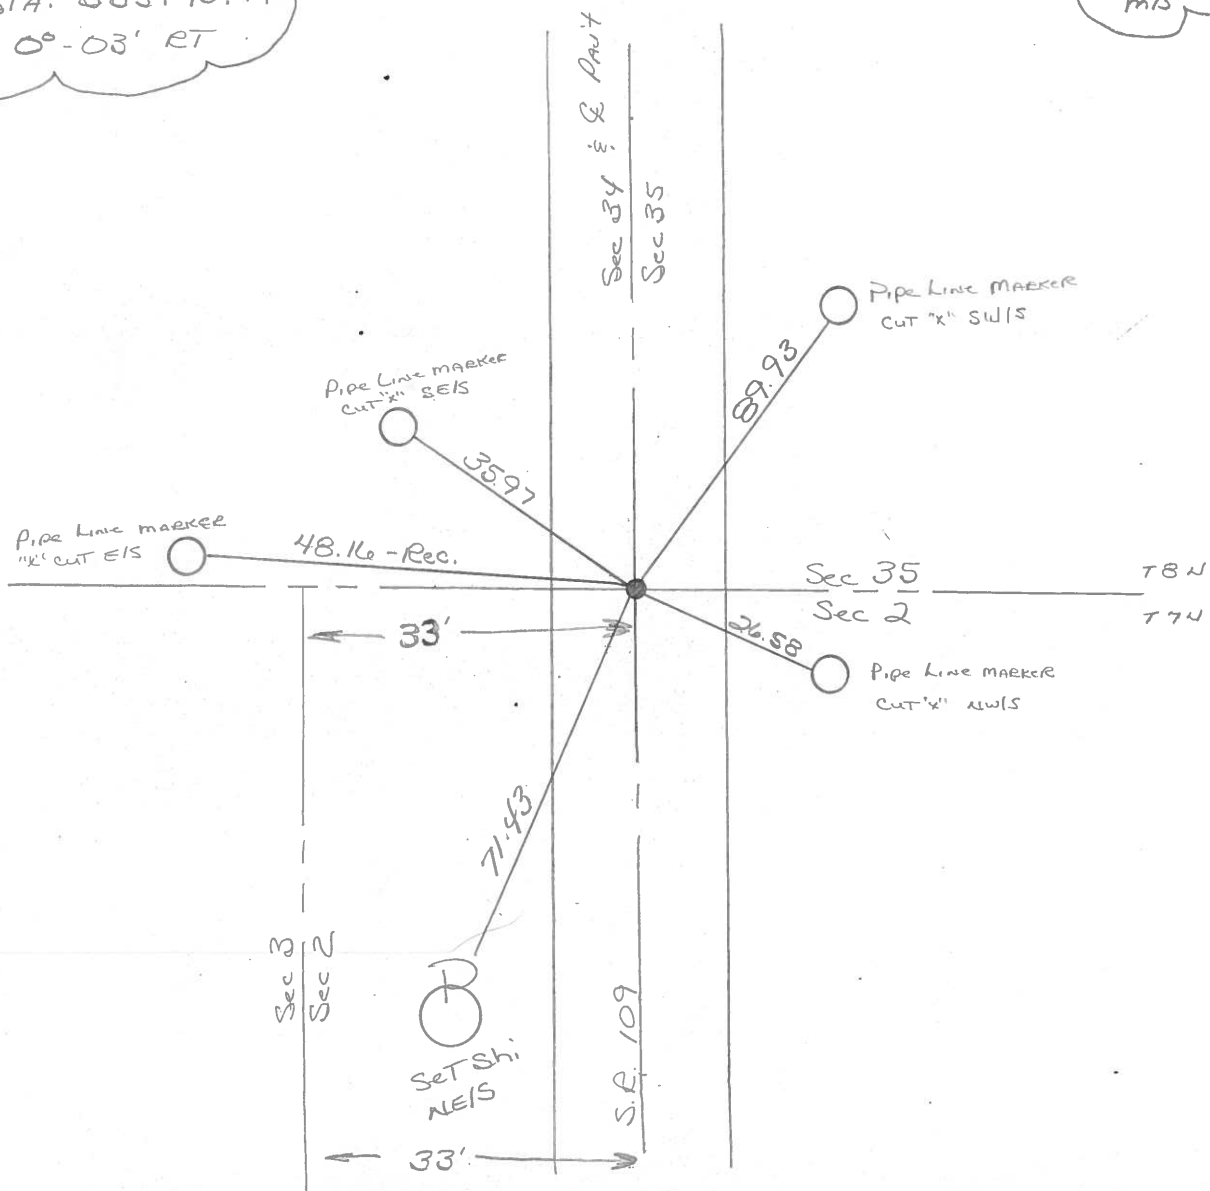
$$\Delta = 0^{\circ} - 03' \text{ RT}$$


Q.D.O.T. DISTRICT 2 SURVEY OFFICE

SHEET 5 OF

County Fulton S.R. 109

Township PIKE

Section 2-34-35-36

T N, R E

Personnel L. Stone

P. Neuser

R. Michalak

D. Curtis

Date 11 April 84


Weather Fair

Temp. 49°

34	35
3	2



REF. NO. 26

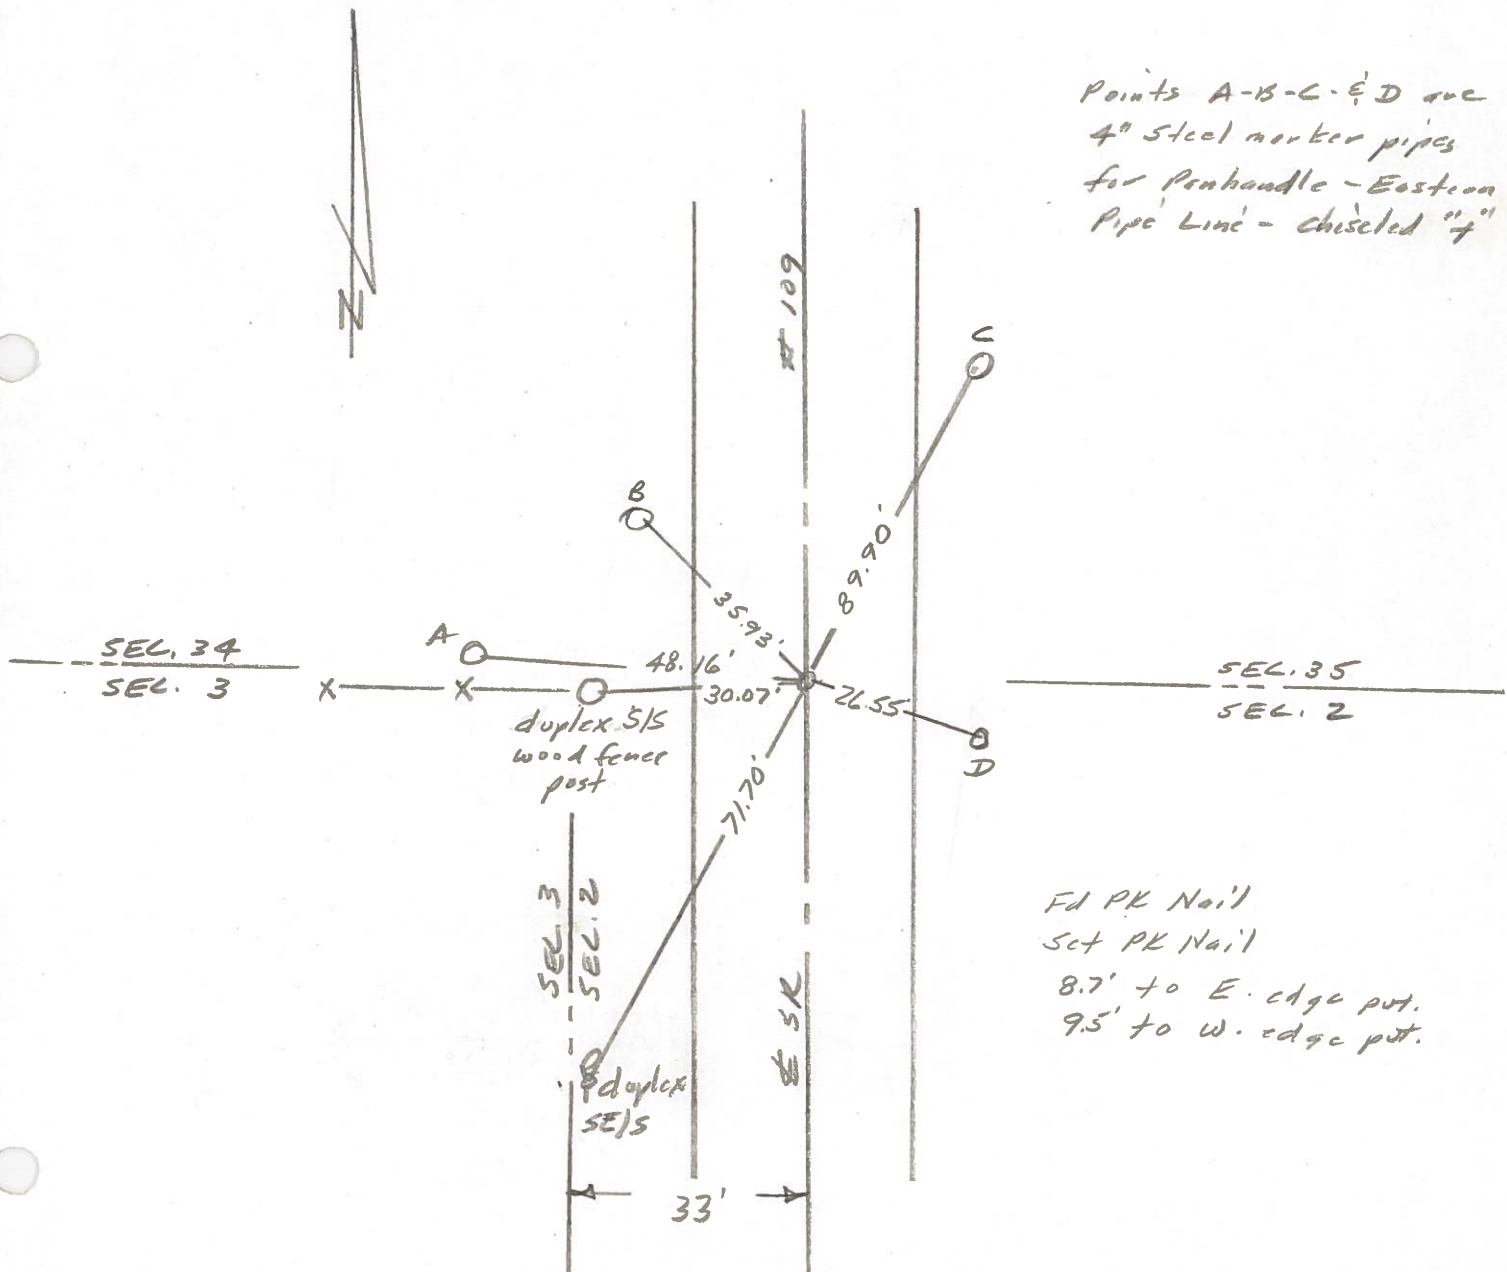

ODOT DISTRICT 2 SURVEY OFFICE

SHEET 5 OF 5

County Fulton S.R. 109

Township Pike

Section 34-35

T N, R E

Personnel L. Stone

P. Newson


R. Michalak

D. Curtis


Date 6 Jan. 82

Weather cloudy

Temp. 35°

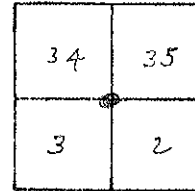

REF. NO. 26

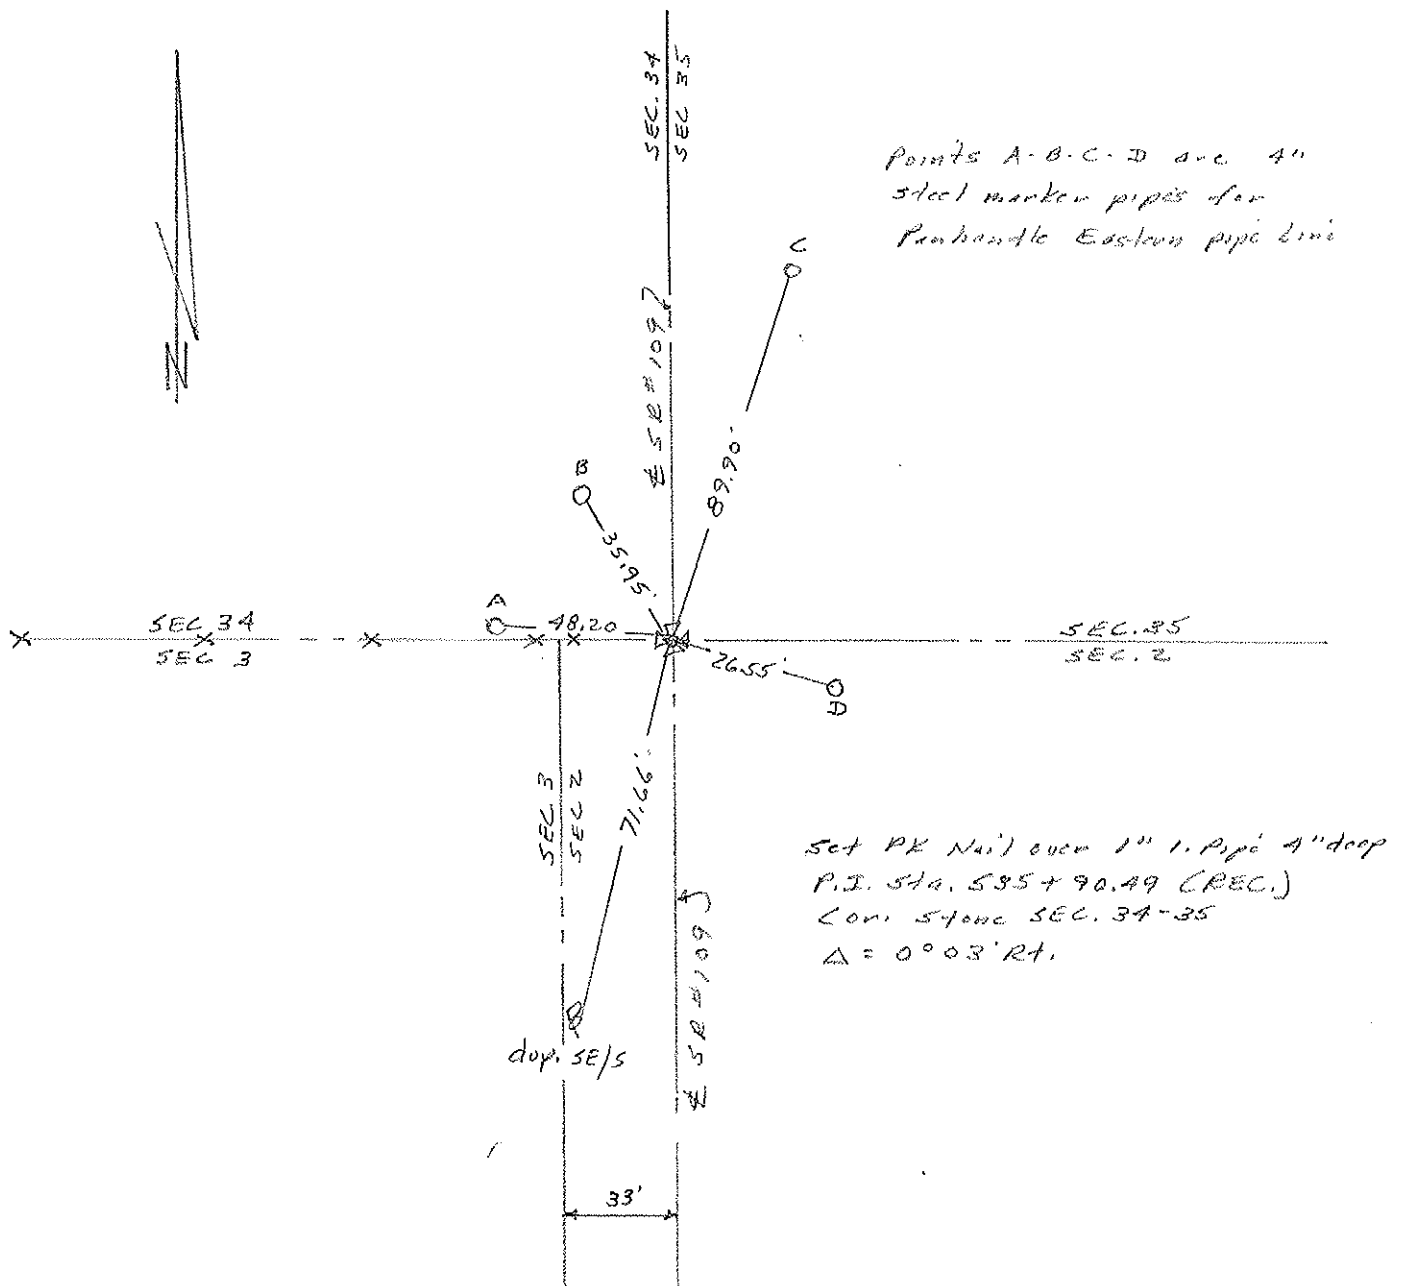

PERSONNEL	TITLE	PERSONNEL	TITLE
1	1	1	1
2	2	2	2
3	3	3	3
100	100	100	100

Red Beach

COUNTY Fulton

DATE JAN - Feb 1977

W. Knape

S. R. 109

WEATHER

SEC. PIKE

TEMP.

DESCRIPTION




CONTROL POINTS

LEFT

CENTER LINE


RIGHT

JOB NO.

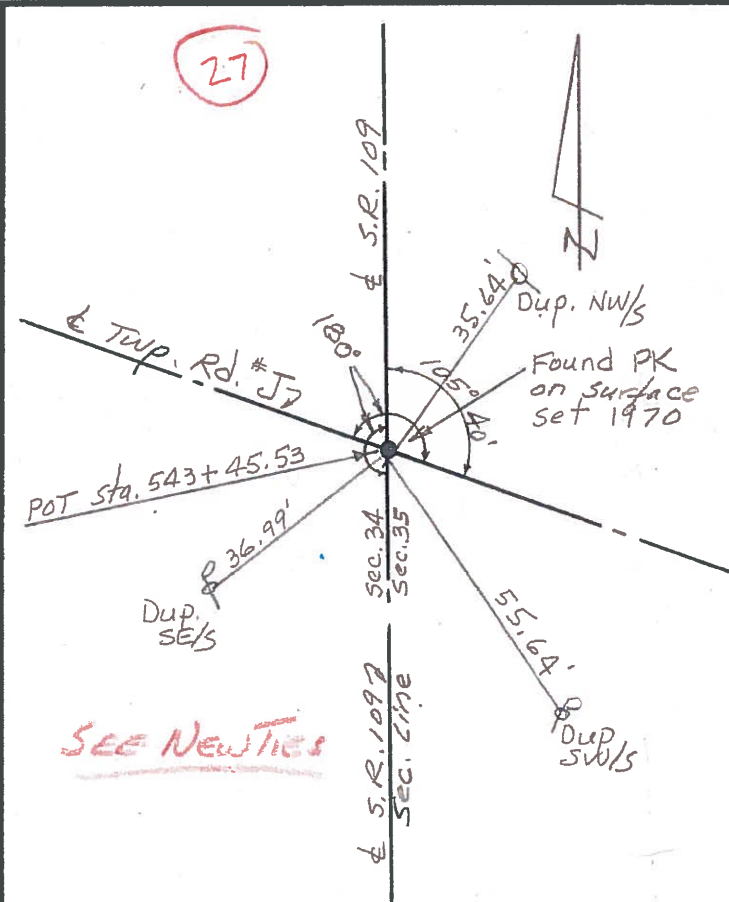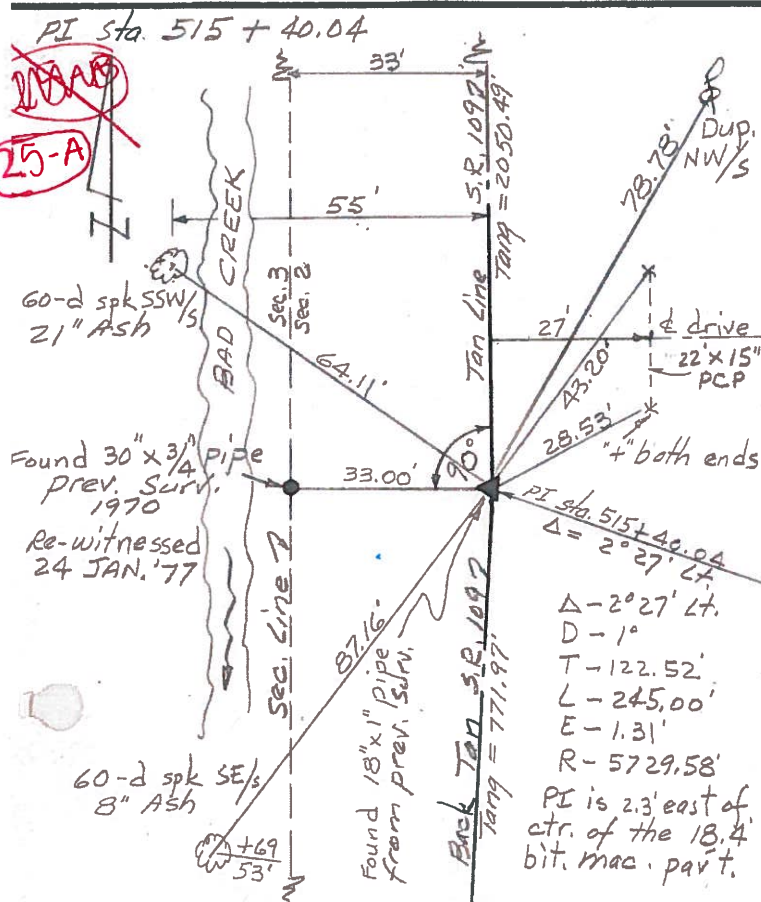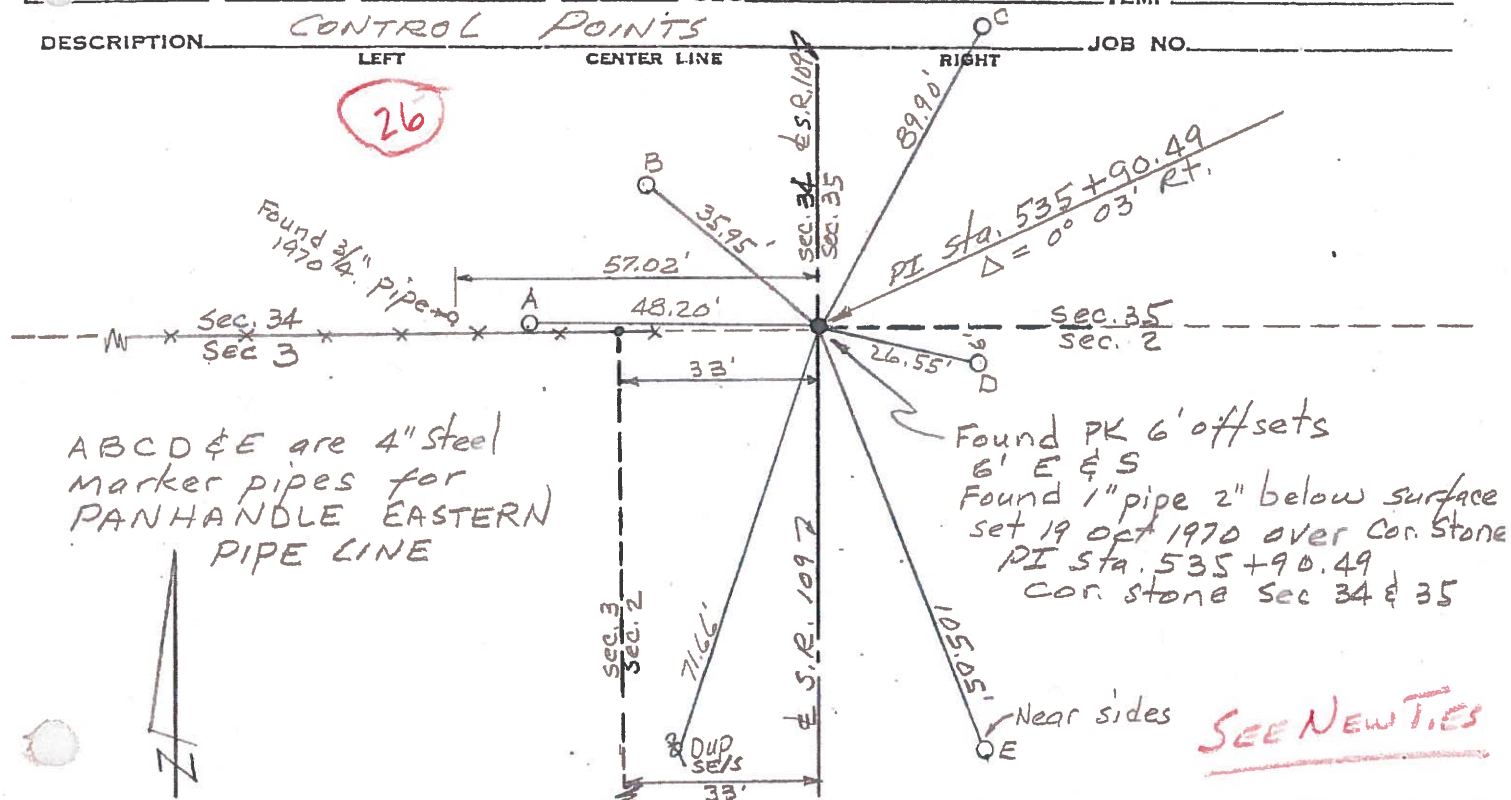


PERSONNEL	TITLE	PERSONNEL	TITLE	COUNTY	DATE	WEATHER	TEMP.
Tomsic		Granata		FULTON	July-18-73	80°	clear
Neuser				S. R. 109			
Boyle				SEC.			

DESCRIPTION MON LEFT CENTER LINE RIGHT JOB NO. 02 4610

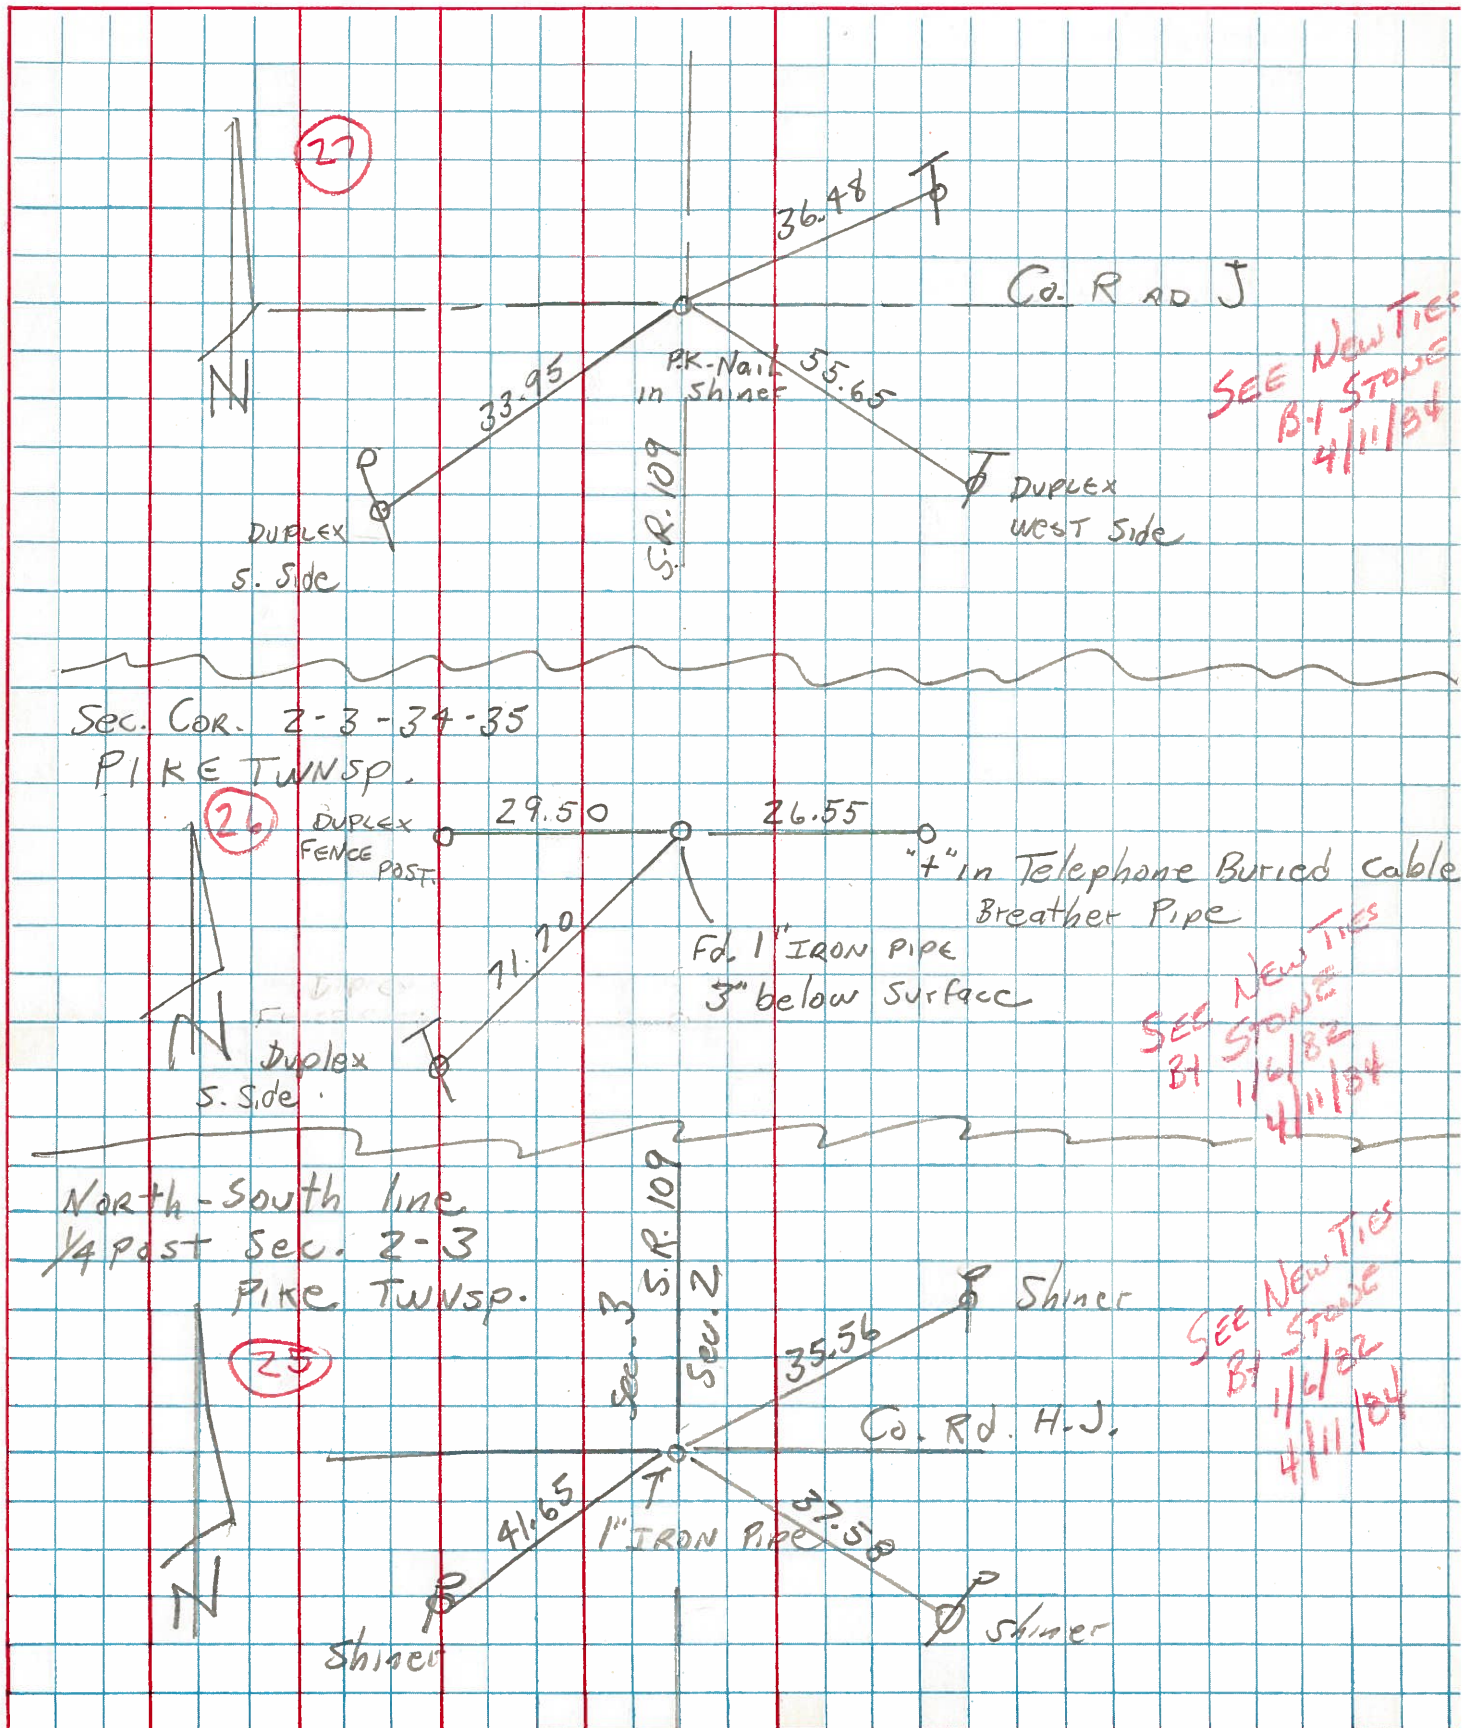

PERSONNEL	TITLE	PERSONNEL	TITLE	COUNTY	DATE	WEATHER	TEMP.
Red Beach				FULTON	OCT-NOV. '70		
Newcomb				109			
Knappe				PIKE TWP			
Wise							
ALIGNMENT & CONTROLS				JOB NO.			


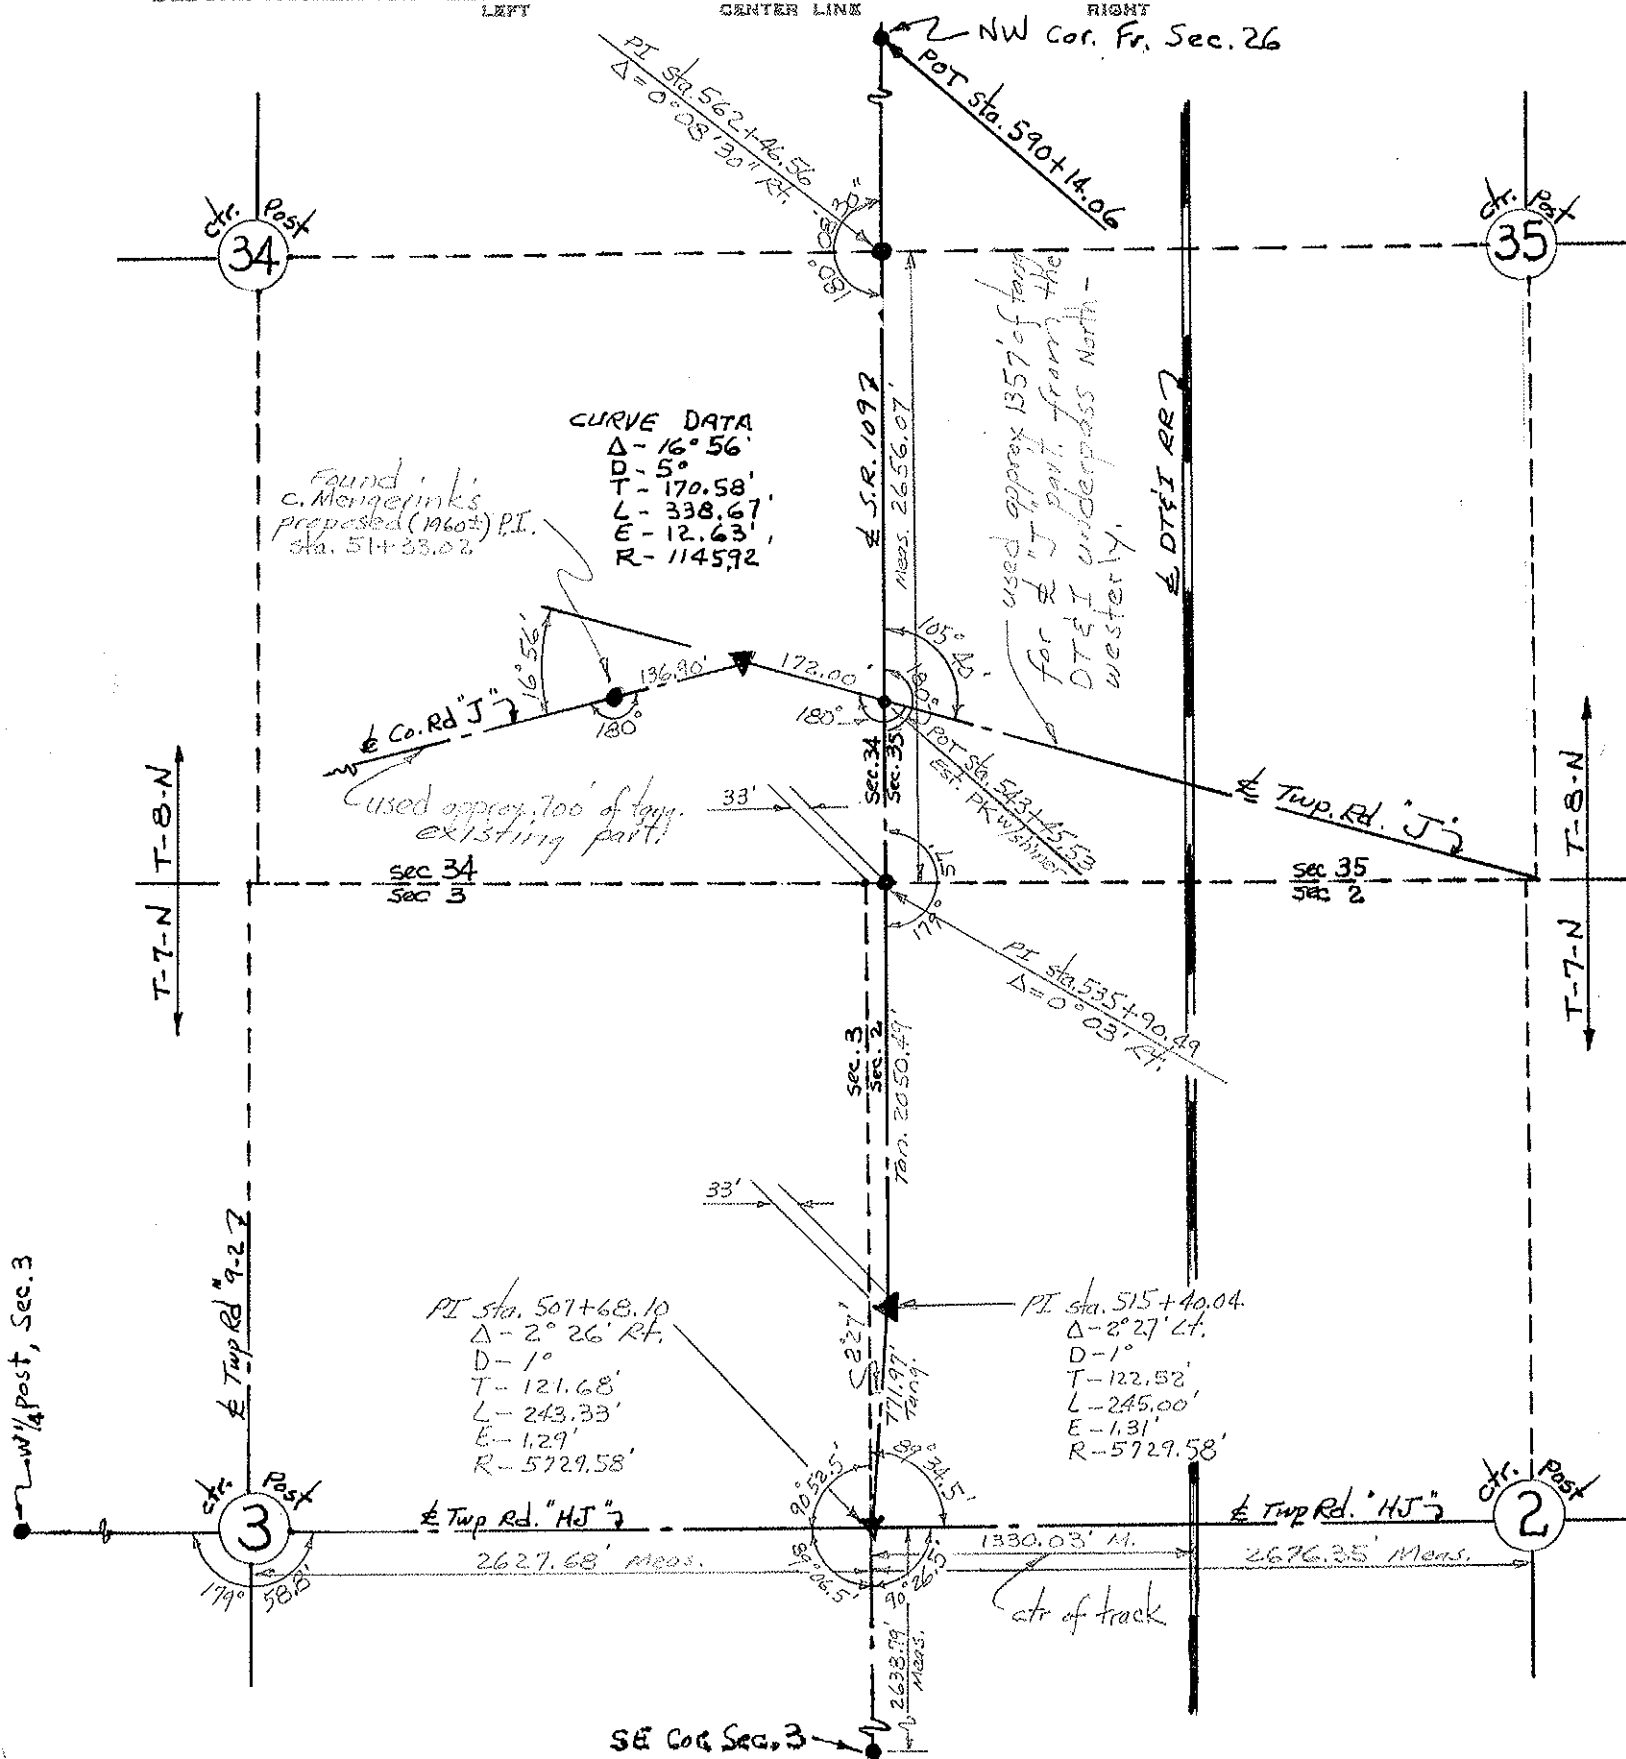


PERSONNEL	TITLE	PERSONNEL	TITLE	COUNTY	DATE	WEATHER
Red Beach				Fulton	Oct. 1970	
Newcomb						
Knappe						
Wise						

S. R. 109

SEC. Pike Twp.

TEMP.

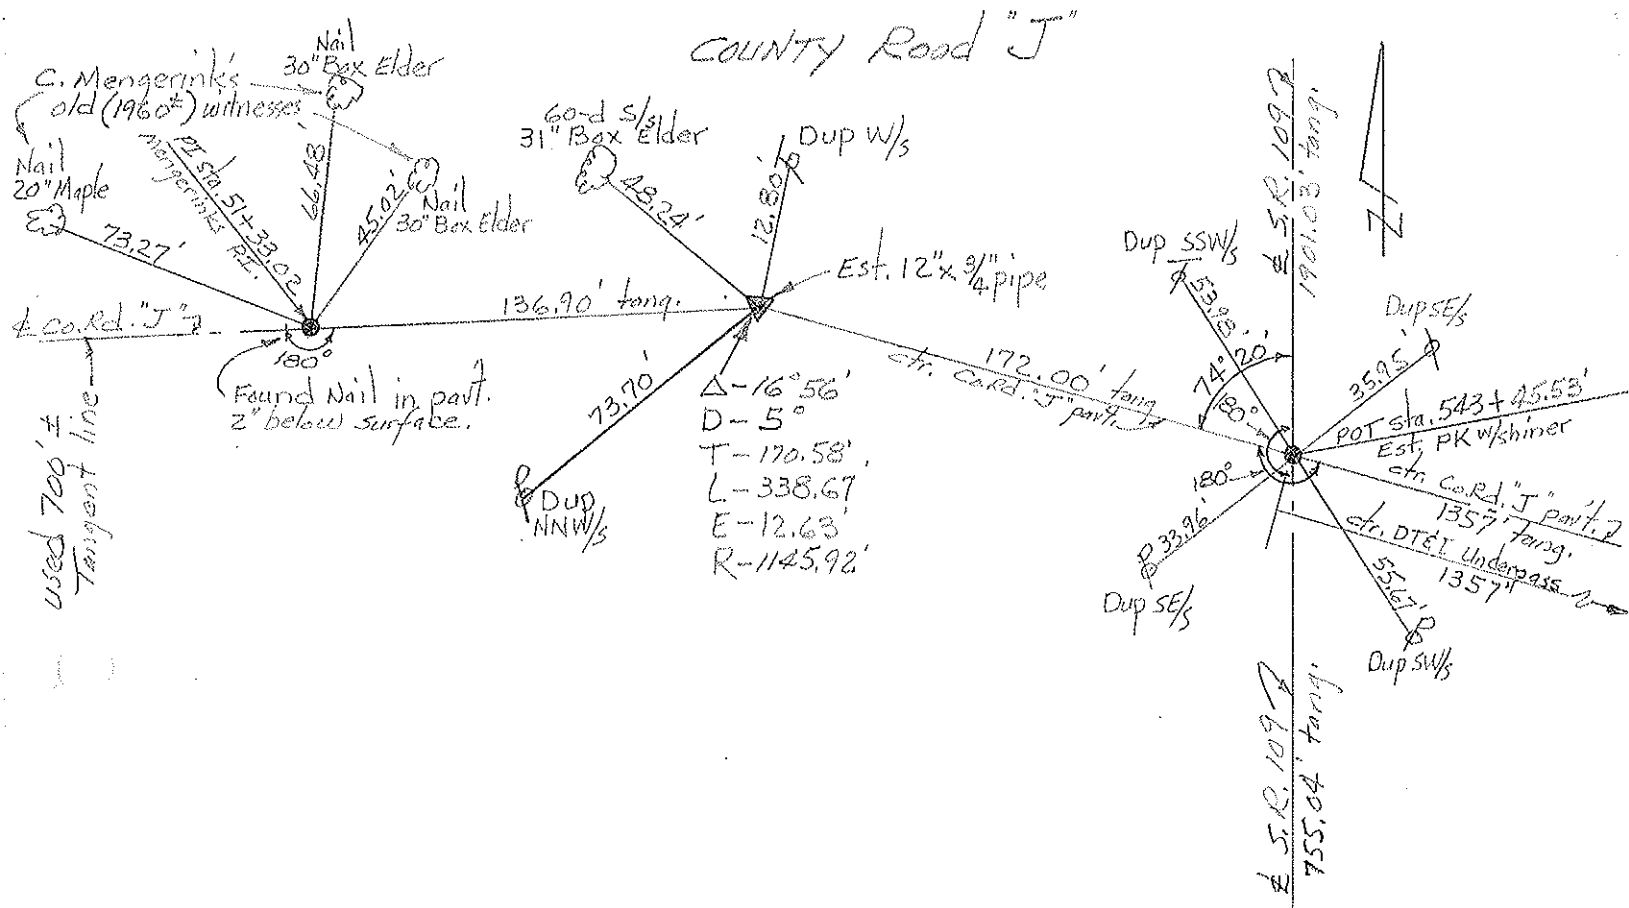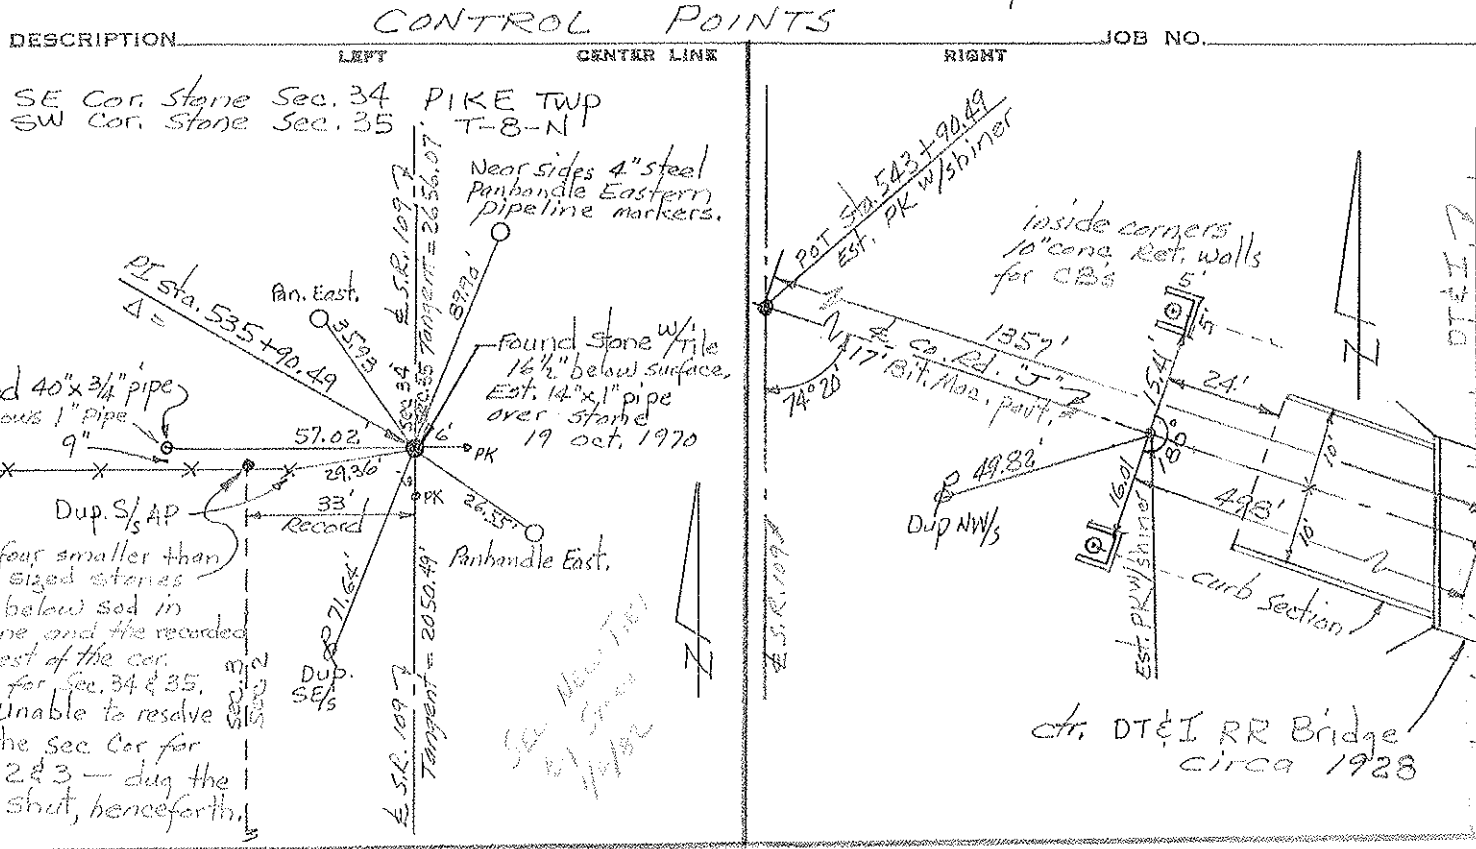

Q.D.O.T. DISTRICT 2 SURVEY OFFICE

SHEET 5 OF

County Fulton S.R. 109

Date 11 April 84

Township PIKE

Weather Fair

Section 34-35

Temp. 49°

T N, R E

Personnel L. Stone

P. Nusco

R. Michalak

D. Curtis

34	35
3	2



REF. NO. 26

