

O.D.O.T. DISTRICT 2 SURVEY OFFICE (USE ONLY)

PERSONNEL

REFERENCE NO. 27

SHEET 10 OF 35

NOTES RHOADES

DATE 4/23/21

ROUTE SR 109

H.C. O'DONNELL

WEATHER CLOUDY

COUNTY FULTON

R.C. RHOADES

TEMP. 46°

TOWNSHIP PIKE

SECTION 35

DWG BY NIESE PID PAVE TRAIN

T 8 N R 7 E

TYPE MONUMENT MAG/WASHER

ON SURFACE - ~~BELOW~~ ON

OFFSET Q PAVEMENT 1.5' LT : ~~RT~~

- TO - EDGE PAVEMENT


STATION: 543+69.72

HORZ.DATUM: NAD83(2011)


GEOID: 18

GRID: NORTHING: 709940.058

EASTING: 1548037.127

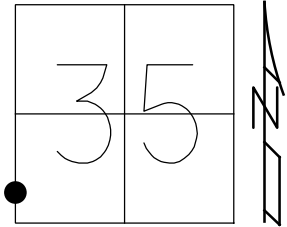

RECORD: P.O.T.
STA 543+45.53
SET P.K./WASHER
10/01/90, MB
SET P.K./WASHER
11/20/96, MRC
FD P.K. NAIL
6/12/12, SAH
SET MAG/WASHER
2/28/13, MC
FD MAG/WASHER
3/5/13, MC
FD MAG/WASHER
REF27
4/23/21, JFO
8/26/21, JFO

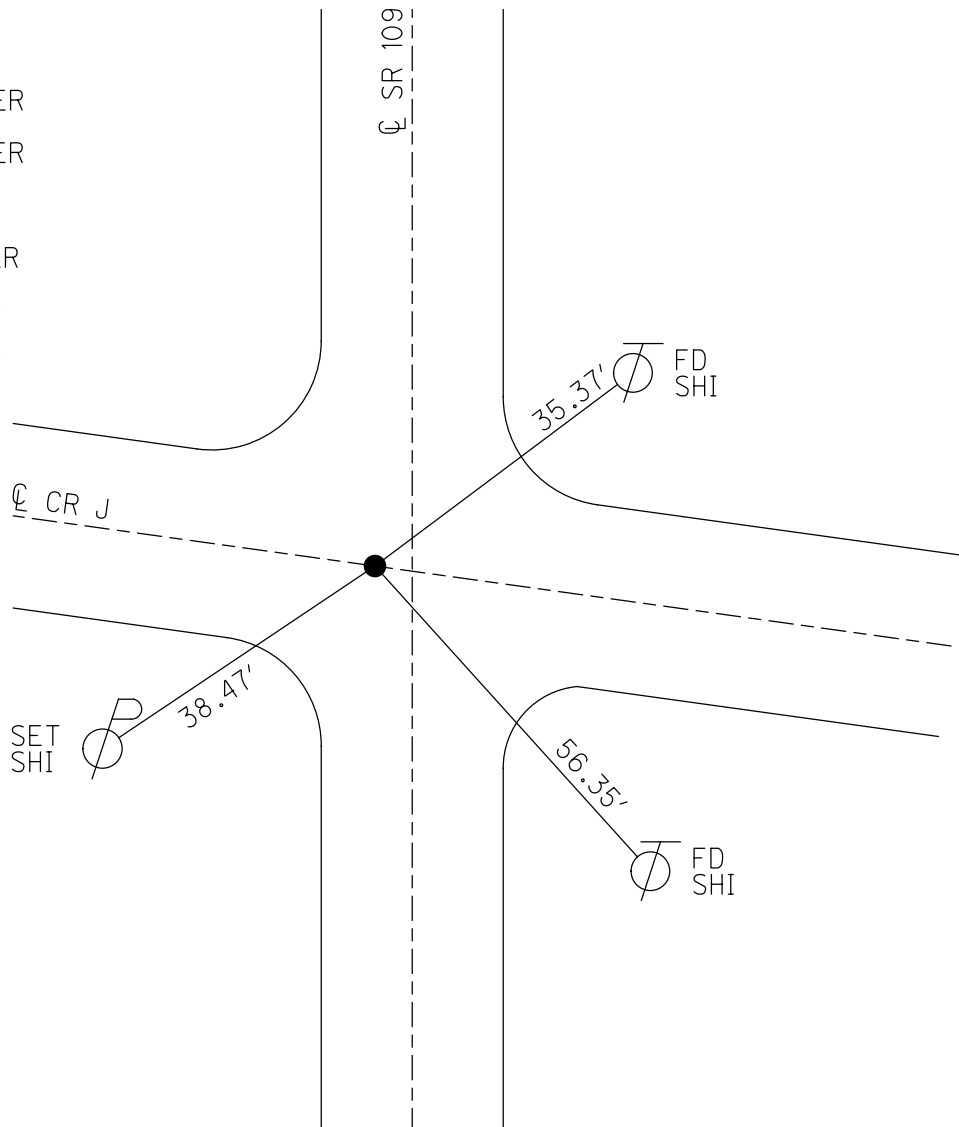

O.D.O.T. DISTRICT 2 SURVEY OFFICE (USE ONLY)

PERSONNEL

REFERENCE NO. 27

SHEET 11 OF 35

NOTES HUSS

DATE 06-12-12

ROUTE SR 109

H.C. HUSS

WEATHER FAIR

COUNTY FULTON

R.C. CANTERBURY

TEMP. 78°

TOWNSHIP PIKE

COUTCHER

SECTION 35

T 8 N R 7 E

TYPE MONUMENT PK NAIL


ON SURFACE - BELOW ON

LEFT - CL PAV'T - RIGHT 1.5'

TO EDGE PAVEMENT

S.L.M. 543+76

Grid: Northing: 709940.065 Easting: 1548037.051

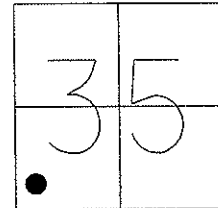


RECORD:

P.O.T STA 543+45.53

10-01-90 SET PK.WASHER, MB
11-20-96 SET PK/WASHER
IN LEVELING COURSE, MRC
02-28-13 SET MAG.WASHER, MC

06-12-12 GPS REF 27
03-05-13 GPS FIN 27, MC

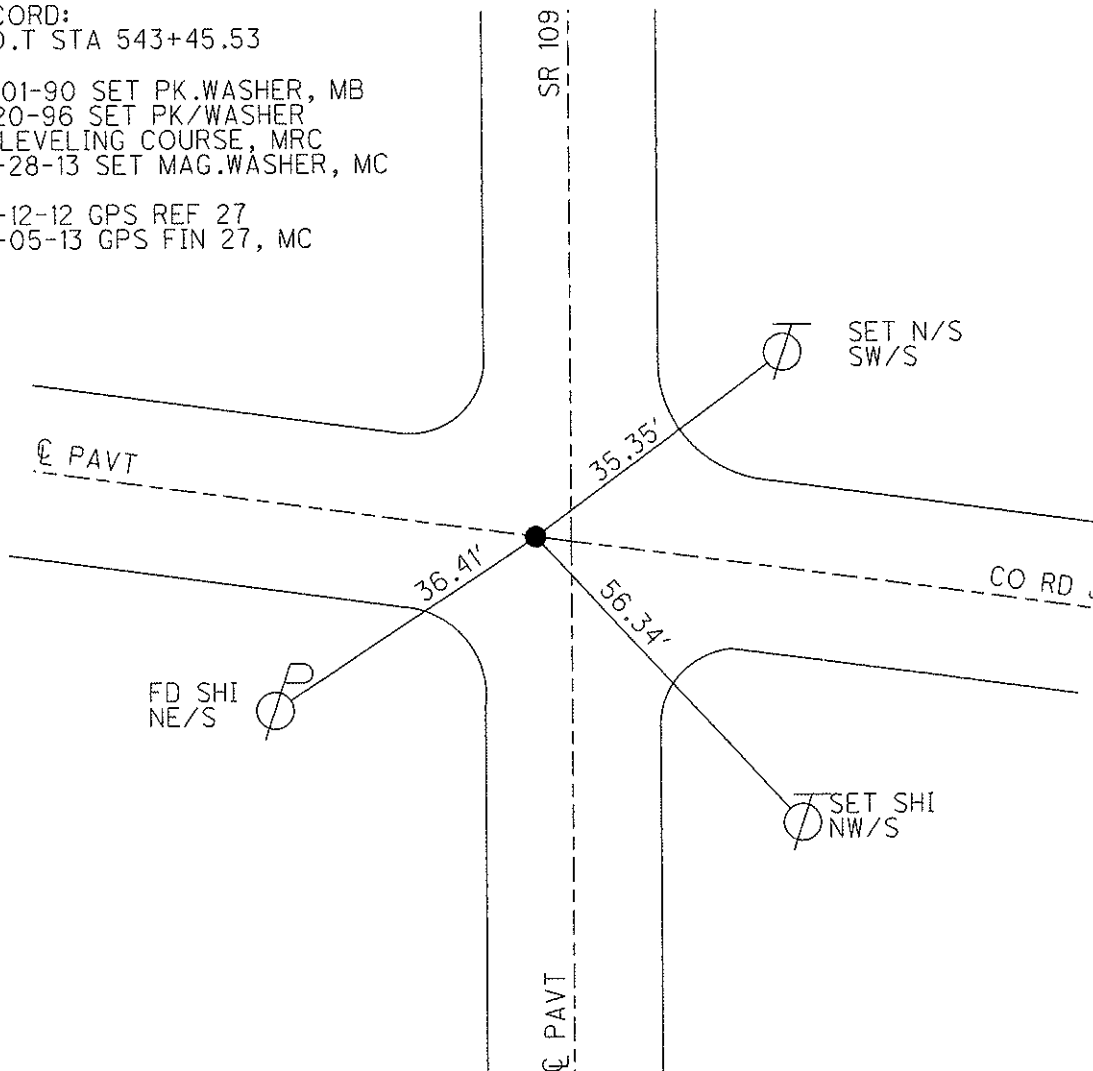

O.D.O.T. DISTRICT 2 SURVEY OFFICE

PERSONNEL

REFERENCE NO. 27

SHEET 9 OF 28

NOTES CANTERBURY

H.C. Rousos

R.C. LOEHRKE

DATE 8-20-96

WEATHER FAIR

TEMP. + 85°

ROUTE 109

COUNTY FULTON

TOWNSHIP Pike

SECTION 35

T8 2 R3 4

Set PK / WASHER
10-2-97

C.L.


TYPE MONUMENT P.K. NAIL

ON SURFACE - ~~BELOW~~ Yes

LEFT - ~~CL~~ PAV'T. - ~~RIGHT~~ 0.24

— TO — EDGE PAVEMENT

S.L.M. 76+570.65 ON E RVT WEST (543+76)

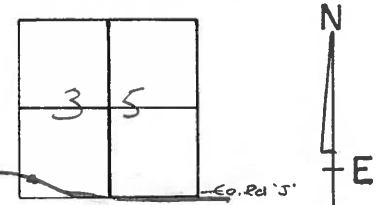


RECORD
P.O.T. STA: 543+45.53

SET P.K. & WASHER
10-1-90
MB

NOTE: POINT IS 0.24^m LT
OF Q PAUT S.R. 109

SET P.K./WASHER IN LEVELING
COURSE 11/20/96. MRC.

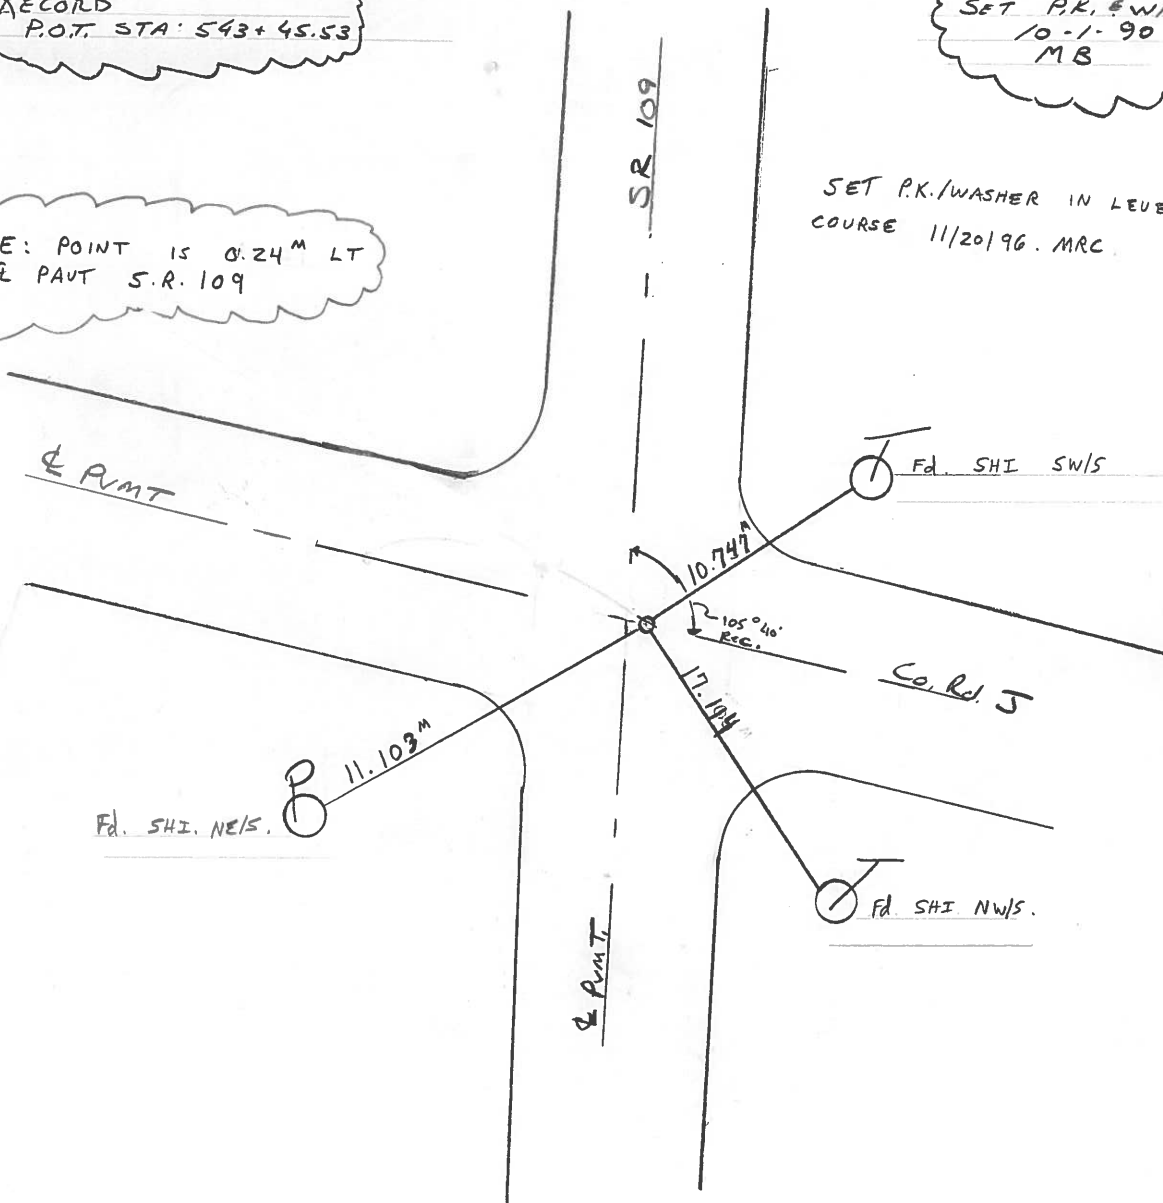

O.D.O.T. DISTRICT 2 SURVEY OFFICE

PERSONNEL

REFERENCE NO. 27

SHEET OF

NOTES BARNHISEL

H.C. " "

R.C. HOFFMAN

DATE 8-31-90

WEATHER Clear

TEMP. +72°

ROUTE 109

COUNTY Fulton

TOWNSHIP Pike

SECTION 35

T 8 N R 7 E


TYPE MONUMENT P.K. NAIL

ON SURFACE - ~~BELOW~~ YES

LEFT - ~~C~~ PAV'T. - RIGHT 1.3

- TO - EDGE PAVEMENT


S.L.M. 543+76 on E Pavt West

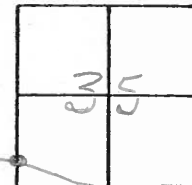

RECORD:

POT. STA: 543+45.53

Set P.K. & Washer
10-1-90
MB

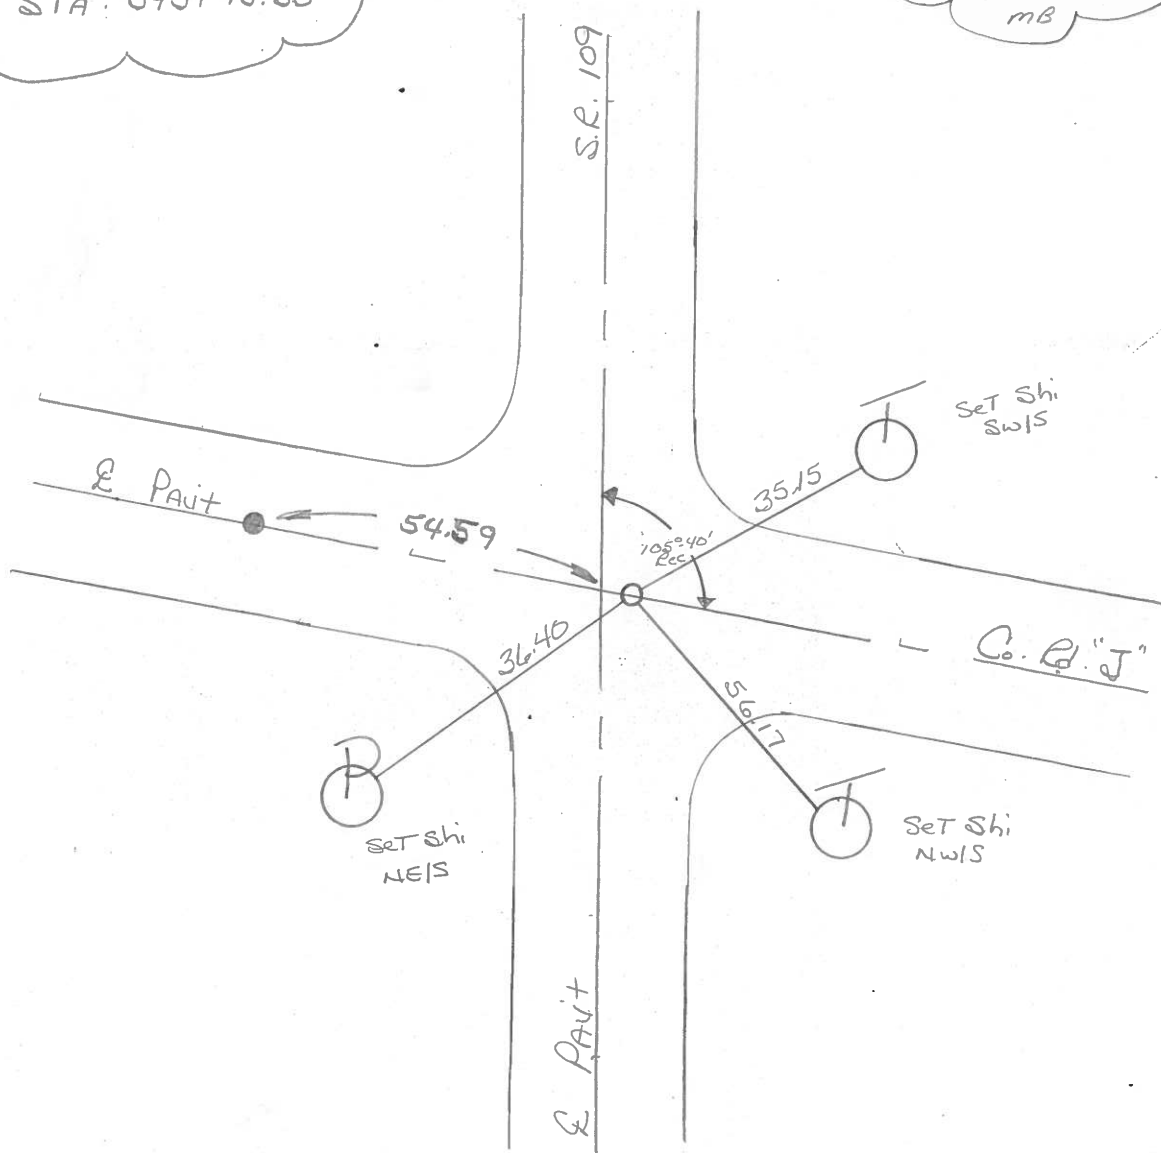

ROAD Intersection Rd 2 + Rd 271

TITLE

Crew Chief

Red Mountain

Red Man

SEC.

35

8 - N

7-2

28

CORNER

Control Panel

TWP.

Pike

DATE _____

3-28-90
5-1-80

WEATHER

Sunny 55°

DESCRIPTION

Revisited Track No. 1 Control Point Sta 54 + 49.24

on re-established	N.A. xlv
-------------------	----------

References Checked 4-2-86

STANLEY, HARRY

SET HARROW TOOTH AFTER

RESURFACING H-19-26 CS.



CROSS ON
NW COR.

Sc/c 35

0

572. 544-4964

Spk

~~52/5~~

NW 15

RD 3

Doc. 35

Sec. 2

TS-N. N-7-E

7-7-4 R-7-E

Re "J"

Rewitnessed Track

Nail Control Point

Sta 54 + 49.64

Spk
NW/s

Sed z

8

✓ 4-06-02

PERSONNEL
 STANLEY
 JOES

TITLE


ROAD Intersection Rd J & Rd B-1

SEC. 2 T. 7-N R. 7-E
35 T. 8-N R. 7-E

CORNER Control Points TWP. PIKE



DATE 3-26-85 WEATHER SUNNY @ 48°



DESCRIPTION: Control Point Rd B-1 = Rewitnessed Existing TRACK Nail. Also Referenced RR Spike

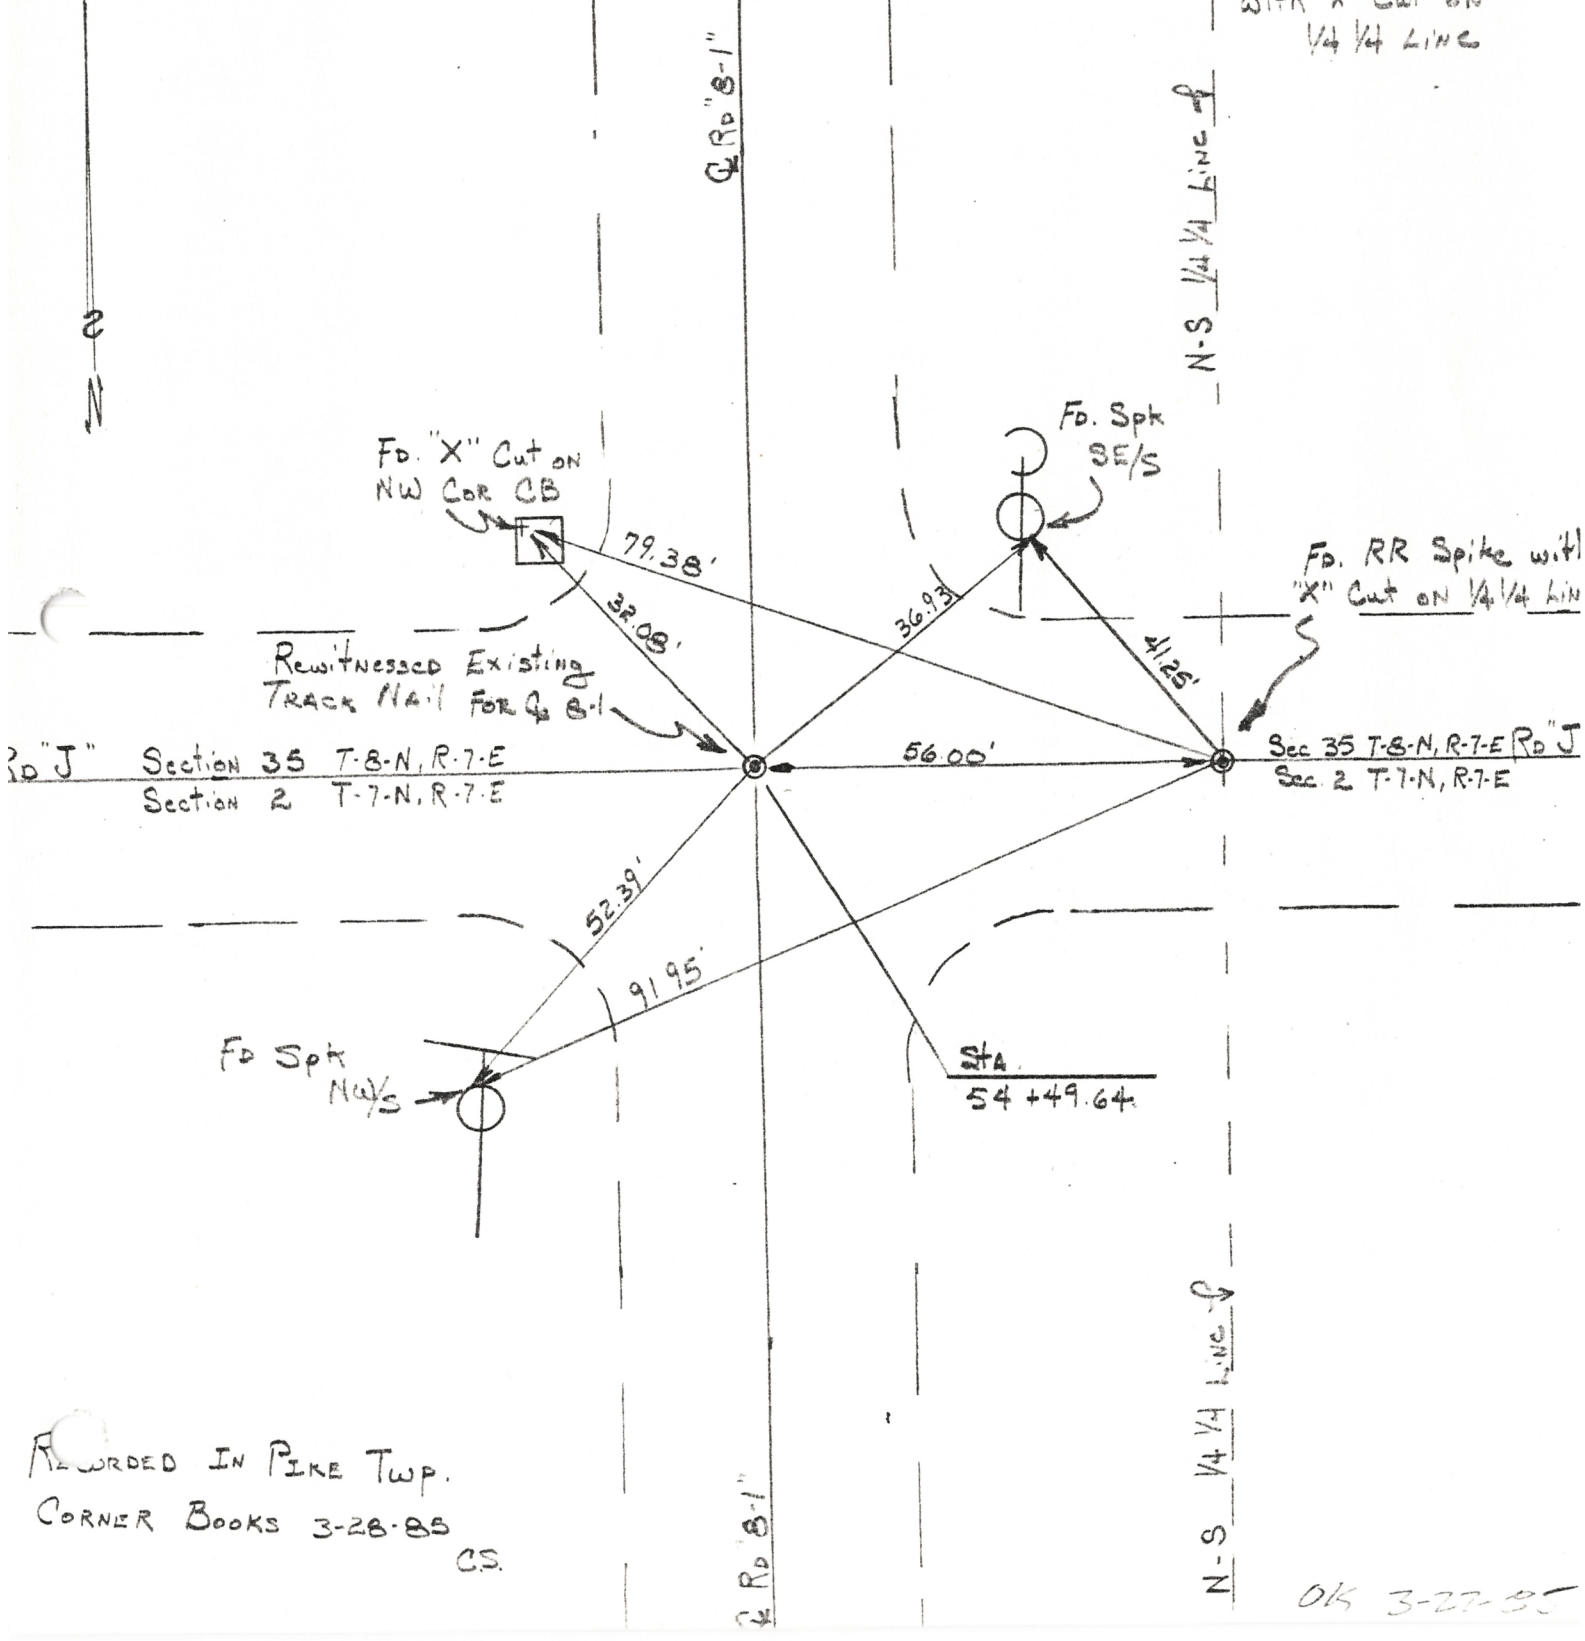

RECORDED IN PIKE TWP.
 CORNER BOOKS 3-28-85
 CS.

OK 3-27-85

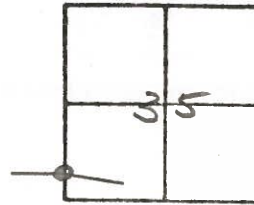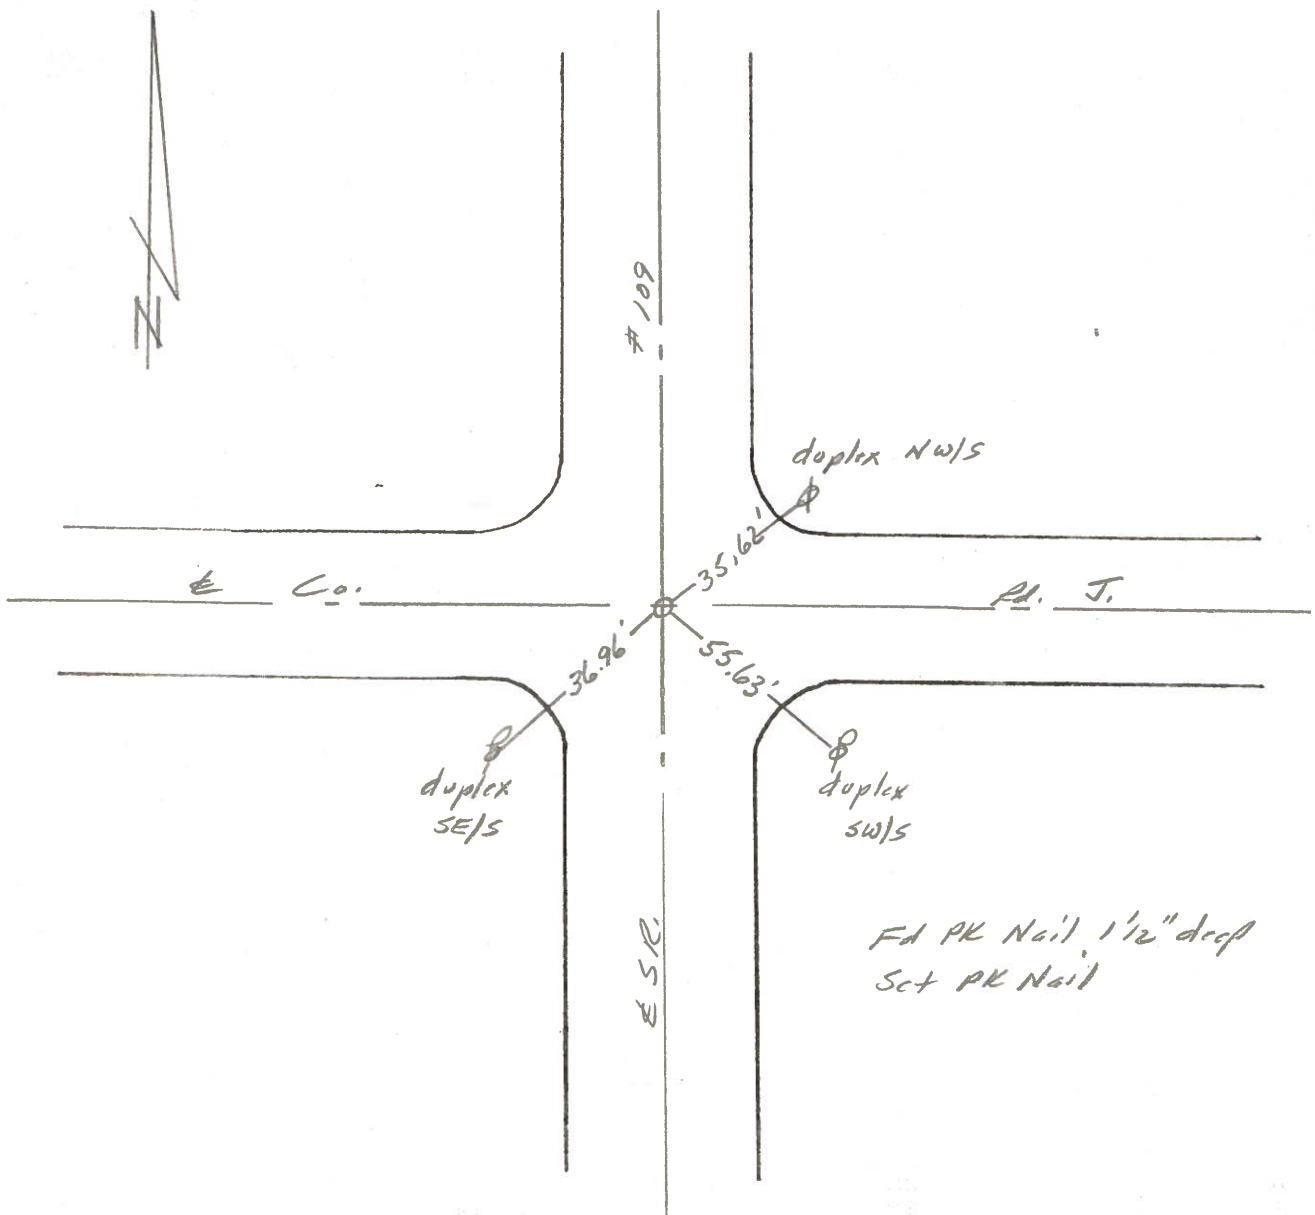County Fulton S.R. 109Township PIKESection 35T N, R EPersonnel L. StoneP. NeuseR. MichalakD. CurtisDate 11 April 84Weather FairTemp. 48°REF. NO. 27

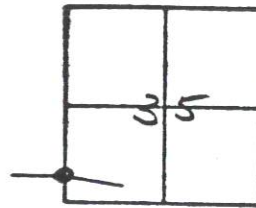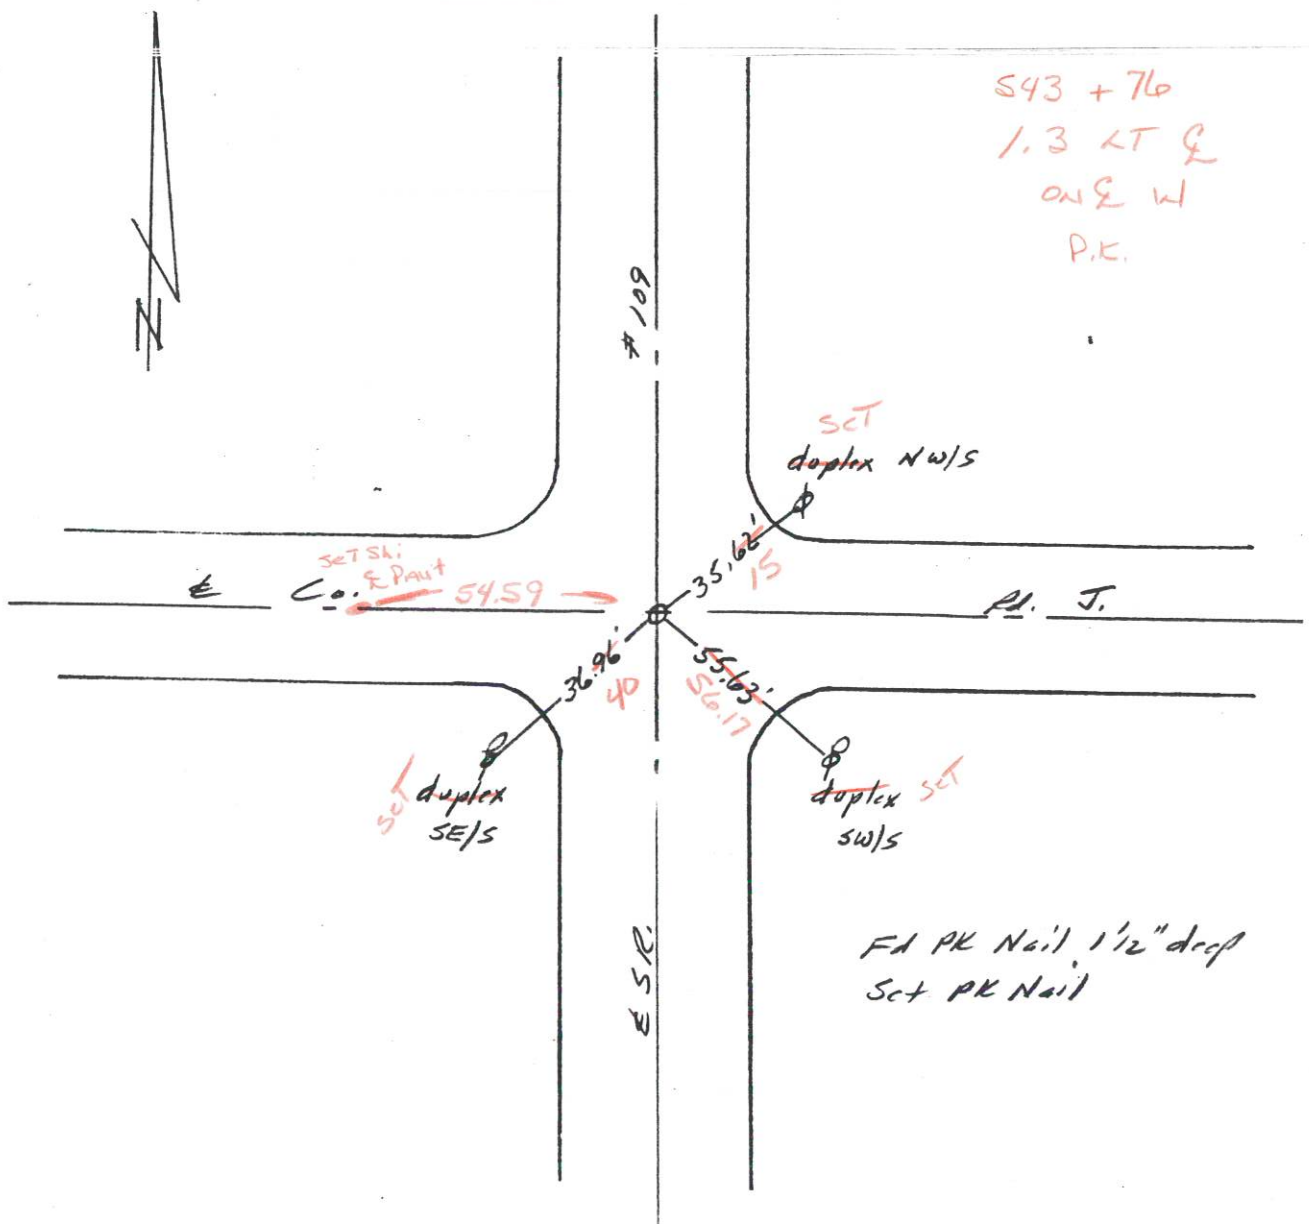County Fulton S.R. 109Township PIKESection 35T N, R EPersonnel I. StoneP. NeuseR. MichaelaleD. CurtisDate 11 April 84Weather FairTemp. 48°REF. NO. 27

PERSONNEL TITLE PERSONNEL TITLE

Red BeachCOUNTY FultonDATE JAN-Feb 1977W. KnapeS. R. 109

WEATHER

SEC. PIKE

TEMP

DESCRIPTION




CONTROL POINTS

JOB NO.

LEFT

CENTER LINE

RIGHT

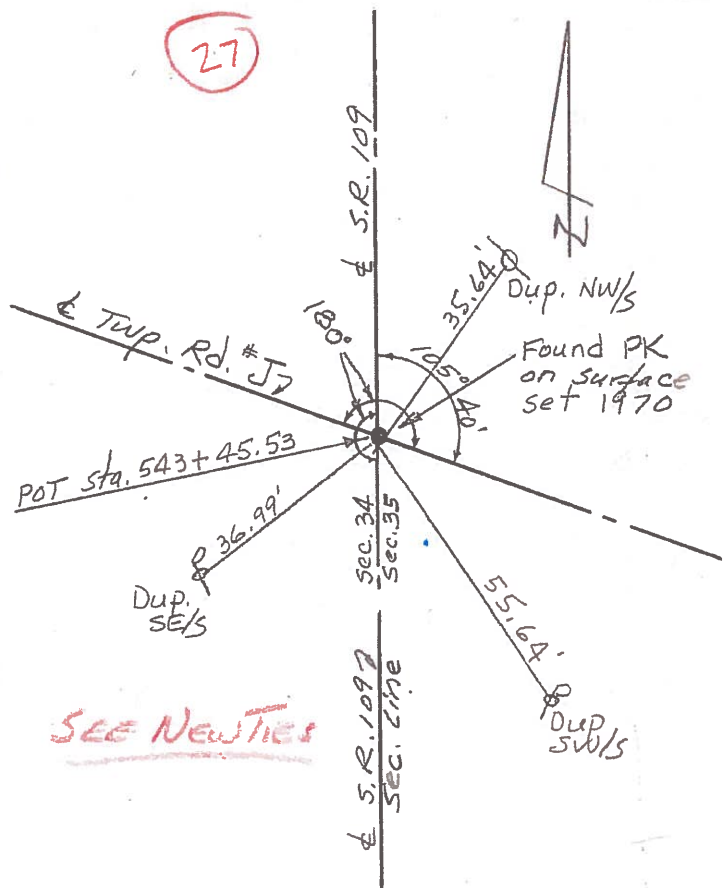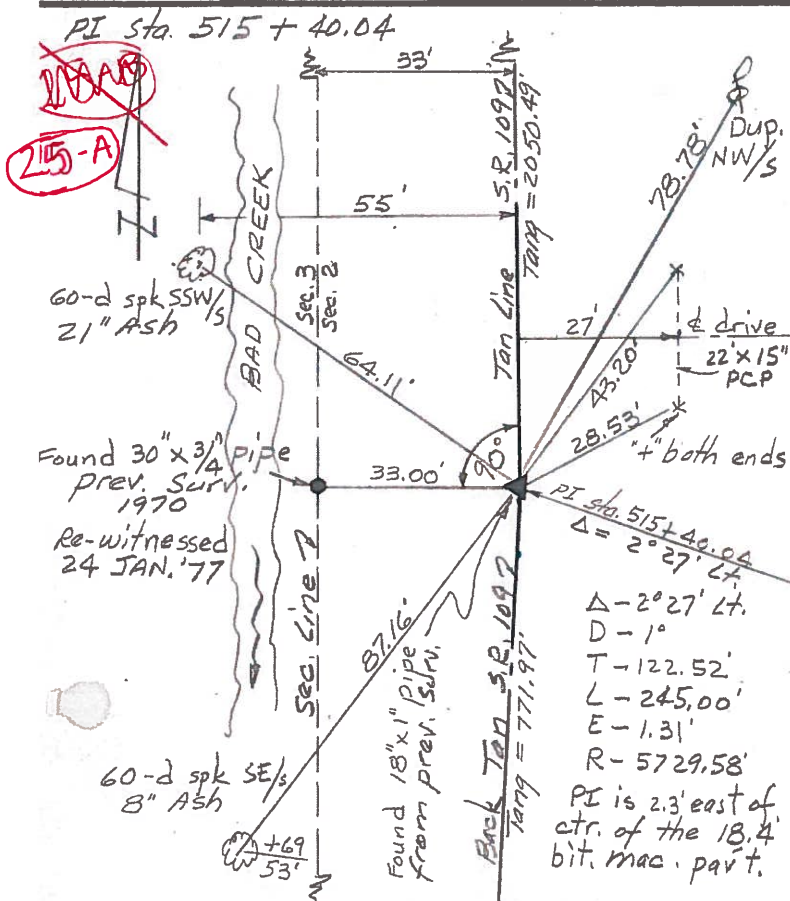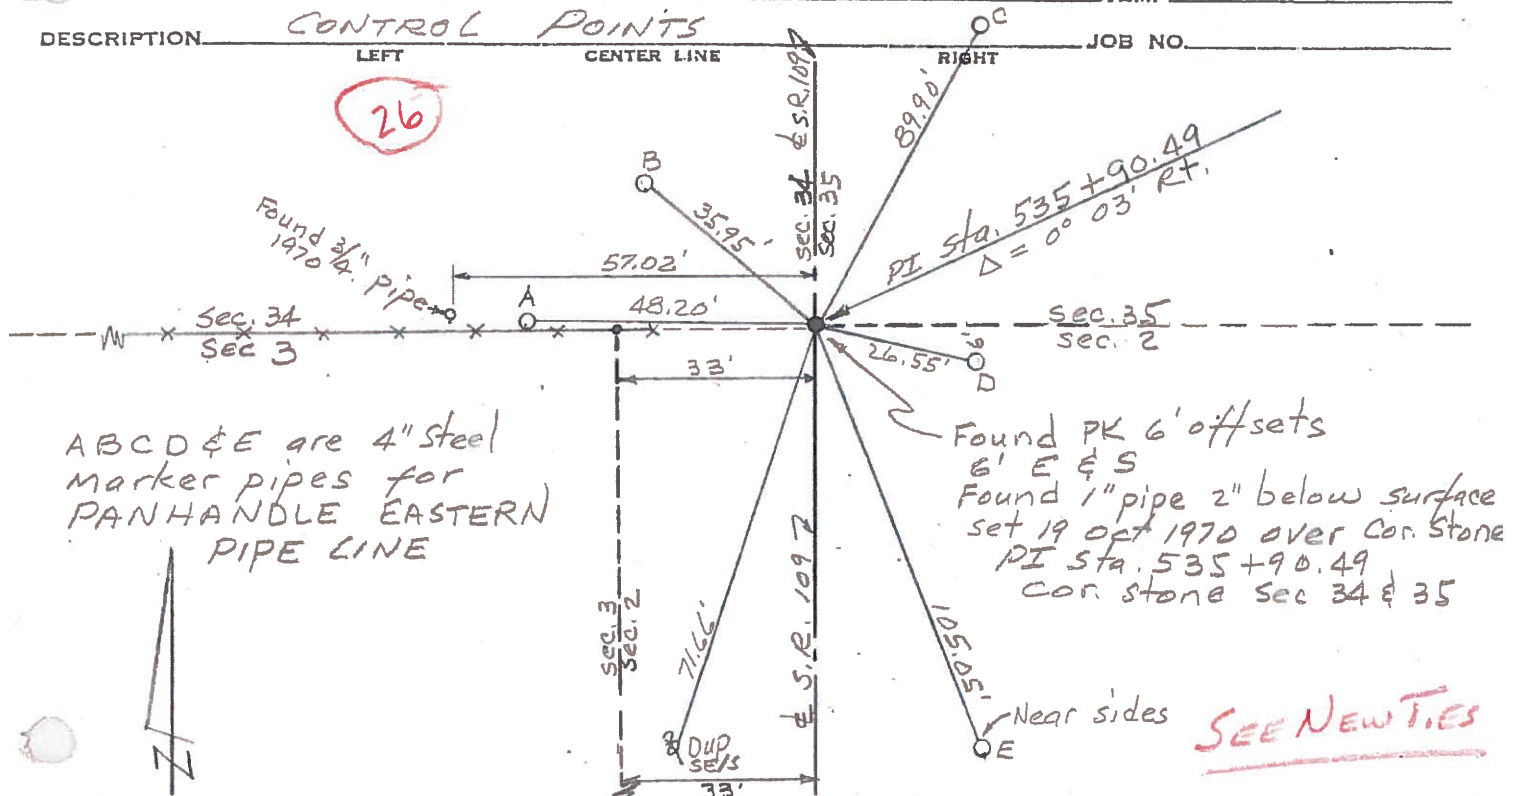

PERSONNEL TITLE PERSONNEL TITLE

Tomsic Granata

COUNTY FultonDATE July-18-73

Neuse

S. R. 109WEATHER 80°

Vango

SEC.

TEMP.

Boyle

clear


DESCRIPTION

MON


LEFT

CENTER LINE

RIGHT

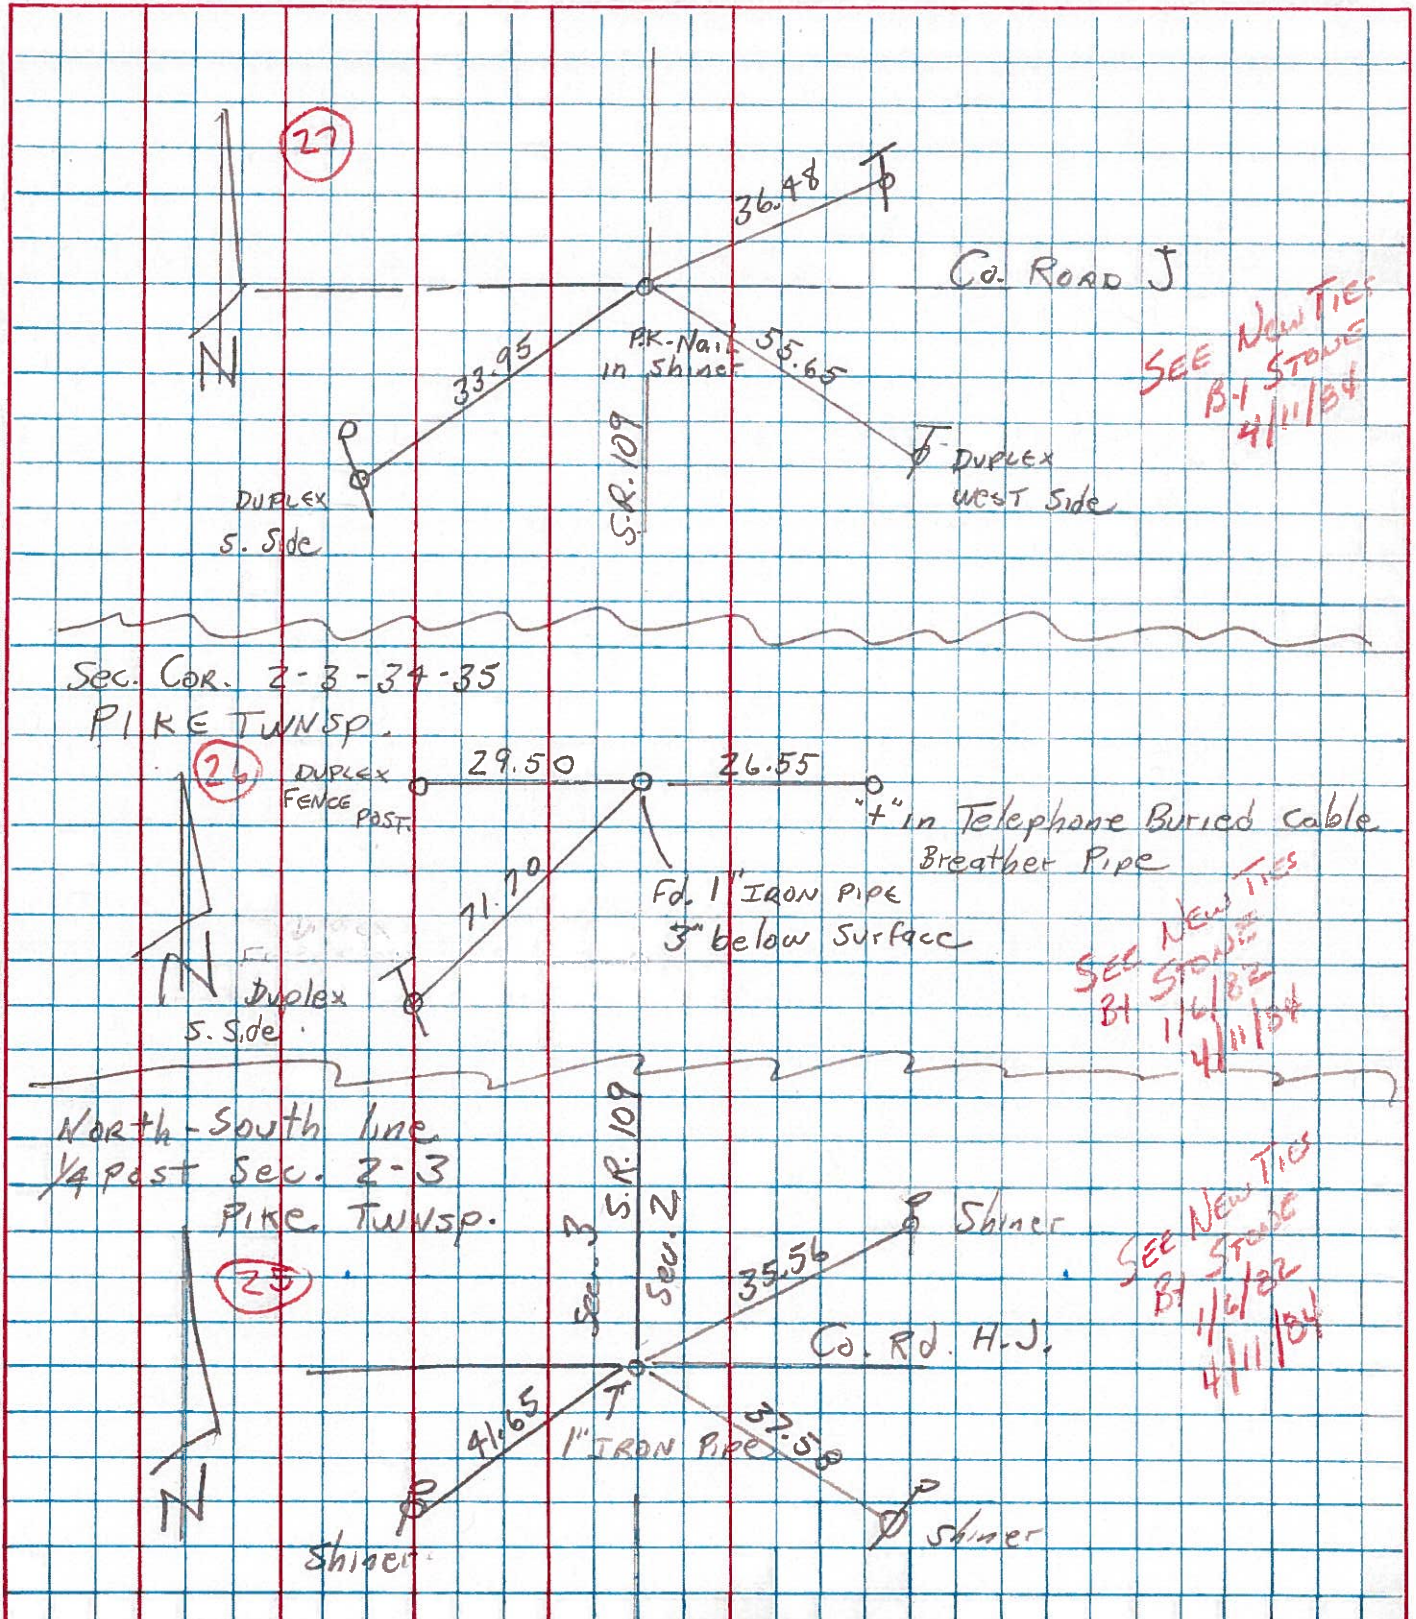JOB NO. 02 4610

PERSONNEL	TITLE	PERSONNEL	TITLE	COUNTY	DATE
Red Beach				FULTON	OCT-NOV. '70
Newcomb				S. R. 109	WEATHER
Knappe				SEC. PIKE TWP	TEMP.
Wise					
ALIGNMENT & CONTROLS				JOB NO.	

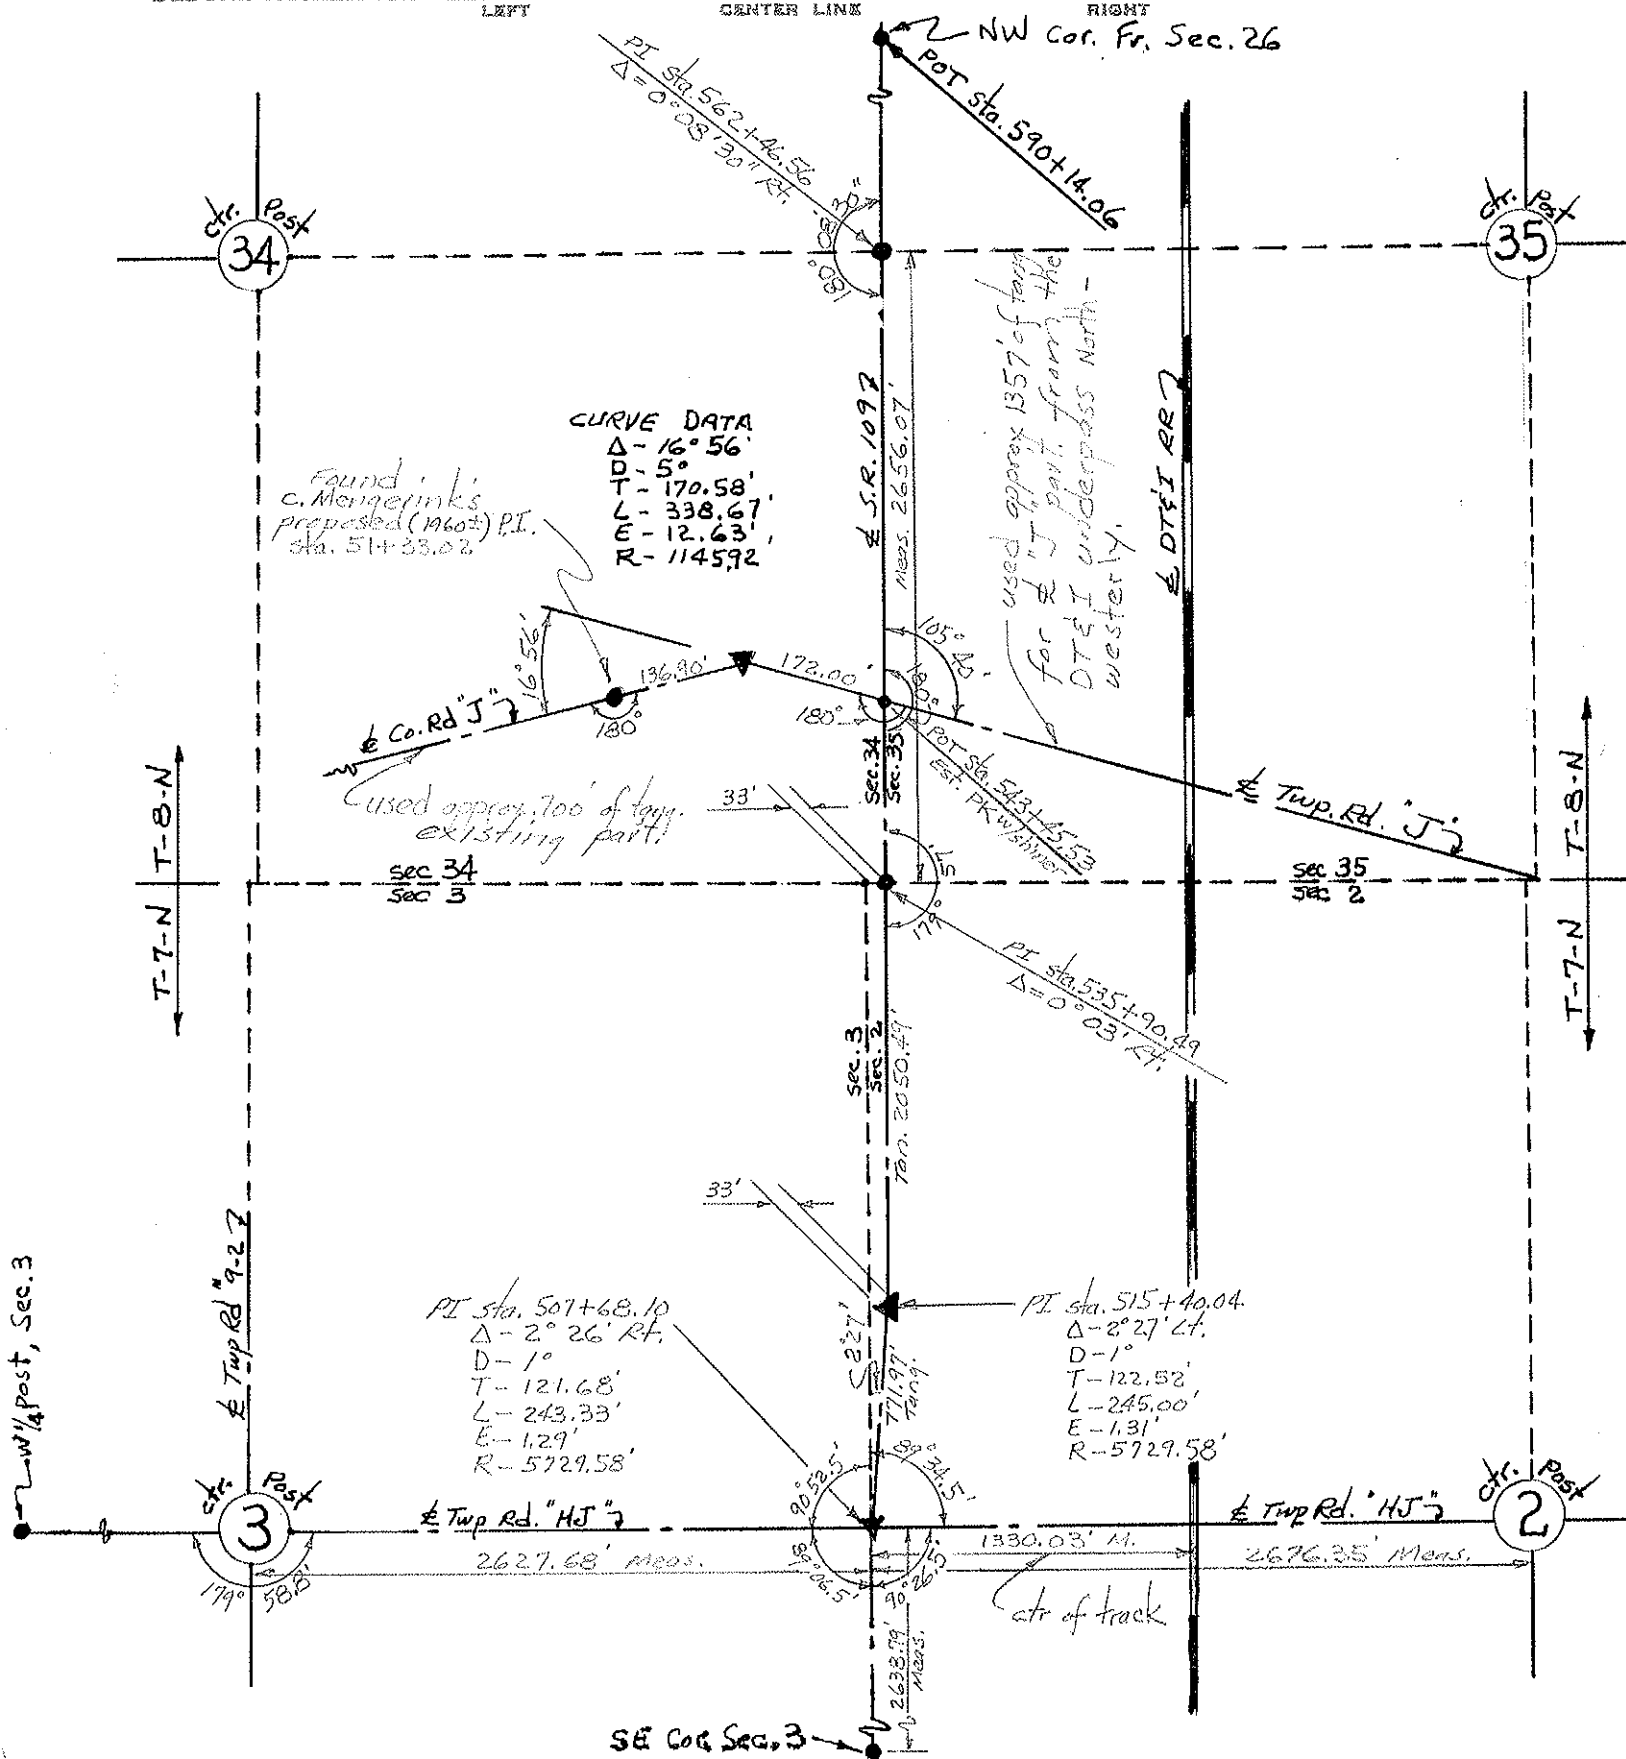

PERSONNEL	TITLE	PERSONNEL	TITLE	COUNTY	DATE
Red Beach				Fulton	Oct. 1970
Newcomb				109	
Knappe					
Wise				Pike Twp.	

DESCRIPTION CONTROL POINTS JOB NO. 1

SE Cor. Stone Sec. 34 PIKE TWP
SW Cor. Stone Sec. 35 T-8-N

LEFT CENTER LINE

PRINT

JOE NO

[illegible]

COUNTY Road "J"