

O.D.O.T. DISTRICT 2 SURVEY OFFICE (USE ONLY)

PERSONNEL

REFERENCE NO. 29

SHEET 12 OF 35

NOTES RHOADES

DATE 4/26/21

ROUTE SR 109

H.C. O'DONNELL

WEATHER CLOUDY

COUNTY FULTON

R.C. NIESE

TEMP. 45°

TOWNSHIP PIKE

SECTION 35

DWG BY NIESE PID PAVE TRAIN

T 8 N R 7 E

TYPE MONUMENT MAG/WASHER

ON SURFACE - ~~BELOW~~ ON

OFFSET 0.8' LT : ~~RT~~

9.4' TO LT EDGE PAVEMENT


STATION: 562+70.62

HORIZ.DATUM: NAD83(2011)


GEOID: 2018

GRID: NORTHING: 711840.620

EASTING: 1548072.922

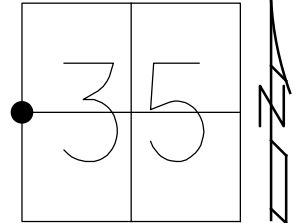

RECORD:
SET P.K./WASHER
10/01/90, MB
SET P.K./WASHER
11/20/96, MRC
FD P.K. NAIL
6/12/12, SAH
SET MAG/WASHER
3/5/13, MC
FD MAG/WASHER
REF29
4/26/21, JFO
8/26/21, JFO

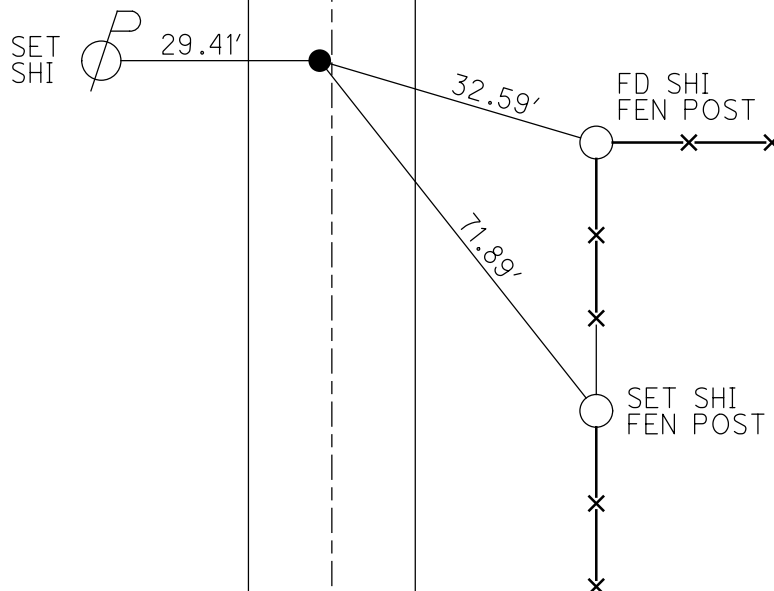

O.D.O.T. DISTRICT 2 SURVEY OFFICE (USE ONLY)

PERSONNEL

REFERENCE NO. 29

SHEET 13 OF 35

NOTES HUSS

DATE 06-12-12

ROUTE SR 109

H.C. HUSS

WEATHER FAIR

COUNTY FULTON

R.C. CANTERBURY

TEMP. 79°

TOWNSHIP PIKE

COUTCHER

SECTION 35

T 8 N R 7 E

TYPE MONUMENT PK NAIL



ON SURFACE - BELOW ON

LEFT - Q PAV'T - RIGHT 0.8'

9.4' TO LT EDGE PAVEMENT

S.L.M. 563+76

Grid: Northing: 711840.612 Easting: 1548072.901

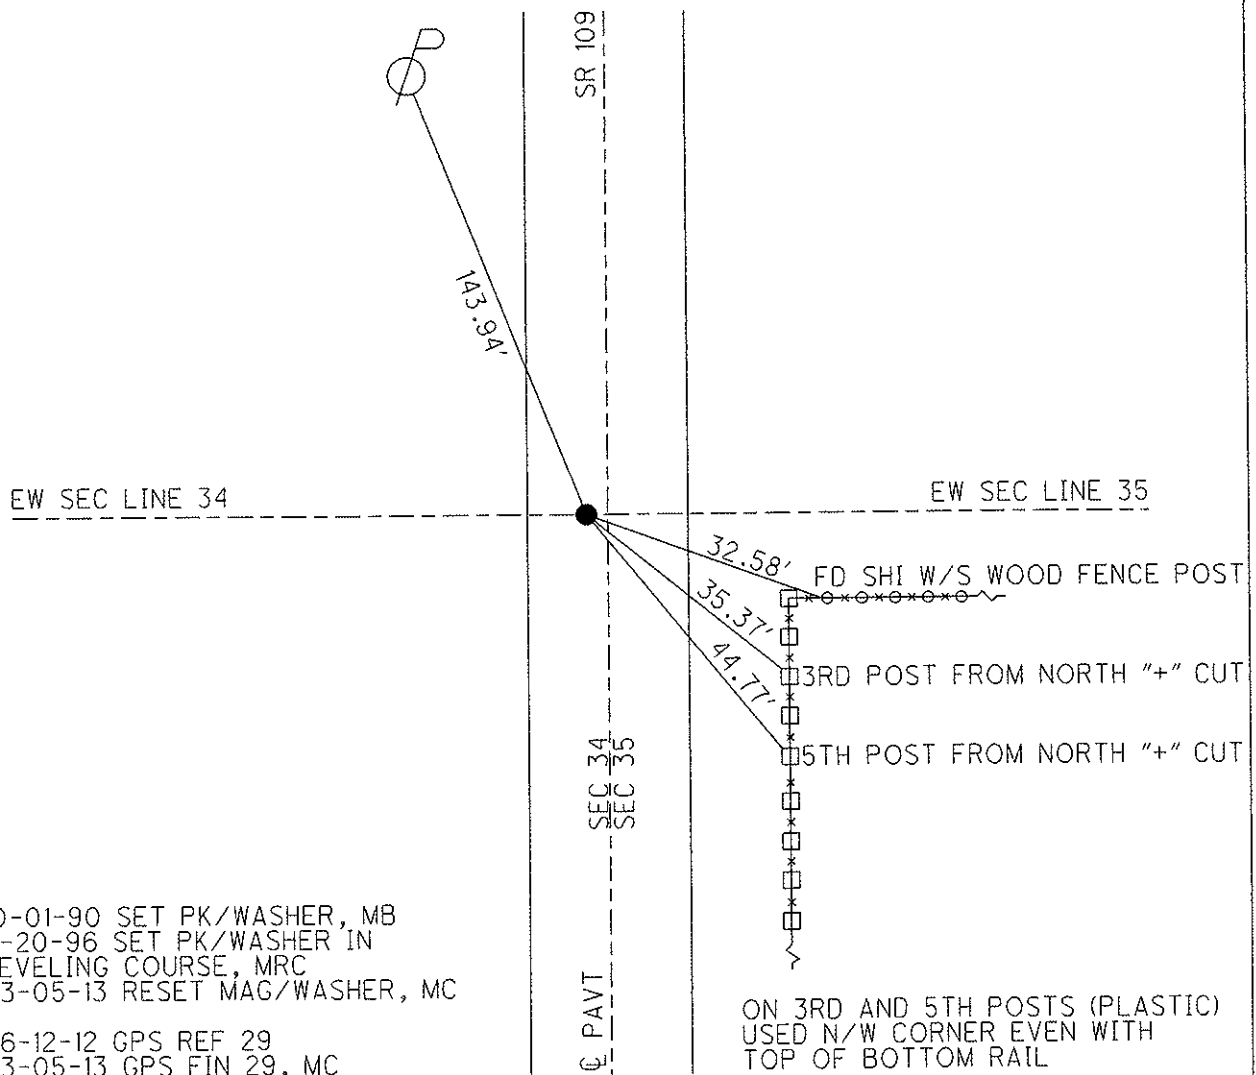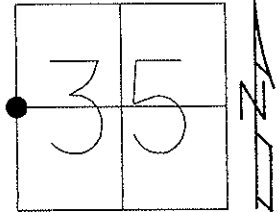

O.D.O.T. DISTRICT 2 SURVEY OFFICE

PERSONNEL

REFERENCE NO. 29

SHEET 11 OF 28

NOTES CANTERBURY

H.C. ROUSOS

R.C. LOEHRKE

DATE 8-20-96

WEATHER FAIR

TEMP. +85°

ROUTE 109

COUNTY FULTON

TOWNSHIP PIKE

SECTION 35

T 8 N R 7 E

Set P.K./WASHER
10-2-97
C.L.


TYPE MONUMENT P.K. NAIL

ON SURFACE - BELOW YES

LEFT- & PAV'T. - RIGHT 0.23' LT &


2.7 TO LT EDGE PAVEMENT

S.L.M. 17 & 147.2 (563 + 74)

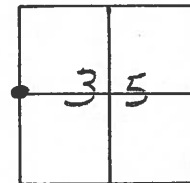

SET P.K./WASHER IN LEVELING
COURSE 11/20/96. MRL.

SET P.K. & WASHER
10-1-90
MB

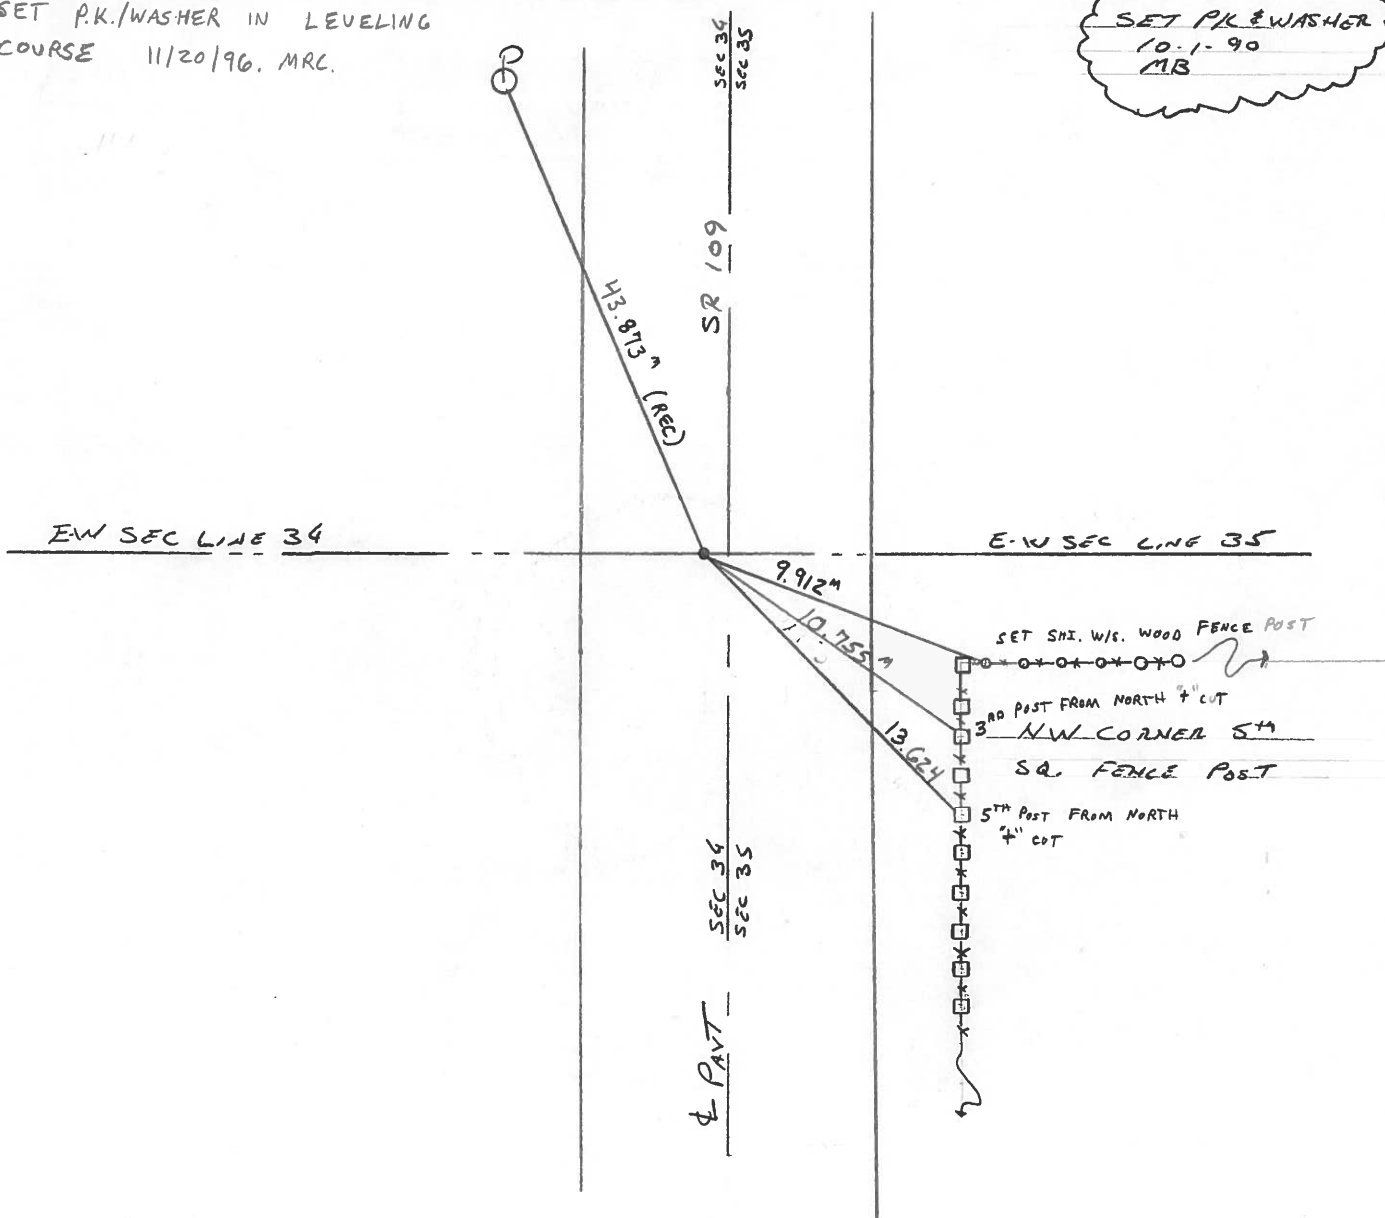

O.D.O.T. DISTRICT 2 SURVEY OFFICE

PERSONNEL

REFERENCE NO. 29

SHEET OF

NOTES BARNHISEL

H.C. " "

R.C. HOFFMAN

DATE 8-31-90

WEATHER Clear

TEMP. +76°

ROUTE 109

COUNTY Fulton

TOWNSHIP Pike

SECTION 35

T.B. N R. 7 E.



TYPE MONUMENT P.K. NAIL

ON SURFACE - BELOW YES

LEFT- & PAW'T. - RIGHT 0.6

9.5 TO LT EDGE PAVEMENT

S.L.M. 563+76

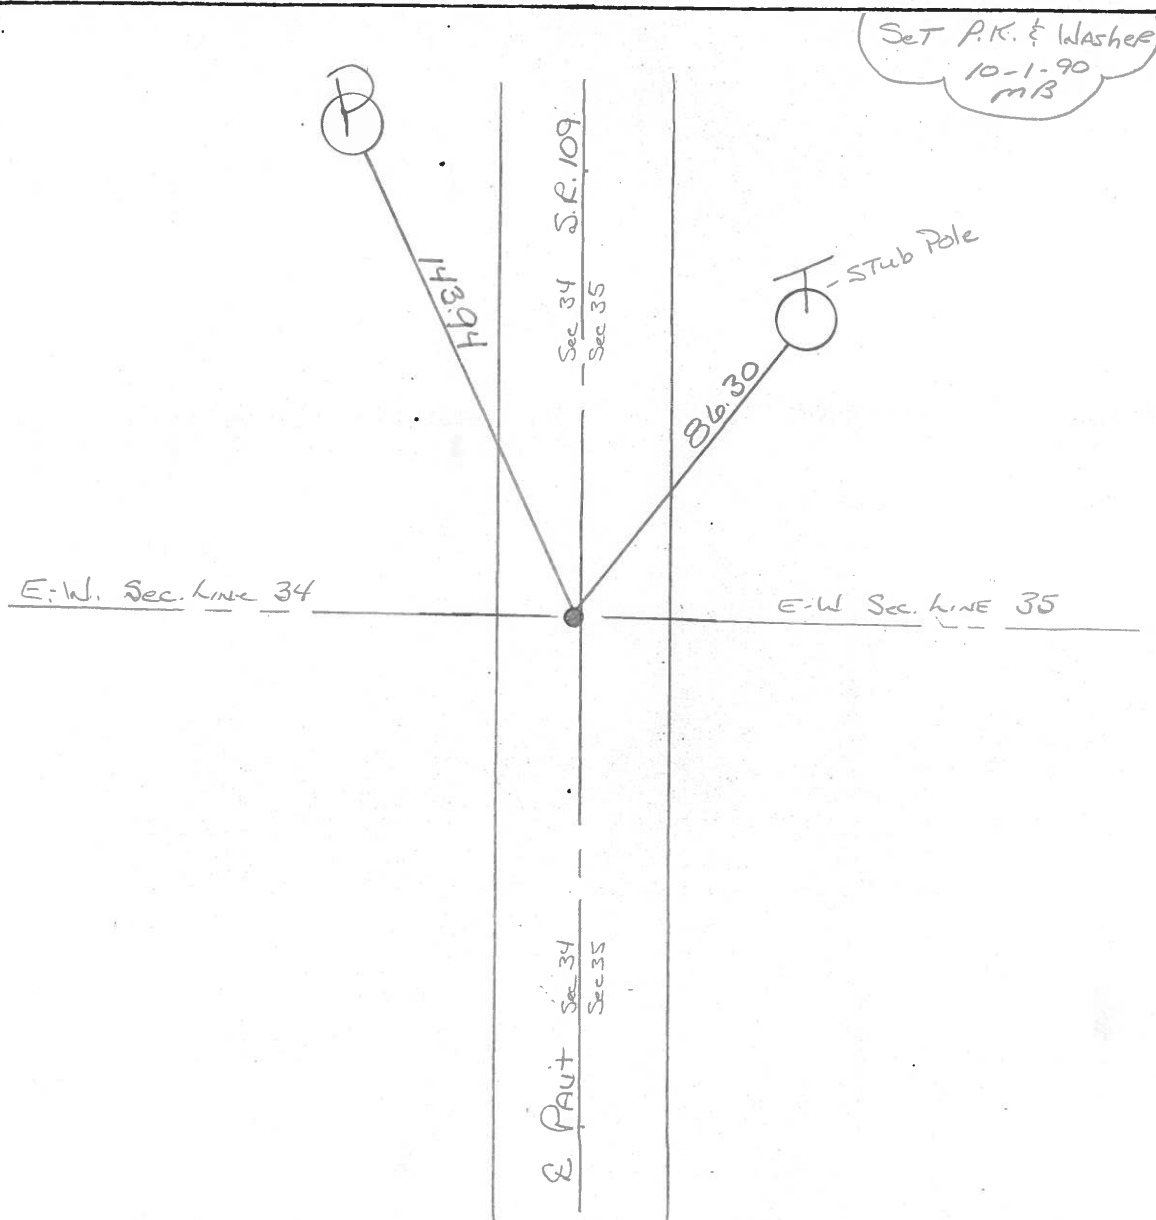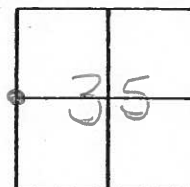

Q.D.O.T. DISTRICT 2 SURVEY OFFICE

SHEET 8 OF

County Fulton S.R. 109

Township PIKE

Section 35

T N, R E

Personnel J. Stone

P. Neuser


R. Michalak

D. Cortis


Date 11 April 84

Weather Fair

Temp. 49°

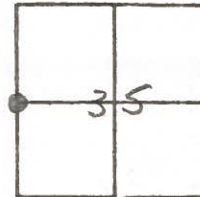

REF. NO. 29

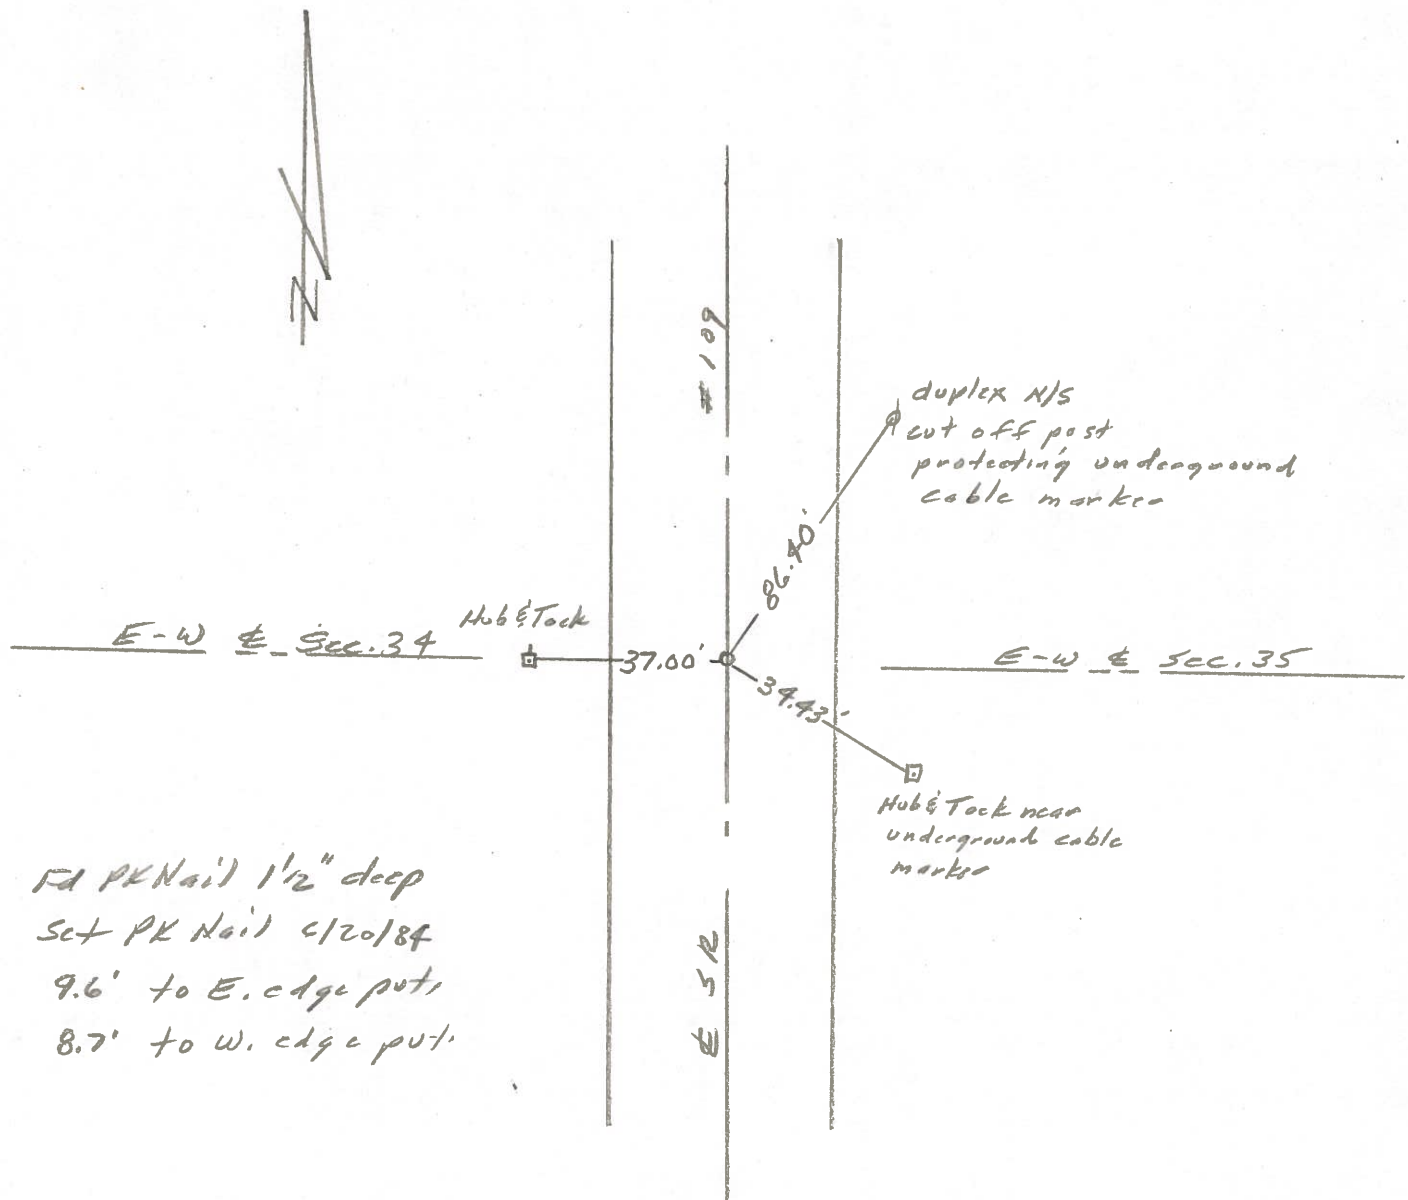

SHEET 8 OF 8

Date 11 April 84

Weather Fair

Temp. 49°

A horizontal number line is shown, divided into 10 equal segments by vertical tick marks. The segments are labeled with integers from 0 to 10. A dot is placed on the tick mark between 3 and 4, and the number 3.5 is written next to it.

N

P. Neuser

R. Michalak

D. Curtis


REF. NO. 29

$$562 + 76$$

P.K. NAIL

O.6 HT F

9.5 TO LT GD

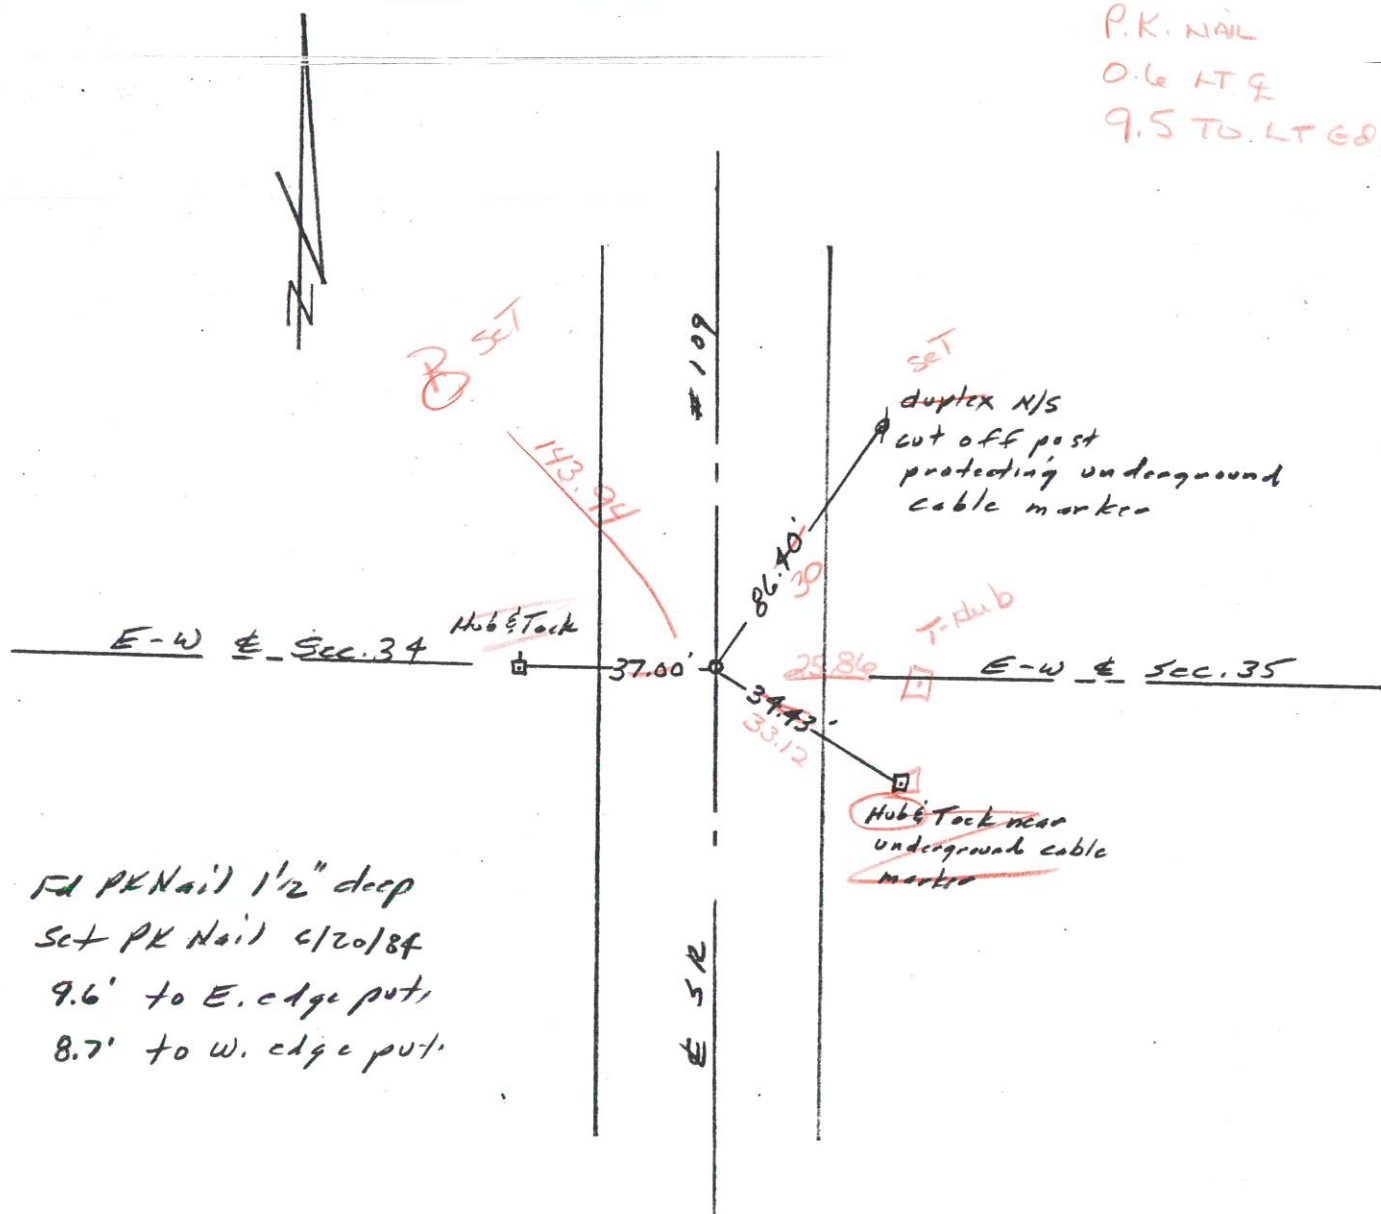

5d PK Nail) 1 1/2" deep
 Set PK Nail) 4/20/84
 9.6' to E. edge put,
 8.7' to W. edge put.

PERSONNEL

TITLE

Chris Stanley

Crew Chief

Justin Arnold

Rod Man

Lee Tennyson

Rod Man

ROAD "8-1" Control Point on 1/4 line

SEC. 35

T- 8-N R- 7-E

CORNER C.P. on 1/4 line TWP. Pike

DATE 5-1-80

WEATHER Sunny 60°

DESCRIPTION

Rewitnessed RR spike on 1/4 line Sta 81+03.03
on re-established Rd R/L &

References Checked 4-2-86

STANLEY, HARRIS

SET HARROW TOOTH AFTER
RESURFACING 11-21-86 CS, JB

Rewitnessed RR spike

on 1/4 Line Sta 81+03.03

SET 1 1/2" PIPE

Ditch

1" Iron
Pipe

1/4 Line Sec. 35

Ditch

Spk + shiner
NW/s Mailbox

Sec 35

Pike

Twp

Top S END
8" CMP
Drive Pipe

Rd "8-1"

OK 4-2-86

ROAD "8-1" + P.I. Control Point Sta 86+63.5

PERSONNEL

TITLE

Chris Stanley

CREW Chief

Justin Arnold

Rod Man

Lee Tennyson

Rod Man

SEC. 35

T- 8-N R- 7-E

CORNER

PI C.P.

TWP. Pike

DATE


5-1-80

WEATHER

Sunny 60°

DESCRIPTION

Witnessed Harrow tooth PI Control Point Sta 86+63.59
on re-established Rd. Rte.

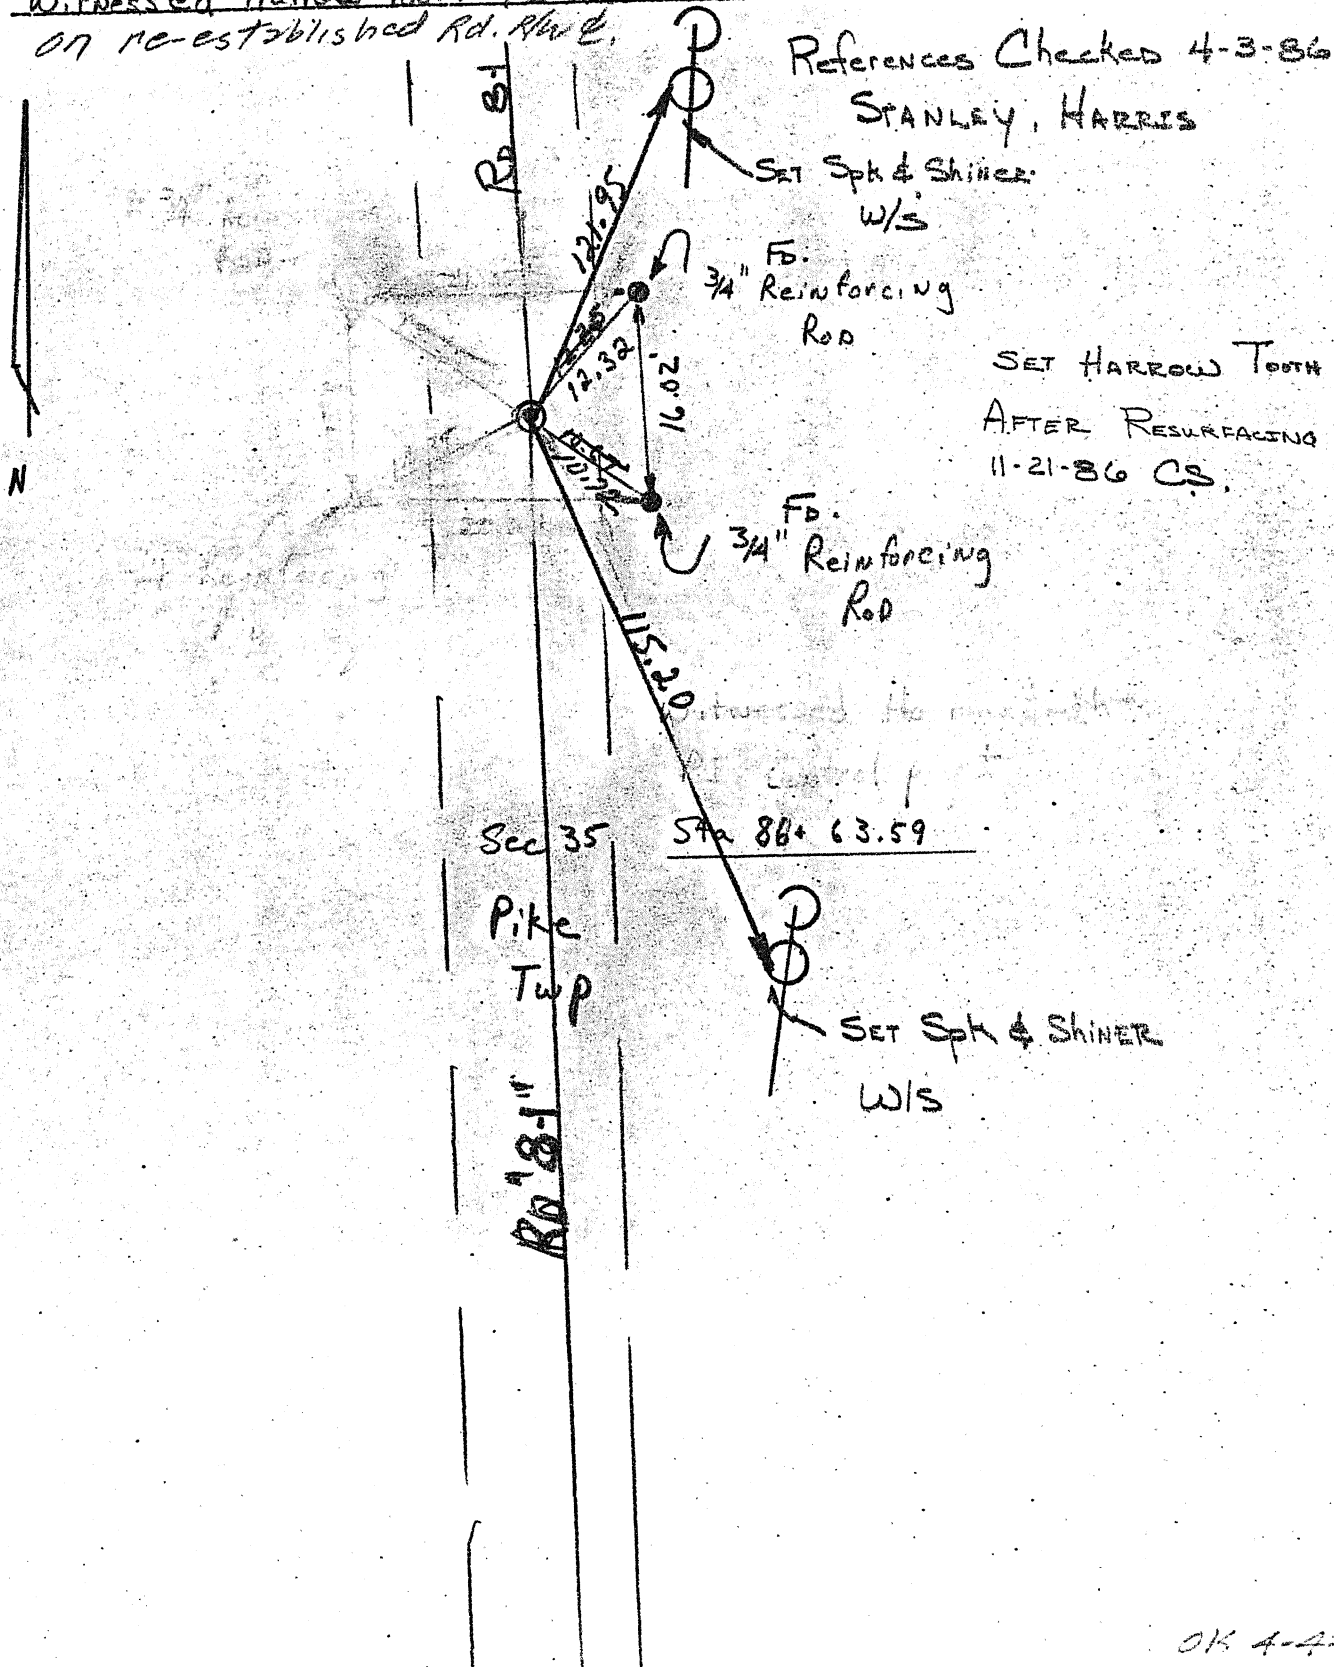

ROAD "8-1" P.I. Control Point Sta 92+06.20

PERSONNEL

TITLE

Chris Stanley

Crew Chief

Justin Arnold

Rod Man

Lee Tennyson

Rod Man

SEC. 35

T- 8-N R- 7-E

CORNER PI C.P.

TWP. Pike

DATE 5-1-80

WEATHER Sunny 60°

DESCRIPTION

Witnessed RR spike P.I. Control Point Sta 92+06.20
on Re-established Rd. R/W

References Checked 4-3-86

STANLEY, HARRIS

SET HARROW TOOTH


AFTER RESURFACING 11-21-86

CS, JD


N

Survey Stake

RD "8-1"

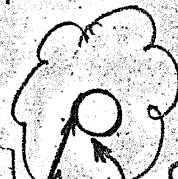

Spk + shiner
NW/s 16"
Black Walnut

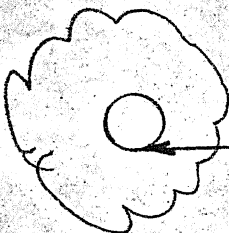

Spk + shiner
S/s 28"
Sugar Maple

30.47
30.50

Witnessed RR spike
P.I. Control Point
Sta 92+06.20


Sec 35

Pike
Twp

62.45
62.50



RD "8-1"

Spk + shiner
NE/s 30"
Sugar
Maple

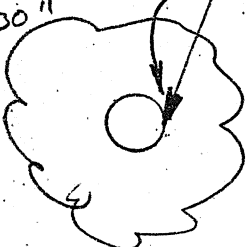


OK 4-2-

PERSONNEL	TITLE	PERSONNEL	TITLE	COUNTY	DATE	WEATHER
Red Beach				Fulton	17 Feb '77	
W. Knape				109		
				PIKE TWP		
DESCRIPTION				TEMP	JOB NO.	

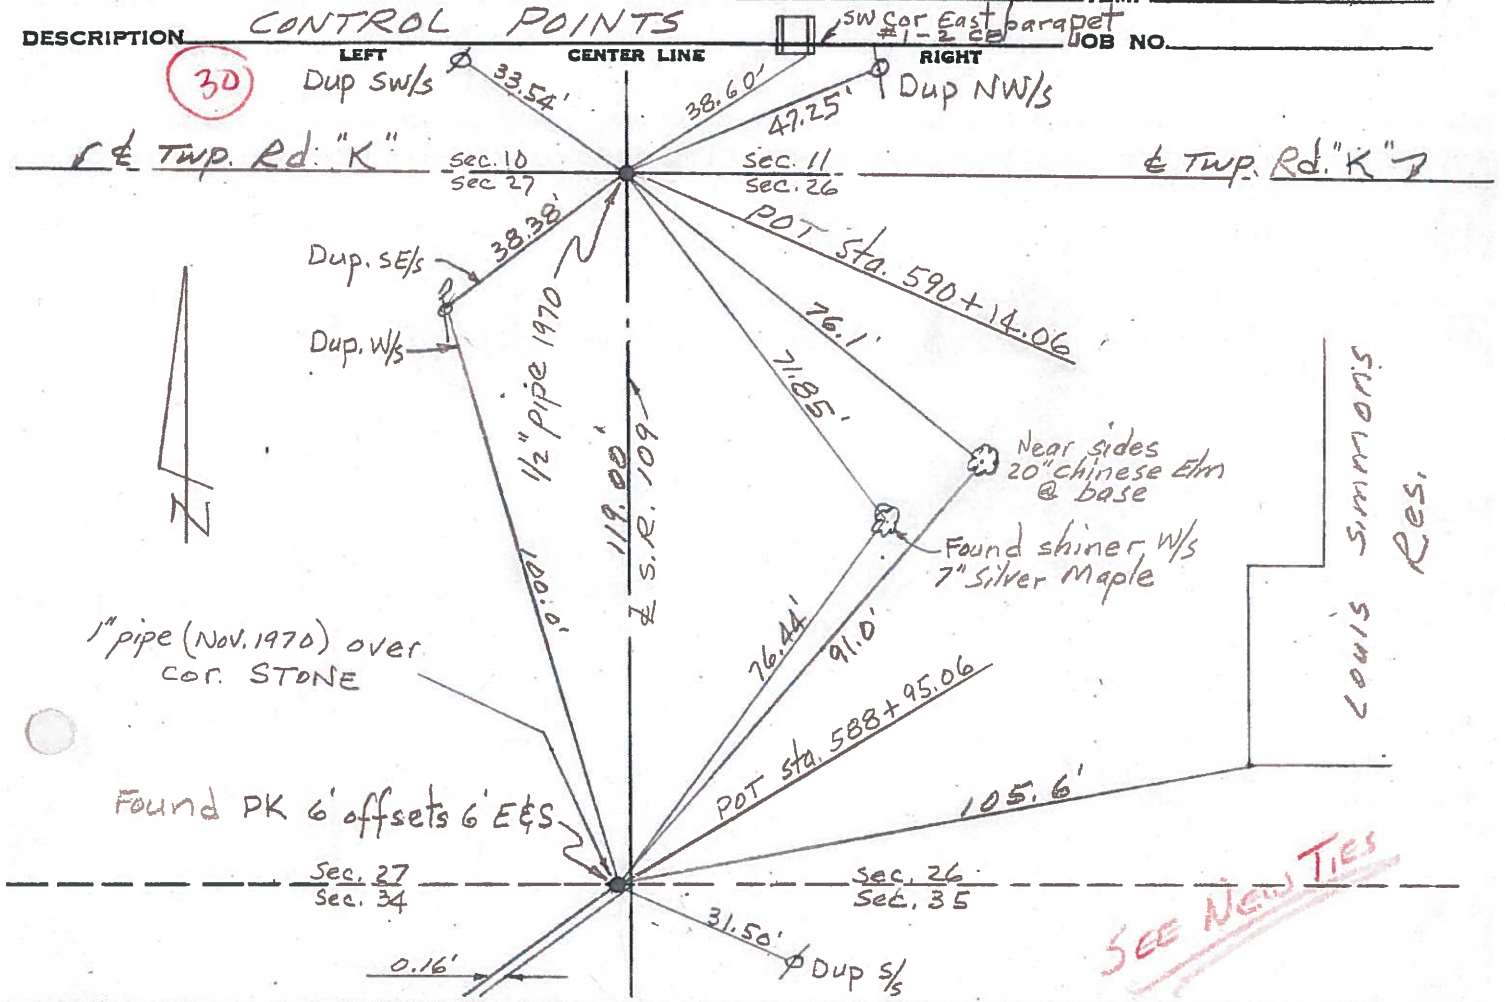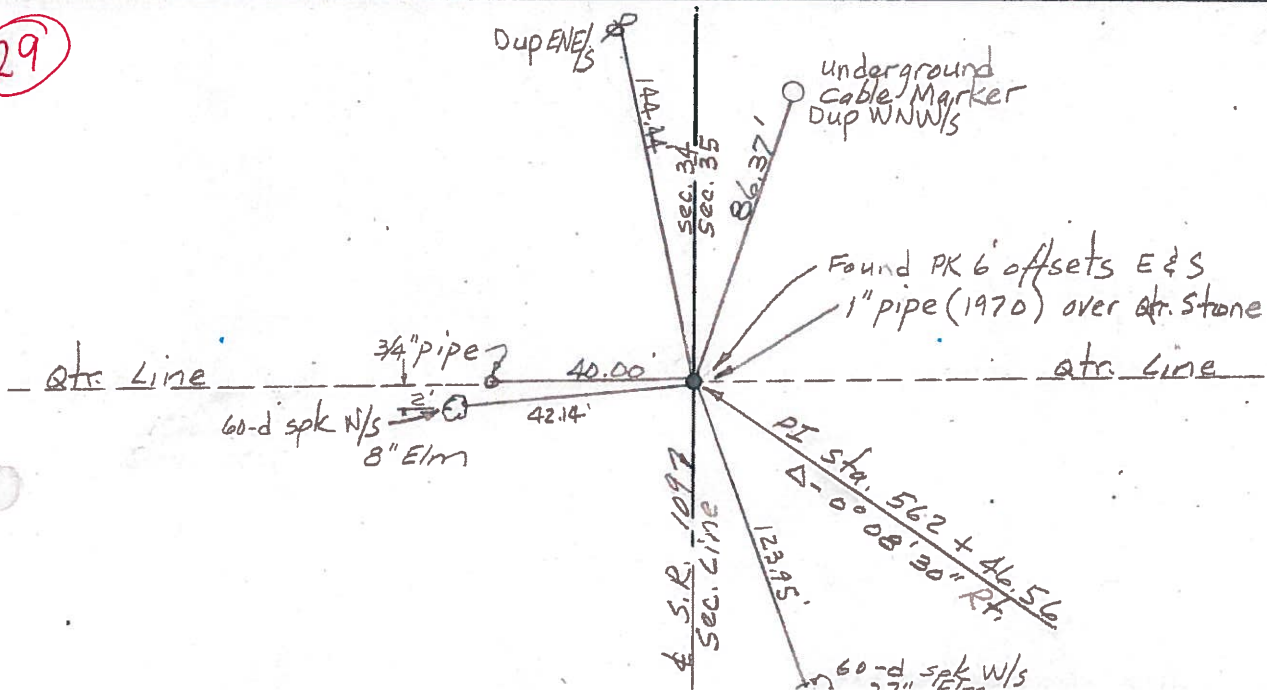**29**

PERSONNEL	TITLE	PERSONNEL	TITLE	COUNTY	DATE	WEATHER	TEMP
Tomsie		Granata		Fulton	July-18-73	clear	85°
Neusser				S. R. 109			
Vango				SEC.			
Boyle							

DESCRIPTION MON. LEFT CENTER LINE RIGHT JOB NO. 024610

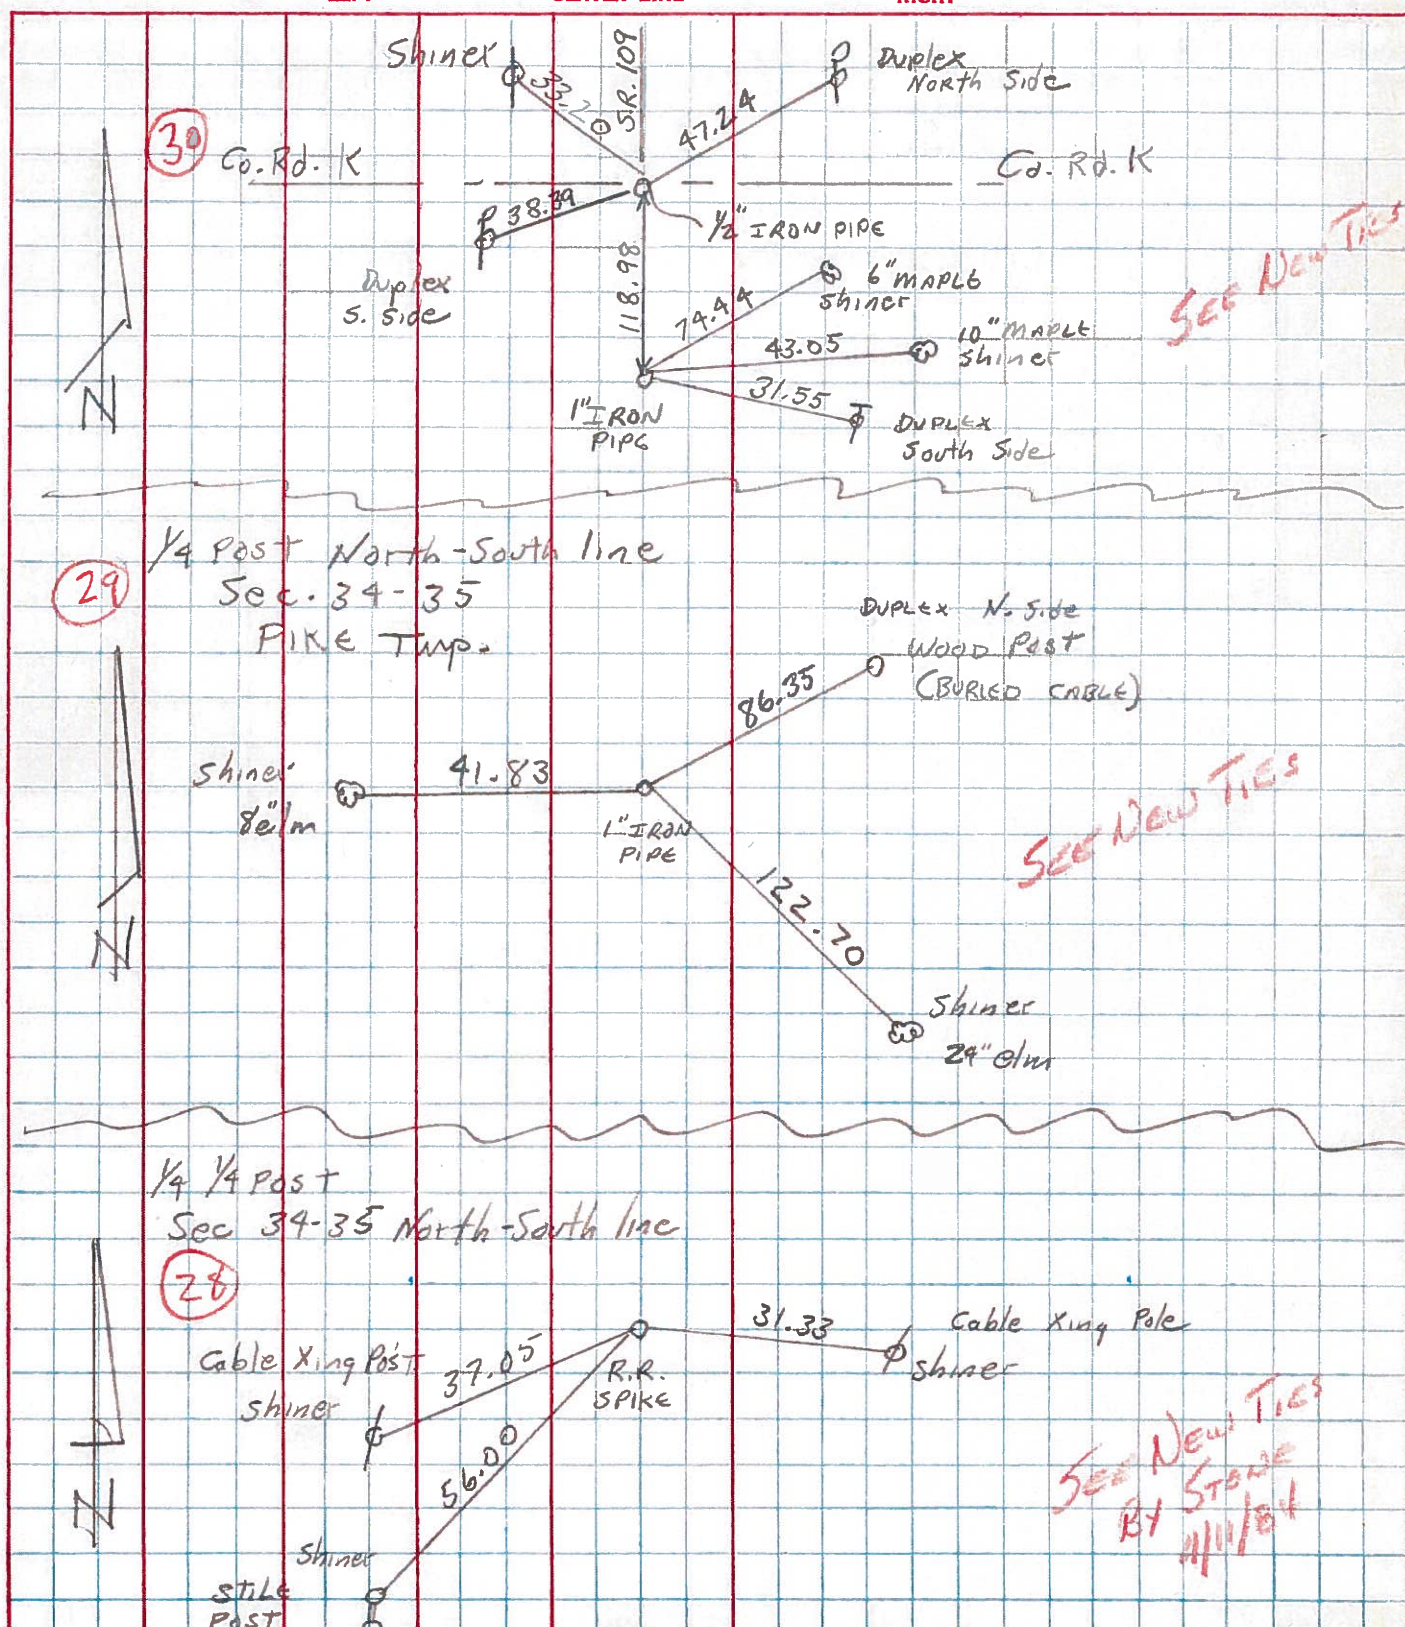





PERSONNEL	TITLE	PERSONNEL	TITLE
Red Beach			
Newcomb			
Knappe			
Wise			

COUNTY FULTON DATE Nov, 1970

S. R. 109 WEATHER _____

SEC. PIKE Twp TEMP. _____

DESCRIPTION _____ CONTROL POINTS _____ JOB NO. _____

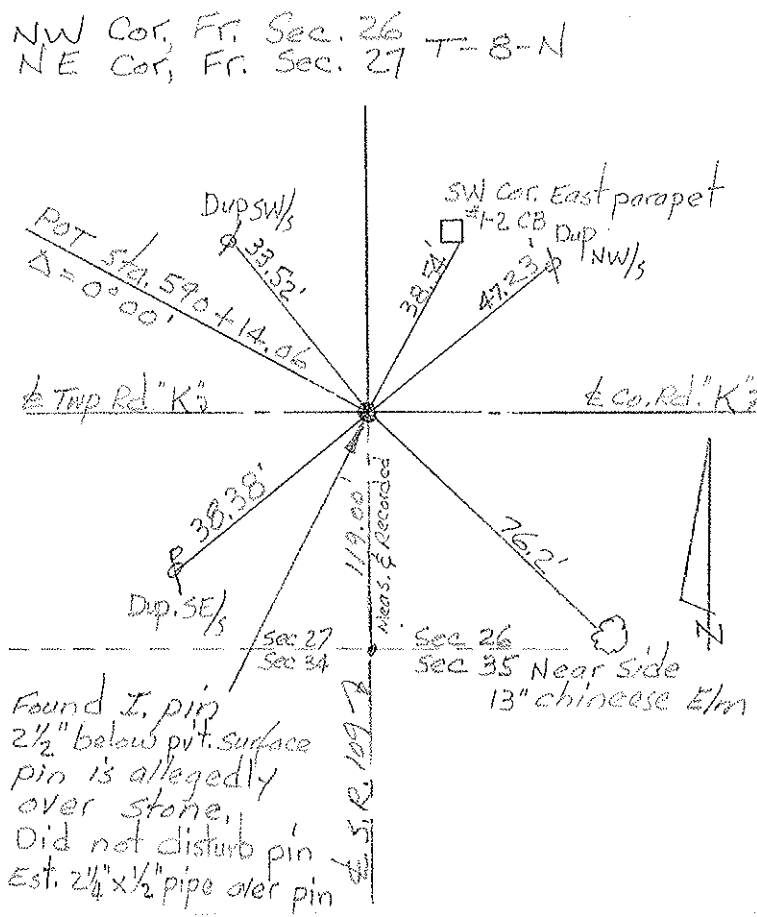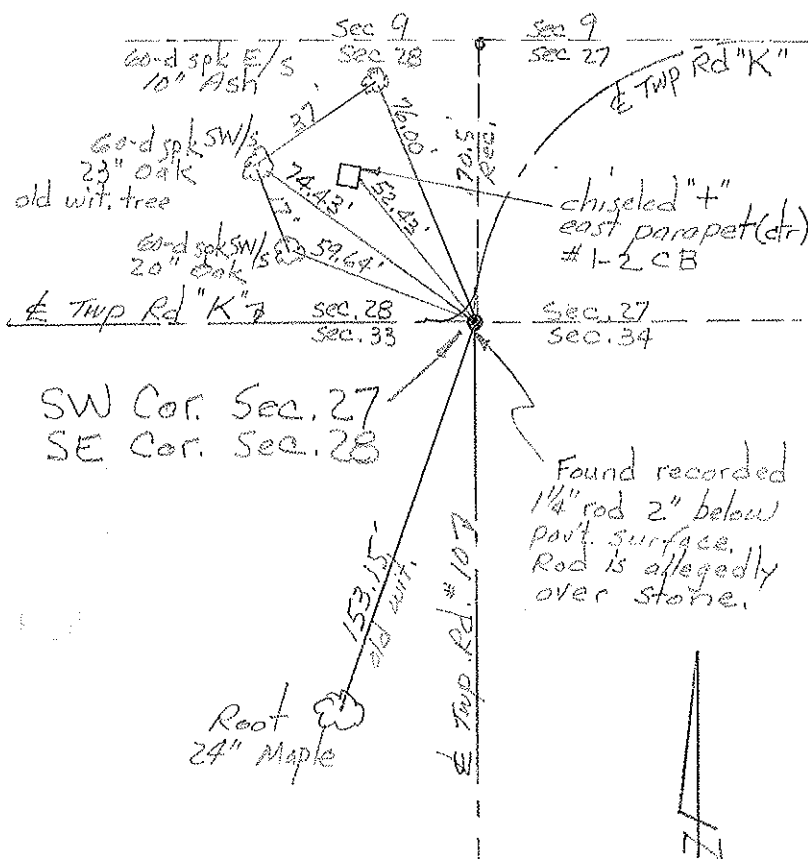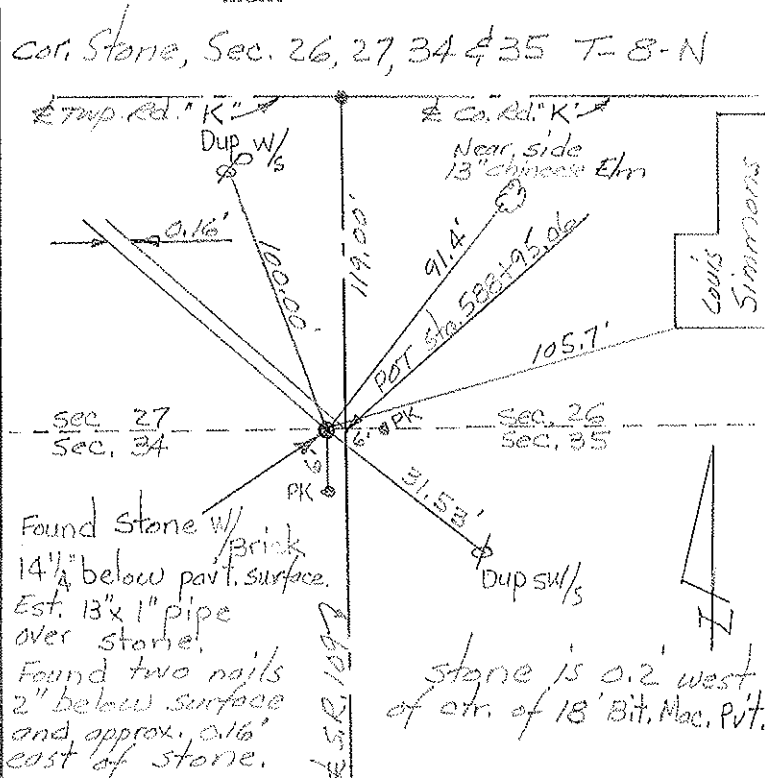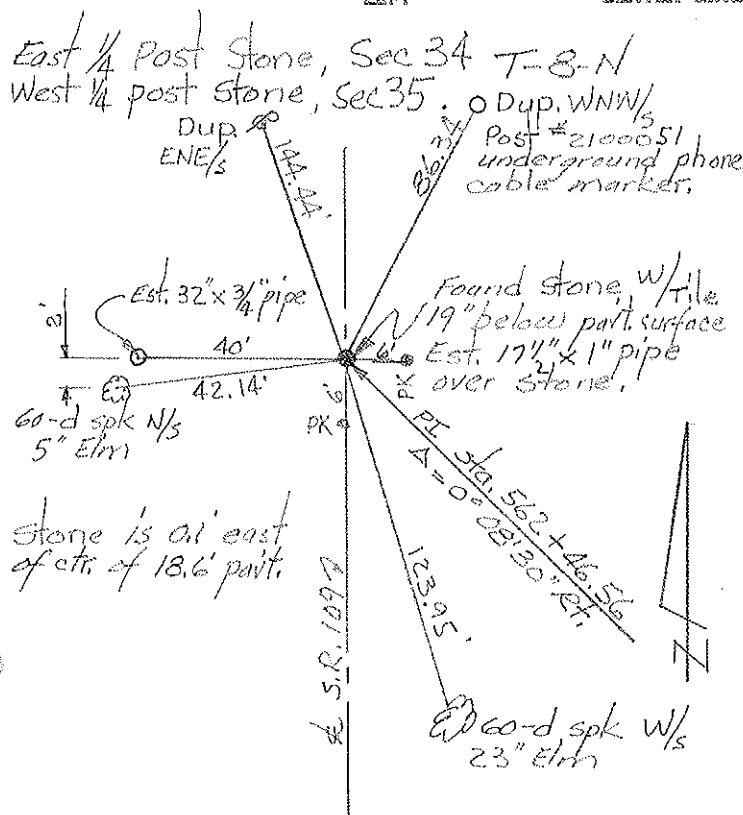

PERSONNEL	TITLE	PERSONNEL	TITLE	COUNTY	DATE
Red Beach				FULTON	OCT-NOV. '70
Newcomb				S. R. 109	WEATHER
Knappe				SEC. PIKE TWP	TEMP.
Wise					
ALIGNMENT & CONTROLS				JOB NO.	

