

O.D.O.T. DISTRICT 2 SURVEY OFFICE (USE ONLY)

PERSONNEL

REFERENCE NO. 29 A

SHEET 13 OF 35

NOTES RHOADES

DATE 4/26/21

ROUTE SR 109

H.C. O'DONNELL

WEATHER CLOUDY

COUNTY FULTON

R.C. NIESE

TEMP. 45°

TOWNSHIP YORK

SECTION 27

DWG BY NIESE

PID PAVE TRAIN

T 8 N R 7 E

TYPE MONUMENT MAG/WASHER

ON SURFACE - ~~BELOW~~ ON

OFFSET 0.8' LT : ~~RT~~

9.2' TO LT EDGE PAVEMENT

STATION: 589+19.01


HORIZ.DATUM: NAD83(2011)

GEOID: 2018

GRID: NORTHING: 714488.408

EASTING: 1548129.308

27

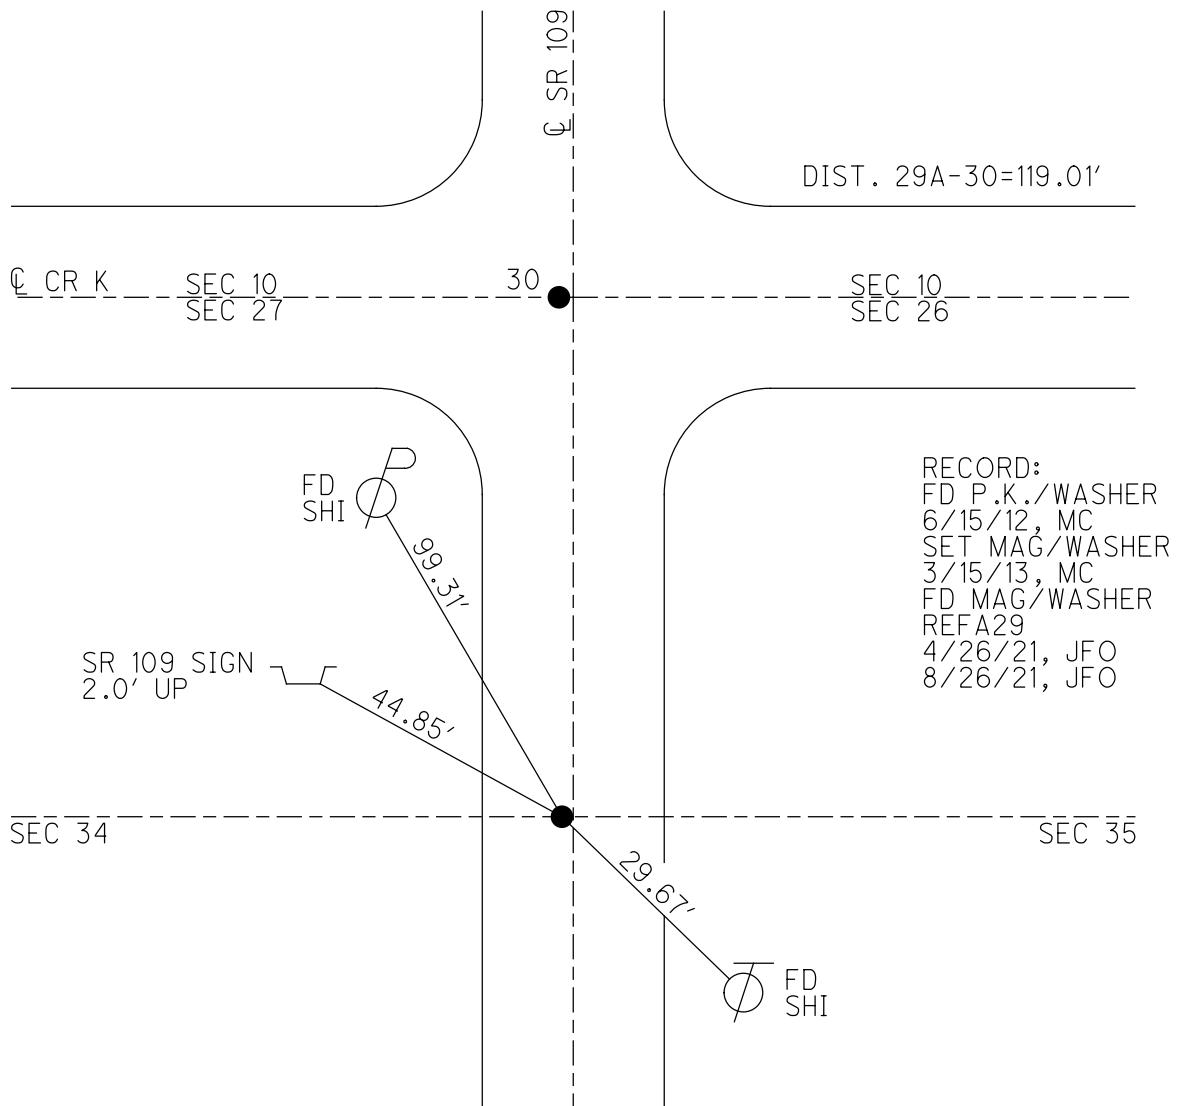

O.D.O.T. DISTRICT 2 SURVEY OFFICE (USE ONLY)

PERSONNEL

REFERENCE NO. 29-A

SHEET 14 OF 35

NOTES CANTERBURY

DATE 06-15-12

ROUTE SR 109

H.C. ROUSOS

WEATHER FAIR

COUNTY FULTON

R.C. CANTERBURY

TEMP. 75°

TOWNSHIP PIKE

HARBAUGH

SECTION 27

COUTCHER

T 8 S R 7 E

TYPE MONUMENT PK/WASHER



ON SURFACE - BELOW ON

LEFT - Q PAV'T - RIGHT 0.8'

9.2' TO LT EDGE PAVEMENT

S.L.M. 589+76

Grid: Northing: 714488.456 Easting: 1548129.237

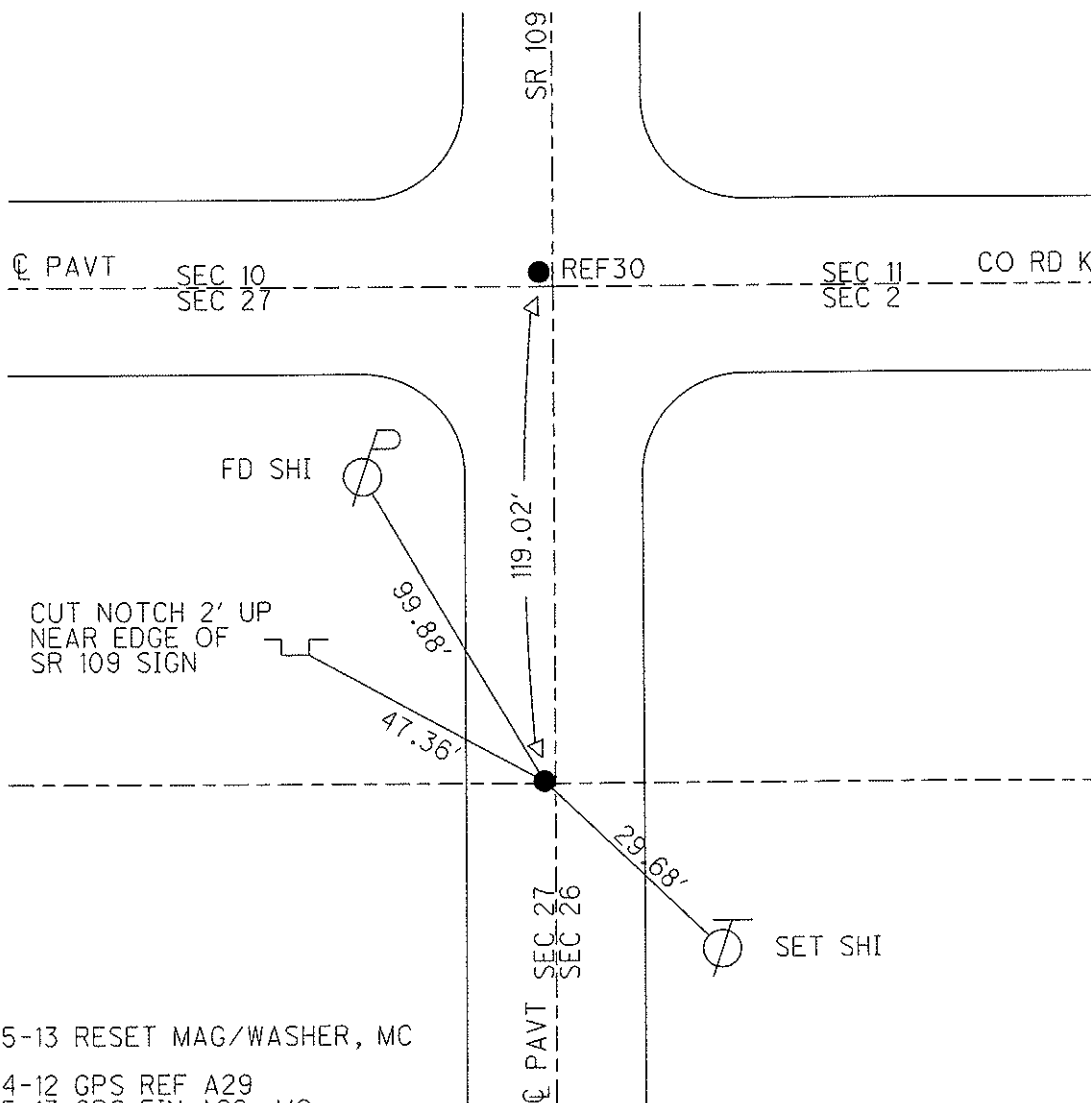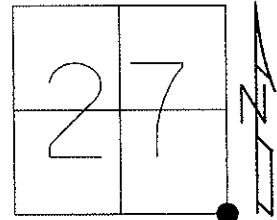

03-15-13 RESET MAG/WASHER, MC

06-14-12 GPS REF A29

03-15-13 GPS FIN A29, MC

O.D.O.T. DISTRICT 2 SURVEY OFFICE

PERSONNEL

REFERENCE NO. 30

SHEET 12 OF 28

NOTES CANTERBURY

H.C. ROUSOS

R.C. LOEHRKE

DATE 8-20-96

WEATHER FAIR

TEMP. +85

ROUTE S.R. 109

COUNTY FULTON

TOWNSHIP PIKE

SECTION NE COR. SEC 27

T 10 S R 3 E

TYPE MONUMENT P.K. & WASHER Reset 10-2-97
C.L.

ON SURFACE - BELOW YES

LEFT- & PAVT. - RIGHT ON &


TO EDGE PAVEMENT

S.L.M. 17+987.10 4.0 N OF & W.

10	11
27	26
34	35



(RECORD STA 590+43)

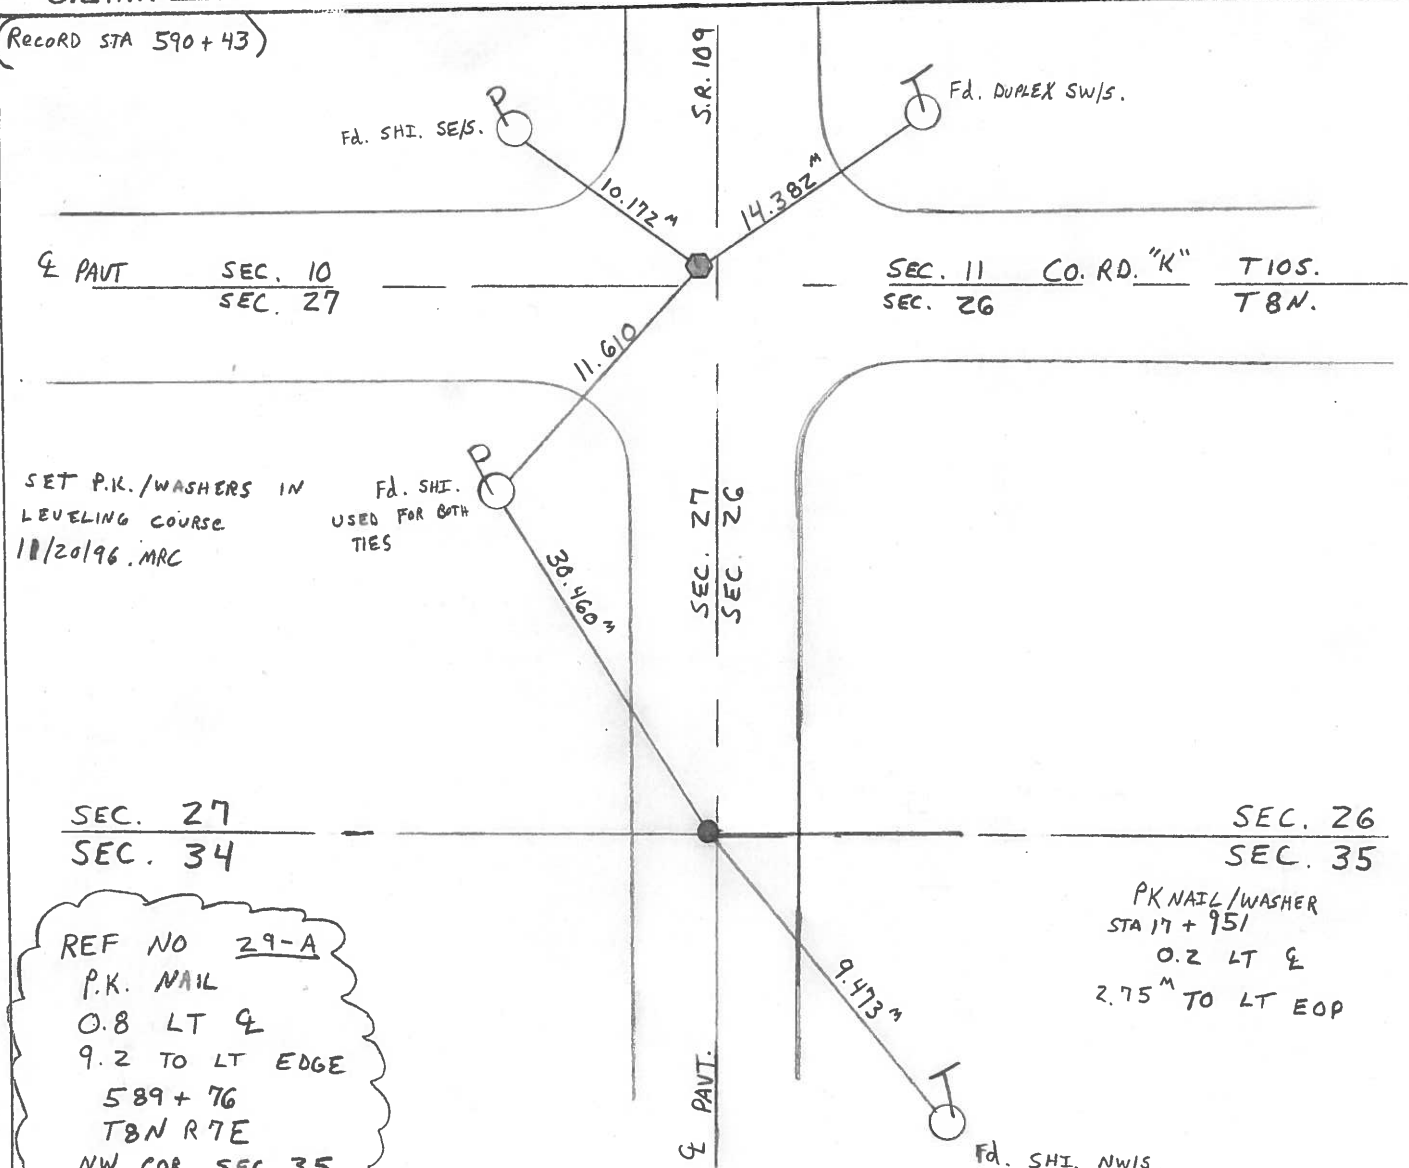

REF NO 29-A
P.K. NAIL
0.8 LT &
9.2 TO LT EDGE
589+76
TBN R7E
NW COR. SEC. 35

O.D.O.T. DISTRICT 2 SURVEY OFFICE

PERSONNEL

REFERENCE NO. 30

SHEET OF

NOTES BARNHISEL

H.C. " "

R.C. HOFFMAN

DATE 8-31-90

WEATHER Clear

TEMP. +77°

ROUTE 109

COUNTY Fulton

TOWNSHIP PIKE

SECTION NE COR. SEC 27

T 10 S R 3 E

TYPE MONUMENT Sm RE Spk

ON SURFACE - BELOW YES

LEFT- & PAV'T. - RIGHT 0.8

- TO - EDGE PAVEMENT


S.L.M. 590 + 43

4.0 N of & W.

10	11
27	26
34	35



Set P.K. & Washer
10-1-90
MB

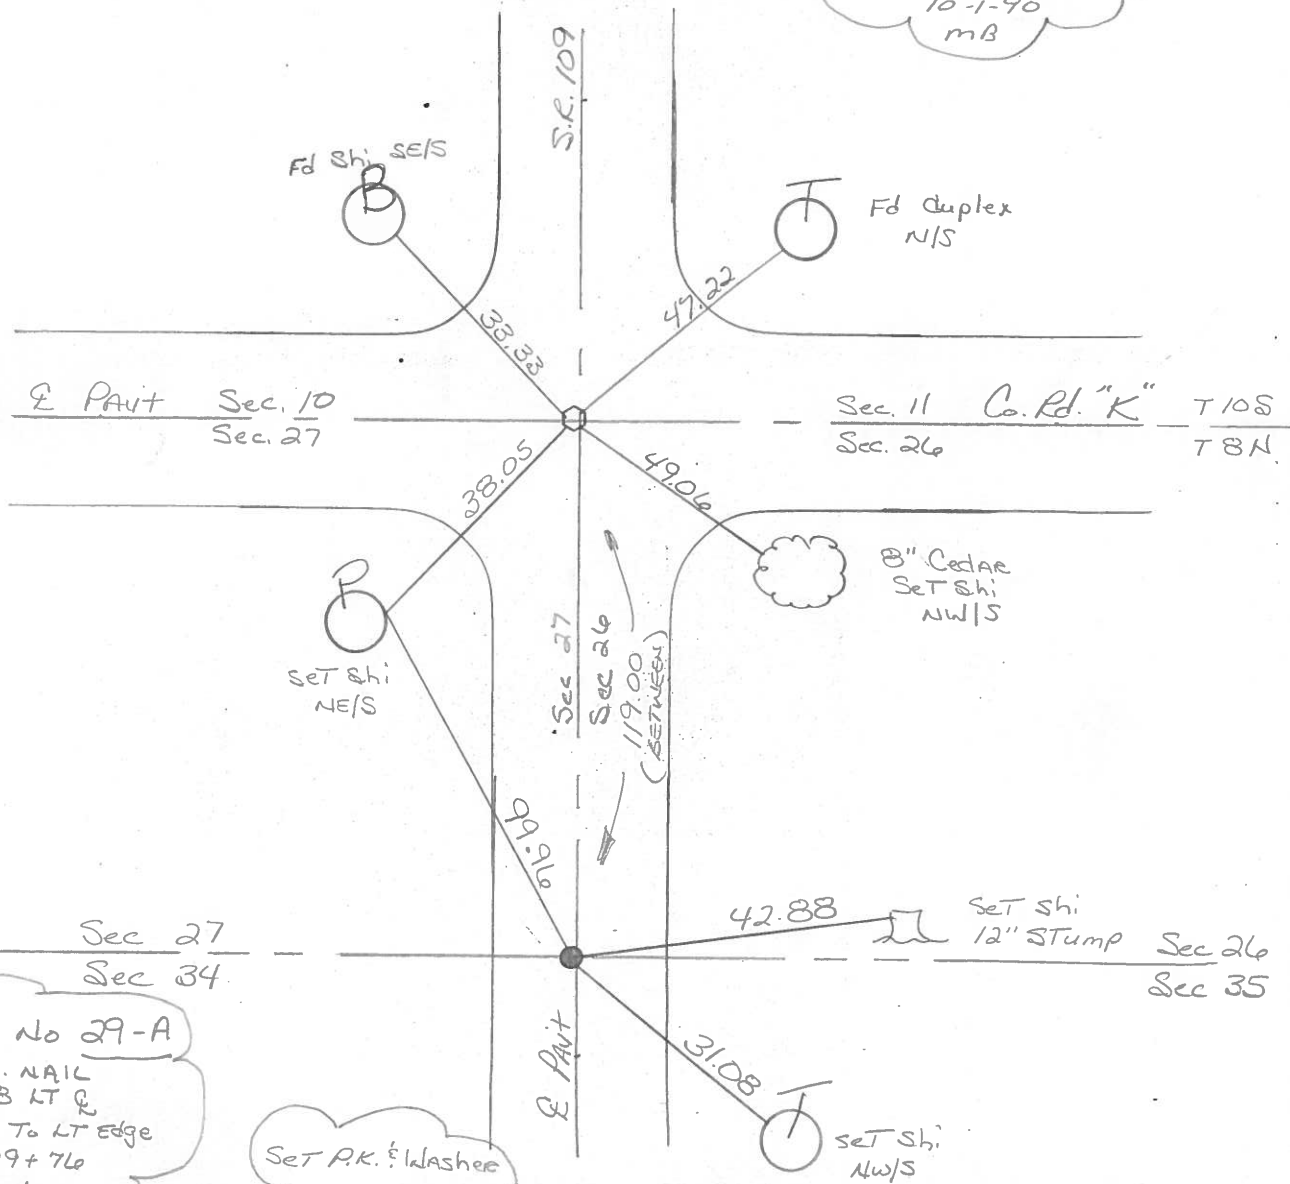

Ref No 29-A

P.K. NAIL

0.8 LT &

9.2 To LT Edge

589 + 76

T8N

R 7 E

Sec NW COR. 35

Set P.K. & Washer
10-1-90
MB

Q.D.O.T. DISTRICT 2 SURVEY OFFICE

SHEET 9 OF

County Fulton S.R. 109

Township PIKE

Section 10-11-26-27

T N, R E

Personnel L. Stone

P. Neusco

P. Michalak

D. Curtis

Date 11 April 84


Weather Fair

Temp. 50°

10	11
27	26



REF. NO. 30

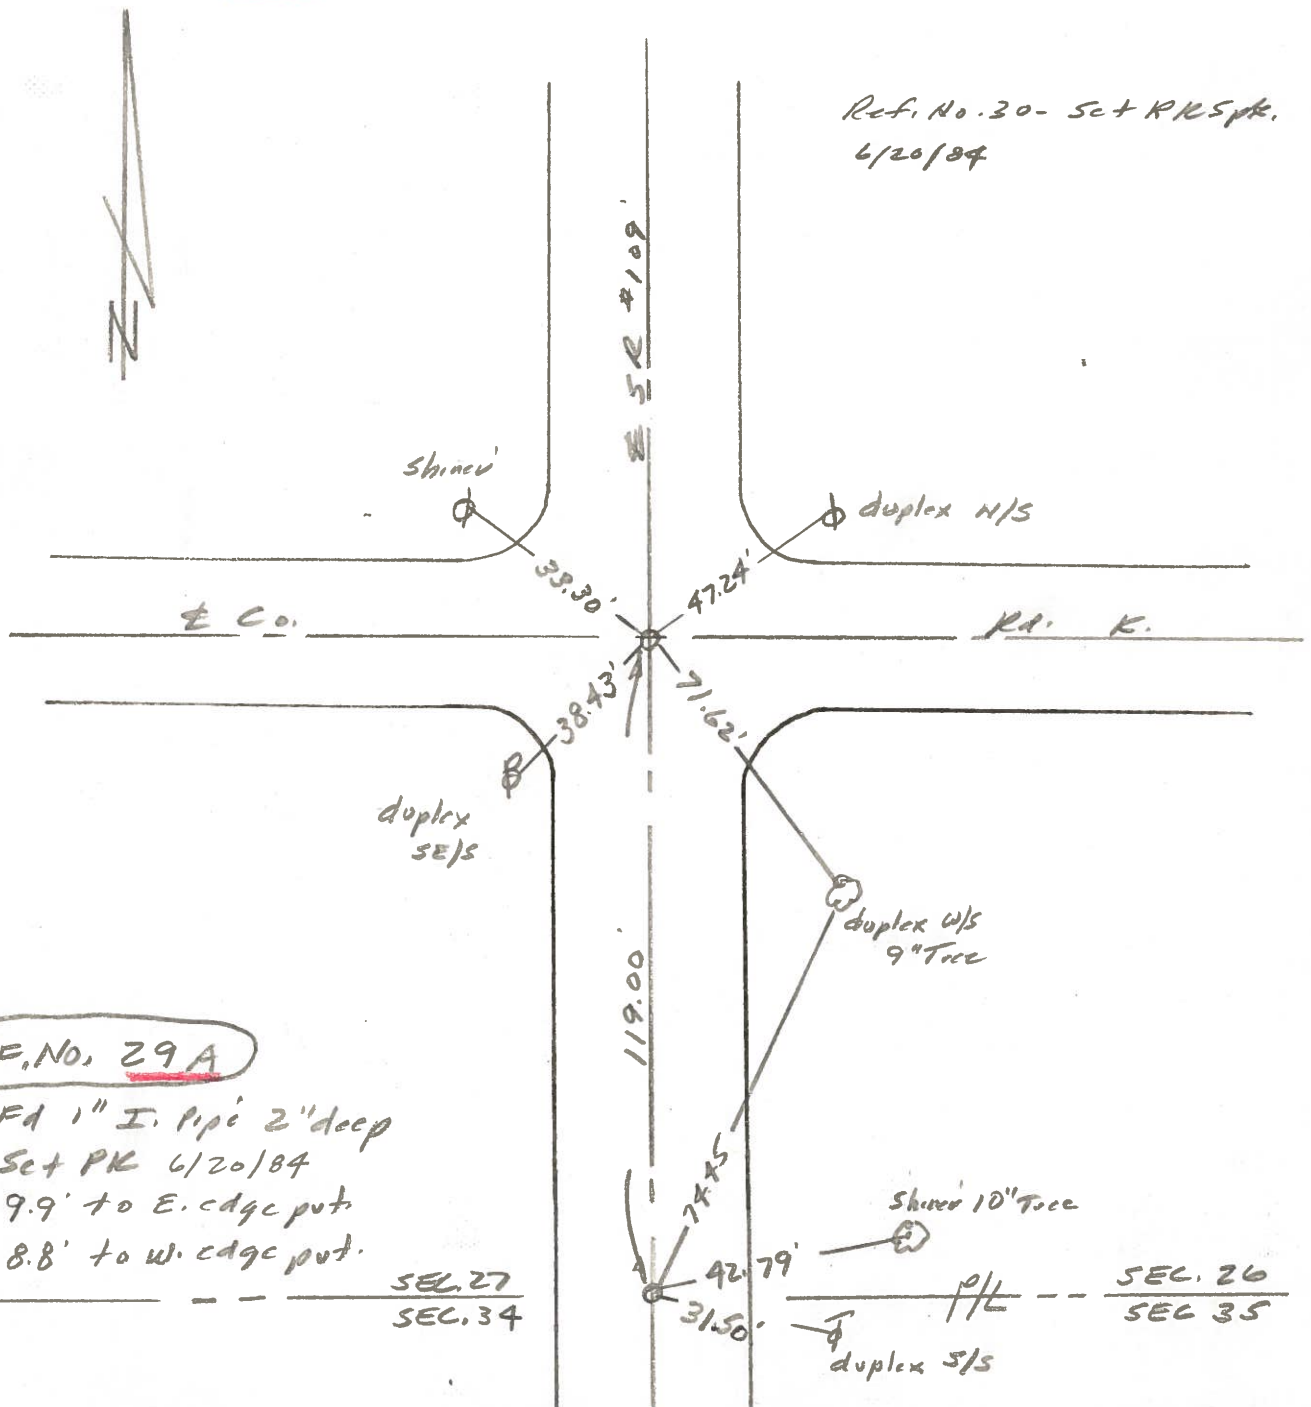

REF. NO. 29A

Fd 1" I. Pipe 2" deep

Set PK 6/20/84

9.9' to E. edge put

8.8' to W. edge put.

SEC. 27
SEC. 34

SEC. 26
SEC. 35

duplex S/S

Date 11 April 84

Weather Fair

Temp. 50°


10	11
27	26

N
A

10 | 11

27 | 26

REF. No. 30

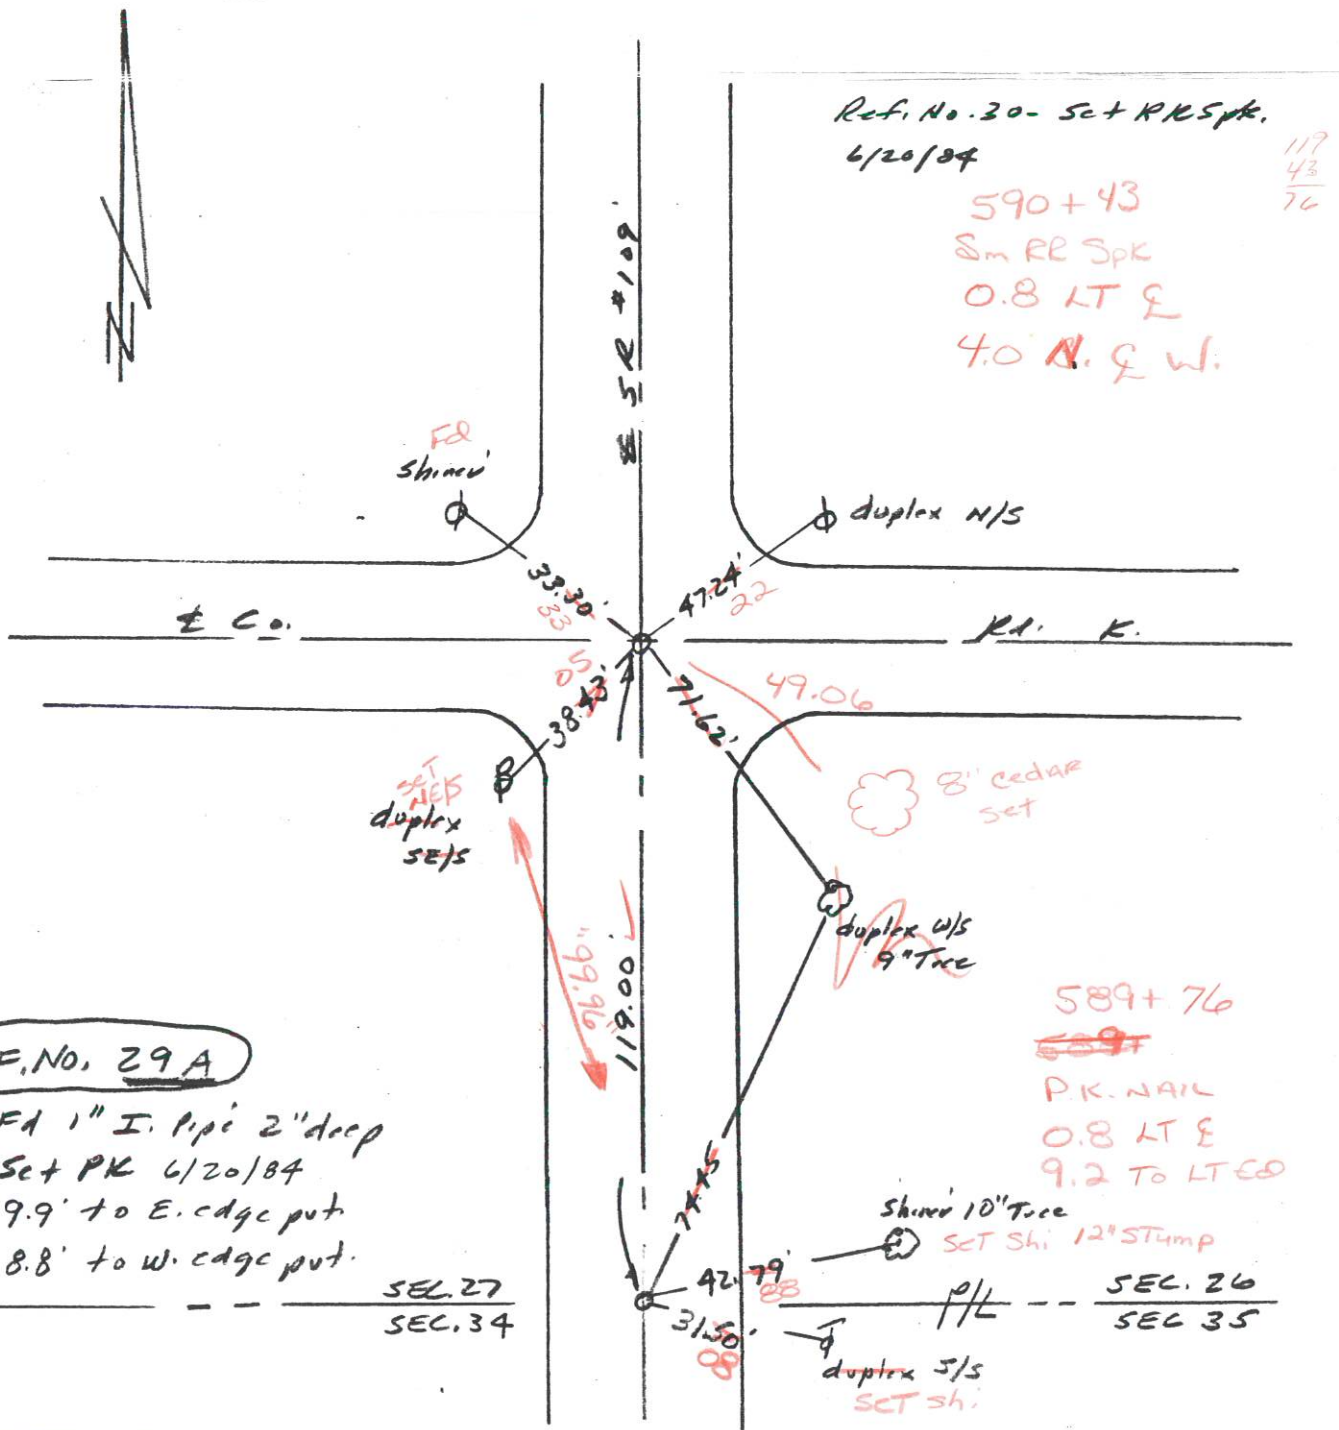



PERSONNEL	TITLE	PERSONNEL	TITLE
Red Beach			
W. Krape			

COUNTY Fulton DATE 17 Feb '77

S. R. 109 WEATHER _____


SEC. PIKE TWP TEMP. _____

DESCRIPTION CONTROL POINTS JOB NO. _____

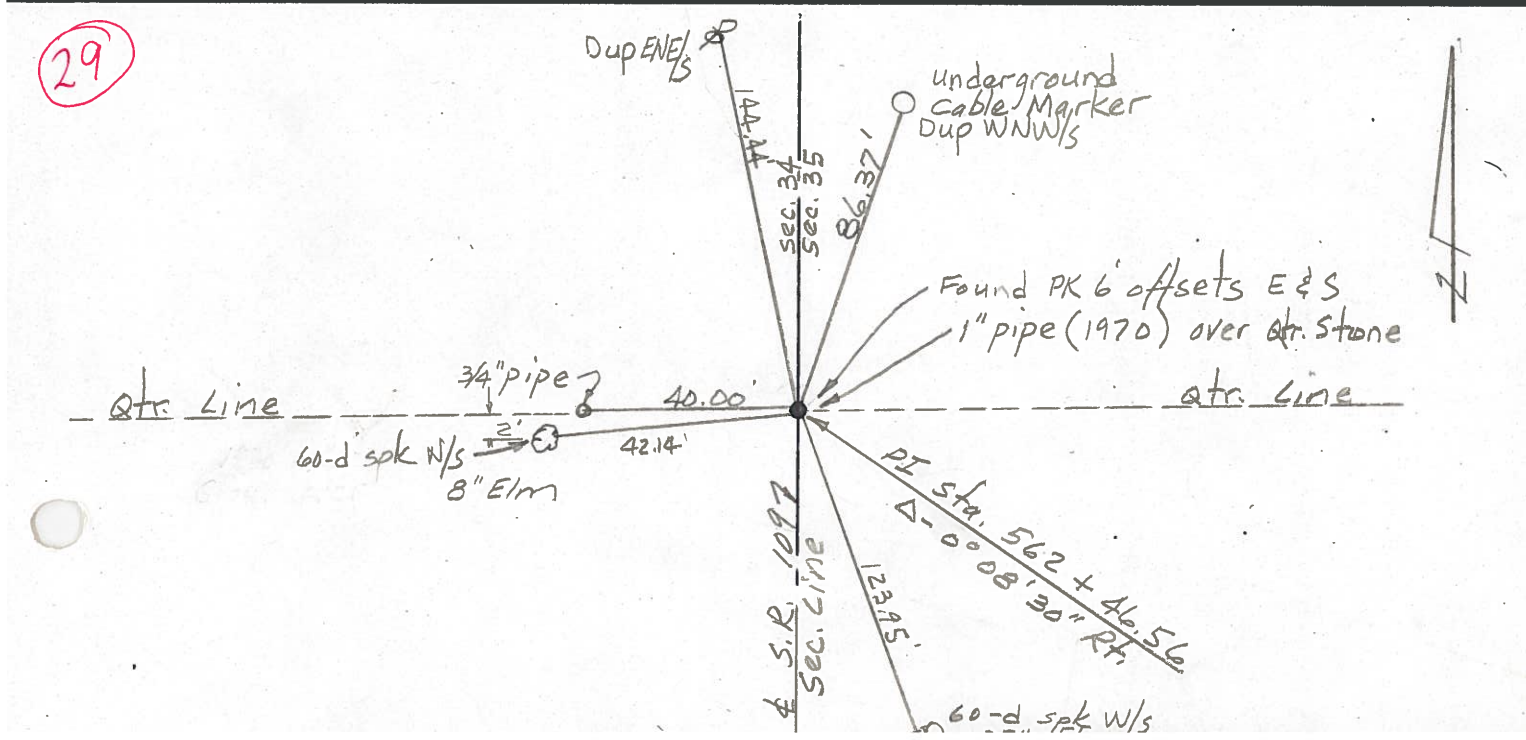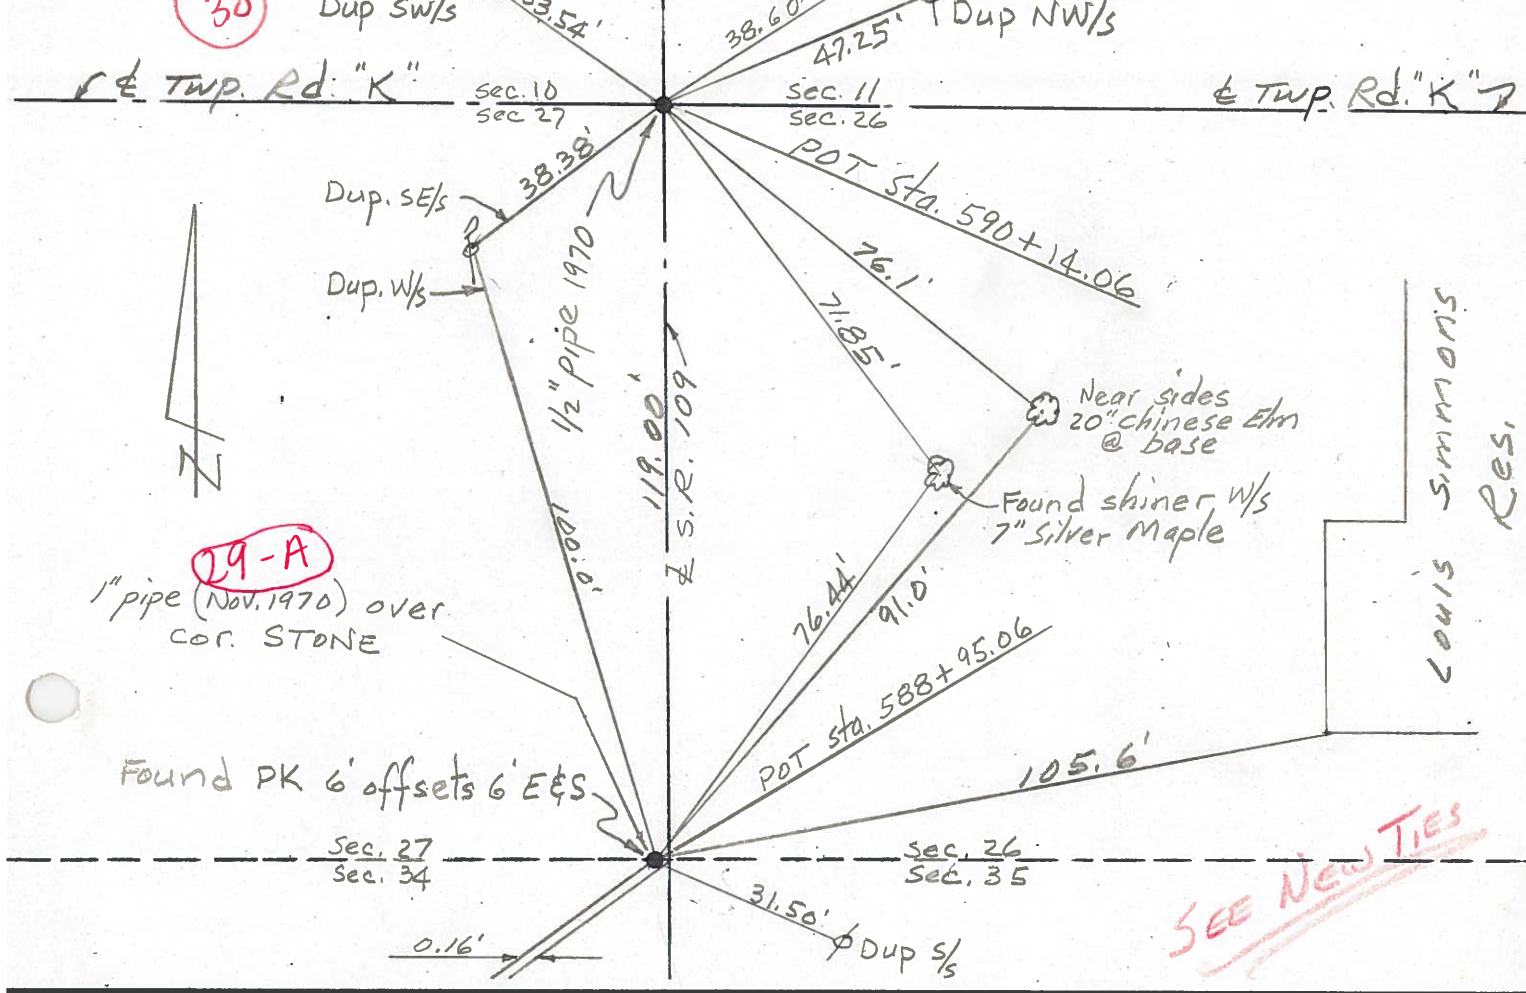





PERSONNEL	TITLE	PERSONNEL	TITLE	COUNTY	DATE	WEATHER	TEMP
Tomsie		Granata		Fulton	July-18-73	clear	85°
Neusser				S. R. 109			
Vango				SEC.			
Boyle							

DESCRIPTION MON. LEFT CENTER LINE RIGHT JOB NO. 024610

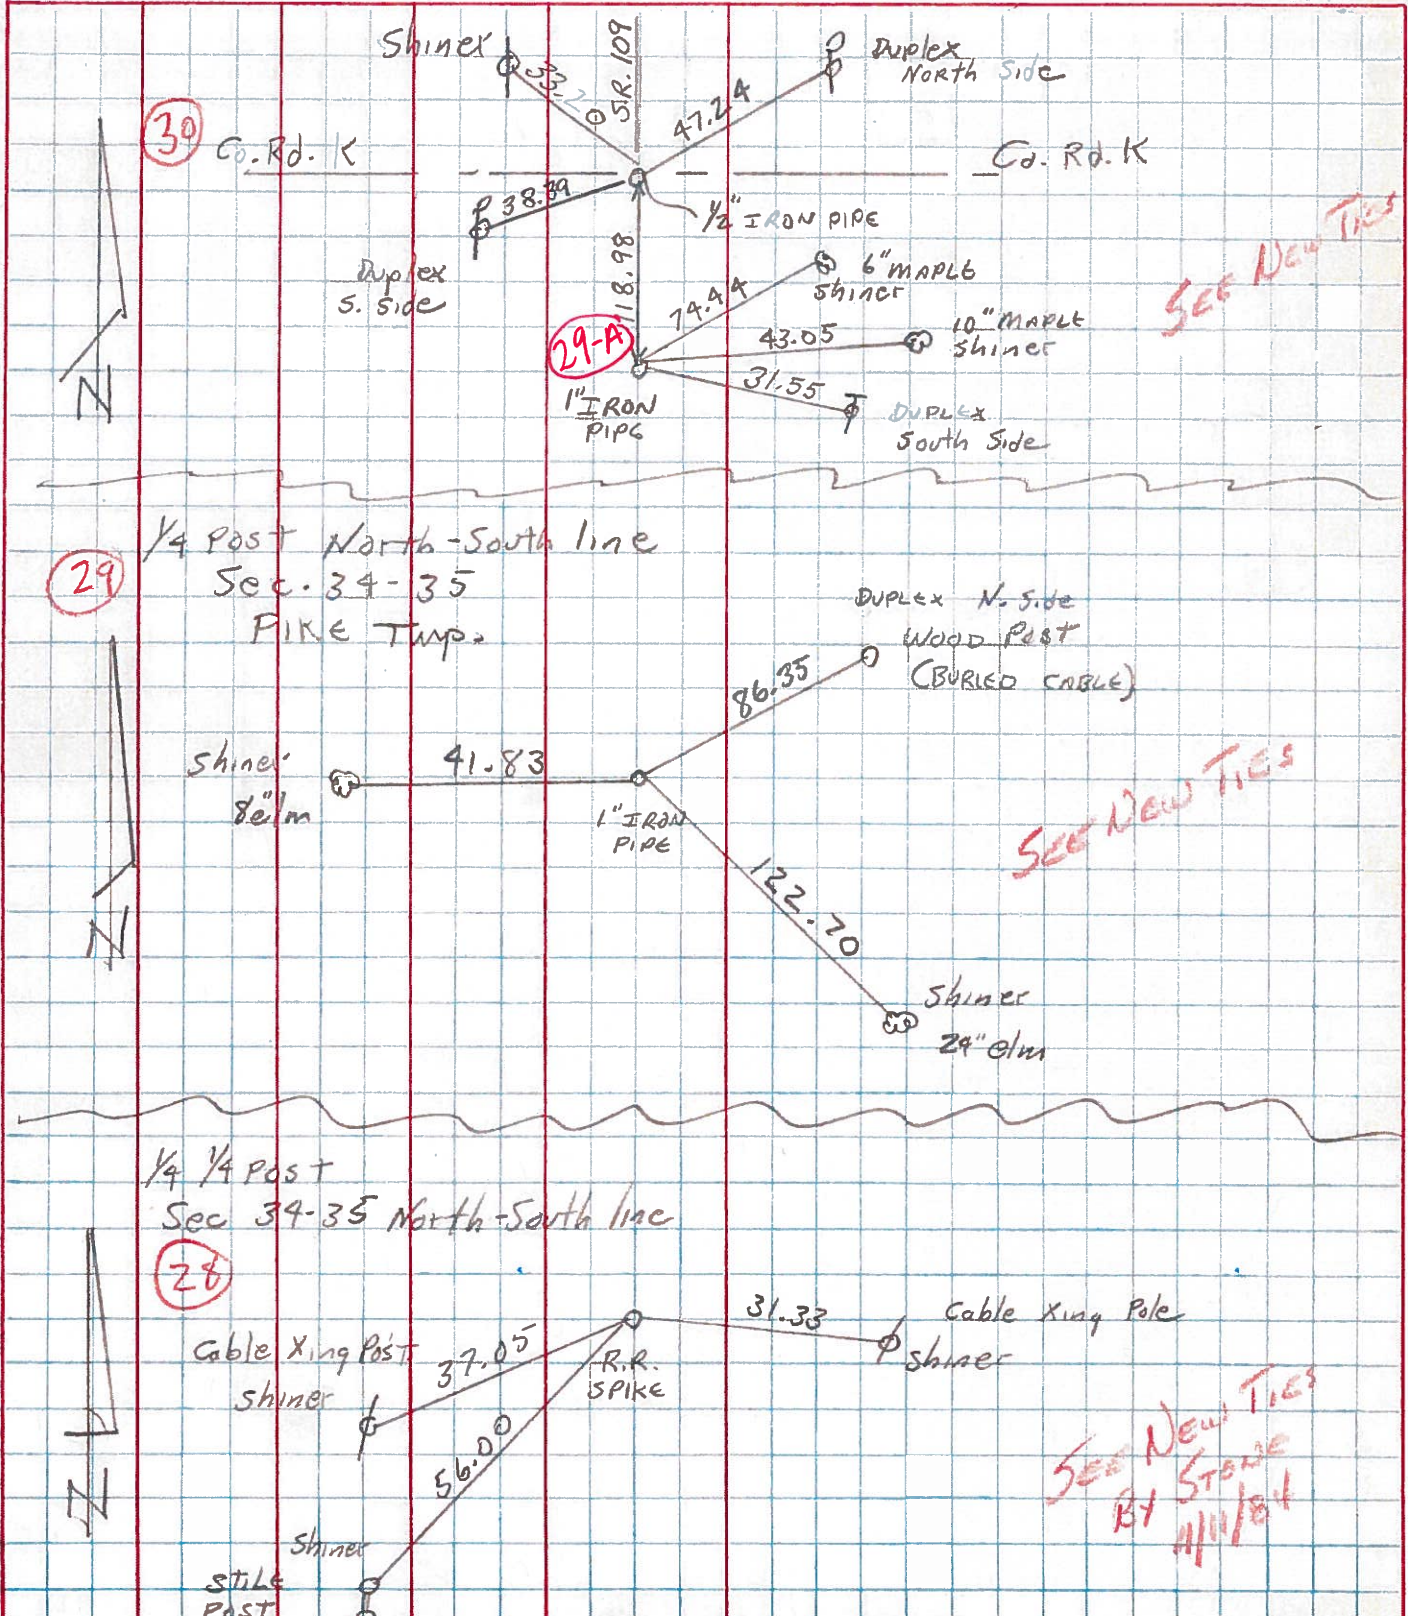

PERSONNEL	TITLE	PERSONNEL	TITLE	COUNTY	DATE
Red Beach				FULTON	Nov, 1970
Newcomb				S. R. 109	WEATHER
Knappe				SEC. PIKE Twp	TEMP.
Wise					

DESCRIPTION _____ CONTROL POINTS _____ JOB NO. _____

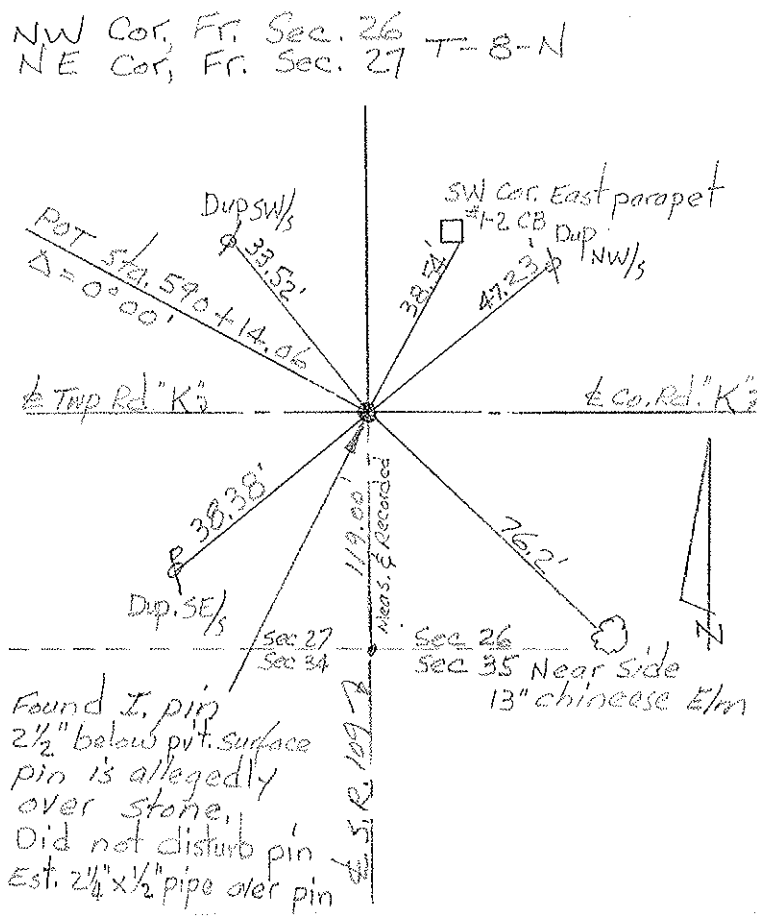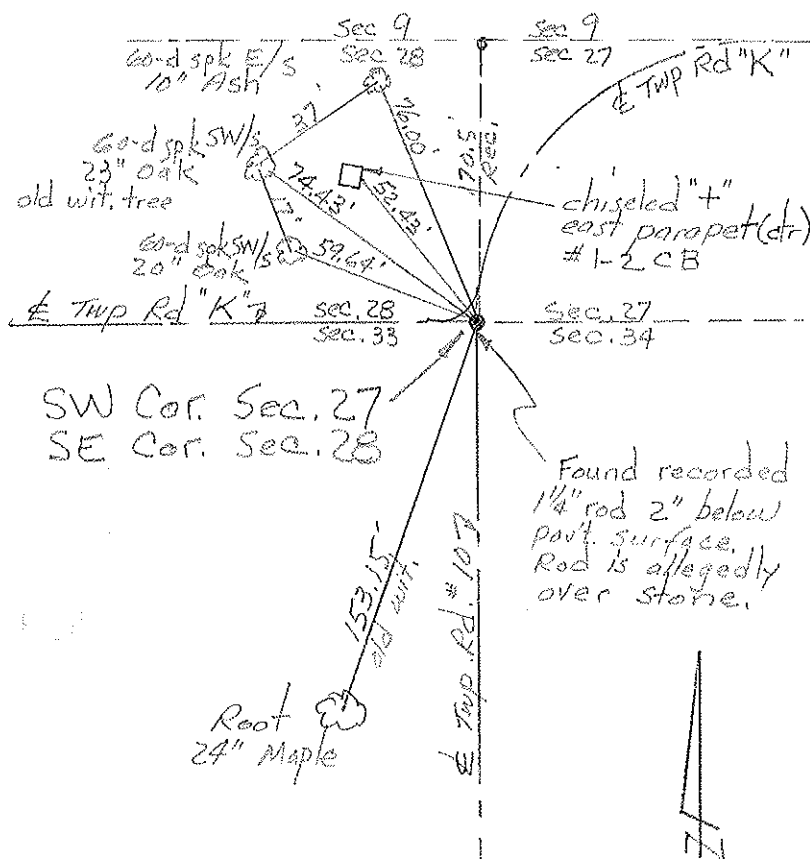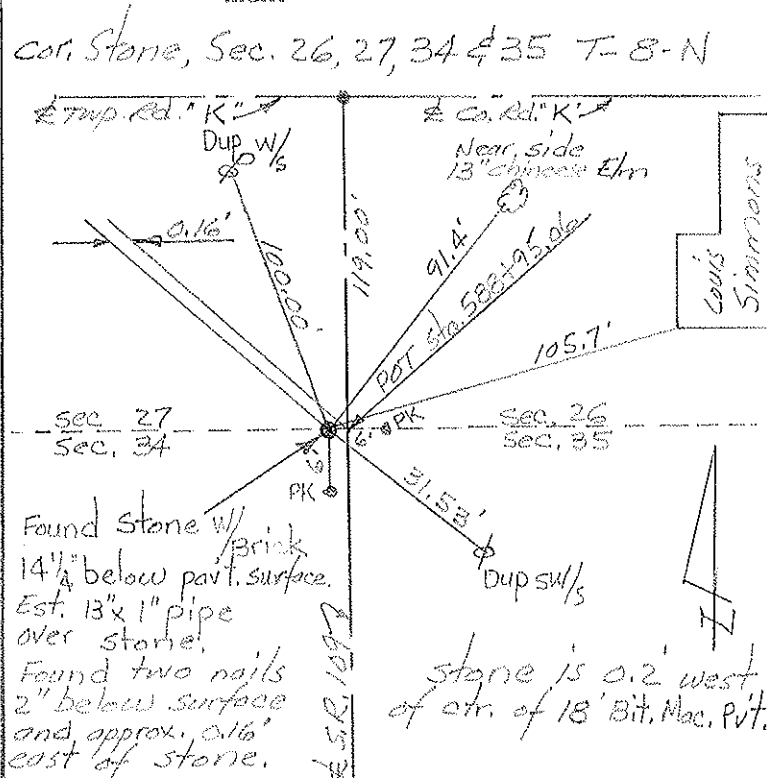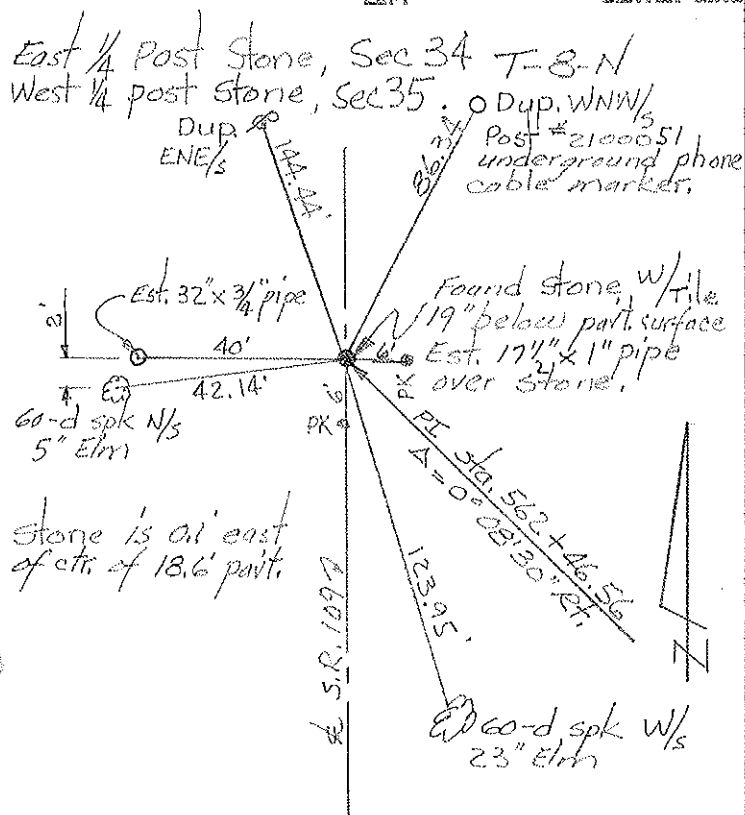

PERSONNEL	TITLE	PERSONNEL	TITLE	COUNTY	DATE
Red Beach				FULTON	Nov. 1970
Newcombs				S. R. 109	WEATHER
Knape				SEC. PIKE Twp.	TEMP
Wise					
DESCRIPTION	CONTROL		POINTS		JOB NO.

